


ACBR-IM-021-1(51) / 56830


**STERLING HIGHWAY: SOLDOTNA URBAN/
KENAI RIVER BRIDGE 0671**

**Drawings for the Existing Kenai River
Bridge 0671 at Soldotna**


Provided by the Office of the Chief Bridge Engineer

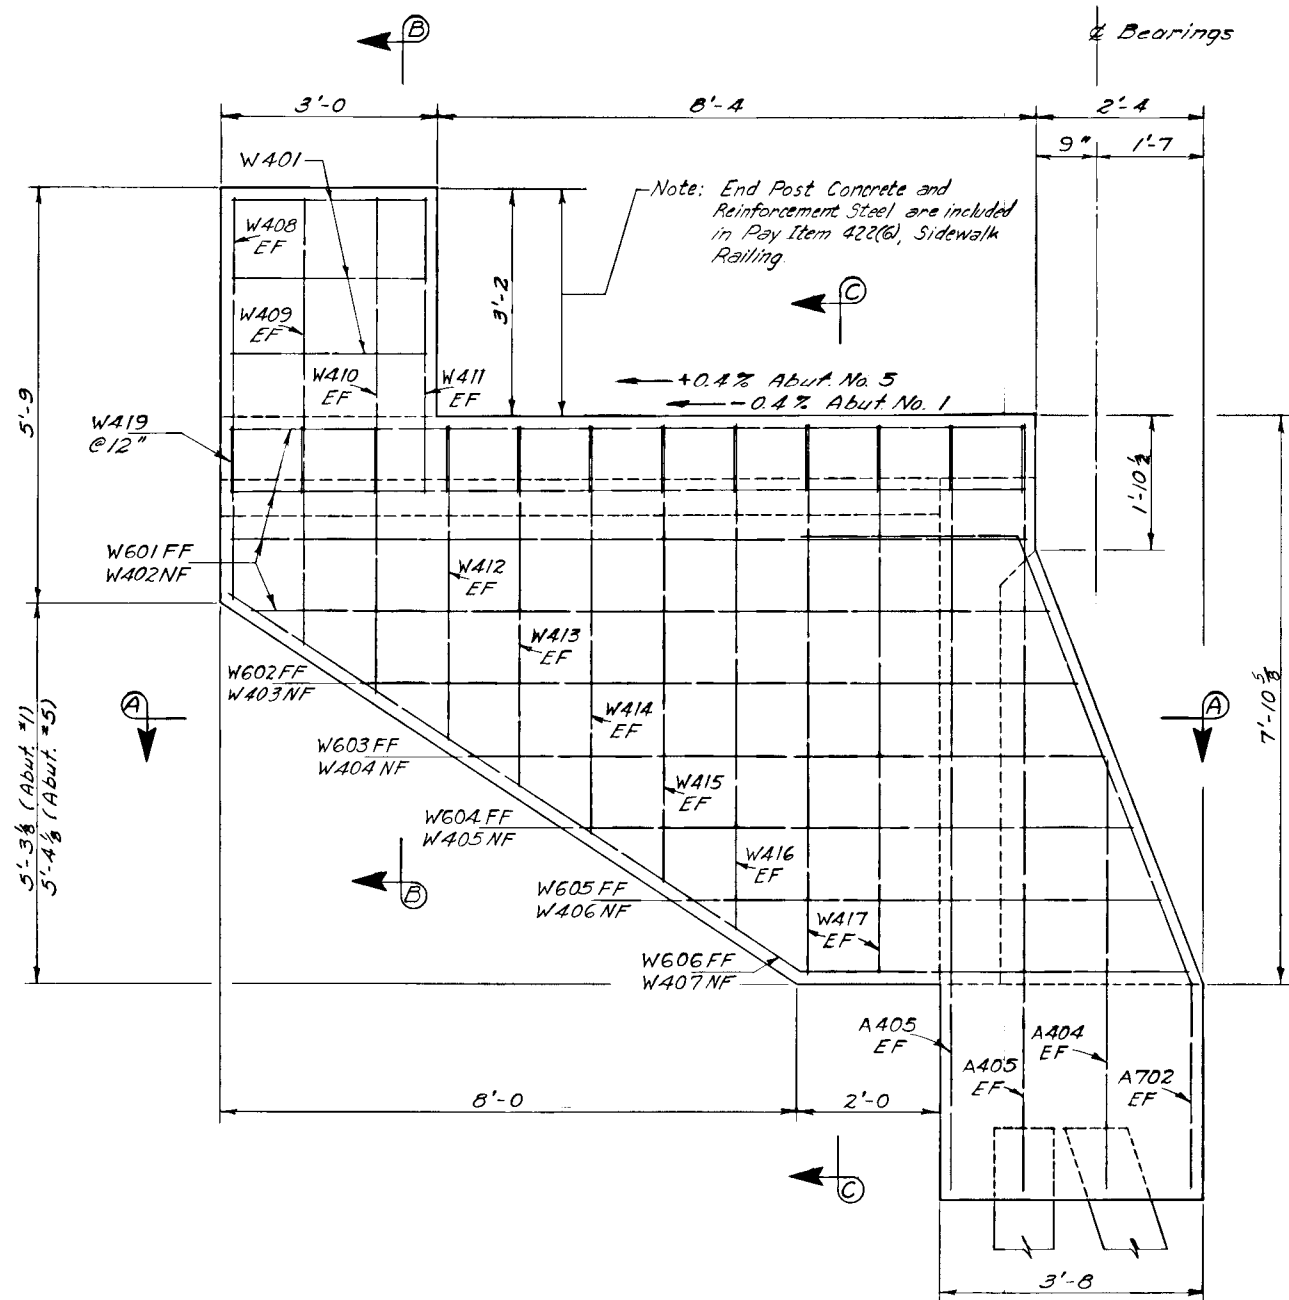


ELEVATION

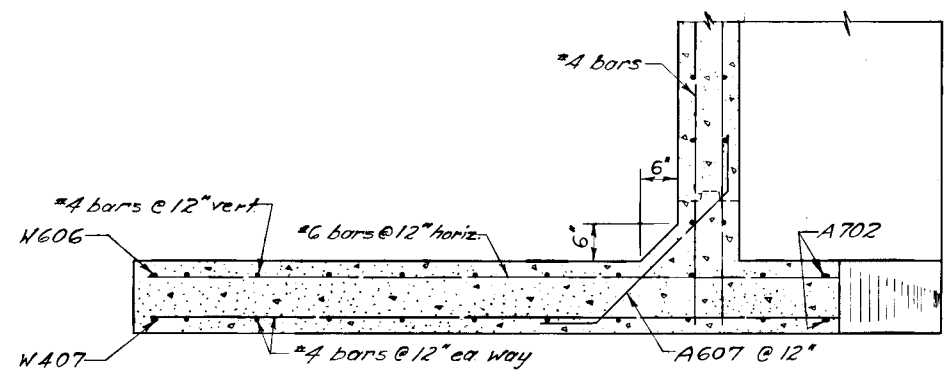

SECTION "A-A"

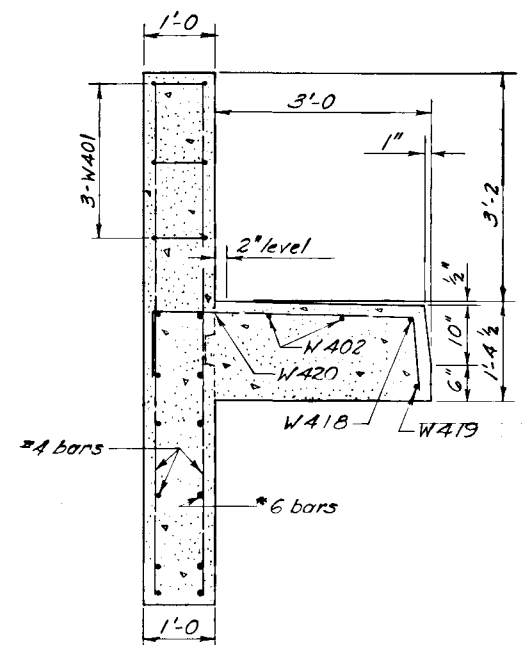

SECTION "B-B"

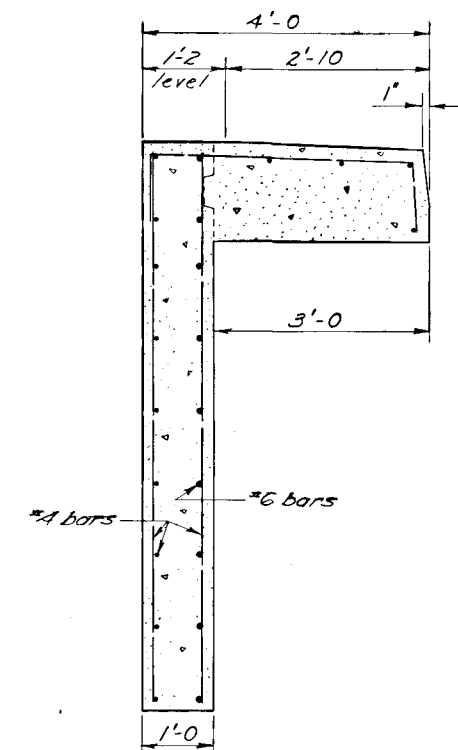


SECTION "C-C"


* See Note

WINGWALL REINFORCING STEEL - 2 ABUTS.					
LOCATION	MARK	NO.	SIZE	LENGTH	TYPE
WINGWALL	W401	12	4	7'-8	bent
	W402	24	4	11'-0	
	W403	4	4	9'-11	
	W404	4	4	8'-9	
	W405	4	4	7'-7	
	W406	4	4	6'-6	
	W407	4	4	14'-10	bent
	W408	8	4	5'-6	
	W409	8	4	6'-2	
	W410	8	4	6'-10	
	W411	8	4	4'-1	
	W412	8	4	4'-4	
	W413	8	4	5'-0	
	W414	8	4	5'-8	
	W415	8	4	6'-4	
	W416	8	4	7'-0	
	W417	16	4	7'-7	
	W601	16	6	11'-0	
SIDEWALK	W418	4	4	12'-6	bent
	W419	4	4	11'-0	bent
	W420	48	4	5'-7	bent
	W421	12	4	2'-0	bent
	W401	12	4	7'-8	bent
	W402	24	4	11'-0	
	W403	4	4	9'-11	
	W404	4	4	8'-9	
	W405	4	4	7'-7	
	W406	4	4	6'-6	

Note: All dimensions are out to out.

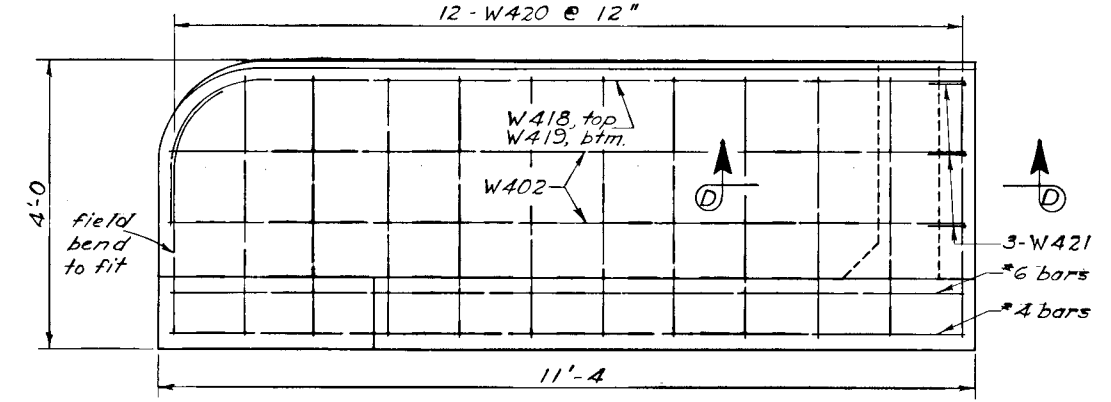

PLAN-SIDEWALK REINF. STEEL

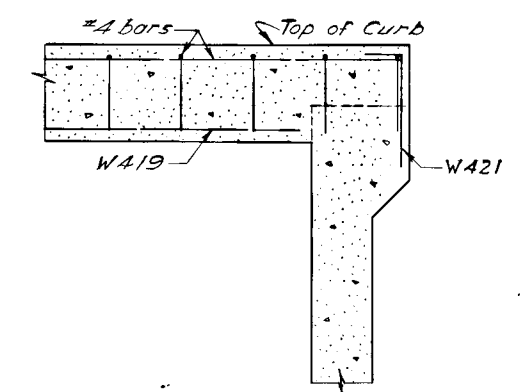

SECTION "D-D"

AS BUILT PLANS

E.J. Beach & R.L. Boyson 10/66
CORRECTIONS TRANSFERRED
LAC DATE 5/8/67
D.H.O. DATE 5/8/67

KENAI RIVER BRIDGE
AT SOLDOTNA
ROUTE NO. F-21
WINGWALL DETAILS


12 6 0 1 2 3
Inches Feet
BRIDGE NO. 671

Alaska Department of Public Works
DIVISION OF HIGHWAYS
Juneau, Alaska

Date 11/2/66
Approved [Signature]


DWG. NO. 1164

PIER CAP ELEV.	
LOCATION	ELEVATION
A	76.38
B	76.53
C	76.15

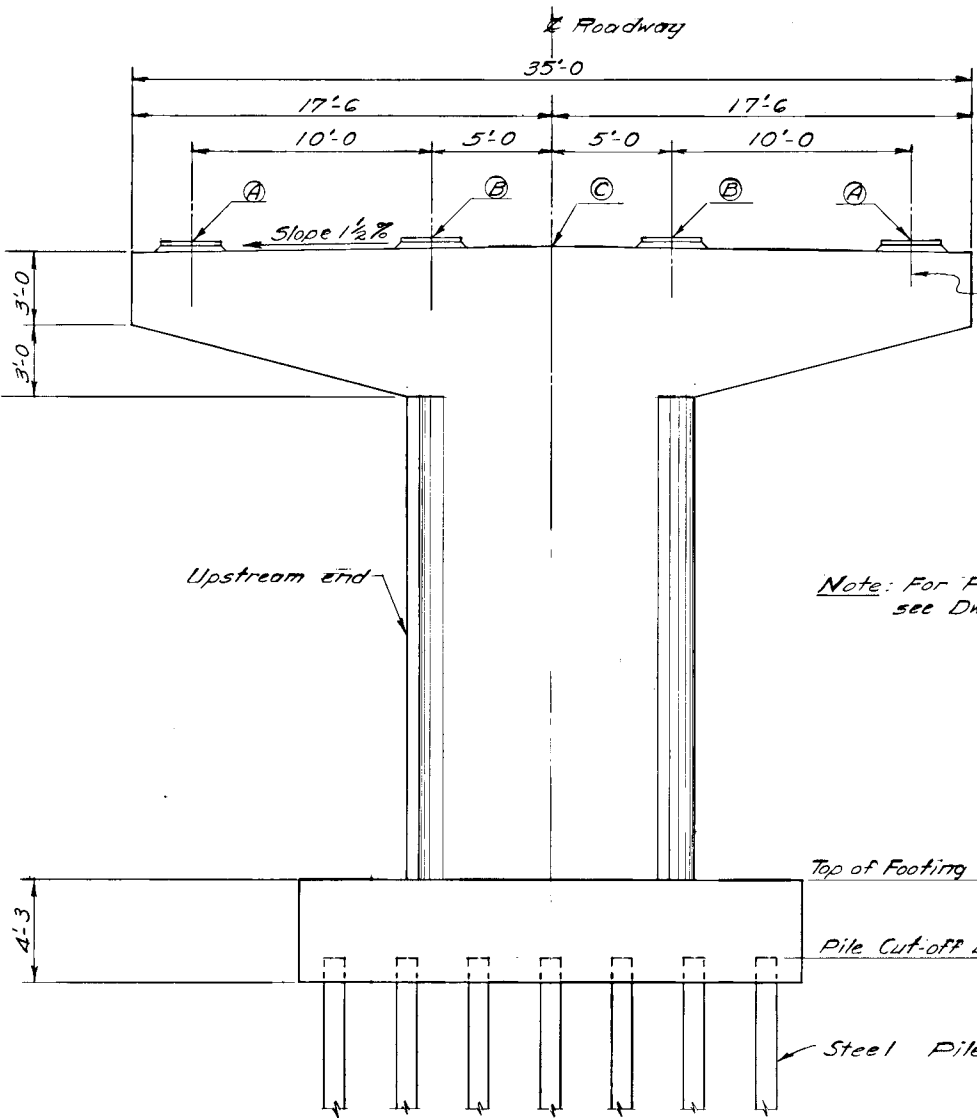

ELEVATION

12 0 5 10
In Feet

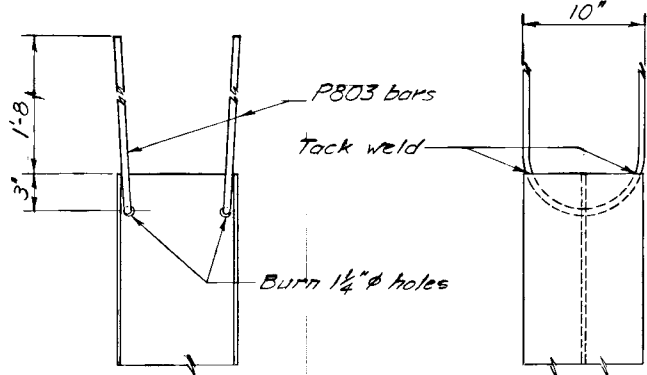


PILE ANCHOR DETAIL

No Scale



See Girder, see Dwg. No. 1172 for Expansion Bearing & Anchor Bolt details.

Note: For Pier Details see Dwg. No. 1167.

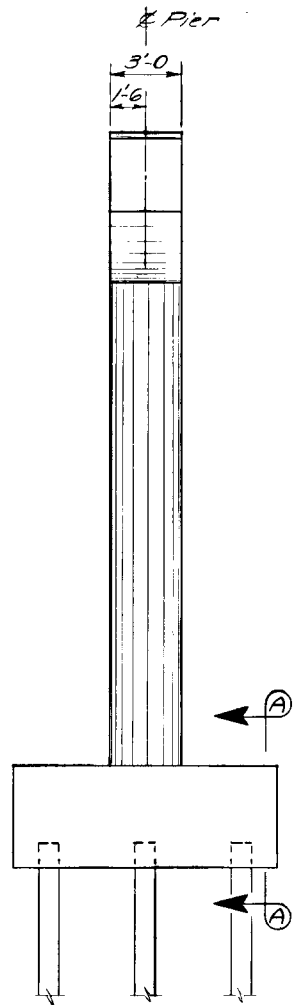

END ELEVATION

12 0 5 10
In Feet

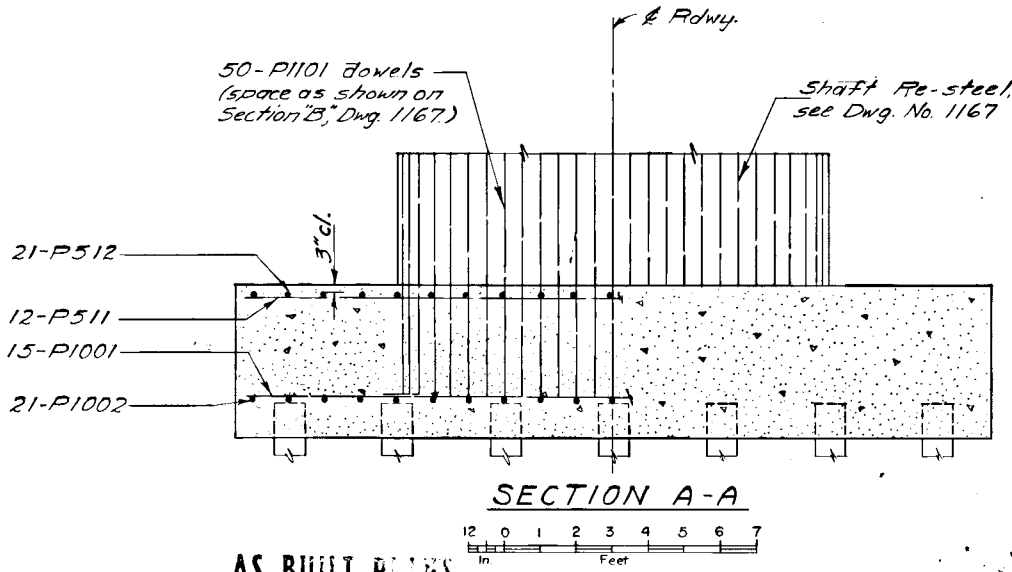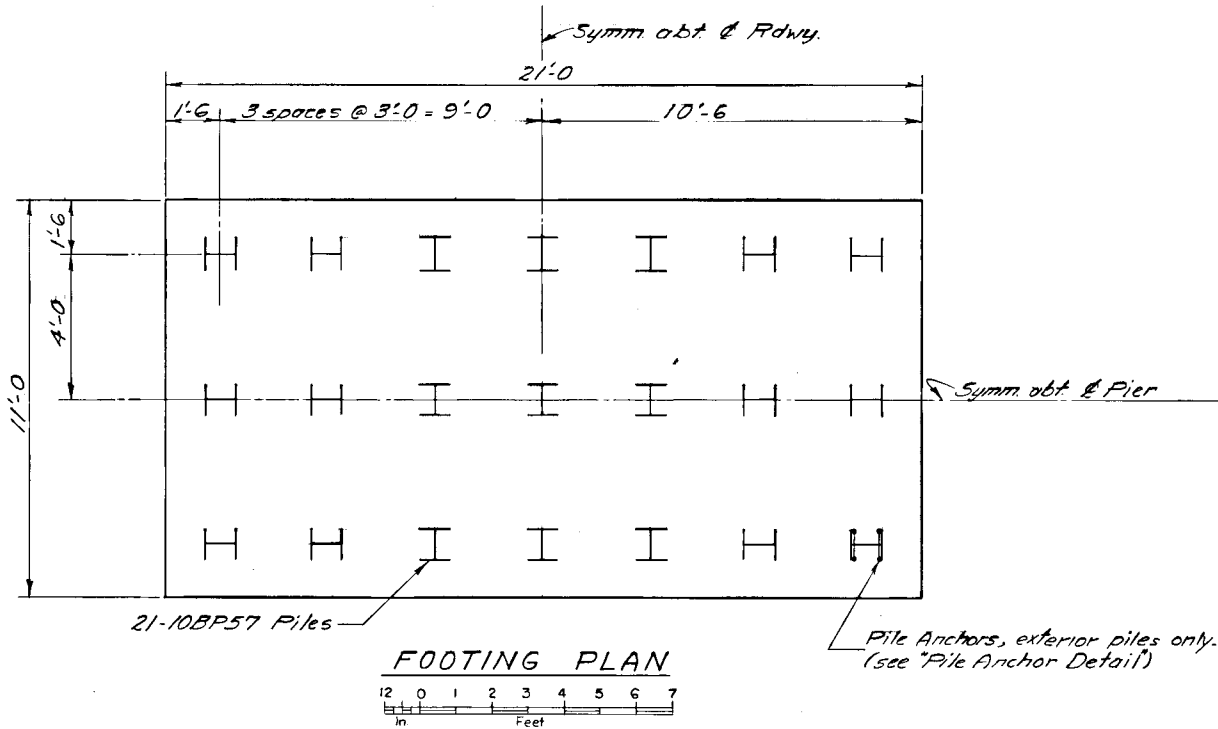

AS BUILT PLANS

E.J. Bach & R.L. Boyesen DATE 10/66
CORRECTIONS TRANSFERRED
LAC DATE 5/8/67
CHECKED DMR DATE 5/9/67

KENAI RIVER BRIDGE
AT SOLDOTNA
ROUTE NO. F-21
PIER NO. 2
SCALE AS SHOWN BRIDGE NO. 671





REVISIONS		
No.	Date	Description

Alaska Department of Public Works
DIVISION OF HIGHWAYS
Juneau, Alaska


Date 11/12/66
Approved [Signature]

PIER CAP ELEV.		
LOCATION	PIER NO. 3	PIER NO. 4
*A	77.06	77.26
*B	77.21	77.41
*C	76.87	77.03

* Elevations A & B are at top of Masonry Plates.

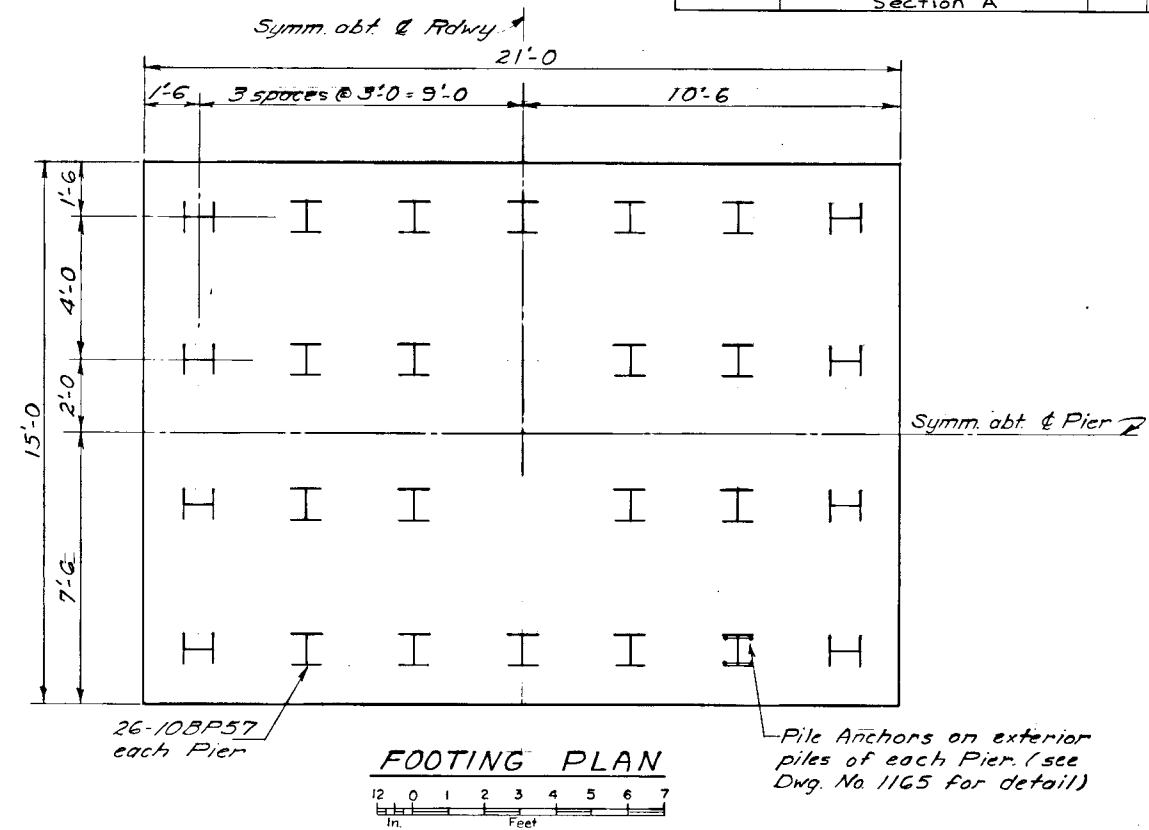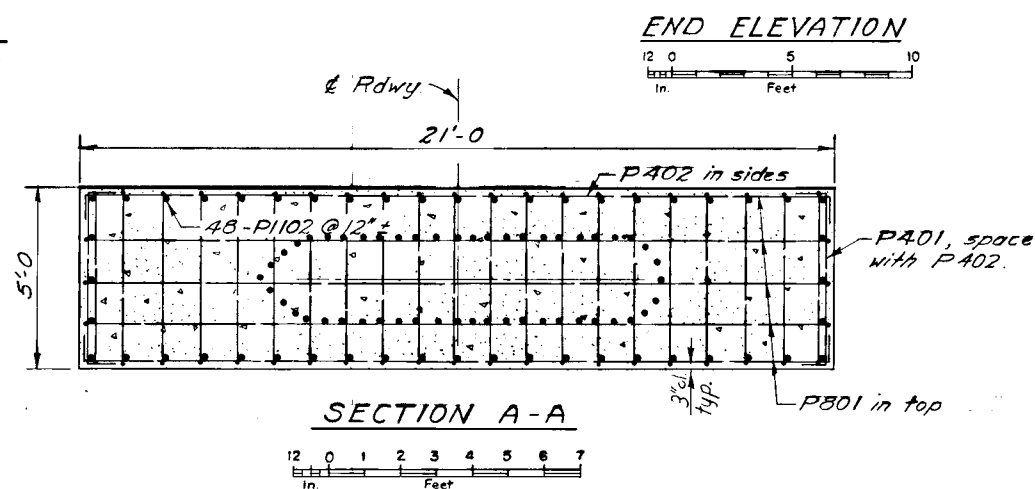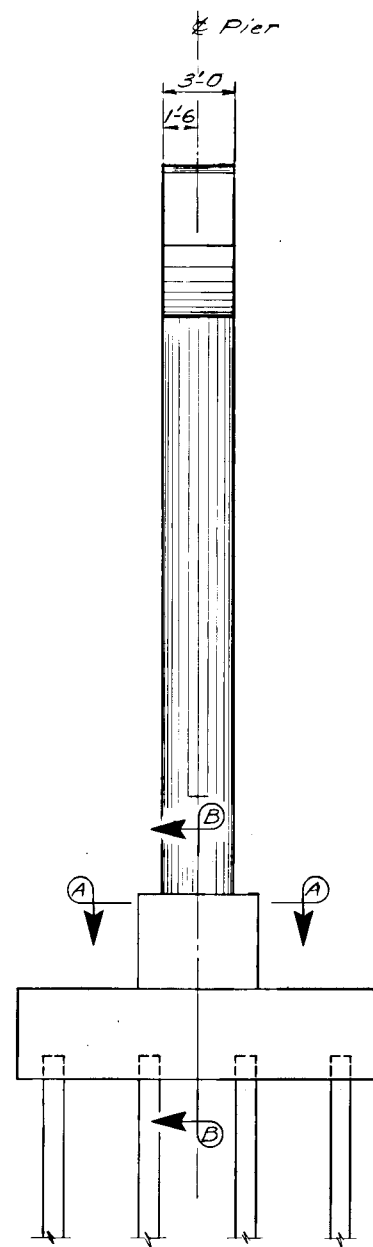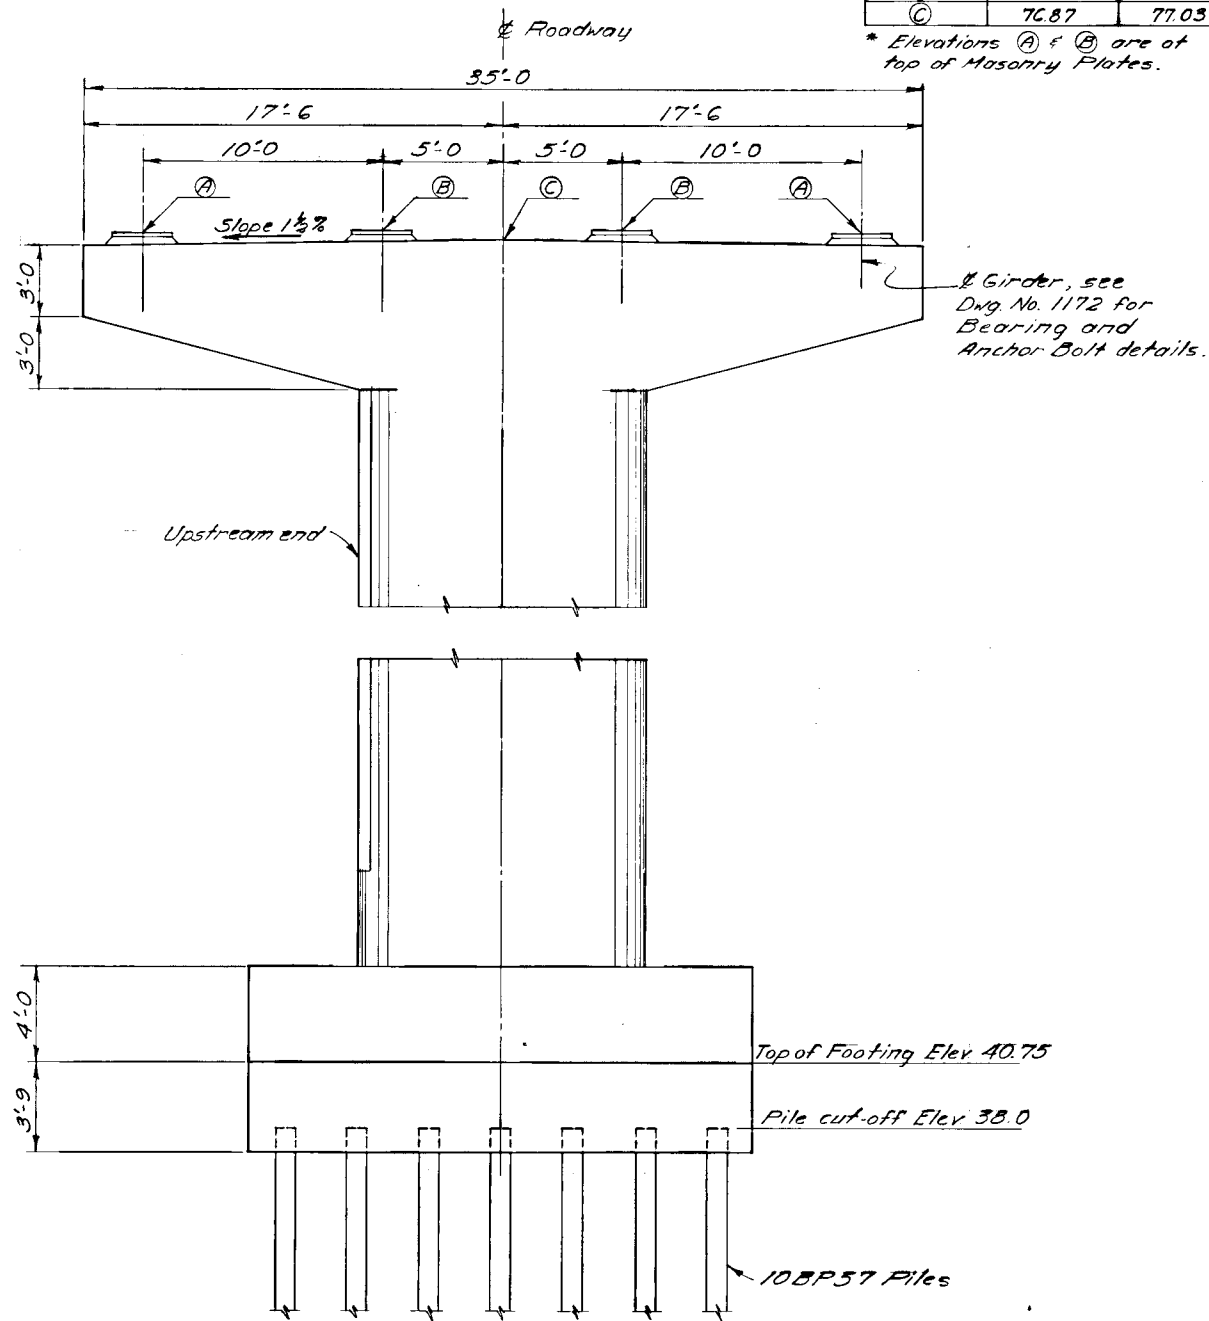

Note: For Pier Details see Dwg. No. 1167

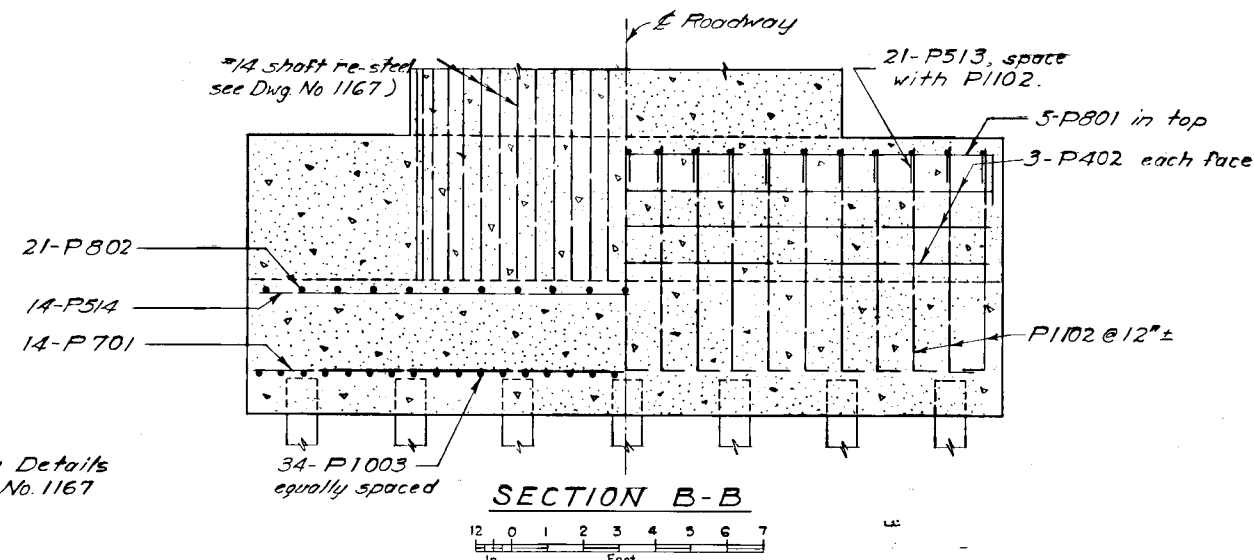

AS BUILT PLANS

E.J. Beach & A.L. Boyesen
Project
CORRECTIONS TRANSFERRED
LAC
DATE 5/8/67
DATE 5/9/67


KENAI RIVER BRIDGE
AT SOLDOTNA
ROUTE NO. F-21
PIER NO. 3 & 4

SCALE AS SHOWN BRIDGE NO. 671


Alaska Department of Public Works
DIVISION OF HIGHWAYS
Juneau, Alaska

Date 1/12/68
Approved [Signature]


DWNG. NO. 1166

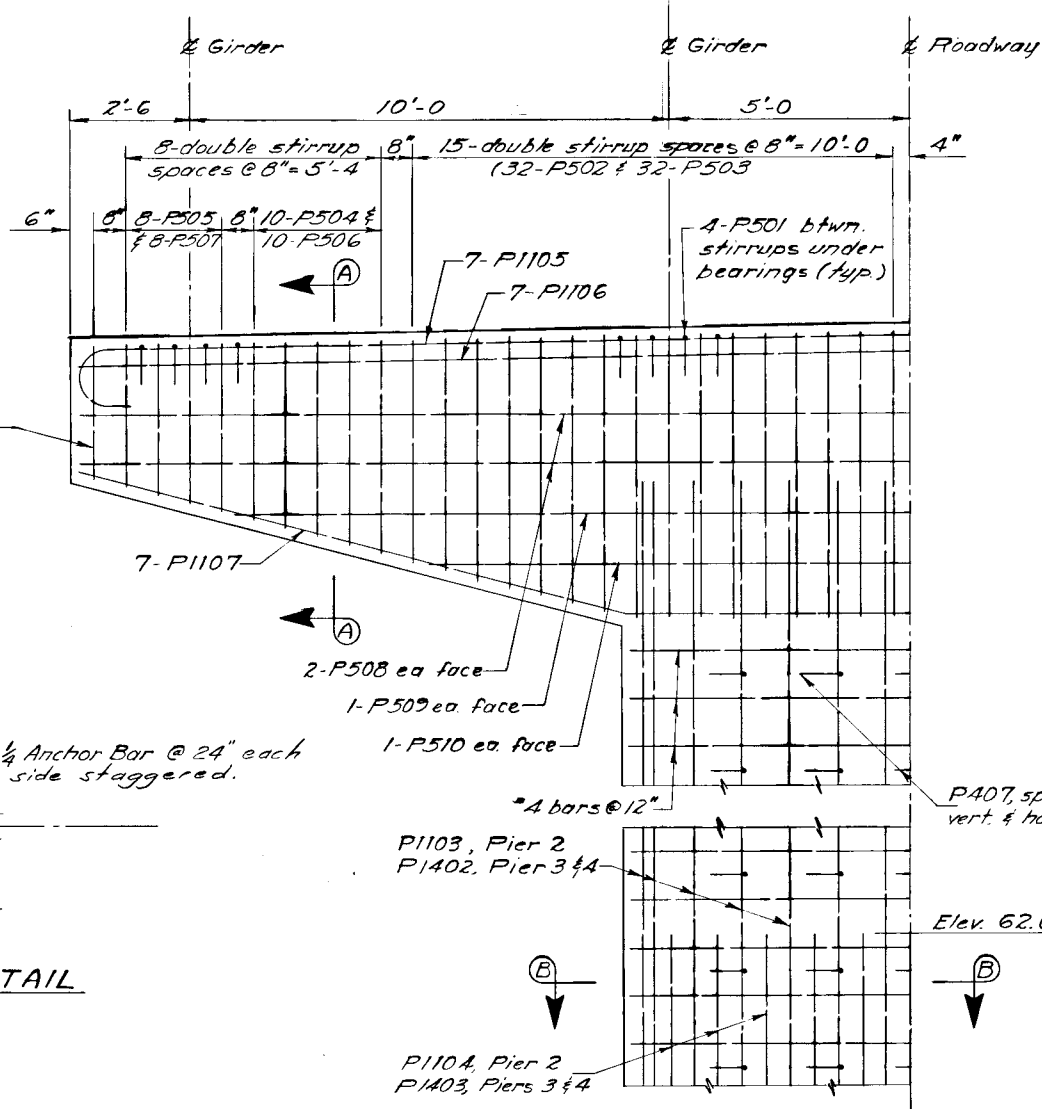


PART PIER ELEVATION (TYP)

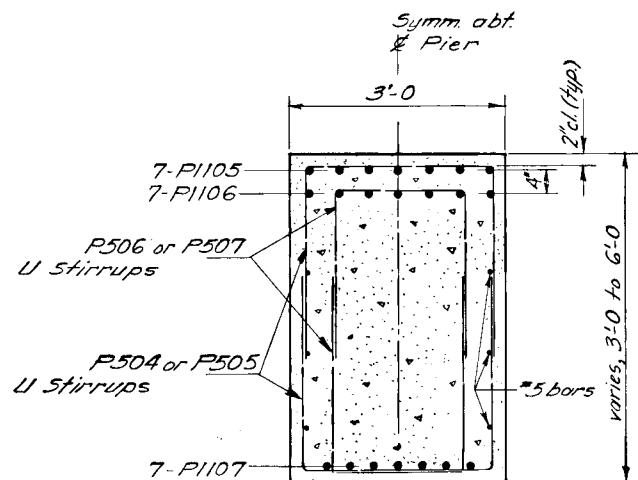

SECTION A-A

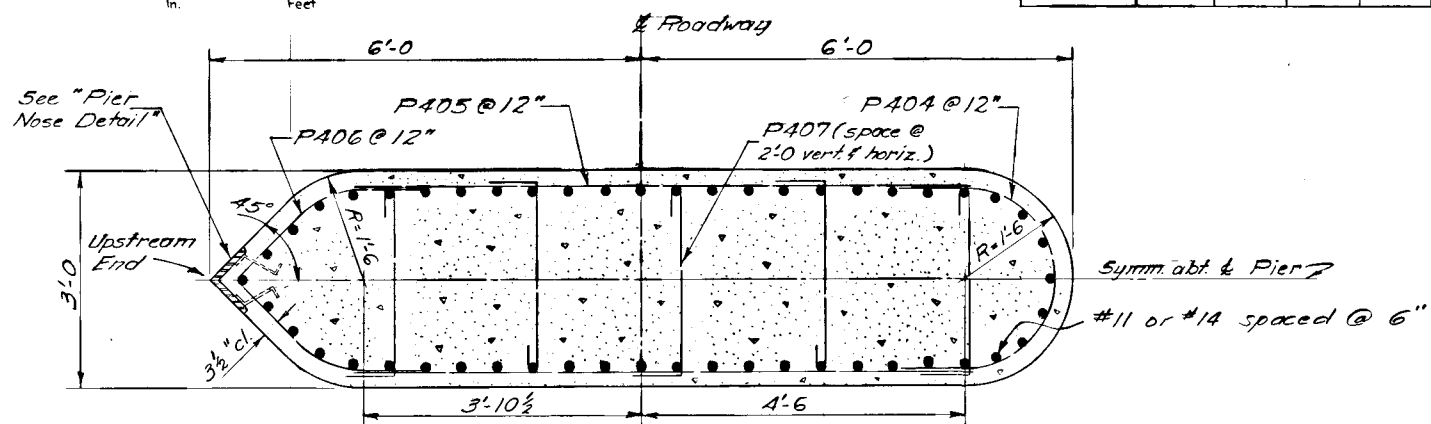

SECTION B-B

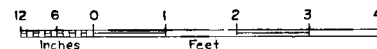

REINFORCING STEEL - 3 PIERS									
LOCATION	MARK	NUMBER				SIZE	LENGTH	TYPE	BENDING DIAGRAMS
		PIER 2	PIER 3	PIER 4	TOTAL				
FOOTING	P401		6	6	12	4	6'-0	bent	

Note: All dimensions are out to out.

AS BUILT PLANS

E.J. Beach & A.L. Boyson DATE 10/66
CORRECTIONS TRANSFERRED
REASON LAC DATE 5/8/67
CHECKED DAD DATE 5/9/67








KENAI RIVER BRIDGE
AT SOLDOTNA
ROUTE NO. F-21
PIER DETAILS

SCALE AS SHOWN BRIDGE NO. 671

Alaska Department of Public Works
DIVISION OF HIGHWAYS
Juneau, Alaska

Date 1/15/16
Approved Charles P. 1/15/16

DWNG. NO. 1167

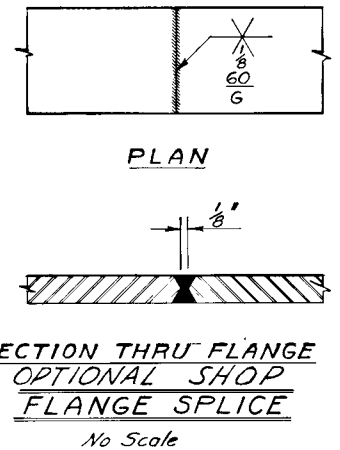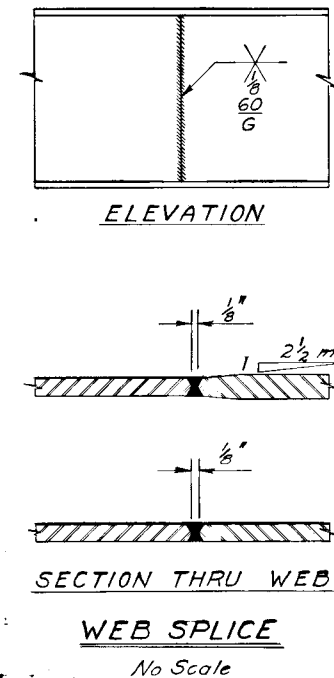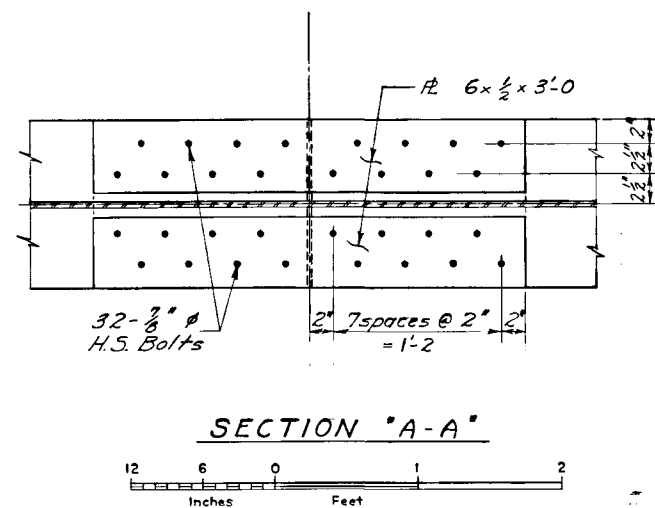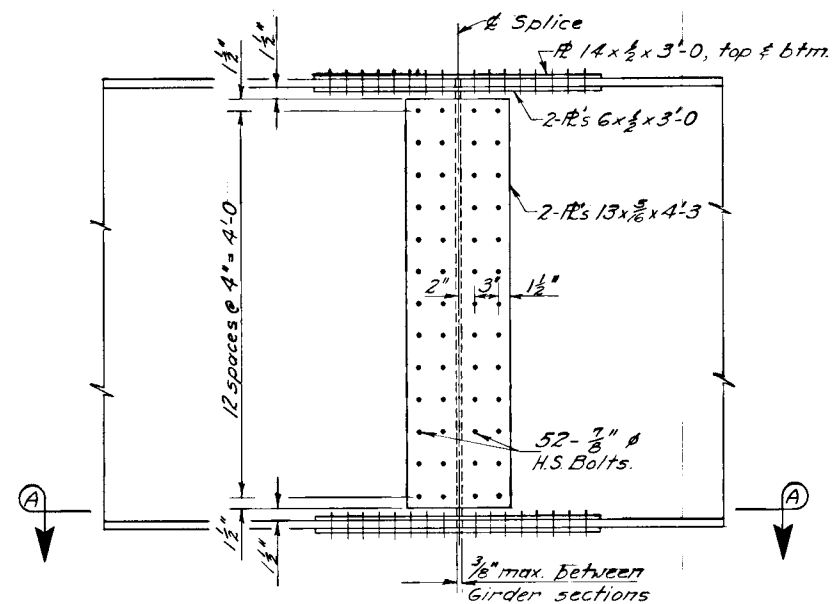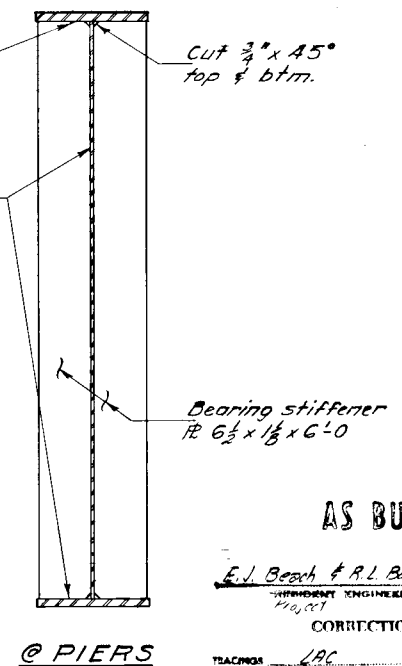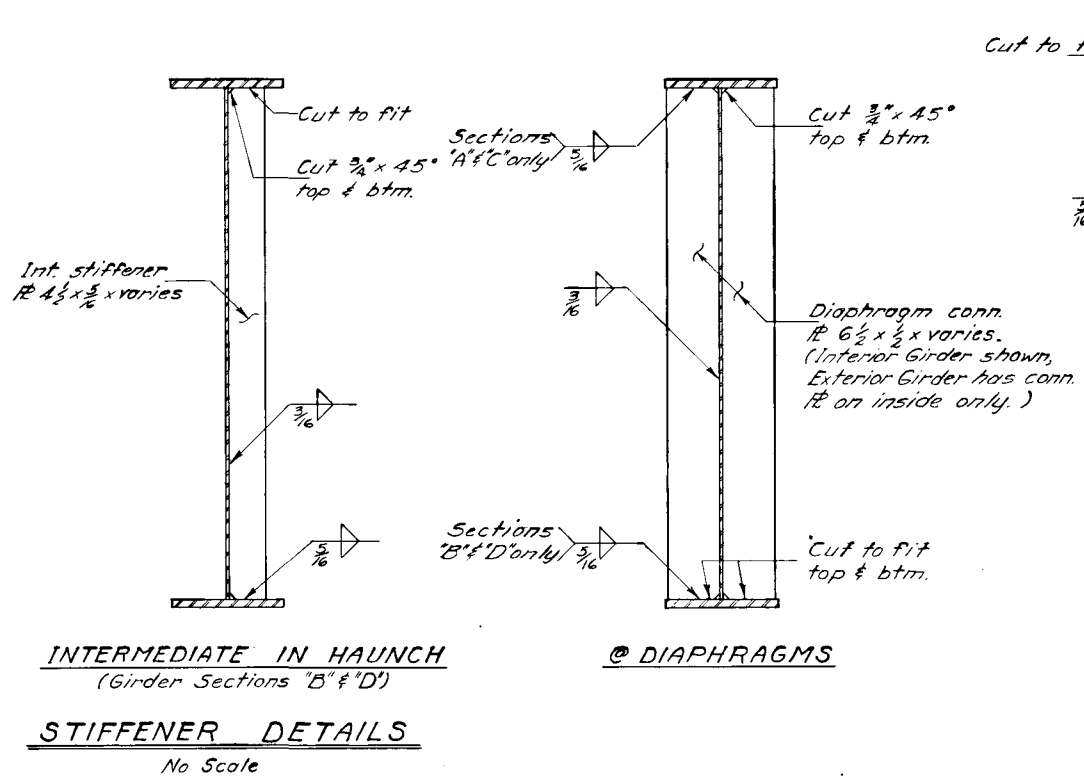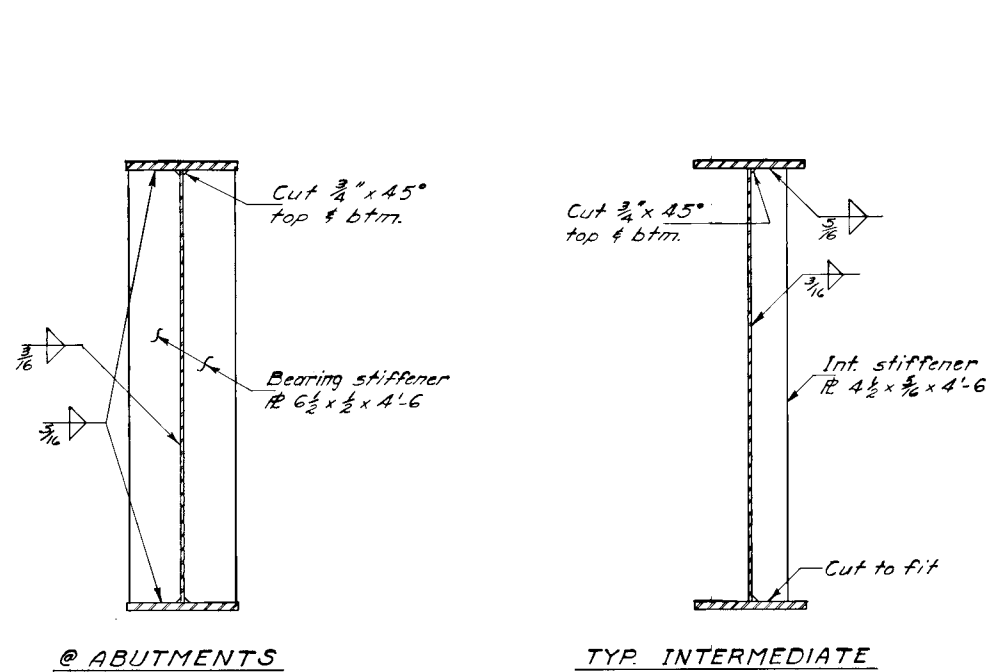

Note:
1" maximum diameter holes in the Girder Webs may be used for Falsework Support at the option of the contractor. Holes shall be spaced 4'-0" minimum center to center and shall not be closer than 6" to any Stiffener.

Note: Run-off plates shall be used for all flange & web butt welds. Welds shall be ground flush in a direction parallel with & Girders.



REVISIONS		
No.	Date	Description

KENAI RIVER BRIDGE
AT SOLDOTNA
ROUTE NO. F-21
GIRDER DETAILS NO. 4
SCALE AS SHOWN BRIDGE NO. 671

Alaska Department of Public Works
DIVISION OF HIGHWAYS
Juneau, Alaska

Date 1/12/66
Approved: Charles P. Smith, P.E.

DWG. NO. 1171

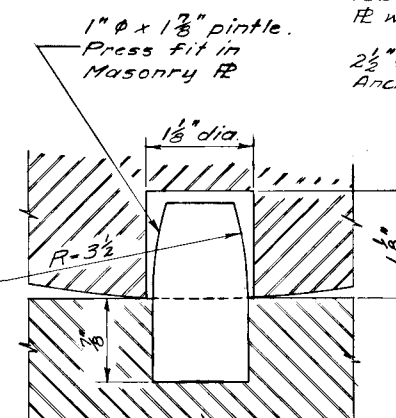
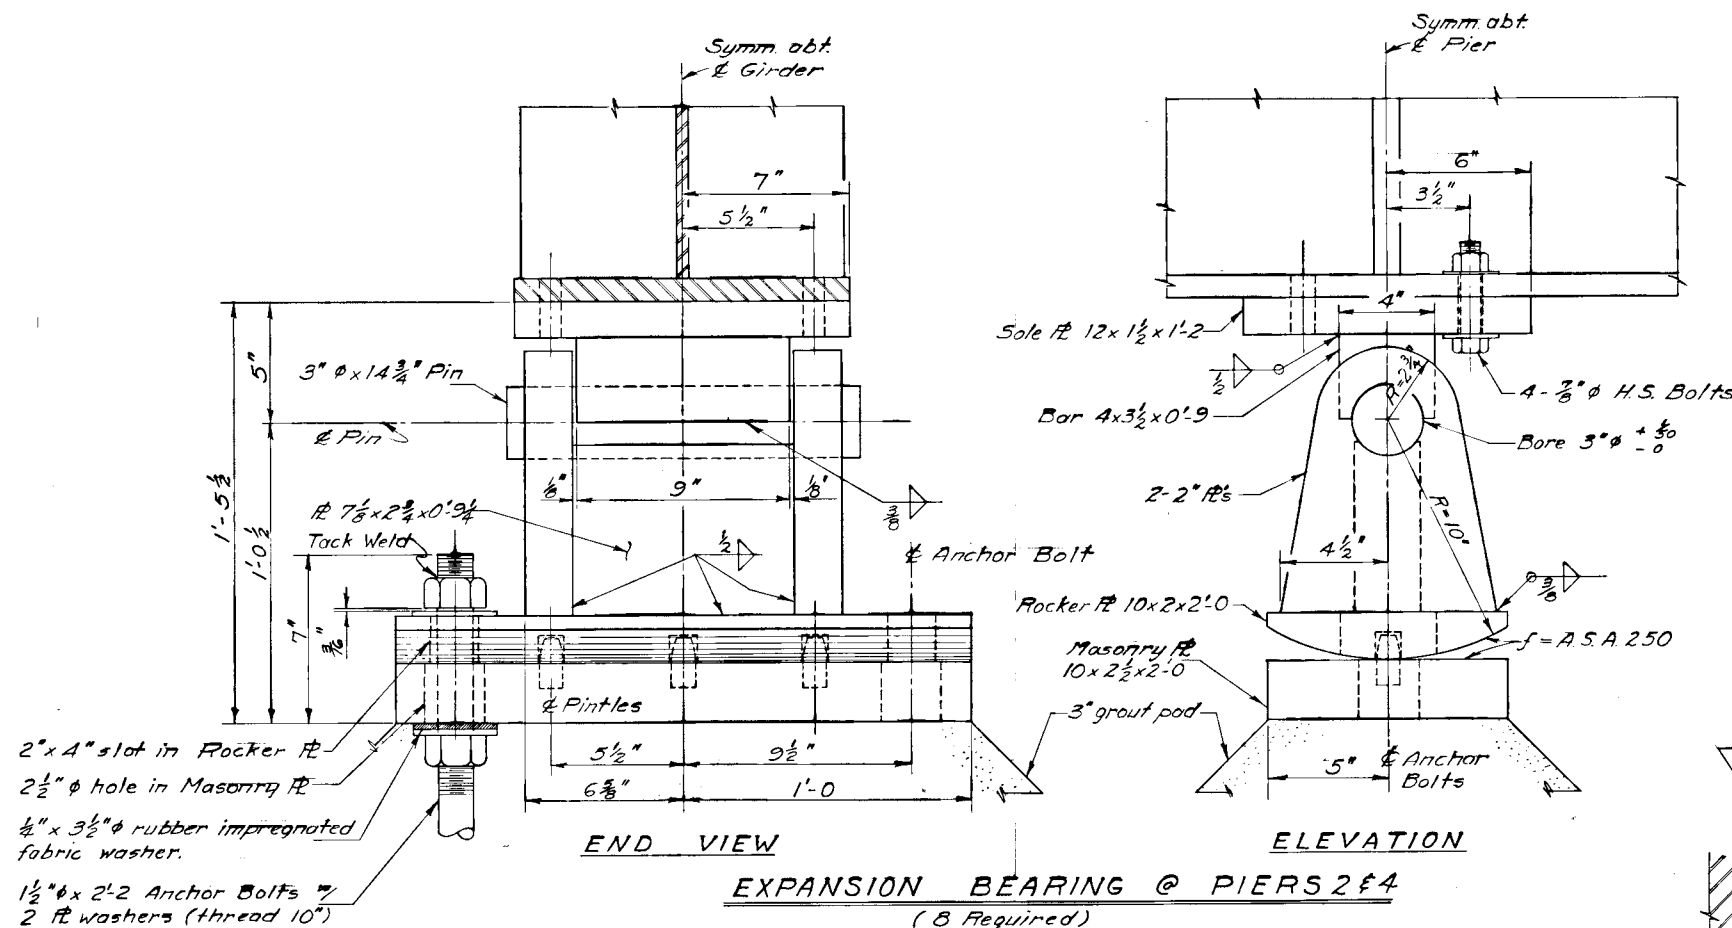


Notes:
Finish on all pins & pin bearing surfaces shall be A.S.A. 125.
Grout pad depth may vary. See Abutment & Pier Details for elevations at top of Masonry R's.
All expansion bearings shall be set vertical at +40° F.

AS BUILT PLANS

E.J. Beach & R.L. Boyson 10166
CORRECTIONS TRANSFERRED
LAC 5/8/67
D.H.D. 5/9/67

REVISIONS		
No.	Date	Description

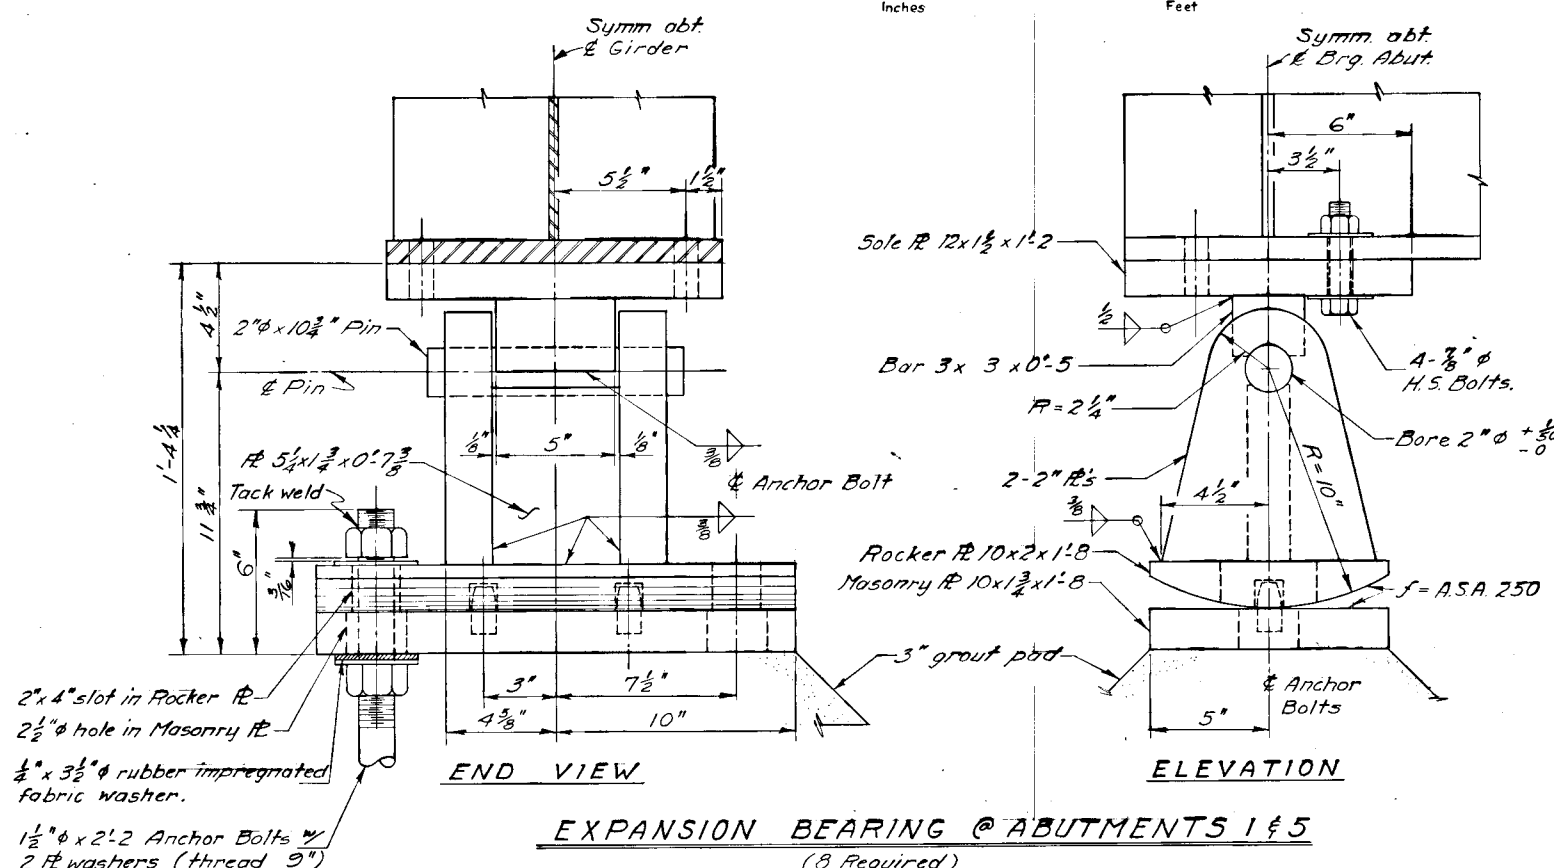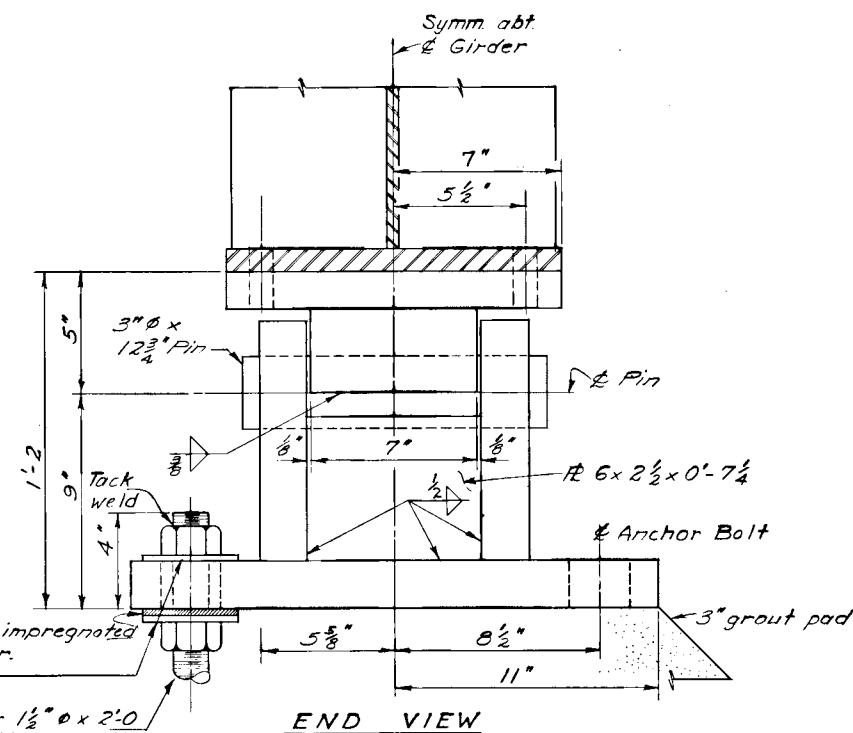


KENAI RIVER BRIDGE AT SOLDOTNA ROUTE NO. F-21 BEARING DETAILS

SCALE AS SHOWN BRIDGE NO. 671

Alaska Department of Public Works
DIVISION OF HIGHWAYS
Juneau, Alaska

Date 4/12/66
Approved R. L. Boyson, P.E.

DWG. NO. 1172

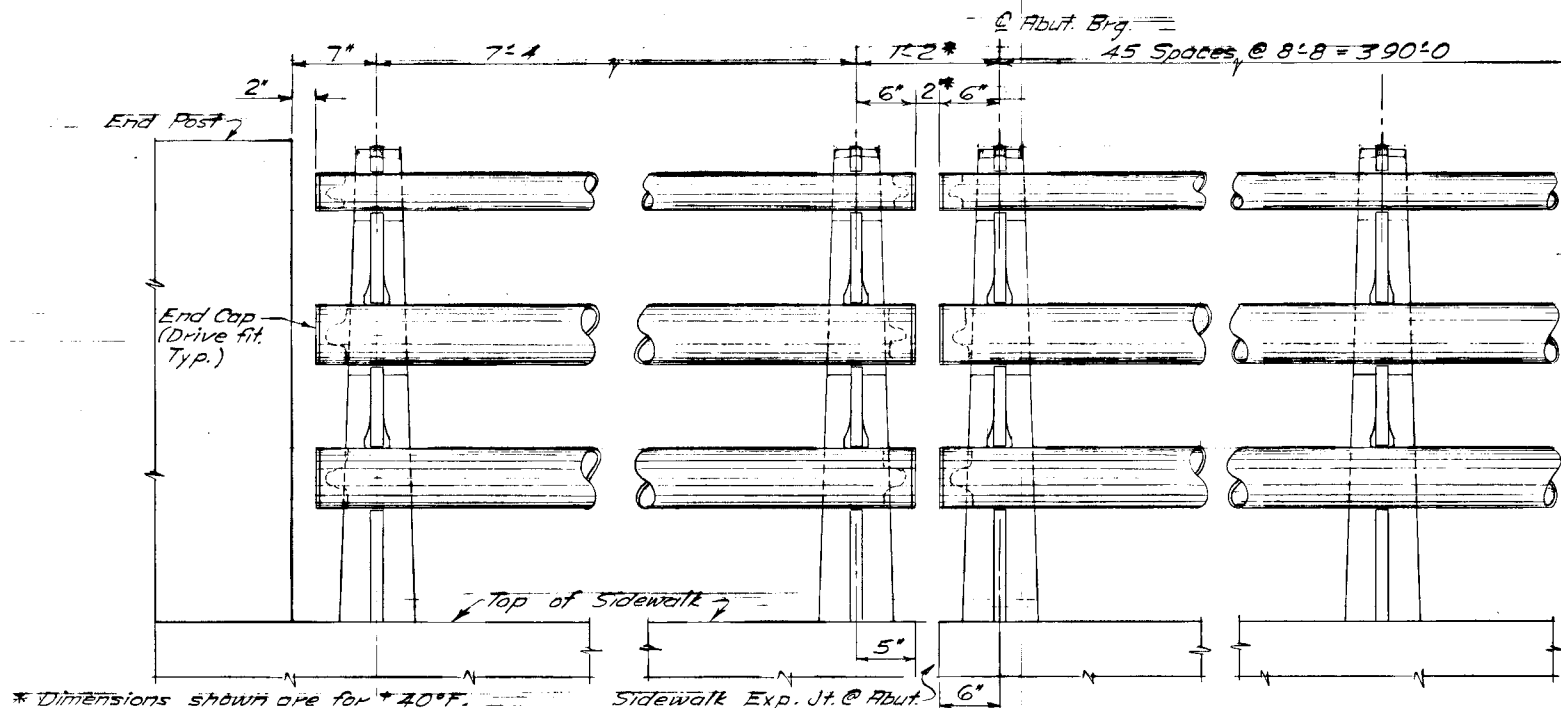


* Dimensions shown are for 40°F.
Vary 5/32" for each 10°F change
in temperature.

ELEVATION

NOTES
 Aluminum surfaces in contact with concrete or steel shall be thoroughly coated with an aluminum impregnated caulking compound.
 All railing & Railposts shall be of the same material (either aluminum or steel) except for the Toggle bolts, anchor bolts and their nuts & washers which shall be galvanized steel.
 Aluminum rails shall be anodized. All steel railing elements shall be galvanized.
 Railing shall be set parallel to Bridge Grade and railposts shall be set normal to railing.
 Provide shims for alignment of railposts.

SIDEWALK REINFORCING STEEL					
LOCATION	MARK NO.	SIZE	LENGTH	TYPE	BENDING DIAGRAMS
	C401	140	4	27'-8"	
	C402	724	4	2'-5" Bent	
	C403	724	4	3'-2" Bent	
	C404	724	4	4'-8" Bent	


Note: All dimensions are out to out

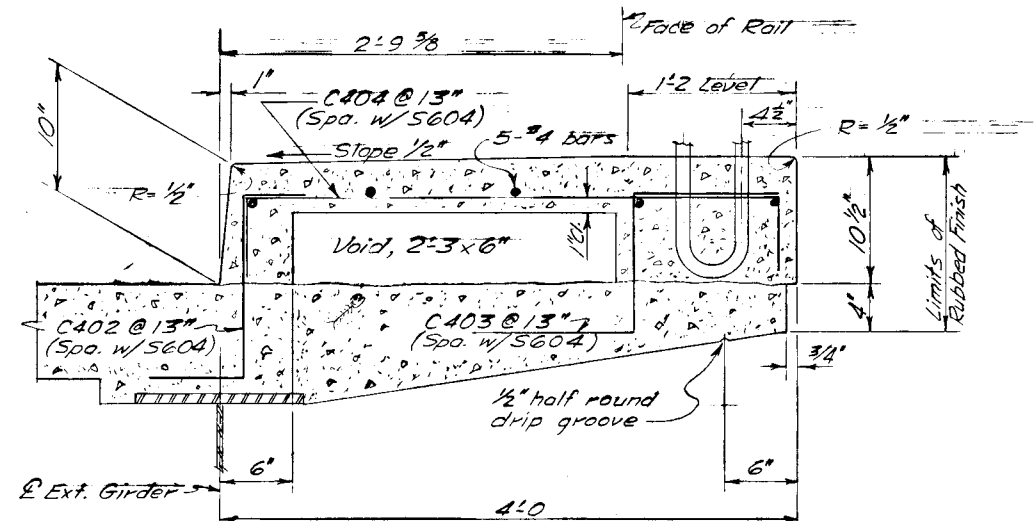


SECTION THRU SIDEWALK

AS BUILT PLANS


E.J. Beach & A.L. Byson 10/66
 PROJECT ENGINEER
 Project
 CORRECTIONS TRANSFERRED
 LAG 5/8/67
 DHD 5/9/67

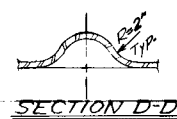


SECTION D-D

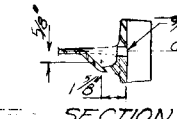


SECTION C-C

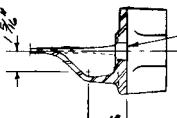

SECTION B-B

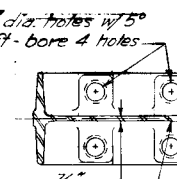

SECTION A-A

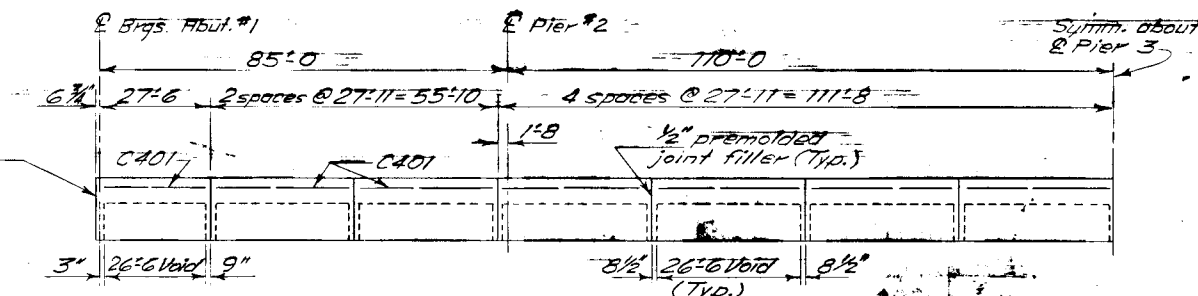


SIDEWALK JOINT & VOID SPACING


Note: Seal top and front face of sidewalk joints with joint sealer.




RAILING SPLICE DETAIL

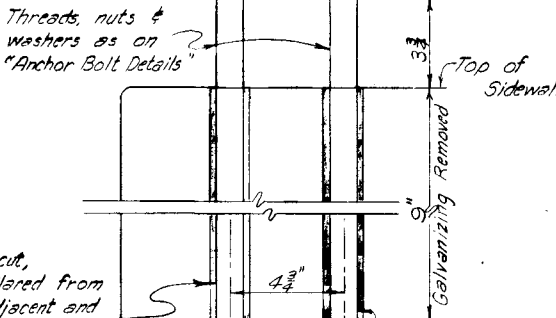

ALTERNATE ANCHOR BOLTS (AS BUILT)

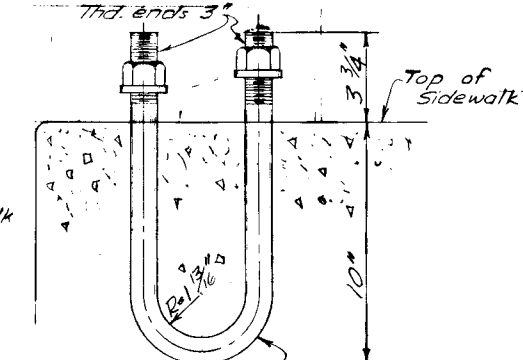

ANCHOR BOLT DETAIL

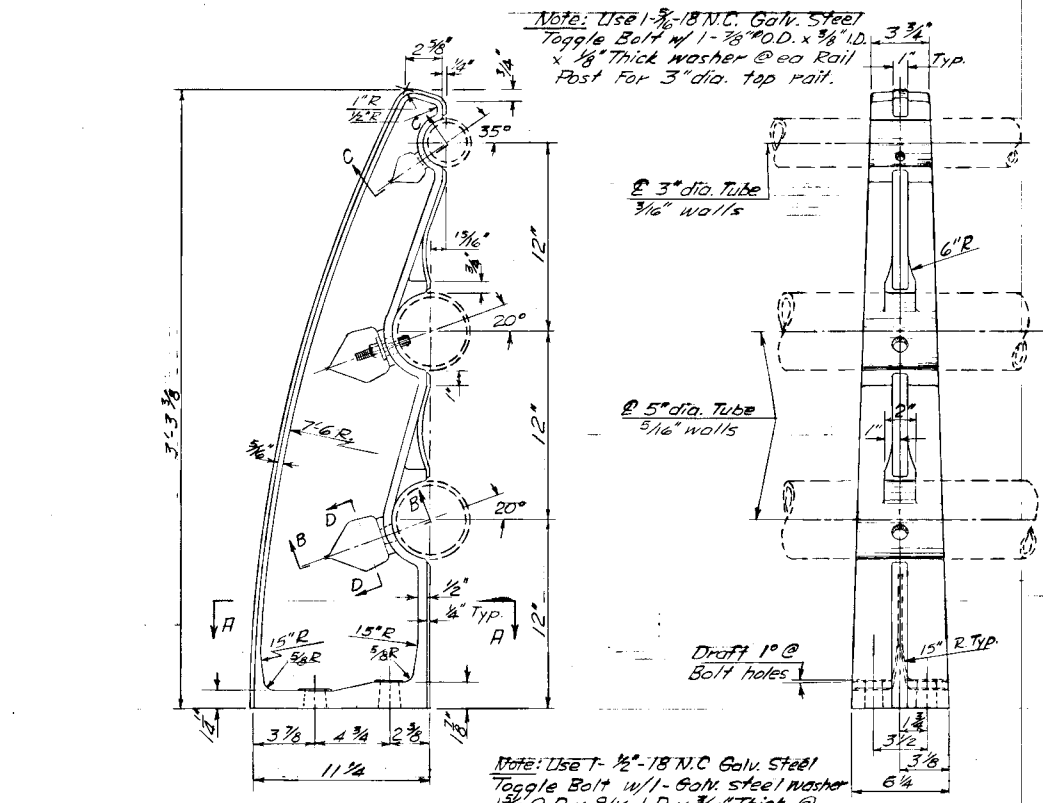

RAIL POST DETAILS

Note: Unless otherwise specified:
 Draft angles to be 3°.
 Corner Radii to be 1/8" R.
 Fillet Radii to be 1/4" R.

Note: Use 1/2"-18 N.C. Galv. Steel
 Toggle Bolt w/ 1/2" Galv. Steel Washer
 1 3/8" O.D. x 9/16" I.D. x 3/16" Thick @
 ea. Rail Post for ea. 5" dia.
 Pipe Rail.

KENAI RIVER BRIDGE
 AT SOLDOTNA
 ROUTE NO. F-21
 CURB & RAIL DETAILS


NO SCALE

State of Alaska
 DEPARTMENT OF HIGHWAYS
 Juneau, Alaska

Date 1/1/66
 Approved J. P. L. B.

BRIDGE NO. 671
 DWG. NO. 1175

Note: Logs of Borings are provided for information only and are not guaranteed to represent the actual sub-surface conditions.

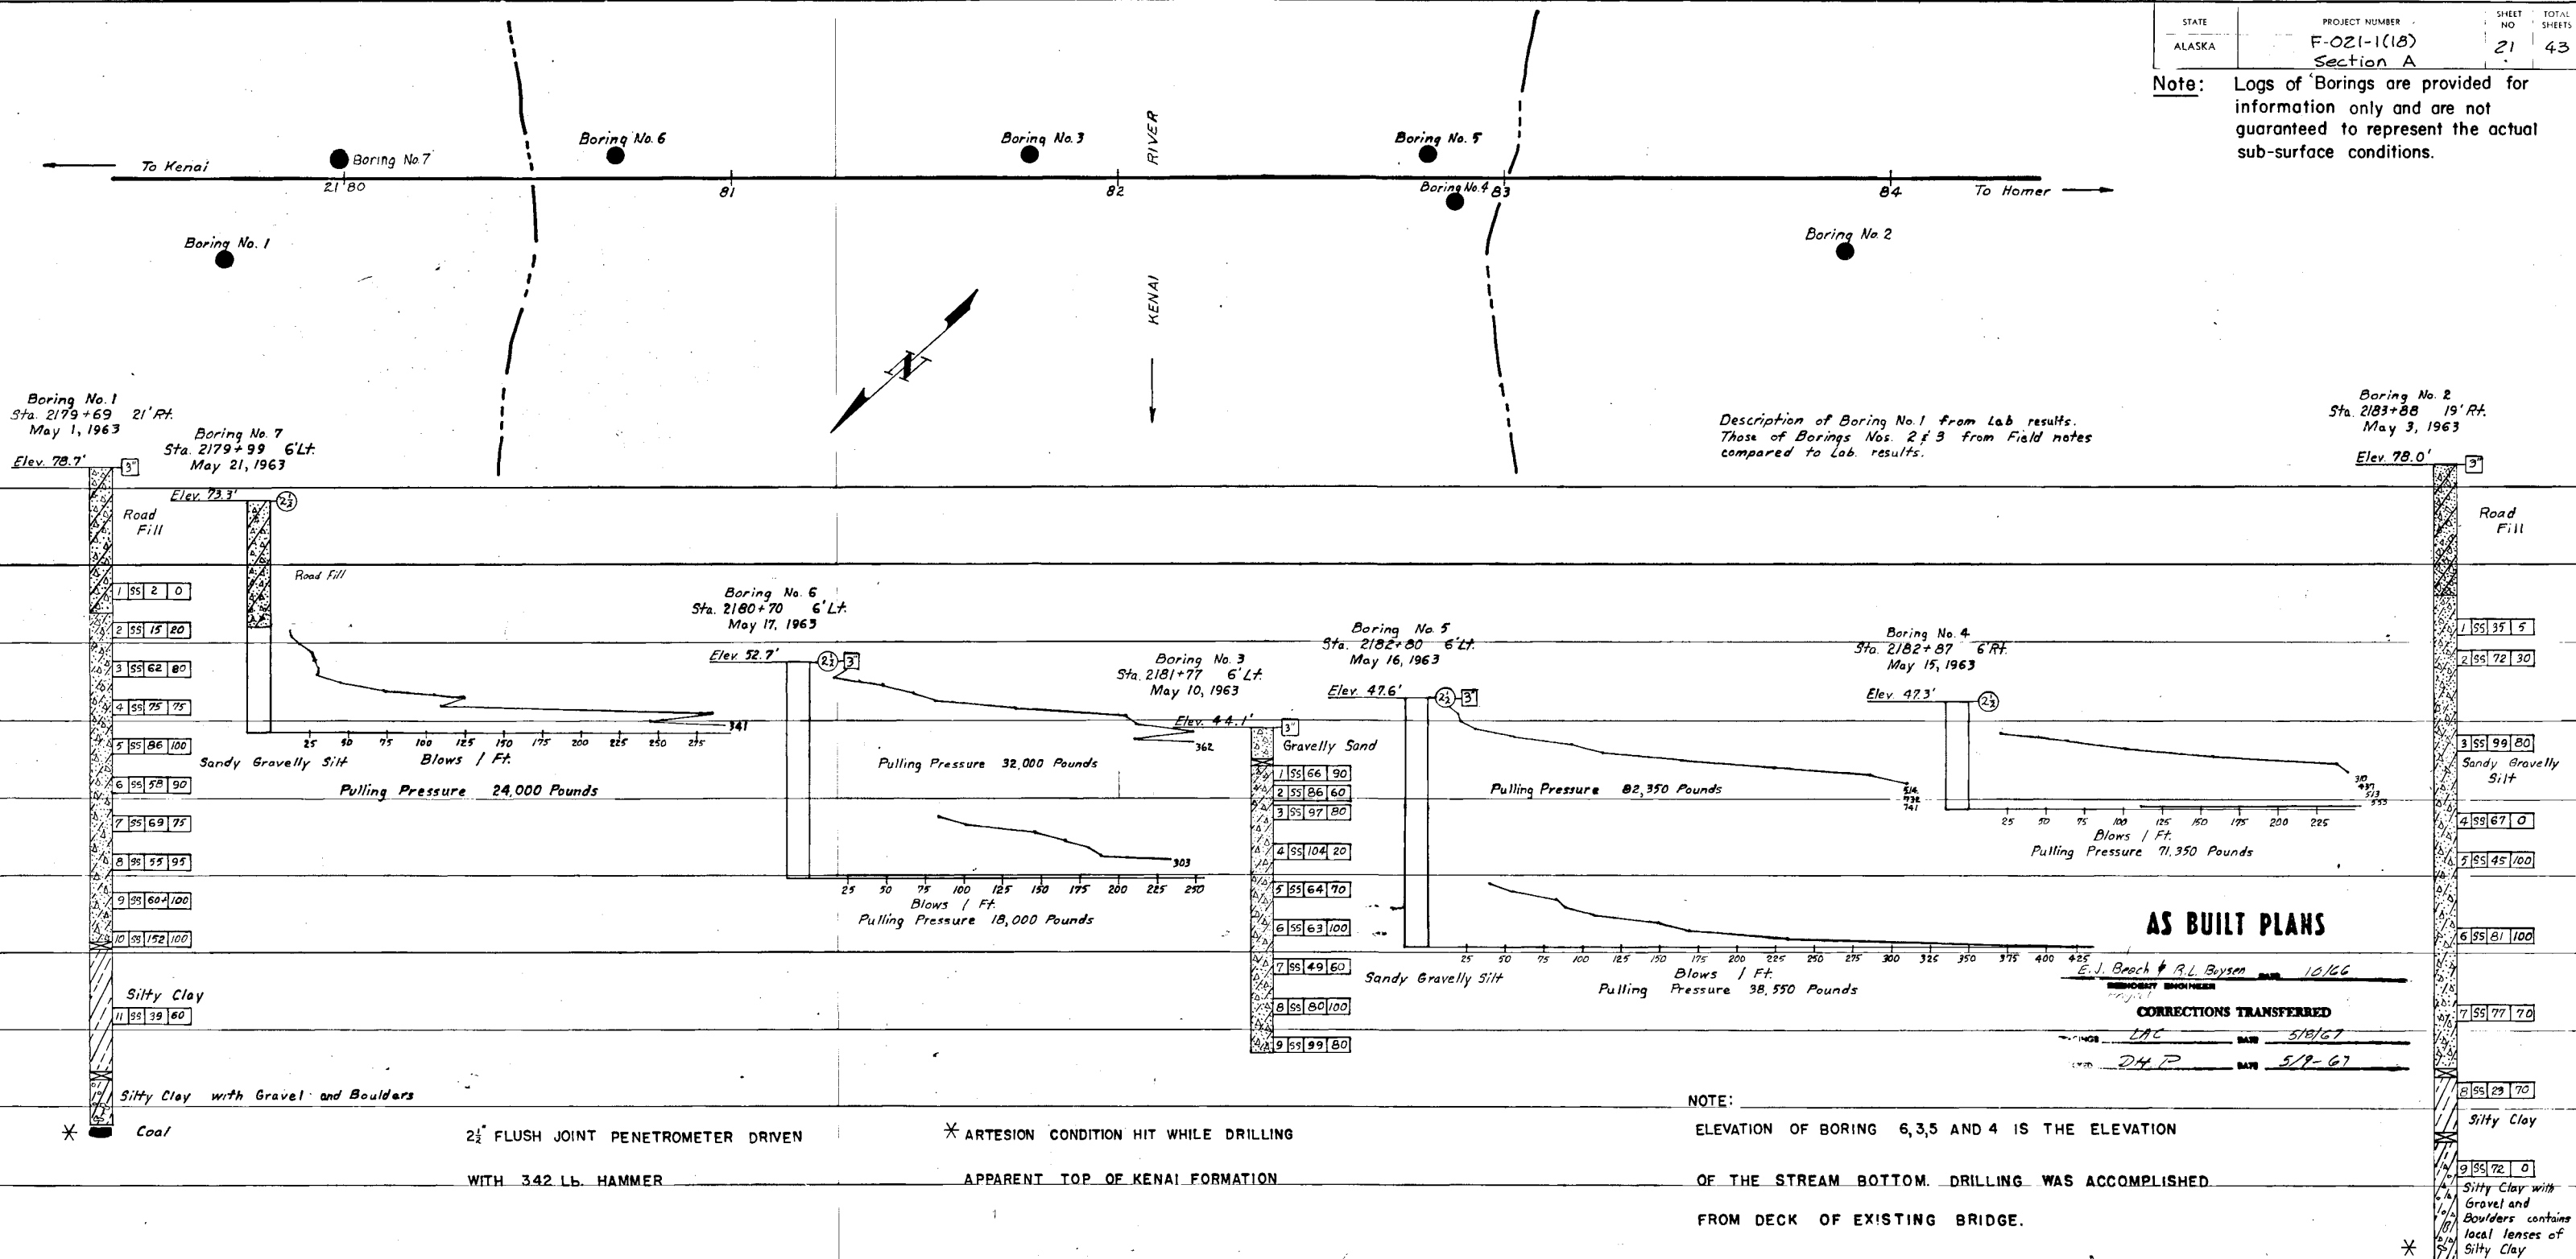

LEGEND OF EARTH MATERIALS

MATERIAL SYMBOLS	CONSISTENCY CLASSIFICATION
Cobbles or Boulders	No. of blows Granular Cohesive
Gravel	0 - 5 very loose very soft
Sand	6 - 10 loose soft
Silt	11 - 20 slightly compact stiff
Clay	21 - 35 compact very stiff
Peat and/or organic matter	36 - 70 dense hard
Fill material	70 + very dense very hard
Sedimentary rock	
Metamorphic rock	
Igneous rock	

LEGEND OF BORING OPERATIONS

ROTARY BORING

Plan of any boring

Flush penetrometer

Penetrometer

Rotary boring

Auger boring

Sample boring

Jet boring

Diamond core boring

Test pit

Moisture %

Unit weight (#/cu ft) dry

Unconfined compressive strength (T/sq.ft)

Consolidation test

Direct shear test

Expansion test

Triaxial compression test

Shear strength (#/sq.ft)

Vane shear (field)

date of boring

Penetration Test

Location

SS-split spoon 2" O.D.

ST-shelby tube 2" O.D.

Top hole elev.

Casing Set

Description of material

Permafrost

Sample No.

Sample type

Blows per foot

elevation ground water surface date measured (24 hr. reading)

Conformable material change

Gradational material change

Estimated material change

Unconformable material change

Graphic representation of driving rate

Blows per foot

Date of boring

Blows per foot (Using a 342 lb. hammer with a 30" drop)

DESIGN PILE TIP ELEVATION

TYPE OF PILE	LOCATION	REMARKS
--------------	----------	---------

NORMAL ALLOWABLE BEARING VALUE T/FT²

ELEV.	LOCATION	REMARKS
-------	----------	---------

KENAI RIVER BRIDGE AT SOLDOTNA

ROUTE NO. F-21

LOG OF TEST BORINGS

NO SCALE BRIDGE NO. 671

Alaska Department of Public Works

DIVISION OF HIGHWAYS

Juneau, Alaska

Date 1/12/66

Approved Charles P. Smith, Jr.

DWNG. NO. 1176