
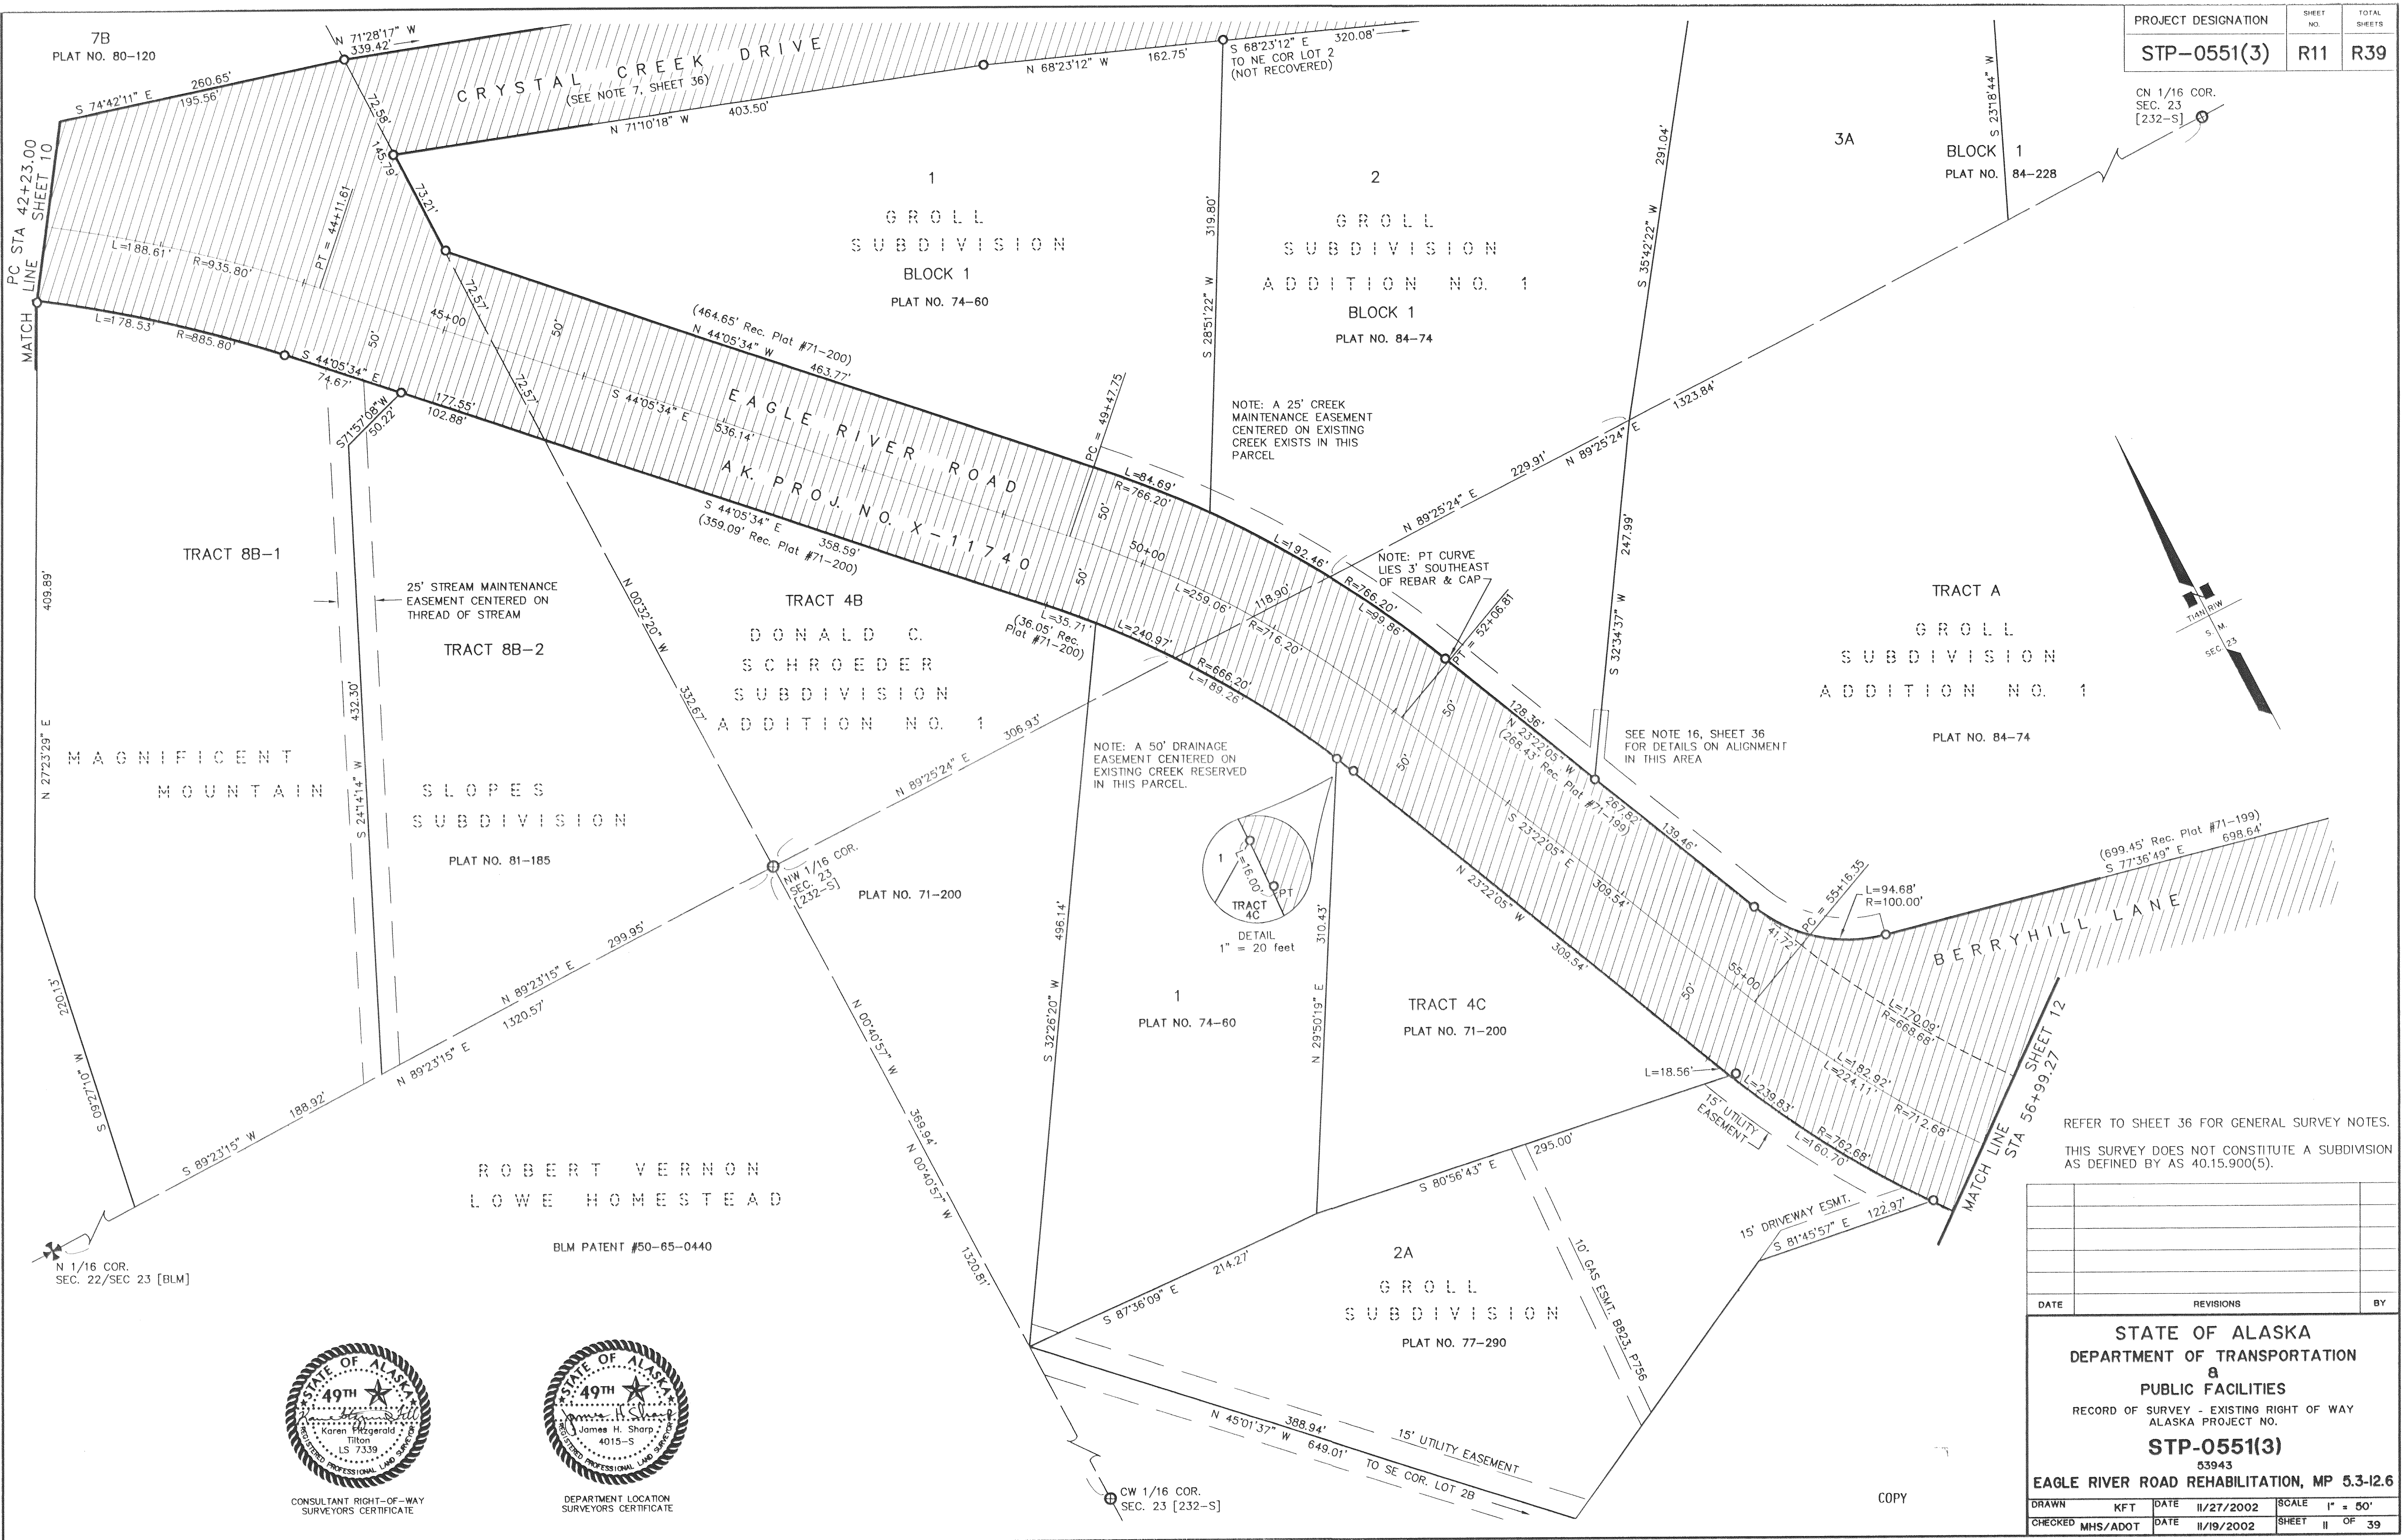


CN 1/16 COR.
SEC. 23
[232-S]

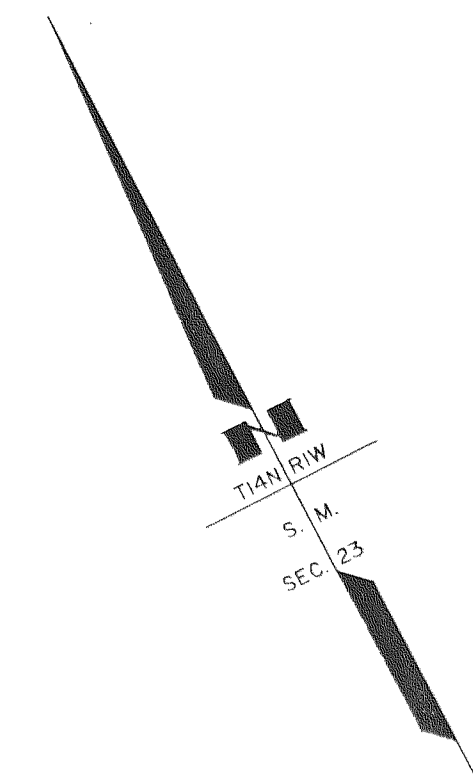

NOTE: A 25' CREEK MAINTENANCE EASEMENT CENTERED ON EXISTING CREEK EXISTS IN THIS PARCEL


NOTE: PT CURVE LIES 3' SOUTHEAST OF REBAR & CAP

NOTE: A 50' DRAINAGE EASEMENT CENTERED ON EXISTING CREEK RESERVED IN THIS PARCEL.

SEE NOTE 16, SHEET 36 FOR DETAILS ON ALIGNMENT IN THIS AREA

REFER TO SHEET 36 FOR GENERAL SURVEY NOTES.
THIS SURVEY DOES NOT CONSTITUTE A SUBDIVISION AS DEFINED BY AS 40.15.900(5).

DATE	REVISIONS	BY

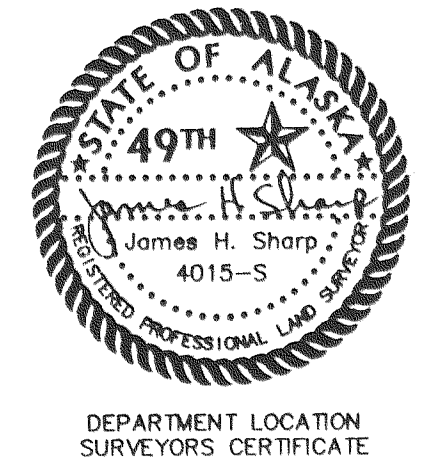

STATE OF ALASKA DEPARTMENT OF TRANSPORTATION & PUBLIC FACILITIES RECORD OF SURVEY - EXISTING RIGHT OF WAY ALASKA PROJECT NO. STP-0551(3) 53943 EAGLE RIVER ROAD REHABILITATION, MP 5.3-12.6			
DRAWN	KFT	DATE	11/27/2002
CHECKED	MHS/ADOT	DATE	11/19/2002
SCALE	1" = 50'	SHEET	11 OF 39