



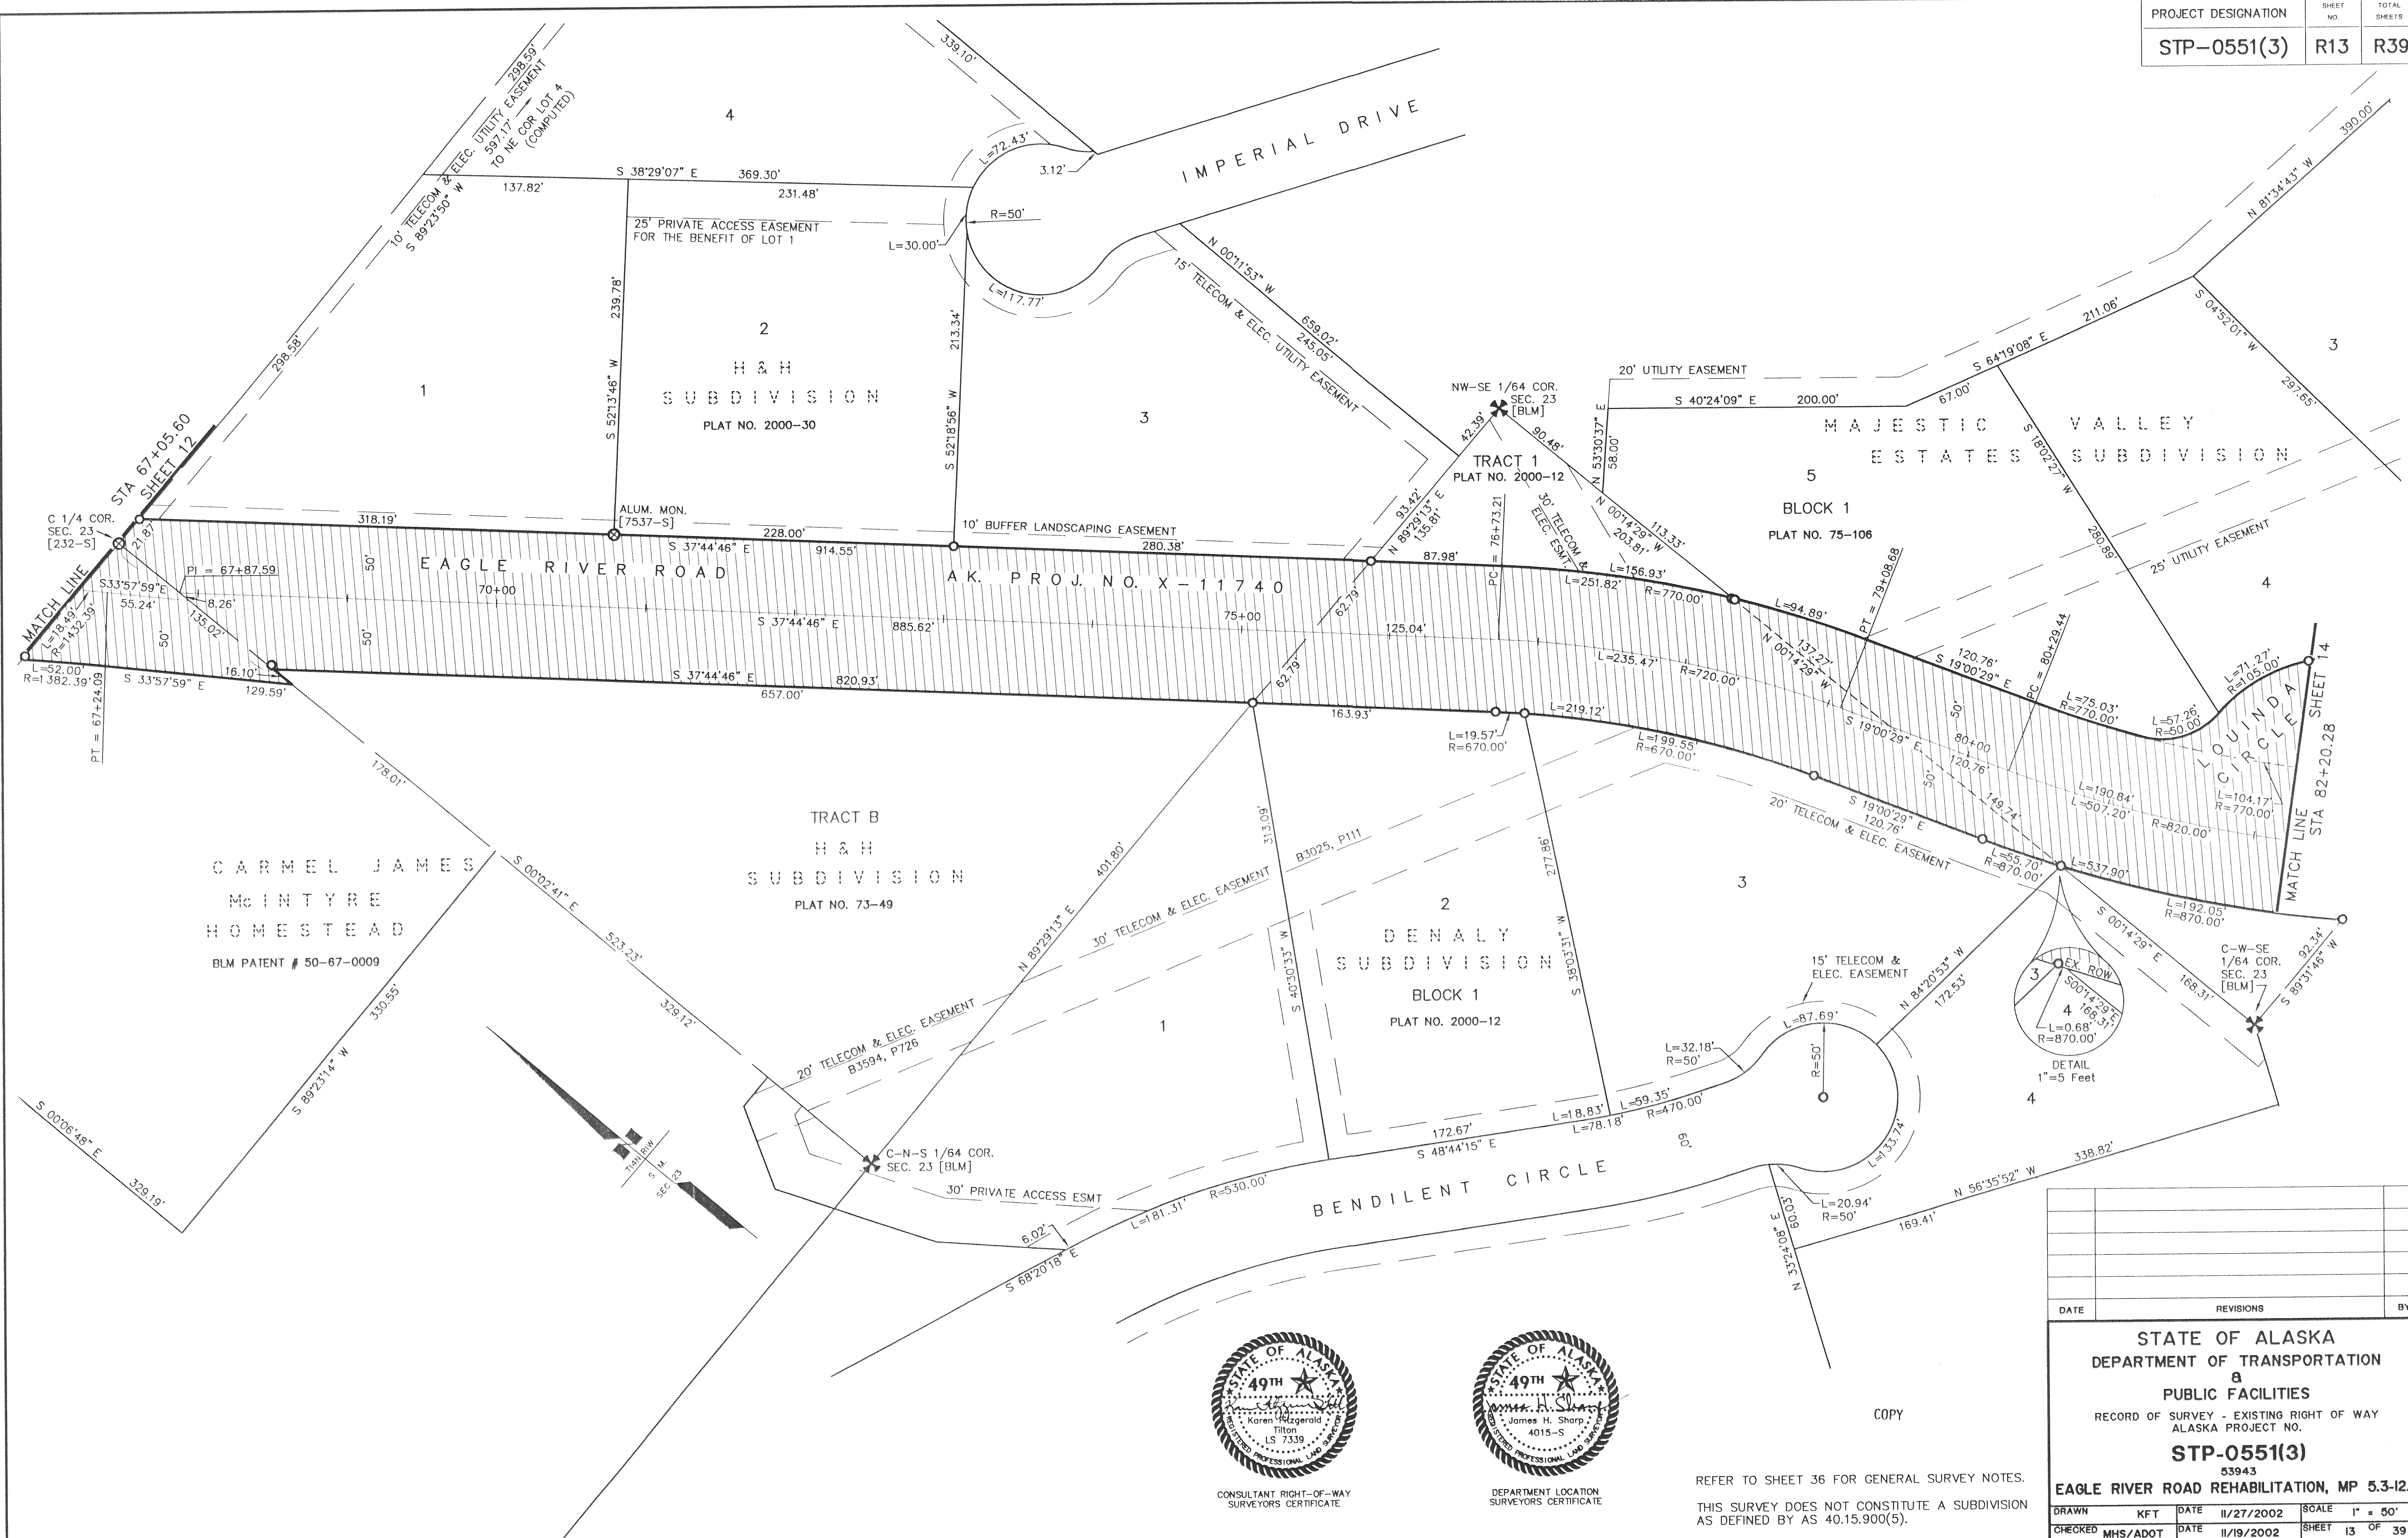

CONSULTANT RIGHT-OF-WAY
SURVEYORS CERTIFICATE

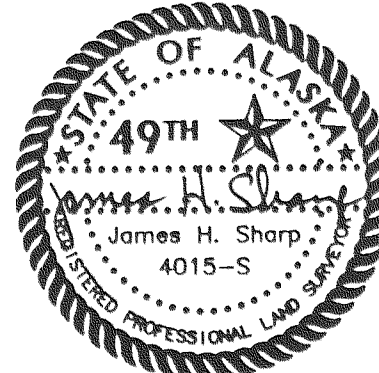

DEPARTMENT LOCATION
SURVEYORS CERTIFICATE

REFER TO SHEET 36 FOR GENERAL SURVEY NOTES.
THIS SURVEY DOES NOT CONSTITUTE A SUBDIVISION
AS DEFINED BY AS 40.15.900(5).

COPY

DATE		REVISIONS		BY	
STATE OF ALASKA DEPARTMENT OF TRANSPORTATION a PUBLIC FACILITIES RECORD OF SURVEY - EXISTING RIGHT OF WAY ALASKA PROJECT NO. STP-0551(3) 53943 EAGLE RIVER ROAD REHABILITATION, MP 5.3-12.6					
DRAWN	KFT	DATE	11/27/2002	SCALE	1" = 50'
CHECKED	MHS/ADOT	DATE	11/19/2002	SHEET	13 OF 39