



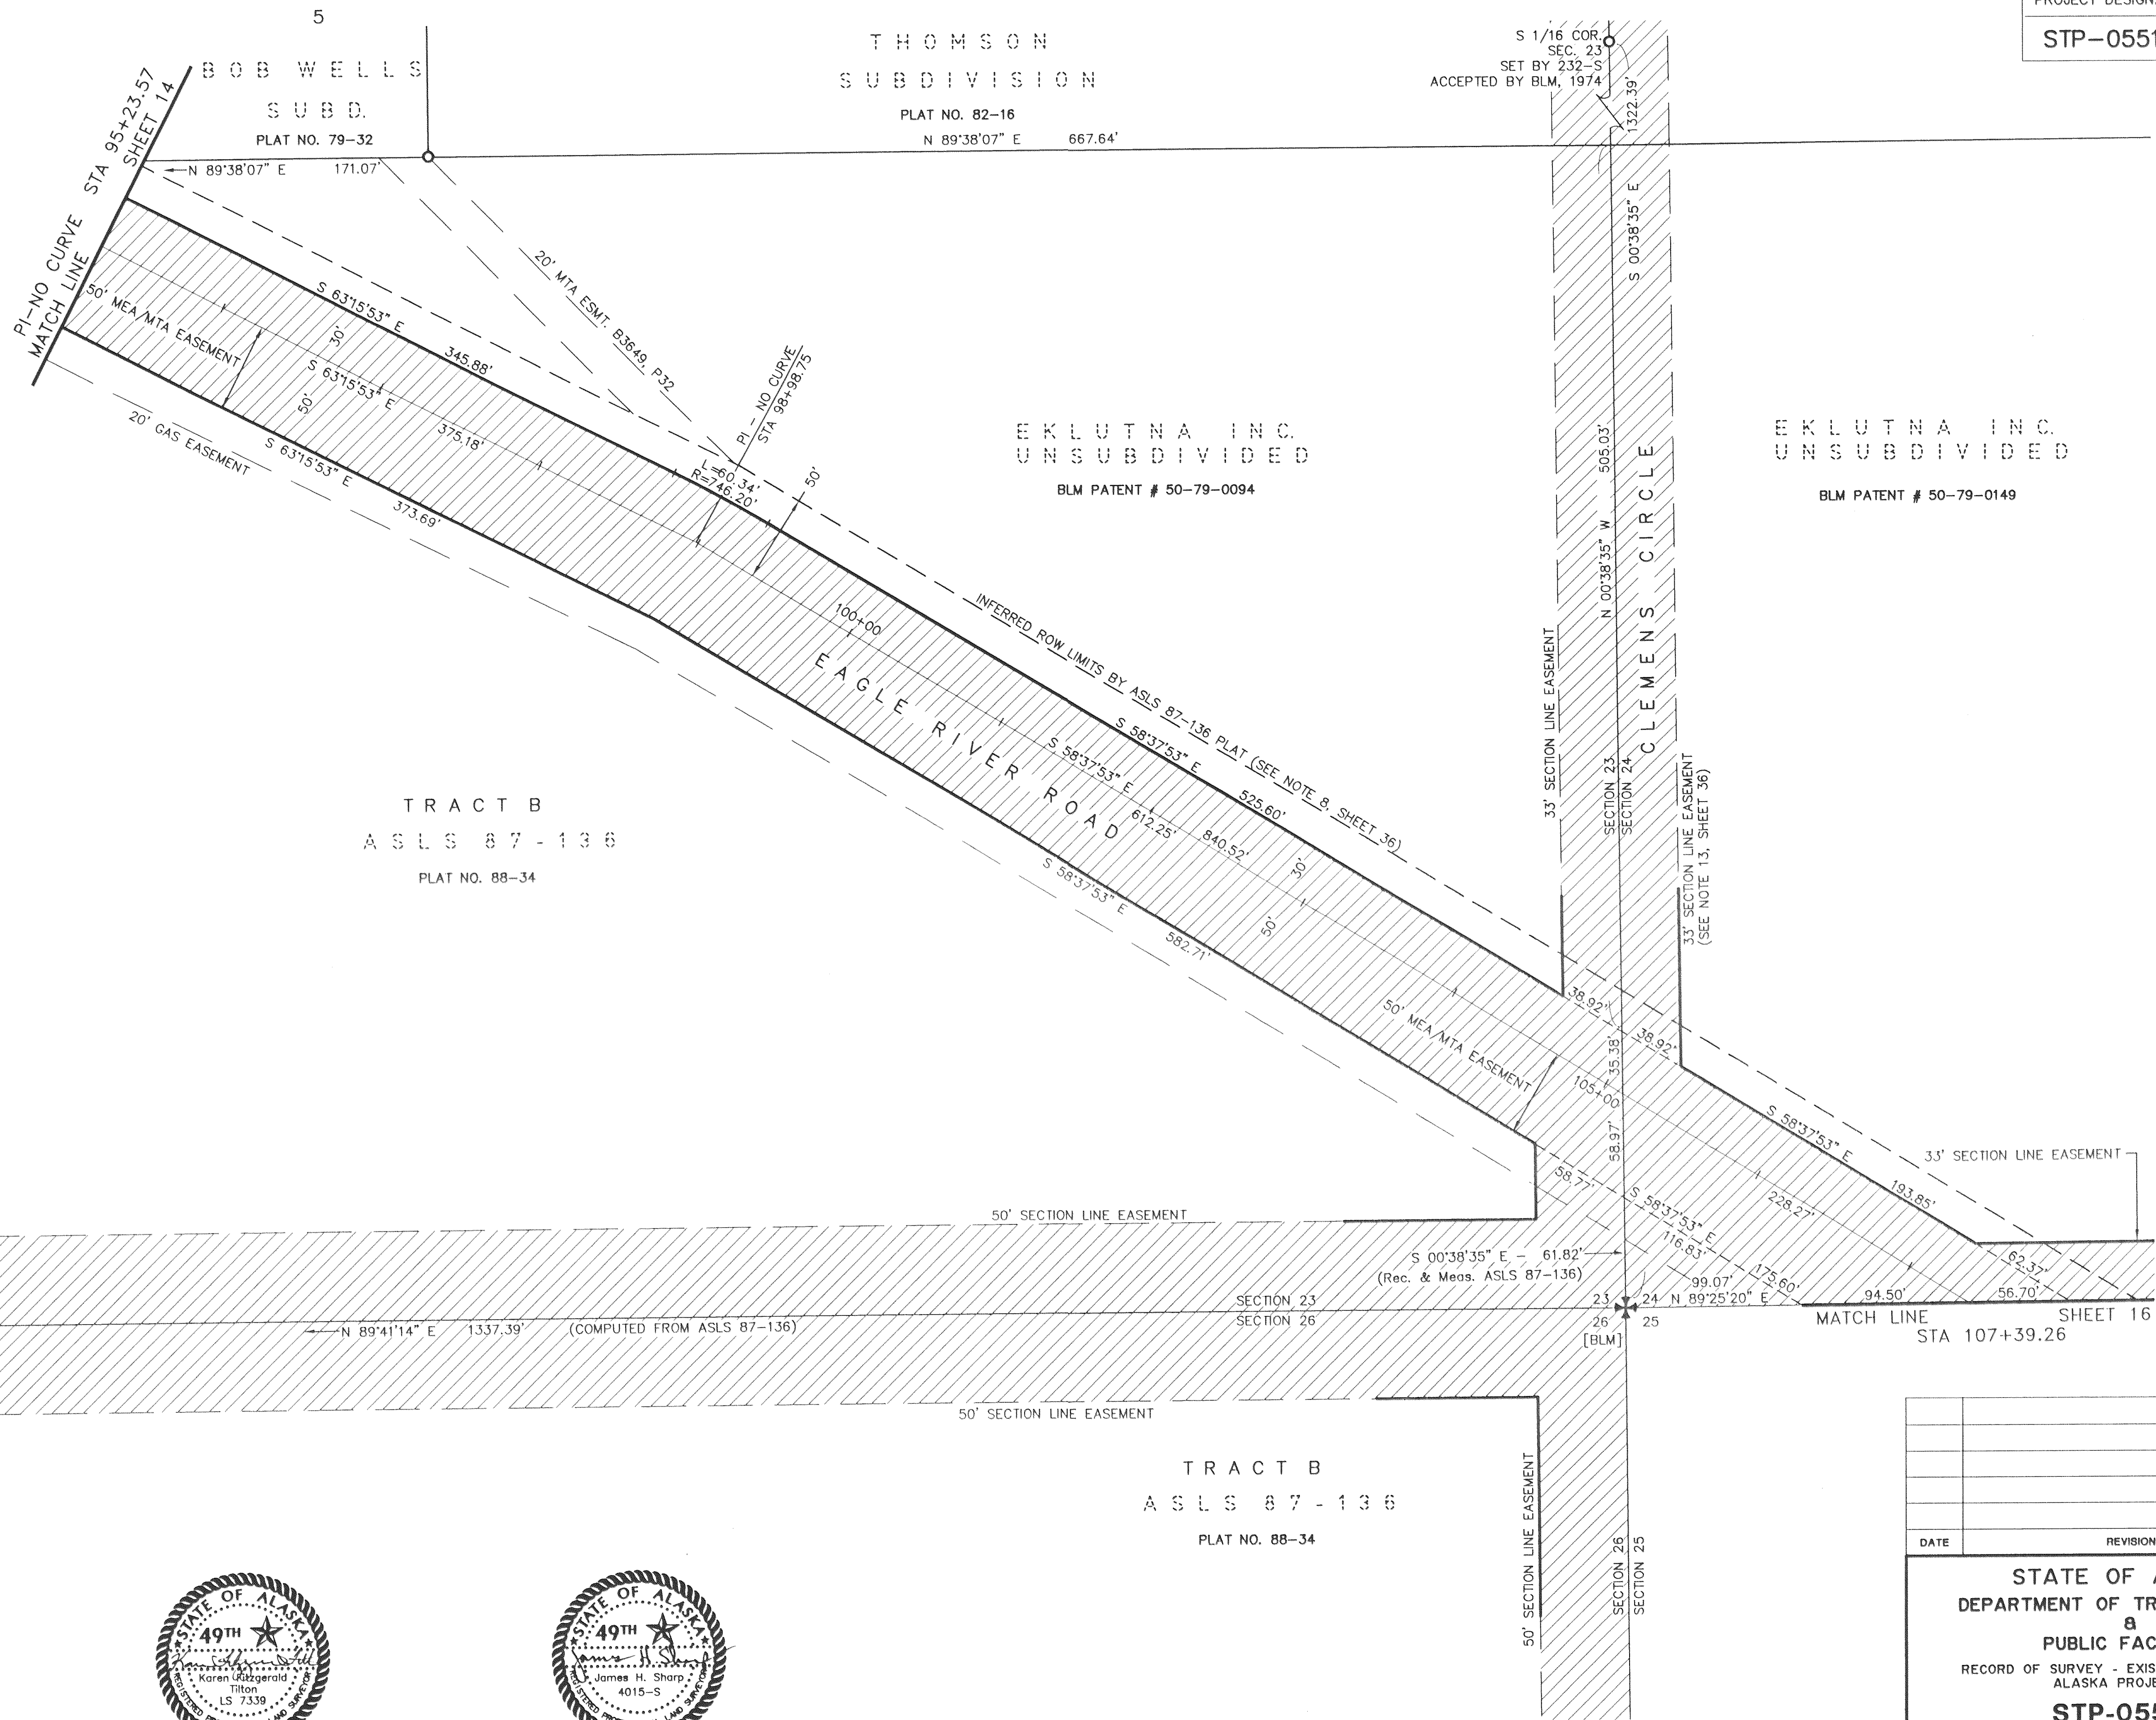

CONSULTANT RIGHT-OF-WAY
SURVEYORS CERTIFICATE

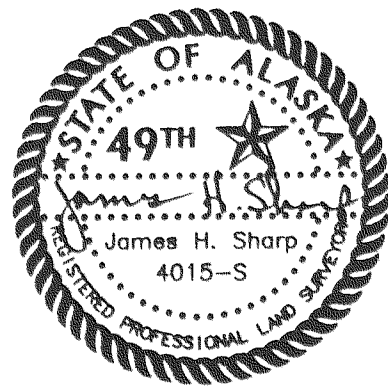

DEPARTMENT LOCATION
SURVEYORS CERTIFICATE

COPY

REFER TO SHEET 36 FOR GENERAL SURVEY NOTES.

THIS SURVEY DOES NOT CONSTITUTE A SUBDIVISION
AS DEFINED BY AS 40.15.900(5).

STATE OF ALASKA DEPARTMENT OF TRANSPORTATION 8 PUBLIC FACILITIES RECORD OF SURVEY - EXISTING RIGHT OF WAY ALASKA PROJECT NO. STP-0551(3) 53943 EAGLE RIVER ROAD REHABILITATION, MP 5.3-12.6			
DRAWN	KFT	DATE	11/27/2002
CHECKED	MHS/ADOT	DATE	11/19/2002
SCALE	1" = 50'	SHEET	15 OF 39

ANCHORAGE RECORDING DISTRICT 2002-157