


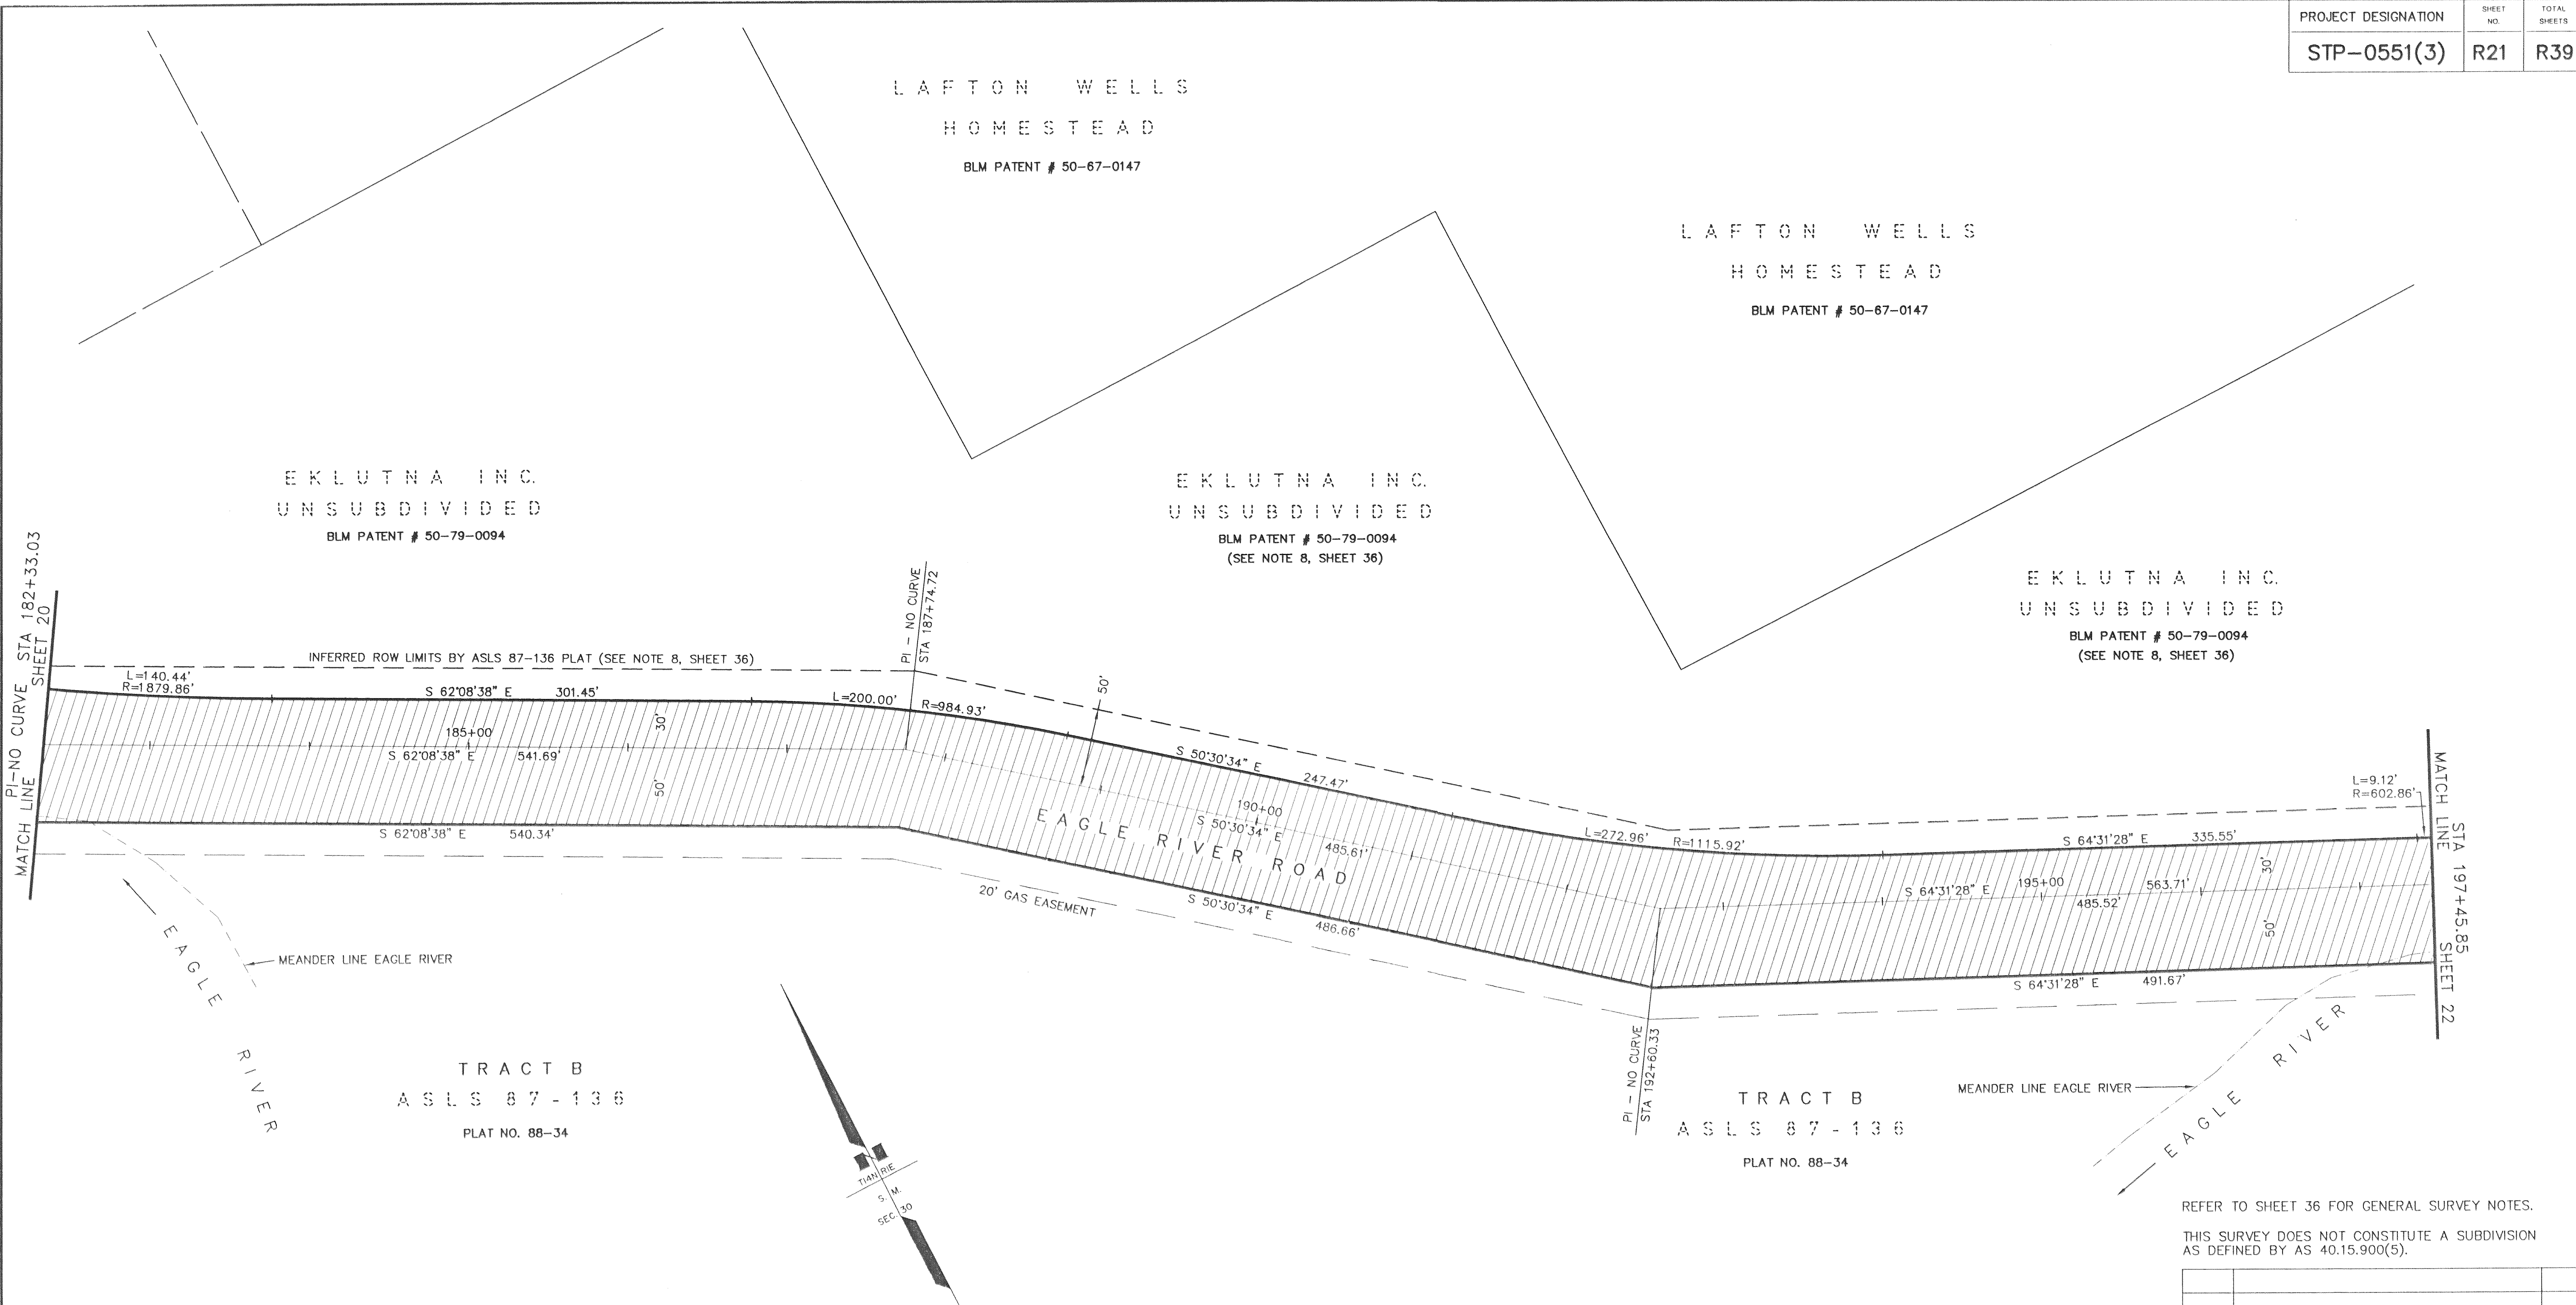


REFER TO SHEET 36 FOR GENERAL SURVEY NOTES.

THIS SURVEY DOES NOT CONSTITUTE A SUBDIVISION AS DEFINED BY AS 40.15.900(5).



CONSULTANT RIGHT-OF-WAY SURVEYORS' CERTIFICATE

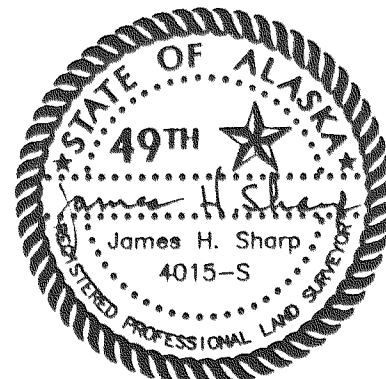

DEPARTMENT LOCATION SURVEYORS' CERTIFICATE

COPY

DATE		REVISIONS		BY
STATE OF ALASKA DEPARTMENT OF TRANSPORTATION a PUBLIC FACILITIES RECORD OF SURVEY - EXISTING RIGHT OF WAY ALASKA PROJECT NO. STP-0551(3) 53943 EAGLE RIVER ROAD REHABILITATION, MP 5.3-12.6				
DRAWN	KFT	DATE	11/27/2002	SCALE 1" = 50'
CHECKED	MHS/ADOT	DATE	11/19/2002	SHEET 21 OF 39