

PROJECT DESIGNATION	SHEET NO.	TOTAL SHEETS
STP-0551(3)	R23	R39

L A F T O N W E L L S
H O M E S T E A D
BLM PATENT # 50-67-0147

E K L U T N A I N C.
U N S U B D I V I D E D
BLM PATENT # 50-79-0094


E K L U T N A I N C.
U N S U B D I V I D E D
BLM PATENT # 50-79-0094
(SEE NOTE 8, SHEET 36)



DEPARTMENT LOCATION
SURVEYORS' CERTIFICATE



CONSULTANT RIGHT-OF-WAY
SURVEYORS' CERTIFICATE

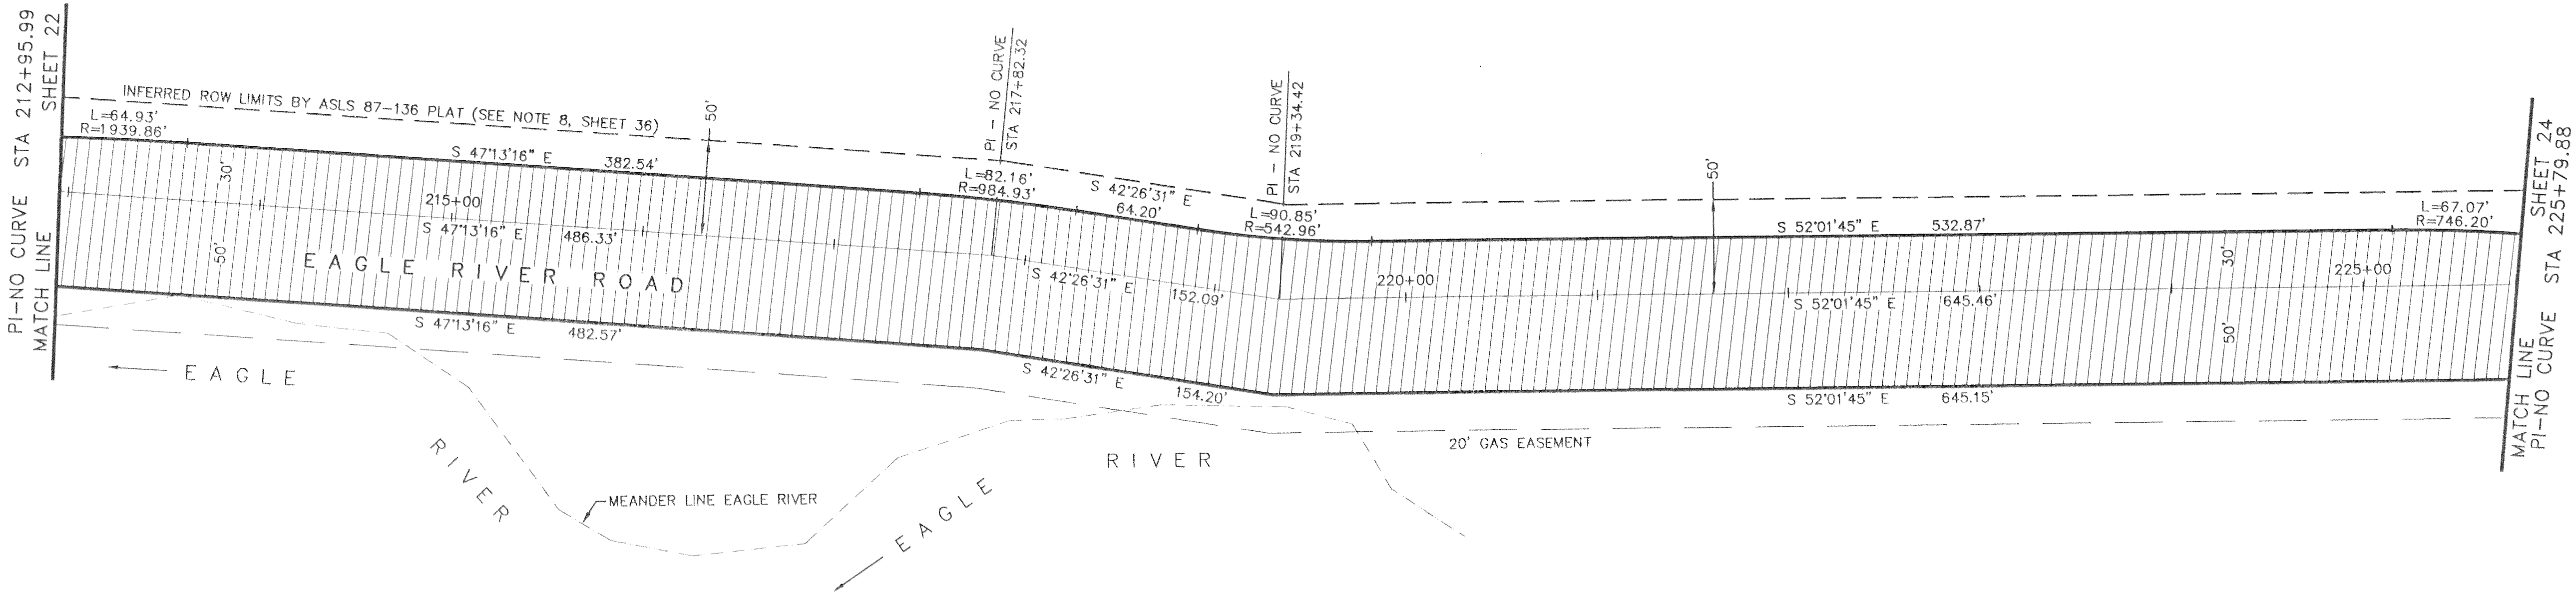

TRACT B
ASLS 87-136
PLAT NO. 88-34

TRACT B
ASLS 87-136
PLAT NO. 88-34

REFER TO SHEET 36 FOR GENERAL SURVEY NOTES.
THIS SURVEY DOES NOT CONSTITUTE A SUBDIVISION
AS DEFINED BY AS 40.15.900(5).

DATE	REVISIONS	BY

STATE OF ALASKA
DEPARTMENT OF TRANSPORTATION
a
PUBLIC FACILITIES
RECORD OF SURVEY - EXISTING RIGHT OF WAY
ALASKA PROJECT NO.
STP-0551(3)
53943
EAGLE RIVER ROAD REHABILITATION, MP 5.3-12.6

DRAWN	KFT	DATE	11/27/2002	SCALE	1" = 50'
CHECKED	MHS/ADOT	DATE	11/19/2002	SHEET	23 OF 39

COPY