


PROJECT DESIGNATION	SHEET NO.	TOTAL SHEETS
STP-0551(3)	R24	R39

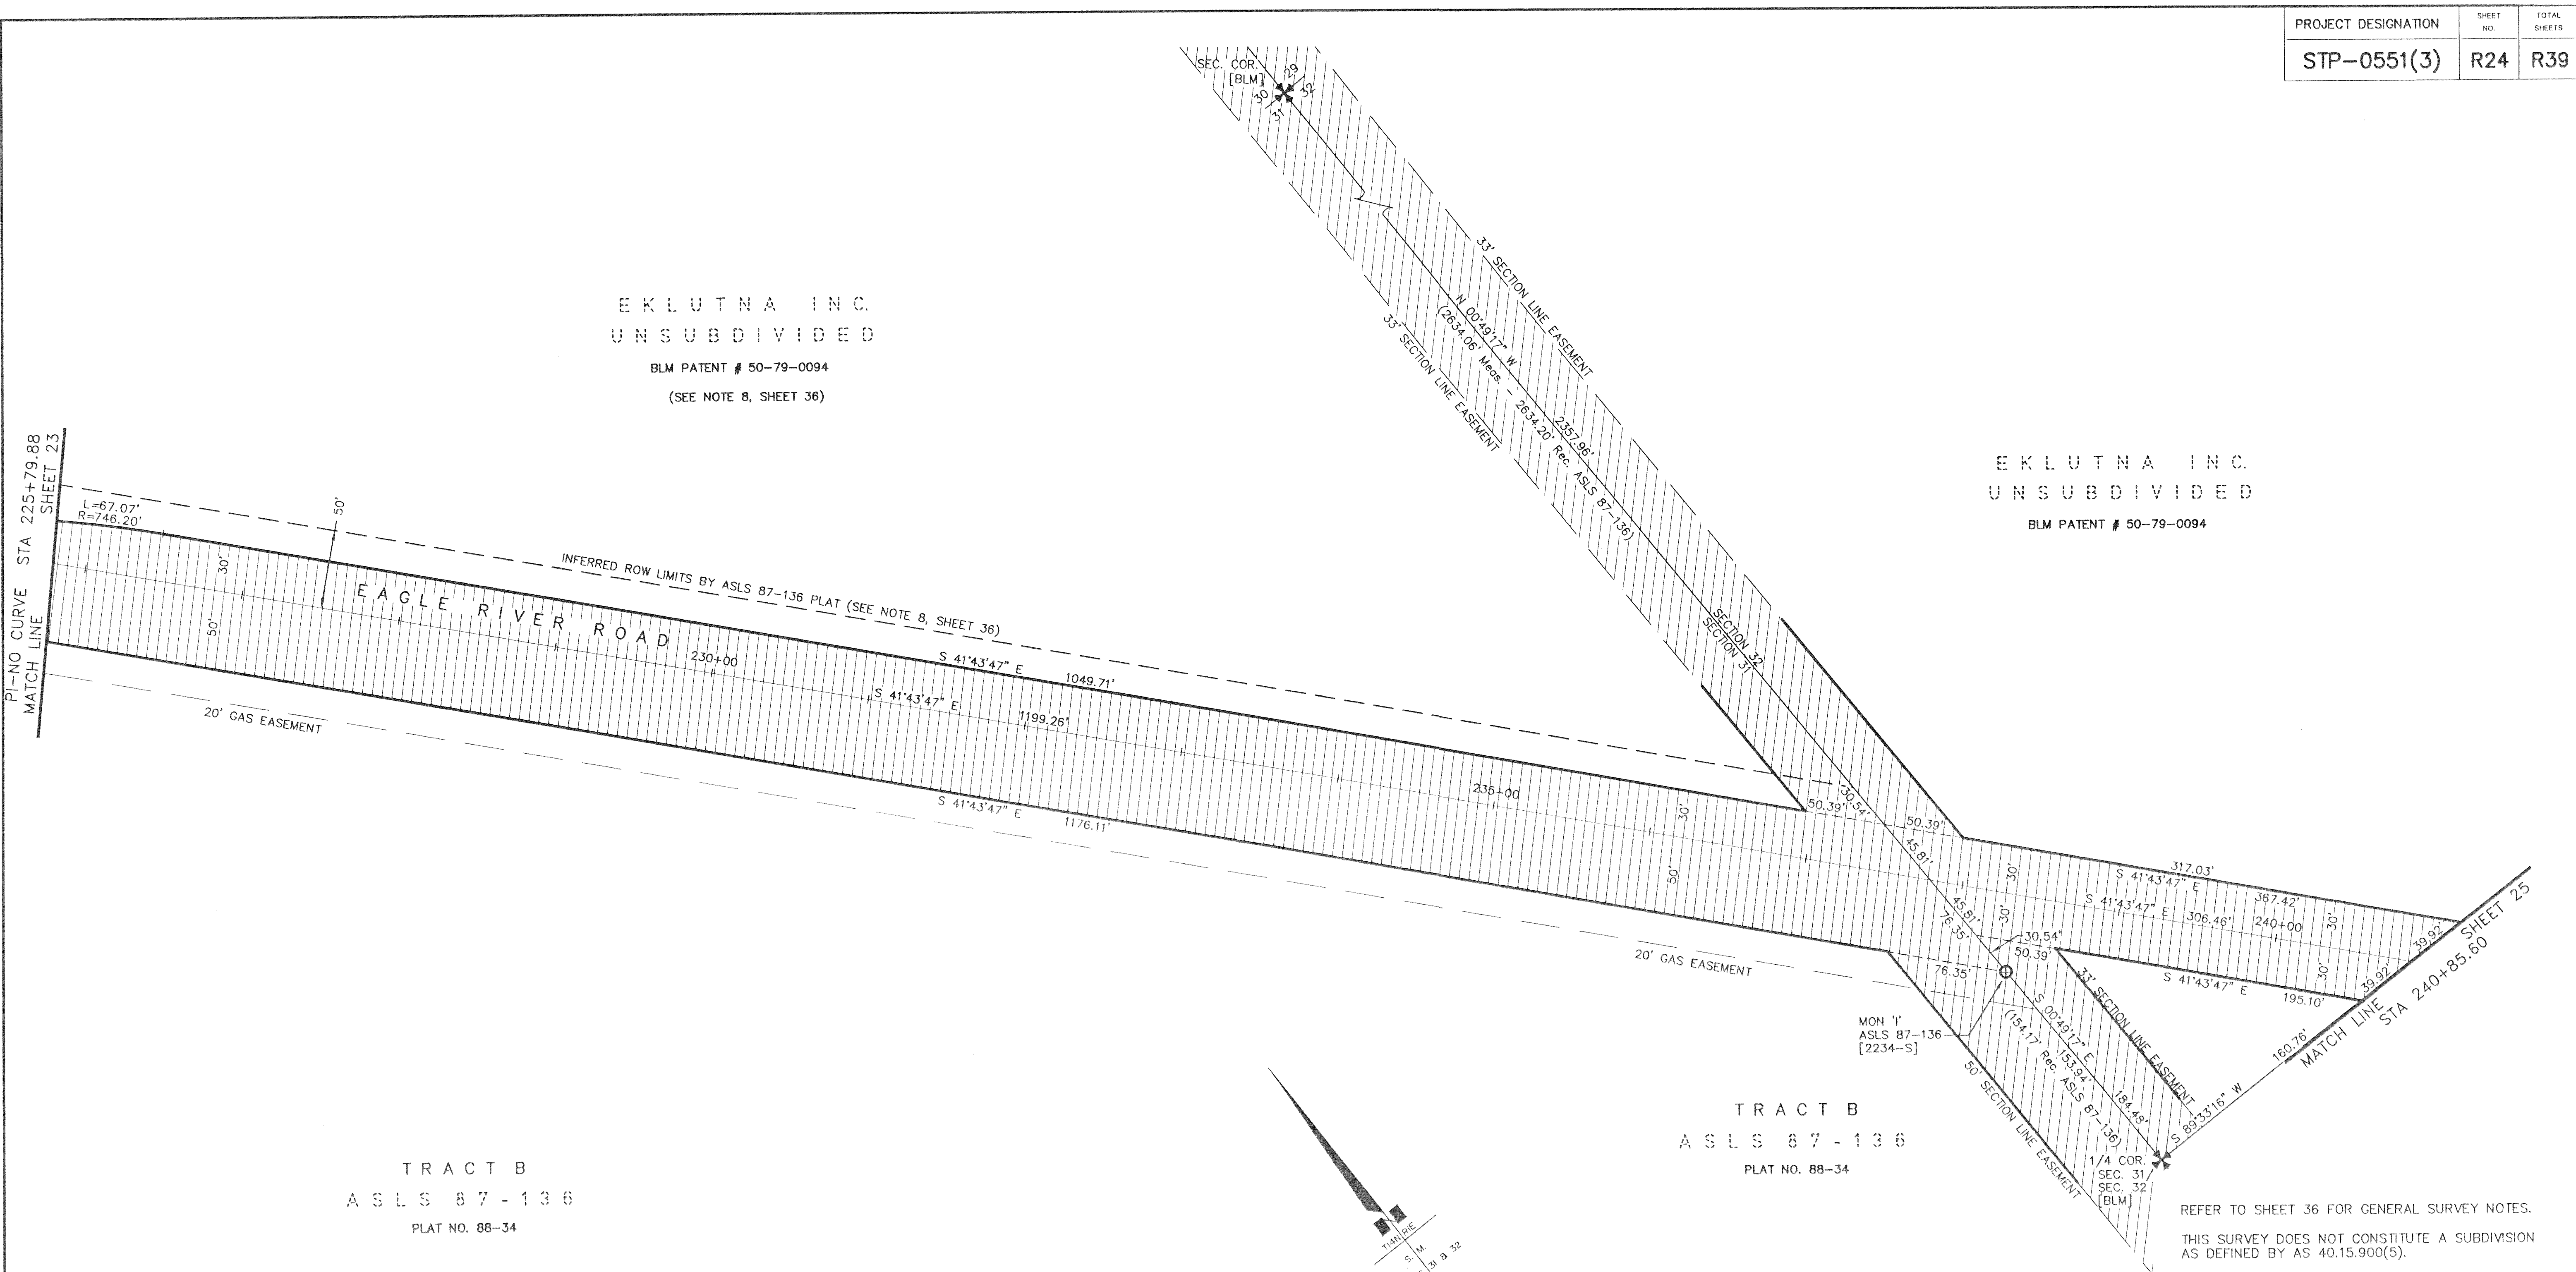

TRACT B
ASLS 87-136
PLAT NO. 88-34


TRACT B
ASLS 87-136
PLAT NO. 88-34

REFER TO SHEET 36 FOR GENERAL SURVEY NOTES.
THIS SURVEY DOES NOT CONSTITUTE A SUBDIVISION
AS DEFINED BY AS 40.15.900(5).

DATE	REVISIONS	BY



CONSULTANT RIGHT-OF-WAY
SURVEYORS CERTIFICATE

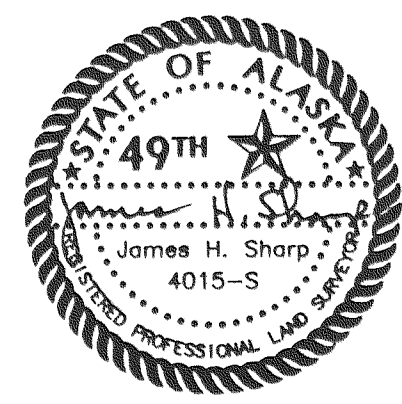

DEPARTMENT LOCATION
SURVEYORS CERTIFICATE

COPY

STATE OF ALASKA DEPARTMENT OF TRANSPORTATION PUBLIC FACILITIES			
RECORD OF SURVEY - EXISTING RIGHT OF WAY ALASKA PROJECT NO.			
STP-0551(3)			
53943			
EAGLE RIVER ROAD REHABILITATION, MP 5.3-12.6			
DRAWN	KFT	DATE	11/27/2002
CHECKED	MHS/ADOT	DATE	11/19/2002
SCALE		1" = 50'	
SHEET		24 OF 39	

Anchorage Recording District 2002-157