


PROJECT DESIGNATION	SHEET NO.	TOTAL SHEETS
STP-0551(3)	R27	R39

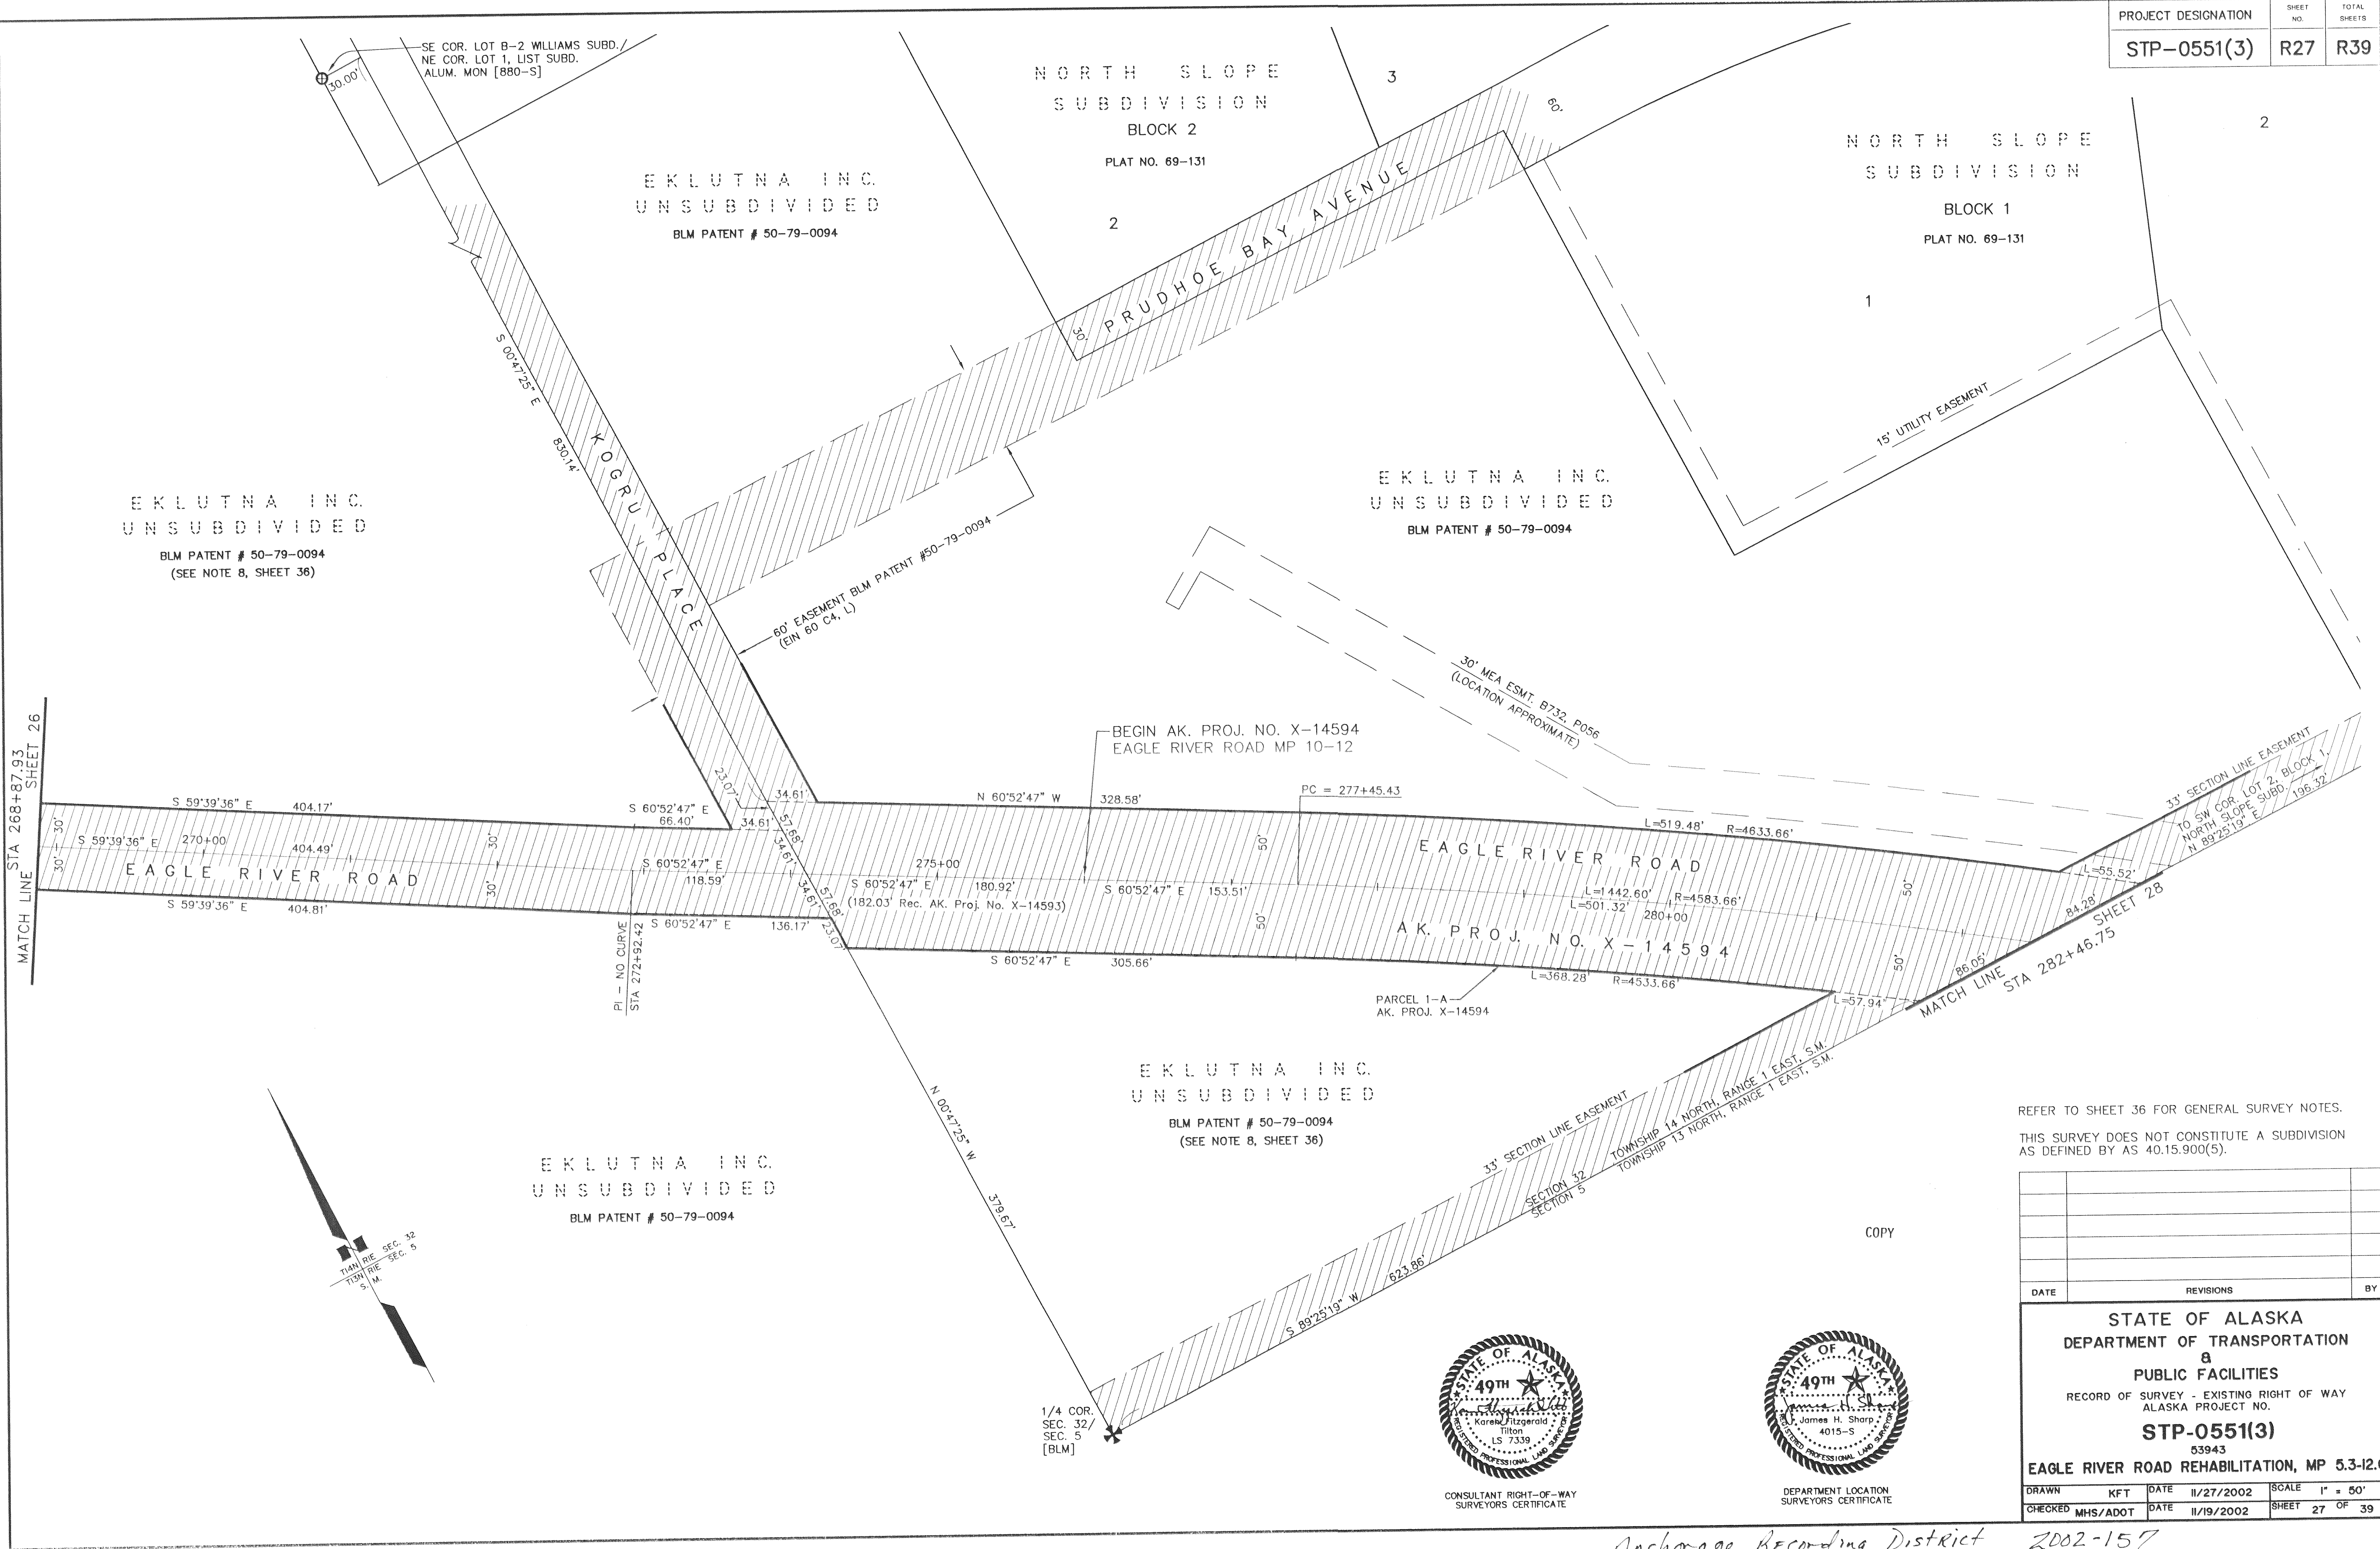

REFER TO SHEET 36 FOR GENERAL SURVEY NOTES.
 THIS SURVEY DOES NOT CONSTITUTE A SUBDIVISION
 AS DEFINED BY AS 40.15.900(5).

DATE			REVISIONS			BY		
STATE OF ALASKA DEPARTMENT OF TRANSPORTATION & PUBLIC FACILITIES RECORD OF SURVEY - EXISTING RIGHT OF WAY ALASKA PROJECT NO. STP-0551(3) 53943 EAGLE RIVER ROAD REHABILITATION, MP 5.3-12.6								
DRAWN	KFT	DATE	11/27/2002	SCALE	1" = 50'			
CHECKED	MHS/ADOT	DATE	11/19/2002	SHEET	27 OF 39			

Anchorage Recording District 2002-157