


PROJECT DESIGNATION	SHEET NO.	TOTAL SHEETS
STP-0551(3)	R28	R39

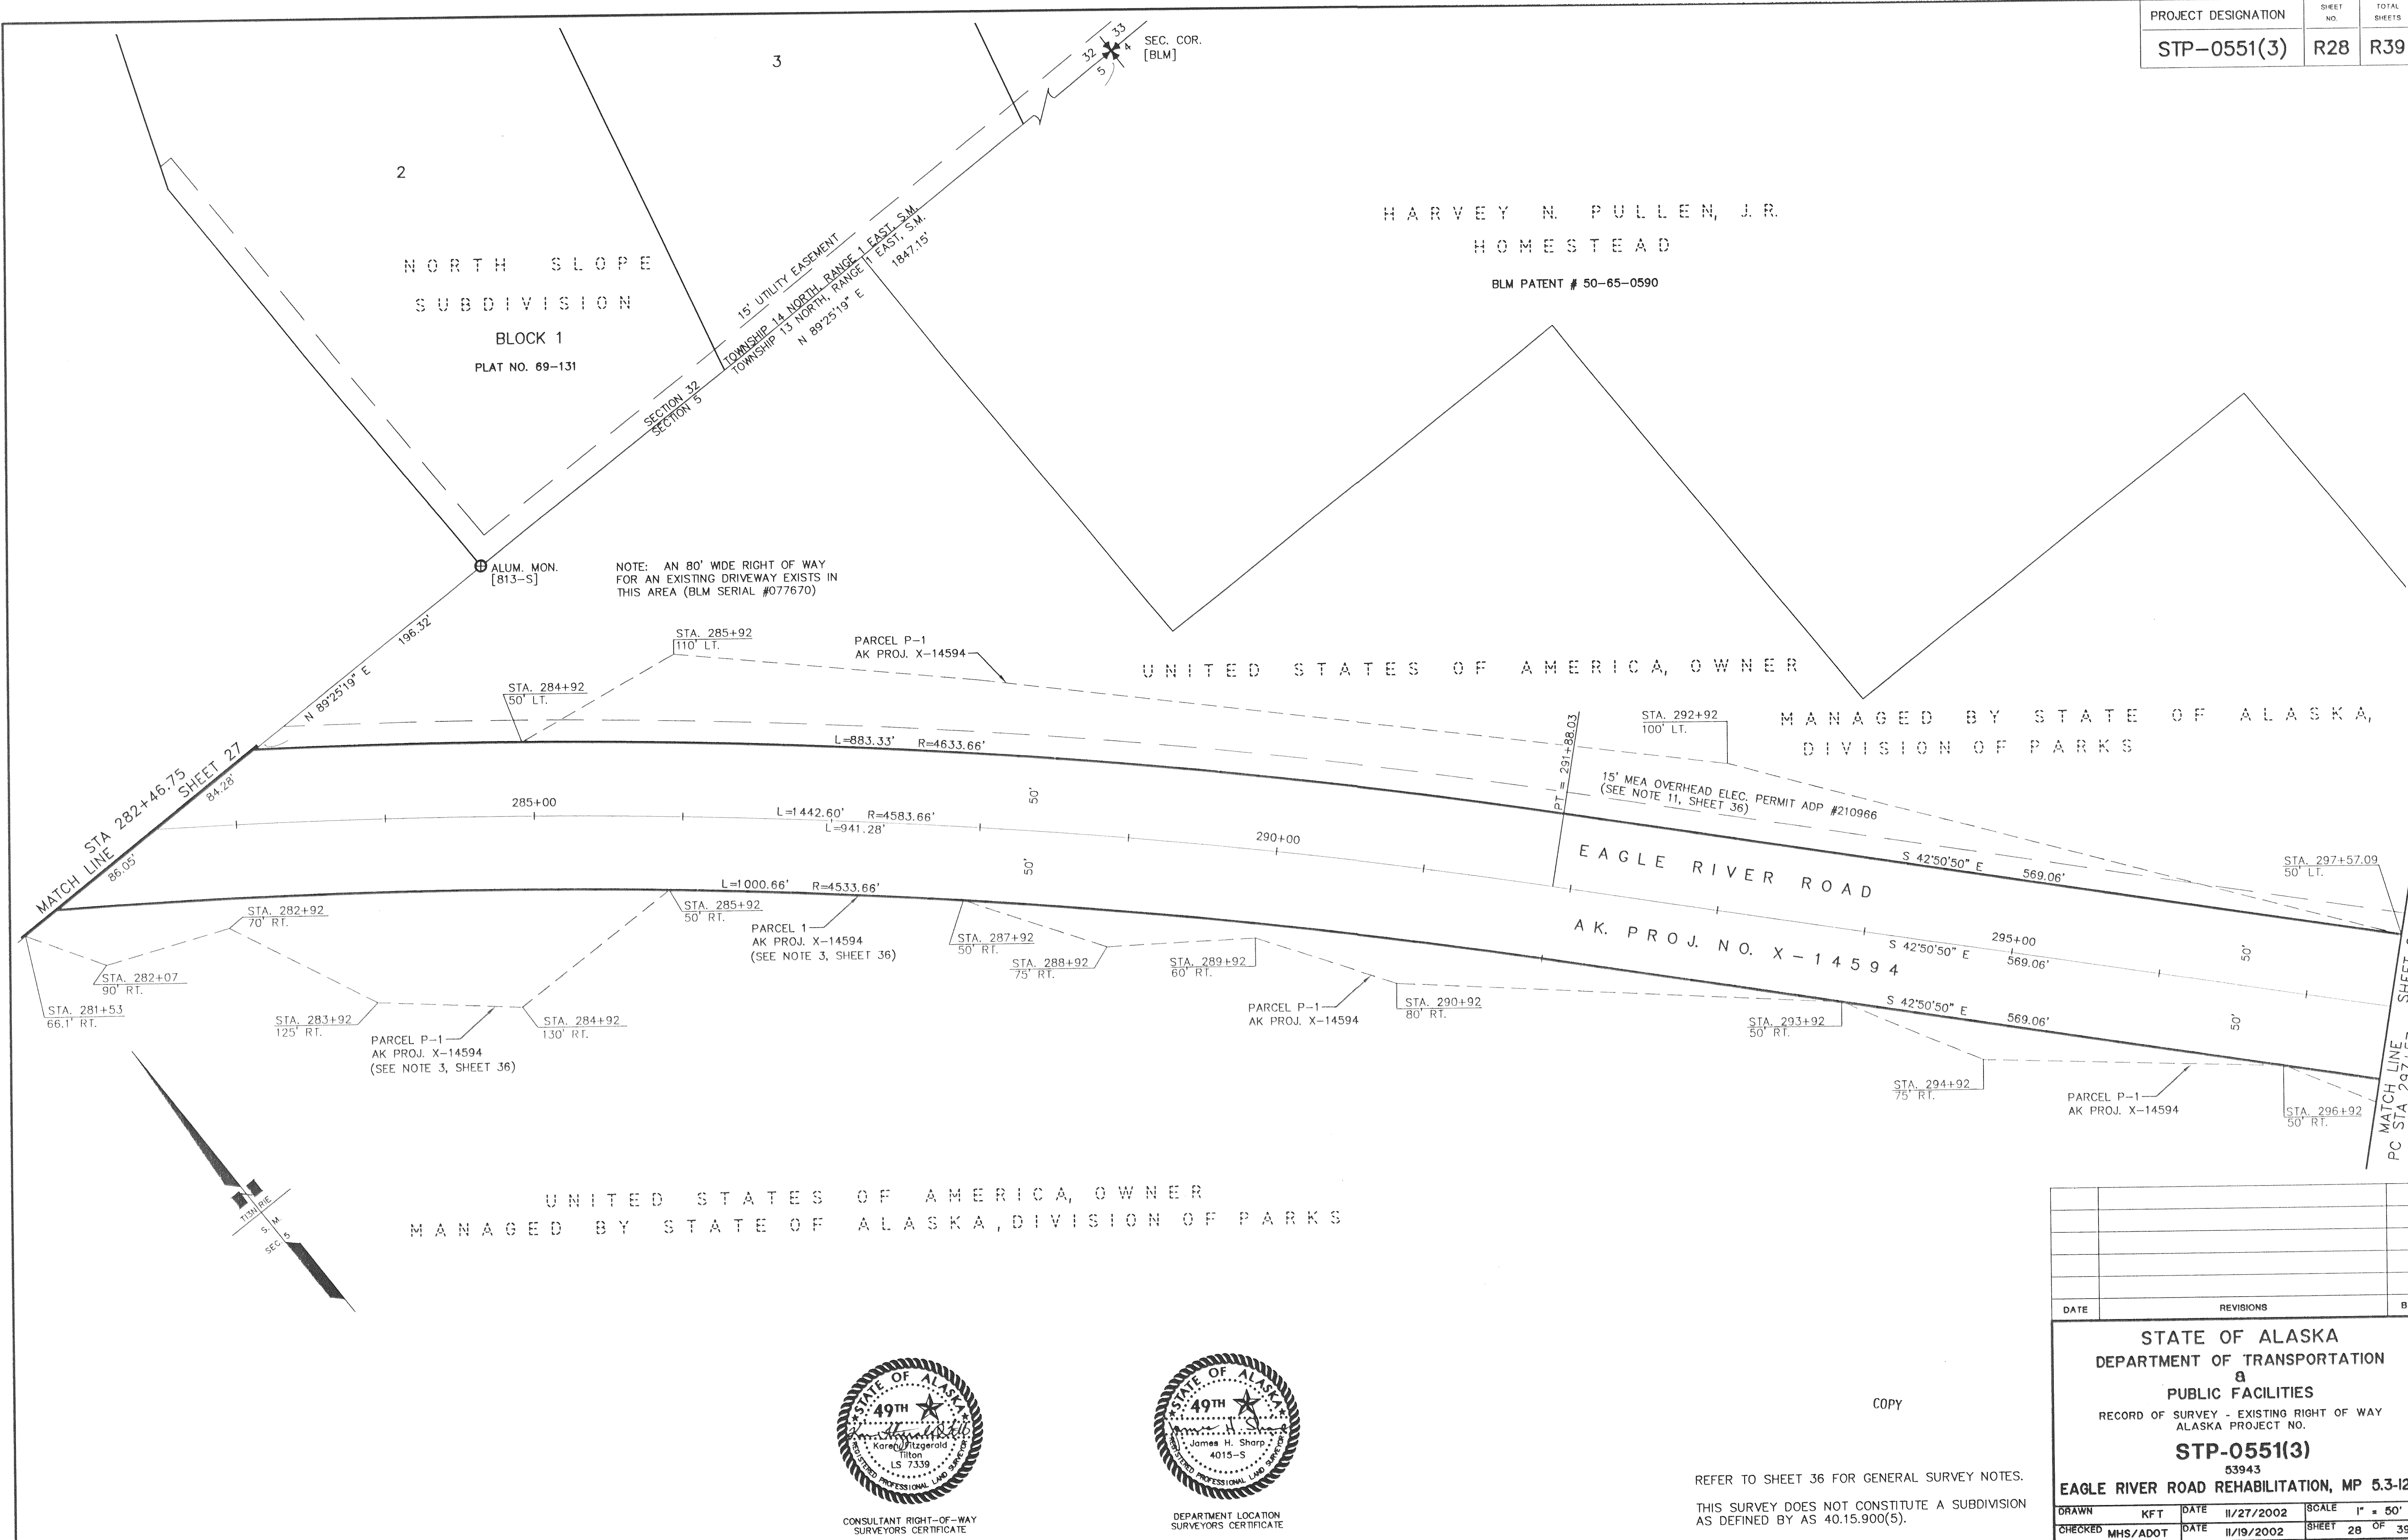

DATE	REVISIONS	BY

STATE OF ALASKA
DEPARTMENT OF TRANSPORTATION
&
PUBLIC FACILITIES
RECORD OF SURVEY - EXISTING RIGHT OF WAY
ALASKA PROJECT NO.
STP-0551(3)
53943
EAGLE RIVER ROAD REHABILITATION, MP 5.3-12.6

DRAWN	KFT	DATE	11/27/2002	SCALE	1" = 50'
CHECKED	MHS/ADOT	DATE	11/19/2002	SHEET	28 OF 39

COPY

REFER TO SHEET 36 FOR GENERAL SURVEY NOTES.

THIS SURVEY DOES NOT CONSTITUTE A SUBDIVISION AS DEFINED BY AS 40.15.900(5).

Anchorage Recording District 2002-157