

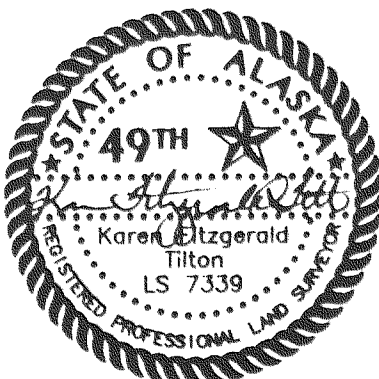


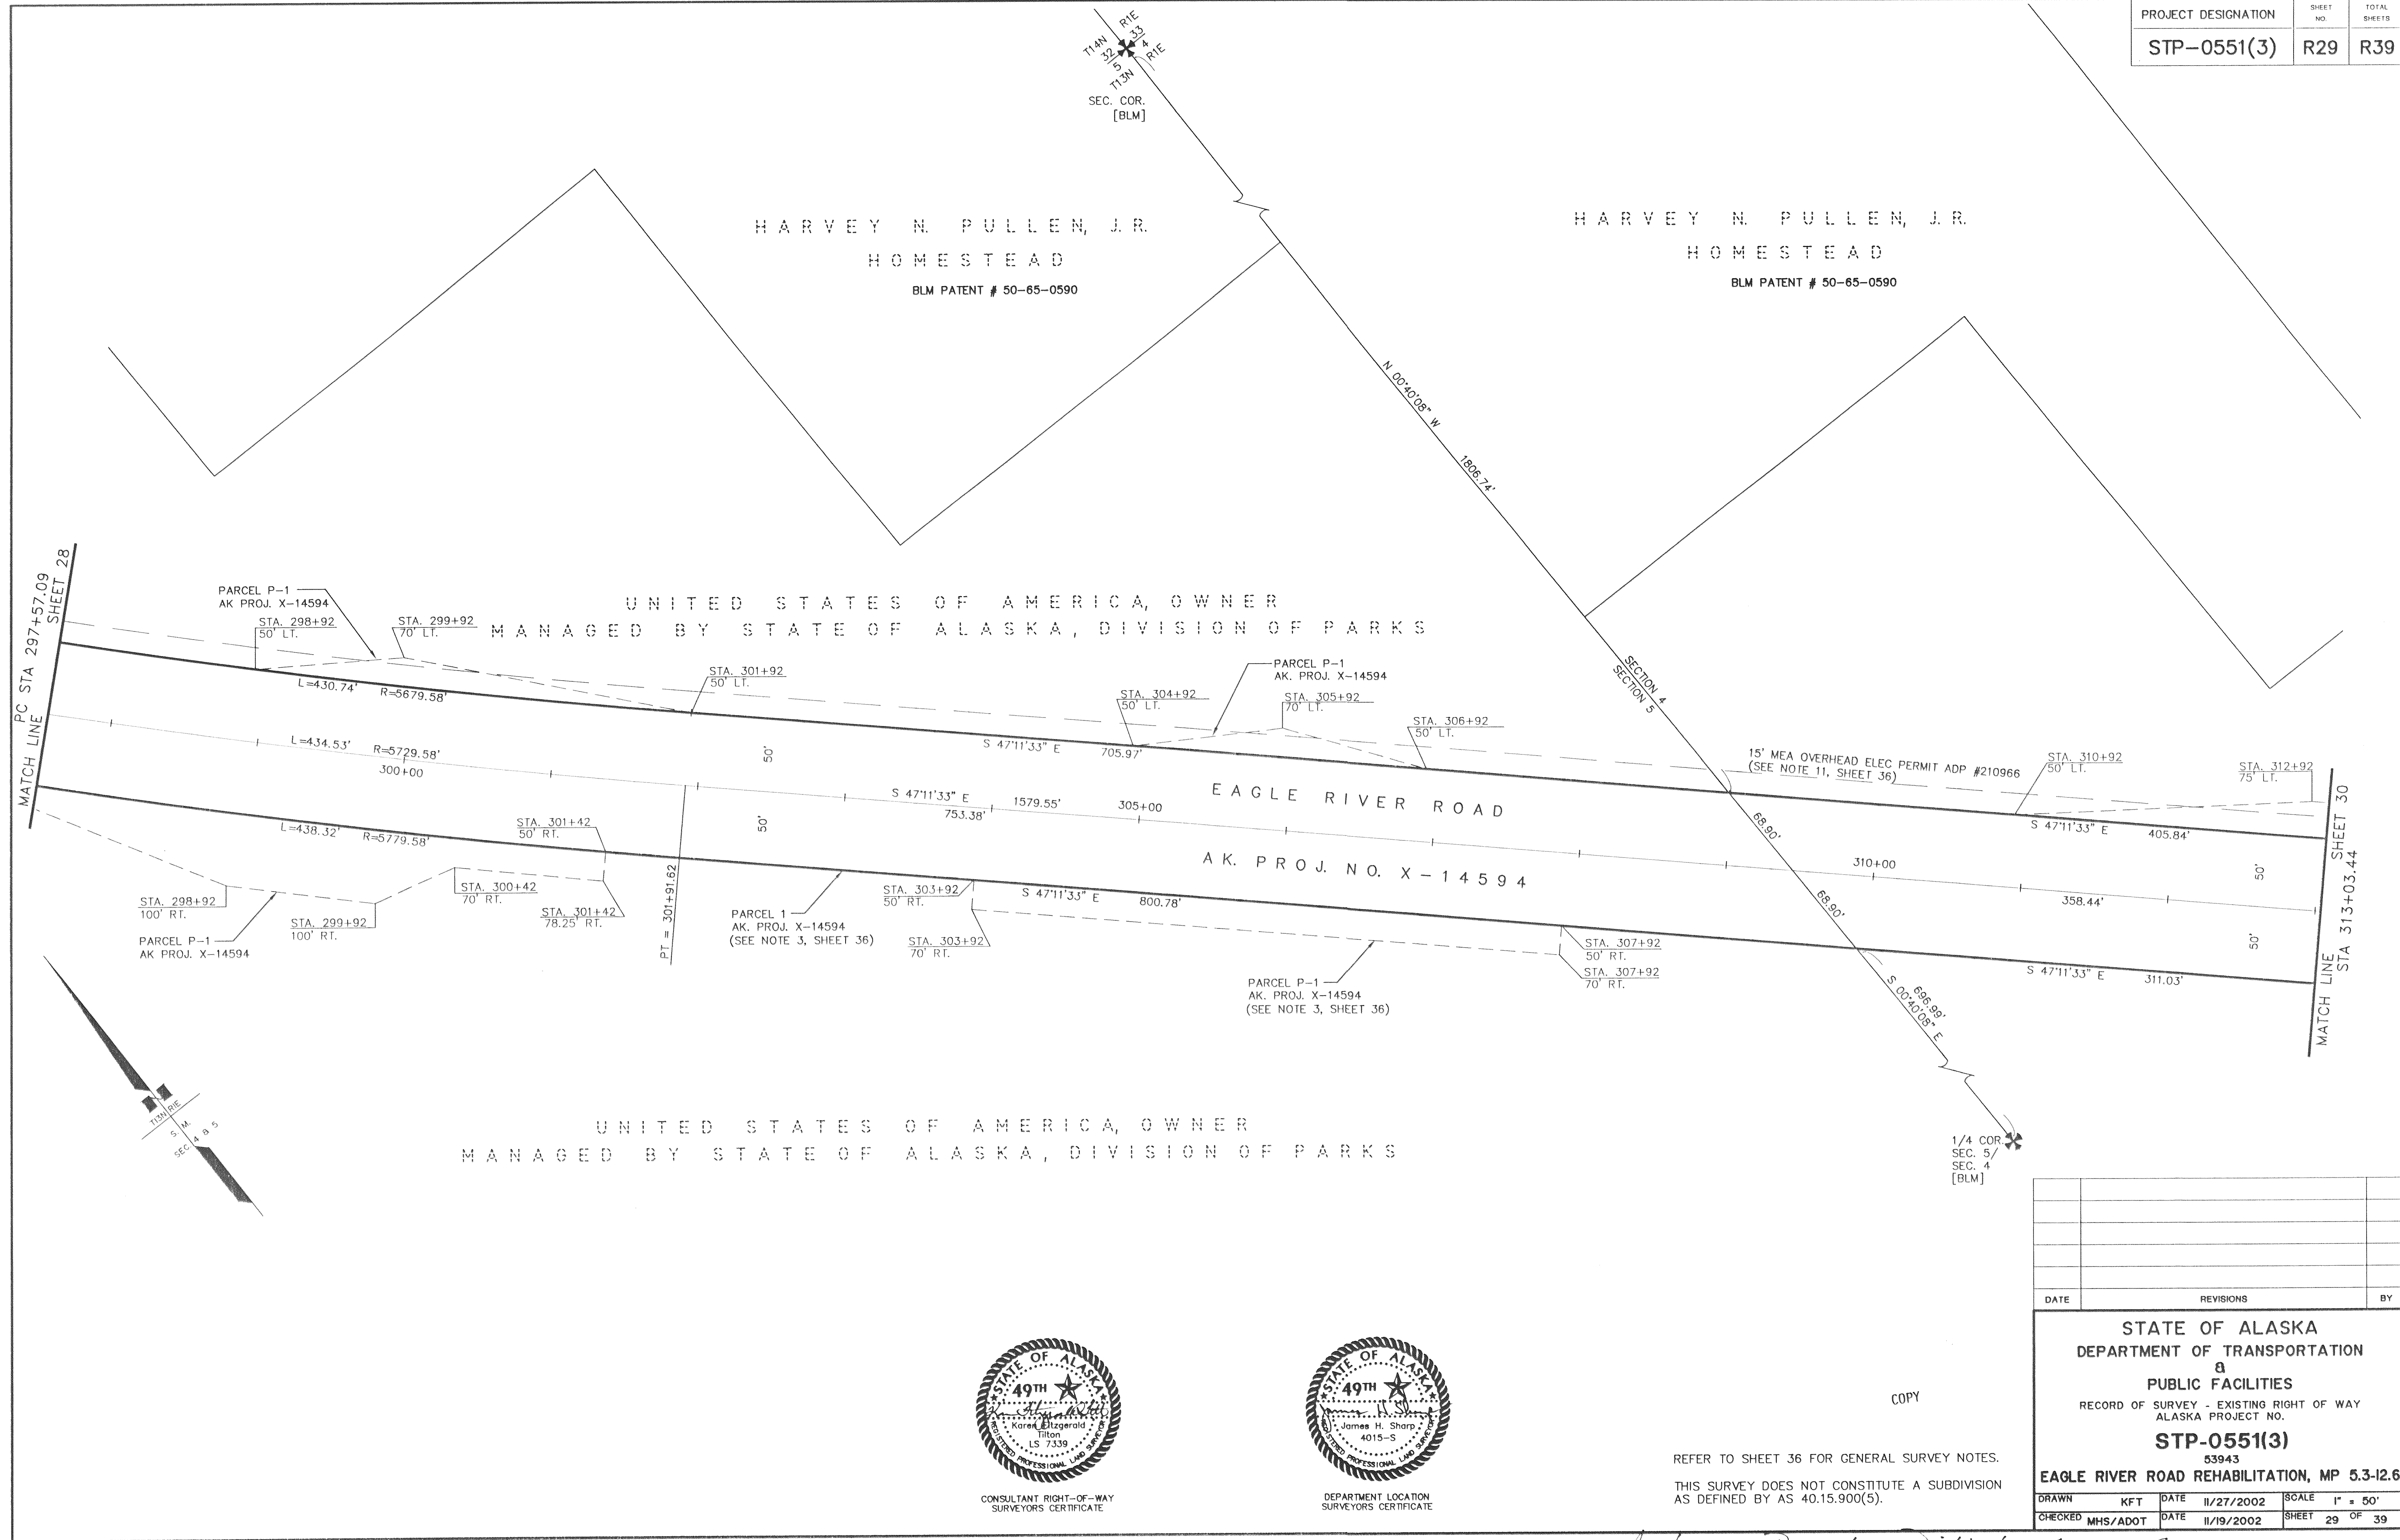

CONSULTANT RIGHT-OF-WAY
SURVEYORS CERTIFICATE

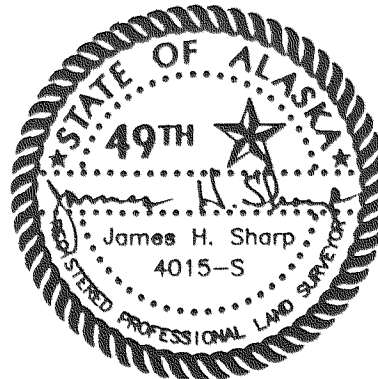

DEPARTMENT LOCATION
SURVEYORS CERTIFICATE

REFER TO SHEET 36 FOR GENERAL SURVEY NOTES.
THIS SURVEY DOES NOT CONSTITUTE A SUBDIVISION
AS DEFINED BY AS 40.15.900(5).

COPY

STATE OF ALASKA DEPARTMENT OF TRANSPORTATION a PUBLIC FACILITIES RECORD OF SURVEY - EXISTING RIGHT OF WAY ALASKA PROJECT NO. STP-0551(3) 53943 EAGLE RIVER ROAD REHABILITATION, MP 5.3-12.6		
DRAWN	KFT	DATE 11/27/2002
CHECKED	MHS/ADOT	DATE 11/19/2002
SCALE 1" = 50'		SHEET 29 OF 39

Anchorage Recording District 2002-157