

PROJECT DESIGNATION	SHEET NO.	TOTAL SHEETS
STP-0551(3)	R33	R39

MATCH LINE STA 354+97.81 SHEET 32

NE-SW-SE 1/256 COR. SEC. 4
ALUM. MON., UNMARKED

PARCEL 1
AK. PROJ. X-14594
(SEE NOTE 3, SHEET 36)

STA. 355+17
50' RT.

STA. 355+92
110' RT.

PARCEL P-1
AK. PROJ. X-14594
(SEE NOTE 3, SHEET 36)

STA. 357+92
60' RT.

STA. 358+92
80' RT.

STA. 359+92
50' RT.

PARCEL 4
AK. PROJ. NO. X-14594

C-S-S-SE 1/256 COR. SEC. 4
UNMARKED ALUM. MON.

PARCEL X-4
PROJ. X-14594
B701, P547
OWNER, DOT&PF

PARCEL 1
AK. PROJ. X-14594
(SEE NOTE 3, SHEET 36)





PARCEL 4
AK. PROJ. NO. X-14594

N 89°20'57" E (COMPUTED) SECTION 4

SECTION 9 MATCH LINE

STA 366+44.23 SHEET 34

UNITED STATES OF AMERICA, OWNER
MANAGED BY STATE OF ALASKA, DIVISION OF PARKS

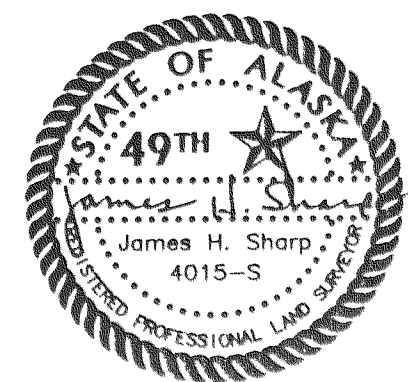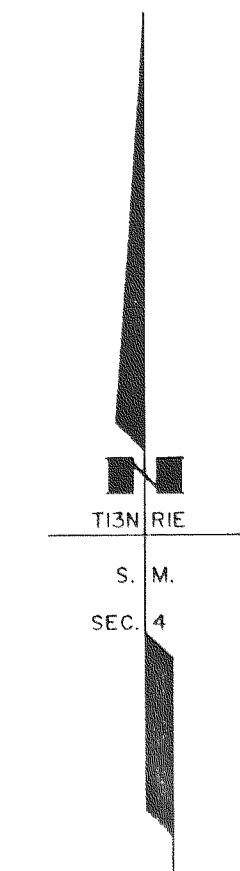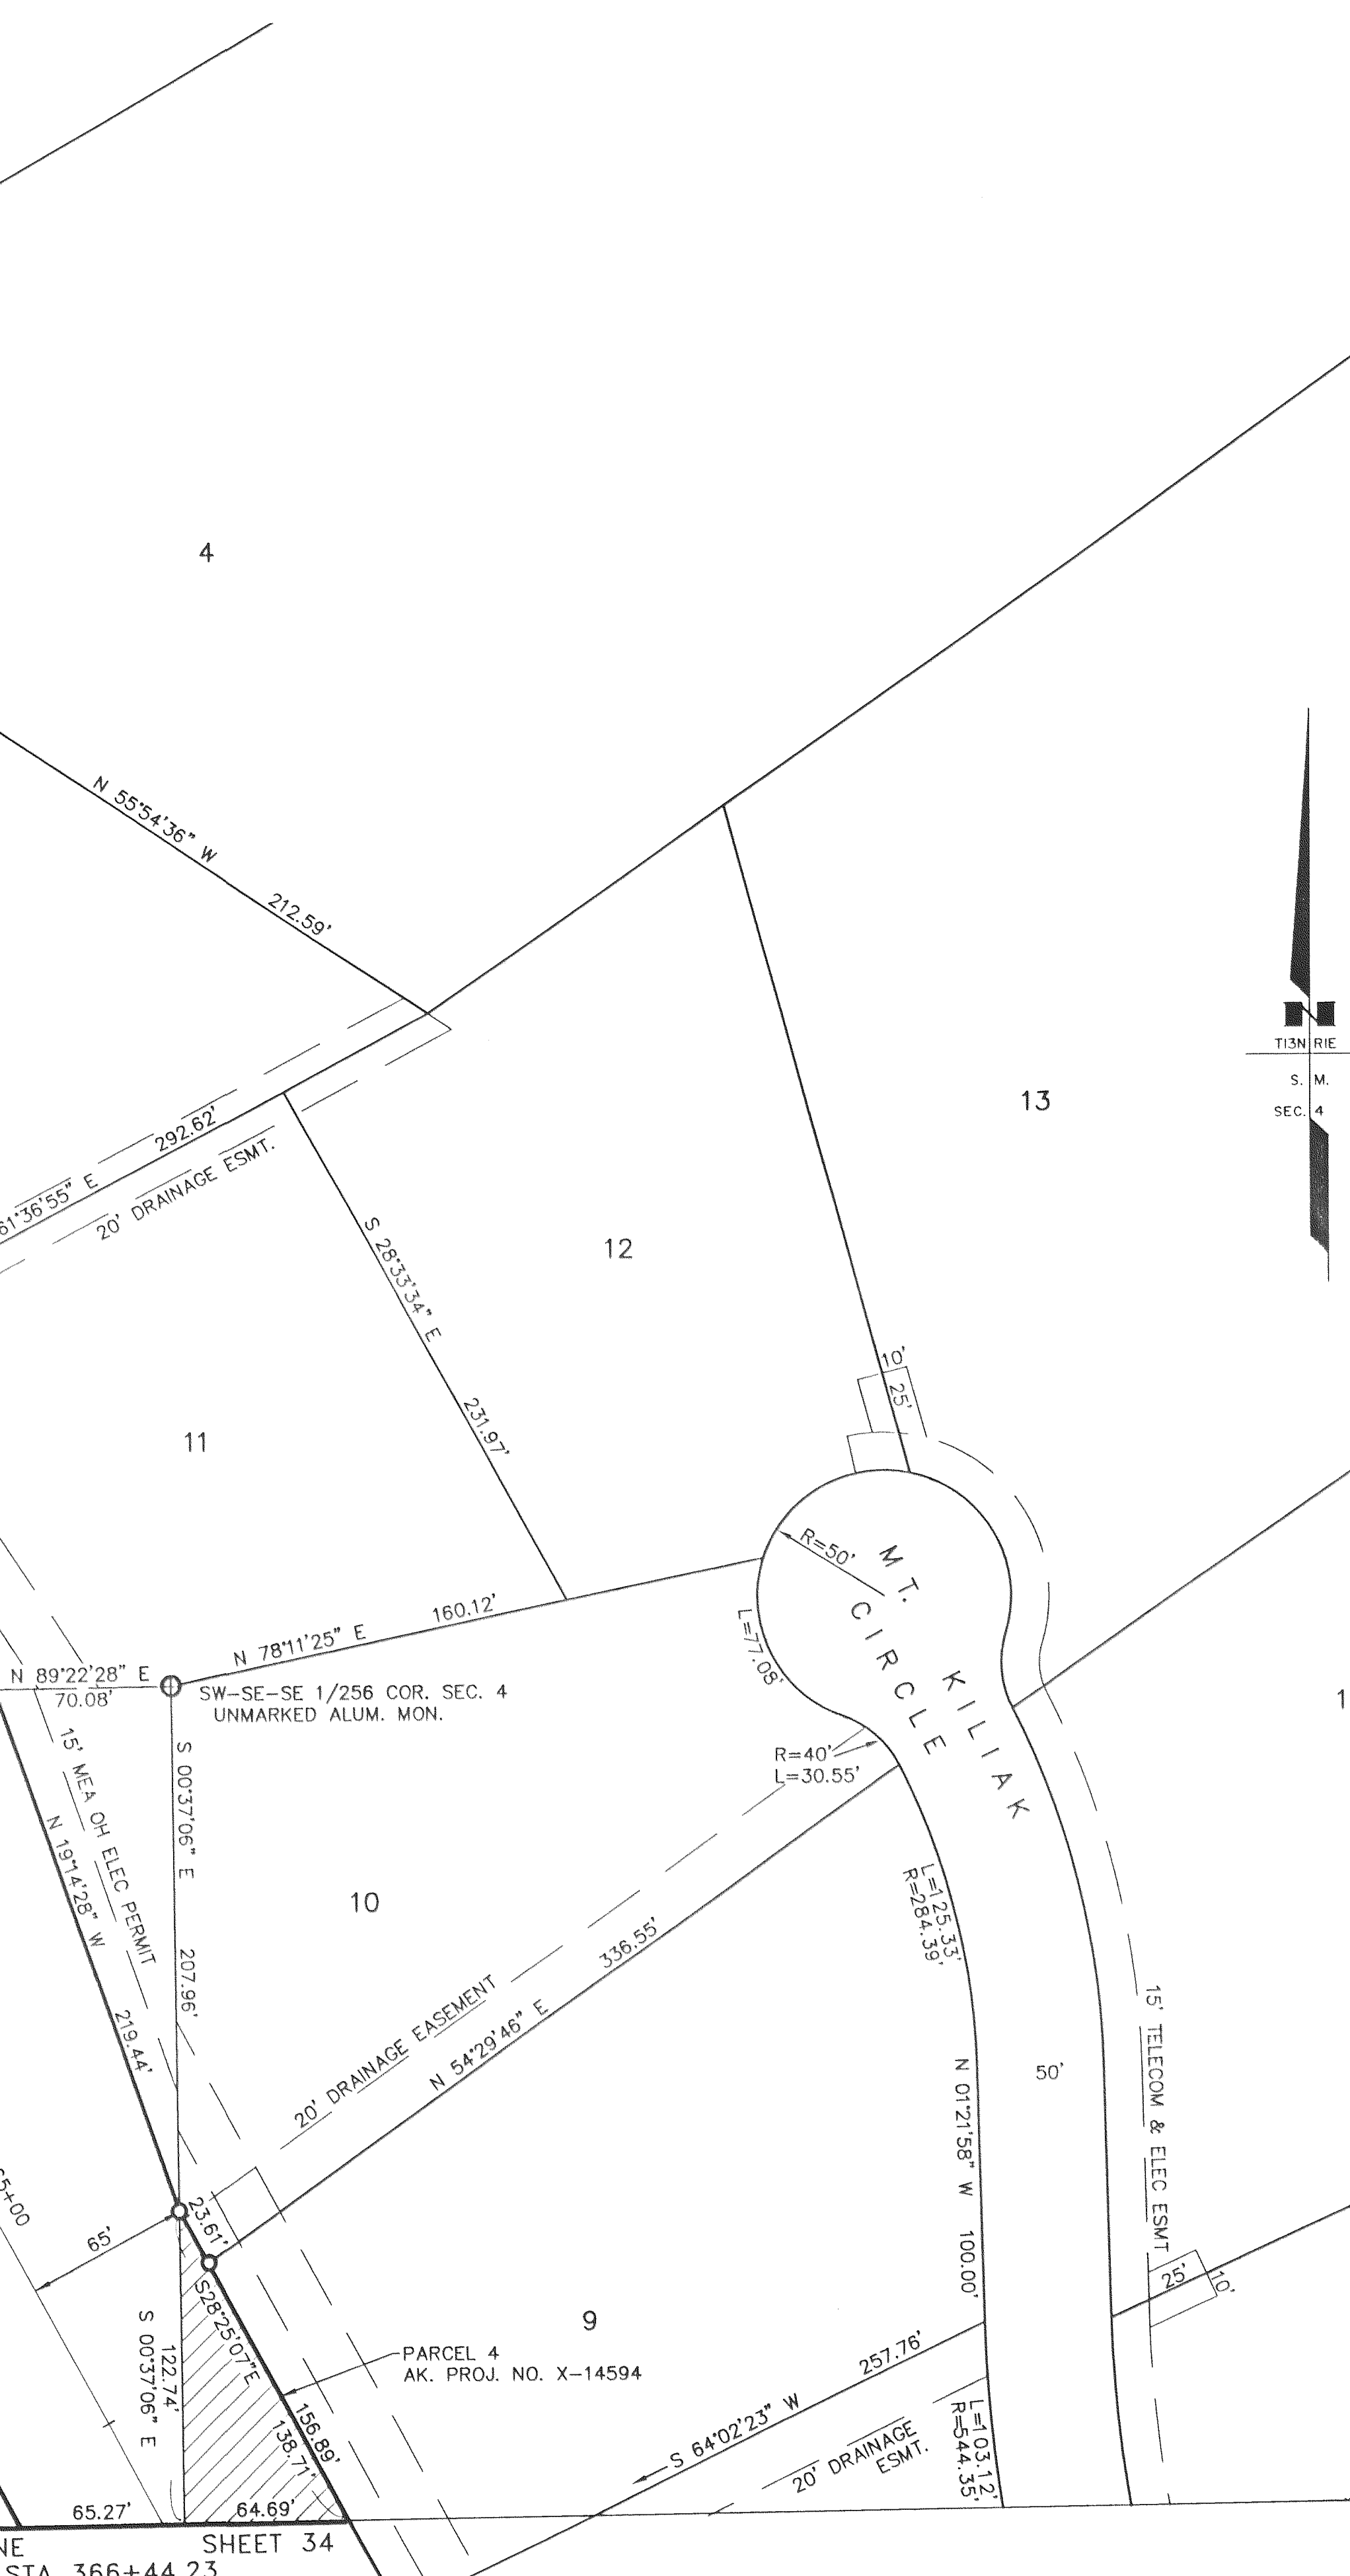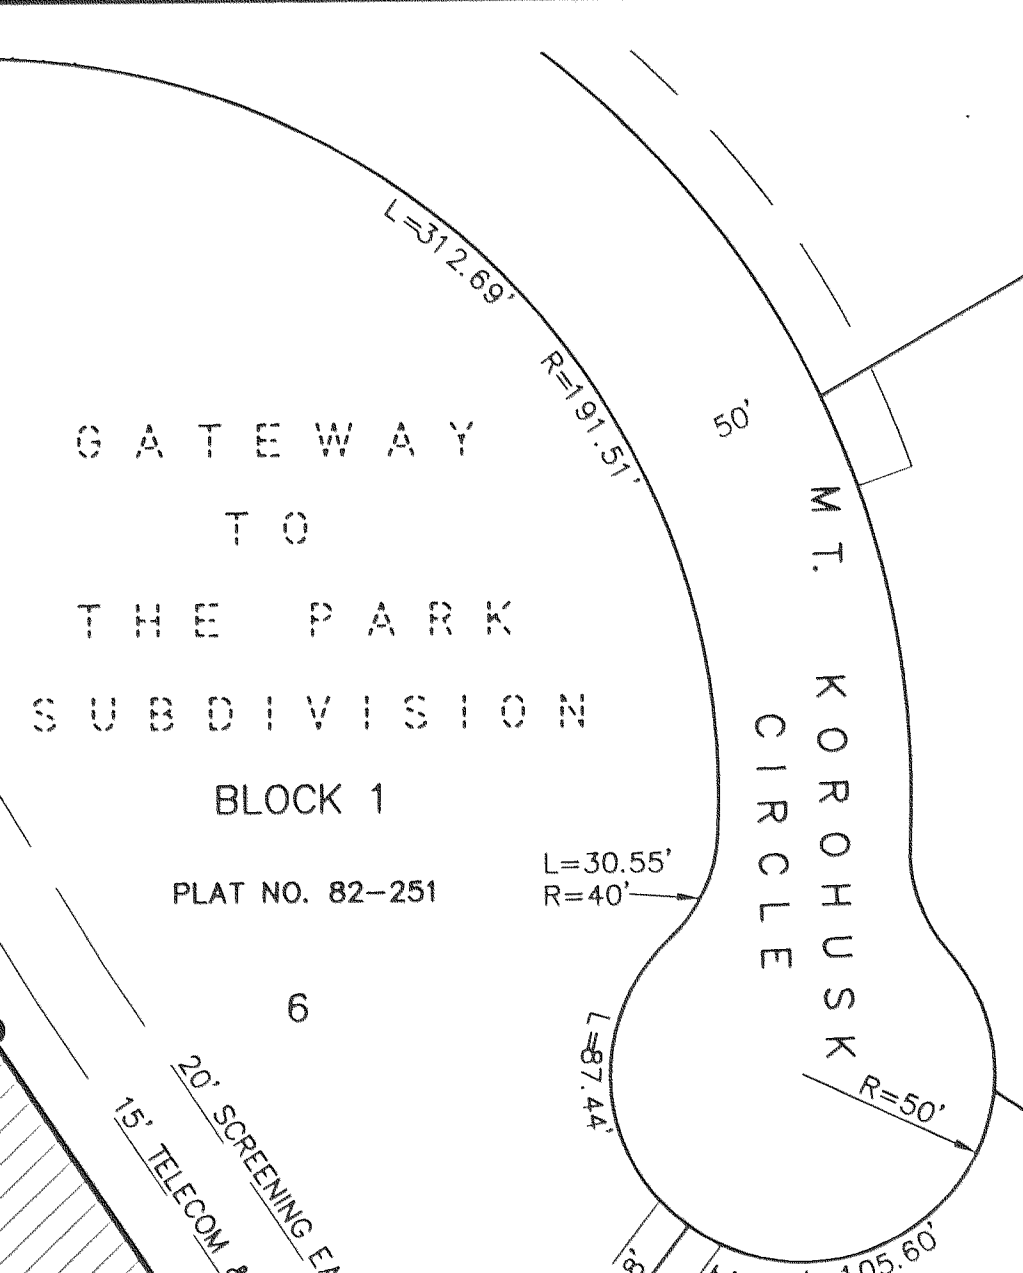

DEPARTMENT LOCATION
SURVEYORS CERTIFICATE



CONSULTANT RIGHT-OF-WAY
SURVEYORS CERTIFICATE

REFER TO SHEET 36 FOR GENERAL SURVEY NOTES.
THIS SURVEY DOES NOT CONSTITUTE A SUBDIVISION
AS DEFINED BY AS 40.15.900(5).

DATE	REVISIONS	BY

STATE OF ALASKA DEPARTMENT OF TRANSPORTATION a PUBLIC FACILITIES RECORD OF SURVEY - EXISTING RIGHT OF WAY ALASKA PROJECT NO. STP-0551(3) 53943 EAGLE RIVER ROAD REHABILITATION, MP 5.3-12.6			
DRAWN	KFT	DATE	11/27/2002
CHECKED	MHS/ADOT	DATE	11/19/2002
SCALE		1" = 50'	
SHEET		33	OF 39

COPY

Anchorage Recording District 2002-157