

RECOVERED CORNERS - SHEETS 27, 28 AND 29						
LOCATION	MONUMENT TYPE	NORTHING	EASTING	STATION	OFFSET	WORK ITEM
Sheet 27						
SE Lot B-2 Williams\NE Lot 1 List	Alum. Mon [880-S]	355249.191	448669.294	269+26.30	746.99 LT	
1/4 Cor. S32\S5 T14N\T13N RIE SM	Brass Cap [BLM]	353924.547	448717.570	276+29.09	379.10 RT	
Sheet 28						
SW Lot 2 B1 North Slope	Brass Cap [813-S]	353934.826	449708.031	284+65.65	170.45 LT	
Sec. Cor. 32\33\5\4 T14N\T13N RIE SM	Brass Cap [BLM]	353951.194	451358.774	295+52.46	1332.93 LT	
Sheet 29						
Sec. Cor. 32\33\5\4 T14N\T13N RIE SM	Brass Cap [BLM]	353951.194	451358.774	295+52.46	1332.93 LT	
1/4 Cor S5\S4 T13N RIE SM	Brass Cap [BLM]	351309.841	451389.605	314+71.98	555.78 RT	

RECOVERED CORNERS - SHEET 34						
LOCATION	MONUMENT TYPE	NORTHING	EASTING	STATION	OFFSET	WORK ITEM
N Lot 1 B2 Gateway to the Park	Rebar	348591.996	455712.277	367+57.71	49.69 RT	
NE Lot 2 B2 Gateway to the Park	Rebar	348213.873	455916.818	371+87.61	49.75 RT	
SW-NE-NE 1/256 Cor. S9 T13N RIE SM	Alum. Mon	347725.980	455721.418	375+23.71	453.79 RT	
NE Lot 4 B2 Gateway to the Park	Rebar	347879.760	456097.368	375+67.38	49.96 RT	
C-S-NE-NE 1/256 Cor. S9 T13N RIE SM	Alum. Mon	347729.740	456051.330	376+77.41	161.85 RT	
SW Lot 19 B1 Gateway to the Park	Rebar	347823.123	456281.013	377+04.59	84.60 LT	
SE Lot 19 B1 Gateway to the Park	Rebar	347863.283	456391.818	377+22.01	201.16 LT	

RECOVERED CORNERS - SHEET 30						
LOCATION	MONUMENT TYPE	NORTHING	EASTING	STATION	OFFSET	WORK ITEM
1/4 Cor S5\S4 T13N RIE SM	Brass Cap [BLM]	351309.841	451389.605	314+71.98	555.78 RT	
SW Lot 1 Duhill	Rebar	351381.105	452379.222	321+94.64	98.26 LT	
C-E-W-W 1/256 S4 T13N RIE SM	Rebar	351321.116	452379.938	322+18.30	42.53 LT	
SW Lot 2 Duhill	Rebar	351382.971	452544.136	323+70.75	149.05 LT	
WC SW Lot 3 Duhill	Rebar with Alum. Cap	351385.412	452751.348	325+95.60	179.75 LT	
PC Lot 1 B3 Falling Water	Rebar	351407.959	452888.907	327+30.24	215.82 LT	
PC Lot 1 B2 Falling Water	Rebar	351349.879	452903.723	327+50.74	159.49 LT	
C 1/4 Cor. S4 T13N RIE SM	Brass Cap [2263-S]	351339.514	454029.197	337+04.89	610.23 LT	

RECOVERED CORNERS - SHEET 35						
LOCATION	MONUMENT TYPE	NORTHING	EASTING	STATION	OFFSET	WORK ITEM
SW-NE-NE 1/256 Cor. S9 T13N RIE SM	Alum. Mon	347725.980	455721.418	375+23.71	453.79 RT	
NE Lot 4 B2 Gateway to the Park	Rebar	347879.760	456097.368	375+67.38	49.96 RT	
C-S-NE-NE 1/256 Cor. S9 T13N RIE SM	Alum. Mon	347729.740	456051.330	376+77.41	161.85 RT	
SW Lot 19 B1 Gateway to the Park	Rebar	347823.123	456281.013	377+04.59	84.60 LT	
SE Lot 19 B1 Gateway to the Park	Rebar	347863.283	456391.818	377+22.01	201.16 LT	
SW Lot 5 B2 Gateway to the Park	Rebar	347528.823	456053.402	378+55.11	255.65 RT	
SW Lot 26 B1 Gateway to the Park	Rebar	347739.665	456465.439	378+65.76	207.08 LT	
NE Lot 6 B2 Gateway to the Park	Rebar	347601.081	456248.122	378+84.22	50.00 RT	
C-E-NE 1/64 Cor. S9 T13N RIE SM	Alum. Mon [2263-S]	347399.836	456054.801	379+69.21	315.80 RT	
PT Lot 18 B1 Gateway to the Park	Rebar	347602.009	456440.058	379+74.75	119.25 LT	
PT Lot 27 B1 Gateway to the Park	Rebar	347611.050	456489.231	379+90.20	166.80 LT	
SW Lot 27 B1 Gateway to the Park	Rebar	347493.481	456441.881	380+71.07	69.20 LT	
SE Lot 6 B2 Gateway to the Park	Rebar	347403.089	456355.218	381+09.32	50.04 RT	
N 1/16 Cor. S9\S10 T13N RIE SM	Brass Cap [2297-S]	347407.164	456714.285			
1/4 Cor. S9\S10 T13N RIE SM	Brass Cap [BLM]	346087.753	456727.871			

RECOVERED CORNERS - SHEETS 31, 32, AND 33						
LOCATION	MONUMENT TYPE	NORTHING	EASTING	STATION	OFFSET	WORK ITEM
Sheet 31						
C 1/4 Cor. S4 T13N RIE SM	Brass Cap [2263-S]	351339.514	454029.197	337+04.89	610.23 LT	
Sheet 32						
C-E-W-SE 1/256th Cor. S4 T13N RIE SM	Alum. Mon	350029.931	455035.288	351+93.13	141.04 LT	
Ang Pt Lot 1 B1 Gateway to the Park	Alum. Mon [2263-S]	349941.576	455036.269	352+59.88	85.10 LT	
NE-SW-SE 1/256 Cor. S4 T13N RIE SM	Alum. Mon	349699.210	455039.230	354+51.46	62.84 RT	
PC Lot 2 B1 Gateway to the Park	Rebar	349752.856	455368.751	355+99.89	234.86 LT	
Sheet 33						
NE-SW-SE 1/256 Cor. S4 T13N RIE SM	Alum. Mon	349699.210	455039.230	354+51.46	62.84 RT	
Ang Pt Lot 6 B1 Gateway to the Park	Alum. Mon [2263-S]	349451.092	455372.509	358+44.85	70.41 LT	
SE Lot 6 B1 Gateway to the Park	Rebar	349291.807	455476.328	360+31.86	77.30 LT	
C-S-S-SE 1/256 Cor. S4 T13N RIE SM	Alum. Mon	349042.621	455377.666	362+02.14	129.52 RT	
SW-SE-SE 1/256 Cor. S4 T13N RIE SM	Alum. Mon	349046.220	455707.171	363+55.79	161.99 LT	
Ang Pt Lot 10 B1 Gateway to the Park	Rebar	348838.326	455709.373	365+39.68	64.99 LT	
NW Lot 9 B1 Gateway to the Park	Rebar	348817.780	455721.038	365+63.30	65.47 LT	

COPY

2002-157

NO CC X2

RECEIVED REC DIST

Date 12-6-2002

Time 12:50 P.M.

Requested by AS/DOT


Address

THIS SURVEY DOES NOT CONSTITUTE A SUBDIVISION AS DEFINED BY AS 40.15.900(5).

DATE	REVISIONS	BY



CONSULTANT RIGHT-OF-WAY SURVEYORS CERTIFICATE

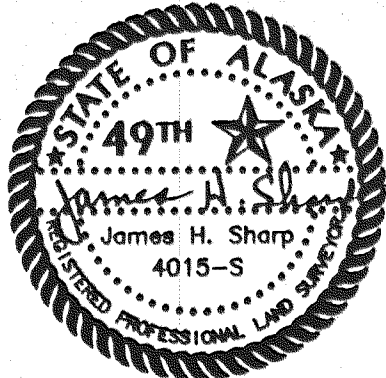

DEPARTMENT LOCATION SURVEYORS CERTIFICATE

STATE OF ALASKA

DEPARTMENT OF TRANSPORTATION

8

PUBLIC FACILITIES

RECORD OF SURVEY - EXISTING RIGHT OF WAY

ALASKA PROJECT NO.

STP-0551(3)

53943

EAGLE RIVER ROAD REHABILITATION, MP 5.3-12.6

DRAWN KFT DATE 11/27/2002 SCALE N/A

CHECKED MHS/ADOT DATE 11/19/2002 SHEET 39 OF 39