

S E C. 1 3


S E C. 2 5

THIS SURVEY DOES NOT CONSTITUTE A SUBDIVISION AS DEFINED BY AS 40.15.900(5).

DATE	REVISIONS	BY

STATE OF ALASKA
DEPARTMENT OF TRANSPORTATION
&
PUBLIC FACILITIES
RECORD OF SURVEY - EXISTING RIGHT OF WAY
ALASKA PROJECT NO.
STP-0551(3)
53943
EAGLE RIVER ROAD REHABILITATION, MP 5.3-12.6

DRAWN	KFT	DATE	11/27/2002	SCALE	1" = 300'
CHECKED	MHS/ADOT	DATE	11/19/2002	SHEET	3 OF 39

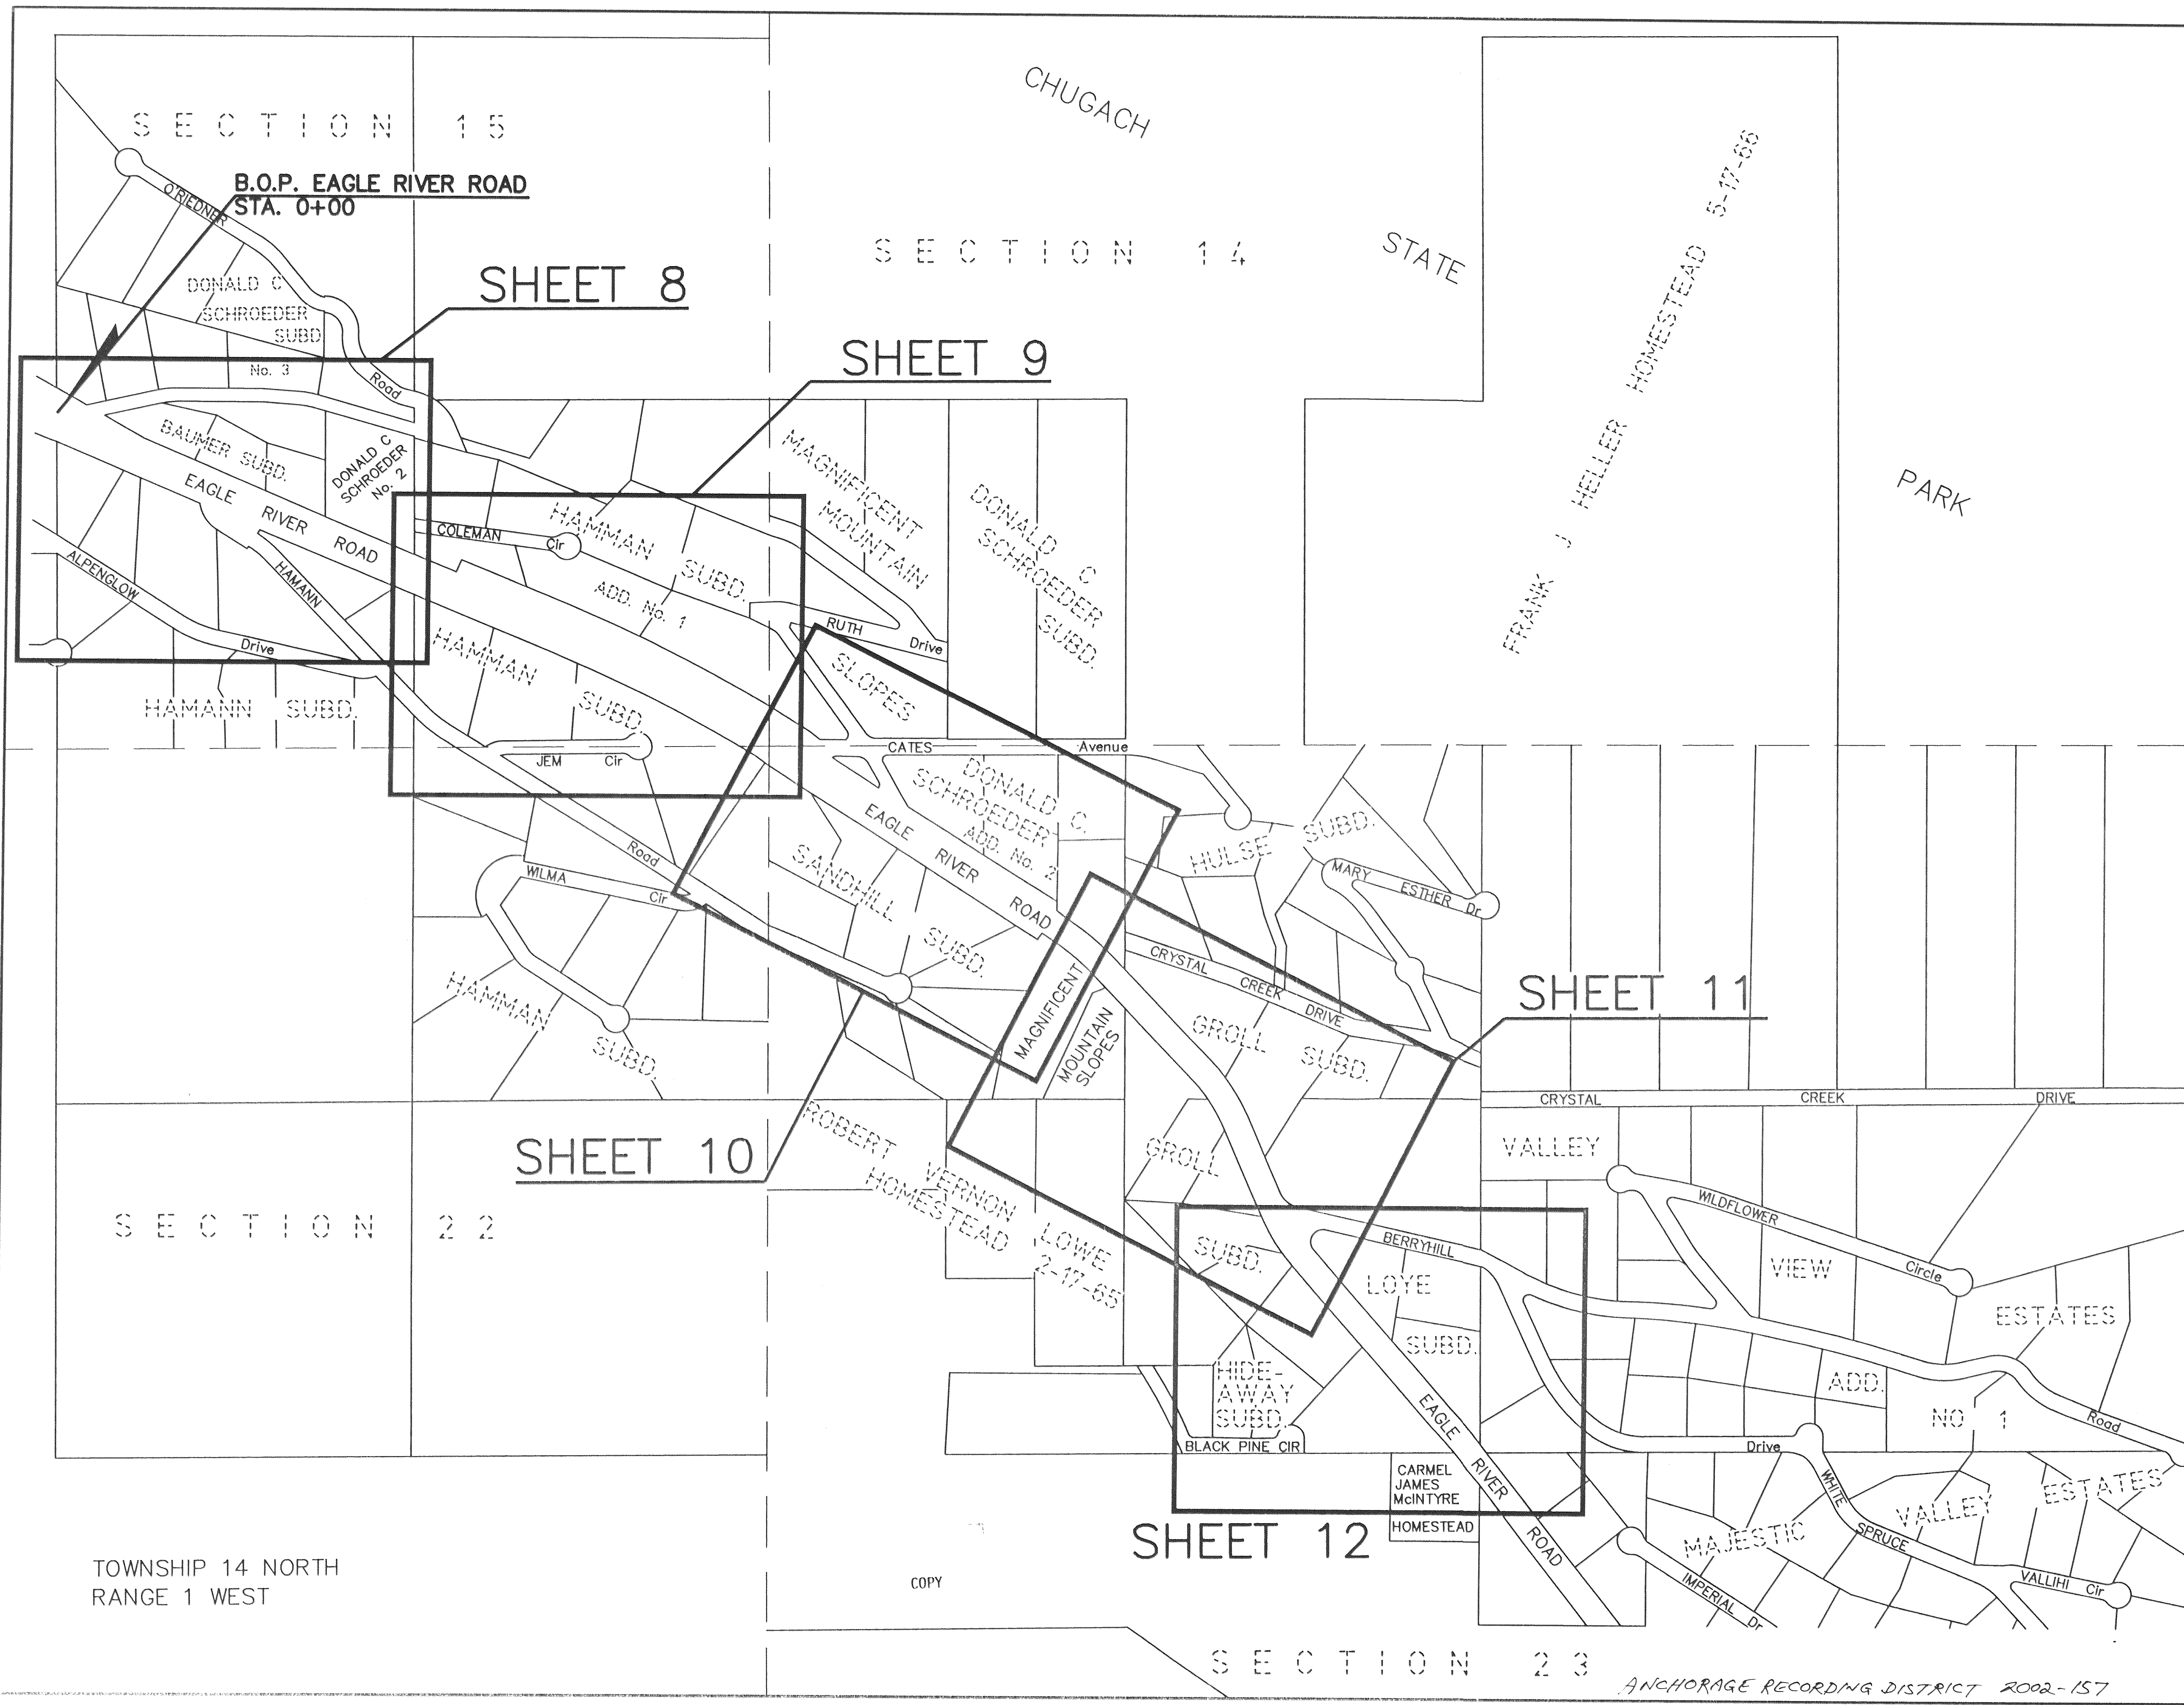

TOWNSHIP 14 NORTH
RANGE 1 WEST

SHEET 12

SHEET 11

SHEET 10

SHEET 9

SHEET 8

ANCHORAGE RECORDING DISTRICT 2002-157