



PROJECT DESIGNATION	SHEET NO.	TOTAL SHEETS
STP-0551(3)	R8	R39

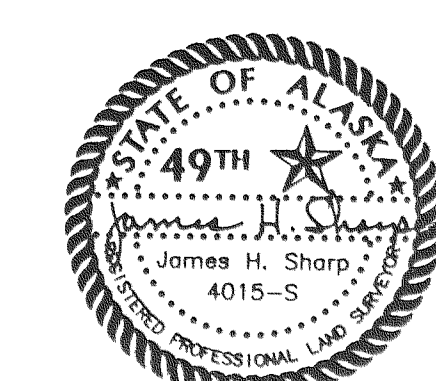

DEPARTMENT LOCATION
SURVEYORS' CERTIFICATE

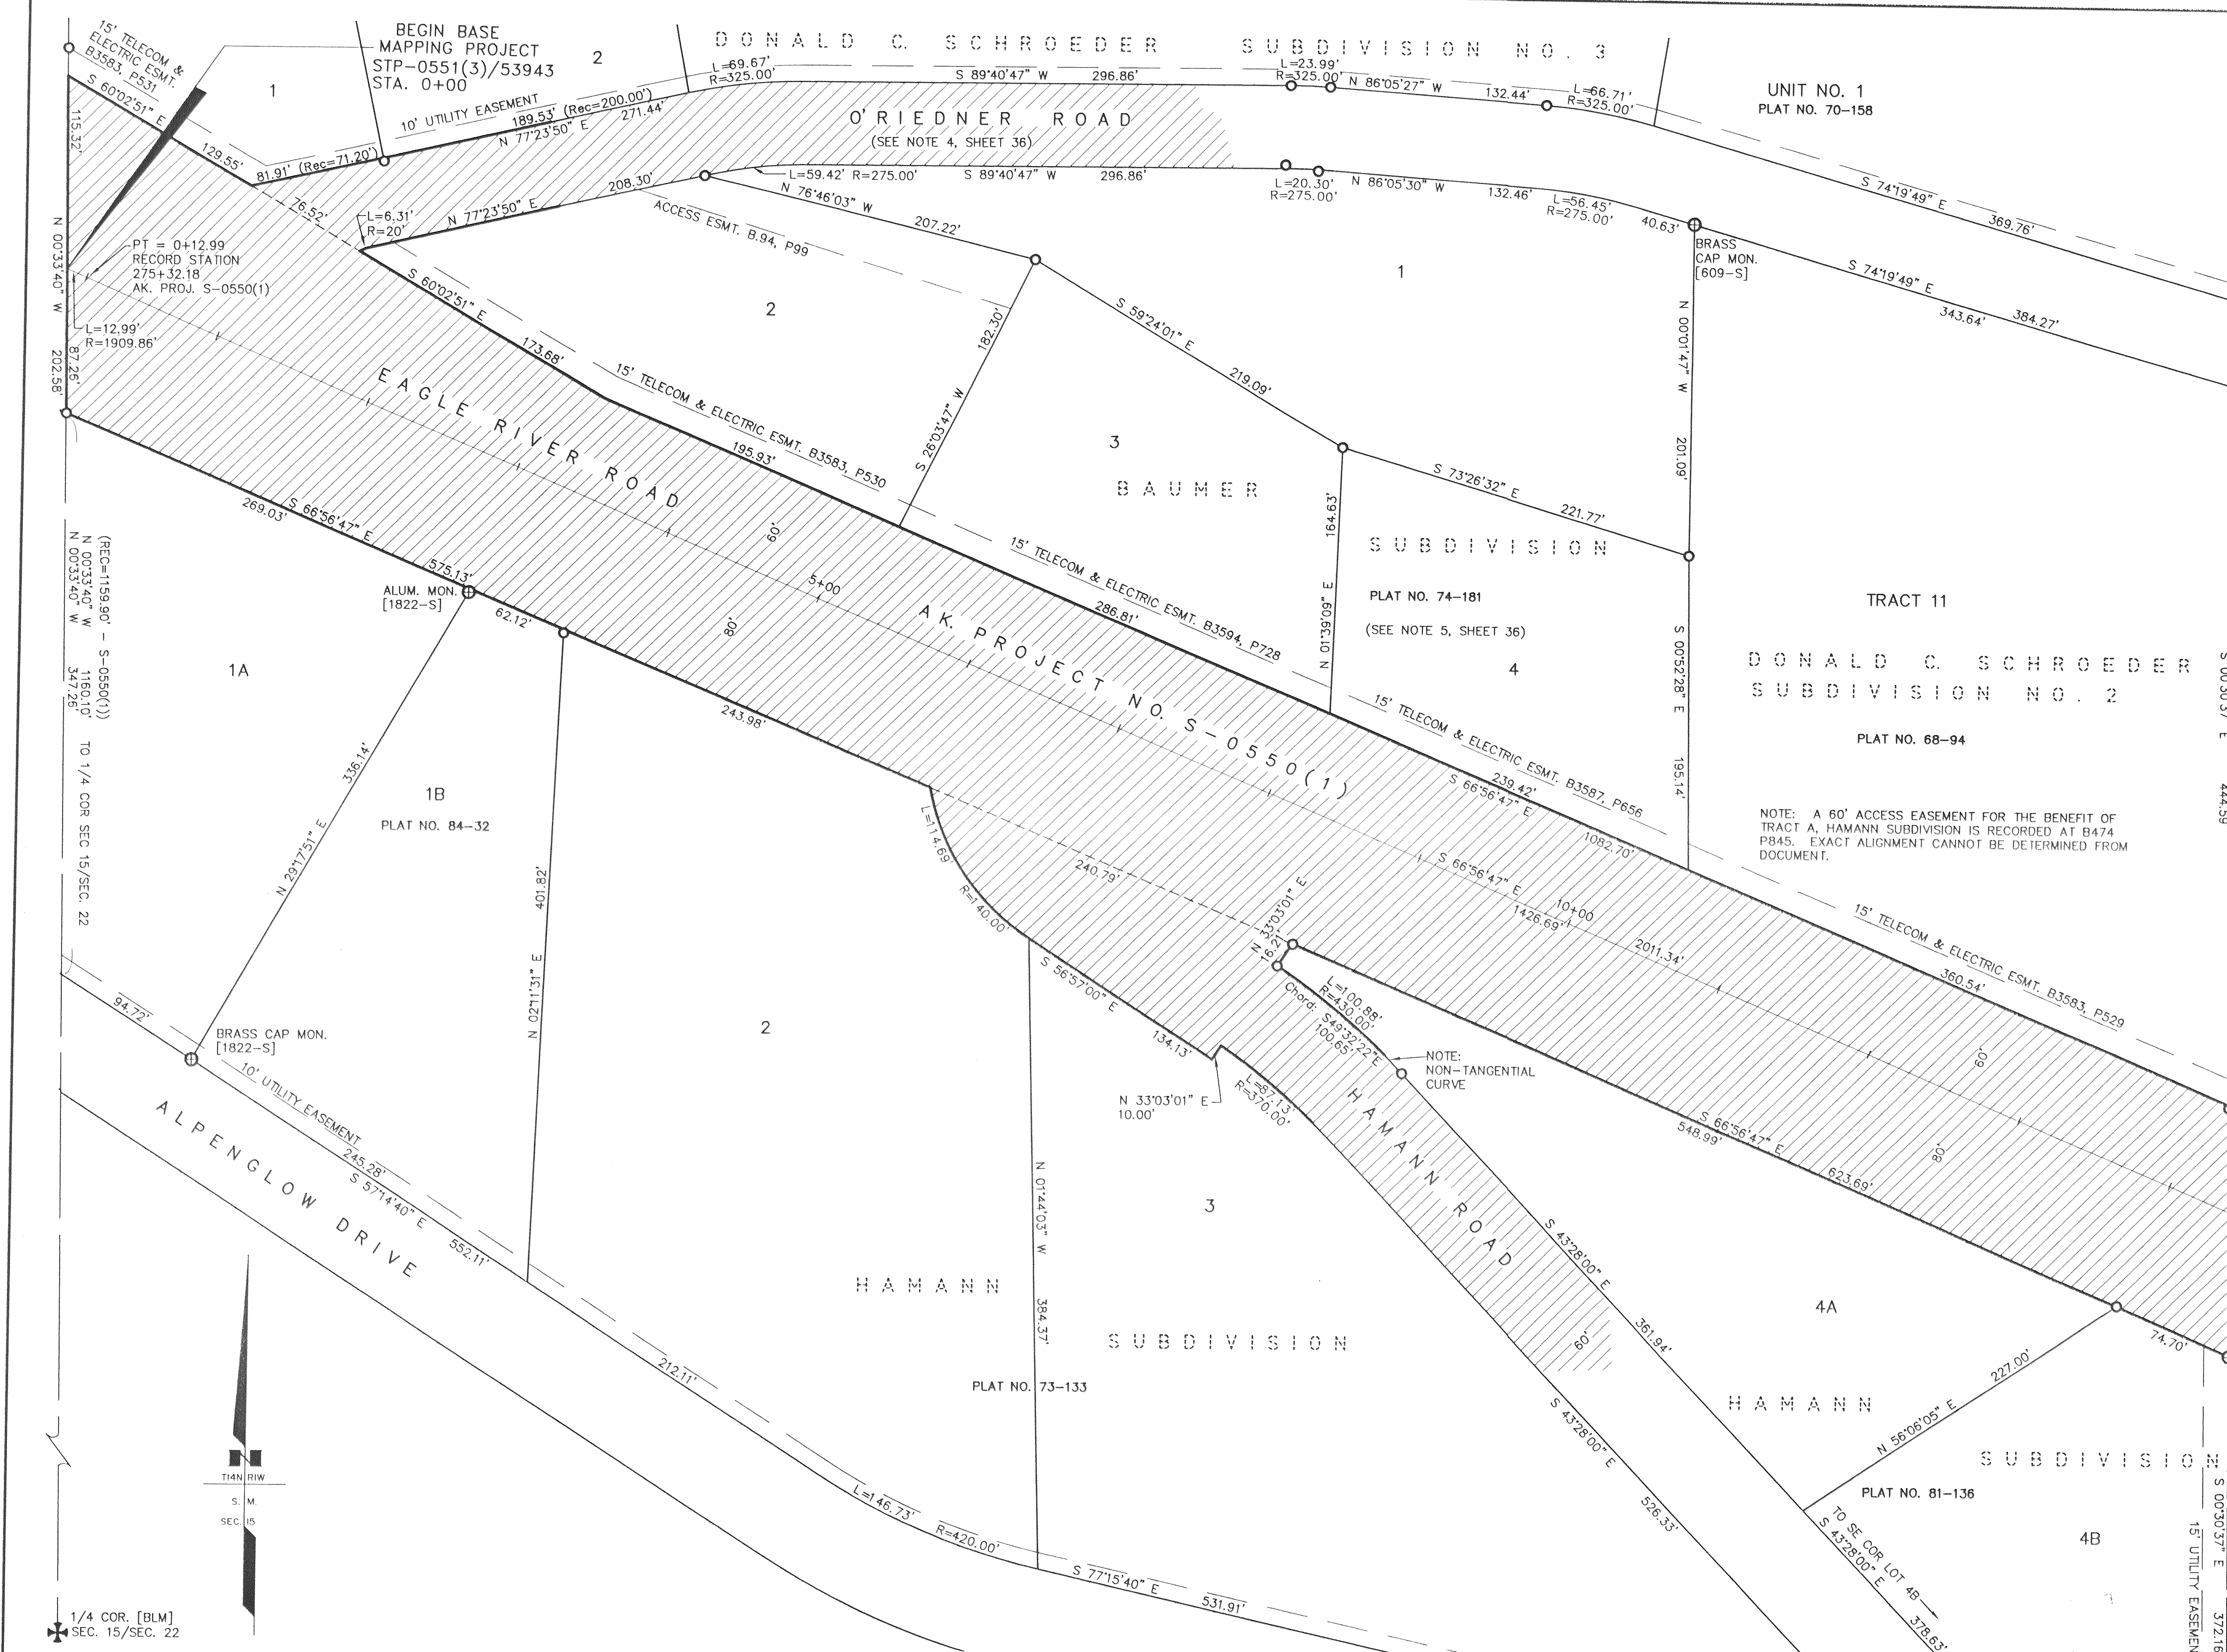

CONSULTANT RIGHT-OF-WAY
SURVEYORS' CERTIFICATE

REFER TO SHEET 36 FOR GENERAL SURVEY NOTES.
THIS SURVEY DOES NOT CONSTITUTE A SUBDIVISION
AS DEFINED BY AS 40.15.900(5).

DATE	REVISIONS	BY

STATE OF ALASKA DEPARTMENT OF TRANSPORTATION a PUBLIC FACILITIES RECORD OF SURVEY - EXISTING RIGHT OF WAY ALASKA PROJECT NO. STP-0551(3) 53943 EAGLE RIVER ROAD REHABILITATION, MP 5.3-12.6			
DRAWN	KFT	DATE	11/27/2002
CHECKED	MHS/ADOT	DATE	11/19/2002
SCALE		1" = 50'	
SHEET		8	OF 39

ANCHORAGE RECORDING DISTRICT 2002-157