
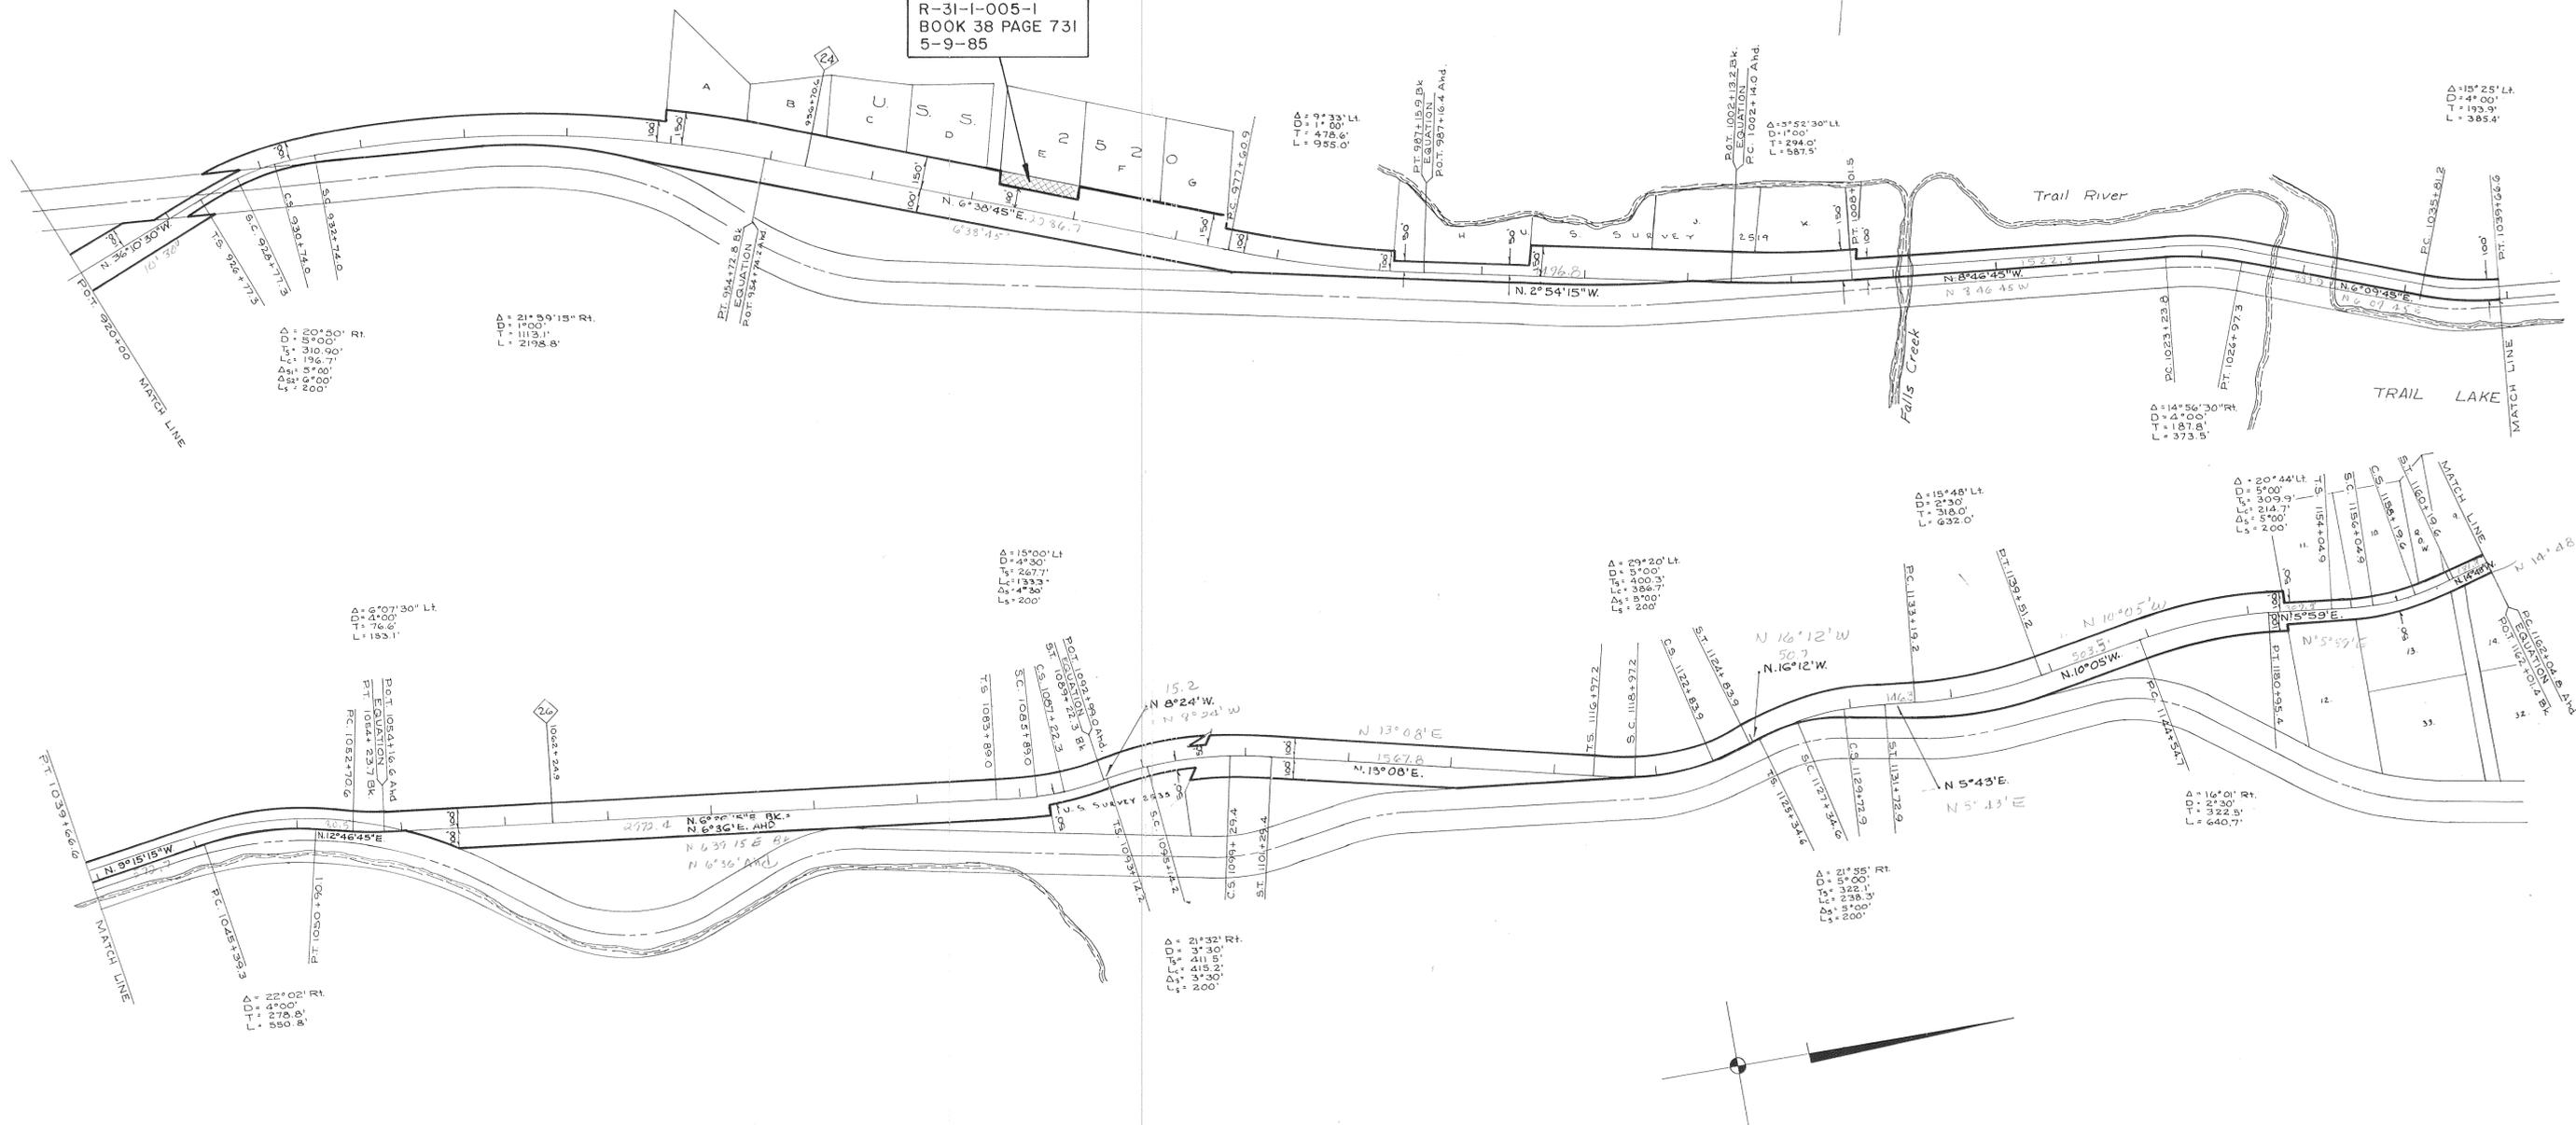


CHUGACH NATIONAL FOREST

R-31-I-005-1  
BOOK 38 PAGE 731  
5-9-85

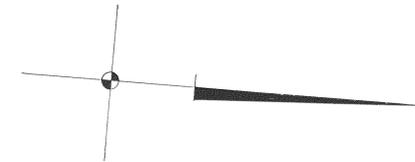

12-8-97	CORRECTED R-31-I-005-1	JGG
4-5-85	ADDED R-31-I-005-1	SMT
DATE	REVISIONS	BY
<p><b>STATE OF ALASKA</b> DEPARTMENT OF HIGHWAYS RIGHT OF WAY MAP ALASKA PROJECT NO. F.A.P. 31 <b>SEWARD HIGHWAY</b></p>		
DRAWN	Chan	DATE 12-29-70
CHECKED	T. A. R.	DATE 12-29-70
		SCALE 1" = 400'
		SHEET 5 OF 15