



- 1) Project control coordinates shown on corresponding sheets were established by using least-squares adjusted, conventional closed – traverse and static GPS techniques.
- 2) All dimensions and coordinates shown are in U.S. Survey Feet unless otherwise noted.
- 3) This survey was completed in March through May 2012, and August 2014.
- 4) Background information is for orientation purpose only.
- 5) See sheets 2–6 for additional coordinate information.
- 6) See sheet 7 for additional cap descriptions.
- 7) All elevations need to be field verified before use.


A Leica DNA03 digital level was used for all leveling on this project. The elevations were computed in Leica Geo Office software using a length weighted adjustment. All level loops closed within Third-Order tolerances per Federal Geodetic Control Committee Standards and Specifications for Geodetic Control Networks.

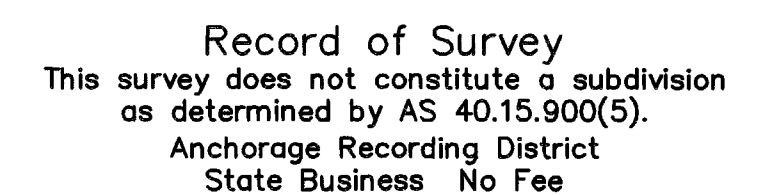

Robert M. Keiner LS-11547 Date 10/29/2015 Anchorage Recording District PL 2015-121

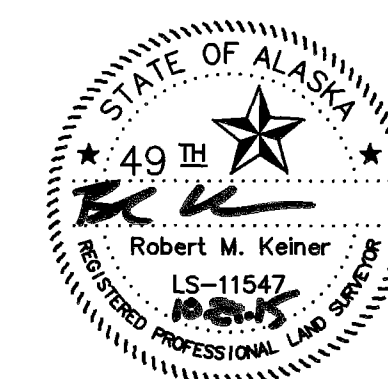

STATE OF ALASKA
DEPARTMENT OF TRANSPORTATION
&
PUBLIC FACILITIES
Survey Control Diagram
AKSAS 53433
Debarr Road Resurfacing
Located within: Sections 13-16 and 21-24,
T13N, R13W, S.M.

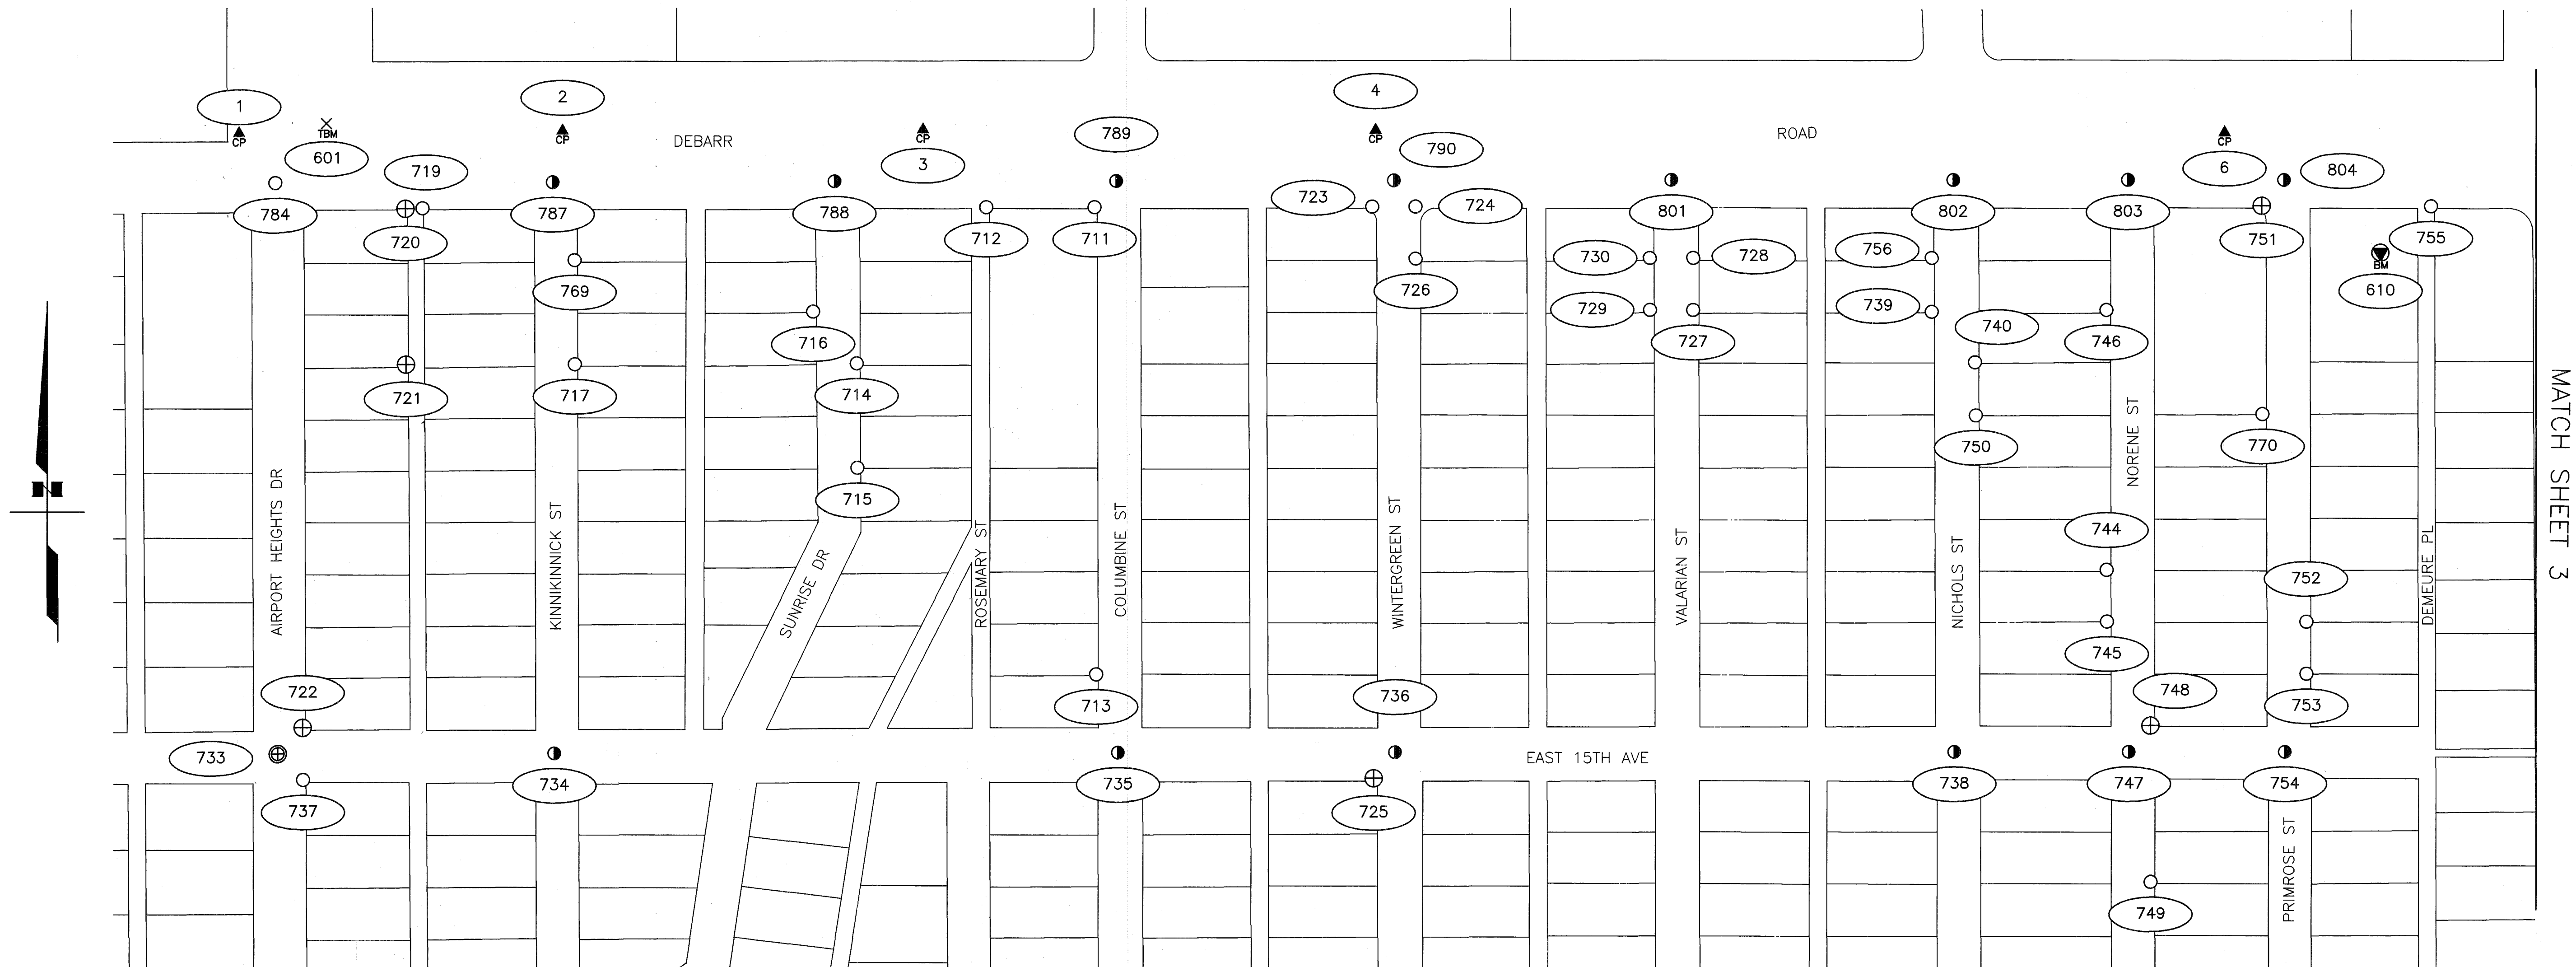

HORIZONTAL CONTROL			
Point	Northing	Easting	Description
1	337583.9711	359196.2663	Set Rbr/PC[DOT]: CP 1
2	337586.5887	359569.2795	Set Rbr/PC[DOT]: CP 2
3	337587.5871	359984.9117	Set Rbr/PC[DOT]: CP 3
4	337587.3734	360506.4221	Set Rbr/PC[DOT]: CP 4
6	337585.7712	361485.1086	Set Rbr/PC[DOT]: CP 6

VERTICAL CONTROL				
Point	Northing	Easting	Elevation	Description
601	337595	359297	134.46	Scribed "X" on NE Signal Pole Bolt: TBM 601
610	337448	361665	150.86	Fd BC/Wall: BM CB 3B

- LEGEND
- ⊕ Primary Centerline Monument
 - Secondary Centerline Monument
 - ⊕ Primary Property Monument
 - Property Misc Corner
 - ▲ CP Control Point
 - Ⓢ BM Vertical Benchmark
 - ✕ TBM Temporary Benchmark



U.S. SURVEY FEET


- NOTES
- 1) See sheets 3-6 for additional coordinate information.
 - 2) See sheets 1 and 7 for cap descriptions.
 - 3) See sheet 1 for control statements and notes.

Anchorage Recording District PL 2015-121

STATE OF ALASKA
DEPARTMENT OF TRANSPORTATION
&
PUBLIC FACILITIES
Survey Control Diagram
AKSAS 53433
Debarr Road Resurfacing
Located within: Sections 13-16 and 21-24,
T13N, R13W, S.M.

DRAWN	BLK	DATE	Oct 21, 2015	SCALE	1" = 100'
CHECKED	RMK	DATE	Oct 21, 2015	SHEET	2 OF 7

Record of Survey
This survey does not constitute a subdivision
as determined by AS 40.15.900(5).
Anchorage Recording District
State Business No Fee

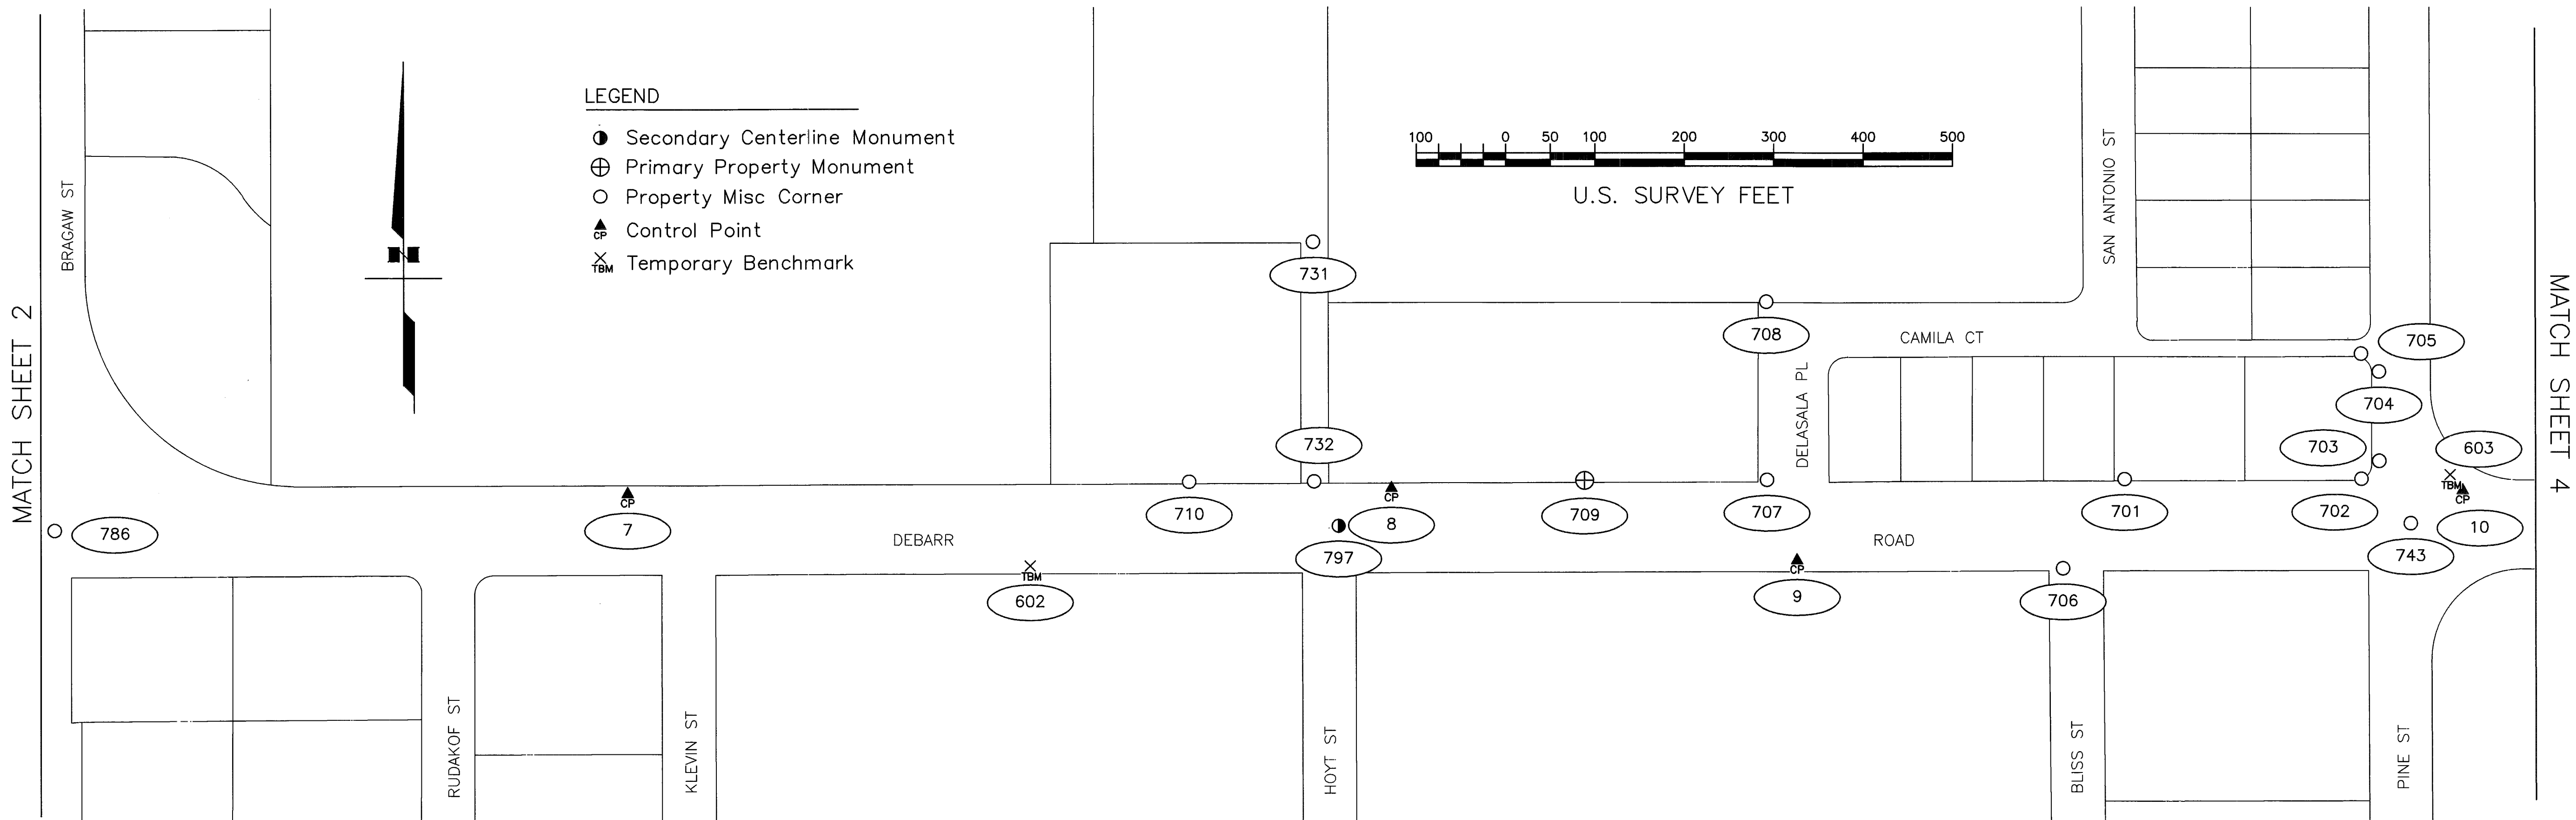


HORIZONTAL CONTROL			
Point	Northing	Easting	Description
7	337572.5238	362519.5364	Set Rbr/PC[DOT]: CP 7
8	337577.9397	363374.4797	Set Rbr/PC[DOT]: CP 8
9	337497.1244	363828.5319	Set Rbr/PC[DOT]: CP 9
10	337575.7844	364573.2283	Set Rbr/PC[DOT]: CP 10

NOTES

- 1) See sheets 2 and 4-6 for additional coordinate information.
- 2) See sheets 1 and 7 for cap descriptions.
- 3) See sheet 1 for control statements and notes.

VERTICAL CONTROL				
Point	Northing	Easting	Elevation	Description
602	337491	362970	154.23	Scribed "X" on NW Fire Hydrant Bolt: TBM 602
603	337594	364559	160.81	Scribed "X" on SW Signal Pole Bolt: TBM 603

Record of Survey
This survey does not constitute a subdivision
as determined by AS 40.15.900(5).
Anchorage Recording District
State Business No Fee

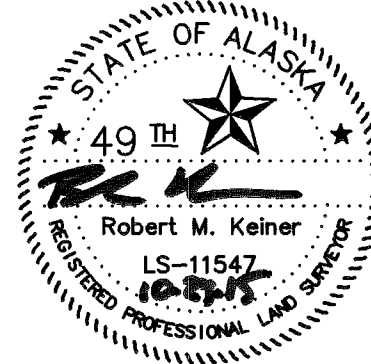

STATE OF ALASKA
DEPARTMENT OF TRANSPORTATION
&
PUBLIC FACILITIES
Survey Control Diagram
AKSAS 53433
Debarr Road Resurfacing
Located within: Sections 13-16 and 21-24,
T13N, R13W, S.M.

DRAWN	BLK	DATE	Oct 21, 2015	SCALE	1" = 100'
CHECKED	RMK	DATE	Oct 21, 2015	SHEET	3 OF 7

Anchorage Recording District PL 2015-121


LEGEND

- ⊕ Primary Centerline Monument
- Secondary Centerline Monument
- ⊕ Primary Property Monument
- Property Misc Corner
- ▲ CP Control Point
- Ⓢ BM Vertical Benchmark
- ✕ TBM Temporary Benchmark

NOTES

- 1) See sheets 2-3 and 5-6 for additional coordinate information.
- 2) See sheets 1 and 7 for cap descriptions.
- 3) See sheet 1 for control statements and notes.

U.S. SURVEY FEET

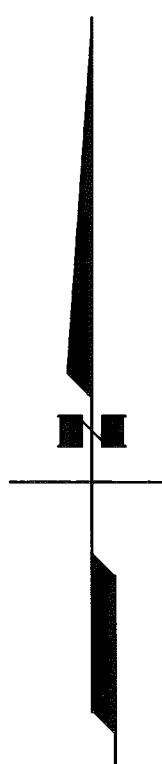

HORIZONTAL CONTROL

Point	Northing	Easting	Description
11	337593.5216	365647.8928	Set Rbr/PC[DOT]: CP 11
12	337590.1469	366273.6755	Set Rbr/PC[DOT]: CP 12
13	337511.0764	366964.8616	Set Rbr/PC[DOT]: CP 13
14	337594.3869	368011.6739	Set Rbr/PC[DOT]: CP 14
15	337597.3992	369030.2536	Set Rbr/PC[DOT]: CP 15
16	337601.7544	370125.1663	Set Rbr/PC[DOT]: CP 16

VERTICAL CONTROL


Point	Northing	Easting	Elevation	Description
604	337620	367193	217.52	Scribed "X" on SW Signal Pole Bolt: TBM 604
605	337604	369776	221.31	Scribed "X" on SW Signal Pole Bolt: TBM 605
611	337370	367918	235.14	Fd BC/Wall: BM GAAB 16

Record of Survey
This survey does not constitute a subdivision
as determined by AS 40.15.900(5).
Anchorage Recording District
State Business No Fee



STATE OF ALASKA DEPARTMENT OF TRANSPORTATION & PUBLIC FACILITIES Survey Control Diagram AKSAS 53433 Debarr Road Resurfacing Located within: Sections 13-16 and 21-24, T13N, R13W, S.M.			
DRAWN	BLK	DATE	Oct 21, 2015
CHECKED	RMK	DATE	Oct 21, 2015
SCALE	1" = 100'	SHEET	4 OF 7

Anchorage Recording District PL 2015-121

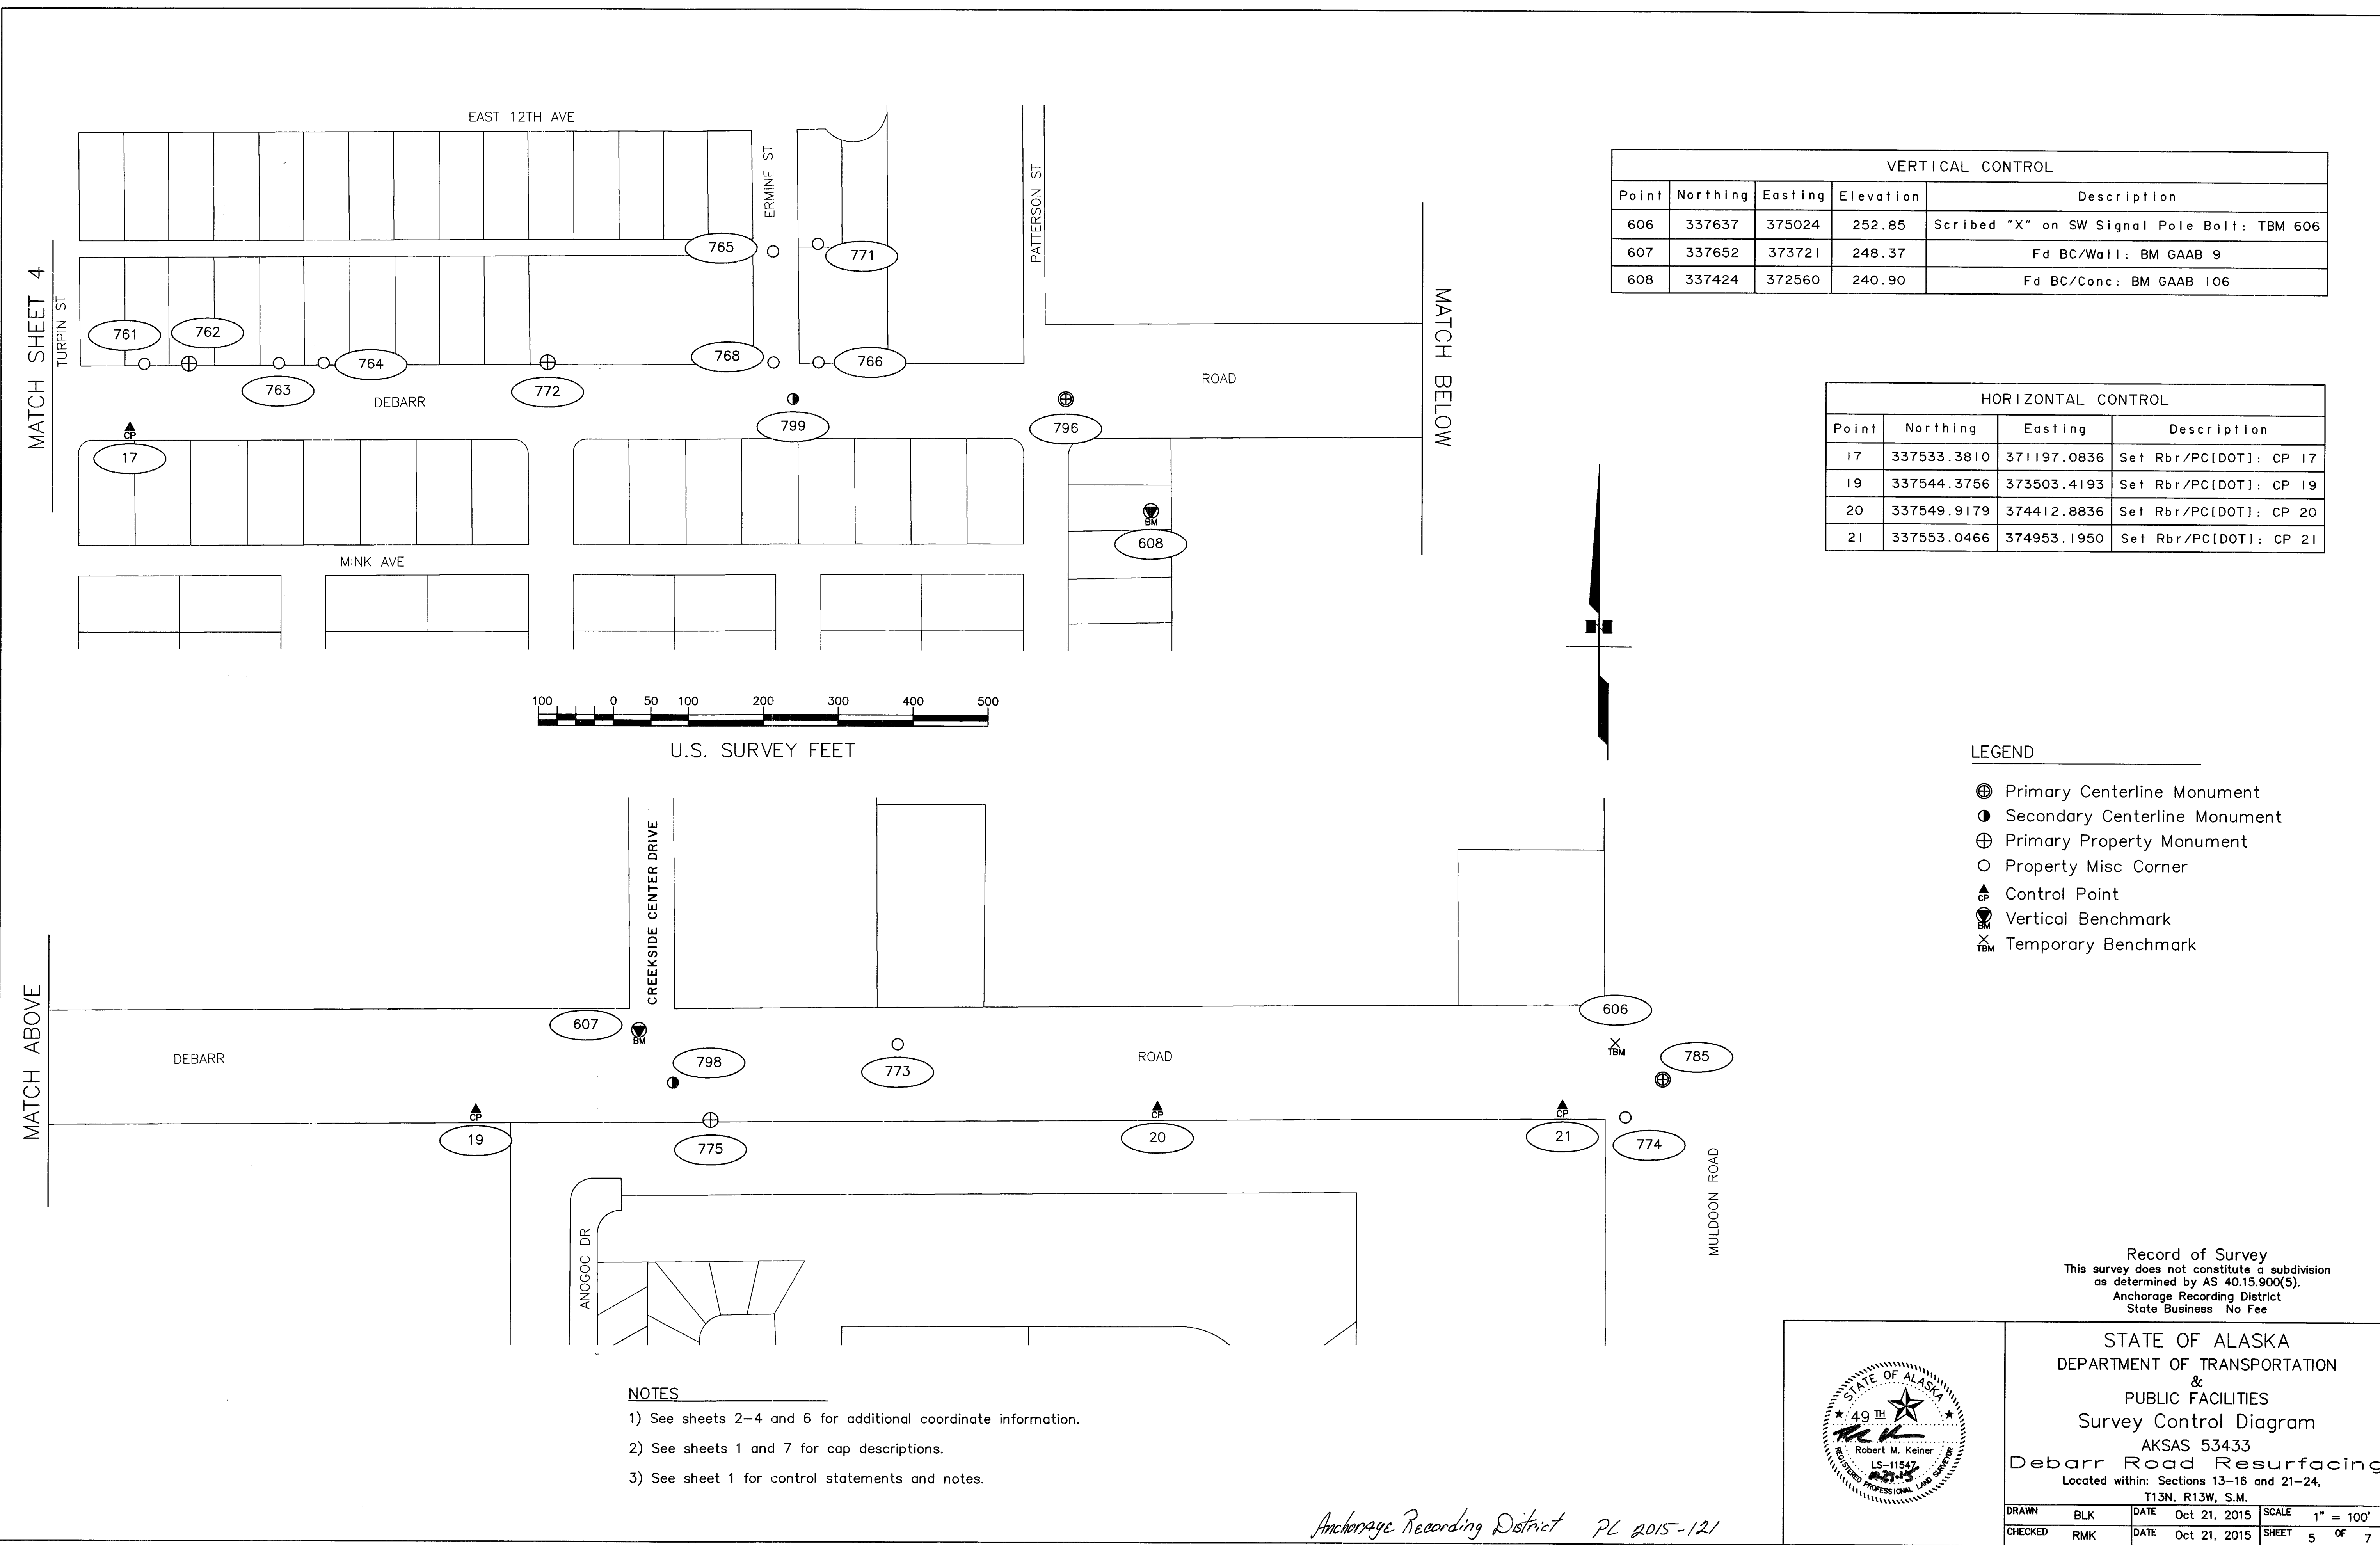

VERTICAL CONTROL				
Point	Northing	Easting	Elevation	Description
606	337637	375024	252.85	Scribed "X" on SW Signal Pole Bolt: TBM 606
607	337652	373721	248.37	Fd BC/Wall: BM GAAB 9
608	337424	372560	240.90	Fd BC/Conc: BM GAAB 106

HORIZONTAL CONTROL			
Point	Northing	Easting	Description
17	337533.3810	371197.0836	Set Rbr/PC[DOT]: CP 17
19	337544.3756	373503.4193	Set Rbr/PC[DOT]: CP 19
20	337549.9179	374412.8836	Set Rbr/PC[DOT]: CP 20
21	337553.0466	374953.1950	Set Rbr/PC[DOT]: CP 21


- LEGEND
- ⊕ Primary Centerline Monument
 - Secondary Centerline Monument
 - ⊕ Primary Property Monument
 - Property Misc Corner
 - ▲ CP Control Point
 - Ⓢ BM Vertical Benchmark
 - ✕ TBM Temporary Benchmark

- NOTES
- 1) See sheets 2-4 and 6 for additional coordinate information.
 - 2) See sheets 1 and 7 for cap descriptions.
 - 3) See sheet 1 for control statements and notes.

Record of Survey
This survey does not constitute a subdivision
as determined by AS 40.15.900(5).
Anchorage Recording District
State Business No Fee

STATE OF ALASKA
DEPARTMENT OF TRANSPORTATION
&
PUBLIC FACILITIES
Survey Control Diagram
AKSAS 53433
Debarr Road Resurfacing
Located within: Sections 13-16 and 21-24,
T13N, R13W, S.M.

DRAWN	BLK	DATE	Oct 21, 2015	SCALE	1" = 100'
CHECKED	RMK	DATE	Oct 21, 2015	SHEET	5 OF 7

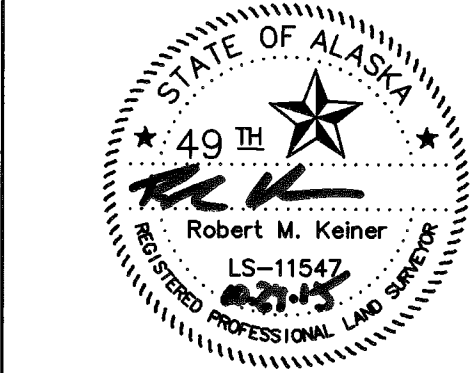

Anchorage Recording District PL 2015-121

MONUMENT SUMMARY

FOUND MONUMENTATION SHEET 2			
Point	Northing	Easting	Description
711	337498.7285	360182.8129	Set Rbr/AC[DOT]: NE L17A B3 Grandview Gardens Subd
712	337498.4990	360057.9574	Fd Rbr/PC: NW L17A B3 Grandview Gardens
713	336959.1766	360184.5736	Fd Rbr: NE L12 B3 Grandview Gardens
714	337318.3486	359908.4796	Fd Rbr: SW L3 B3 Grandview Gardens
715	337197.8036	359909.1664	Fd IP: SW L5 B3 Grandview Gardens
716	337378.0682	359858.1086	Fd Rbr: SE L16 B2 Grandview Gardens
717	337317.6001	359583.4590	Fd IP: SW L3 B2 Grandview Gardens
719	337497.7604	359407.7663	Fd Rbr/PC: NW L21 B1 Grandview Gardens
720	337497.1900	359388.1146	Fd AM: NE L1 B1 Grandview Gardens
721	337317.2298	359388.6770	Fd AM[4053]: SE L2 B1 Grandview Gardens
722	336897.3780	359269.4219	Fd BC/IP: SW L9 B1 Grandview Gardens
723	337499.4790	360502.6233	Set BC[DOT]: NE L10 B7 Grandview Gardens
724	337499.5259	360552.5948	Set BC[DOT]: NW L1 B9 Grandview Gardens
725	336839.7604	360504.0490	Fd BC/IP: NE L1 B8A Grandview Gardens
726	337439.4110	360552.5589	Fd Rbr: SW L1 B9 Grandview Gardens
727	337380.1704	360872.5783	Fd Rbr: SW L1A B10 Grandview Gardens
728	337440.3402	360872.7649	Fd Rbr: SW L1 B10 Grandview Gardens
729	337380.1565	360822.8598	Fd Rbr: SE L10A B9 Grandview Gardens
730	337440.1322	360822.7260	Fd IP: SE L10 B9 Grandview Gardens
733	336867.2906	359240.6683	Fd BC/Bx[MOA]: S1 15th Ave and Airport Heights Rd
734	336867.9459	359559.6108	Fd Rbr: S1 15th Ave and Kinnikinnick Rd
735	336869.2663	360209.5815	Fd Rbr: S1 15th Ave and Columbine Rd
736	336869.6952	360528.9217	Fd Rbr: S1 15th Ave and Wintergreen Rd
737	336837.4568	359269.5673	Fd Rbr: NW L1 B4 Grandview Gardens
738	336871.0656	361173.5580	Fd Rbr: S1 15th Ave and Nichols Rd
739	337378.8139	361147.5472	Fd Rbr: SE L10A B10 Grandview Gardens
740	337320.7530	361197.5127	Fd Rbr/PC[6914]: NW L4 B11 Grandview Gardens
744	337081.2964	361349.3256	Fd Rbr: SE L7 B11 Grandview Gardens
745	337021.3407	361349.4129	Fd Rbr: SE L8 B11 Grandview Gardens
746	337381.1106	361348.8276	Fd Rbr/AC: SE L2 B11 Grandview Gardens
747	336871.3815	361374.6918	Fd Rbr: S1 15th Ave and Norene Rd
748	336901.4363	361399.6479	Fd BC/IP: SW L20 B11 Grandview Gardens
749	336721.4458	361399.8851	Fd Rbr: SW L19 B14 Grandview Gardens
750	337259.4544	361198.6013	Fd Rbr: NW L5 B11 Grandview Gardens
751	337501.8600	361528.0750	Fd BC/IP: NE L11B B11 Grandview Gardens
752	337021.8160	361579.3905	Fd Rbr/AC[6915]: SW L8 B12 Grandview Gardens
753	336961.7609	361579.5356	Fd Rbr/AC[6915]: SW L9 B12 Grandview Gardens
754	336871.7161	361554.6924	Fd Rbr: S1 15th Ave and Primrose Rd
755	337501.7114	361723.2659	Fd IP: NW L11B B12 Grandview Gardens
756	337440.9350	361147.6355	Fd Rbr: SE L10 B10 Grandview Gardens

FOUND MONUMENTATION SHEET 2			
Point	Northing	Easting	Description
769	337437.7551	359583.0581	Fd Rbr: SW L1 B2 Grandview Gardens
770	337261.5891	361528.9902	Fd Rbr/PC: SW L11B B11 Grandview Gardens
784	337526.8953	359237.9548	Set Rbr/AC[DOT]: 1/4 S161S21 xT13N R3W SM
787	337527.4390	359557.9108	Fd Rbr: S1 Debarr Rd and Kinnikinnick St
788	337528.2020	359882.9034	Fd Rbr/AC: S1 Debarr Rd and Sunrise Dr
789	337528.8049	360207.6841	Fd Rbr/AC[6504]: S1 Debarr Rd and Columbine St
790	337529.4266	360527.5205	Fd Rbr/AC[6504]: S1 Debarr Rd and Wintergreen St
801	337530.1691	360847.4623	Fd Rbr/AC[6504]: S1 Debarr Rd and Valarian St
802	337530.7916	361172.3325	Fd Rbr/AC: S1 Debarr Rd and Nichols St
803	337531.2347	361373.6895	Fd Rbr/AC[6504]: S1 Debarr Rd and Norene St
804	337531.5768	361553.6916	Fd Rbr/AC[6504]: S1 Debarr Rd and Primrose St

FOUND MONUMENTATION SHEET 3			
Point	Northing	Easting	Description
701	337588.1274	364194.8630	Fd Rbr/PC: SW L33 B4 Australaska
702	337588.8409	364459.9434	Fd Rbr/PC[6091]: SE Angle Point S Line L34 B4 Australaska
703	337608.9166	364479.9071	Fd Rbr/PC: SE Angle Point E Line L34 B4 Australaska
704	337708.4652	364479.5529	Fd Brass Nail: NE Angle Point E Line L34 B4 Australaska
705	337728.3873	364459.5206	Fd Rbr/PC[6091]: NE Angle Point N Line L34 B4 Australaska
706	337488.0416	364125.9538	Fd Rbr: NE Tract 3 Russian Jack Commons
707	337587.2239	363794.8044	Fd Rbr: SE Tract B-14 Australaska
708	337785.6343	363794.1890	Fd Rbr: NE Tract B-14 Australaska
709	337586.6154	363590.7985	Fd AM[7839]: NE Tract B-14 Australaska
710	337585.5826	363148.0182	Fd Rbr/AC[6714]: SW Tract B-12 Australaska
731	337853.2756	363286.8879	Fd Rbr/AC: NE Tract B-12 Australaska
732	337585.8700	363287.9371	Fd Rbr/AC: SE Tract B-12 Australaska
743	337539.0448	364515.1329	Set Rbr/AC[DOT]: 1/4 S151S22 xT13N R3W SM
786	337532.3411	361878.2258	Set Rbr/AC[DOT]: S16/S151S21/S22 xT13N R3W SM
797	337535.9191	363315.3323	Fd Rbr: S1 Debarr Rd and Hoyt St

FOUND MONUMENTATION NOT SHOWN			
Point	Northing	Easting	Description
742	336420.9060	361149.6885	Fd Rbr: SE L14 B15 Grandview Gardens
757	336187.7894	363348.9508	Fd Rbr: SW Tract B-3 Russian Jack Vista
776	336648.2577	375039.8701	Fd BC[6714]: SE Tract 1 Alaska Village
777	338907.9979	375028.0938	Fd AM[6714]: NE Tract B-1 KT Square
778	338515.4107	375030.8831	Fd Rbr/AC[DOWL]: DOWL Control Point
779	335900.5592	364487.7353	Rbr/PC[6091]: NE Tract B-1 Russian Jack Manor Unit 1
780	335599.9556	364489.2611	Rbr/PC[6091]: SE Tract B-1 Russian Jack Manor Unit 1
781	338858.1198	364510.5166	Fd Rbr/AC[5464]: S1 Pine St and Roberto Ave
783	338533.0945	375030.6519	Fd AM[6714]: SE Tract B-1 KT Square

NOTES

- 1) See sheets 2–5 for additional coordinate information.
- 2) See sheets 1 and 7 for cap descriptions.
- 3) See sheet 1 control statements and notes.


FOUND MONUMENTATION SHEET 4A			
Point	Northing	Easting	Description
718	337554.9644	367152.9408	Fd BC/Bx[DOH]: S1 Debarr Rd and Boniface Pkwy
758	337605.1805	367195.9188	Fd AC/Bx: SW Tract A3 Waldec
759	337606.1339	367490.7406	Fd Rbr/PC: SE Tract A3 Waldec
760	337855.2034	367194.9701	Fd Rbr: NW Tract A3 Waldec
800	337555.0560	367160.9376	Fd BC/Bx[DOT]: S151S14/S221S23 xT13N R3W SM

FOUND MONUMENTATION SHEET 4B			
Point	Northing	Easting	Description
741	337563.6103	369805.0609	Fd BC/Bx[DOH]: S1 Debarr Rd and Edwards St
782	337618.0036	370731.8463	Fd Rbr: SW L5 Debarr Vista
791	337559.7966	368636.7372	Fd Rbr/AC: S1 Debarr Rd and Nunaka Dr
792	337561.4921	369181.7709	Fd Rbr/AC: S1 Debarr Rd and Atkinson Dr
793	337559.2109	368485.9018	Fd Rbr/AC: S1 Debarr Rd and Norman St
794	337564.1960	369969.9966	Fd Rbr: S1 Debarr Rd and Beaver Pl
795	337566.2201	370465.4294	Fd Rbr/AC: S1 Debarr Rd and Summit View St

FOUND MONUMENTATION SHEET 5A			
Point	Northing	Easting	Description
761	337619.1015	371215.9336	Fd Rbr: SW L2 B1 Debarr Vista
762	337619.5821	371275.6026	Fd AM[6091]: SW L3 B1 Debarr Vista
763	337620.2394	371395.4948	Fd Rbr/PC[6091]: SW L5 B1 Debarr Vista
764	337620.6336	371455.2725	Fd Rbr: SW L6 B1 Debarr Vista
765	337770.1026	372054.7163	Fd Rbr: NE L1A B1A Debarr Vista Fifth Addn
766	337622.3919	372115.7966	Fd Rbr: SW L1A B9 Debarr Vista Fifth Addn
768	337622.2215	372055.5515	Set Rbr/AC[DOT]: SE L1A B1A Debarr Vista Fifth Addn
771	337780.2957	372114.5030	Fd Rbr: NW L1A B9 Debarr Vista Fifth Addn
772	337621.9772	371754.2424	Fd AM: SW L1A B1A Debarr Vista Fifth Addn
796	337573.9094	372445.8117	Fd BC/Bx: S1 Debarr Rd and Patterson St
799	337573.2194	372081.8693	Fd Rbr: S1 Debarr Rd and Ermine St


FOUND MONUMENTATION SHEET 5B			
Point	Northing	Easting	Description
773	337632.8405	374066.0912	Fd Rbr/AC[6714]: SW L3 KT Square
774	337538.3723	375037.0966	Set BC[DOT]: NE Tract 1 Alaska Village
775	337531.5212	373816.5873	Fd BC[5318]: NW Tract 1 Alaska Village
785	337588.6699	375086.9053	Fd BC/Bx[DOH]: S1 Debarr Rd and Muldoon Rd
798	337581.1922	373766.3454	Fd Rbr: S1 Debarr Rd and Creekside Center Dr

Record of Survey
This survey does not constitute a subdivision
as determined by AS 40.15.900(5).
Anchorage Recording District
State Business No Fee

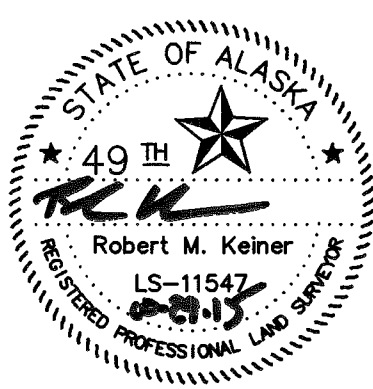


STATE OF ALASKA DEPARTMENT OF TRANSPORTATION & PUBLIC FACILITIES Survey Control Diagram AKSAS 53433 Debarr Road Resurfacing Located within: Sections 13–16 and 21–24, T13N, R13W, S.M.			
DRAWN	BLK	DATE	Oct 21, 2015
CHECKED	RMK	DATE	Oct 21, 2015
SCALE	N/A	SHEET	6 OF 7


Anchorage Recording District PL 2015-121

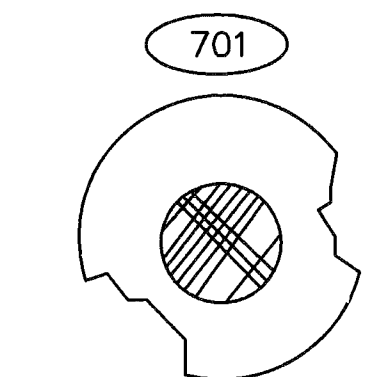


701
-FOUND-
1 1/4" RED PLASTIC CAP,
FLUSH WITH GRADE,
GOOD CONDITION

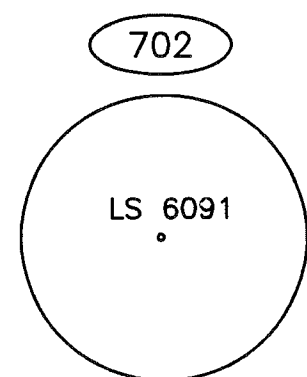


702
-FOUND-
1 1/4" YELLOW PLASTIC CAP,
FLUSH WITH GRADE,
GOOD CONDITION, SAME FOR 705

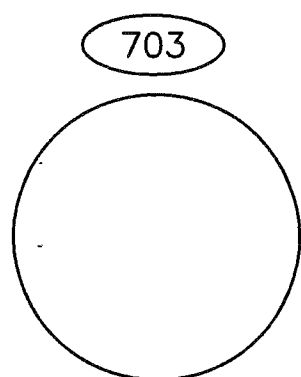


703
-FOUND-
1 1/4" RED PLASTIC CAP,
FLUSH WITH GRADE,
SCRAPPED, SOLID CONDITION

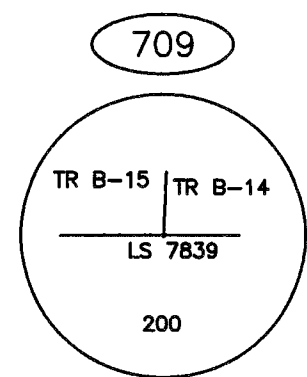


709
-FOUND-
2 1/2" ALUMINUM MONUMENT,
0.1' BELOW GRADE,
SOLID CONDITION

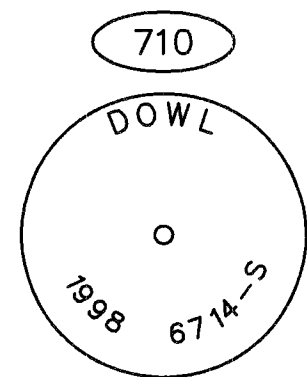


710
-FOUND-
2" ALUMINUM CAP,
0.2' BELOW GRADE,
GOOD CONDITION

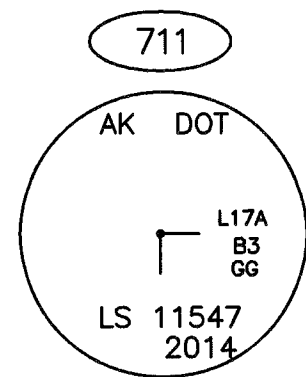


711
-SET-
2" ALUMINUM CAP ON
5/8" x 24" REBAR,
SET IN CONCRETE CURB,
CAP ROTATED 90° CLOCKWISE

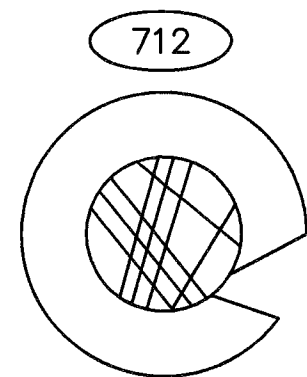


712
-FOUND-
1 1/4" YELLOW PLASTIC CAP,
0.1' ABOVE GRADE,
GOOD CONDITION

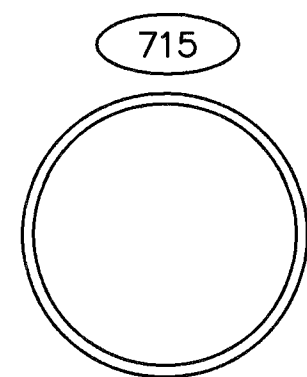


715
-FOUND-
1" IRON PIPE,
1.1' BELOW GRADE,
SOLID CONDITION

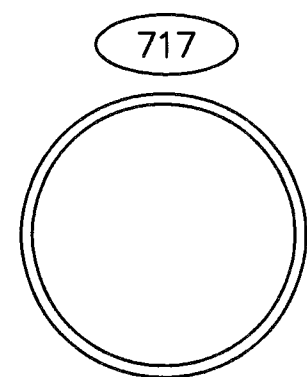


717
-FOUND-
1" IRON PIPE,
0.4' ABOVE GRADE,
SOLID CONDITION

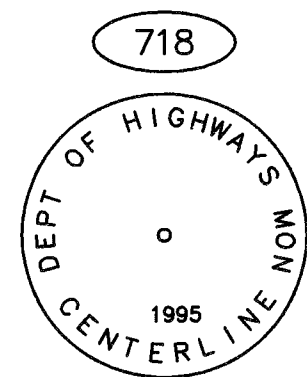


718
-FOUND-
3" BRASS CAP,
0.4' BELOW GRADE, IN CASE,
SOLID CONDITION

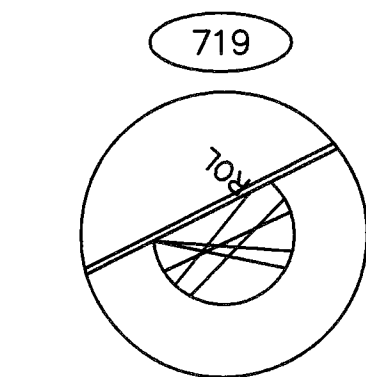


719
-FOUND-
1 1/4" ORANGE PLASTIC CAP,
0.3' BELOW GRADE,
GOOD CONDITION

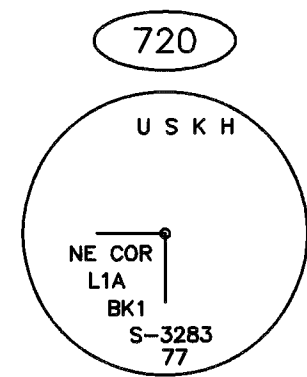


720
-FOUND-
3 1/4" ALUMINUM MONUMENT,
1.0' BELOW GRADE,
GOOD CONDITION

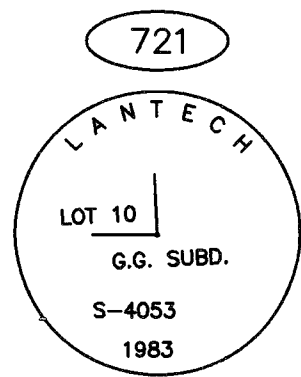


721
-FOUND-
2 1/2" ALUMINUM MONUMENT,
0.2' BELOW GRADE,
DINGED, GOOD CONDITION

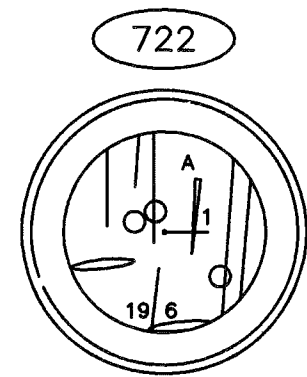


722
-FOUND-
1 1/2" BRASS CAP,
0.1' ABOVE GRADE,
DINGED, SOLID CONDITION

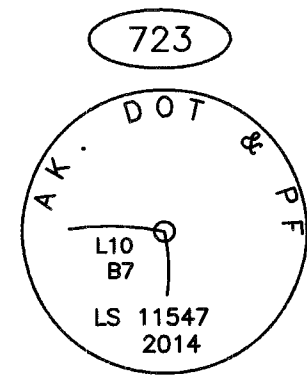


723
-SET-
2 1/2" BRASS CAP,
FLUSH WITH GRADE

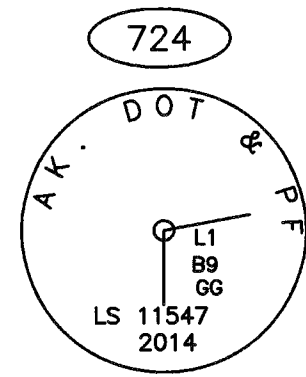


724
-SET-
2 1/2" BRASS CAP,
FLUSH WITH GRADE

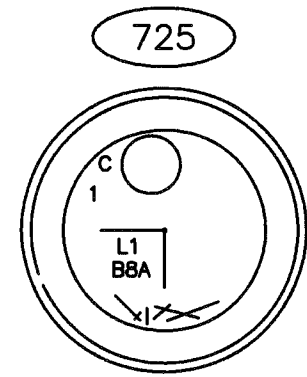


725
-FOUND-
1 1/2" BRASS CAP,
1.2' BELOW GRADE,
DINGED, SOLID CONDITION

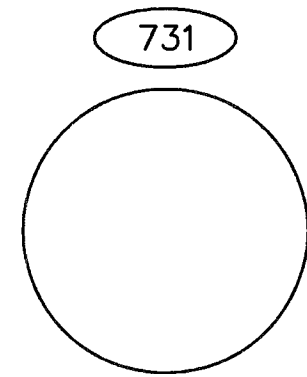


731
-FOUND-
1 1/2" ALUMINUM CAP,
FLUSH WITH GRADE,
SCRAPPED, SOLID CONDITION,
SAME FOR 732

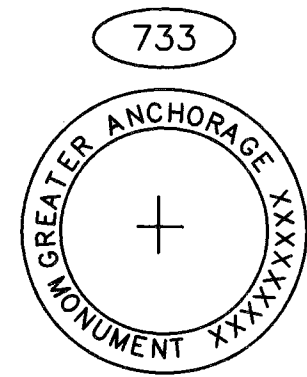


733
-FOUND-
3" BRASS CAP,
0.8' BELOW GRADE, IN CASE,
DINGED, SOLID CONDITION

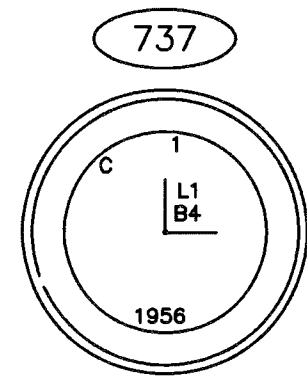


737
-FOUND-
1 1/2" BRASS CAP,
0.1' BELOW GRADE,
DINGED, SOLID CONDITION

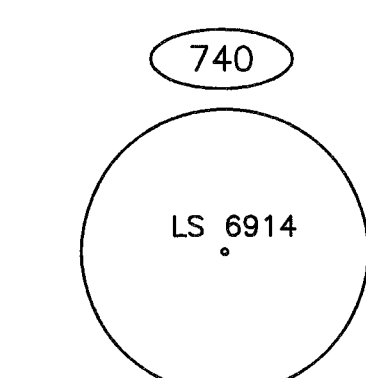


740
-FOUND-
1 1/4" ORANGE PLASTIC CAP,
0.1' ABOVE GRADE,
SOLID CONDITION

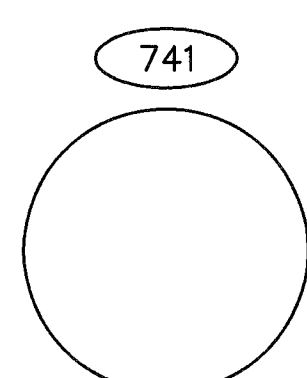


741
-FOUND-
2 1/2" BRASS CAP,
0.3' BELOW GRADE, IN CASE,
DINGED, SOLID CONDITION

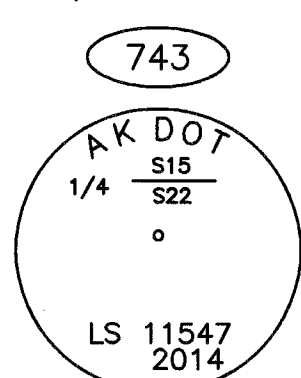


743
-SET-
2" ALUMINUM CAP ON
5/8" x 24" REBAR,
FLUSH WITH GRADE

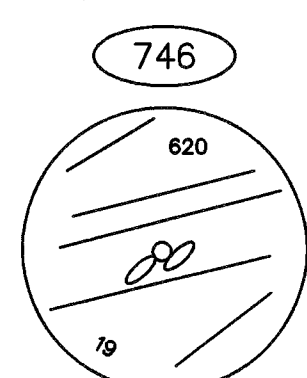


746
-FOUND-
2 1/2" ALUMINUM CAP,
0.1' BELOW GRADE,
GOOD CONDITION

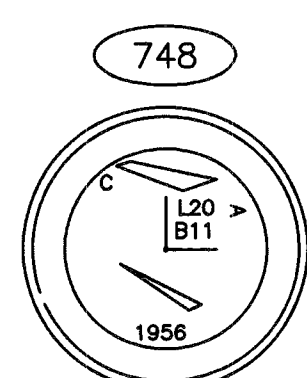


748
-FOUND-
1 1/2" BRASS CAP,
1.6' BELOW GRADE,
DINGED, SOLID CONDITION

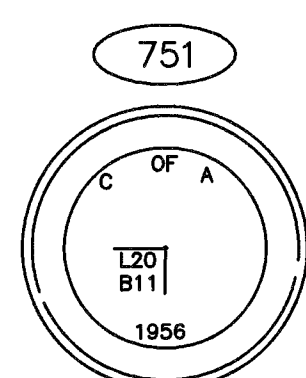


751
-FOUND-
1 1/2" BRASS CAP,
0.6' ABOVE GRADE,
DINGED, SOLID CONDITION

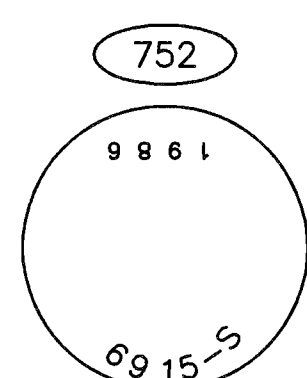


752
-FOUND-
2" ALUMINUM CAP,
FLUSH WITH GRADE,
SCRAPPED, SOLID CONDITION

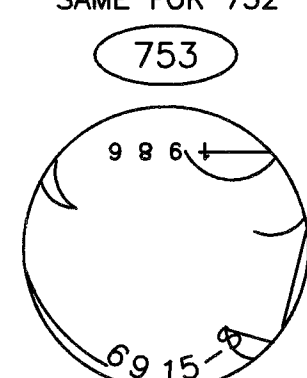


753
-FOUND-
2" ALUMINUM CAP,
FLUSH WITH GRADE,
SCRAPPED, SOLID CONDITION

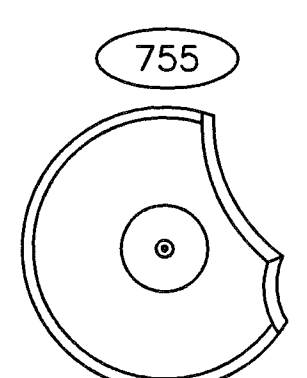


755
-FOUND-
1" IRON PIPE, MAG NAIL,
0.3' ABOVE GRADE,
SOLID CONDITION

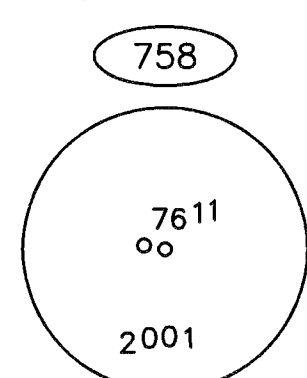


758
-FOUND-
2" ALUMINUM CAP,
0.7' BELOW GRADE, IN CASE,
SOLID CONDITION

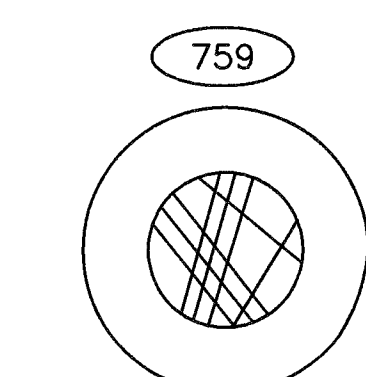


759
-FOUND-
1 1/4" YELLOW PLASTIC CAP,
0.1' ABOVE GRADE,
GOOD CONDITION

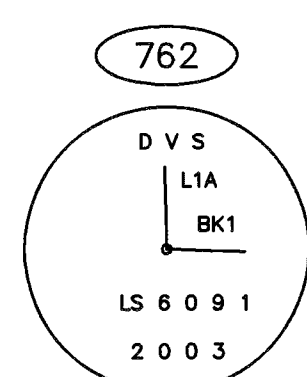


762
-FOUND-
3 1/4" ALUMINUM MONUMENT,
0.3' BELOW GRADE,
GOOD CONDITION

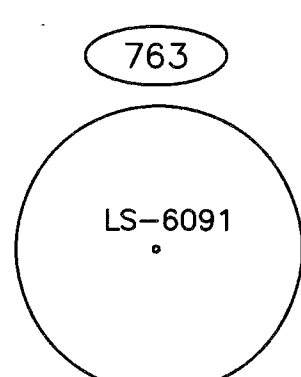


763
-FOUND-
1 1/4" YELLOW PLASTIC CAP,
FLUSH WITH GRADE,
GOOD CONDITION, SAME FOR 780

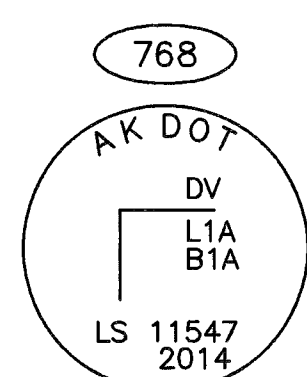


768
-SET-
2" ALUMINUM CAP ON
5/8" x 24" REBAR,
0.1' BELOW GRADE

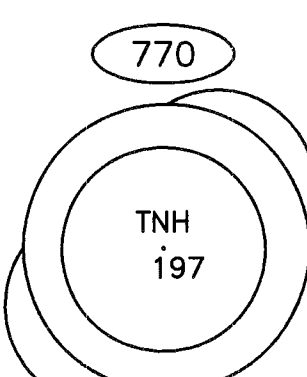


770
-FOUND-
1 1/4" YELLOW PLASTIC CAP,
0.3' BELOW GRADE,
SOLID CONDITION

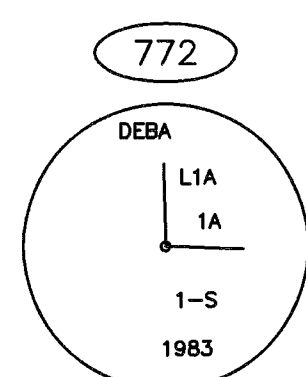


772
-FOUND-
2 1/2" ALUMINUM MONUMENT,
0.4' BELOW GRADE,
DINGED, LEANING NORTH

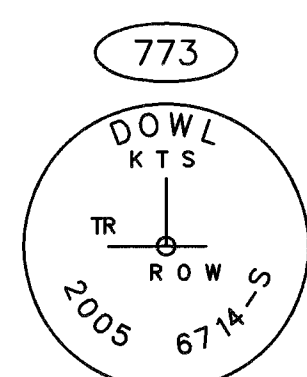


773
-FOUND-
2" ALUMINUM CAP,
0.1' BELOW GRADE,
DINGED, GOOD CONDITION

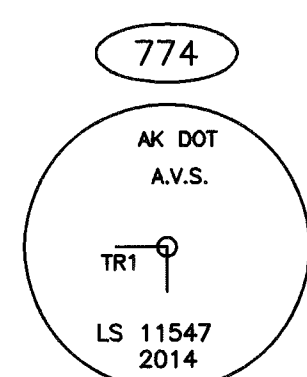


774
-SET-
2 1/2" BRASS CAP,
FLUSH WITH GRADE

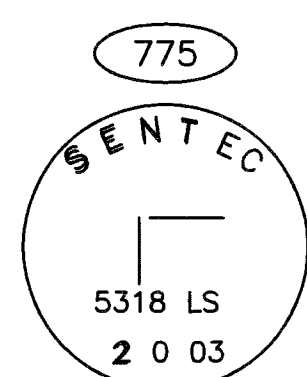


775
-FOUND-
2" BRASS CAP,
FLUSH WITH GRADE,
DINGED, GOOD CONDITION

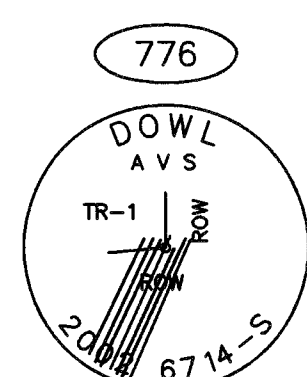


776
-FOUND-
2" BRASS CAP,
FLUSH WITH GRADE,
DINGED, SOLID CONDITION

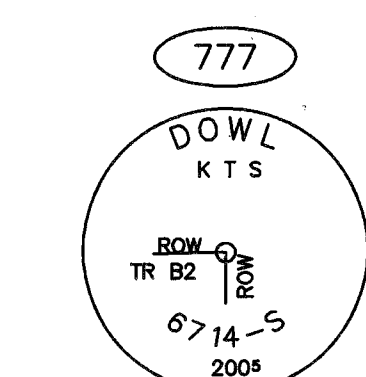


777
-FOUND-
3 1/4" ALUMINUM MONUMENT,
0.2' BELOW GRADE,
GOOD CONDITION

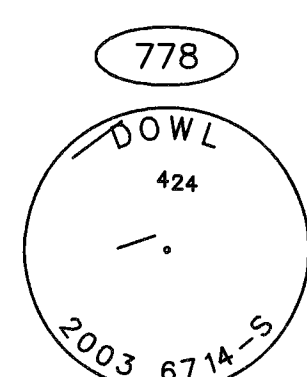


778
-FOUND-
2" ALUMINUM CAP,
FLUSH WITH GRADE,
GOOD CONDITION

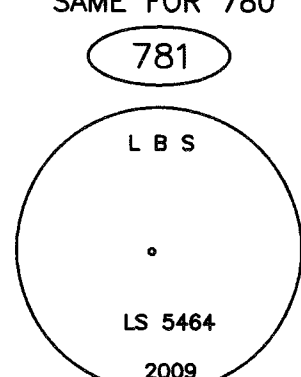


781
-FOUND-
2" ALUMINUM CAP,
FLUSH WITH GRADE,
GOOD CONDITION

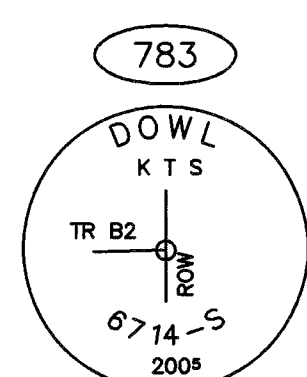


783
-FOUND-
3 1/4" ALUMINUM MONUMENT,
0.2' BELOW GRADE,
GOOD CONDITION

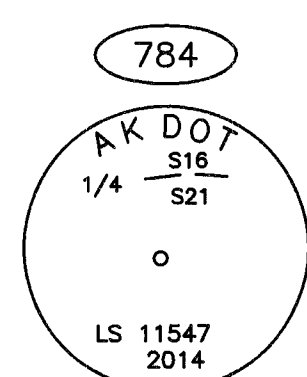


784
-SET-
2" ALUMINUM CAP ON
5/8" x 24" REBAR,
FLUSH WITH GRADE

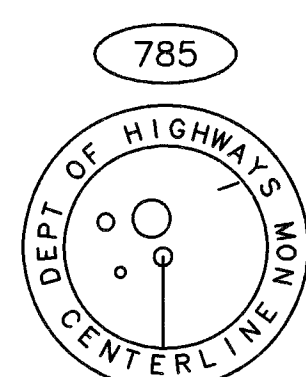


785
-FOUND-
2 1/2" BRASS CAP,
0.7' BELOW GRADE, IN CASE,
DINGED, SOLID CONDITION

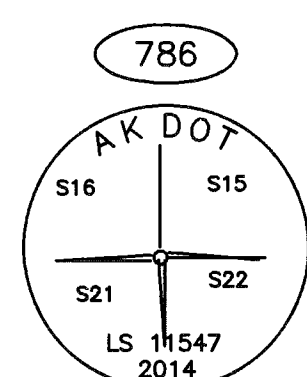


786
-SET-
2" ALUMINUM CAP ON
5/8" x 24" REBAR,
FLUSH WITH GRADE

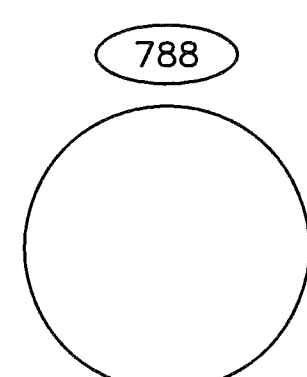


788
-FOUND-
1 1/2" ALUMINUM CAP,
0.1' BELOW GRADE,
SCRAPPED, SOLID CONDITION

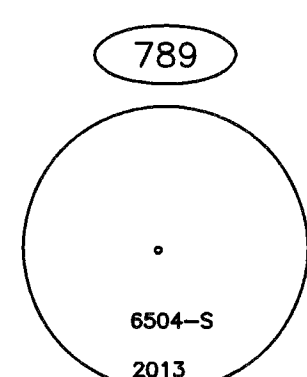


789
-FOUND-
1 1/2" ALUMINUM MONUMENT,
FLUSH WITH GRADE,
GOOD CONDITION

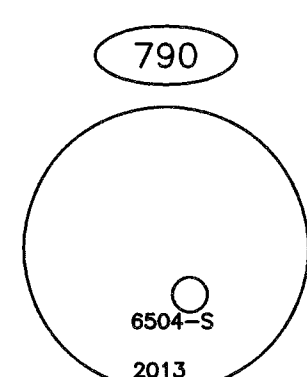


790
-FOUND-
1 1/2" ALUMINUM MONUMENT,
FLUSH WITH GRADE,
GOOD CONDITION

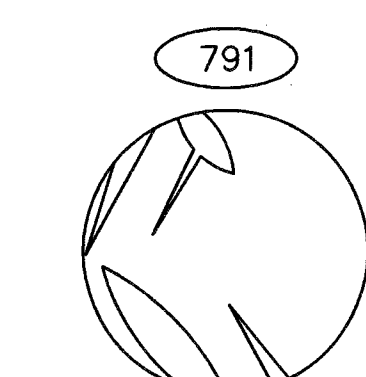


791
-FOUND-
1 1/2" ALUMINUM CAP,
FLUSH WITH GRADE,
SCRAPPED, SOLID CONDITION
SAME FOR 792 AND 795

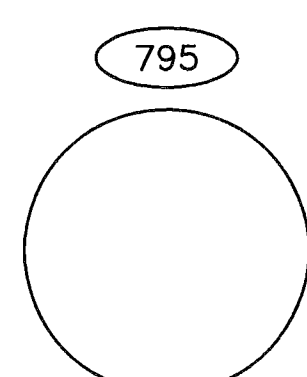


795
-FOUND-
1 1/2" ALUMINUM MONUMENT,
FLUSH WITH GRADE,
SCRAPPED, DINGED, SOLID CONDITION

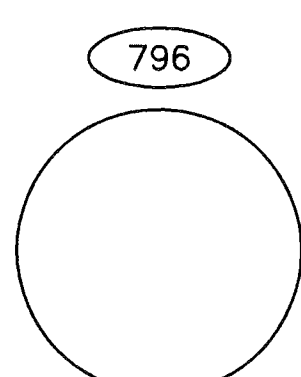


796
-FOUND-
2 1/2" BRASS CAP,
0.3' BELOW GRADE, IN CASE,
DINGED, SOLID CONDITION

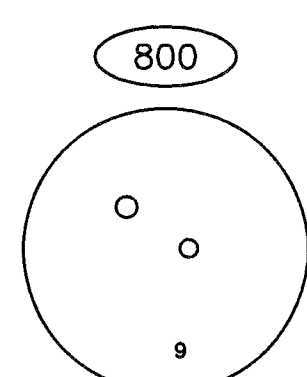


800
-FOUND-
2 1/2" BRASS CAP,
0.2' BELOW GRADE, IN CASE,
DINGED, SOLID CONDITION

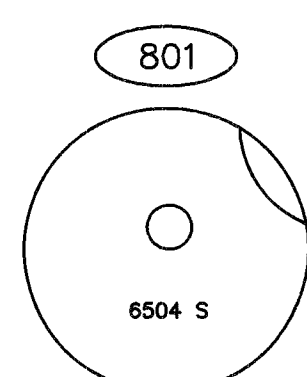


801
-FOUND-
1 1/2" ALUMINUM MONUMENT,
0.1' BELOW GRADE,
SCRAPPED, DINGED, SOLID
CONDITION

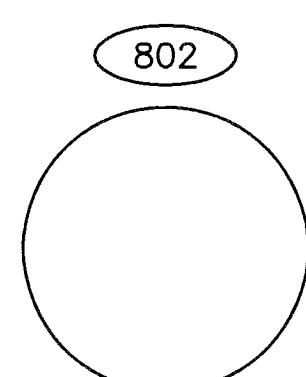

802
-FOUND-
2" ALUMINUM MONUMENT,
FLUSH WITH GRADE,
SCRAPPED, GOOD CONDITION

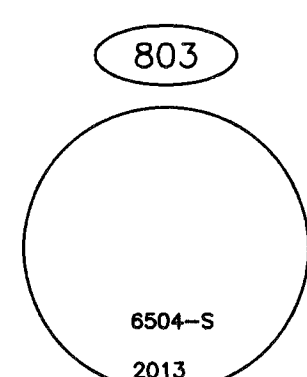



803
-FOUND-
2" ALUMINUM CAP,
FLUSH WITH GRADE,
GOOD CONDITION

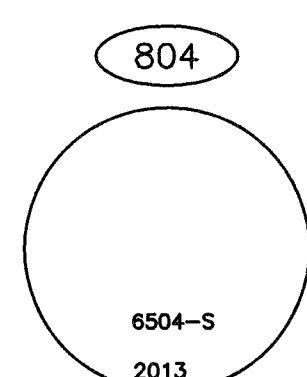

804
-FOUND-
2" ALUMINUM CAP,
FLUSH WITH GRADE,
GOOD CONDITION

NOTES

- 1) See sheets 1-6 for coordinate information.
- 2) See sheet 1 for additional cap descriptions, control information, and notes.

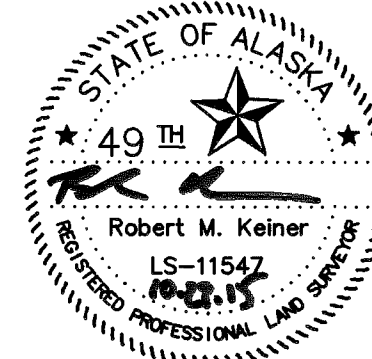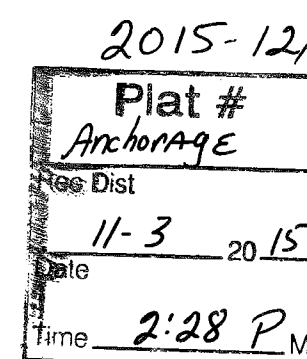

Record of Survey
This survey does not constitute a subdivision
as determined by AS 40.15.900(5).
Anchorage Recording District
State Business No Fee

STATE OF ALASKA DEPARTMENT OF TRANSPORTATION & PUBLIC FACILITIES Survey Control Diagram AKSAS 53433 Debarr Road Resurfacing Located within: Sections 13-16 and 21-24, T13N, R13W, S.M.			
DRAWN	BLK	DATE	Oct 21, 2015
CHECKED	RMK	DATE	Oct 21, 2015
SCALE	N/A	SHEET	7 OF 7