
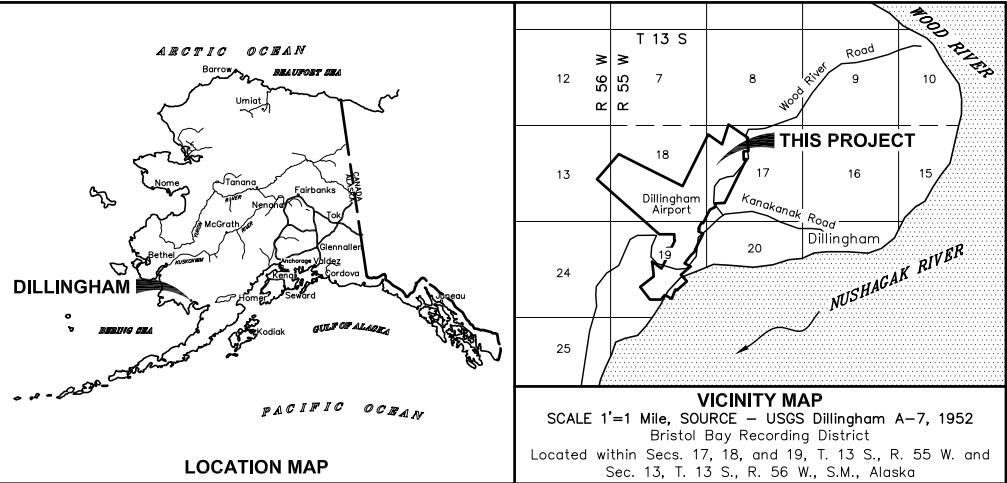


LAND OCCUPANCY						
BLK	LOT	ADA NO.	AREA (SQ FT)	OCCUPANT	BEGIN DATE	EXP. DATE
ITEM	1	06669	1600	FAA – PAPI, R/W 01	06/22/2006	09/30/2022
	2	07092	104,544	FAA – LOCALIZER	07/01/1994	09/30/2014
	3	07092		FAA – VASI, R/W 19	07/01/1994	09/30/2014
	4	06621	40,075	FAA – DIRECTION FINDER	07/01/1991	09/30/2030
	5	08342	612,018	FAA – ODALS & 10' CABLE ROW	10/01/2005	09/30/2024
	6	08730	16	FAA – SAWS SITE	06/17/2010	09/30/2030
	7	06669	2500	FAA – AWOS	06/01/1992	09/30/2022
	8	05174		JOHN C. MOORES – WATER WELL	11/12/1982	11/12/2037

NOTES

- The information provided here is based on a field survey performed by WHPacific Inc. from October 27, 2013 to October 31, 2013.
- All dimensions and coordinates shown hereon are in U.S. Survey Feet.
- See Sheet 5 for Survey Control information.
- The locations and elevations of all utilities shown are approximate only; locations have not been field verified. Additional utilities that are not shown hereon may also exist.

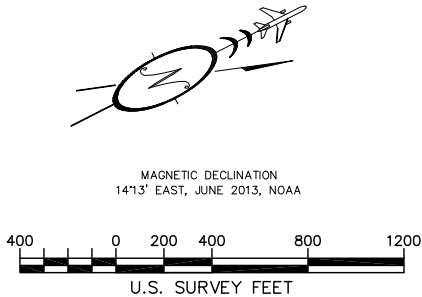

LEGEND

●	FOUND MONUMENT	BRL	BUILDING RESTRICTION LINE		ABOVE GROUND FUEL TANKS
⚡	ELECTRIC PEDESTAL	CL	CENTERLINE		ASPHALT
⚡	TELEPHONE PEDESTAL	LT	LEFT		AVIGATION & HAZARD EASEMENT
⌵	UTILITY POLE	ROW	RIGHT OF WAY		BUILDINGS
⌵	CATCH BASIN	RPZ	RUNWAY PROTECTION ZONE		GRAVEL
⌵	STORM DRAIN MANHOLE	RT	RIGHT		
⌵	SANITARY SEWER MANHOLE	R/W	RUNWAY		
---	BUILDING RESTRICTION LINE	STA	STATION		
---	EXISTING FACILITIES	T/W	TAXIWAY		
---	GRAVEL ROADS	TOFA	TAXIWAY OBJECT FREE AREA		
---	ASPHALT ROADS	TSR	TAXIWAY SAFETY AREA		
---	UGP	---	---		
---	UNDERGROUND	---	---		
---	UNDERGROUND	---	---		
---	UNDERGROUND	---	---		
---	UNDERGROUND	---	---		
---	FENCE	---	---		
---	CULVERT	---	---		

Item three (3).
Private residence
See page 8 of 14.

Asbuilt road. CL
Profile and shoulders
every 100'. Be sure
to locate gates and
update LO. Bullets 6
& 7 Jennifer Bailey
memo to Matt
Burkholder 4/28/15

Item four (4).
Private residence.
See page 8 of 14.

Item five (5)
Private Residence
See page 8 of 14.

Item two (2).
Private residence
See page 6 of 14.

REFERENCE DOCUMENTS

This Land Occupancy Map (LO) was compiled from the following sources:
Dillingham Airport Property Plan, dated 12/11/2003, and provided by the Department of Transportation
Dillingham Airport, Record of Survey, Plat 2014-11, Bristol Bay Recording District
Dillingham Land Occupancy Map, dated 08/10/2010, and provided by the Department of Transportation
Dillingham Airport Lease documents provided by the Department of Transportation
Dillingham Airport Lease Lot As-Built Surveys provided by the Department of Transportation
Dillingham Airport Layout Plan, dated 06/15/2012, FAA Conditional Approval, dated 07/10/2012, and provided by the Department of Transportation.
Dillingham Airport Survey Control Sheet, Runway Rehabilitation, Project 53424, dated 12/2005, and provided by the Department of Transportation.

STATE OF ALASKA DEPARTMENT OF TRANSPORTATION AND PUBLIC FACILITIES AVIATION LEASING DILLINGHAM AIRPORT LAND OCCUPANCY			
APPROVED		NAME: _____	
TITLE: _____		DATE: _____	
BY	DATE	CHANGE	SCALE
REVISIONS		1" = 400'	DWN BRM DATE 4/17/15
			SHEET 1 OF 4