
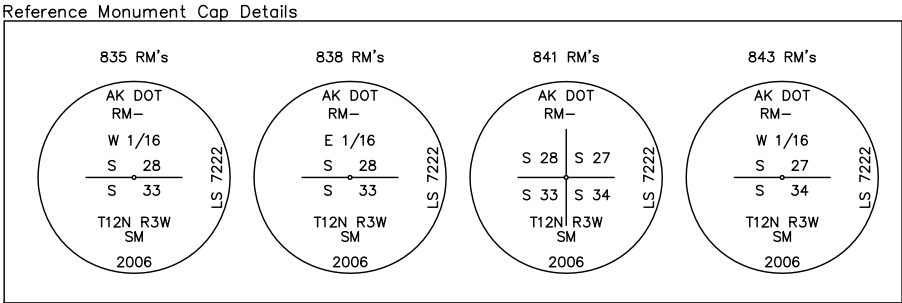


- Legend
- ⊕ Primary Reference Monument – Set this Survey
 - Secondary Centerline Monument
 - Misc. Property Corner

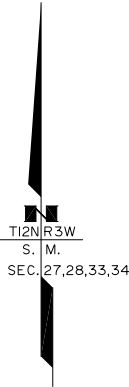

Reference Monument Positions				
Pt. #	Northing	Easting	Description	Ref. Mon. to True Point
850	295309.4061	358807.1925	835 RM-1 Set AM	S36°41'00"W 29.16 Ft.
851	295310.7676	358773.9084	835 RM-2 Set AM	S32°39'57"E 29.39 Ft.
852	295331.1941	361400.7044	838 RM-1 Set AM	S33°01'28"E 47.41 Ft.
853	295331.6698	361456.3571	838 RM-2 Set AM	S36°32'56"W 50.07 Ft.
854	295334.1731	362701.8730	841 RM-1 Set AM	S47°31'38"E 59.09 Ft.
855	295325.9809	362792.0238	841 RM-2 Set AM	S55°44'46"W 56.34 Ft.
856	295324.4389	364043.9865	843 RM-1 Set AM	S46°08'04"E 30.07 Ft.
857	295325.2919	364089.2587	843 RM-2 Set AM	S46°17'11"W 32.02 Ft.

Notes:

- The purpose of this survey was to re-establish the monuments located within the road surface of Dearmoun Road after construction. The monuments existing pre-construction were tied with static GPS techniques, referenced to control outside the project area. These locations were re-established and monumented by DOT/PF Survey Crews in April 2006.
- The majority of the original control for this project was destroyed during construction. The original coordinate system was re-created by tying several undisturbed monuments that had been previously tied for the Right-of-Way survey prior to construction. The GPS Network created for this survey was constrained using the previously determined values for these monuments. All of the positions computed fit within tolerance throughout the project, therefore Planset Values were held on all positions.
- For points 835, 838, 841, and 843 the Department set Reference Monuments instead of the actual monument, as these points fell in the traffic lane, and would be unusable for survey purposes. These Reference Monuments perpetuate the locations, and allow surveys to be done without causing extra safety concerns or disrupting traffic.
- Refer to DOT/PF Survey Field Book 97.03.03 for specific notes regarding this survey.
- This survey was completed in January 2005 and April 2006 by DOT Survey Crews.
- The background information shown is for orientation purposes only.
- Refer to State of Alaska Department of Transportation & Public Facilities Right of Way Map "STP-0510(2)/53987 Dearmoun Road Rehabilitation: Westwind to E. 140th Avenue" for current alignment information.
- This survey was performed under the direct supervision of Michael E. Miller, P.L.S. while in service of the Department. He has since retired, and was replaced by Anthony Boneta, P.L.S. Anthony has reviewed and approved this survey. Hence the monuments are stamped LS-7222, while this sheet is signed LS-10393.

Monument Positions			
Pt. #	Description	Northing	Easting
830	BOP STA. 0+200.369	295310.7942	357801.0426
831	PC 0+408.710	295293.5548	358484.3572
832	PT 0+460.974	295286.9911	358655.6961
833	NE COR. LOT 13A, STRZELEWICZ	295250.9613	358759.5574
834	PC 0+463.683	295286.5348	358664.5730
835	W 1/16 COR., S1 DEARMOUN RD/SABINE STREET	295286.0226	358789.7736
836	PT 0+570.565	295277.8983	359015.0864
837	1/4 COR. SEC 28/23	295288.9494	360108.6548
810	POT 1+050.000	295281.1781	360588.0301
838	E 1/16 COR., S1 DEARMOUN RD/THUNDER STREET	295291.4468	361426.5406
839	NE COR. LOT 1, MARIE ACRES SUBD	295241.8386	361755.5127
840	NE COR. LOT 2A, FEJES SUBD	295258.7287	362415.8493
842	NO CURVE PI	295285.6775	362745.5019
841	SECTION COR. 27,28,33,34; S1 DEARMOUN RD/ELMORE RD	295294.2716	362745.4592
843	W 1/16 COR., S1 DEARMOUN RD/DAVIS STREET	295303.1673	364066.1177
844	PC 2+213.128	295296.6400	364404.0051
845	SE COR. LOT 62, BLM SUBD. SMALL TRACT	295307.6919	364725.6849


Surveyor's Certificate

I hereby certify that I am properly Registered and Licensed to practice Land Surveying in the State of Alaska, and that this drawing represents a survey made by me or under my direct supervision, and that the monuments shown hereon actually exist as described, and that all dimensions and other details are correct to the extent shown hereon.

Anthony P. Boneta

LS-10393

Date

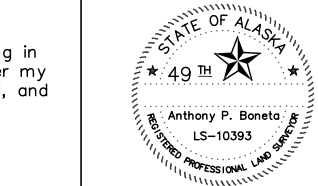

Record of Survey

This survey does not constitute a subdivision as determined by AS 40.15.900(5).

Anchorage Recording District

State Business No Fee

STATE OF ALASKA

DEPARTMENT OF TRANSPORTATION

&

PUBLIC FACILITIES

Record of Survey

Federal / State Project No.

STP-0510(2) / AKSAS 53987

Dearmoun Road Rehabilitation – Westwind to 140th Ave.

Located within: Sections 27,28,33 & 34, T12N, R3W, S.M. Alaska

DRAWN	RMK	DATE	Dec 17, 2009	SCALE	1" = 250'
CHECKED	APB	DATE	Dec 18, 2009	SHEET	1 OF 1