

④ #52462 KGB: 0.3 → 6.8

UNIT STA: 175' START FIN
#110 4:35 PM 1:25 3:00
GPS
MK-SAI 1325m
STATIC BASE

110 #162 4:23 PM 11:44 2:54
GPS
MK-6A 1289m
STATIC BASE


110 #1273 4:35 PM 11:53 12:35
PAC 1325m
FD 6"X6" CONC. K.O.W. MON
BROKEN TOP, TIED CENTER
OF CONCRETE BASE

R.O.W

ISSUE

④ AUG 29, 2013
F. DONNELLY
W. JOHNSON

#1273

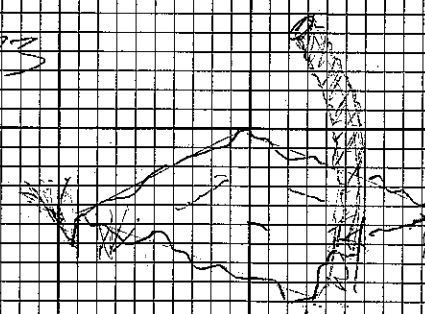

5/8" REINFOR-
CEMENT REBAR,
NOT CENTERED
IN MON