

IONUMENT
BENT;
CED AT
ECTION
7-17

FOUND 2 1/2" BRASS CAP MONUMENT
ON 1" IRON PIPE 0.4"
ABOVE GROUND

SET 3 1/4" X 30" ALUMINUM
MONUMENT ON 3" ALUMINUM PIPE
FLUSH WITH GROUND

CAP
GROUND

FOUND 2 1/2" BRASS CAP MONUMENT
ON 1" IRON PIPE 0.1"
ABOVE GROUND

FOUND 2 1/2" BRASS CAP MONUMENT
ON 1" IRON PIPE 0.3"
ABOVE GROUND

LEGEND

WAR

WAR

MONUMENT AS NOTED HEREON

REBAR WITH 1" PLASTIC CAP STAMPED "LS-6091"

HIGHWAY RIGHT OF WAY MONUMENT

ON PER PLAT NO. 77-17

ON PER PLAT NO. 75-61

ON PER PLAT NO. 84-297

ON PER STATE OF ALASKA / DEPARTMENT OF



ISION - THIS SURVEY

PER RECORD SOURCE

-TANGENTIAL CURVE

ISION

ED BY BEARING-BEARING INTERSECTION

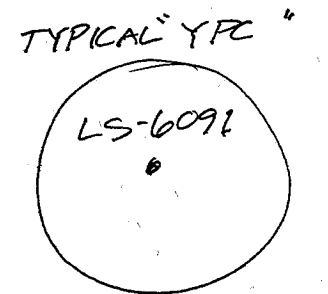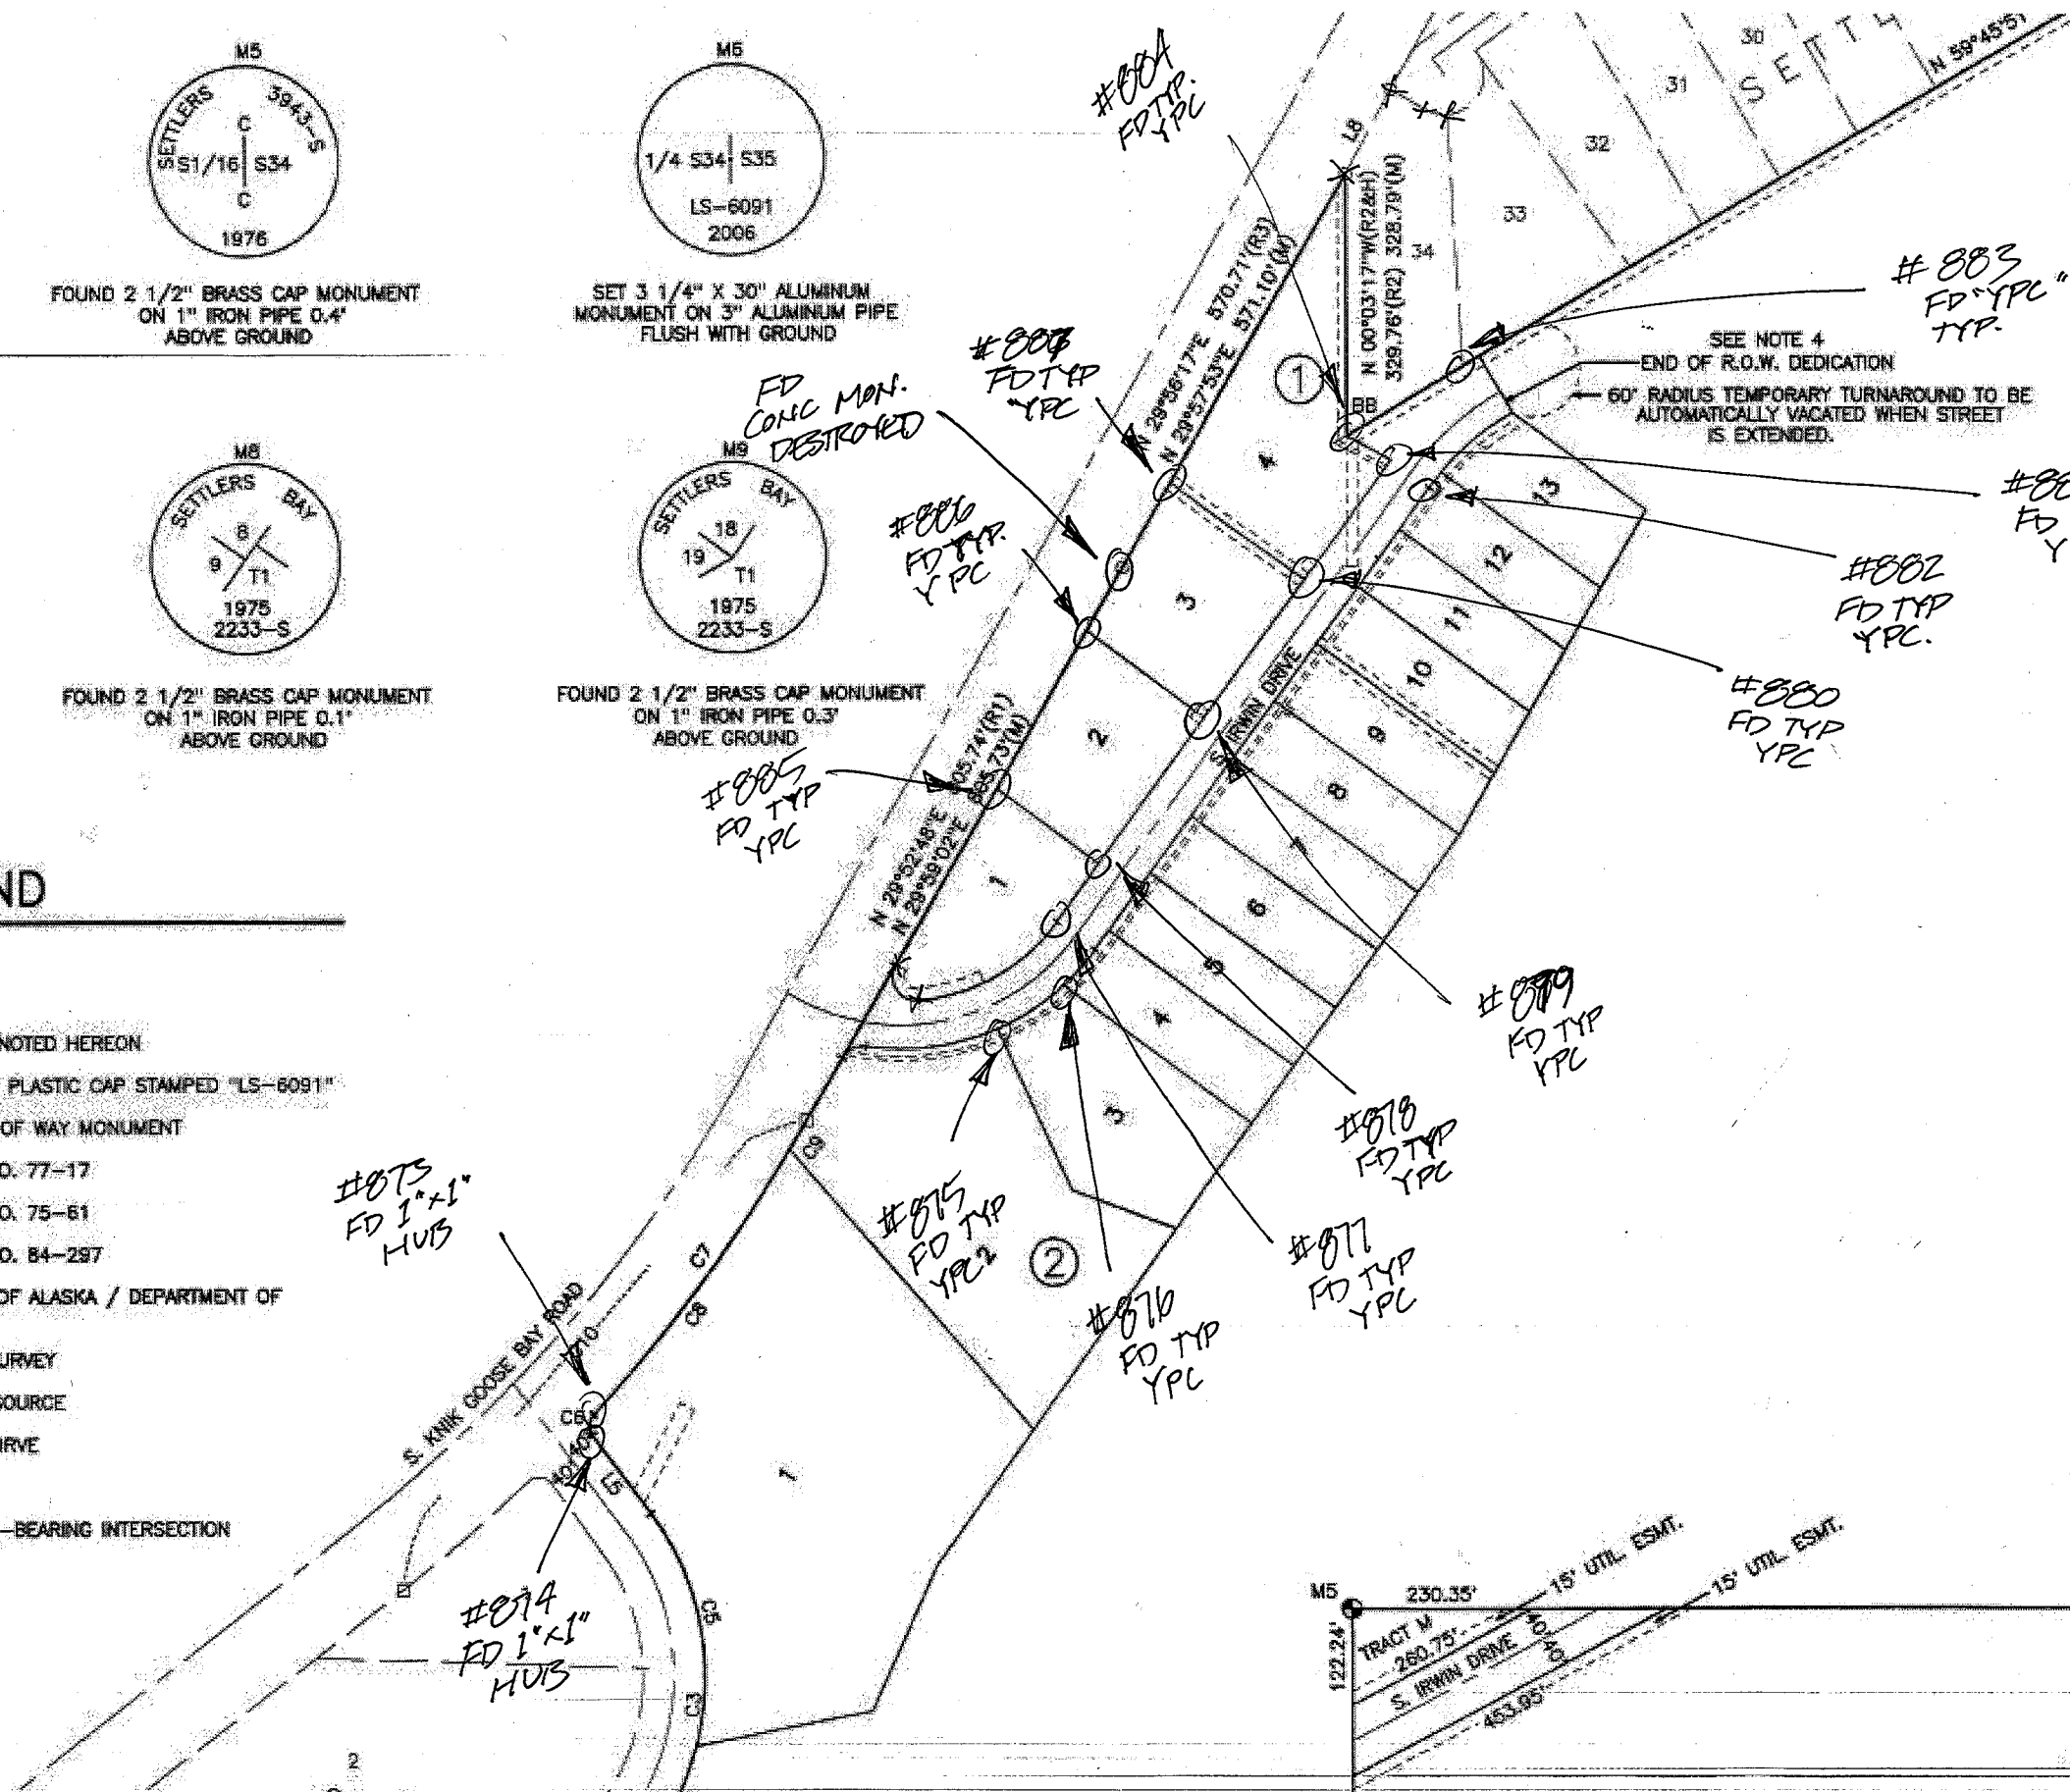

TRACT A-1
180.11 ACRES

SETTLERS
BAY SUB.
UNIT NO. 6
PLAT #2007-71

