



SURVEY REQUEST

Project name:	Sterling Hwy: MP 173-179 Pavement Preservation		
From: (Section, Design Group)	Highway Design; Sean Baski's Group	Date Submitted:	3/15/13
Request initiated by:	Steven Rzepka	Phone:	907-269-0592
State/Federal/AIP Project #:	55260/NH-0211(059)		
Desired Completion Date:	September 1, 2013	Collo Code:	24417245
		Ledger Code:	30366922
Project Scope & Survey Limits: (include exhibits as attachments)	Program Code:	57202	Account Code: 73652

(Please contact Right of Way Engineering prior to filling this out, as their requirements may directly affect the survey effort required. Include their response)

Please provide monument summary sheet from the intersection of the Sterling Hwy and W. Pioneer Ave (CDS MP 132.0) through the Sterling Hwy at Lands End (CDS MP 138.2). See attached vicinity map.

Project Scope: Resurface the Sterling Highway from Pioneer Avenue (historic MP 173) to the end of the Homer spit (historic MP 179.3), a distance of approximately 6.3 miles. The project will include, as necessary, improvements to curb ramps, guardrail, guardrail end treatments, guardrail delineation, dam safety inspection of the Sterling Highway embankment where it serves as a dam for Beluga Lake, ATRs, dig-outs, drainage, signs, and striping.

(This section for Survey Section use)

Survey Assigned to:

Estimated Completion Date:


Hz/Vert Control:

ROW/Monument Ties:

TIN/Topo:

Other:

Completed by _____ Date Completed _____
Notes: _____

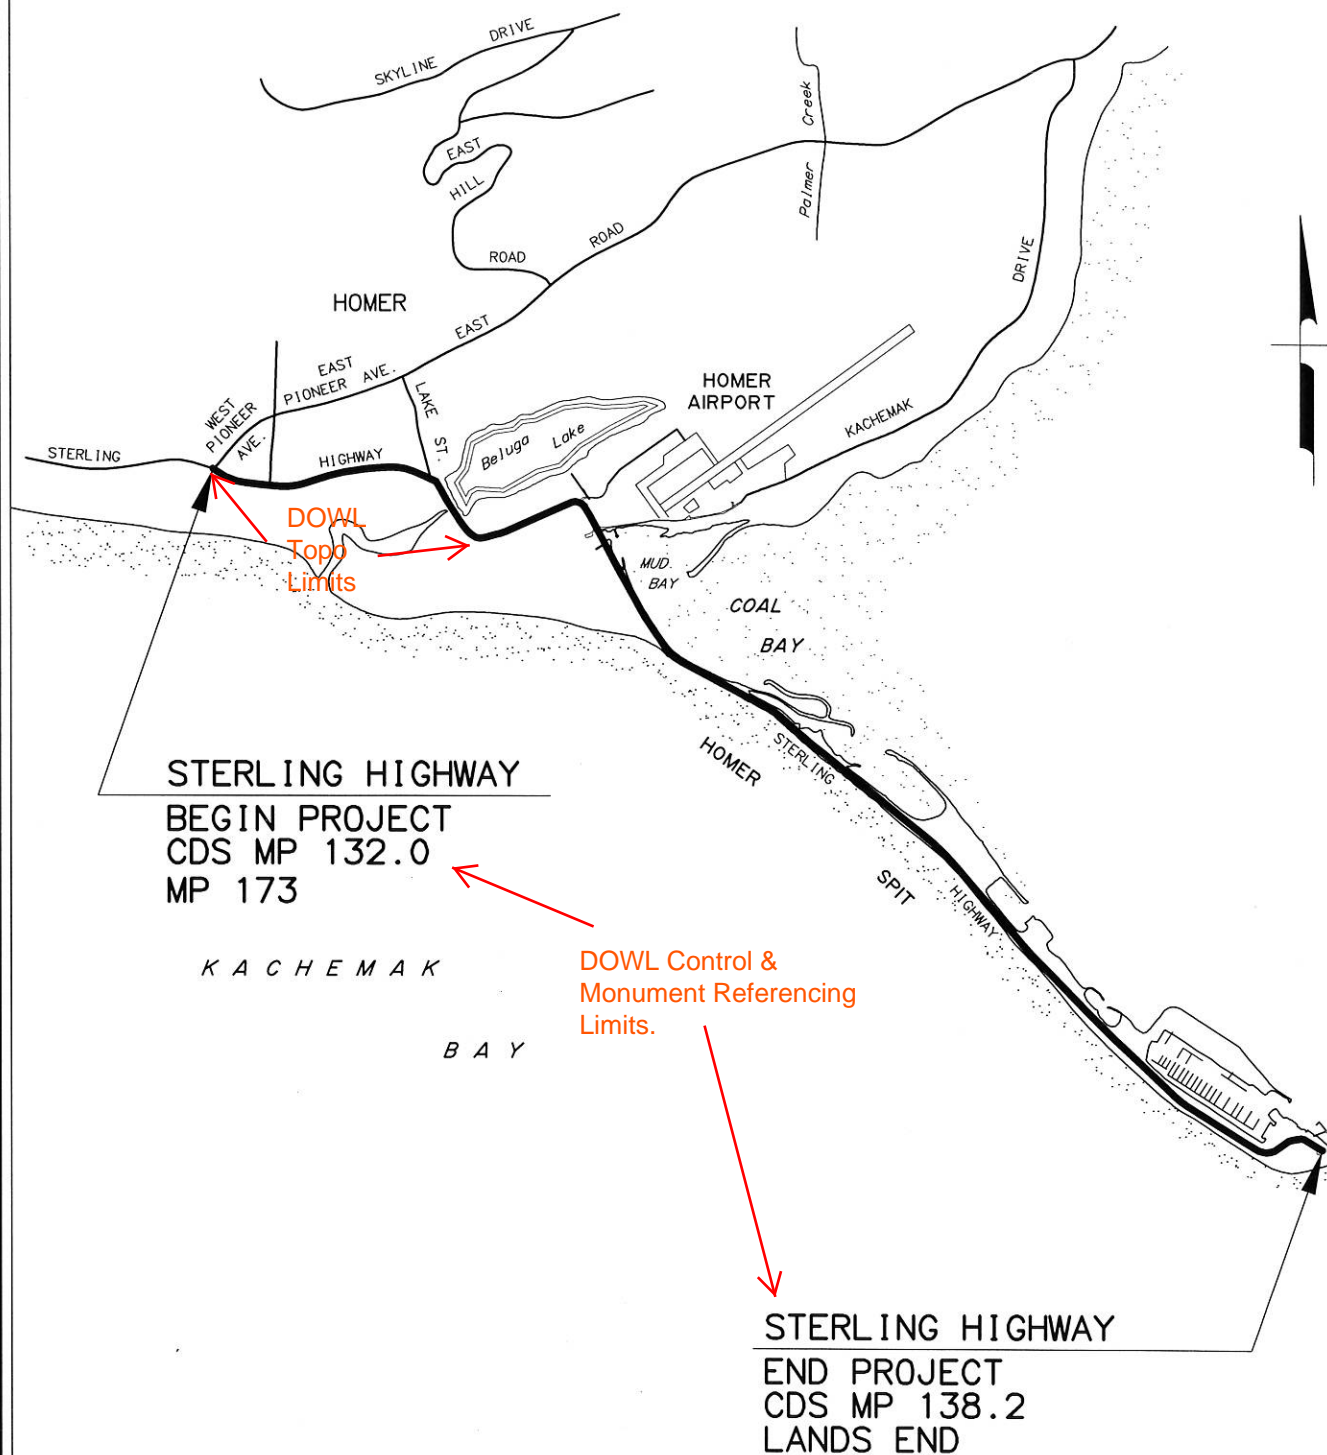

STATE OF ALASKA
DEPARTMENT OF TRANSPORTATION
AND PUBLIC FACILITIES
STERLING HIGHWAY
MP 173 TO LAND'S END

HOMER
VICINITY MAP