

(10)

11.29.05


Loop TBM-3 #605 to ^{SPRINGER} BM ~~605~~ #606Job GH112905
DNA LEVEL #48

POINT	DESC	RAW	ADJ EL
605	TBM-3	16.511	
1350	TP		
1358			
606	^{SPRINGER} BM- GPS	29.206	129.749 USE
1359			
1367	TP		
605	TBM-3	16.533	

EOL = 0.022

Loop DIST = 9329.11 FT

SEE PAGE 15 FOR SKETCH OF BM SPRINGER

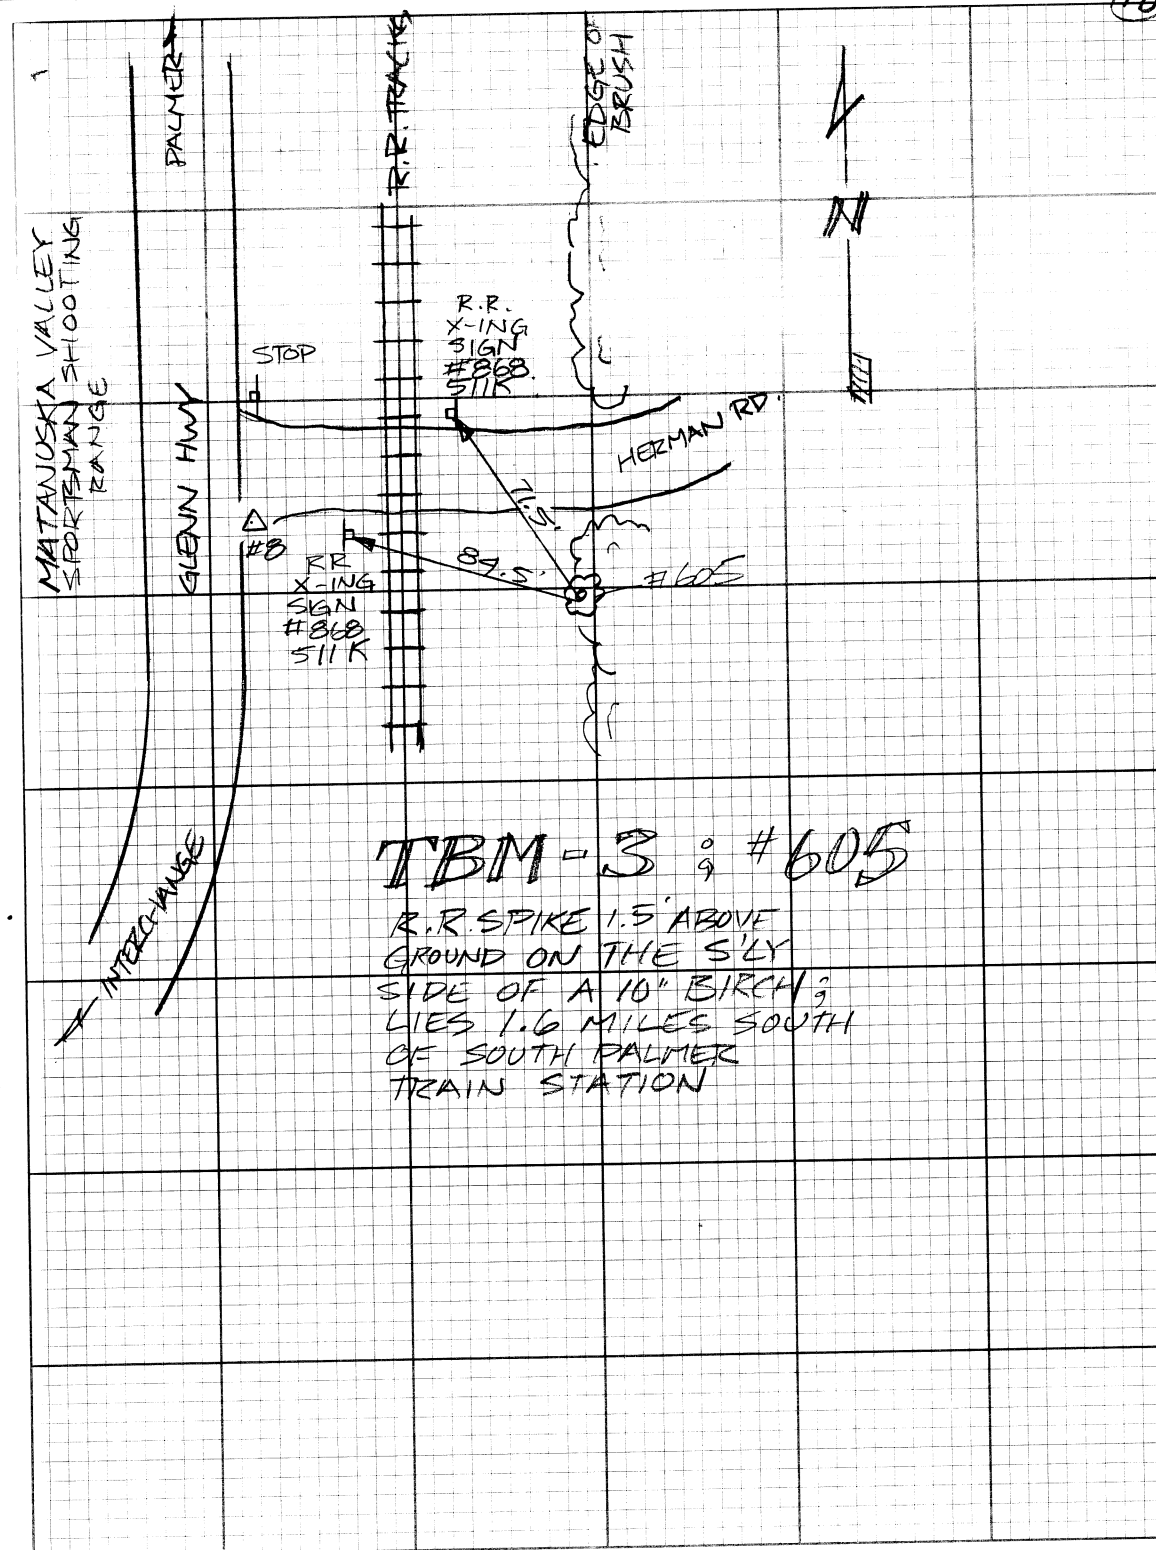


(10)

11.30.05

11
 Loop #606 ~~B.M. GPS~~ ^{SPRINGER} TO #607 TBM-4

Job GH113005
 DNA LEVEL #48

POINT	DESC	RAW	ADJ EL
606 1400 1407	B.M. GPS ^{SPRINGER} TP	100.00	
607 1408 1409	TBM-4 TP	121.910	151.645 USE
606	B.M. GPS	100.006	
	EOL 0.006		
Loop Distance: 8284.42 FT			

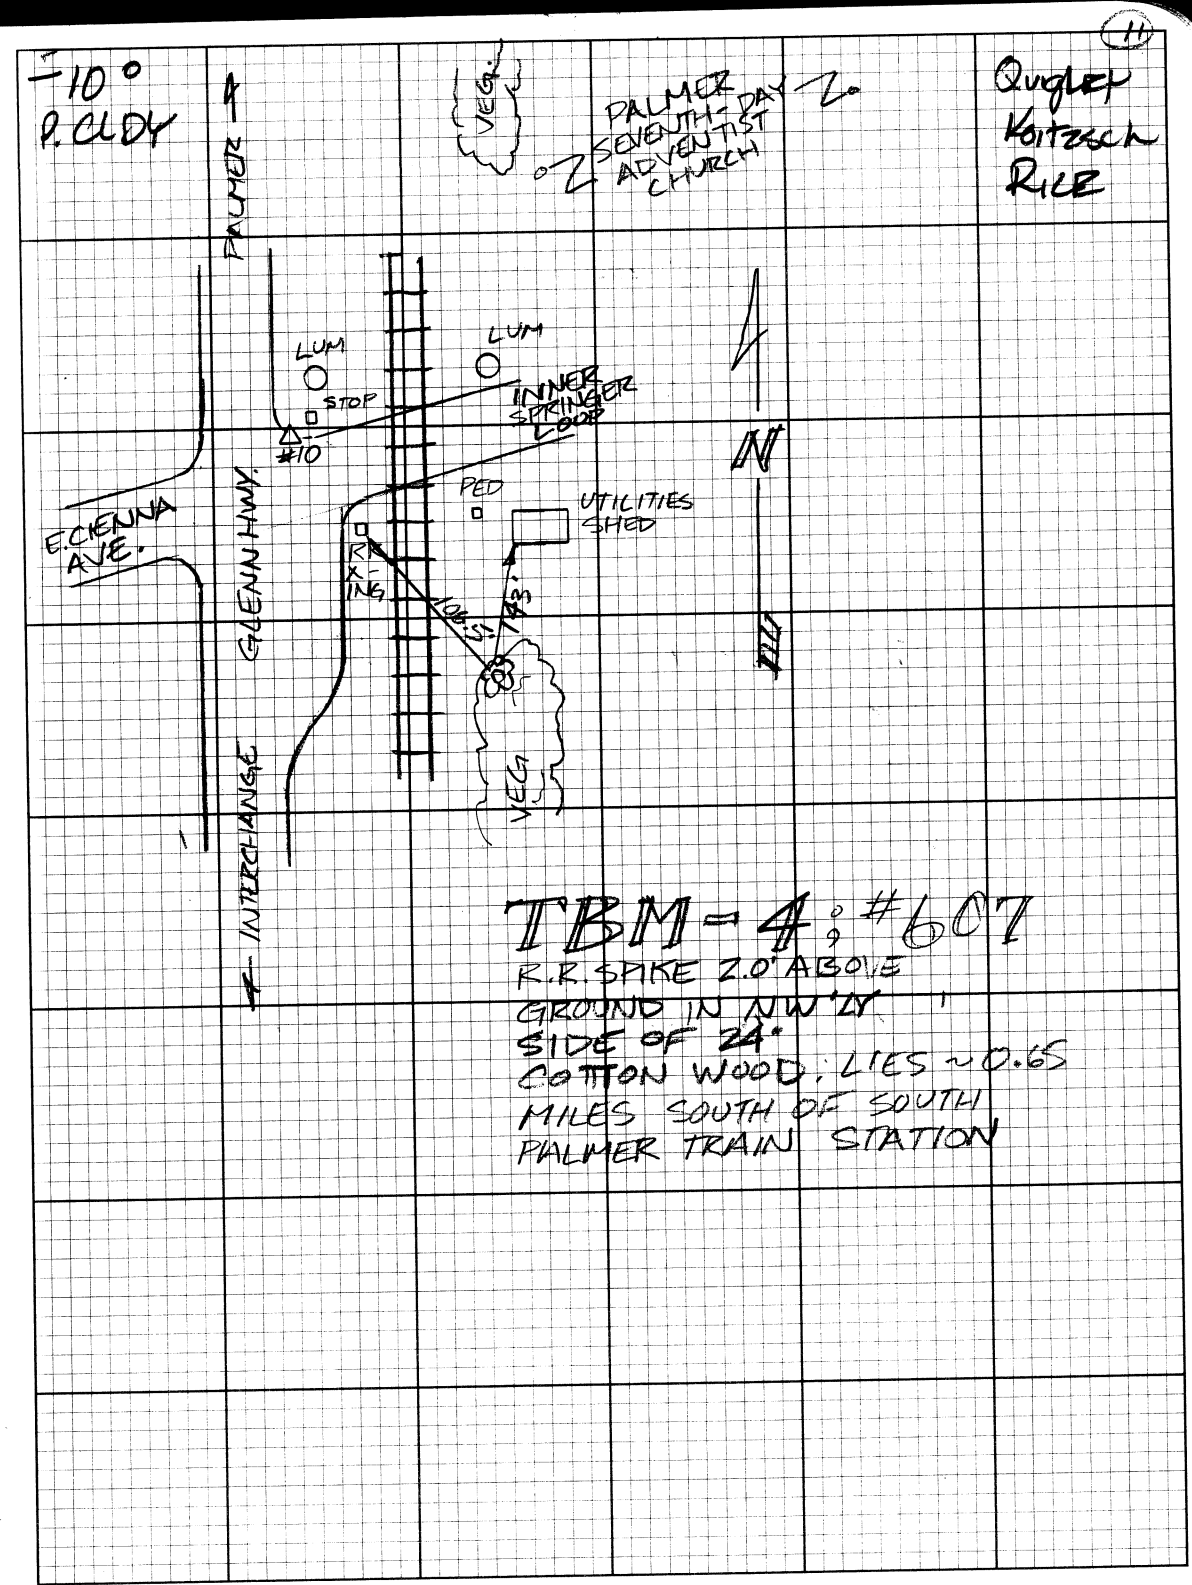

(12)

11.30.05

Loop - TBM-4 #607 to GPS #52

Job 6#113005

PBINT	DESC	RAW	ADJ EL
607	TBM-4	121.910	151.645
1420	TP		
1425			
7	CP. 7	147.538	
1426			
52	GPS-52 DEPOT	145.638	175.364
1427	TP		USE
1433			
607	TBM-4	121.909	

EOC -0.001

Loop Dist = 7056.82 FT

GLENN 84.42

(12)

