


(29)

CONTROL CP 107

* NOTE = CP 7 DESTROYED REPLACED BY
CP 107

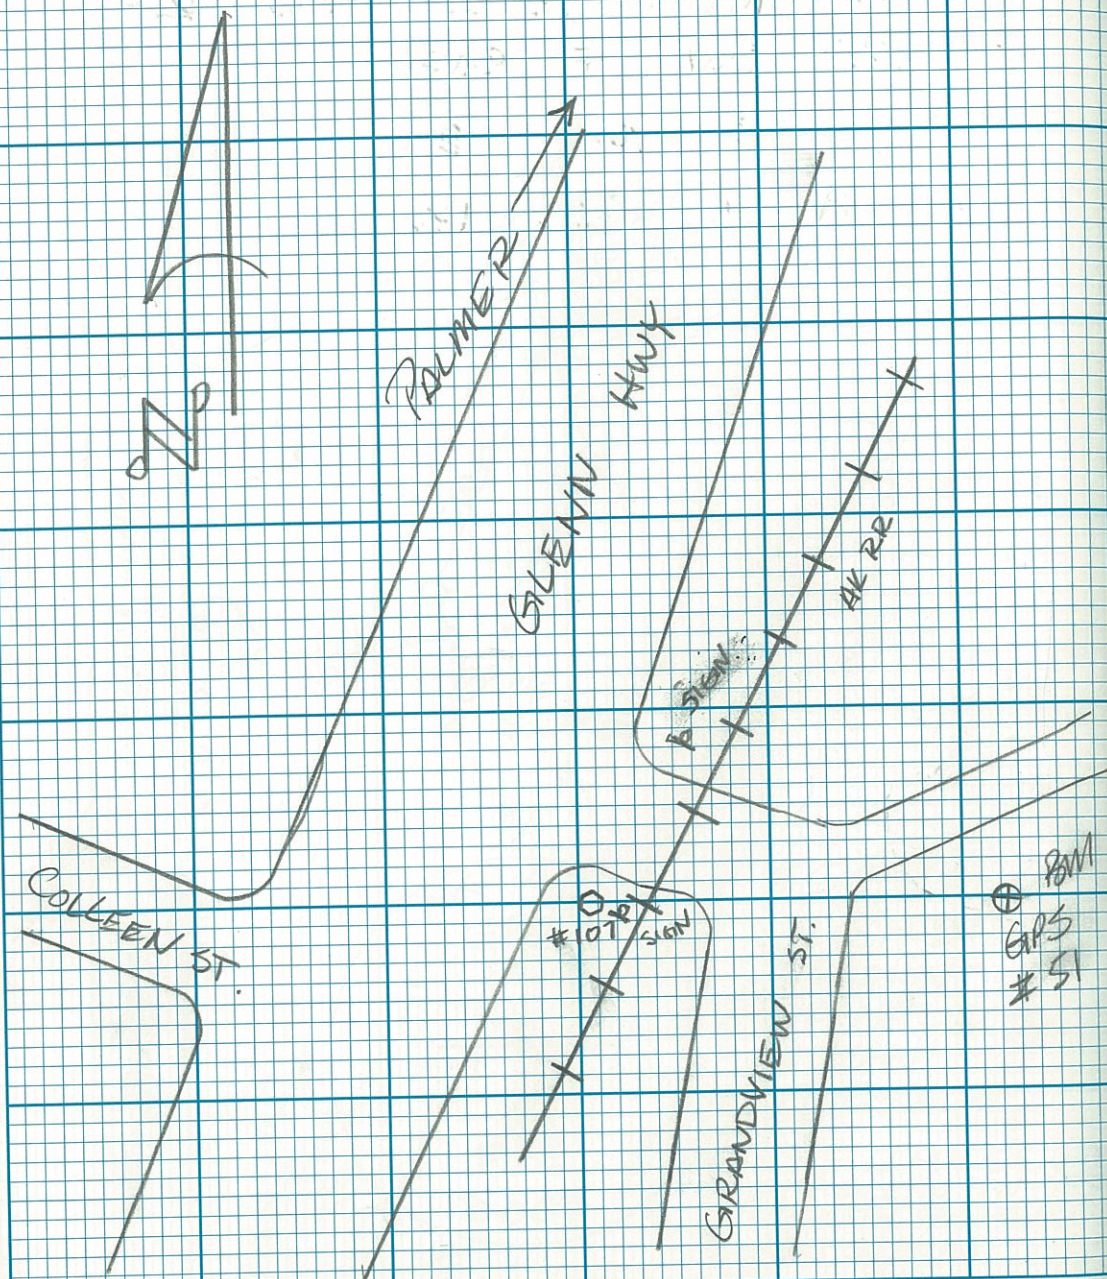

(39)

#107 RBRVPL SET OF THE EDGE
OF PAVEMENT. 12.50' NW TRAF SIGN
145.20 SW OF TRAF STOP SIGN.
2.25 MILES NORTH EAST OF PARKS
GLENN INTERCHANGE.




SET 30" RBR
OPC

(40)

CONTROL CP#108

* CP# DESTROYED REPLACED BY 108

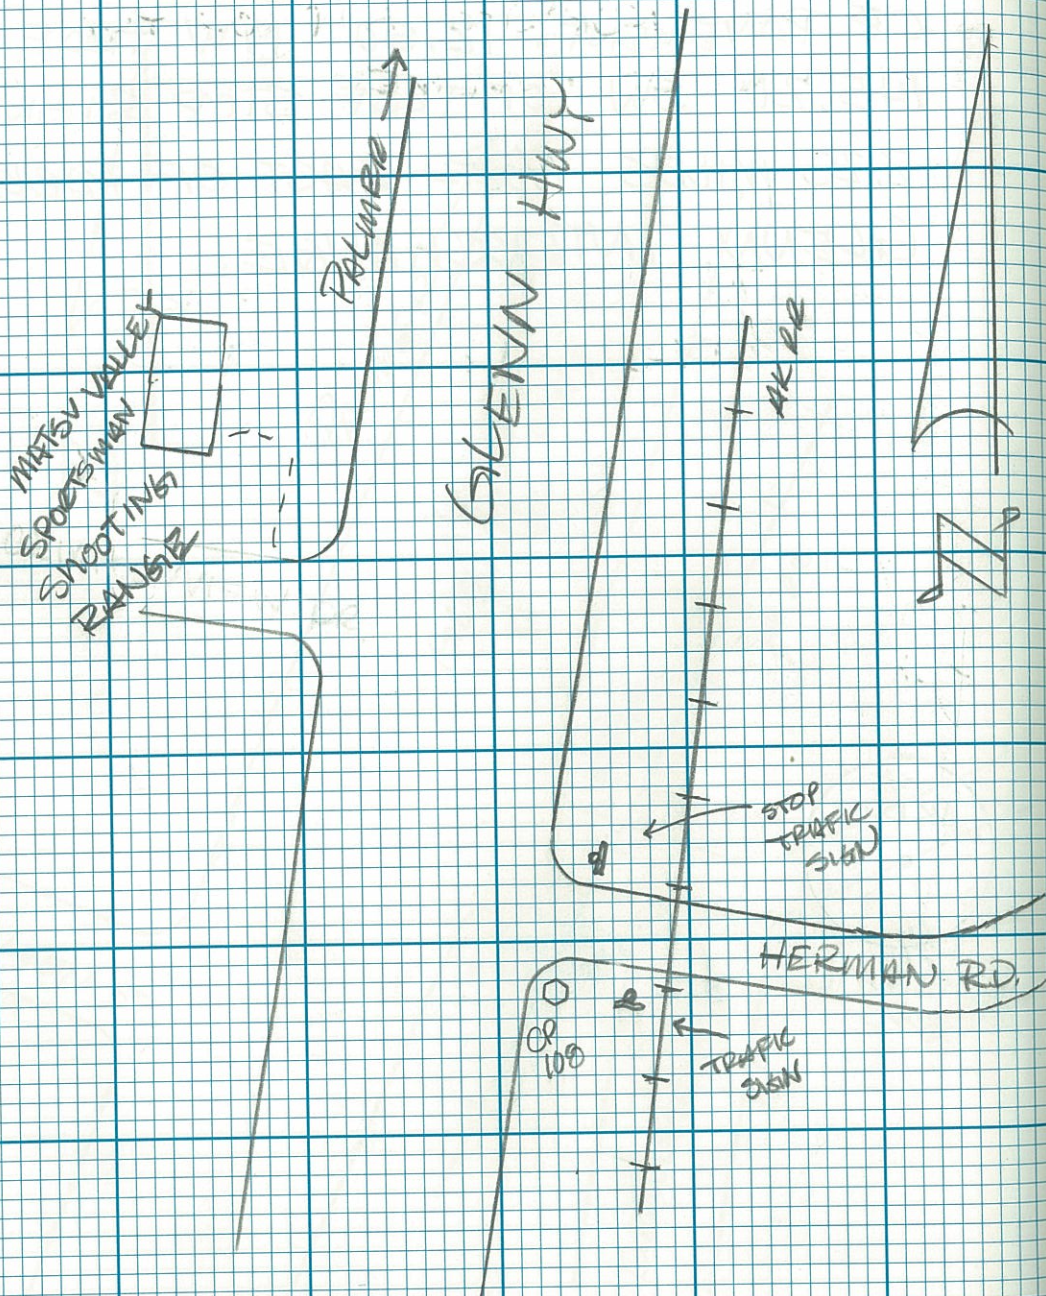

(40)

#108 RBRNPC SET OF THE
EDGE OF PAVEMENT. 29.40' NW
TRAF SIGN, 40.00' SW OF TRAF
SIGN.

2.74 MILES NORTH EAST OF
PARKS GLENN INTERCHANGE.




SET 30" RBE
CPC

(41)

CONTROL POINT 109


* CP 9 DESTROYED REPLACED
BY #109

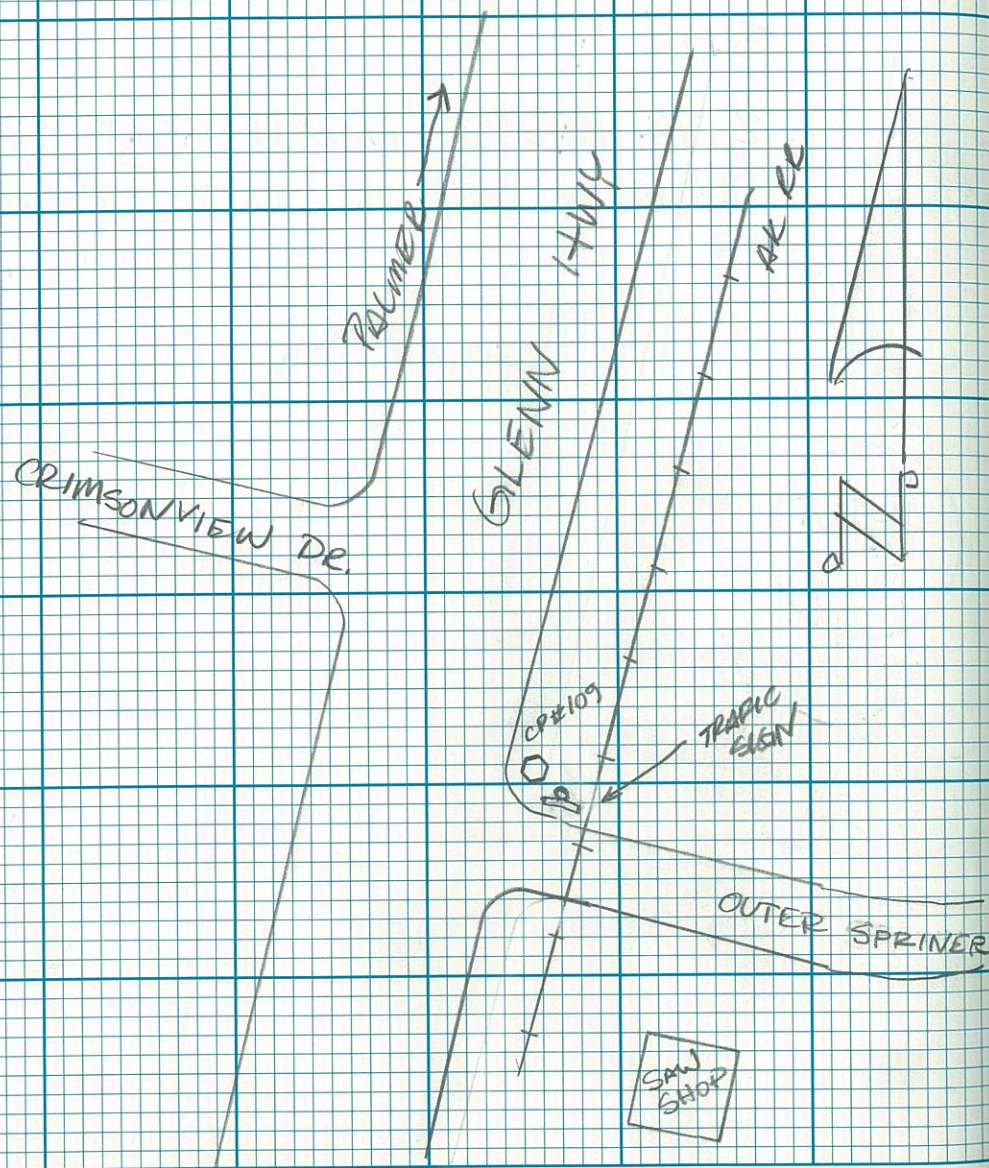

(41)

#109 RBE\PC SET OFF
PAVEMENT. 18.50' NW OF TRAF
SIGN. 84.70' SW OF TRAF SIGN


3.4 MILES NORTH EAST OF
DARKS GLENN INTERCHANGE

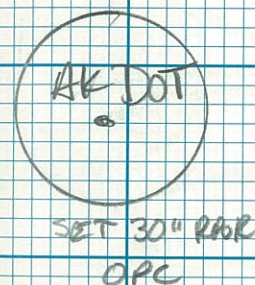

(42)

CONTROL POINT #110

* NOTE CP 10 DESTROYED AND
REPLACED BY CP 110

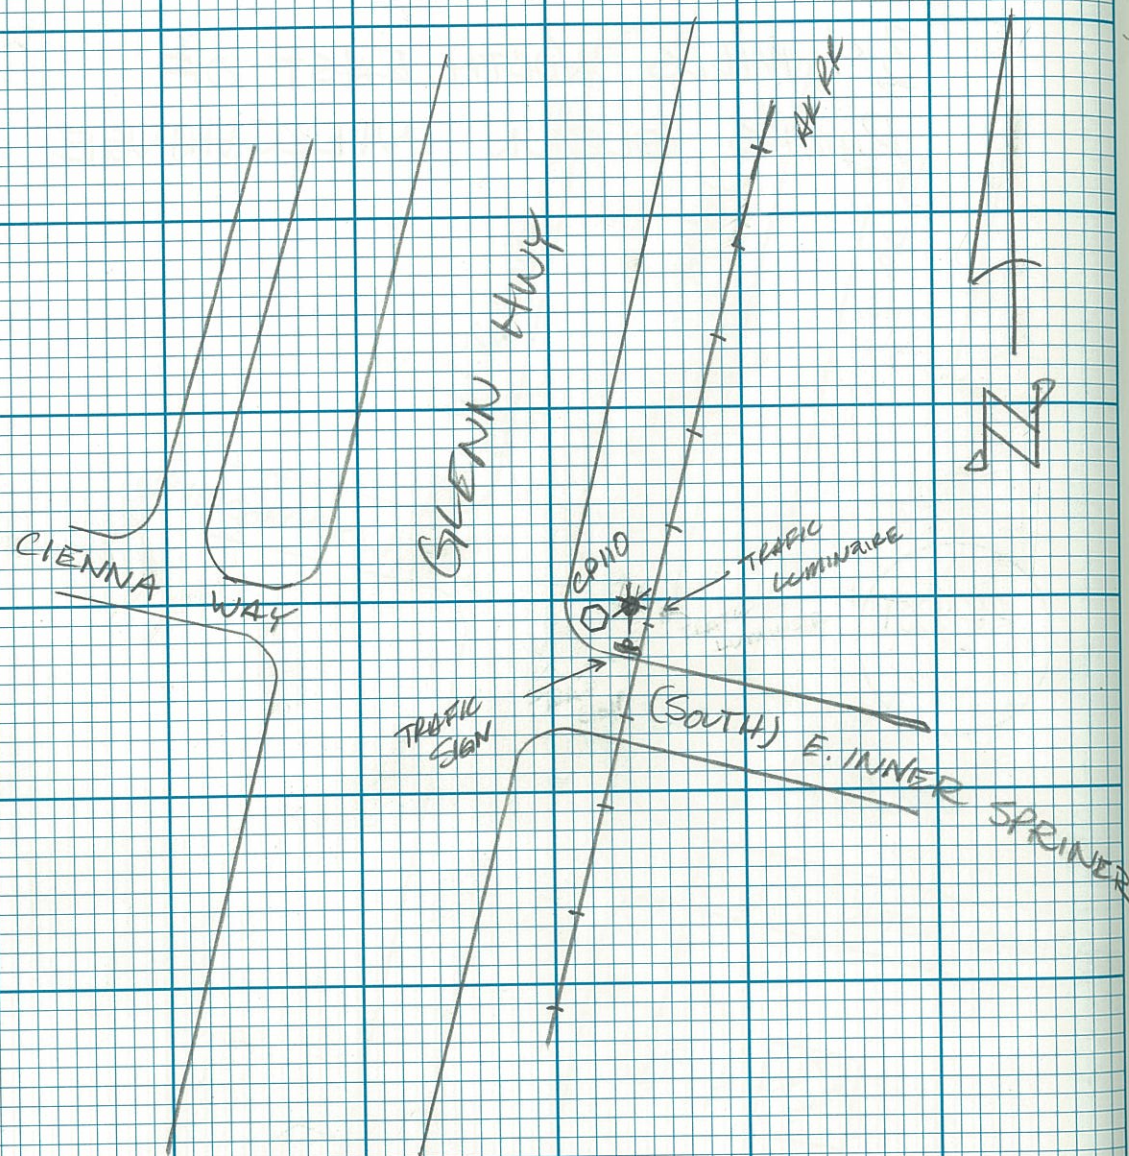

(42)

#110 RBR \ PC SET OFF THE
PAVEMENT. 5.90' WEST OF TRAF
LUM, 19.30' NORTH WEST OF TRAF
SIGN

3.85 MILES NORTH EAST OF
PARKS GLENN INTERCHANGE

