


PROTRACTED SECTION 3

PROTRACTED SECTION 10

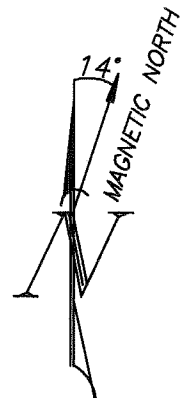


APPROXIMATE MEAN DECLINATION, 2012
WWW.NGDC.NOAA.GOV/GEOMAGMODELS/DECLINATION.JSP

SCALE: 1" = 50'

INTERIM CONVEYANCE 342

N 2105519.288
E 1667989.342
EL 37.0

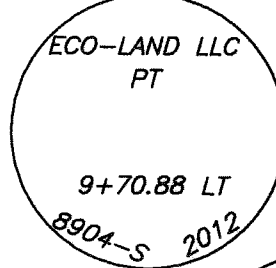


R = 570.01'
D = 20°47'40"
L = 206.87'
CRD = S55°39'55"W 205.74'


N 2105403.247
E 1667819.399
EL 36.7



R = 520.01'
D = 20°47'40"
L = 188.73'
CRD = N55°39'55"E 187.69'

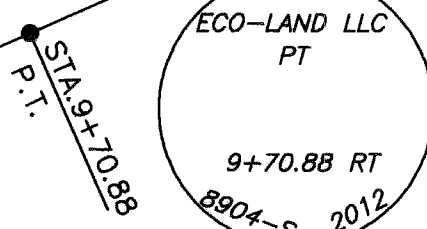

N 2105473.575
E 1668009.601
EL 37.0

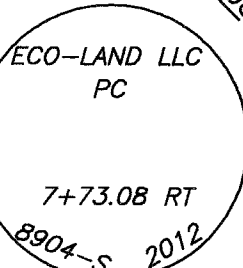

N 2105367.702
E 1667854.601
EL 36.8

PROTRACTED SECTION 10
INTERIM CONVEYANCE 342

MATCH LINE
STATION 18+00
SHEET #3

P.C.
STA 18+78.5c

S66°03'45"W 908.06'

CENTERLINE
N66°03'45"E 908.06'

KANEKTOK RIVER ROAD
EASEMENT "A"

25'
25'


GRAPHIC SCALE



Scale 1" = 50 ft

DATE OF SURVEY: BEGIN: MAY 30, 2012 END: JUNE 3, 2012	SURVEYOR: ECO-LAND, LLC P.O. BOX 1444 NOME, ALASKA 99762-1444
** RECORD OF SURVEY ** KANEKTOK RIVER ROAD BEING A PORTION OF B.I.A. ROUTE 2700 STATION 0+00 B.O.P. THRU STATION 36+60.83 -AND- BORROW SITE ROAD B.I.A. ROUTE 3000 STATION 36+60.83 THRU STATION 47+52.50 E.O.P. within protracted Sections 2,3,10 & 11, T.5 S., R.74 WEST, SEWARD MERIDIAN, ALASKA THE WHOLE OF WHICH CONTAINS 5.26 ACRES * BETHEL RECORDING DISTRICT *	
DRAWN BY: R.S.M. DATE: JUNE 29, 2012 SHEET: 2 OF 5	CHECKED: R.S.M. APPROVED: R.S.M. REVISIONS: FILE #: AK12-006
GRANTOR: QANIRTUUG INCORPORATED P.O. BOX 59 QUINHAGAK, ALASKA 99655	

BETHEL RECORDING DISTRICT PLAT 2012-35

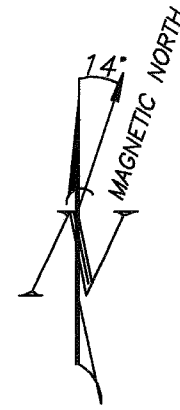


APPROXIMATE MEAN DECLINATION, 2012
WWW.NGDC.NOAA.GOV/GEOMAGMODELS/DECLINATION.JSP

SCALE: 1" = 50'


INTERIM CONVEYANCE 342

PROTRACTED SECTION 3

PROTRACTED SECTION 10

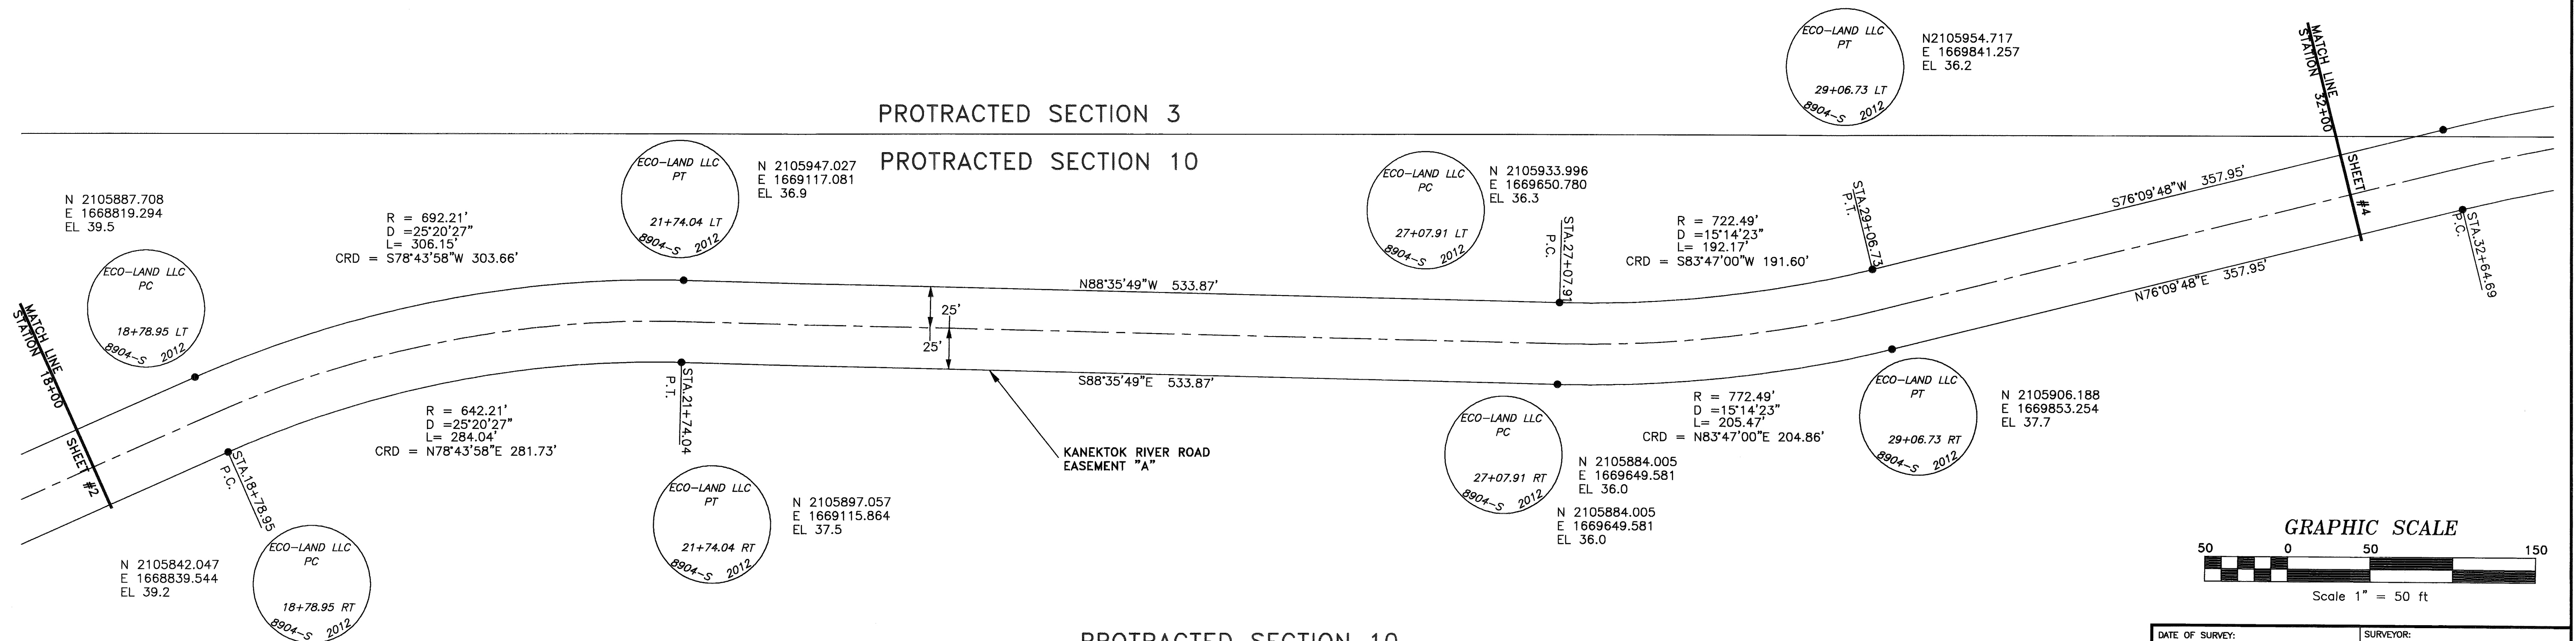

PROTRACTED SECTION 10
INTERIM CONVEYANCE 342

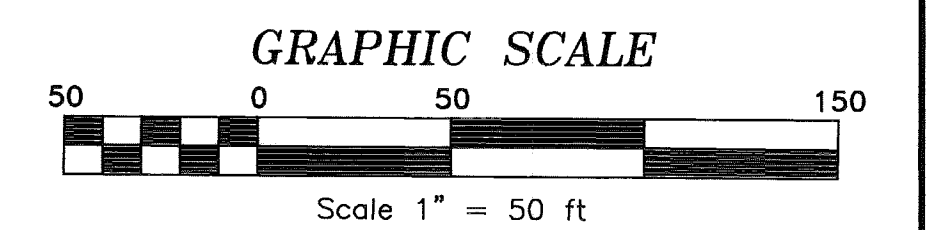


DATE OF SURVEY: BEGIN: MAY 30, 2012 END: JUNE 3, 2012	SURVEYOR: ECO-LAND, LLC P.O. BOX 1444 NOME, ALASKA 99762-1444
** RECORD OF SURVEY ** KANEKTOK RIVER ROAD BEING A PORTION OF B.I.A. ROUTE 2700 STATION 0+00 B.O.P. THRU STATION 36+60.83 -AND- BORROW SITE ROAD B.I.A. ROUTE 3000 STATION 36+60.83 THRU STATION 47+52.50 E.O.P. within protracted Sections 2,3,10 & 11, T.5 S., R.74 WEST, SEWARD MERIDIAN, ALASKA THE WHOLE OF WHICH CONTAINS 5.26 ACRES * BETHEL RECORDING DISTRICT *	
DRAWN BY: R.S.M. DATE: JUNE 29, 2012 SHEET: 3 OF 5	CHECKED: R.S.M. APPROVED: R.S.M. REVISIONS: GRANTOR: QANIRTUQU INCORPORATED P.O. BOX 69 QUINHAGAK, ALASKA 99655 FILE #: AK12-006

BETHEL RECORDING DISTRICT PLAT 2012-35

APPROXIMATE MEAN DECLINATION, 2012
WWW.NGDC/NOAA.GOV/GEOMAGMODELS/DECLINATION.JSP


SCALE: 1" = 50'

INTERIM CONVEYANCE 342

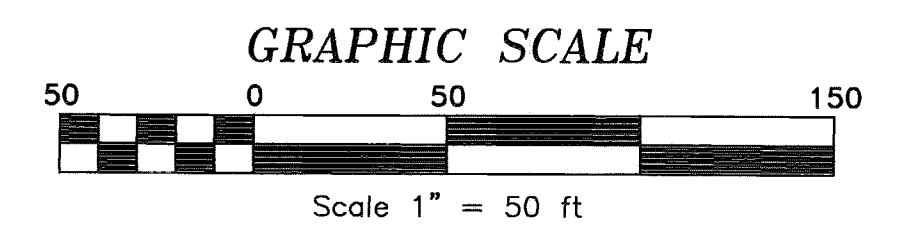

DATE OF SURVEY: BEGIN: MAY 30, 2012 END: JUNE 3, 2012	SURVEYOR: ECO-LAND, LLC P.O. BOX 1444 NOME, ALASKA 99762-1444
** RECORD OF SURVEY ** KANEKTOK RIVER ROAD BEING A PORTION OF B.I.A. ROUTE 2700 STATION 0+00 B.O.P. THRU STATION 36+60.83 -AND- BORROW SITE ROAD B.I.A. ROUTE 3000 STATION 36+60.83 THRU STATION 47+52.50 E.O.P. within protracted Sections 2, 3, 10 & 11, T.5 S., R.74 WEST, SEWARD MERIDIAN, ALASKA THE WHOLE OF WHICH CONTAINS 5.26 ACRES * BETHEL RECORDING DISTRICT *	
DRAWN BY: R.S.M. DATE: JUNE 29, 2012 SHEET: 4 OF 5	CHECKED: R.S.M. APPROVED: R.S.M. REVISIONS: FILE #: AK12-006
GRANTOR: QANIRTUQU INCORPORATED P.O. BOX 69 QUINHAGAK, ALASKA 99655	

C:\NOME\12\005\DWGS\AK12-006.6.14.12.DWG-SHT4

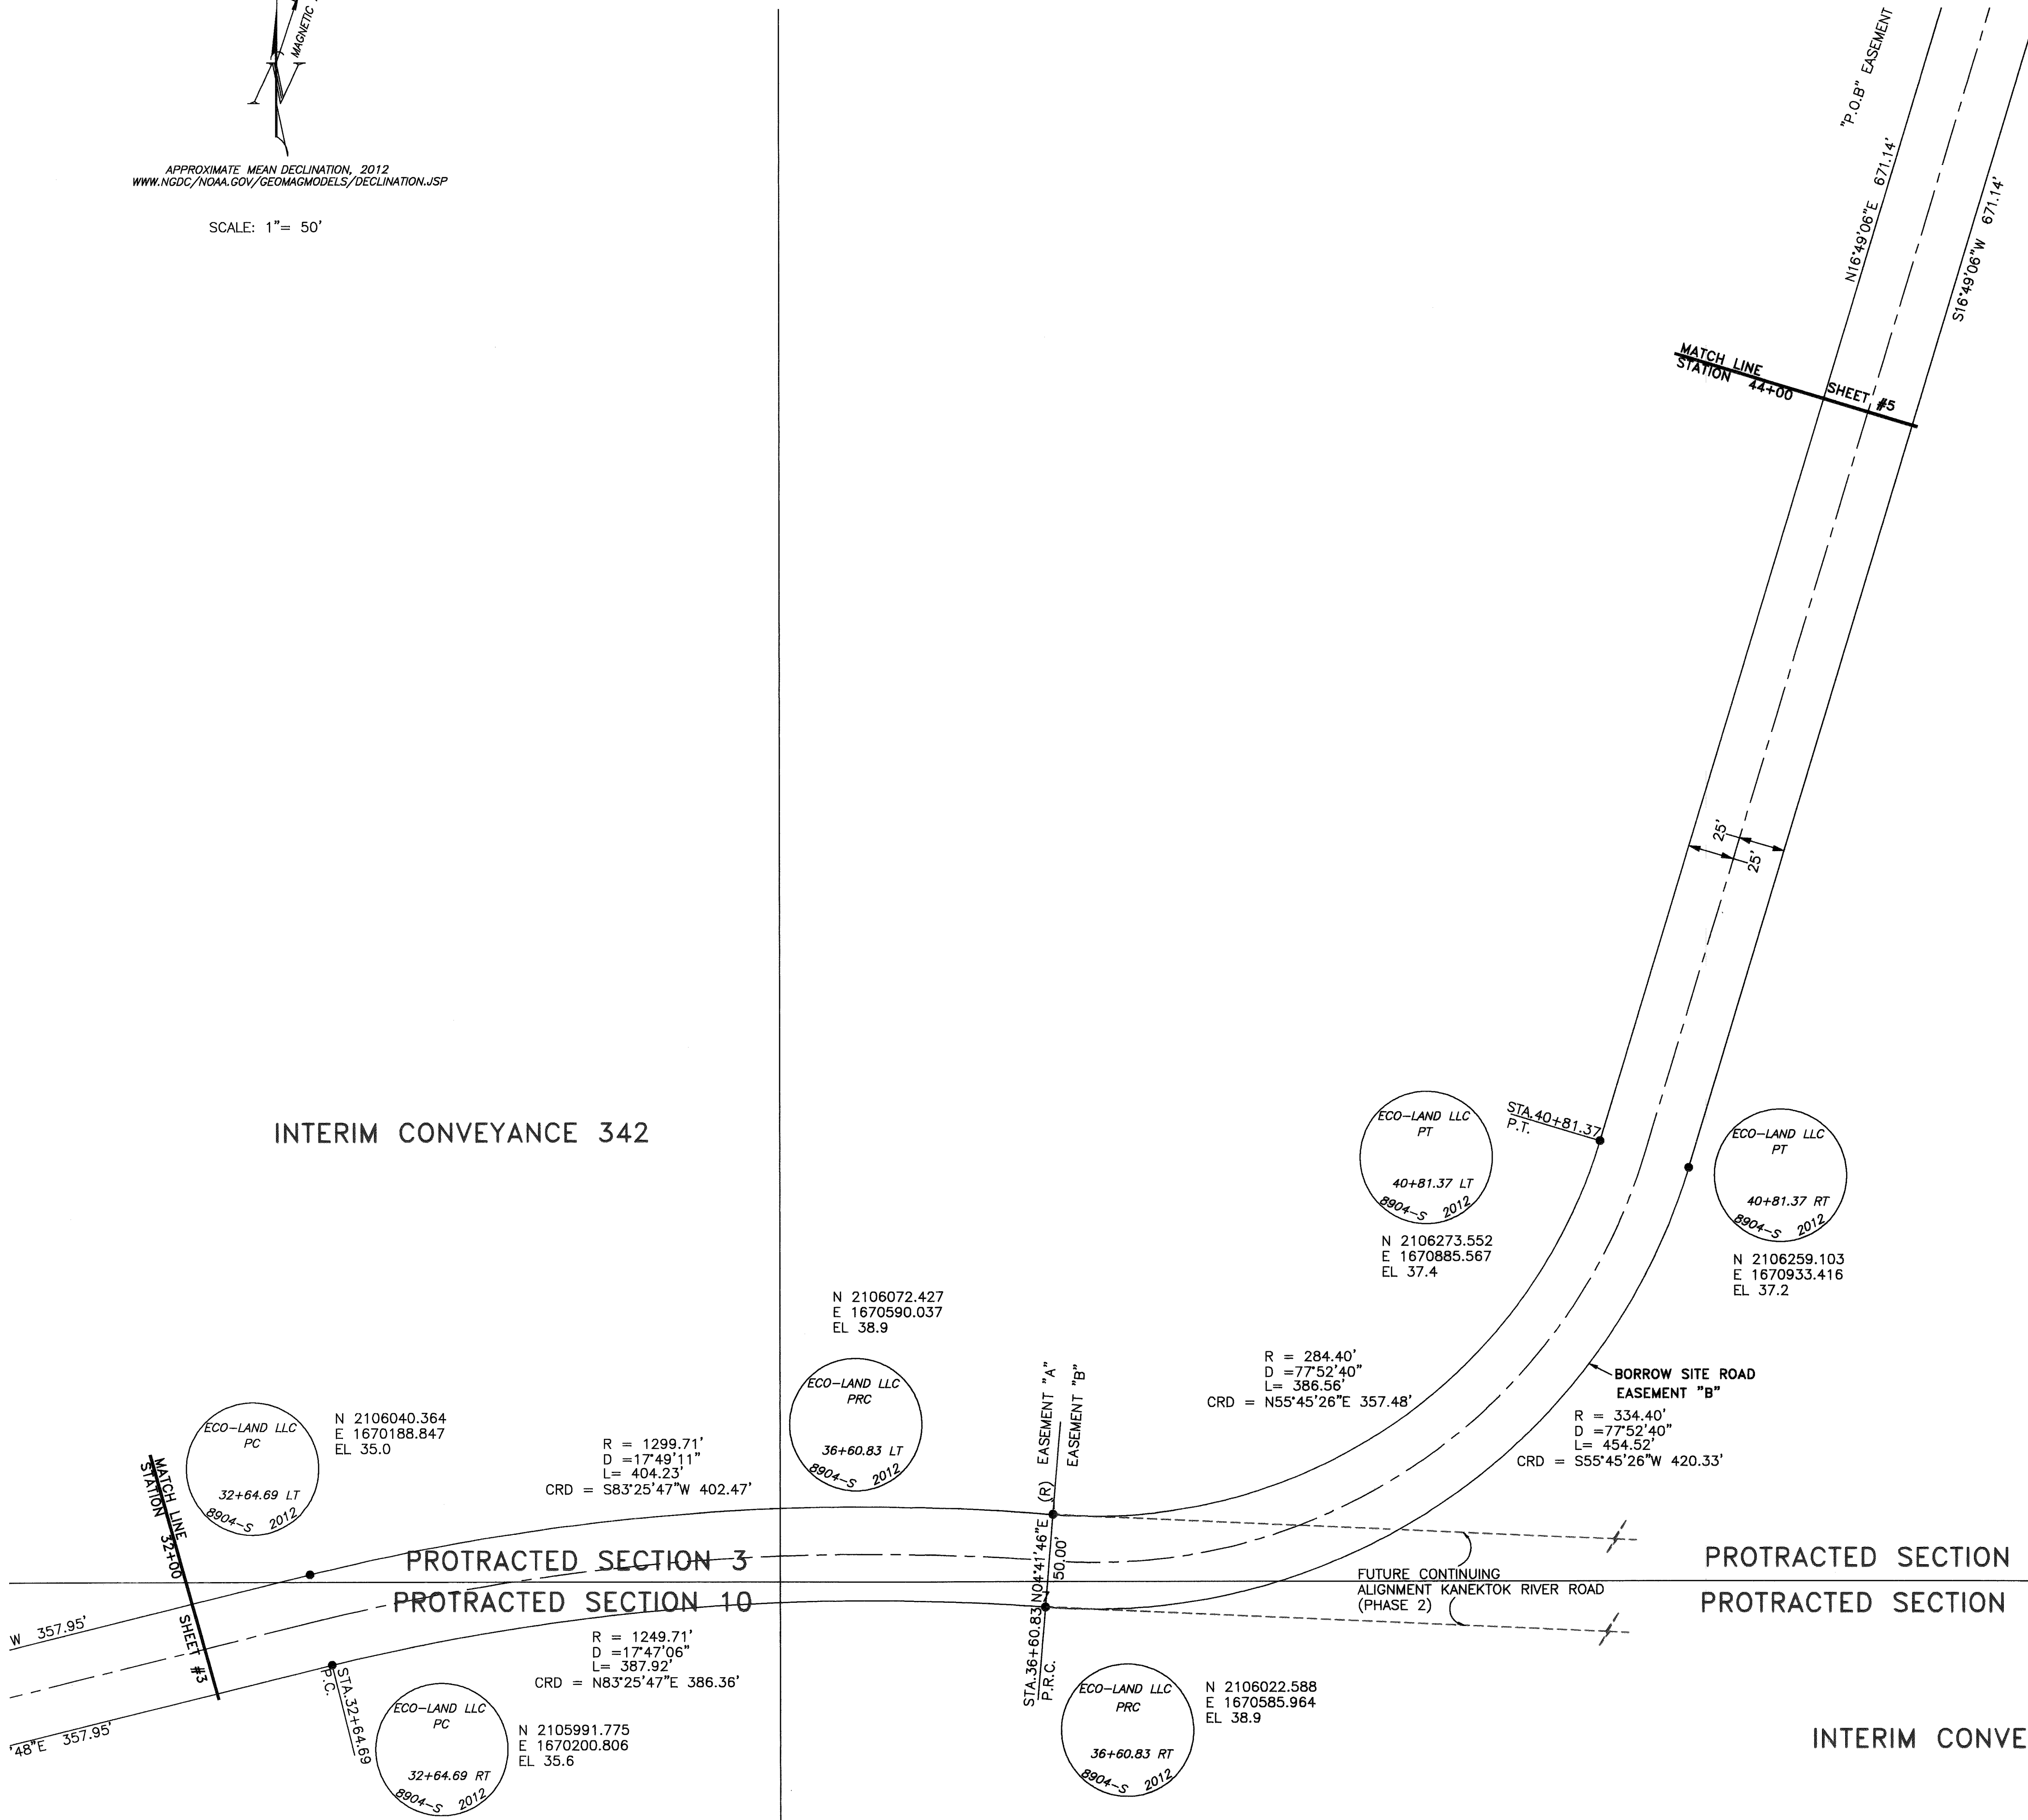

INTERIM CONVEYANCE 342

BETHEL RECORDING DISTRICT PLAN 2012-35

APPROXIMATE MEAN DECLINATION, 2012
WWW.NOAA.GOV/GEOMAGMODELS/DECLINATION.JSP

SCALE: 1" = 50'

PROTRACTED SECTION 2

