



SET 36" ROR/AC
DOWN .05' IN PAVED
PULLOUT 45' FROM
GUARDRAIL, 99' FROM
CAMERA SIGN TO THE
SOUTH, ACROSS STREET
FROM MERGE LANE SIGN

SET JAN 11, 2003

MILLER
WILLIAMS

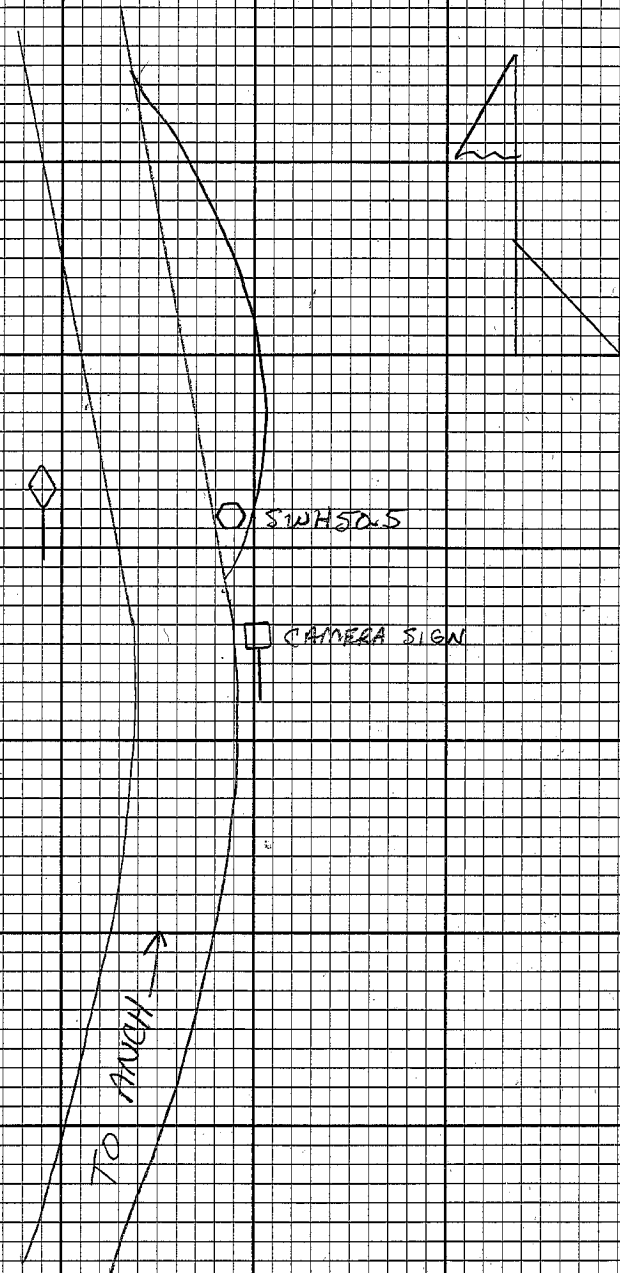

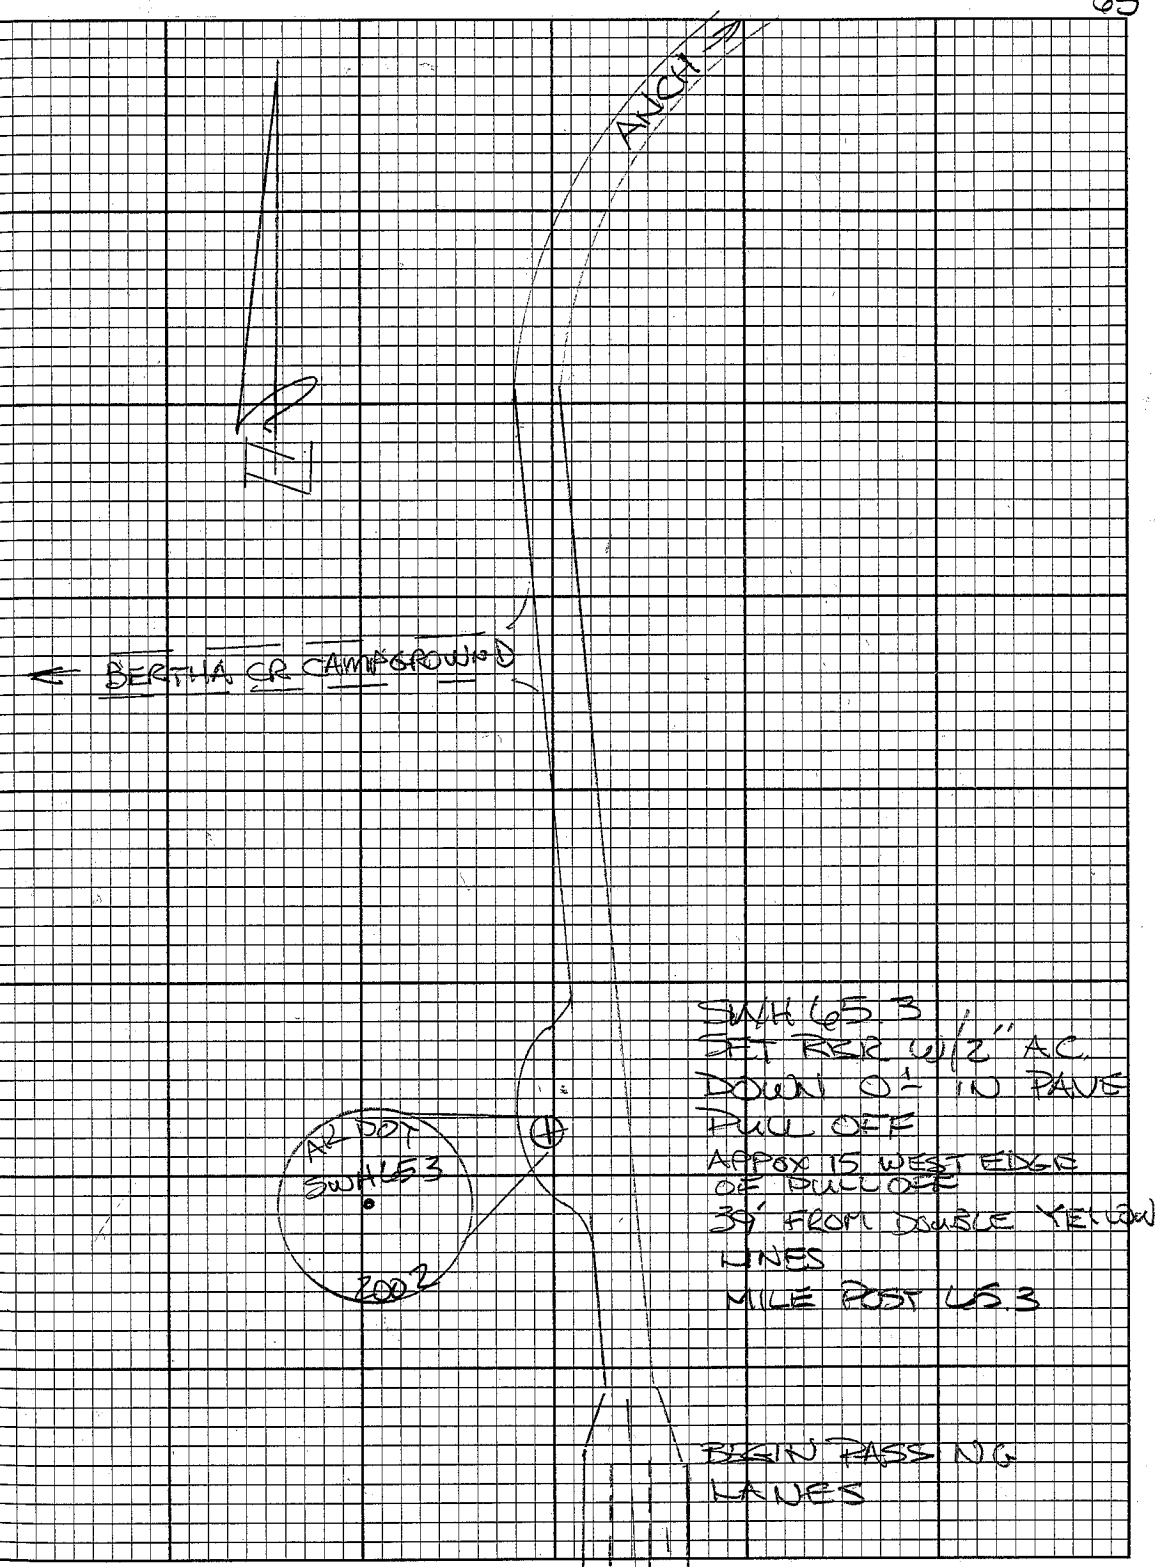

SWH 67?

SWH 653 @ MD 65.3
 SET RBR W/ 2' AC
 DOWN OL 10 LARGE
 PAUS PULLOFF

SEWARD

AK 207

AK 207

SWH 653

2002

T


WARNING AVALANCHE
 SIGN @ 435' FT.

IN LINE
W/ NORTH SIDE
OF BATHROOMS

AXIDOX
SWH 683

2008

SWH 683 @ MP 68.3
SET PSE w/ 2" AC
DOWN 0' IN LARGE
BATHROOM PULLOFF
ATOP TURNAGAIN PASS


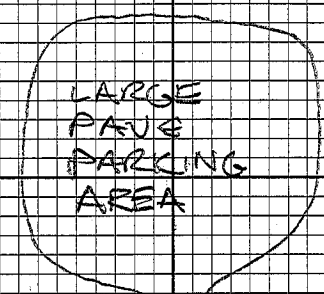


LARGE
PAVED
PARKING
AREA


AC BOX
SWH 69.8
2002

T
SS.

SWH 69.8 @ MP 69.8
SET REBAR W/ 2" AC
DOWN 0' IN
SOUTH EDGE OF
DRIVE

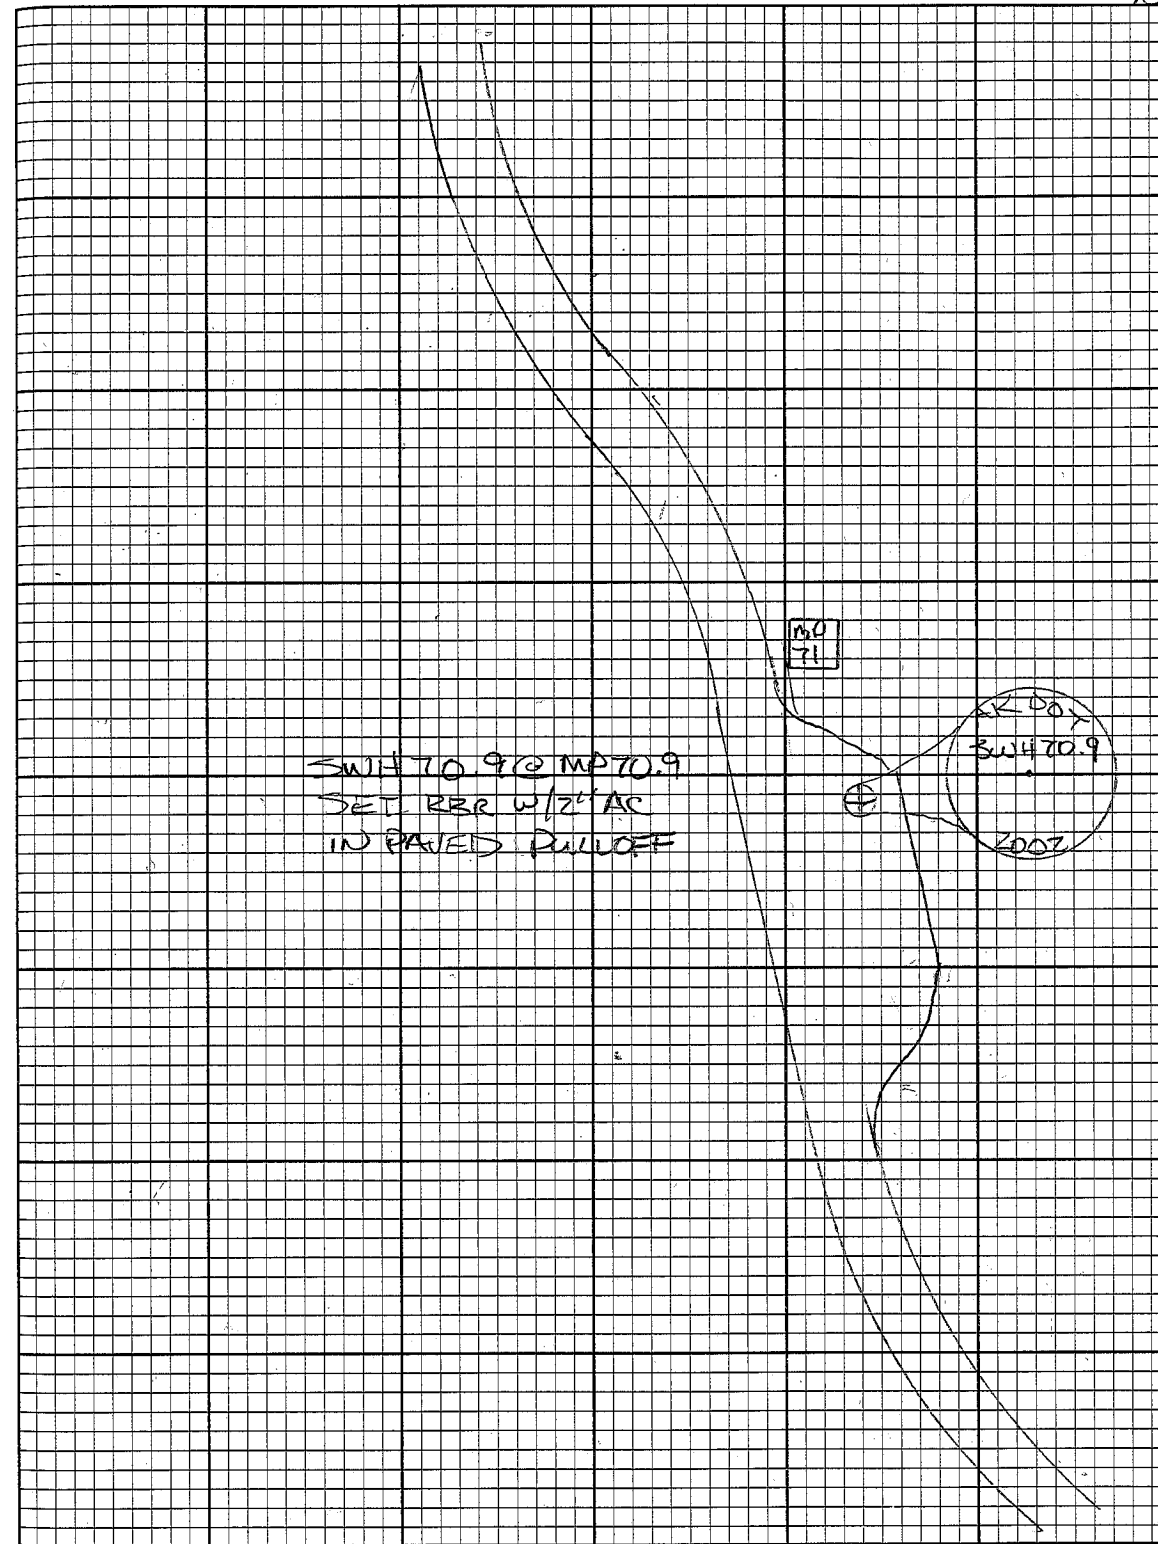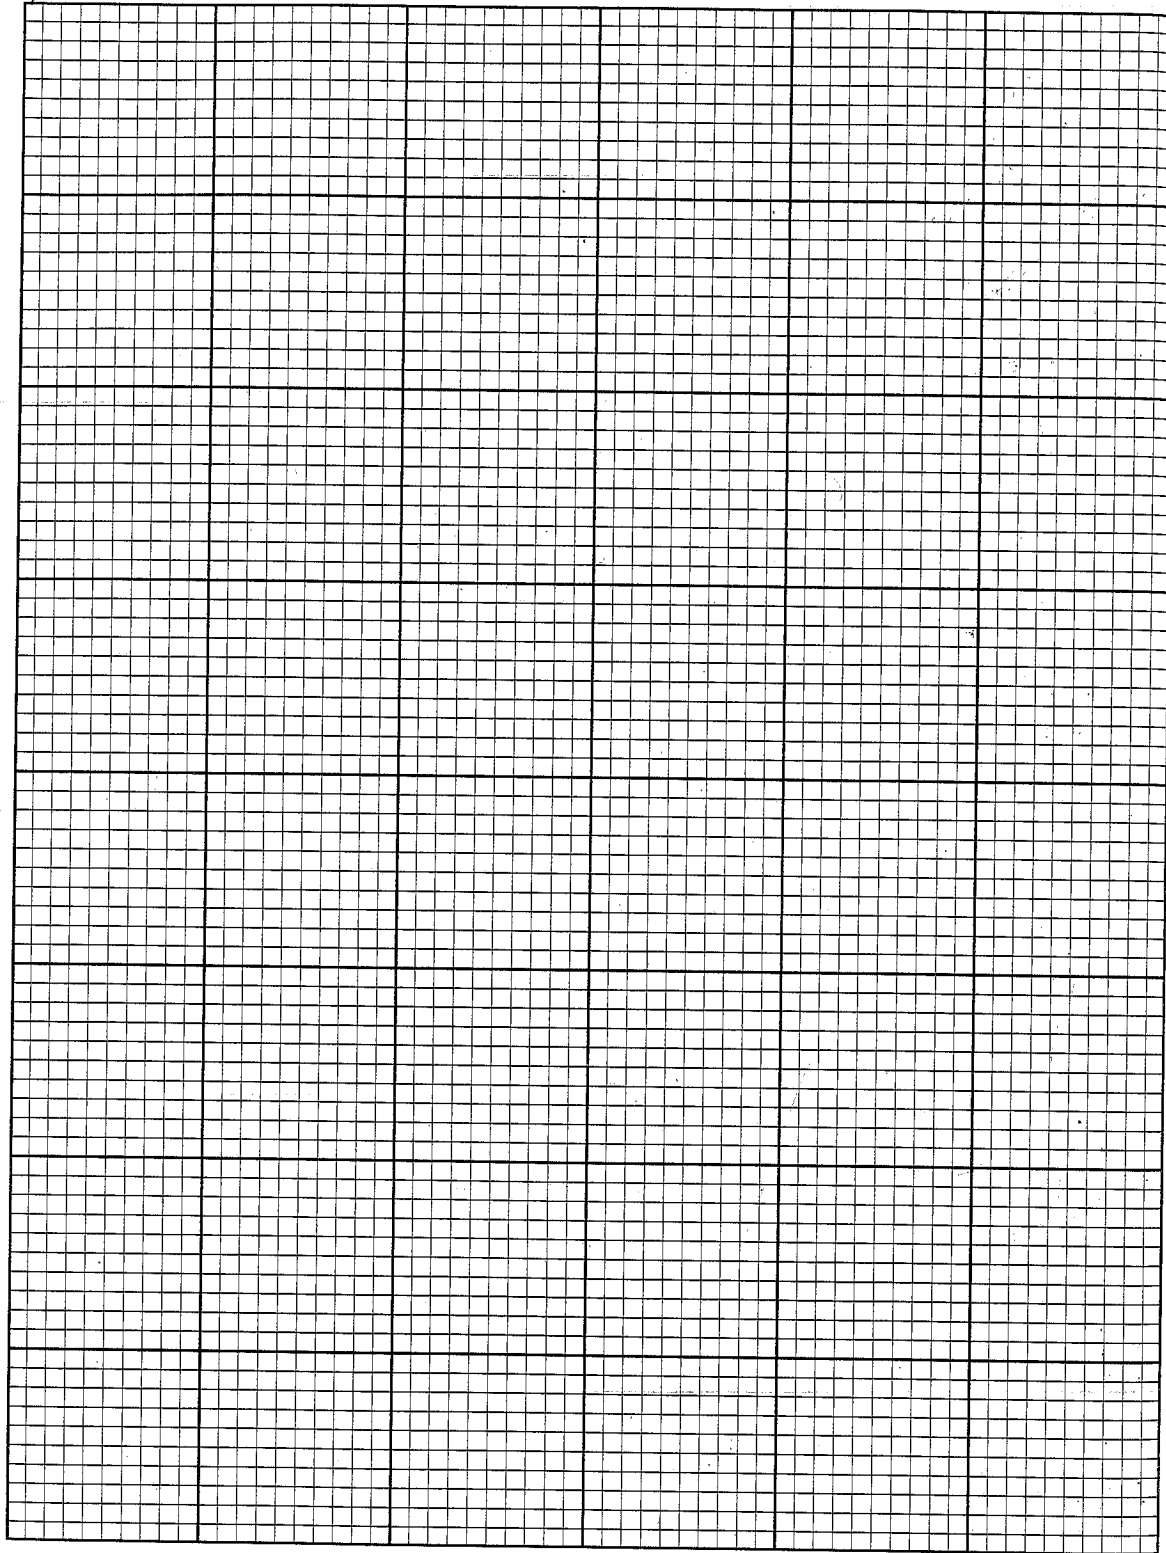

SWH 72.4

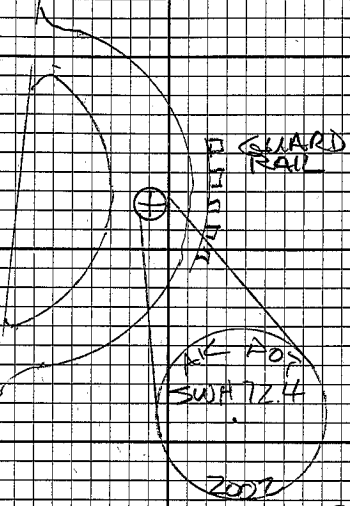

SWH 72.4 @
MP 72.4
SET RBBW 12" AC
DOWN OF
IN PAVE PULLOFF
15' FROM GUARD
RAIL

SW 1/4 14 @ MP 74.4
 SET RAIL W/ 2" AC
 DOWN 3' IN
 PAVE PULLOFF
 30' FROM GUARD
 RAIL

GUARD
RAIL

AK 20
SW 1/4 14

2002

0/11 EEST