




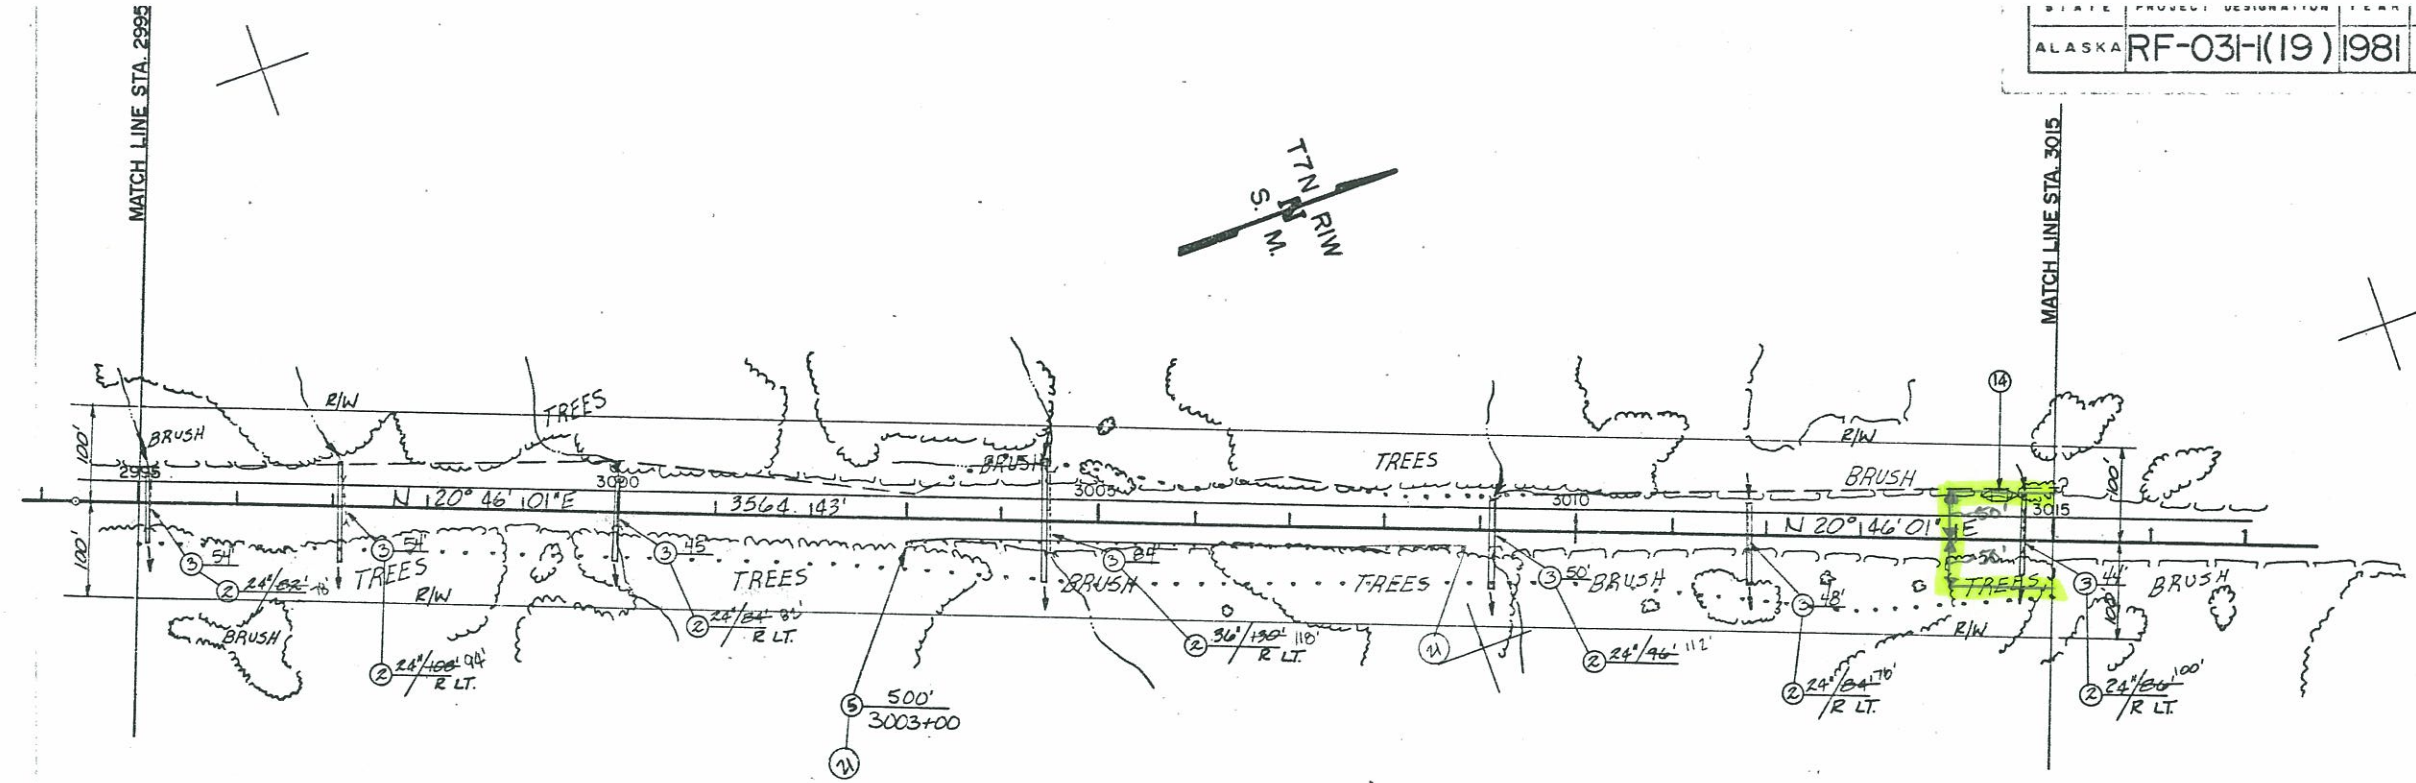


EMBANKMENT 23,112 C.Y. ① ① 12252 C.Y. COMMON FROM SHT. 14
 COMMON EXC. 3,163 C.Y. ② 11458 C.Y. COMMON FROM SHT. 15
 MUCK EXC. 946 C.Y. ③ 1,133 C.Y. BACKFILL - COMMON FROM SHT. 31
 ④ 815 C.Y. STRIPPING TO BE WASTED

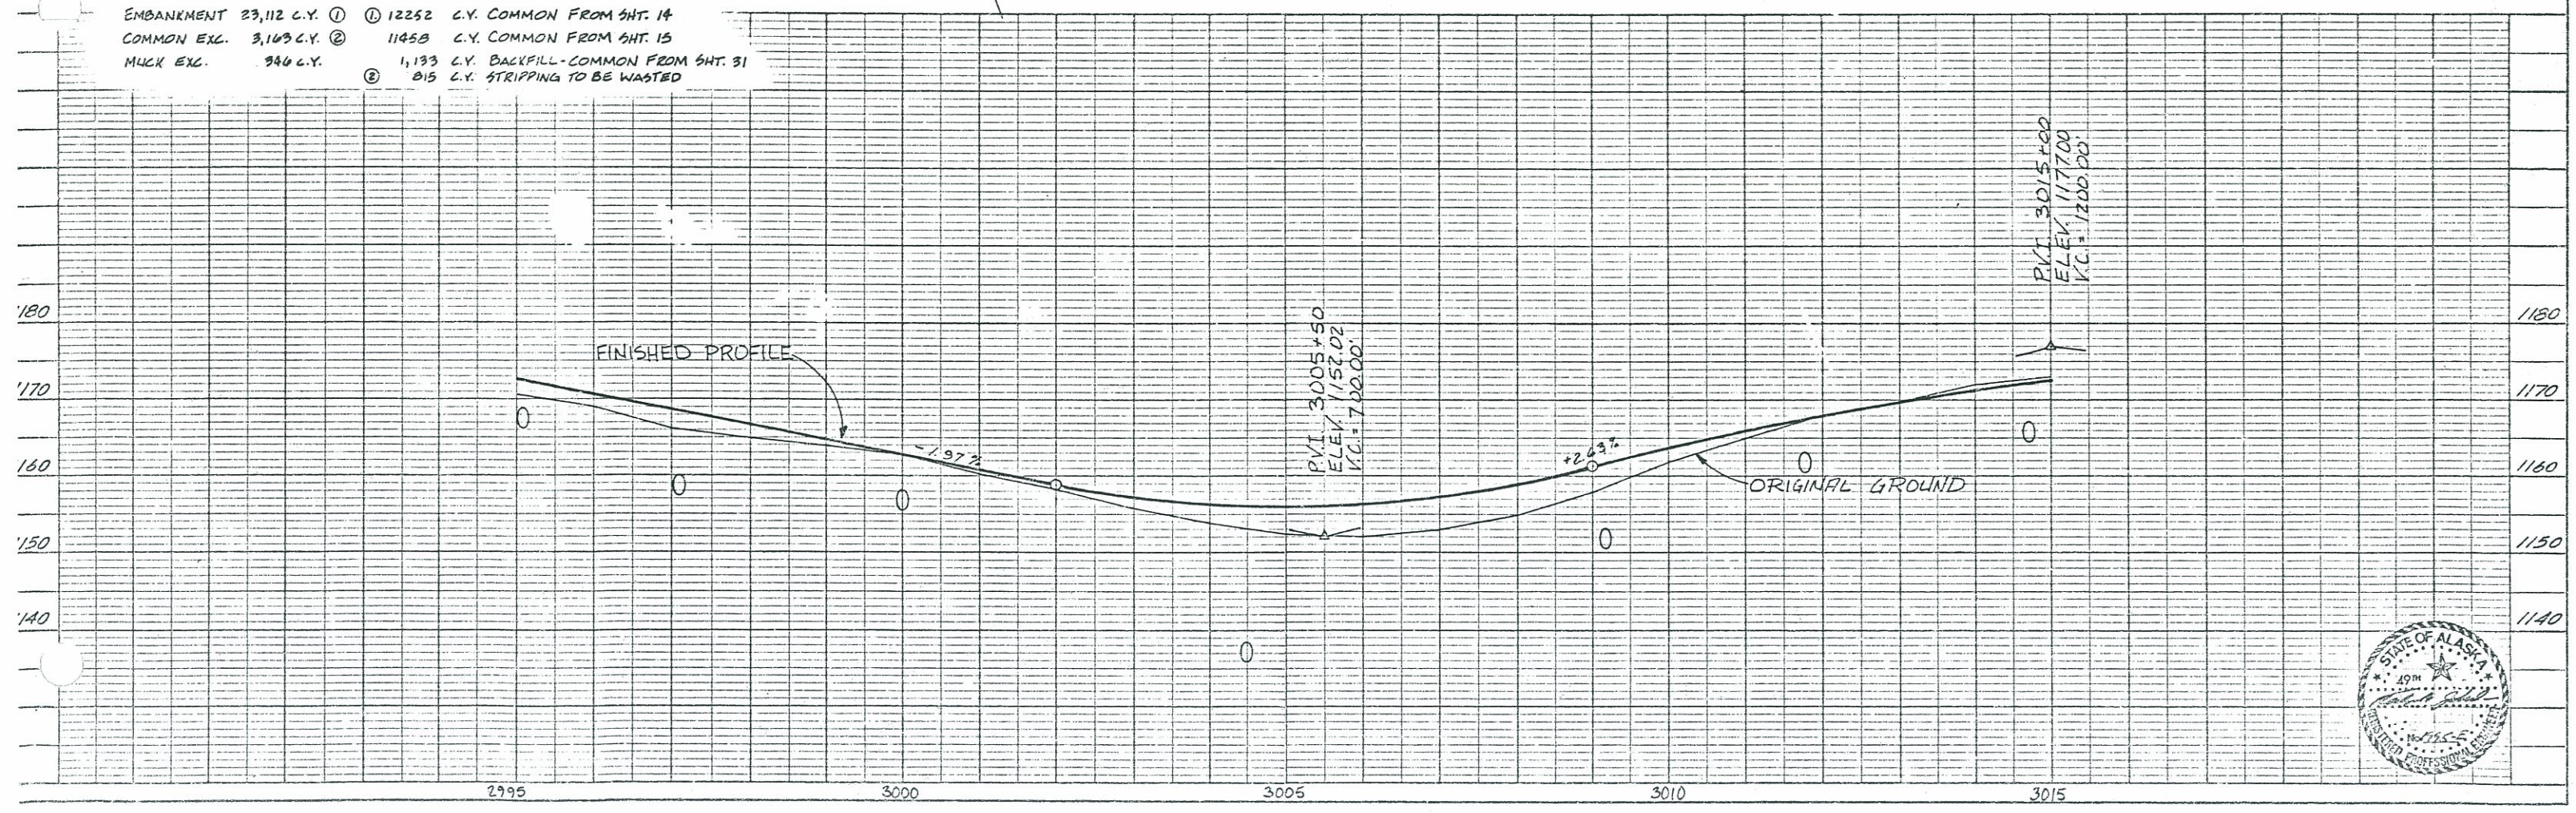

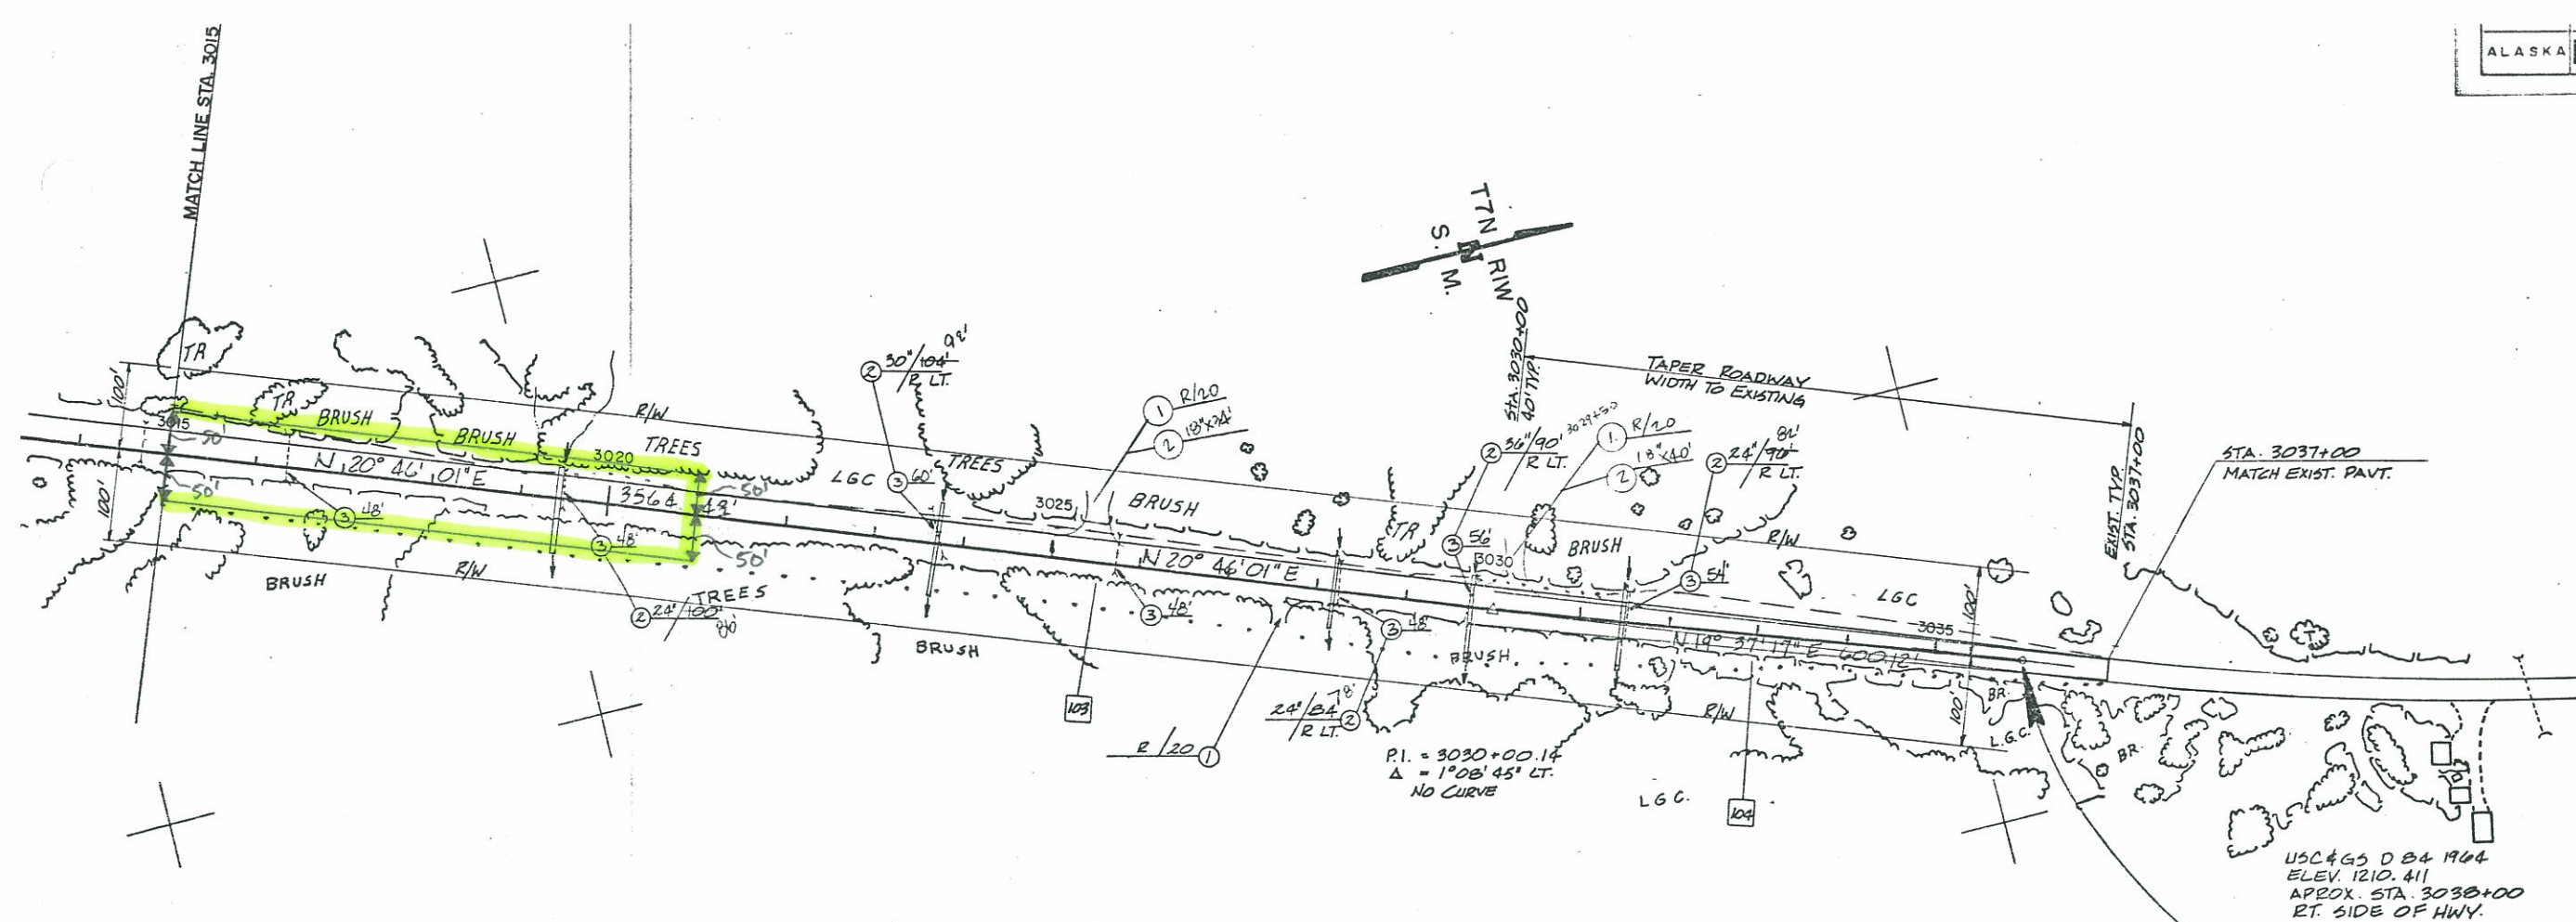

EMBANKMENT 15,100 C.Y. ① ① 11813 C.Y. COMMON FROM SHT. 14
 COMMON EXC. 3,114 C.Y. ② ② 3159 C.Y. BACKFILL COMMON FROM SHT. 31
 MUCK EXC. 1,247 C.Y. ② ② 246 C.Y. STRIPPING TO BE WASTED

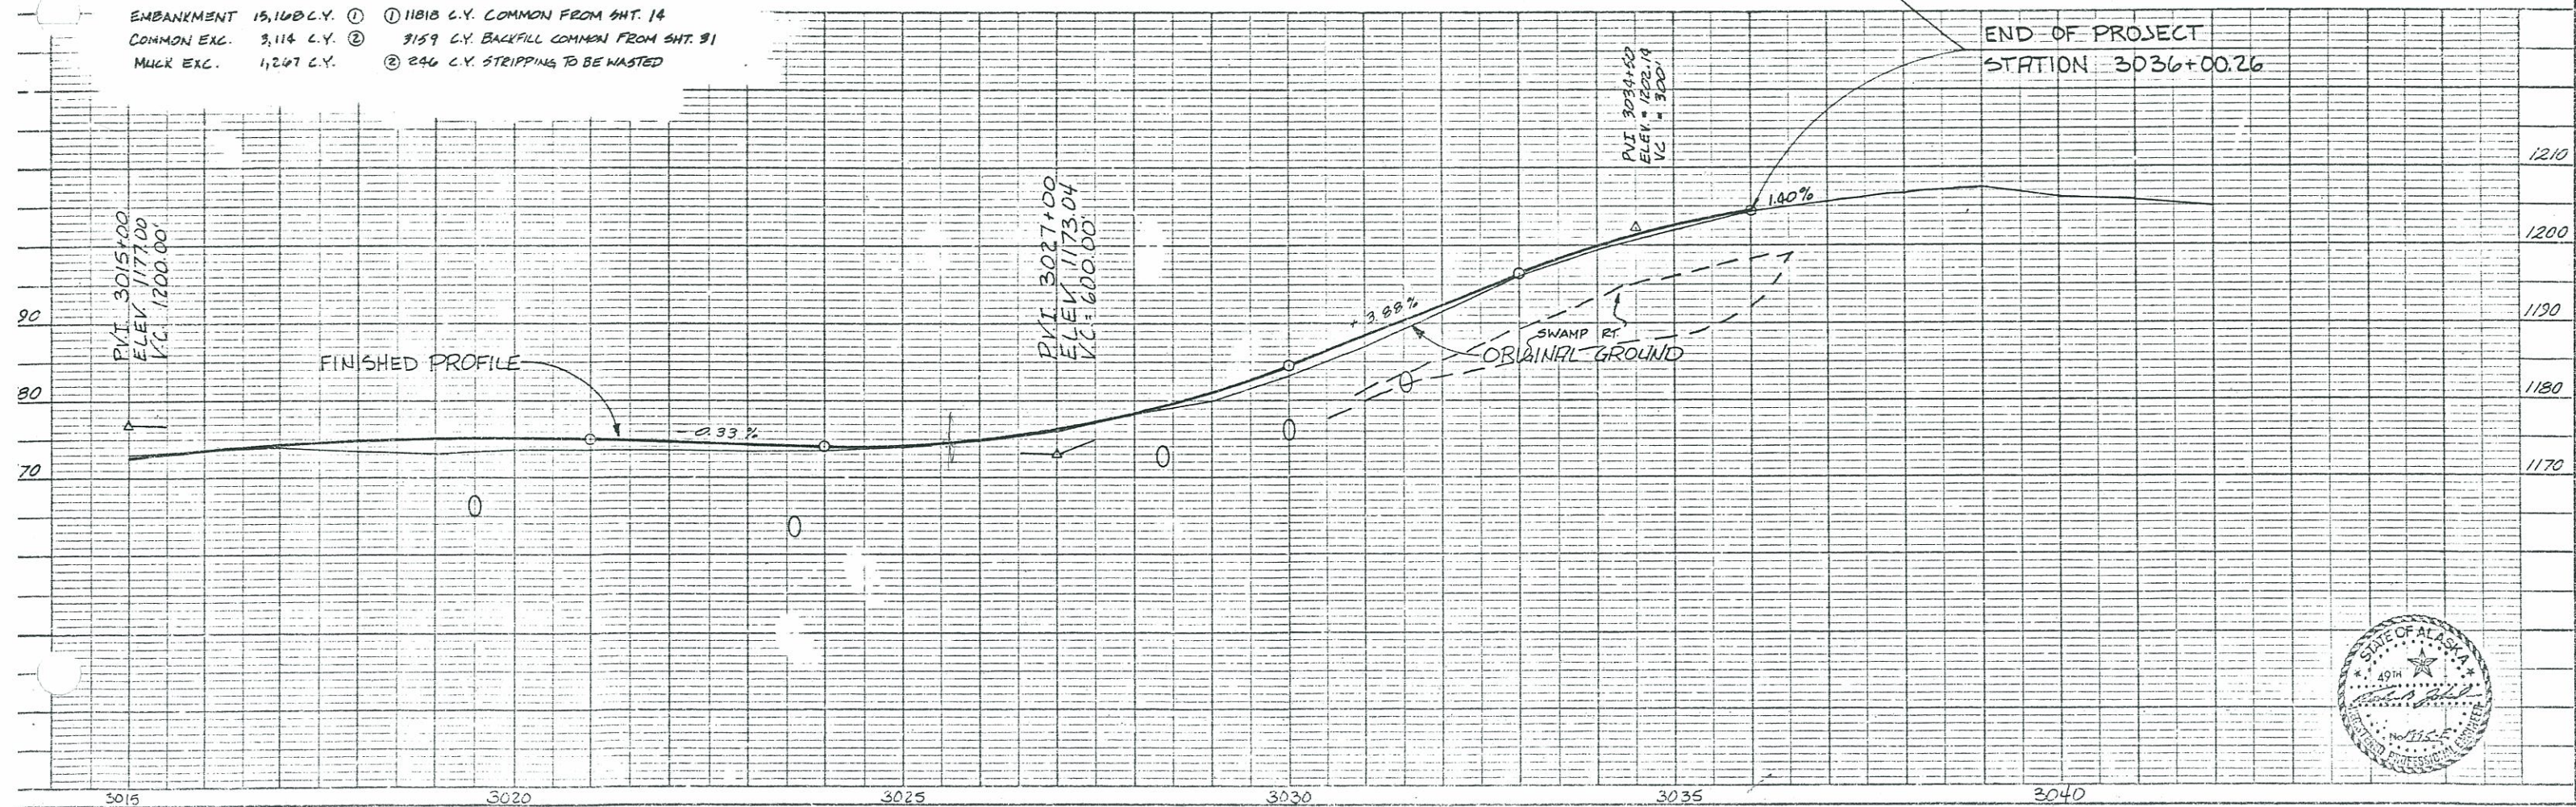

DESIGNED BY
CHECKED BY
DRAWN BY
DATE: 8-23-93
PROJECT: Seward Highway
SHEET: 10 OF 10

BEGIN PROJECT

STA. 10+00
N = 47592.7075
E = 94972.3199

FOUND CENTERLINE MONUMENT
N 44,665.3736
E 93,862.5312

REMOVE EXISTING MAILBOX
AND CONSTRUCT NEW MAILBOX
AT STA. 12+42.25' RT.

DO NOT DISTURB
EXISTING GATE

EXISTING 24" CMP
OUTLET EXTENDED 20'
END SECTIONS ADDED TO INLET AND OUTLET

SEWARD HIGHWAY

REMOVE EXISTING GATE AND
POSTS. INSTALL NEW GATE,
AS PER GATE DETAIL, AT STA.
11+85.99' RT.
GATE NOT INSTALLED
PER FOREST SERVICE.

BLOCK
MINE #2

BLOCK
MINE #3

END SECTIONS
ADDED TO
EXISTING PIPE

EXISTING 36" CMP
OUTLET EXTENDED
10', END SECTIONS
ADDED TO INLET
AND OUTLET.

MUCK EXCAVATION AREA

FINISHED PROFILE GRADE

ORIGINAL GROUND


MATCH EXISTING PAVEMENT
V.P.C. STA. 10+00
ELEV. 1173.75

V.P.I. STA. 13+00
ELEV. 1177.00
600' V.C.

V.P.T. STA. 16+00
ELEV. 1190.29

V.P.C. STA. 18+00
ELEV. 1199.14

V.P.I. STA. 20+00
ELEV. 1208.00
400' V.C.

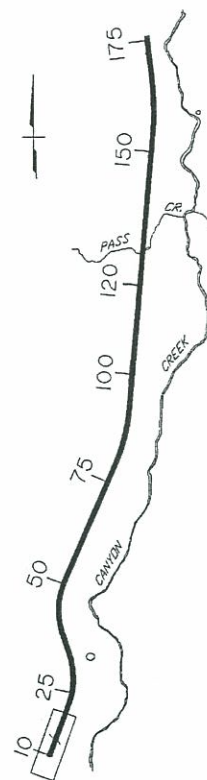

STATE OF ALASKA
DEPARTMENT OF TRANSPORTATION
AND
PUBLIC FACILITIES
SEWARD HIGHWAY
M.P. 50 TO M.P. 53

SHEET NO.	TOTAL SHEETS
F1	71
STATE	YEAR
ALASKA	1993

PROJECT DESIGNATION

IM-0A3-2(8)


ADDENDUM NO.

ATTACHMENT NO.


REVISIONS

NO.	DATE	DESCRIPTION


DESIGNED BY
CHECKED BY
DRAWN BY
DATE
PROJECT DESIGNATION
COMPUTER DESIGNATION
AUTOCAD-KAREN-3000/1133-46
XREF-F-33-46, PROJECT 53PAP
8-23-93

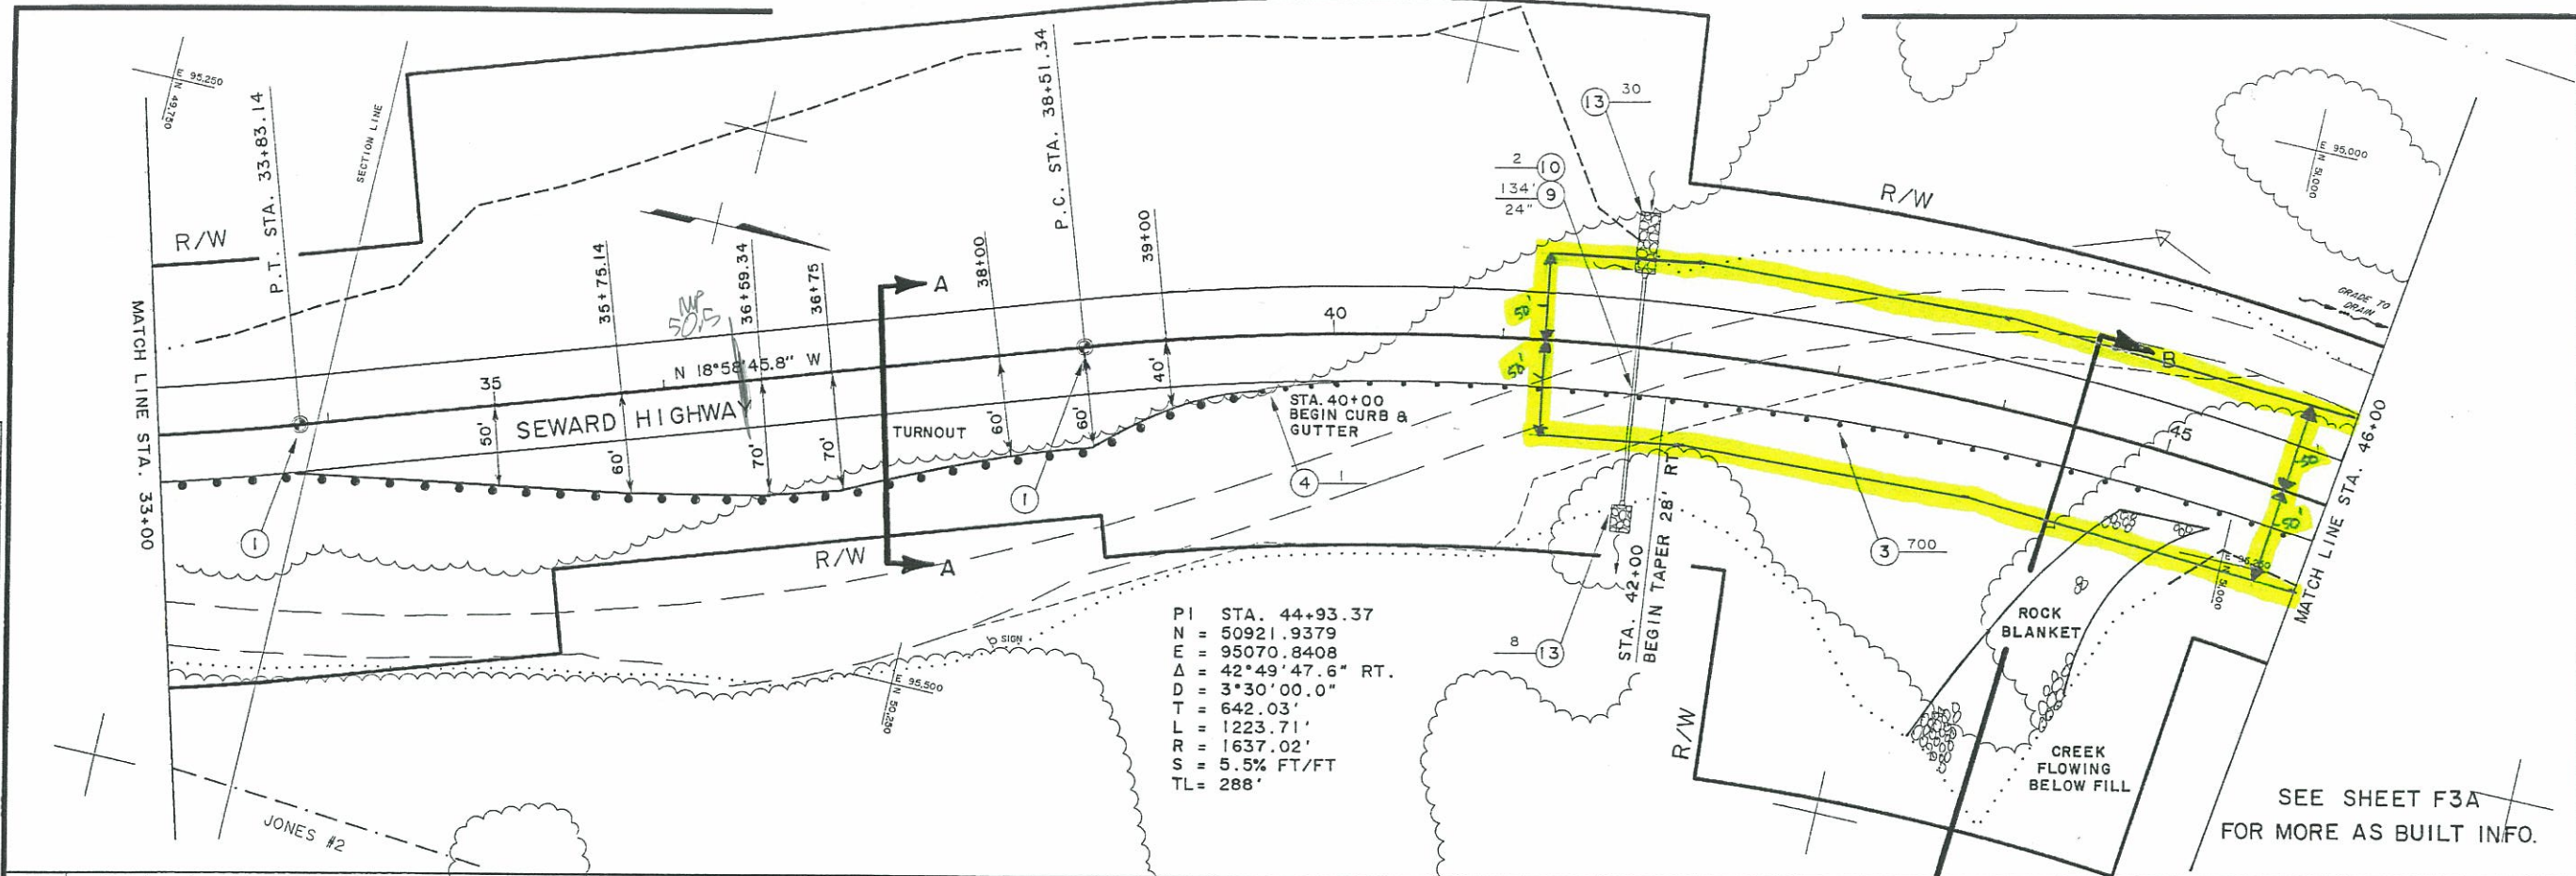

PI STA. 44+93.37
N = 50921.9379
E = 95070.8408
Δ = 42°49'47.6" RT.
D = 3°30'00.0"
T = 642.03'
L = 1223.71'
R = 1637.02'
S = 5.5% FT/FT
TL = 288'

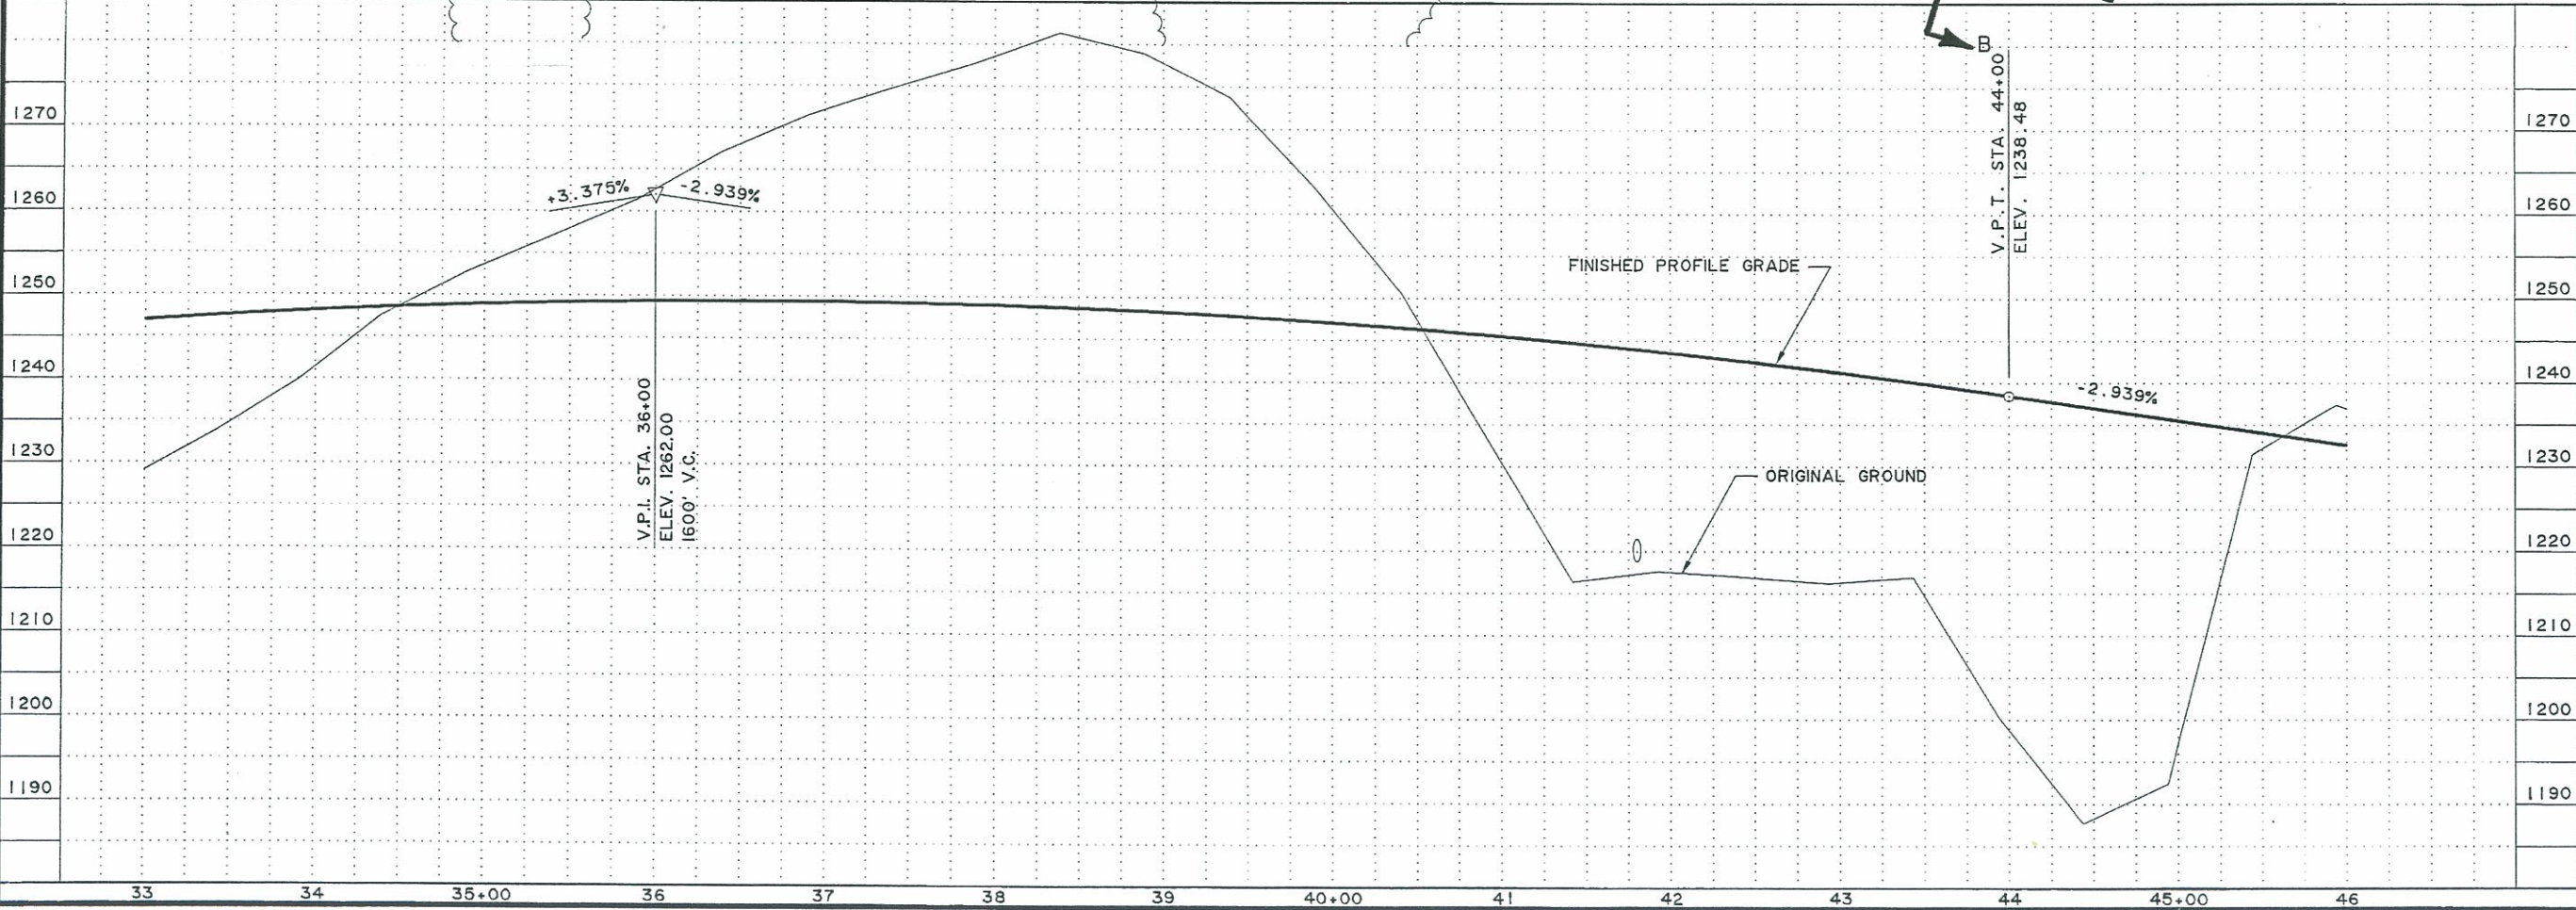


SHEET NO.	TOTAL SHEETS	
F3	71	
STATE	YEAR	
ALASKA	1993	
PROJECT DESIGNATION		
IM-0A3-2(8)		
ADDENDUM NO.		
ATTACHMENT NO.		
REVISIONS		
NO.	DATE	DESCRIPTION


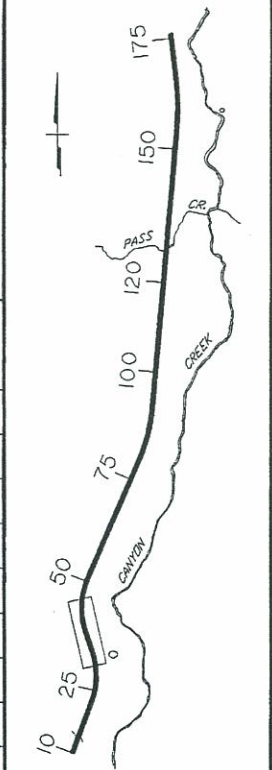


STATE OF ALASKA
DEPARTMENT OF TRANSPORTATION
AND
PUBLIC FACILITIES
SEWARD HIGHWAY
M.P. 50 TO M.P. 53

DESIGNED BY
CHECKED BY
DRAFTED BY
SPECIFICATIONS
COMPUTER DESIGNATION
XREF: F4E-59, PROFILE, ESRMAP
AUTOCAD-KAREN-5000BVD11V4E-59
8-21-93
NMM


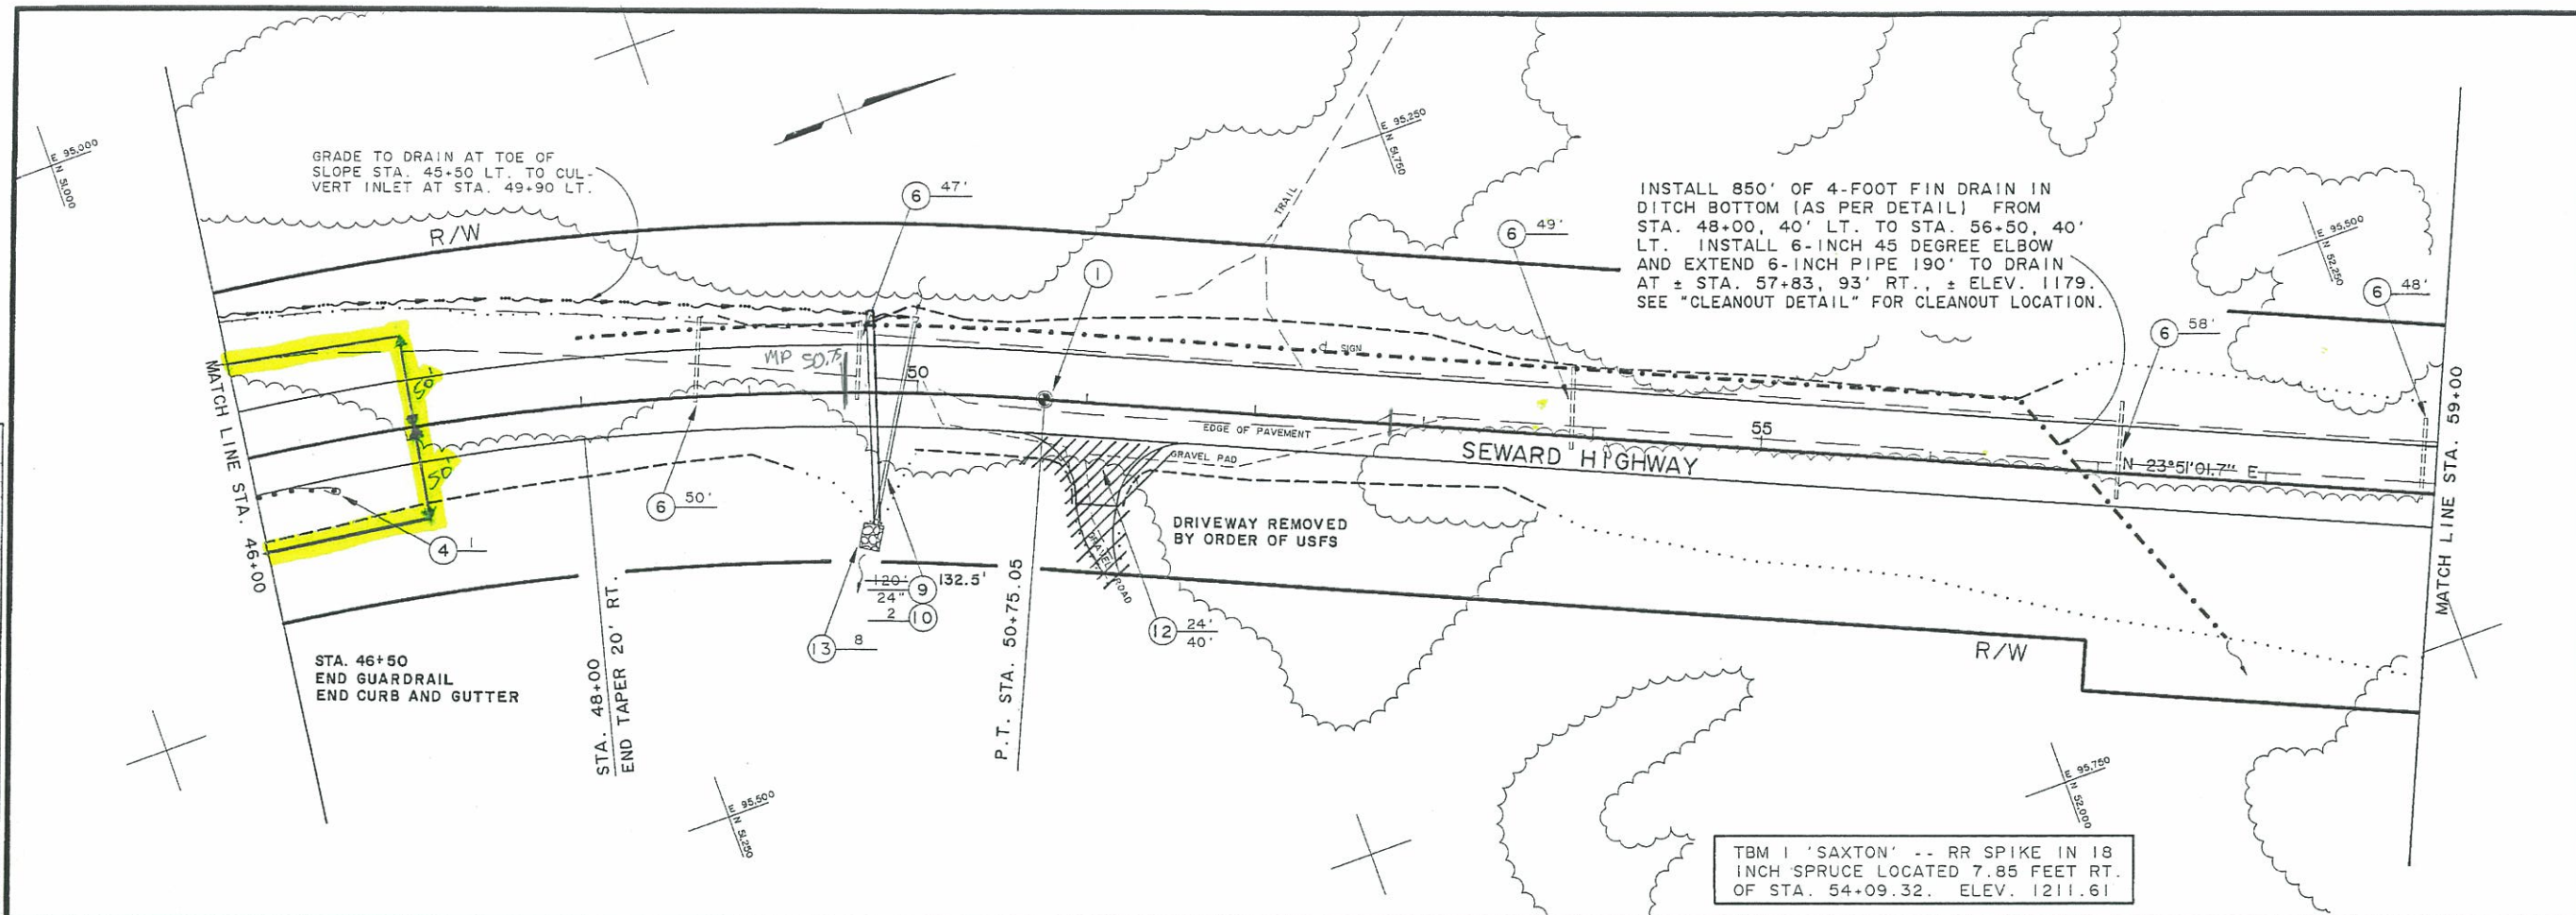


SHEET NO.	TOTAL SHEETS	
F4	71	
STATE	YEAR	
ALASKA	1993	
PROJECT DESIGNATION		
IM-0A3-2(8)		
ADDENDUM NO.		
ATTACHMENT NO.		
REVISIONS		
NO.	DATE	DESCRIPTION

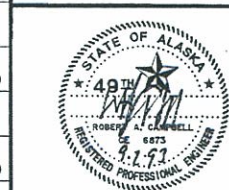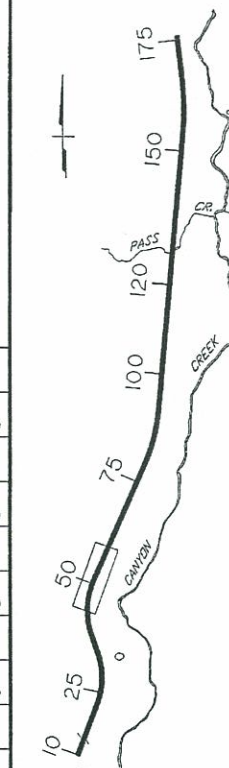


STATE OF ALASKA
DEPARTMENT OF TRANSPORTATION
AND
PUBLIC FACILITIES
SEWARD HIGHWAY
M.P. 50 TO M.P. 53

SPECIFICATIONS
DESIGNED BY
CHECKED BY
DRAWN BY
DATE
PROJECT DESIGNATION
AUTOCAD-KAREN-2000A-BOHNUS-98
XREF-FEB-98, PROFILE, SPNAP
8-23-93

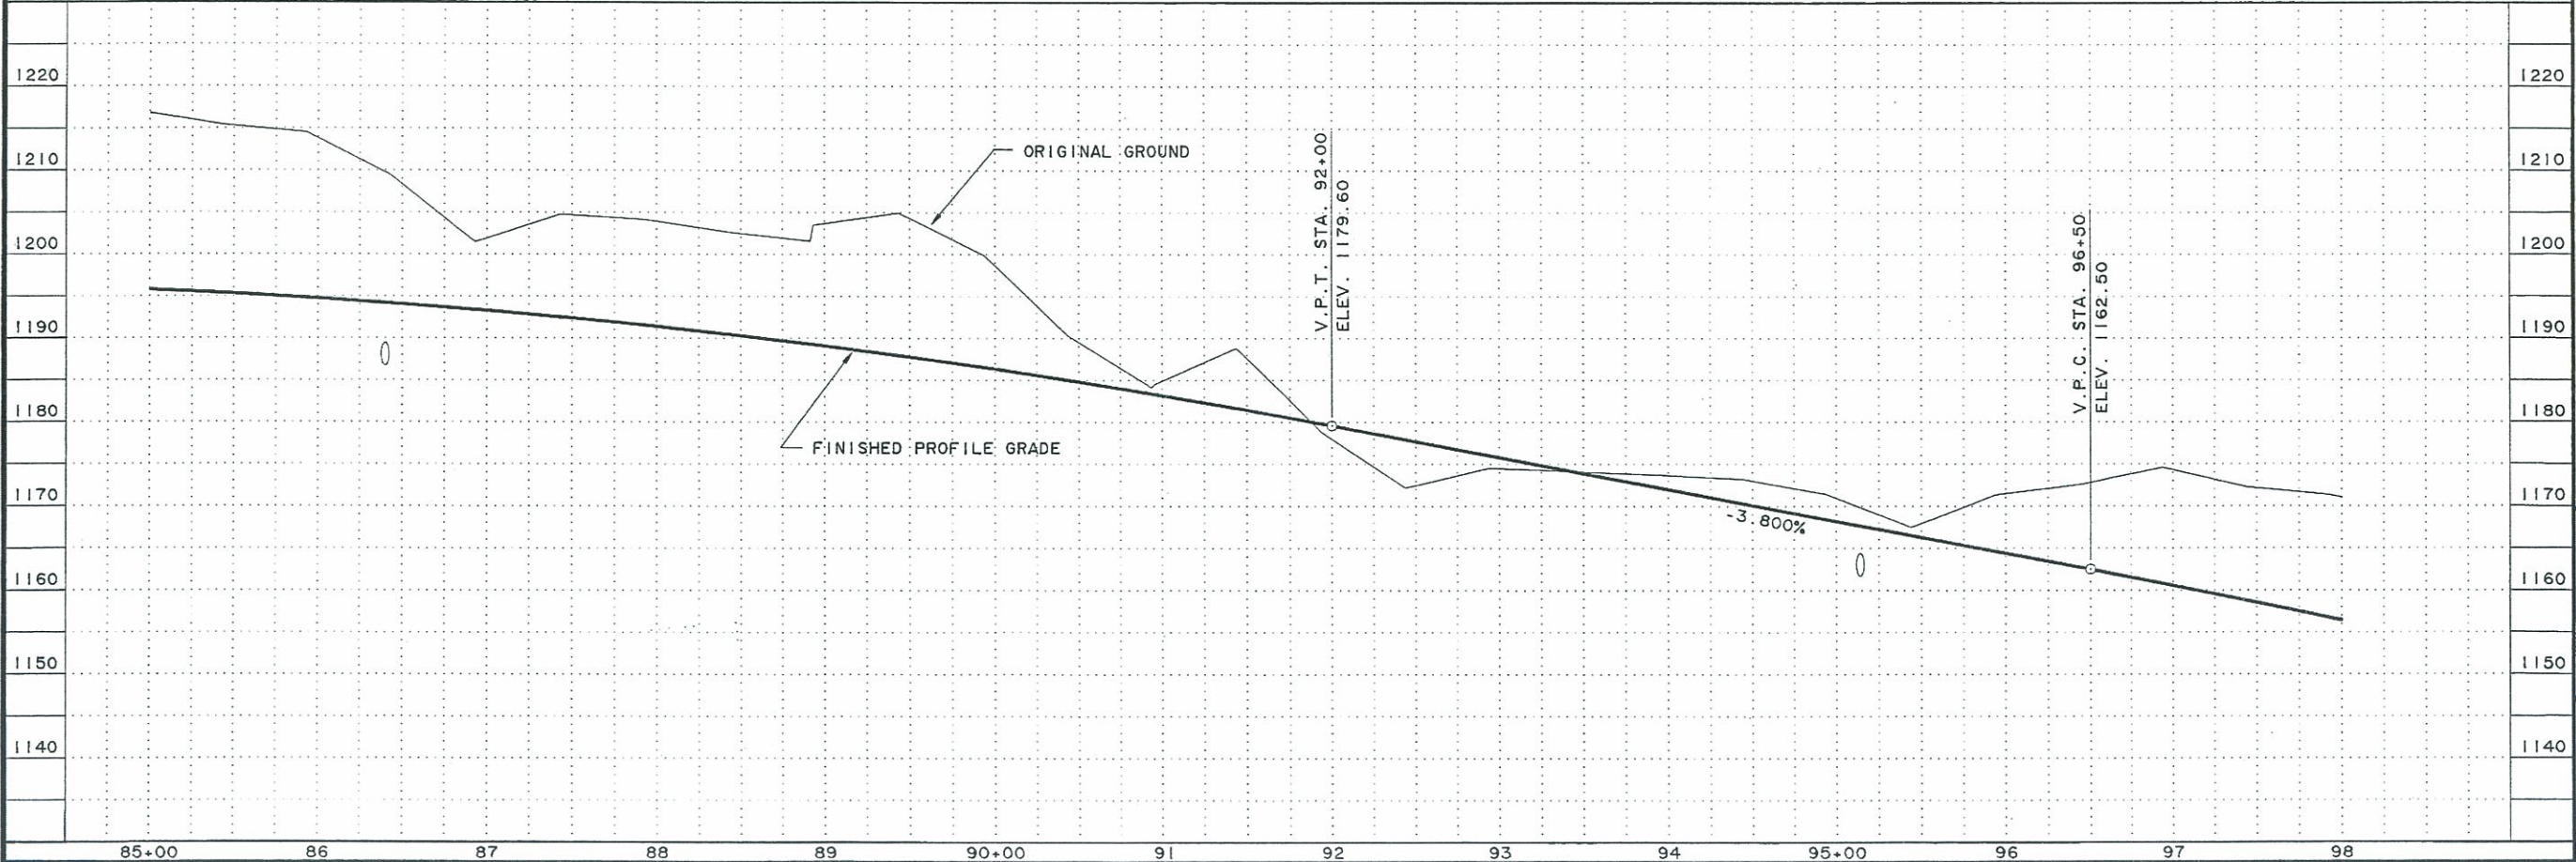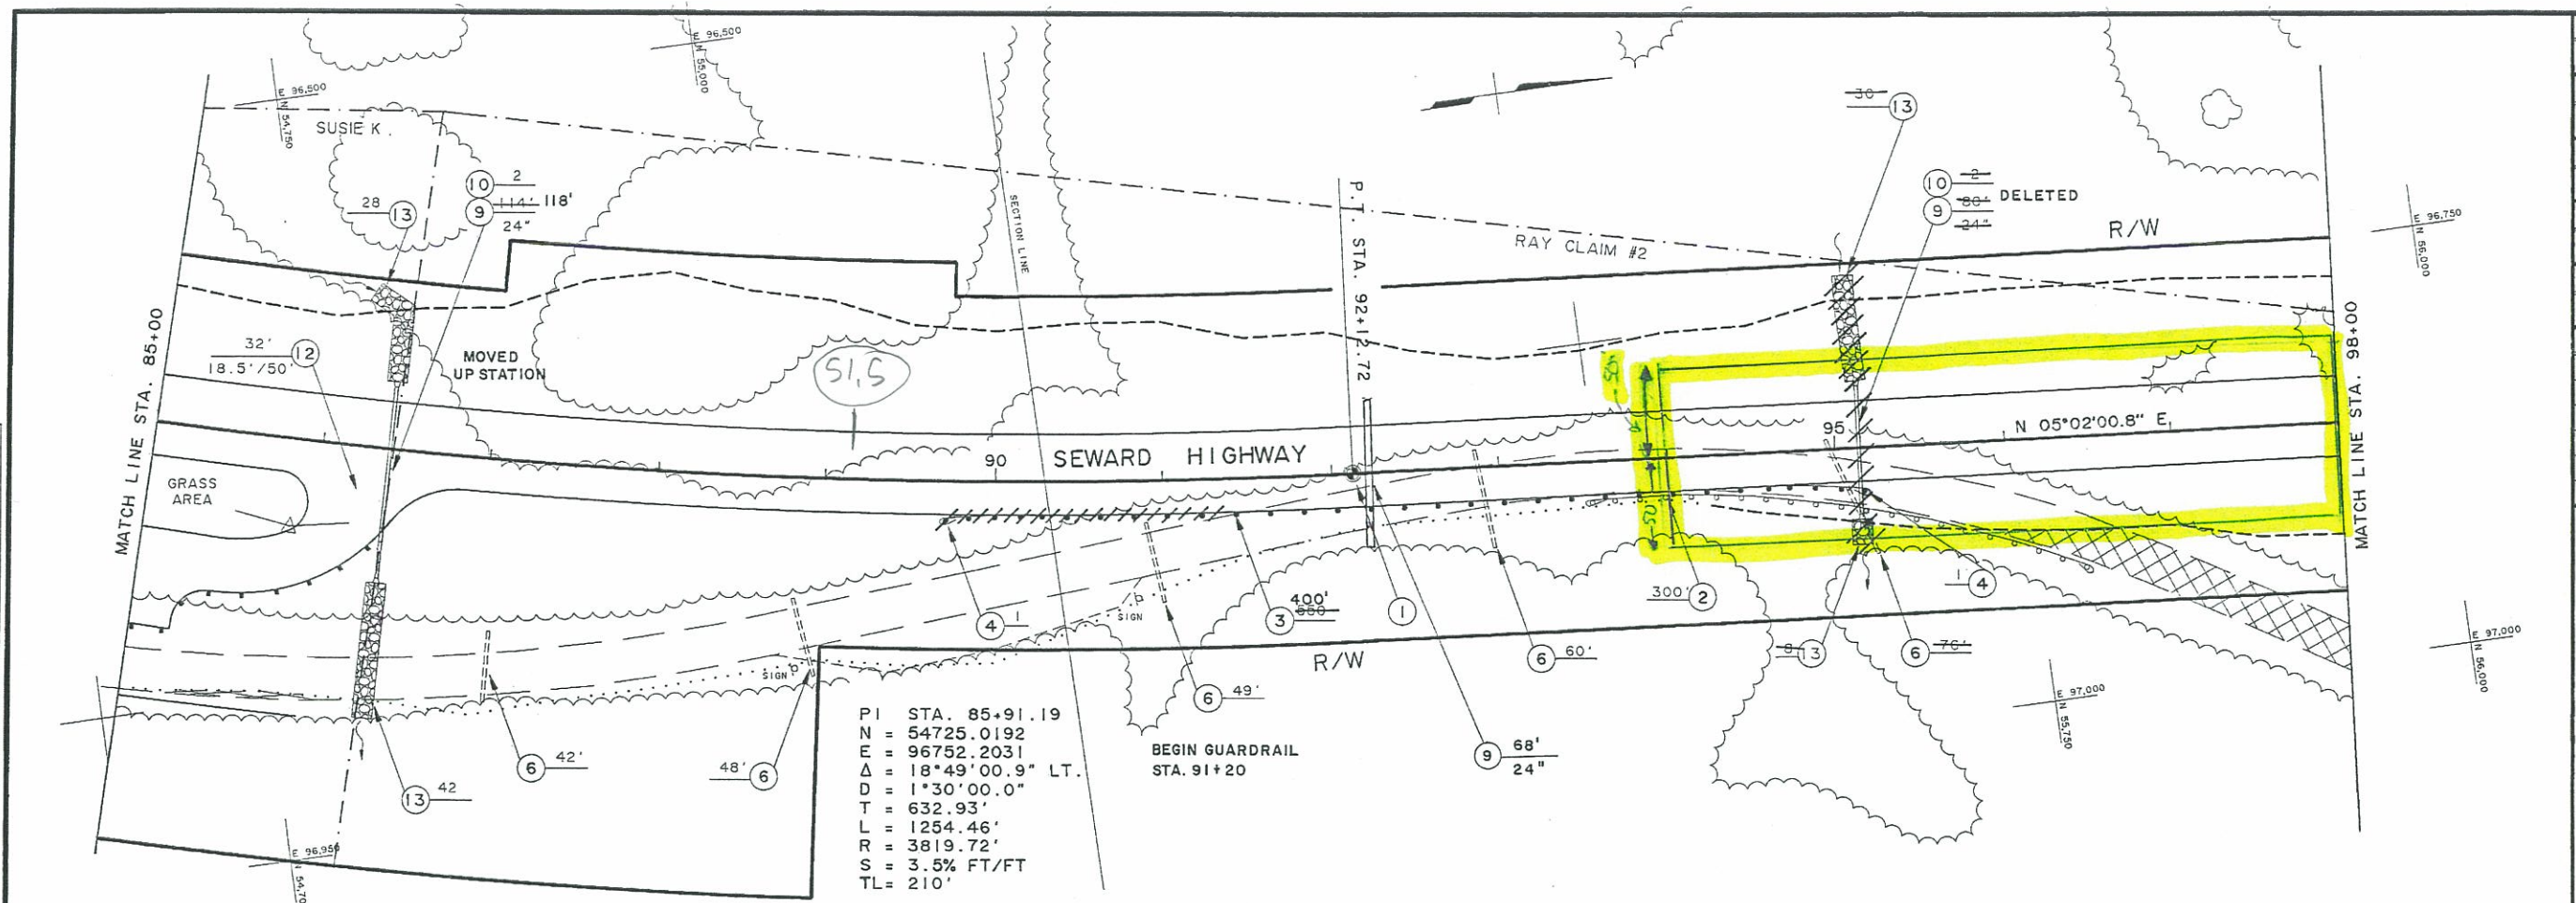


SHEET NO.	TOTAL SHEETS	
F7	71	
STATE	YEAR	
ALASKA	1993	
PROJECT DESIGNATION		
IM-OA3-2(8)		
ADDENDUM NO.		
ATTACHMENT NO.		
REVISIONS		
NO.	DATE	DESCRIPTION

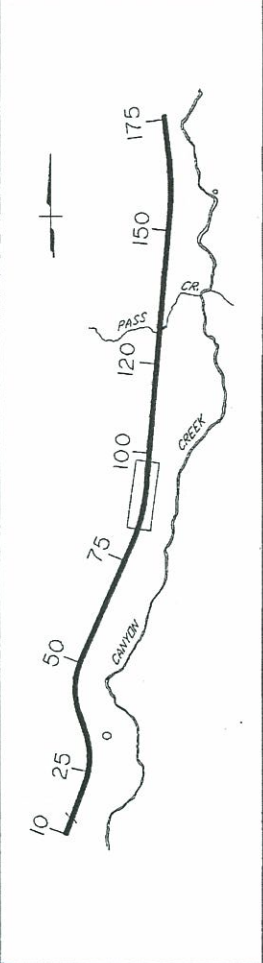


STATE OF ALASKA
DEPARTMENT OF TRANSPORTATION
AND
PUBLIC FACILITIES
SEWARD HIGHWAY
M.P. 50 TO M.P. 53

DESIGNED BY
CHECKED BY
DRAFTED BY
XREF: 59-09, PROFILE, 53PMAP
AUTOCAD-KAREL-59000-50THIN-09
COMPUTER DESIGNATION

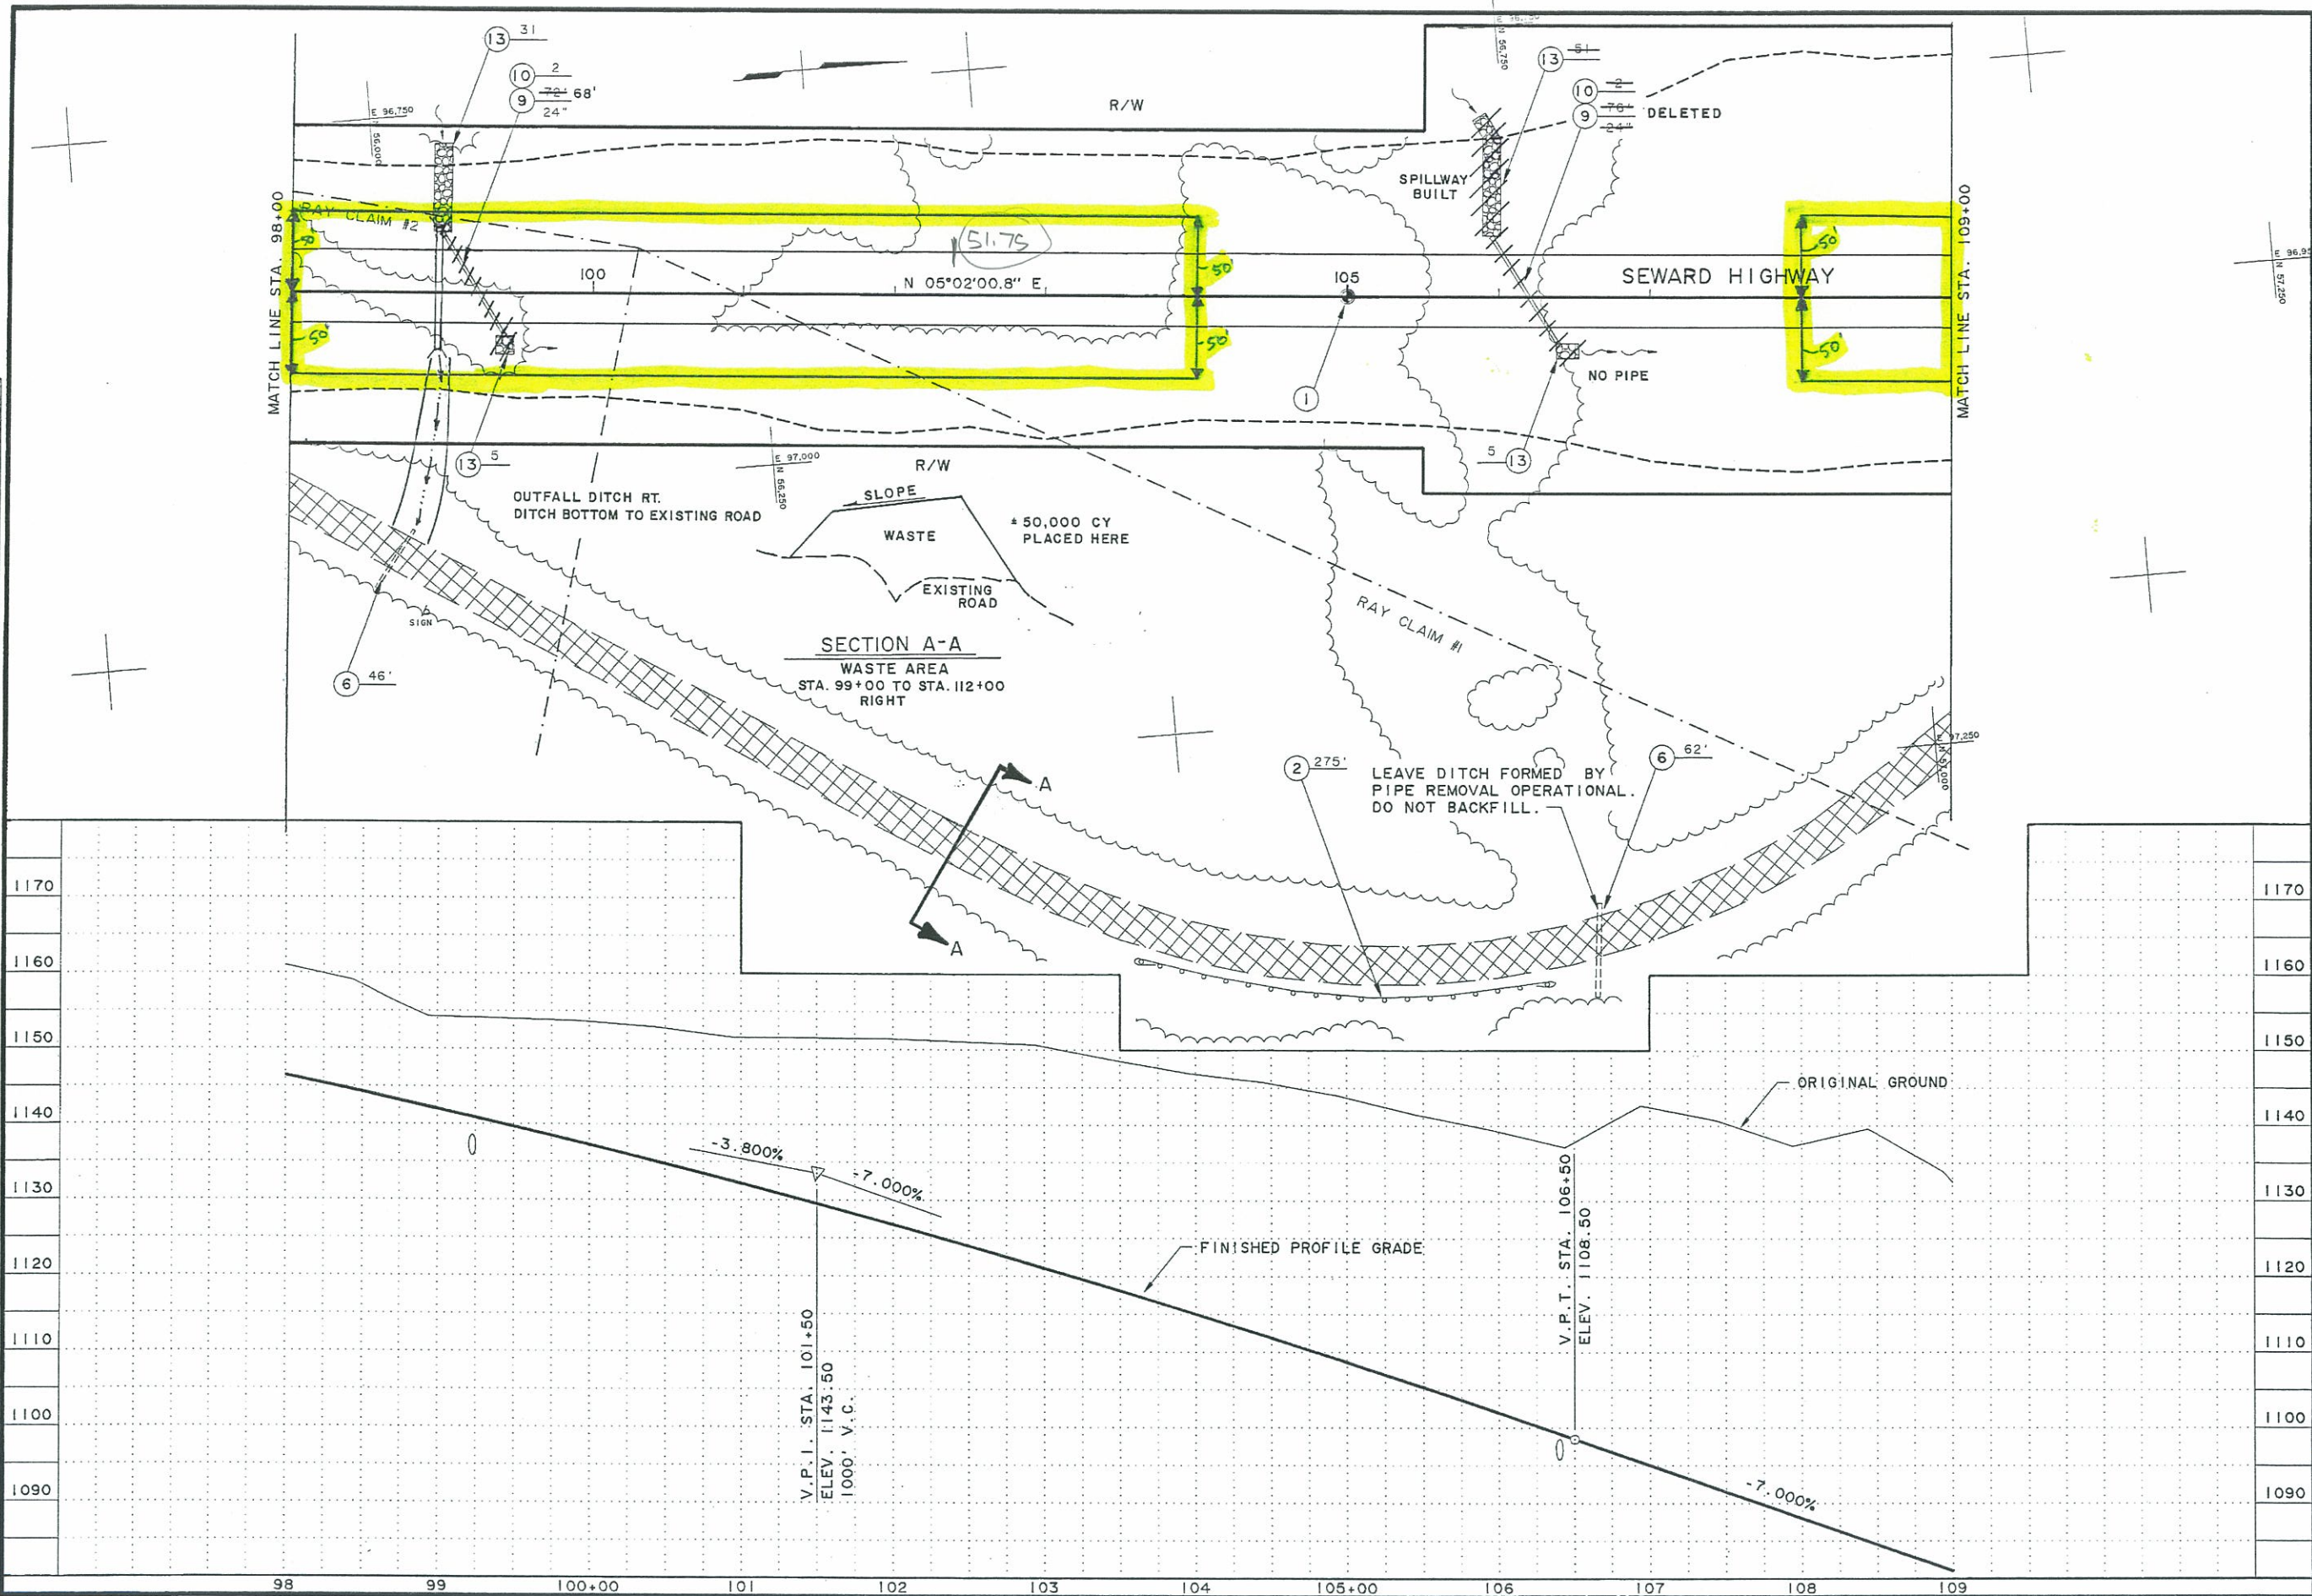

SHEET NO.	TOTAL SHEETS	
F8	71	
STATE	YEAR	
ALASKA	1993	
PROJECT DESIGNATION		
IM-0A3-2(8)		
ADDENDUM NO.		
ATTACHMENT NO.		
REVISIONS		
NO.	DATE	DESCRIPTION

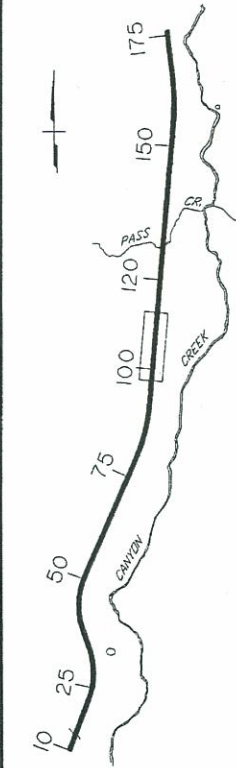

STATE OF ALASKA
DEPARTMENT OF TRANSPORTATION
AND
PUBLIC FACILITIES
SEWARD HIGHWAY
M.P. 50 TO M.P. 53


SPECIFICATIONS
STANDARDS
COMPUTER
DESIGNATION
AUTOCAD-KAREN-GRODINSKI-174
XREF... LUG-74L PROFILE, S37MAP
DESIGNED BY
CHECKED BY
CREATED BY KAH
B-21-53

SHEET NO.	TOTAL SHEETS
F13	71
STATE	YEAR
ALASKA	1993



PROJECT DESIGNATION
IM-0A3-2(8)

ADDENDUM NO.
ATTACHMENT NO.


REVISIONS		
NO.	DATE	DESCRIPTION

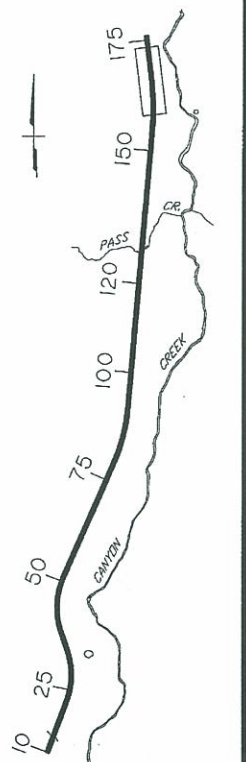


STATE OF ALASKA
DEPARTMENT OF TRANSPORTATION
AND
PUBLIC FACILITIES
SEWARD HIGHWAY
M.P. 50 TO M.P. 53

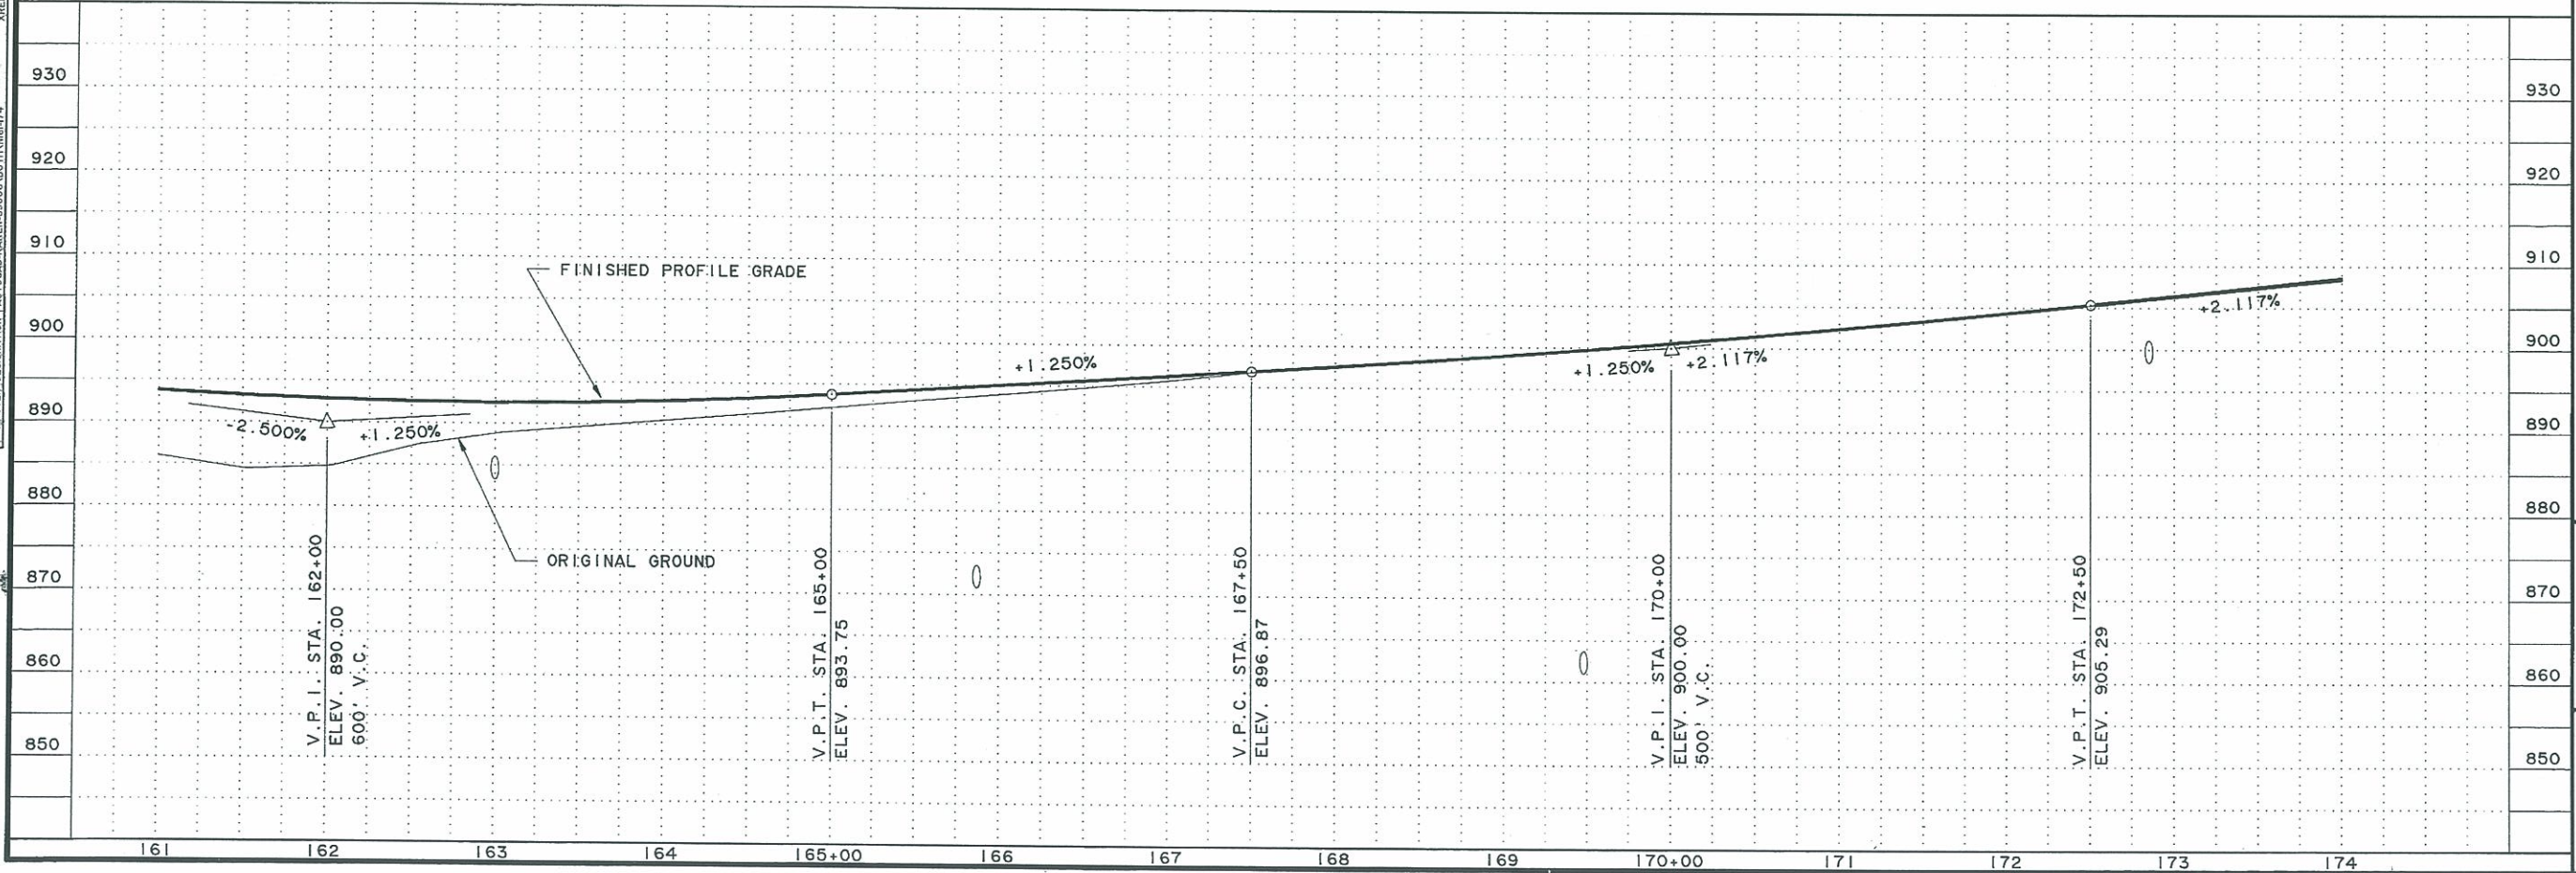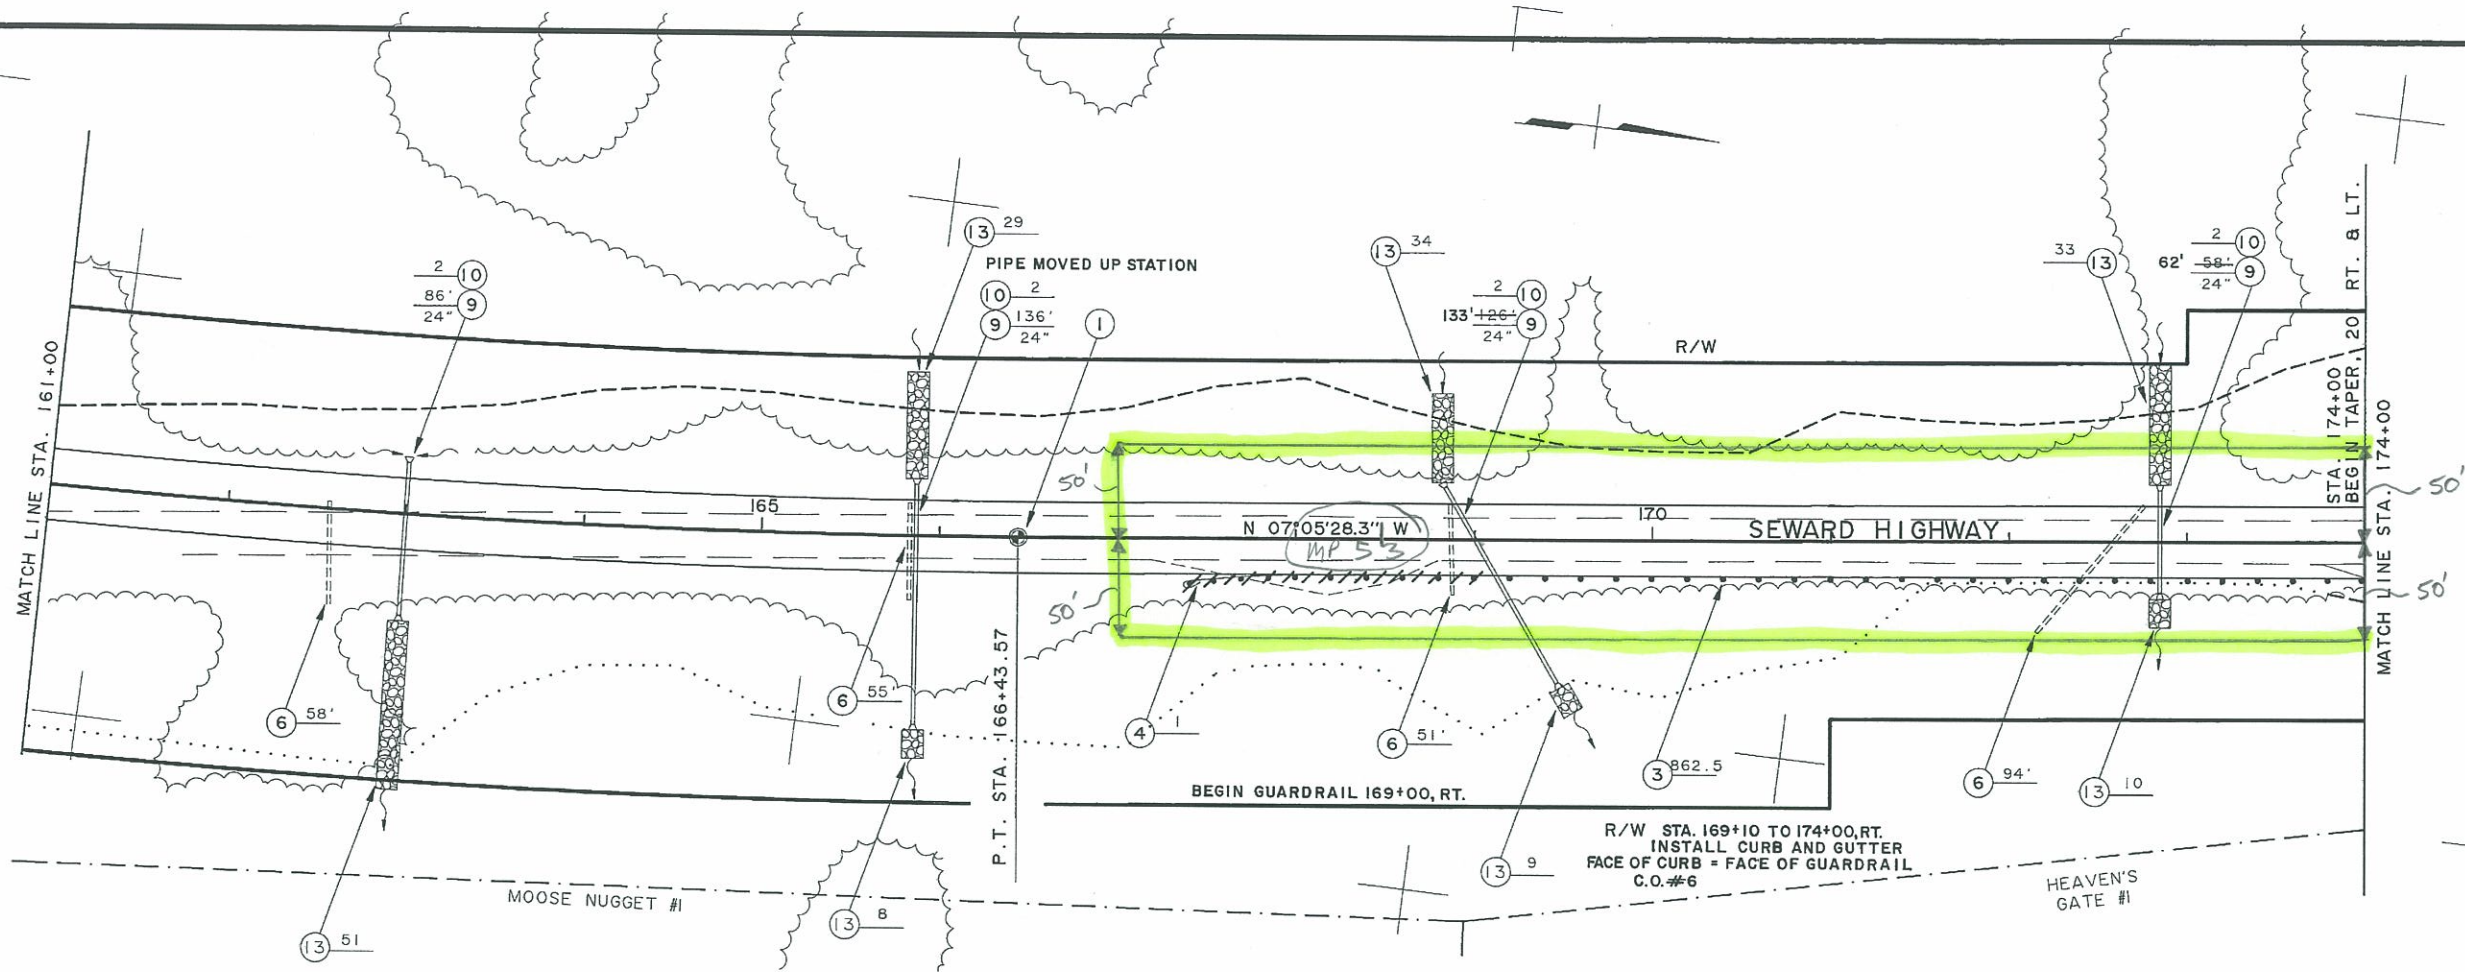

SPECIFICATIONS
STANDARDS
COMPUTER DESIGNATION AUTOCAD-KAREN-99008-BOTHIN74187
XREF -- L174.00, PROFILE, 53PMAP
DESIGNED BY
CHECKED BY
DRAWN BY KUH
8-13-93

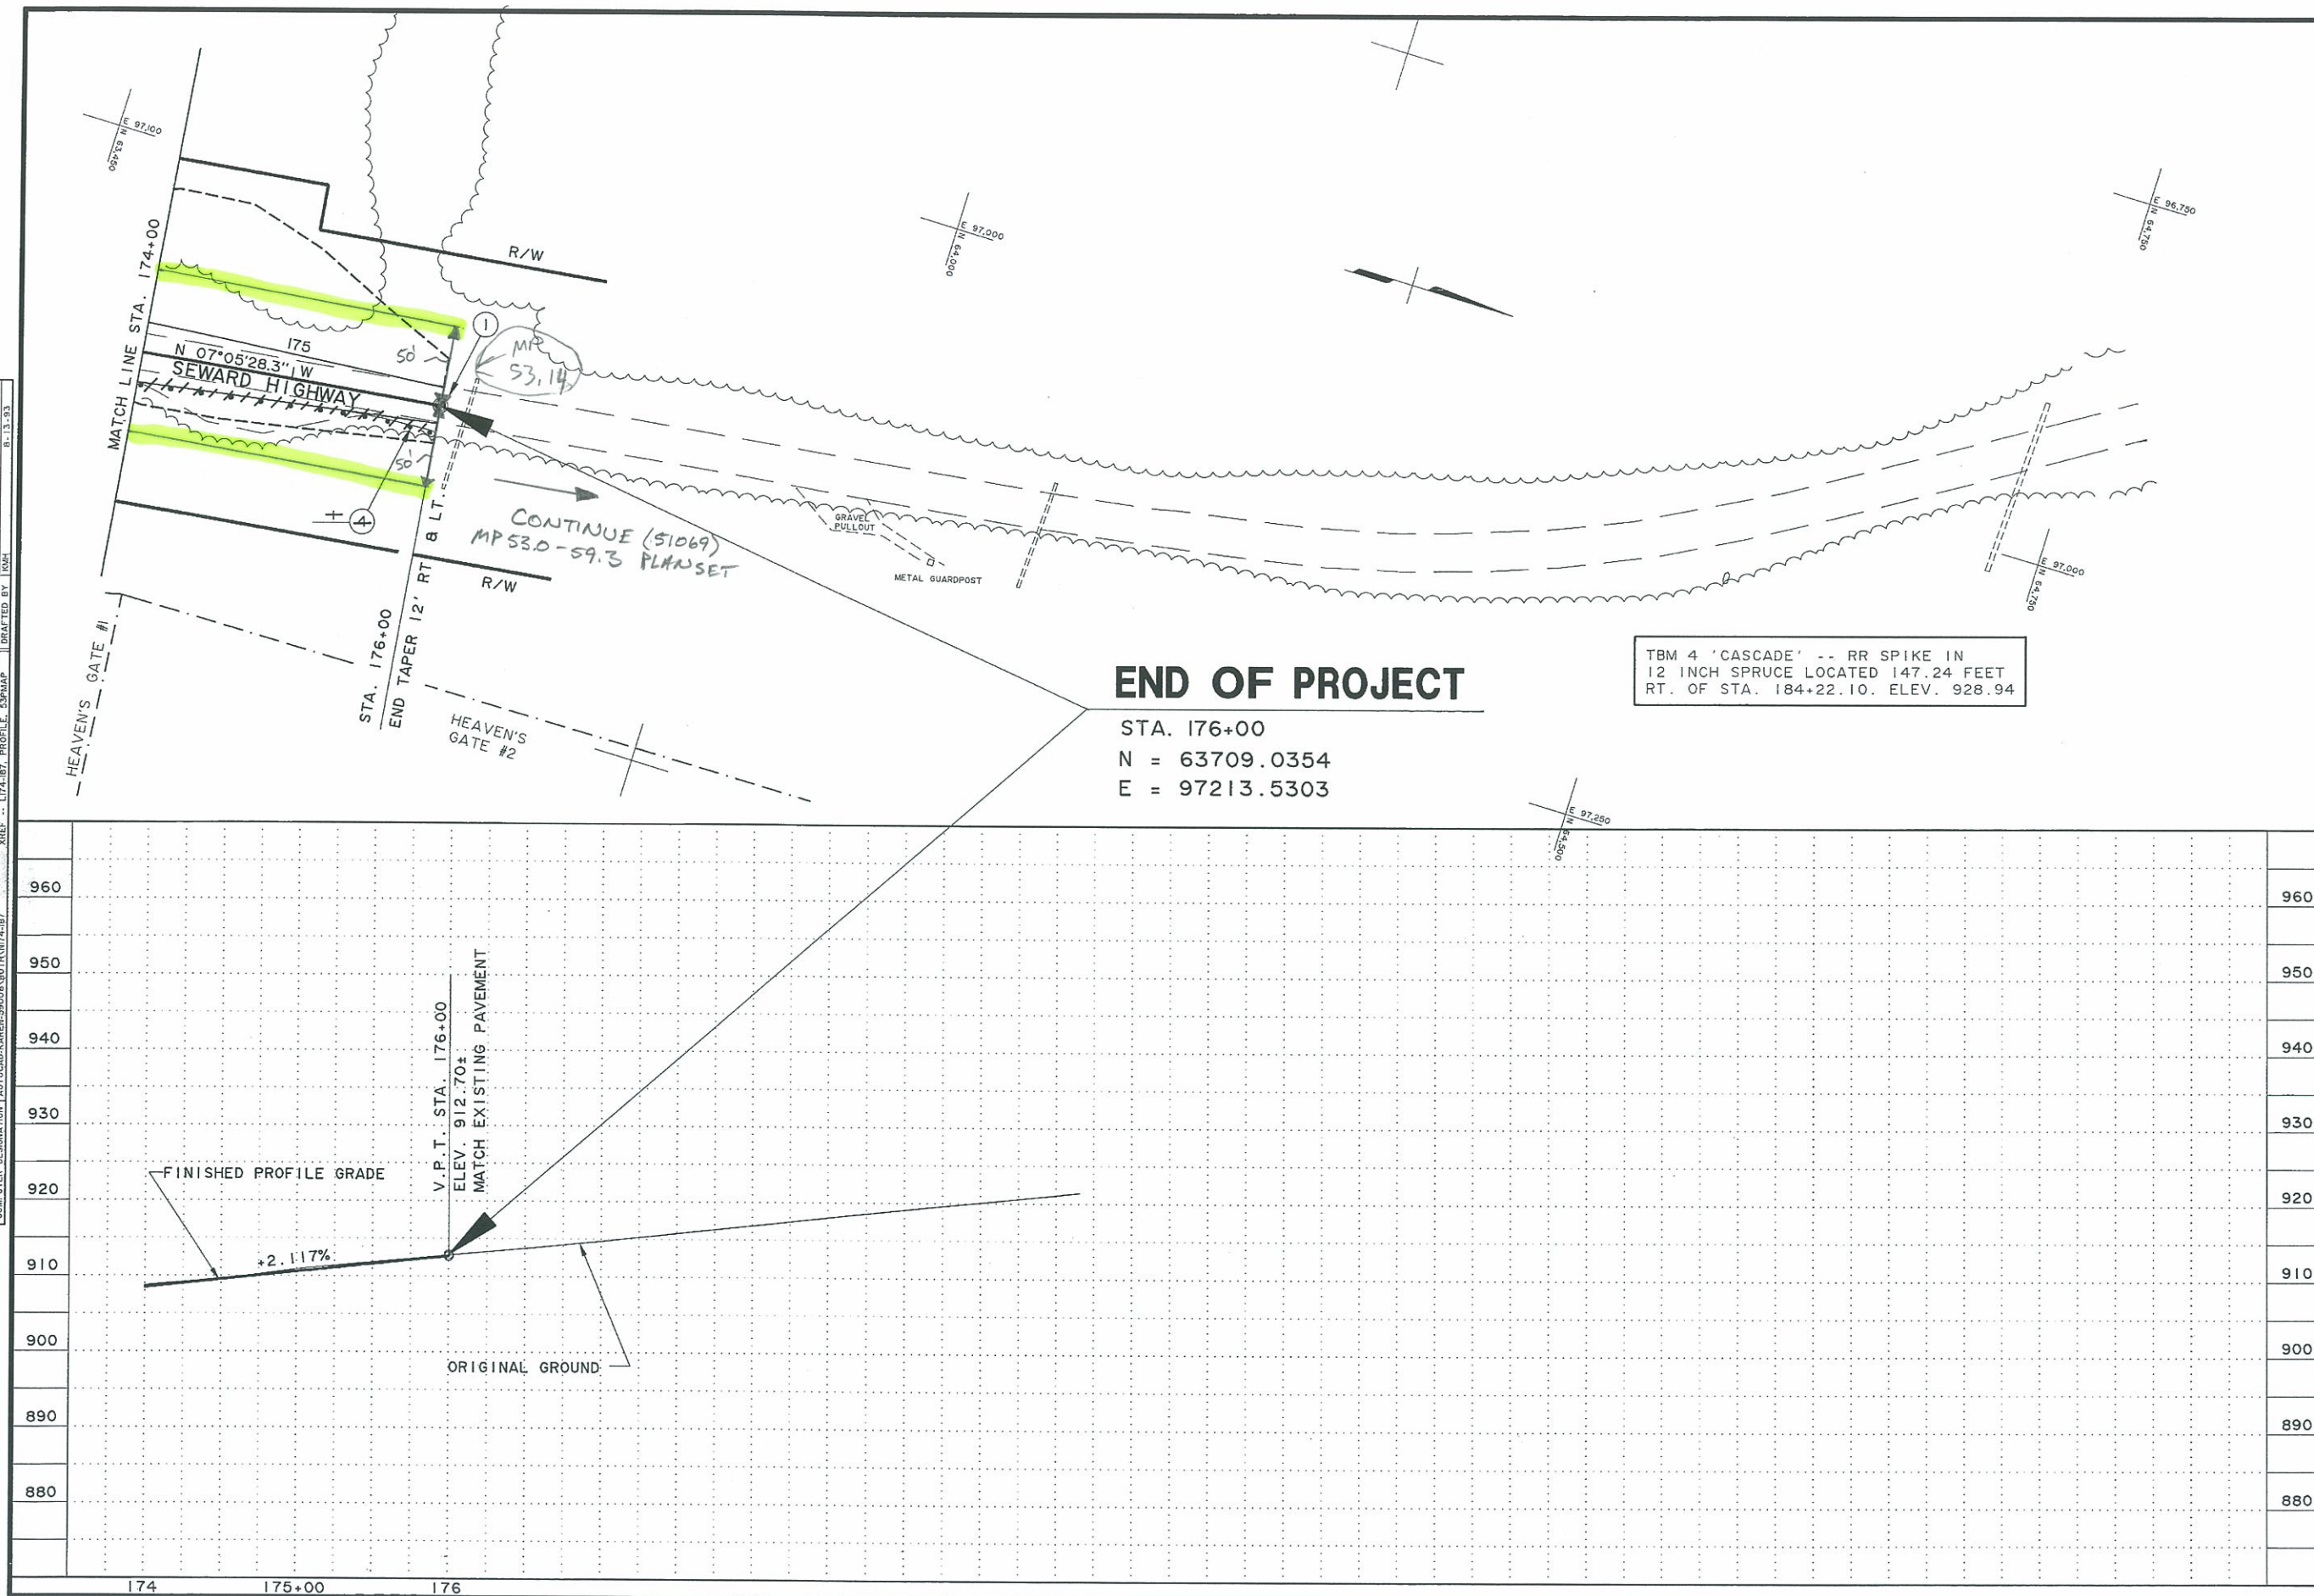

SHEET NO.		TOTAL SHEETS	
F 14		71	
STATE		YEAR	
ALASKA		1993	
PROJECT DESIGNATION			
IM-0A3-2(8)			
ADDENDUM NO.			
ATTACHMENT NO.			
REVISIONS			
NO.	DATE	DESCRIPTION	

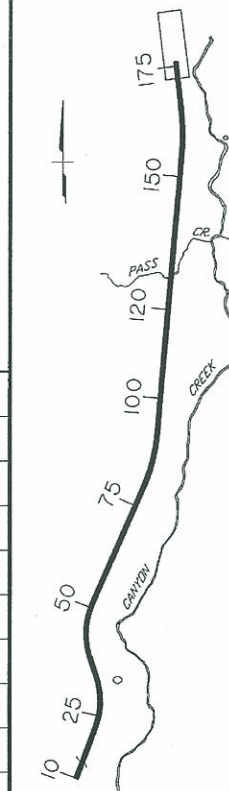


STATE OF ALASKA
DEPARTMENT OF TRANSPORTATION
AND
PUBLIC FACILITIES
SEWARD HIGHWAY
M.P. 50 TO M.P. 53

Q:\P\5000\01\DATA\559P15 THU Nov 2 15:49:23 1995 karen - AutoCAD 12
HP DesignJet 500 C Macintosh DVI HPB2.0 DUTROMA.CPS II HP-GL/2 ADI 4.2 Ver 2.0 - by Hamlet-Packard

FOR PURPOSE
OF THIS DWG
USE 7+000M
AS MP 53


DESIGNED BY	CM	11-2-95
CHECKED BY	CM	
DRAFTED BY	CM	
DATE	11-2-95	
SCALE	1"=5'	
COMPUTER DESIGNATION	101	
SPECIFICATIONS	AUTOCAD-KAREN-SIDORS DATA 159P	

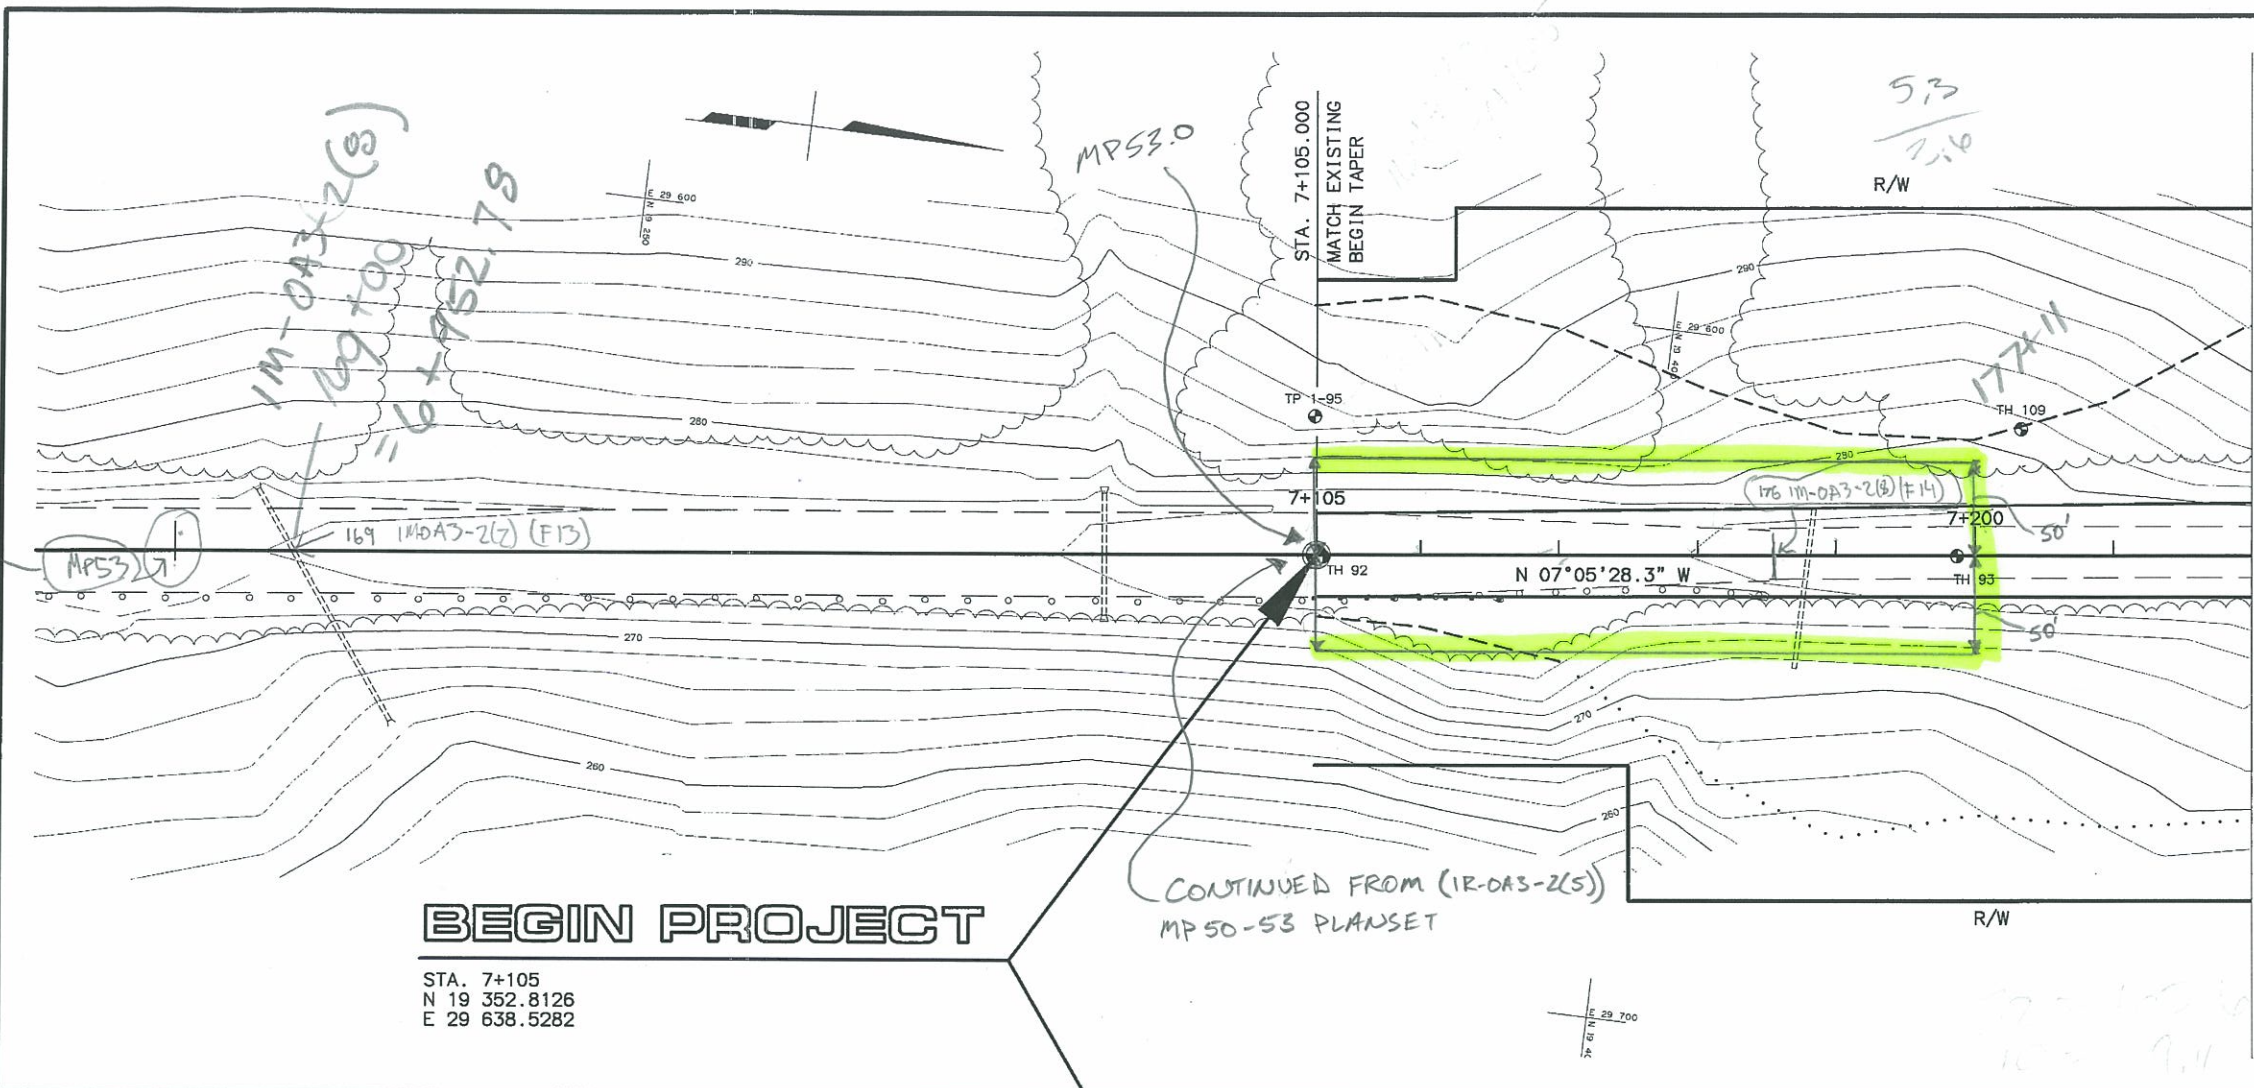

BEGIN PROJECT

STA. 7+105
N 19 352.8126
E 29 638.5282

CONTINUED FROM (1R-0A3-2(5))
MP 50-53 PLANSET

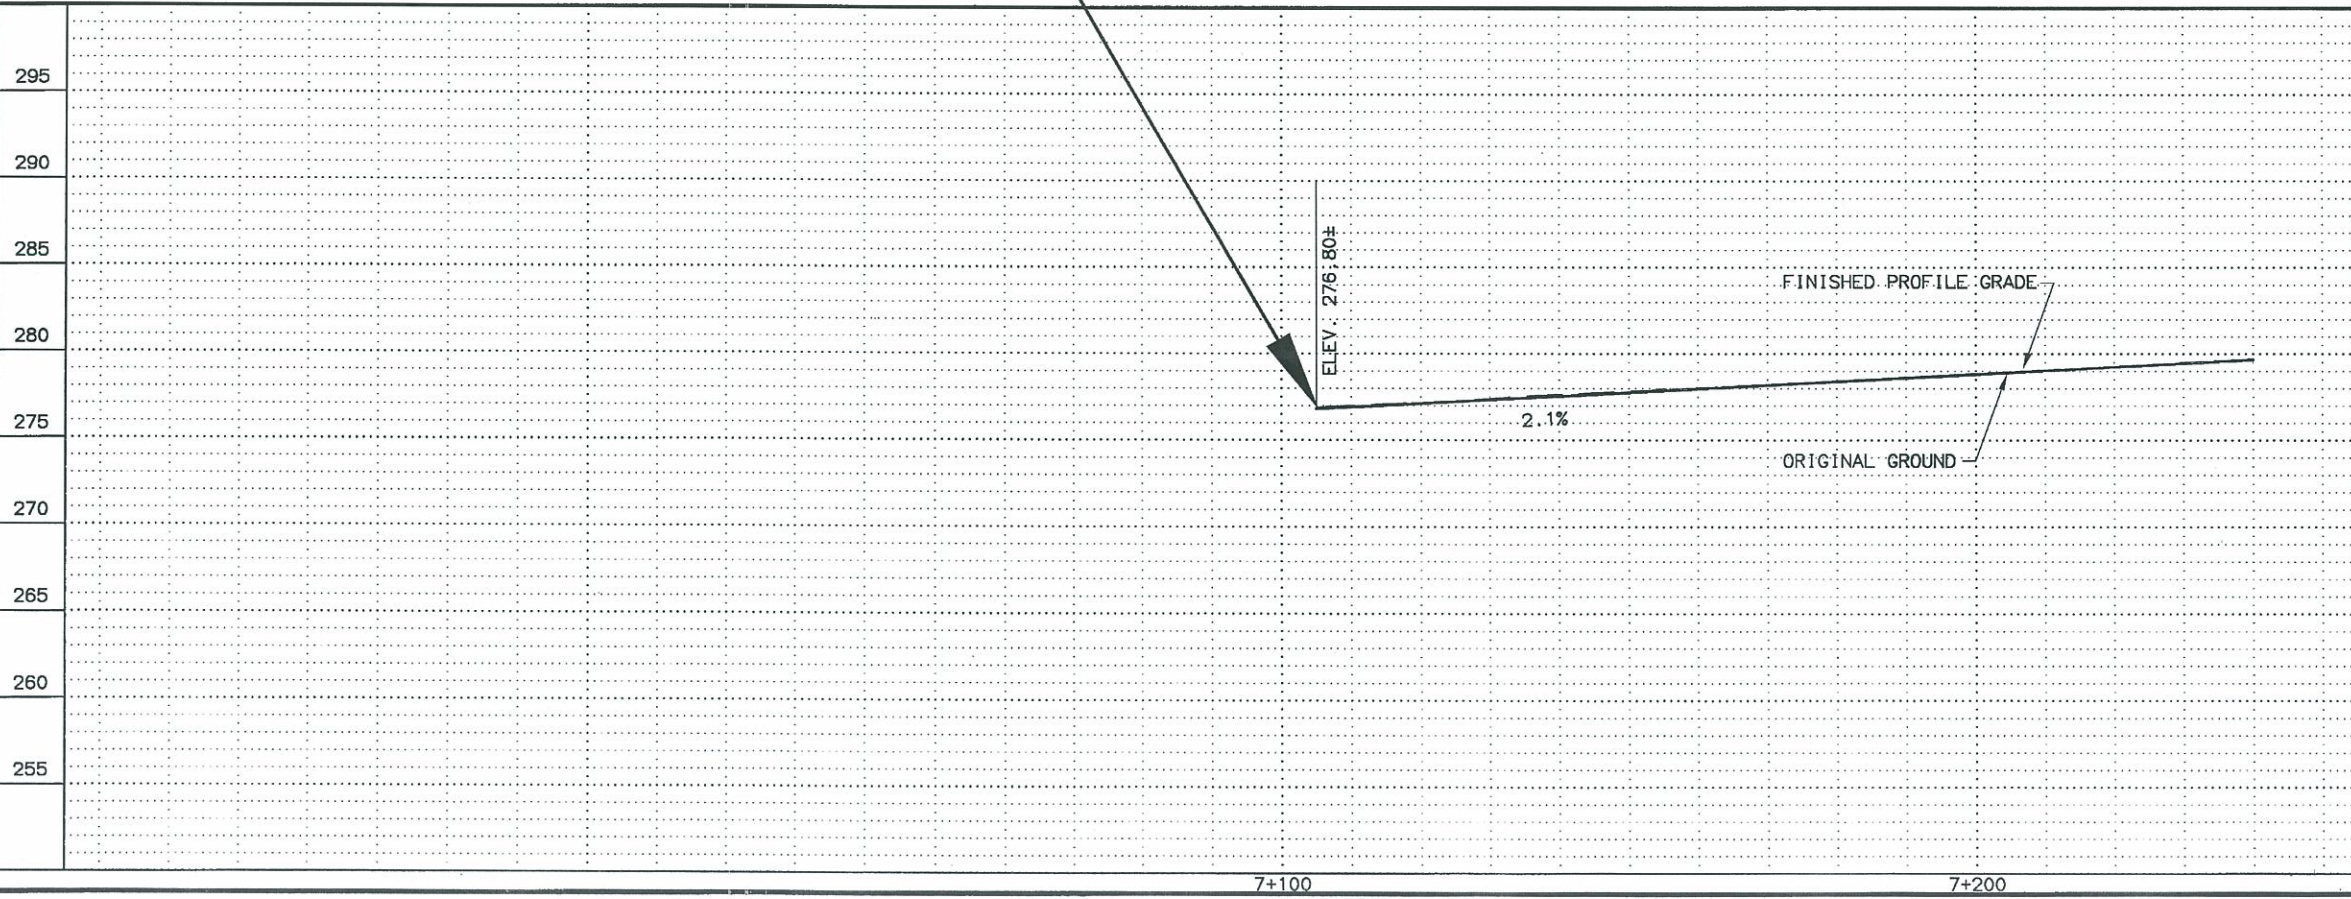


SHEET NO.		TOTAL SHEETS	
F1		187	
STATE		YEAR	
ALASKA		1995	
PROJECT DESIGNATION			
NH-BR-0A3-2(9)			
ADDENDUM NO.			
ATTACHMENT NO.			
REVISIONS			
NO.	DATE	DESCRIPTION	

NOTE:
DIMENSIONS ARE IN METERS
UNLESS OTHERWISE NOTED.

STATE OF ALASKA
DEPARTMENT OF TRANSPORTATION
AND
PUBLIC FACILITIES
SEWARD HIGHWAY
MILEPOST 53.0 TO 59.3
PLAN AND PROFILE


J:\AS000\DATA\550015 TH 112 2 15 50 18 1995 KERN - AUGUST 12
P:\Design\600 C:\MAD\2\UNIVERSITY\AS000\DATA\550015 TH 112 2 15 50 18 1995 KERN - AUGUST 12
P:\Design\600 C:\MAD\2\UNIVERSITY\AS000\DATA\550015 TH 112 2 15 50 18 1995 KERN - AUGUST 12

DESIGNED BY	NUM	11-2-95
CHECKED BY	KM	
DRAFTED BY	KM	
VIEW: SHOT		
SCALE: METRIC 1" = 3'		
COMPUTER DESIGNATION		

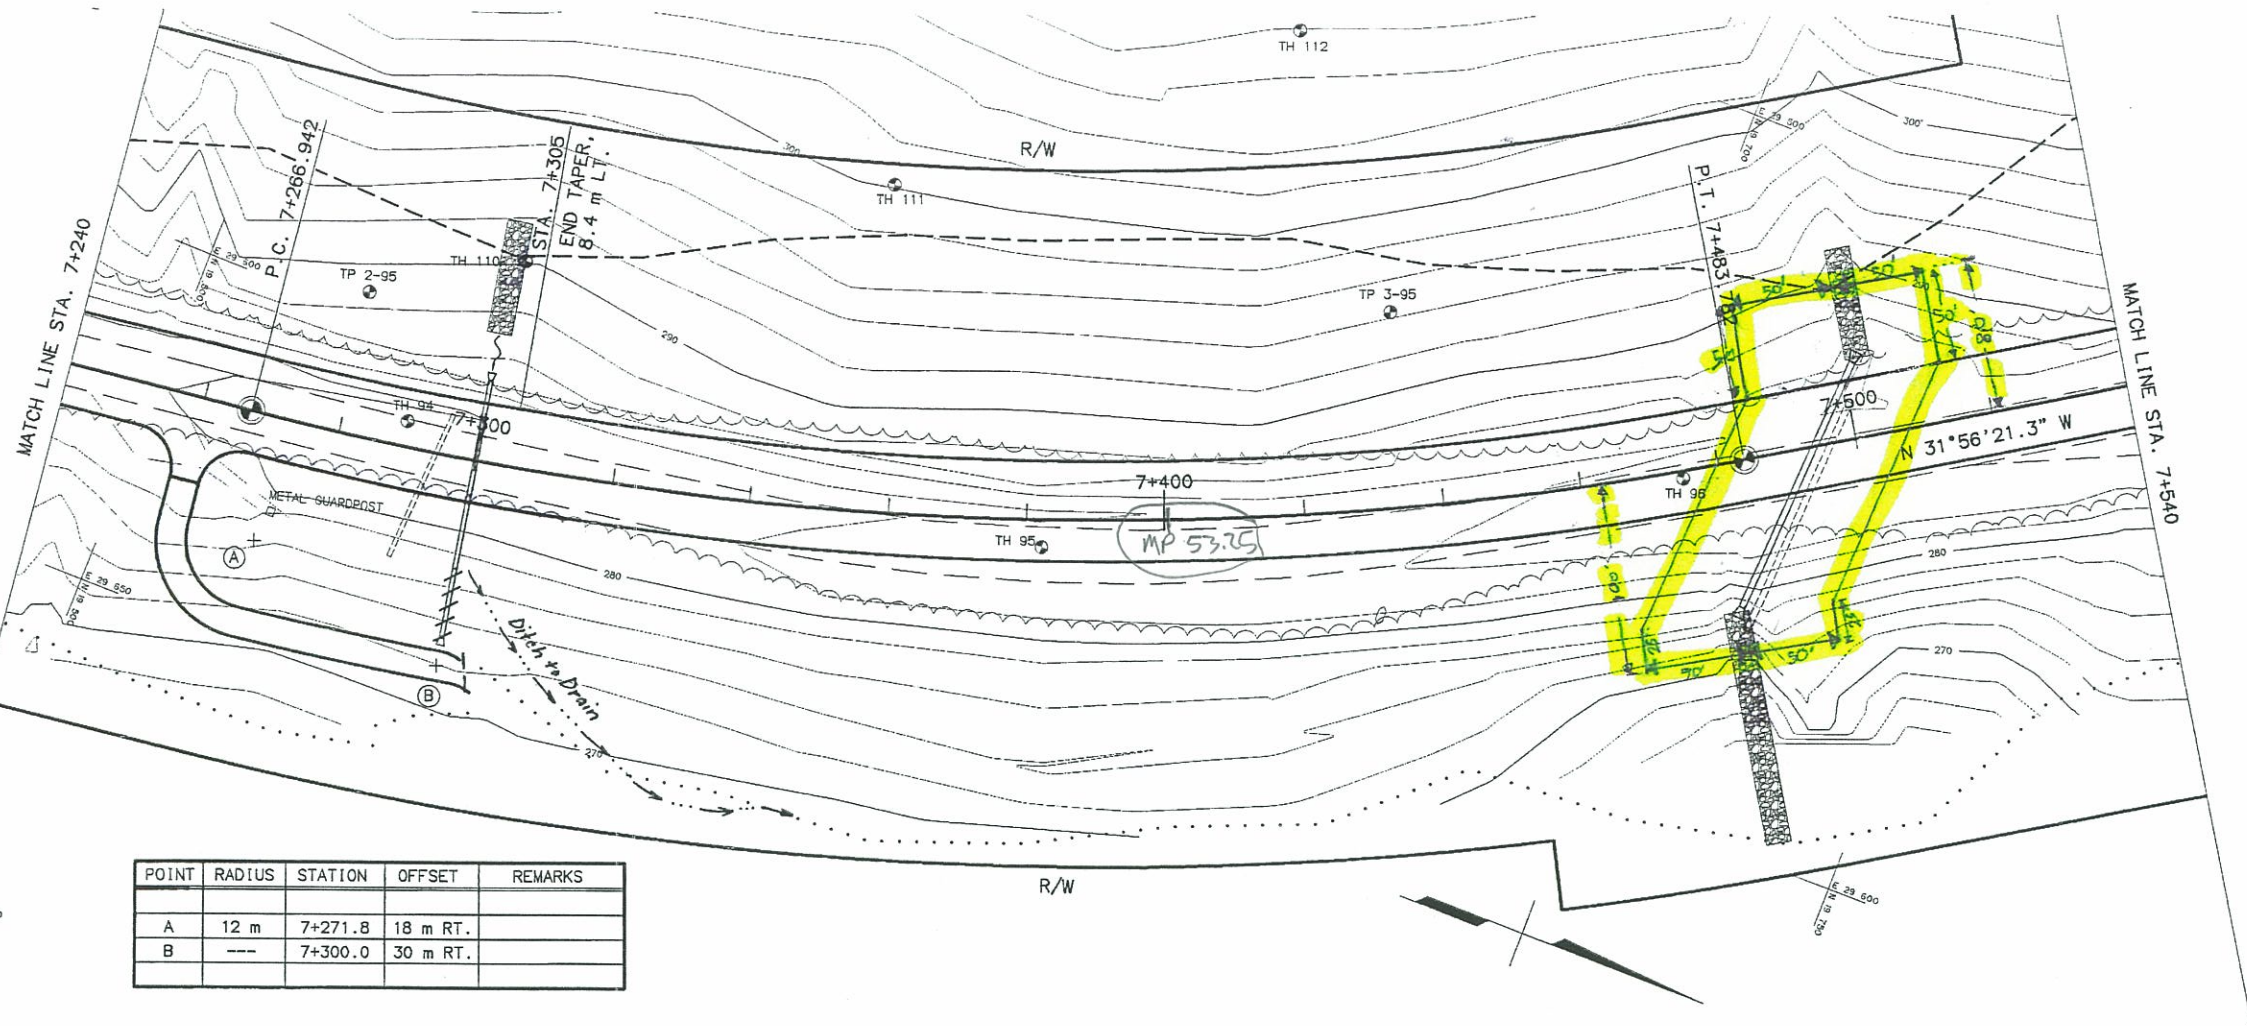

POINT	RADIUS	STATION	OFFSET	REMARKS
A	12 m	7+271.8	18 m RT.	
B	---	7+300.0	30 m RT.	


SHEET NO.	TOTAL SHEETS	
F2	187	
STATE	YEAR	
ALASKA	1995	
PROJECT DESIGNATION		
NH-BR-0A3-2(9)		
ADDENDUM NO.		
ATTACHMENT NO.		
REVISIONS		
NO.	DATE	DESCRIPTION

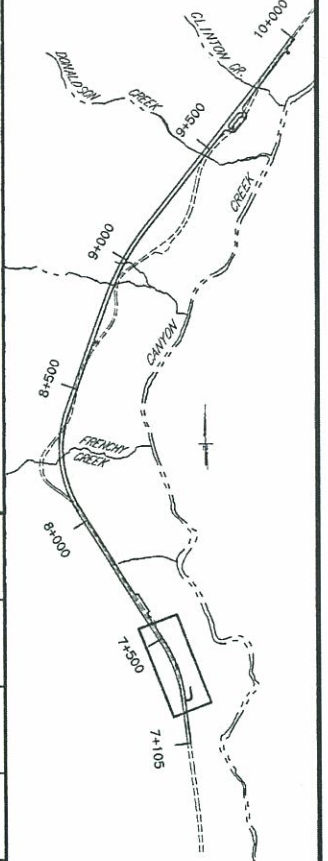

NOTE:
DIMENSIONS ARE IN METERS
UNLESS OTHERWISE NOTED.



STATE OF ALASKA
DEPARTMENT OF TRANSPORTATION
AND
PUBLIC FACILITIES
SEWARD HIGHWAY
MILEPOST 53.0 TO 59.3
PLAN AND PROFILE

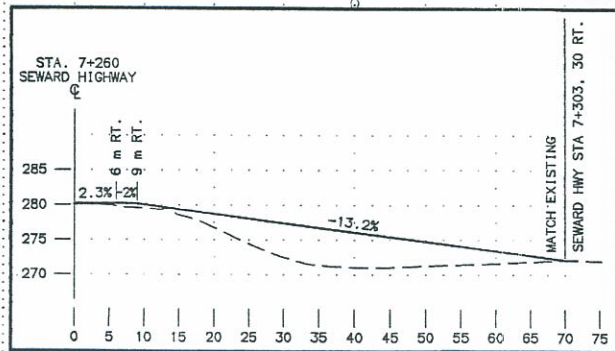


PIPE INSTALLATION SUMMARY									
STATION	SKIEW	DIAMETER (mm)	INLET ELEV. (m)	OUTLET ELEV. (m)	LENGTH (m)	% GRADE	END SECTION	DOUBLE THAW PIPE (m)	REMARKS
7+300.00	-	600	279.66	272.26	19.68	18.63	2	20.84	
7+493.97	35° LT	900	283.68	281.92	38.19	4.23	2	39.12	

D:\PROJECTS\001\1359915_Thu Nov 2 15:51:10 1995 Karen - Autocad 12
HP DesignPlot 600 C:\MCD\12\HP\PLT\001\001A.CFG 11 HP-GL/2 ADI 4.2 Ver 2.0 - by Hinkley-Packard

DESIGNED BY: KMM
CHECKED BY: KMM
DRAWN BY: KMM
VIEW: SITE
AUTOCAD-KAREN-3000B-DATA\SHPP
SCALE - METRIC 1"=5'
COMPUTER DESIGNATION


MATCH LINE STA. 7+540

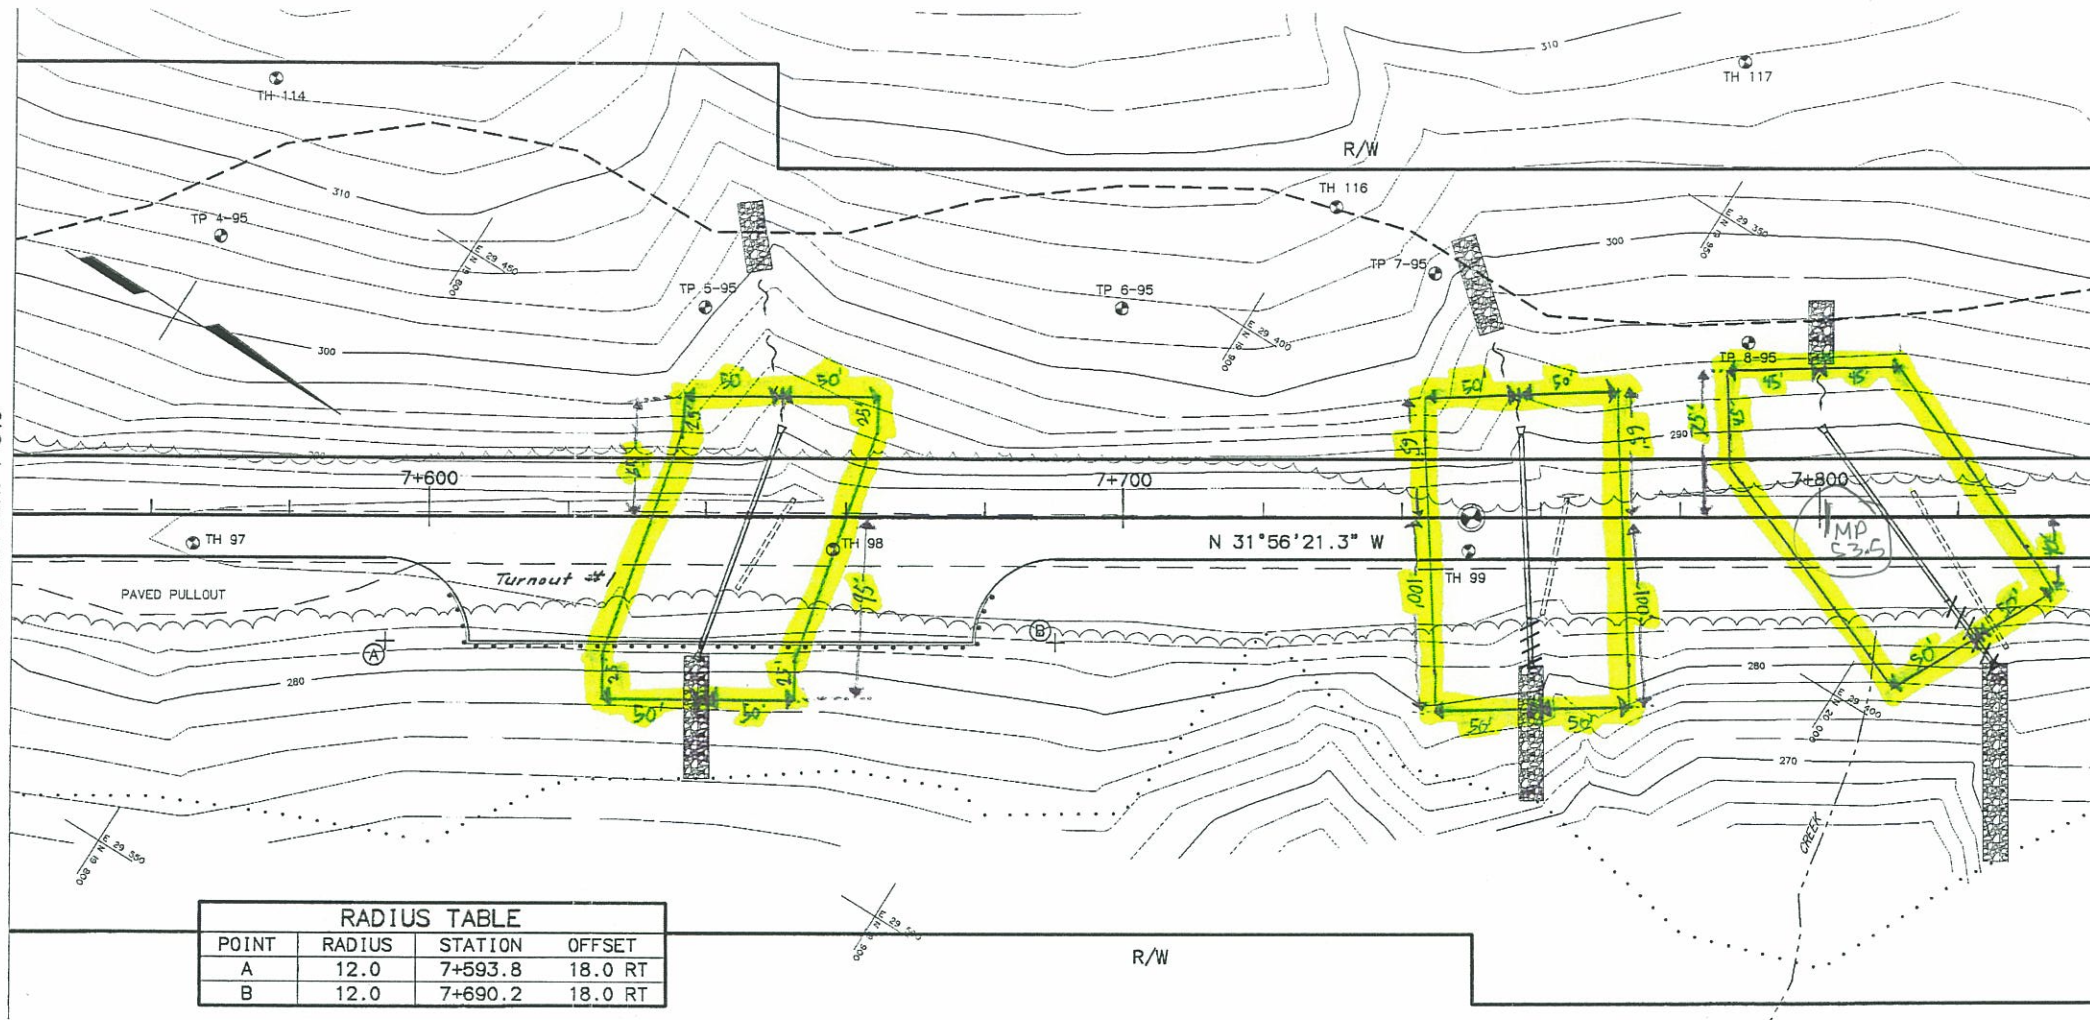

RADIUS TABLE			
POINT	RADIUS	STATION	OFFSET
A	12.0	7+593.8	18.0 RT
B	12.0	7+690.2	18.0 RT

MATCH LINE STA. 7+840

SHEET NO.	TOTAL SHEETS	
F3	187	
STATE	YEAR	
ALASKA	1995	
PROJECT DESIGNATION		
NH-BR-0A3-2(9)		
ADDENDUM NO.		
ATTACHMENT NO.		
REVISIONS		
NO.	DATE	DESCRIPTION

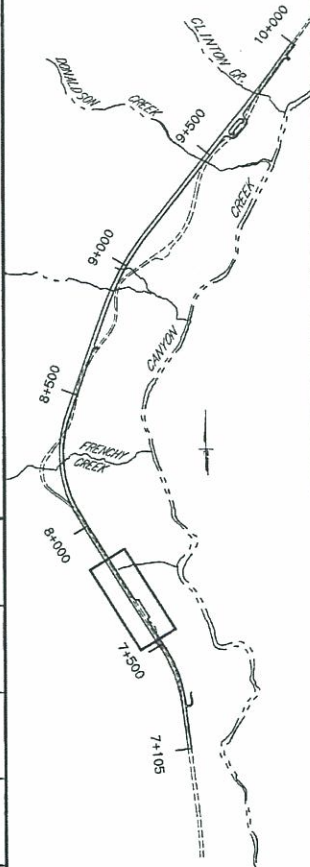


NOTE:
DIMENSIONS ARE IN METERS
UNLESS OTHERWISE NOTED.



STATE OF ALASKA
DEPARTMENT OF TRANSPORTATION
AND
PUBLIC FACILITIES

SEWARD HIGHWAY
MILEPOST 53.0 TO 59.3
PLAN AND PROFILE

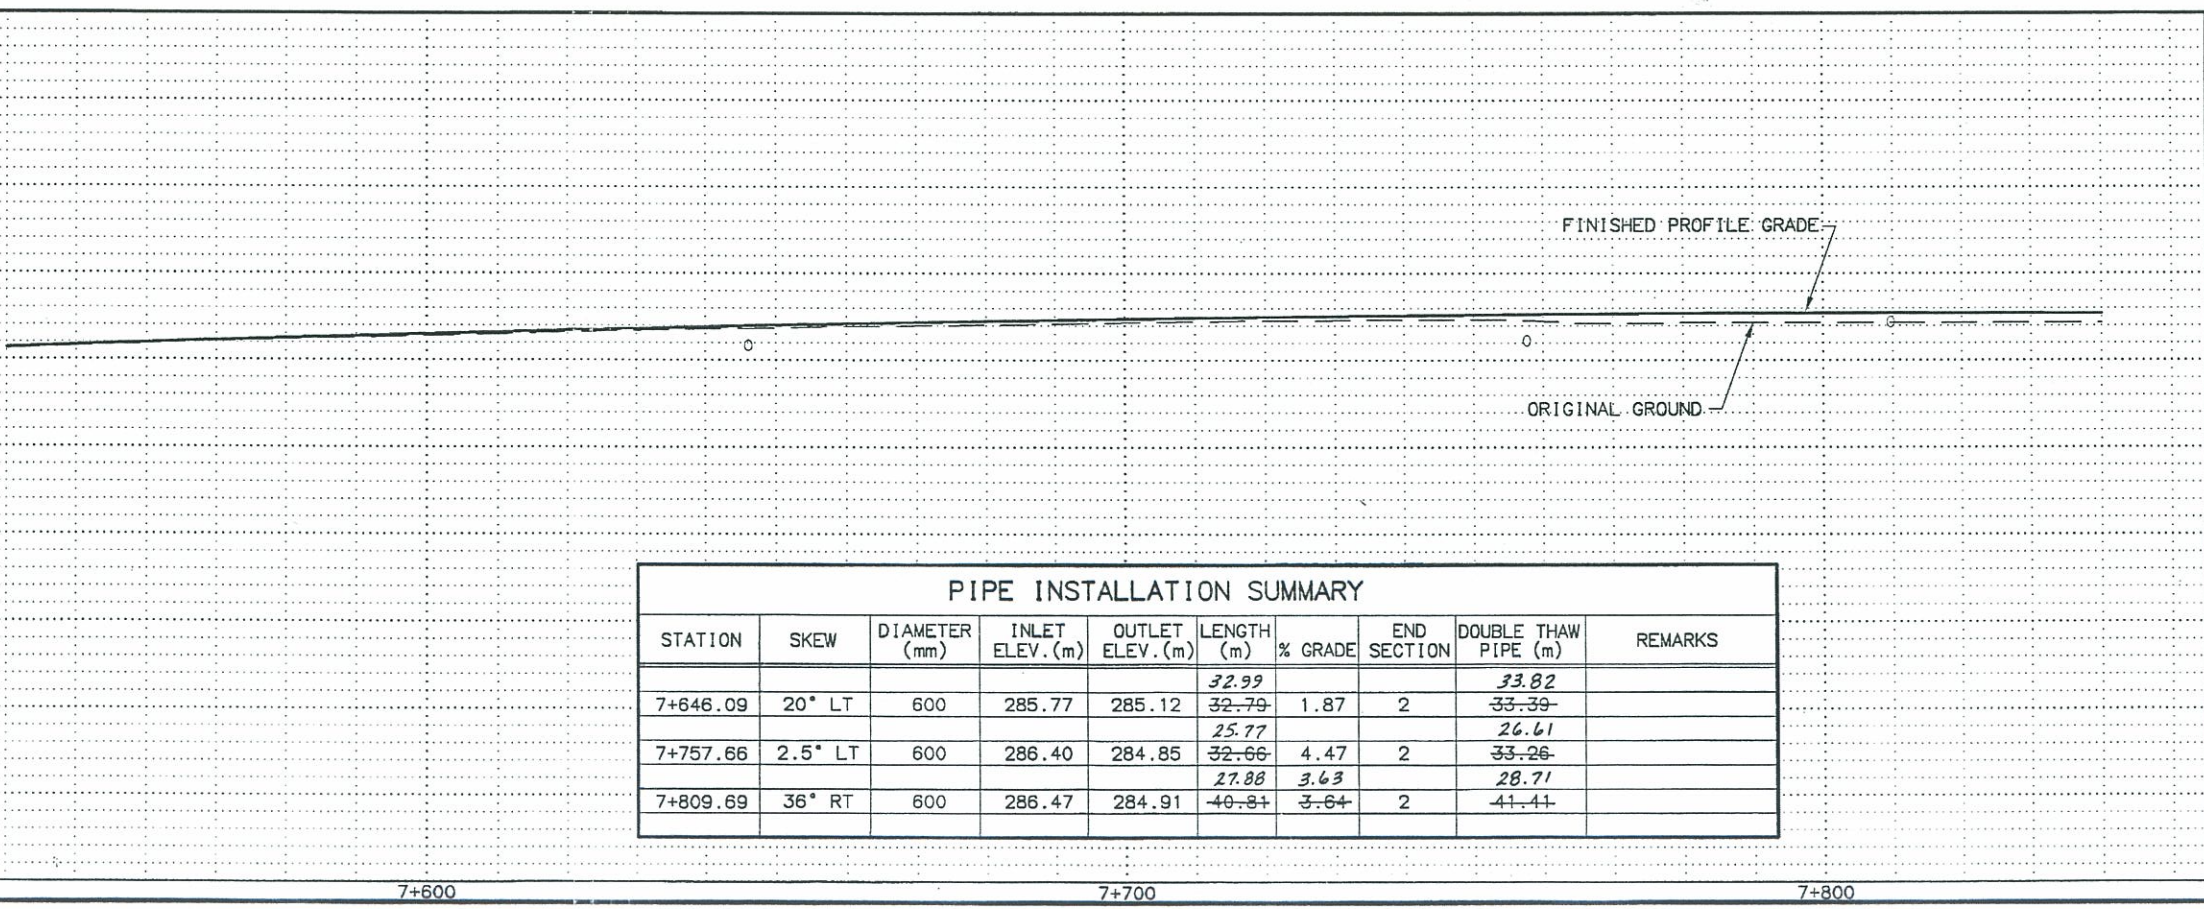


PIPE INSTALLATION SUMMARY									
STATION	SKEW	DIAMETER (mm)	INLET ELEV. (m)	OUTLET ELEV. (m)	LENGTH (m)	% GRADE	END SECTION	DOUBLE THAW PIPE (m)	REMARKS
7+646.09	20° LT	600	285.77	285.12	32.99	1.87	2	33.82	
7+757.66	2.5° LT	600	286.40	284.85	32.66	4.47	2	33.26	
7+809.69	36° RT	600	286.47	284.91	40.84	3.63	2	41.41	



STATE OF ALASKA
DEPARTMENT OF TRANSPORTATION
AND
PUBLIC FACILITIES


SEWARD HIGHWAY
MILEPOST 53.0 TO 59.3
PLAN AND PROFILE

PIPE INSTALLATION SUMMARY									
STATION	SKEW	DIAMETER (mm)	INLET ELEV. (m)	OUTLET ELEV. (m)	LENGTH (m)	% GRADE	END SECTION	DOUBLE THAW PIPE (m)	REMARKS
			285.89	284.41	26.77	5.02		27.65	
7+918.85	4.5° LT	600	286.09	283.76	32.78	6.71	2	33.38	
					28.76	5.10		29.61	
7+965.80	6.5° RT	600	285.78	283.68	42.92	4.67	2	43.52	
					41.90	5.74		42.73	
8+028.41	10° RT	600	285.45	282.67	48.44	5.61	2	49.04	

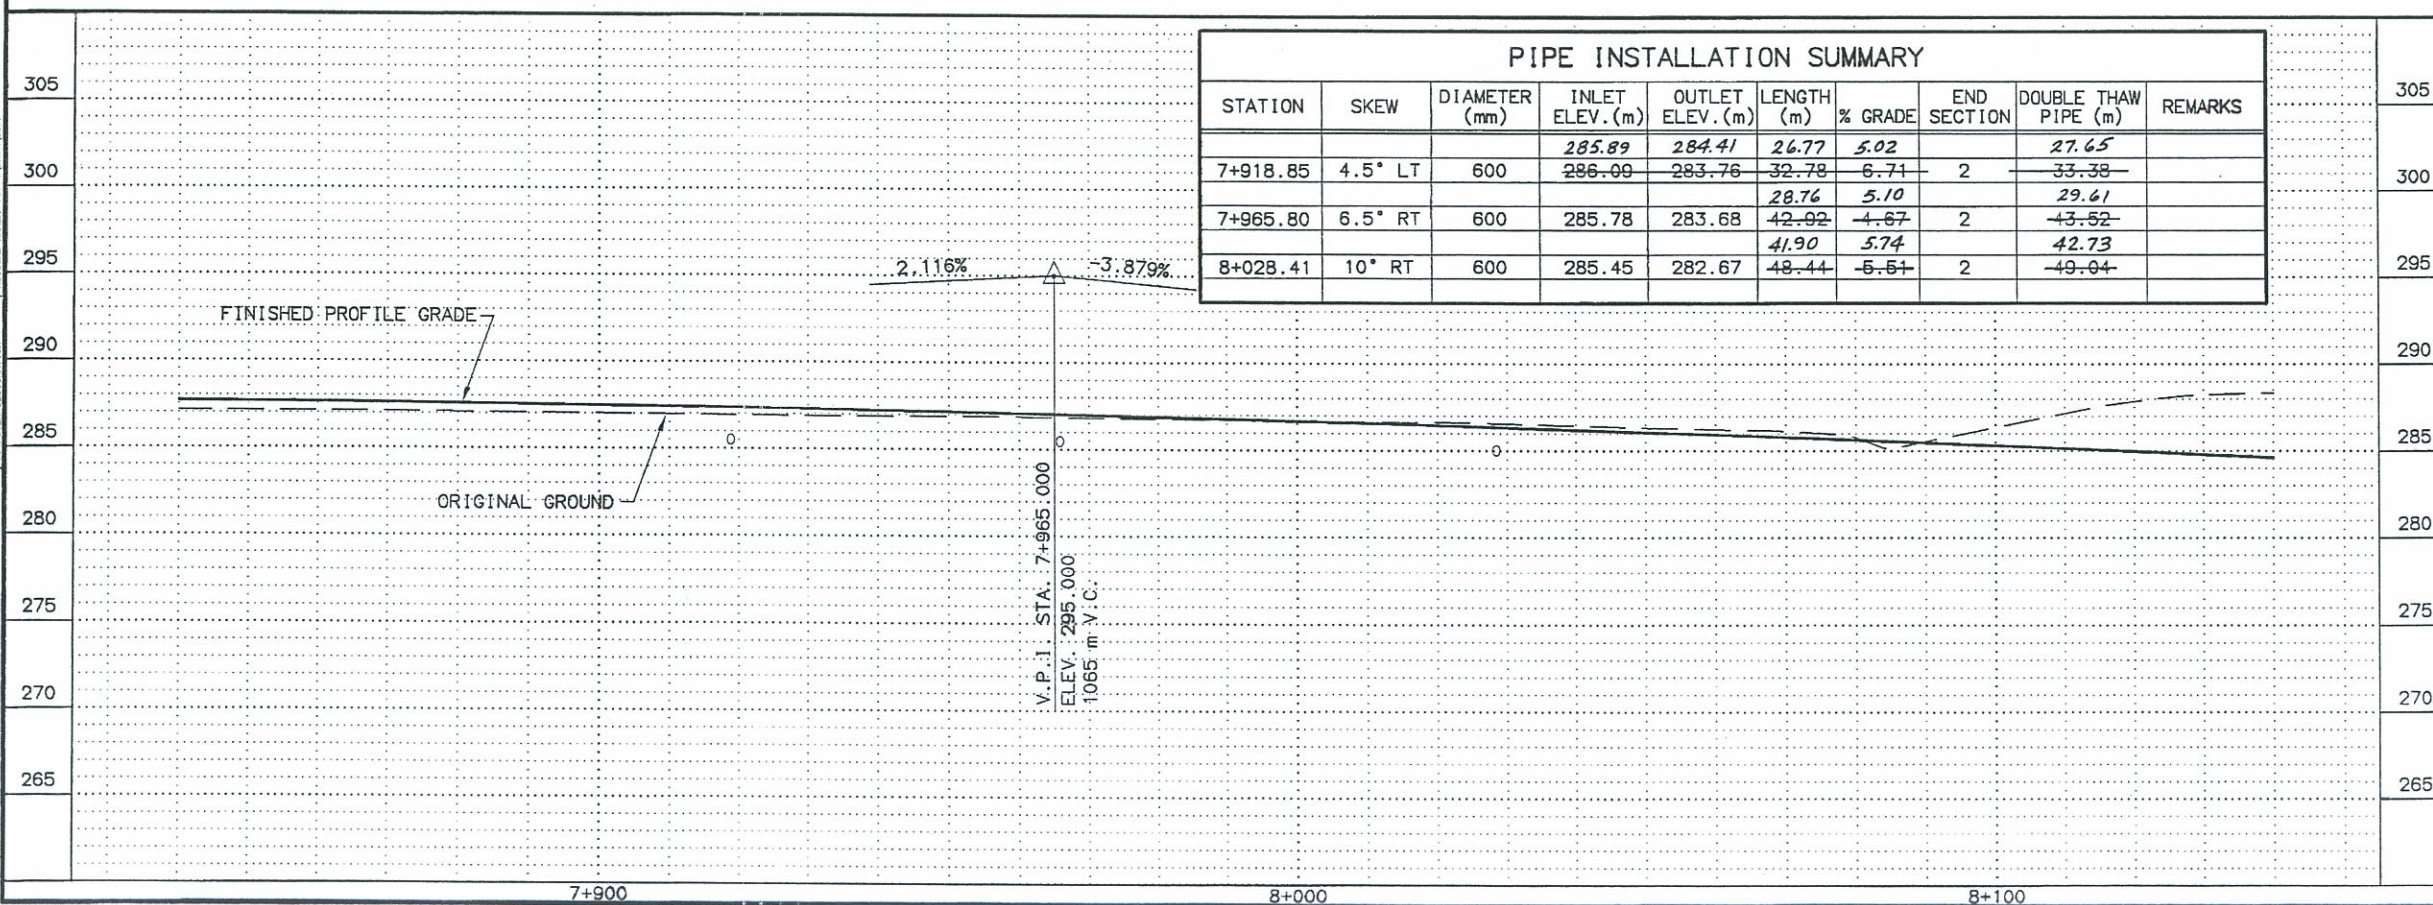


D:\PROJECTS\DATA\59715 - THE HWY 2 SE 53 TO 59.3 KAREN - AUTOCAD 12
HP DesignPlot 600 C:\MCD\2\DATA\59715\HP-612\AUT 4.2 Ver 2.0 - by Hewlett-Packard

DESIGNED BY	11-2-95
CHECKED BY	
DRAFTED BY	
VIEW* SITUATION	
SCALE - METRIC	
COMPUTER DESIGNATION	

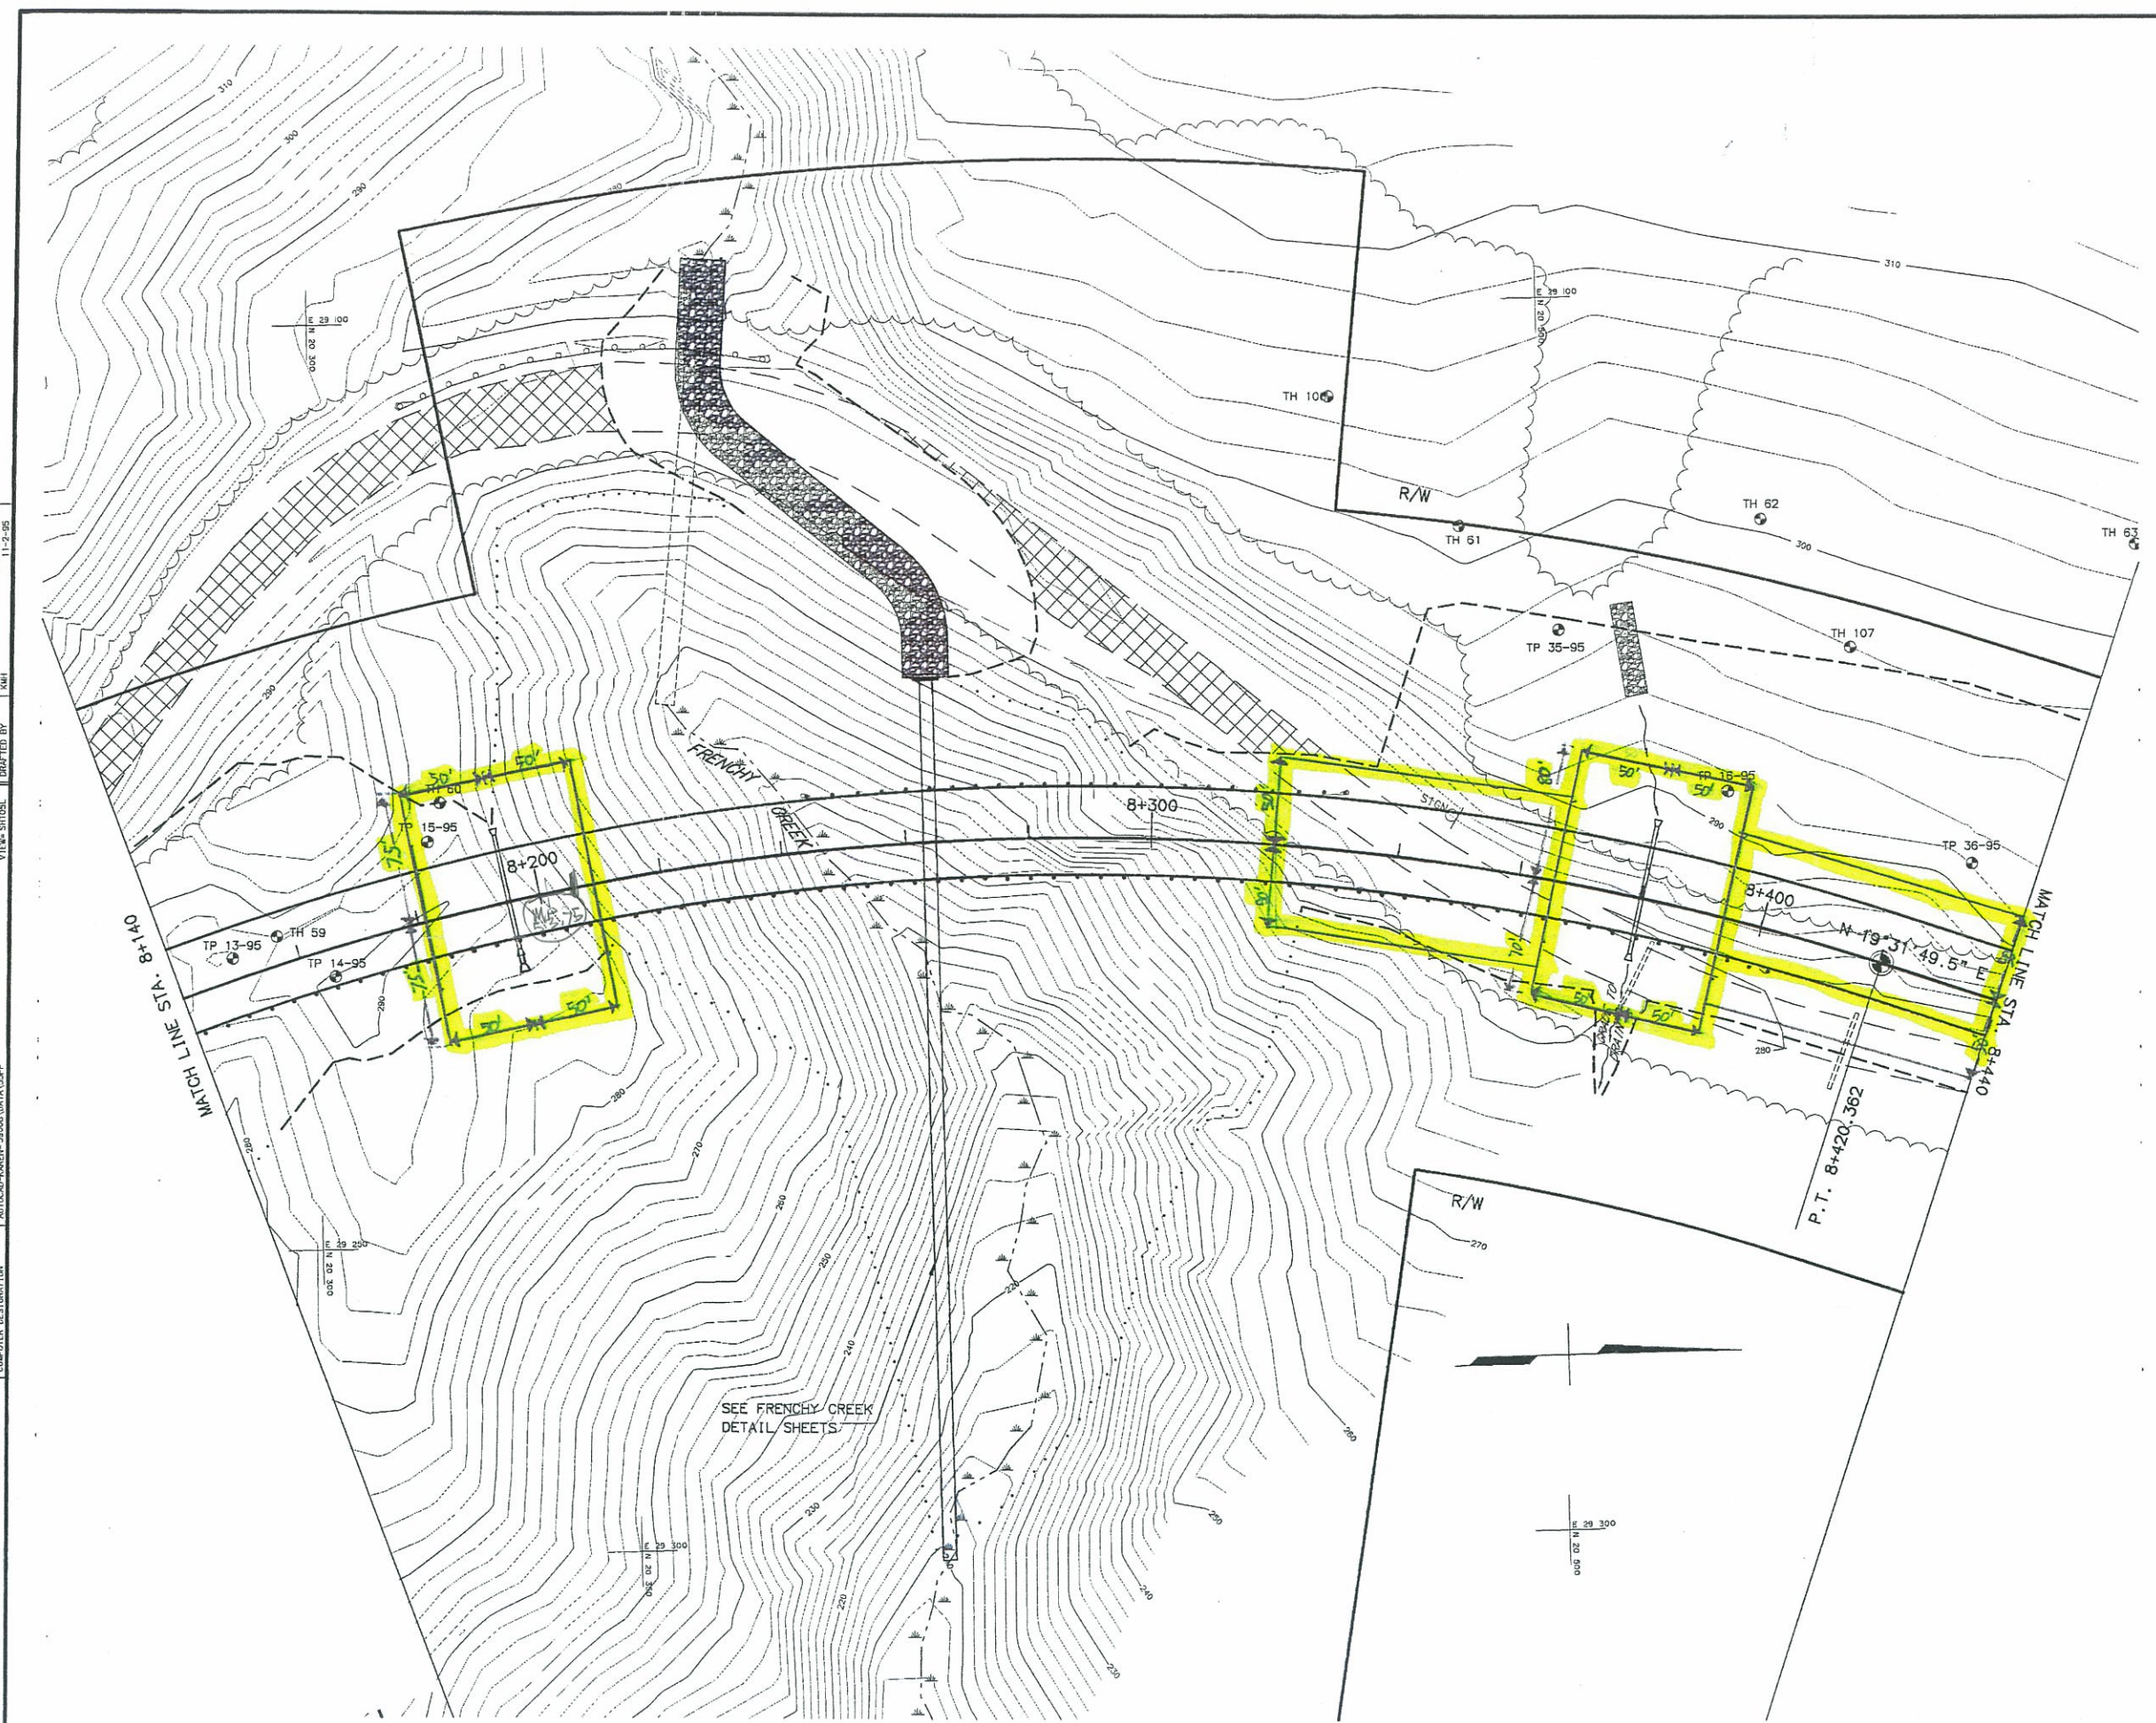

SHEET NO.	TOTAL SHEETS	
F5	187	
STATE	YEAR	
ALASKA	1995	
PROJECT DESIGNATION		
NH-BR-0A3-2(9)		
ADDENDUM NO.		
ATTACHMENT NO.		
REVISIONS		
NO.	DATE	DESCRIPTION


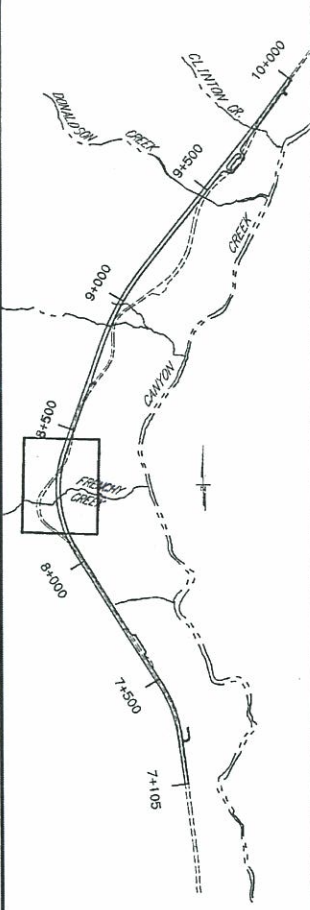


NOTE:
DIMENSIONS ARE IN METERS
UNLESS OTHERWISE NOTED.



STATE OF ALASKA
DEPARTMENT OF TRANSPORTATION
AND
PUBLIC FACILITIES

SEWARD HIGHWAY
MILEPOST 53.0 TO 59.3
PLAN AND PROFILE

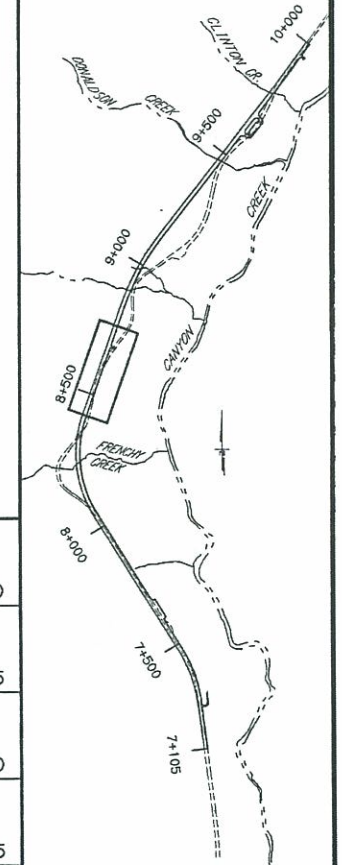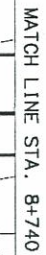


NOTE:
DIMENSIONS ARE IN METERS
UNLESS OTHERWISE NOTED.



STATE OF ALASKA
DEPARTMENT OF TRANSPORTATION
AND
PUBLIC FACILITIES


SEWARD HIGHWAY
MILEPOST 53.0 TO 59.3
PLAN AND PROFILE

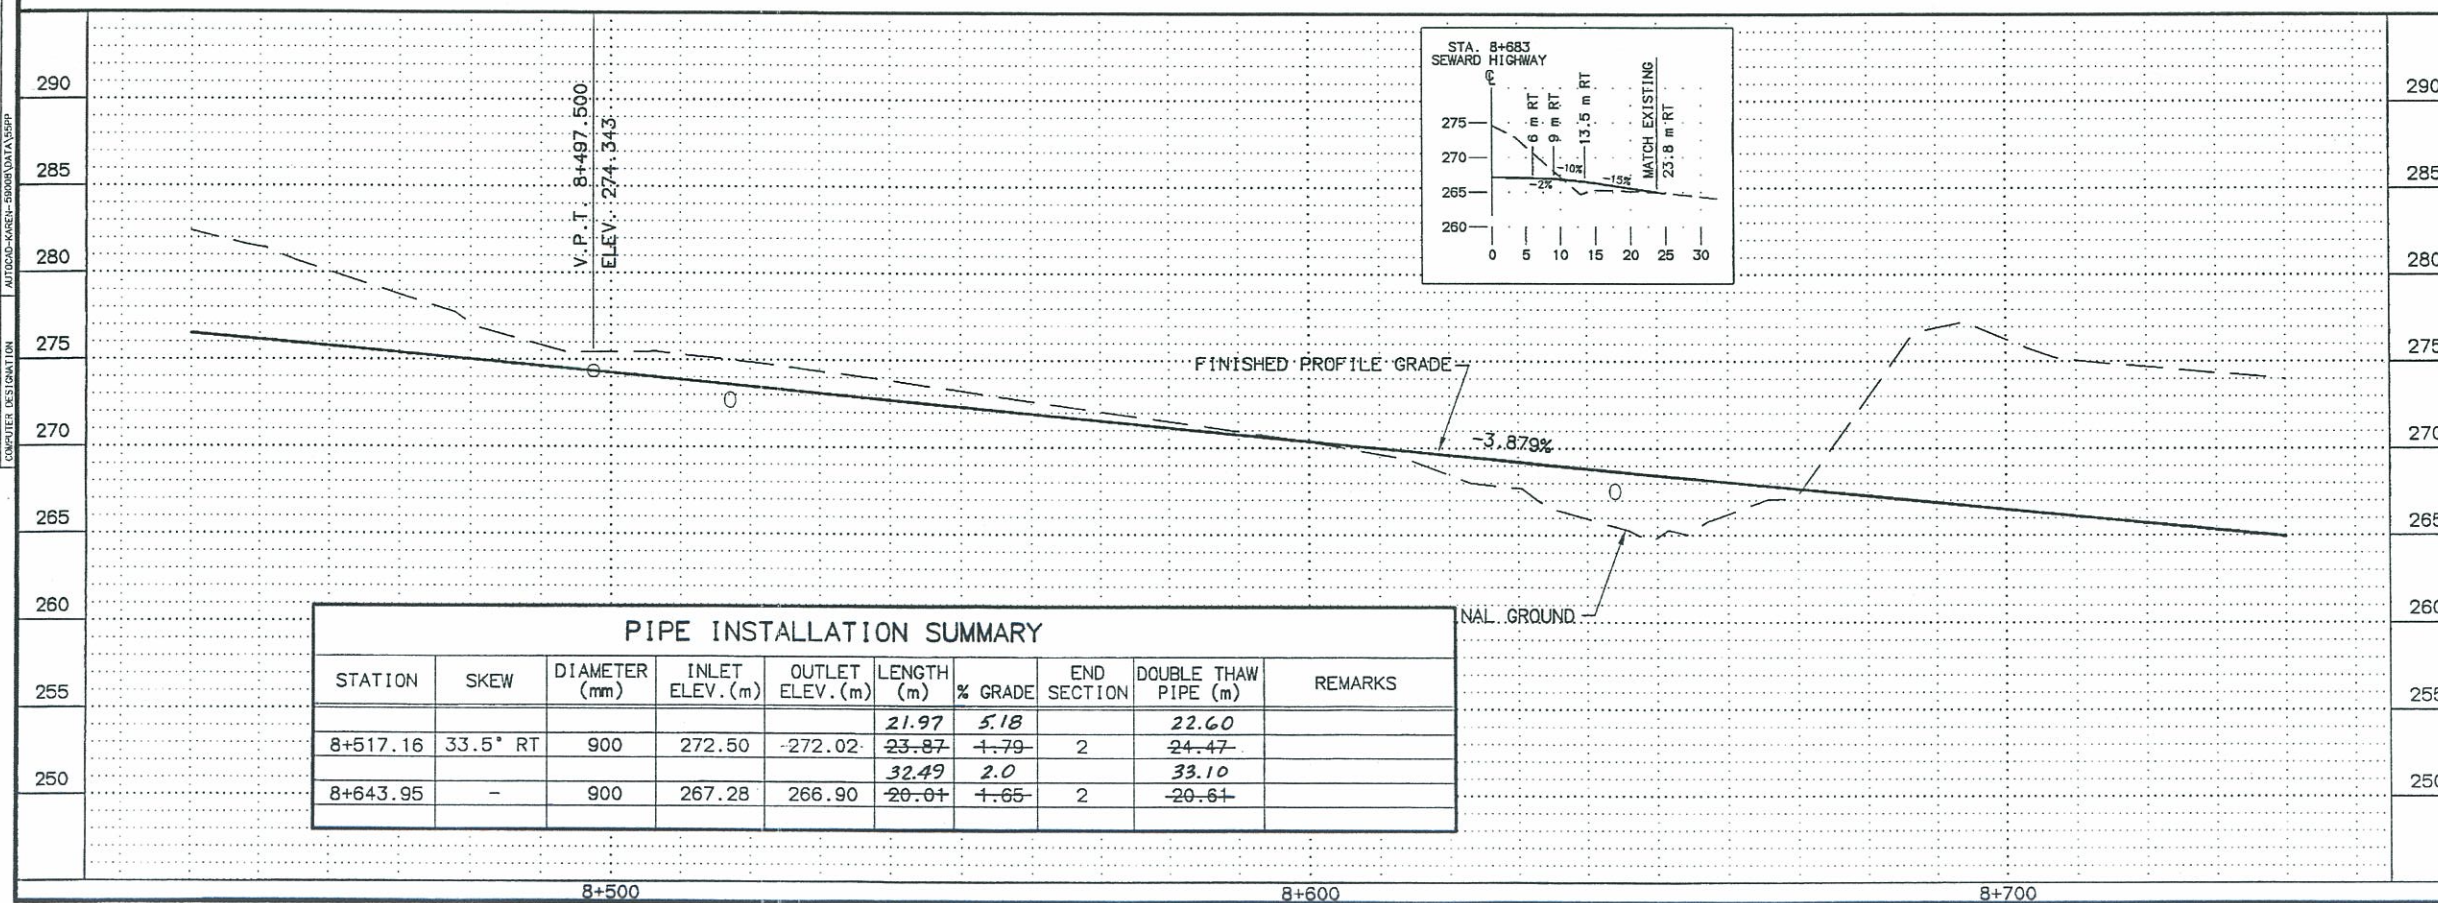


\\PVS008\DATA\5509P15 Thu Nov 2 15:55:18 1995 Karen - AutoCad 12
3 Designat: 600 C:\MAD\2\DRW\14\141000A.DWG 1: HP-GL/2 ADI 4.2 Ver. 2.0 - by Hewlett-Packard

VIEW: SHOTS	SCALE: 1"=5'	COMPUTER DESIGNATION
DESIGNED BY: KMM	SCALE: 1"=5'	COMPUTER DESIGNATION
DRAWN BY: KMM	SCALE: 1"=5'	COMPUTER DESIGNATION
CHECKED BY: KMM	SCALE: 1"=5'	COMPUTER DESIGNATION
DATE: 11-2-95	SCALE: 1"=5'	COMPUTER DESIGNATION


MATCH LINE STA. 8+740

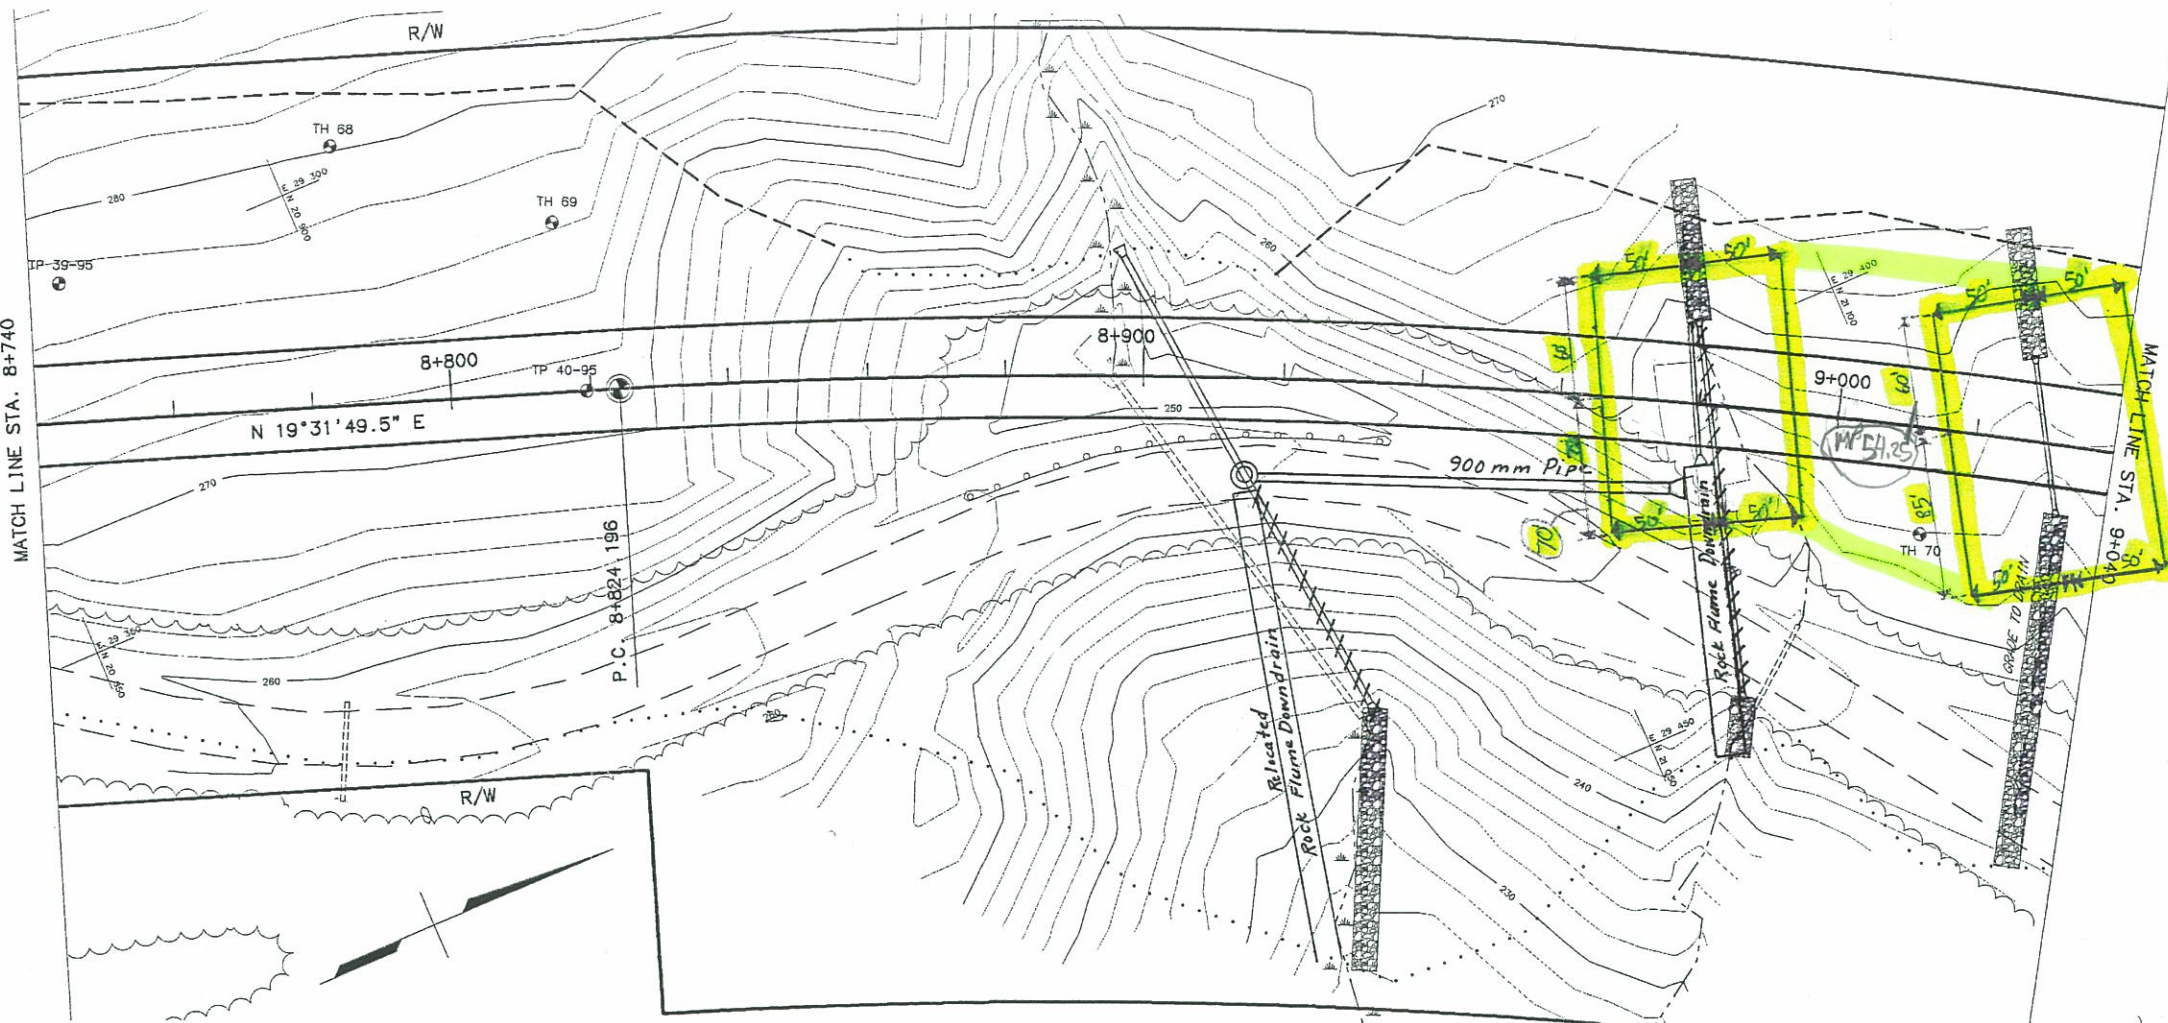

SHEET NO.	TOTAL SHEETS	
F8	187	
STATE	YEAR	
ALASKA	1995	
PROJECT DESIGNATION		
NH-BR-0A3-2(9)		
ADDENDUM NO.		
ATTACHMENT NO.		
REVISIONS		
NO.	DATE	DESCRIPTION

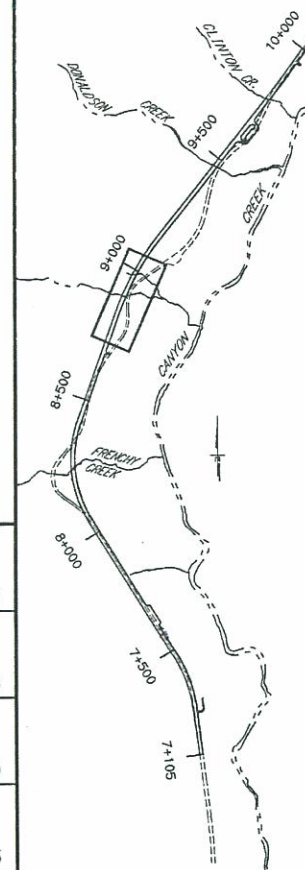

PIPE INSTALLATION SUMMARY									
STATION	SKEW	DIAMETER (mm)	INLET ELEV. (m)	OUTLET ELEV. (m)	LENGTH (m)	% GRADE	END SECTION	DOUBLE THAW PIPE (m)	REMARKS
8+906.61	30° RT	900	252.13	249.20	58.63	4.00	1	59.46	Sec C.O.# 14
8+981.32	11.5° RT	600	254.80	251.56	33.0	6.1	2	33.6	
9+030.06	15.5° RT	600	252.94	252.58	19.78	4.75	2	20.40	
8+890		600			17.0	2.00	2	N/A	

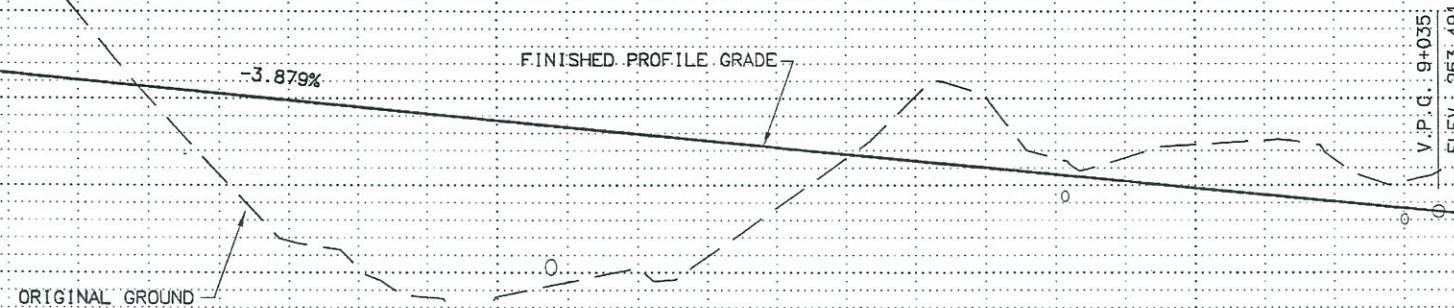

NOTE:
DIMENSIONS ARE IN METERS
UNLESS OTHERWISE NOTED.




STATE OF ALASKA
DEPARTMENT OF TRANSPORTATION
AND
PUBLIC FACILITIES
SEWARD HIGHWAY
MILEPOST 53.0 TO 59.3
PLAN AND PROFILE

\\FS0008\DATA\SSP\15 TH MAY 2 15:57:06 1995 karen - autocad 12
P:\Design\600 C:\ACAD\2000\VP\600\2\01\600A.CFG 1:1P-6/2 A01 4.2 Ver 2.0 - by Hewlett-Packard


DESIGNED BY	KUM
CHECKED BY	KUM
DRAFTED BY	KUM
VIEW-SHEET	11-2-95
SPECIFICATIONS	AUTOCAD-MATH-SOFTWARE\SSP
SCALE - METRIC	1"=5'
COMPUTER DESIGNATION	

MATCH LINE STA. 9+360

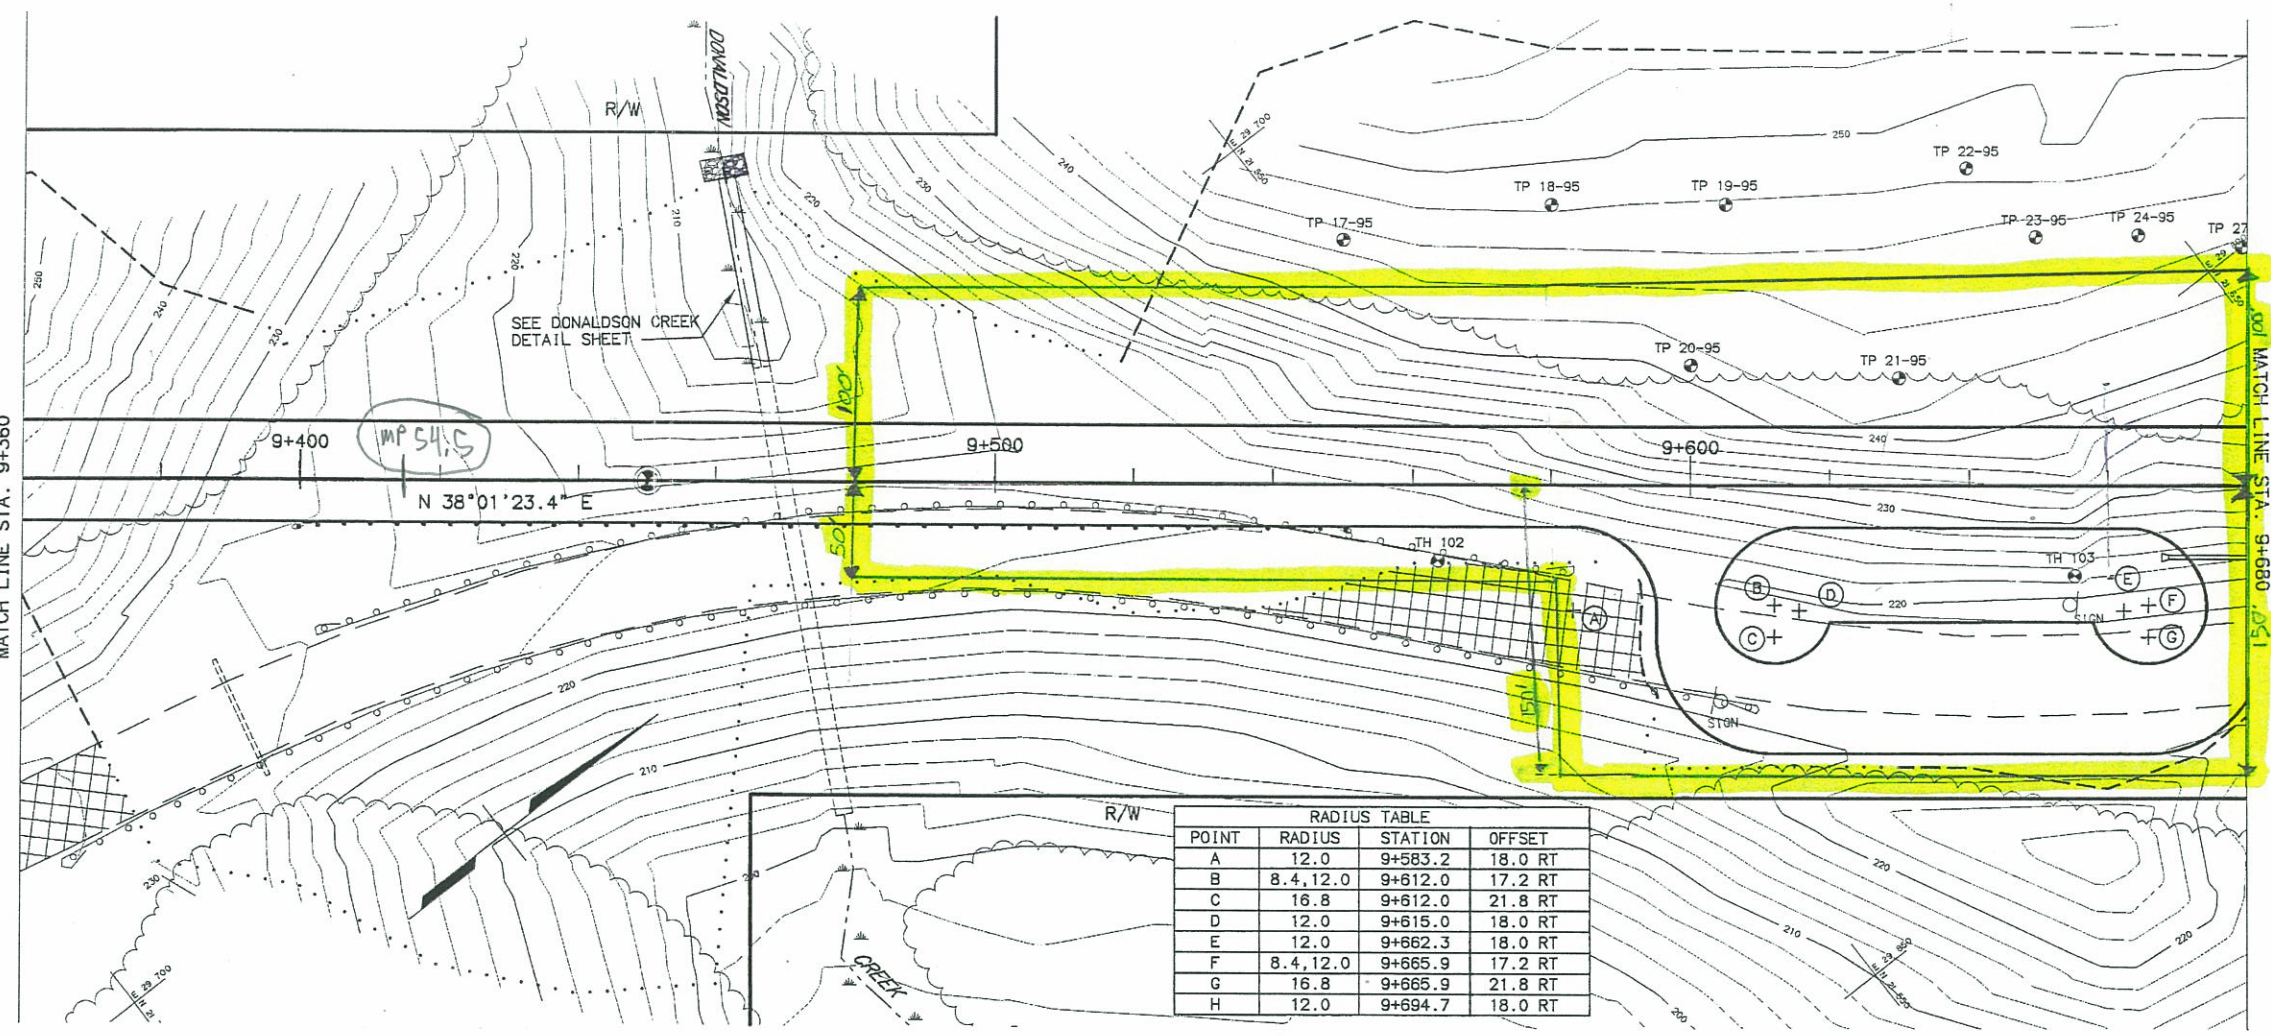

RADIUS TABLE			
POINT	RADIUS	STATION	OFFSET
A	12.0	9+583.2	18.0 RT
B	8.4, 12.0	9+612.0	17.2 RT
C	16.8	9+612.0	21.8 RT
D	12.0	9+615.0	18.0 RT
E	12.0	9+662.3	18.0 RT
F	8.4, 12.0	9+665.9	17.2 RT
G	16.8	9+665.9	21.8 RT
H	12.0	9+694.7	18.0 RT

MATCH LINE STA. 9+680

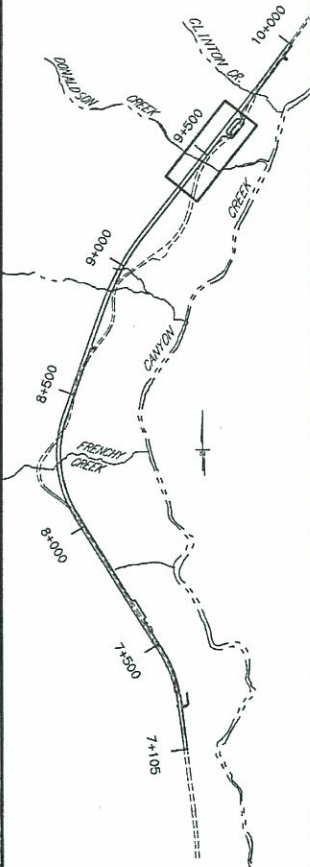





NOTE:
DIMENSIONS ARE IN METERS
UNLESS OTHERWISE NOTED.



STATE OF ALASKA
DEPARTMENT OF TRANSPORTATION
AND
PUBLIC FACILITIES

SEWARD HIGHWAY
MILEPOST 53.0 TO 59.3
PLAN AND PROFILE

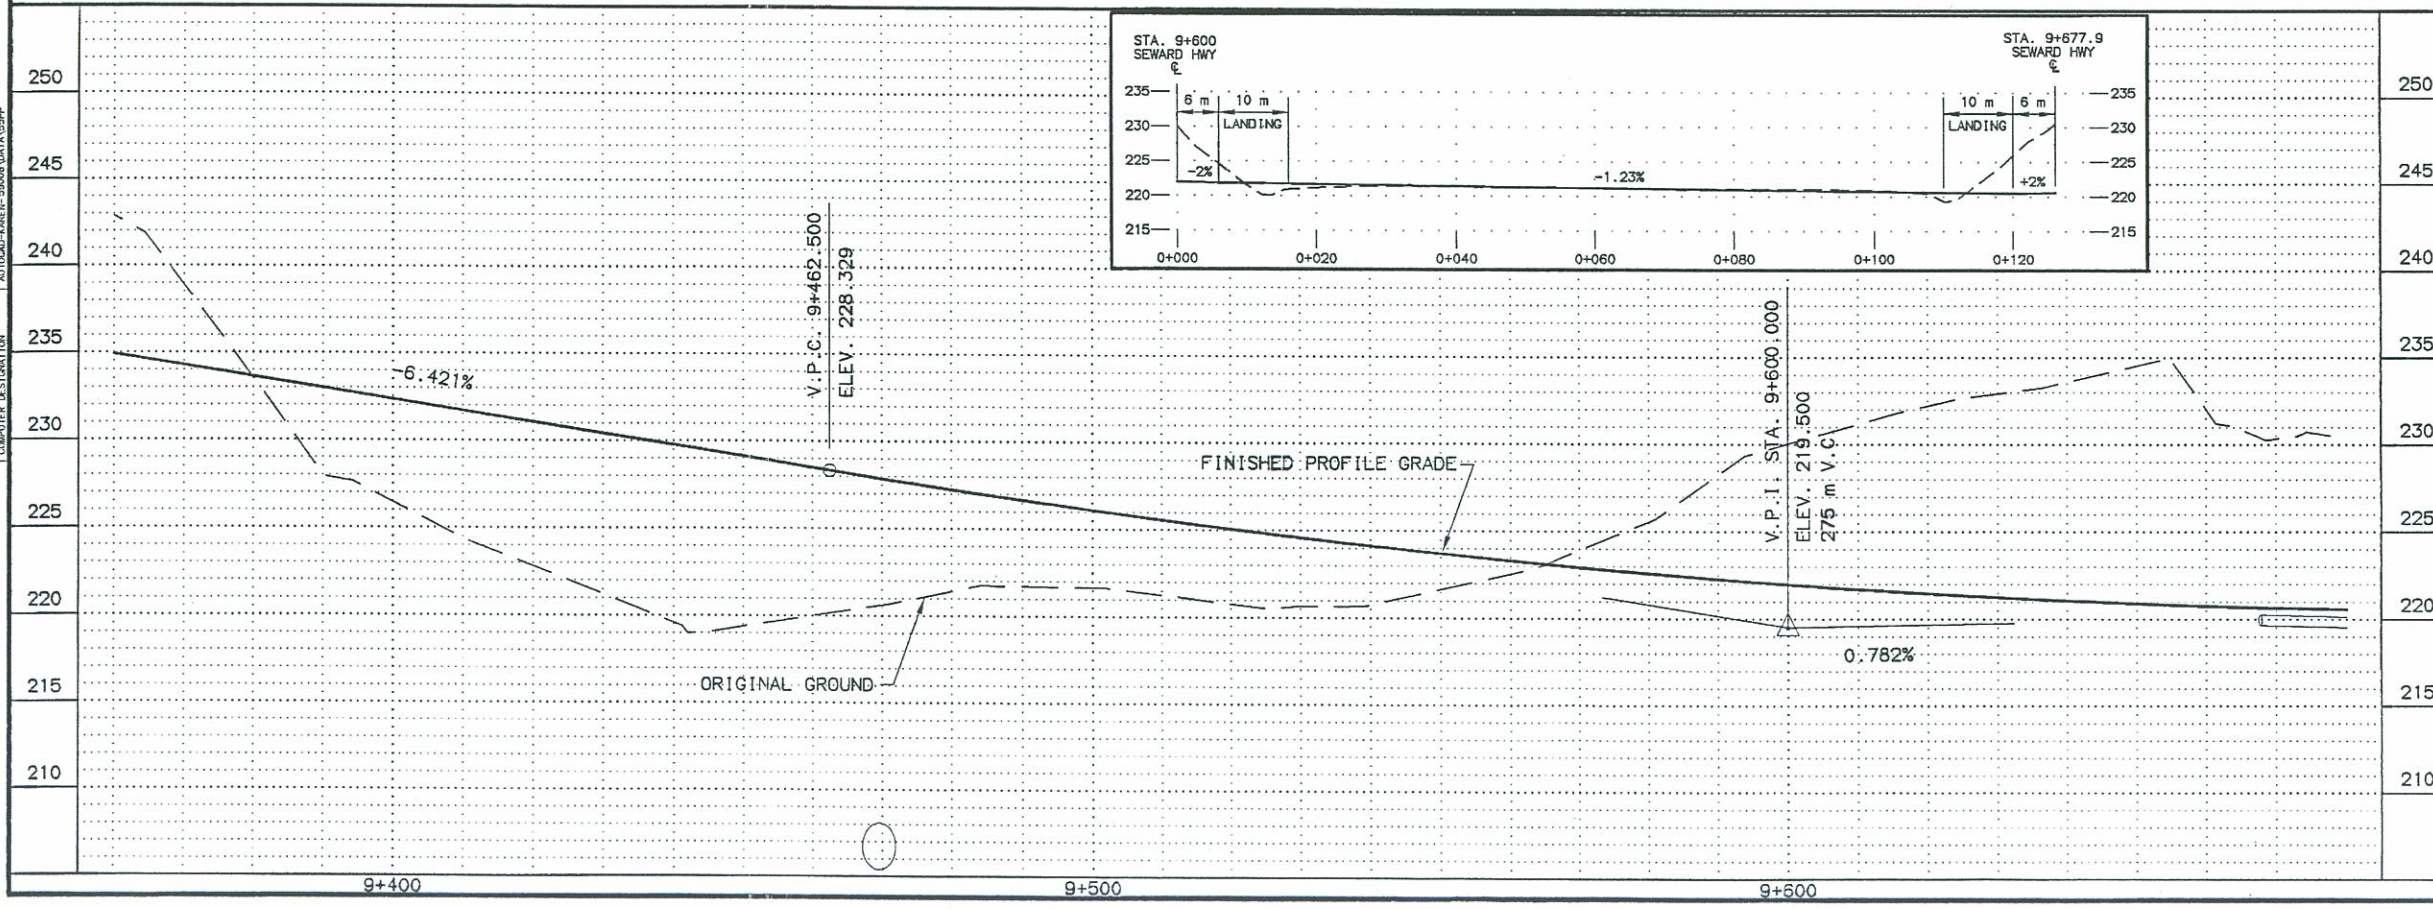


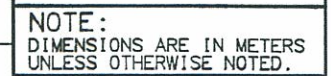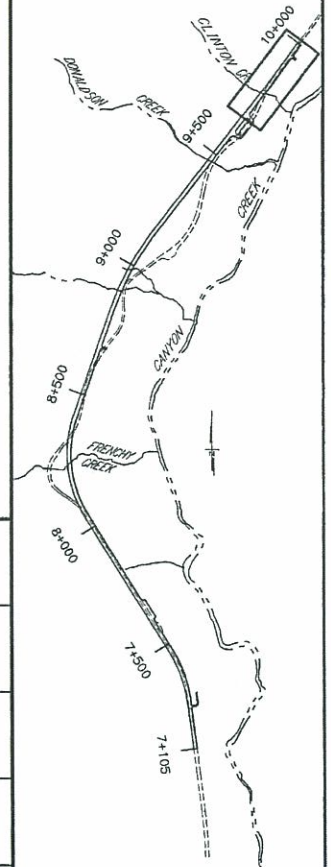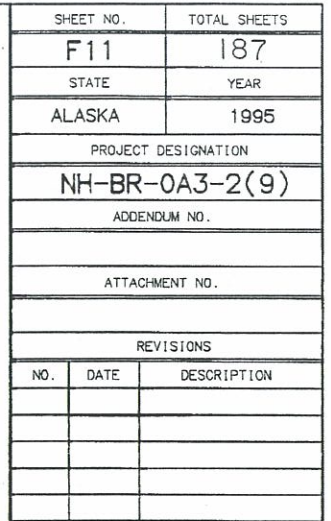

STATE OF ALASKA
DEPARTMENT OF TRANSPORTATION
AND
PUBLIC FACILITIES

SEWARD HIGHWAY
ILEPOST 53.0 TO 59.3


PLAN AND PROFILE

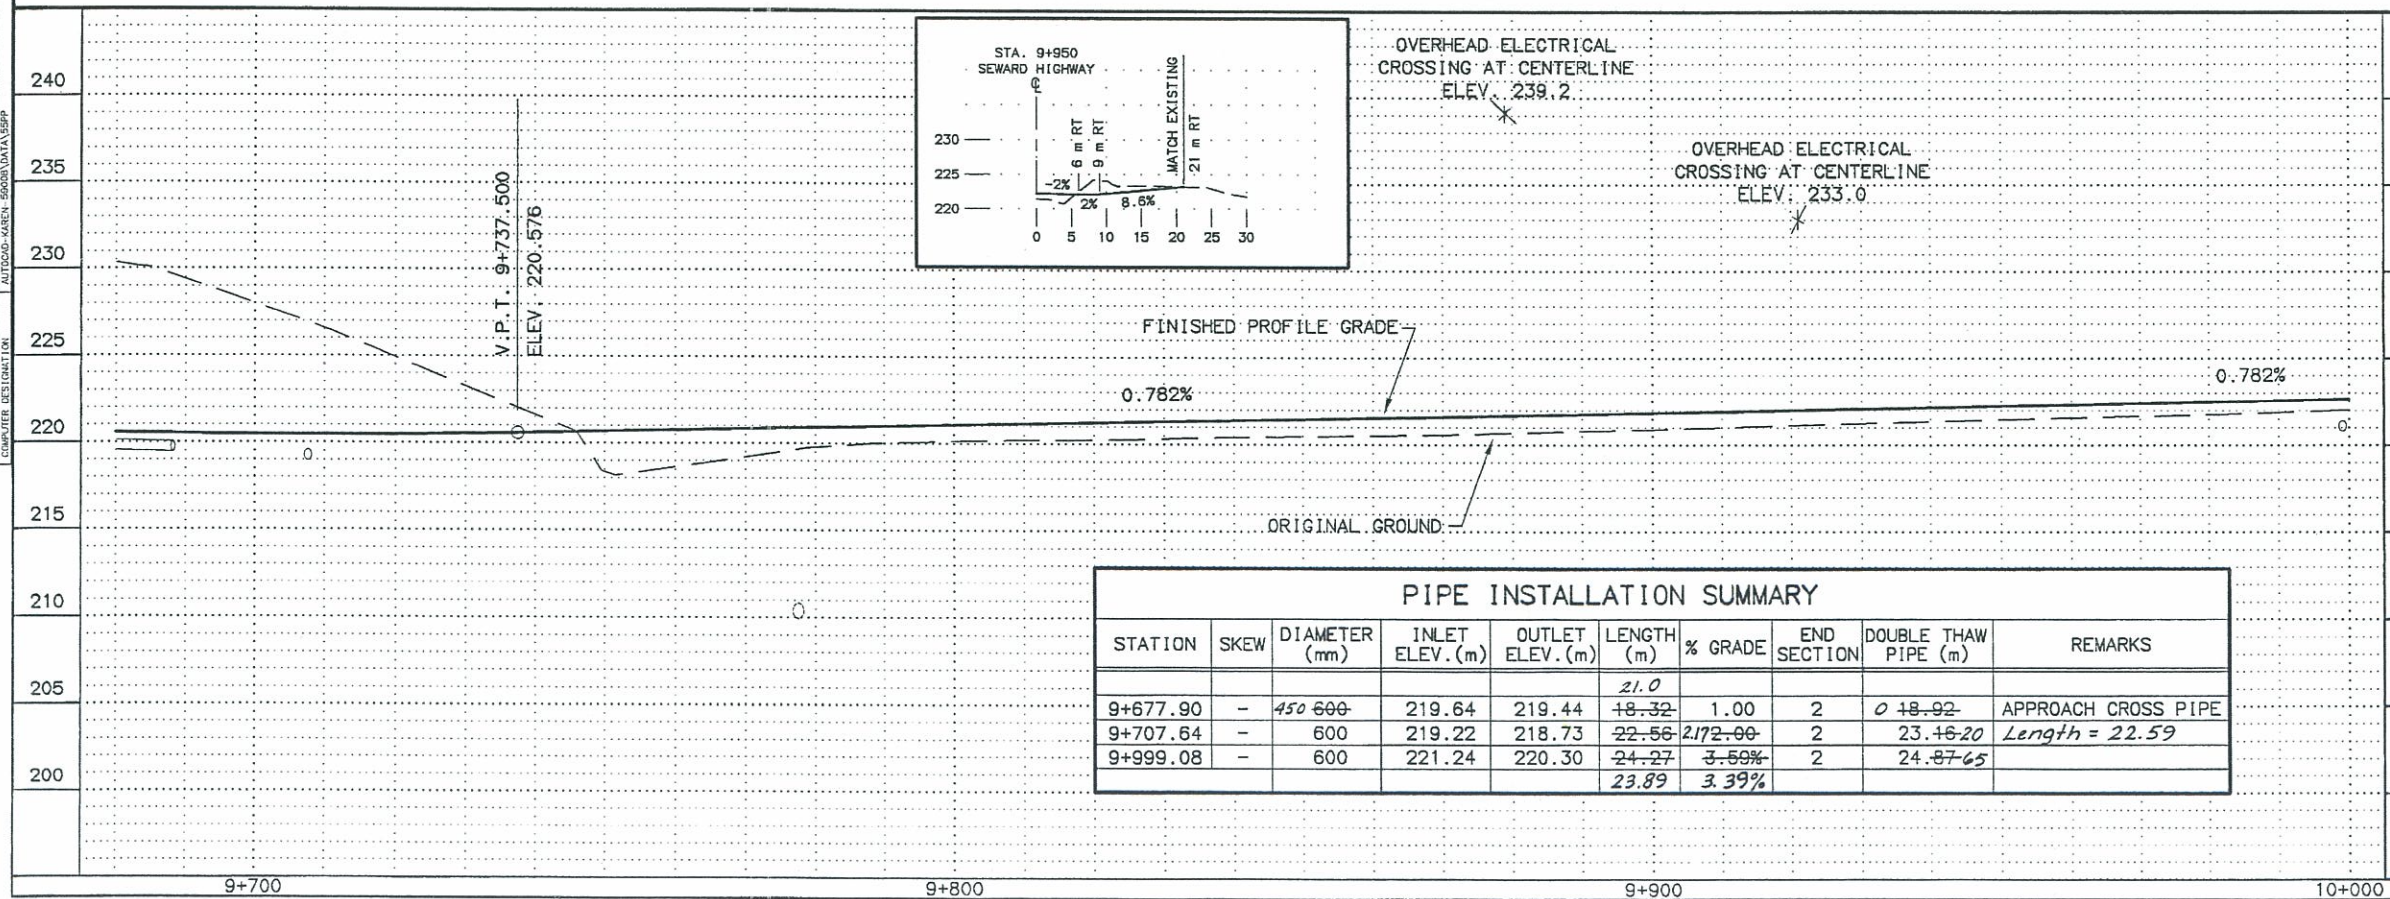

DESIGNED BY TRG
CHECKED BY WAR
DRAFTED BY JMH

SPECIFICATIONS
STANDARDS
COMPUTER DESIGNATION 351916/STGPP01 1=500. 12/04/95 at 11:18 by GEP

PLOT VIEWS: F16
FH16

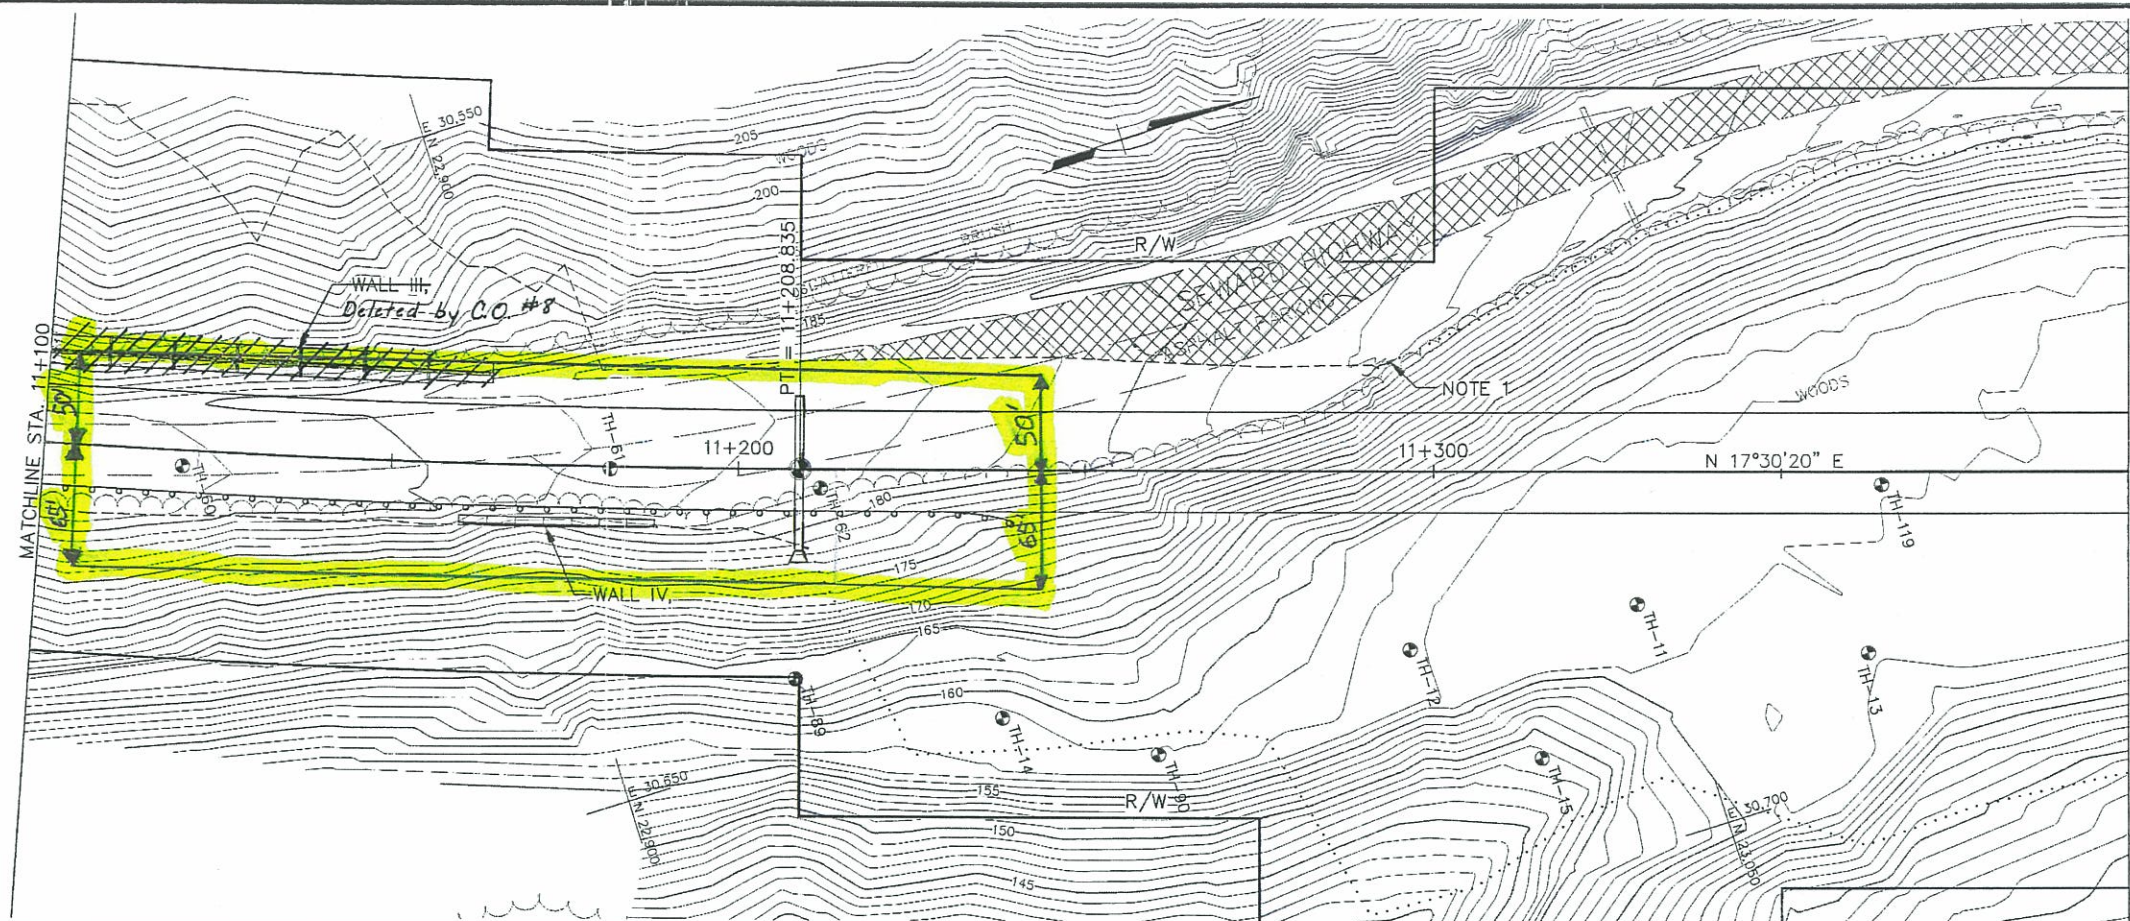


MATCHLINE STA. 11+400

Sta.	Length	Grade	End Section	Thaw Pipe
11+208	24 m	5.5%	I	24.76 m

NOTES:

1. MAINTAIN DRAINAGE AT TOE OF SLOPE FLATTENING, STA. 11+300 TO 11+575, LEFT SIDE.

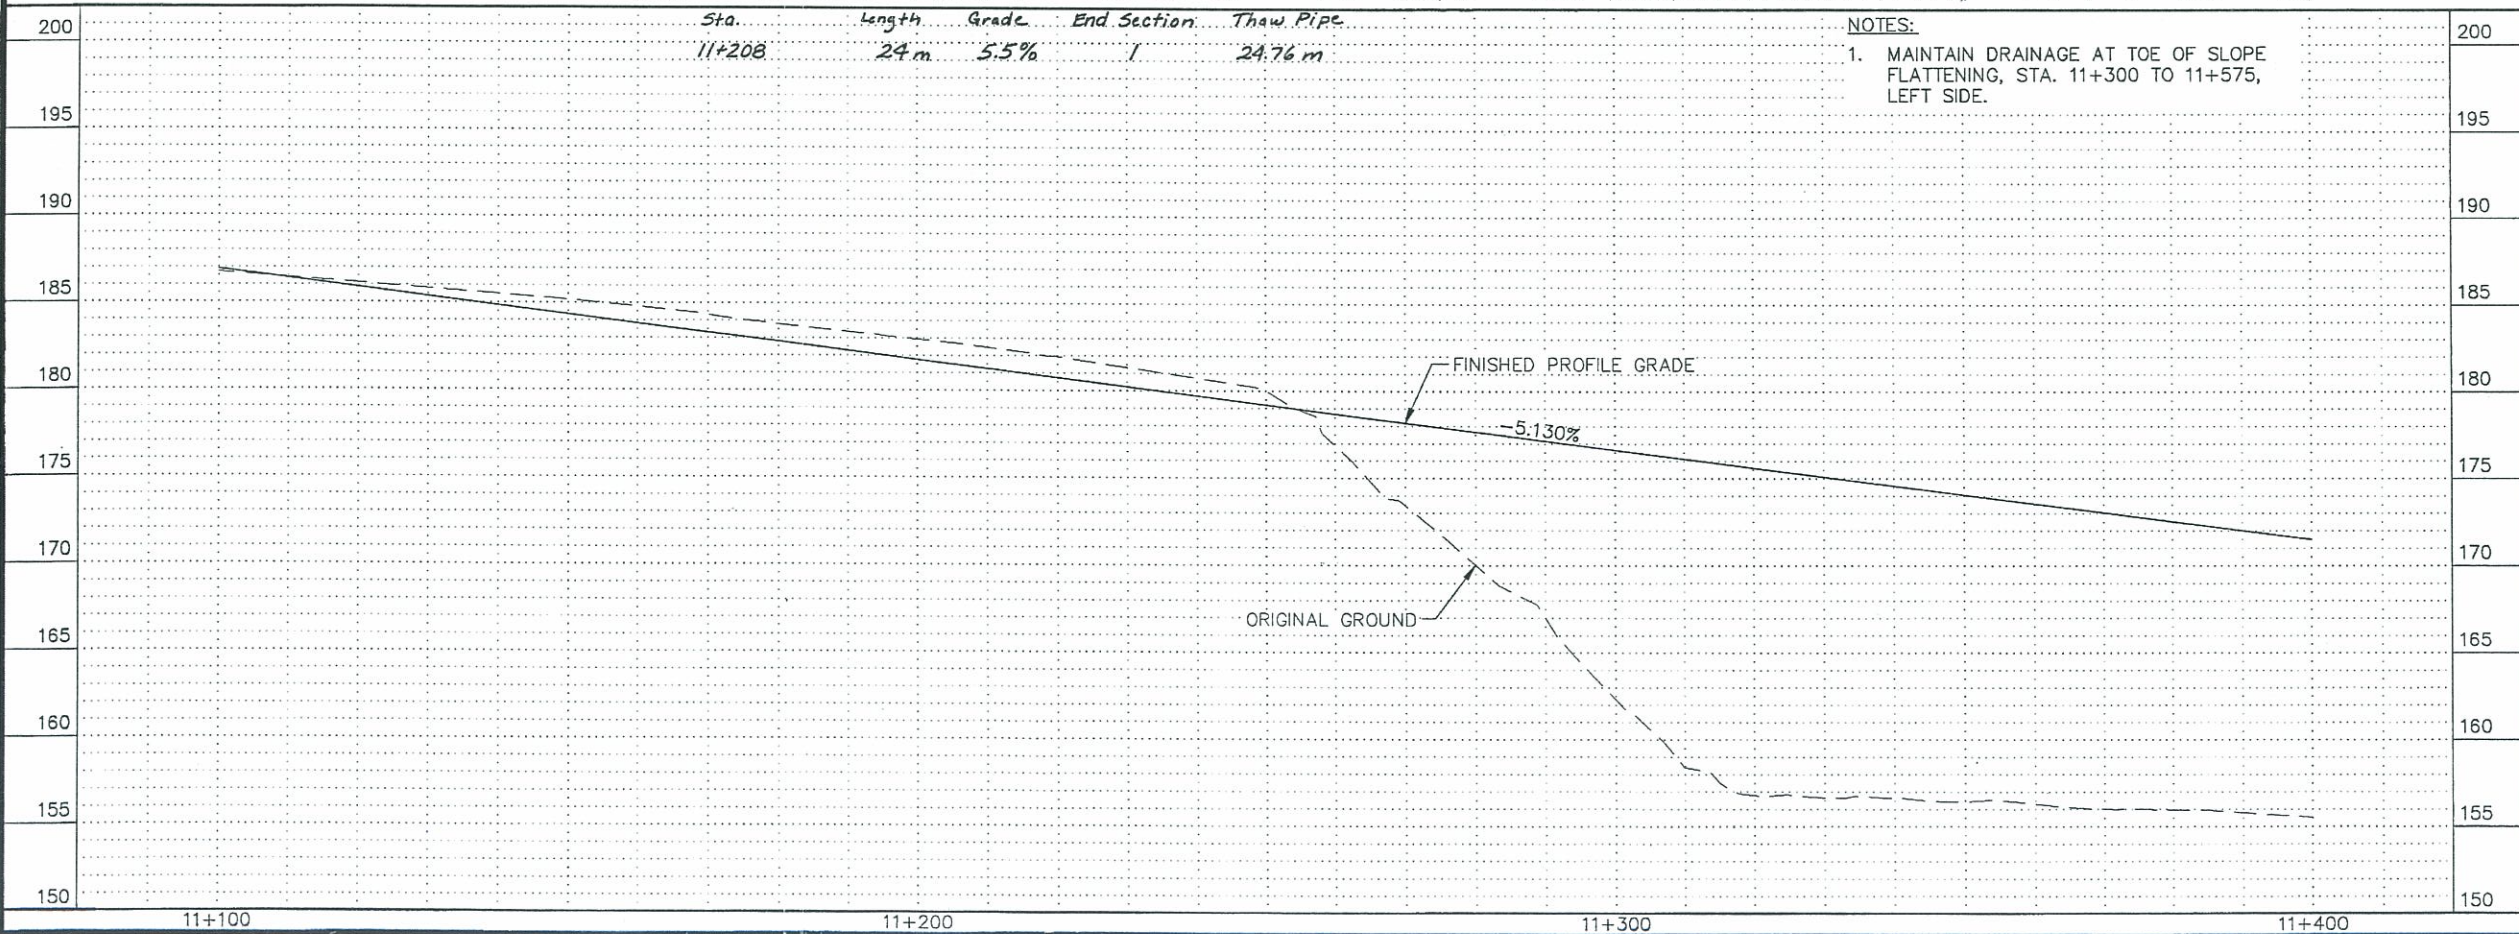


SHEET NO.	TOTAL SHEETS	
F16	187	
STATE	YEAR	
ALASKA	1995	
PROJECT DESIGNATION		
NH-BR-OA3-2(9)/51069		
ADDENDUM NO.		
ATTACHMENT NO.		
REVISIONS		
NO.	DATE	DESCRIPTION

STATE OF ALASKA
49th
Robert P. Grier
CE 3041
12/14/95


STATE OF ALASKA
DEPARTMENT OF TRANSPORTATION
AND
PUBLIC FACILITIES
SEWARD HIGHWAY
M.P. 53.0 TO M.P. 59.3
PLAN AND PROFILE SHEET
STA. 11+100 TO STA. 11+400

DESIGNED BY RFG
CHECKED BY JAV
DRAFTED BY JAV
SPECIFICATIONS
STANDARDS
COMPUTER DESIGNATION 351916.916#P01, 1=500, 11/30/95 at 11:48 by NRY
PLOTVIEW: F26
FH26

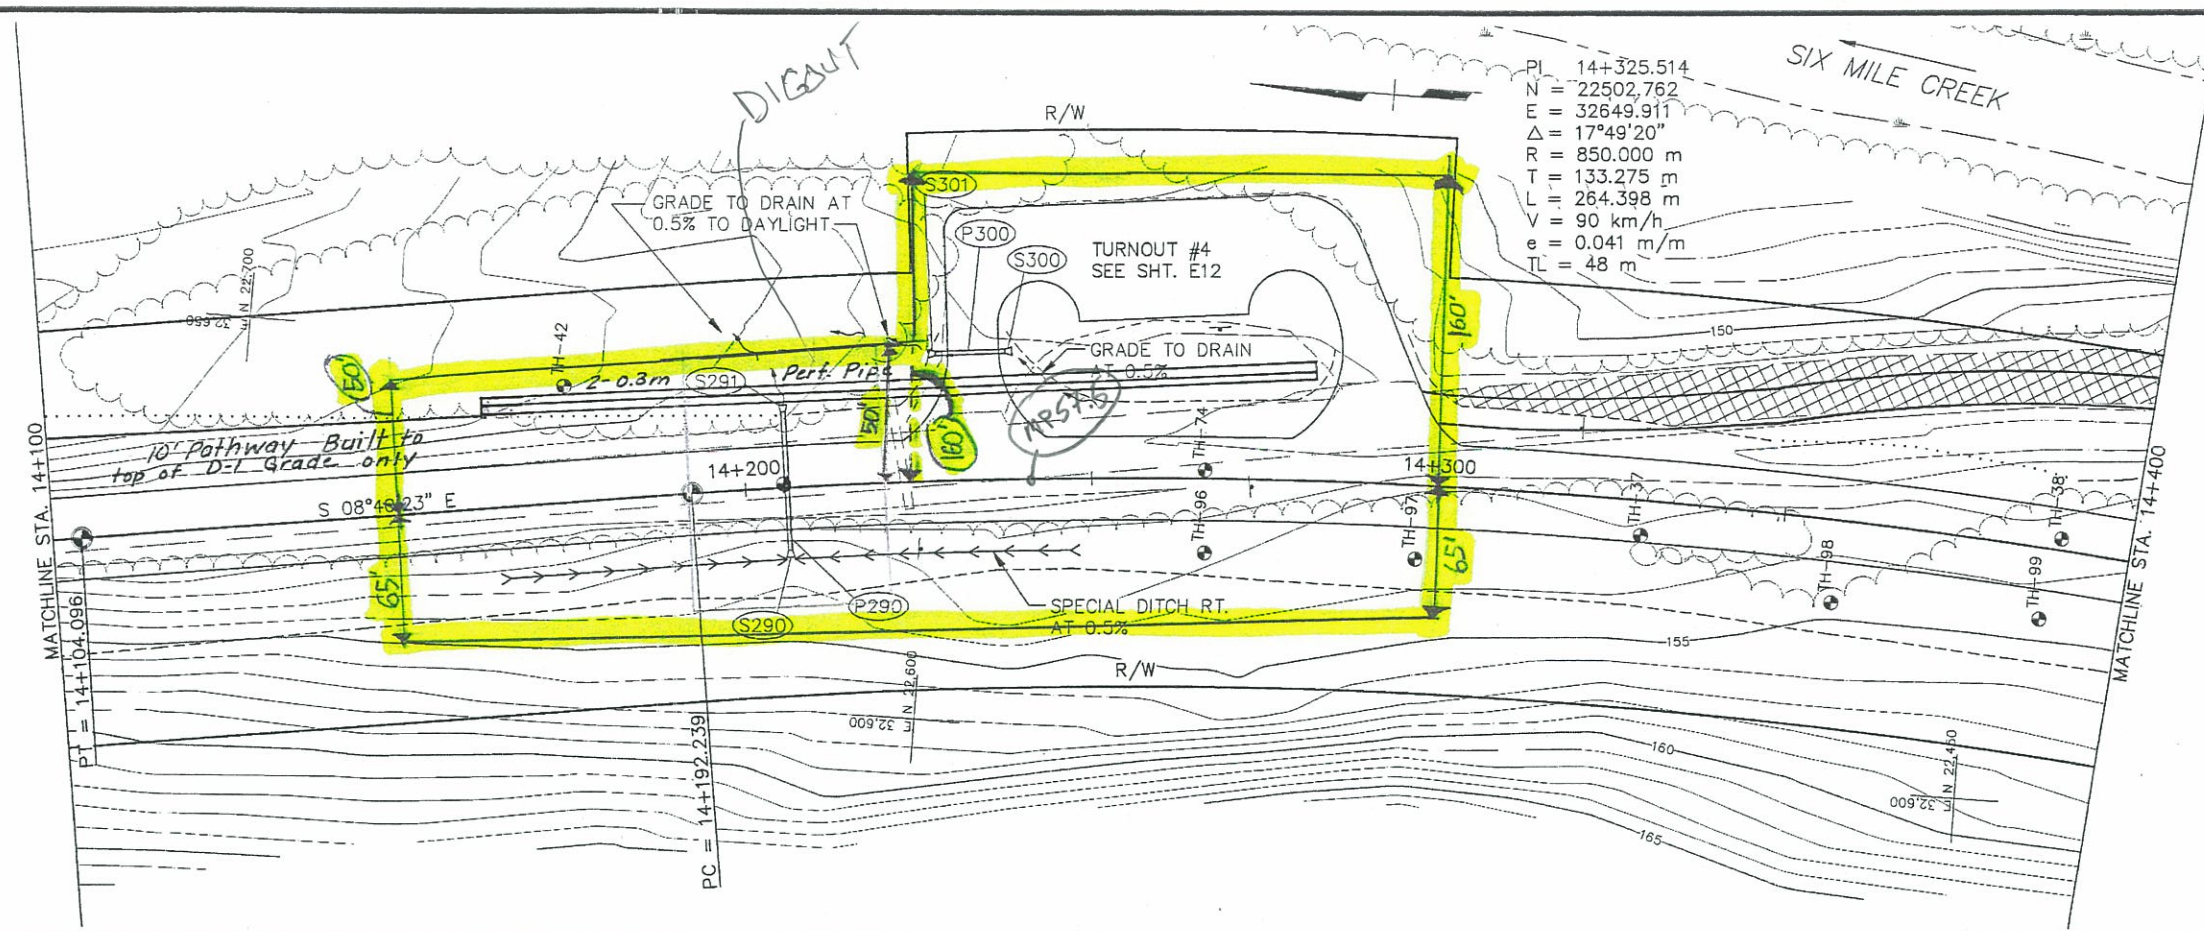

PIPE	TYPE	DIA. (mm)	C - C LENGTH	FROM	TO	ELEVATION		MAX COVER	% GRADE	DOUBLE THAW PIPE
						IN	OUT			
P290	PIPE	600	21.90	S290	S291	150.32	149.92	1.5 m	2.00	N/A
P300	PIPE	600	9.96	S300	S301	150.96	150.80	1.0 m	2.00	N/A

STRUCTURE	TYPE	STATION	OFFSET	TOP OF CASTING	TYPE CASTING
S290	E.S.	14+206.00	10.00 RT.		N/A
S291	E.S.	14+206.00	11.90 LT.		N/A
S300	E.S.	14+238.70	18.40 LT.		N/A
S301	E.S.	14+227.00	18.30 LT.		N/A

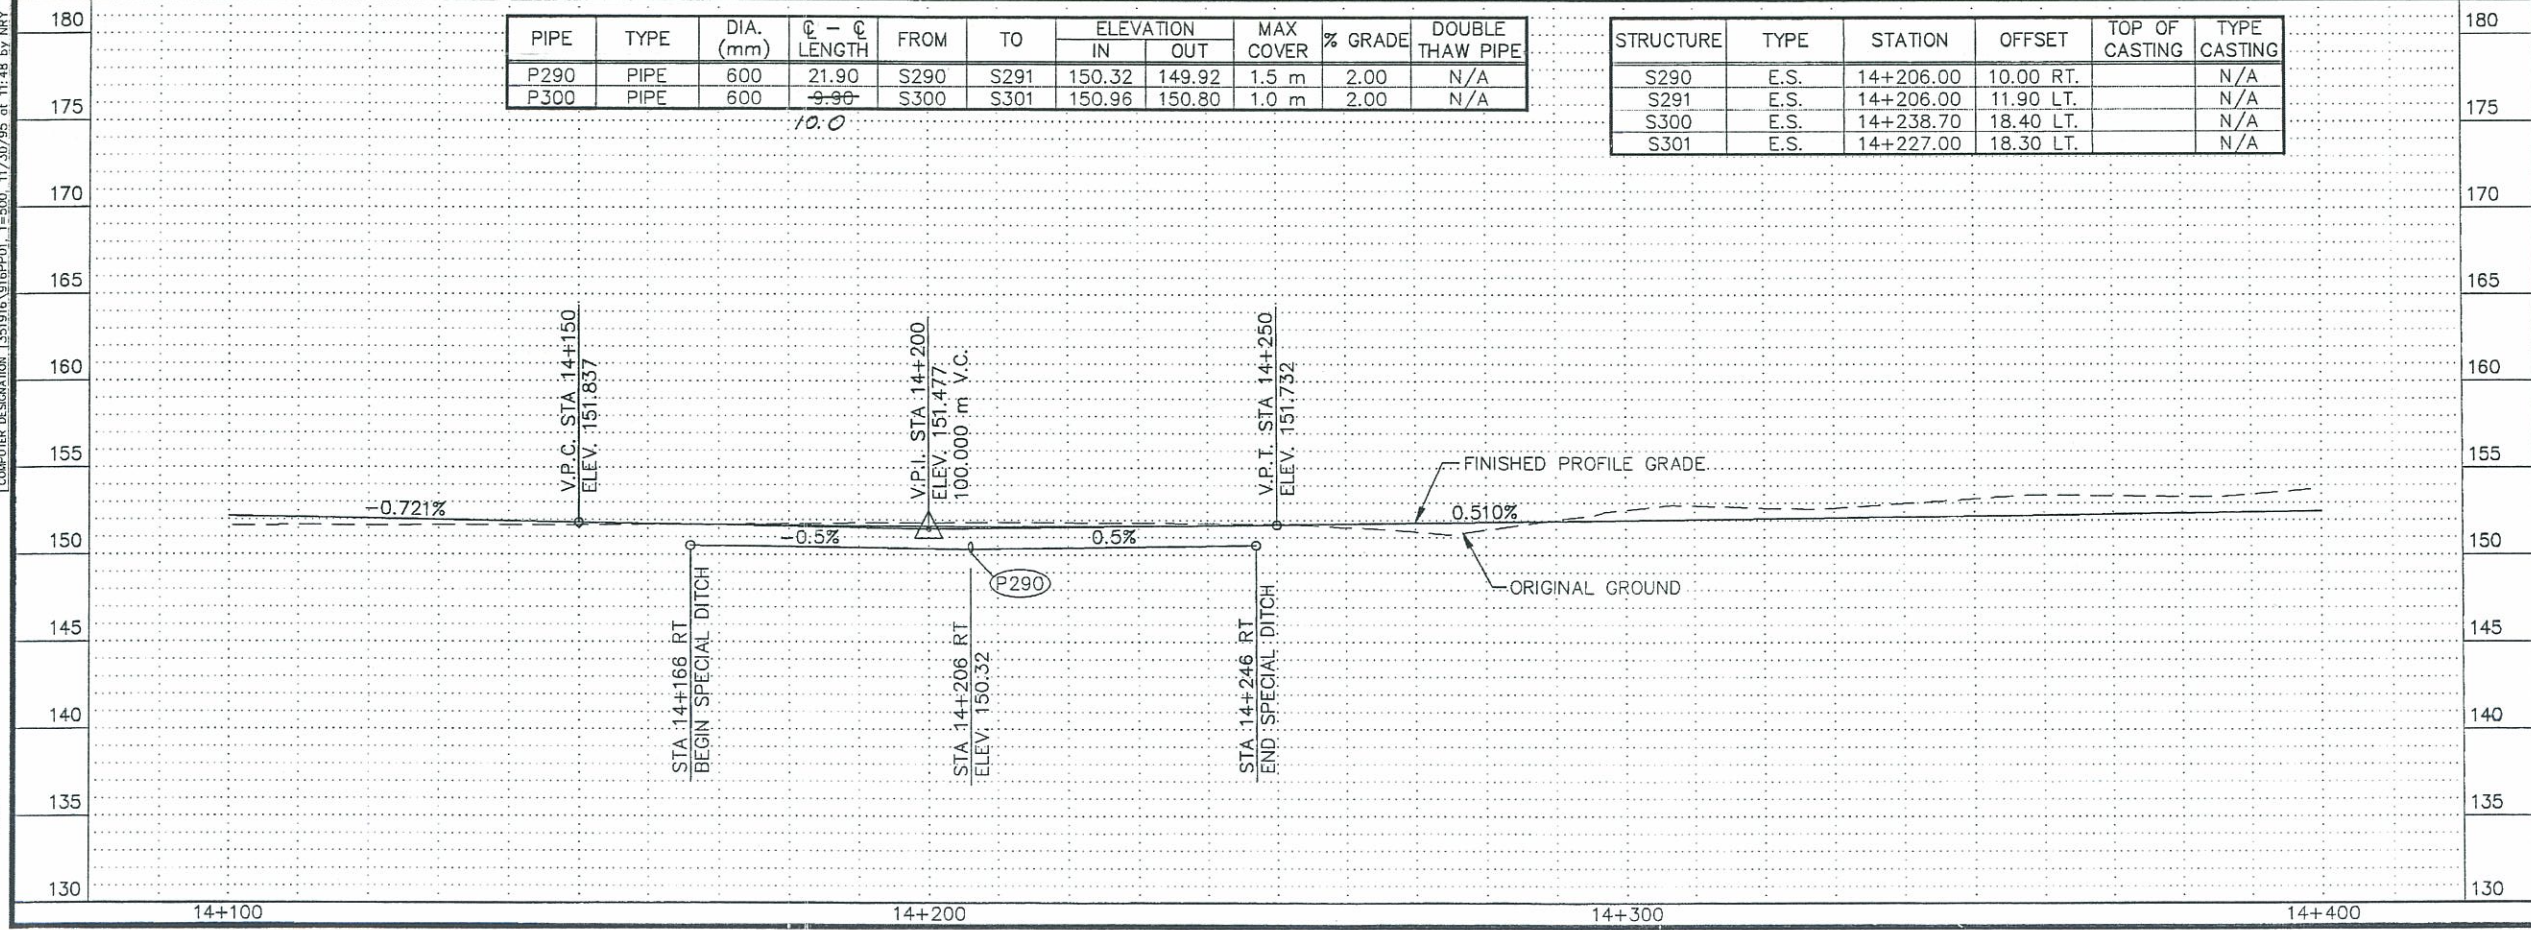


SHEET NO.	TOTAL SHEETS	
F26	187	
STATE	YEAR	
ALASKA	1995	
PROJECT DESIGNATION		
NH-BR-0A3-2(9)/51069		
ADDENDUM NO.		
ATTACHMENT NO.		
REVISIONS		
NO.	DATE	DESCRIPTION


STATE OF ALASKA
49TH
Robert P. Grier
CE 3041
Professional Engineer

STATE OF ALASKA
DEPARTMENT OF TRANSPORTATION
AND
PUBLIC FACILITIES
SEWARD HIGHWAY
M.P. 53.0 TO M.P. 59.3
PLAN AND PROFILE SHEET
STA. 14+100 TO STA. 14+400

DESIGNED BY: JRG
CHECKED BY: WAR
DRAFTED BY: JWH
SPECIFICATIONS: FH28
STANDARDS: 11/30/95 at 11:48 by NRY
COMPUTER DESIGNATION: 351916 916P01 1=500 11/30/95 at 11:48 by NRY

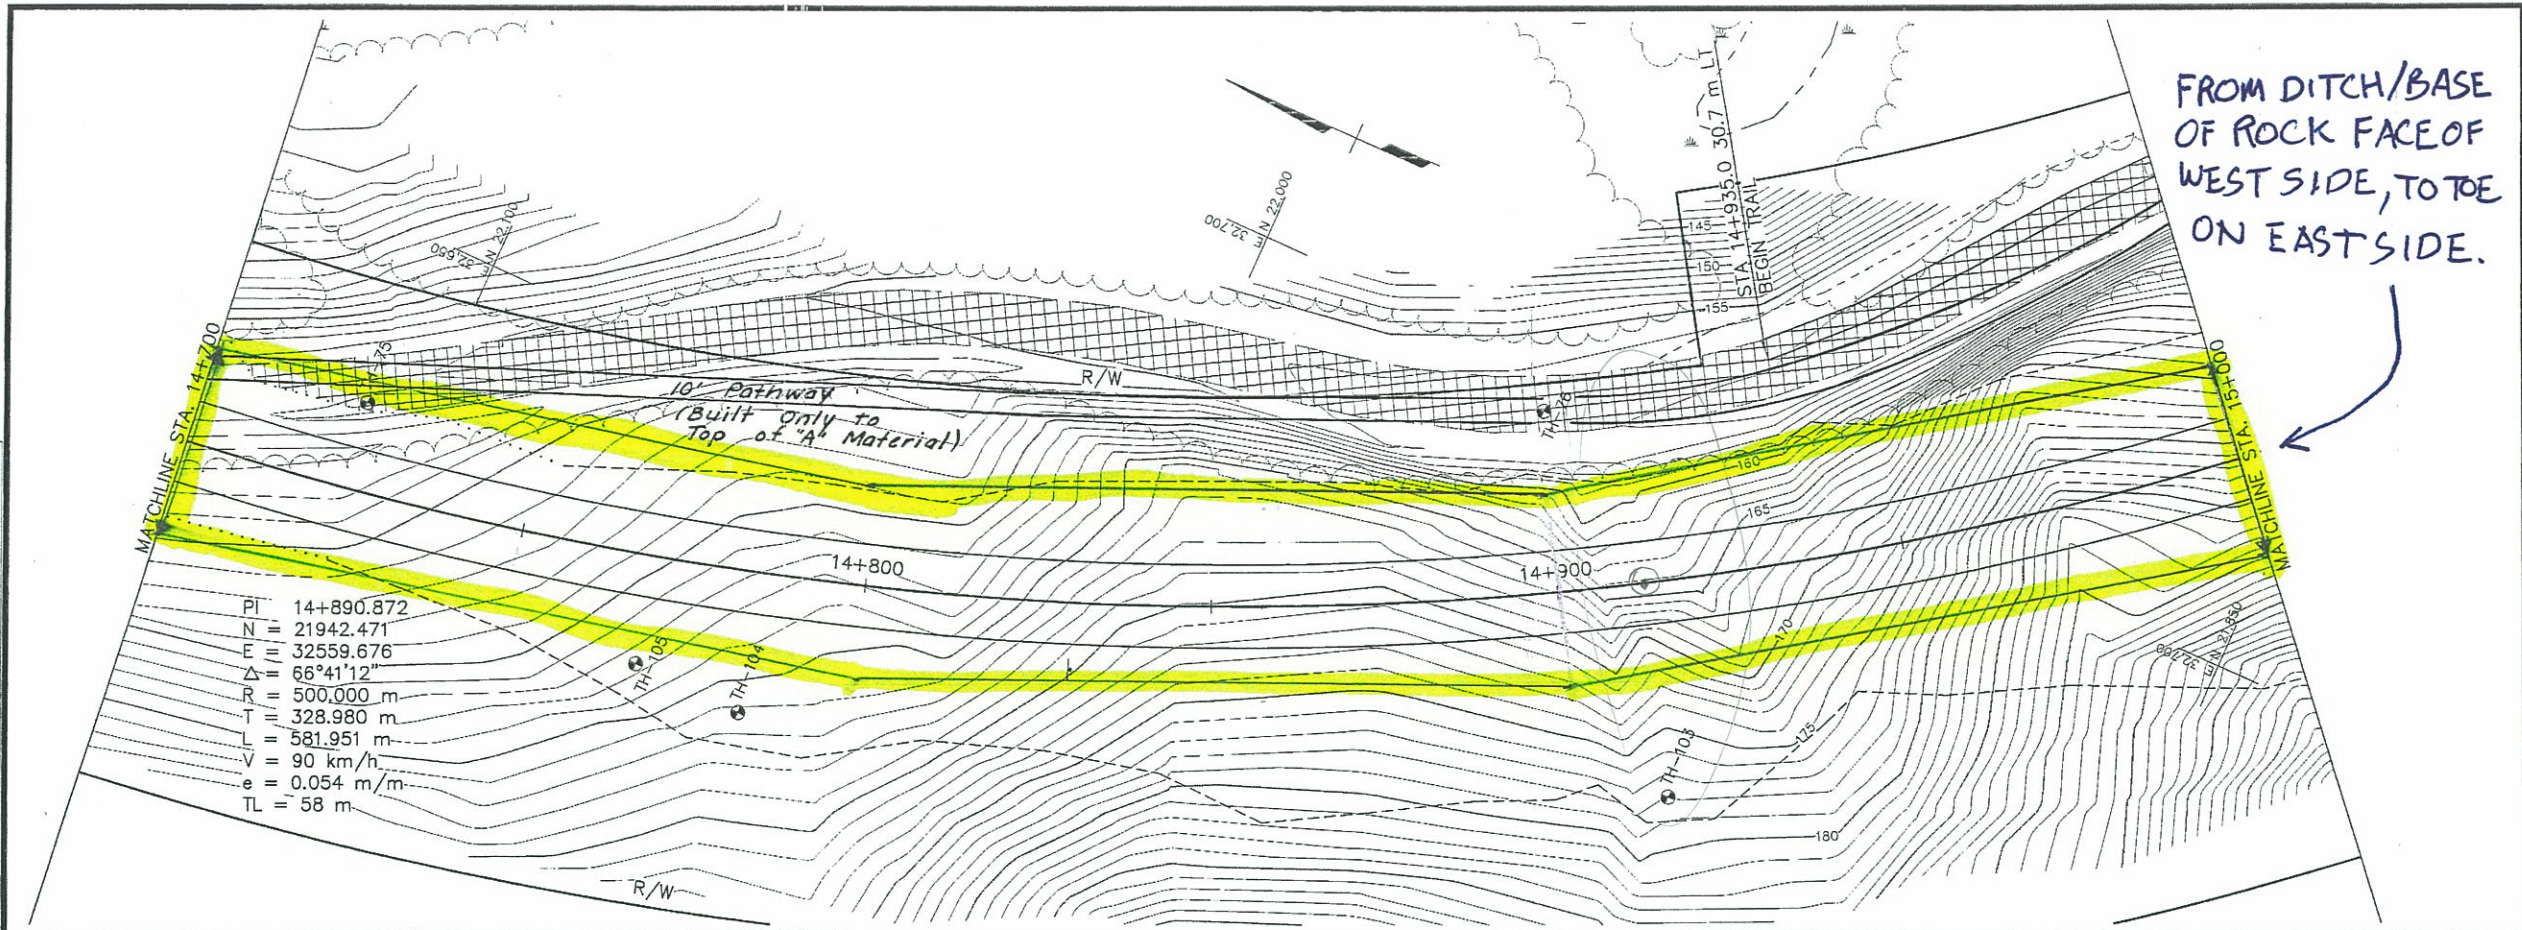

PI 14+890.872
N = 21942.471
E = 32559.676
Δ = 66°41'12"
R = 500.000 m
T = 328.980 m
L = 581.951 m
V = 90 km/h
e = 0.054 m/m
TL = 58 m

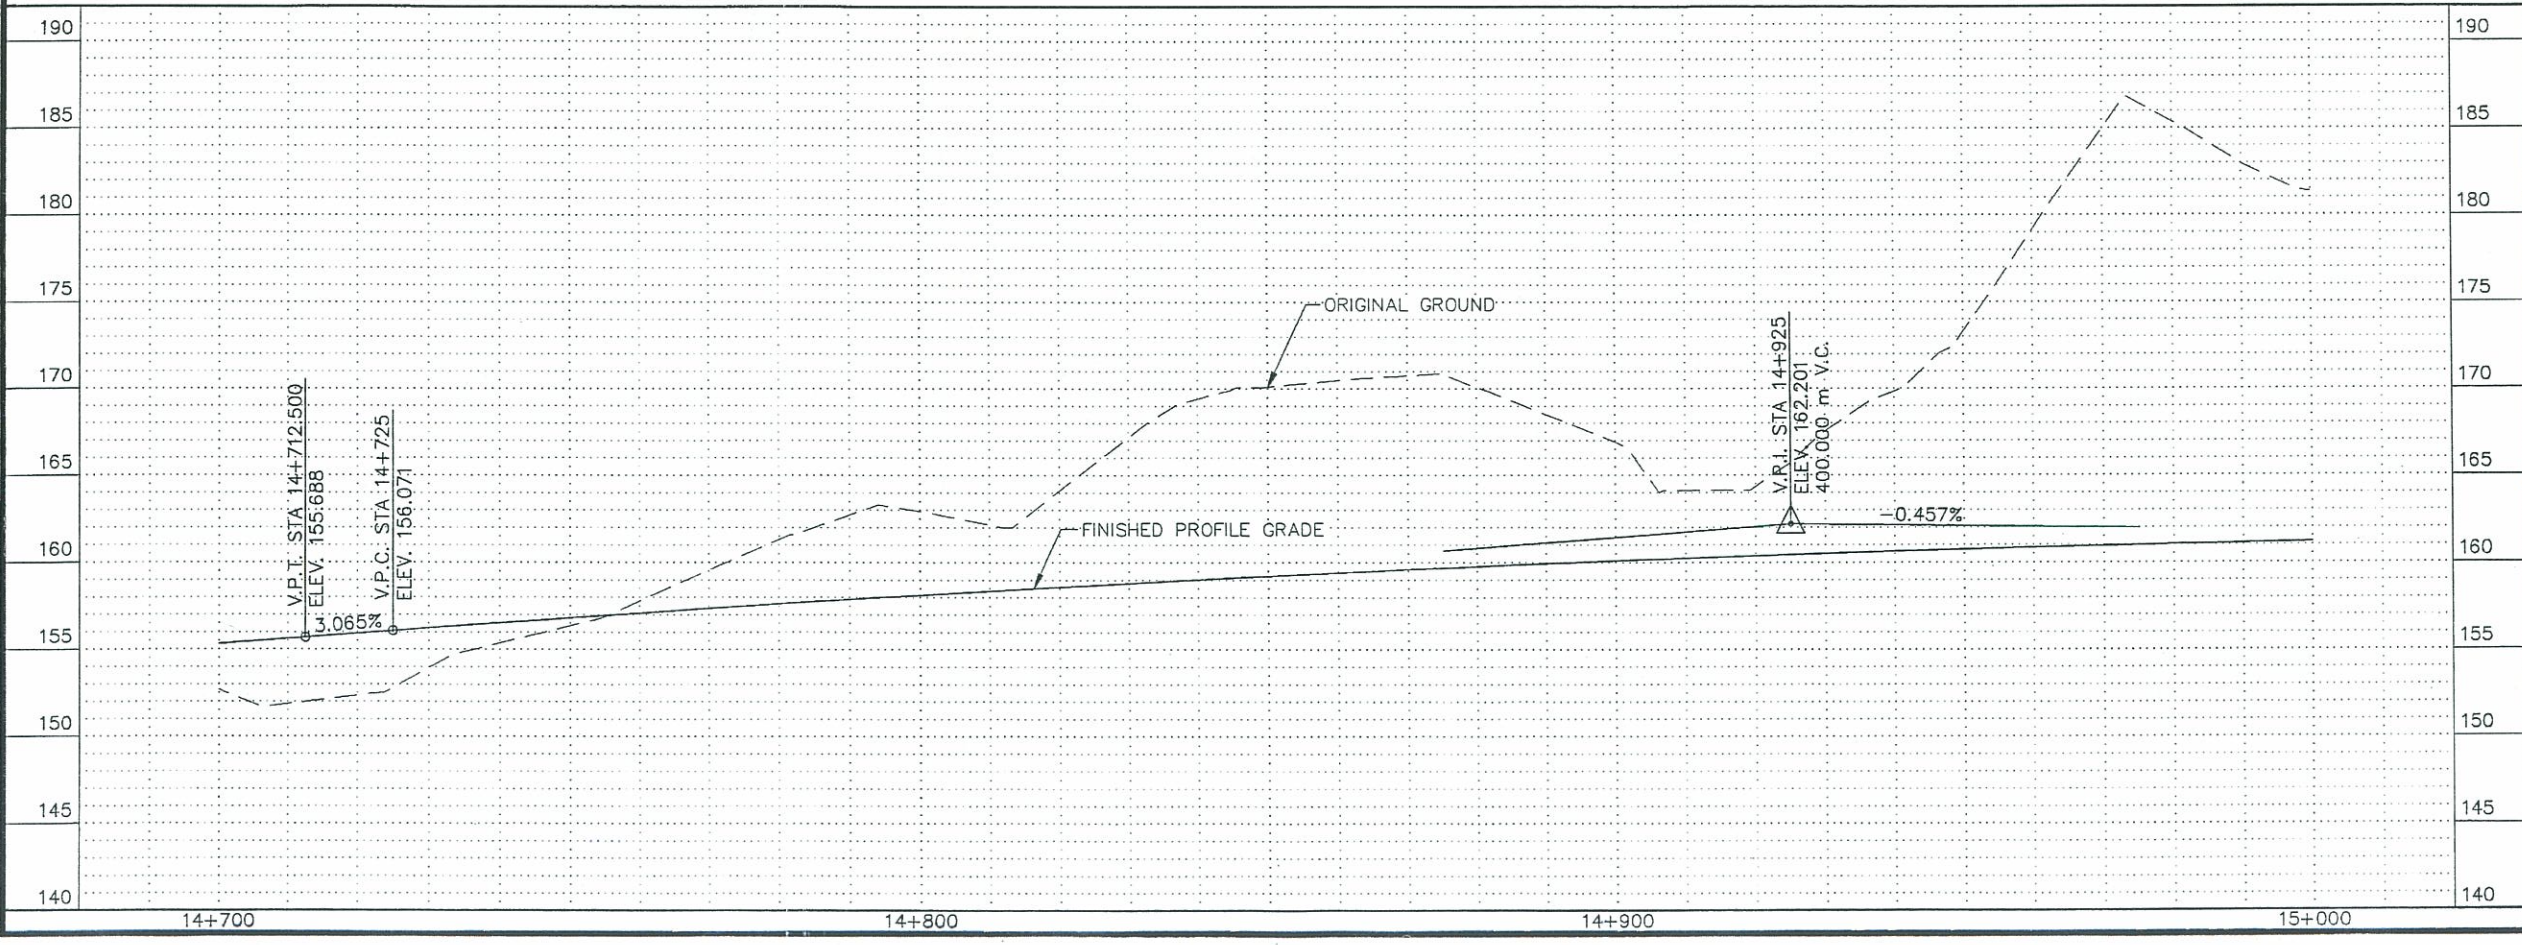


SHEET NO.	TOTAL SHEETS	
F28	187	
STATE	YEAR	
ALASKA	1995	
PROJECT DESIGNATION		
NH-BR-0A3-2(9)/51069		
ADDENDUM NO.		
ATTACHMENT NO.		
REVISIONS		
NO.	DATE	DESCRIPTION

STATE OF ALASKA
49th
Robert P. Grier
CE 3041
12/4/95

STATE OF ALASKA
DEPARTMENT OF TRANSPORTATION
AND
PUBLIC FACILITIES
SEWARD HIGHWAY
M.P. 53.0 TO M.P. 59.3
PLAN AND PROFILE SHEET
STA. 14+700 TO STA. 15+000


DESIGNED BY: RBC
CHECKED BY: RBC
DRAFTED BY: WAI
SPECIFICATIONS: F33
COMPUTER: FH33
PLOTVEWS: F33
FH33

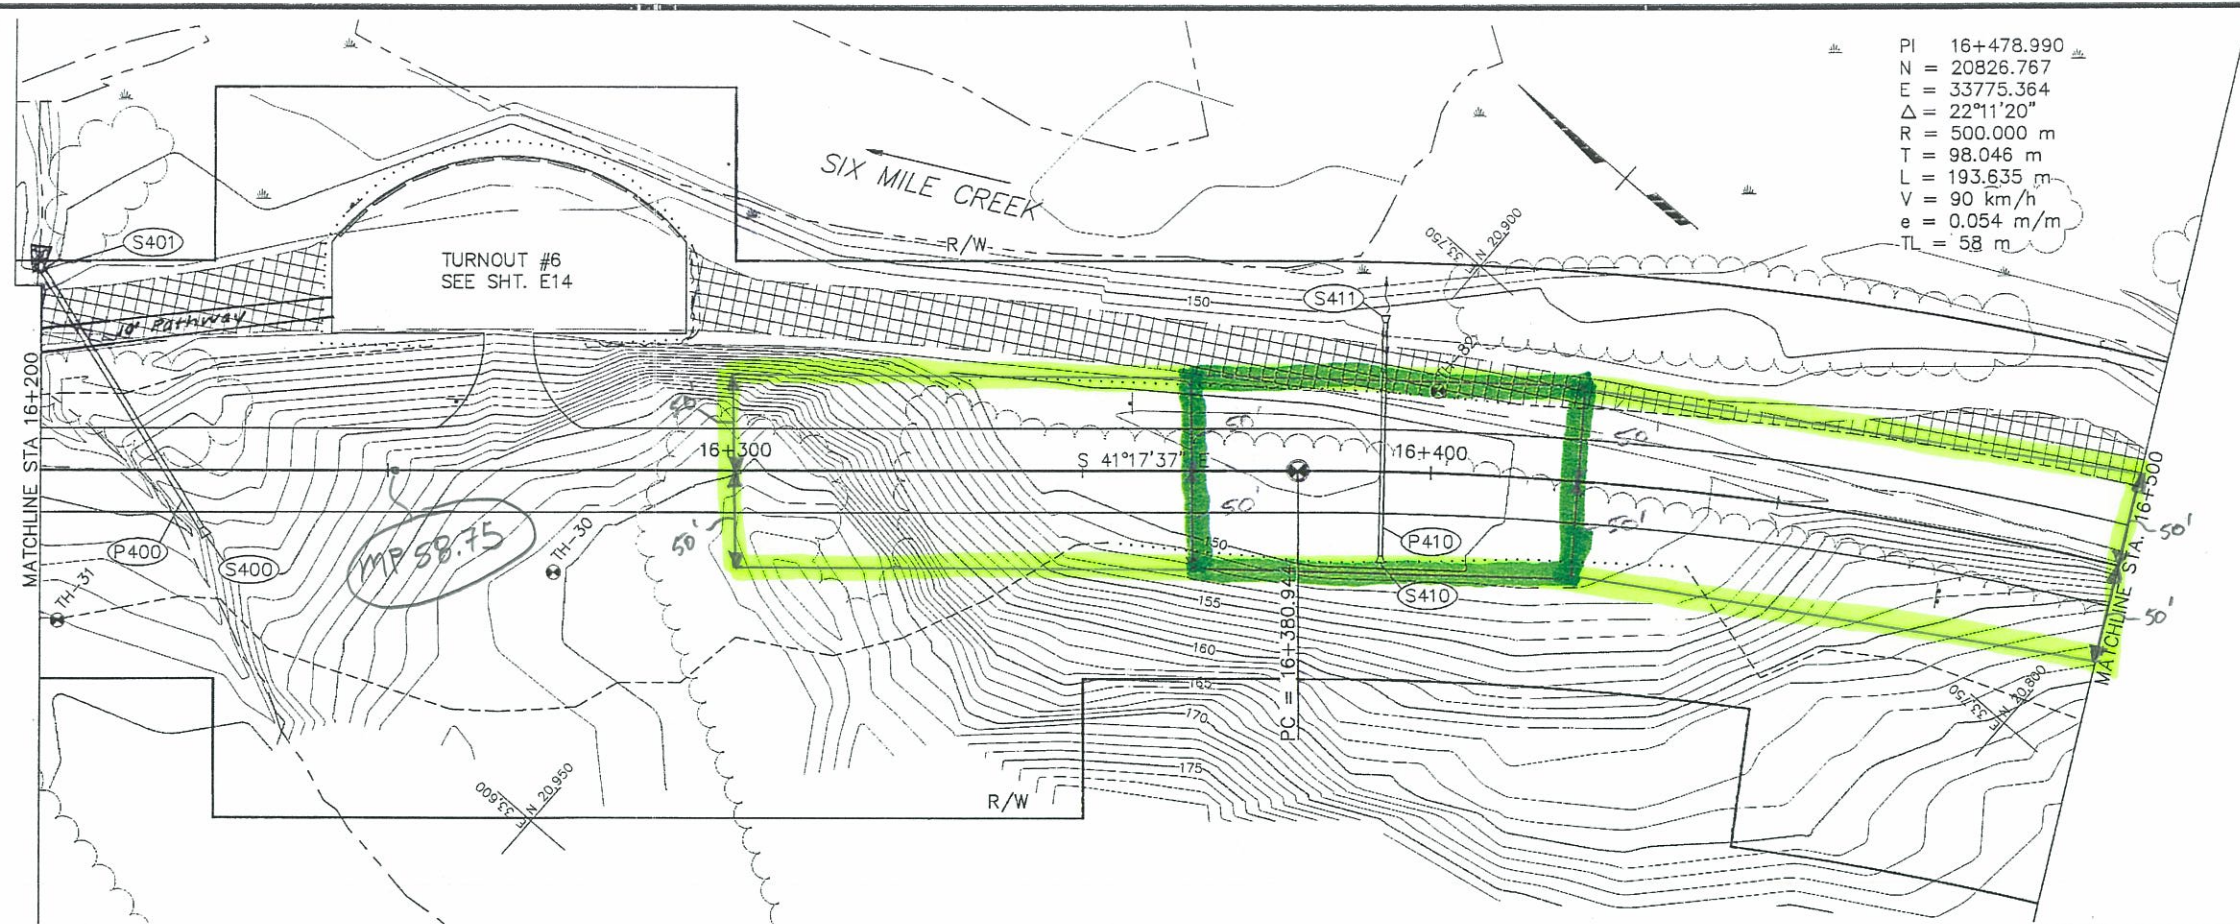


PI 16+478.990
N = 20826.767
E = 33775.364
 $\Delta = 22^\circ 11' 20''$
R = 500.000 m
T = 98.046 m
L = 193.635 m
V = 90 km/h
e = 0.054 m/m
TL = 58 m

PIPE	TYPE	DIA. (mm)	C - C LENGTH	FROM	TO	ELEVATION		MAX COVER	% GRADE	DOUBLE THAW PIPE
						IN	OUT			
P400	PIPE	750	33.19	S400	S401	151.58	149.06	3.5 m	5.80	43.9 m
P410	PIPE	600	33.19	S410	S411	149.52	148.80	3.5 m	2.00	N/A

STRUCTURE	TYPE	STATION	OFFSET	TOP OF CASTING	TYPE CASTING
S400	E.S.	16+223.91	9.46 RT.		N/A
S401	E.S.	16+199.53	29.55 LT.		N/A
S410	E.S.	16+393.00	13.15 RT.		N/A
S411	E.S.	16+393.00	22.35 LT.		N/A

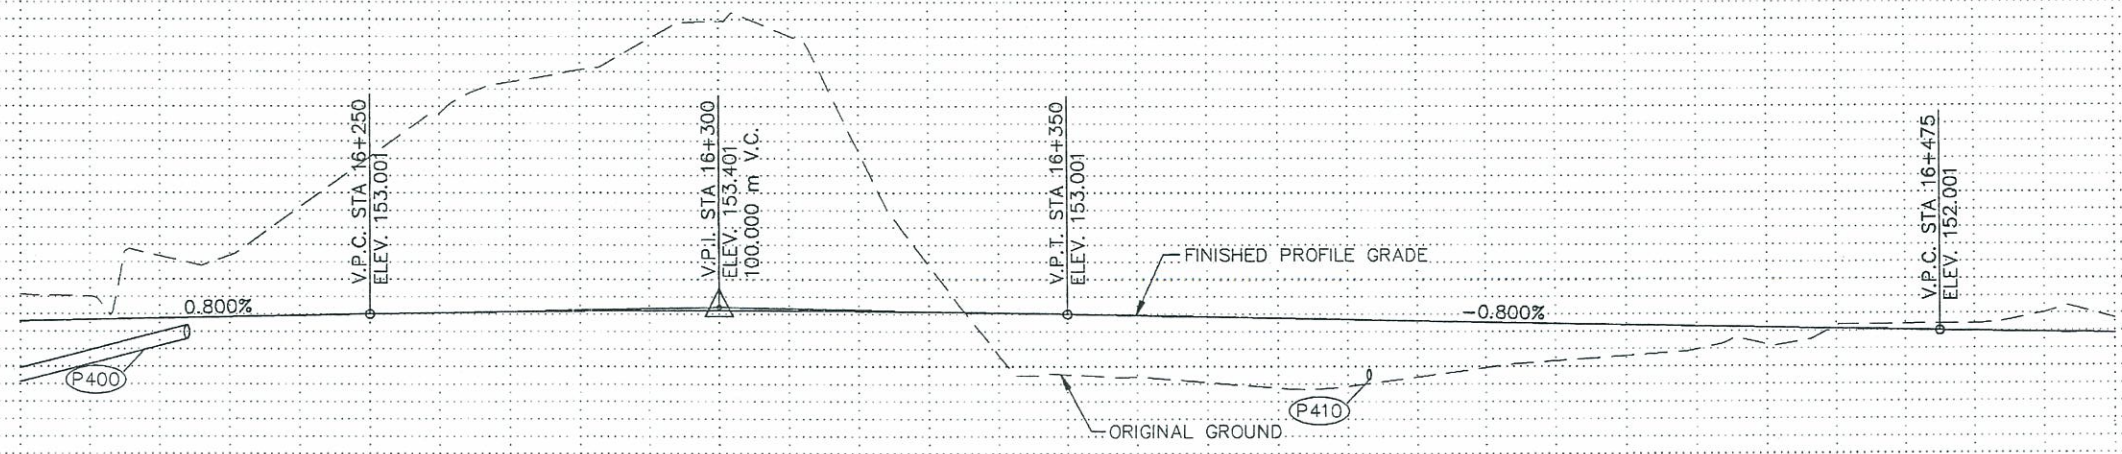


SHEET NO.		TOTAL SHEETS	
F33		187	
STATE		YEAR	
ALASKA		1995	
PROJECT DESIGNATION			
NH-BR-OA3-2(9)/51069			
ADDENDUM NO.			
ATTACHMENT NO.			
REVISIONS			
NO.	DATE	DESCRIPTION	

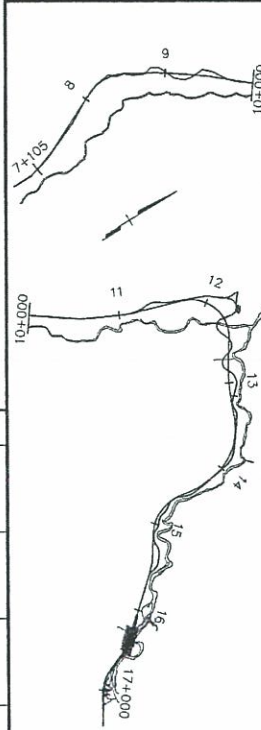

STATE OF ALASKA
DEPARTMENT OF TRANSPORTATION
AND
PUBLIC FACILITIES
SEWARD HIGHWAY
M.P. 53.0 TO M.P. 59.3
PLAN AND PROFILE SHEET
STA. 16+200 TO STA. 16+500

C:\PROJECTS\9913A\99P65 Win Mar 6 16:54:36 1995 Karen - Autocad 12
MP Designport 600 C:\VAD\2\UNIV\HGL2\JULI00\VA.CFG 11:40:02/2 ADI 4.2 Ver 2.0 - by Hewlett-Packard

SPECIFICATIONS	DESIGNED BY	3-6-95
	CHECKED BY	
	DRAFTED BY	KMH
STANDARDS	DESIGNATION	SH 13
	COMPUTER DESIGNATION	AUTOCAD-KAREN-5913A59P65
	COMPUTER DESIGNATION	


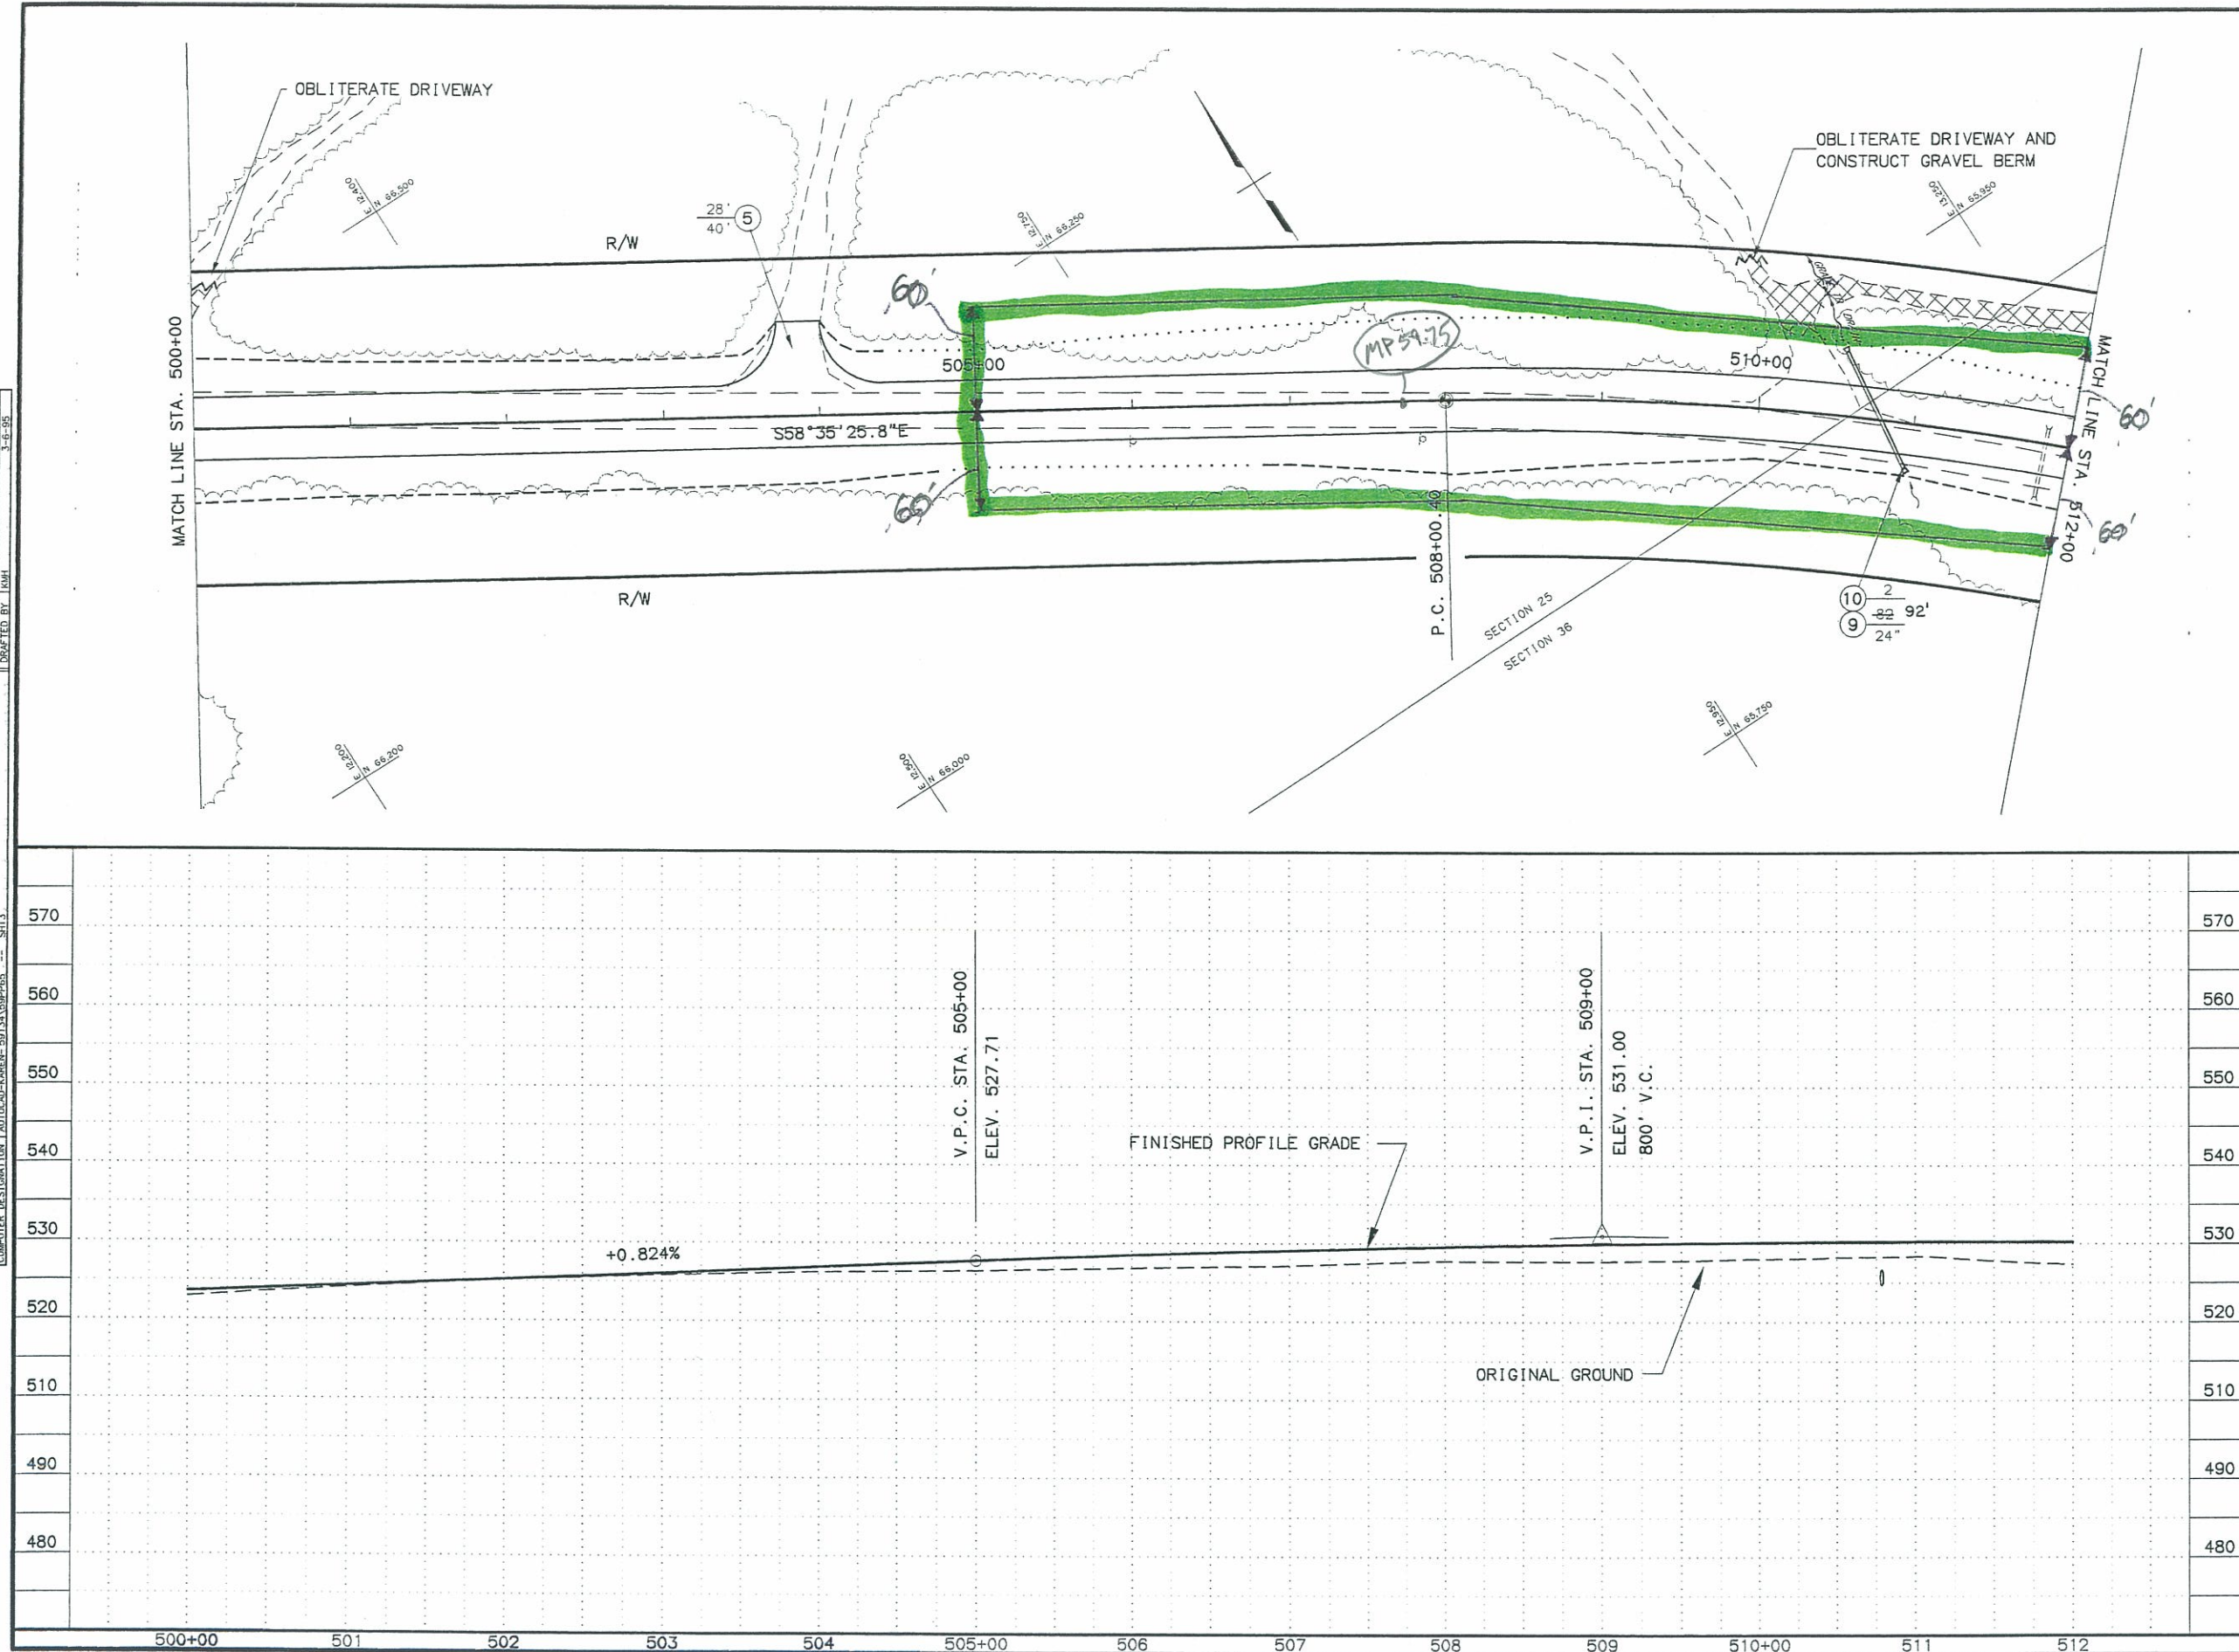


SHEET NO.		TOTAL SHEETS	
F3		131	
STATE		YEAR	
ALASKA		1995	
PROJECT DESIGNATION			
IR-0A3-2(6)			
ADDENDUM NO.			
ATTACHMENT NO.			
REVISIONS			
NO.	DATE	DESCRIPTION	



STATE OF ALASKA
DEPARTMENT OF TRANSPORTATION
AND
PUBLIC FACILITIES

SEWARD HIGHWAY
MP 59.3 TO MP 65.5

SPECIFICATIONS	DESIGNED BY
STANDARDS	CHECKED BY
COMPUTER DESIGNATION	DRAFTED BY
AUTOCAD-KAREN- 59134.69P85	KWH
	3-6-95

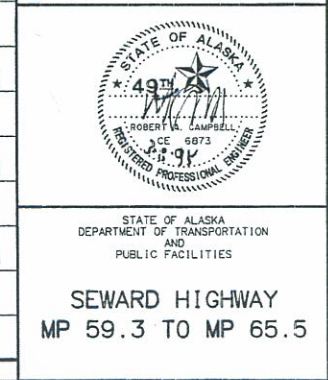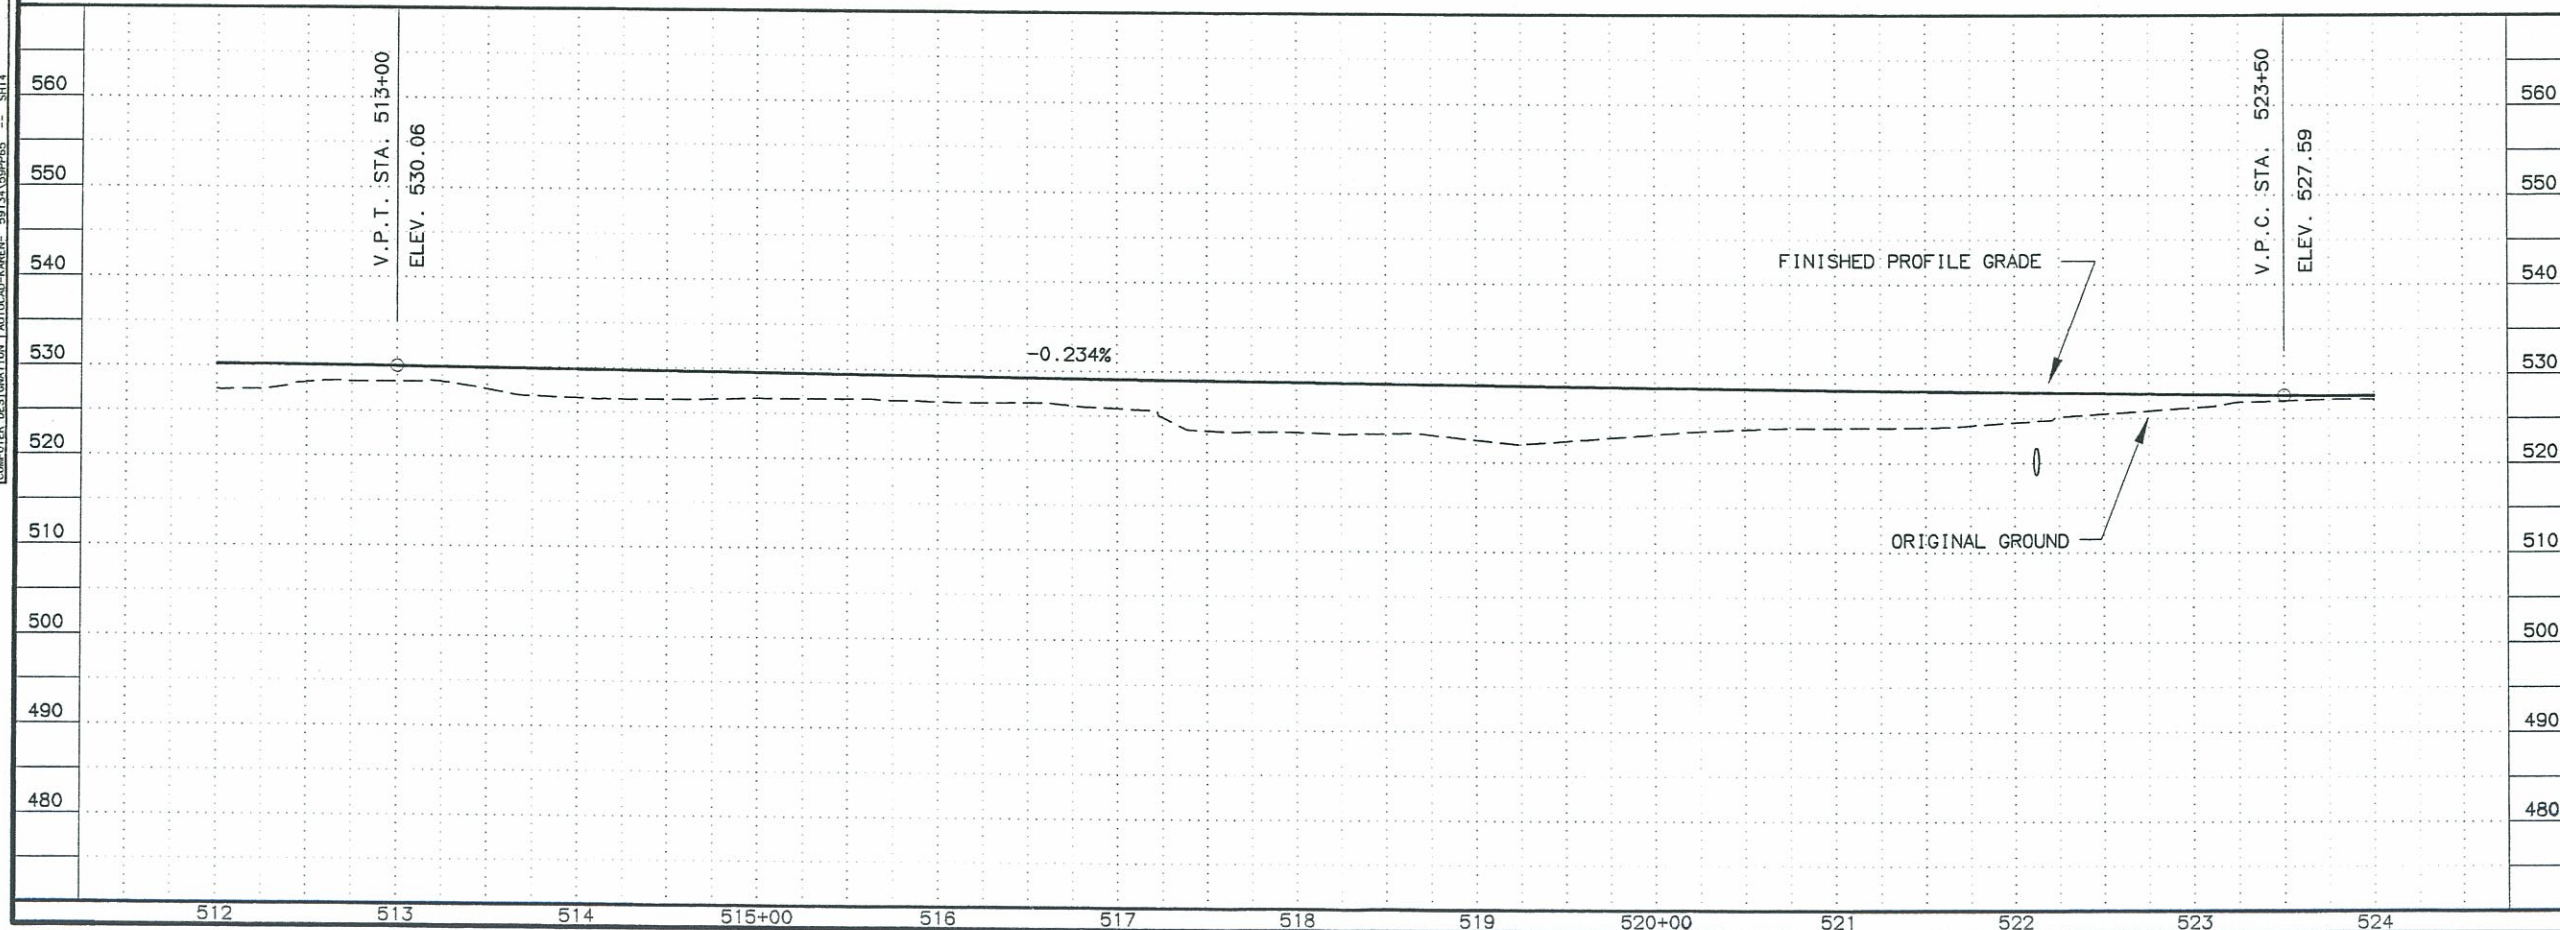

SPECIFICATIONS		DESIGNED BY
STANDARD		CHECKED BY
COMPUTER DESIGNATION	AUTOSAD-KAREN- 59134159P65 -- SIT16	DRAFTED BY
		MMH
		3-6-95

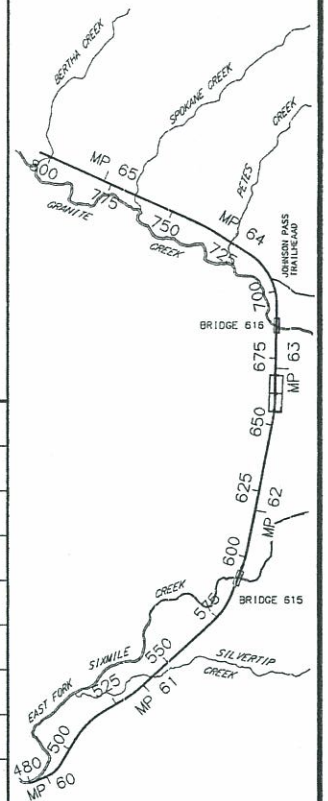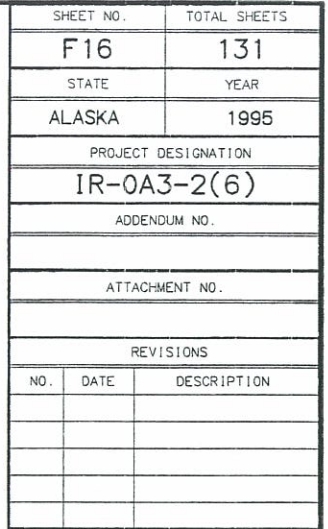


STATE OF ALASKA
DEPARTMENT OF TRANSPORTATION
AND
PUBLIC FACILITIES

SEWARD HIGHWAY
MP 59.3 TO MP 65.5

C:\PROJECTS\913A\913A.DWG, Mon Mar 6 17:15:19 1995, Karen - AutoCAD 12
HP DesignPlot 600 C:\MCD\2\DRW\HP62\OUT\913A.DWG, C:\HP-GL\2\ADT 4.2 Ver 2.0 - by Hewlett-Packard

SPECIFICATIONS	
STANDARDS	COMPUTER DESIGNATION
DESIGNED BY	AUTOCAD-KAREN-913A.DWG
DRAWN BY	MM
SHEET 17	

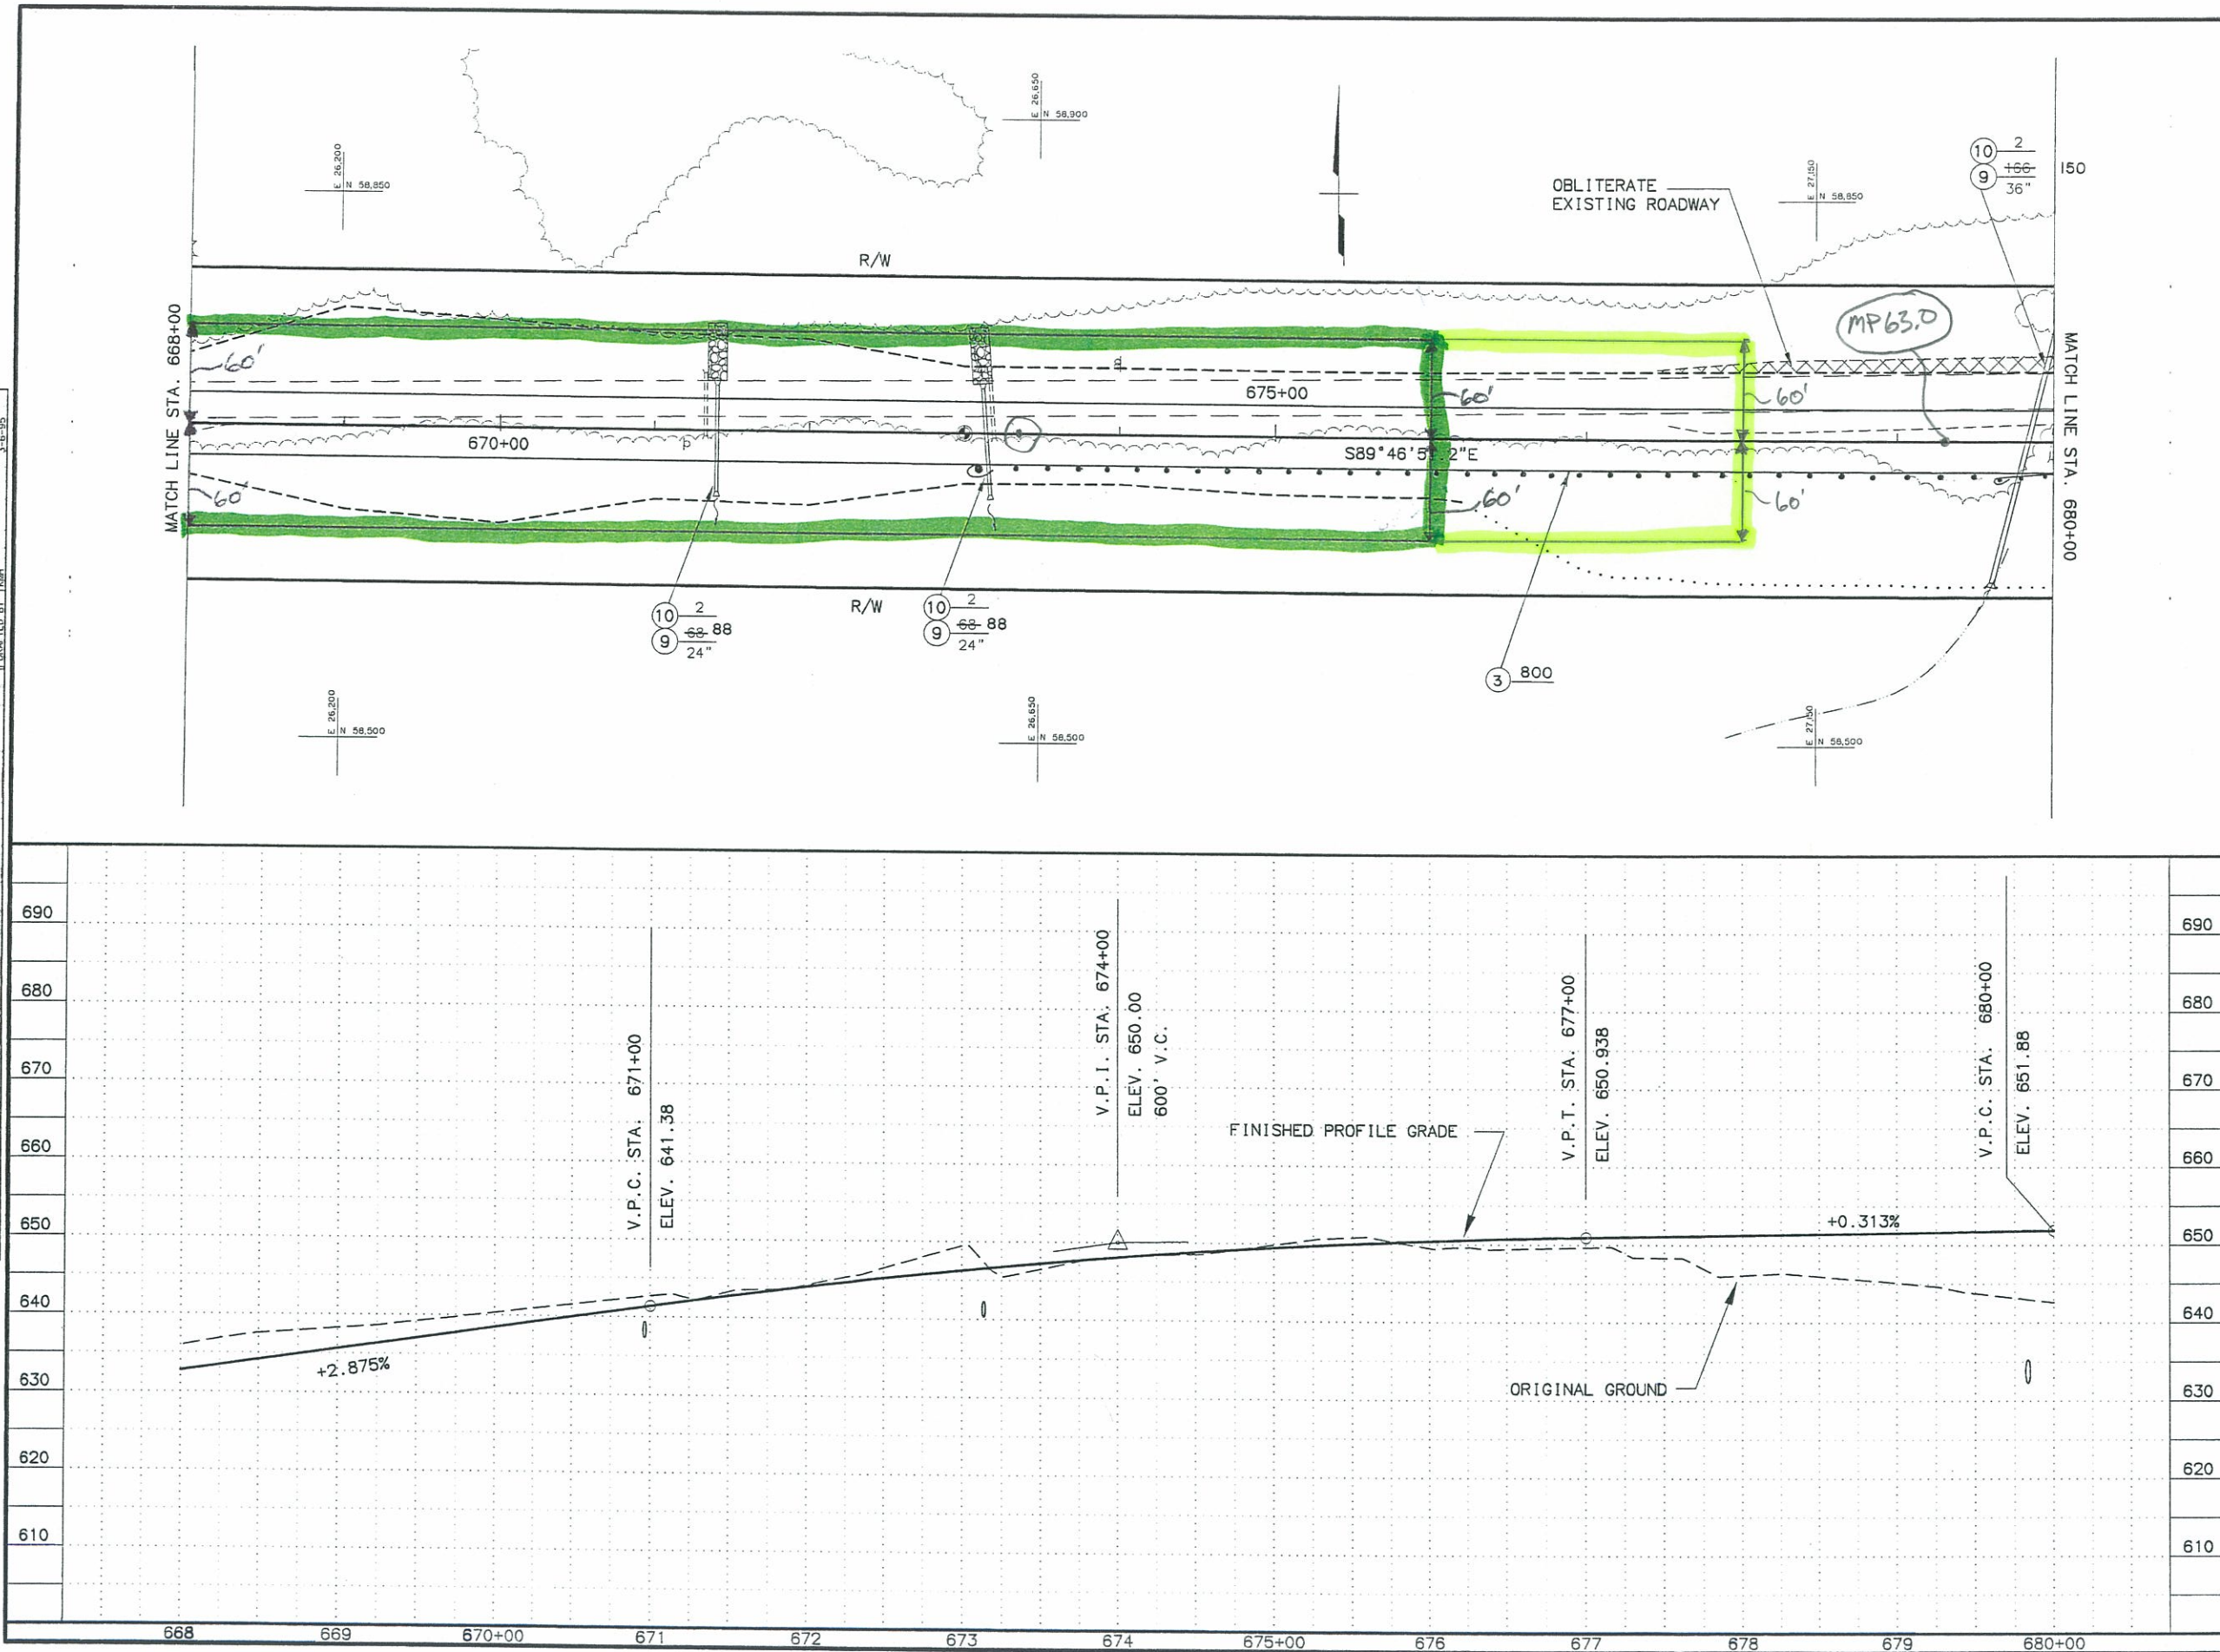

SHEET NO.	TOTAL SHEETS	
F17	131	
STATE	YEAR	
ALASKA	1995	
PROJECT DESIGNATION		
IR-0A3-2(6)		
ADDENDUM NO.		
ATTACHMENT NO.		
REVISIONS		
NO.	DATE	DESCRIPTION

STATE OF ALASKA
49TH
ROBERT A. CAMPBELL
REGISTERED PROFESSIONAL ENGINEER
1987

STATE OF ALASKA
DEPARTMENT OF TRANSPORTATION
AND
PUBLIC FACILITIES

SEWARD HIGHWAY
MP 59.3 TO MP 65.5