

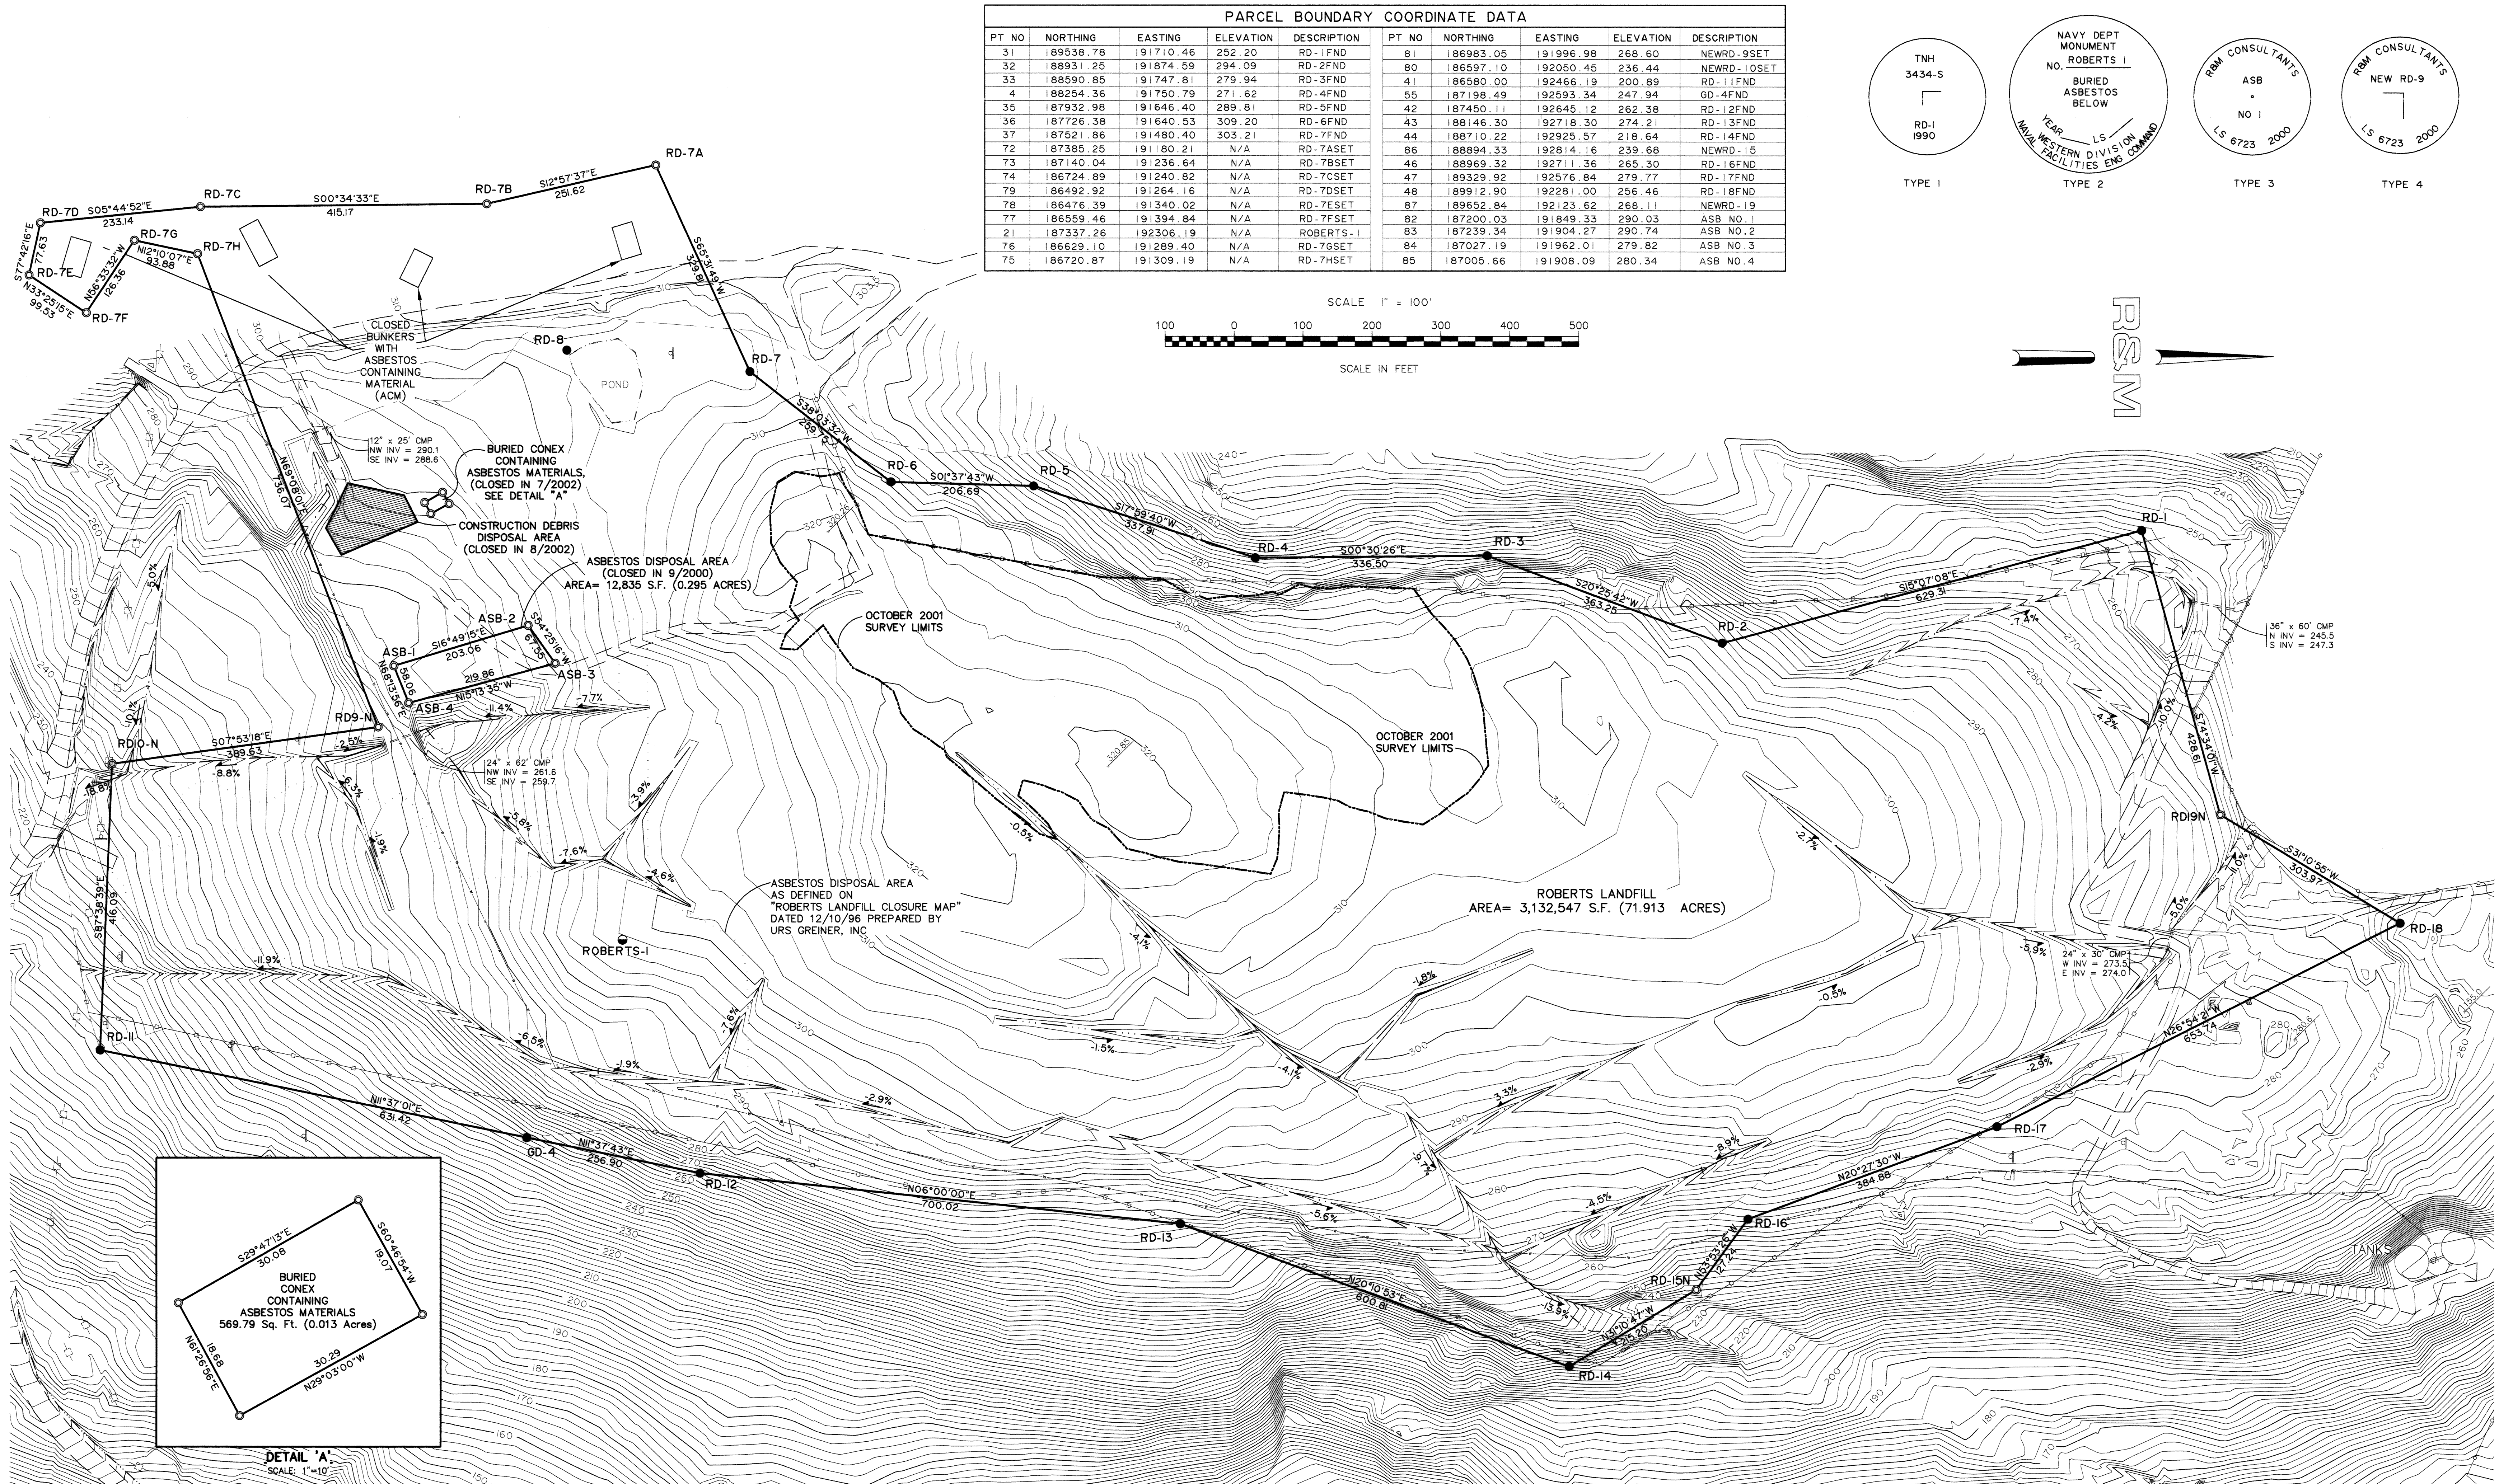


project:02/251127 Survey\adsk-landfill, 1=100, 08/29/02 at 10:17 by kslp
VIEW: 42x30, SOL: 1, DT055
XREF: RM_42X30-FT

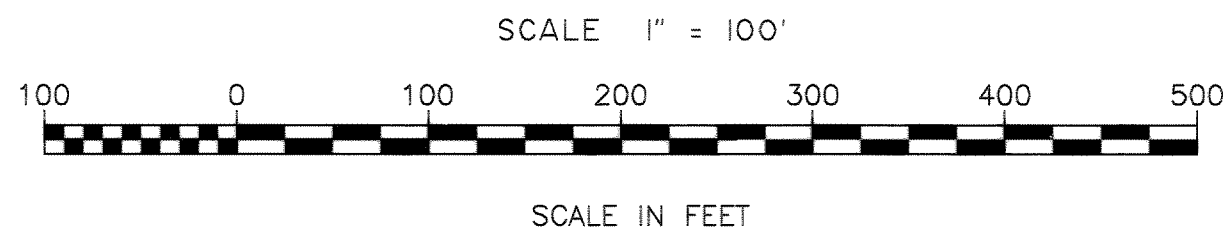

| PARCEL BOUNDARY COORDINATE DATA | | | | | | | |
|---------------------------------|----------|-----------|-----------|-------------|--------|----------|-----------|
| PT. NO | NORTHING | EASTING | ELEVATION | DESCRIPTION | PT. NO | NORTHING | EASTING |
| 31 | 89538.78 | 191710.46 | 252.20 | RD-1FND | 81 | 86983.05 | 191996.98 |
| 32 | 88931.25 | 191874.59 | 294.09 | RD-2FND | 80 | 86597.10 | 192050.45 |
| 33 | 88590.85 | 191747.81 | 279.94 | RD-3FND | 41 | 86580.00 | 192466.19 |
| 4 | 88254.36 | 191750.79 | 271.62 | RD-4FND | 55 | 87198.49 | 192593.34 |
| 35 | 87932.98 | 191646.40 | 289.81 | RD-5FND | 42 | 87450.11 | 192645.12 |
| 36 | 87726.38 | 191640.55 | 309.20 | RD-6FND | 43 | 88146.30 | 192718.30 |
| 37 | 87521.86 | 191480.40 | 303.21 | RD-7FND | 44 | 88710.22 | 192925.57 |
| 72 | 87385.25 | 191180.21 | N/A | RD-7ASET | 86 | 88894.35 | 192814.15 |
| 73 | 87140.04 | 191236.64 | N/A | RD-7BSET | 46 | 88969.32 | 192711.36 |
| 74 | 86724.89 | 191240.82 | N/A | RD-7CSET | 47 | 89329.92 | 192576.84 |
| 79 | 86492.92 | 191264.16 | N/A | RD-7DSET | 48 | 89912.90 | 192281.00 |
| 78 | 86476.39 | 191340.02 | N/A | RD-7ESET | 87 | 89662.84 | 192123.62 |
| 77 | 86559.46 | 191394.84 | N/A | RD-7FSET | 82 | 87200.03 | 191849.33 |
| 21 | 87337.26 | 192306.19 | N/A | ROBERTS-I | 83 | 87239.34 | 191904.27 |
| 76 | 86629.10 | 191289.40 | N/A | RD-7GSET | 84 | 87027.19 | 191962.01 |
| 75 | 86720.87 | 191309.19 | N/A | RD-7HSET | 85 | 87005.66 | 191908.09 |

TYPICAL MONUMENT CAP MARKINGS

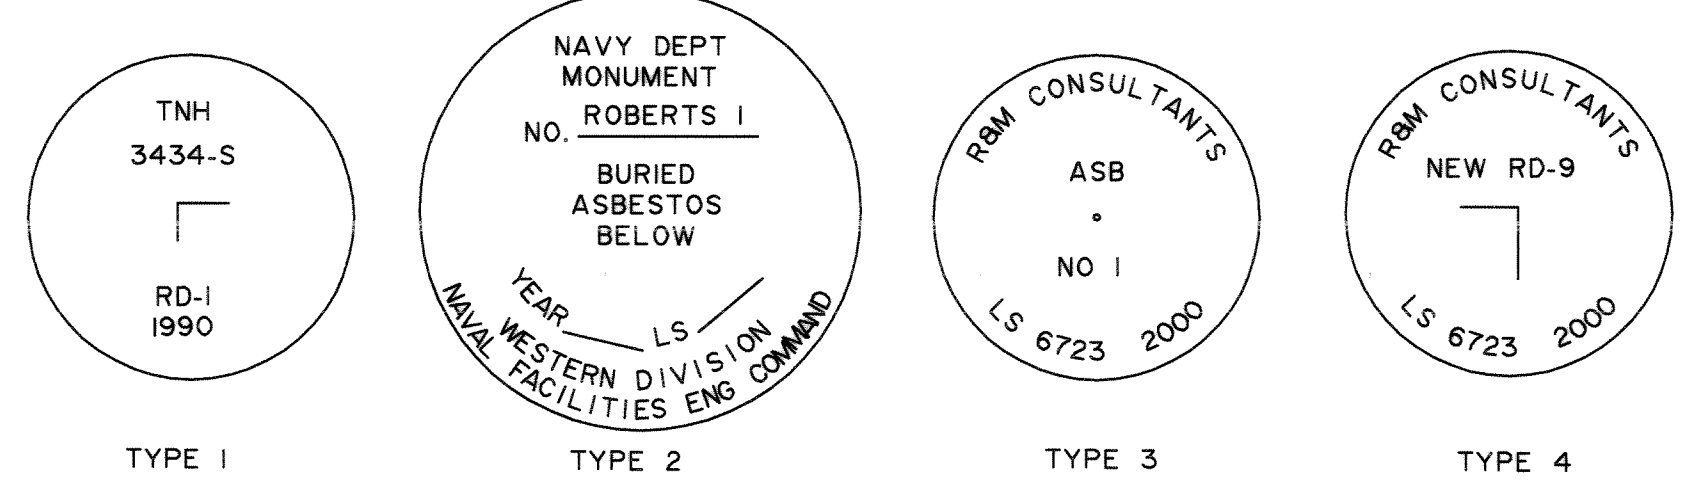

N

LEGEND

- Sanitary Sewer Manhole
- Fire Hydrant
- Water Gate Valve
- Utility Pole
- Anchor/Guy
- Fence/Line
- Spot Elevation
- Ditch/Line Grade
- Sign
- Water Line
- Found 2-1/2" Aluminum Cap Monument (Type 1)
- Found 3-1/4" Aluminum Cap Monument (Type 2)
- Set 2" Aluminum Cap on 5/8" X 30" Rebar (Types 3 and 4)

SURVEY NOTES


- The basis of bearing for this project is oriented to the record bearing between RD-1 and RD-2 as shown on the drawing titled "Naval Air Station Adak, Alaska, Adak Solid Waste disposal Project, Project P-882 Roberts Dump, Boundary Survey" prepared by Tryck, Nymon & Hayes, dated August 16, 1991.
- The project coordinates are referenced to the local Navy Grid System, 1944 Datum based on the coordinate value at RD-1 as shown on the above described drawing.
- The vertical control is referenced to the elevation at RD-3 as shown on the above described drawing.
- The information shown is based on field surveys performed by R&M Consultants Inc., during 9/2000 and 10/2001.
- The contour interval shown is 2 feet. The distances shown are ground distances reduced to horizontal in U.S. Survey feet.
- The Boundary information shown is based on the drawing described in note 1 and direction from Bristol Environmental & Engineering Services Corp.

SURVEYOR'S CERTIFICATE

I hereby certify that I am properly registered and licensed to practice Land Surveying in the State of Alaska, and that this survey drawing represents a survey made by me or under my direct supervision, and that the monuments shown hereon actually exist as described, and that all dimensions and other details are correct to the extent shown hereon.

Lendie C. Story, L.S. 7843

9-11-02
DATE

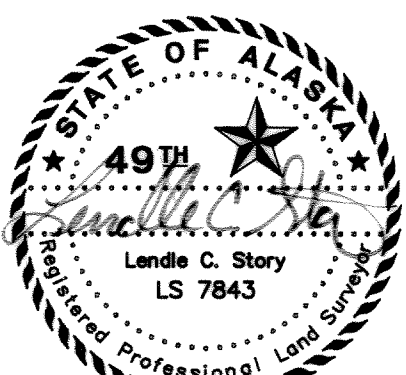

2002-10
Mountain 25 REC DIST
Date 9-25-2002
Time 3:40 P.M.
Requested By BRISL
Address Bristol Environmental & Engineering Services Corp.

20-CC

| REVISION | |
|---|-----------------------------|
| DATE | DESCRIPTION |
| 8/22/02 | ADDITIONAL TOPOGRAPHY ADDED |
| BOUNDARY AND TOPOGRAPHIC SURVEY FOR ADAK ROBERTS LANDFILL LOCATED ON ADAK ISLAND, ALASKA R&M CONSULTANTS, INC. 9101 Vanguard Drive, Anchorage, Alaska 99507 | |
| DRAWN: KSLP | SCALE: 1"=100' |
| CHECKED: LCS | PROJECT: 151141/251127 |
| FIELD BK: 5-389-1 | DATE: 8/29/02 |
| | GRID: ADAK |
| | SHEET: 1 OF 1 |

R&M



2000 W. International Airport Road, #C-1
Anchorage, AK 99502-1116
907-563-0013 Phone
907-563-6713 Fax

September 25, 2002

State of Alaska
Department of Natural Resources
550 West 7th Avenue, Suite 1200
Anchorage AK 99501-3564

To Whom It May Concern:

The following document is enclosed for recording purposes:

Title:

*Boundary and Topographic Survey for Adak Roberts Landfill
Located on Adak Island, Alaska*

Recording District:

Aleutian Islands

Please return two conformed copies (full scale on mylar) of this document to:

Bristol Environmental and Engineering Services Corporation
2000 W. International Airport Rd. #C-1
Anchorage, AK 99502-1116

If you have questions or require additional information, please call me at (907) 563-0013.

Sincerely,

Bristol Environmental and Engineering Services Corp.

A handwritten signature in black ink, appearing to read "Kyle Petersen".

Kyle Petersen
Staff Engineer

Aleutian Island 2002-10


NOTICE OF CLOSURE OF LANDFILL

Pursuant to 18 AAC 60.395, Department of the Navy hereby notices all potential purchasers of this property that the property located at Adak Island, Alaska within unsurveyed Township 96 South, Range 195 West of the Seward Meridian, Alaska within the area bounded by the following Adak Island, Navy Grid System, 1944 Datum, U.S. Survey Feet coordinate values:

| Northing | Easting | Descriptor |
|-----------|-----------|------------|
| 189538.78 | 191710.46 | RD-1 |
| 188931.25 | 191874.60 | RD-2 |
| 188590.85 | 191747.81 | RD-3 |
| 188254.37 | 191750.79 | RD-4 |
| 187932.98 | 191646.40 | RD-5 |
| 187726.38 | 191640.53 | RD-6 |
| 187521.86 | 191480.40 | RD-7 |
| 187385.25 | 191180.21 | RD-7A |
| 187140.04 | 191236.64 | RD-7B |
| 186724.89 | 191240.82 | RD-7C |
| 186492.93 | 191264.16 | RD-7D |
| 186476.39 | 191340.02 | RD-7E |
| 186559.46 | 191394.84 | RD-7F |
| 186629.10 | 191289.40 | RD-7G |
| 186720.87 | 191309.19 | RD-7H |
| 186983.05 | 191996.98 | RD9-N |
| 186597.10 | 192050.45 | RD10-N |
| 186580.00 | 192466.19 | RD-11 |
| 187198.49 | 192593.34 | GD-4 |
| 187450.11 | 192645.12 | RD-12 |
| 188146.30 | 192718.30 | RD-13 |
| 188710.22 | 192925.57 | RD-14 |
| 188894.33 | 192814.16 | RD-15N |
| 188969.32 | 192711.36 | RD-16 |
| 189329.92 | 192576.84 | RD-17 |
| 189912.90 | 192281.00 | RD-18 |
| 189652.84 | 192123.62 | RD19N |

Aleutian Island - 2002.10

and situated in the Aleutian Islands recording district was used as a Class II Municipal Solid Waste Landfill (MSWLF), as defined in 18 AAC 60.300 and 18 AAC 990, and use of this property is therefore restricted under 18 AAC 60.397(c)(3).

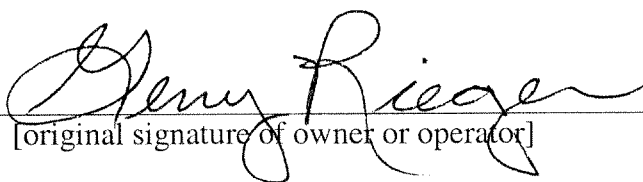
[original signature of owner or operator]

Date: September 17, 2002

Printed Name/Title: Gerry Rieger, P.E., Environmental Project Manager

Mailing Address: Naval Facilities Engineering Command

19917 7th Avenue N.E.

Poulsbo, WA 98370-7570

See 11 AAC 05.010(a)(14) for the required fee. Print or type legibly in English; if necessary, attach and refer to attachments or exhibits (not larger than 8.5" x 14"). This form is intended to comply with the recording requirements of AS 40.17.030 and 11 AAC 06.040.

Alutian Island 2002-10