
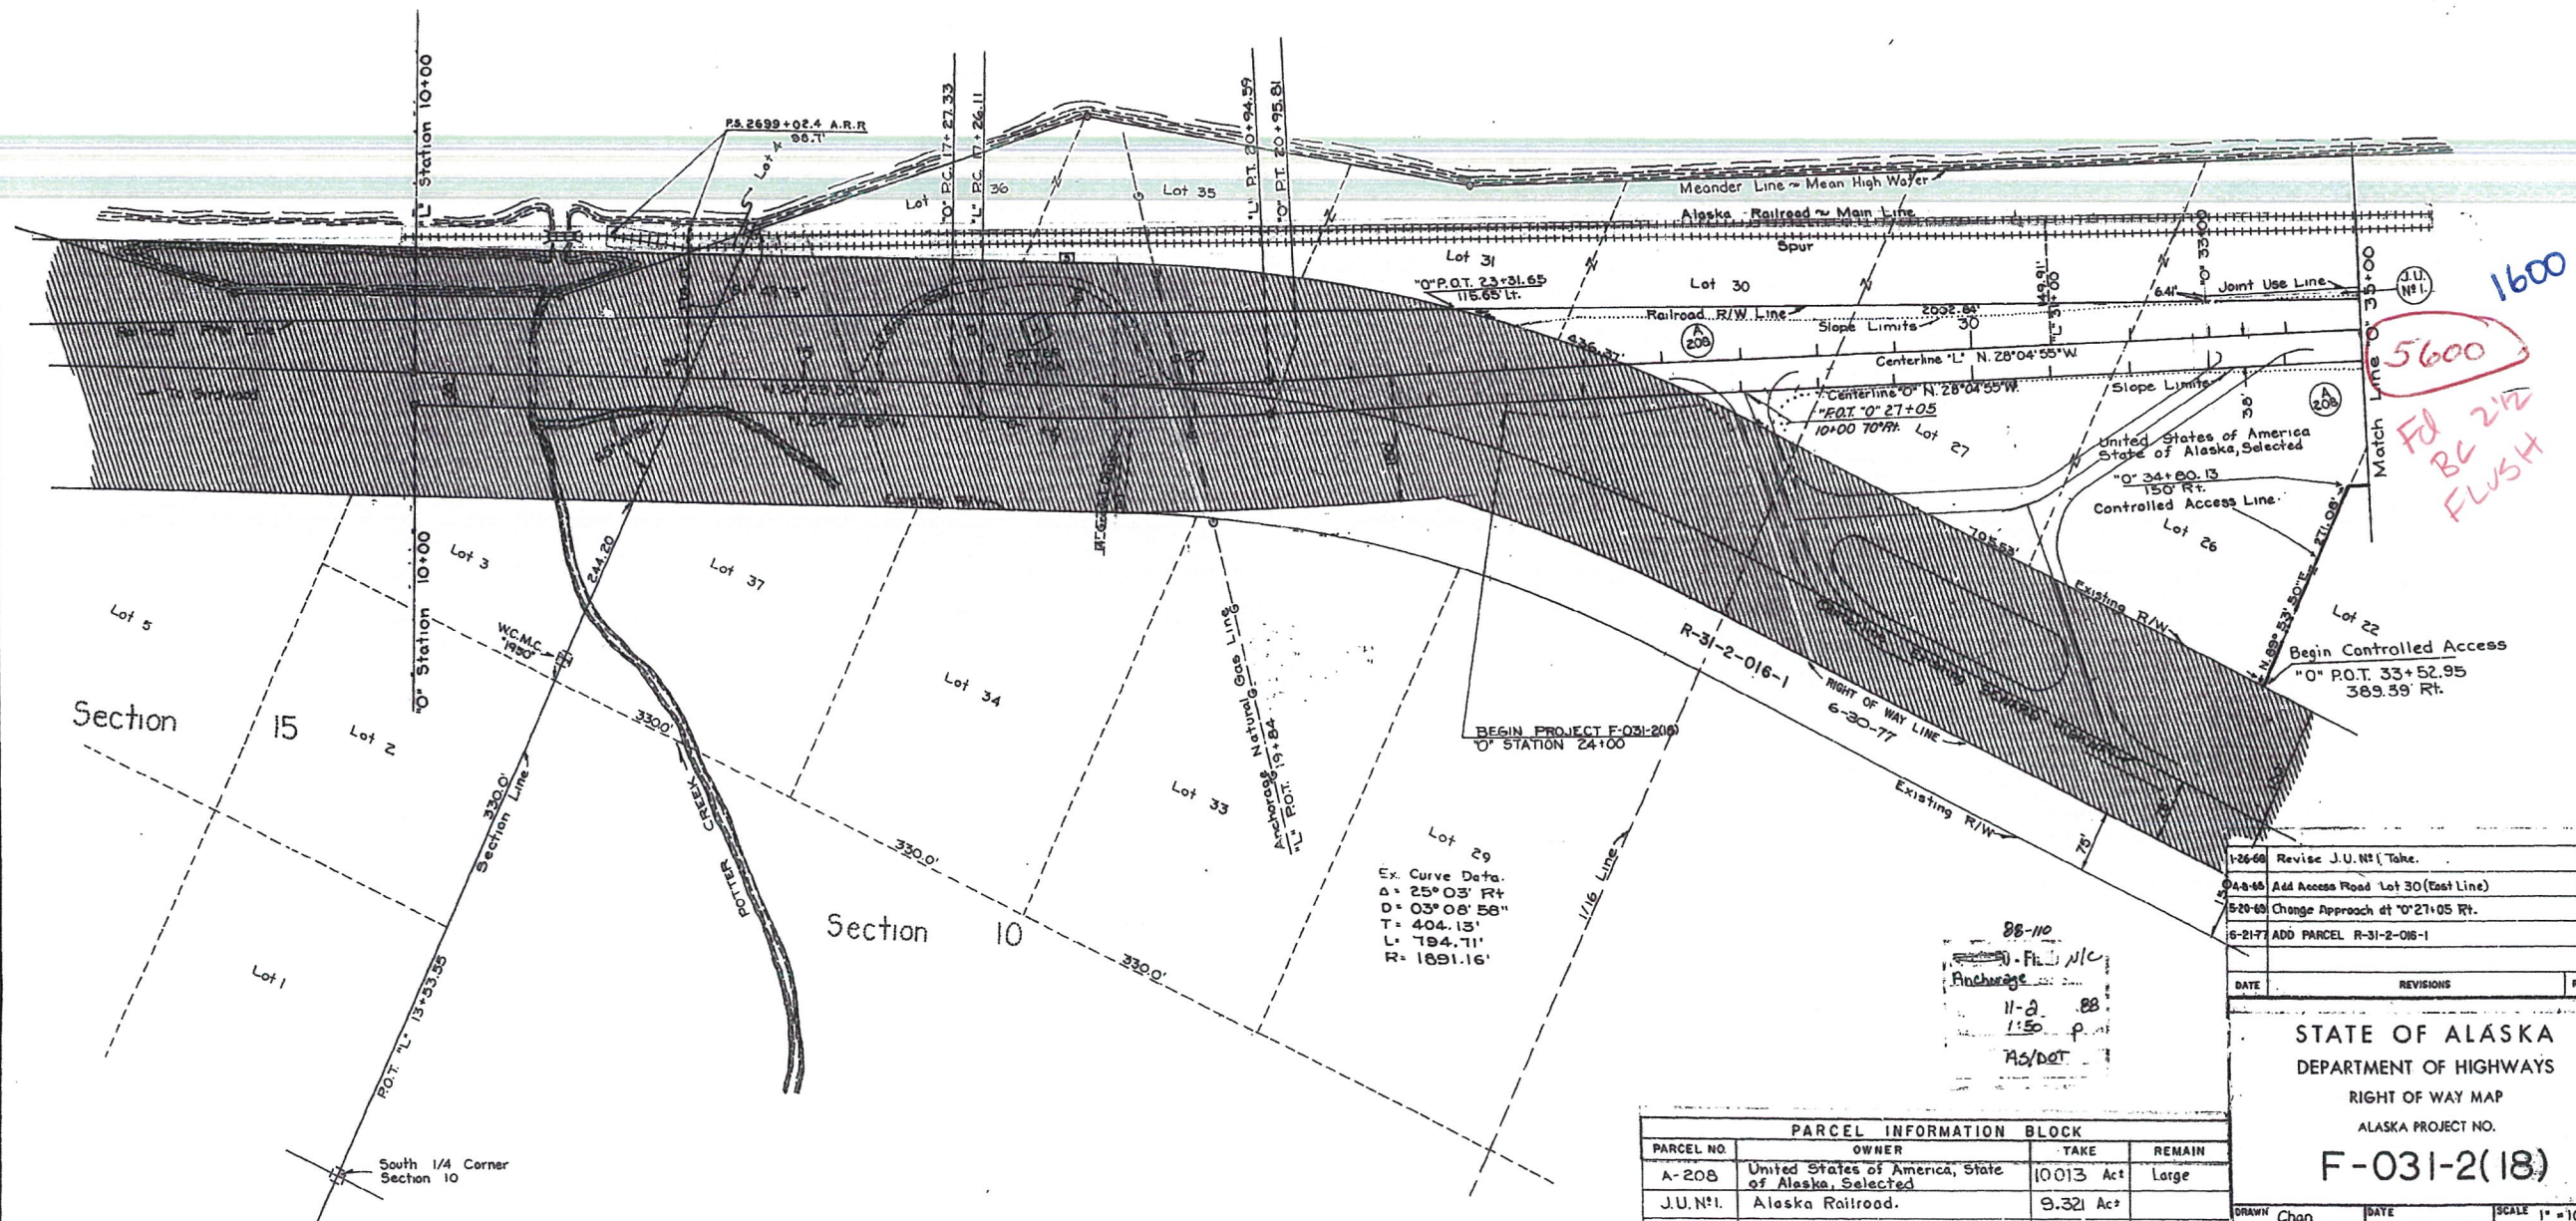


TURNAGAIN

ARM

"O" R1 19+11.63
 Δ = 3°41'05" Lt.
 D = 1°00'
 T = 184.30'
 L = 368.48'
 R = 5729.58'
 "L" R1 19+10.41
 Δ = 3°41'05" Lt.
 D = 1°00'
 T = 184.30'
 L = 368.48'
 R = 5729.58'

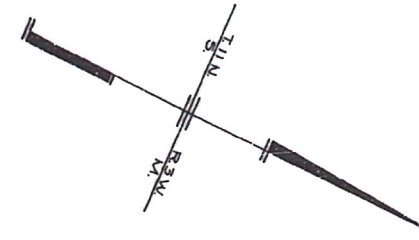

Lot 29
 Ex. Curve Data:
 Δ = 25°03' Rt.
 D = 03°08' 58"
 T = 404.13'
 L = 794.71'
 R = 1891.16'

PARCEL INFORMATION BLOCK			
PARCEL NO.	OWNER	TAKE	REMAIN
A-208	United States of America, State of Alaska, Selected	10013 Ac	Large
J.U.N#1	Alaska Railroad.	9.321 Ac	


DATE	REVISIONS	REVISED BY
1-26-66	Revise J.U.N#1 Take.	Jeh.
4-4-66	Add Access Road Lot 30 (East Line)	Jeh.
5-29-66	Change Approach at 0+27+05 Rt.	Jeh.
6-21-77	ADD PARCEL R-31-2-016-1	R.H.

STATE OF ALASKA
 DEPARTMENT OF HIGHWAYS
 RIGHT OF WAY MAP
 ALASKA PROJECT NO.
F-031-2(18)

DRAWN Chan
 CHECKED
 DATE
 SCALE 1" = 100'
 SHEET 7 OF 27

ARM

"L" P.I. 49+01.17
 $\Delta = 17^{\circ} 08' 26''$ L.I.
 D = 1°00'
 T = 863.47'
 L = 1714.03'
 R = 5729.58'

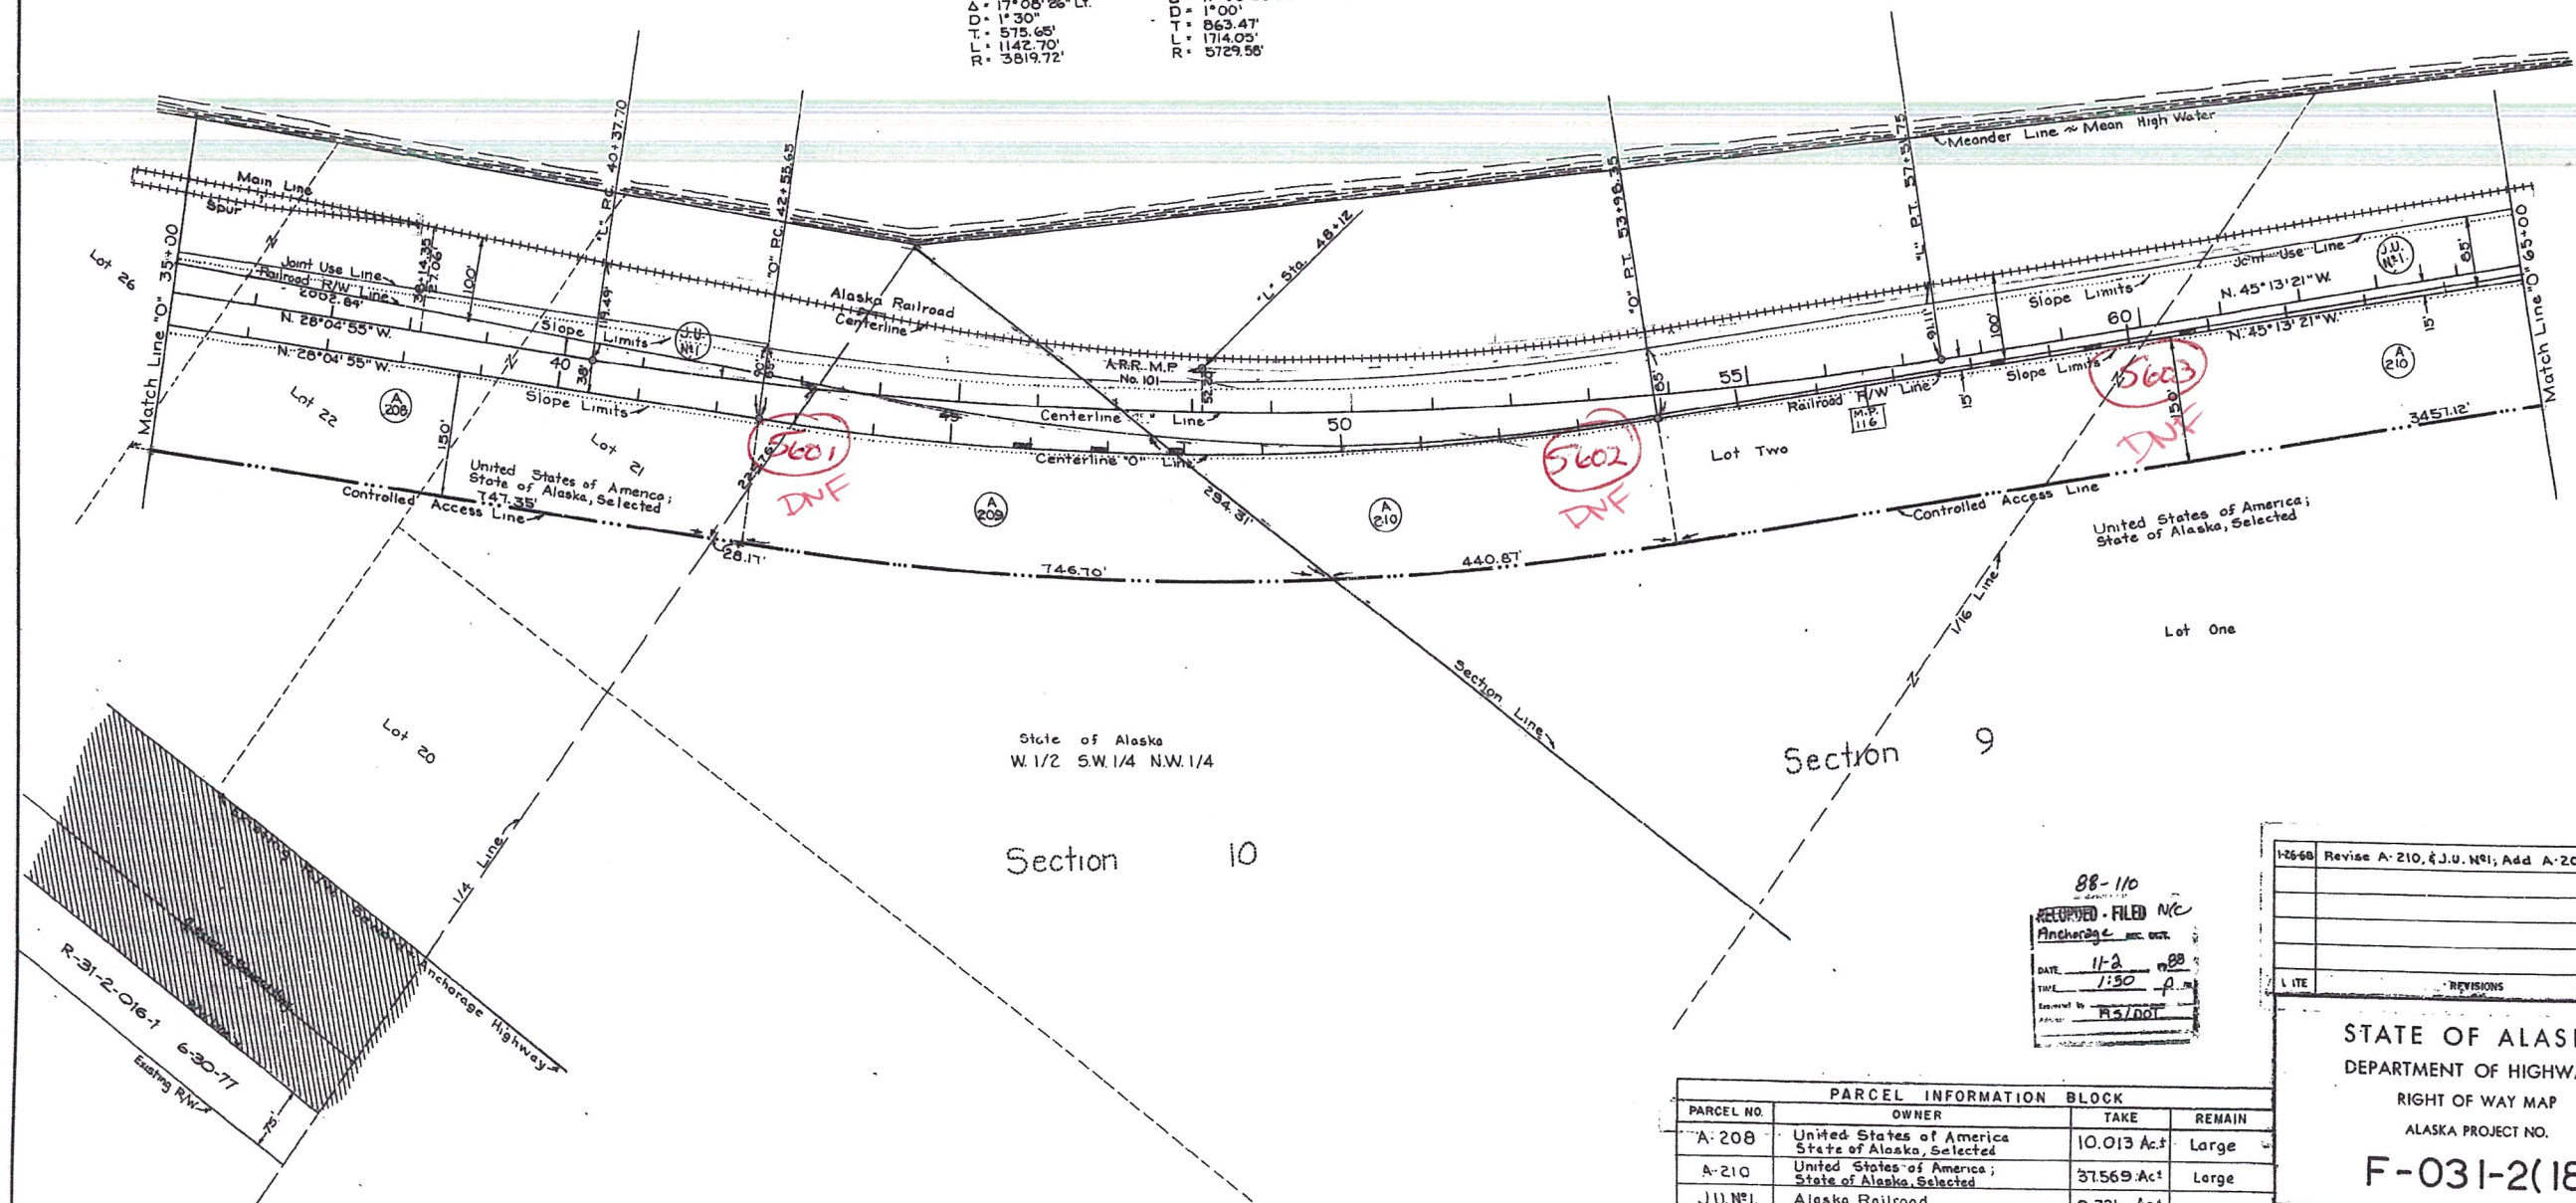

PARCEL INFORMATION BLOCK			
PARCEL NO.	OWNER	TAKE	REMAIN
A-208	United States of America State of Alaska, Selected	10.013 Ac.±	Large
A-210	United States of America; State of Alaska, Selected	37.569 Ac.±	Large
J.U.NF1.	Alaska Railroad	9.321 Ac.±	
A-209	State of Alaska.	2.526 Ac.±	16.639 Ac.

1-26-68	Revise A-210, & J.U. W&I; Add A-205	Jch.
1	ITE	REVISIONS
		RVSD BY

STATE OF ALASKA
DEPARTMENT OF HIGHWAYS

RIGHT OF WAY MAP



ALASKA PROJECT NO.

F-031-2(18)

DRAWN	Chan	DATE
CHECKED		DATE
SCALE 1" = 600'		SHEET 8 OF 27

TURNAGAIN

ARM

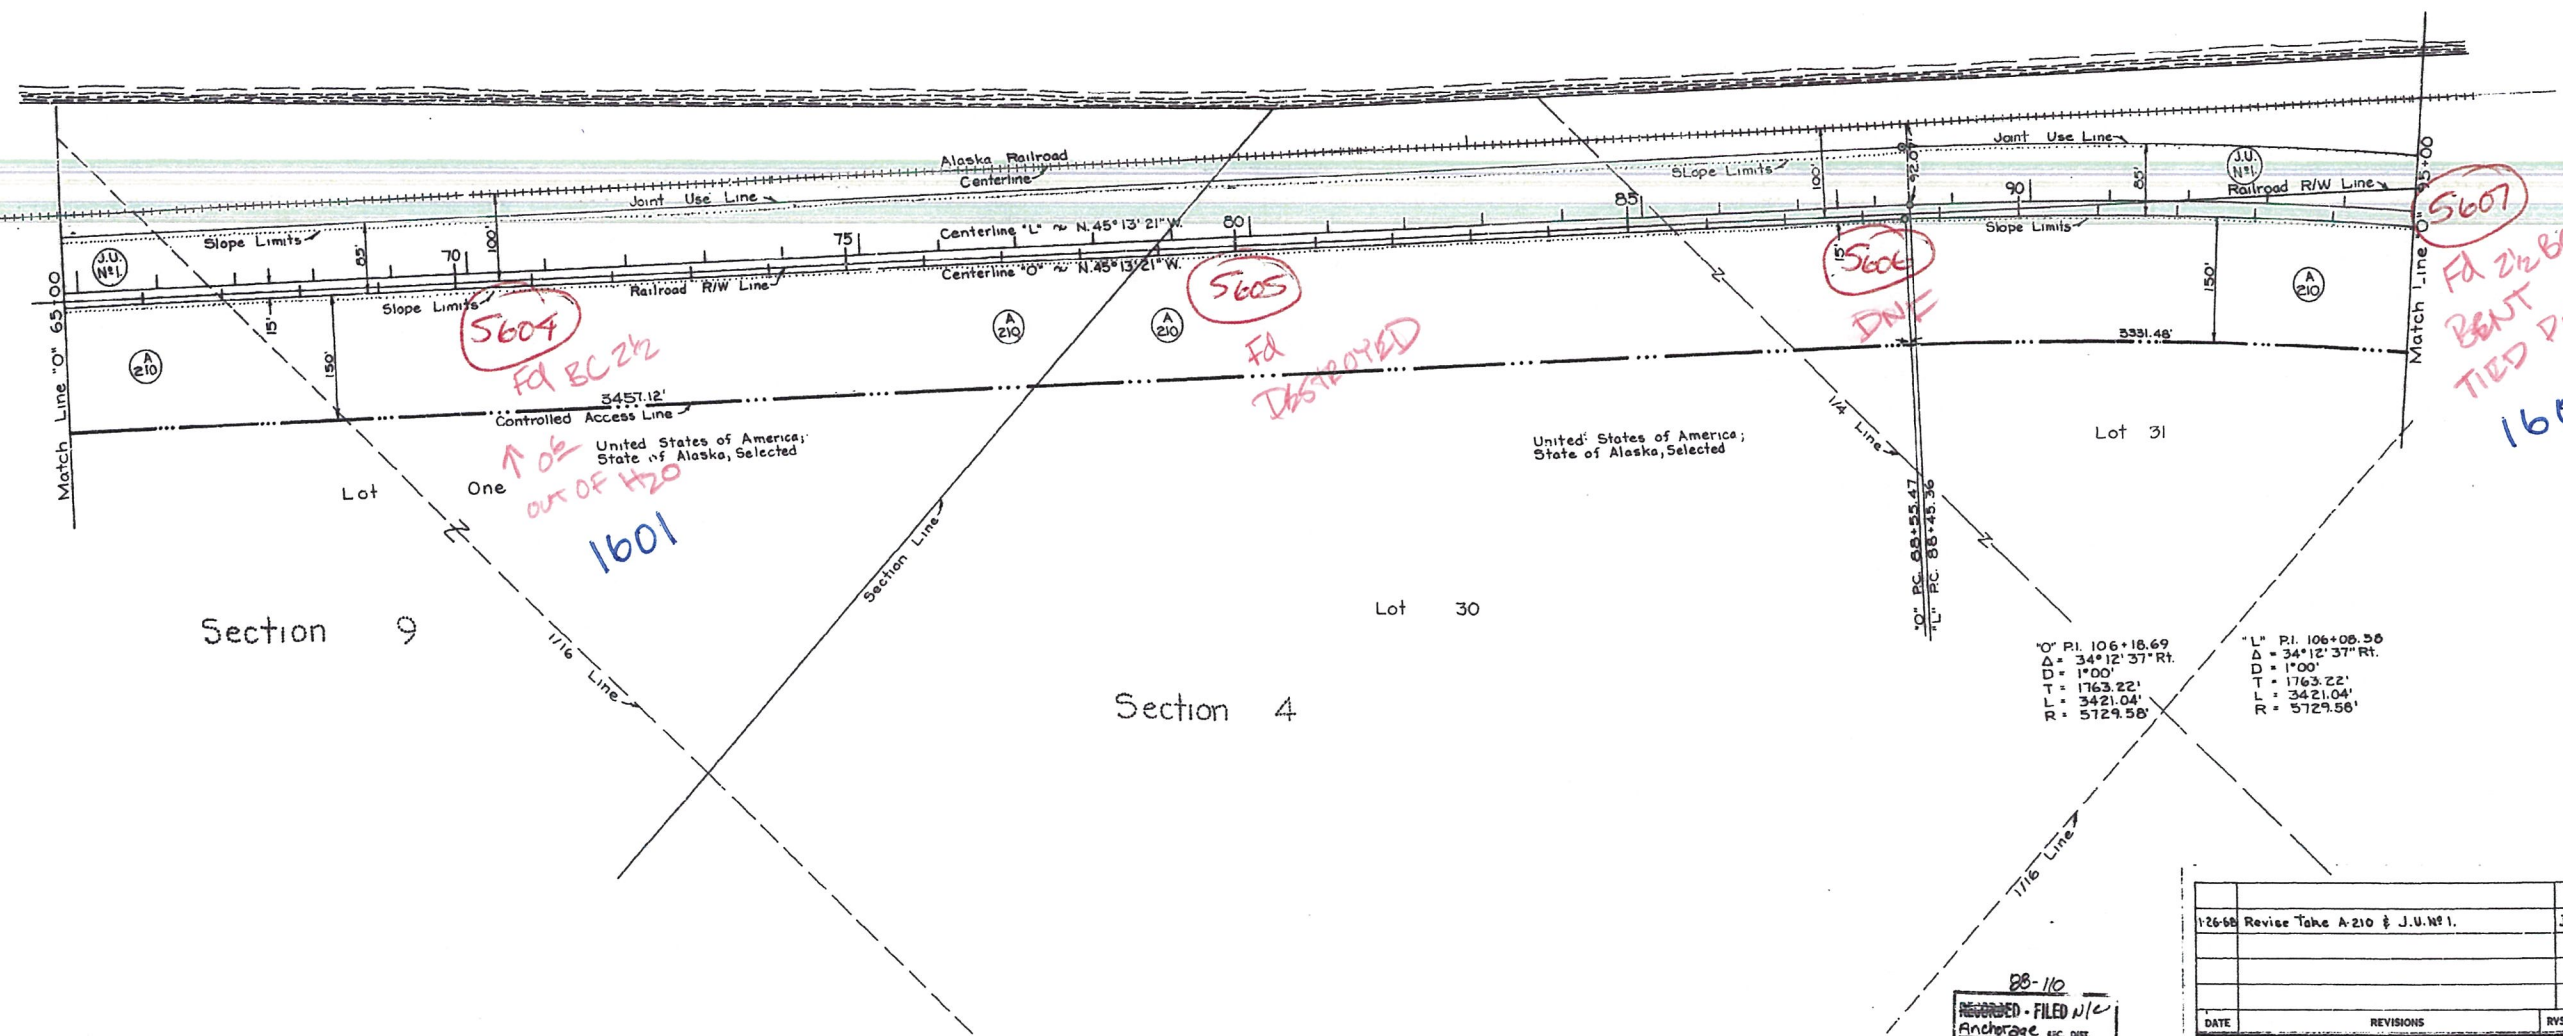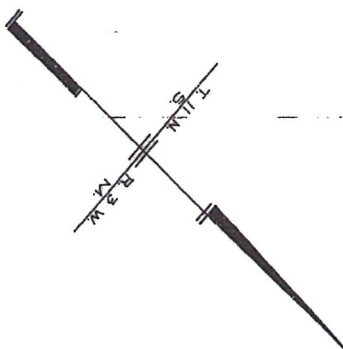

0° P.I. 106+18.69
Δ = 34°12'37" Rt.
D = 1°00'
T = 1763.22'
L = 3421.04'
R = 5129.58'

1° P.I. 106+08.58
Δ = 34°12'37" Rt.
D = 1°00'
T = 1763.22'
L = 3421.04'
R = 5129.58'


88-110
RECORDED - FILED N/C
ANCHORAGE REC. DIST.
DATE 11-2-88
TIME 1:50 P.M.
BY [Signature]

PARCEL INFORMATION BLOCK			
PARCEL NO.	OWNER	TAKE	REMAIN
J.U.N#1	Alaska Railroad	9.321 Ac.	
A-210	United States of America; State of Alaska, Selected	37.569 Ac.	Large

1-26-88	Revise Take A-210 & J.U.N#1.	Jeh.
DATE	REVISIONS	REVISED BY
STATE OF ALASKA DEPARTMENT OF HIGHWAYS RIGHT OF WAY MAP ALASKA PROJECT NO. F-031-2(18)		
DRAWN Chan	DATE	SCALE 1" = 100'
CHECKED	DATE	SHEET 9 OF 27

TURNAGAIN

ARM

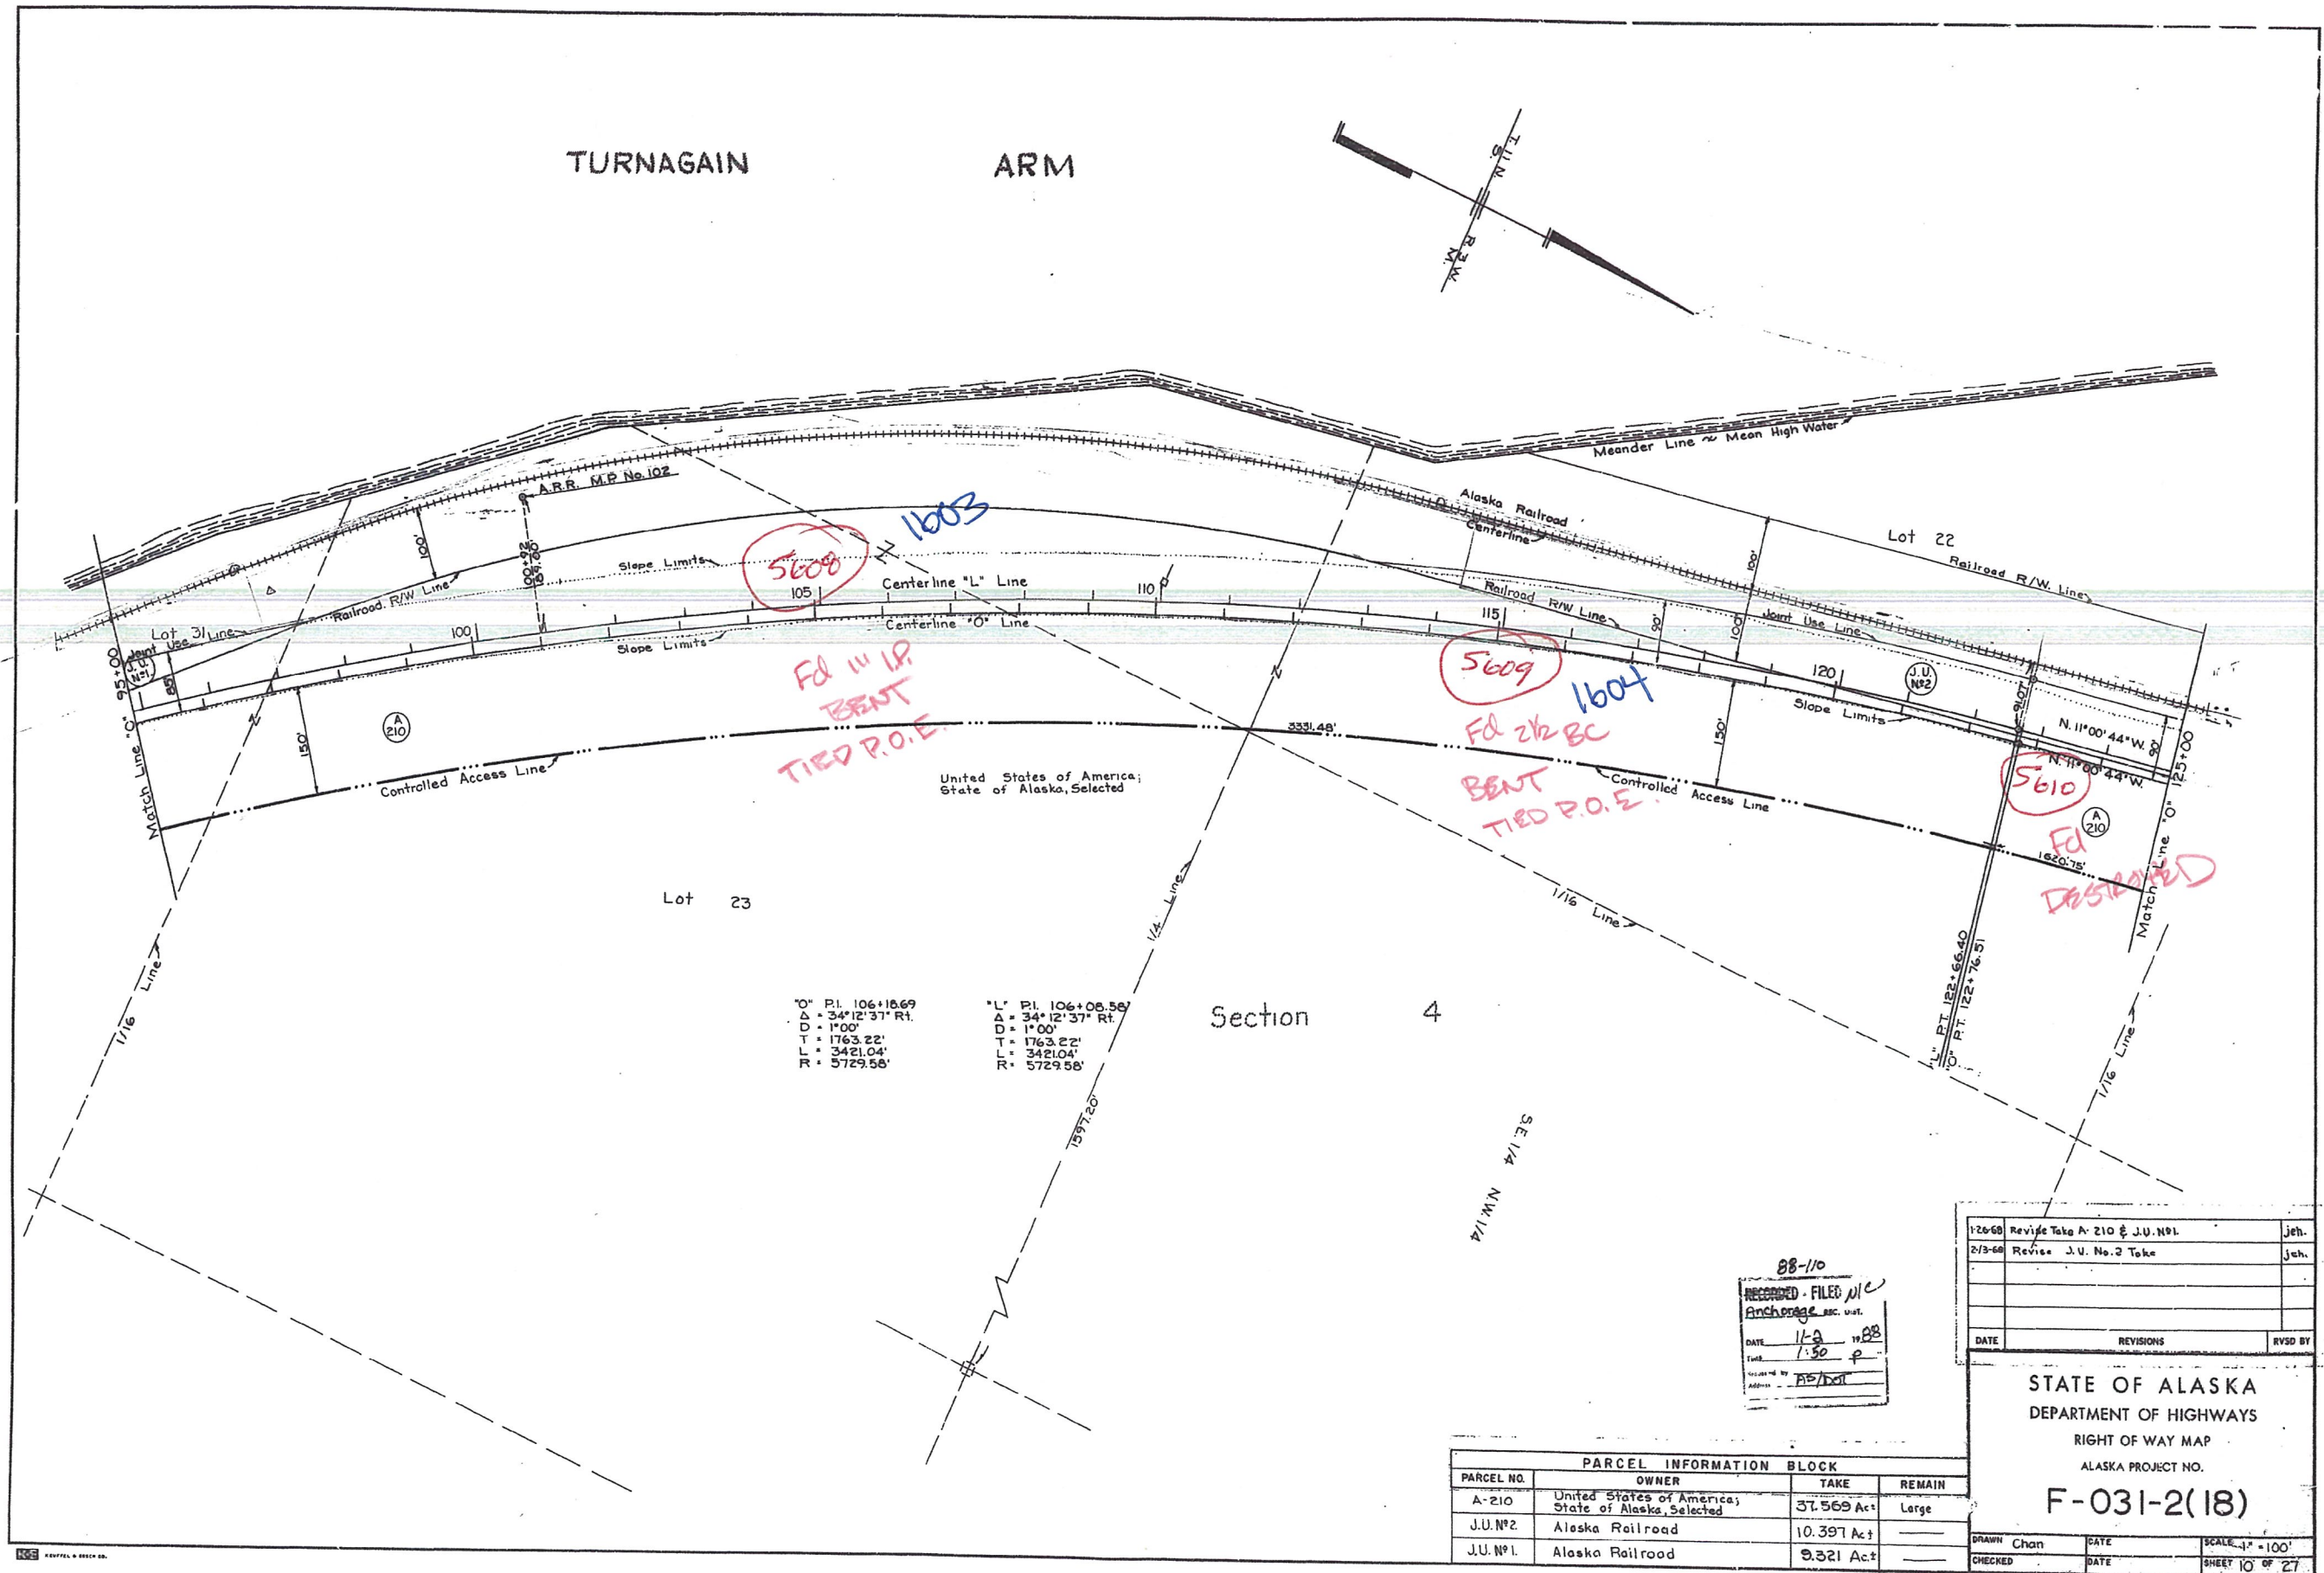

"O" P.I. 106+16.69
 Δ = 34°12'37" Rt.
 D = 1°00'
 T = 1763.22'
 L = 3421.04'
 R = 5729.58'

"L" P.I. 106+08.58
 Δ = 34°12'37" Rt.
 D = 1°00'
 T = 1763.22'
 L = 3421.04'
 R = 5729.58'

Section 4


88-110
 RECORDED - FILED N/C
 Anchorage, Alaska
 DATE 11-9-88
 TIME 1:50 P.
 BY [Signature]

12-68	Revise Take A-210 & J.U.NP1	jeh.
2/3-68	Revise J.U. No. 2 Take	jeh.
DATE	REVISIONS	REVISED BY

PARCEL INFORMATION BLOCK			
PARCEL NO.	OWNER	TAKE	REMAIN
A-210	United States of America; State of Alaska, Selected	37.569 Ac.	Large
J.U.NP2	Alaska Railroad	10.397 Ac.	
J.U.NP1	Alaska Railroad	9.321 Ac.	

STATE OF ALASKA
 DEPARTMENT OF HIGHWAYS
 RIGHT OF WAY MAP
 ALASKA PROJECT NO.
F-031-2(18)

DRAWN Chan DATE SCALE 1" = 100'
 CHECKED DATE SHEET 10 OF 27

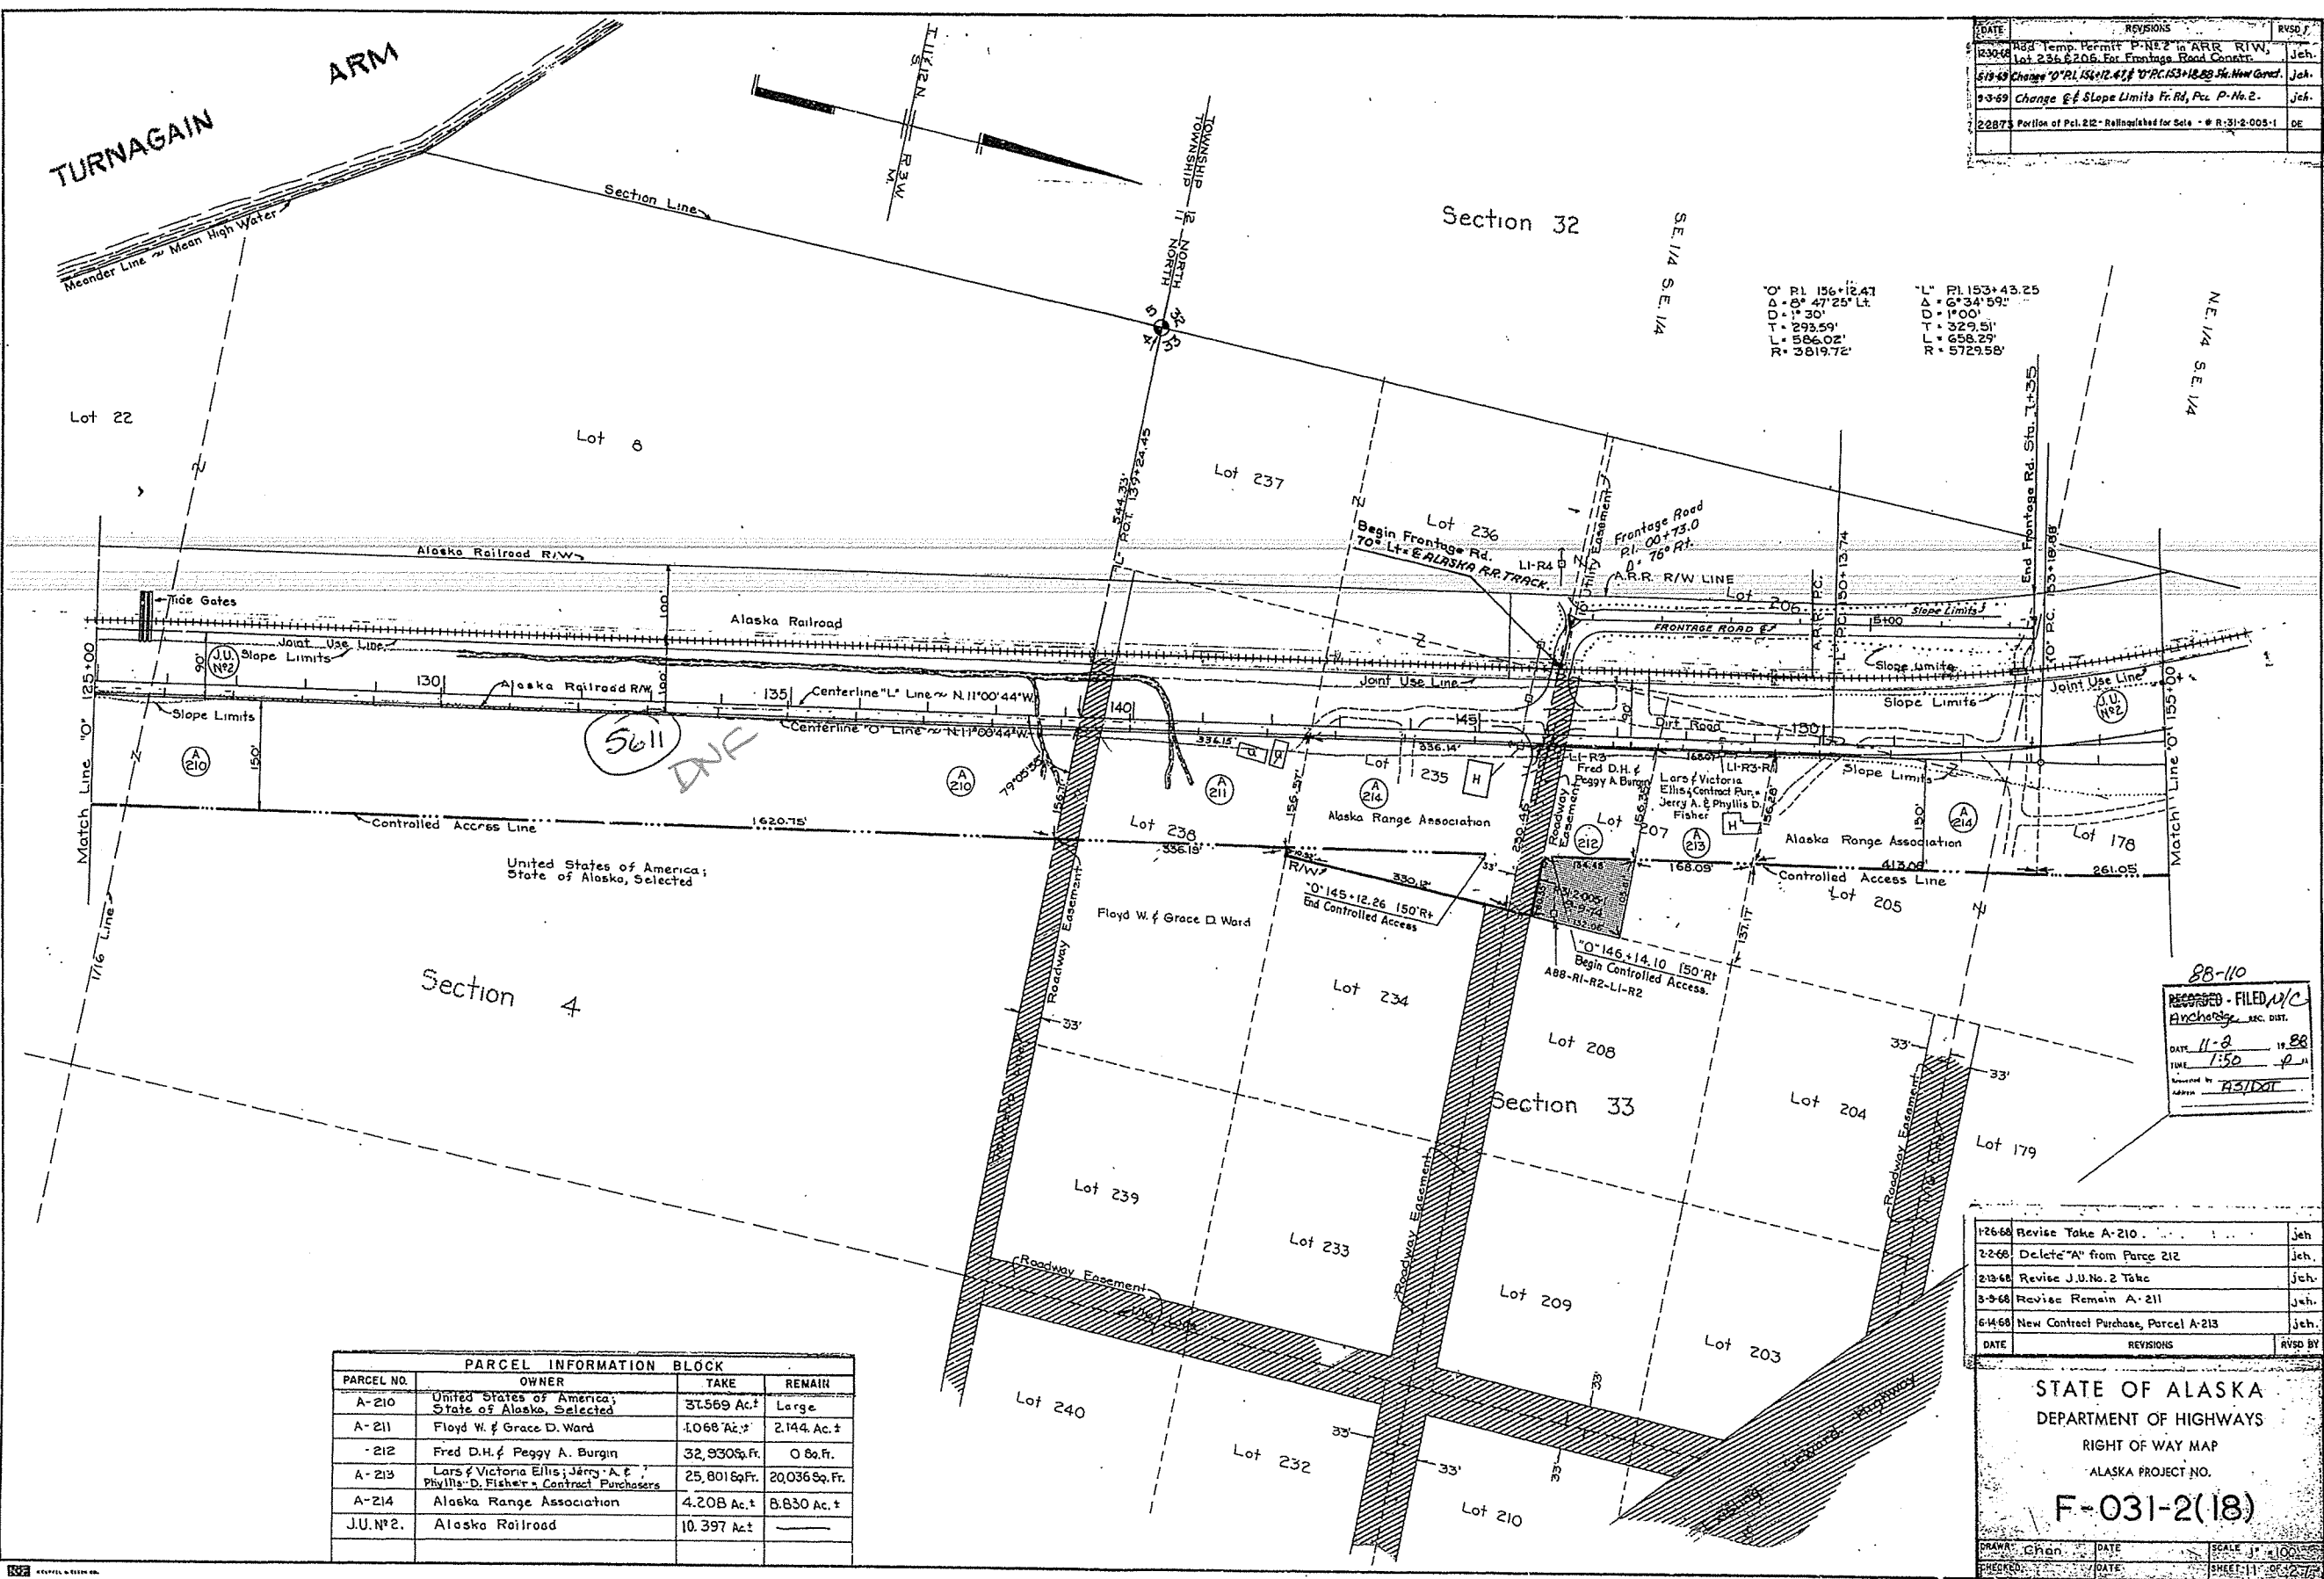

DATE	REVISIONS	BY
12-30-88	Revise Temp. Permit P-112 in ARR R/W, Lot 236 & 208. For Frontage Road Connect.	Jeh.
5-19-89	Change "O" PL 154+12.41 to "O" PL 153+12.25. New Curve.	Jeh.
9-3-89	Change "E" Slope Limits Fr. Rd. to P-112.	Jeh.
2-28-75	Portion of Pcl. 212 - Relinquished for Sale - R-312-005-1	DE

PARCEL INFORMATION BLOCK			
PARCEL NO.	OWNER	TAKE	REMAIN
A-210	United States of America; State of Alaska, Selected	37,569 Ac.±	Large
A-211	Floyd W. & Grace D. Ward	1,068 Ac.±	2,144 Ac.±
A-212	Fred D.H. & Peggy A. Burgin	32,930 Sq. Ft.	0 Sq. Ft.
A-213	Lars & Victoria Ellis; Jerry A. & Phyllis D. Fisher - Contract Purchasers	25,801 Sq. Ft.	20,036 Sq. Ft.
A-214	Alaska Range Association	4,208 Ac.±	8,830 Ac.±
J.U. No. 2.	Alaska Railroad	10,397 Ac.±	—

88-110
RECORDED - FILED
ANCHORAGE, ALASKA
DATE 11-8 1988
TIME 1:50 P.M.
BY H3120T

DATE	REVISIONS	BY
12-6-88	Revise Take A-210.	Jeh.
2-2-88	Delete "A" from Parcel 212	Jeh.
2-13-88	Revise J.U. No. 2 Take	Jeh.
3-9-88	Revise Remain A-211	Jeh.
6-14-88	New Contract Purchase, Parcel A-213	Jeh.

STATE OF ALASKA
DEPARTMENT OF HIGHWAYS
RIGHT OF WAY MAP
ALASKA PROJECT NO.
F-031-2(18)

DRAWN: Chan DATE: SCALE: 1" = 100'
CHECKED: DATE: SHEET: 11 OF 21