

STATE OF ALASKA

DEPARTMENT OF TRANSPORTATION
AND PUBLIC FACILITIES

CENTRAL REGION
ALASKA

PROJECT LOCATION
GIRDWOOD

REVISIONS		
NO.	DATE	DESCRIPTION

YEAR	STATE	PROJECT DESIGNATION	SHEET NO.	TOTAL SHEETS
2002	ALASKA	NH-0A3-1(28)/54433	A1	222
CDS ROUTE: 130000		CDS MILEPOINT: 96.6 TO 101.2		

METRIC PLANS


ALL DIMENSIONS ARE
IN METERS UNLESS
OTHERWISE NOTED.

AS ADVERTISED
CENTRAL REGION
DATE DECEMBER 4, 2002

NH-0A3-1(28) / 54433 AS BUILT PLANS SEWARD HWY MP 96 TO MP 102 SAFETY, ROADWAY & RECREATIONAL IMPROVEMENTS, REBID

GRADING, DRAINAGE, PAVING, SIGNING AND STRIPING

DESIGNED BY
CHECKED BY
DRAFTED BY
SCALE = 40
VIEW=PILOT
AUTOCAD-KAREN.HA-2003/04/04 11:26:02
SPECIFICATIONS
SCALE 1"=1'
COMPUTER DESIGNATION

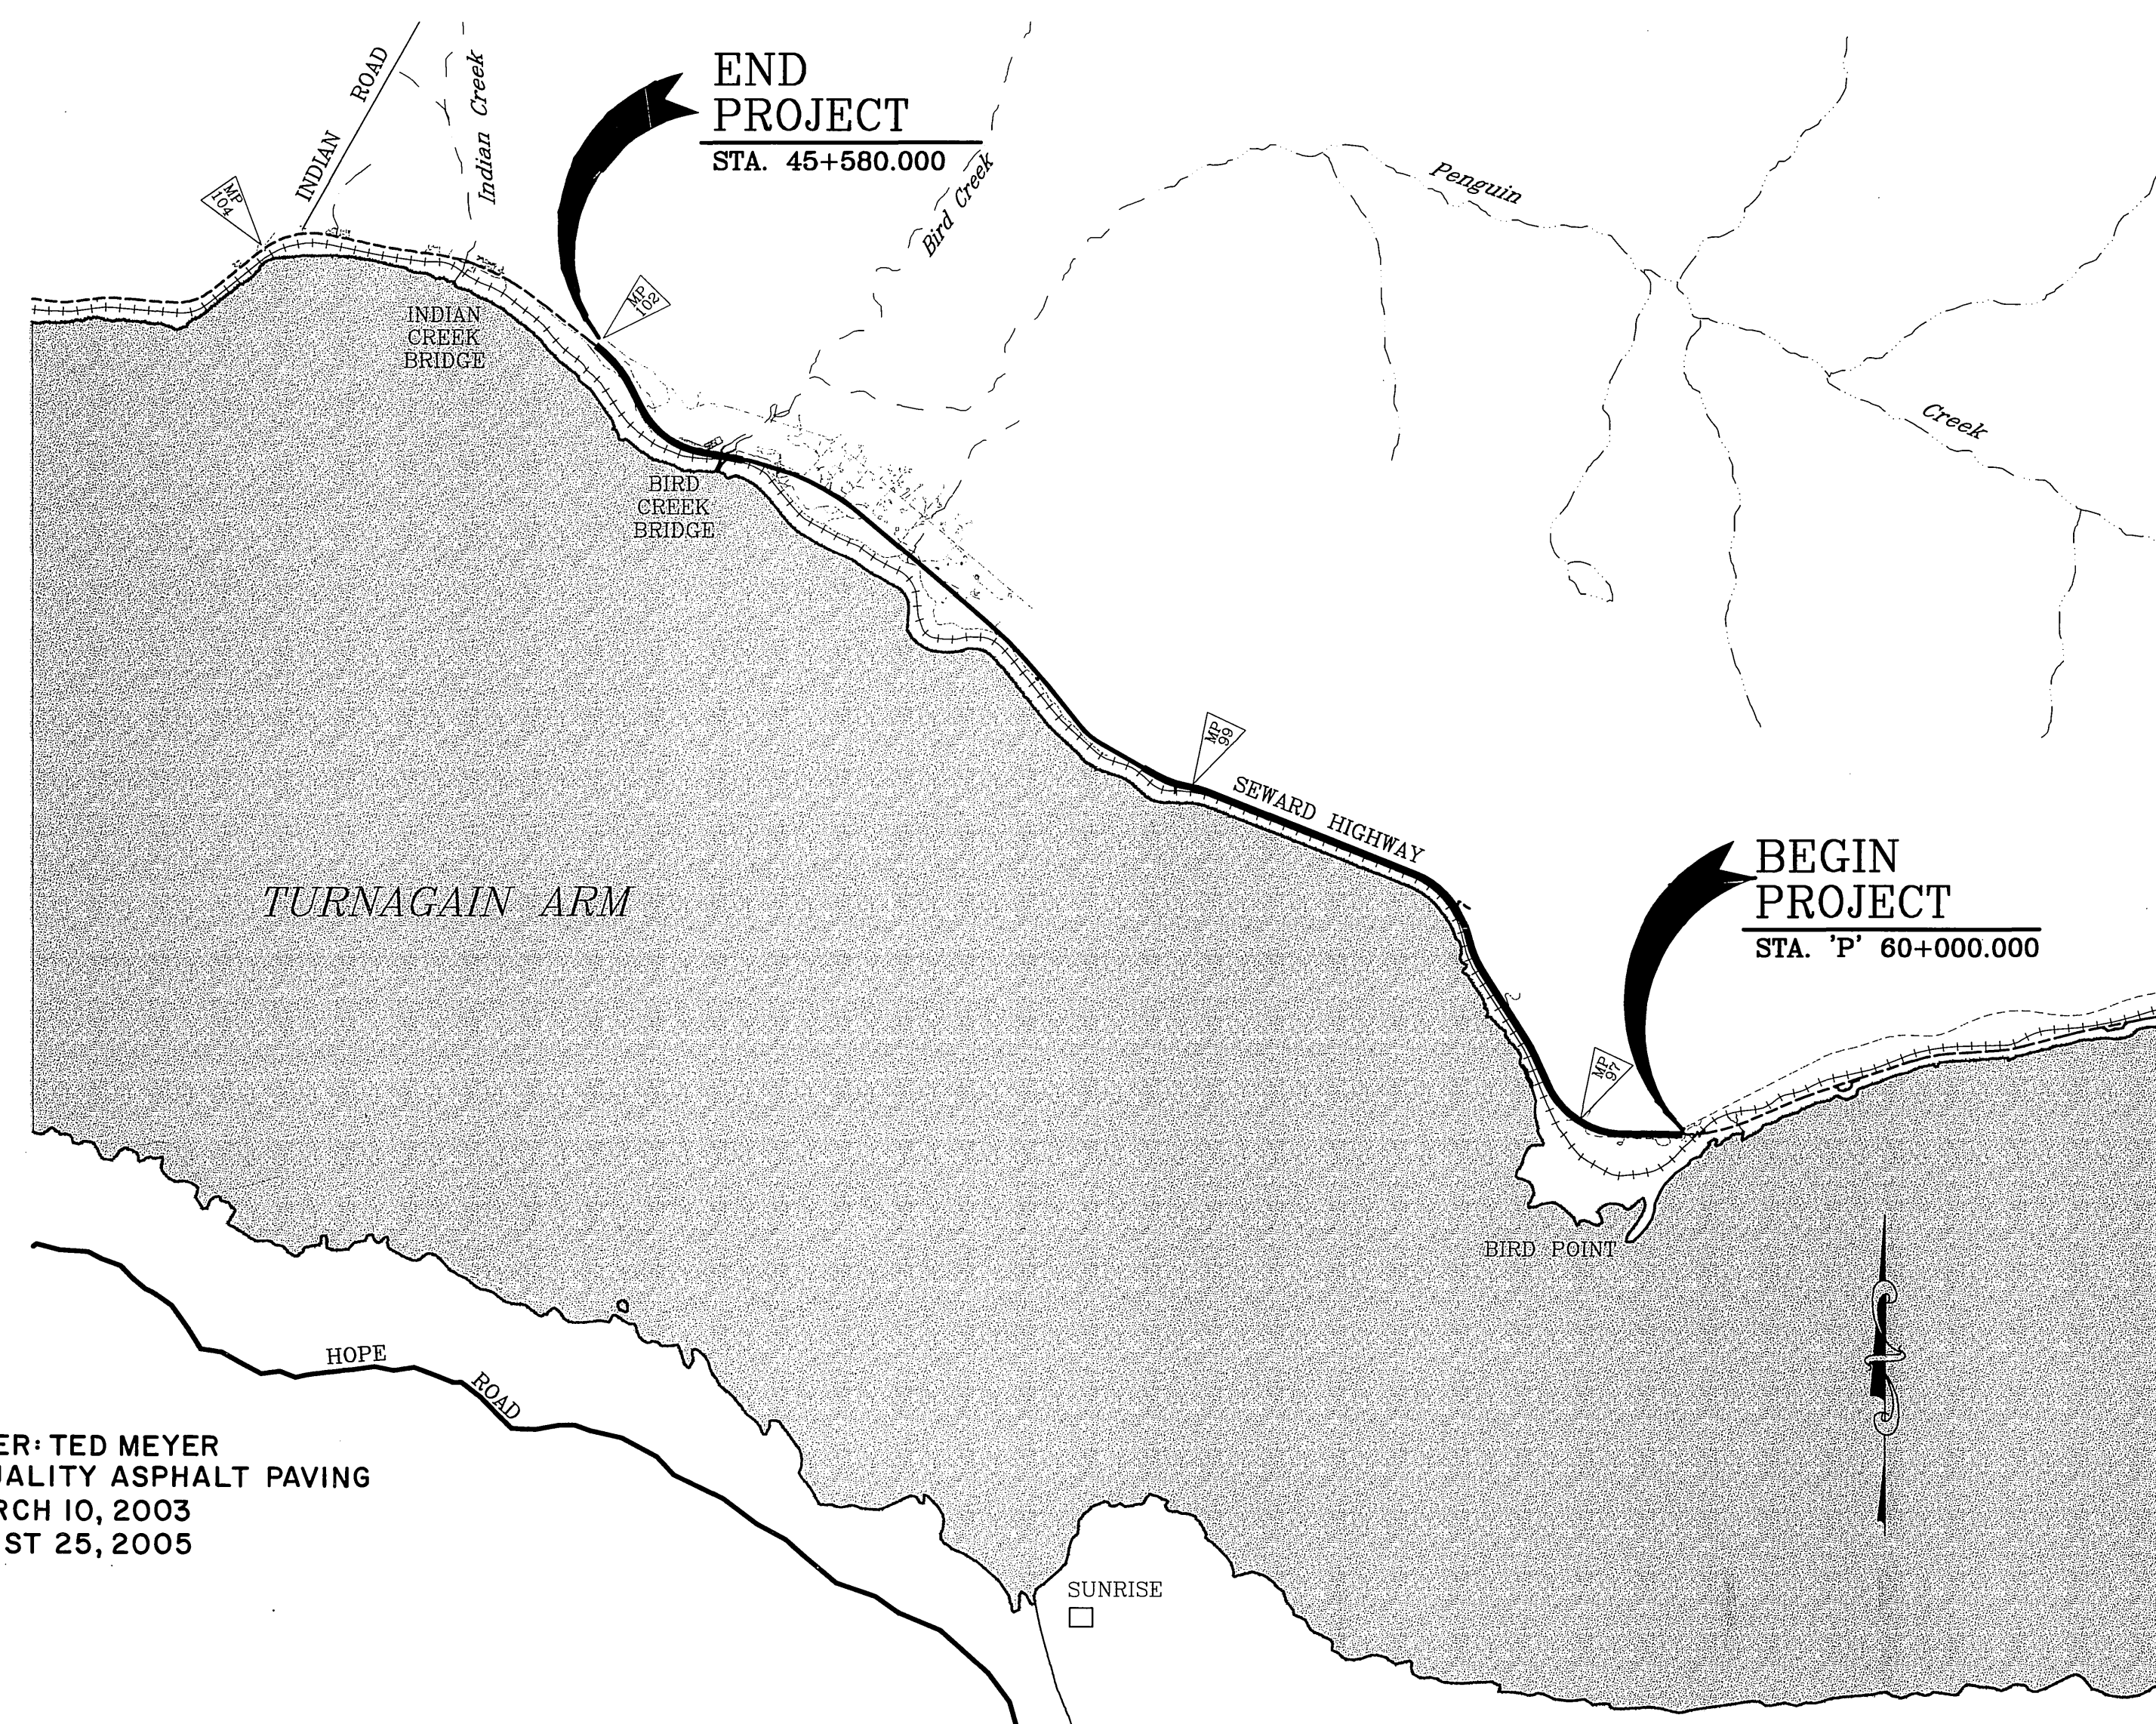

THE FOLLOWING STANDARD DRAWINGS APPLY TO THIS PROJECT:

A-1[M]
C-03.10[M], C-04.11[M], C-05.10[M]
D-01.02[M], D-04.20[M], D-06.10[M], D-07.00[M],
D-24.00[M], D-26.04[M]
E-09.00[M]
G-00.01[M], G-04.07W[M], G-10.01[M]
G-20.01[M]
I-30.01[M], I-81.00[M]
M-13.01[M], M-16.01[M]
S-05.01[M], S-20.00[M], S-30.03[M],
T-05.00[M], T-20.01[M], T-21.02[M], T-22.03[M]

THE FOLLOWING ALASKA RAILROAD STANDARD DRAWINGS APPLY TO THIS PROJECT:

1.13, 1.16, 1.21
2.21, 2.71, 2.81
3.1
4.12
5.12
6.1
7.0, 8.1
30.02, 30.10, 30.2, 30.21, 30.22, 30.91, 30.93,
30.94
90.4

*AS MODIFIED HEREIN

DESIGN DESIGNATIONS

SEWARD HIGHWAY	
A.D.T. 2002	7,989
A.D.T. 2012	10,227
V. (KPH)	110
D.	45/55
T. (%)	7.9
E.A.L.	1,271,473


INDEX

SHEET NO.	DESCRIPTION
A1	TITLE SHEET
A2 TO A5	SURVEY CONTROL SHEET
B1 TO B7	TYPICAL SECTIONS
C1 TO C2	ESTIMATE OF QUANTITIES
D1 TO D9	SUMMARY SHEETS
E1 TO E30	DETAIL SHEETS
PLAN AND PROFILE SHEETS:	
F1 TO F13	BIRD FLATS AREA HIGHWAY
FR1 TO FR11	BIRD FLATS AREA RAILROAD
FP1 TO FP18	BIRD FLATS AREA PATHWAY
FO1 TO FO7	OVERLAY; BIRD FLATS TO BIRD CREEK
FCR1 TO FCR4	BIRD CREEK AREA HIGHWAY
FPK1 TO FPK2	BIRD CREEK AREA PARKING LOT
FPL1 TO FPL4	BIRD CREEK AREA LEFT PATHWAY
FPR1 TO FPR2	BIRD CREEK AREA RIGHT PATHWAY
G1	BRIDGE NO. 643 FINISH PAVEMENT ELEVATIONS
J1 TO J32	TRAFFIC SHEETS
K1 TO K7	TRAFFIC CONTROL SHEETS
N1 TO N5	BIRD CREEK BRIDGE NO. 643
S1 to S17	ALASKA COMMUNICATIONS UTILITY SHEETS
T1 to T23	FIBER STAR UTILITY SHEETS
U1 to U23	GCI UTILITY SHEETS

ROADWAY SUMMARY

LENGTH OF PAVING	8440 m
WIDTH OF ROADWAY	12-16.8 m
BRIDGE NO. 643, BIRD CREEK	61.9 m

STATE OF ALASKA
DEPARTMENT OF TRANSPORTATION
& PUBLIC FACILITIES

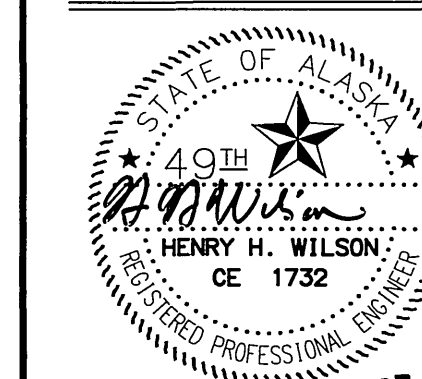


APPROVED: 11/26/02

REGIONAL PRECONSTRUCTION ENGINEER

CONCUR: 11/26/02
DIRECTOR, CONSTRUCTION & OPERATIONS



CERTIFIED TRUE & CORRECT AS-BUILT OF ACTUAL FIELD CONDITIONS:

CONSTRUCTION PROJECT MANAGER

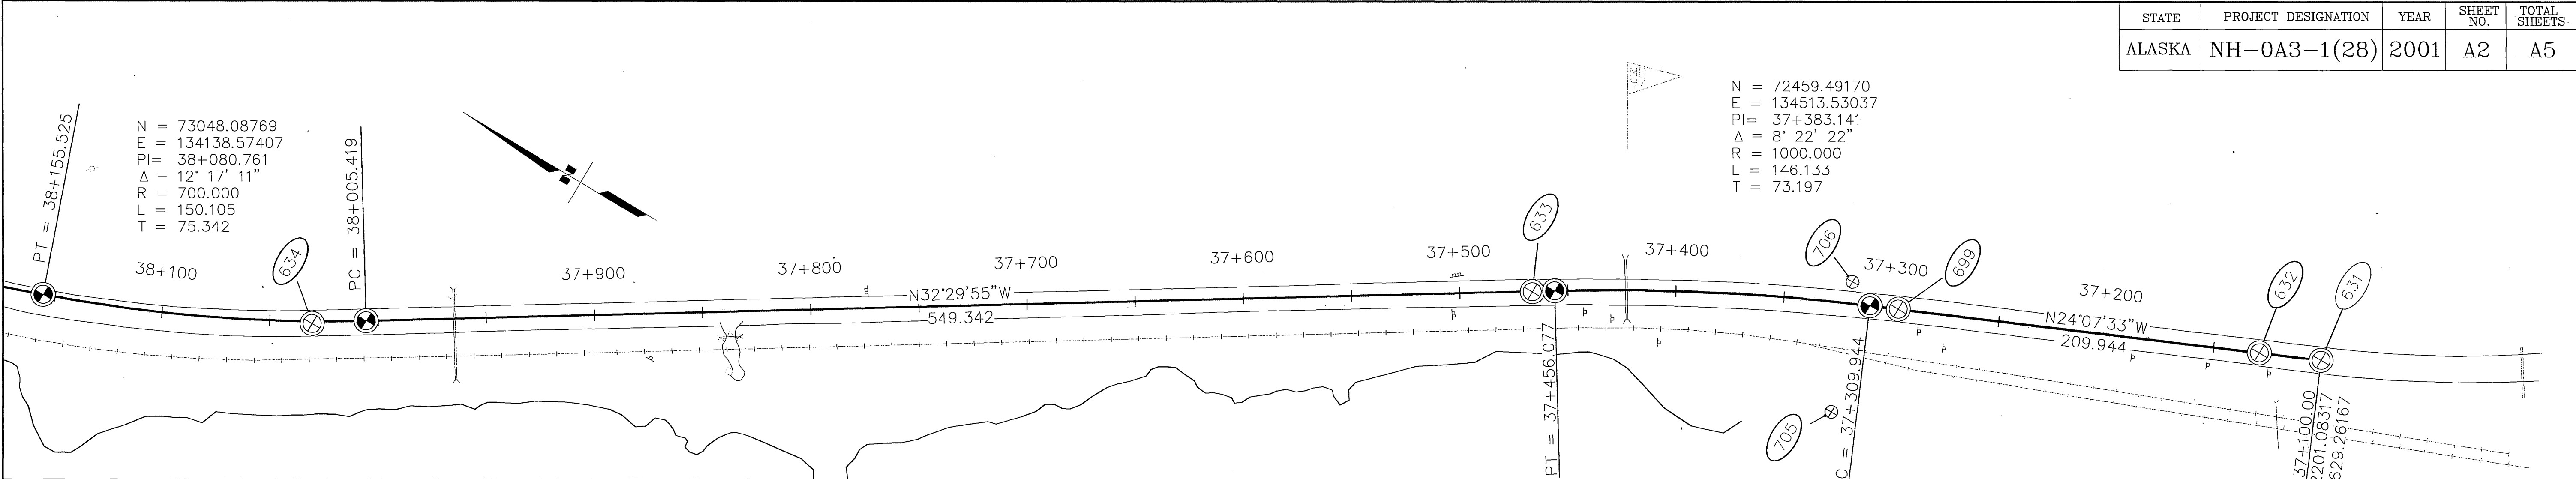

Point	Station	Offset	Northing	Easting	Elevation	Description (Project No. Reference)	642(4)	642(8)	642(9)	642(10)	Monument of Record Form
631	37+099.929	0	72201.01726	134629.28918		AC/BX: PT 1217+05.59 (IM-0A3-1(21) Phase IV)		X	X	X	X
20100	37+100	0	72201.08317	134629.26170		BOP	X			X	X
632	37+128.703	0	72227.27908	134617.52952		AC/BX: EOP 1218+00 (IM-0A3-1(21) Phase IV)		X	X	X	X
699	37+296.684	0	72380.58675	134548.86888		BC/BX: PC 1308+42.47 (ER-AO 27(1))		X	X	X	X
20101	37+309.944	0	72392.68876	134543.44890		PC	X			X	X
706	37+319.229	10.015	72405.32320	134548.71570		USS 9012 Corner 1BL1		X	X		X
705	37+322.317	-50.865	72382.58630	134492.16060		USS 9012 Corner 1AL1		X	X		X
20104	37+456.077	0	72521.22611	134474.20340		PT	X			X	X
633	37+466.395	-0.254	72529.79197	134468.44548	8.408	BC/BX: PT 1313+98.99 (ER-AO 27(1))		X	X	X	X
20105	38+005.419	0	72984.54419	134179.05350		PC	X			X	X
634	38+030.362	-1.035	73005.29080	134165.13765	8.592	BC/BX: PC 1332+50.07 (ER-AO 27(1))		X	X	X	X
20108	38+155.525	0	73118.78971	134112.54360		PT	X			X	X
635	38+213.044	-0.421	73172.62140	134092.27567		BC/BX: PT 1338+50.87 (ER-AO 27(1))		X	X	X	X
704	38+224.070	-47.898	73166.56550	134043.91240		USS 9012 Corner 2AL1		X	X		X
20109	38+277.023	0	73232.80625	134070.56590		PC	X			X	X
636	38+338.970	14.778	73296.21853	134060.28005		BC/BX: PC 1342+70.33 (ER-AO 27(1))		X	X	X	X
20130	38+600	0	73504.279	133899.934		POC	X			X	X
1	38+644.816	53.132	73574.66136	133903.79980		RBR/PC: TS BI-1					
637	38+856.761	39.683	73691.39789	133712.23340		BC/BX: PT 1360+64.87 (ER-AO 27(1))		X	X	X	X
703	38+868.784	52.603	73708.64320	133706.59200		USS 9012 Corner 3BL1		X	X		X
20112	38+912.340	0	73679.39013	133643.84920		PT	X			X	X

- NOTES:
- Whether listed or not, all monuments or property markers, corners, or accessories, which will be disturbed or buried, shall be referenced or re-established in their original position (A.S. 19.10.260) and recorded (A.S. 34.65.040).
 - Centerline monument positions at the P.C.'s, P.T.'s, and No-Curve P.I.'s have been marked with aluminum capped rebars installed by AKDOT prior to construction. These positions shall be verified and referenced by the contractor's surveyor prior to any activity which might disturb their position. Monuments to be installed as a part of this project shall be set at these positions.

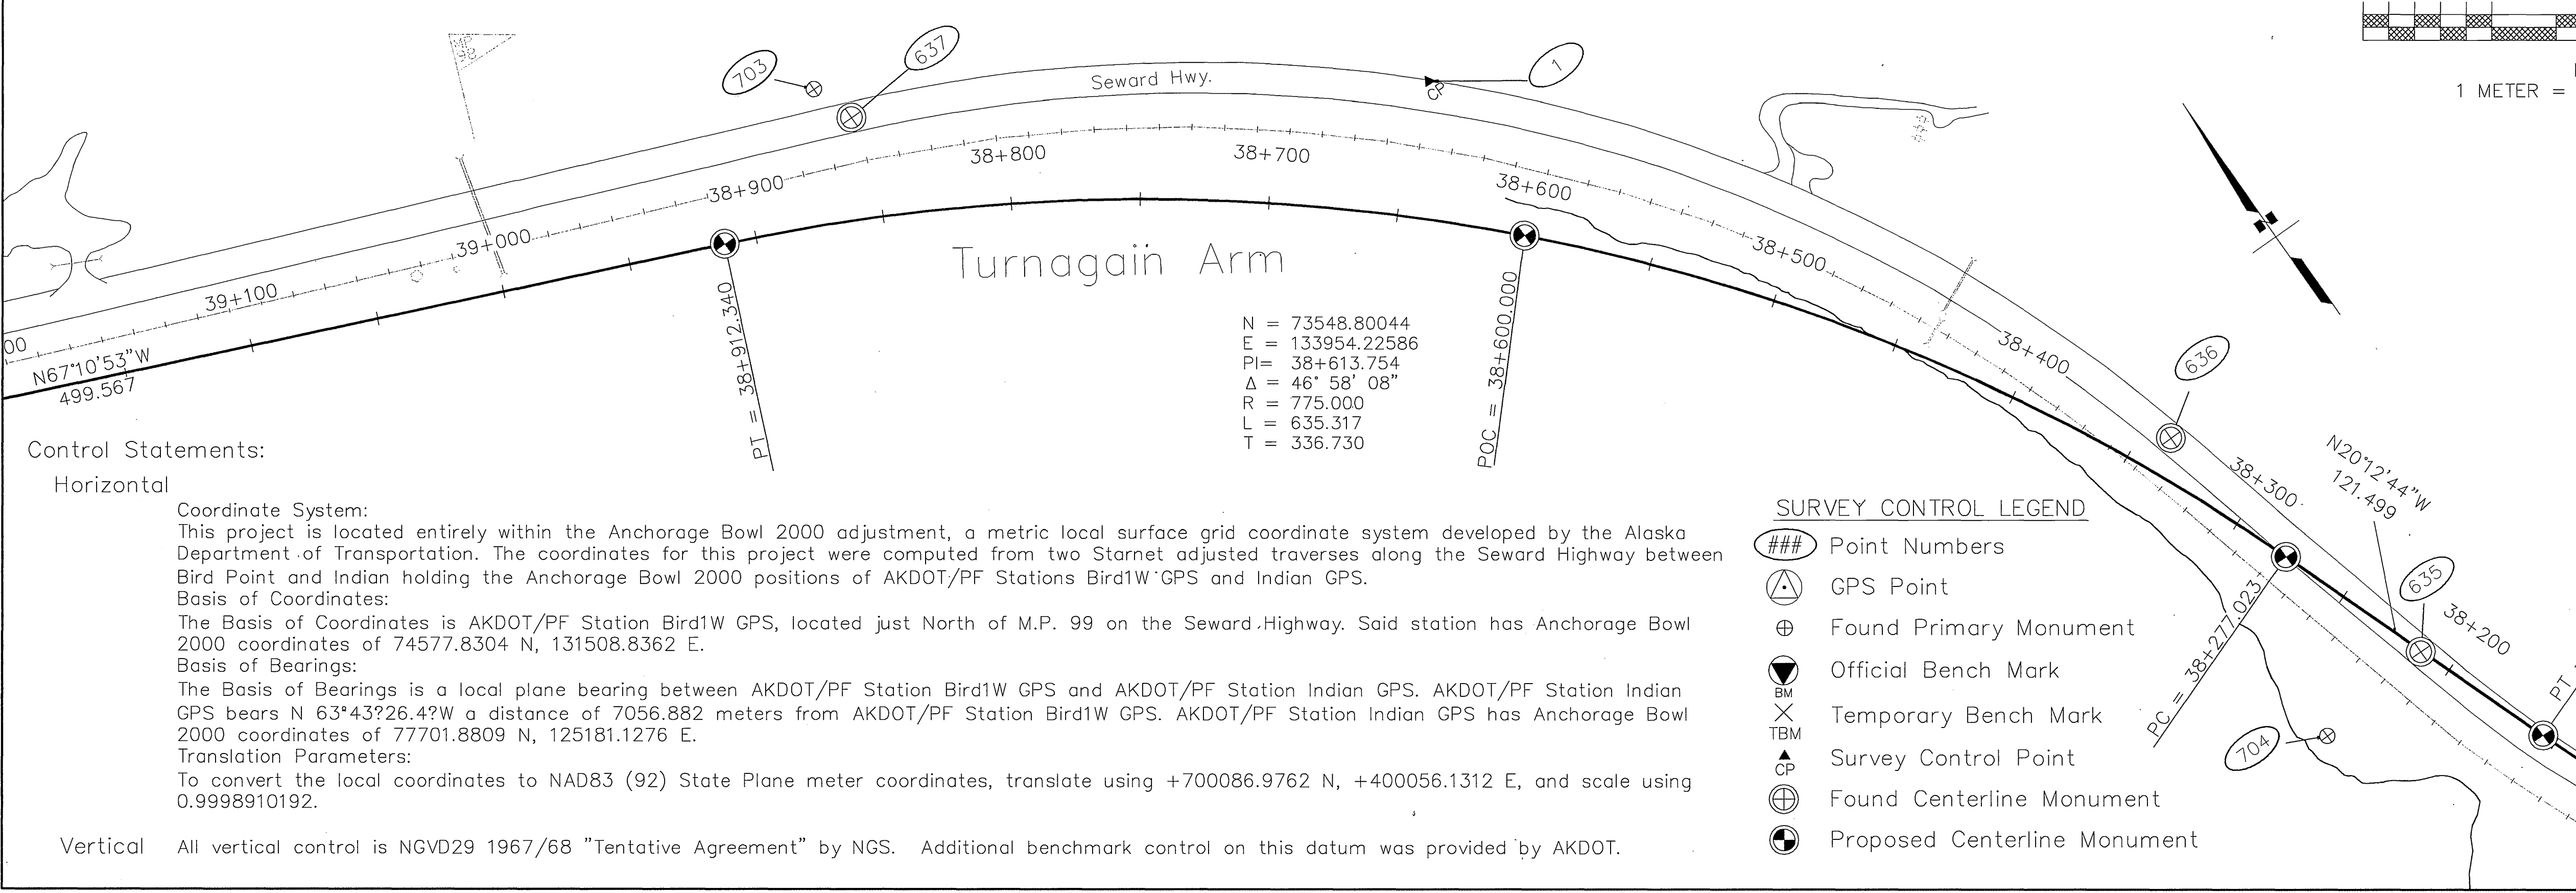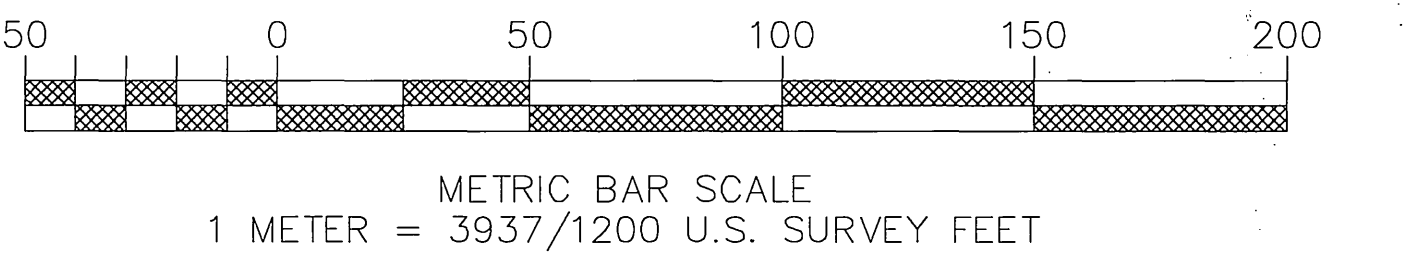

Control Statements:
Horizontal

Coordinate System:
This project is located entirely within the Anchorage Bowl 2000 adjustment, a metric local surface grid coordinate system developed by the Alaska Department of Transportation. The coordinates for this project were computed from two Starnet adjusted traverses along the Seward Highway between Bird Point and Indian holding the Anchorage Bowl 2000 positions of AKDOT/PF Stations Bird1W GPS and Indian GPS.
Basis of Coordinates:
The Basis of Coordinates is AKDOT/PF Station Bird1W GPS, located just North of M.P. 99 on the Seward Highway. Said station has Anchorage Bowl 2000 coordinates of 74577.8304 N, 131508.8362 E.
Basis of Bearings:
The Basis of Bearings is a local plane bearing between AKDOT/PF Station Bird1W GPS and AKDOT/PF Station Indian GPS. AKDOT/PF Station Indian GPS bears N 63°43'26.4\"/>


Vertical All vertical control is NGVD29 1967/68 "Tentative Agreement" by NGS. Additional benchmark control on this datum was provided by AKDOT.

- SURVEY CONTROL LEGEND
- ### Point Numbers
 - ⊕ GPS Point
 - ⊕ Found Primary Monument
 - ⊕ Official Bench Mark
 - ⊕ Temporary Bench Mark
 - ⊕ Survey Control Point
 - ⊕ Found Centerline Monument
 - ⊕ Proposed Centerline Monument




DATE	REVISIONS	BY
STATE OF ALASKA DEPARTMENT OF TRANSPORTATION AND PUBLIC FACILITIES SEWARD HIGHWAY MP 96 TO MP 102 SAFETY, ROADWAY & RECREATIONAL IMPROVEMENTS		
Survey Control Sheet		
DRAWN	BK	DATE 8/08/2001
CHECKED	DATE	SCALE 1:1500
		SHEET 1 OF 4


STATE	PROJECT DESIGNATION	YEAR	SHEET NO.	TOTAL SHEETS
ALASKA	NH-0A3-1(28)	2001	A3	A5

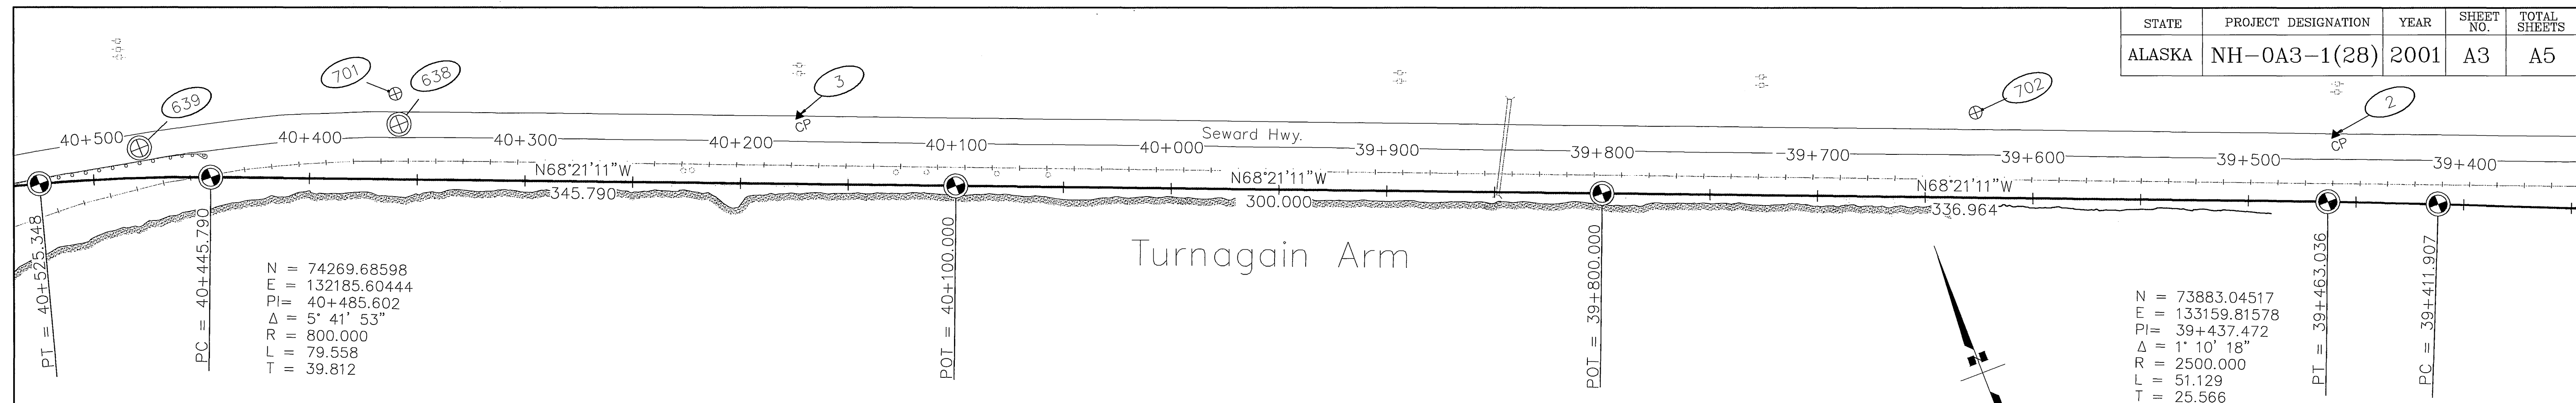


Point	Station	Offset	Northing	Easting	Elevation	Description	642(4)	642(8)	642(9)	642(10)	Monument of Record	Form
20113	39+411.907	0	73873.13044	133183.38040		PC	X			X		X
2	39+460.192	31.403	73920.60069	133150.31340		RBR/PC: TS BI-2						
20116	39+463.036	0	73892.47593	133136.05330		PT	X			X		X
702	39+626.927	39.696	73989.82910	132998.36400		USS 9012 Corner 4BL2		X	X			X
20131	39+800	0	74016.777	132822.854		POT	X			X		X
20132	40+100	0	74127.443	132544.011		POT	X			X		X
3	40+173.218	31.935	74184.13483	132487.73750		RBR/PC[DOWL]: TS BI-3						
638	40+358.674	25.693	74246.74550	132313.05782		BC/BX: PC 596+01.81 (F-031-2(55))		X	X	X		X
701	40+360.477	39.83	74260.55000	132316.59670		USS 9012 Corner 5BL3		X	X			X
20117	40+445.790	0	74254.99988	132222.60870		PC	X			X		X
639	40+478.434	13.89	74279.52820	132196.62246		BC/BX: PT 600+29.83 (F-031-2(55))		X	X	X		X
20120	40+525.348	0	74280.62558	132147.32490		PT	X			X		X
640	40+596.366	1.994	74302.05765	132079.58885		BC/BX: PC 604+20.97 (F-031-2(55))		X	X	X		X
20121	40+646.901	0	74314.02593	132030.45130		PC	X			X		X
4	40+715.236	-5.869	74331.07738	131963.71260	19.965	RBR/PC: TS BI-4						
641	40+785.545	-0.01	74367.10980	131902.70385		BC/BX: PT 610+42.03 (F-031-2(55))		X	X	X		X
20124	40+788.977	0	74368.80068	131899.71720		PT	X			X		X
40000	40+906.243	0	74426.57403	131797.6709		EOP	X			X		X
642			74581.61852	131523.81253		BC/BX: PC 624+69.93 (F-031-2(55))		X	X	X		X
509			74577.83041	131508.83620		BC/ROD[DOT]: BIRD1W GPS 1993						
643			74734.02950	131348.70821		BC/BX: PT 632+36.63/ PC 632+3 (F-031-2(55))		X	X	X		X

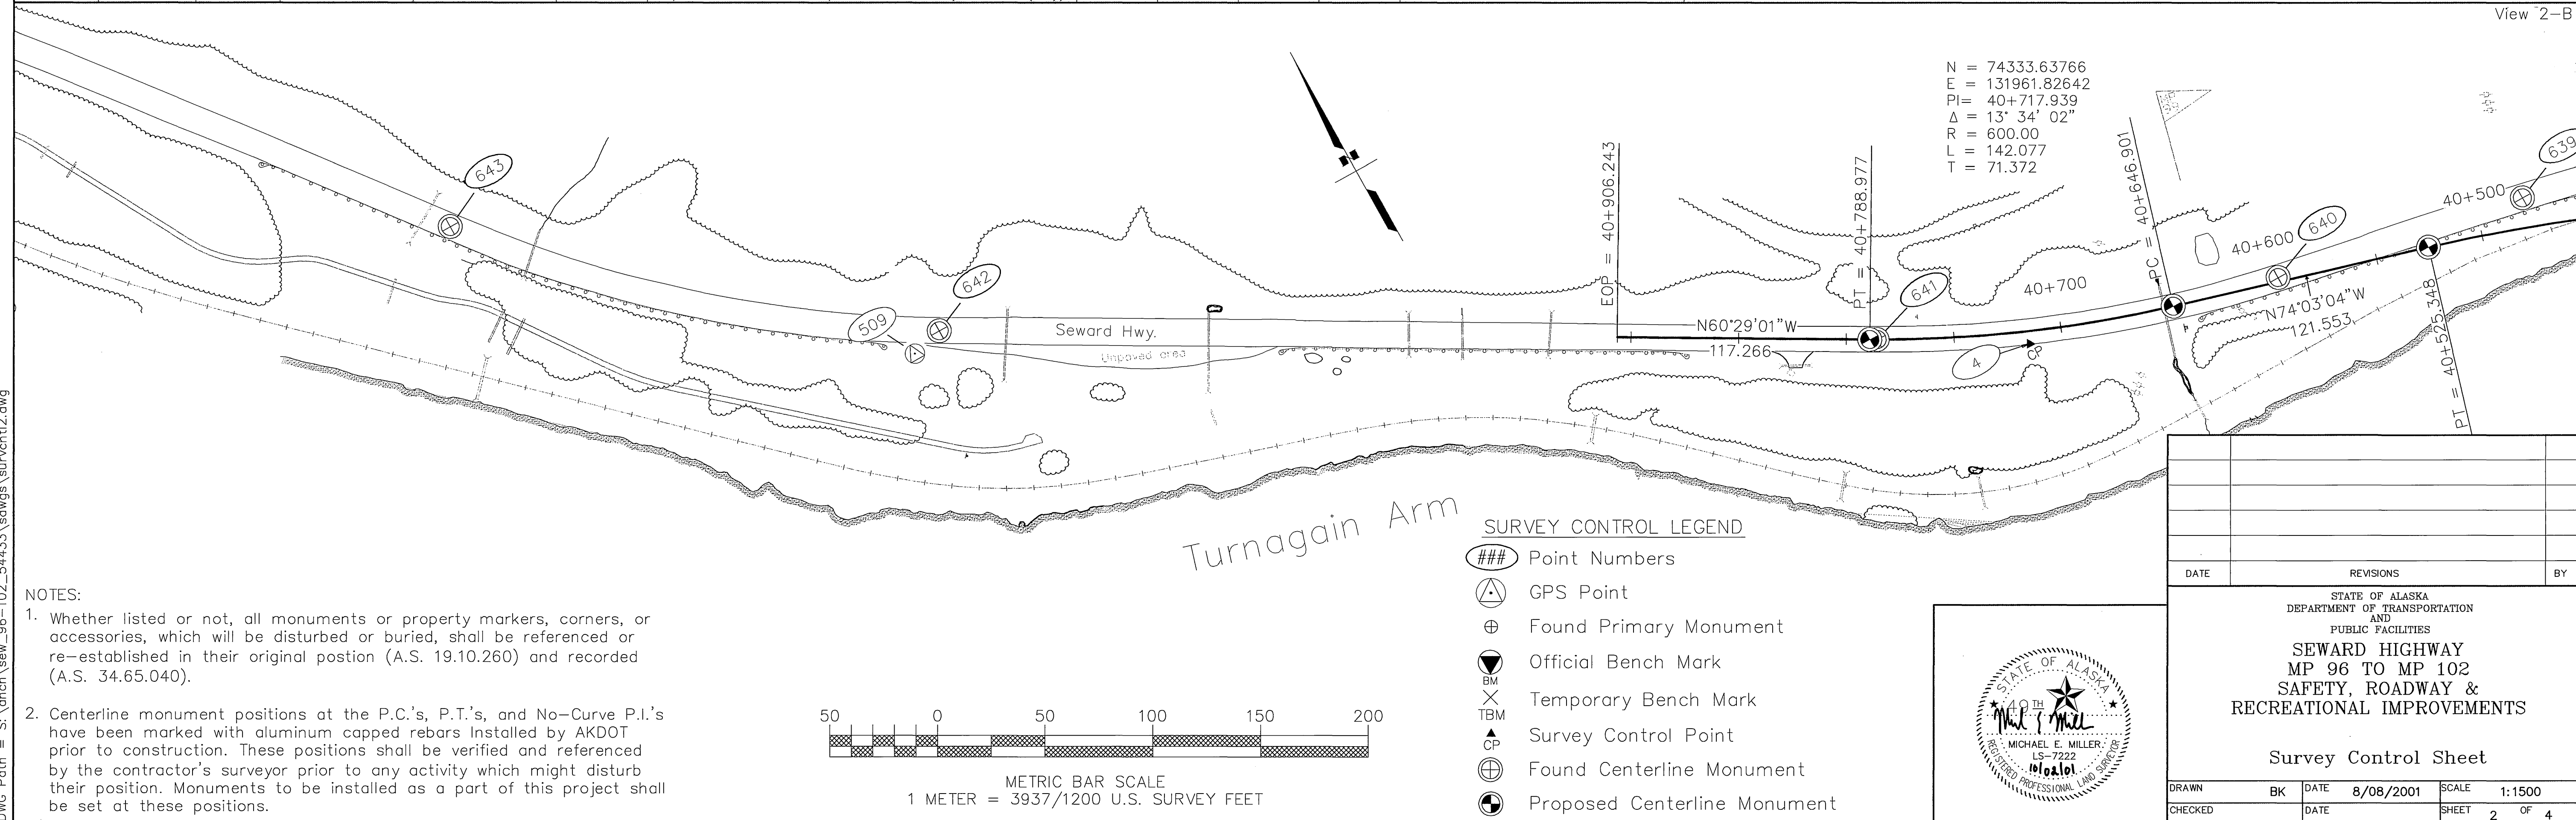

DESIGNED BY
CHECKED BY
DRAFTED BY
VIEW- 1
AUTOCAD D./SDSKPROJ/63577/77B7YP
SPECIFICATIONS
SCALE 1"=1'
COMPUTER DESIGNATION

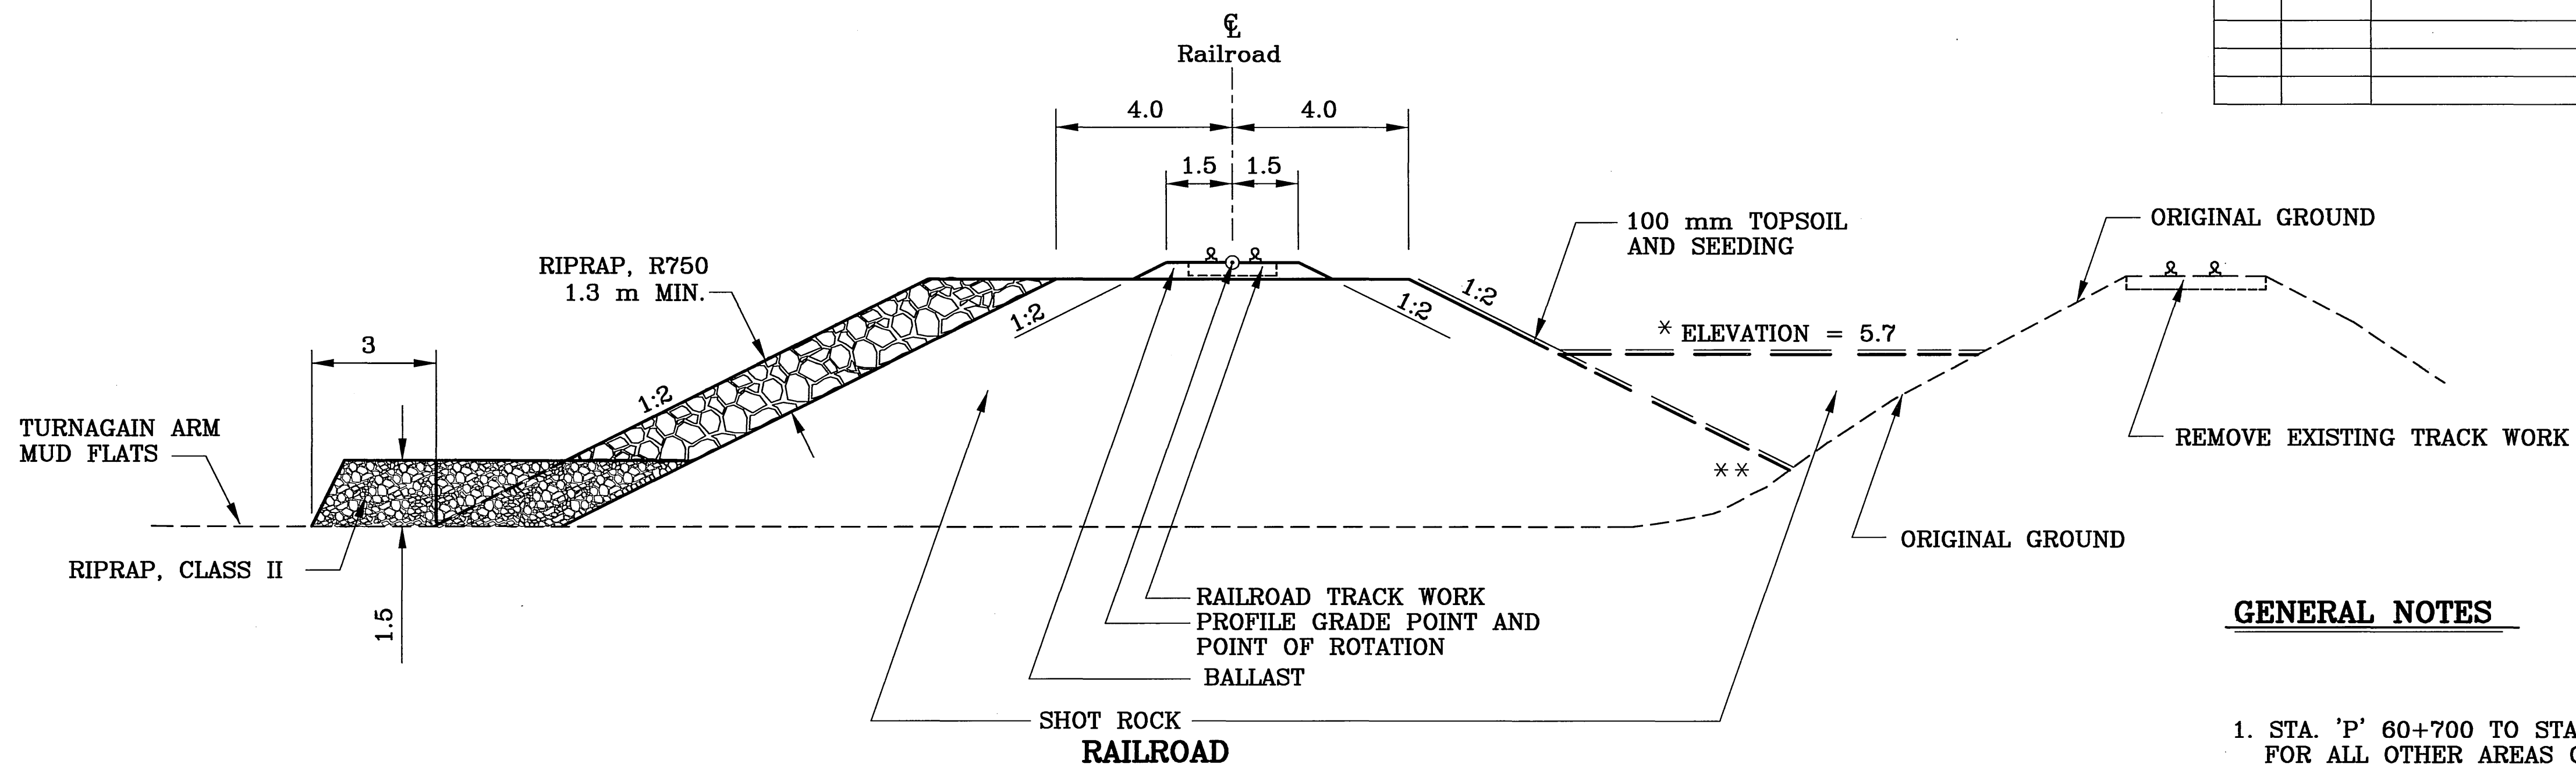


STA. 'R' 2+000 TO STA. 'R' 5+140.000
* STA. 'R' 2+000 TO STA. 'R' 4+260
** SEE RAILROAD FLAT BOTTOM DITCH TYPICAL

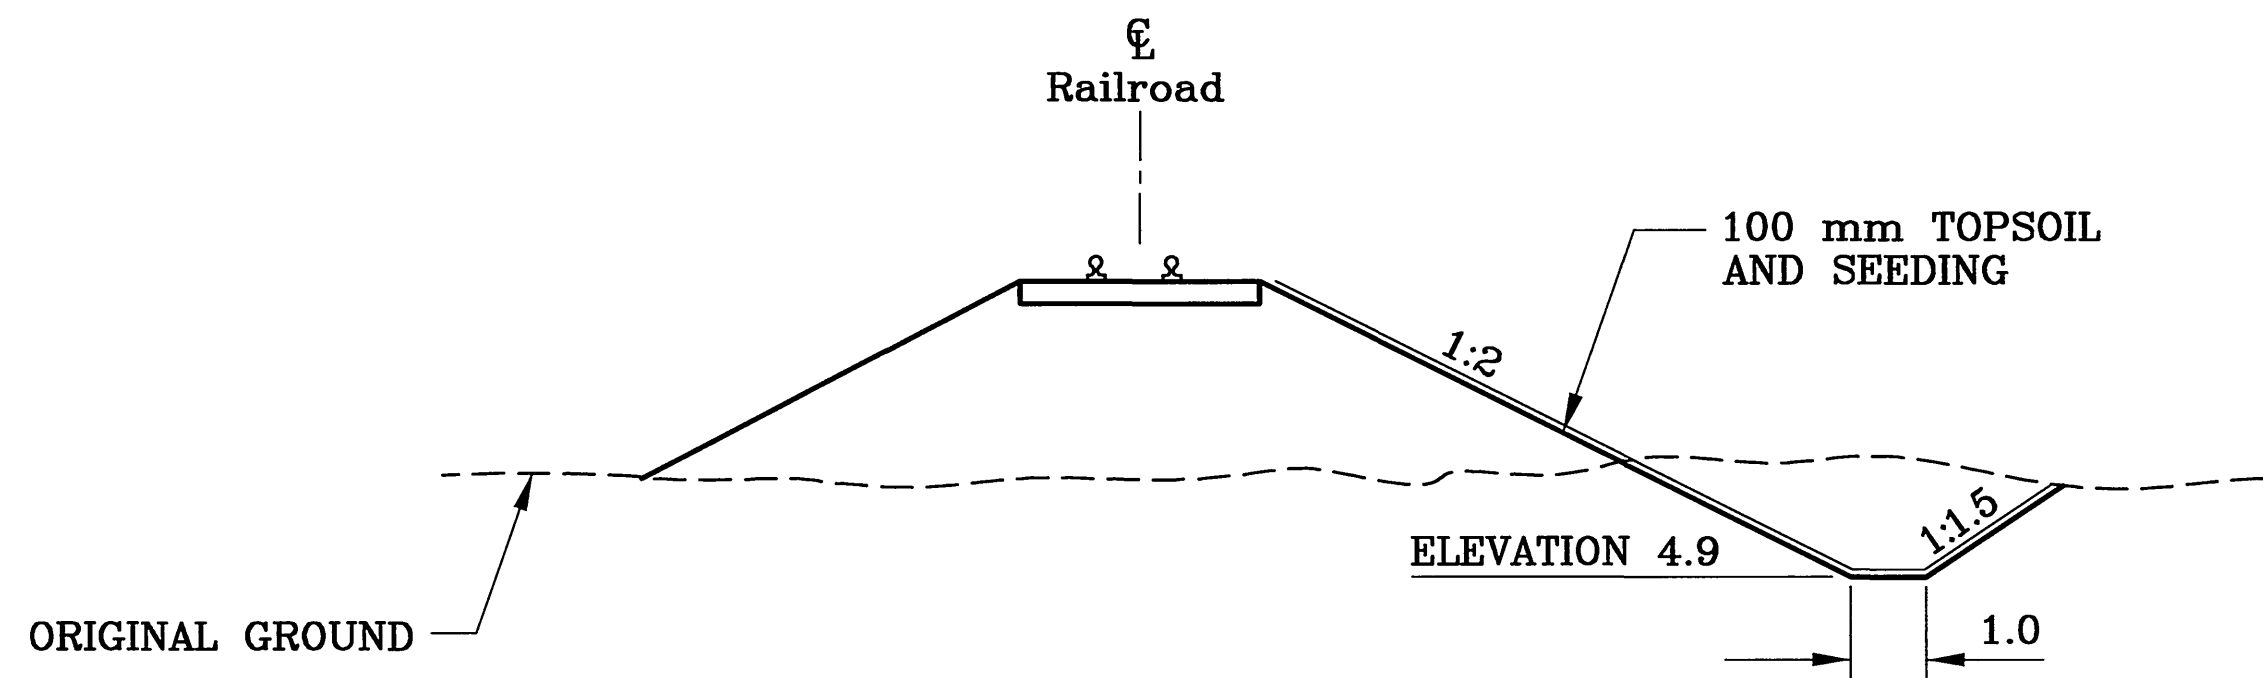

RAILROAD FLAT BOTTOM DITCH

STA. 'R' 4+500 TO STA. 'R' 4+640, RT.
STA. 'R' 4+900 TO STA. 'R' 5+050, RT.

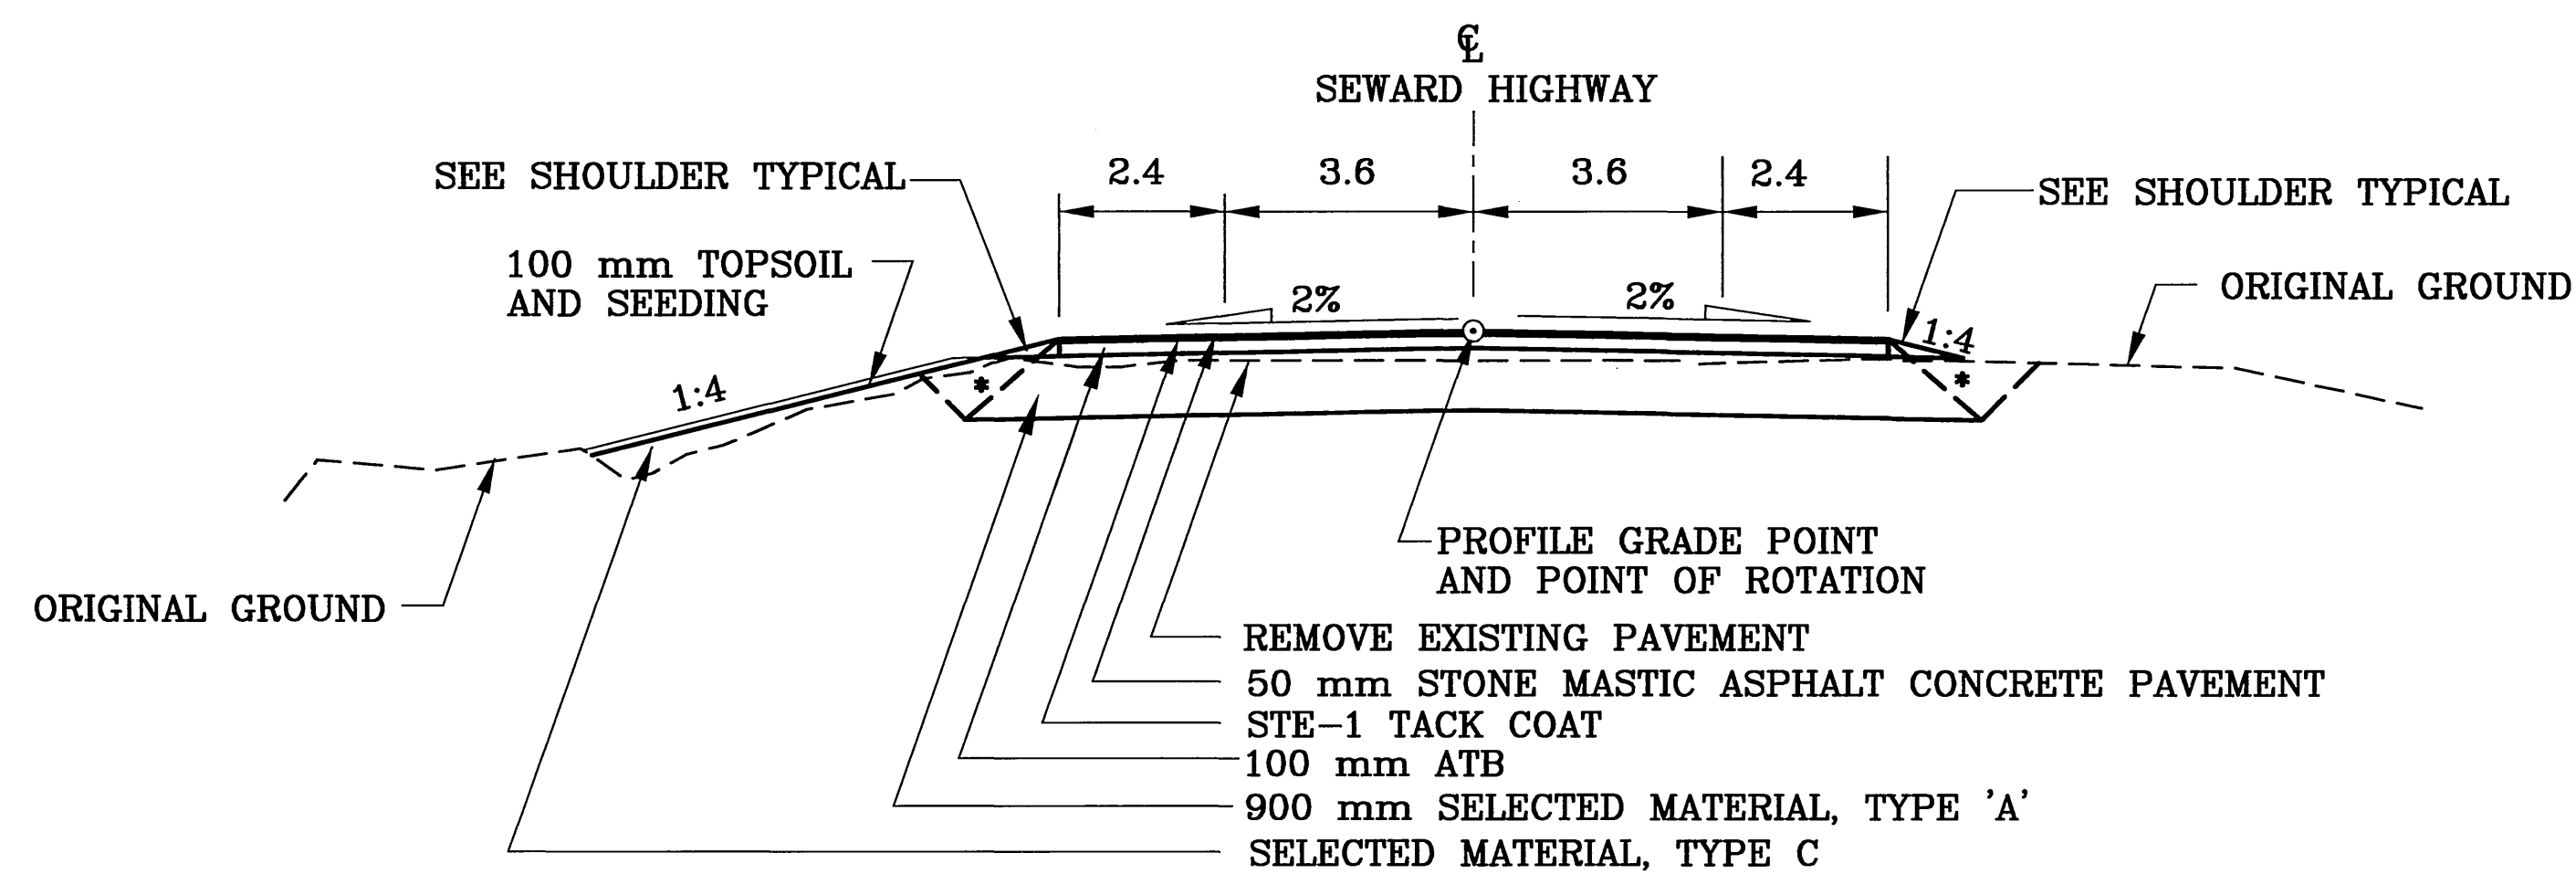

SEWARD HIGHWAY


STA. 37+100 TO STA. 37+680
STA. 40+600 TO STA. 40+906.25
*SEE SELECT 'A' EMBANKMENT

REVISIONS			STATE	PROJECT DESIGNATION	YEAR	SHEET NO.	TOTAL SHEETS
No.	DATE	DESCRIPTION					
			ALASKA	NH-0A3-1(28)	2002	B1	B7

GENERAL NOTES


1. STA. 'P' 60+700 TO STA. 'P' 62+160 CLEAR TO 1.0 m BEYOND CATCH POINT. FOR ALL OTHER AREAS OF THE PROJECT CLEAR 3.0 m BEYOND THE SLOPE CATCH POINT, OR AS DIRECTED BY THE ENGINEER.
2. CUT/FILL TRANSITIONS WILL BE 30 m OR AS DIRECTED BY THE ENGINEER
3. NO SLOPES WILL BE STEEPER THAN 1:2 UNLESS OTHERWISE SHOWN IN THE PLANS.
4. RIPRAP ON RAILROAD EMBANKMENT IS NOT REQUIRED WHERE NATURAL ROCK CROPPINGS ARE ENCOUNTERED. OVERSIZED STONES MAY BE PLACED IN THESE AREAS AS DIRECTED BY THE ENGINEER.
5. ALL TOPSOIL SHALL BE CLASS B.
6. ALL OTHER AREAS DISTURBED BY CONSTRUCTION WILL RECEIVE SEEDING.
7. SHOT ROCK SHALL MEET THE REQUIREMENTS OF SELECTED MATERIAL, TYPE A.

HIGHWAY SLOPE EXCEPTION TABLE				
STATION TO STATION	OFFSET	SLOPE		REMARKS
		CUT	FILL	
37+720 TO 37+910	RT.	1:0.5		SEE ROCK CUT TYPICAL, SHEET B7
37+970 TO 38+300	RT.	1:0.5		SEE ROCK CUT TYPICAL, SHEET B7

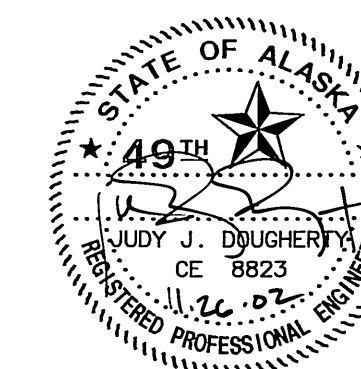



STATE OF ALASKA
DEPARTMENT OF TRANSPORTATION
AND
PUBLIC FACILITIES
**SEWARD HIGHWAY
MP 96 TO MP 102
SAFETY, ROADWAY AND
RECREATIONAL IMPROVEMENTS**
TYPICAL SECTIONS

REVISIONS			STATE	PROJECT DESIGNATION	YEAR	SHEET NO.	TOTAL SHEETS
No.	DATE	DESCRIPTION	ALASKA	NH-0A3-1(28)	2002	B2	B7
			THIS SHEET IS REPLACED BY SHEET B2A.				

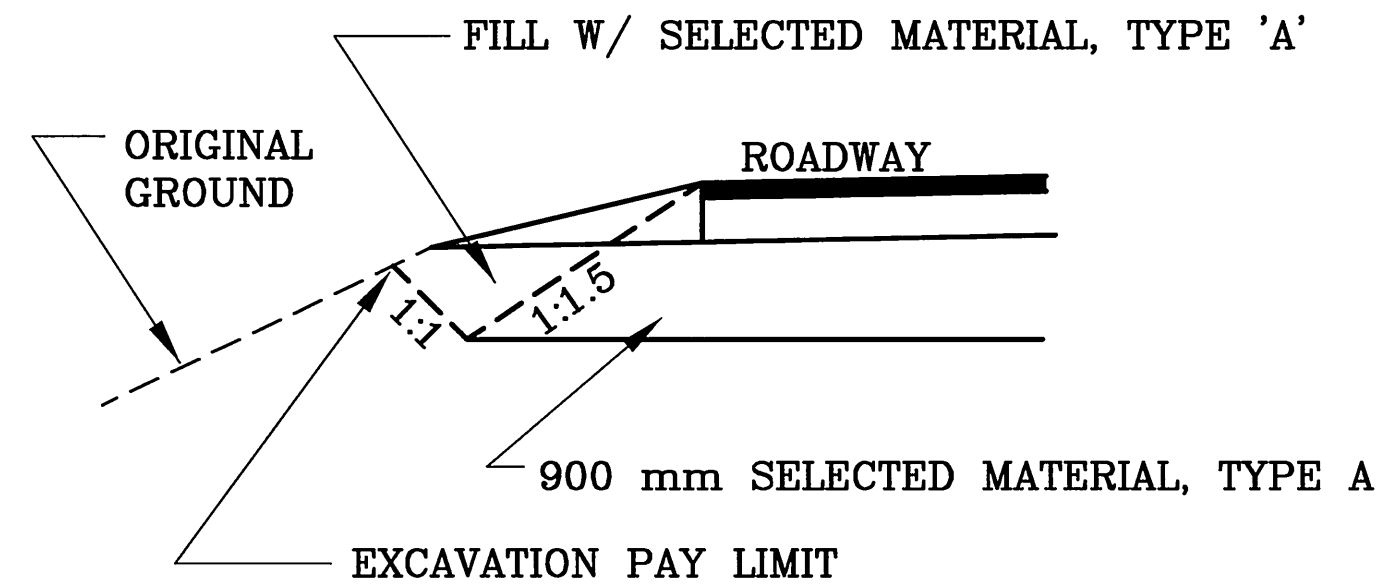

****SELECT 'A' EMBANKMENT**

GUARDRAIL WIDENING EXCEPTION
SEE GUARDRAIL SUMMARY FOR LOCATIONS

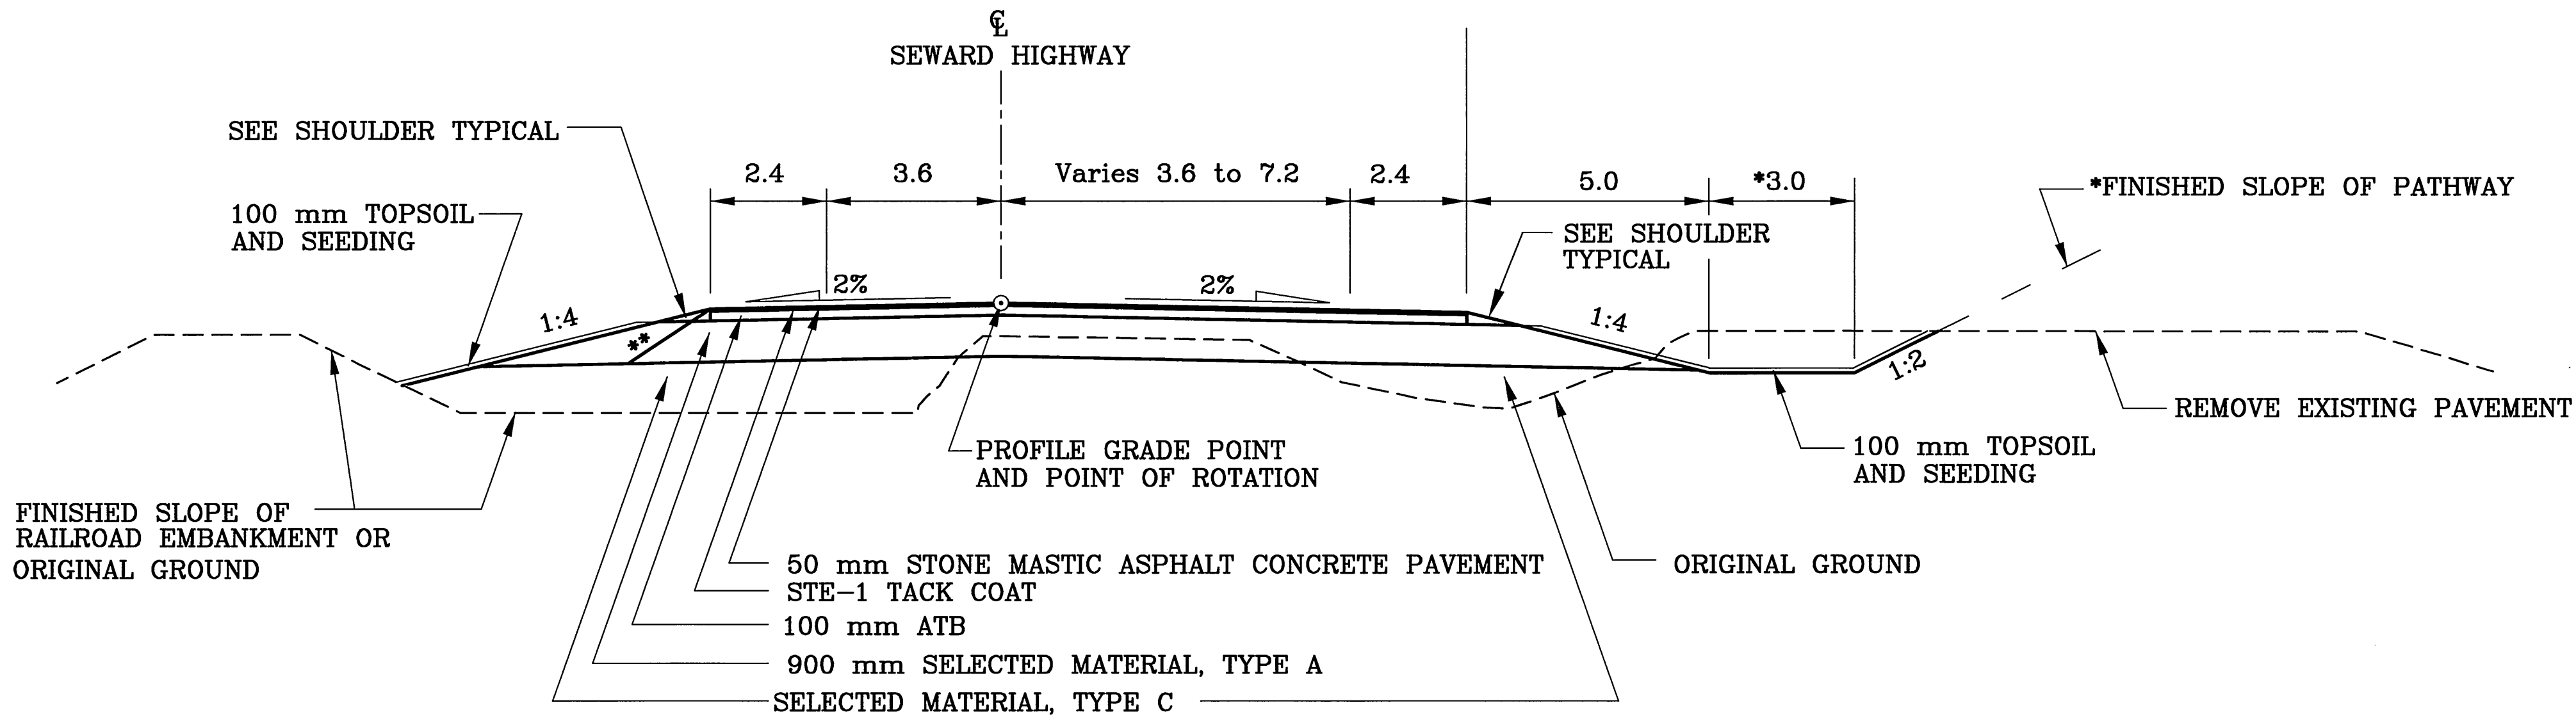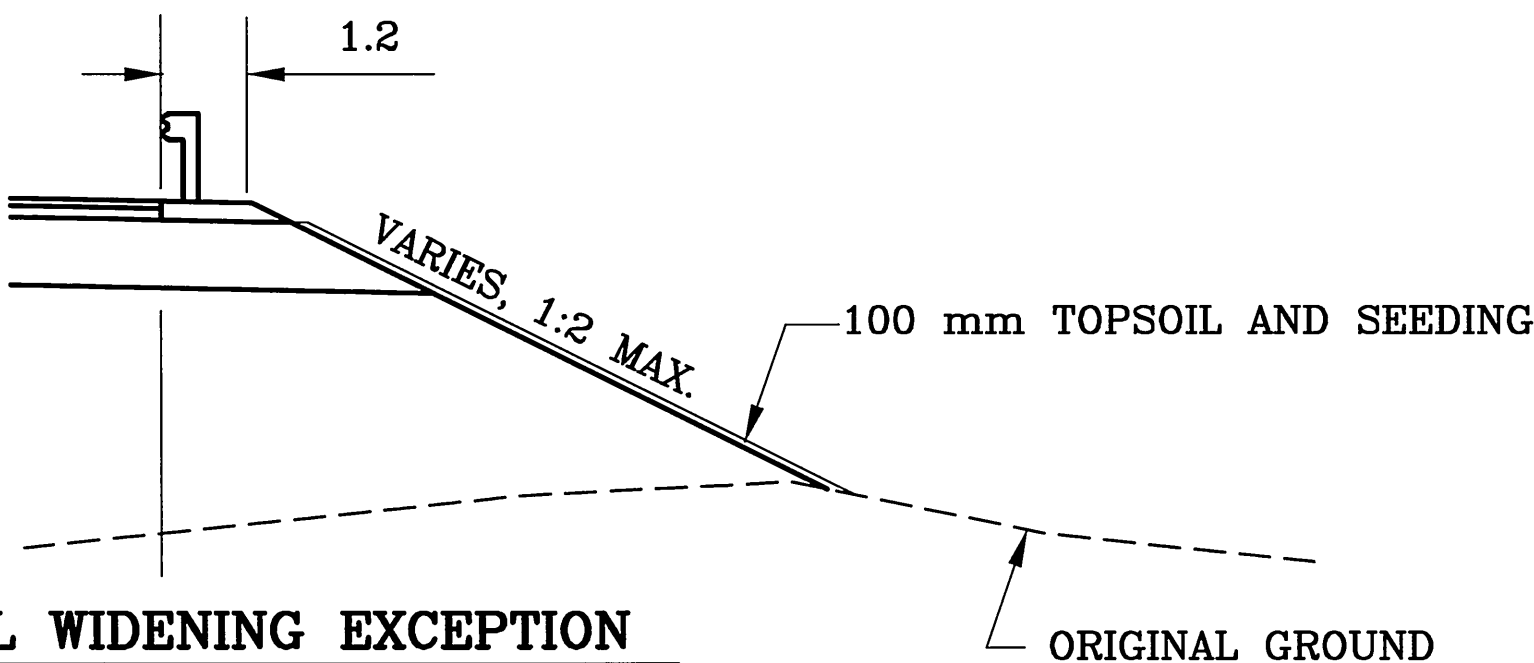


SEWARD HIGHWAY

STA. 37+680 TO STA. 40+600


*DITCH NARROWS TO "V" AND DEPTH VARIES WHERE PATHWAY MERGES
TOWARD ROADWAY TO ACCOMMODATE ANADROMOUS STREAM PIPES
STA. 38+870 TO STA. 39+120 AND STA. 39+750 TO STA. 39+930

**SEE SELECT 'A' EMBANKMENT TYPICAL, STA. 37+680 LT. TO STA. 39+200 LT.

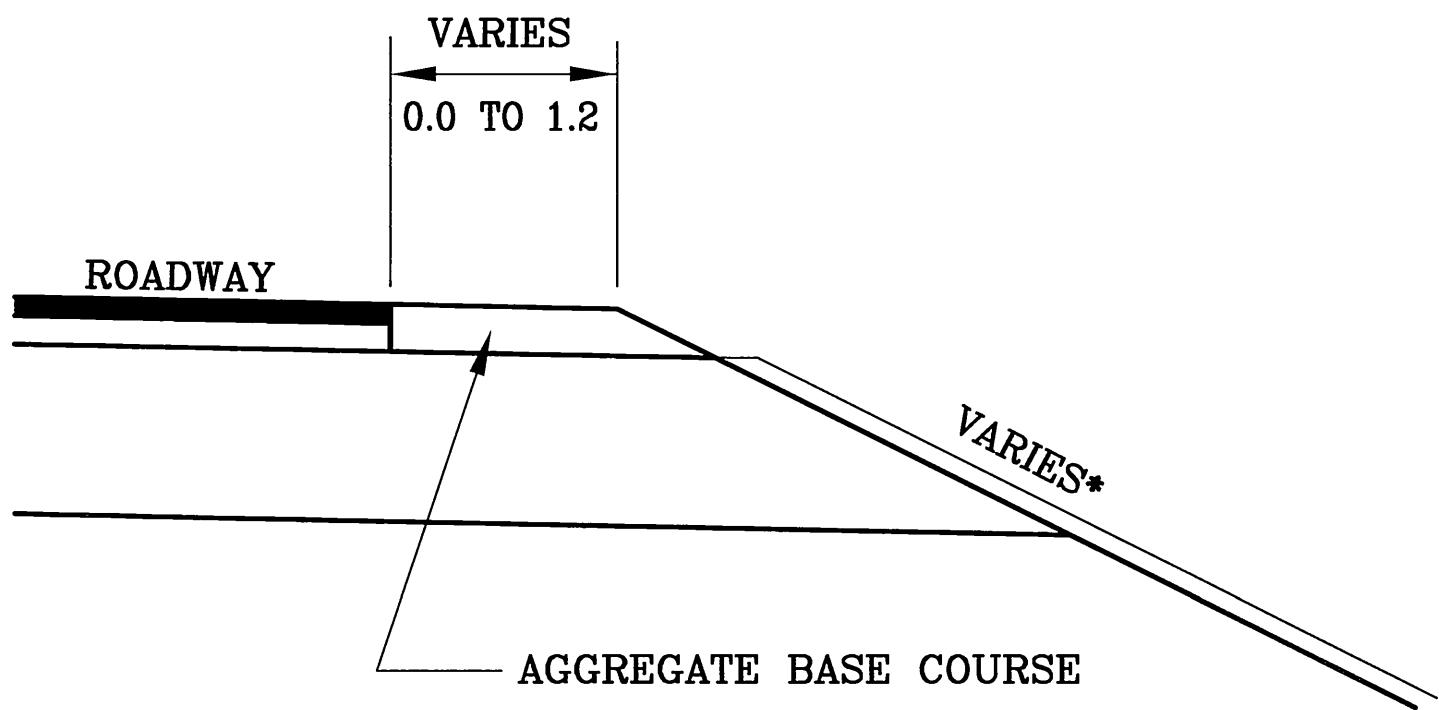

SHOULDER


*SEE TYPICAL SECTIONS

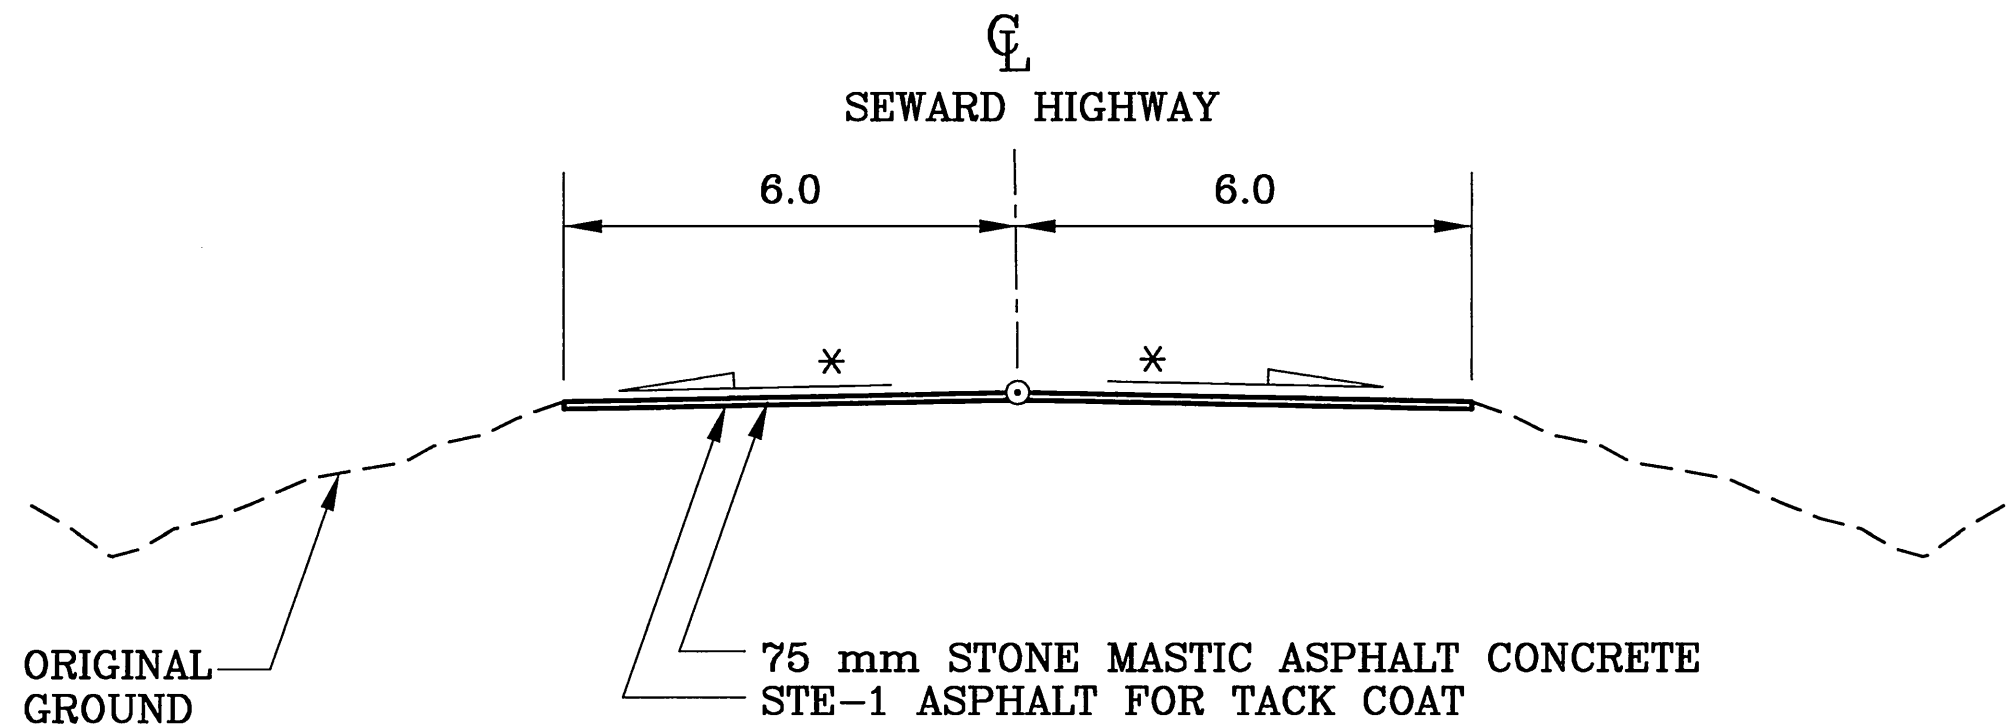

HIGHWAY TYPICAL SECTION
MP 99 TO BIRD CREEK

STA. 40+906.250 TO STA. 44+495.000


* MATCH EXISTING CROSS SLOPE

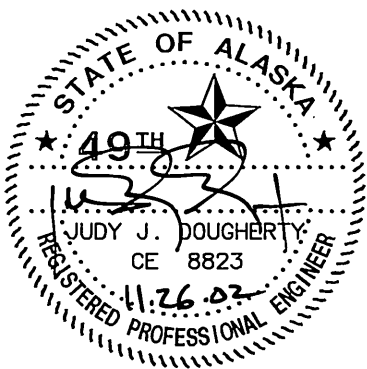


STATE OF ALASKA
DEPARTMENT OF TRANSPORTATION
AND
PUBLIC FACILITIES
SEWARD HIGHWAY
MP 96 TO MP 102
SAFETY, ROADWAY AND
RECREATIONAL IMPROVEMENTS

TYPICAL SECTIONS

CHANGE ORDER NO. 6

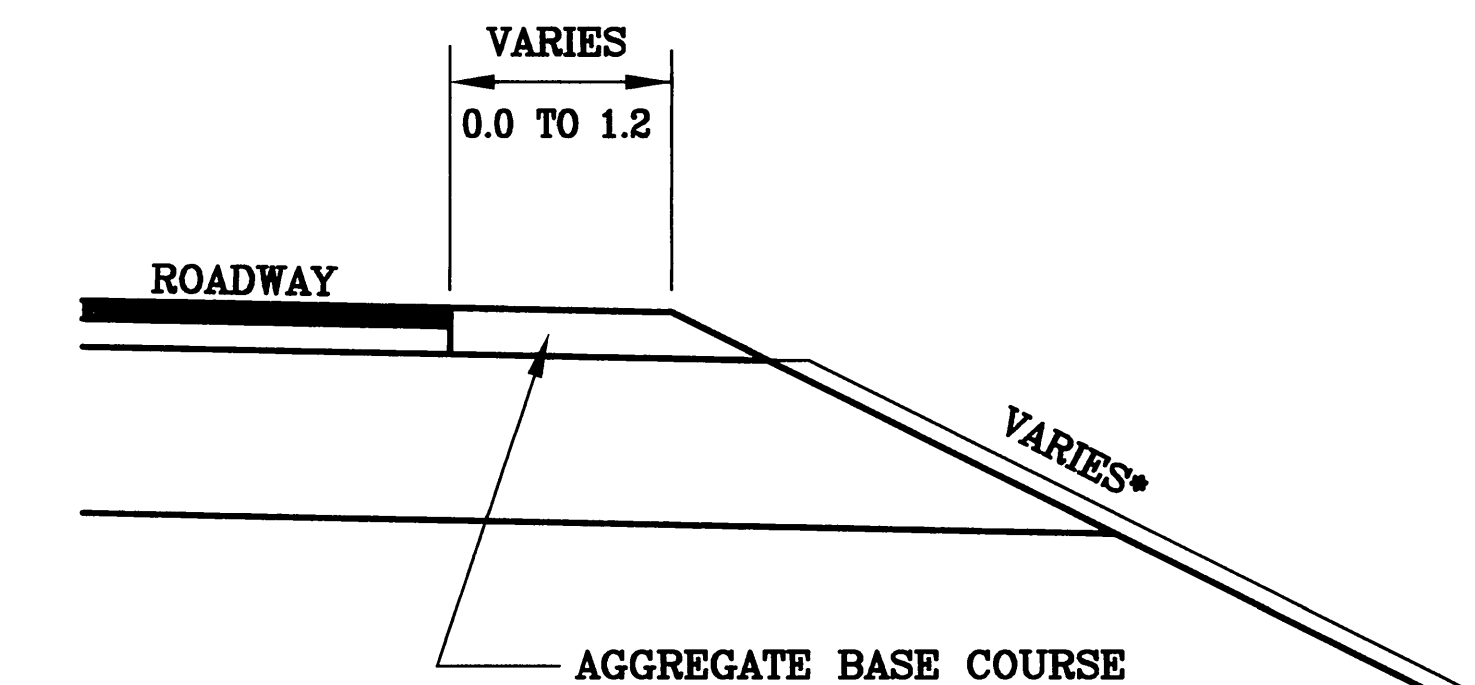


*SEE TYPICAL SECTIONS

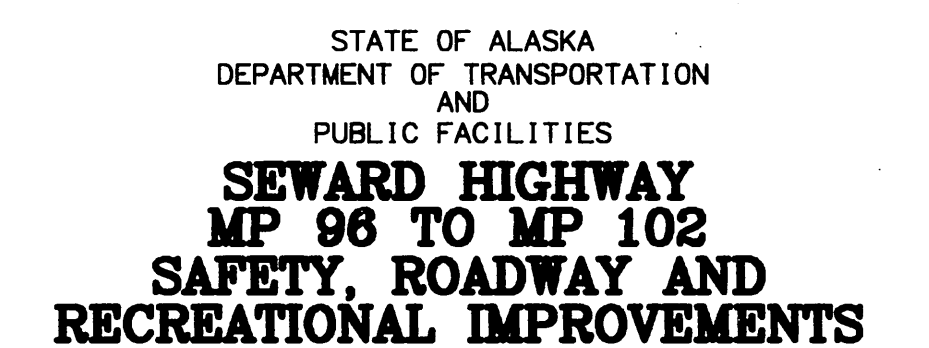


TYPICAL SECTIONS

REVISIONS			STATE	PROJECT DESIGNATION	YEAR	SHEET NO.	TOTAL SHEETS
No.	DATE	DESCRIPTION					
			ALASKA	NH-0A3-1(28)	2002	B3	B7

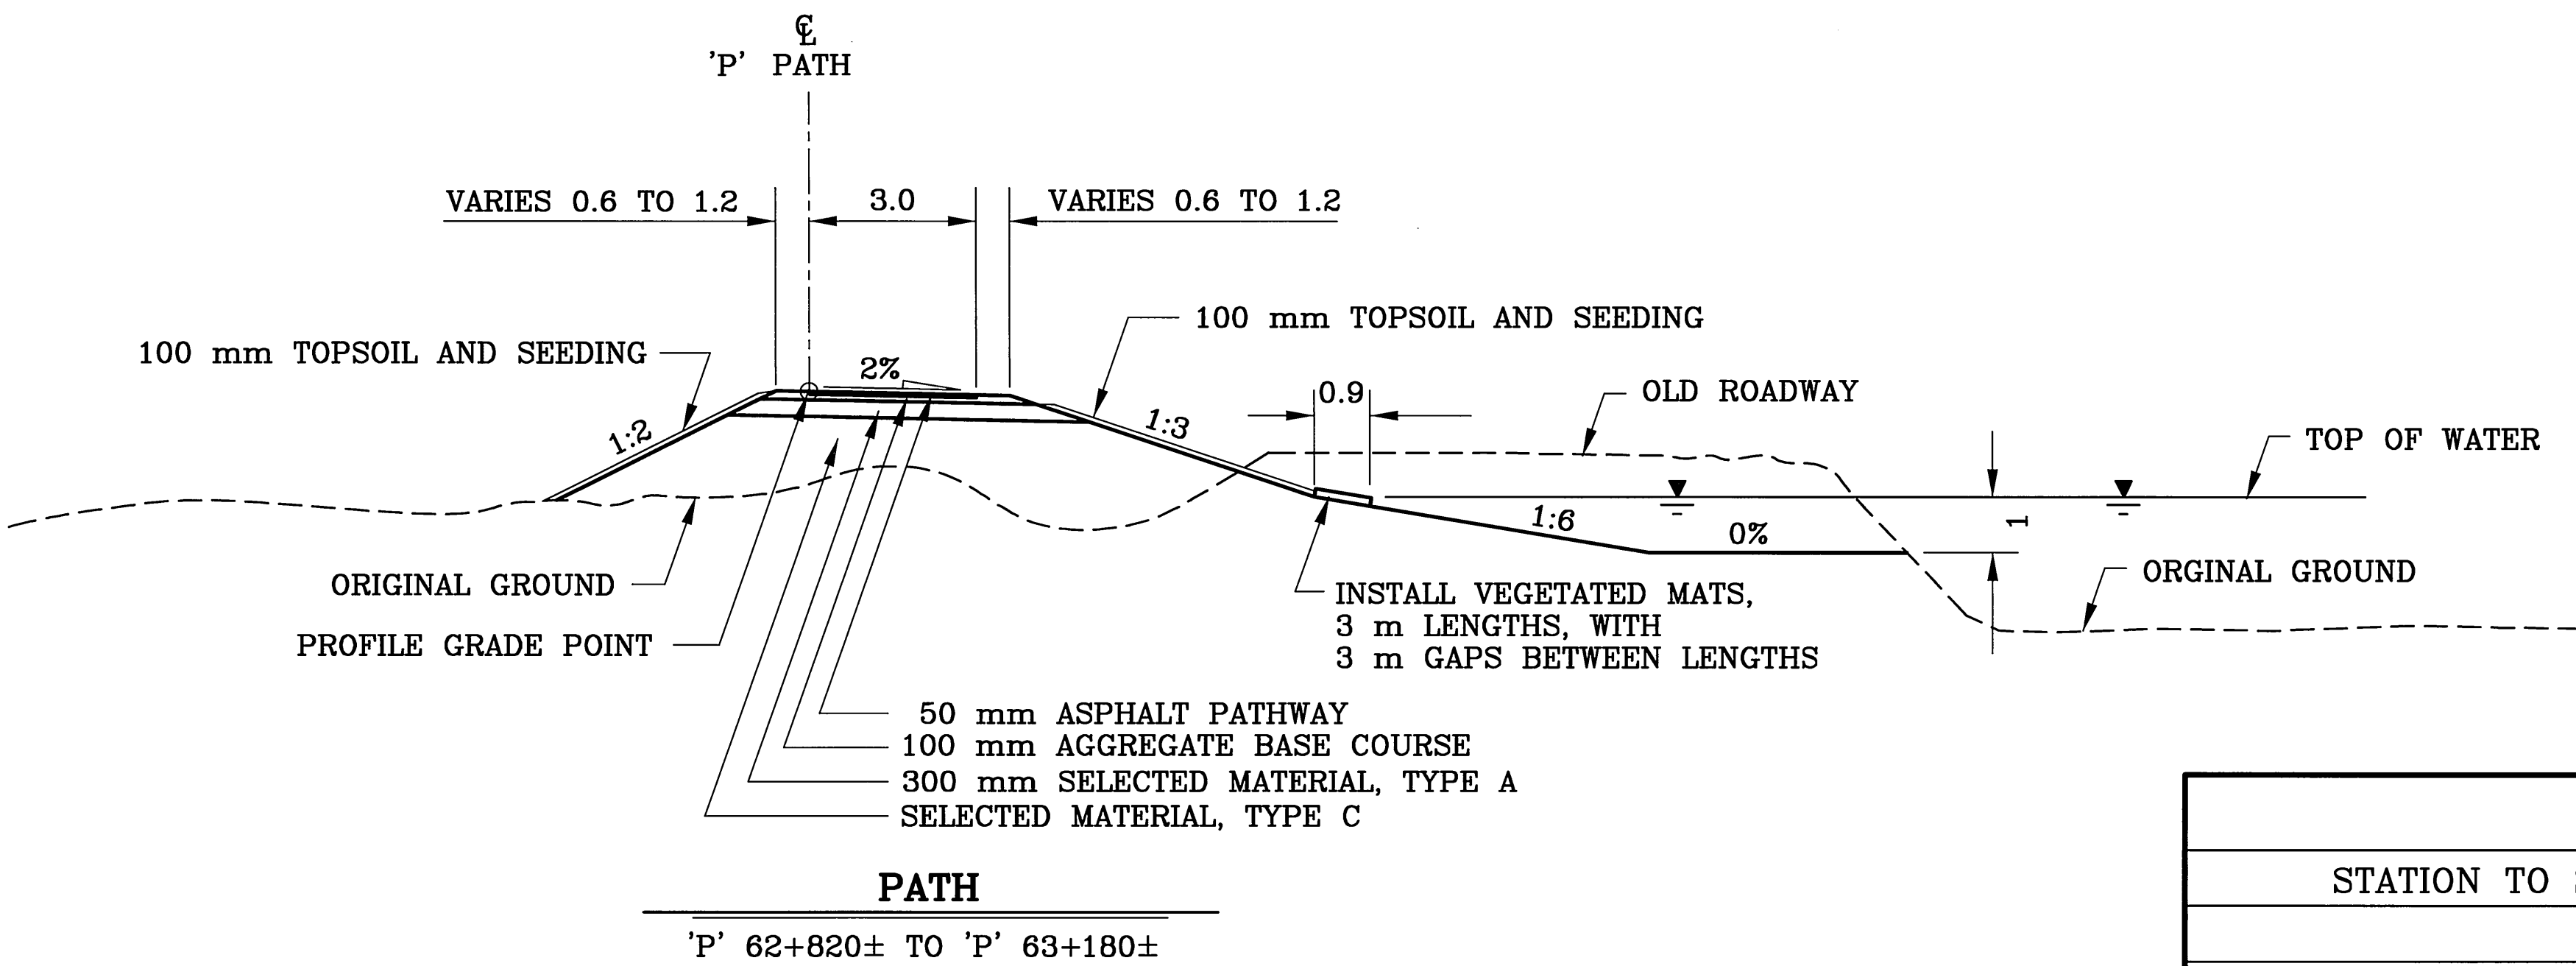


PATH SLOPE EXCEPTION TABLE				
STATION TO STATION	OFFSET	SLOPE		REMARKS
		CUT	FILL	
'P' 62+050 TO 'P' 62+630	RT.	1:0.5		SEE ROCK CUT TYPICAL, SHEET B7
'P' 62+080 TO 'P' 62+280	LT.	1:0.5		SEE ROCK CUT TYPICAL, SHEET B7
'P' 64+680 TO 'P' 64+765	LT.	1:2		*3 m WIDE BY 0.9 m DEEP DITCH
'P' 64+767.85 TO 'P' 64+814.85	LT. & RT.			SEE PEDESTRIAN UNDERCROSSING DETAIL

* DEPTH FROM FINISHED PATH SHOULDER.

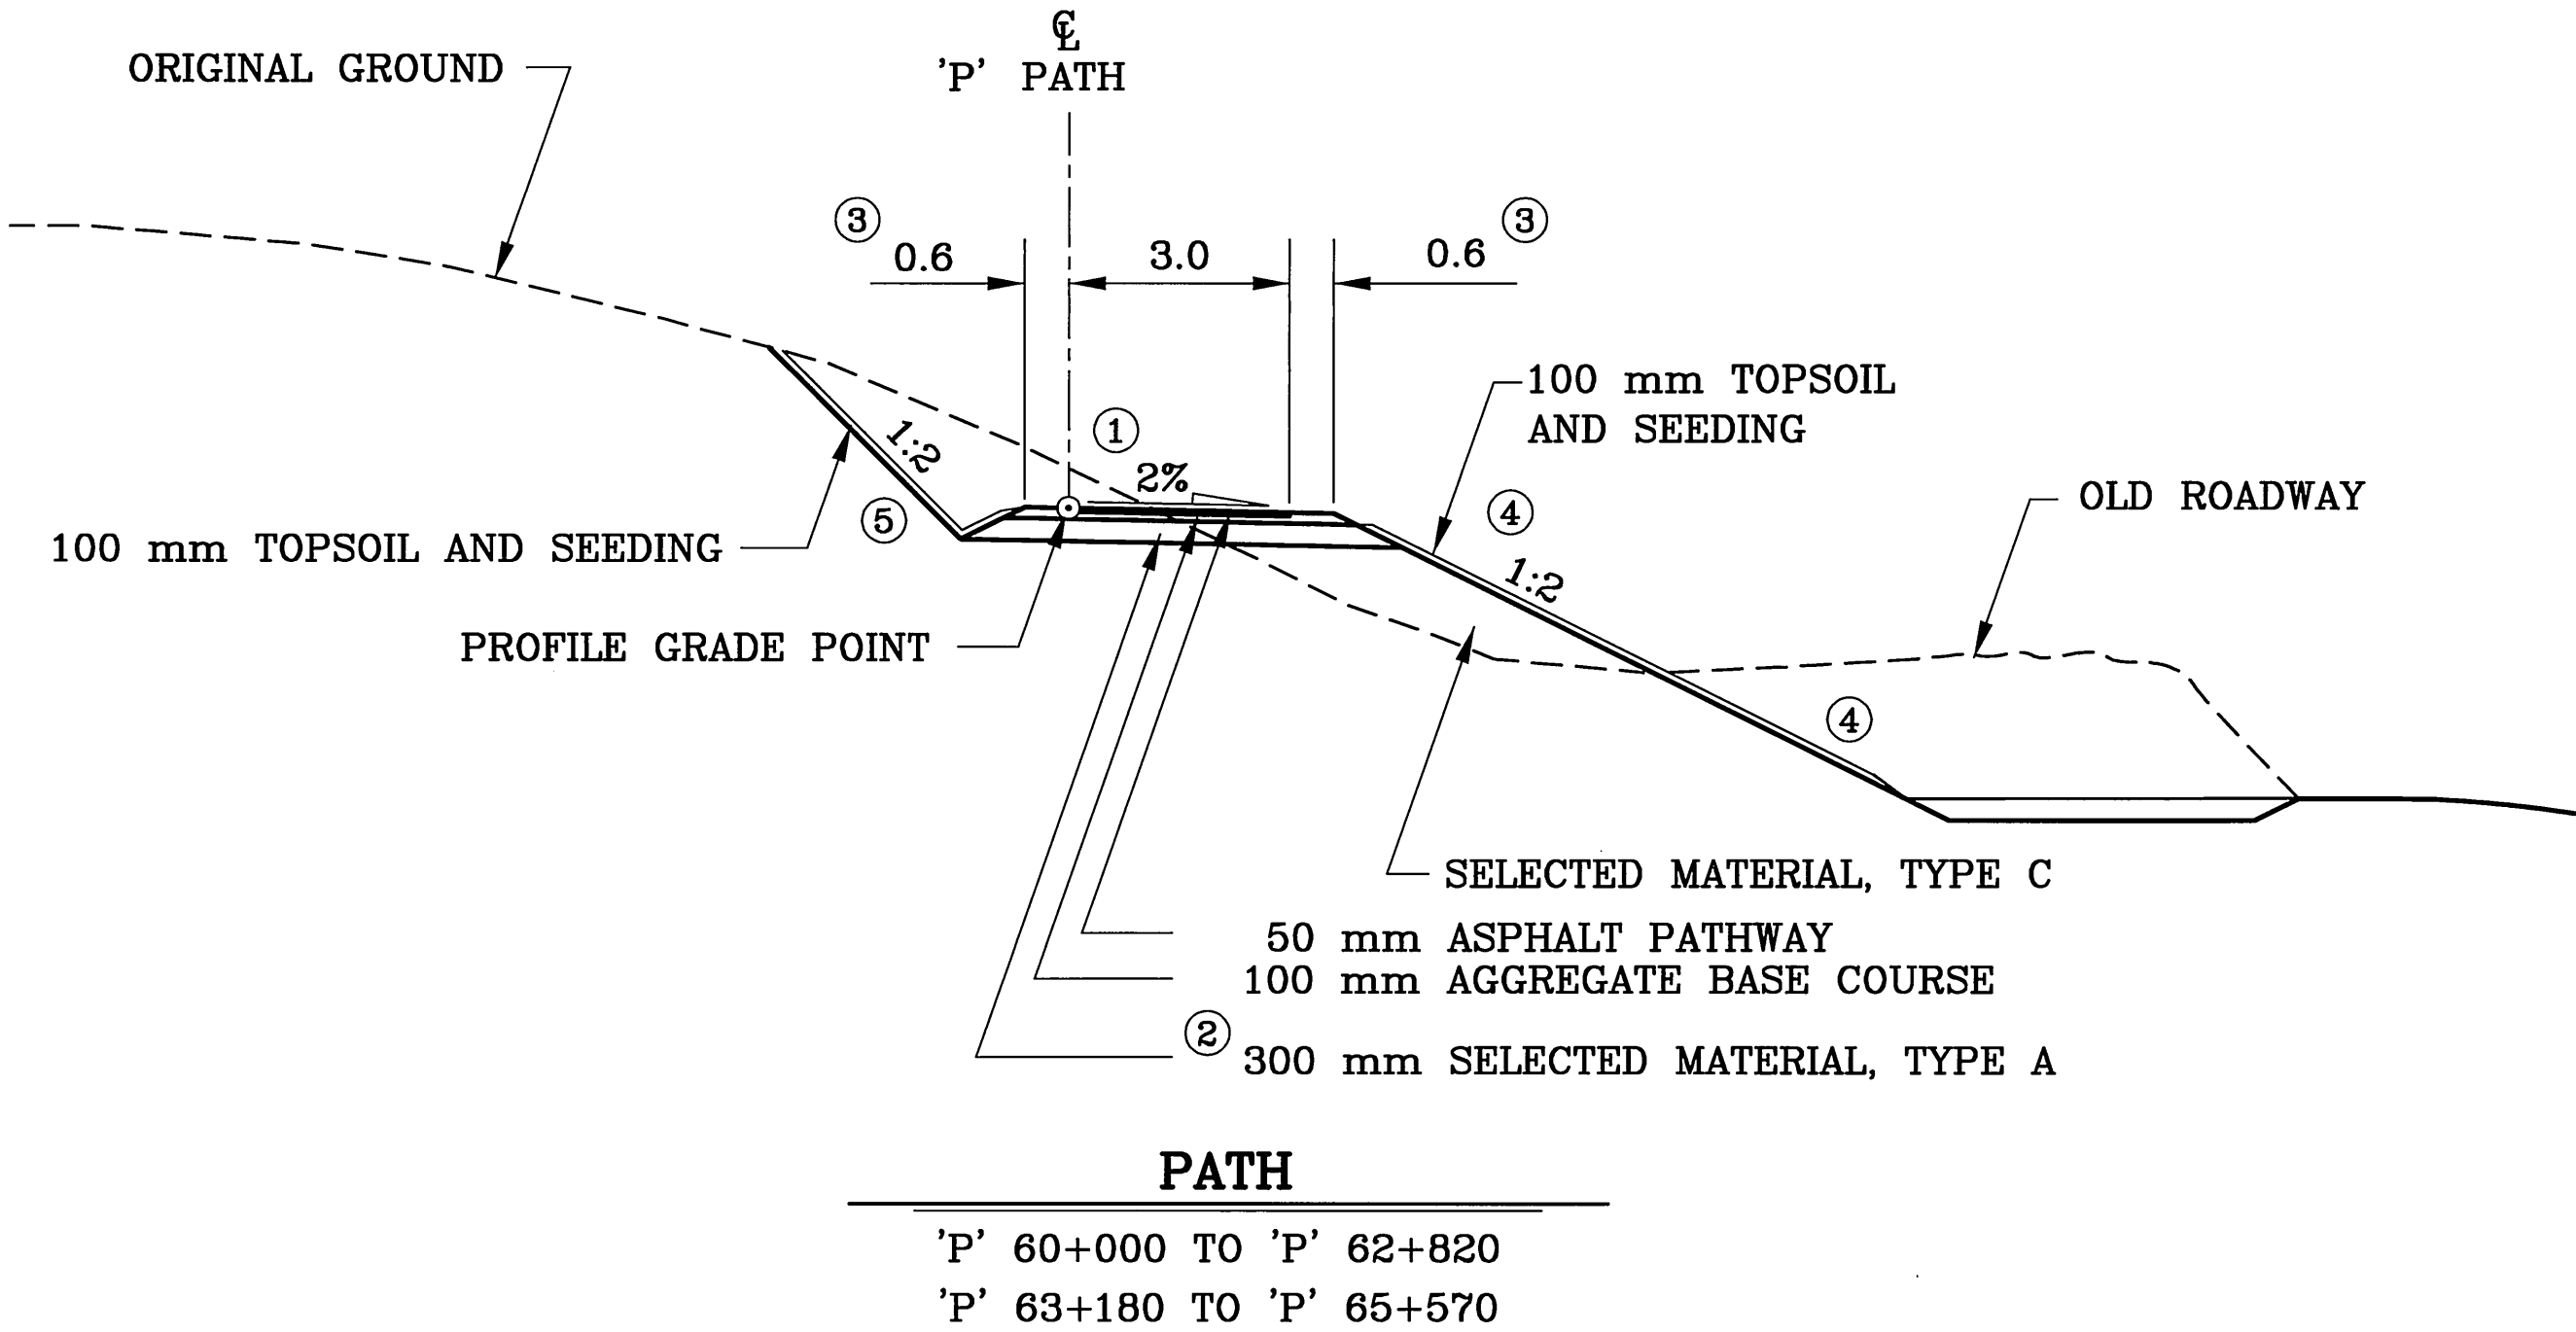

- ORIENT CROSS SLOPE TO ACCOMMODATE PREVAILING CROSS DRAINAGE
- STA. 'P' 63+890 TO STA. 'P' 64+730 AND STA. 'P' 64+920 TO STA. 'P' 65+440
DELETE 300mm SELECTED MATERIAL, TYPE A REQUIREMENT. SHAPE THE EXISTING
HIGHWAY AND RAILROAD AGGREGATE IN PLACE OF SELECTED MATERIAL, TYPE A.
- STA. 'P' 60+660 TO STA. 'P' 60+820, 1.2 m LT. AND RT.
STA. 'P' 62+610 TO STA. 'P' 63+840, 1.2 m LT. AND RT.
- STA. 'P' 62+740 TO STA. 'P' 62+780, RT.
STA. 'P' 63+200 TO STA. 'P' 63+440, RT., INSTALL 1.5 SQ. m LAND SOD BLOCKS
1.5 m GAPS BETWEEN BLOCKS AT TOE OF EMBANKMENT.
STA. 'P' 63+880 TO STA. 'P' 64+240, RT.
1:3 EXCAVATE OLD ROADWAY TO 0.3 m BELOW ELEVATION
OF ADJACENT WETLANDS.
- STA. 'P' 65+020 TO STA. 'P' 65+200, LT.
STA. 'P' 65+470 TO STA. 'P' 65+550, LT.
EXCAVATE EXISTING GROUND BETWEEN PATHWAY AND
RAILROAD AS DIRECTED BY THE ENGINEER.

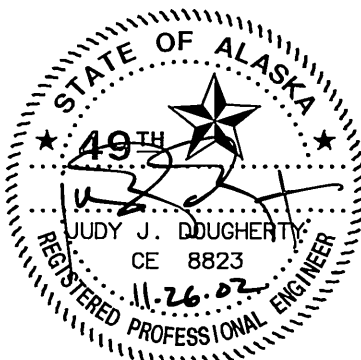






STATE OF ALASKA
DEPARTMENT OF TRANSPORTATION
AND
PUBLIC FACILITIES
**SEWARD HIGHWAY
MP 96 TO MP 102
SAFETY, ROADWAY AND
RECREATIONAL IMPROVEMENTS**

TYPICAL SECTIONS

REVISIONS			STATE	PROJECT DESIGNATION	YEAR	SHEET NO.	TOTAL SHEETS
No.	DATE	DESCRIPTION	ALASKA	NH-0A3-1(28)	2002	B4	B7

NOTE

- FOR STA. 44+650.868 TO STA. 44+712.691
SEE "BIRD CREEK BRIDGE" GENERAL LAYOUT.

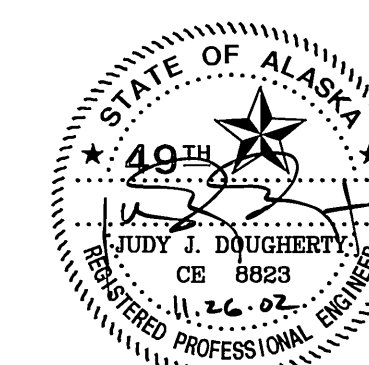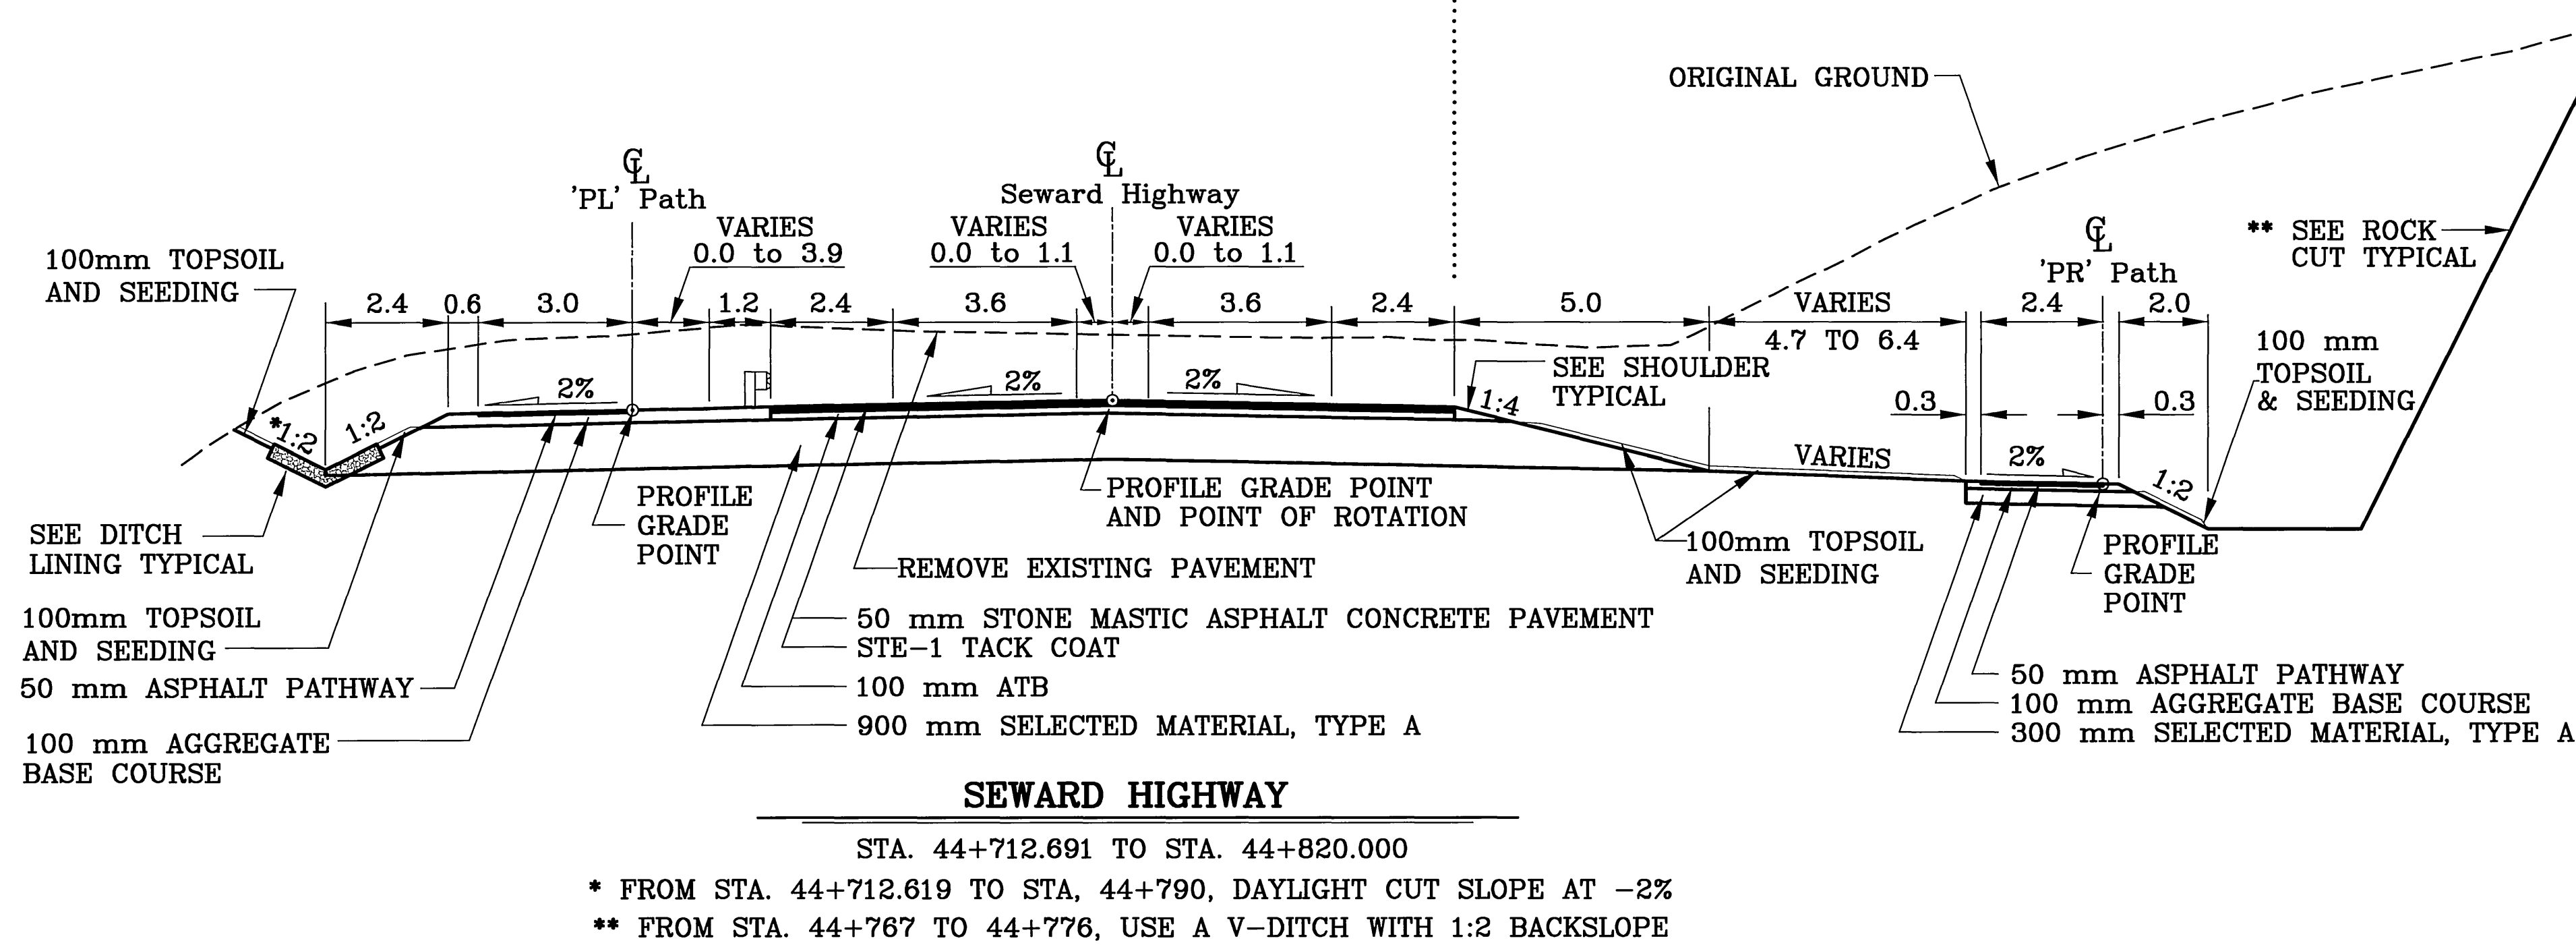
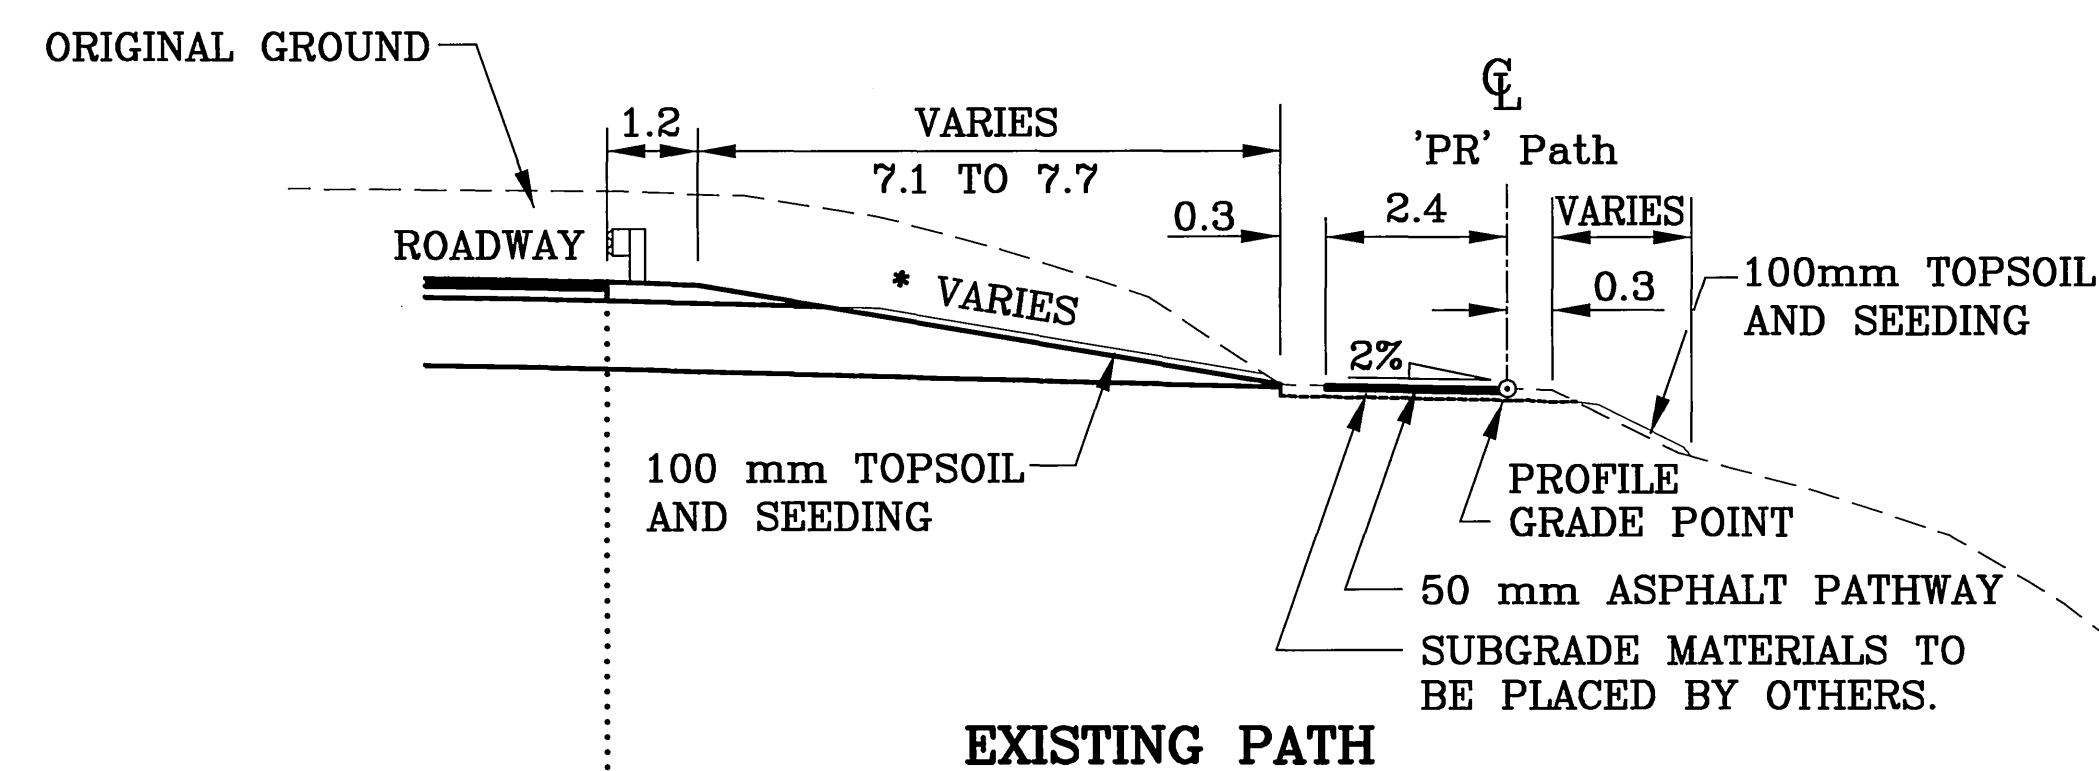
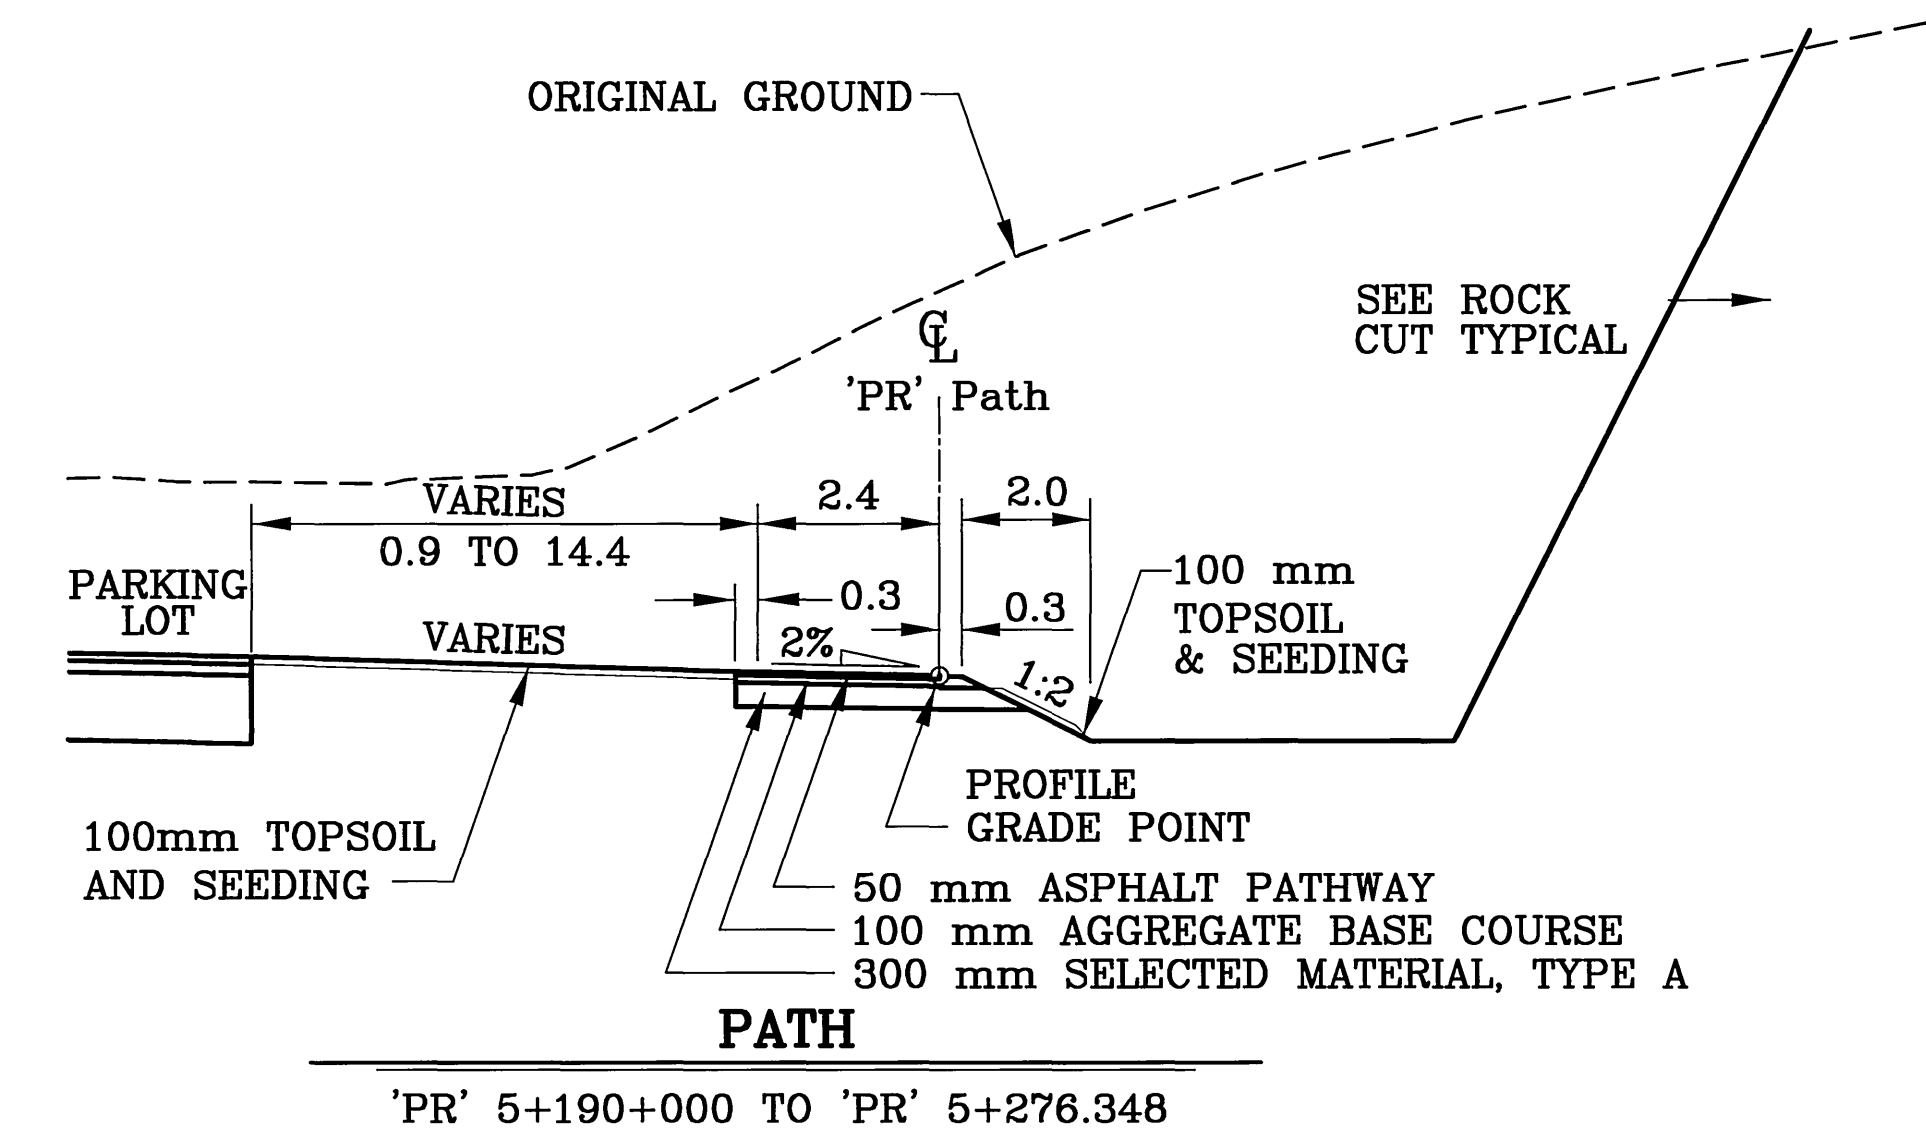
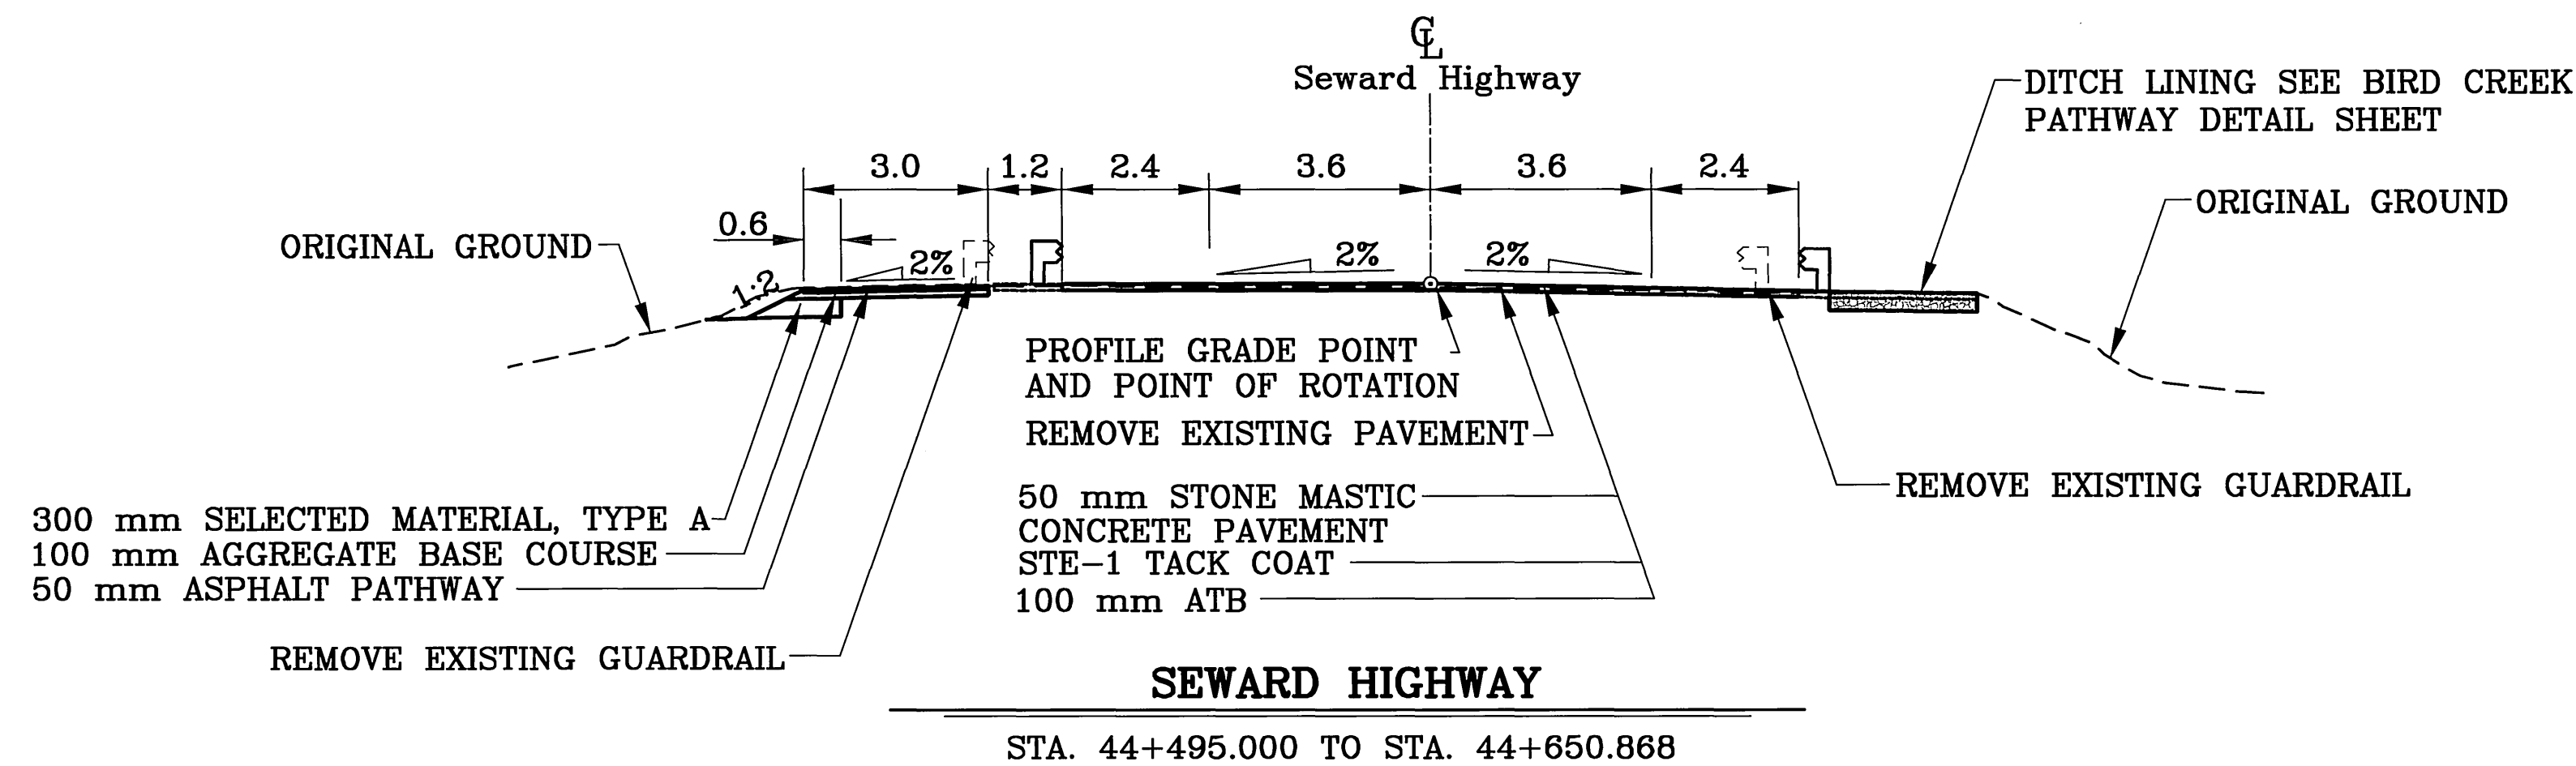


STATE OF ALASKA
DEPARTMENT OF TRANSPORTATION
AND
PUBLIC FACILITIES

**SEWARD HIGHWAY
MP 96 TO MP 102
SAFETY, ROADWAY &
RECREATIONAL IMPROVEMENTS**

TYPICAL SECTIONS



DESIGNED BY
CHECKED BY
DRAFTED BY
11/21/02
CU
VIEW=1
AUTOCAD CARGILEE D./SDSKPROJ/63577/8180TYP
SPECIFICATIONS
SCALE 1"=1'
COMPUTER DESIGNATION

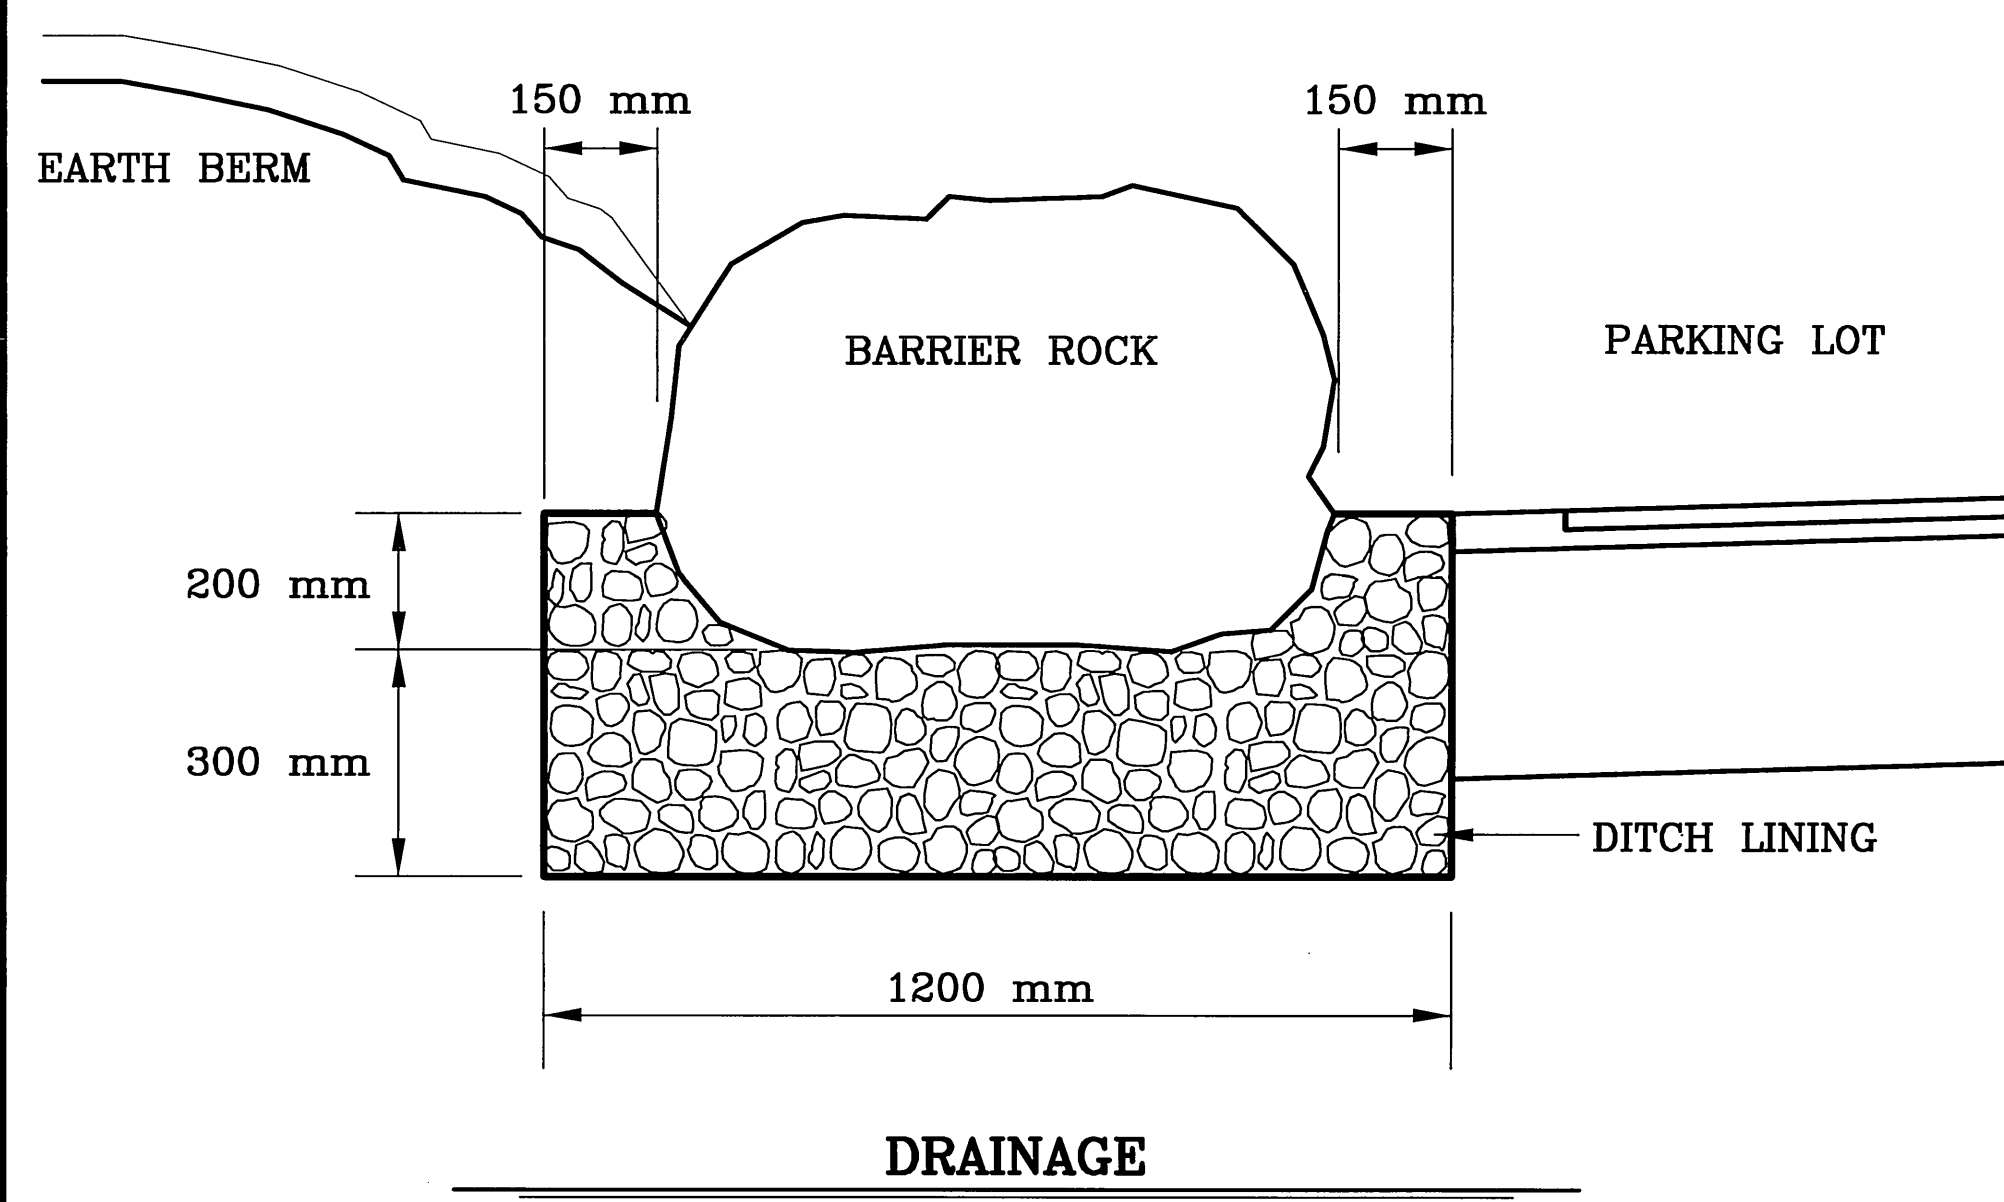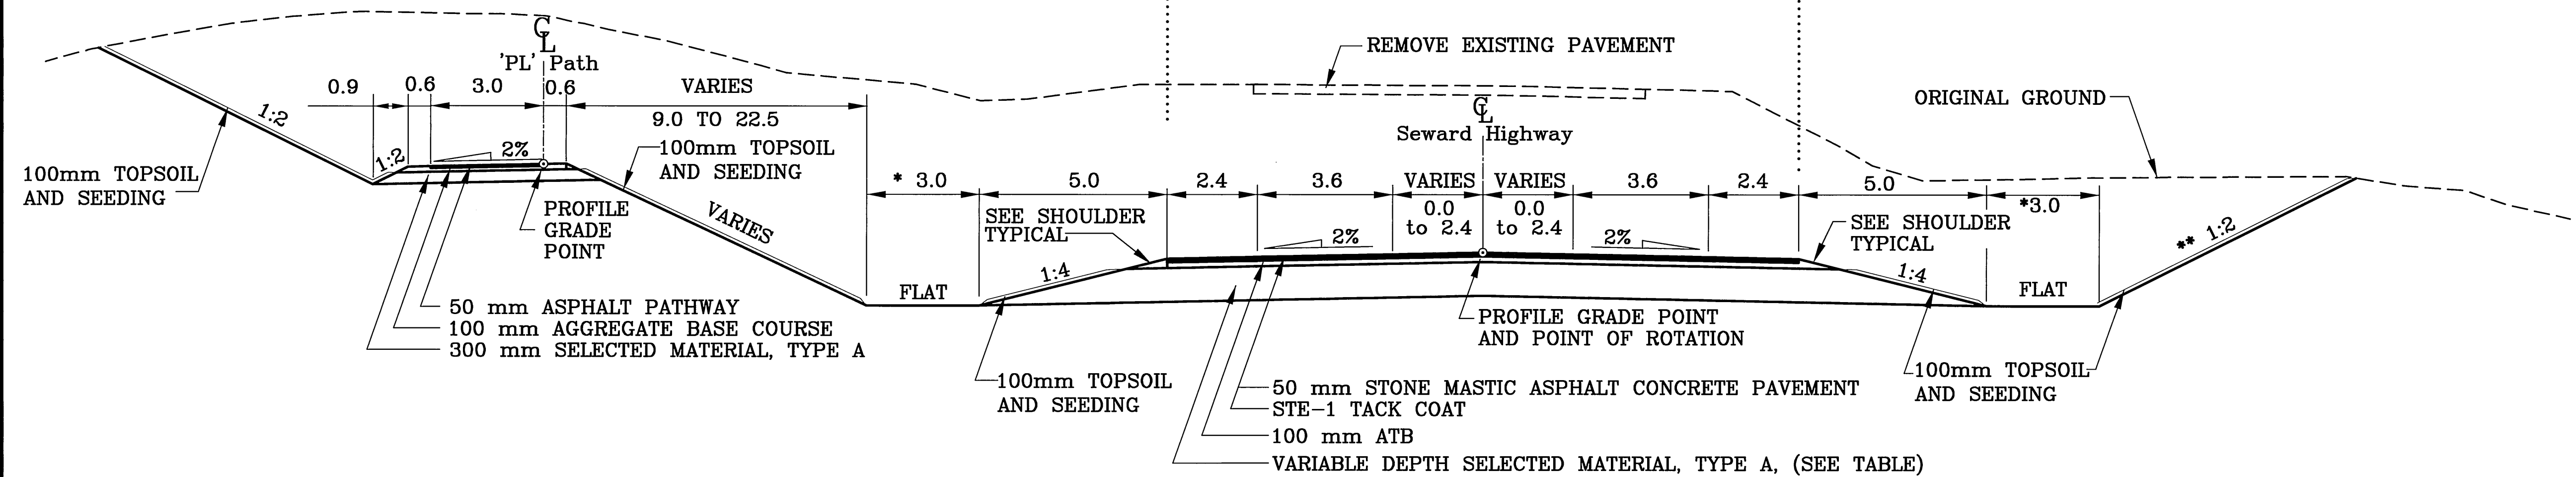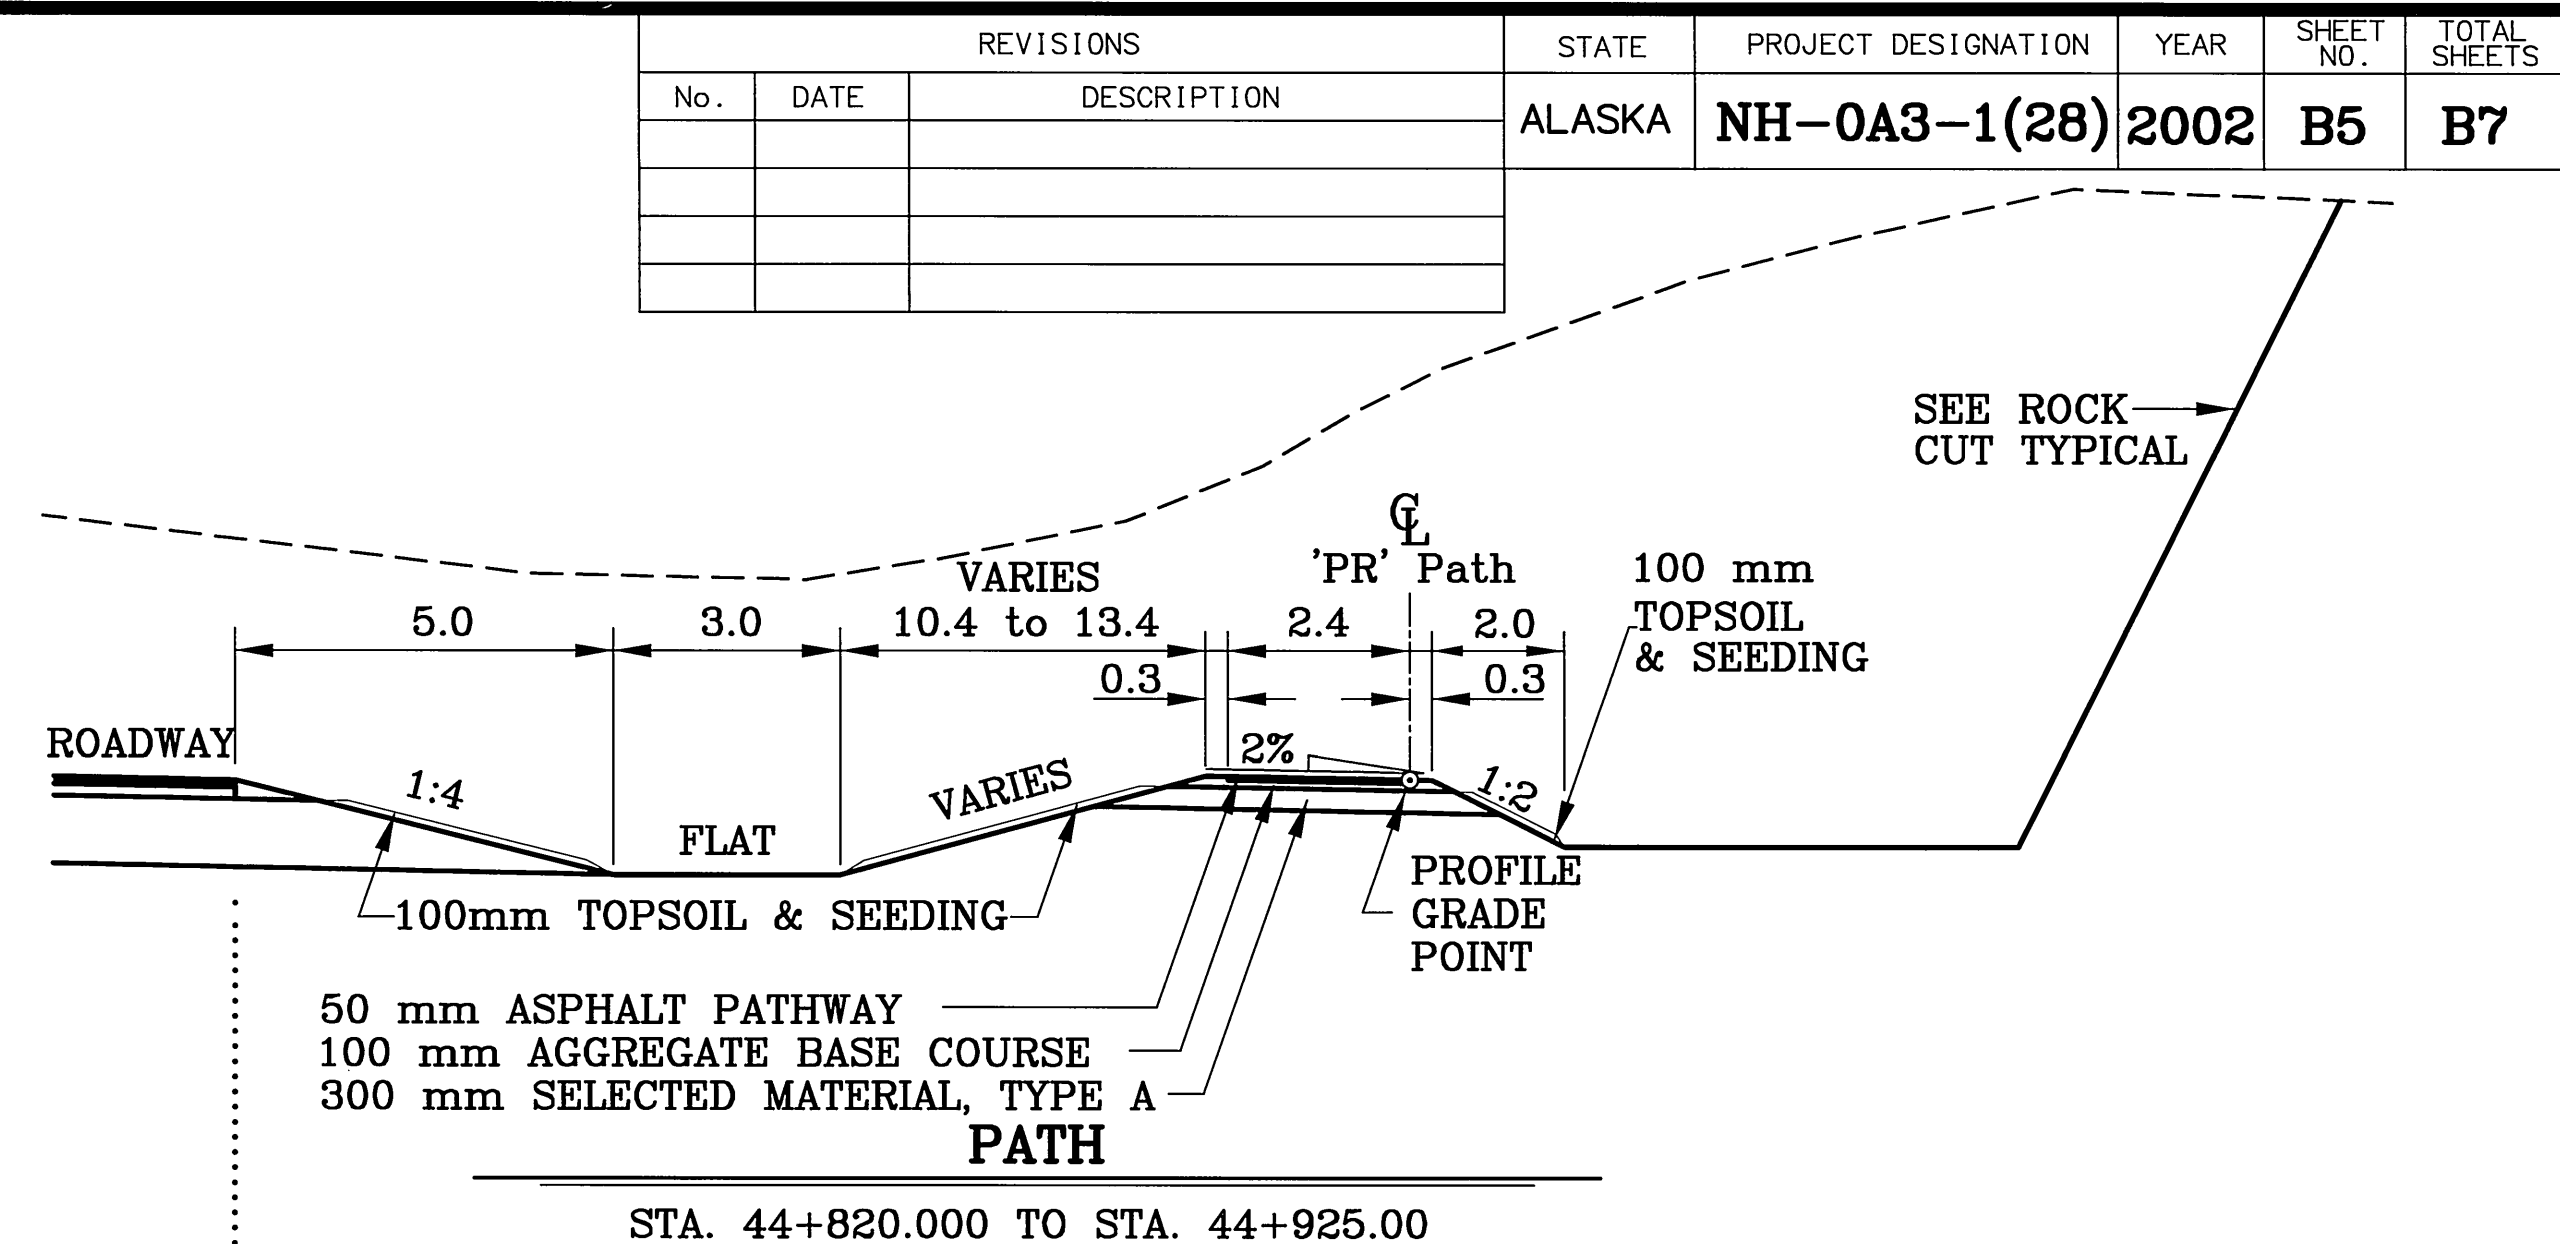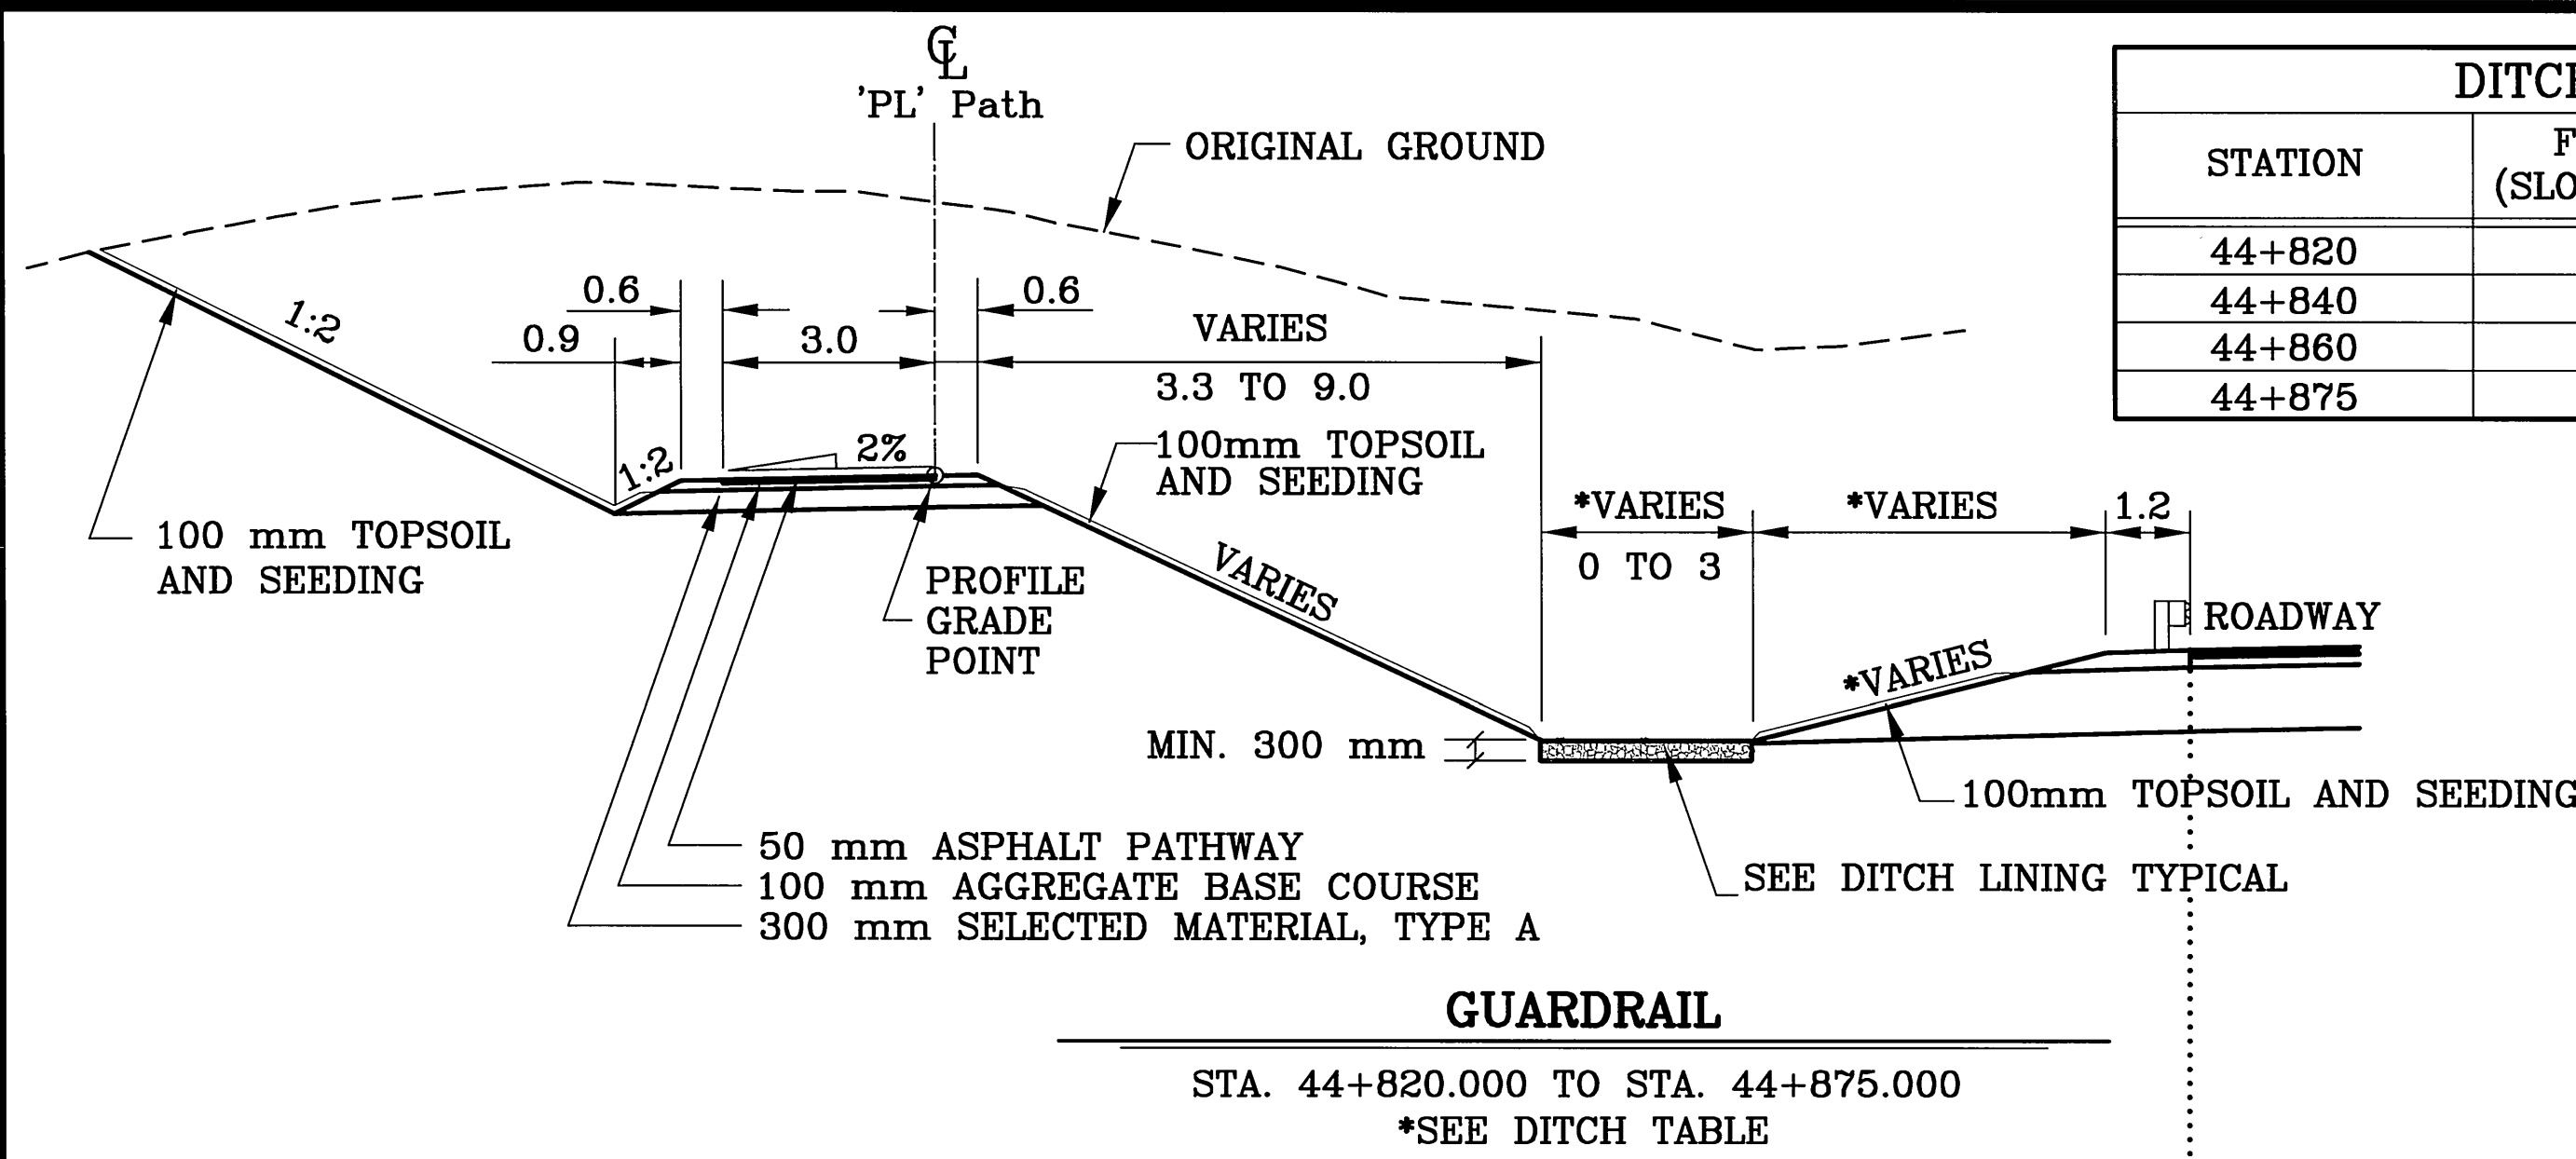

SEWARD HIGHWAY
STA. 44+820.000 TO STA. 45+580.000
* SEE DITCH LINING TYPICAL
** SEE ROCK CUT TYPICAL FOR EXCEPTIONS


TABLE OF SELECTED MATERIAL, TYPE A	
STATION TO STATION	DEPTH** (mm)
44+820 TO 44+850	900
44+850 TO 44+910	600
44+910 TO 45+135	900
44+135 TO 45+390	600
45+390 TO 45+580	900

** TRANSITION 1:10 BETWEEN 600mm AND 900mm
SELECTED MATERIAL, TYPE A AREAS.

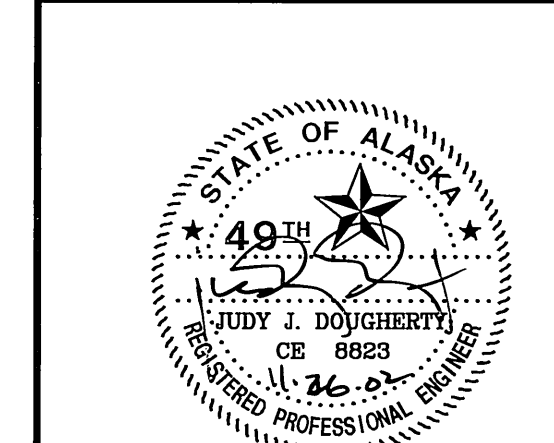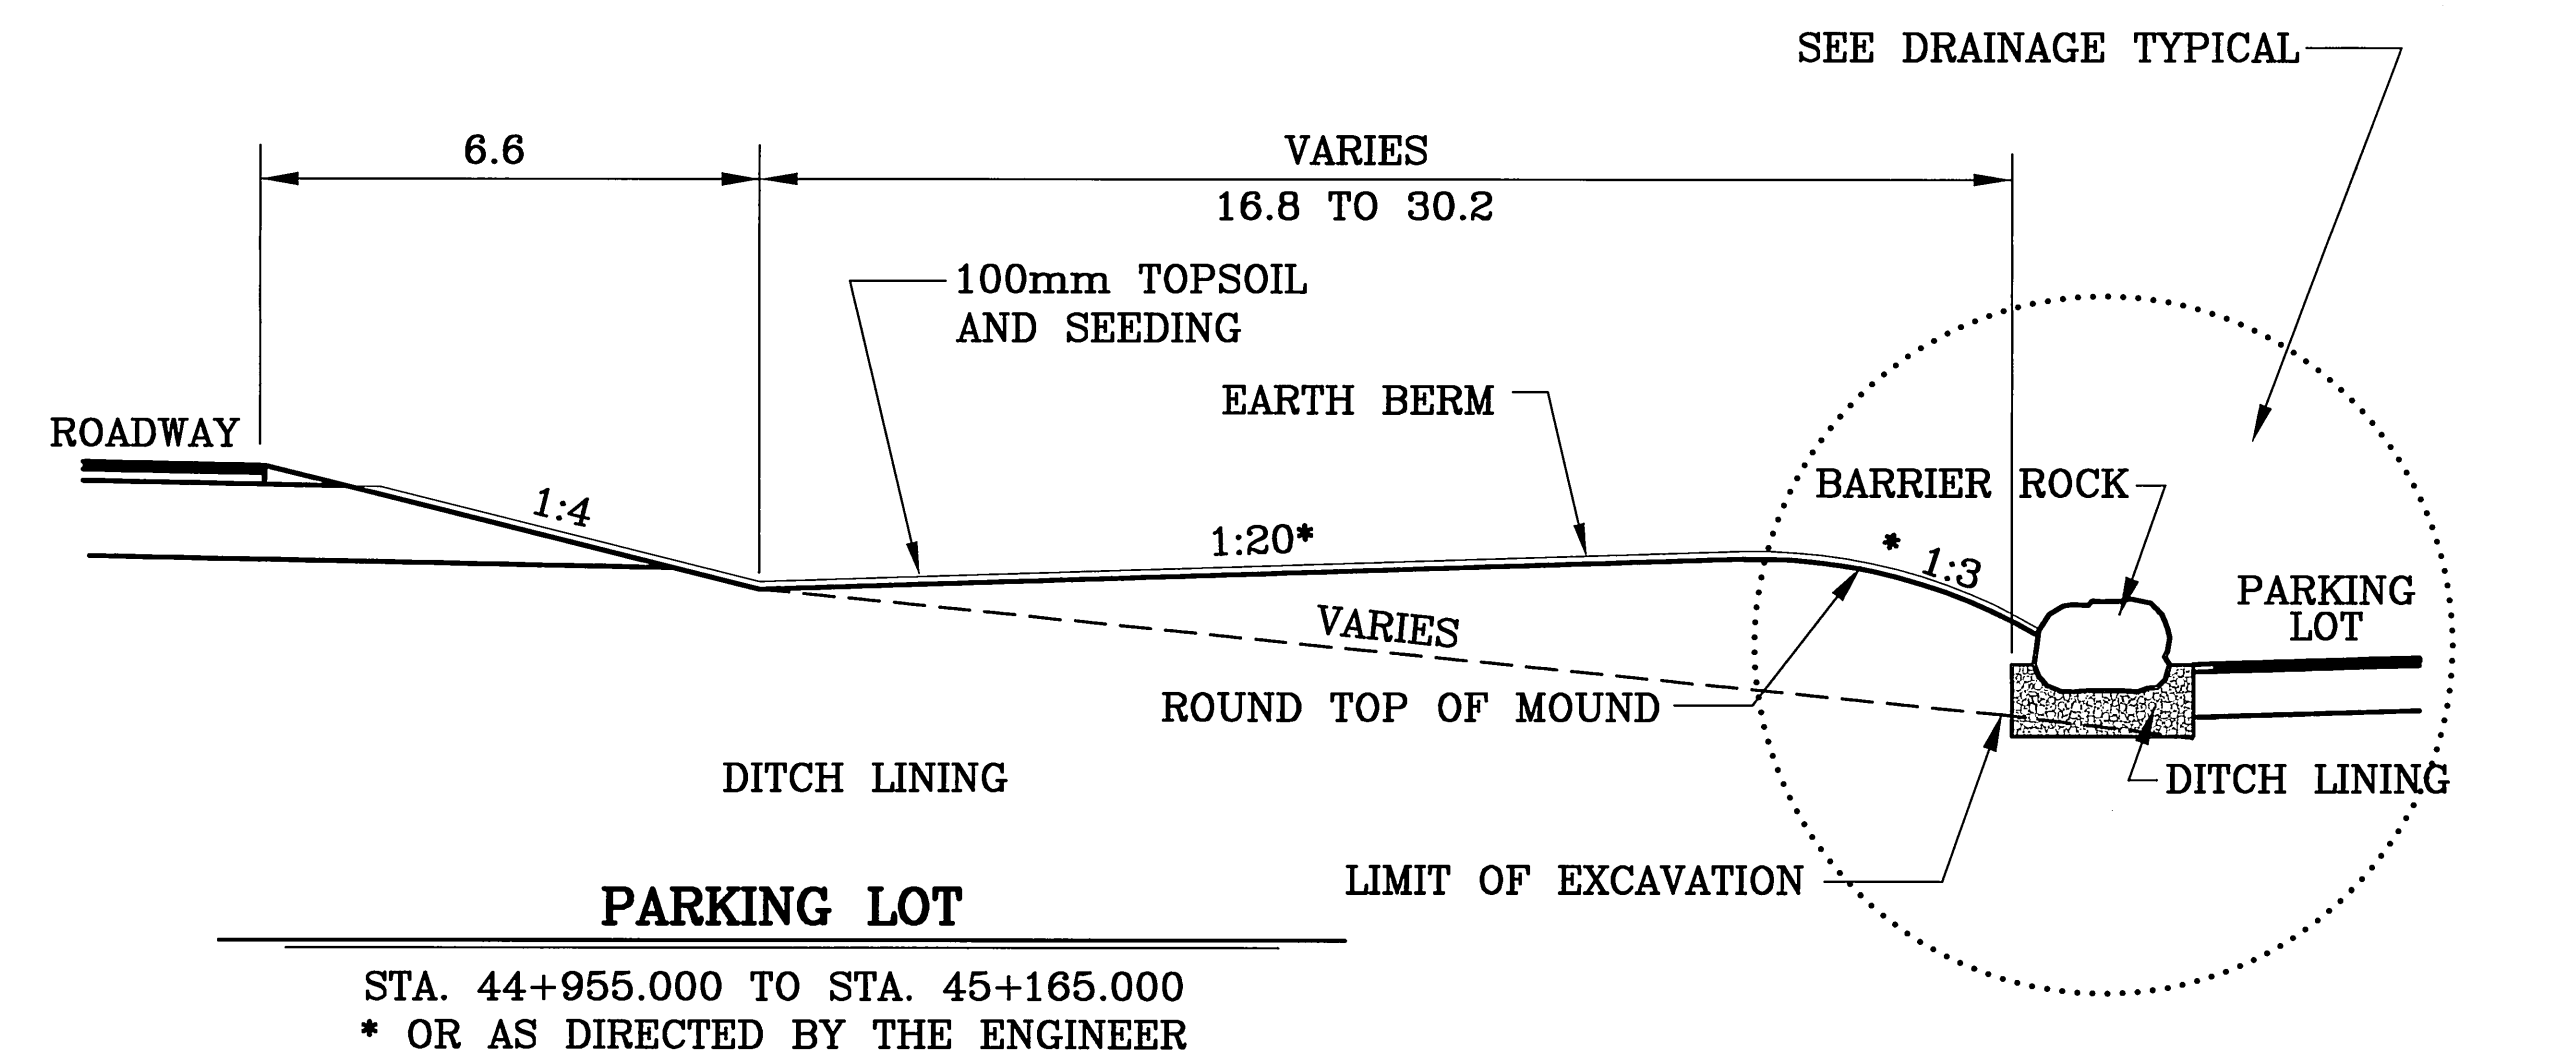

STATE OF ALASKA
DEPARTMENT OF TRANSPORTATION
AND
PUBLIC FACILITIES
**SEWARD HIGHWAY
MP 96 TO MP 102
SAFETY, ROADWAY &
RECREATIONAL IMPROVEMENTS**
TYPICAL SECTIONS

REVISIONS			STATE	PROJECT DESIGNATION	YEAR	SHEET NO.	TOTAL SHEETS
No.	DATE	DESCRIPTION	ALASKA	NH-0A3-1(28)	2002	B6	B7

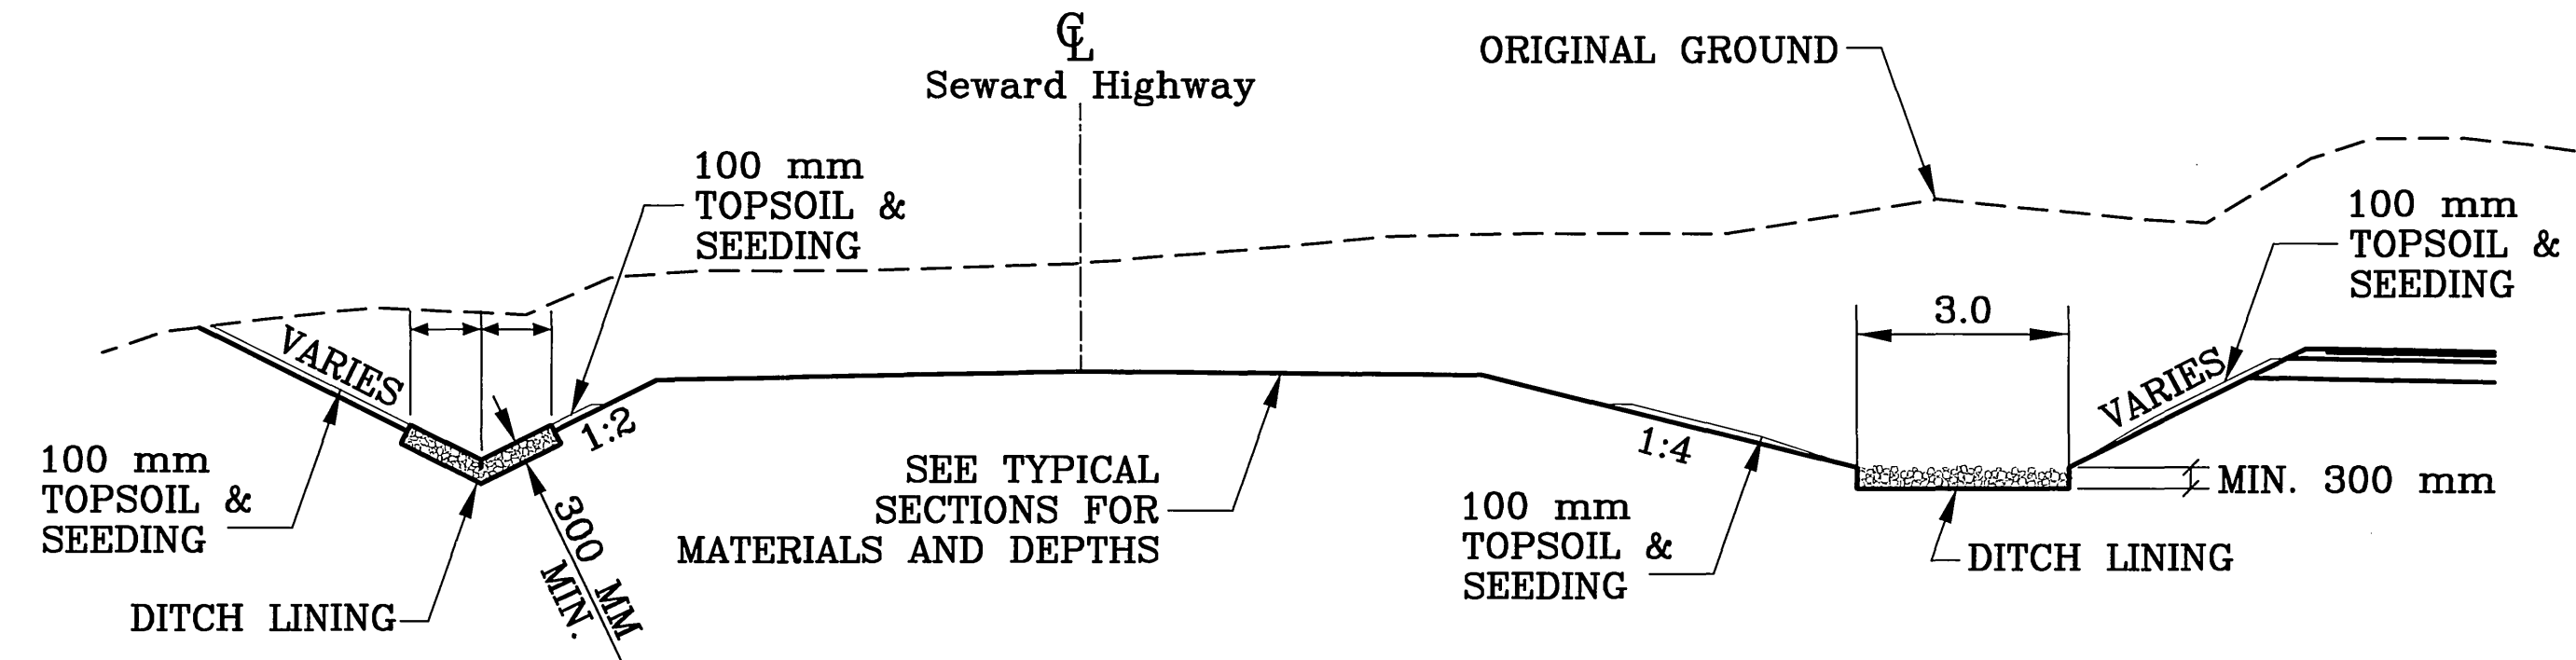


DITCH LINING

44+712.691 TO 44+875.000, LT.
44+910.000 TO 45+130.000, LT.
44+930.000 TO 44+960.000, RT.
45+050.000 TO 45+130.000, RT.
45+270.000 TO 45+580.000, LT.
45+360.000 TO 45+580.000, RT.


NOTE:
DITCH LINING TO BE PLACED IN
HIGHWAY DITCHES STA. 44+712.691 TO
STA. 45+580.000 THAT ARE NOT ROCK CUT.

ROCK CUT DITCH TABLE			
STATION TO STATION	OFFSET	DITCH WIDTH (m)	REMARKS
45+130 TO 45+360	RT.	3.0	
'PL' 4+150 TO 'PL' 4+250	LT.	3.0	
'PL' 4+785 TO 'PL' 4+815	LT.	3.0	
'PR' 5+048 TO 'PR' 5+135	RT.	6.0	TRANSITION FROM 6M TO 16M FROM STA. 'PR' 5+135 TO STA. 'PR' 5+170
'PR' 5+170 TO 'PR' 5+250	RT.	16.0	TRANSITION FROM 16M TO 25M AND 0.5:1 SLOPE TO 0.25:1 SLOPE FROM STA. 'PR' 5+250 TO STA. 'PR' 5+276.3

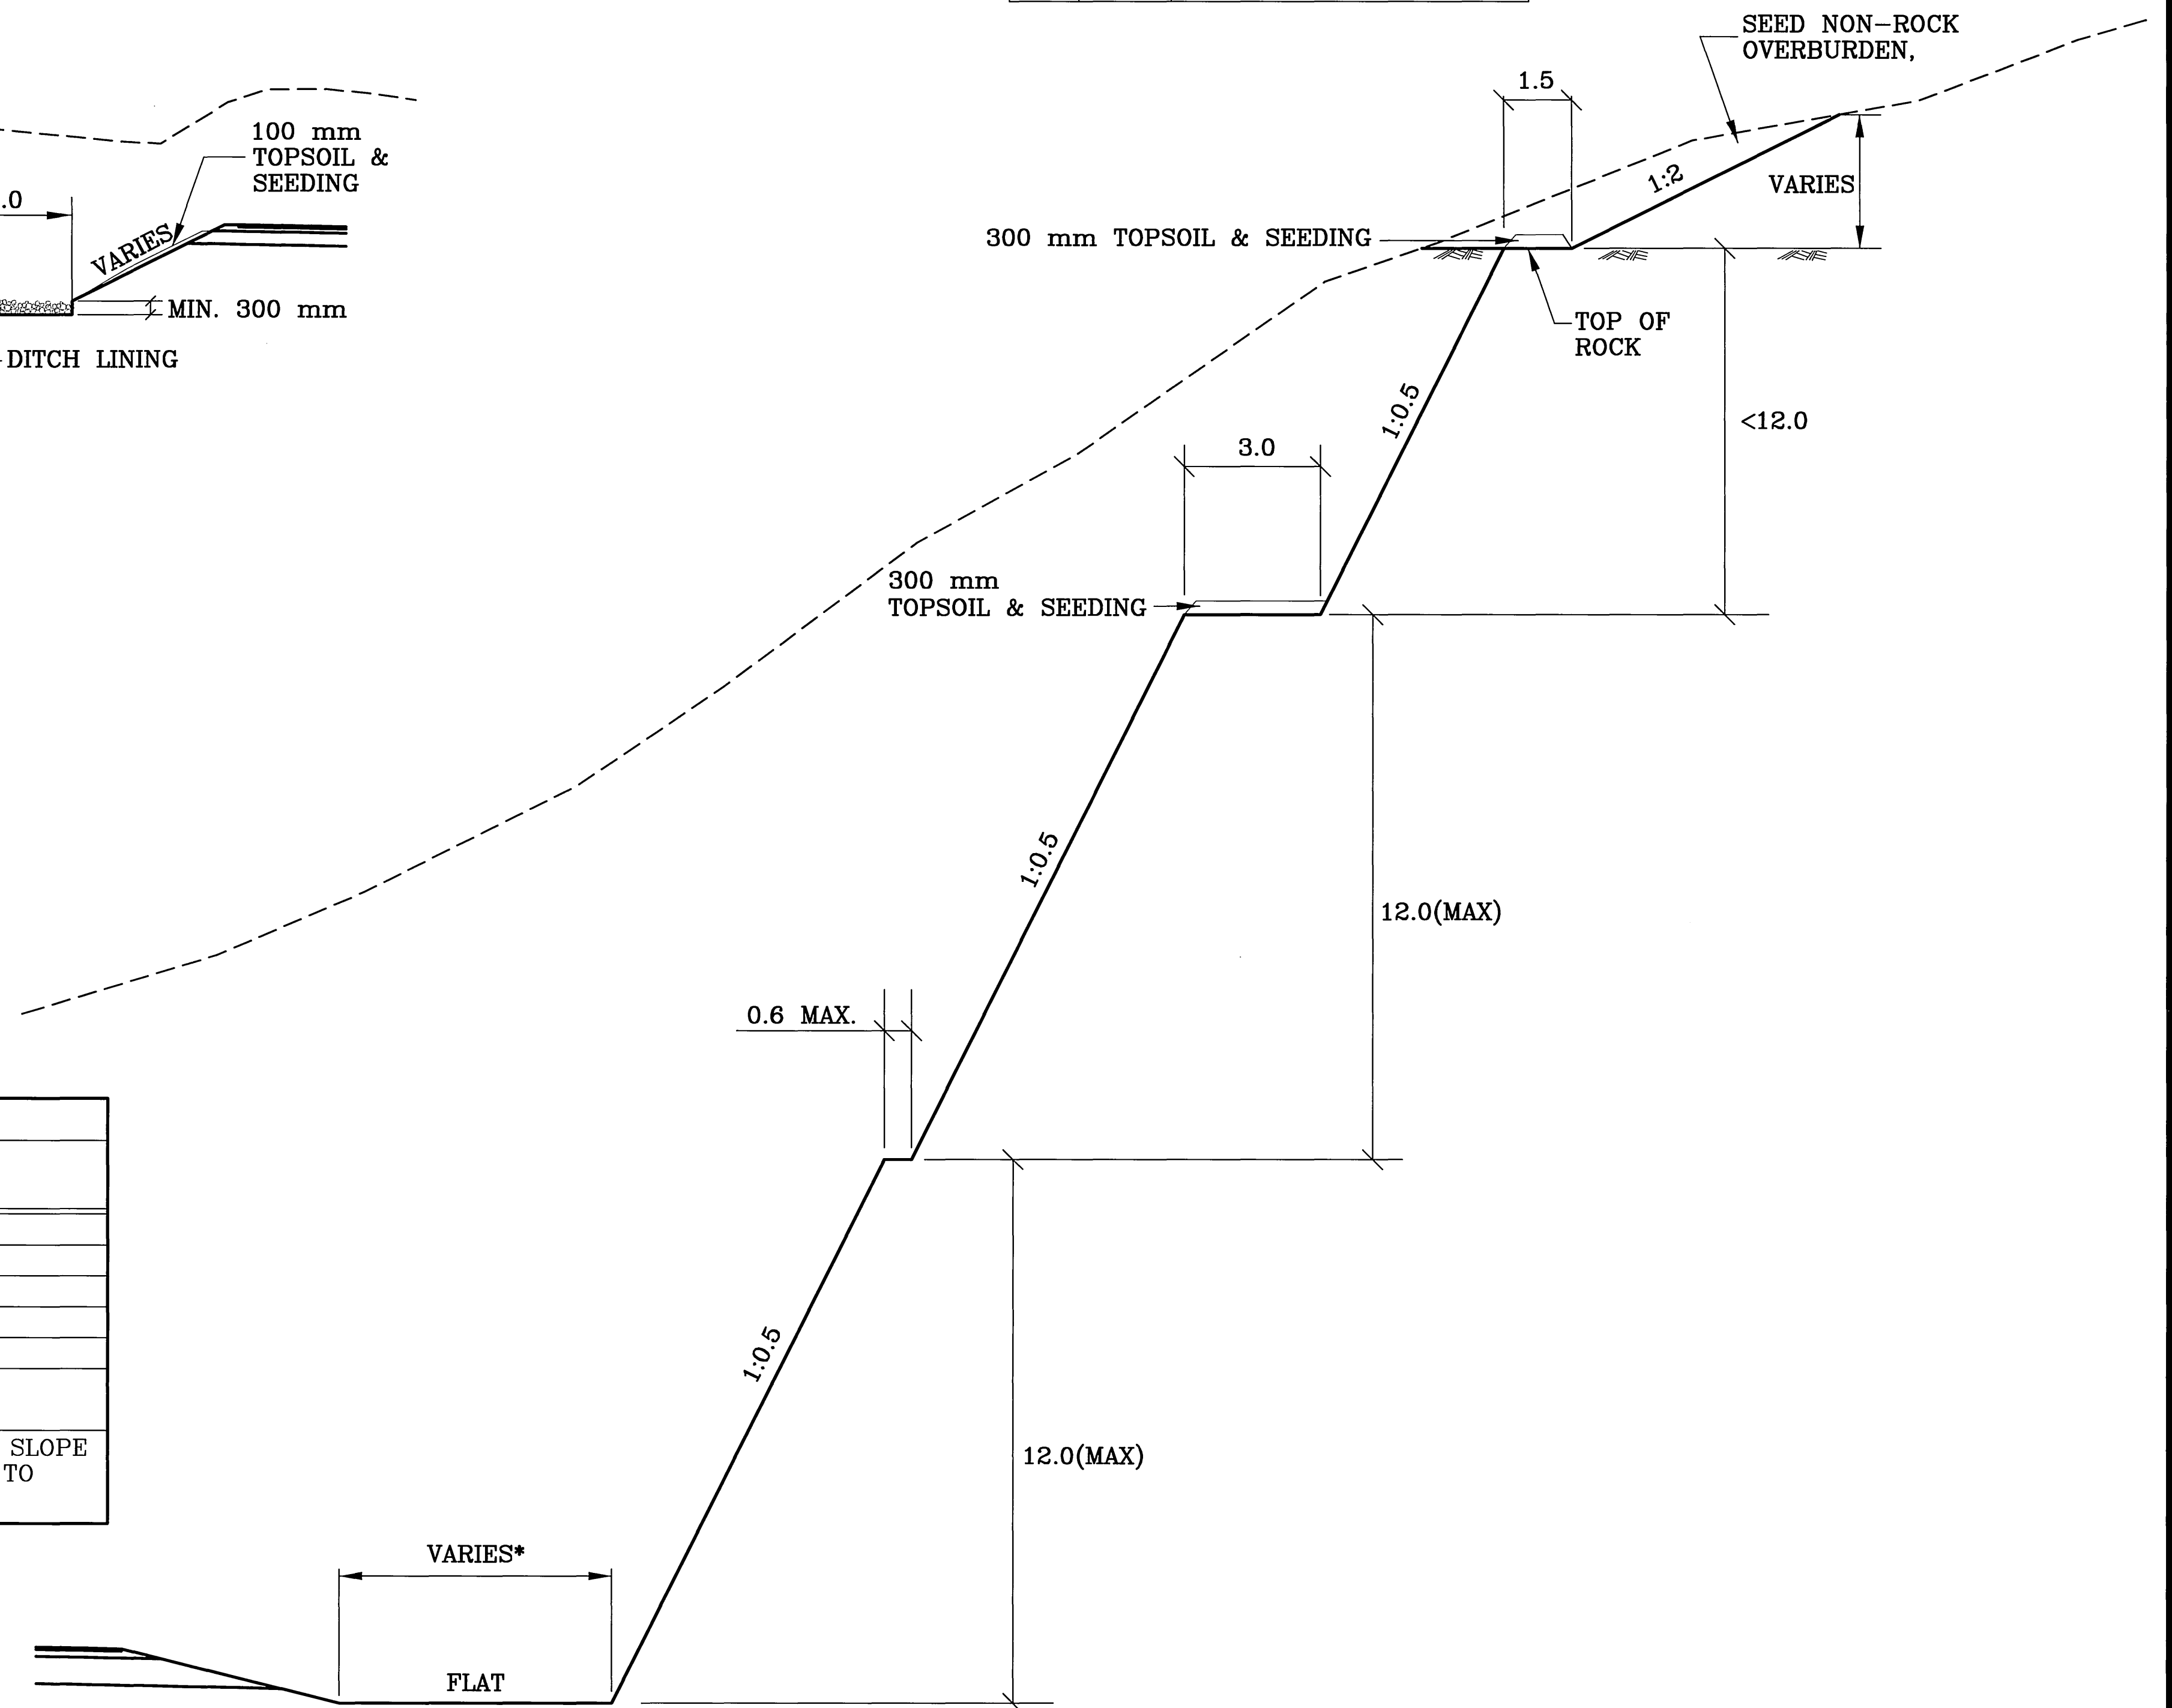

ROCK CUT

* SEE ROCK CUT DITCH TABLE

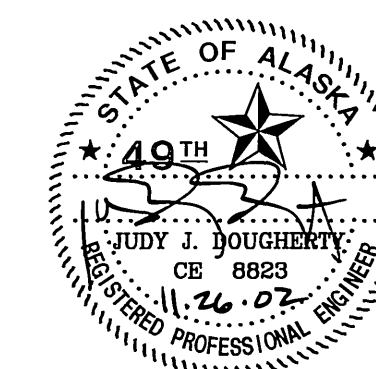


STATE OF ALASKA
DEPARTMENT OF TRANSPORTATION
AND
PUBLIC FACILITIES

**SEWARD HIGHWAY
MP 96 TO MP 102
SAFETY, ROADWAY &
RECREATIONAL IMPROVEMENTS**

TYPICAL SECTIONS

SPECIFICATIONS		DESIGNED BY	
SCALE 1=1		CHECKED BY	
COMPUTER DESIGNATION	VIEW# 3	DRAWN BY	
	AUTOCAD CAROLEE D:/593KPRO/53577/B/ROTP		
			11-20-02


REVISIONS			STATE	PROJECT DESIGNATION	YEAR	SHEET NO.	TOTAL SHEETS
No.	DATE	DESCRIPTION	ALASKA	NH-0A3-1(28)	2002	B7	B7

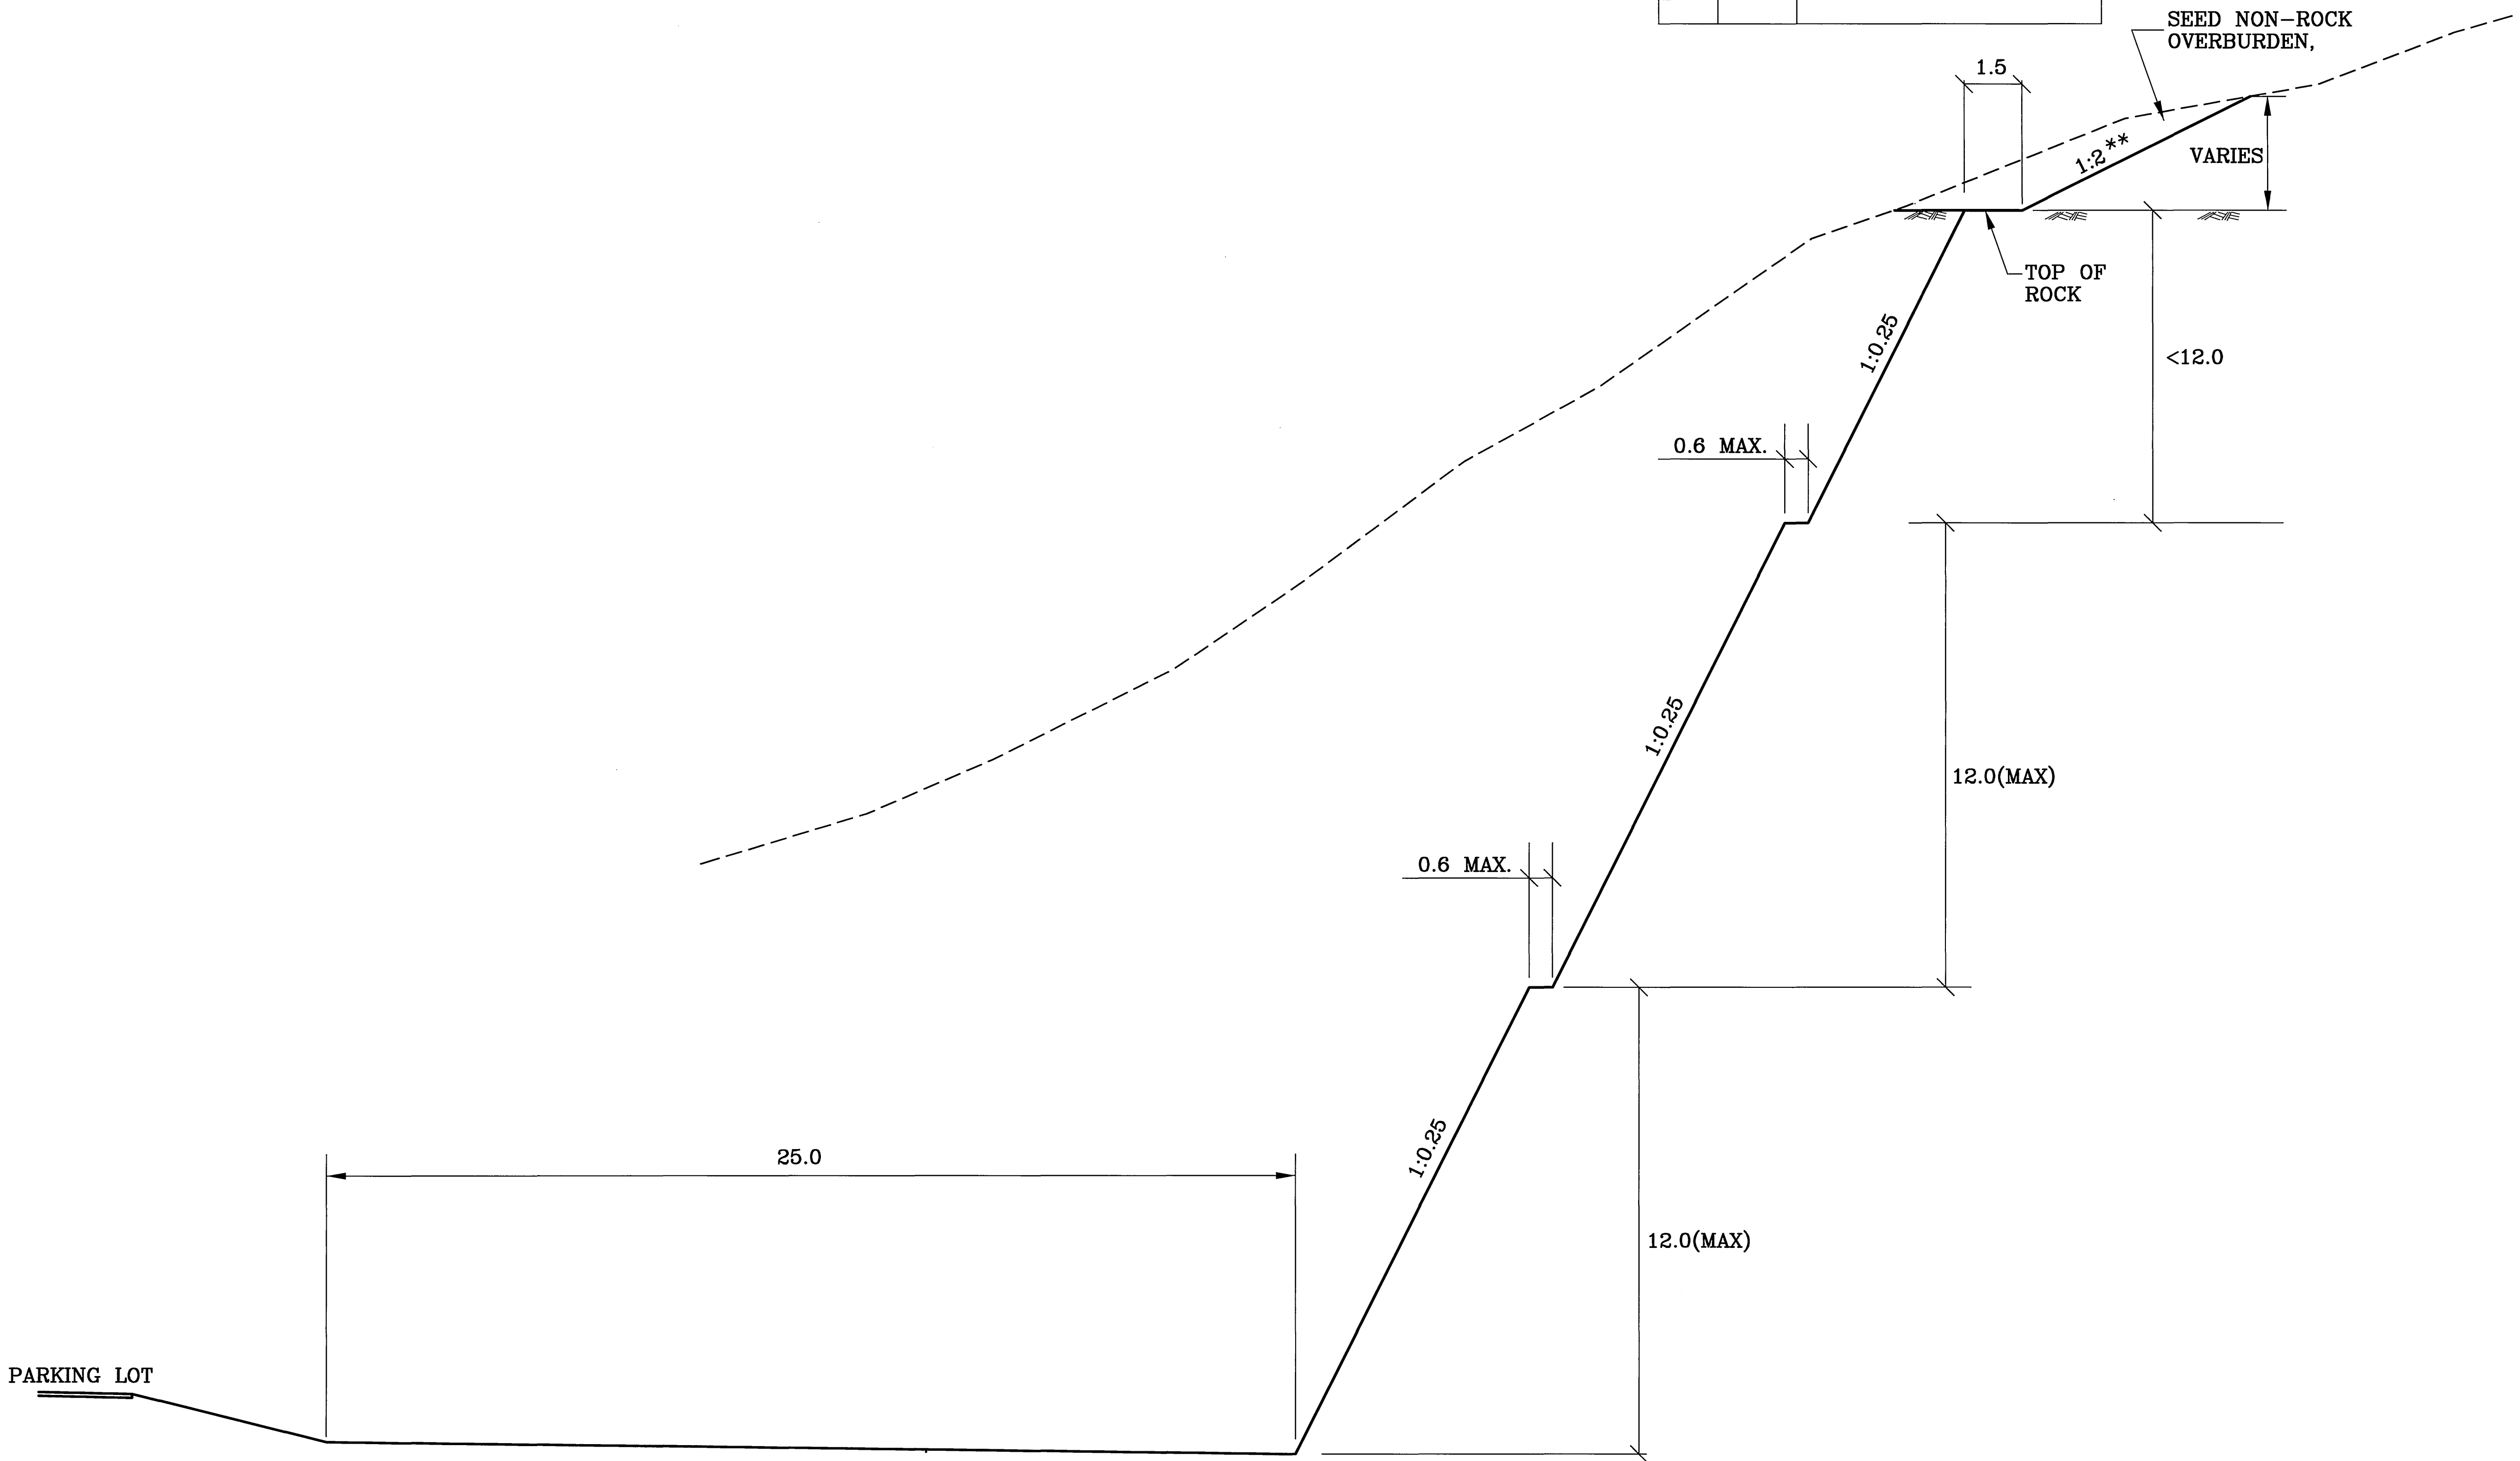

ROCK CUT-PARKING LOT CUT

'PK' 10+090 TO 'PK' 10+259.786 RT.

** OR AS DIRECTED BY THE ENGINEER

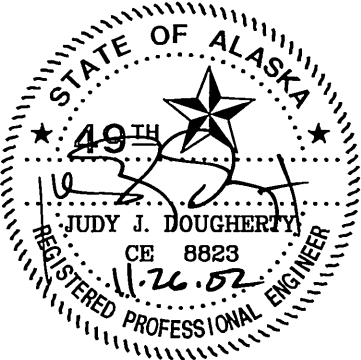

STATE OF ALASKA
DEPARTMENT OF TRANSPORTATION
AND
PUBLIC FACILITIES

**SEWARD HIGHWAY
MP 96 TO MP 102
SAFETY, ROADWAY &
RECREATIONAL IMPROVEMENTS**

TYPICAL SECTIONS

TEMP-CAROLEE-D:\SDS\PROJ\63577\77ESTM.DWG
DESIGNED BY
CHECKED BY
DRAFTED BY
VIEW- 1 of 1
KMH
11-26-02
SPECIFICATIONS
SCALE 1"=1
COMPUTER DESIGNATION
AUTOCAD-KAREN-D:\SDS\PROJ\63577\DATA\77ESTM.DWG

ESTIMATE OF QUANTITIES				
ITEM NO.	ITEM	PAY UNIT	TOTAL QUANTITY	
109(1A)	SEWARD HWY MP 94 ROCK EXCAVATION C.O. #11	L.S.	ALL REQUIRED	
201 (3A)	CLEARING AND GRUBBING	ha	11.541	12.0
201(4)	TUB GRINDING C.O. #11	L.S.	ALL REQUIRED	
202 (1)	REMOVAL OF STRUCTURES AND OBSTRUCTIONS	L.S.	ALL REQUIRED	
202 (2)	REMOVAL OF PAVEMENT	m ²	83,140	74,370
202 (4)	REMOVAL OF CULVERT PIPE	m	70.5	286.6
303(2)	DETOUR BASE COURSE RECONDITION C.O. #2	L.S.	ALL REQUIRED	
203 (6)	UNCLASSIFIED EXCAVATION DELETED BY C.O.#11	m³	1,094,603	
203(12)	DRAIN HOLES	m	119.7	917
241 (1)	RAILROAD BALLAST	Mg	13,515.0	15,120
242 (1)	RAILROAD TRACKWORK	m	3,140	
242 (2)	TRACKWORK REMOVAL	L.S.	ALL REQUIRED	
245 (1)	GRADE CROSSING	L.S.	ALL REQUIRED	
242 (3)	MODIFIED RAILROAD TRACKWORK C.O. #3	L.S.	ALL REQUIRED	
301 (1)	AGGREGATE BASE COURSE	Mg	4,743.3	16,677
306 (1)	ATB	Mg	19,700.7	16,620
401 (1B)	ASPHALT CONCRETE, TYPE II, CLASS B	Mg	16,876.6	3,145
401 (2)	ASPHALT CEMENT, GRADE PG 52-28	Mg	986.52	179
401 (3)	TEMPORARY PAVEMENT	Mg	2,413.0	1,242
401 (6)	ASPHALT PRICE ADJUSTMENT	C.S.	ALL REQUIRED	
301 (1A)	AGGREGATE BASE COURSE, PATHWAY C.O. #7	L.S.	ALL REQUIRED	
402 (1)	STE-1 ASPHALT FOR TACK COAT	Mg	40.42	89
203 (3A)	UNCLASSIFIED EXCAVATION C.O. #11	L.S.	ALL REQUIRED	
203 (13)	CRUSHING CREDIT, SELECT MATERIAL, TYPE A C.O. #8	L.S.	ALL REQUIRED	
407(1)	STONE MASTIC ASPHALT CONCRETE DELETED BY C.O. #7	Mg	16,107	
407(2)	ASPHALT CEMENT, GRADE PG 58-28 DELETED BY C.O. #7	Mg	1,047	
407(4)	ASPHALT PRICE ADJUSTMENT DELETED BY C.O. #7	C.S.	ALL REQUIRED	
306(2)	ASPHALT CEMENT FOR ATB, GRADE PG 52-28 C.O. #8	Mg	91.80	
306(6)	ATB PRICE ADJUSTMENT C.O. #8	C.S.	ALL REQUIRED	
501(1)	CLASS A CONCRETE	L.S.	ALL REQUIRED	
109(3A)	RE- CUT COMMON SLOPES C.O. #11	L.S.	ALL REQUIRED	
504(1)	STRUCTURAL STEEL	L.S.	ALL REQUIRED	
109(5A)	SOIL NAILS & SHOTCRETE AT COMMON GUT C.O. #11	L.S.	ALL REQUIRED	
109(4)	DUAL PASSING LANE MODIFICATIONS C.O. #6	L.S.	ALL REQUIRED	
507 (1)	STEEL BRIDGE RAILING	m	124	
507 (2)	PEDESTRIAN RAILING	m	62	
109(6)	VACUUM GUARDRAIL POST HOLES C.O. #8	L.S.	ALL REQUIRED	
508(1)	WATERPROOFING MEMBRANE	L.S.	ALL REQUIRED	
109(7)	REINSTALL PEDESTRIAN SIGN C.O. #9	L.S.	ALL REQUIRED	
602 (2)	STRUCTURAL PLATE PIPE-ARCH SPAN 4216, RISE 3708, THICKNESS 2.77 mm	m	47	
109(21)	DIFFERING SITE CONDITION, OLD BRIDGE REMOVAL C.O. #7	L.S.	ALL REQUIRED	
109(22)	RAPTOR OBSERVER C.O. #8	L.S.	ALL REQUIRED	
603 (9-1000)	1000 mm CORRUGATED ALUMINUM PIPE	m	194.05	192.5
603 (9-1500)	1500 mm CORRUGATED ALUMINUM PIPE	m	136.2	
603 (11-1000)	END SECTION FOR 1000 mm CORRUGATED ALUMINUM PIPE	EACH	6	
109 (23)	PEDESTRIAN BRIDGE ABUTMENT, SIDEWALK & RIPRAP REPAIRS C.O. #7	L.S.	ALL REQUIRED	
603 (17-450)	450 mm PIPE	m	122.29	55.5
603 (17-600)	600 mm PIPE	m	327.33	192.5
603 (17-900)	900 mm PIPE	m	149.39	84.8
109 (23A)	BRIDGE DECK PATCHES C.O. #9	L.S.	ALL REQUIRED	
603 (20-600)	END SECTION FOR 600 mm PIPE	EACH	42	53
603 (20-900)	END SECTION FOR 900 mm PIPE	EACH	12	11
109(24)	LITTLE PENGUIN CREEK PARKING LOT C.O. #10	L.S.	ALL REQUIRED	
109(25)	INTERPRETIVE KIOSK PAD PAVING C.O. #10	L.S.	ALL REQUIRED	

REVISIONS			STATE	PROJECT DESIGNATION	YEAR	SHEET NO.	TOTAL SHEETS
No.	DATE	DESCRIPTION	ALASKA	NH-0A3-1(28)	2002	C1	C2

ESTIMATE OF QUANTITIES			
ITEM NO.	ITEM	PAY UNIT	TOTAL QUANTITY
603(17-900A)	SPECIAL 900mm PIPE C.O. #7	L.S.	ALL REQUIRED
604 (5)	INLET, TYPE A	EACH	2
604(5A)	MODIFIED TYPE II MANHOLE C.O. #9	L.S.	ALL REQUIRED
606(20)	W-BEAM GUARDRAIL W/EXISTING WOOD POSTS C.O. #9	m	139.0
606 (1)	W-BEAM GUARDRAIL	m	2,162.7 3,060.1
606 (6)	REMOVING AND DISPOSING OF GUARDRAIL	m	1,685.0 3,672
606 (11)	EXTRUDER TERMINAL (ET-2000)	EACH	21 22
606 (12)	GUARDRAIL/BRIDGE RAIL CONNECTION	EACH	4
607(3)	CHAINLINK FENCE C.O. #10	m	567.0
607(9)	PATHWAY BOLLARD POSTS C.O. #10	EACH	11
615 (4A)	ADDITIONAL RIGID DELINEATORS C.O. #10	L.S.	ALL REQUIRED
608 (7)	ASPHALT PATHWAY	Mg	2,910.6 2,576
618 (5)	ADDED WILDFLOWERS C.O. #9	Kg	102.14
610 (2)	DITCH LINING	Mg	805.5 1,800
611 (2)	RIPRAP, CLASS I	Mg	47.6 450
611 (2A)	RIPRAP, CLASS II	Mg	80,621 51,932
611 (2B)	RIPRAP, R750	Mg	66,066 94,842
630(1)	GEOTEXTILE, SEPARATION C.O. #10	m ²	3,666
615 (1)	STANDARD SIGN	m ²	73.36 57.8
615 (2)	REMOVE AND RELOCATE EXISTING SIGN	EACH	10 12
615 (4)	DELINEATOR, RIGID	EACH	165 202
642(13)	PROVIDE CROSS SECTIONS & QUANTITY CALCULATIONS C.O. #2	L.S.	ALL REQUIRED
680(10A)	FURNISH & INSTALL SINGLE INNERDUCT, PLOWED C.O. #4	m	2,912.82
618 (2)	SEEDING	kg	1,203.29 725
618 (3)	WATER FOR SEEDING	kL	23,251 6,955
680(6C)	MODIFICATIONS TO GCI VAULT #1 C.O. #5	L.S.	ALL REQUIRED
620 (1)	TOPSOIL	m ²	201,791 144,050
680(11A)	FURNISH & INSTALL TWO INNERDUCT, PLOWED C.O. #2	m	1,980.37
621 (1A)	TREE, WHITE SPRUCE	EACH	58 40
621 (2J)	SHRUB, PRICKLY ROSE	EACH	69 84
680(12A)	FURNISH & INSTALL THREE INNERDUCTS C.O. #4	m	410.60
623 (5)	VEGETATED MATS, INSTALLED	m ²	162.0 157
623 (6)	WETLAND SOD BLOCK, INSTALLED	m ²	107.2 106
631 (2)	GEOTEXTILE, EROSION CONTROL, CLASS I	m ²	0 647
680 (20)	ALASKA FIBER STAR CABLE PULLING ASSISTANCE C.O. #8	L.S.	ALL REQUIRED
639 (6)	APPROACH	EACH	27 26
640 (1)	MOBILIZATION AND DEMOBILIZATION	L.S.	ALL REQUIRED
109(2A)	CUT #6 SLIDE REPAIR, MATERIAL HAUL OFF, TRUCKS S.A. #1	CMVM	18,010



STATE OF ALASKA
DEPARTMENT OF TRANSPORTATION
AND
PUBLIC FACILITIES
**SEWARD HIGHWAY
MP 96 TO MP 102
SAFETY, ROADWAY &
RECREATIONAL IMPROVEMENTS**

ESTIMATE OF QUANTITIES

TEMP-CAROLEE-D\305KPROJ\3597\7TESTM.DWG

DESIGNED BY
CHECKED BY
DRAFTED BY

VIEW- 1 of 1

11-26-02

10/4

SPECIFICATIONS
SCALE 1"=1'

COMPUTER DESIGNATION


AUTOCAD-KAREN-H-D\305KPROJ\3597\DATA\7785TM.DWG

ESTIMATE OF QUANTITIES			
ITEM NO.	ITEM	PAY UNIT	TOTAL QUANTITY
641 (1)	EROSION AND POLLUTION CONTROL ADMINISTRATION	L.S.	ALL REQUIRED
641 (2)	TEMPORARY EROSION AND POLLUTION CONTROL	C.S.	ALL REQUIRED
641 (5)	SILT FENCE	m	1,711.19 886
641 (6)	STRAW BALE	m	151.92 63
642 (1)	CONSTRUCTION SURVEYING	L.S.	ALL REQUIRED
642 (3)	THREE PERSON SURVEY PARTY	HOURL	102.71 60
642 (4)	SET PRIMARY MONUMENT	EACH	22 17
642 (8)	ADJUST EXISTING MONUMENT	EACH	0 29
642 (9)	REFERENCE EXISTING MONUMENT	EACH	35 20
642 (10)	MONUMENT CASE	EACH	27 20
642 (12)	FINAL TRAVERSE	L.S.	ALL REQUIRED
642 (17)	SUPPLY AND SET RAILROAD CURVE TAB	L.S.	ALL REQUIRED
643 (2)	TRAFFIC MAINTENANCE	L.S.	ALL REQUIRED
643 (3)	PERMANENT CONSTRUCTION SIGNS	L.S.	ALL REQUIRED
643 (15)	FLAGGING	C.S.	ALL REQUIRED
643 (23)	TRAFFIC PRICE ADJUSTMENT	C.S.	ALL REQUIRED
643 (25)	TRAFFIC CONTROL	C.S.	ALL REQUIRED
644 (1)	FIELD OFFICE	L.S.	ALL REQUIRED
644 (2)	FIELD LABORATORY DELETED BY C.O. #1	L.S.	ALL REQUIRED
645 (1)	TRAINING PROGRAM, 3 TRAINEES/APPRENTICES	L.H.	3,679 1,500
646 (1)	CPM SCHEDULING	L.S.	ALL REQUIRED
647 (1)	WIDE PAD DOZER, 48 KW MINIMUM	C.S.	ALL REQUIRED
650 (8)	SINGLE ENTRANCE GATE	EACH	3
650 (8A)	RELOCATE SINGLE ENTRANCE GATE	EACH	1
650 (9)	DOUBLE ENTRANCE GATE	EACH	6 4
650 (17)	CONCRETE PARKING BUMPER	EACH	78
650 (18)	PARKING BUMPER	EACH	24
650 (21)	BARRIER ROCK	EACH	507 285
650 (30B)	INTERPRETIVE KIOSK, TYPE B	EACH	1
650 (38)	ENTRANCE SIGN	EACH	1
650 (45)	DOUBLE TOILET SCREEN	EACH	2
660 (12)	UNDERPASS LIGHTING SYSTEM COMPLETE	L.S.	ALL REQUIRED
661 (3)	LOAD CENTER, TYPE 2	EACH	1
670 (10B)	METHYL METHACRYLATE PAVEMENT MARKINGS	LITER	8,204.4 8,172
680(6)	FURNISH AND INSTALL TELEPHONE HANDHOLE AND/OR VAULT	EACH	14
680(6A)	FURNISH TELEPHONE HANDHOLE	EACH	1

REVISIONS			STATE	PROJECT DESIGNATION	YEAR	SHEET NO.	TOTAL SHEETS
No.	DATE	DESCRIPTION	ALASKA	NH-0A3-1(28)	2002	C2	C2

ESTIMATE OF QUANTITIES			
ITEM NO.	ITEM	PAY UNIT	TOTAL QUANTITY
680(6B)	INSTALL TELEPHONE VAULT	EACH	4 5
680(9)	TELEPHONE SYSTEM AS-BUILTS	L.S.	ALL REQUIRED
680(10)	FURNISH AND INSTALL SINGLE INNERDUCT	m	35.0 3,461
680(11)	FURNISH AND INSTALL TWO INNERDUCTS	m	2,450.63 4,830
680(12)	INSTALL THREE INNERDUCTS	m	61.70 58.58
680(13)	FURNISH TWO AND INSTALL FIVE INNERDUCTS	m	2,551.50 3564.6
680(14)	INSTALL TWO CONDUITS	m	11.25 12
680(15)	INSTALL 2 CONDUITS, 3 INNERDUCTS, FURNISH AND INSTALL 2 INNERDUCTS	m	0 45
680(16)	INSTALL 2 CONDUITS AND 3 INNERDUCTS CONCRETE ENCASED	m	900.69 902.18
680(17)	INSTALL FIBER OPTIC CABLE	m	3,366.2 3496.1

TABLE OF ESTIMATING FACTORS		
ITEM NO.	ITEM DESCRIPTION	ESTIMATING FACTOR
241(1)	RAILROAD BALLAST	2.371 Mg/m
301(1)	AGGREGATE BASE COURSE	2.371 Mg/m ³
306(1)	ATB	2.40 Mg/m ³
401(1B)	ASPHALT CONCRETE, TYPE II, CLASS B	2.43 Mg/m ³
401(2)	ASPHALT CEMENT PG 52-28	5.5% of Total Weight of 401(1B)
401(3)	TEMPORARY ASPHALT	2.43 Mg/m ³
402(1)	STE-1 ASPHALT FOR TACK COAT	0.000343 Mg/m ²
407(1)	STONE MASTIC ASPHALT CONCRETE	2.40 Mg/m ³
407(2)	ASPHALT CEMENT, GRADE PG 58-28	6.5% of Total Weight of 407(1)
608(7)	ASPHALT PATHWAY	2.430 Mg/m ³
610(2)	DITCH LINING	1.72 Mg/m ³
611(2)	RIPRAP, CLASS I	1.72 Mg/m ³
611(2A)	RIPRAP, CLASS II	1.72 Mg/m ³
611(2B)	RIPRAP, R750	1.72 Mg/m ³
618(2)	SEEDING	50 kg/ha ³
618(3)	WATER FOR SEEDING	8.345 kl water/kg seed

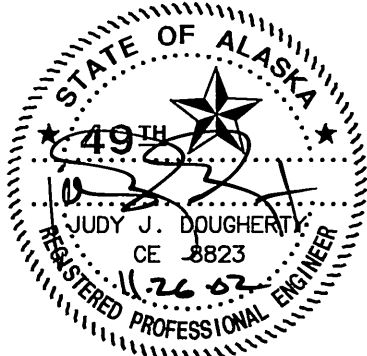


STATE OF ALASKA
DEPARTMENT OF TRANSPORTATION
AND
PUBLIC FACILITIES
**SEWARD HIGHWAY
MP 96 TO MP 102
SAFETY, ROADWAY &
RECREATIONAL IMPROVEMENTS**

ESTIMATE OF QUANTITIES

EARTHWORK SUMMARY								REVISIONS			STATE	PROJECT DESIGNATION	YEAR	SHEET NO.	TOTAL SHEETS
								No.	DATE	DESCRIPTION	ALASKA	NH-0A3-1(28)	2002	D1	D9
SHEET	STATION TO STATION	ESTIMATED EXCAVATION						ESTIMATED EMBANKMENT							
		COMMON EXCAVATION (UNUSEABLE) CM	COMMON EXCAVATION (USEABLE) CM	ROCK EXCAVATION CM	203(3) UNCLASSIFIED EXCAVATION CM	*SHRUNK COMMON EXCAVATION (USEABLE) CM	**SWELLED ROCK EXCAVATION CM	241(1) RAILROAD BALLAST CM	***SHOT ROCK CM	611(2) RIPRAP, CLASS I CM	611(2A) RIPRAP, CLASS II CM	611(2B) RIPRAP, R750 CM	SELECTED MATERIAL, TYPE C CM	SELECTED MATERIAL, TYPE A CM	TOTAL EMBANKMENT CM
F1	37+100 TO 37+280	170	2,962		3,132	2,665									
F2	37+280 TO 37+580	443	5,212		5,655	4,691									
F3	37+580 TO 37+880	846	5,554	6,172	12,572	4,999	6,789							1,078	1,078
F4	37+880 TO 38+180	1,628	5,700	5,968	13,296	5,130	6,565							2,930	2,930
F5	38+180 TO 38+480	416	932	576	1,924	839	634						4,976	5,544	10,520
F6	38+480 TO 38+790												17,838	6,336	24,174
F7	38+790 TO 39+100		574		574	517							12,983	6,336	19,319
F8	39+100 TO 39+400		2,636		2,636	2,372							7,946	5,544	13,490
F9	39+400 TO 39+700	974	2,550		3,524	2,295							7,544	6,336	13,880
F10	39+700 TO 40+000	686	2,360		3,046	2,124							6,716	5,544	12,260
F11	40+000 TO 40+300	968	1,936		2,904	1,742							9,546	6,142	15,688
F12	40+300 TO 40+600		820		820	738							20,049	4,485	24,534
F13	40+600 TO 40+905.6		4,546		4,546	4,091								984	984
FP1 TO FP7	'P' 60+000 TO 'P' 62+040	4,918			4,918								11,567	3,564	15,131
FP7 TO FP8	'P' 62+040 TO 'P' 62+296(BK)			20,437	20,437		22,481						43	371	414
FP8 TO FP9	'P' 62+589(AD) TO 'P' 62+800			2,215	2,215		2,437						4,909	412	5,321
FP9 TO FP11	'P' 62+800 TO 'P'63+460	5,023	28,468		33,491	25,621							20,237	1,330	21,567
FP11 TO FP12	'P' 63+460 TO 'P' 63+880	24			24								3,292	805	4,097
FP12 TO FP14	'P' 63+880 TO 'P' 64+240	2,720	15,414		18,134	13,873							117	494	611
FP14 TO FP18	'P' 64+240 TO 'P' 65+575	2,217			2,217								6,358	1,867	8,225
FR1	R' 2+000 TO 'R' 2+240	162			162			487	12,231		1,767	1,865			16,350
FR2	R' 2+240 TO 'R' 2+540							609	42,211		3,029	2,354			48,203
FR3	R' 2+540 TO 'R' 2+840							609	62,128		3,045	3,734			69,516
UNCLASSIFIED EXCAVATION = COMMON EXCAVATION (UNUSEABLE) + COMMON EXCAVATION (USEABLE) + ROCK EXCAVATION															
* ESTIMATED SHRUNK COMMON EXCAVATION (USEABLE) = 0.90 X COMMON EXCAVATION(USEABLE)															
** SWELLED ROCK EXCAVATION = 1.10 X ROCK EXCAVATION															
*** SHOT ROCK EMBANKMENT = 1.15 X NEAT LINE VOLUME OF SHOT ROCK															
TOTAL EMBANKMENT = RAILROAD BALLAST + SHOT ROCK + RIPRAP, CLASS I + RIPRAP, CLASS II + RIPRAP, R750 + SELECTED MATERIAL, TYPE C + SELECTED MATERIAL, TYPE A															
											STATE OF ALASKA 4982 1982 JUDY J. DOUGHERTY CE 8823 REGISTERED PROFESSIONAL ENGINEER				
											STATE OF ALASKA DEPARTMENT OF TRANSPORTATION AND PUBLIC FACILITIES SEWARD HIGHWAY MP 96 TO MP 102 SAFETY, ROADWAY & RECREATIONAL IMPROVEMENTS SUMMARY TABLES				

REVISIONS			STATE	PROJECT DESIGNATION	YEAR	SHEET NO.	TOTAL SHEETS
No.	DATE	DESCRIPTION	ALASKA	NH-0A3-1(28)	2002	D2	D9

SPECIFICATIONS		DESIGNED BY
SCALE	DATE	CHECKED BY
		DRAWN BY
		DATED BY
TEMP-CARLEE-D:\DISKPROJ\5357\775M.DWG		W/EN= D2
		AUTOCAD-KAREN-D:\DISKPROJ\5357\DATA\775M.DWG
		COMPUTER DESIGNATION
		6/12/02
		11-21-02

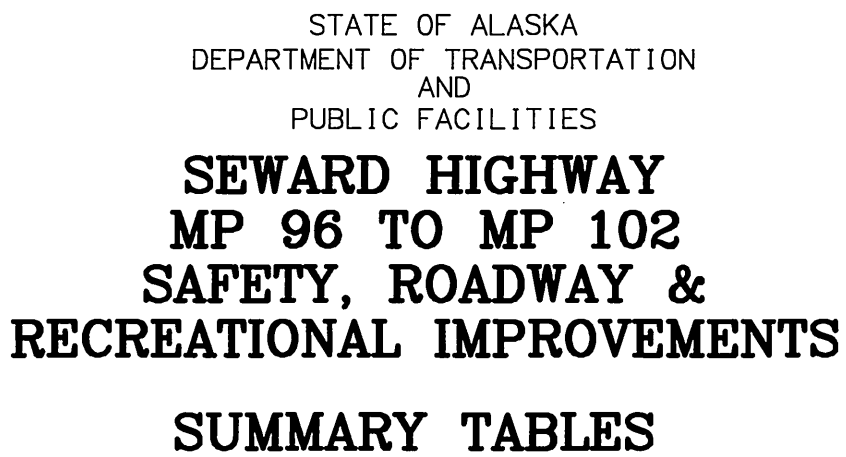

														REVISIONS			STATE	PROJECT DESIGNATION	YEAR	SHEET NO.	TOTAL SHEETS
														No.	DATE	DESCRIPTION	ALASKA	NH-0A3-1(28)	2002	D3	D9

														REVISIONS			STATE	PROJECT DESIGNATION	YEAR	SHEET NO.	TOTAL SHEETS
														No.	DATE	DESCRIPTION	ALASKA	NH-0A3-1(28)	2002	D4	D9
PIPE INSTALLATION SUMMARY																					
SHEET	STATION	OFFSET	202(4) REMOVAL LENGTH	SKEW	602(2) STRUCTURAL PLATE PIPE ARCH (m)	603(17-450) 450mm PIPE (m)	603(17-600) 600mm PIPE (m)	603(17-900) 900mm PIPE (m)	603(9-1000) 1000mm CAP (m)	603(9-1500) 1500mm CAP (m)	603(20-600) END SECTION FOR 600mm PIPE(EACH)	603(20-900) END SECTION FOR 900mm PIPE(EACH)	603(11-1000) END SECTION FOR 1000mm CAP(EACH)	INLET ELEVATION	INLET OFFSET	OUTLET OFFSET	OUTLET ELEVATION	% GRADE	REMARKS		
FP6	'P' 61+642.0	C.L.		22° LT.			15.027-3				2			17.8516.49	5.4 RT.	1.9 LT.	17.4914.35	5.0014.3	RIPRAP OUTLET END		
FP6	'P' 61+649.0	C.L.	+644.5	25° LT.			18.5 9-0				2			17.4529	5.7 RT.	3.3 LT.	17.0014.59	5.0014.6	RIPRAP OUTLET END		
	'P' 61+783.0	C.L.					13.4				2			23.44			22.76				
FP7	'P' 61+887.5	C.L.		37° RT.				2 2.9834.6				2		21.30	5.1 RT.	1.5 LT.	20.97	4.4 5.00	RIPRAP INLET & OUTLET ENDS		
FP7	'P' 61+926.0	C.L.					5.8 0				2 0			20.78	4.2 RT.	1.6 LT.	20.49	5.00	RIPRAP OUTLET END DELETED		
FP7	'P' 61+949.0	C.L.	+936.0				21.9 5-8				2			20.58	4.2 RT.	1.6 LT.	20.29	5.00	RIPRAP INLET & OUTLET ENDS		
FP7	'P' 61+968.0	C.L.						19.2 7-8				2		19.18	5.0 RT.	2.8 LT.	18.79	5.00	RIPRAP OUTLET END		
FP7	'P' 61+974.0	C.L.						6.0				2		19.28	4.2 RT.	1.8 LT.	18.98	5.00	RIPRAP OUTLET END		
FP7	'P' 61+988.5	C.L.						6.2				2		19.00	4.2 RT.	2.0 LT.	18.69	5.00	RIPRAP OUTLET END		
	'P' 62+116.0	C.L.				8.1															
FP10	'P' 63+282.0	C.L.	+294.0				8-0	15.60			2	2		7.12	2.2 LT.	5.8 RT.	6.96	2.00			
FP13	'P' 64+094.0	C.L.	+088.0				14.4 6-5				2			6.94	1.6 LT.	4.9 RT.	6.81	2.00			
	'P' 62+808.0	LT. / RT.				17.22 LT.	16.76 RT.				2										
FP15	'P' 64+680.0	C.L.					6.0				2			8.40	1.2 LT.	4.8 RT.	8.34	1.00			
FP16	'P' 64+760.0	C.L.					5.5				2			8.91	4.2 RT.	1.3 LT.	8.76	2.72			
	'P' 62+634.0	C.L.				7.0															
	984.0																				
FP16	'P' 64+085.0	C.L.	9.3				9.0 6-0				2			7.65	4.2 RT.	1.8 LT.	7.54	2.00			
	'P' 65+087.8	C.L.				13.10															
FP17	'P' 65+094.0	C.L.	13.5																		
FP17	'P' 65+158.0	C.L.	12.3				12.4				2			6.08	7.4 RT.	5.0 LT.	5.83	2.00			
FP17	'P' 65+277.0	C.L.	12.2				10.0	8.2			2	2		6.75	5.6 RT.	2.6 LT.	6.59	2.00			
	'P' 65+378.4	C.L.				11.57															
	'P' 65+456.0	C.L.					10.0				2								ADDED		
FR8	'R' 4+300.0	C.L.							21.6				1	5.20	8.0 RT.	13.1 LT.	4.77	2.00	PERCHED PIPE, END SECTION ON INLET, SEE NOTE 4		
FR9	'R' 4+435.0	C.L.							21.6				1	5.20	8.0 RT.	13.1 LT.	4.77	2.00	PERCHED PIPE, END SECTION ON INLET, SEE NOTE 4		
FR9	'R' 4+568.0	C.L.							21.6 5				1	5.20	8.0 RT.	13.1 LT.	4.77	2.00	PERCHED PIPE, END SECTION ON INLET, SEE NOTE 4		
FR9	'R' 4+635.0	C.L.							21.6 45				1	5.20	8.0 RT.	13.1 LT.	4.77	2.00	PERCHED PIPE, END SECTION ON INLET, SEE NOTE 4		
FR10	'R' 4+754.0	C.L.							21.6 5				1	5.20	8.0 RT.	13.1 LT.	4.77	2.00	PERCHED PIPE, END SECTION ON INLET, SEE NOTE 4		
	588.0																				
FCR1	44+599.0	RT.		9°13'11"LT.		11.0 9-8								8.65	5.7 RT.	15.5 RT.	8.56	0.92	CONNECT PIPE INLET TO TYPE 'A' INLET BOX		
FCR1	44+598.0	LT.				7.0 4-8								8.65	5.7 LT.	11.1 LT.	8.62	0.50	CONNECT PIPE INLET TO TYPE 'A' INLET BOX		
	588.0																				
FPR1	'PR' 5+155.0	C.L.				7.01 4-7								17.39	3.6 LT.	1.1 RT.	17.22	3.62			
FPR1	'PR' 5+185.8	C.L.		43°45'36"RT.		0 7-5								17.50	1.7 LT.	3.6 RT.	17.65	2.03			
FPL1	'PL' 4+099.3	C.L.	17.1	50°20'24"LT.		15.1 15-4								14.93	5.6 RT.	19.8 LT.	14.64	1.88			
	'PL' 4+980	C.L.				5.03															
FPK1	'PK' 10+094.0	C.L.				18.9								20.03	6.5 LT.	6.8 RT.	19.50	3.98			
+015.0						20.16															

DESIGNED BY
CHECKED BY
DRAWN BY

11-14-02

VIEW# 04

AUTOCAD-DRAWN-D:\SUBAREA\58377\DATA\72501.DWG


SPECIFICATIONS
SCALE 1"=100'
COMPUTER DESIGNATION

STATE OF ALASKA
DEPARTMENT OF TRANSPORTATION
AND
PUBLIC FACILITIES

497
JUDY J. DOUGHERTY
CE 8823
11.26.02
REGISTERED PROFESSIONAL ENGINEER

SEWARD HIGHWAY
MP 96 TO MP 102
SAFETY, ROADWAY &
RECREATIONAL IMPROVEMENTS

SUMMARY TABLES

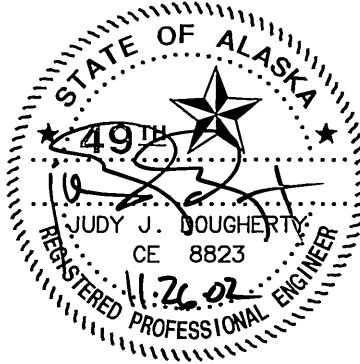

STATE OF ALASKA
DEPARTMENT OF TRANSPORTATION
AND
PUBLIC FACILITIES

SEWARD HIGHWAY
MP 96 TO MP 102
SAFETY, ROADWAY &
RECREATIONAL IMPROVEMENTS

SUMMARY TABLES

TEMP-CARLEE-D:\505KPROJ\35377\75JUL.DWG

DESIGNED BY
CHECKED BY
DRAFTED BY

VIEW= D5

SPECIFICATIONS
SCALE 1=1
COMPUTER DESIGNATION

11-14-02

6/12/02


AUTOCAD-KAREN-D:\505KPROJ\35377\DATA\75JUL.DWG

202(1)		
REMOVAL OF STRUCTURES & OBSTRUCTIONS		
SHEET	REMOVAL ITEM	REMARKS
F13	ARTILLERY GUN MOUNT	
FCR1	CHAIN LINK FENCE	
FCR1	CONCRETE SLAB	
FCR1	BRIDGE RAILING	BRIDGE NO. 643
FCR1	PEDESTRIAN RAILING	BRIDGE NO. 643
FCR2	ELECTRICAL UNIT FOR PEDESTRIAN SIGN	

604(5)						
INLET SUMMARY						
SHEET	STRUCTURE	STATION	OFFSET	TYPE	TYPE OF CASTING	TOP OF CASTING ELEVATION
		588				
FCR1	S-1	44+ 603.000	5.7 RT.	TYPE A	GUTTER INLET	9+ 8 45
FCR1	S-2	44+ 603.000	5.7 LT.	TYPE A	GUTTER INLET	9+ 8 40
		588				

GUARDRAIL SUMMARY								
SHEET	STATION TO STATION		OFFSET	606(1) W-BEAM GUARDRAIL (m)	606(6) REMOVING AND DISPOSING OF GUARDRAIL (m)	606(11) EXTRUDER TERMINAL (ET-2000) EACH	606(12) GUARDRAIL / BRIDGE RAIL CONNECTION EACH	REMARKS
	274.60	664.10		389.5				
F11-F13	40+264.04	TO 40+677.14	LT.	420.0		2		SEE GUARDRAIL DETAIL-LONG SPAN W-BEAM GUARDRAIL
	376.30	574.42		198.12				
F12	40+859.42	TO 40+686.86	RT.	834.1		2		SEE GUARDRAIL DETAIL-LONG SPAN W-BEAM GUARDRAIL
F12	40+448.20	TO 40+515.00	RT.		67.0			
	41+265.00	TO 41+272.62		7.62				
F12-F13	40+515.00	TO 40+635.00	LT.		120.0	1		
	882.90	050.50						
F01	40+873.38	TO 41+063.38	LT.	167.2 64	190	2		
F01-F02	41+846.57	TO 41+546.77	LT.	279.1	300	2		
	256.90	535.00		278.12				
F02-F03	41+751.97	TO 42+006.57	LT.	331.8	255	2		
	764.00	41+996.40		232.4				
F03	42+220.61	TO 42+298.61	LT.	53.2 34	76	2		
	232.16	285.50						
F04-F05	42+998.93	TO 43+165.59	LT.	144.4 78	167	2		
	43+010.20	155.0						
F04-F05	43+100.87	TO 43+188.27	RT.	64.6 76	87	2		
	112.00	176.76						
F06-F07	44+260.91	TO 44+650.87	RT.	830.8	352	1	1	SEE GUARDRAIL DETAIL-RUB RAIL DETAIL
	262.0	647.06		346.31				
F07	44+378.45	TO 44+650.87	LT.	212.8	234	1	1	SEE GUARDRAIL DETAIL-RUB RAIL DETAIL
	391.15	647.06		217.17				
FCR1	44+712.69	TO 44+768.99	RT.	34.29	61	1	1	
	718.39	752.69						
FCR1-FCR2	44+712.60	TO 44+874.10	LT.	144.4 78	95	1	1	SEE GUARDRAIL DETAIL
	716.50	861.28						
FDET1 FDET2	'DET' 3+000.00 TO 'DET' 3+786.60		RT.	775.2	775.2	1		TEMPORARY GUARDRAIL FOR DETOUR ROUTE
FDET1 FDET2	'DET' 3+000.00 TO 'DET' 3+881.60		LT.	870.2	870.2	1		TEMPORARY GUARDRAIL FOR DETOUR ROUTE
	41+478	TO 41+493.34		15.34				
	41+880	TO 41+887.62		7.62				

REVISIONS			STATE	PROJECT DESIGNATION	YEAR	SHEET NO.	TOTAL SHEETS
No.	DATE	DESCRIPTION	ALASKA	NH-0A3-1(28)	2002	D5	D9

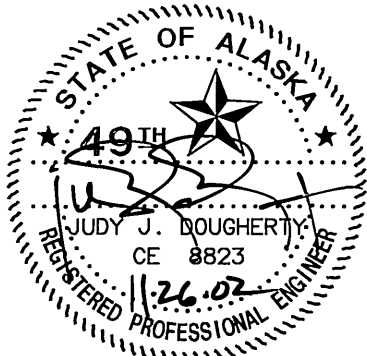

STATE OF ALASKA
DEPARTMENT OF TRANSPORTATION
AND
PUBLIC FACILITIES

**SEWARD HIGHWAY
MP 96 TO MP 102
SAFETY, ROADWAY &
RECREATIONAL IMPROVEMENTS**

SUMMARY TABLES

TEMP-CARLEE-D:\SOSKPRO\53571\77SUM.DWG

DESIGNED BY
CHECKED BY
DRAFTED BY

11-14-02

3/6/02

VIEW= D6

AUTOCAD-KAREN-P:\SOSKPRO\53571\DATA\77SUM.DWG

SPECIFICATIONS
SCALE 1"=1'


COMPUTER DESIGNATION

RIPRAP SUMMARY										
SHEET	STATION TO STATION	DIMENSION		611(2) RIPRAP CLASS I PIPE INLET	611(2) RIPRAP CLASS I PIPE OUTLET	611(2) RIPRAP CLASS I VOLUME (m³)	611(2A) RIPRAP CLASS II VOLUME (m³)	611(2B) RIPRAP R750 VOLUME (m³)	631(2) GEOTEXTILE SEPARATION (m²)	REMARKS
		A (m)	B (m)							
FP4	'P' 61+010.0	3	0.5		X	7.2			21.2	
FP4	'P' 61+010.0	4	0.5	X		9.6			25.8	
FP5	'P' 61+349.0	10	0.5		X	24.0			53.4	
FP5	'P' 61+450.0	4	0.5		X	9.6			25.8	
FP5	'P' 61+471.5	8	0.5		X	19.2			44.2	
FP5	'P' 61+492.0	8	0.5		X	19.2			44.2	
FP6	'P' 61+529.0	8	0.5		X	19.2			44.2	
FP6	'P' 61+541.0	8	0.5		X	19.2			44.2	
FP6	'P' 61+584.0	4	0.5		X	9.6			25.8	
FP6	'P' 61+596.0	7	0.5		X	16.8			39.6	
FP6	'P' 61+642.0	5	0.5		X	12.0			30.4	
FP6	'P' 61+649.0	4	0.5		X	9.6			25.8	
FP7	'P' 61+887.5	5	0.7		X	13.6			33.0	
FP7	'P' 61+887.5	3	0.7	X		8.2			23.0	
FP7	'P' 61+926.0	6	0.5		X	14.4			35.0	
FP7	'P' 61+940.0	3	0.5		X	7.4			21.2	
FP7	'P' 61+940.0	3	0.5	X		7.4			21.2	
FP7	'P' 61+968.0	5	0.7		X	13.6			33.0	
FP7	'P' 61+974.0	5	0.7		X	13.6			33.0	
FP7	'P' 61+988.5	3	0.7		X	8.2			23.0	
FR1-FR11	'R' 2+090.0 TO 'R' 5+020.0						29,918.0			SEE RAILROAD TYPICAL SECTION
FR1-FR11	'R' 2+050.0 TO 'R' 5+020							28,262.0		SEE RAILROAD TYPICAL SECTION
	ARTILLERY PAD						275.0	279.0		

REVISIONS			STATE	PROJECT DESIGNATION	YEAR	SHEET NO.	TOTAL SHEETS
No.	DATE	DESCRIPTION					
			ALASKA	NH-0A3-1(28)	2002	D6	D9

APPROACH					
SHEET	STATION	OFFSET	WIDTH	RADIUS	REMARKS
F6	38+511	RT.	6.0	6.0	UTILITY ACCESS
F11	40+088	LT.	6.1	6.0	ARTILLERY GUN PAD
F13	40+722	LT.	12.0	*	* AS DIRECTED BY THE ENGINEER
F13	40+774	LT.	12.0	*	* AS DIRECTED BY THE ENGINEER
F03	42+355	RT.	6.0	6.0	SEE NOTE 1
F04	42+639	RT.	4.2	6.0	SEE NOTE 1
F04	42+718	RT.	6.0	12.0	SEE NOTE 1
F04	42+723	LT.	4.2	6.0	SEE NOTE 1
F04	42+843	RT.	6.0	6.0	SEE NOTE 1
F04	43+057	RT.	6.6	6.0	SEE NOTE 1
F05	43+206	RT.	6.0	12.0	SEE NOTE 1
F05	43+242	RT.	7.2	12.0	KONIKSON RD, SEE NOTE 1
F05	43+436	RT.	4.2	6.0	SEE NOTE 1
F05	43+464	RT.	7.2	12.0	SEE NOTE 1
F05	43+516	RT.	7.2	12.0	SEE NOTE 1
F05	43+557	RT.	7.2	12.0	SAWMILL RD, SEE NOTE 1
F05	43+565	LT.	4.2	6.0	SEE NOTE 1
F05	43+612	RT.	7.2	12.0	SEE NOTE 1
F05	43+642	RT.	4.8	6.0	SEE NOTE 1
F05	43+749	RT.	6.0	12.0	STELLAR JAY LANE, SEE NOTE 1
F06	43+866	RT.	7.2	12.0	SEE NOTE 1
F06	44+059	RT.	7.2	12.0	SEE NOTE 1
F06	44+244	LT.	7.2	12.0	BIRD CREEK CAMPGROUND ACCESS, SEE NOTE 1
F06	44+248	RT.	10.9	12.0	BIRD CREEK OVERLOOK ACCESS, SEE NOTE 1
FCR2	44+940	RT.	10.8	12.0	PARKING LOT ACCESS
FPK1	'PK' 10+190	LT.	3.7	6.0	SERVICE ROAD ACCESS

NOTE 1.
OVERLAY EXISTING PAVEMENT TO
MATCH ROADWAY.

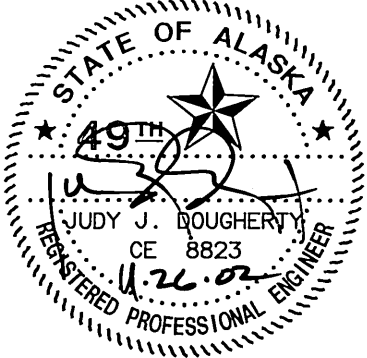

STATE OF ALASKA
DEPARTMENT OF TRANSPORTATION
AND
PUBLIC FACILITIES

**SEWARD HIGHWAY
MP 96 TO MP 102
SAFETY, ROADWAY &
RECREATIONAL IMPROVEMENTS**

SUMMARY TABLES

DESIGNED BY
CHECKED BY
DRAFTED BY

11-14-02

VIEW: D7

AUTOCAD-KAREN-P-5058KPROJ-6587A\DATA\TFSUM.DWG

SPECIFICATIONS
SCALE 1"=1'

COMPUTER DESIGNATION

641(3)

SILT FENCE				
SHEET	STATION	OFFSET	QUANTITY(m)	REMARKS
F2-F3	37+560 TO 37+680	RT.	120	
F6-F8	38+540 TO 39+130	RT.	590	
F10	39+760 TO 39+920	RT.	160	
FCR1	44+785	RT.	10	
FCR2	44+875	LT.	5	

641(4)

STRAW BALE				
SHEET	STATION TO STATION	OFFSET	QUANTITY (m)	REMARKS
FCR1	44+785	RT.	8.4	
FCR2	44+875	LT.	6.0	
FCR2	44+915	LT.	6.0	
FCR2	44+990	LT.	6.0	
FCR2	45+065	LT.	6.0	
FCR3	45+140	LT.	6.0	
FCR3	45+215	RT. LT.	6.0 6.0	
FCR3	45+290	RT. LT.	6.0 6.0	

REVISIONS			STATE	PROJECT DESIGNATION	YEAR	SHEET NO.	TOTAL SHEETS
No.	DATE	DESCRIPTION	ALASKA	NH-0A3-1(28)	2002	D7	D9

650(8)

SINGLE ENTRANCE GATE			
SHEET	STATION	OFFSET	REMARKS
			CHANGED TO DOUBLE GATE
F6	38+510	20.0 RT.	OFFSET MEASURED TO CENTER OF GATE
FR11	'P' 65+487	41.0 RT.	OFFSET MEASURED TO CENTER OF GATE
FPK1	'PK' 10+075	19.0 RT.	OFFSET MEASURED TO CENTER OF GATE
	10 + 240	10.0 LT.	

650(9)


DOUBLE ENTRANCE GATE			
SHEET	STATION	OFFSET	REMARKS
F3	37+838	LEFT	
FR7	'R' 3+900	RIGHT	ACCESS TO ARTILLERY PAD
	38+510	20 RT.	
FPK1	'PK' 10+025	CENTERLINE	
FPK1	'PK' 10+165	12.6 RT.	
FPK1	'PK' 10+170	12.6 LT.	

650(30B)

INTERPRETIVE KIOSK, TYPE B			
SHEET	STATION	OFFSET	REMARKS
FPR1	'PR' 5+195	4.9 LT.	OFFSET MEASURED TO CENTER OF STRUCTURE

650(38)

ENTRANCE SIGN			
SHEET	STATION	OFFSET	REMARKS
FPK1	'PK' 10+024	10.0 RT.	

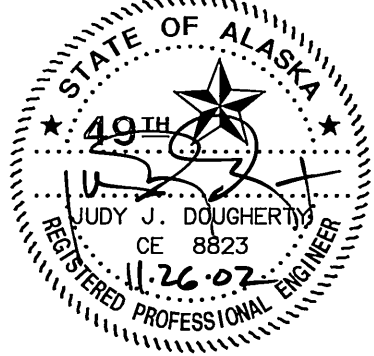

STATE OF ALASKA
DEPARTMENT OF TRANSPORTATION
AND
PUBLIC FACILITIES

**SEWARD HIGHWAY
MP 96 TO MP 102
SAFETY, ROADWAY &
RECREATIONAL IMPROVEMENTS**

SUMMARY TABLES

DESIGNED BY
CHECKED BY
DRAFTED BY
6/19/02
VIEW= DB
AUTOCAD-KAREN-DAVIDSKPROJ-65876\DATA\725\DWG-11-20-02
SPECIFICATIONS
SCALE 1"=1'
COMPUTER DESIGNATION

680(6)

FURNISH AND INSTALL TELEPHONE HANDHOLE AND/OR VAULT

STATION	OFFSET	QUANTITY(EACH)	REMARKS	
ACS				
36+225	18.9 RT.	1	DELETED,USED EXISTING VAULT	
36+225	14.9 LT.	1	DELETED,USED EXISTING VAULT	
37+250 478.2	5.1 8.0 LT.	1		
38+455 630.0	7.0 LT.	1		
39+660	8.0 LT.	1		
43+440	15.3 LT.	1		
40+340	1243 8.0 LT.	1		
45+025	22.48LT.	1		
45+320	23.4 LT.	1		
40+985	2.95 RT.	1		
GCI				
37+024.18 124.00	4.11 11.83 LT.	1		
38+407.56	10.06 LT.	1		
39+145.60	11.00 LT.	1		
39+877.70	11.00 LT.	1		
40+340.00 1243 LT.	87.00 RT.	1		
AFS				
"R" 3+980 39+943	4.27 RT. LT.	1		

680(6A)

FURNISH TELEPHONE HANDHOLE

STATION	OFFSET	QUANTITY(EACH)	REMARKS	
AFS				
"R" 5+444.4 001.0	3.65 LT.	1		

680(6B)

INSTALL TELEPHONE VAULT

STATION	OFFSET	QUANTITY(EACH)	TYPE	REMARKS
ACS				
BETWEEN 40+600 AND 40+600	18.9 RT.	1	4890	
42+180	9.7 RT.	1	3048	
GCI				
44+730.29 00	10.53 LT.	1	3048	
"PL" 4+448.51	1.37 RT.	1	3048	
45+598.78	21.22 LT.	1	3048	

REVISIONS			STATE	PROJECT DESIGNATION	YEAR	SHEET NO.	TOTAL SHEETS
No.	DATE	DESCRIPTION	ALASKA	NH-0A3-1(28)	2002	D8	D9

680(10)

FURNISH AND INSTALL SINGLE INNERDUCT

STATION	QUANTITY(m)	REMARKS
AFS		
"R" 2+060 TO "R" 2+085	15.0	
"R" 5+111.1 TO "R" 3+880	1236 850	"R" 3+725 TO "R" 3+075
"R" 3+880 TO "R" 1+075	2215 76	38+167 TO 38+243
RAIL CROSSING 37+840	20.0	

680(11)

FURNISH AND INSTALL TWO INNERDUCTS

STATION	QUANTITY(m)	REMARKS
ACS		
36+015, 42.3 RT. TO 36+225, 14.9 RT.	222.65	
36+225, 14.9 RT. TO 36+225, 18.9 LT.	33.80	
36+225, 18.9 LT. TO 36+525, 24.54 LT.	300.00	
36+525, 24.54 LT. TO 36+525, 41.14 LT.	16.64	
36+525, 41.14 LT. TO 36+645, 55.9 LT.	120.90	
36+645, 55.9 LT. 37+250, 8.0 LT.	540.01	
37+250, 8.0 LT. TO 38+245, 7.19 LT.	955.00	
40+800, 11.9 RT. TO 42+180, 9.7 RT.	1380.00	
42+180, 9.7 RT. TO 43+440, 9.1 RT.	1260.00	

680(12)

INSTALL THREE INNERDUCTS

STATION	QUANTITY(m)	REMARKS
GCI		
44+730.29, 8.63 RT. TO 44+730.29, 10.53 LT.	19.20	
45+596, 23.4 LT. TO 45+598.78, 21.22 LT.	2.78	
45+598.78, 21.22 LT. TO 45+600, 10.67 RT.	31.60	

STATE OF ALASKA

49TH

JUDY J. DAUGHERY

CE 8823

REGISTERED PROFESSIONAL ENGINEER

STATE OF ALASKA
DEPARTMENT OF TRANSPORTATION
AND
PUBLIC FACILITIES
**SEWARD HIGHWAY
MP 96 TO MP 102
SAFETY, ROADWAY &
RECREATIONAL IMPROVEMENTS**

SUMMARY TABLES

DESIGNED BY
CHECKED BY
DRAFTED BY

VIEW- D9

6/19/02

SPECIFICATIONS
SCALE 1"=1'

AUTOCAD-KAREN-D-5083KPROJ-458577-DATA\77501.DWG 11-20-02

COMPUTER DESIGNATION

REVISIONS			STATE	PROJECT DESIGNATION	YEAR	SHEET NO.	TOTAL SHEETS
No.	DATE	DESCRIPTION	ALASKA	NH-0A3-1(28)	2002	D9	D9


FURNISH TWO AND INSTALL FIVE INNERDUCTS		
STATION	QUANTITY(m)	REMARKS
COMMON TRENCH FOR ACS AND GCI		
38+245.4, 8.71 LT. TO 38+407.56, 10.06 LT.	162.16	
38+407.56, 10.06 LT TO 38+455, 7 LT.	47.44	
38+455, 7 LT. TO 39+145.6, 10.06 LT.	690.60	
39+145.6, 10.06 LT. TO 39+660, 8 LT.	514.40	
39+660, 8 LT. TO 39+877.7, 11 LT.	217.70	
39+877.7, 11 LT. TO 40+340, 8 LT.	462.3	
40+340, 37 RT. TO 40+800, 11.89 RT.	460.00	

INSTALL TWO CONDUITS		
STATION	QUANTITY(m)	REMARKS
ACS		
44+718 TO 44+730, RT.	12	

INSTALL 2 CONDUITS, 3 INNERDUCTS, FURNISH AND INSTALL 2 INNERDUCTS		
STATION	QUANTITY(m)	REMARKS
COMMON TRENCH FOR ACS AND GCI		
40+340, 8 LT. TO 40+340, 37 RT.	45	

INSTALL 2 CONDUITS AND 3 INNERDUCTS CONCRETE ENCASED		
STATION	QUANTITY(m)	REMARKS
COMMON TRENCH FOR ACS AND GCI		
44+730.29, 10.53 LT. TO 45+596, 23.4 LT.	902.18	

INSTALL FIBER OPTIC CABLE		
STATION	QUANTITY(m)	REMARKS
AFS		
001		
"R' 5+111.1 TO "R" 2+880- 3+751	1231.1 1257.0	
"R" 3+880 TO "R" 1+675	2205.0 2109.21	
751		

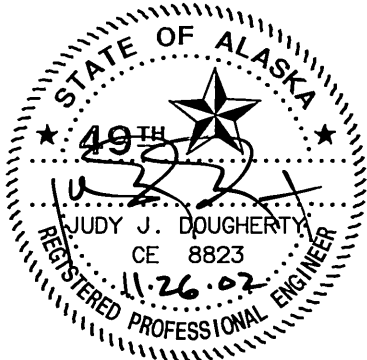

STATE OF ALASKA
DEPARTMENT OF TRANSPORTATION
AND
PUBLIC FACILITIES


SEWARD HIGHWAY
MP 96 TO MP 102
SAFETY, ROADWAY &
RECREATIONAL IMPROVEMENTS

SUMMARY TABLES


REVISIONS			STATE	PROJECT DESIGNATION	YEAR	SHEET NO.	TOTAL SHEETS
No.	DATE	DESCRIPTION					
			ALASKA	NHI-0A3-1(28)	2002	E1	E30

NOTES:


1. SURVEYORS WILL STAKE GUNMOUNT PIPE LOCATION PRIOR TO CONSTRUCTION STAKING OF PAD. FINAL LOCATION OF PAD AND GUNMOUNT LOCATION AS DIRECTED BY THE ENGINEER.
2. TOMBSTONES TO BE CONSTRUCTED FROM CONCRETE, CLASS A.
3. COORDINATE PAD PLACEMENT AND GUNMOUNT ORIENTATION WITH ADOT MAINTENANCE PERSONNEL PRIOR TO CONSTRUCTION.
4. EXCAVATE AND POUR CONCRETE PRIOR TO PLACING ASPHALT CONCRETE PAVEMENT.

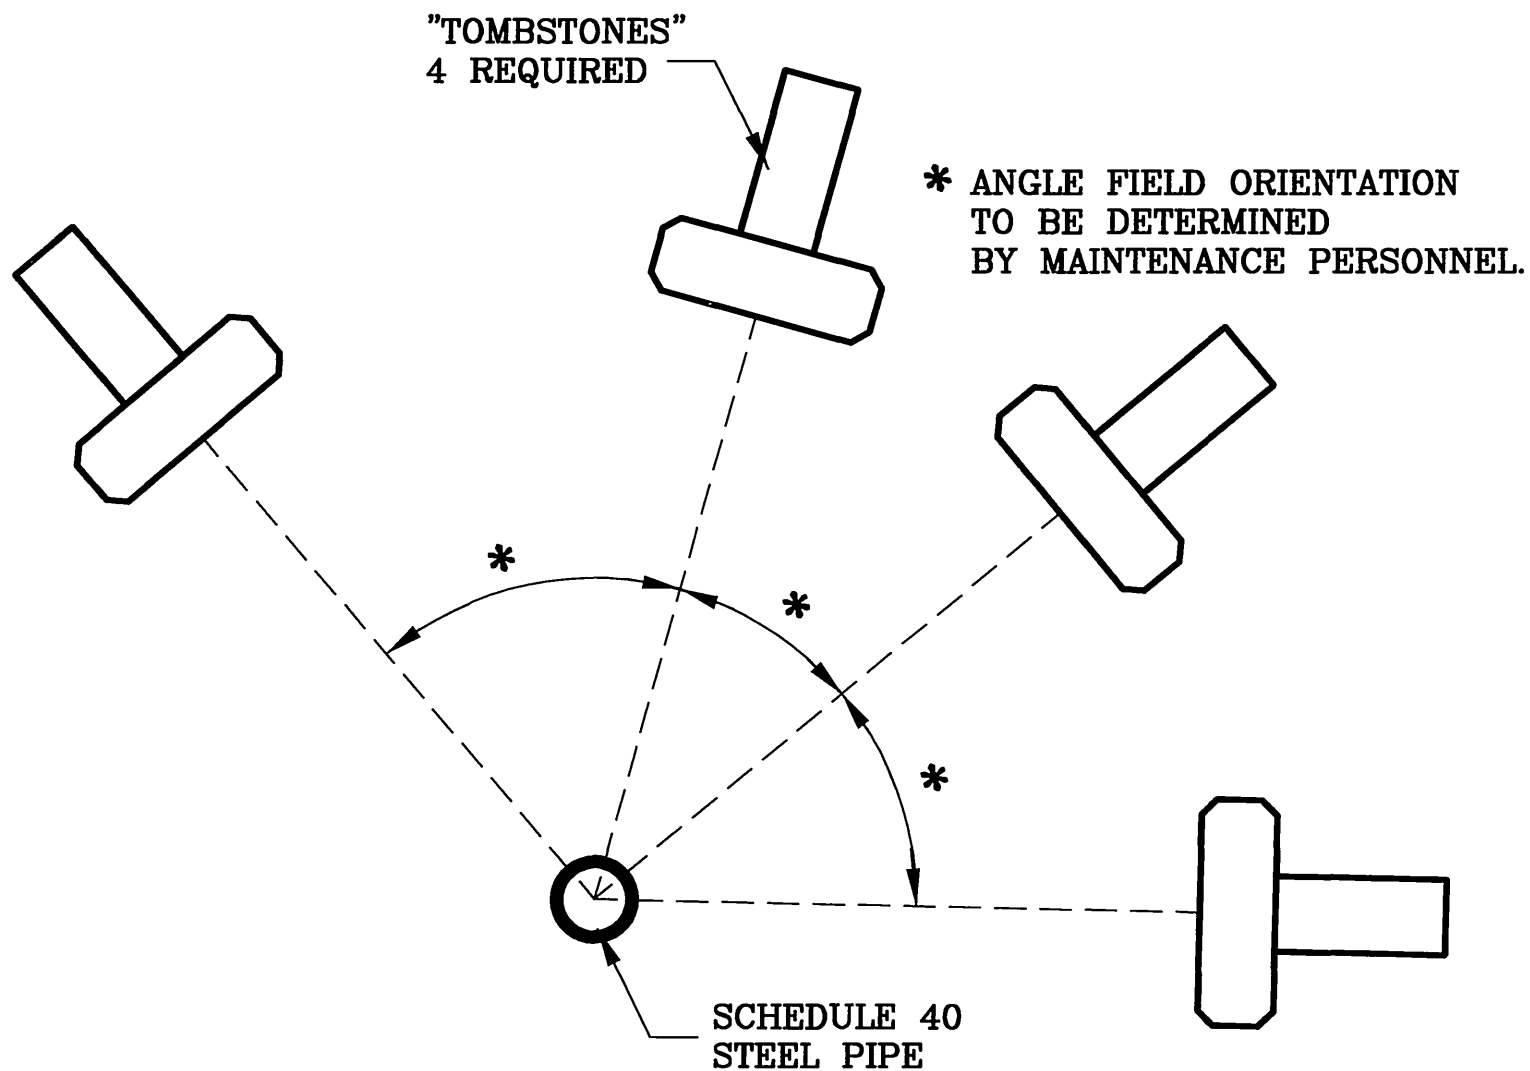


PLAN LAYOUT

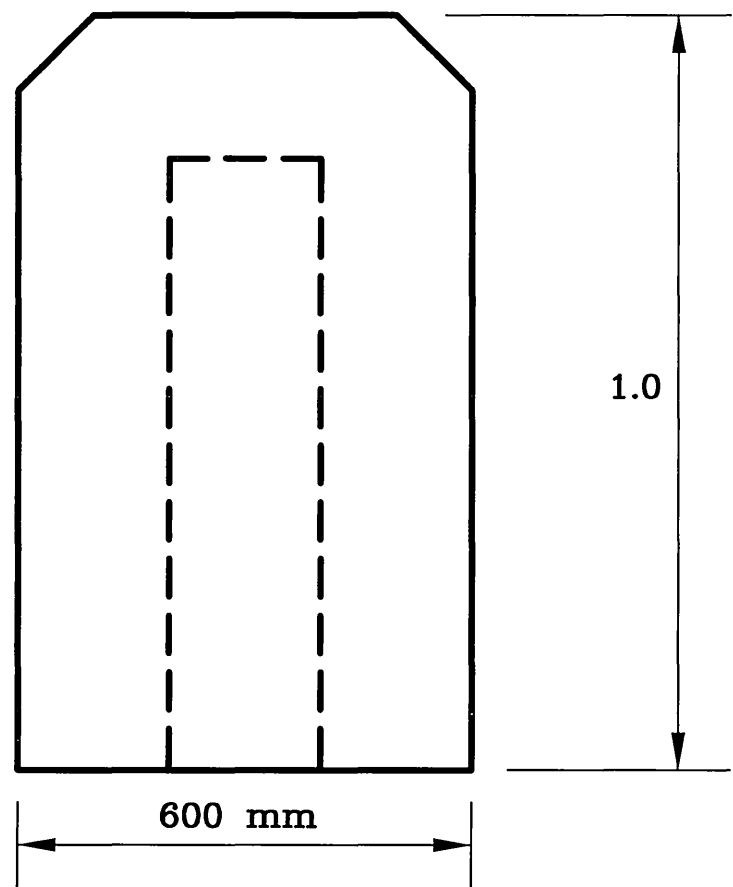


"TOMBSTONE" FRONT VIEW

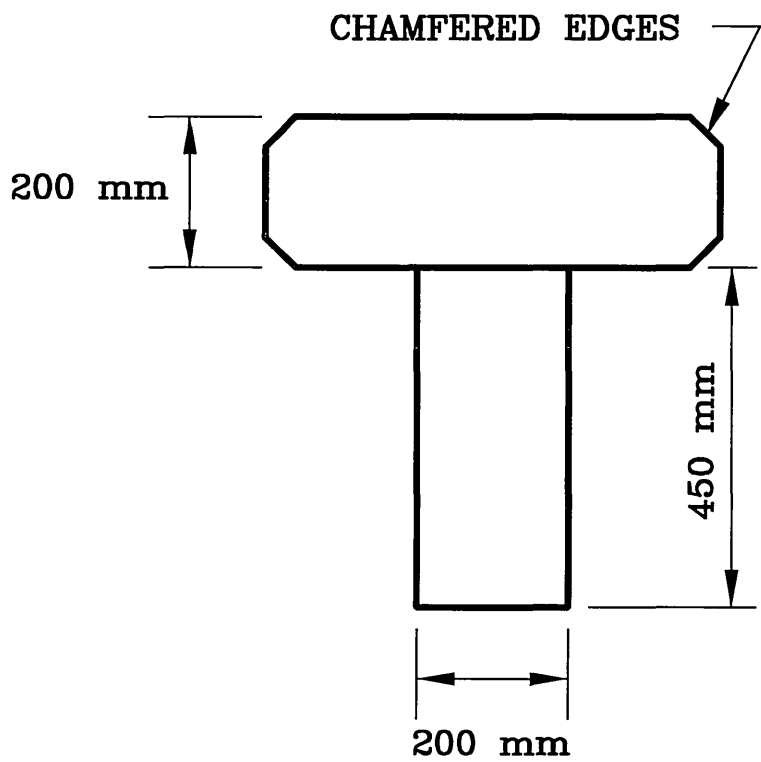


"TOMBSTONE" PLAN VIEW

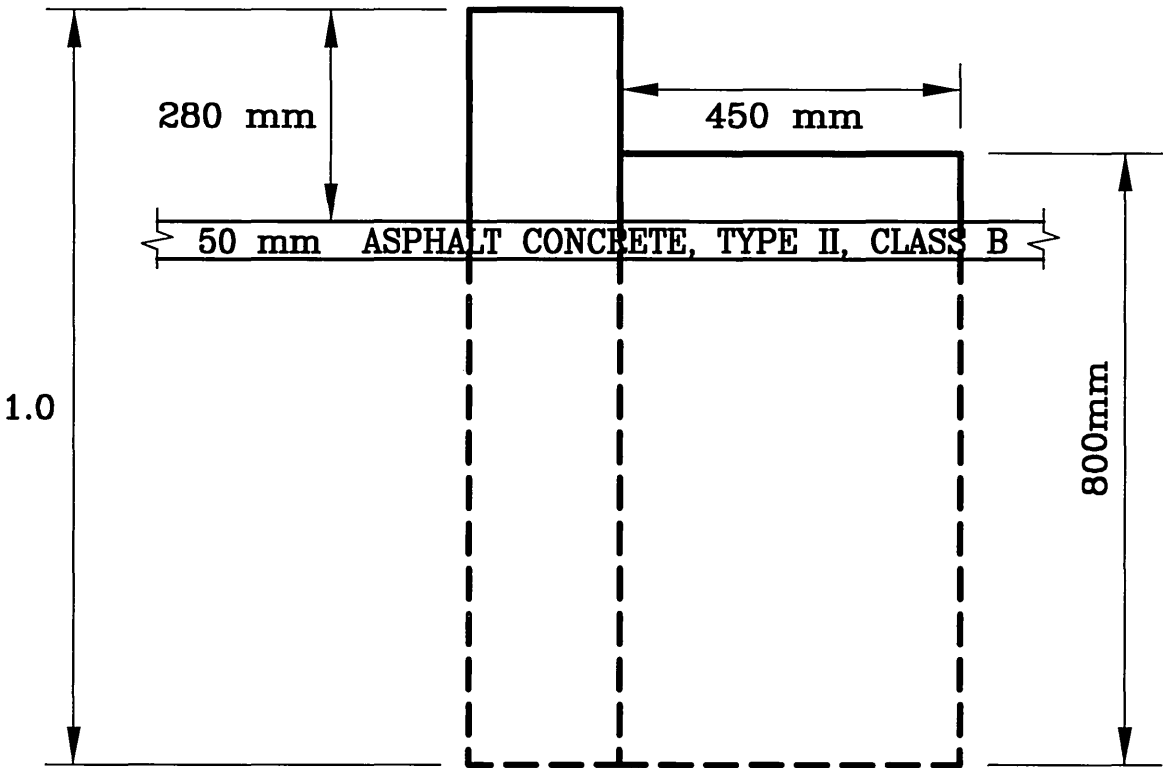

"TOMBSTONE" SIDE VIEW

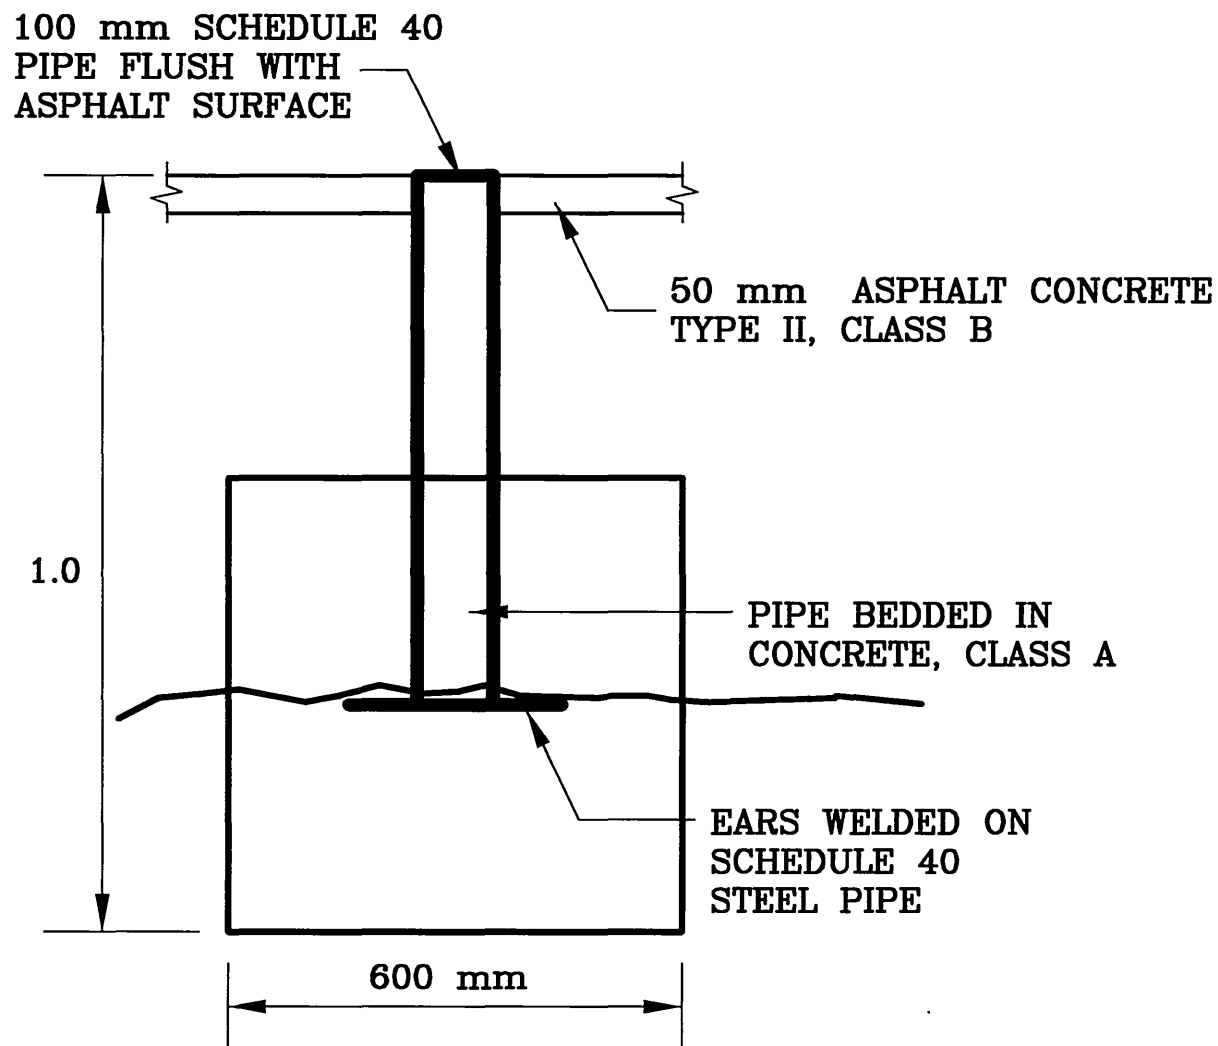

ARTILLERY GUNMOUNT
PIPE SIDE VIEW




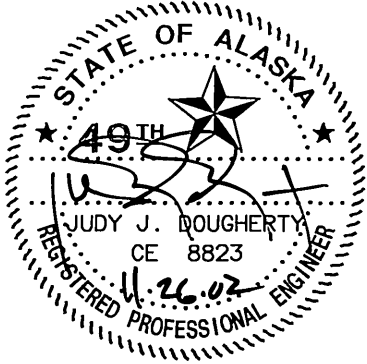


STATE OF ALASKA
DEPARTMENT OF TRANSPORTATION
AND
PUBLIC FACILITIES
SEWARD HIGHWAY
MP 96 TO MP 102
SAFETY, ROADWAY &
RECREATIONAL IMPROVEMENTS

ARTILLERY
GUNMOUNT DETAILS

NOTES: _____

1. STRUCTURE PLATE STEEL THICKNESS SHALL BE 2.77 mm.
2. STRUCTURAL PLATE BOLTS SHALL BE INSTALLED WITH NUTS ON THE EXTERIOR OF THE STRUCTURE.
3. FIELD MADE BOLT HOLES SHALL BE REAMED OR DRILLED.
4. CONSTRUCTION EQUIPMENT SHALL NOT BE ALLOWED TO DRIVE ACROSS THE STRUCTURE UNTIL 1 m OF COMPACTED BACKFILL COVER IS IN PLACE NO TRAFFIC WILL BE ALLOWED WITHOUT A MINIMUM OF 0.6 m OF COVER ABOVE THE PIPE.
5. BEDDING SHALL BE SELECTED MATERIAL, TYPE A. MATERIAL GREATER THAN 75 mm SHALL NOT BE ALLOWED AGAINST THE PIPE.
6. ALL CONCRETE SHALL BE CLASS "A".
7. REINFORCING STEEL SHALL BE A.S.T.M. A615M GRADE 420.

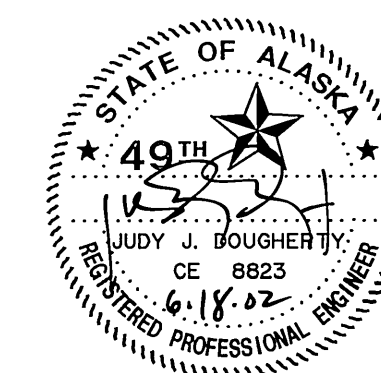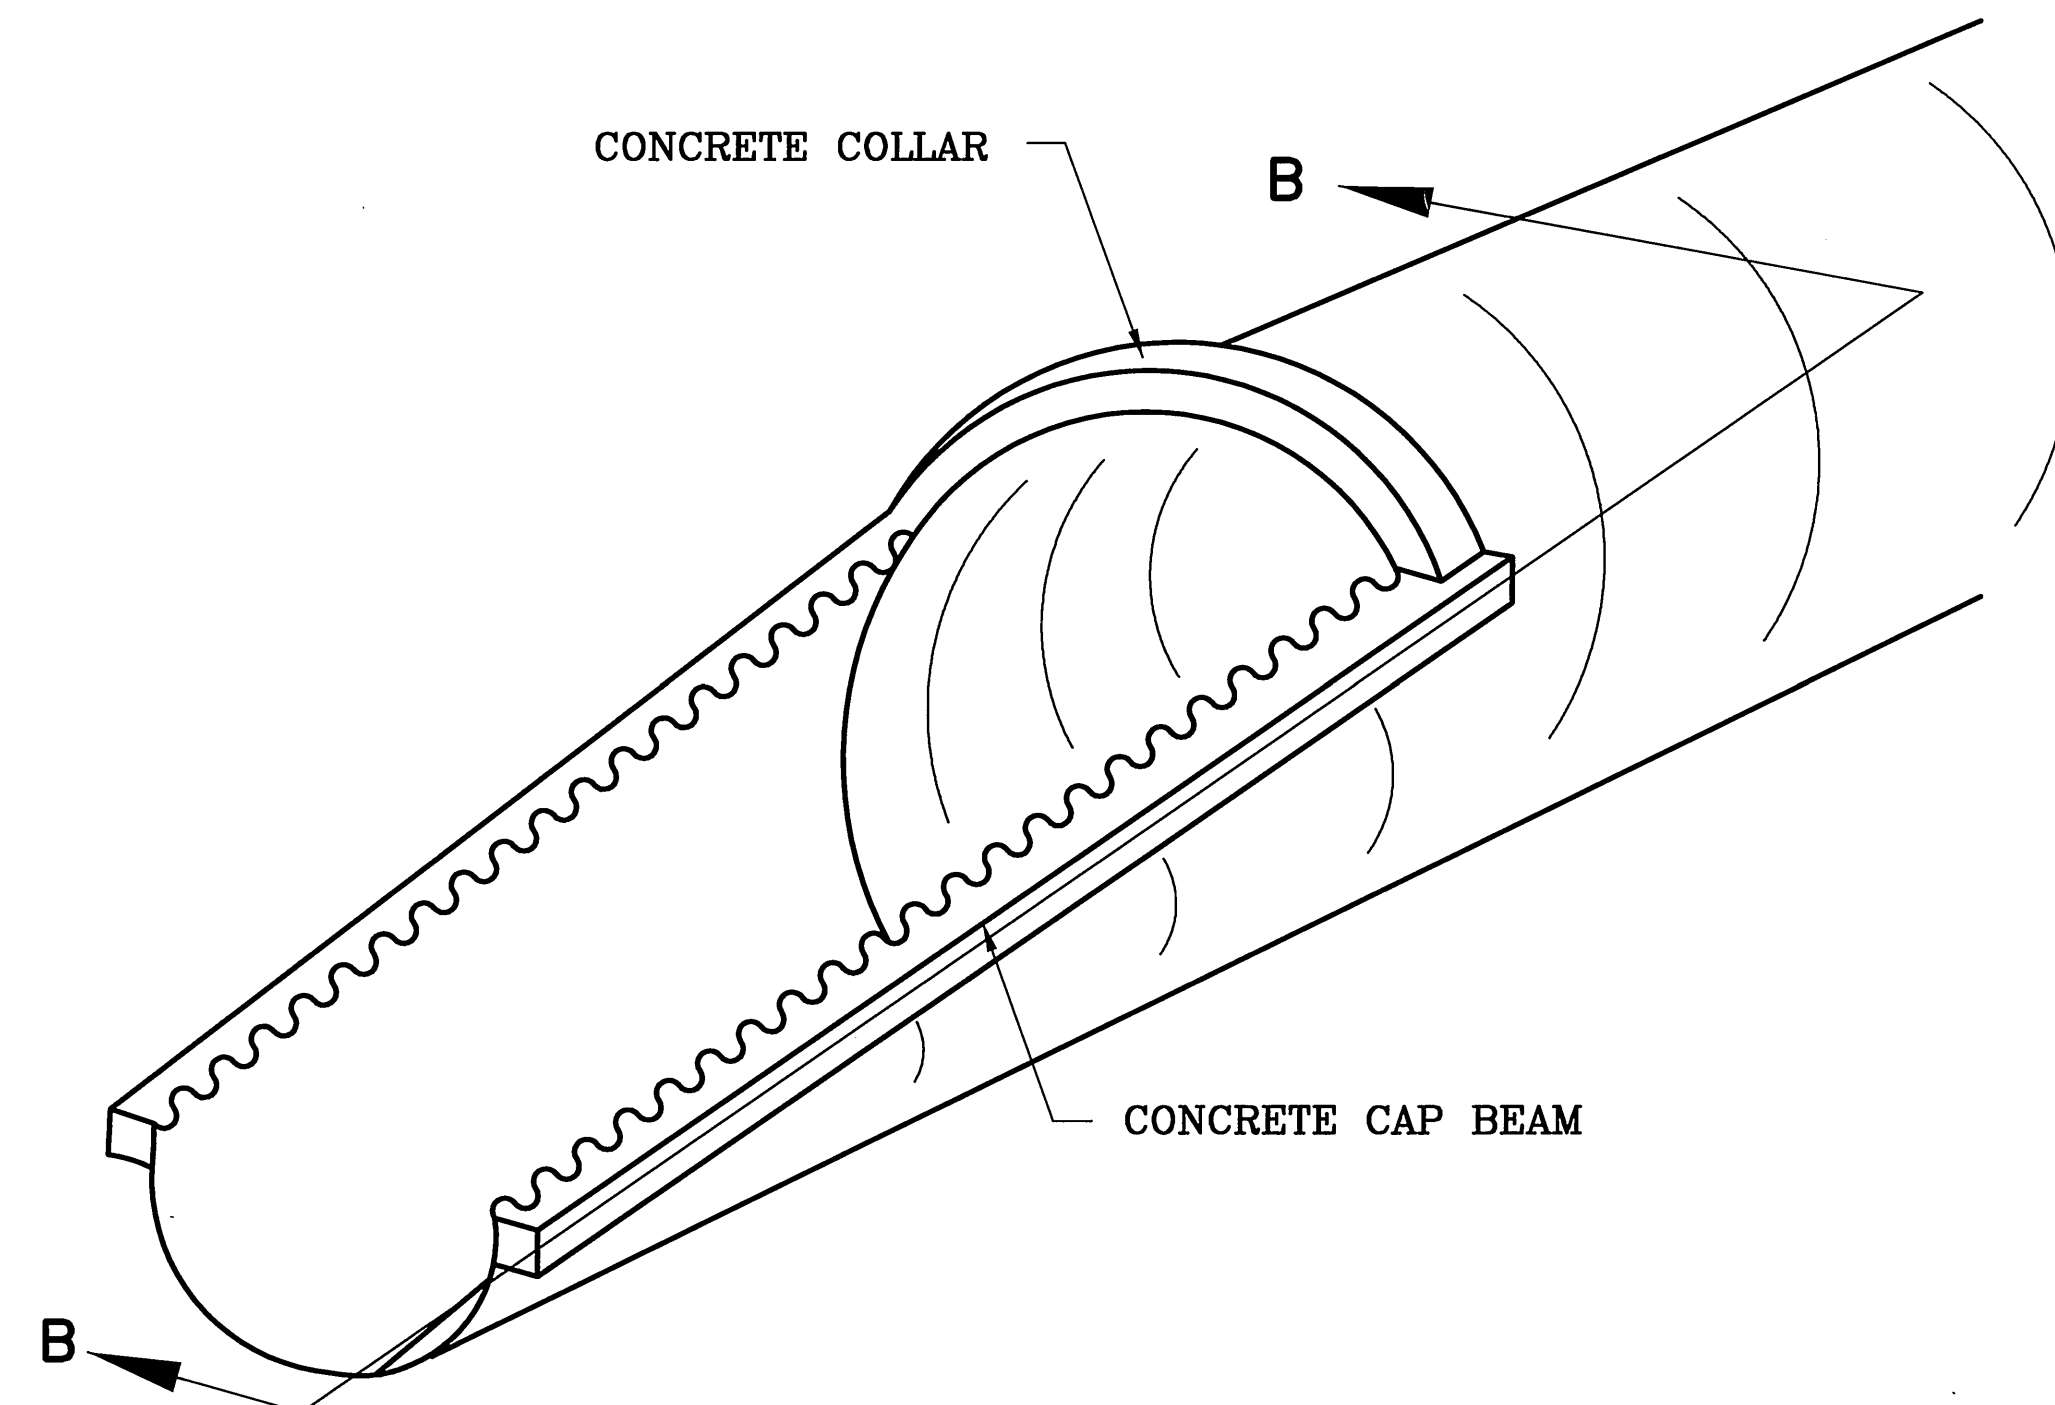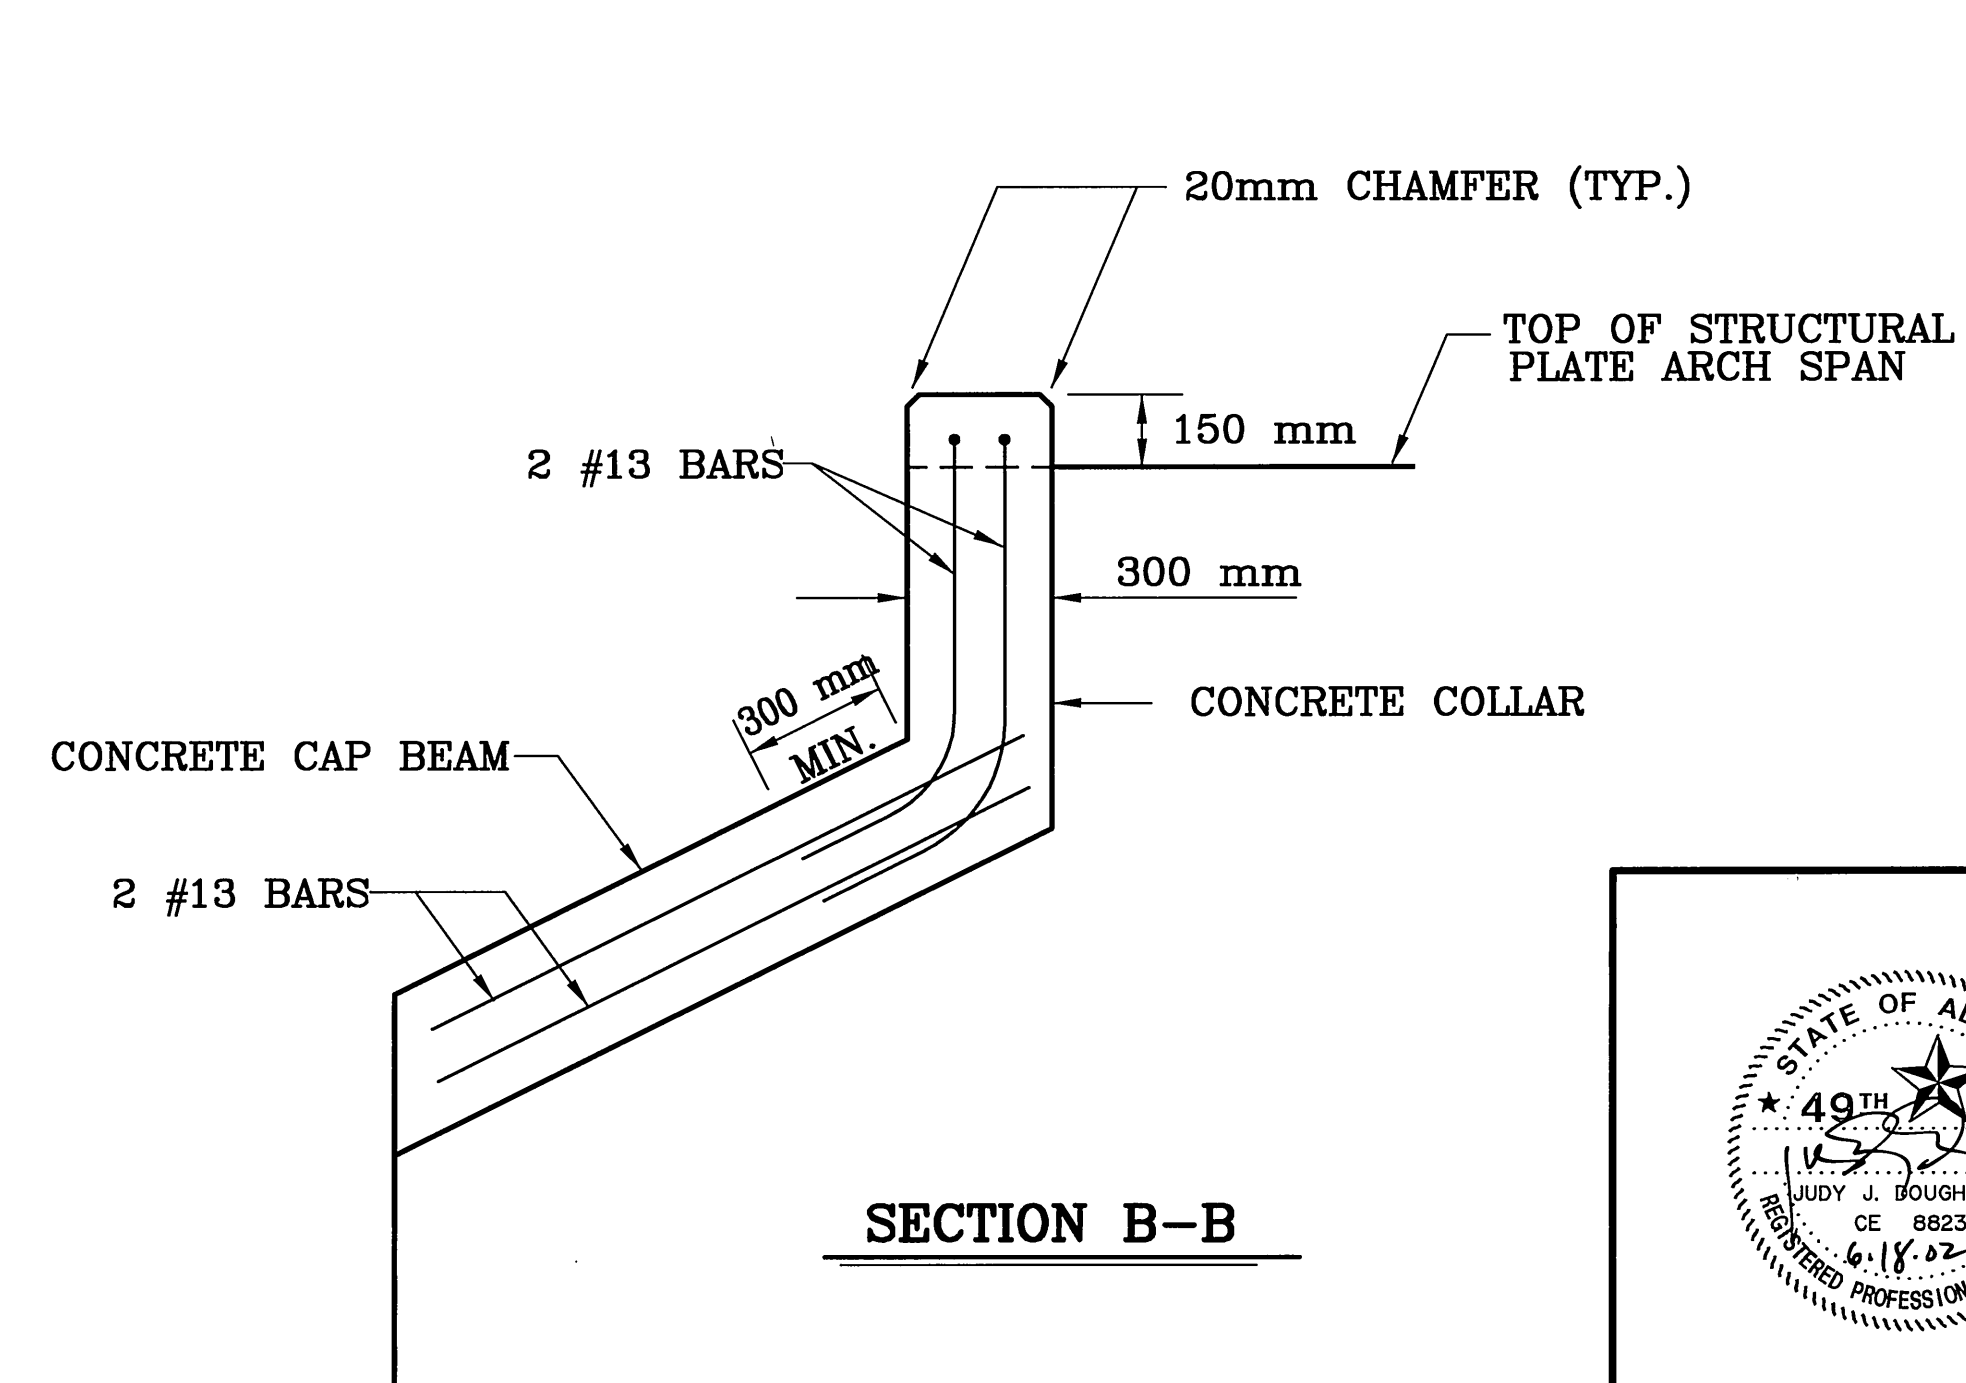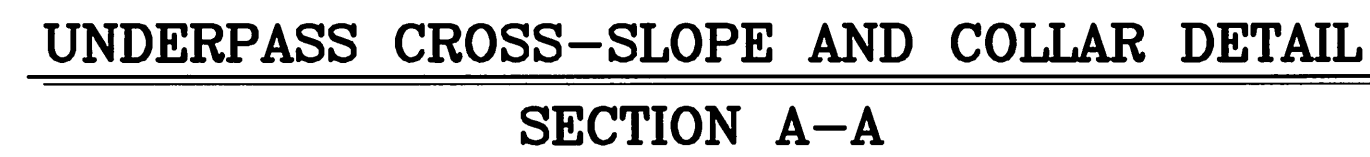


STATE OF ALASKA
DEPARTMENT OF TRANSPORTATION
AND
PUBLIC FACILITIES
**SEWARD HIGHWAY
MP 96 TO MP 102
SAFETY, ROADWAY AND
RECREATIONAL IMPROVEMENTS**


**STRUCTURAL PLATE PIPE ARCH
DETAILS**

REVISIONS			STATE	PROJECT DESIGNATION	YEAR	SHEET NO.	TOTAL SHEETS
No.	DATE	DESCRIPTION	ALASKA	NH-0A3-1(28)	2002	E4	E30

DESIGNED BY	6/12/02
CHECKED BY	KMH
DRAFTED BY	
VIEW#	2
AUTOCAD-KAREN-	53577/771UBE
COMPUTER DESIGNATION	
SPECIFICATIONS	
SCALE	1=1

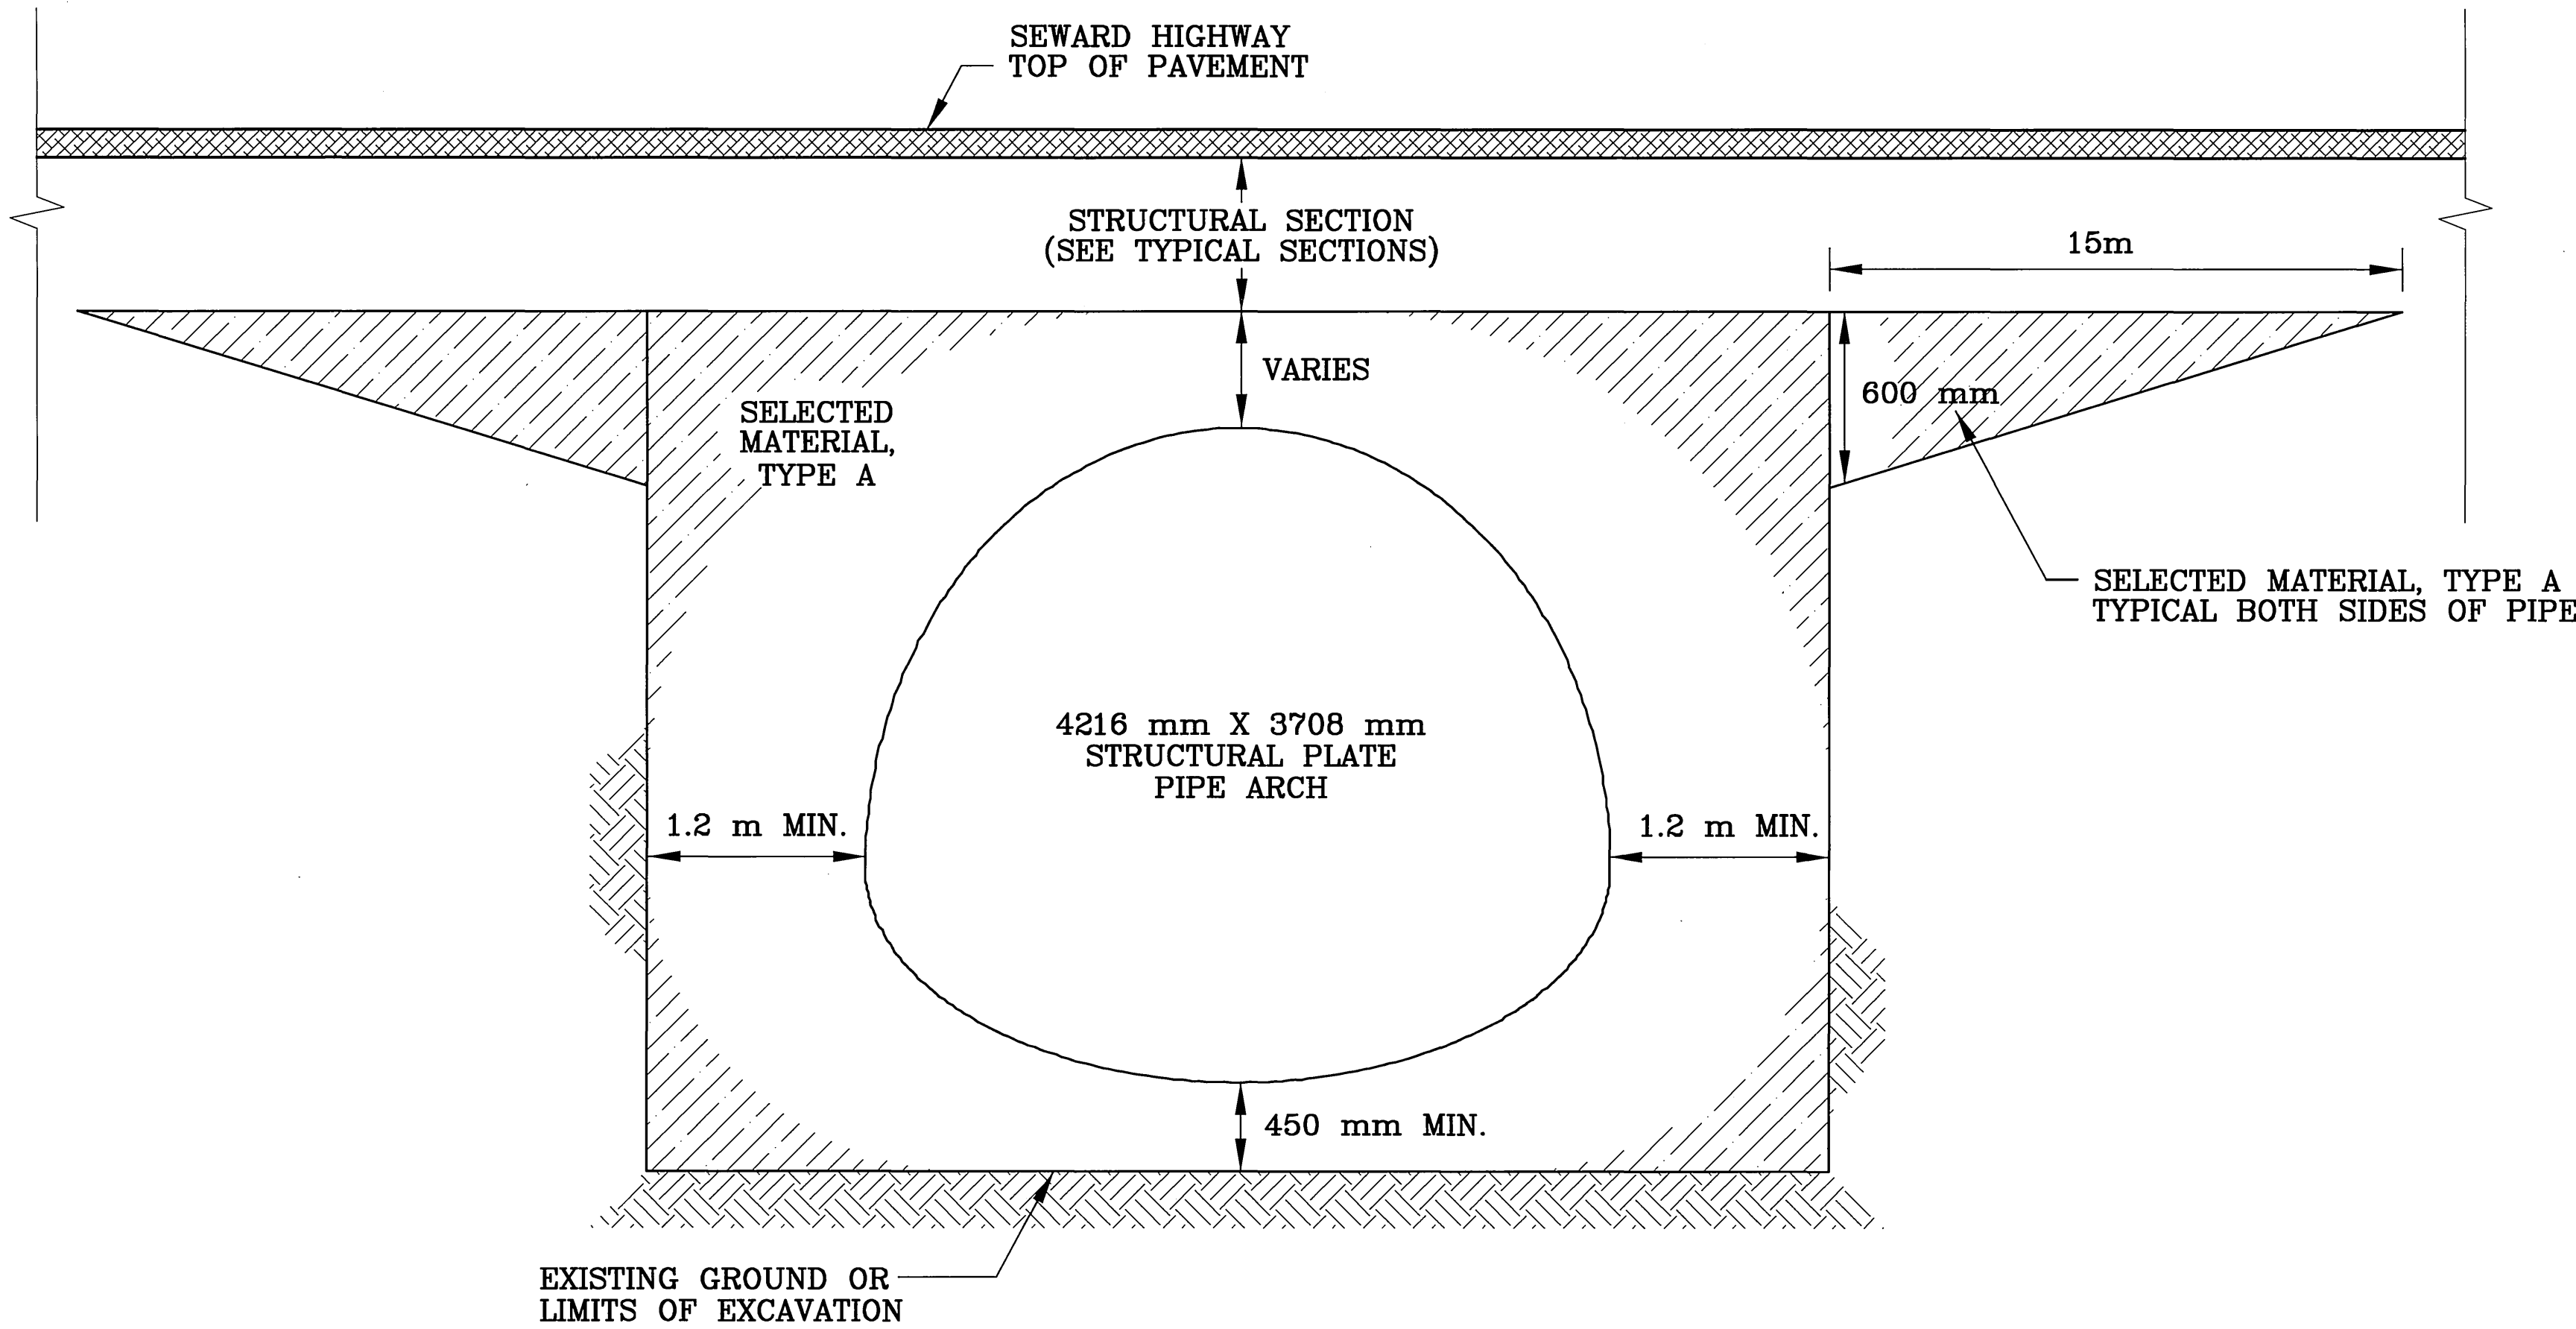


PIPE ARCH BACKFILL AND BEDDING DETAIL

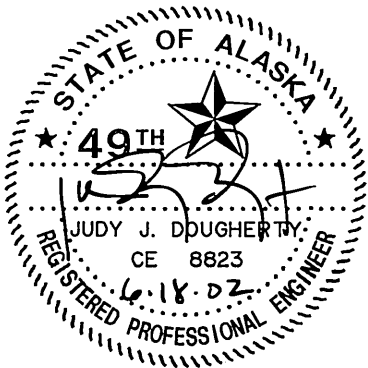

STATE OF ALASKA
DEPARTMENT OF TRANSPORTATION
AND
PUBLIC FACILITIES
**SEWARD HIGHWAY
MP 96 TO MP 102
SAFETY, ROADWAY AND
RECREATIONAL IMPROVEMENTS**
**STRUCTURAL PLATE PIPE ARCH
DETAILS**

REVISIONS			STATE	PROJECT DESIGNATION	YEAR	SHEET NO.	TOTAL SHEETS
No.	DATE	DESCRIPTION	ALASKA	NHI-0A3-1(28)	2002	E5	E30

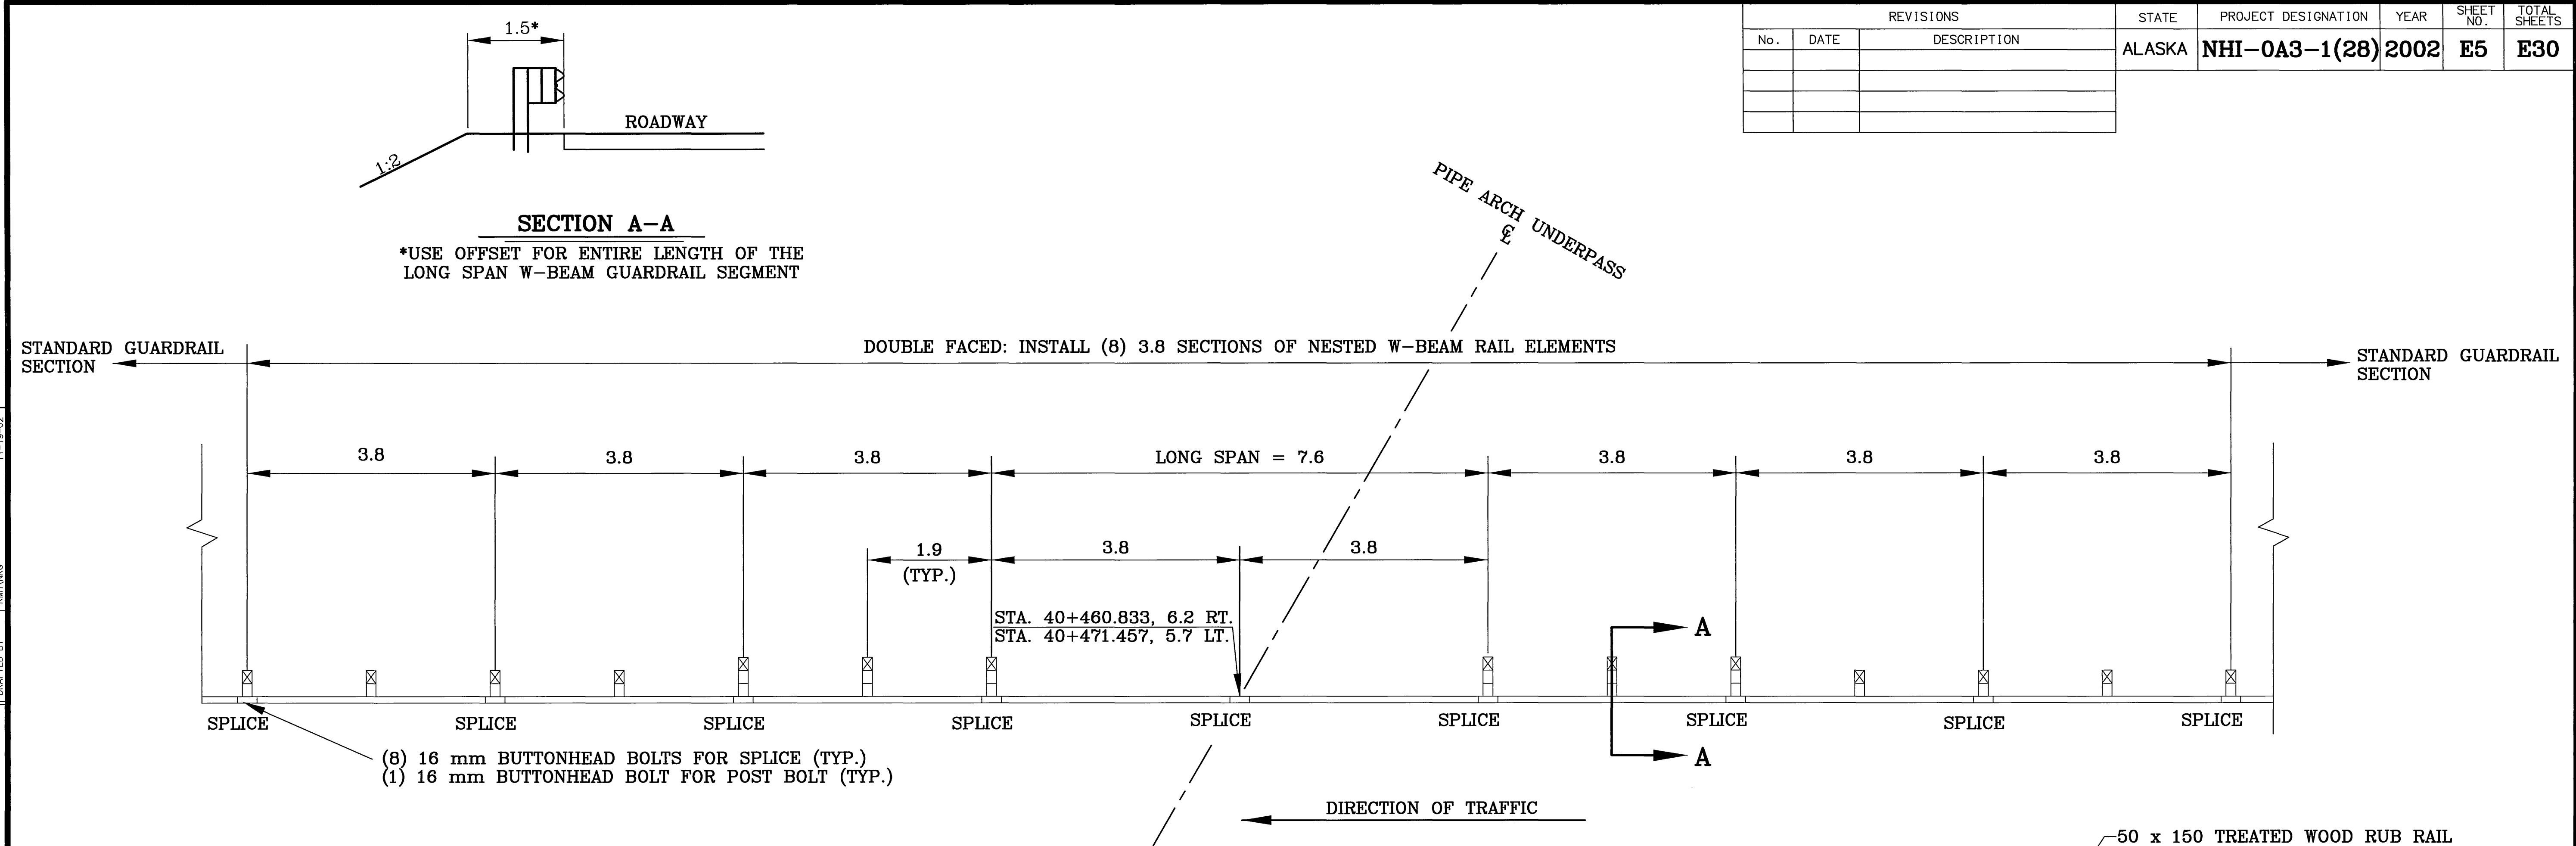

LONG-SPAN W-BEAM GUARDRAIL
LEFT AND RIGHT SIDE


LEGEND

- STANDARD GUARDRAIL POST
- LONG SPAN WOOD GUARDRAIL POST (SEE DETAIL)


LONG SPAN W-BEAM GUARDRAIL

- CENTER LONG SPAN OF W-BEAM GUARDRAIL OVER PIPE ARCH UNDERPASS. DO NOT INSTALL POSTS WITHIN LONG SPAN.
- REFERENCE STANDARD DRAWING G-00.01[M], G-04.07W[M] FOR MAKING SPLICE CONNECTIONS AND OTHER STANDARD INSTALLATION DETAILS.
- NESTED SECTIONS CONSIST OF TWO SECTIONS OF W-BEAM GUARDRAIL ELEMENTS, ONE SET INSIDE THE OTHER.
- ALL SPLICES SHALL BE LAPPED IN DIRECTION OF ADJACENT TRAFFIC.

(2) 150 x 200 x 350 WOOD POST BLOCK

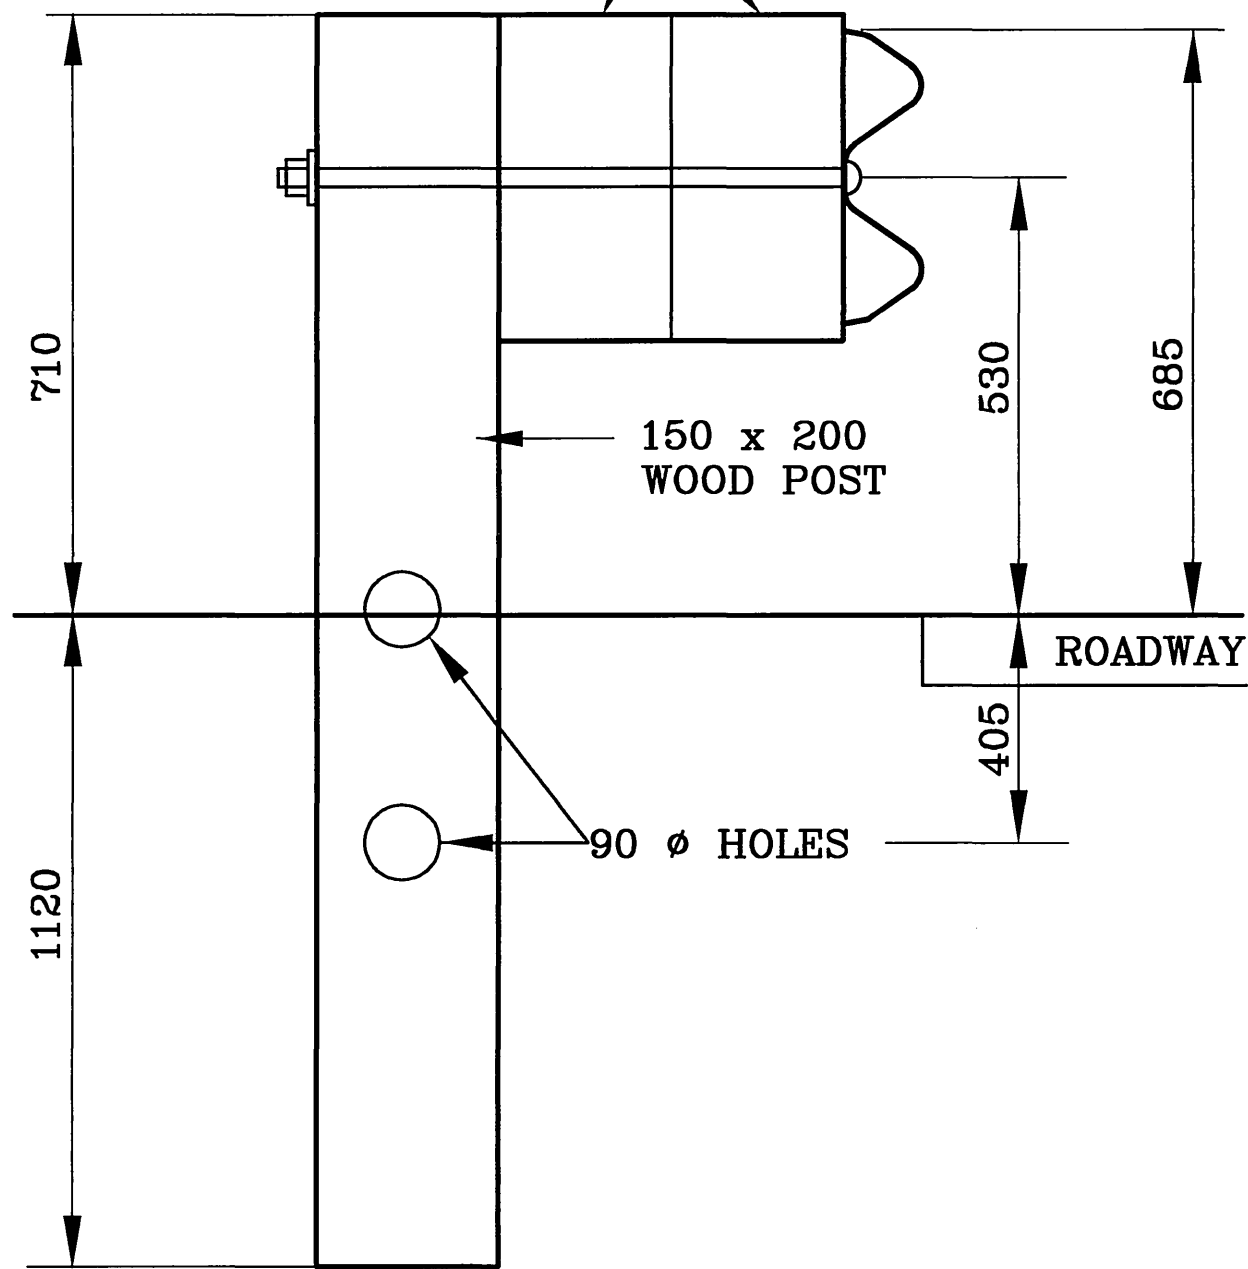


LONG SPAN GUARDRAIL POST DETAIL

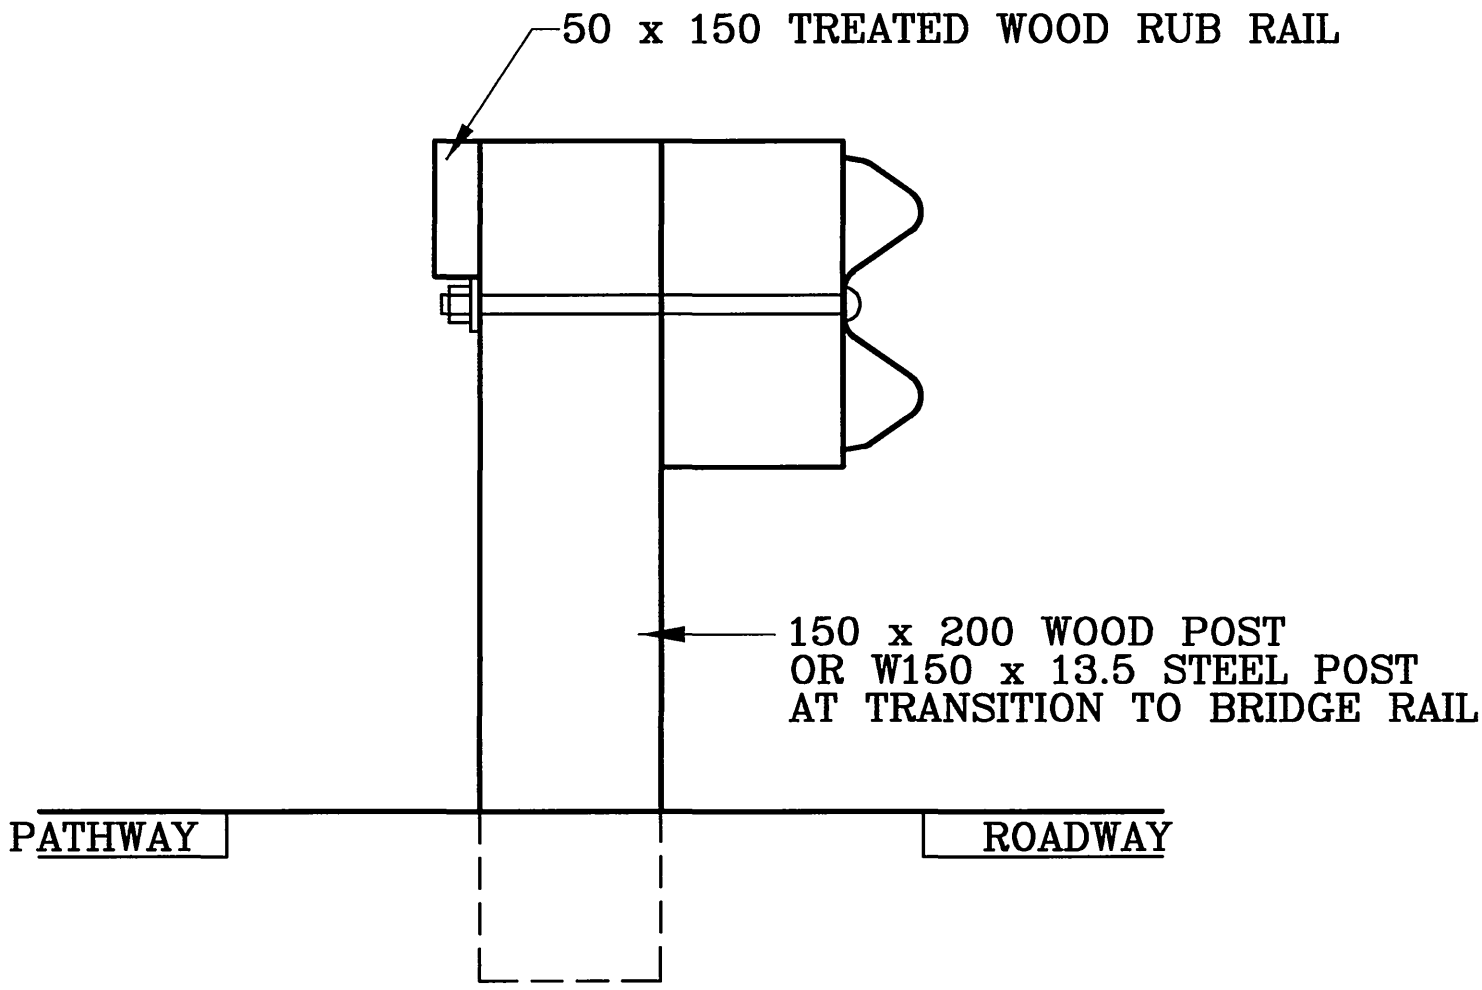

RUB RAIL DETAIL


RUB RAIL NOTES:

- FASTEN RUB RAIL TO EACH GUARDRAIL POST WITH 2-16d GALVANIZED NAILS OR 6 mm BOLTS.
- JOINTS IN RUB RAIL TO BE MADE AT GUARDRAIL POSTS.
- GUARD RAIL NUT AND BOLT NOT TO EXTEND BEYOND RUB RAIL.

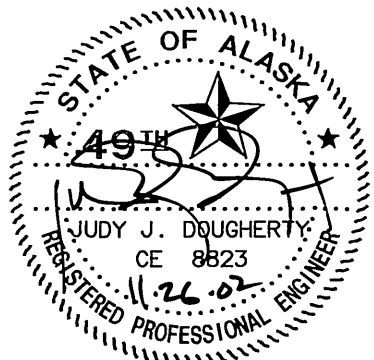

STATE OF ALASKA
DEPARTMENT OF TRANSPORTATION
AND
PUBLIC FACILITIES
**SEWARD HIGHWAY
MP 96 TO MP 102
SAFETY, ROADWAY &
RECREATIONAL IMPROVEMENTS**
GUARDRAIL DETAILS


DESIGNED BY
CHECKED BY
DRAFTED BY
PLOT SCALE: 1:1
AUTOCAD-CAROL-EE-TRAFFIC-USE77ML0272.3
COMPUTER DESIGNATION
SPECIFICATIONS
SCALE: 1:1
SHEET NO. 1

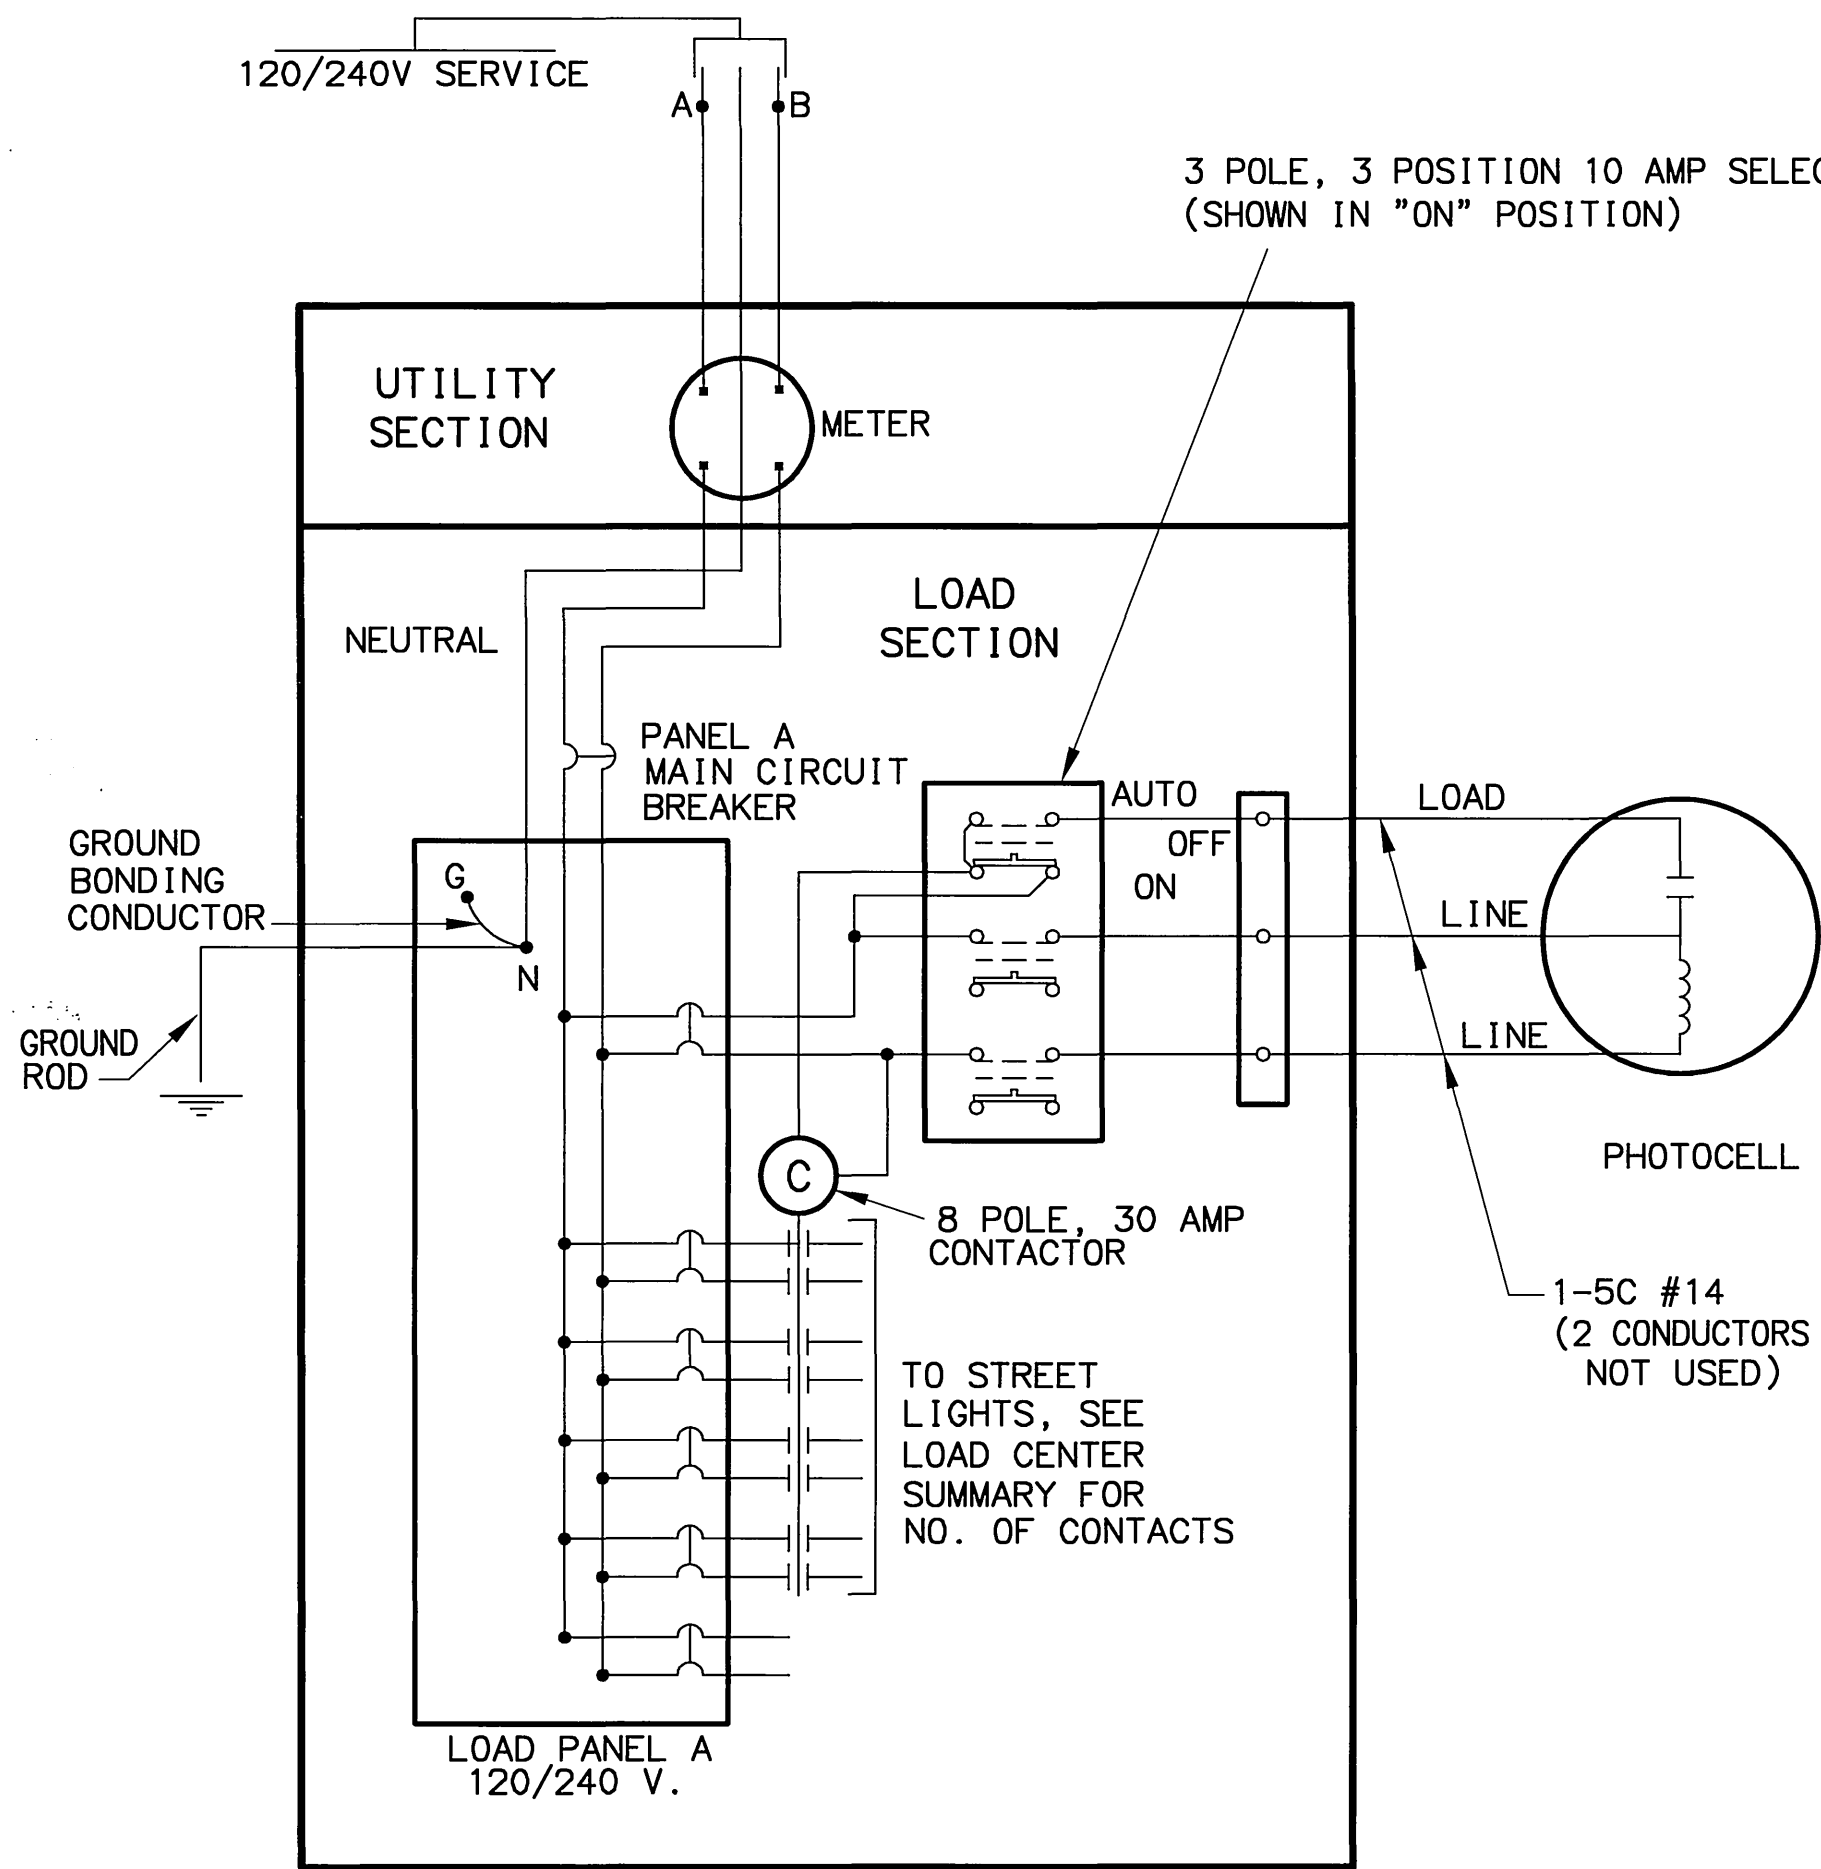


LOAD CENTER ONE LINE DIAGRAM AND
SELECTOR SWITCH WIRING

WIRING NOTES:


- FURNISH ALL EQUIPMENT NOTED IN THE LOAD CENTER SUMMARY, PLUS TWO 20-AMP 2-POLE SPARE CIRCUIT BREAKERS, AND SPACE FOR A MINIMUM OF TWO ADDITIONAL TWO-POLE CIRCUIT BREAKERS, IN EACH LOAD PANEL. SEE SUMMARIES FOR LOAD PANEL VOLTAGES, CURRENT RATINGS, SHORT CIRCUIT INTERRUPTING RATINGS, AND THE NAME OF THE SERVING UTILITY.
- SIZE THE TYPE 2 AND 3 LOAD CENTER CABINETS TO HOLD THE EQUIPMENT SHOWN IN THE WIRING DIAGRAM AND DETAILED IN EACH LOAD CENTER SUMMARY, ALLOWING SPACE FOR WIRING PER THE NATIONAL ELECTRICAL CODE. INSTALLING A METER BASE AND MAIN BREAKER IN A SEPARATE ENCLOSURE IS ALLOWABLE. HOWEVER IN THIS CASE, FURNISH A BREAKER PANEL WITH A MAIN BREAKER.
- LABEL ALL CIRCUIT BREAKERS AS TO FUNCTION AND POSITION. LABEL THE SELECTOR SWITCH "LIGHTING" AND ITS POSITIONS "ON-OFF-AUTO".
- THE VOLTAGE FOR THE PHOTOELECTRIC CONTROL EQUIPMENT SHALL BE 240-VOLT, DERIVED FROM THE SERVICE VOLTAGE, OR FROM A CONTROL TRANSFORMER.
- LABEL ALL CIRCUIT BREAKERS AS TO FUNCTION AND POSITION.
- INSTALL THE PHOTOELECTRIC CONTROL UNIT ON THE LOAD CENTER AT A HEIGHT TO PREVENT BEING COVERED BY SNOW, AND WITH THE CONTROL WINDOW FACING NORTH AND/OR AWAY FROM ARTIFICIAL LIGHT SOURCES THAT WILL INTERFERE WITH NATURAL AMBIENT LIGHT CONTROL.
- STORE A SCHEMATIC DIAGRAM, A CIRCUIT DIRECTORY, AND A MATERIALS LIST INCLUDING THE MANUFACTURERS' NAMES AND PART/CATALOG NUMBERS, ALL LAMINATED IN PLASTIC, IN A METAL POCKET ATTACHED TO THE INSIDE OF THE LOAD CENTER.
- WHEN METAL HALIDE OR MERCURY VAPOR LAMPED FIXTURES ARE USED, PROVIDE A REMOTE BULB THERMOSTAT, SO THAT THE CONTACT CLOSING AND THE LIGHTS TURN ON WHEN THE TEMPERATURE DROPS TO -9°C. WIRE THERMOSTAT SO THAT ITS CONTACT IS PARALLEL THE CONTACT IN THE PHOTOELECTRIC CELL

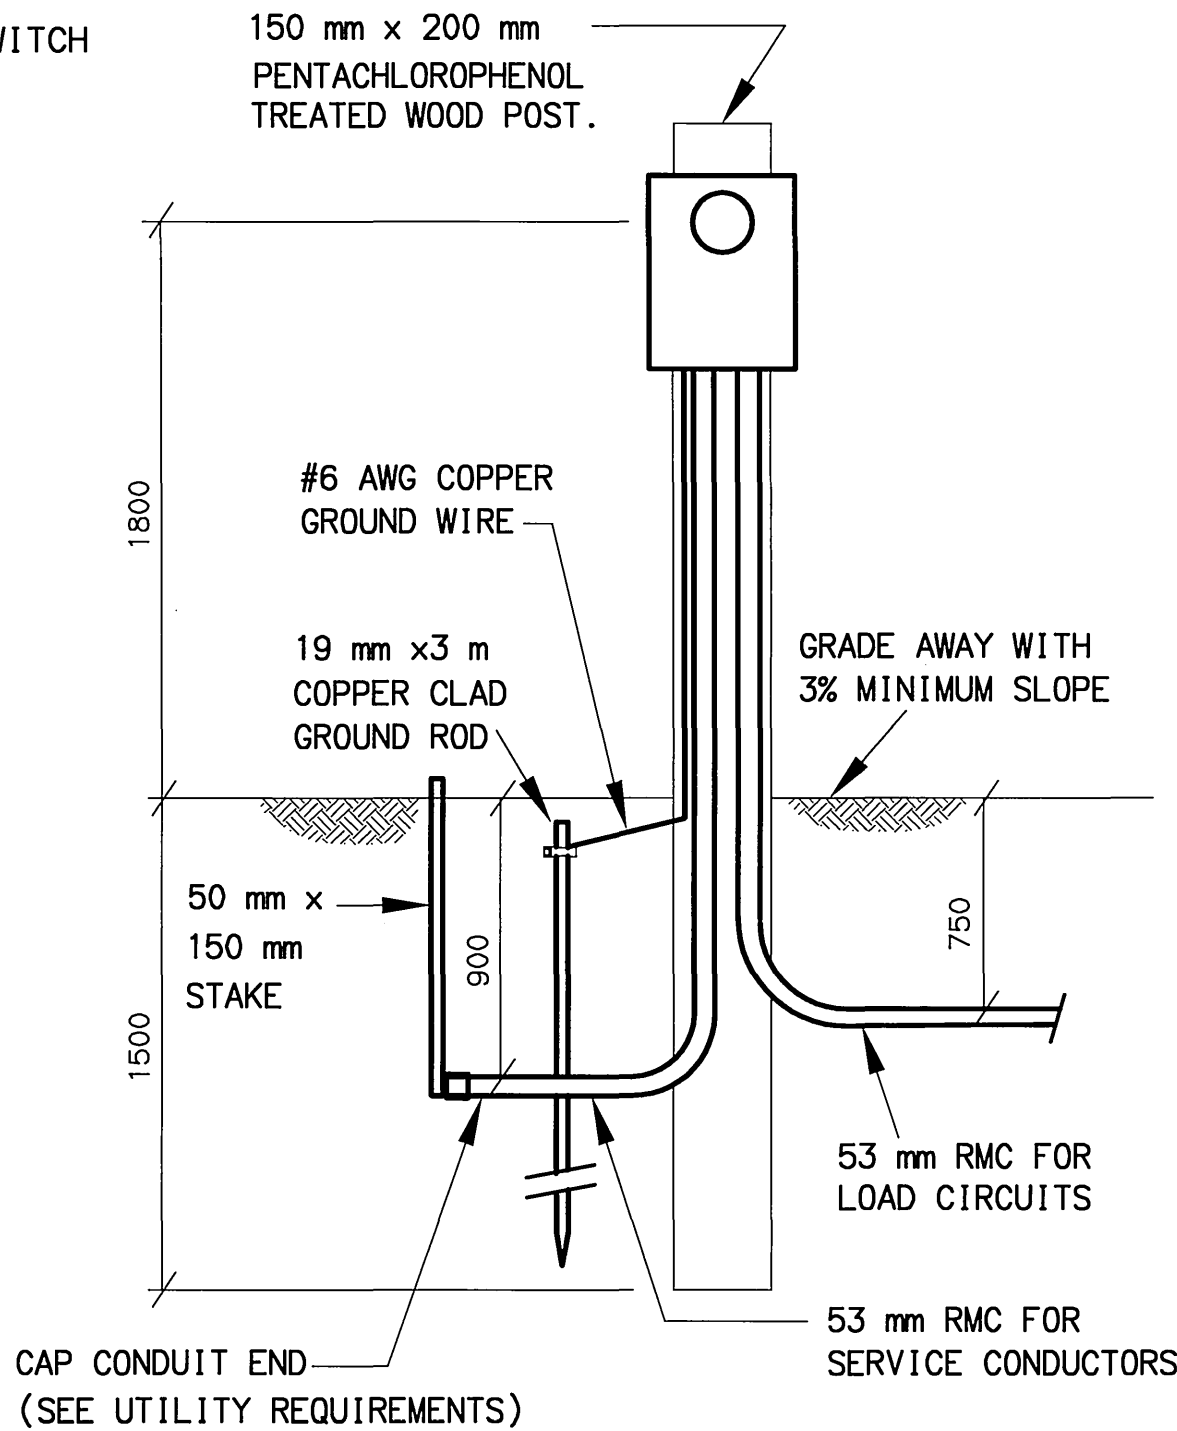

TYPE 2 LOAD CENTER
SINGLE POST - STANDARD

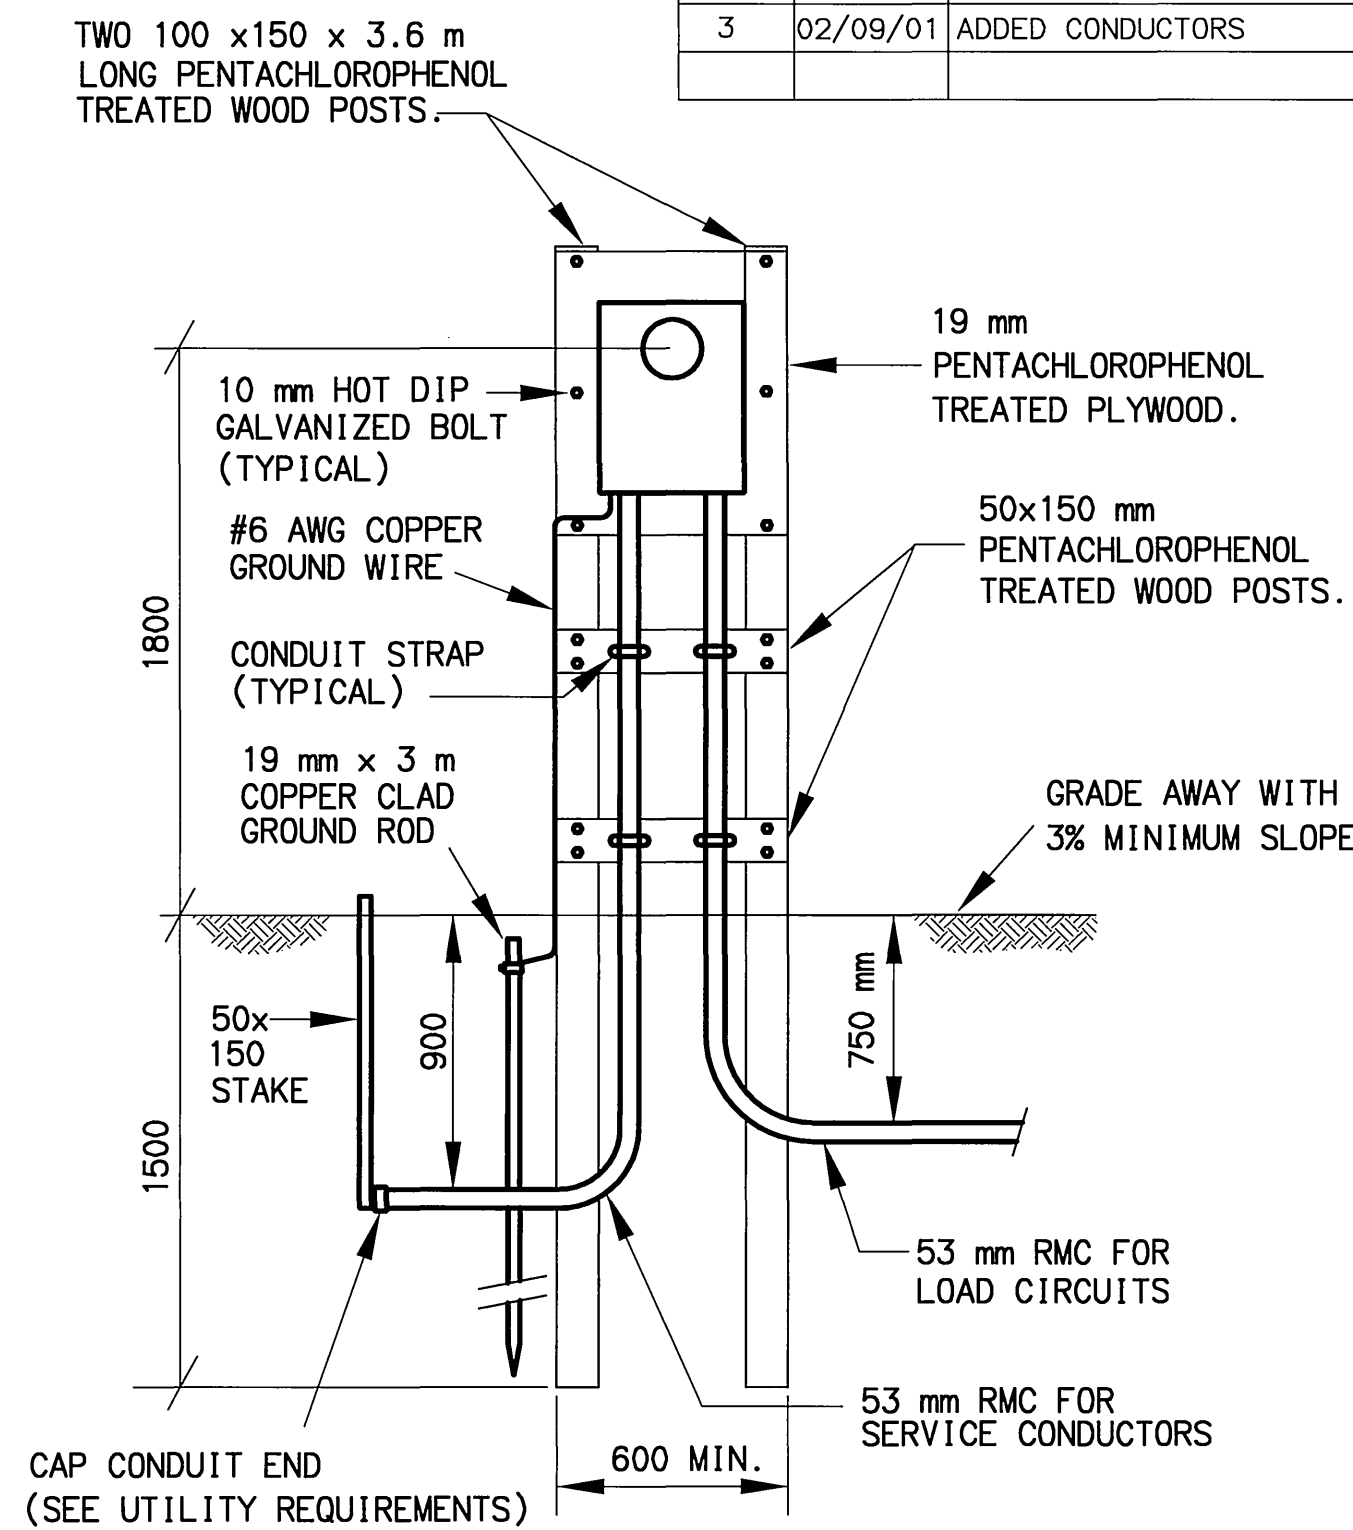

TYPE 2 LOAD CENTER
DUAL POST - ALTERNATE

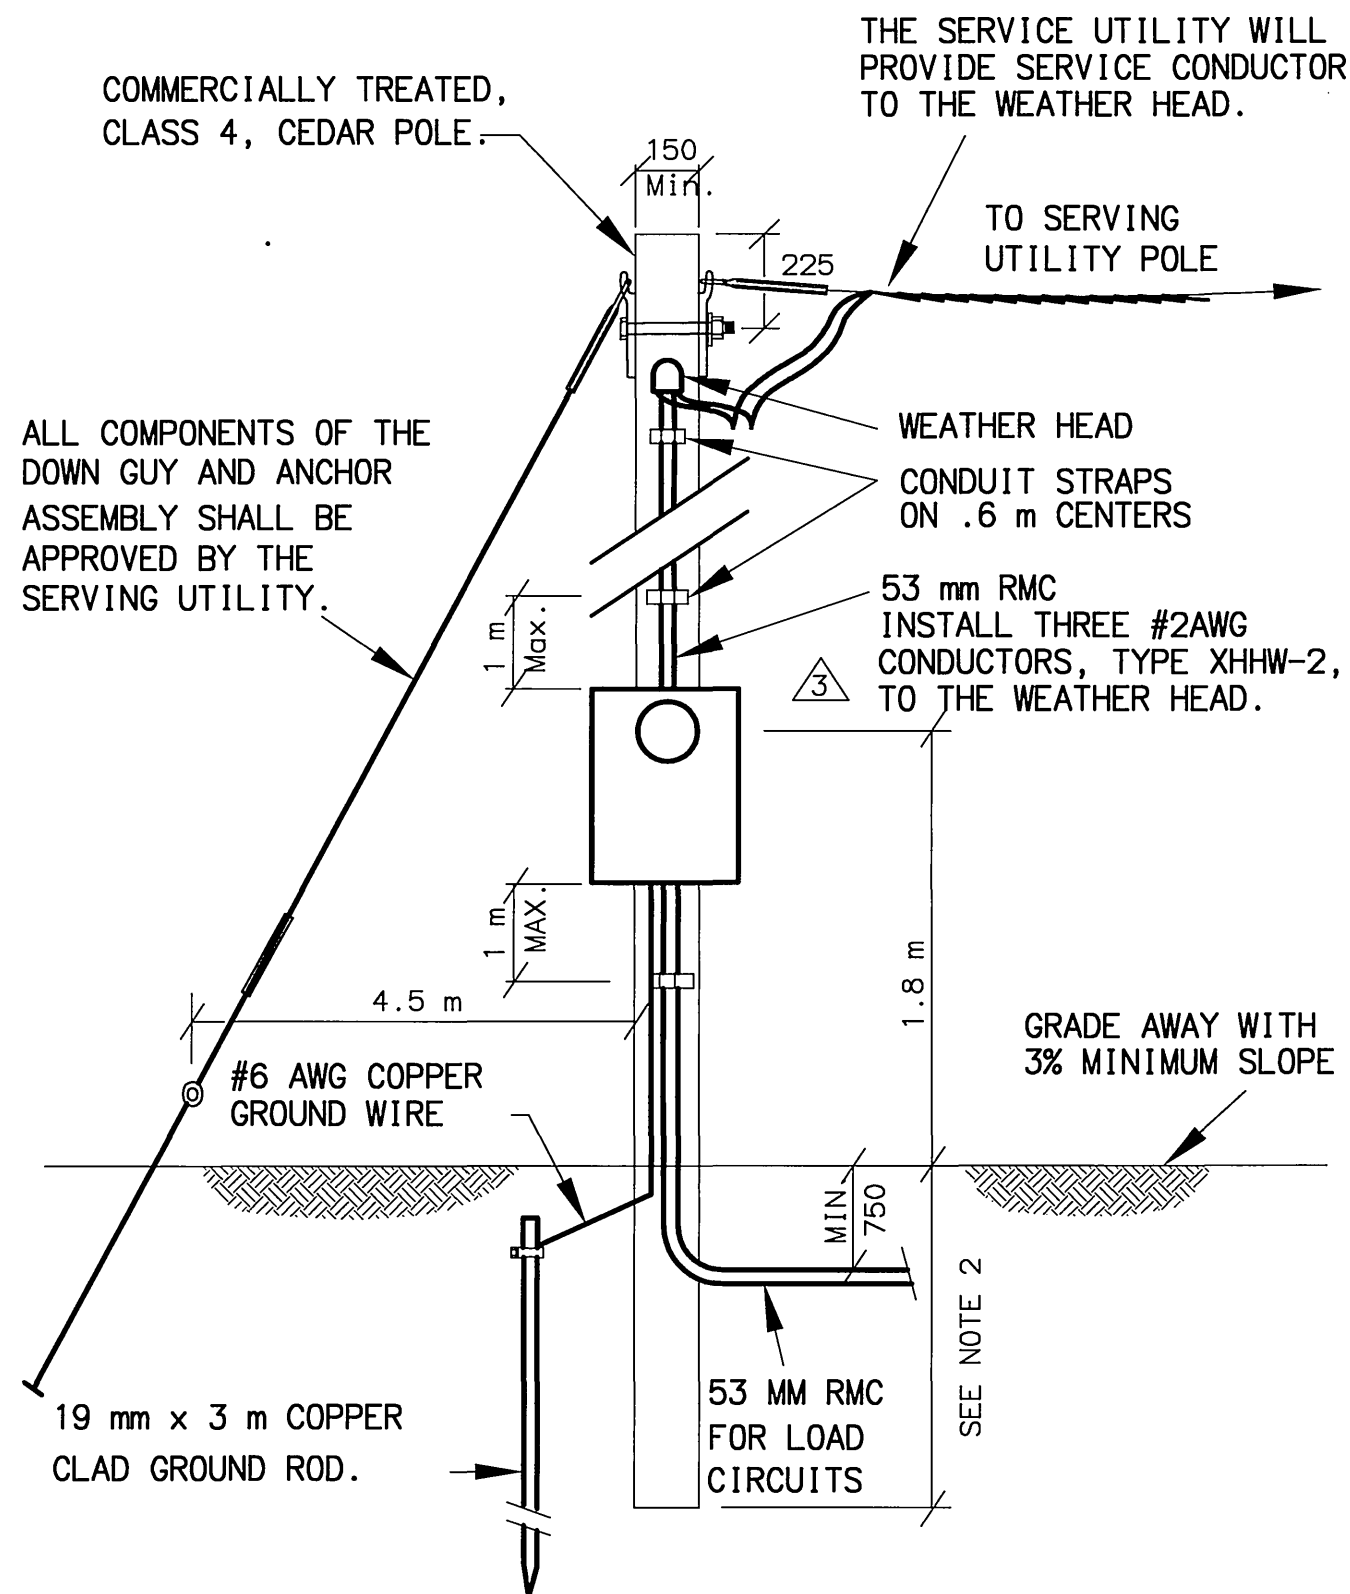

TYPE 3 LOAD CENTER

INSTALLATION NOTES:

- INSTALL TYPE 3 LOAD CENTER POLES OF SUFFICIENT LENGTH TO PROVIDE THE FOLLOWING MINIMUM GROUND TO SERVICE CONDUCTOR CLEARANCE:
 - 6.4 METERS, IF THE SERVICE CONDUCTORS ARE LOCATED ABOVE ROADWAYS OR PARKING AREAS.
 - 8.6 METERS IF THE SERVICE CONDUCTORS ARE LOCATED WITHIN 6.1 METERS OF A RAILROAD TRACK.
 - 5.5 METERS IN ALL OTHER CIRCUMSTANCES.
- SET THE BUTT END OF TYPE 3 LOAD CENTER POLES TO THE FOLLOWING MINIMUM DEPTH:
 - 10 PERCENT OF ITS LENGTH PLUS 0.6 m, OR 1.5 m, WHICHEVER IS GREATER, IF IT IS INSTALLED IN EARTH OTHER THAN SOLID ROCK OR MUSKEG.
 - 10 PERCENT OF ITS LENGTH, OR 1.2 m, WHICHEVER IS GREATER, IF IT IS INSTALLED IN SOLID ROCK.
 - CONSIDER MUSKEG TO BE AIR, AND SET THE BUTT ENDS TO THE DEPTH GIVEN IN A OR B, WHICHEVER APPLIES, IN THE UNDERLYING EARTH OR ROCK.

WHENEVER MORE THAN 0.6 m OF EARTH OVERLAYS ROCK, OR THE DIAMETER OF THE DRILLED HOLE IN ROCK EXCEEDS TWICE THE DIAMETER OF THE POLE AT THE GROUND LINE, CONSIDER THE INSTALLATION AS EARTH.

- ATTACH ALL CONDUITS TO THE POSTS AND POLES USING TWO HOLE RIGID METAL CONDUIT STRAPS LOCATED ON 0.6 m MAXIMUM CENTERS.
- ATTACH ALL GROUND CONDUCTORS TO THE POSTS AND POLES USING CABLE STAPLES LOCATED ON 0.3 m CENTERS.

UTILITY REQUIREMENTS:

- USE THE SINGLE-POST TYPE 2 "STANDARD" LOAD CENTER IN ALL LOCATIONS EXCEPT WHERE THE SERVING UTILITY REQUIRES THE TWO-POST TYPE 2 "ALTERNATIVE" LOAD CENTER. REFER TO THE LOAD CENTER SUMMARY FOR WHICH TO INSTALL.
- THE LENGTH AND TYPE OF SERVICE ENTRANCE CONDUIT INSTALLED BY THE CONTRACTOR VARIES BY UTILITY. REGARDLESS OF ITS LENGTH, INSTALL A PULL ROPE IN THE SERVICE CONDUIT AND A CAP ON THE BURIED END: MARK THE BURIED END WITH A 50 mm X 150 mm STAKE. SEE THE LOAD CENTER SUMMARIES FOR THE FOLLOWING INFORMATION.
 - STATION AND OFFSET OF THE LOAD CENTER AND POWER SOURCE.
 - WHERE THE CONTRACTOR TERMINATES THE SERVICE ENTRANCE CONDUIT.
 - THE TYPE OF SERVICE ENTRANCE CONDUIT (SUCH AS RIGID METAL CONDUIT OR LIQUID-TIGHT FLEXIBLE METAL CONDUIT).
 - THE MAXIMUM AND MINIMUM DISTANCES ALLOWED BETWEEN THE TYPE-3 LOAD CENTER POLE AND UTILITY POLE TO WHICH THE AERIAL DROP IS CONNECTED.

ALL DIMENSIONS IN MILLIMETER (mm) UNLESS OTHERWISE NOTED.




STATE OF ALASKA
DEPARTMENT OF TRANSPORTATION
AND
PUBLIC FACILITIES
**SEWARD HIGHWAY
MP 96 TO MP 102
SAFETY, ROADWAY AND
RECREATIONAL IMPROVEMENTS**
**TYPE 2 AND 3
LOAD CENTER DETAILS**

REVISIONS			PROJECT DESIGNATION		YEAR	SHEET NO.	TOTAL SHEETS
No.	DATE	DESCRIPTION	NH-0A3-I(28)/54433		2002	E7	E30


LIGHTING NOTES:

1. INITIAL LIGHTING LEVEL – 110 LUX. UNIFORMITY RATIO – AVERAGE TO MIN. NOT TO EXCEED 3.0:1.
2. ENCLOSURE SHALL BE FABRICATED FROM 10 GAUGE MILD STEEL. ALL SEAMS TO BE CONTINUOUSLY WELDED AND GROUND SMOOTH. FIXTURE SUPPORT BOLTS IN THE ENCLOSURE SHALL MATCH THE MOUNTING HOLES IN THE SELECTED FIXTURE. SUPPORT ANGLES ON THE ENCLOSURE SHALL BE ATTACHED TO THE ENCLOSURE WITH 25 mm WELDS SPACED A MAXIMUM OF 75 mm ON CENTER, OR WITH CONTINUOUS WELDS. ENCLOSURE TO BE HOT DIPPED GALVANIZED AFTER FABRICATION. THREADED FASTENERS SHALL NOT BE GALVANIZED, AND THREADED HOLES TO BE TAPPED AFTER GALVANIZING. CONTRACTOR SHALL VERIFY THE DIMENSIONS OF THE FIXTURE PRIOR TO FABRICATING ENCLOSURE.
3. CONDUITS TO THE JUNCTION BOXES TO BE SUPPORTED BY THE SHELL OF THE TUNNEL, AND ATTACHED WITH GALVANIZED CONDUIT CLAMPS ATTACHED TO THE TUNNEL SHELL WITH EITHER POWDER DRIVEN FASTENERS OR SELF TAPPING BOLTS. SPACING OF CLAMPS NOT TO EXCEED 1.5 METERS, AND WITHIN 0.5 METERS OF THE JUNCTION BOX.
4. CONDUCTORS INSIDE OF ENCLOSURE THAT CAN CONTACT THE BALLAST SHALL BE RATED 200°C, SF-2 OR EQUAL. A TERMINAL STRIP, MOUNTED IN THE ENCLOSURE, MAY BE USED TO CONNECT WIRES WITH A LOWER TEMPERATURE RATED WIRING TO THE 200°C WIRING, OR THE WIRES MAY BE SPLICED OUTSIDE OF THE ENCLOSURE IN THE J-BOX. WIRING ENTERING THE ENCLOSURE, THROUGH THE TOP, SHALL BE PROVIDED WITH A WATER TIGHT COMPRESSION SEAL.
5. ATTACH JUNCTION BOXES TO THE TUNNEL SHELL BY CONTINUOUS WELDS.
6. ENCLOSURE TO BE ATTACHED TO THE TUNNEL SHELL EITHER BY CAPTIVE, OR SELF TAPPING, STAINLESS STEEL BOLTS, SO THAT THE ENCLOSURES CAN BE INSTALLED, AND REMOVED, FROM INSIDE THE TUNNEL.
7. CAP ALL UNUSED OPENINGS IN ELECTRICAL ITEMS WITH WATER PROOF PLUGS.
8. FIXTURES ARE TO BE INSTALLED CENTERED IN THE TUNNEL SO THAT THE 90° PLANE LIGHT DISTRIBUTION IS IN LINE WITH THE LONGITUDINAL DIMENSION OF THE TUNNEL.
9. GROUNDING: ALL LIGHTING ENCLOSURES SHALL BE CONNECTED TO THE GROUND IN THE TYPE 1A JUNCTION BOX, WITH A CONTINUOUS CONDUCTOR INSTALLED IN THE CONDUIT. THE JUNCTION BOX GROUND CONDUCTOR SHALL BE A MINIMUM OF #6 AWG BARE COPPER CONNECTED TO THE SHELL OF THE TUNNEL INSTEAD OF A GROUND ROD. CONNECTION TO THE TUNNEL SHALL BE MADE USING A COMPRESSION FITTING BOLTED OR THERMITE WELDED. (CADWELD, THERMOWELD, OR EQUIVALENT).
10. PROVIDE A WATER TIGHT FITTING WHERE THE CONDUCTORS ENTER THE ENCLOSURE. THE SEAL AROUND THE CONDUCTORS SHALL USE A RUBBER GROMMET COMPRESSED WITH AN EXTERNAL TREADED CAP.
11. THE TYPE 1A JUNCTION BOX FEEDING THE UNDERPASS LIGHTING SHALL BE LOCATED LOWER THAN THE JUNCTION BOXES FEEDING THE LIGHT FIXTURES TO ALLOW CONDUITS TO DRAIN.
12. PROVIDE AND INSTALL S.E.C. MODEL LG-191511-C-1X1 OR EQUAL HEAVY DUTY STEEL WIRE GUARDS.


Summary of Load Center: A				
Load center type:		2		
		Location Data:		
Load center:		20.0 meters right of station	40+460	
Power source:		36.0 meters right of station	40+675	
Photoelectric control: None required				
Service voltage:		1 phase, 3 wire, 120/240 volts AC with grounded neutral		
Provide meter socket?Yes				
Main Breaker A:		240 volt, 2 pole,	100 amperes	
Contactor :		None required		
Panel A				
Circuit Number	Description	KVA	Breaker	
		Load	Amps	Poles
DA1	Pedestrian Undercrossing Luminaires	1.3	20	2
DA2	Spare		20	2
DA3	Spare		20	2
DA4	Spare		20	2
DA5	Spare		20	2
DA6	Spare		20	2

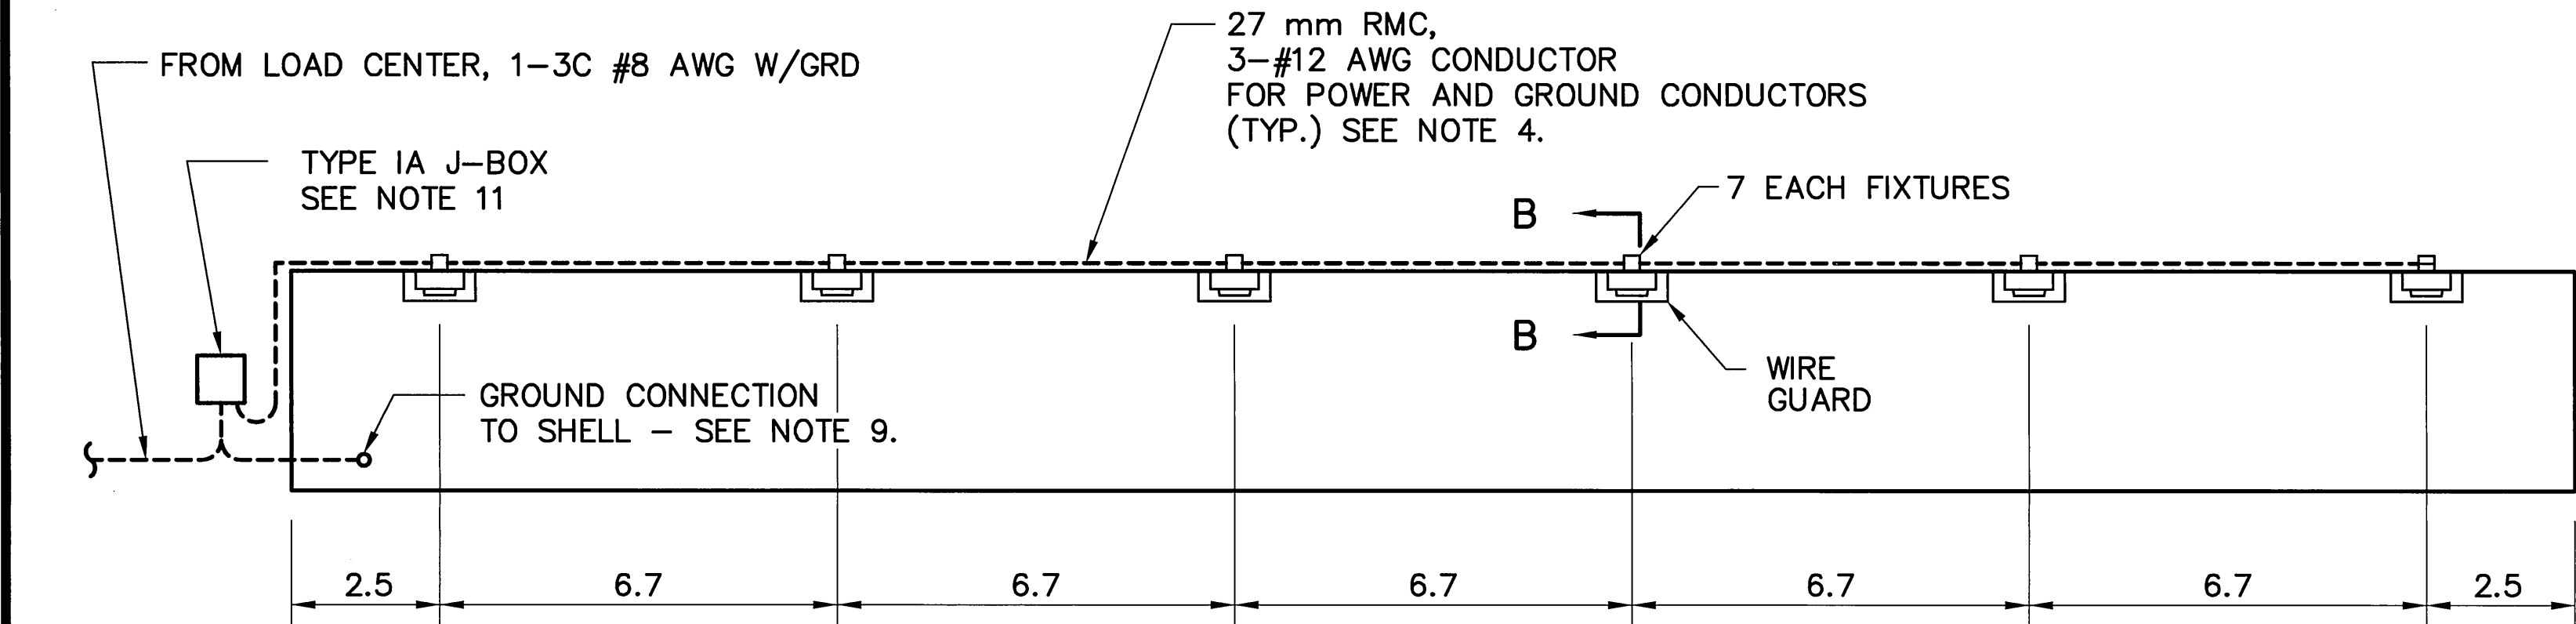


PEDESTRIAN UNDERCROSSING LIGHTING

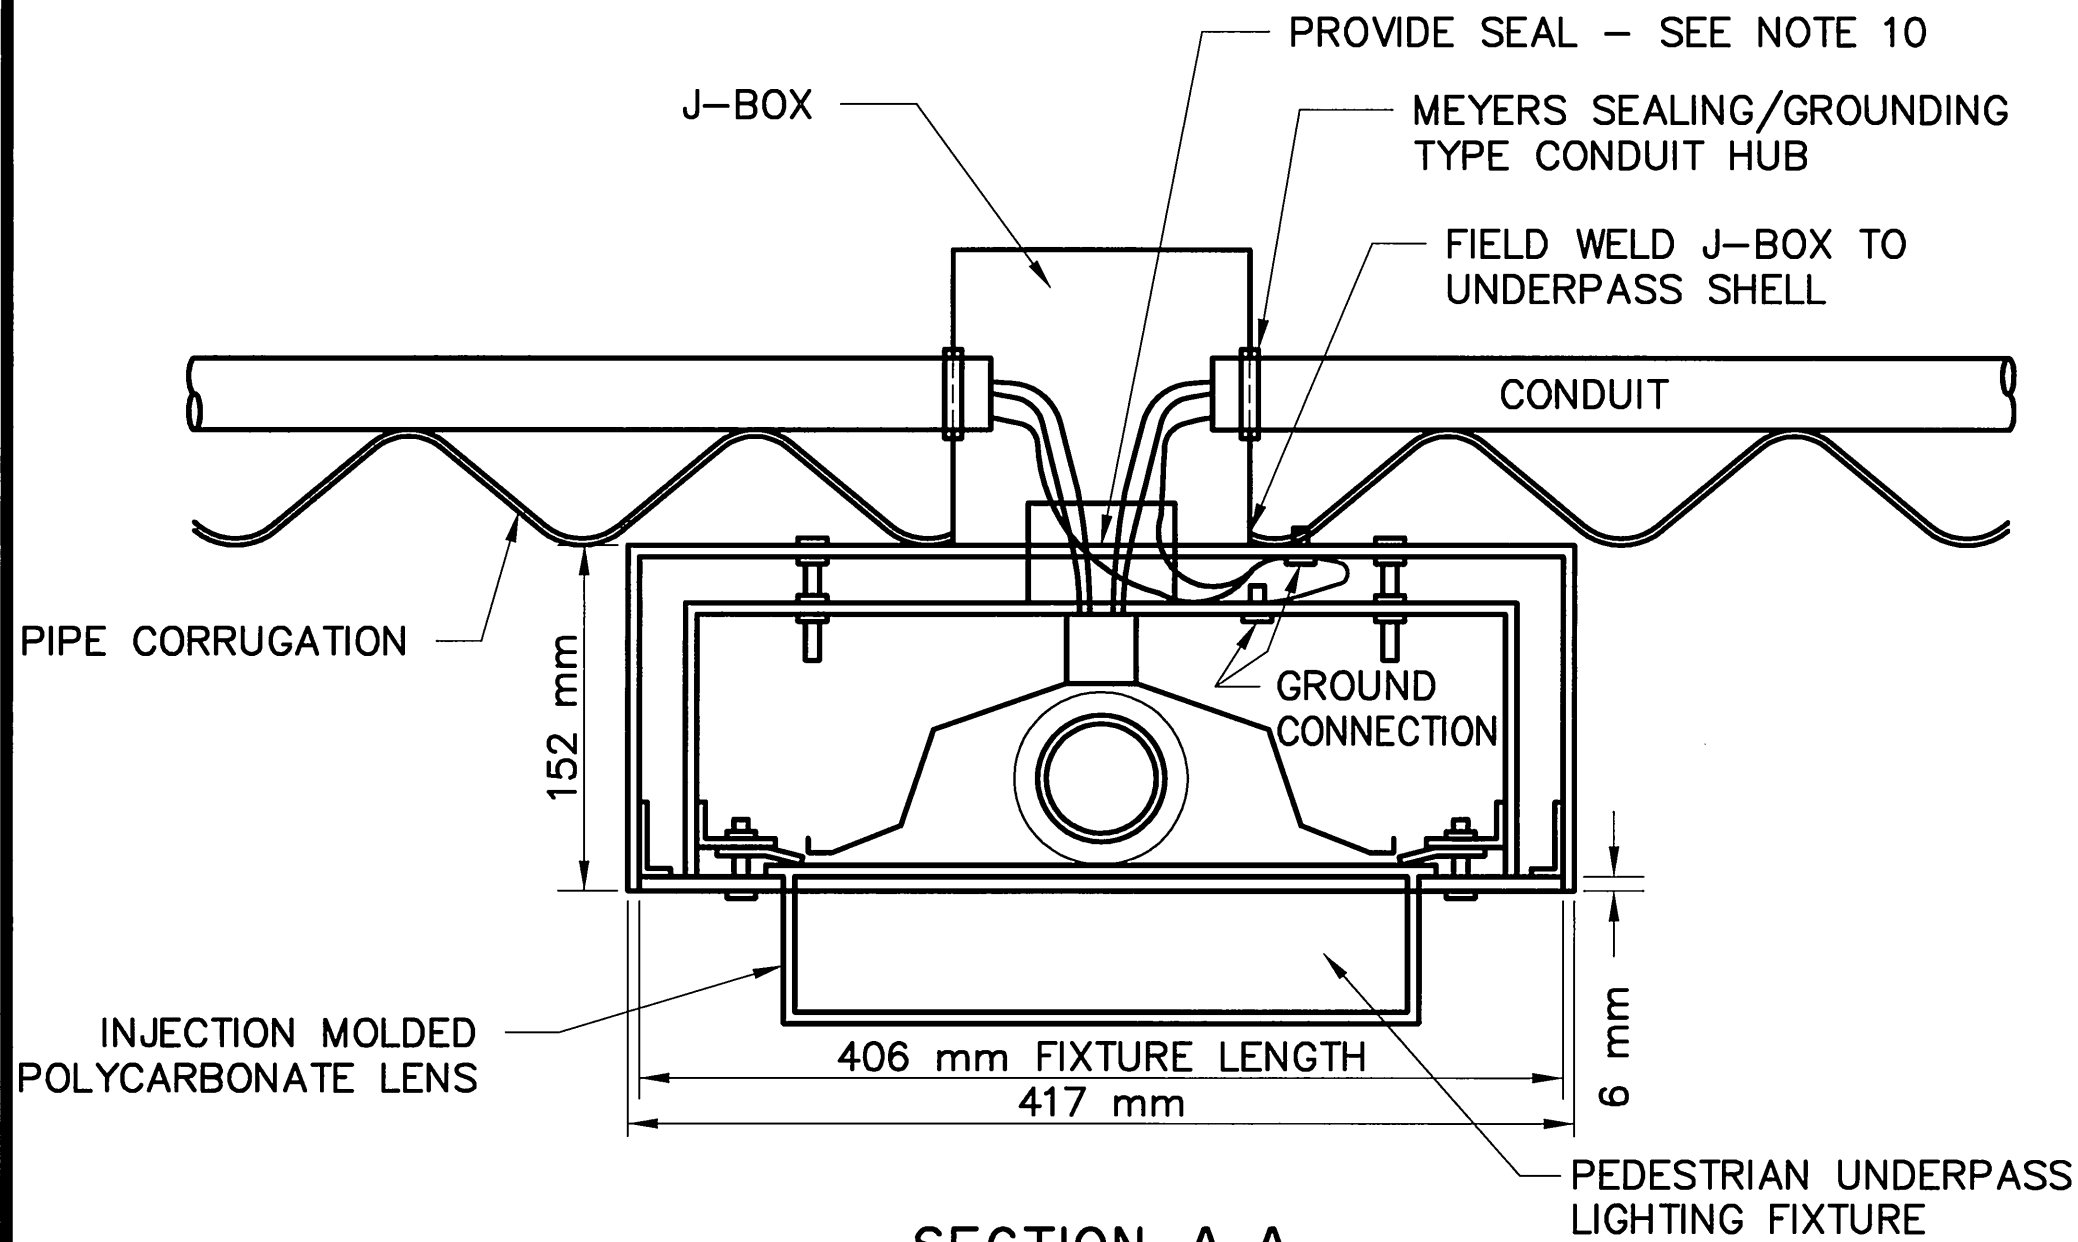


SECTION A-A
90° PLANE

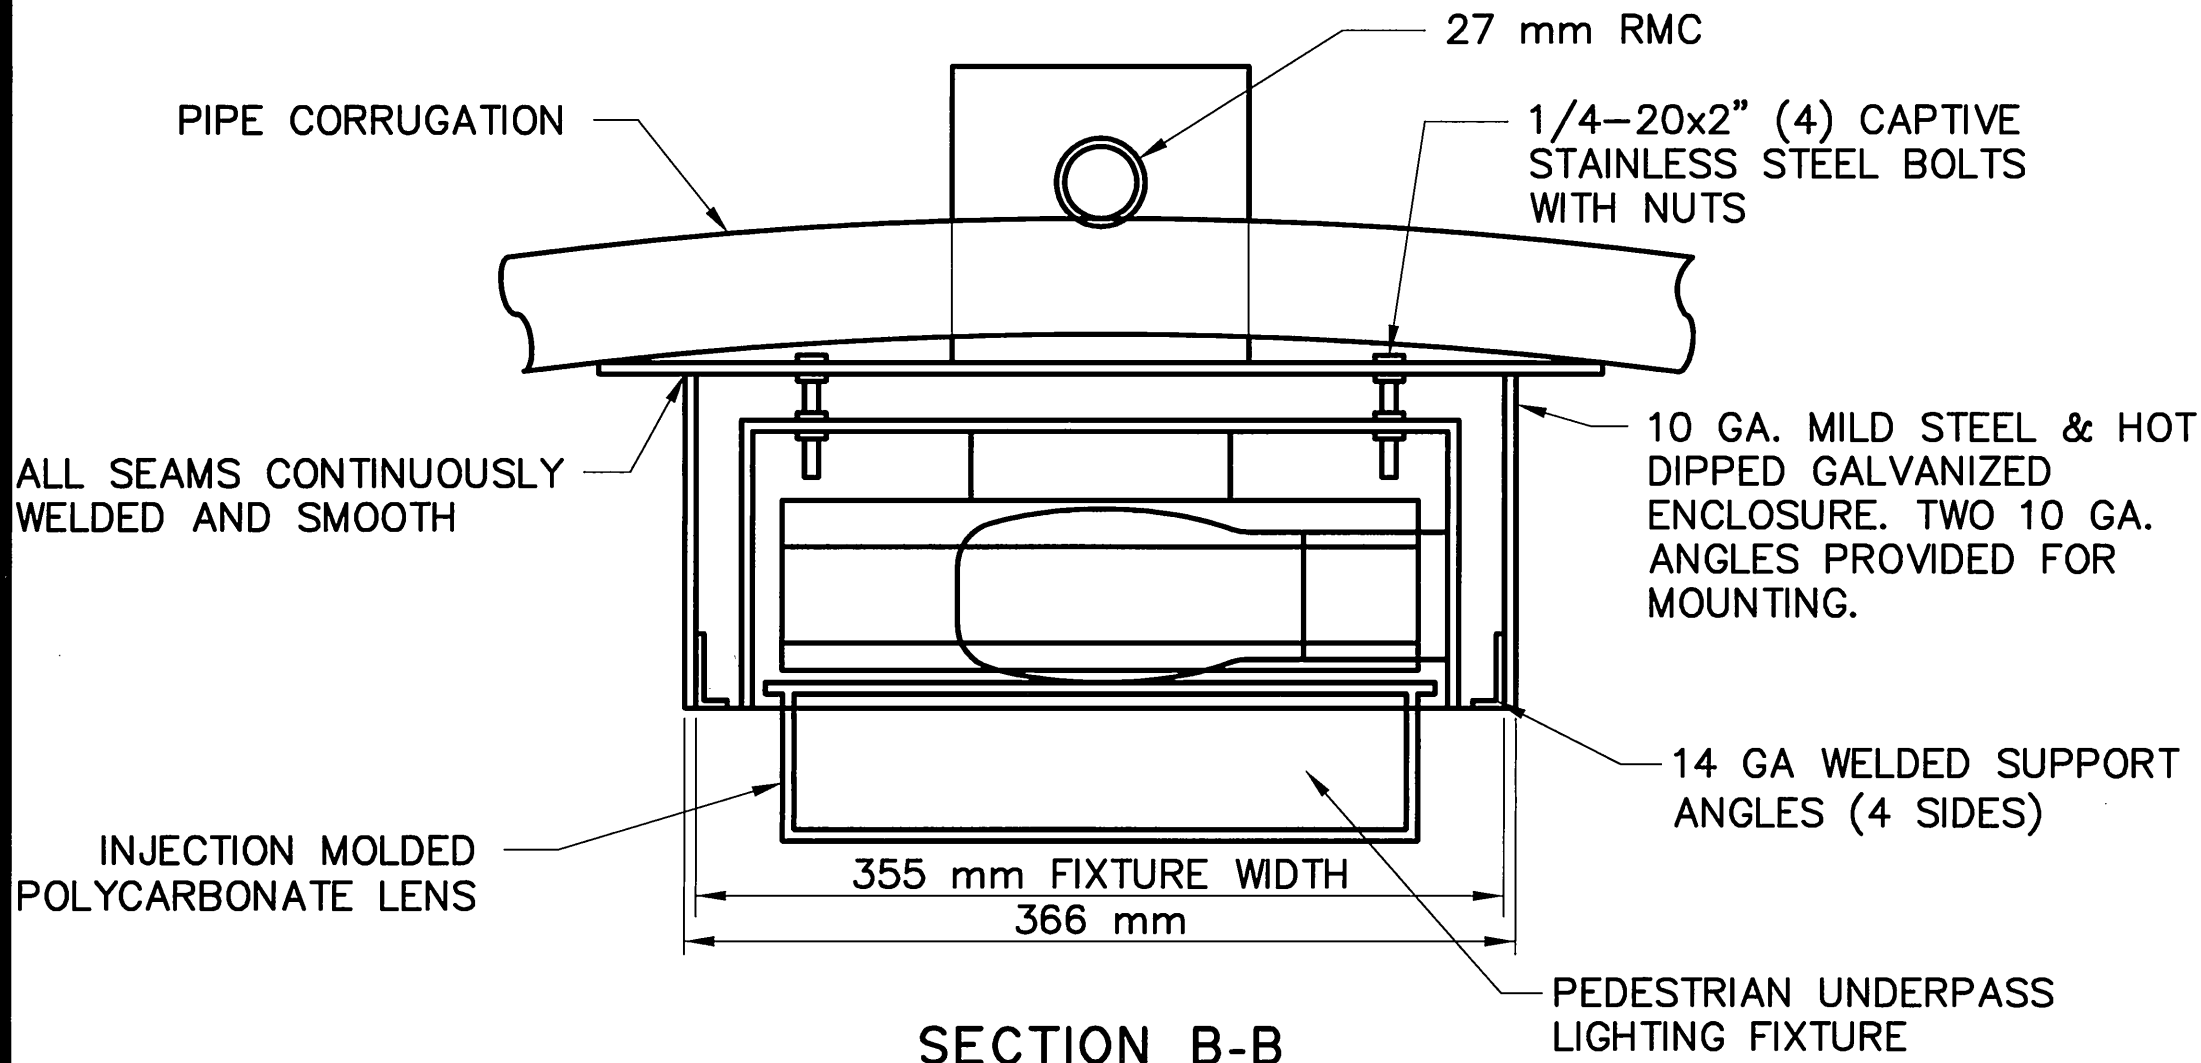


SECTION B-B
0° PLANE

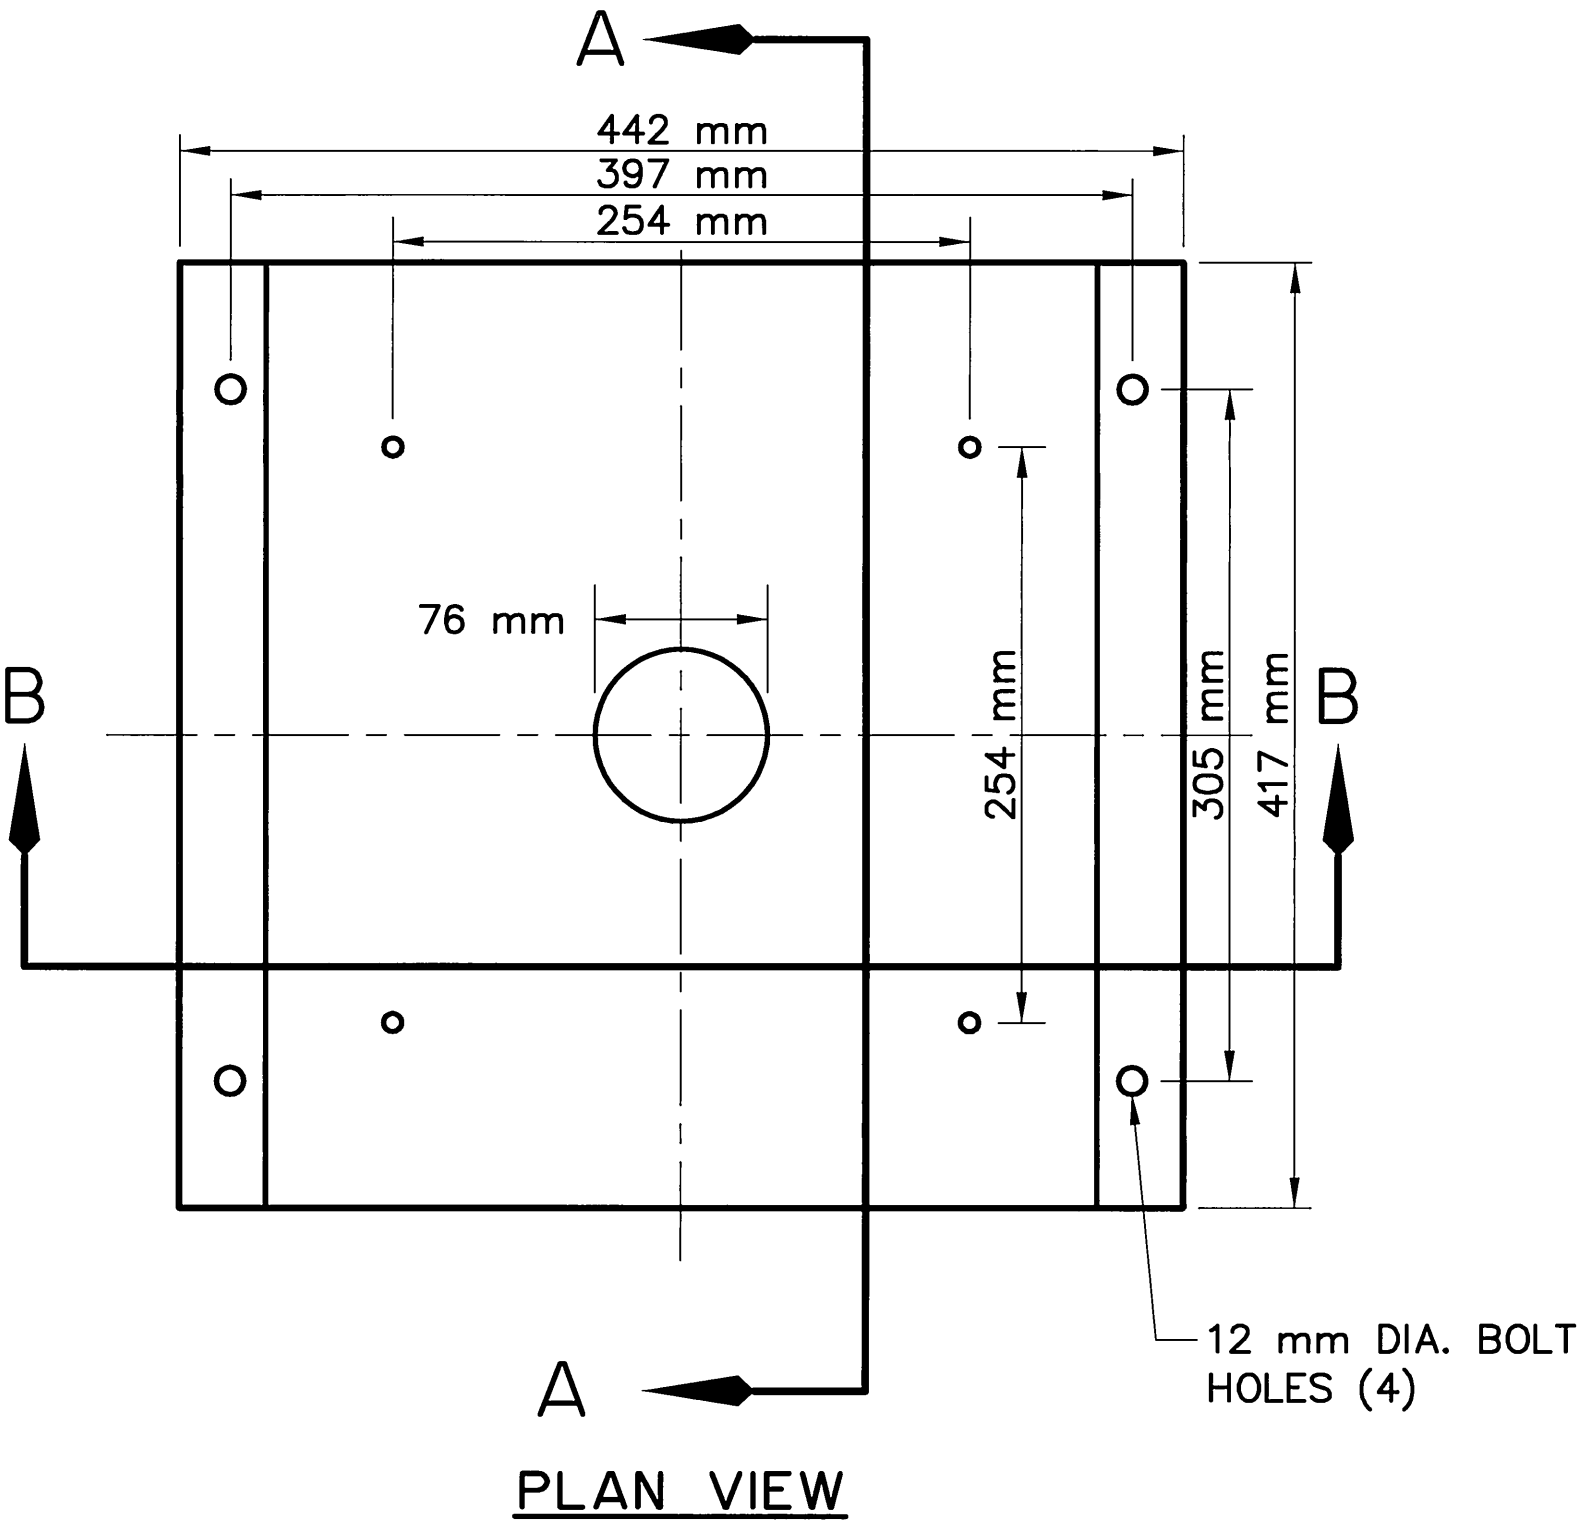




PLAN VIEW

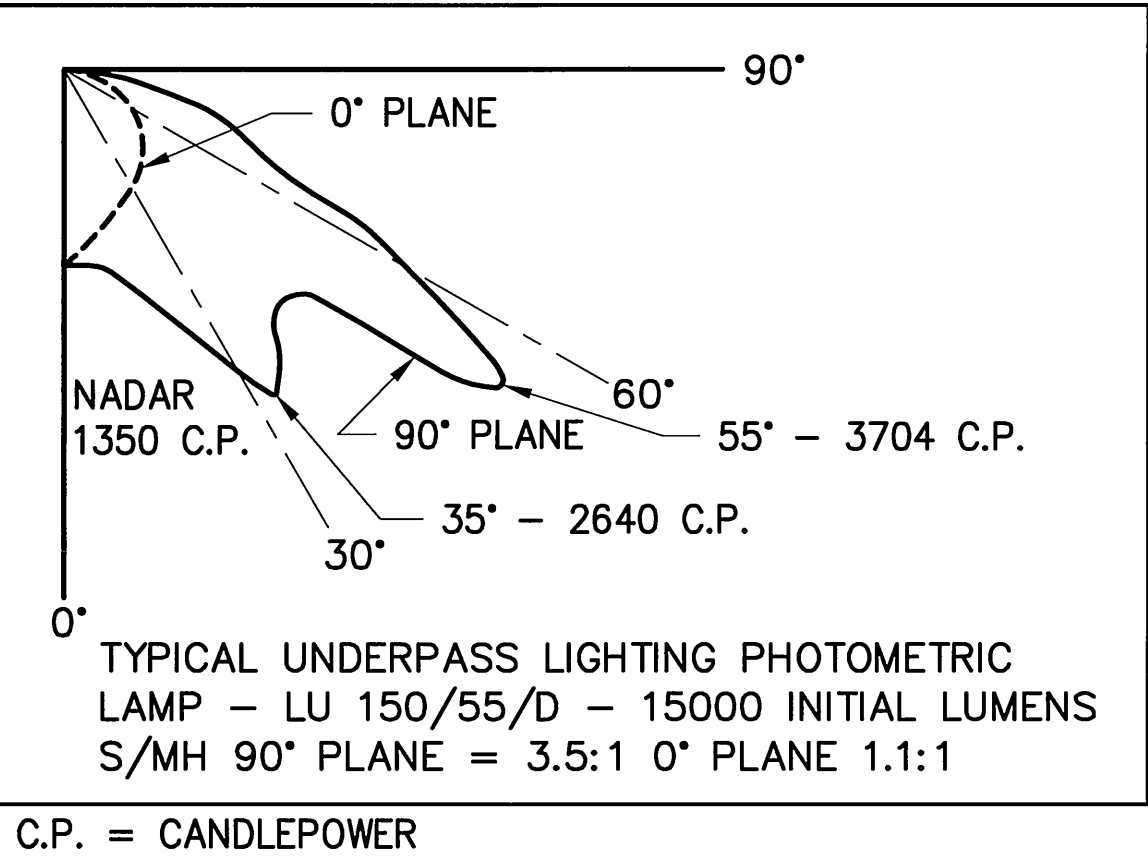

STATE OF ALASKA
DEPARTMENT OF TRANSPORTATION
AND
PUBLIC FACILITIES
**SEWARD HIGHWAY
MP 96 TO MP 102
SAFETY, ROADWAY AND
RECREATIONAL IMPROVEMENTS**
**PEDESTRIAN
UNDERCROSSING ILLUMINATION**

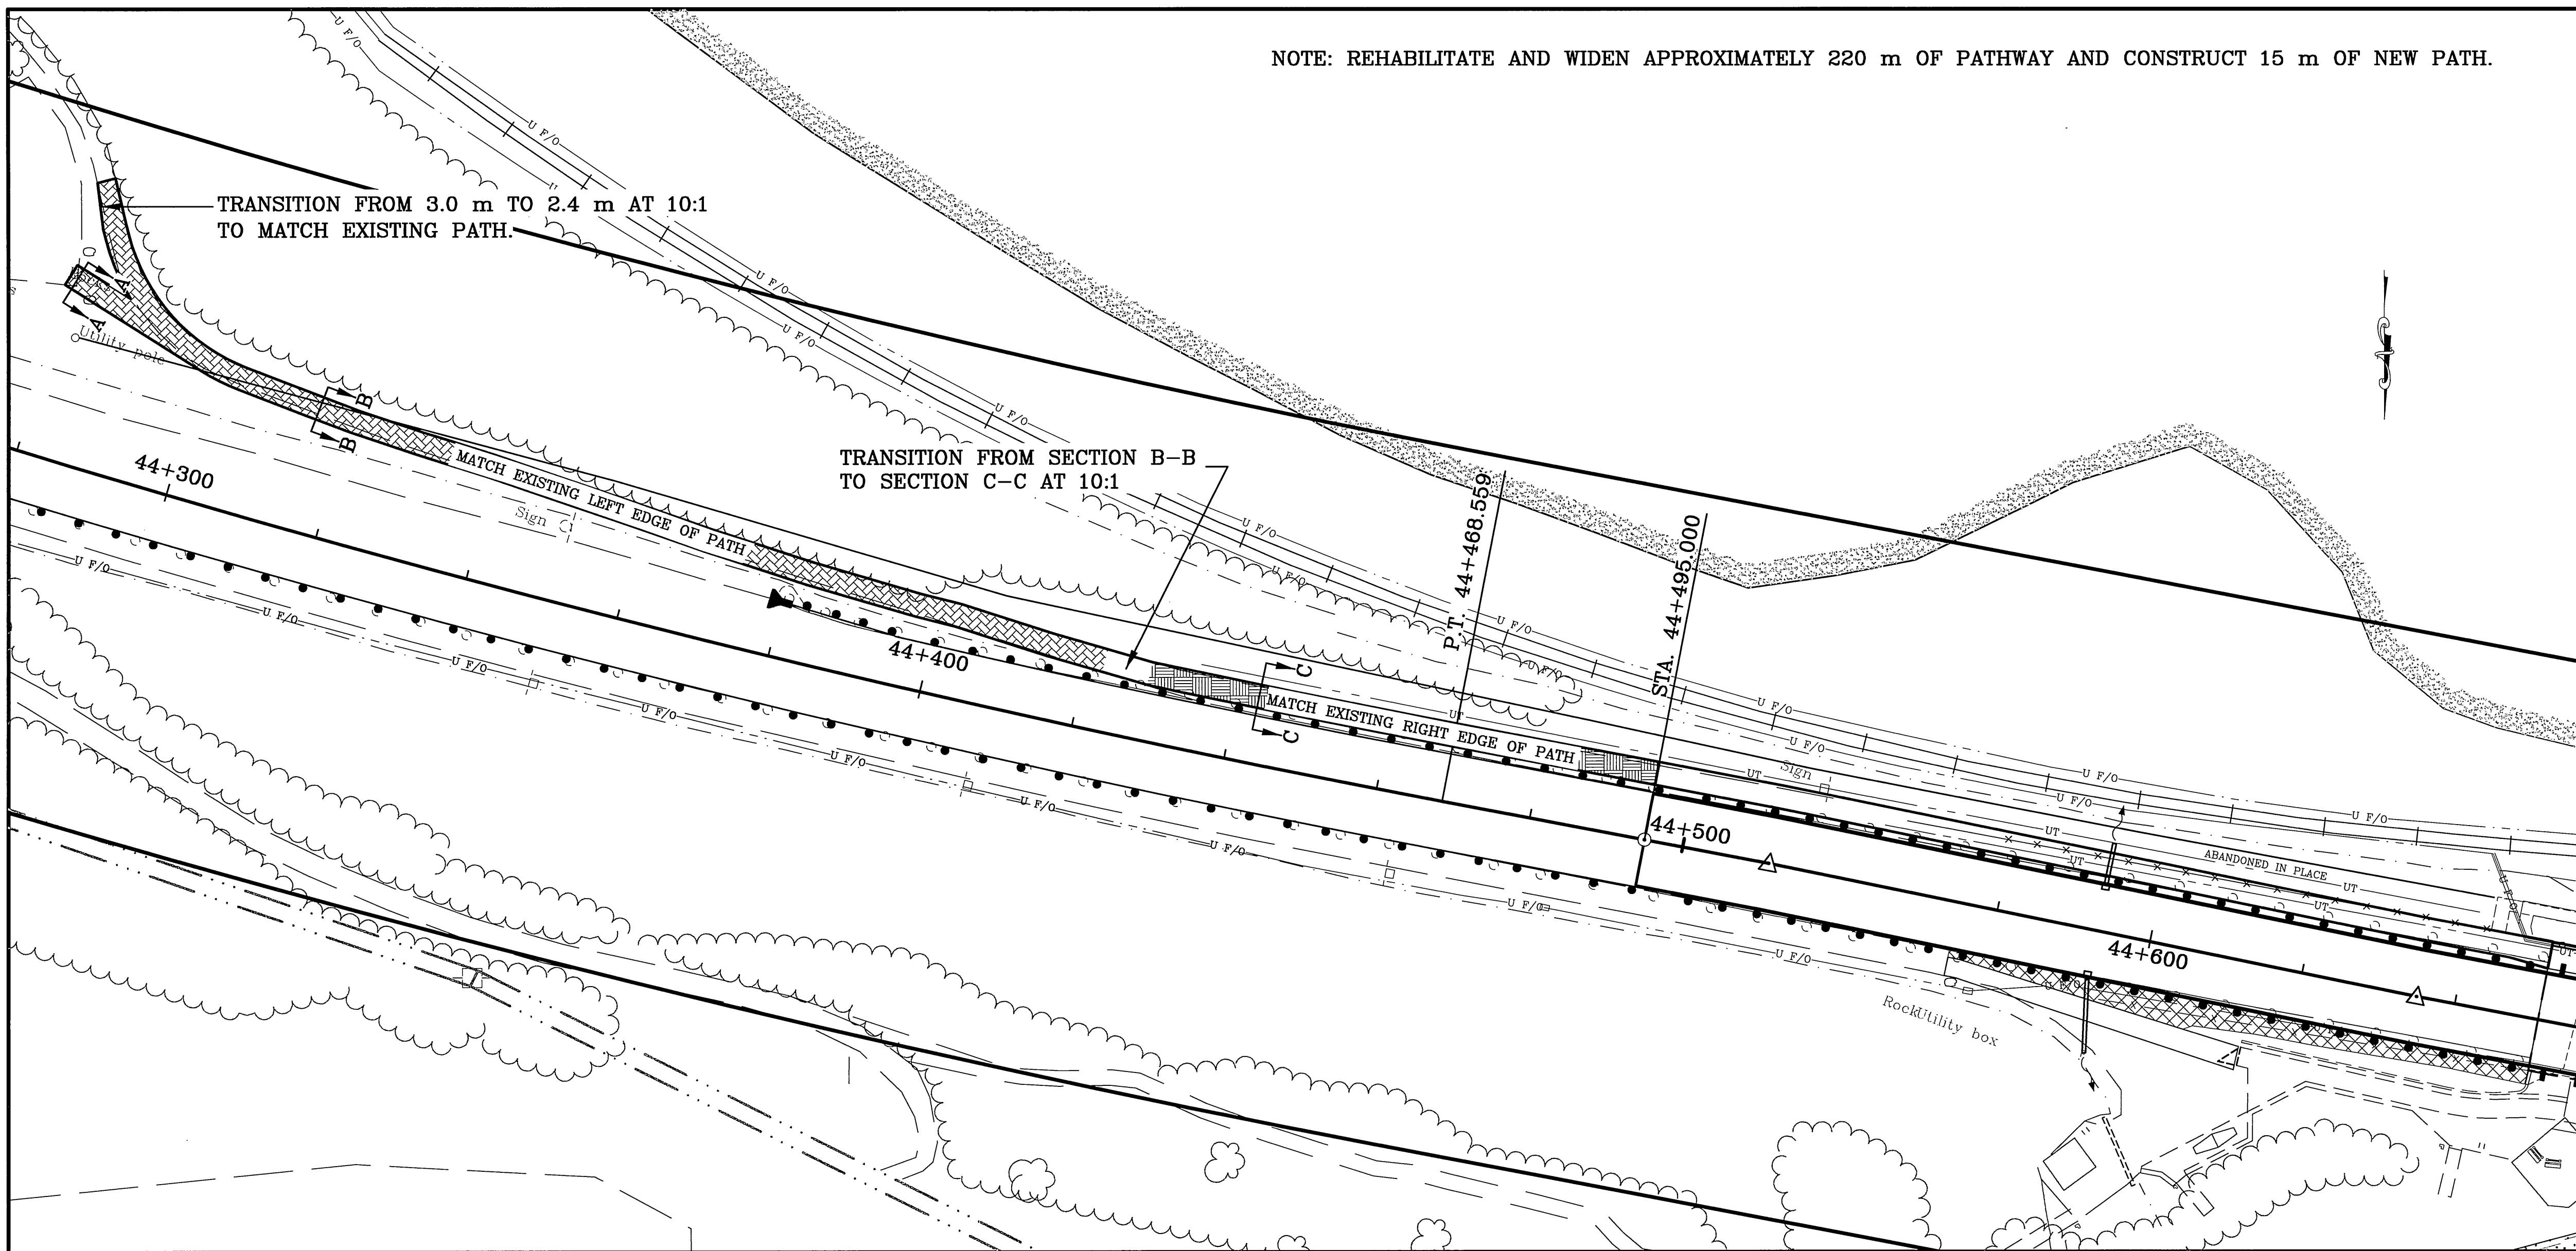

SPECIFICATIONS
SCALE 1"=1'
COMPUTER DESIGNATION
DESIGNED BY
CHECKED BY
DRAFTED BY
VIEW=HALF 01 AT 5
8-22-01 9:27:38 am EST
KMH

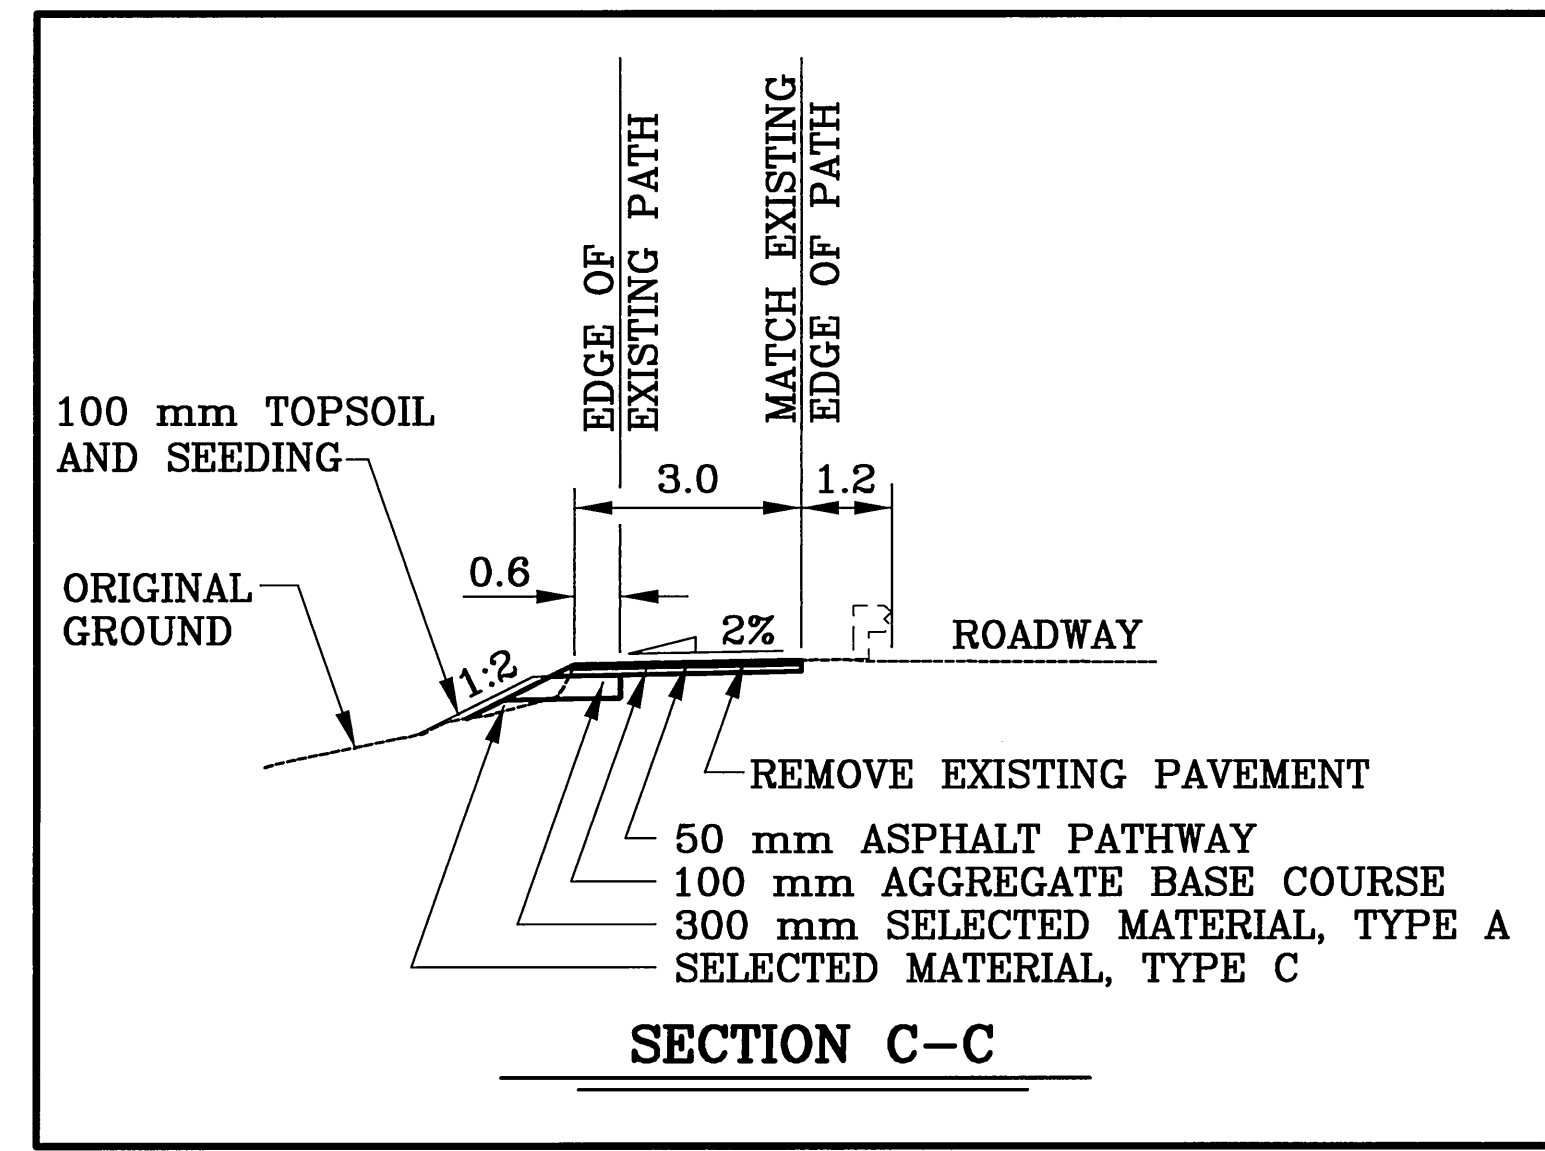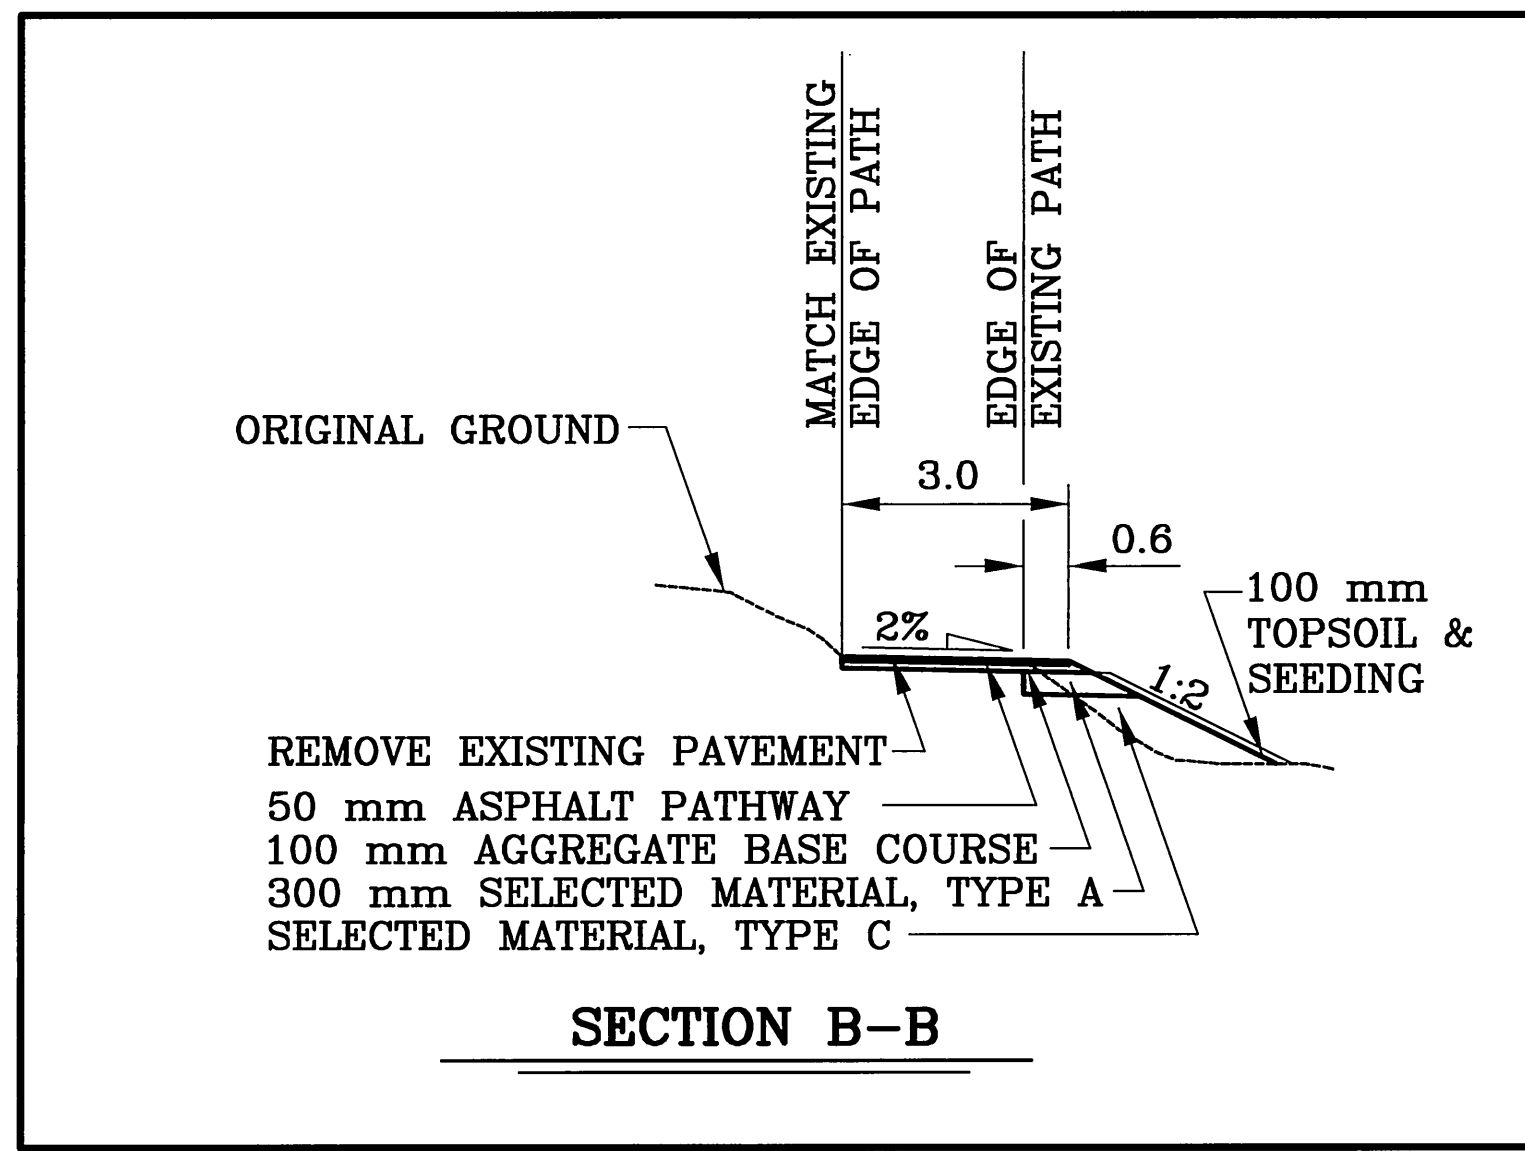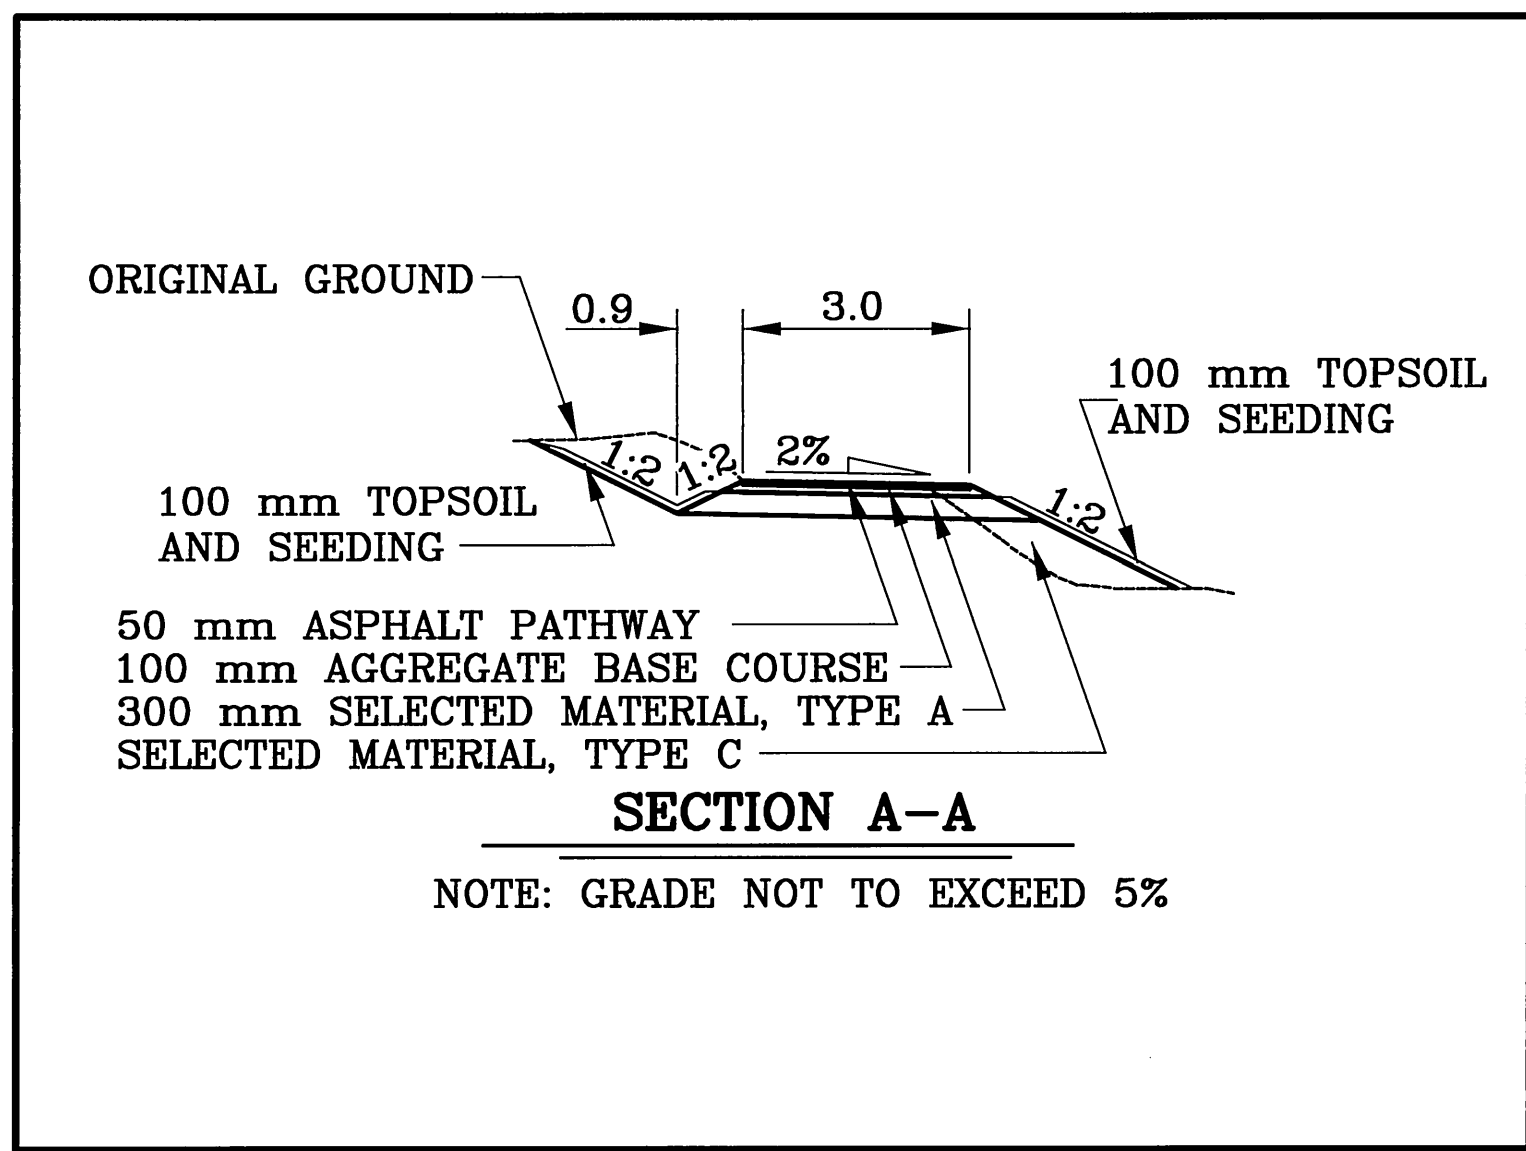


SHEET NO.	TOTAL SHEETS	
E8	E30	
STATE	YEAR	
ALASKA	2002	
PROJECT DESIGNATION		
NH-0A3-1(28)		
ADDENDUM NO.		
ATTACHMENT NO.		
REVISIONS		
NO.	DATE	DESCRIPTION


NOTE:
DIMENSIONS ARE IN METERS
UNLESS OTHERWISE NOTED.

STATE OF ALASKA
49th
JUDY J. BOUGHREY
CE 8823
6.18.12
REGISTERED PROFESSIONAL ENGINEER

STATE OF ALASKA
DEPARTMENT OF TRANSPORTATION
AND PUBLIC FACILITIES
SEWARD HIGHWAY
MP 96 TO MP 102
SAFETY, ROADWAY &
RECREATIONAL IMPROVEMENTS
BIRD CREEK PATHWAY
REHABILITATION DETAIL

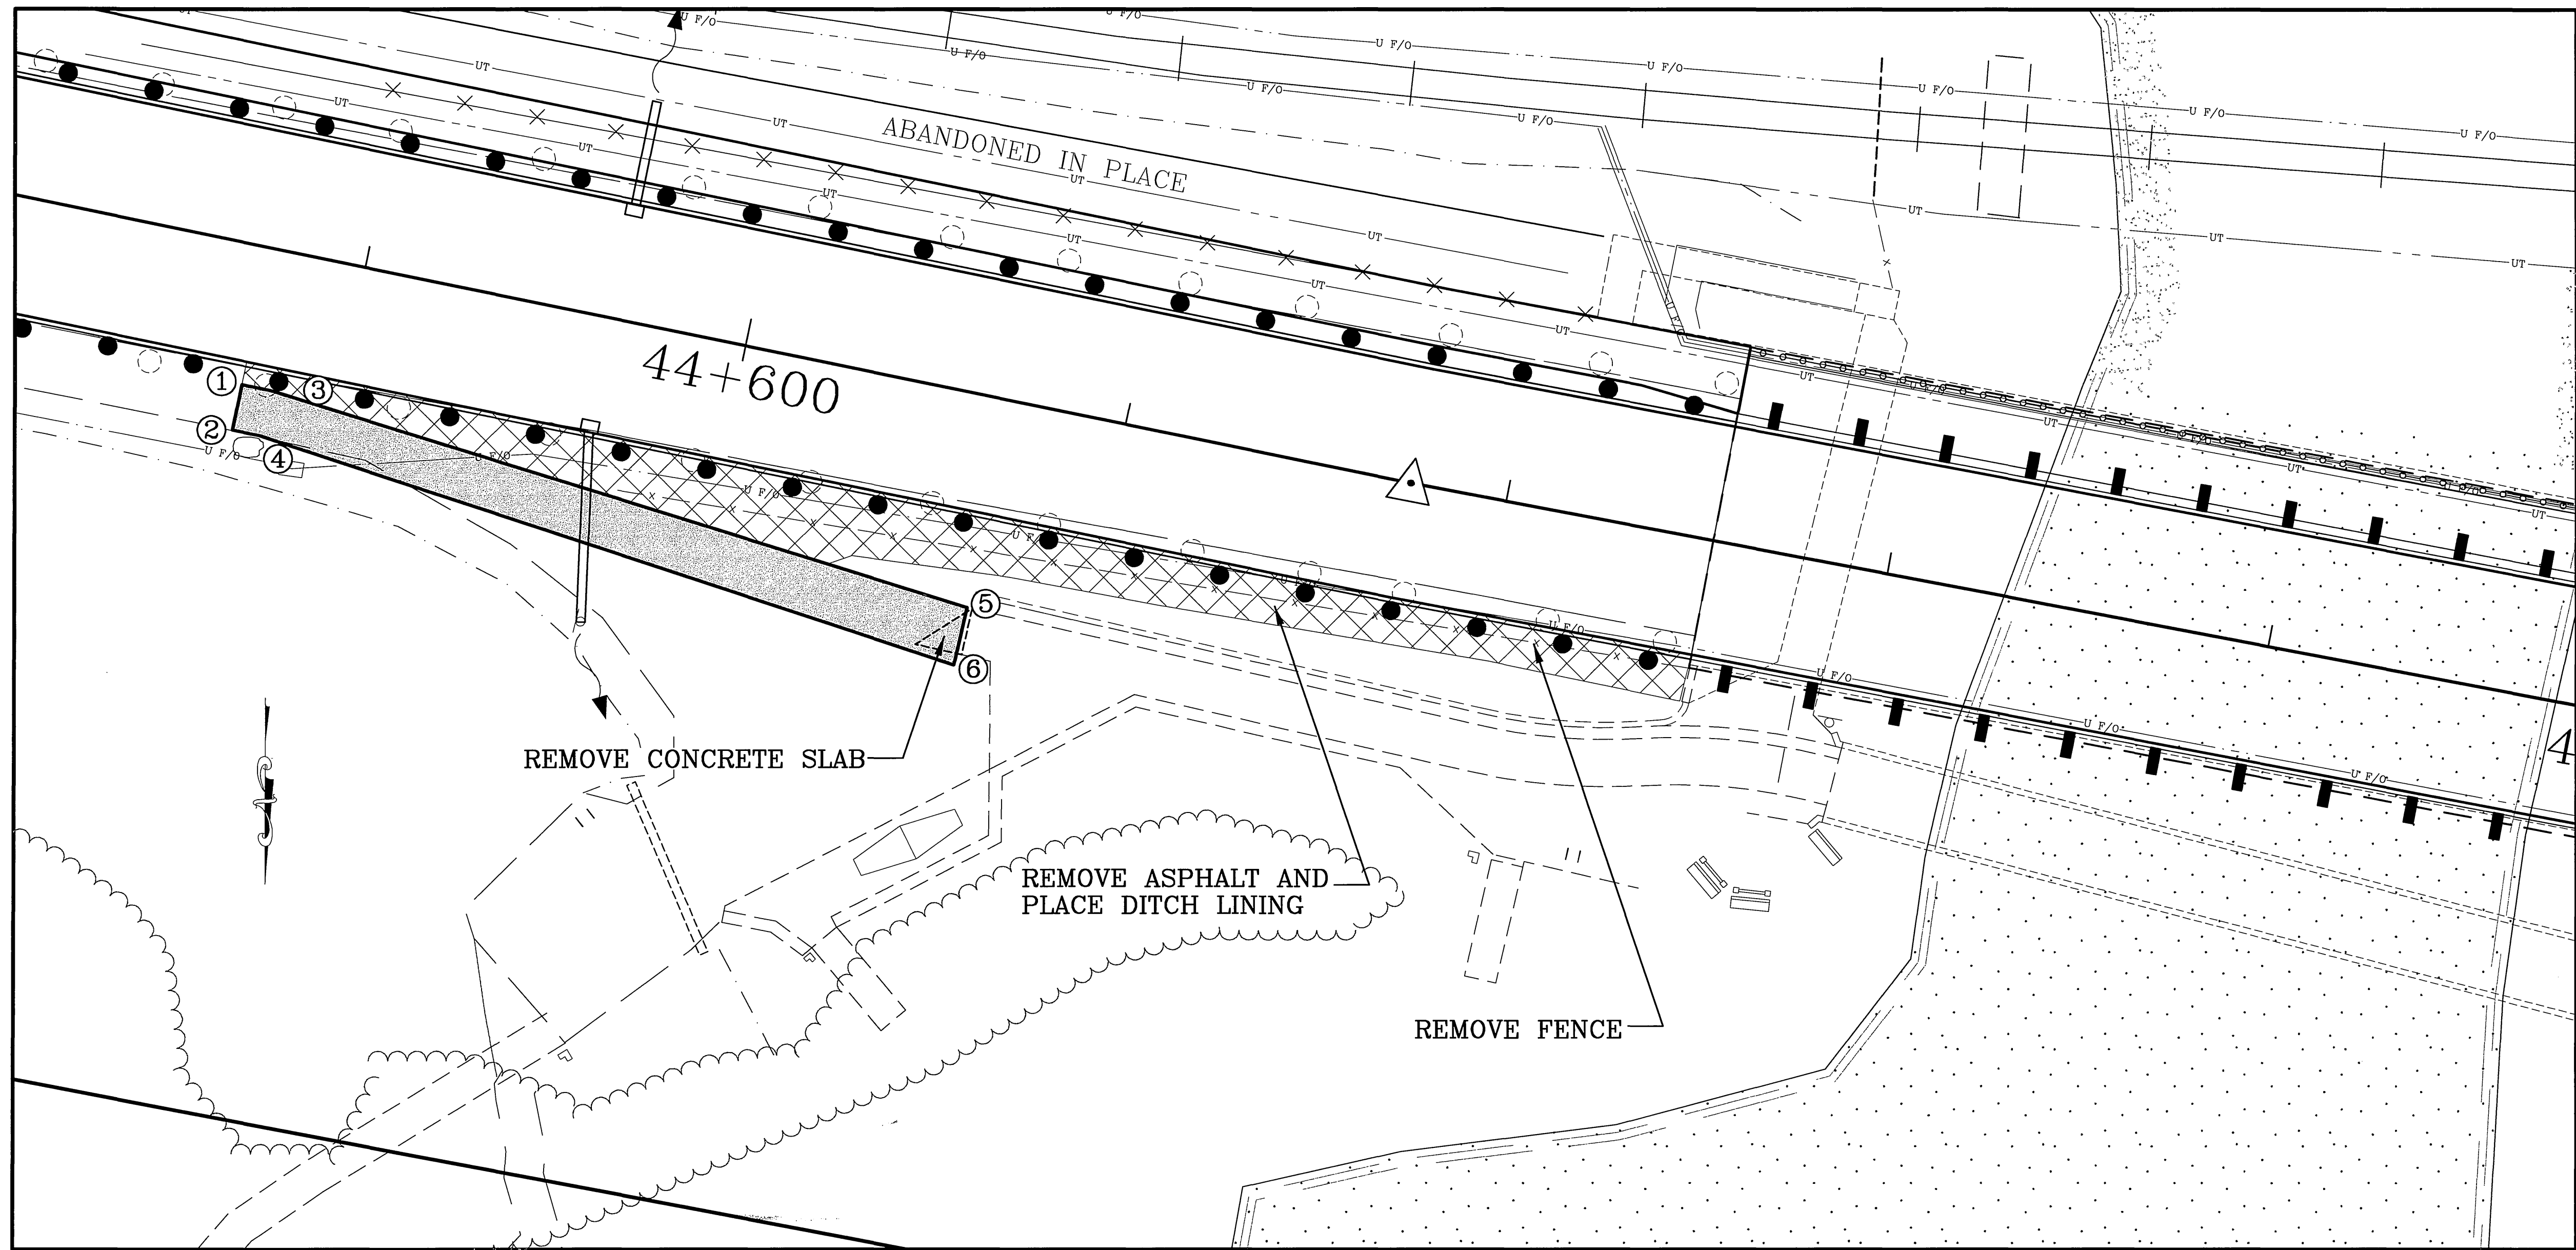

PATHWAY DETAIL TABLE		
POINT	STATION	OFFSET
①	44+575.000	7.2 RT.
②	44+595.000	9.6 RT.
③	44+576.585	7.2 RT.
④	44+576.585	9.6 RT.
⑤	44+613.907	10.9 RT.
⑥	44+613.907	14.0 RT.

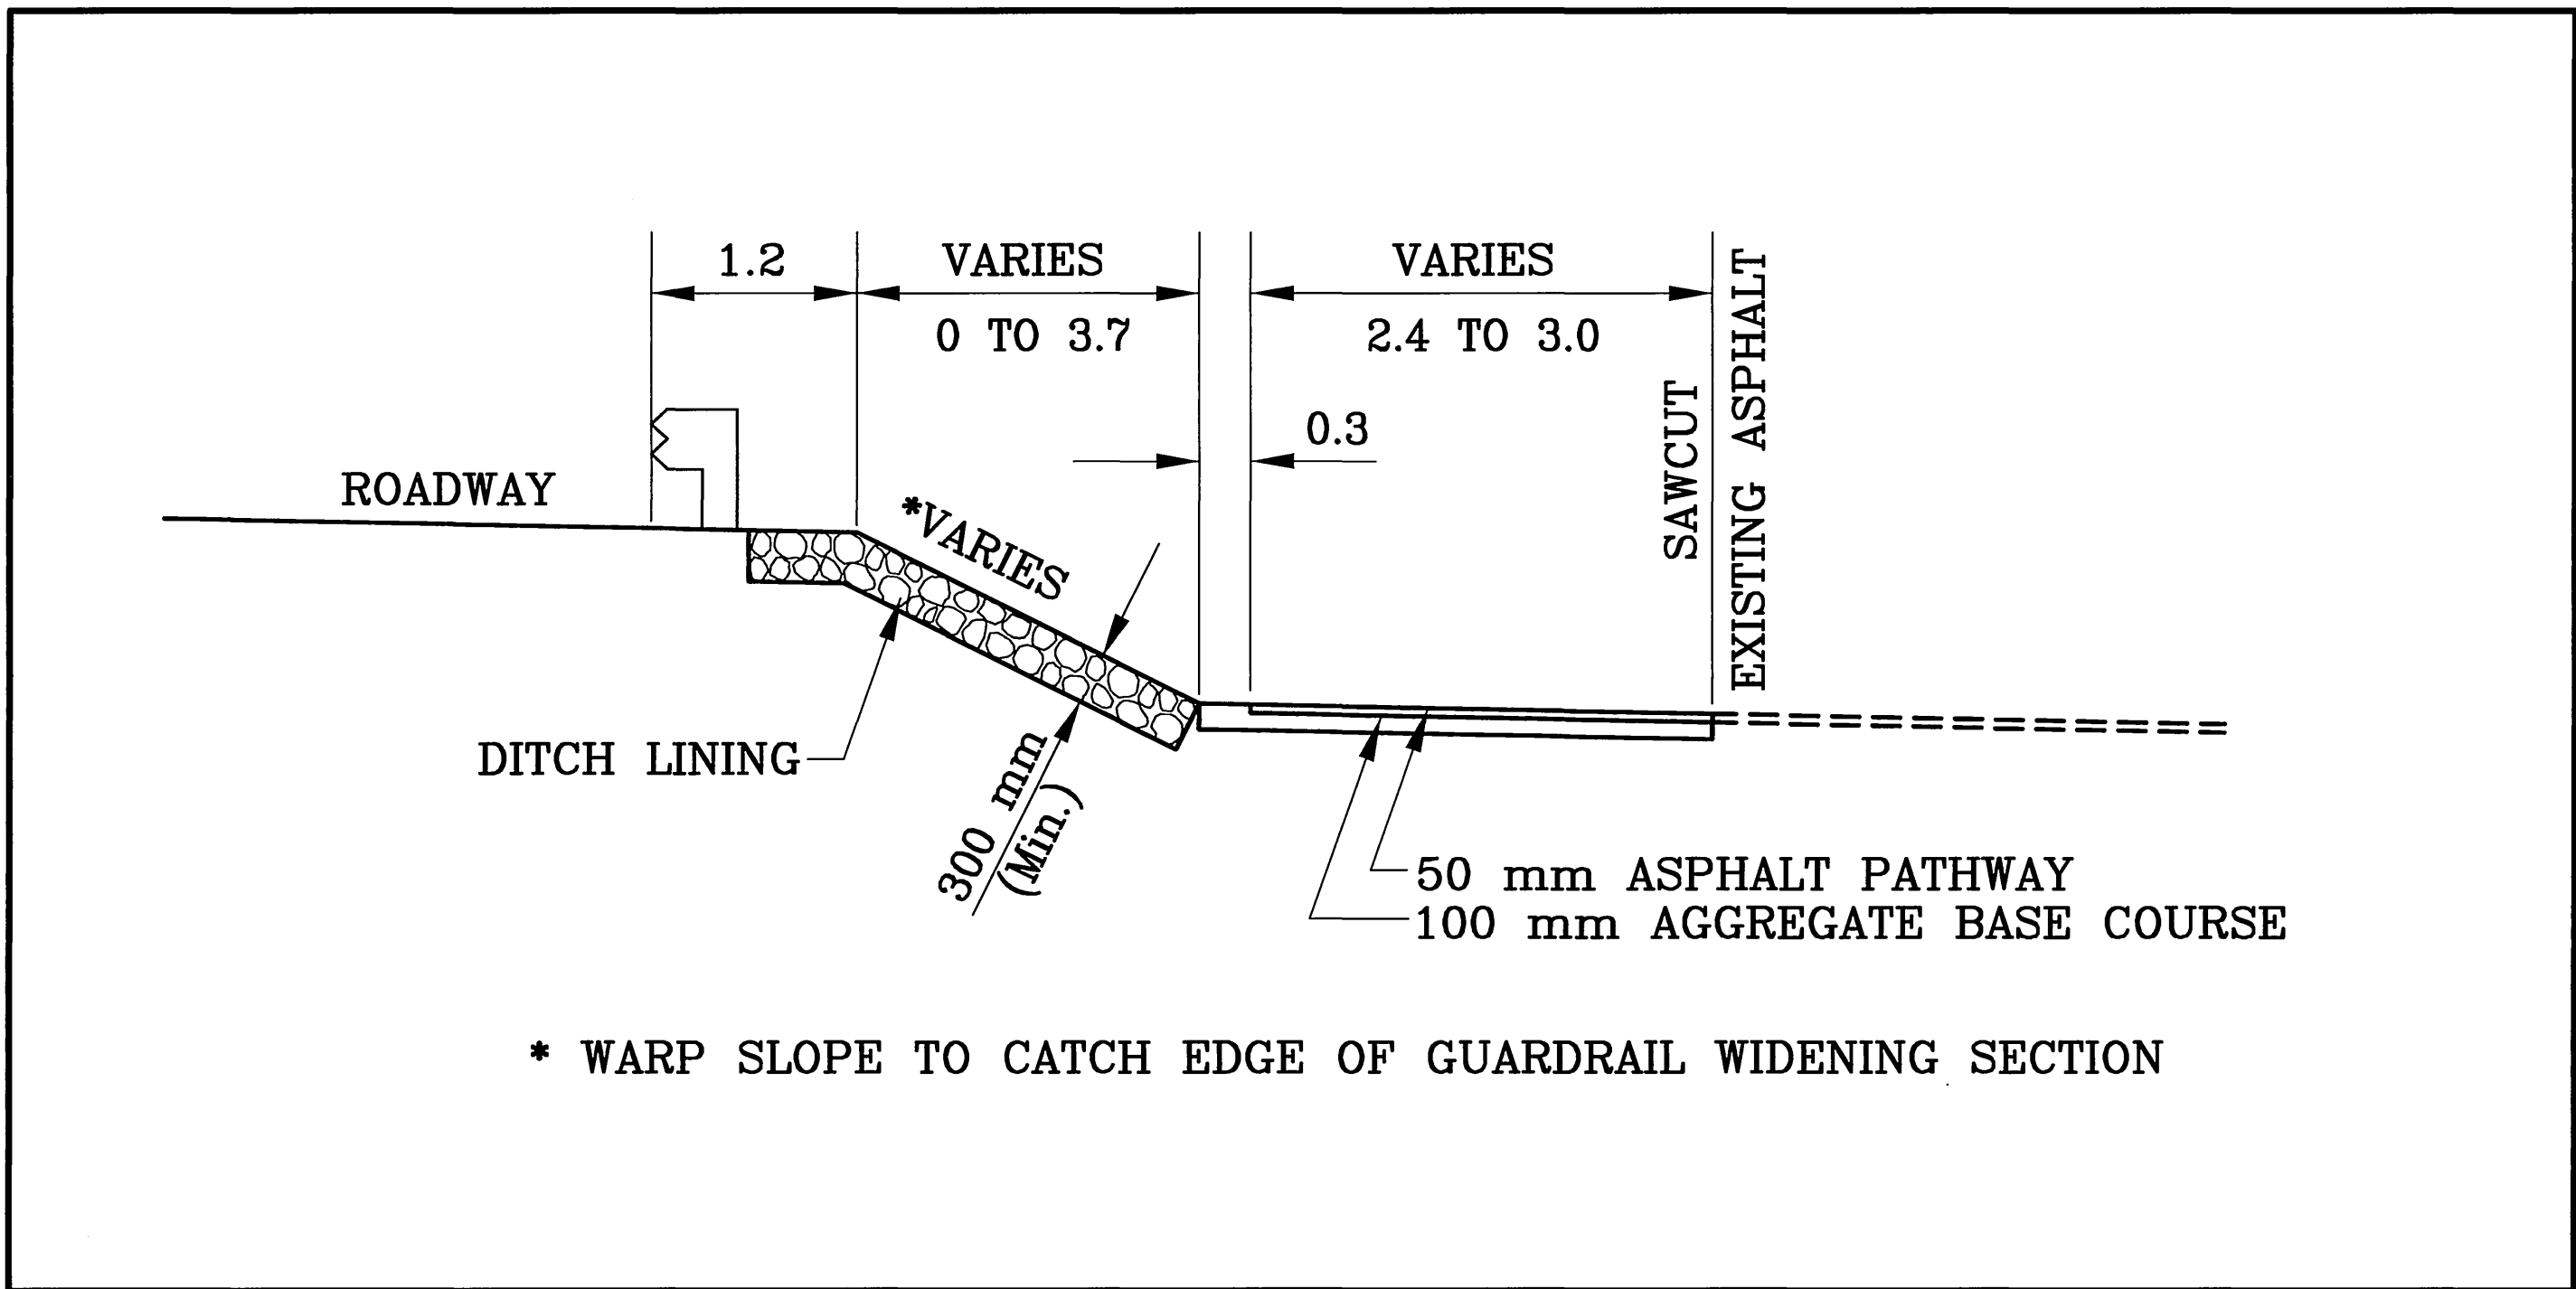


SPECIFICATIONS
SCALE 1"=1'
COMPUTER DESIGNATION

DESIGNED BY
CHECKED BY
DRAFTED BY

AUTOCAD-KAREN-
D:\505KPROJ\33577\DATA\NONREPO\7CONNECT.DWG 8-22-01 9:50:48 am EST KKH

SHEET NO.	TOTAL SHEETS	
E9	E30	
STATE	YEAR	
ALASKA	2002	
PROJECT DESIGNATION		
NH-OA3-1(28)		
ADDENDUM NO.		
ATTACHMENT NO.		
REVISIONS		
NO.	DATE	DESCRIPTION

NOTE:
DIMENSIONS ARE IN METERS
UNLESS OTHERWISE NOTED.

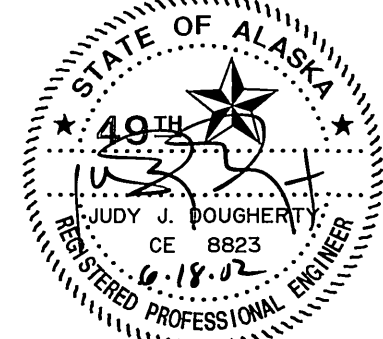


STATE OF ALASKA
DEPARTMENT OF TRANSPORTATION
AND PUBLIC FACILITIES
SEWARD HIGHWAY
MP 96 TO MP 102
SAFETY, ROADWAY &
RECREATIONAL IMPROVEMENTS
PATHWAY
DETAIL


LAYOUT TABLE		
POINT	STATION	OFFSET
①	'PK' 10+077.922	17.4 RT.
②	'PK' 10+082.073	18.0 RT.
③	'PK' 10+082.939	18.1 RT.
④	'PK' 10+088.579	18.1 RT.

RADIUS TABLE			
POINT	STATION	OFFSET	RADIUS
Ⓐ	'PK' 10+028.799	30.4 LT.	25.0
Ⓑ	'PK' 10+075.172	8.6 LT.	25.0
Ⓒ	'PK' 10+082.500	2.0 LT.	6.8
Ⓓ	'PK' 10+148.900	2.0 RT.	6.8
Ⓔ	'PK' 10+150.000	CENTERLINE	15.0
Ⓕ	'PK' 10+205.000	0.5 RT.	25.0

REVISIONS			STATE	PROJECT DESIGNATION	YEAR	SHEET NO.	TOTAL SHEETS
No.	DATE	DESCRIPTION	ALASKA	NH-0A3-1(28)	2002	E10	E30

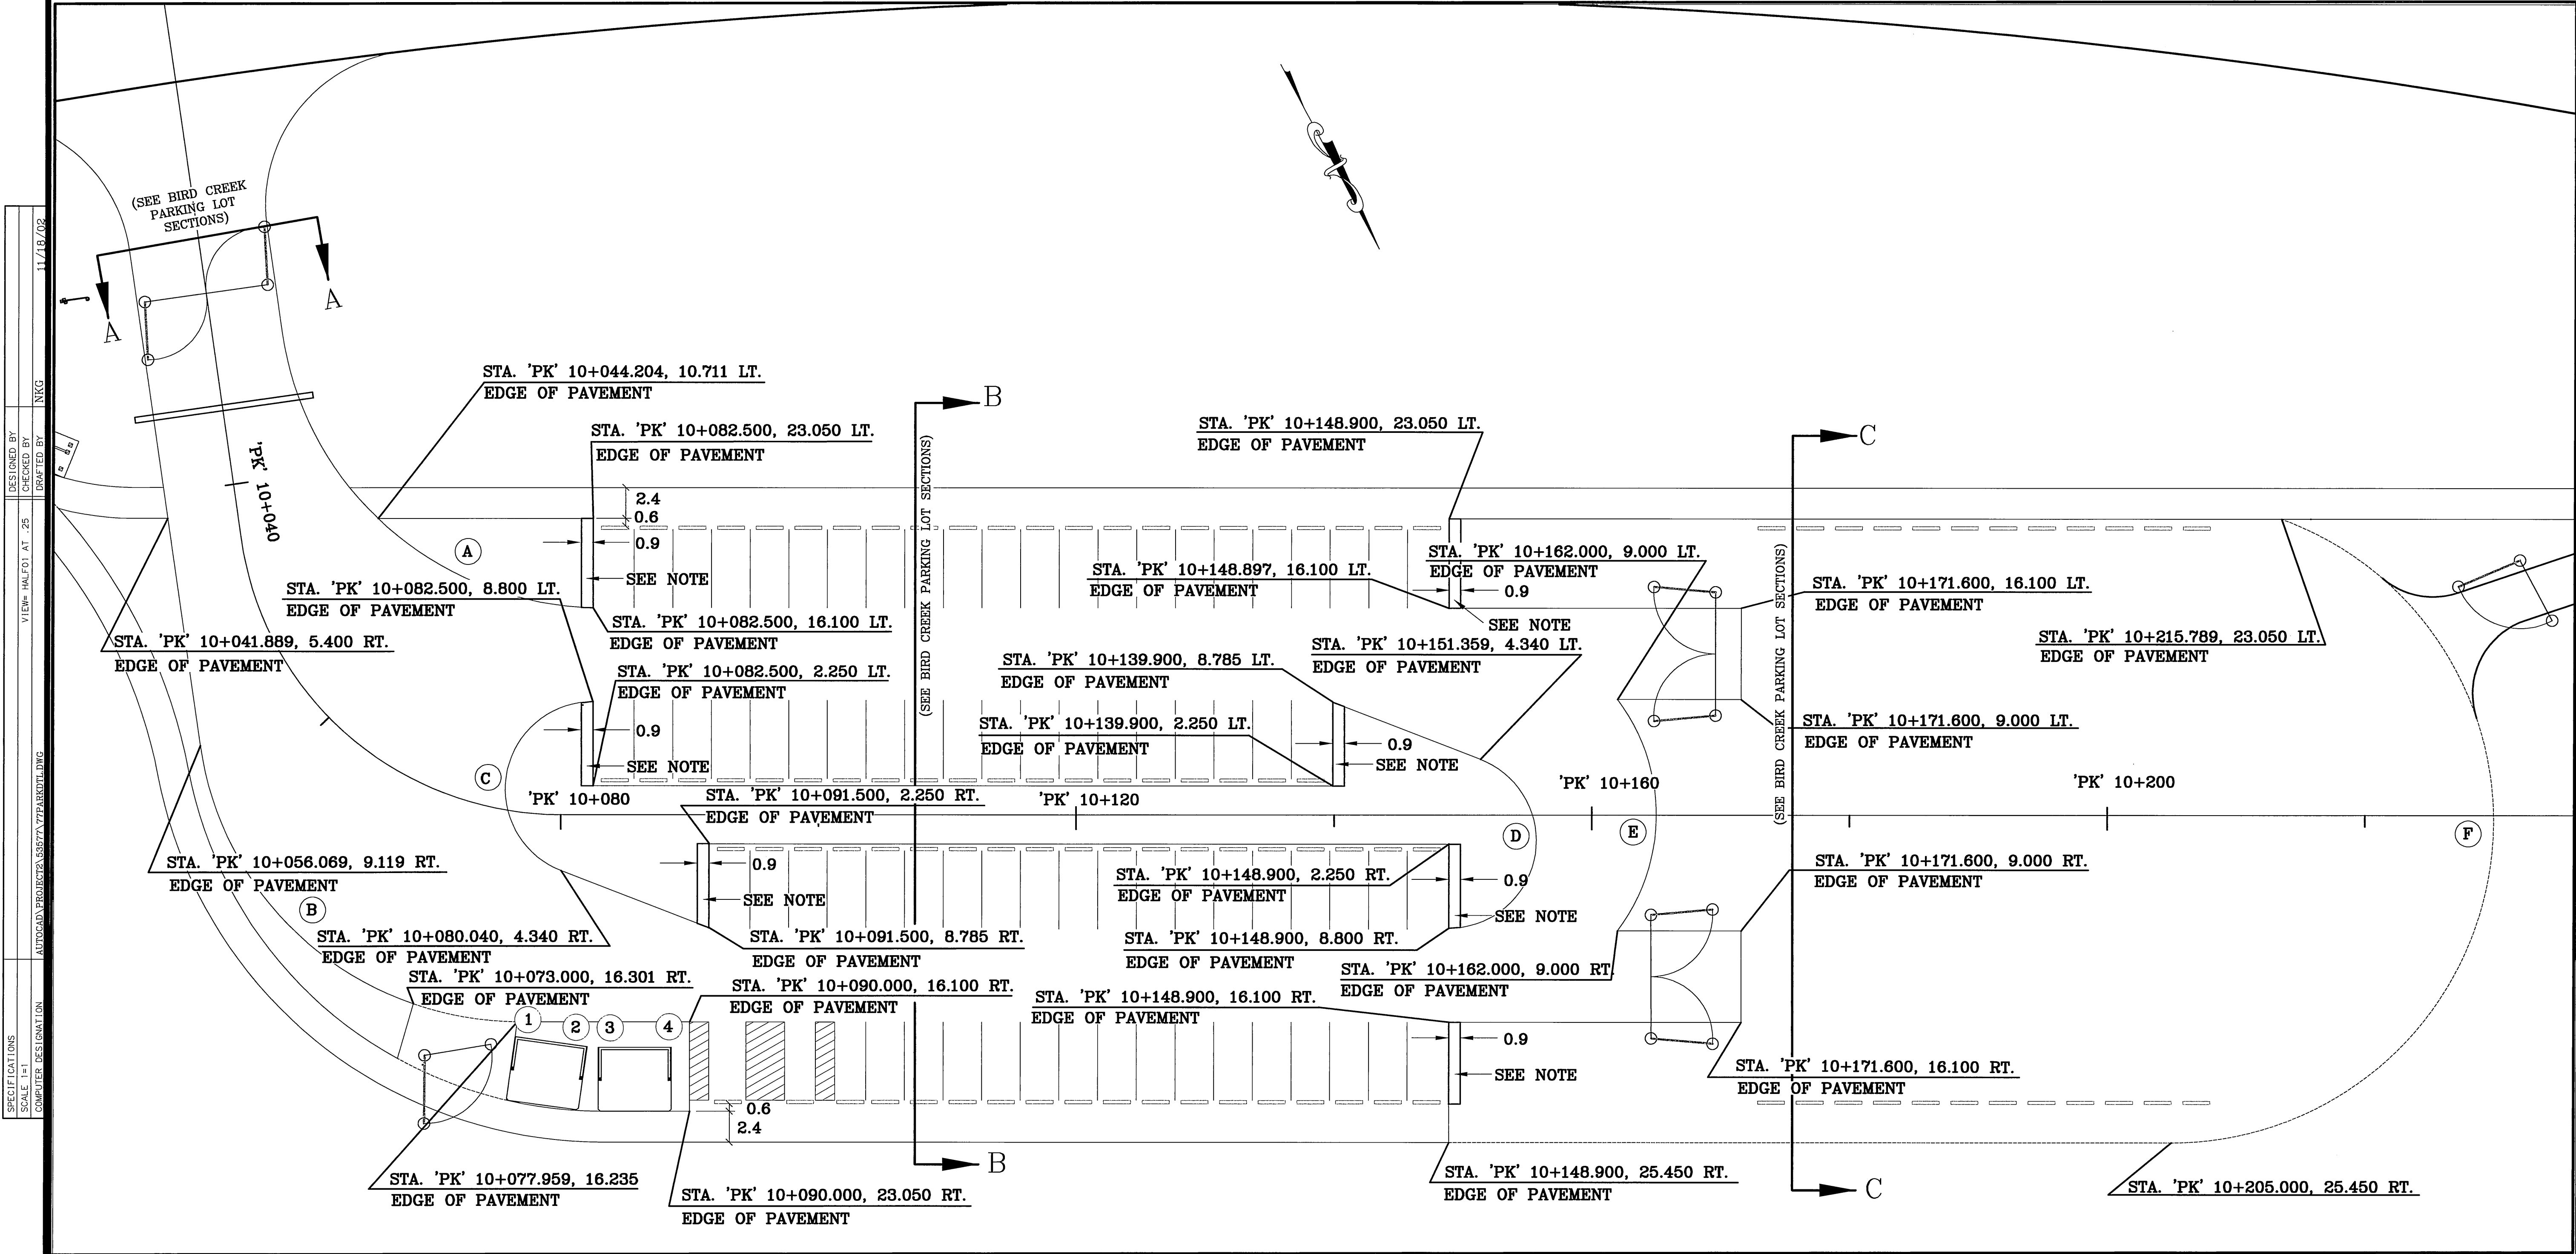



NOTE: LEAVE 900 mm WIDE EXPOSED AGGREGATE BASE COURSE ADJACENT TO PARKING SPACES AS SHOWN IN LAYOUT PLAN. DO NOT TOPSOIL OR SEED THESE AREAS.

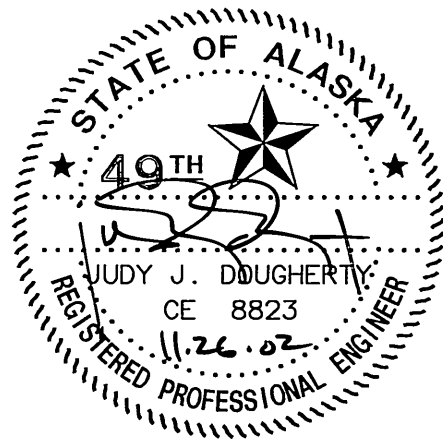

STATE OF ALASKA
DEPARTMENT OF TRANSPORTATION
AND
PUBLIC FACILITIES
**SEWARD HIGHWAY
MP 96 TO MP 102
SAFETY, ROADWAY &
RECREATIONAL IMPROVEMENTS
BIRD CREEK PARKING LOT
LAYOUT**

REVISIONS			STATE	PROJECT DESIGNATION	YEAR	SHEET NO.	TOTAL SHEETS
No.	DATE	DESCRIPTION					
			ALASKA	NH-0A3-1(28)	2002	E11	E30

DESIGNED BY	
CHECKED BY	
DRAFTED BY	KMH
SPECIFICATIONS	
SCALE 1"=1'	
COMPUTER DESIGNATION	
AUTOCAD-KAREN-68877\DATA\778077P.DWG 11-19-02	
V:\EW-SECT-1 at 1	

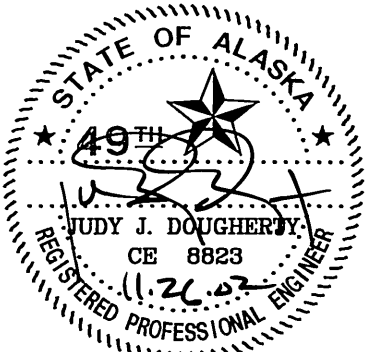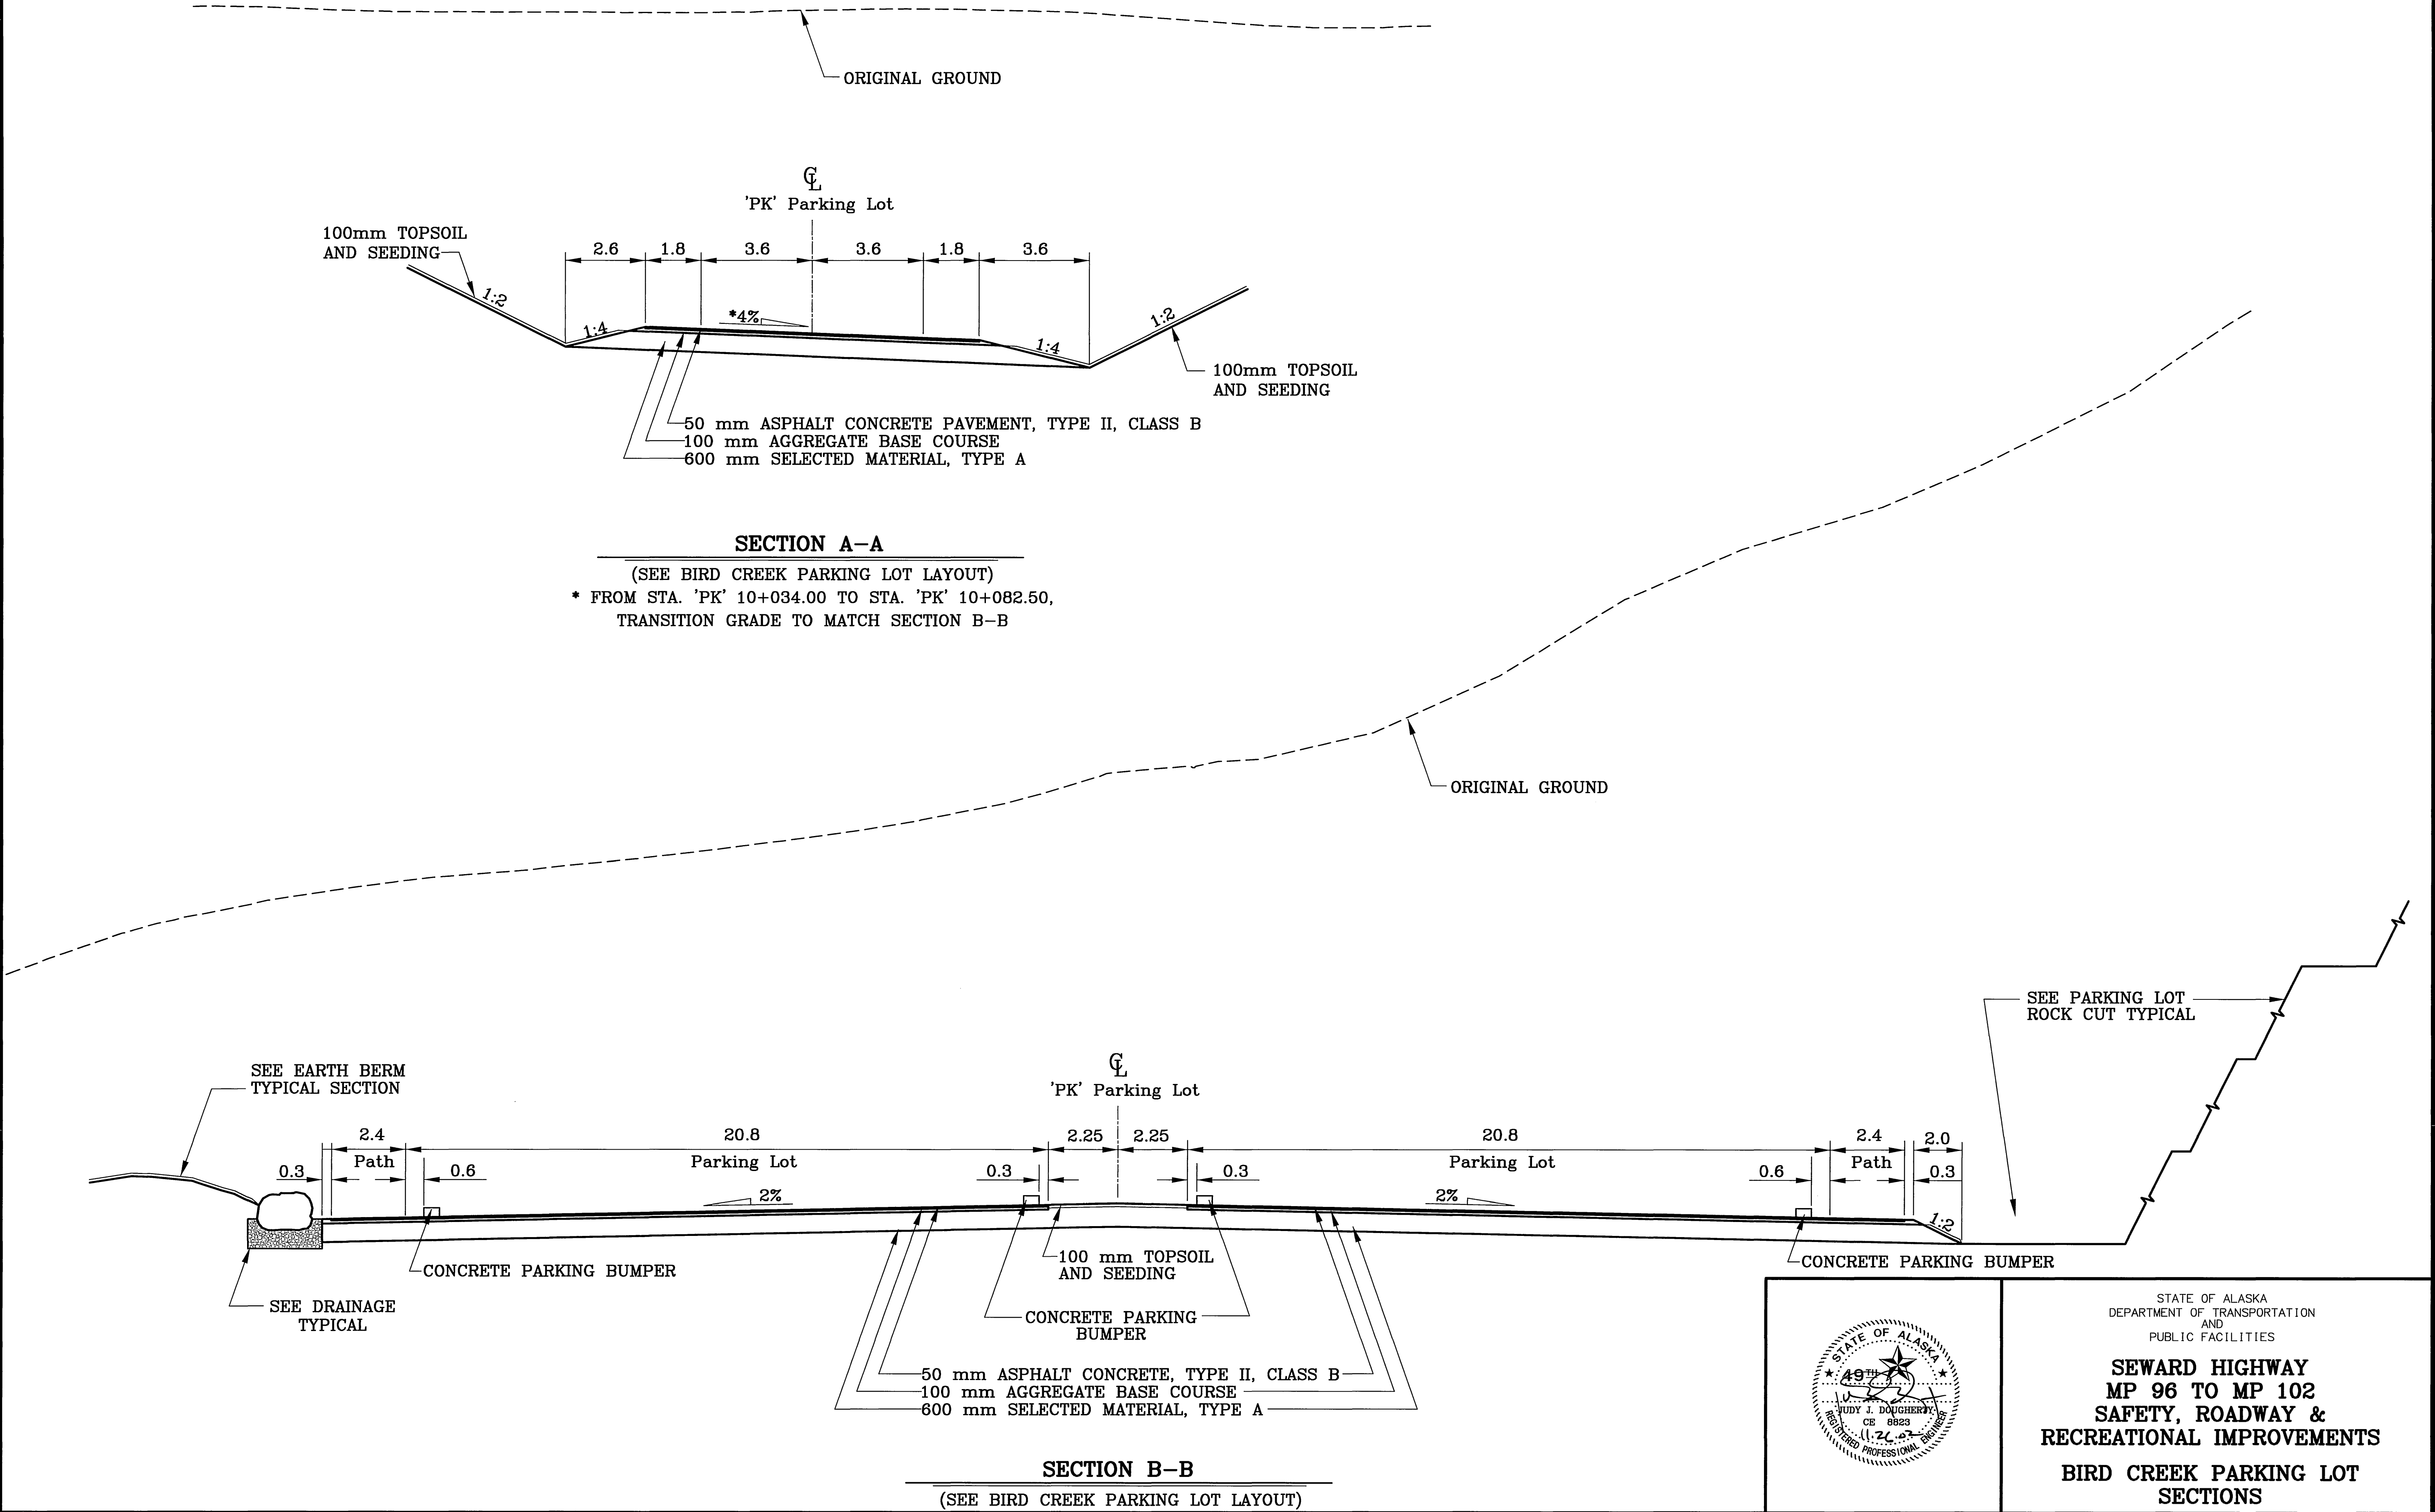


STATE OF ALASKA
DEPARTMENT OF TRANSPORTATION
AND
PUBLIC FACILITIES

**SEWARD HIGHWAY
MP 96 TO MP 102
SAFETY, ROADWAY &
RECREATIONAL IMPROVEMENTS
BIRD CREEK PARKING LOT
SECTIONS**

REVISIONS			STATE	PROJECT DESIGNATION	YEAR	SHEET NO.	TOTAL SHEETS
No.	DATE	DESCRIPTION					
			ALASKA	NH-0A3-1(28)	2002	E12	E30

DESIGNED BY	KMH
CHECKED BY	
DRAFTED BY	
SPECIFICATIONS	
SCALE 1"=1'	
COMPUTER DESIGNATION	
AUTOCAD-KAREN-SBB7A\DATA\7\BBDTTP.DWG 11-20-02	
VIEW=SECT-2 AT 1	

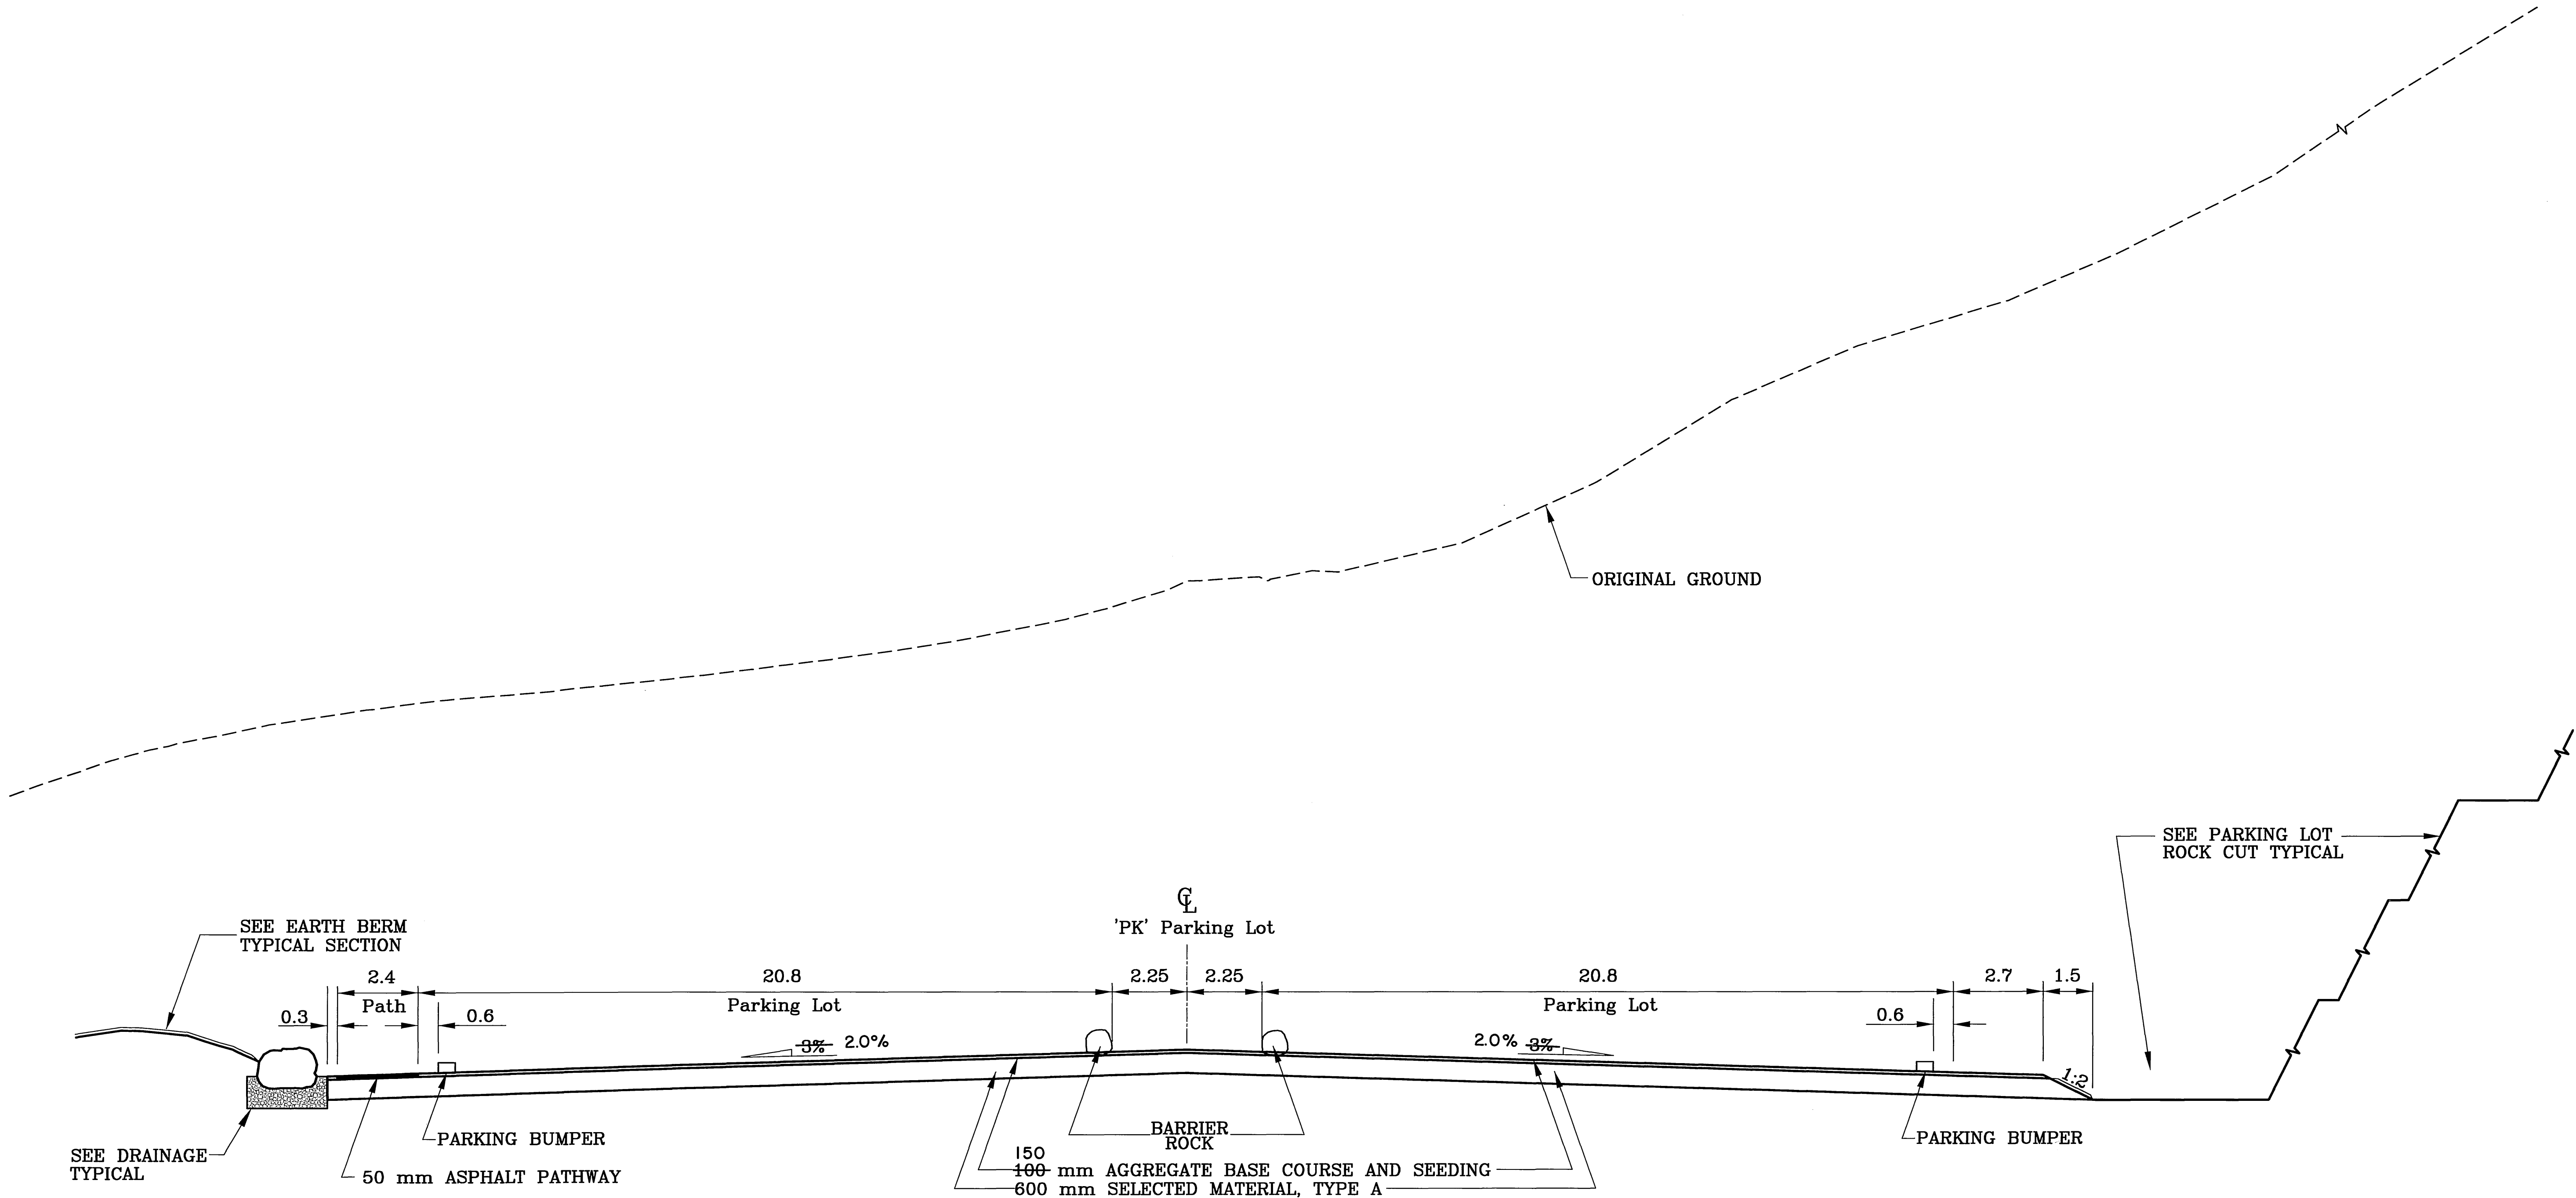

SECTION C-C
(SEE BIRD CREEK PARKING LOT LAYOUT)




STATE OF ALASKA
DEPARTMENT OF TRANSPORTATION
AND
PUBLIC FACILITIES

**SEWARD HIGHWAY
MP 96 TO MP 102
SAFETY, ROADWAY &
RECREATIONAL IMPROVEMENTS**



**BIRD CREEK PARKING LOT
SECTIONS**

REVISIONS			STATE	PROJECT DESIGNATION	YEAR	SHEET NO.	TOTAL SHEETS
No.	DATE	DESCRIPTION					
			ALASKA	NH-0A3-1(28)	2002	E13	E30

SPECIFICATIONS	DESIGNED BY	CHECKED BY
SCALE 1"=1'	VIEW# HALF 01 AT 25	DRAFTED BY
COMPUTER DESIGNATION	65877 DATA PARK VTPARKSCAP.DWG	11-19-02

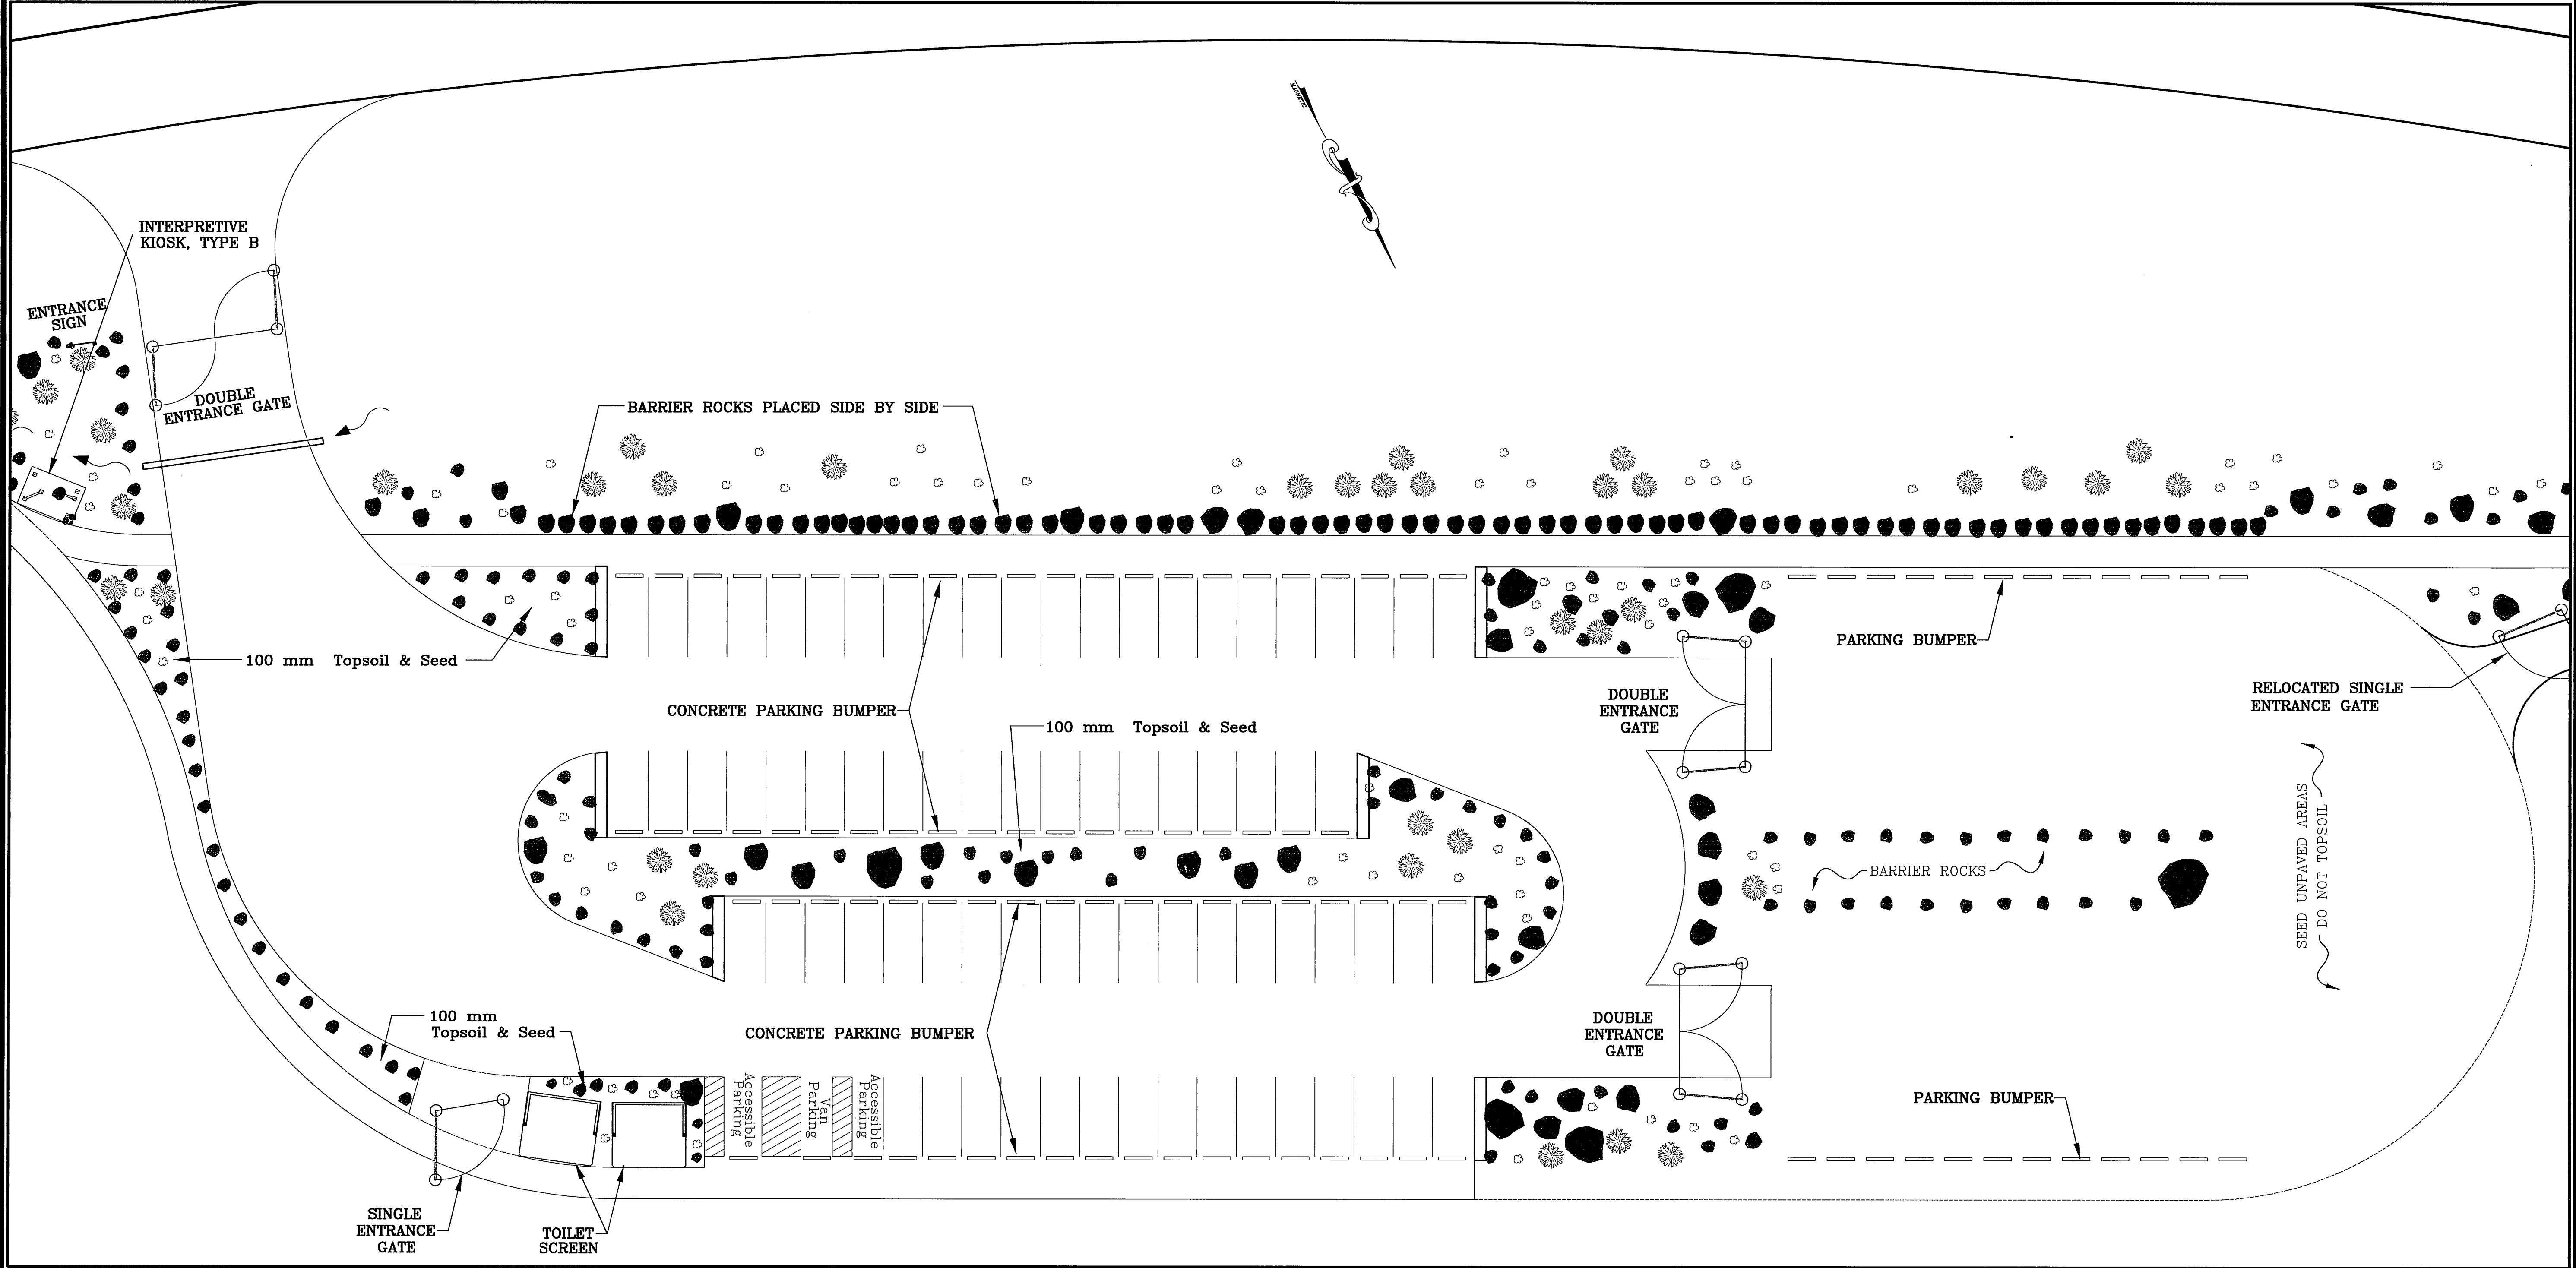


LEGEND	
	PRICKLY ROSE 0.6 m
	WHITE SPRUCE 1.2 m

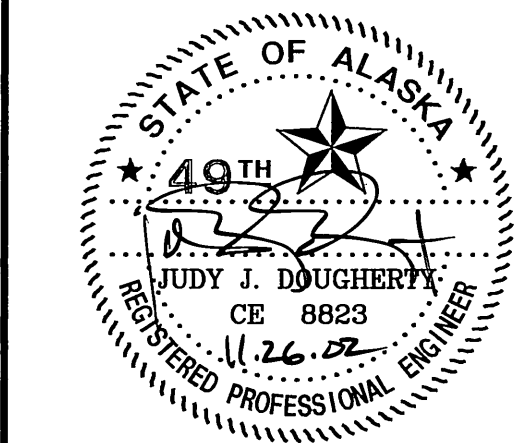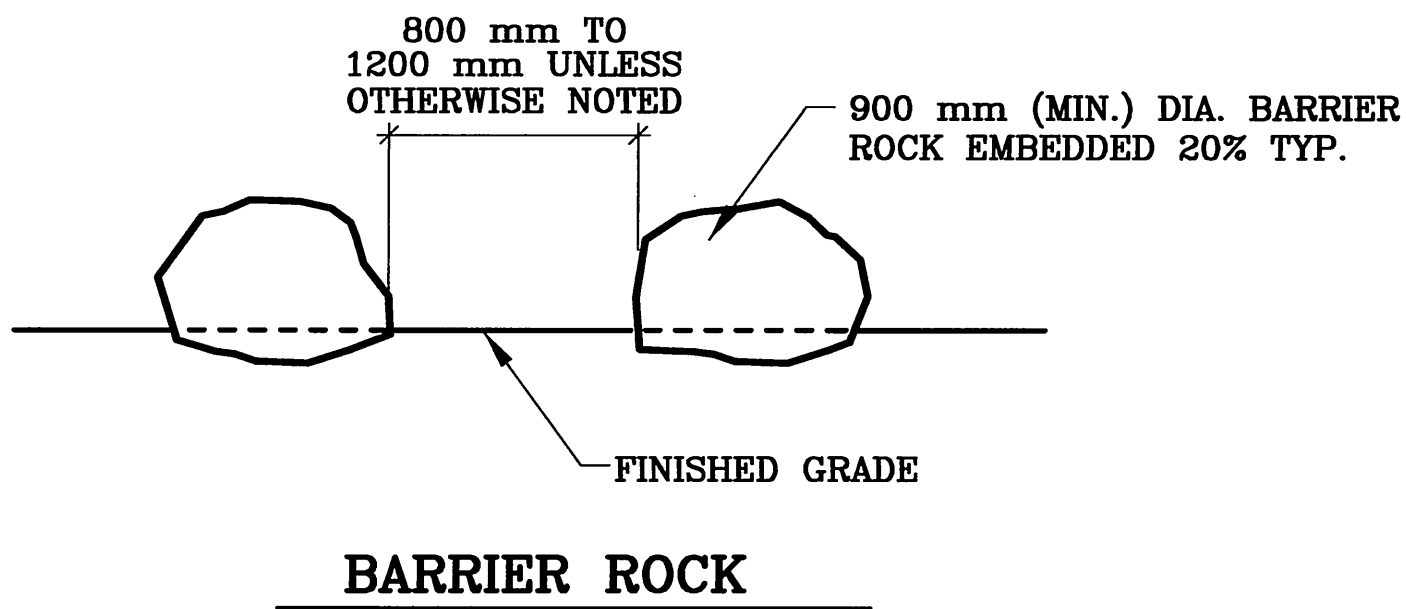

DEPARTMENT OF TRANSPORTATION
AND
PUBLIC FACILITIES
SEWARD HIGHWAY
MP 96 TO MP 102
**SAFETY, ROADWAY &
RECREATIONAL IMPROVEMENTS**
BIRD CREEK PARKING LOT
LANDSCAPING PLAN


REVISIONS			STATE	PROJECT DESIGNATION	YEAR	SHEET NO.	TOTAL SHEETS
No.	DATE	DESCRIPTION					
			ALASKA	NH-0A3-1(28)	2002	E14	E30

DESIGNED BY	
CHECKED BY	
DRAFTED BY	
VIEW	HALFOI AT 1:25
DATE	10-02-95 8:00 AM EST
DWG	8-22-01
DATA	UNIMBERD PARK 77PARKSCAP.DWG
FILE	D:\SUSKPCRA\63577\DATA\UNIMBERD PARK 77PARKSCAP.DWG
SPECIFICATIONS	
SCALE	1"=1'
COMPUTER DESIGNATION	

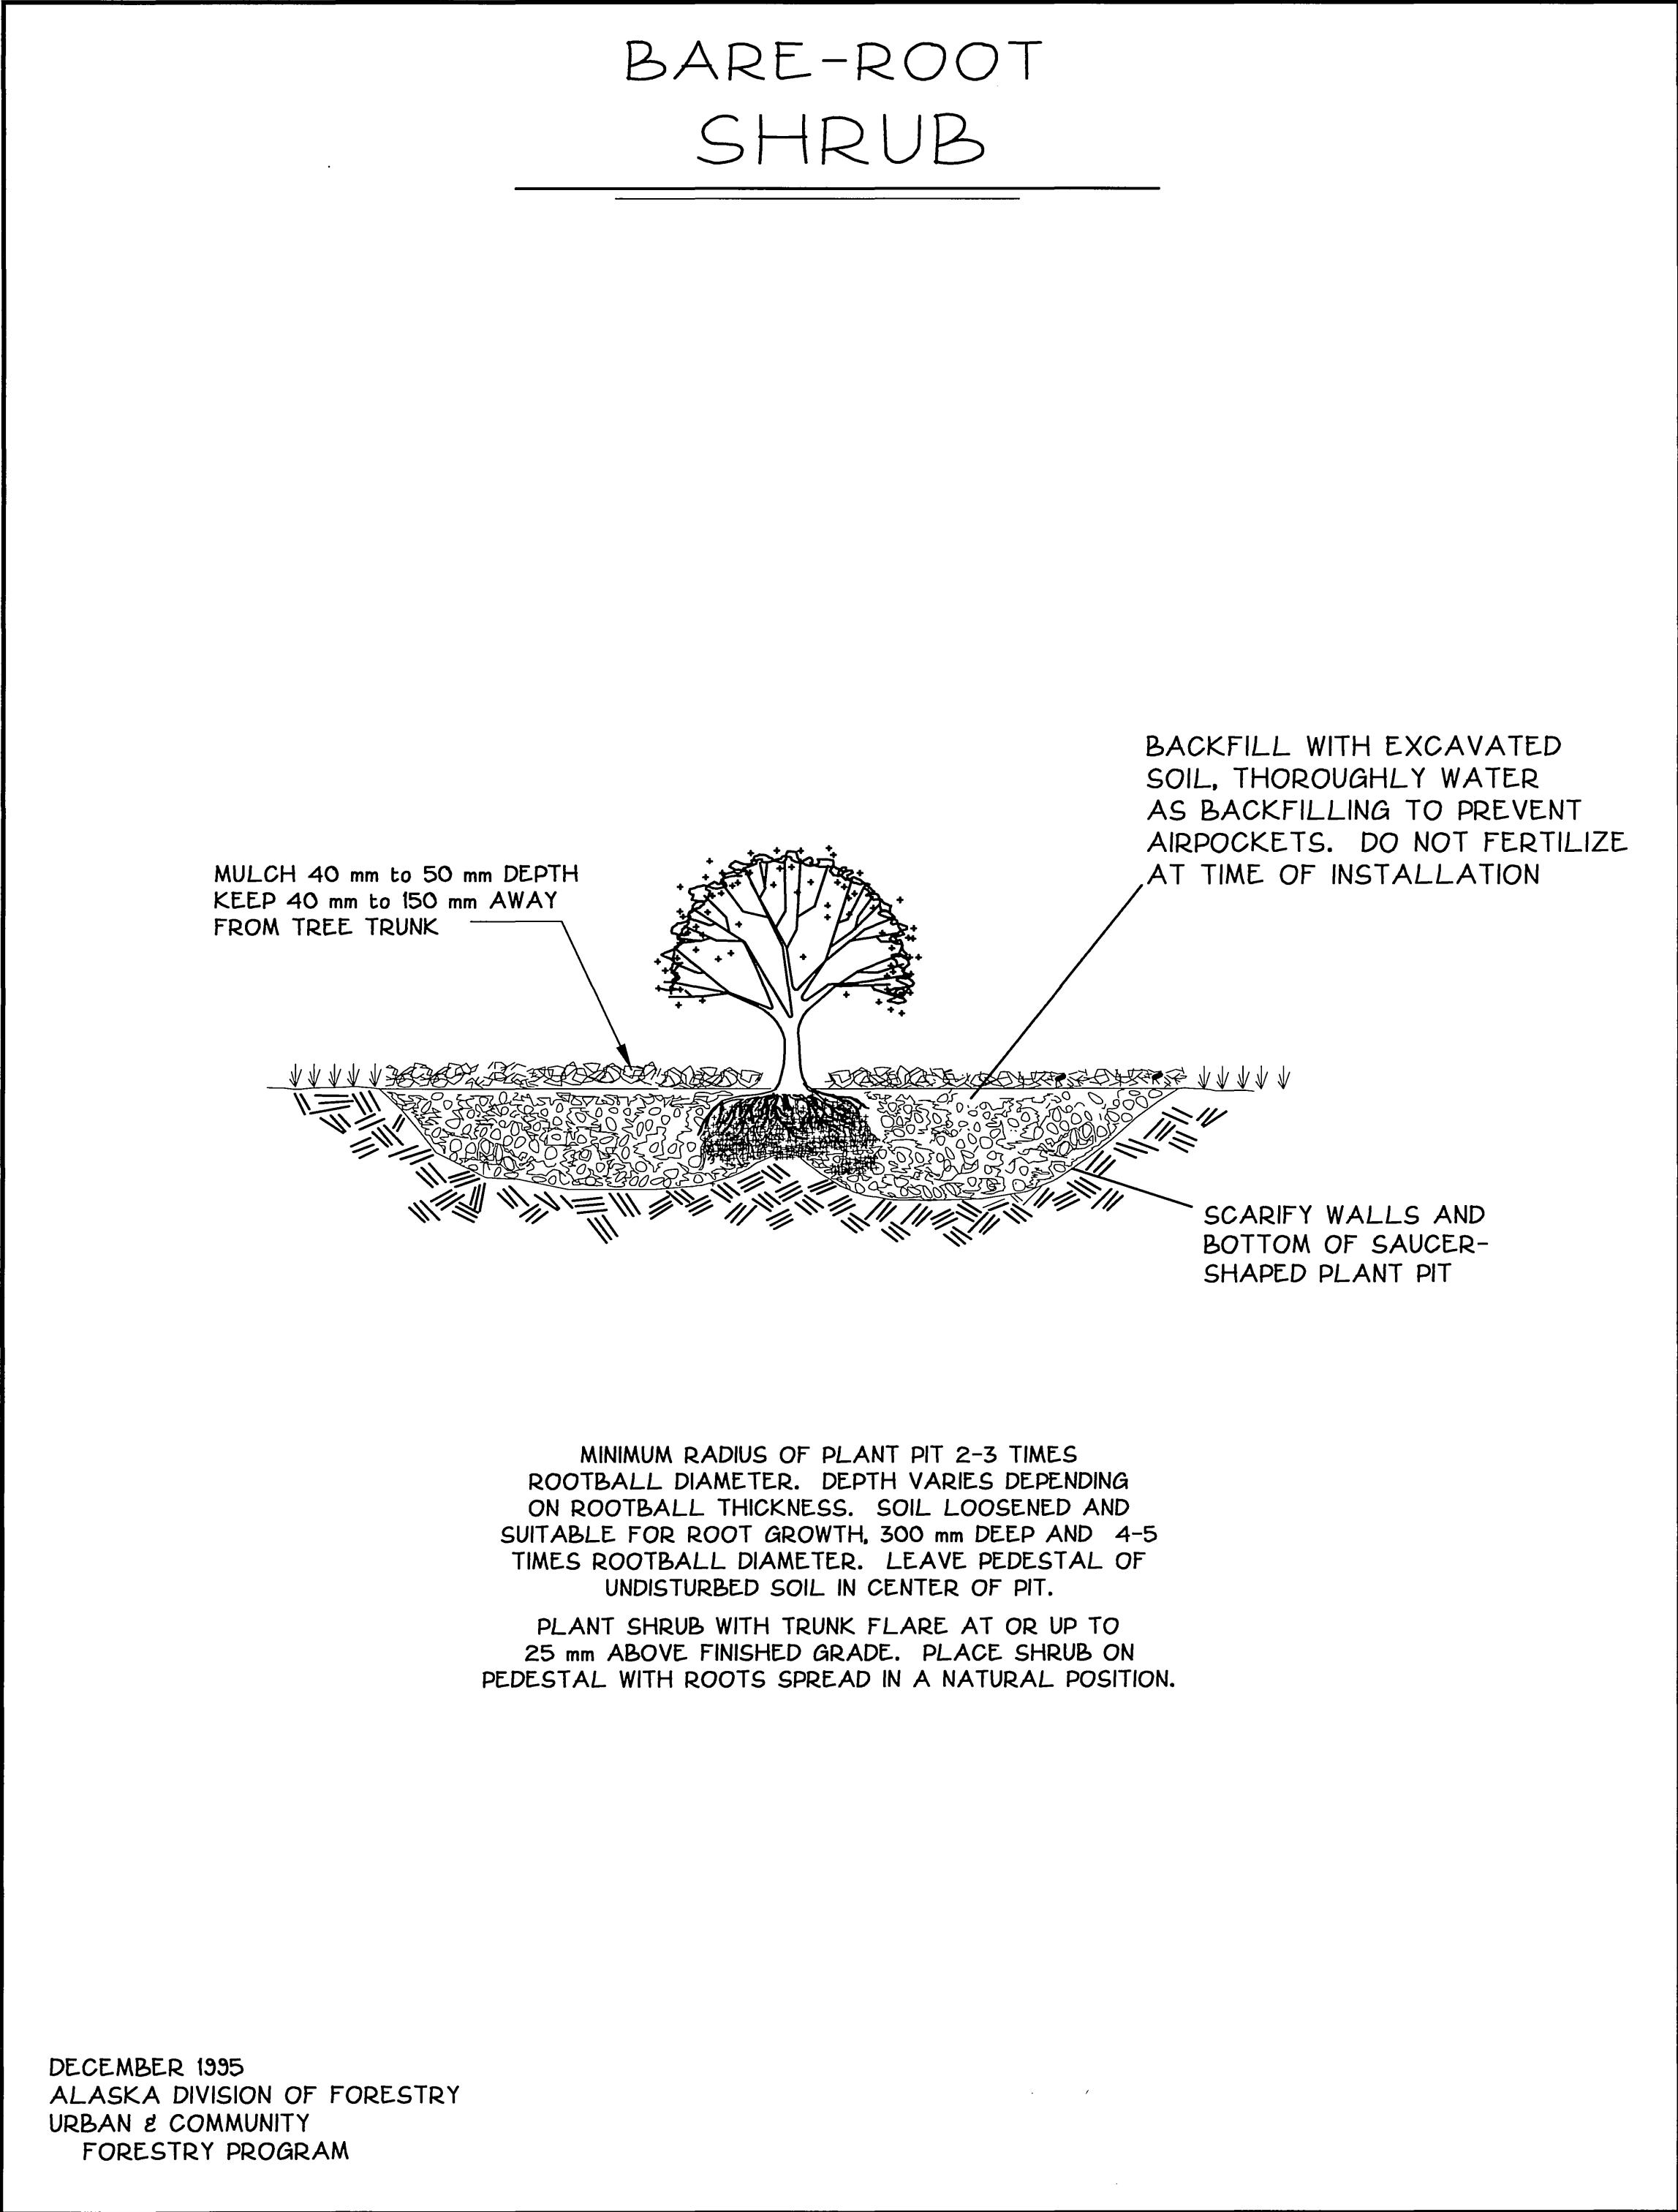


LANDSCAPE\NEWTREES 1:30 2/97

ADOPTED BY CENTRAL REGION
ADOT & PF 1996.

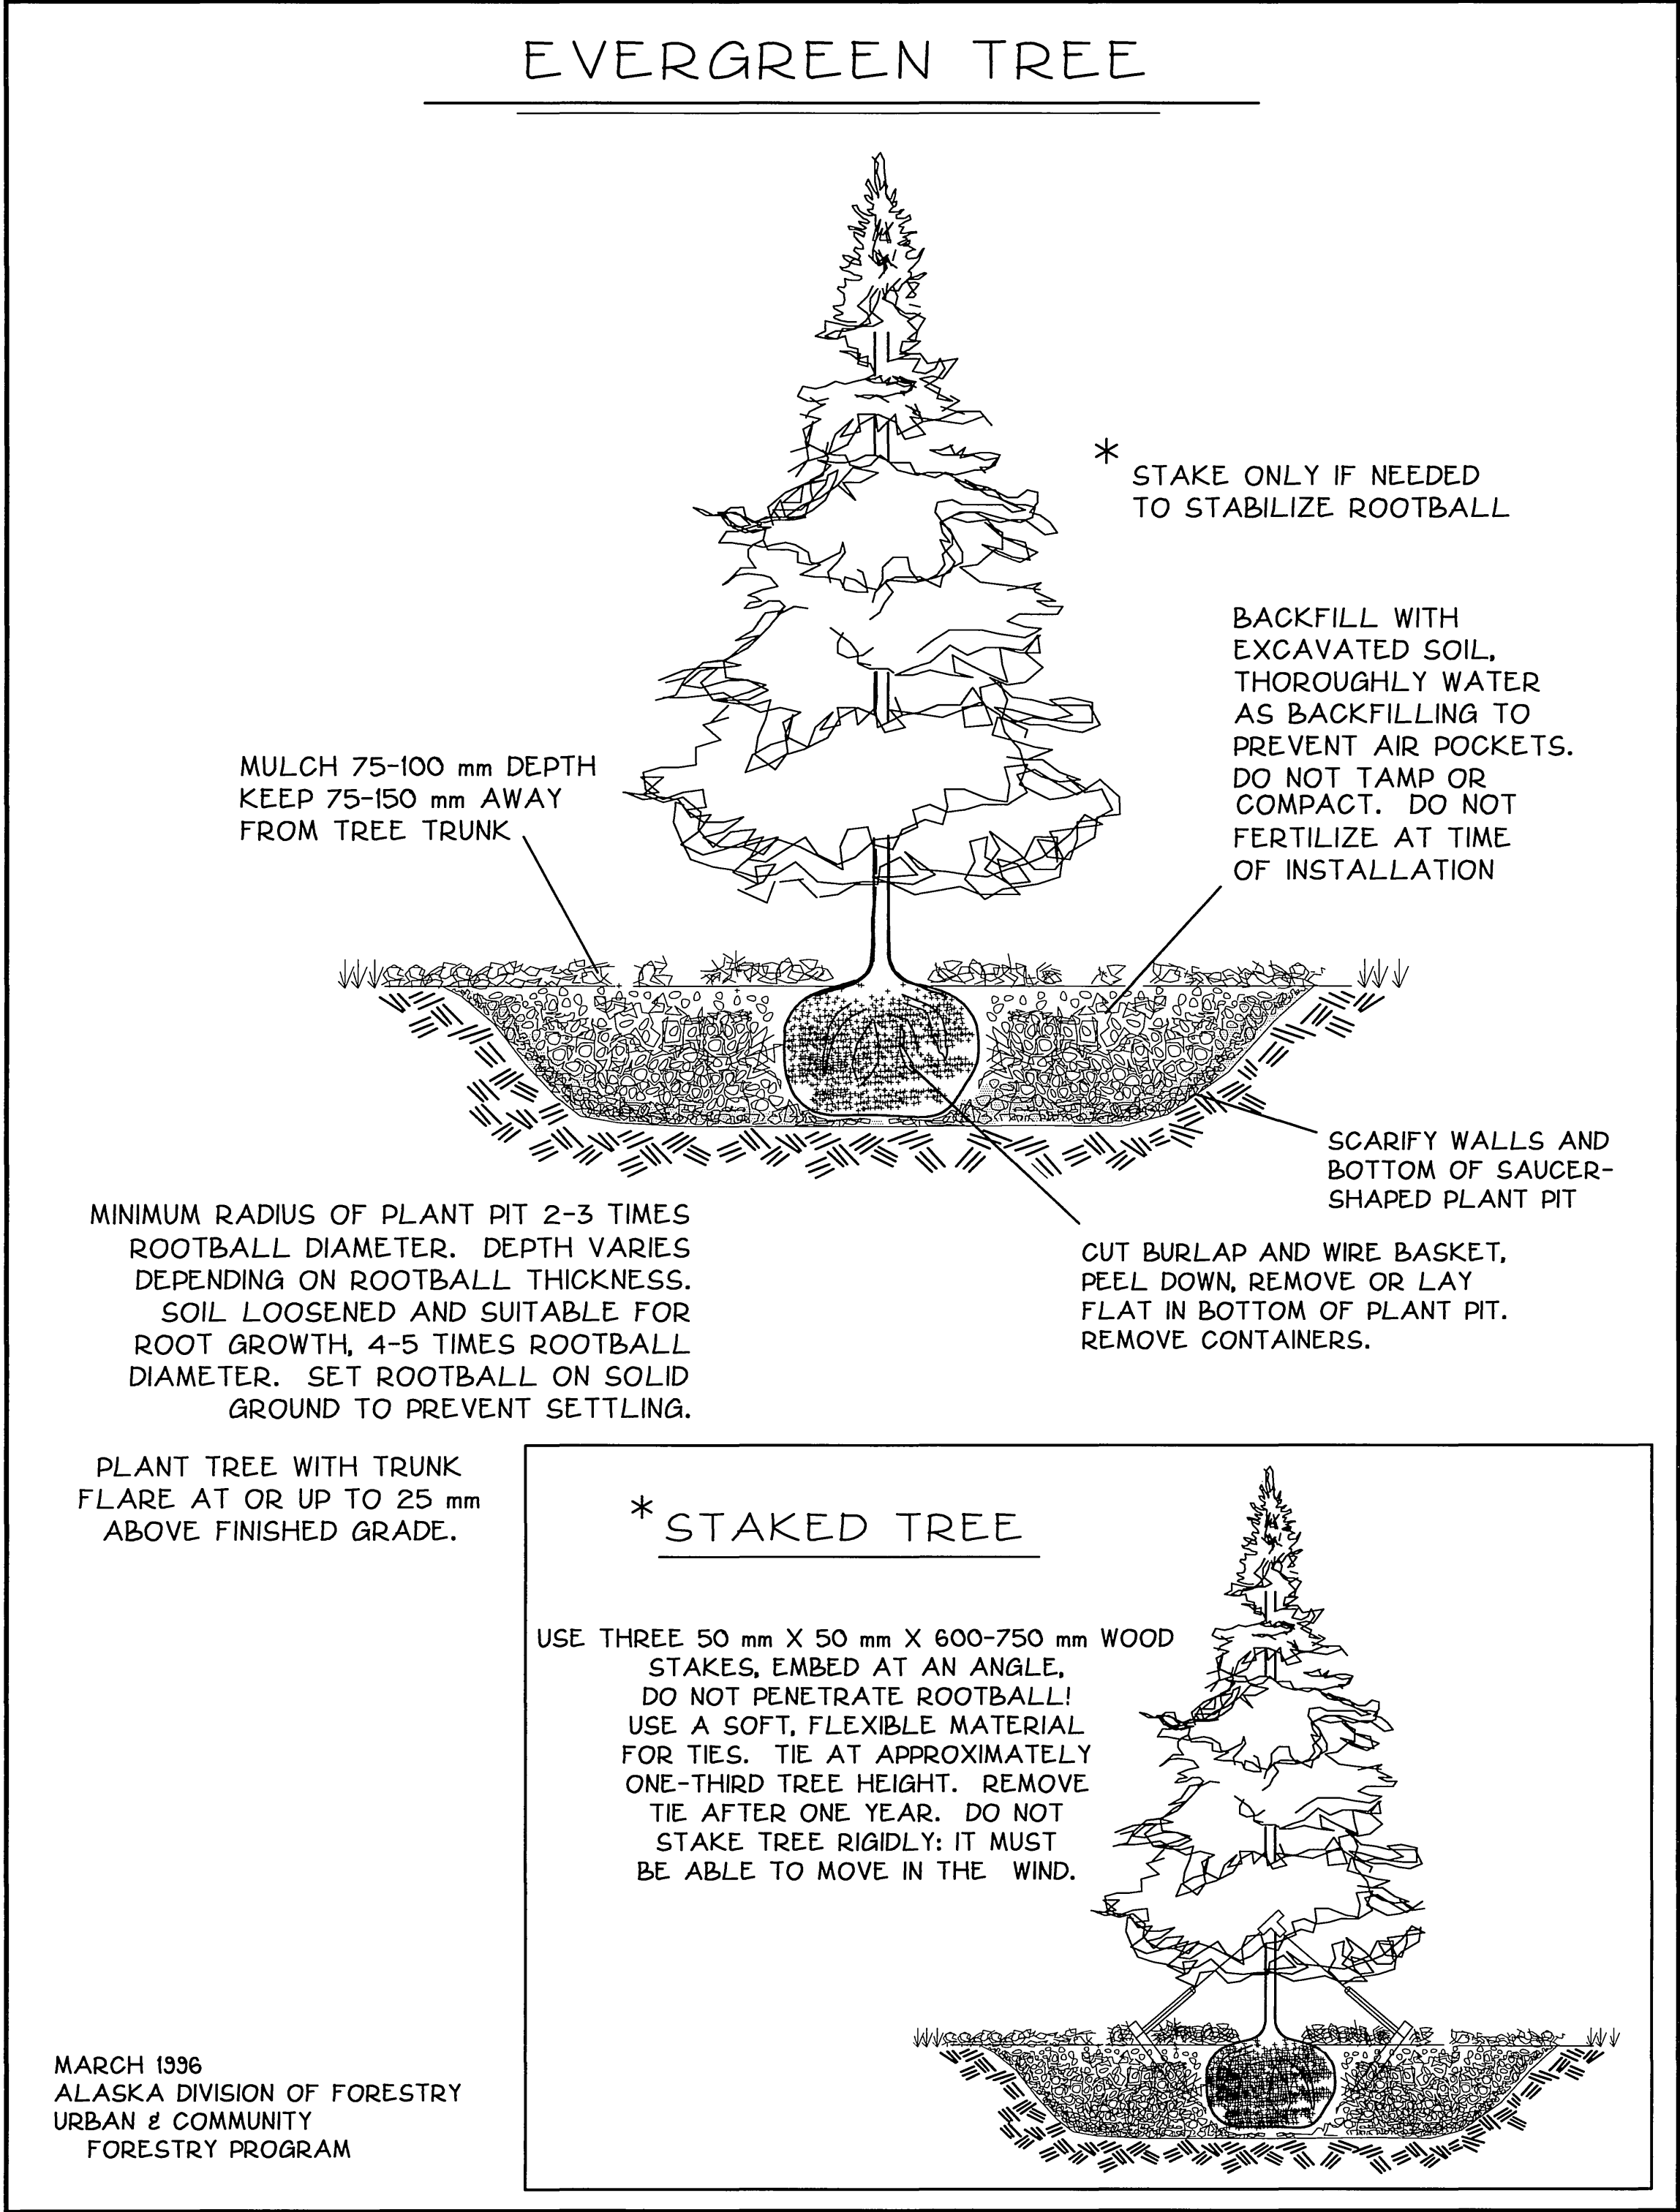


LANDSCAPE\NEWTREES 1:30 2/97


ADOPTED BY CENTRAL REGION
ADOT & PF 1996.

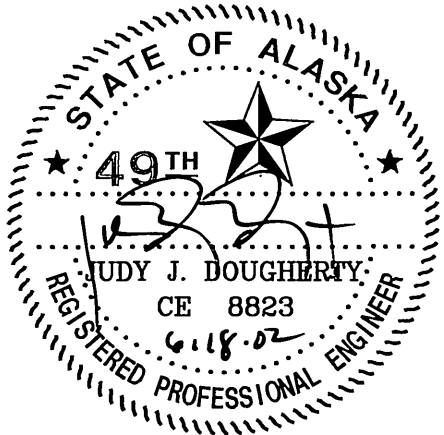

STATE OF ALASKA
DEPARTMENT OF TRANSPORTATION
AND
PUBLIC FACILITIES
SEWARD HIGHWAY
MP 96 TO MP 102
SAFETY, ROADWAY &
RECREATIONAL IMPROVEMENTS
BIRD CREEK PARKING LOT
PLANT DETAILS

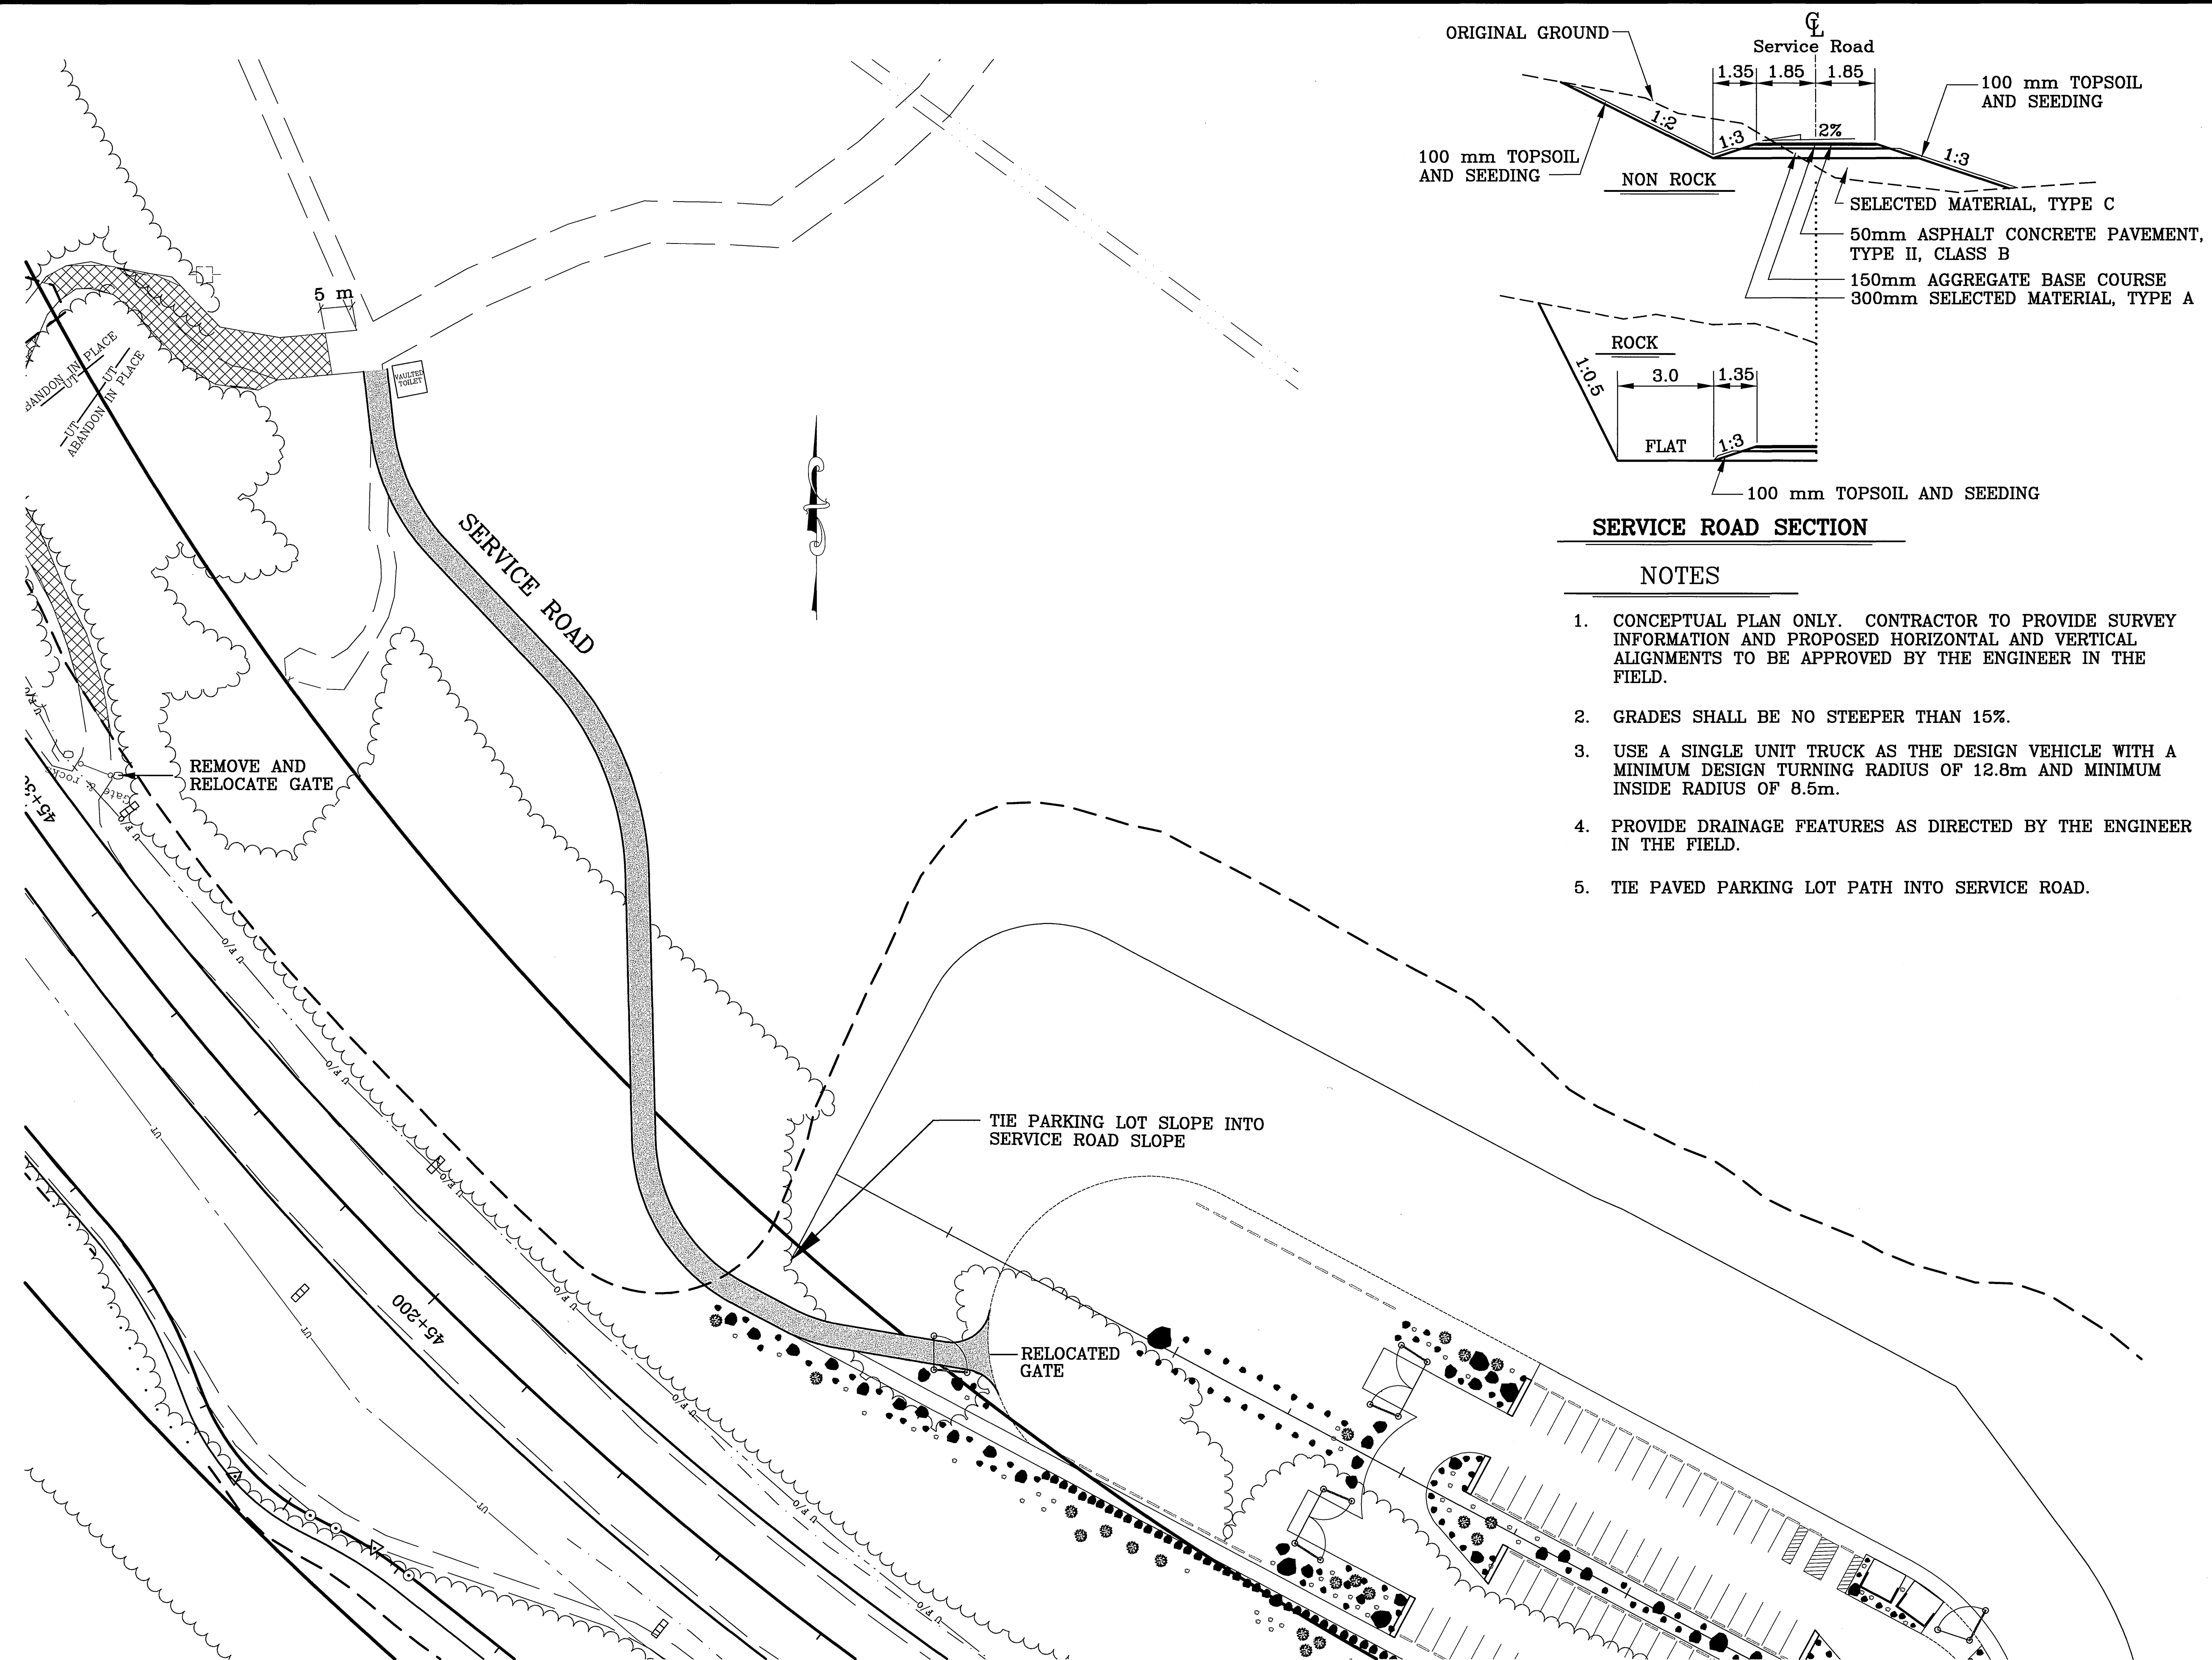

NOTE :
DIMENSIONS ARE IN METERS
UNLESS OTHERWISE NOTED.

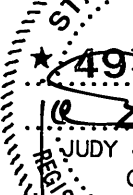


STATE OF ALASKA
DEPARTMENT OF TRANSPORTATION
AND PUBLIC FACILITIES


SEWARD HIGHWAY
MP 96 TO MP 102
SAFETY, ROADWAY &
RECREATIONAL IMPROVEMENTS

BIRD CREEK SERVICE ROAD
DETAIL SHEET

NOTE:
DIMENSIONS ON
THIS SHEET ARE
IN ENGLISH UNITS.

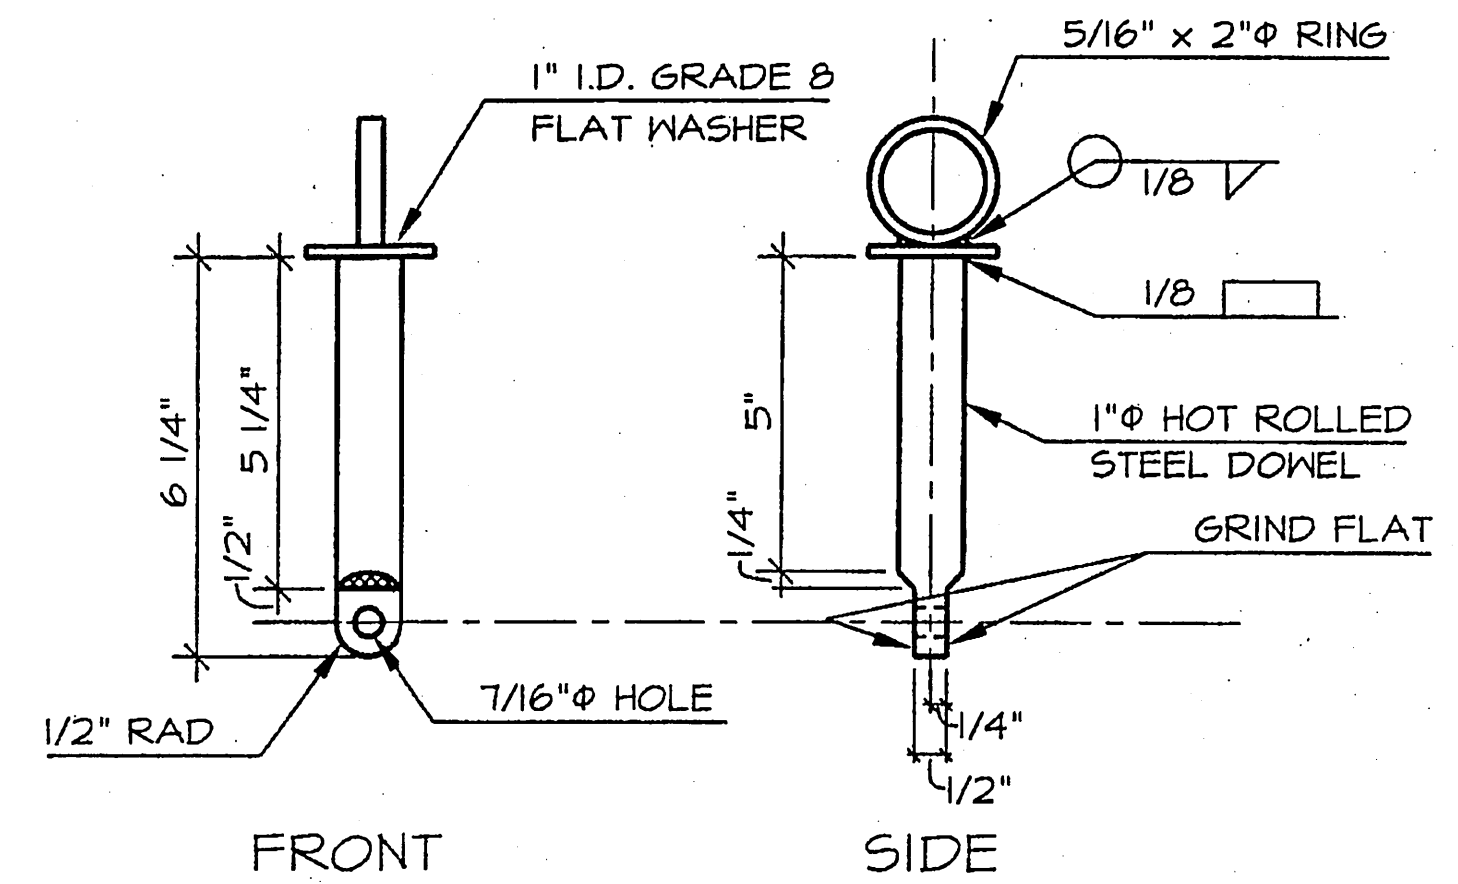


① LATCH PIN


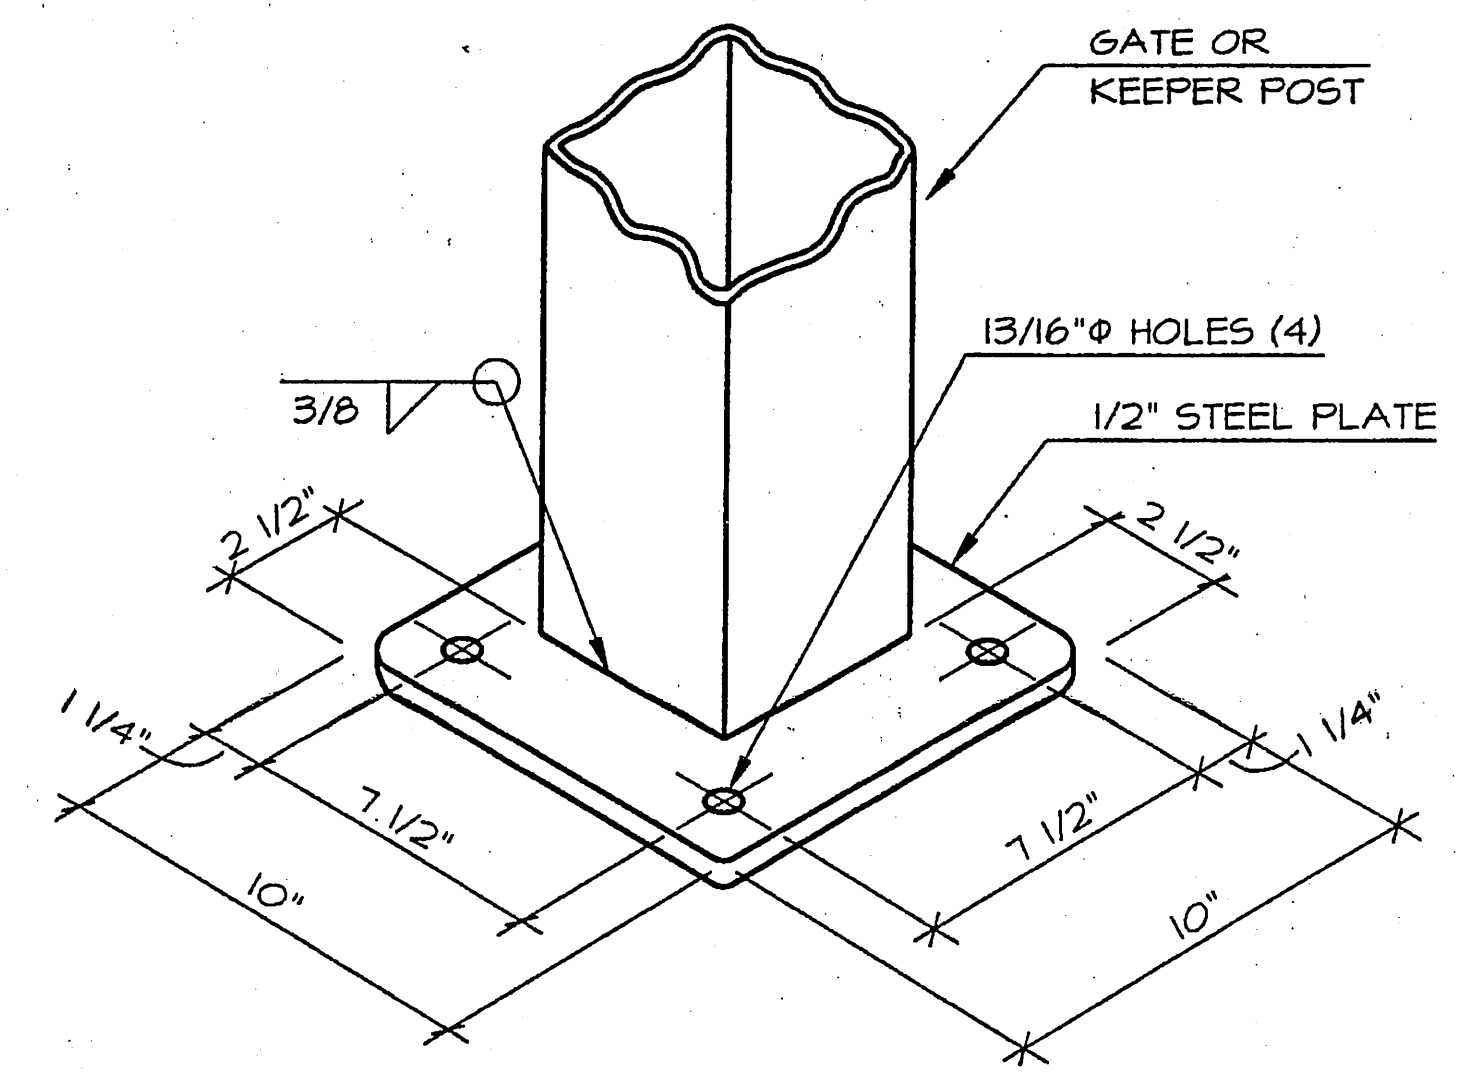


NOTE: FASTEN PLATES WITH 4 - 3/4" x 2" STEEL BOLTS WITH FLAT WASHERS, LOCK WASHERS, AND NUTS


② STEEL PLATE (TYP.)

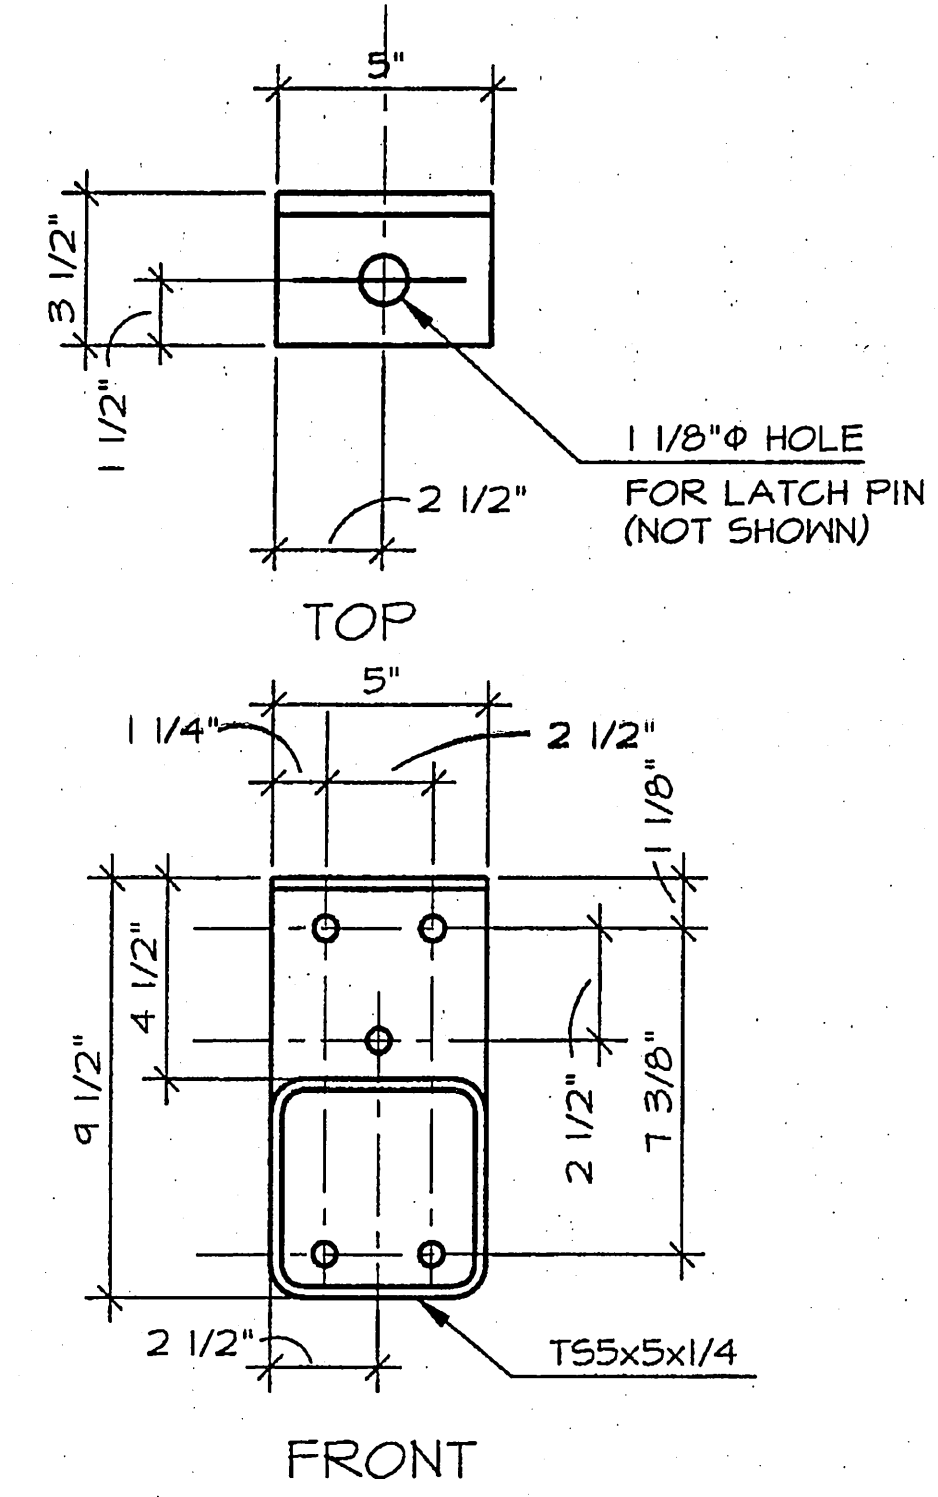

③ KEEPER BRACKET

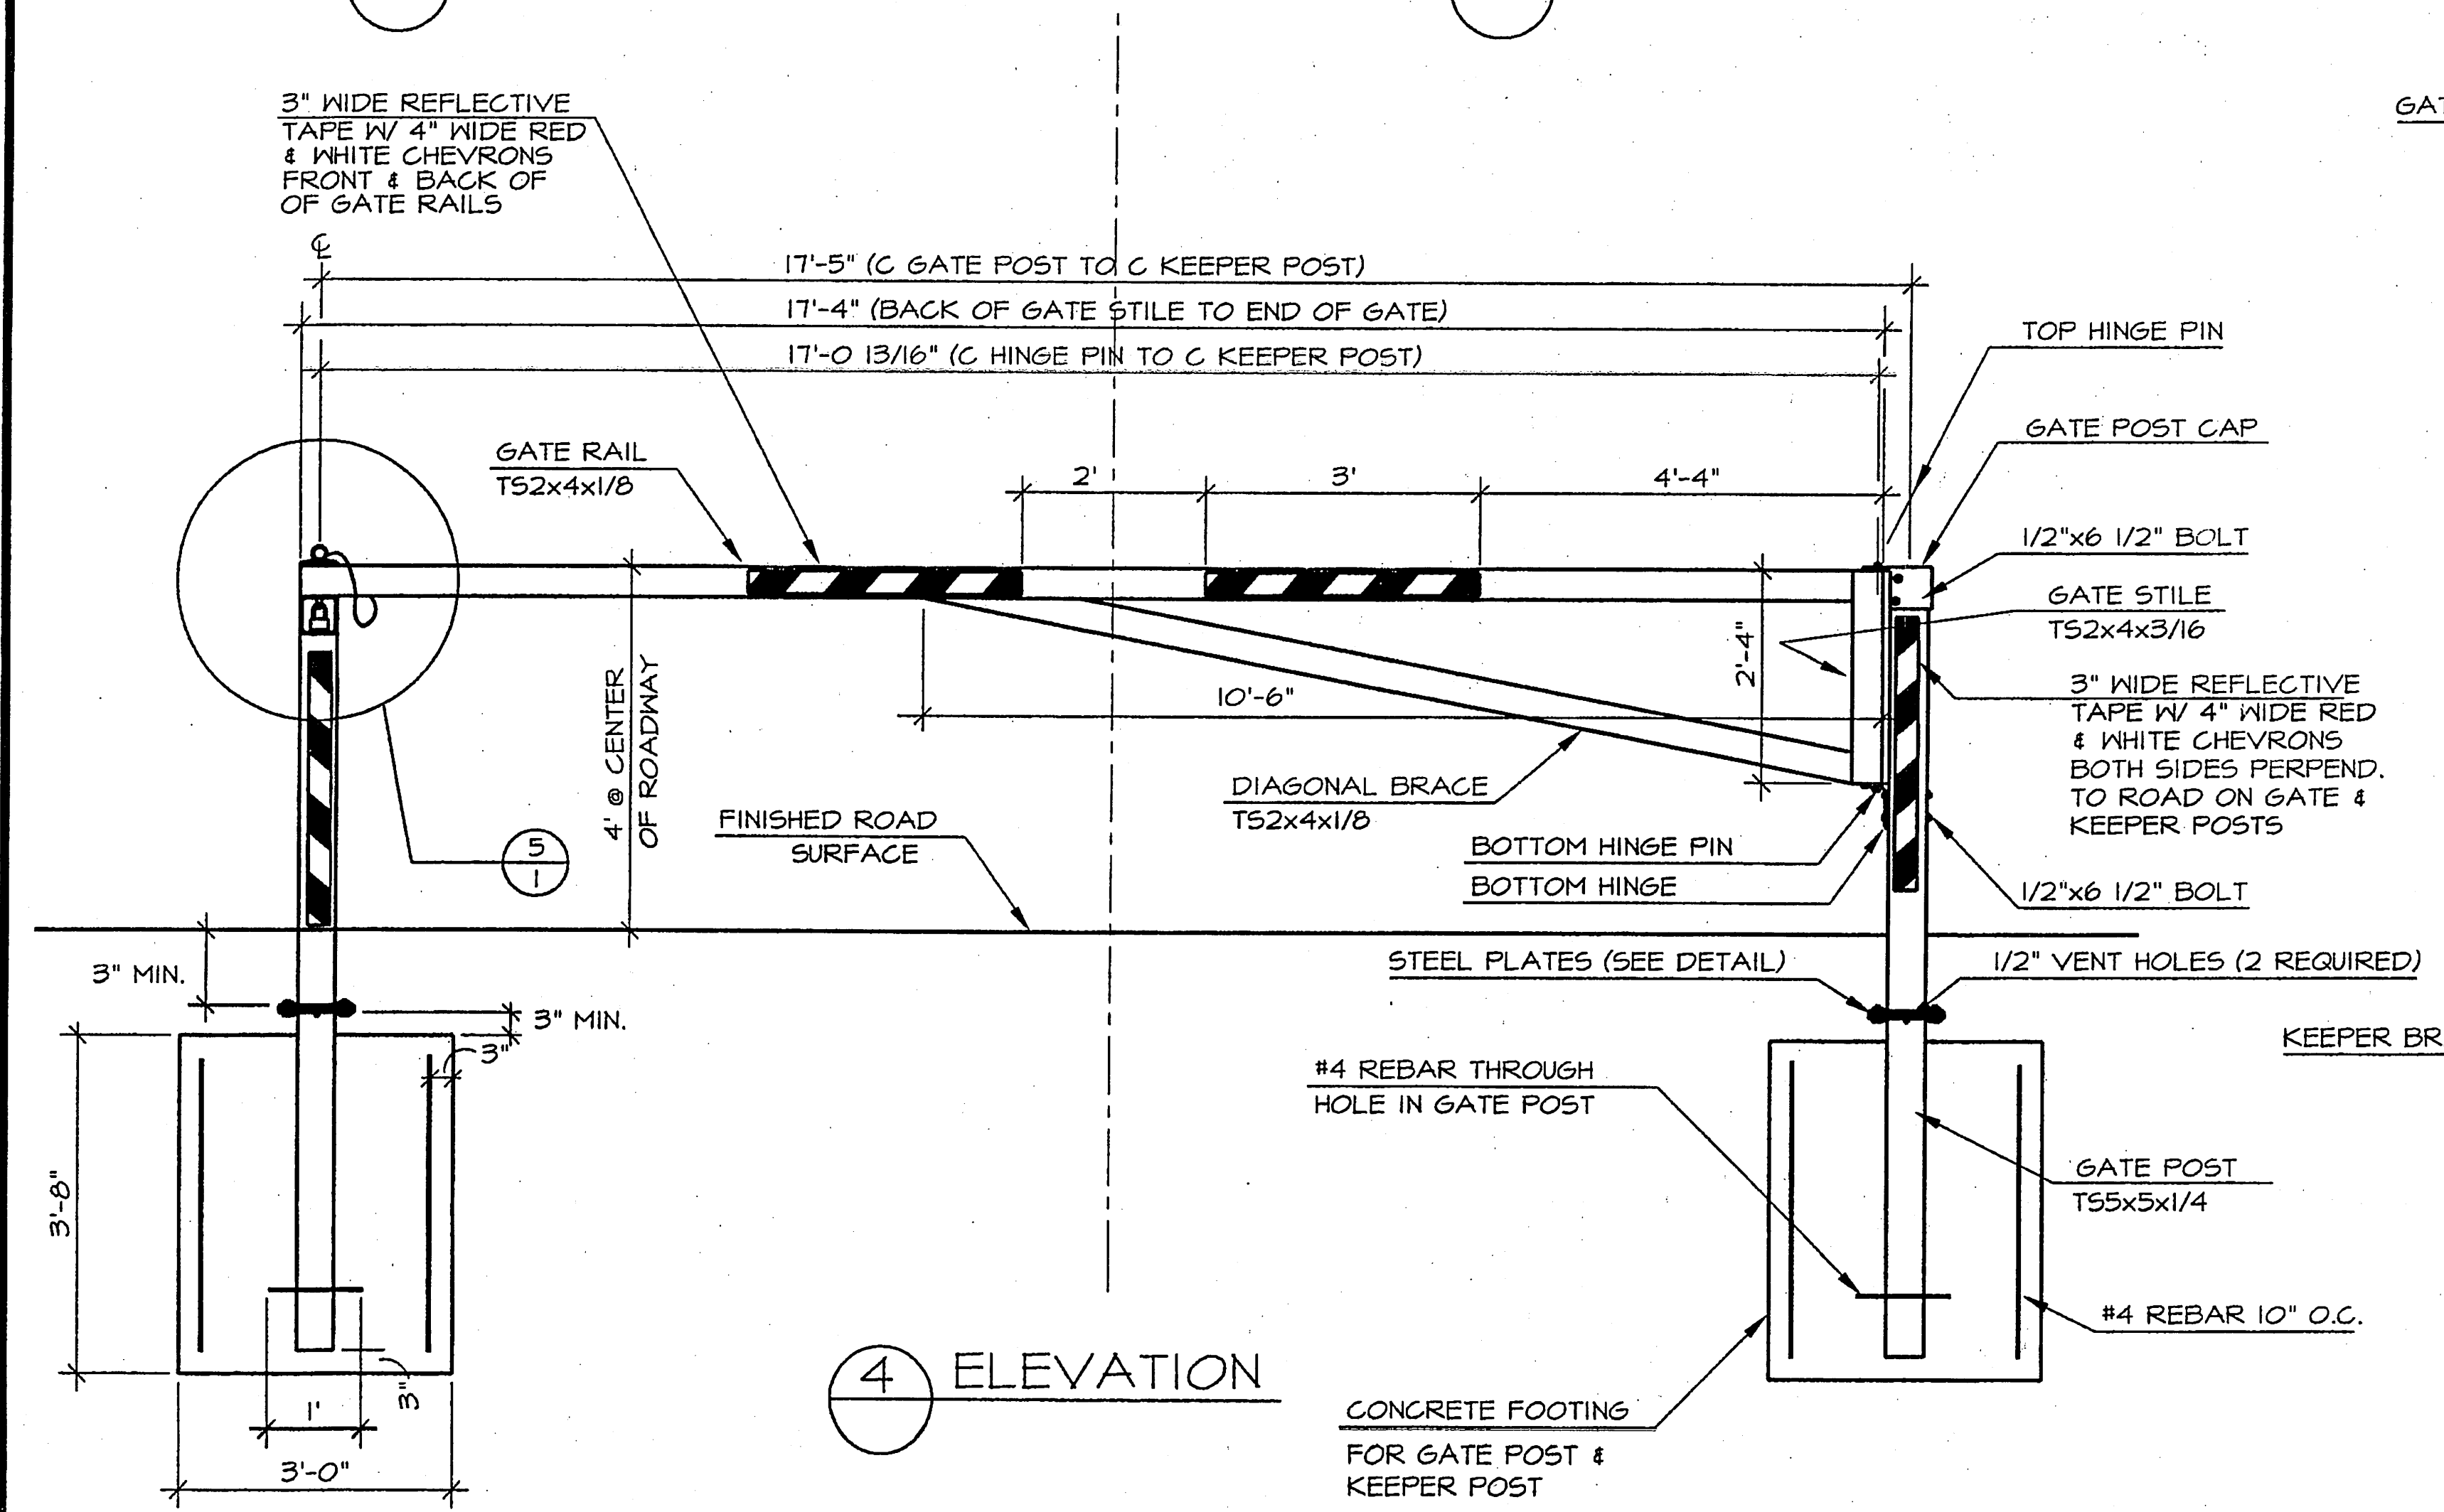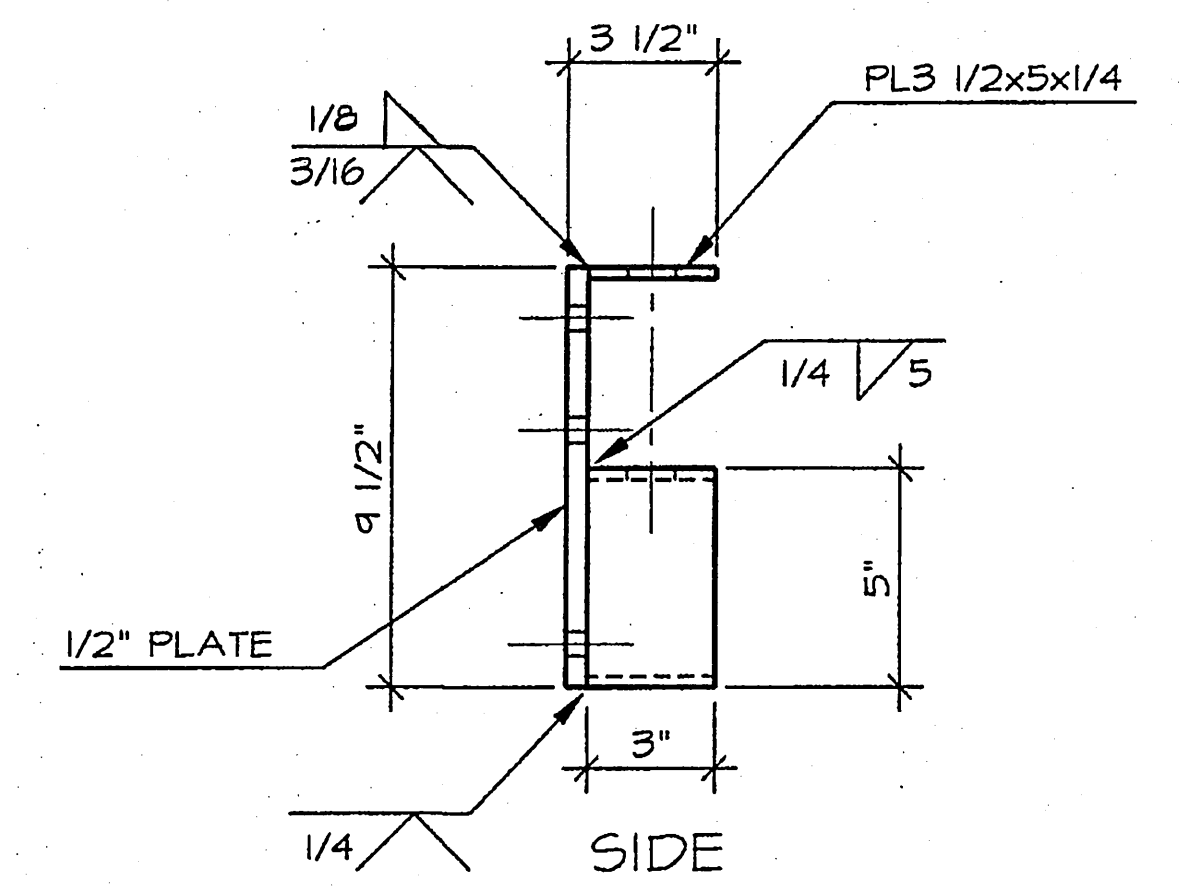


④ ELEVATION


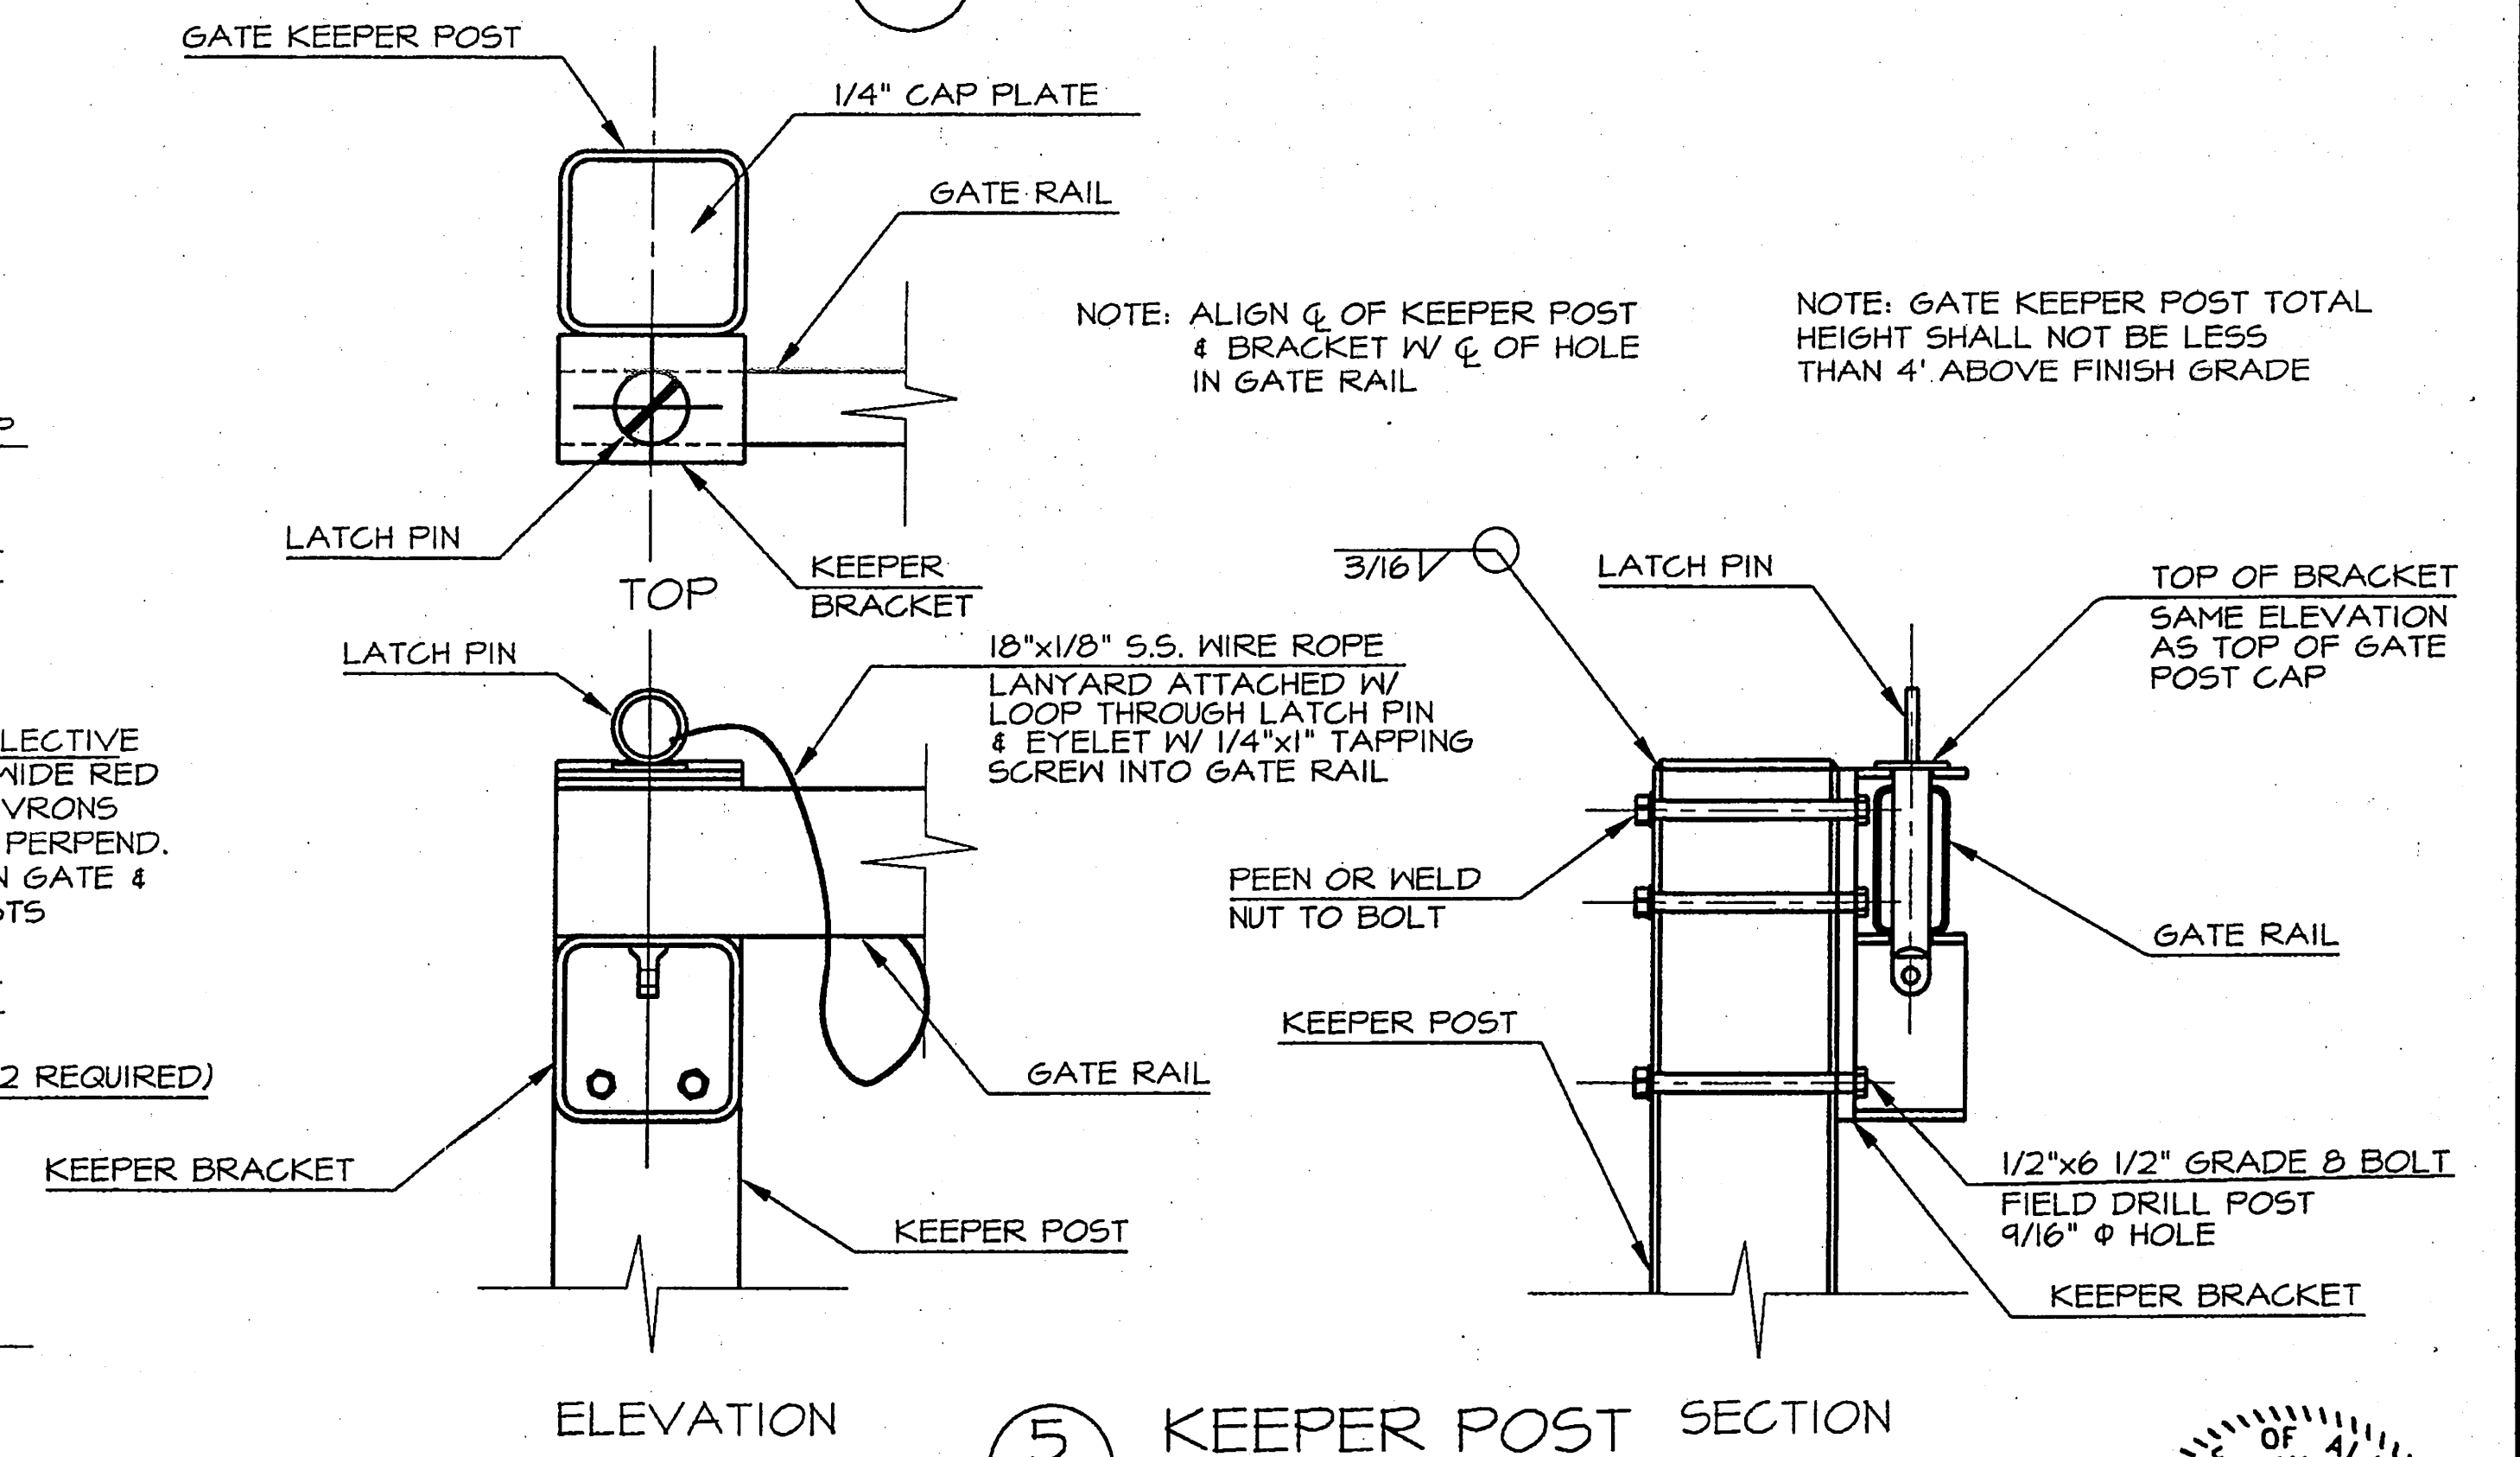


⑤ KEEPER POST SECTION


NO.	REVISION	DATE	APPROVED
11	MOD. WELD SYMBOLS & PLATE HOLE SIZES	4/98	DH
10	REDESIGN & REDRAW	2/98	DH

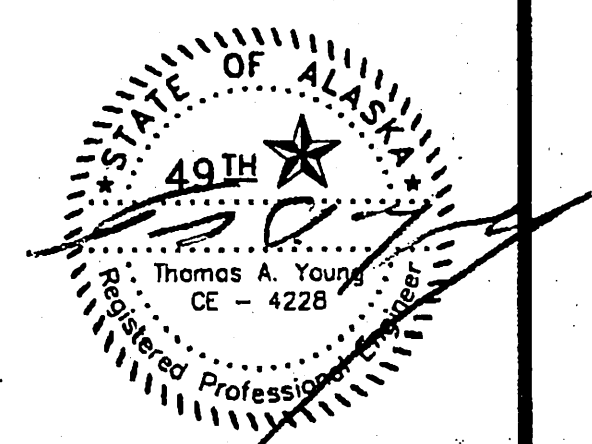


NOTE:
DIMENSIONS ON
THIS SHEET ARE
IN ENGLISH UNITS.

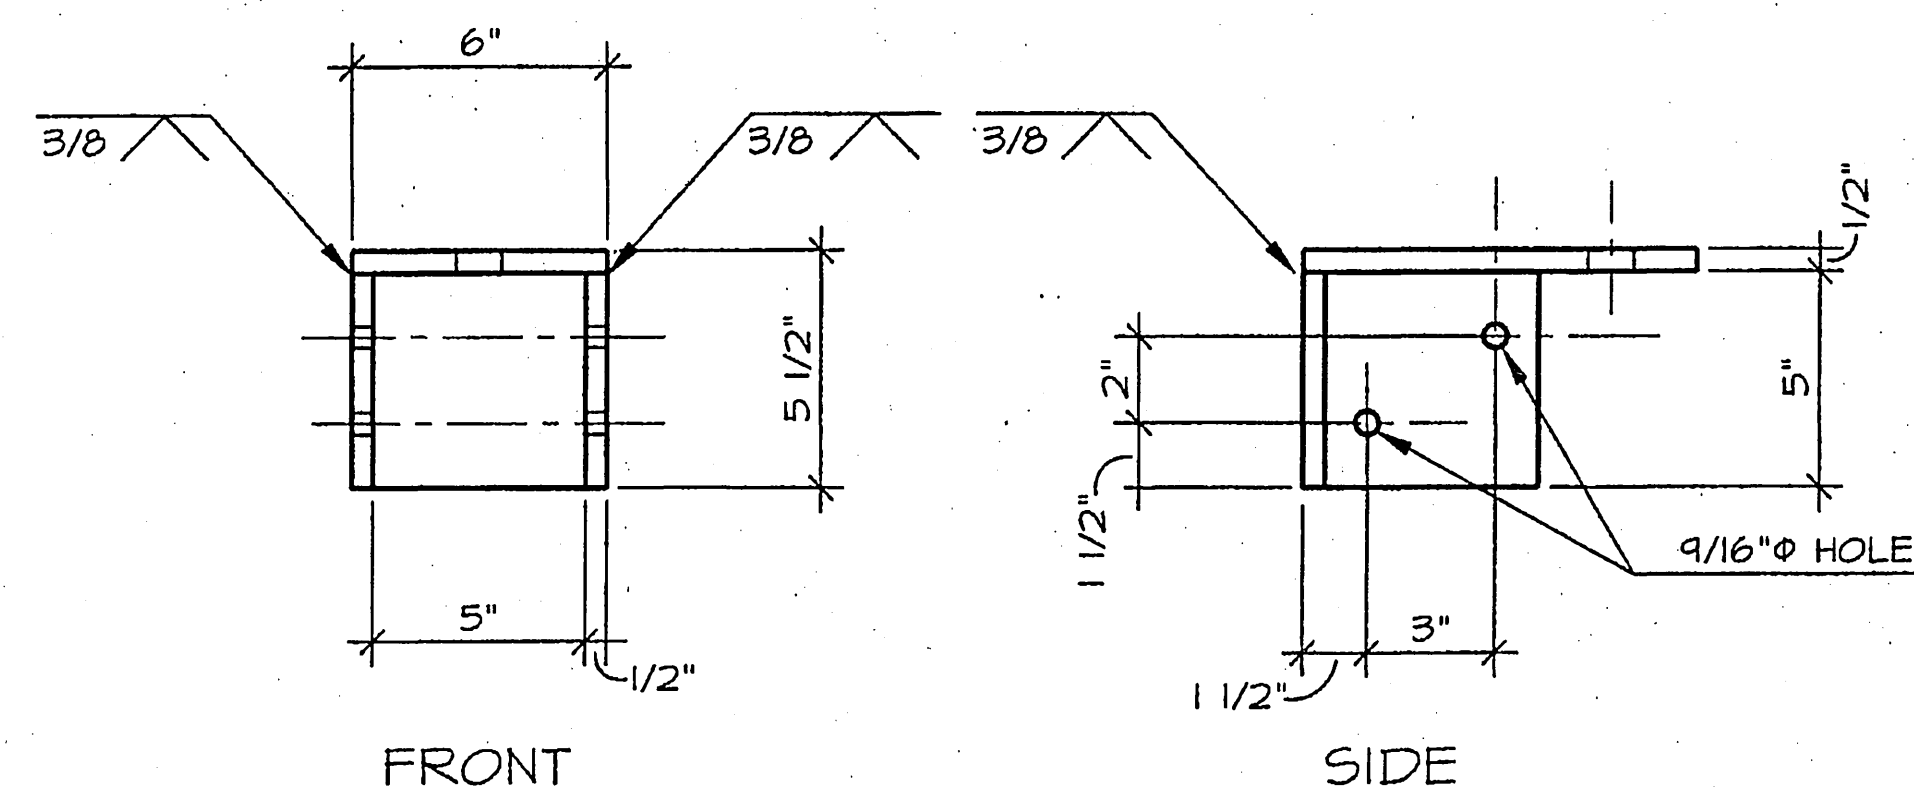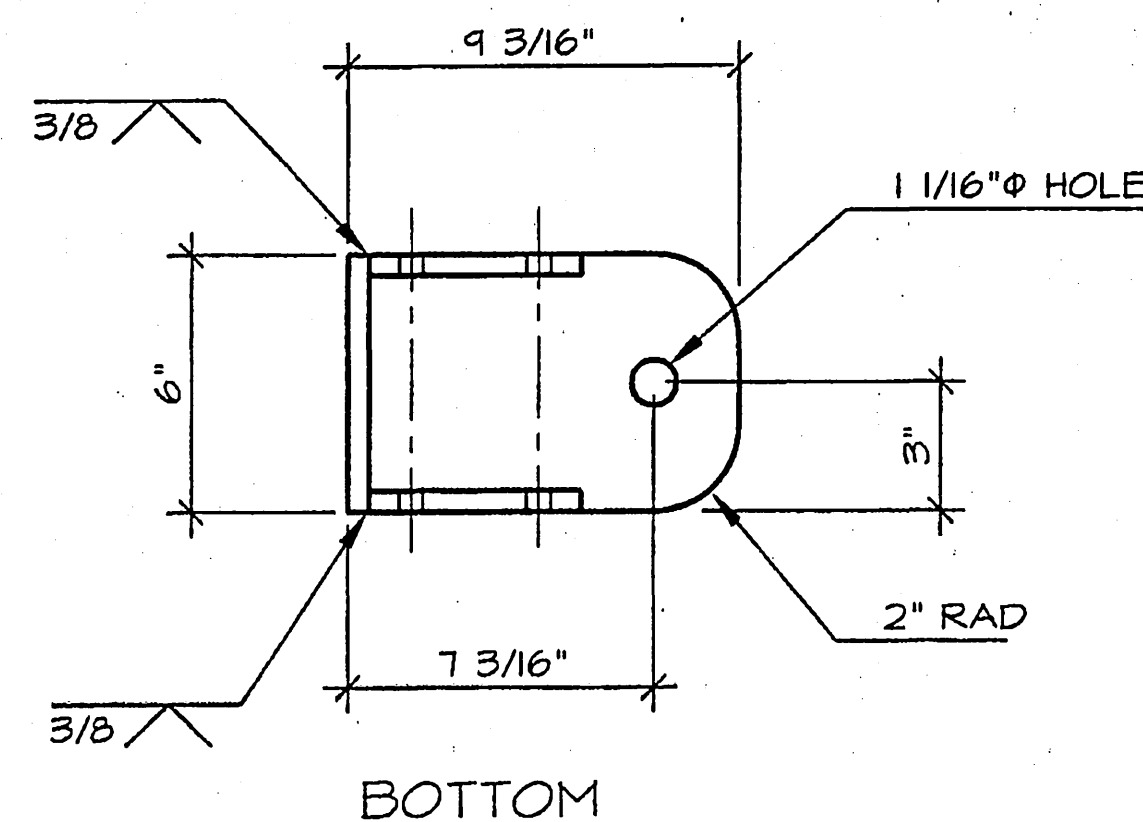


1 GATE POST CAP

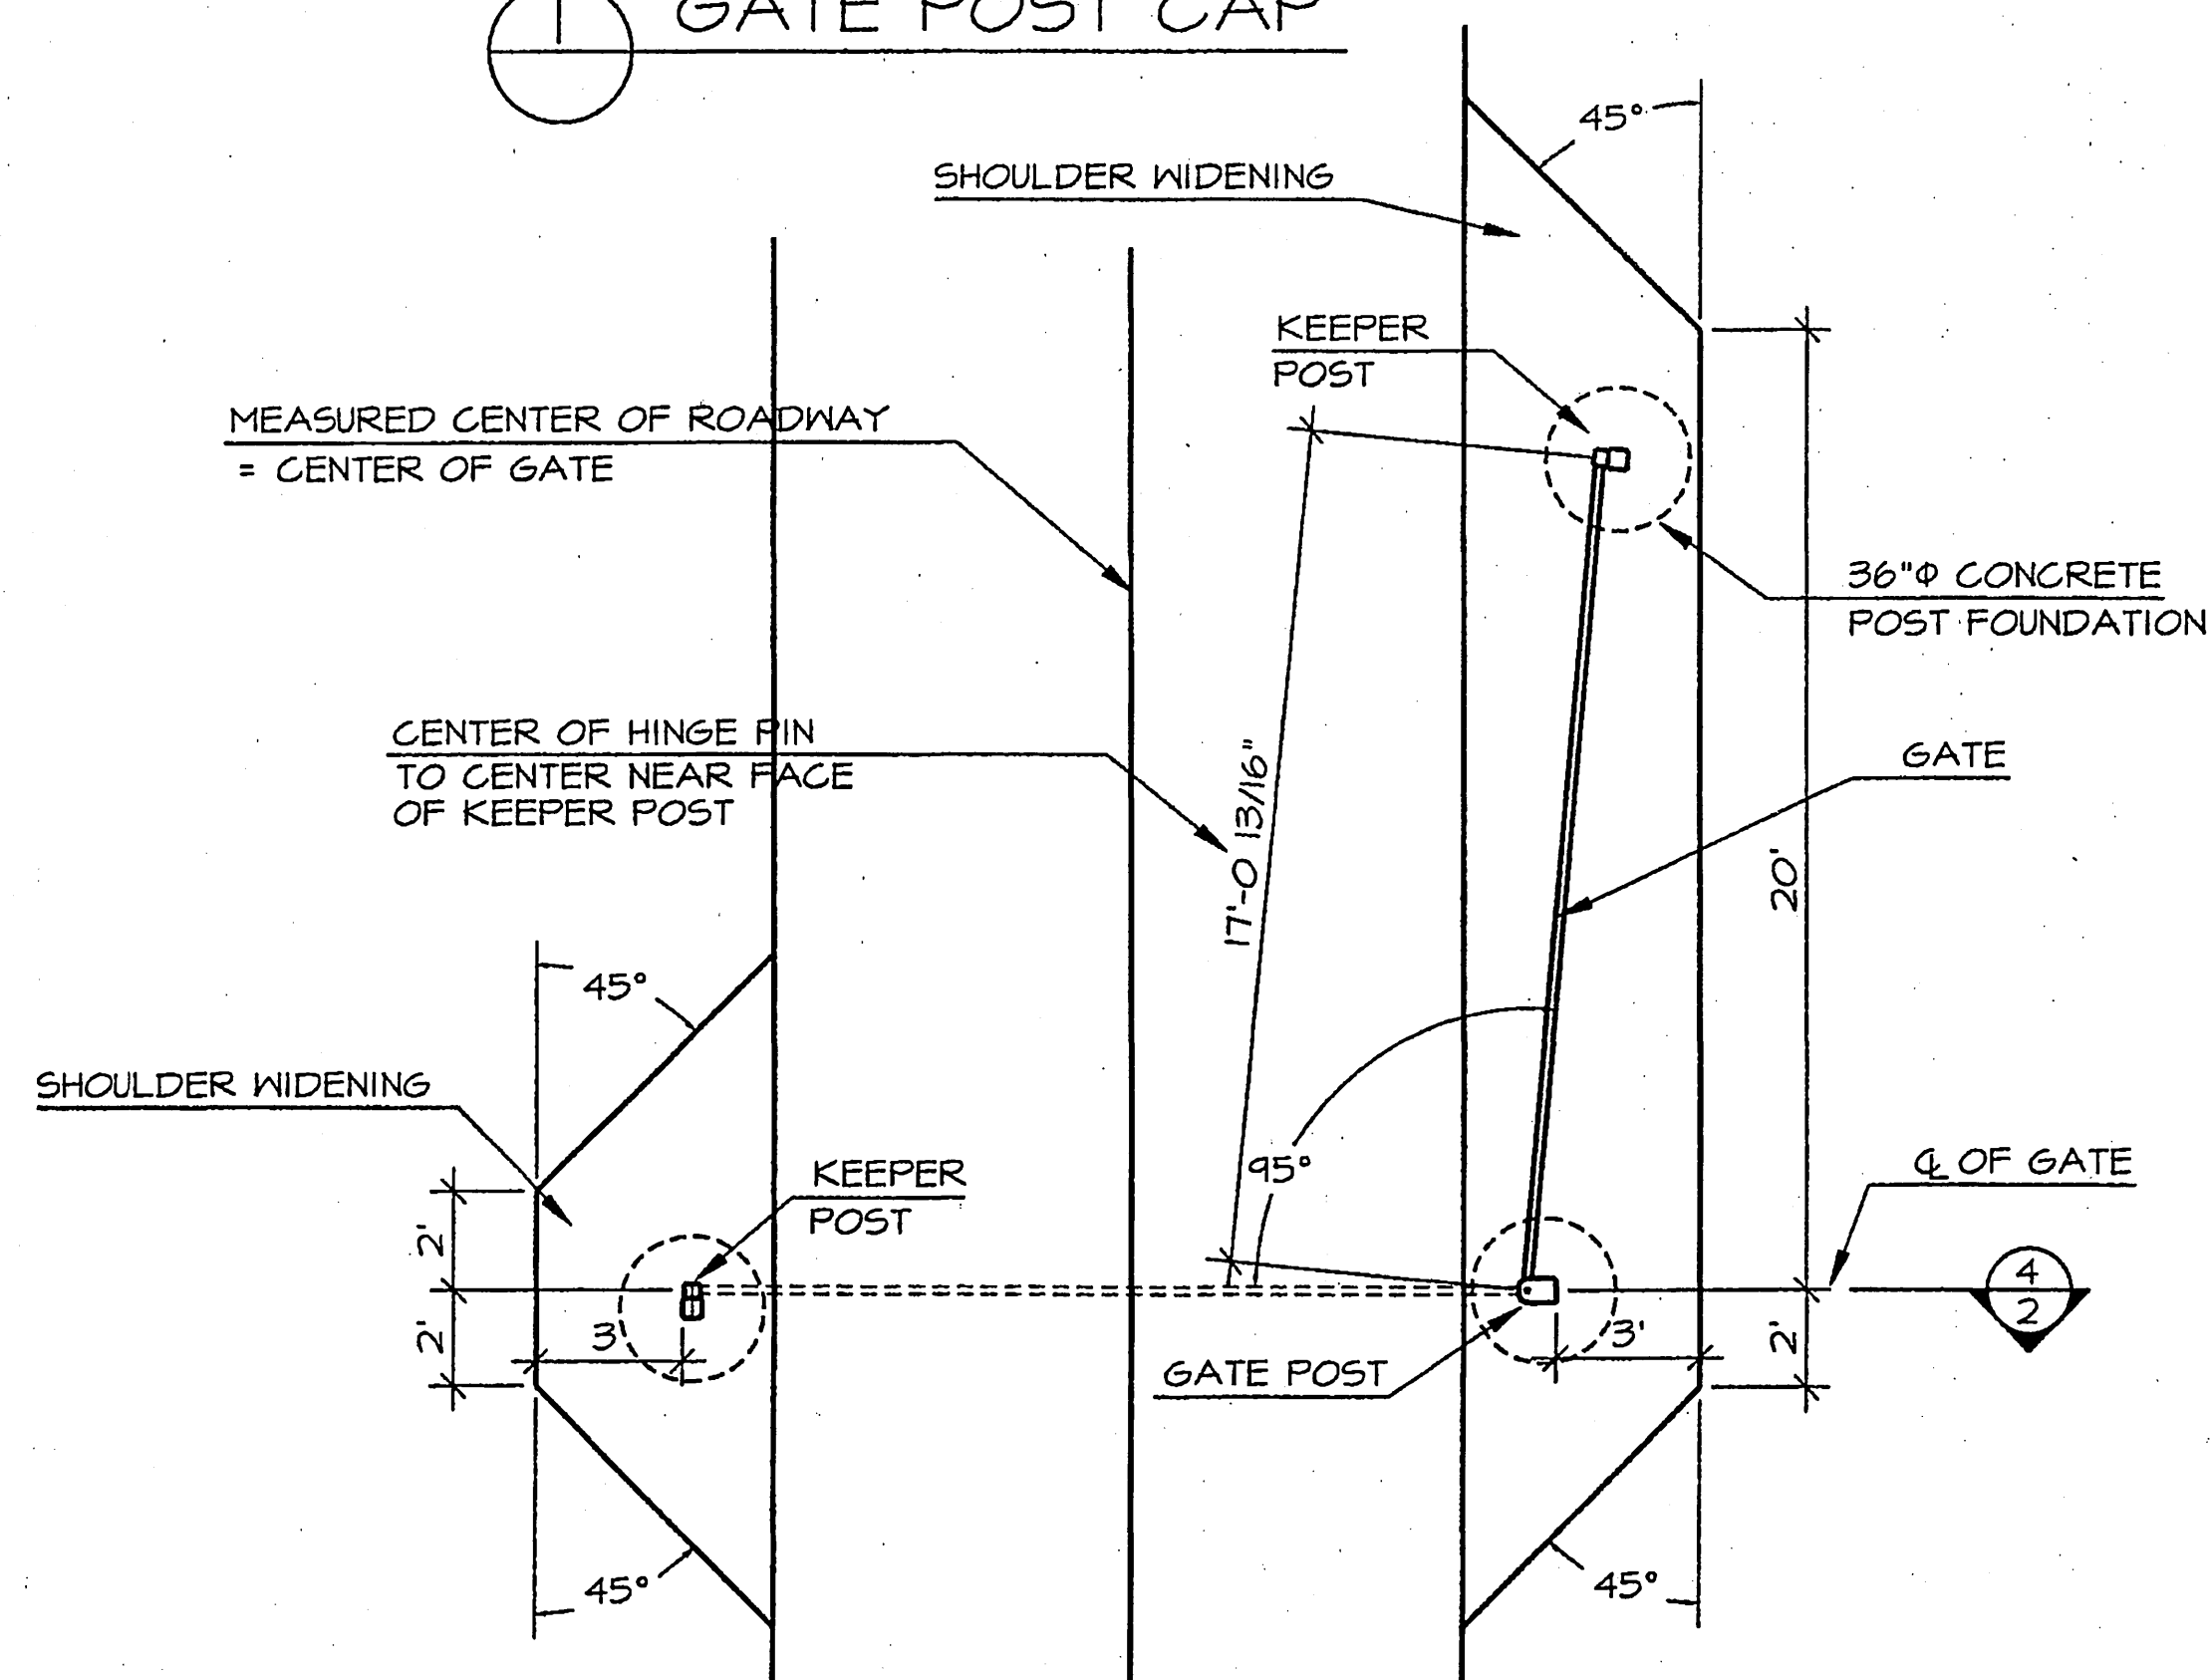


2 SITE PLAN

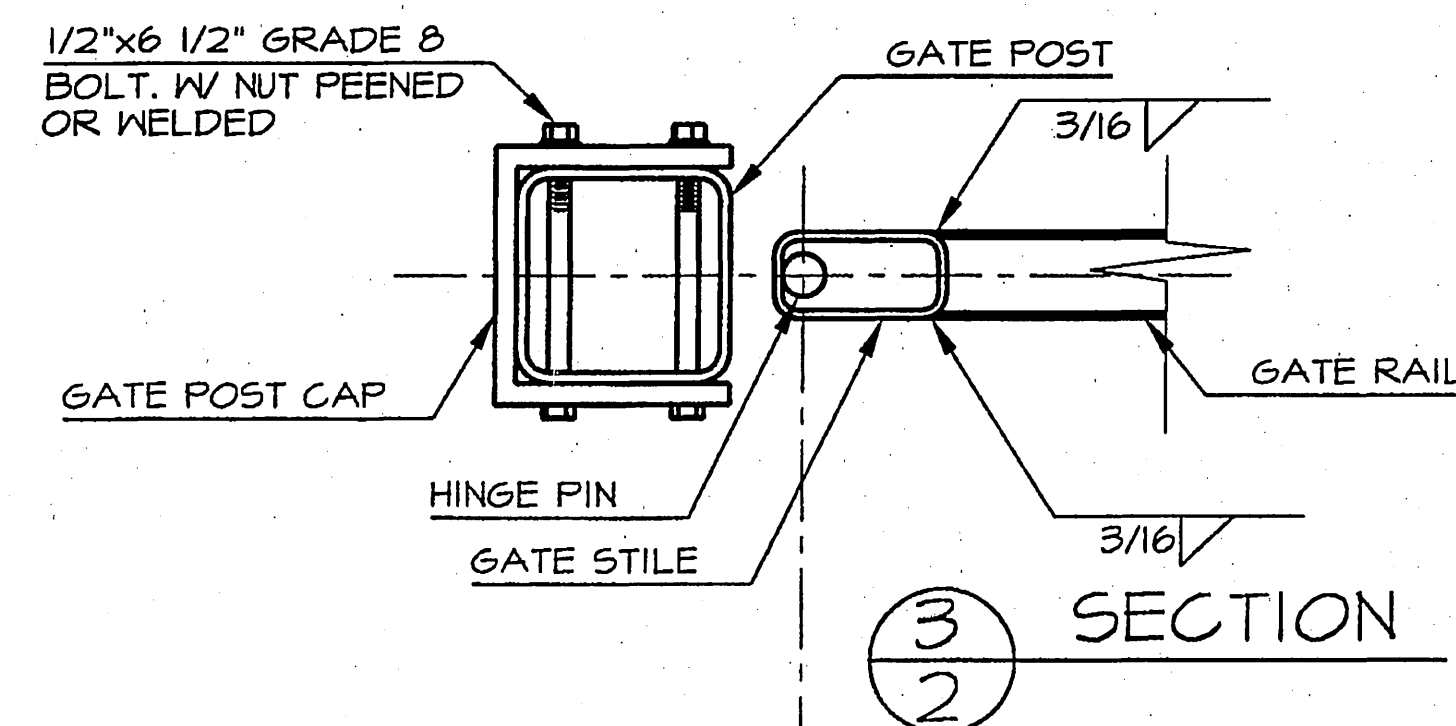

3 SECTION

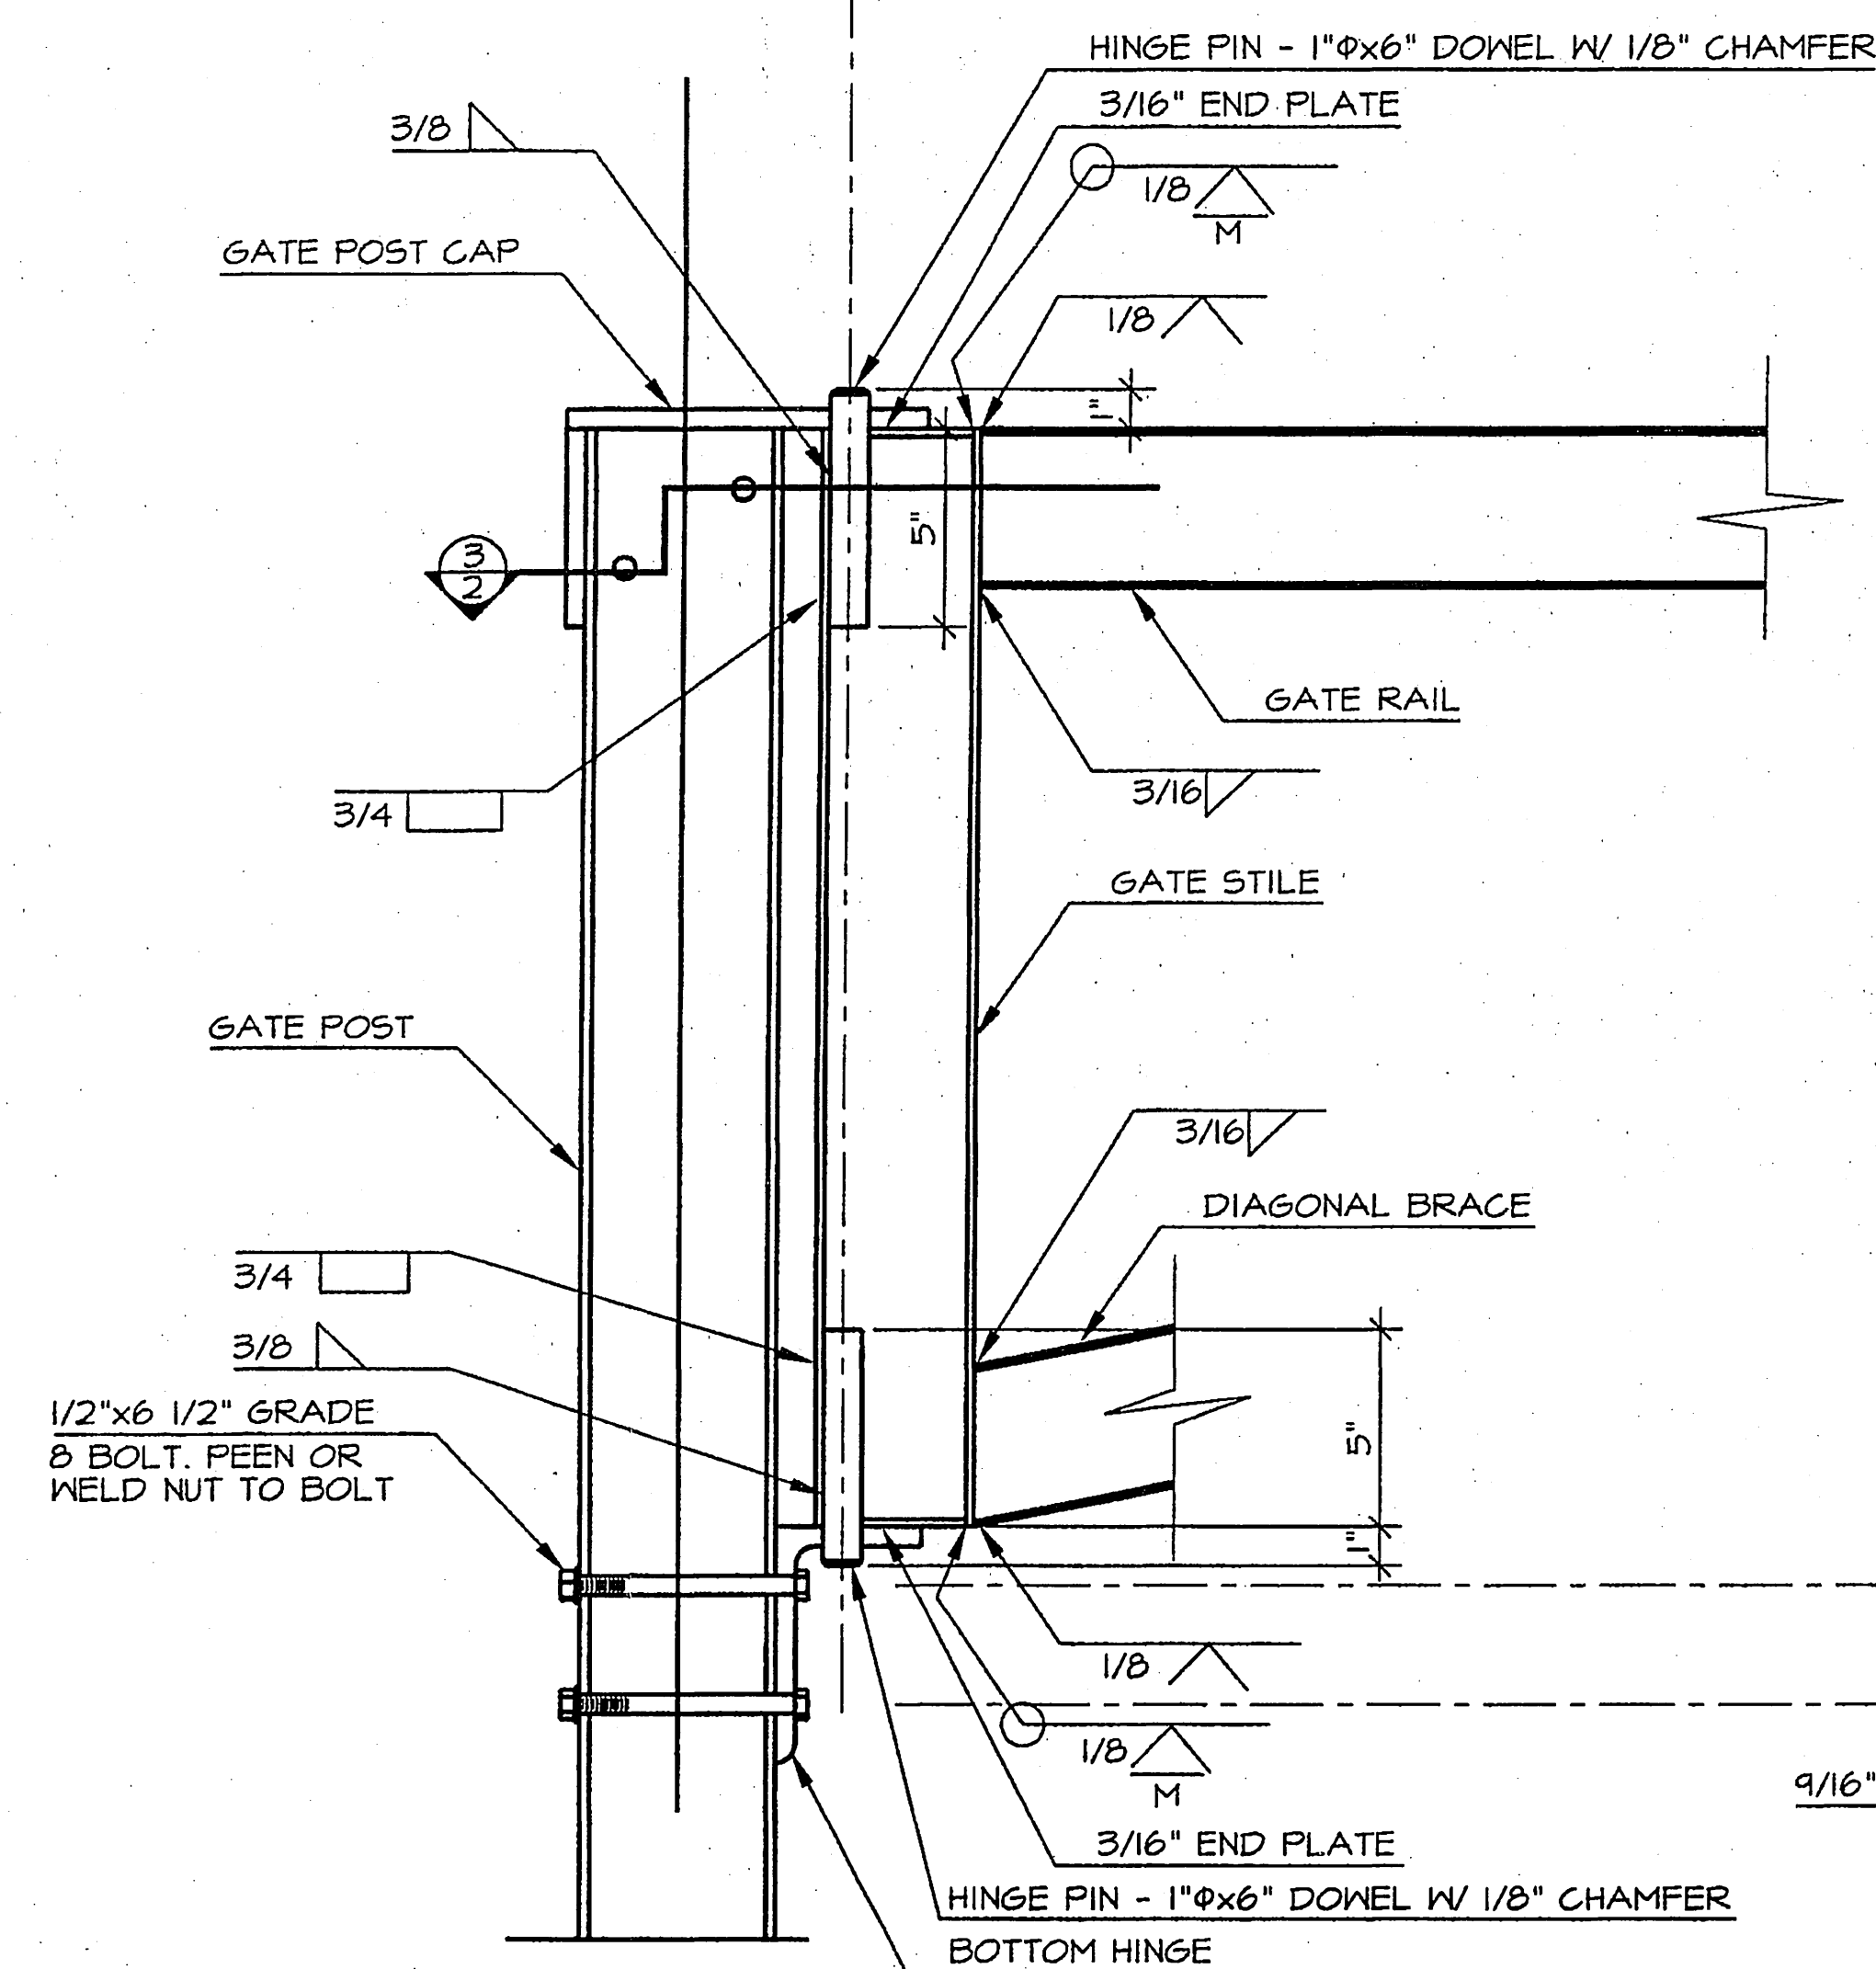

4 SECTION

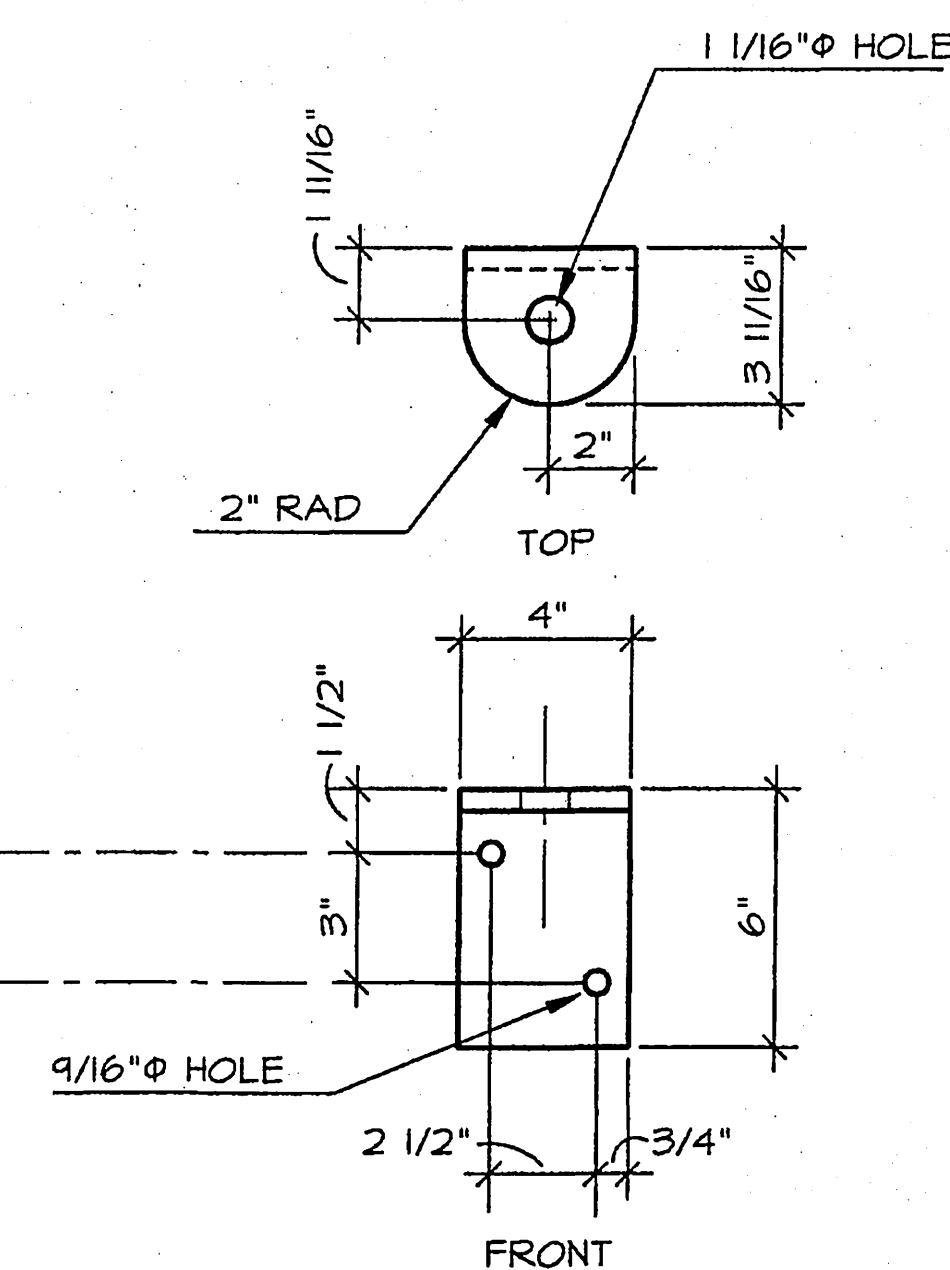

5 BOTTOM HINGE

11	CH. DIST FROM GATE PIN TO C KEEPER POST	4/98	DH
10	REDESIGN & REDRAW	2/98	DH
NO.	REVISION	DATE	APPROVED


DEPARTMENT OF NATURAL RESOURCES
DIVISION OF PARKS AND OUTDOOR RECREATION
STATE OF ALASKA

DESIGN & CONSTRUCTION SECTION

SINGLE GATE

PREPARED:
DRAWN: RK
REVIEWED: DH TY
DATE: 10/14/85



SHEET 2
G-1
OF 2 SHEETS

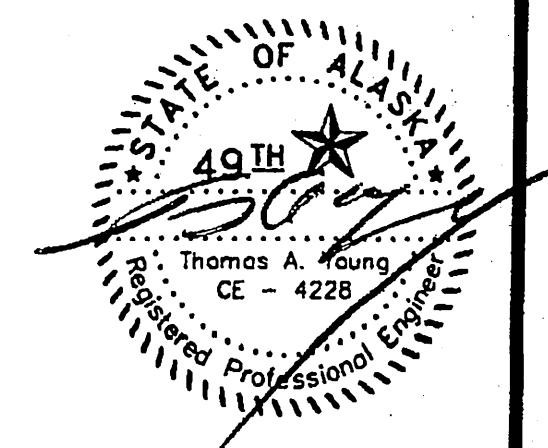



STATE	PROJECT DESIGNATION	YEAR	SHEET NO.	TOTAL SHEETS
ALASKA	NH-0A3-1(28)	2001	E 20	E 30

NOTE:


1. All wood shall be pressure treated with water born salts CCA-C ANPA Standard P-5 to a min. retention of 6.4 kg cubic meter.
2. All posts will be set plumb into hand dug or augered holes, or driven plumb. Delete 2x4 on driven posts.

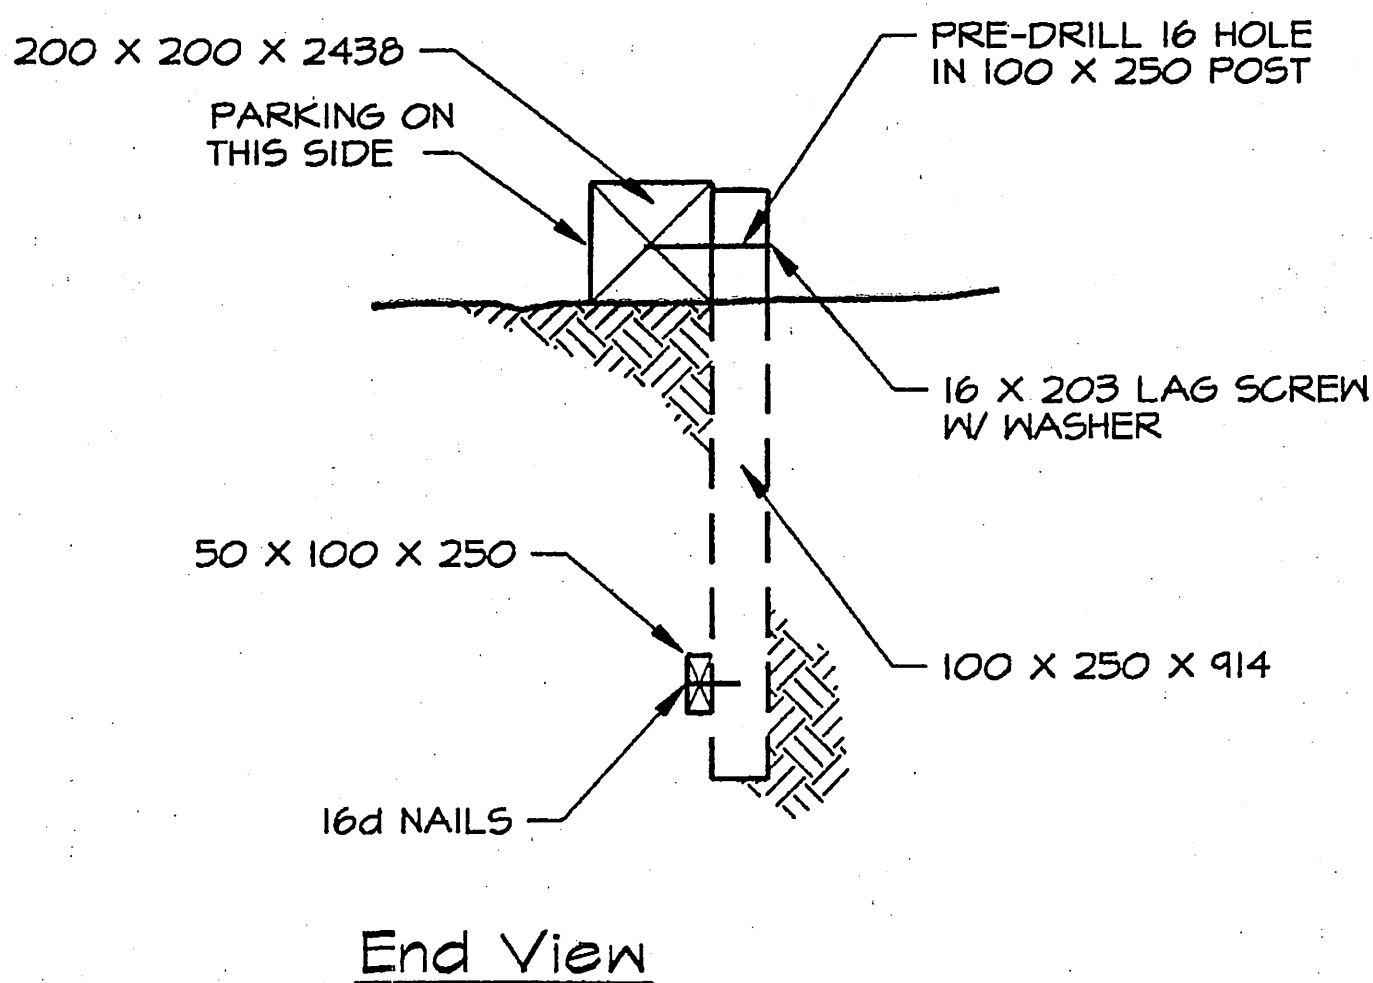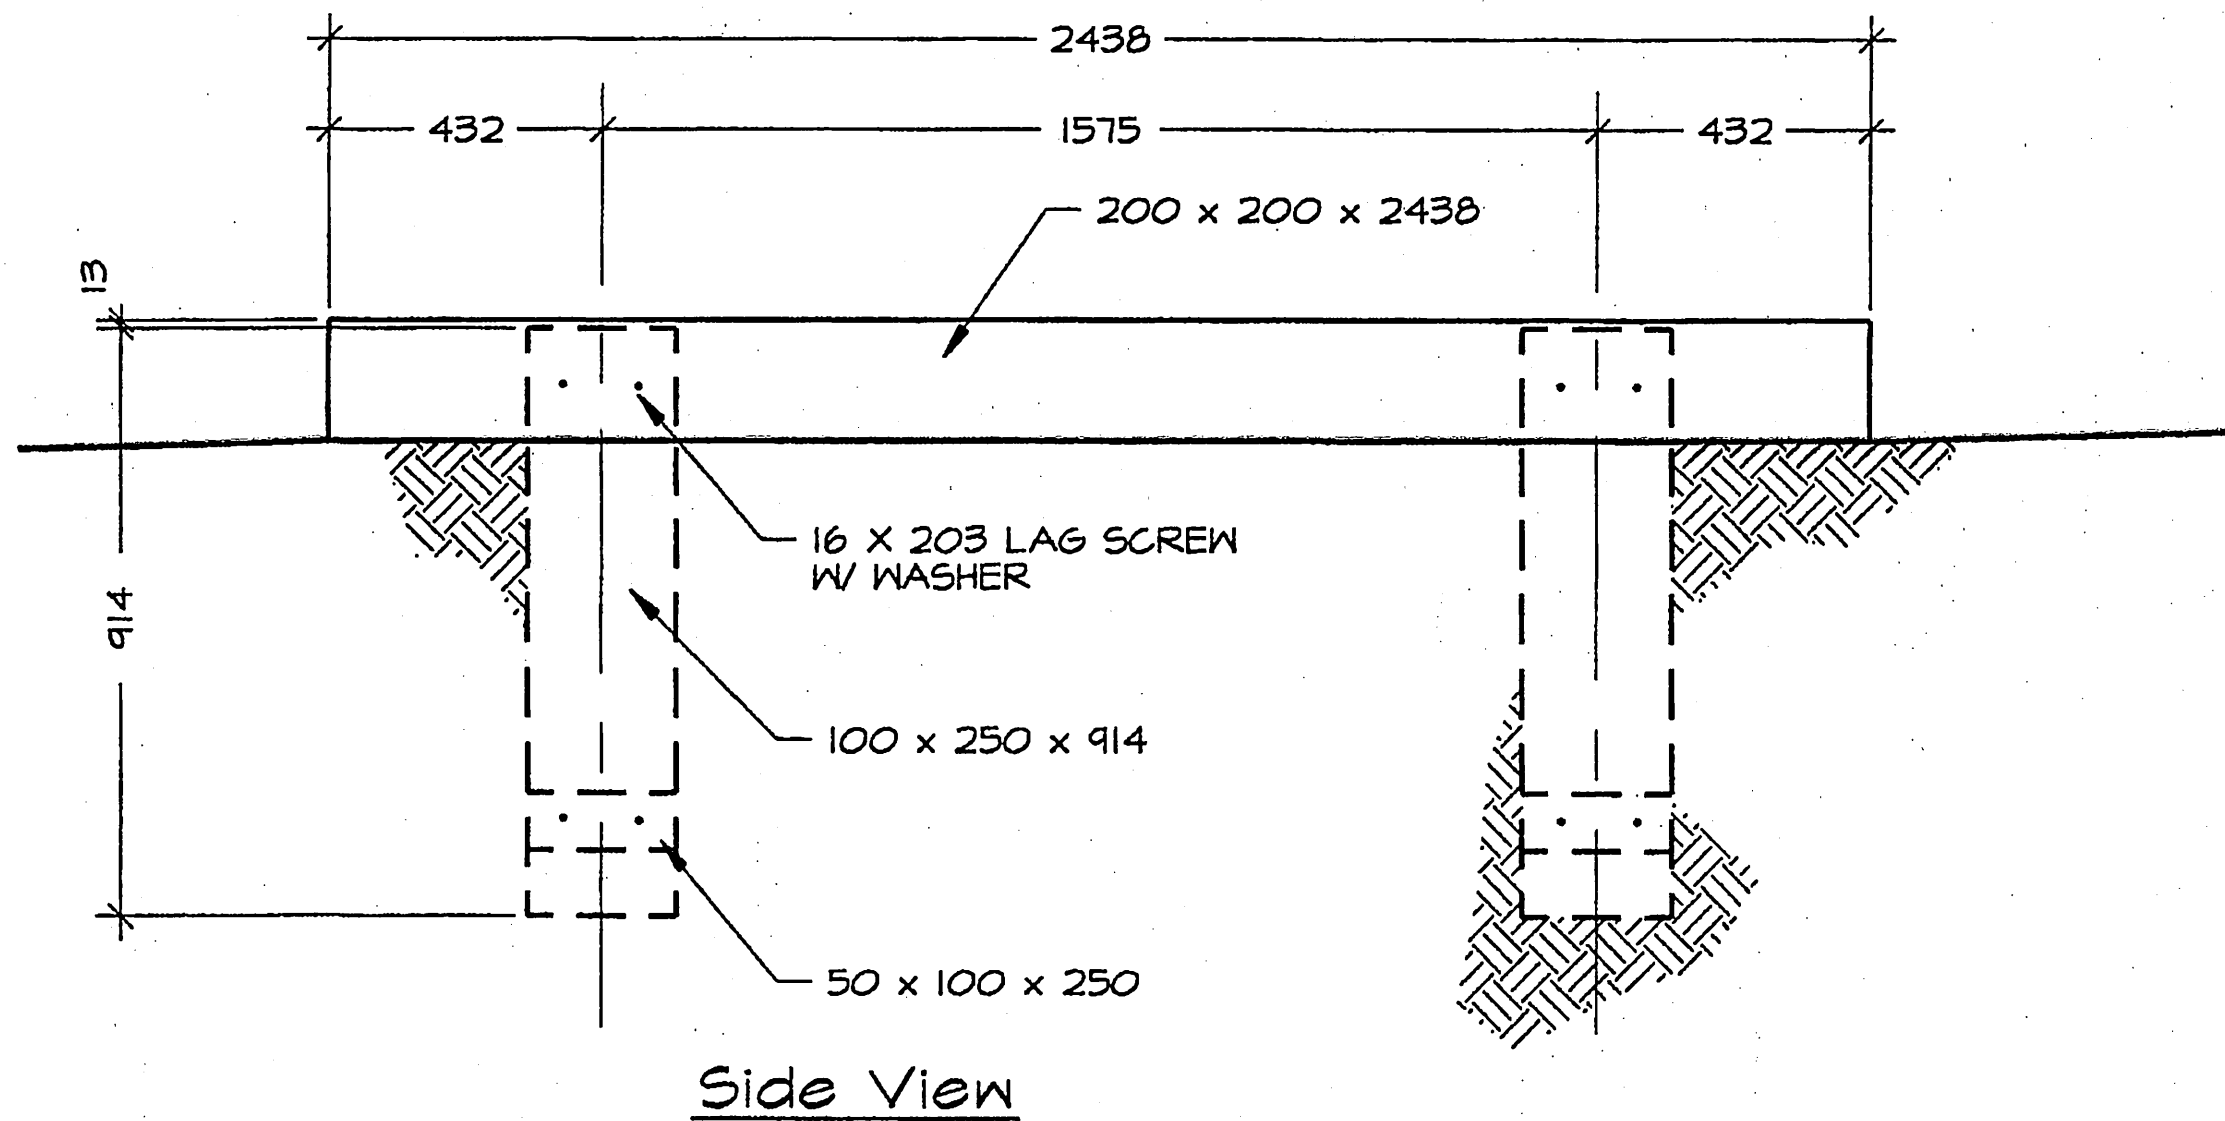


Wood Parking Bumper

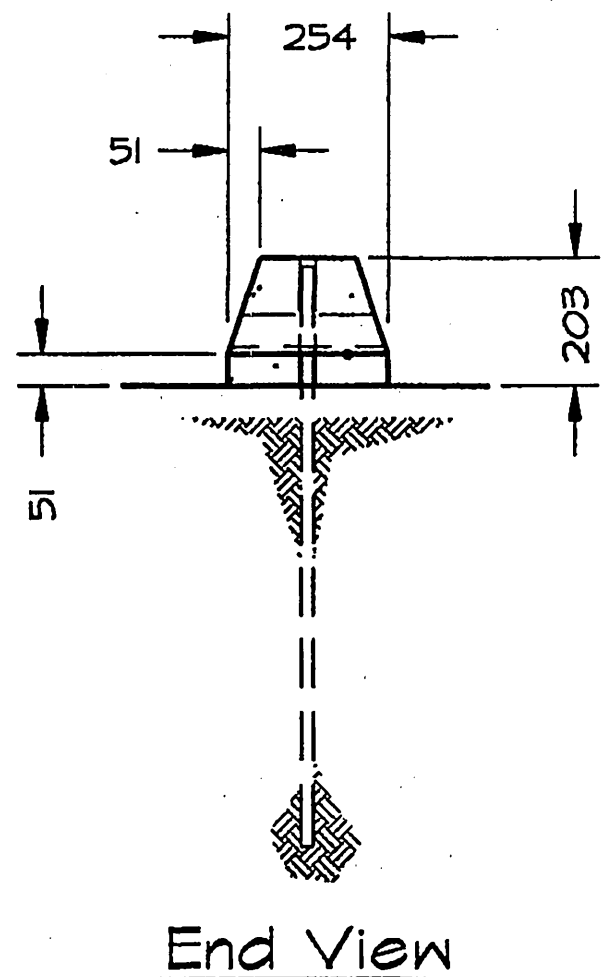
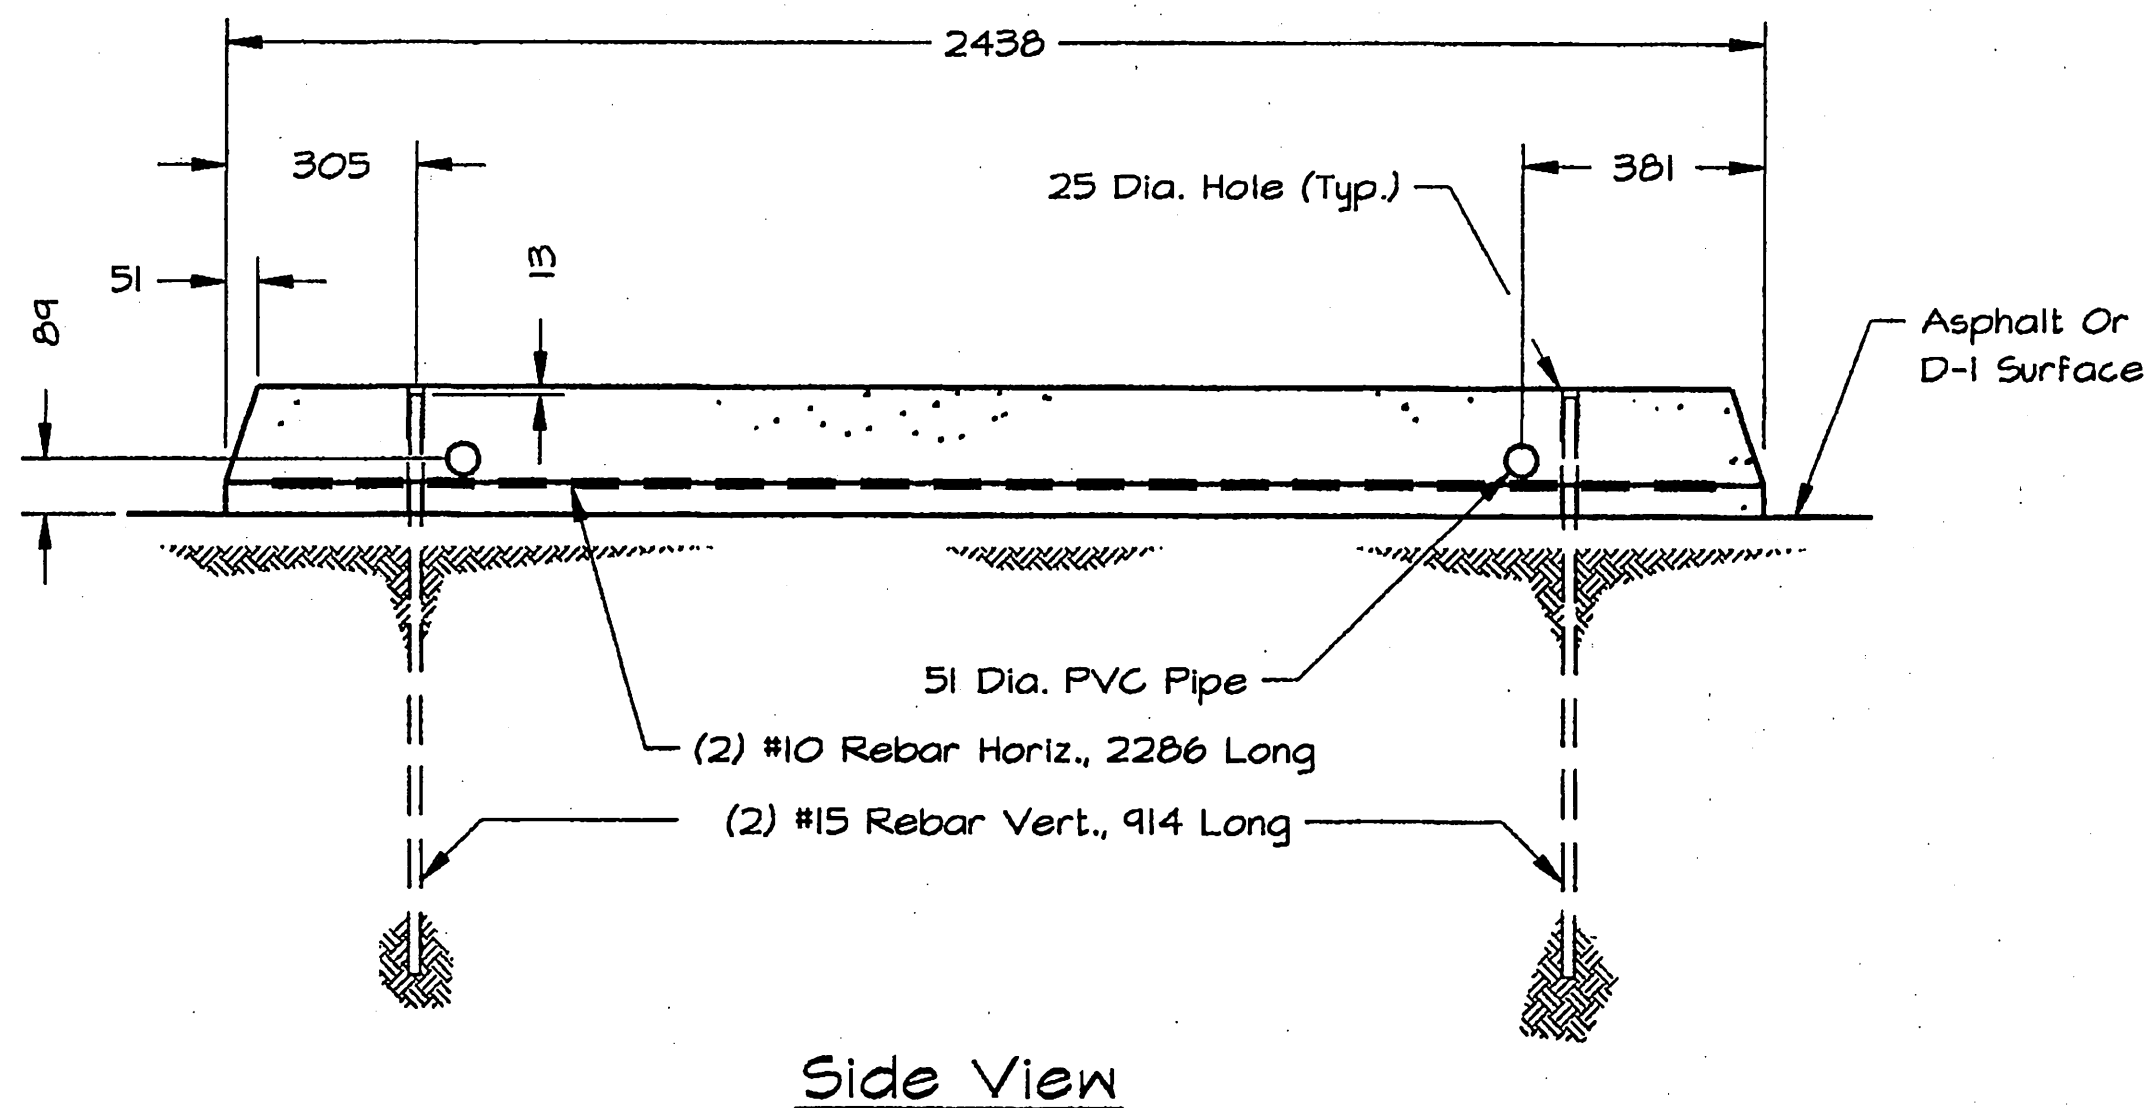


Concrete Parking Bumper

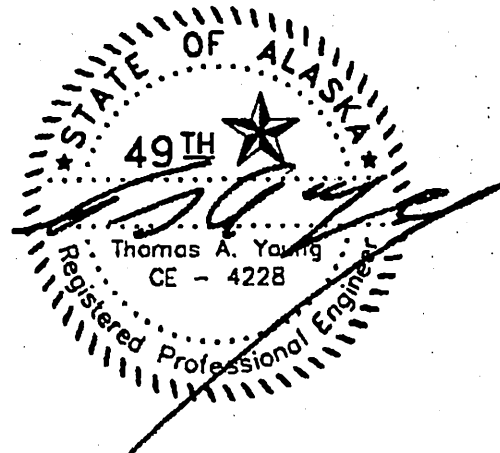


STATE	PROJECT DESIGNATION	YEAR
ALASKA	NH-0A3-1(28)	2001

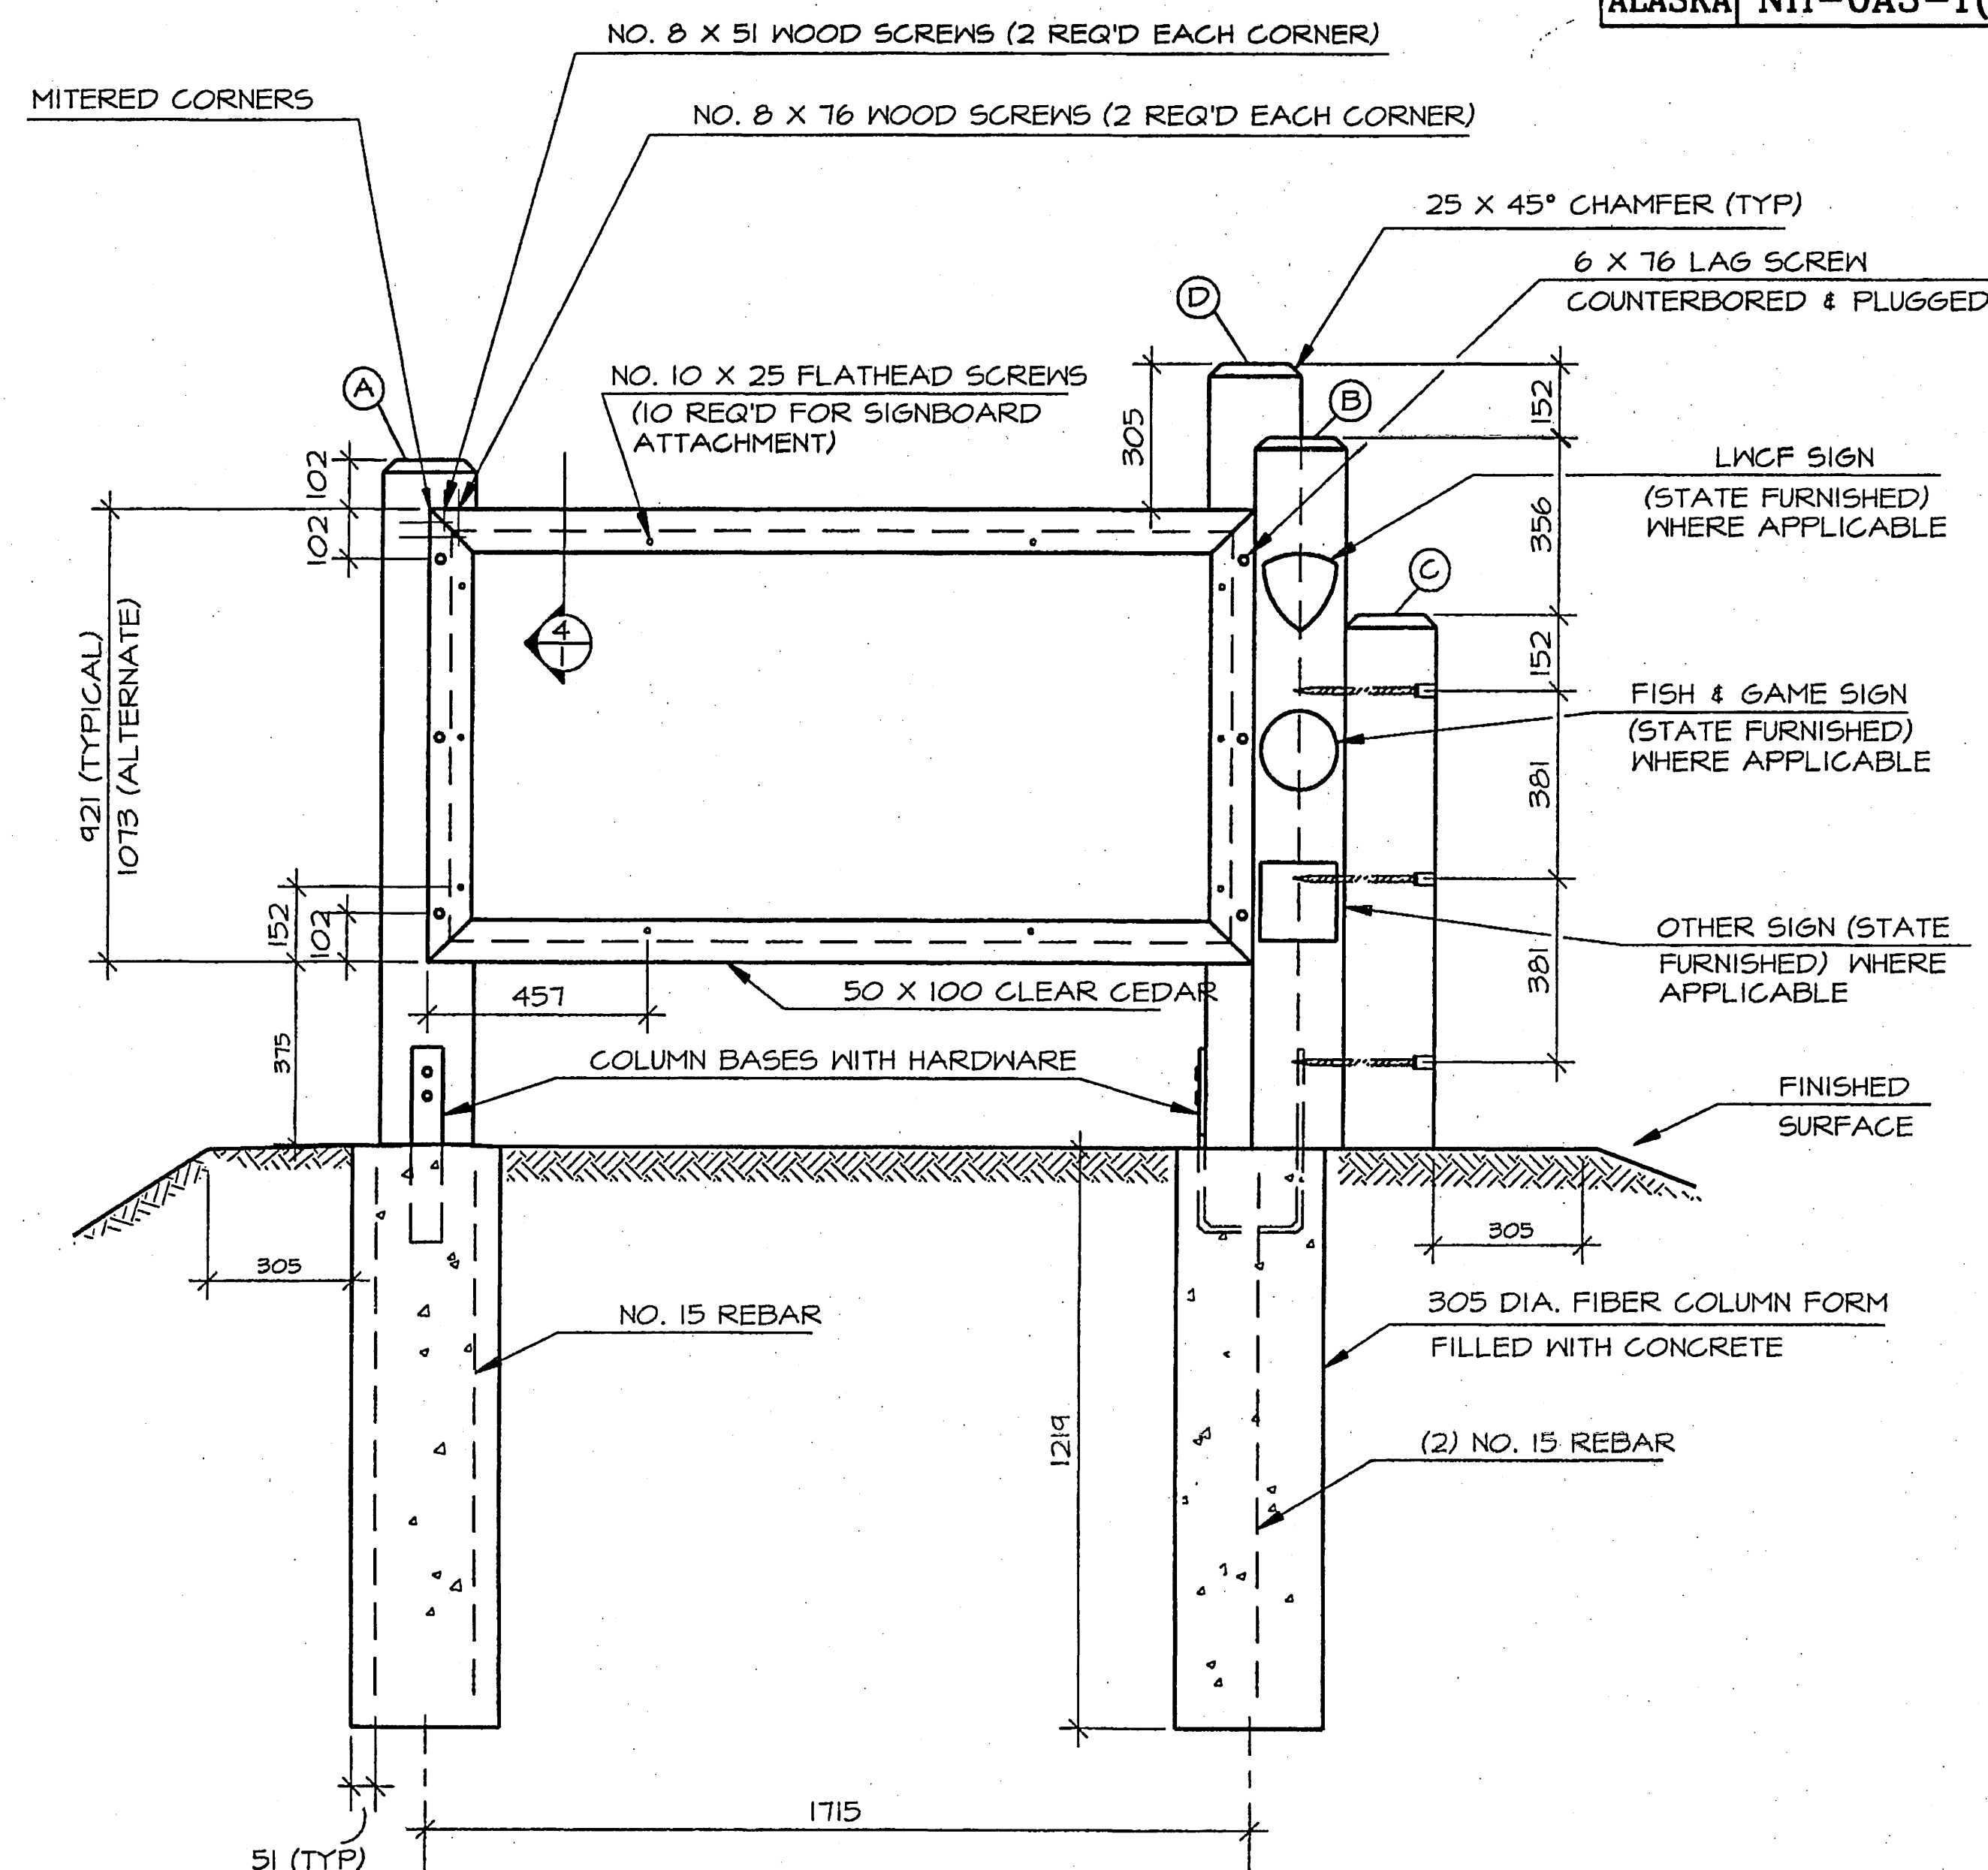

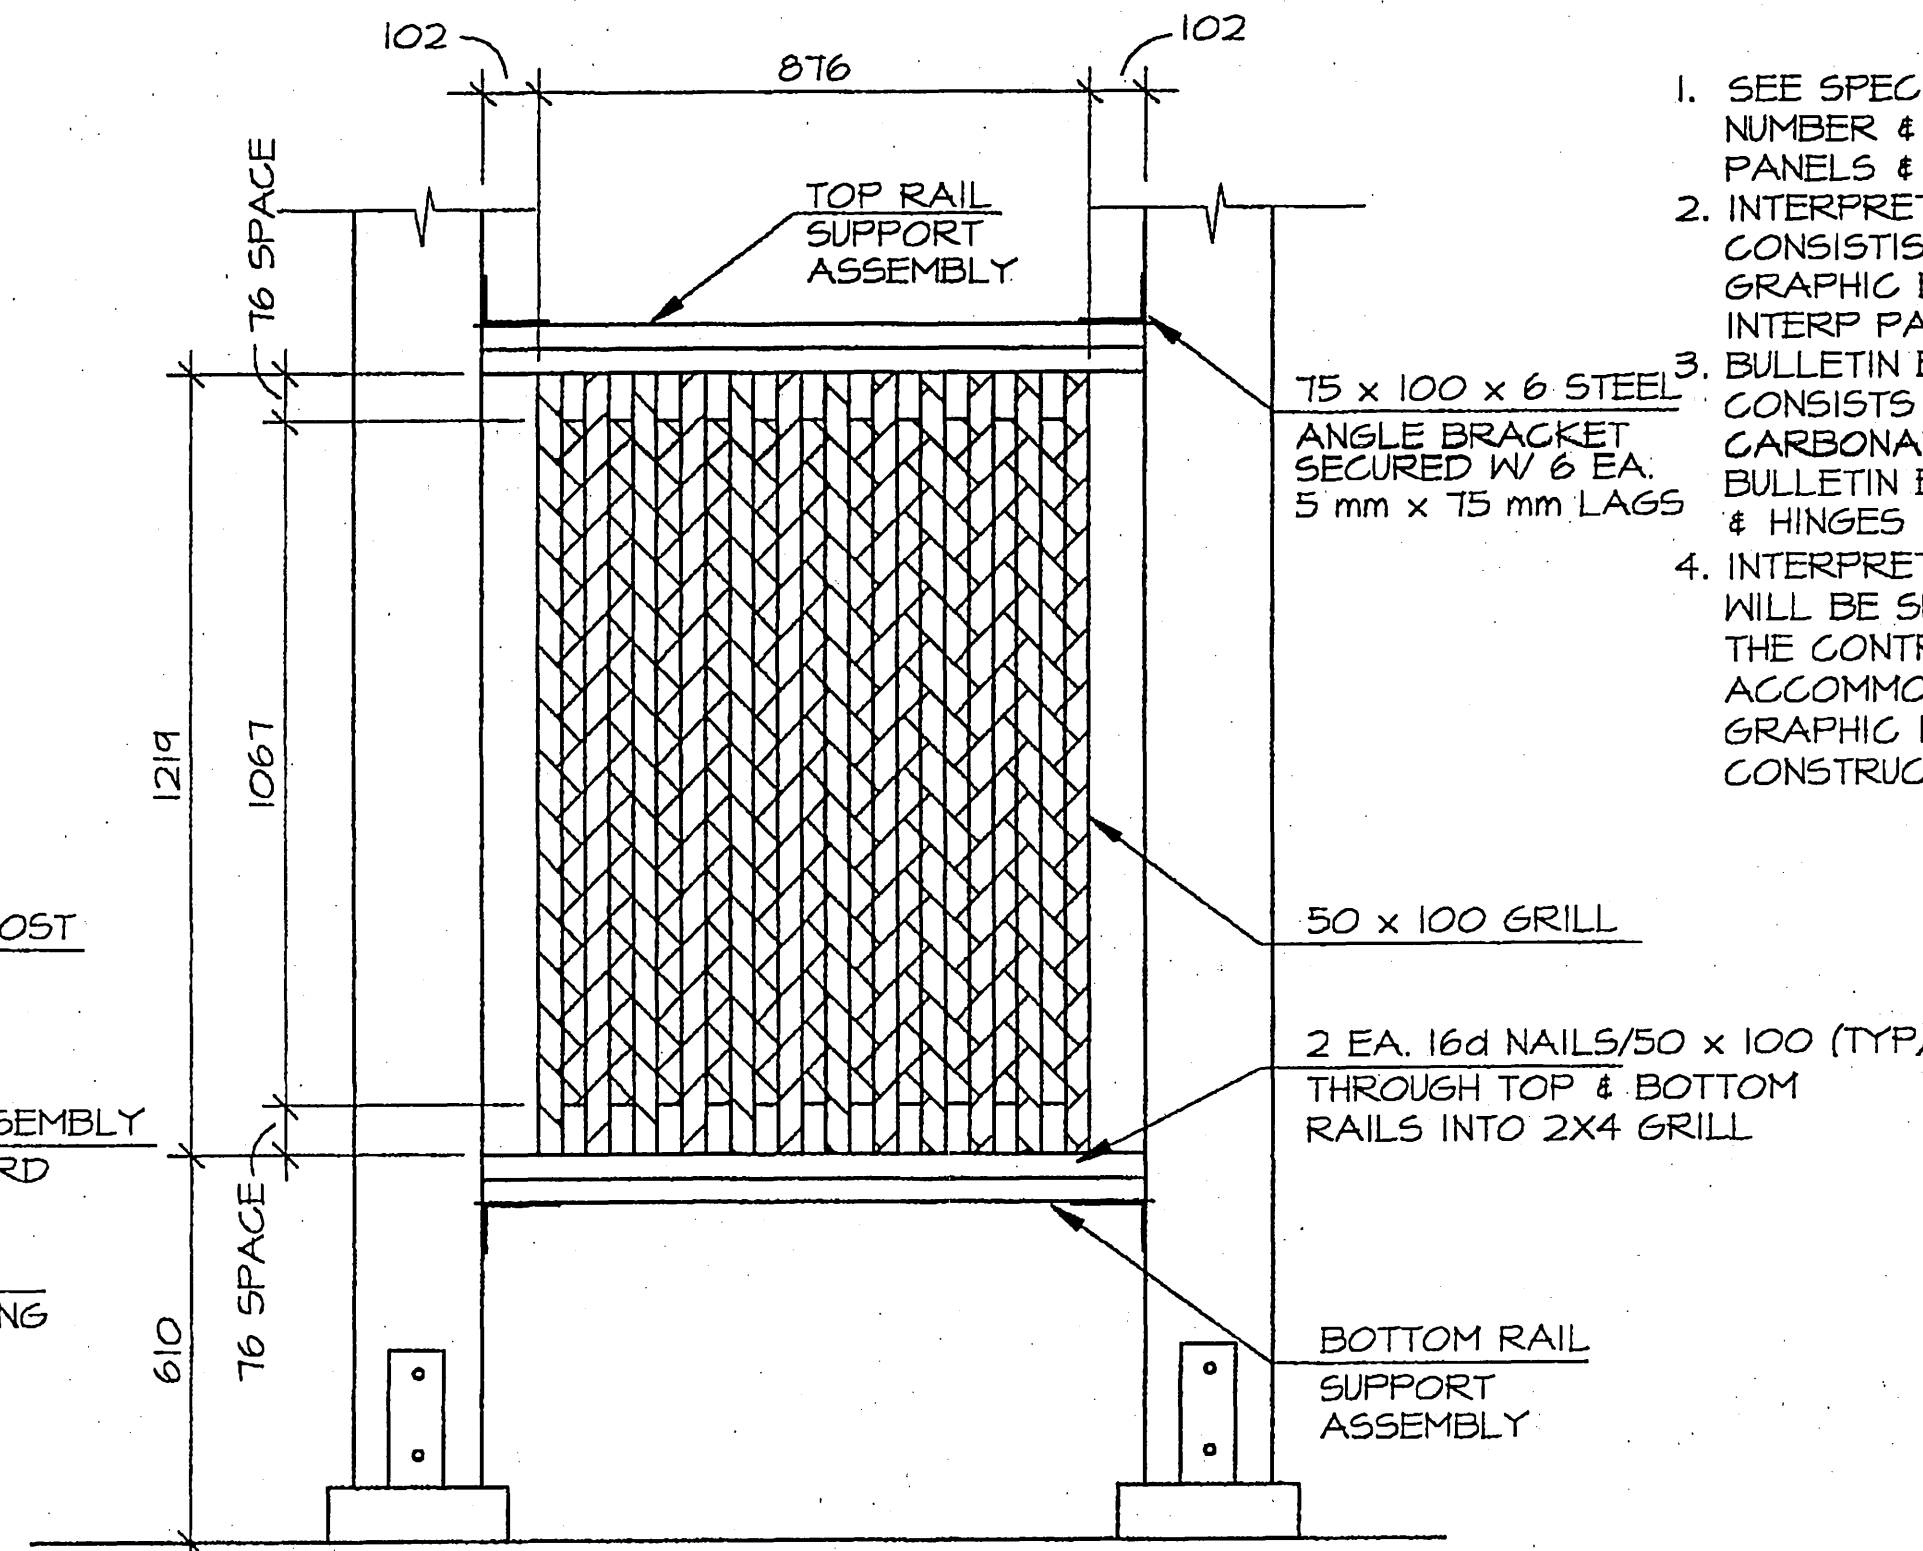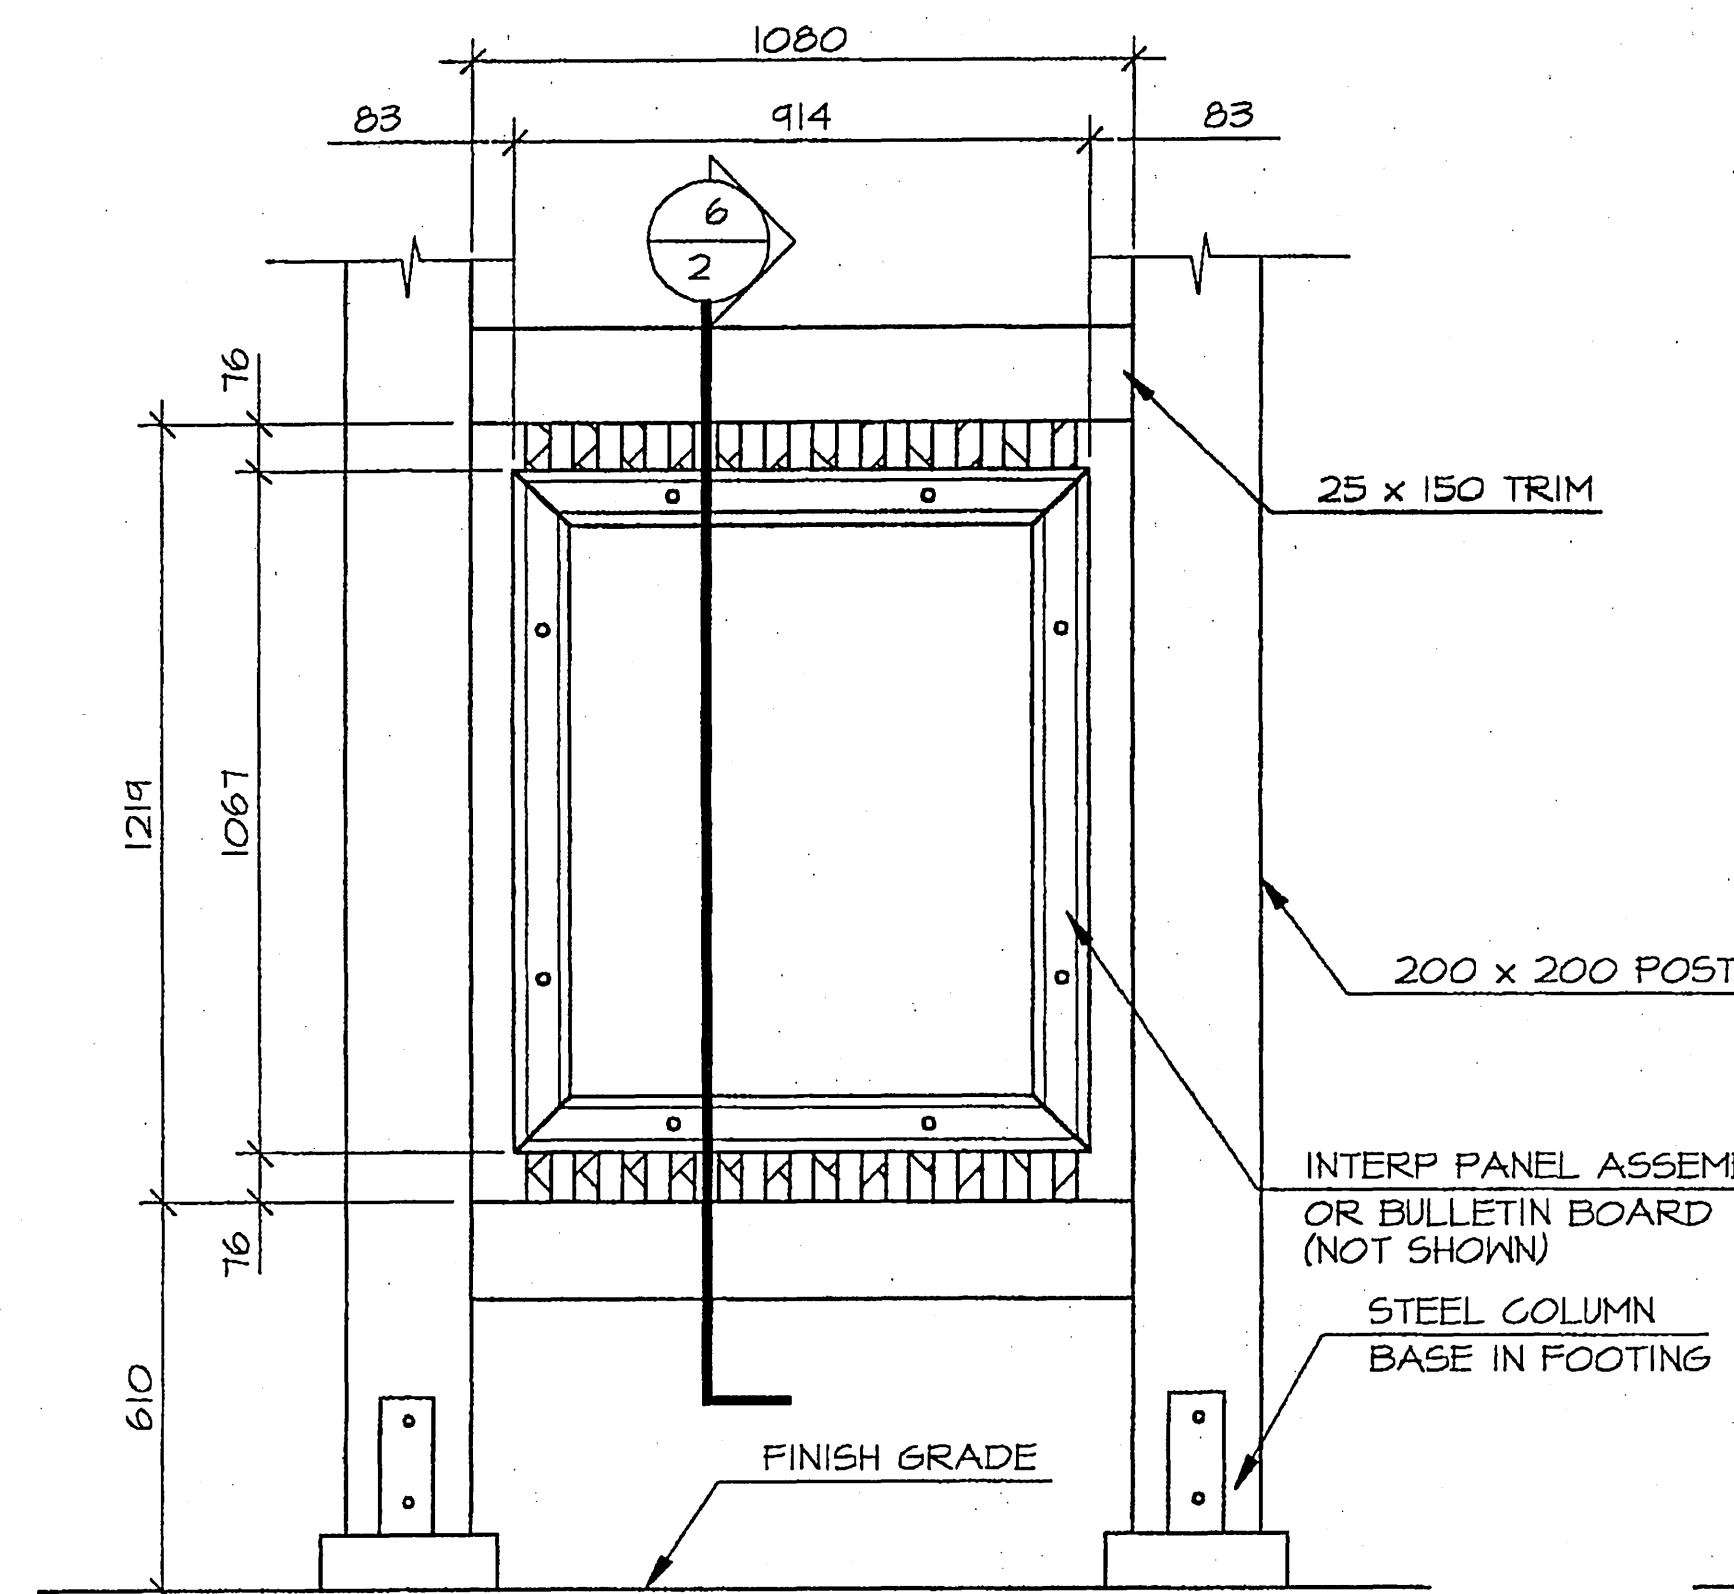


NOTES:

- SEE SPECIFICATIONS FOR ACTUAL NUMBER & LOCATION OF INTERP PANELS & BULLETIN BOARDS
- INTERPRETIVE PANEL ASSEMBLY CONSISTS OF INTERPRETIVE GRAPHIC BACKING BOARD & INTERP PANEL FRAME.
- BULLETIN BOARD ASSEMBLY CONSISTS OF CLEAR POLY-CARBONATE, SOUND BOARD, BULLETIN BOARD FRAME & HINGES
- INTERPRETIVE PANEL GRAPHIC WILL BE SUPPLIED BY OTHERS. THE CONTRACTOR SHALL MAKE ACCOMMODATIONS FOR THIS GRAPHIC IN MEASUREMENTS & CONSTRUCTION.

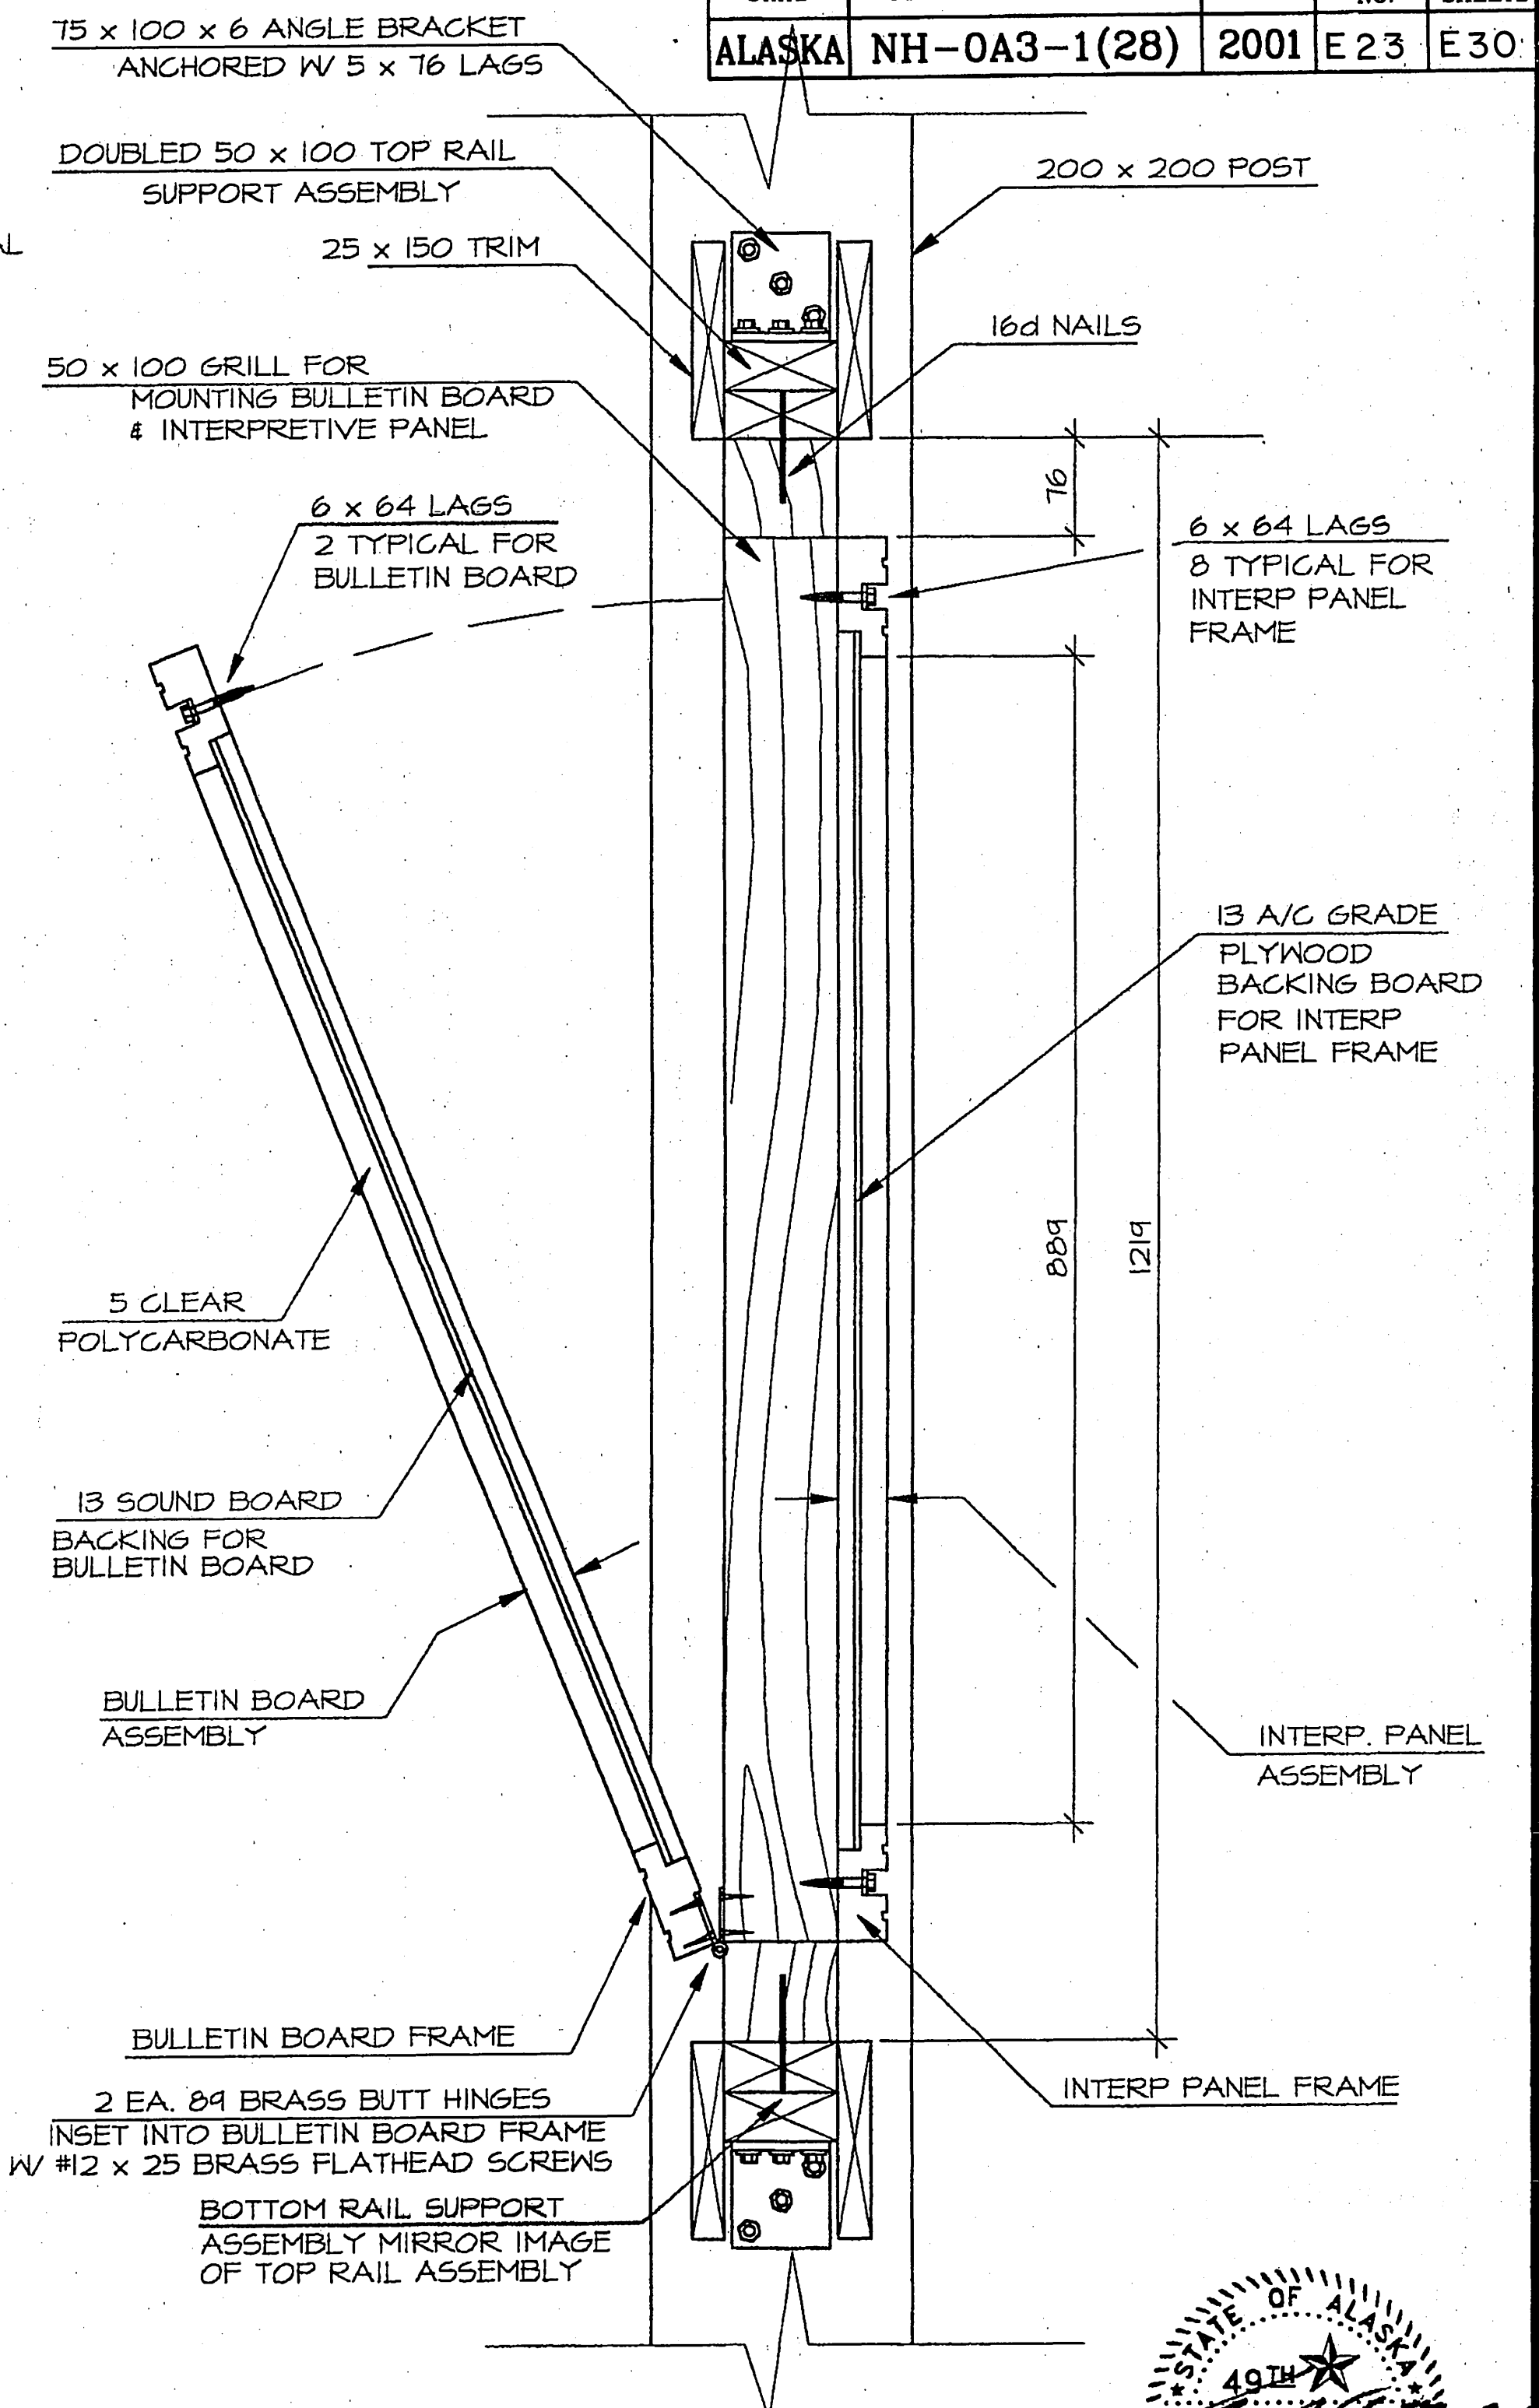


1 50x100 GRILL
2 W INTERP PANEL

2 50x100 GRILL
2

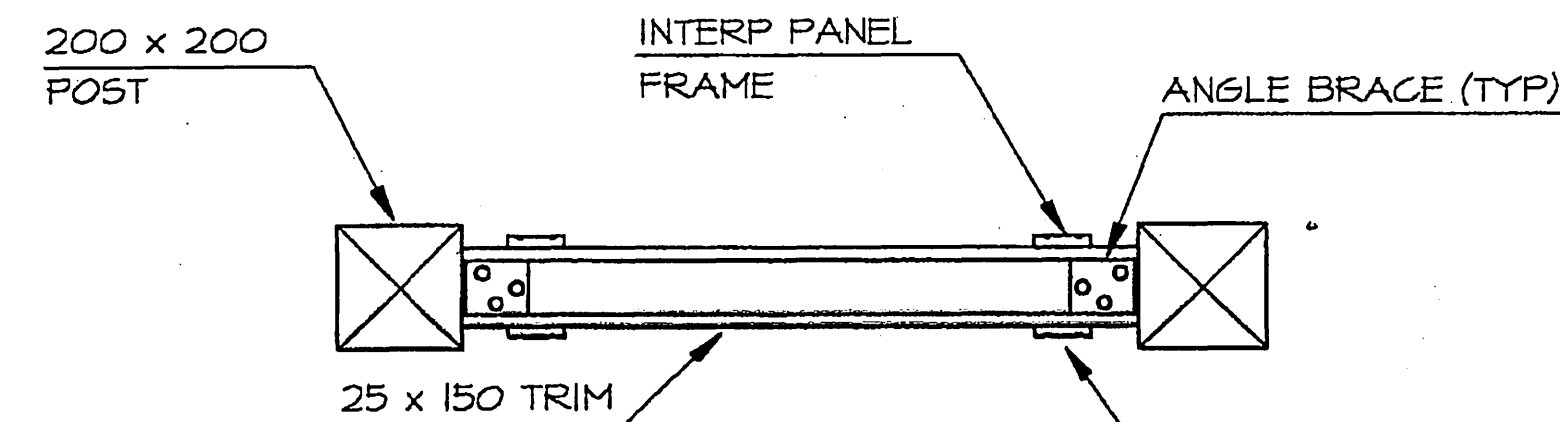


NOTCH POSTS PERPENDICULAR TO CENTERLINE OF FRAME TO CREATE FLAT SURFACES FOR MOUNTING FRAME, ANGLE BRACKETS & TRIM. DO NOT NOTCH FULL LENGTH OF SIGN.

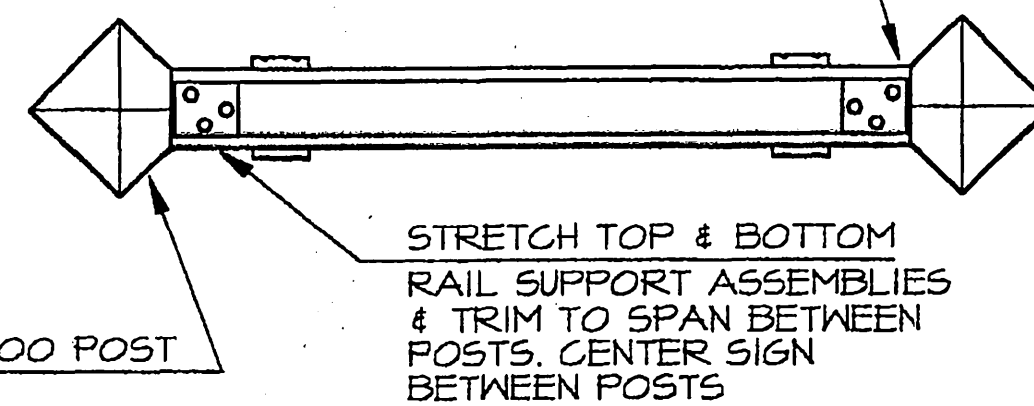


STRETCH TOP & BOTTOM RAIL SUPPORT ASSEMBLIES & TRIM TO SPAN BETWEEN POSTS. CENTER SIGN BETWEEN POSTS.

3 50x100 GRILL SECTION
2 PERPENDICULAR TO POST

4 50x100 GRILL SECTION
2 ANGLED TO POST

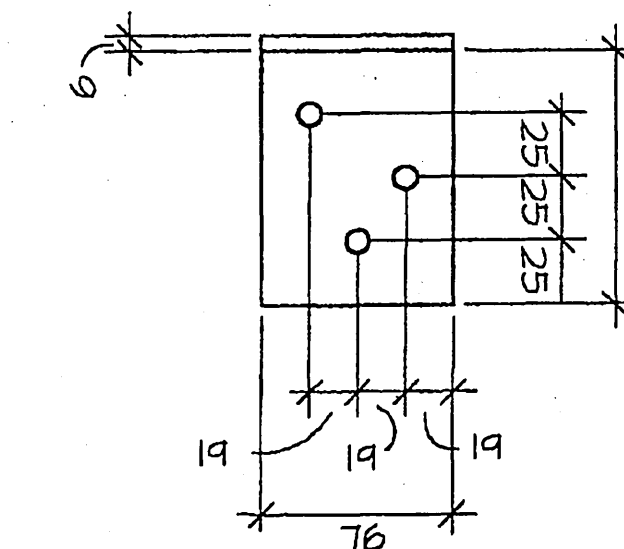


NOTE: 6 mm MILD STEEL 4 REQUIRED PER SIGN

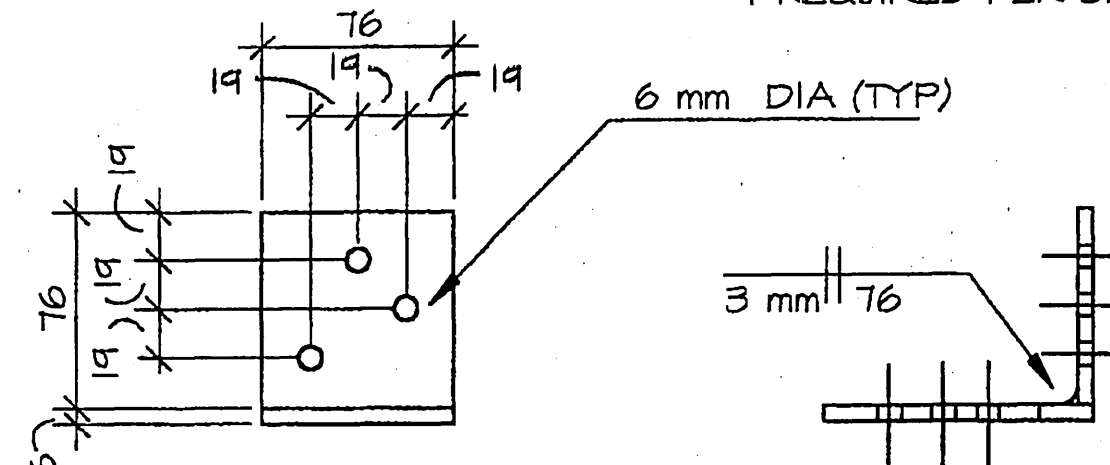


5 ANGLE BRACKET
2

6 SUPPORT GRILL
2 SECTION

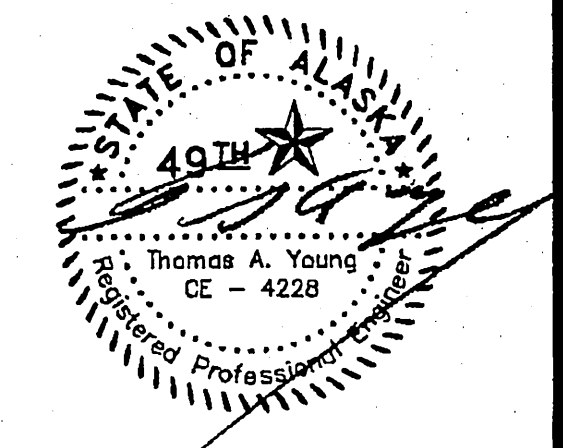

NO.	REVISION	DATE	APPROVED

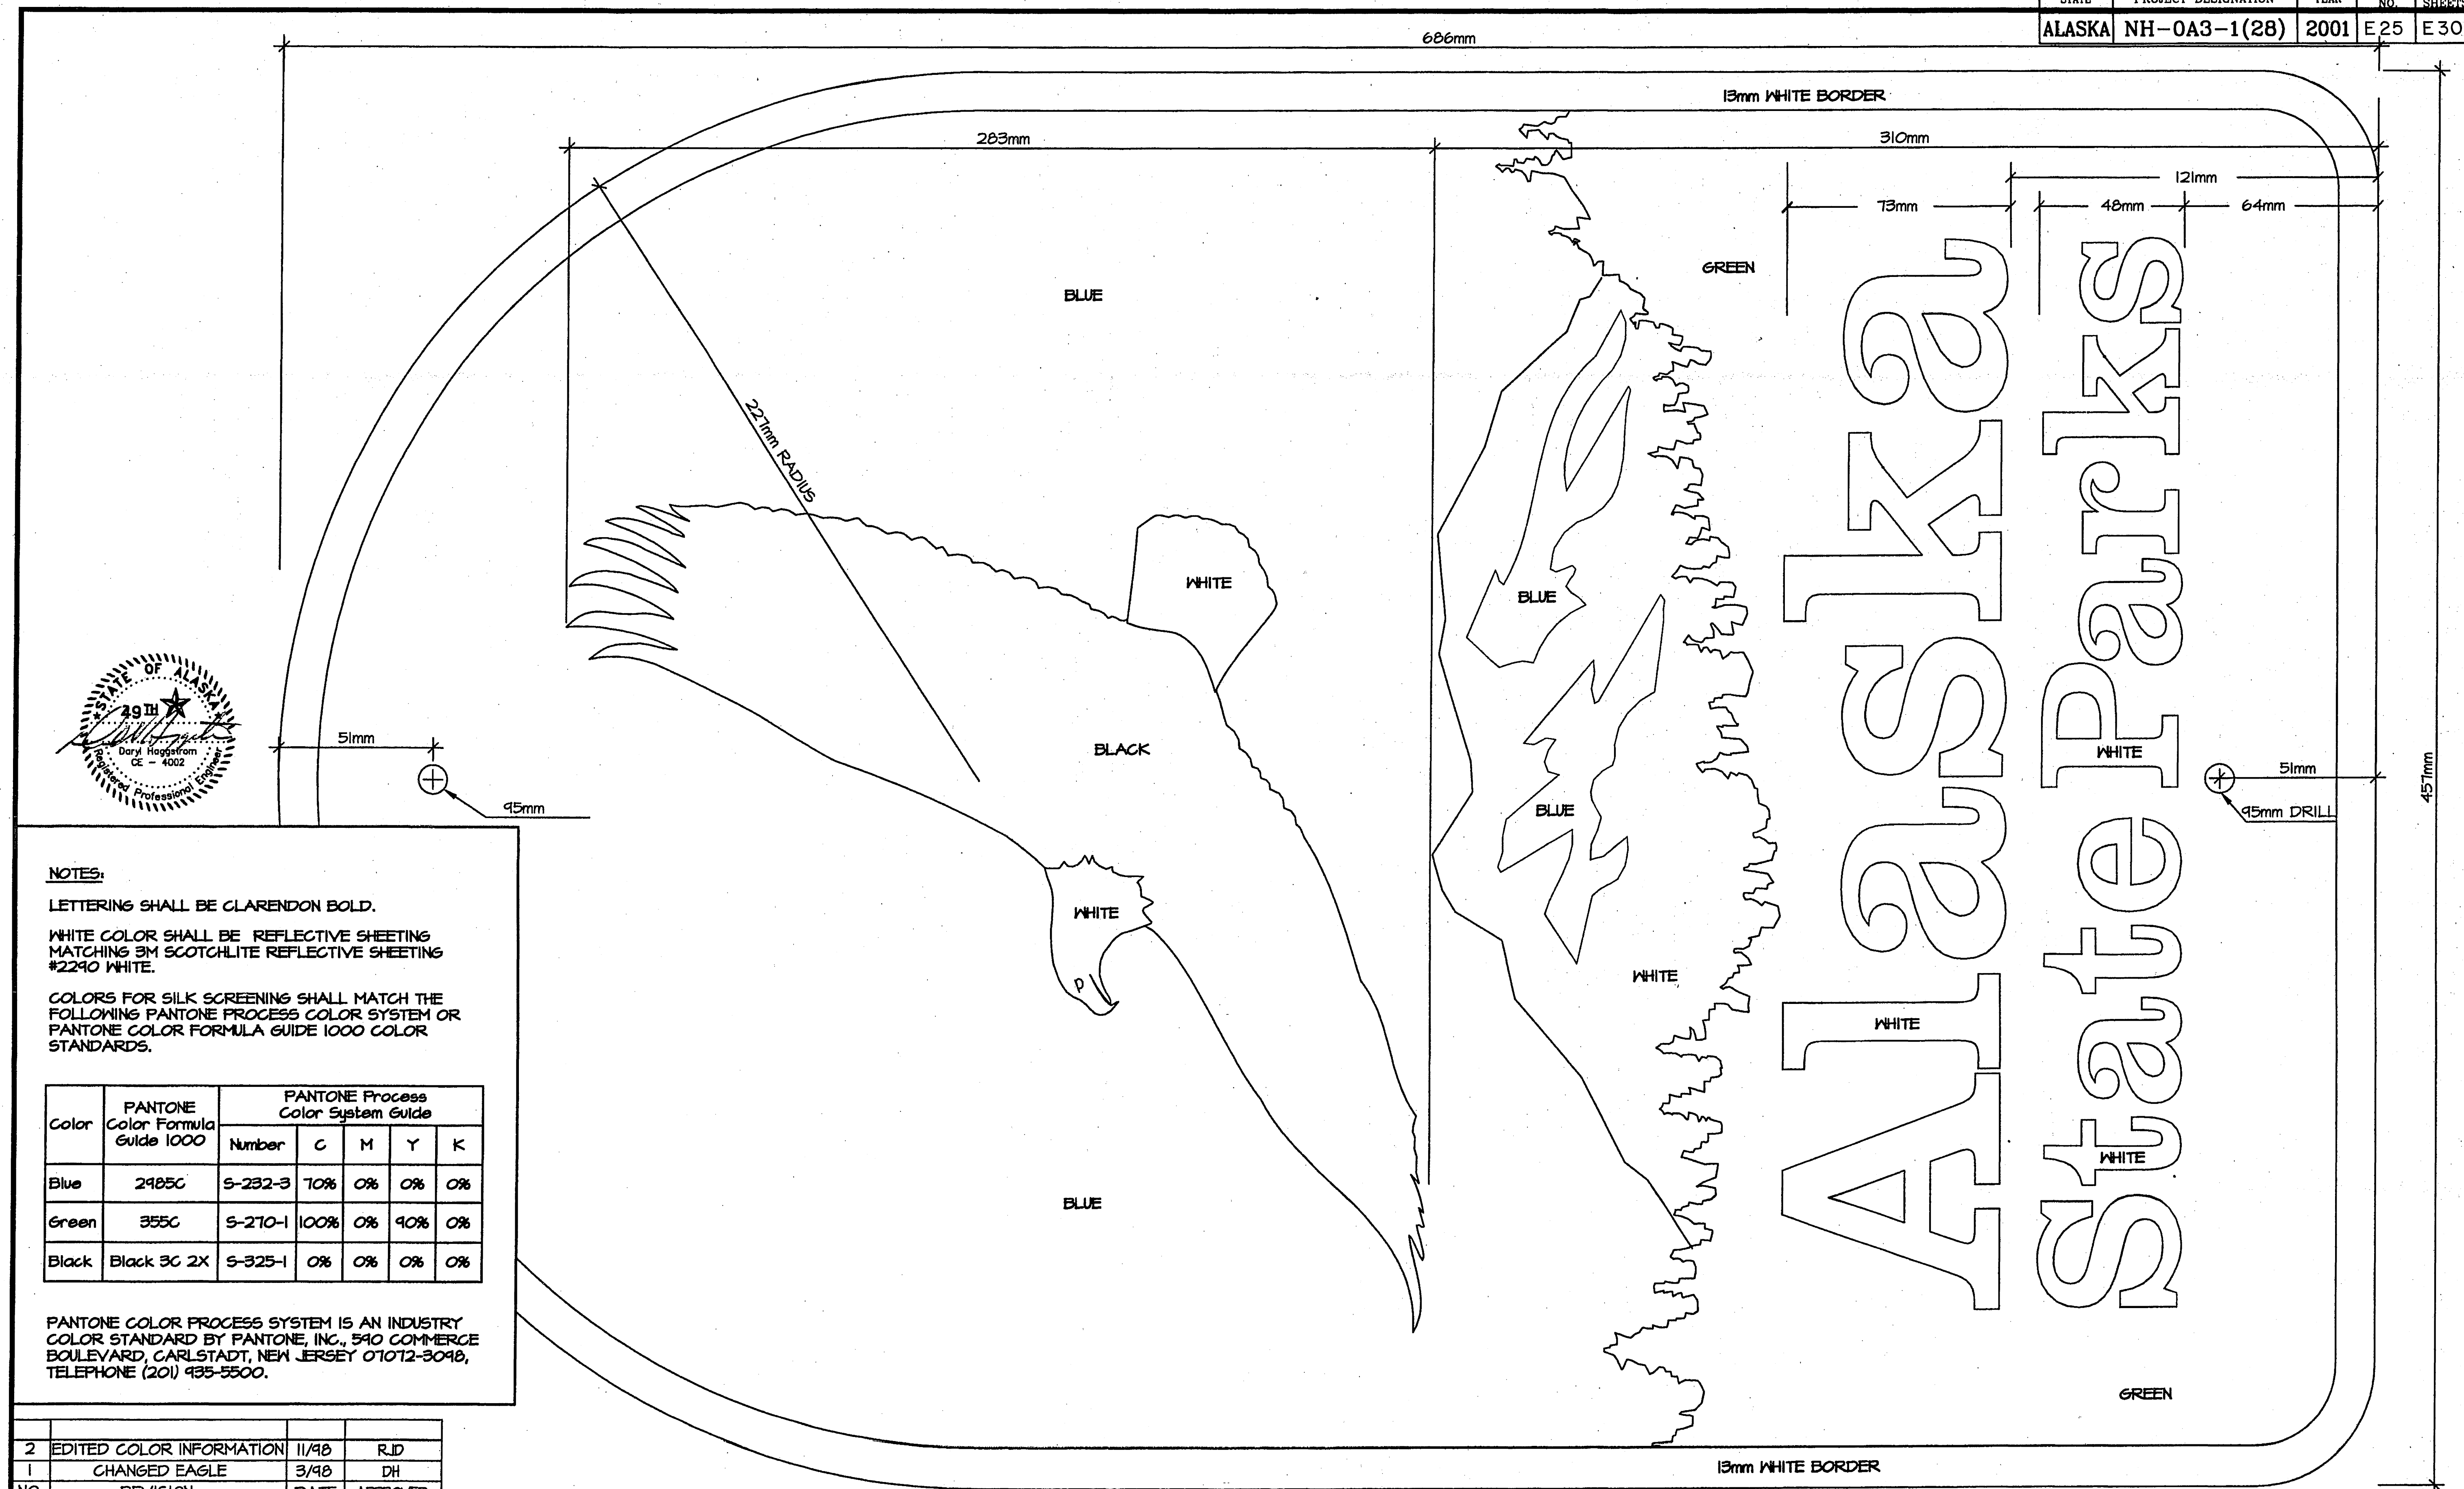

NOTES:

LETTERING SHALL BE CLARENDON BOLD.

WHITE COLOR SHALL BE REFLECTIVE SHEETING MATCHING 3M SCOTCHLITE REFLECTIVE SHEETING #2290 WHITE.

COLORS FOR SILK SCREENING SHALL MATCH THE FOLLOWING PANTONE PROCESS COLOR SYSTEM OR PANTONE COLOR FORMULA GUIDE 1000 COLOR STANDARDS.

Color	PANTONE Color Formula Guide 1000	PANTONE Process Color System Guide				
		Number	C	M	Y	K
Blue	2985C	S-232-3	70%	0%	0%	0%
Green	355C	S-270-1	100%	0%	40%	0%
Black	Black 3C 2X	S-325-1	0%	0%	0%	0%

PANTONE COLOR PROCESS SYSTEM IS AN INDUSTRY COLOR STANDARD BY PANTONE, INC., 540 COMMERCE BOULEVARD, CARLSTADT, NEW JERSEY 07012-3040, TELEPHONE (201) 935-5500.

NO.	REVISION	DATE	APPROVED
2	EDITED COLOR INFORMATION	11/98	RJD
1	CHANGED EAGLE	3/98	DH


DEPARTMENT OF NATURAL RESOURCES
DIVISION OF PARKS AND OUTDOOR RECREATION
STATE OF ALASKA

DESIGN & CONSTRUCTION SECTION


EAGLE LOGO SIGN

PREPARED: BOB
DRAWN: TBT
REVIEWED: DH
DATE: FEB 98
SHEET 1
S-15[M]
OF 1 SHEETS


STATE	PROJECT DESIGNATION	YEAR	SHEET NO.	TOTAL SHEETS
ALASKA	NH-0A3-1(28)	2001	E 26	E 30

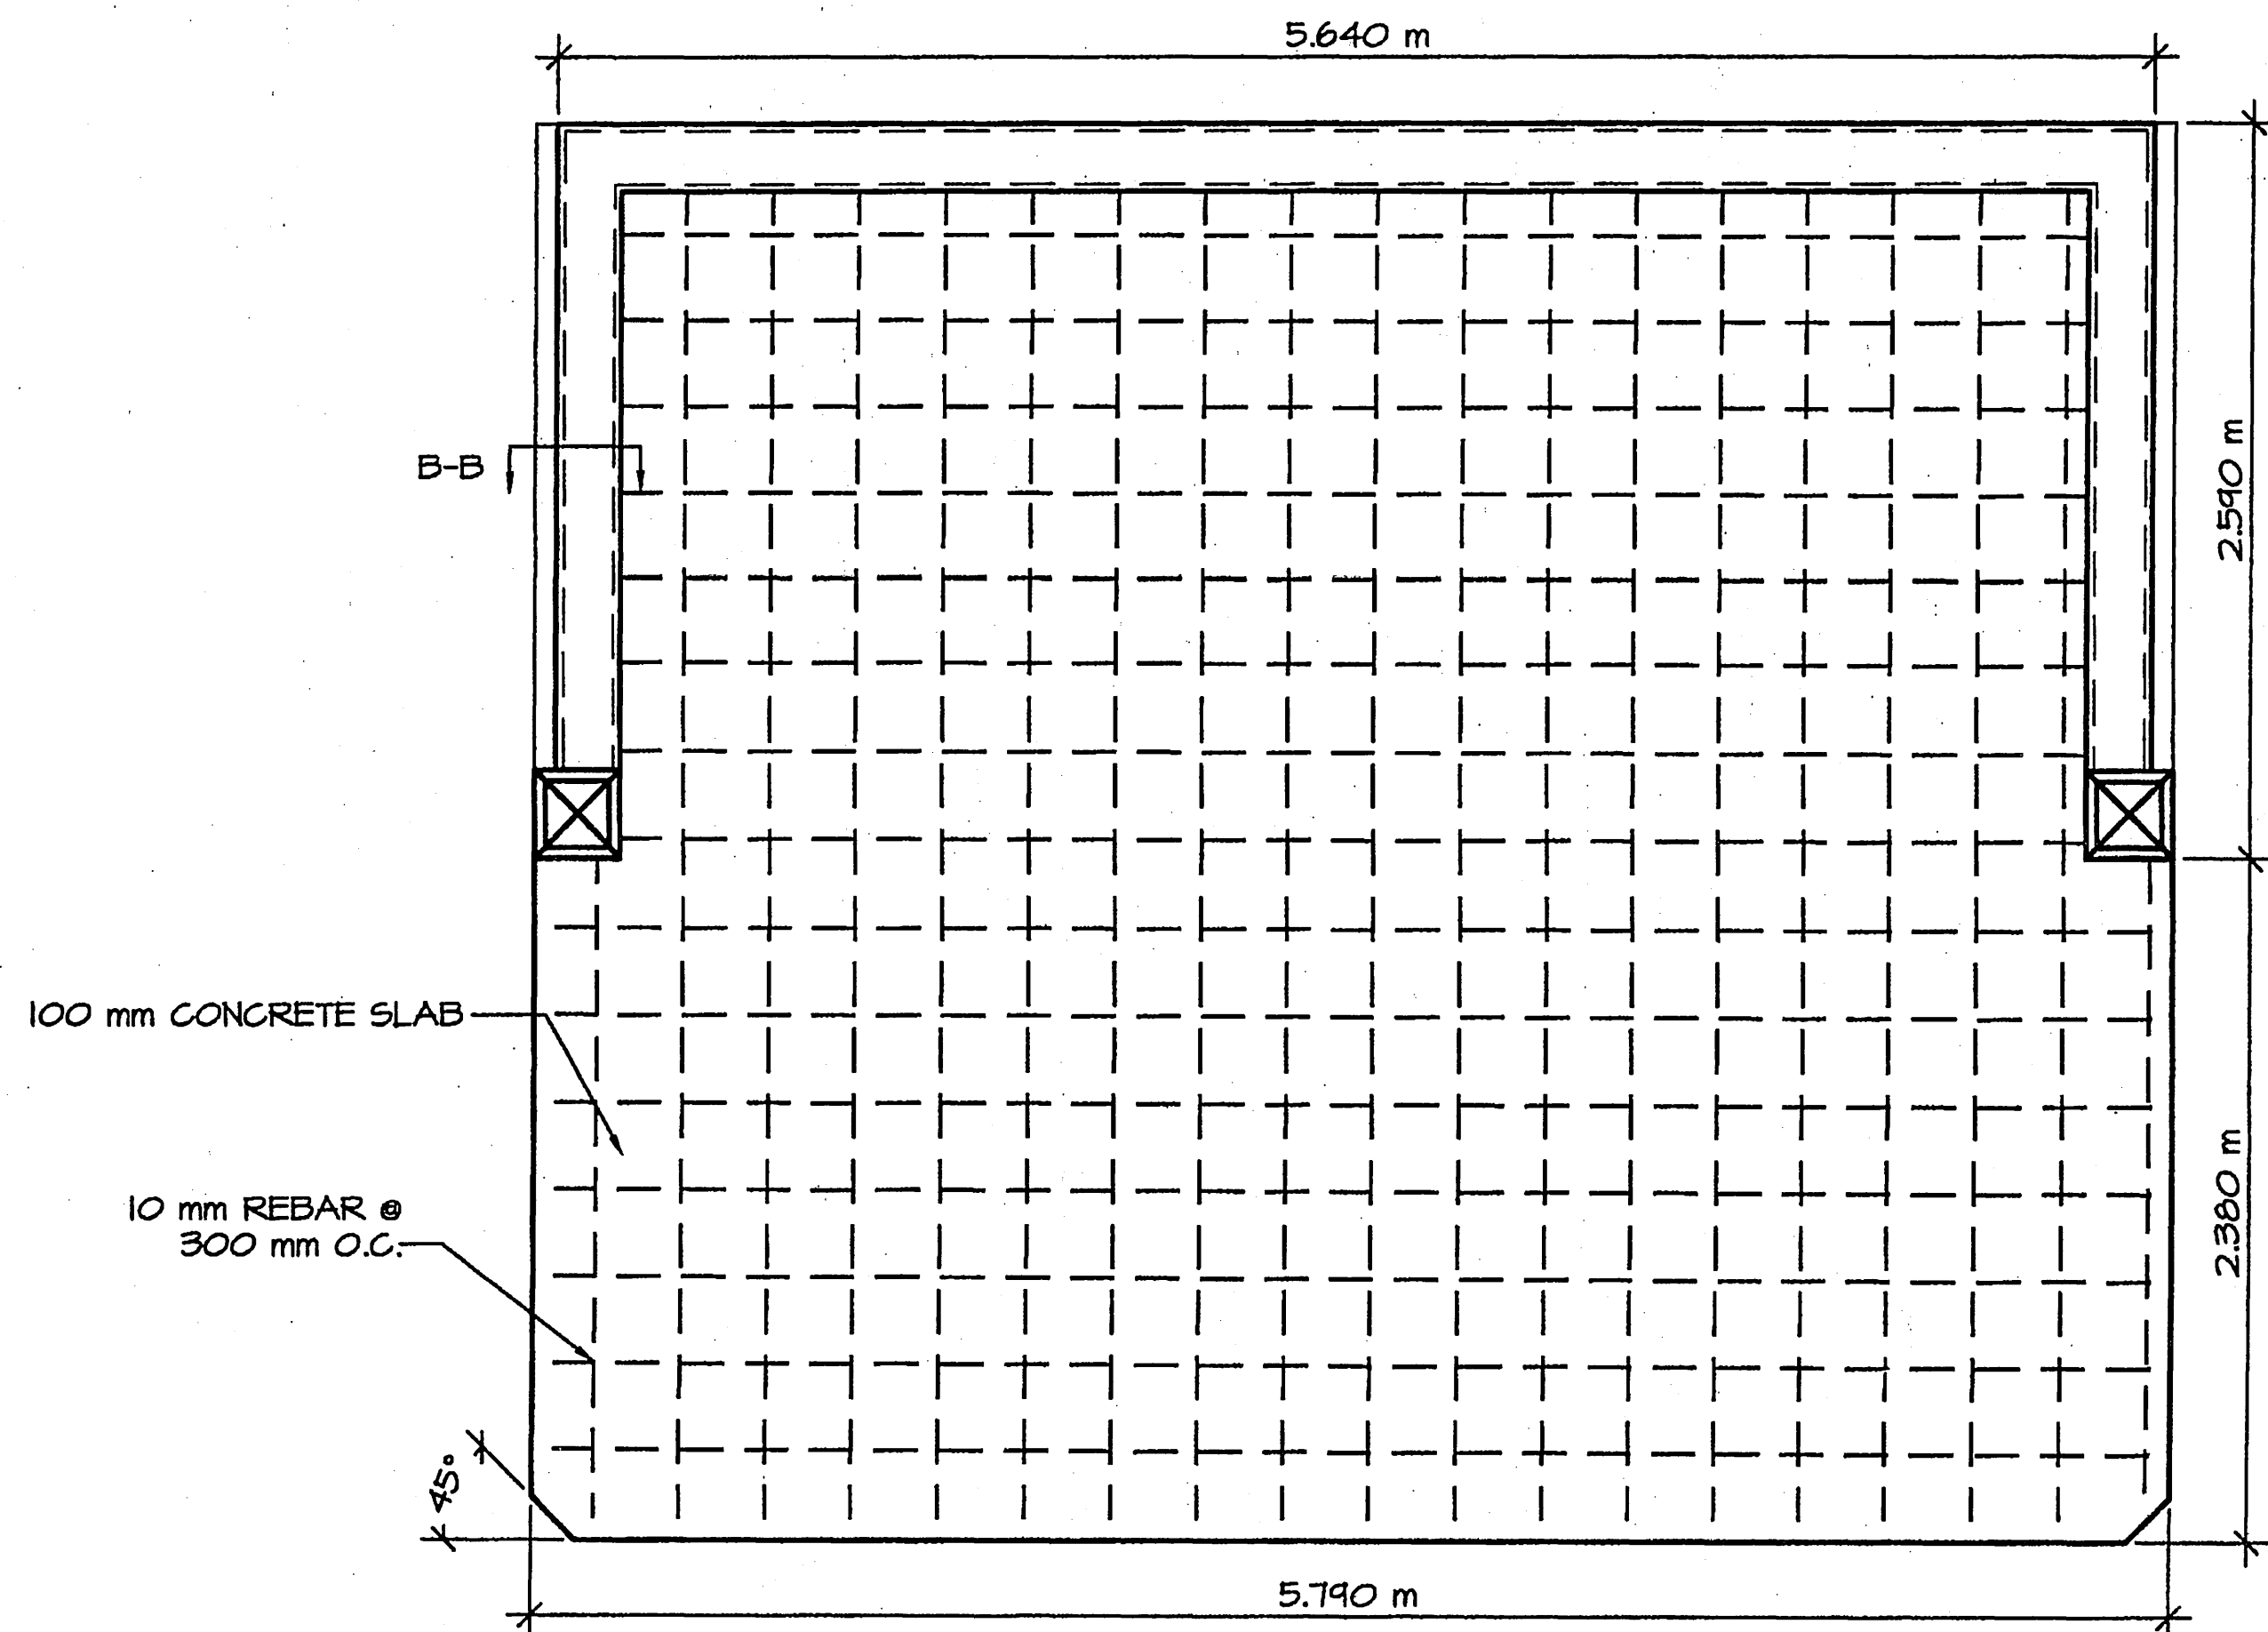


PLAN

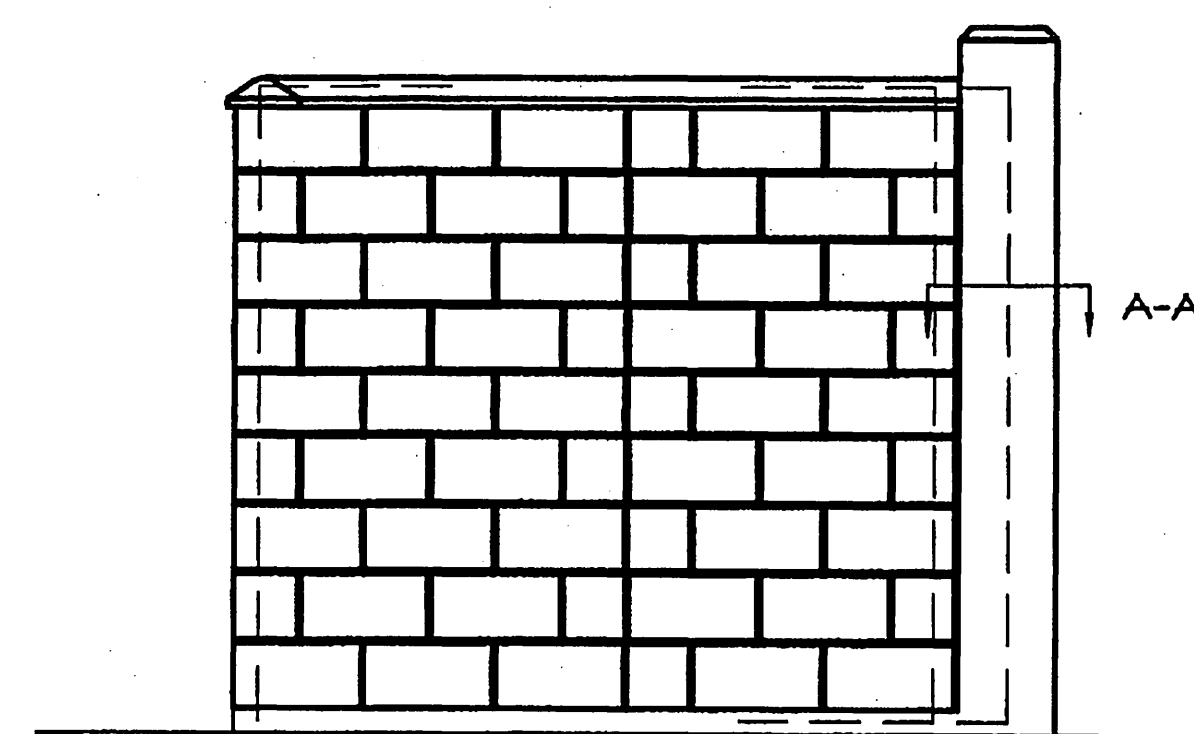


SIDE ELEVATION

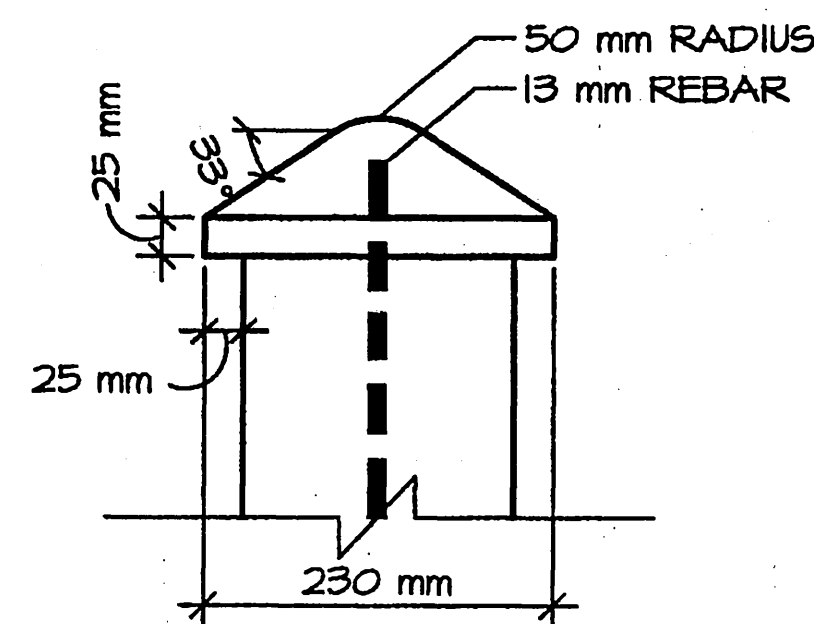


DETAIL
CONCRETE CAP

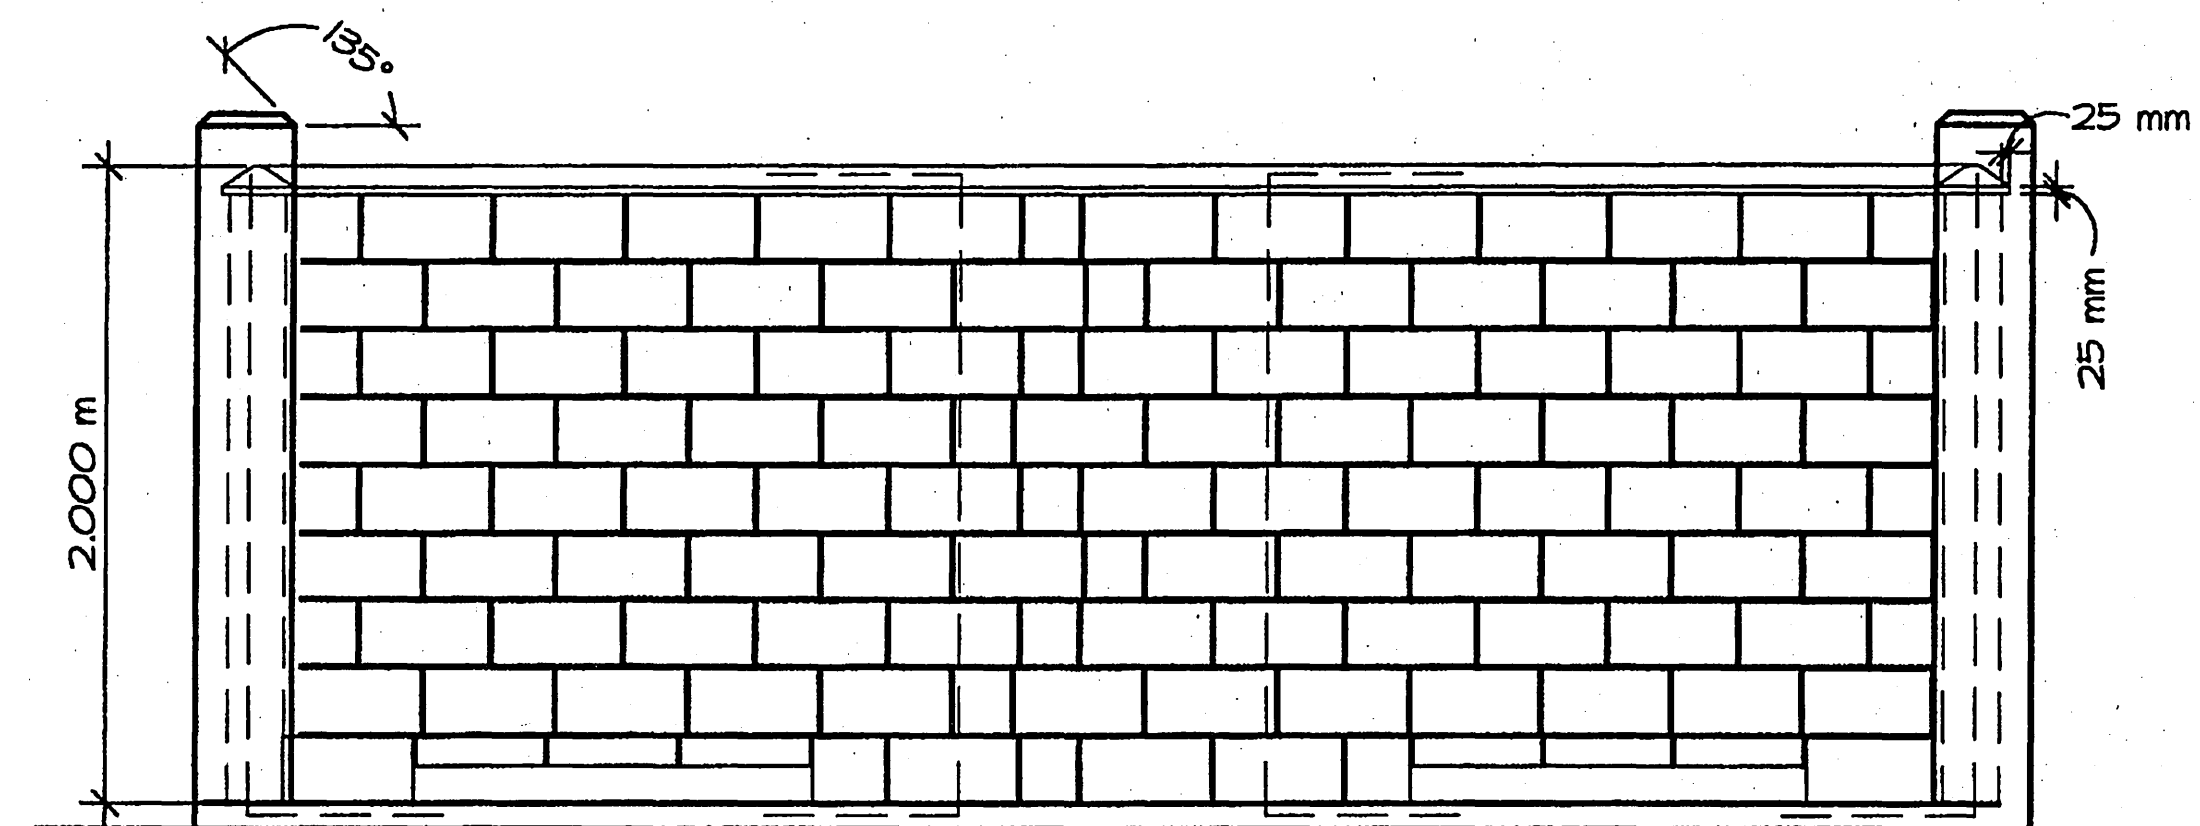


FRONT ELEVATION

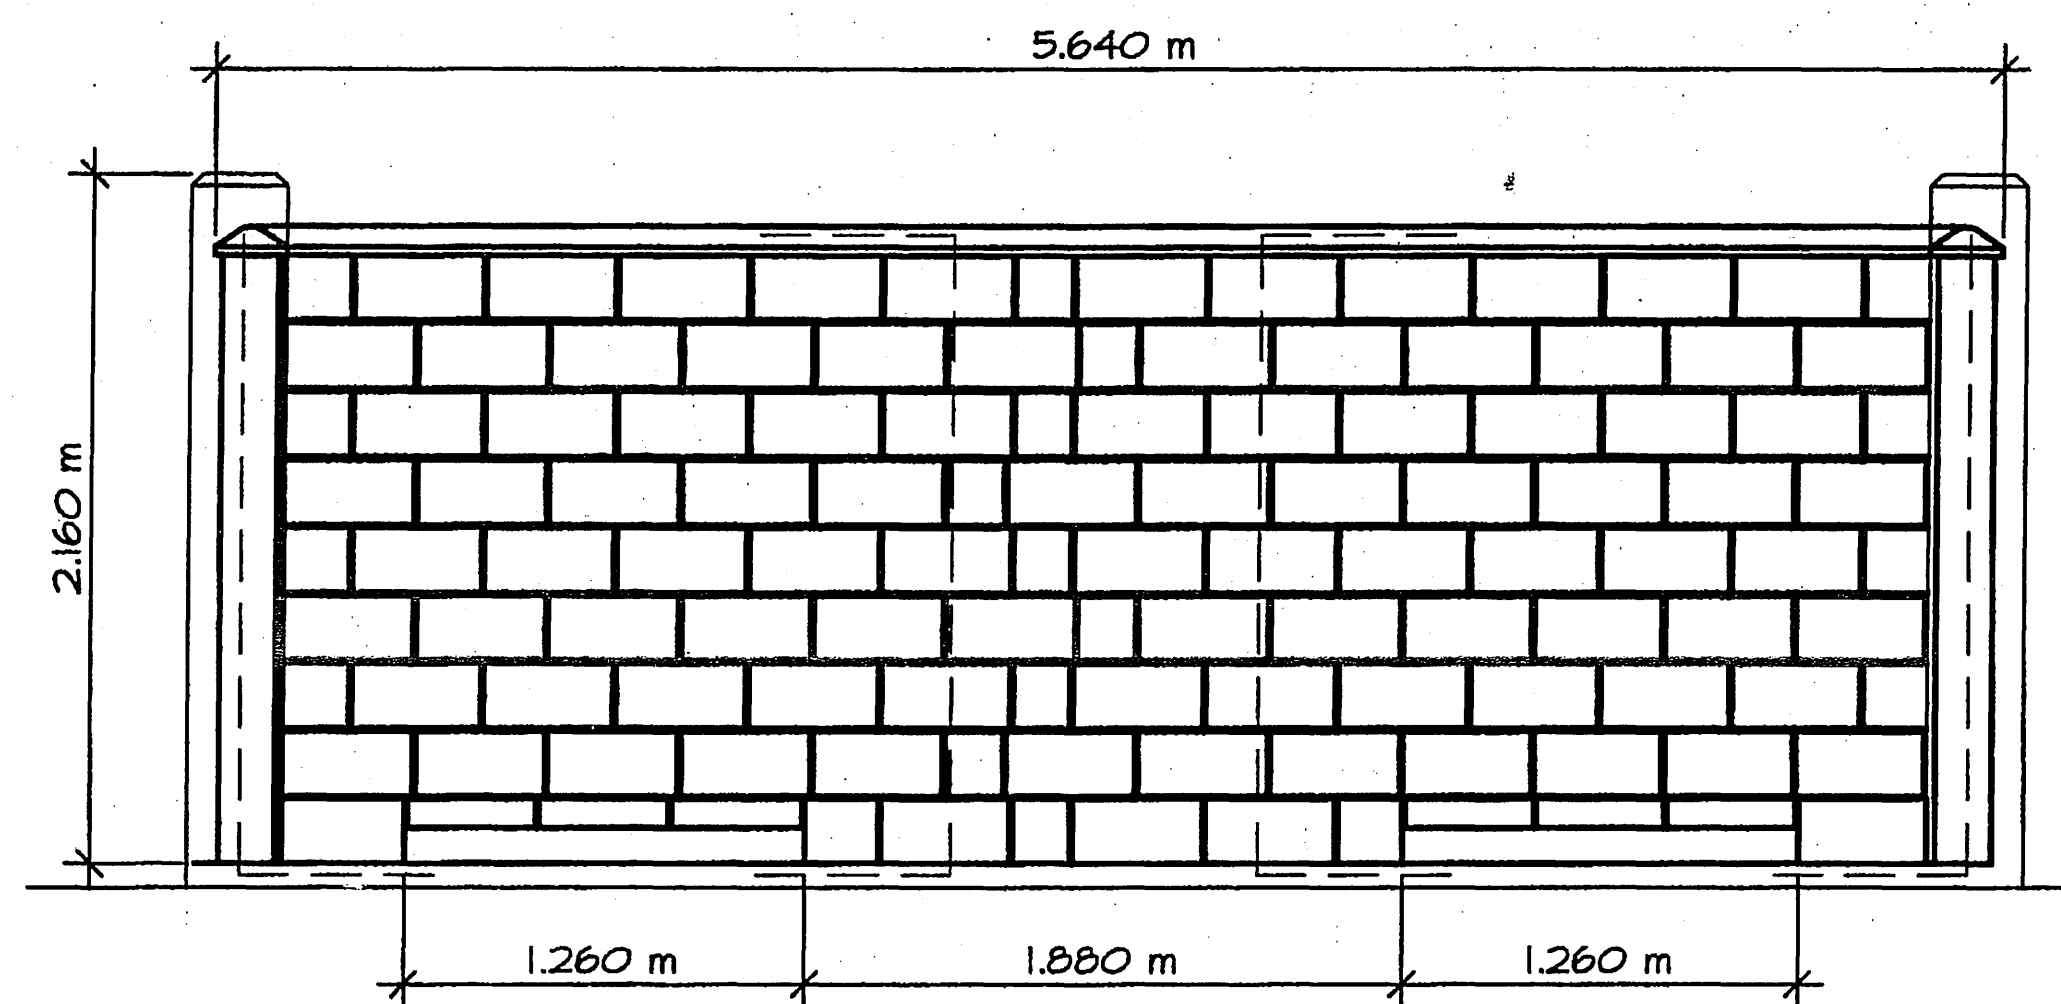


BACK ELEVATION

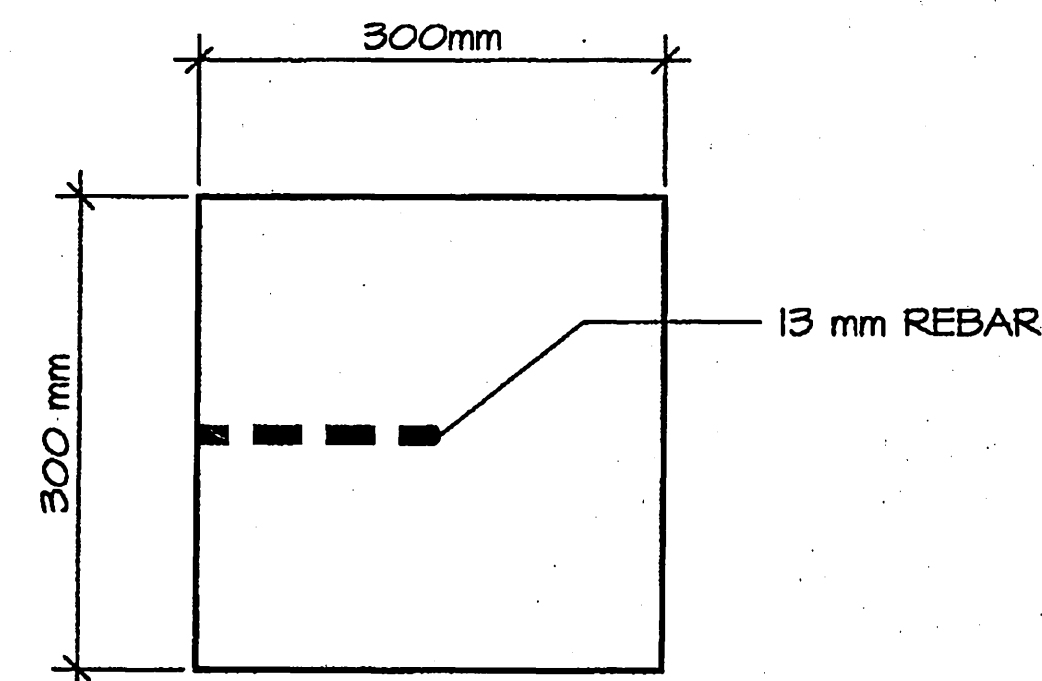

SECTION A-A

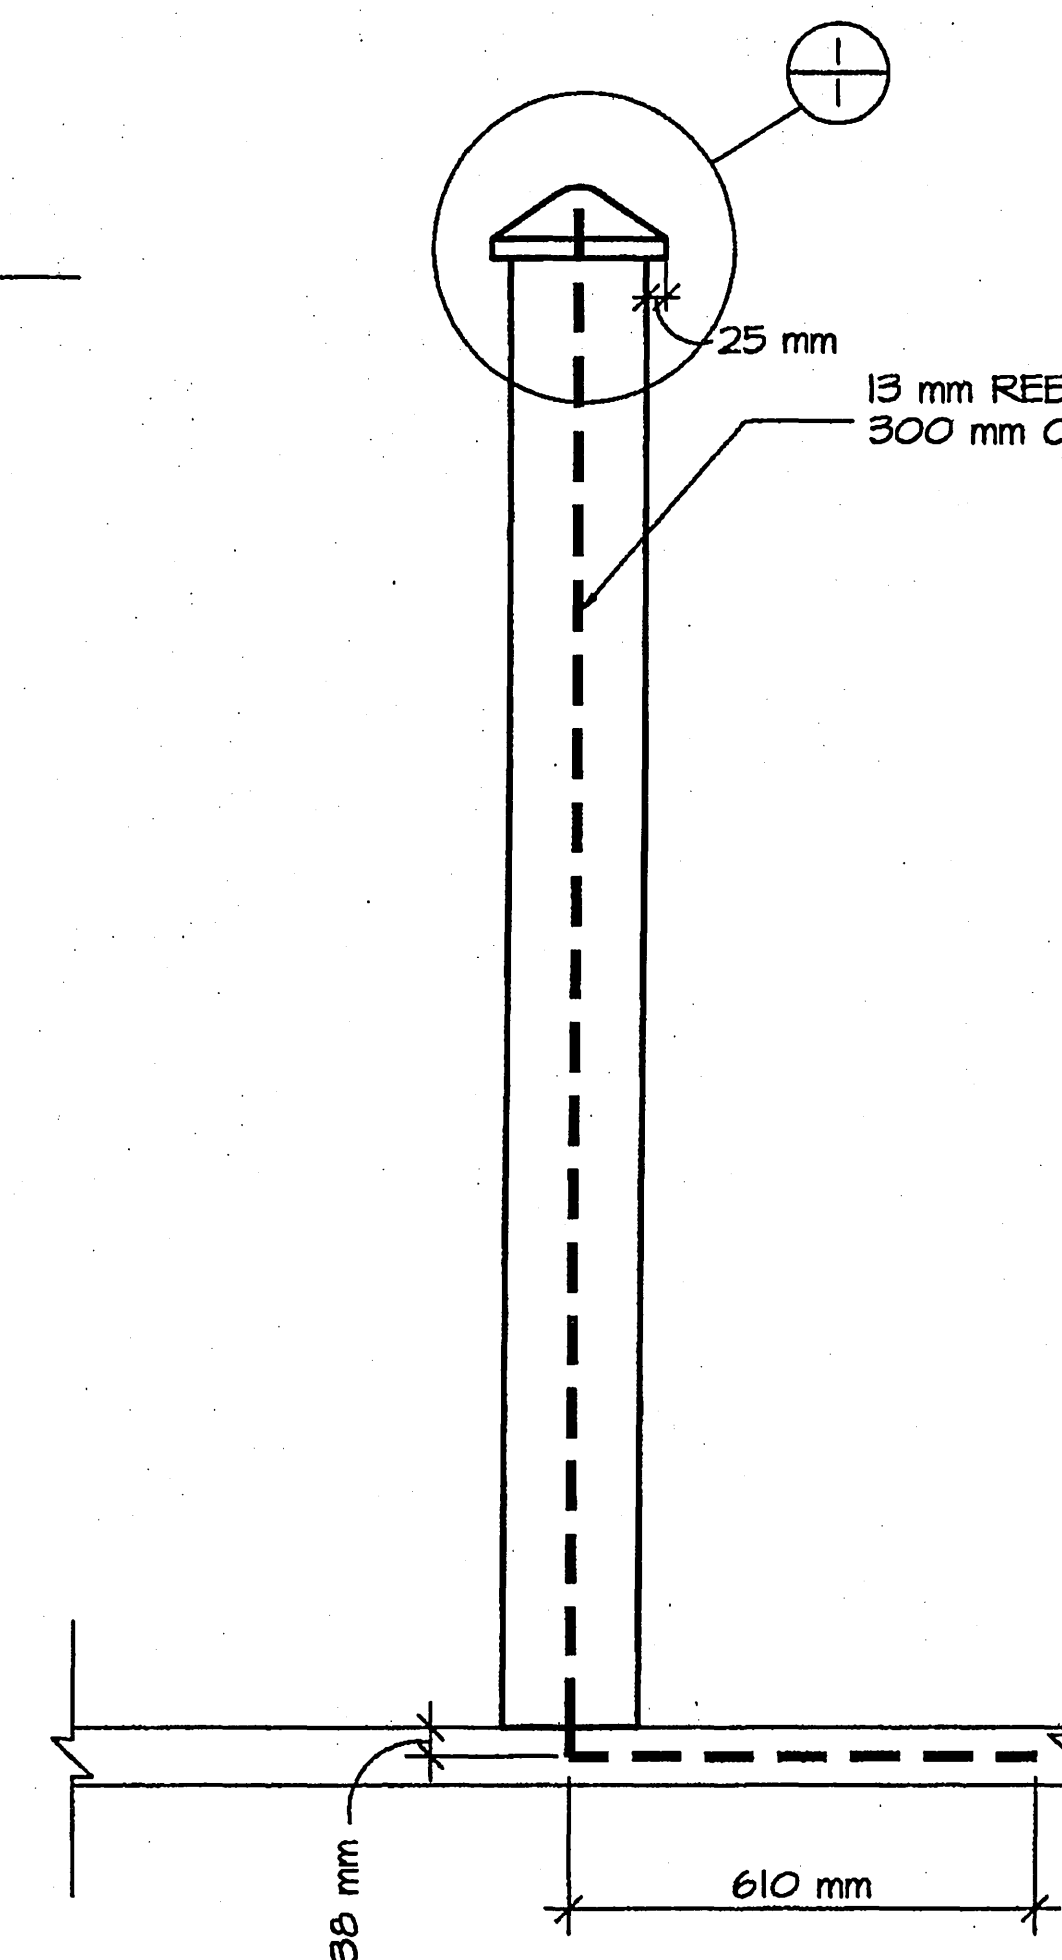

SECTION B-B

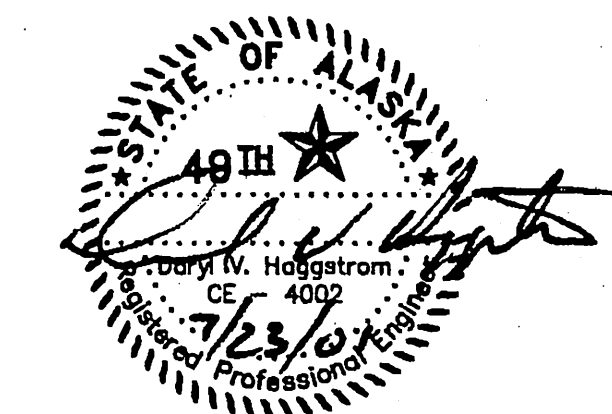

DEPARTMENT OF NATURAL RESOURCES
DIVISION OF PARKS AND OUTDOOR RECREATION STATE OF ALASKA

DESIGN & CONSTRUCTION SECTION




DOUBLE TOILET SCREEN

PREPARED: BE
DRAWN: JS
REVIEWED: DH
DATE: 3/01

SHEET
OF 1 SHEETS

SPECIFICATIONS
SCALE 1:1
COMPUTER DESIGNATION

DESIGNED BY
VIEW-HALF AT
CHECKED BY
AUTOCAD-KAREN-D. VANDERKAM 10/20/02
DRAFTED BY
KMH


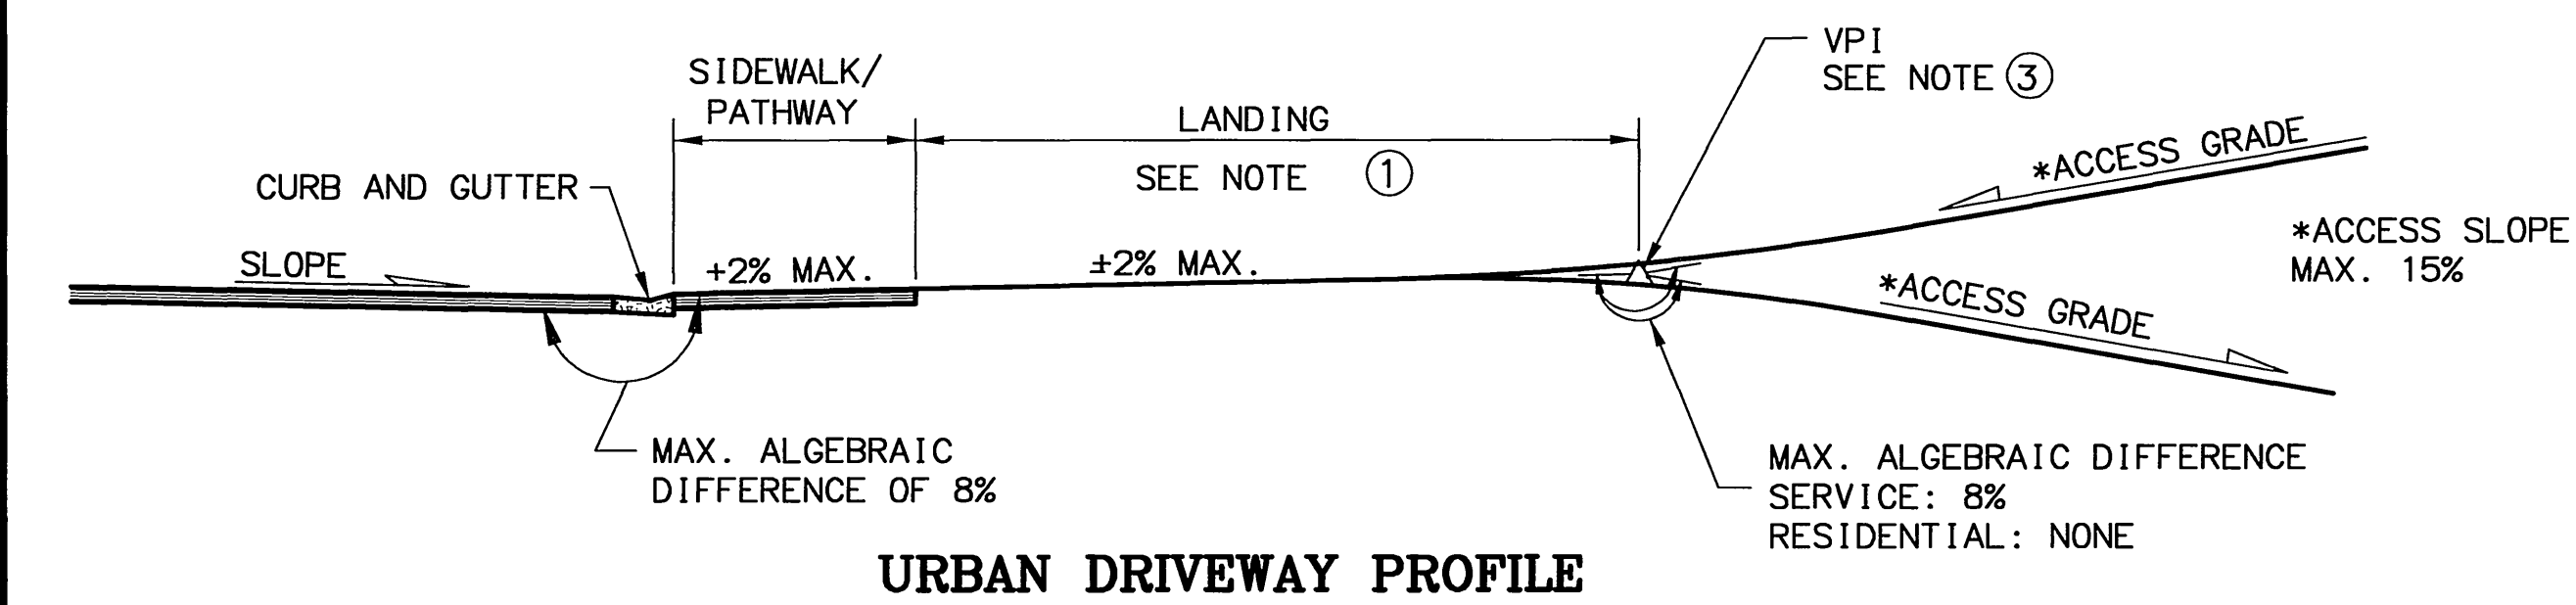
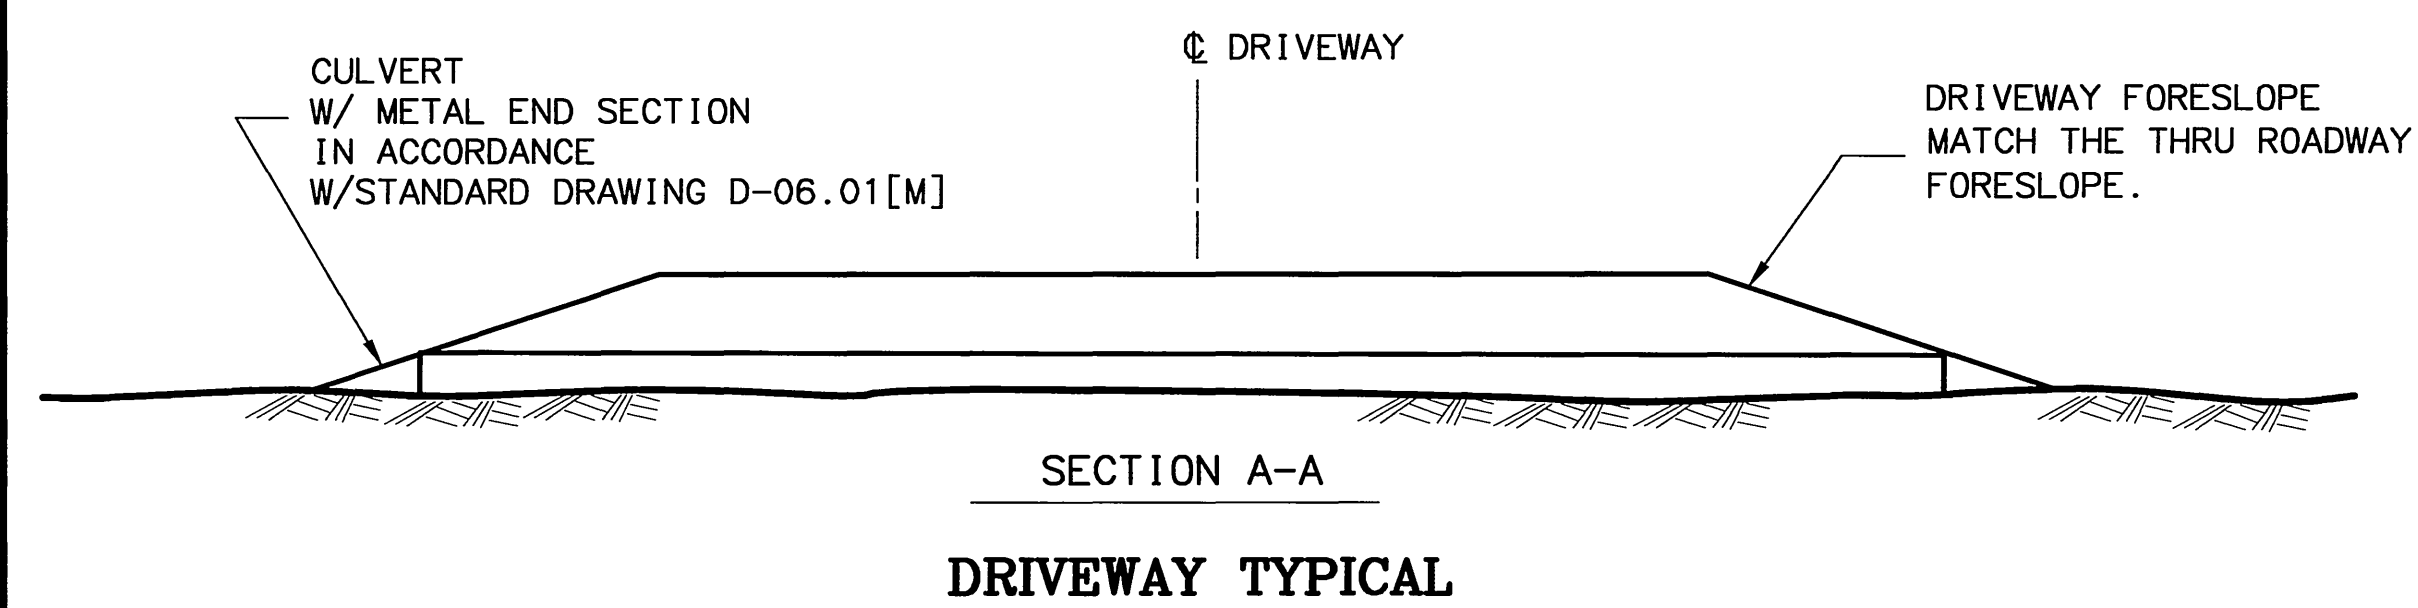
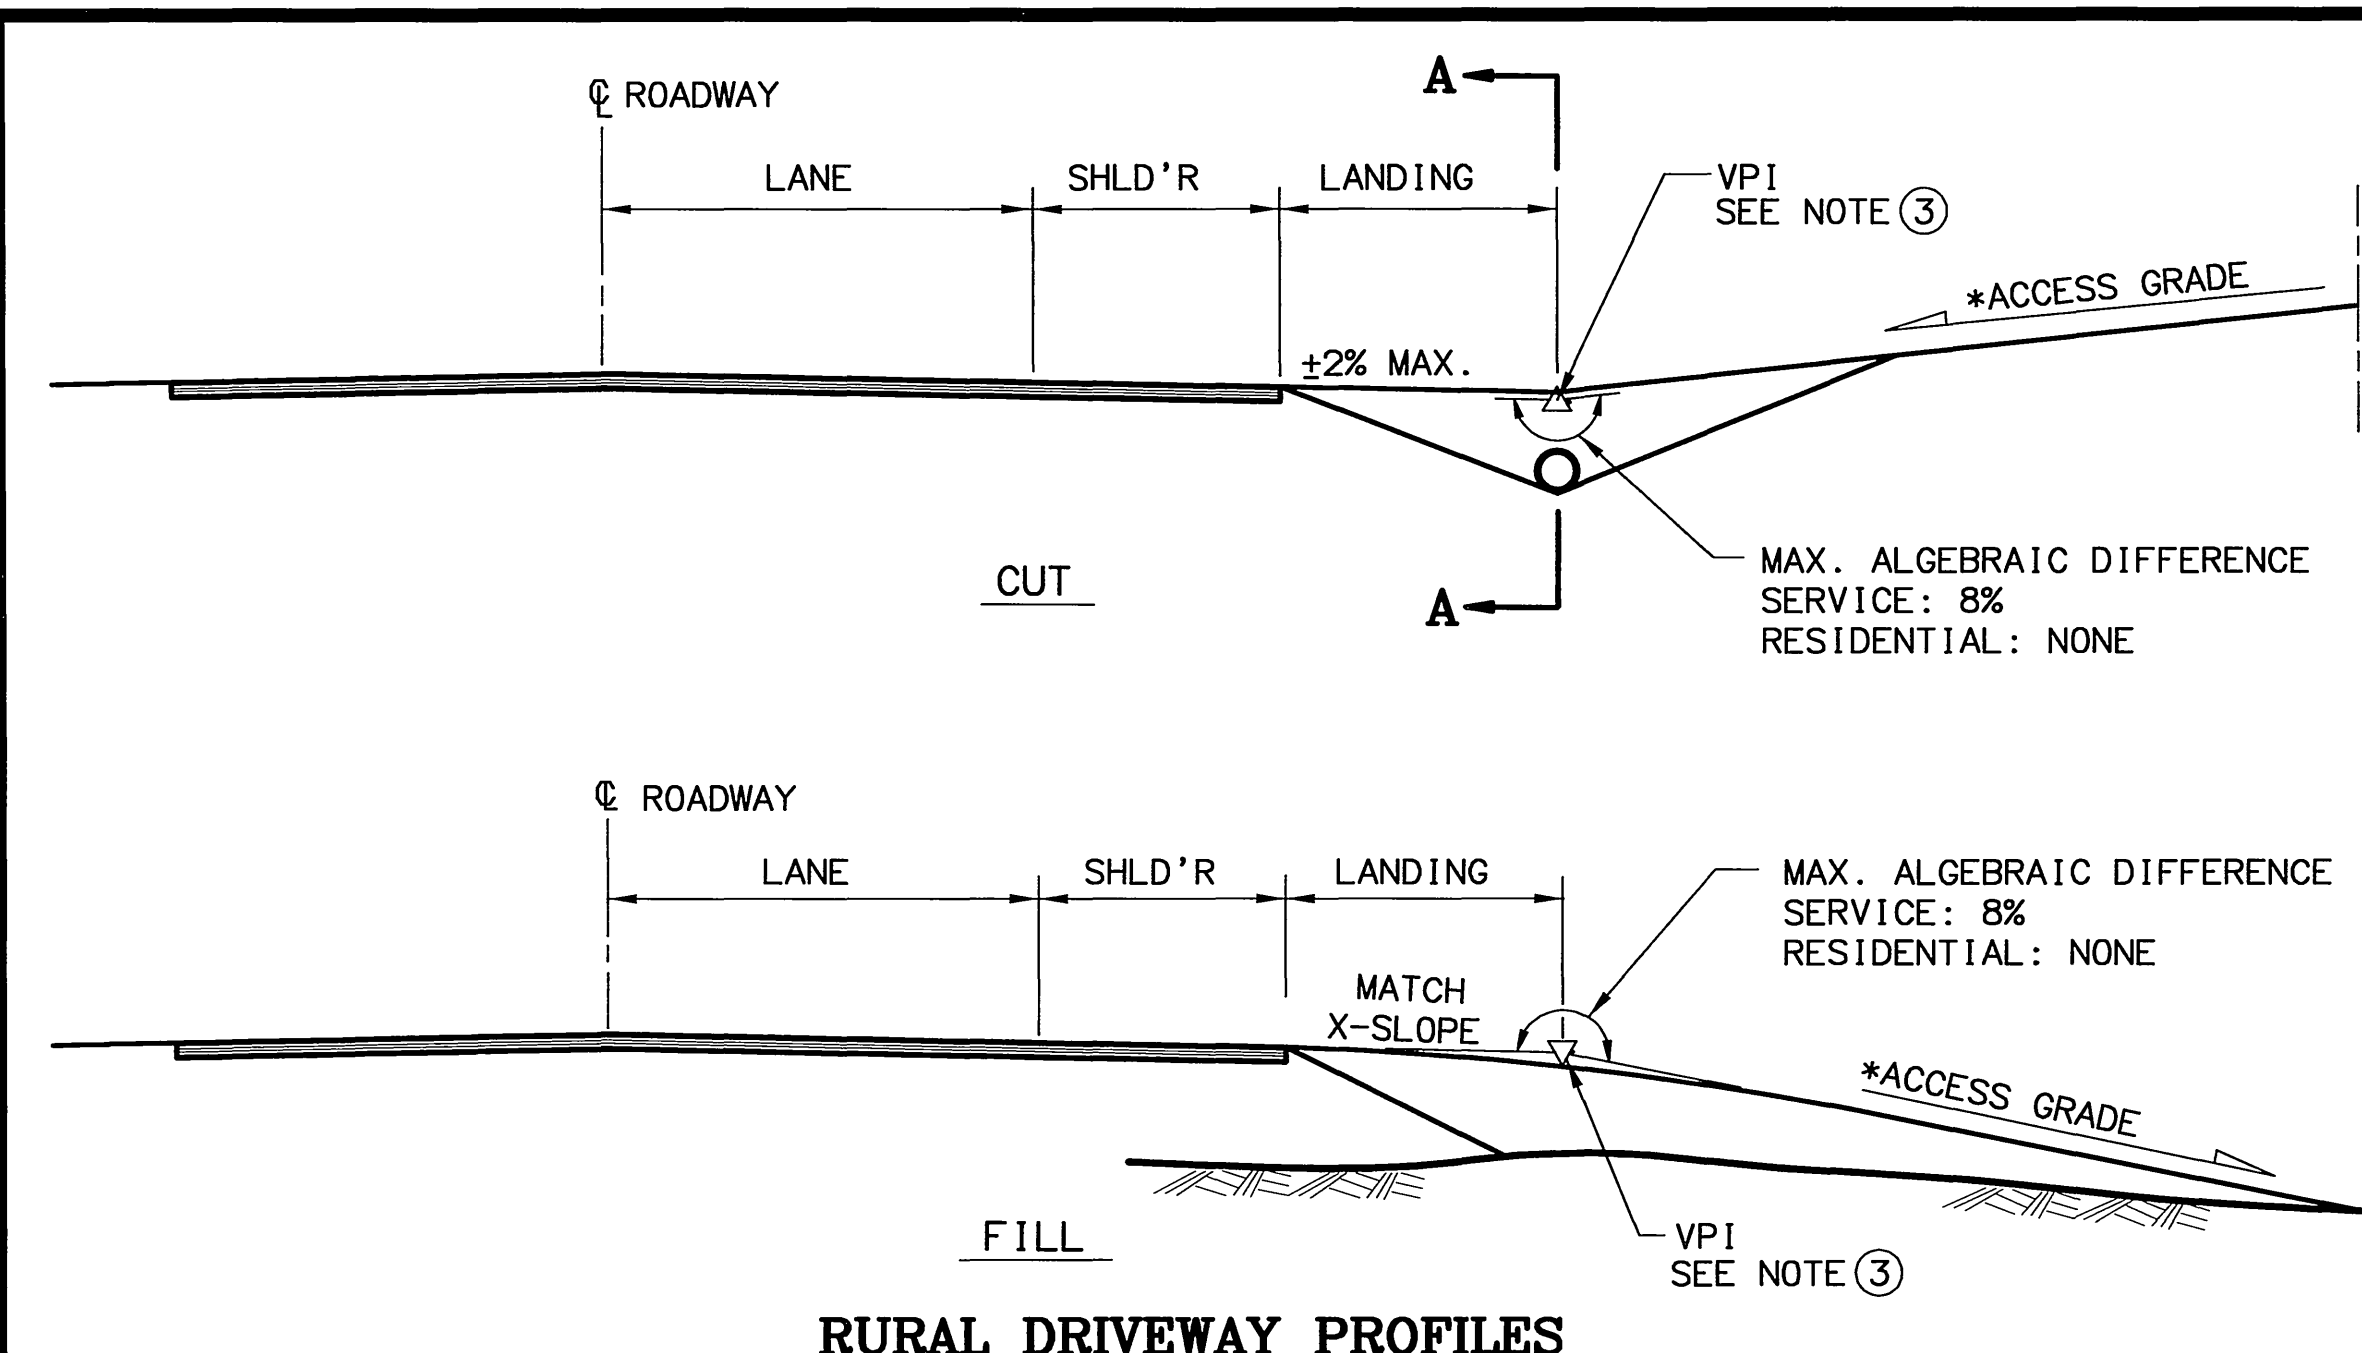


LANDING TABLE	
DRIVEWAY TYPE	LENGTH ①
RESIDENTIAL	3.0
② SERVICE	9.0

NOTES

- SEE PLANS, OTHERWISE USE LANDING TABLE.
- SERVICE DRIVEWAY = COMMERCIAL DRIVEWAY
- DRIVEWAY VERTICAL CURVES REQUIREMENTS:
CREST- 20 mm MAXIMUM HUMP IN 3 m CHORD
SAG- 50 mm MAXIMUM DEPRESSION IN 3 m CHORD

DRIVEWAY CONSTRUCTION TABLE		
DRIVEWAY TYPE	WIDTH	RADIUS
RESIDENTIAL	4.2 TO 6.0	6.0
② SERVICE	7.2 TO 10.4	12.0

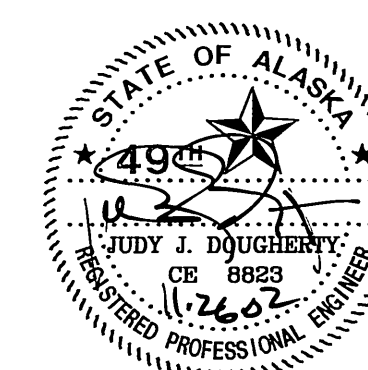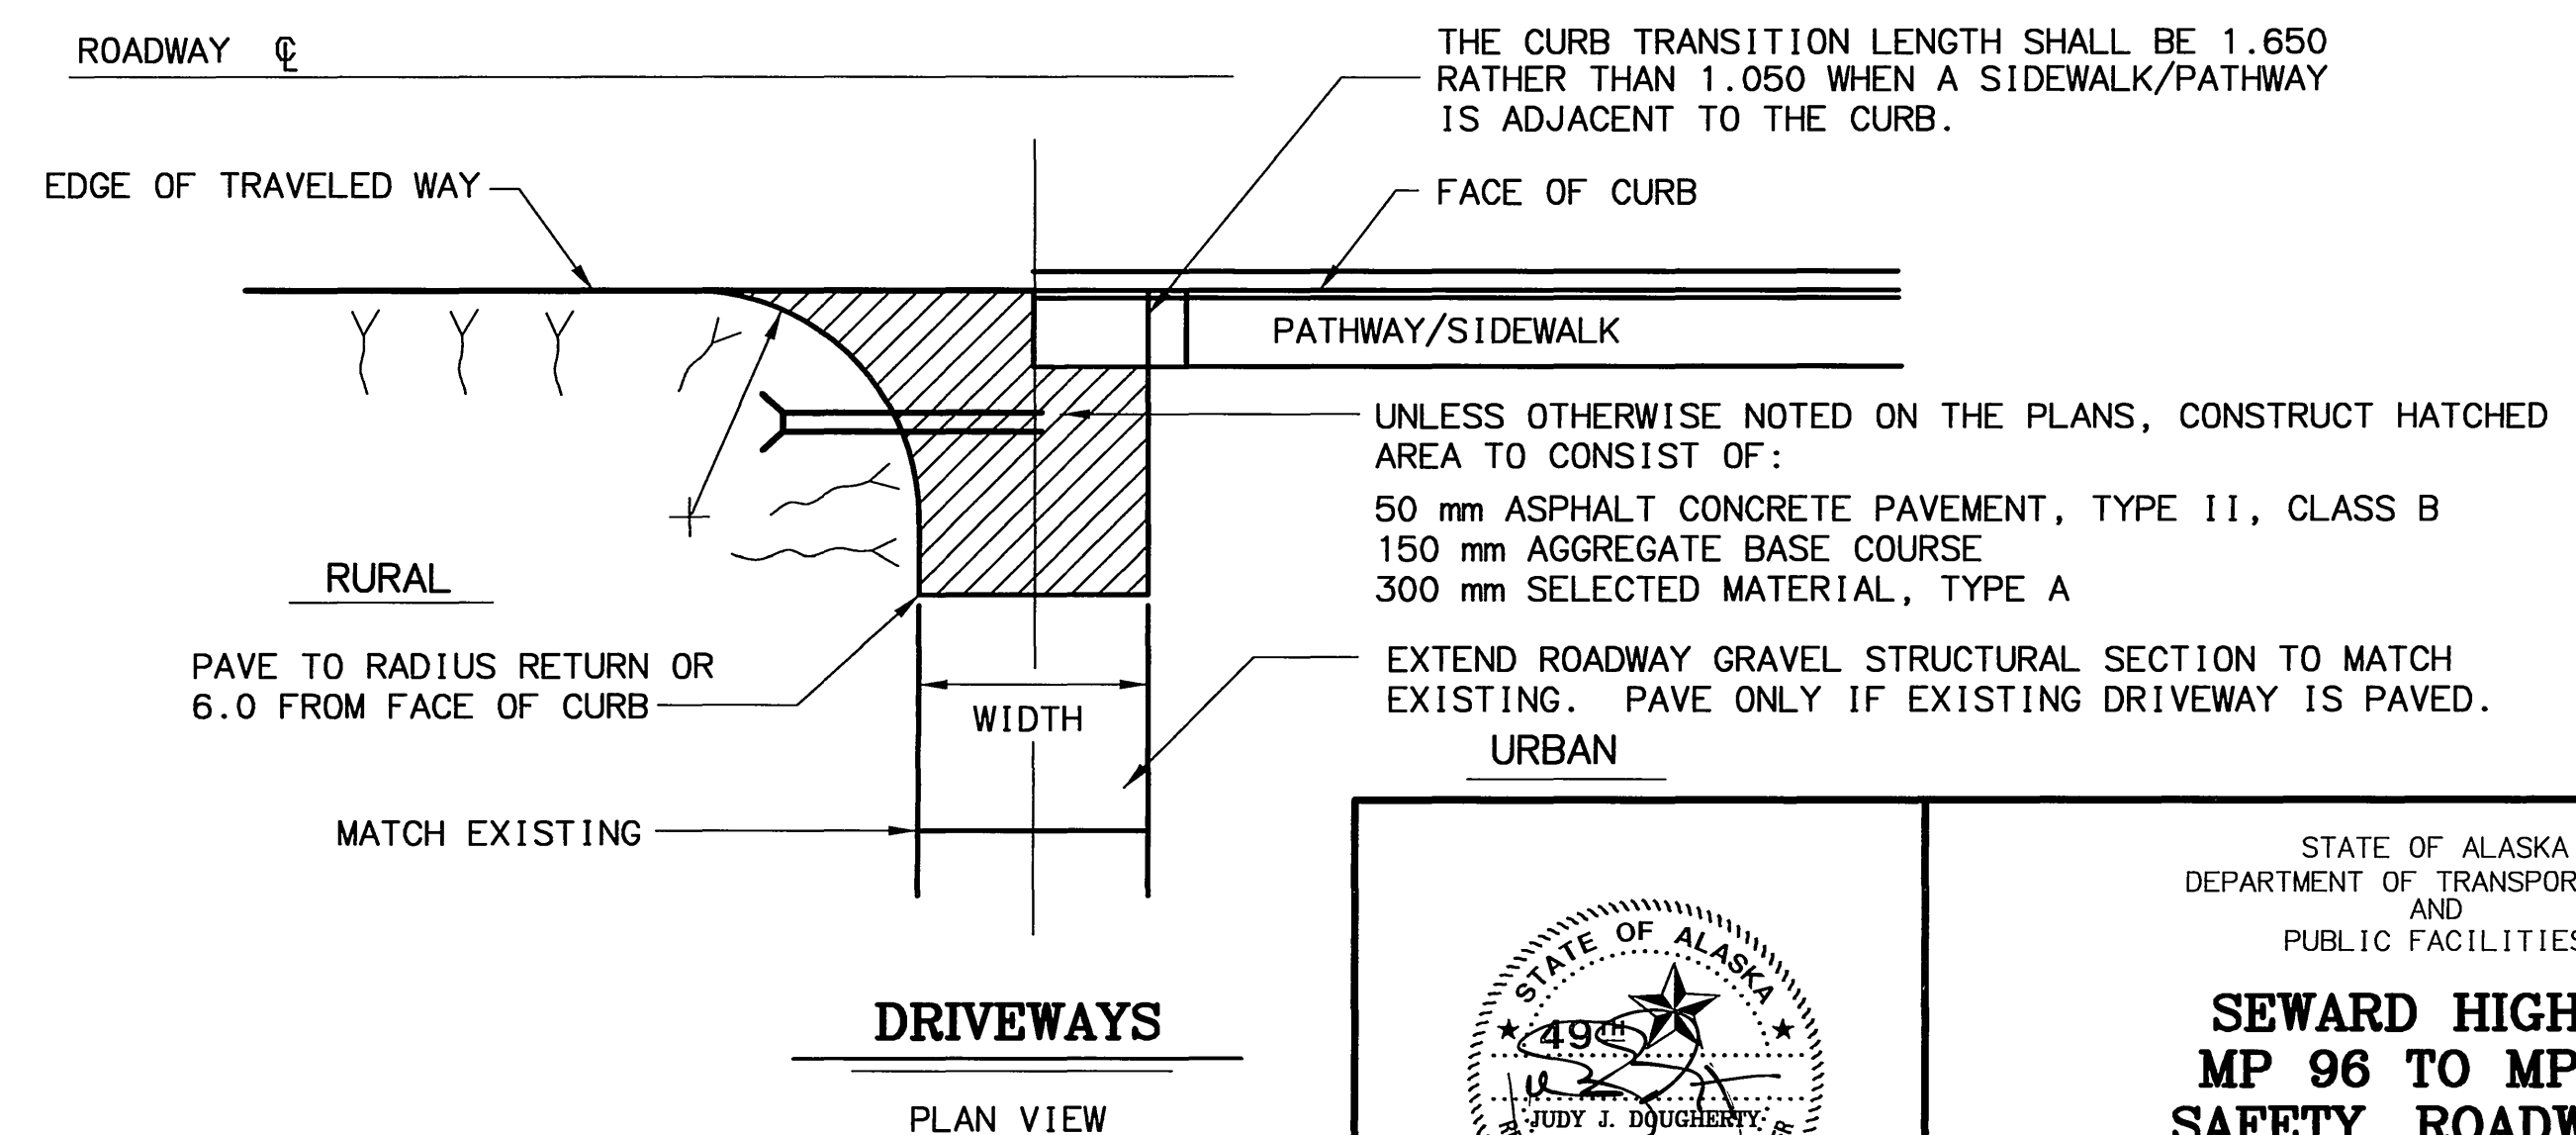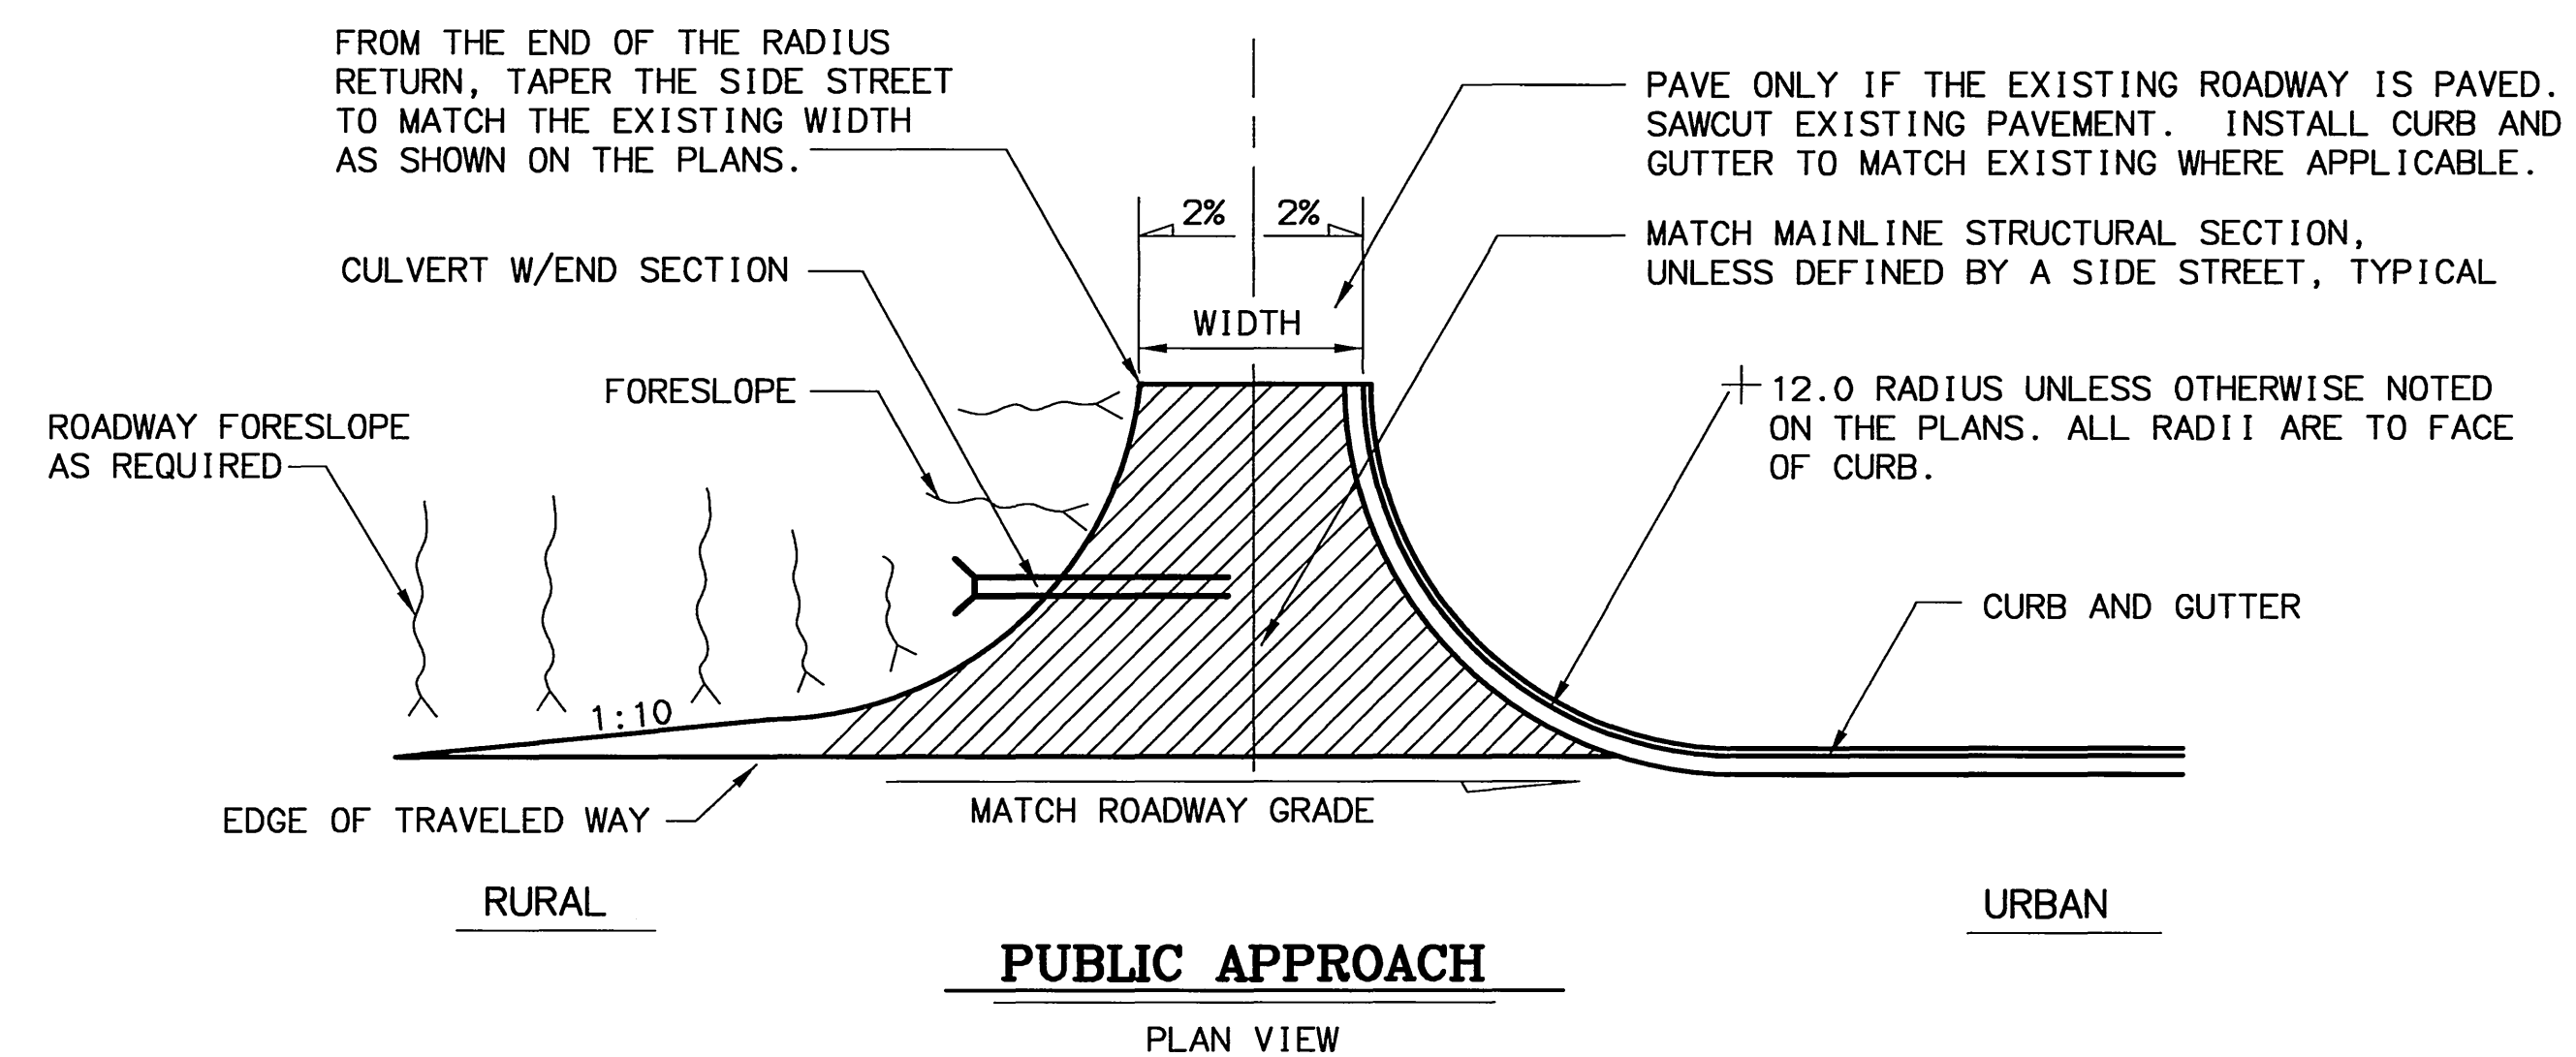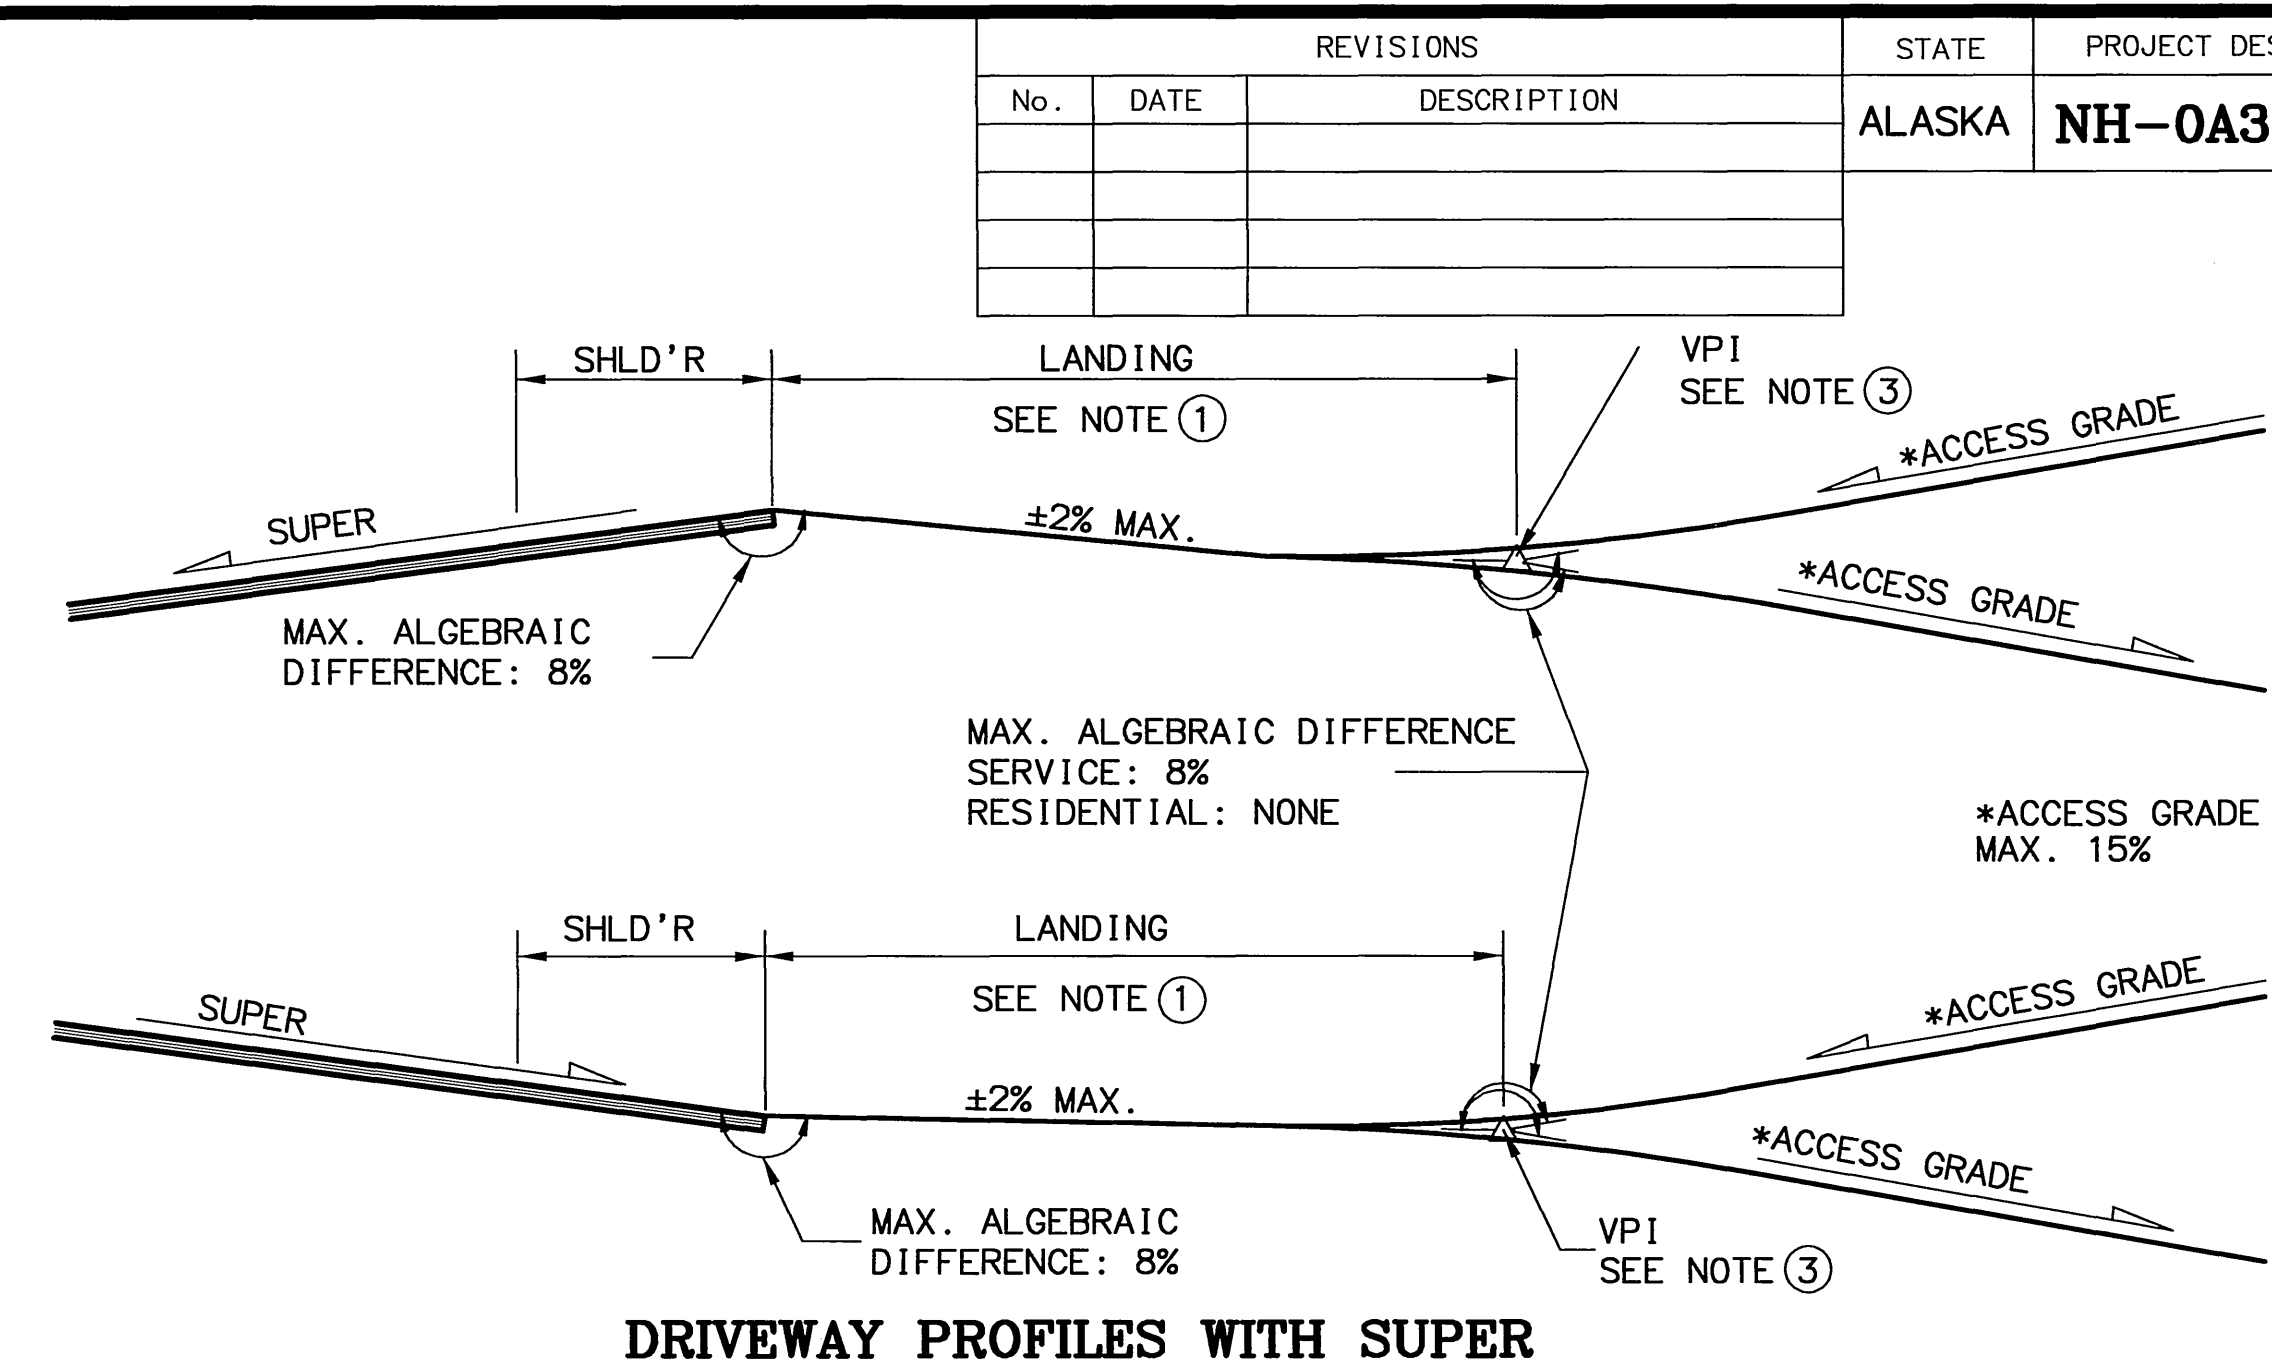


STATE OF ALASKA
DEPARTMENT OF TRANSPORTATION
AND
PUBLIC FACILITIES


**SEWARD HIGHWAY
MP 96 TO MP 102
SAFETY, ROADWAY &
RECREATIONAL IMPROVEMENTS**

DRIVEWAY AND APPROACH DETAILS

REVISIONS			STATE	PROJECT DESIGNATION	YEAR	SHEET NO.	TOTAL SHEETS
No.	DATE	DESCRIPTION					
			ALASKA	NH-0A3-1(28)	2002	E28	E30

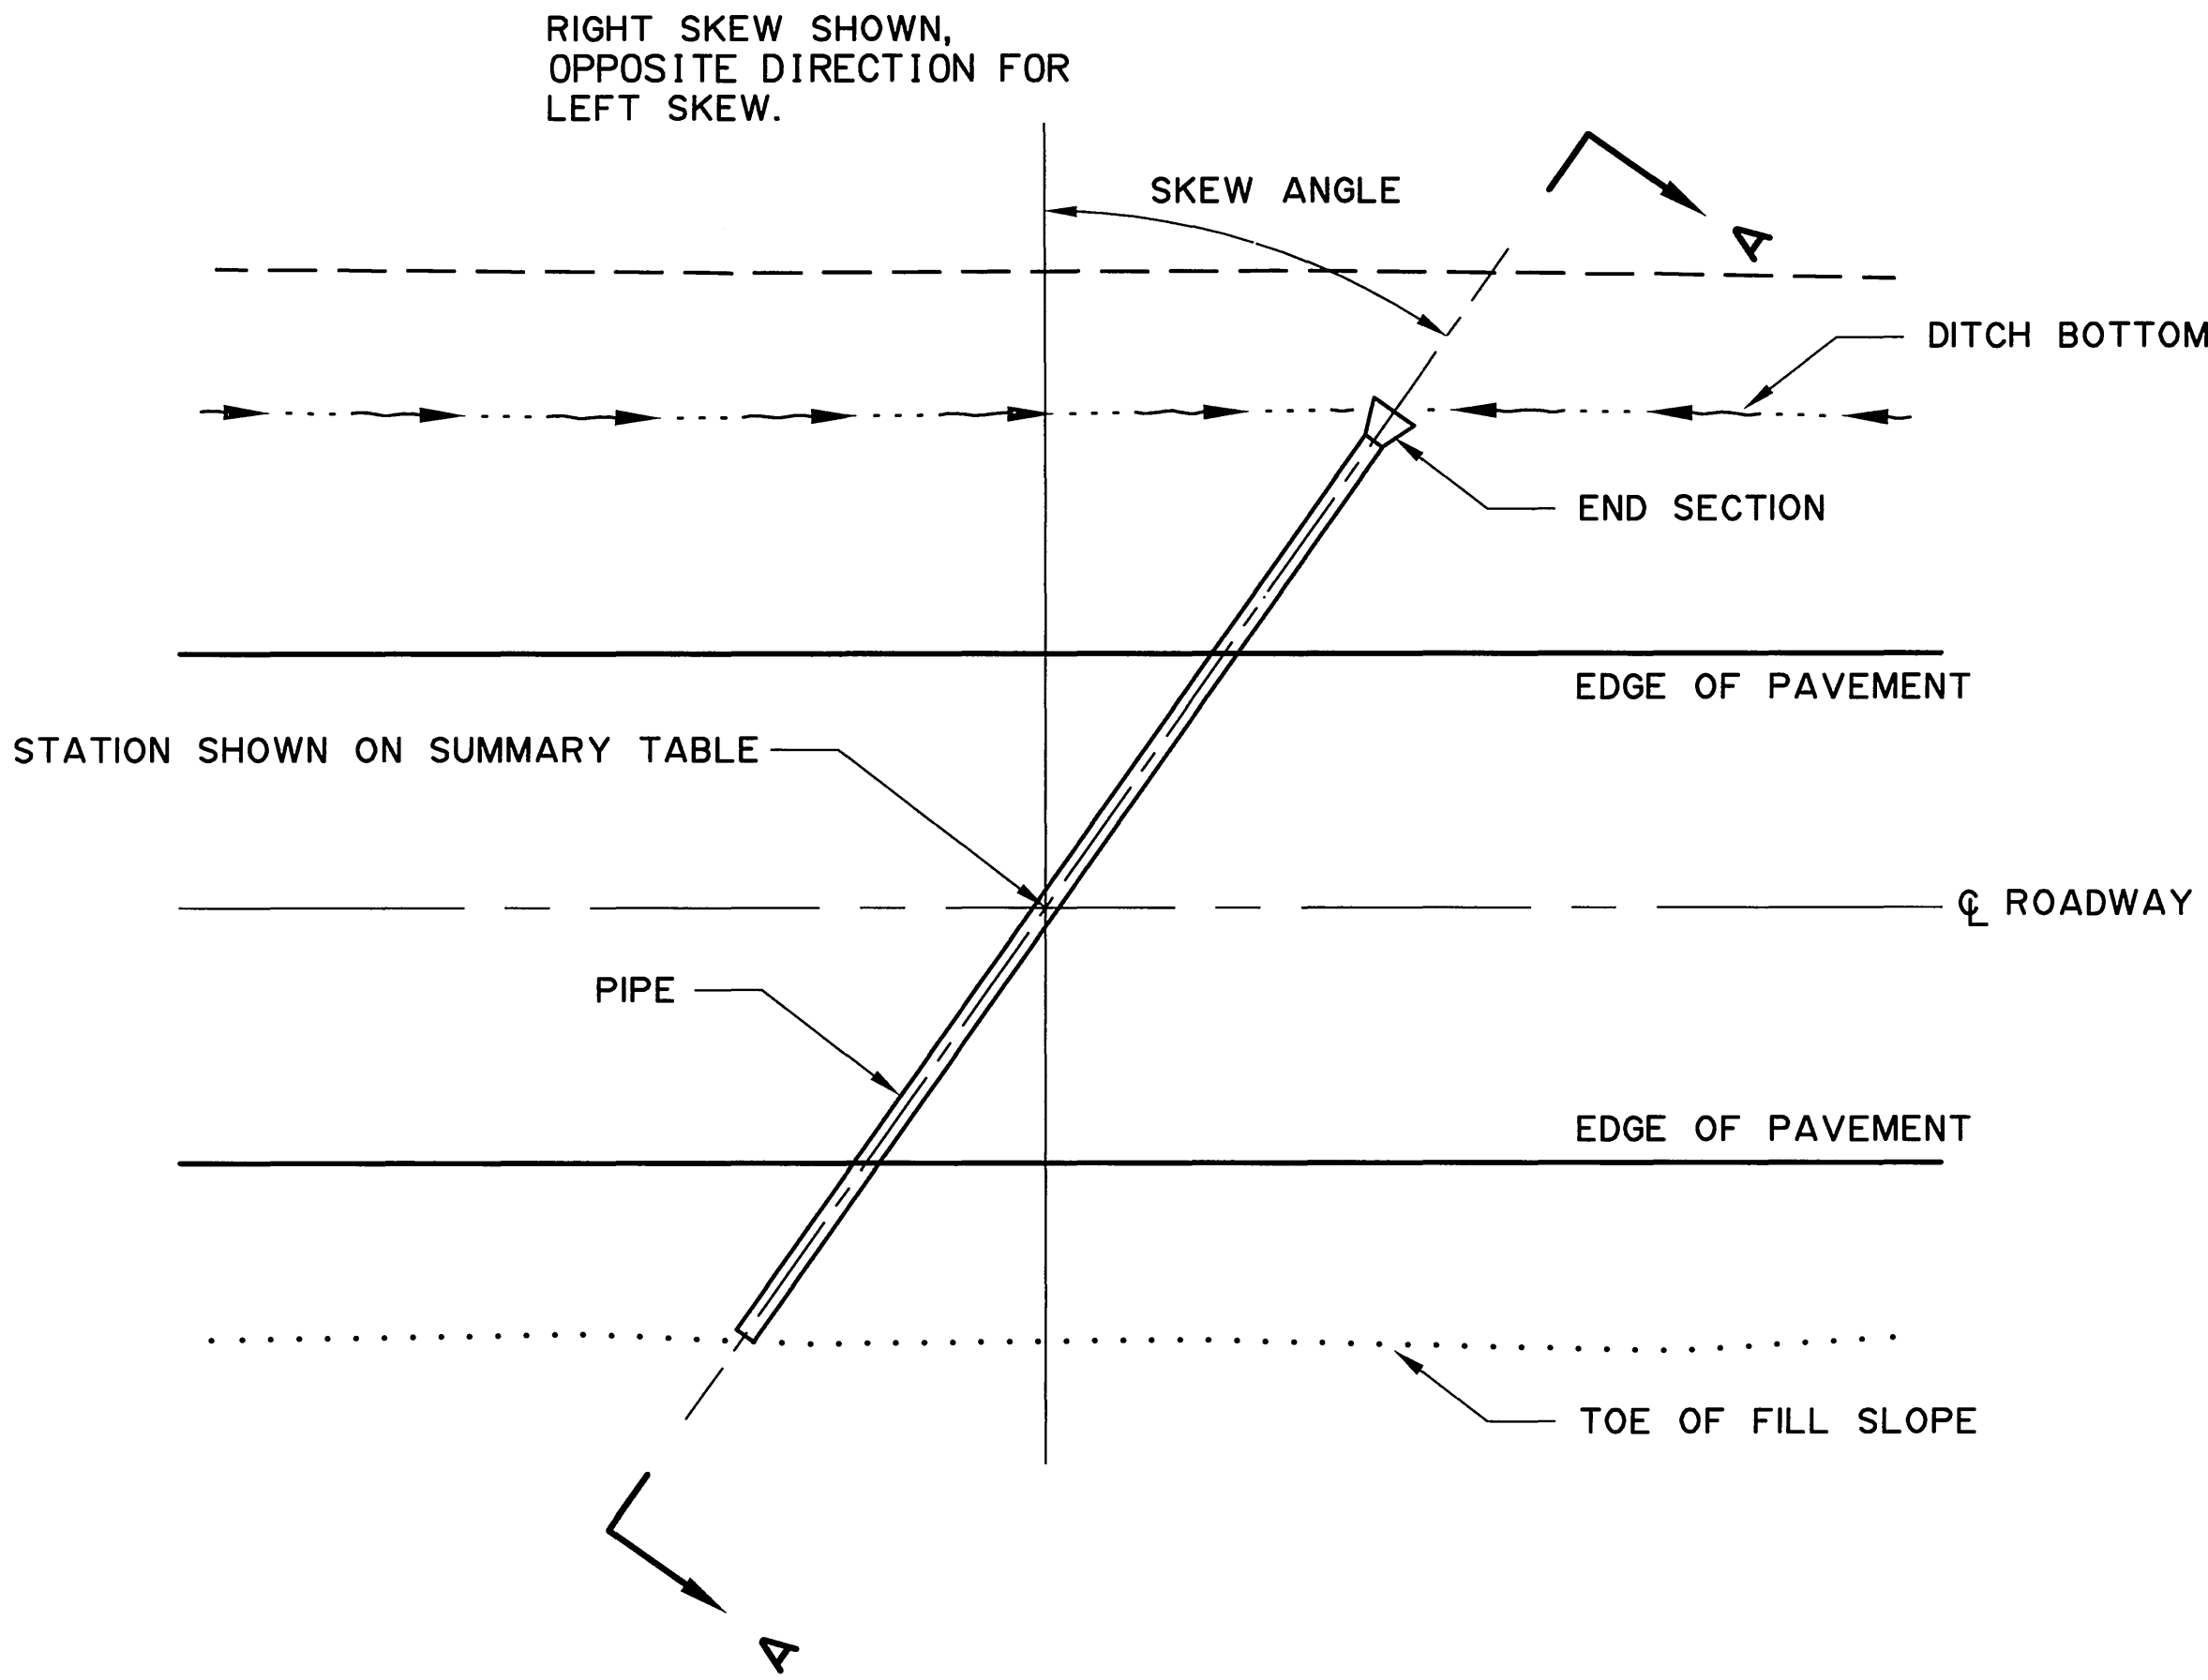


PLAN VIEW

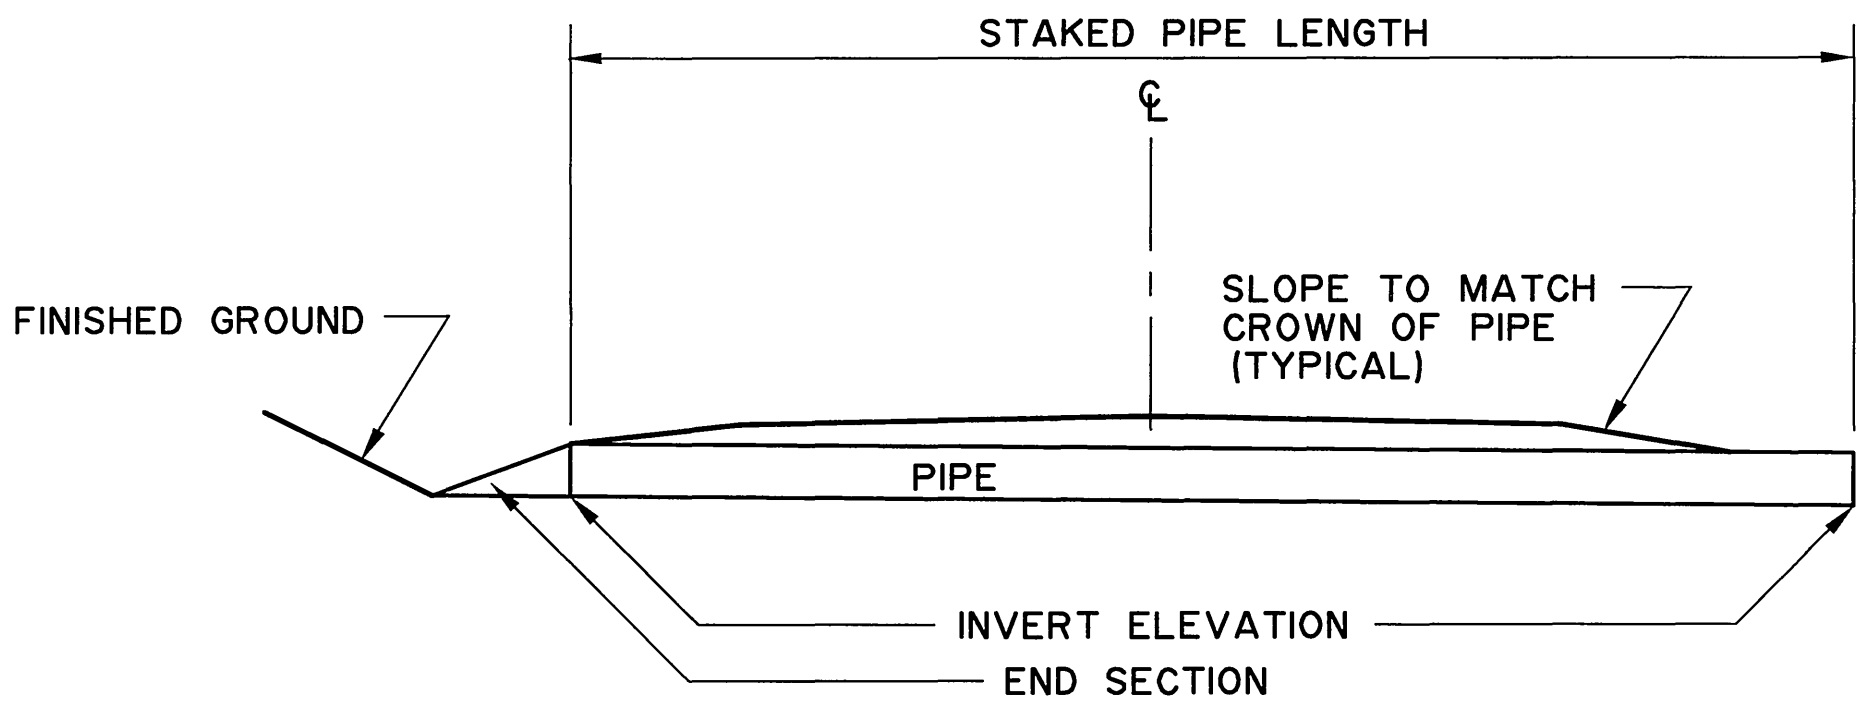


SECTION A-A

PIPE INSTALLATION DETAIL

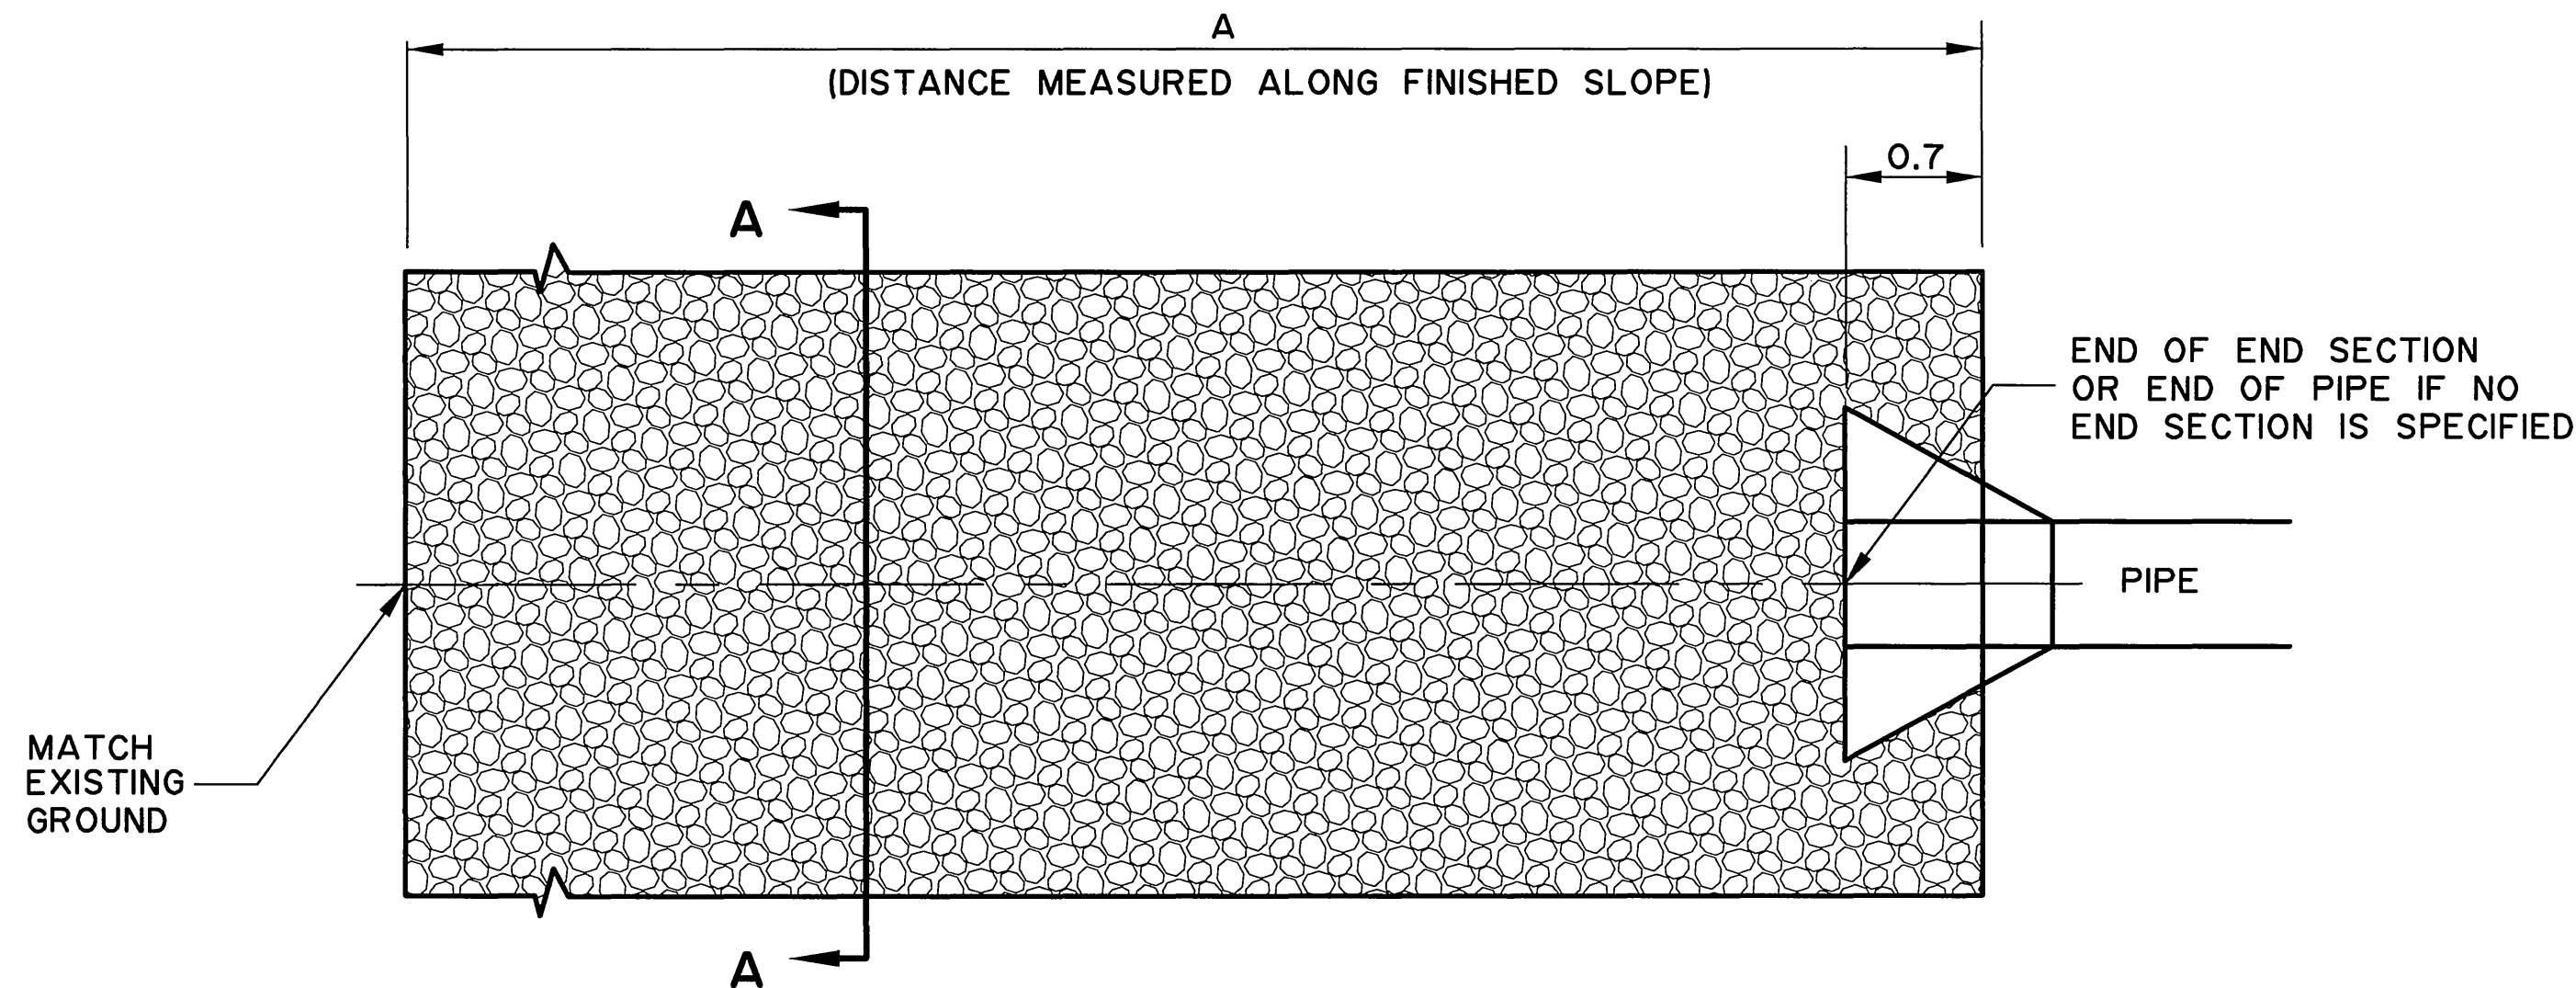


PLAN VIEW

SEE RIPRAP SUMMARY FOR DIMENSIONS A AND B.

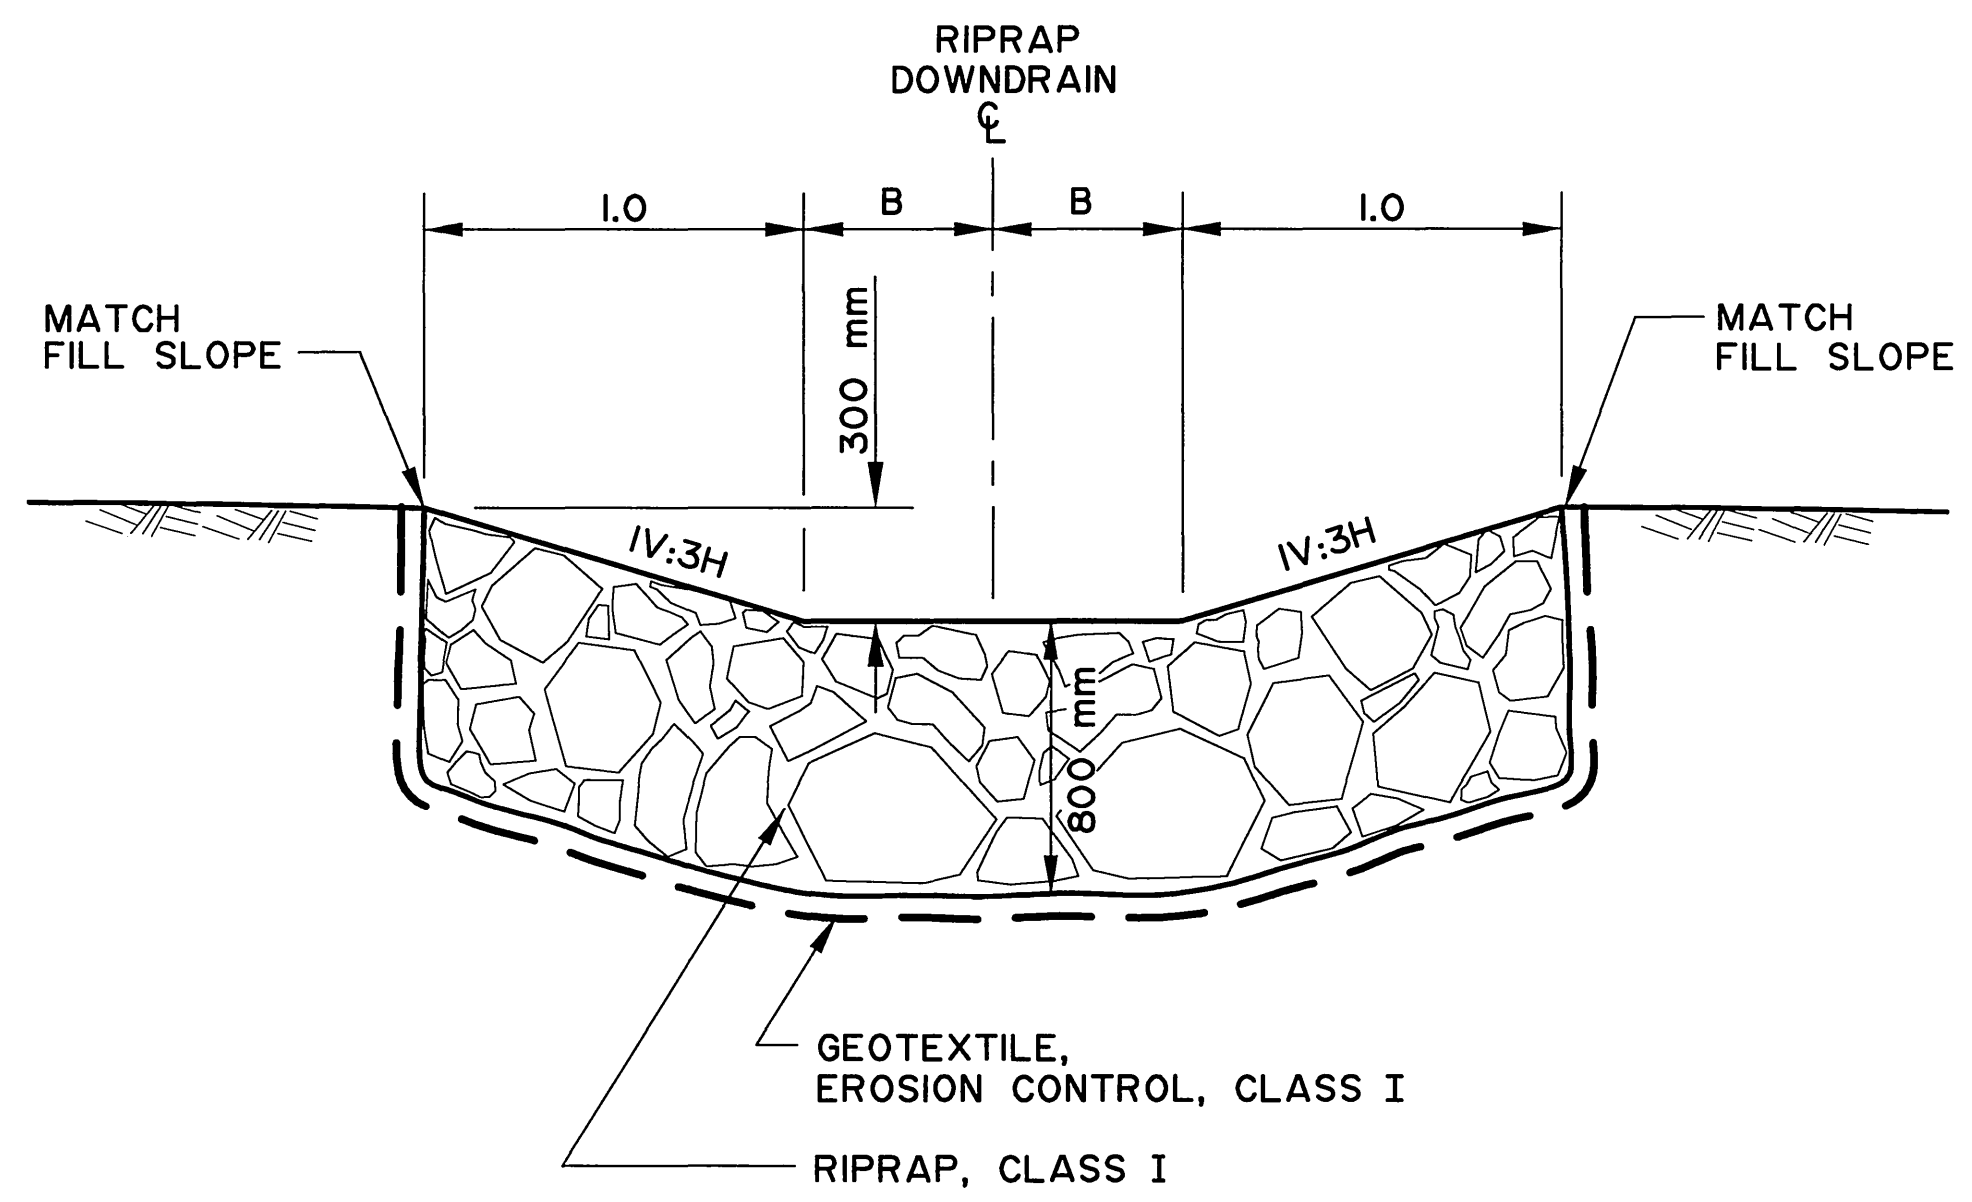

SECTION A-A

RIPRAP DOWNDRAIN

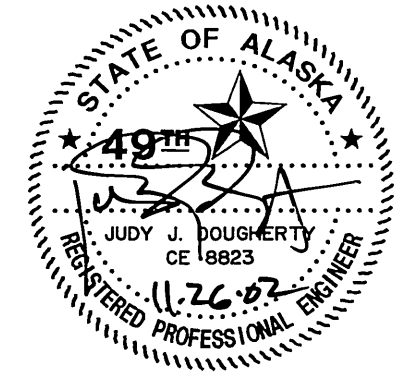

STATE OF ALASKA
DEPARTMENT OF TRANSPORTATION
AND
PUBLIC FACILITIES
**SEWARD HIGHWAY
MP 96 TO MP 102
SAFETY, ROADWAY AND
RECREATIONAL IMPROVEMENTS**

**PIPE AND
RIPRAP DOWNDRAIN DETAILS**

GENERAL NOTES:

- 1.SILT FENCE SUPPORTS SHALL BE 50mm PVC PIPE REINFORCED WITH IRON PIPE OR #15 M REBAR, 50 mm X 50 mm WOOD POSTS, OR AS APPROVED BY THE ENGINEER.

2. INSTALLATION AND APPLICATION SHALL BE IN ACCORDANCE WITH THE PRACTICES AS OUTLINED IN THE EROSION AND SEDIMENT CONTROL PLAN.

3. FILTER FABRIC END PIECES SHALL BE OVERLAPPED APPROX. 150 mm AT FENCE SUPPORTS.
4. FILTER FABRIC SHALL BE HUNG TAUT, NOT LOOSE OR FOLDED.

5. THE CONTRACTOR SHALL INSPECT AND REPAIR FENCE AFTER EACH STORM EVENT.


6. SILT FENCE SHALL BE PLACED ON SLOPE CONTOURS TO MAXIMIZE PONDING EFFICIENCY.

7. DO NOT PLACE SILT FENCE ACROSS CREEKS OR STREAMS.


REVISIONS			STATE	PROJECT DESIGNATION	YEAR	SHEET NO.	TOTAL SHEETS
No.	DATE	DESCRIPTION					
			ALASKA	NH-0A3-1(28)	2002	E29	E30

FOR USE IN WATER


- 1.SECURE THE ENDS OF SILT FENCE TO THE BANK.
- 2.SILT FENCE FRAMEWORK SHALL BE FINISHED 50 mm x 50 mm WOOD, 75 mm DIAMETER WOOD, 20 M REBAR WITH PVC SLEEVES, 20 mm IRON PIPE, OR OTHER POSTS CAPABLE OF SUPPORTING THE INSTALLATION, AS APPROVED BY THE ENGINEER.
- 3.THE WIRE MESH SUPPORT SHALL BE WWF 150 mm x 150 mm, W1 x W1 OR AS APPROVED BY THE ENGINEER.
- 4.FENCE ANCHORED IN STANDING WATER SHALL HAVE THE BOTTOM ANCHORED WITH SANDBAGS OR CONCRETE BLOCKS AS DETAILED BELOW.

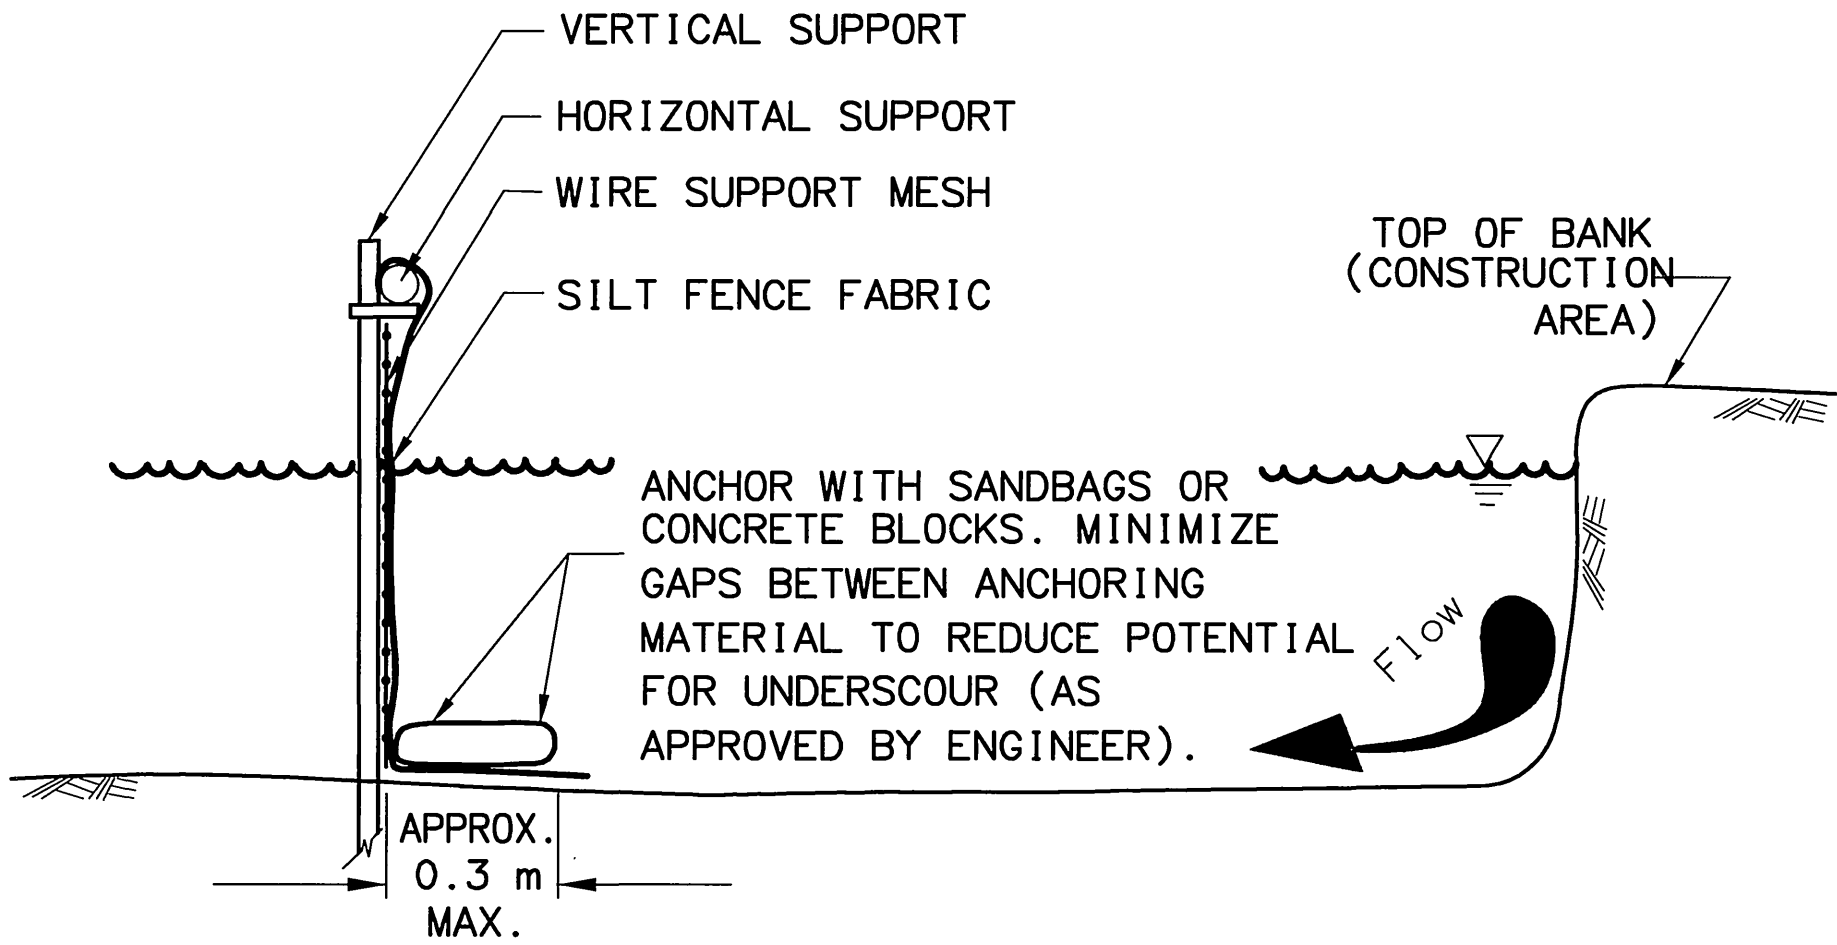


CROSS SECTION VIEW

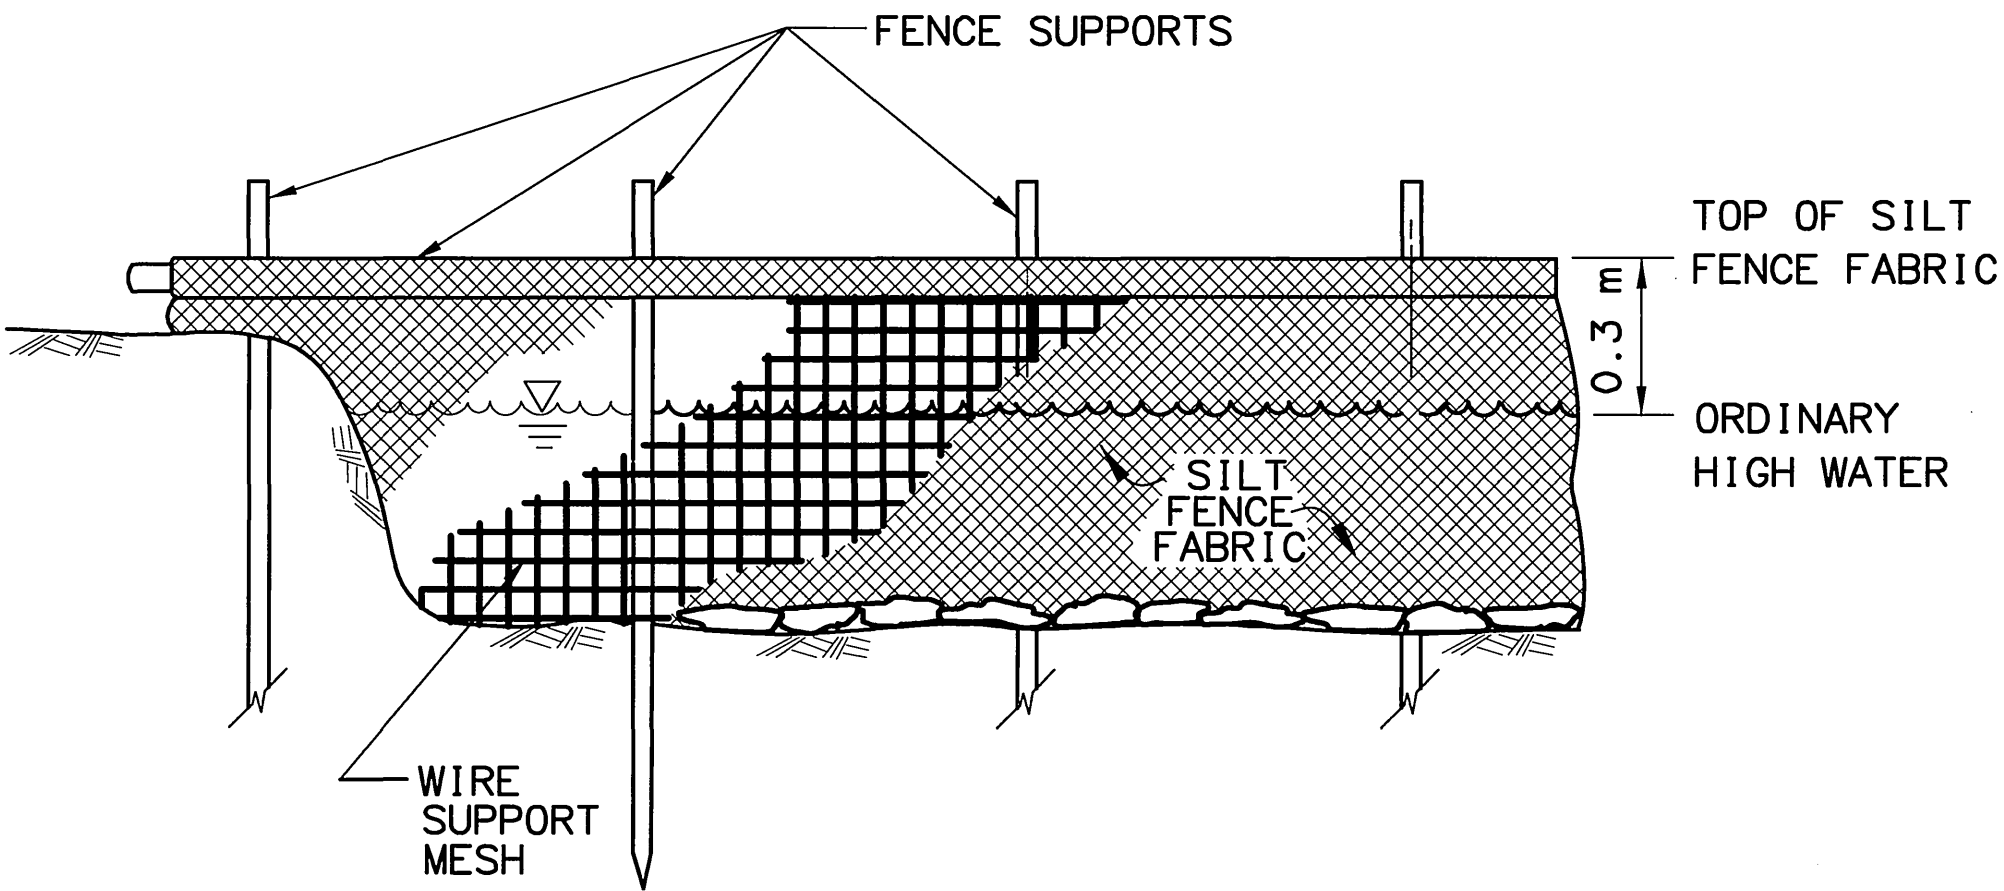

TYPICAL

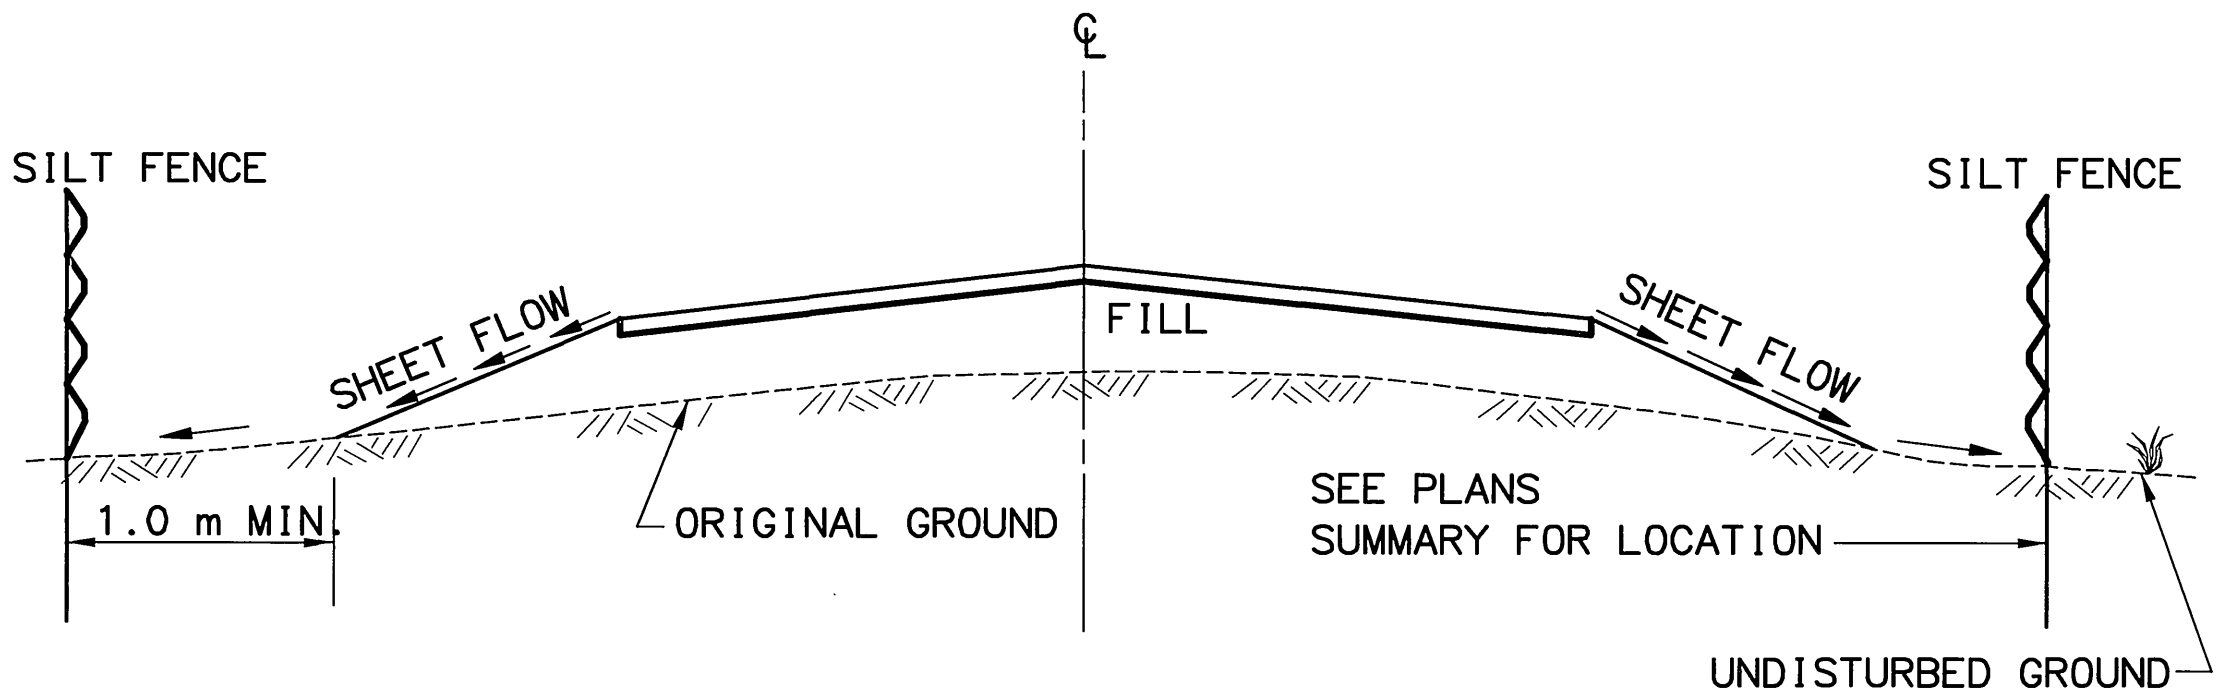


SECTION A-A

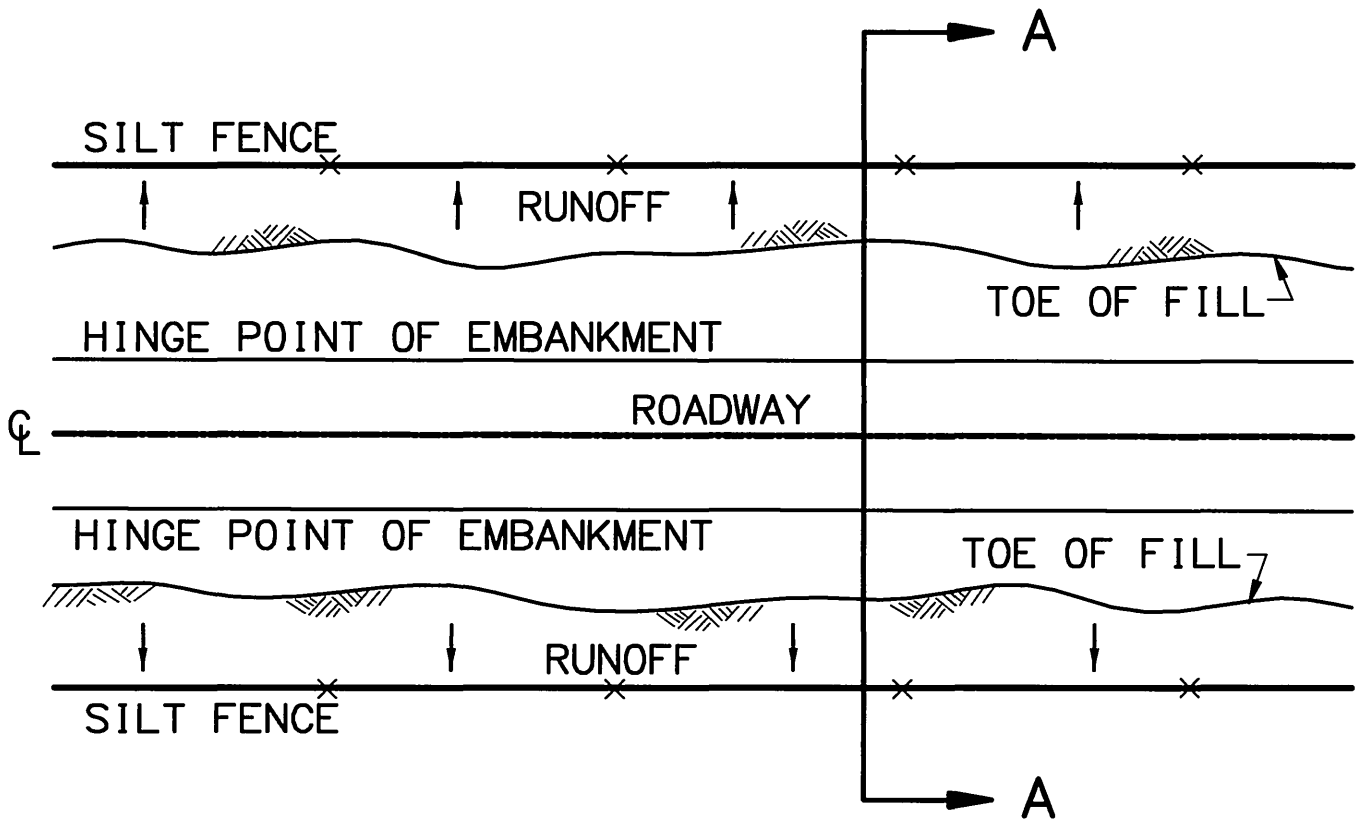


PLAN VIEW

FOR USE ON LAND


1. FENCE SHALL BE PLACED AT LEAST 1 m FROM THE TOE OF EMBANKMENT OR EXCAVATION AREAS, OR AS DIRECTED BY THE ENGINEER.
2. ACCUMULATION OF SEDIMENT BEHIND SILT FENCE SHALL BE REMOVED WHEN DEPTH REACHES 150 mm. REMOVED SEDIMENT SHALL BE DEPOSITED TO AN AREA THAT WILL NOT CONTRIBUTE SEDIMENT OFF-SITE AND CAN BE PERMANENTLY STABILIZED.

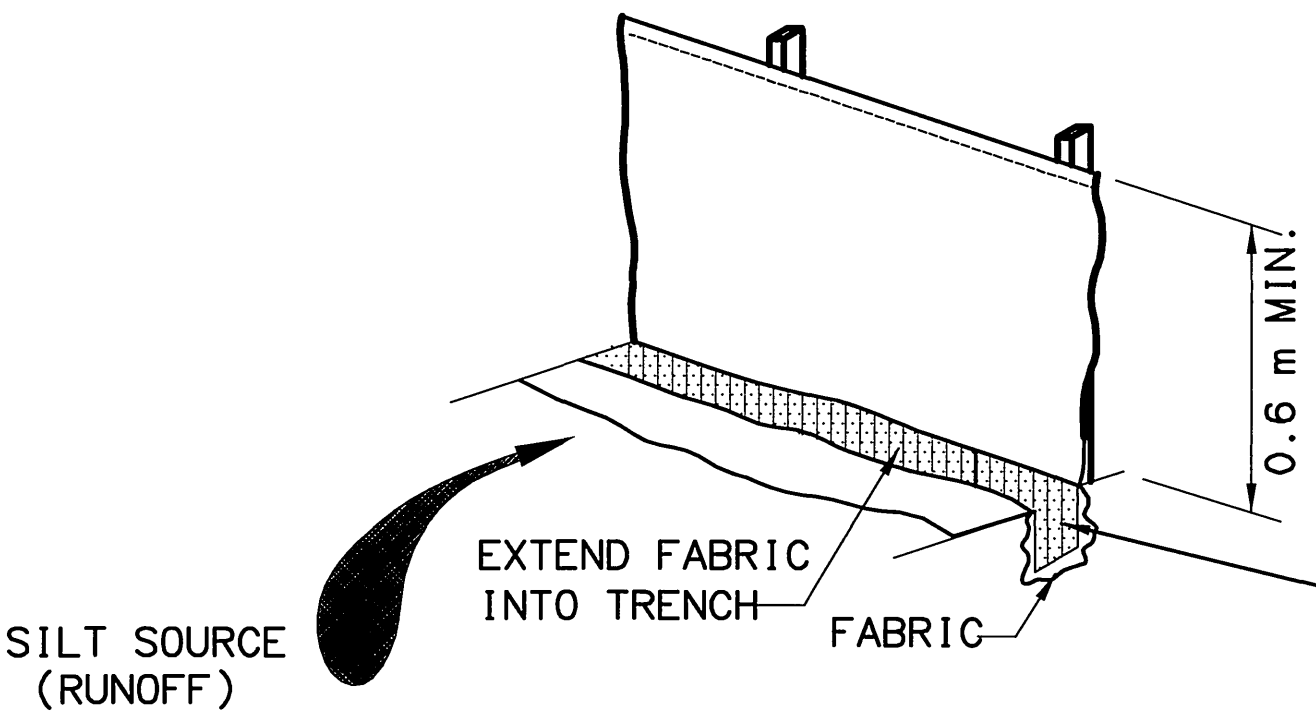


TRENCH ALTERNATE

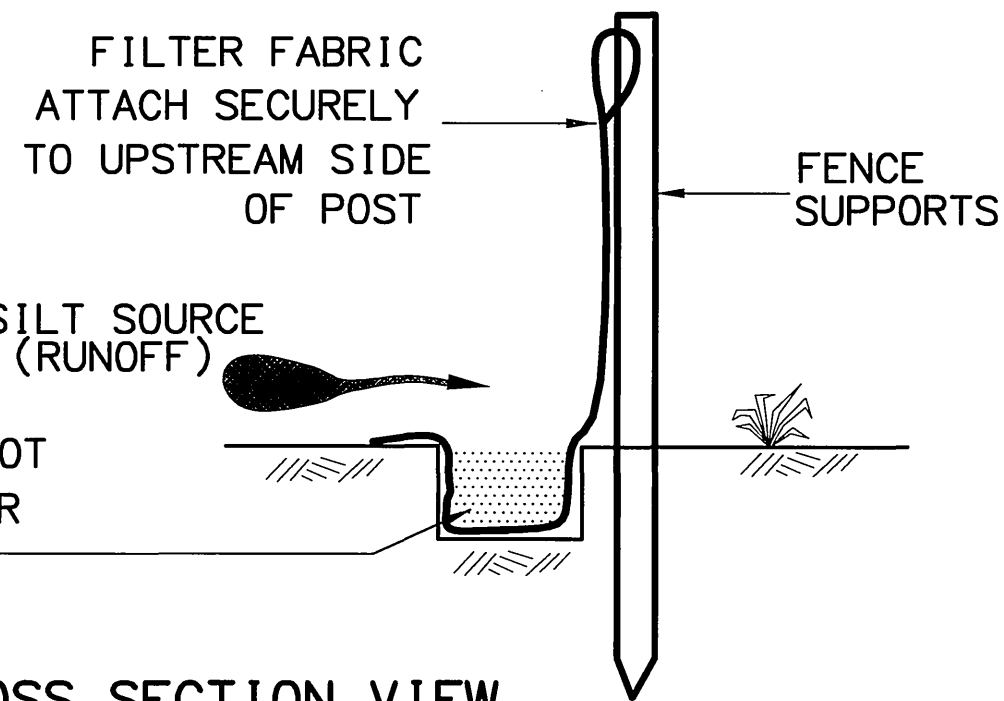


CROSS SECTION VIEW

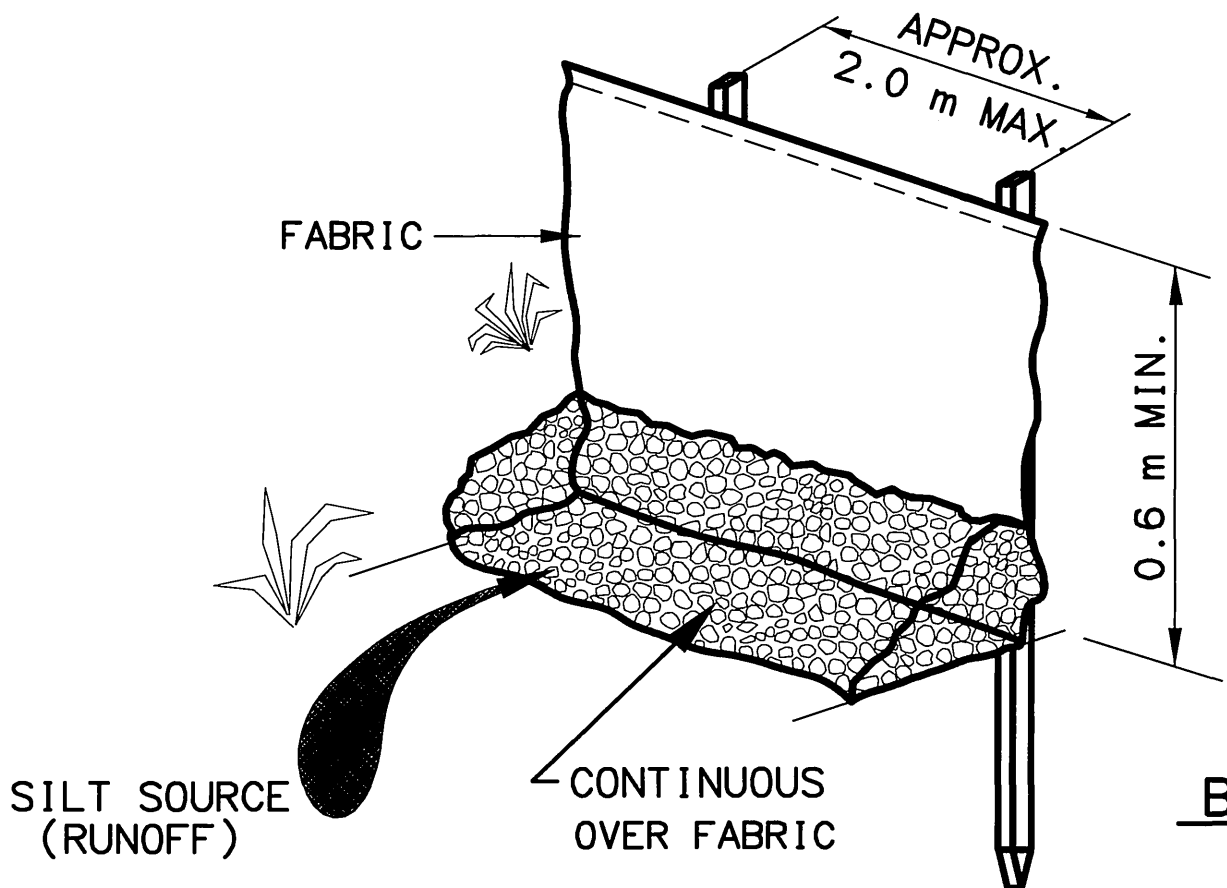

BACKFILL ALTERNATE

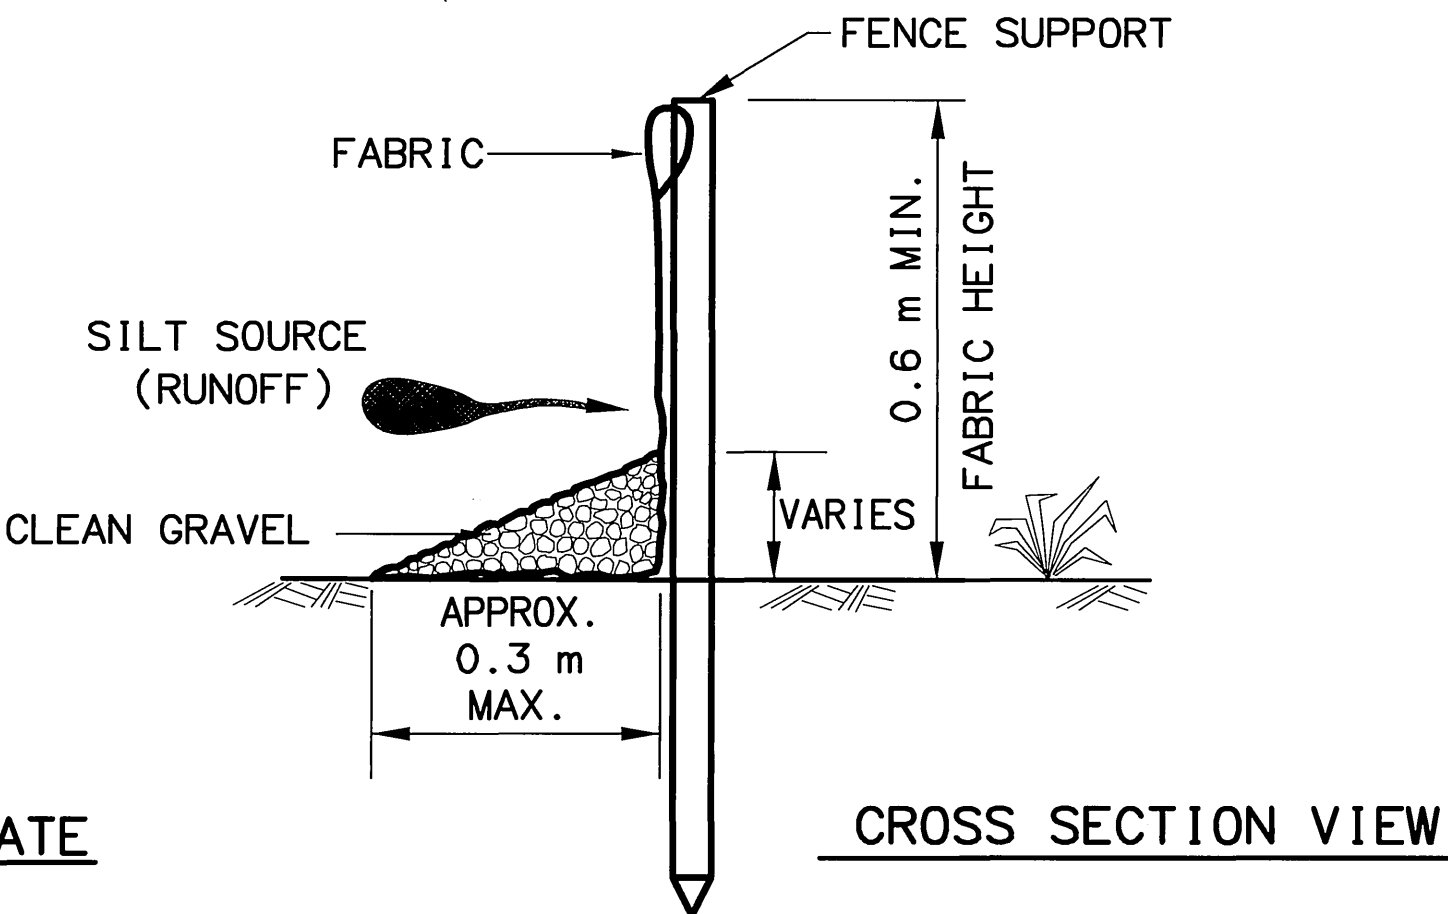


CROSS SECTION VIEW

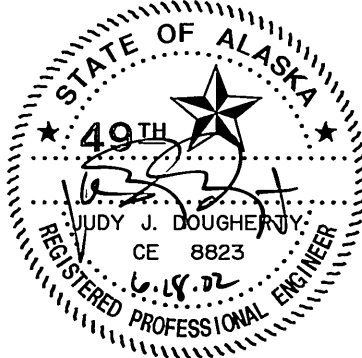


STATE OF ALASKA
DEPARTMENT OF TRANSPORTATION
AND
PUBLIC FACILITIES
SEWARD HIGHWAY
MP 96 TO MP 102
SAFETY, ROADWAY &
RECREATIONAL IMPROVEMENTS
EROSION AND SEDIMENT CONTROL
SILT FENCE DETAILS


REVISIONS			STATE	PROJECT DESIGNATION	YEAR	SHEET NO.	TOTAL SHEETS
No.	DATE	DESCRIPTION	ALASKA	NH-0A3-1(28)	2002	E30	E30

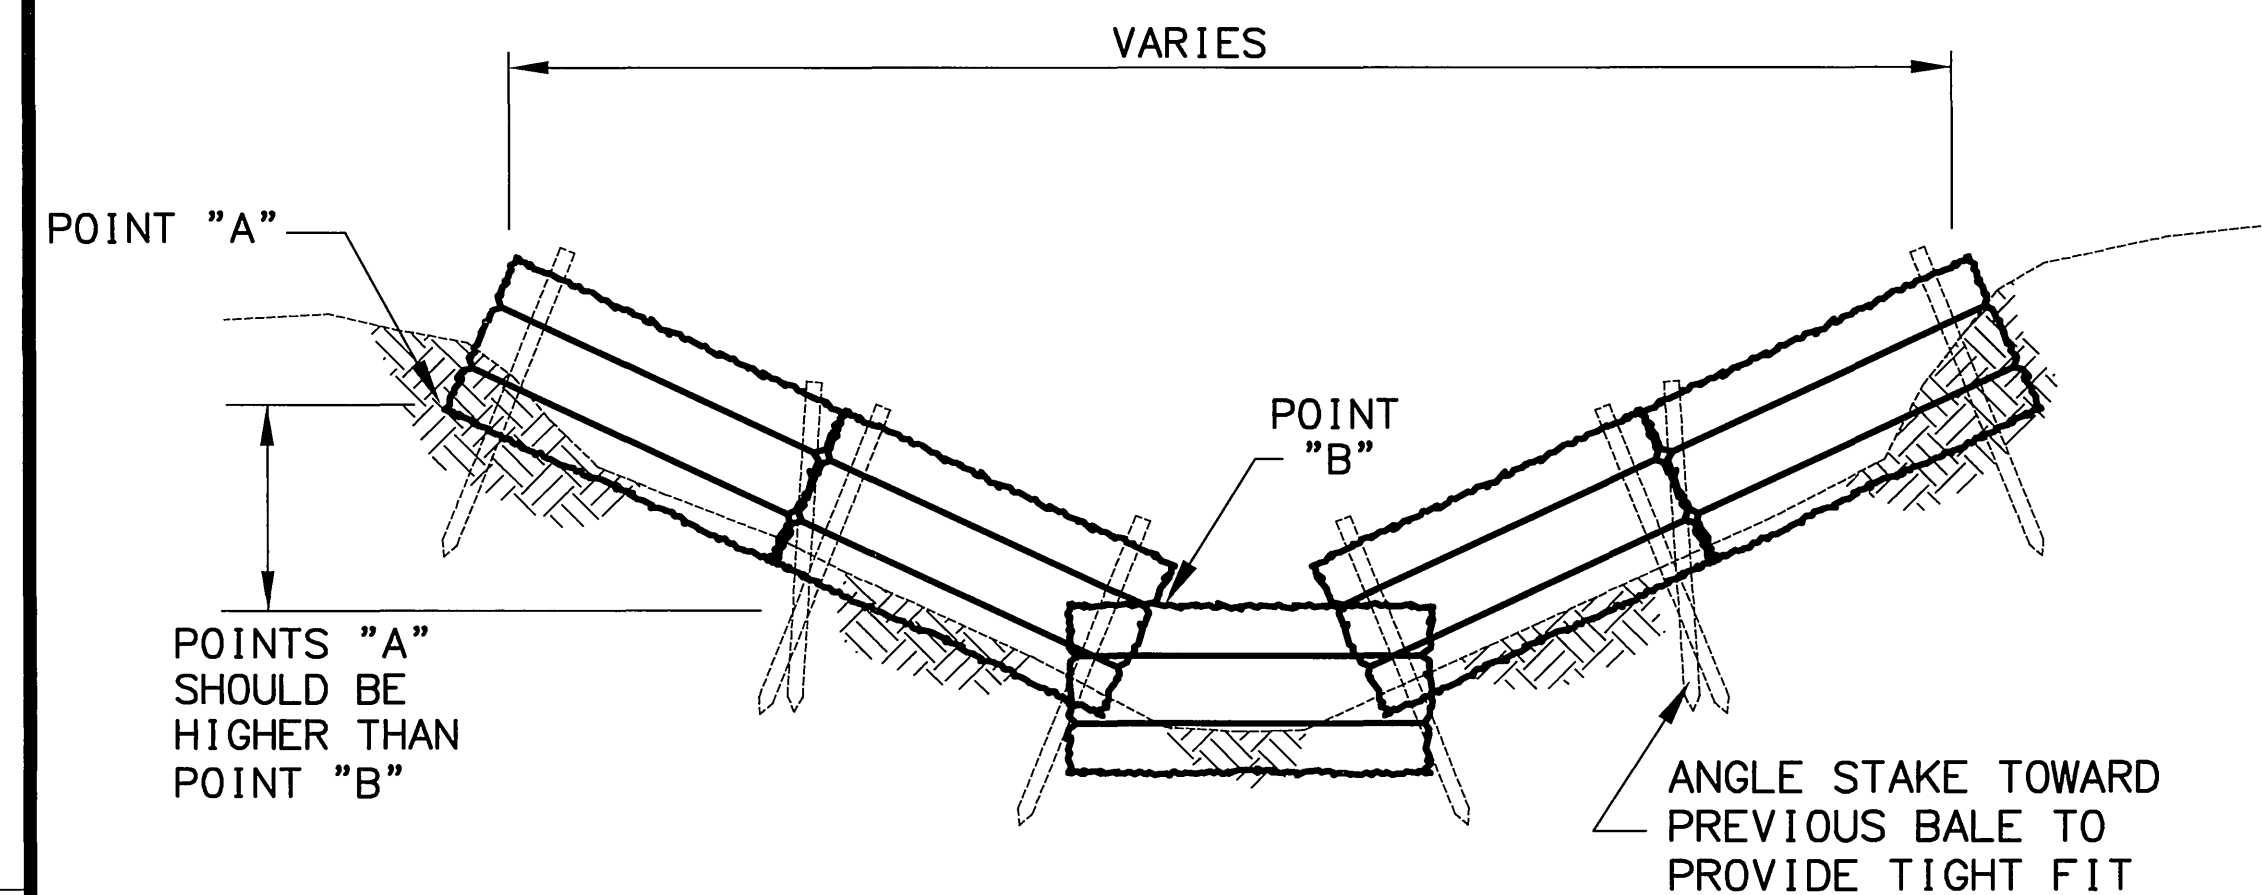

ELEVATION-DITCH LINE

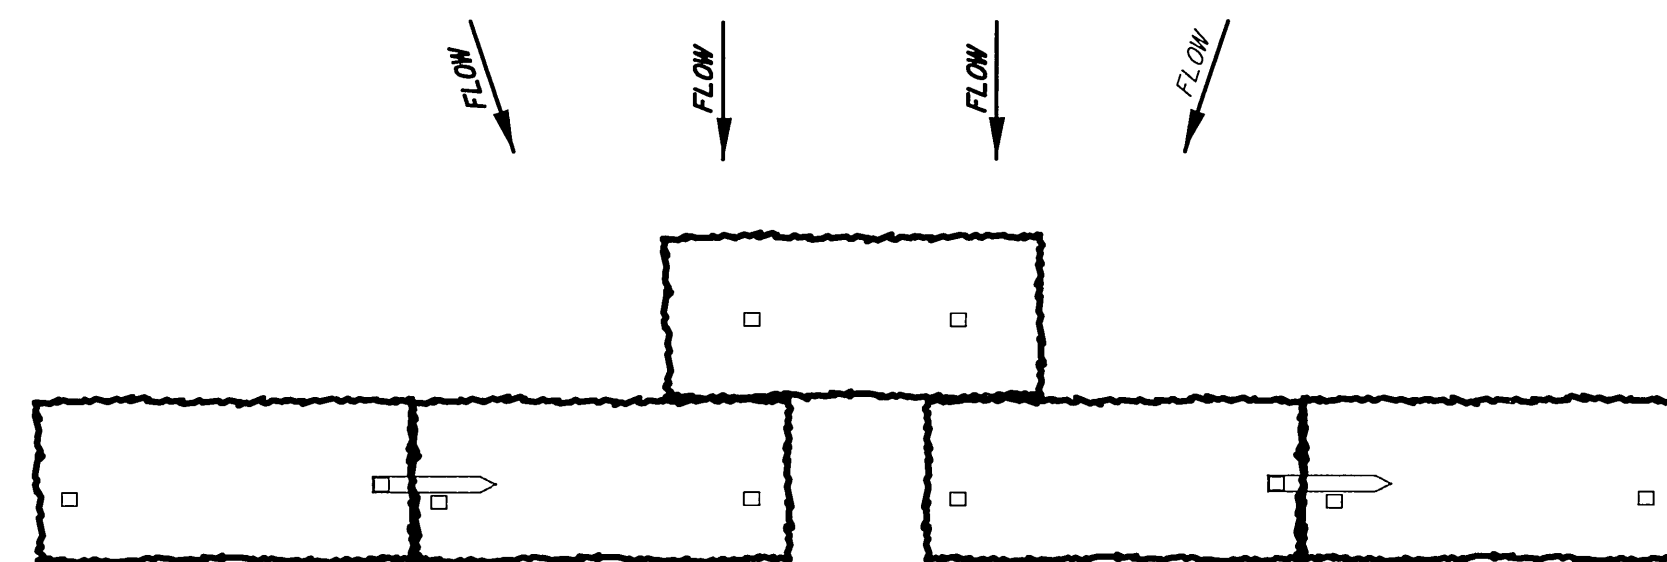


PLAN-DITCH LINE

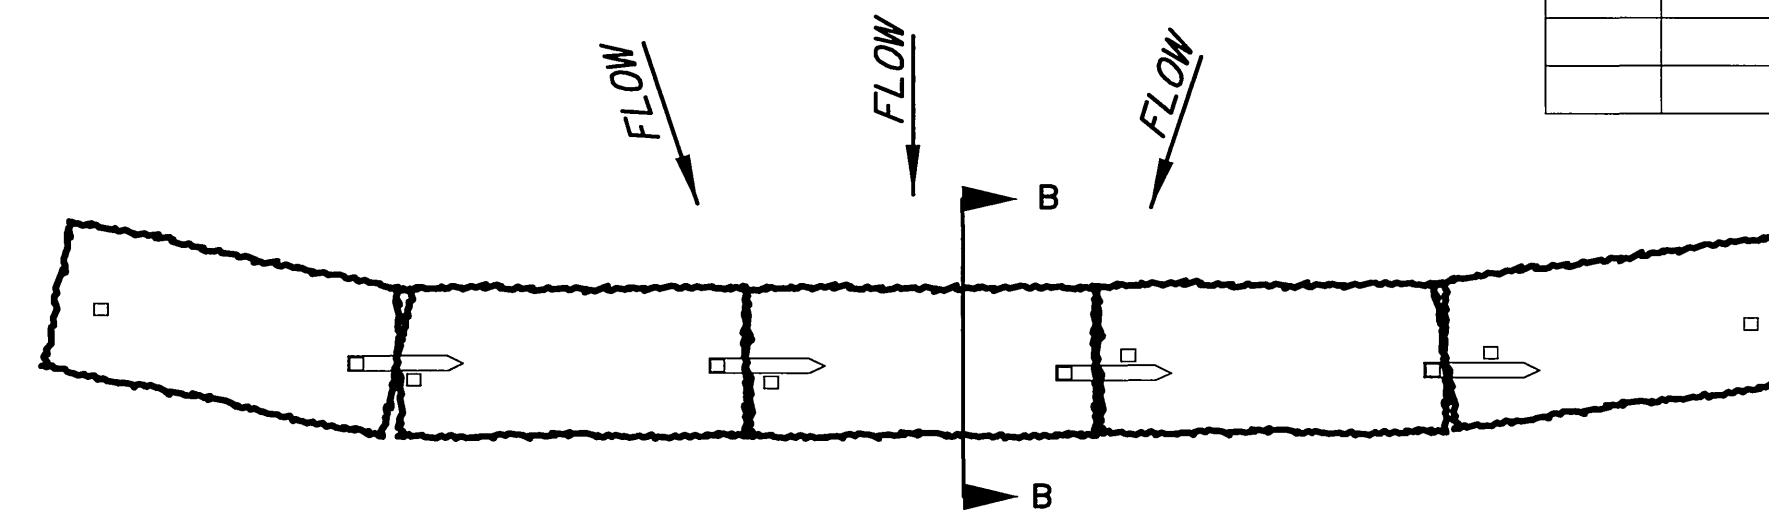

PLAN VIEW - TOE OF SLOPE


JOINT STAKES ARE DRIVEN DIAGONALLY TO PIN ADJACENT BALES AND PROVIDE TIGHT FIT.

ANGLE STAKE TOWARD PREVIOUS BALE TO PROVIDE TIGHT FIT

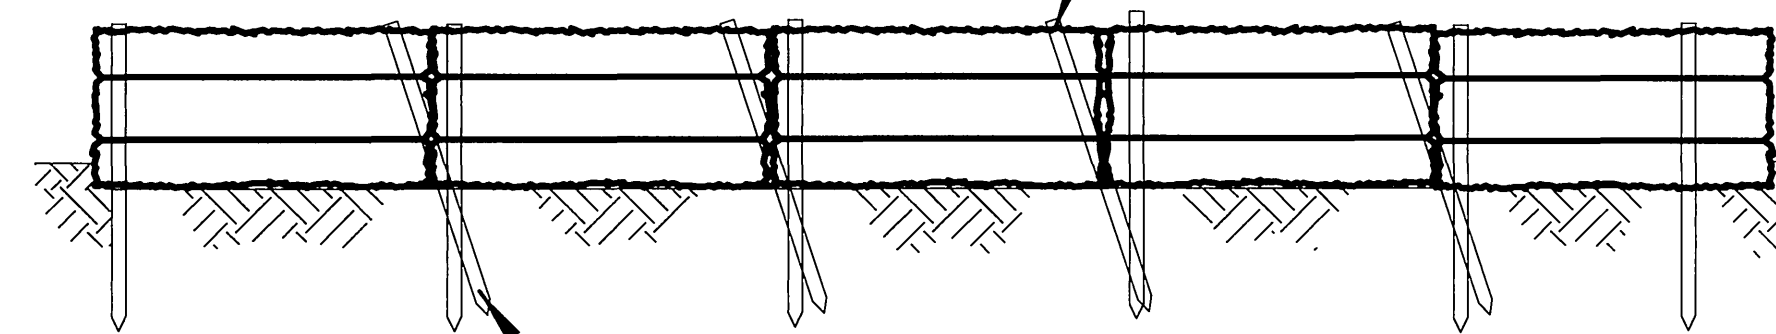


WOODEN STAKES OR NO. 5 REBAR DRIVEN THROUGH BALE


ELEVATION- TOE OF SLOPE
WITH JOINT STAKES DETAIL

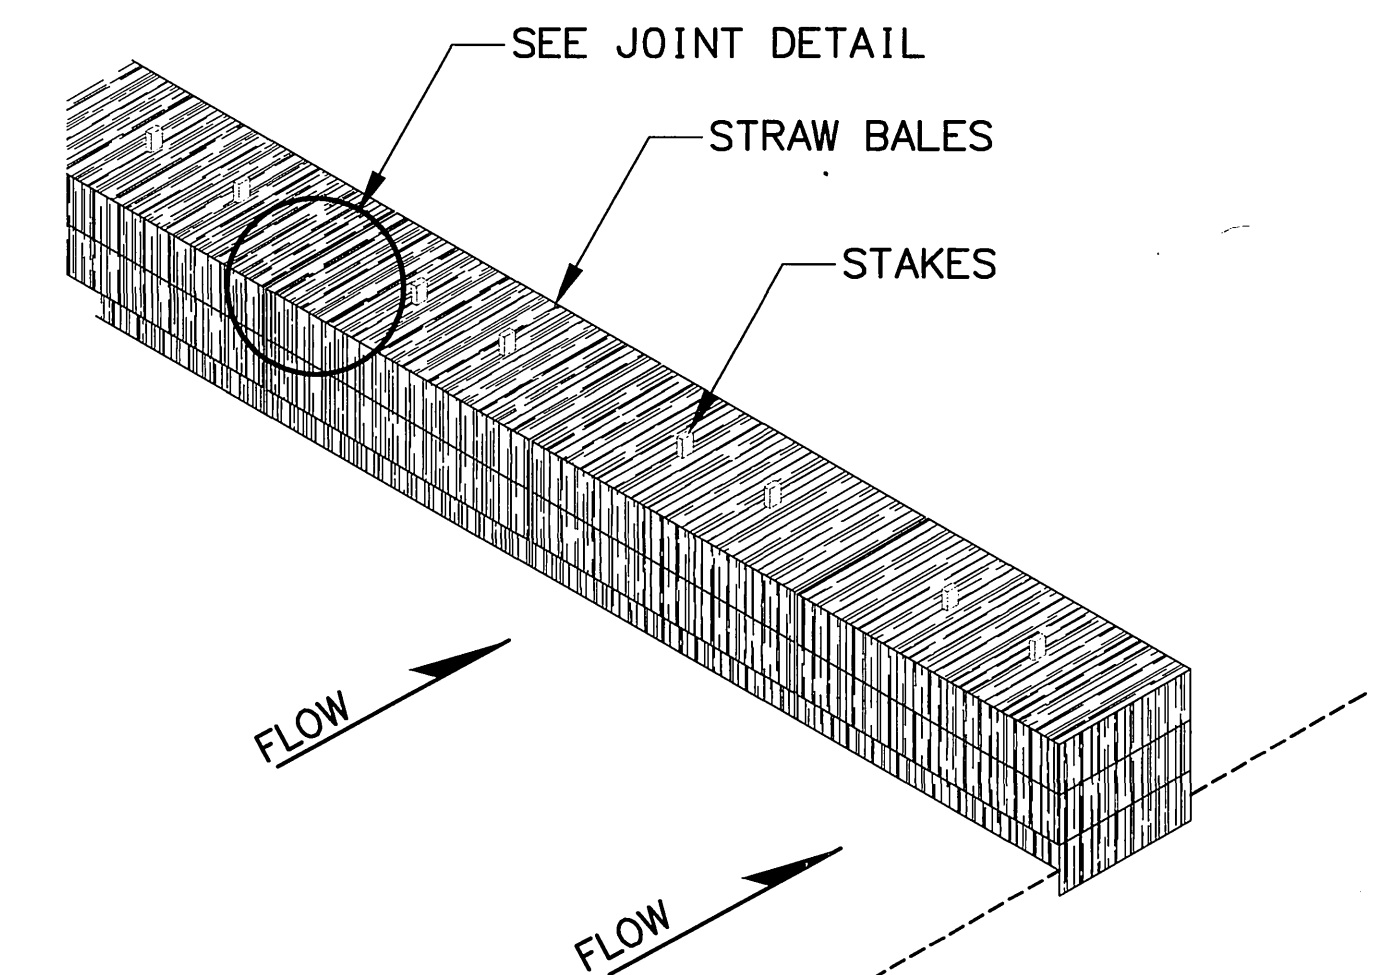

STRAW BALE PLACEMENT DETAIL

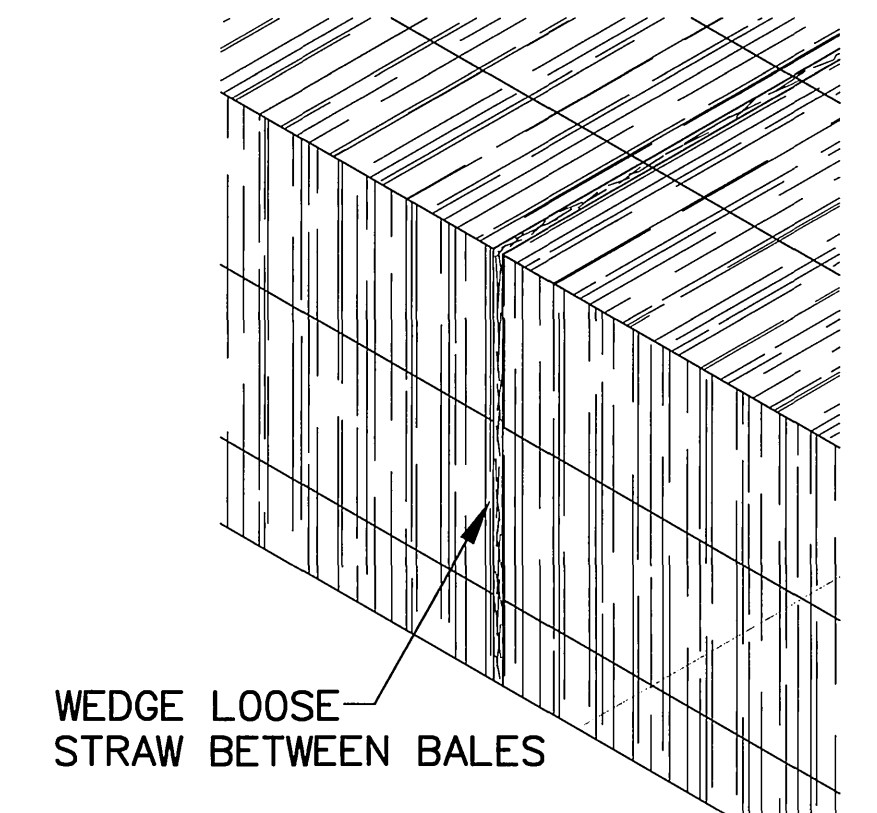


JOINT DETAIL

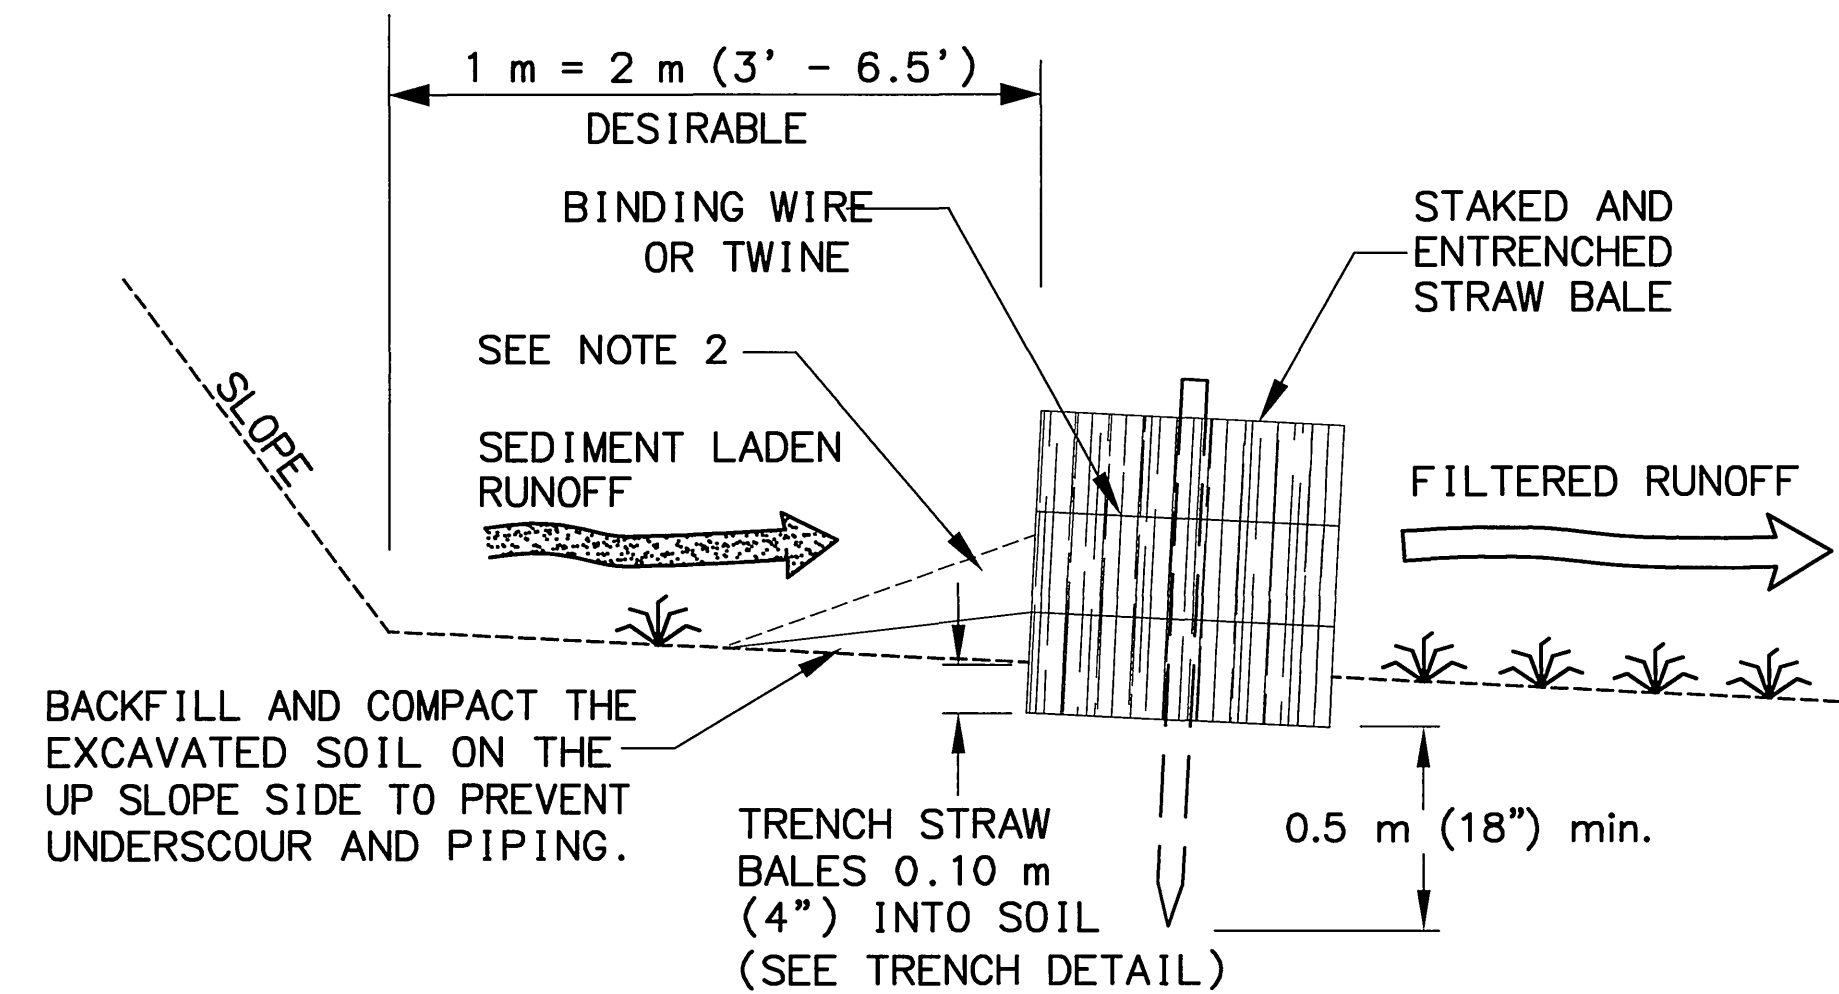

BACKFILL AND COMPACT THE EXCAVATED SOIL ON THE UP SLOPE SIDE TO PREVENT UNDERSCOUR AND PIPING.


SECTION B-B

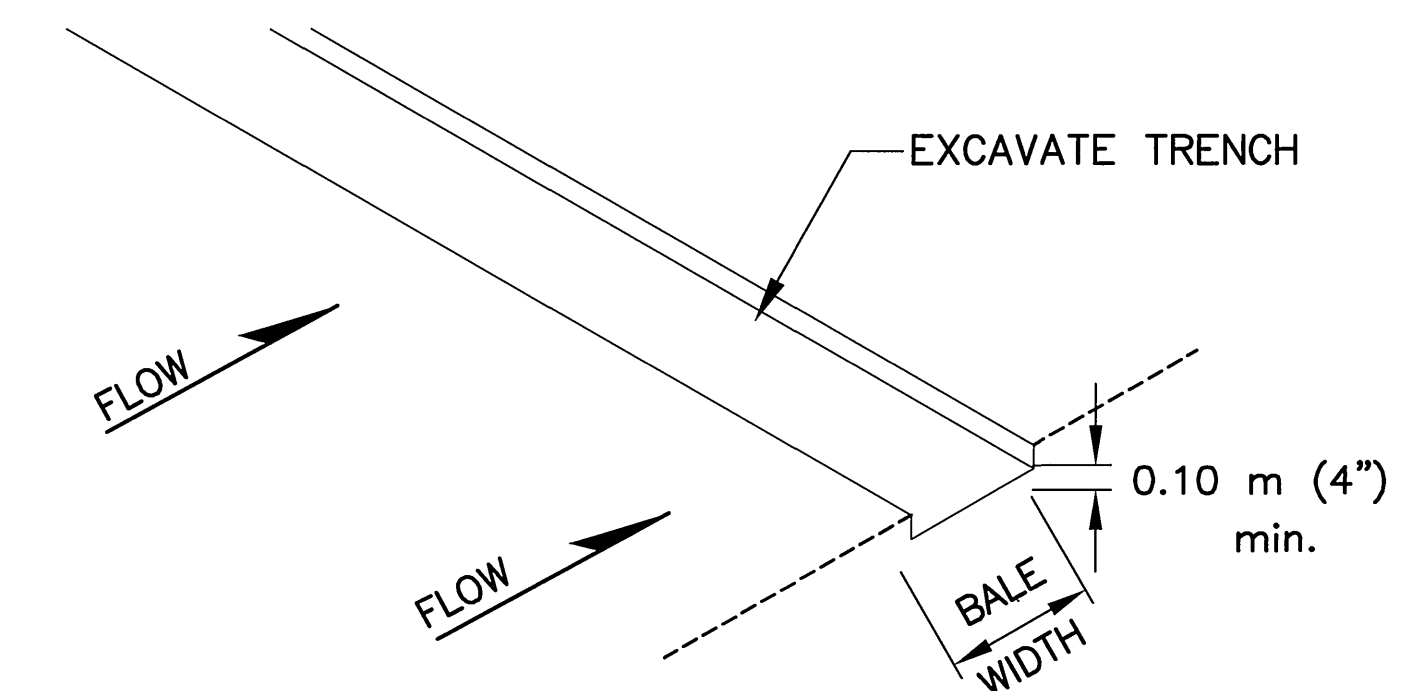

TRENCH DETAIL


NOTES:

1. STRAW BALES SHALL BE INSTALLED PRIOR TO ANY GROUND DISTURBING ACTIVITY. INSTALL BALES SUCH THAT TWINE/WIRE IS PARALLEL TO GROUND SURFACE (SEE TYPICAL SECTION B-B).
2. REMOVAL OF TRAPPED SEDIMENT TO AN AREA NOT SUBJECT TO EROSION IS REQUIRED WHEN THE SEDIMENT HAS REACHED A HEIGHT OF 0.15 m (6"). WHEN APPROVED BY THE ENGINEER, BALES MAY BE LEFT IN PLACE TO DECOMPOSE, OR MAY BE SPREAD WITH THE ACCUMULATED SEDIMENT AND SEEDED.

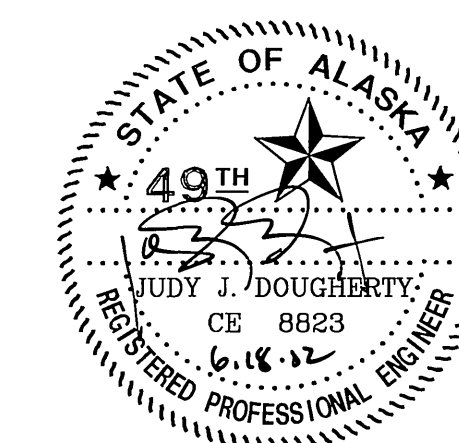


STATE OF ALASKA
DEPARTMENT OF TRANSPORTATION
AND
PUBLIC FACILITIES
SEWARD HIGHWAY
MP 96 TO MP 102
SAFETY, ROADWAY &
RECREATIONAL IMPROVEMENTS
EROSION & SEDIMENT CONTROL
TEMPORARY CHECK DAM
STRAW BALE BARRIER


REVISIONS			STATE	PROJECT DESIGNATION	YEAR	SHEET NO.	TOTAL SHEETS
No.	DATE	DESCRIPTION	ALASKA	NH-0A3-1(28)	2005	E31	E33

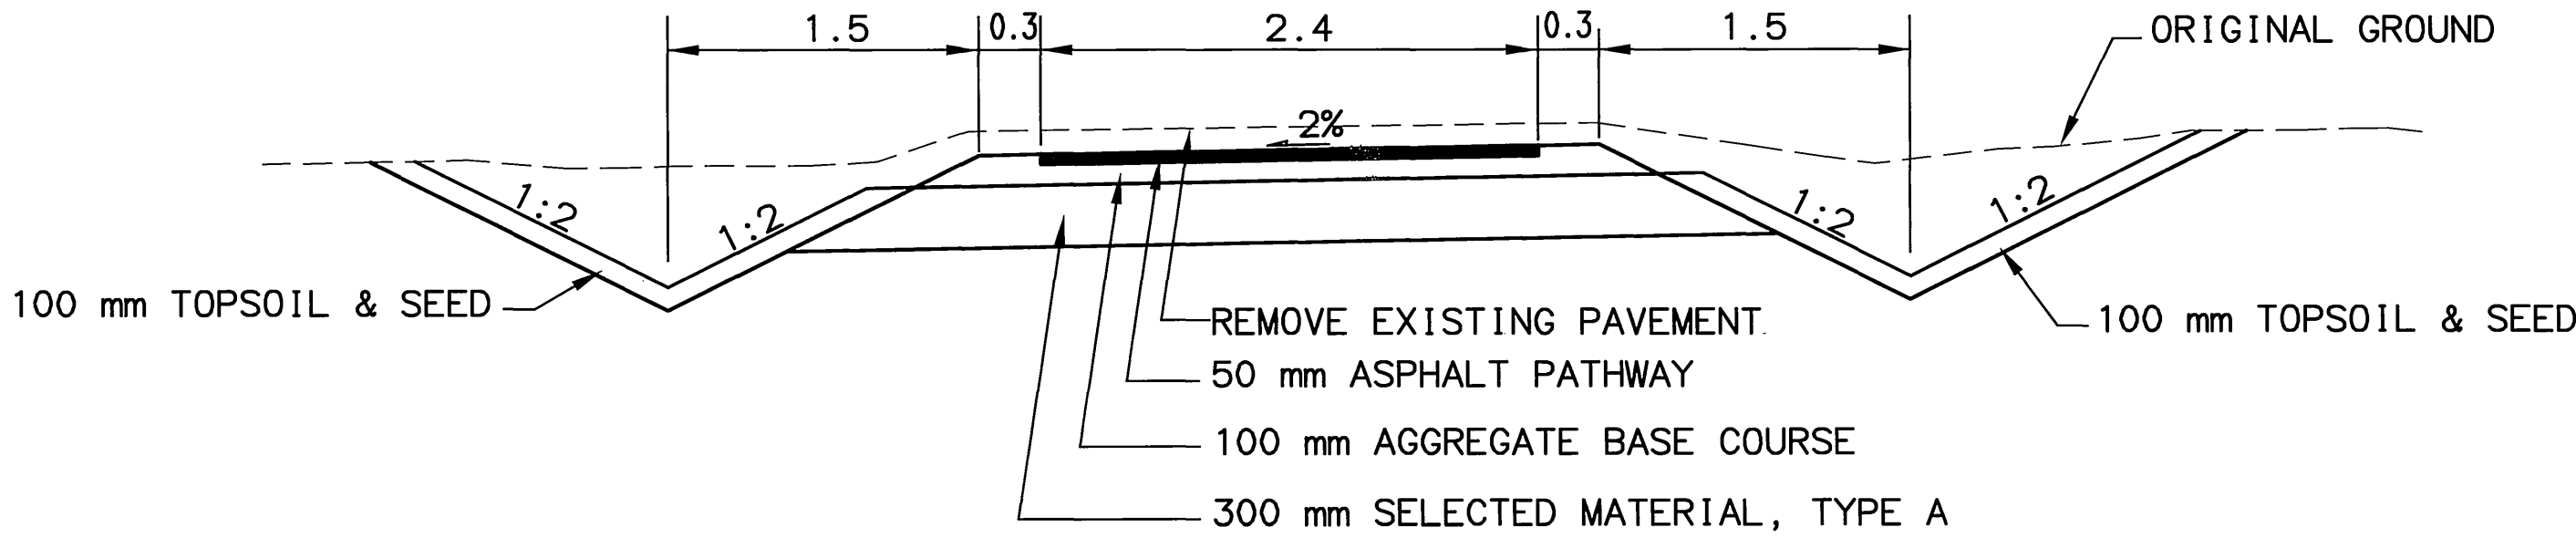

PATHWAY
SECTION A - A

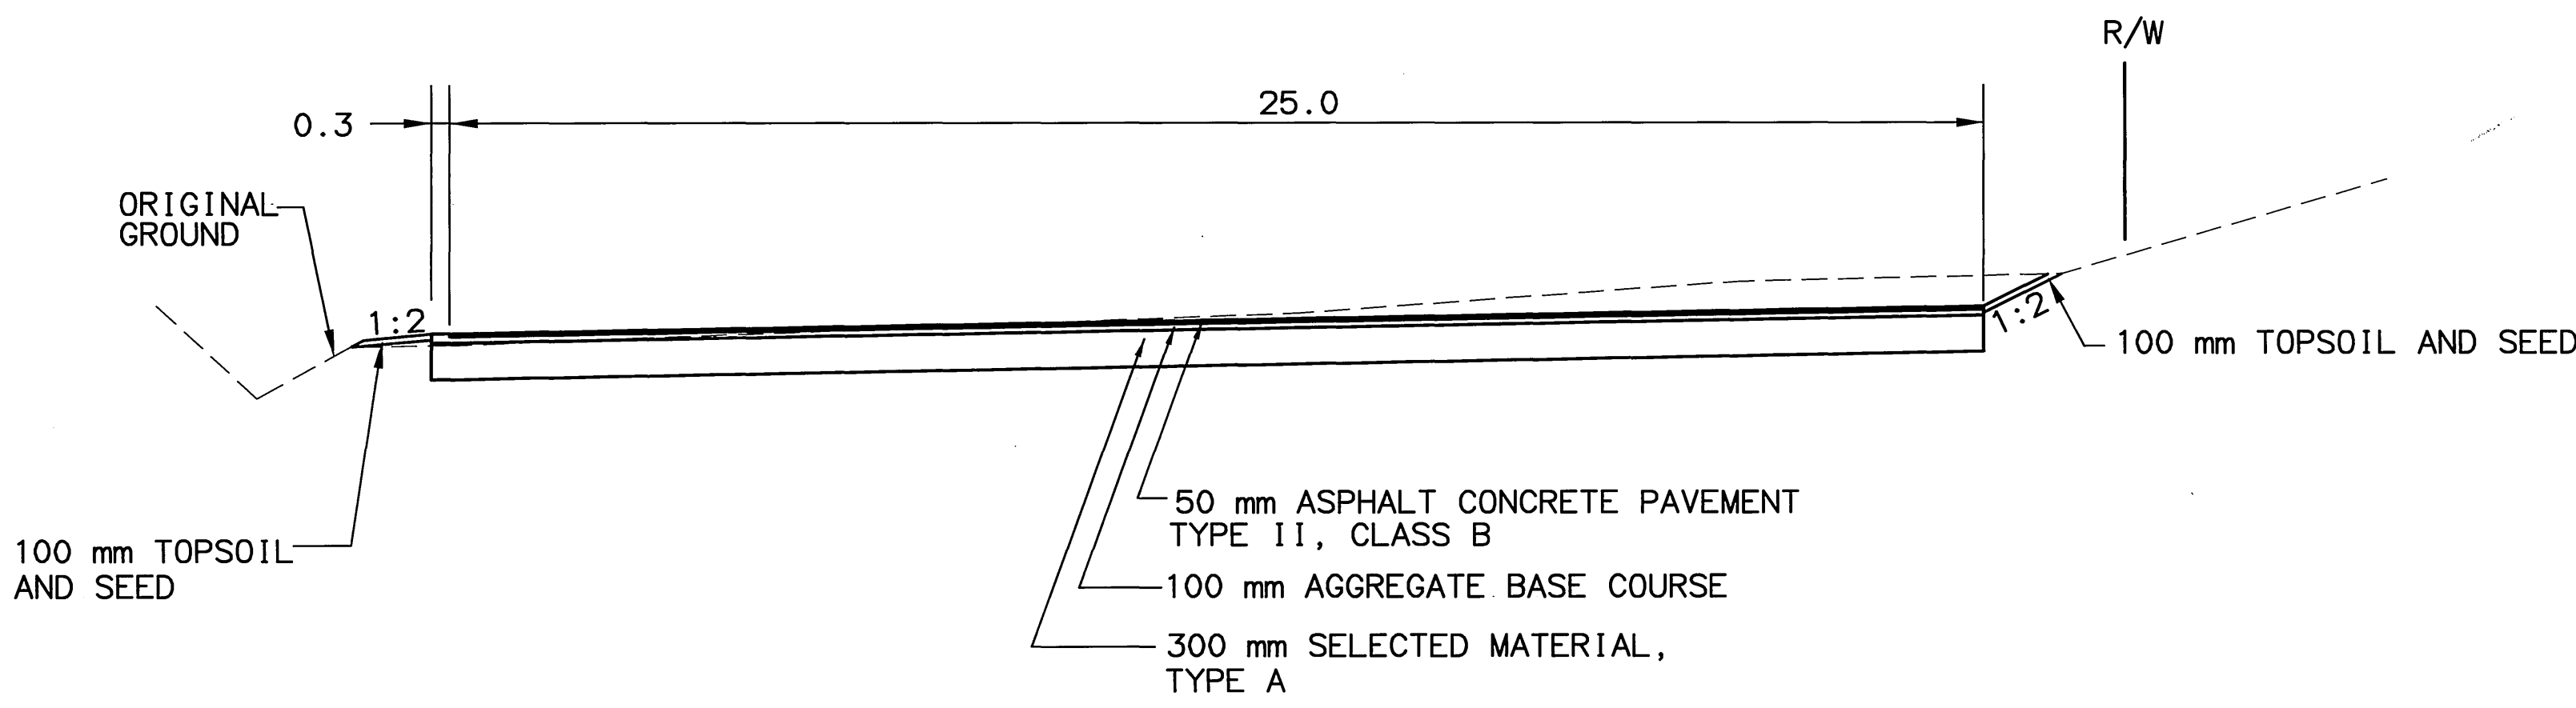

PARKING LOT
SECTION B - B

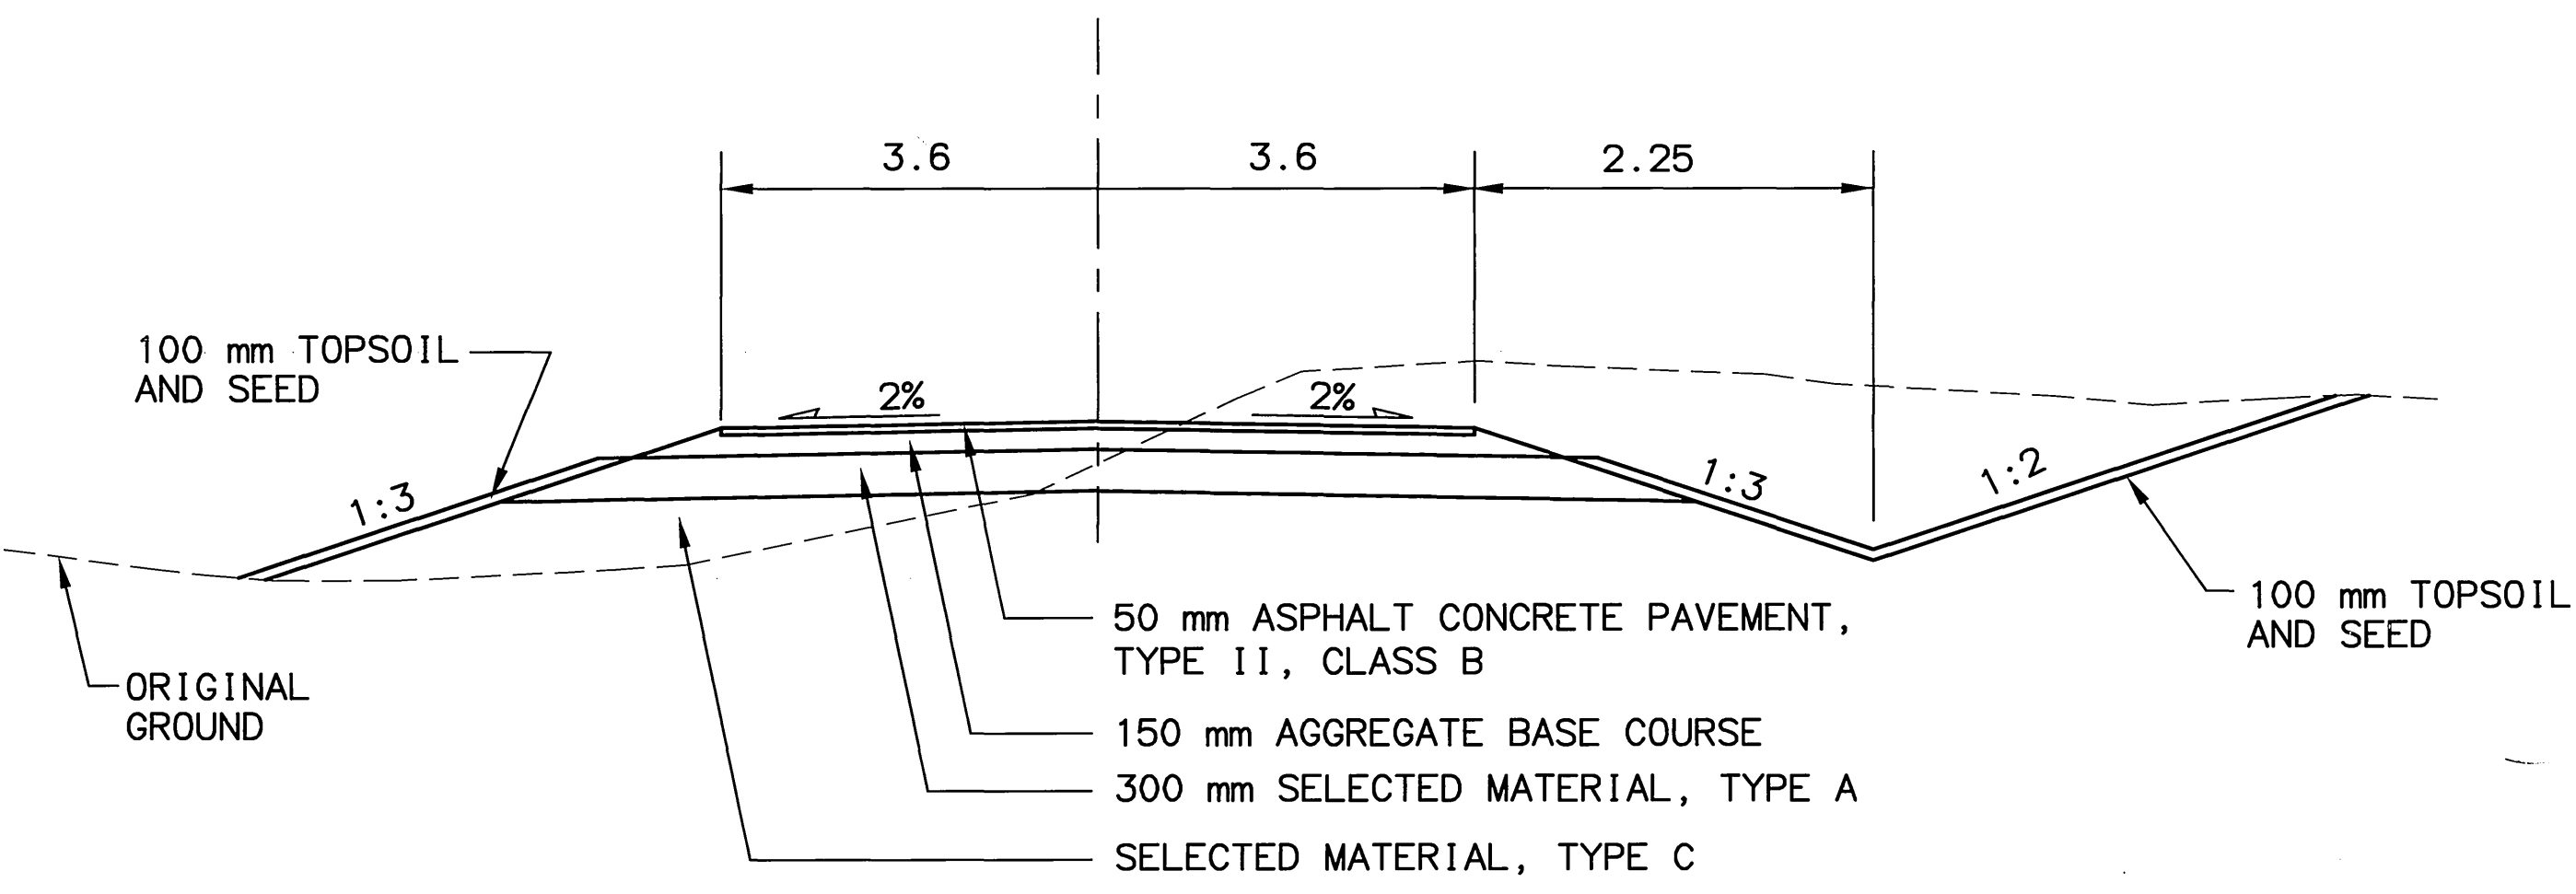

DRIVEWAY SECTION


SPECIFICATIONS	DESIGNED BY	CHECKED BY	DRAFTED BY
SCALE 1=1	VIEW# 1 of 1		
COMPUTER DESIGNATION	AUTOCAD-NANCY-SEWARD-HIGHWAY-PRKLOTYP.DWG	9-23-02	06/28/05



STATE OF ALASKA
DEPARTMENT OF TRANSPORTATION
AND
PUBLIC FACILITIES
SEWARD HIGHWAY
MP 96 TO MP 102
SAFETY, ROADWAY &
RECREATIONAL IMPROVEMENTS
LITTLE PENGUIN CREEK
PARKING LOT
SECTIONS

NOTES:
1. 4" TOPSOIL AND SEED ALL DISTURBED AREAS.

REVISIONS			STATE	PROJECT DESIGNATION	YEAR	SHEET NO.	TOTAL SHEETS
No.	DATE	DESCRIPTION	ALASKA	NH-0A3-1(28)	2005	E32	E33

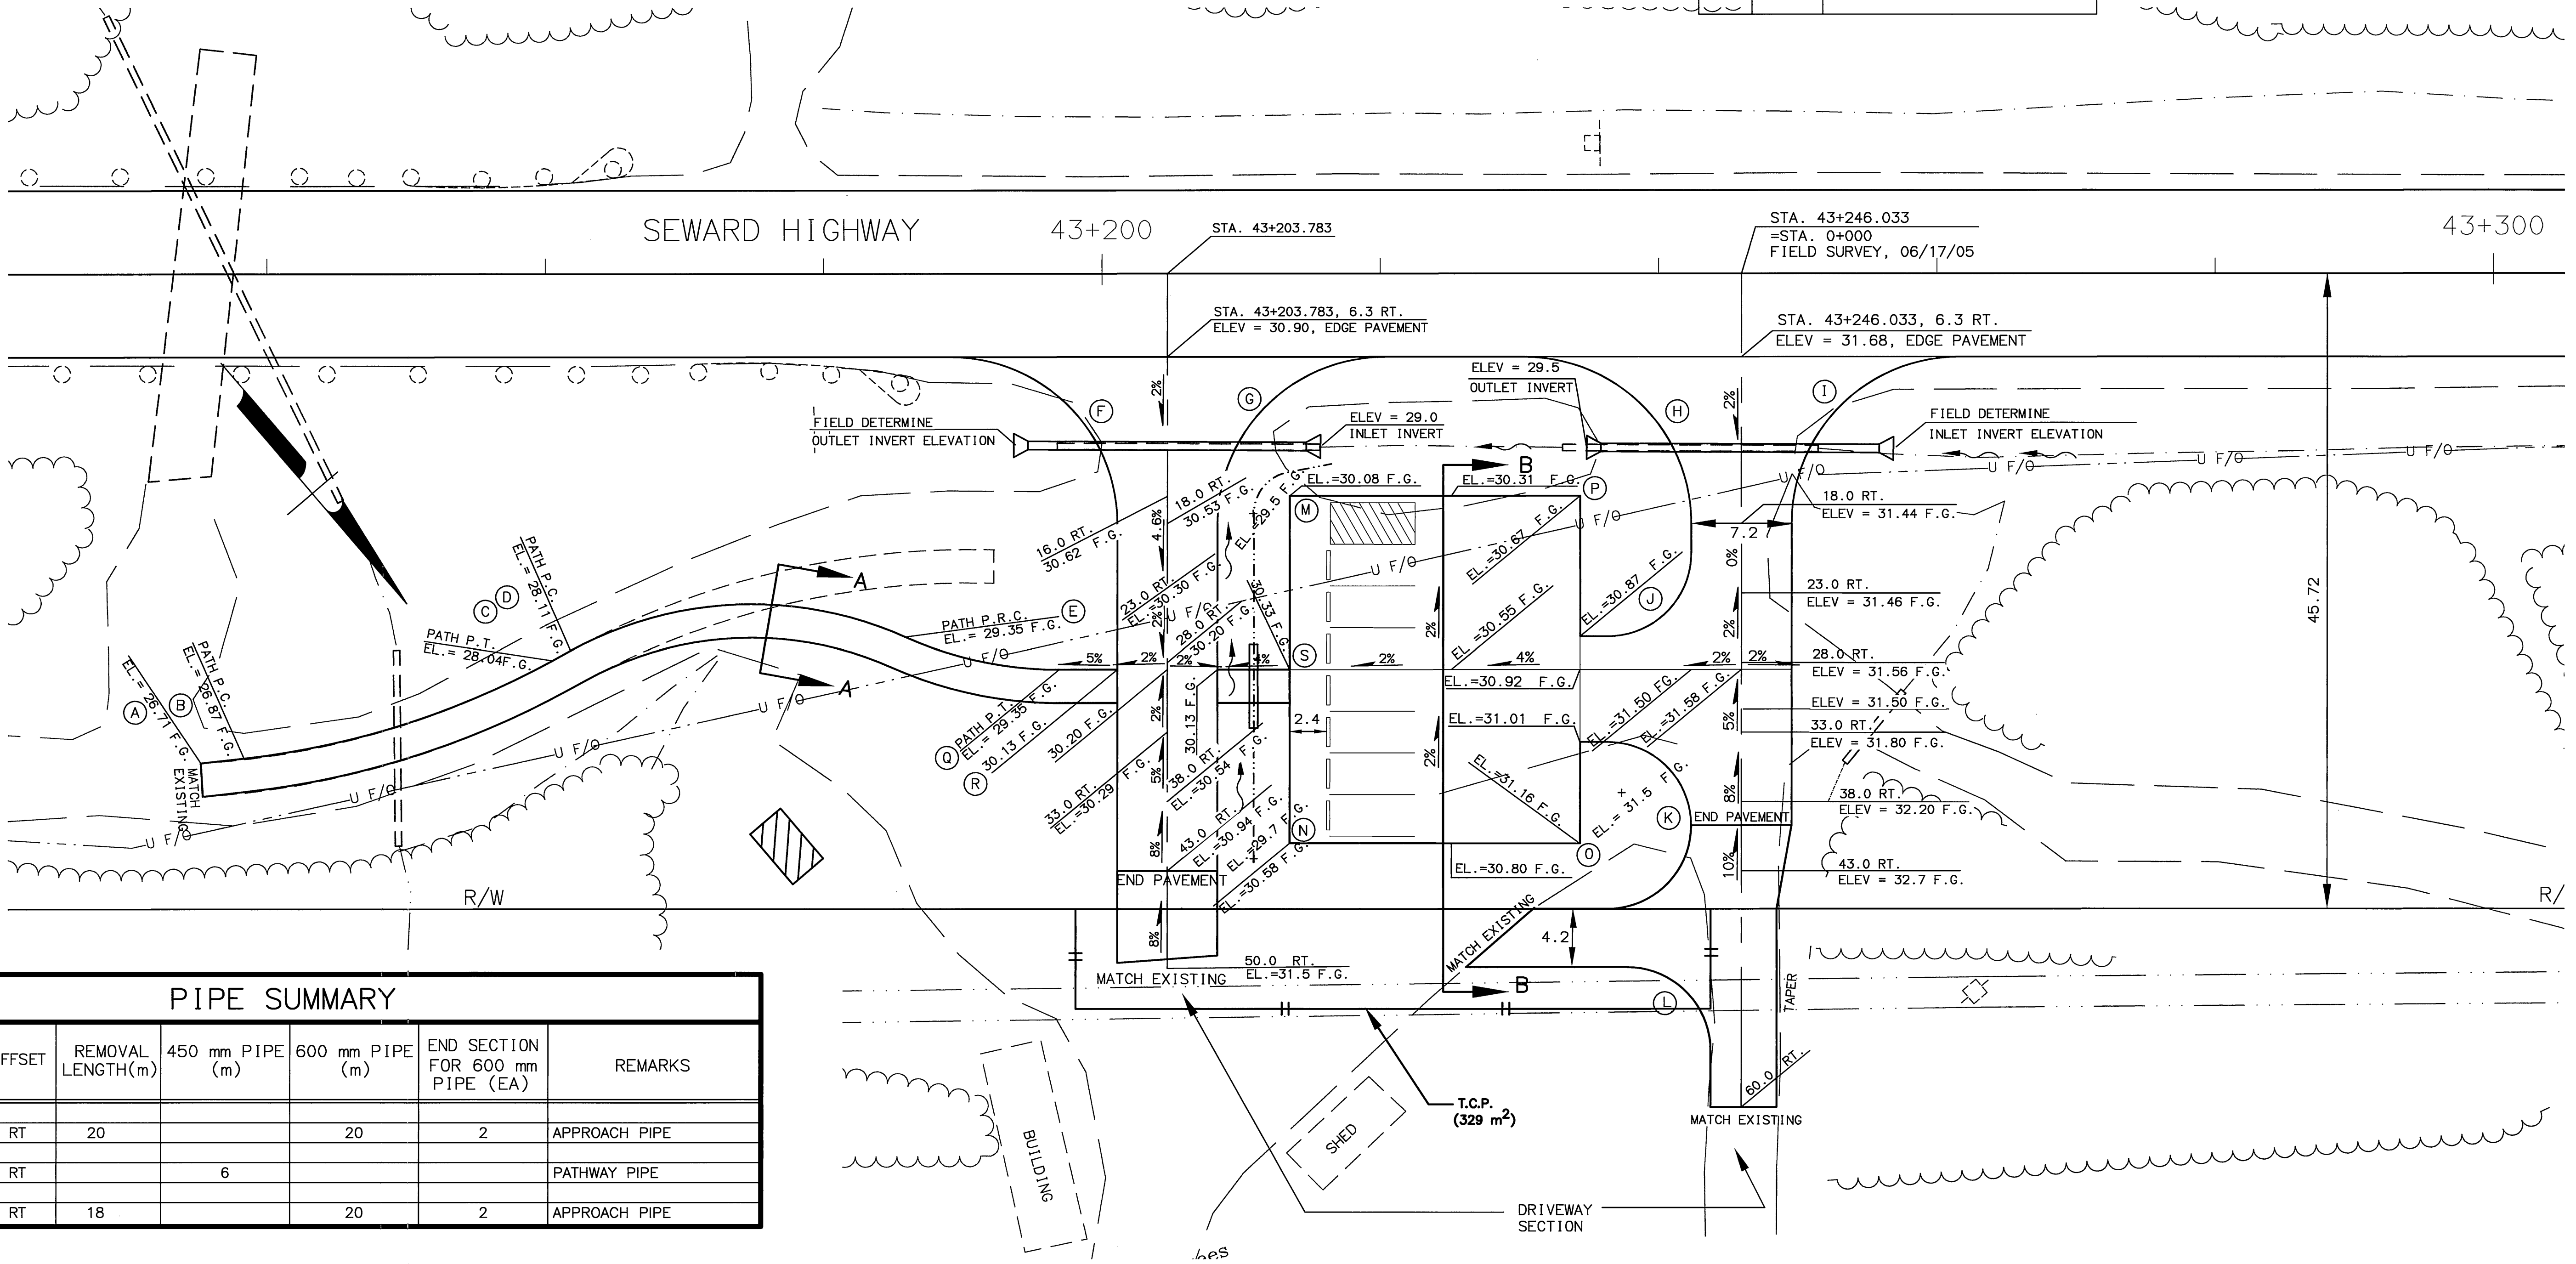

PIPE SUMMARY

STATION	OFFSET	REMOVAL LENGTH(m)	450 mm PIPE (m)	600 mm PIPE (m)	END SECTION FOR 600 mm PIPE (EA)	REMARKS
43+204.00	RT	20		20	2	APPROACH PIPE
43+211.00	RT		6			PATHWAY PIPE
43+246.00	RT	18		20	2	APPROACH PIPE

RADIUS POINT TABLE

POINT	STATION	OFFSET (RT)	RADIUS	REMARKS
(A)	43+135.35	35.21		PATHWAY @ MATCH EXISTING
(B)	43+138.45	34.86	60.0	PATHWAY CONSTRUCTION @ POINT OF CURVATURE
(C)	43+160.61	27.83		PATHWAY CONSTRUCTION @ POINT OF TANGENCY
(D)	43+161.91	27.11	27.00	PATHWAY CONSTRUCTION @ POINT OF CURVATURE
(E)	43+185.95	26.14		PATHWAY CONSTRUCTION @ POINT OF REVERSE CURVE
(F)	43+189.18	18.00	12.00	APPROACH RADIUS POINT
(G)	43+220.38	18.00	12.00	APPROACH RADIUS POINT
(H)	43+230.43	18.00	12.00	APPROACH RADIUS POINT
(I)	43+261.63	18.00	12.00	APPROACH RADIUS POINT
(J)	43+236.43	20.12	6.00	PARKING LOT ENTRANCE RADIUS POINT
(K)	43+236.43	39.72	6.00	PARKING LOT ENTRANCE & DRIVEWAY RADIUS POINT

RADIUS POINT TABLE


POINT	STATION	OFFSET (RT)	RADIUS	REMARKS
(L)	43+237.82	55.92	6.00	DRIVEWAY RADIUS POINT
(M)	43+213.58	16.00		CORNER OF PARKING LOT
(N)	43+213.58	41.00		CORNER OF PARKING LOT
(O)	43+234.43	41.00		CORNER OF PARKING LOT
(P)	43+234.43	16.00		CORNER OF PARKING LOT
(Q)	43+197.00	28.50		PATHWAY CONSTRUCTION @ : POINT OF TANGENCY
(R)	43+210.18	28.50		PATHWAY CONSTRUCTION @ : EDGE DRIVEWAY
(S)	43+213.58	28.50		PATHWAY CONSTRUCTION @ : EDGE OF PARKING LOT



STATE OF ALASKA
DEPARTMENT OF TRANSPORTATION
AND
PUBLIC FACILITIES
**SEWARD HIGHWAY
MP 96 TO MP 102
SAFETY, ROADWAY &
RECREATIONAL IMPROVEMENTS**

LITTLE PENGUIN CREEK
PARKING LOT LAYOUT

REVISIONS			STATE	PROJECT DESIGNATION	YEAR	SHEET NO.	TOTAL SHEETS
No.	DATE	DESCRIPTION	ALASKA	NH-0A3-1(28)	2002	E33	E33

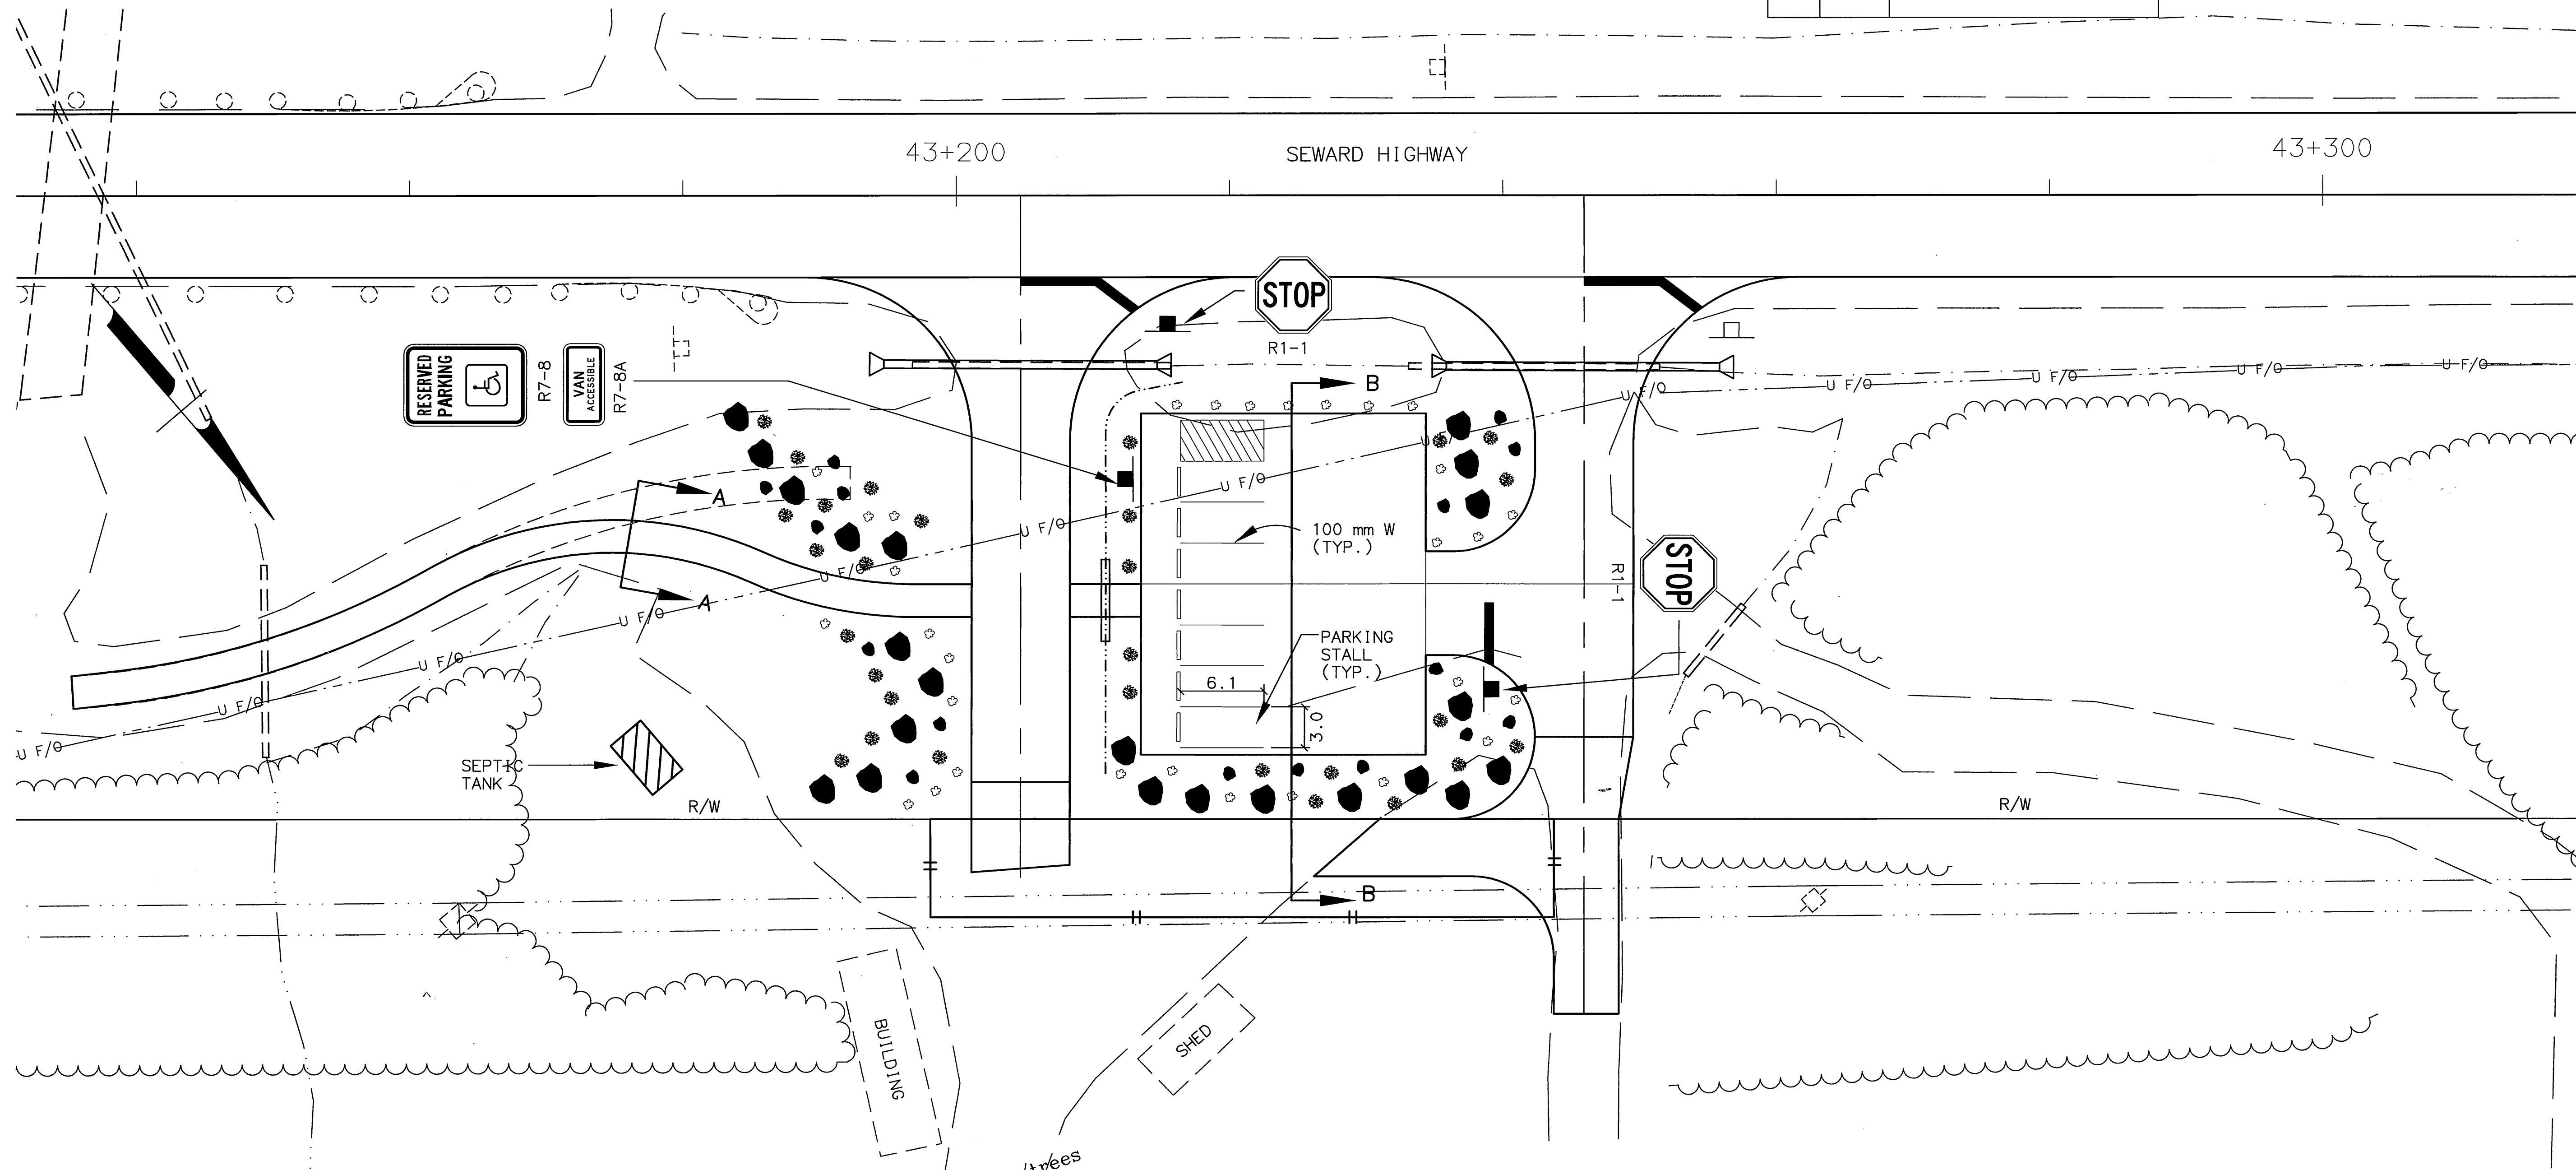


PARKING LOT SIGN SUMMARY

STATION	REF. ϕ	TYPE	LEGEND	SIZE (m)		AREA (m ²)	SIGN FACES	POST SIZE	THICKNESS (mm)	
				W	H				FRAMED	UNFRAMED
43+213	RT	R7-8		0.3	0.45	0.14	NW	1-65 mm P.T.		3.2
		R7-8A		0.3	0.15	0.05	NW			3.2
43+217	RT	R1-1		0.75	0.75	0.56	NE	1-65 mm P.T.		3.2
43+239	RT	R1-1		0.75	0.75	0.56	SE	1-65 mm P.T.		3.2



LEGEND

- WHITE SPRUCE 1.2 m
- PRICKLY ROSE 0.6 m
- BARRIER ROCK

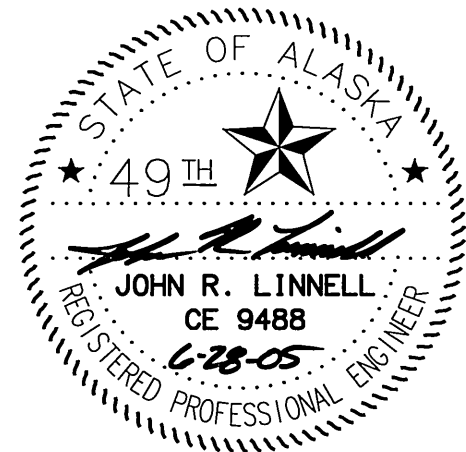


STATE OF ALASKA
DEPARTMENT OF TRANSPORTATION
AND
PUBLIC FACILITIES
SEWARD HIGHWAY
MP 96 TO MP 102
SAFETY, ROADWAY &
RECREATIONAL IMPROVEMENTS
LITTLE PENGUIN CREEK
PARKING LOT LANDSCAPING AND
SIGNING AND STRIPING

DESIGNED BY	VIEW= HALFO2	DESIGNED BY	8/8/01
DRAWN BY		DRAWN BY	KMH
CHECKED BY		CHECKED BY	
APPROVED BY		APPROVED BY	
PROJECT LOCATION	AUTOCAD-CAROLEE-SS04PROJ\3571\7PP		
SCALE 1"=1'			
COMPUTER DESIGNATION			

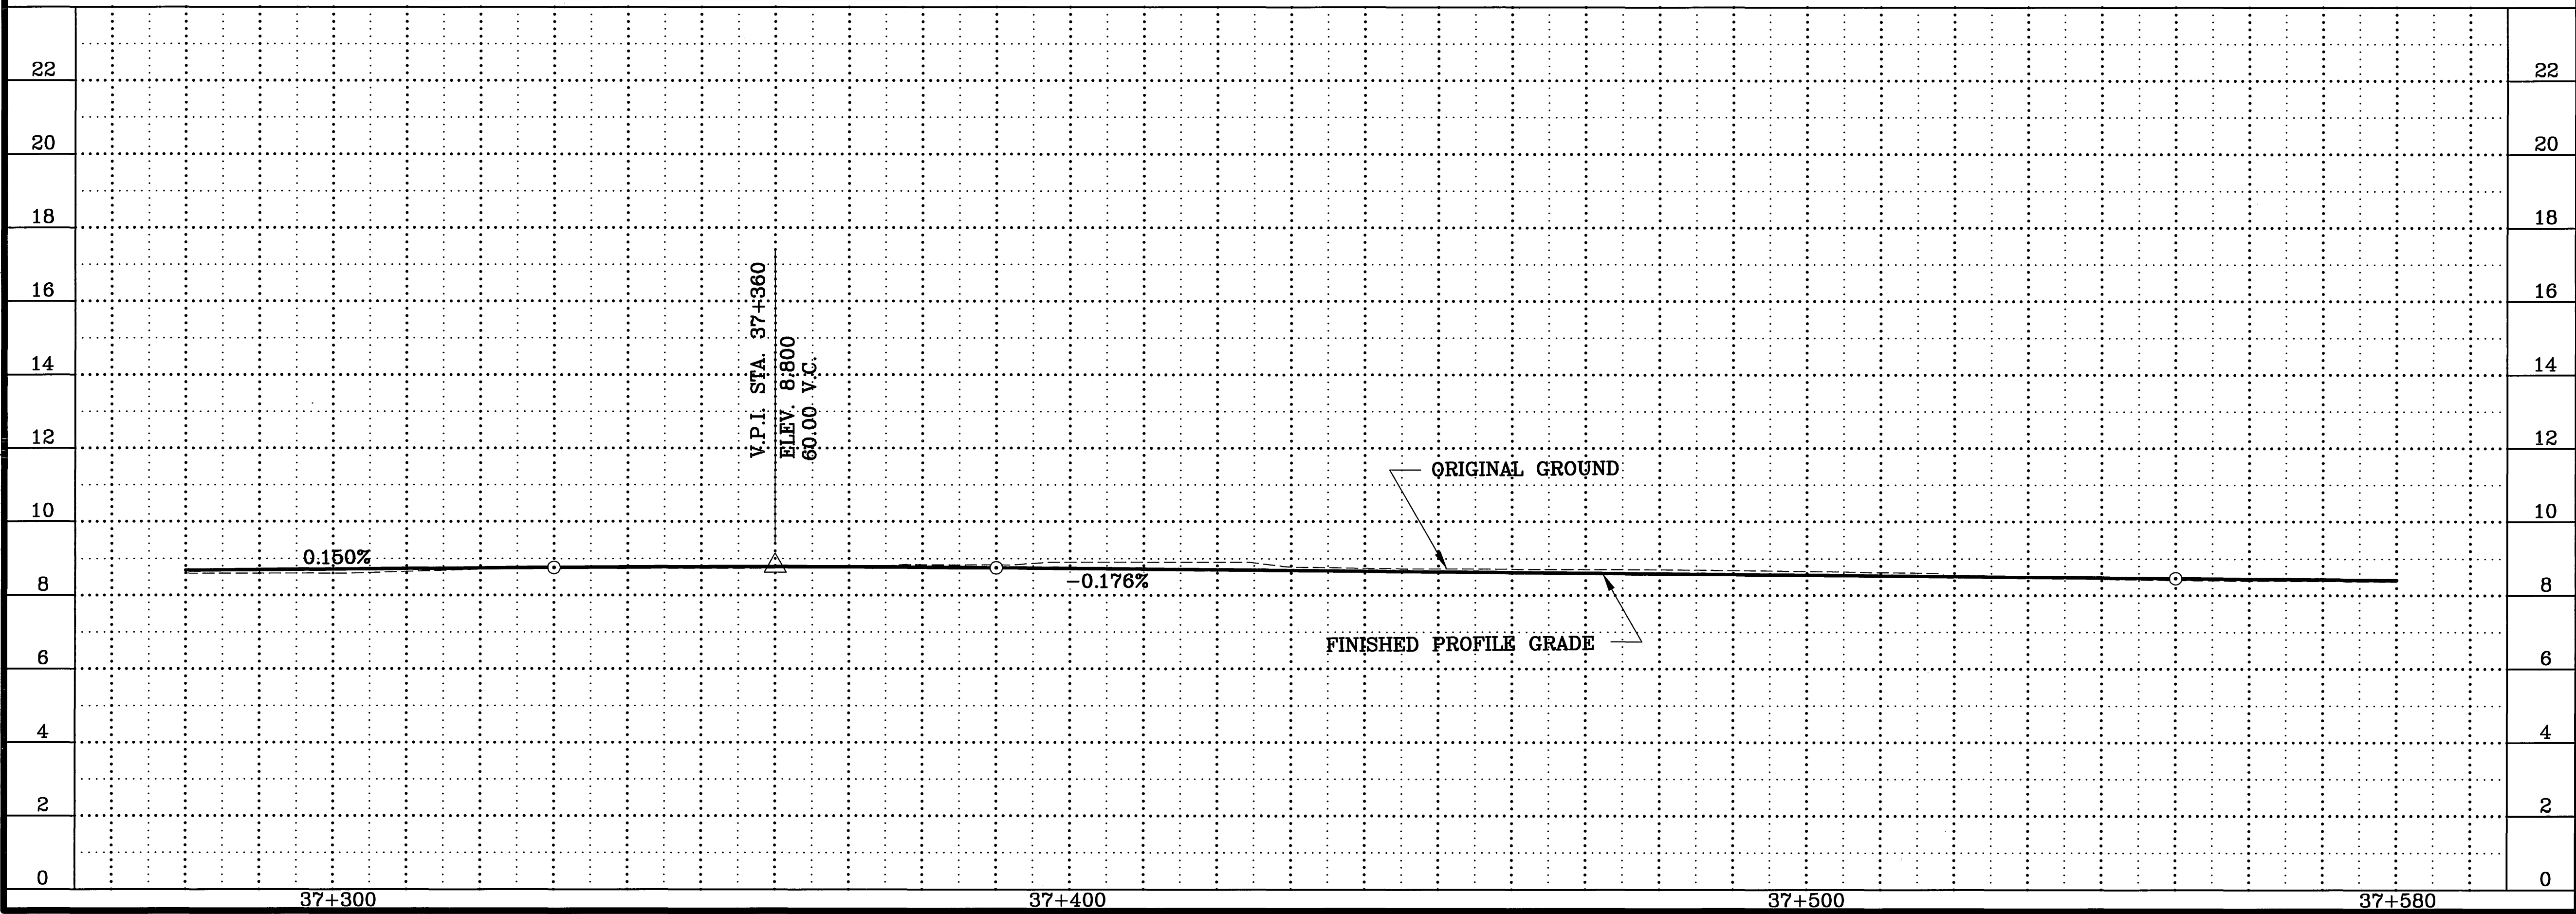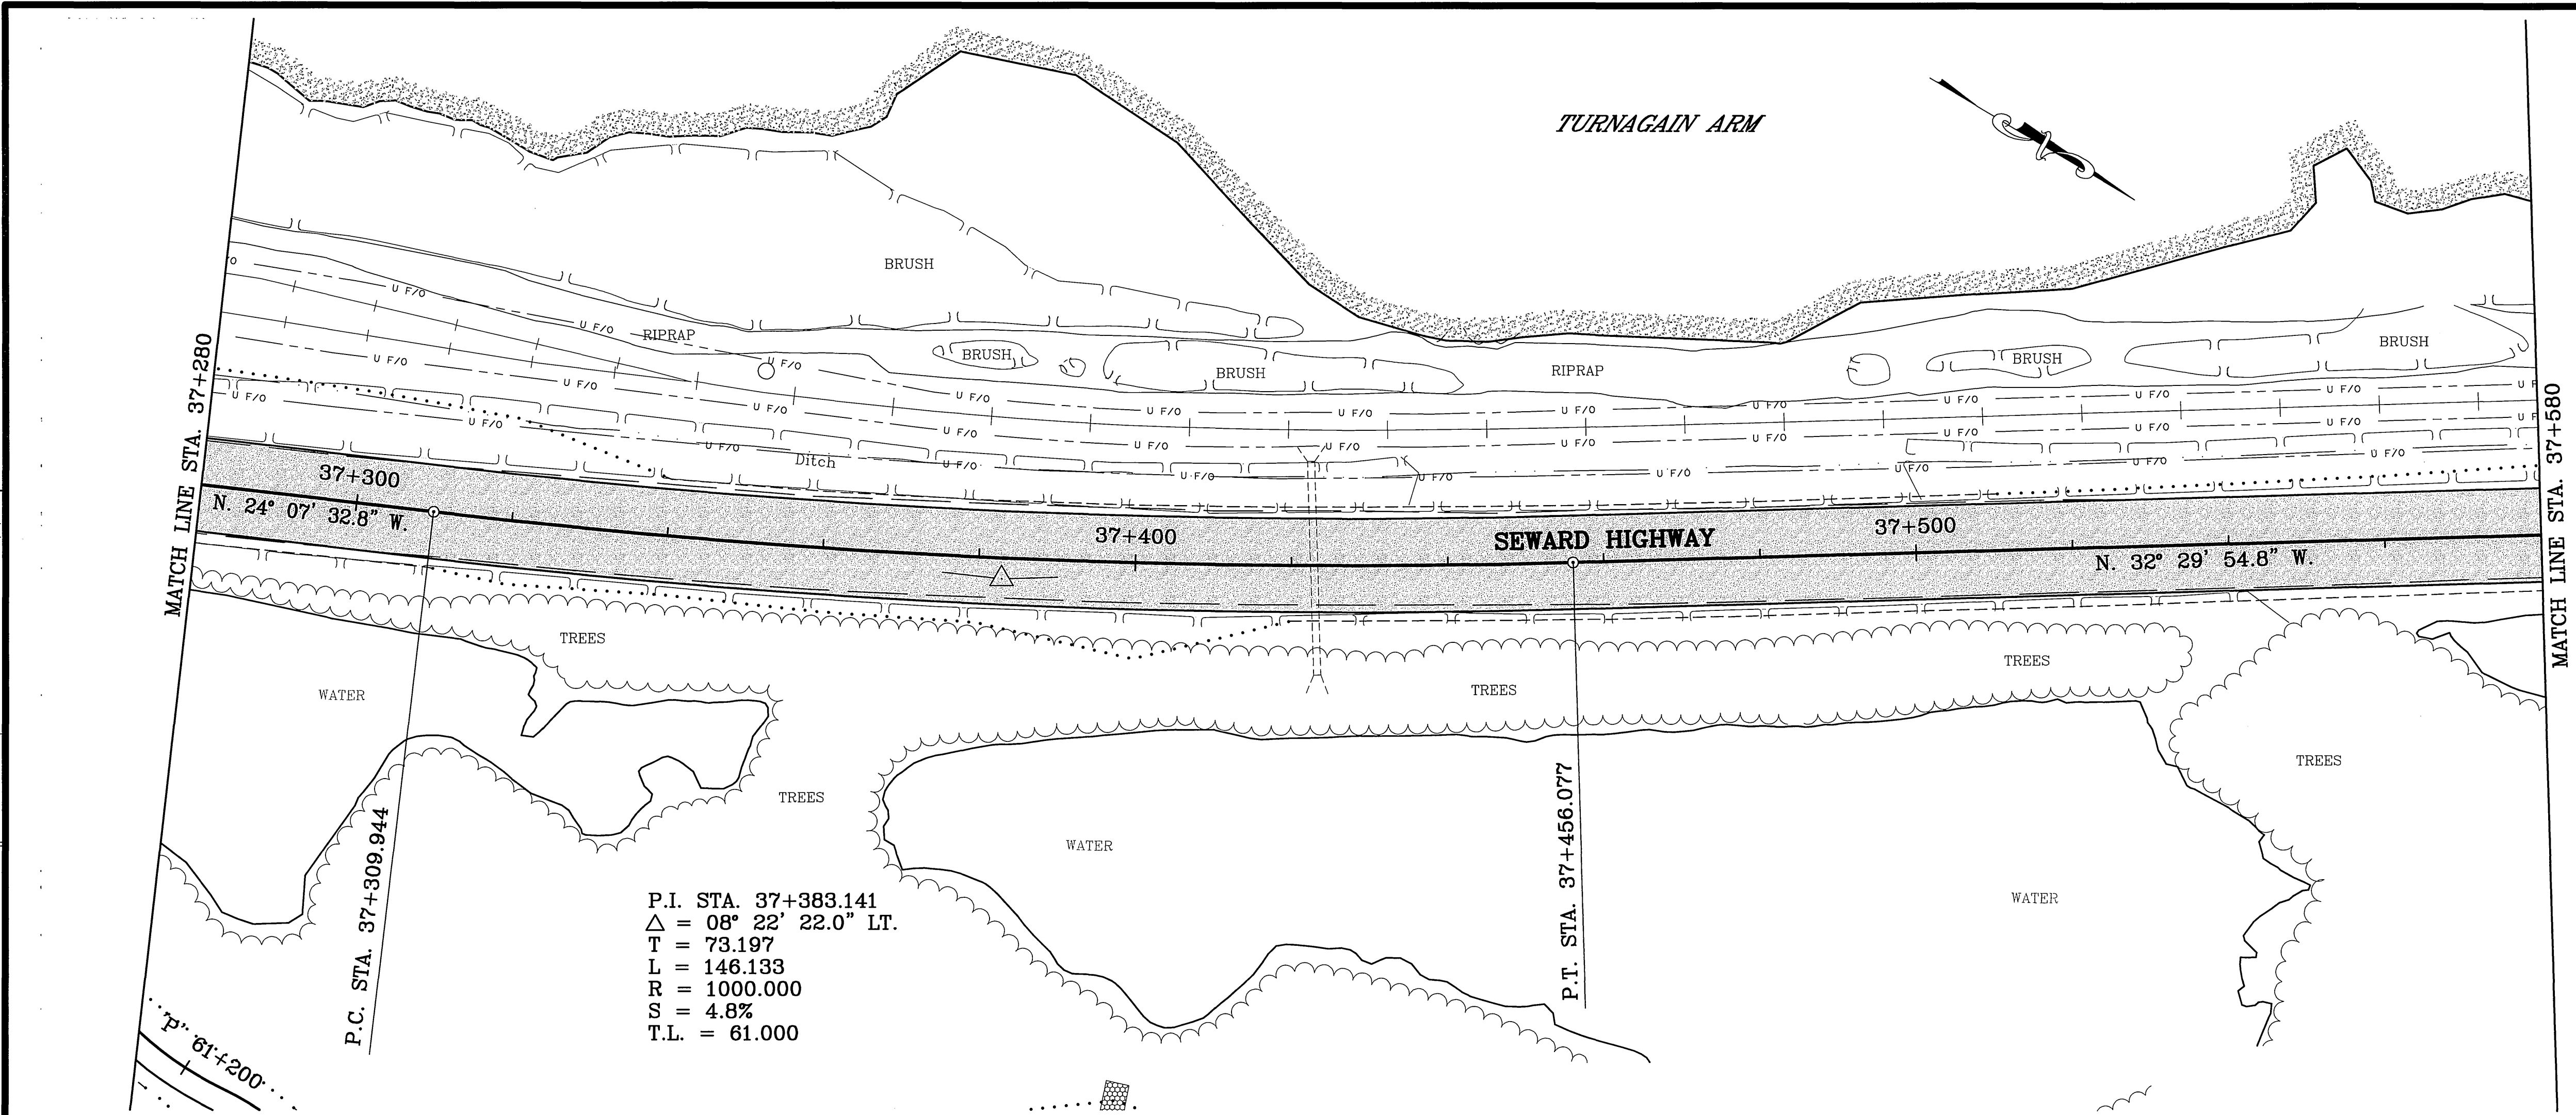


SHEET NO.	TOTAL SHEETS	
F2	F13	
STATE	YEAR	
ALASKA	2002	
PROJECT DESIGNATION		
NH-0A3-1(28)		
ADDENDUM NO.		
ATTACHMENT NO.		
REVISIONS		
NO.	DATE	DESCRIPTION


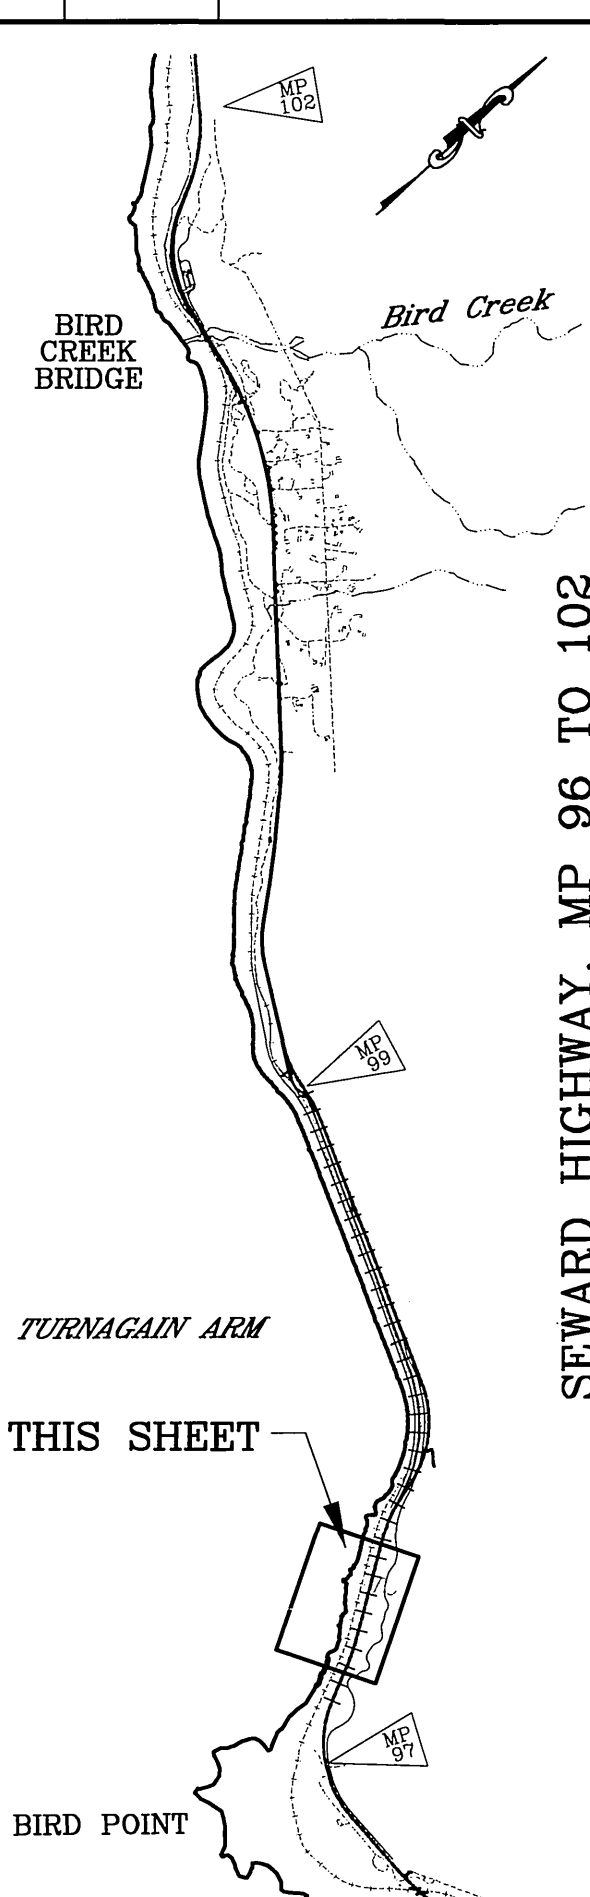


SEWARD HIGHWAY, MP 96 TO 102

NOTE:
DIMENSIONS ARE IN METERS
UNLESS OTHERWISE NOTED.

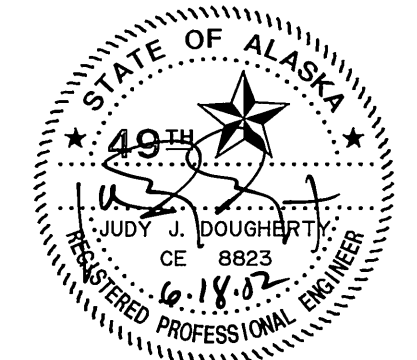


STATE OF ALASKA
DEPARTMENT OF TRANSPORTATION
AND PUBLIC FACILITIES
SEWARD HIGHWAY
MP 96 TO MP 102
SAFETY, ROADWAY AND
RECREATIONAL IMPROVEMENTS
BIRD FLATS AREA
HIGHWAY
PLAN AND PROFILE

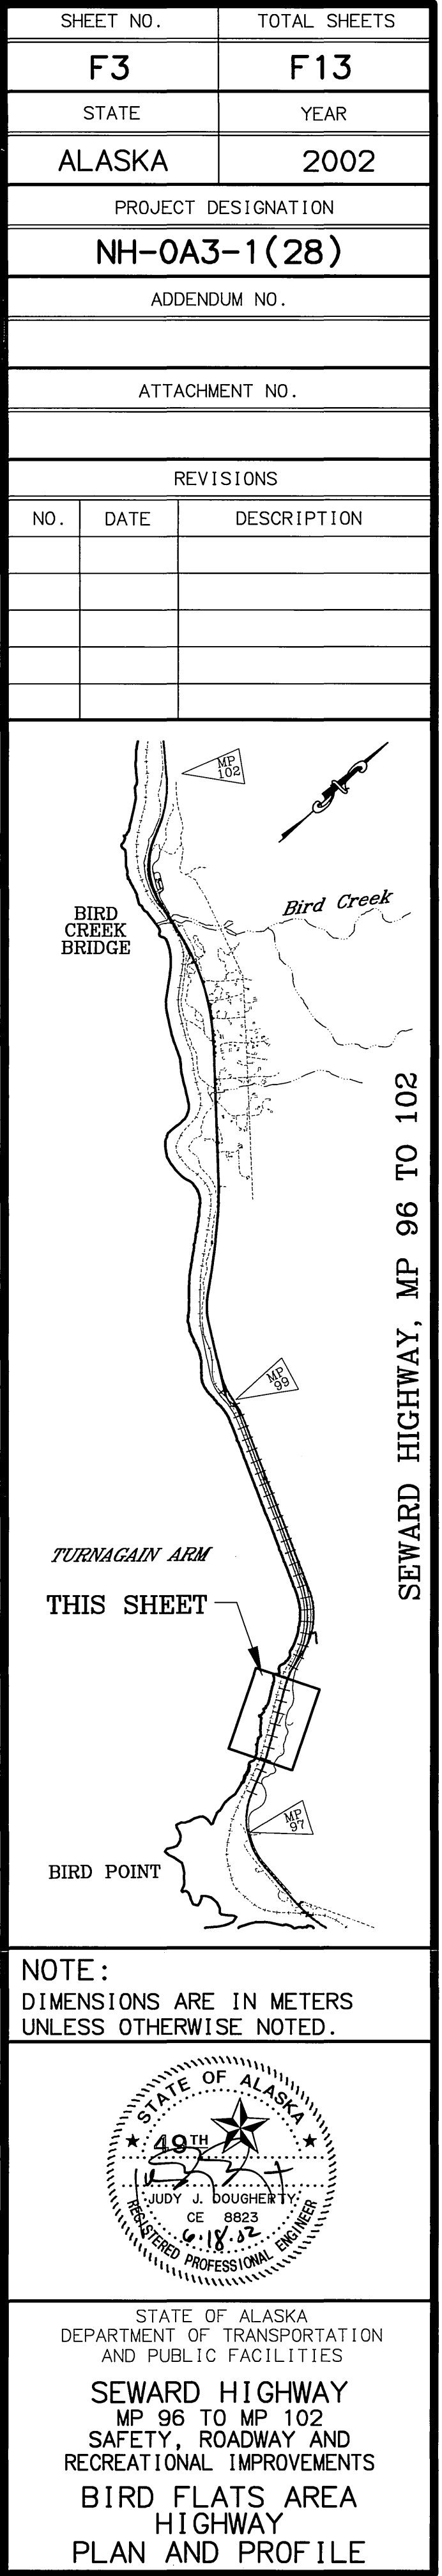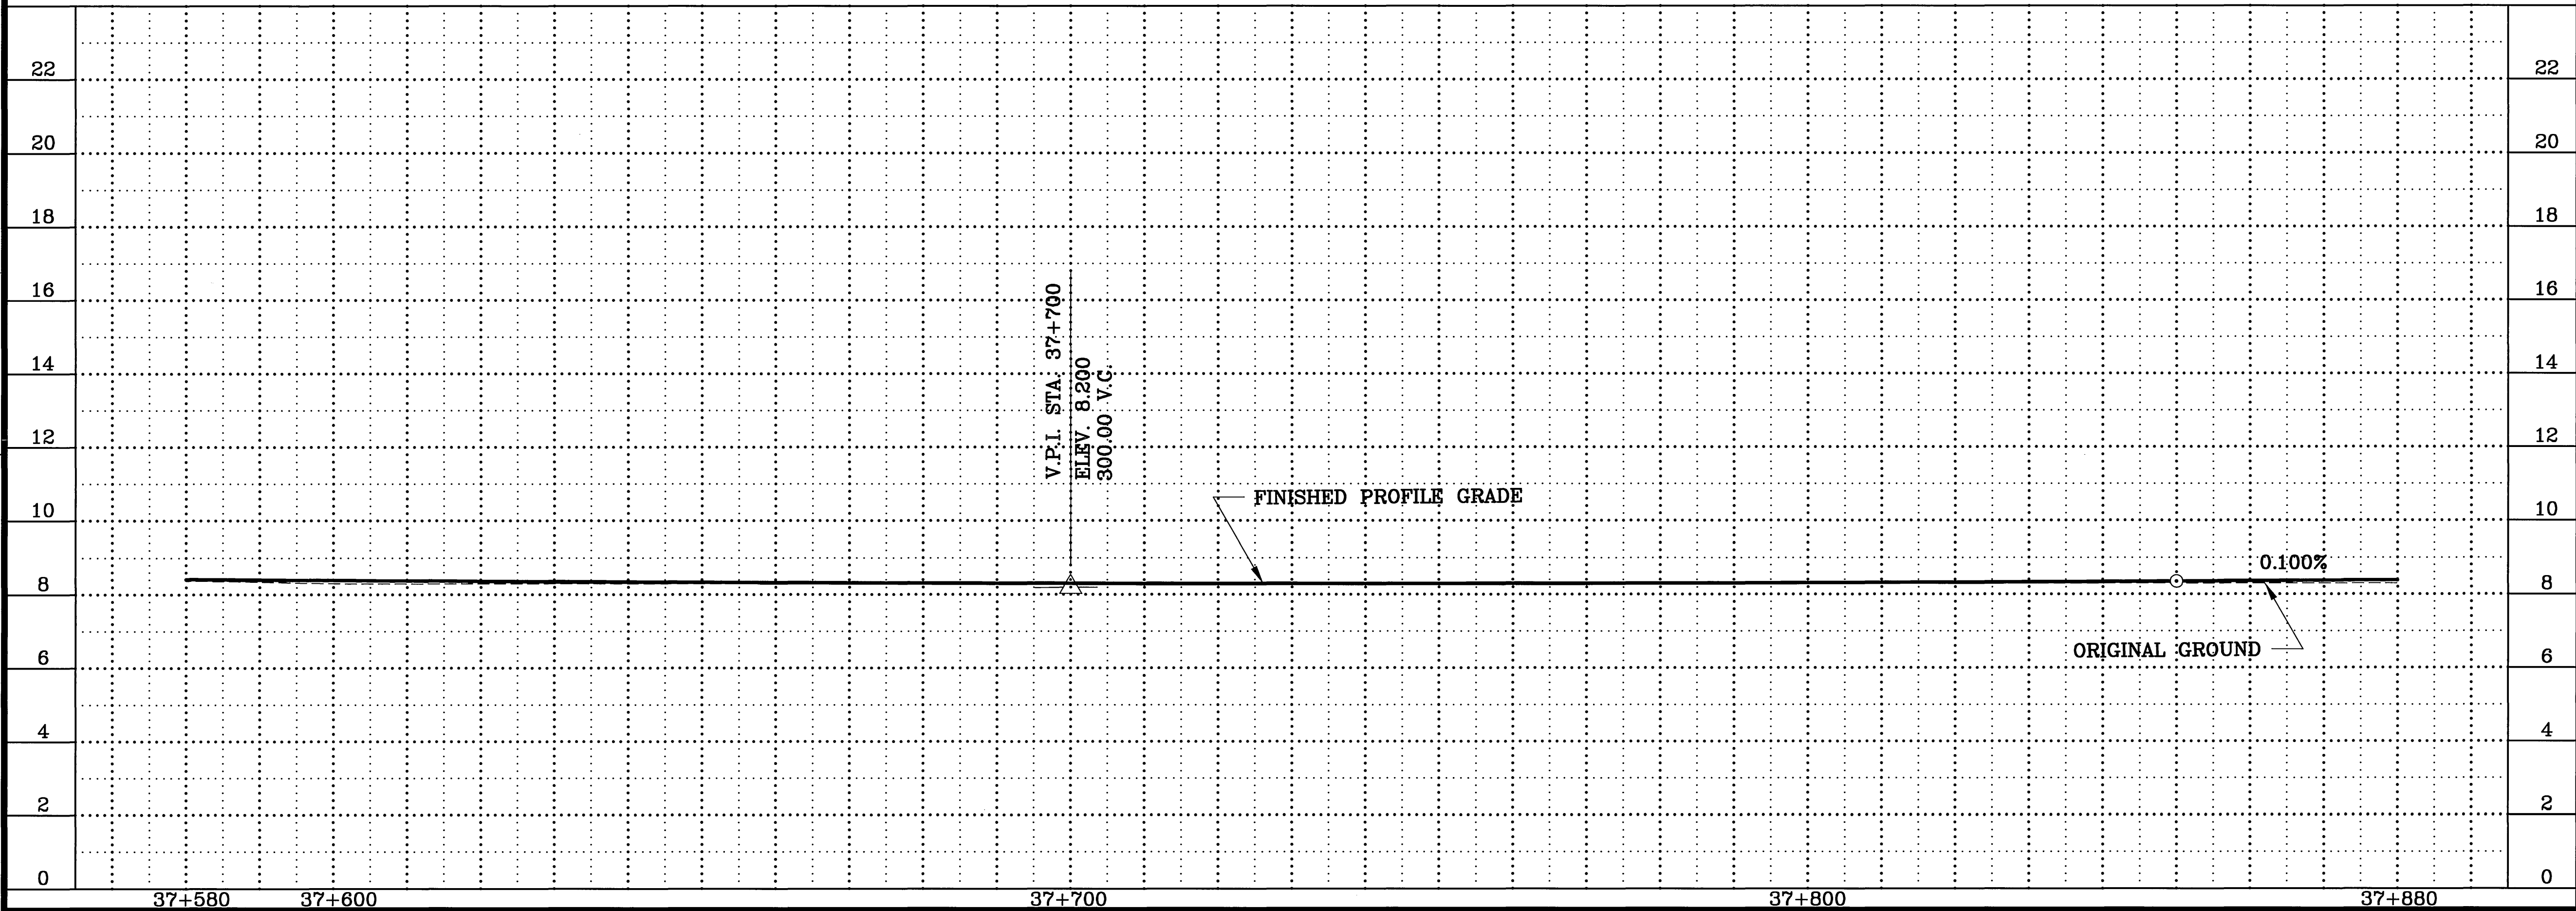

SHEET NO.		TOTAL SHEETS	
F3		F13	
STATE		YEAR	
ALASKA		2002	
PROJECT DESIGNATION			
NH-0A3-1(28)			
ADDENDUM NO.			
ATTACHMENT NO.			
REVISIONS			
NO.	DATE	DESCRIPTION	
		</	

DESIGNED BY
CHECKED BY
DRAFTED BY
VIEW- HALE04
AUTOCAD-CAROLEE.SDS/PROJ/53577/7TPP
SPECIFICATIONS
SCALE
COMPUTER DESIGNATION

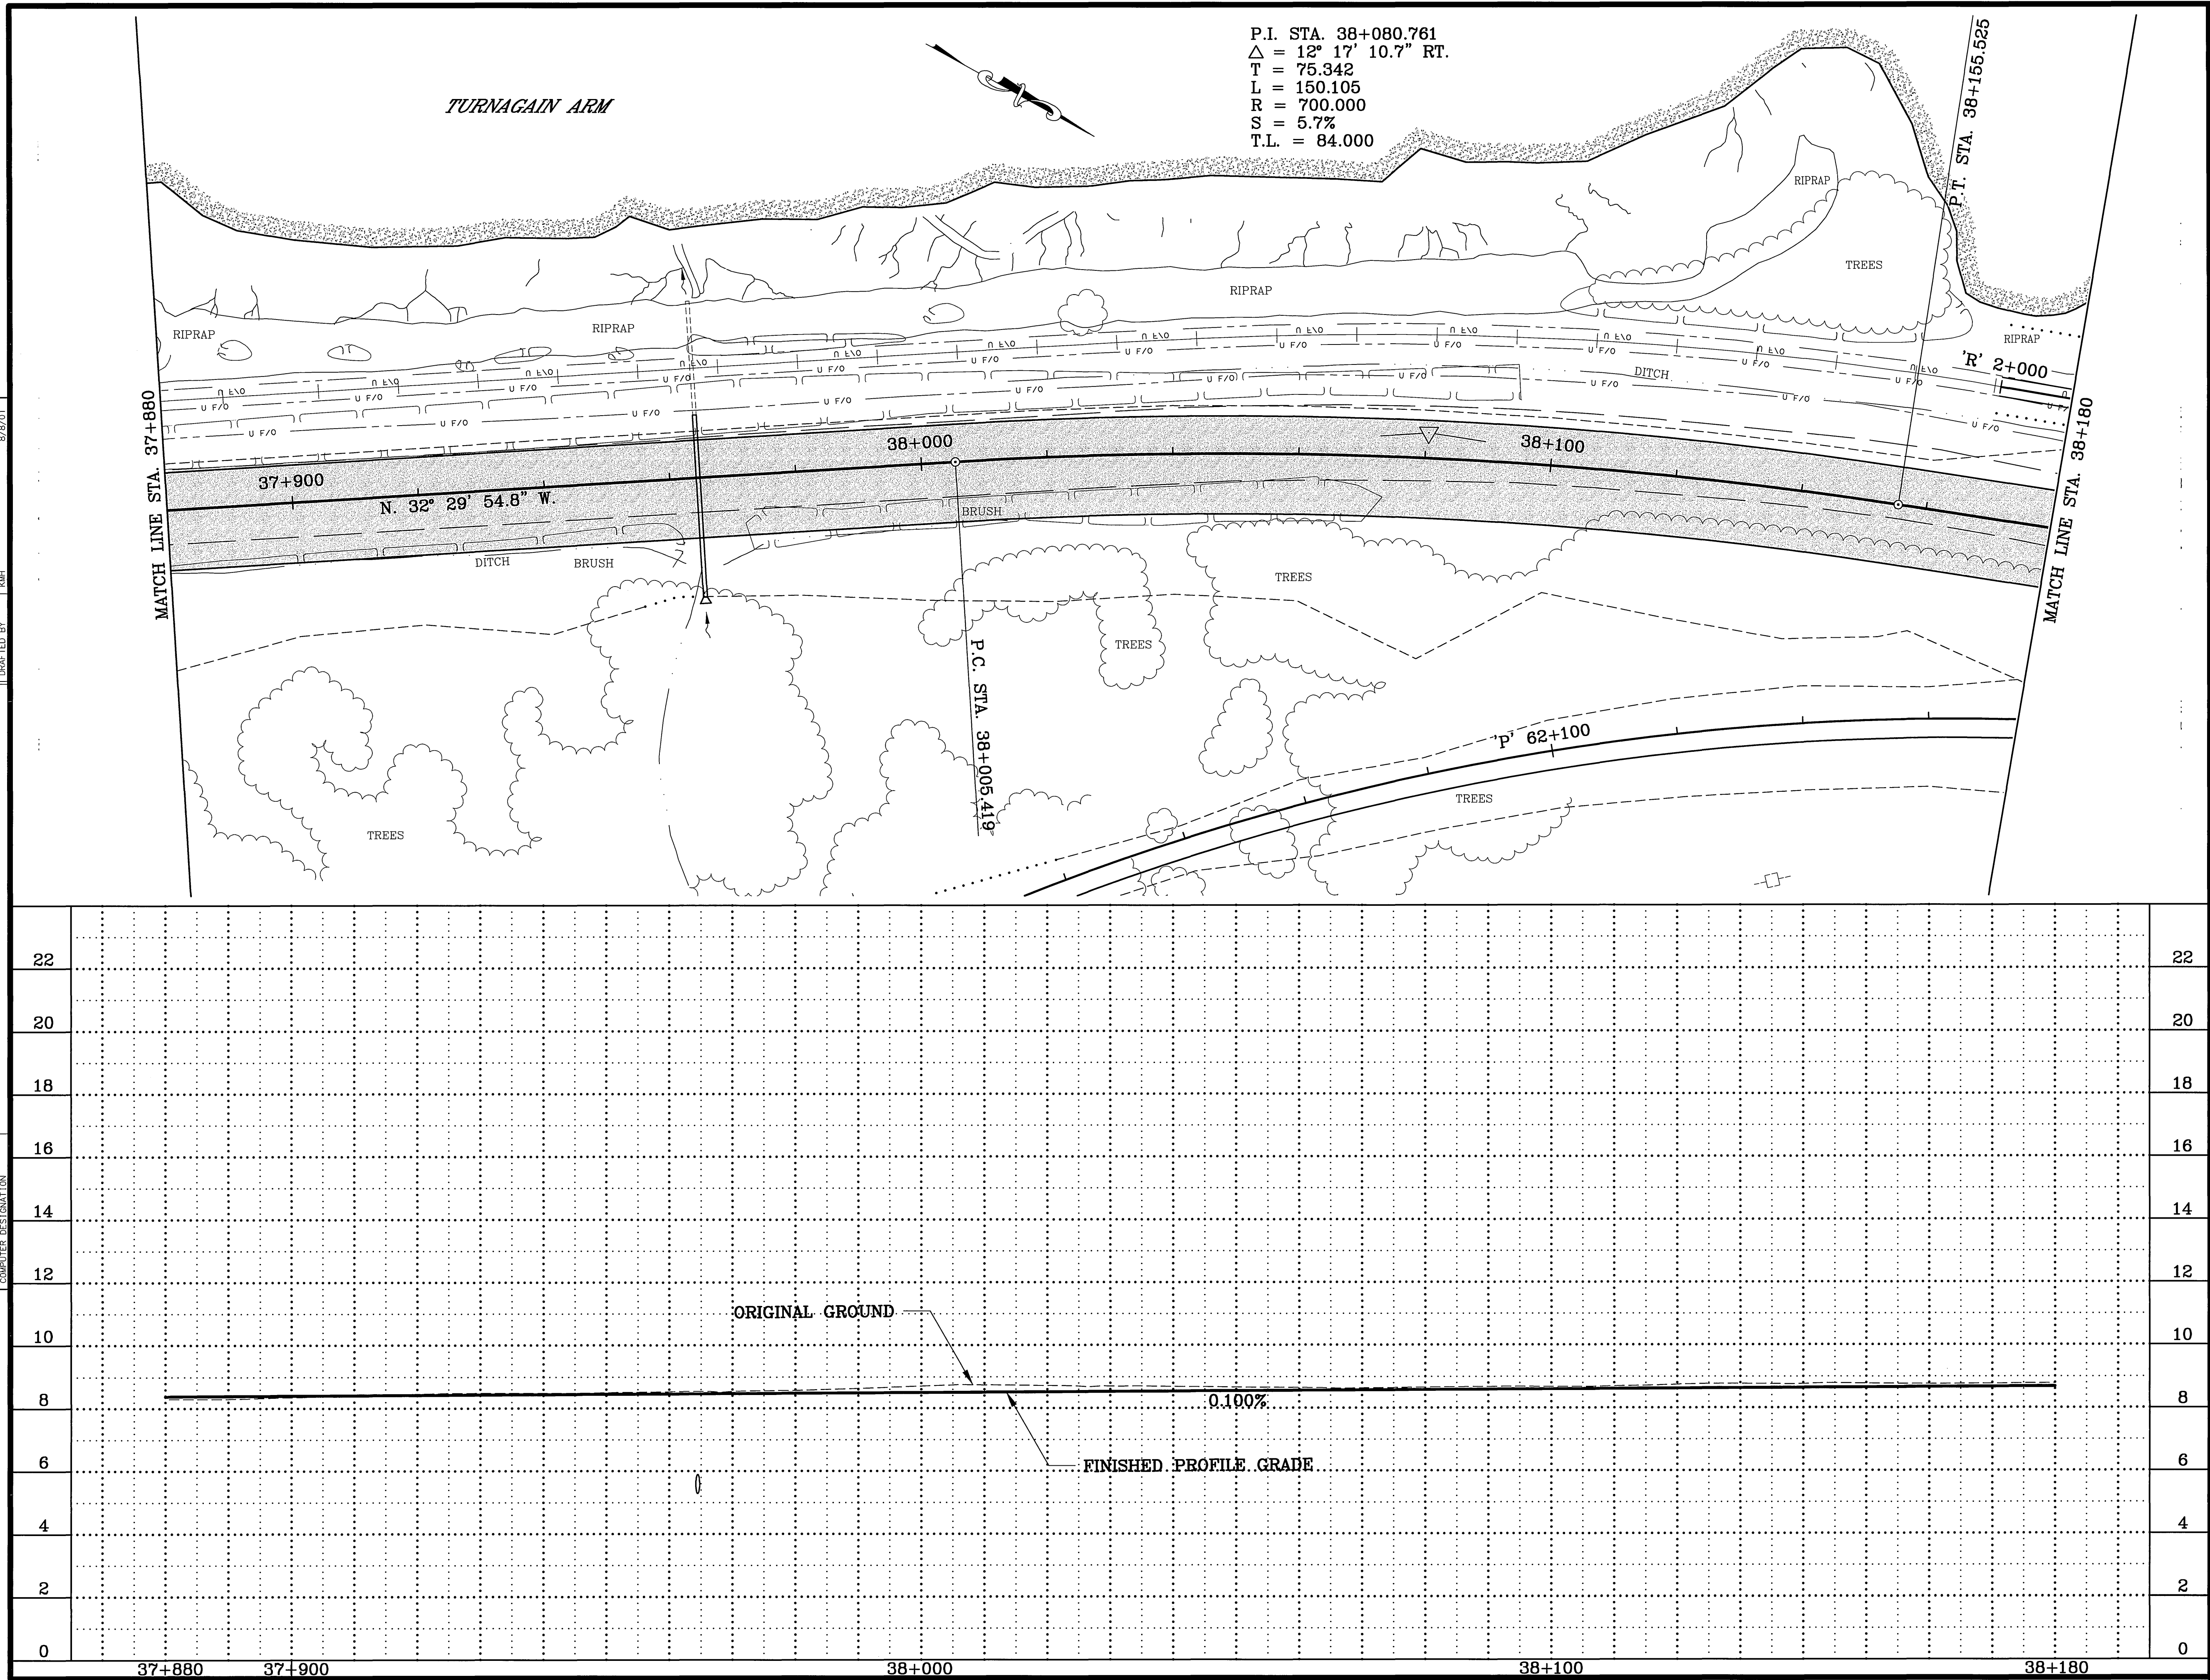

SHEET NO.	TOTAL SHEETS	
F4	F13	
STATE	YEAR	
ALASKA	2002	
PROJECT DESIGNATION		
NH-0A3-1(28)		
ADDENDUM NO.		
ATTACHMENT NO.		
REVISIONS		
NO.	DATE	DESCRIPTION

BIRD CREEK BRIDGE

Bird Creek

TURNAGAIN ARM

THIS SHEET

BIRD POINT


NOTE:
DIMENSIONS ARE IN METERS
UNLESS OTHERWISE NOTED.

STATE OF ALASKA
49th
AUDY J. DOUGHERTY
CE 8823
1997
REGISTERED PROFESSIONAL ENGINEER

STATE OF ALASKA
DEPARTMENT OF TRANSPORTATION
AND PUBLIC FACILITIES

SEWARD HIGHWAY
MP 96 TO MP 102
SAFETY, ROADWAY AND
RECREATIONAL IMPROVEMENTS
BIRD FLATS AREA
HIGHWAY
PLAN AND PROFILE

DESIGNED BY
CHECKED BY
DRAFTED BY
8/8/01
KMH
VIEW- MALES
AUTOCAD-CAROLEE.SSDPROD\5577\7TPP
COMPUTER DESIGNATION
SCALE 1"=1'
SPECIFICATIONS

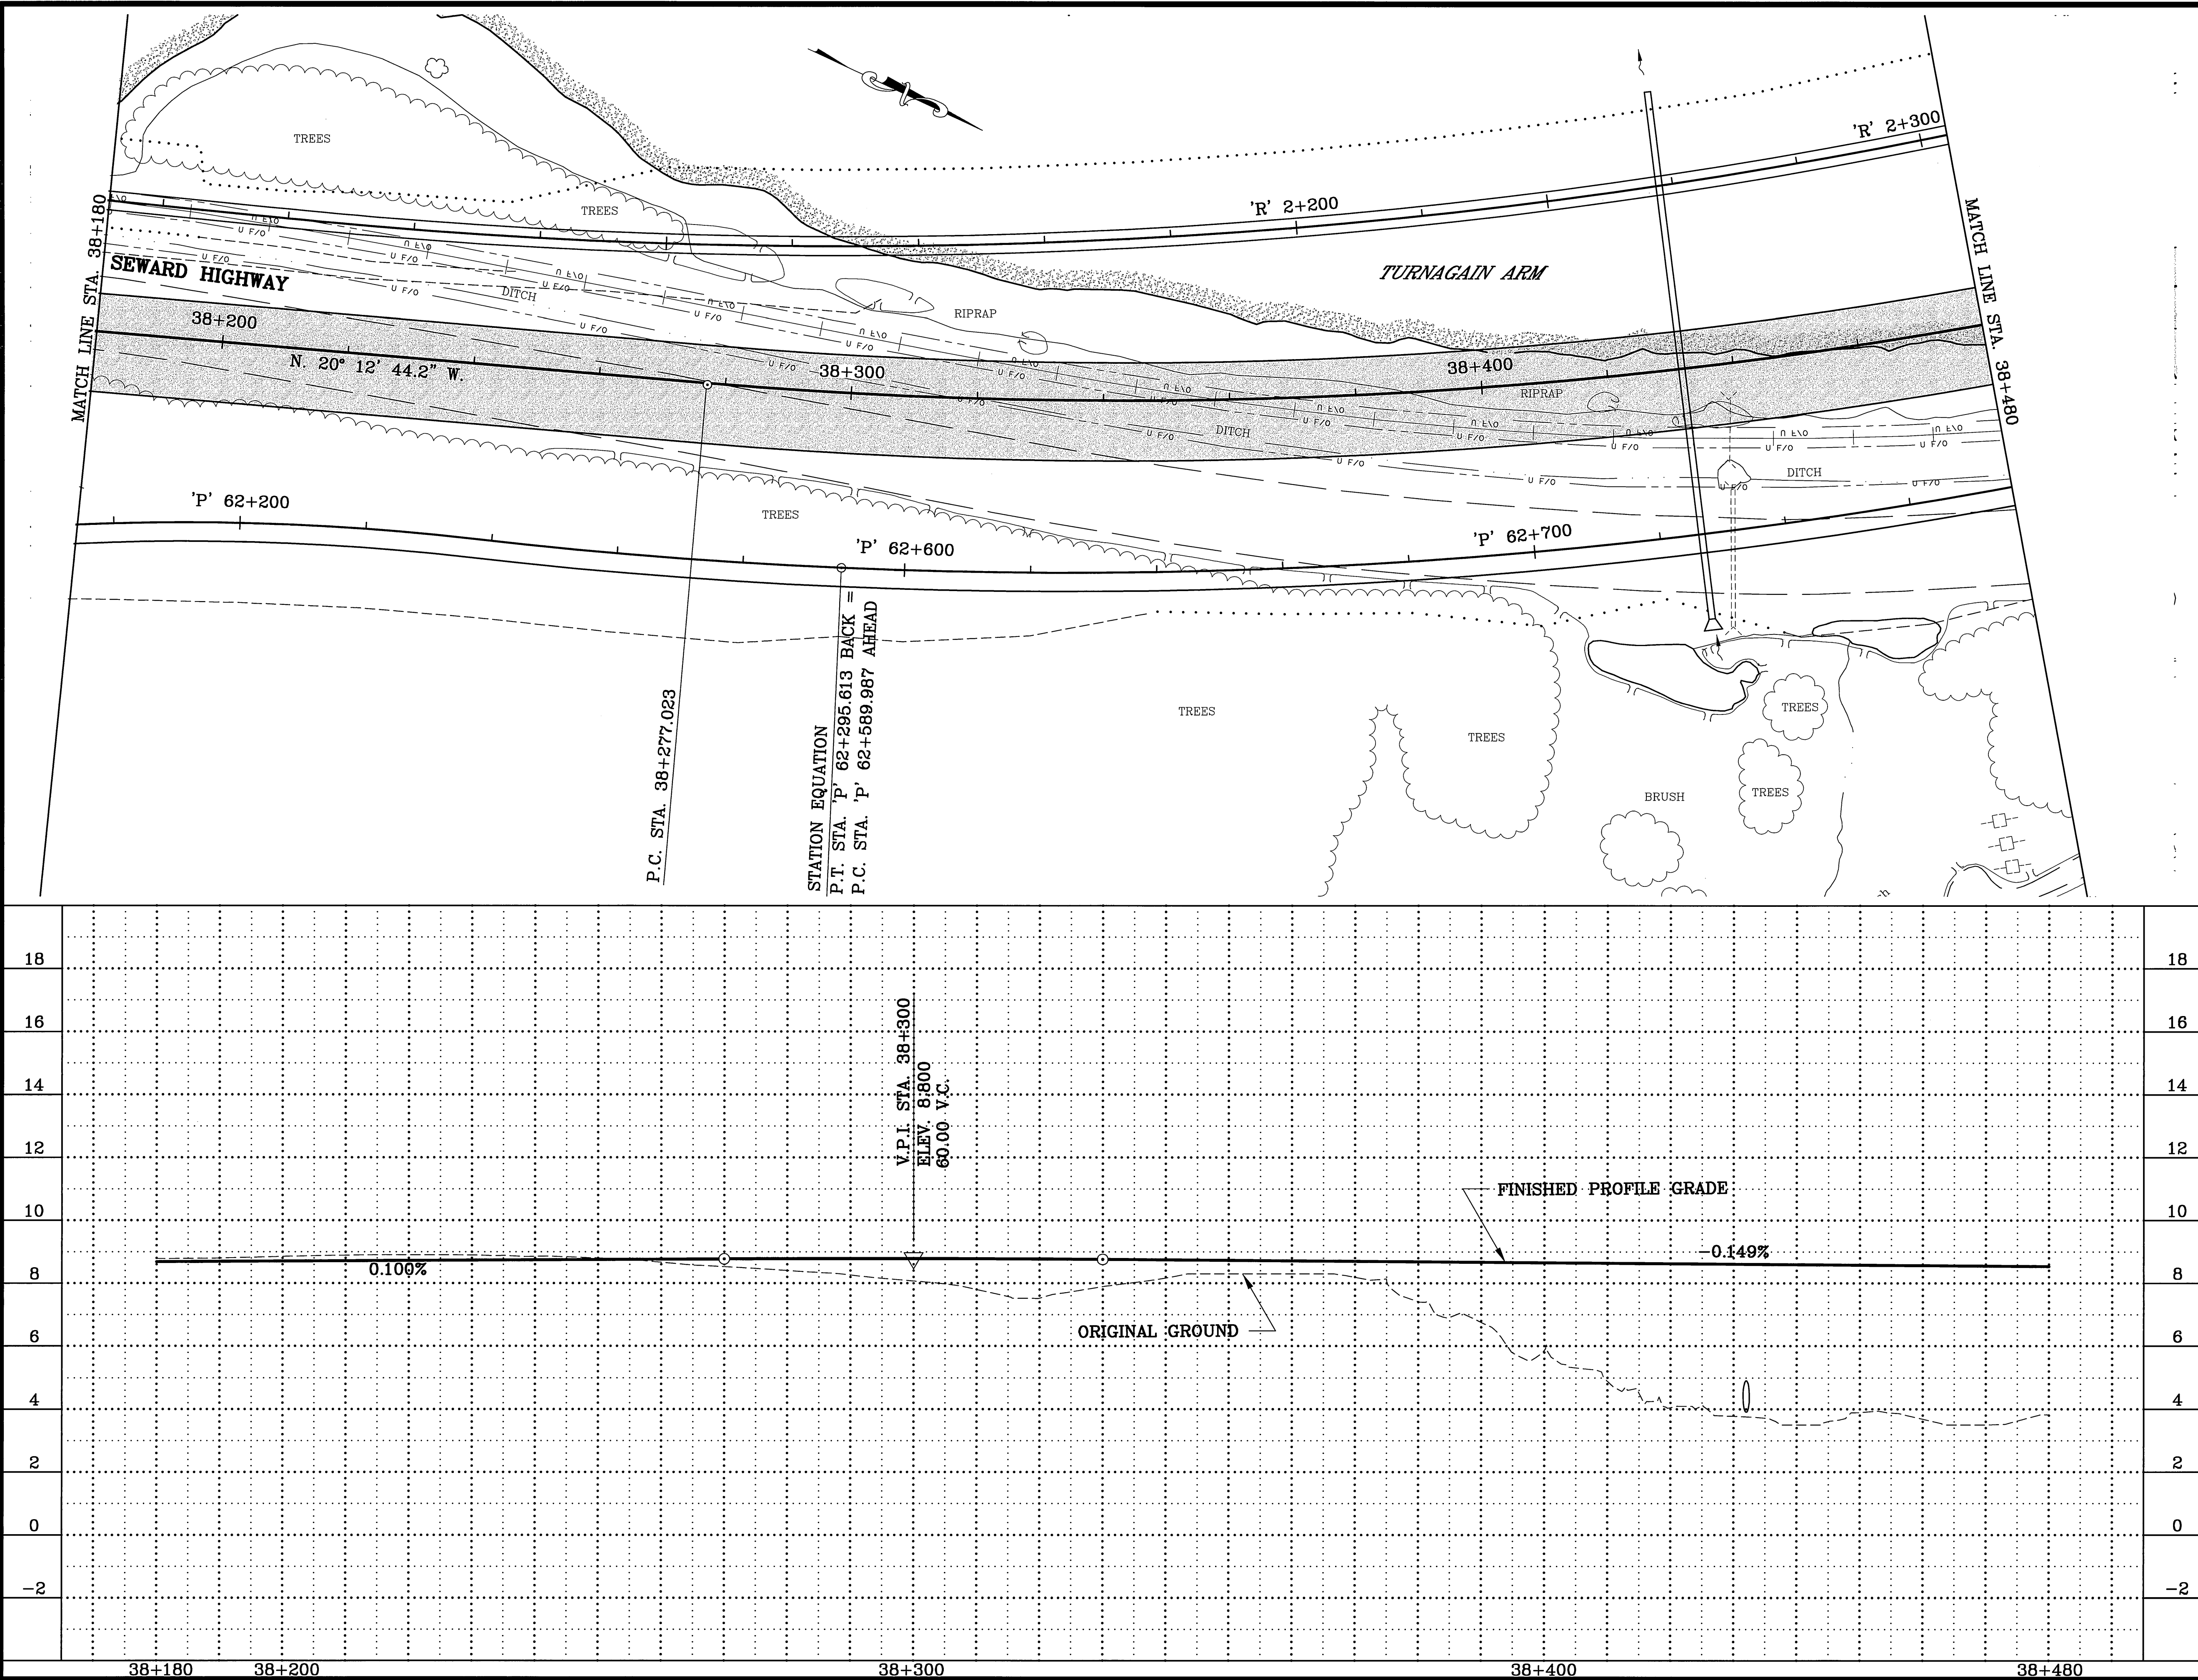


SHEET NO.	TOTAL SHEETS	
F5	F13	
STATE	YEAR	
ALASKA	2002	
PROJECT DESIGNATION		
NH-0A3-1(28)		
ADDENDUM NO.		
ATTACHMENT NO.		
REVISIONS		
NO.	DATE	DESCRIPTION

SEWARD HIGHWAY, MP 96 TO 102

NOTE:
DIMENSIONS ARE IN METERS
UNLESS OTHERWISE NOTED.

STATE OF ALASKA
DEPARTMENT OF TRANSPORTATION
AND PUBLIC FACILITIES
SEWARD HIGHWAY
MP 96 TO MP 102
SAFETY, ROADWAY AND
RECREATIONAL IMPROVEMENTS
BIRD FLATS AREA
HIGHWAY
PLAN AND PROFILE

DESIGNED BY: 8/8/01
VIEW: HALF
CHECKED BY: KMH
DRAWN BY: KMH
SPECIFICATIONS: AUTOCAD-CAROLLEE, SDC/PRO/5557/77PP
SCALE: 1"=1'
COMPUTER DESIGNATION:

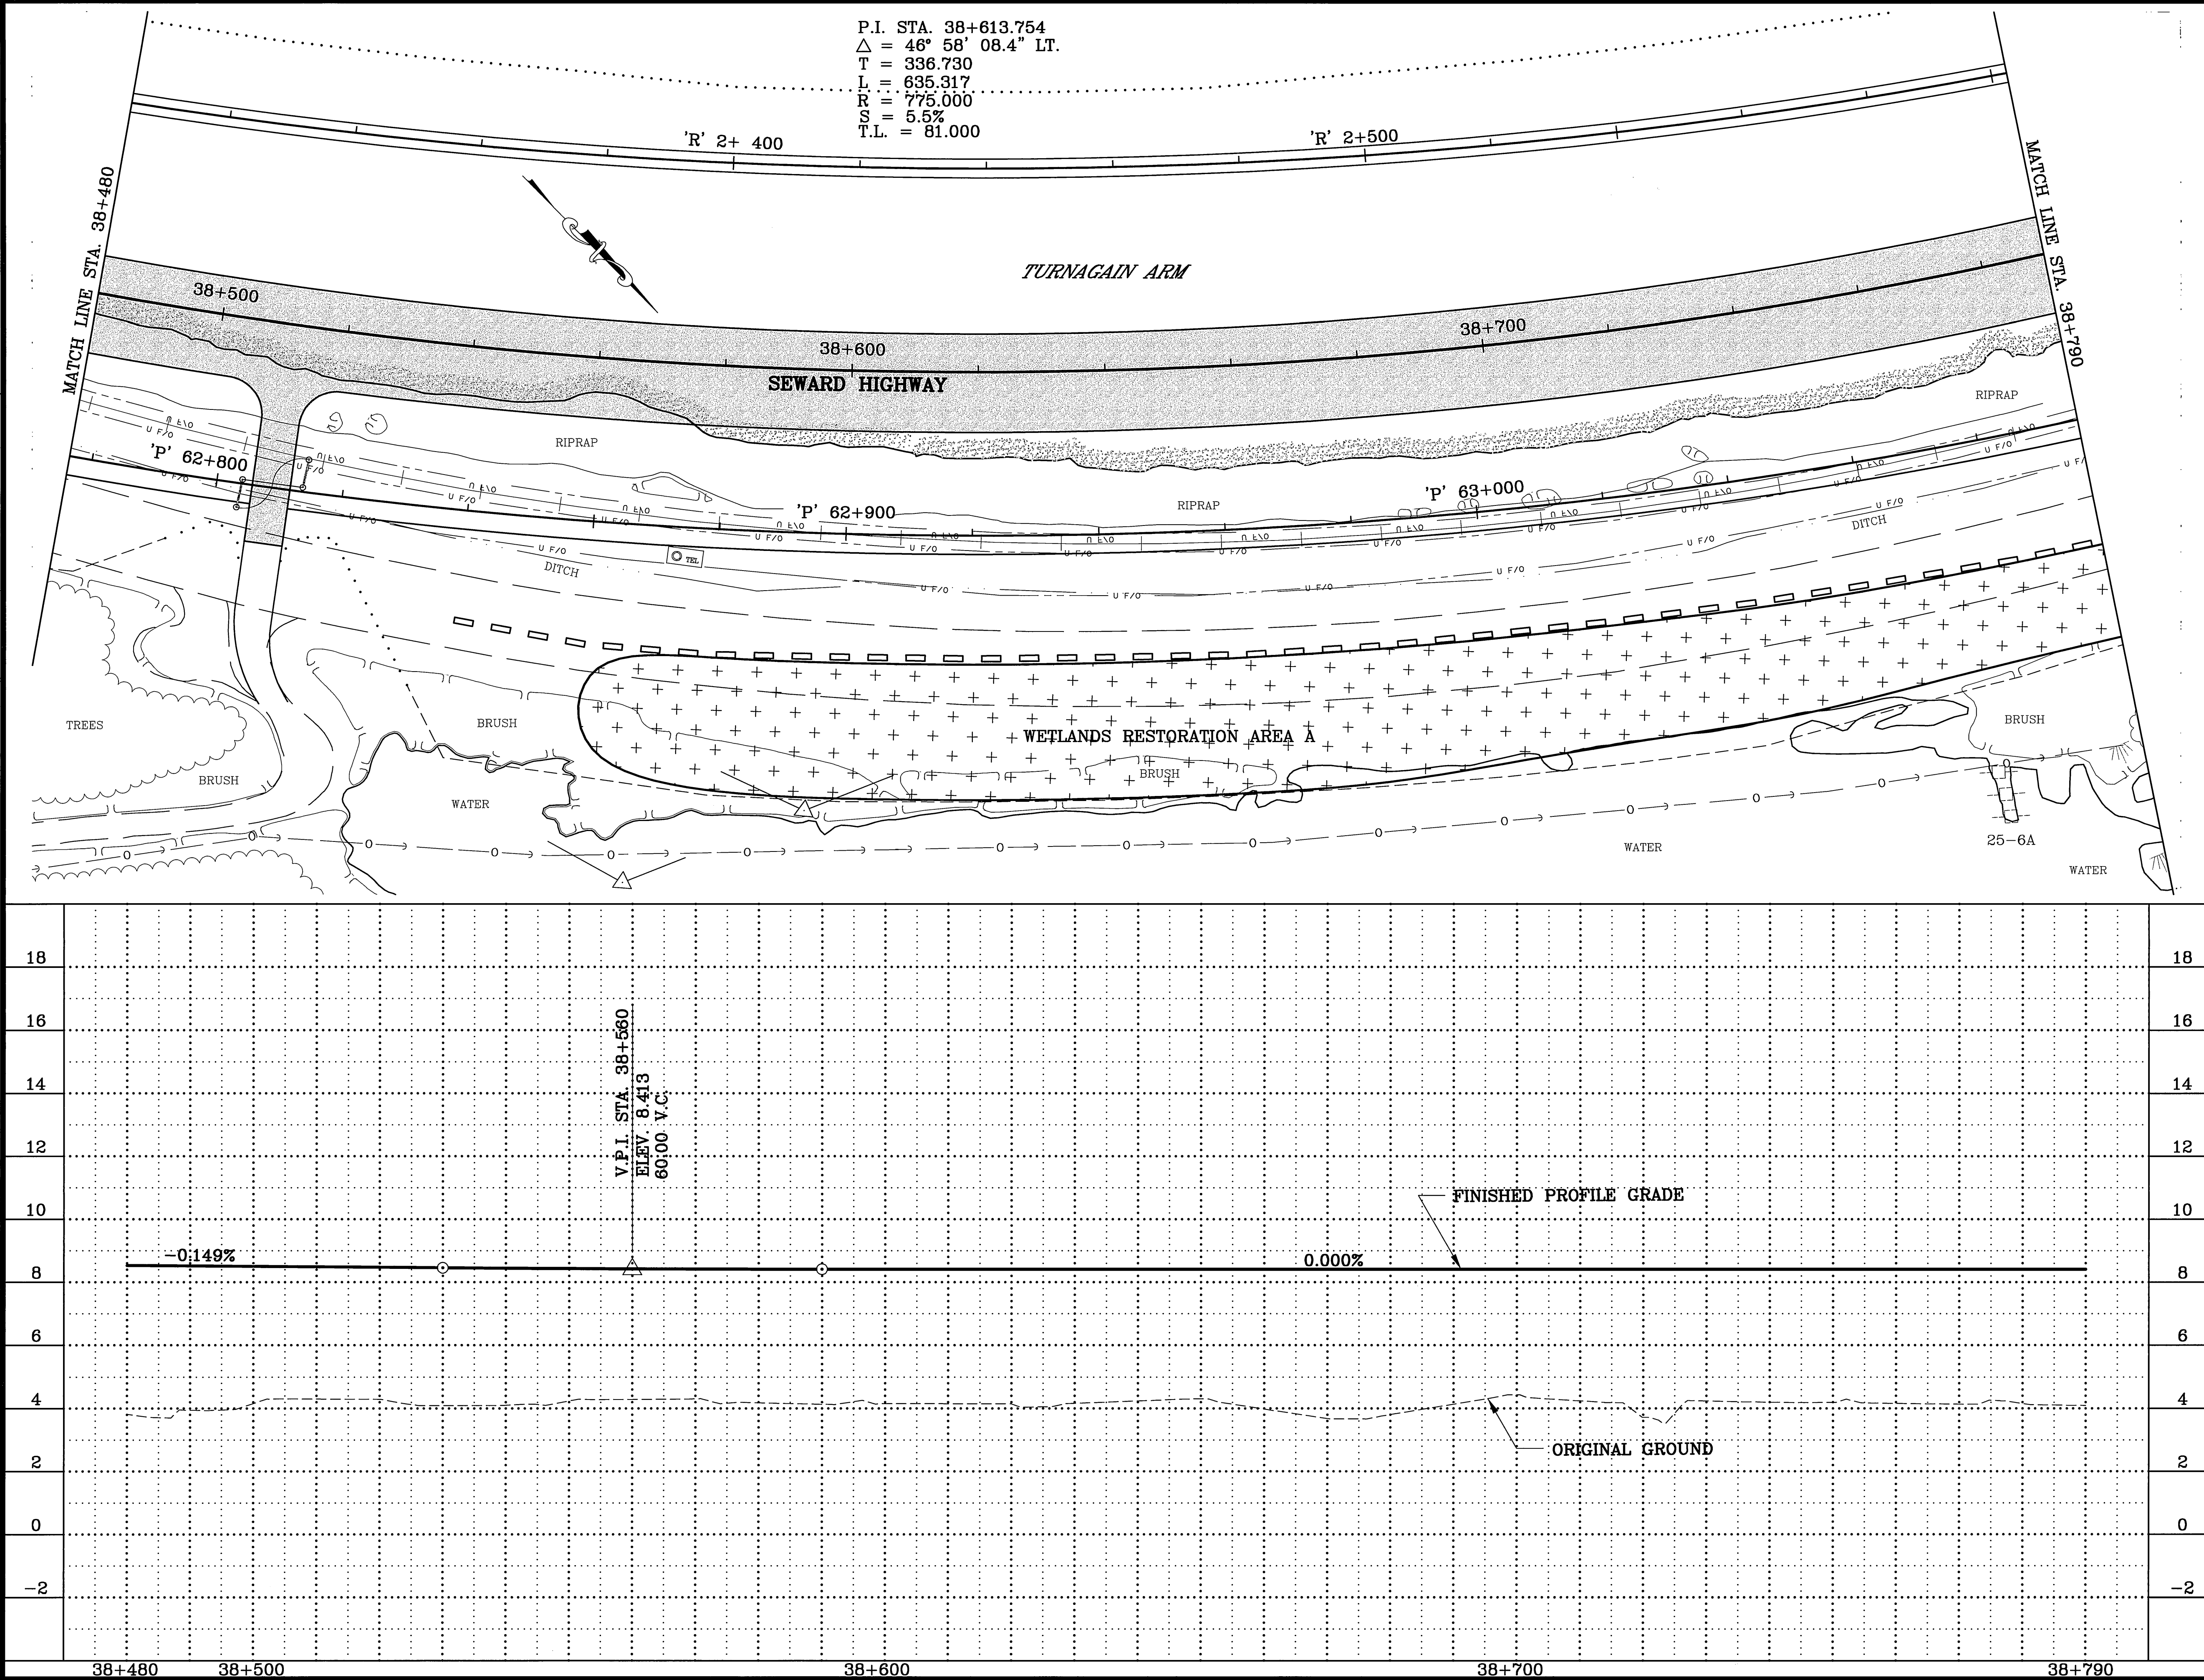

SHEET NO.	TOTAL SHEETS	
F6	F13	
STATE	YEAR	
ALASKA	2002	
PROJECT DESIGNATION		
NH-0A3-1(28)		
ADDENDUM NO.		
ATTACHMENT NO.		
REVISIONS		
NO.	DATE	DESCRIPTION

BIRD CREEK BRIDGE

Bird Creek

TURNAGAIN ARM

THIS SHEET


BIRD POINT

NOTE:
DIMENSIONS ARE IN METERS
UNLESS OTHERWISE NOTED.

STATE OF ALASKA
49th
AUDY J. DOUGHERTY
CE 8823
REGISTERED PROFESSIONAL ENGINEER

STATE OF ALASKA
DEPARTMENT OF TRANSPORTATION
AND PUBLIC FACILITIES
SEWARD HIGHWAY
MP 96 TO MP 102
SAFETY, ROADWAY AND
RECREATIONAL IMPROVEMENTS
BIRD FLATS AREA
HIGHWAY
PLAN AND PROFILE

DESIGNED BY: AUTOCAD-CAROLEE: SSKAPROU/US577/TPP
VIEW: HALFOZ
SCALE: 1"=100'
COMPUTER DESIGNATION: 8/8/01
DRAFTED BY: KMH

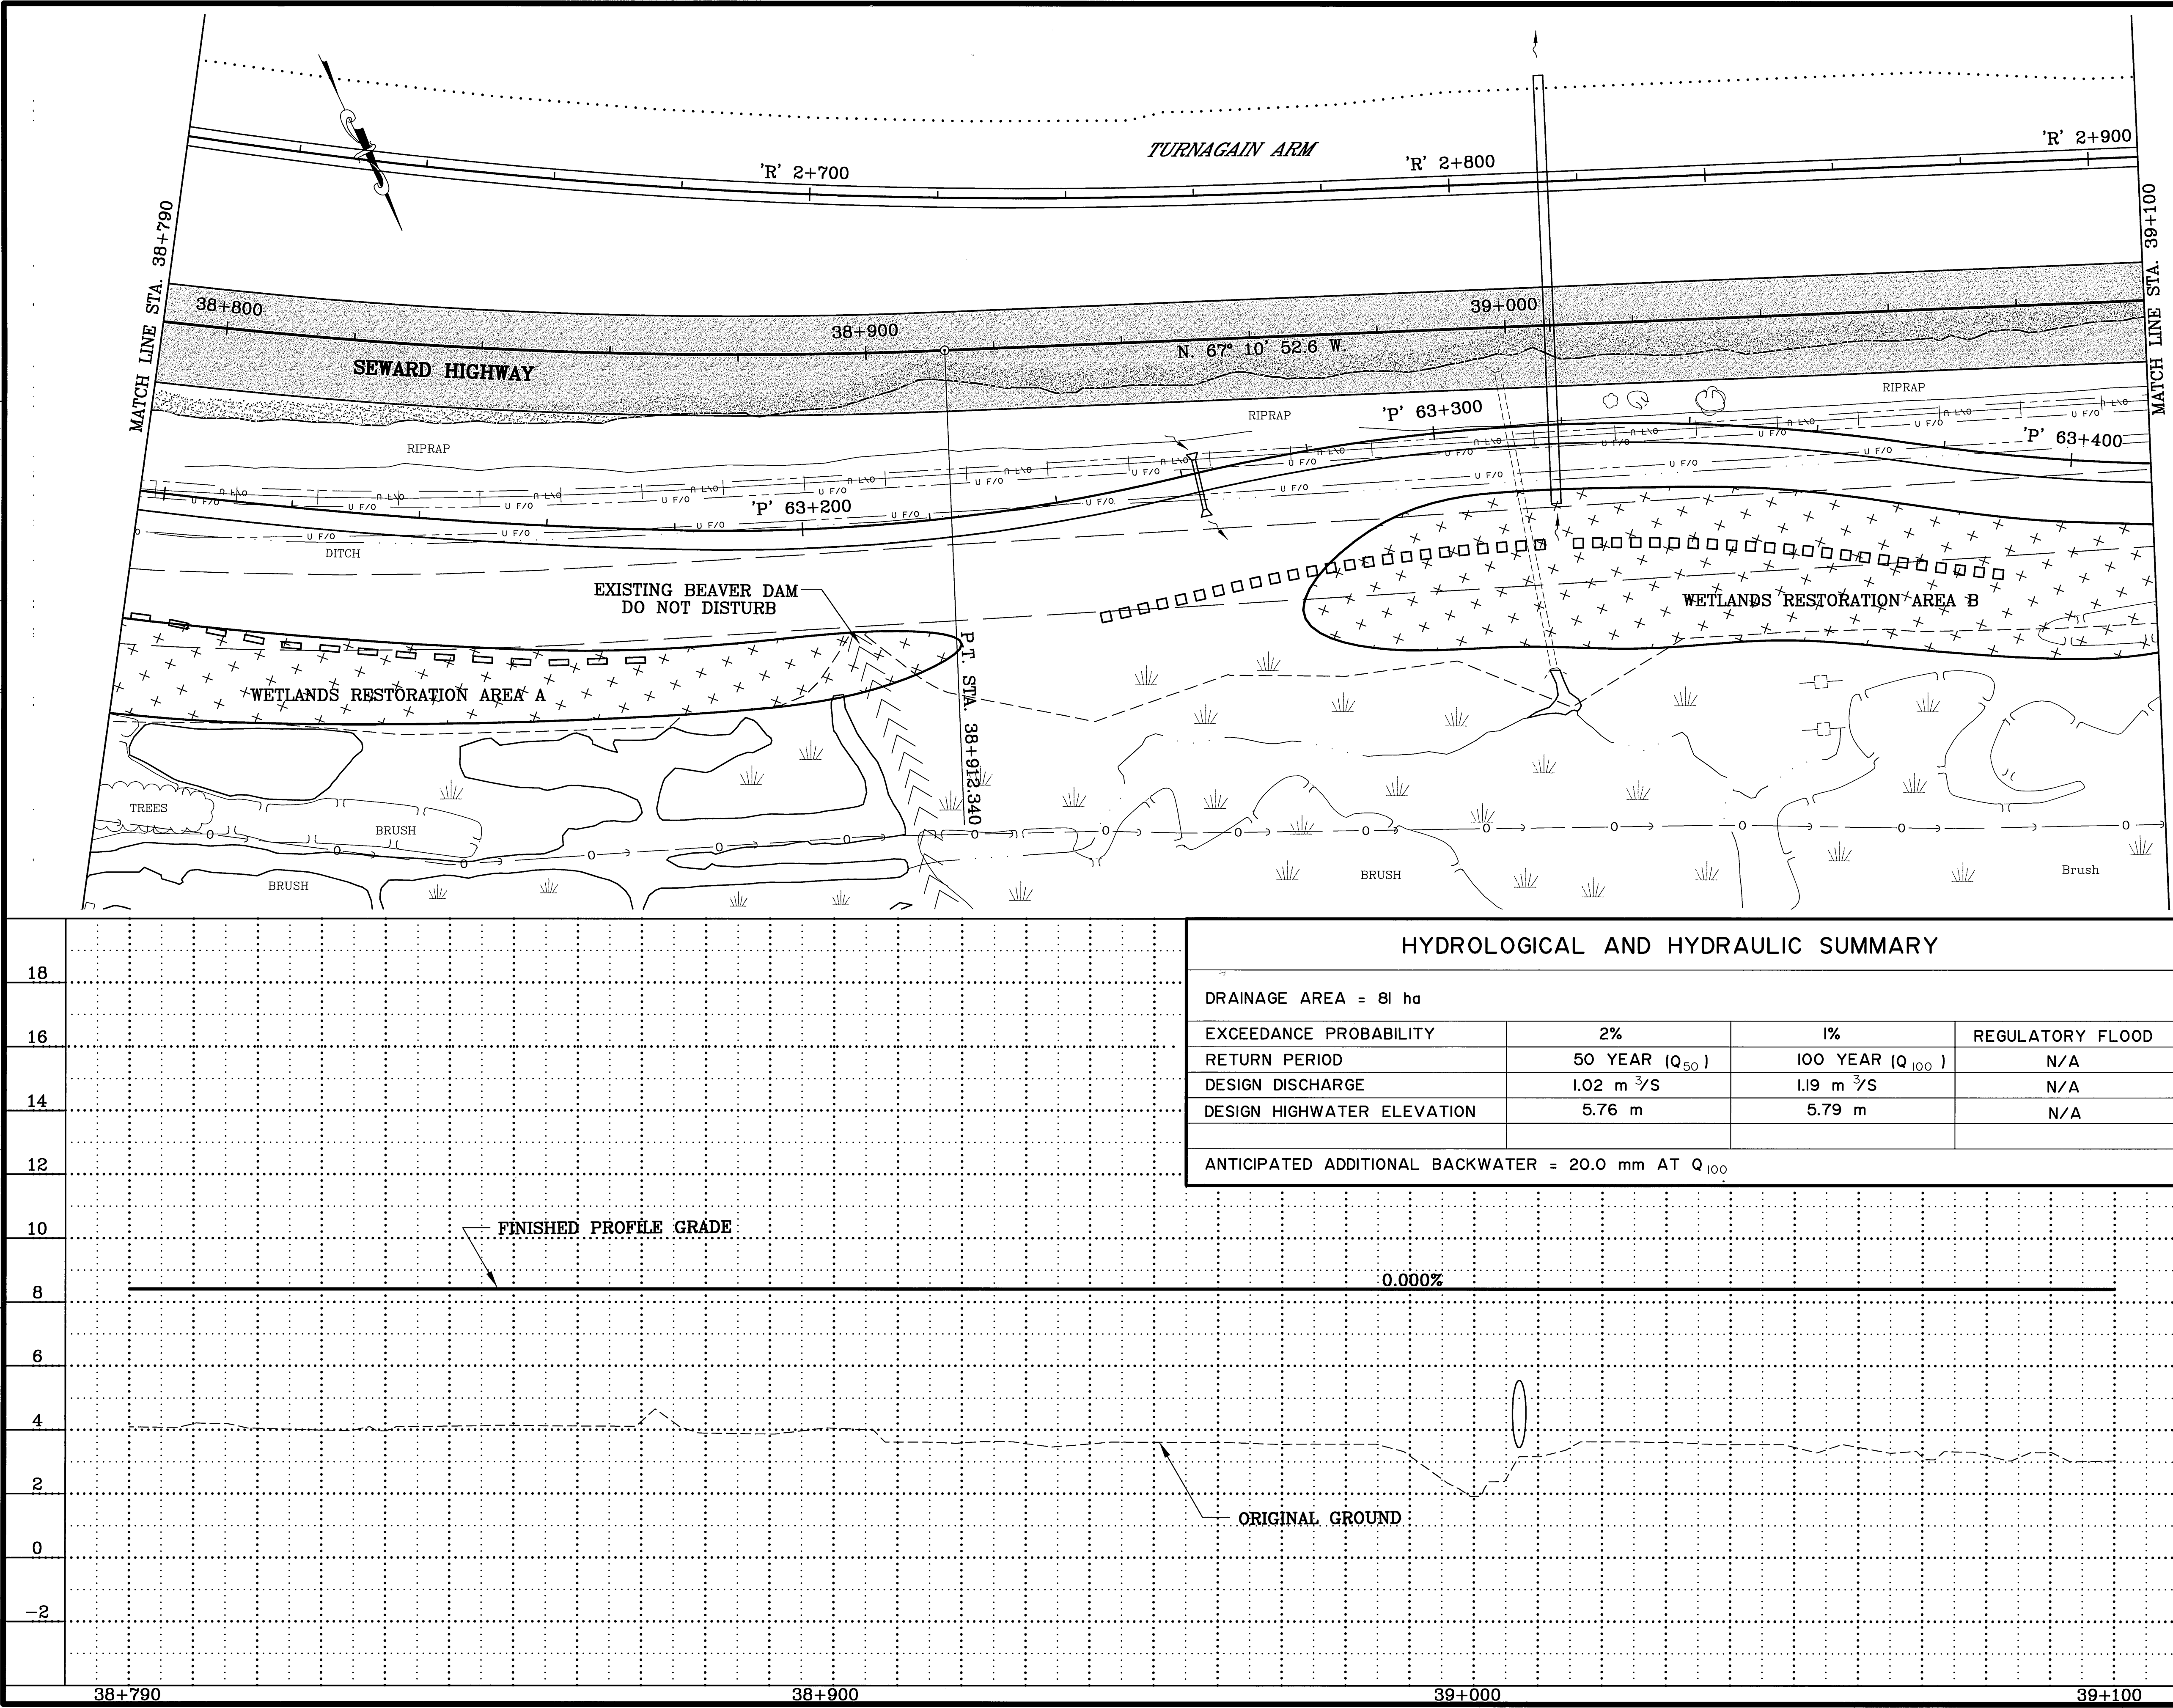


SHEET NO.	TOTAL SHEETS	
F7	F13	
STATE	YEAR	
ALASKA	2002	
PROJECT DESIGNATION		
NH-0A3-1(28)		
ADDENDUM NO.		
ATTACHMENT NO.		
REVISIONS		
NO.	DATE	DESCRIPTION

NOTE:
DIMENSIONS ARE IN METERS
UNLESS OTHERWISE NOTED.

STATE OF ALASKA
49th
JUDY J. DOUGHERTY
CE 8823
REGISTERED PROFESSIONAL ENGINEER

STATE OF ALASKA
DEPARTMENT OF TRANSPORTATION
AND PUBLIC FACILITIES
SEWARD HIGHWAY
MP 96 TO MP 102
SAFETY, ROADWAY AND
RECREATIONAL IMPROVEMENTS
BIRD FLATS AREA
HIGHWAY
PLAN AND PROFILE

DESIGNED BY
CHECKED BY
DRAWN BY
8/2/01
V/ENR-MALEF08
AUTOCAD-CARLEE-SSKPROJ\53577\77PP
SCALE 1"=100'
COMPUTER DESIGN

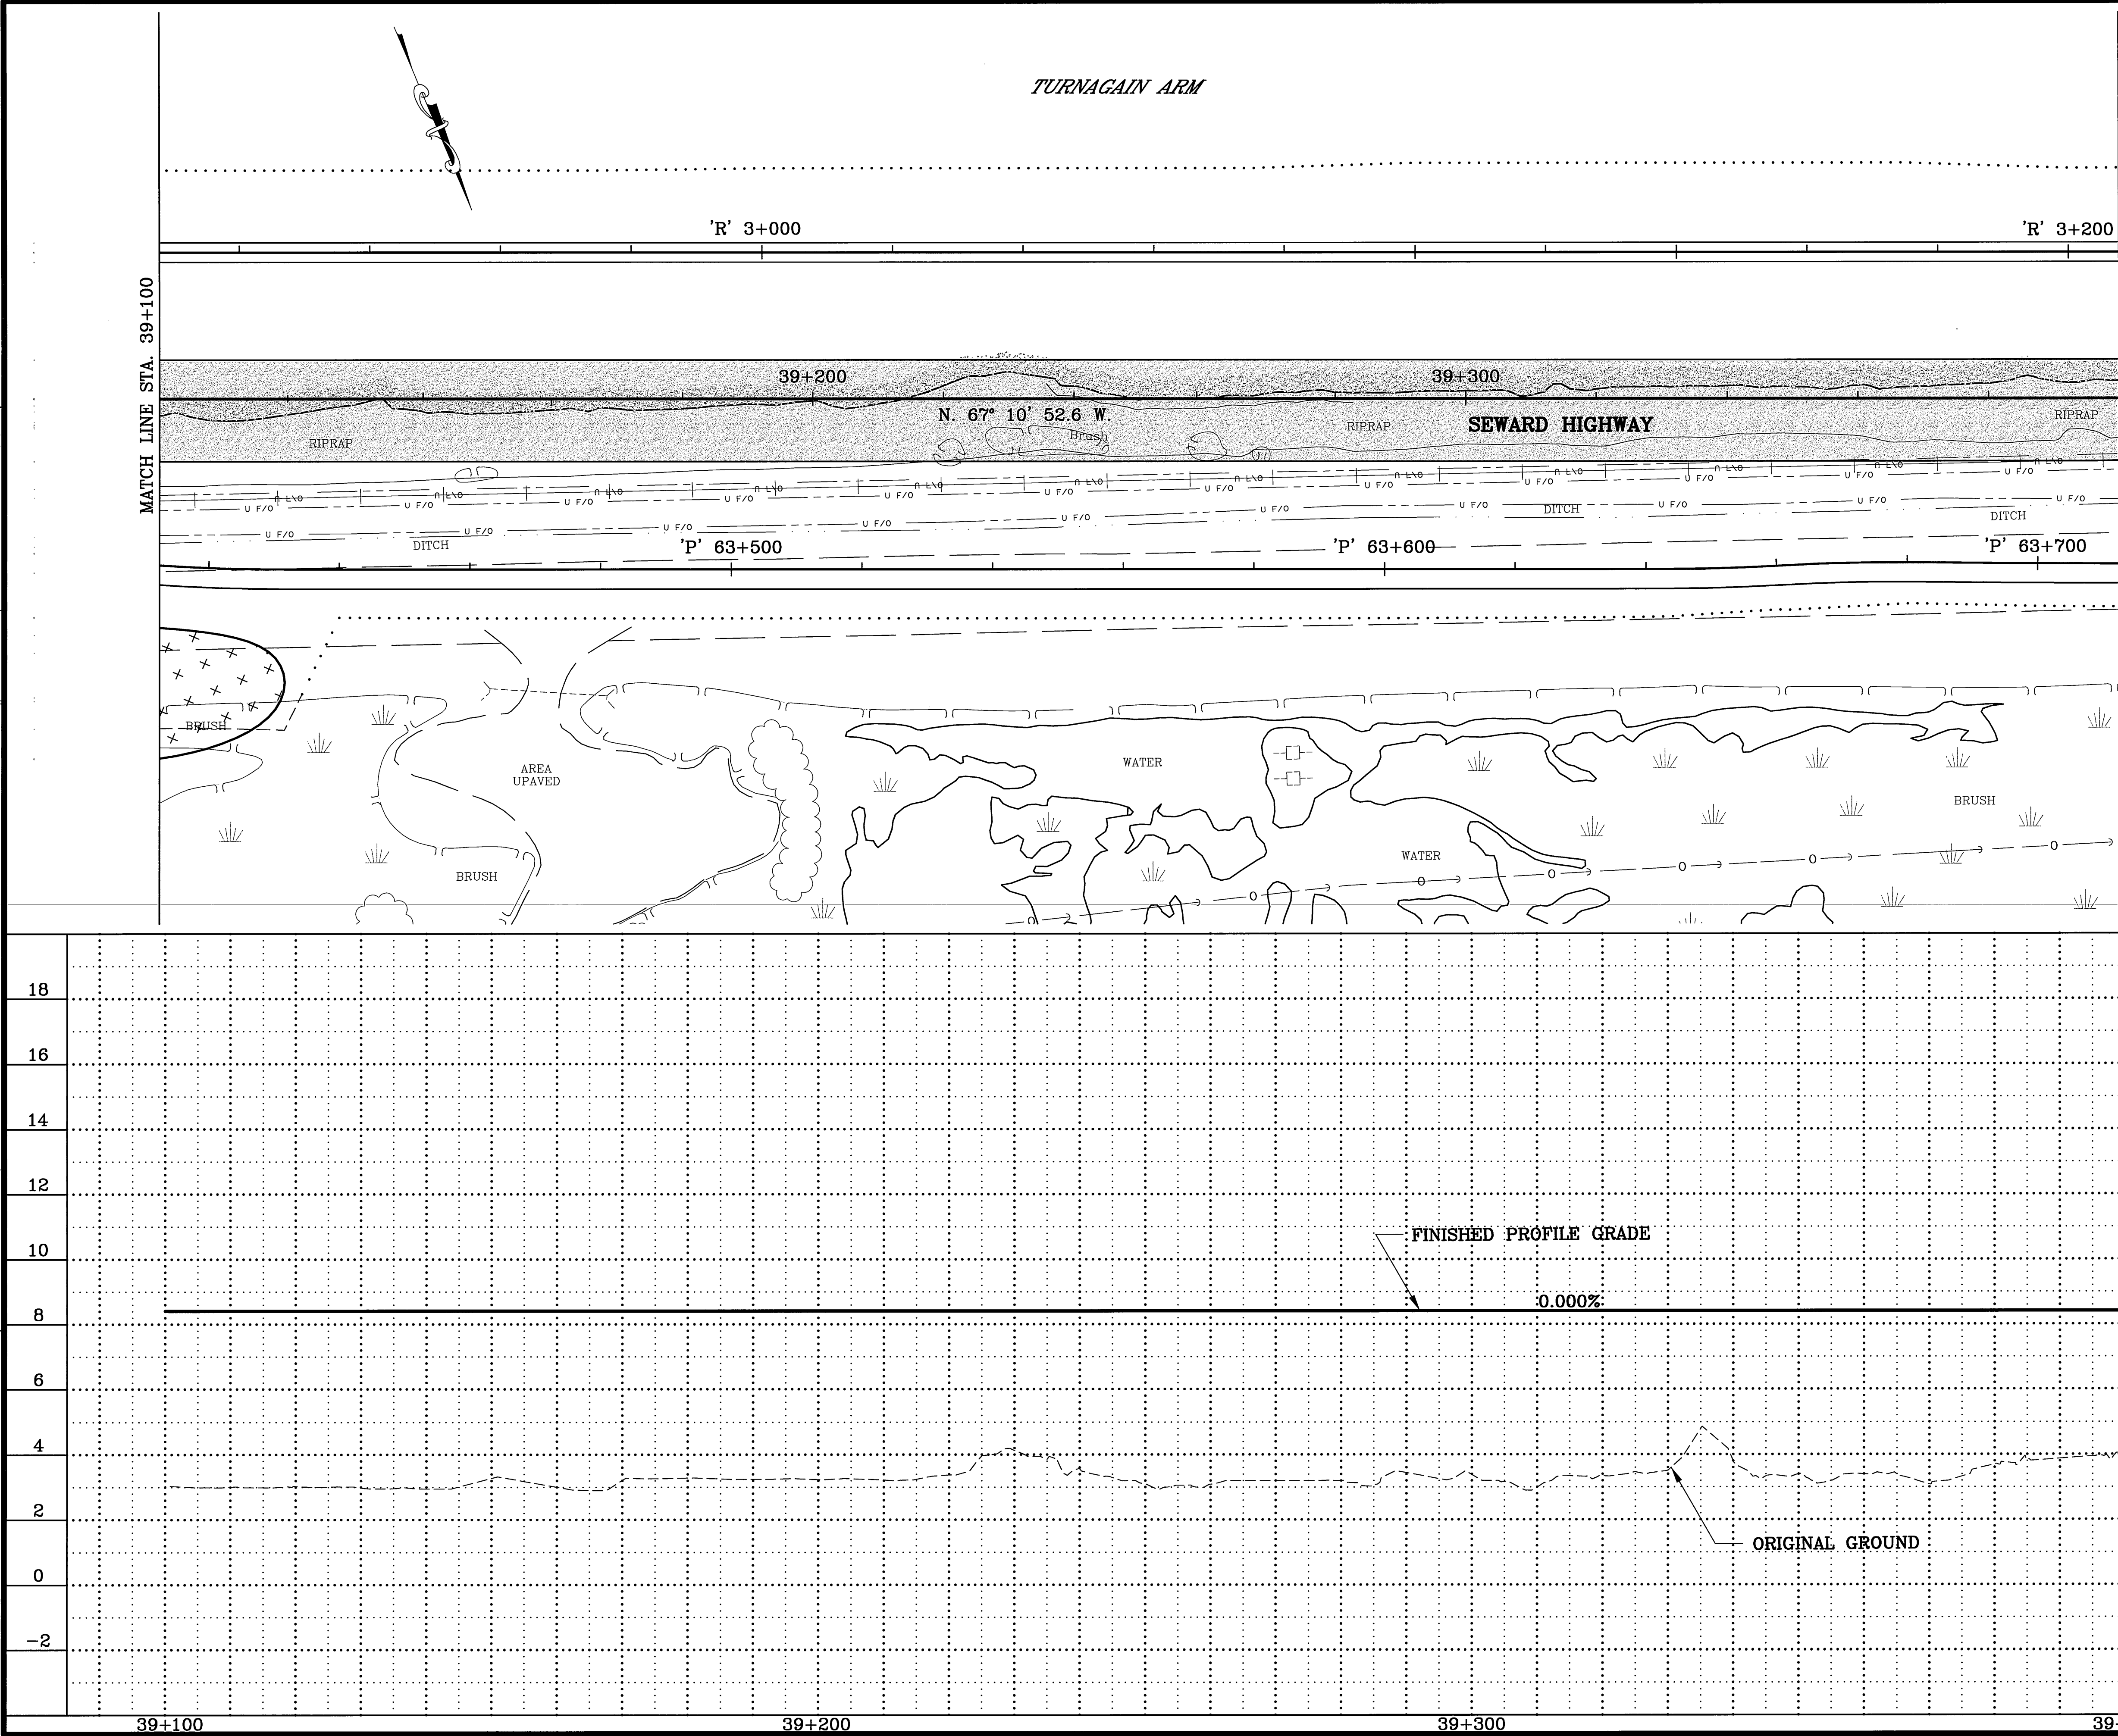



SHEET NO.	TOTAL SHEETS	
F8	F13	
STATE	YEAR	
ALASKA	2002	
PROJECT DESIGNATION		
NH-0A3-1(28)		
ADDENDUM NO.		
ATTACHMENT NO.		
REVISIONS		
NO.	DATE	DESCRIPTION

SEWARD HIGHWAY, MP 96 TO 102

NOTE:
DIMENSIONS ARE IN METERS
UNLESS OTHERWISE NOTED.

STATE OF ALASKA
DEPARTMENT OF TRANSPORTATION
AND PUBLIC FACILITIES
SEWARD HIGHWAY
MP 96 TO MP 102
SAFETY, ROADWAY AND
RECREATIONAL IMPROVEMENTS
BIRD FLATS AREA
HIGHWAY
PLAN AND PROFILE


DESIGNED BY
CHECKED BY
DATE
8/2/01
V/ENR- HALE
TRACTED BY
KMH
SPECIFICATIONS
AUTOCAD-CAROLEE-SSK/PROJ-53577/7PP
COMPUTER DESIGNATION

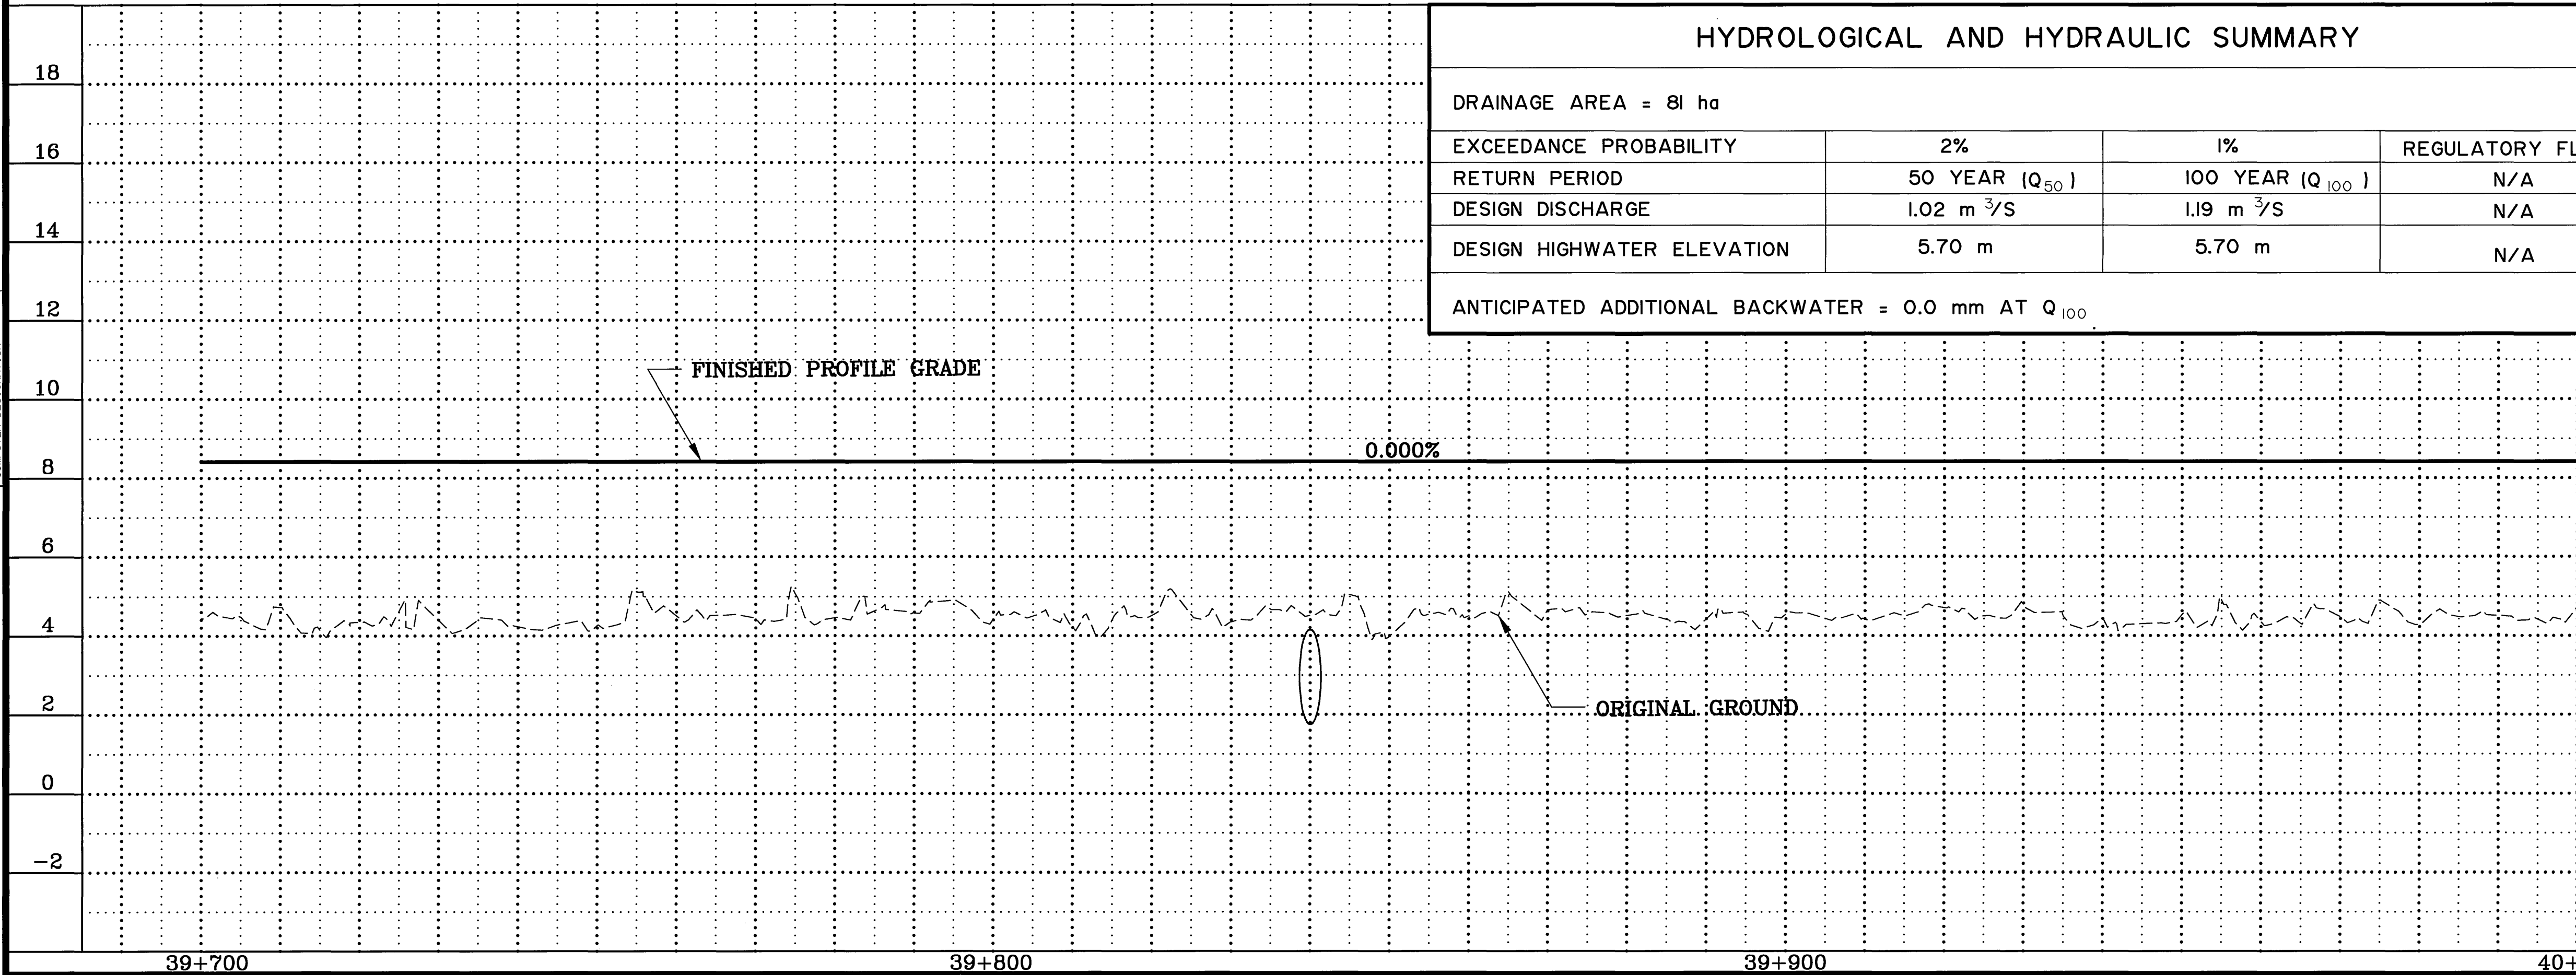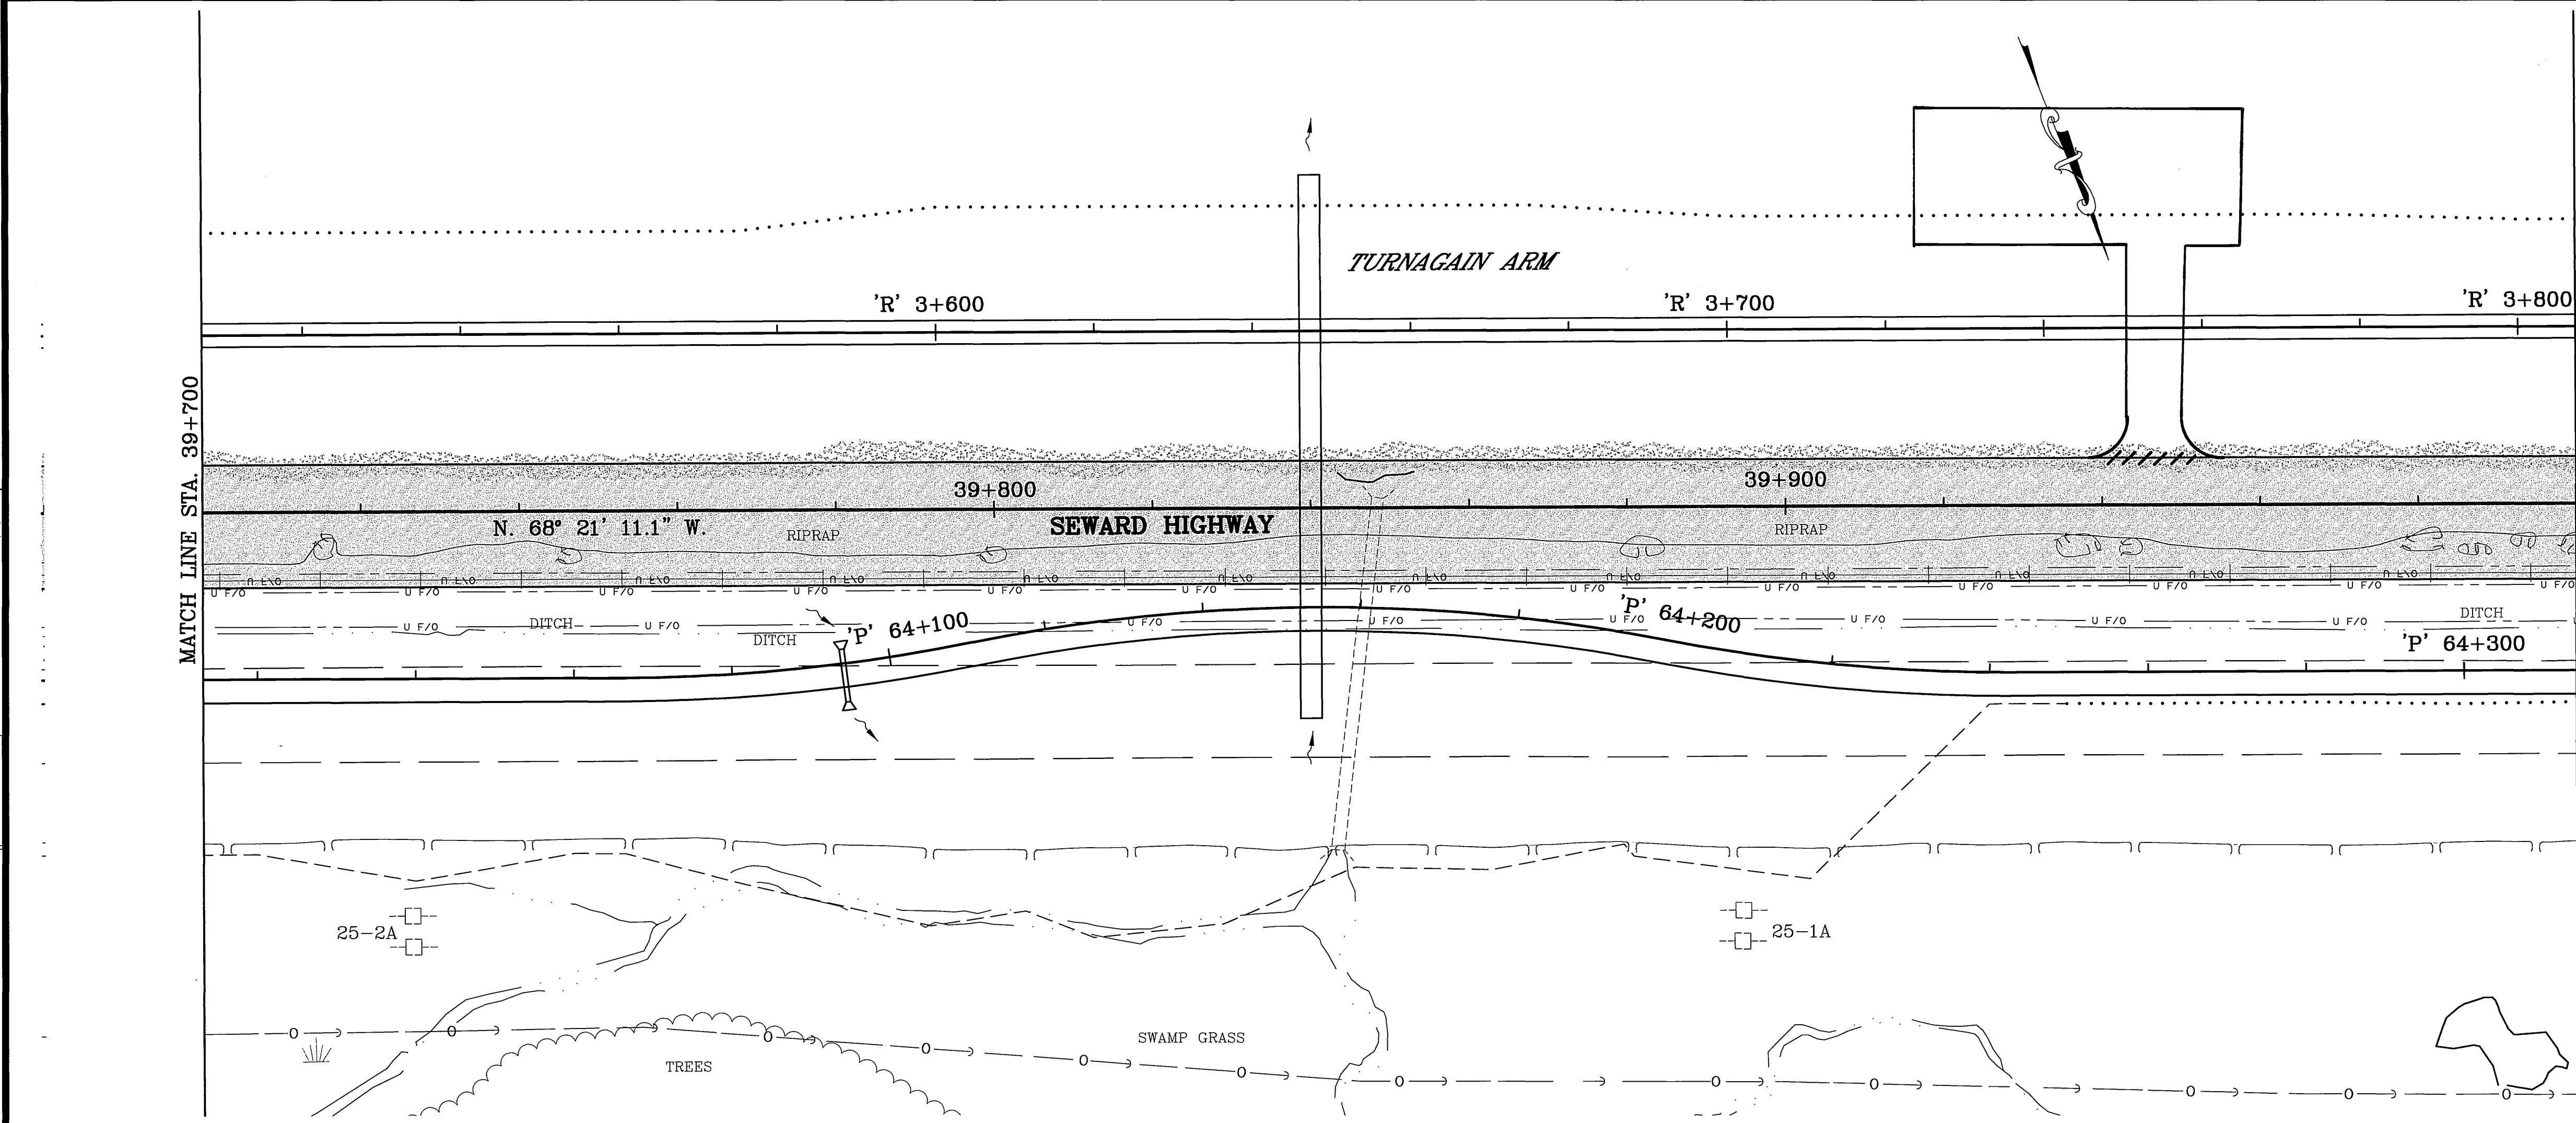

HYDROLOGICAL AND HYDRAULIC SUMMARY			
DRAINAGE AREA = 81 ha			
EXCEEDANCE PROBABILITY	2%	1%	REGULATORY FLOOD
RETURN PERIOD	50 YEAR (Q_{50})	100 YEAR (Q_{100})	N/A
DESIGN DISCHARGE	1.02 m ³ /S	1.19 m ³ /S	N/A
DESIGN HIGHWATER ELEVATION	5.70 m	5.70 m	N/A
ANTICIPATED ADDITIONAL BACKWATER = 0.0 mm AT Q_{100}			

MATCH LINE STA. 40+000

SHEET NO.	TOTAL SHEETS	
F 10	F 13	
STATE	YEAR	
ALASKA	2002	
PROJECT DESIGNATION		
NH-0A3-1(28)		
ADDENDUM NO.		
ATTACHMENT NO.		
REVISIONS		
NO.	DATE	DESCRIPTION

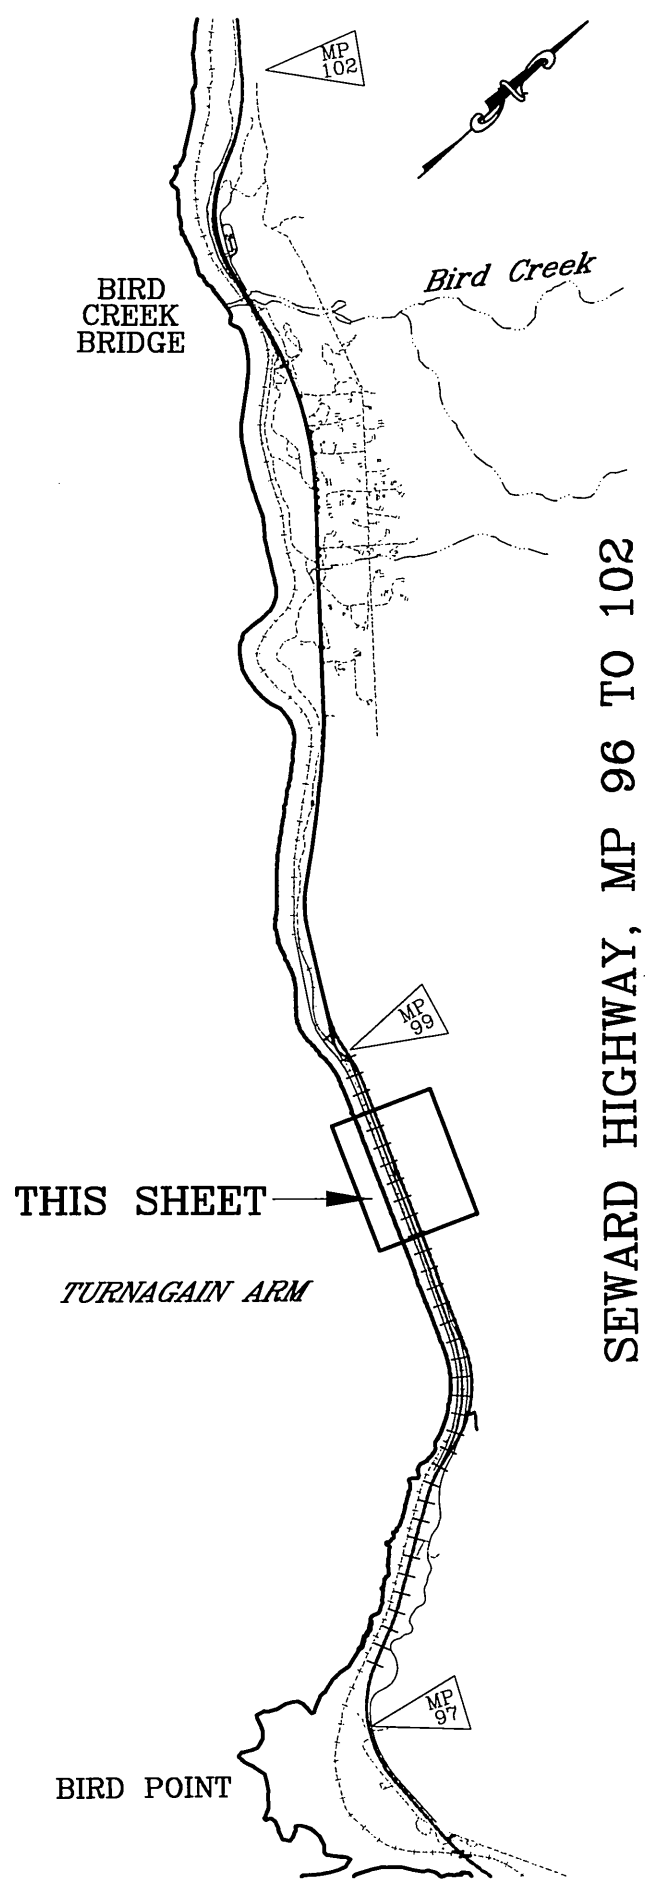


NOTE:
DIMENSIONS ARE IN METERS
UNLESS OTHERWISE NOTED.

STATE OF ALASKA
49TH
JUDY L. DOUGHERTY
CE 8823
4-18-02
REGISTERED PROFESSIONAL ENGINEER

STATE OF ALASKA
DEPARTMENT OF TRANSPORTATION
AND PUBLIC FACILITIES
SEWARD HIGHWAY
MP 96 TO MP 102
SAFETY, ROADWAY AND
RECREATIONAL IMPROVEMENTS
BIRD FLATS AREA
HIGHWAY
PLAN AND PROFILE

SPECIFICATIONS	DESIGNED BY	8/8/01
SCALE 1"=40'	CHECKED BY	
COMPUTER DESIGN	DATE	
	VIEW- HALF	
	DATE	

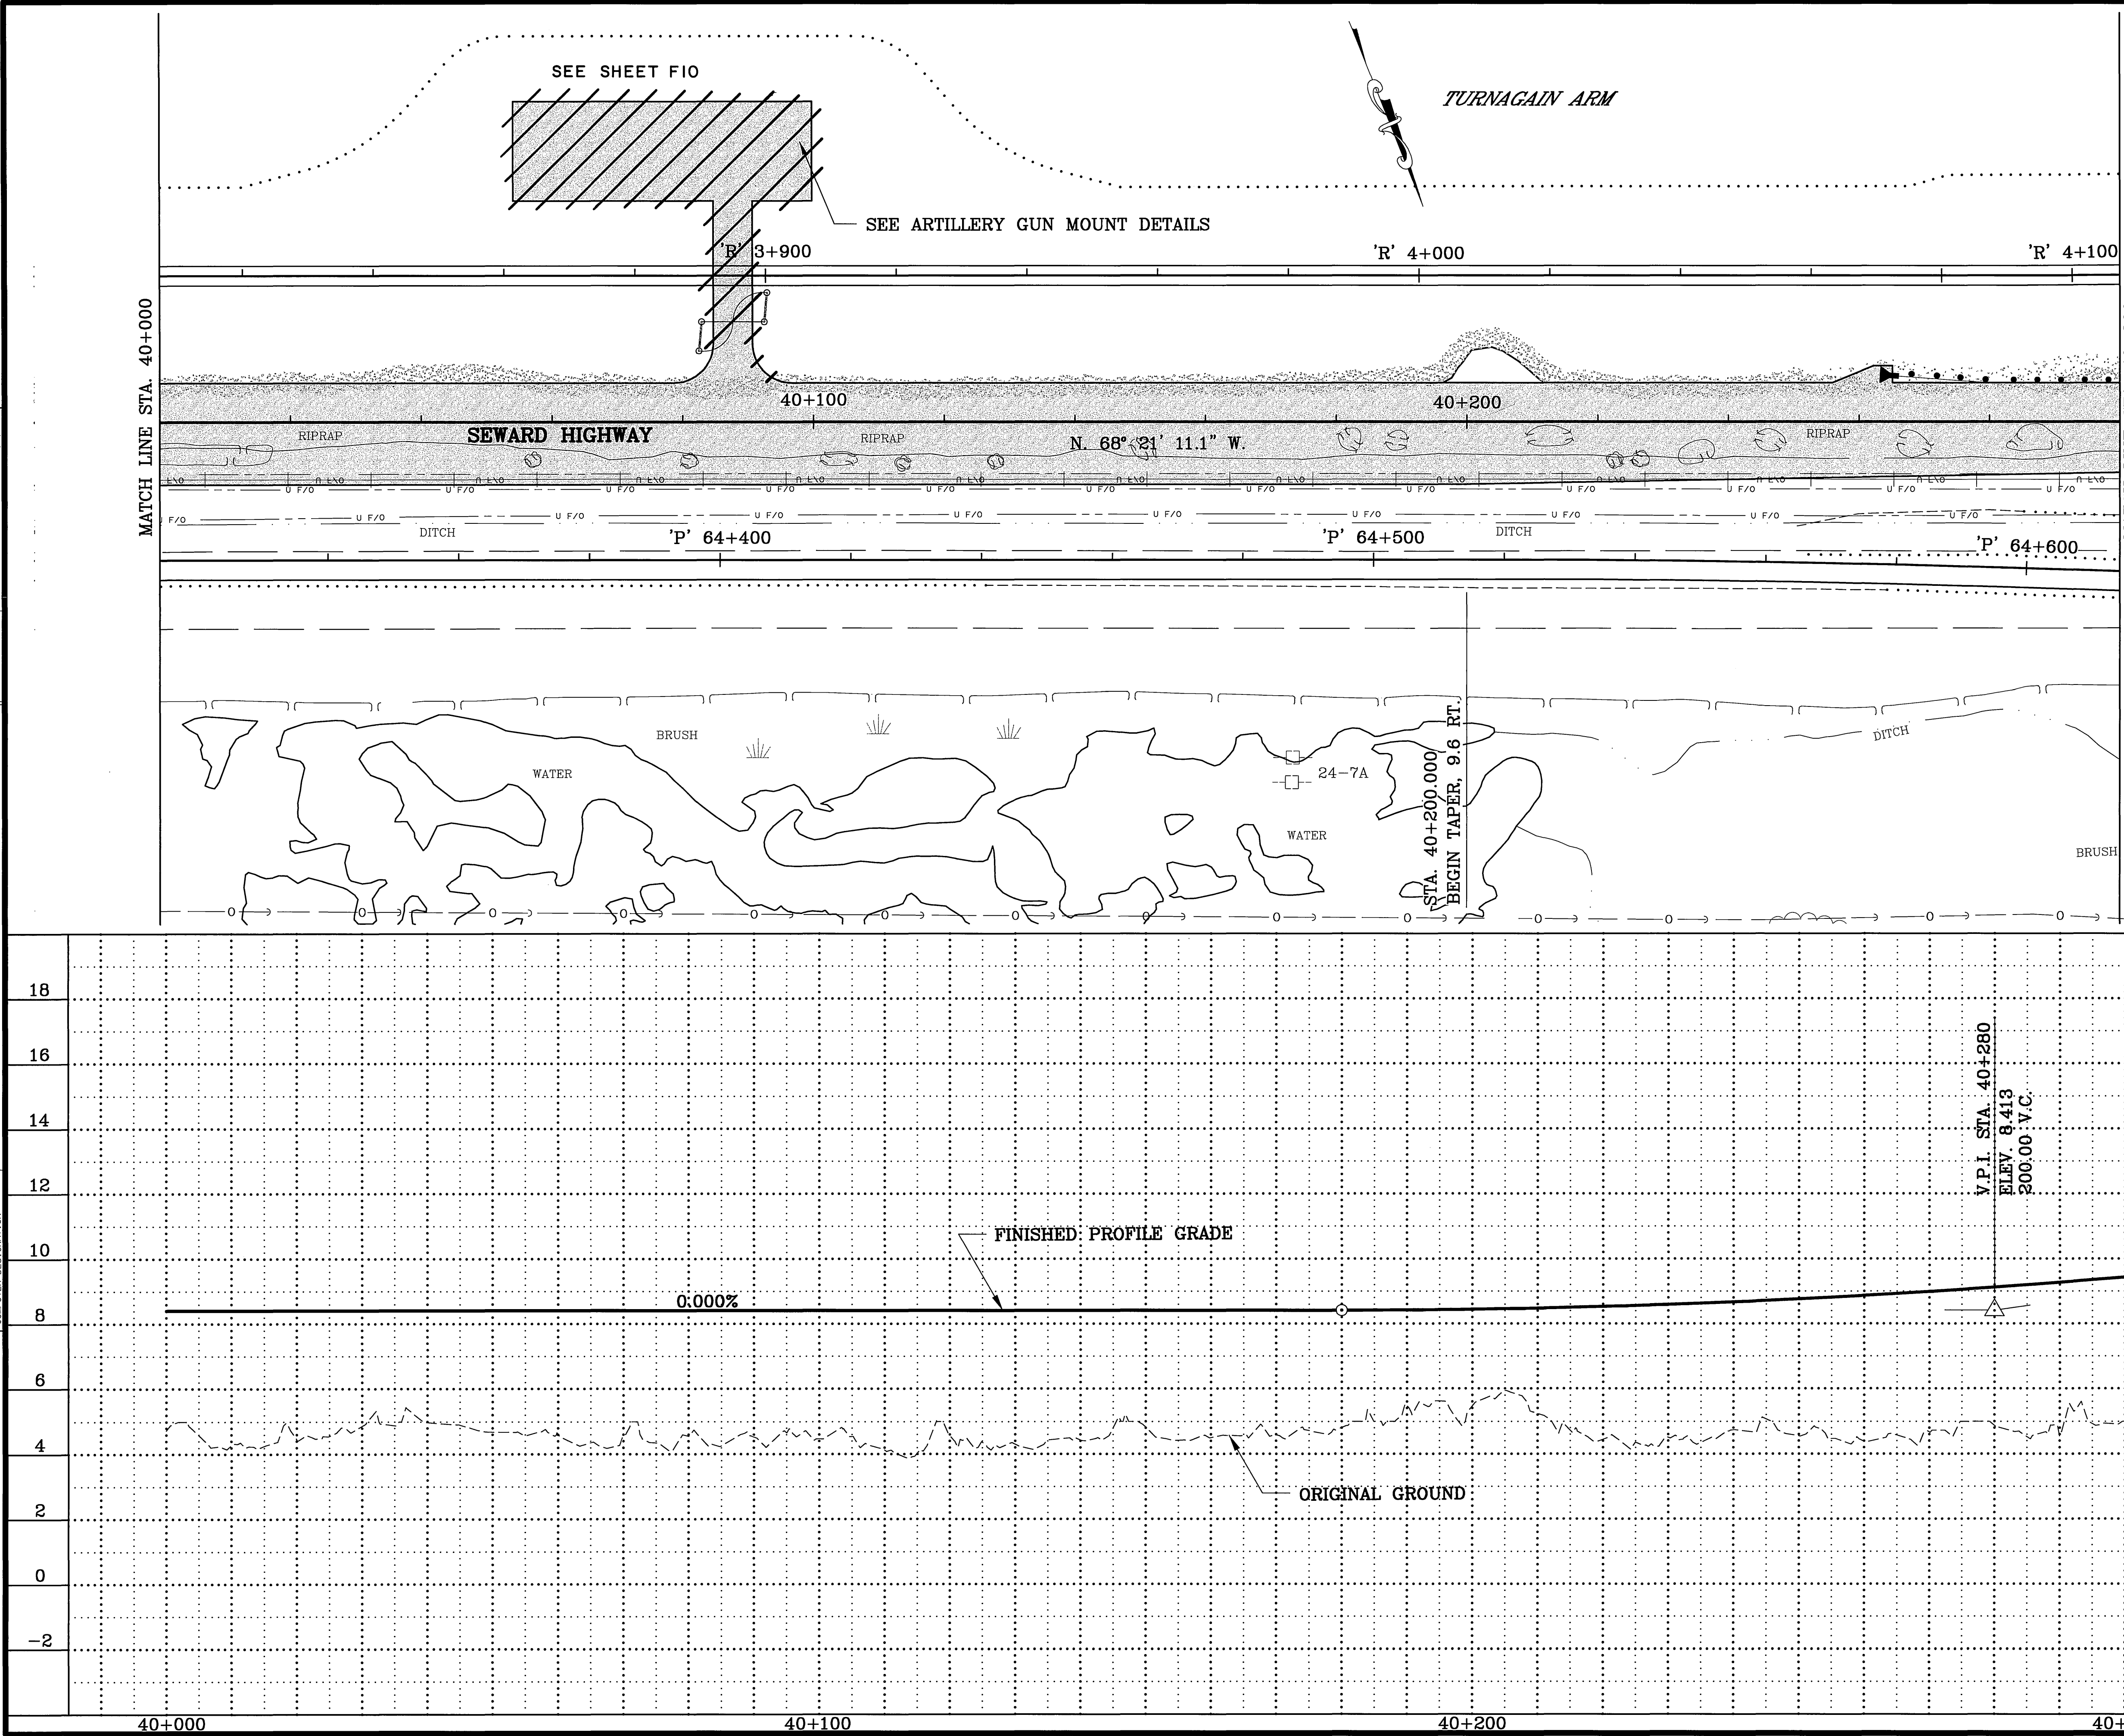

SHEET NO.	TOTAL SHEETS	
F11	F13	
STATE	YEAR	
ALASKA	2002	
PROJECT DESIGNATION		
NH-0A3-1(28)		
ADDENDUM NO.		
ATTACHMENT NO.		
REVISIONS		
NO.	DATE	DESCRIPTION

THIS SHEET



SEWARD HIGHWAY, MP 96 TO 102

NOTE:
DIMENSIONS ARE IN METERS
UNLESS OTHERWISE NOTED.


STATE OF ALASKA
DEPARTMENT OF TRANSPORTATION
AND PUBLIC FACILITIES

SEWARD HIGHWAY
MP 96 TO MP 102
SAFETY, ROADWAY AND
RECREATIONAL IMPROVEMENTS
BIRD FLATS AREA
HIGHWAY
PLAN AND PROFILE

DESIGNED BY	VIEW- HALE2	8/8/01
CHECKED BY	QW4	
DRAFTED BY		
SPECIFICATIONS	AUTOCAD-CRUISE-SSSOPRO\53577\7PP	
SCALE 1"=		
COMPUTER DESIGNATION		

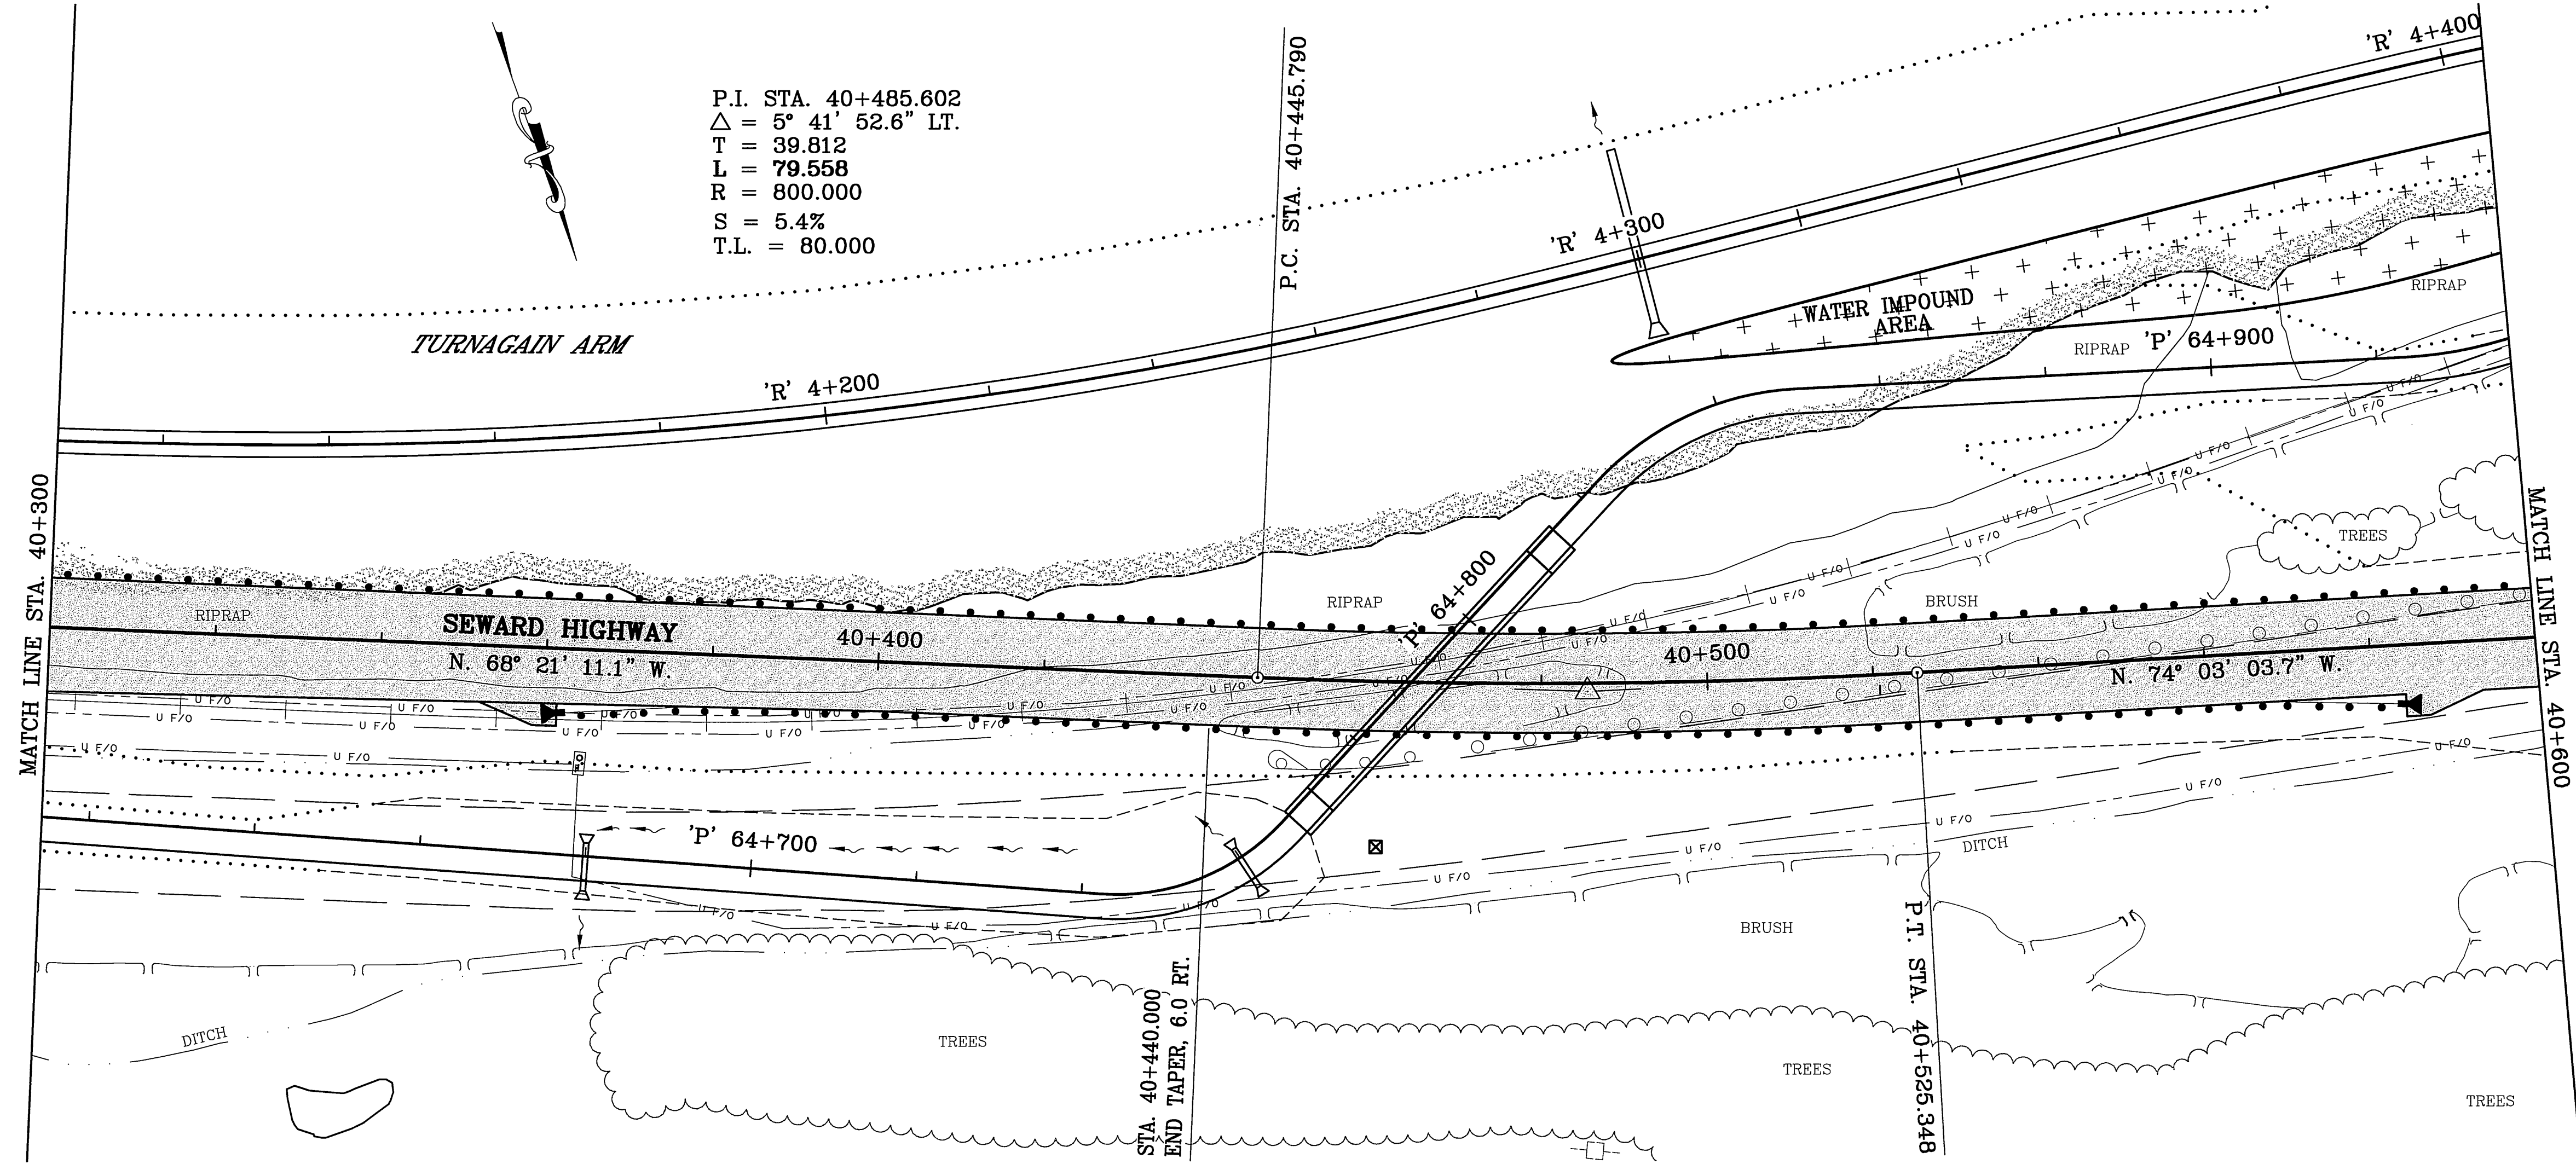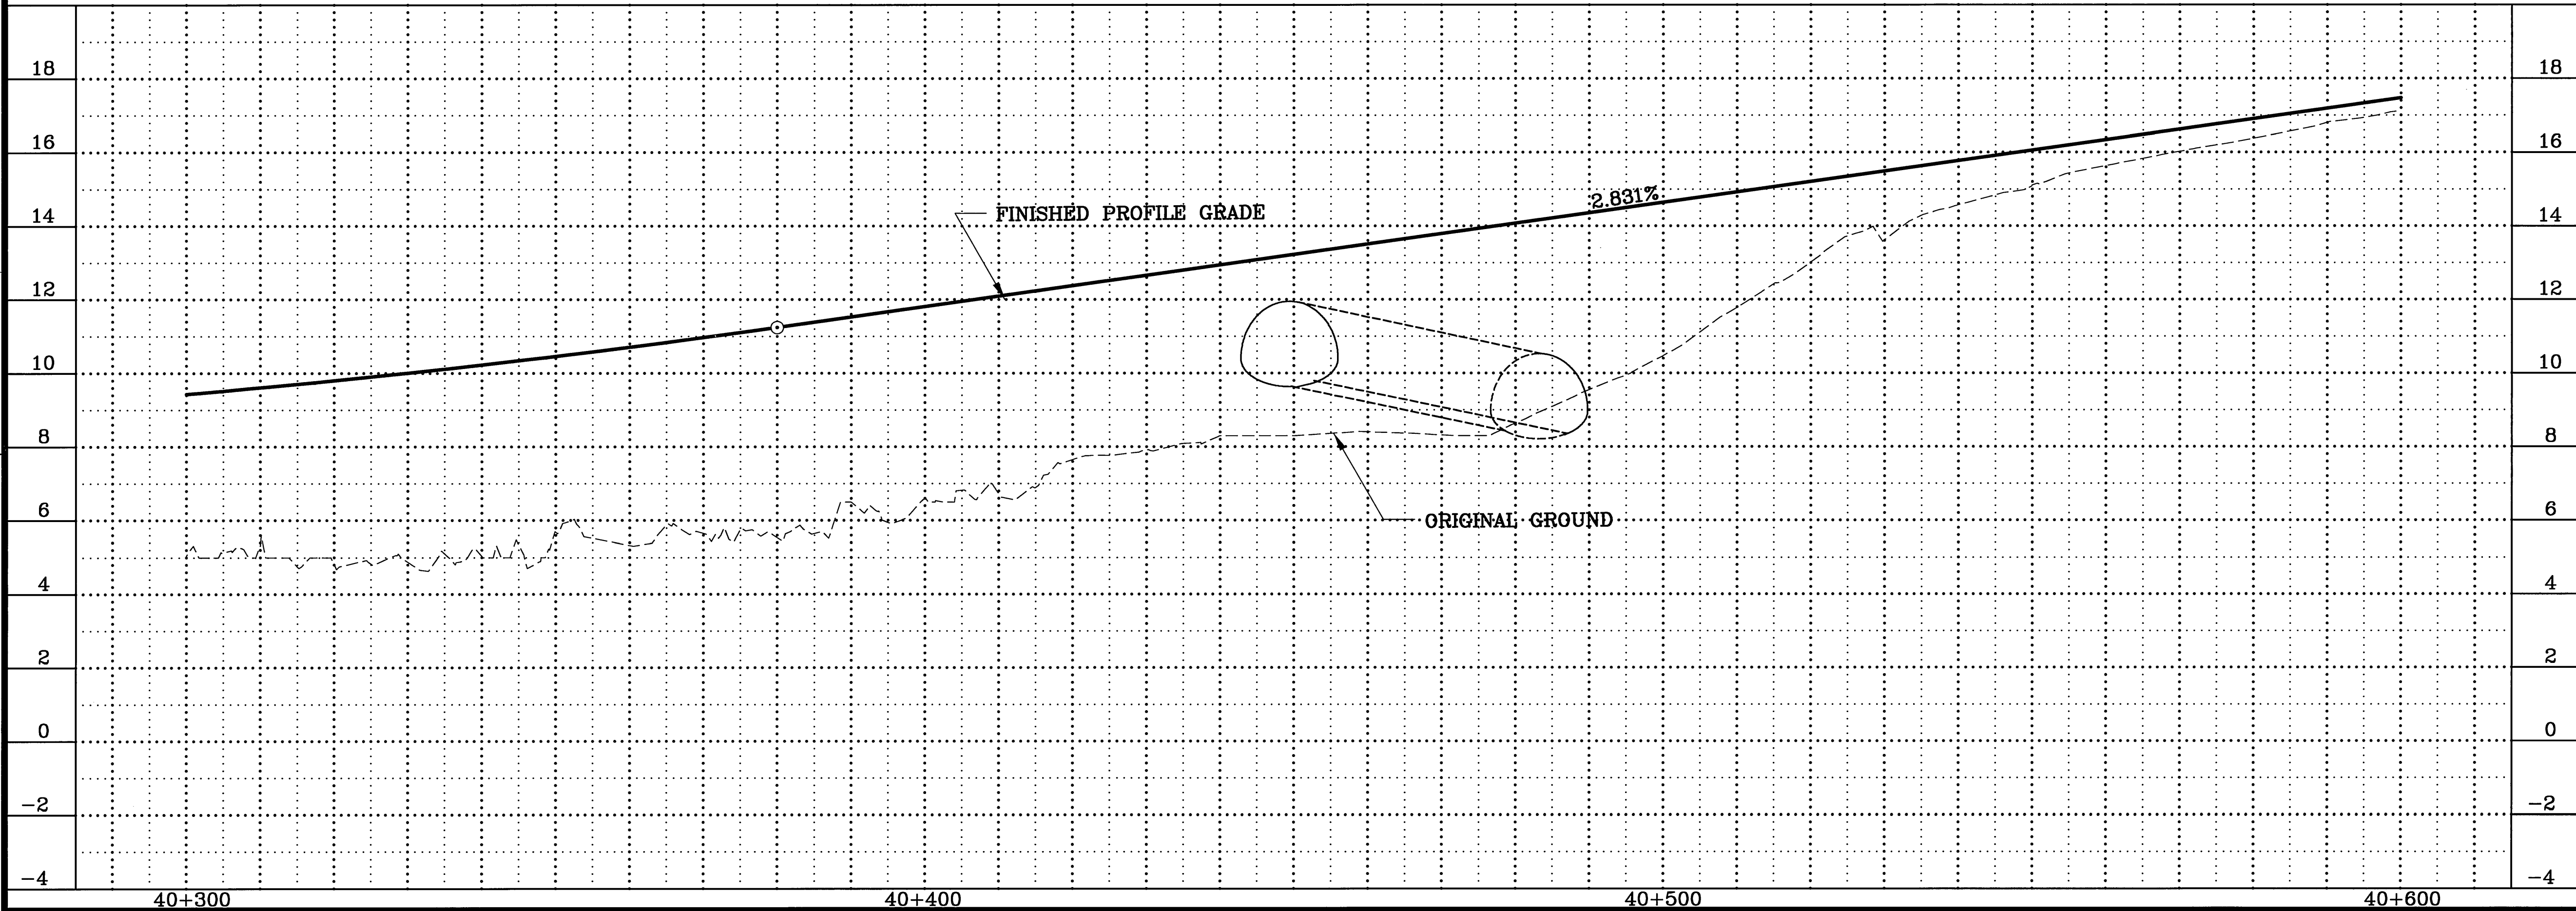

SHEET NO.	TOTAL SHEETS	
F12	F13	
STATE	YEAR	
ALASKA	2002	
PROJECT DESIGNATION		
NH-0A3-1(28)		
ADDENDUM NO.		
ATTACHMENT NO.		
REVISIONS		
NO.	DATE	DESCRIPTION

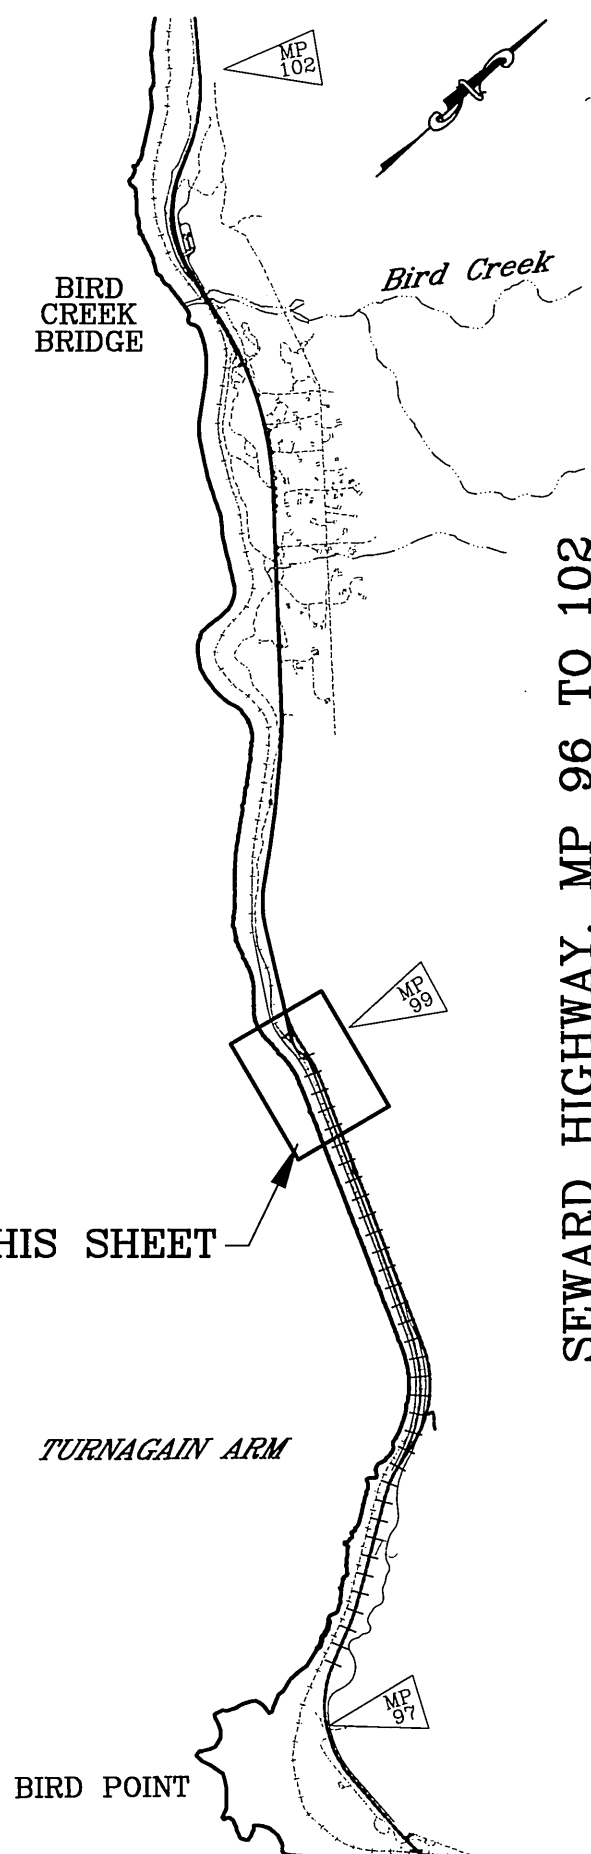

THIS SHEET

TURNAGAIN ARM


BIRD POINT

BIRD CREEK BRIDGE

Bird Creek

SEWARD HIGHWAY, MP 96 TO 102



NOTE:
DIMENSIONS ARE IN METERS
UNLESS OTHERWISE NOTED.

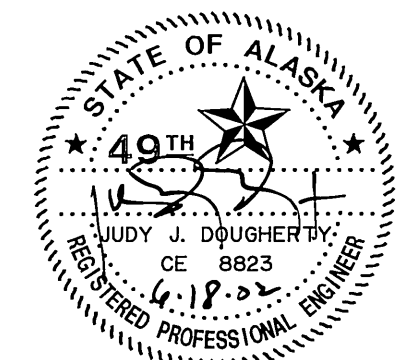


STATE OF ALASKA
DEPARTMENT OF TRANSPORTATION
AND PUBLIC FACILITIES

SEWARD HIGHWAY
MP 96 TO MP 102
SAFETY, ROADWAY AND
RECREATIONAL IMPROVEMENTS
BIRD FLATS AREA
HIGHWAY
PLAN AND PROFILE

DESIGNED BY: B/S/OI
CHECKED BY: KMH
DRAWN BY: KMH
SPECIFICATIONS: VIEW: HALF
AUTOCAD-CAROLEE: SSSPROJ\3577\77P
SCALE: 1"=1'
COMPUTER DESIGNATION:

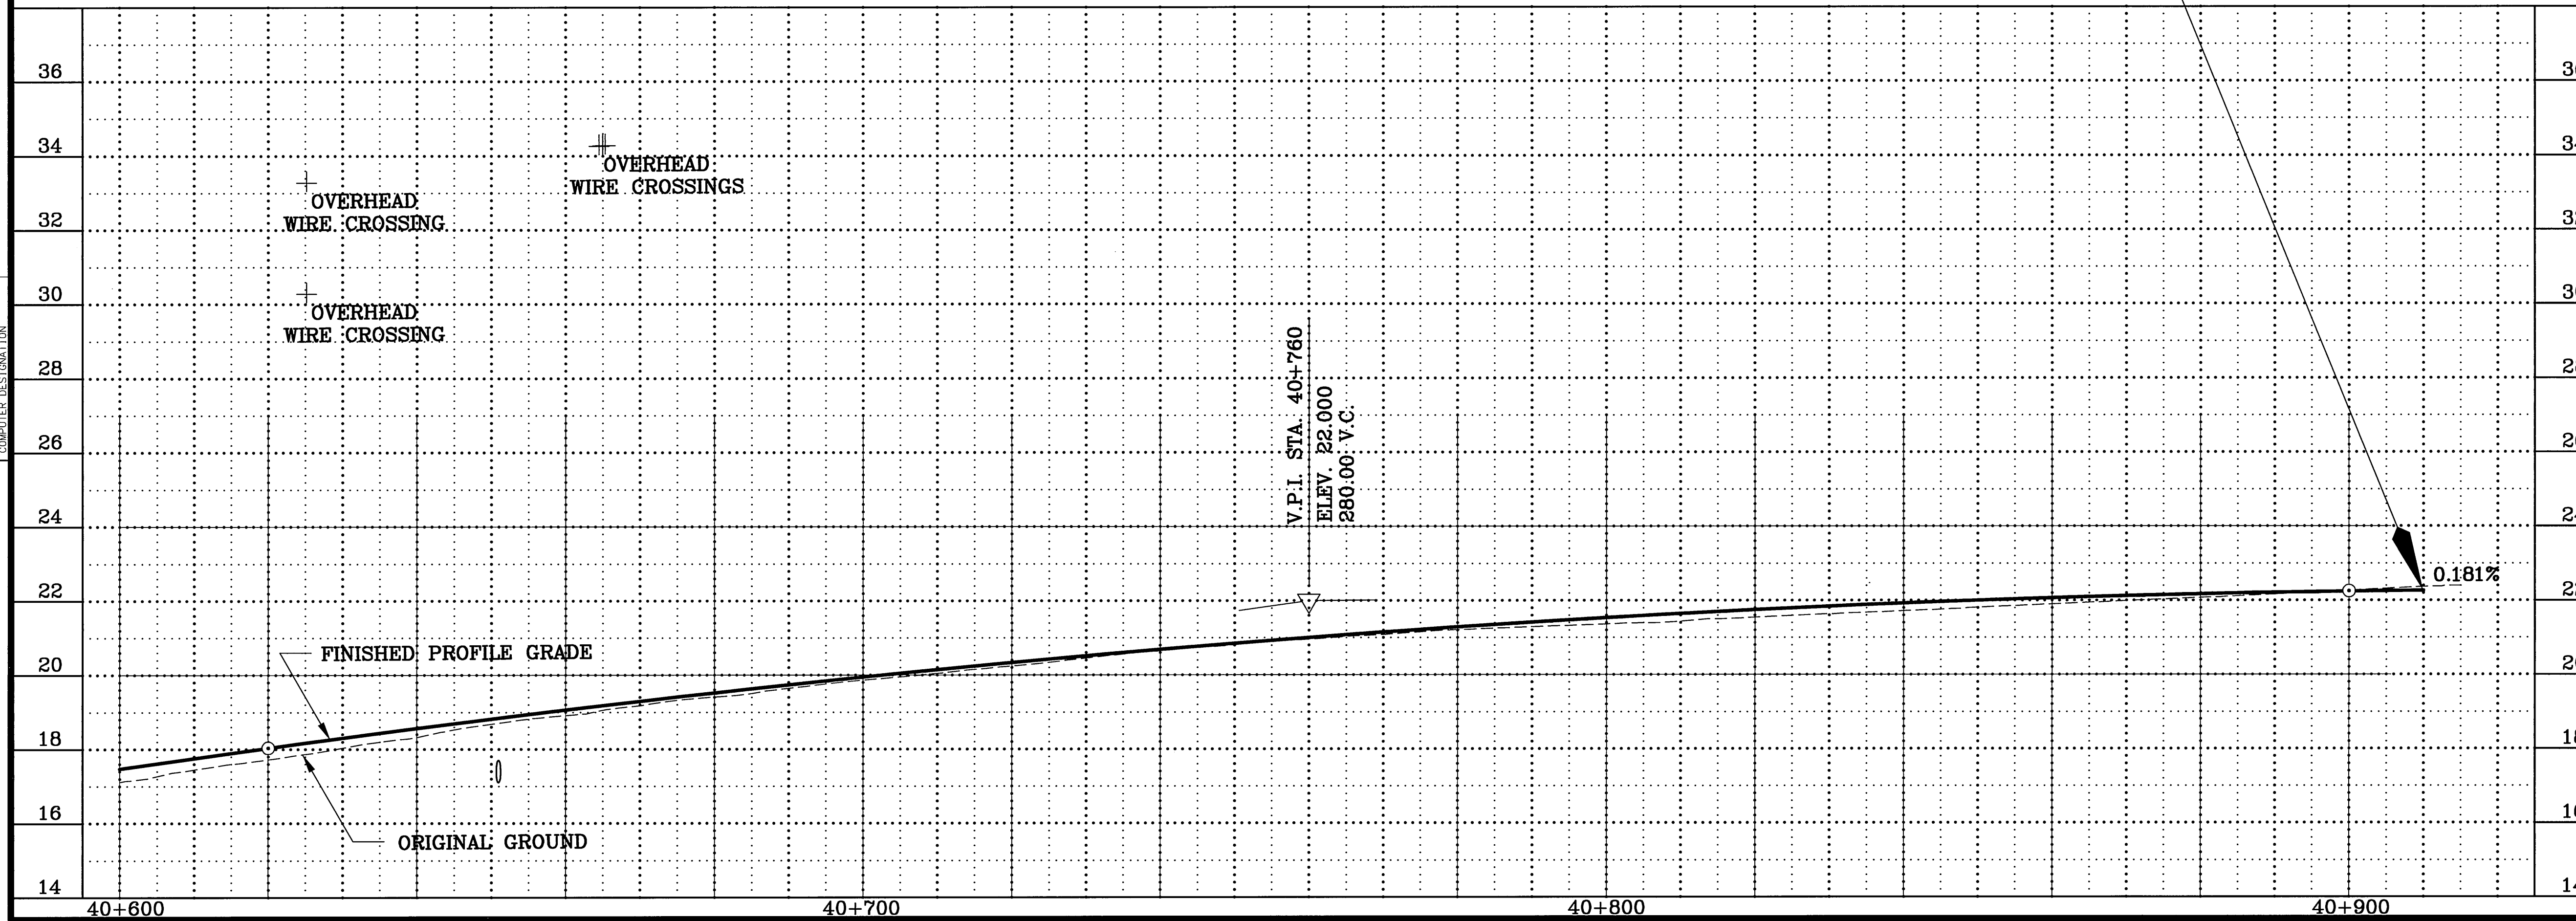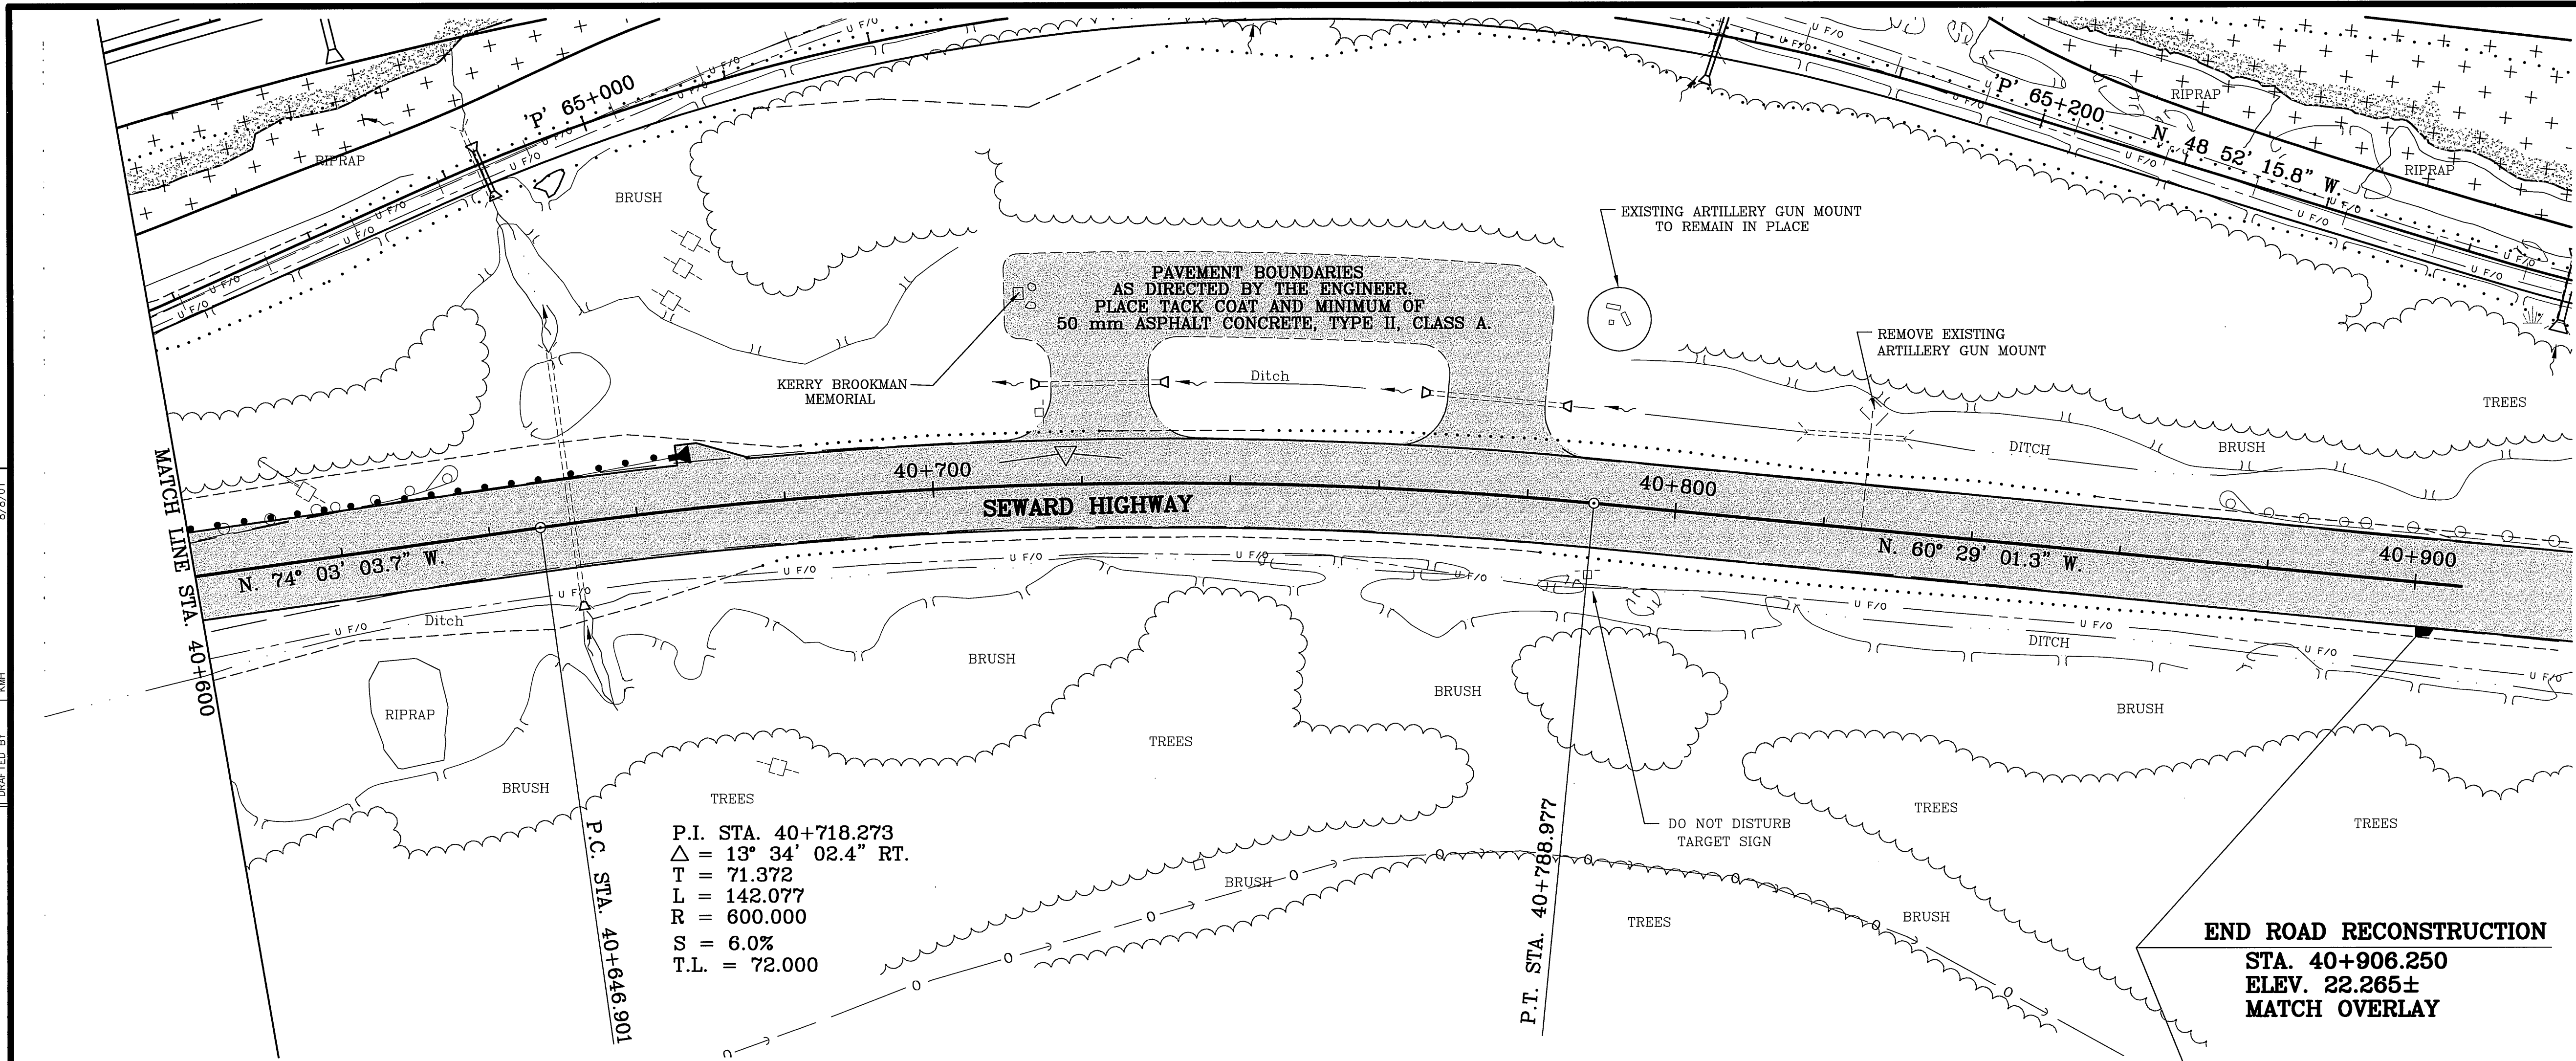


SHEET NO.	TOTAL SHEETS	
F13	F13	
STATE	YEAR	
ALASKA	2002	
PROJECT DESIGNATION		
NH-0A3-1(28)		
ADDENDUM NO.		
ATTACHMENT NO.		
REVISIONS		
NO.	DATE	DESCRIPTION

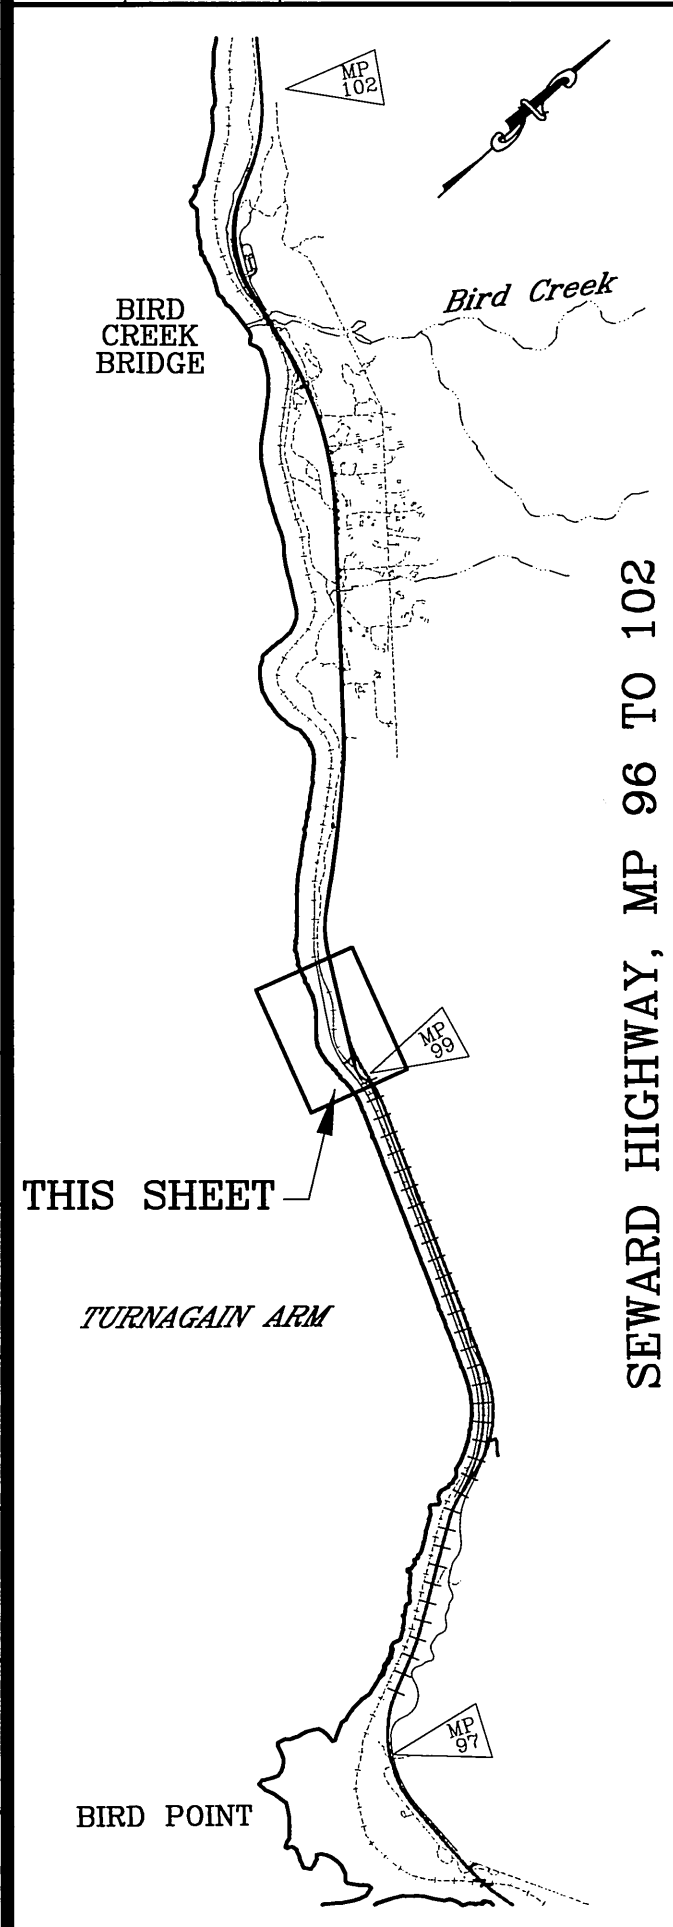



NOTE:
DIMENSIONS ARE IN METERS
UNLESS OTHERWISE NOTED.

STATE OF ALASKA
JUDY J. OUGHERTY
CE 8823
REGISTERED PROFESSIONAL ENGINEER

STATE OF ALASKA
DEPARTMENT OF TRANSPORTATION
AND PUBLIC FACILITIES
SEWARD HIGHWAY
MP 96 TO MP 102
SAFETY, ROADWAY AND
RECREATIONAL IMPROVEMENTS
BIRD FLATS AREA
HIGHWAY
PLAN AND PROFILE

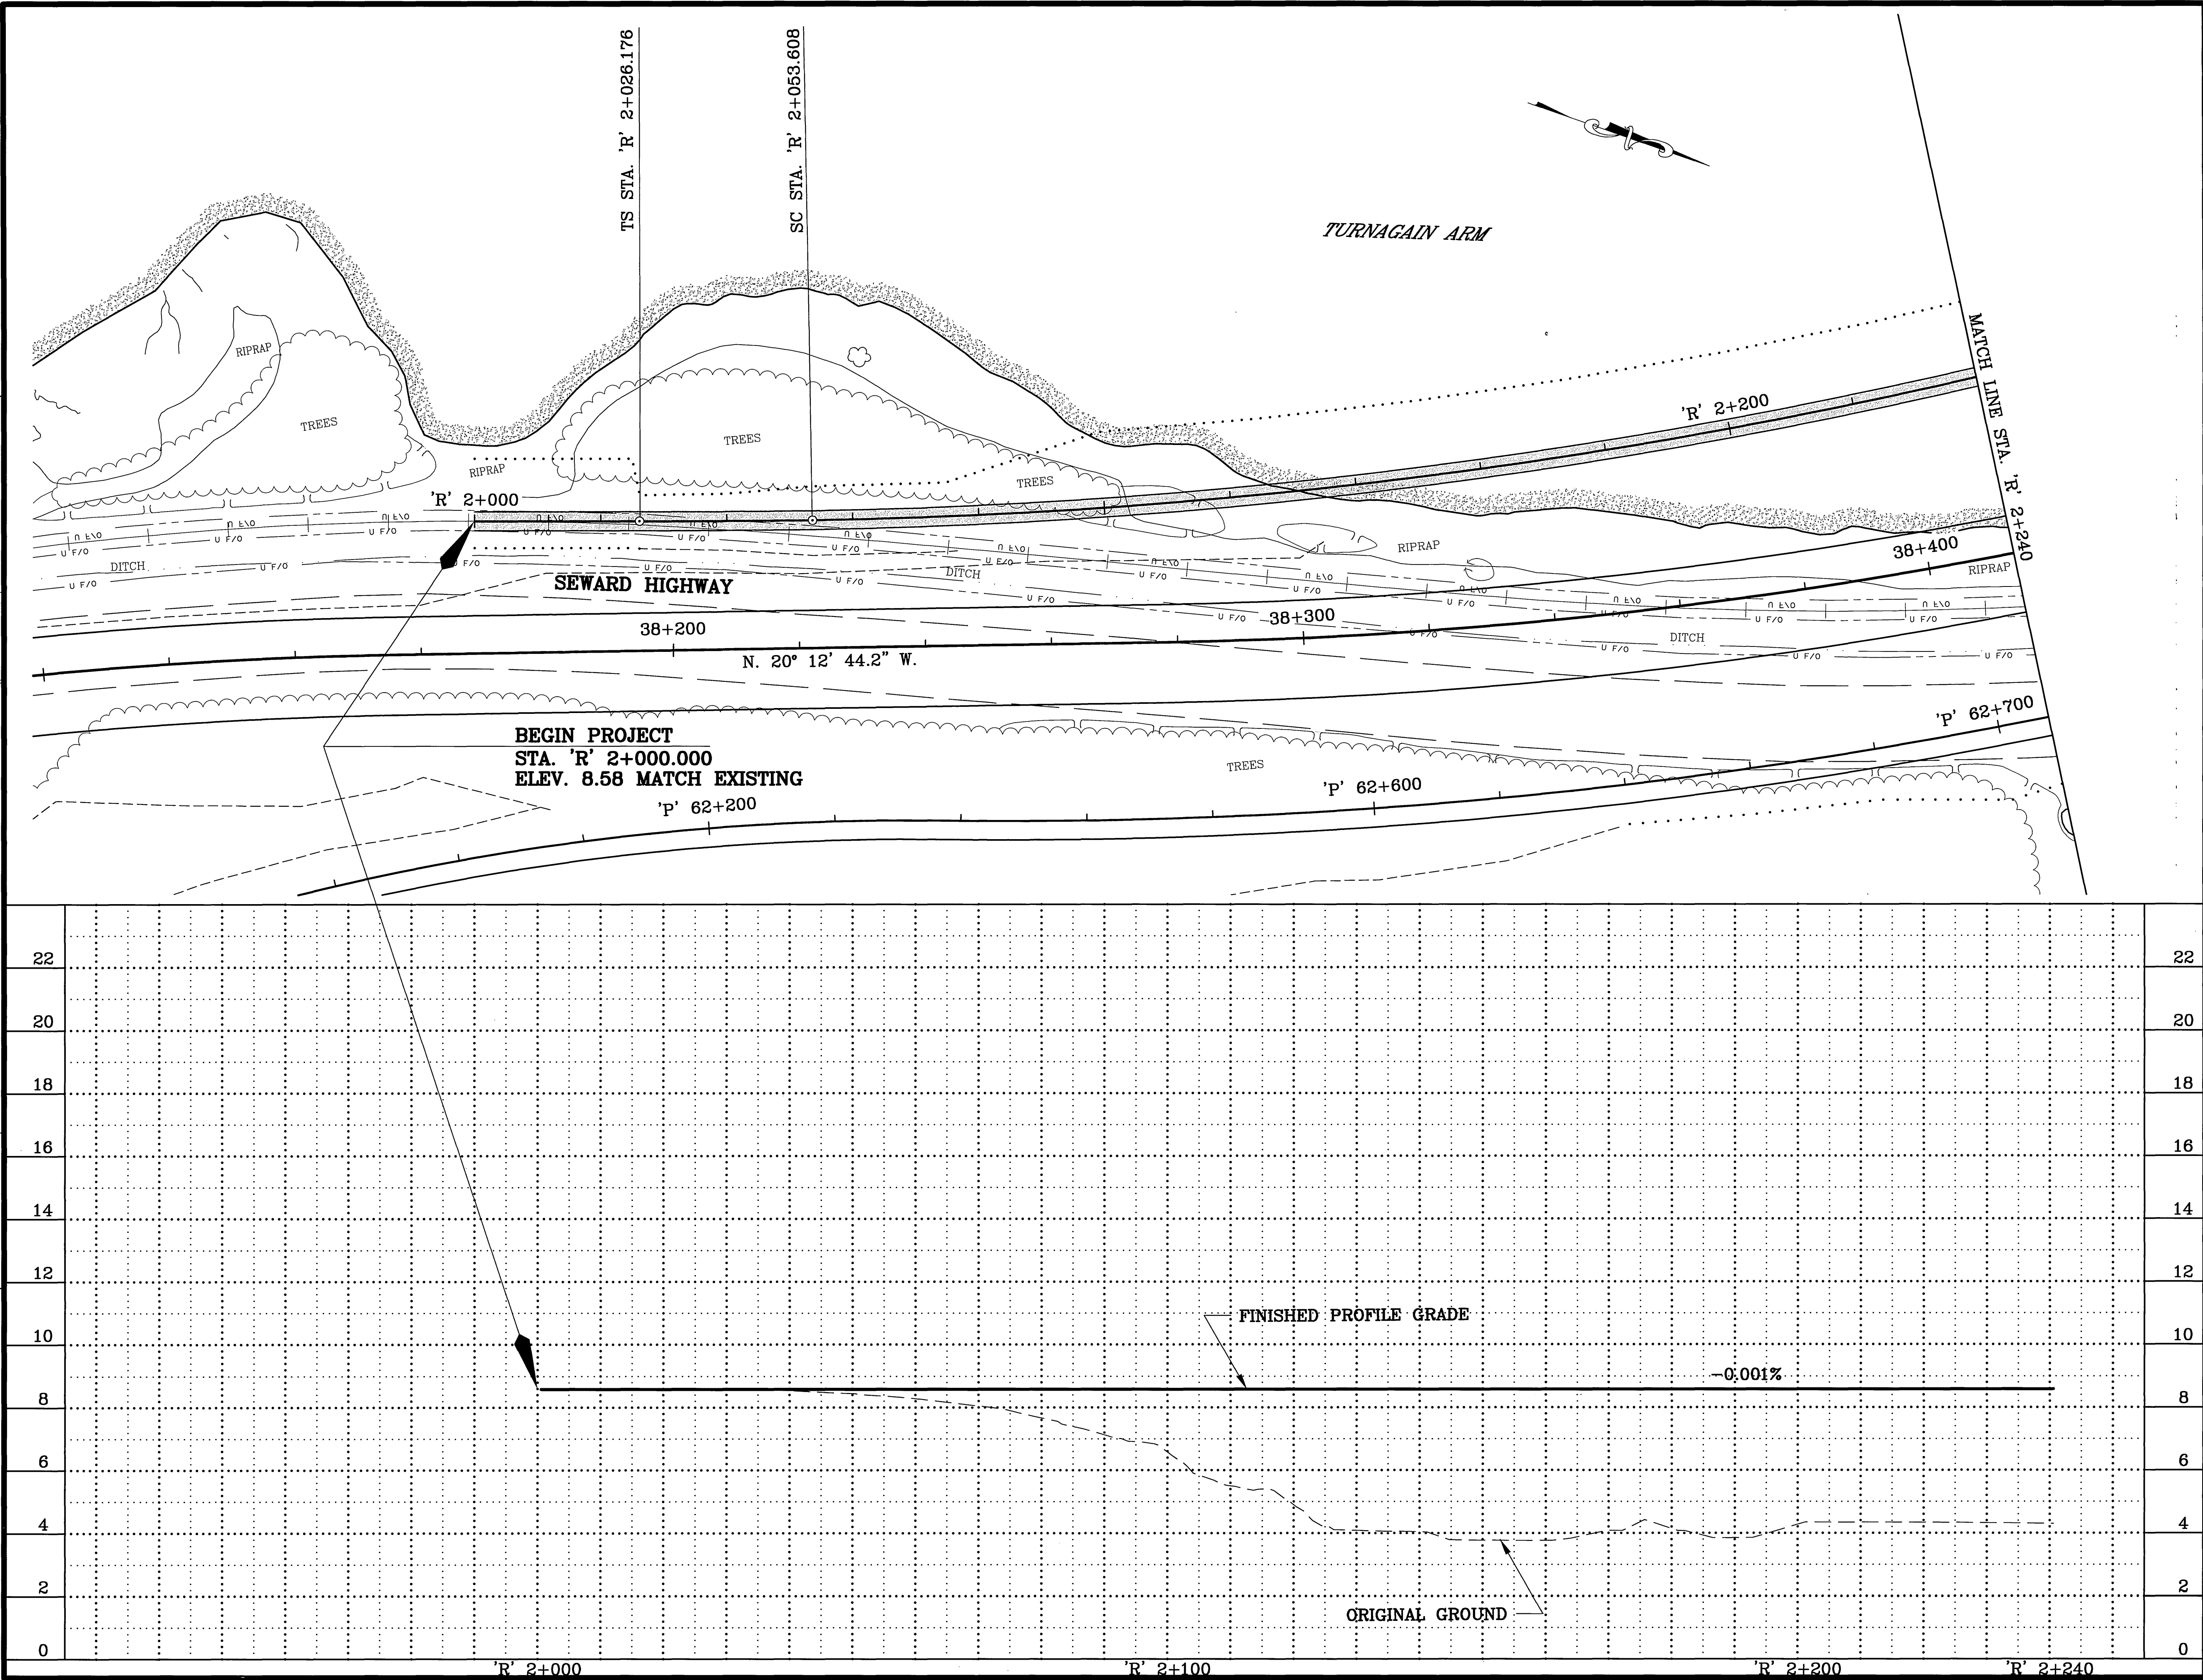[illegible]


DESIGNED BY
CHECKED BY
DATE
6/12/02
KMH
VIEW
HALF 200
AUTOCAD-CAROLEE SDB/PROJ/3577/7PP-
COMPUTER DESIGNATION

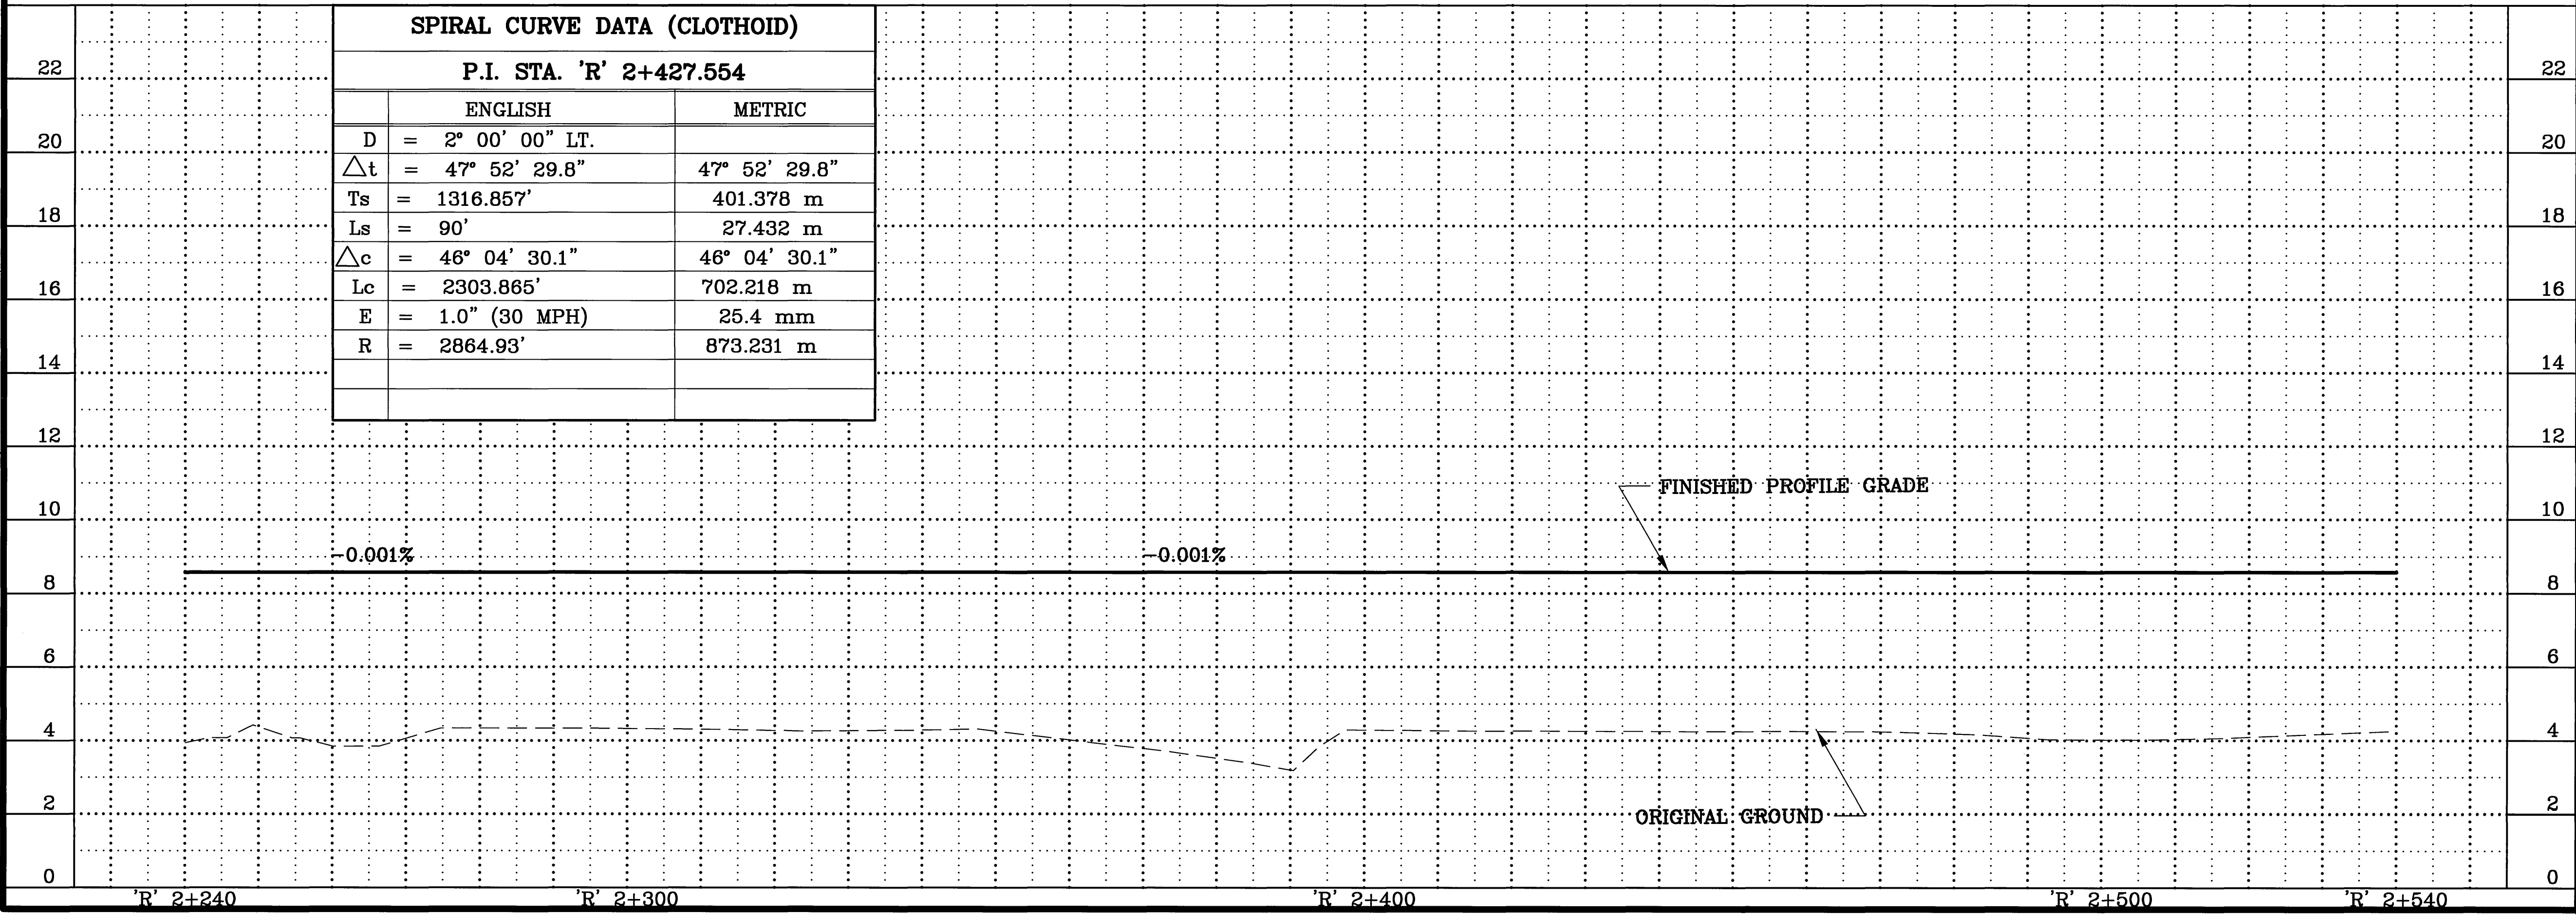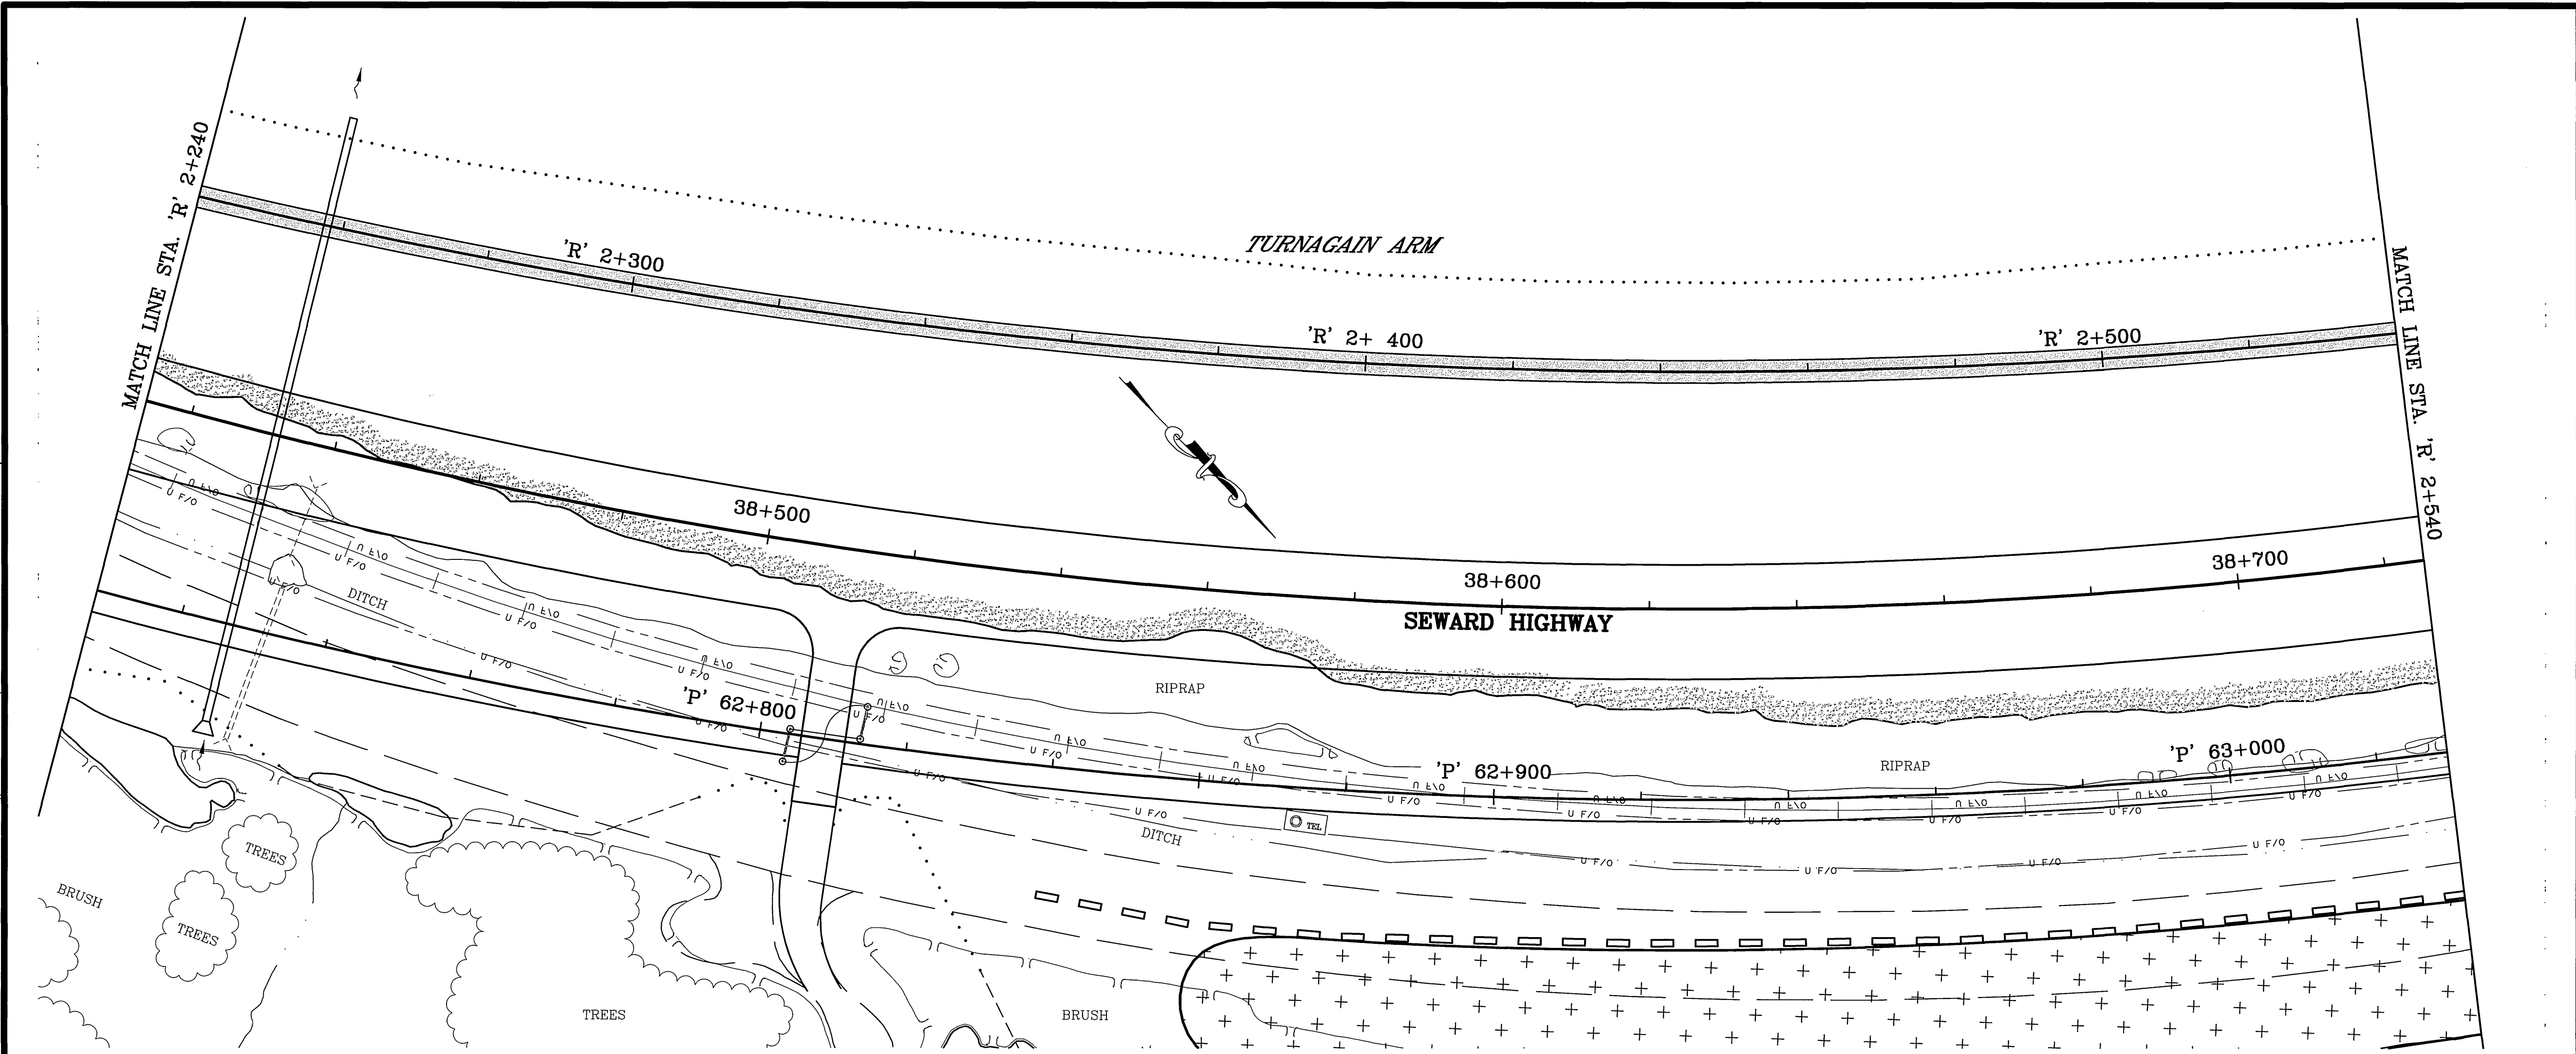

SHEET NO.	TOTAL SHEETS	
FR2	FR11	
STATE	YEAR	
ALASKA	2002	
PROJECT DESIGNATION		
NH-0A3-1(28)		
ADDENDUM NO.		
ATTACHMENT NO.		
REVISIONS		
NO.	DATE	DESCRIPTION


NOTE:
DIMENSIONS ARE IN METERS
UNLESS OTHERWISE NOTED.

STATE OF ALASKA
DEPARTMENT OF TRANSPORTATION
AND PUBLIC FACILITIES
SEWARD HIGHWAY
MP 96 TO MP 102
SAFETY, ROADWAY AND
RECREATIONAL IMPROVEMENTS
BIRD FLATS AREA
RAILROAD
PLAN AND PROFILE

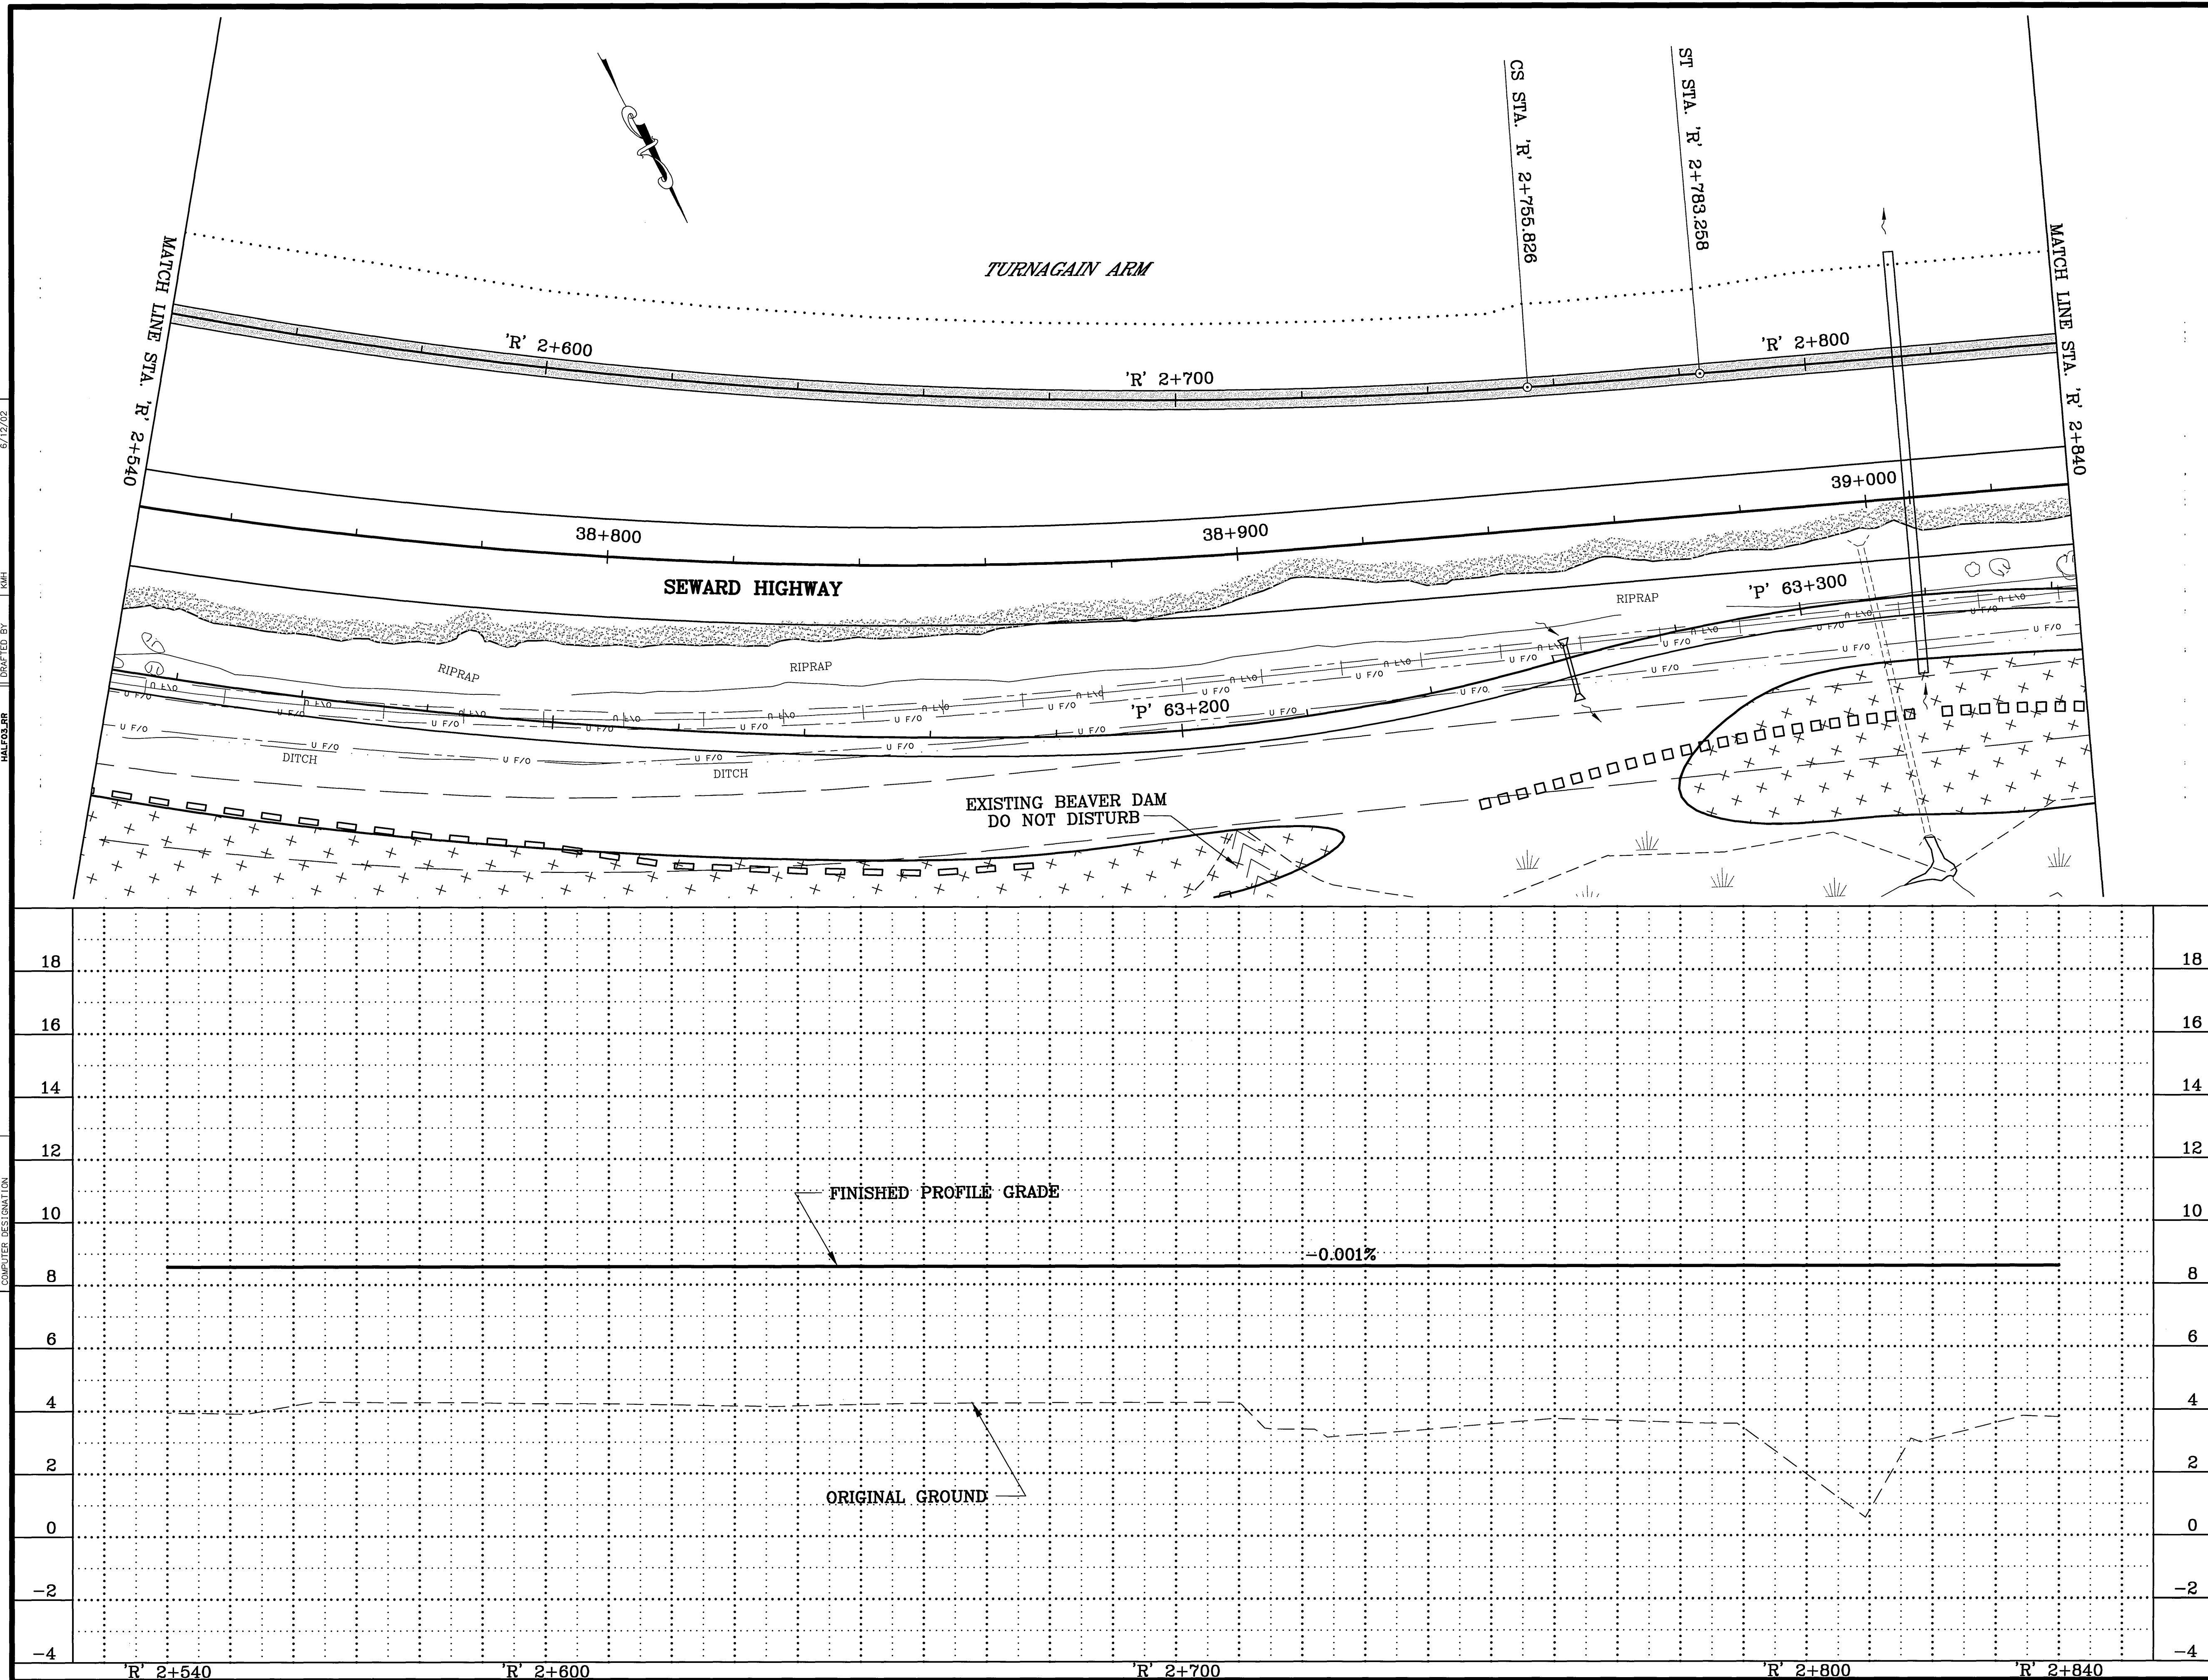

A detailed map of Seward Highway from milepost 96 to 102. The map is oriented vertically. At the top, a north arrow points towards the upper right. The highway runs from the bottom towards the top. At the bottom, it is labeled 'BIRD POINT'. Moving up, the highway is labeled 'TURNAGAIN ARM'. A rectangular box on the highway is labeled 'THIS SHEET' with an arrow pointing to it. Further up, the highway is labeled 'BIRD CREEK BRIDGE'. At the top, the highway is labeled 'SEWARD HIGHWAY, MP 96 TO 102'. A 'Bird Creek' flows into the highway from the right. Several milepost markers are shown: 'MP 96' at the bottom, 'MP 97' and 'MP 98' on the left side, and 'MP 102' at the top. The map shows various road features, including curves, bridges, and a junction with a road labeled 'RD 102'.

DESIGNED BY
CHECKED BY
DRAWN BY
DATE
VIEW#
HALFOUR
AUTOCAD-CARLEE SISKRO/AS3577/7PP-
SCALE 1/4" = 10'-0"
COMPUTER DESIGNATION

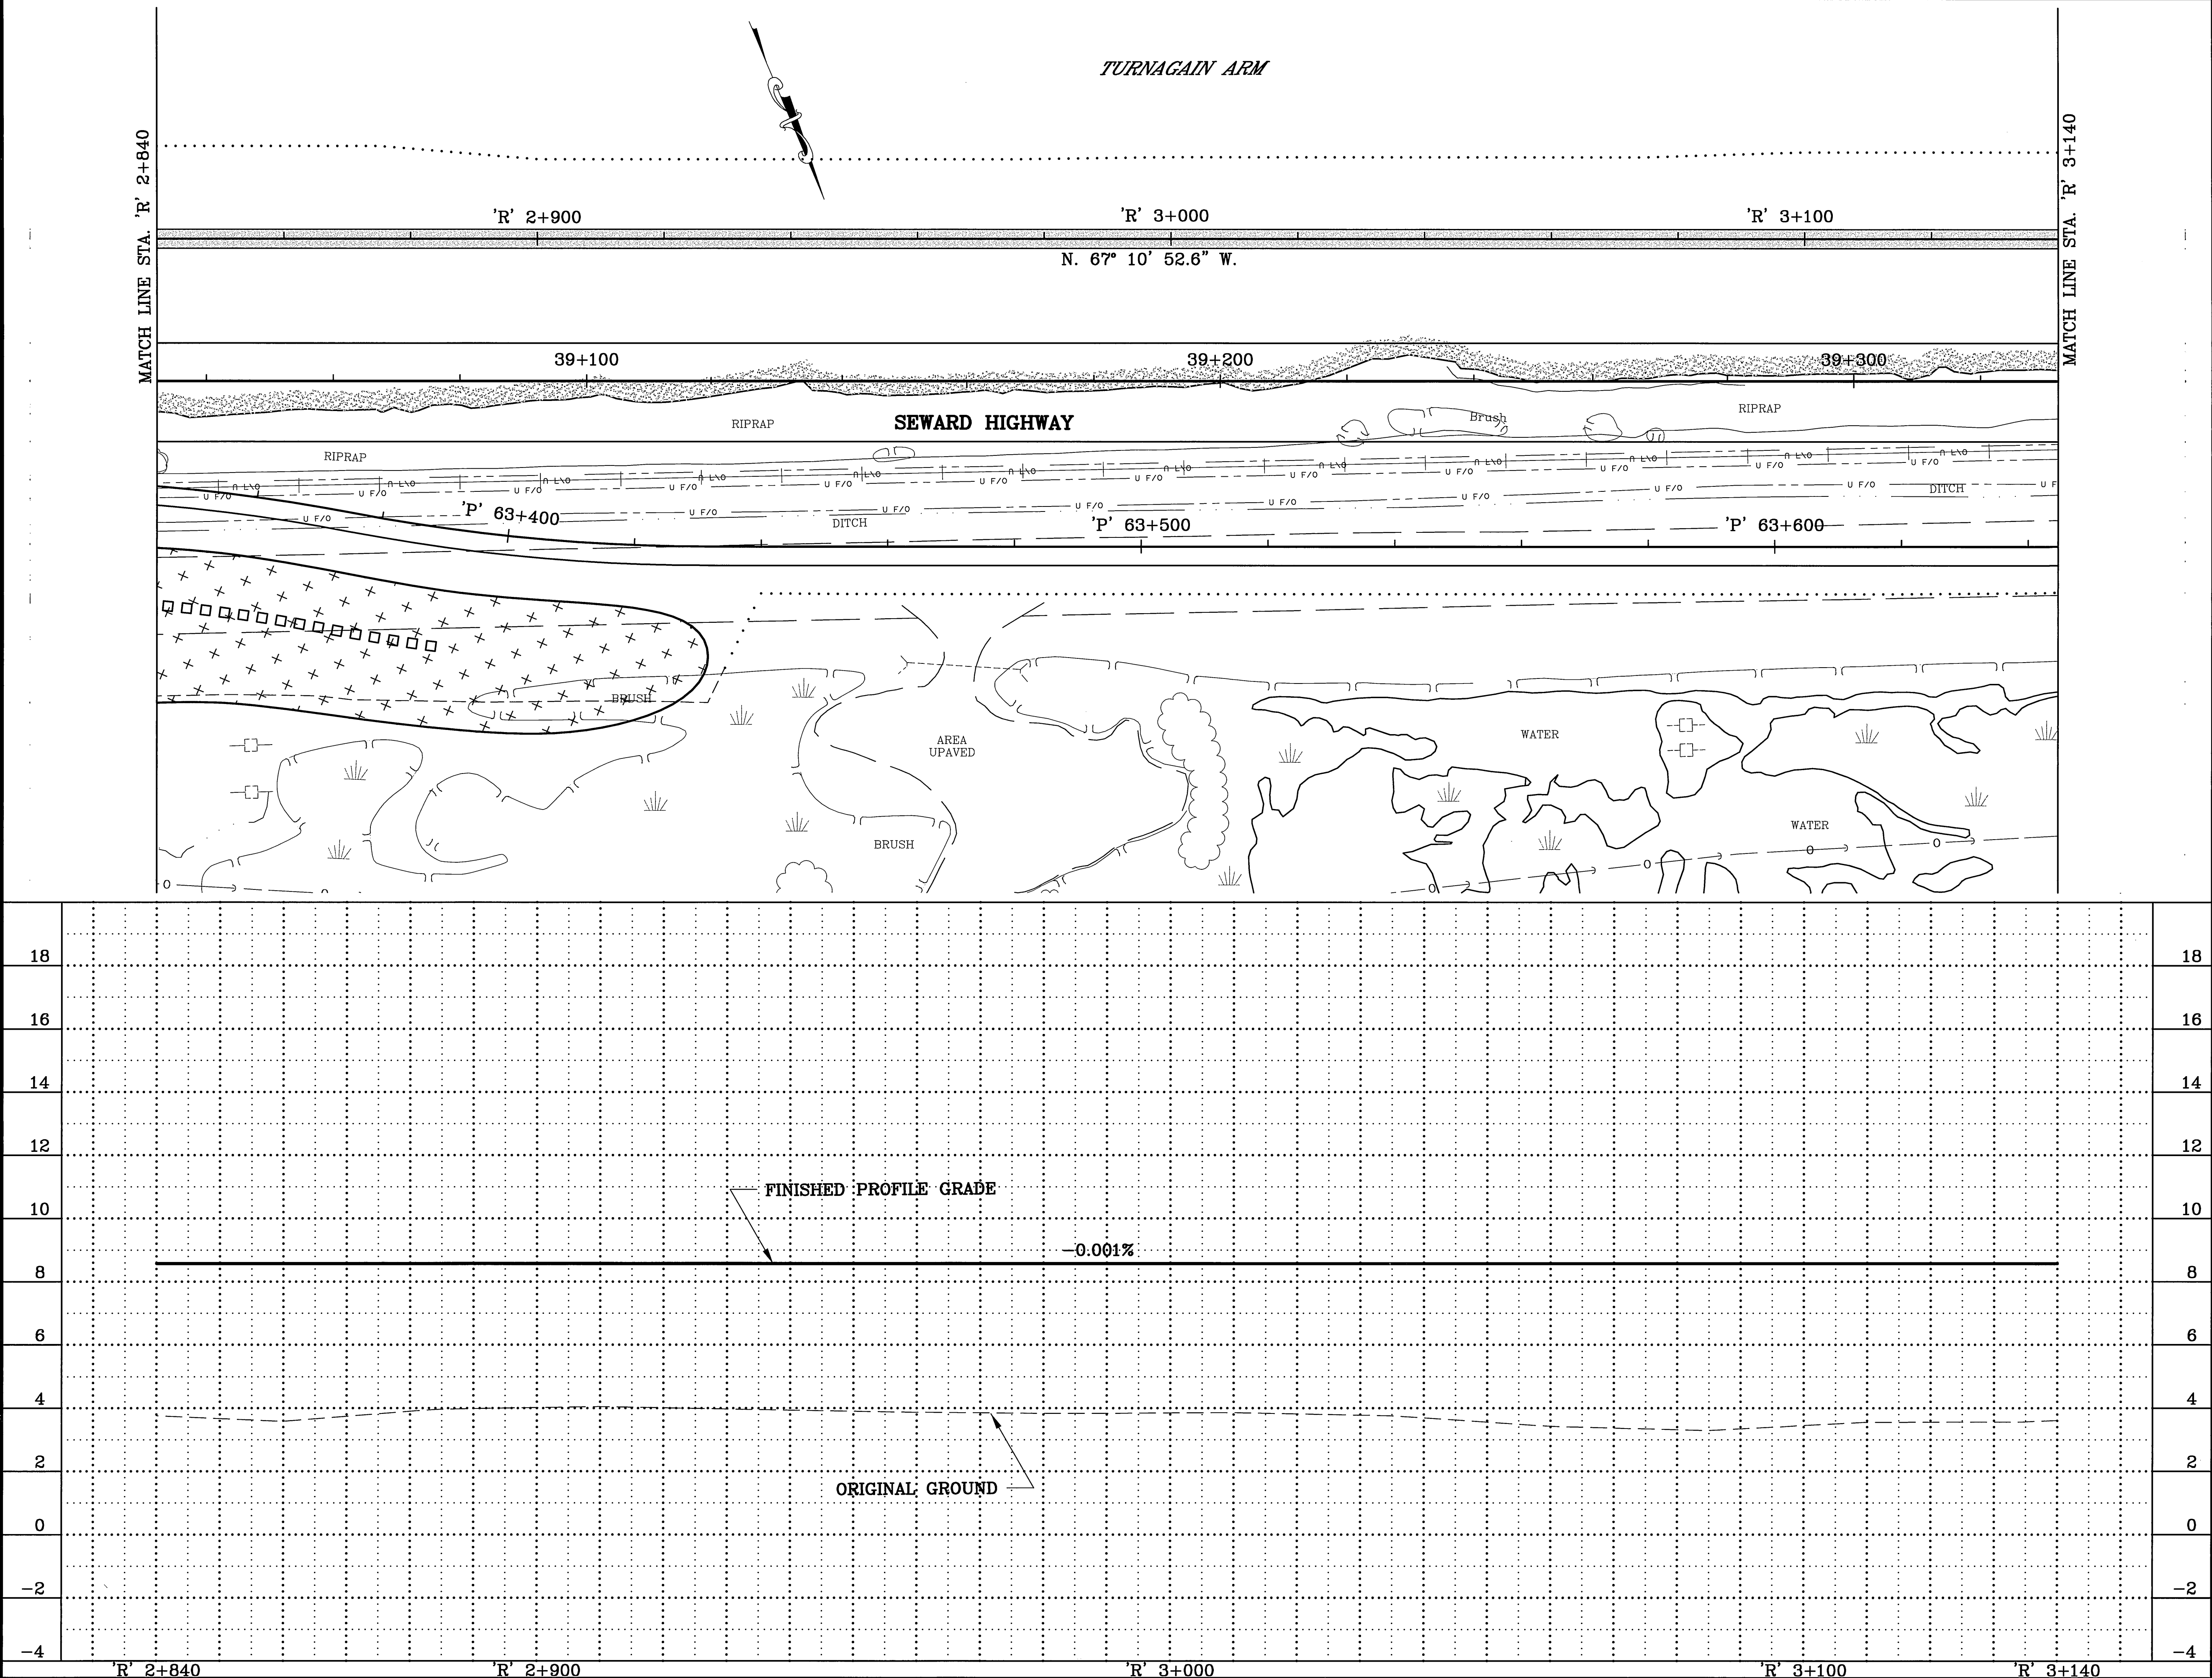

SHEET NO.	TOTAL SHEETS	
FR4	FR11	
STATE	YEAR	
ALASKA	2002	
PROJECT DESIGNATION		
NH-0A3-1(28)		
ADDENDUM NO.		
ATTACHMENT NO.		
REVISIONS		
NO.	DATE	DESCRIPTION

BIRD CREEK BRIDGE

Bird Creek

TURNAGAIN ARM

THIS SHEET

BIRD POINT


SEWARD HIGHWAY, MP 96 TO 102

NOTE:
DIMENSIONS ARE IN METERS
UNLESS OTHERWISE NOTED.



STATE OF ALASKA
DEPARTMENT OF TRANSPORTATION
AND PUBLIC FACILITIES
SEWARD HIGHWAY
MP 96 TO MP 102
SAFETY, ROADWAY AND
RECREATIONAL IMPROVEMENTS
BIRD FLATS AREA
RAILROAD
PLAN AND PROFILE

SPECIFICATIONS
SCALE 1"=100'
COMPUTER DESIGNATION
AUTOCAD-CARLEE/SISKPROJ/53577/77P-
VIEW-
HALFOUR
DESIGNED BY
CHECKED BY
DRAWN BY
DATE
6/12/02

MATCH LINE STA. 'R' 3+140

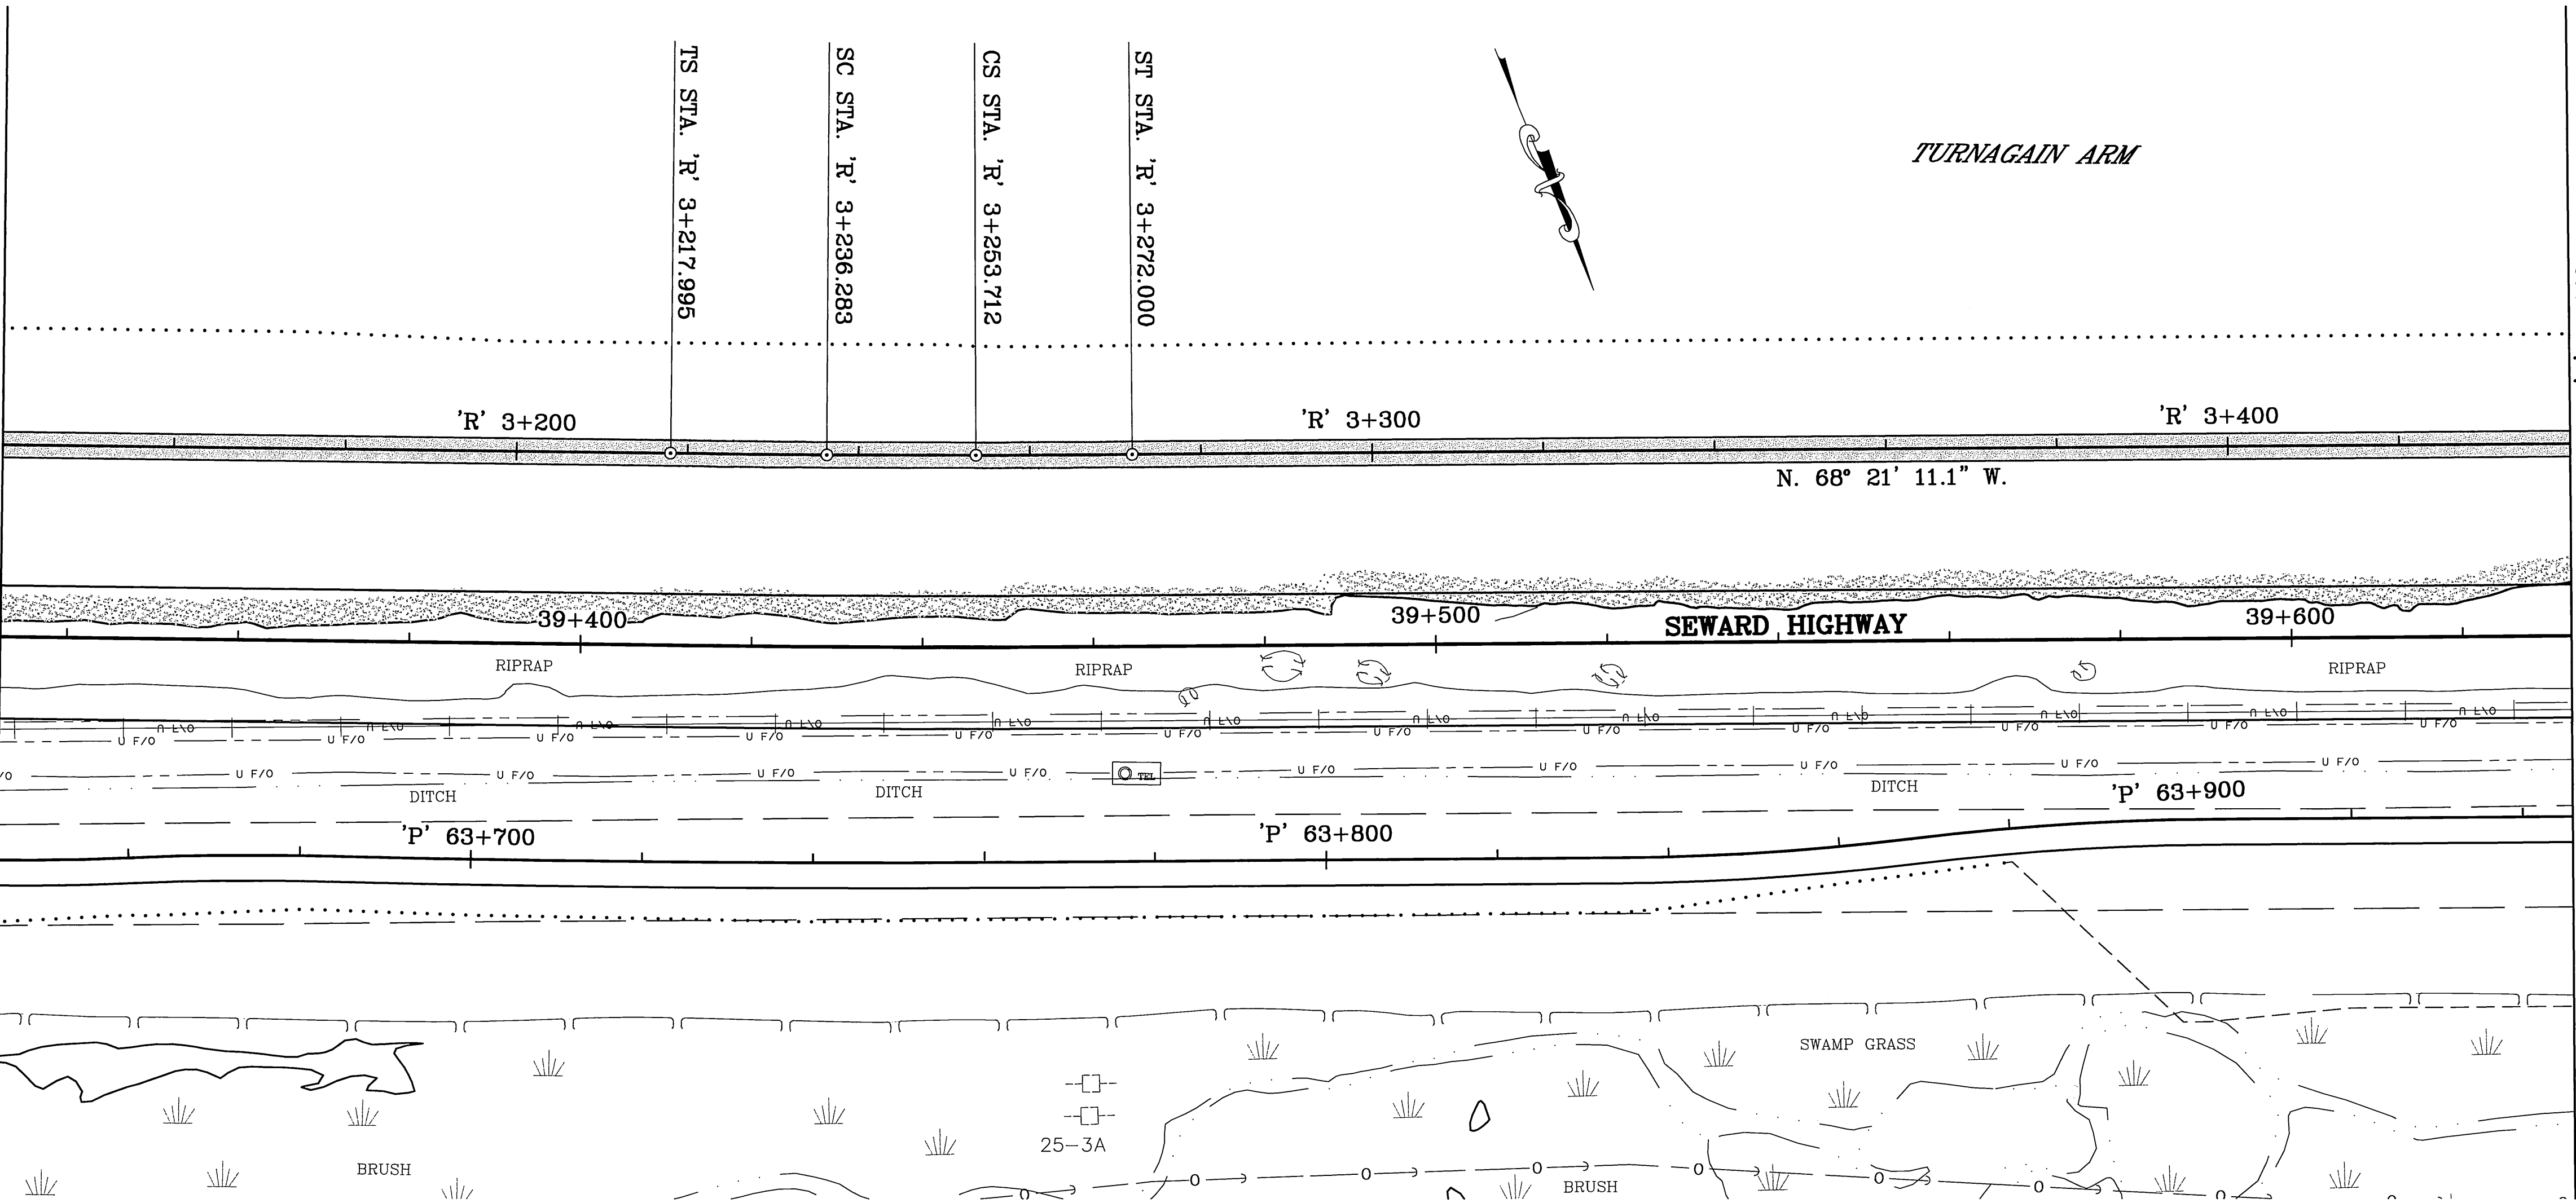

MATCH LINE STA. 'R' 3+440

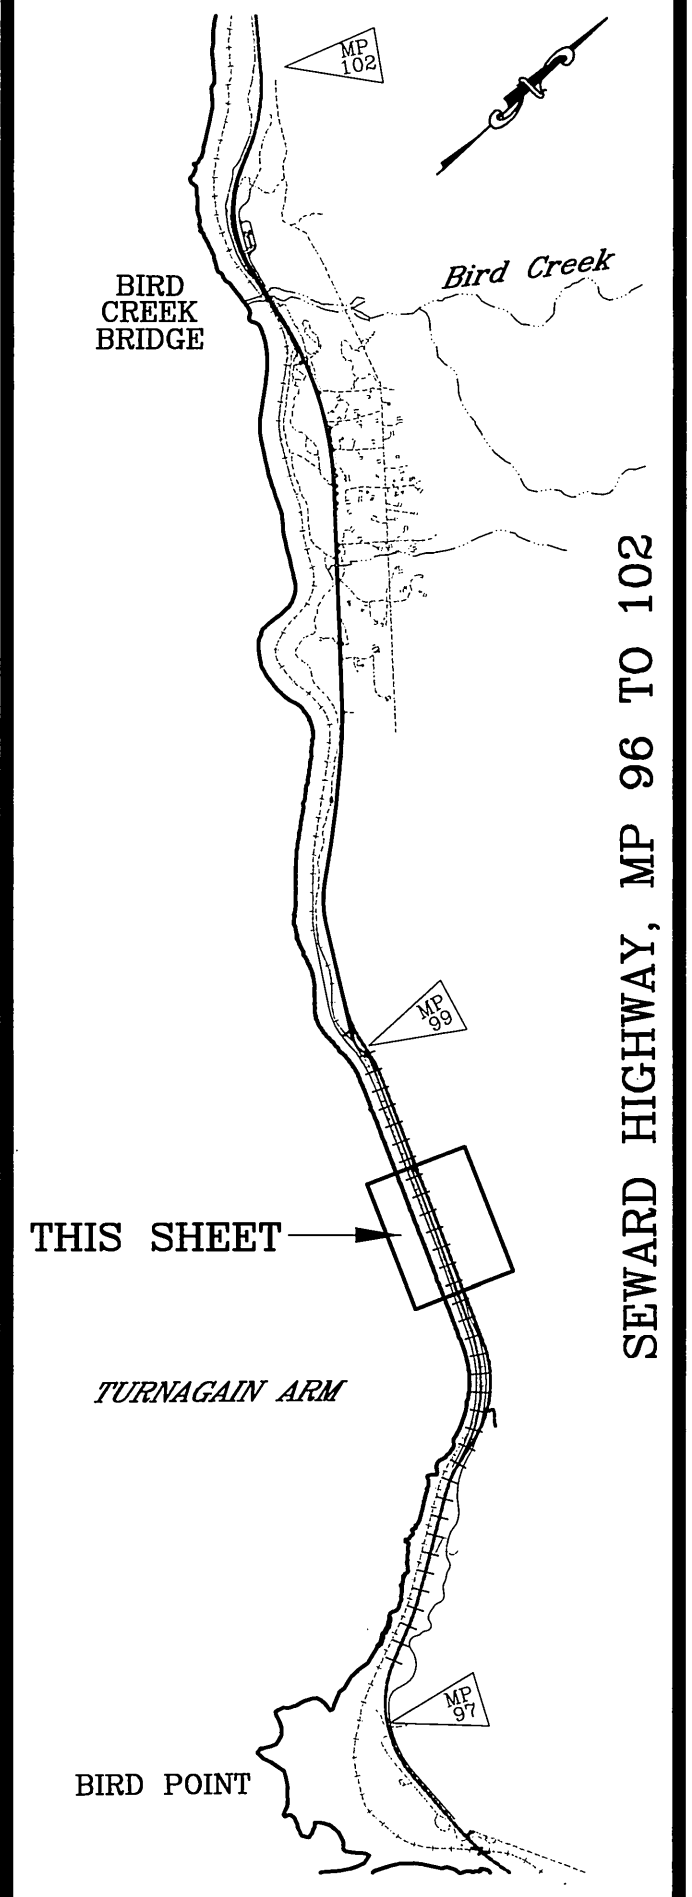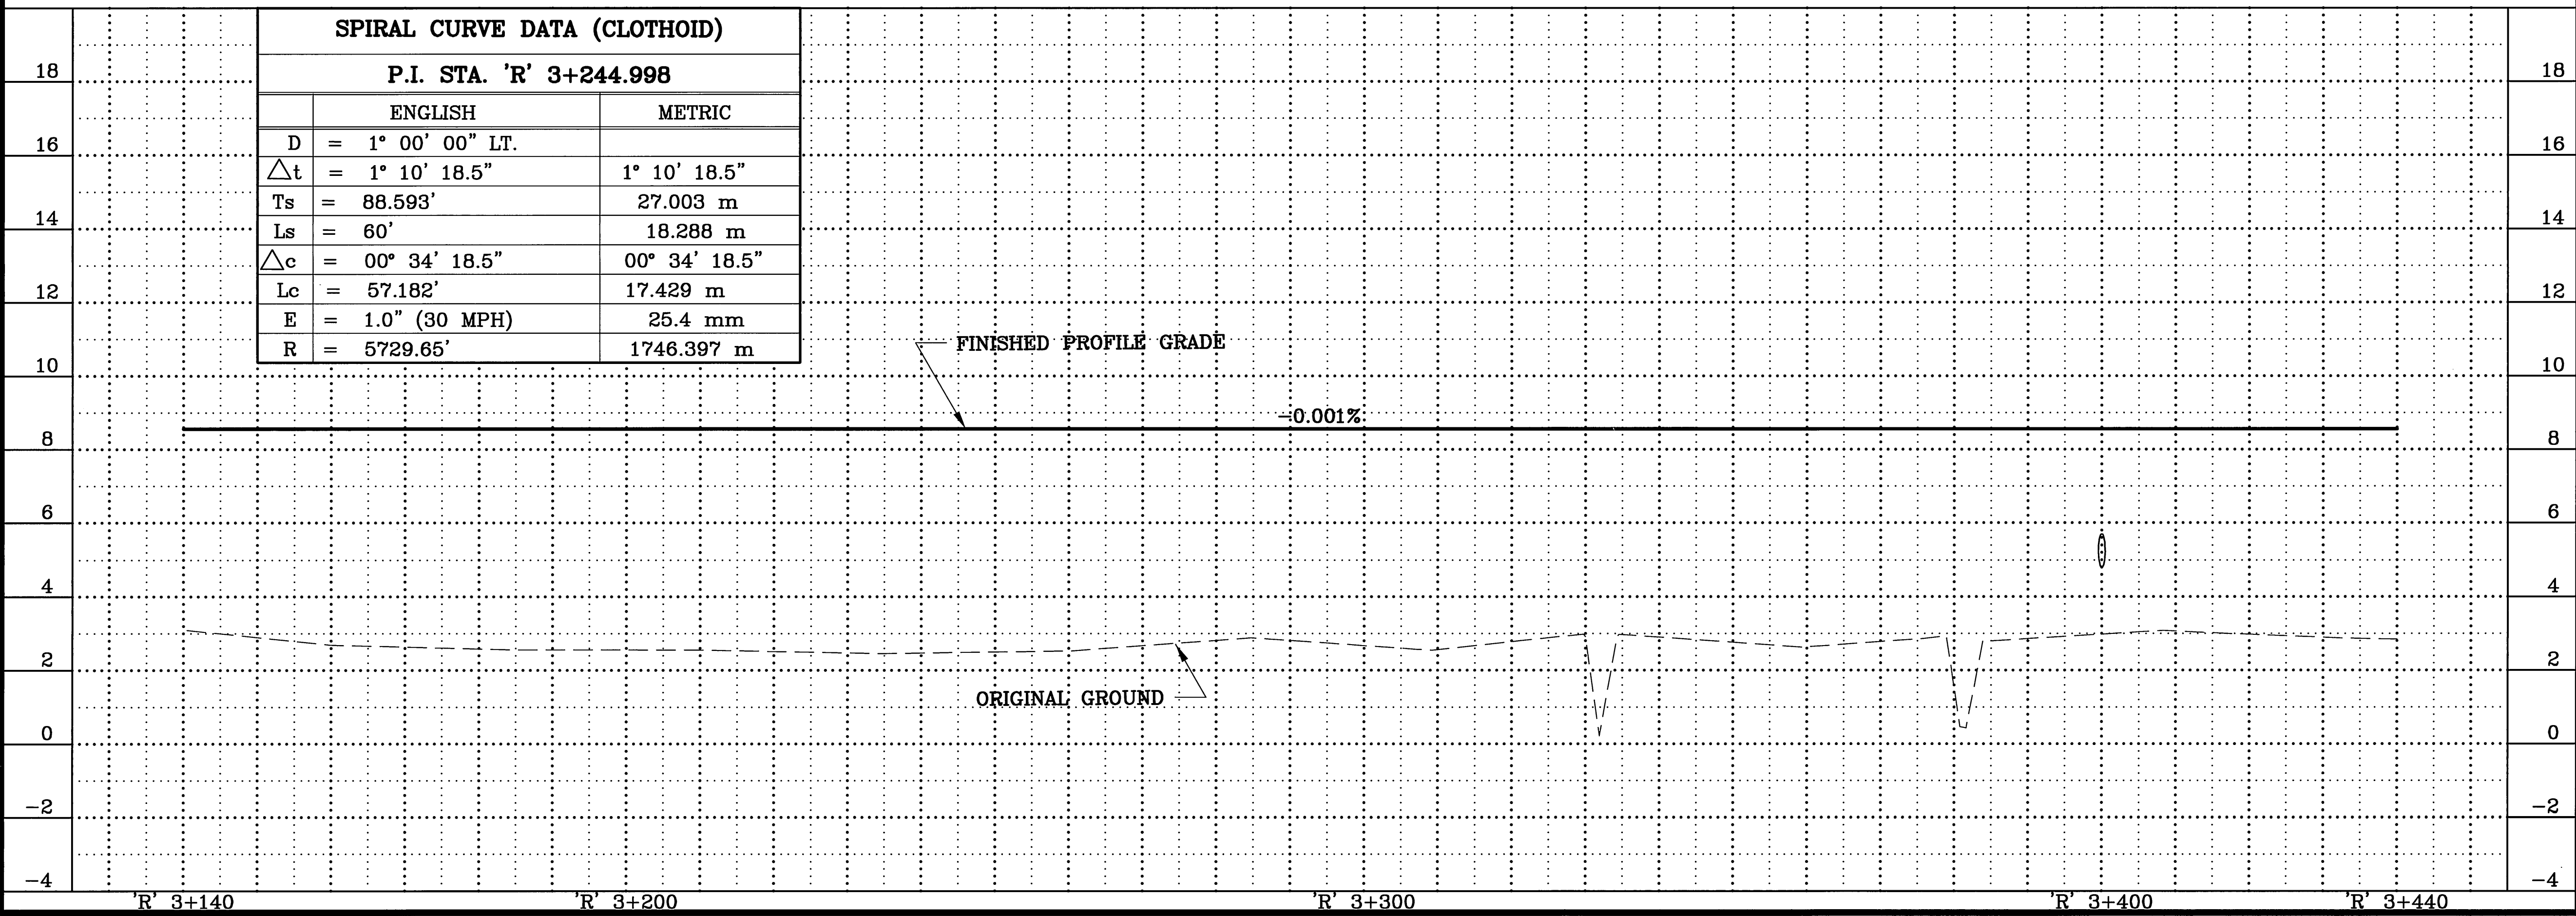


NOTE:
DIMENSIONS ARE IN METERS
UNLESS OTHERWISE NOTED.

STATE OF ALASKA
DEPARTMENT OF TRANSPORTATION
AND PUBLIC FACILITIES
SEWARD HIGHWAY
MP 96 TO MP 102
SAFETY, ROADWAY AND
RECREATIONAL IMPROVEMENTS
BIRD FLATS AREA
RAILROAD
PLAN AND PROFILE

SHEET NO.	TOTAL SHEETS	
FR5	FR11	
STATE	YEAR	
ALASKA	2002	
PROJECT DESIGNATION		
NH-0A3-1(28)		
ADDENDUM NO.		
ATTACHMENT NO.		
REVISIONS		
NO.	DATE	DESCRIPTION

DESIGNED BY	6/12/02
CHECKED BY	KWH
DRAWN BY	KWH
VIEW#	HALFOG-RI
SPECIFICATIONS	AUTOCAD-CAROL.EVANS/SKIPRO/53577/7PP-
SCALE 1"=1'	
COMPUTER DESIGNATION	

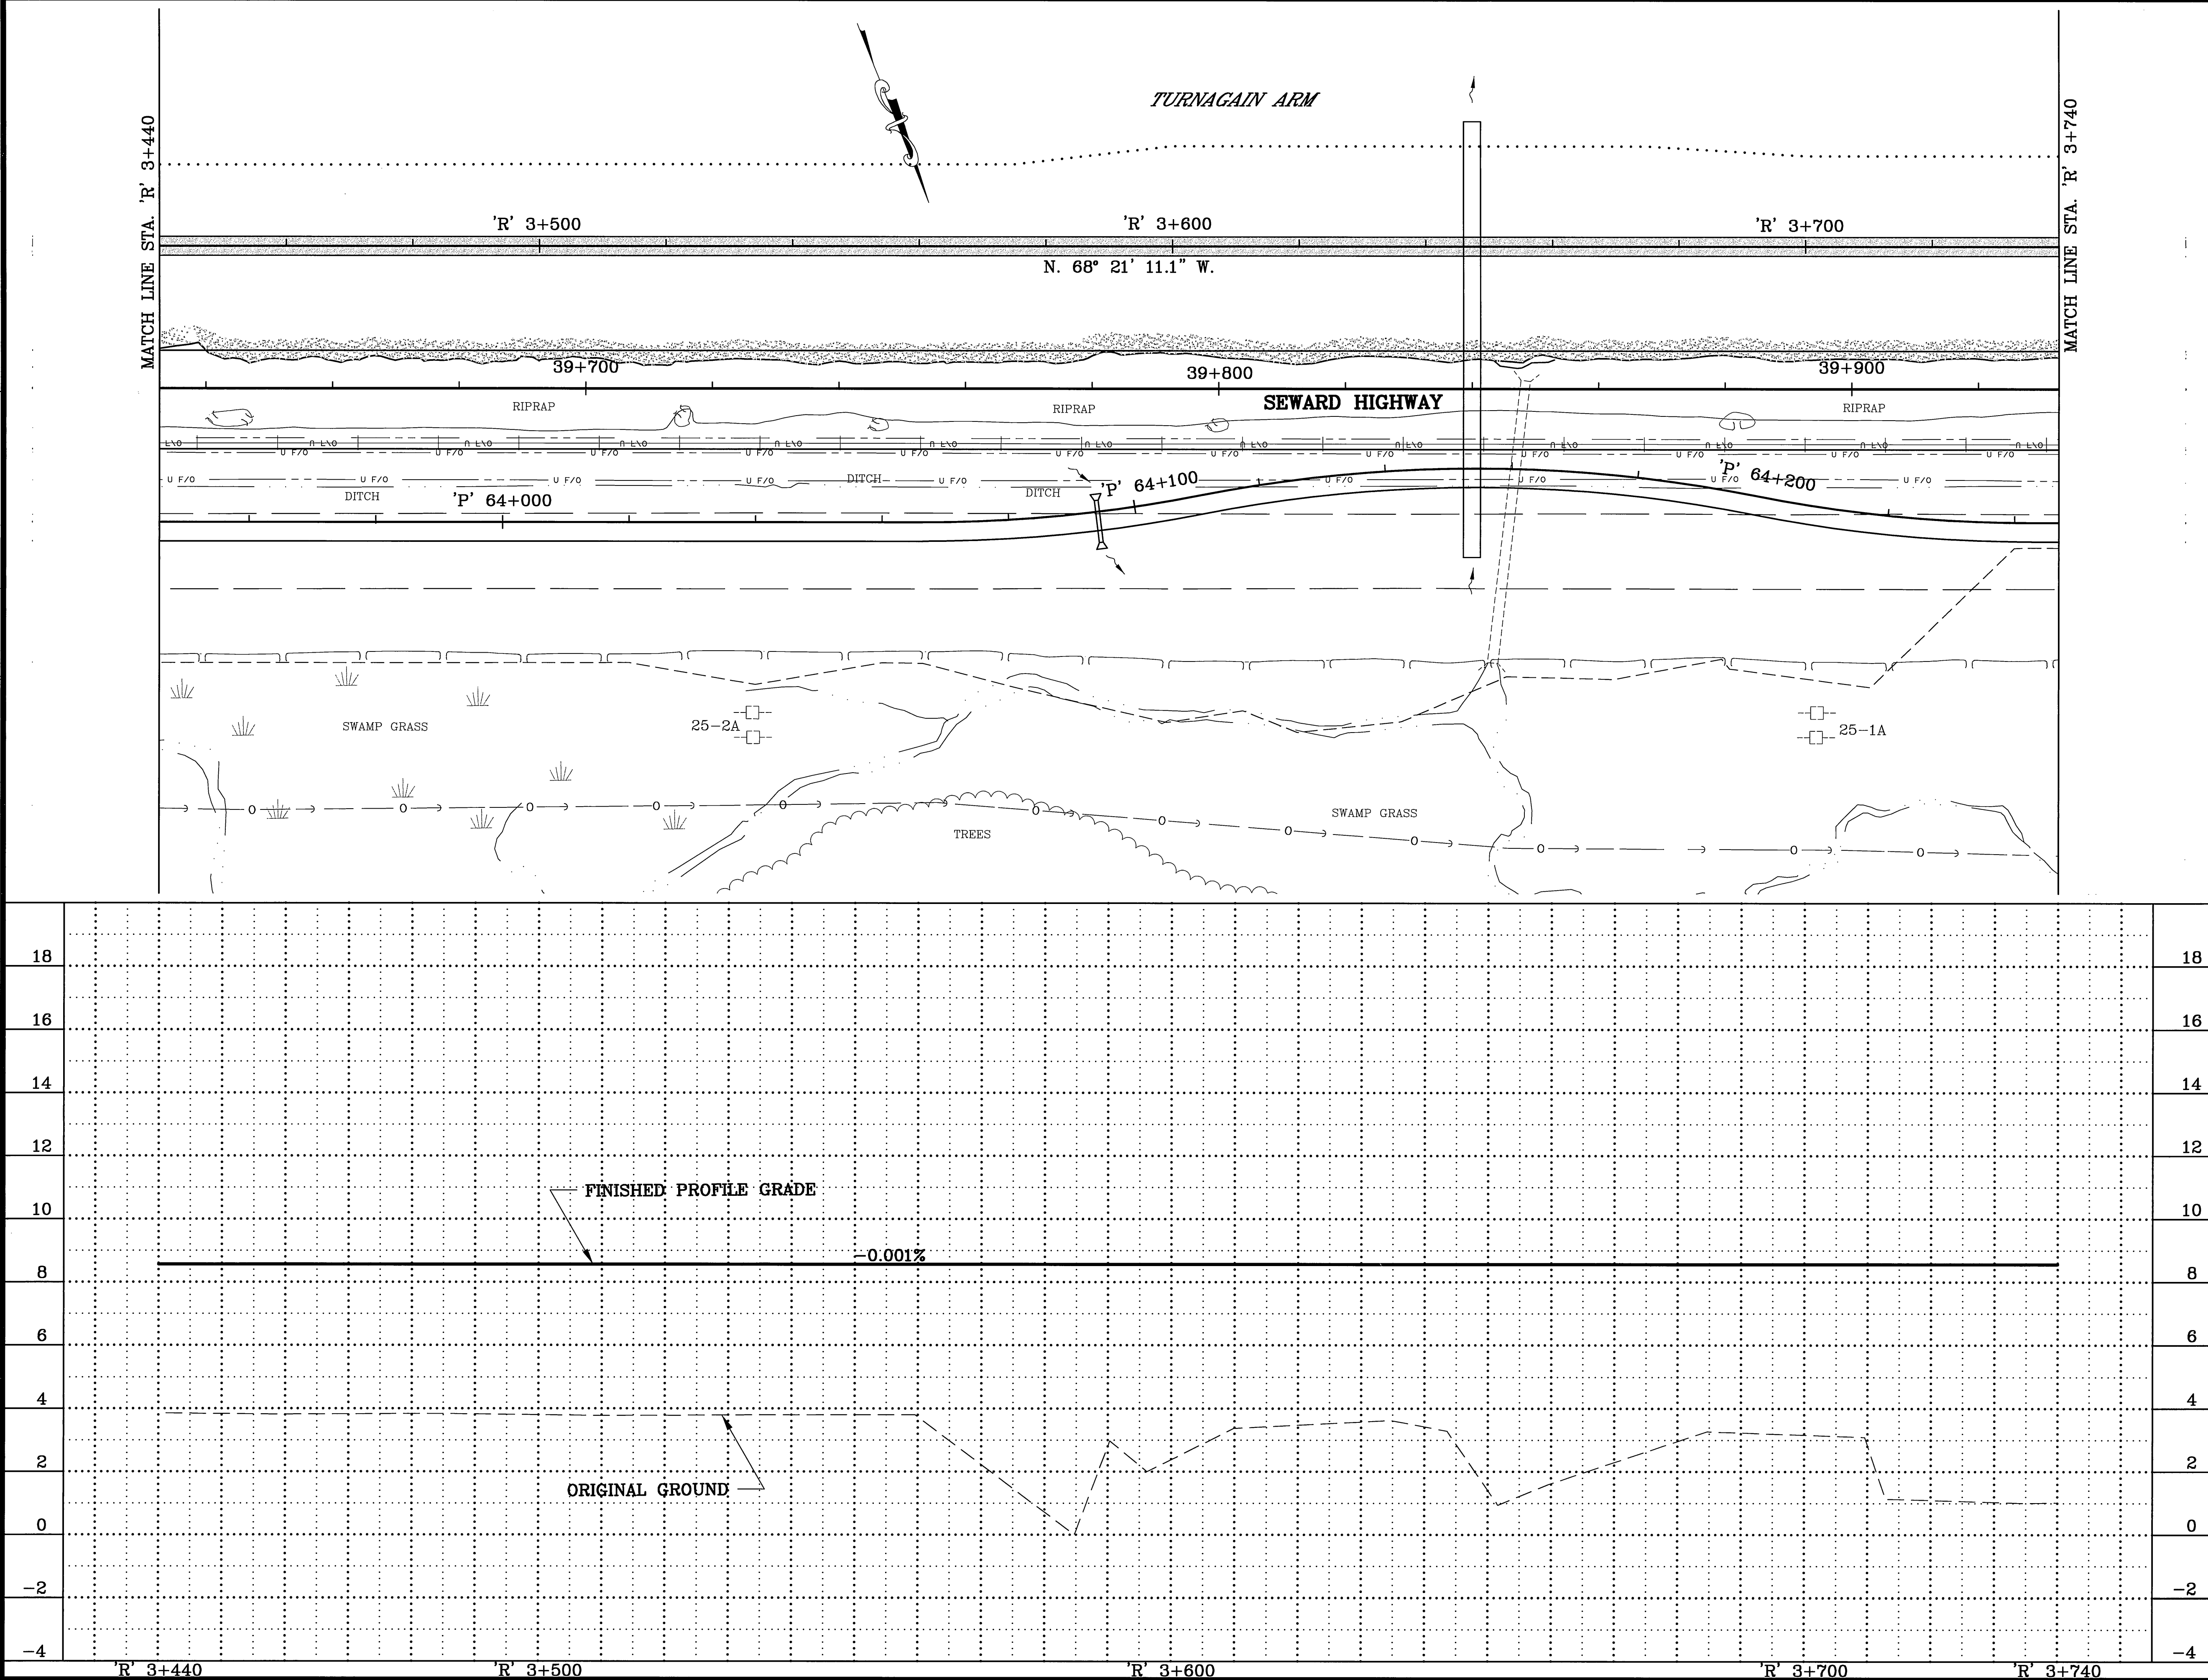

SHEET NO.	TOTAL SHEETS	
FR6	FR11	
STATE	YEAR	
ALASKA	2002	
PROJECT DESIGNATION		
NH-0A3-1(28)		
ADDENDUM NO.		
ATTACHMENT NO.		
REVISIONS		
NO.	DATE	DESCRIPTION

THIS SHEET

TURNAGAIN ARM

BIRD CREEK BRIDGE


BIRD POINT

SEWARD HIGHWAY, MP 96 TO 102

NOTE:
DIMENSIONS ARE IN METERS
UNLESS OTHERWISE NOTED.

STATE OF ALASKA
DEPARTMENT OF TRANSPORTATION
AND PUBLIC FACILITIES
SEWARD HIGHWAY
MP 96 TO MP 102
SAFETY, ROADWAY AND
RECREATIONAL IMPROVEMENTS
BIRD FLATS AREA
RAILROAD
PLAN AND PROFILE

SPECIFICATIONS SCALE 1"=1'	DESIGNED BY AUTOCAD-CAROLEE SISK/PROJ/3577/7/PP-	VIEW- HALF PT. RR	6/12/02
	CHECKED BY		
	DRAFTED BY	KMH	


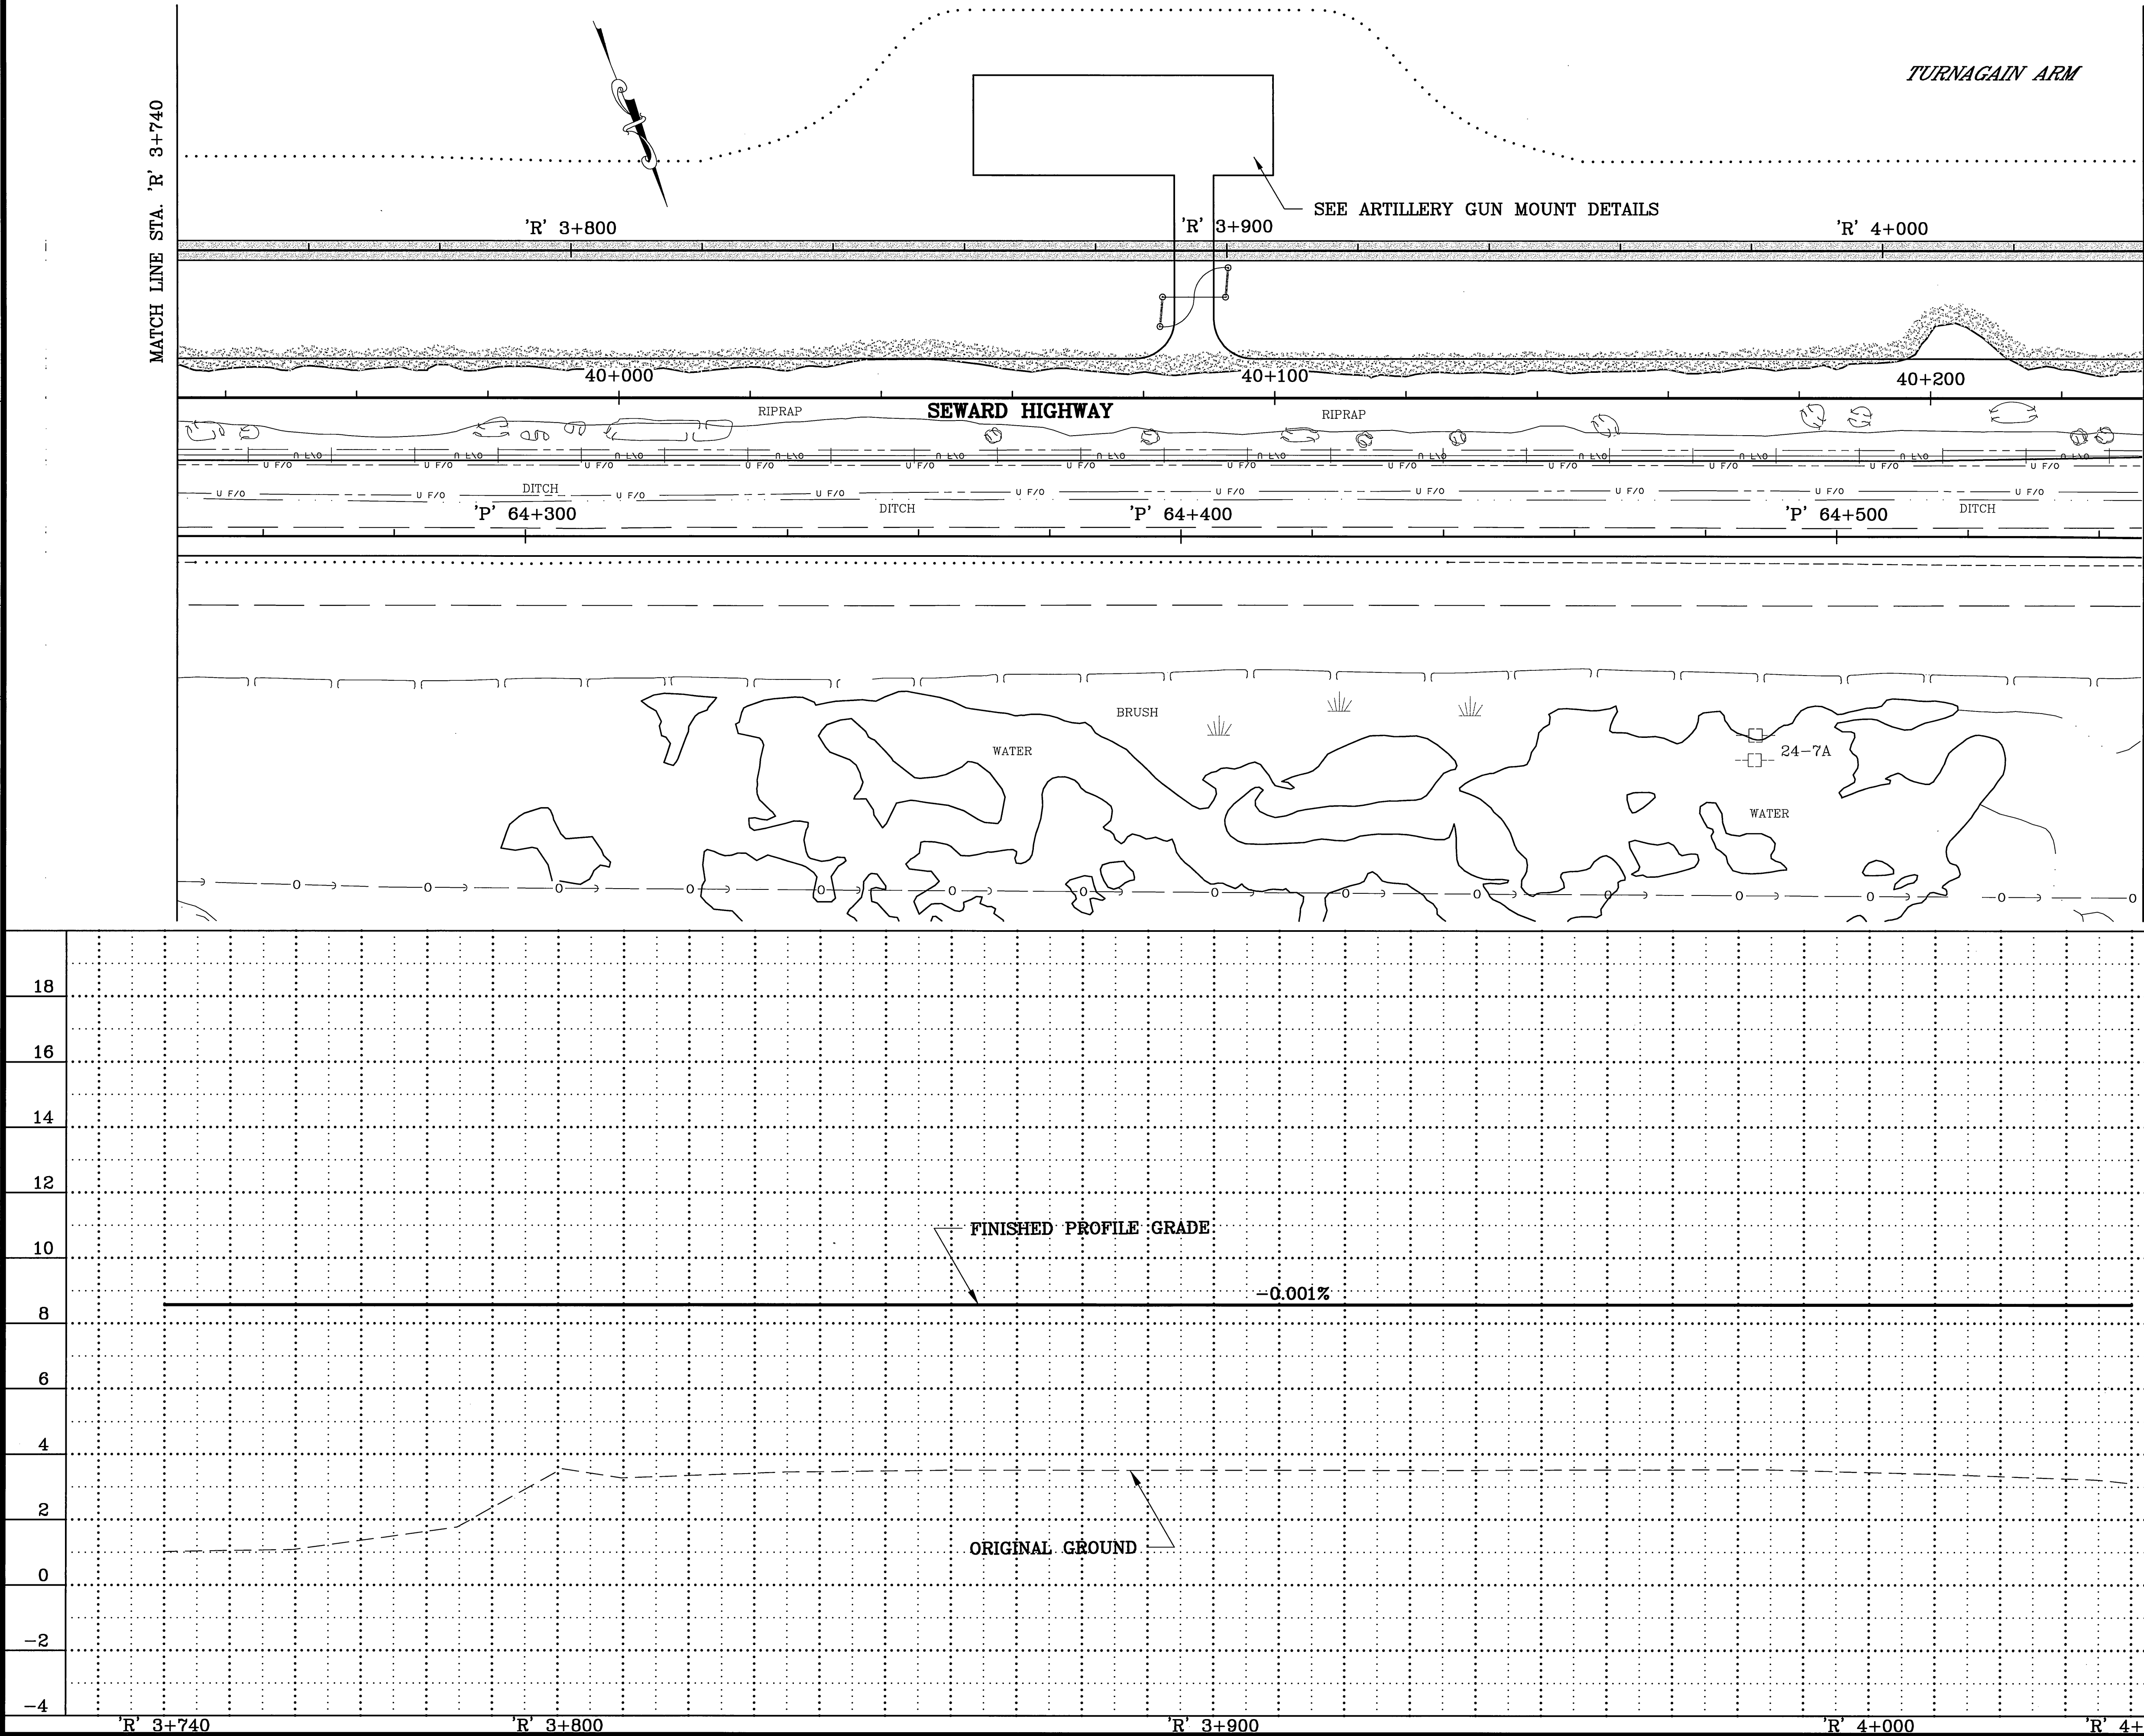


SHEET NO.	TOTAL SHEETS	
FR7	FR11	
STATE	YEAR	
ALASKA	2002	
PROJECT DESIGNATION		
NH-0A3-1(28)		
ADDENDUM NO.		
ATTACHMENT NO.		
REVISIONS		
NO.	DATE	DESCRIPTION

NOTE:
DIMENSIONS ARE IN METERS
UNLESS OTHERWISE NOTED.

STATE OF ALASKA
DEPARTMENT OF TRANSPORTATION
AND PUBLIC FACILITIES
SEWARD HIGHWAY
MP 96 TO MP 102
SAFETY, ROADWAY AND
RECREATIONAL IMPROVEMENTS
BIRD FLATS AREA
RAILROAD
PLAN AND PROFILE

DESIGNED BY: AUTOCAD-CAROLLEE SISK/PROJ. 13537717PP-
CHECKED BY: WJH
DRAWN BY: KMH
DATE: 6/12/02
VIEW: HAL FOR RR
COMPUTER DESIGNATION: 13537717PP-

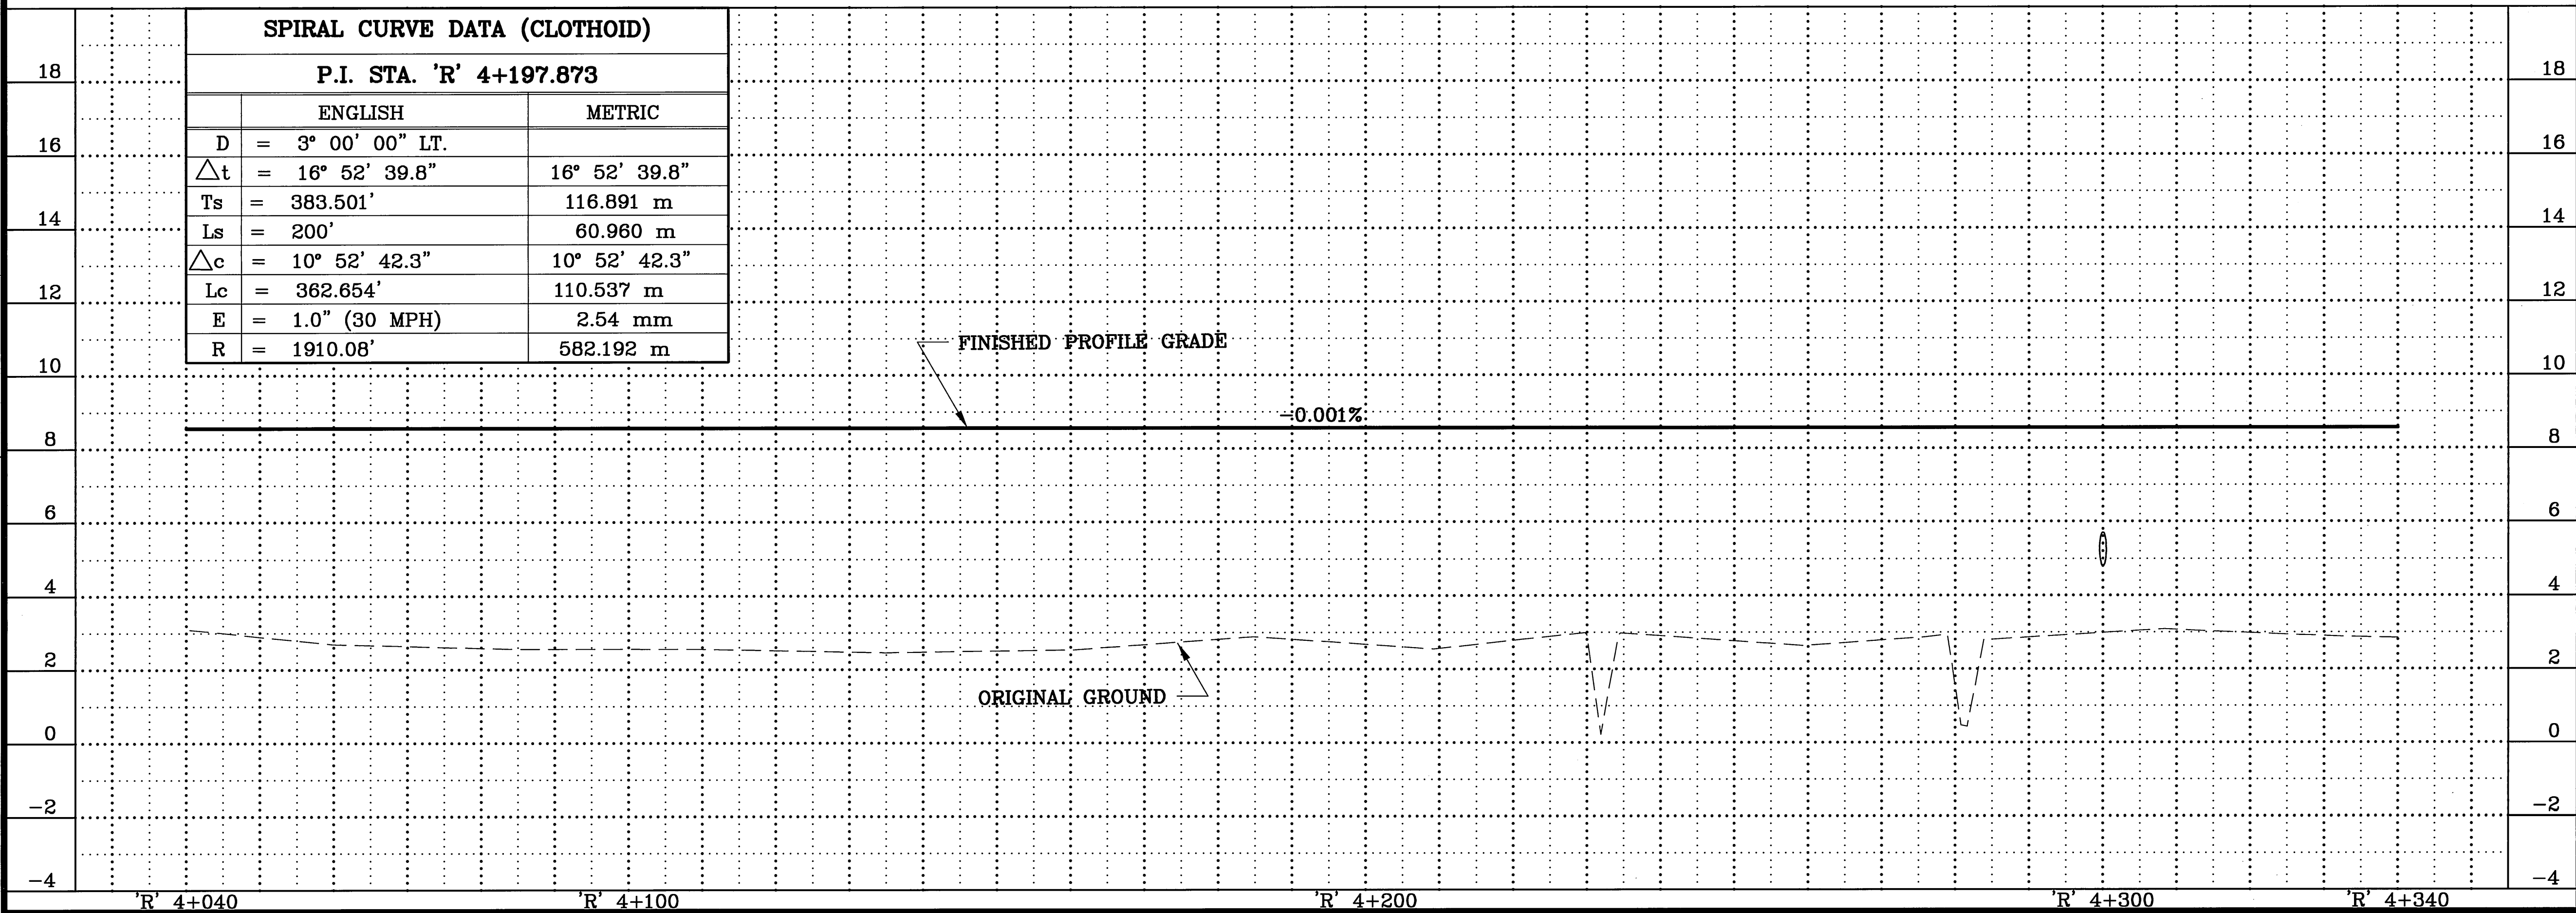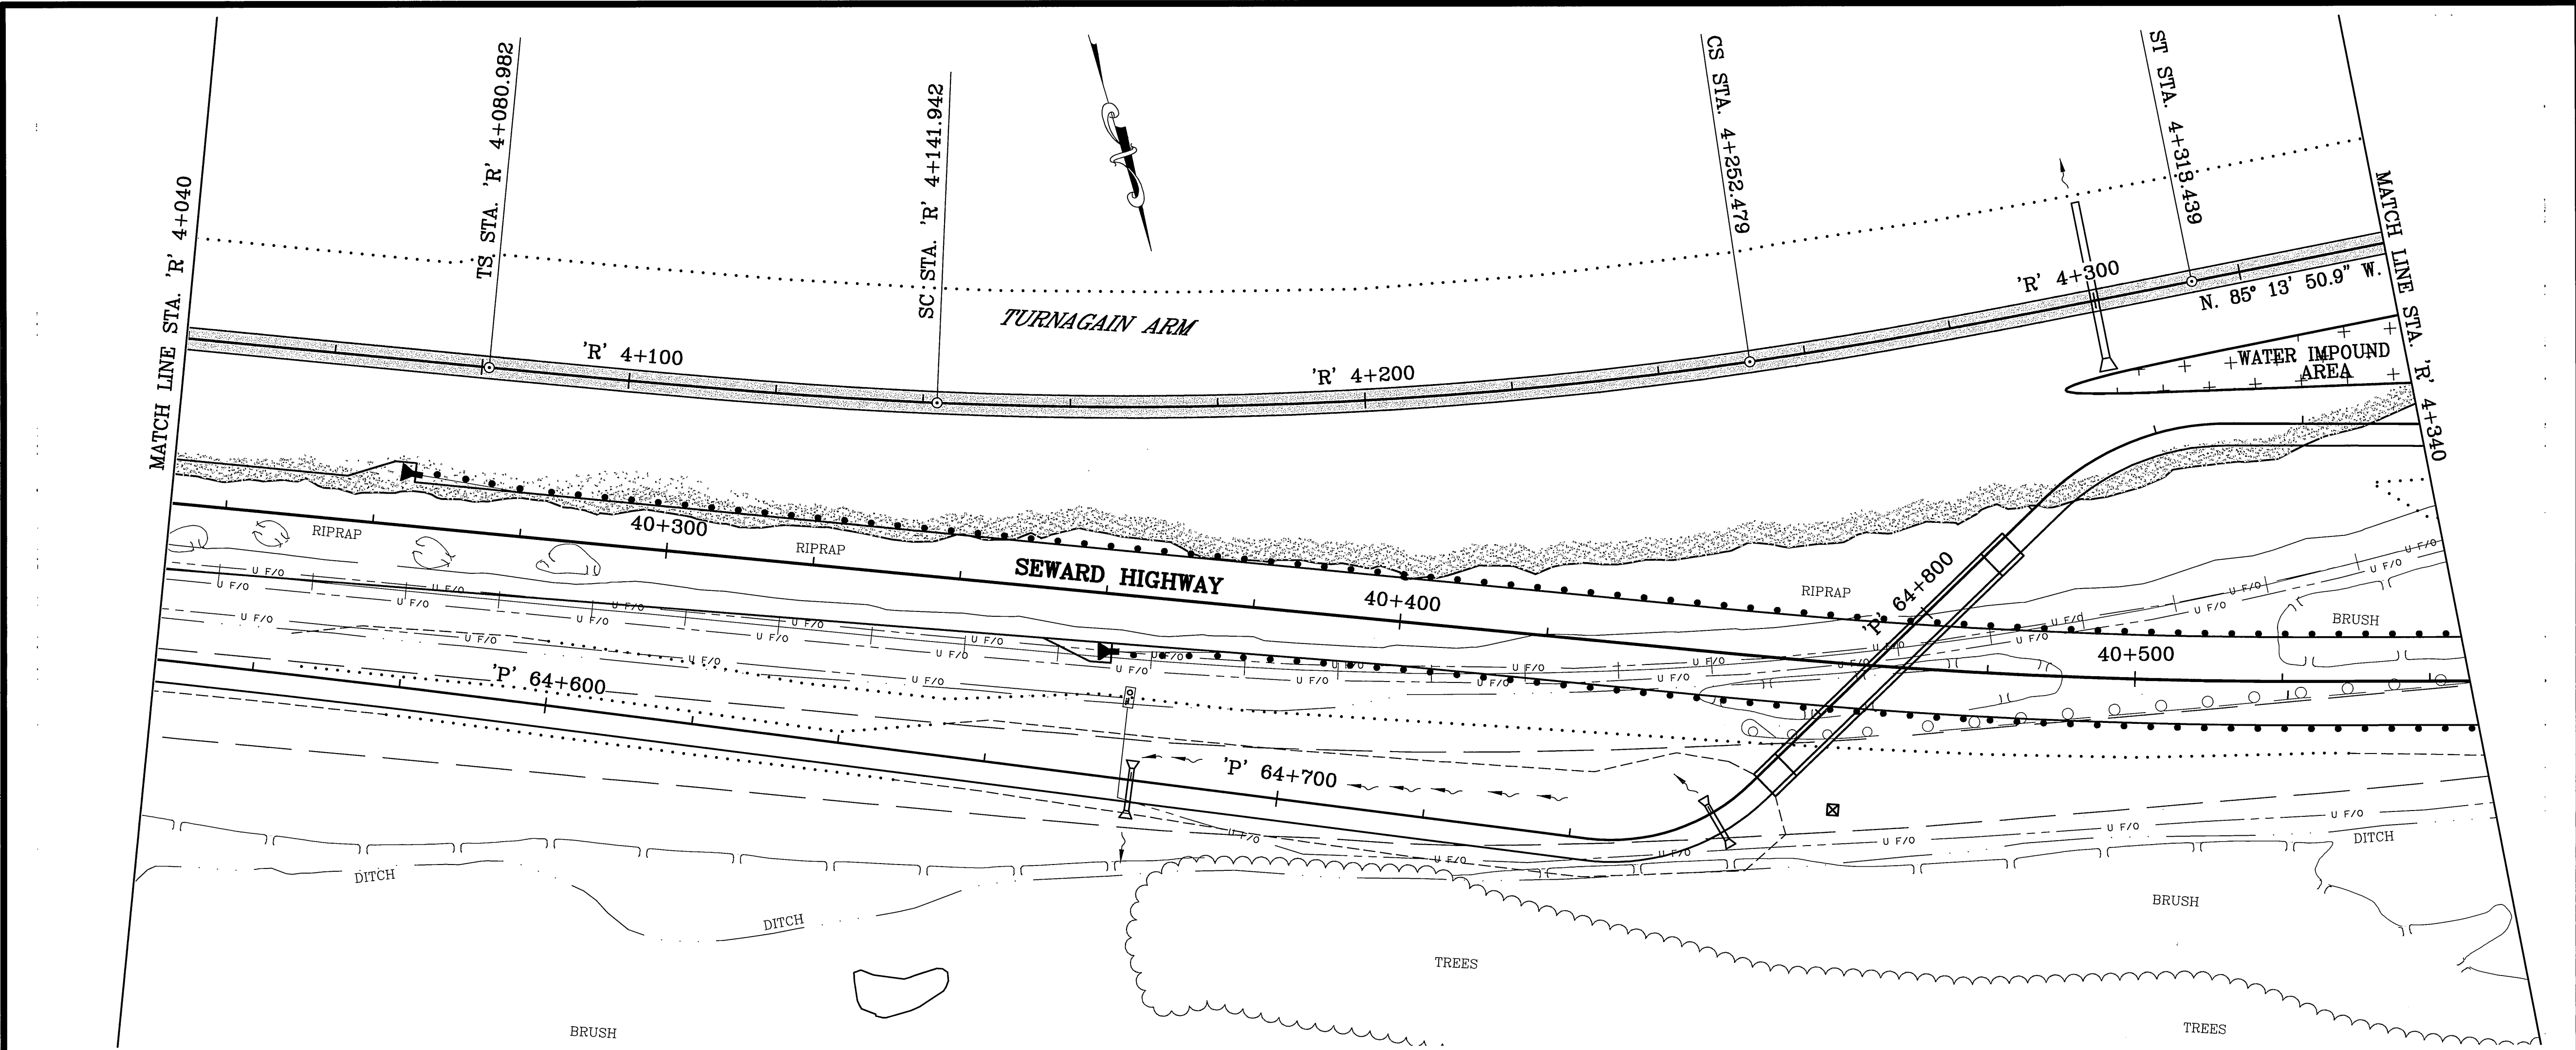

SHEET NO.	TOTAL SHEETS	
FR8	FR11	
STATE	YEAR	
ALASKA	2002	
PROJECT DESIGNATION		
NH-0A3-1(28)		
ADDENDUM NO.		
ATTACHMENT NO.		
REVISIONS		
NO.	DATE	DESCRIPTION

SEWARD HIGHWAY, MP 96 TO 102



NOTE:
DIMENSIONS ARE IN METERS
UNLESS OTHERWISE NOTED.

STATE OF ALASKA
DEPARTMENT OF TRANSPORTATION
AND PUBLIC FACILITIES
SEWARD HIGHWAY
MP 96 TO MP 102
SAFETY, ROADWAY AND
RECREATIONAL IMPROVEMENTS
BIRD FLATS AREA
RAILROAD
PLAN AND PROFILE

DESIGNED BY
CHECKED BY
DRAFTED BY
VIEW=

6/12/02
RME
HALF09.RR

SPECIFICATIONS
SCALE 1"=1'
COMPUTER DESIGNATION

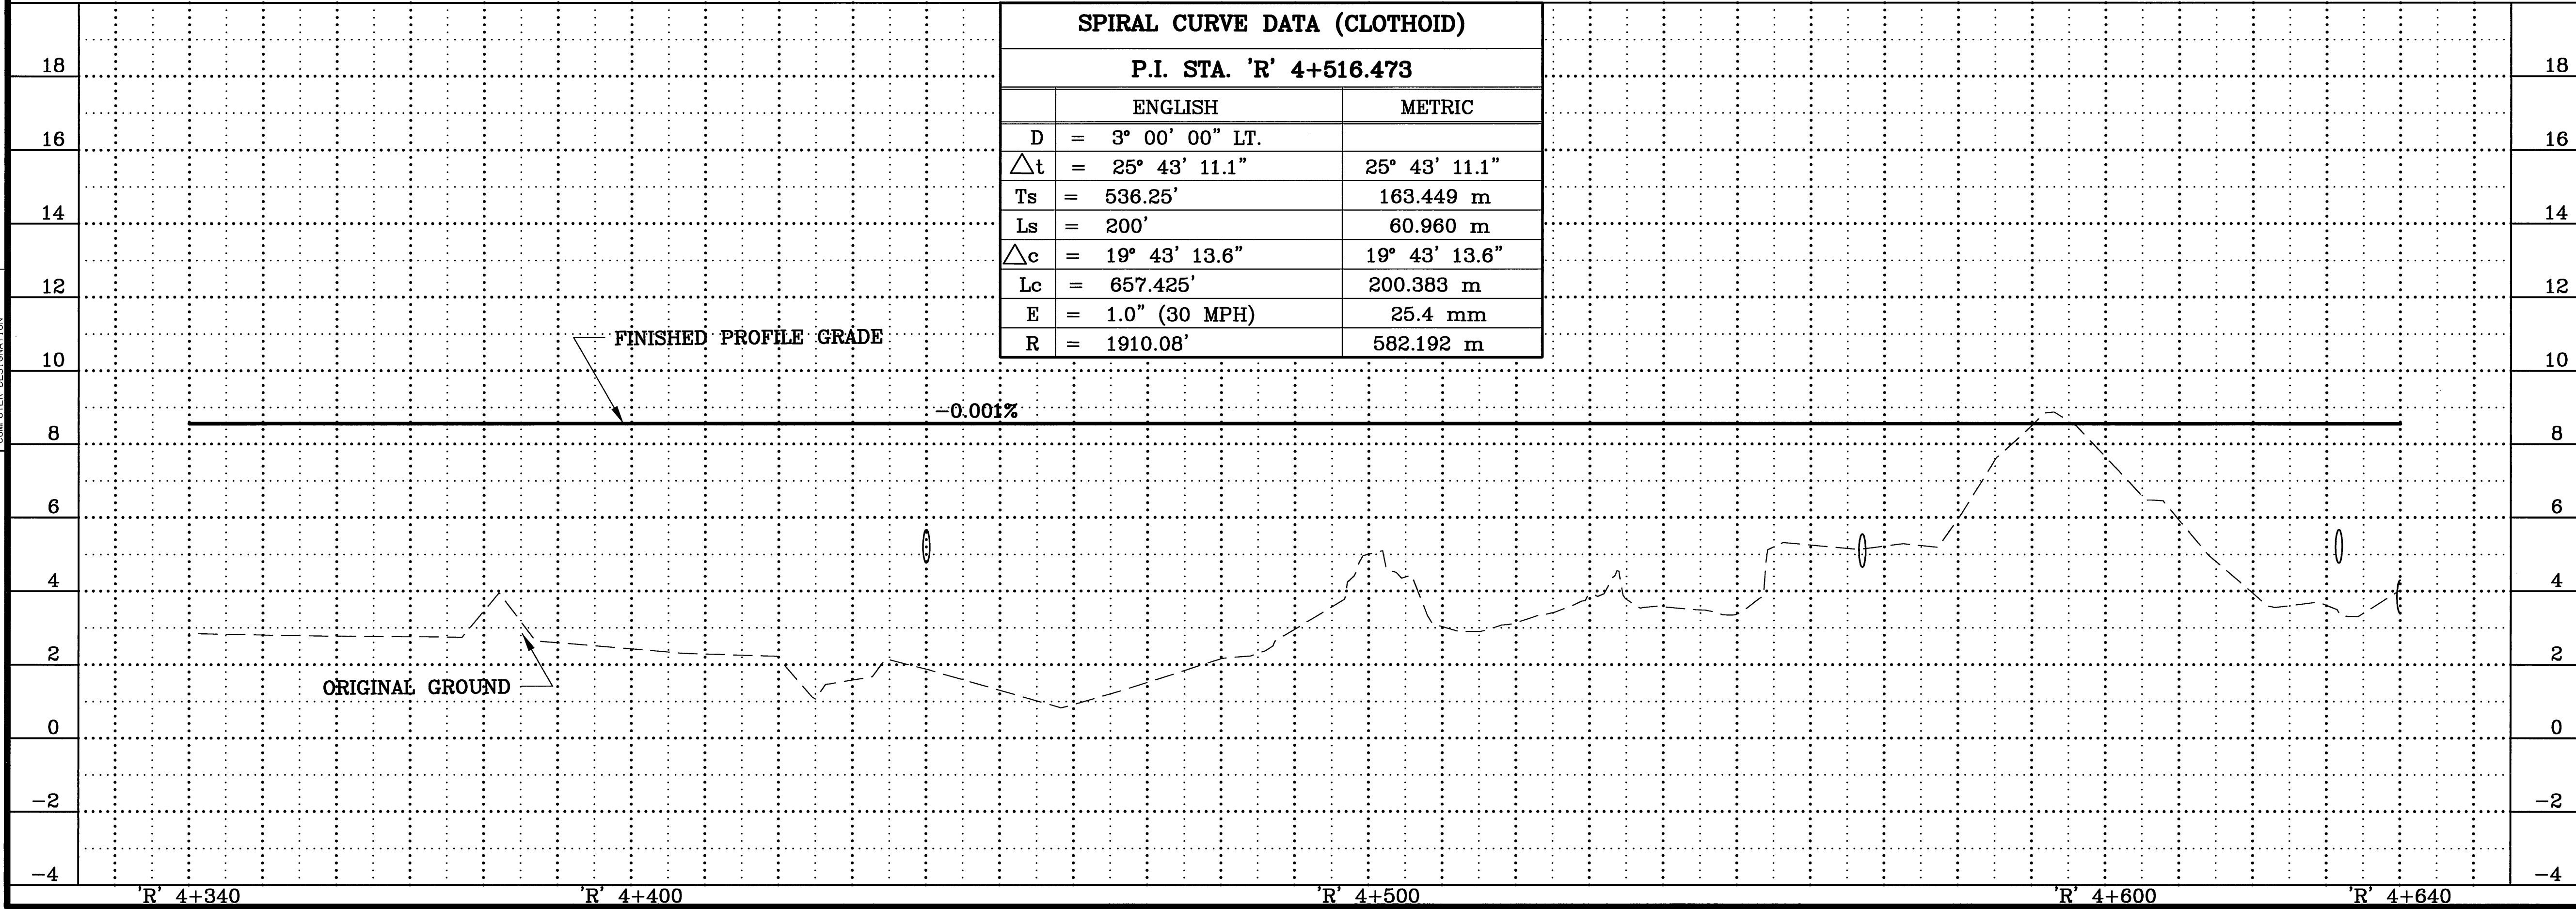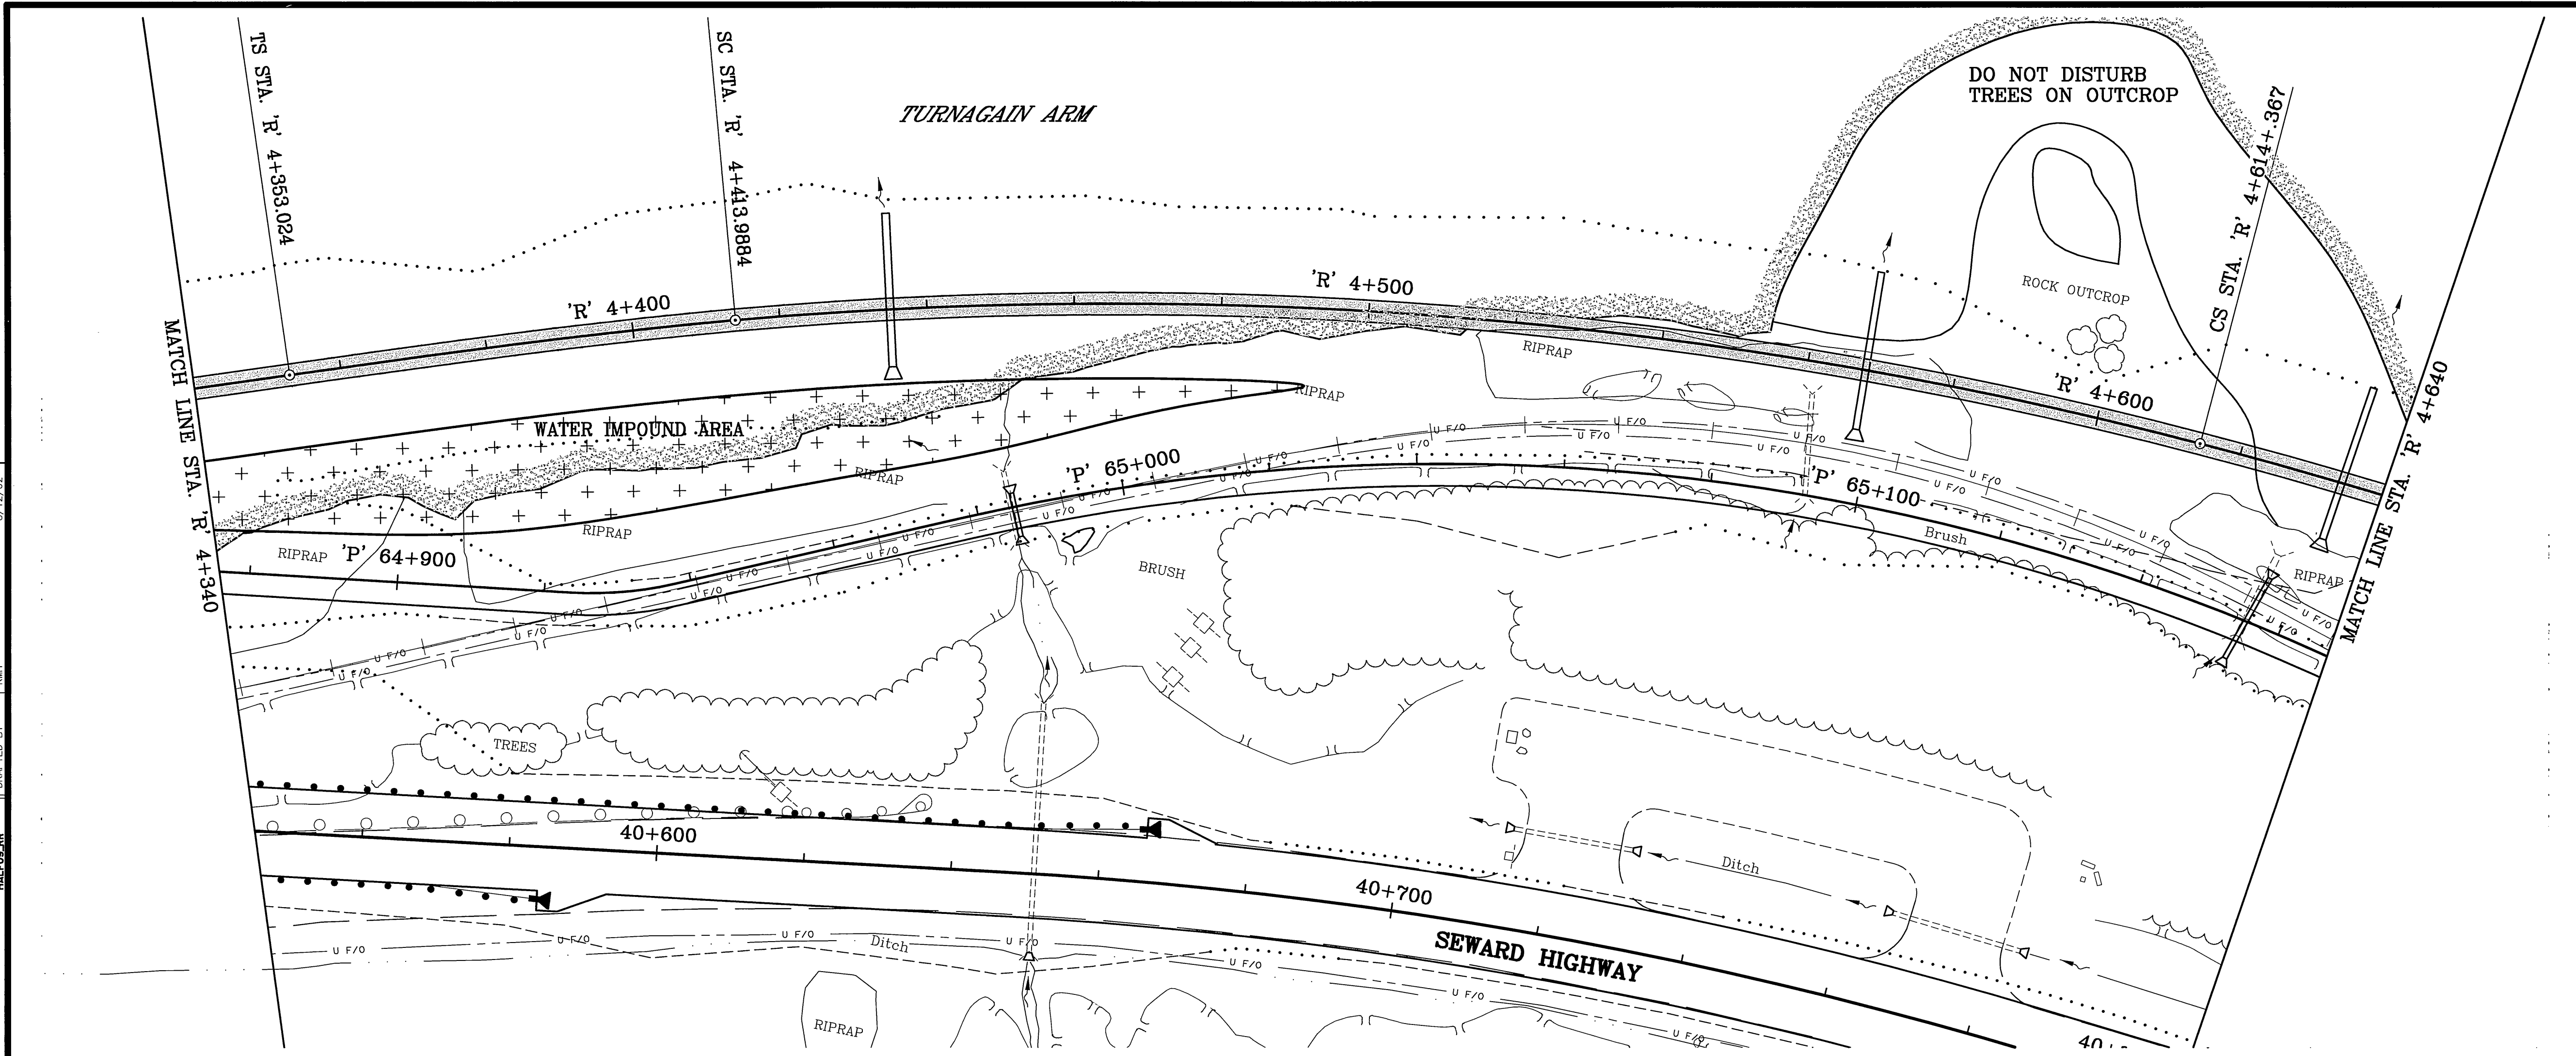

SPIRAL CURVE DATA (CLOTHOID)		
P.I. STA. 'R' 4+516.473		
	ENGLISH	METRIC
D	= 3° 00' 00" LT.	
Δt	= 25° 43' 11.1"	25° 43' 11.1"
Ts	= 536.25'	163.449 m
Ls	= 200'	60.960 m
Δc	= 19° 43' 13.6"	19° 43' 13.6"
Lc	= 657.425'	200.383 m
E	= 1.0" (30 MPH)	25.4 mm
R	= 1910.08'	582.192 m

SHEET NO.	TOTAL SHEETS	
FR9	FR11	
STATE	YEAR	
ALASKA	2002	
PROJECT DESIGNATION		
NH-0A3-1(28)		
ADDENDUM NO.		
ATTACHMENT NO.		
REVISIONS		
NO.	DATE	DESCRIPTION

THIS SHEET


TURNAGAIN ARM

BIRD POINT

NOTE:
DIMENSIONS ARE IN METERS
UNLESS OTHERWISE NOTED.

STATE OF ALASKA
DEPARTMENT OF TRANSPORTATION
AND PUBLIC FACILITIES
SEWARD HIGHWAY
MP 96 TO MP 102
SAFETY, ROADWAY AND
RECREATIONAL IMPROVEMENTS
BIRD FLATS AREA
RAILROAD
PLAN AND PROFILE

DESIGNED BY
SCALE 1"=1'
COMPUTER DESIGNATION
AUTOCAD-CAROLEE SODOROV 13577177P-
VIEW
HAL-DO-RR
DATE
8/12/02
BY
KMH

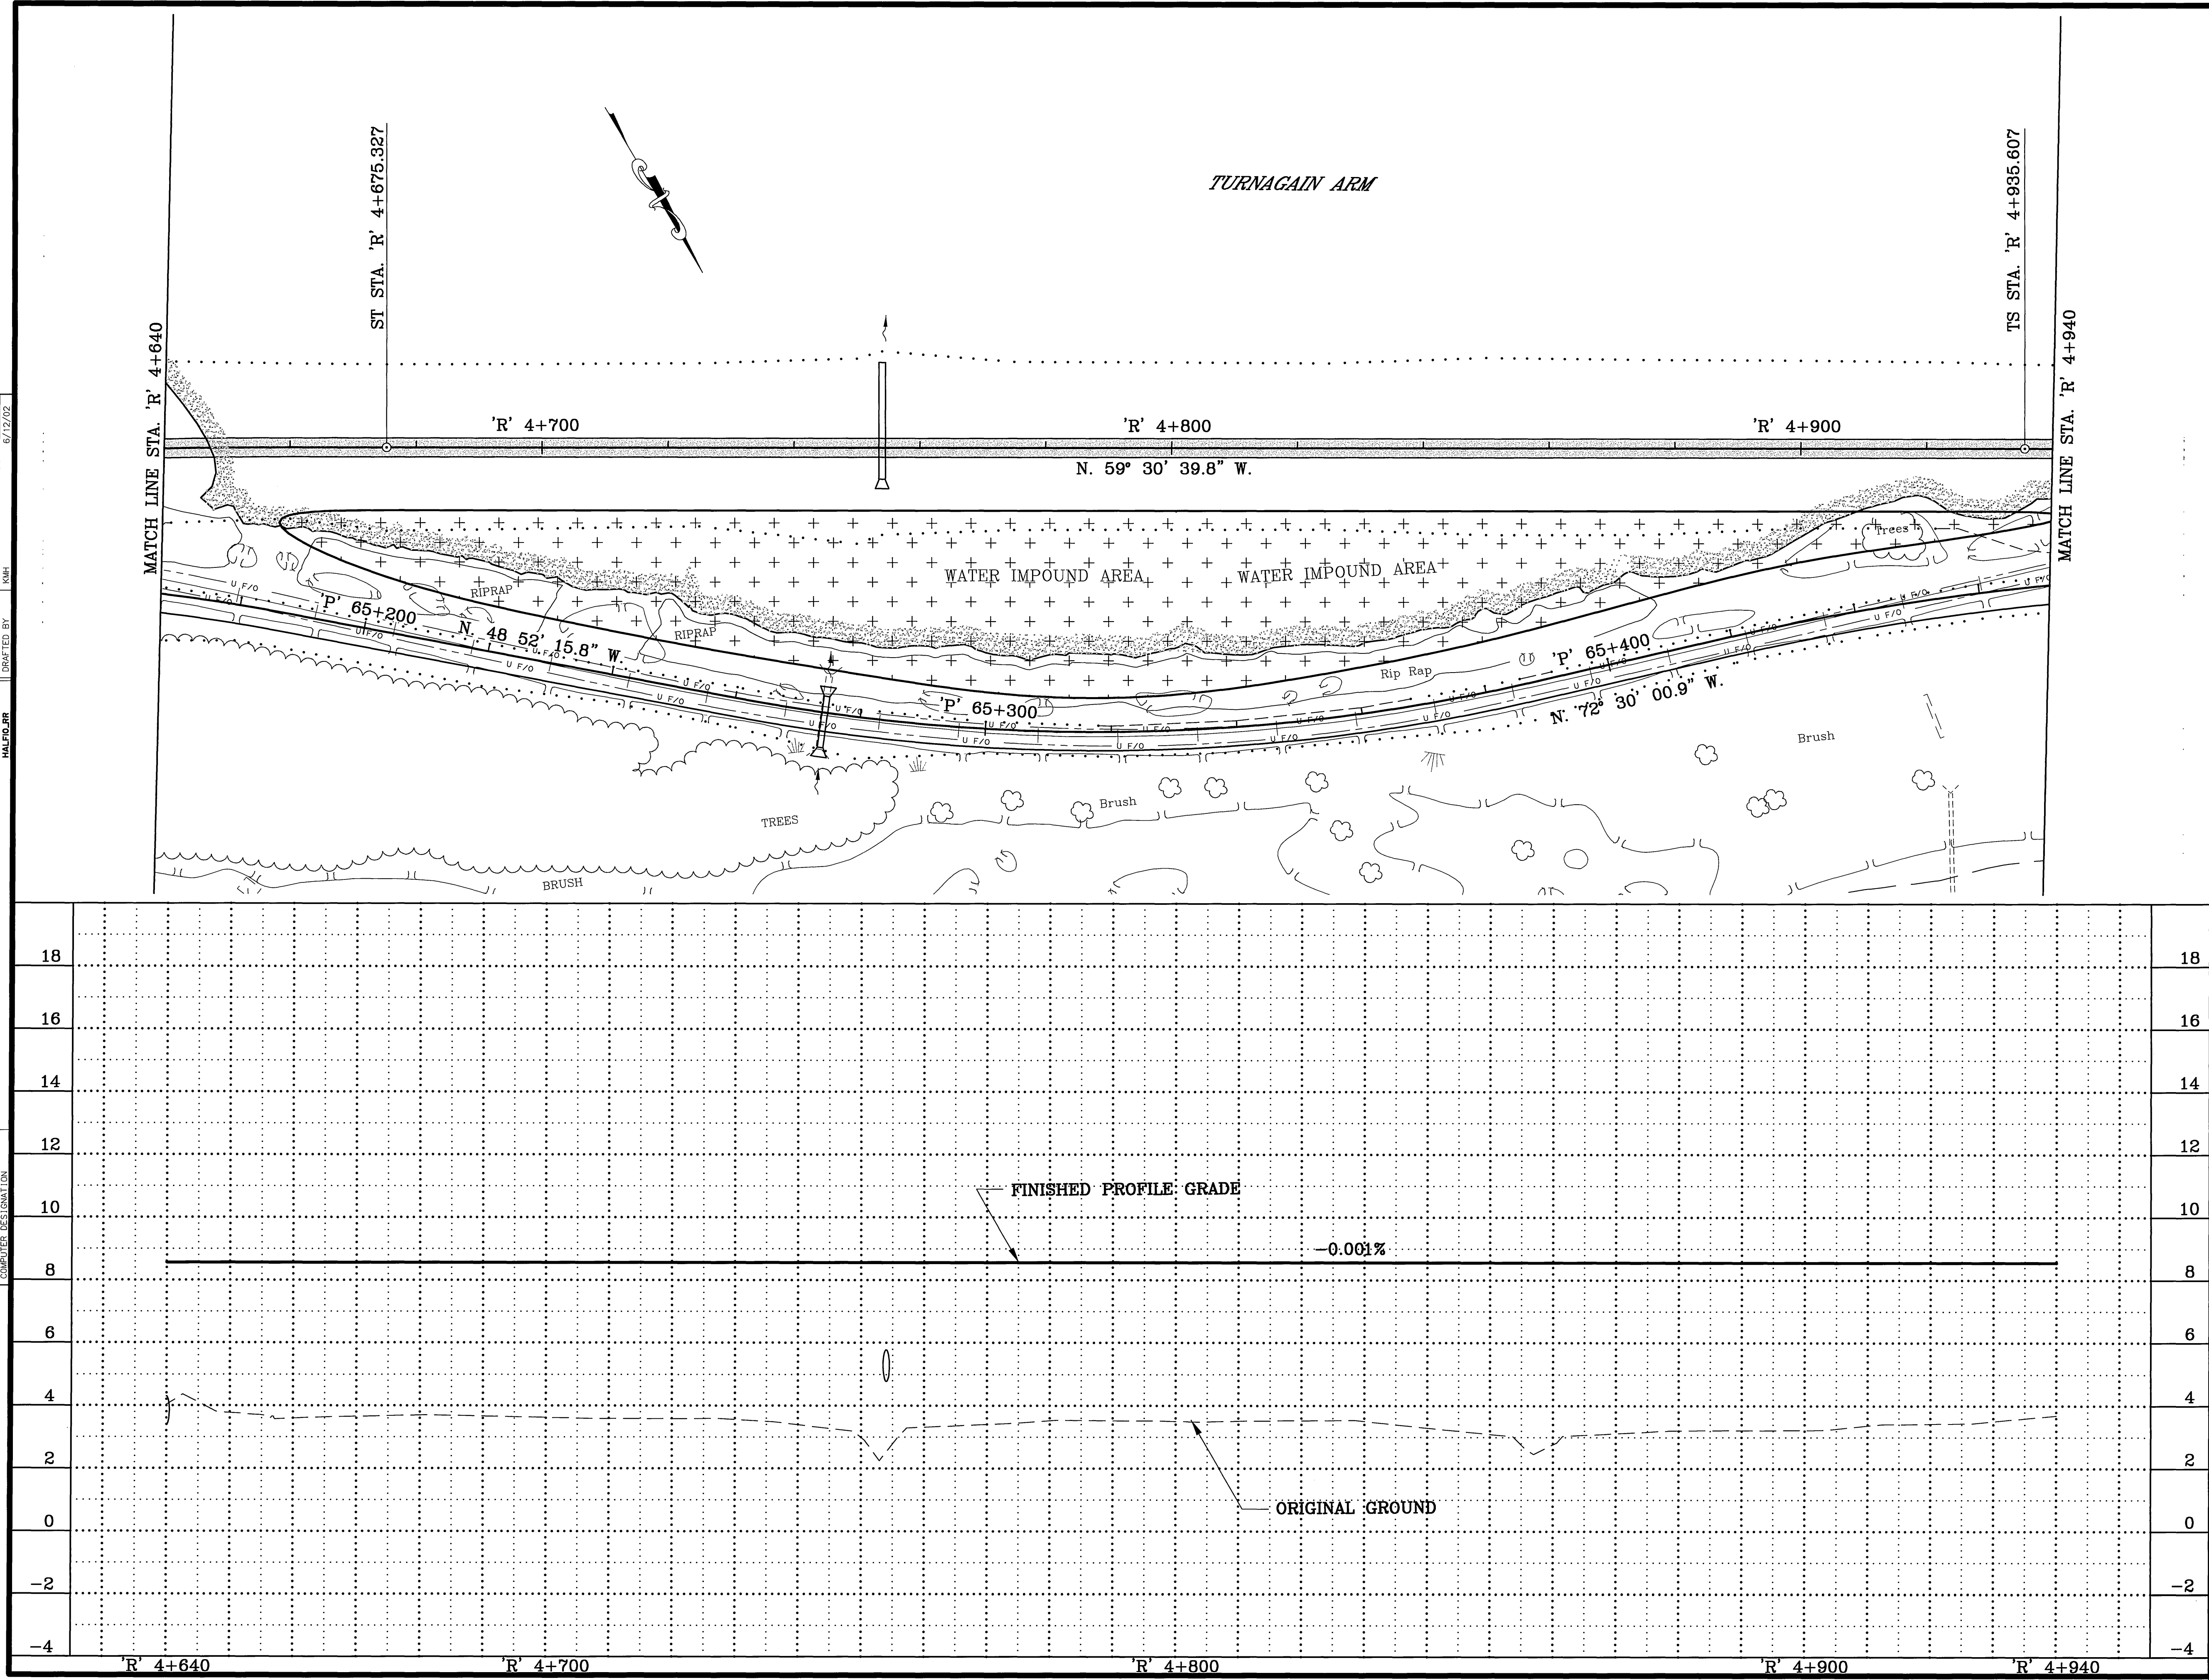

SHEET NO.		TOTAL SHEETS	
FR10		FR11	
STATE		YEAR	
ALASKA		2002	
PROJECT DESIGNATION			
NH-0A3-1(28)			
ADDENDUM NO.			
ATTACHMENT NO.			
REVISIONS			
NO.	DATE	DESCRIPTION	

THIS SHEET

TURNAGAIN ARM

BIRD CREEK BRIDGE

BIRD POINT


SEWARD HIGHWAY, MP 96 TO 102

NOTE:
DIMENSIONS ARE IN METERS
UNLESS OTHERWISE NOTED.

STATE OF ALASKA
49TH
JUDY A. ROUGHERTY
CE 8823
6.18.02
REGISTERED PROFESSIONAL ENGINEER

STATE OF ALASKA
DEPARTMENT OF TRANSPORTATION
AND PUBLIC FACILITIES
SEWARD HIGHWAY
MP 96 TO MP 102
SAFETY, ROADWAY AND
RECREATIONAL IMPROVEMENTS
BIRD FLATS AREA
RAILROAD
PLAN AND PROFILE

SECTION LINES
SCALE 1" = 100'
COMPUTER DESIGNATION
DESIGNED BY
CHECKED BY
DATE
VIEW
HALF-PI PATH
DATE
NAME

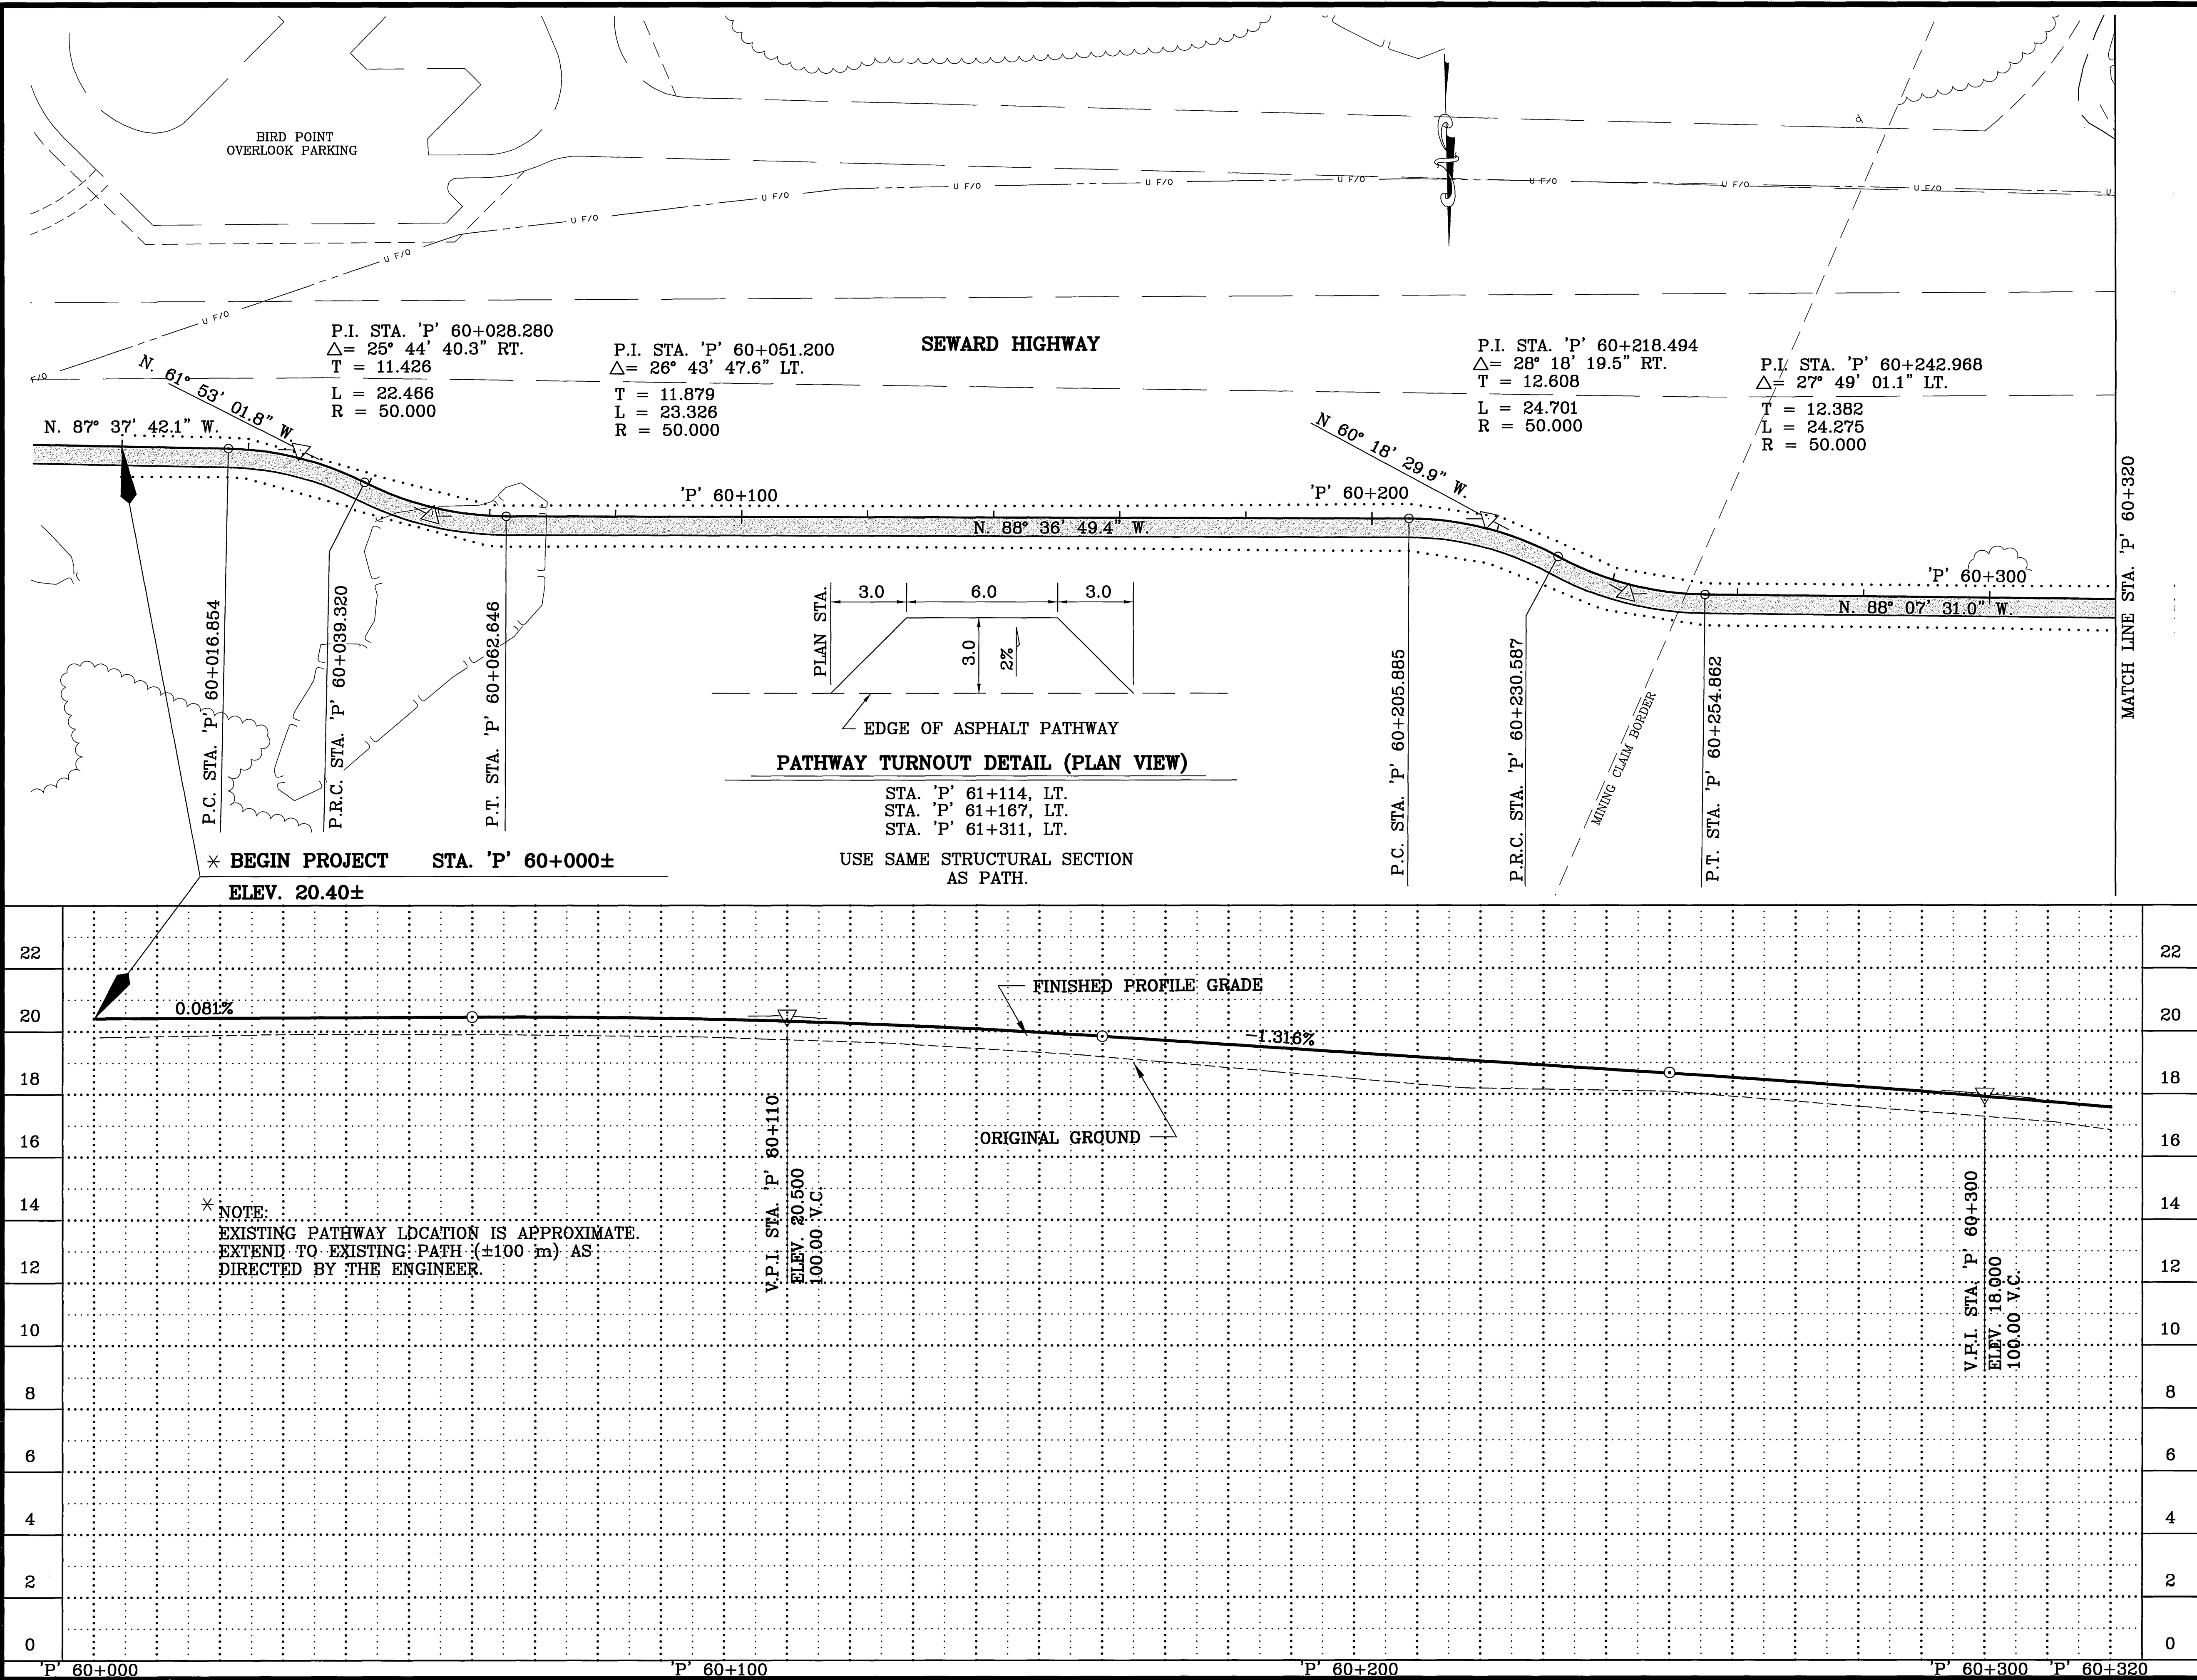

SHEET NO.		TOTAL SHEETS	
FP1		FP18	
STATE		YEAR	
ALASKA		2002	
PROJECT DESIGNATION			
NH-0A3-1(28)			
ADDENDUM NO.			
ATTACHMENT NO.			
REVISIONS			
NO.	DATE	DESCRIPTION	

BIRD CREEK BRIDGE

Bird Creek

TURNAGAIN ARM

THIS SHEET

BIRD POINT


SEWARD HIGHWAY, MP 96 TO 102

NOTE:
DIMENSIONS ARE IN METERS
UNLESS OTHERWISE NOTED.

STATE OF ALASKA
49TH
AUDREY J. DAUGHERTY
CE 9823
4.18.12
REGISTERED PROFESSIONAL ENGINEER

STATE OF ALASKA
DEPARTMENT OF TRANSPORTATION
AND PUBLIC FACILITIES
SEWARD HIGHWAY
MP 96 TO MP 102
SAFETY, ROADWAY AND
RECREATIONAL IMPROVEMENTS
BIRD FLATS AREA
PATHWAY
PLAN AND PROFILE

DESIGNATIONS	DESIGNED BY	VIEW#	DATE
SCALE: 1"=100'	CHECKED BY	HALFOZ PATH	6/12/02
COMPUTER DESIGNATION	DRAFTED BY		

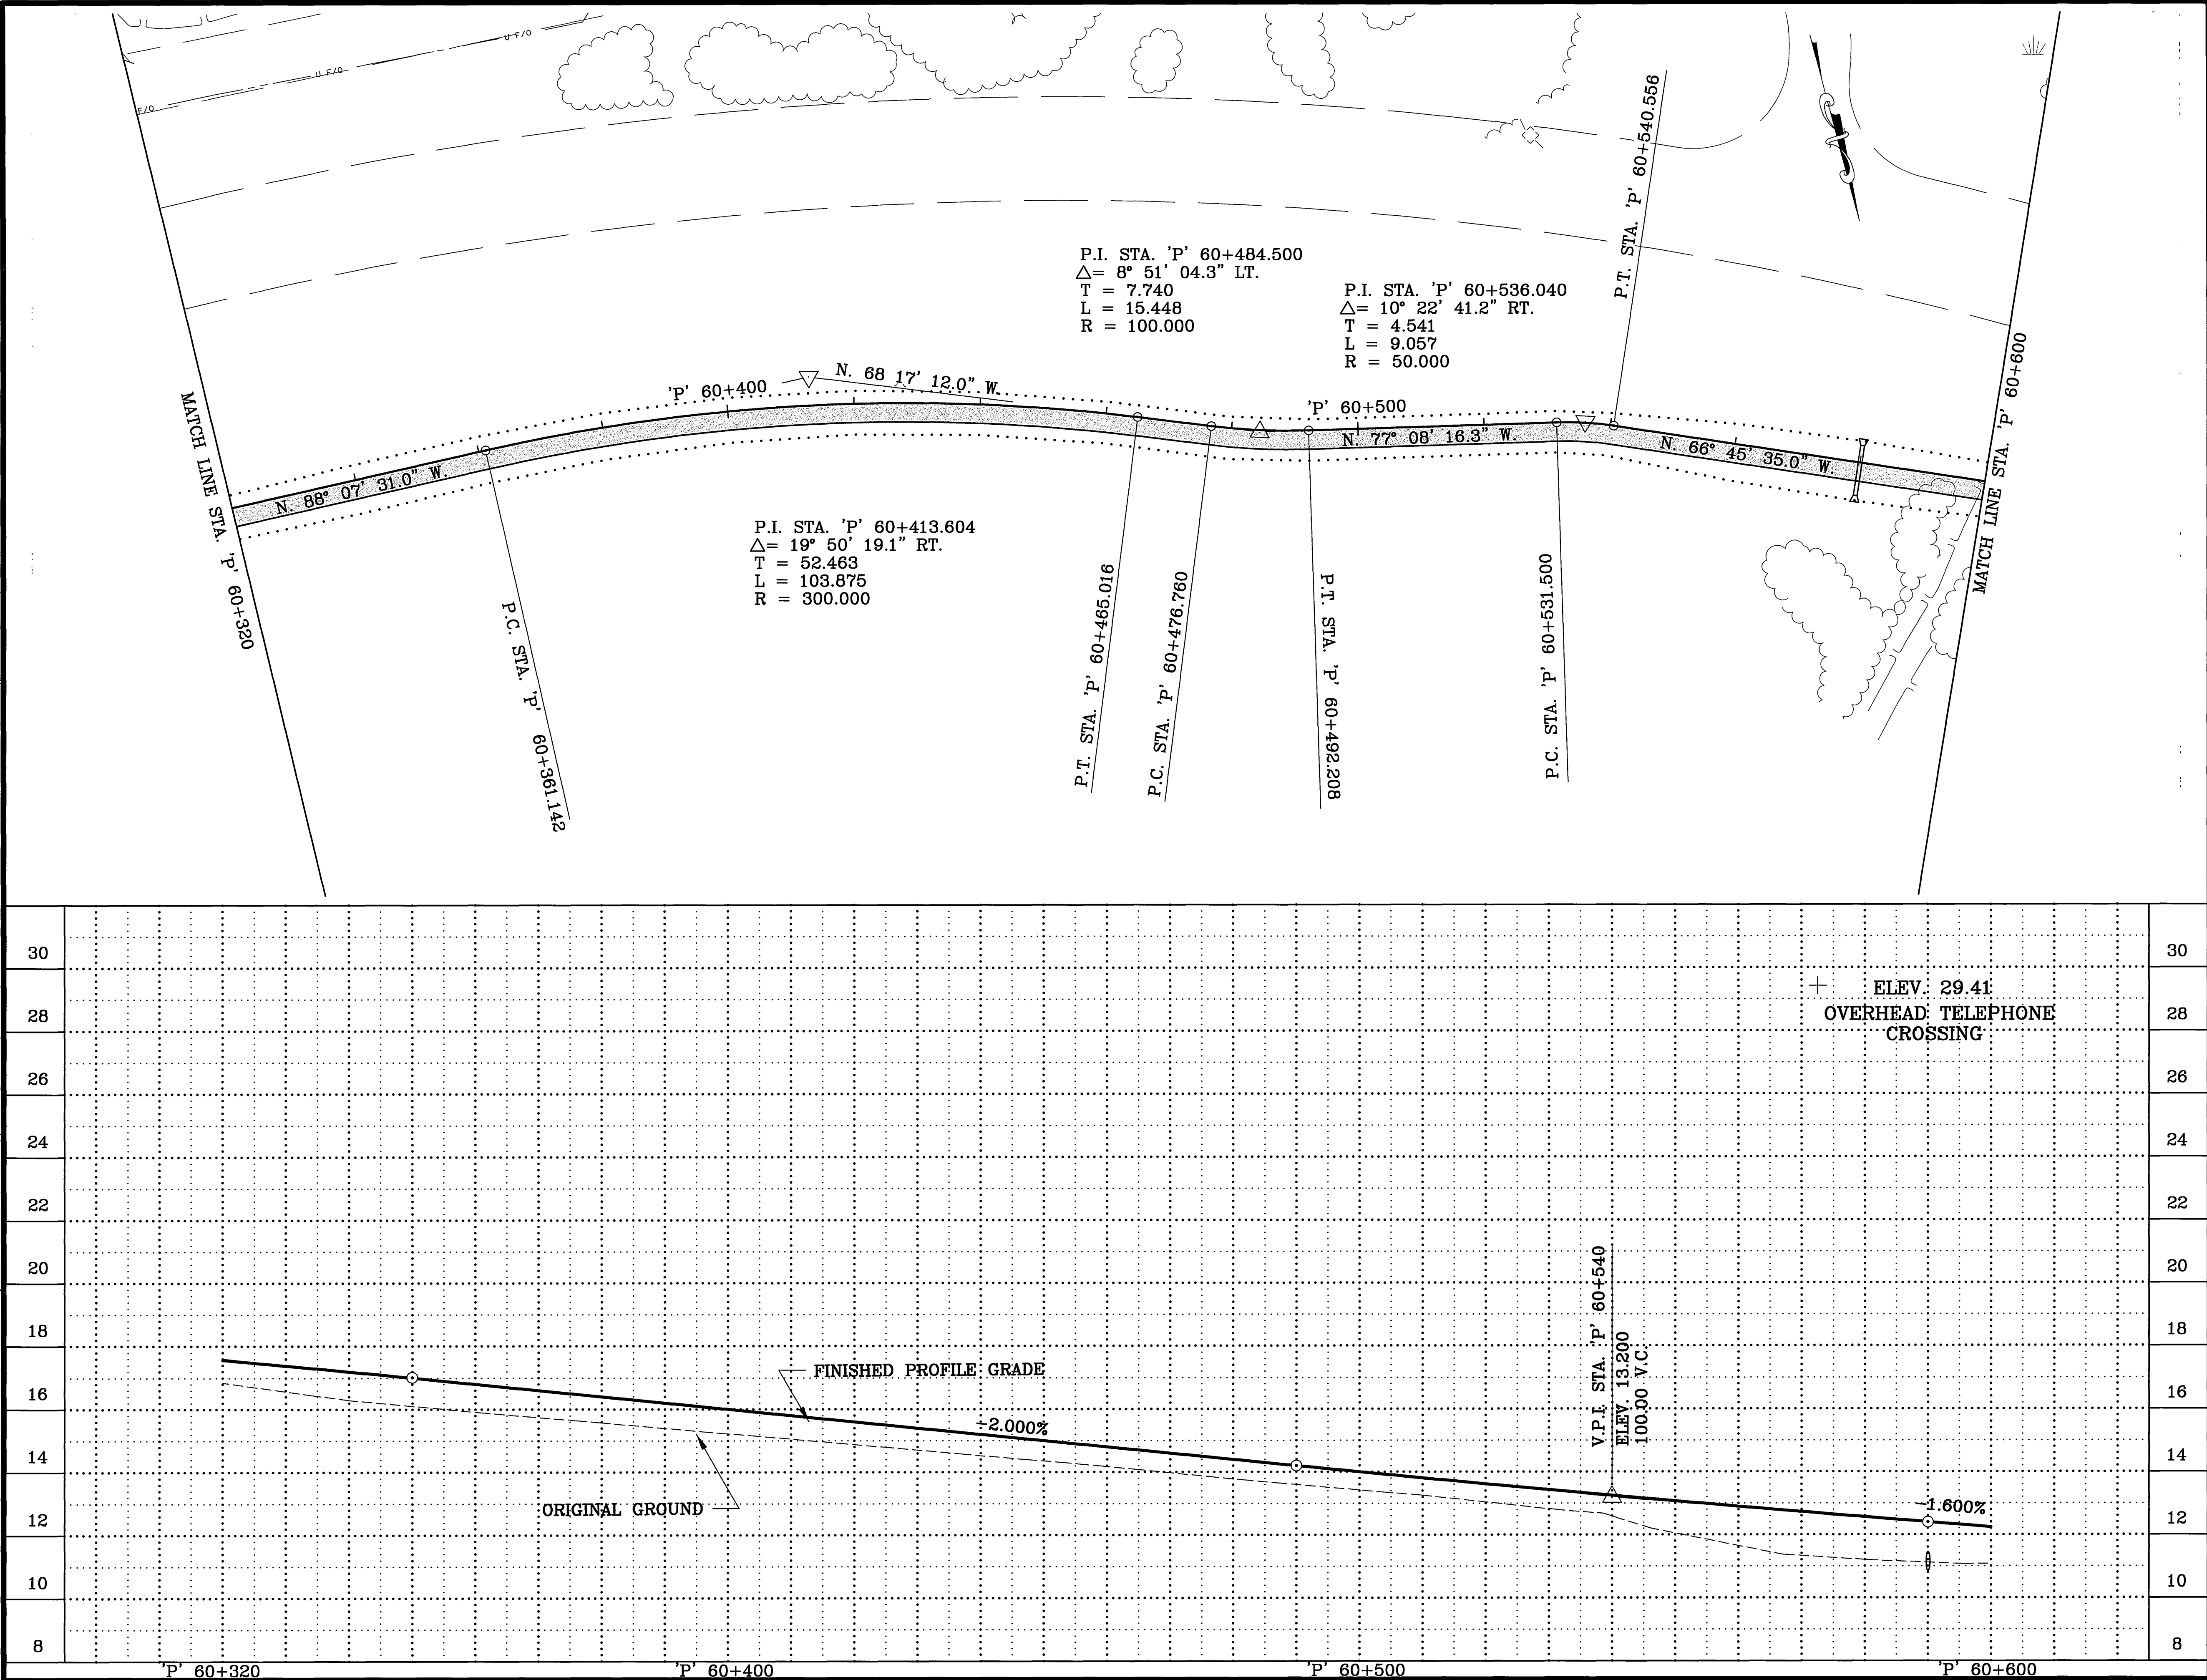

SHEET NO.	TOTAL SHEETS	
FP2	FP18	
STATE	YEAR	
ALASKA	2002	
PROJECT DESIGNATION		
NH-0A3-1(28)		
ADDENDUM NO.		
ATTACHMENT NO.		
REVISIONS		
NO.	DATE	DESCRIPTION

BIRD CREEK BRIDGE

TURNAGAIN ARM

BIRD POINT



SEWARD HIGHWAY, MP 96 TO 102

NOTE: DIMENSIONS ARE IN METERS UNLESS OTHERWISE NOTED.

STATE OF ALASKA
49TH
AUDREY J. DOUGHERTY
CE 8823
11.14.02
REGISTERED PROFESSIONAL ENGINEER

STATE OF ALASKA
DEPARTMENT OF TRANSPORTATION
AND PUBLIC FACILITIES
SEWARD HIGHWAY
MP 96 TO MP 102
SAFETY ROADWAY AND
RECREATIONAL IMPROVEMENTS
BIRD FLATS AREA
PATHWAY
PLAN AND PROFILE

SPECIFICATIONS
SCALE 1"=1'
COMPUTER DESIGNATION
DESIGNED BY
CHECKED BY
VIEW=HALF03-PATH
6/12/02
KMH

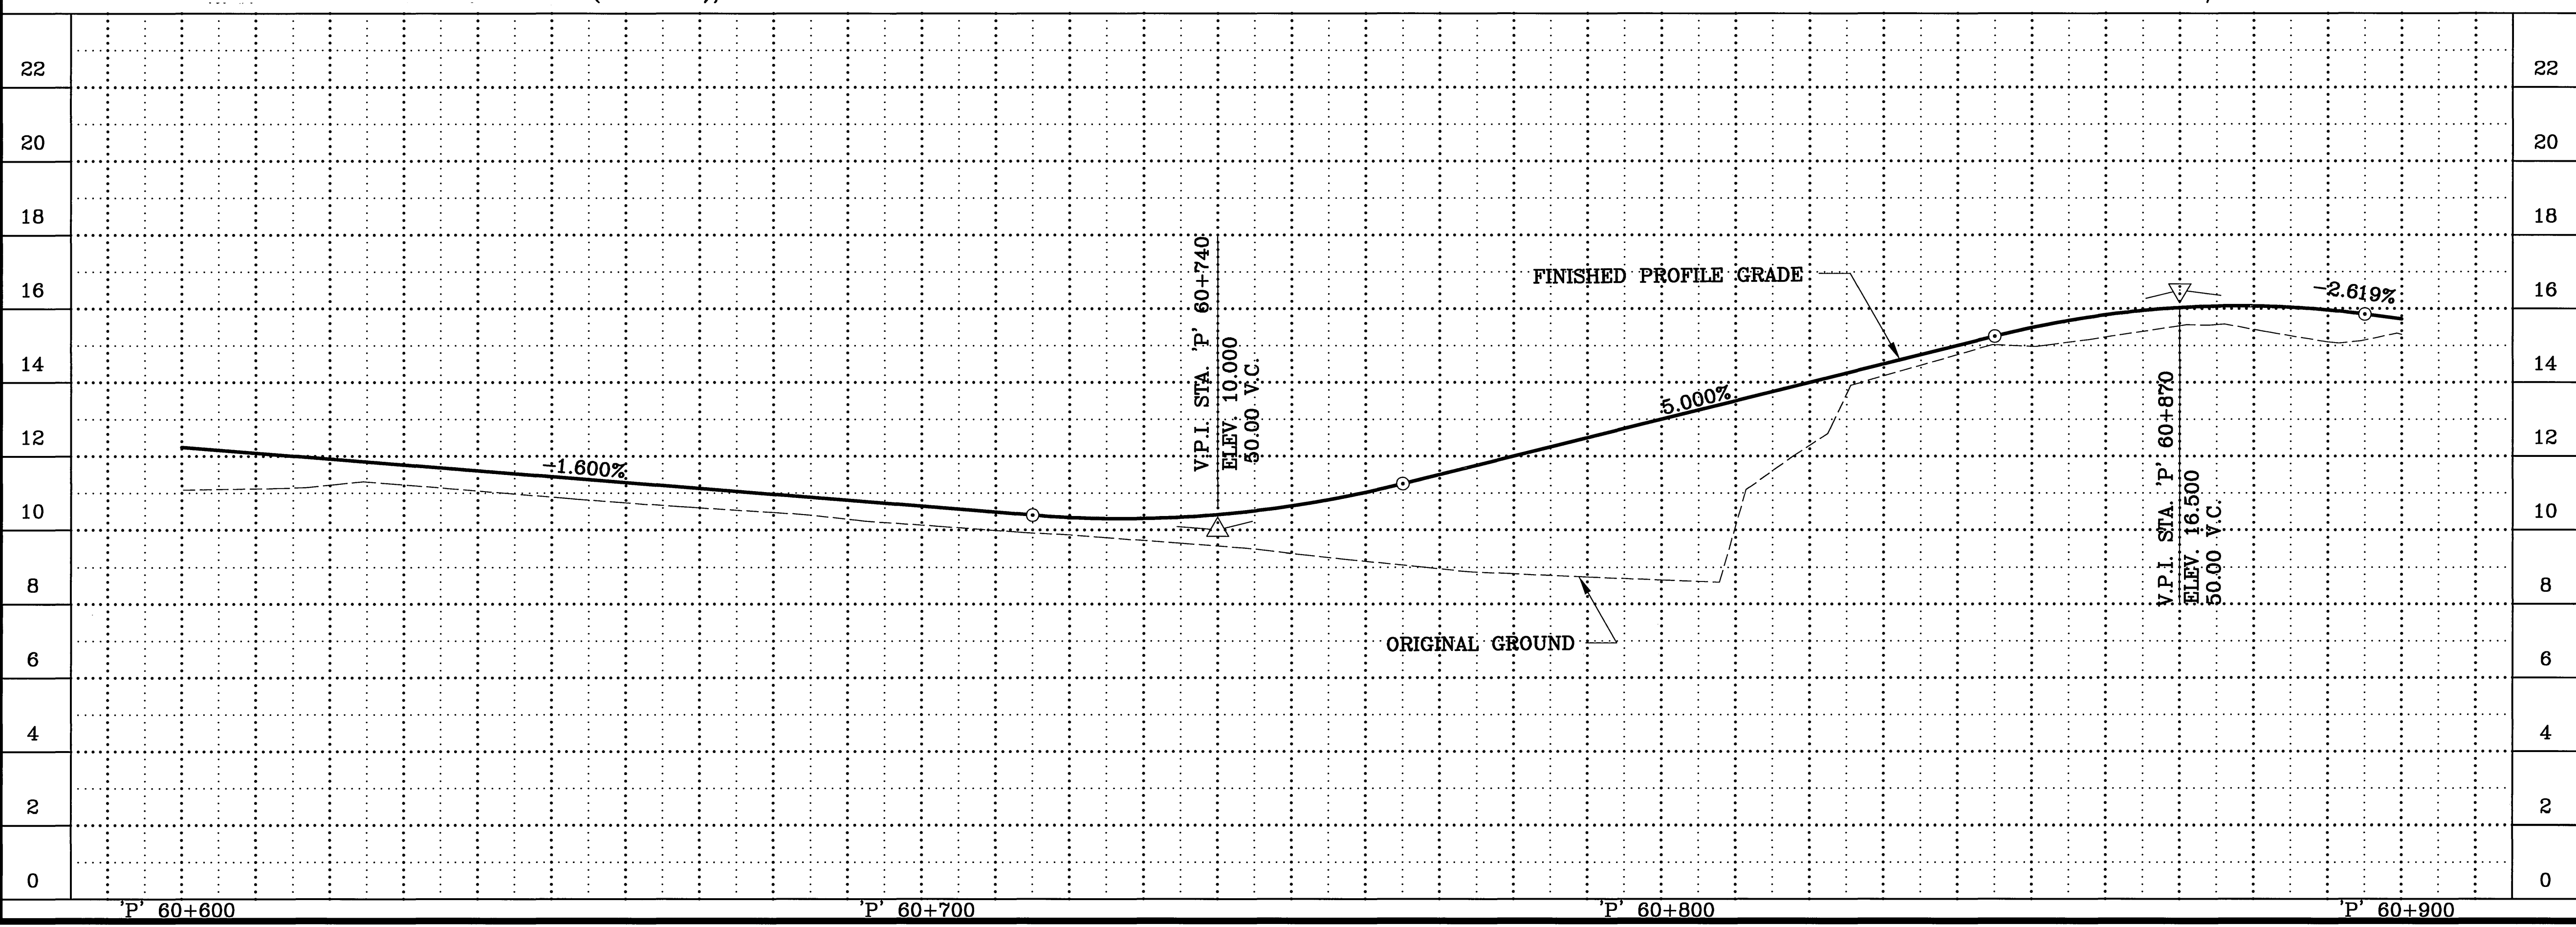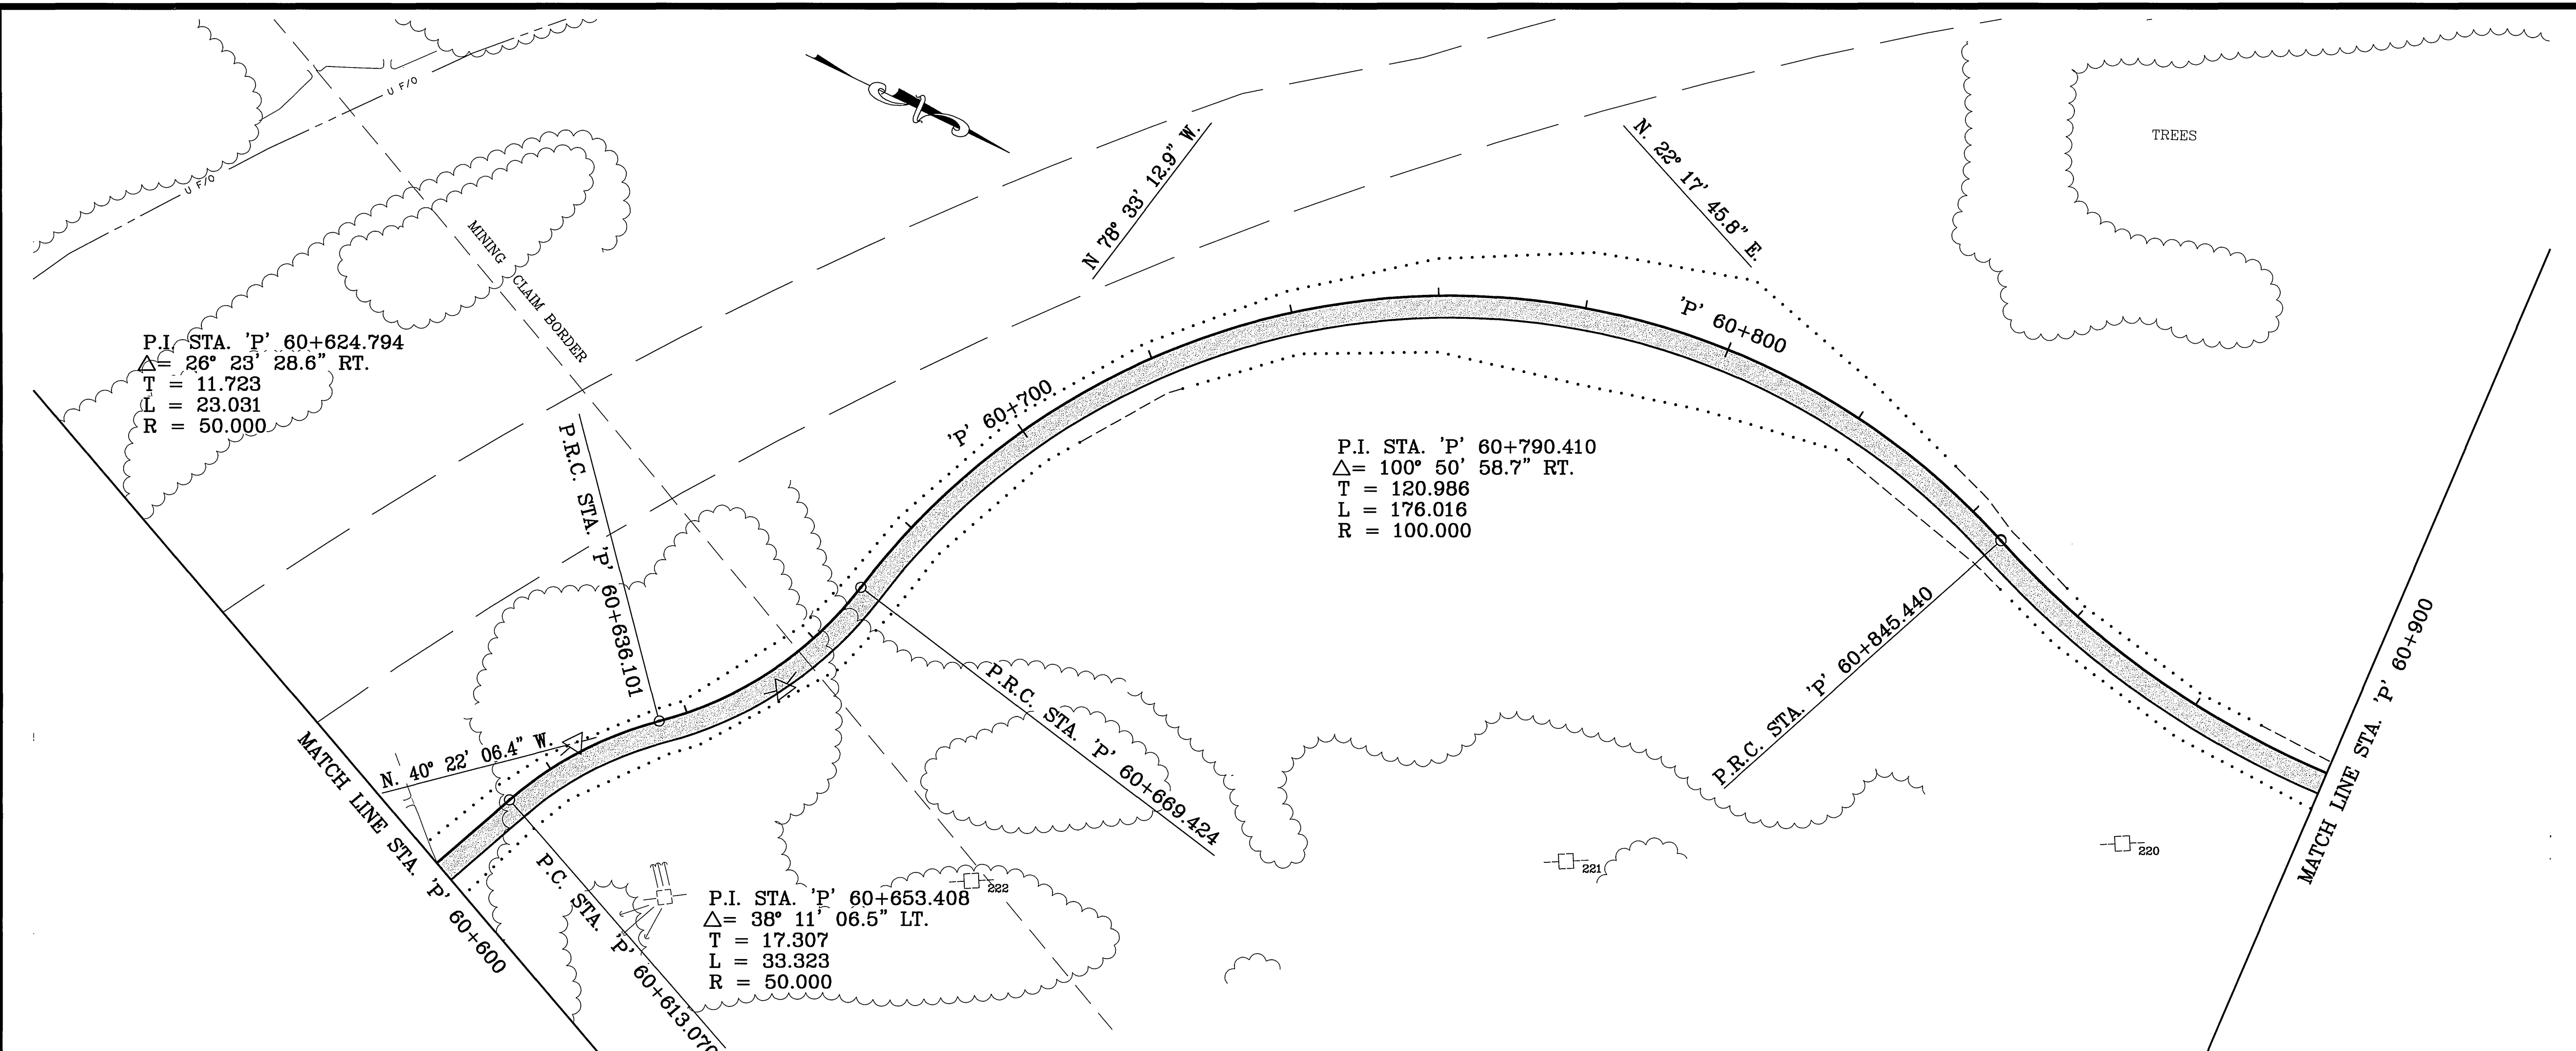

SHEET NO.	TOTAL SHEETS	
FP3	FP18	
STATE	YEAR	
ALASKA	2002	
PROJECT DESIGNATION		
NH-0A3-1(28)		
ADDENDUM NO.		
ATTACHMENT NO.		
REVISIONS		
NO.	DATE	DESCRIPTION

BIRD CREEK BRIDGE

Bird Creek

TURNAGAIN ARM



BIRD POINT

SEWARD HIGHWAY, MP 96 TO 102



NOTE:
DIMENSIONS ARE IN METERS
UNLESS OTHERWISE NOTED.

STATE OF ALASKA
49TH
JUDY J. DOUGHERTY
CE 8823
11/05
REGISTERED PROFESSIONAL ENGINEER

STATE OF ALASKA
DEPARTMENT OF TRANSPORTATION
AND PUBLIC FACILITIES
SEWARD HIGHWAY
MP 96 TO MP 102
SAFETY, ROADWAY AND
RECREATIONAL IMPROVEMENTS
BIRD FLATS AREA
PATHWAY
PLAN AND PROFILE

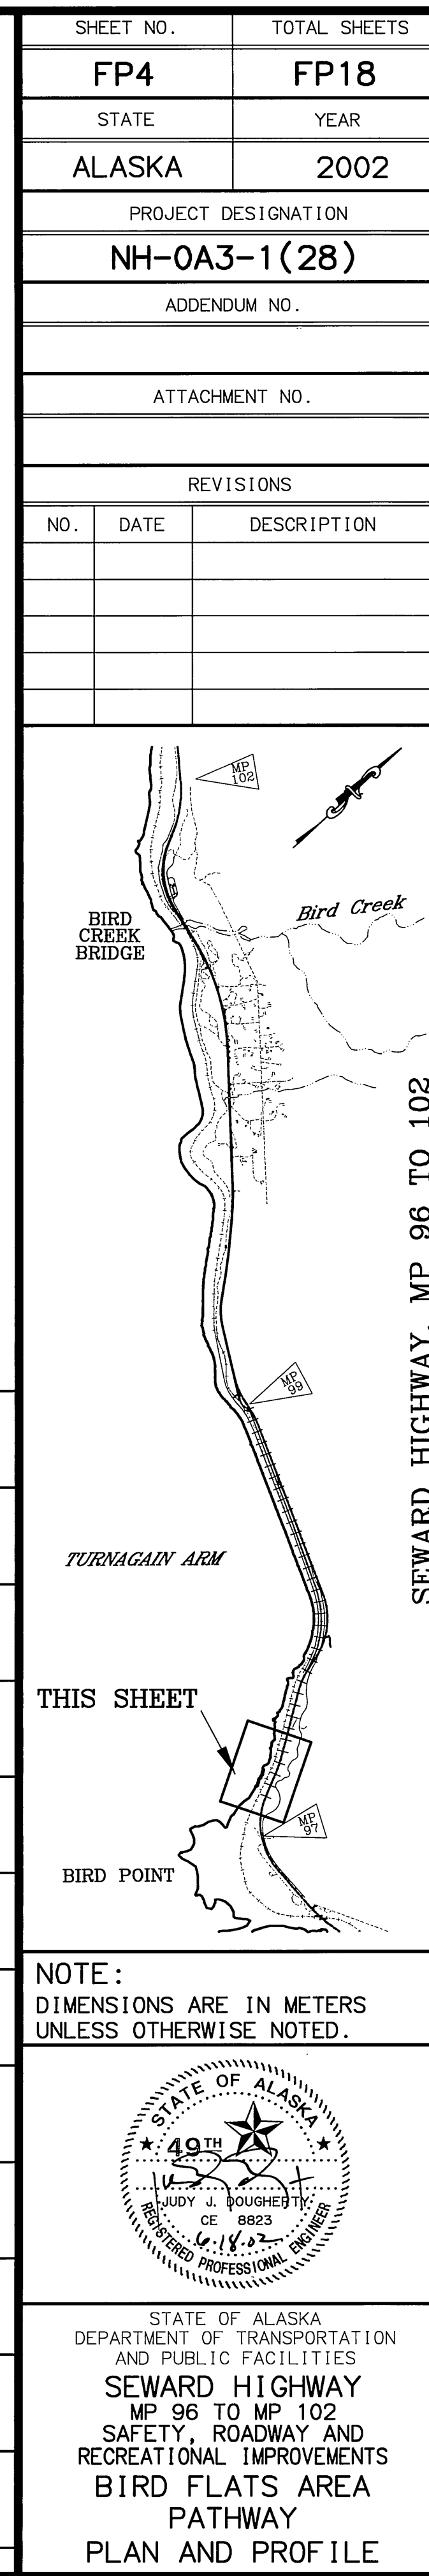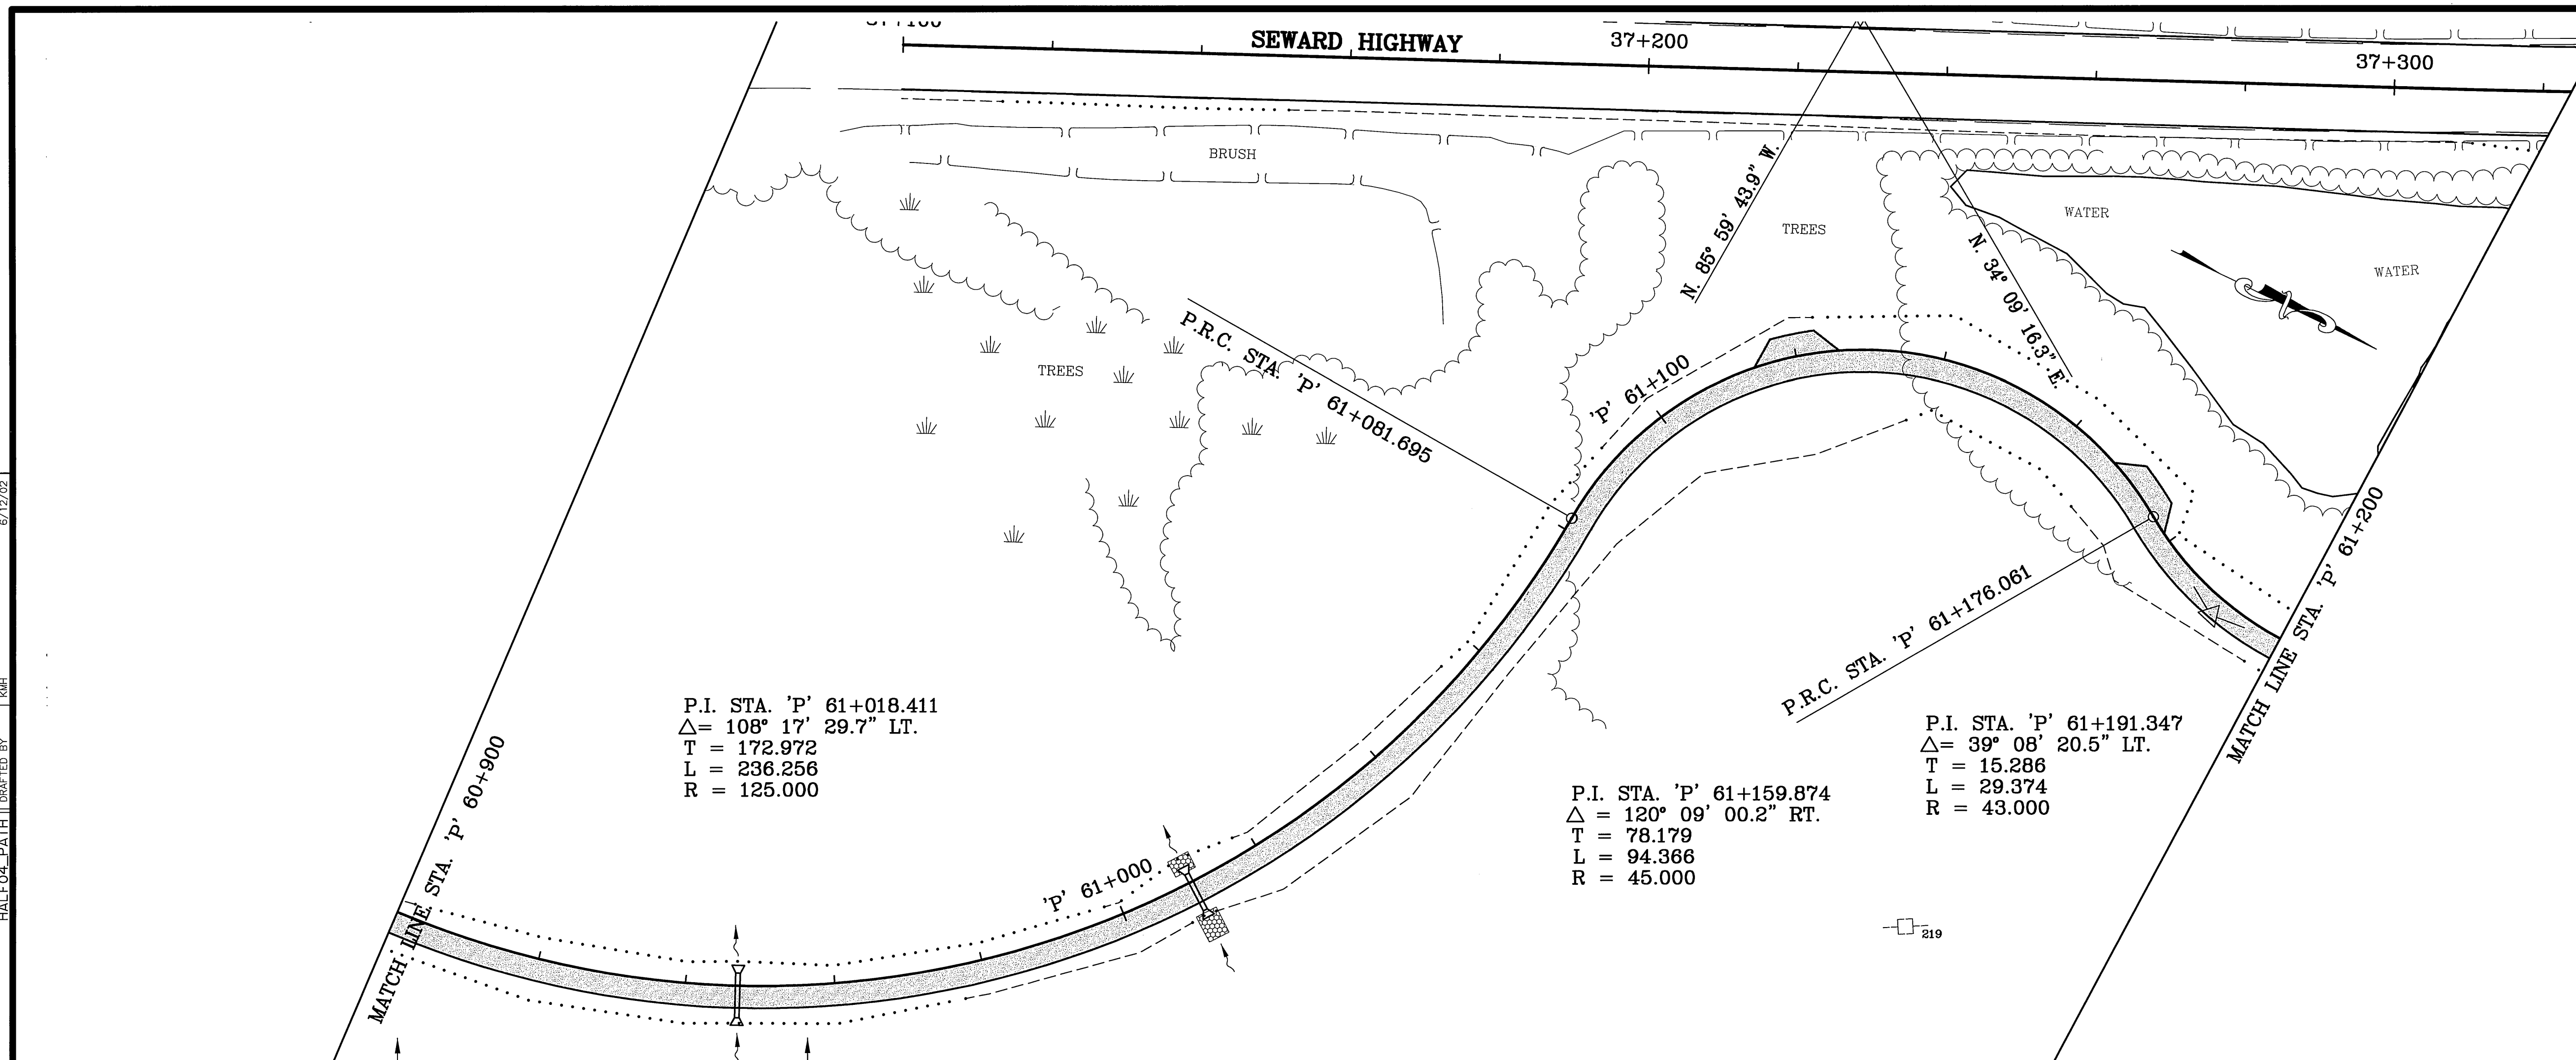

DESIGNED BY
CHECKED BY
DATE
VIEW#
HALF05_PATH
DATE
SPECIFICATIONS
SCALE 1/4" = 100'
COMPUTER DESIGNATION
AUTOCAD-CAROL.EE-SDS@PROL\5357177P

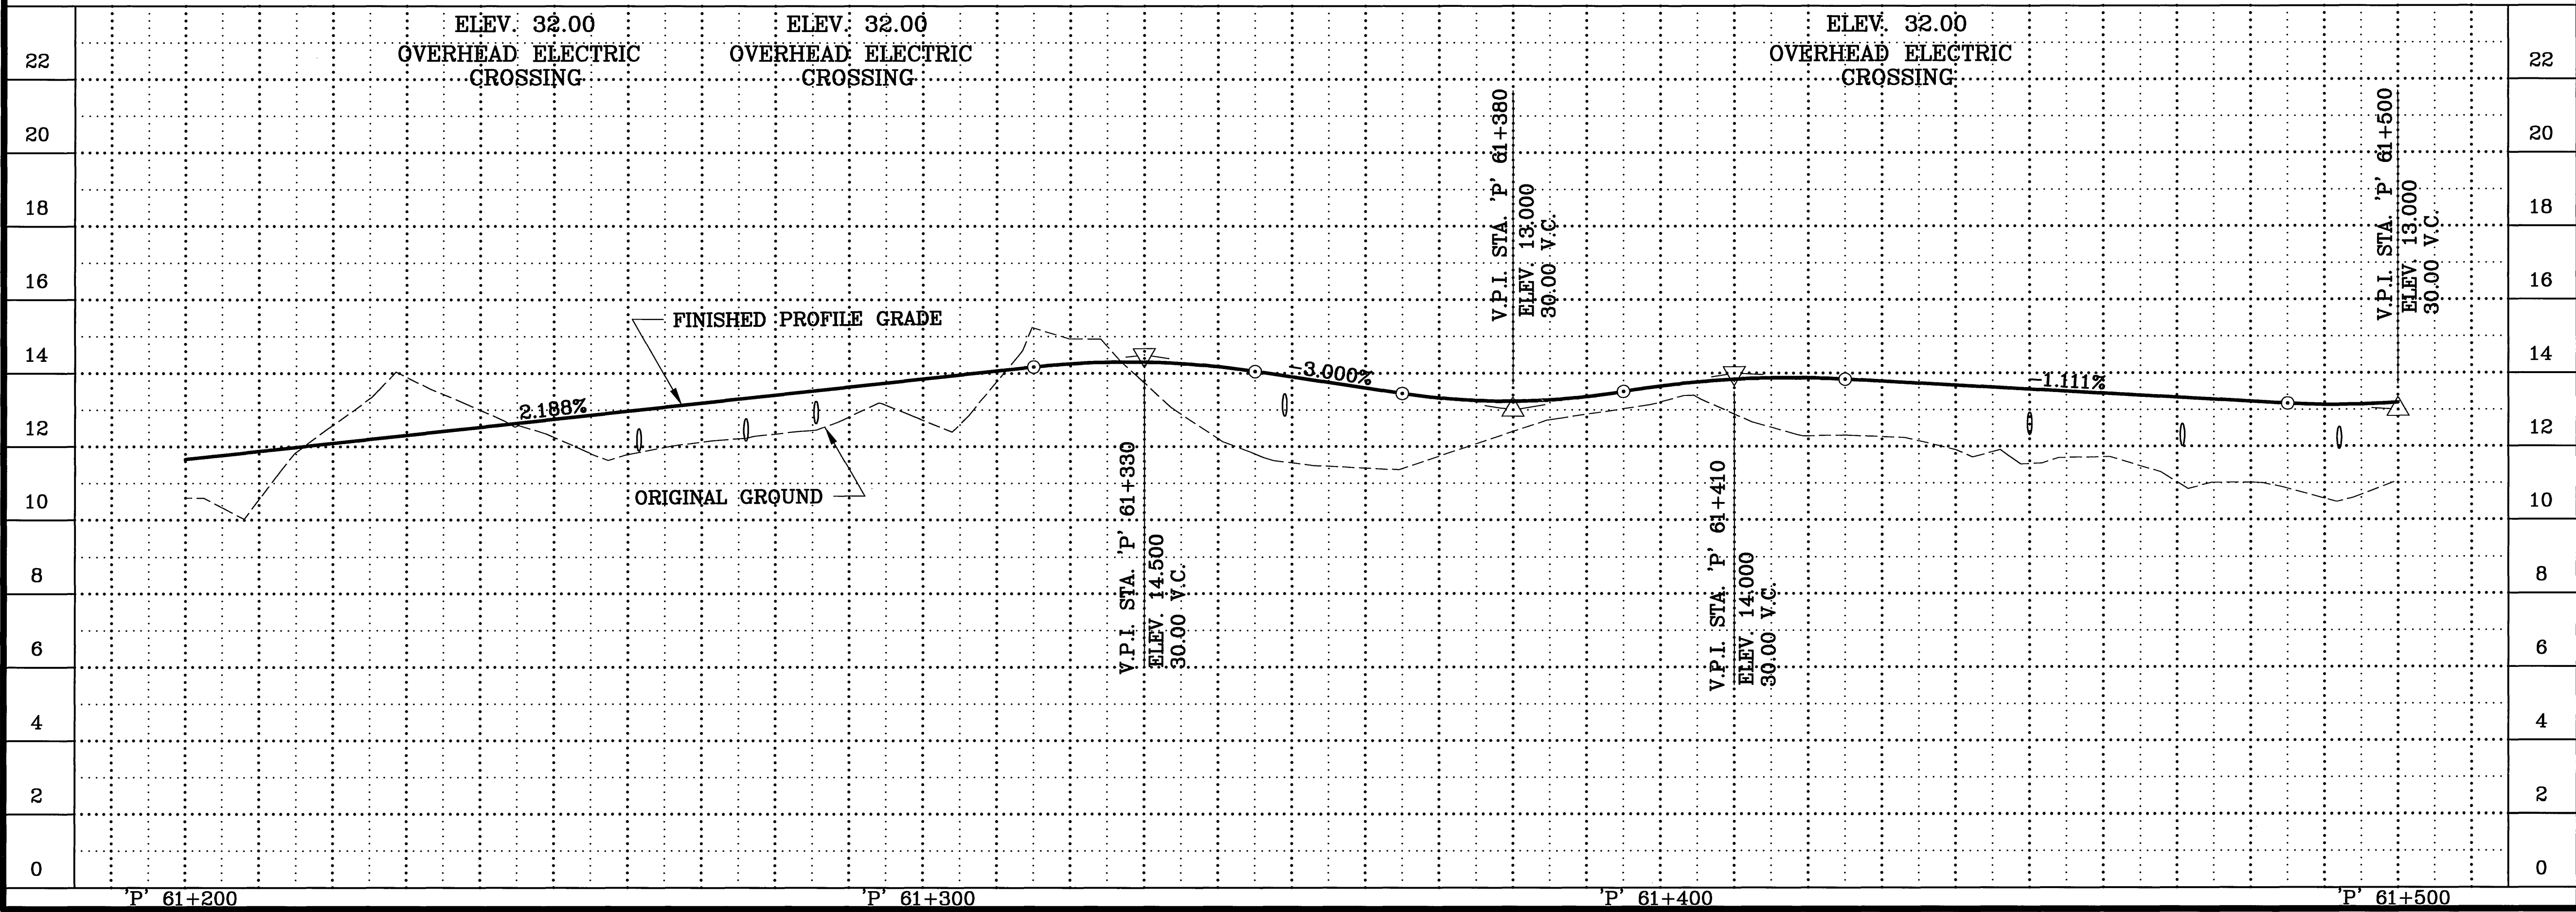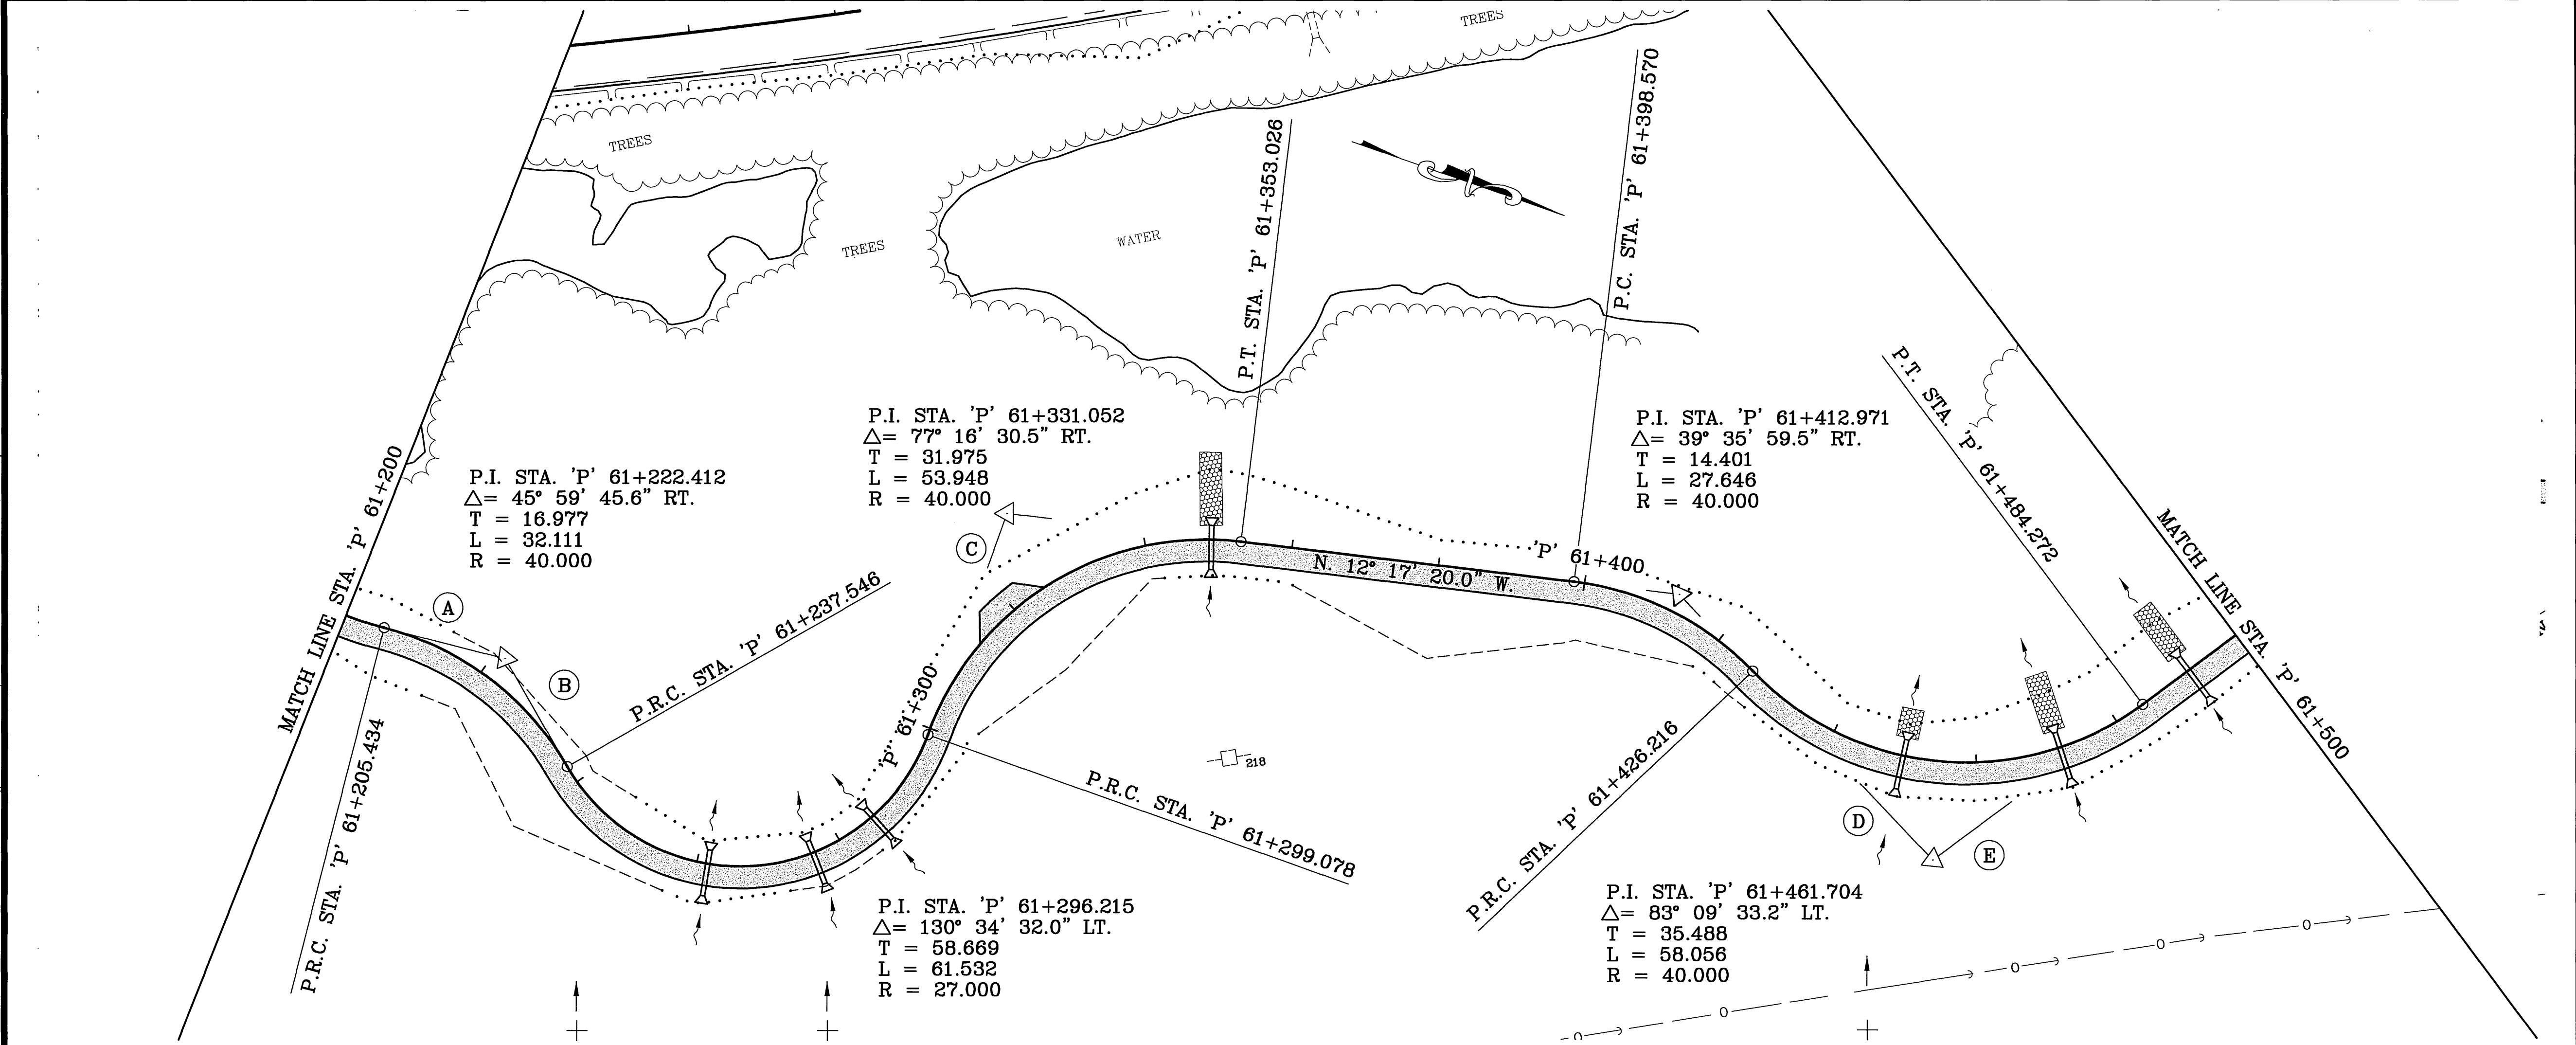



SHEET NO.		TOTAL SHEETS	
FP5		FP18	
STATE		YEAR	
ALASKA		2002	
PROJECT DESIGNATION			
NH-0A3-1(28)			
ADDENDUM NO.			
ATTACHMENT NO.			
REVISIONS			
NO.	DATE	DESCRIPTION	

SEWARD HIGHWAY, MP 96 TO 102

NOTE:
DIMENSIONS ARE IN METERS
UNLESS OTHERWISE NOTED.

STATE OF ALASKA
DEPARTMENT OF TRANSPORTATION
AND PUBLIC FACILITIES
SEWARD HIGHWAY
MP 96 TO MP 102
SAFETY, ROADWAY AND
RECREATIONAL IMPROVEMENTS
BIRD FLATS AREA
PATHWAY
PLAN AND PROFILE

DESIGNED BY: 6/12/02
CHECKED BY: KWH
HALF-SCALE PATH: 1/2"=100'
AUTOCAD-CORRECT: SCSKPRO\53577177PP
COMPUTER DESIGN: 1/2"=100'

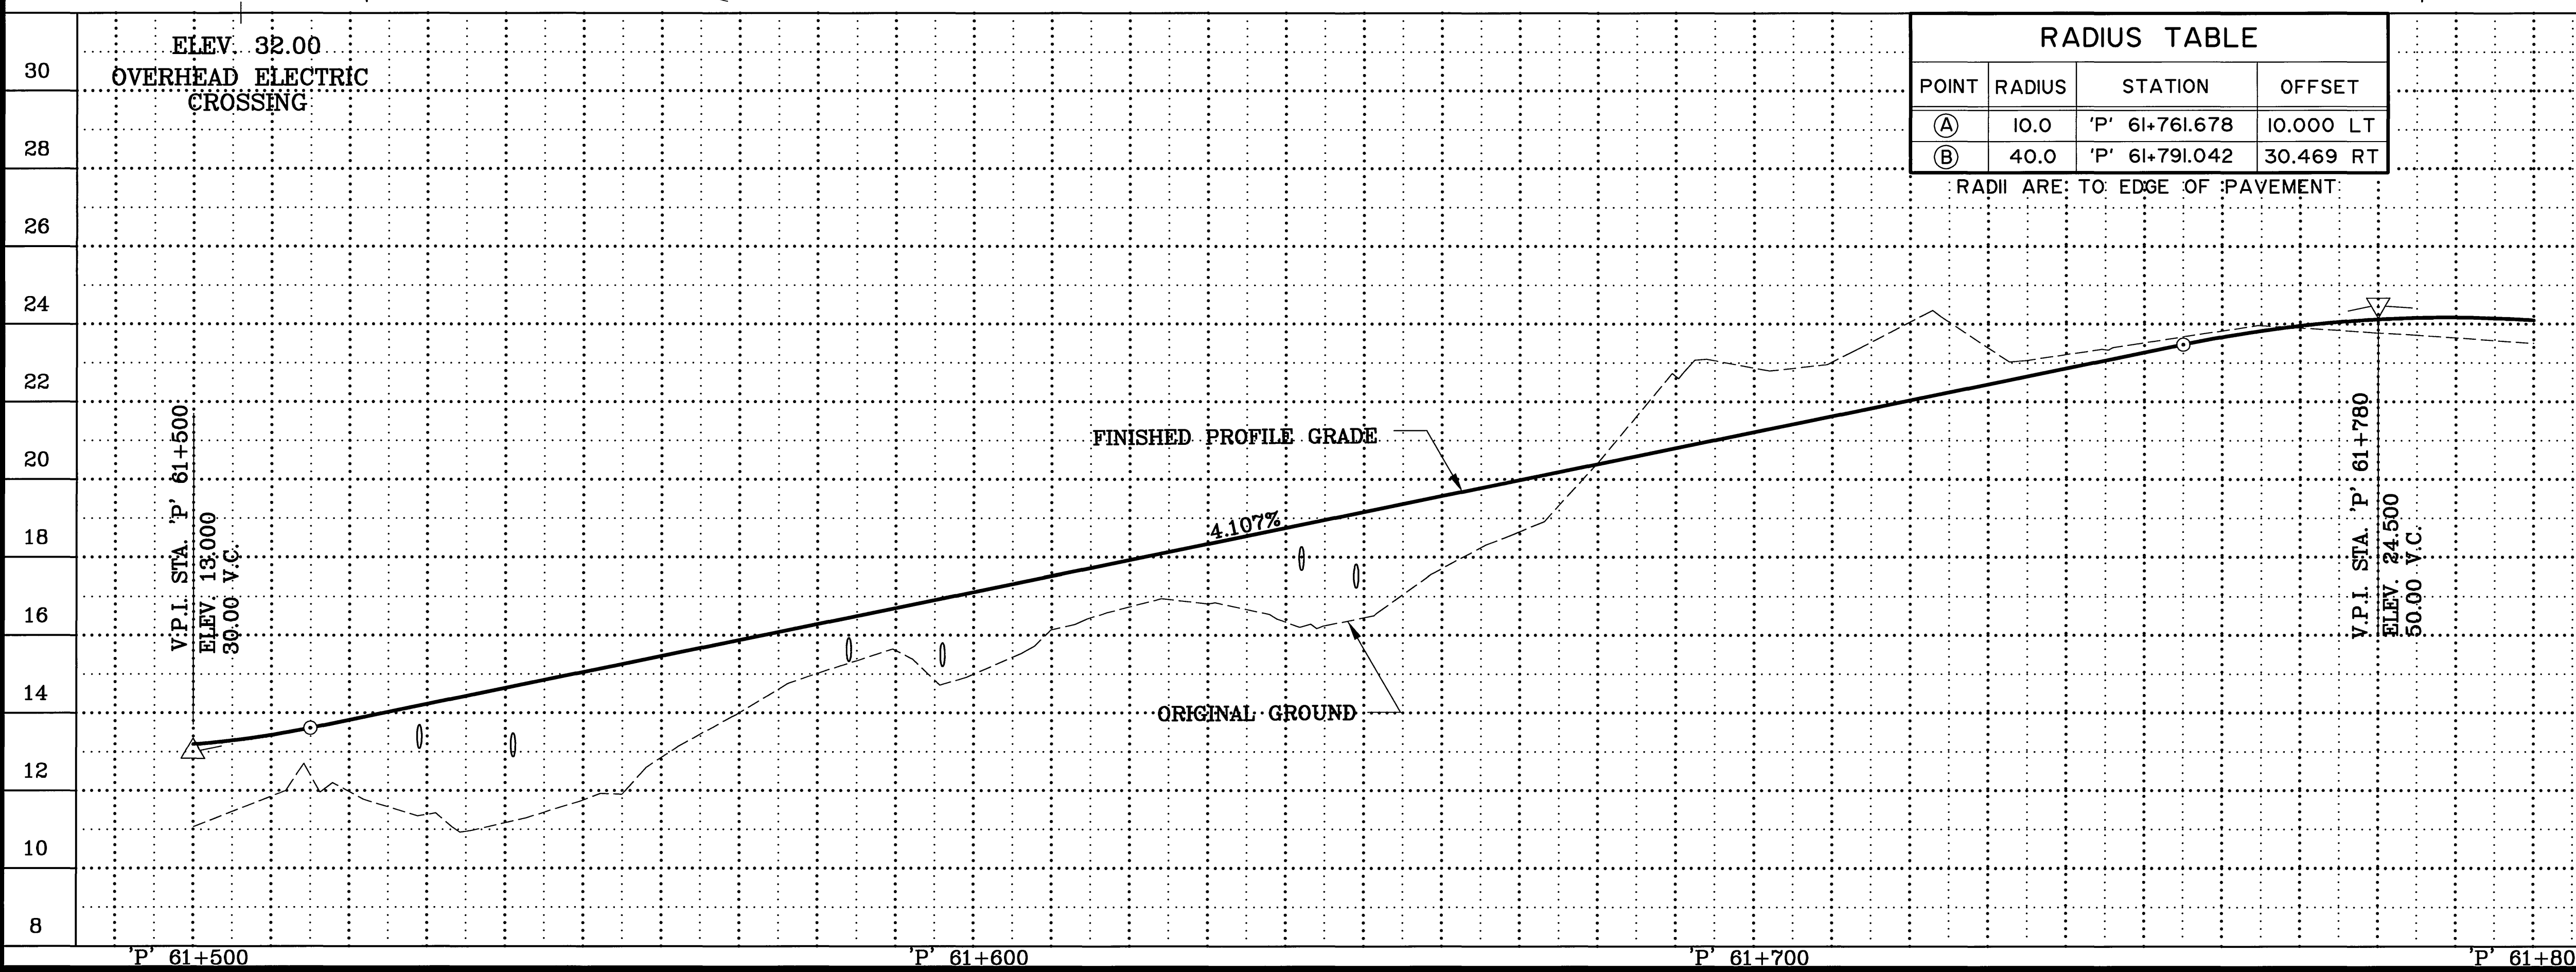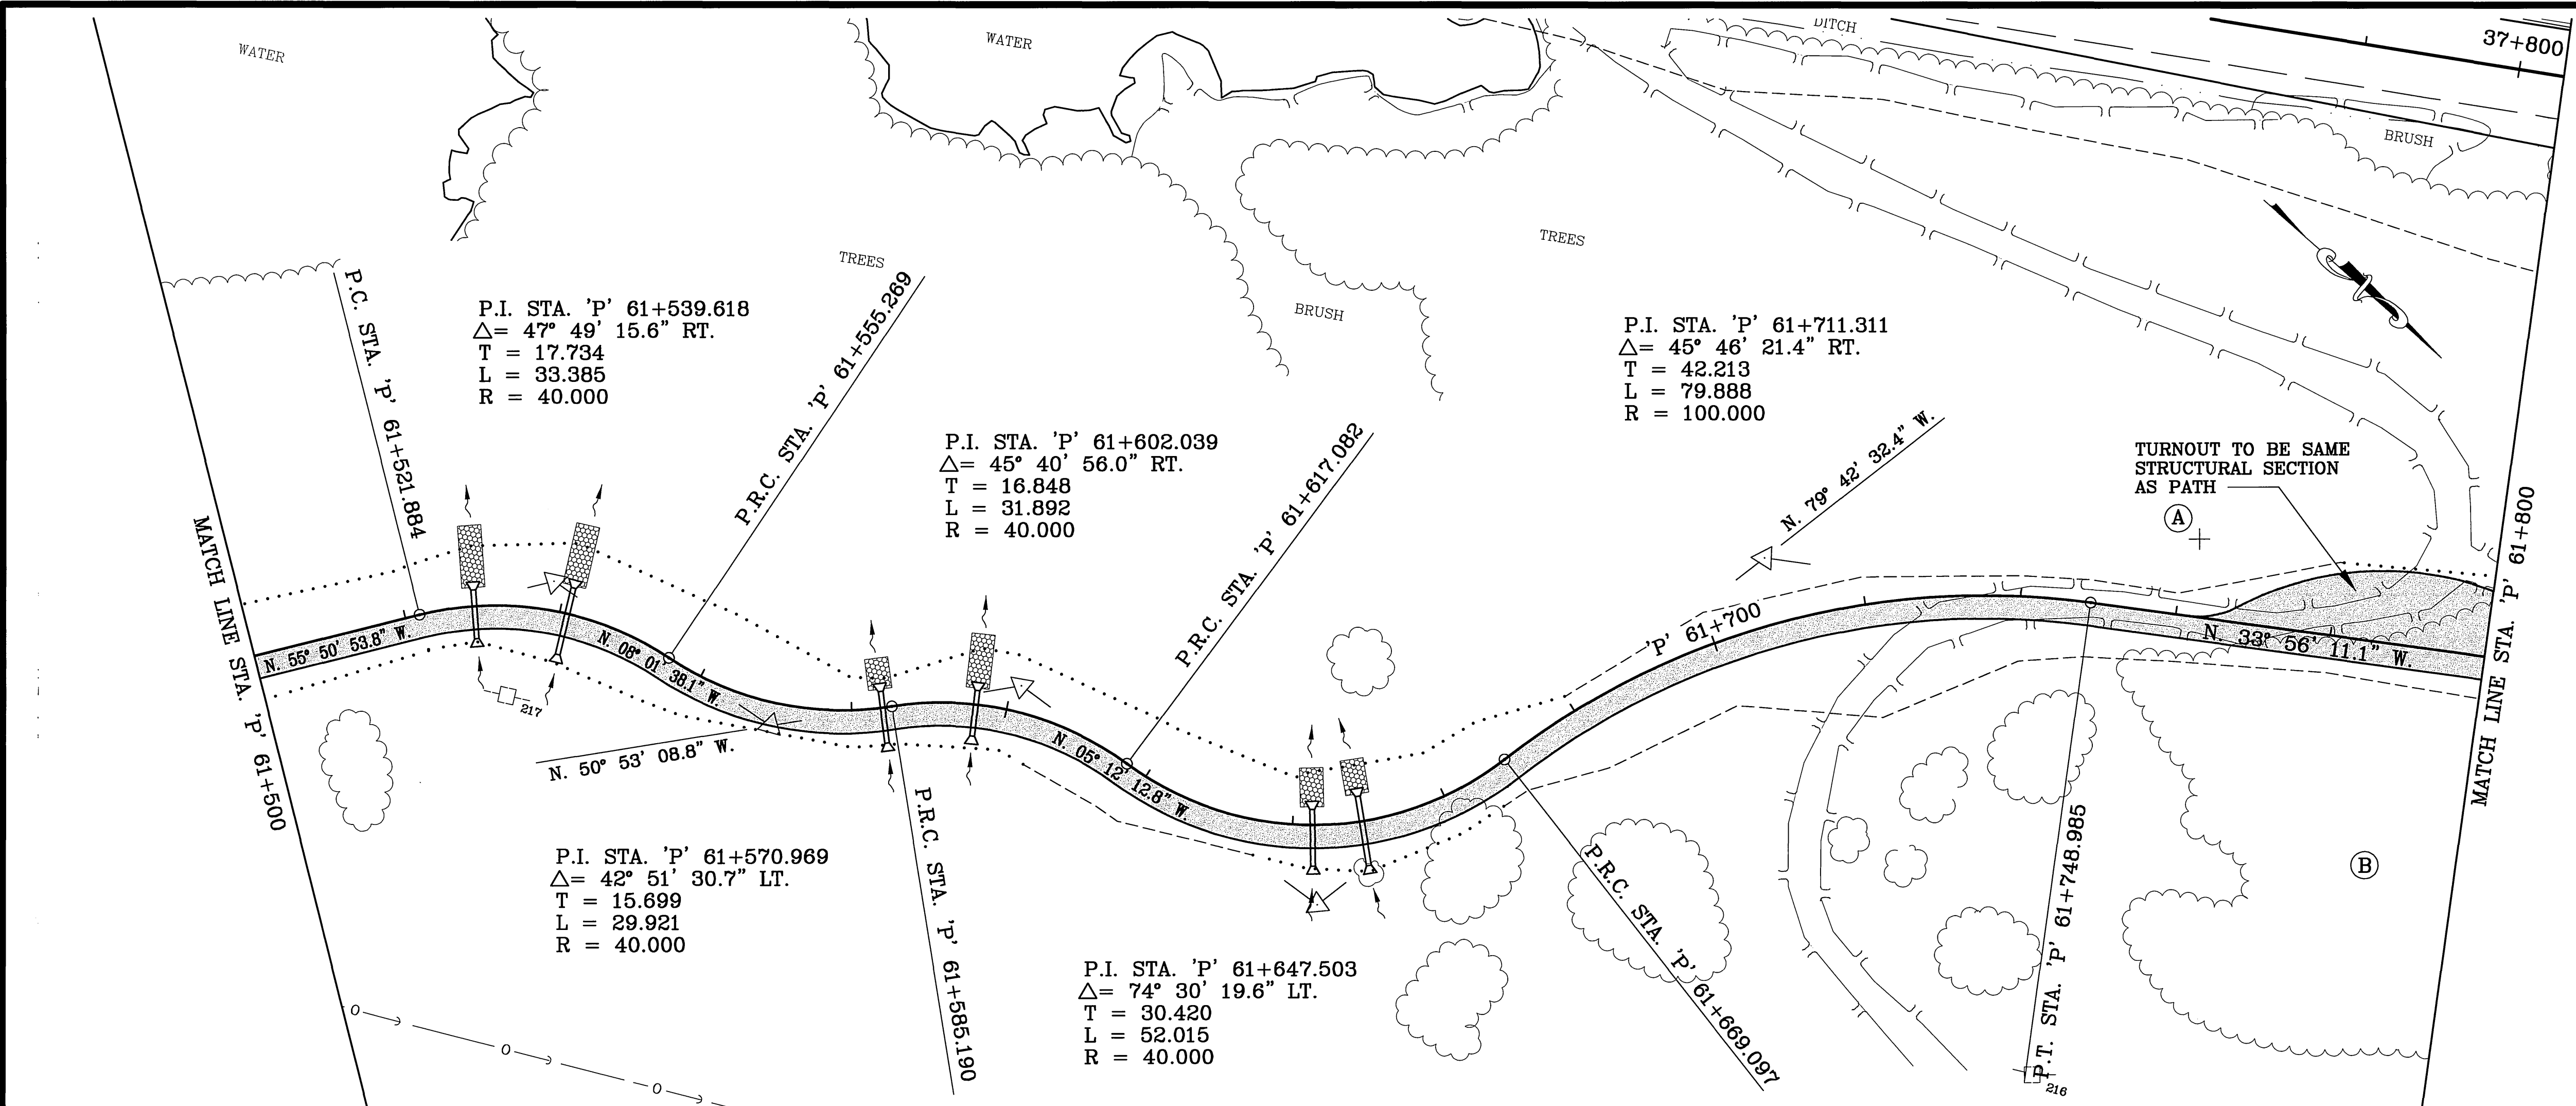

RADIUS TABLE			
POINT	RADIUS	STATION	OFFSET
(A)	10.0	'P' 61+761.678	10.000 LT
(B)	40.0	'P' 61+791.042	30.469 RT

RADI ARE: TO EDGE OF PAVEMENT

SHEET NO.	TOTAL SHEETS	
FP6	FP18	
STATE	YEAR	
ALASKA	2002	
PROJECT DESIGNATION		
NH-0A3-1(28)		
ADDENDUM NO.		
ATTACHMENT NO.		
REVISIONS		
NO.	DATE	DESCRIPTION

BIRD CREEK BRIDGE

TURNAGAIN ARM

BIRD POINT

SEWARD HIGHWAY, MP 96 TO 102


THIS SHEET

NOTE: DIMENSIONS ARE IN METERS UNLESS OTHERWISE NOTED.

STATE OF ALASKA
49TH
JUDY J. POUGHERTY
CE 8823
REGISTERED PROFESSIONAL ENGINEER

STATE OF ALASKA
DEPARTMENT OF TRANSPORTATION
AND PUBLIC FACILITIES
SEWARD HIGHWAY
MP 96 TO MP 102
SAFETY, ROADWAY AND
RECREATIONAL IMPROVEMENTS
BIRD FLATS AREA
PATHWAY
PLAN AND PROFILE

DESIGNED BY
CHECKED BY
DATE
6/12/02
VIEW#
HALF OF PATH
DRAWN BY
KMH
SPECIFICATIONS
AUTOCAD-CARLEE.SDSKPROJ\357717PP
SCALE 1"=100'
COMPUTER DESIGNATION

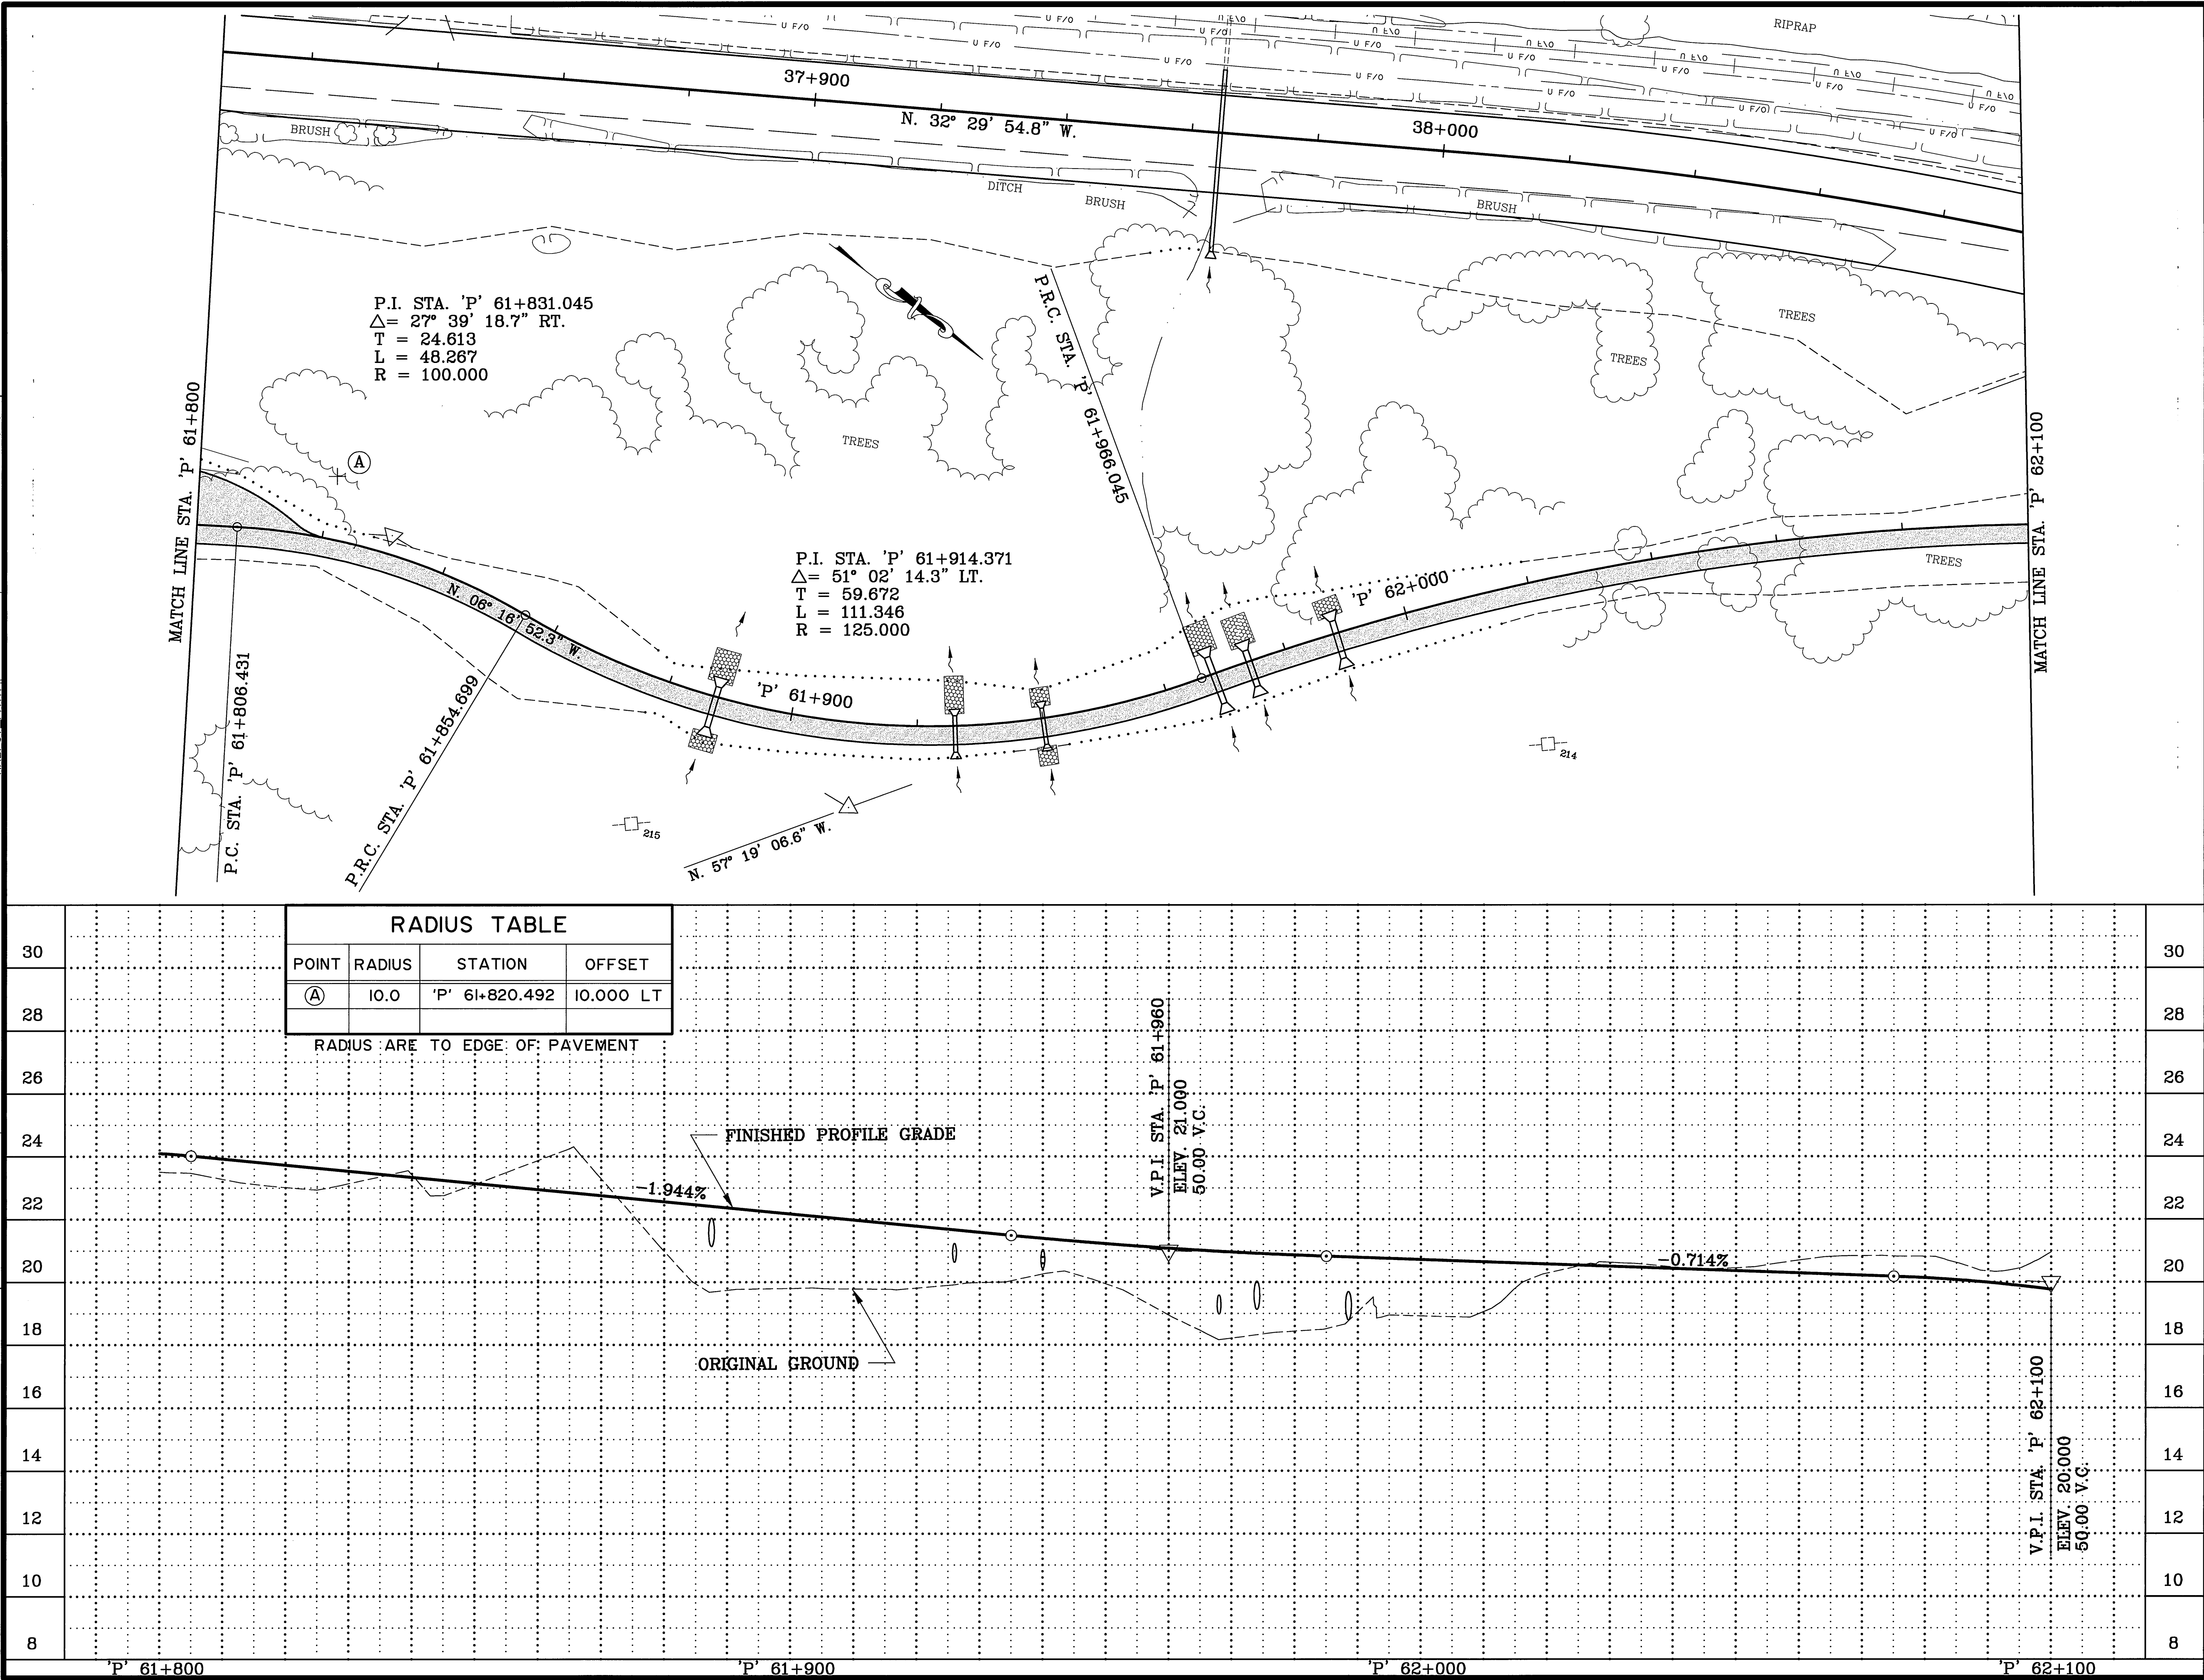

SHEET NO.	TOTAL SHEETS	
FP7	FP18	
STATE	YEAR	
ALASKA	2002	
PROJECT DESIGNATION		
NH-0A3-1(28)		
ADDENDUM NO.		
ATTACHMENT NO.		
REVISIONS		
NO.	DATE	DESCRIPTION

BIRD CREEK BRIDGE

Bird Creek

TURNAGAIN ARM

THIS SHEET

BIRD POINT


NOTE:
DIMENSIONS ARE IN METERS
UNLESS OTHERWISE NOTED.

STATE OF ALASKA
49TH
JUDY L. DOUGHERTY
CE 8823
REGISTERED PROFESSIONAL ENGINEER

STATE OF ALASKA
DEPARTMENT OF TRANSPORTATION
AND PUBLIC FACILITIES
SEWARD HIGHWAY
MP 96 TO MP 102
SAFETY, ROADWAY AND
RECREATIONAL IMPROVEMENTS
BIRD FLATS AREA
PATHWAY
PLAN AND PROFILE

SEWARD HIGHWAY, MP 96 TO 102

DESIGNED BY
CHECKED BY
AUTOCAD-CARLEE SSSPROJ\5577\7PP
DATE
6/12/02
VIEW
HALF OR PATH
KMH
DRAFTED BY

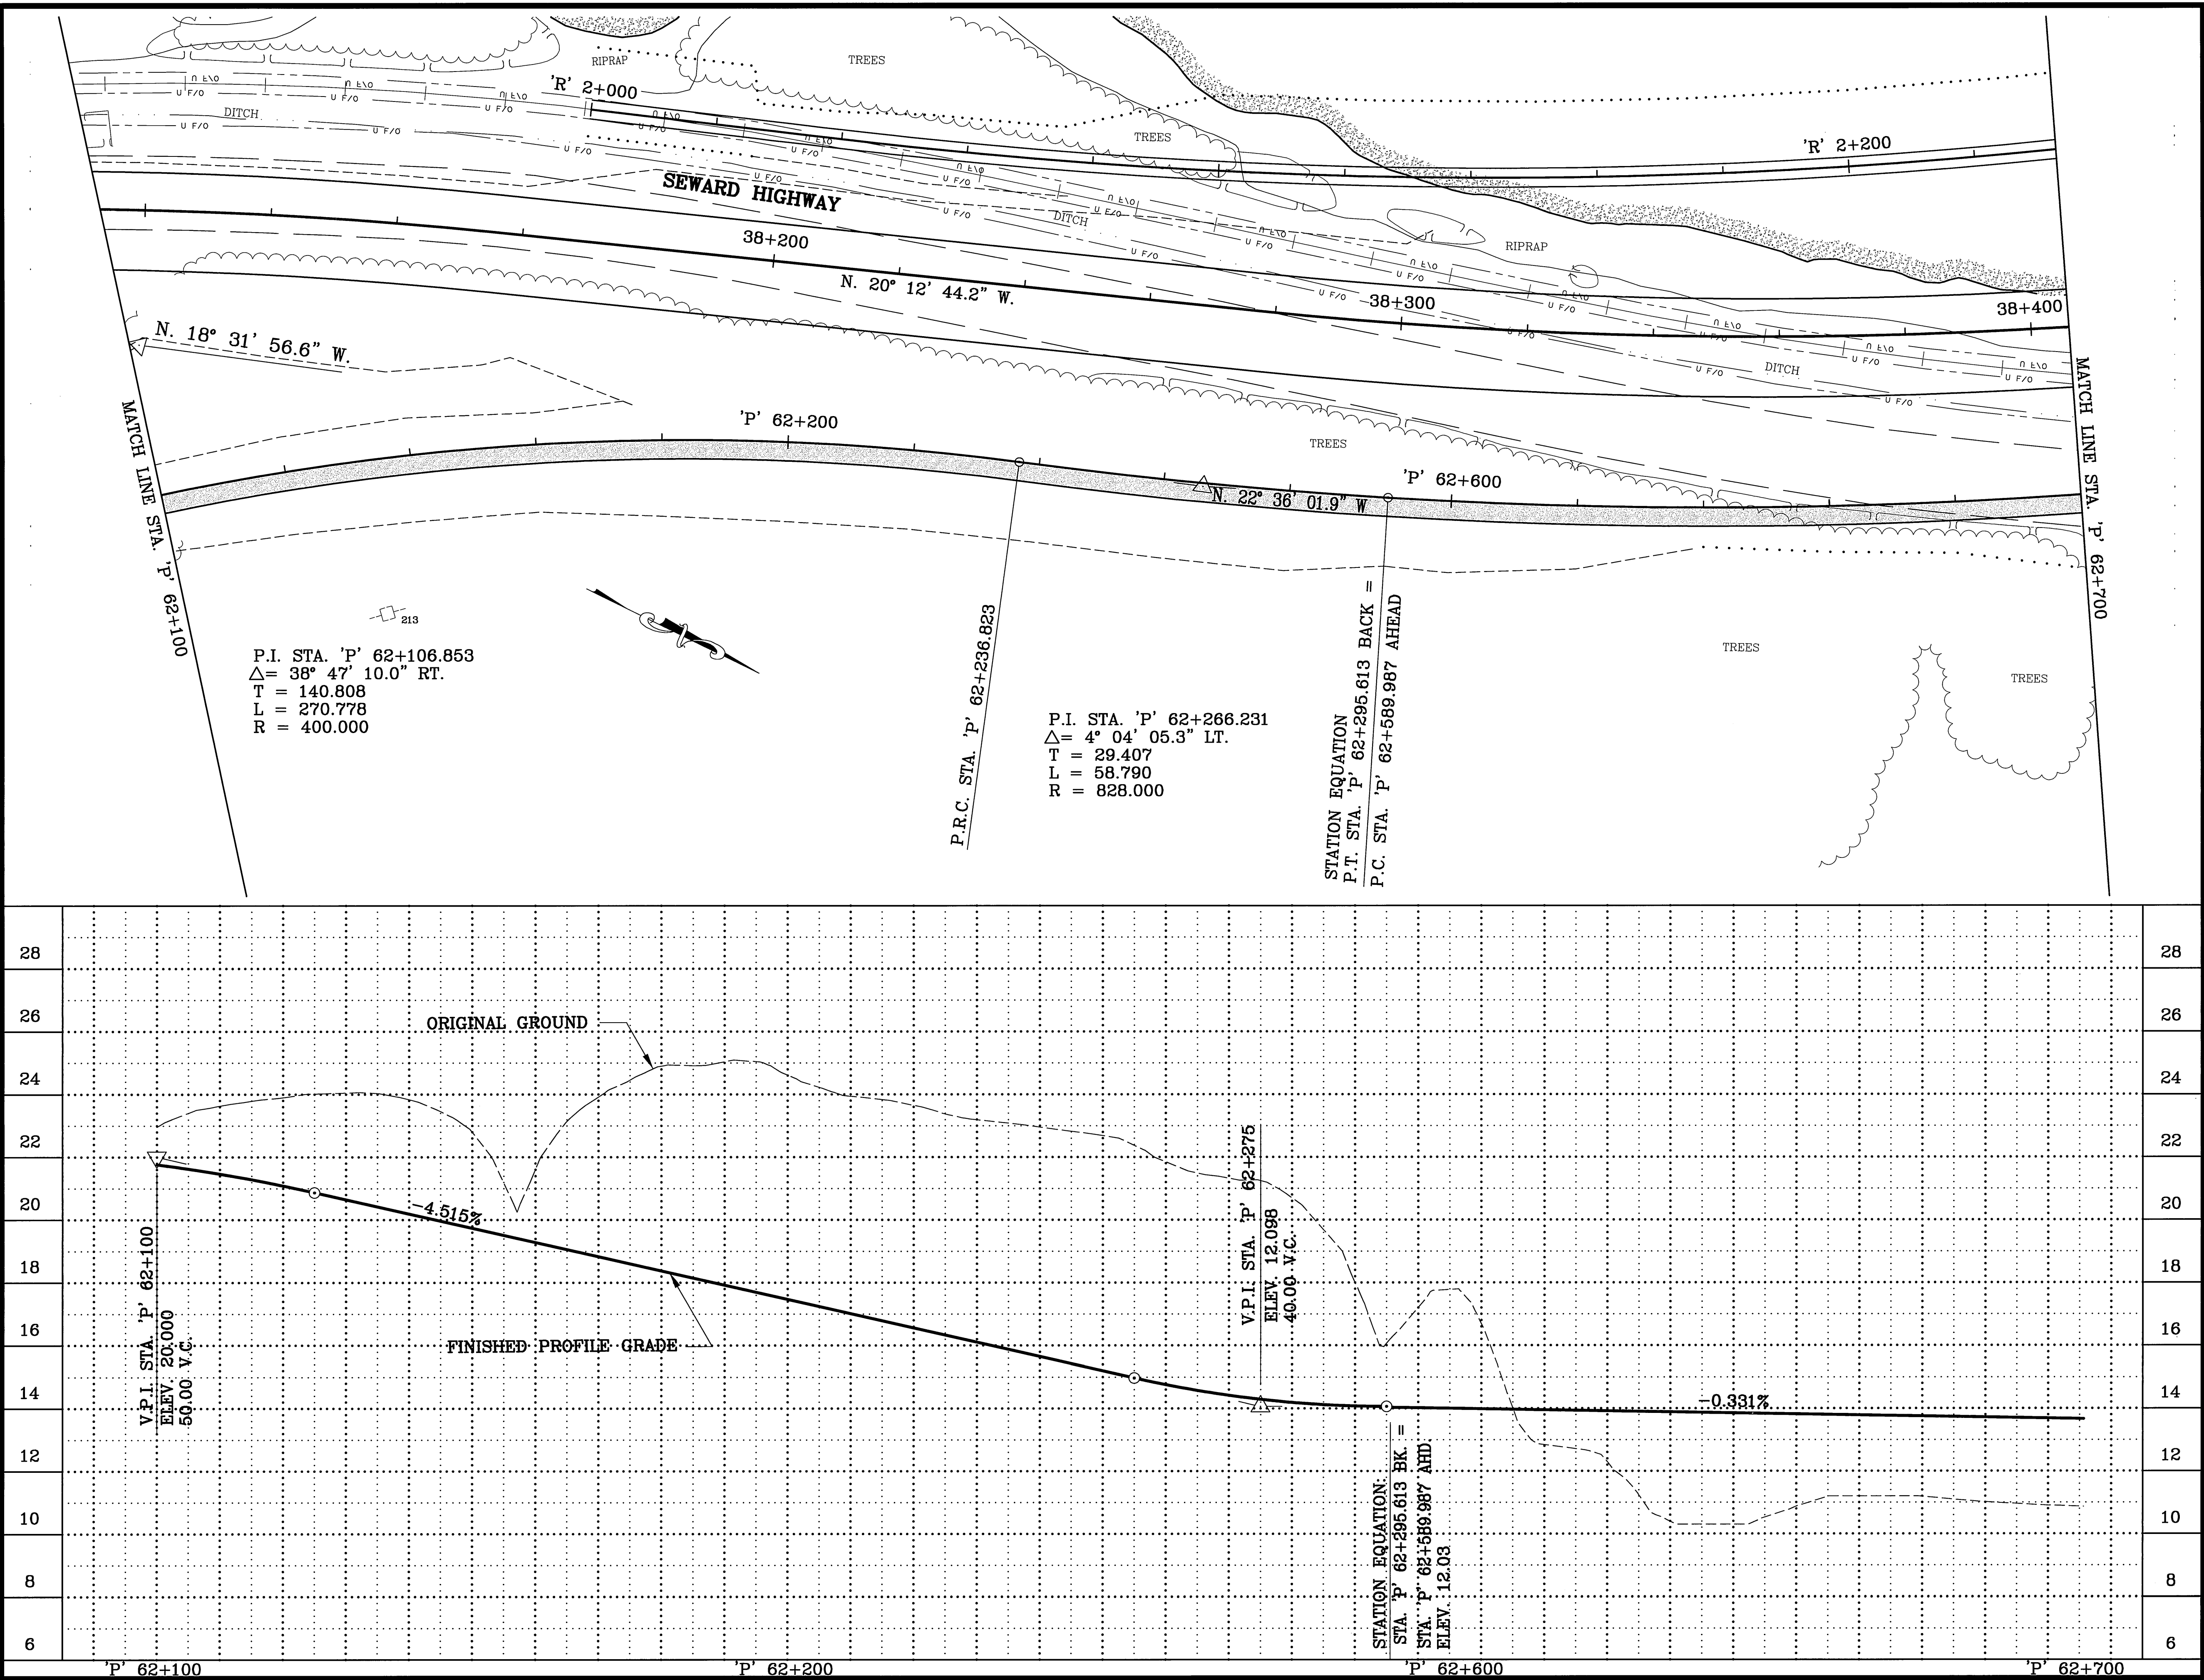

SHEET NO.	TOTAL SHEETS	
FP8	FP18	
STATE	YEAR	
ALASKA	2002	
PROJECT DESIGNATION		
NH-0A3-1(28)		
ADDENDUM NO.		
ATTACHMENT NO.		
REVISIONS		
NO.	DATE	DESCRIPTION

BIRD CREEK BRIDGE

Bird Creek

TURNAGAIN ARM

THIS SHEET

BIRD POINT



SEWARD HIGHWAY, MP 96 TO 102

NOTE:
DIMENSIONS ARE IN METERS
UNLESS OTHERWISE NOTED.


STATE OF ALASKA
49th
RUDY J. DOUGHERTY
CE 8823
6/15/02
REGISTERED PROFESSIONAL ENGINEER

STATE OF ALASKA
DEPARTMENT OF TRANSPORTATION
AND PUBLIC FACILITIES
SEWARD HIGHWAY
MP 96 TO MP 102
SAFETY, ROADWAY AND
RECREATIONAL IMPROVEMENTS
BIRD FLATS AREA
PATHWAY
PLAN AND PROFILE


DESIGNED BY: 6/12/02
CHECKED BY: KMH
AUTOCAD-CARLEE.SDS/PROJ/03577/77PP
SCALE: 1"=40'
COMPUTER DESIGN: HALF-09_PATH

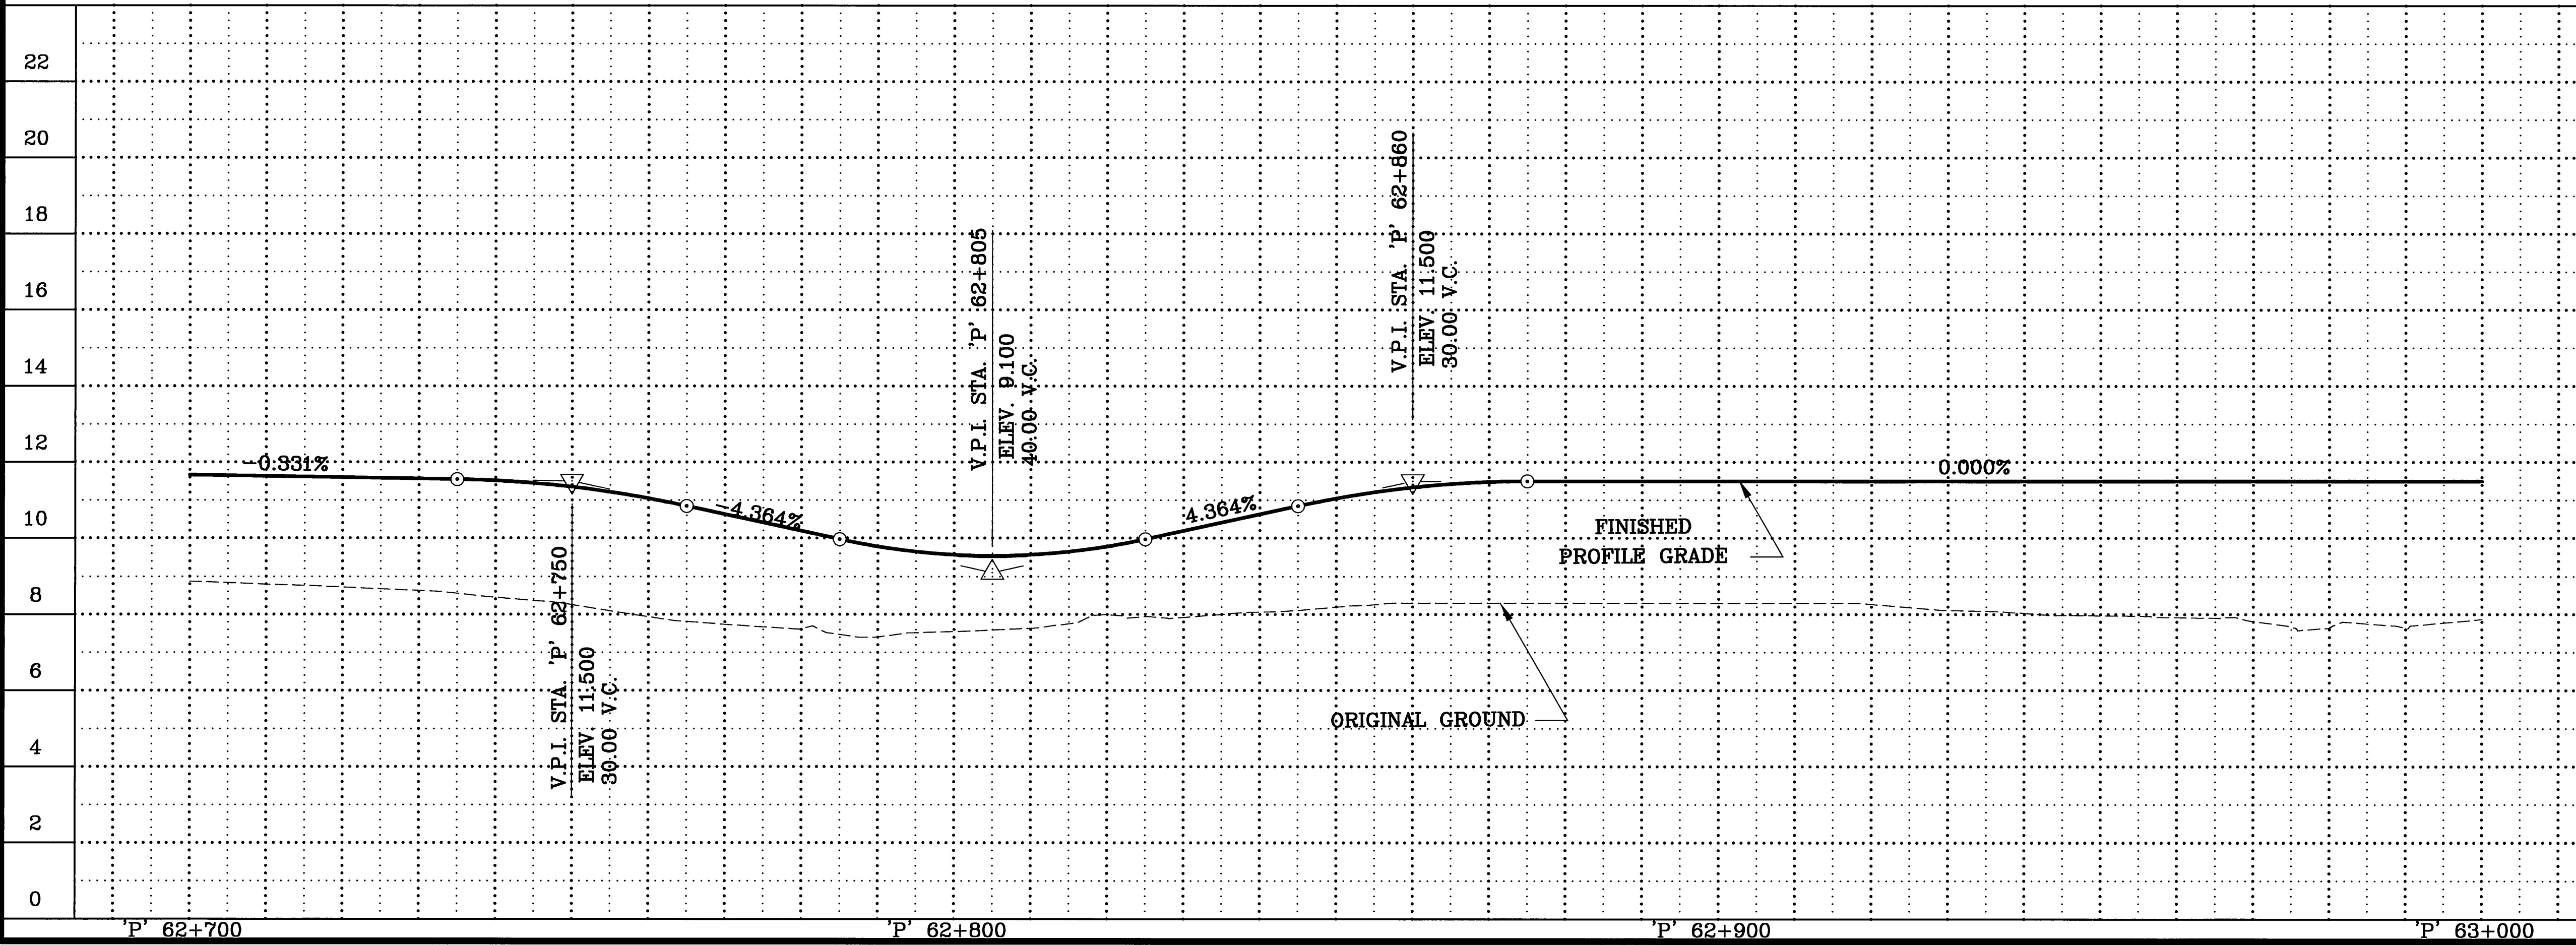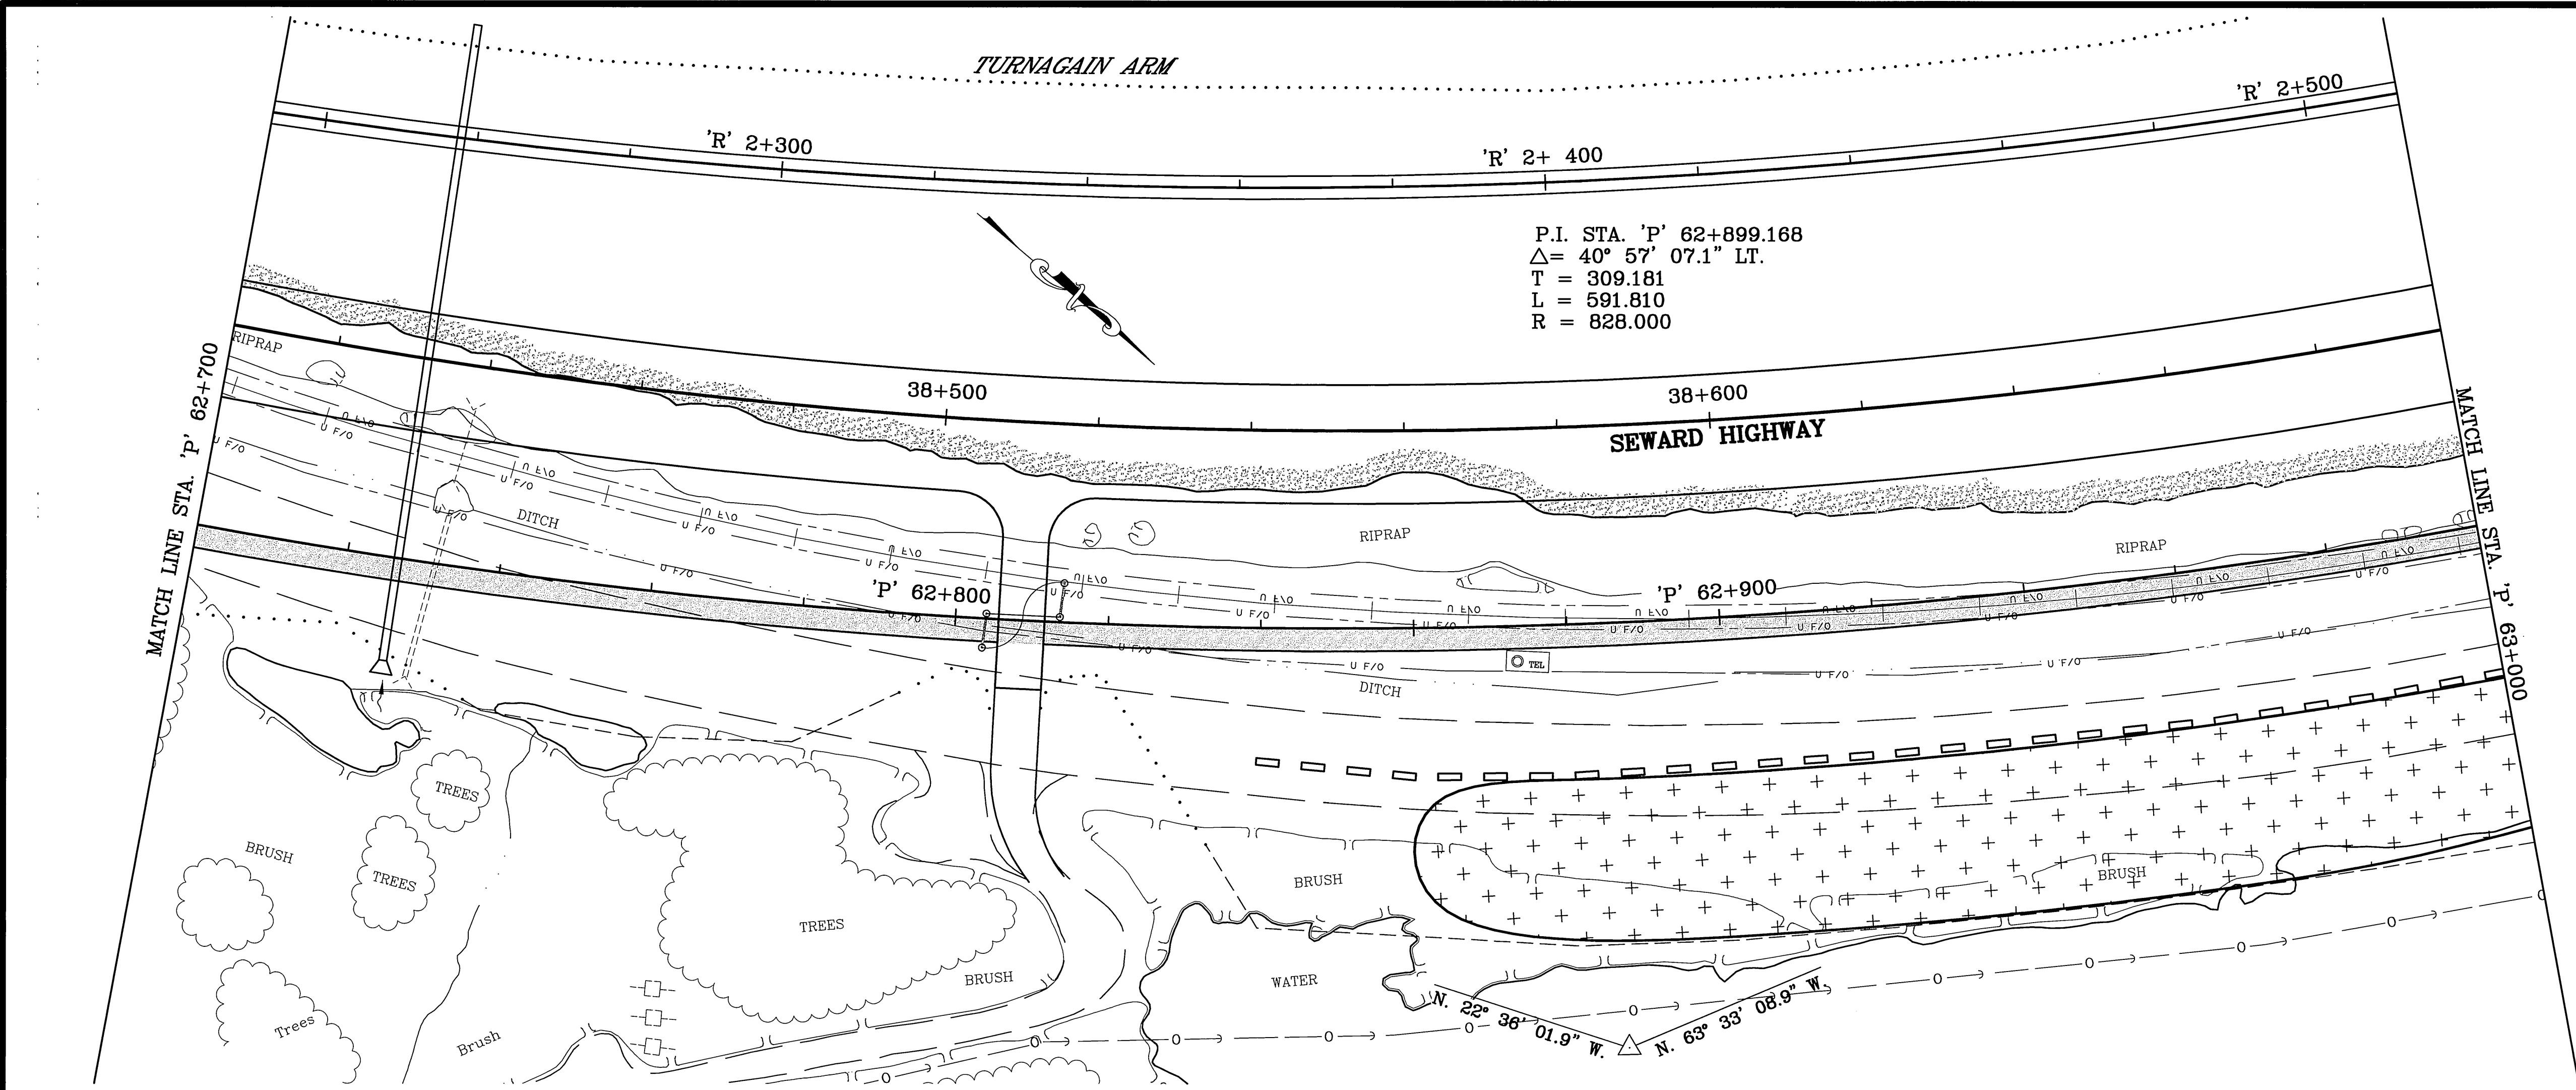

SHEET NO.		TOTAL SHEETS	
FP9		FP18	
STATE		YEAR	
ALASKA		2002	
PROJECT DESIGNATION			
NH-0A3-1(28)			
ADDENDUM NO.			
ATTACHMENT NO.			
REVISIONS			
NO.	DATE	DESCRIPTION	


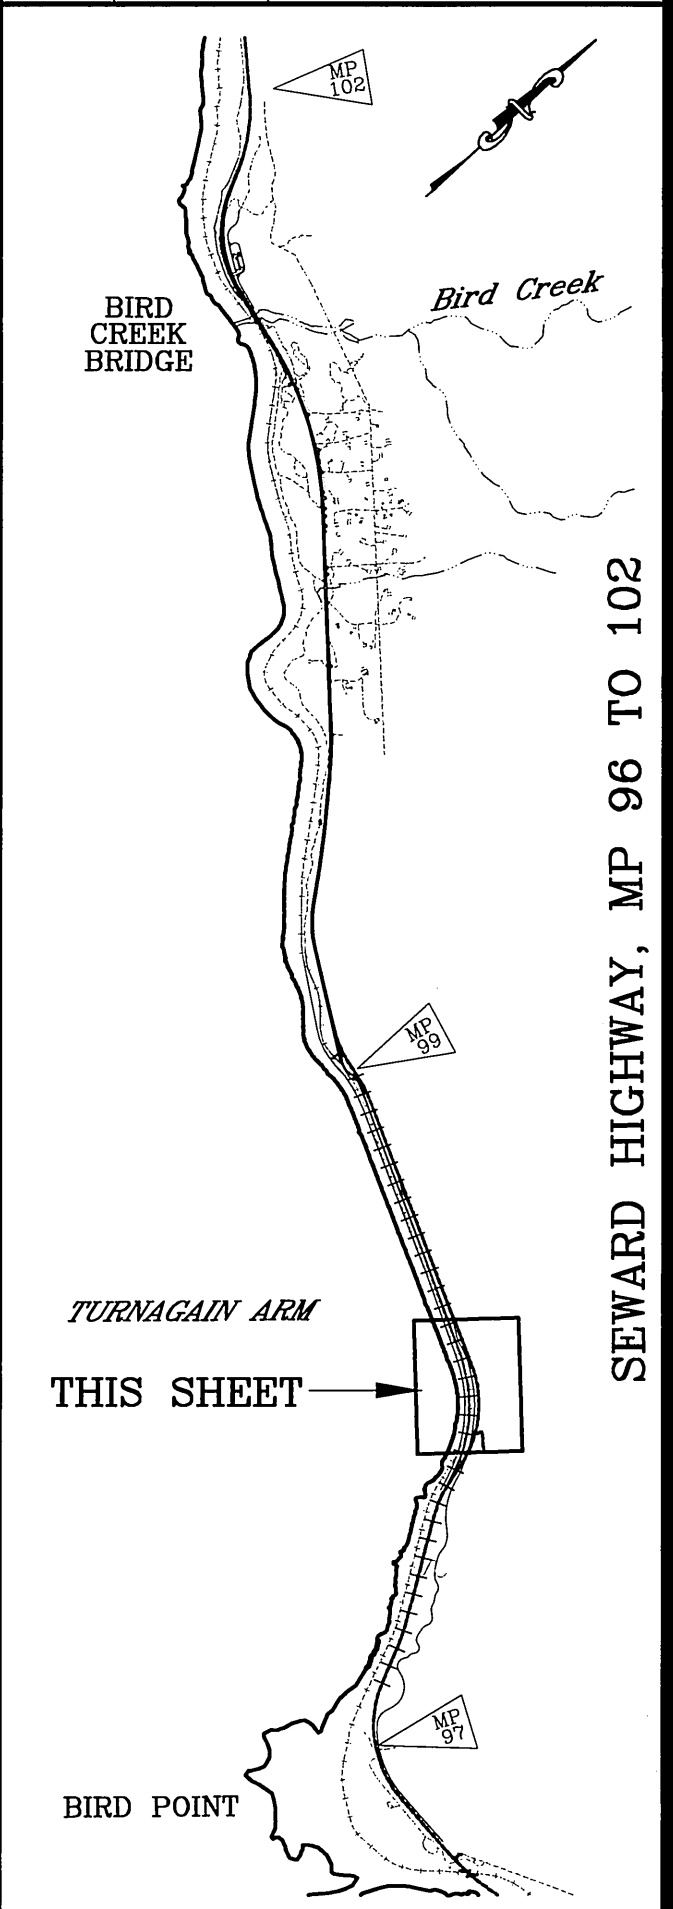


NOTE:
DIMENSIONS ARE IN METERS
UNLESS OTHERWISE NOTED.

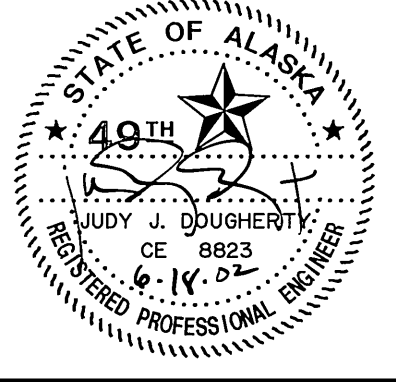

STATE OF ALASKA
DEPARTMENT OF TRANSPORTATION
AND PUBLIC FACILITIES
SEWARD HIGHWAY
MP 96 TO MP 102
SAFETY, ROADWAY AND
RECREATIONAL IMPROVEMENTS
BIRD FLATS AREA
PATHWAY
PLAN AND PROFILE

DESIGNED BY
VIEW-
HALF O. PATH
8/12/02
AUTOCAD-CAROL LEE, SDG/GRU/5557/17PP
COMPUTER DESIGNATION

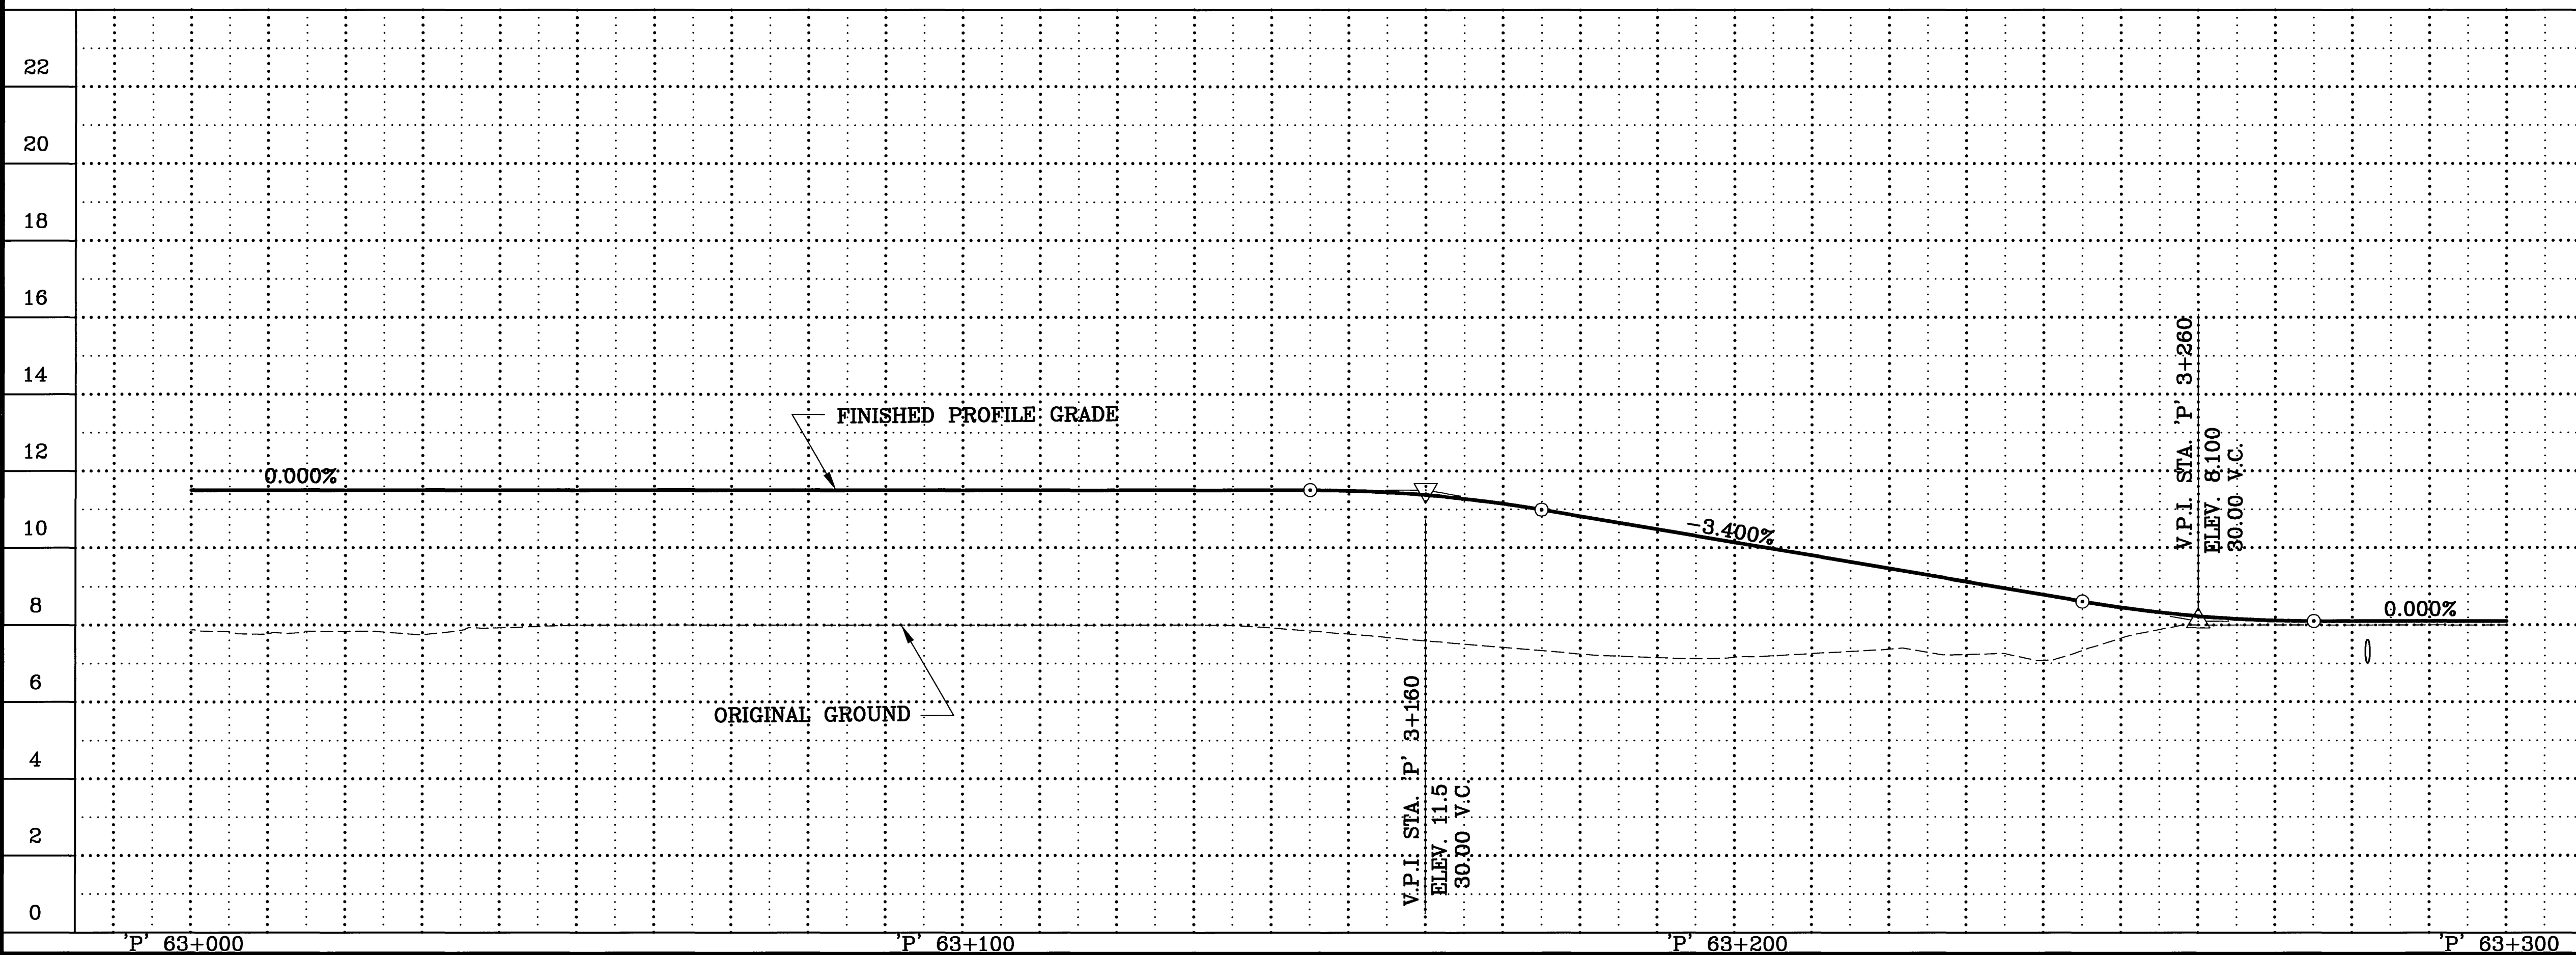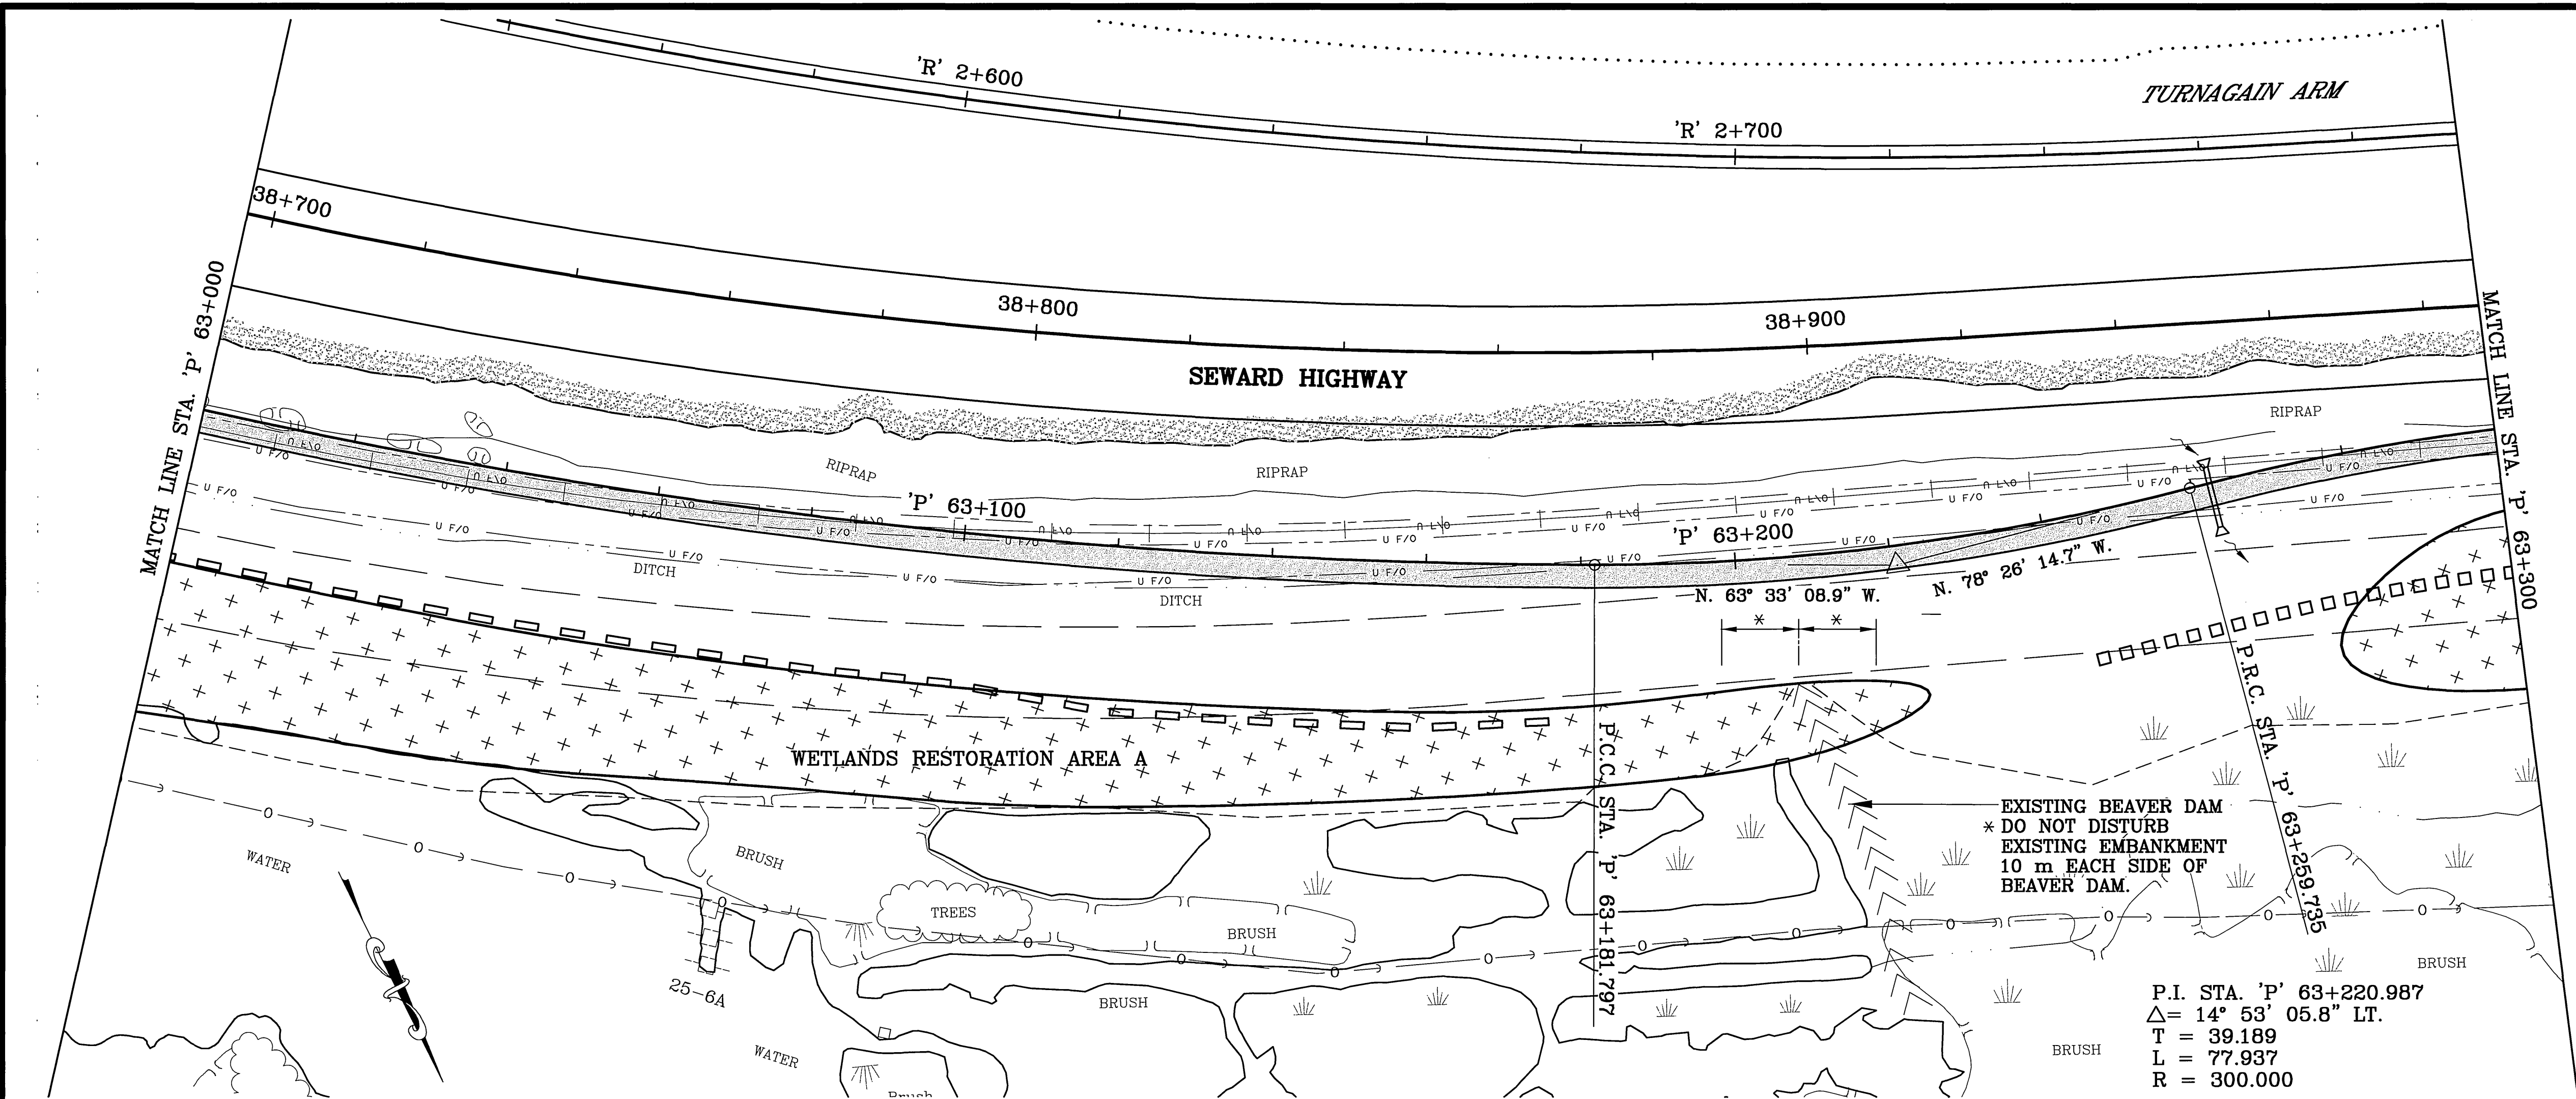


SHEET NO.	TOTAL SHEETS	
FP10	FP18	
STATE	YEAR	
ALASKA	2002	
PROJECT DESIGNATION		
NH-0A3-1(28)		
ADDENDUM NO.		
ATTACHMENT NO.		
REVISIONS		
NO.	DATE	DESCRIPTION


NOTE:
DIMENSIONS ARE IN METERS
UNLESS OTHERWISE NOTED.

STATE OF ALASKA
DEPARTMENT OF TRANSPORTATION
AND PUBLIC FACILITIES
SEWARD HIGHWAY
MP 96 TO MP 102
SAFETY, ROADWAY AND
RECREATIONAL IMPROVEMENTS
BIRD FLATS AREA
PATHWAY
PLAN AND PROFILE

DESIGNATIONS	DESIGNED BY	6/12/02
SCALE 1"=100'	DESIGNED BY	
COMPUTER DESIGNATION	DRAWN BY	
	CHECKED BY	
	HAL F.I. PATH	
	VIEW	
	DATE	

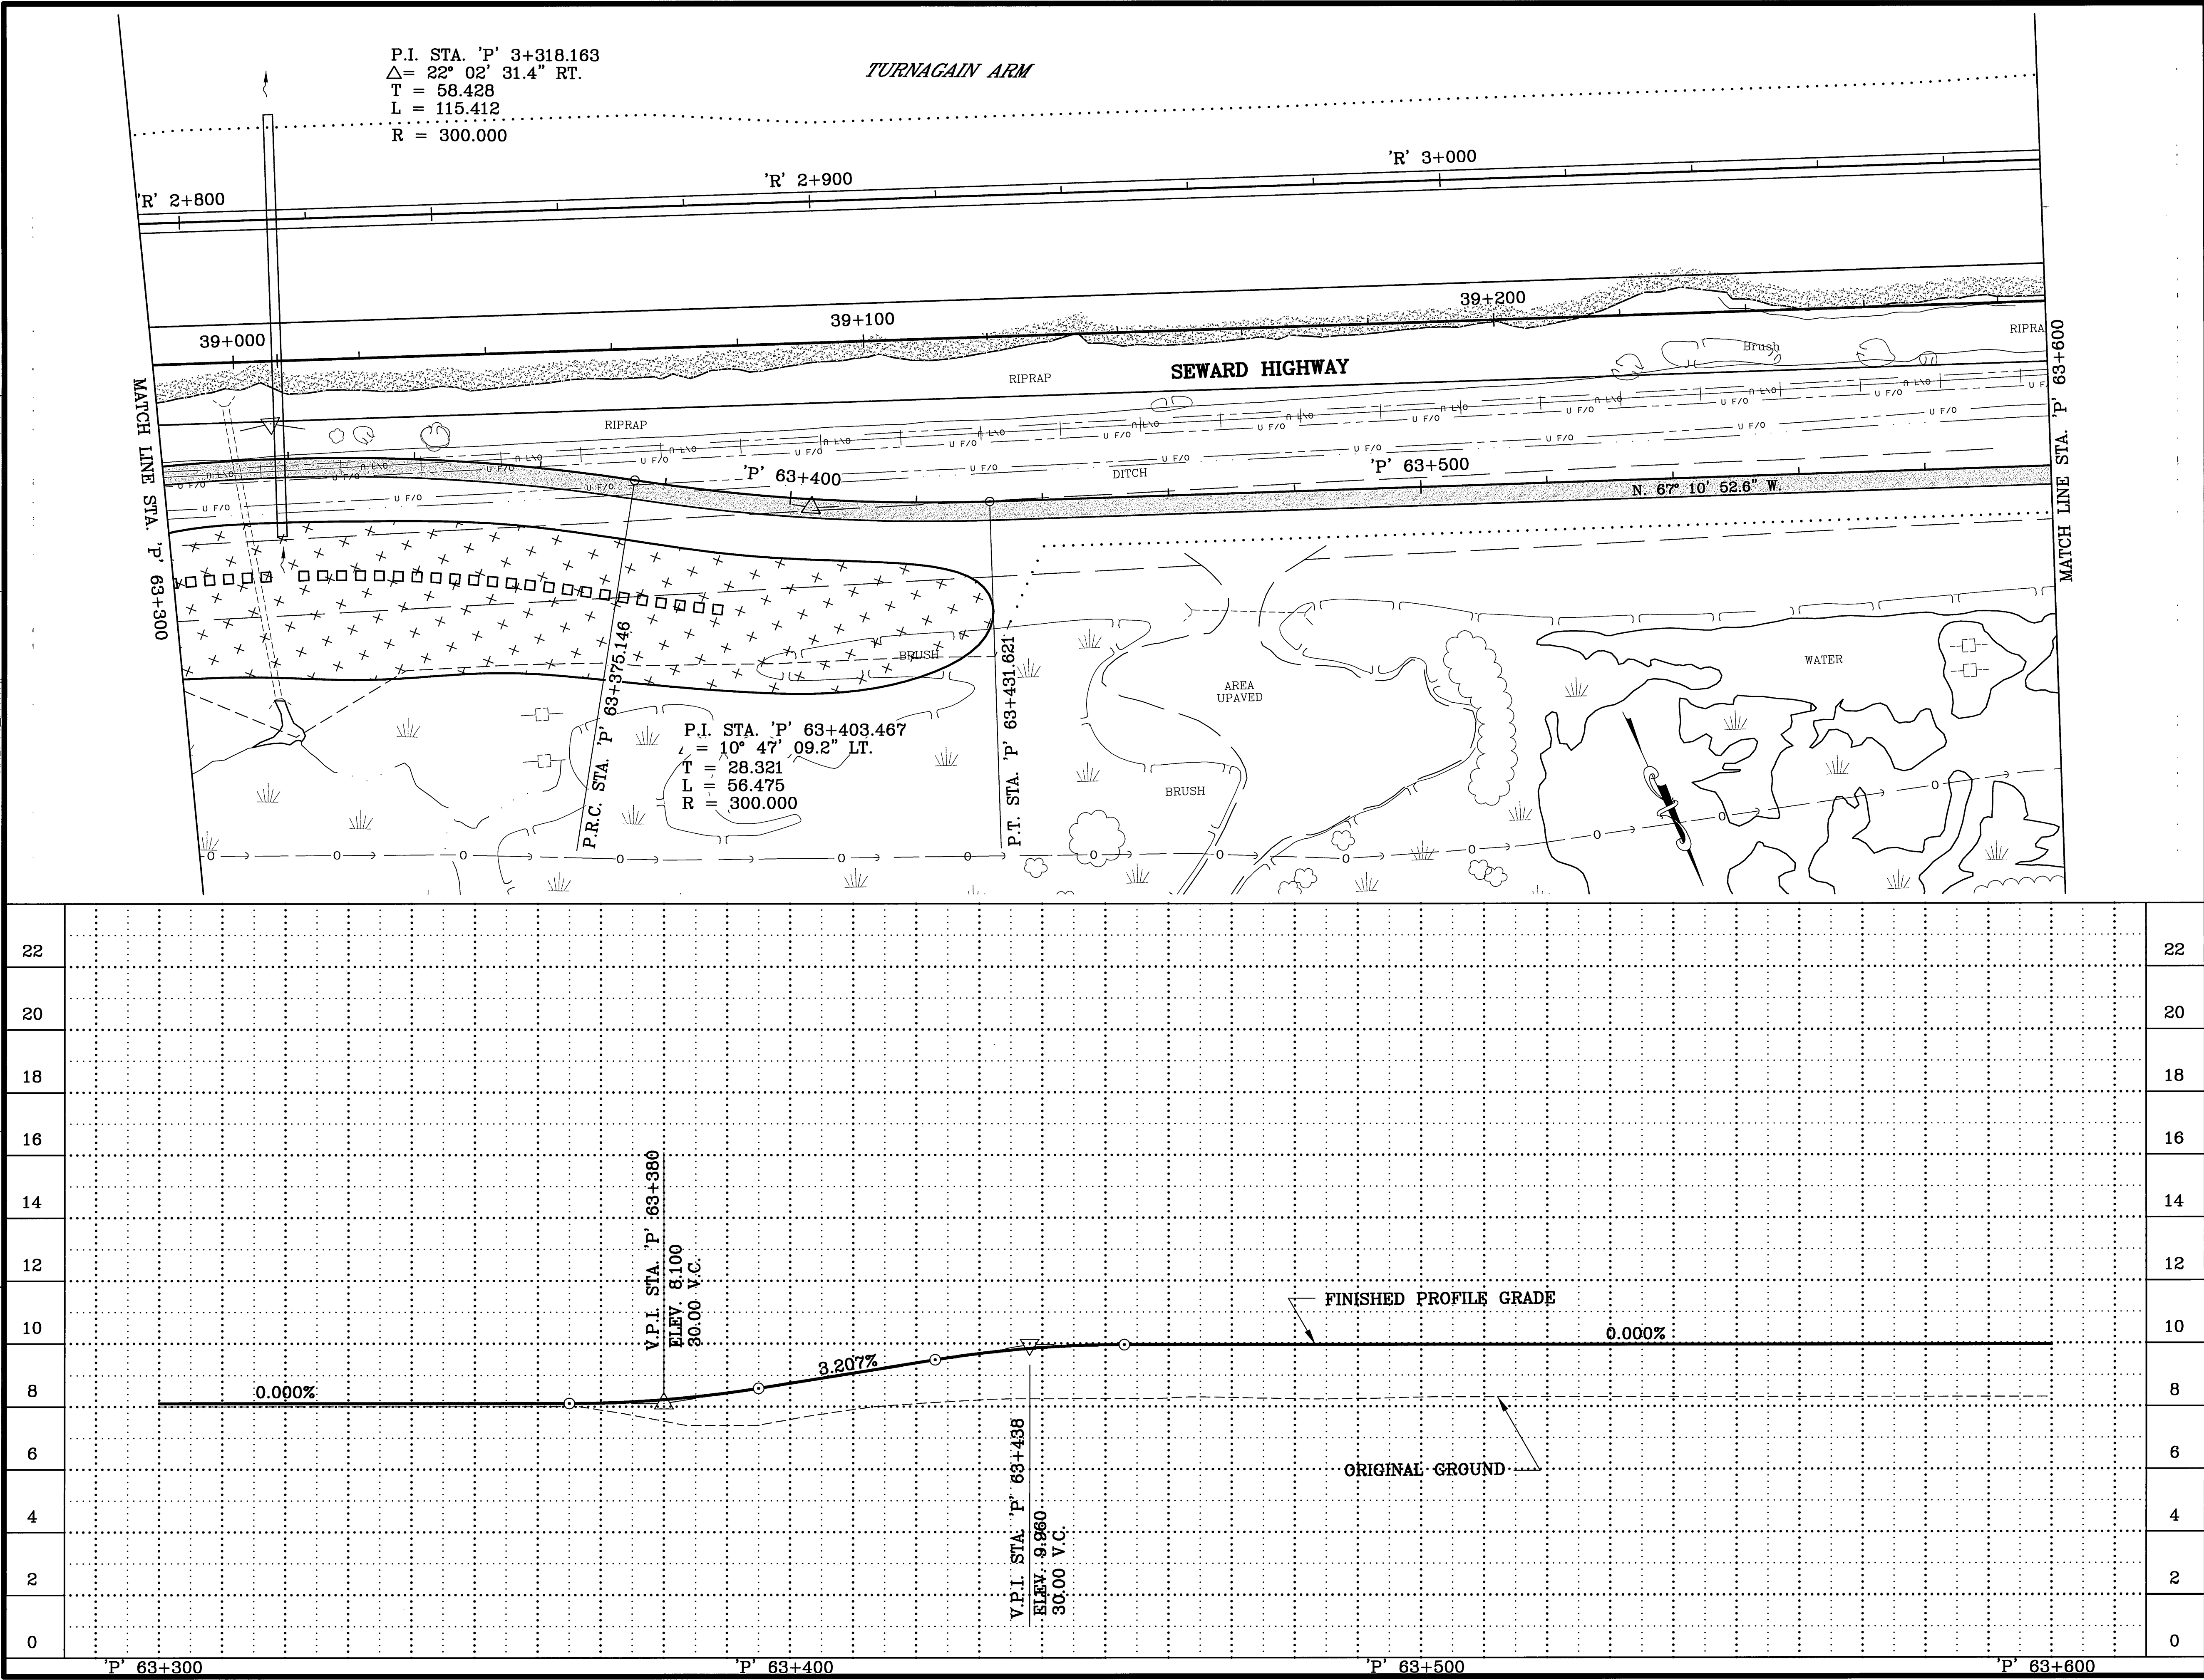

SHEET NO.	TOTAL SHEETS	
FP11	FP18	
STATE	YEAR	
ALASKA	2002	
PROJECT DESIGNATION		
NH-0A3-1(28)		
ADDENDUM NO.		
ATTACHMENT NO.		
REVISIONS		
NO.	DATE	DESCRIPTION

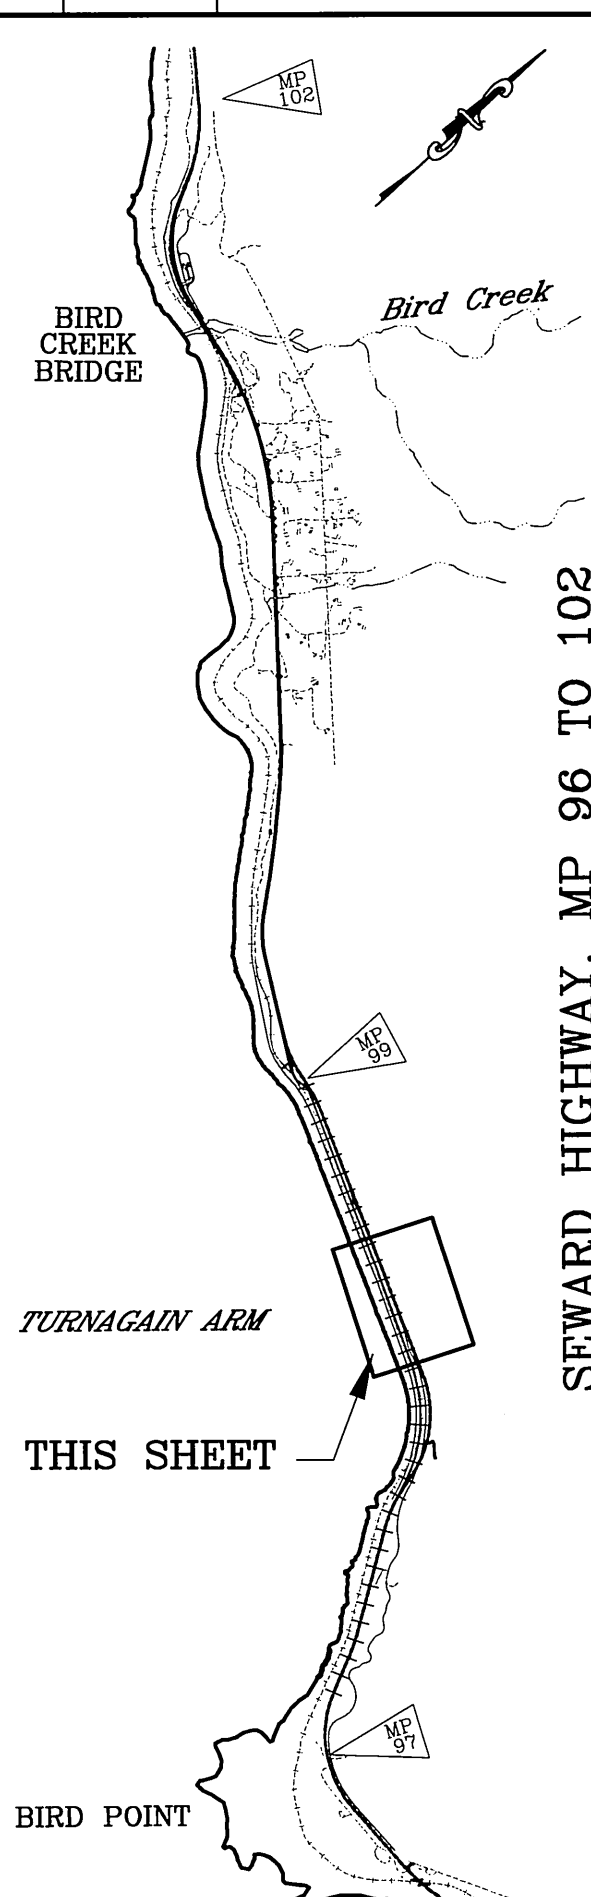

BIRD CREEK BRIDGE

BIRD CREEK


TURNAGAIN ARM

THIS SHEET

BIRD POINT

SEWARD HIGHWAY, MP 96 TO 102



NOTE:
DIMENSIONS ARE IN METERS
UNLESS OTHERWISE NOTED.

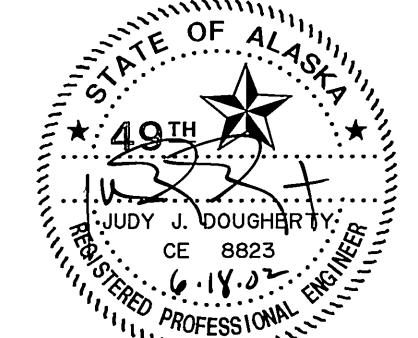

STATE OF ALASKA
DEPARTMENT OF TRANSPORTATION
AND PUBLIC FACILITIES
SEWARD HIGHWAY
MP 96 TO MP 102
SAFETY, ROADWAY AND
RECREATIONAL IMPROVEMENTS
BIRD FLATS AREA
PATHWAY
PLAN AND PROFILE

DESIGNED BY
VIEW-
HALE 12 PATH
6/12/02

AUTOCAD-CAROLEE.SBS (PROJ) 63577\7TPP
COMPUTER DESIGNATION

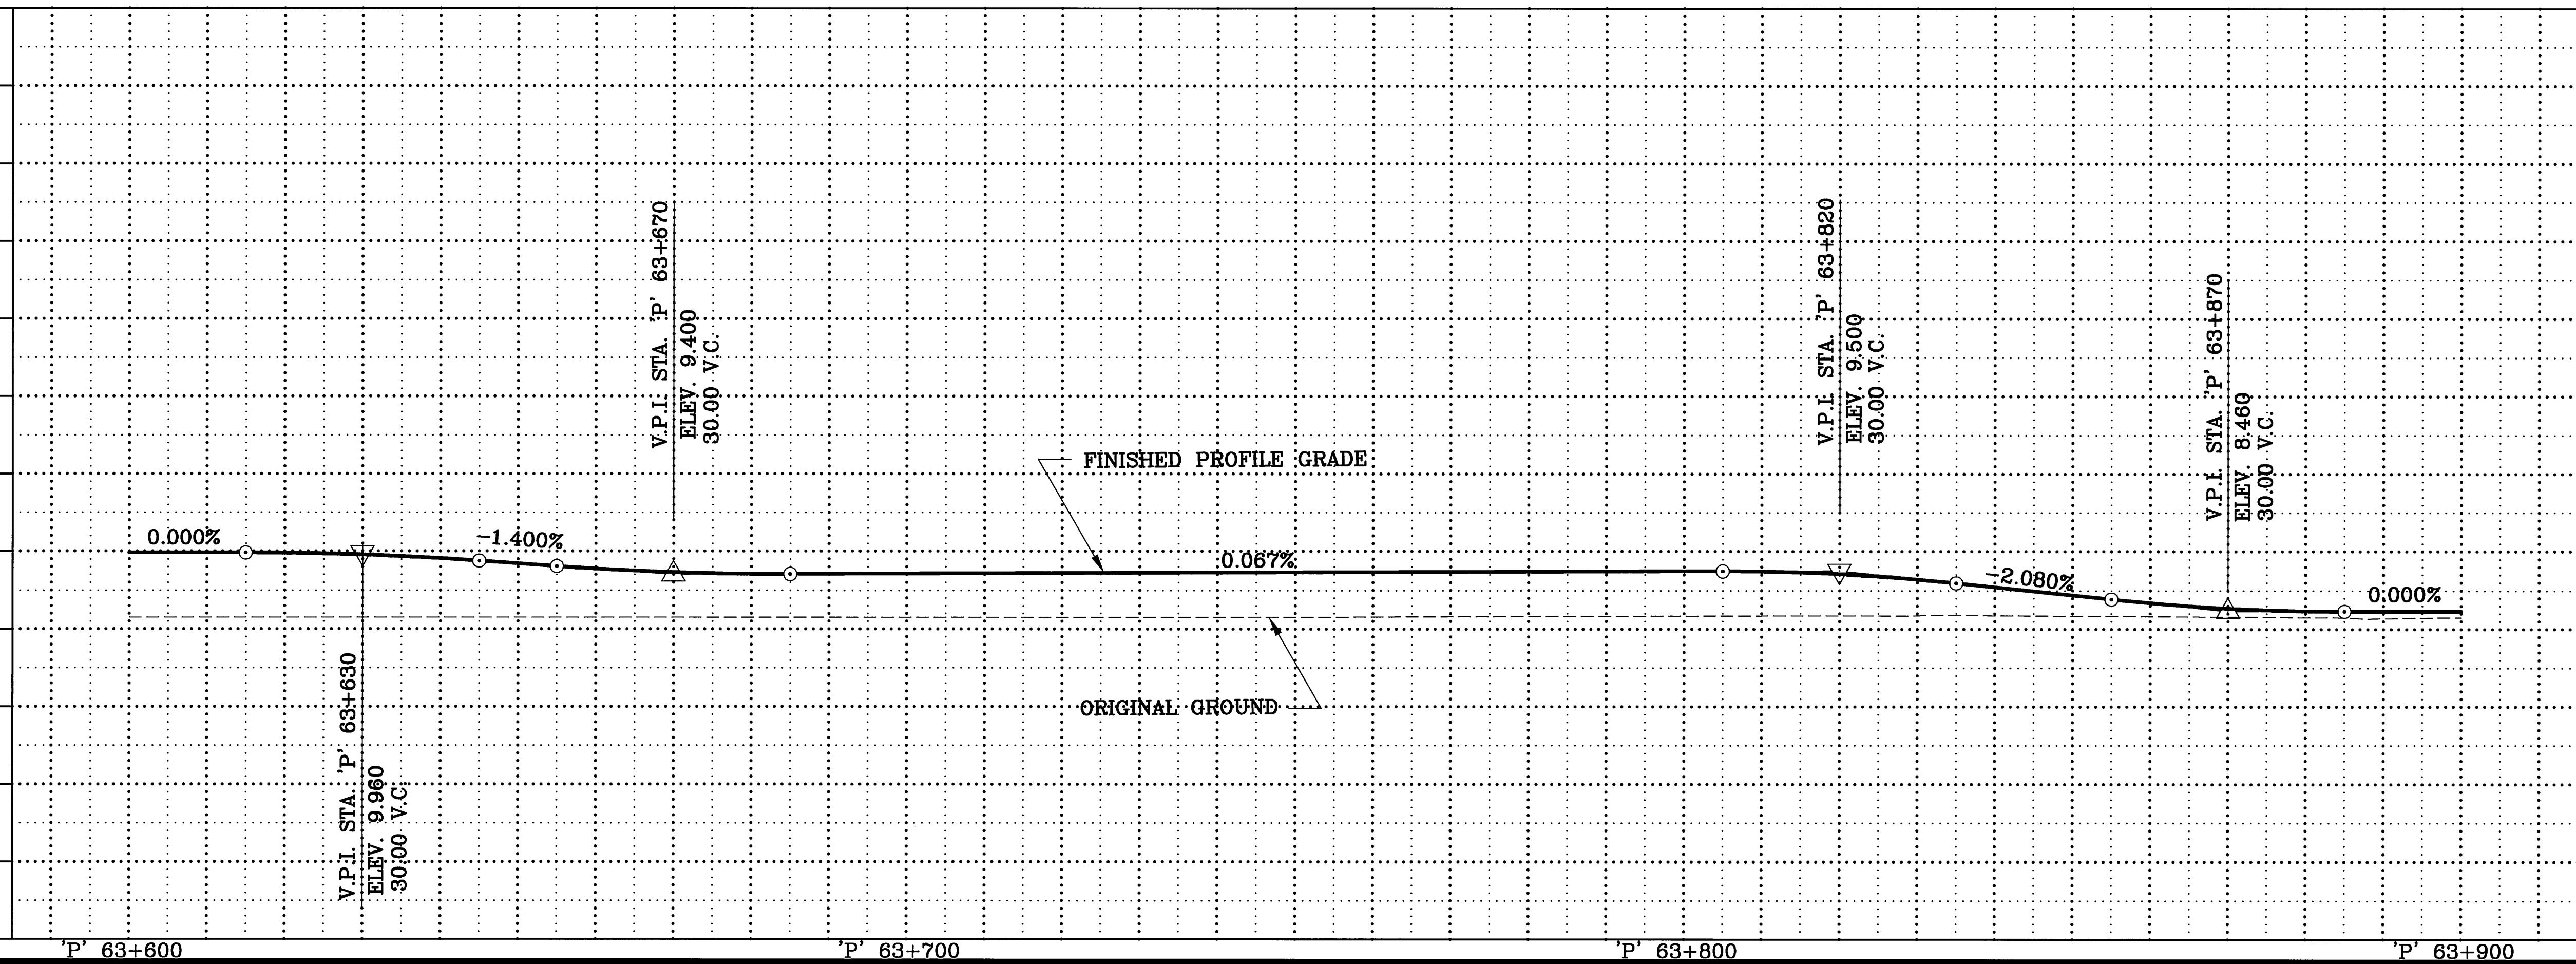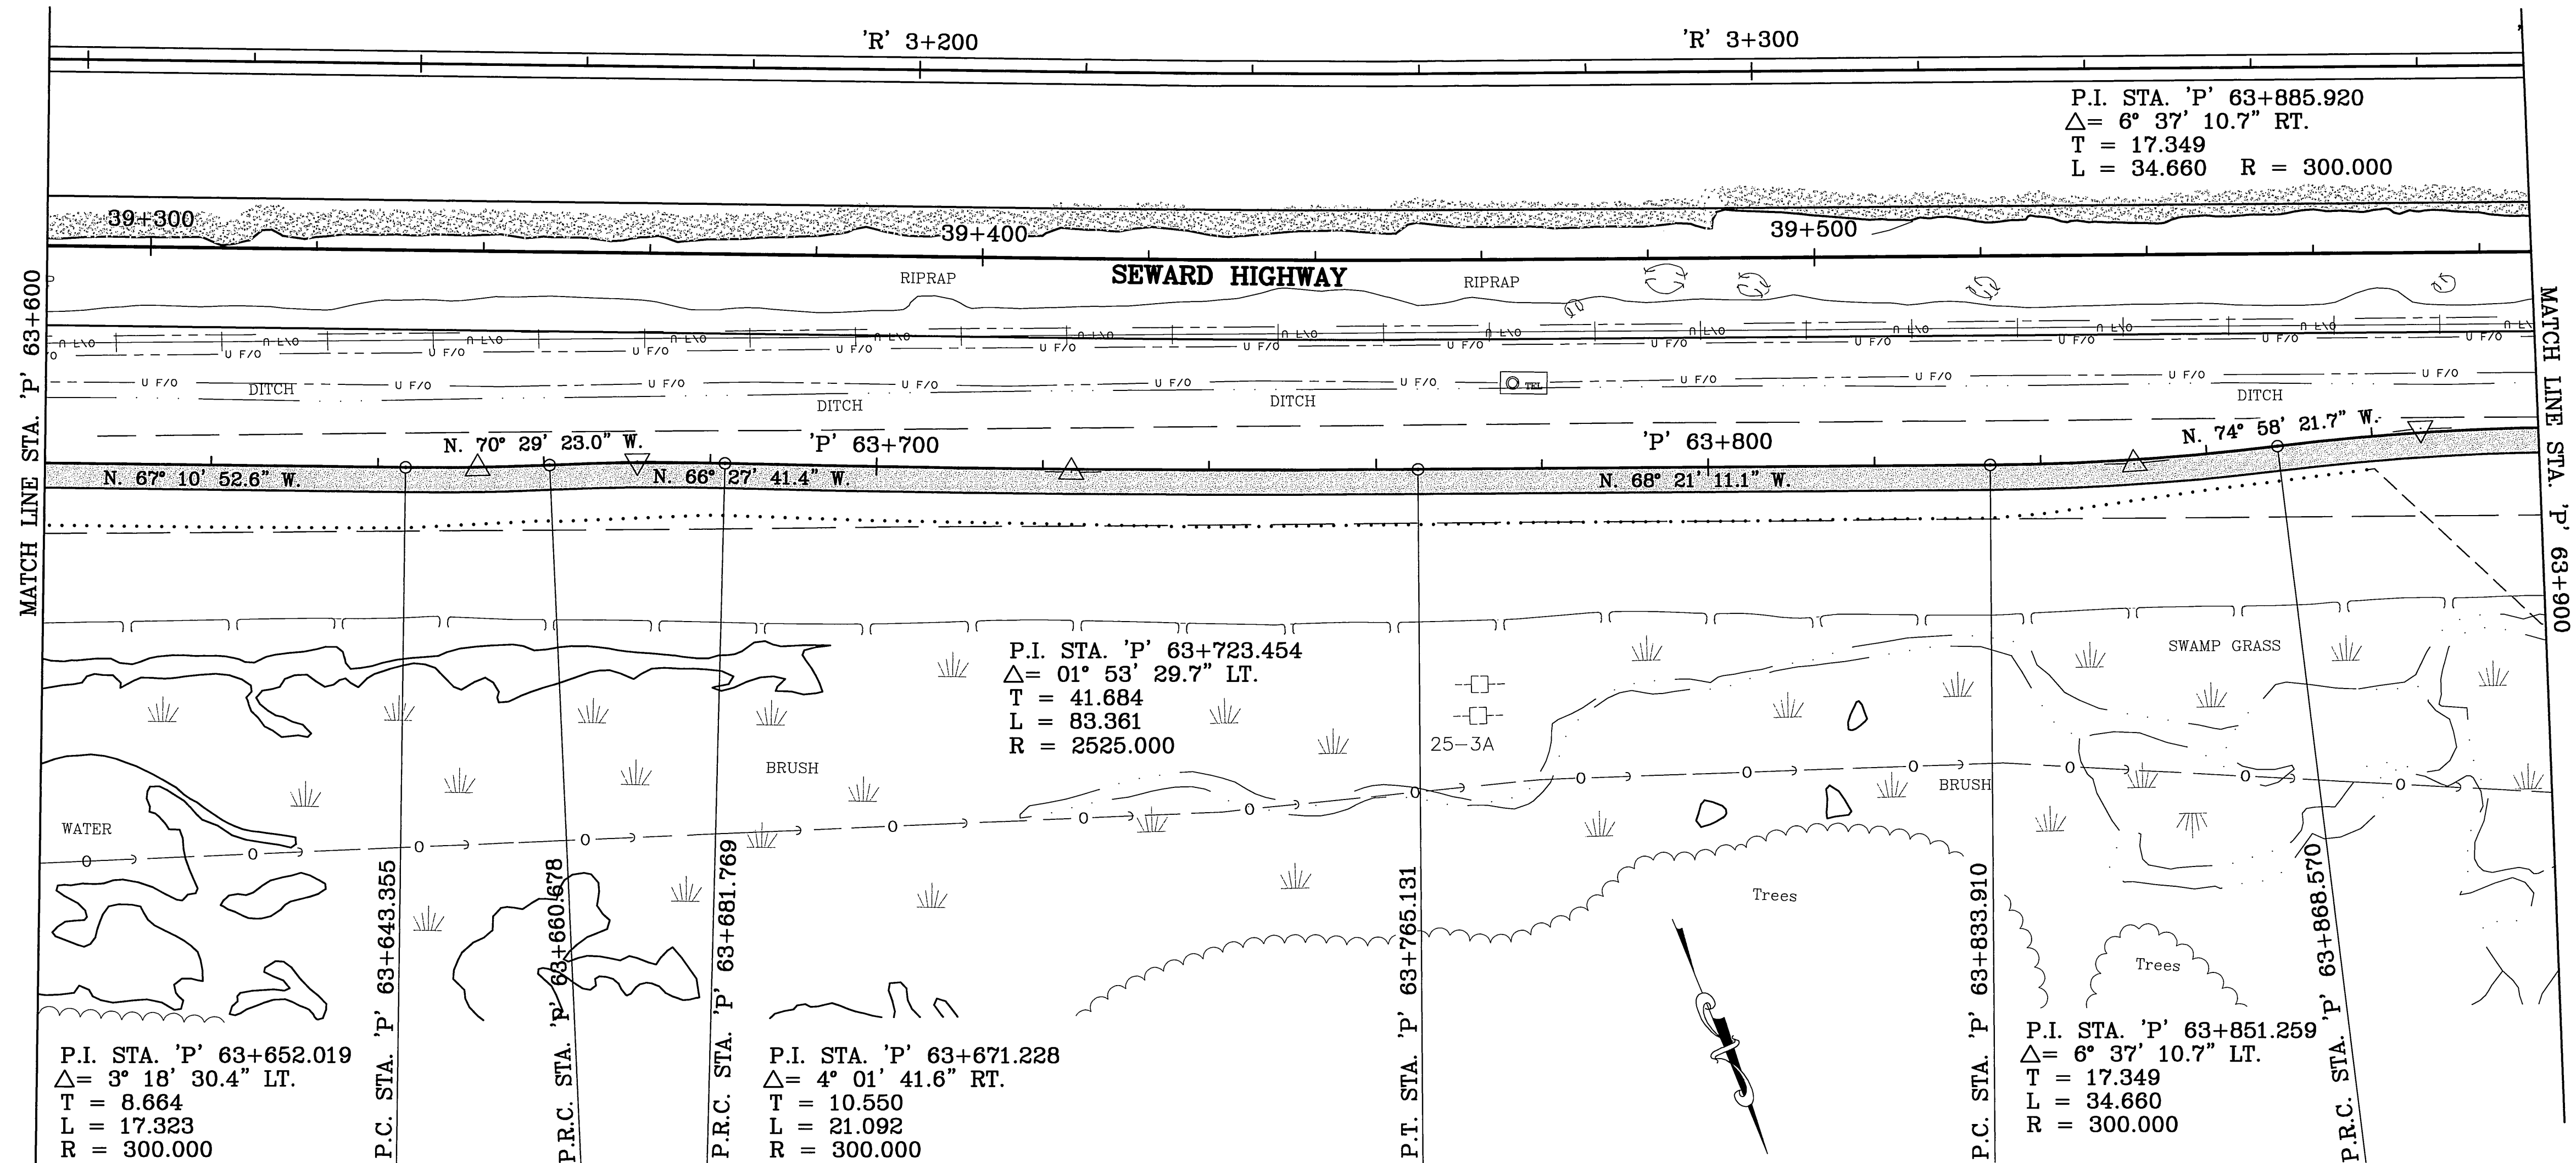

SHEET NO.	TOTAL SHEETS	
FP12	FP18	
STATE	YEAR	
ALASKA	2002	
PROJECT DESIGNATION		
NH-0A3-1(28)		
ADDENDUM NO.		
ATTACHMENT NO.		
REVISIONS		
NO.	DATE	DESCRIPTION

BIRD CREEK BRIDGE

Bird Creek

THIS SHEET

TURNAGAIN ARM

BIRD POINT



SEWARD HIGHWAY, MP 96 TO 102

NOTE:
DIMENSIONS ARE IN METERS
UNLESS OTHERWISE NOTED.

STATE OF ALASKA
49TH
JUDY J. DOUGHERTY
CE 8823
6-14-02
REGISTERED PROFESSIONAL ENGINEER

STATE OF ALASKA
DEPARTMENT OF TRANSPORTATION
AND PUBLIC FACILITIES
SEWARD HIGHWAY
MP 96 TO MP 102
SAFETY, ROADWAY AND
RECREATIONAL IMPROVEMENTS
BIRD FLATS AREA
PATHWAY
PLAN AND PROFILE

DESIGNED BY
CHECKED BY
DATE 6/12/02
WEN
HALE 13 PATH
CREATED BY
KMH
SPECIFICATIONS
AUTOCAD-CAROLEE.SBKPROJ\5357717PP
SCALE 1"=100'
COMPUTER DESIGNATION

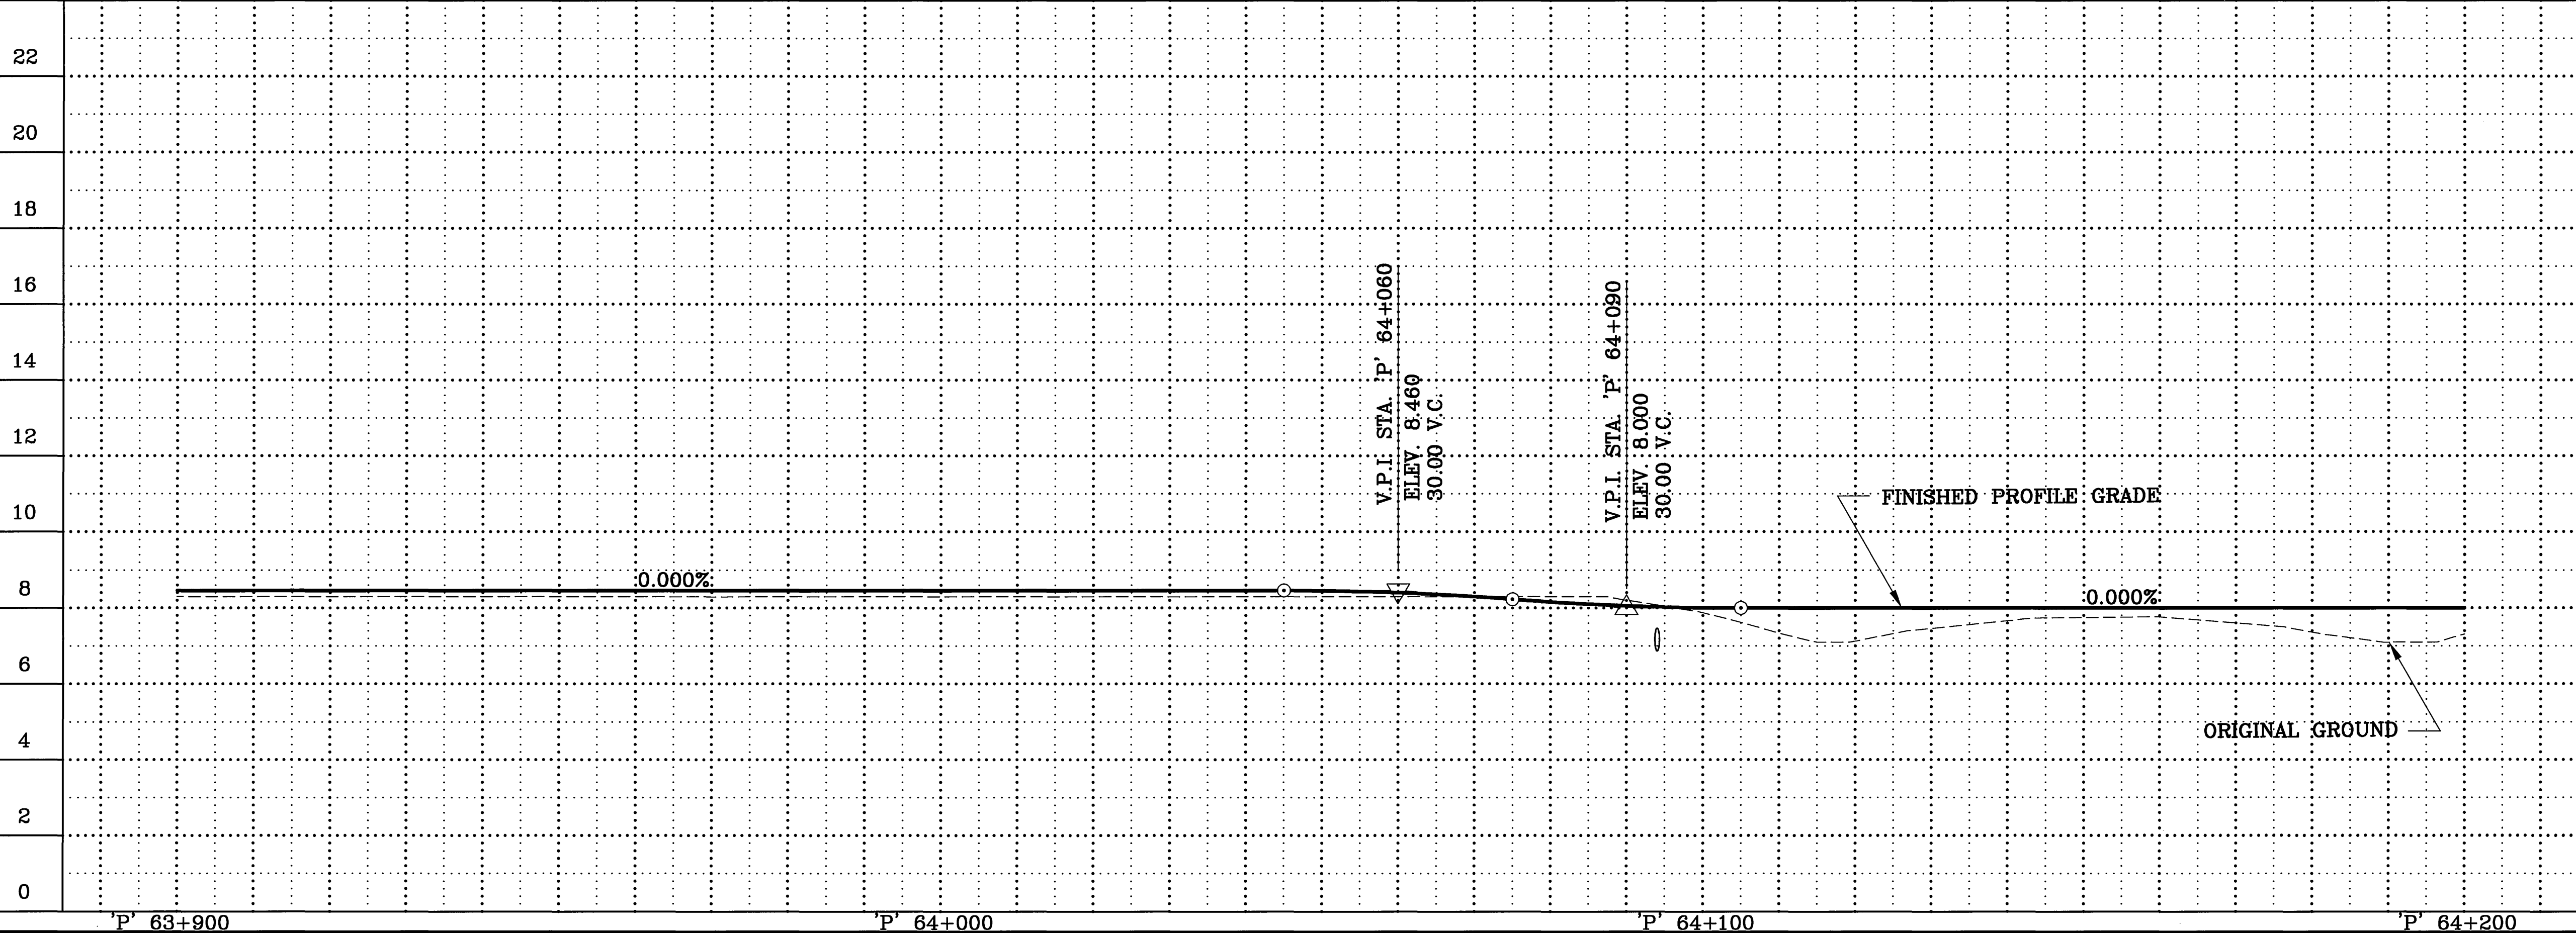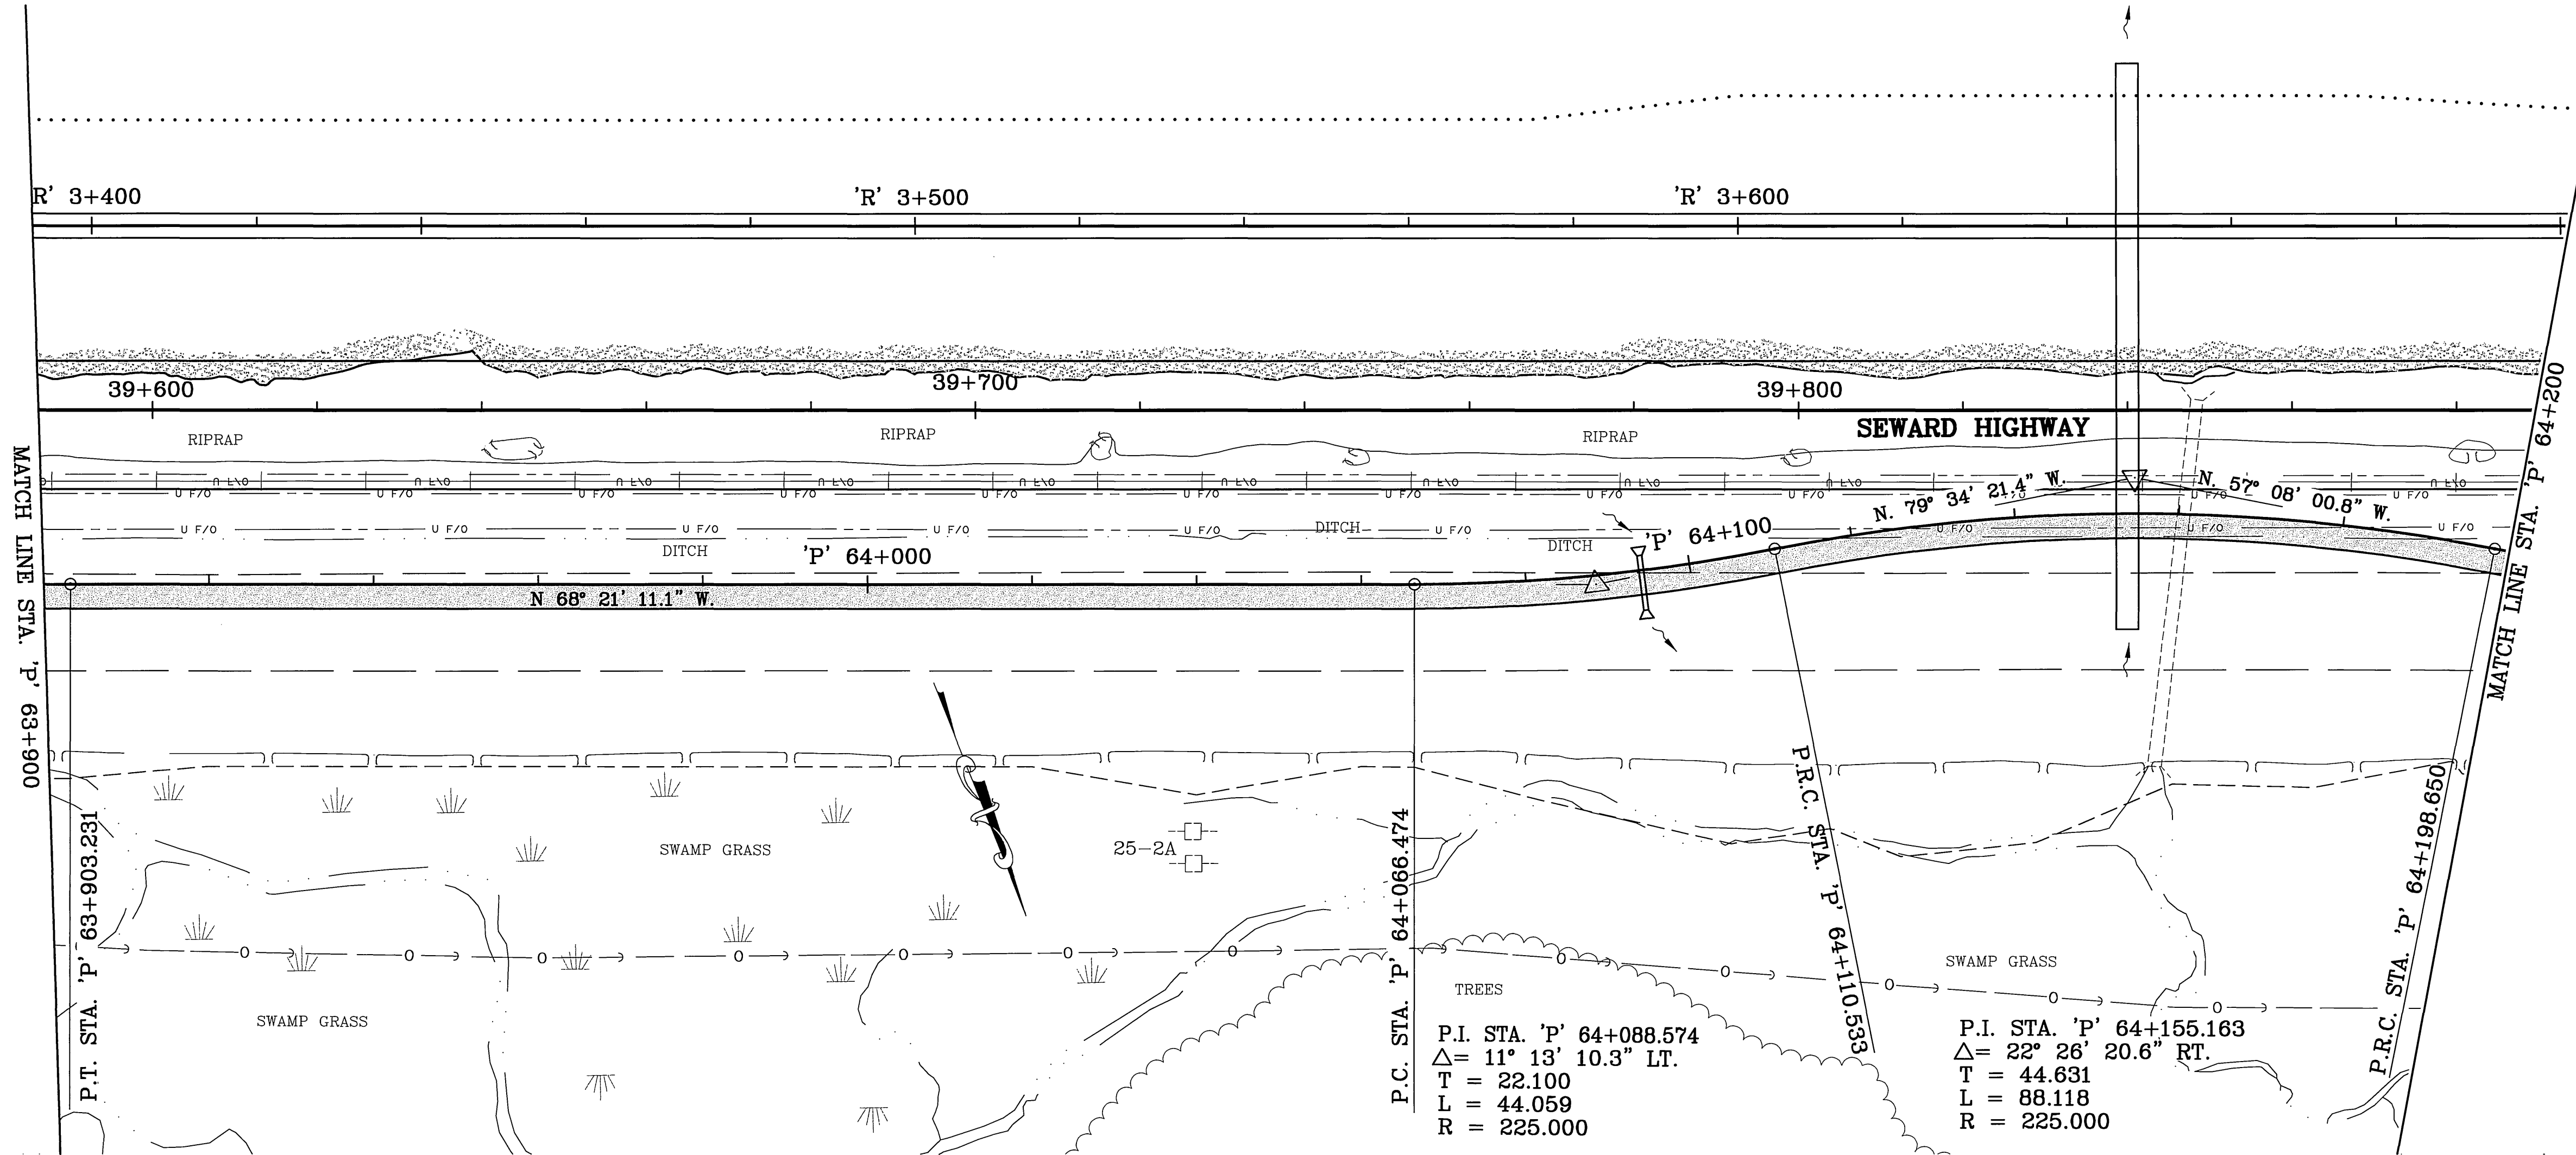



SHEET NO.		TOTAL SHEETS	
FP13		FP18	
STATE		YEAR	
ALASKA		2002	
PROJECT DESIGNATION			
NH-0A3-1(28)			
ADDENDUM NO.			
ATTACHMENT NO.			
REVISIONS			
NO.	DATE	DESCRIPTION	

SEWARD HIGHWAY, MP 96 TO 102

NOTE:
DIMENSIONS ARE IN METERS
UNLESS OTHERWISE NOTED.

STATE OF ALASKA
DEPARTMENT OF TRANSPORTATION
AND PUBLIC FACILITIES
SEWARD HIGHWAY
MP 96 TO MP 102
SAFETY, ROADWAY AND
RECREATIONAL IMPROVEMENTS
BIRD FLATS AREA
PATHWAY
PLAN AND PROFILE

DESIGNED BY
CHECKED BY
DATE
8/12/02
HALE 14 PATH
WSP
AUTOCAD-CRUISE, SPSORCA\3577\77PP
SCALE 1"=100'
COMPUTER DESIGNATION

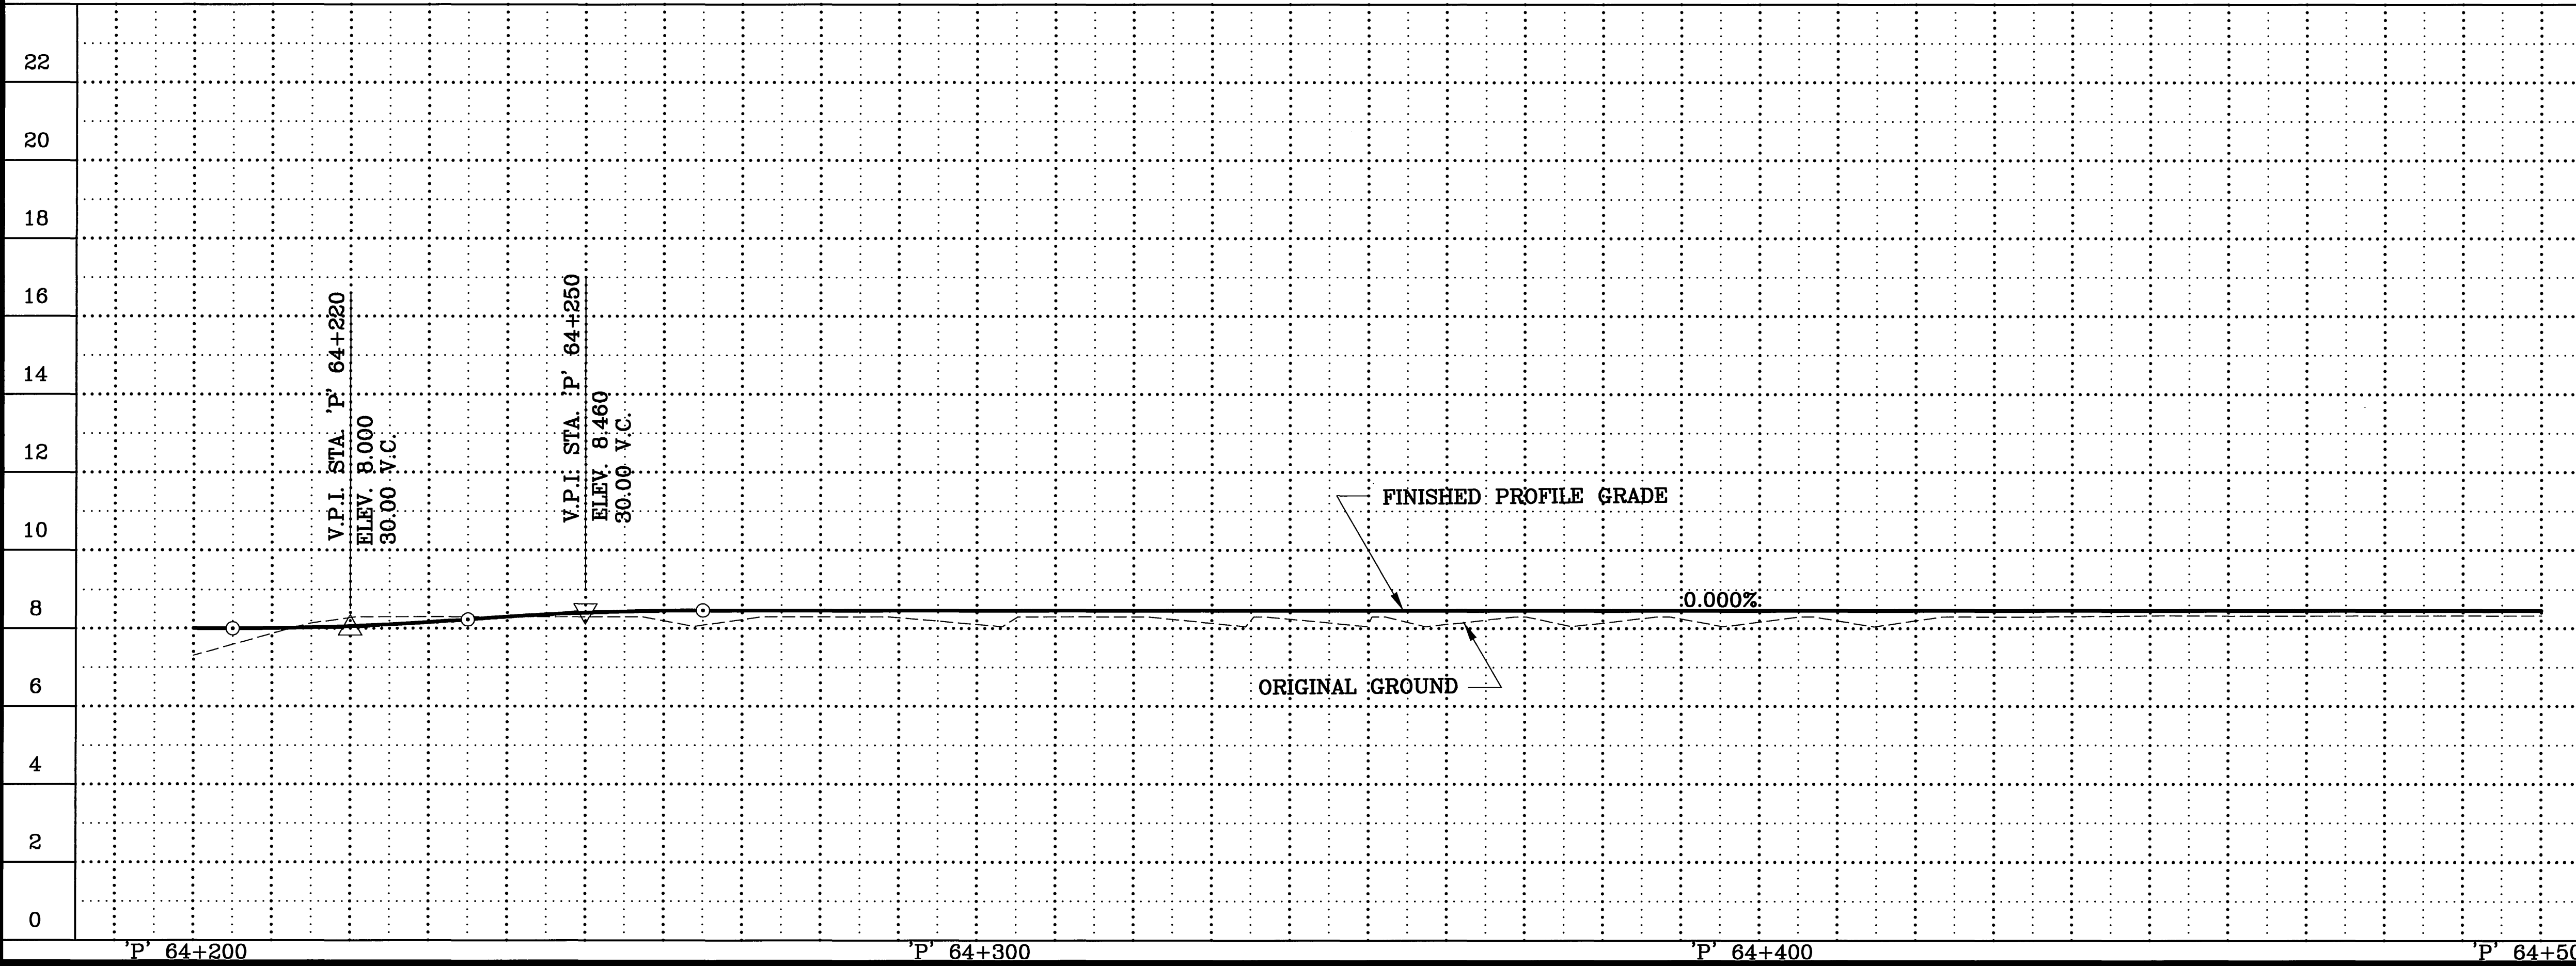
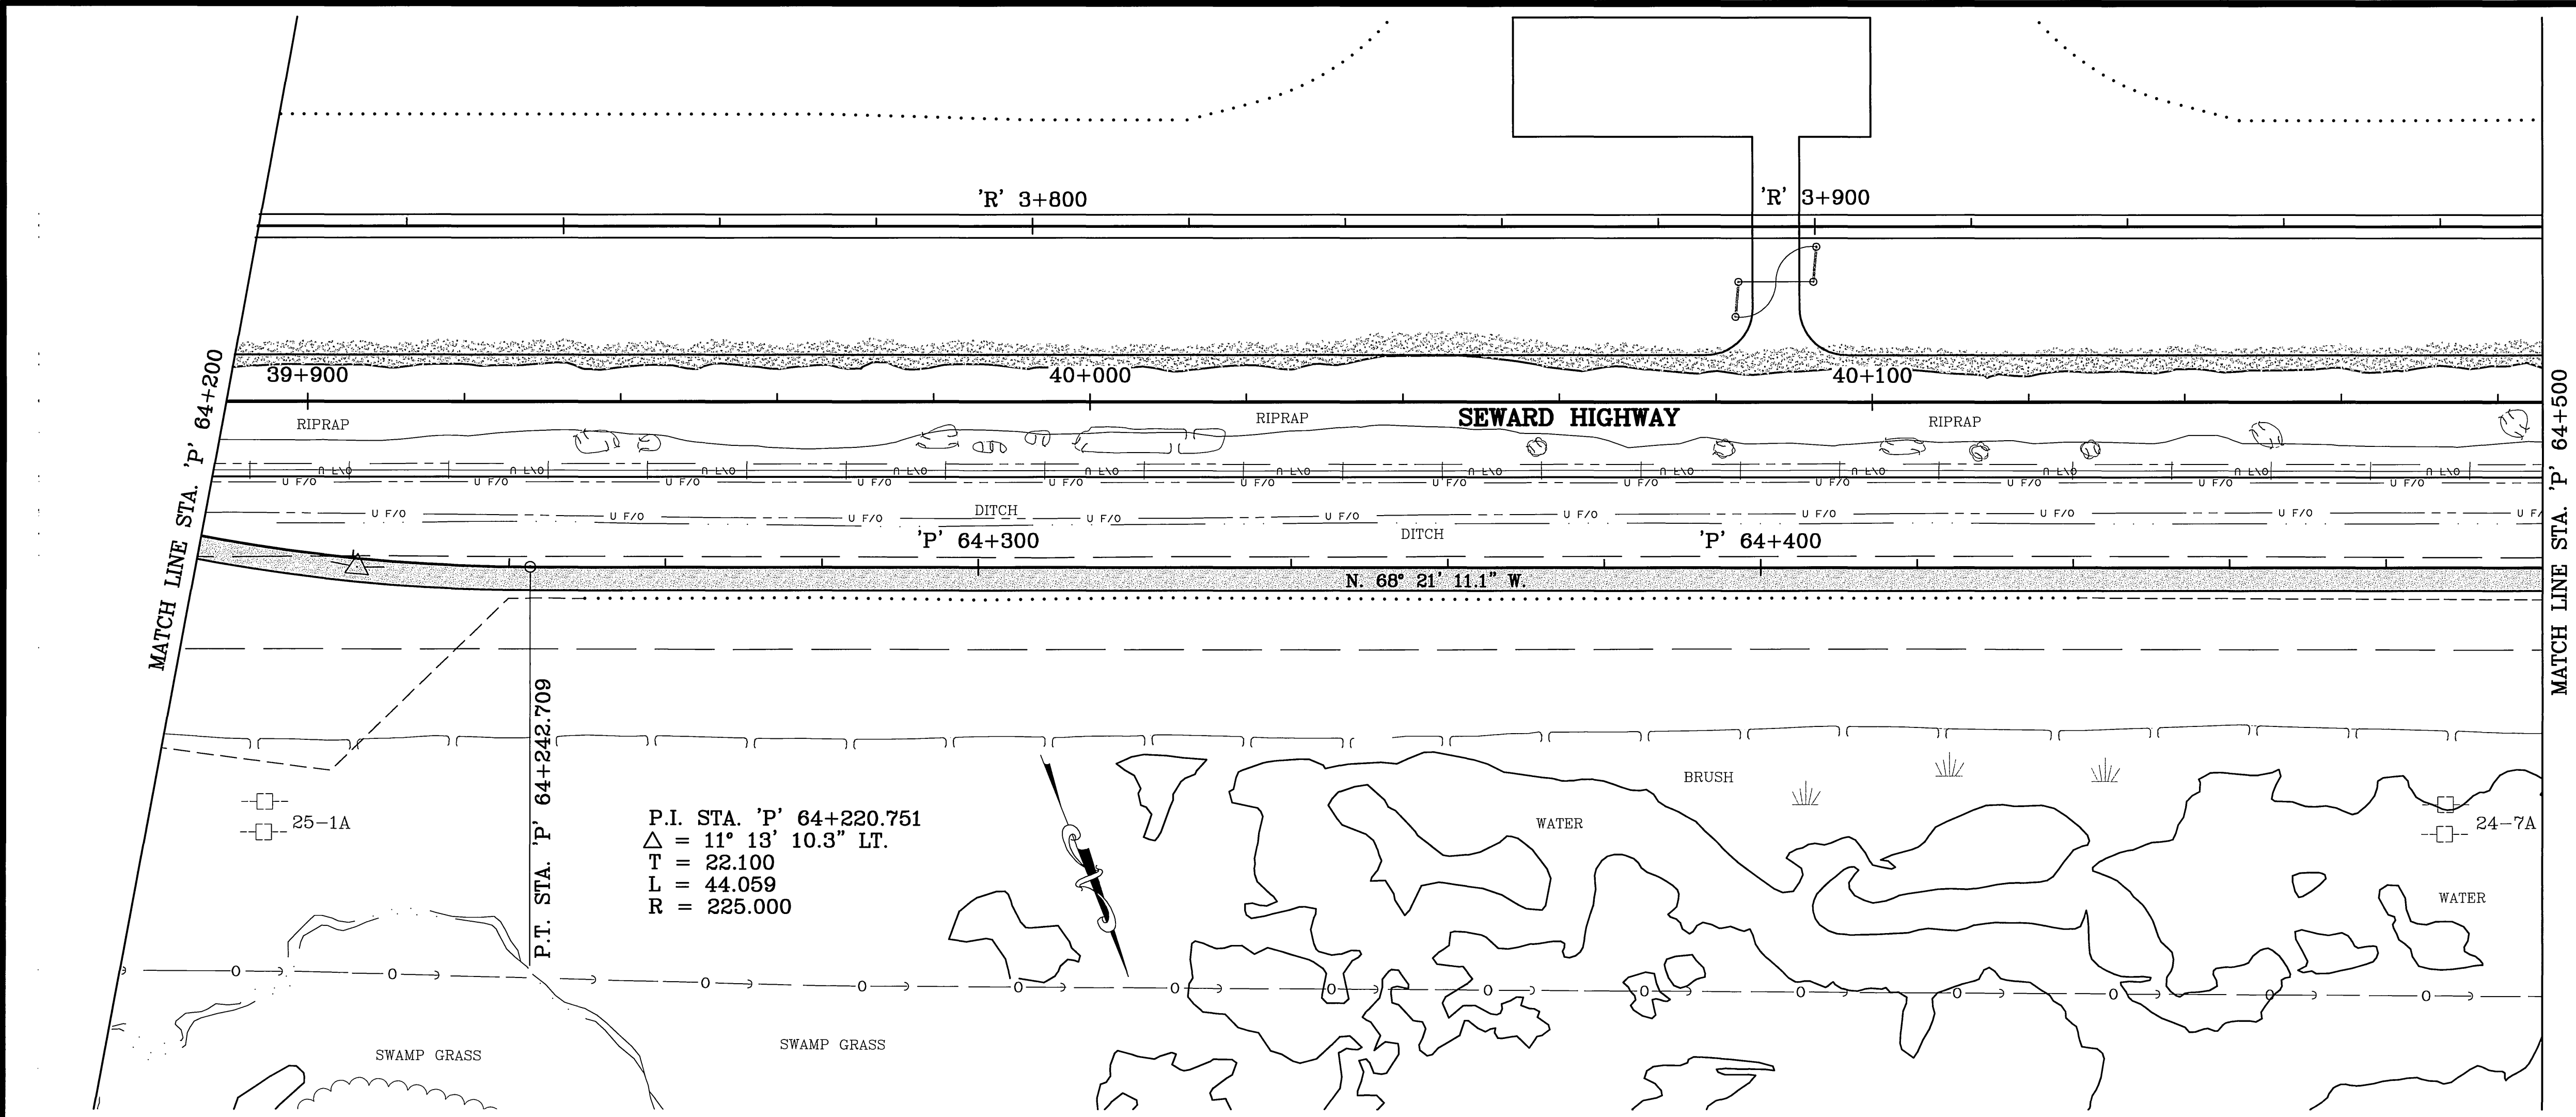


SHEET NO.	TOTAL SHEETS	
FP14	FP18	
STATE	YEAR	
ALASKA	2002	
PROJECT DESIGNATION		
NH-0A3-1(28)		
ADDENDUM NO.		
ATTACHMENT NO.		
REVISIONS		
NO.	DATE	DESCRIPTION

NOTE:
DIMENSIONS ARE IN METERS
UNLESS OTHERWISE NOTED.

STATE OF ALASKA
DEPARTMENT OF TRANSPORTATION
AND PUBLIC FACILITIES
SEWARD HIGHWAY
MP 96 TO MP 102
SAFETY, ROADWAY AND
RECREATIONAL IMPROVEMENTS
BIRD FLATS AREA
PATHWAY
PLAN AND PROFILE

DESIGNED BY	VIEW	DATE
CHECKED BY	HALF S. PATH	6/12/02
DRAFTED BY	KMH	
SPECIFICATIONS	AUTOCAD-CAROLEE.SDSKPROJ\3577\77PP	
SCALE 1"=1'		
COMPUTER DESIGNATION		

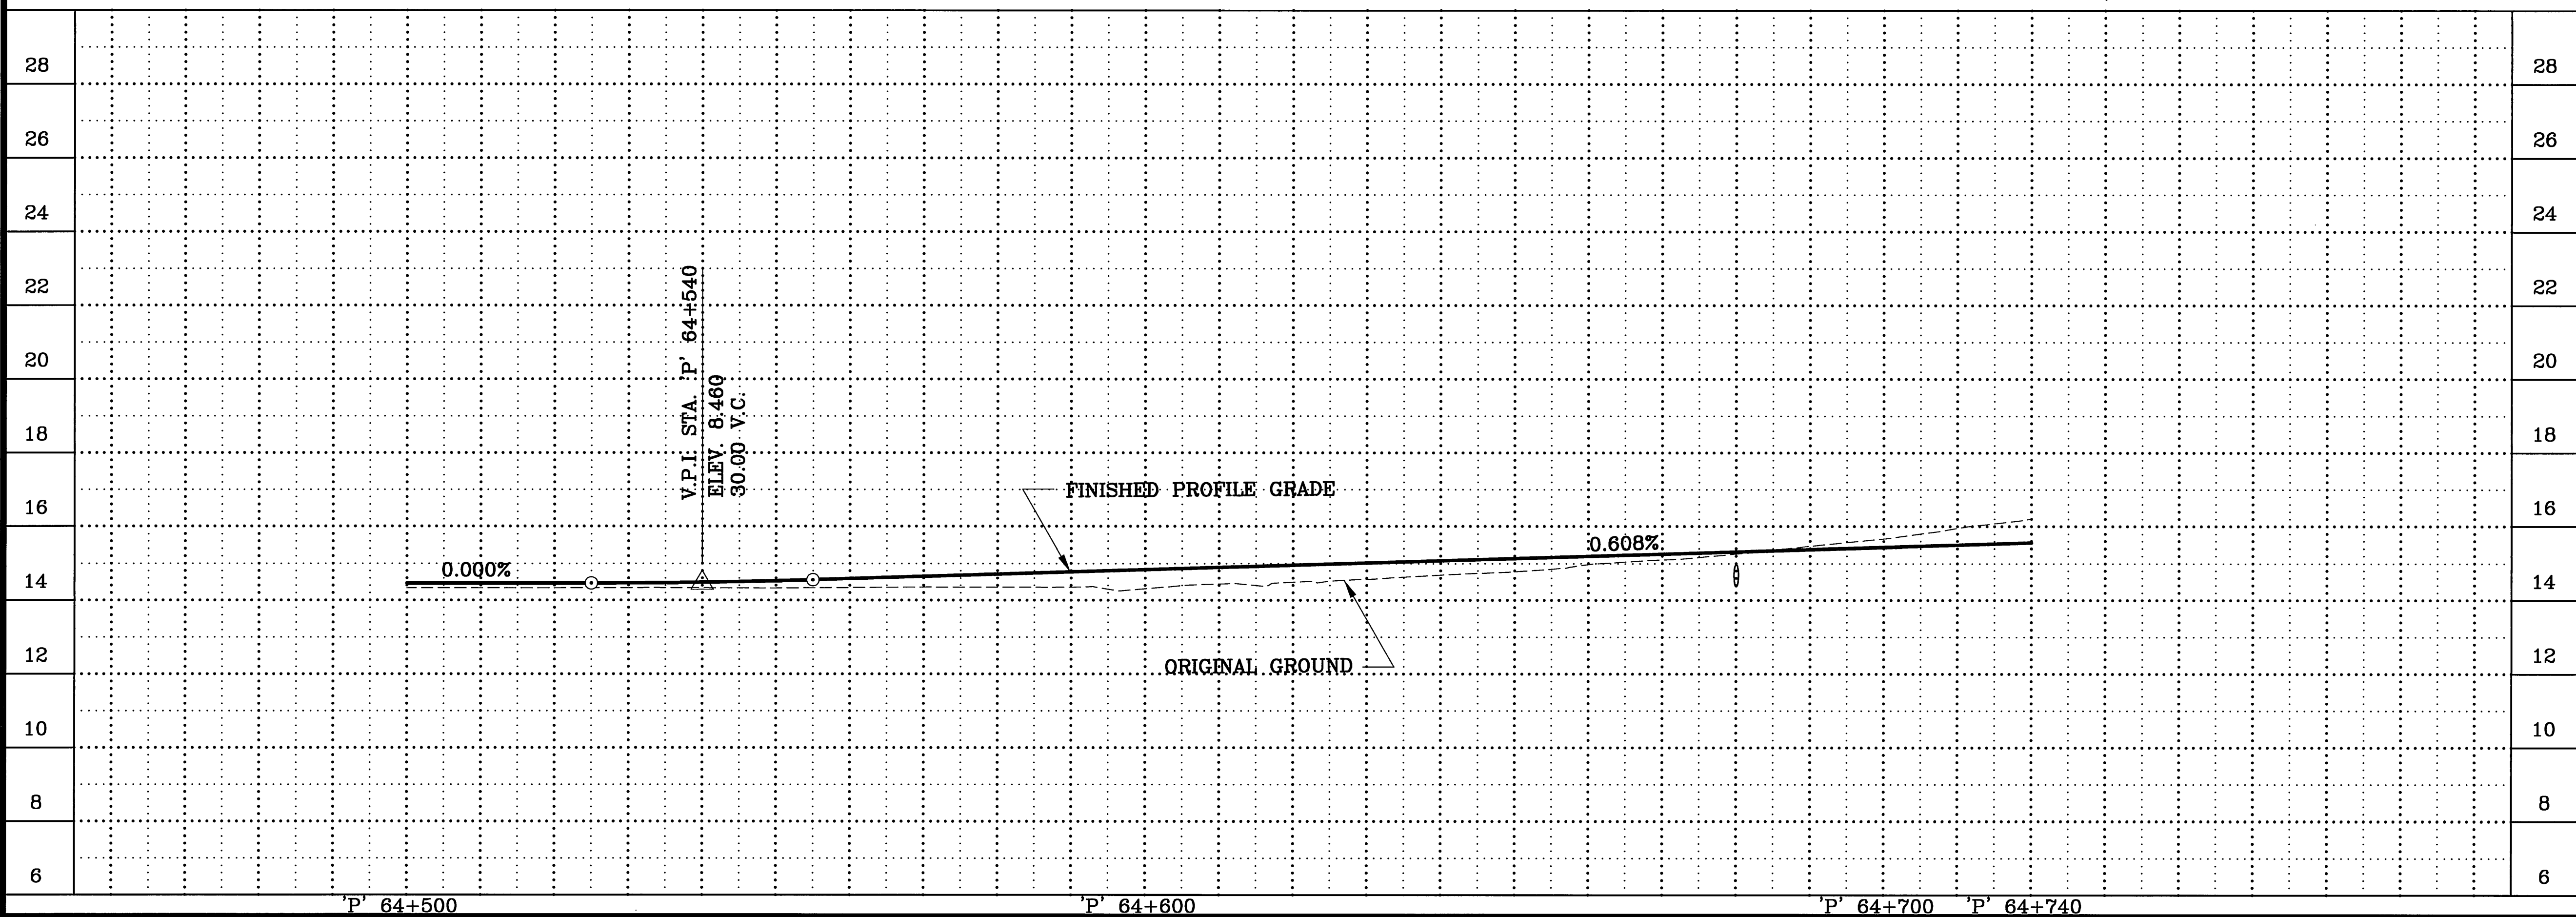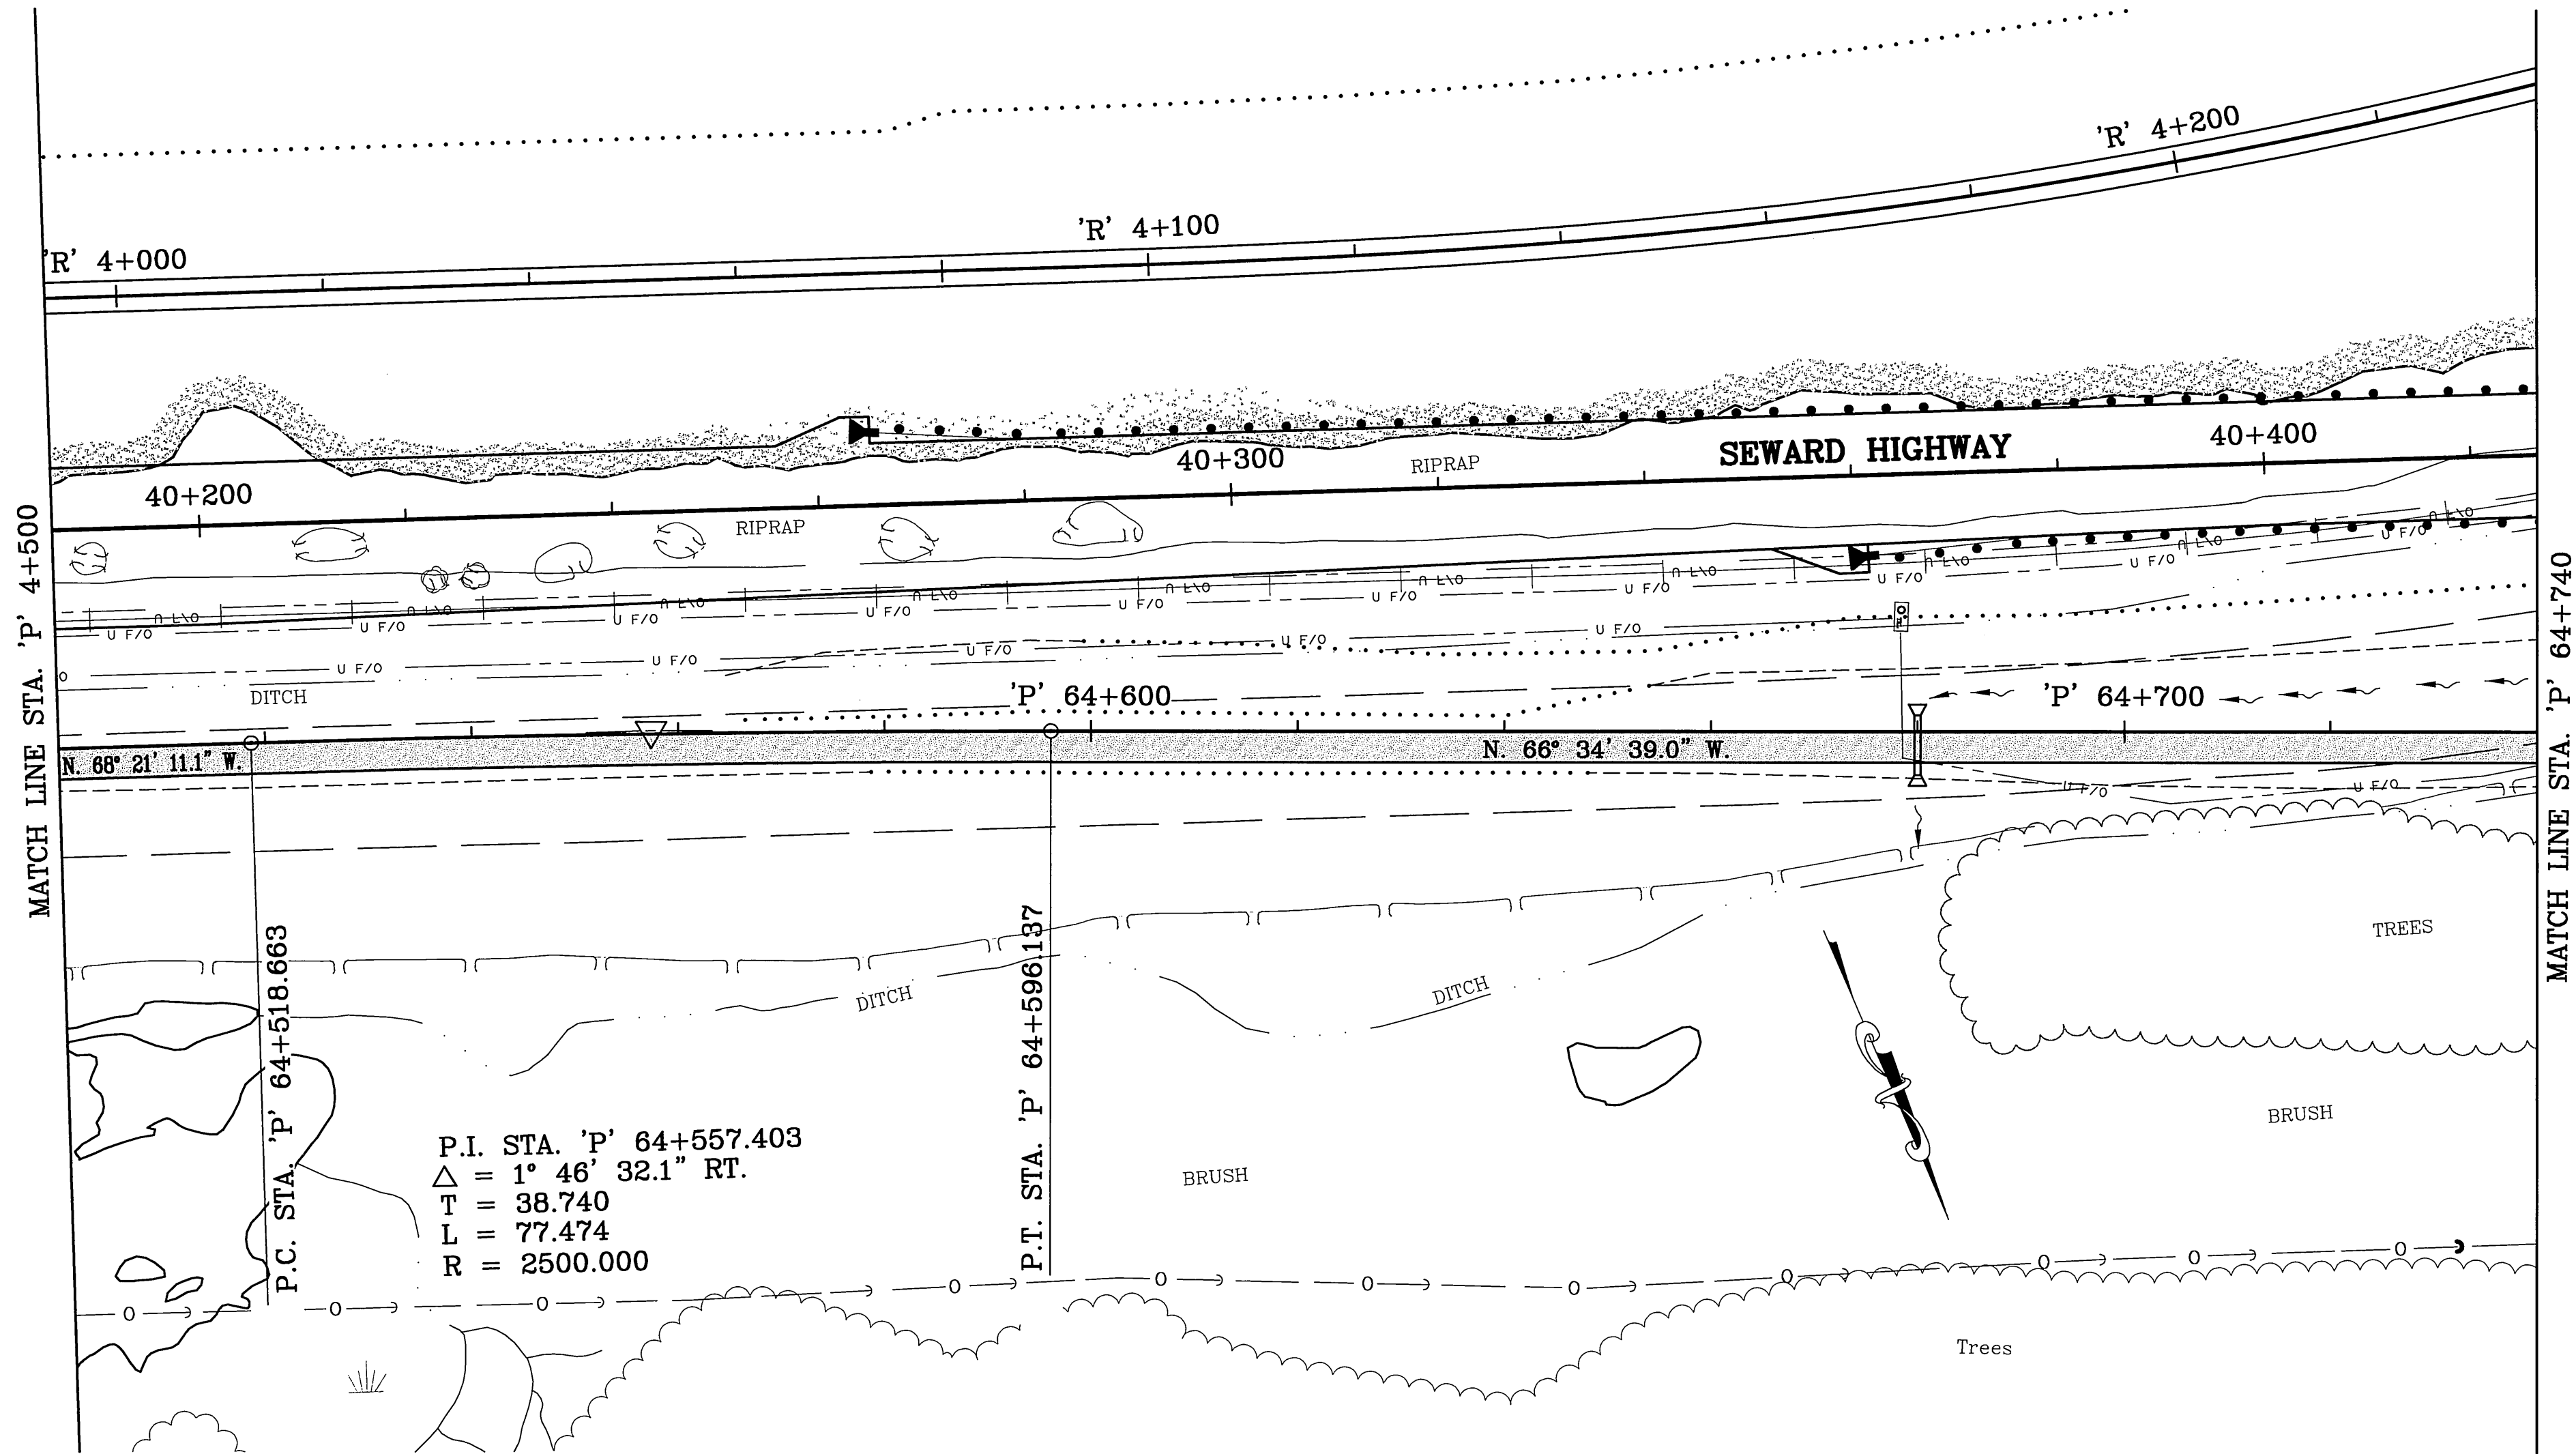

SHEET NO.	TOTAL SHEETS	
FP15	FP18	
STATE	YEAR	
ALASKA	2002	
PROJECT DESIGNATION		
NH-0A3-1(28)		
ADDENDUM NO.		
ATTACHMENT NO.		
REVISIONS		
NO.	DATE	DESCRIPTION

SEWARD HIGHWAY, MP 96 TO 102

THIS SHEET



TURNAGAIN ARM

BIRD POINT

NOTE:
DIMENSIONS ARE IN METERS
UNLESS OTHERWISE NOTED.

STATE OF ALASKA
DEPARTMENT OF TRANSPORTATION
AND PUBLIC FACILITIES
SEWARD HIGHWAY
MP 96 TO MP 102
SAFETY, ROADWAY AND
RECREATIONAL IMPROVEMENTS
BIRD FLATS AREA
PATHWAY
PLAN AND PROFILE

SPECIFICATIONS
SCALE: 1"=1'
COMPUTER DESIGNATION
DESIGNED BY
CHECKED BY
VIEW= HALF 16' PATH
DRAFTED BY
6/12/02

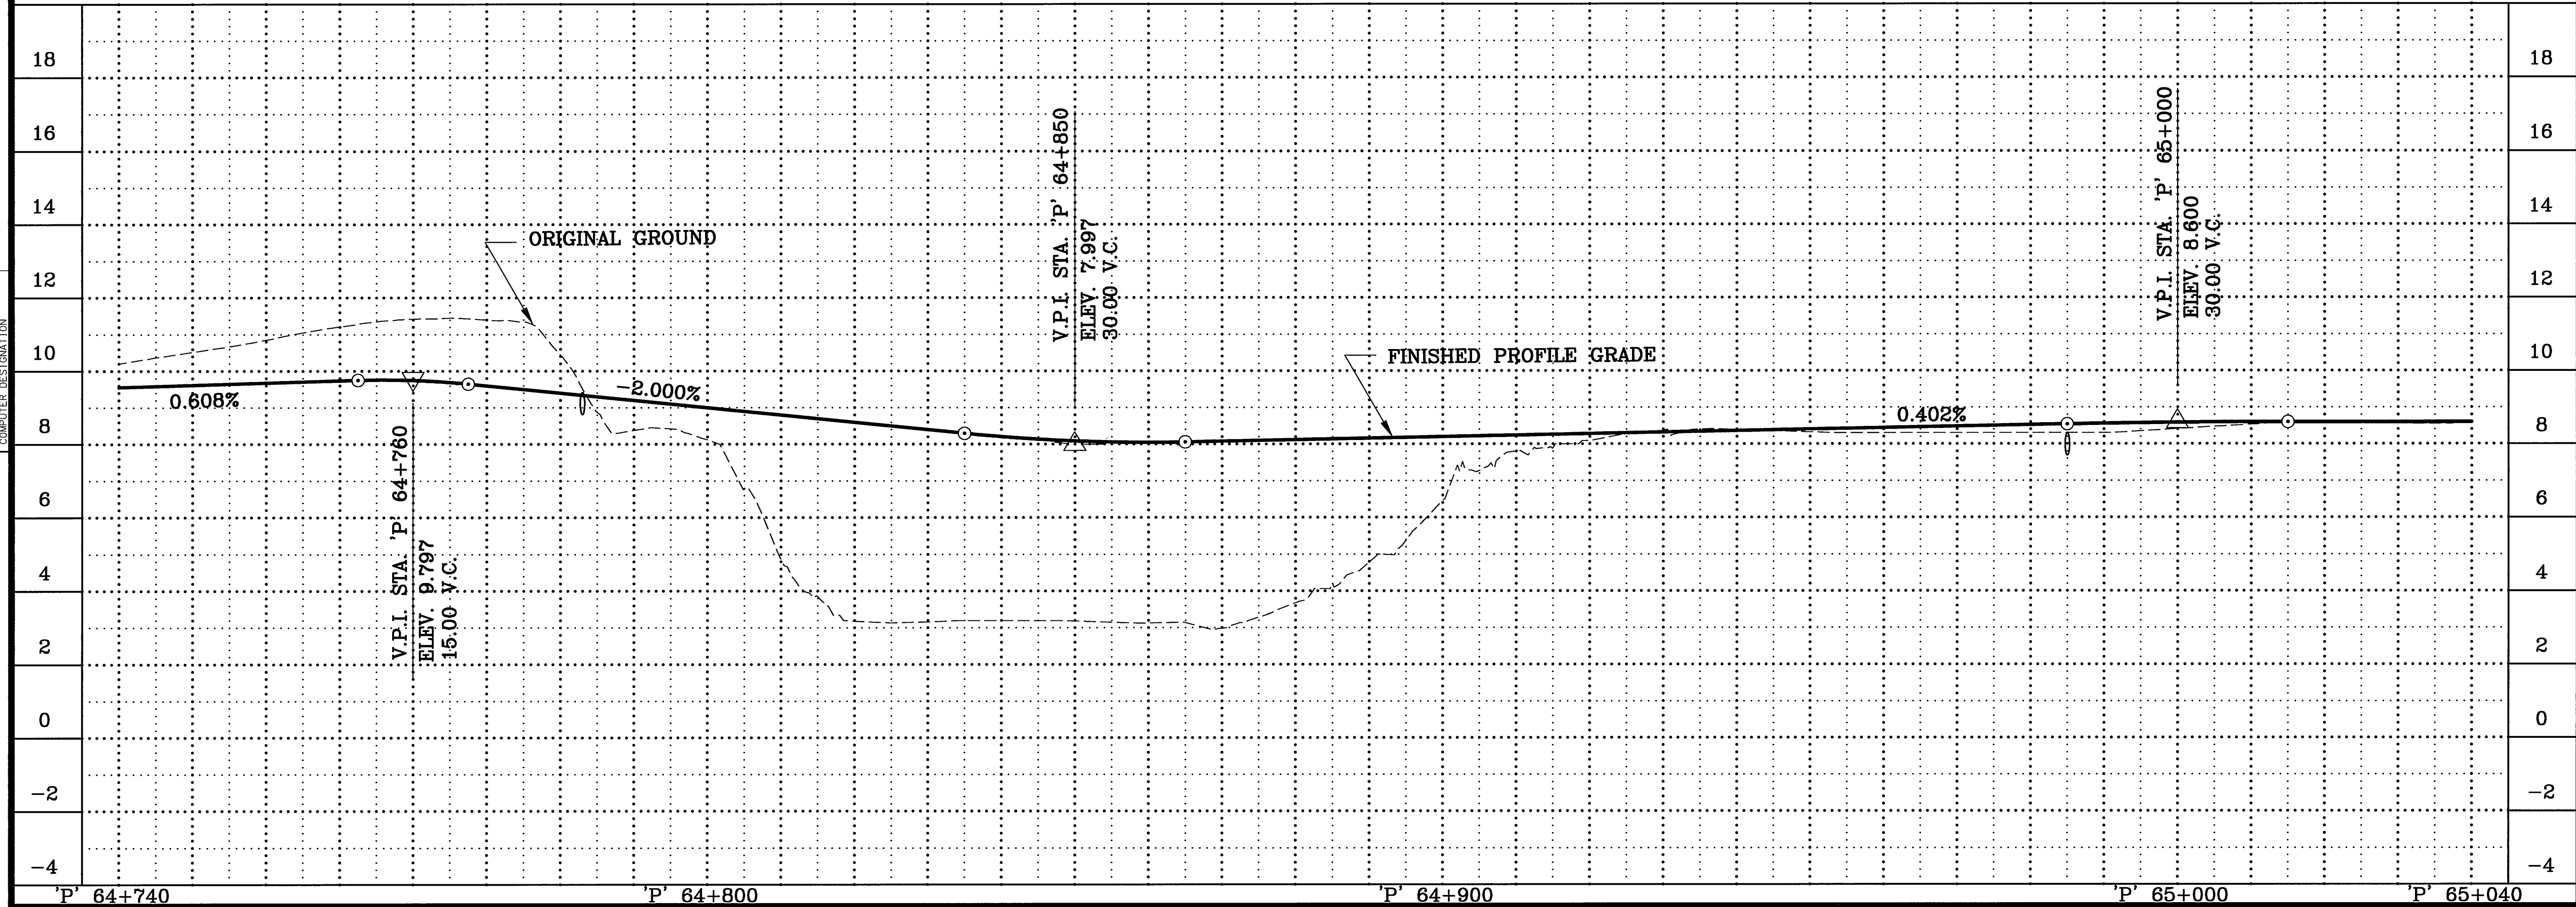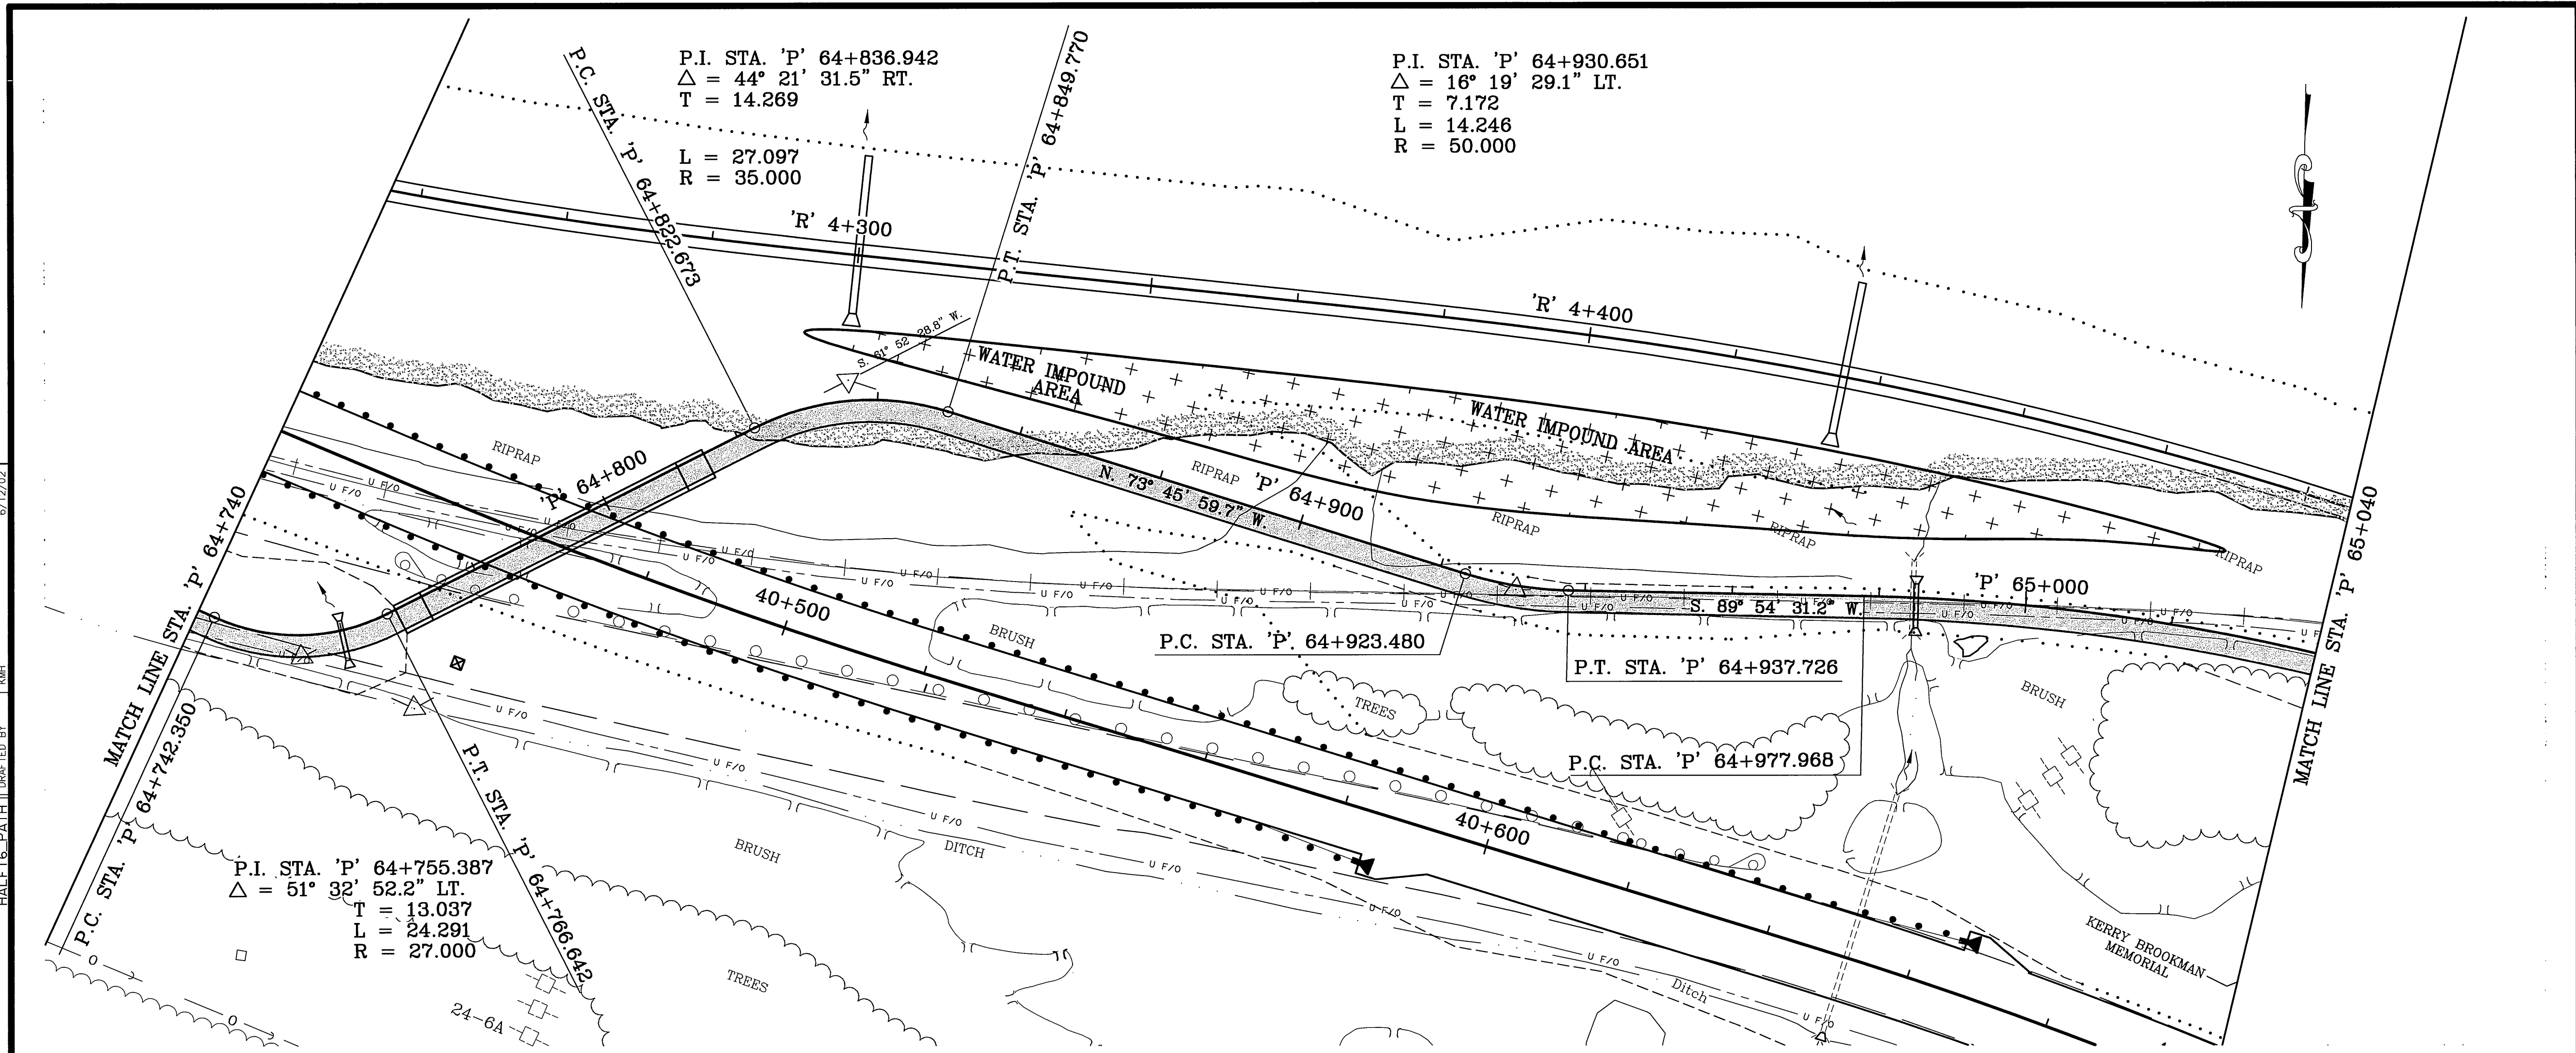

SHEET NO.	TOTAL SHEETS	
FP16	FP18	
STATE	YEAR	
ALASKA	2002	
PROJECT DESIGNATION		
NH-0A3-1(28)		
ADDENDUM NO.		
ATTACHMENT NO.		
REVISIONS		
NO.	DATE	DESCRIPTION

THIS SHEET

BIRD CREEK BRIDGE

BIRD CREEK

TURNAGAIN ARM

BIRD POINT



SEWARD HIGHWAY, MP 96 TO 102

NOTE:
DIMENSIONS ARE IN METERS
UNLESS OTHERWISE NOTED.

STATE OF ALASKA
DEPARTMENT OF TRANSPORTATION
AND PUBLIC FACILITIES
JUDY J. DOUGHERTY
REGISTERED PROFESSIONAL ENGINEER
CE 8823
12.02

STATE OF ALASKA
DEPARTMENT OF TRANSPORTATION
AND PUBLIC FACILITIES
SEWARD HIGHWAY
MP 96 TO MP 102
SAFETY, ROADWAY AND
RECREATIONAL IMPROVEMENTS
BIRD FLATS AREA
PATHWAY
PLAN AND PROFILE

DESIGNED BY
CHECKED BY
DATE
6/12/02
VIEW-
HALF 17 PATH
AUTOCAD-CAROL LEE, SUGARPO, 53571, 77P
COMPUTER DESIGNATION

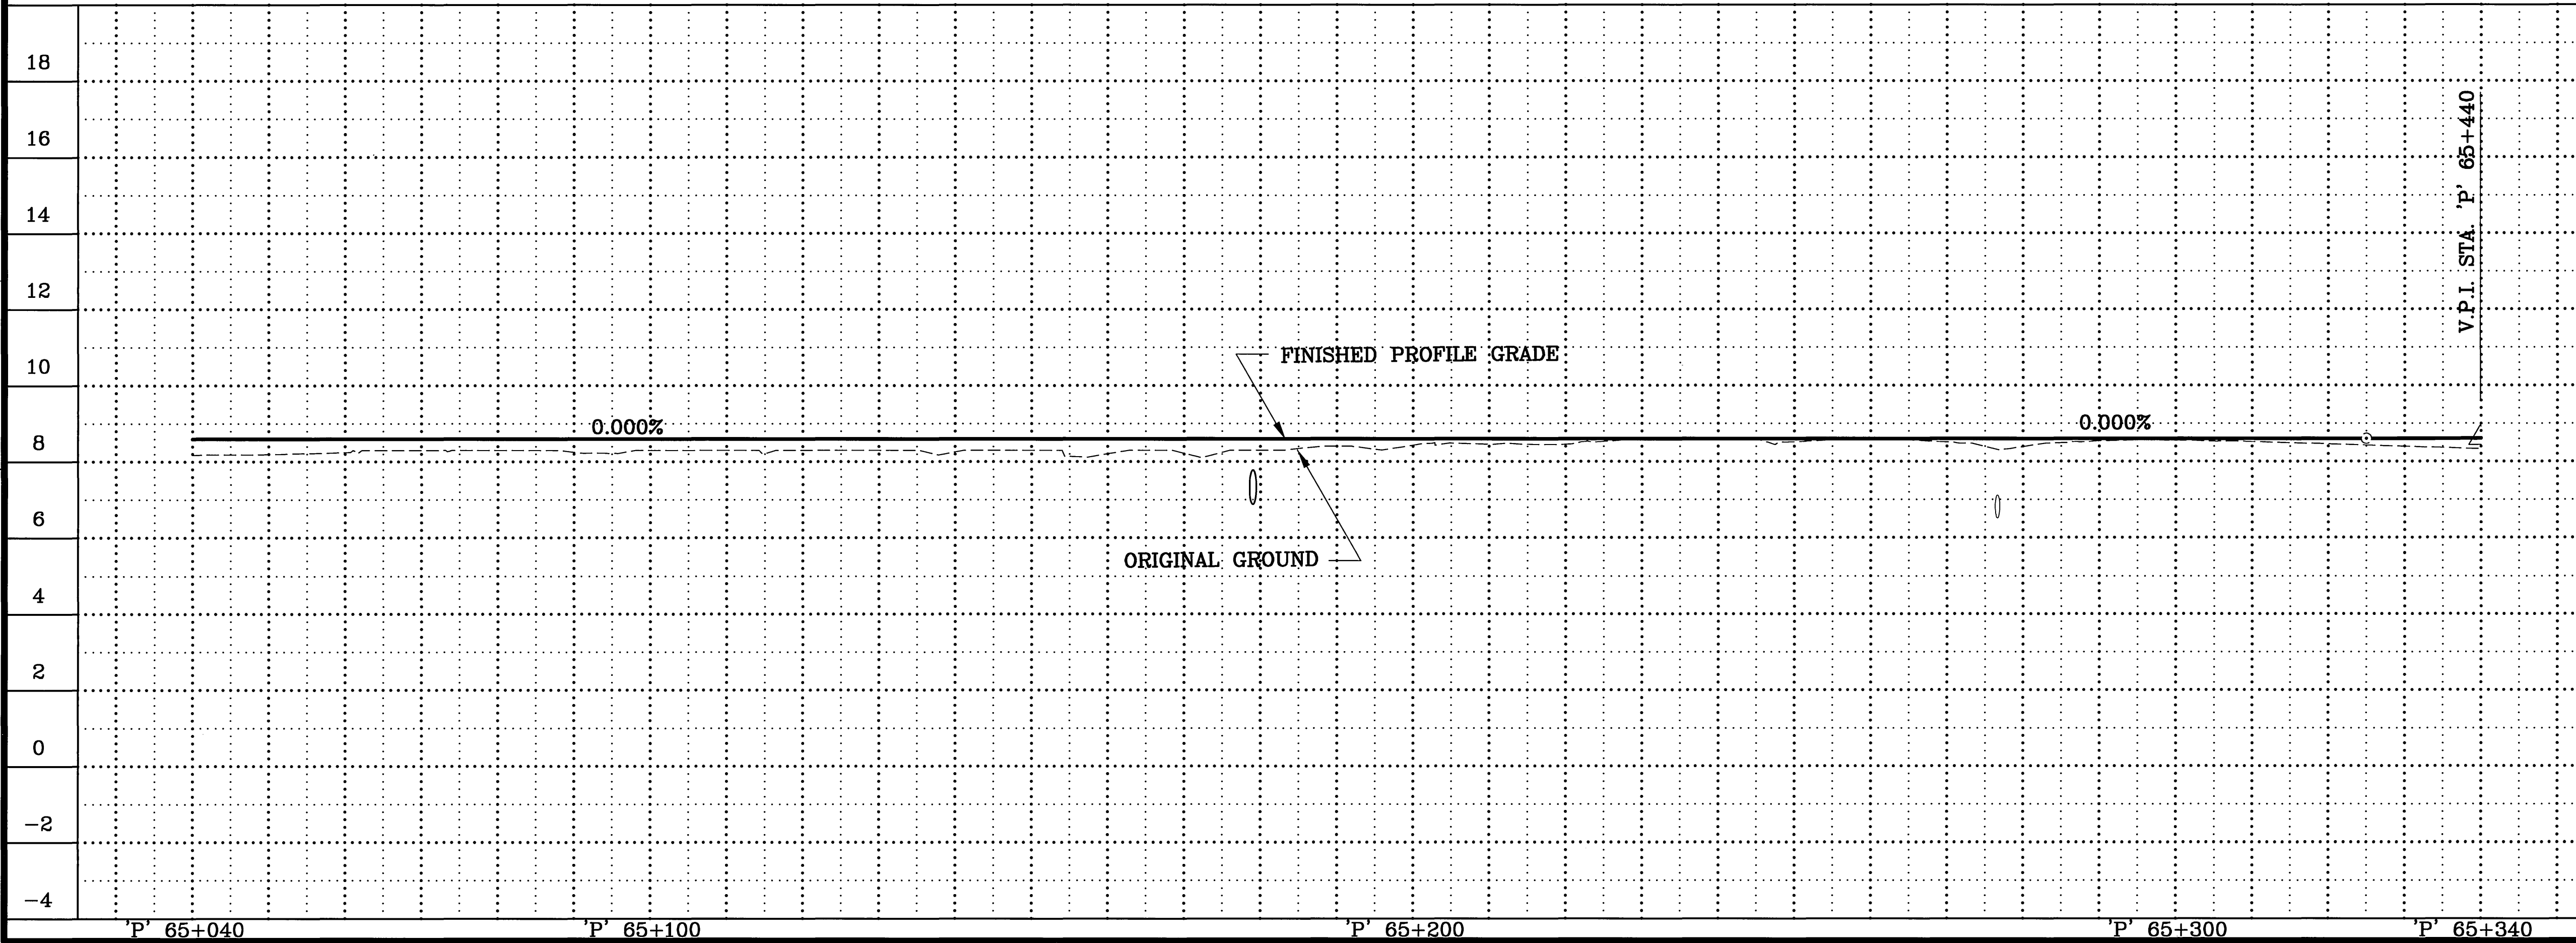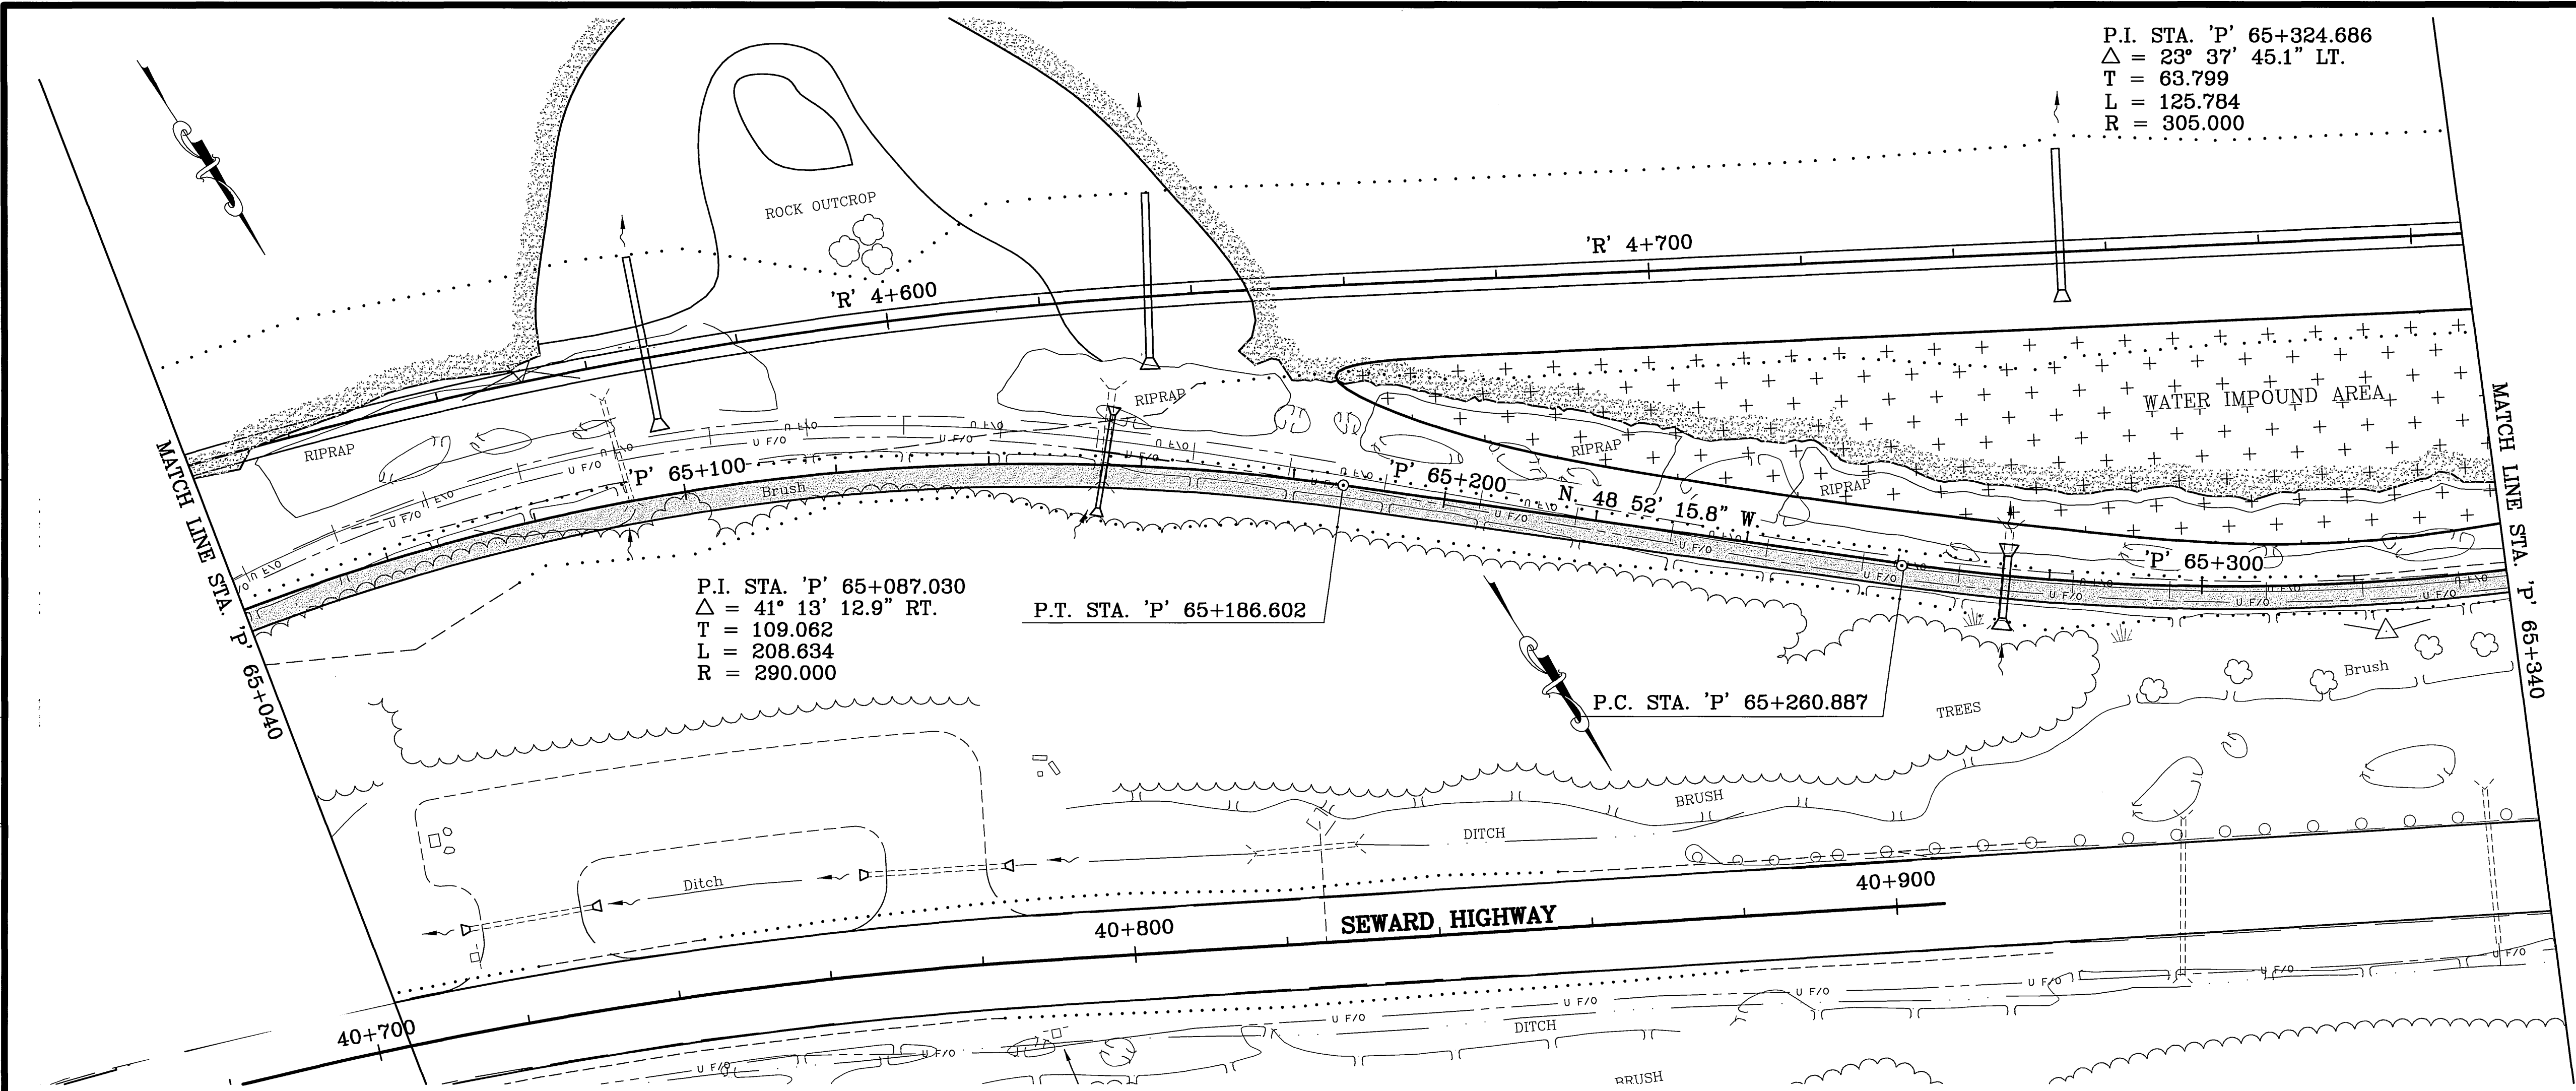



SHEET NO.	TOTAL SHEETS	
FP17	FP18	
STATE	YEAR	
ALASKA	2002	
PROJECT DESIGNATION		
NH-0A3-1(28)		
ADDENDUM NO.		
ATTACHMENT NO.		
REVISIONS		
NO.	DATE	DESCRIPTION

SEWARD HIGHWAY, MP 96 TO 102

NOTE:
DIMENSIONS ARE IN METERS
UNLESS OTHERWISE NOTED.

STATE OF ALASKA
DEPARTMENT OF TRANSPORTATION
AND PUBLIC FACILITIES
SEWARD HIGHWAY
MP 96 TO MP 102
SAFETY, ROADWAY AND
RECREATIONAL IMPROVEMENTS
BIRD FLATS AREA
PATHWAY
PLAN AND PROFILE

DESIGNED BY
CHECKED BY
DATE
6/12/02
VIEW
HALF B. PATH
DRAFTED BY
KMH
SPECIFICATIONS
AUTOCAD-CAROLEE-SSK/PROJ/5577/TPP
SCALE 1"=100'
COMPUTER DESIGNATION

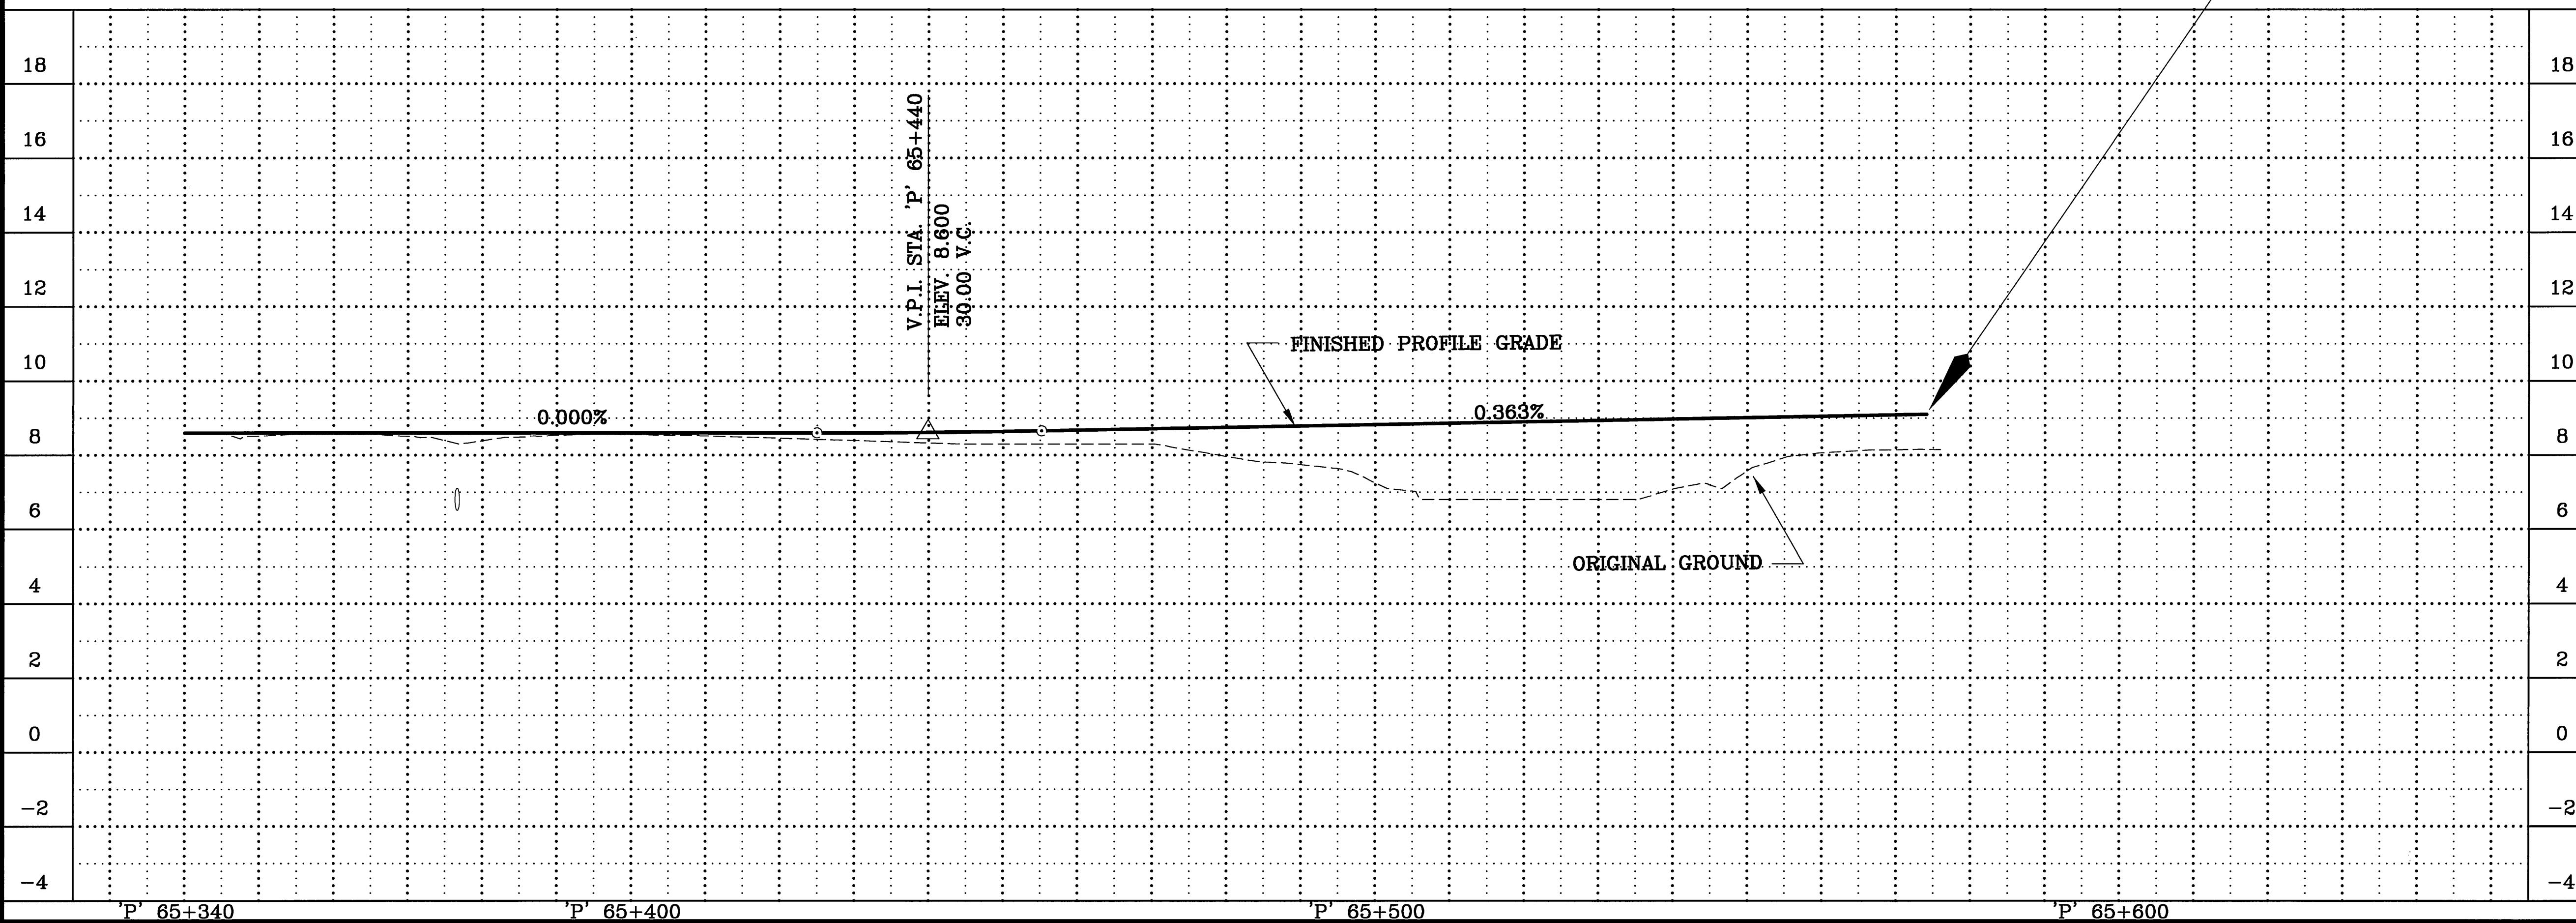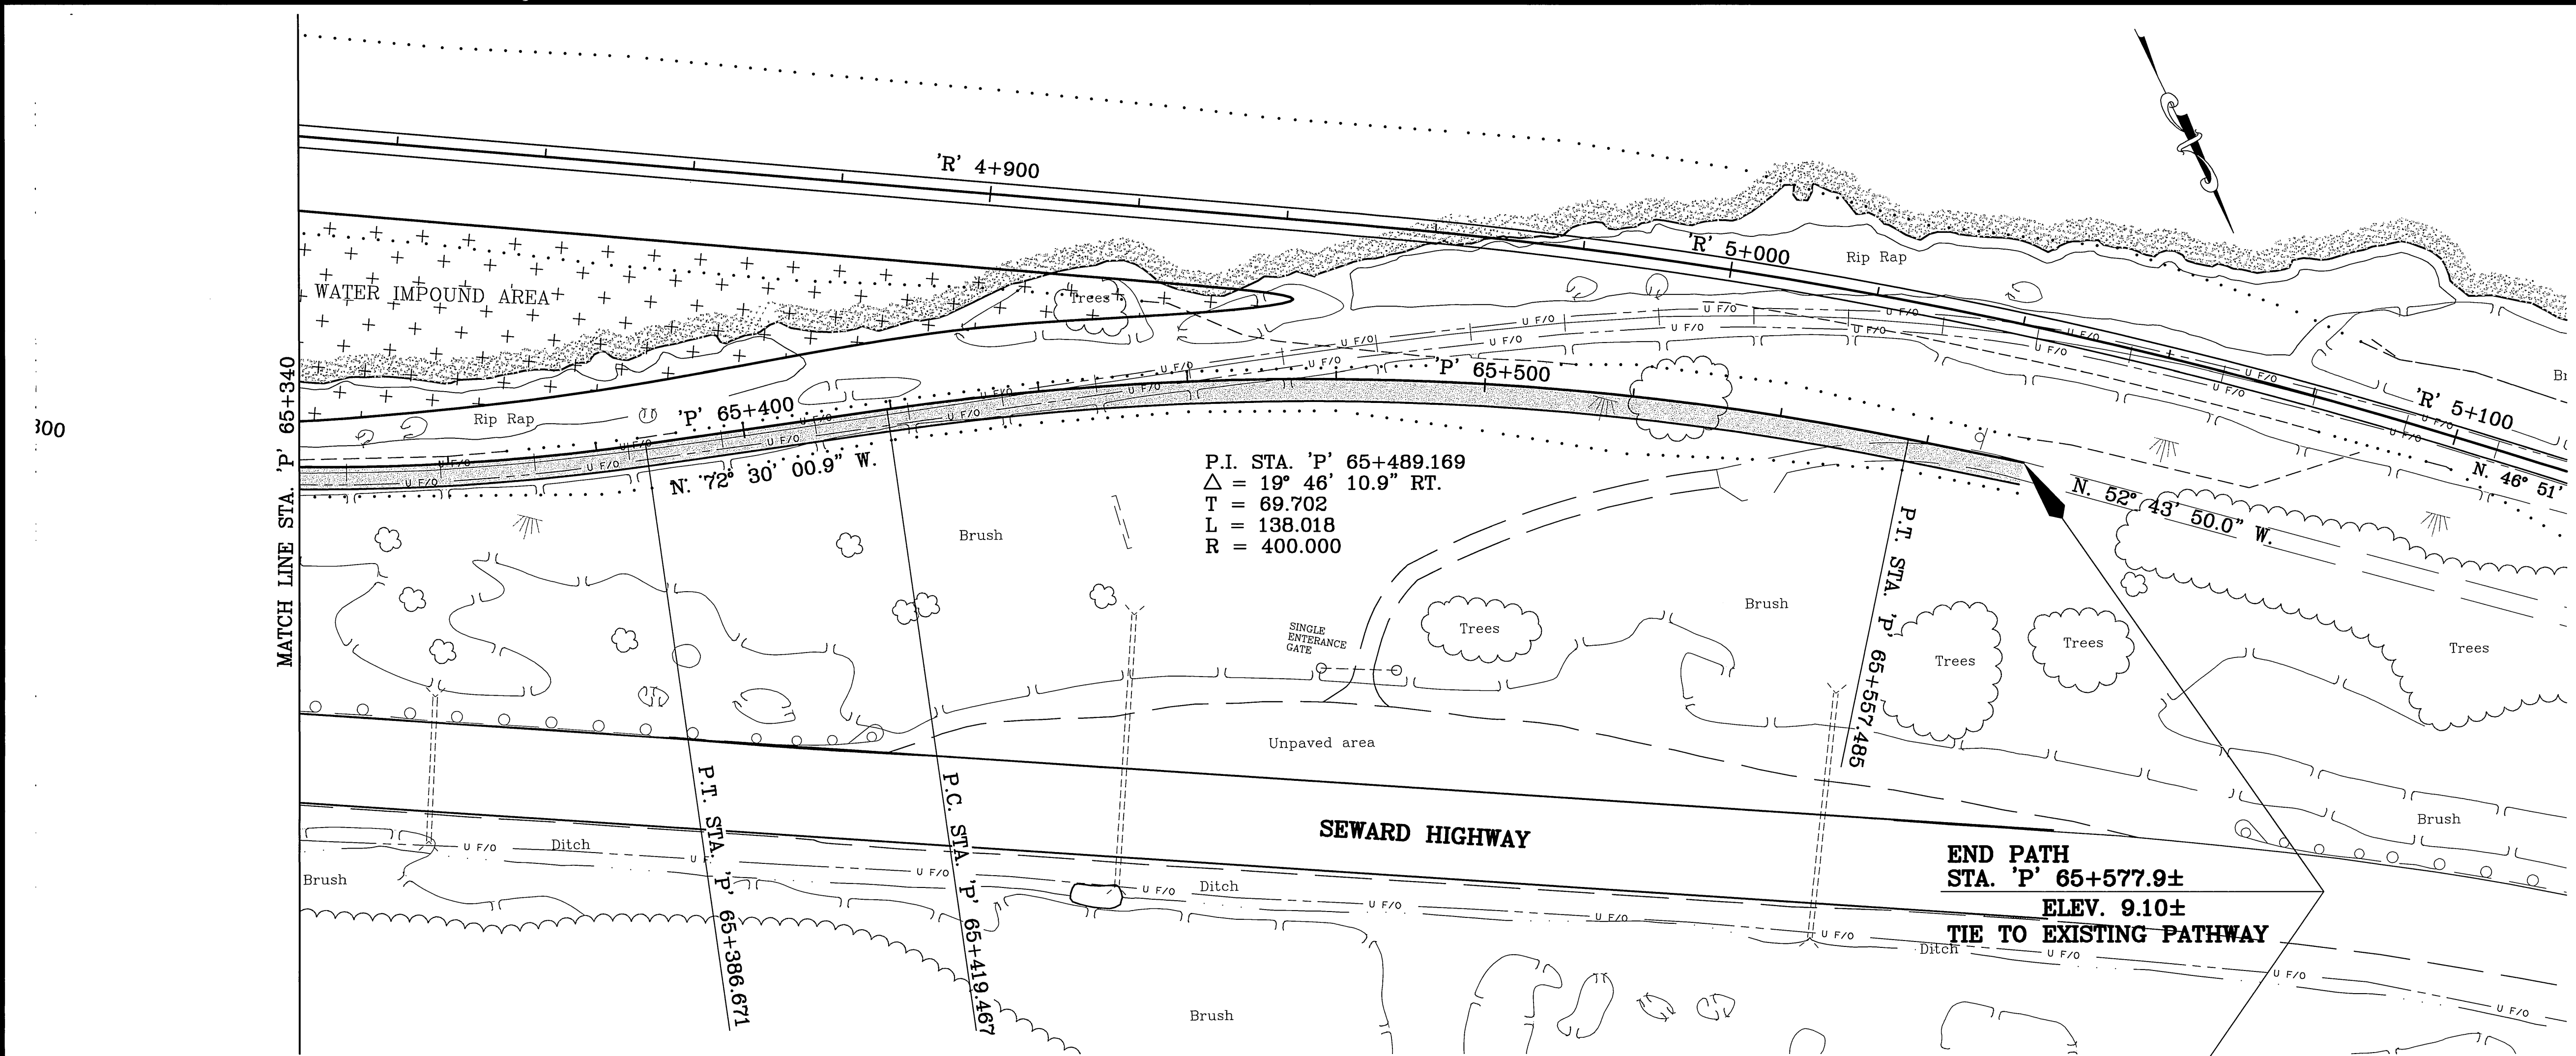

SHEET NO.	TOTAL SHEETS	
FP18	FP18	
STATE	YEAR	
ALASKA	2002	
PROJECT DESIGNATION		
NH-0A3-1(28)		
ADDENDUM NO.		
ATTACHMENT NO.		
REVISIONS		
NO.	DATE	DESCRIPTION

BIRD CREEK BRIDGE

BIRD CREEK

THIS SHEET

TURNAGAIN ARM


BIRD POINT

NOTE:
DIMENSIONS ARE IN METERS
UNLESS OTHERWISE NOTED.

STATE OF ALASKA
49th
JUDY J. DOUGHERTY
CE 8823
REGISTERED PROFESSIONAL ENGINEER

STATE OF ALASKA
DEPARTMENT OF TRANSPORTATION
AND PUBLIC FACILITIES
SEWARD HIGHWAY
MP 96 TO MP 102
SAFETY, ROADWAY AND
RECREATIONAL IMPROVEMENTS
BIRD FLATS AREA
PATHWAY
PLAN AND PROFILE

SPECIFICATIONS	AUTOCAD-KAREN-	VIEW#	DESIGNED BY
SCALE 1"=1'	D:\585KPROJ\53577\DATA\INDMB\RD\770LCL.DWG	B 20.18 mm EST	CHECKED BY
COMPUTER DESIGNATION			DRAFTED BY
			KMH

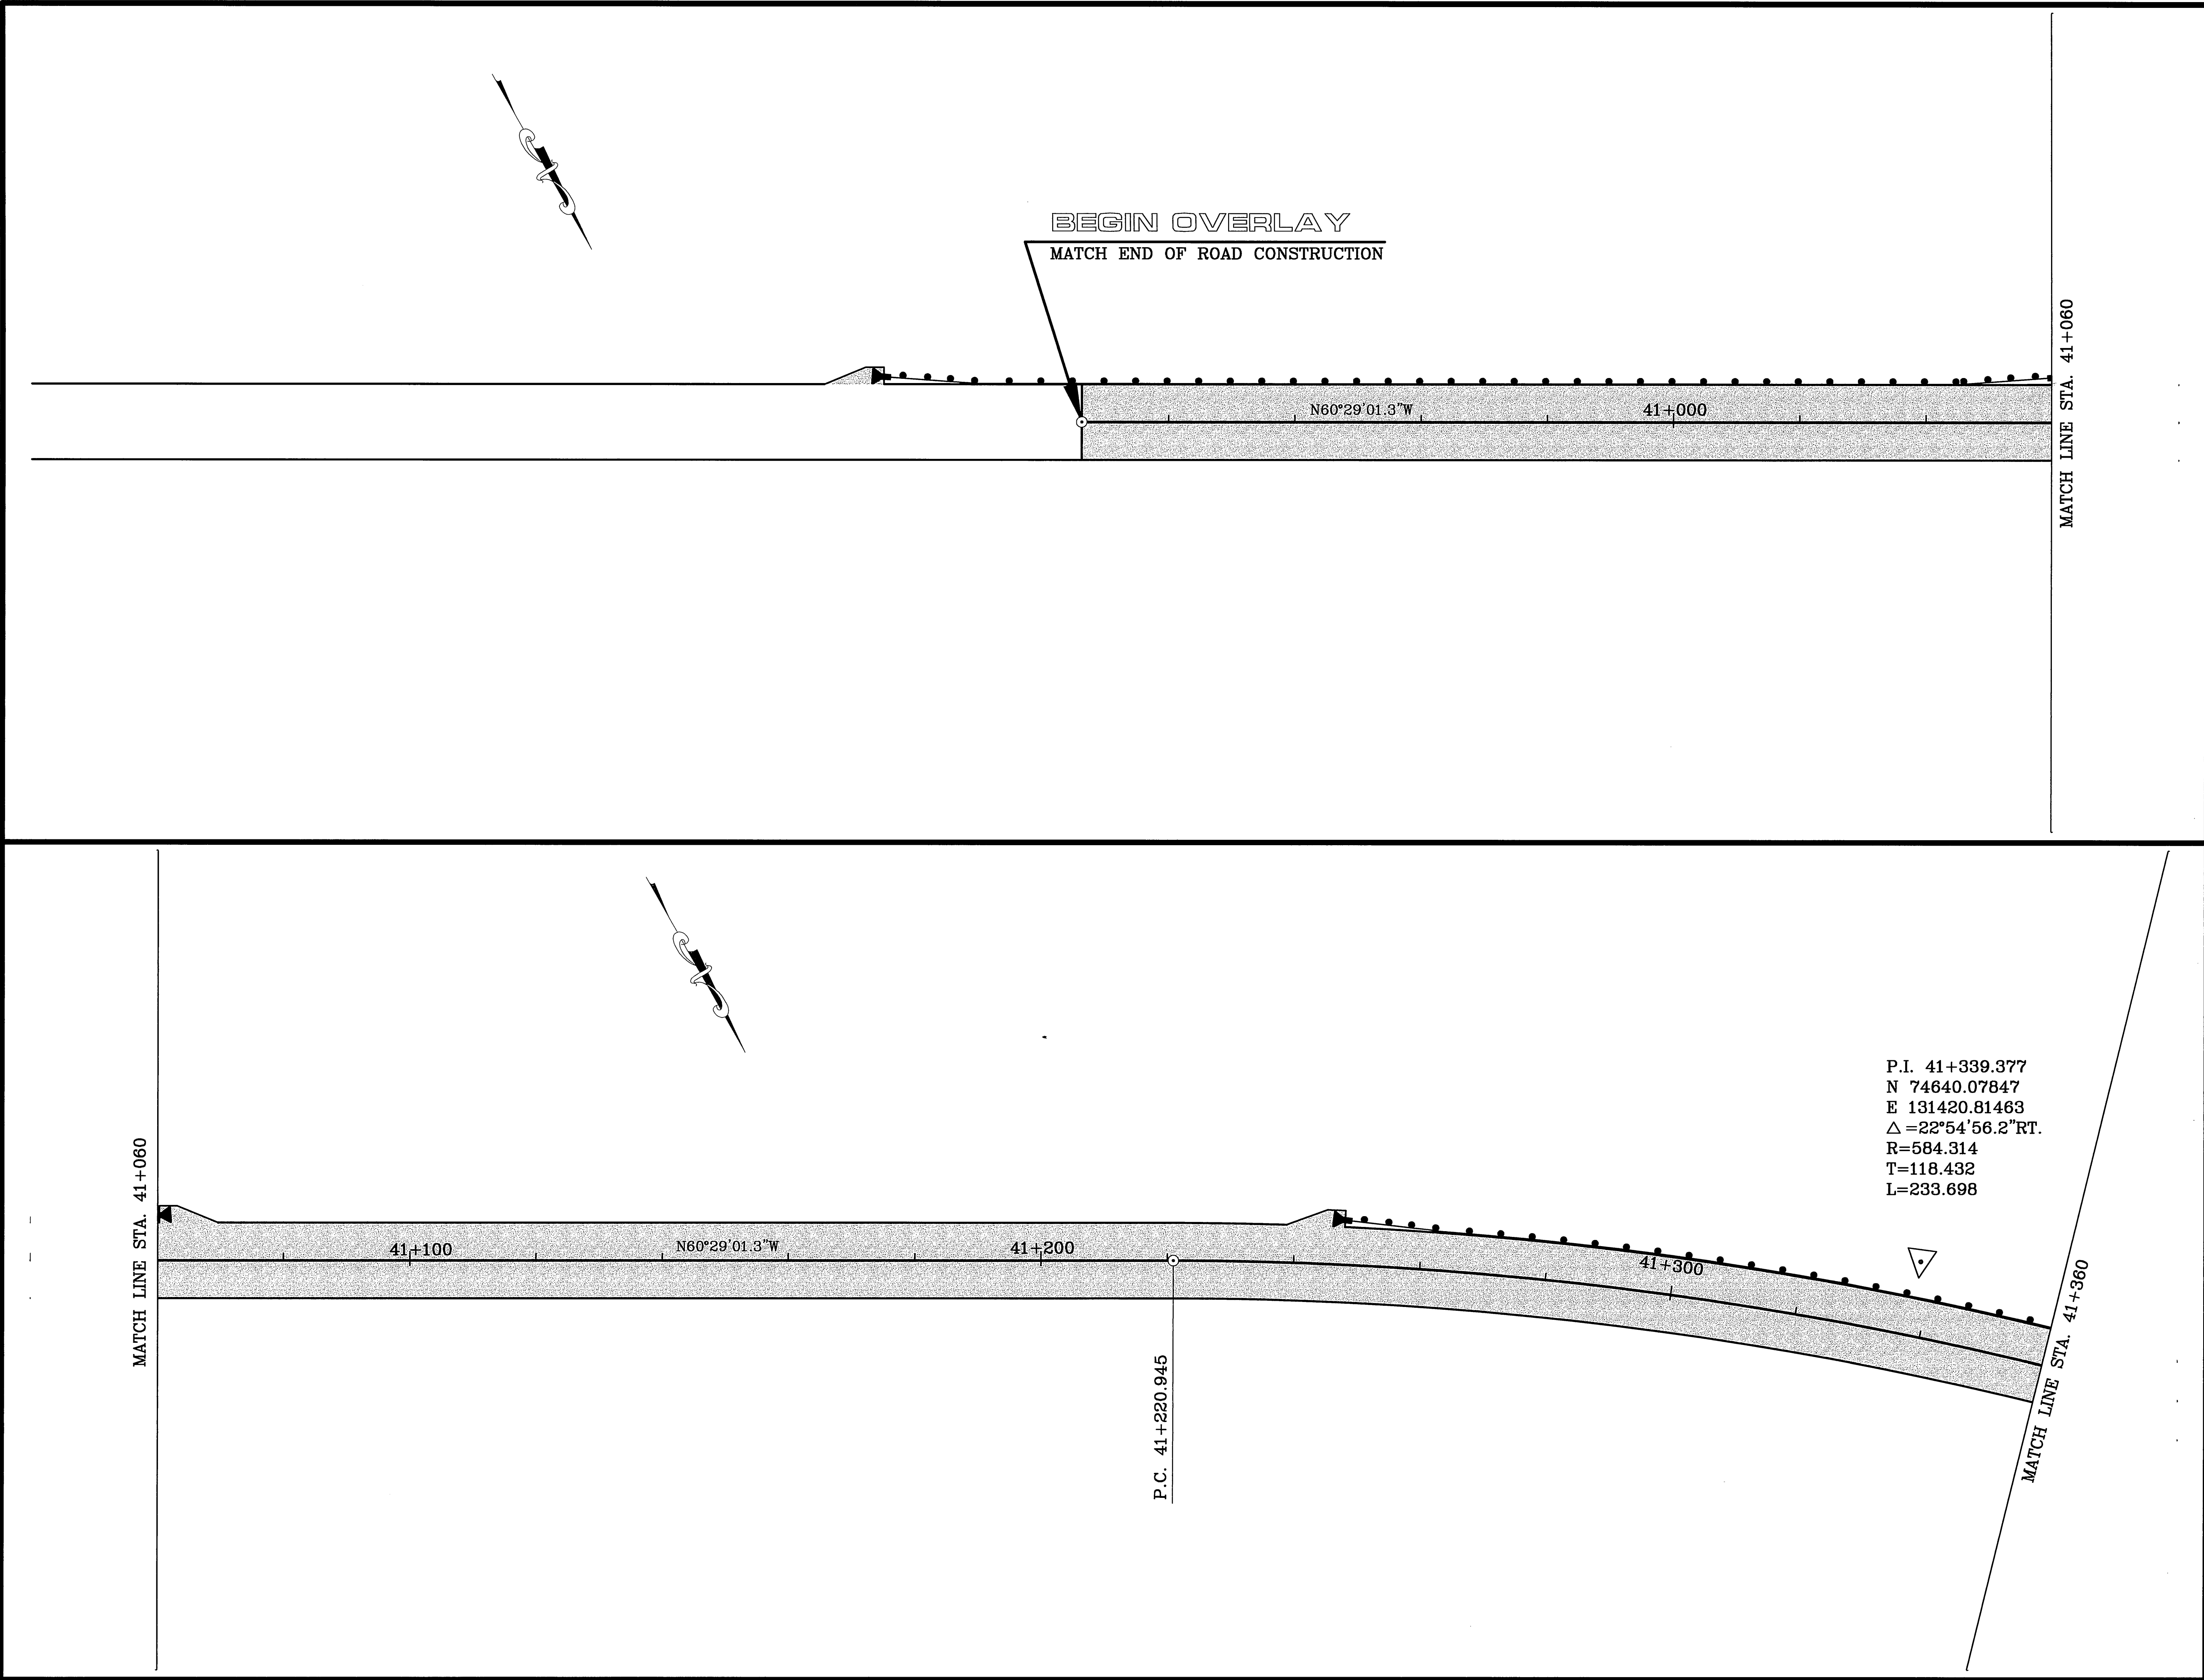


SHEET NO.	TOTAL SHEETS	
F01	F07	
STATE	YEAR	
ALASKA	2002	
PROJECT DESIGNATION		
NH-0A3-1(28)		
ADDENDUM NO.		
ATTACHMENT NO.		
REVISIONS		
NO.	DATE	DESCRIPTION

NOTE:
DIMENSIONS ARE IN METERS
UNLESS OTHERWISE NOTED.

STATE OF ALASKA
DEPARTMENT OF TRANSPORTATION
AND PUBLIC FACILITIES
SEWARD HIGHWAY
MP 96 TO MP 102
**SAFETY, ROADWAY &
RECREATIONAL IMPROVEMENTS
OVERLAY**
BIRD FLATS TO BIRD CREEK
PLAN SHEET

SPECIFICATIONS	DESIGNED BY	
	AUTODAD-KAREN-	
SCALE 1"=1'	CHECKED BY	
	D:\NSDKPROJ\3357\DATA\INDMB\RD\770LCL.DWG B-27-01 B-20.18 am EST	
COMPUTER DESIGNATION	VIEW=	
	KM4	

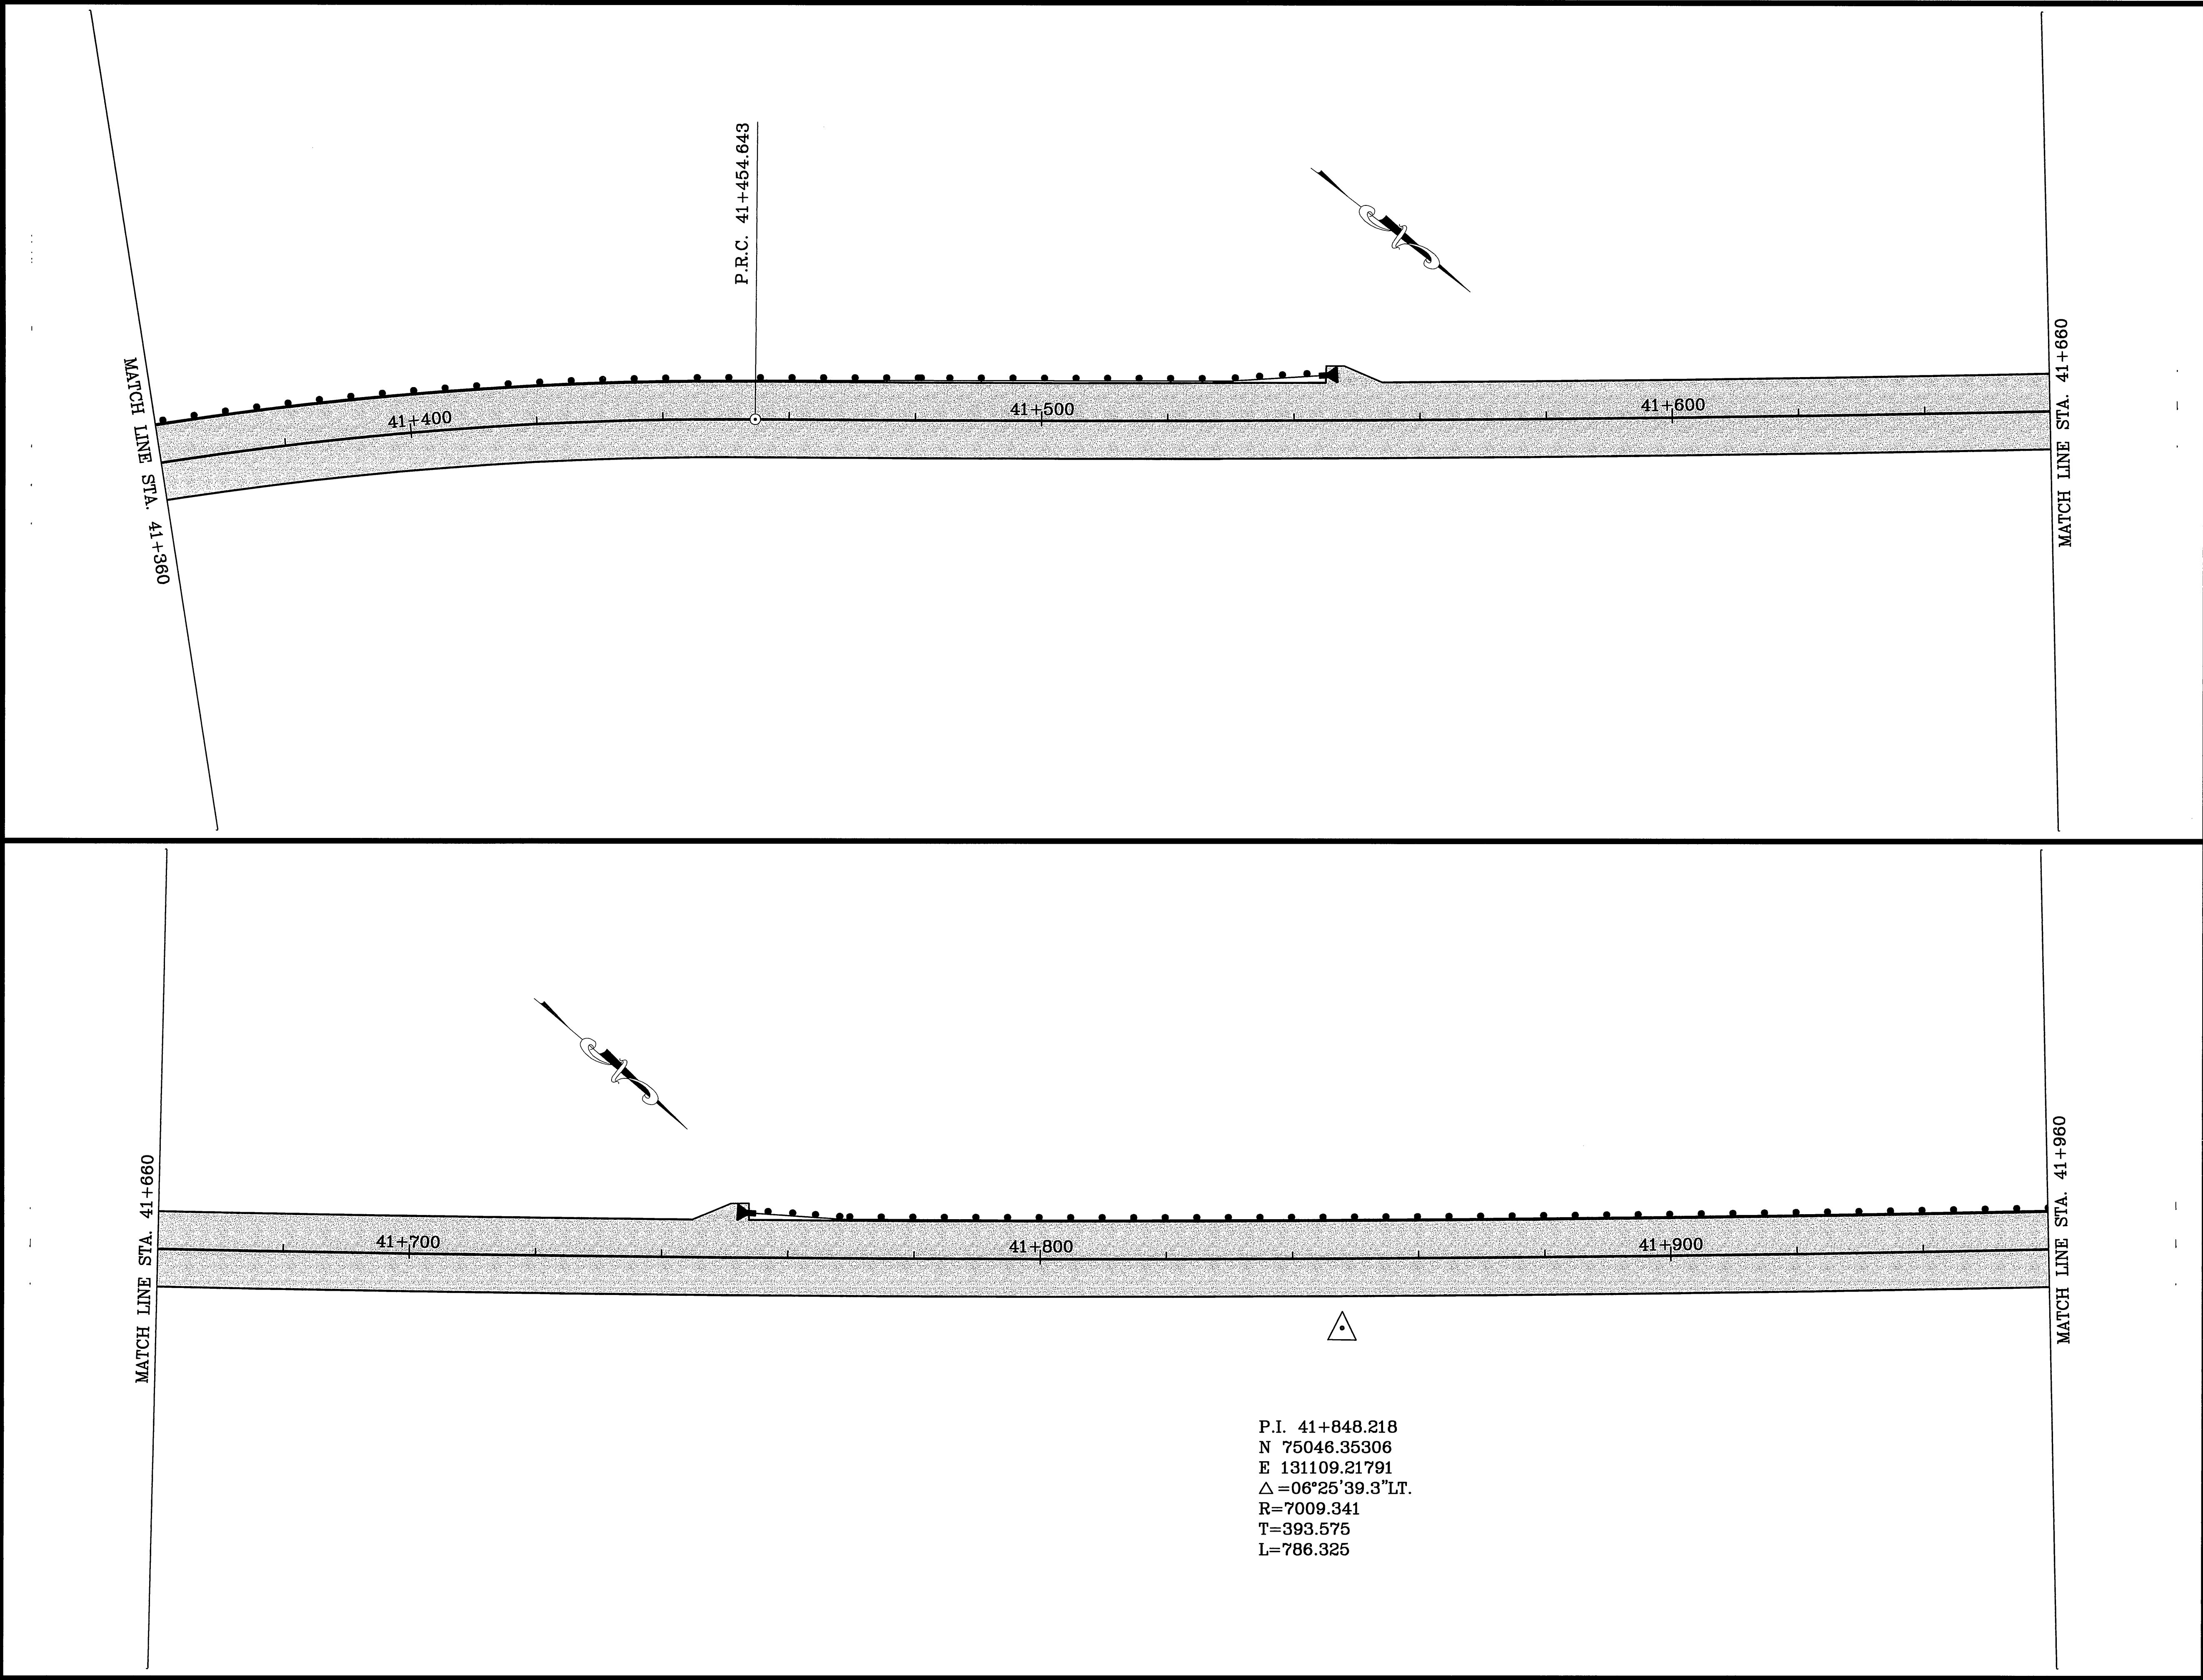

SHEET NO.	TOTAL SHEETS	
F02	F07	
STATE	YEAR	
ALASKA	2002	
PROJECT DESIGNATION		
NH-OA3-1(28)		
ADDENDUM NO.		
ATTACHMENT NO.		
REVISIONS		
NO.	DATE	DESCRIPTION

BIRD CREEK BRIDGE

45+500 45+200 44+900 44+500 44+000 43+500 43+000 42+500 42+000 41+500 41+000 40+500 40+000 39+500 39+000 38+500 38+000 37+500 37+100

BIRD POINT


TURNAGAIN ARM

SHEET F02

NOTE:
DIMENSIONS ARE IN METERS
UNLESS OTHERWISE NOTED.

STATE OF ALASKA
DEPARTMENT OF TRANSPORTATION
AND PUBLIC FACILITIES
SEWARD HIGHWAY
MP 96 TO MP 102
SAFETY, ROADWAY &
RECREATIONAL IMPROVEMENTS
OVERLAY
BIRD FLATS TO BIRD CREEK
PLAN SHEET

SPECIFICATIONS	AUTOCAD-KAREN-	DESIGNED BY	
SCALE 1"=1'	D:\SSK\PROJ\33577\DATA\INDB\REV7\OLCL.DWG 9-27-01 8:20:16 am EST	CHECKED BY	
COMPUTER DESIGNATION		DRAFTED BY	KMH

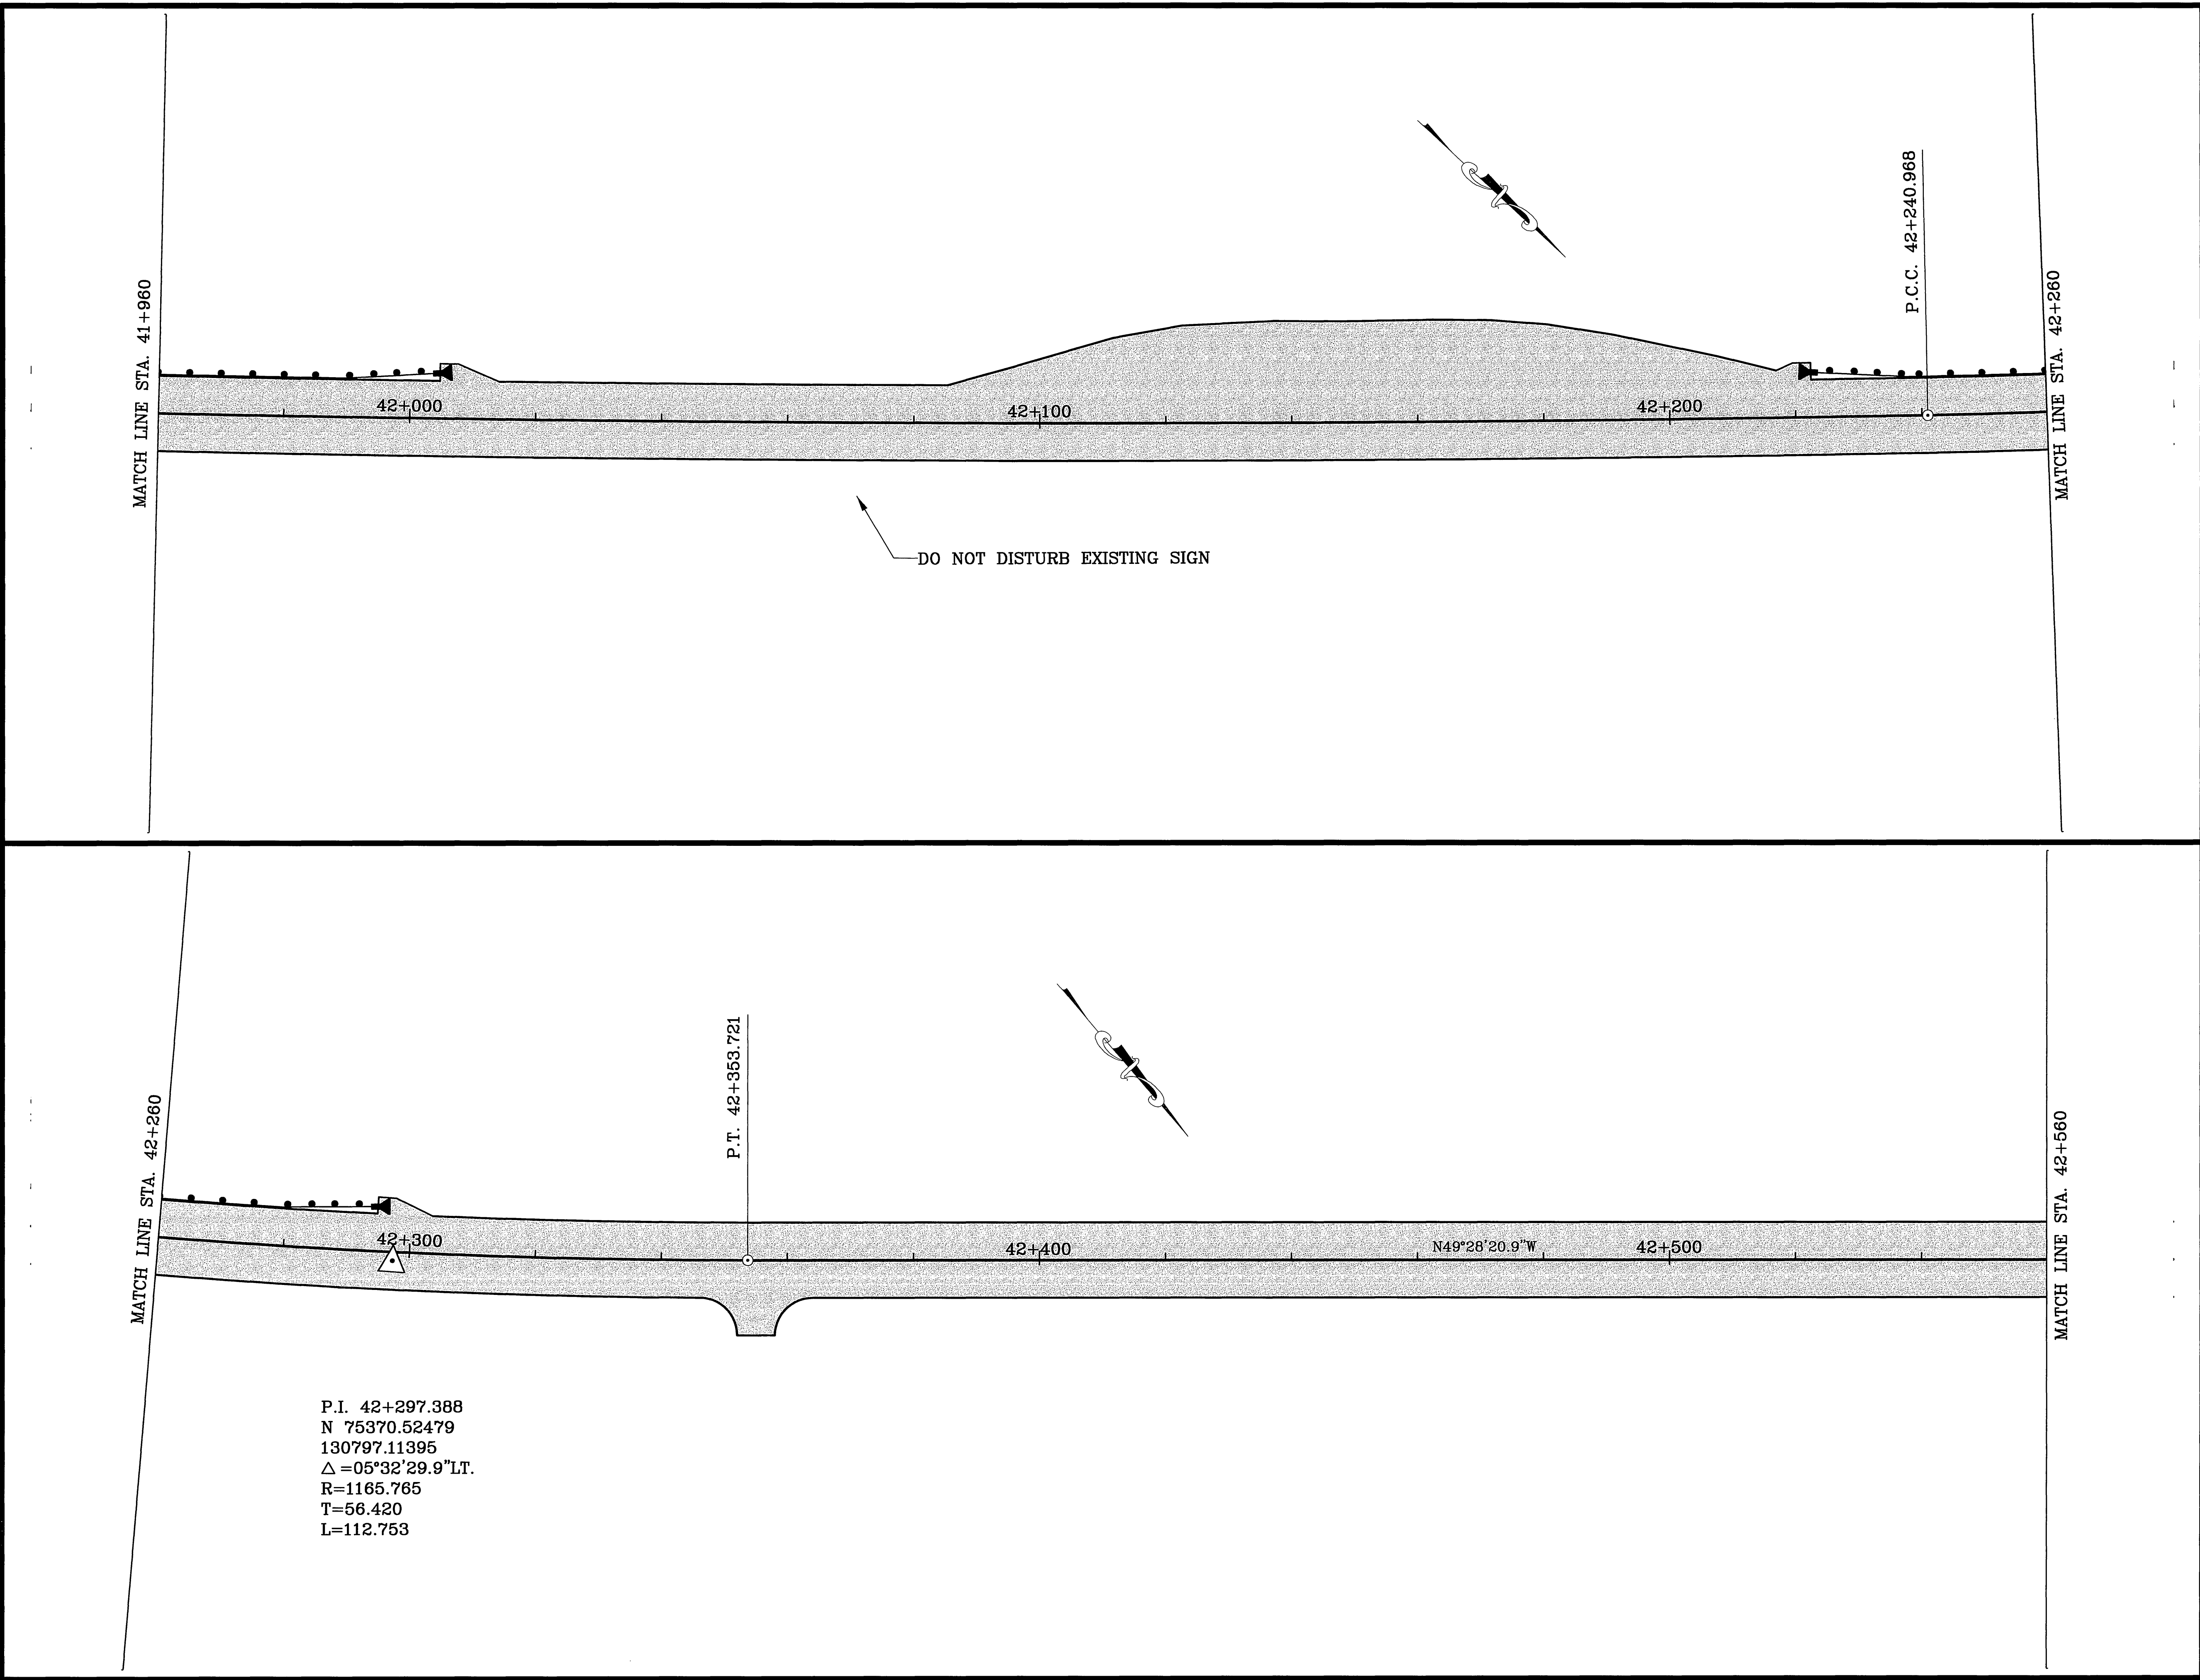


SHEET NO.		TOTAL SHEETS	
F03		F07	
STATE		YEAR	
ALASKA		2002	
PROJECT DESIGNATION			
NH-0A3-1(28)			
ADDENDUM NO.			
ATTACHMENT NO.			
REVISIONS			
NO.	DATE	DESCRIPTION	

NOTE:
DIMENSIONS ARE IN METERS
UNLESS OTHERWISE NOTED.

STATE OF ALASKA
DEPARTMENT OF TRANSPORTATION
AND PUBLIC FACILITIES
SEWARD HIGHWAY
MP 96 TO MP 102
**SAFETY, ROADWAY &
RECREATIONAL IMPROVEMENTS
OVERLAY**
BIRD FLATS TO BIRD CREEK
PLAN SHEET

SPECIFICATIONS	AUTOCAD-KAREN-	DESIGNED BY
SCALE 1"=1	D:\S056PROJ\5357\DATA\INDIBI\RD.776\CL.DWG	CHECKED BY
COMPUTER DESIGNATION	9-27-01	DRAFTED BY
	VIEW=	KME
	8:20:16 am EST	

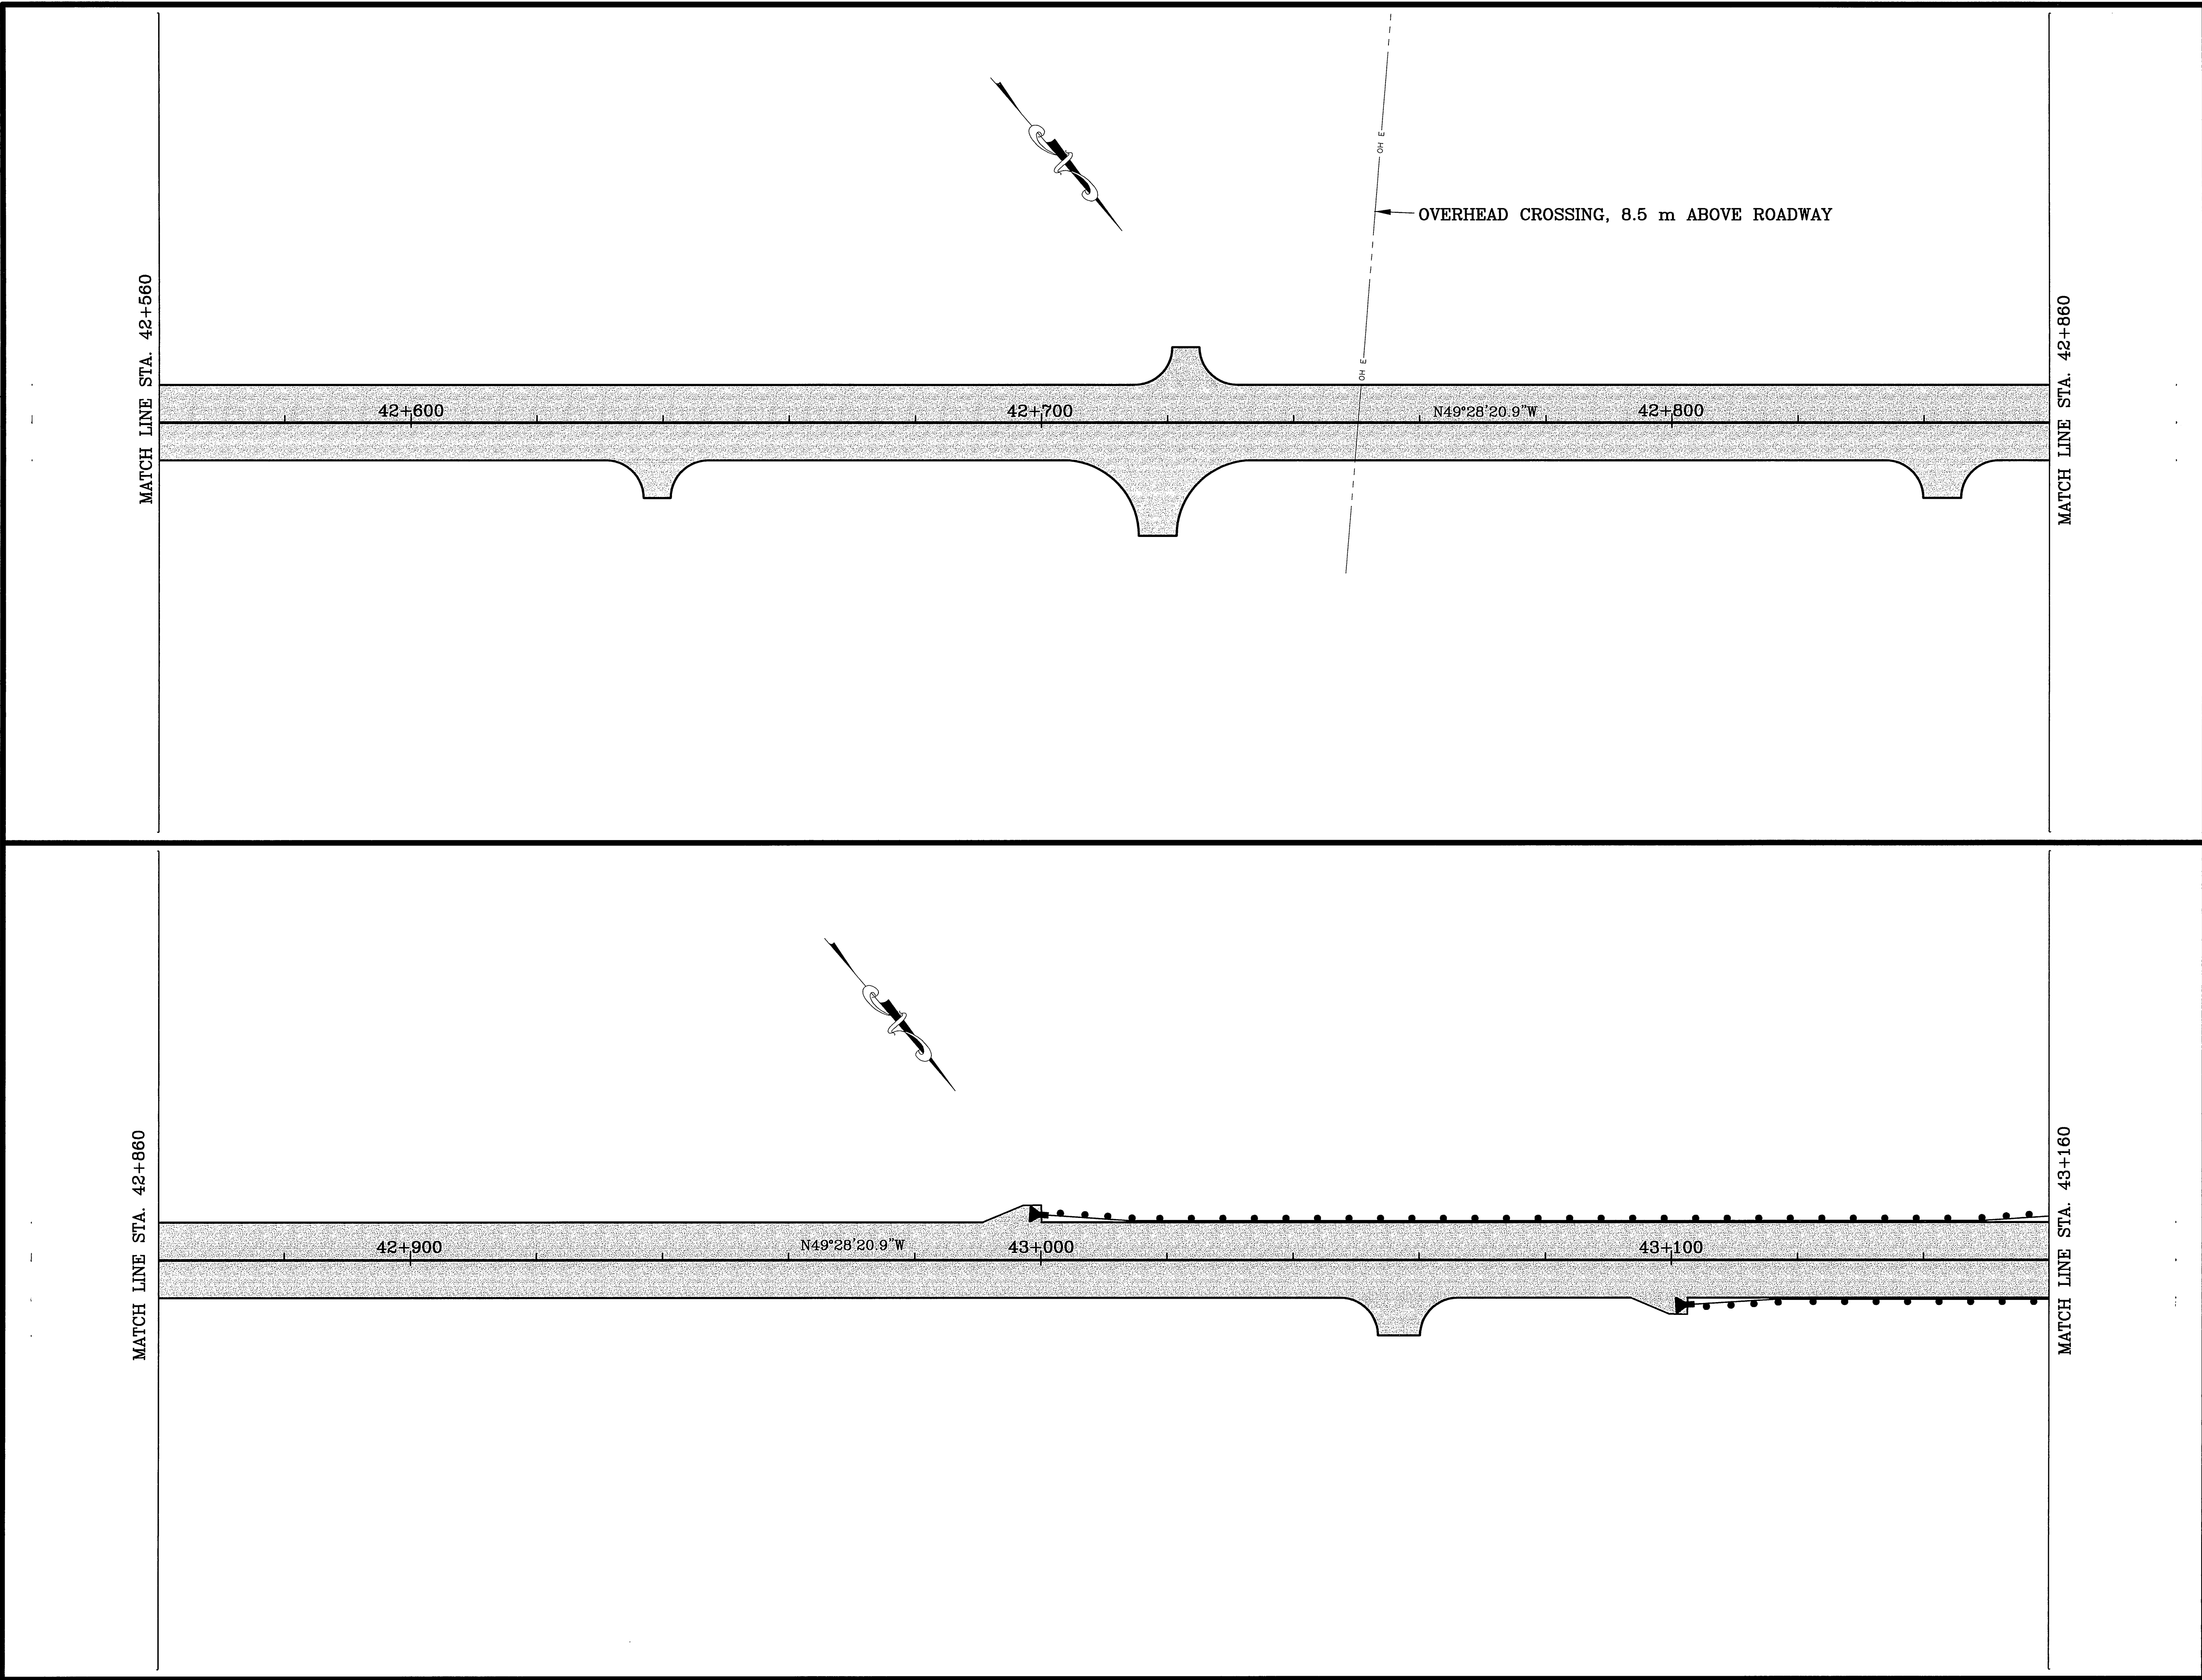

SHEET NO.	TOTAL SHEETS	
F04	F07	
STATE	YEAR	
ALASKA	2002	
PROJECT DESIGNATION		
NH-0A3-1(28)		
ADDENDUM NO.		
ATTACHMENT NO.		
REVISIONS		
NO.	DATE	DESCRIPTION

BIRD CREEK BRIDGE

SHEET F04

45+500 45+200 44+900 44+500 44+000 43+500 43+000 42+500 42+000 41+500 41+000 40+500 40+000 39+500 39+000 38+500 38+000 37+500 37+100


BIRD POINT

TURNAGAIN ARM

NOTE:
DIMENSIONS ARE IN METERS
UNLESS OTHERWISE NOTED.

STATE OF ALASKA
DEPARTMENT OF TRANSPORTATION
AND PUBLIC FACILITIES
SEWARD HIGHWAY
MP 96 TO MP 102
**SAFETY, ROADWAY &
RECREATIONAL IMPROVEMENTS
OVERLAY**
BIRD FLATS TO BIRD CREEK
PLAN SHEET

SPECIFICATIONS	AUTOCAD-KAREN-	VIEW=
SCALE: 1"=1'	D:\S05K\PROJ\35577\DATA\1\IND\B1\RD\770\CL1.DWG 9-27-01 8:20:16 am EST	
COMPUTER DESIGNATION		
	DESIGNED BY	
	CHECKED BY	
	DRAFTED BY	RMH

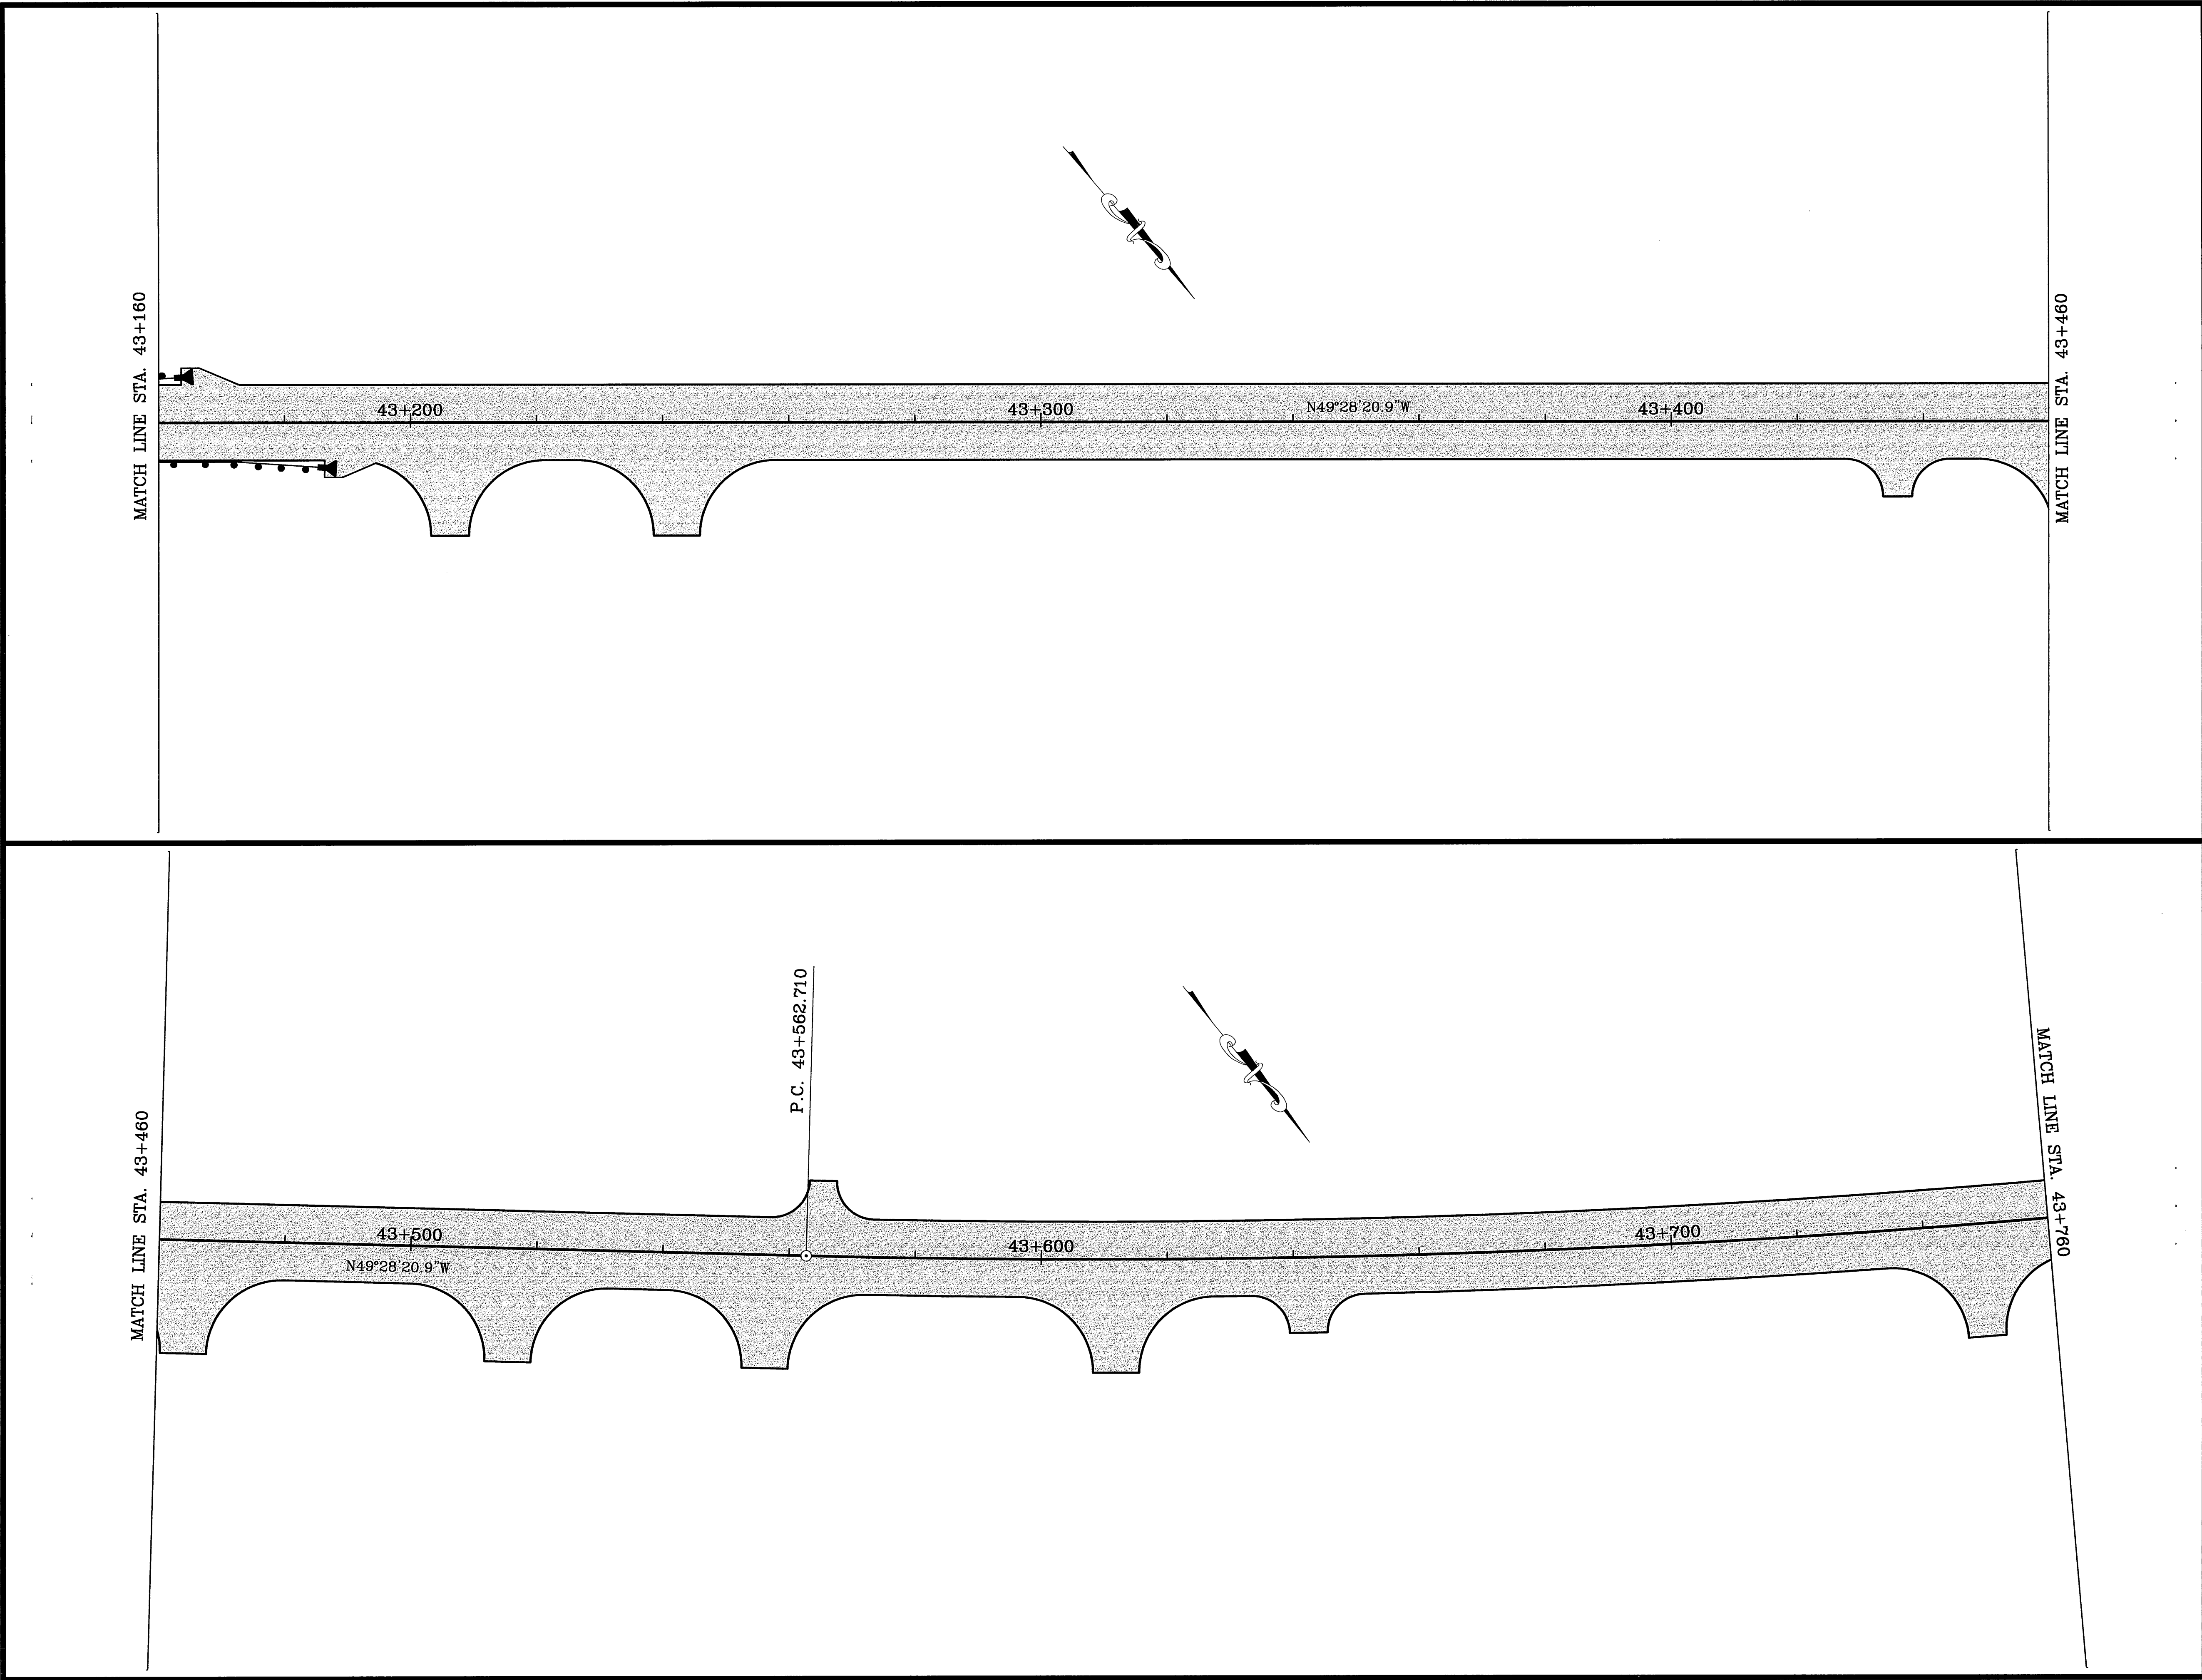


SHEET NO.	TOTAL SHEETS	
F05	F07	
STATE	YEAR	
ALASKA	2002	
PROJECT DESIGNATION		
NH-OA3-1(28)		
ADDENDUM NO.		
ATTACHMENT NO.		
REVISIONS		
NO.	DATE	DESCRIPTION

NOTE:
DIMENSIONS ARE IN METERS
UNLESS OTHERWISE NOTED.

STATE OF ALASKA
DEPARTMENT OF TRANSPORTATION
AND PUBLIC FACILITIES
SEWARD HIGHWAY
MP 96 TO MP 102
SAFETY, ROADWAY &
RECREATIONAL IMPROVEMENTS
OVERLAY
BIRD FLATS TO BIRD CREEK
PLAN SHEET

SPECIFICATIONS	DESIGNED BY	KMH
SCALE 1"=1'	CHECKED BY	
COMPUTER DESIGNATION	DRAFTED BY	
AUTOCAD-KAREN-	VIEW#	
D:\SDSKPROJ\33577\DATA\INDB\REV7\CL.DWG	9-27-01	8:20:16 am EST

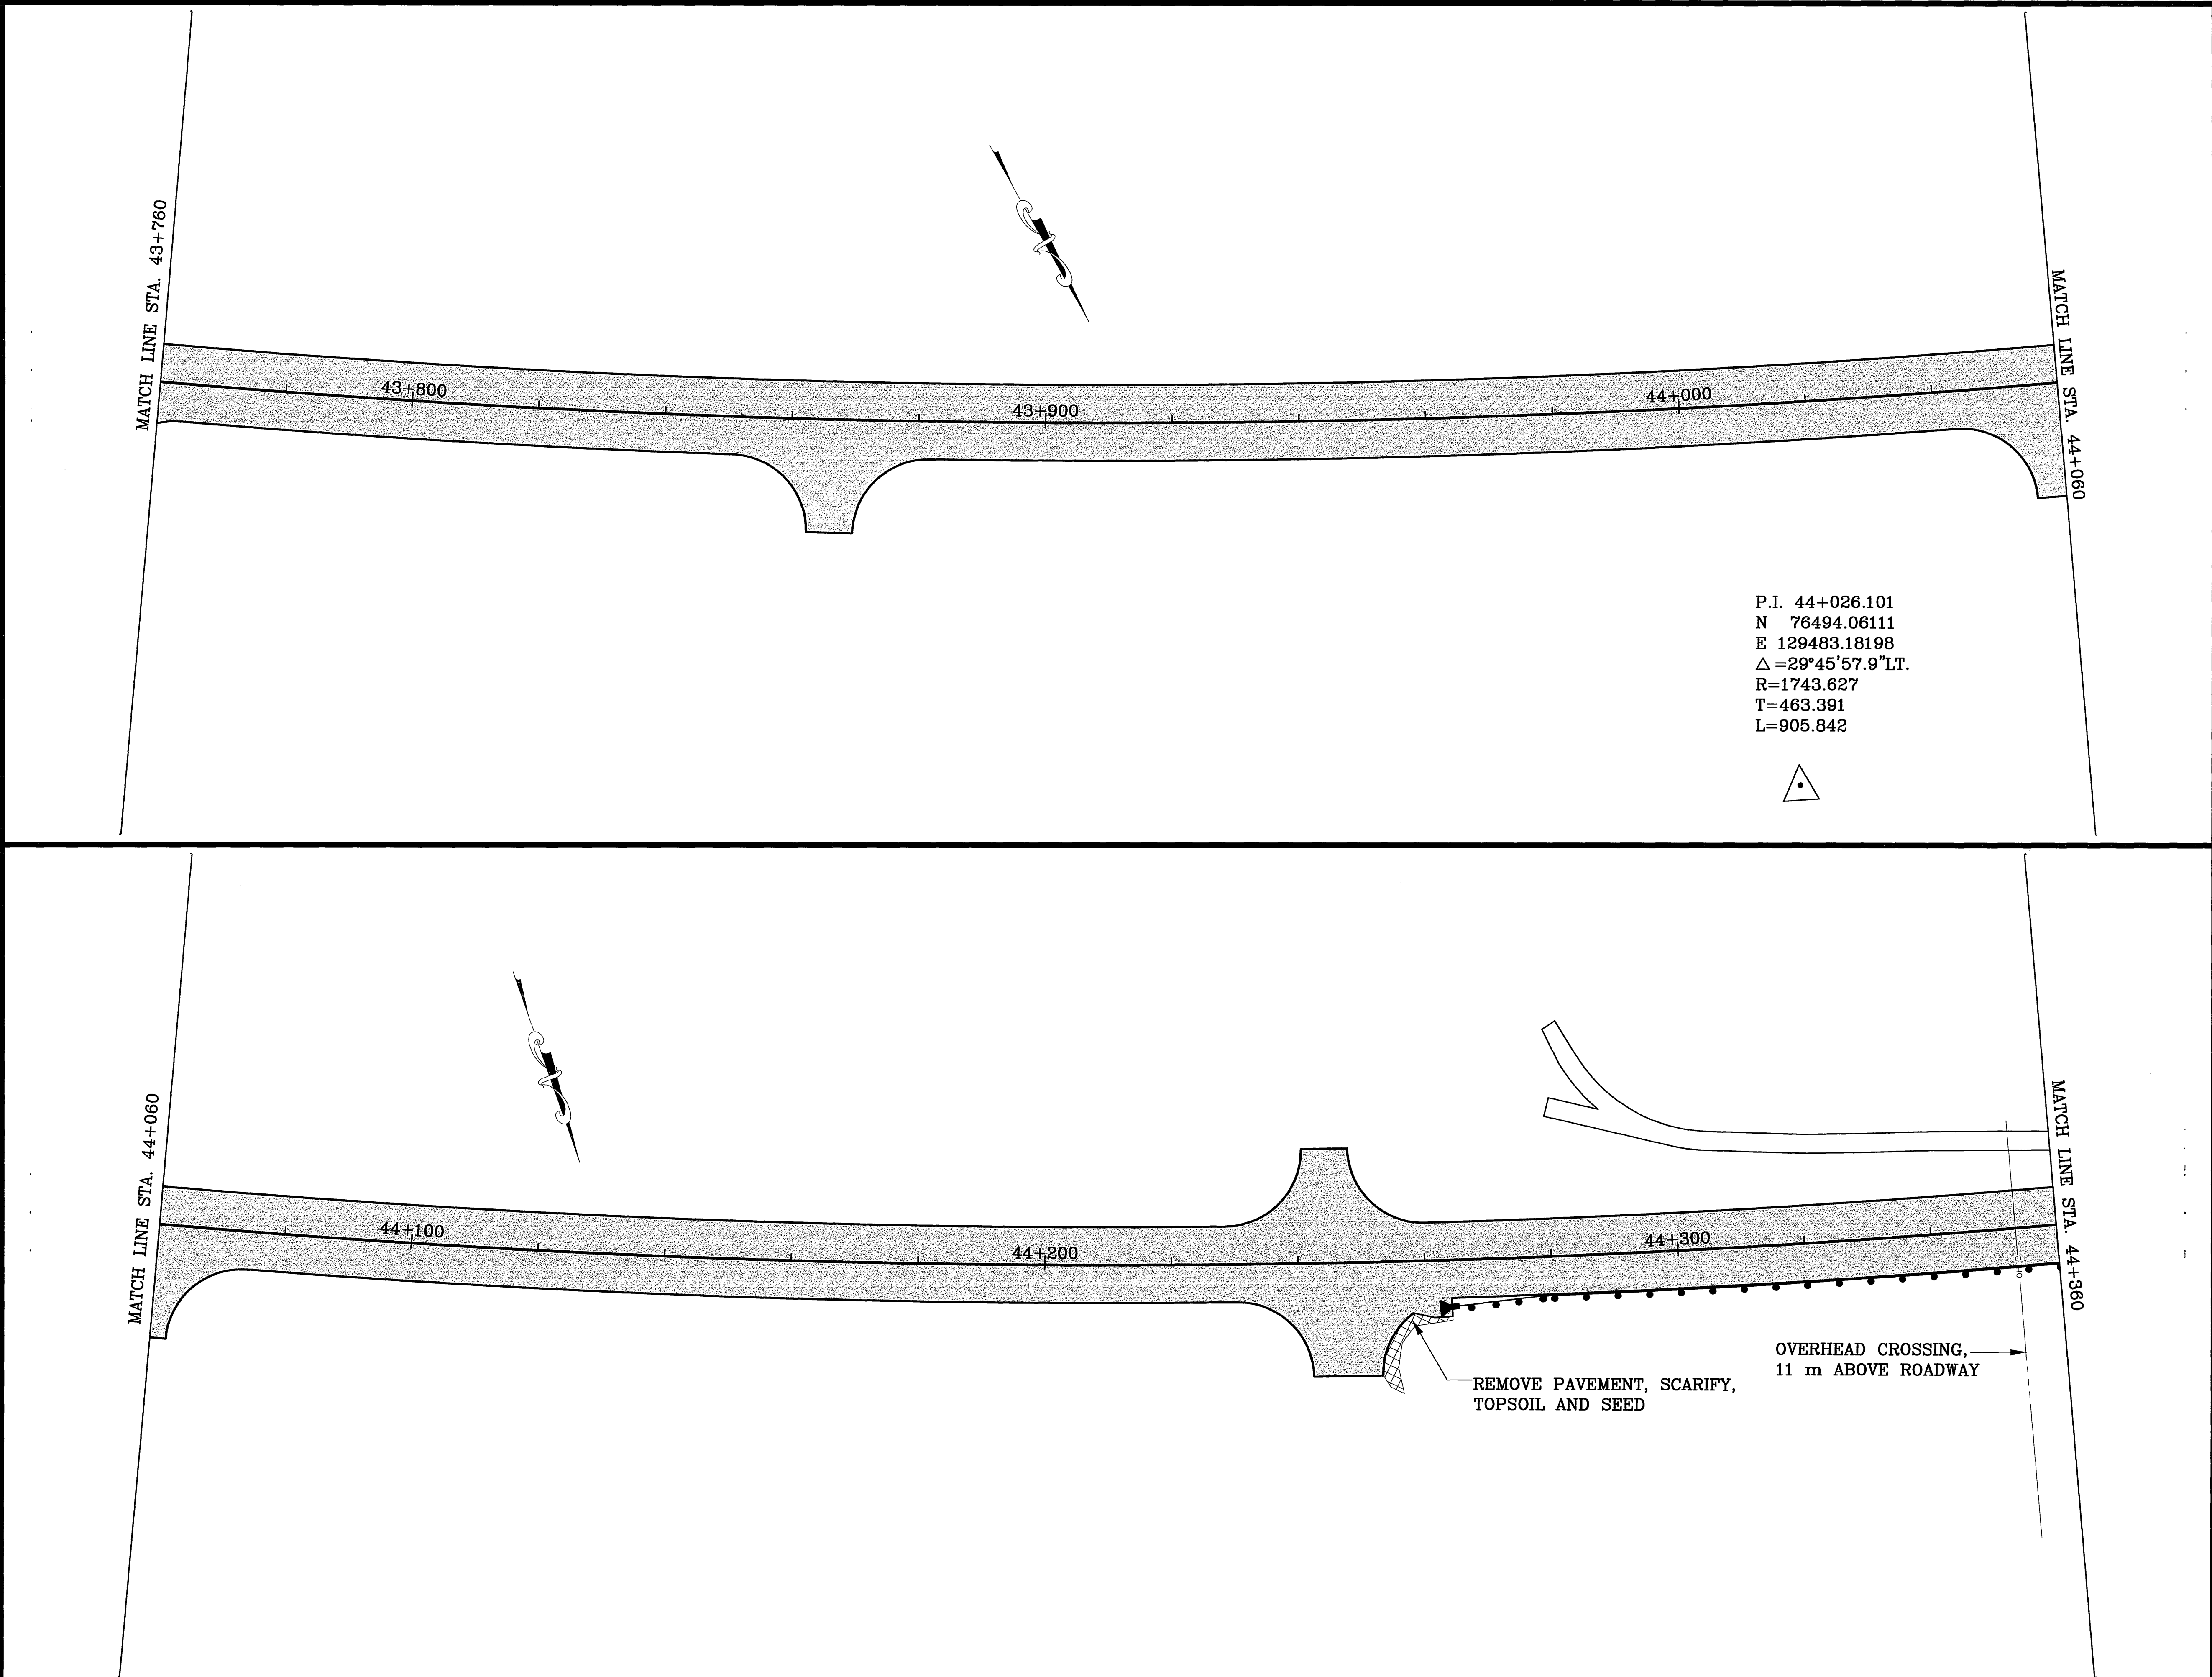


SHEET NO.	TOTAL SHEETS	
F06	F07	
STATE	YEAR	
ALASKA	2002	
PROJECT DESIGNATION		
NH-OA3-1(28)		
ADDENDUM NO.		
ATTACHMENT NO.		
REVISIONS		
NO.	DATE	DESCRIPTION

NOTE:
DIMENSIONS ARE IN METERS
UNLESS OTHERWISE NOTED.


STATE OF ALASKA
49th
JUDY J. BOUGHEN
CE 8823
REGISTERED PROFESSIONAL ENGINEER

STATE OF ALASKA
DEPARTMENT OF TRANSPORTATION
AND PUBLIC FACILITIES
SEWARD HIGHWAY
MP 96 TO MP 102
**SAFETY, ROADWAY &
RECREATIONAL IMPROVEMENTS**
OVERLAY
BIRD FLATS TO BIRD CREEK
PLAN SHEET

SPECIFICATIONS	AUTOCAD-KAREN-		V/EW=	DESIGNED BY
	SCALE 1"=1'			
COMPUTER DESIGNATION	D:\S95\PROJ\5357\DATA\INDMB\RD\79\LCL.DWG		8-27-01 8:20:16 am EST	DRAFTED BY

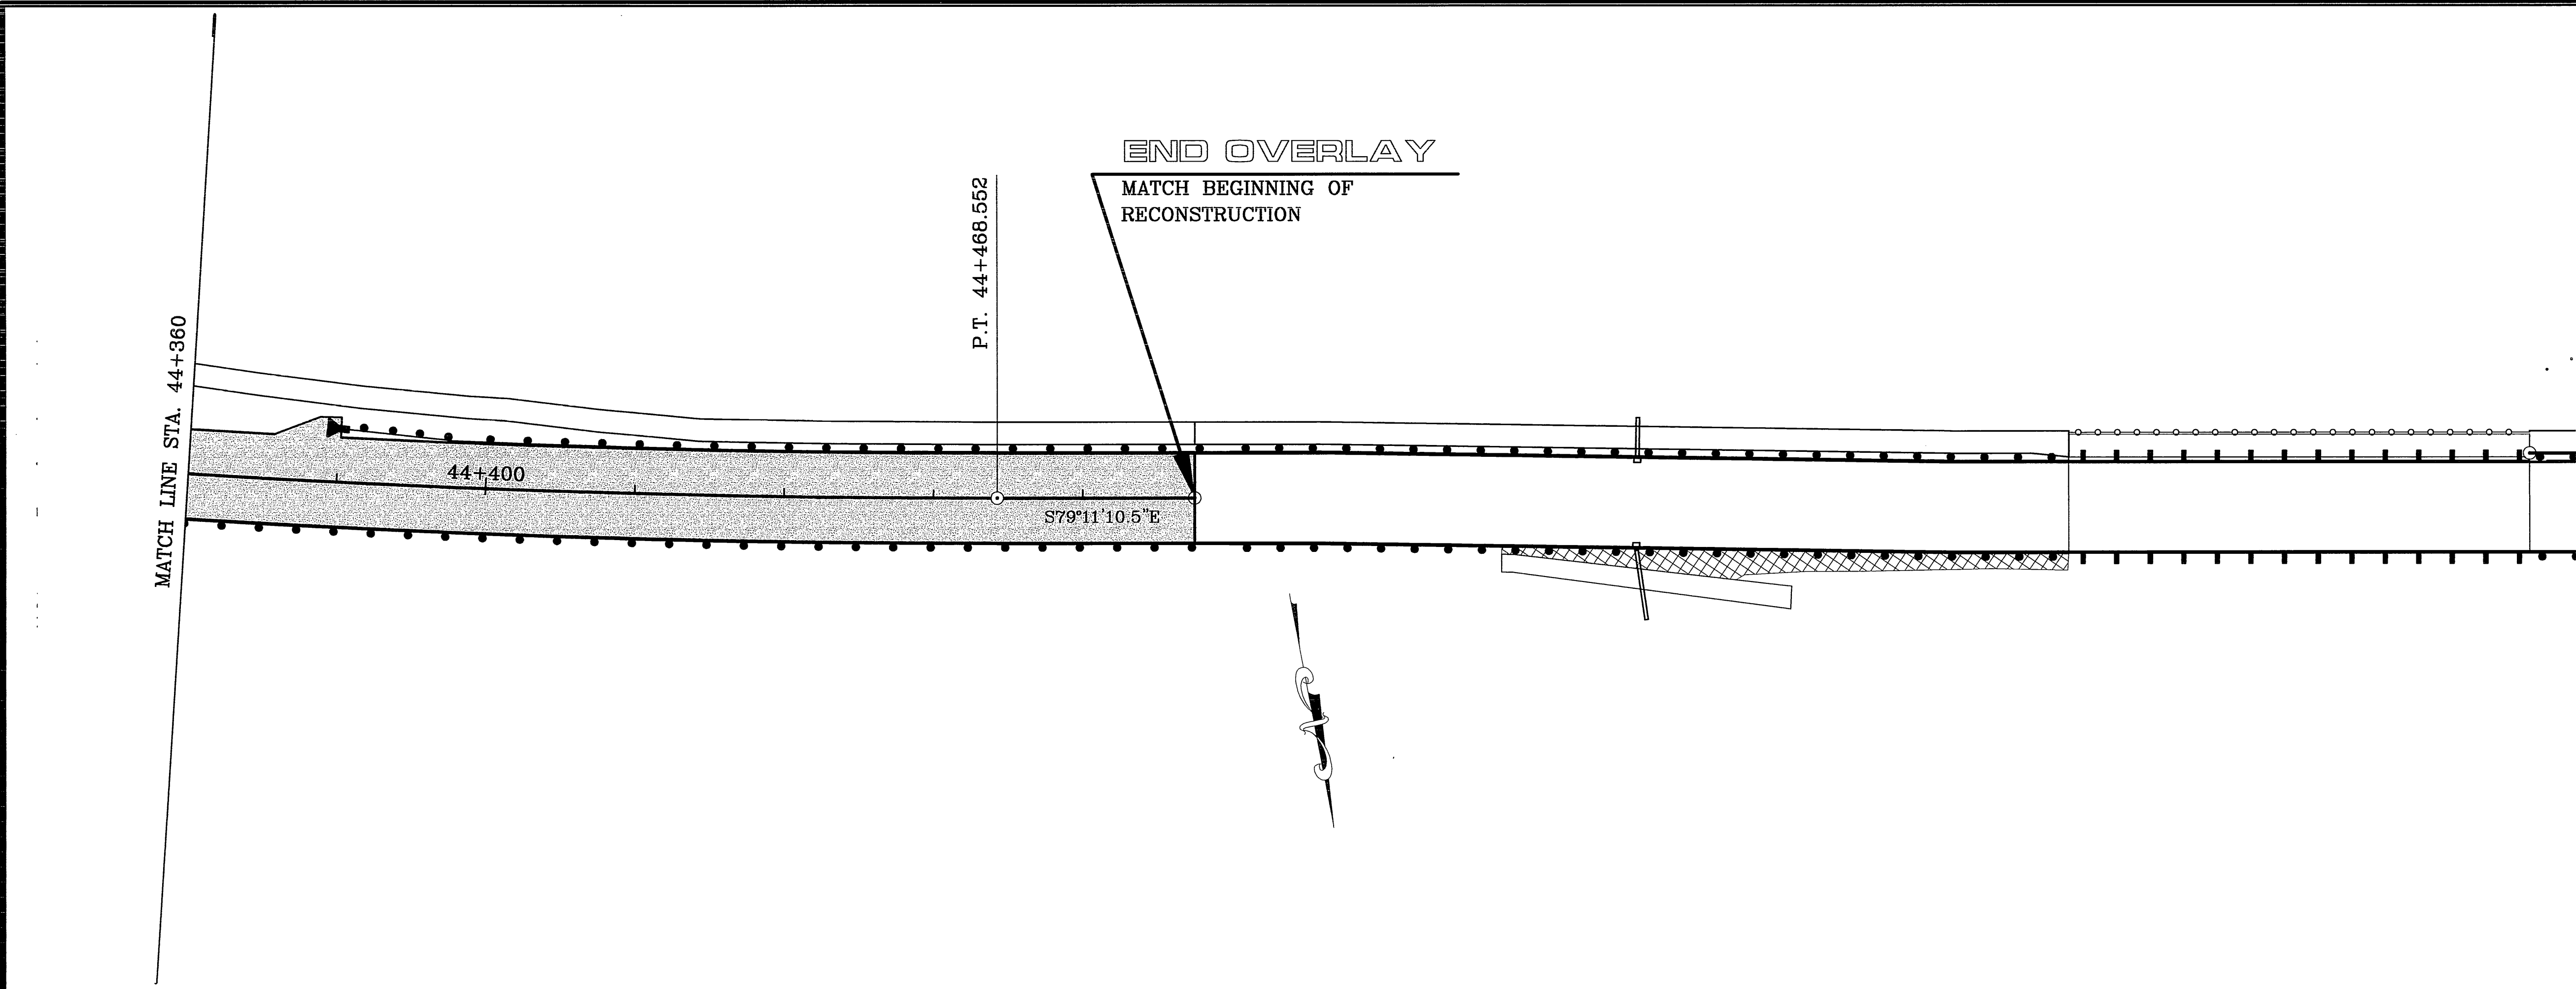

SHEET NO.		TOTAL SHEETS
F07		F07
STATE		YEAR
ALASKA		2002
PROJECT DESIGNATION		
NH-0A3-1(28)		
ADDENDUM NO.		
ATTACHMENT NO.		
REVISIONS		
NO.	DATE	DESCRIPTION

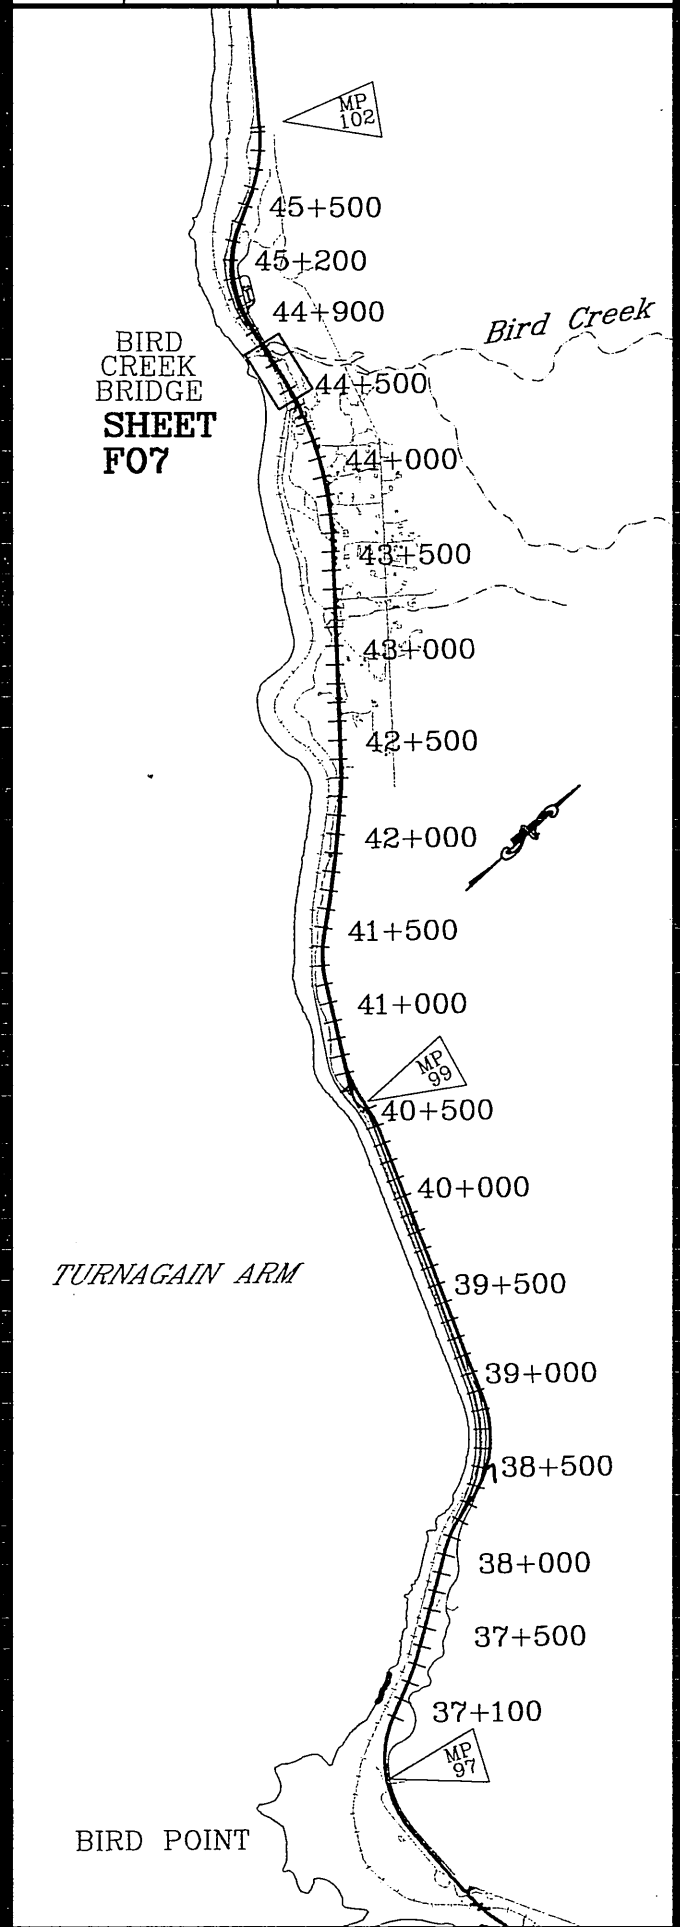

NOTE:
DIMENSIONS ARE IN METERS
UNLESS OTHERWISE NOTED.

STATE OF ALASKA

49TH



JUDY J. DOUGHERTY

CE 8823

REGISTERED PROFESSIONAL ENGINEER

STATE OF ALASKA
DEPARTMENT OF TRANSPORTATION
AND PUBLIC FACILITIES
SEWARD HIGHWAY
MP 96 TO MP 102
SAFETY, ROADWAY &
RECREATIONAL IMPROVEMENTS
OVERLAY
BIRD FLATS TO BIRD CREEK
PLAN SHEET

SHEET NO. TOTAL SHEETS
FCR1 FCR4
STATE YEAR
ALASKA 2002
PROJECT DESIGNATION
NH-0A3-1(28)
ADDENDUM NO.
ATTACHMENT NO.
REVISIONS
NO. DATE DESCRIPTION
DESIGNED BY
CHECKED BY
DRAFTED BY
VIEW= 10:23:14 am EST
SPECIFICATIONS
SCALE 1"=1'
COMPUTER DESIGNATION
AUTOCAD-KAREN-
D:\305KPR0A\3377\DATA\IN06\RD\78\BPP.DWG 9-20-01

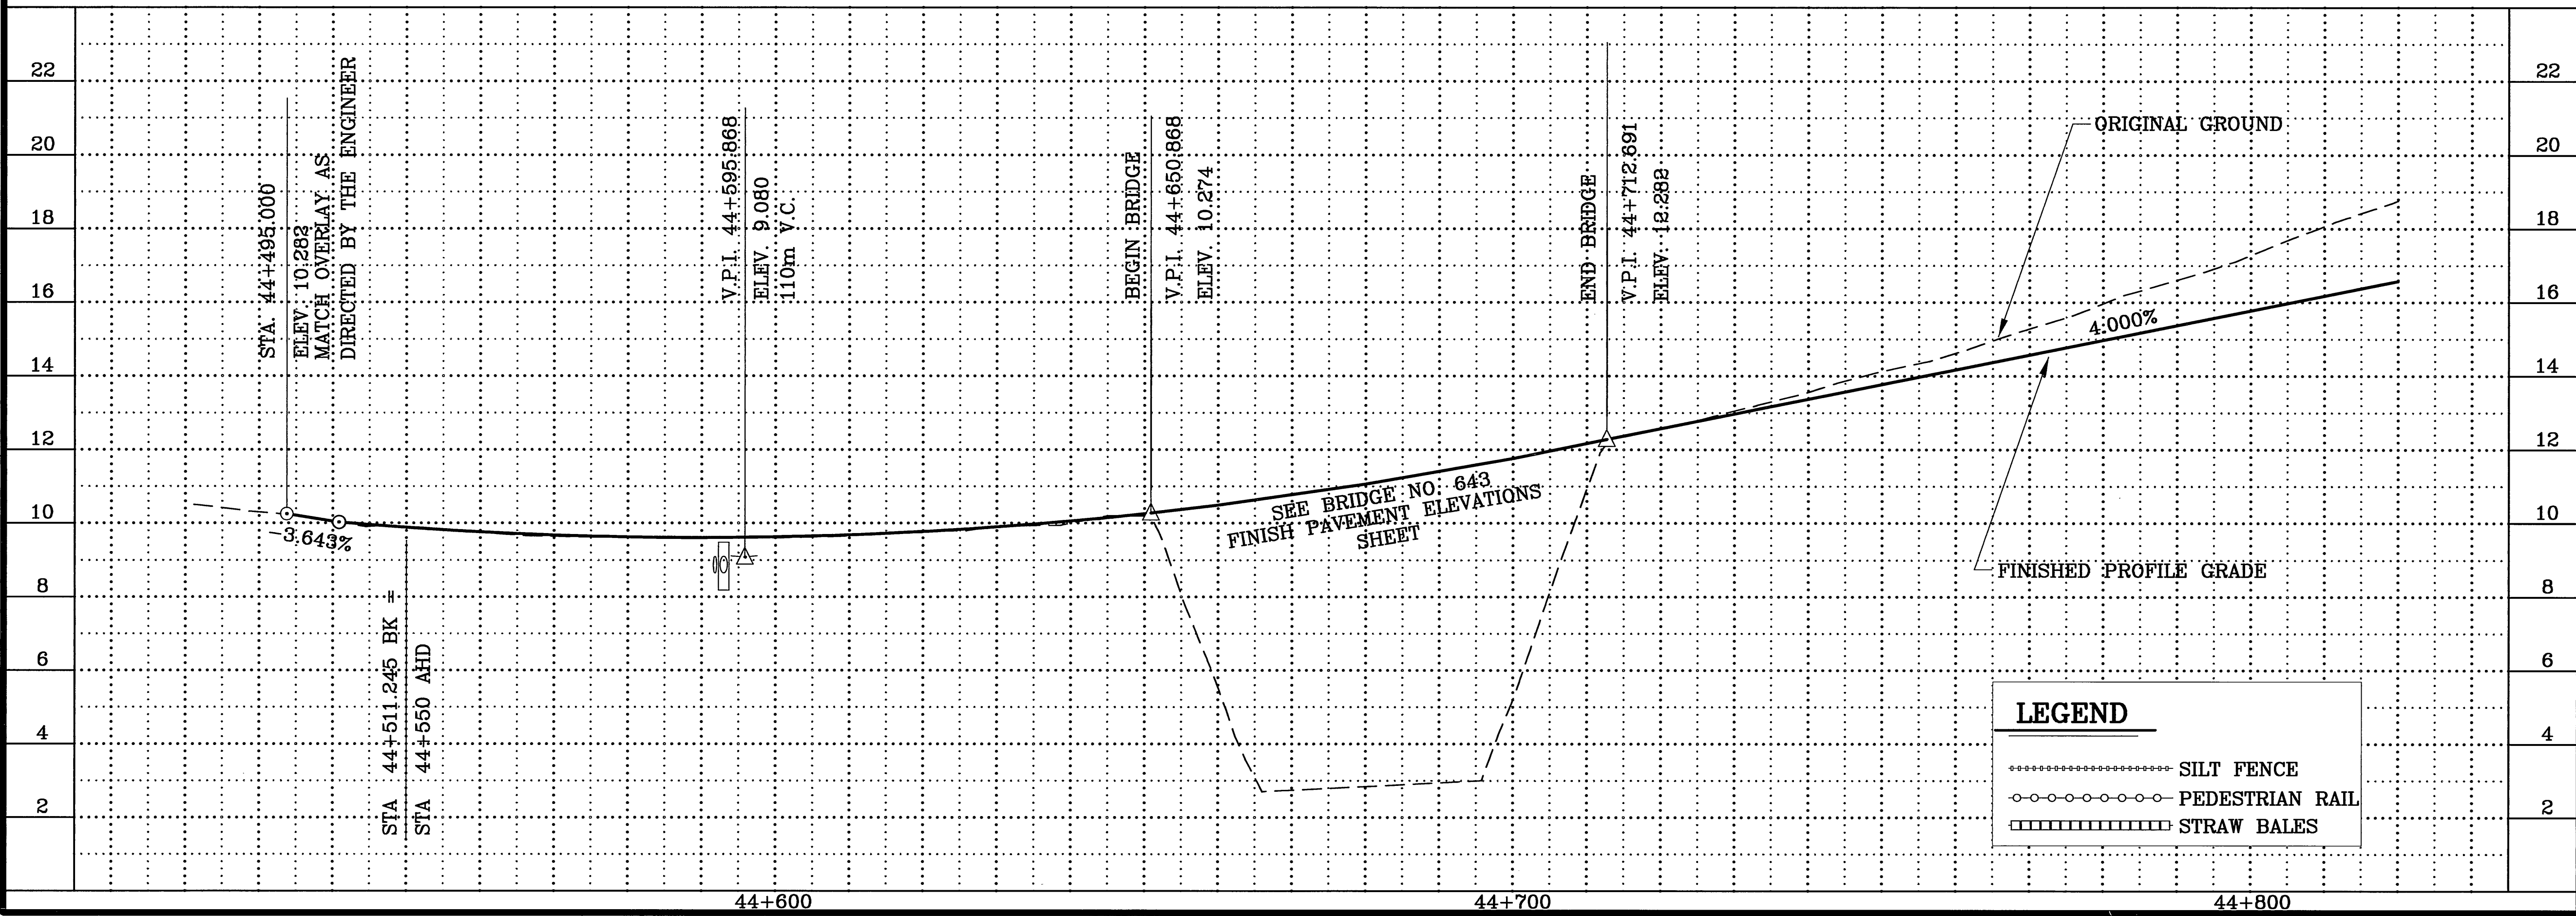
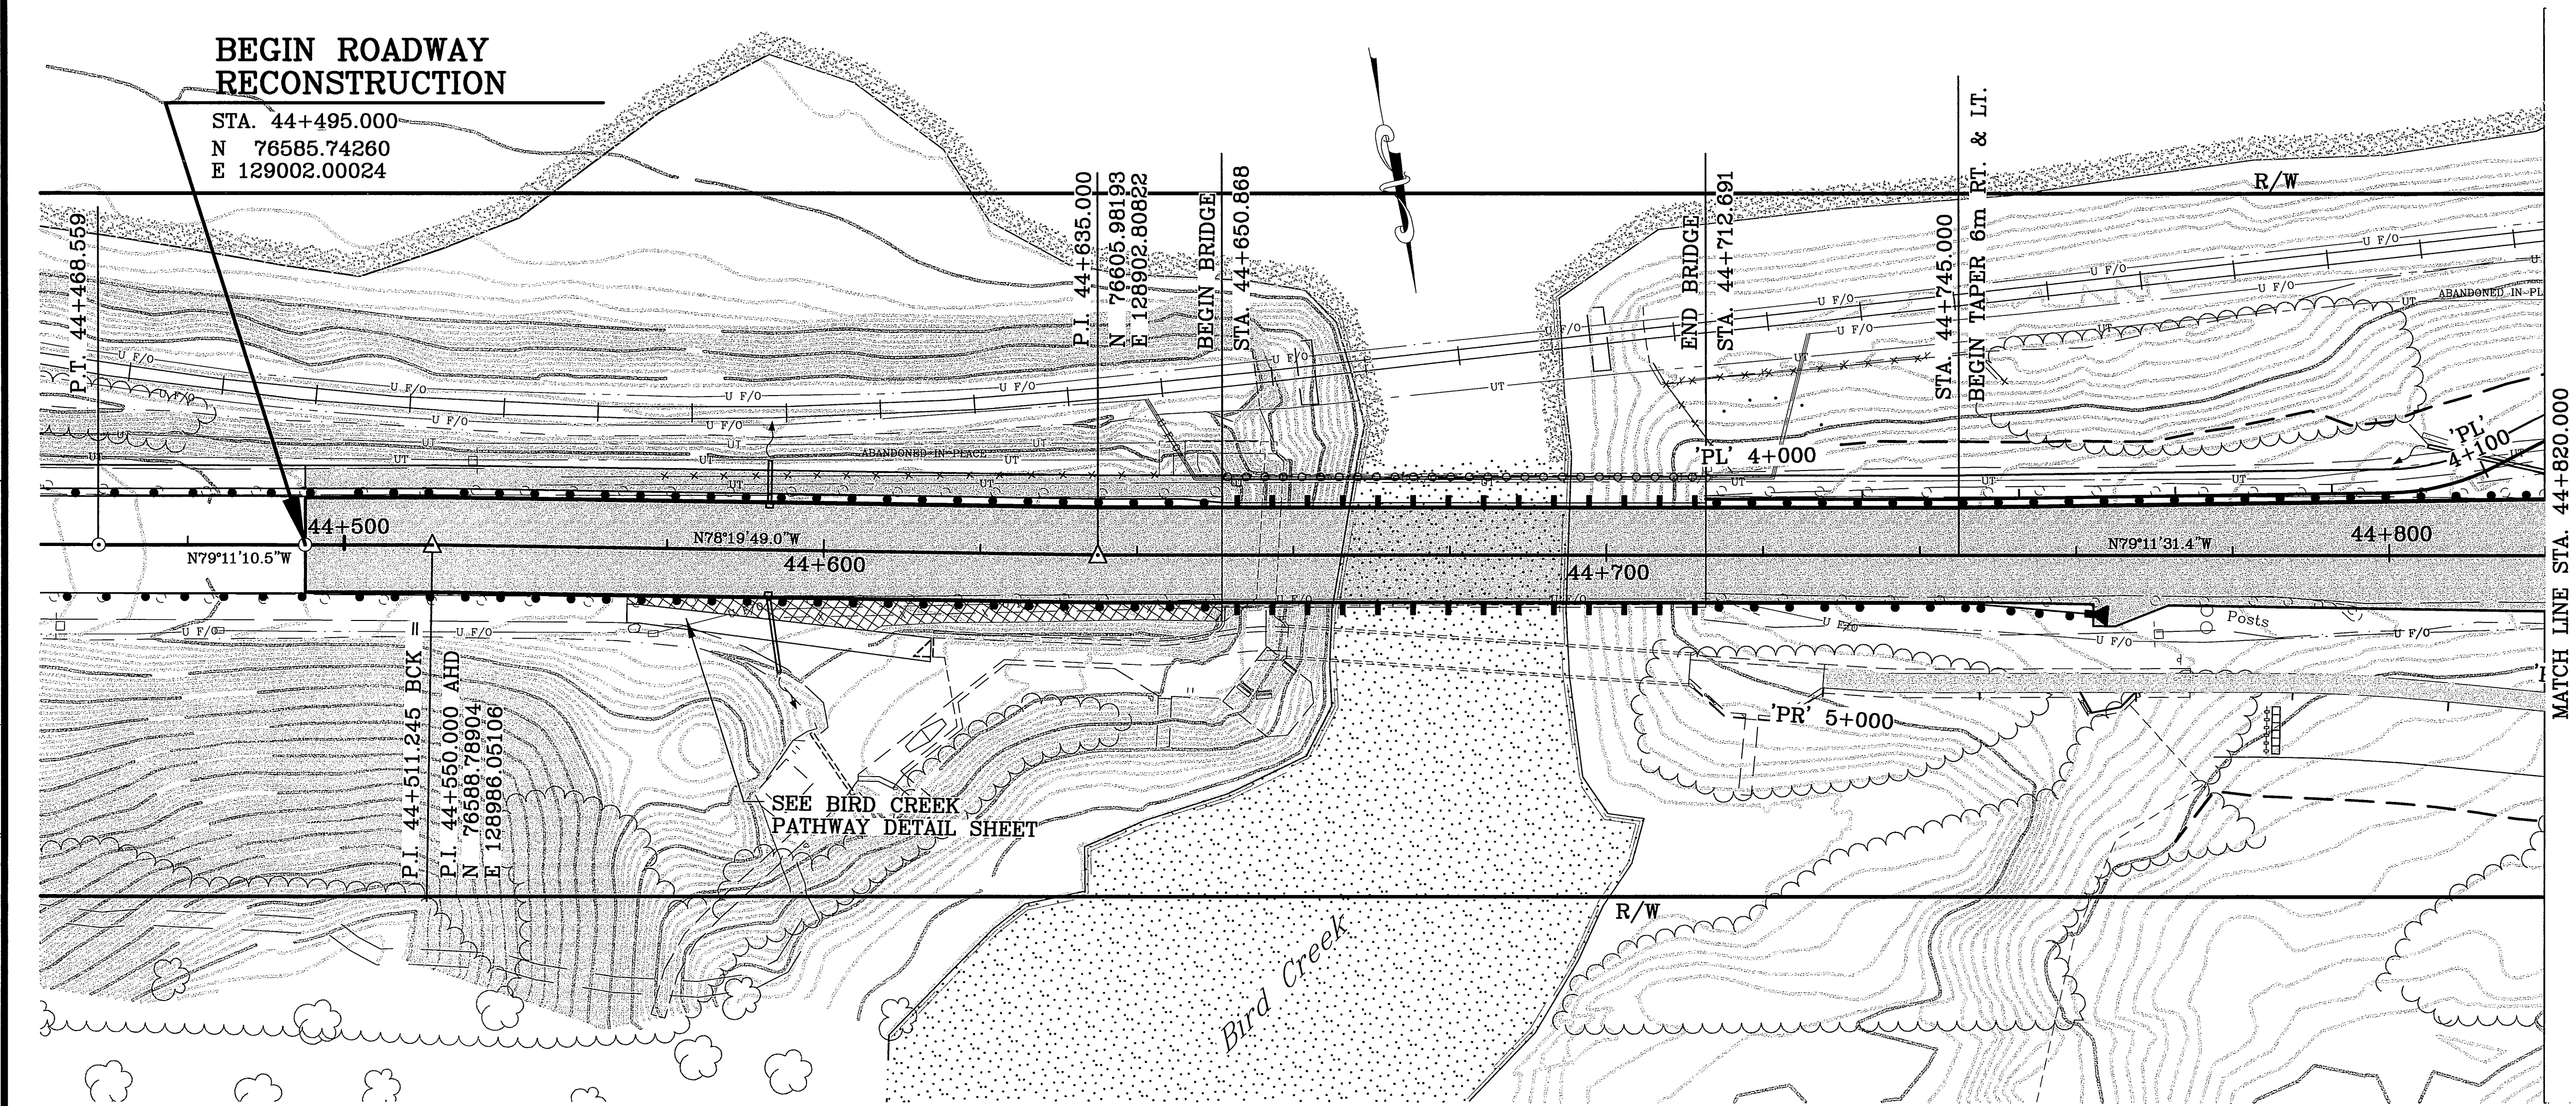


SHEET FCR 1
BIRD CREEK BRIDGE
45+500
45+200
44+900
44+500
44+000
43+500
37+100
TURNAGAIN ARM
BIRD POINT

NOTE:
DIMENSIONS ARE IN METERS
UNLESS OTHERWISE NOTED.

STATE OF ALASKA
JUDY J. DOUGHERTY
CE 6623
REGISTERED PROFESSIONAL ENGINEER
STATE OF ALASKA
DEPARTMENT OF TRANSPORTATION
AND PUBLIC FACILITIES
SEWARD HIGHWAY
MP 96 TO MP 102
SAFETY, ROADWAY &
RECREATIONAL IMPROVEMENTS
BIRD CREEK AREA
HIGHWAY
PLAN AND PROFILE

SPECIFICATIONS	DESIGNED BY	
SCALE 1"=1'	CHECKED BY	
COMPUTER DESIGNATION	DRAFTED BY	KMH
AUTOCAD-KAREN- D:\SDSKPROJ\53577\DATA\1\NONBIRD\77B1RDPP.DWG 9-20-01 10:23:14 am EST		
VIEW=		

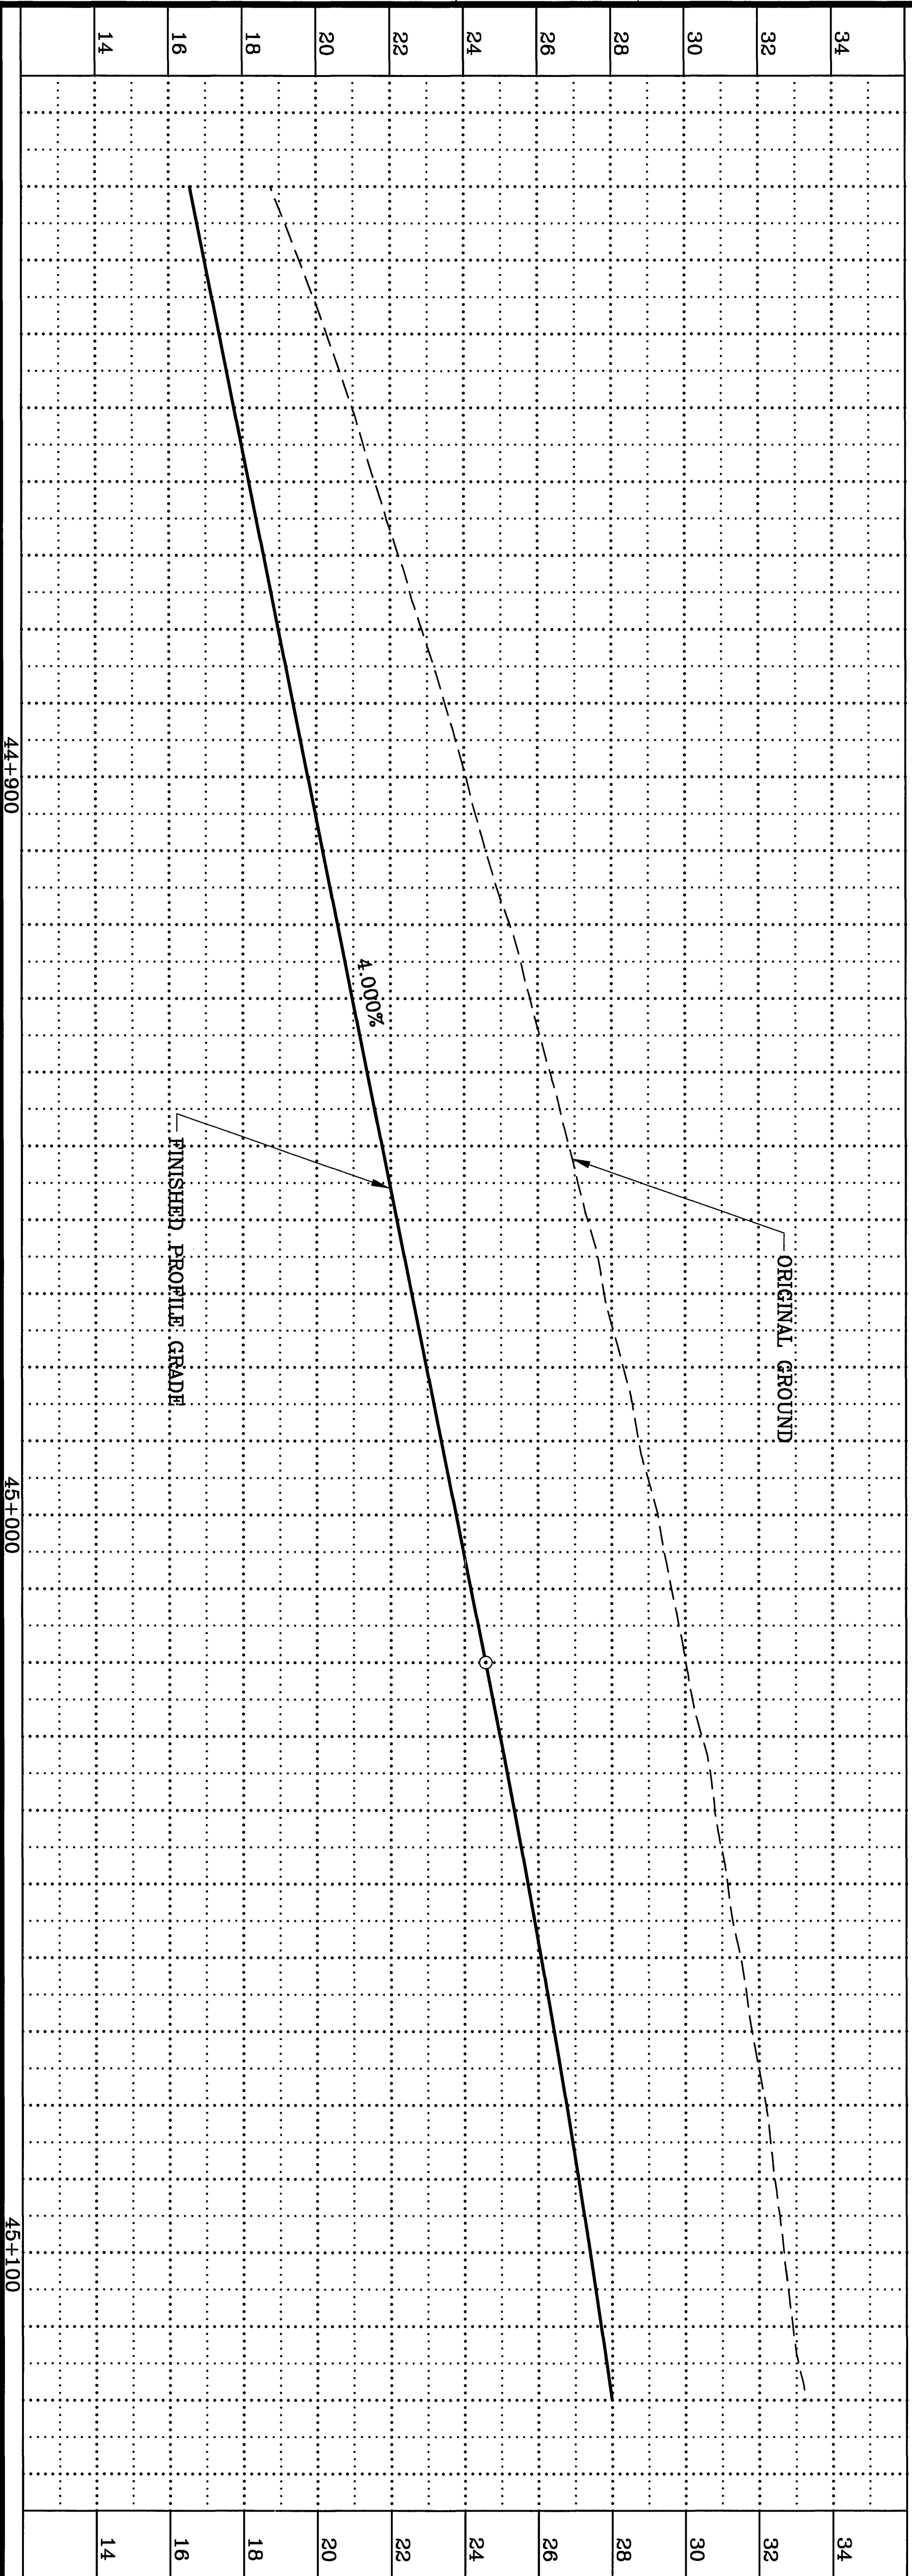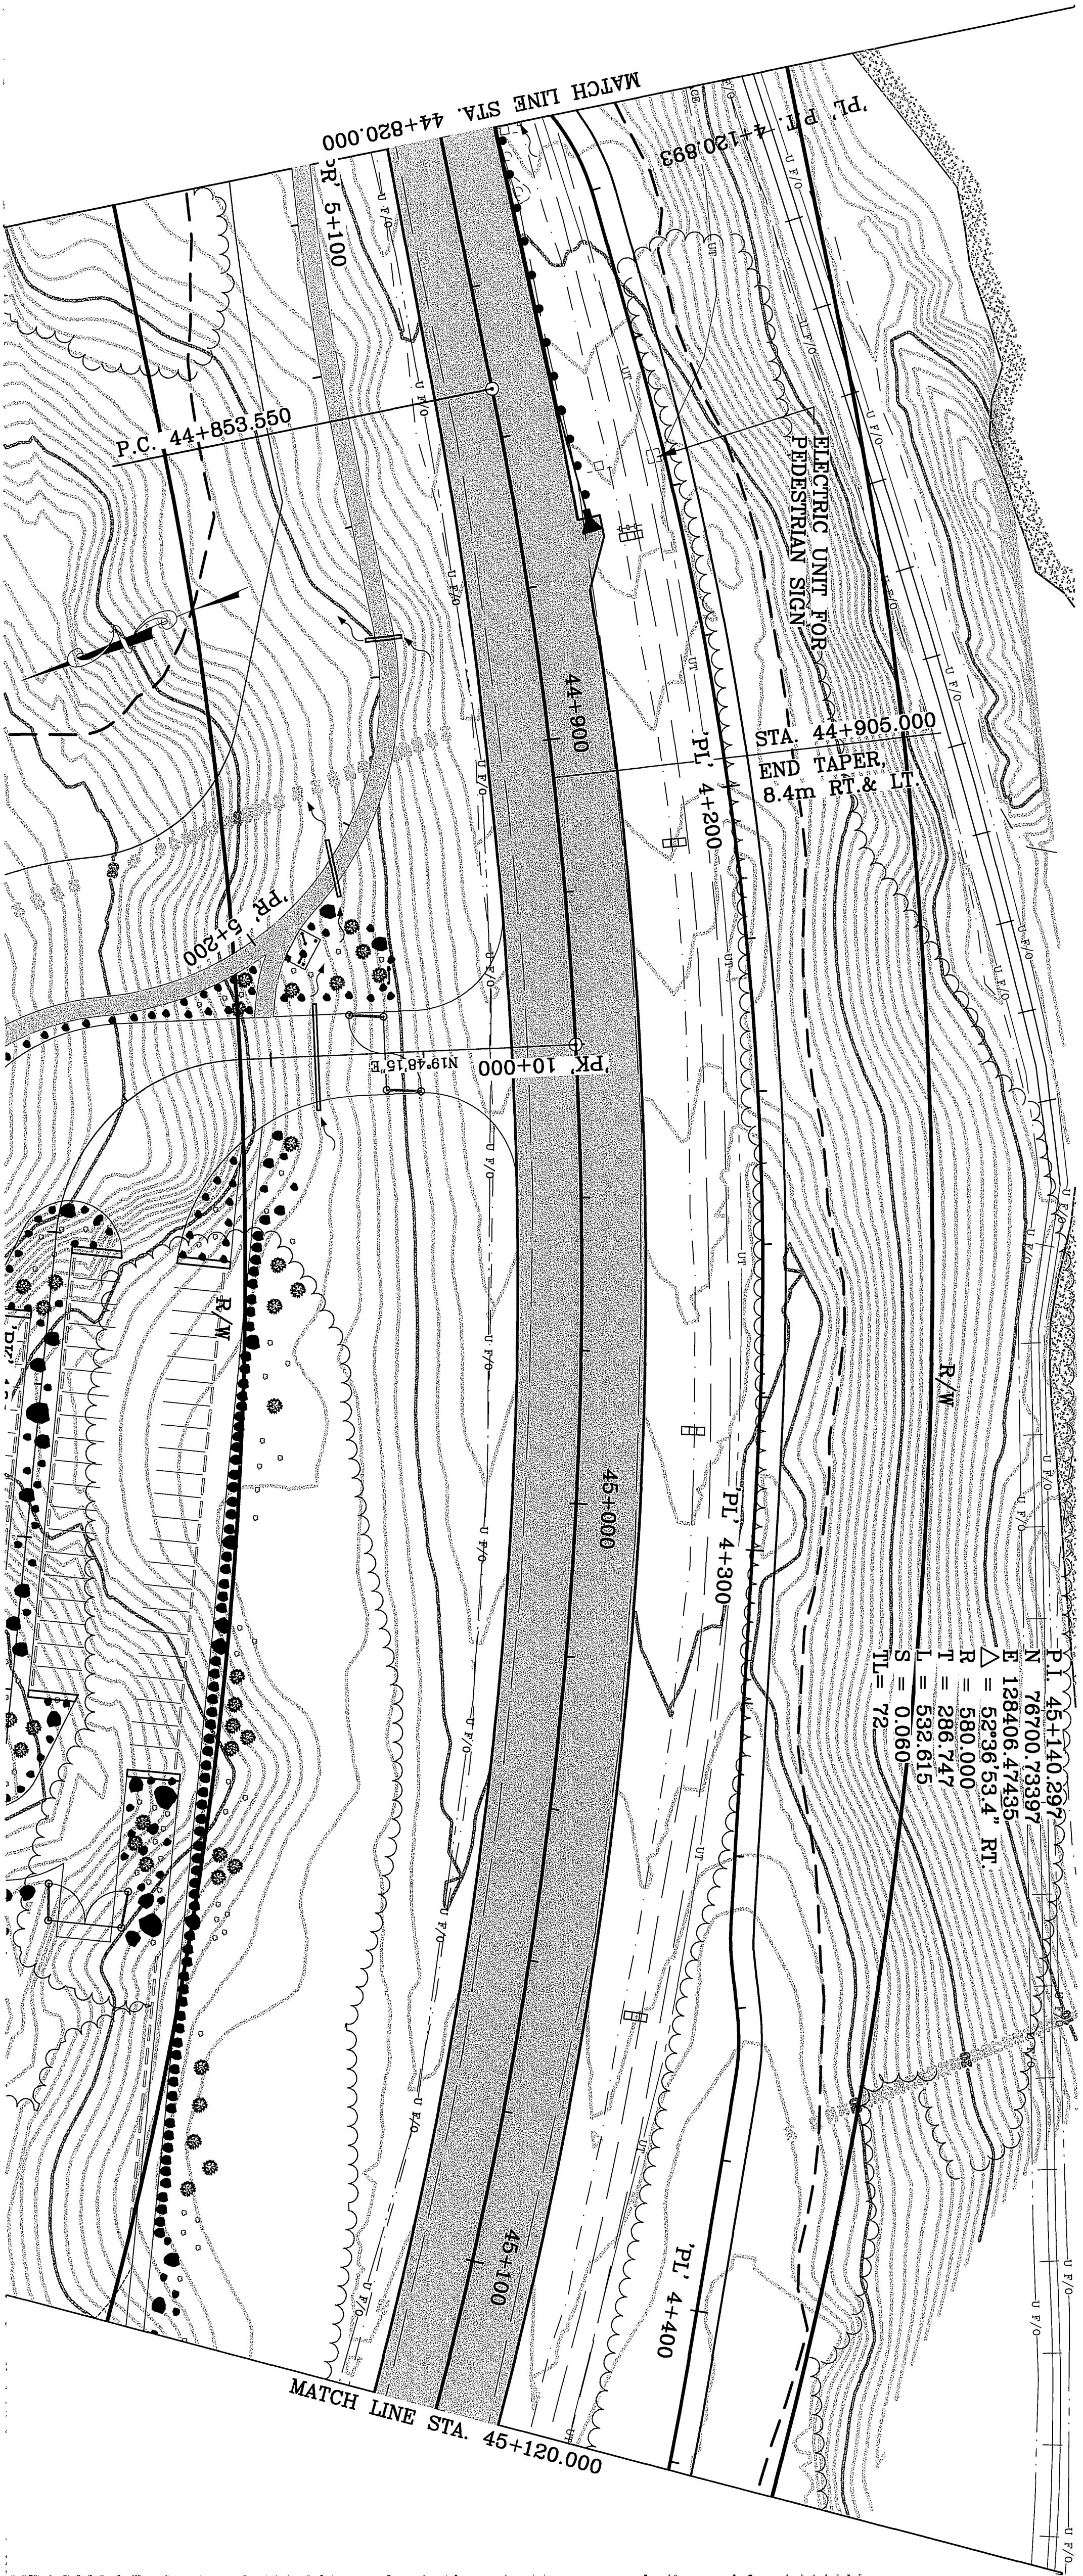

SHEET NO. TOTAL SHEETS

FCR2 FCR4

STATE YEAR

ALASKA 2002

PROJECT DESIGNATION

NH-0A3-1(28)

ADDENDUM NO.

ATTACHMENT NO.

REVISIONS

NO. DATE DESCRIPTION

STATE OF ALASKA
DEPARTMENT OF TRANSPORTATION
AND PUBLIC FACILITIES
SEWARD HIGHWAY
MP 96 TO MP 102
SAFETY, ROADWAY &
RECREATIONAL IMPROVEMENTS
BIRD CREEK AREA
HIGHWAY
PLAN AND PROFILE

NOTE:
DIMENSIONS ARE IN METERS
UNLESS OTHERWISE NOTED.

700MAGALIN AREA

BIRD POINT

40+000

39+500

39+000

38+500

38+000

37+500

37+100

40+000

41+000

41+500

42+000



521+000

521+500

522+000

5

SPECIFICATIONS
SCALE 1"=1'
COMPUTER DESIGNATION
AUTOCAD-KAREN-
D:\305KPCRA\3377\DATA\INNOB\RD\78\BPP.DWG 9-20-01 10:23:14 am EST
DESIGNED BY
CHECKED BY
DRAFTED BY

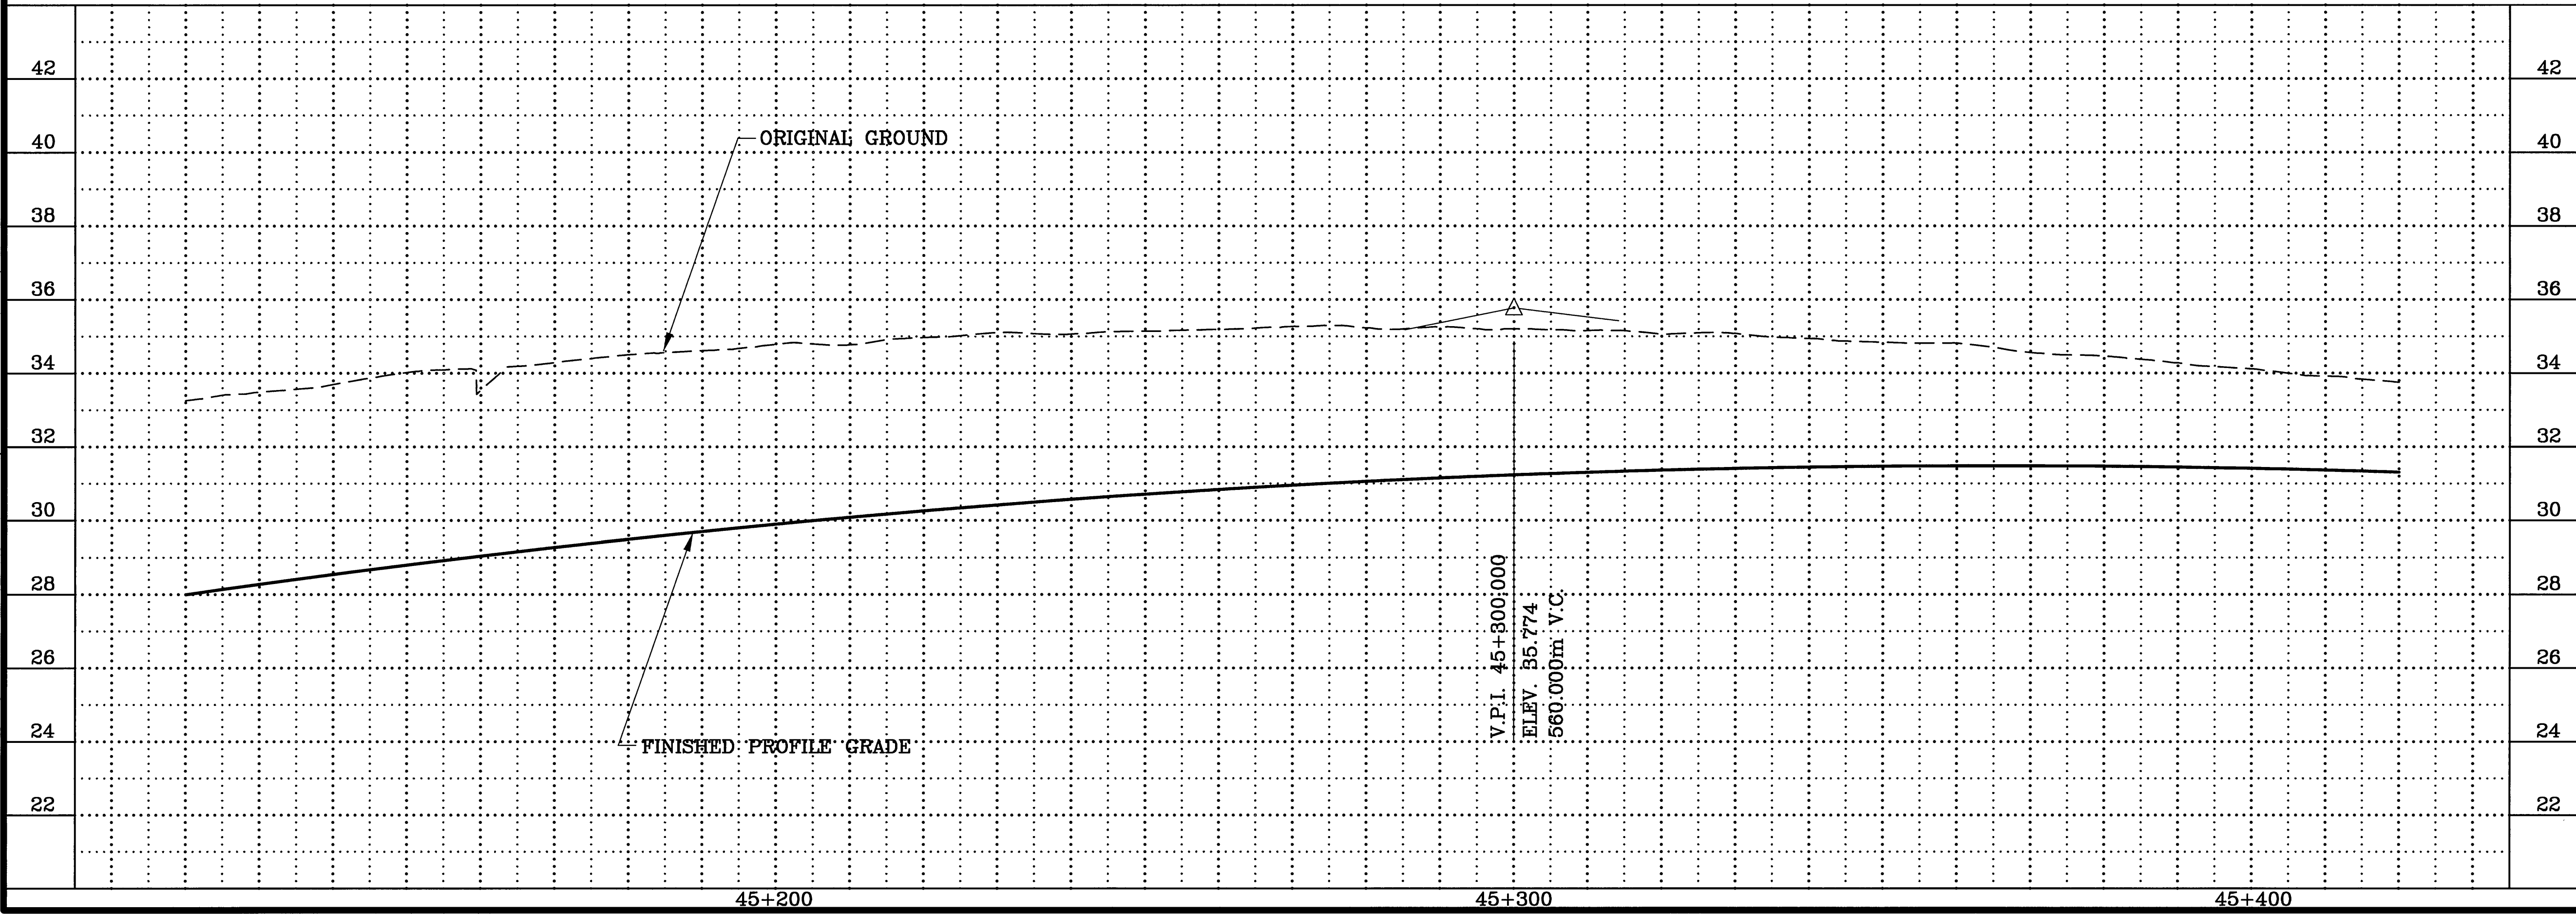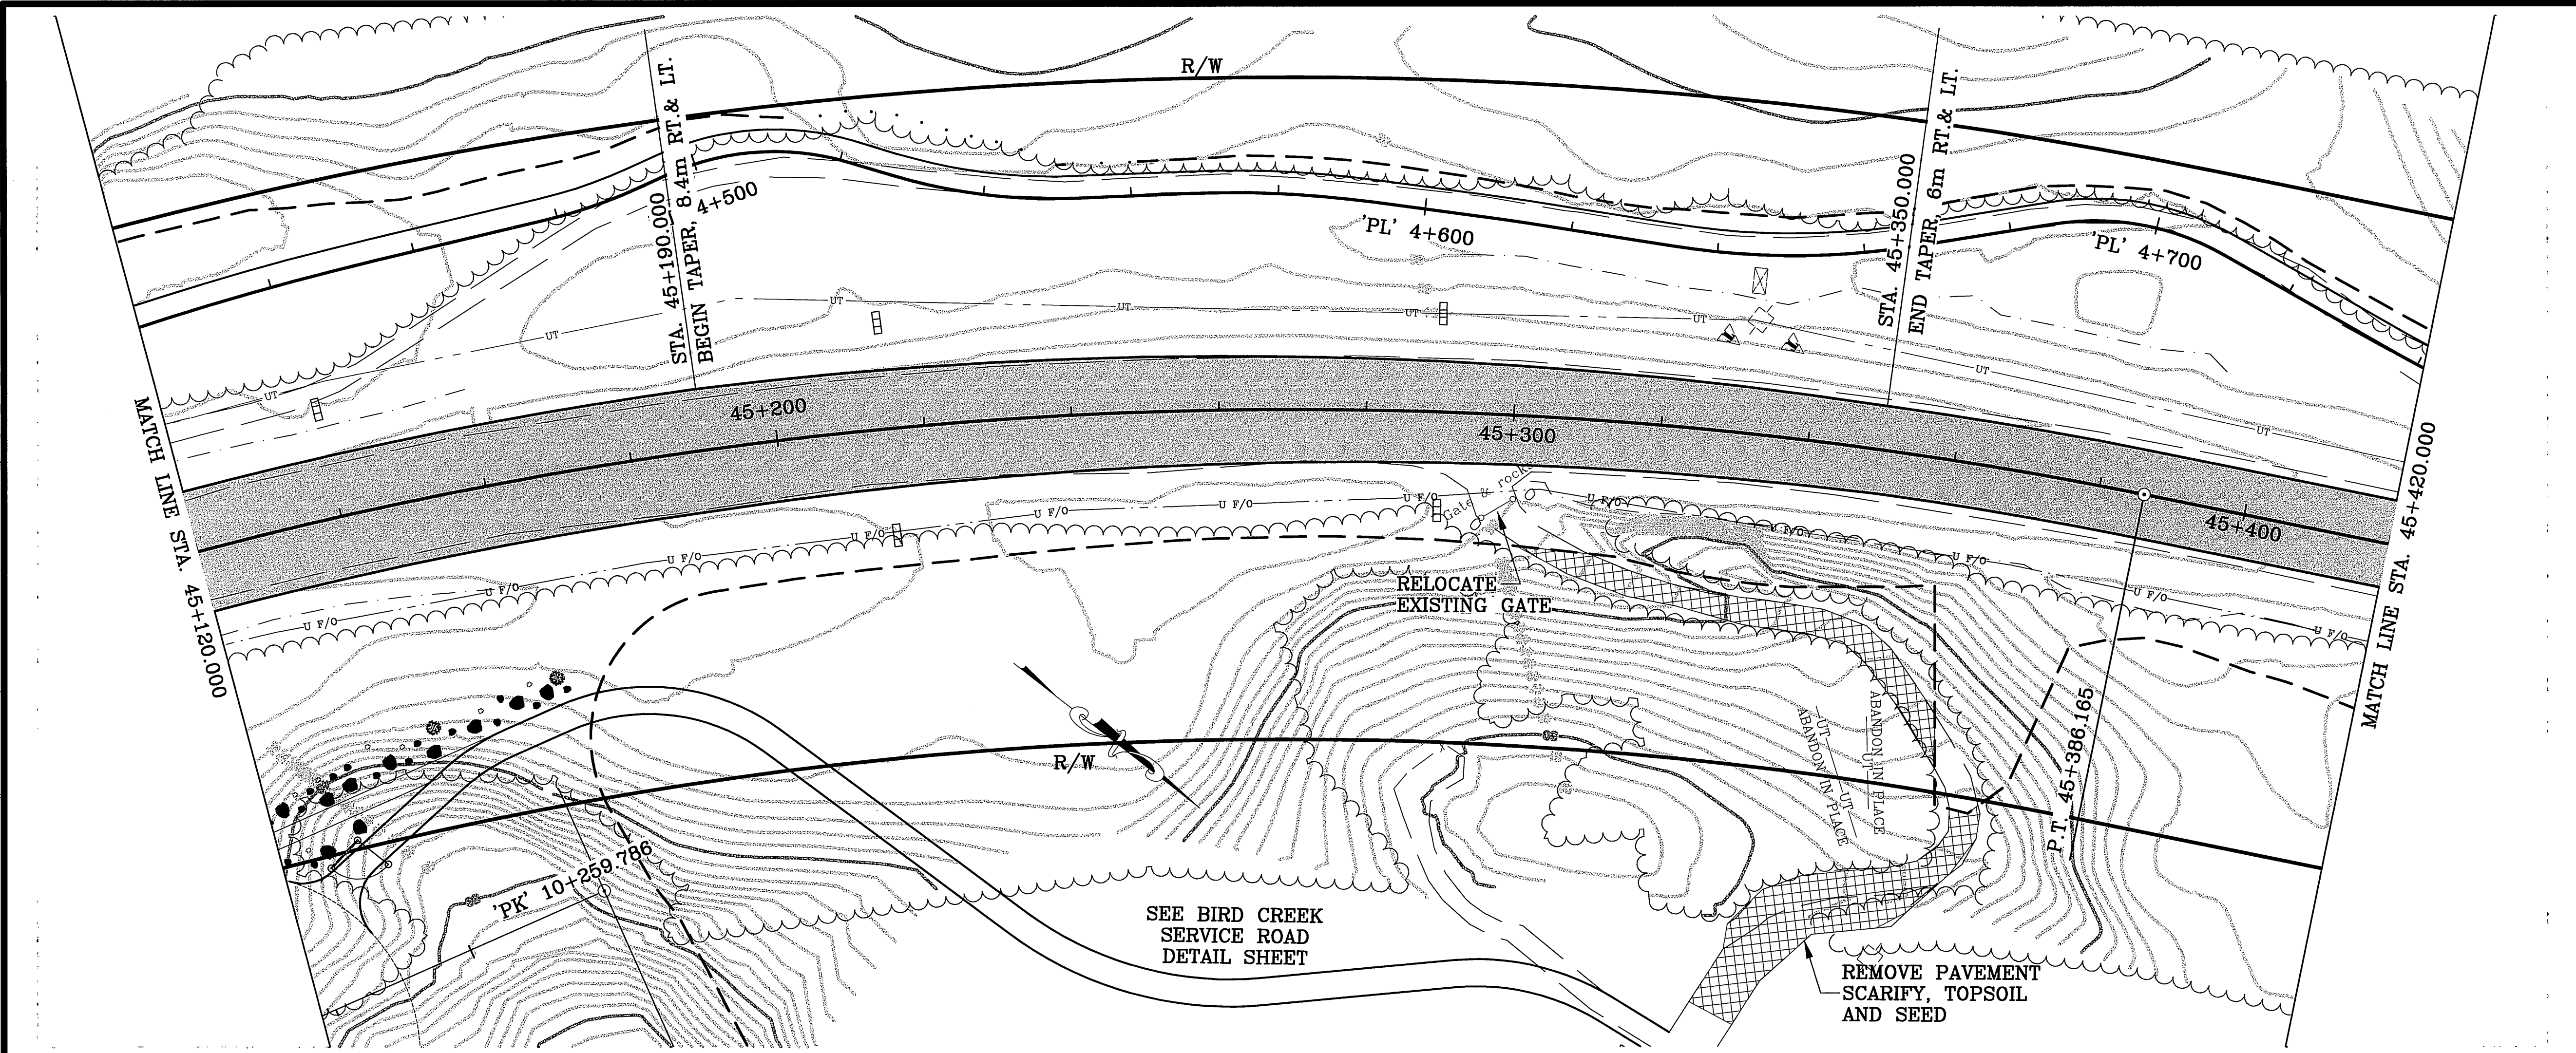

SHEET NO.		TOTAL SHEETS	
FCR3		FCR4	
STATE		YEAR	
ALASKA		2002	
PROJECT DESIGNATION			
NH-0A3-1(28)			
ADDENDUM NO.			
ATTACHMENT NO.			
REVISIONS			
NO.	DATE	DESCRIPTION	

SHEET FCR 3

BIRD CREEK BRIDGE

BIRD CREEK

TURNAGAIN ARM

BIRD POINT


NOTE:
DIMENSIONS ARE IN METERS
UNLESS OTHERWISE NOTED.

STATE OF ALASKA
49th
JUDY J. DOUGHERTY
1982
REGISTERED PROFESSIONAL ENGINEER
N-2442


STATE OF ALASKA
DEPARTMENT OF TRANSPORTATION
AND PUBLIC FACILITIES
SEWARD HIGHWAY
MP 96 TO MP 102
SAFETY, ROADWAY &
RECREATIONAL IMPROVEMENTS

BIRD CREEK AREA
HIGHWAY
PLAN AND PROFILE

SPECIFICATIONS	DESIGNED BY	
	CHECKED BY	
	DRAWN BY	
SCALE 1"=1'	VIEW=	
	COMPUTER DESIGNATION	
	DATE	
AUTOCAD-KAREN- D:\SISK\PROJ\3577\DATA\IN\BIRD\781\BPP.DWG 9-20-01 10:23:14 am EST		

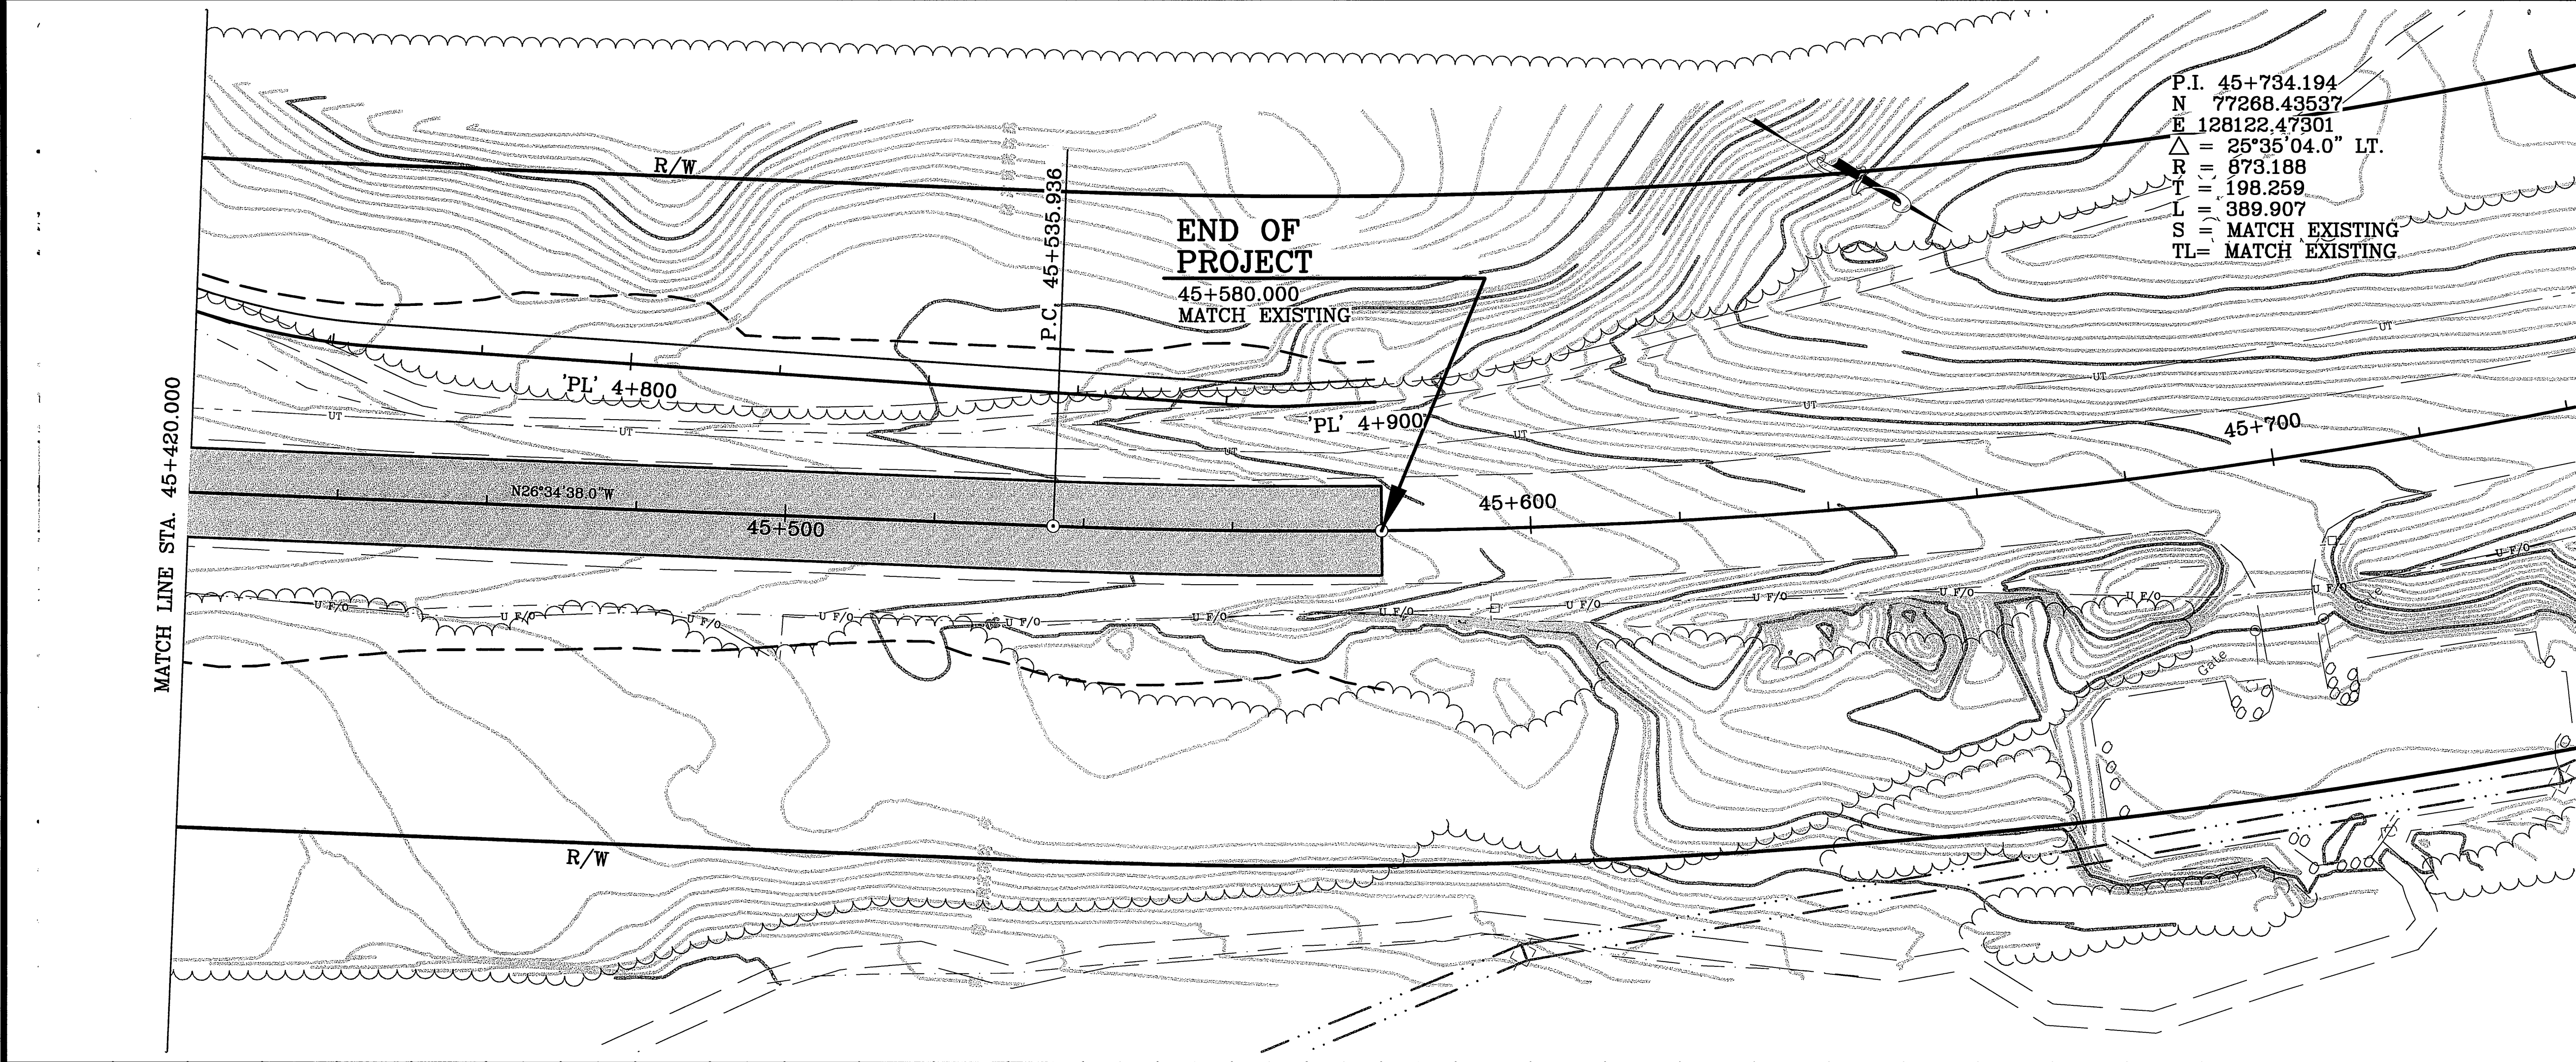

P.I. 45+734.194
N 77268.43537
E 128122.47301
 $\Delta = 25^\circ 35' 04.0''$ LT.
R = 873.188
T = 198.259
L = 389.907
S = MATCH EXISTING
TL = MATCH EXISTING

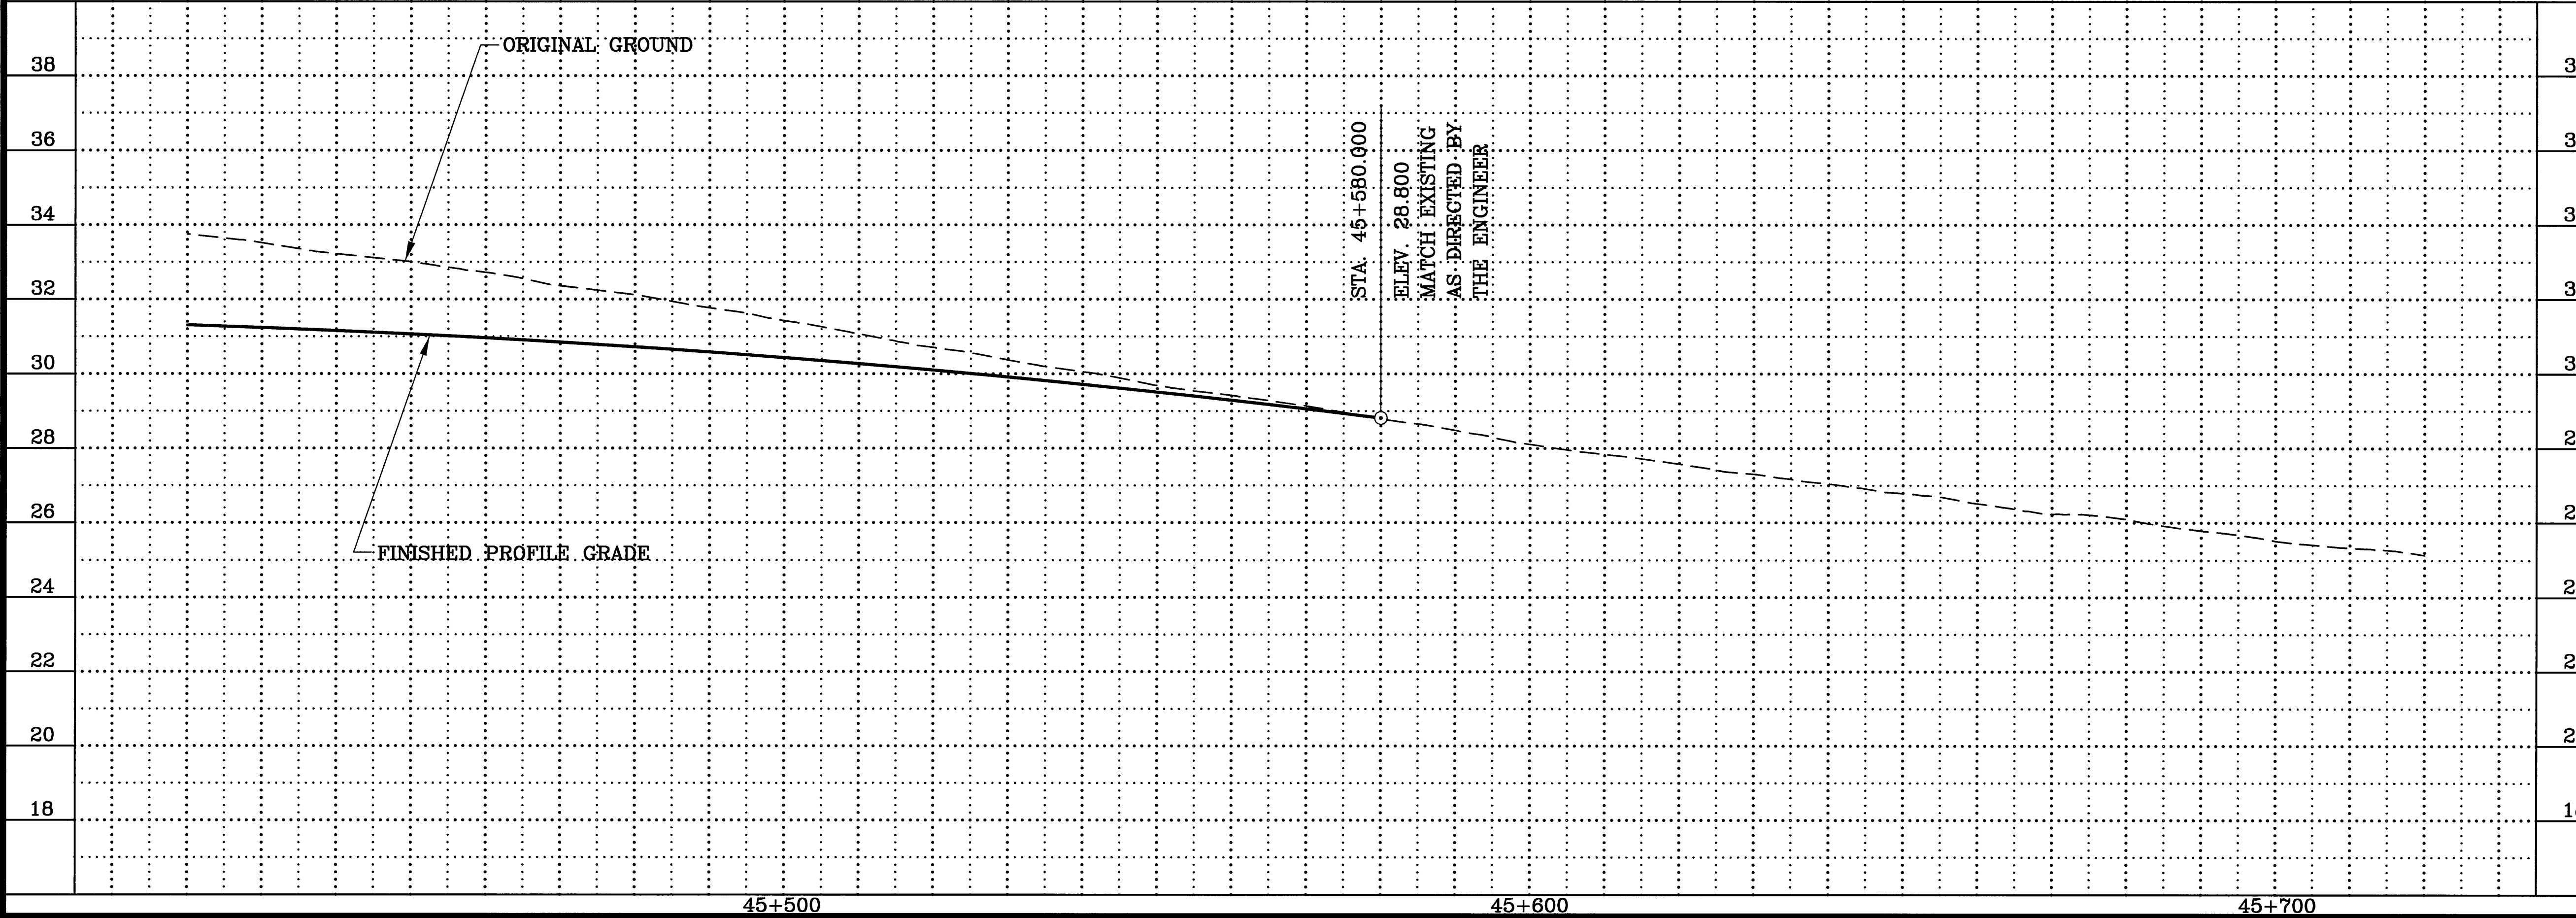

SHEET NO.	TOTAL SHEETS	
FCR4	FCR4	
STATE	YEAR	
ALASKA	2002	
PROJECT DESIGNATION		
NH-0A3-1(28)		
ADDENDUM NO.		
ATTACHMENT NO.		
REVISIONS		
NO.	DATE	DESCRIPTION


NOTE:
DIMENSIONS ARE IN METERS
UNLESS OTHERWISE NOTED.

STATE OF ALASKA
JUDY J. DOUGHERTY
CE 8823
REGISTERED PROFESSIONAL ENGINEER

STATE OF ALASKA
DEPARTMENT OF TRANSPORTATION
AND PUBLIC FACILITIES
**SEWARD HIGHWAY
MP 96 TO MP 102
SAFETY, ROADWAY &
RECREATIONAL IMPROVEMENTS**

**BIRD CREEK AREA
HIGHWAY
PLAN AND PROFILE**

DESIGNED BY: 11-B-02
CHECKED BY: JKH
VIEW#:
AUTOCAD-KAREN-
5397A\DATA\7611\cddp\pk.dwg
SPECIFICATIONS
SCALE 1"=1'
COMPUTER DESIGNATION

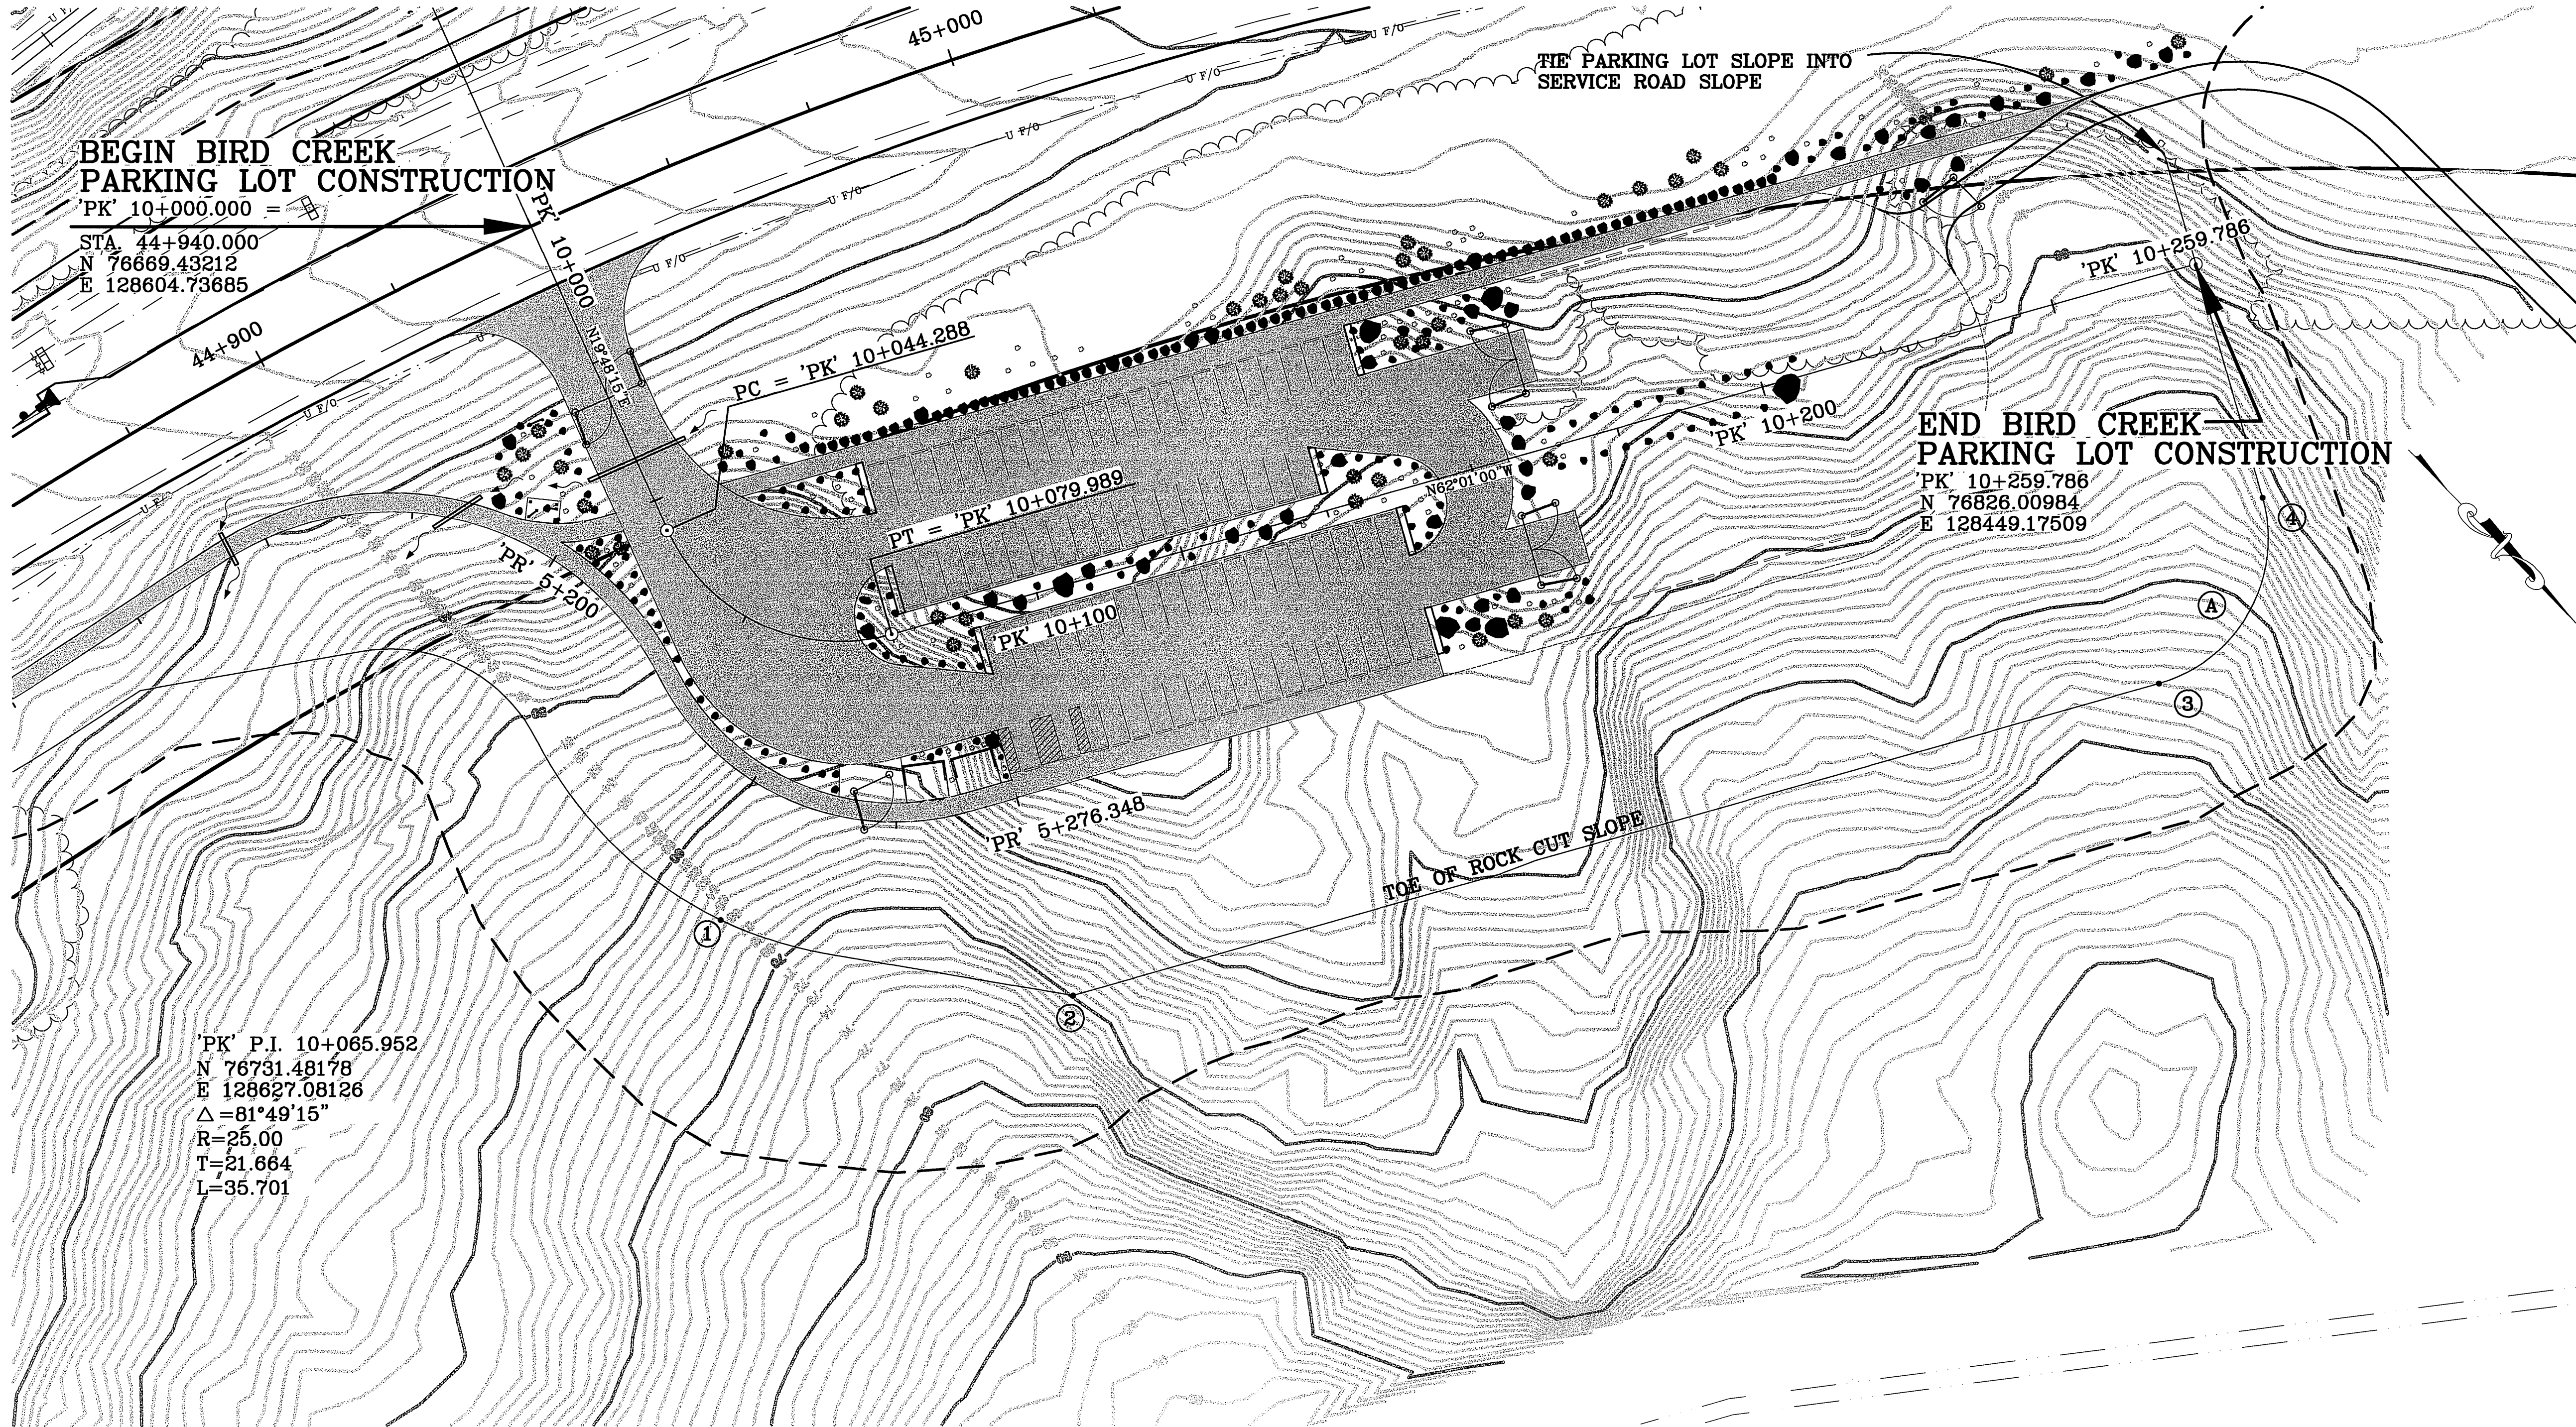

OFFSET POINT TABLE		
POINT	STATION	OFFSET
①	'PK' 10+072.462	41.5 RT.
②	'PK' 10+090.000	52.8 RT.
③	'PK' 10+239.786	52.4 RT.
④	'PK' 10+259.786	32.4 RT.


RADIUS TABLE			
POINT	STATION	OFFSET	RADIUS
Ⓐ	'PK' 10+239.786	32.4 RT.	20.0

SHEET NO.	TOTAL SHEETS	
FPK1	FPK2	
STATE	YEAR	
ALASKA	2002	
PROJECT DESIGNATION		
NH-0A3-1(28)		
ADDENDUM NO.		
ATTACHMENT NO.		
REVISIONS		
NO.	DATE	DESCRIPTION


NOTE:
DIMENSIONS ARE IN METERS
UNLESS OTHERWISE NOTED.

STATE OF ALASKA
DEPARTMENT OF TRANSPORTATION
AND PUBLIC FACILITIES
SEWARD HIGHWAY
MP 96 TO MP 102
SAFETY, ROADWAY &
RECREATIONAL IMPROVEMENTS
BIRD CREEK PARKING LOT
PLAN

48
46
44
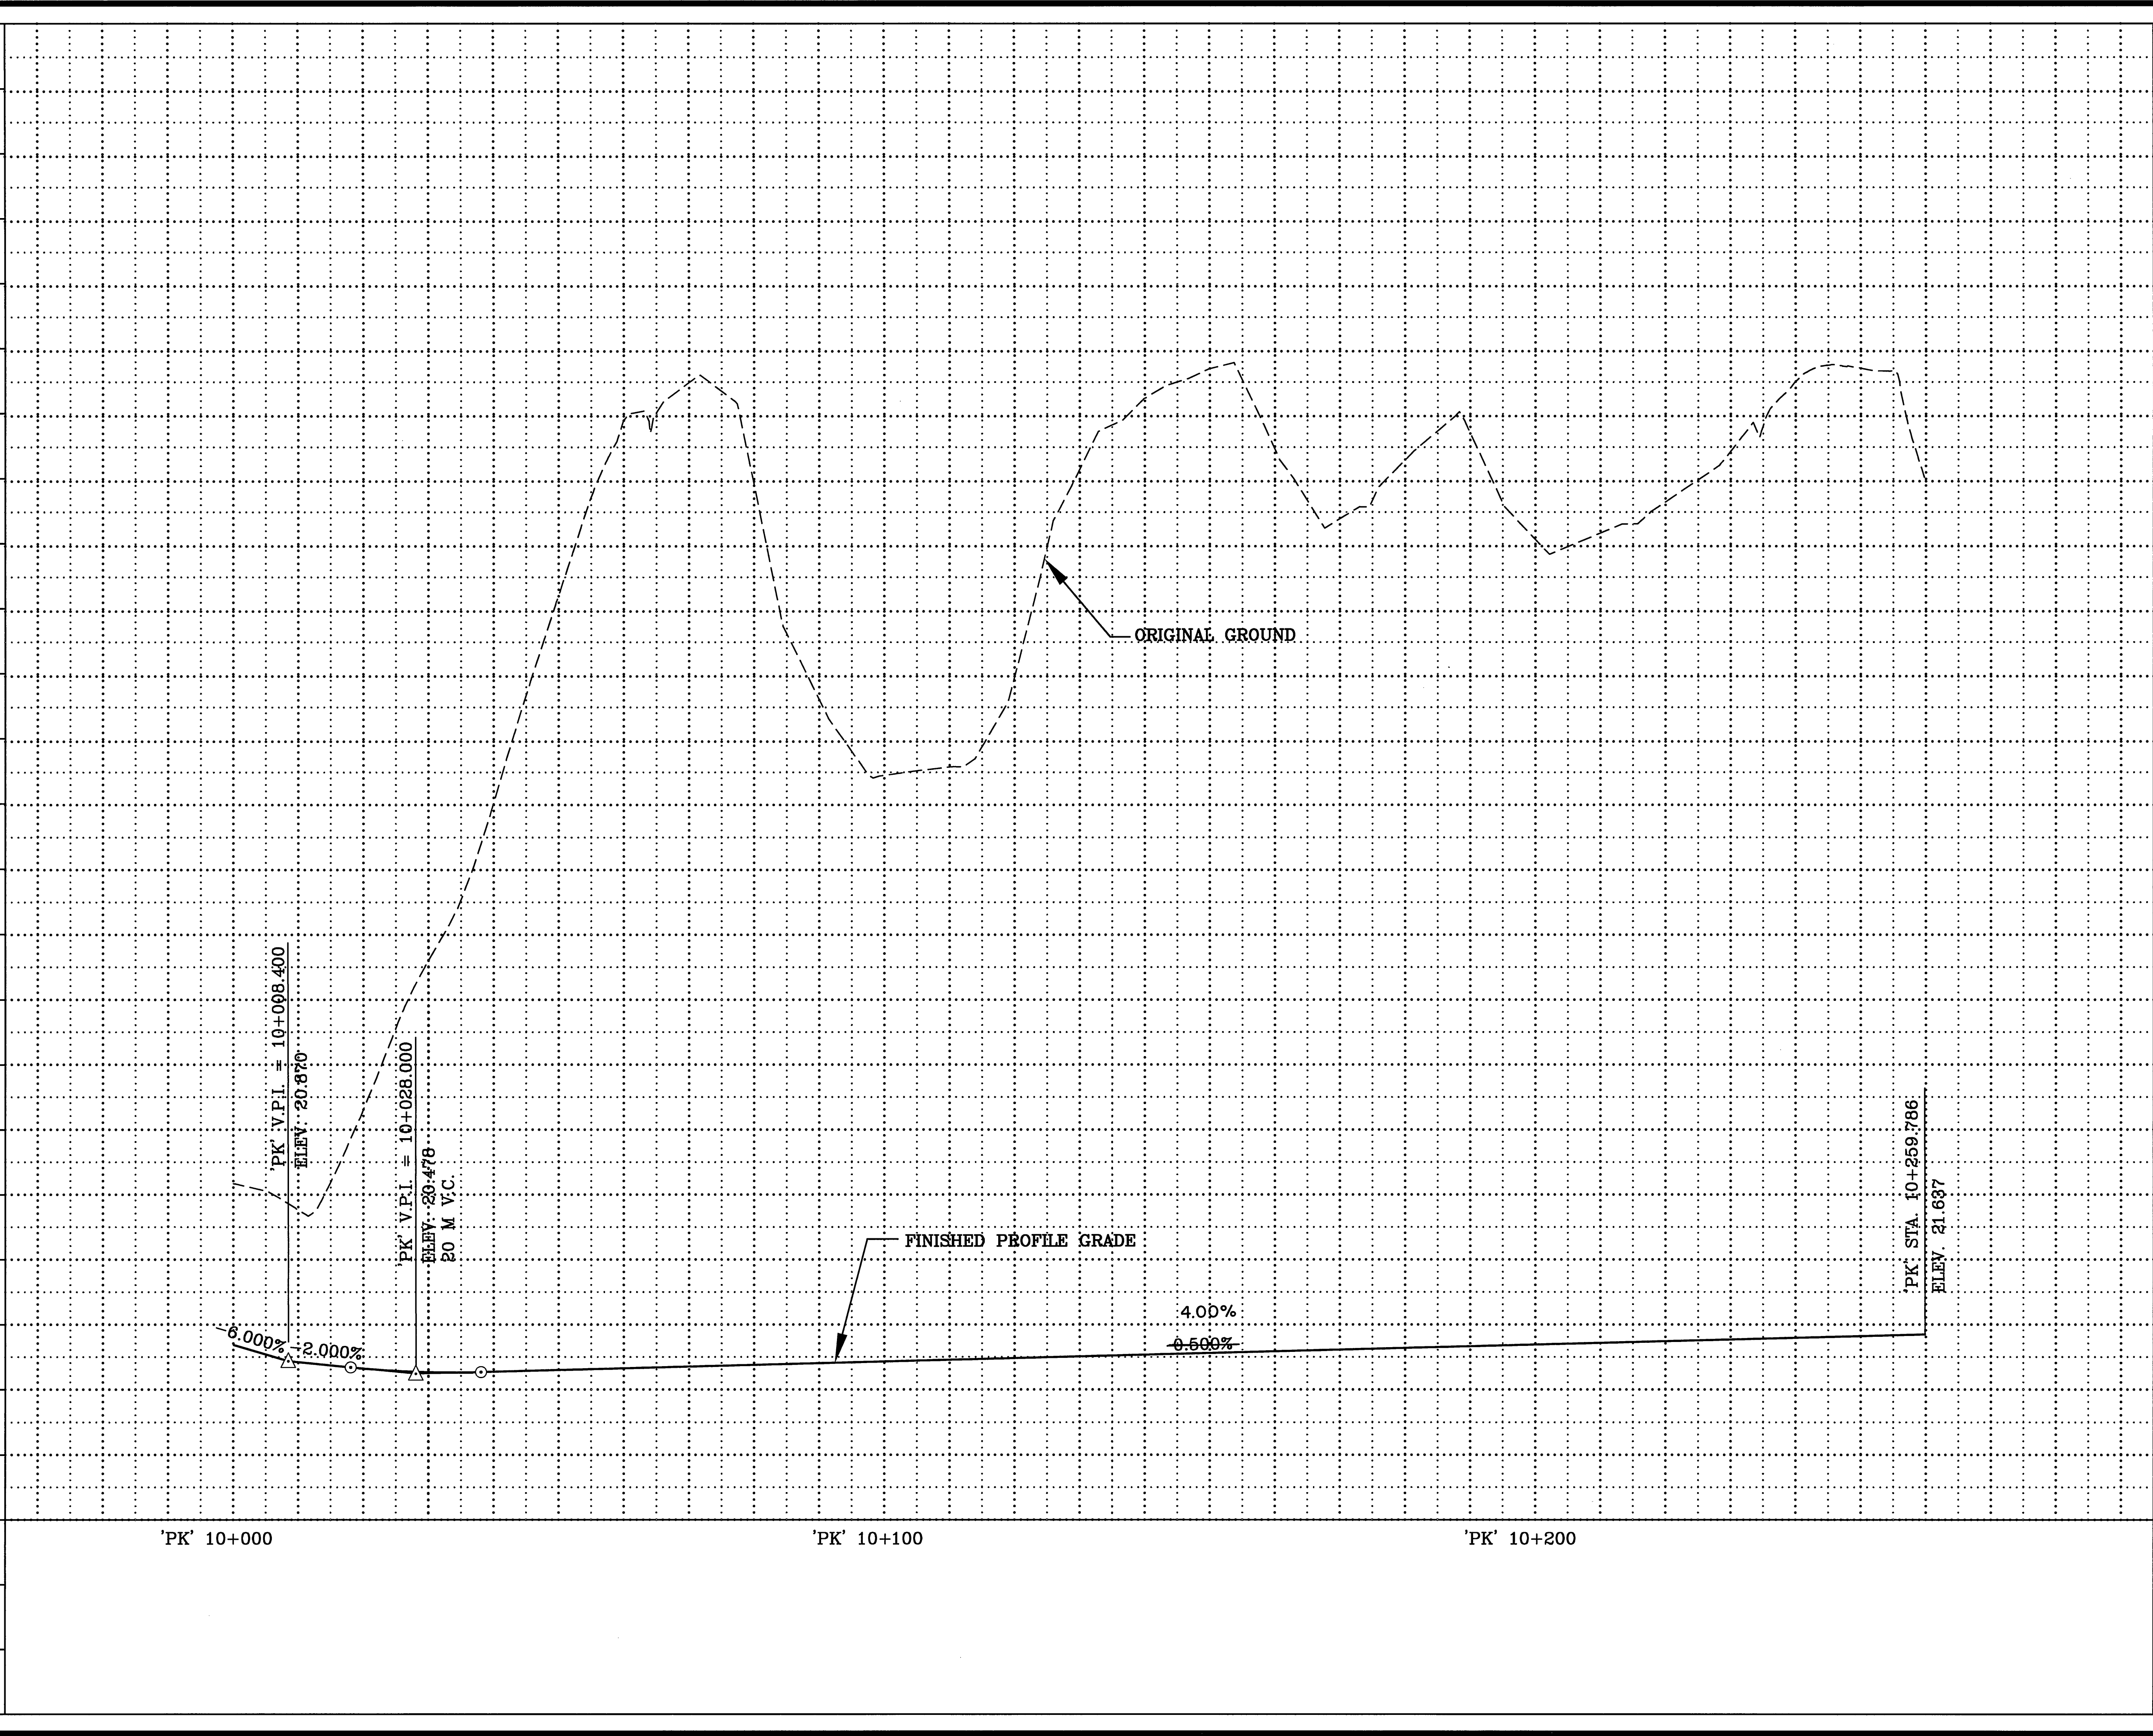[illegible]

SPECIFICATIONS
SCALE 1"=1'
COMPUTER DESIGNATION
AUTOCAD-KAREN-
D:\S\KROJ\33577\DATA\IN\BIRD\781\RD\PL.DWG 11-18-02
VIEW
DESIGNED BY
CHECKED BY
DRAFTED BY
KMH

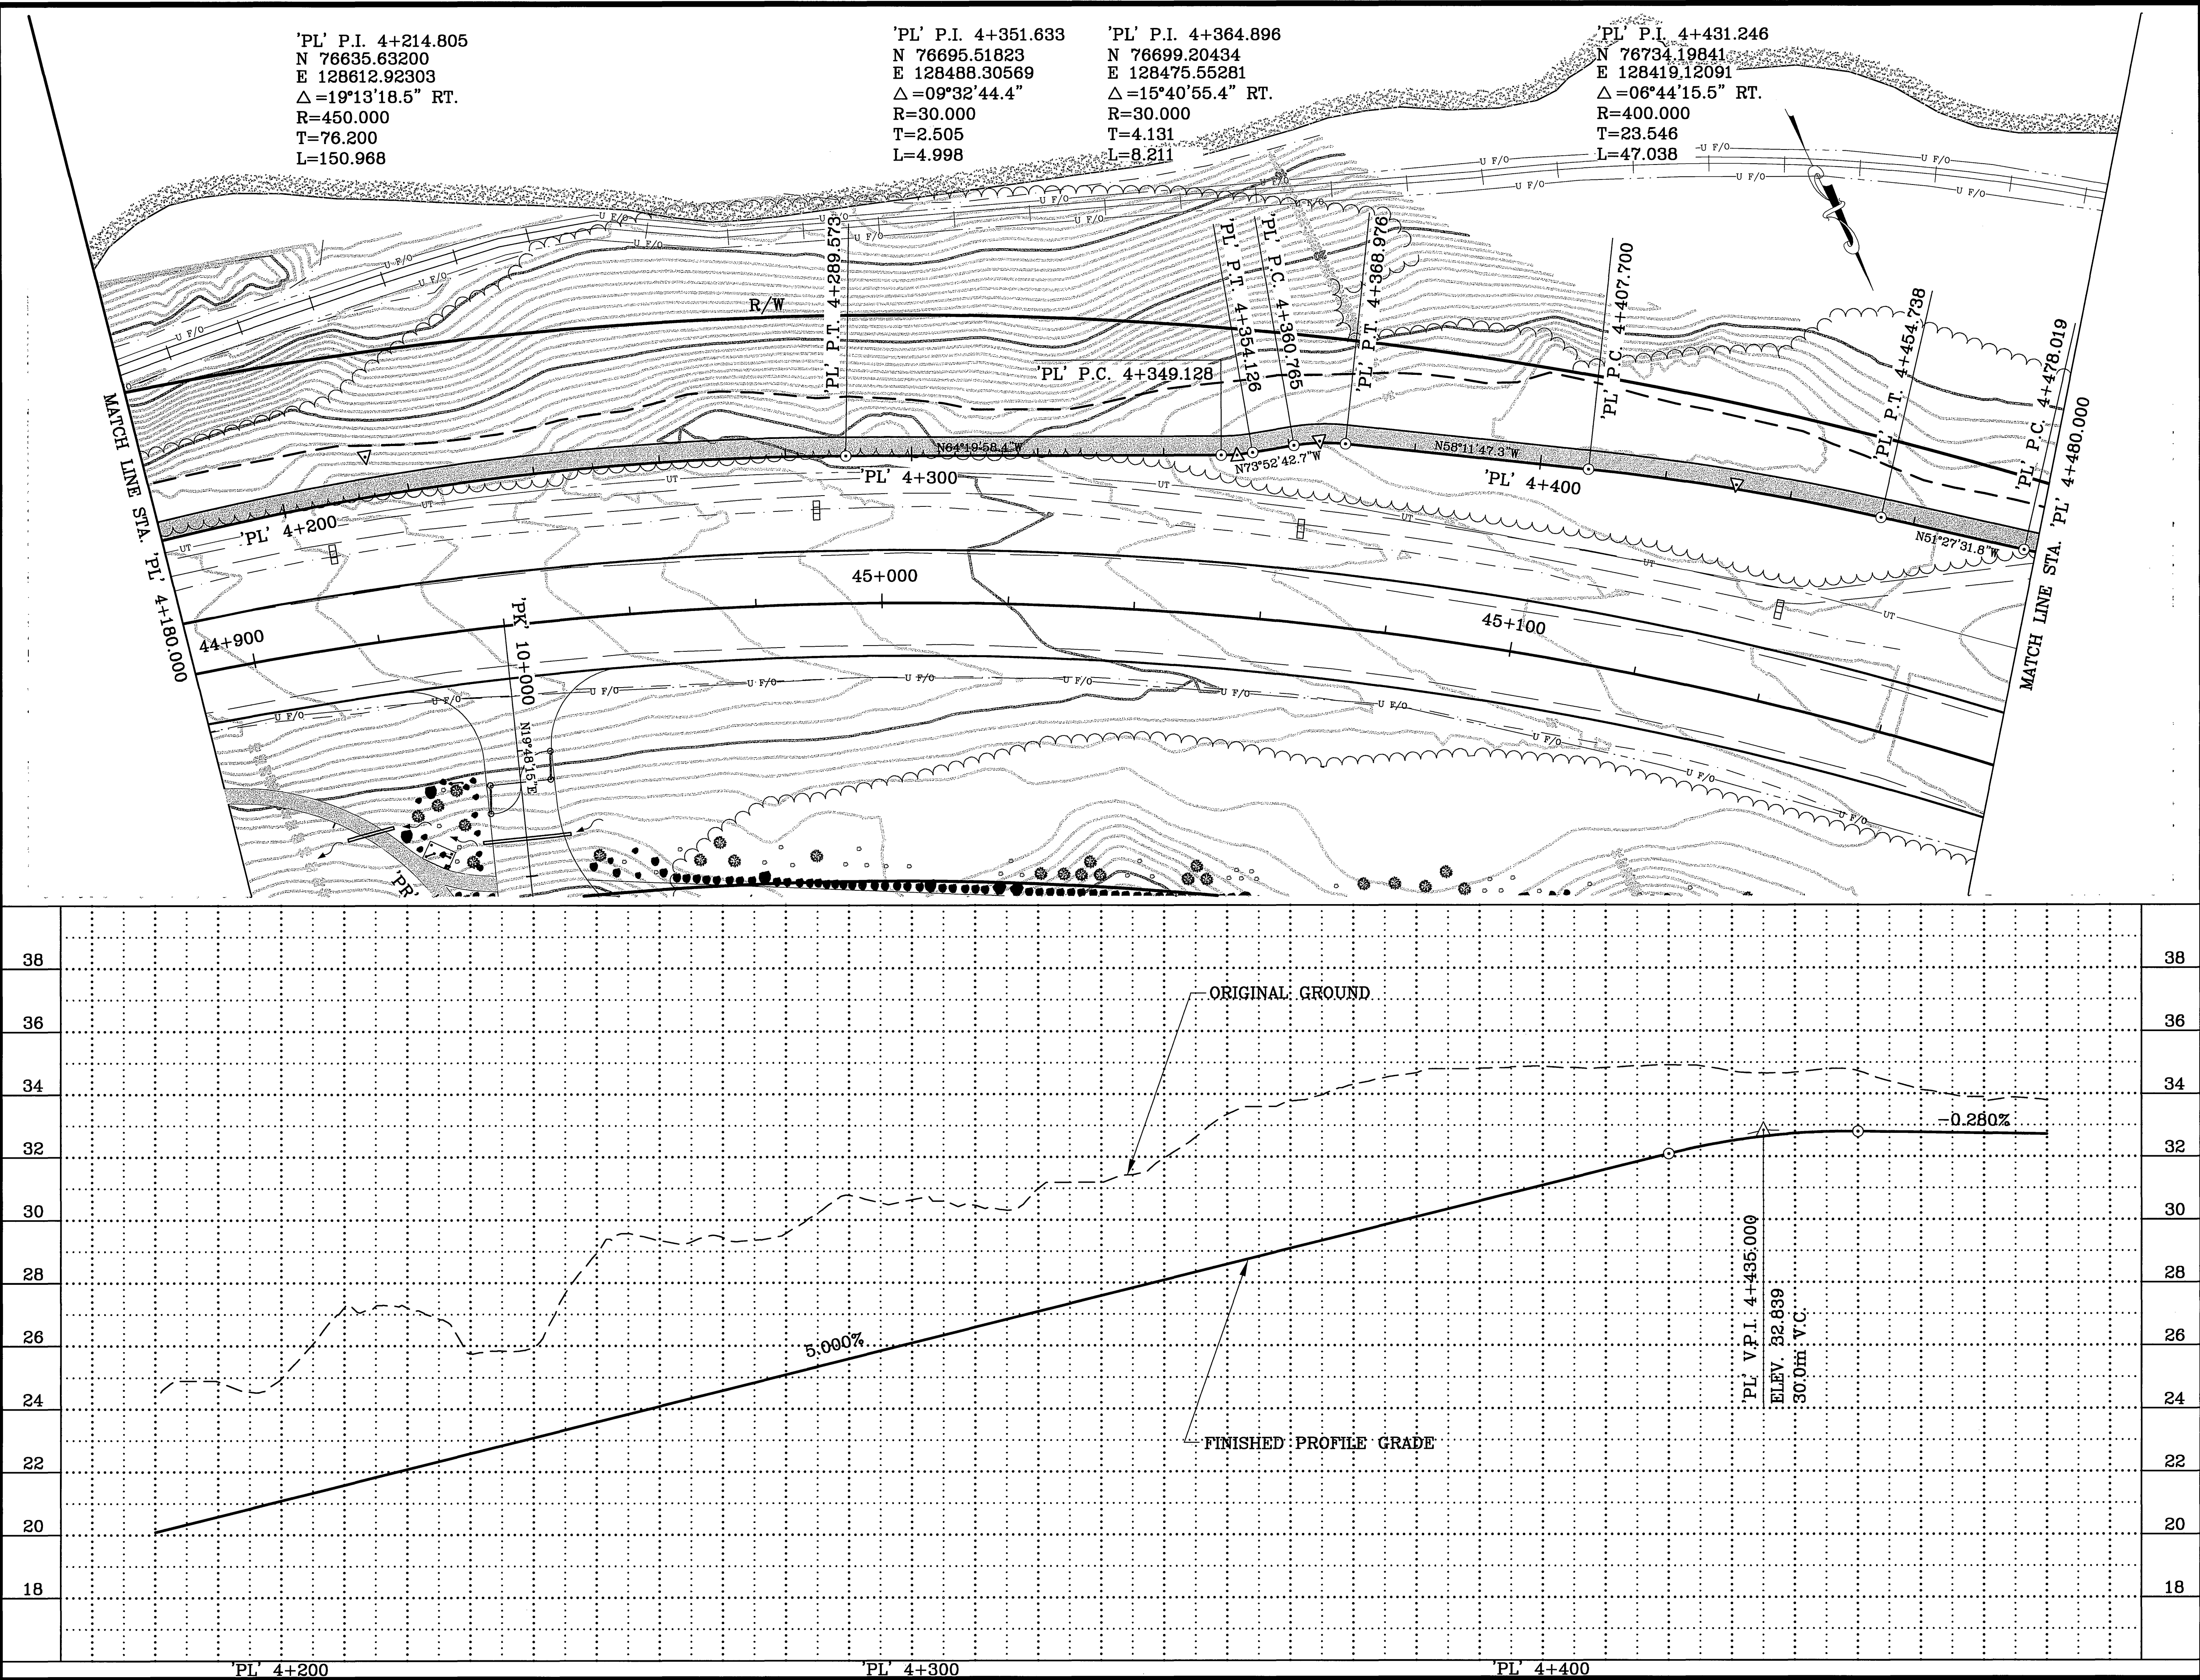

SHEET NO.	TOTAL SHEETS	
FPL2	FPL4	
STATE	YEAR	
ALASKA	2002	
PROJECT DESIGNATION		
NH-0A3-1(28)		
ADDENDUM NO.		
ATTACHMENT NO.		
REVISIONS		
NO.	DATE	DESCRIPTION

SHEET FPL 2
BIRD CREEK BRIDGE

Bird Creek

TURNAGAIN ARM

BIRD POINT

NOTE:
DIMENSIONS ARE IN METERS
UNLESS OTHERWISE NOTED.



STATE OF ALASKA
49th
JUDY J. DUGHERTY
CE 8823
REGISTERED PROFESSIONAL ENGINEER

STATE OF ALASKA
DEPARTMENT OF TRANSPORTATION
AND PUBLIC FACILITIES
SEWARD HIGHWAY
MP 96 TO MP 102
SAFETY, ROADWAY &
RECREATIONAL IMPROVEMENTS
BIRD CREEK LEFT PATHWAY
PLAN AND PROFILE

DESIGNED BY
CHECKED BY
DRAFTED BY
VIEW=

AUTOCAD-KAREN-
D:\ASDK\PROJ\03577\DATA\IN\03577\BPP\PL.DWG 11-18-02

SPECIFICATIONS
SCALE 1"=1'
COMPUTER DESIGNATION

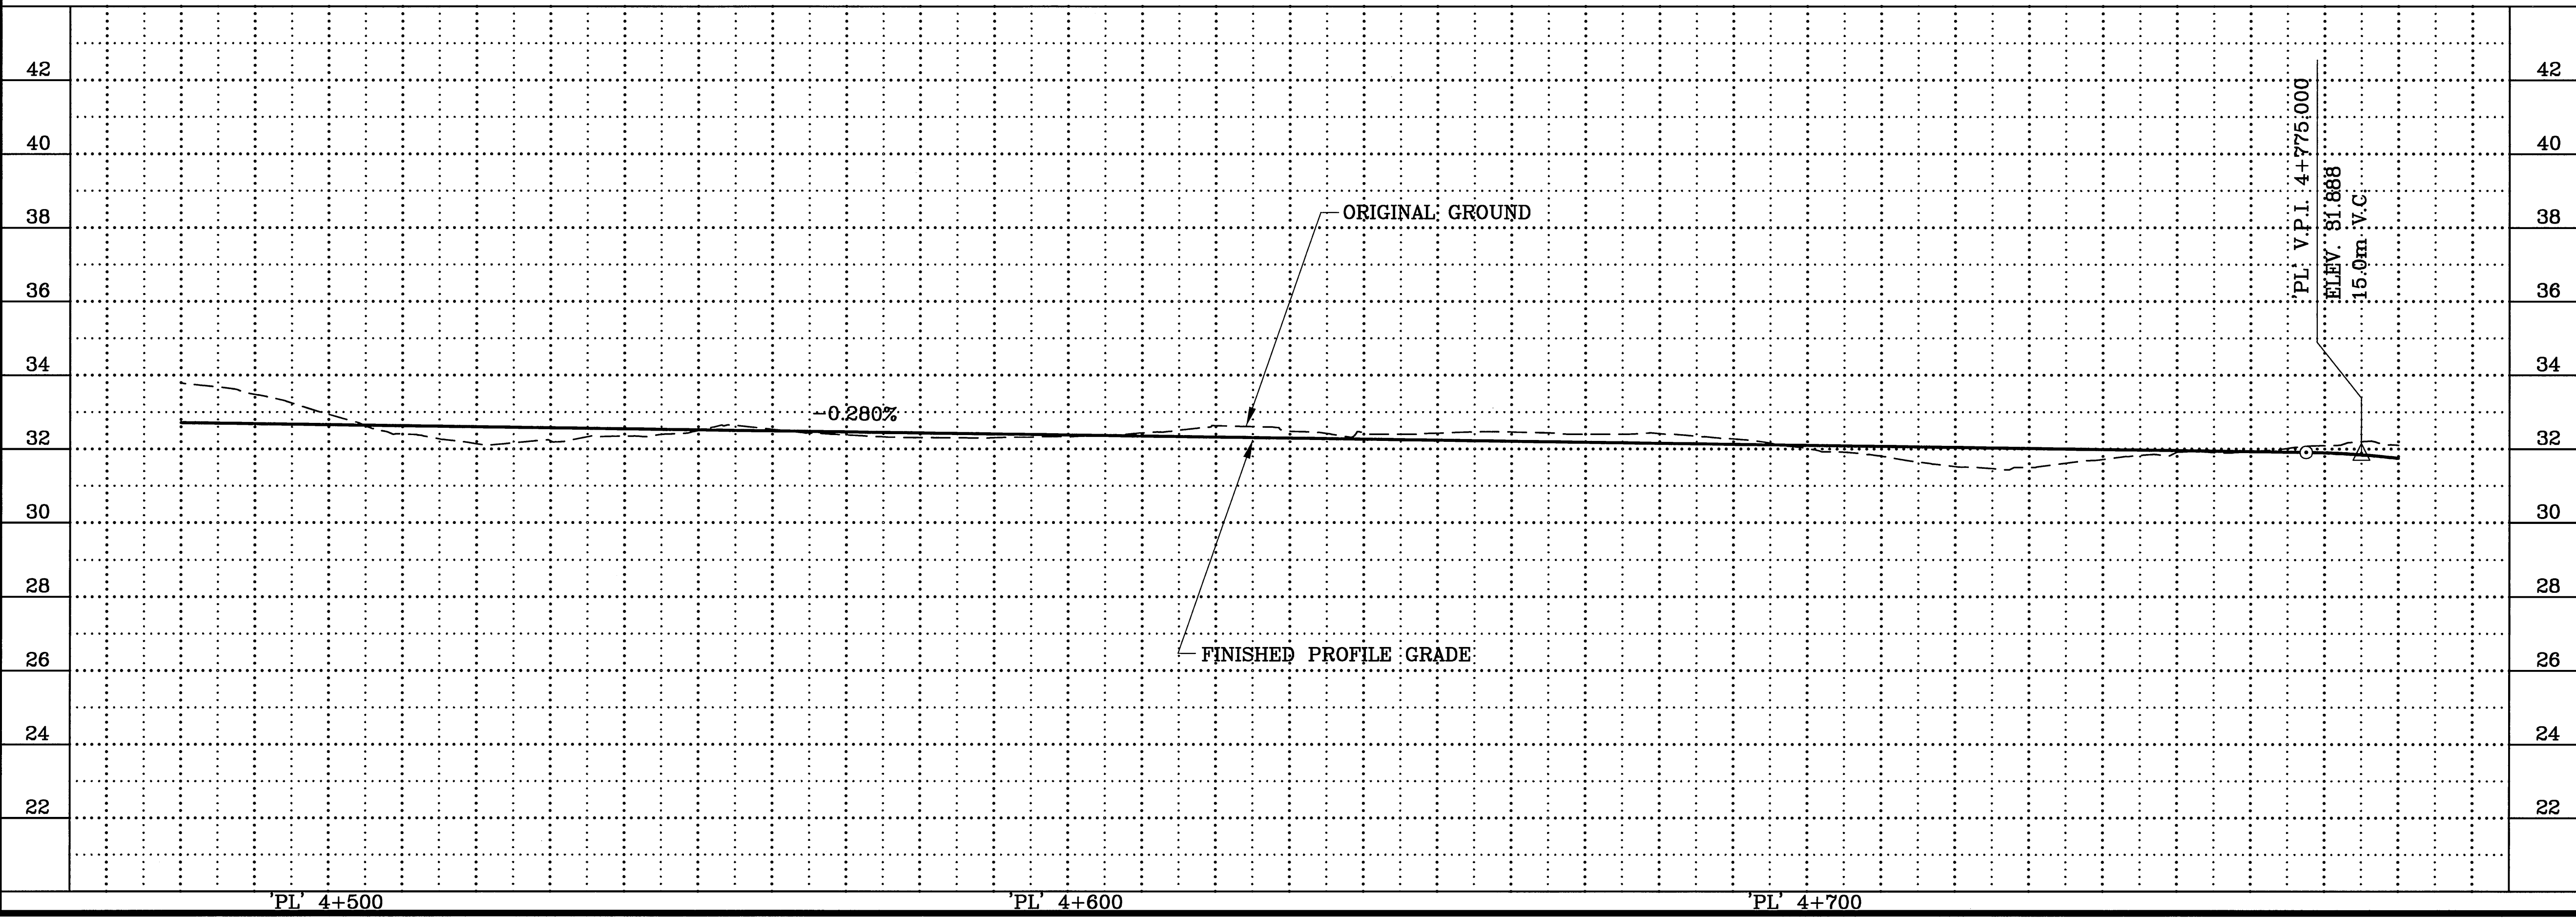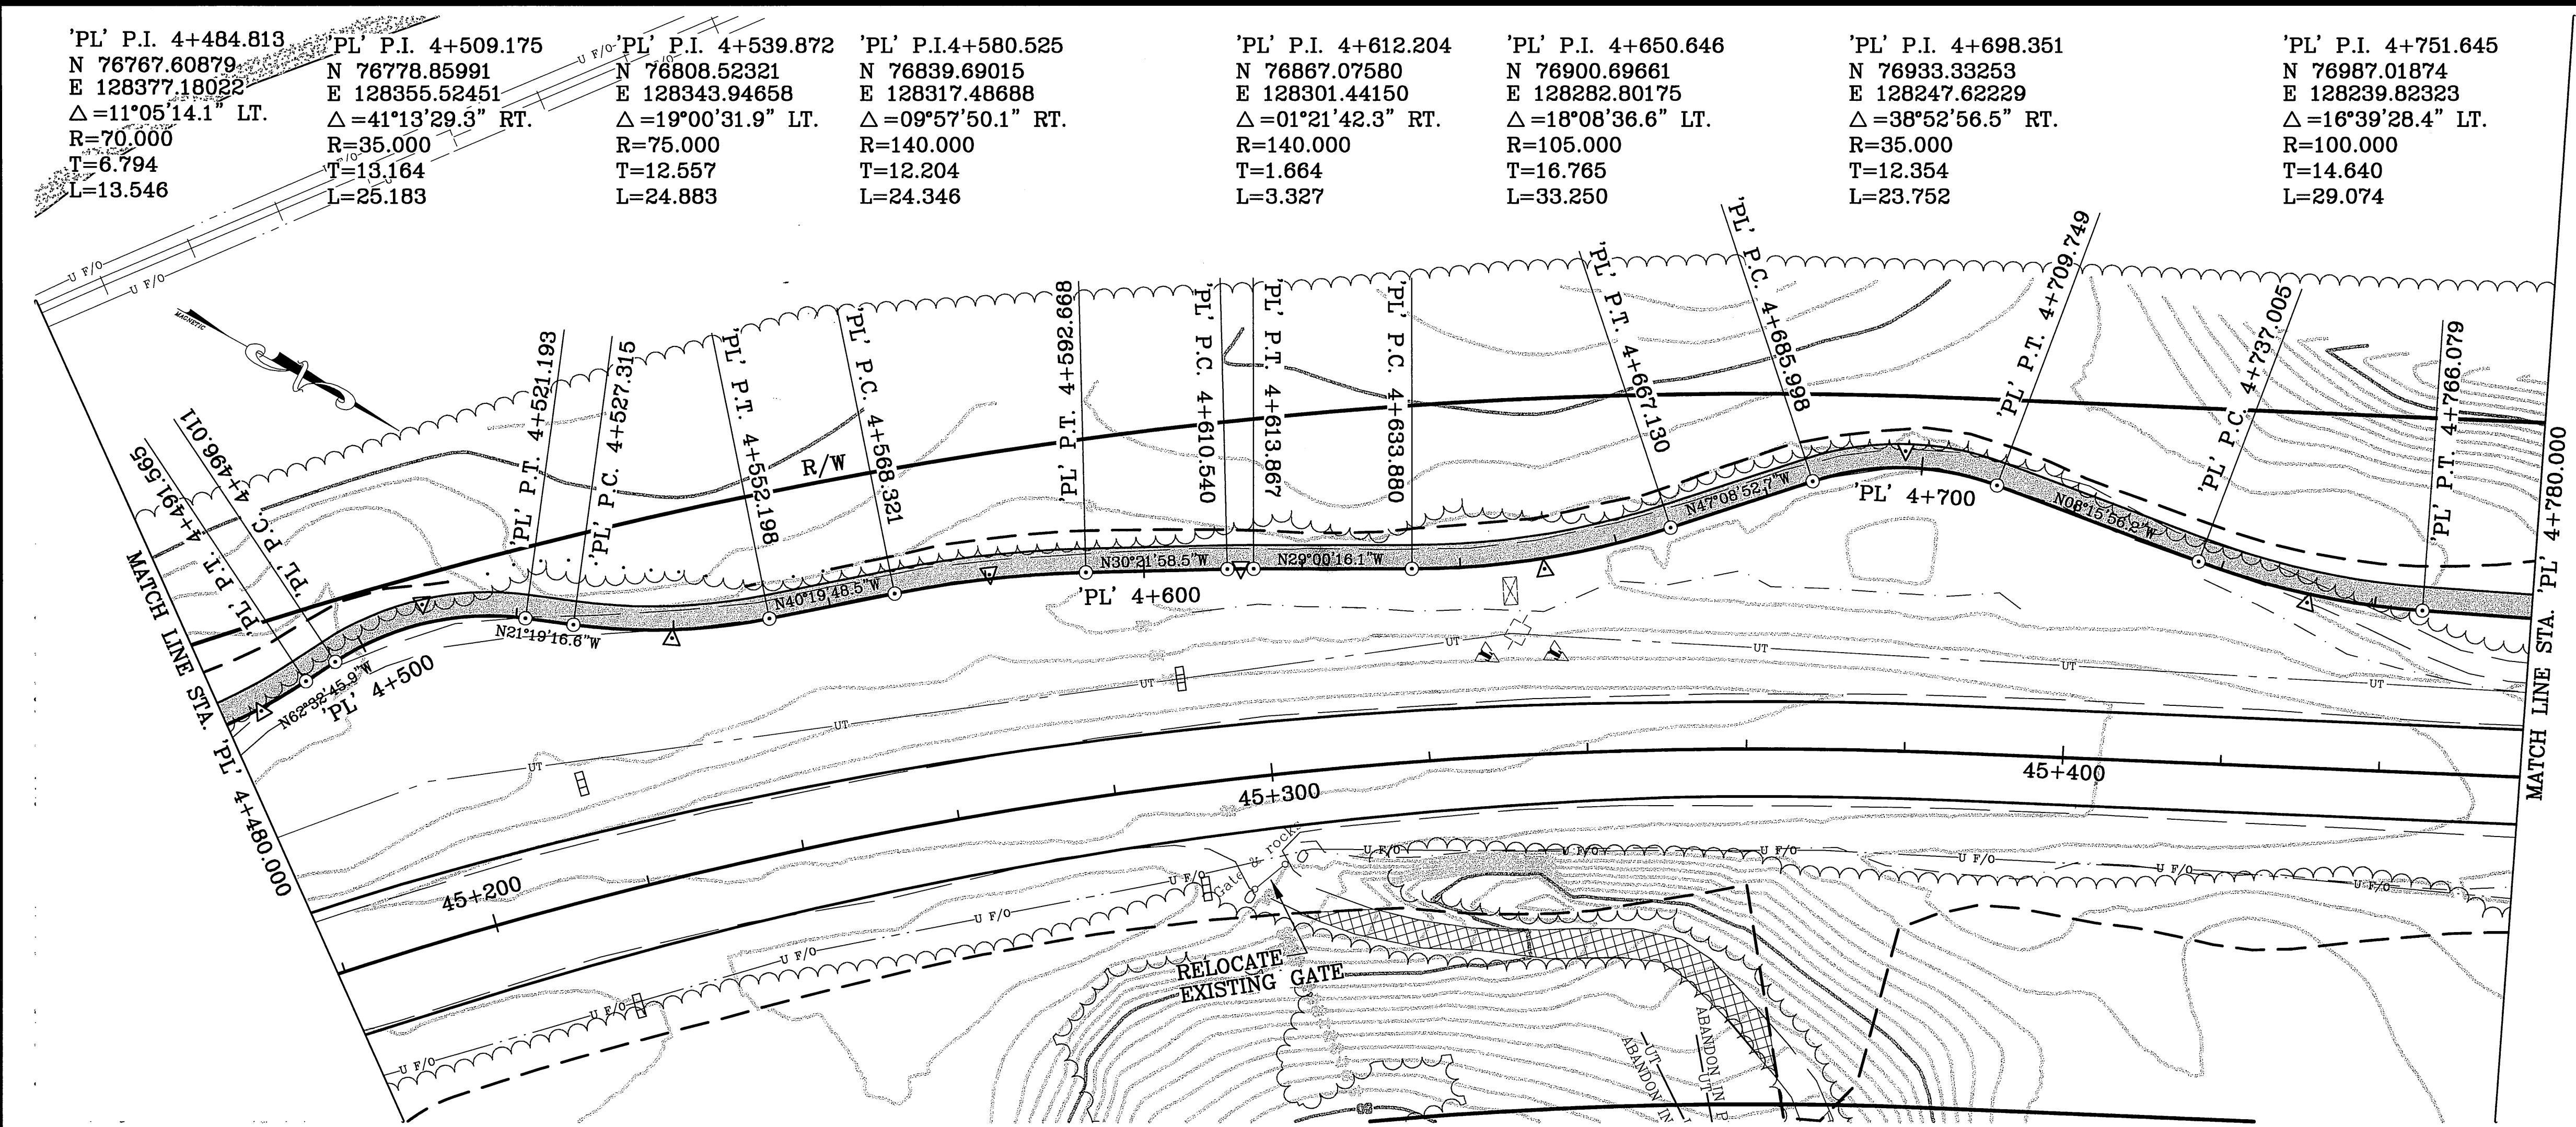


SHEET NO.	TOTAL SHEETS	
FPL3	FPL4	
STATE	YEAR	
ALASKA	2002	
PROJECT DESIGNATION		
NH-0A3-1(28)		
ADDENDUM NO.		
ATTACHMENT NO.		
REVISIONS		
NO.	DATE	DESCRIPTION

NOTE:
DIMENSIONS ARE IN METERS
UNLESS OTHERWISE NOTED.


STATE OF ALASKA
49th
JUDY J. ROBERTS
CE 8823
REGISTERED PROFESSIONAL ENGINEER

STATE OF ALASKA
DEPARTMENT OF TRANSPORTATION
AND PUBLIC FACILITIES
SEWARD HIGHWAY
MP 96 TO MP 102
SAFETY, ROADWAY &
RECREATIONAL IMPROVEMENTS
BIRD CREEK LEFT PATHWAY
PLAN AND PROFILE


SHEET NO.		TOTAL SHEETS	
FPL4		FPL4	
STATE		YEAR	
ALASKA		2002	
PROJECT DESIGNATION			
NH-OA3-1(28)			
ADDENDUM NO.			
ATTACHMENT NO.			
REVISIONS			
NO.	DATE	DESCRIPTION	

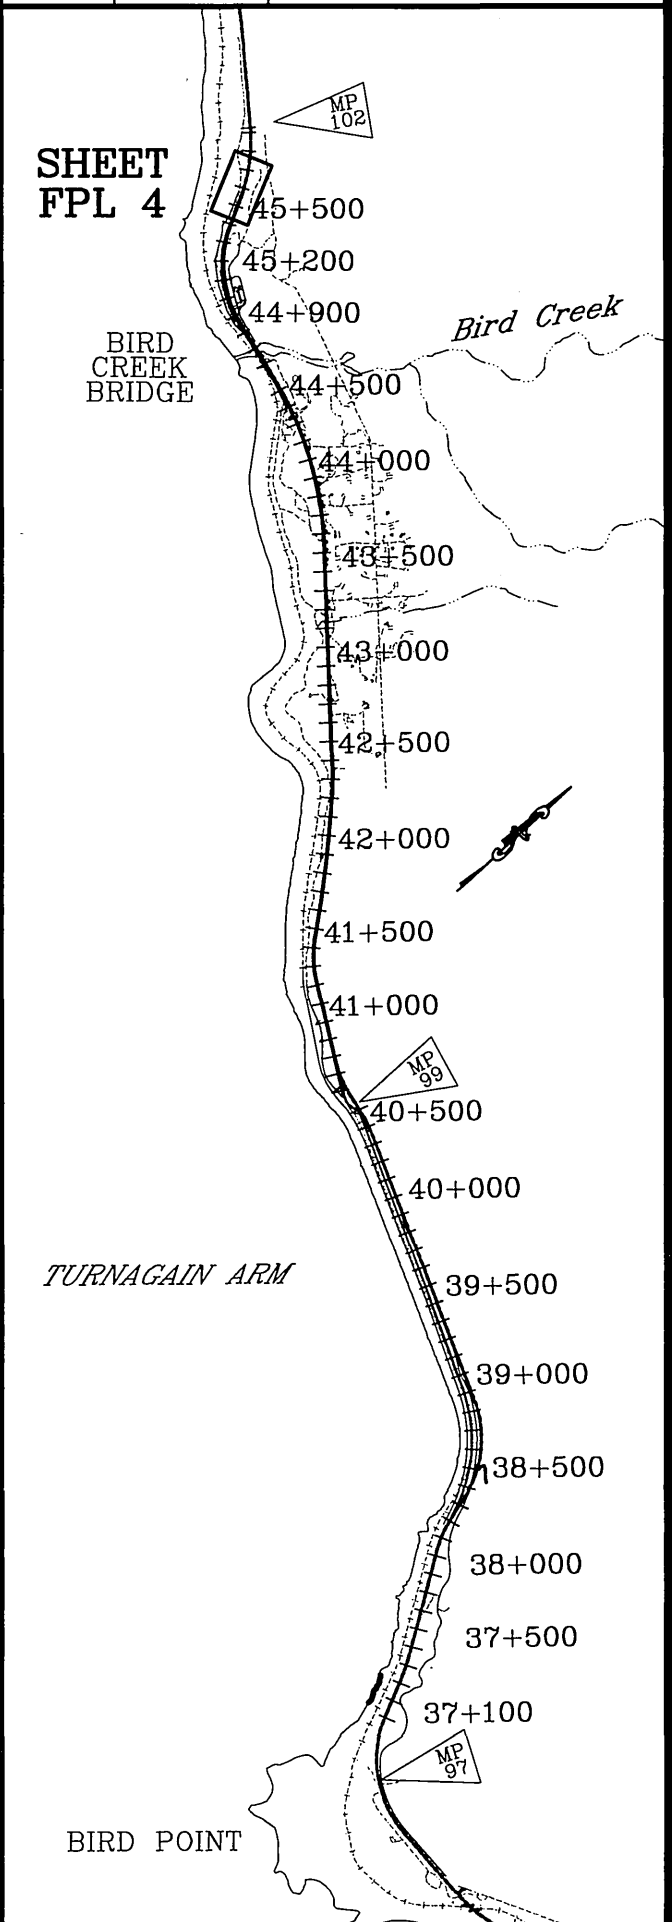


NOTE:
DIMENSIONS ARE IN METERS
UNLESS OTHERWISE NOTED.

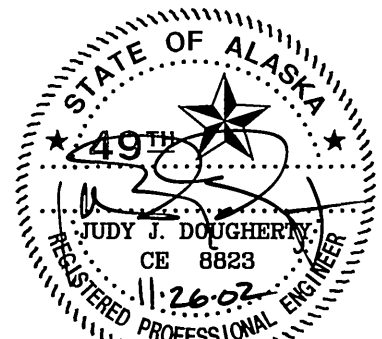

STATE OF ALASKA
DEPARTMENT OF TRANSPORTATION
AND PUBLIC FACILITIES
SEWARD HIGHWAY
MP 96 TO MP 102
SAFETY, ROADWAY &
RECREATIONAL IMPROVEMENTS
BIRD CREEK LEFT PATHWAY
PLAN AND PROFILE

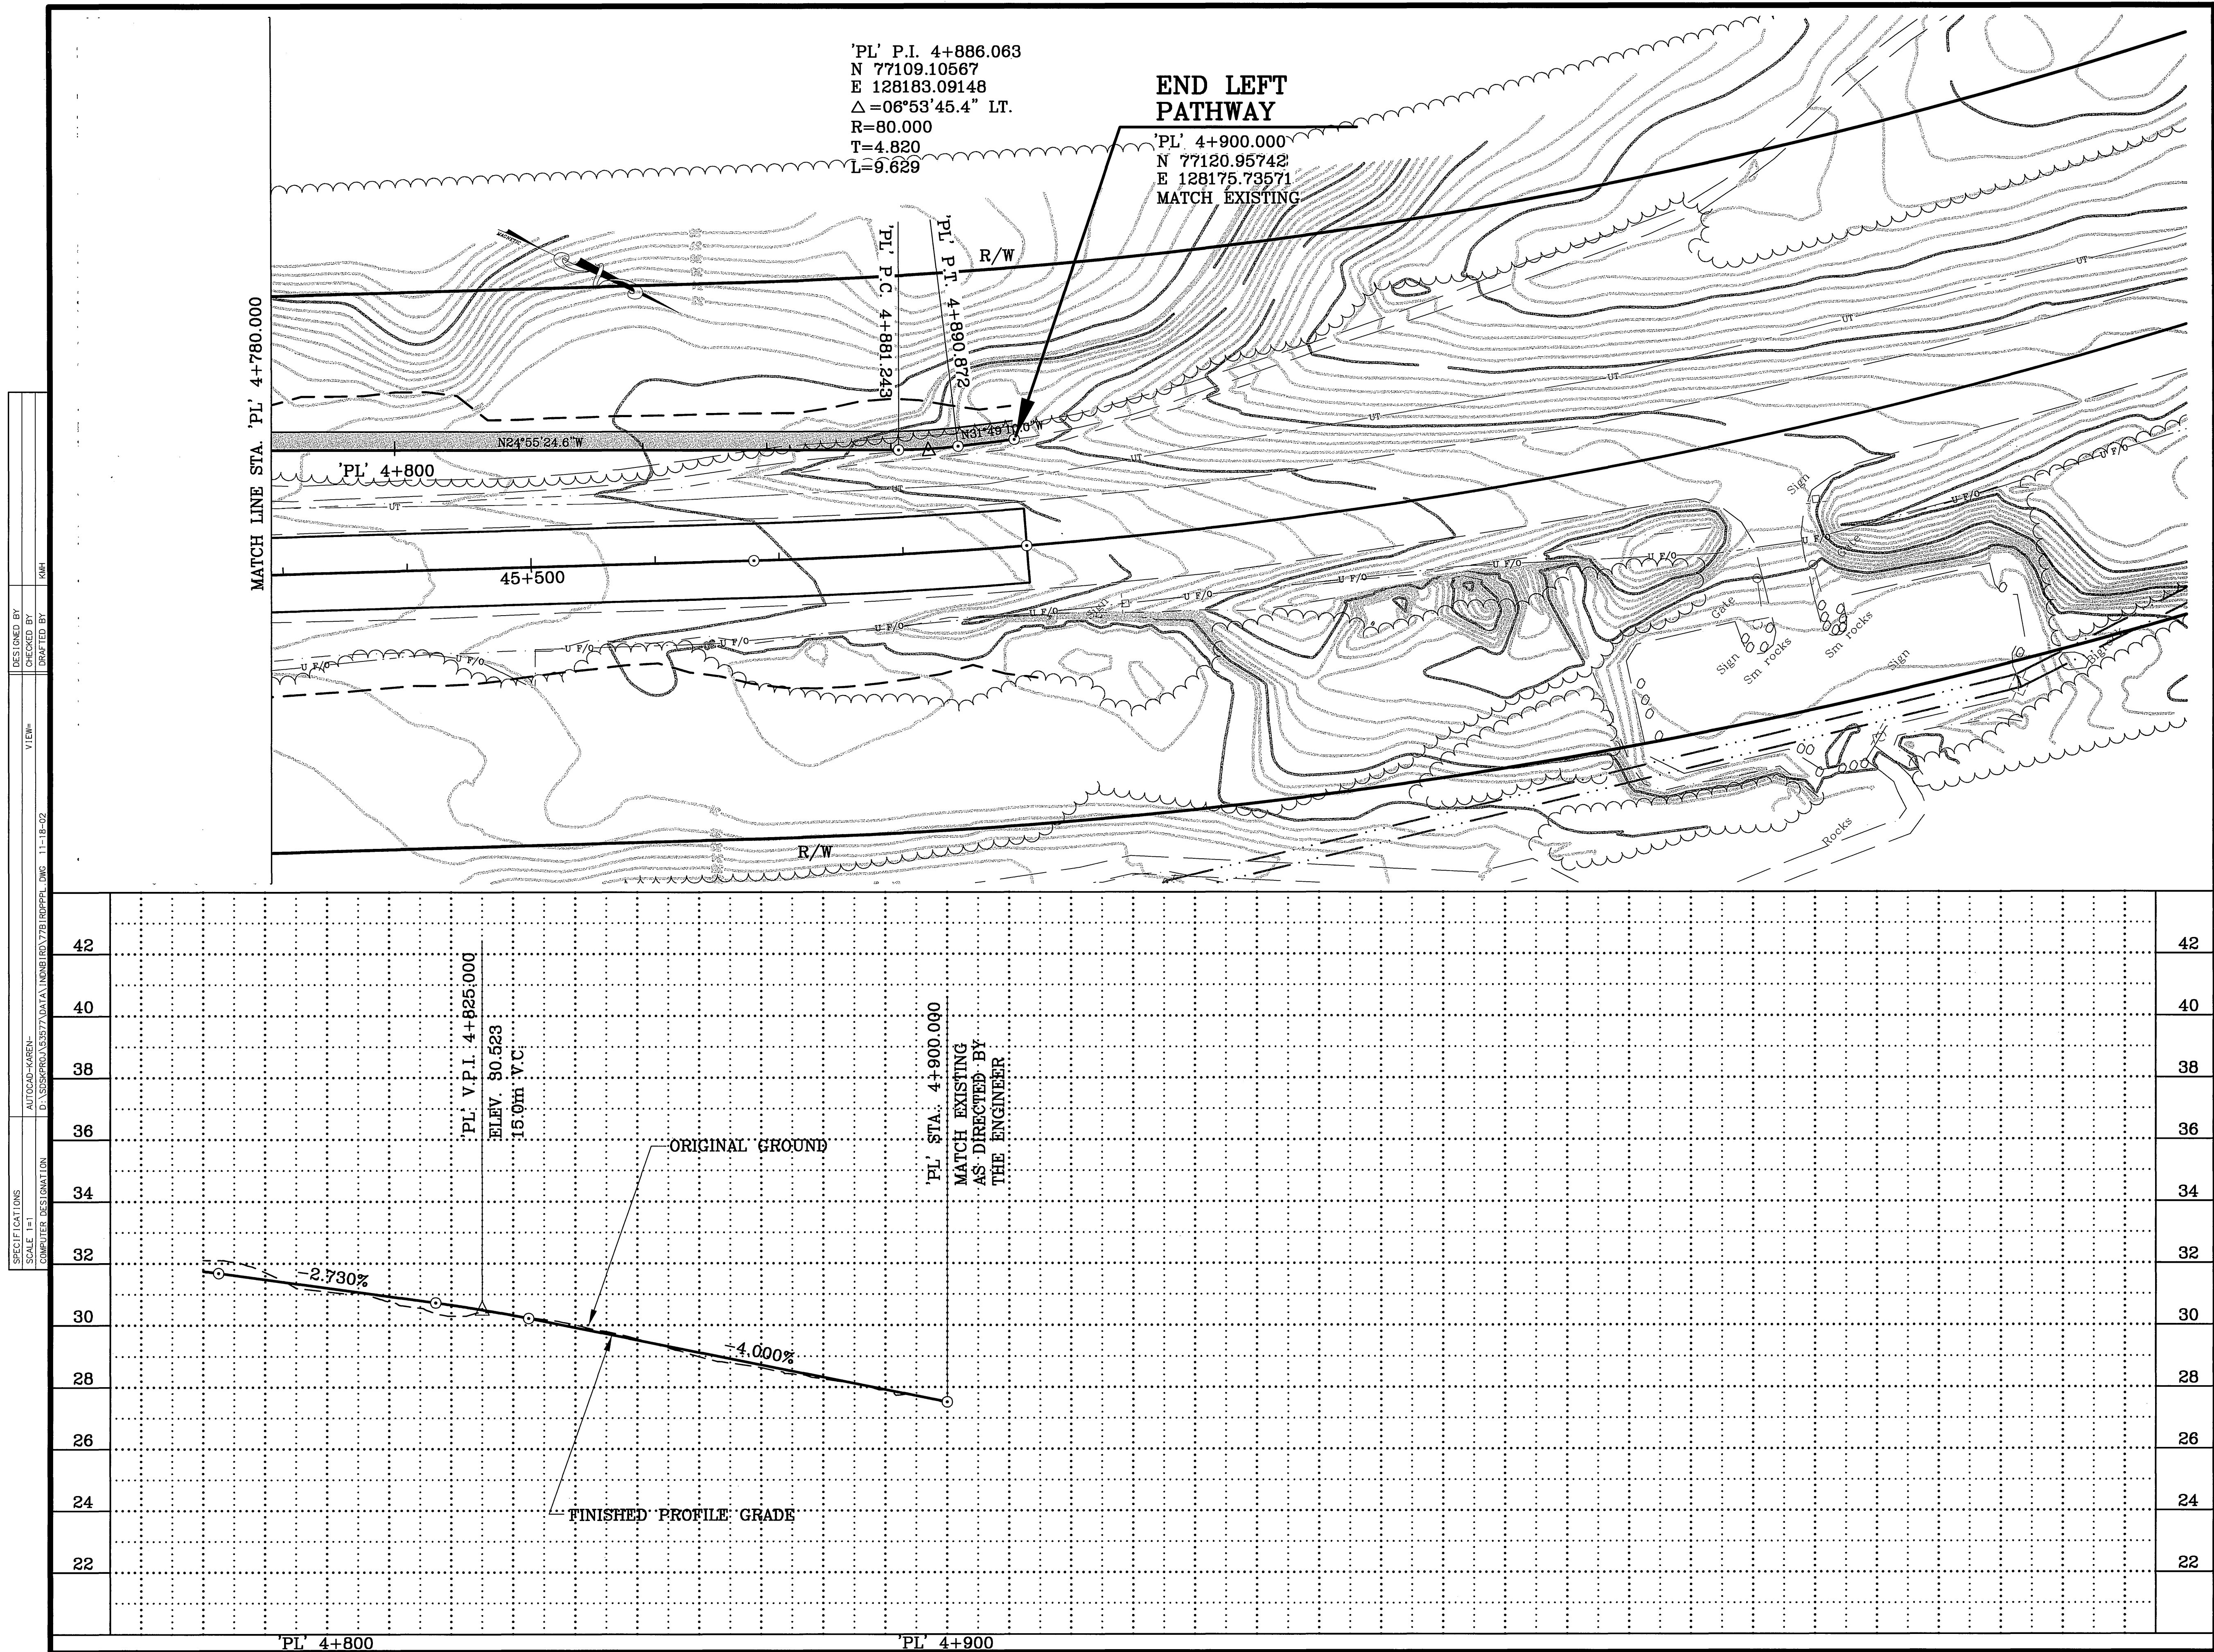

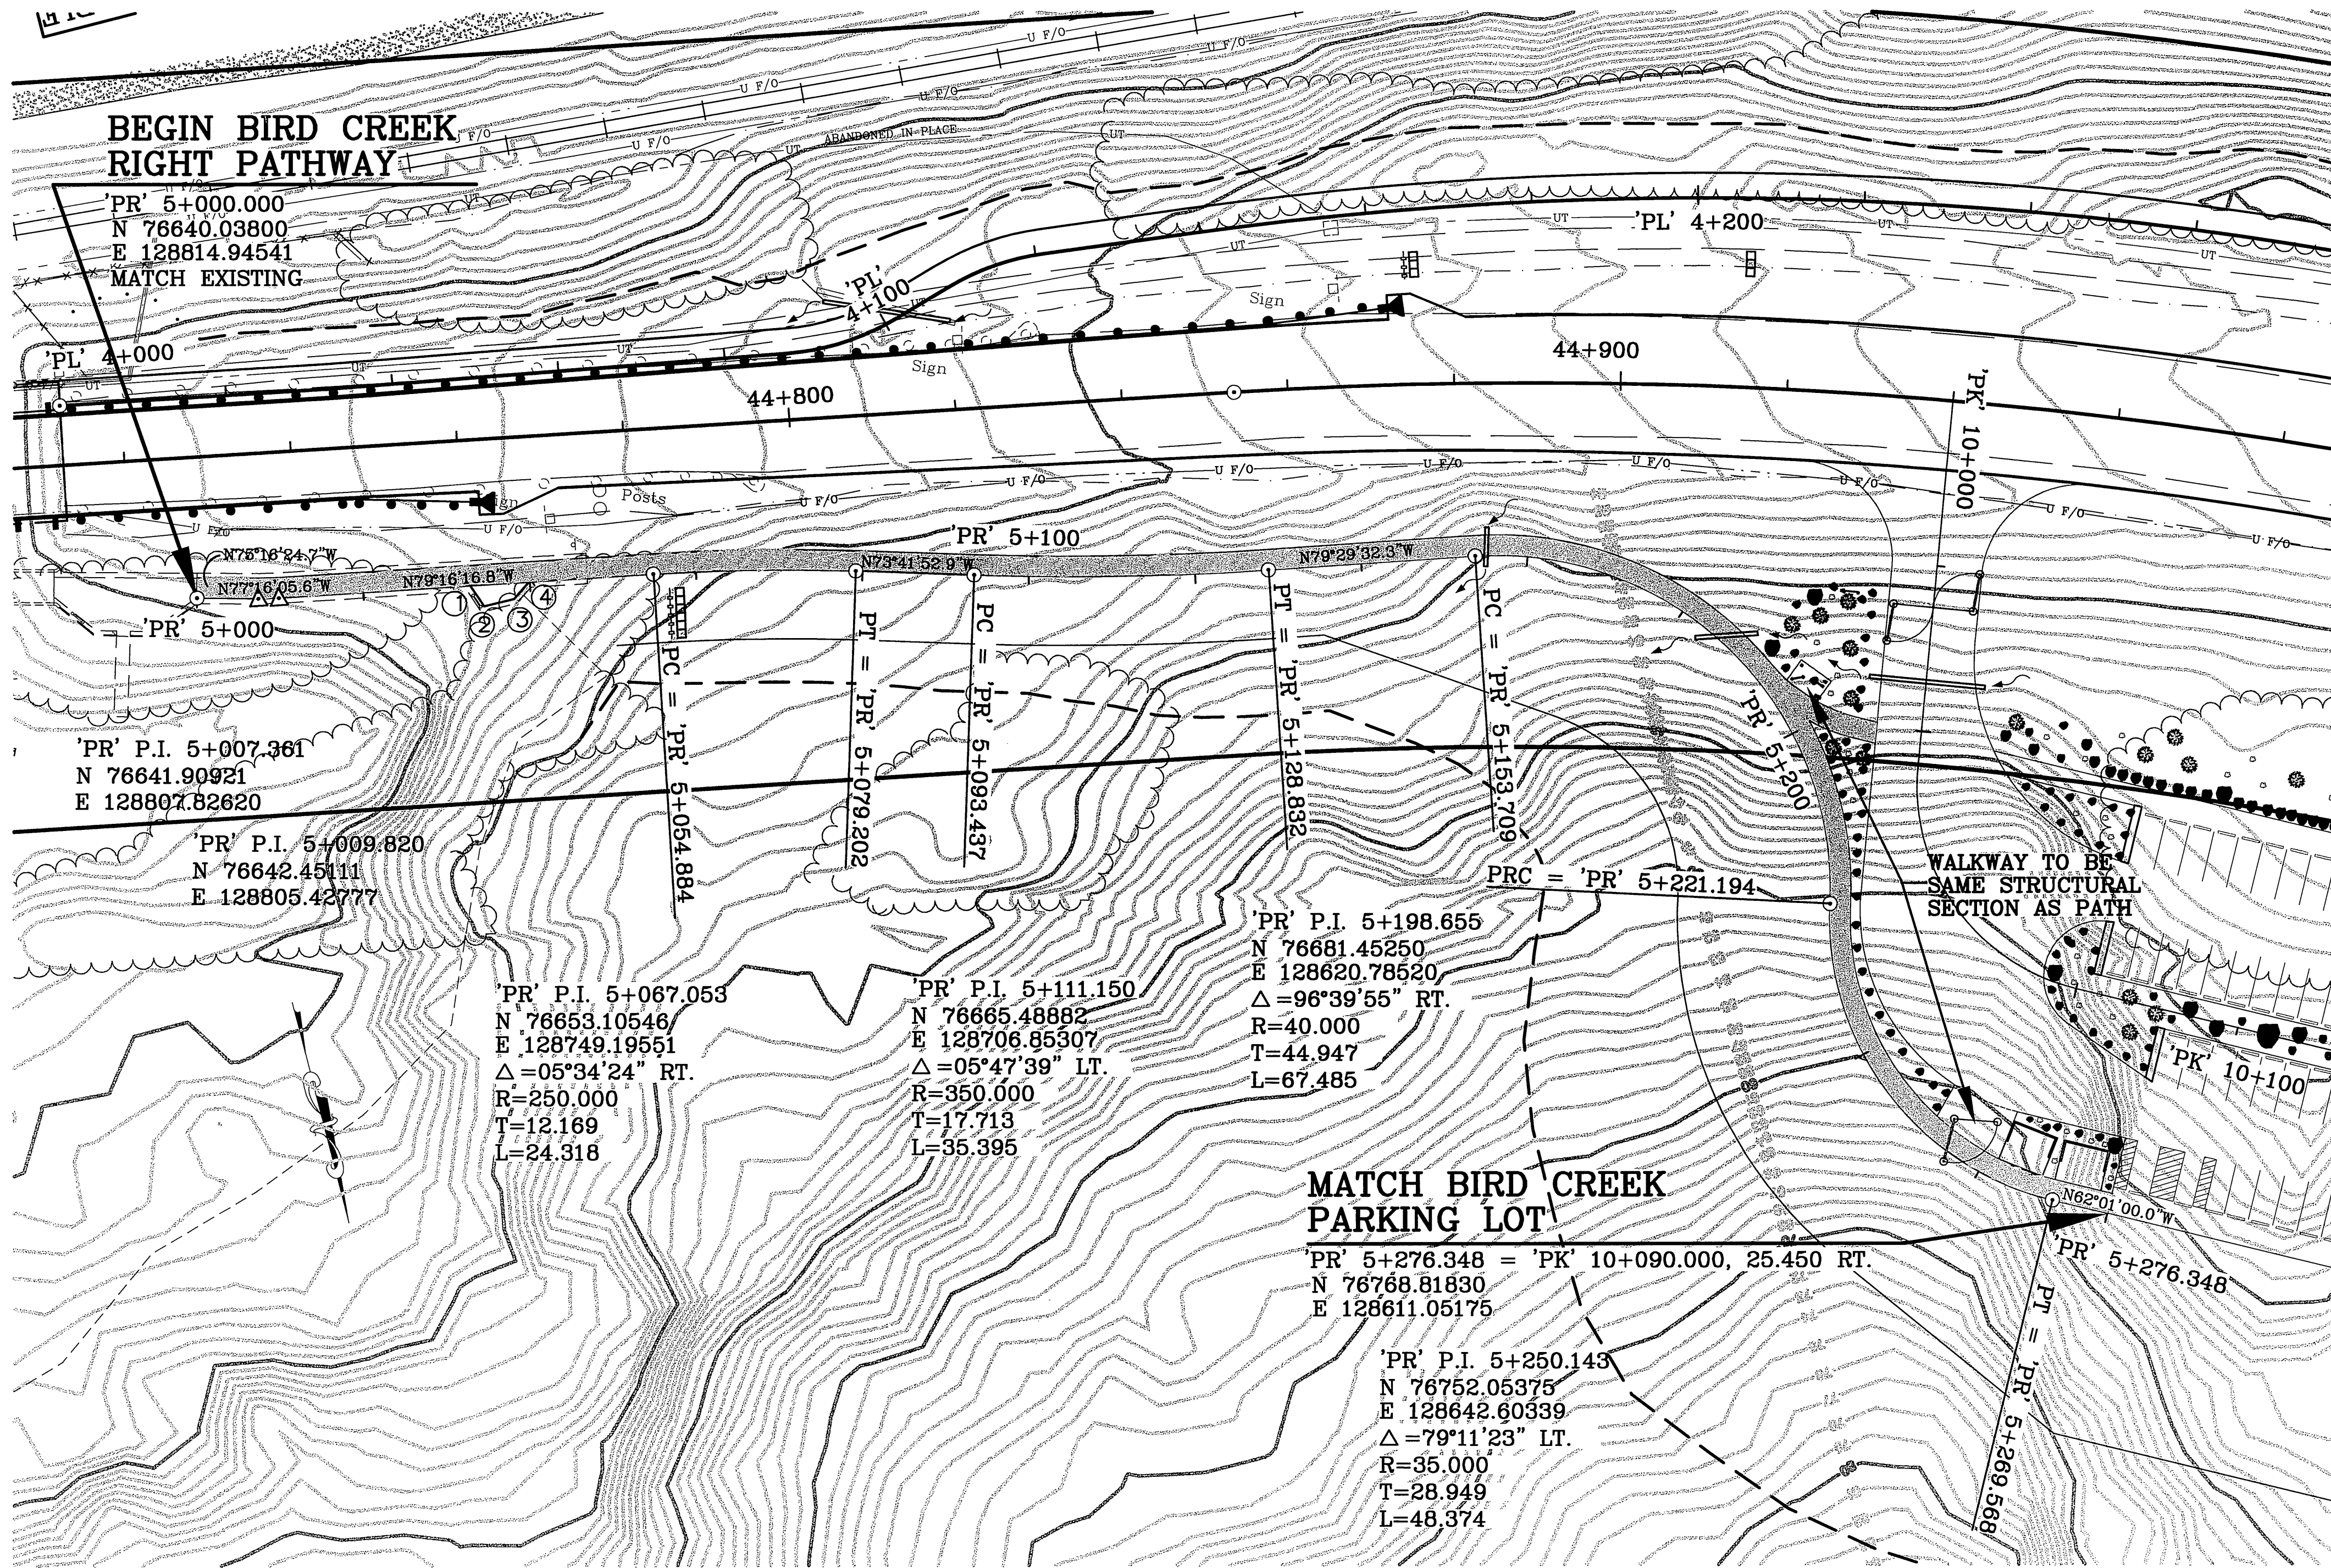

RADIUS TABLE			
POINT	STATION	OFFSET	RADIUS
①	'PR' 5+191.599	22.4 LT.	20.0
②			
③			
④			

PAVEMENT OFFSET TABLE		
POINT	STATION	OFFSET
①	'PR' 5+032.833	0.0 RT.
②	'PR' 5+034.330	2.6 RT.
③	'PR' 5+037.979	1.9 RT.
④	'PR' 5+039.898	0.0 RT.


DESIGNED BY: 11/21/02
CHECKED BY: NG
VIEW: 11/21/02
AUTOCAD-NANCY
AUTOCAD-PROJECT/33377/776/RRPRR.DWG
COMPUTER DESIGNATION: 11/21/02

SHEET NO.	TOTAL SHEETS	
FPR1	FPR2	
STATE	YEAR	
ALASKA	2002	
PROJECT DESIGNATION		
NH-OA3-1(28)		
ADDENDUM NO.		
ATTACHMENT NO.		
REVISIONS		
NO.	DATE	DESCRIPTION

NOTE:
DIMENSIONS ARE IN METERS
UNLESS OTHERWISE NOTED.

STATE OF ALASKA
49th
JUDY J. DOWNHILL
CE 8823
11.24.02
REGISTERED PROFESSIONAL ENGINEER

STATE OF ALASKA
DEPARTMENT OF TRANSPORTATION
AND PUBLIC FACILITIES
SEWARD HIGHWAY
MP 96 TO MP 102
SAFETY, ROADWAY &
RECREATIONAL IMPROVEMENTS
BIRD CREEK RIGHT PATHWAY
PLAN

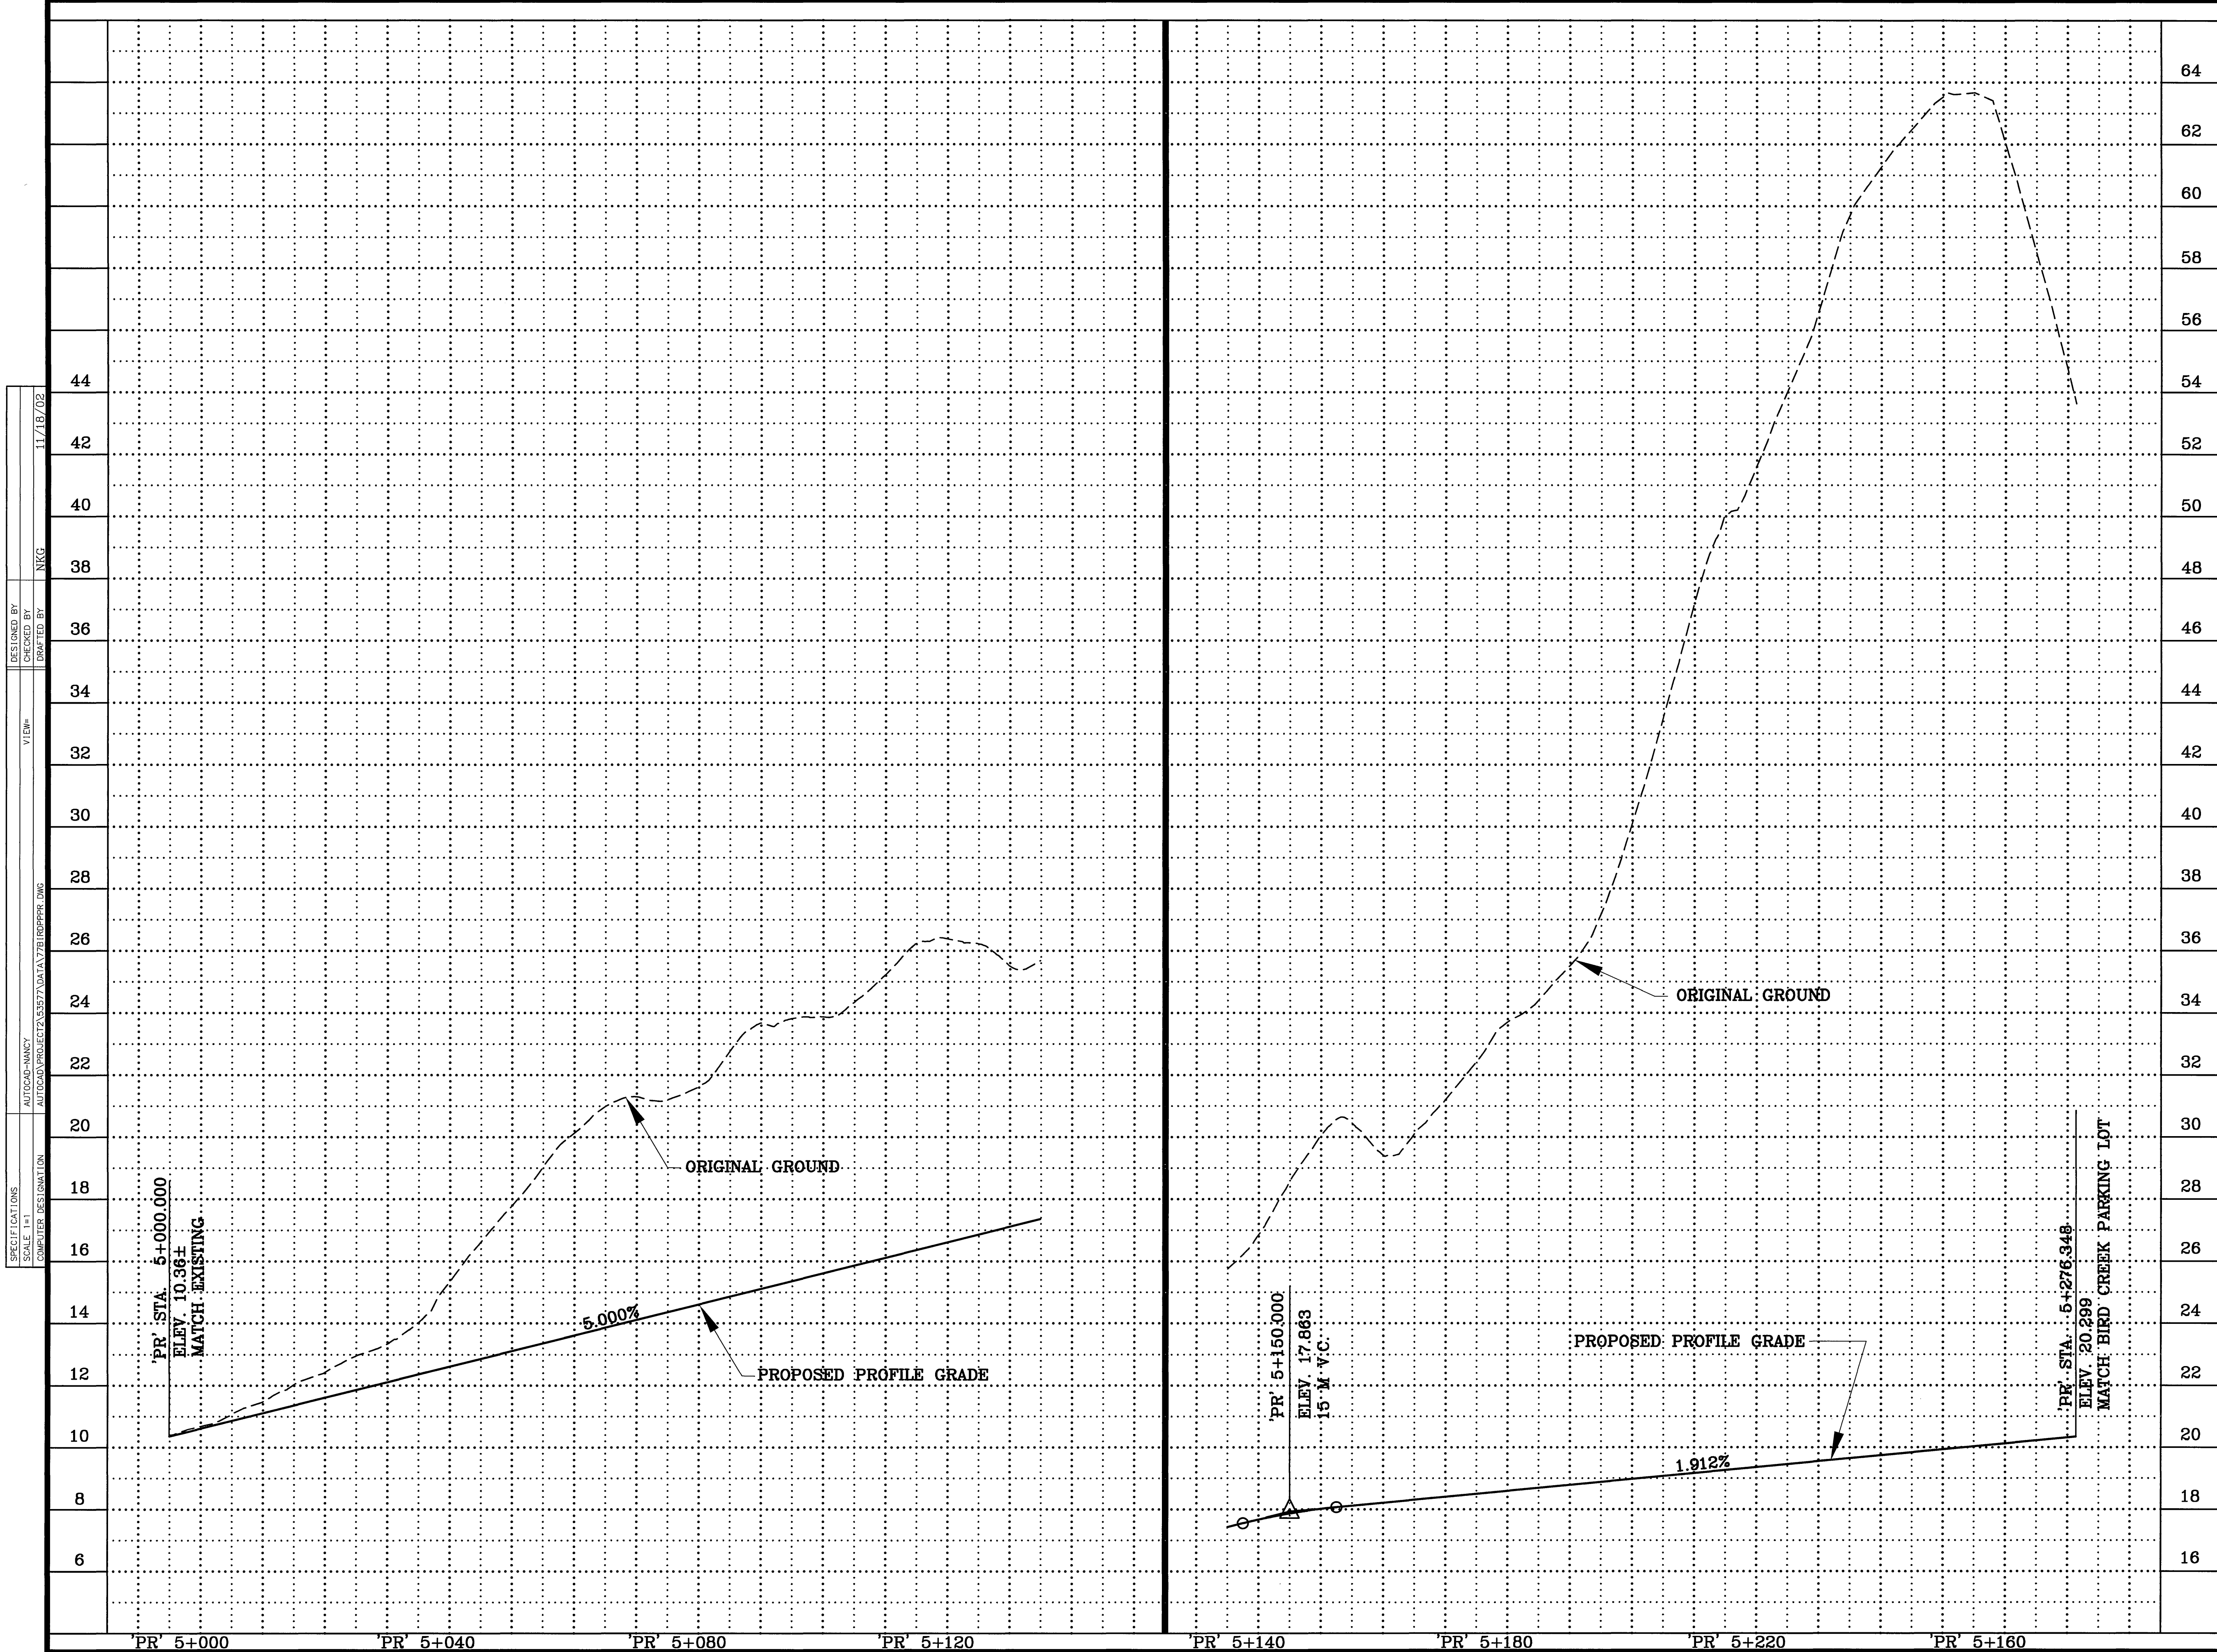

SPECIFICATIONS
SCALE 1"=1'
COMPUTER DESIGNATION
AUTOCAD-MANCY
DESIGNED BY
CHECKED BY
DRAFTED BY
VIEW#
NKG
11/18/02

SHEET NO.	TOTAL SHEETS	
FPR2	FPR2	
STATE	YEAR	
ALASKA	2002	
PROJECT DESIGNATION		
NH-0A3-1(28)		
ADDENDUM NO.		
ATTACHMENT NO.		
REVISIONS		
NO.	DATE	DESCRIPTION

SHEET FPR 2
BIRD CREEK BRIDGE

Bird Creek

TURNAGAIN ARM


BIRD POINT

NOTE:
DIMENSIONS ARE IN METERS
UNLESS OTHERWISE NOTED.


STATE OF ALASKA
49th
JUDY J. DOUGHERTY
C.E. 8823
11-26-97
REGISTERED PROFESSIONAL ENGINEER

STATE OF ALASKA
DEPARTMENT OF TRANSPORTATION
AND PUBLIC FACILITIES
SEWARD HIGHWAY
MP 96 TO MP 102
SAFETY, ROADWAY &
RECREATIONAL IMPROVEMENTS
BIRD CREEK RIGHT PATHWAY
PROFILE

REVISIONS			STATE	PROJECT DESIGNATION	YEAR	SHEET NO.	TOTAL SHEETS
No.	DATE	DESCRIPTION					
			ALASKA	NH-0A3-1(28)	2002	G1	G1

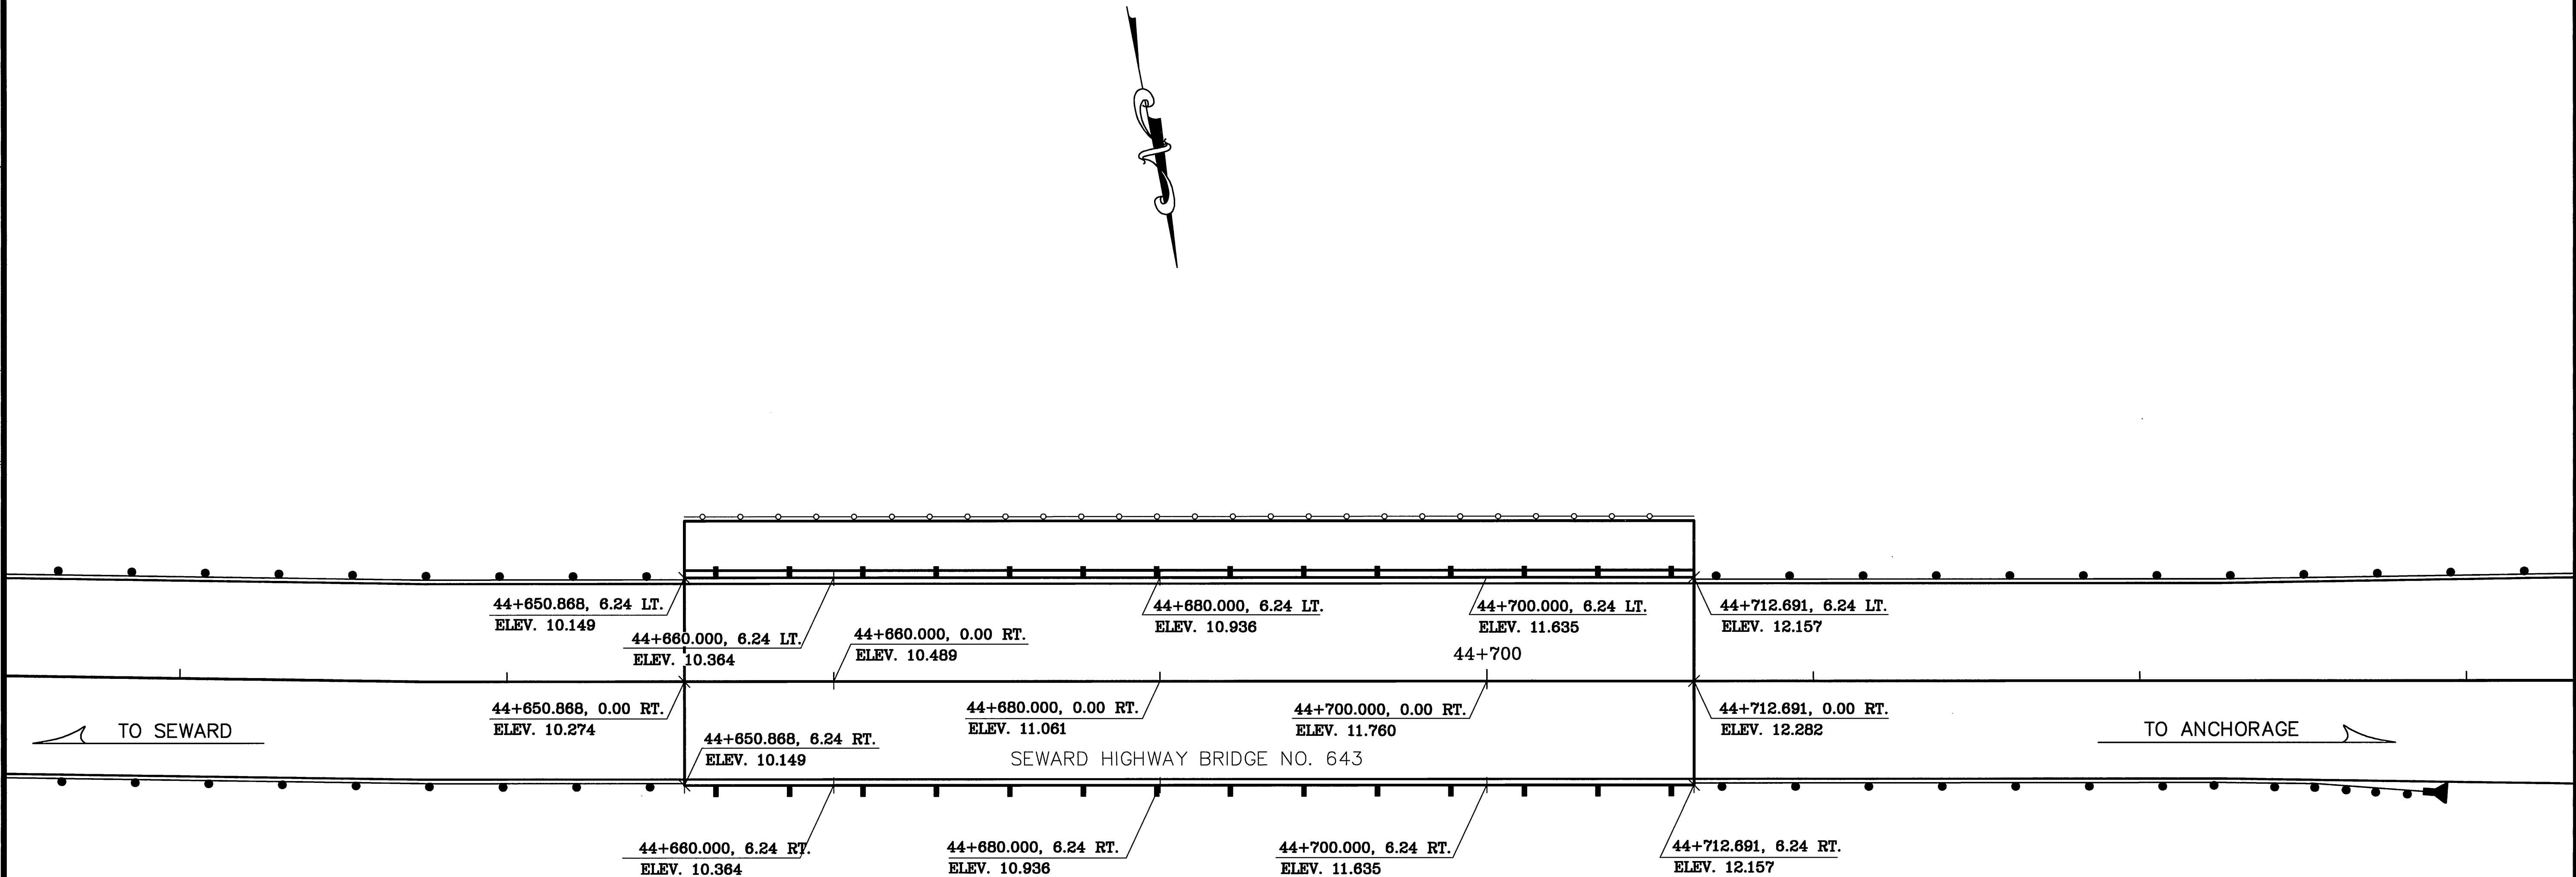


BRIDGE NO. 643 FINISH PAVEMENT ELEVATIONS

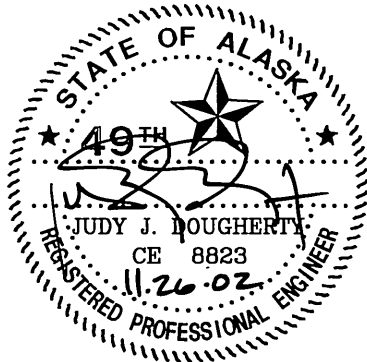


STATE OF ALASKA
DEPARTMENT OF TRANSPORTATION
AND
PUBLIC FACILITIES
**SEWARD HIGHWAY
MP 96 TO MP 102
SAFETY, ROADWAY &
RECREATIONAL IMPROVEMENTS**
**BRIDGE NO. 643
FINISH PAVEMENT ELEVATIONS**

SHEET NO.	TOTAL SHEETS	
J1	J32	
STATE	YEAR	
ALASKA	2002	
PROJECT DESIGNATION		
NH-0A3-1(28)		
ADDENDUM NO.		
ATTACHMENT NO.		
REVISIONS		
NO.	DATE	DESCRIPTION

NOTE:
DIMENSIONS ARE IN METERS
UNLESS OTHERWISE NOTED.

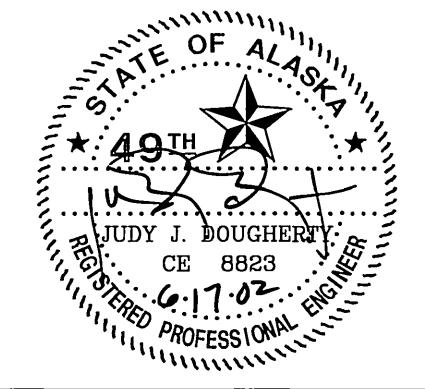


STATE OF ALASKA
DEPARTMENT OF TRANSPORTATION
AND PUBLIC FACILITIES
SEWARD HIGHWAY
MP 96 TO MP 102
SAFETY, ROADWAY AND
RECREATIONAL IMPROVEMENTS
SIGNING AND STRIPING

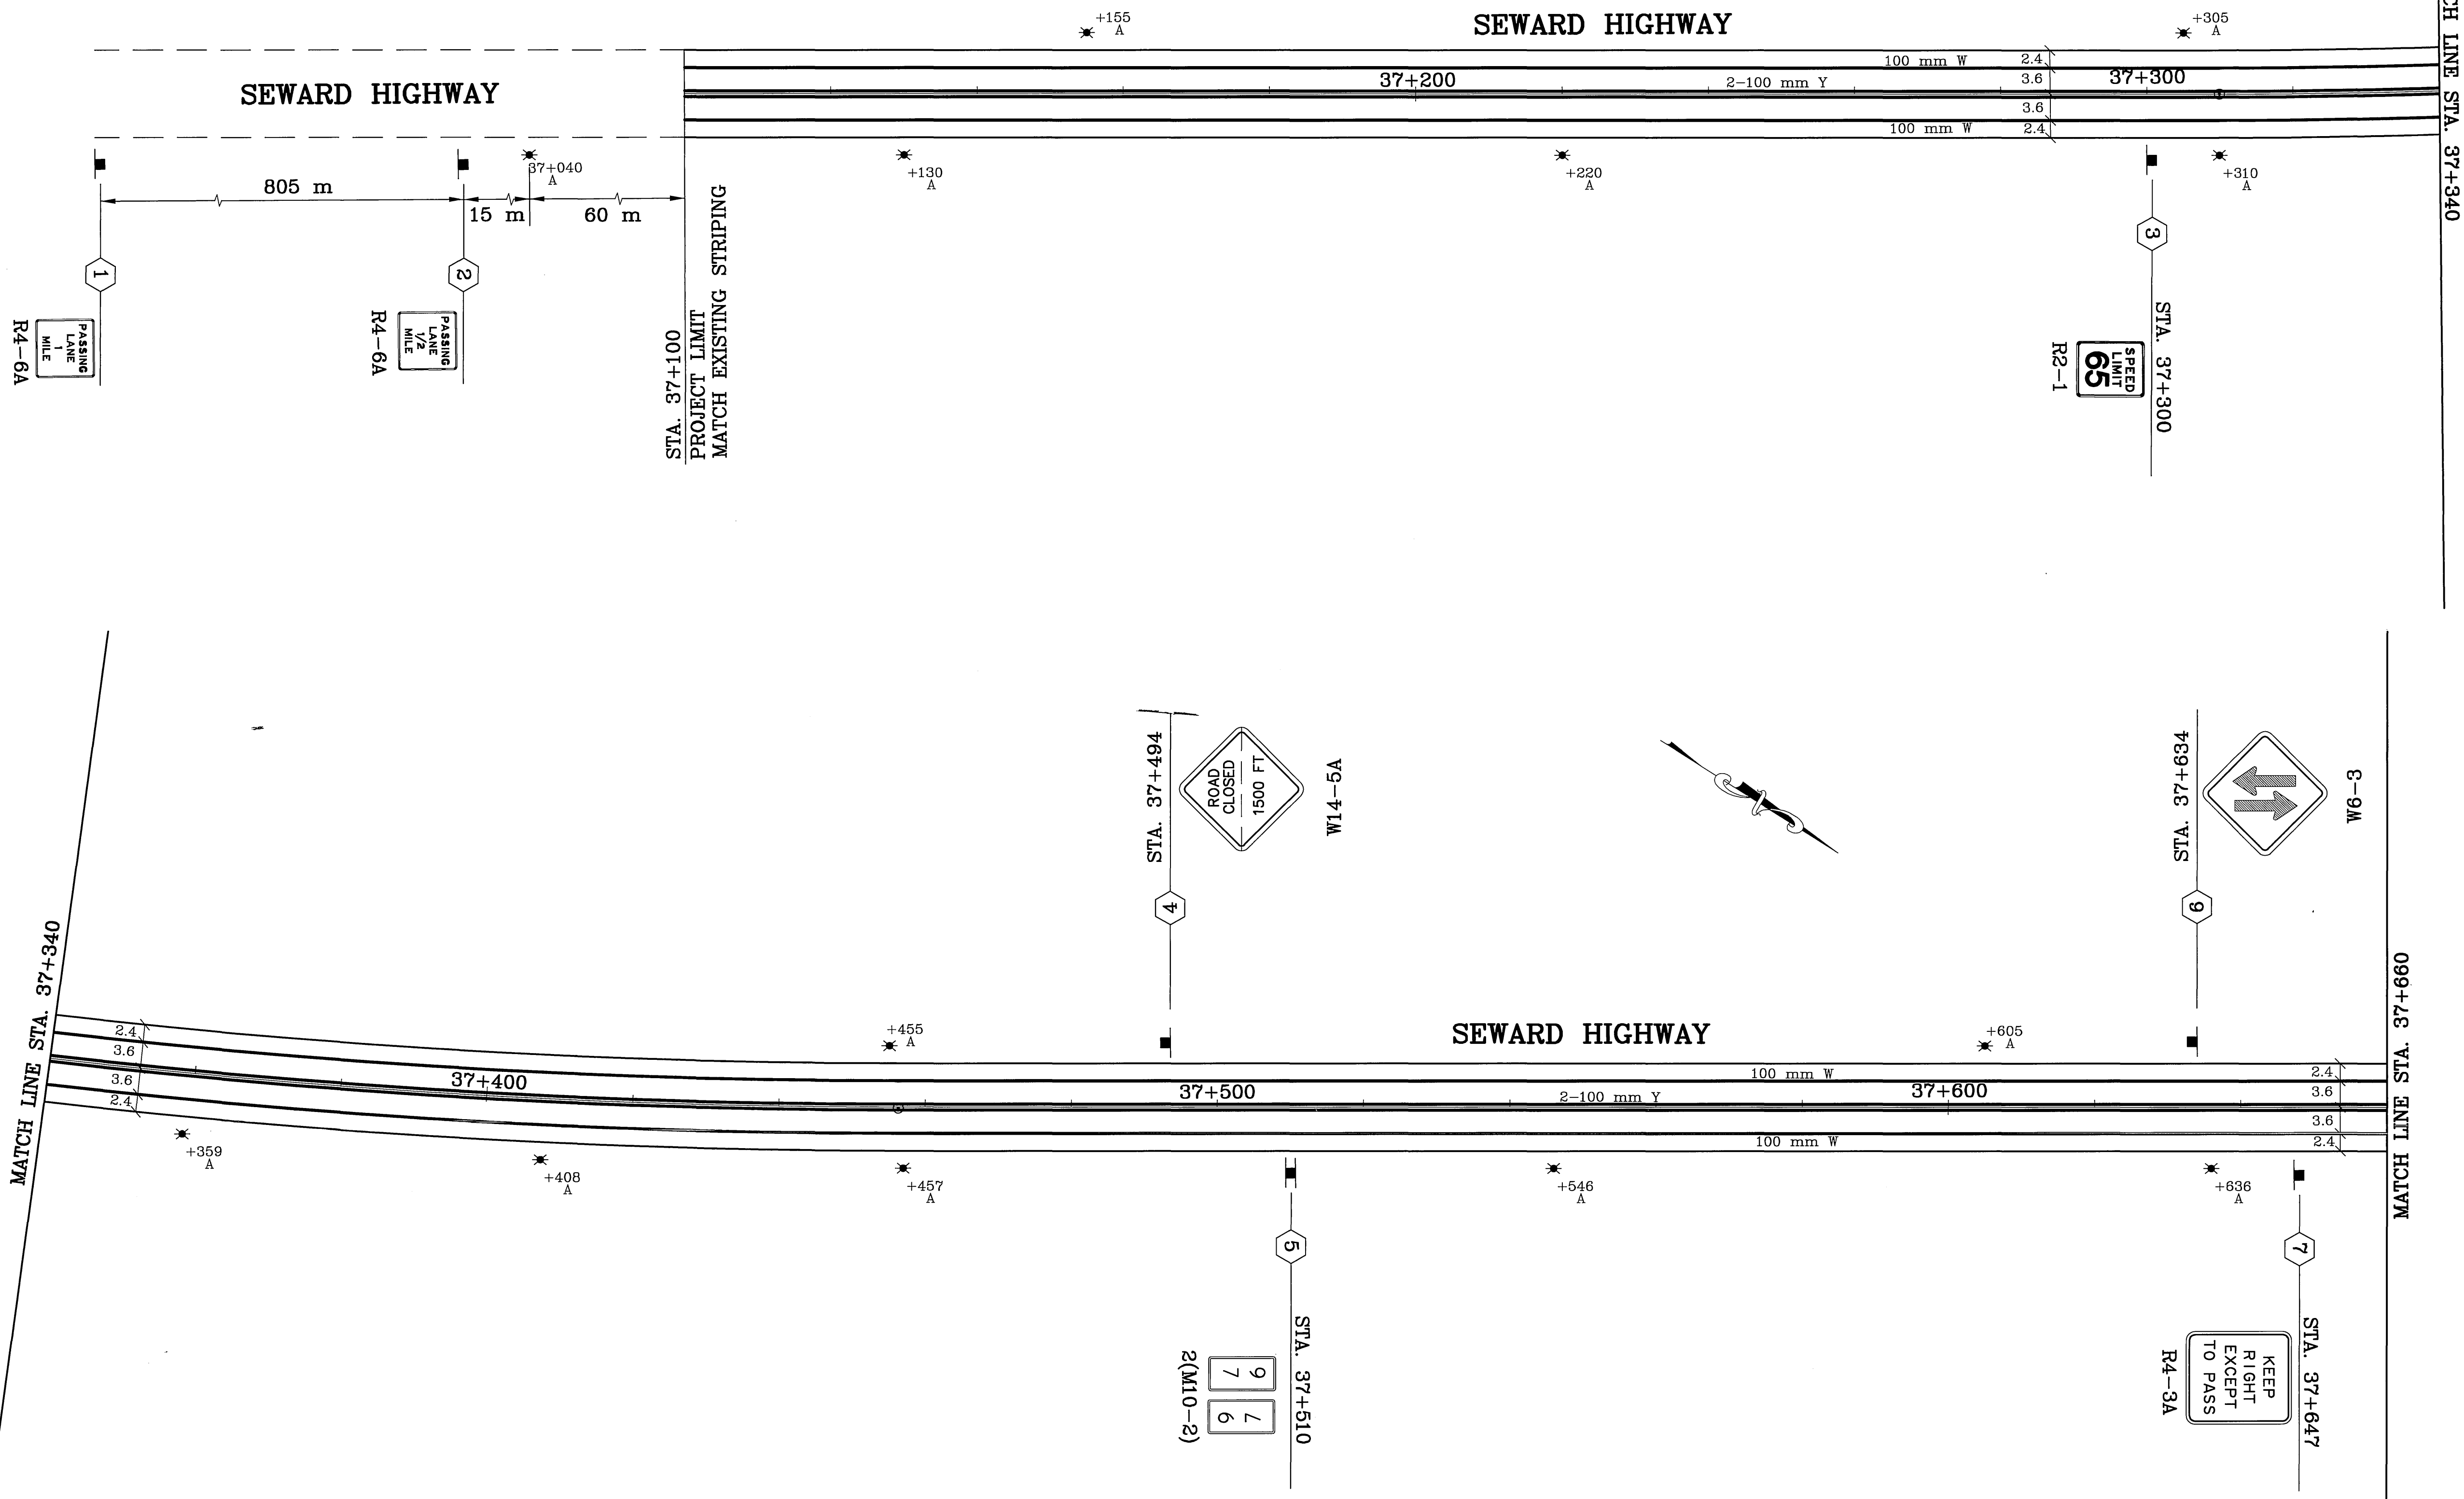

SPECIFICATIONS	DESIGNED BY	6/12/02
SCALE 1"=1'	CHECKED BY	KMH
AUTOCAD-CAROLEE: SSKPROJ\33577\STRIP	DRAFTED BY	
COMPUTER DESIGNATION	VIEW#	


SPECIFICATIONS	DESIGNED BY	6/12/02
SCALE 1"=1'	CHECKED BY	KMH
COMPUTER DESIGNATION	DRAFTED BY	
	VIEW#	
	AUTOCAD-CAROLEE: S55KPROJ\33977\STRIP	
	D:\S55KPROJ\33977\DATA\IND8\RD78\IRPPTRE.DWG	B-21-01 2:52:26 pm EST

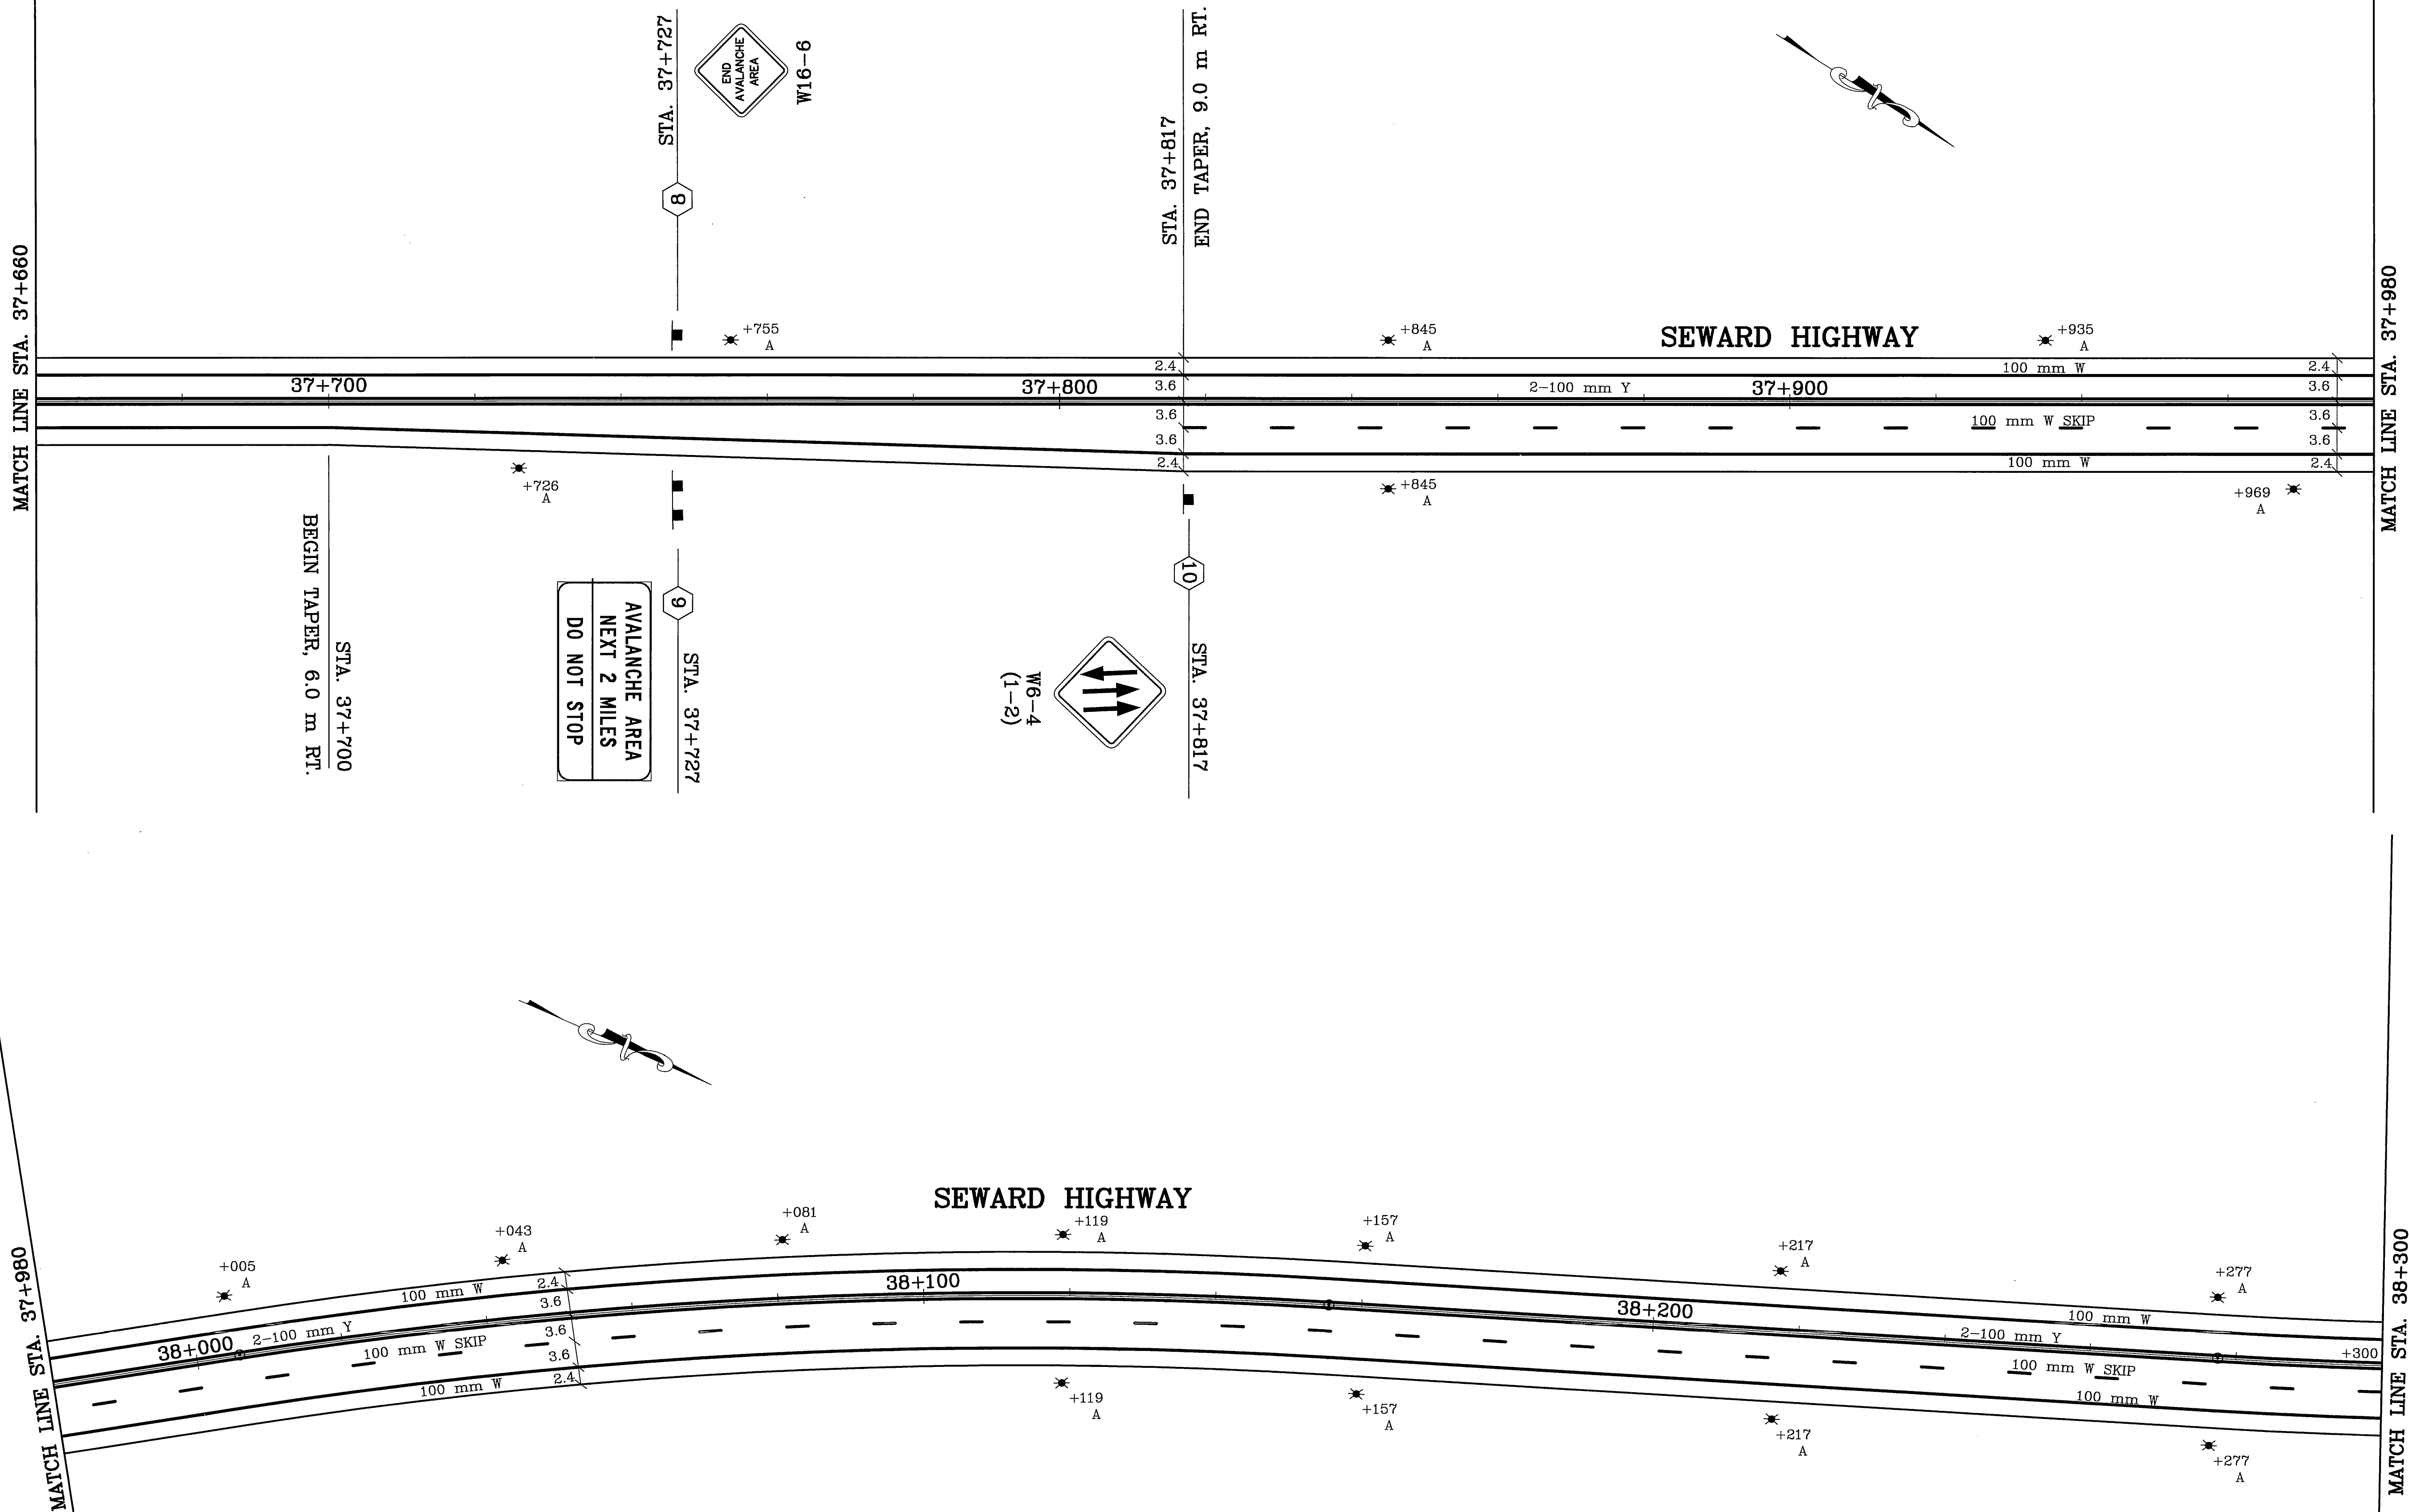

SHEET NO.		TOTAL SHEETS	
J2		J32	
STATE		YEAR	
ALASKA		2002	
PROJECT DESIGNATION			
NH-OA3-1(28)			
ADDENDUM NO.			
ATTACHMENT NO.			
REVISIONS			
NO.	DATE	DESCRIPTION	

THIS SHEET REPLACED BY J2A
CHANGE ORDER NO. 6

NOTE:
DIMENSIONS ARE IN METERS
UNLESS OTHERWISE NOTED.

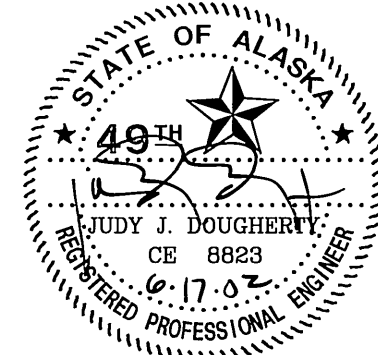


STATE OF ALASKA
DEPARTMENT OF TRANSPORTATION
AND PUBLIC FACILITIES

SEWARD HIGHWAY
MP 96 TO MP 102
SAFETY, ROADWAY AND
RECREATIONAL IMPROVEMENTS

SIGNING AND STRIPING

AS-BUILT 4/1/12

SPECIFICATIONS	DESIGNED BY	VIEW#2
SCALE 1"=100'	CHECKED BY	
AUTOCAD: CAROLLE 544433 STRIPE CHANGEORDER	DRAWN BY	
COMPUTER DESIGNATION	DATE 4/26/04	

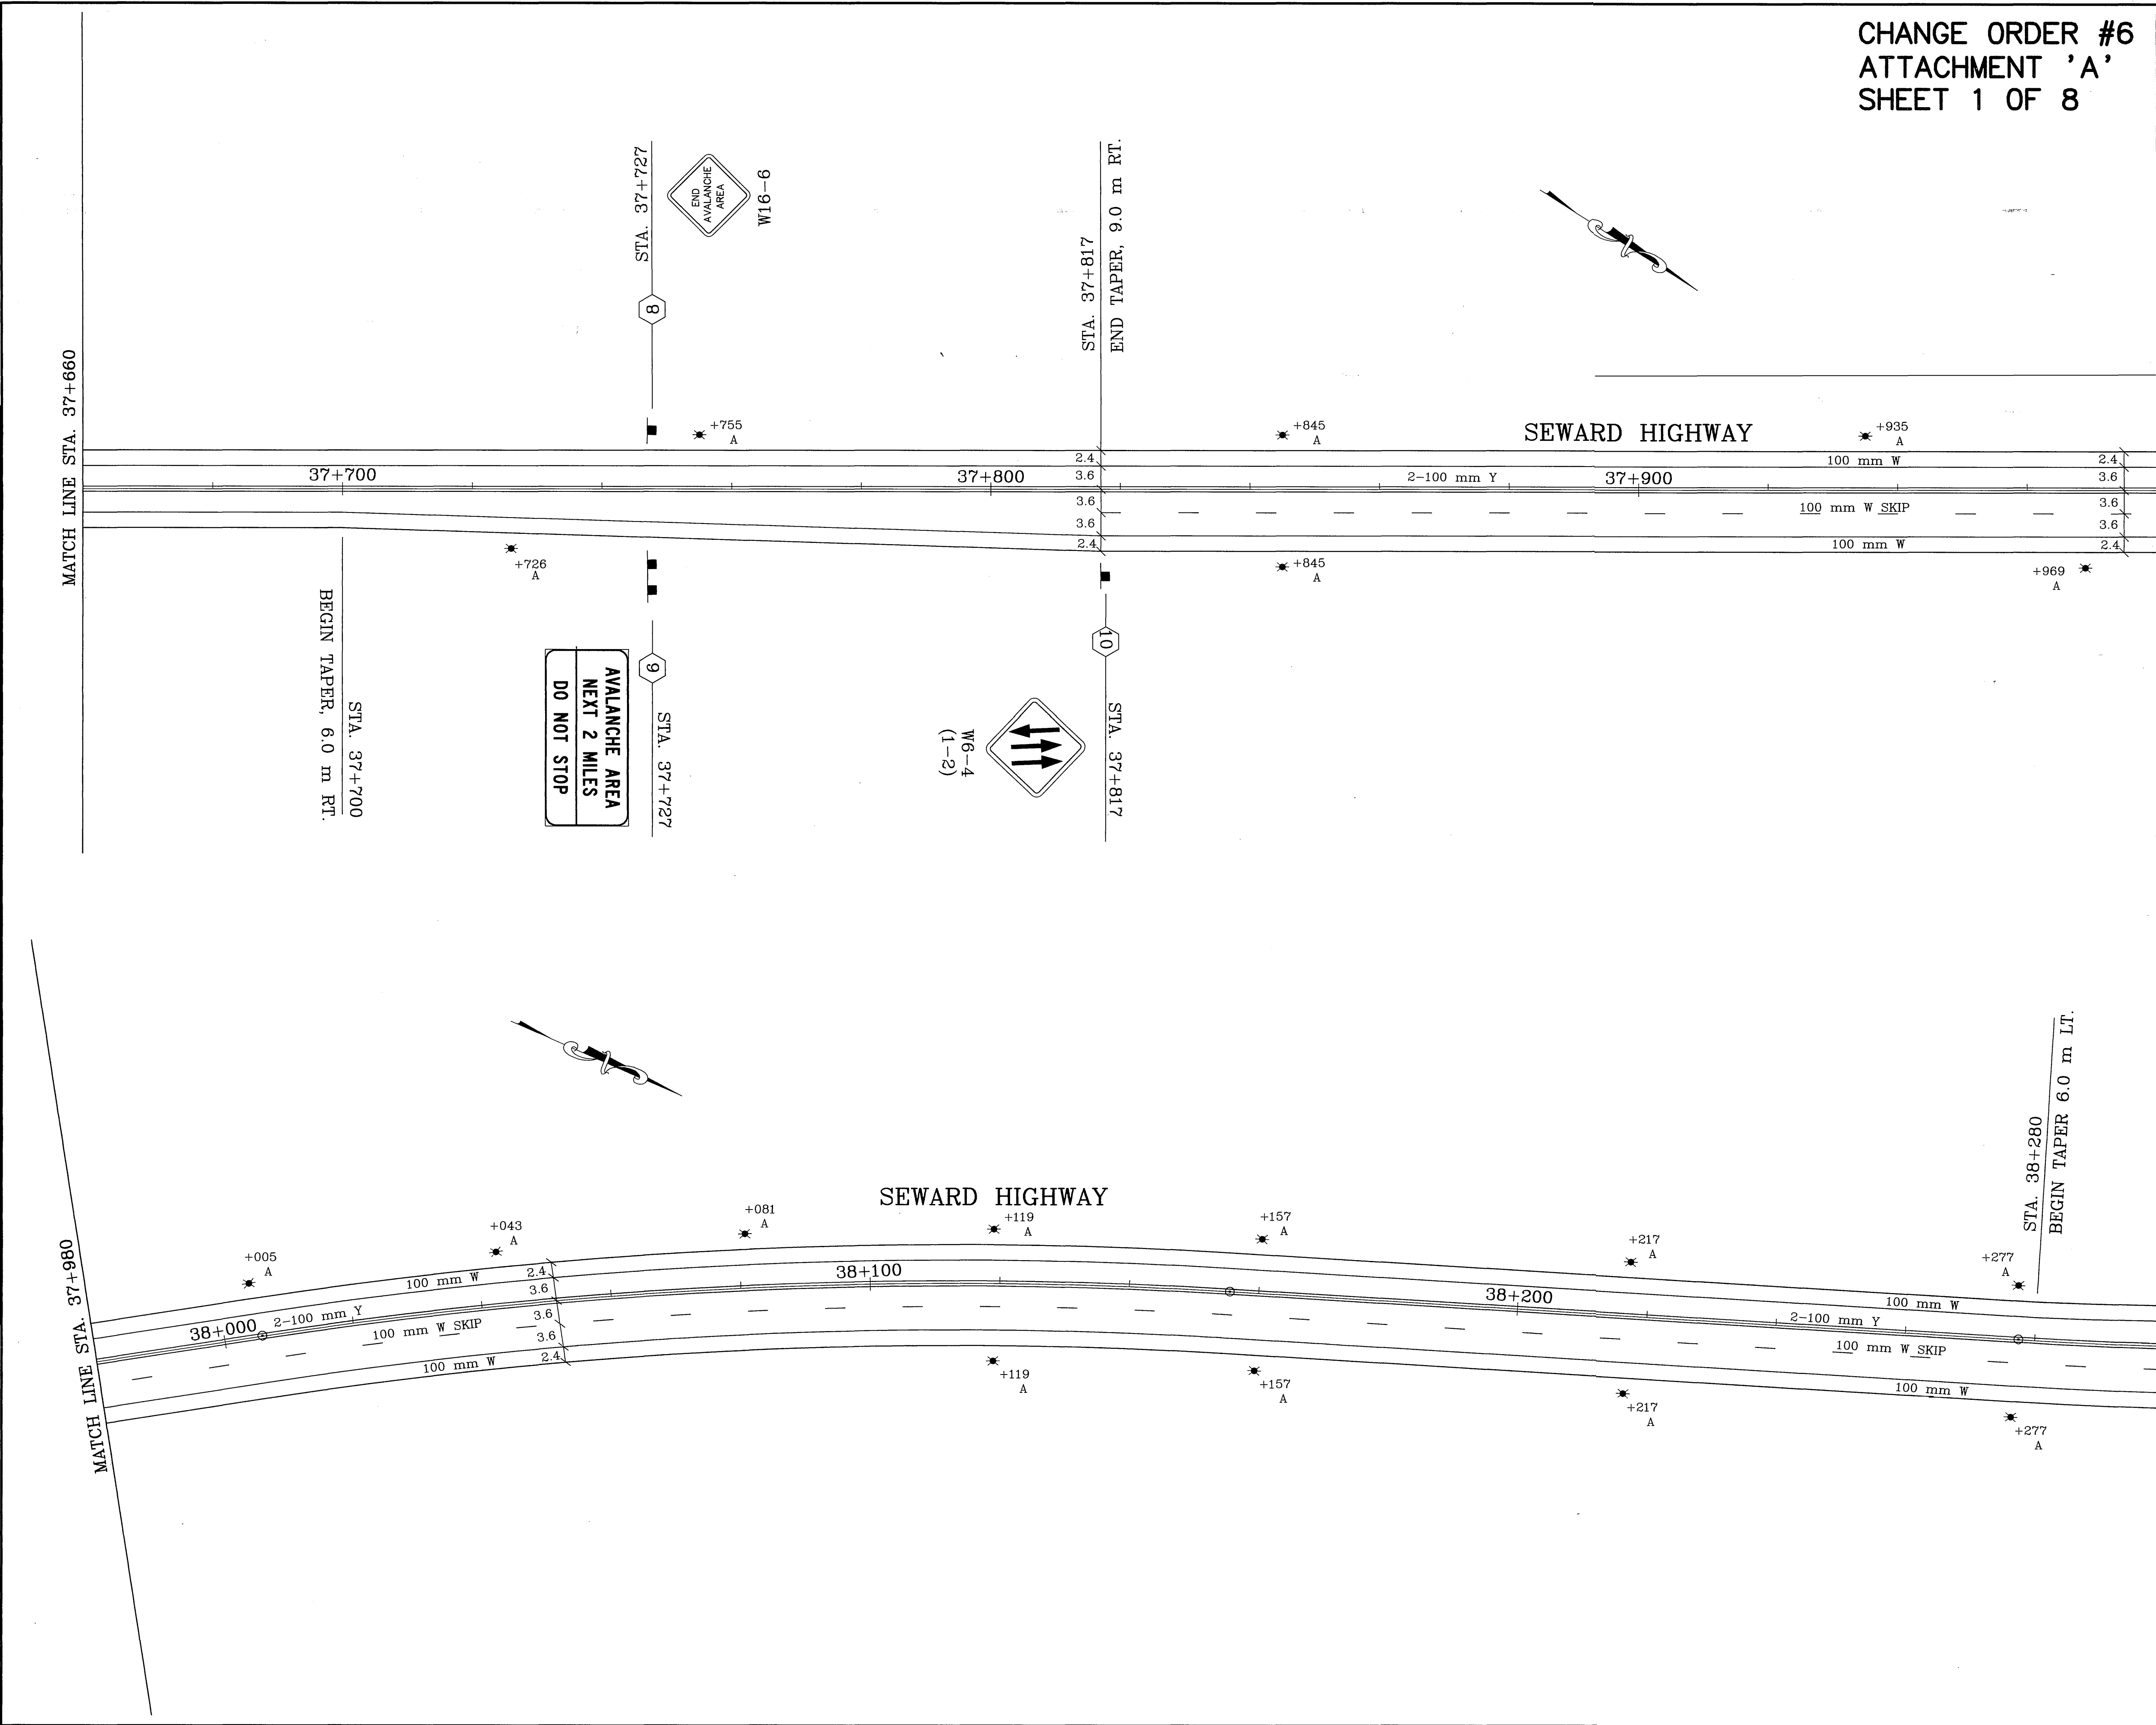

CHANGE ORDER #6
ATTACHMENT 'A'
SHEET 1 OF 8


MATCH LINE STA. 37+980

MATCH LINE STA. 38+300

SHEET NO.	TOTAL SHEETS	
J2A	J32	
STATE	YEAR	
ALASKA	2004	
PROJECT DESIGNATION		
NH-0A3-1(28)		
ADDENDUM NO.		
ATTACHMENT NO.		
REVISIONS		
NO.	DATE	DESCRIPTION

CHANGE ORDER NO. 6

NOTE:
DIMENSIONS ARE IN METERS
UNLESS OTHERWISE NOTED.

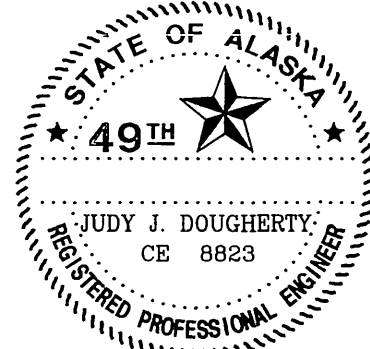


STATE OF ALASKA
DEPARTMENT OF TRANSPORTATION
AND PUBLIC FACILITIES

SEWARD HIGHWAY
MP 96 TO MP 102
SAFETY, ROADWAY AND
RECREATIONAL IMPROVEMENTS

SIGNING AND STRIPING


SPECIFICATIONS	
SCALE 1"=1	COMPUTER DESIGNATION
AUTOCAD-CAROLEE: S:\S6KPROJ\33577\STRIP\PE	
D:\S6KPROJ\33577\DATA\INDMB\RD\77B1RDPTR.DWG 8-21-01 2:52:26 pm EST	
DESIGNED BY	VIEW=
CHECKED BY	DATE
DRAFTED BY	DATE

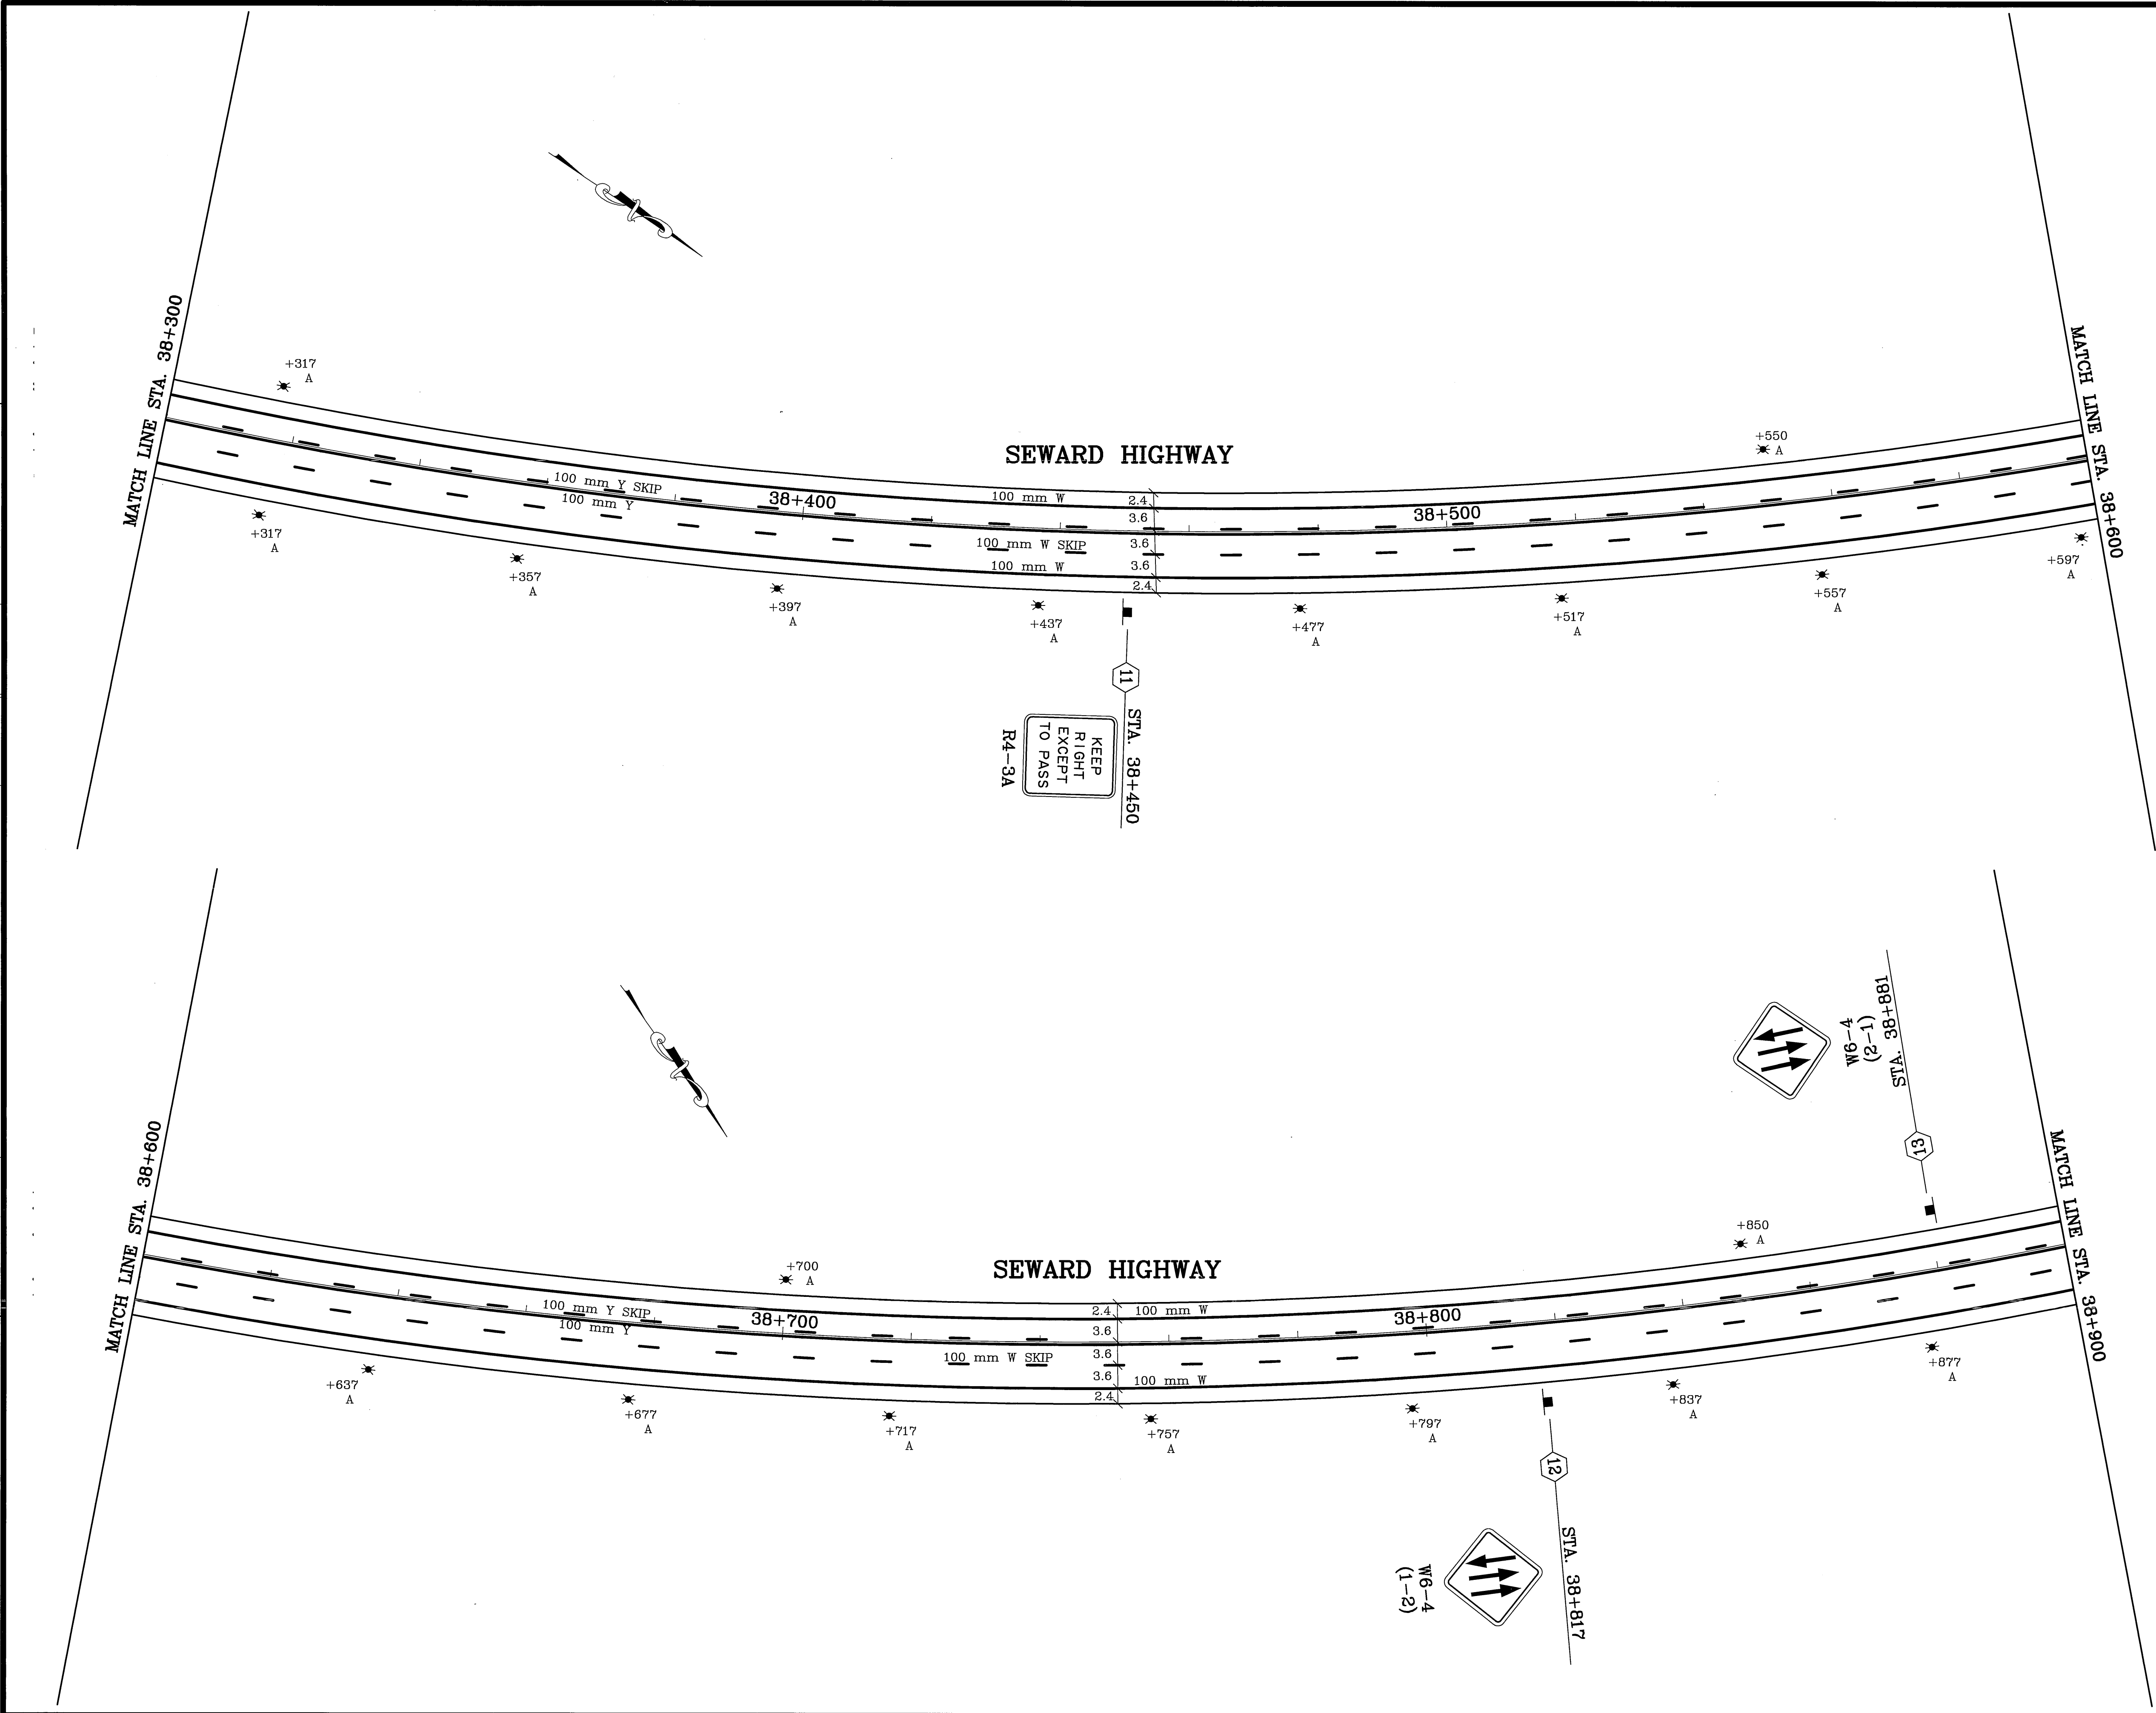

SHEET NO.		TOTAL SHEETS	
J3		J32	
STATE		YEAR	
ALASKA		2002	
PROJECT DESIGNATION			
NH-0A3-1(28)			
ADDENDUM NO.			
ATTACHMENT NO.			
REVISIONS			
NO.	DATE	DESCRIPTION	

THIS SHEET REPLACED BY J3A
CHANGE ORDER NO. 6

NOTE:
DIMENSIONS ARE IN METERS
UNLESS OTHERWISE NOTED.

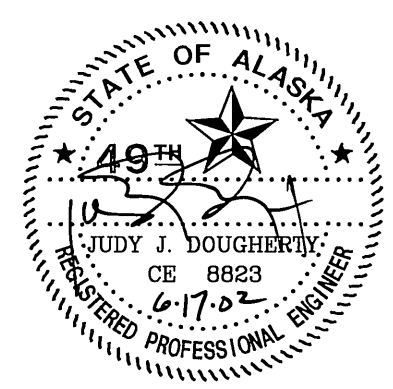


STATE OF ALASKA
DEPARTMENT OF TRANSPORTATION
AND PUBLIC FACILITIES
SEWARD HIGHWAY
MP 96 TO MP 102
SAFETY, ROADWAY AND
RECREATIONAL IMPROVEMENTS
SIGNING AND STRIPING

AS-BUILT 4/1/12

SPECIFICATIONS	DESIGNED BY
SCALE 1"=1'	CJ
COMPUTER DESIGNATION	4/28/04
AUTOCAD: CAROLEE 544433\STRIPING_CHANGEORDER	
VIEW-3	


CHANGE ORDER #6
ATTACHMENT 'A'
SHEET 2 OF 8

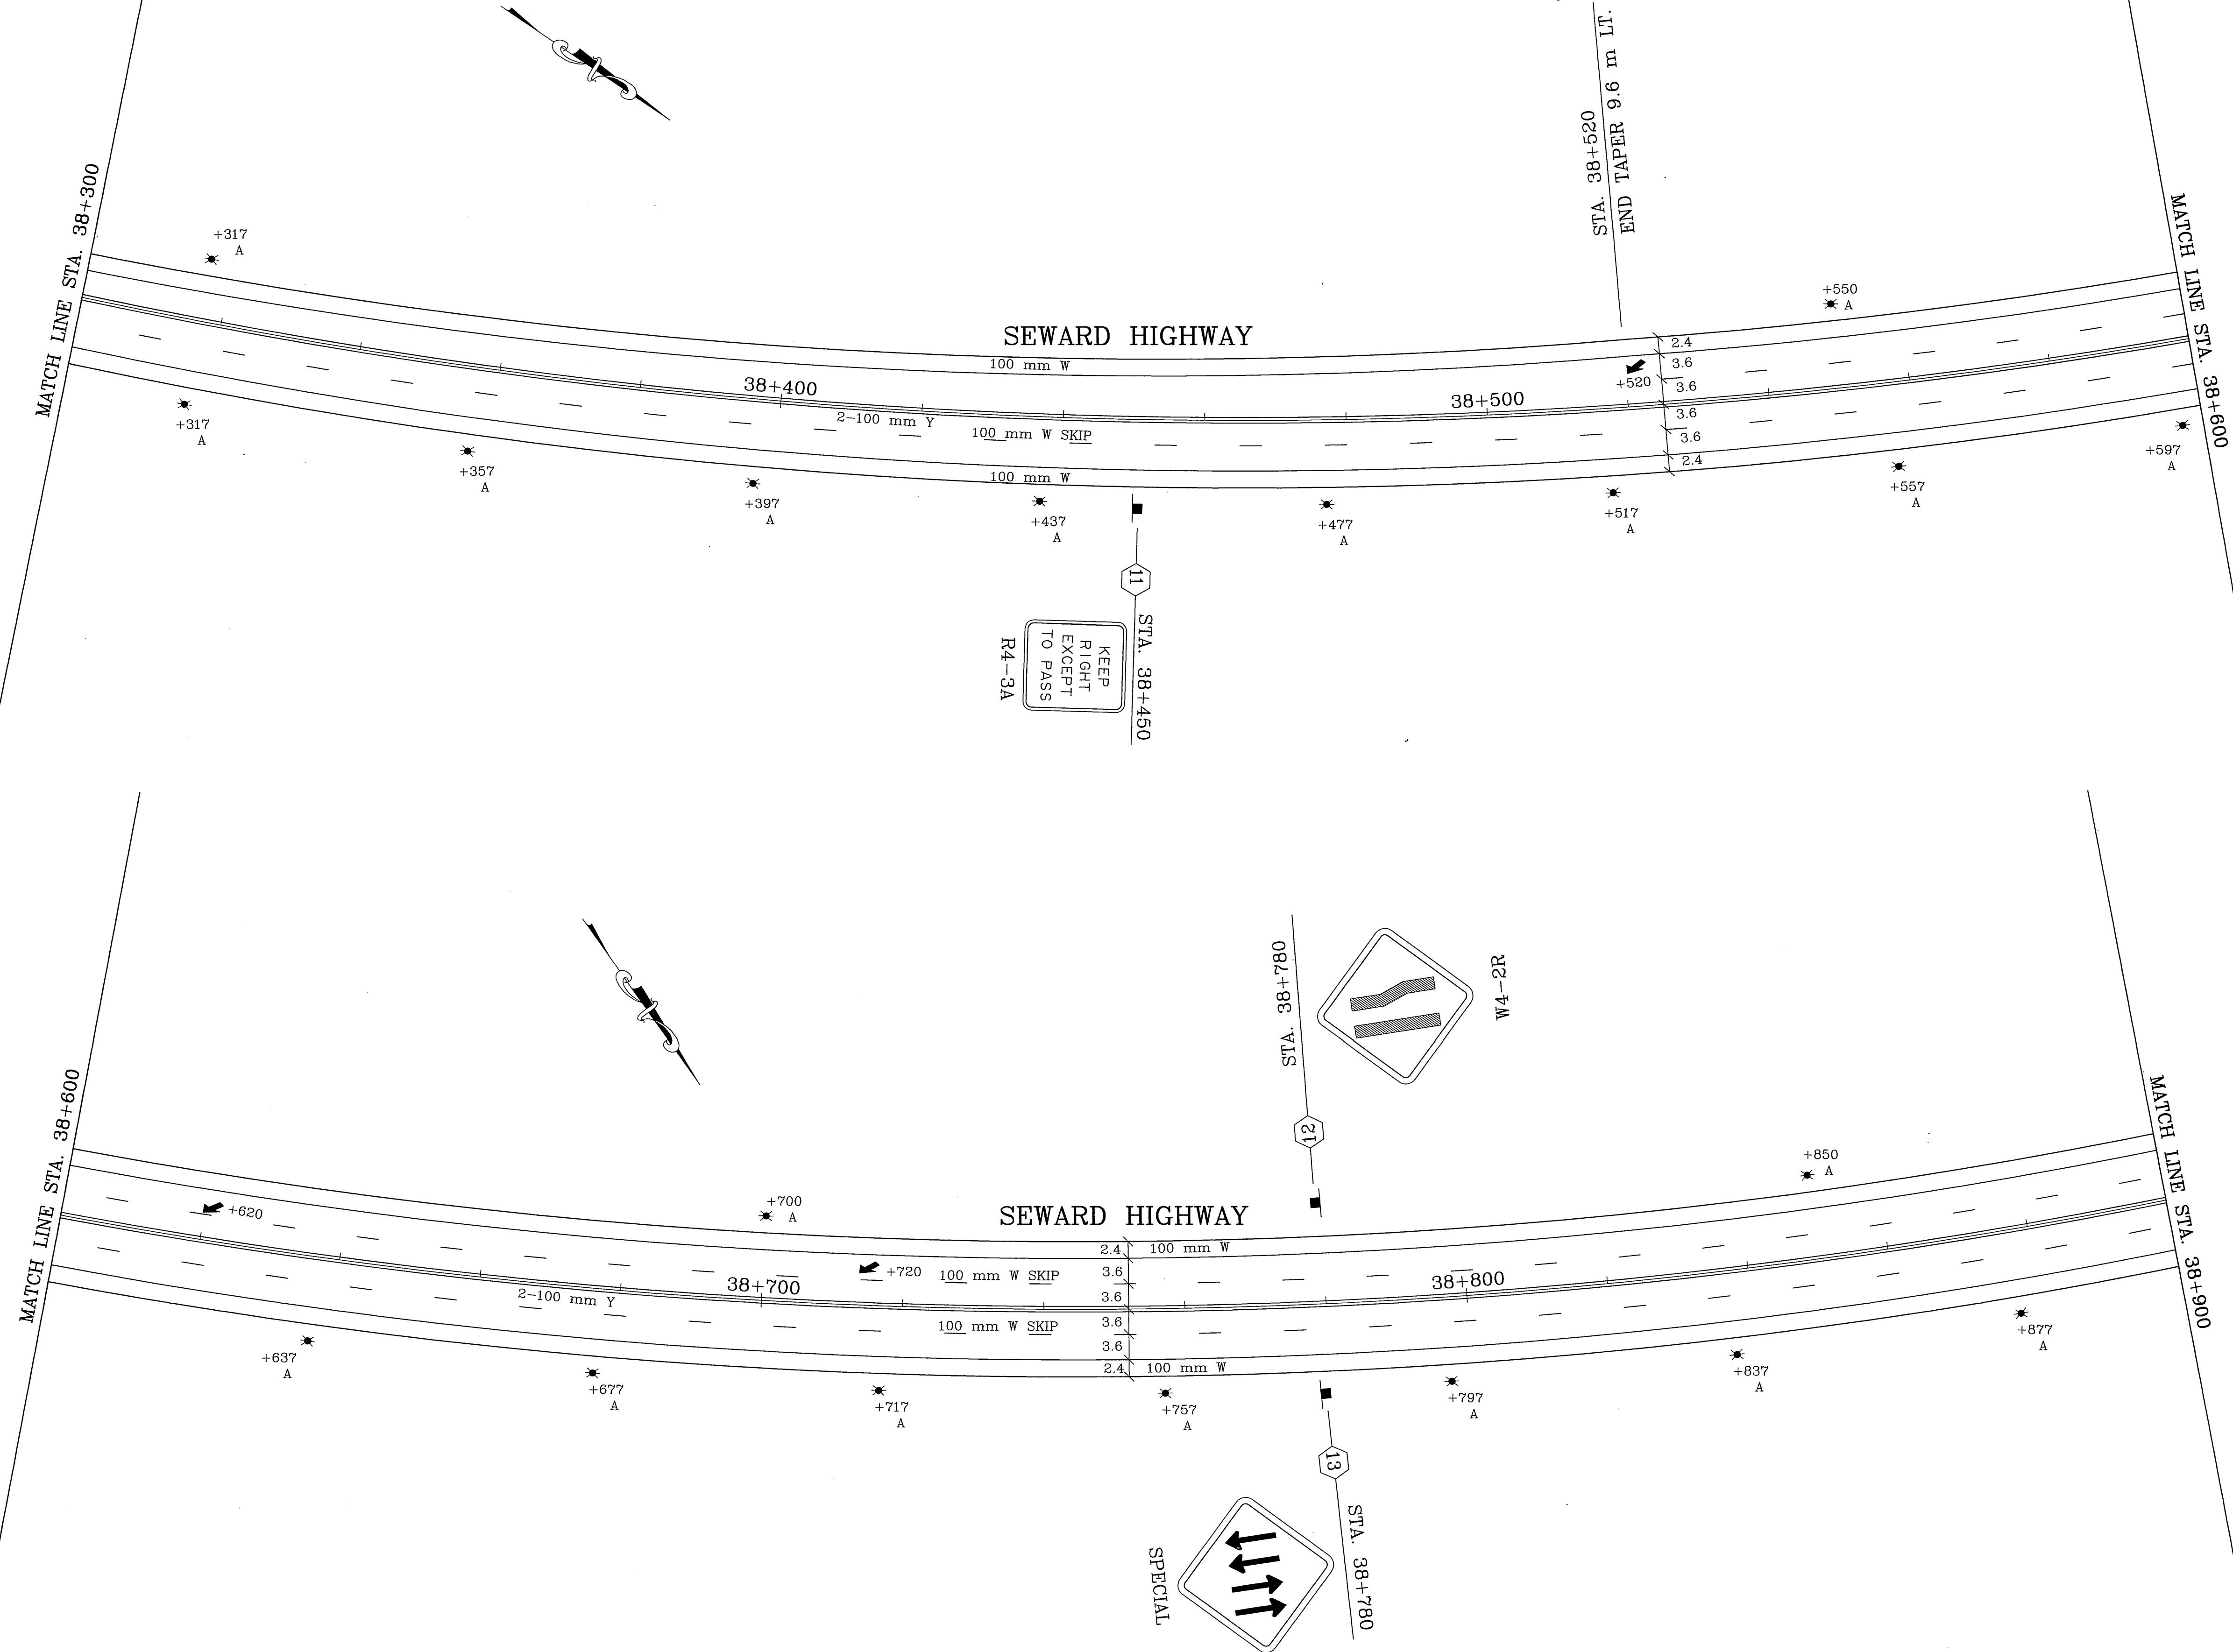

SHEET NO.	TOTAL SHEETS	
J3A	J32	
STATE	YEAR	
ALASKA	2004	
PROJECT DESIGNATION		
NH-0A3-1(28)		
ADDENDUM NO.		
ATTACHMENT NO.		
REVISIONS		
NO.	DATE	DESCRIPTION

CHANGE ORDER NO. 6


NOTE:
DIMENSIONS ARE IN METERS
UNLESS OTHERWISE NOTED.

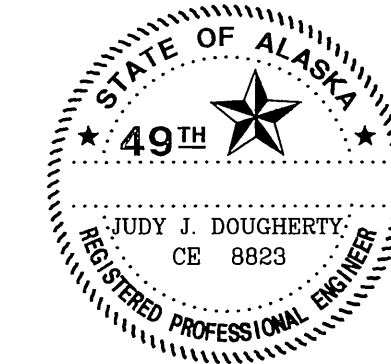


STATE OF ALASKA
DEPARTMENT OF TRANSPORTATION
AND PUBLIC FACILITIES
SEWARD HIGHWAY
MP 96 TO MP 102
SAFETY, ROADWAY AND
RECREATIONAL IMPROVEMENTS
SIGNING AND STRIPING

SPECIFICATIONS	DESIGNED BY	6/12/02
SCALE 1"=1'	CHECKED BY	KWH
COMPUTER DESIGNATION	DRAFTED BY	
	VIEW#	
	D:\SDSKPRO\A\33577\DATA\NONBI\RD\VTB1\DDPTRF.DWG	3-10-01 2:52:26 PM EST
	AUTOCAD-CAROLEE: SDDSKPRO\A\33577\A\STRIP	

MATCH LINE STA. 39+200

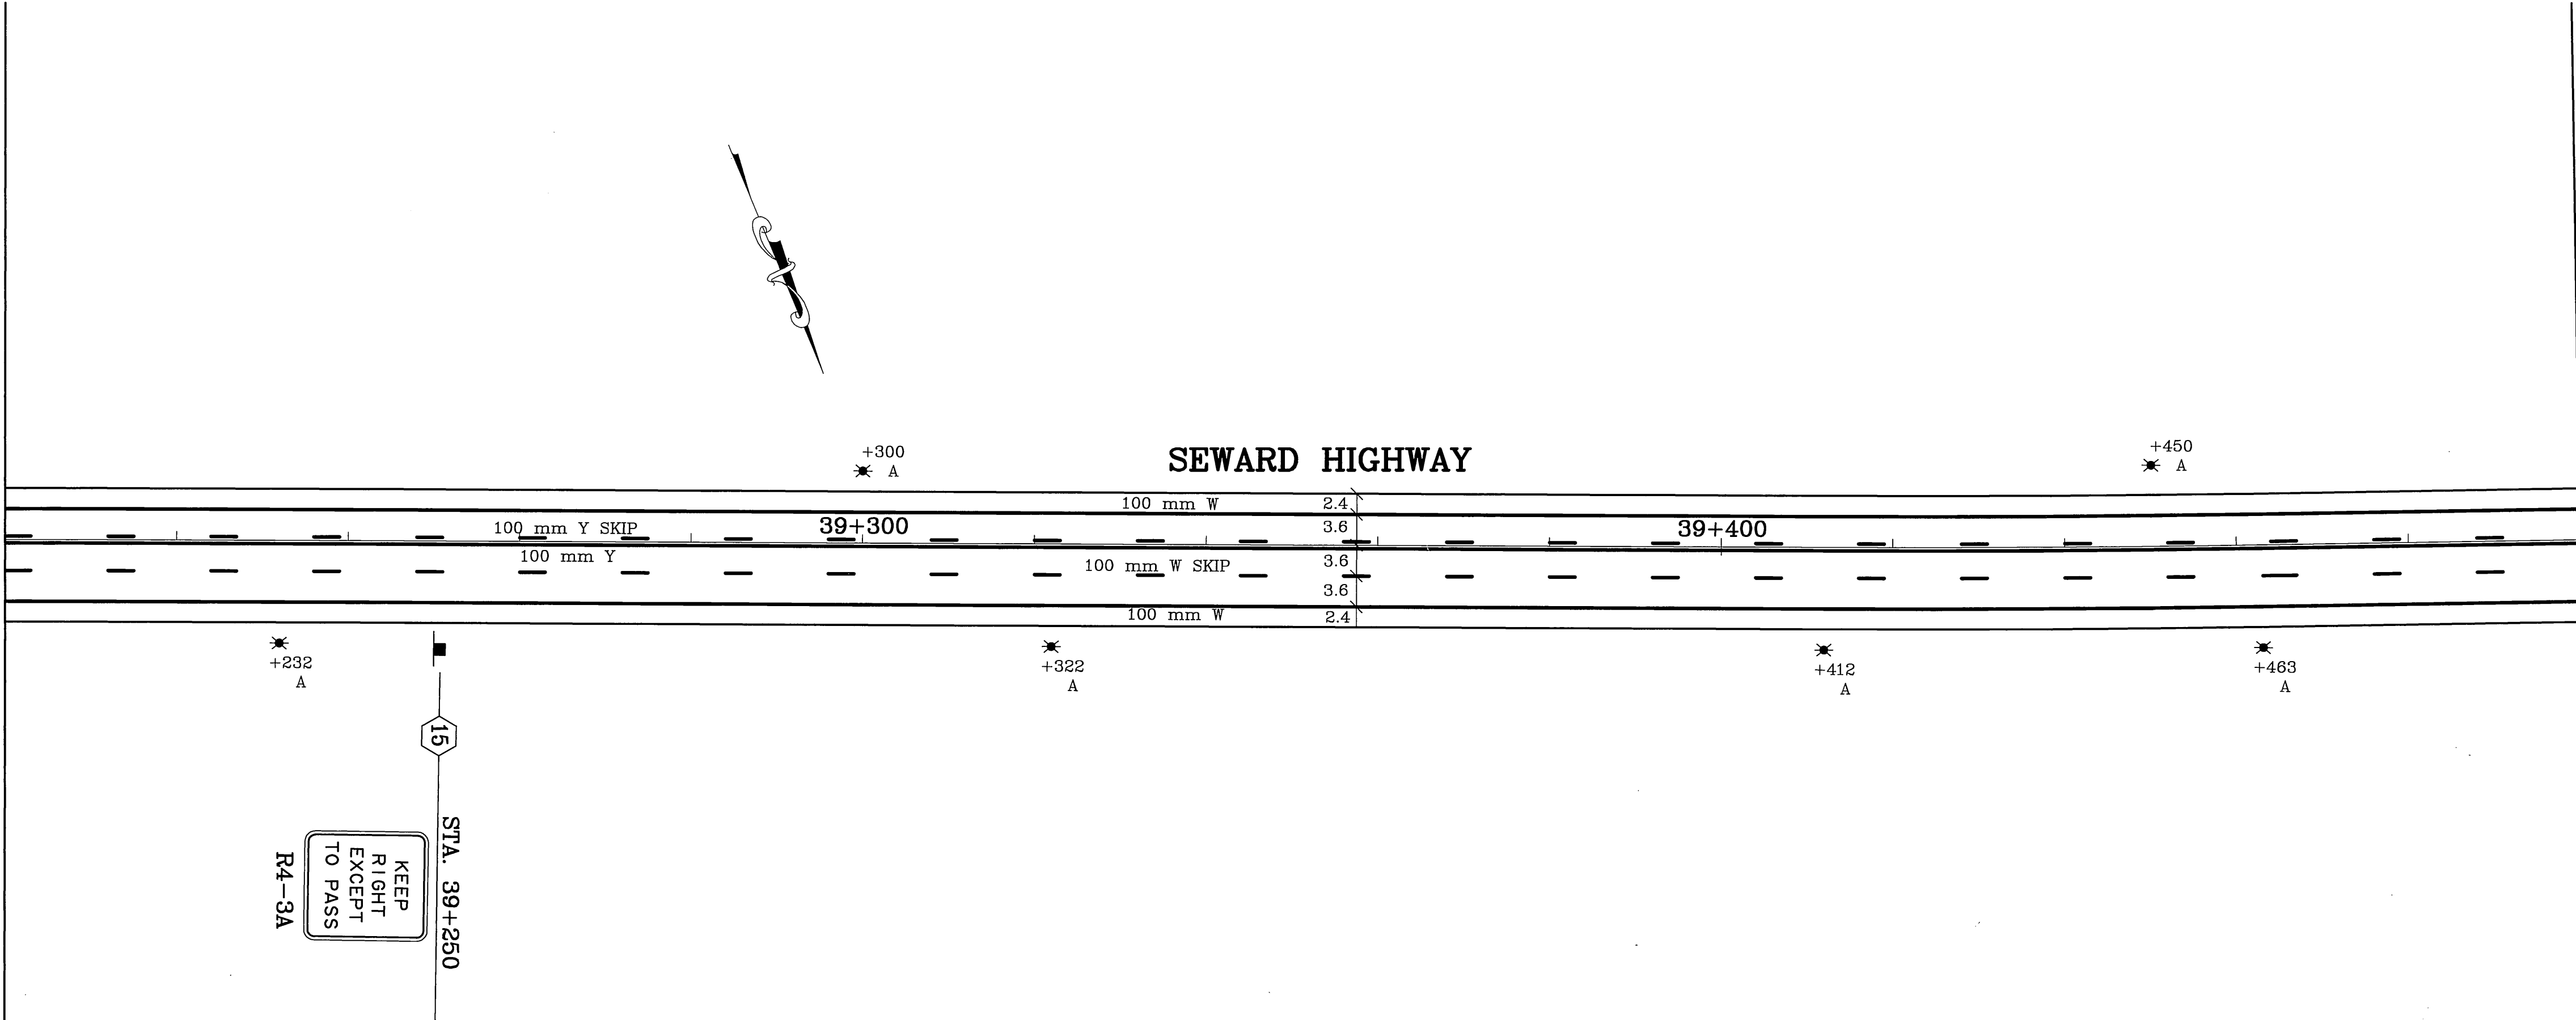

MATCH LINE STA. 38+900

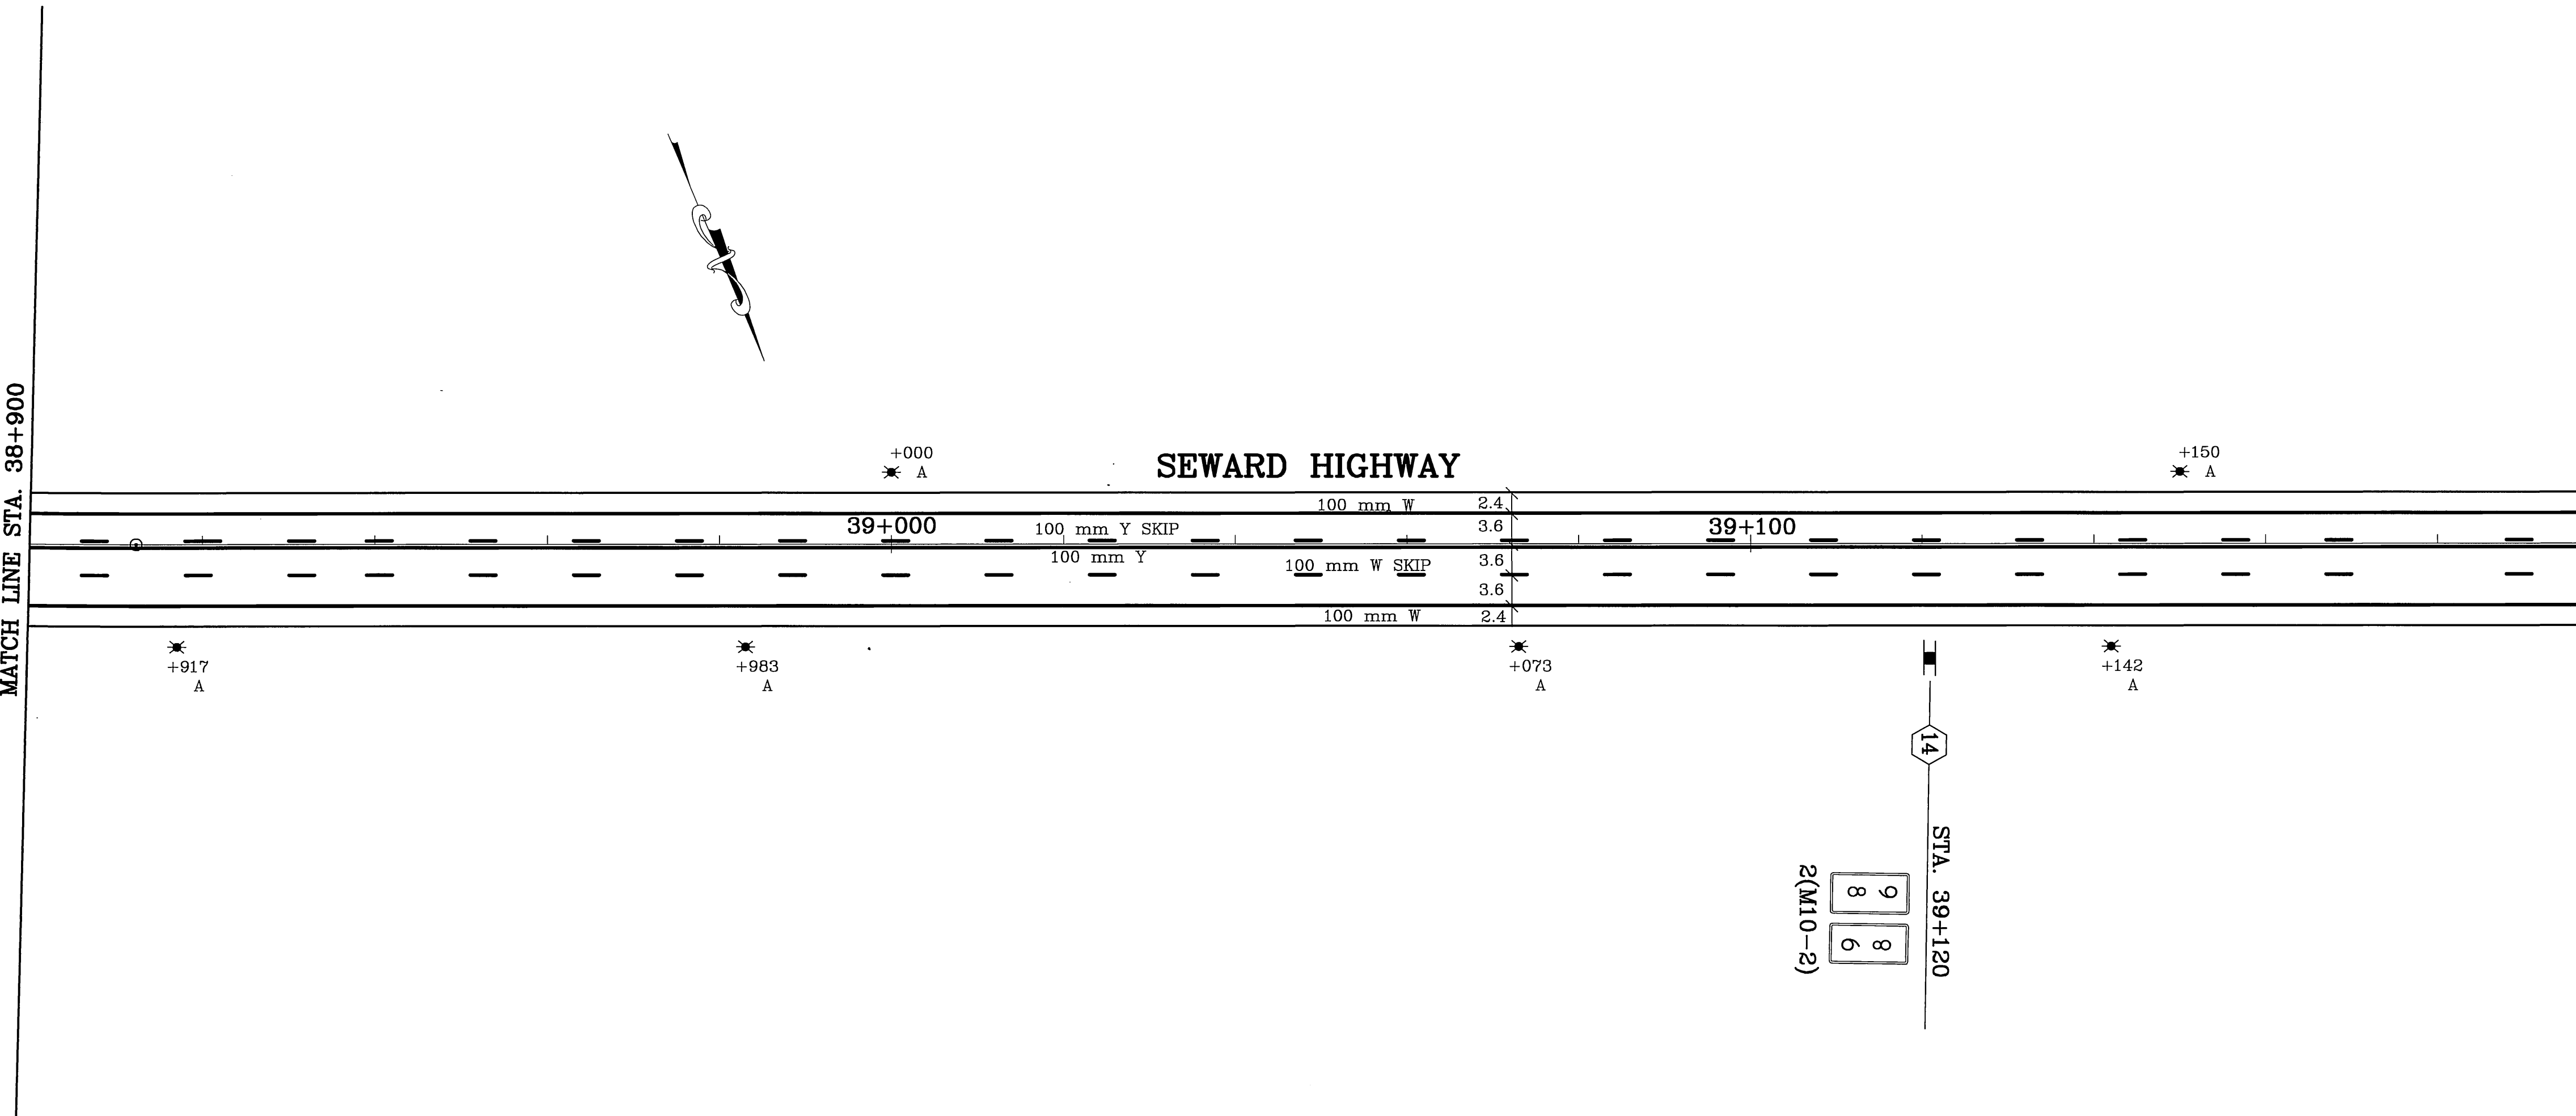


MATCH LINE STA. 39+500

MATCH LINE STA. 39+200

SHEET NO.		TOTAL SHEETS	
J4		J32	
STATE		YEAR	
ALASKA		2002	
PROJECT DESIGNATION			
NH-0A3-1(28)			
ADDENDUM NO.			
ATTACHMENT NO.			
REVISIONS			
NO.	DATE	DESCRIPTION	

THIS SHEET REPLACED BY J4A
CHANGE ORDER NO.6

NOTE:
DIMENSIONS ARE IN METERS
UNLESS OTHERWISE NOTED.

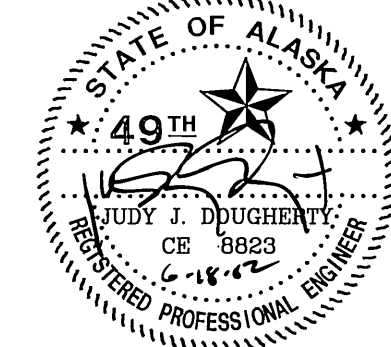


STATE OF ALASKA
DEPARTMENT OF TRANSPORTATION
AND PUBLIC FACILITIES
SEWARD HIGHWAY
MP 96 TO MP 102
SAFETY, ROADWAY AND
RECREATIONAL IMPROVEMENTS
SIGNING AND STRIPING


AS-BUILT 4/1/12

SPECIFICATIONS	DESIGNED BY
SCALE 1"=100'	CHECKED BY
AUTOCAD: CDRLEE 54433\STRIP-CHANGECOR	DRAFTED BY
COMPUTER DESIGNATION	CJ 4/26/04
VIEW=4	

MATCH LINE STA. 39+200

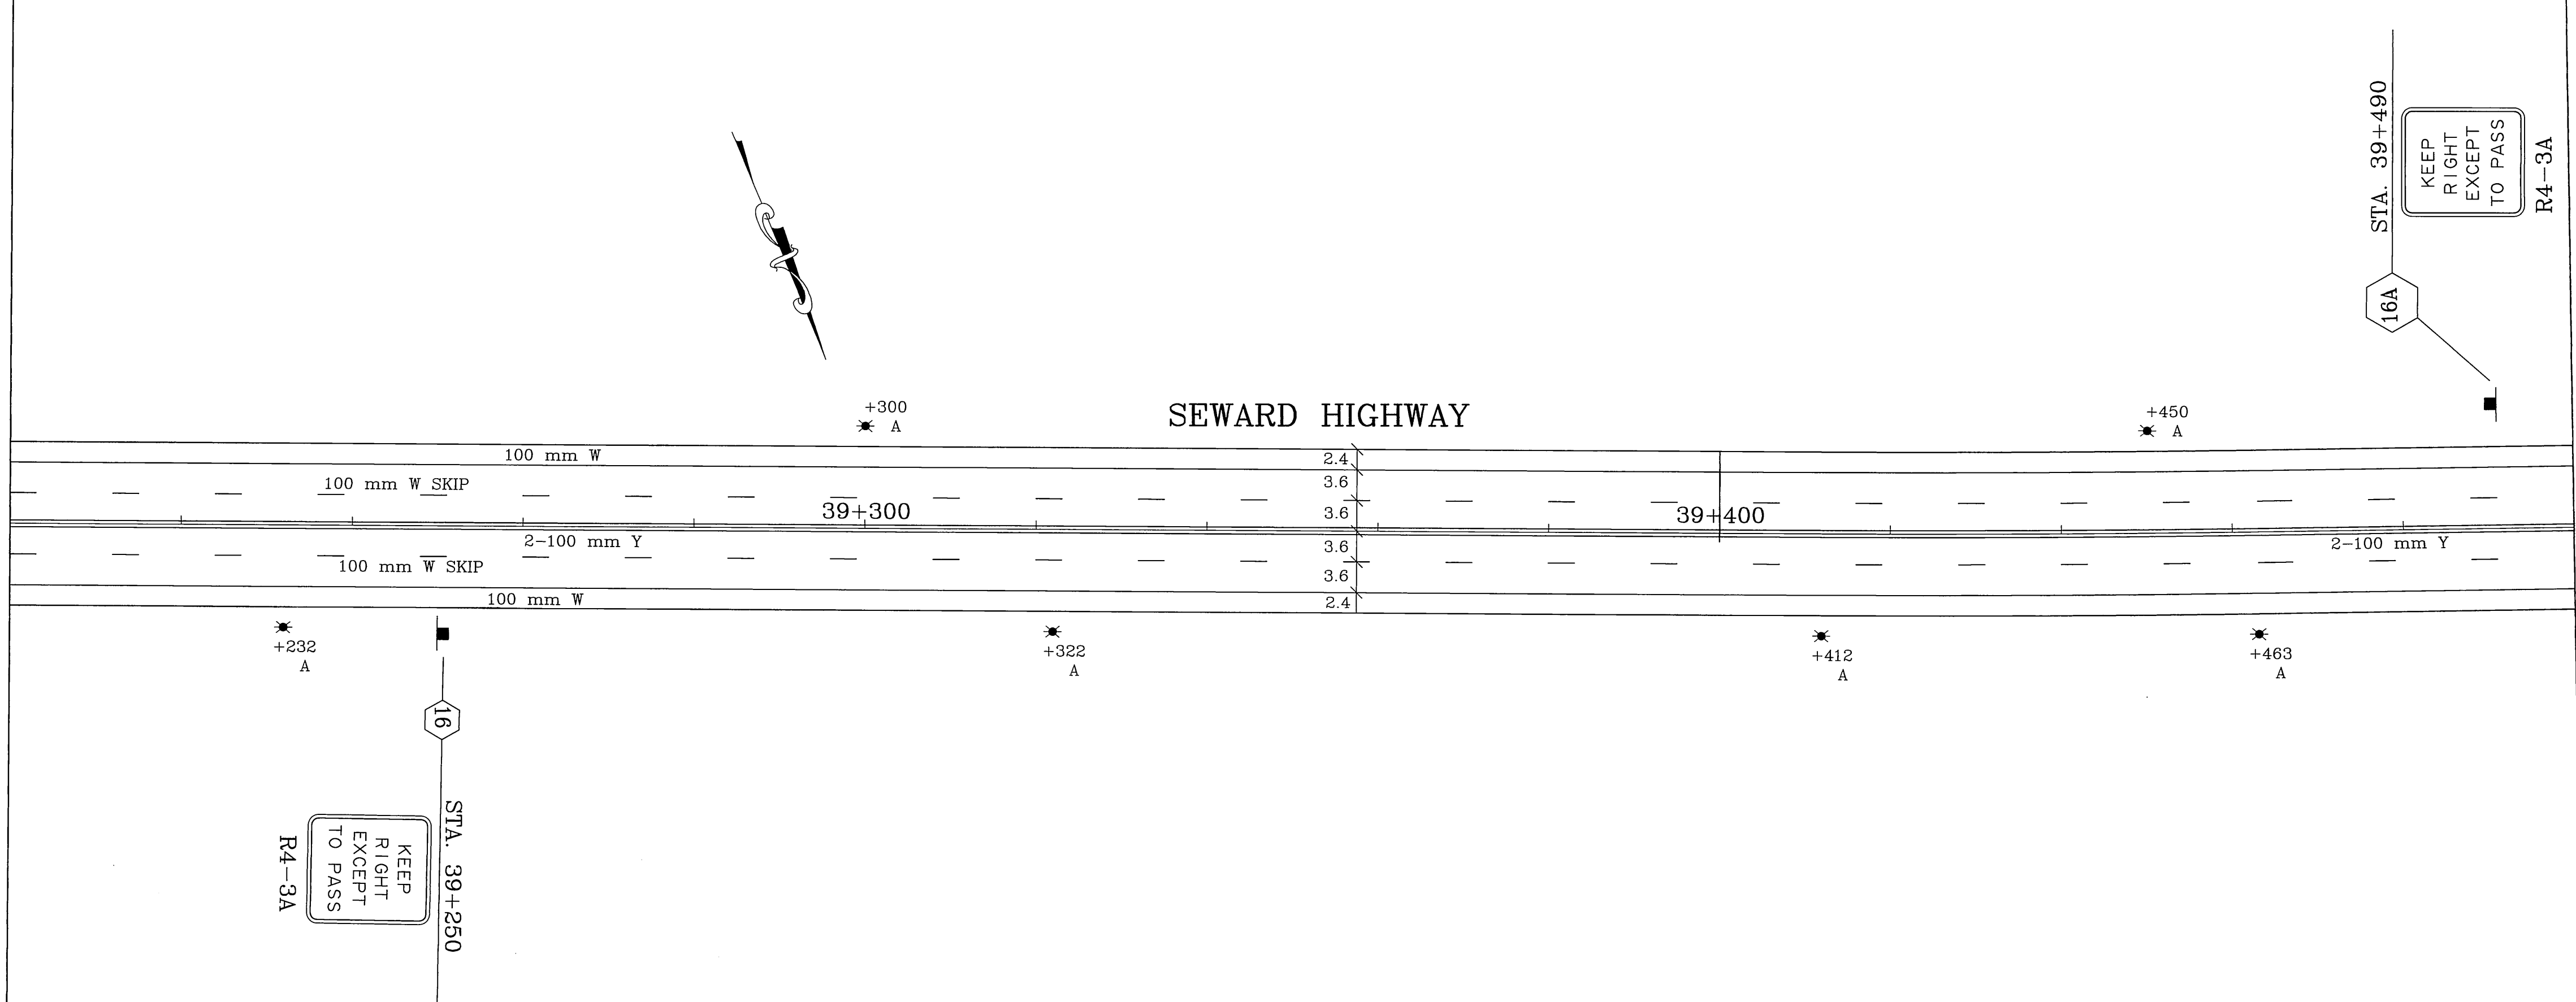

MATCH LINE STA. 38+900

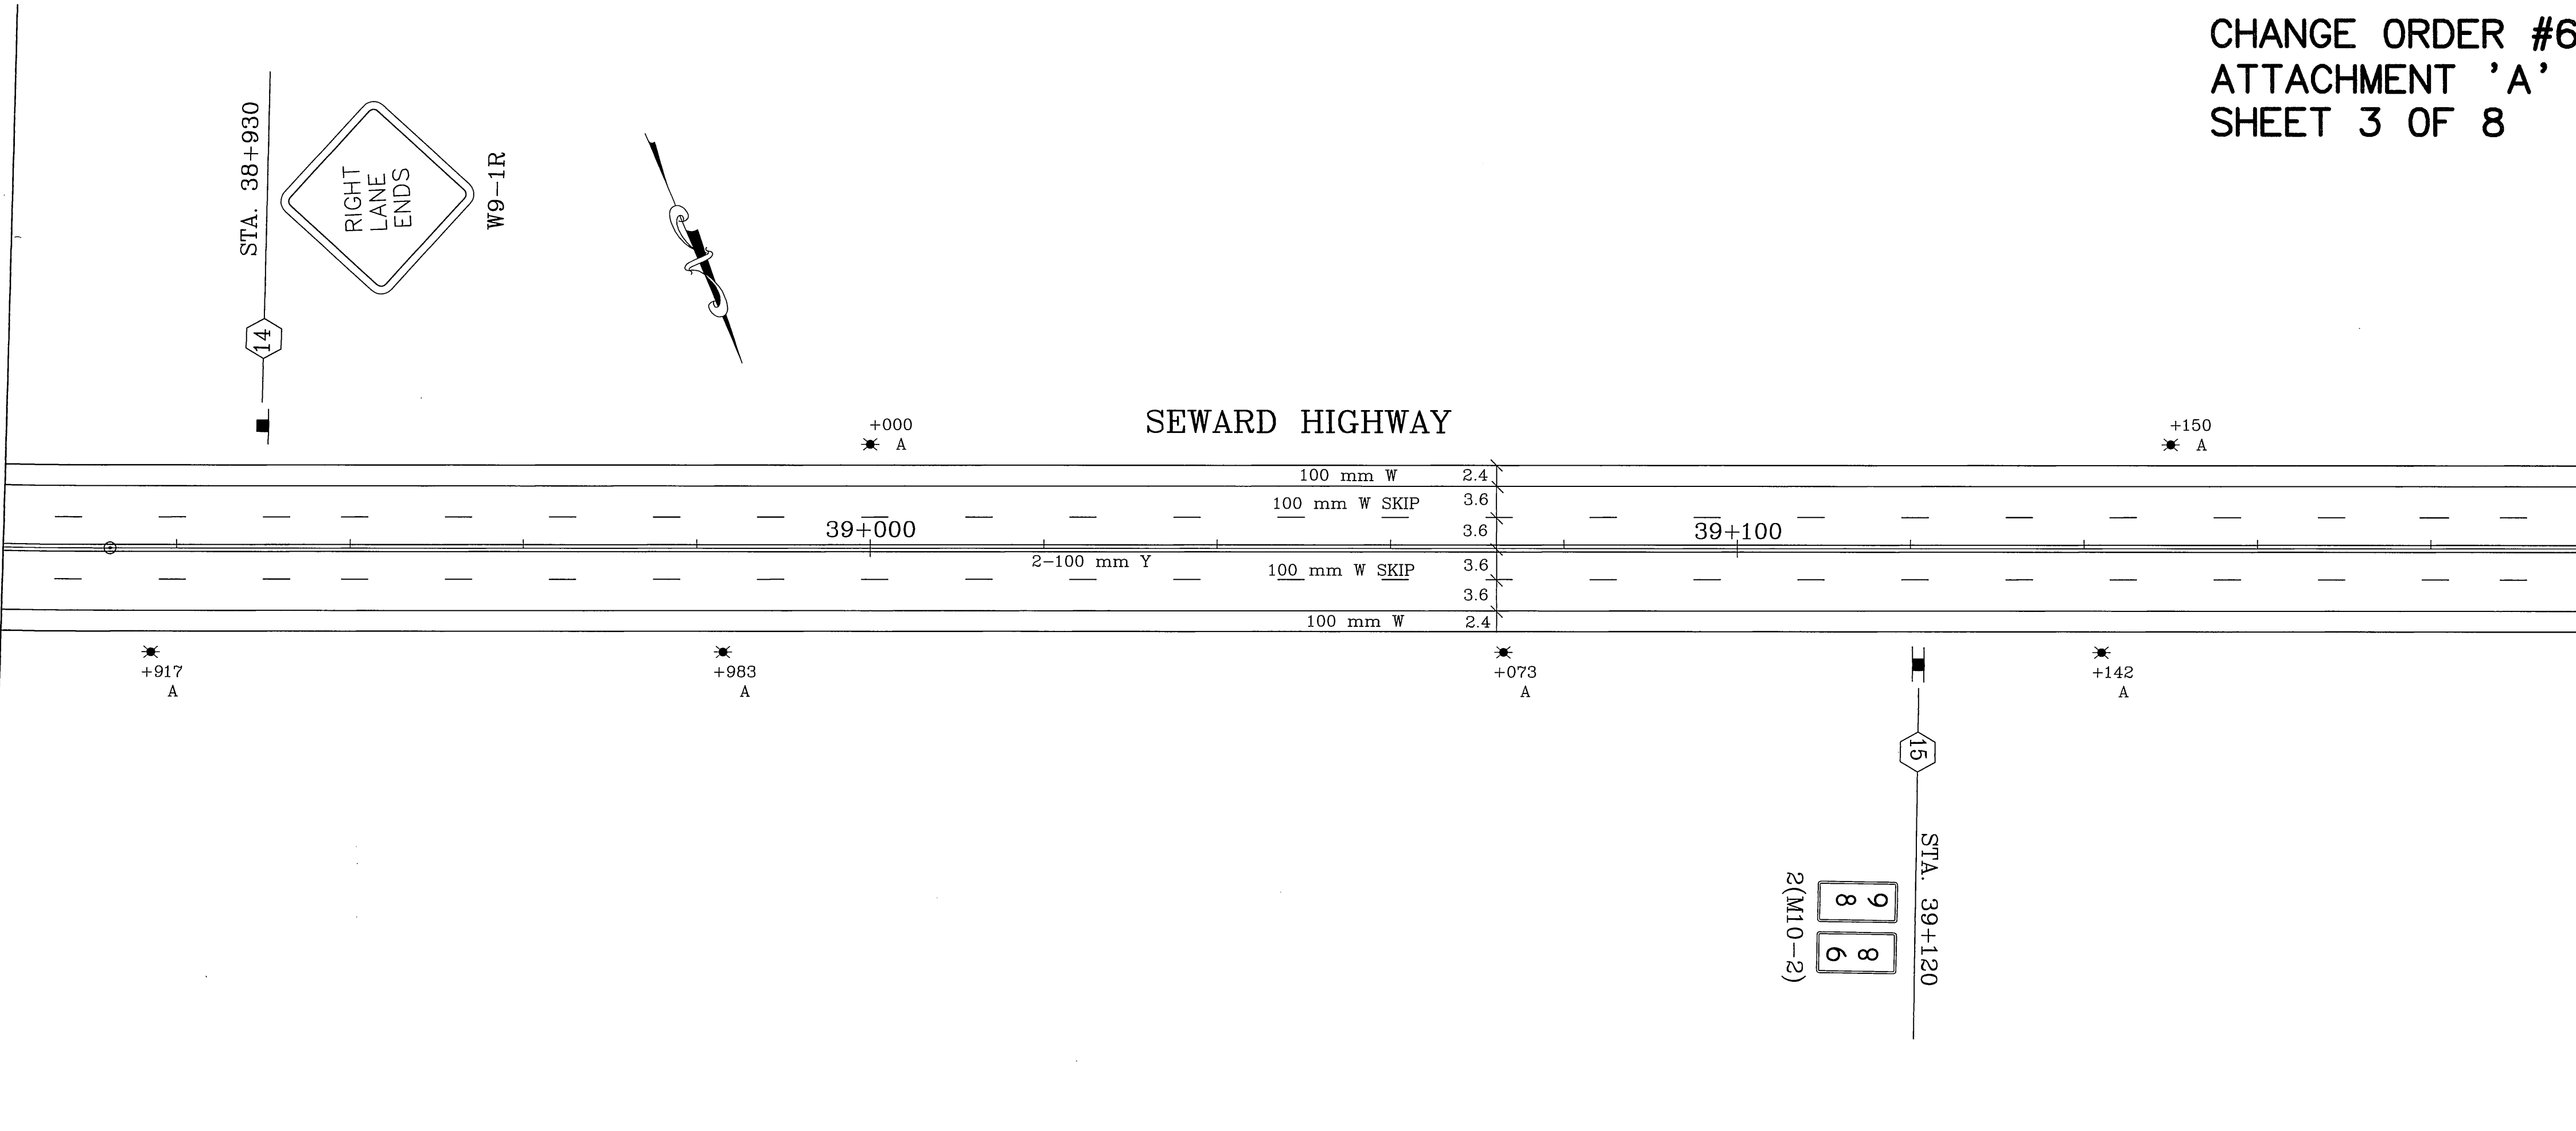

MATCH LINE STA. 39+500


MATCH LINE STA. 39+200

CHANGE ORDER #6
ATTACHMENT 'A'
SHEET 3 OF 8

SHEET NO.	TOTAL SHEETS	
J4A	J32	
STATE	YEAR	
ALASKA	2004	
PROJECT DESIGNATION		
NH-OA3-1(28)		
ADDENDUM NO.		
ATTACHMENT NO.		
REVISIONS		
NO.	DATE	DESCRIPTION

CHANGE ORDER NO. 6

NOTE:
DIMENSIONS ARE IN METERS
UNLESS OTHERWISE NOTED.

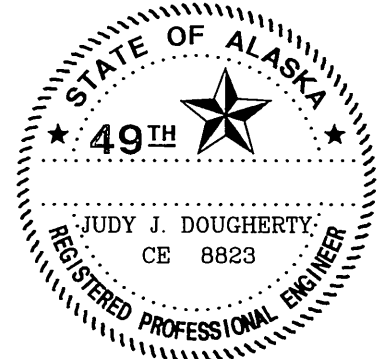


STATE OF ALASKA
DEPARTMENT OF TRANSPORTATION
AND PUBLIC FACILITIES
SEWARD HIGHWAY
MP 96 TO MP 102
SAFETY, ROADWAY AND
RECREATIONAL IMPROVEMENTS
SIGNING AND STRIPING

SPECIFICATIONS	DESIGNED BY	6/12/02
SCALE 1"=1'	CHECKED BY	
COMPUTER DESIGNATION	DRAFTED BY	KMH
	VIEW#	
	AUTOCAD-CAROLEE: S05KPR0A\33577\STRIP	8-21-01 2:52:26 PM EST
	D:\S05KPR0A\33577\DATA\N05B1R0\781R0P0TRF.DWG	

MATCH LINE STA. 39+800

MATCH LINE STA. 39+500

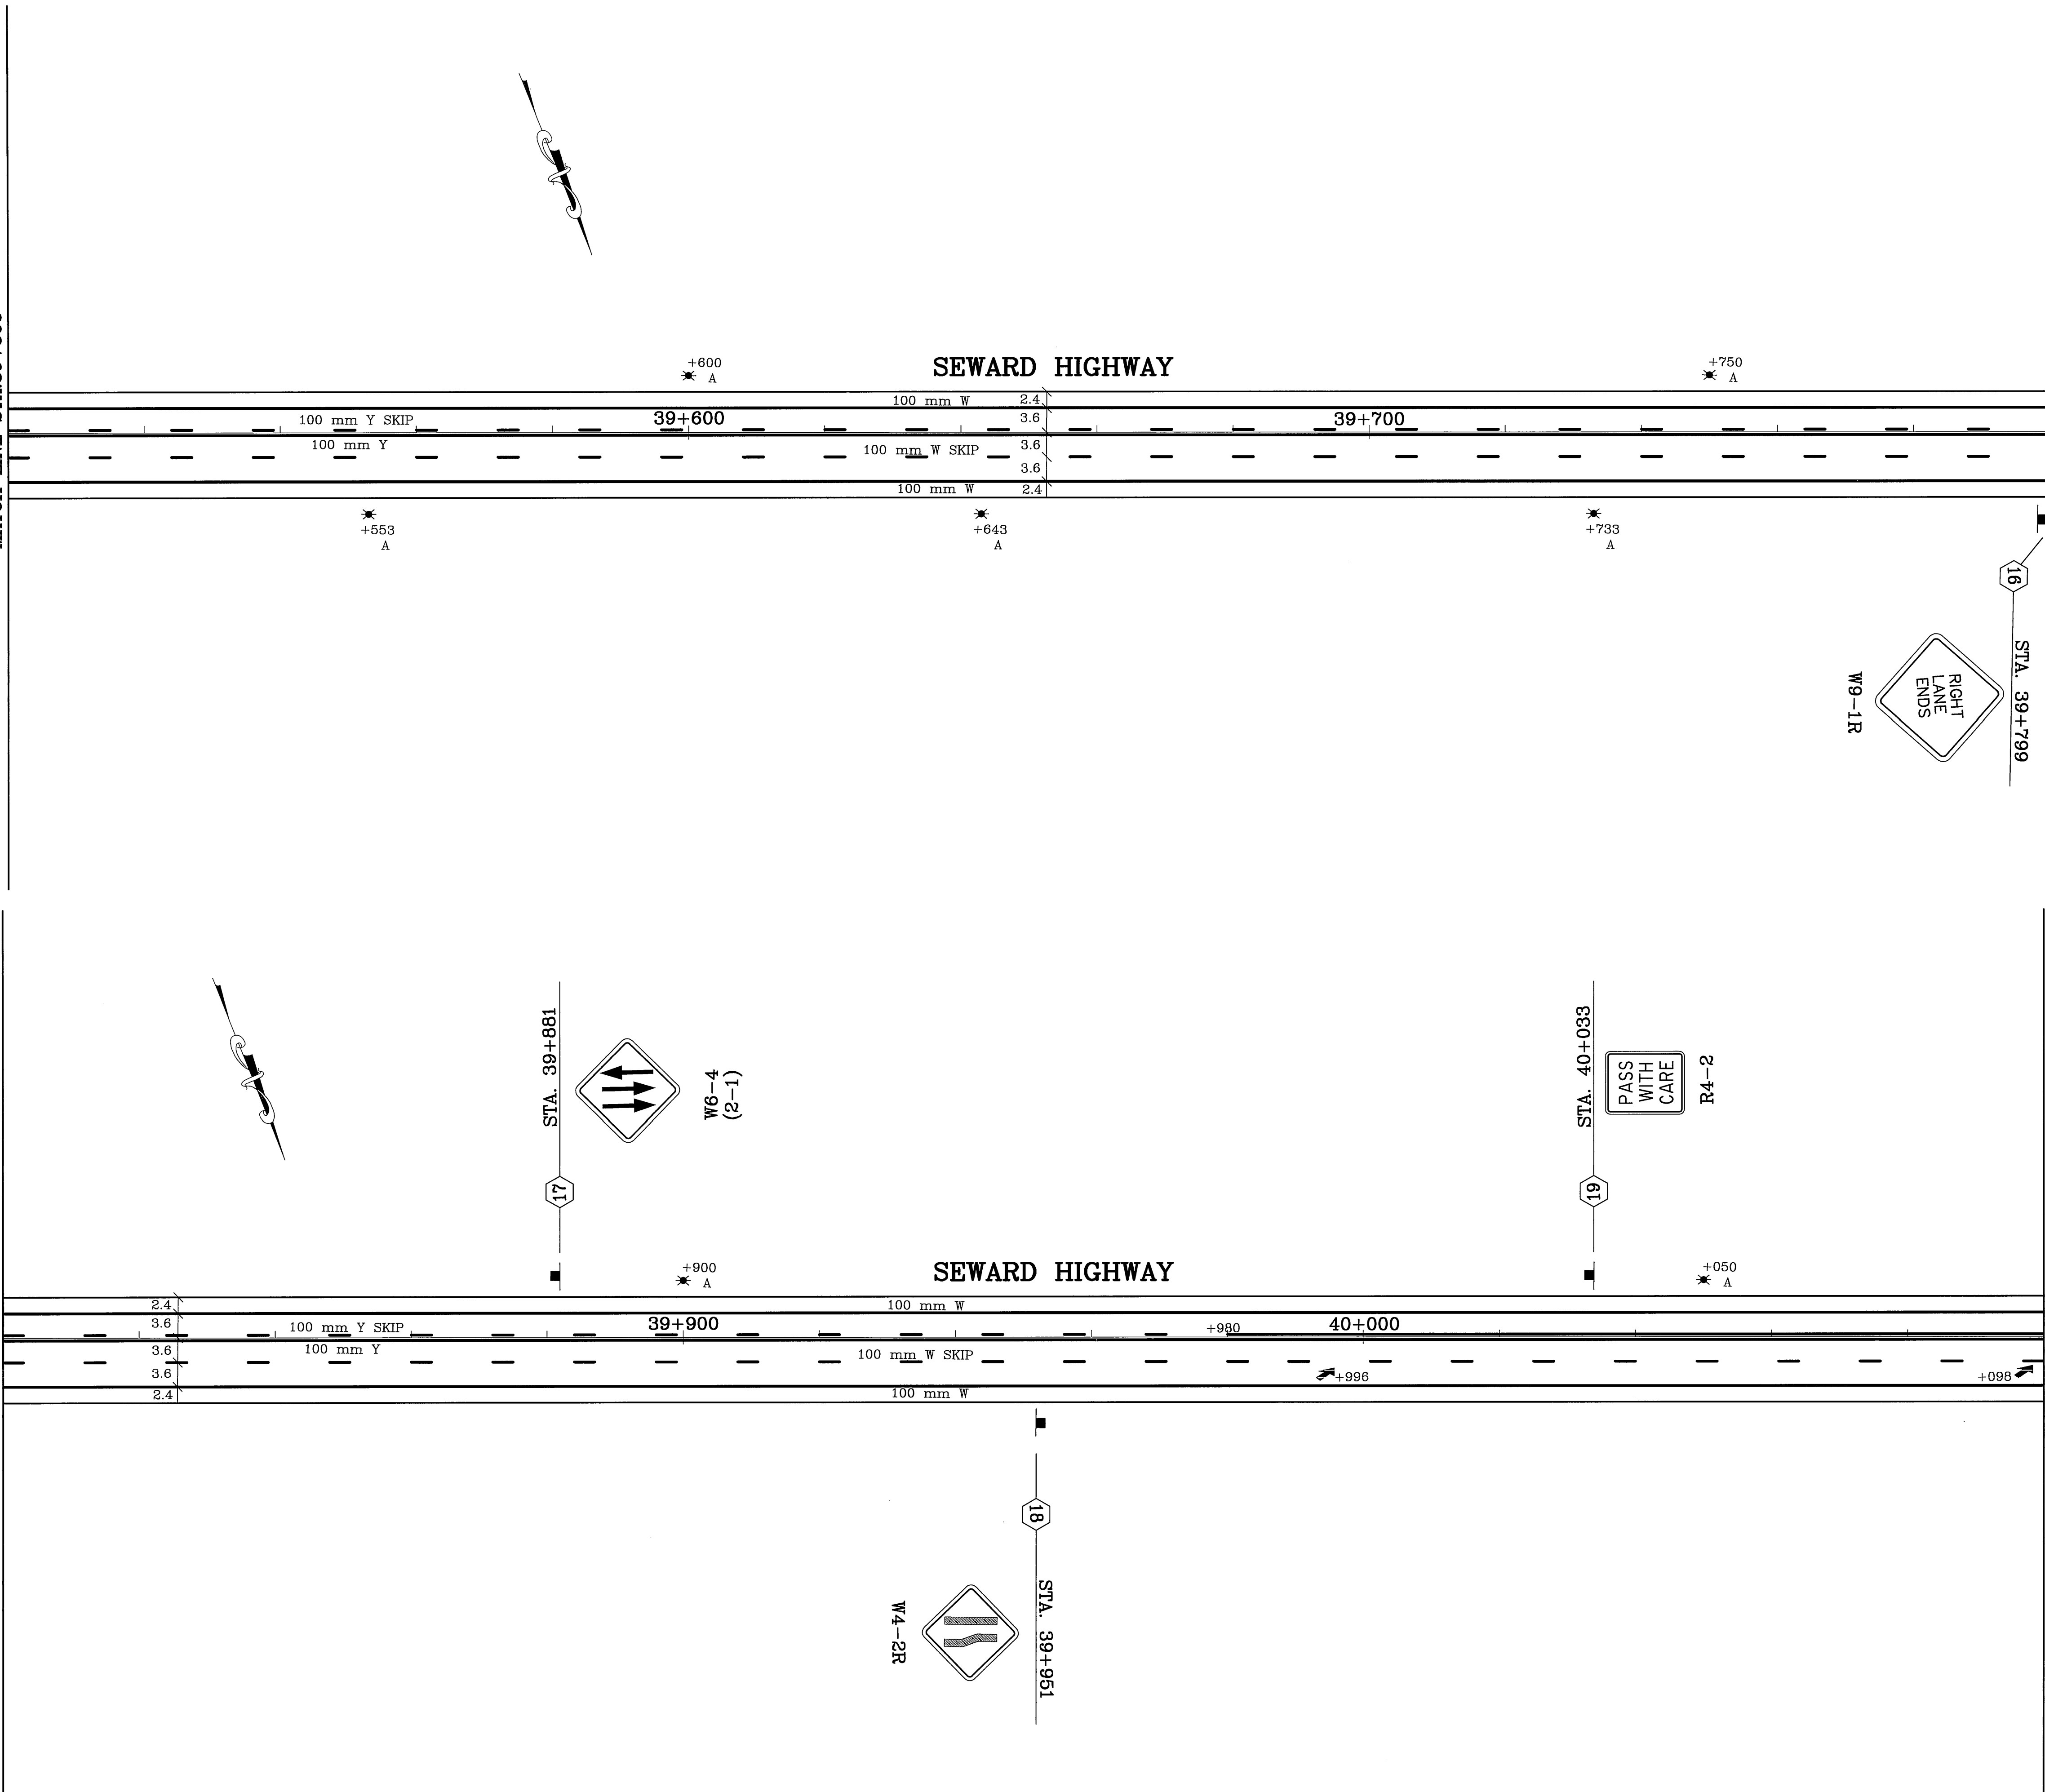

MATCH LINE STA. 40+100

MATCH LINE STA. 39+800


SHEET NO.	TOTAL SHEETS	
J5	J32	
STATE	YEAR	
ALASKA	2002	
PROJECT DESIGNATION		
NH-0A3-1(28)		
ADDENDUM NO.		
ATTACHMENT NO.		
REVISIONS		
NO.	DATE	DESCRIPTION

THIS SHEET REPLACED BY J5A
CHANGE ORDER NO. 6

NOTE:
DIMENSIONS ARE IN METERS
UNLESS OTHERWISE NOTED.

STATE OF ALASKA
DEPARTMENT OF TRANSPORTATION
AND PUBLIC FACILITIES
SEWARD HIGHWAY
MP 96 TO MP 102
SAFETY, ROADWAY AND
RECREATIONAL IMPROVEMENTS
SIGNING AND STRIPING

SPECIFICATIONS	DESIGNED BY
SCALE 1=1	CHECKED BY
	VIEW=6
COMPUTER DESIGNATION	DRAFTED BY
	CJ 4/27/04

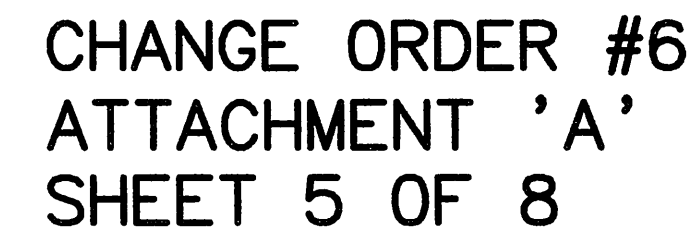
CHANGE ORDER NO. 6

STATE OF ALASKA
DEPARTMENT OF TRANSPORTATION
AND PUBLIC FACILITIES

SEWARD HIGHWAY
MP 96 TO MP 102
SAFETY, ROADWAY AND
RECREATIONAL IMPROVEMENTS

SIGNING AND STRIPING


SPECIFICATIONS	DESIGNED BY	6/12/02
SCALE 1"=1'	CHECKED BY	
COMPUTER DESIGNATION	DRAFTED BY	KMH
AUTOCAD-CAROLEE: S05KPR0A\53577\STRIP	VIEW=	
D:\S05KPR0A\53577\DATA\INDM81R0\7818DPPREF.DWG	3-10-01 2:52:26 PM EST	

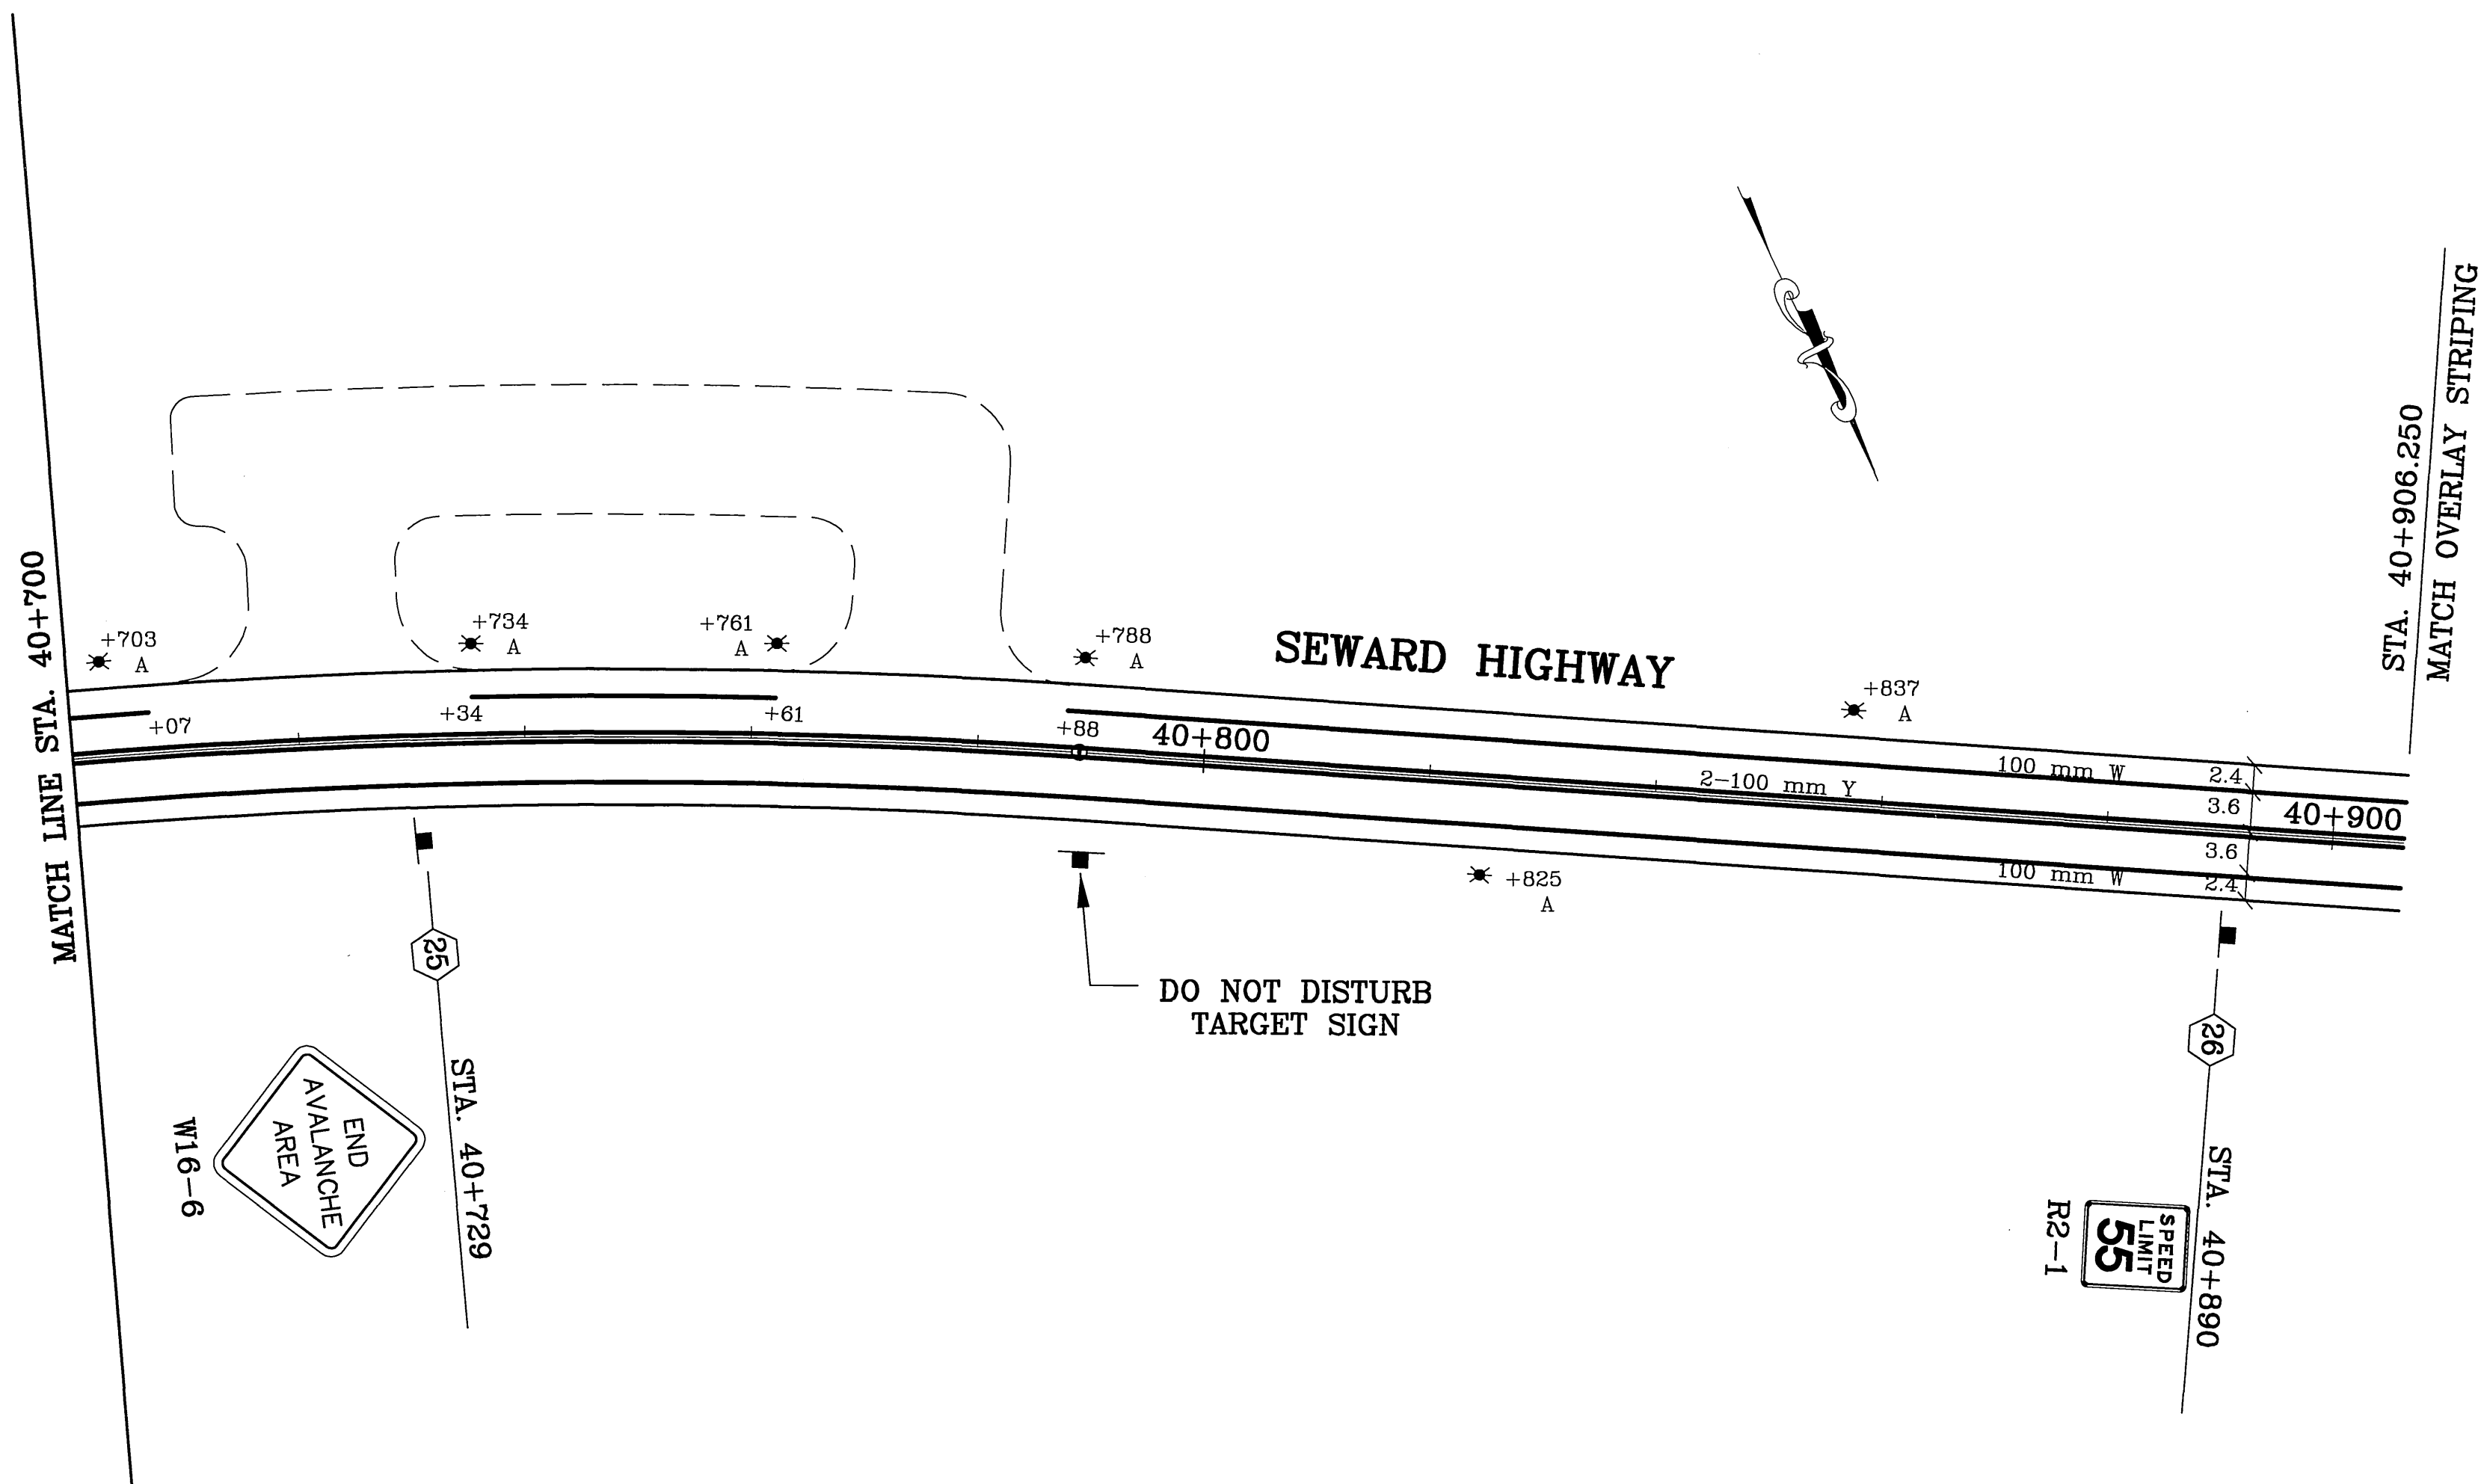

SHEET NO.	TOTAL SHEETS	
J7	J32	
STATE	YEAR	
ALASKA	2002	
PROJECT DESIGNATION		
NH-0A3-1(28)		
ADDENDUM NO.		
ATTACHMENT NO.		
REVISIONS		
NO.	DATE	DESCRIPTION

THIS SHEET REPLACED BY J7A.
CHANGE ORDER NO. 6


NOTE:
DIMENSIONS ARE IN METERS
UNLESS OTHERWISE NOTED.

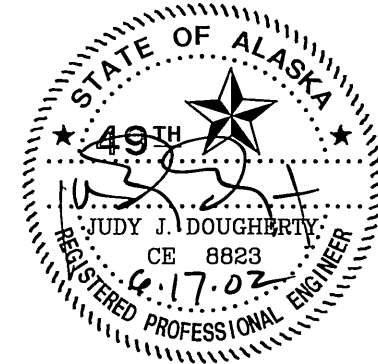

STATE OF ALASKA
DEPARTMENT OF TRANSPORTATION
AND PUBLIC FACILITIES
SEWARD HIGHWAY
MP 96 TO MP 102
SAFETY, ROADWAY AND
RECREATIONAL IMPROVEMENTS
SIGNING AND STRIPING

AS-BUILT 4/1/12

SPECIFICATIONS	DESIGNED BY	VIEW-7
SCALE 1"=1'	CHECKED BY	
COMPUTER DESIGNATION	DRAFTED BY	CJ 4/26/04

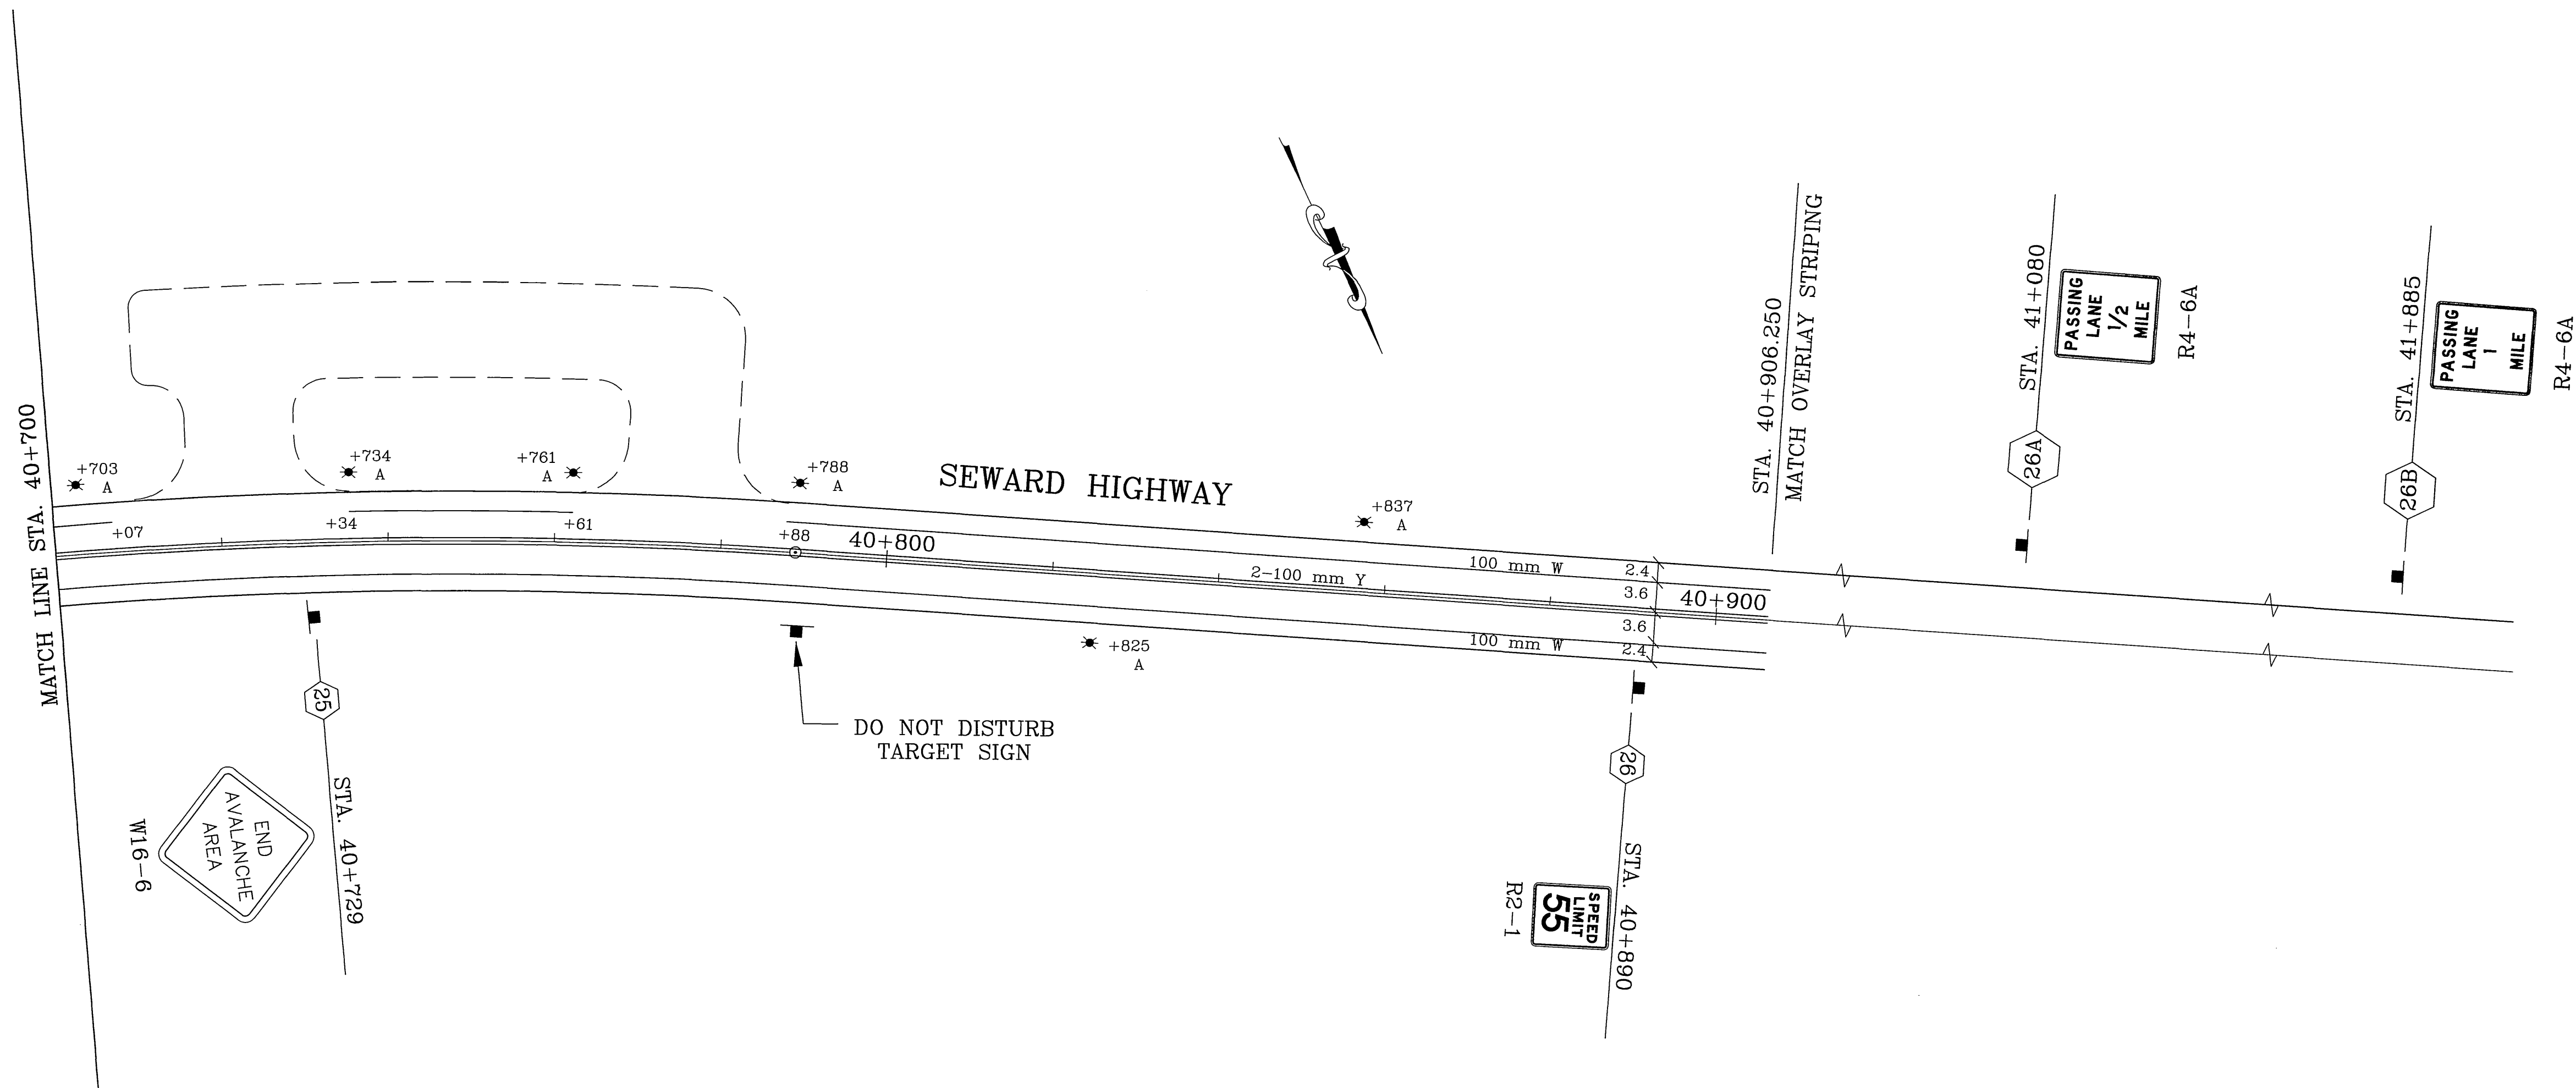


CHANGE ORDER #6
ATTACHMENT 'A'
SHEET 6 OF 8

SHEET NO.		TOTAL SHEETS	
J7A		J32	
STATE		YEAR	
ALASKA		2004	
PROJECT DESIGNATION			
NH-0A3-1(28)			
ADDENDUM NO.			
ATTACHMENT NO.			
REVISIONS			
NO.	DATE	DESCRIPTION	

CHANGE ORDER NO. 6


NOTE:
DIMENSIONS ARE IN METERS
UNLESS OTHERWISE NOTED.

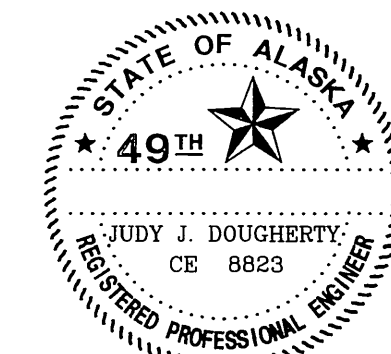

STATE OF ALASKA
DEPARTMENT OF TRANSPORTATION
AND PUBLIC FACILITIES
SEWARD HIGHWAY
MP 96 TO MP 102
SAFETY, ROADWAY AND
RECREATIONAL IMPROVEMENTS
SIGNING AND STRIPING


DESIGNED BY	VIEWMALED01 AT 5
CHECKED BY	
DATE	11.15.22
DESIGNED BY	KMH
SCALE	1:1.15.22
COMPUTER DESIGNATION	D:\3555\FR00\35577\DATA\IND001\RD\7701\THE DWG 9.25.01 11.15.22
PROJECT DESIGNATION	

MATCH LINE STA. 41+060

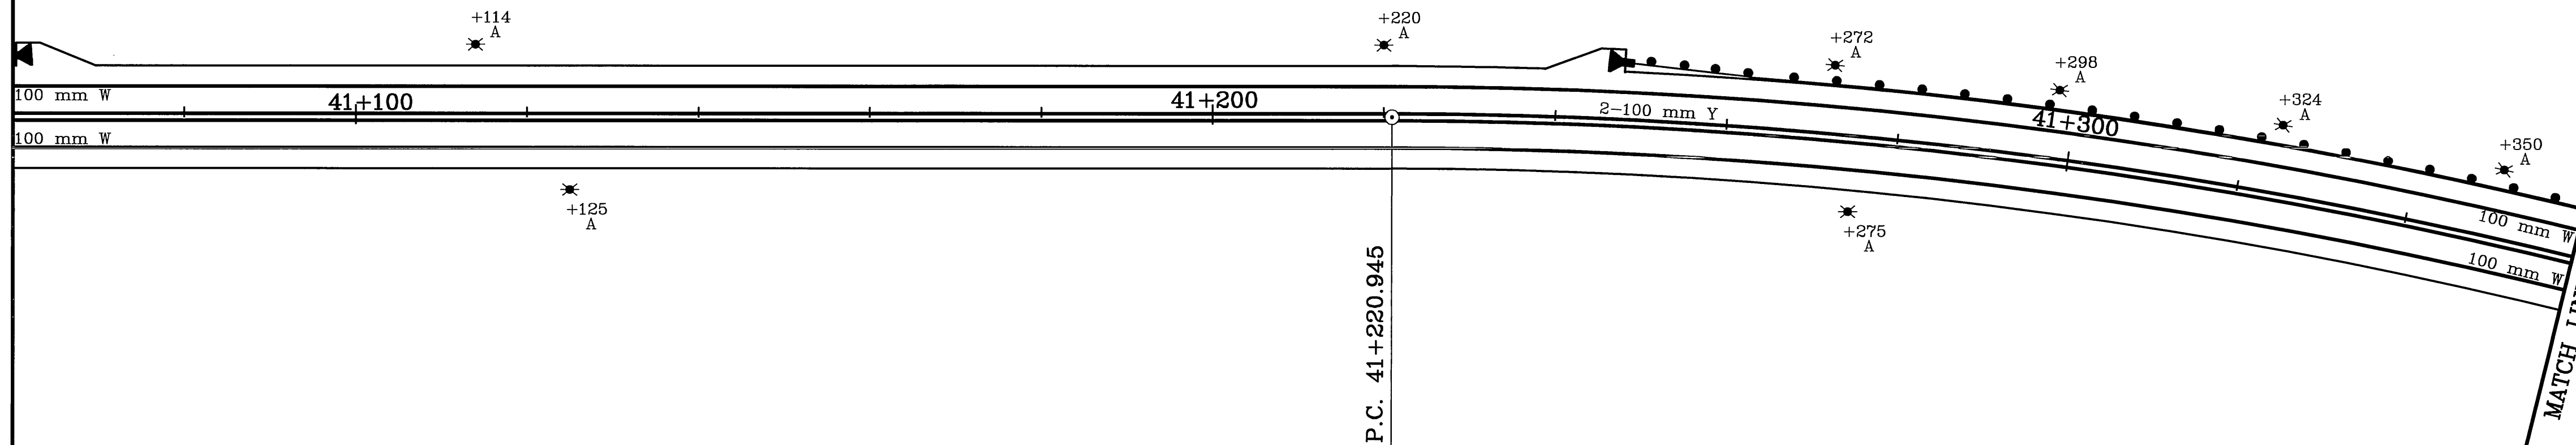


BEGIN OVERLAY

MATCH END OF
CONSTRUCTION STRIPING
STA. 40+906.25

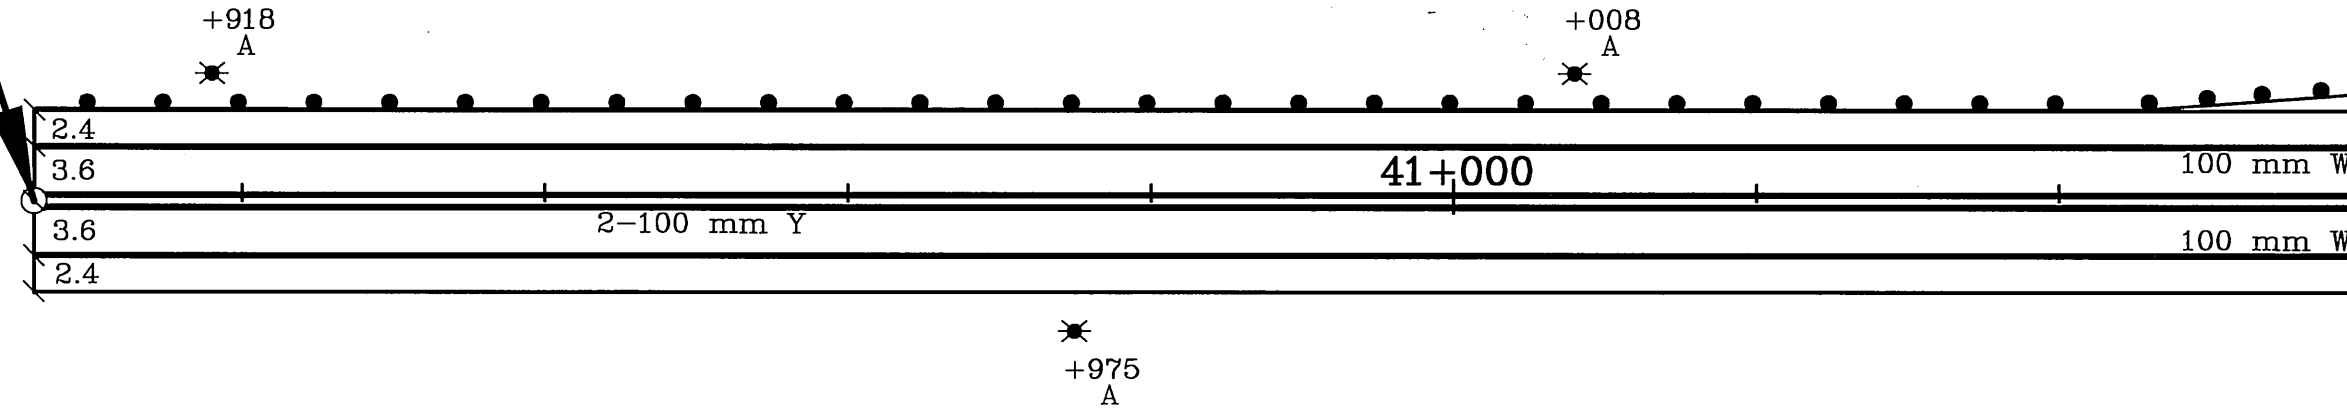


MATCH LINE STA. 41+060

SHEET NO.		TOTAL SHEETS	
J8		J32	
STATE		YEAR	
ALASKA		2002	
PROJECT DESIGNATION			
NH-0A3-1(28)			
ADDENDUM NO.			
ATTACHMENT NO.			
REVISIONS			
NO.	DATE	DESCRIPTION	

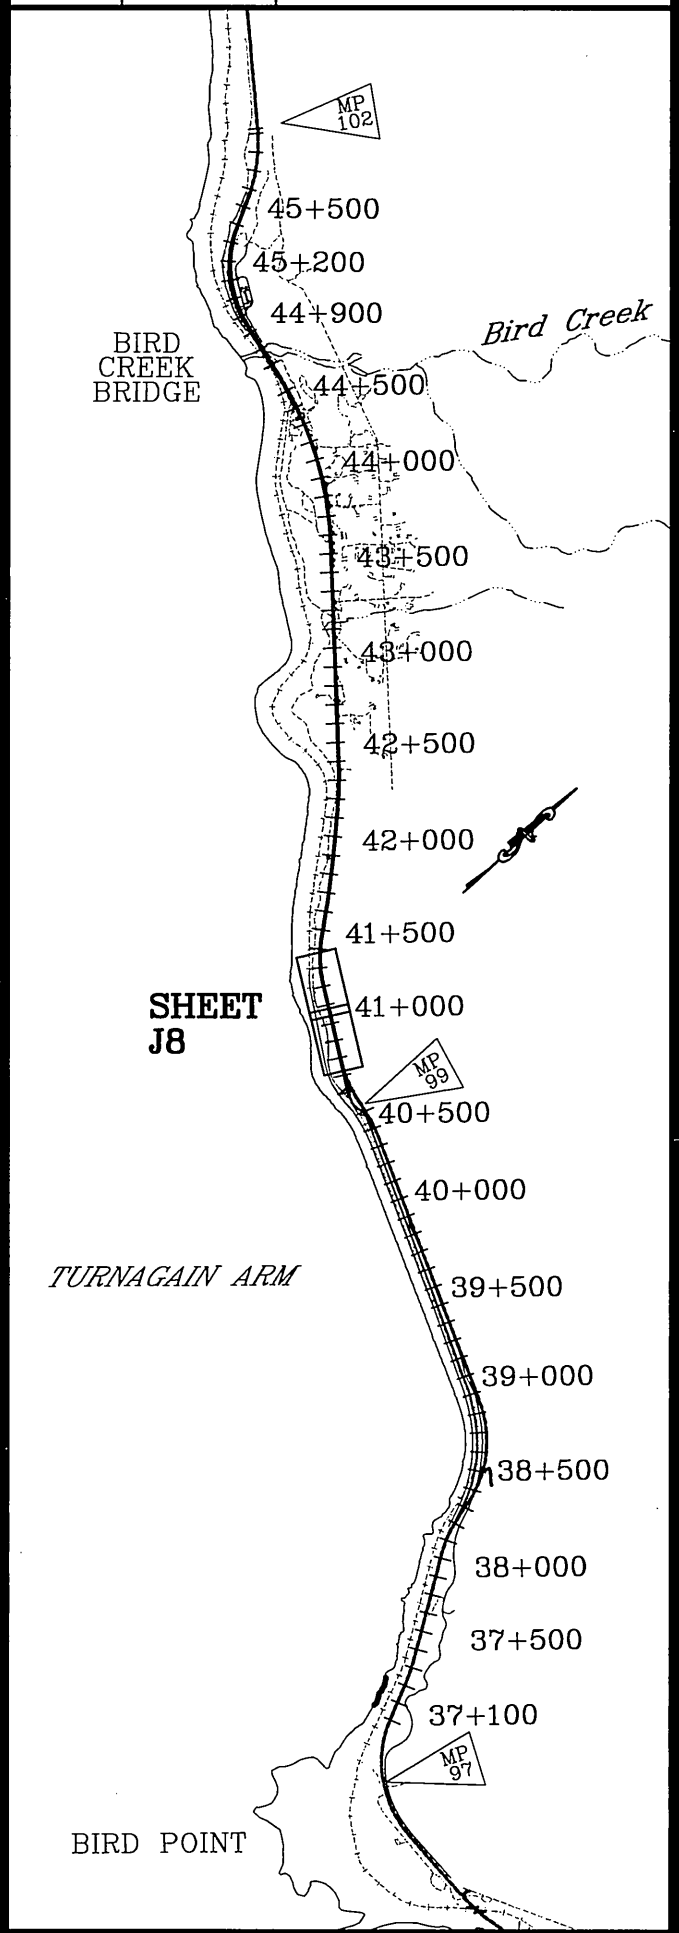


NOTE:
DIMENSIONS ARE IN METERS
UNLESS OTHERWISE NOTED.

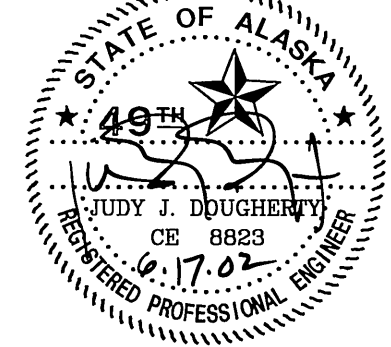


STATE OF ALASKA
DEPARTMENT OF TRANSPORTATION
AND PUBLIC FACILITIES
SEWARD HIGHWAY
MP 96 TO MP 102
SAFETY, ROADWAY &
RECREATIONAL IMPROVEMENTS
OVERLAY
BIRD FLATS TO BIRD CREEK
SIGNING AND STRIPING


SHEET NO.		TOTAL SHEETS	
J9		J32	
STATE		YEAR	
ALASKA		2002	
PROJECT DESIGNATION			
NH-0A3-1(28)			
ADDENDUM NO.			
ATTACHMENT NO.			
REVISIONS			
NO.	DATE	DESCRIPTION	

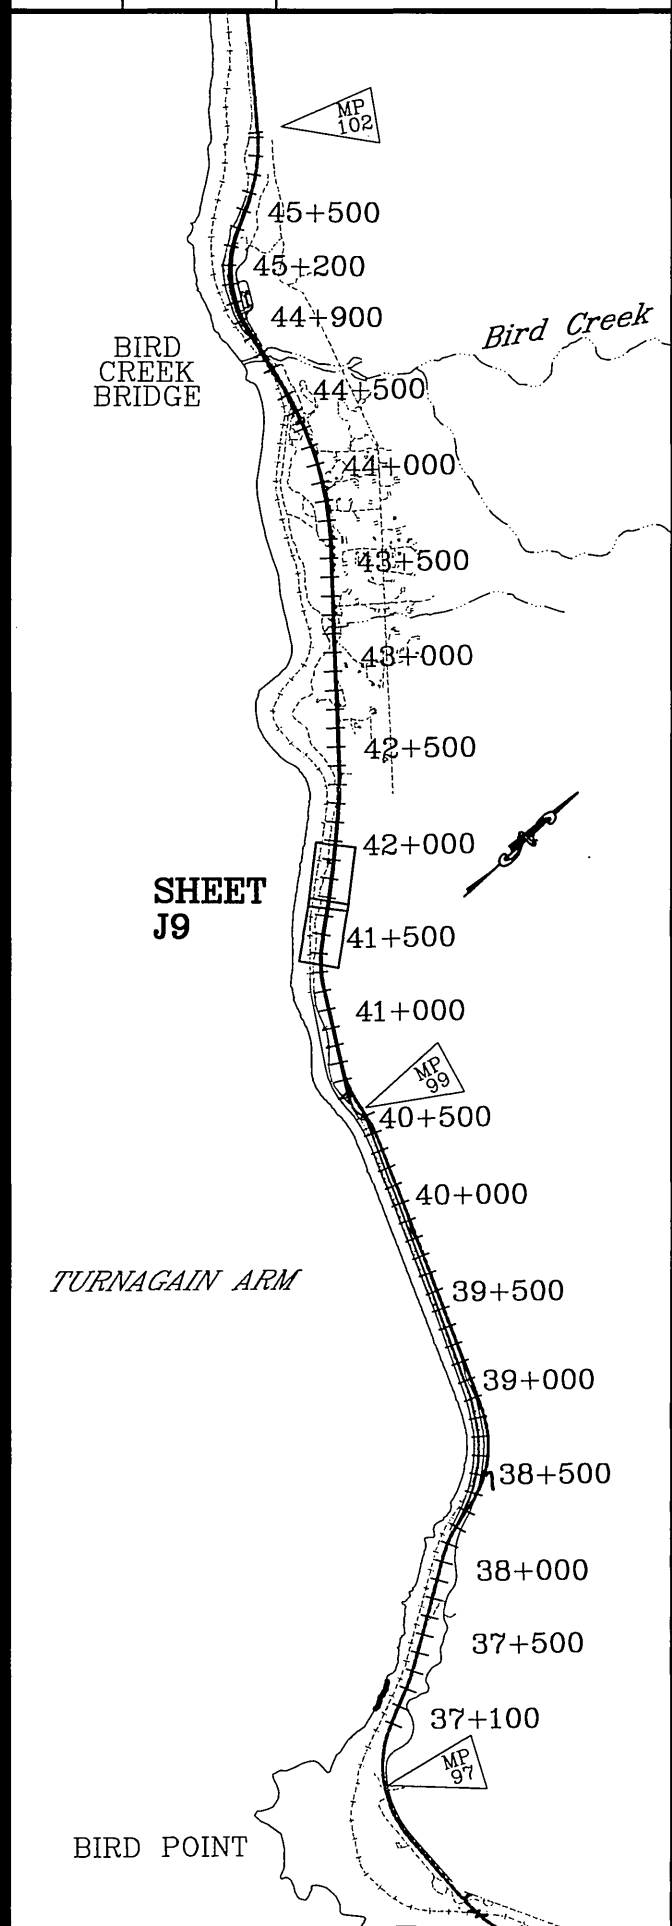

NOTE:
DIMENSIONS ARE IN METERS
UNLESS OTHERWISE NOTED.

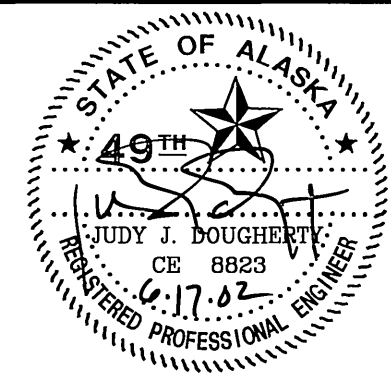


STATE OF ALASKA
DEPARTMENT OF TRANSPORTATION
AND PUBLIC FACILITIES
**SEWARD HIGHWAY
MP 96 TO MP 102
SAFETY, ROADWAY &
RECREATIONAL IMPROVEMENTS
OVERLAY
BIRD FLATS TO BIRD CREEK
SIGNING AND STRIPING**

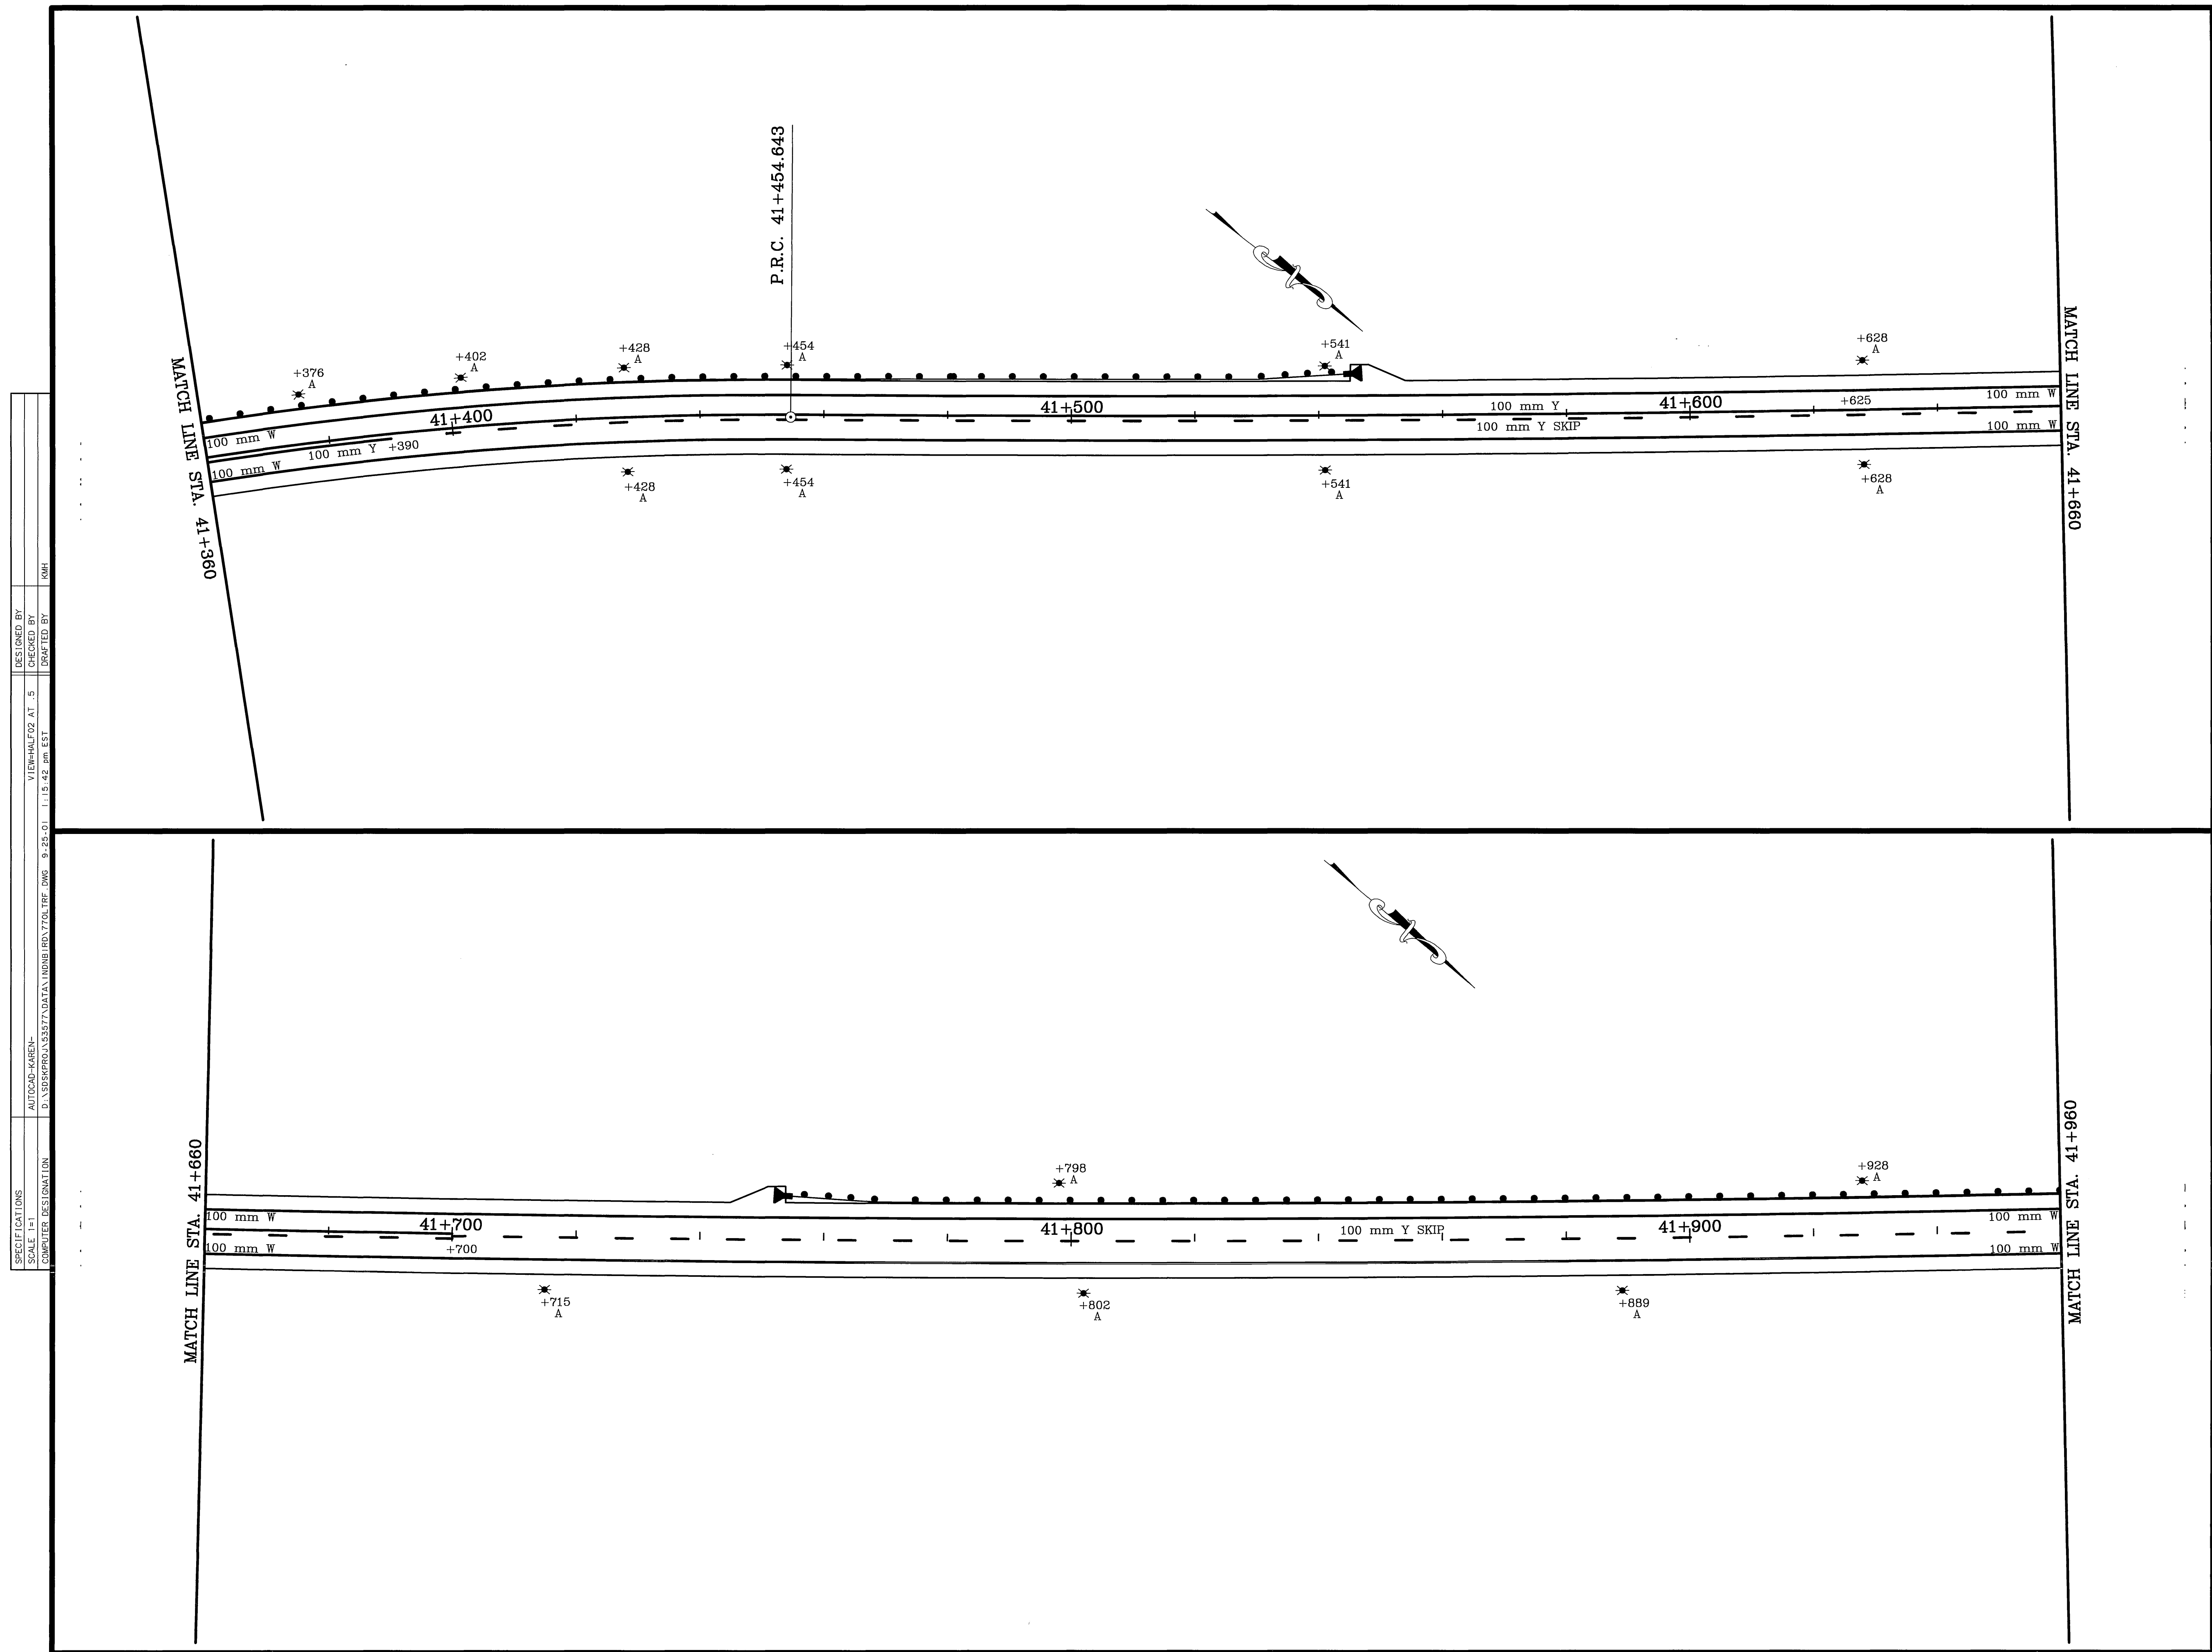


DESIGNED BY	AUTOCAD-KAREN-
CHECKED BY	VIEW- MAF03 AT 5
DATE	1.15.02
PROJECT NO.	9.25.01
PROJECT NAME	1.15.02
PROJECT LOCATION	1.15.02
PROJECT DESCRIPTION	1.15.02
PROJECT DRAWING NO.	1.15.02
PROJECT DATE	1.15.02
PROJECT SCALE	1.15.02
PROJECT STATUS	1.15.02
PROJECT COMMENTS	1.15.02

MATCH LINE STA. 41+960

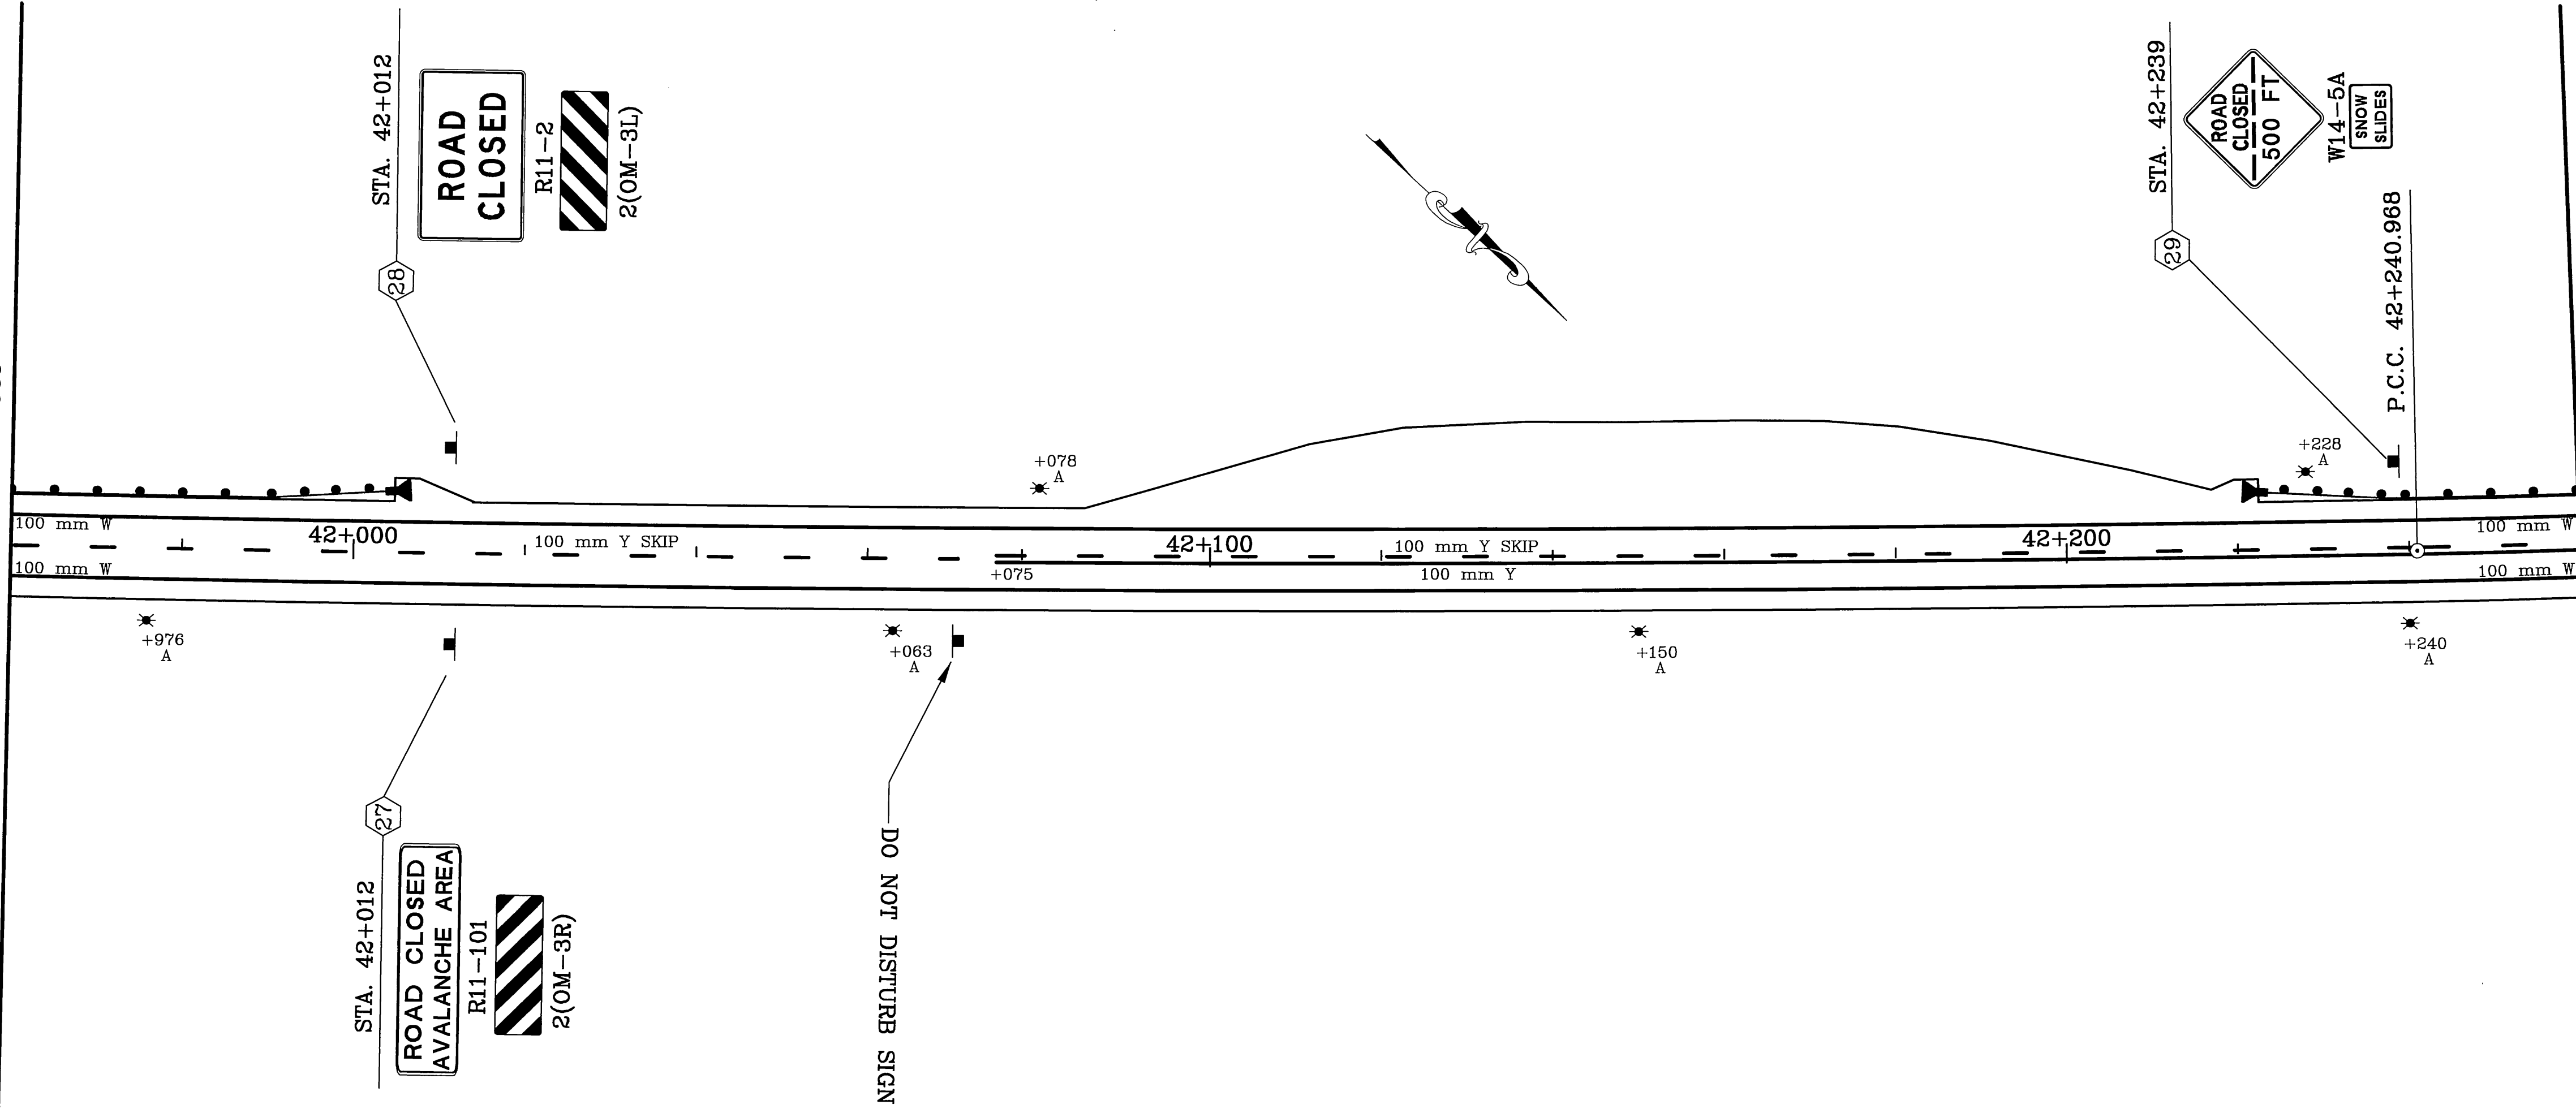

MATCH LINE STA. 42+260

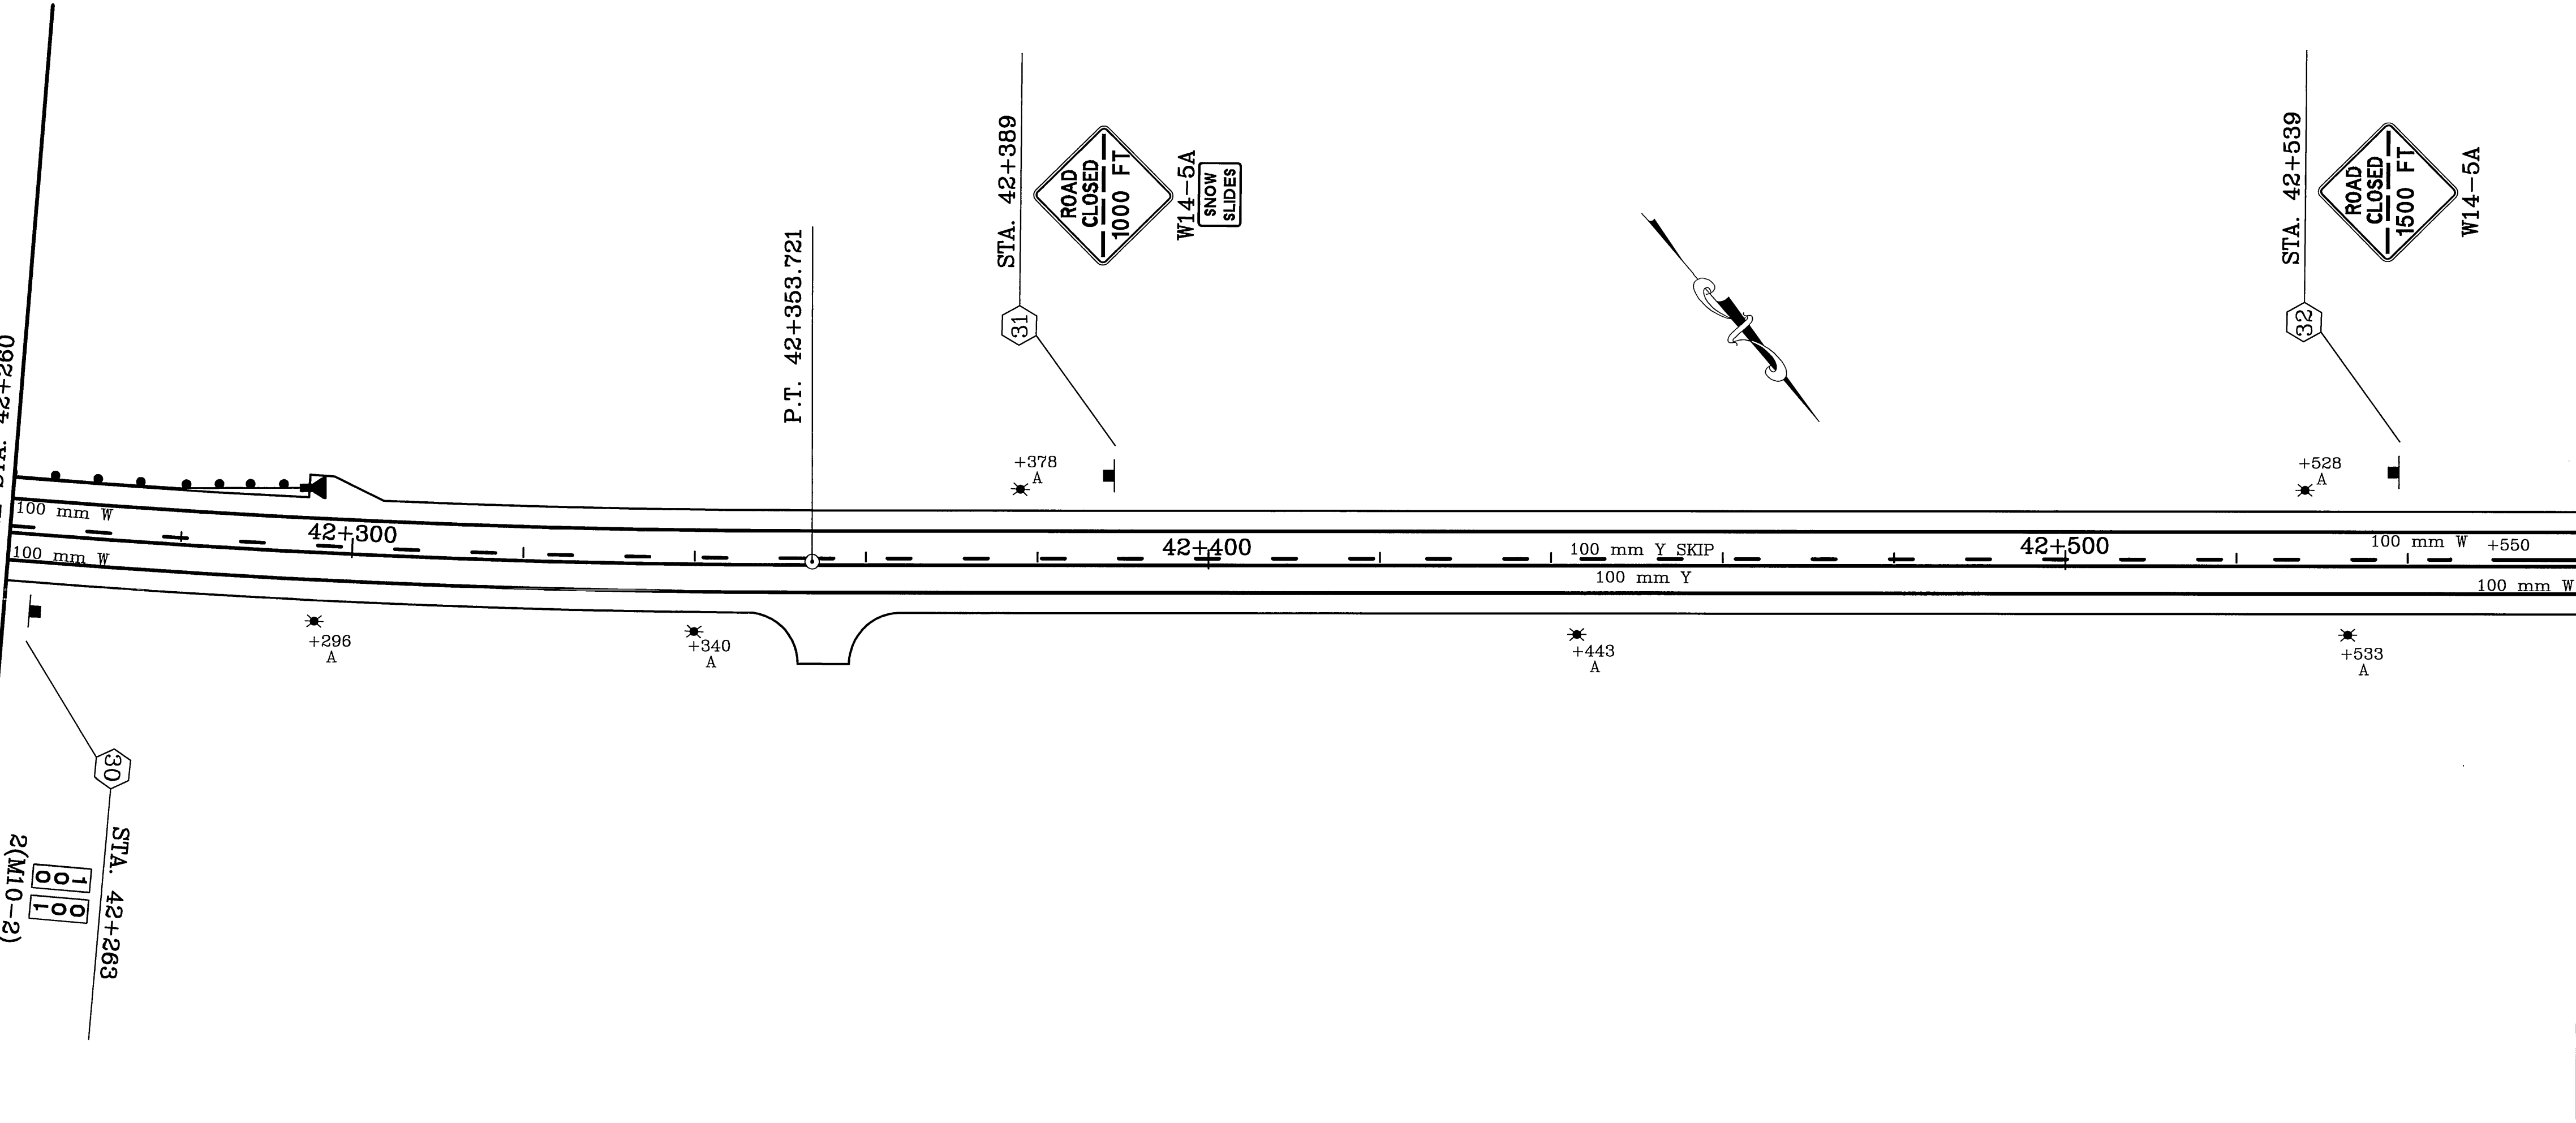

MATCH LINE STA. 42+260

MATCH LINE STA. 42+560


SHEET NO.	TOTAL SHEETS	
J10	J32	
STATE	YEAR	
ALASKA	2002	
PROJECT DESIGNATION		
NH-OA3-1(28)		
ADDENDUM NO.		
ATTACHMENT NO.		
REVISIONS		
NO.	DATE	DESCRIPTION

NOTE:
DIMENSIONS ARE IN METERS
UNLESS OTHERWISE NOTED.


STATE OF ALASKA
49th
JUDY J. ROUGHARTY
CE 8823
6.17.02
REGISTERED PROFESSIONAL ENGINEER

STATE OF ALASKA
DEPARTMENT OF TRANSPORTATION
AND PUBLIC FACILITIES
SEWARD HIGHWAY
MP 96 TO MP 102
SAFETY, ROADWAY &
RECREATIONAL IMPROVEMENTS
OVERLAY
BIRD FLATS TO BIRD CREEK
SIGNING AND STRIPING



SHEET NO.		TOTAL SHEETS	
J11		J32	
STATE		YEAR	
ALASKA		2002	
PROJECT DESIGNATION			
NH-OA3-1(28)			
ADDENDUM NO.			
ATTACHMENT NO.			
REVISIONS			
NO.	DATE	DESCRIPTION	

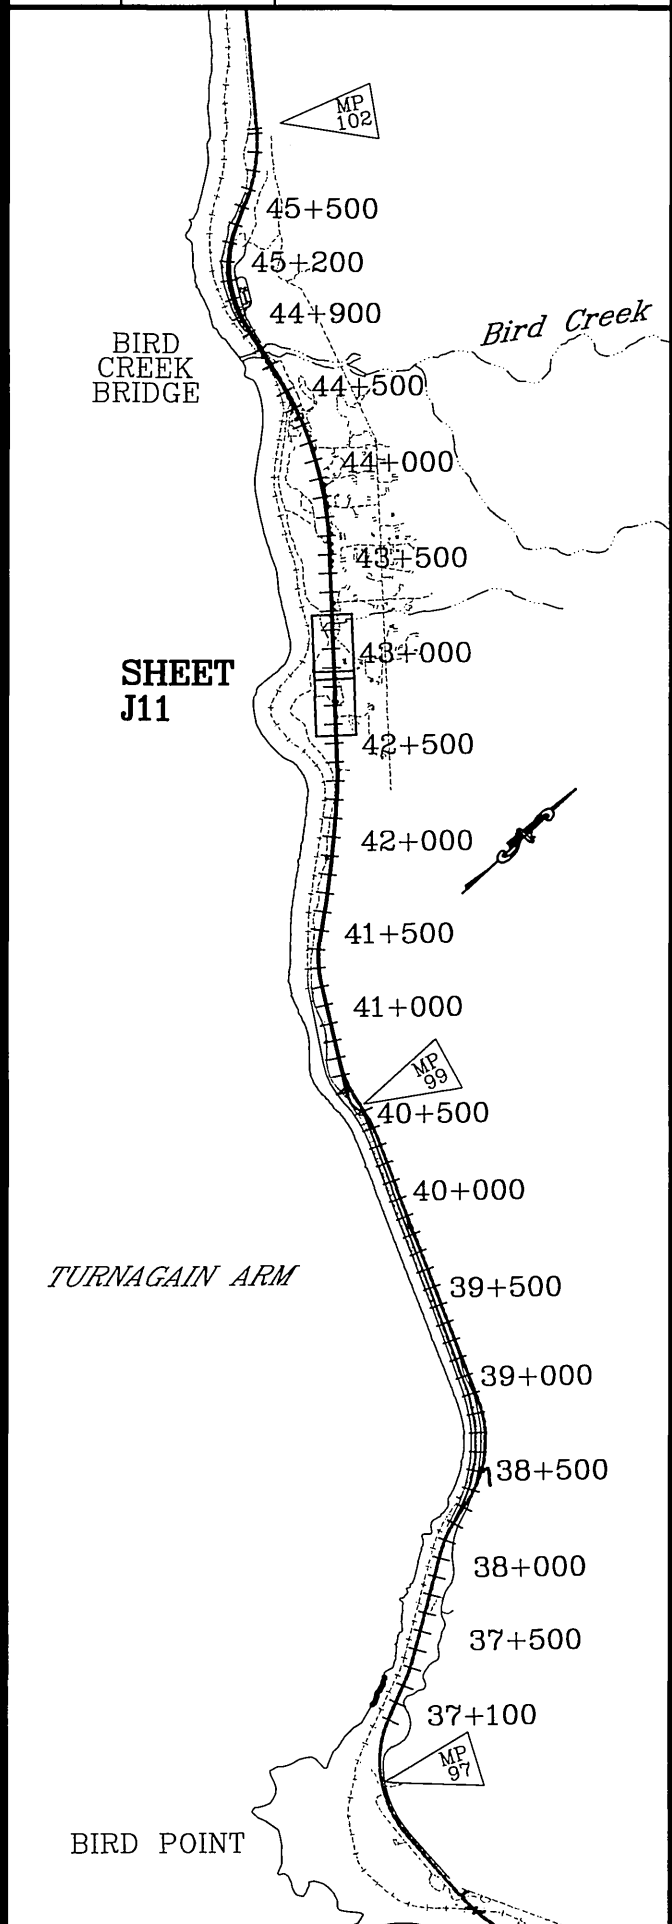

NOTE:
DIMENSIONS ARE IN METERS
UNLESS OTHERWISE NOTED.

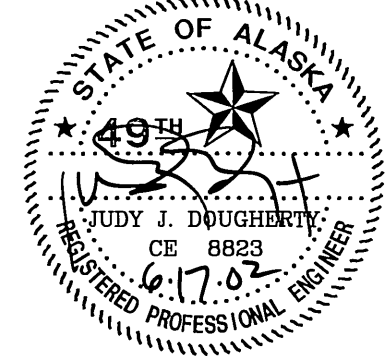


STATE OF ALASKA
DEPARTMENT OF TRANSPORTATION
AND PUBLIC FACILITIES
**SEWARD HIGHWAY
MP 96 TO MP 102
SAFETY, ROADWAY &
RECREATIONAL IMPROVEMENTS
OVERLAY
BIRD FLATS TO BIRD CREEK
SIGNING AND STRIPING**

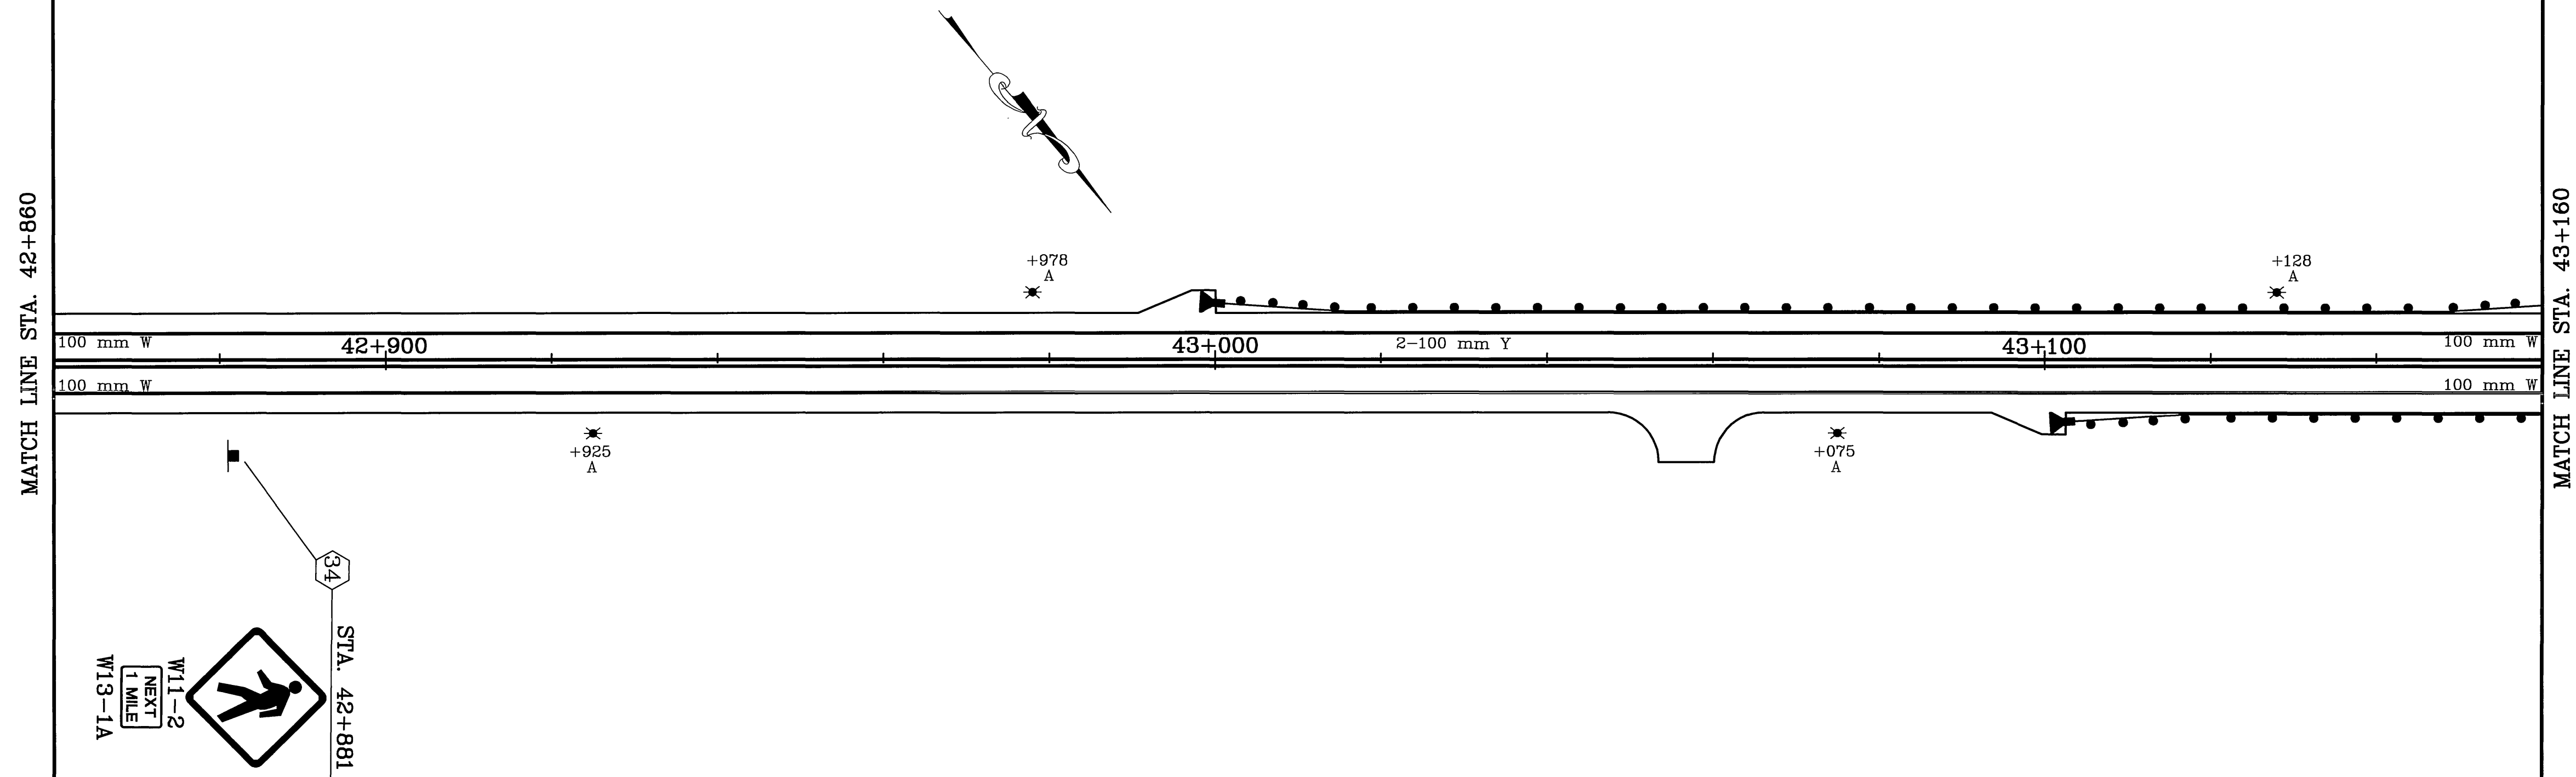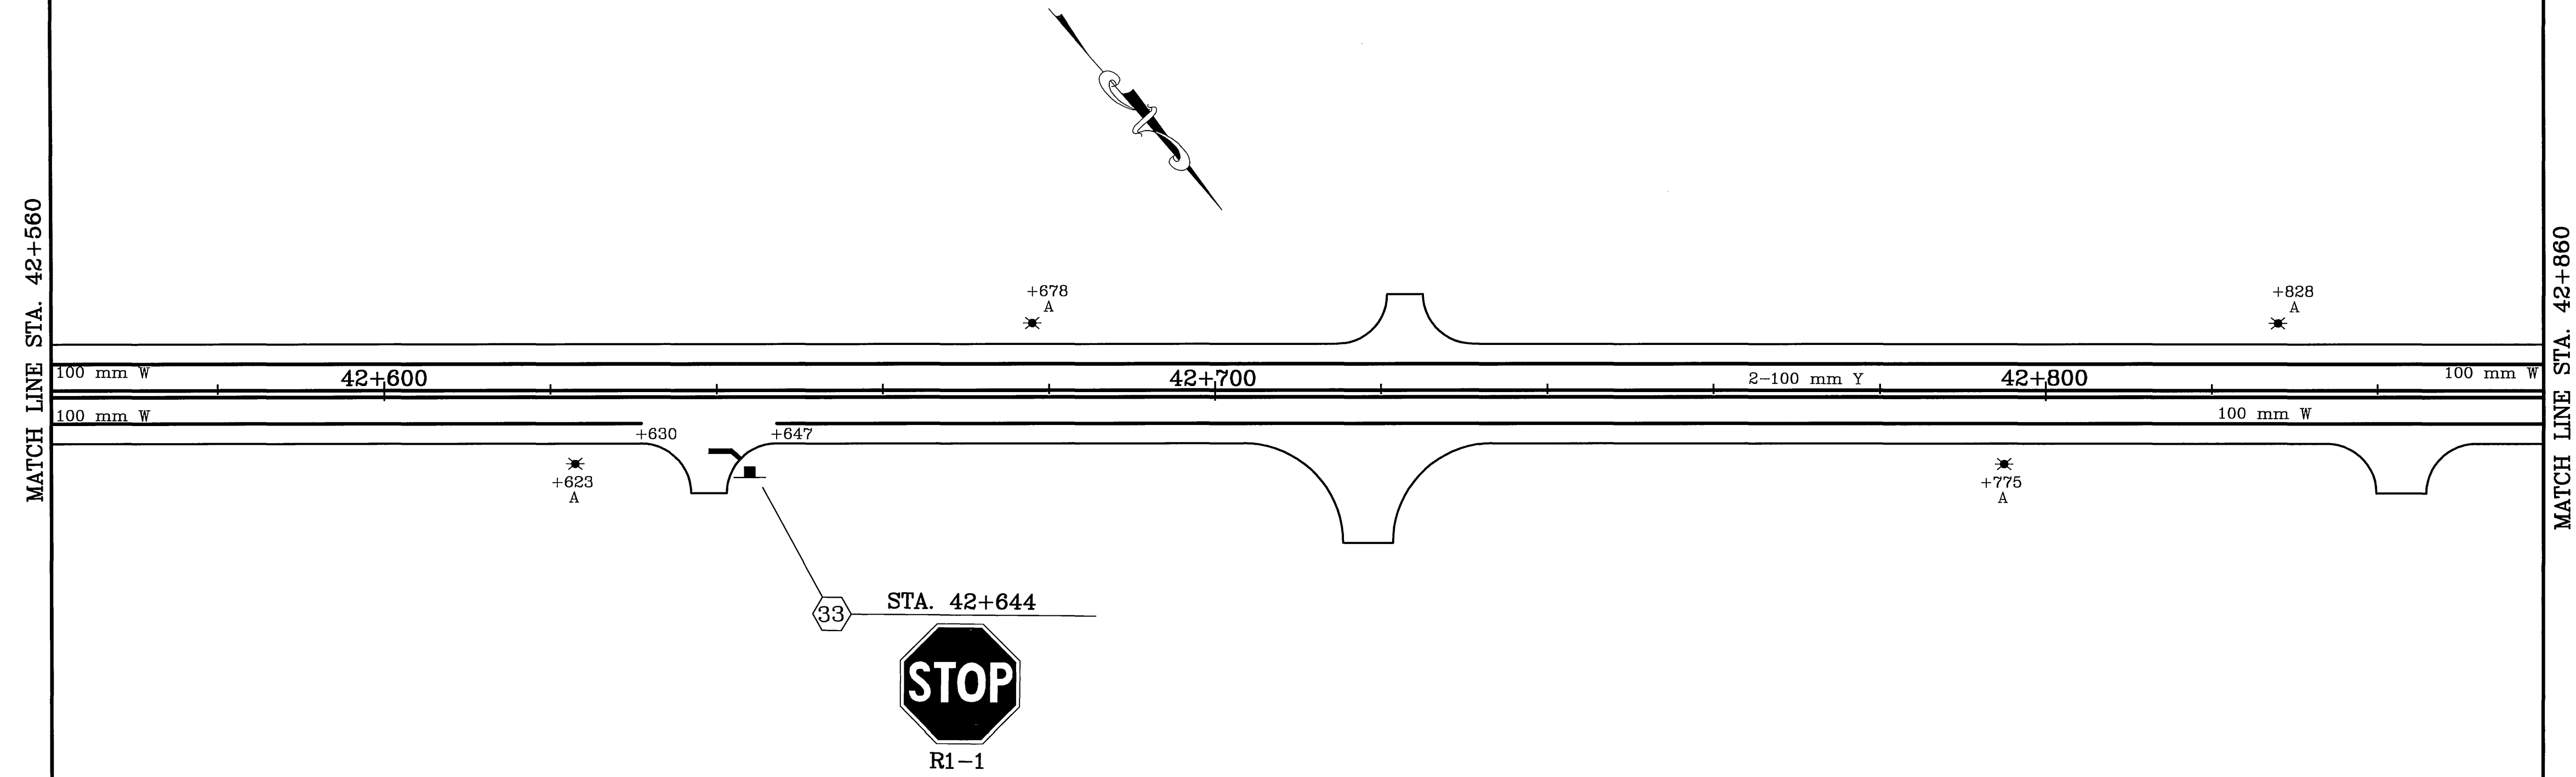

SPECIFICATIONS	DESIGNED BY
SCALE 1:1	CHECKED BY
AUTOCAD-KAREN-	VIEW/HALF/4 AT .5
COMPUTER DESIGNATION	D:\SDSKPROJ\A3557\DATA\NONB17VOL.TRF DWG 9-25-01 1:1 5.42 pm EST
	DRAFTED BY
	KMH


SPECIFICATIONS	AUTOCAD-KAREN	DESIGNED BY
SCALE 1"=1'	D:\32826\603\3557\DATA\RD\BIB\RD\N701.PDF DWG 9-25-01 1:15:42 pm EST	DESIGNED BY
COMPUTER DESIGNATION	VIEW-HALFDS AT .5	DESIGNED BY
		KMH

MATCH LINE STA. 43+160

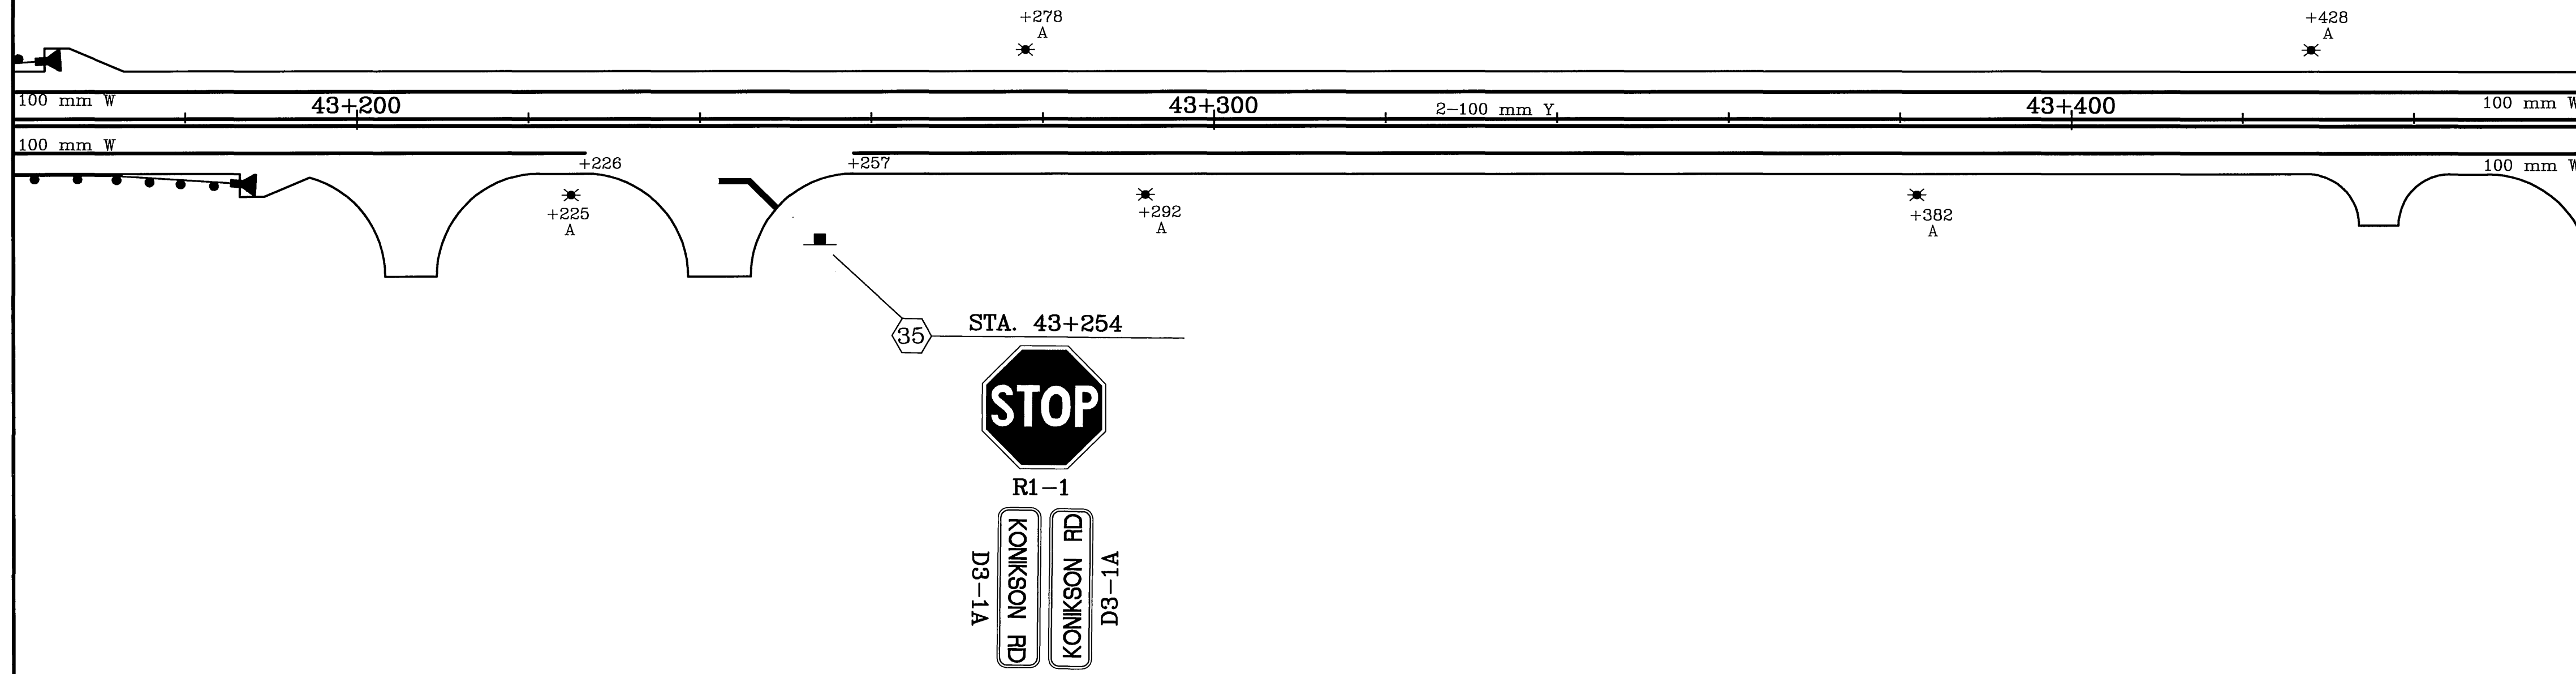


MATCH LINE STA. 43+460

MATCH LINE STA. 43+460

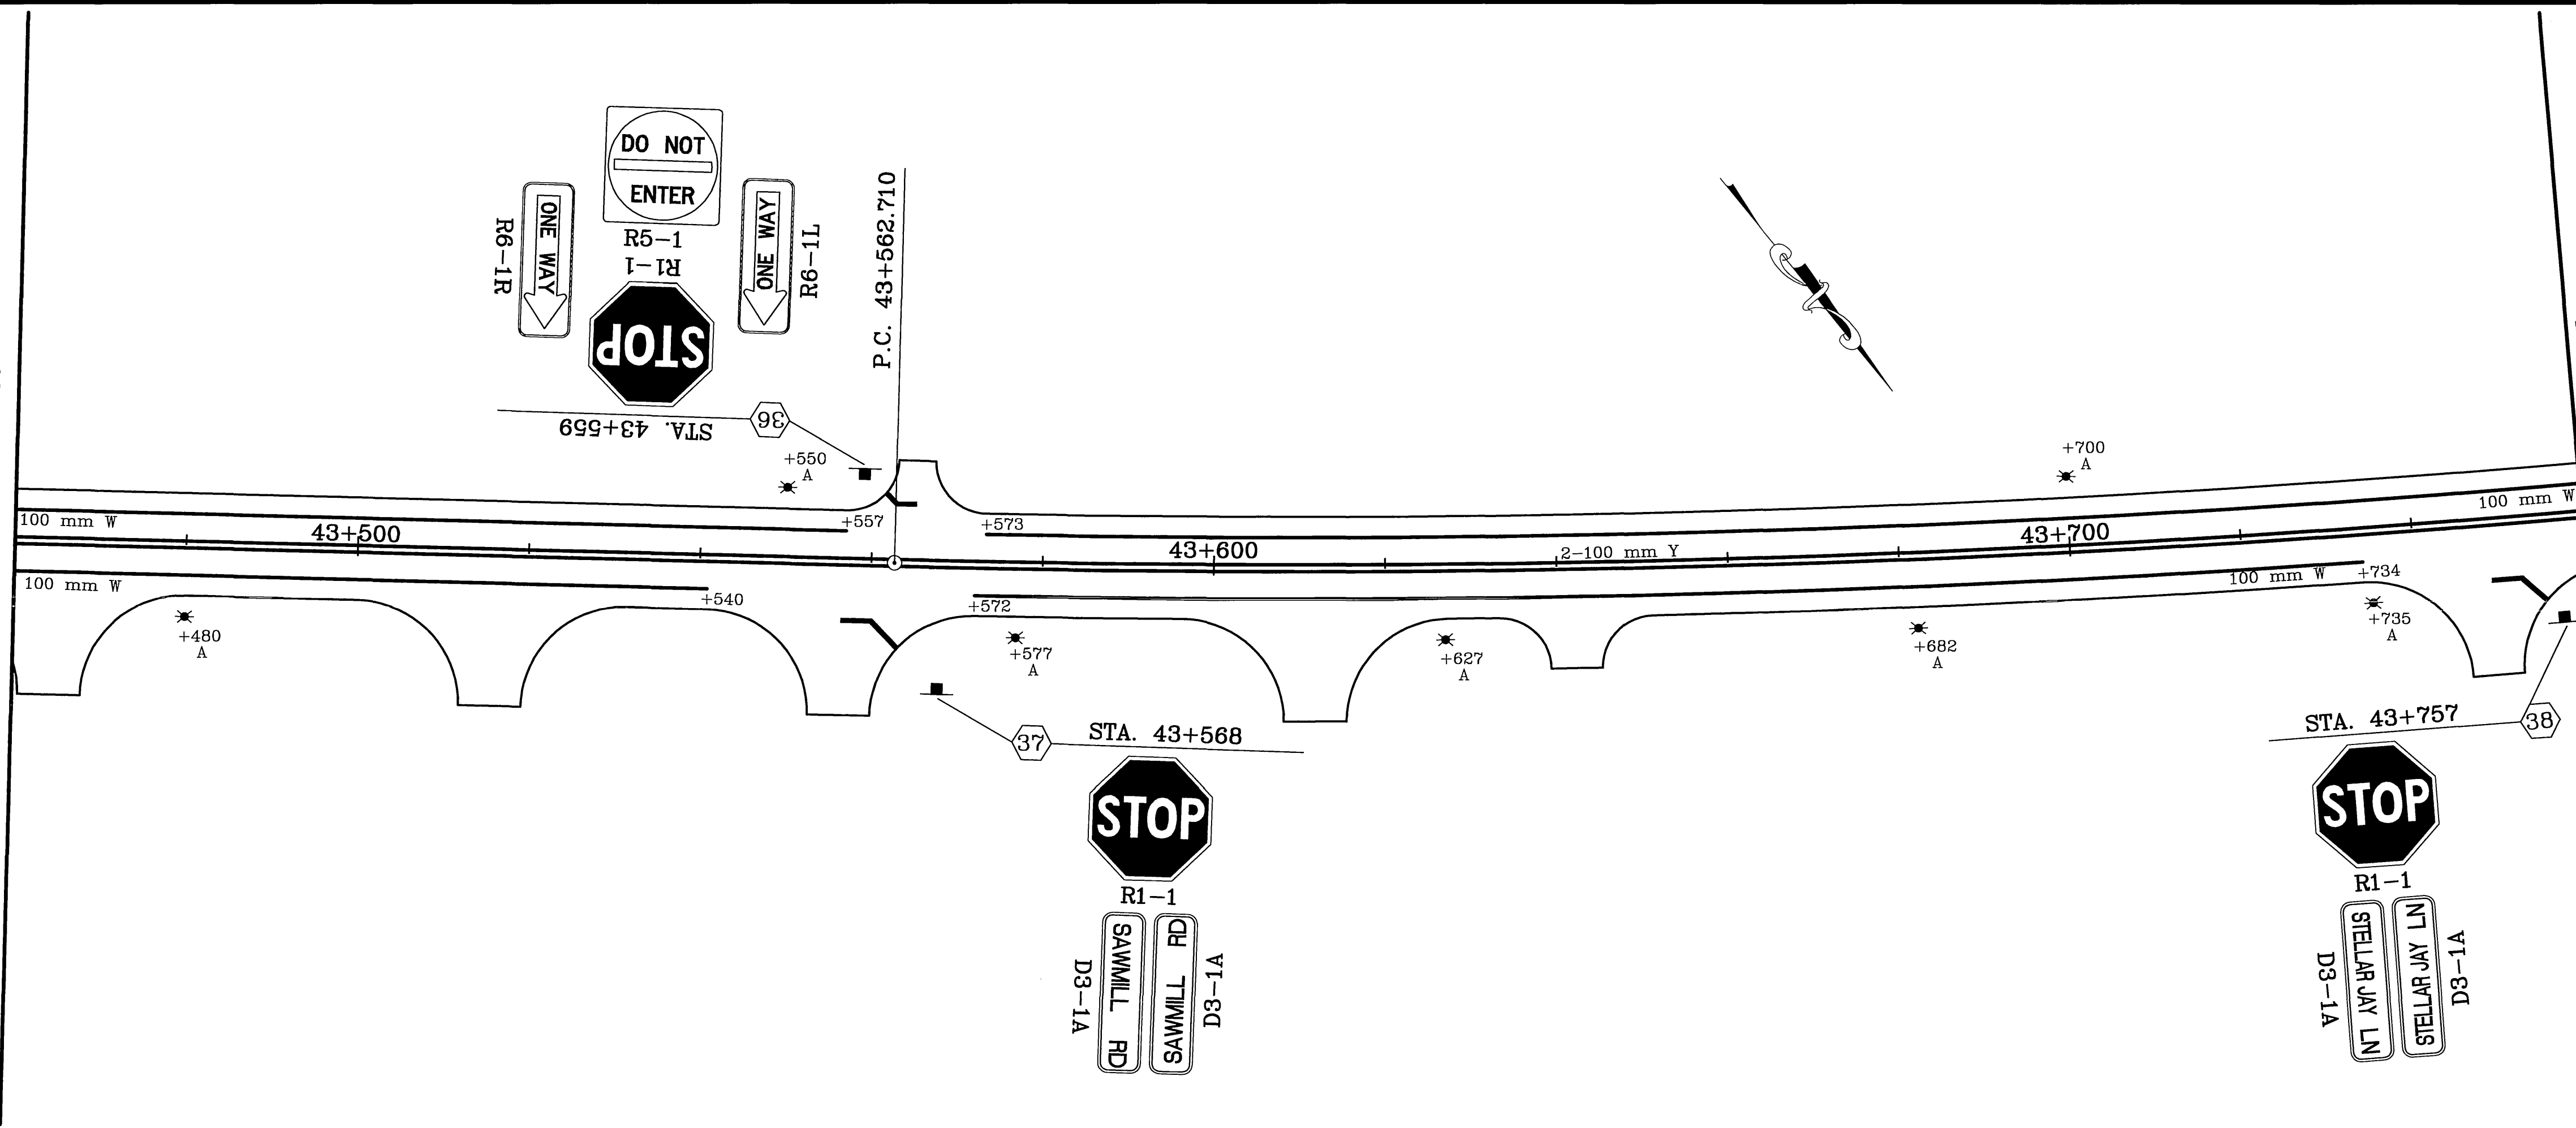

MATCH LINE STA. 43+760

SHEET NO.	TOTAL SHEETS	
J12	J32	
STATE	YEAR	
ALASKA	2002	
PROJECT DESIGNATION		
NH-0A3-1(28)		
ADDENDUM NO.		
ATTACHMENT NO.		
REVISIONS		
NO.	DATE	DESCRIPTION

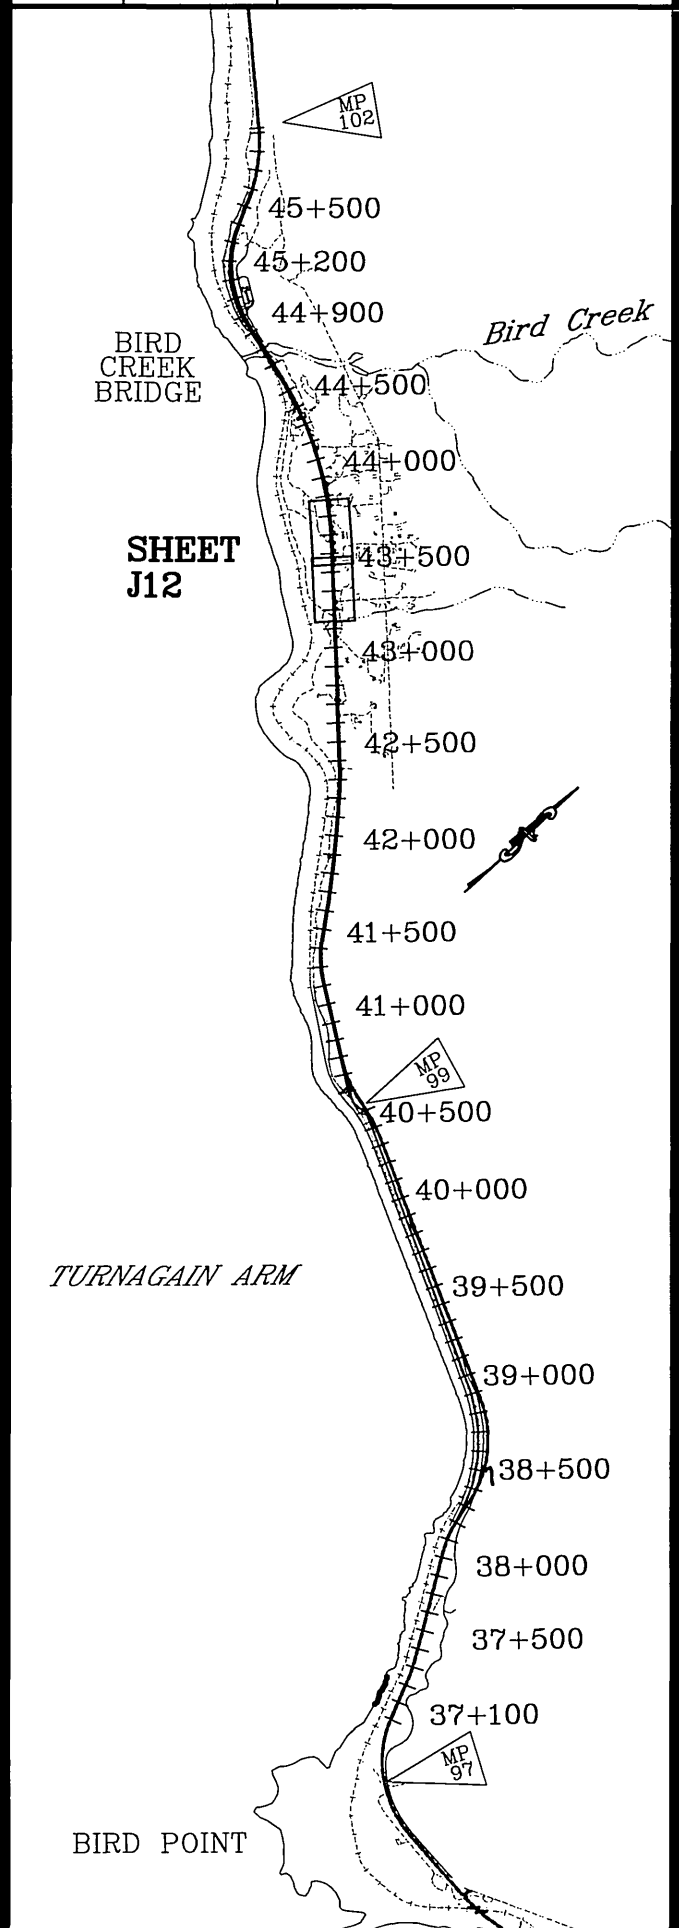


NOTE:
DIMENSIONS ARE IN METERS
UNLESS OTHERWISE NOTED.


STATE OF ALASKA
49TH
JUDY J. DOUGHERTY
CE 8823
6-17-02
REGISTERED PROFESSIONAL ENGINEER

STATE OF ALASKA
DEPARTMENT OF TRANSPORTATION
AND PUBLIC FACILITIES
SEWARD HIGHWAY
MP 96 TO MP 102
SAFETY, ROADWAY &
RECREATIONAL IMPROVEMENTS
OVERLAY
BIRD FLATS TO BIRD CREEK
SIGNING AND STRIPING



SHEET NO.		TOTAL SHEETS	
J13		J32	
STATE		YEAR	
ALASKA		2002	
PROJECT DESIGNATION			
NH-OA3-1(28)			
ADDENDUM NO.			
ATTACHMENT NO.			
REVISIONS			
NO.	DATE	DESCRIPTION	

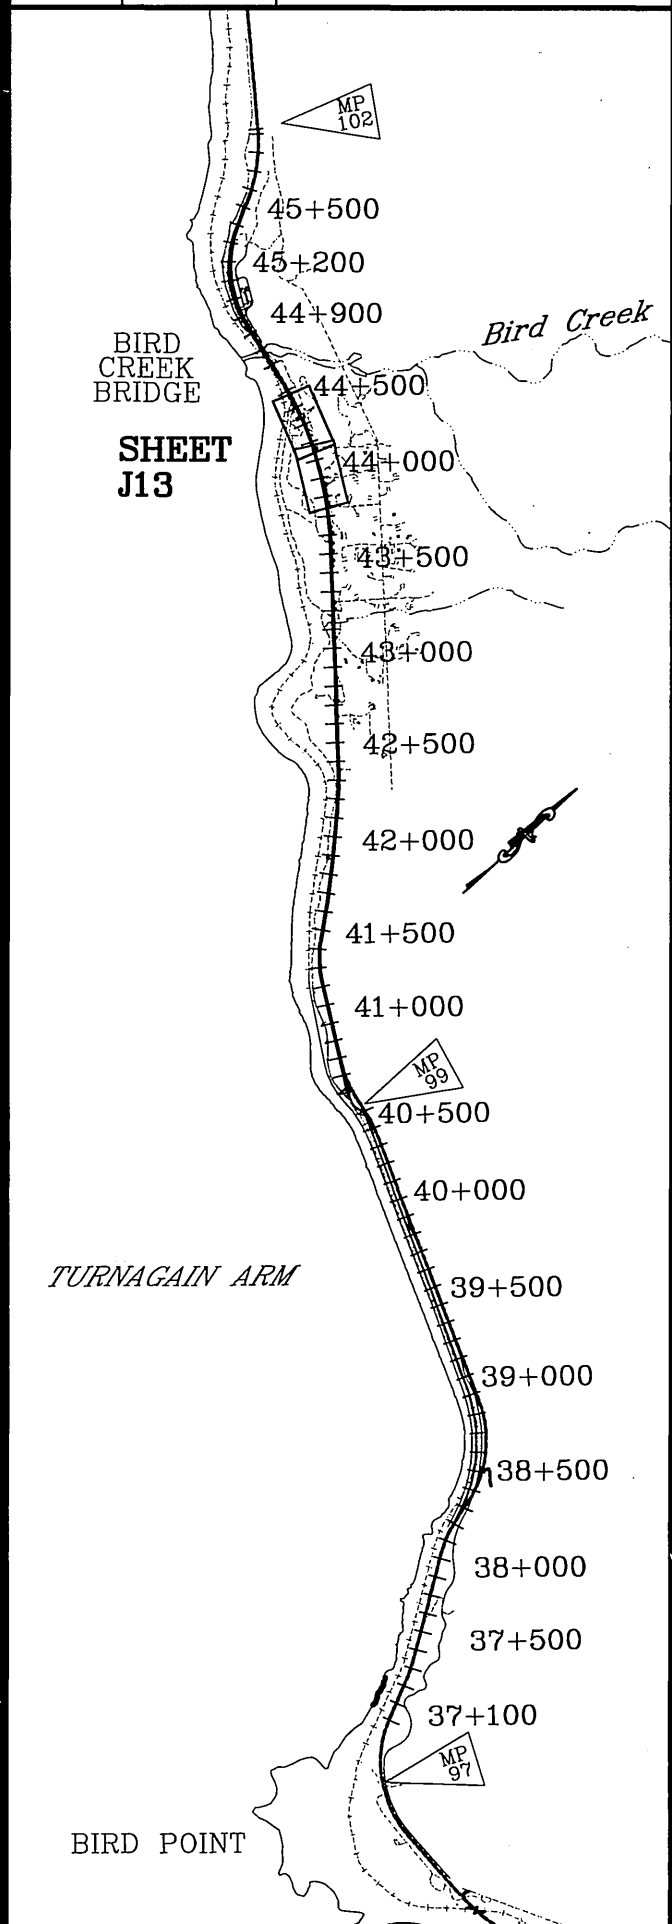


NOTE:
DIMENSIONS ARE IN METERS
UNLESS OTHERWISE NOTED.

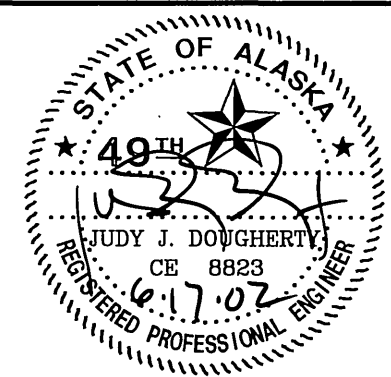


STATE OF ALASKA
DEPARTMENT OF TRANSPORTATION
AND PUBLIC FACILITIES
**SEWARD HIGHWAY
MP 96 TO MP 102
SAFETY, ROADWAY &
RECREATIONAL IMPROVEMENTS
OVERLAY
BIRD FLATS TO BIRD CREEK
SIGNING AND STRIPING**

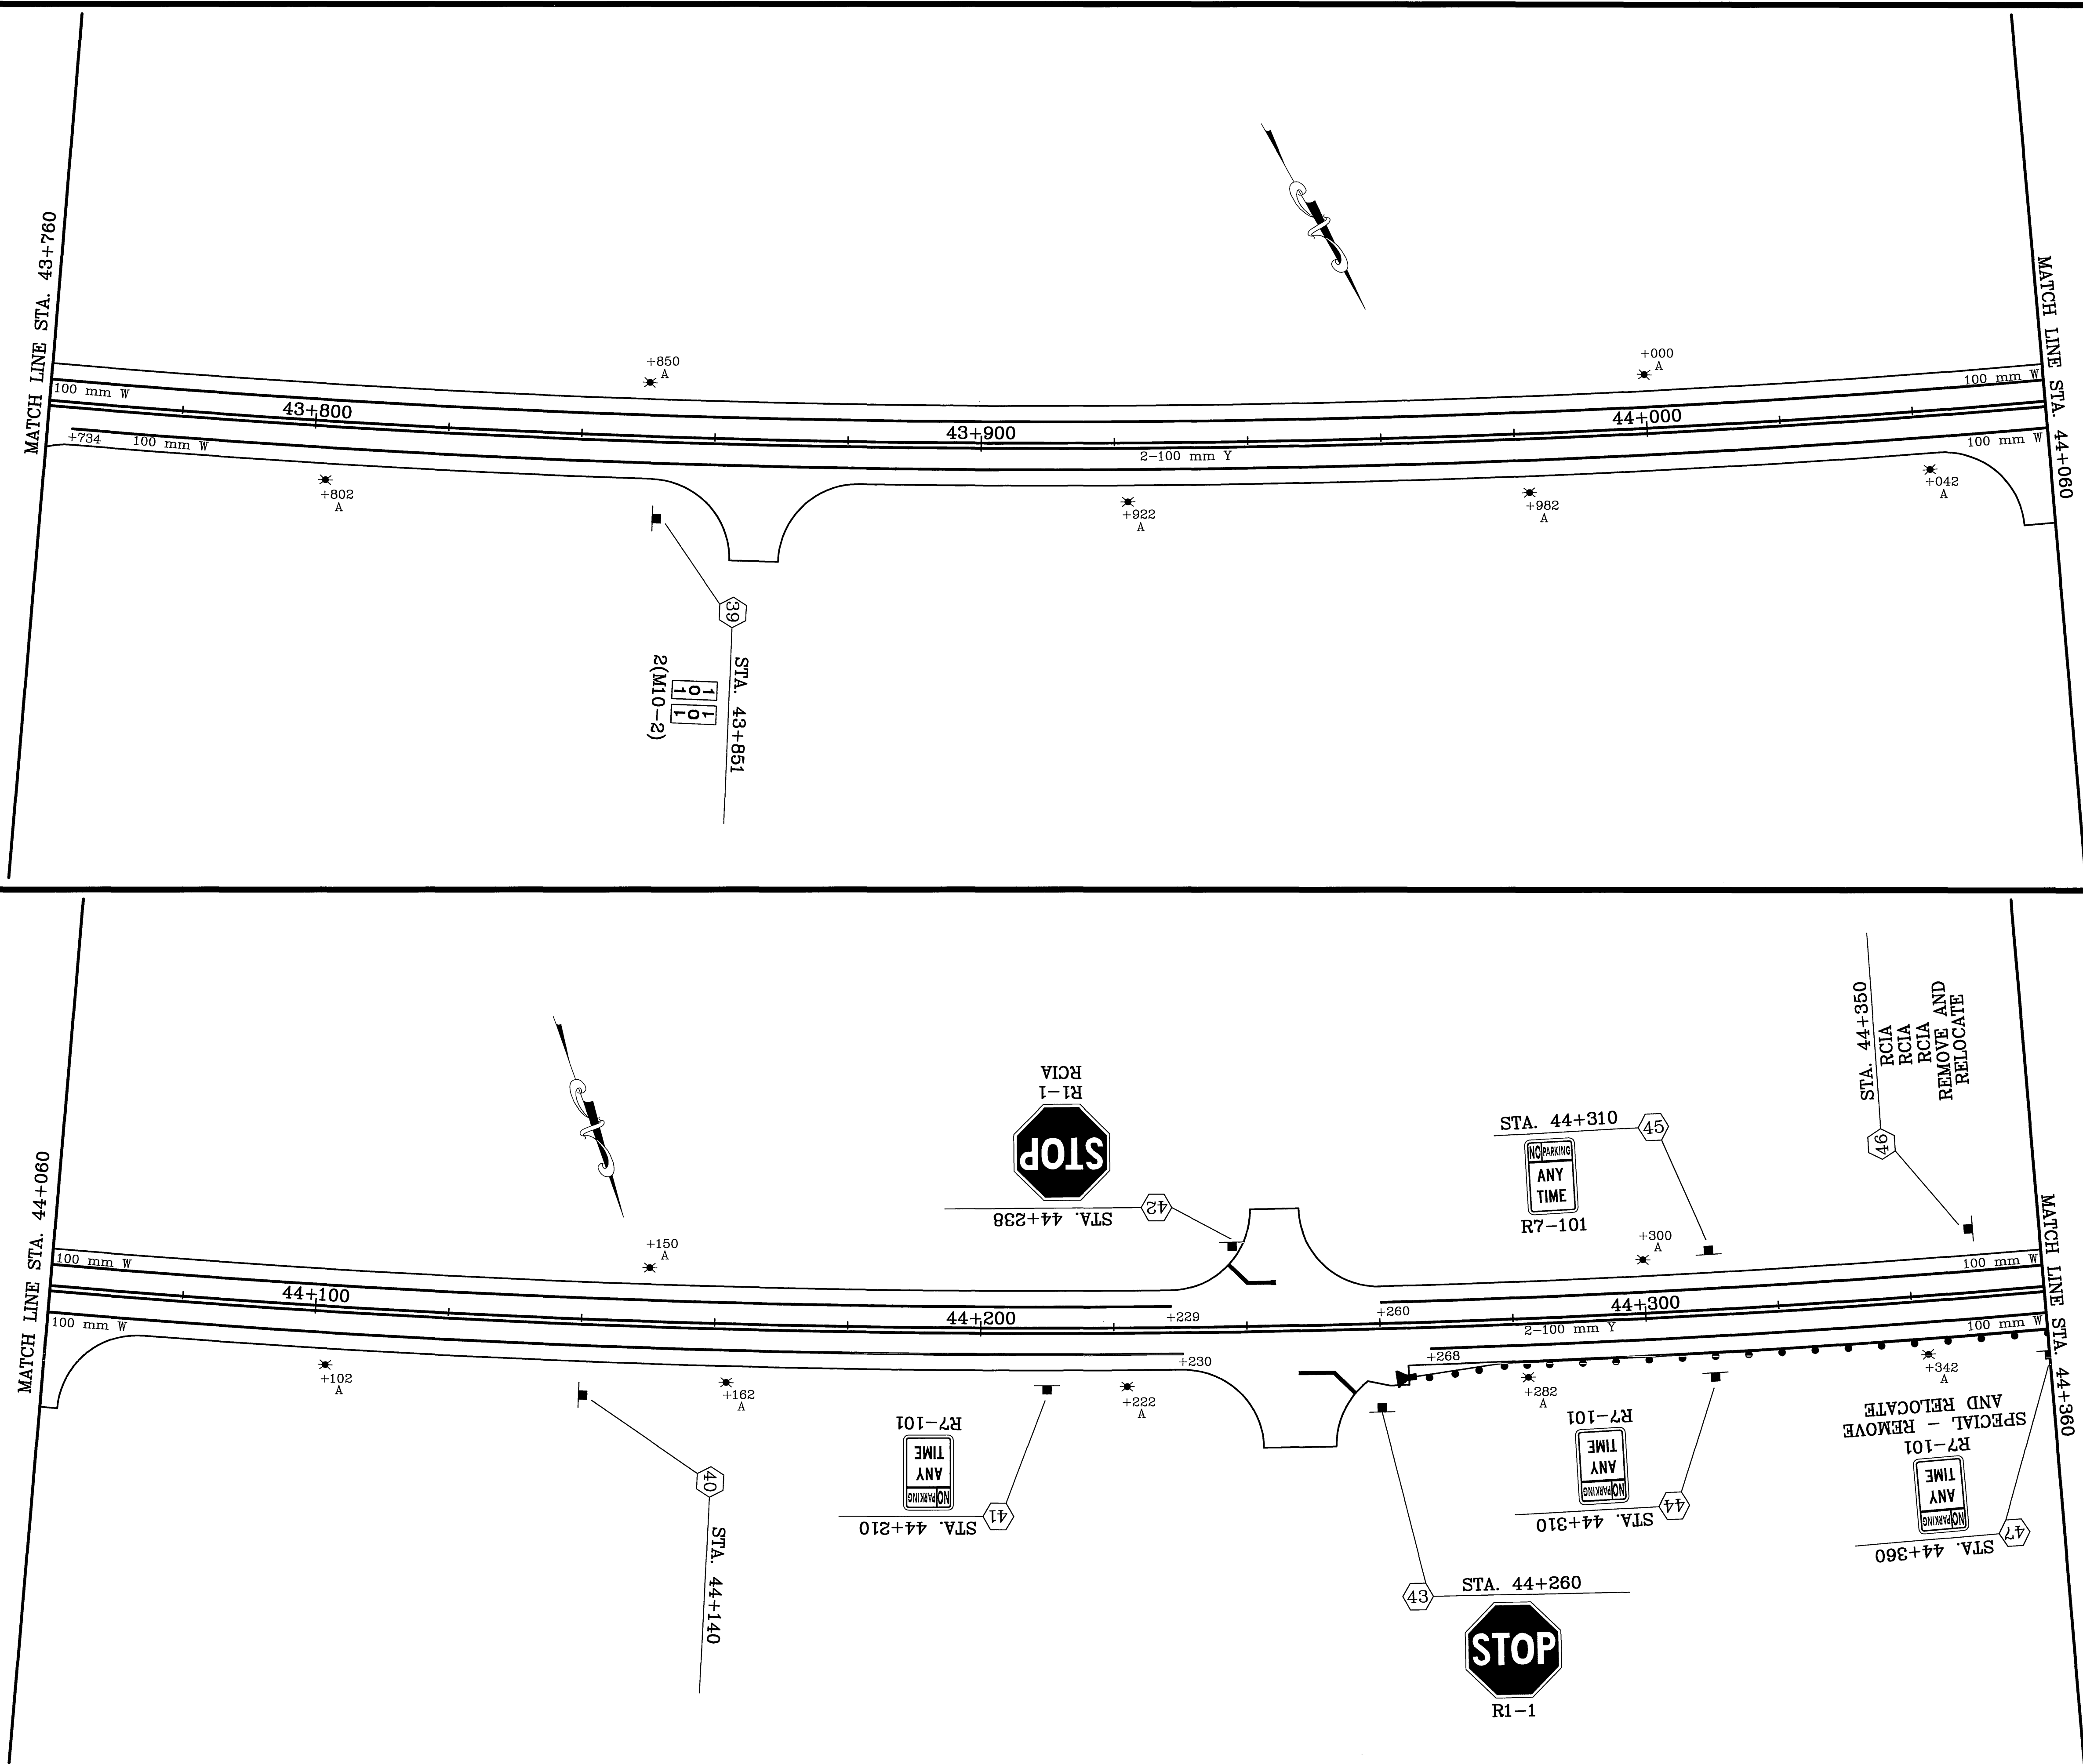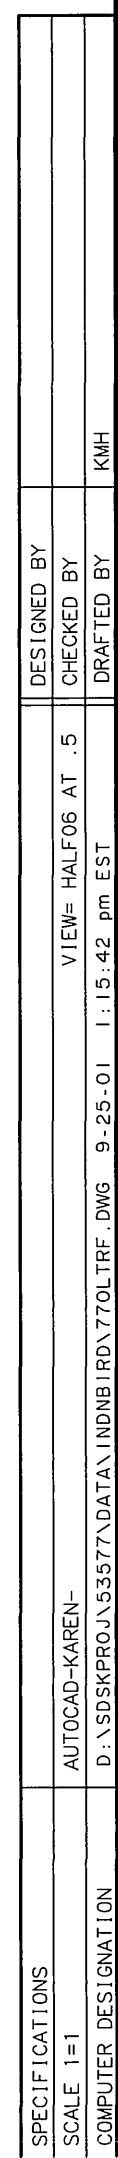

SPECIFICATIONS
SCALE 1"=100'
COMPUTER DESIGNATION
AUTOCAD-KAREN
D:\S006250\15357\DATA\N008\RD\76180P07REF.DWG 9-25-01 1:22:43 PM EST
VIEWNAME:01 AT:5
DESIGNED BY
DRAFTED BY
4044

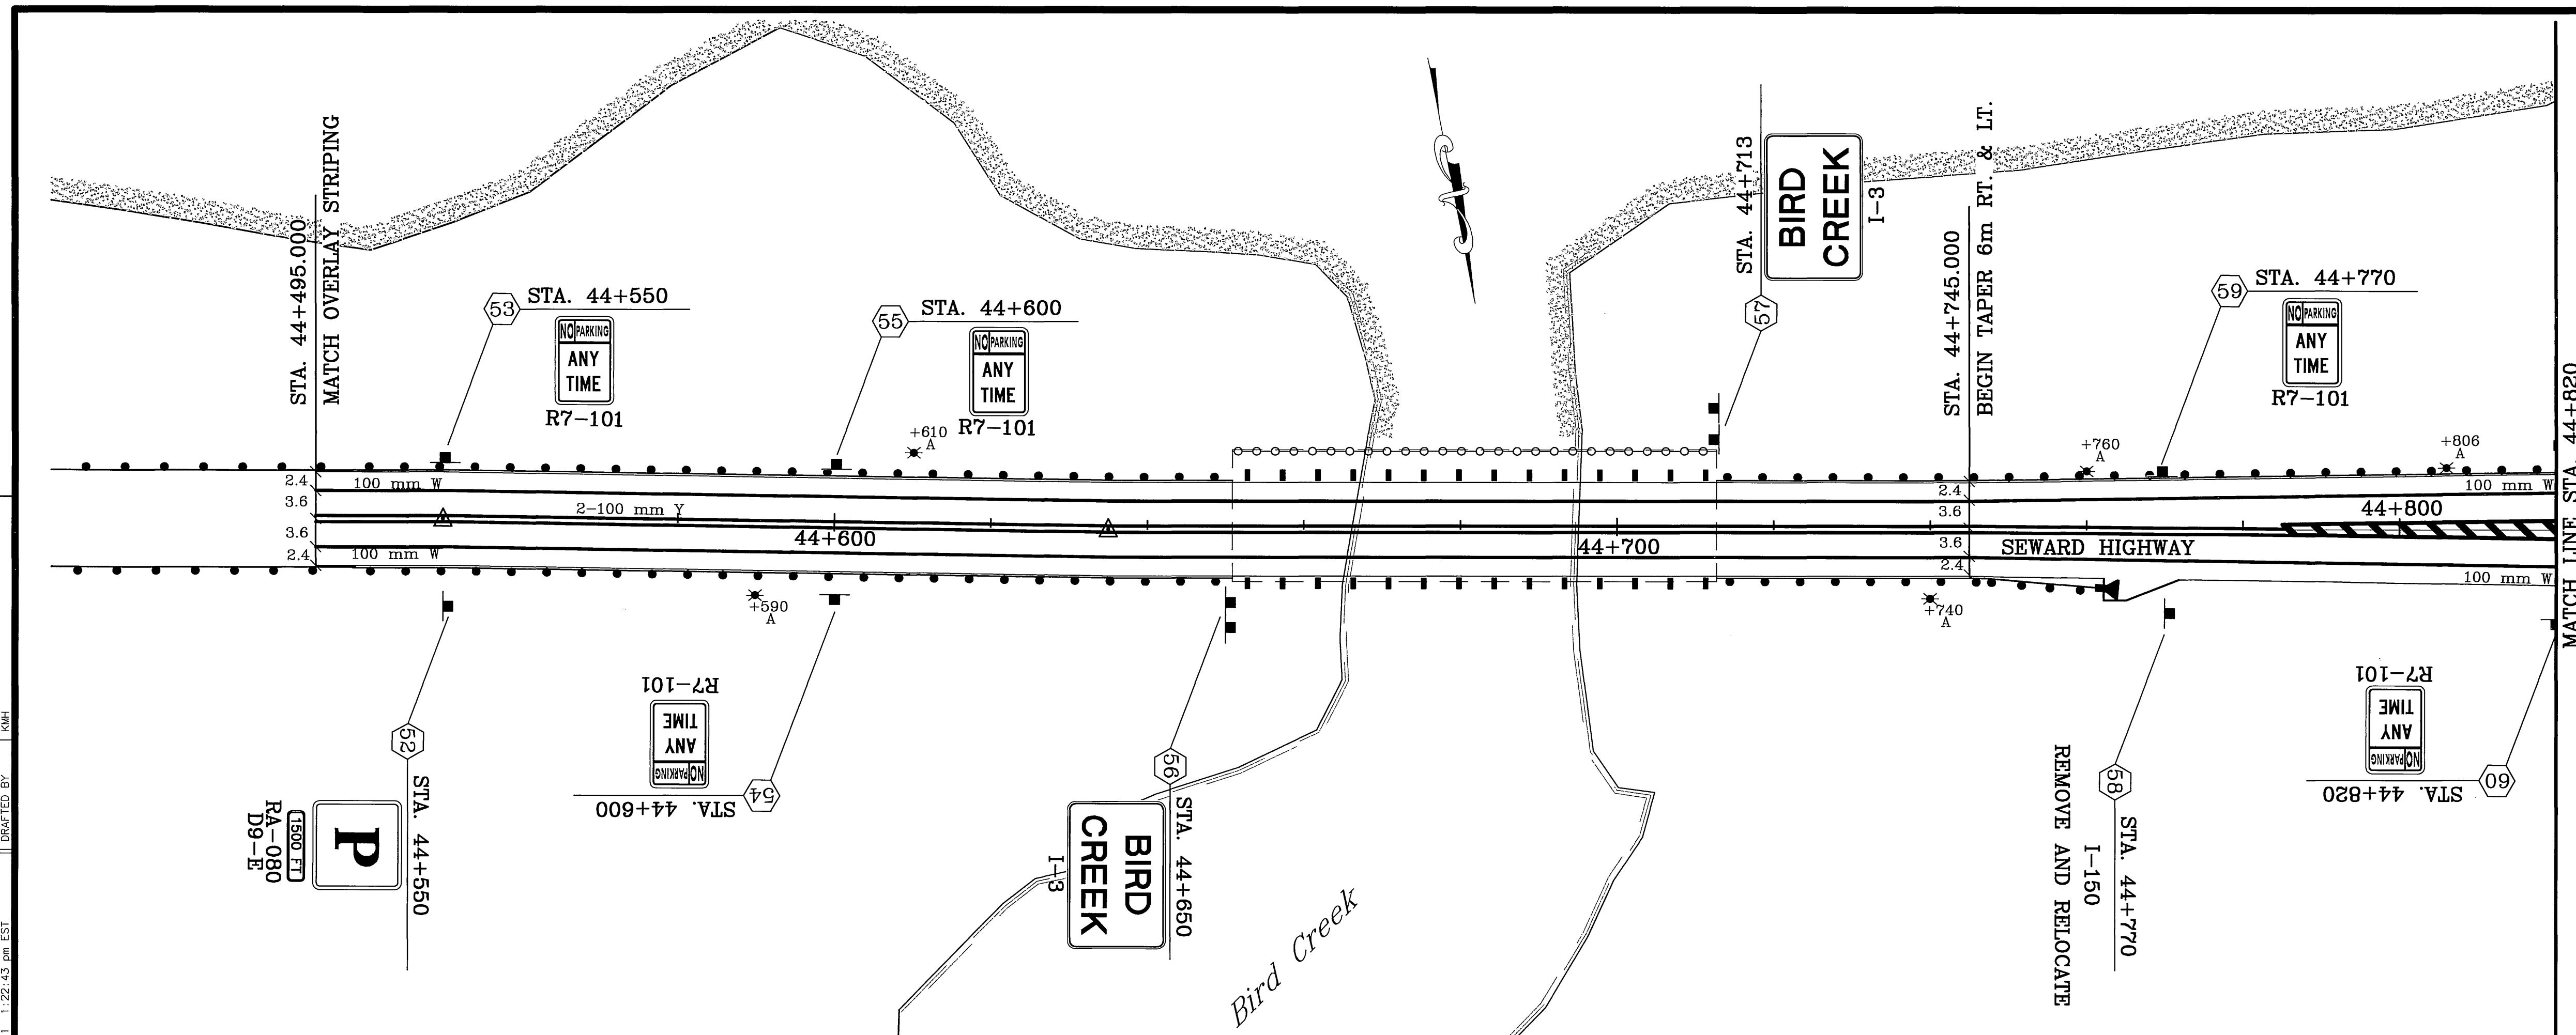

REMOVE AND RELOCATE

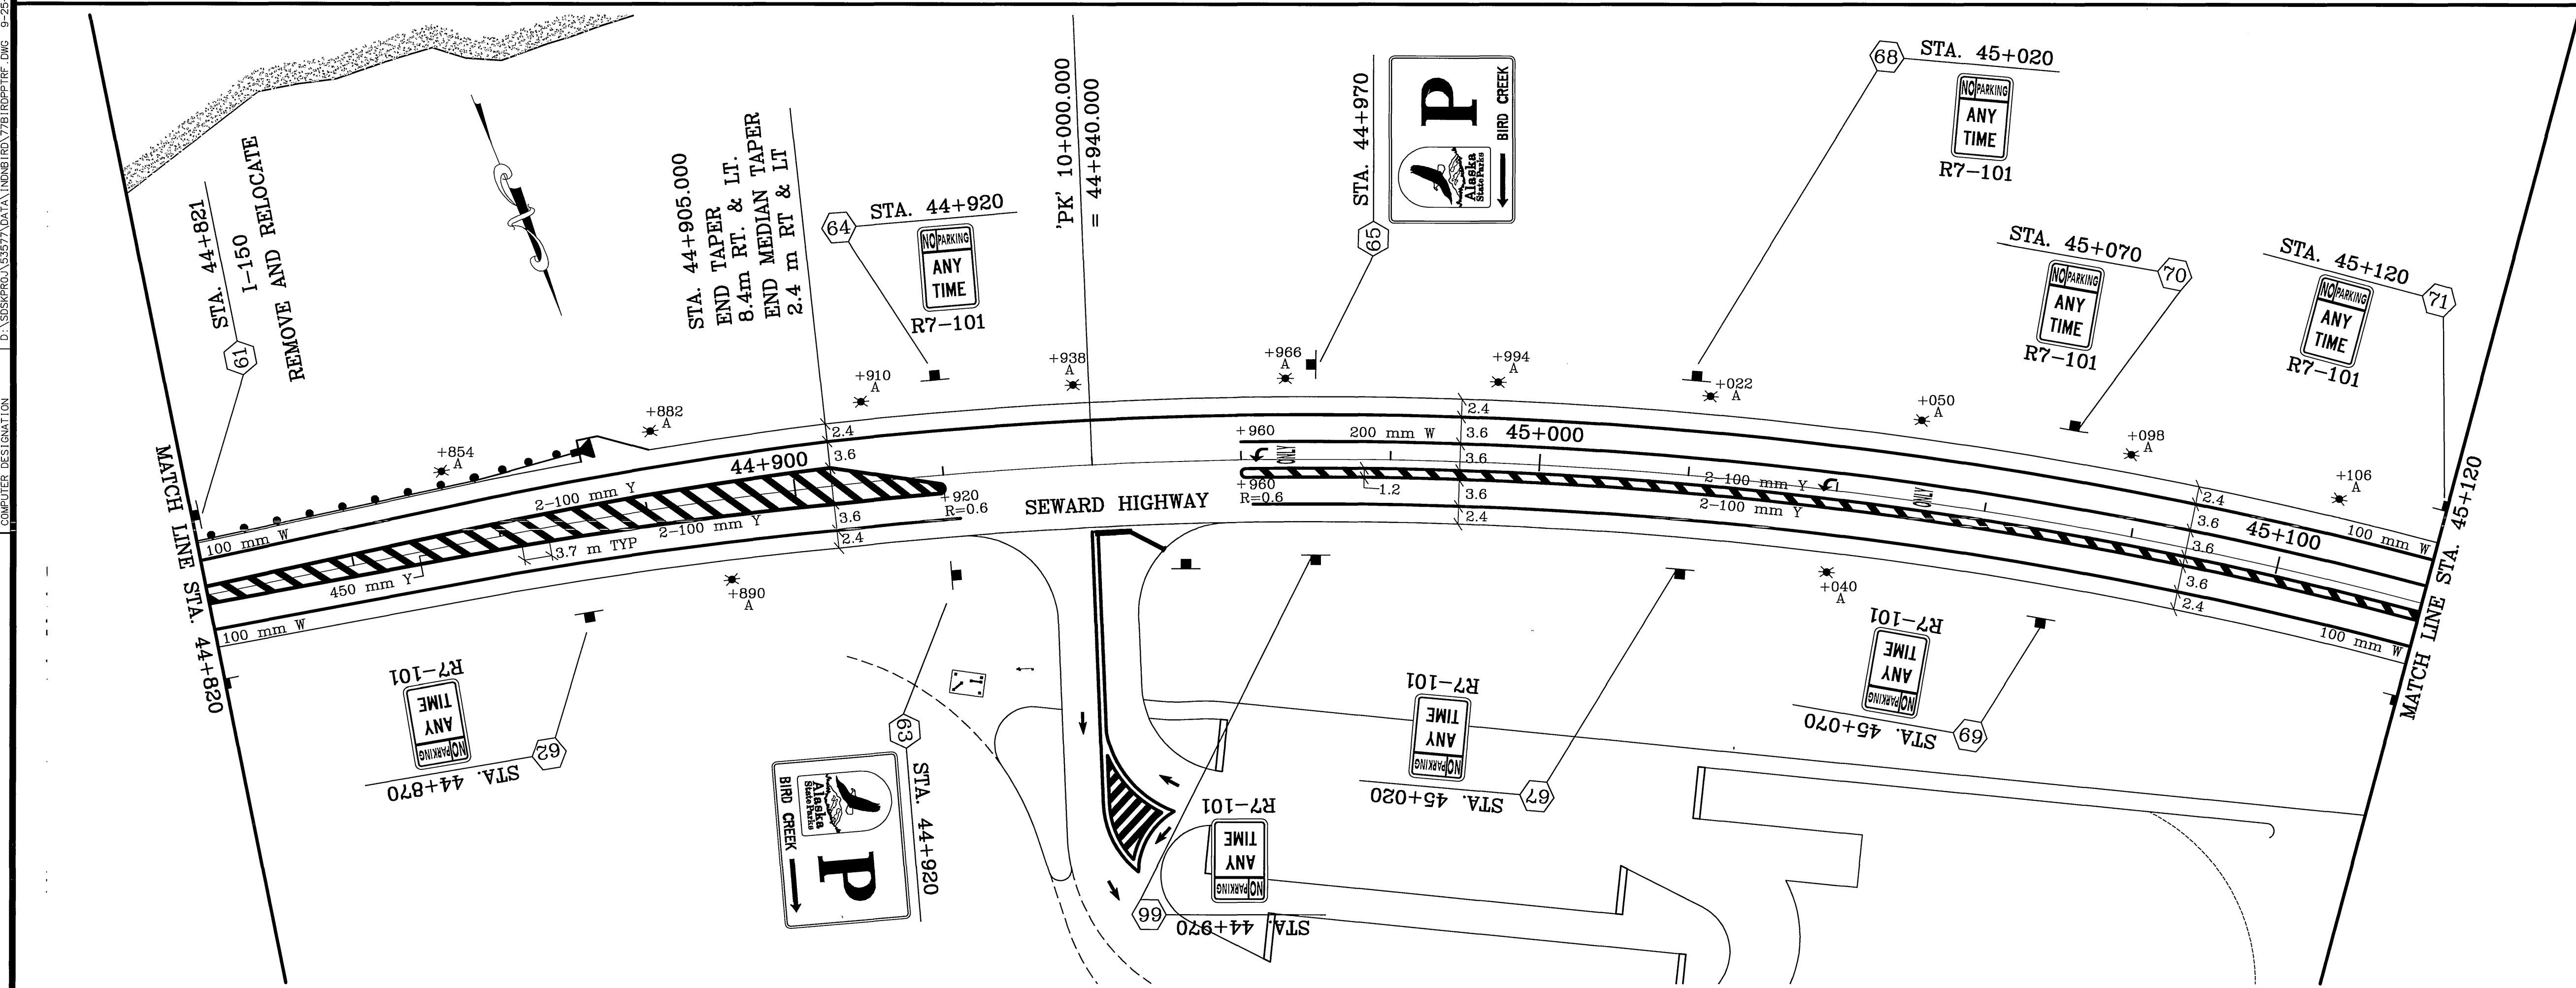


SHEET NO.	TOTAL SHEETS
J15	J32
STATE	YEAR
ALASKA	2002


PROJECT DESIGNATION
NH-OA3-1(28)
ADDENDUM NO.

ATTACHMENT NO.

REVISIONS		
NO.	DATE	DESCRIPTION


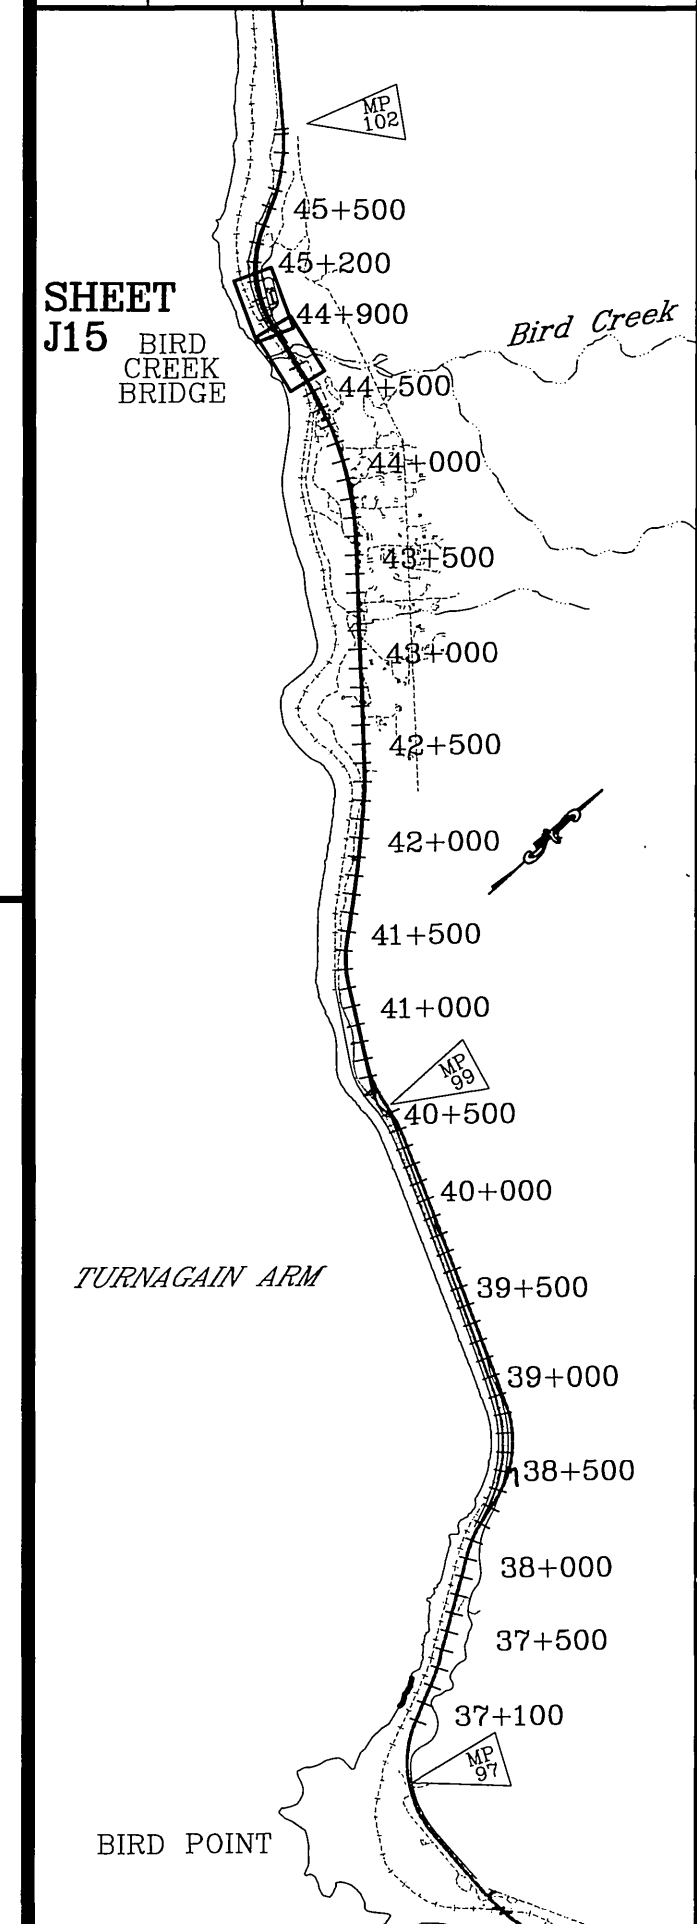


NOTE:
DIMENSIONS ARE IN METERS
UNLESS OTHERWISE NOTED.

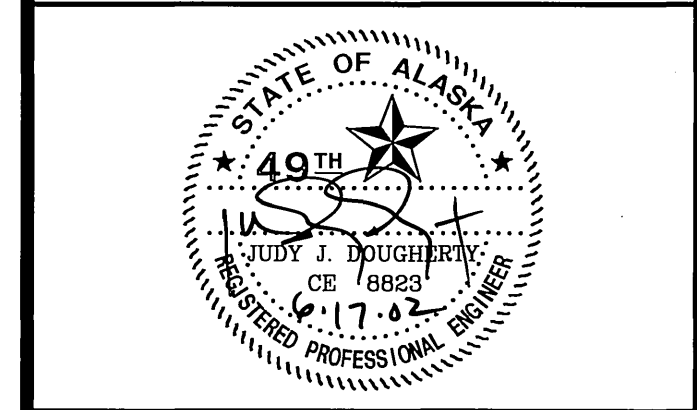


STATE OF ALASKA
DEPARTMENT OF TRANSPORTATION
AND PUBLIC FACILITIES
**SEWARD HIGHWAY
MP 96 TO MP 102
SAFETY, ROADWAY &
RECREATIONAL IMPROVEMENTS
SIGNING AND STRIPING**


SPECIFICATIONS	AUTOCAD-KAREN-	DESIGNED BY
SCALE 1"=100'	D:\SSA\PROJ\3537\DATA\UNB\RD\7B\RDPTFR.DWG 9-25-01 1:22:43 pm EST	CHECKED BY
COMPUTER DESIGNATION		DRAWN BY
		KMH

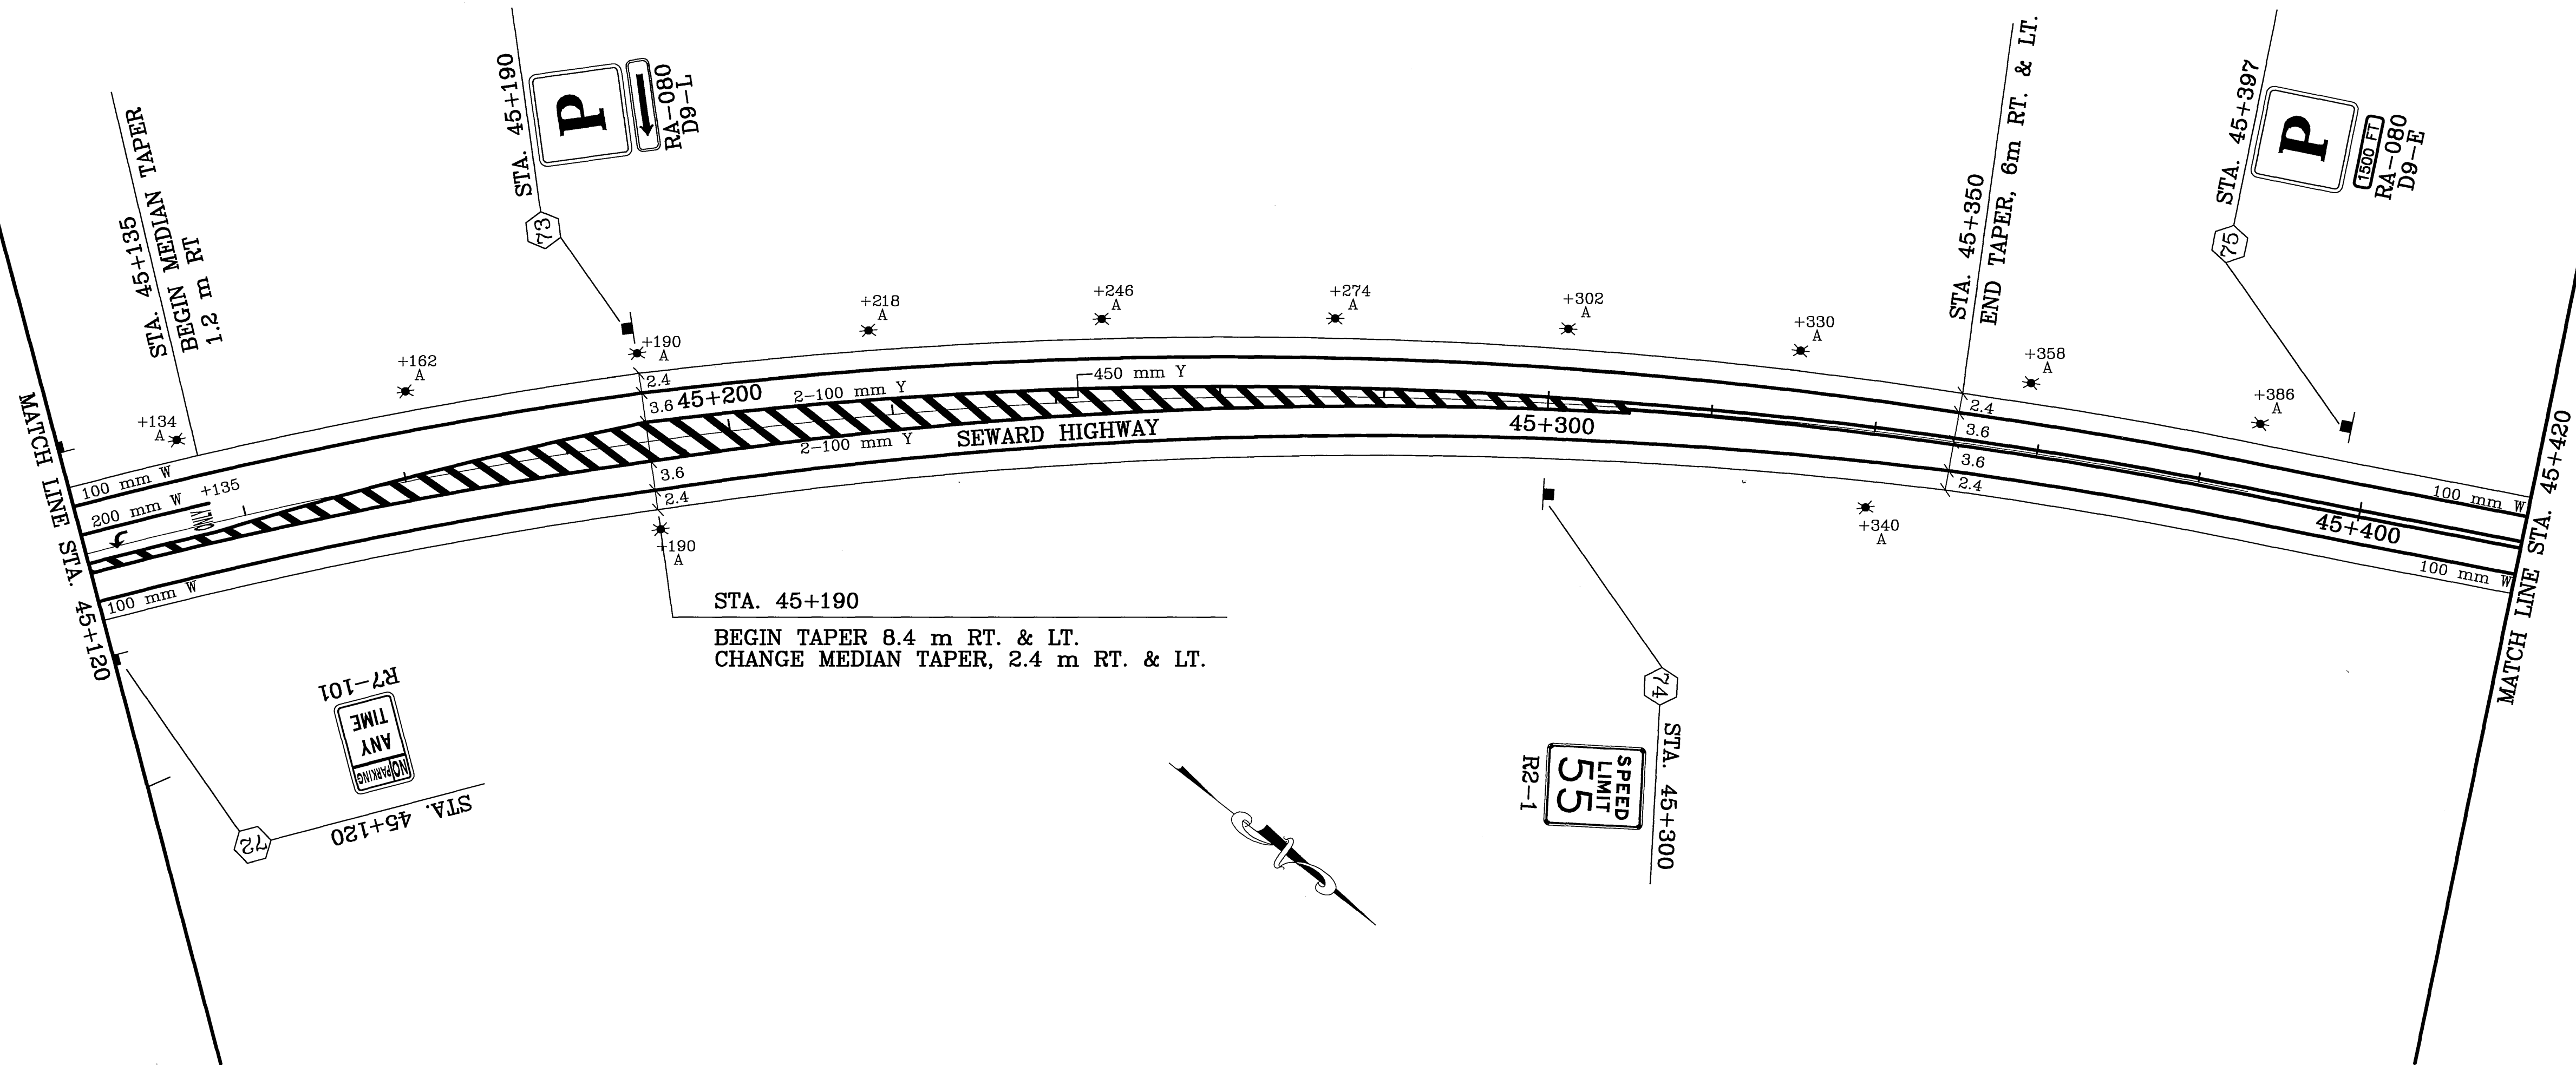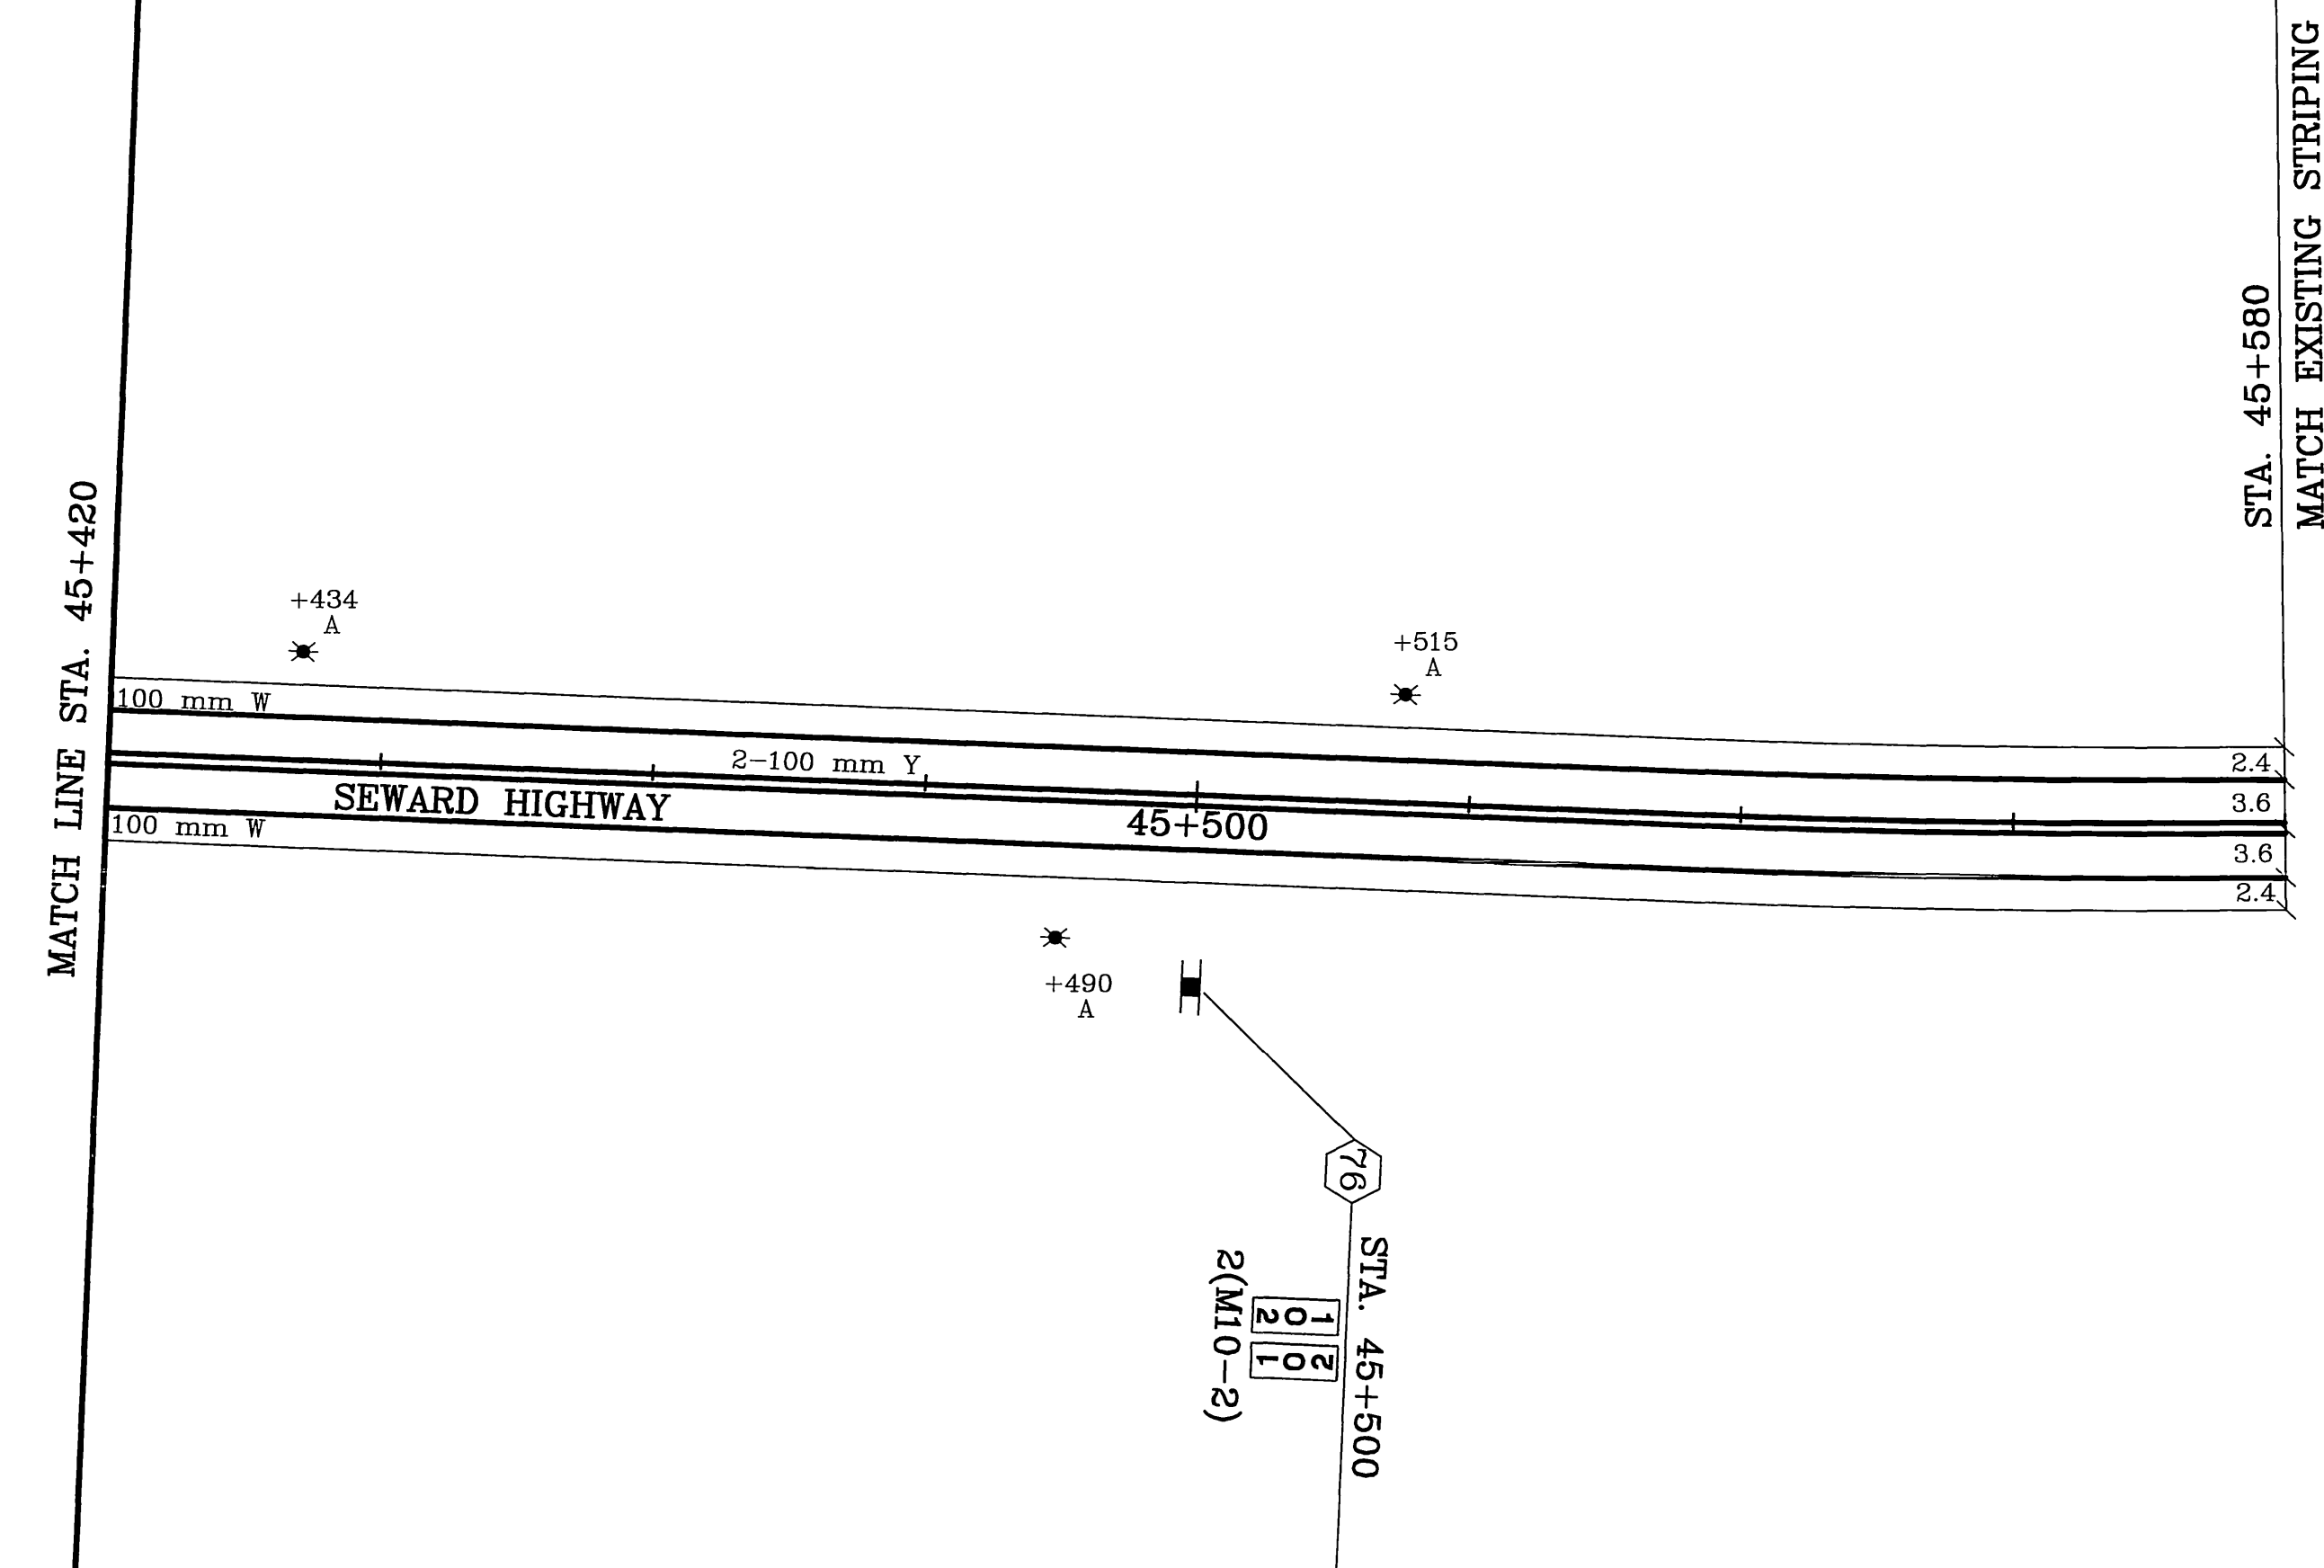

SHEET NO.	TOTAL SHEETS	
J16	J32	
STATE	YEAR	
ALASKA	2002	
PROJECT DESIGNATION		
NH-OA3-1(28)		
ADDENDUM NO.		
ATTACHMENT NO.		
REVISIONS		
NO.	DATE	DESCRIPTION

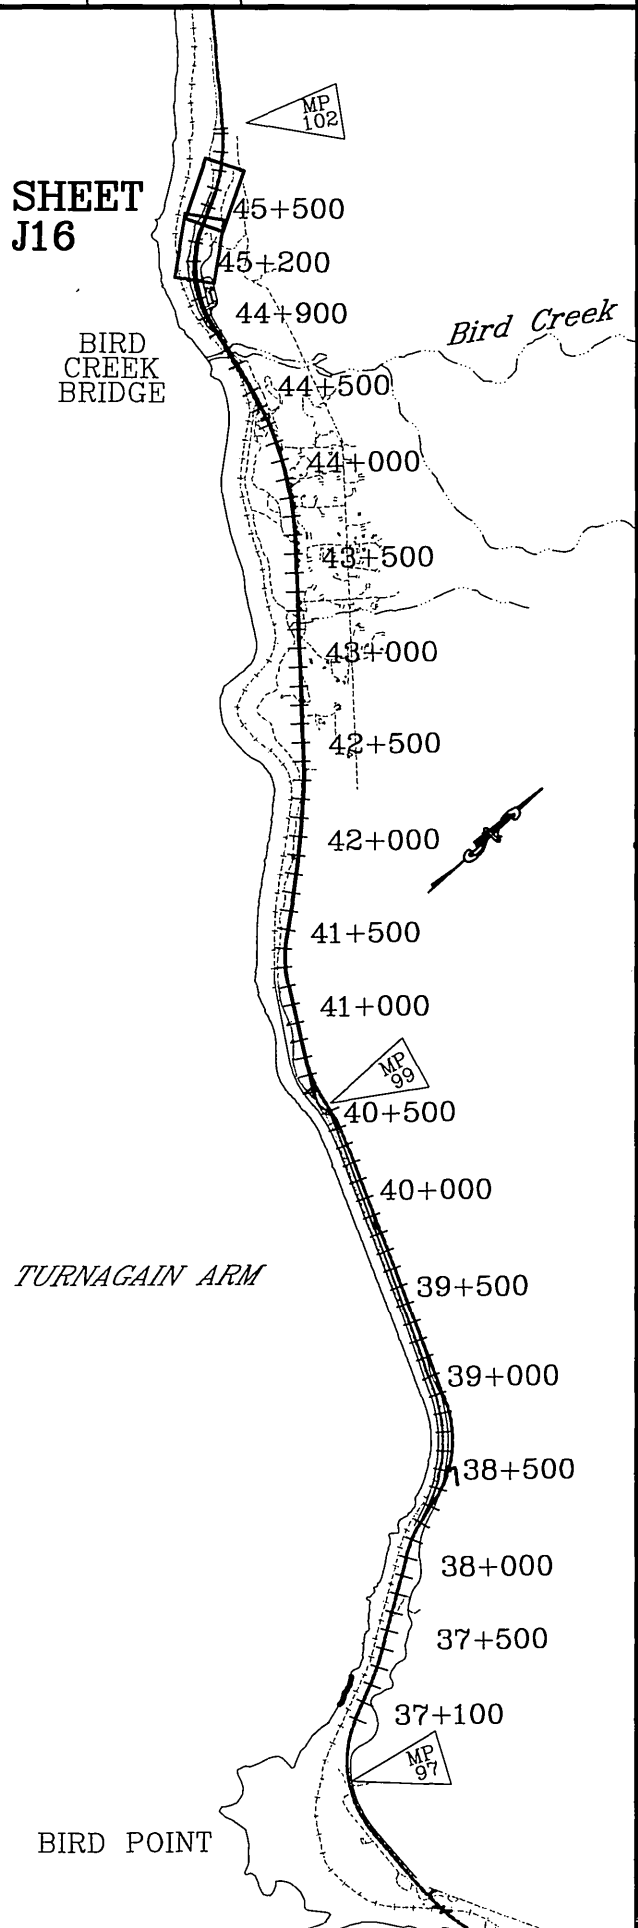



NOTE:
DIMENSIONS ARE IN METERS
UNLESS OTHERWISE NOTED.

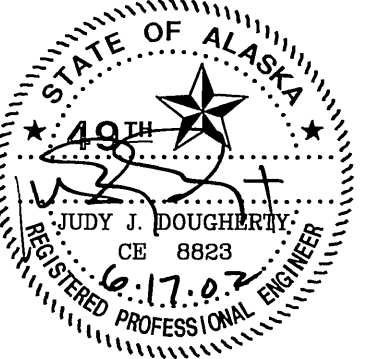

STATE OF ALASKA
DEPARTMENT OF TRANSPORTATION
AND PUBLIC FACILITIES
SEWARD HIGHWAY
MP 96 TO MP 102
SAFETY, ROADWAY &
RECREATIONAL IMPROVEMENTS
SIGNING AND STRIPING

REVISIONS			STATE	PROJECT DESIGNATION	YEAR	SHEET NO.	TOTAL SHEETS
No.	DATE	DESCRIPTION	ALASKA	NH-0A3-1(28)	2002	J17	J32

DESIGNED BY	NRG
CHECKED BY	
DRAWN BY	
VIEW/HALF/01 AT .25	
53577A.DRAW\77PARKING.DWG - 11-14-02	
SPECIFICATIONS	
SCALE 1"=1'	
COMPUTER DESIGNATION	

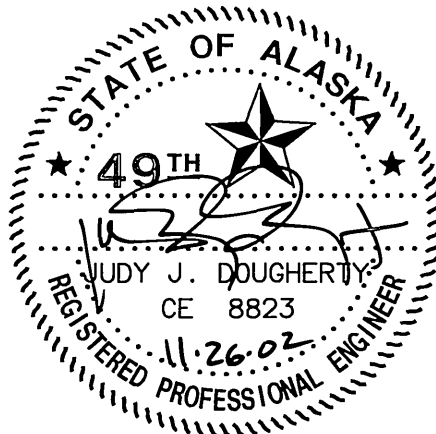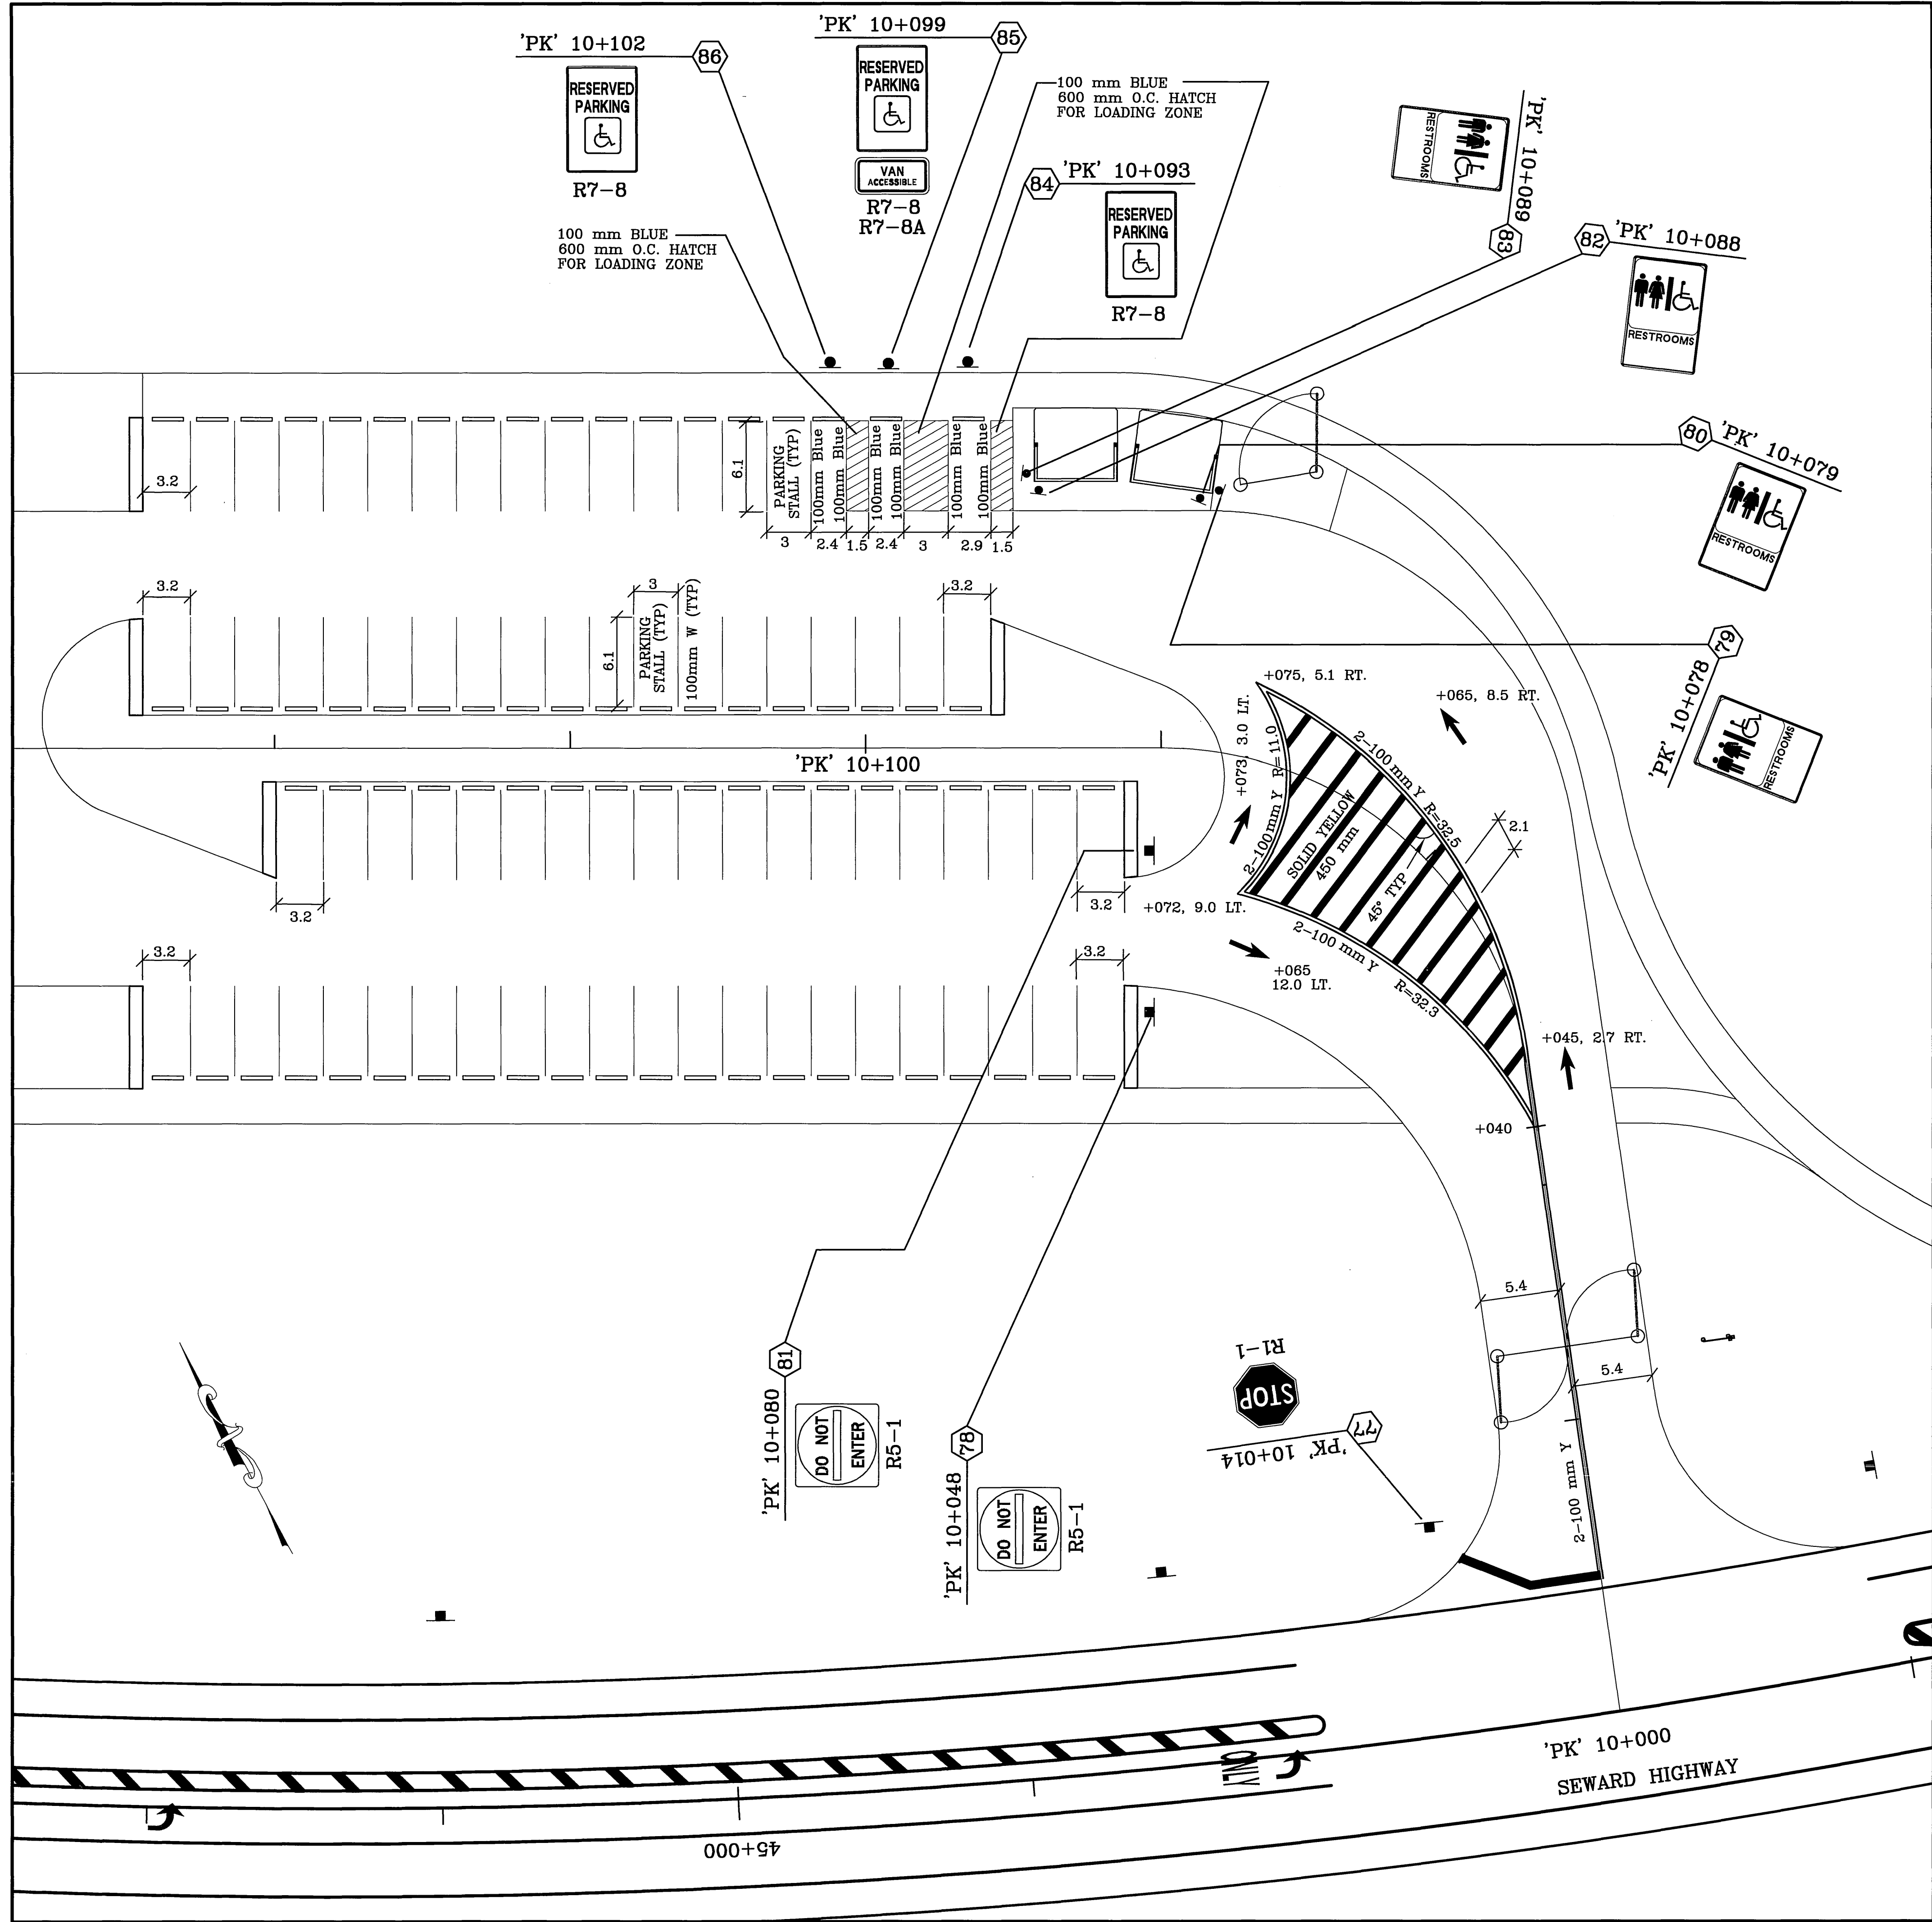

STATE OF ALASKA
DEPARTMENT OF TRANSPORTATION
AND
PUBLIC FACILITIES

**SEWARD HIGHWAY
MP 96 TO MP 102
SAFETY, ROADWAY &
RECREATIONAL IMPROVEMENTS**



**BIRD CREEK PARKING LOT
SIGNING AND STRIPING**

REVISIONS			STATE	PROJECT DESIGNATION	YEAR	SHEET NO.	TOTAL SHEETS
No.	DATE	DESCRIPTION	ALASKA	NH-0A3-1(28)	2002	J18	J32

STRIPING NOTES:

1. ALL FINAL PAVEMENT MARKINGS SHALL BE METHYLMETHACRYLATE.
2. USE $V=40$ KPH FOR "ONLY" AND "ARROW" SEPARATION "D" AS SHOWN ON STANDARD DRAWING T-21.02[M].
3. DIMENSIONS REFERENCE FACE OF CURB, EDGE OF PAVEMENT OR CENTER OF STRIPE.
4. USE $S=450$ mm FOR "APPROACH TO OBSTRUCTIONS" MARKING LAYOUT AS SHOWN ON STANDARD DRAWING T-20.01[M].
5. MATCH THE EXISTING STRIPING OF SEWARD HIGHWAY OR REESTABLISH AS DIRECTED BY THE ENGINEER.
6. THE BEGINNING AND ENDING OF THE NO PASSING ZONES SHOWN ARE APPROXIMATE. THE ENGINEER WILL ESTABLISH THE ACTUAL BEGINNING AND ENDING OF THE NO PASSING ZONES IN THE FIELD.
7. INSTALL ALL PAVEMENT MARKINGS AT A 2.3 mm YIELD THICKNESS, EXCEPT THE FOLLOWING MARKINGS:


<u>PAVEMENT MARKING TYPE</u>	<u>YIELD THICKNESS</u>
ONLYS AND ARROWS	3.0 mm
TWO WAY LEFT TURN ARROWS	3.0 mm
LANE DROP ARROWS	3.0 mm
CROSSWALKS & STOP BARS	3.0 mm
DIAGONALS & CHEVRONS	1.5 mm

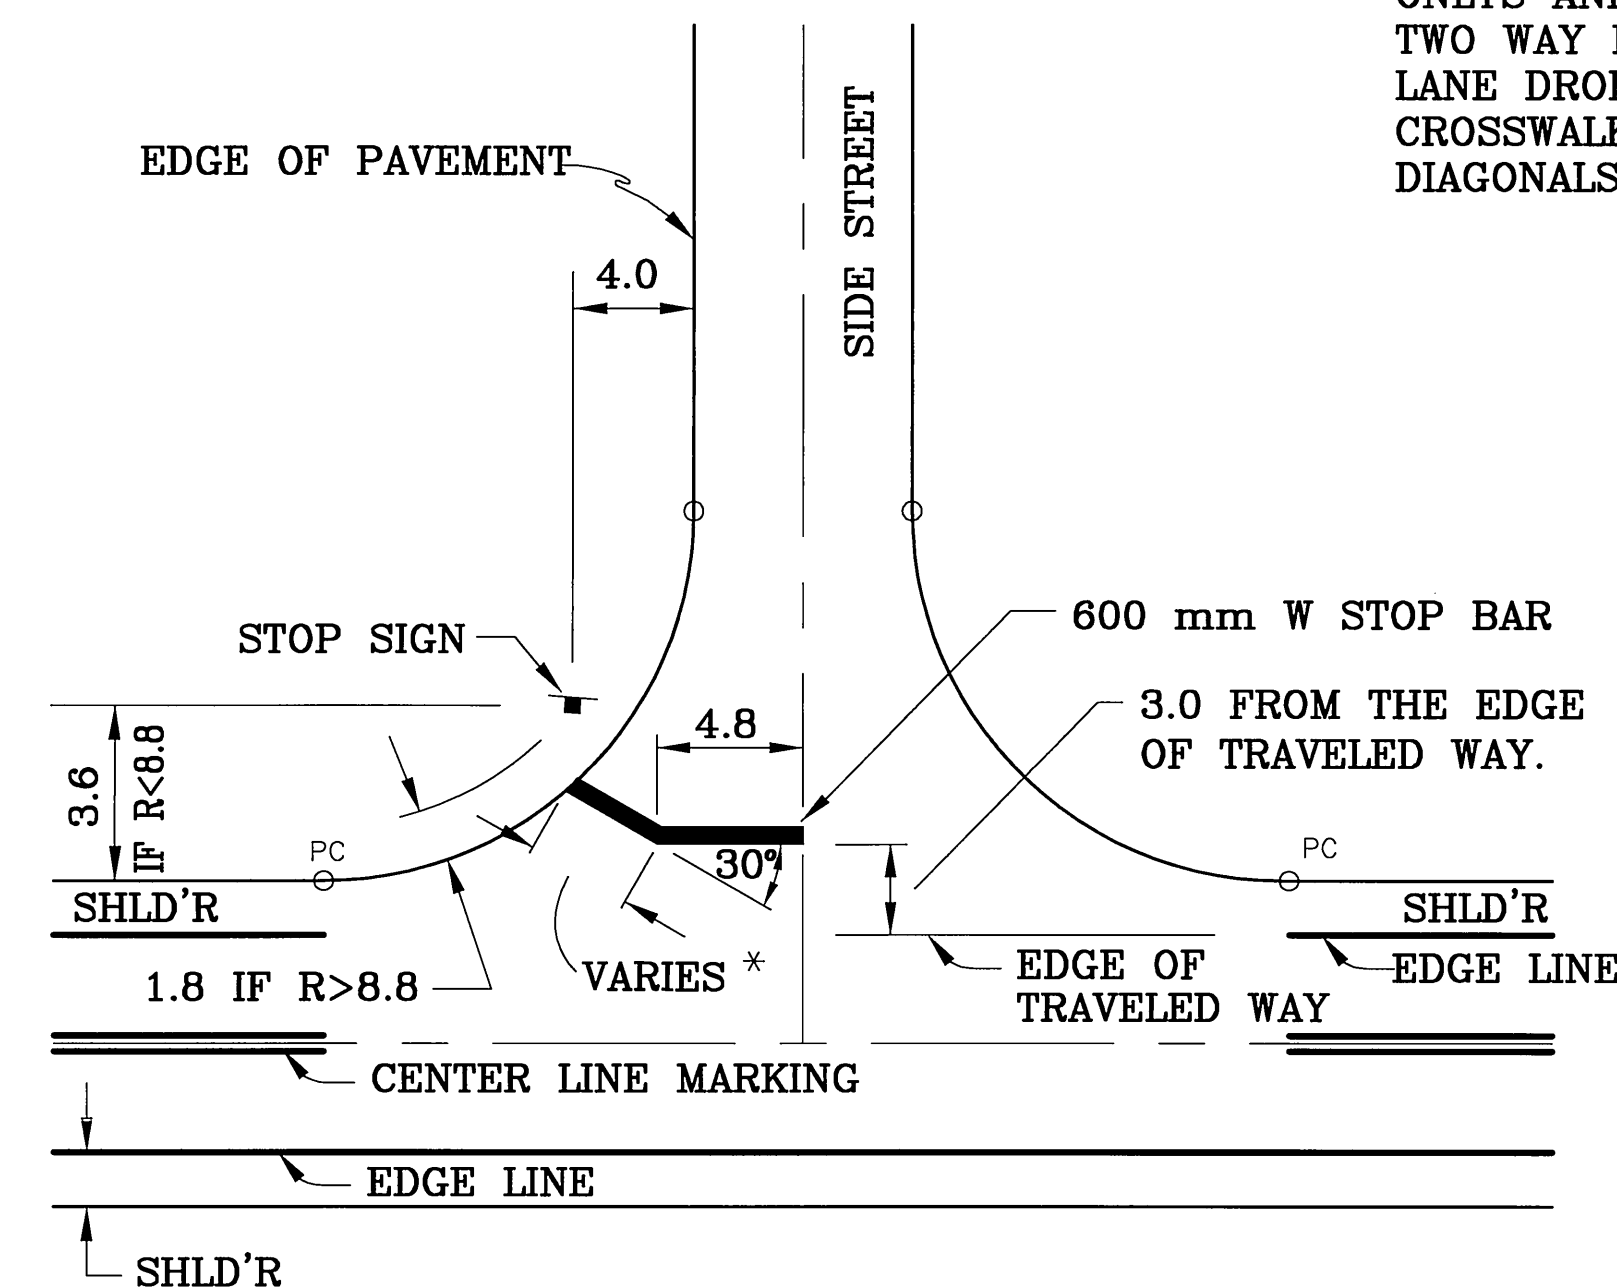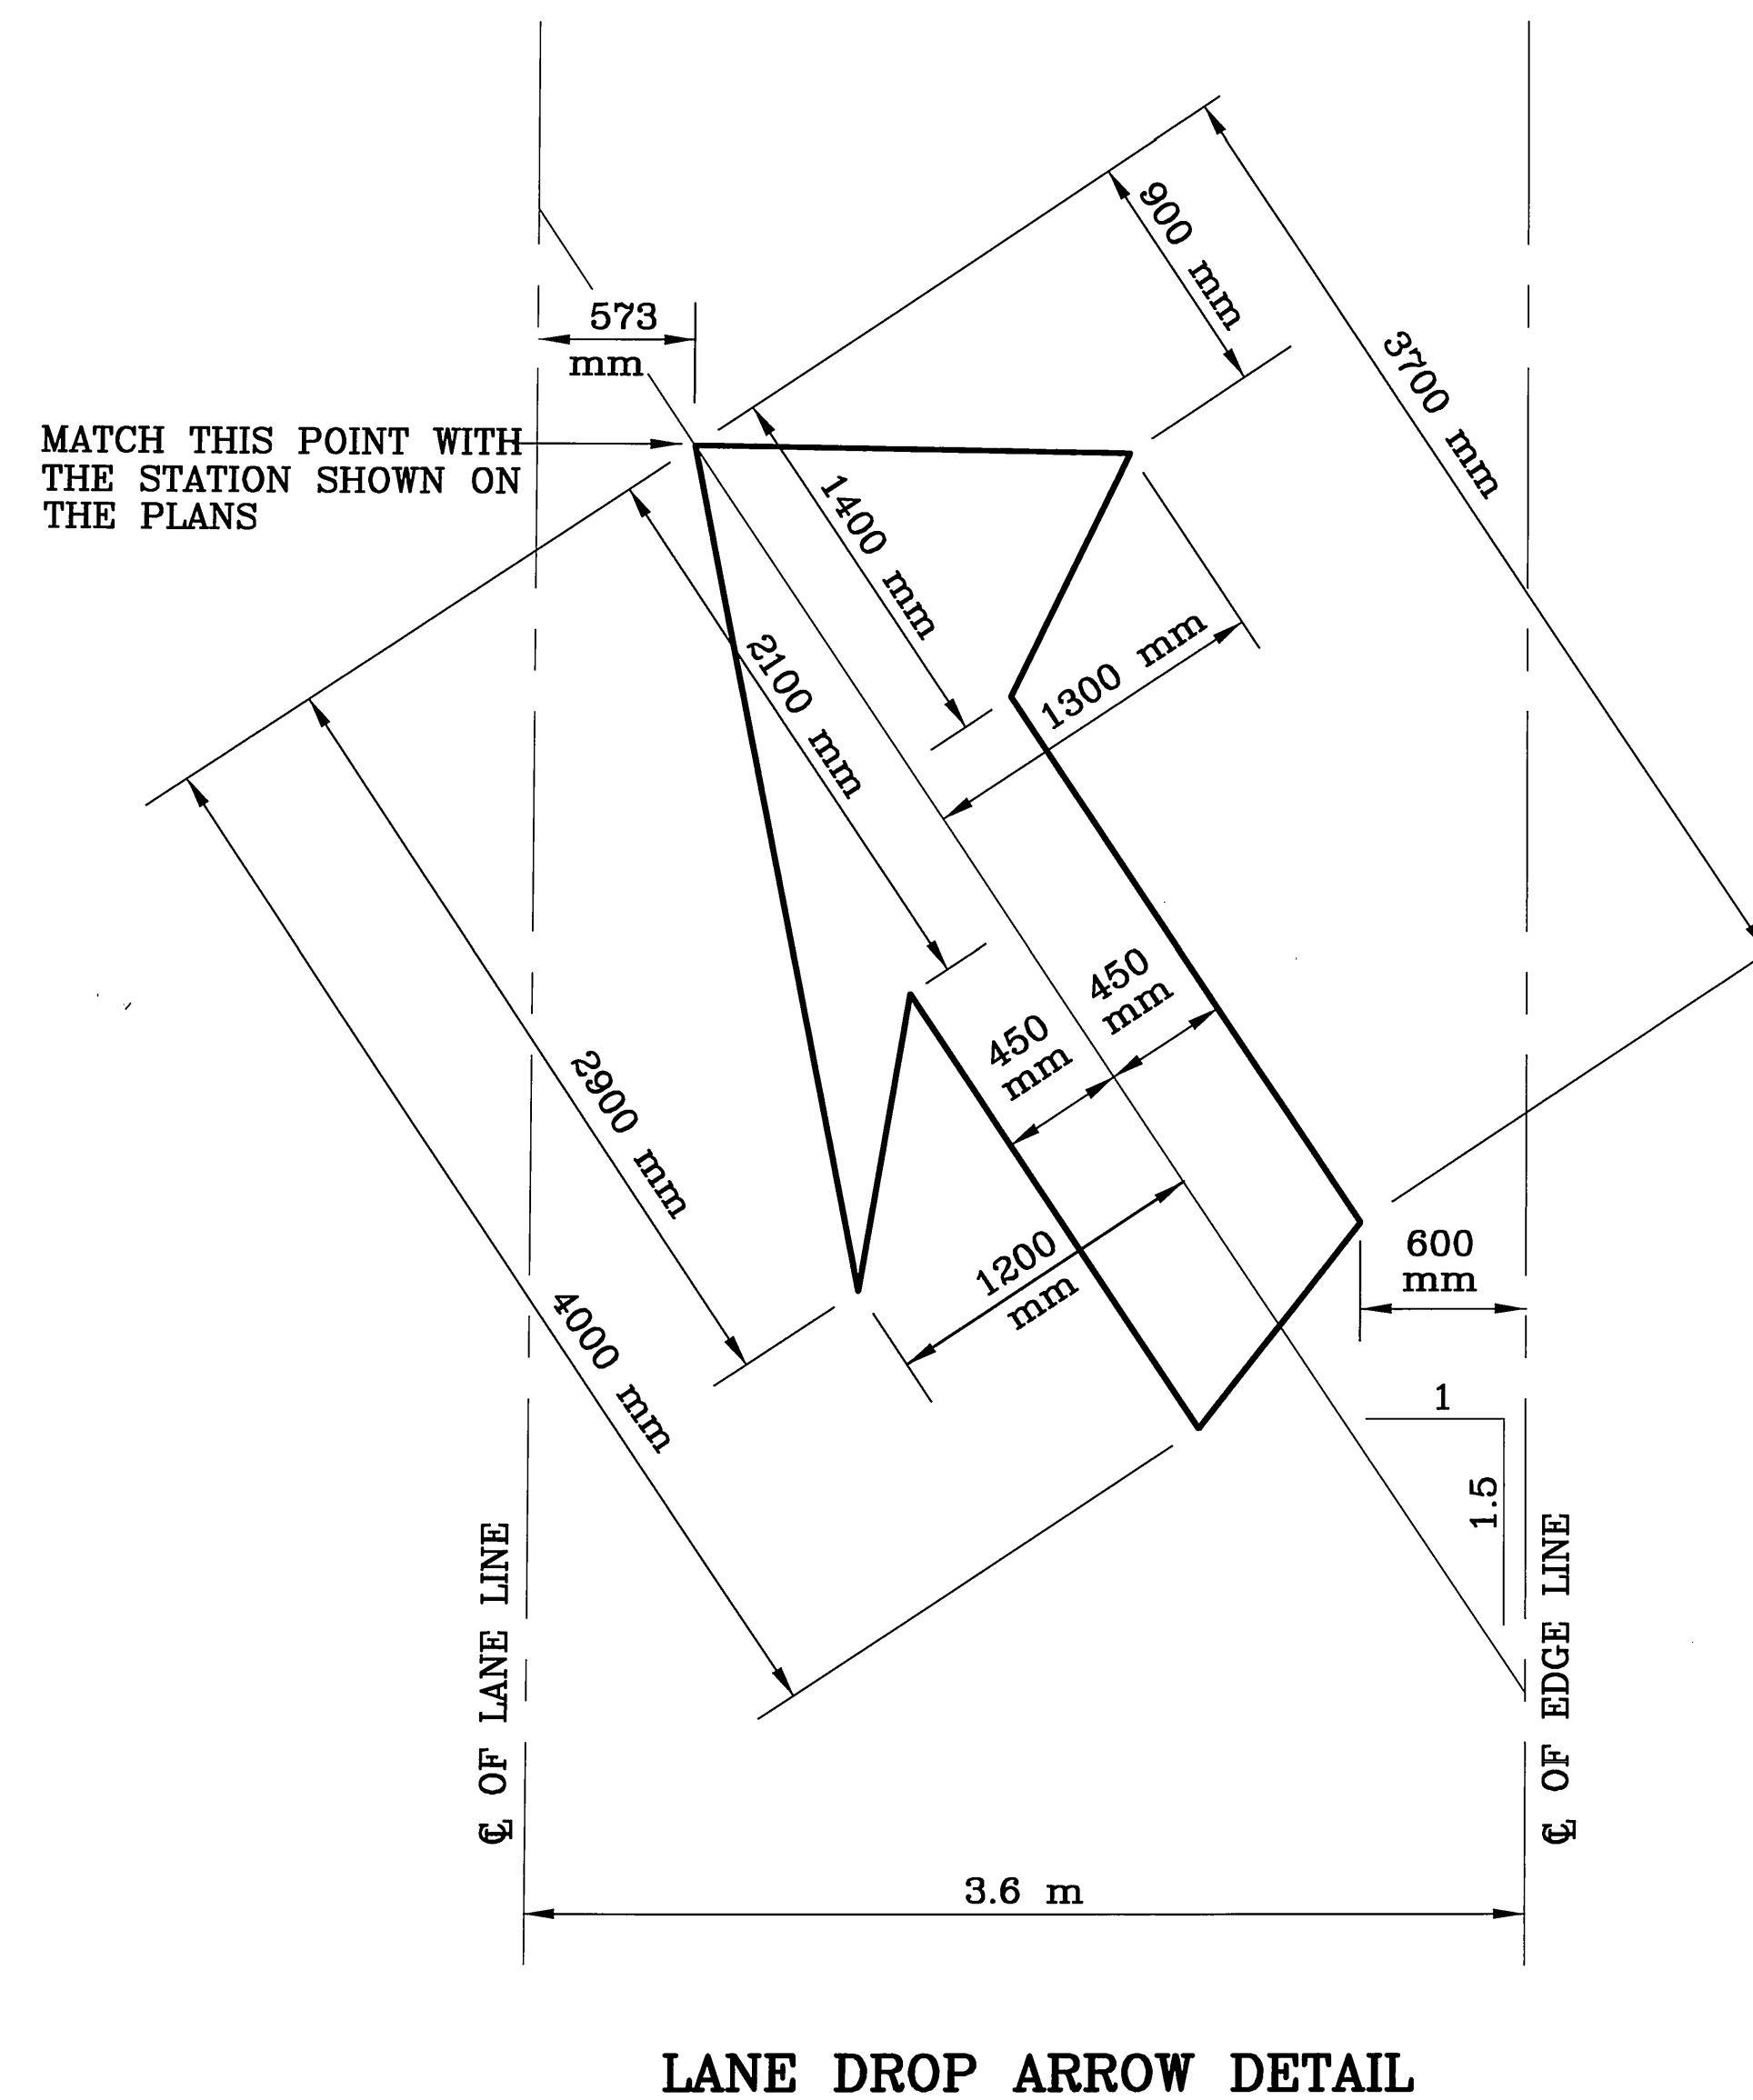

STOP BAR AND STOP SIGN INSTALLATION DETAIL

(WITHOUT PATHWAY)

* OMIT ANGLE IF IS LESS THAN 2.4 m.

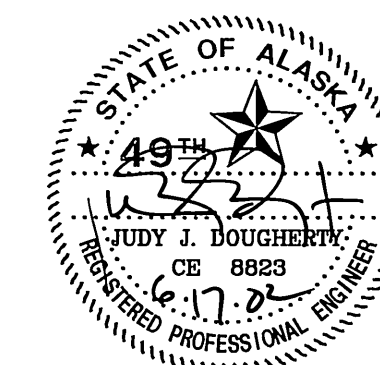

STATE OF ALASKA
DEPARTMENT OF TRANSPORTATION
AND
PUBLIC FACILITIES










**SEWARD HIGHWAY
MP 96 TO MP 102
SAFETY, ROADWAY &
RECREATIONAL IMPROVEMENTS**








STRIPING DETAILS

SPECIFICATIONS		DESIGNED BY
SCALE 1"=1		VIEW-HALF @ 1
COMPUTER DESIGNATION		CHECKED BY
		DRAWN BY
		DATE
		PROJECT
		DESCRIPTION
		REVISIONS
		APPROVED BY
		DATE

SIGN SUMMARY


REVISIONS			STATE	PROJECT DESIGNATION	YEAR	SHEET NO.	TOTAL SHEETS
No.	DATE	DESCRIPTION	ALASKA	NH-0A3-1(28)	2002	J19	J32
			THIS SHEET IS REPLACED BY SHEET J19A				

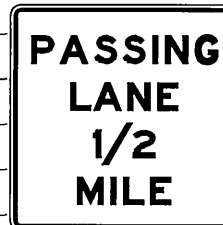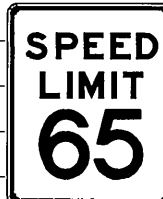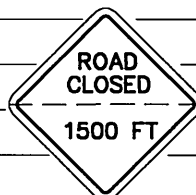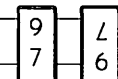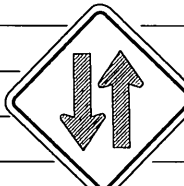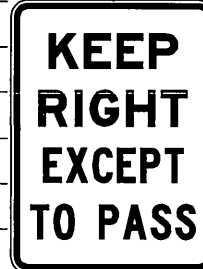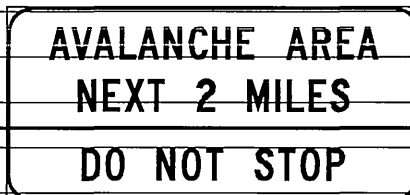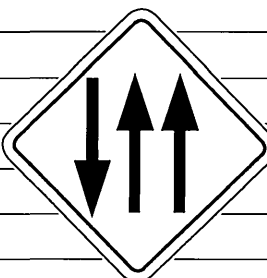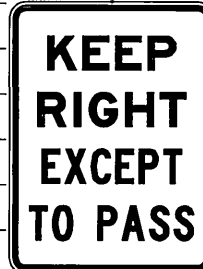SHEET NO.	POST NO.	STATION	REF. CL	TYPE	LEGEND	SIZE		AREA (m ²)	SIGN FACES	POST SIZE	THICKNESS (mm)		REMARKS
						METER					FRAMED	UNFRAMED	
						W	H						
						1.05	1.20	1.26	S	1-75 mm T.		3.2	SEE SIGNING AND STRIPING SHEET FOR LOCATION
						1.05	1.20	1.26	S	1-75 mm T.		3.2	SEE SIGNING AND STRIPING SHEET FOR LOCATION
						0.75	0.9	0.68	S	1-75 mm T.		3.2	
						0.9	0.9	0.81	N	1-75 mm T.		3.2	HINGE SIGN
						0.15	0.3	0.09	N/S	1-65 mm P.T.		3.2	
						0.9	0.9	0.81	N	1-75 mm T.		3.2	
						0.9	1.20	1.08	S	1-65 mm P.T.		3.2	
						0.9	0.9	0.81	N	1-75 mm T.		3.2	
						2.6	1.2	3.12	S	2-80 mm P.	3.2		HINGE SIGN SEE SPECIFICATIONS
						1.2	1.2	1.44	S	1-90 mm T.	3.2		
						0.9	1.20	1.08	S	1-65 mm P.T.		3.2	

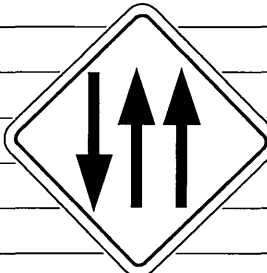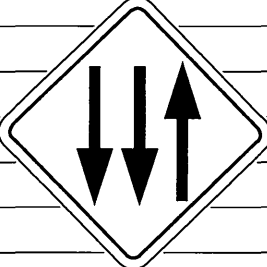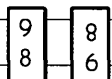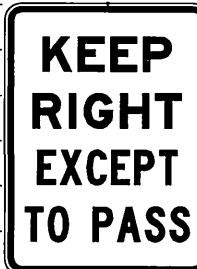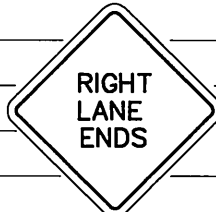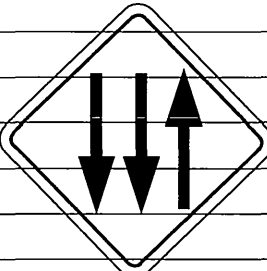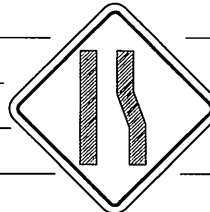SHEET NO.	POST NO.	STATION	REF. CL	TYPE	LEGEND	SIZE		AREA (m ²)	SIGN FACES	POST SIZE	THICKNESS (mm)		REMARKS
						METER					FRAMED	UNFRAMED	
						W	H						
						1.2	1.2	1.44	S	1-90 mm T.	3.2		
J3	12	38+817	RT.	W6-4 (1-2)									
						1.2	1.2	1.44	E	1-90 mm T.	3.2		
J3	13	38+881	LT.	W6-4 (2-1)									
						0.15	0.3	0.09	E/W	1-65 mm P.T.		3.2	
J4	14	39+120	RT.	2(M10-2)									
						0.9	1.20	1.08	S	1-65 mm P.T.		3.2	
J4	15	39+250	RT.	R4-3A									
						0.9	0.9	0.81	E	1-75 mm T.		3.2	
J5	16	39+799	RT.	W9-1R									
						1.2	1.2	1.44	W	1-90 mm T.	3.2		
J5	17	39+881	LT.	W6-4 (2-1)									
						0.9	0.9	0.81	E	1-75 mm T.		3.2	
J5	18	39+951	RT.	W4-2R									
						0.6	0.75	0.45	W	1-65 mm P.T.		3.2	
J5	19	40+033	LT.	R4-2									

NOTE REFERENCES

1. MOVE EXISTING SIGN IF HORIZONTAL CLEARANCE FROM ANY PART OF THE SIGN AND THE PATHWAY IS LESS THAN 0.6m. NEW LOCATION SHALL BE APPROVED BY THE ENGINEER.

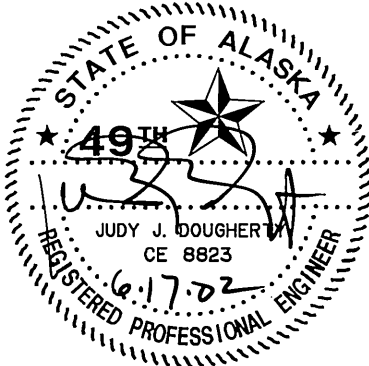

STATE OF ALASKA
DEPARTMENT OF TRANSPORTATION
AND
PUBLIC FACILITIES
**SEWARD HIGHWAY
MP 96 TO MP 102
SAFETY, ROADWAY AND
RECREATIONAL IMPROVEMENTS
SIGN SUMMARY**











AS-BUILT 4/1/12









DESIGNED BY: 4/27/04
CHECKED BY: CU
VIEW# 1
LTS/SCALE = 1
AUTOCAD-CAROLEE: 84433\SUMSIGN.CHG
COMPUTER DESIGNATION: SCALE 1"=1

SIGN SUMMARY

CHANGE ORDER NO. 6
ATTACHMENT 'A'
SHEET 7 OF 8


REVISIONS			STATE	PROJECT DESIGNATION	YEAR	SHEET NO.	TOTAL SHEETS
No.	DATE	DESCRIPTION	ALASKA	NH-0A3-1(28)	2004	J19A	J32

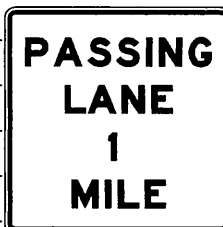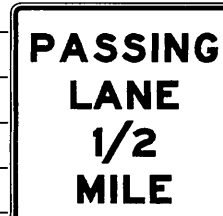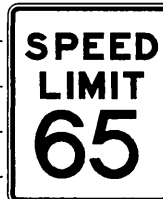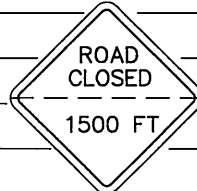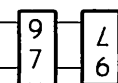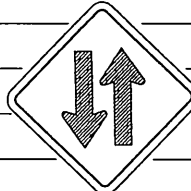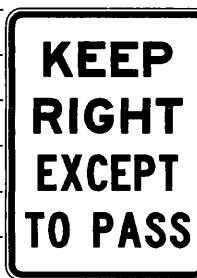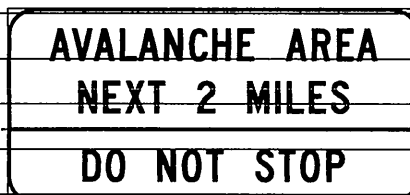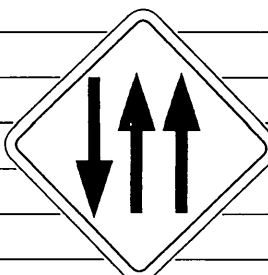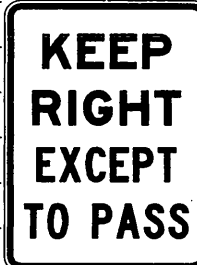SHEET NO.	POST NO.	STATION	REF. CL	TYPE	LEGEND	SIZE		AREA (m ²)	SIGN FACES	POST SIZE	THICKNESS (mm)		REMARKS
						METER					FRAMED	UNFRAMED	
						W	H						
						1.05	1.20	1.26	S	1-75 mm T.		3.2	SEE SIGNING AND STRIPING SHEET FOR LOCATION
						1.05	1.20	1.26	S	1-75 mm T.		3.2	SEE SIGNING AND STRIPING SHEET FOR LOCATION
						0.75	0.9	0.68	S	1-75 mm T.		3.2	
						0.9	0.9	0.81	N	1-75 mm T.		3.2	HINGE SIGN
						0.15	0.3	0.09	N/S	1-65 mm P.T.		3.2	
						0.9	0.9	0.81	N	1-75 mm T.		3.2	
						0.9	1.20	1.08	S	1-65 mm P.T.		3.2	
						0.9	0.9	0.81	N	1-75 mm T.		3.2	
						2.6	1.2	3.12	S	2-80 mm P.	3.2		HINGE SIGN SEE SPECIFICATIONS
						1.2	1.2	1.44	S	1-90 mm T.	3.2		
						0.9	1.20	1.08	S	1-65 mm P.T.		3.2	

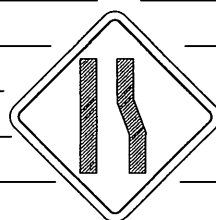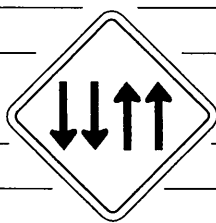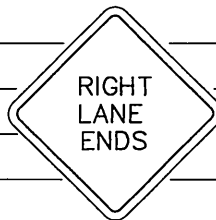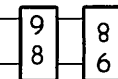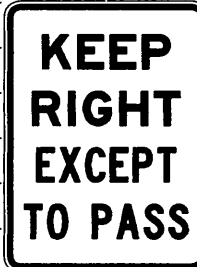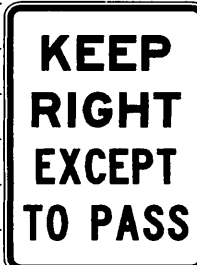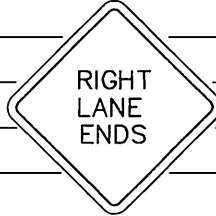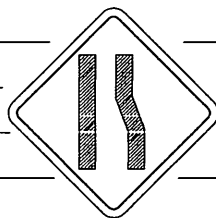SHEET NO.	POST NO.	STATION	REF. CL	TYPE	LEGEND	SIZE		AREA (m ²)	SIGN FACES	POST SIZE	THICKNESS (mm)		REMARKS
						METER					FRAMED	UNFRAMED	
						W	H						
						1.2	1.2	1.44	W	1-75 mm T.		3.2	
						1.2	1.2	1.44	E	1-75 mm T.		3.2	
						1.2	1.2	1.44	W	1-75 mm T.		3.2	
						0.15	0.3	0.09	E/W	1-65 mm P.T.		3.2	
						0.9	1.20	1.08	S	1-65 mm P.T.		3.2	
						0.9	1.20	1.08	W	1-65 mm P.T.		3.2	
						0.9	0.9	0.81	E	1-75 mm T.		3.2	
						0.9	0.9	0.81	E	1-75 mm T.		3.2	

NOTE REFERENCES


1. MOVE EXISTING SIGN IF HORIZONTAL CLEARANCE FROM ANY PART OF THE SIGN AND THE PATHWAY IS LESS THAN 0.6m. NEW LOCATION SHALL BE APPROVED BY THE ENGINEER.

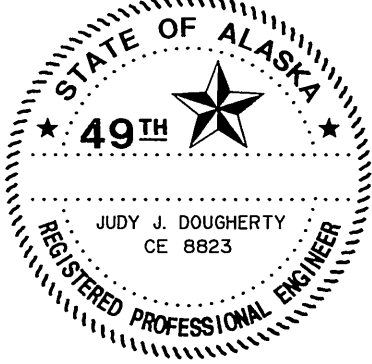

STATE OF ALASKA
DEPARTMENT OF TRANSPORTATION
AND
PUBLIC FACILITIES
**SEWARD HIGHWAY
MP 96 TO MP 102
SAFETY, ROADWAY AND
RECREATIONAL IMPROVEMENTS
SIGN SUMMARY**

REVISIONS			STATE	PROJECT DESIGNATION	YEAR	SHEET NO.	TOTAL SHEETS
No.	DATE	DESCRIPTION	ALASKA	NH-0A3-1(28)	2002	J20	J32
			THIS SHEET IS REPLACED BY SHEET J20A				

REVISIONS			STATE	PROJECT DESIGNATION	YEAR	SHEET NO.	TOTAL SHEETS
No.	DATE	DESCRIPTION	ALASKA	NH-0A3-1(28)	2002	J20	J32
			THIS SHEET IS REPLACED BY SHEET J20A				








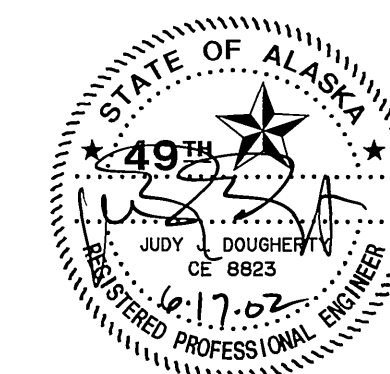
[illegible][illegible]


STATE OF ALASKA
DEPARTMENT OF TRANSPORTATION
AND
PUBLIC FACILITIES
**SEWARD HIGHWAY
MP 96 TO MP 102
SAFETY, ROADWAY AND
RECREATIONAL IMPROVEMENTS
SIGN SUMMARY**

SIGN SUMMARY

REVISIONS			STATE	PROJECT DESIGNATION	YEAR	SHEET NO.	TOTAL SHEETS
No.	DATE	DESCRIPTION	ALASKA	NH-0A3-1(28)	2004	J20A	J32

CHANGE ORDER NO. 6
ATTACHMENT 'A'
SHEET 8 OF 8

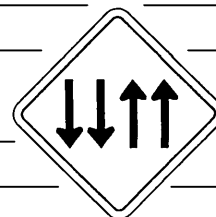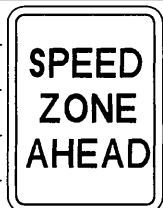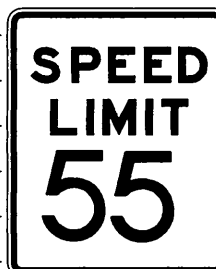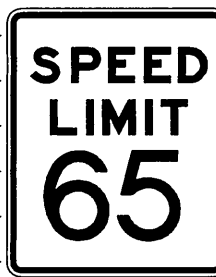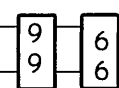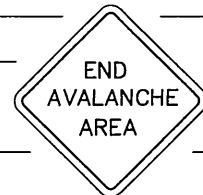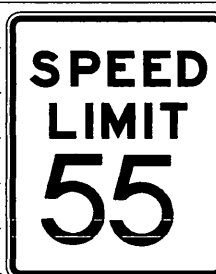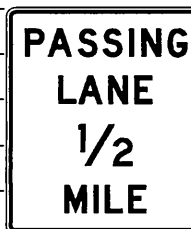SHEET NO.	POST NO.	STATION	REF. CL	TYPE	LEGEND	SIZE		AREA (m ²)	SIGN FACES	POST SIZE	THICKNESS (mm)		REMARKS
						METER					FRAMED	UNFRAMED	
						W	H						
						1.2	1.2	1.44	W	1-75 mm T.		3.2	
						0.45	0.6	0.27	E	1-65 mm P.T.		3.2	
						0.75	0.9	0.68	E	1-75 mm T.		3.2	
						0.75	0.9	0.68	W	1-75 mm T.		3.2	
						0.15	0.3	0.09	E/W	1-65 mm P.T.		3.2	
					AVALANCHE AREA NEXT 2 MILES DO NOT STOP	2.6	1.2	3.12	W	2-80 mm P.	3.2		HINGE SIGN SEE SPECIFICATIONS
						0.9	0.9	0.81	E	1-75 mm T.		3.2	
						0.75	0.9	0.68	E	1-75 mm T.		3.2	
						1.05	1.20	1.26	W	1-75 mm T.		3.2	
						1.05	1.20	1.26	W	1-75 mm T.		3.2	

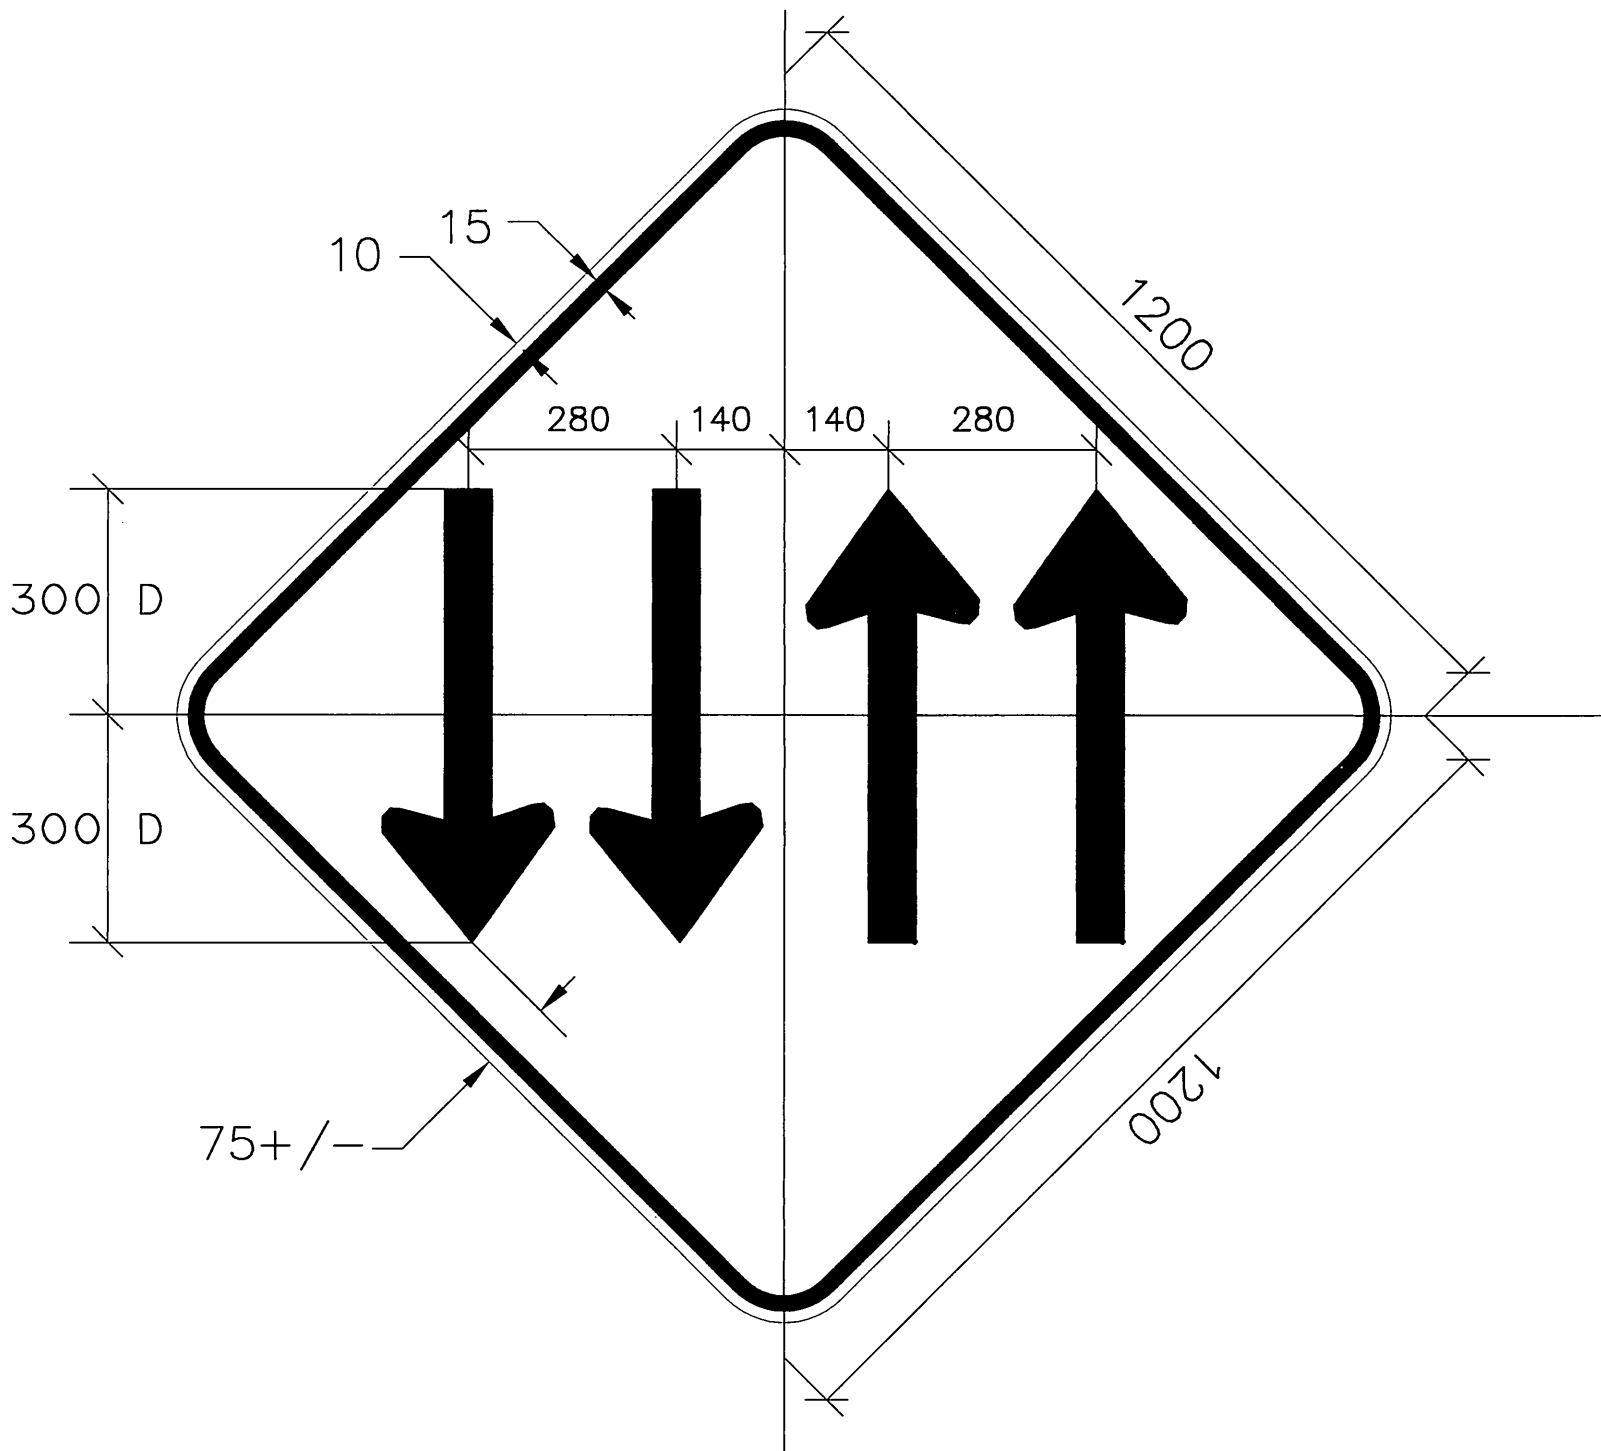


SPECIAL DETAIL

150 SERIES D CAPS
LEGEND - BLACK
BACKGROUND - WHITE

AS-BUILT 4/1/12


DESIGNED BY	VIEW= 2	4/26/04
CHECKED BY		
DRAFTED BY		
SCALE 1"=1	LTSCALE = 1	
COMPUTER DESIGNATION	AUTOCAD-CAROLEE: 54433\SMS\IGL\CHANGEORDER	




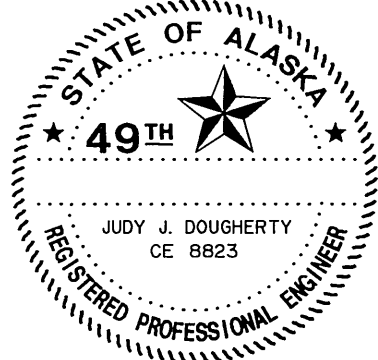



STATE OF ALASKA
DEPARTMENT OF TRANSPORTATION
AND
PUBLIC FACILITIES
SEWARD HIGHWAY
MP 96 TO MP 102
SAFETY, ROADWAY AND
RECREATIONAL IMPROVEMENTS
SIGN SUMMARY

DESIGNED BY: JWH-S1
CHECKED BY: JWH
DATE: 10/13/02
SCALE: 1" = 100'
COMPUTER DESIGNATION: AUTOCAD-KAREN-D:\ASSETS\03\ASSET\DATA\N008160\7585552.DWG 9-25-01 1:32:13 PM EST 10/13/02

REVISIONS			STATE	PROJECT DESIGNATION	YEAR	SHEET NO.	TOTAL SHEETS
No.	DATE	DESCRIPTION					
			ALASKA	NH-0A3-1(28)	2002	J21	J32

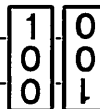SHEET NO.	POST NO.	STATION	REF. CL	TYPE	LEGEND	SIZE		AREA (m ²)	SIGN FACES	POST SIZE	THICKNESS (mm)		REMARKS
						Meter					FRAMED	UNFRAMED	
						W	H						
J10	27	42+012	RT.	R11-101		0.6	1.5	0.90	W			3.2	INSTALL ON AVALANCHE GATE
			RT.	2(OM-3R)		0.90	0.30	0.54	W			3.2	INSTALL ON AVALANCHE GATE
J10	28	42+012	LT.	R11-2		1.2	0.75	0.90	W			3.2	INSTALL ON AVALANCHE GATE
			LT.	2(OM-3L)		0.90	0.30	0.54	W			3.2	INSTALL ON AVALANCHE GATE
J10	29	42+239	LT.	W14-5A		0.90	0.90	0.81	W	1-75 mm T.		3.2	HINGE SIGN
						0.60	0.60	0.36	W			3.2	BLACK ON YELLOW
J10	30	42+263	RT.	2(M10-2)		0.15	0.3	0.09	E/W	1-65 mm P.T.		3.2	
J10	31	42+389	LT.	W14-5A		0.90	0.90	0.81	W	1-75 mm T.		3.2	HINGE SIGN
						0.60	0.60	0.36	W			3.2	BLACK ON YELLOW
J10	32	42+539	LT.	W14-5A		0.90	0.90	0.81	W	1-75 mm T.		3.2	HINGE SIGN
J11	33	42+644	RT.	R1-1		0.75	0.75	0.56	N	1-65 mm P.T.		3.2	
J11	34	42+881	RT.	W11-2		0.90	0.90	0.81	W	1-75 mm T.		3.2	
			RT.	W13-1A		0.60	0.45	0.27	W				

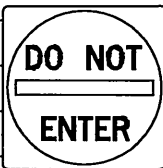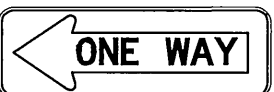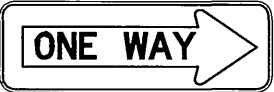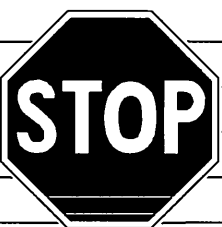SHEET NO.	POST NO.	STATION	REF. CL	TYPE	LEGEND	SIZE		AREA (m ²)	SIGN FACES	POST SIZE	THICKNESS (mm)		REMARKS
						Meter					FRAMED	UNFRAMED	
						W	H						
J12	35	43+254	RT.	R1-1		0.75	0.75	0.56	N	1-65 mm P.T.		3.2	
				D3-1A		1.20	0.23	0.55	E/W			3.2	2 SIGNS BACK TO BACK
J12	36	43+559	LT.	R1-1		0.75	0.75	0.56	S	1-65 mm P.T.		3.2	
				R5-1		0.60	0.60	0.36	N			3.2	
				R6-1L		0.90	0.30	0.27	E			3.2	
				R6-RL		0.90	0.30	0.27	W			3.2	
J12	37	43+568	RT.	R1-1		0.75	0.75	0.56	N	1-65 mm P.T.		3.2	
				D3-1A		1.20	0.23	0.55	E/W			3.2	2 SIGNS BACK TO BACK
J13	38	43+757	RT.	R1-1		0.75	0.75	0.56	N	1-65 mm P.T.		3.2	
				D3-1A		1.50	0.23	0.69	E/W			3.2	2 SIGNS BACK TO BACK

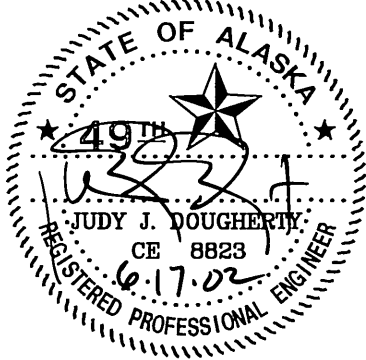


STATE OF ALASKA
DEPARTMENT OF TRANSPORTATION
AND
PUBLIC FACILITIES
**SEWARD HIGHWAY
MP 96 TO MP 102
SAFETY, ROADWAY &
RECREATIONAL IMPROVEMENTS**
SIGN SUMMARY

DESIGNED BY: VIEWS: 11/11/2002
CHECKED BY: 11/11/2002
DATE: 11/11/2002
SCALE: 1"=100'
PROJECT: SEWARD HIGHWAY
SHEET NO.: 11/11/2002
SHEET TOTAL: 11/11/2002

REVISIONS			STATE	PROJECT DESIGNATION	YEAR	SHEET NO.	TOTAL SHEETS
No.	DATE	DESCRIPTION					
			ALASKA	NH-0A3-1(28)	2002	J22	J32

SHEET NO.	POST NO.	STATION	REF. CL	TYPE	LEGEND	SIZE		AREA (m ²)	SIGN FACES	POST SIZE	THICKNESS (mm)		REMARKS
						Meter					FRAMED	UNFRAMED	
						W	H						
J13	39	43+851	RT.	2(M10-2)		0.15	0.3	0.09	E/W	1-65 mm P.T.		3.2	
J13	40	44+140	RT.	RCIA		1.05	1.5		W	2-100 mm P.			REMOVE AND RELOCATE
			RT.	RCIA		1.05	1.5		W				REMOVE AND RELOCATE
			RT.	RCIA		0.45	0.69		W				REMOVE AND RELOCATE
J13	41	44+210	RT.	R7-101		0.3	0.45	0.14	S	1-65 mm P.T.		3.2	
J13	42	44+238	LT.	R1-1		0.75	0.75	0.56	S	1-65 mm P.T.		3.2	
			LT.	RCIA		0.45	0.60		E				REMOVE AND RELOCATE
J13	43	44+260	RT.	R1-1		0.75	0.75	0.56	N	1-65 mm P.T.		3.2	
J13	44	44+310	RT.	R7-101		0.3	0.45	0.14	S	1-65 mm P.T.		3.2	
J13	45		LT.	R7-101		0.3	0.45	0.14	N	1-65 mm P.T.		3.2	
J13	46	44+350	RT.	RCIA		1.05	1.5		E	2-100 mm P.			REMOVE AND RELOCATE
			RT.	RCIA		1.05	1.5		E				REMOVE AND RELOCATE
			RT.	RCIA		0.45	0.69		E				REMOVE AND RELOCATE
J13	47	44+360	RT.	R7-101		0.3	0.45	0.14	S	1-65 mm P.T.		3.2	
			RT.	SPECIAL		0.3	0.45		E				REMOVE AND RELOCATE
J14	48	44+410	RT.	R7-101		0.3	0.45	0.14	S	1-65 mm P.T.		3.2	
			RT.	SPECIAL		0.3	0.45		E				REMOVE AND RELOCATE
J14	49	44+410	LT.	R7-101		0.3	0.45	0.14	N	1-65 mm P.T.		3.2	



SHEET NO.	POST NO.	STATION	REF. CL	TYPE	LEGEND	SIZE		AREA (m ²)	SIGN FACES	POST SIZE	THICKNESS (mm)		REMARKS
						Meter					FRAMED	UNFRAMED	
						W	H						
	50	44+460	RT.	R7-101		0.3	0.45	0.14	S	1-65 mm P.T.		3.2	
			RT.	SPECIAL		0.3	0.45		E				REMOVE AND RELOCATE
	51	44+460	LT.	R7-101		0.3	0.45	0.14	N	1-65 mm P.T.		3.2	



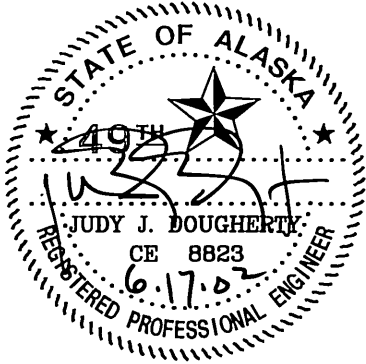



STATE OF ALASKA
DEPARTMENT OF TRANSPORTATION
AND
PUBLIC FACILITIES
**SEWARD HIGHWAY
MP 96 TO MP 102
SAFETY, ROADWAY &
RECREATIONAL IMPROVEMENTS**
SIGN SUMMARY

DESIGNED BY: LJS/SCALE = 1/4" = 1' VIEW: SS3
CHECKED BY: AUTOCAD: KAREN-D./S:\SPRINT\5877\DATA\IN\BIRD\ROAD\SS3\SUM.DWG 9-25-01 1:32:13 pm EST
DRAFTED BY: KWH
SPECIFICATIONS: SCALE 1/4" = 1' COMPUTER DESIGNATION

REVISIONS			STATE	PROJECT DESIGNATION	YEAR	SHEET NO.	TOTAL SHEETS
No.	DATE	DESCRIPTION					
			ALASKA	NH-0A3-1(28)	2002	J23	J32

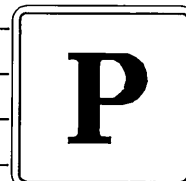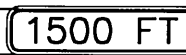SHEET NO.	POST NO.	STATION	REF. CL	TYPE	LEGEND	SIZE		AREA (m ²)	SIGN FACES	POST SIZE	THICKNESS (mm)		REMARKS
						Meter					FRAMED	UNFRAMED	
						W	H						
J15	52	44+550	RT.	RA-080		0.6	0.6	0.36	E	1-65 mm P.T.		3.2	
				D9-E		0.6	0.15	0.09	E			3.2	WHITE ON BROWN
J15	53	44+550	LT.	R7-101		0.3	0.45	0.14	N	1-65 mm P.T.		3.2	
J15	54	44+600	RT.	R7-101		0.3	0.45	0.14	S	1-65 mm P.T.		3.2	
J15	55		LT.	R7-101		0.3	0.45	0.14	N	1-65 mm P.T.		3.2	
J15	56	44+650	RT.	I-3		1.35	0.9	1.22	E	2-80 mm P.		3.2	SEE SPECIFICATIONS
J15	57	44+713	LT.	I-3		1.35	0.9	1.22	W	2-80 mm P.		3.2	SEE SPECIFICATIONS
J15	58	44+770	RT.	I-150		0.75	0.9		E	1-65 mm P.T.		3.2	REMOVE AND RELOCATE
J15	59	44+770	LT.	R7-101		0.3	0.45	0.14	N	1-65 mm P.T.		3.2	
J15	60	44+820	RT.	R7-101		0.3	0.45	0.14	S	1-65 mm P.T.		3.2	
J15	61	44+821	LT.	I-150		0.75	0.9		E	1-65 mm P.T.		3.2	REMOVE AND RELOCATE
J15	62	44+870	RT.	R7-101		0.3	0.45	0.14	S	1-65 mm P.T.		3.2	
J15	63	44+920	RT.			1.2	0.9	1.08	E	1-75 mm T.		3.2	SEE SPECIFICATIONS
J15	64	44+920	LT.	R7-101		0.3	0.45	0.14	N	1-65 mm P.T.		3.2	

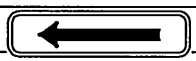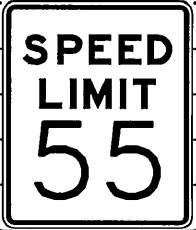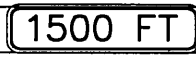
SHEET NO.	POST NO.	STATION	REF. CL	TYPE	LEGEND	SIZE		AREA (m ²)	SIGN FACES	POST SIZE	THICKNESS (mm)		REMARKS
						Meter					FRAMED	UNFRAMED	
						W	H						
						1.2	0.9	1.08	W	1-75 mm T.		3.2	SEE SPECIFICATIONS
J15	66	44+970	RT.	R7-101		0.3	0.45	0.14	S	1-65 mm P.T.		3.2	
J15	67	45+020	RT.	R7-101		0.3	0.45	0.14	S	1-65 mm P.T.		3.2	
J15	68		LT.	R7-101		0.3	0.45	0.14	N	1-65 mm P.T.		3.2	
J15	69	45+070	RT.	R7-101		0.3	0.45	0.14	S	1-65 mm P.T.		3.2	
J15	70		LT.	R7-101		0.3	0.45	0.14	N	1-65 mm P.T.		3.2	
J15	71	45+120	LT.	R7-101		0.3	0.45	0.14	N	1-65 mm P.T.		3.2	
J16	72		RT.	R7-101		0.3	0.45	0.14	S	1-65 mm P.T.		3.2	
J16	73	45+190	LT.	RA-080		0.6	0.6	0.36	N	1-65 mm P.T.		3.2	
				D9-L		0.6	0.15	0.09	N			3.2	WHITE ON BROWN
J16	74	45+300	RT.	R2-1		0.75	0.90	0.68	S	1-75 mm T.		3.2	
J16	75	45+397	LT.	RA-080		0.6	0.6	0.36	N	1-65 mm P.T.		3.2	
				D9-E		0.6	0.15	0.09	N			3.2	WHITE ON BROWN

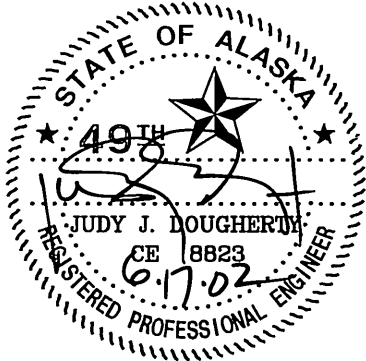

STATE OF ALASKA
DEPARTMENT OF TRANSPORTATION
AND
PUBLIC FACILITIES
**SEWARD HIGHWAY
MP 96 TO MP 102
SAFETY, ROADWAY &
RECREATIONAL IMPROVEMENTS**
SIGN SUMMARY

[illegible]

SPECIFICATIONS SCALE 1:1	DESIGNED BY CHECKED BY VIEW: SS4 LSCALE = 1
COMPUTER DESIGNATION AUTOCAD-KAREN-53577\DATA\775NSUM.DWG	DRAFTED BY: KMH 11-13-02

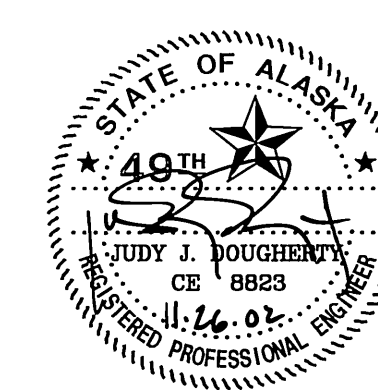











STATE OF ALASKA
DEPARTMENT OF TRANSPORTATION
AND
PUBLIC FACILITIES







**SEWARD HIGHWAY
MP 96 TO MP 102
SAFETY, ROADWAY &
RECREATIONAL IMPROVEMENTS**

SIGN SUMMARY

RAILROAD SIGN SUMMARY


REVISIONS			STATE	PROJECT DESIGNATION	YEAR	SHEET NO.	TOTAL SHEETS
No.	DATE	DESCRIPTION					
			ALASKA	NH-0A3-1(28)	2002	J25	J32

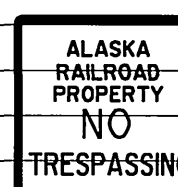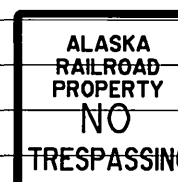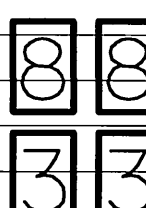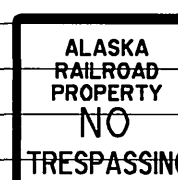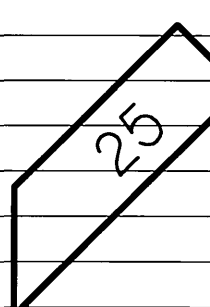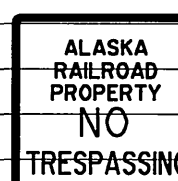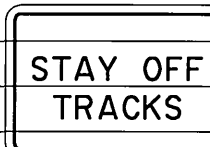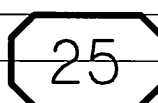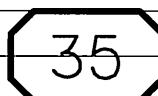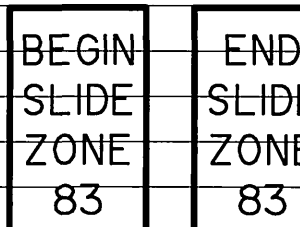SHEET NO.	POST NO.	STATION	REF. CL	TYPE	LEGEND	SIZE		AREA (m ²)	SIGN FACES	POST SIZE	THICKNESS (mm)		REMARKS
						METER					FRAMED	UNFRAMED	
						W	H						
		'R' 2+071	LT.	RAILROAD		0.30	0.23	0.07	N	1-65 mm P.T.		3.2	SEE RAILROAD STANDARD DRAWING 30.10
		'R' 2+100	RT.	RAILROAD		0.60	0.60	0.36	E	1-65 mm P.T.		3.2	SEE RAILROAD STANDARD DRAWING 30.93 SIGN B
		'R' 2+500	RT.	RAILROAD		0.60	0.60	0.36	E	1-65 mm P.T.		3.2	SEE RAILROAD STANDARD DRAWING 30.93 SIGN B
		'R' 2+700	RT.	RAILROAD		0.20	0.30	0.12	N/S	1-65 mm P.T.		3.2	SEE RAILROAD STANDARD DRAWING 30.2
		'R' 2+780	LT.	RAILROAD		0.30	0.23	0.07	N	1-65 mm P.T.		3.2	SEE RAILROAD STANDARD DRAWING 30.10
		'R' 3+050	RT.	RAILROAD		0.60	0.60	0.36	N	1-65 mm P.T.		3.2	SEE RAILROAD STANDARD DRAWING 30.93 SIGN B
		'R' 3+102	RT.	RAILROAD		0.75	0.30	0.23	S	1-65 mm P.T.		3.2	SEE RAILROAD STANDARD DRAWING 30.91
		'R' 3+500	RT.	RAILROAD		0.60	0.60	0.36	N	1-65 mm P.T.		3.2	SEE RAILROAD STANDARD DRAWING 30.93 SIGN B
		'R' 3+880	RT.	SPECIAL		0.45	0.45	0.20	N	1-65 mm P.T.		3.2	SEE SPECIFICATIONS
						0.30	0.45	0.14	N			3.2	SEE SPECIFICATIONS
		'R' 3+907	RT.	RAILROAD		0.30	0.51	0.15	S	1-65 mm P.T.		3.2	SEE RAILROAD STANDARD DRAWING 30.91
		'R' 3+907	LT.	RAILROAD		0.30	0.51	0.15	N	1-65 mm P.T.		3.2	SEE RAILROAD STANDARD DRAWING 30.91
		'R' 3+940	LT.	RAILROAD		0.75	0.30	0.34	N/S	1-65 mm P.T.		3.2	SEE RAILROAD STANDARD DRAWING 30.22 "BEGIN SLIDE ZONE" SIDE FACES NORTH

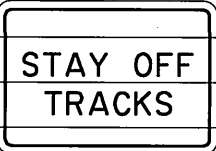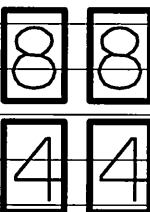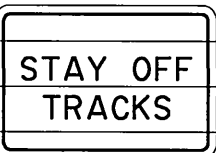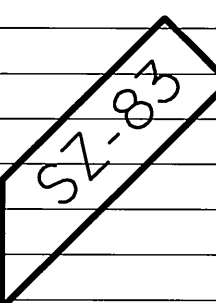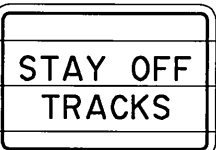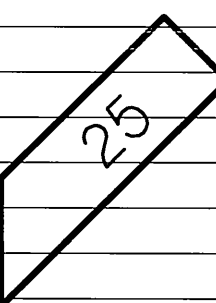SHEET NO.	POST NO.	STATION	REF. CL	TYPE	LEGEND	SIZE		AREA (m ²)	SIGN FACES	POST SIZE	THICKNESS (mm)		REMARKS
						METER					FRAMED	UNFRAMED	
						W	H						
		'R' 4+240	RT.	SPECIAL		0.45	0.45	0.20	E	1-65 mm P.T.		3.2	SEE SPECIFICATIONS
						0.30	0.45	0.14	E			3.2	SEE SPECIFICATIONS
		'R' 4+360	RT.	RAILROAD		0.20	0.30	0.12	N/S	1-65 mm P.T.		3.2	SEE RAILROAD STANDARD DRAWING 30.2
						0.20	0.30	0.12	N/S			3.2	
		'R' 4+580	RT.	SPECIAL		0.45	0.45	0.20	E	1-65 mm P.T.		3.2	SEE SPECIFICATIONS
						0.30	0.45	0.14	E			3.2	SEE SPECIFICATIONS
		'R' 5+035	LT.	RAILROAD		0.75	0.30	0.23	N	1-65 mm P.T.		3.2	SEE RAILROAD STANDARD DRAWING 30.21
		'R' 5+060	RT.	SPECIAL		0.45	0.45	0.20	E	1-65 mm P.T.		3.2	SEE SPECIFICATIONS
						0.30	0.45	0.14	E			3.2	SEE SPECIFICATIONS
		'R' 5+115	RT.	RAILROAD		0.75	0.30	0.23	S	1-65 mm P.T.		3.2	SEE RAILROAD STANDARD DRAWING 30.91

NOTE REFERENCES

1. ARRC SHALL FIELD VERIFY PLACEMENT OF NEW SIGNS BEFORE INSTALLATION.

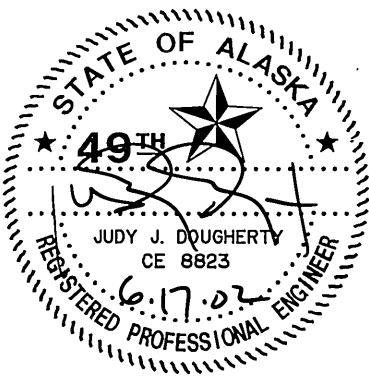

STATE OF ALASKA
DEPARTMENT OF TRANSPORTATION
AND
PUBLIC FACILITIES
**SEWARD HIGHWAY
MP 96 TO MP 102
SAFETY, ROADWAY AND
RECREATIONAL IMPROVEMENTS
SIGN SUMMARY**

DESIGNED BY: AUTOCAD-MARY-TRAFFIC
CHECKED BY: IJ
PLOT SCALE: 1:1
DRAFTED BY: MOH
D:\SSK\PROJ\N3577\DATA\77WINDFRAMING.DWG 9-25-01 1:34:33 PM EST
SPECIFICATIONS
SCALE: 1:1
COMPUTER DESIGNATION


Sign Post Spacing for Pipe and Tube Sign Supports				
Sign Width	No. of Posts	Post Centers		
		Overhang	Between Post	Overhang
3.00 m	2	0.6 m	1 space at 1.8 m	0.6 m
3.15 m to 3.90 m	2	Varies	1.8 m	Varies

Limit the use of pipes and tubes to signs less than 4 m wide.

W Shape Sign Post Spacing				
Sign Width	No. of Posts	Post Centers		
		Overhang	Between Post	Overhang
3.00 m to 3.90 m	2	Varies	1 space at 2.40 m	Varies
4.05 m to 6.00 m	2	0.2W	1 space at 0.6W	0.18W
6.15 m to 6.75 m	3	Varies	2 spaces at 2.40 m	Varies
6.90m to 8.85 m	3	0.15W	2 spaces at 0.35W	0.045W
9.00 m to 9.45 m	4	Varies	3 spaces at 2.40 m	Varies
9.30 m to 12.00 m	4	0.125W	3 spaces at 0.25W	0.381W

Use w shape posts on signs at least 3.0 m wide.



SIGN POST SPACING

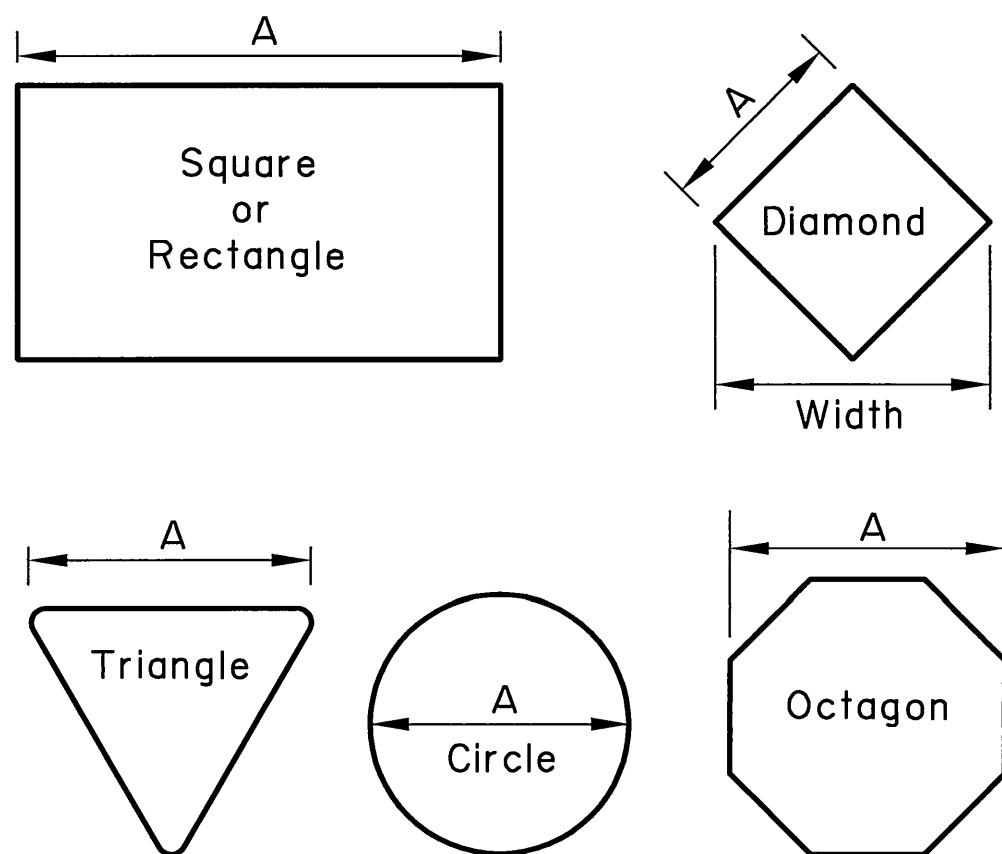


Maximum size unframed signs using 3.2 mm thick aluminum sheeting.	
Sign Shape	A
Squares, Shields, and Route Markers	1.20 m
Rectangles	1.20 m
Diamonds	1.20 m
Triangles	1.20 m
Rounds and Octagons	1.20 m

Install wind framing on all signs that exceed the dimensions listed.

LIGHT SIGNS

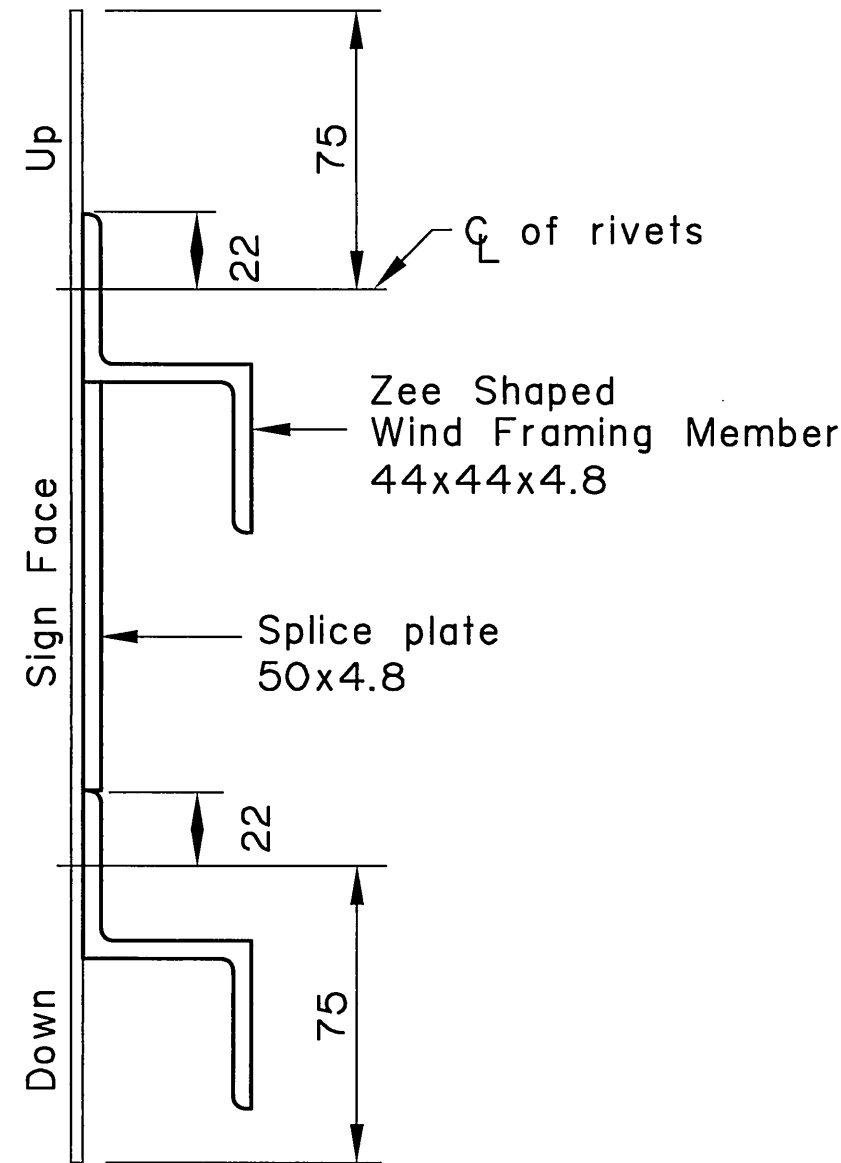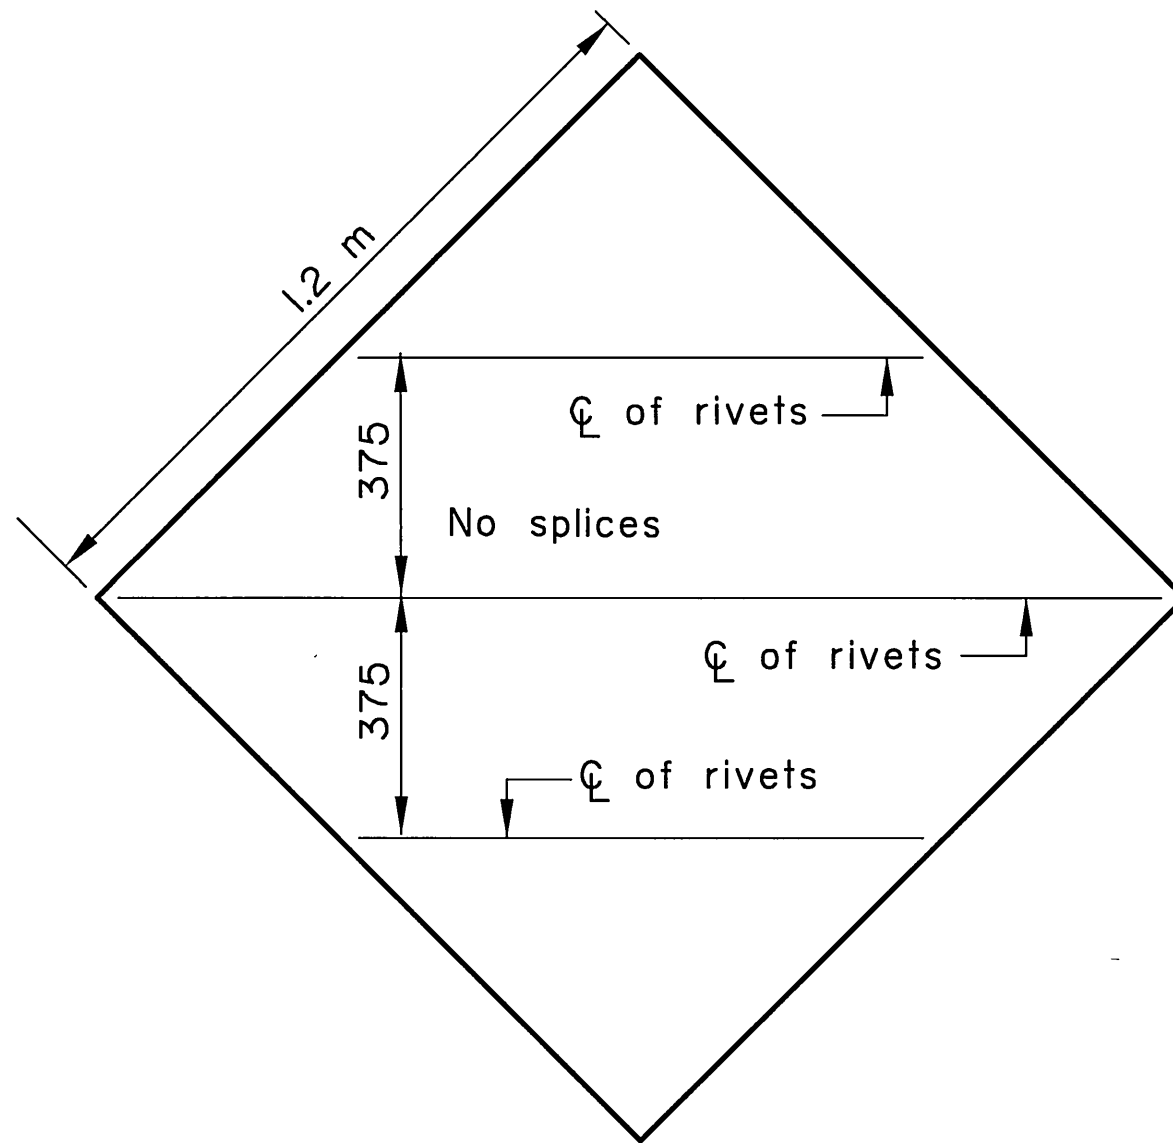

SECTION A - A

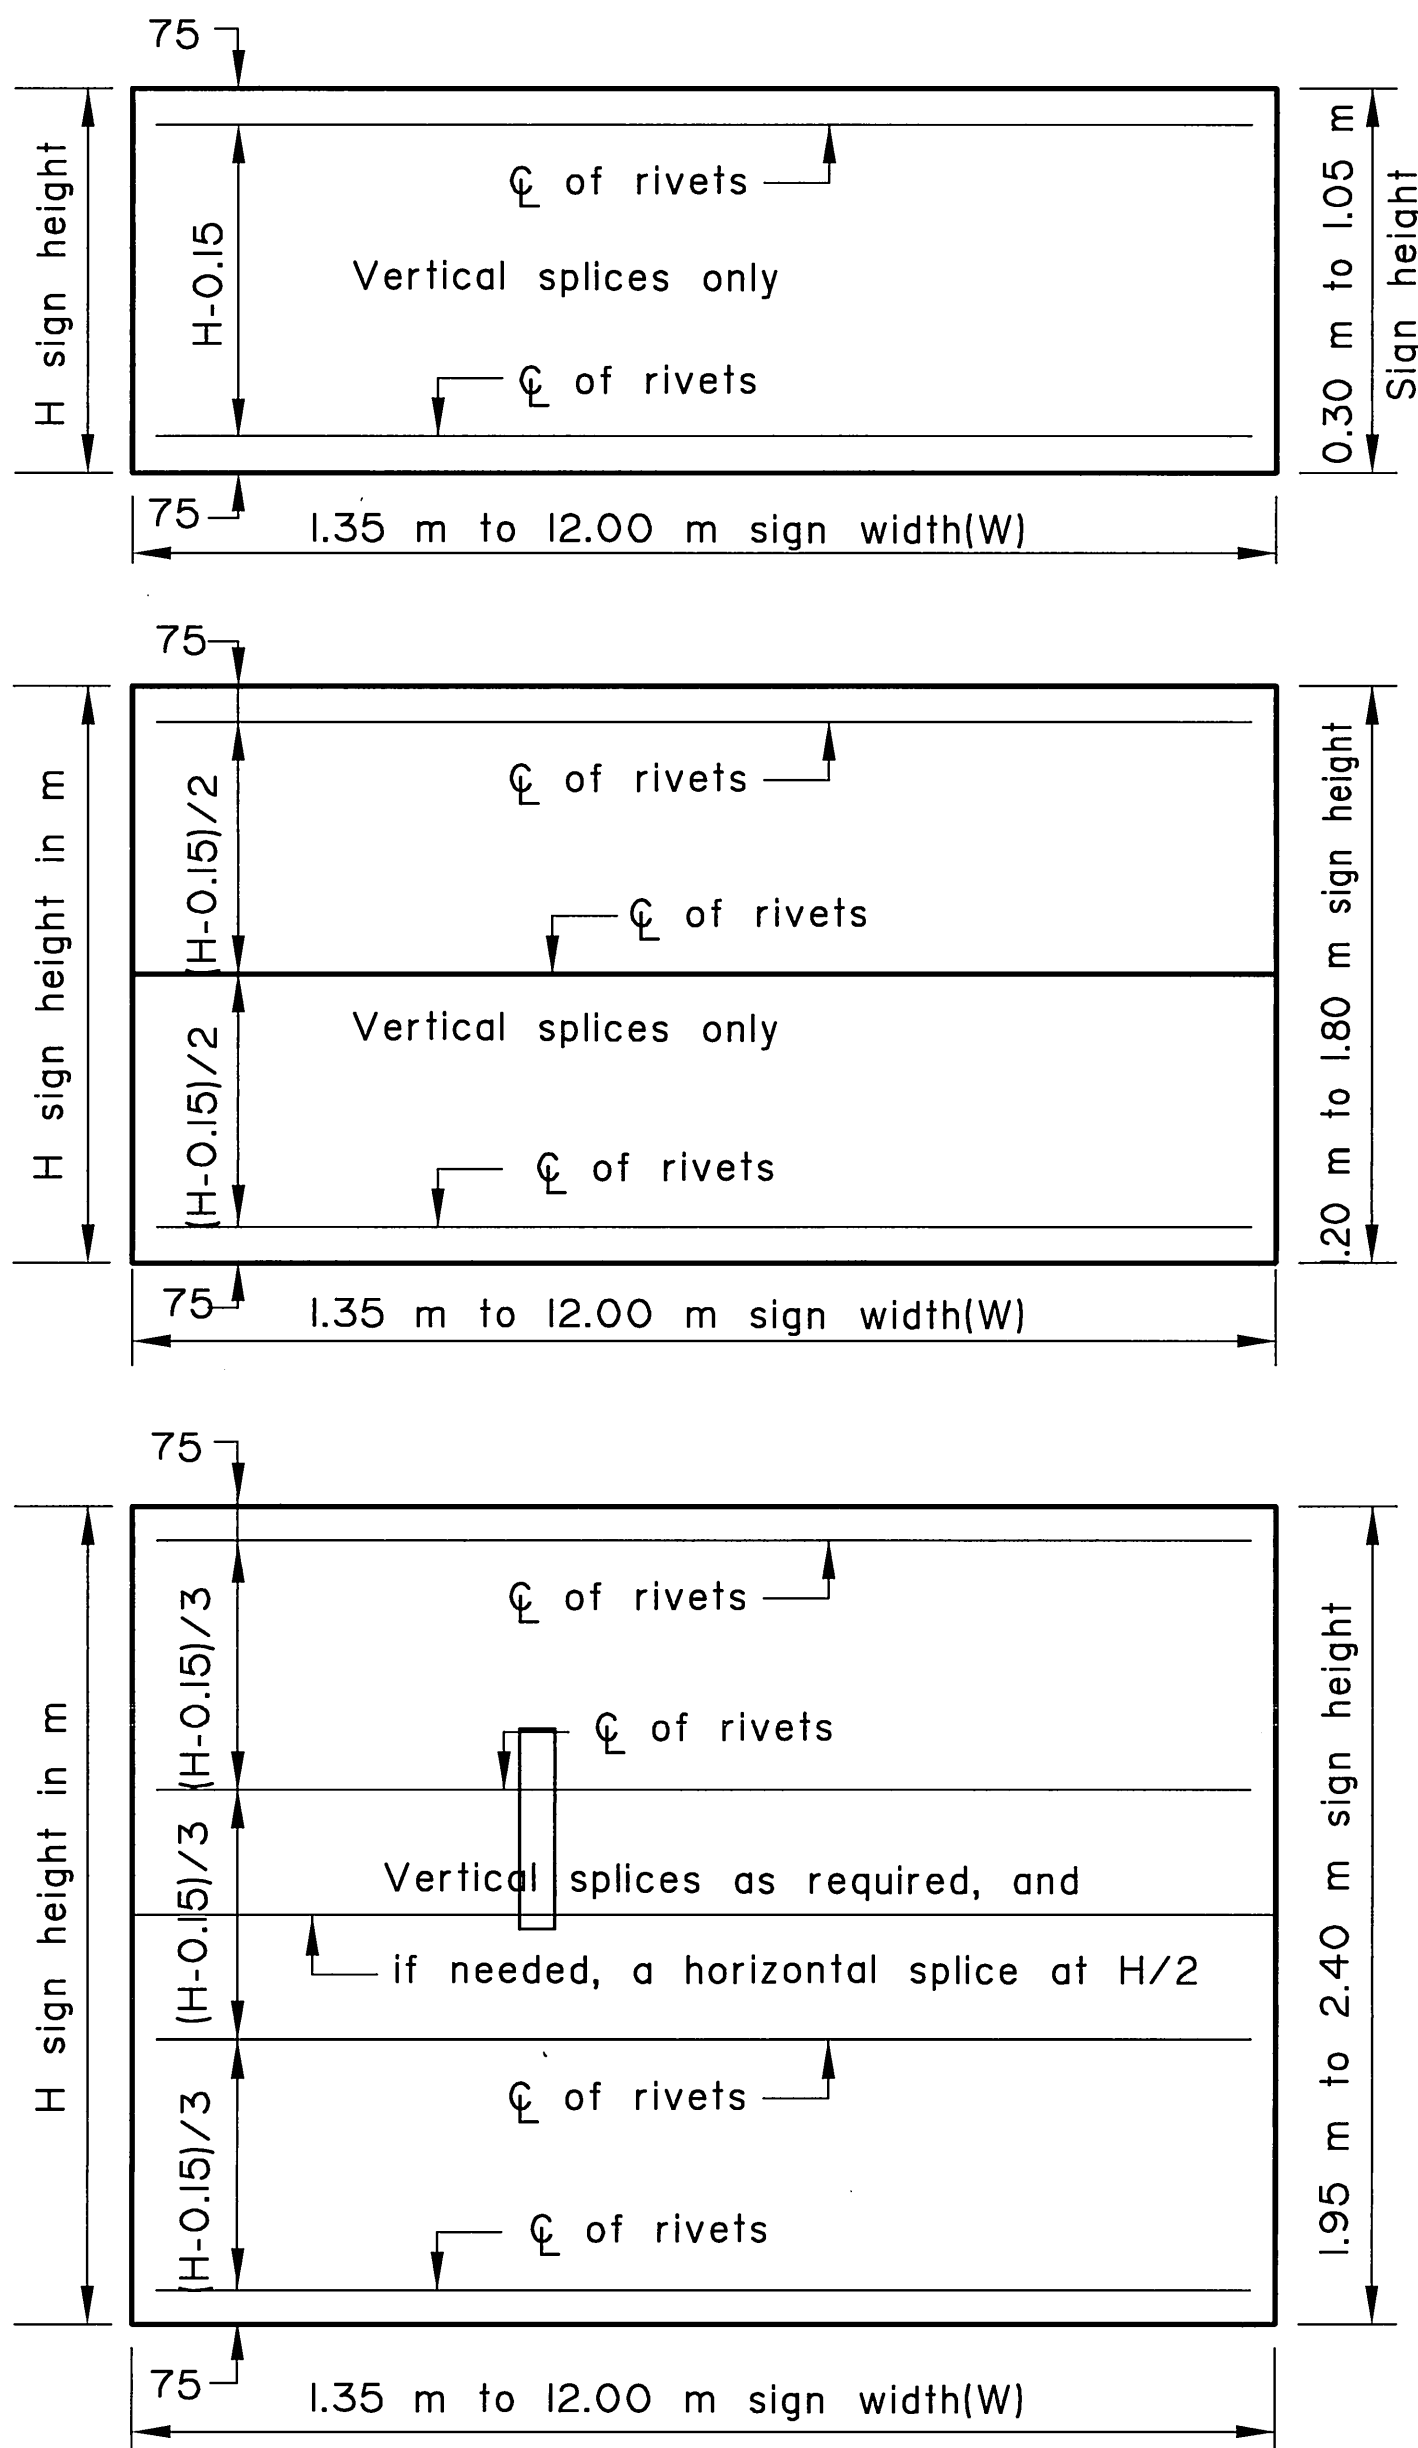


WIND FRAMING LOCATIONS

REVISIONS			PROJECT DESIGNATION		YEAR	SHEET NO.	TOTAL SHEETS
No.	DATE	DESCRIPTION	NHI-0A3-1(28)		2002	J26	J32


NOTES:

- SEE THE STANDARD SPECIFICATIONS FOR THE ALUMINUM ALLOYS THAT YOU MAY USE FOR SIGN SHEETING AND WIND FRAMING MEMBERS.
- FABRICATE ALL SIGNS FROM 3.2 mm THICK ALUMINUM SHEETING.
- SIGN FABRICATORS MAY USE ALTERNATES TO THE ZEE SHAPED FRAMING MEMBER WITH APPROVAL OF THE ENGINEER, IF THE FRAME MANUFACTURER CERTIFIES THEIR DESIGN EQUALS OR EXCEEDS THE STRENGTH OF THE ZEE SHAPED DESIGN.
- INSTALL ONE PIECE WIND FRAMING MEMBERS ON ALL SIGNS UP TO 7.20 m WIDE. USE ONE SPLICE IN EACH WIND FRAME ON ALL SIGNS WIDER THAN 7.2 m, LOCATING THE AT LEAST 450 mm FROM ALL POSTS AND PANEL EDGES. STAGGER THE SPLICE IN ADJACENT FRAMING MEMBERS AT LEAST 2.4 m APART.
- ATTACH WIND FRAMING MEMBERS WITH RIVETS OR WITH AN ENGINEER APPROVED, DOUBLE SIDED, HIGH STRENGTH, ADHESIVE TAPE. CLEAN AND HANDLE THE SHEETING AND FRAMING MEMBERS AND APPLY THE TAPE IN ACCORDANCE WITH THE TAPE MANUFACTURER'S WRITTEN INSTRUCTIONS. THE TAPE MANUFACTURER'S WRITTEN INSTRUCTIONS. INSTALL TWO RIVETS IN BOTH ENDS OF EACH FRAMING MEMBER.
- USE 4.8 mm DIAMETER RIVETS CONFORMING TO ALUMINUM ALLOY 6061-T6 FOR COLD DRIVEN RIVETS, OR ALUMINUM ALLOY 6061-T43 FOR HOT DRIVEN RIVETS.
- SIGN FABRICATORS MAY USE SIGN PANELS EXTRUDED WITH INTEGRAL FRAMING WITH APPROVAL OF THE ENGINEER, IF THE MANUFACTURER CERTIFIES THEIR DESIGN EQUALS OR EXCEEDS THE STRENGTH OF THE 3.2 mm THICK PANEL WITH FRAMING ATTACHED TO IT.
- FRAME ALL SIGNS TALLER THAN 2.4 m WITH FIVE WIND FRAMING MEMBERS LOCATED (H-0.15)/4 SPACES. IF NEEDED, MAKE A HORIZONTAL SPICE AT THE MIDDLE WIND FRAME.

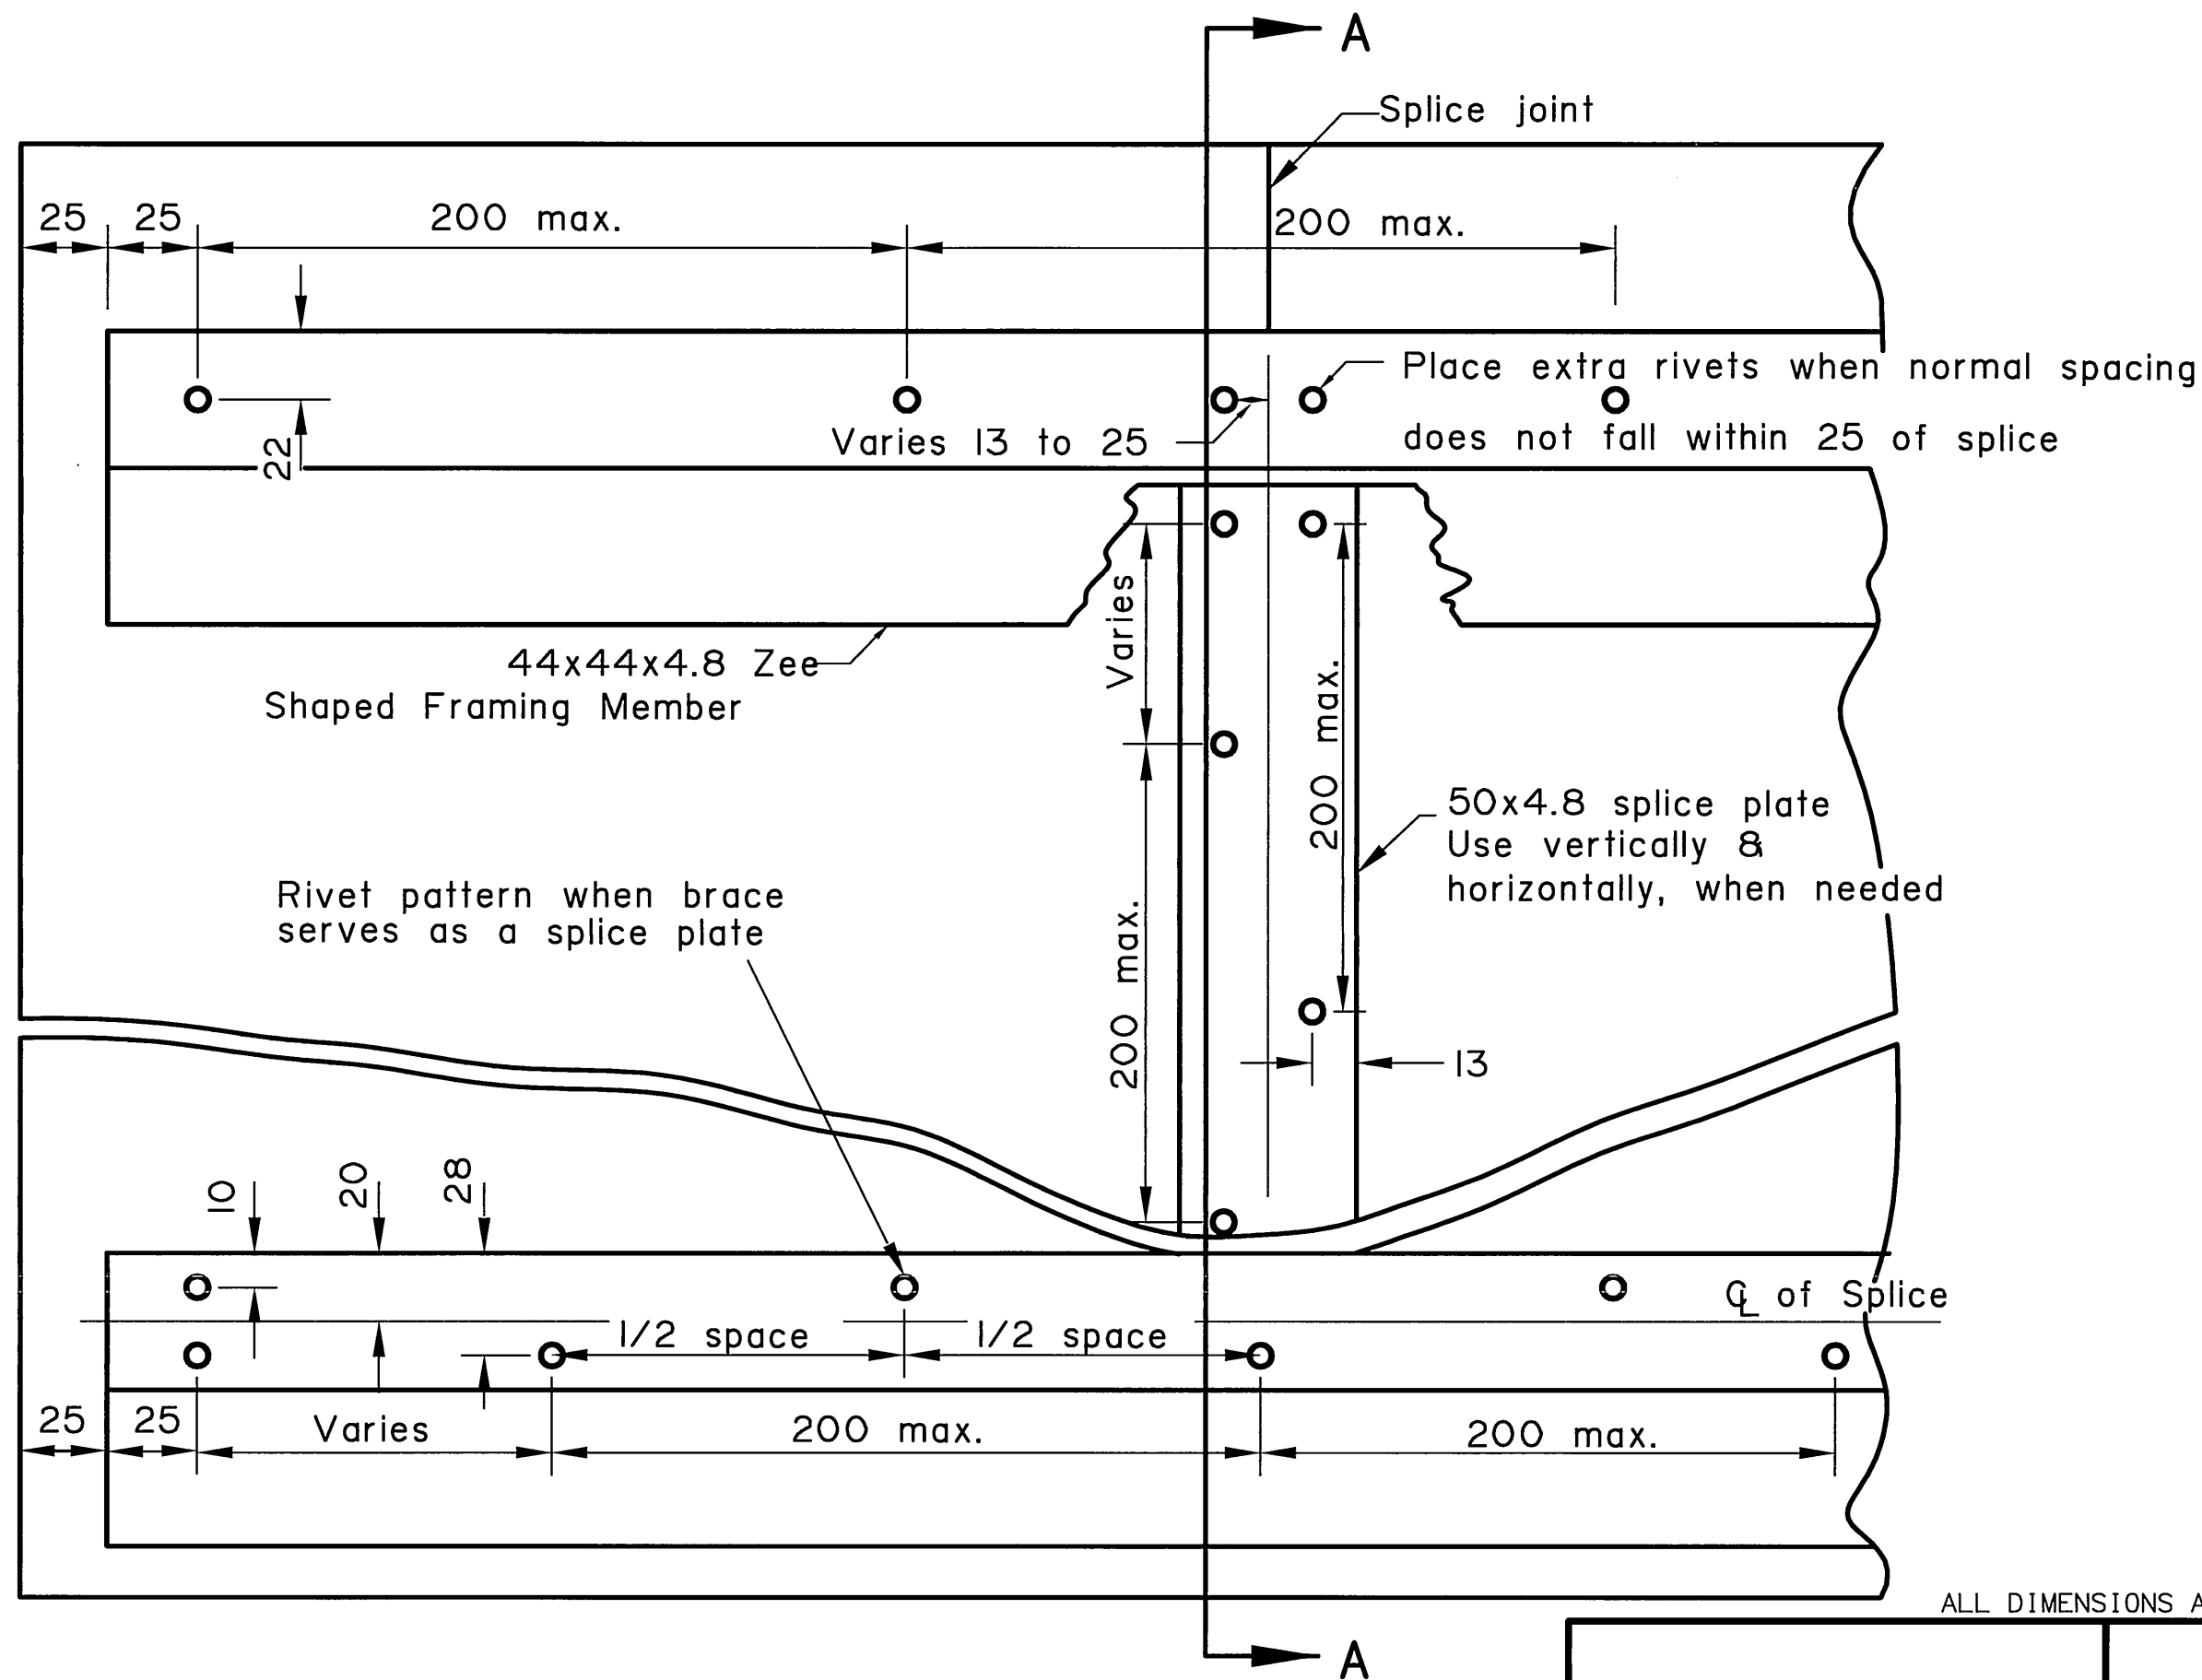

ALL DIMENSIONS ARE IN MILLIMETERS (mm) UNLESS OTHERWISE NOTED.


RIVET DETAIL FOR ZEE SHAPED WIND FRAMING & SPLICE PLATE

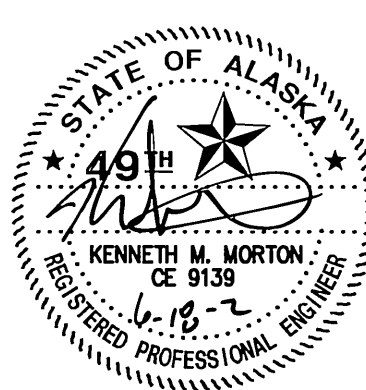


STATE OF ALASKA
DEPARTMENT OF TRANSPORTATION
AND
PUBLIC FACILITIES
**SEWARD HIGHWAY
MP 96 TO MP 102
SAFETY, ROADWAY &
RECREATIONAL IMPROVEMENTS**

WIND FRAMING DETAILS


REVISIONS			STATE	PROJECT DESIGNATION	YEAR	SHEET NO.	TOTAL SHEETS
No.	DATE	DESCRIPTION	ALASKA	NHI-0A3-1(28)	2002	J27	J32

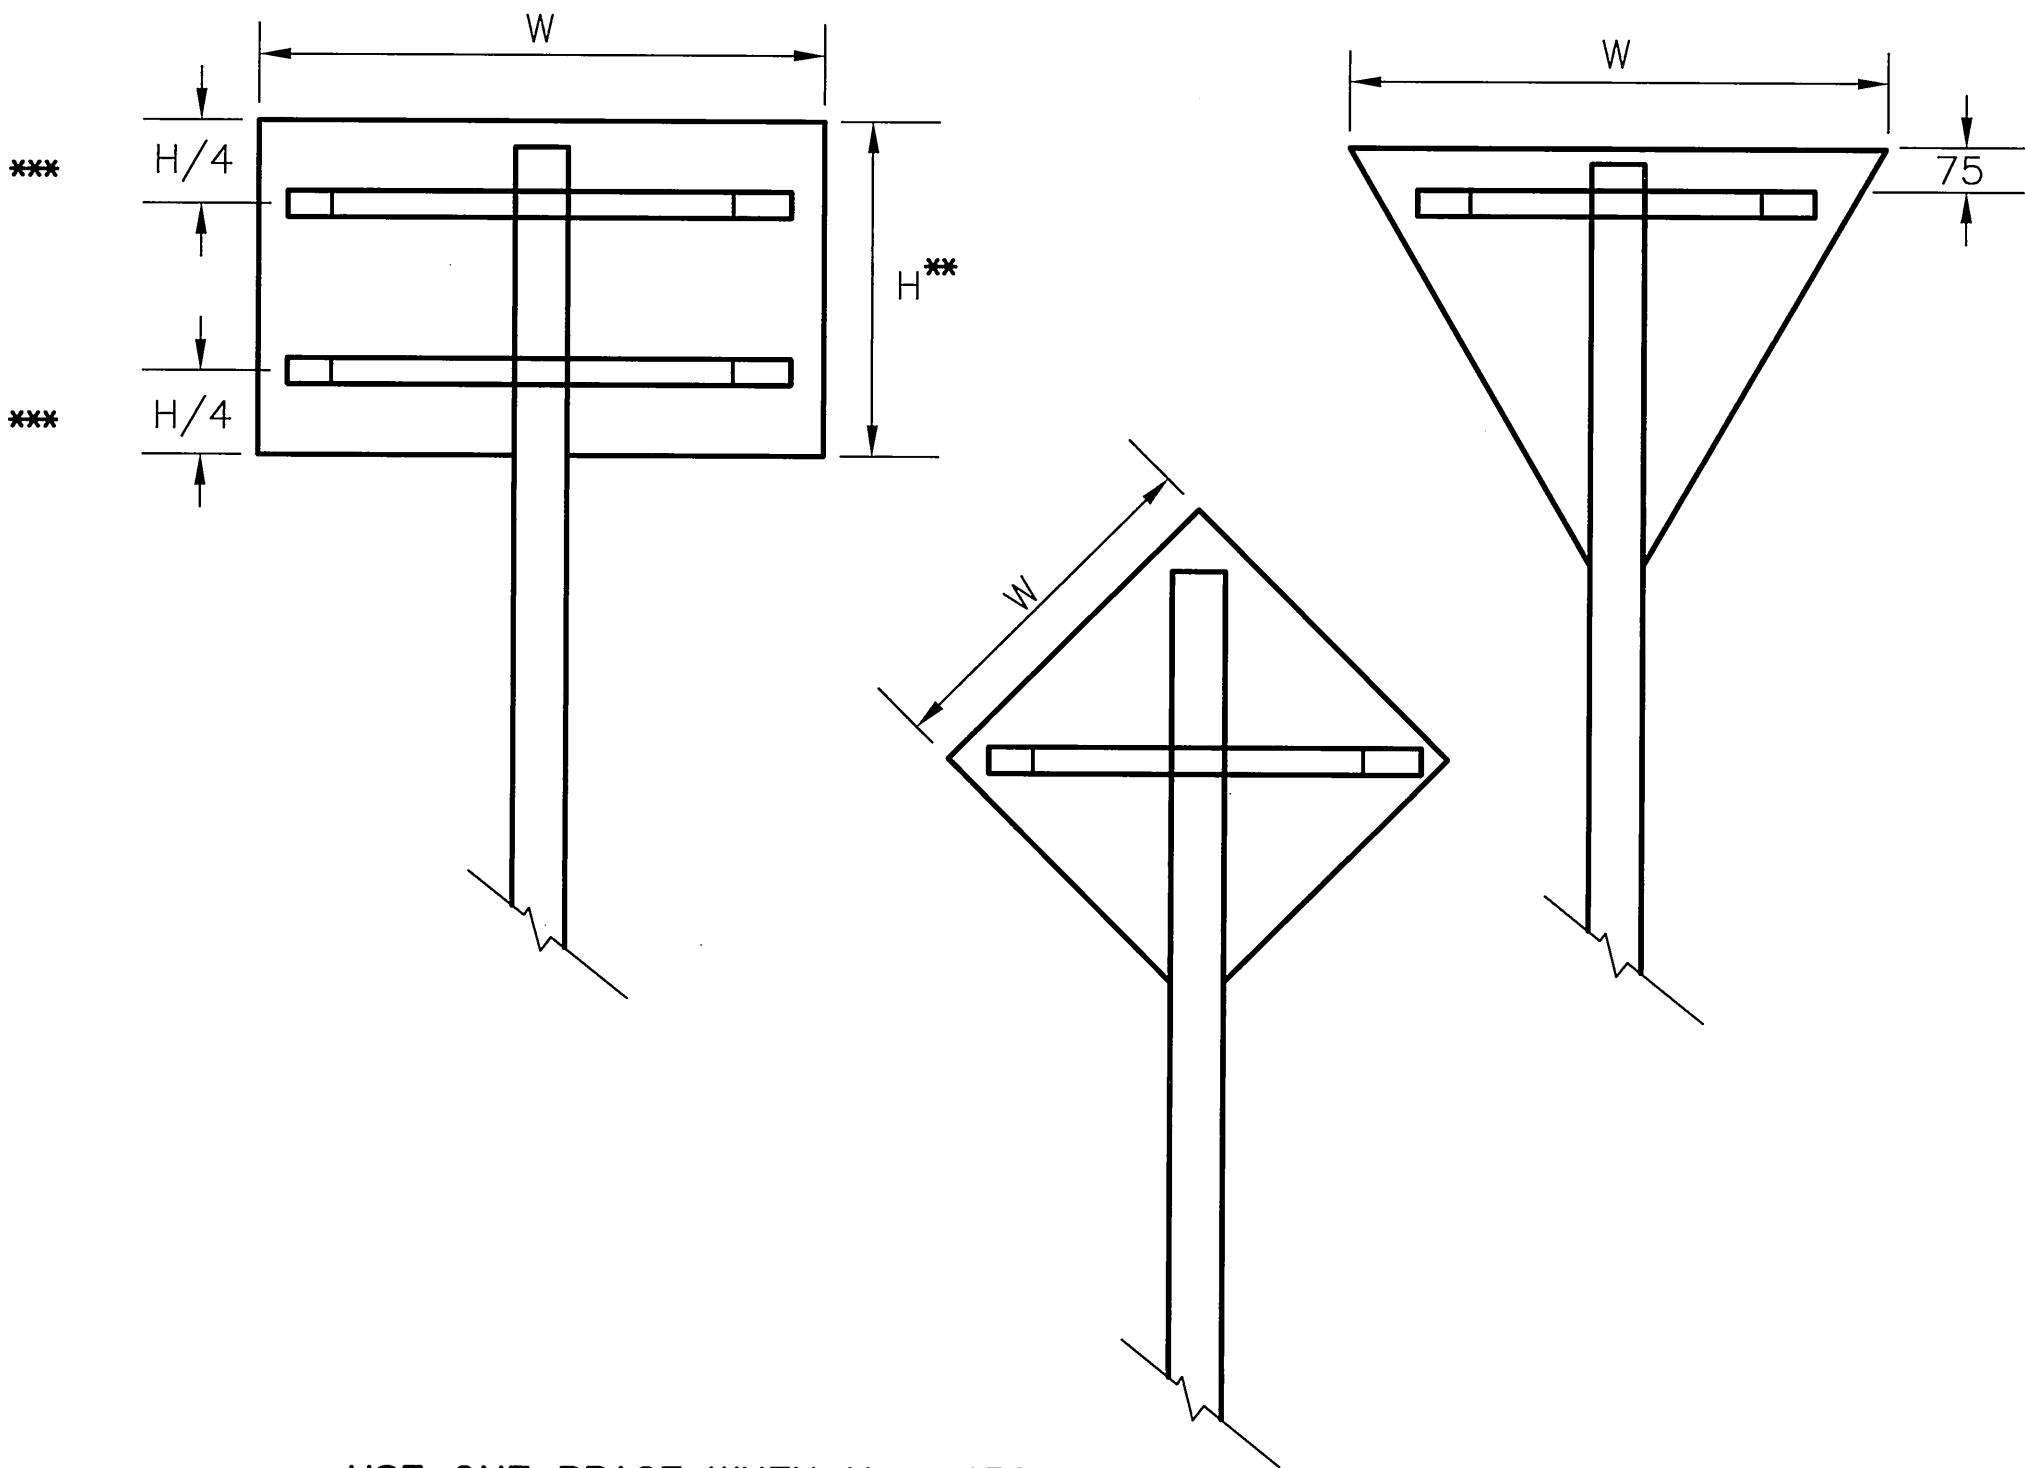

- ** USE ONE BRACE WHEN $H \leq 450$
 USE TWO BRACES WHEN $450 < H \leq 1200$
 USE THREE BRACES WHEN $H > 1200$
- *** POSITION OF BRACE MAY BE VARIED TO MATCH
 PREDRILLED MOUNTING HOLES IN PANEL.

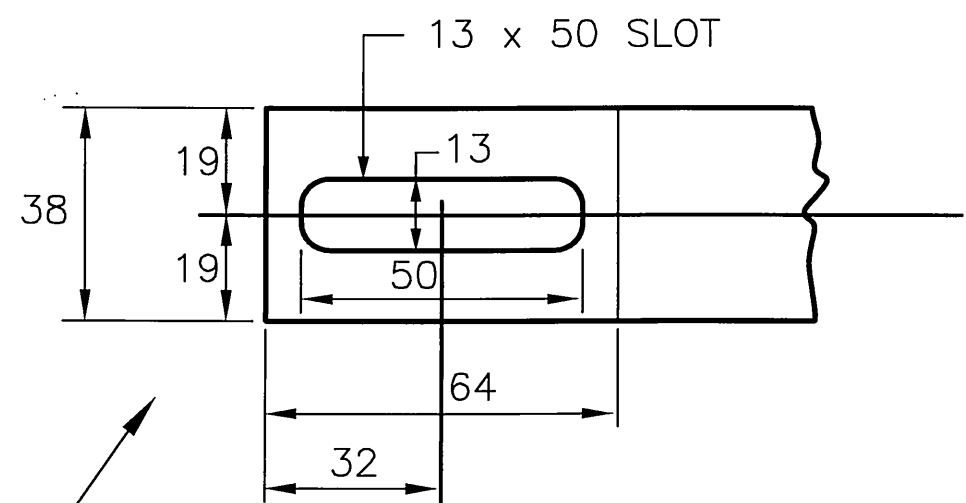


DETAIL OF BRACE SLOT
 ELEVATION VIEW

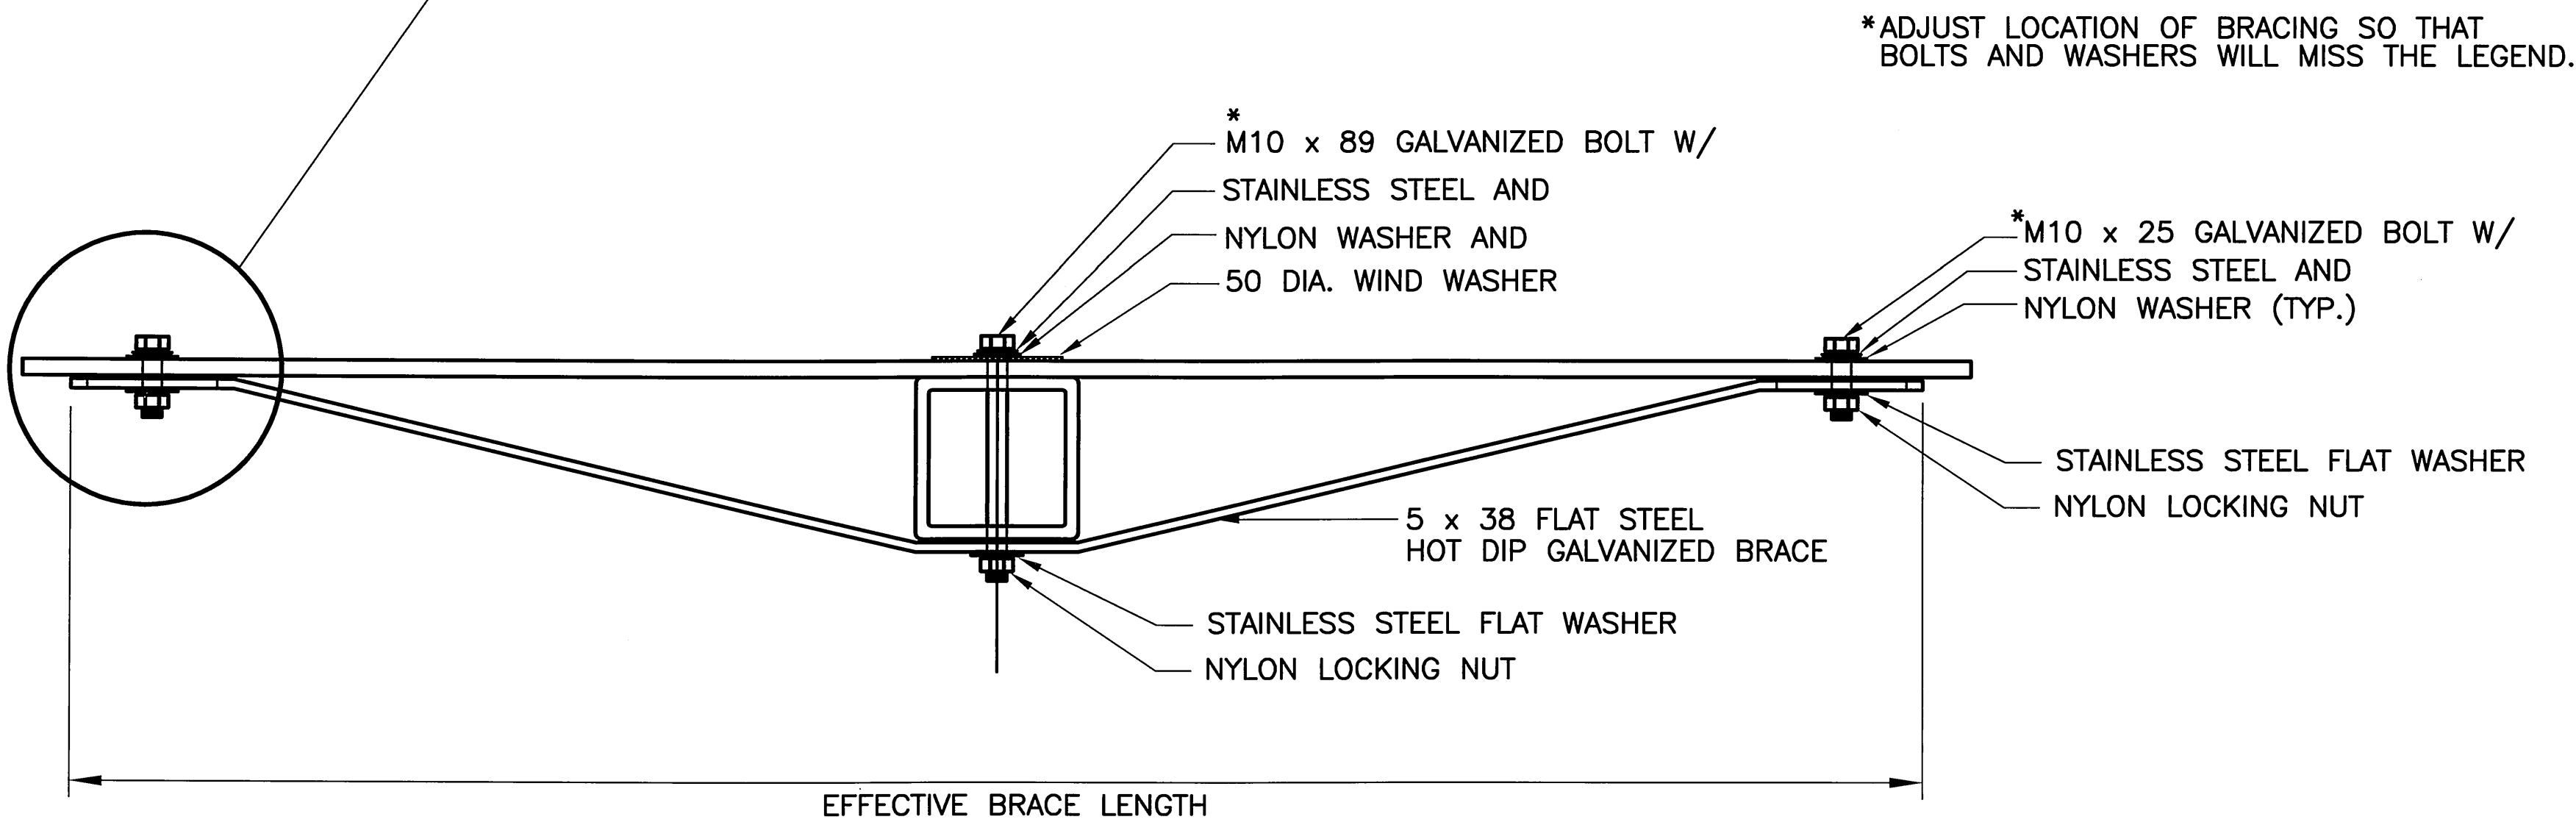

TUBE POST SIGN BRACING
 PLAN VIEW

SIGN WIDTH(W)	EFFECTIVE BRACE LENGTH		
	WARNING	YIELD	OTHER
750	900	600	600
900	1050	750	750
1050	1200	-	900
1200	USE TWO POSTS	900	1050

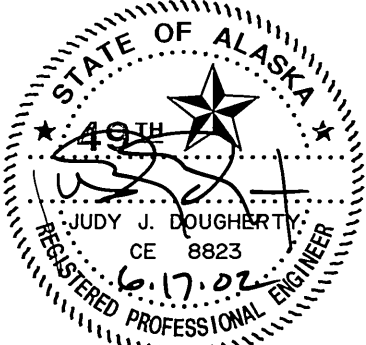

STATE OF ALASKA
 DEPARTMENT OF TRANSPORTATION
 AND
 PUBLIC FACILITIES

**SEWARD HIGHWAY
 MP 96 TO MP 102
 SAFETY, ROADWAY &
 RECREATIONAL IMPROVEMENTS**



**SIGN BRACING DETAIL
 FOR TUBES**

SPECIFICATIONS	DESIGNED BY		VIEW=	DESIGNED BY		
	CHECKED BY			CHECKED BY		
	DRAFTED BY			DRAFTED BY		
SCALE 1"=1'	AUTOCAD-KAREN-D:\SISKIYOU\68777\DATA\75SIGN\TIS.DWG		9-25-01	137455 PM EST		
COMPUTER DESIGNATION						

REVISIONS			STATE	PROJECT DESIGNATION	YEAR	SHEET NO.	TOTAL SHEETS
No.	DATE	DESCRIPTION					
			ALASKA	NHI-0A3-1(28)	2002	J29	J32

SIGNING NOTES:

- THE STATIONS AT WHICH THE SIGNS ARE TO BE INSTALLED ARE APPROXIMATE, INSTALL STOP SIGNS IN ACCORDANCE WITH THE STOP SIGN AND STOP BAR INSTALLATION DETAILS, AND ALL OTHER SIGNS AT LOCATIONS AS DIRECTED BY THE ENGINEER.
- INTERPRET THE ABBREVIATED POST TYPE SHOWN IN THE SIGN SUMMARY AS FOLLOWS:
 - PT MEANS A PERFORATED STEEL TUBE.
 - T MEANS A SQUARE STEEL TUBE.
 - P MEANS A ROUND STEEL PIPE.
 - W MEANS A WIDE FLANGE BEAM.
 - POPL MEANS POLE PLATE INSTALLED PER DETAIL.
- WHEN TUBES AND PIPES ARE USED TO SUPPORT A SIGN, INSTALL THE OUTER POSTS ON MAXIMUM 1.8 m CENTER. WHEN WIDE FLANGE POSTS ARE USED, INSTALL THE W SHAPE POSTS IN EACH SIGN INSTALLATION ON MINIMUM 2.4 m CENTERS.
- FABRICATE THE POST(S) IN EACH SIGN INSTALLATION LONG ENOUGH TO PROVIDE THE FOLLOWING MINIMUM CLEARANCES.
 - 2.15 m BETWEEN THE BOTTOM OF SIGN AND THE EDGE OF PAVEMENT.
 - 2.15 m BETWEEN THE BOTTOM OF SIGN AND THE GROUND AT THE SHORTEST POST.
 - 2.75 m BETWEEN THE TOP OF SIGN AND THE GROUND AT THE SHORTEST POST.
 - 1.0 m BETWEEN THE GROUND AND THE CORNER OF SIGN IN A CUT SECTION.
- IN EACH MULTI-POST SIGN INSTALLATION, FABRICATE THE POSTS WITH THEIR TOPS LEVEL WITH ONE ANOTHER.
- INSTALL THE TOP EDGE OF ALL SIGN PANELS ABOVE AND WITHIN 25 mm OF THE TOP(S) OF SIGN POST(S), EXCEPT WHEN D3-1 STREET NAME SIGNS ARE TO BE INSTALLED.
- ATTACH FRAMED SIGNS TO THEIR SUPPORT POSTS AT ALL LOCATIONS WHERE THE WIND BEAMS CROSS EACH POST.
- FOR PERFORATED STEEL TUBES (PTs), INSTALL THE CONCRETE FOUNDATION OPTION SHOWN ON STANDARD DRAWING S-30.01[M].
- PROVIDE 0.6 m OF CLEARANCE BETWEEN THE EDGE OF PATHWAYS AND EDGE OF SIGNS. FOR TRAPEZOIDAL SIGN ENDS OVER A PATHWAY, PROVIDE THE 0.6 m CLEARANCE TO AT LEAST 2.4 m ABOVE THE PATHWAY.
- SIGN MOUNTING HEIGHT IS 2.1 m AS SHOWN ON STANDARD DRAWING S-05.00[M]. THIS ALSO APPLIES TO MILEPOST SIGNS. LOCATE MILE POST AS DIRECTED BY THE ENGINEER.
- SINGLE POST SIGNS (NON D-3'S) WITH HORIZONTAL DIMENSIONS EQUAL TO OR GREATER THAN 0.6 m SHALL USE THE SIGN BRACING DETAIL FOR TUBES.

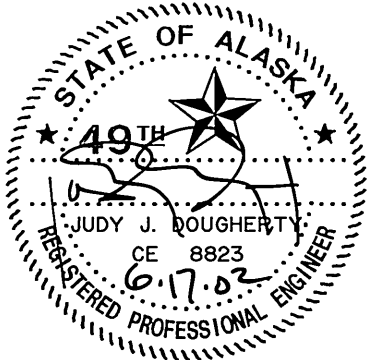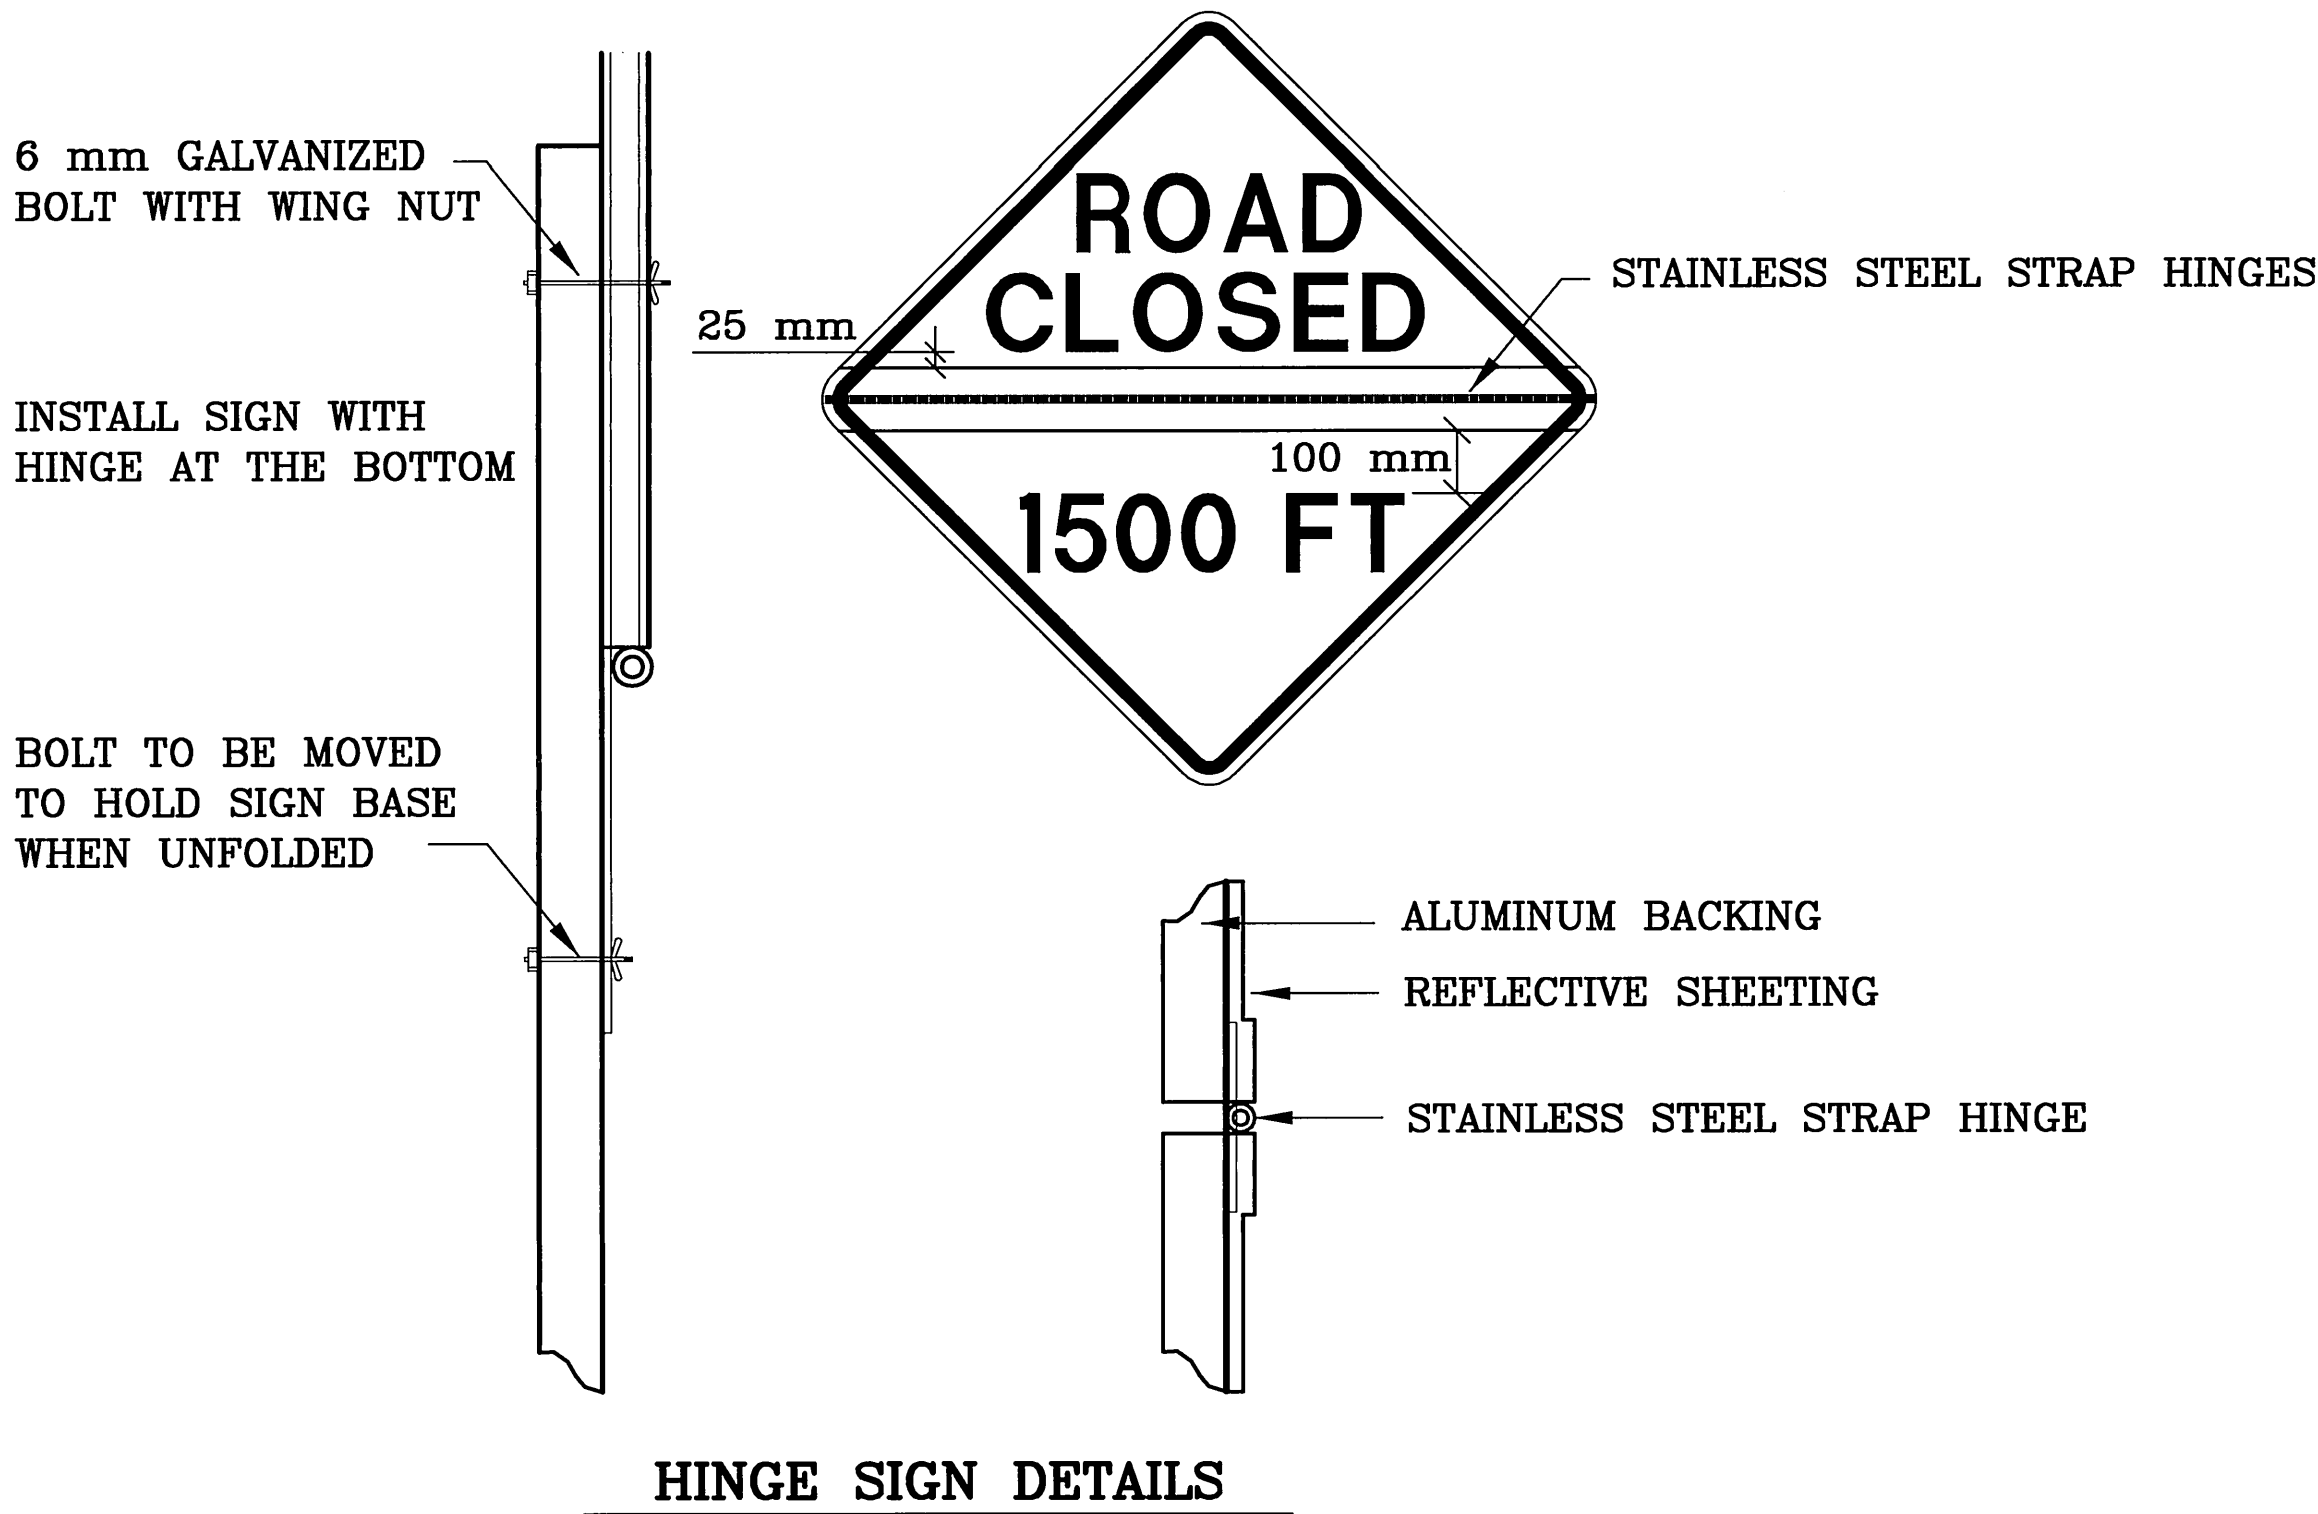


STATE OF ALASKA
DEPARTMENT OF TRANSPORTATION
AND
PUBLIC FACILITIES

**SEWARD HIGHWAY
MP 96 TO MP 102
SAFETY, ROADWAY &
RECREATIONAL IMPROVEMENTS**


SIGNING DETAILS

SPECIFICATIONS	DESIGNED BY	JED
SCALE	DRAWN BY	JED
COMPUTER DESIGNATION	CHECKED BY	ING
	DATE	2/15/01
	PROJECT	111111
	DATE	9-25-01
	DATE	12-29-01
	DATE	12-29-01


REVISIONS			STATE	PROJECT DESIGNATION	YEAR	SHEET NO.	TOTAL SHEETS
No.	DATE	DESCRIPTION	ALASKA	NH-0A3-1(28)	2002	J30	J32

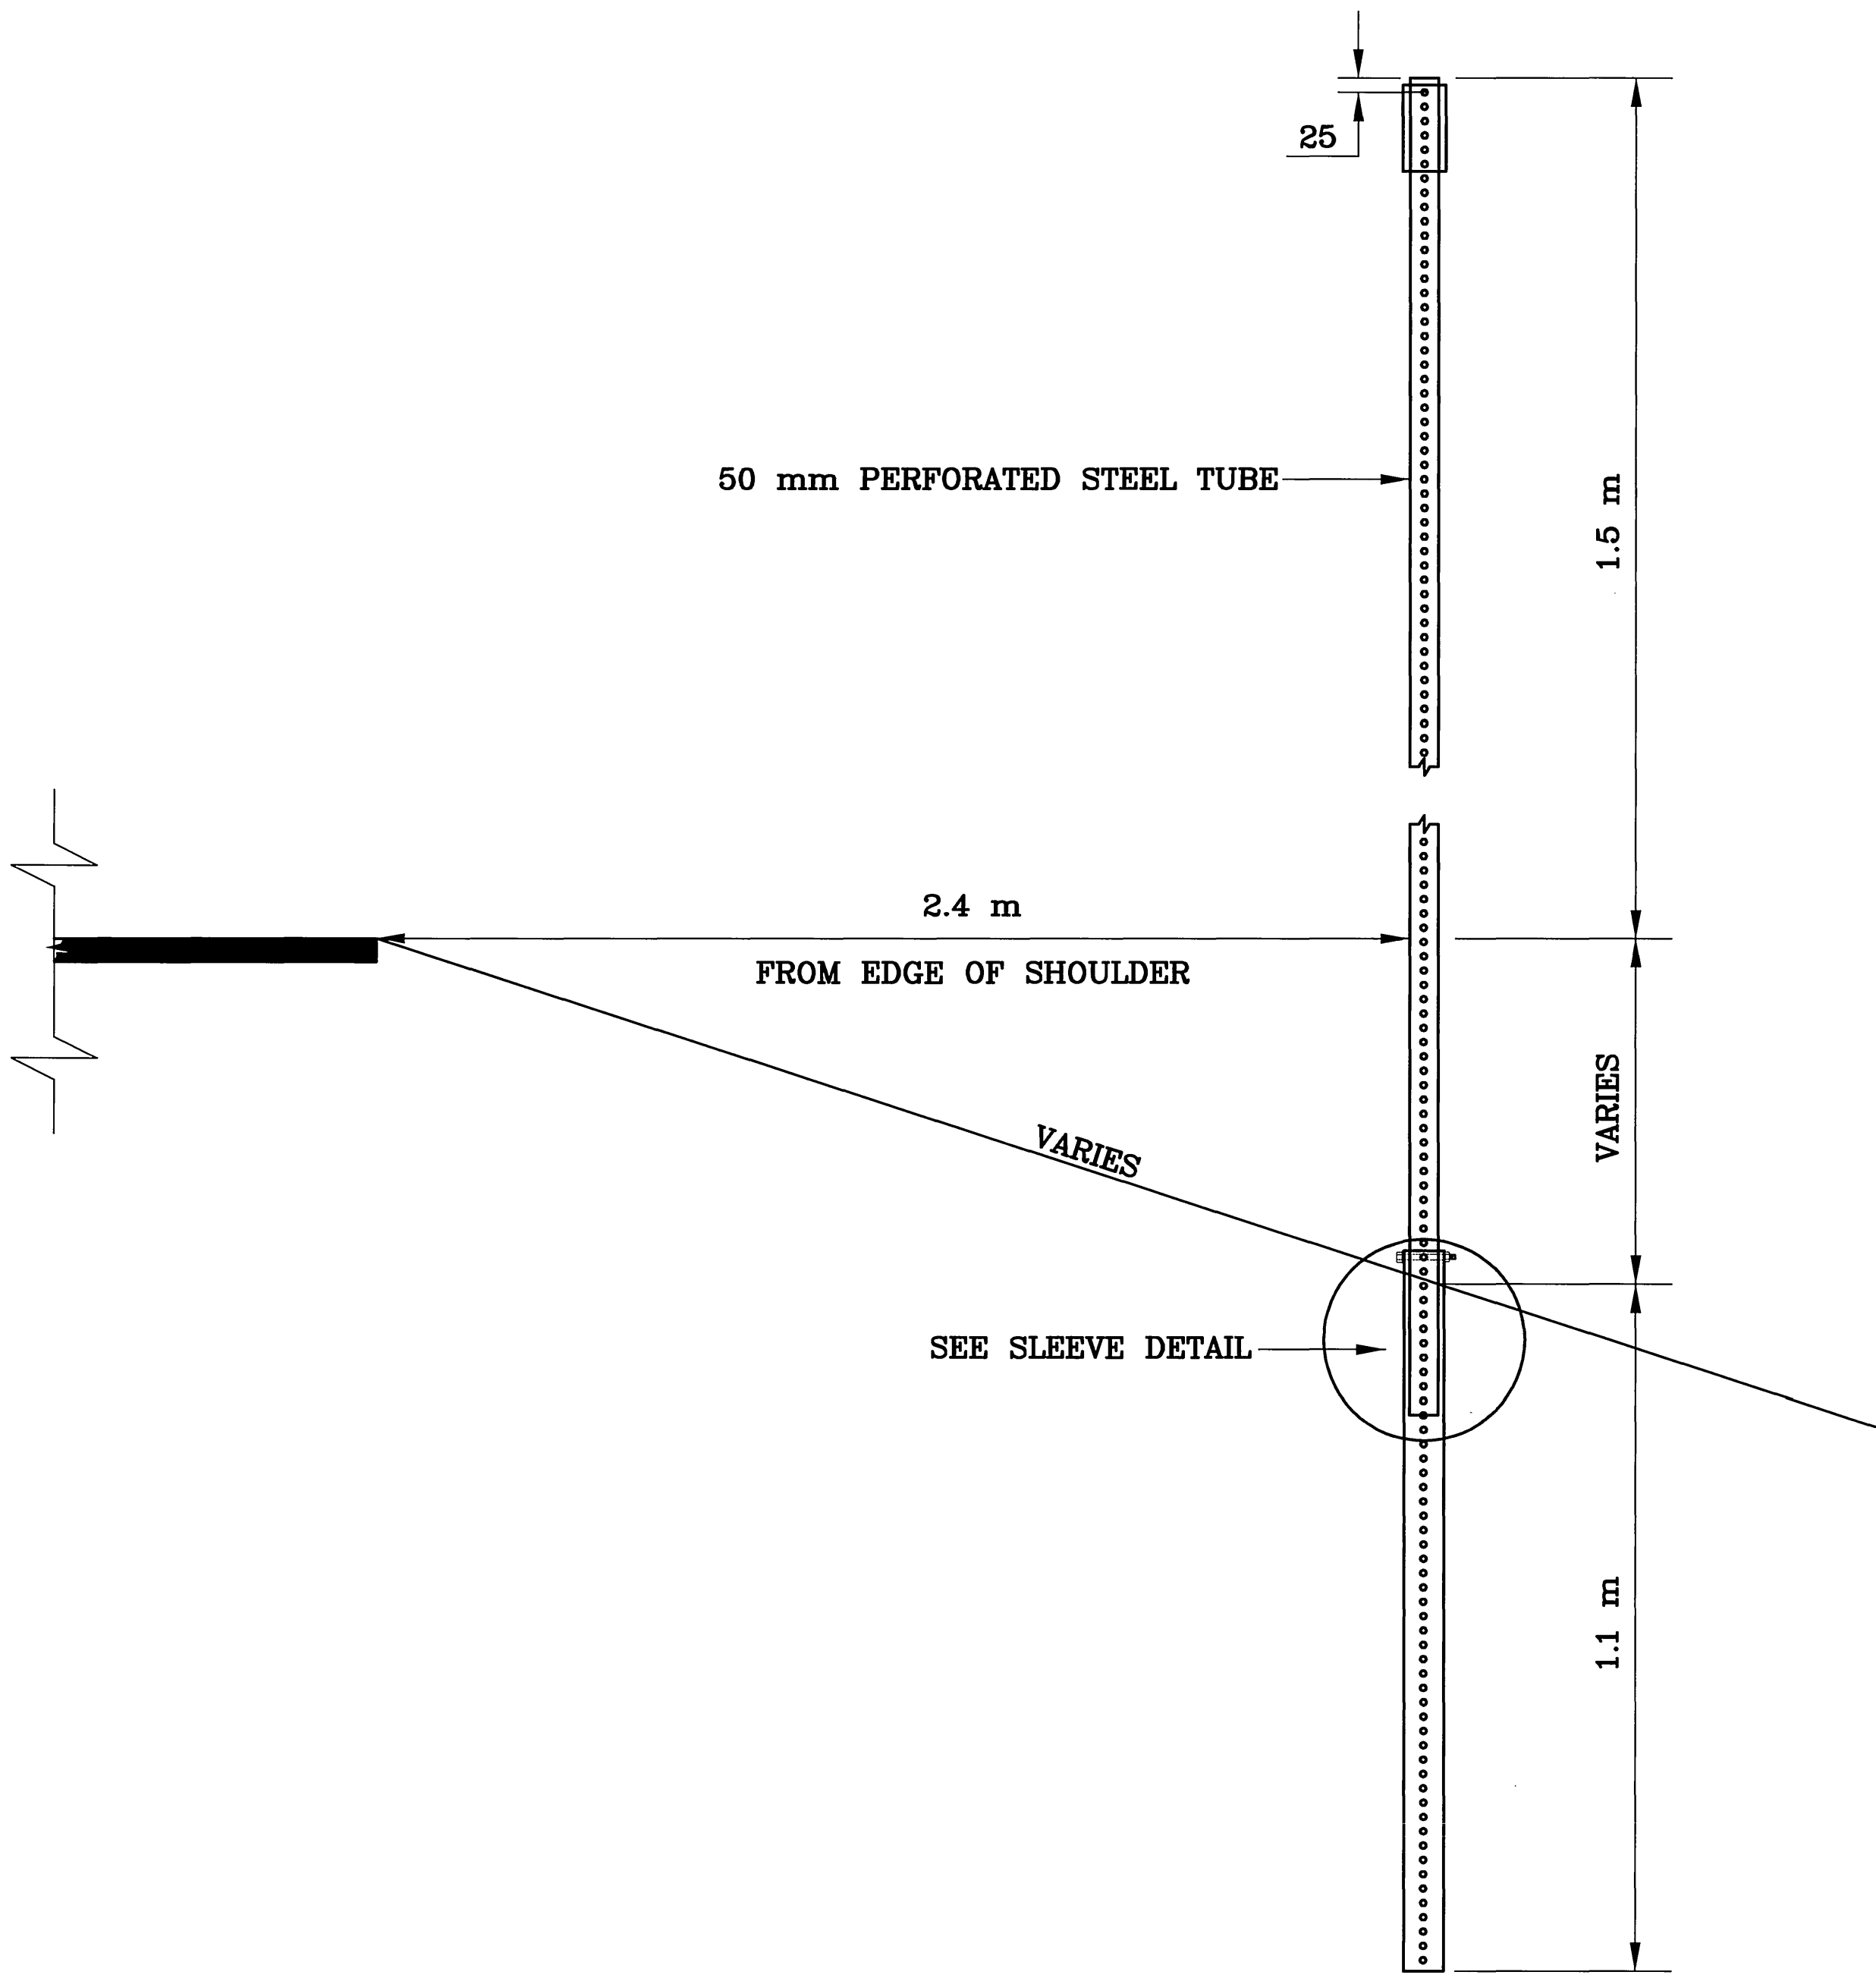


DELINEATOR DETAIL

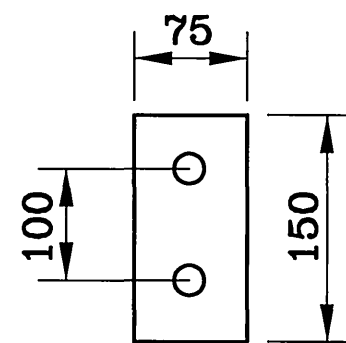

REFLECTOR

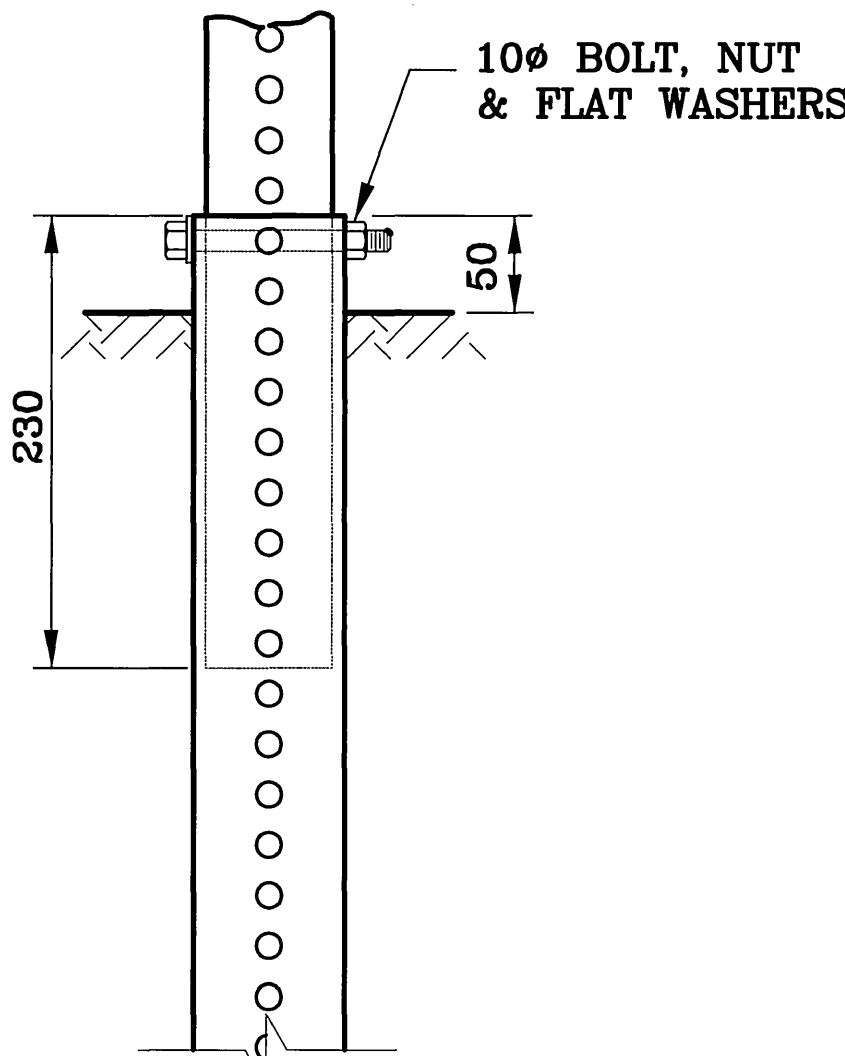


SLEEVE DETAIL

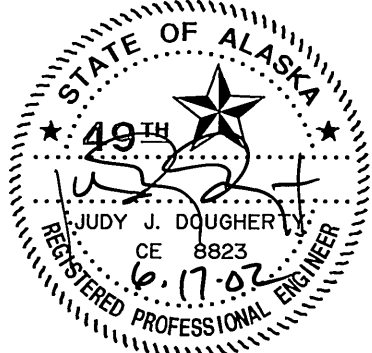

STATE OF ALASKA
DEPARTMENT OF TRANSPORTATION
AND
PUBLIC FACILITIES
SEWARD HIGHWAY
MP 96 TO MP 102
SAFETY, ROADWAY &
RECREATIONAL IMPROVEMENTS

DELINEATOR DETAILS

DESIGNED BY	MOH
CHECKED BY	
DRAFTED BY	
PLOT SCALE:	1=1
DATE:	9-25-01
FILE NAME:	14336.dwg
COMPUTER DESIGNATION	14336

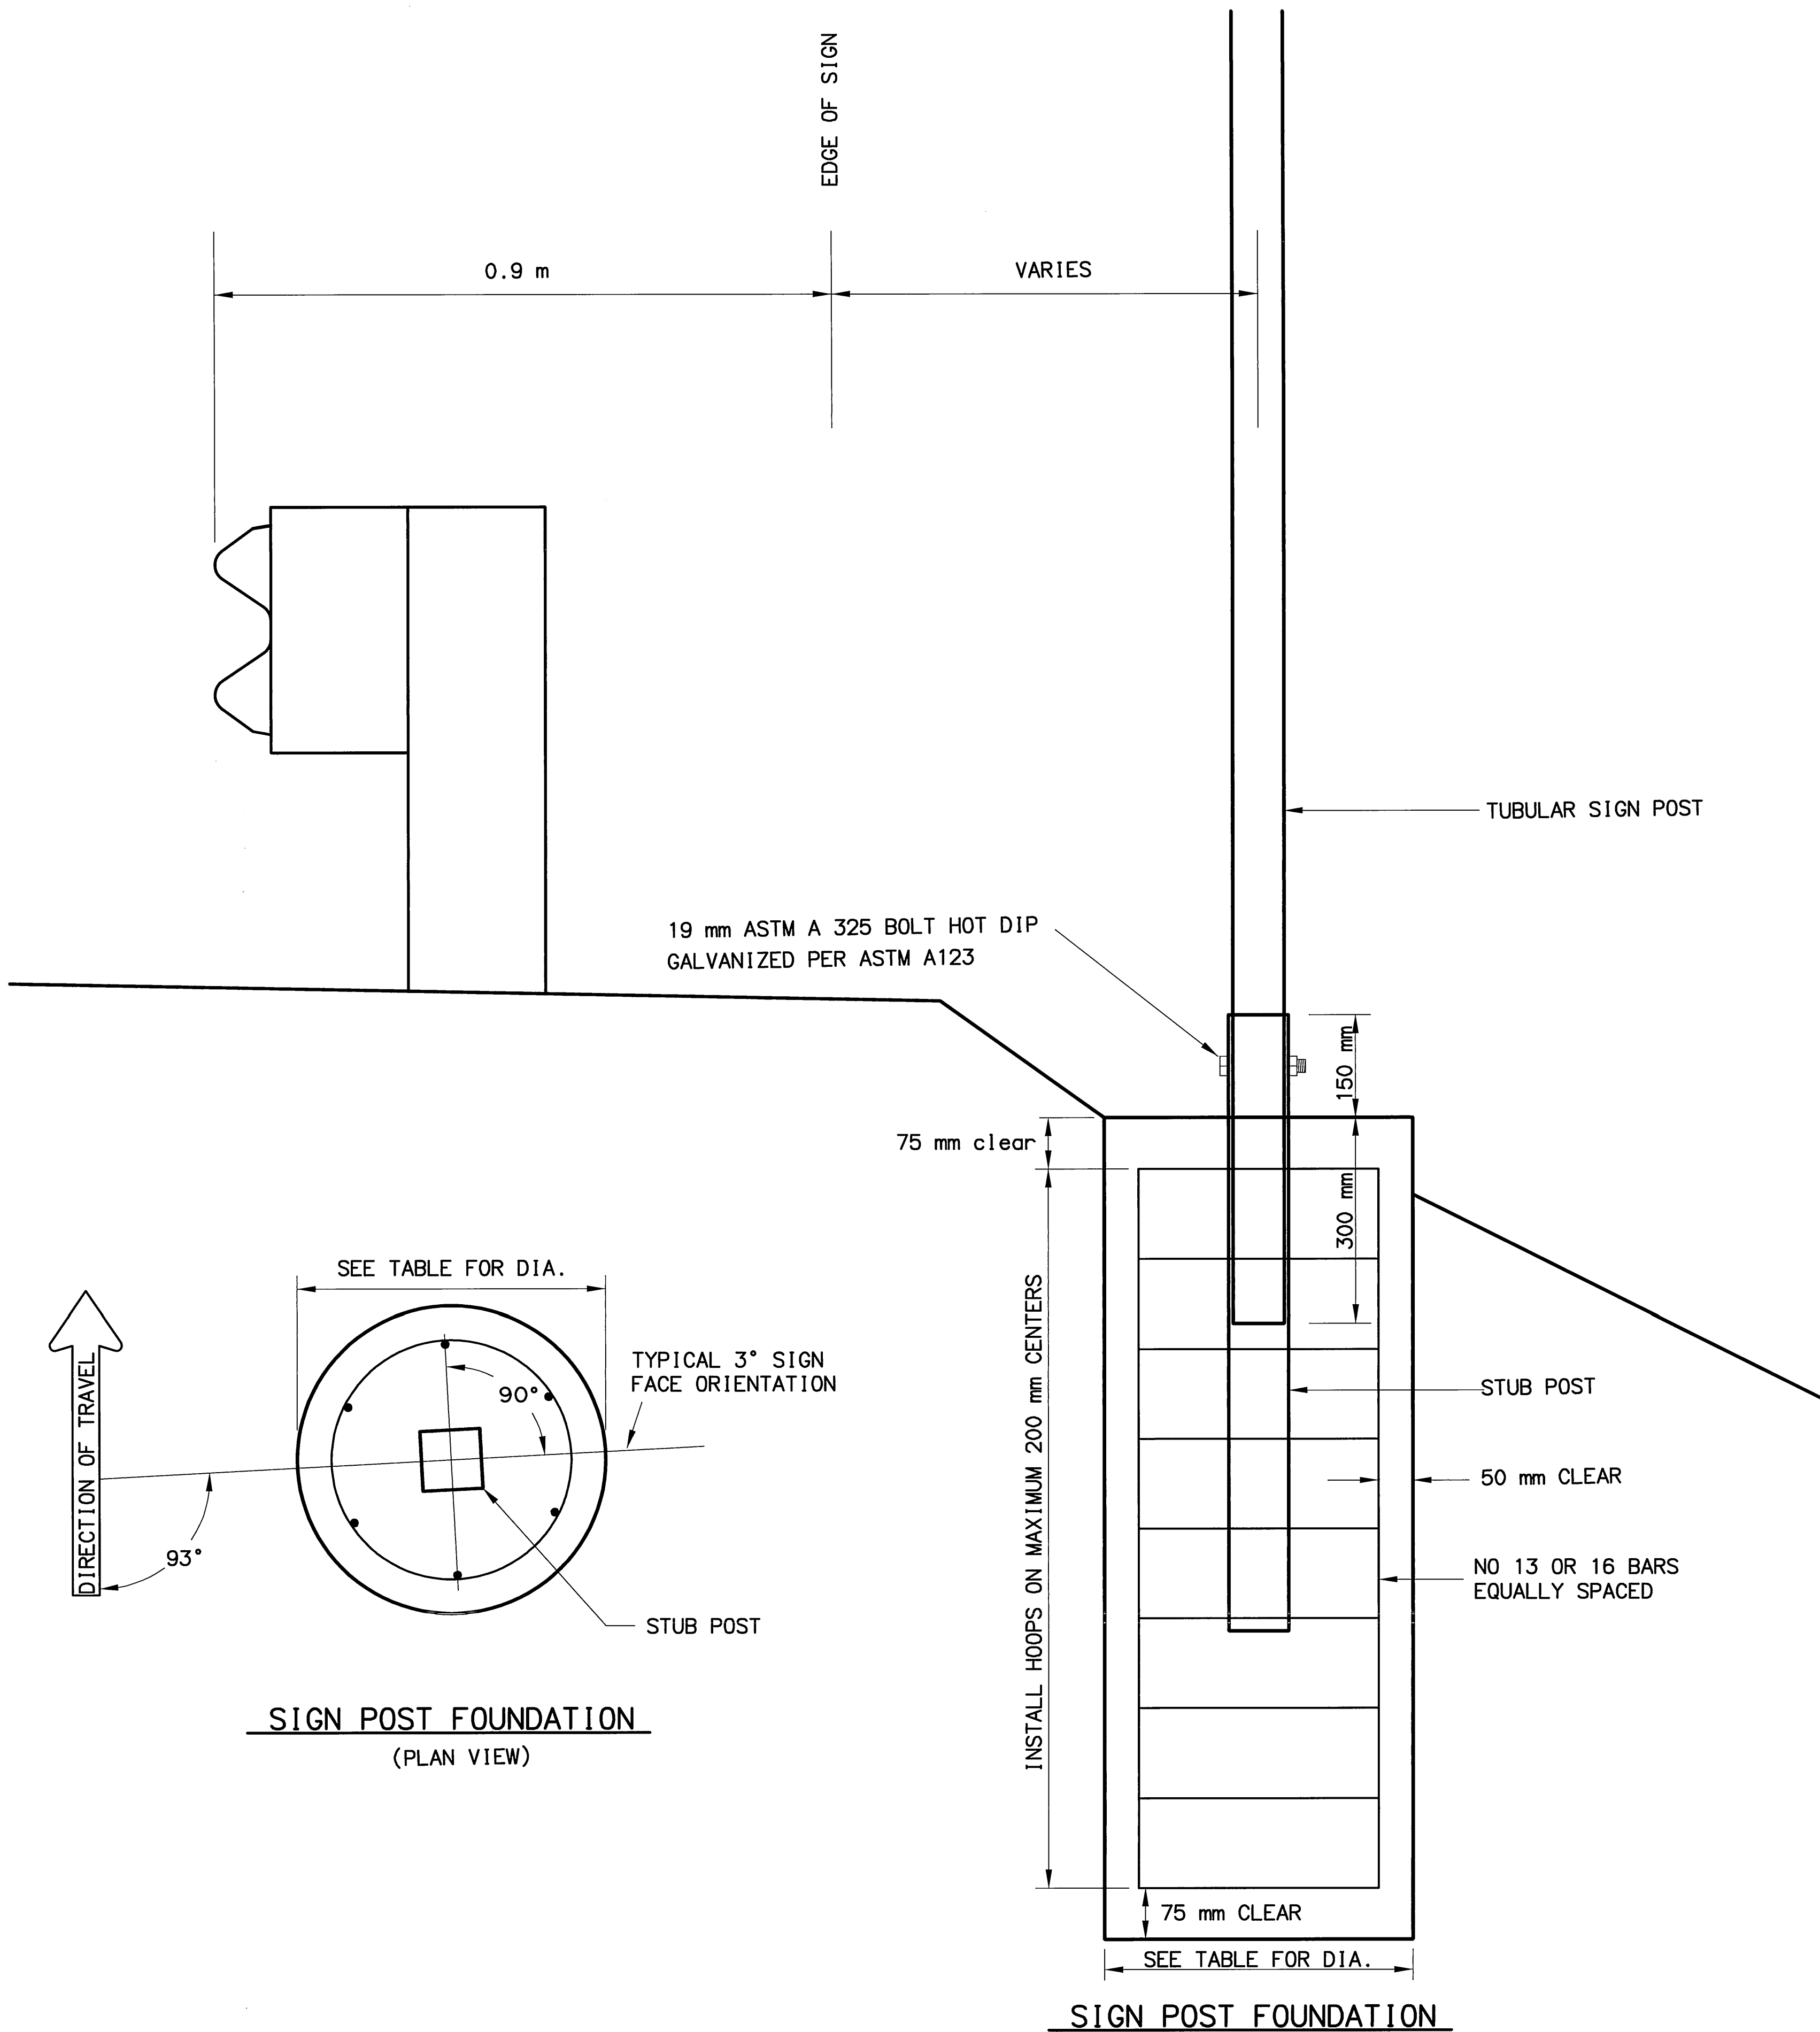

REVISIONS			PROJECT DESIGNATION	YEAR	SHEET NO.	TOTAL SHEETS
No.	DATE	DESCRIPTION				
			NH-0A3-1(28)	2002	J32	J32

NOTES:

1. INSTALL ALL SIGNS THAT FALL BEHIND A GUARDRAIL, BARRIER, OR WALL PER THE DETAILS SHOWN ON THIS SHEET. INSTALL SIGNS WITHIN 6 METERS OF GUARDRAIL TERMINAL ENDS ON BREAKAWAY BASES.
2. FURNISH STEEL TUBE SIGN POSTS THAT CONFORM TO A.S.T.M. A500, GRADE B, AND MEET A.S.T.M. A123 FOR HOT DIP GALVANIZING.
3. INSTALL TUBES AND STUB POSTS WITH A 4.76 mm WALL THICKNESS.
4. CAST THE SIGN FOUNDATIONS IN ACCORDANCE WITH ALASKA STANDARD SPECIFICATION 660-2.03. FURNISH GRADE 60 STEEL BARS FOR CONCRETE REINFORCEMENT CONFORMING TO AASHTO M31.

Post Size & Type	Foundation *			Reinforcement						Stub Post	
	Dia.	Min. Depth	C.M. Conc.	Qty.	Size	Lgth.	Size	Dia.	Lgth.	Size	Length
65 mm Tube	0.30	1.35	0.10	6	#13	1.20	#13	0.20	6.4	75 mm	0.90
75 mm Tube	0.45	1.20	0.19	6	#13	1.05	#13	0.36	9.8	90 mm	0.90
90 mm Tube	0.45	1.35	0.21	6	#13	1.20	#13	0.36	11.2	100 mm	0.90
100 mm Tube	0.75	1.20	0.53	7	#16	1.05	#13	0.66	16.1	115 mm	0.90
115 mm Tube	0.75	1.35	0.60	7	#16	1.20	#13	0.66	18.4	125 mm	0.90




*FOUNDATIONS SIZED FOR USE WHERE THERE ARE NO LOOSE, HIGH MOISTURE, OR FINE GRAINED SOILS. CONTACT THE STATE GEOTECHNICAL ENGINEER WHEN THESE SOILS ARE ENCOUNTERED.





STATE OF ALASKA
DEPARTMENT OF TRANSPORTATION
AND
PUBLIC FACILITIES
SEWARD HIGHWAY
MP 96 TO MP 102
**SAFETY, ROADWAY &
RECREATIONAL IMPROVEMENTS**
BEHIND GUARDRAIL SIGN POST
& FOUNDATION DETAILS

DESIGNED BY: VJH/HI
SCALE: 1:1
COMPUTER DESIGNATION: AUTOCAD-KAREN-D:\SINKPROJ\65677\DATA\770CHTEL.DWG 8-25-01 11:21:05 AM EST
SPECIFICATIONS: 11/2/00


REVISIONS			STATE	PROJECT DESIGNATION	YEAR	SHEET NO.	TOTAL SHEETS
No.	DATE	DESCRIPTION					
①	1/23/98	NOTE #4 PEDESTRIAN DETOUR	ALASKA	NHI-0A3-1(28)	2002	K1	K7
②	23/2/99	SYMBOLS /B. LANES CLOSED /E. SIDEWALK					
③	2/7/00	MODIFIED TITLE					

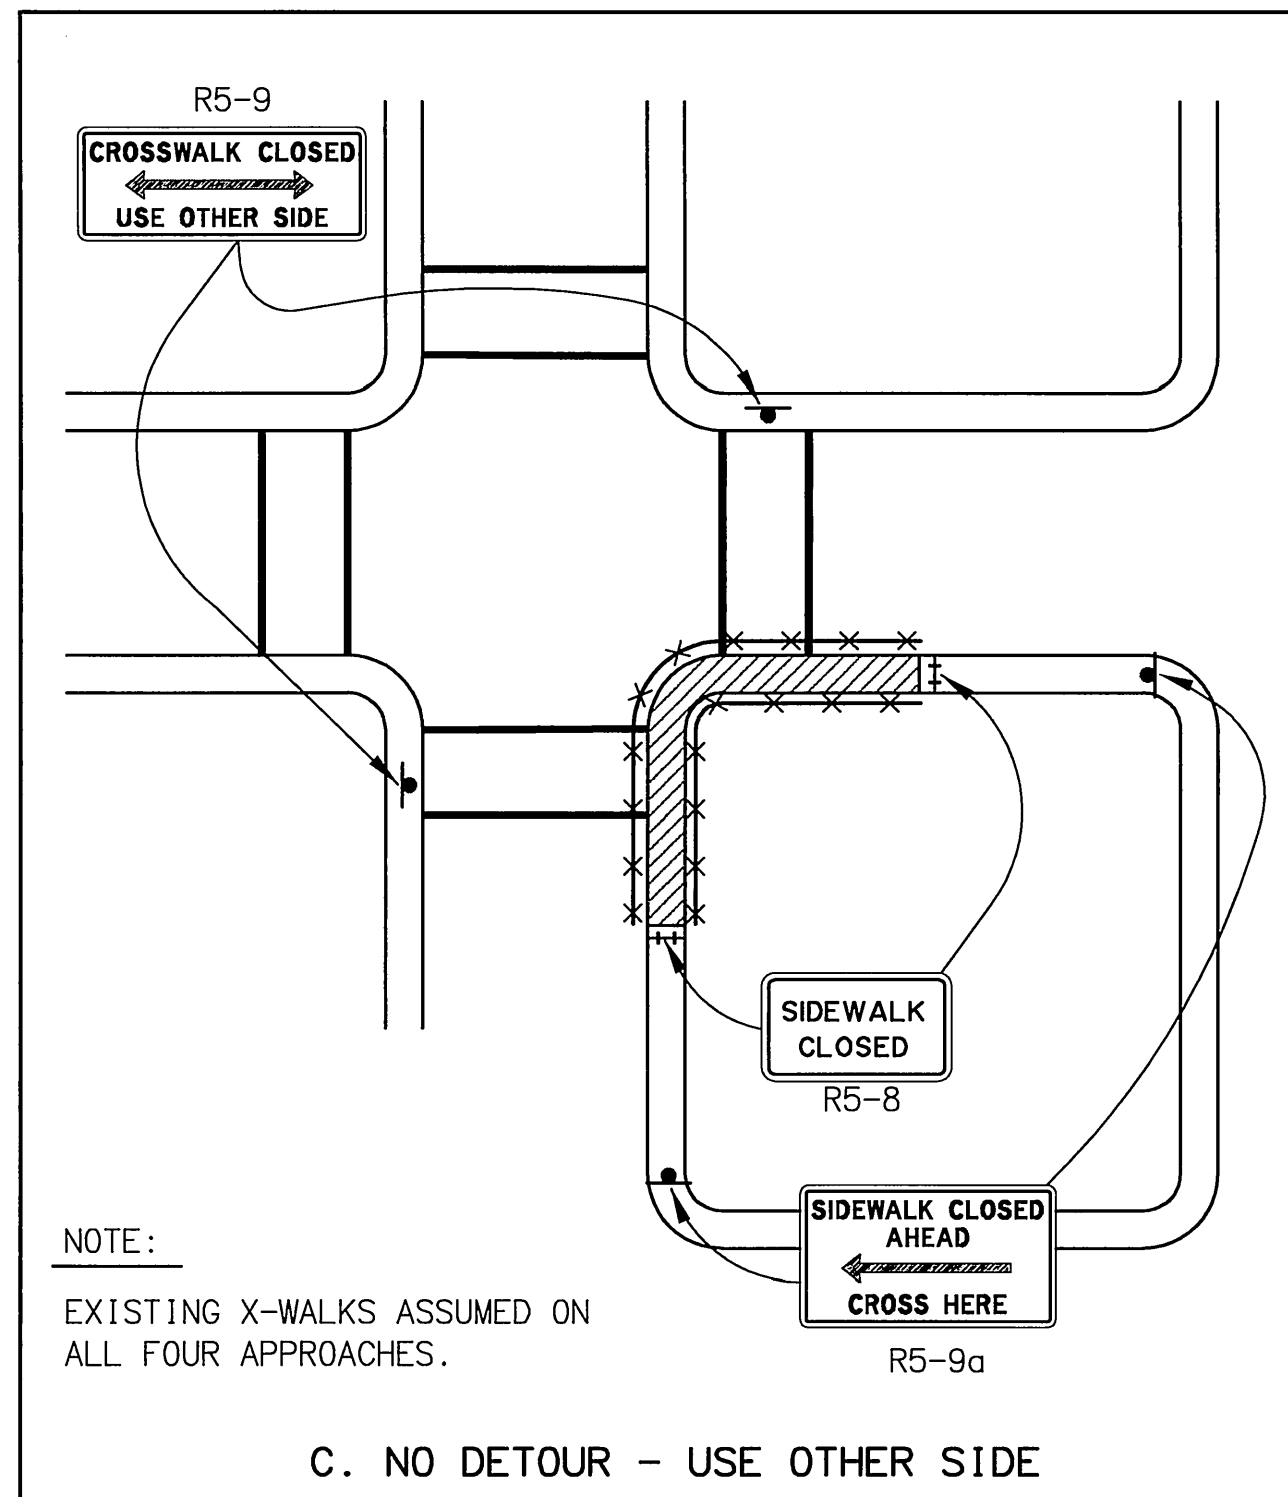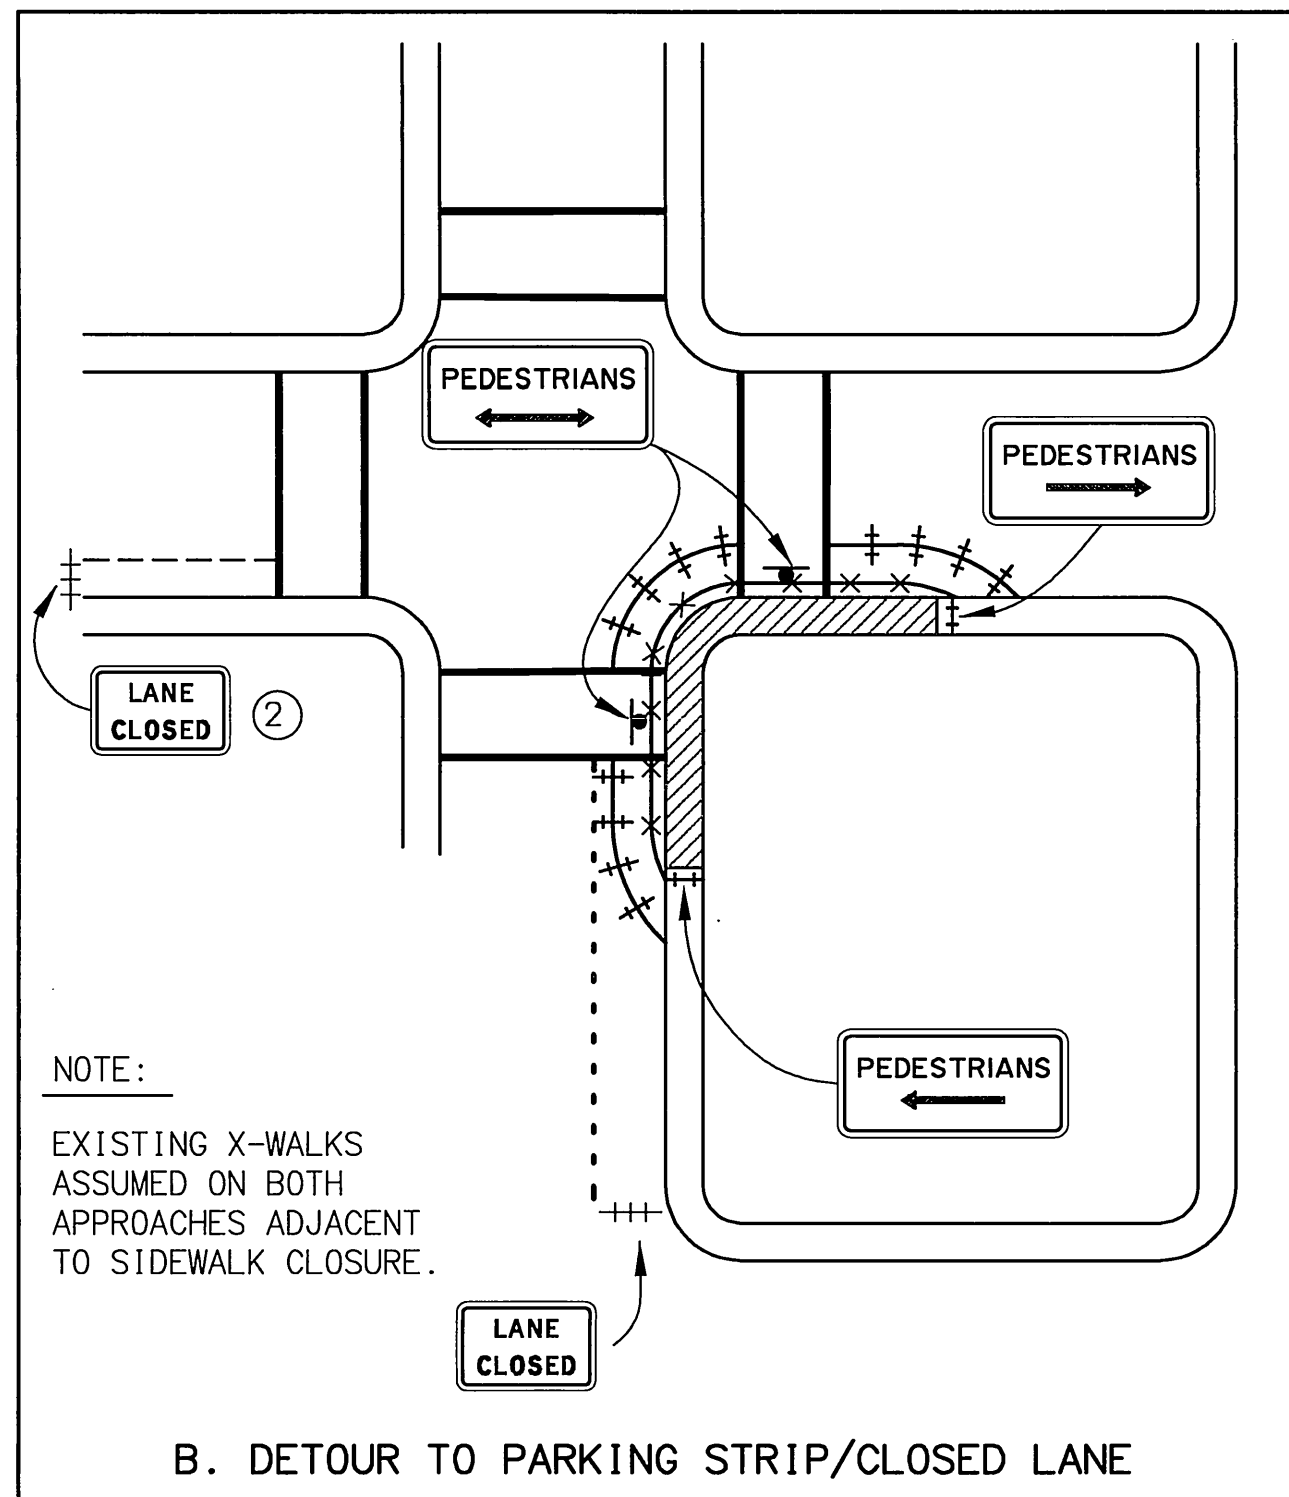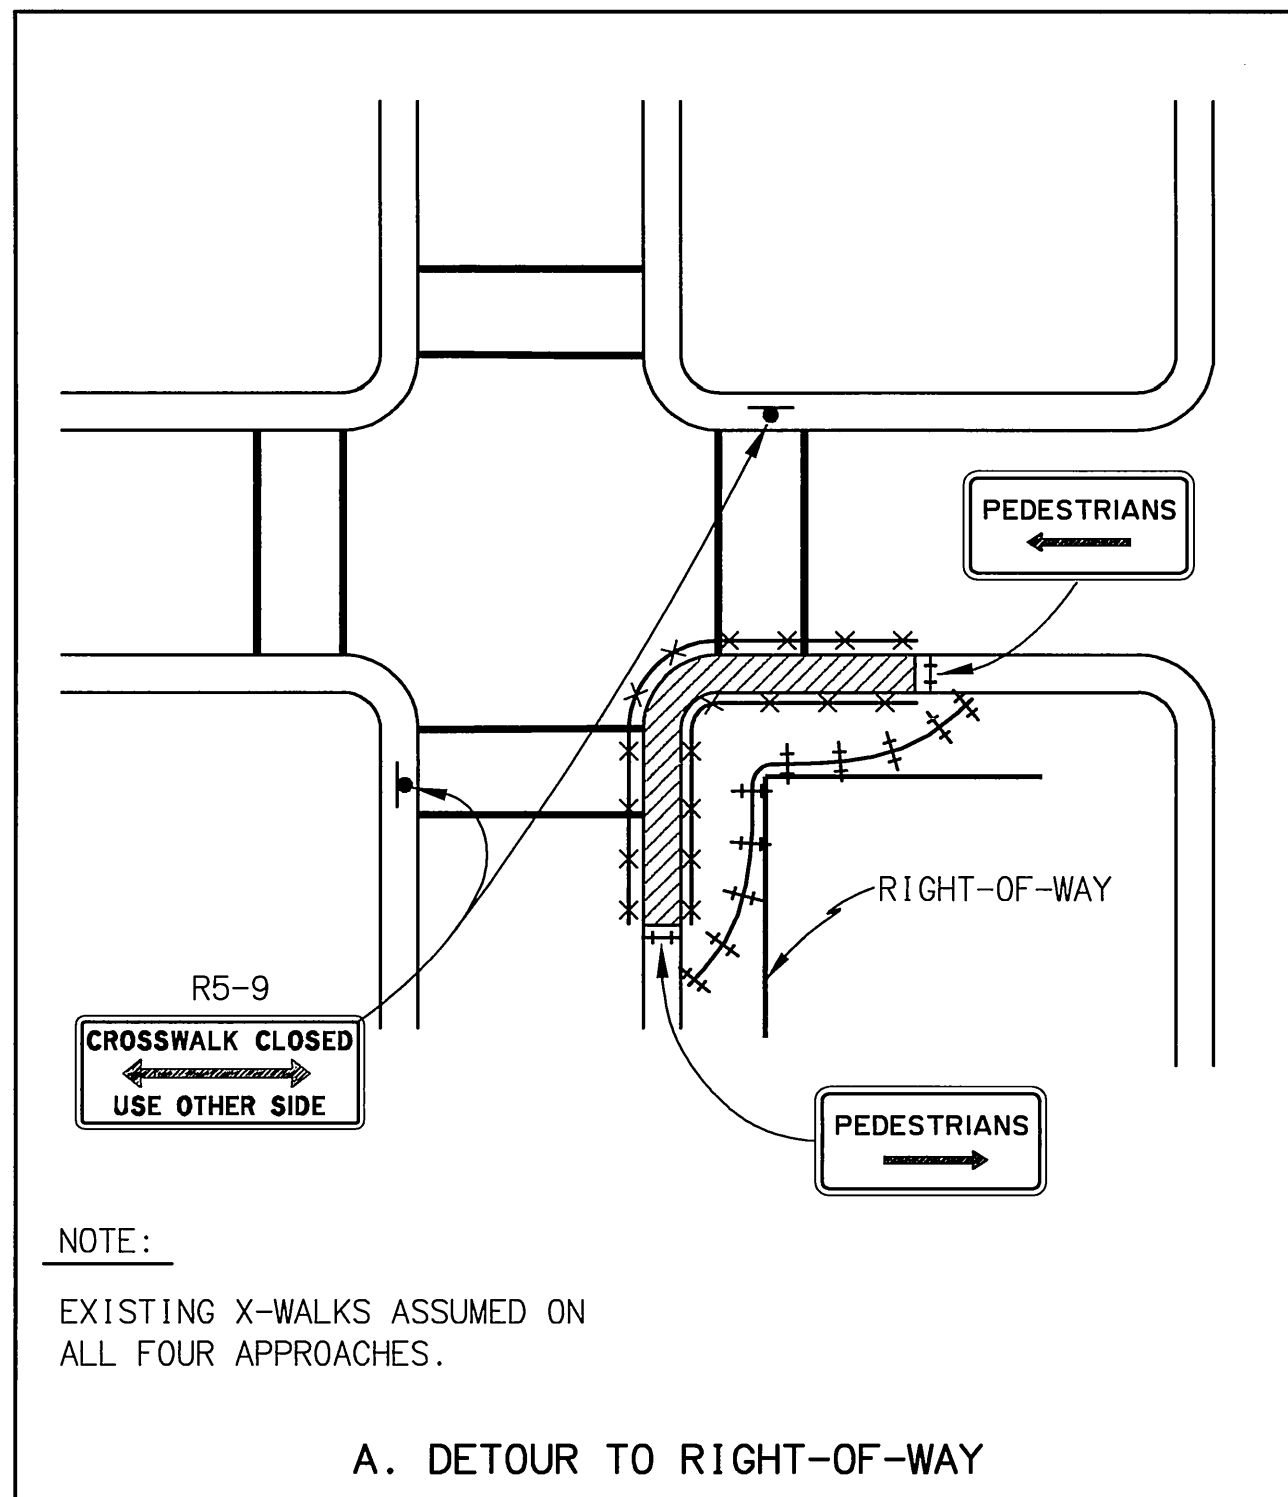

TYPICAL SIDEWALK, PATHWAY, OR SHOULDER CLOSURE AT INTERSECTIONS

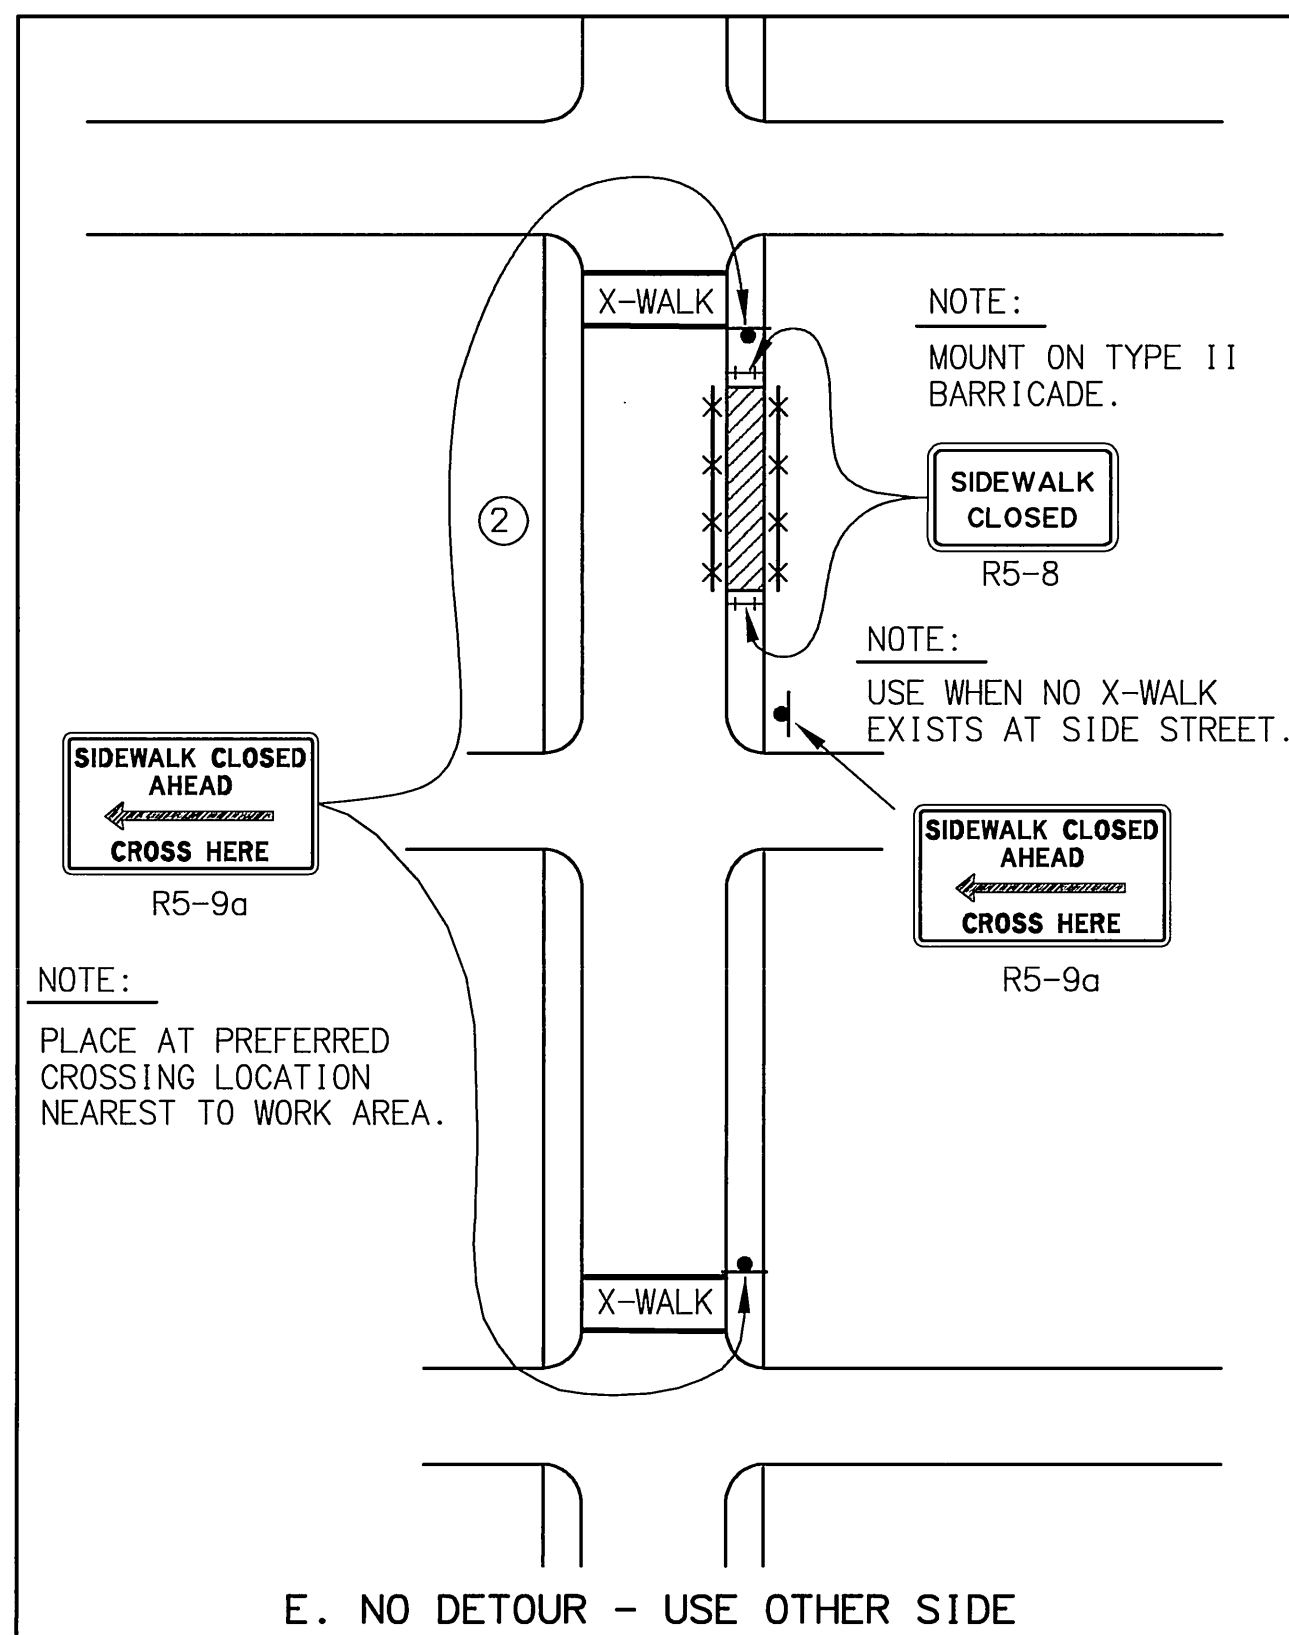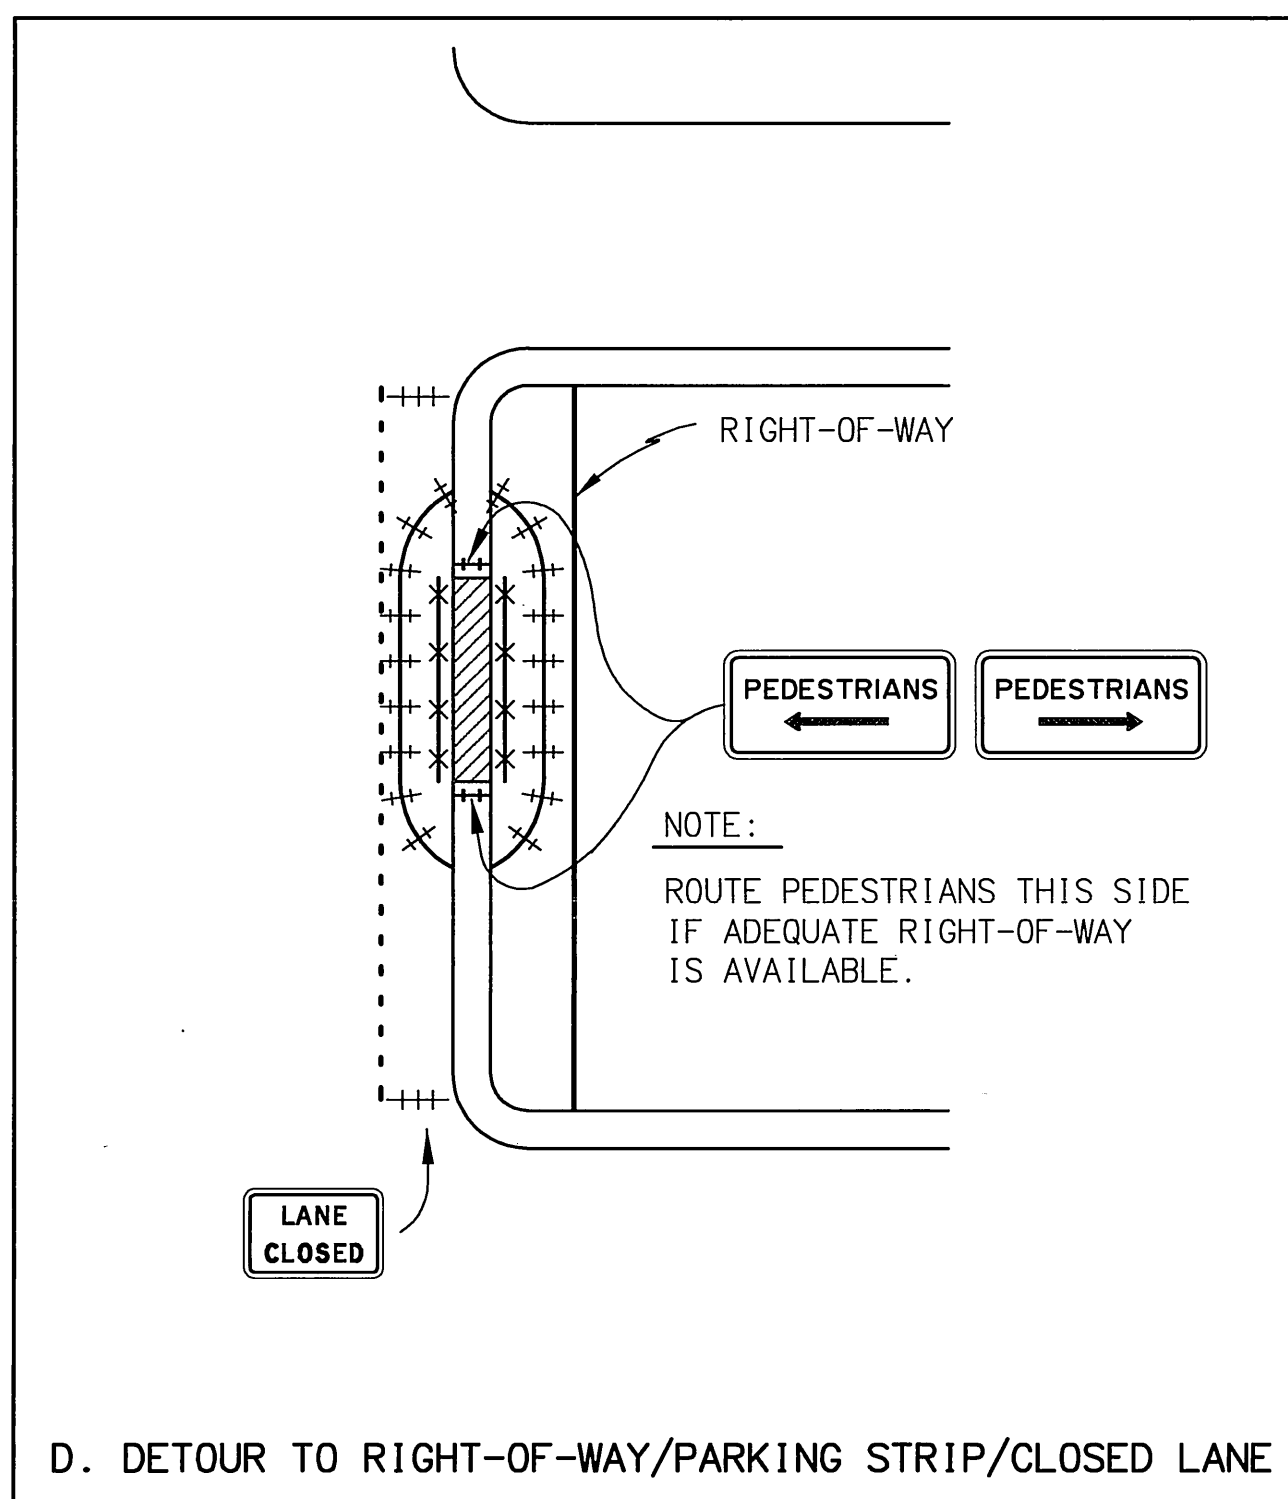

TYPICAL SIDEWALK, PATHWAY OR SHOULDER CLOSURE AT MID-BLOCK LOCATIONS

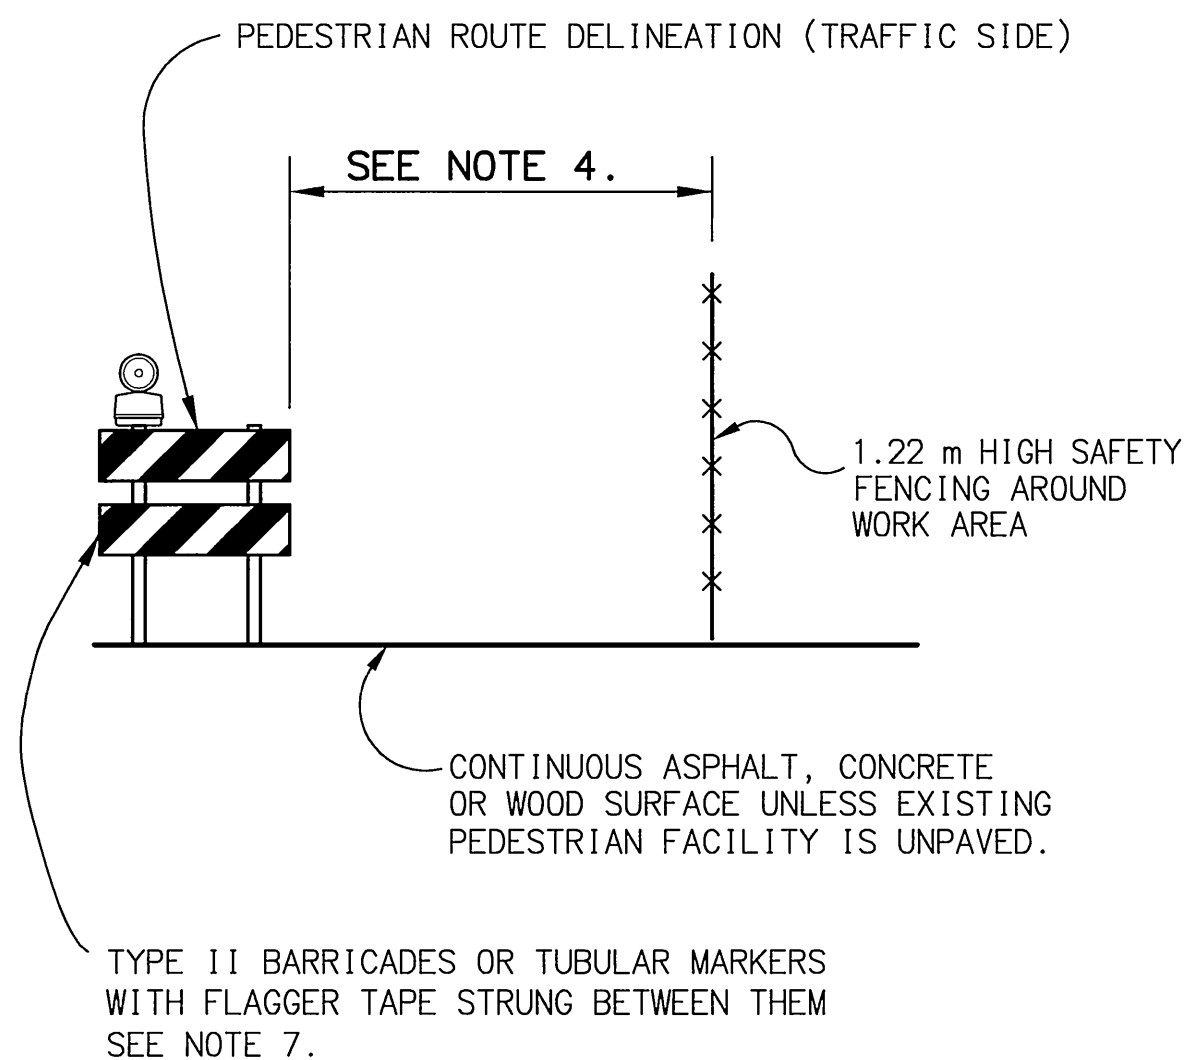


NOTES:

1. LETTER SIZES ARE 75 MM CAPITALS, SERIES C.
2. WHENEVER PEDESTRIAN TRAFFIC CONTROL DEVICES ARE NOT IN PLACE OR ARE REMOVED TEMPORARILY TO ACCOMMODATE CONSTRUCTION ACTIVITIES, THE CONTRACTOR SHALL PROVIDE A WORKER TO DIRECT PEDESTRIANS ALONG THE PROPER ROUTE.
3. USE WARNING LIGHTS IN ACCORDANCE WITH THE ALASKA TRAFFIC MANUAL DURING HOURS OF DARKNESS.
- ① 4. MAINTAIN FULL EXISTING PEDESTRIAN FACILITY WIDTH UP TO 1.5 m.
5. ONLY THE TRAFFIC CONTROL DEVICES CONTROLLING PEDESTRIAN FLOWS ARE SHOWN. OTHER DEVICES MAY BE NEEDED TO CONTROL TRAFFIC ON THE ROADWAYS.
6. PLACE SIGNS ALONG A TEMPORARY WALKWAY TO GUIDE OR DIRECT PEDESTRIANS. EXAMPLES INCLUDE KEEP RIGHT AND KEEP LEFT.
7. ON ROADWAYS WITH A POSTED SPEED LIMIT GREATER THAN 40 mph USE PORTABLE CONCRETE BARRIERS OR A LANE OF THE ROADWAY TO SEPARATE PEDESTRIANS FROM TRAFFIC.
8. COVER PEDESTRIAN TRAFFIC SIGNAL DISPLAYS CONTROLLING CLOSED CROSSWALKS.

LEGEND:

- ② ++ TYPE II BARRICADE OR TUBULAR MARKER
- +++ TYPE III BARRICADE
- SAFETY FENCE
- SIGN
- /// WORK AREA

ALL DIMENSIONS ARE IN MILLIMETERS (mm) UNLESS OTHERWISE NOTED.




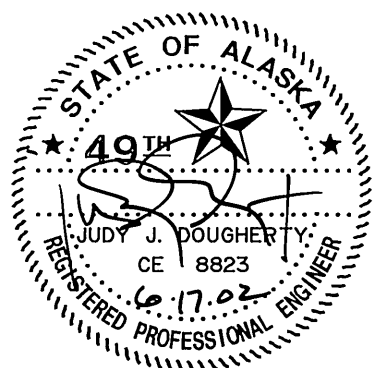


STATE OF ALASKA
DEPARTMENT OF TRANSPORTATION
AND
PUBLIC FACILITIES
**SEWARD HIGHWAY
MP 96 TO MP 102
SAFETY, ROADWAY &
RECREATIONAL IMPROVEMENTS**
**PEDESTRIAN TRAFFIC
CONTROL DETAILS**
[METRIC]

REVISIONS			STATE	PROJECT DESIGNATION	YEAR	SHEET NO.	TOTAL SHEETS
No.	DATE	DESCRIPTION					
1	1/23/98	NOTE #8	ALASKA	NHI-0A3-1(28)	2002	K2	K7
2	1/15/99	MODIFIED NOTE-TABLE 1					
3	5/25/99	MODIFIED NOTE #1.					
4	2/7/00	MODIFIED TITLE					

NOTES:

1. TRAFFIC CONTROL DEVICES REQUIRED BY THE GUIDELINES ON THIS SHEET ARE INTENDED FOR CONDITIONS WHICH WILL BE IN PLACE LONGER THAN ONE CONTINUOUS WORK SHIFT. AN APPROVED TRAFFIC CONTROL PLAN IS REQUIRED PRIOR TO BEGINNING WORK.
2. THE GROUND CROSS SECTION AT A LOCATION BEFORE CONSTRUCTION DETERMINES WHETHER TRAFFIC CONTROL DEVICES ARE NEEDED AT THE SAME LOCATION DURING CONSTRUCTION.
3. GUARDRAIL EXISTING AT A LOCATION BEFORE CONSTRUCTION SHALL REMAIN IN PLACE DURING CONSTRUCTION OR APPROVED ALTERNATE DEVICES INSTALLED.
4. INSTALL TRAFFIC CONTROL DEVICES BETWEEN THE EDGE OF TRAVELLED WAY AND THE WORK AREA ON ANY ROADWAY OPENED TO TRAFFIC WHEN REQUIRED BY THIS DRAWING.
5. EXISTING ROADWAY ALIGNMENTS
INSTALL TRAFFIC CONTROL DEVICES WHEN WORK OCCURS IN THE DEVICES REQUIRED AREAS SHOWN ON THIS DRAWING.
6. DETOURS, TEMPORARY ROADWAYS, OR NEW ROADWAYS NOT YET COMPLETE.
INSTALL TRAFFIC CONTROL DEVICES WHEN ANY OF THE FOLLOWING CONDITIONS EXIST:
- A. THE HORIZONTAL OR VERTICAL CURVATURE IS MORE SEVERE THAN BEFORE CONSTRUCTION BEGAN.
- B. THE ROADWAY OR SHOULDER WIDTH IS LESS THAN BEFORE CONSTRUCTION BEGAN.
- C. THE BACKSLOPE OR FORESLOPE IS STEEPER THAN BEFORE CONSTRUCTION BEGAN.
- D. THE HEIGHT OF THE FORESLOPE IS GREATER THAN BEFORE CONSTRUCTION BEGAN.
7. DROPOFFS
INSTALL TRAFFIC CONTROL DEVICES IN ACCORDANCE WITH THE FORESLOPE SECTION DETAIL AND TABLE 1.
8. ON ANY NEWLY CONSTRUCTED SLOPE STEEPER THAN 1:4 TO 1:3 PROVIDE A 3 METER FLAT RECOVERY AREA AT THE TOE OF SLOPE OR INSTALL TRAFFIC CONTROL DEVICES IN ACCORDANCE WITH THE FORESLOPE SECTION DETAIL.
9. TRAFFIC CONTROL DEVICE REQUIREMENTS
- A. ON ROADWAYS WITH A SPEED LIMIT GREATER THAN 64 KILOMETERS PER HOUR OR AVERAGE DAILY TRAFFIC VOLUME GREATER THAN 4000 VEHICLES PER DAY INSTALL TEMPORARY PORTABLE CONCRETE BARRIER, TEMPORARY GUARDRAIL OR ON MULTI-LANE ROADWAYS CLOSE THE LANE CLOSEST TO THE WORK AREA AND INSTALL DRUMS SPACED IN ACCORDANCE WITH THE ALASKA TRAFFIC MANUAL.
- TERMINATE RUNS OF TEMPORARY PORTABLE CONCRETE BARRIER USING ONE OF THE FOLLOWING THREE METHODS:
- I.) TEMPORARY CRASH ATTENUATOR.
- II.) RIGID TO SEMI-RIGID GUARDRAIL TRANSITION WITH SLOTTED RAIL TERMINAL OR OTHER APPROVED CRASHWORTHY END TREATMENT.
- III.) FLARE THE ENDS OF THE TEMPORARY BARRIER AWAY FROM THE ROADWAY AT A RATE OF 1:15 ON A TRANSVERSE SLOPE OF 1:10 OR FLATTER TO THE OUTSIDE EDGE OF THE CLEAR ZONE AND INSTALL A SLOPING END TREATMENT, PER STANDARD DRAWING G-45.01[M].
- TERMINATE RUNS OF TEMPORARY GUARDRAIL USING EITHER OF THE FOLLOWING TWO METHODS:
- I.) SLOTTED RAIL TERMINAL OR OTHER APPROVED CRASHWORTHY END TREATMENT.
- II.) FLARE THE ENDS OF THE TEMPORARY GUARDRAIL AWAY FROM THE ROADWAY AT A RATE OF 1:15 ON A TRANSVERSE SLOPE OF 1:10 OR FLATTER TO THE OUTSIDE EDGE OF THE CLEAR ZONE.
- B. ON ALL OTHER ROADWAYS INSTALL TYPE II BARRICADES, DRUMS OR DELINEATORS WHEN DEVICES ARE REQUIRED. SPACE THE DEVICES IN ACCORDANCE WITH THE REQUIREMENTS FOR SPACING TYPE II BARRICADES AND DRUMS SET FORTH IN THE ALASKA TRAFFIC MANUAL.

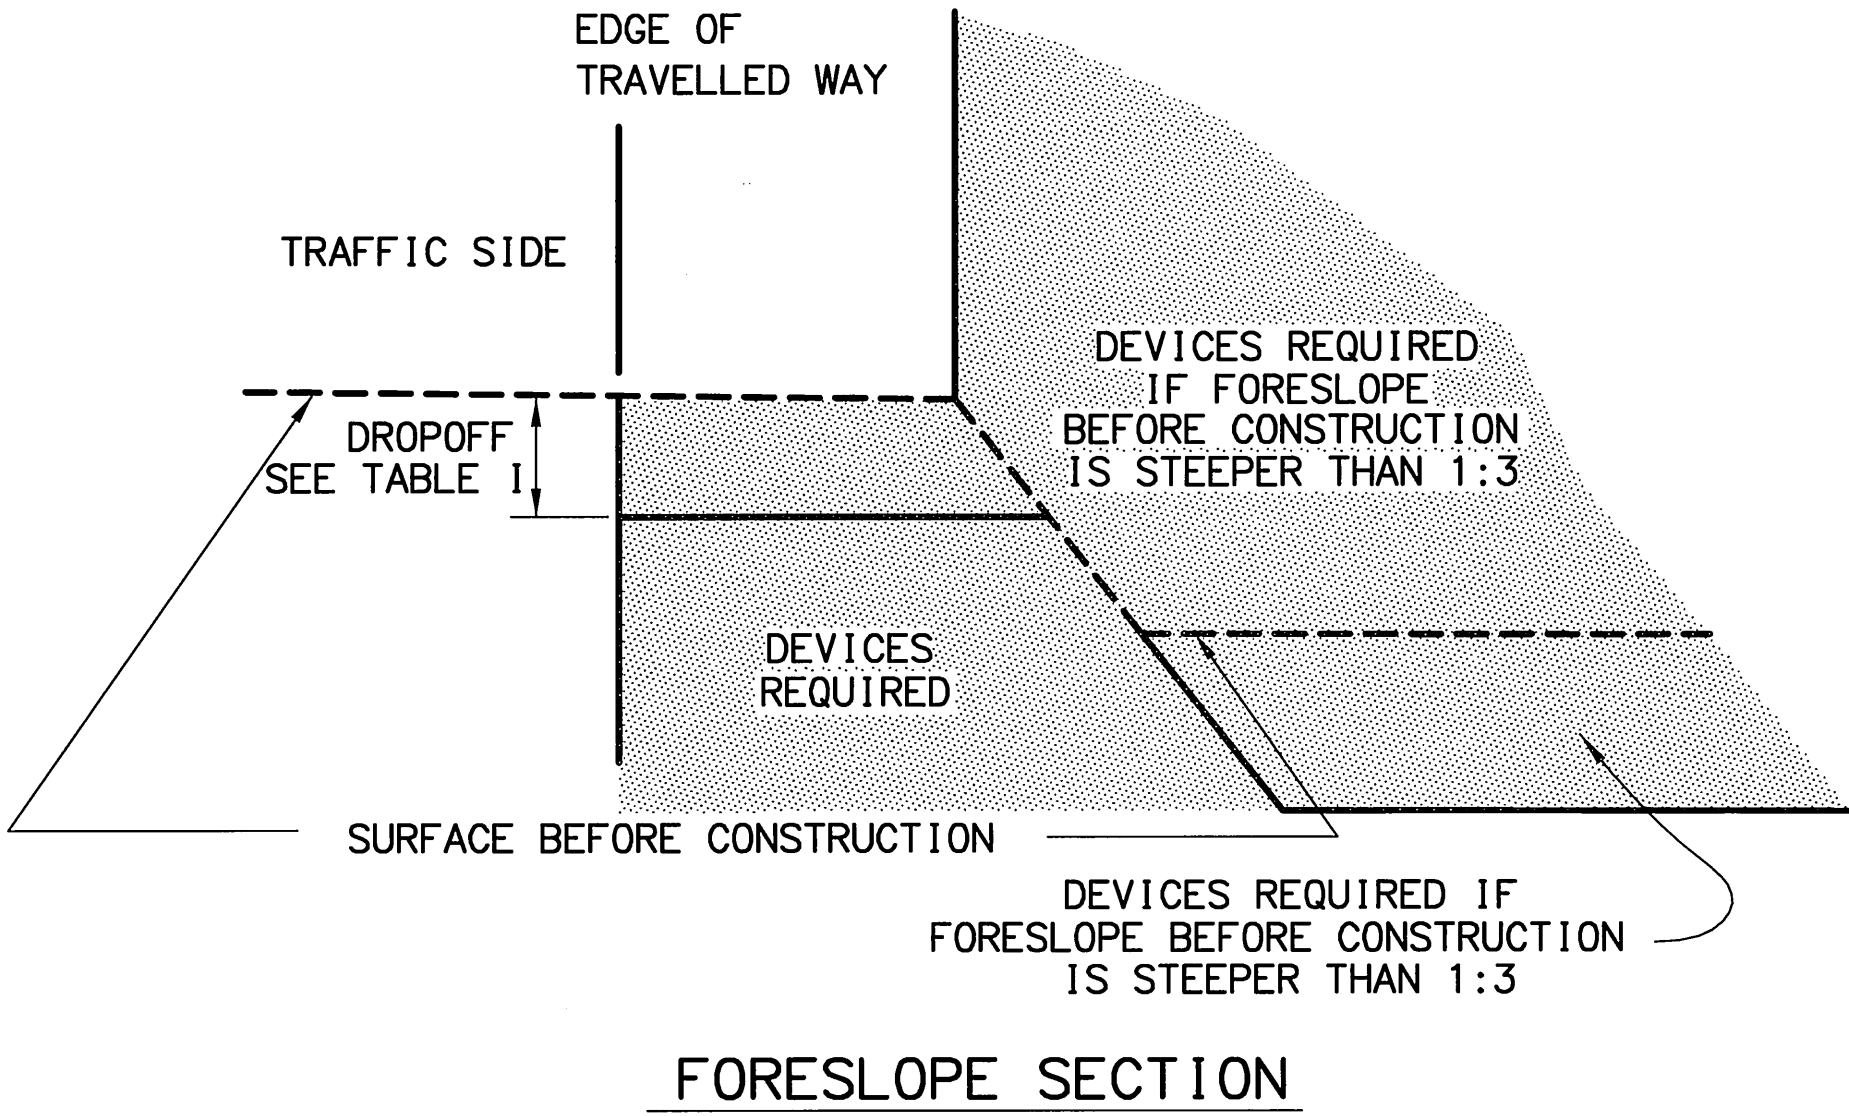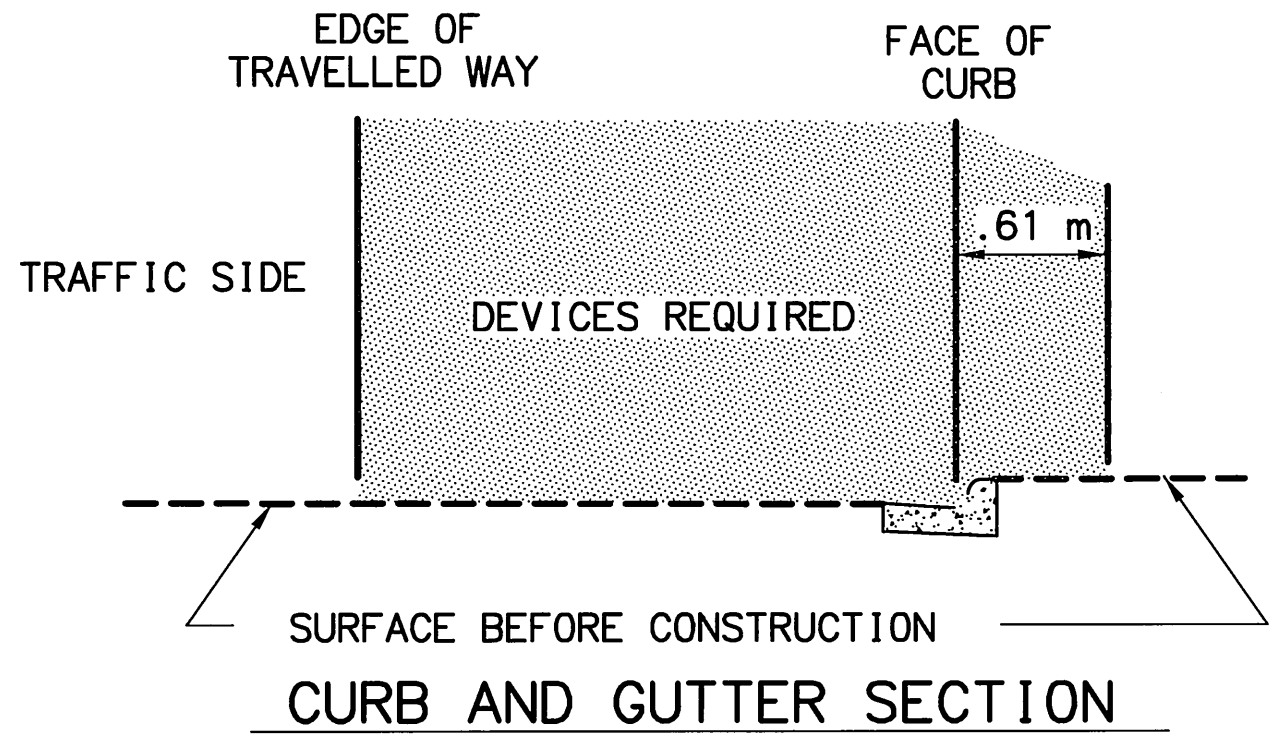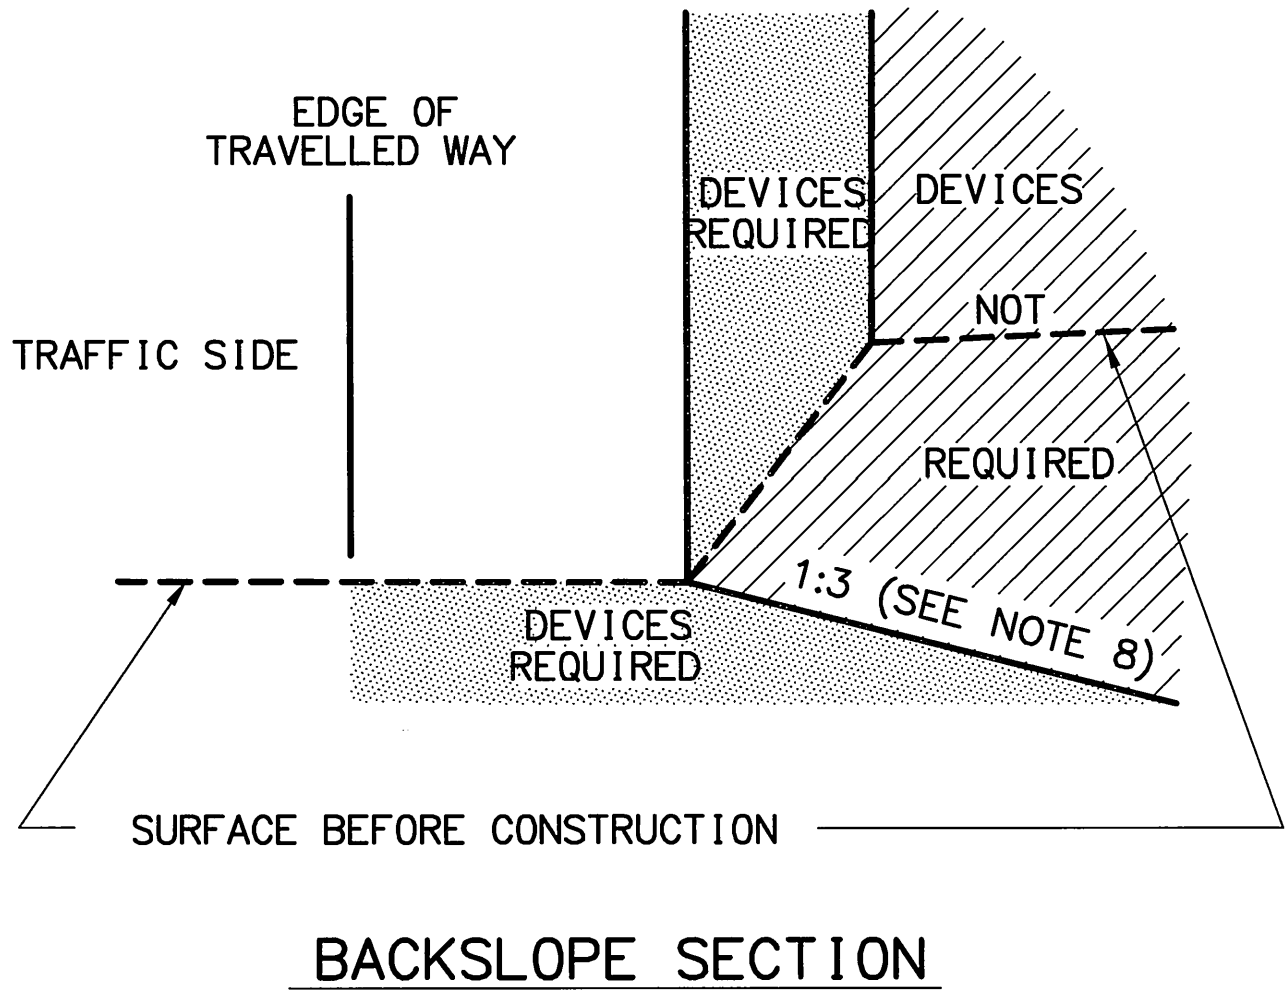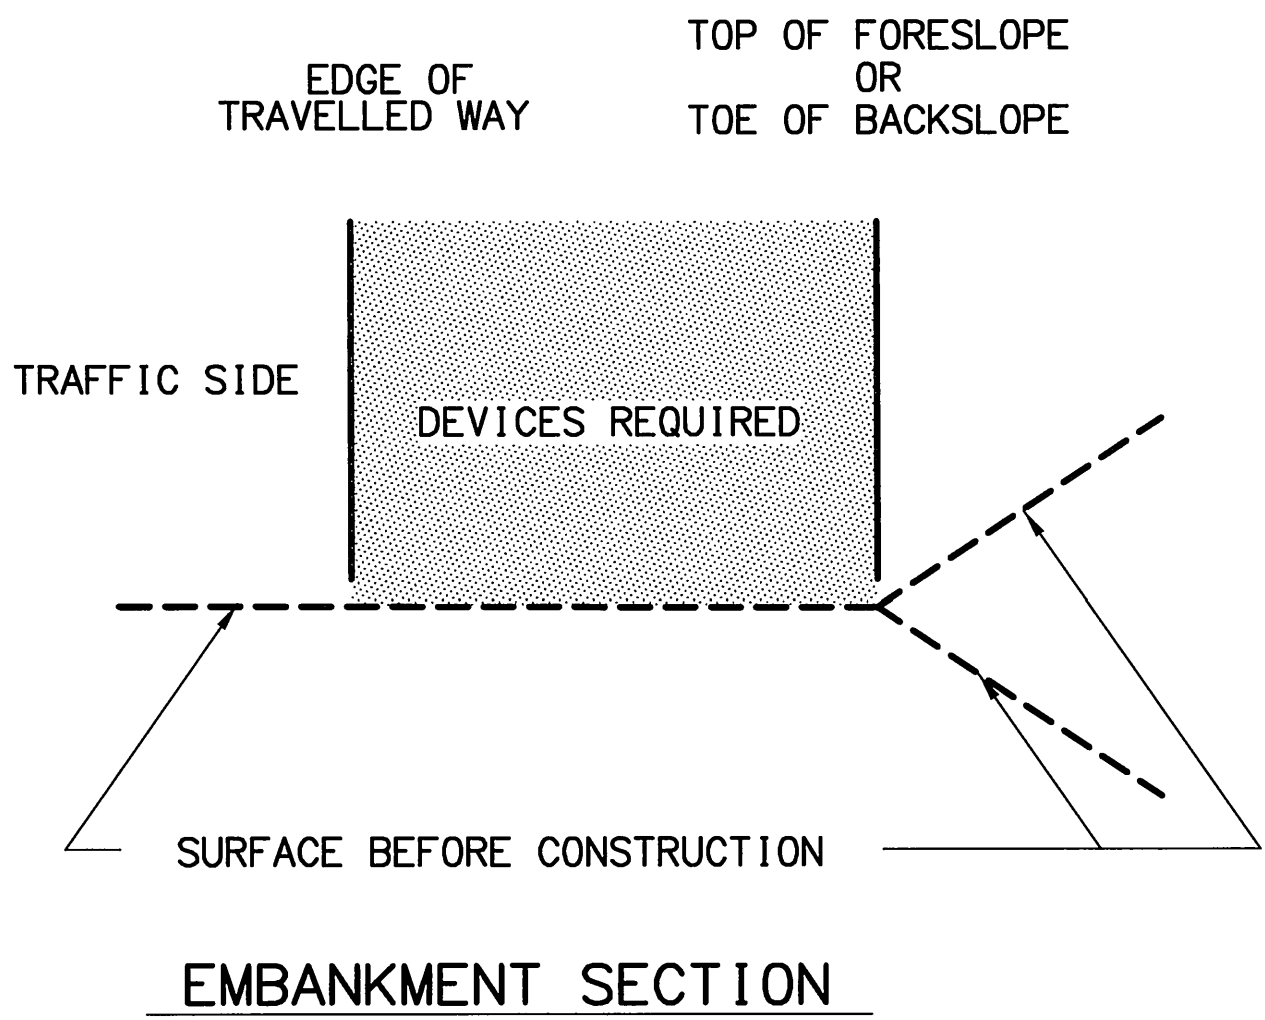


LEGEND

- WORK AREA WHERE TRAFFIC CONTROL DEVICES ARE REQUIRED
- WORK AREA WHERE TRAFFIC CONTROL DEVICES ARE NOT REQUIRED
- SURFACE BEFORE CONSTRUCTION
- CONSTRUCTION AREA BOUNDARY

* TABLE 1 TRAFFIC CONTROL DEVICES REQUIRED FOR DROPOFFS ADJACENT TO TRAVELLED WAY			
ROADWAY TYPE	DROPOFF $\leq$ 51	51 < DROPOFF < 305	DROPOFF $\geq$ 305
AVERAGE DAILY TRAFFIC > 4000 OR SPEED > 64 kmh	TUBULAR CANDLES OR DELINEATORS	TYPE II BARRICADES OR DRUMS	TEMPORARY PORTABLE CONCRETE BARRIER OR TEMPORARY GUARDRAIL
ALL OTHER ROADWAYS	NONE REQUIRED	TYPE II BARRICADES OR DRUMS	TYPE II BARRICADES OR DRUMS

* SPACE THE DEVICES IN ACCORDANCE WITH REQUIREMENTS FOR SPACING TYPE II BARRICADES AND DRUMS SET FORTH IN THE ALASKA TRAFFIC MANUAL.

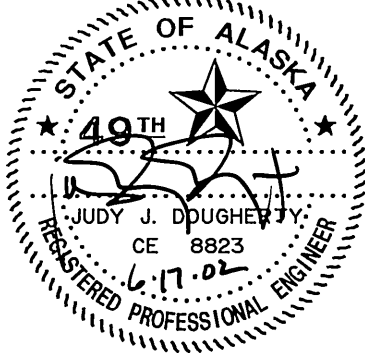


STATE OF ALASKA
DEPARTMENT OF TRANSPORTATION
AND
PUBLIC FACILITIES
**SEWARD HIGHWAY
MP 96 TO MP 102
SAFETY, ROADWAY &
RECREATIONAL IMPROVEMENTS**
**TRAFFIC CONTROL DEVICES
FOR ROADSIDES**
[METRIC]

REVISIONS			STATE	PROJECT DESIGNATION	YEAR	SHEET NO.	TOTAL SHEETS
No.	DATE	DESCRIPTION					
			ALASKA	NH-0A3-1(28)	2002	K3	K7

DETOUR NOTES:

1. CONSTRUCT SUPERELEVATION TRANSITIONS ACCORDING TO THE SUPERELEVATION SUMMARY TABLE.

PROFILE GRADE INFORMATION				
V.P.I. STATION	ELEVATION	GRADE (%)	VERTICAL CURVE LENGTH	REMARKS
'DET' 3+000.000	14.337	6.390		BEGIN ALIGNMENT, MATCH EXISTING
'DET' 3+090.000	20.088	4.200	120	
'DET' 3+400.000	33.108	-0.350	180	
'DET' 3+735.000	31.936	-2.900	210	
'DET' 3+890.000	27.441	-2.180	70	
'DET' 3+946.178	26.216			END ALIGNMENT, MATCH EXISTING

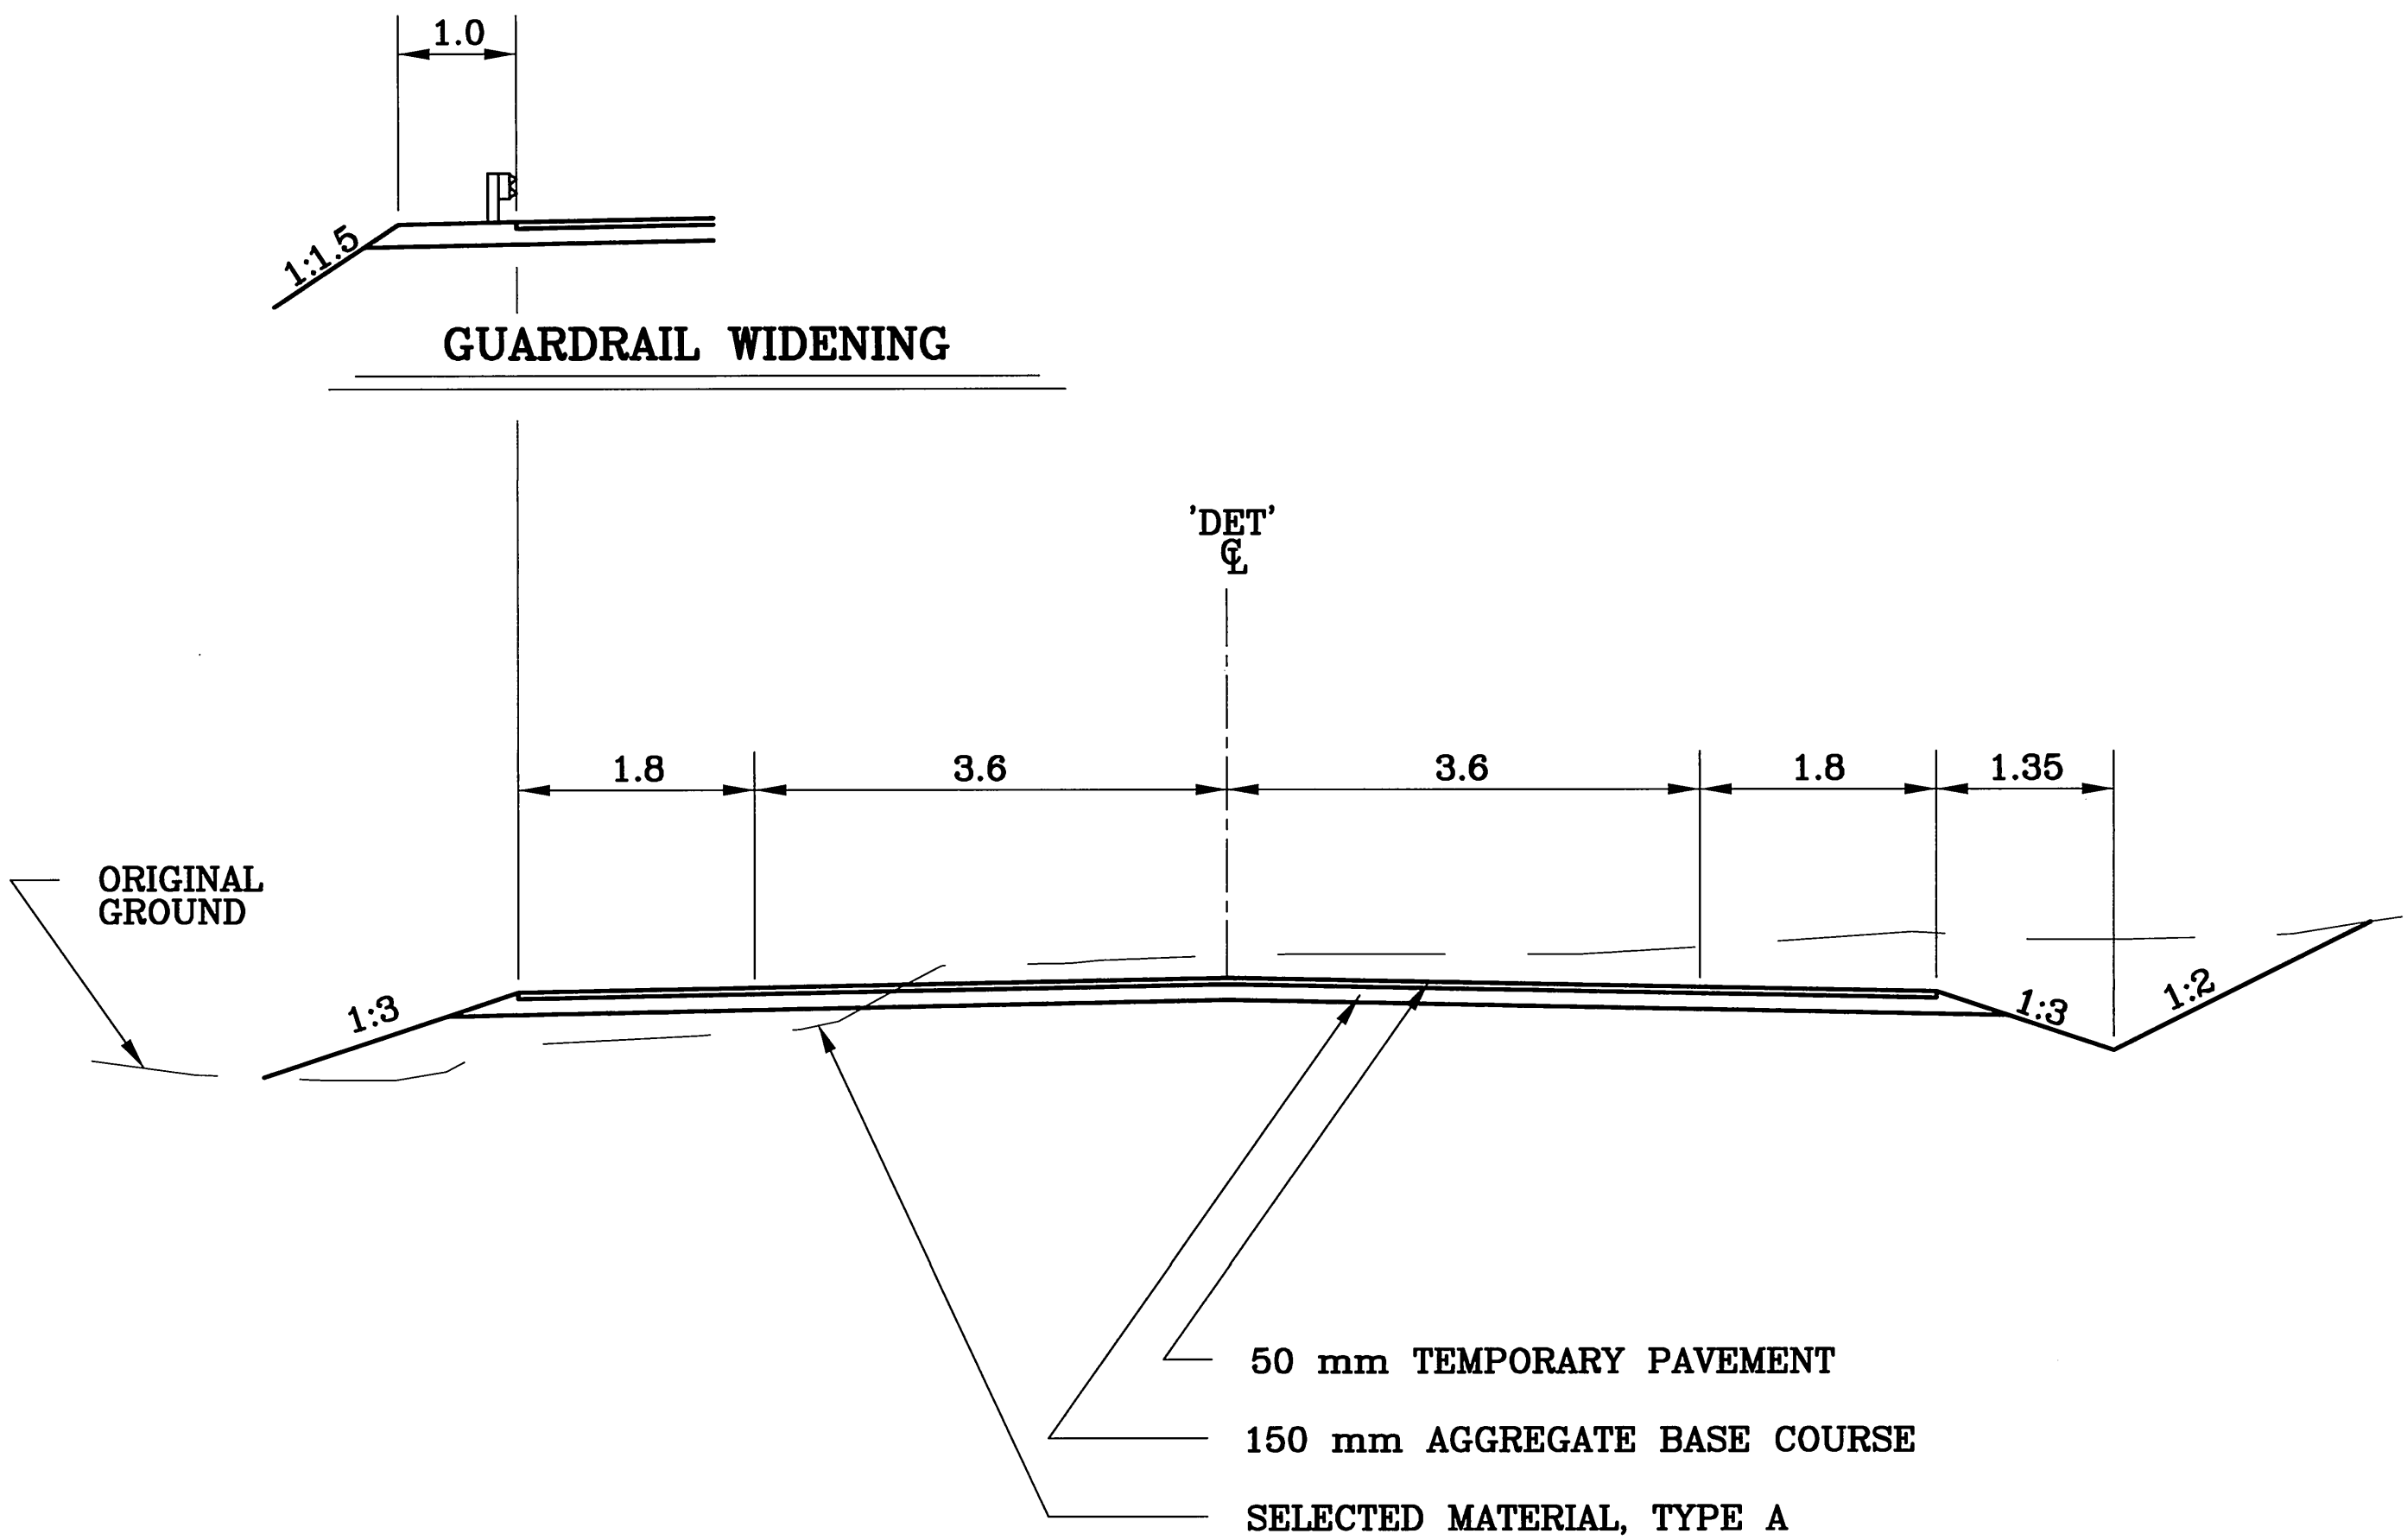

DETOUR TYPICAL SECTION

STA. 'DET' 3+000.000 TO STA. 'DET' 3+946.178


SUPERELEVATION TRANSITION SUMMARY TABLE		
STATION		REMARKS
BEGIN TRANSITION	END TRANSITION	
'DET' 3+000	'DET' 3+037	TRANSITION FROM NORMAL CROWN TO 4% LT. CROSS SLOPE
'DET' 3+037	'DET' 3+081	TRANSITION FROM 4% LT. TO 0% CROSS SLOPE
'DET' 3+081	'DET' 3+125	TRANSITION FROM 0% TO 6% RT. CROSS SLOPE
'DET' 3+161	'DET' 3+180	TRANSITION FROM 6% RT. TO 4.2% RT. CROSS SLOPE
'DET' 3+542	'DET' 3+590	TRANSITION FROM 4.2% RT. TO 6% RT. CROSS SLOPE
'DET' 3+627	'DET' 3+685	TRANSITION FROM 6% RT. TO 0% CROSS SLOPE
'DET' 3+685	'DET' 3+745	TRANSITION FROM 0% TO 6% LT. CROSS SLOPE
'DET' 3+745	'DET' 3+782	TRANSITION FROM 6% LT. TO 0% CROSS SLOPE
'DET' 3+782	'DET' 3+820	TRANSITION FROM 0% TO 6% RT. CROSS SLOPE
'DET' 3+820	'DET' 3+859	TRANSITION FROM 6% RT. TO 0% CROSS SLOPE
'DET' 3+859	'DET' 3+898	TRANSITION FROM 0% TO 6% LT. CROSS SLOPE
'DET' 3+898	'DET' 3+945	TRANSITION FROM 6% LT. TO NORMAL CROWN



STATE OF ALASKA
DEPARTMENT OF TRANSPORTATION
AND
PUBLIC FACILITIES
**SEWARD HIGHWAY
MP 96 TO MP 102
SAFETY, ROADWAY AND
RECREATIONAL IMPROVEMENTS**
DETOUR PLAN VIEW

REVISIONS			STATE	PROJECT DESIGNATION	YEAR	SHEET NO.	TOTAL SHEETS
No.	DATE	DESCRIPTION	ALASKA	NH-0A3-1(28)	2002	K4	K7

SPECIFICATIONS	DESIGNED BY	11/13/02
SCALE 1"=1'	CHECKED BY	
COMPUTER DESIGNATION	DRAWN BY	

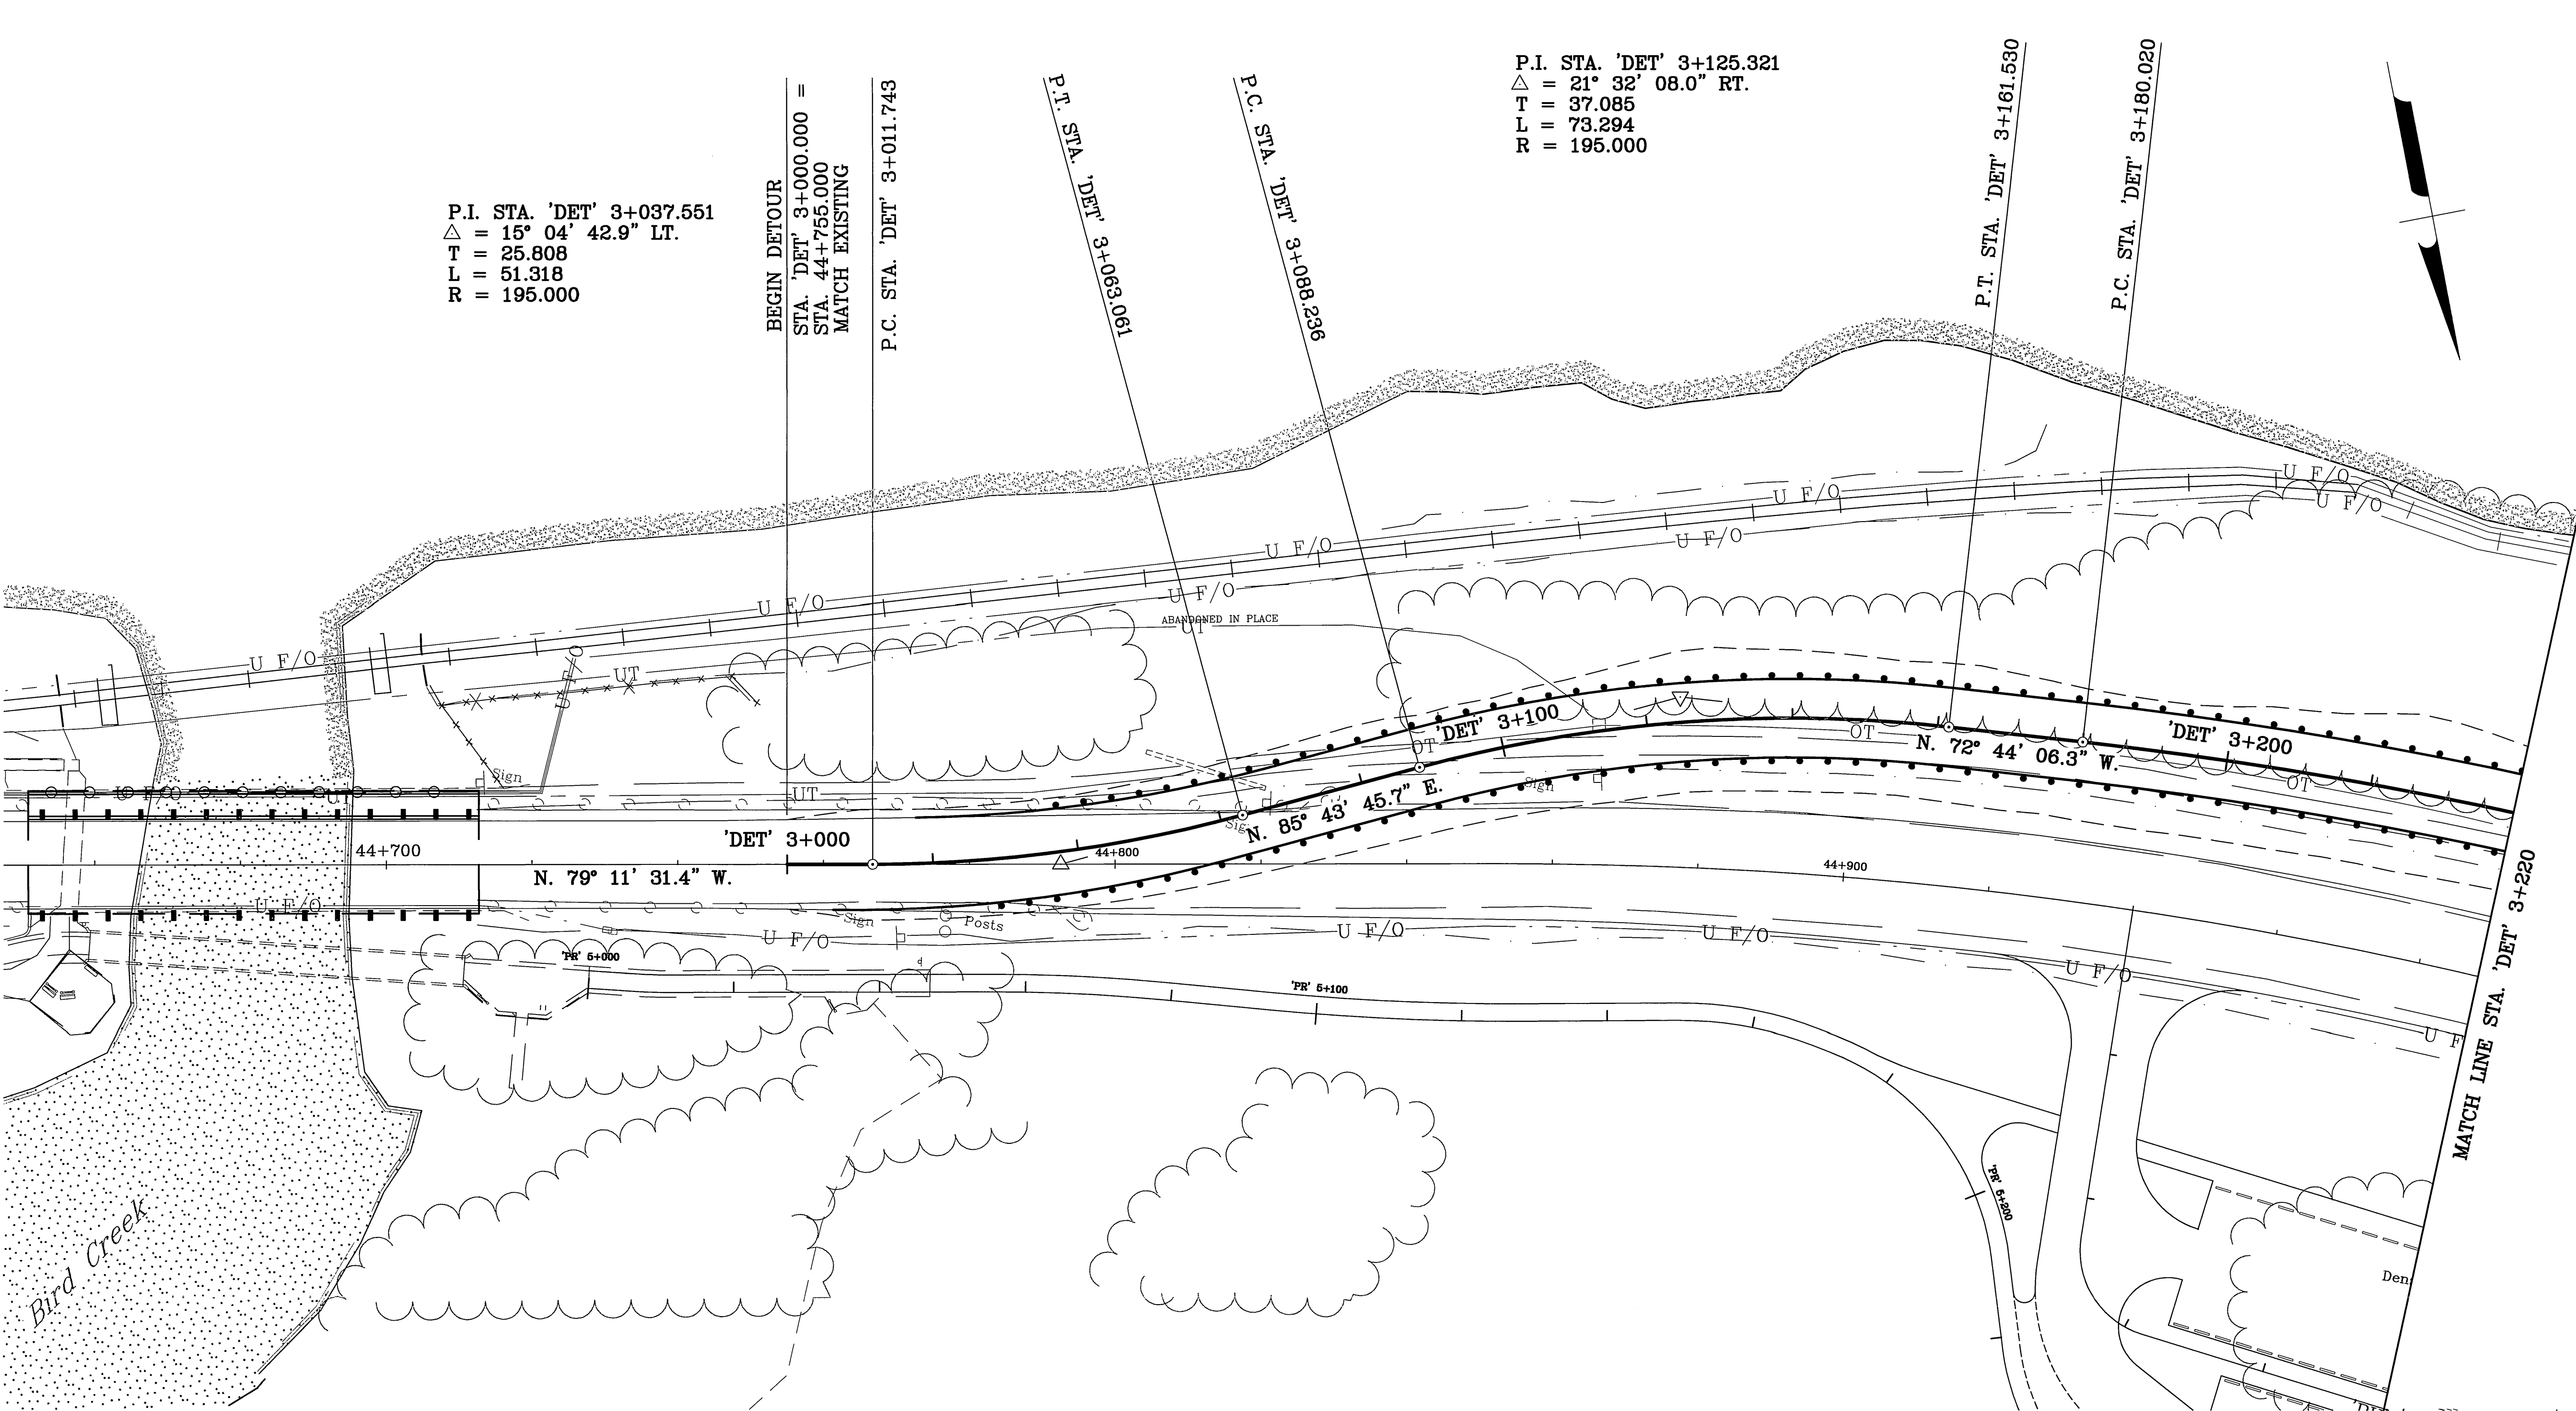

P.I. STA. 'DET' 3+125.321
 $\Delta = 21^\circ 32' 08.0''$ RT.
 T = 37.085
 L = 73.294
 R = 195.000


P.I. STA. 'DET' 3+037.551
 $\Delta = 15^\circ 04' 42.9''$ LT.
 T = 25.808
 L = 51.318
 R = 195.000

BEGIN DETOUR
 STA. 'DET' 3+000.000 =
 STA. 44+755.000
 MATCH EXISTING
 P.C. STA. 'DET' 3+011.743

STATE OF ALASKA
DEPARTMENT OF TRANSPORTATION
AND
PUBLIC FACILITIES


SEWARD HIGHWAY
MP 96 TO MP 102
SAFETY, ROADWAY AND
RECREATIONAL IMPROVEMENTS

DETOUR PLAN VIEW

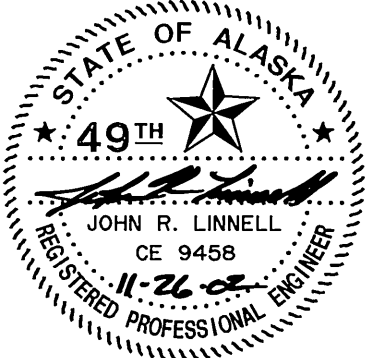

REVISIONS			STATE	PROJECT DESIGNATION	YEAR	SHEET NO.	TOTAL SHEETS
No.	DATE	DESCRIPTION					
			ALASKA	NH-0A3-1(28)	2002	K5	K7



SPECIFICATIONS	DESIGNED BY	11/13/02
SCALE 1"=1'	CHECKED BY	
COMPUTER DESIGNATION	DRAWN BY	KMH
	AUTOCAD-CARLEE SEWARD/DAVID FOUR	

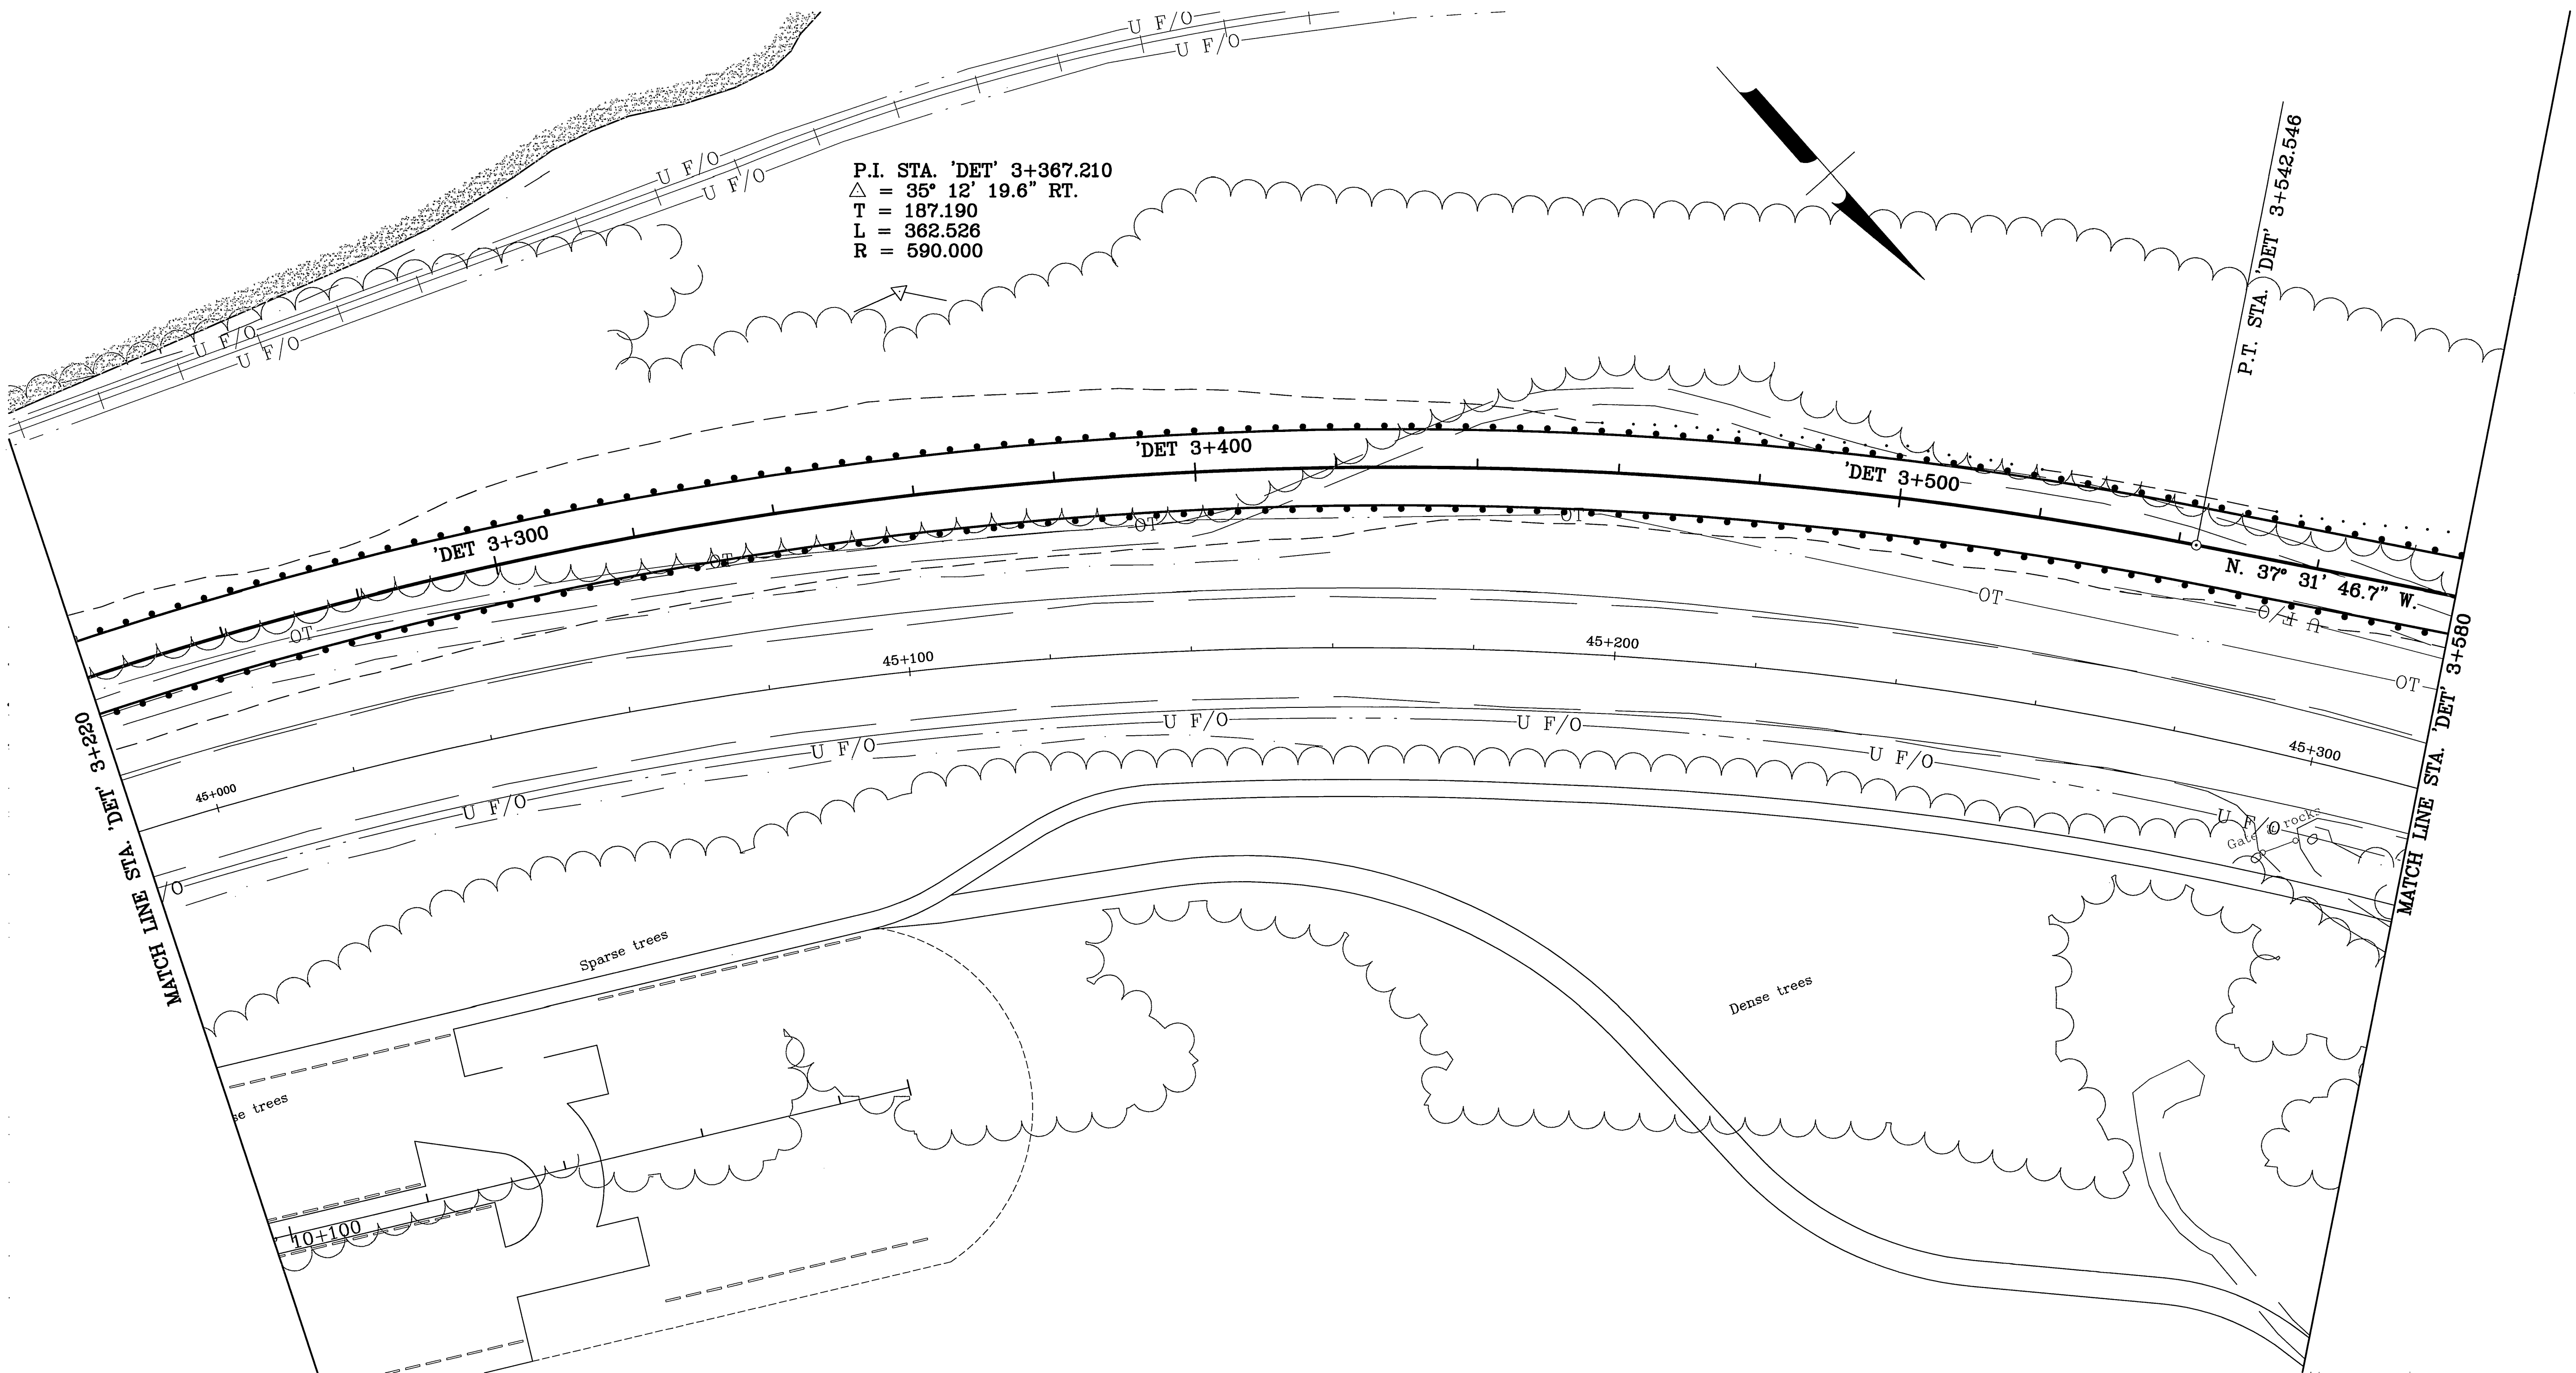

STATE OF ALASKA
 DEPARTMENT OF TRANSPORTATION
 AND
 PUBLIC FACILITIES
**SEWARD HIGHWAY
 MP 96 TO MP 102
 SAFETY, ROADWAY AND
 RECREATIONAL IMPROVEMENTS**
 DETOUR PLAN VIEW

REVISIONS			STATE	PROJECT DESIGNATION	YEAR	SHEET NO.	TOTAL SHEETS
No.	DATE	DESCRIPTION	ALASKA	NH-0A3-1(28)	2002	K6	K7


SPECIFICATIONS	DESIGNED BY	11/13/02
SCALE 1"=1'	CHECKED BY	
COMPUTER DESIGNATION	DRAWN BY	
	DATE	

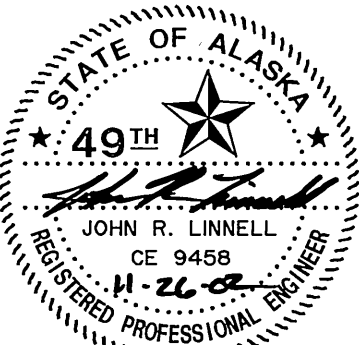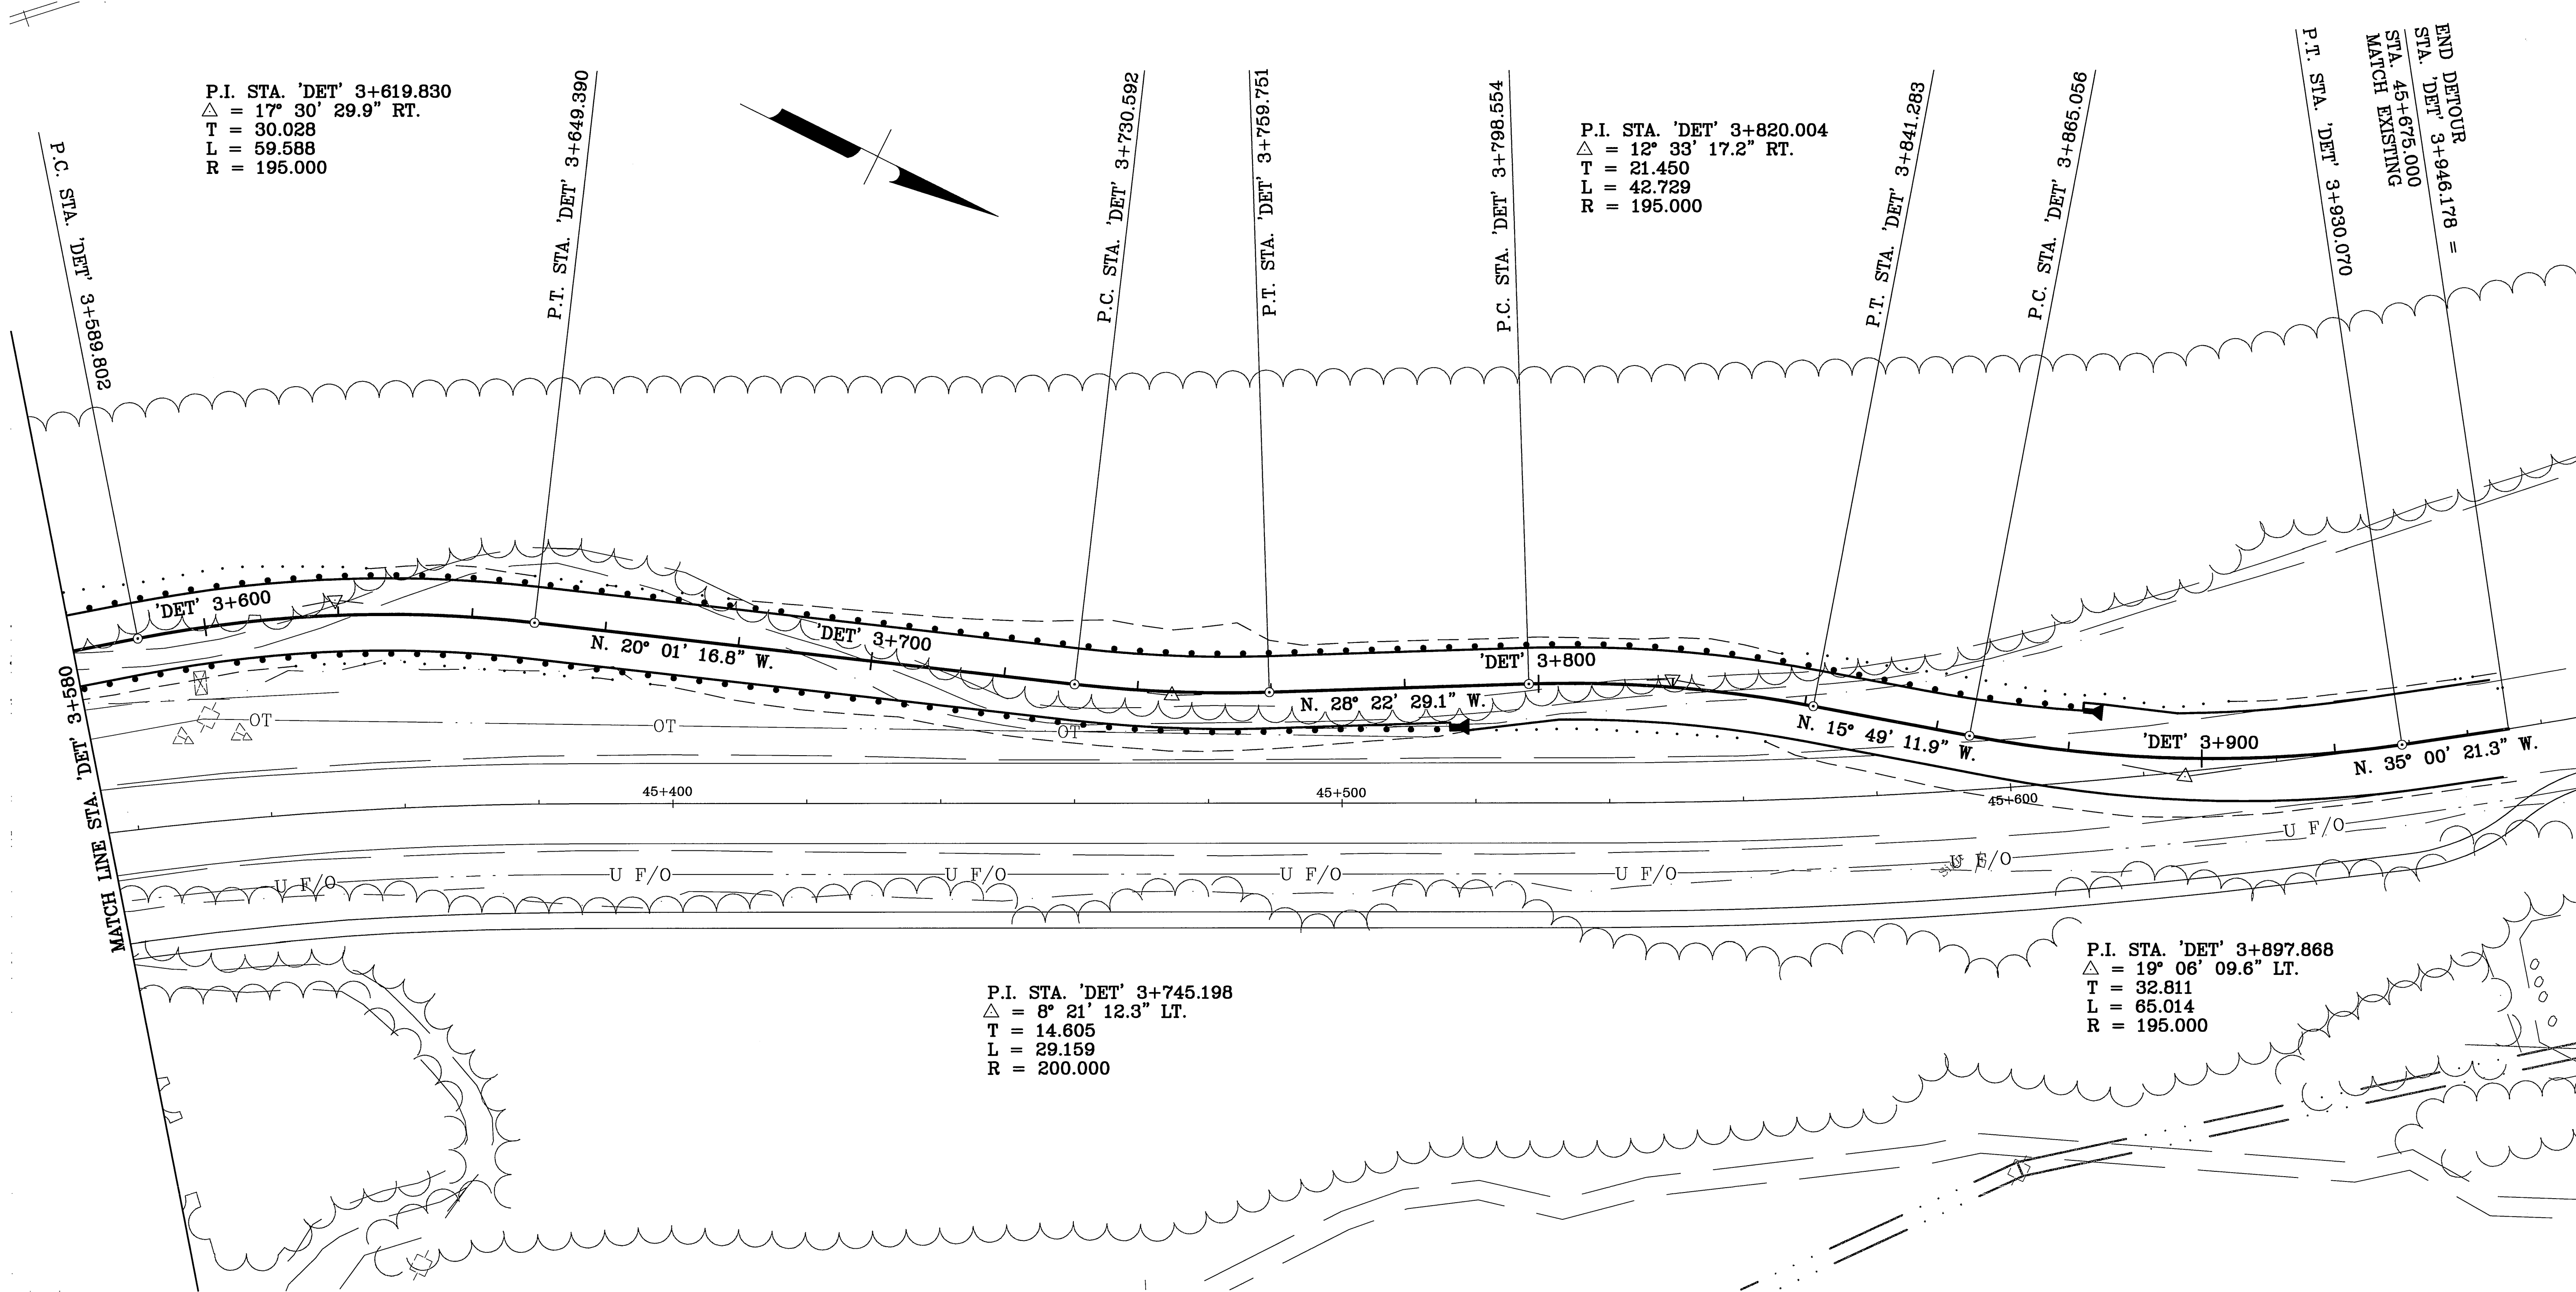

STATE OF ALASKA
DEPARTMENT OF TRANSPORTATION
AND
PUBLIC FACILITIES
**SEWARD HIGHWAY
MP 96 TO MP 102
SAFETY, ROADWAY AND
RECREATIONAL IMPROVEMENTS**
DETOUR PLAN VIEW



REVISIONS			STATE	PROJECT DESIGNATION	YEAR	SHEET NO.	TOTAL SHEETS
No.	DATE	DESCRIPTION					
			ALASKA	NH-0A3-1(28)	2002	K7	K7

SPECIFICATIONS	DESIGNED BY	KMH
	DRAWN BY	
	CHECKED BY	
SCALE	VIEW	
COMPUTER DESIGNATION	AUTOCAD-NANCY-55577 DATA\77C_PCS.DWG	11-18-02


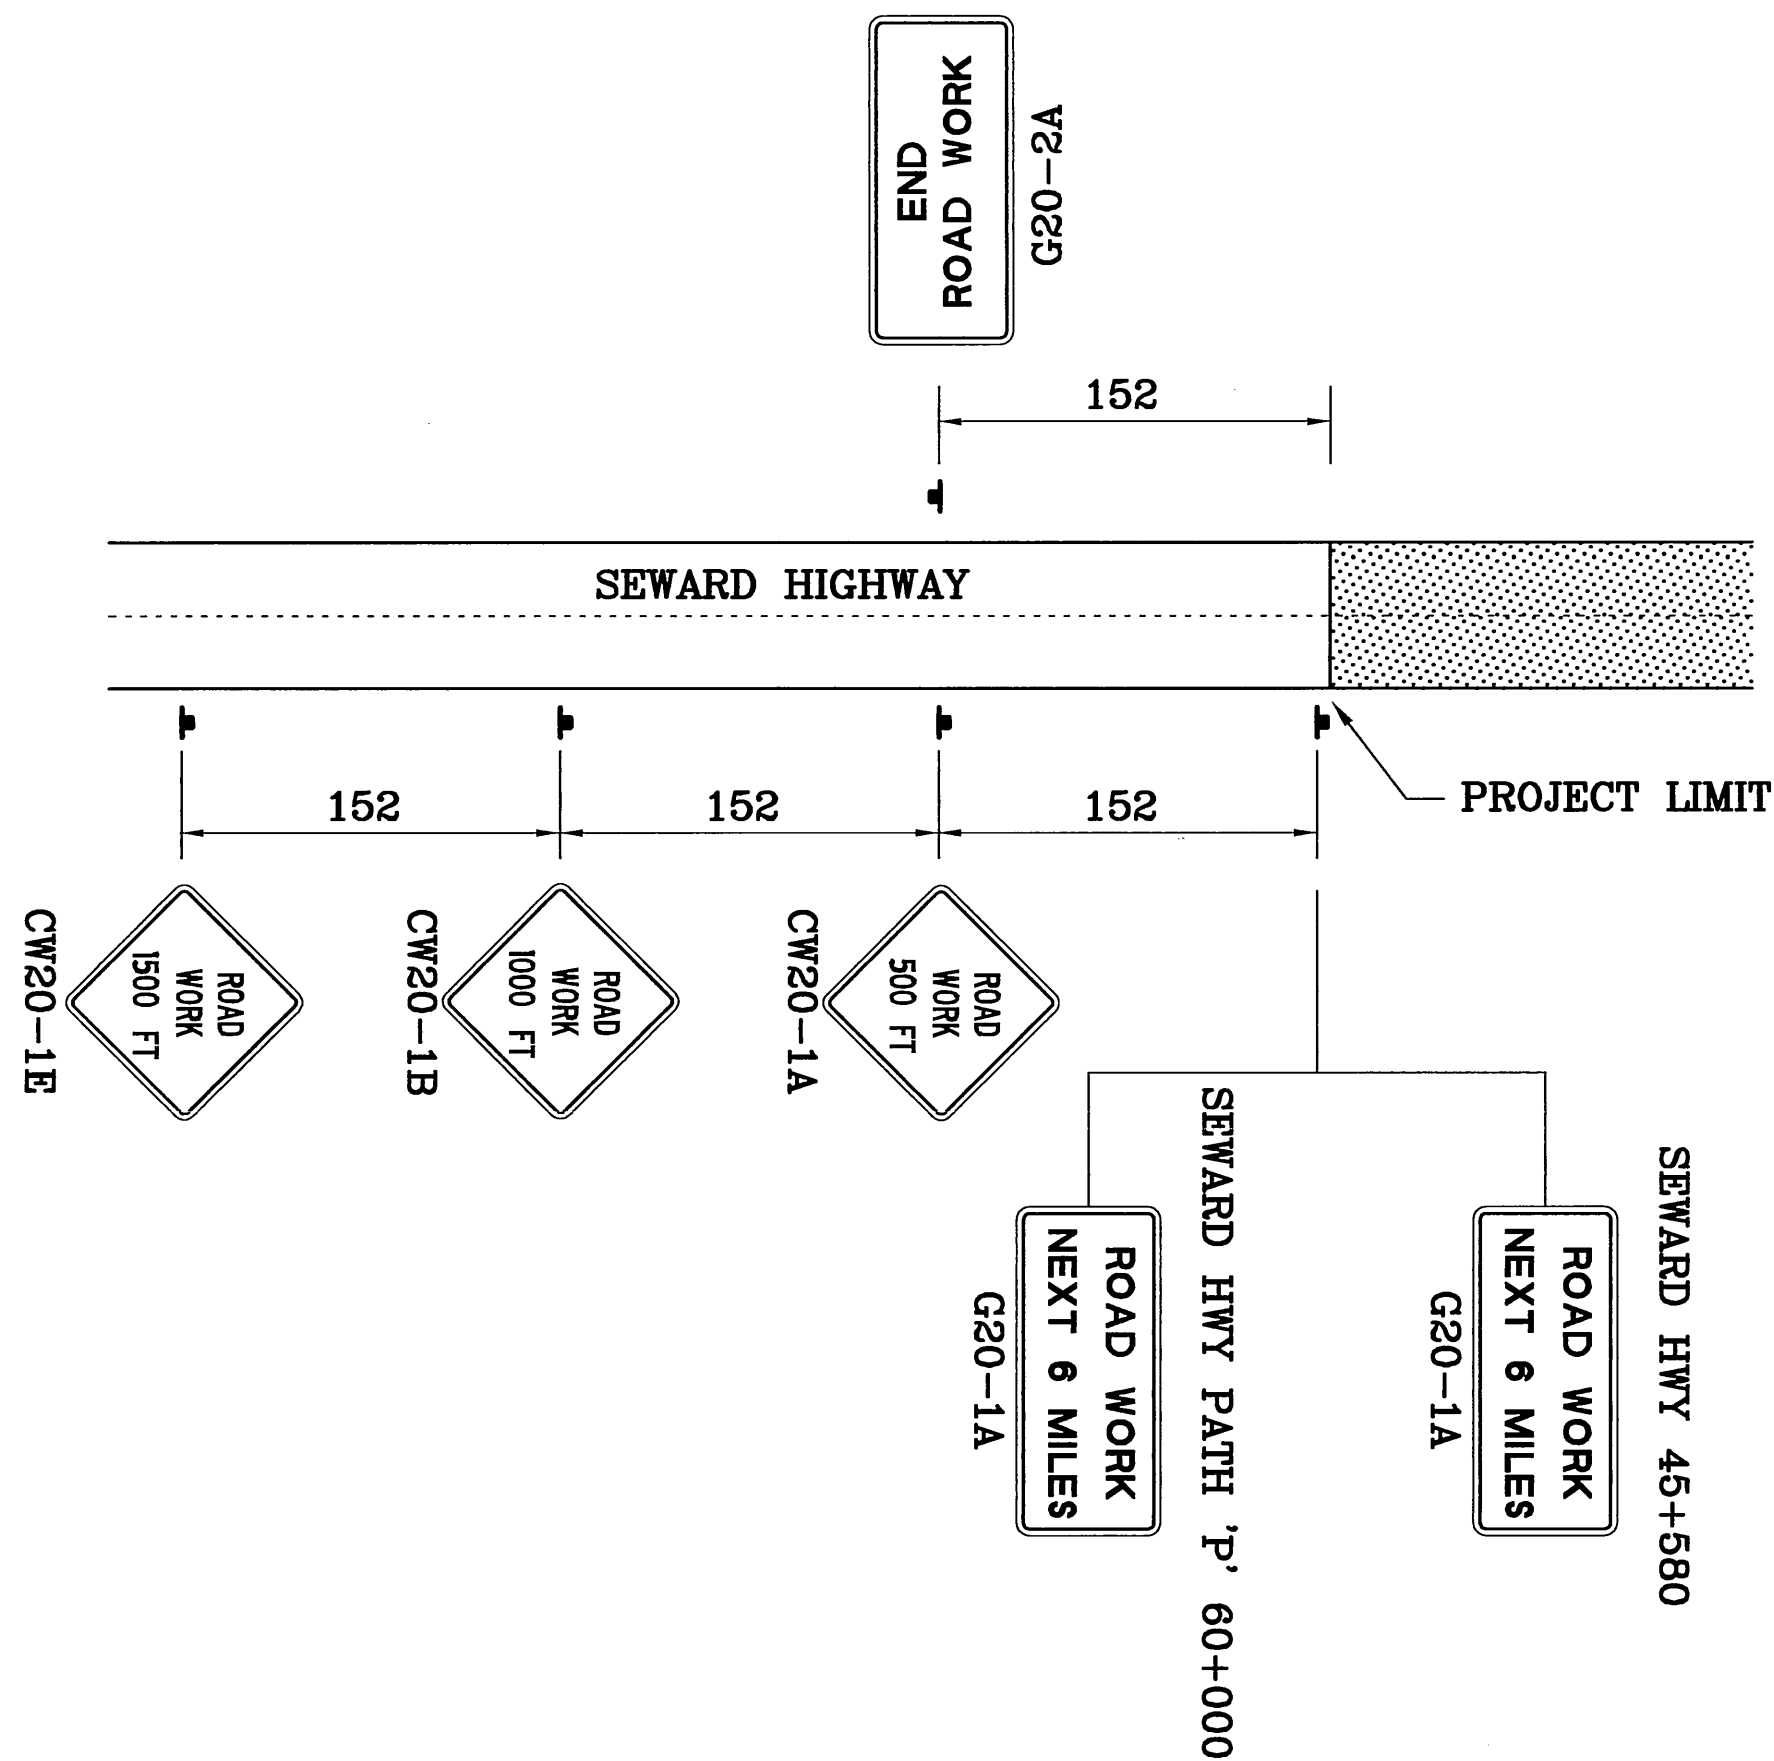


STATE OF ALASKA
DEPARTMENT OF TRANSPORTATION
AND
PUBLIC FACILITIES
**SEWARD HIGHWAY
MP 96 TO MP 102
SAFETY, ROADWAY AND
RECREATIONAL IMPROVEMENTS**
**PERMANENT CONSTRUCTION
SIGNING DETAIL**

STATE	PROJECT DESIGNATION	YEAR	SHEET NO.	TOTAL SHEETS
ALASKA	NH-OA3-I(28)/54433	2001	NI	N5

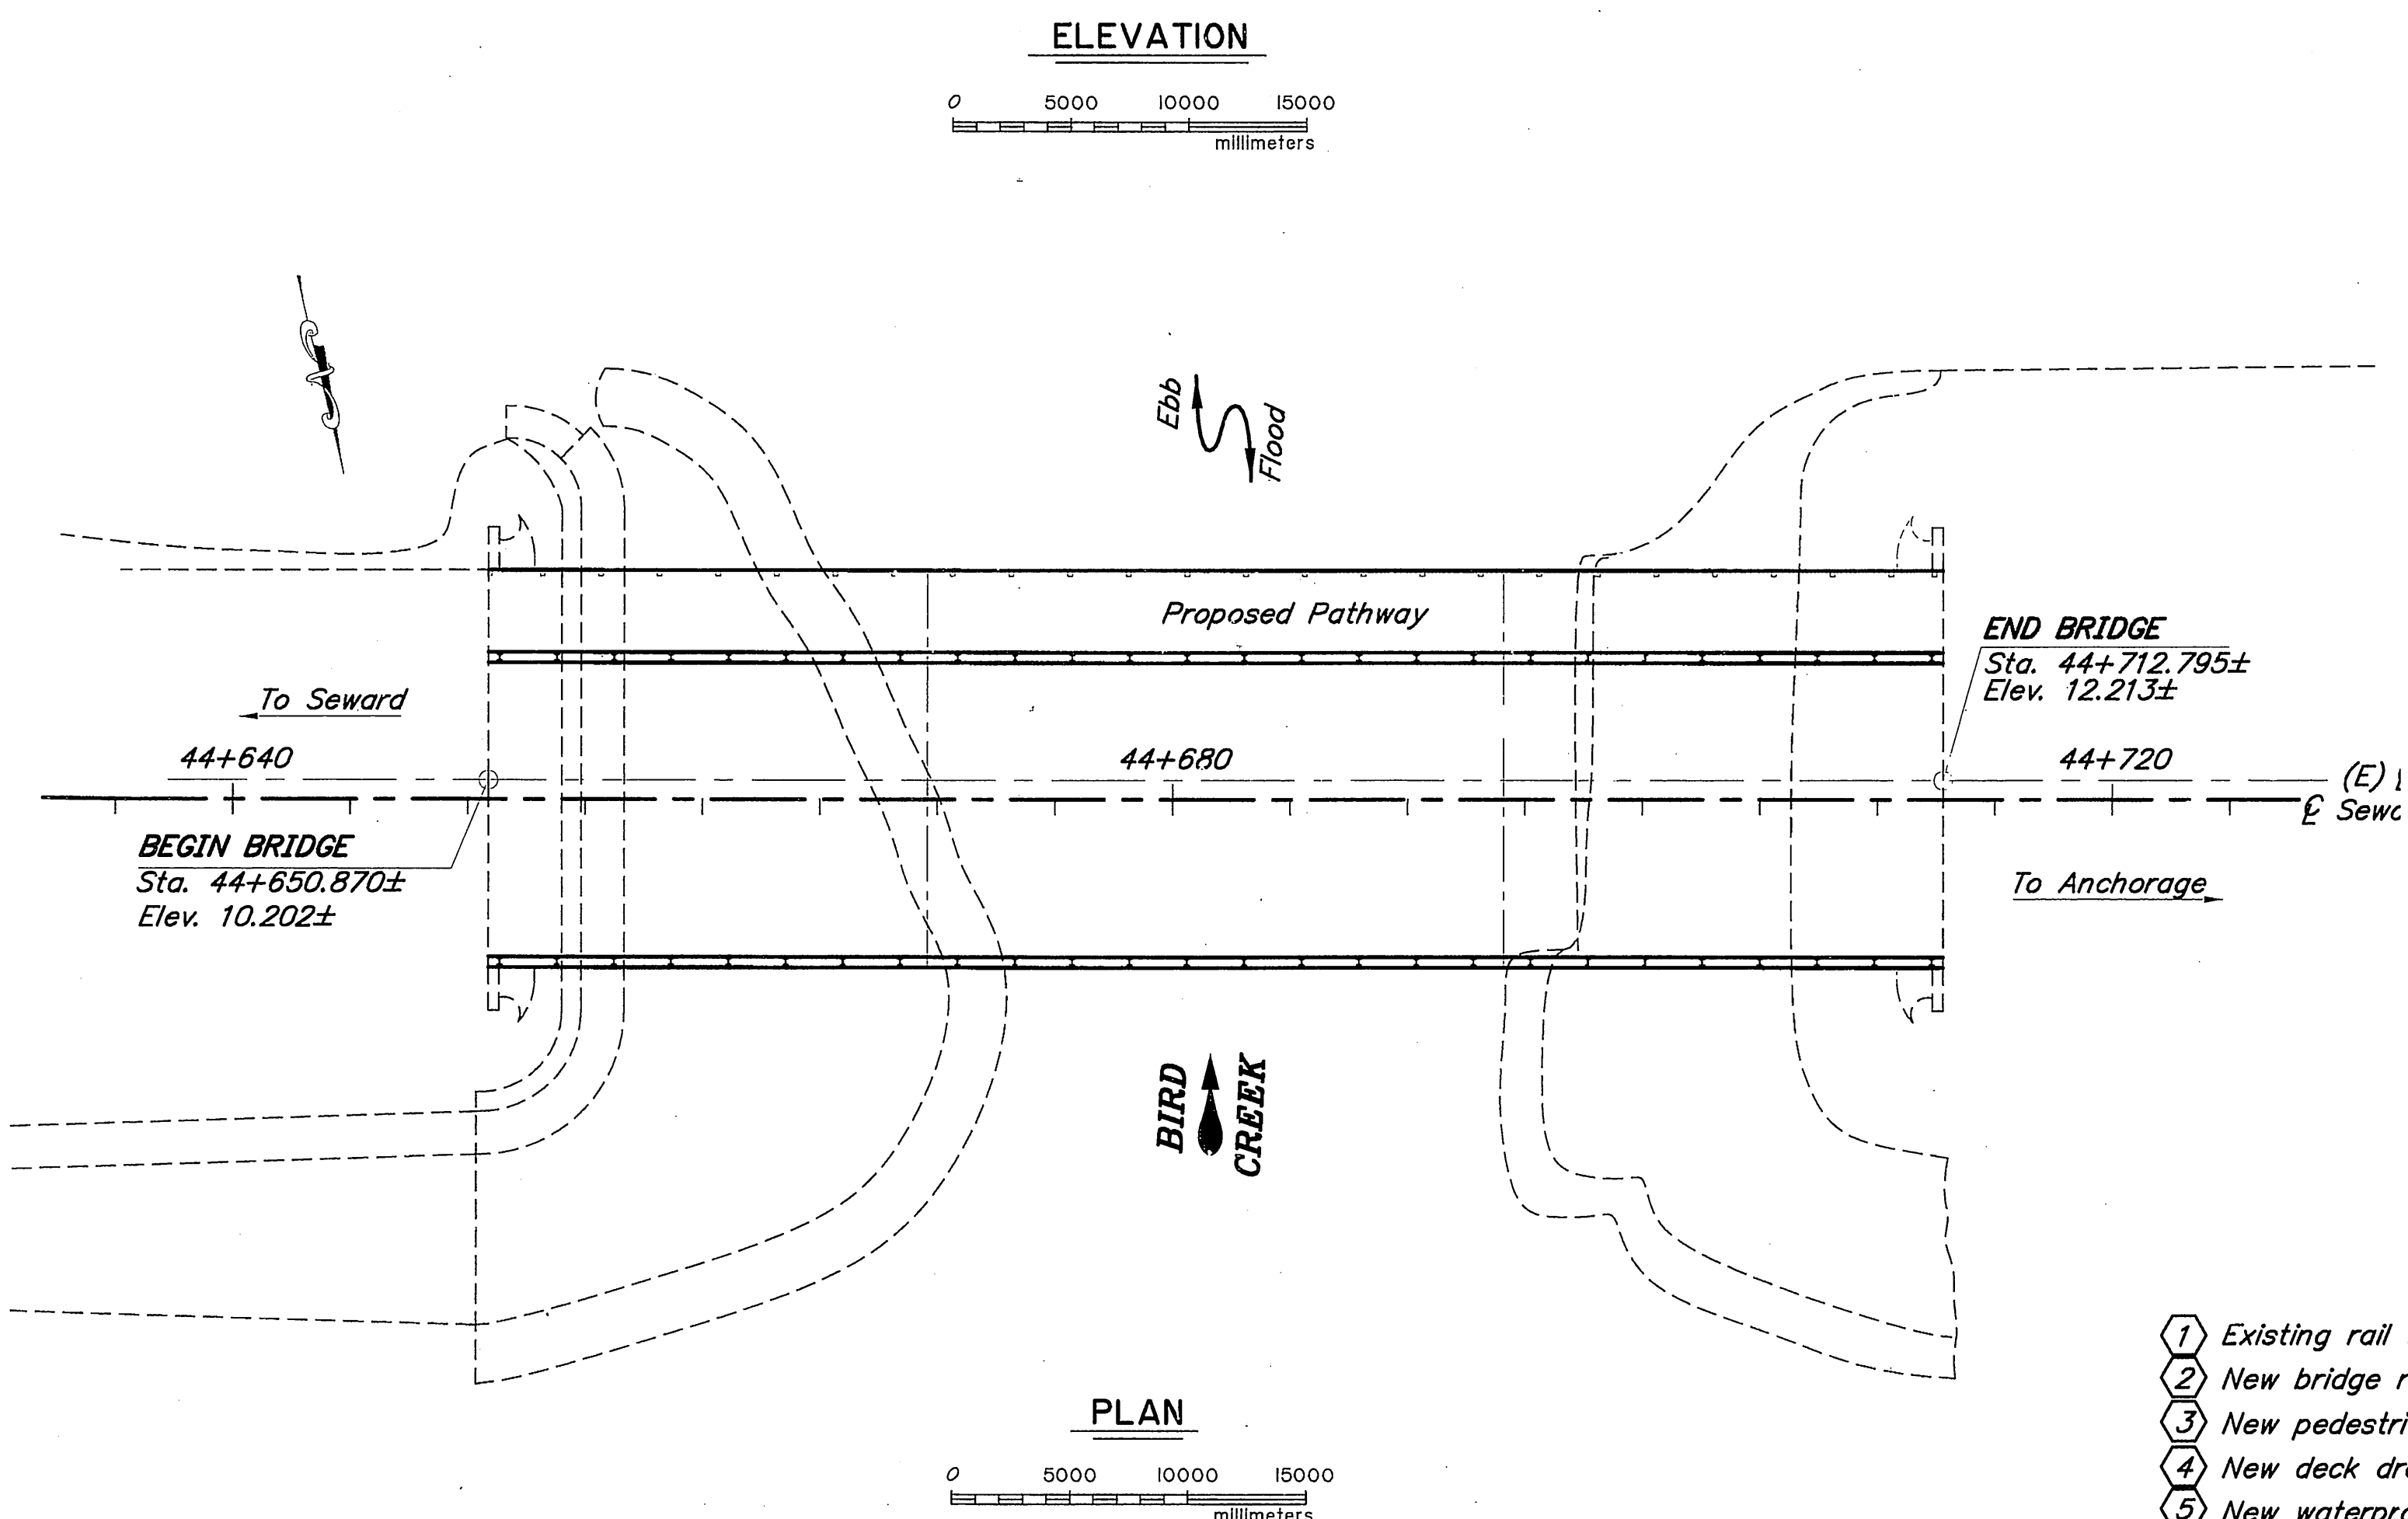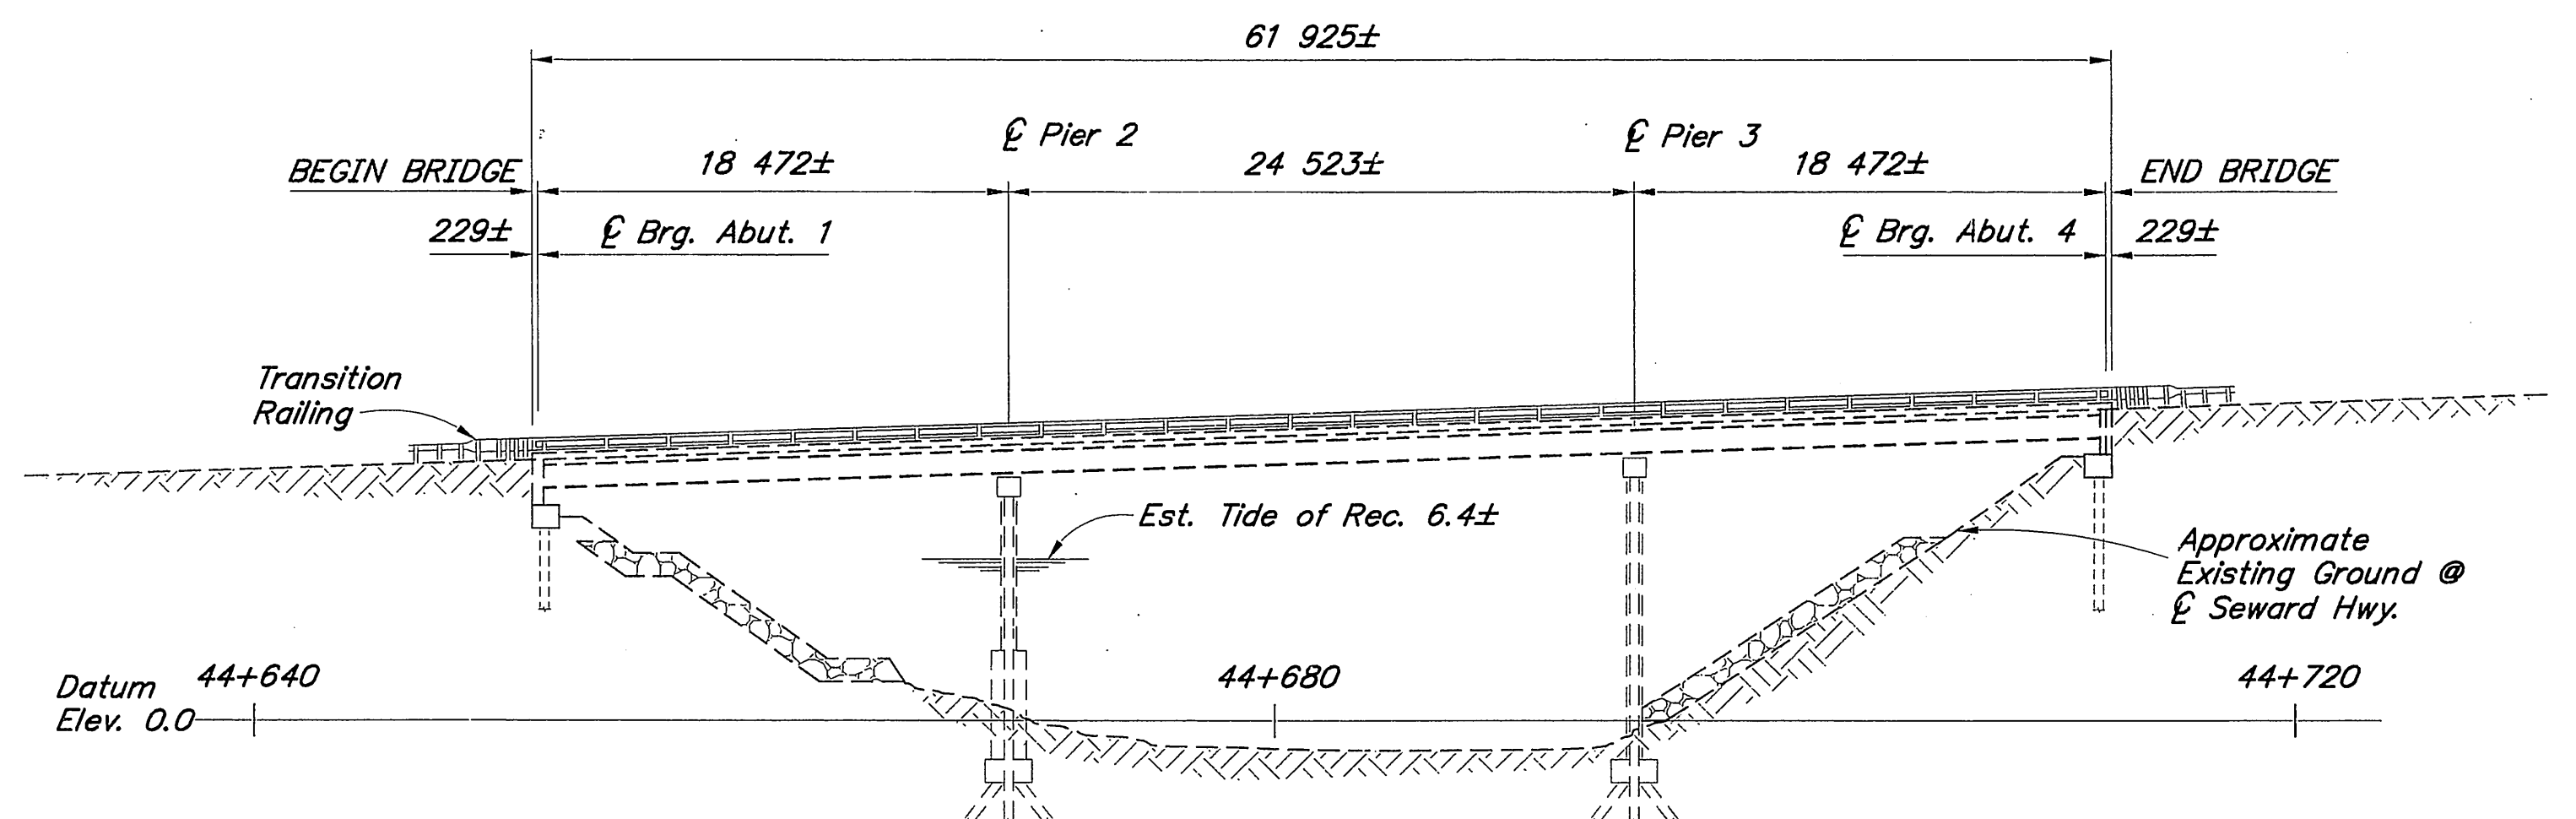

- ① Existing rail (to be removed)
- ② New bridge rail
- ③ New pedestrian rail.
- ④ New deck drains.
- ⑤ New waterproofing membrane and A/C overlay. (see sheet G1)

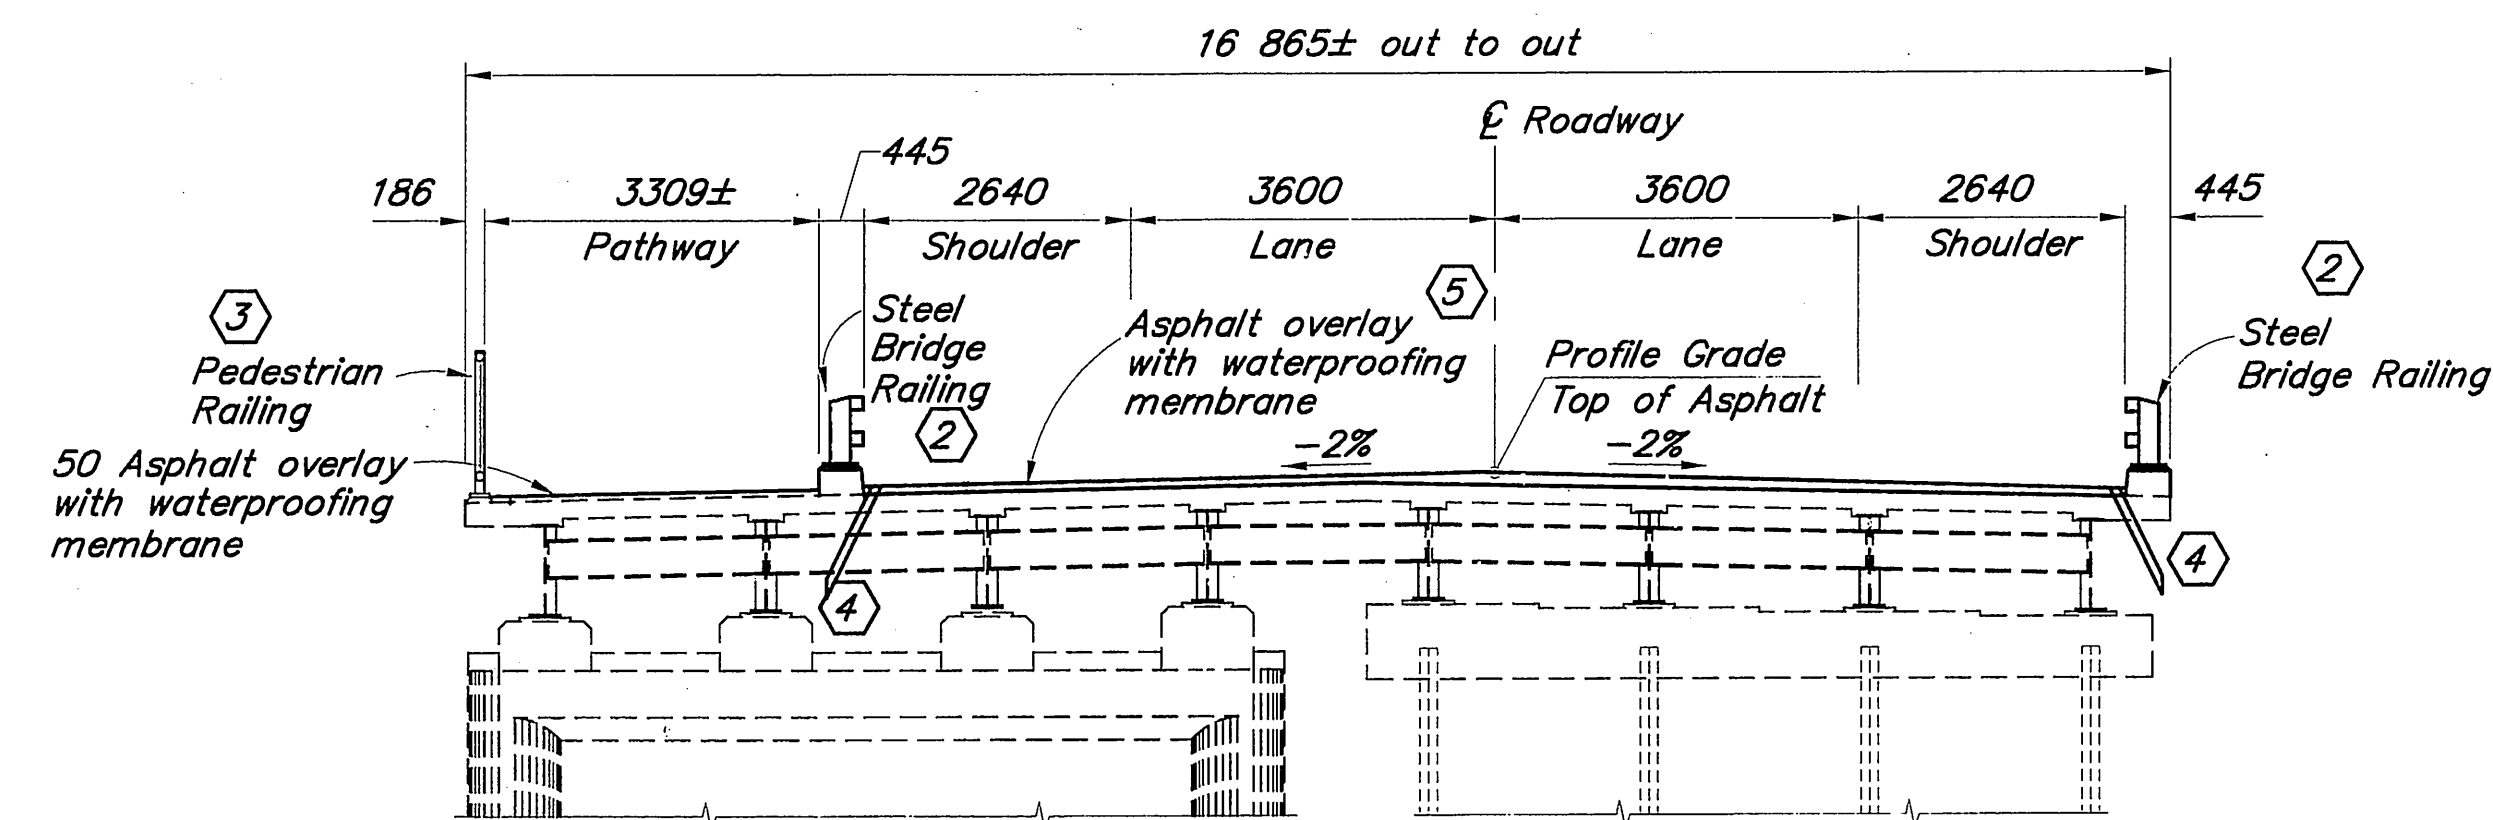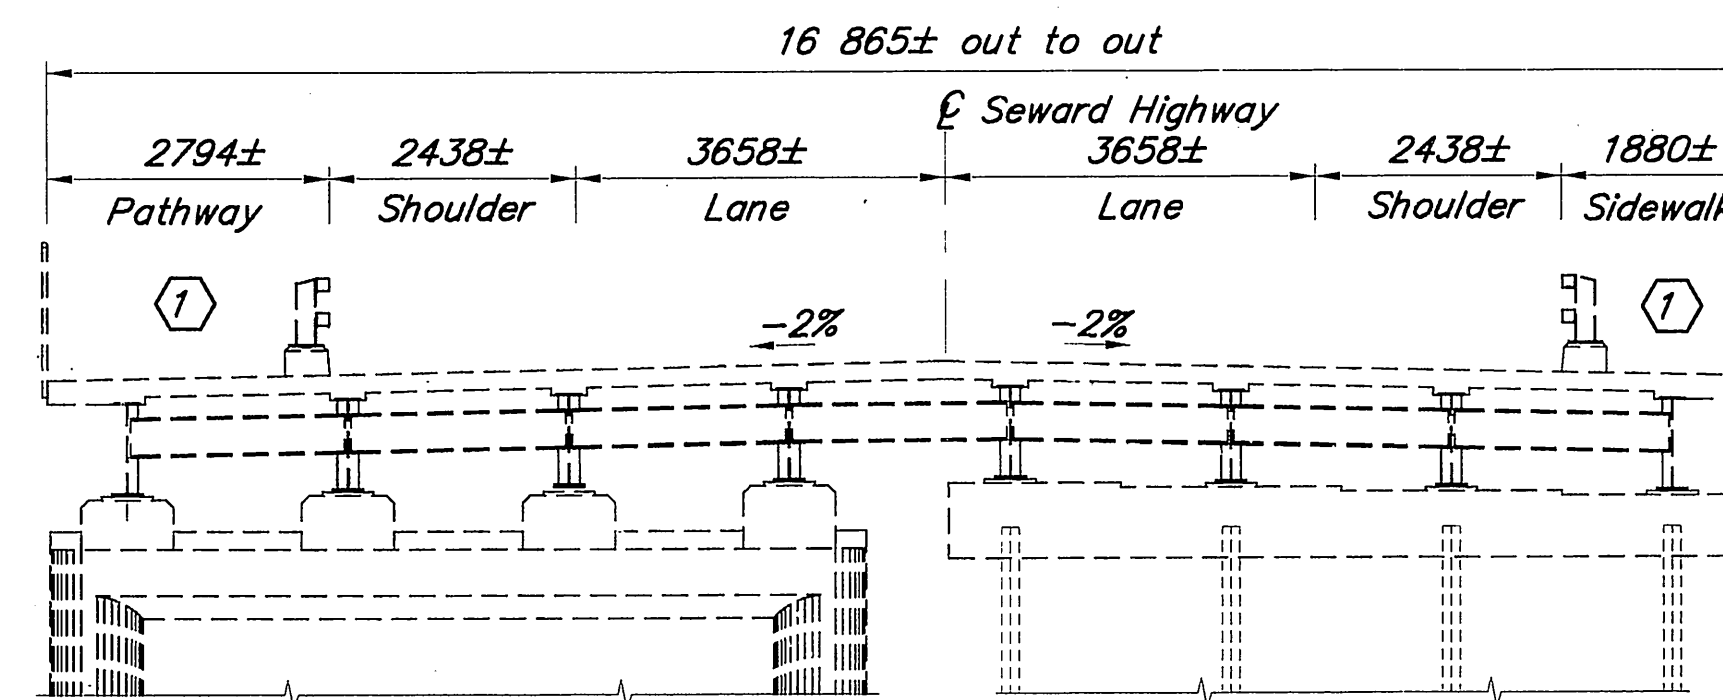

DRAWING INDEX

TITLE	DWG. NO.
GENERAL LAYOUT	1
TYPICAL SECTION	2
STEEL BRIDGE RAILING	3
PEDESTRIAN RAILING	4
THREE BEAM TRANSITION	5

NOTES:

(E) Existing


----- Denotes Existing

————— Denotes New Construction


Elevations, Benchmarks and Dimensions are based on "AS-BUILT" plans. Contractor shall verify all controlling field dimensions before ordering or fabricating any material.

DESIGNED BY: Frank Muchmore	CHECKED BY: ELMER E. MARX	LAYOUT BY: Frank Muchmore	CHECKED BY: Sam Sallie
DRAWN BY: Sam Sallie	CHECKED BY: ELMER E. MARX	SPECIFICATIONS BY: Frank Muchmore	PLANS & SPEC. COMPARED: ELMER E. MARX
QUANTITIES BY: Frank Muchmore	CHECKED BY: ELMER MARX	APPROVAL RECOMMENDED BY: [Signature]	

STATE OF ALASKA
DEPARTMENT OF TRANSPORTATION
AND PUBLIC FACILITIES
BRIDGE SECTION

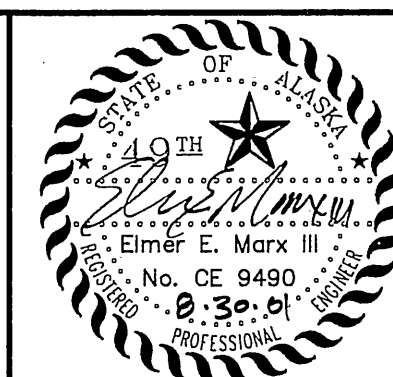

BIRD CREEK BRIDGE
SEWARD HIGHWAY
GENERAL LAYOUT

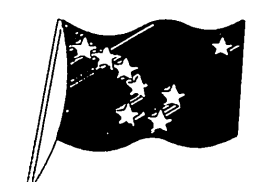

BRIDGE NO. 643
DWG. NO. 1

STATE	PROJECT DESIGNATION	YEAR	SHEET NO.	TOTAL SHEETS
ALASKA	NH-OA3-I(28)/54433	2001	N2	N5

GENERAL NOTES

SPECIFICATION:

Design: AASHTO Standard Specifications for Highway Bridges, 1996 with latest Interims.

Construction: State of Alaska Standard Specifications for Highway Construction 1998 with Standard Modifications and Special Porvisions.

DESIGN STRENGTH:

Cast in Place Concrete: f'c = 28 MPa

Reinforcing Steel: fy = 420 MPa

Structural Steel: fy = 250 MPa

STRUCTURAL MATERIALS:



Concrete: Use Class "A" Concrete.

Reinforcing Steel: Use ASTM A615M, Grade 420.




Structural Steel: Use ASTM A709M, Grade 250, unless otherwise noted.

Use ASTM A500, Grade B for drain tubes.

Galvanize deck drains in accordance with AASHTO M111.

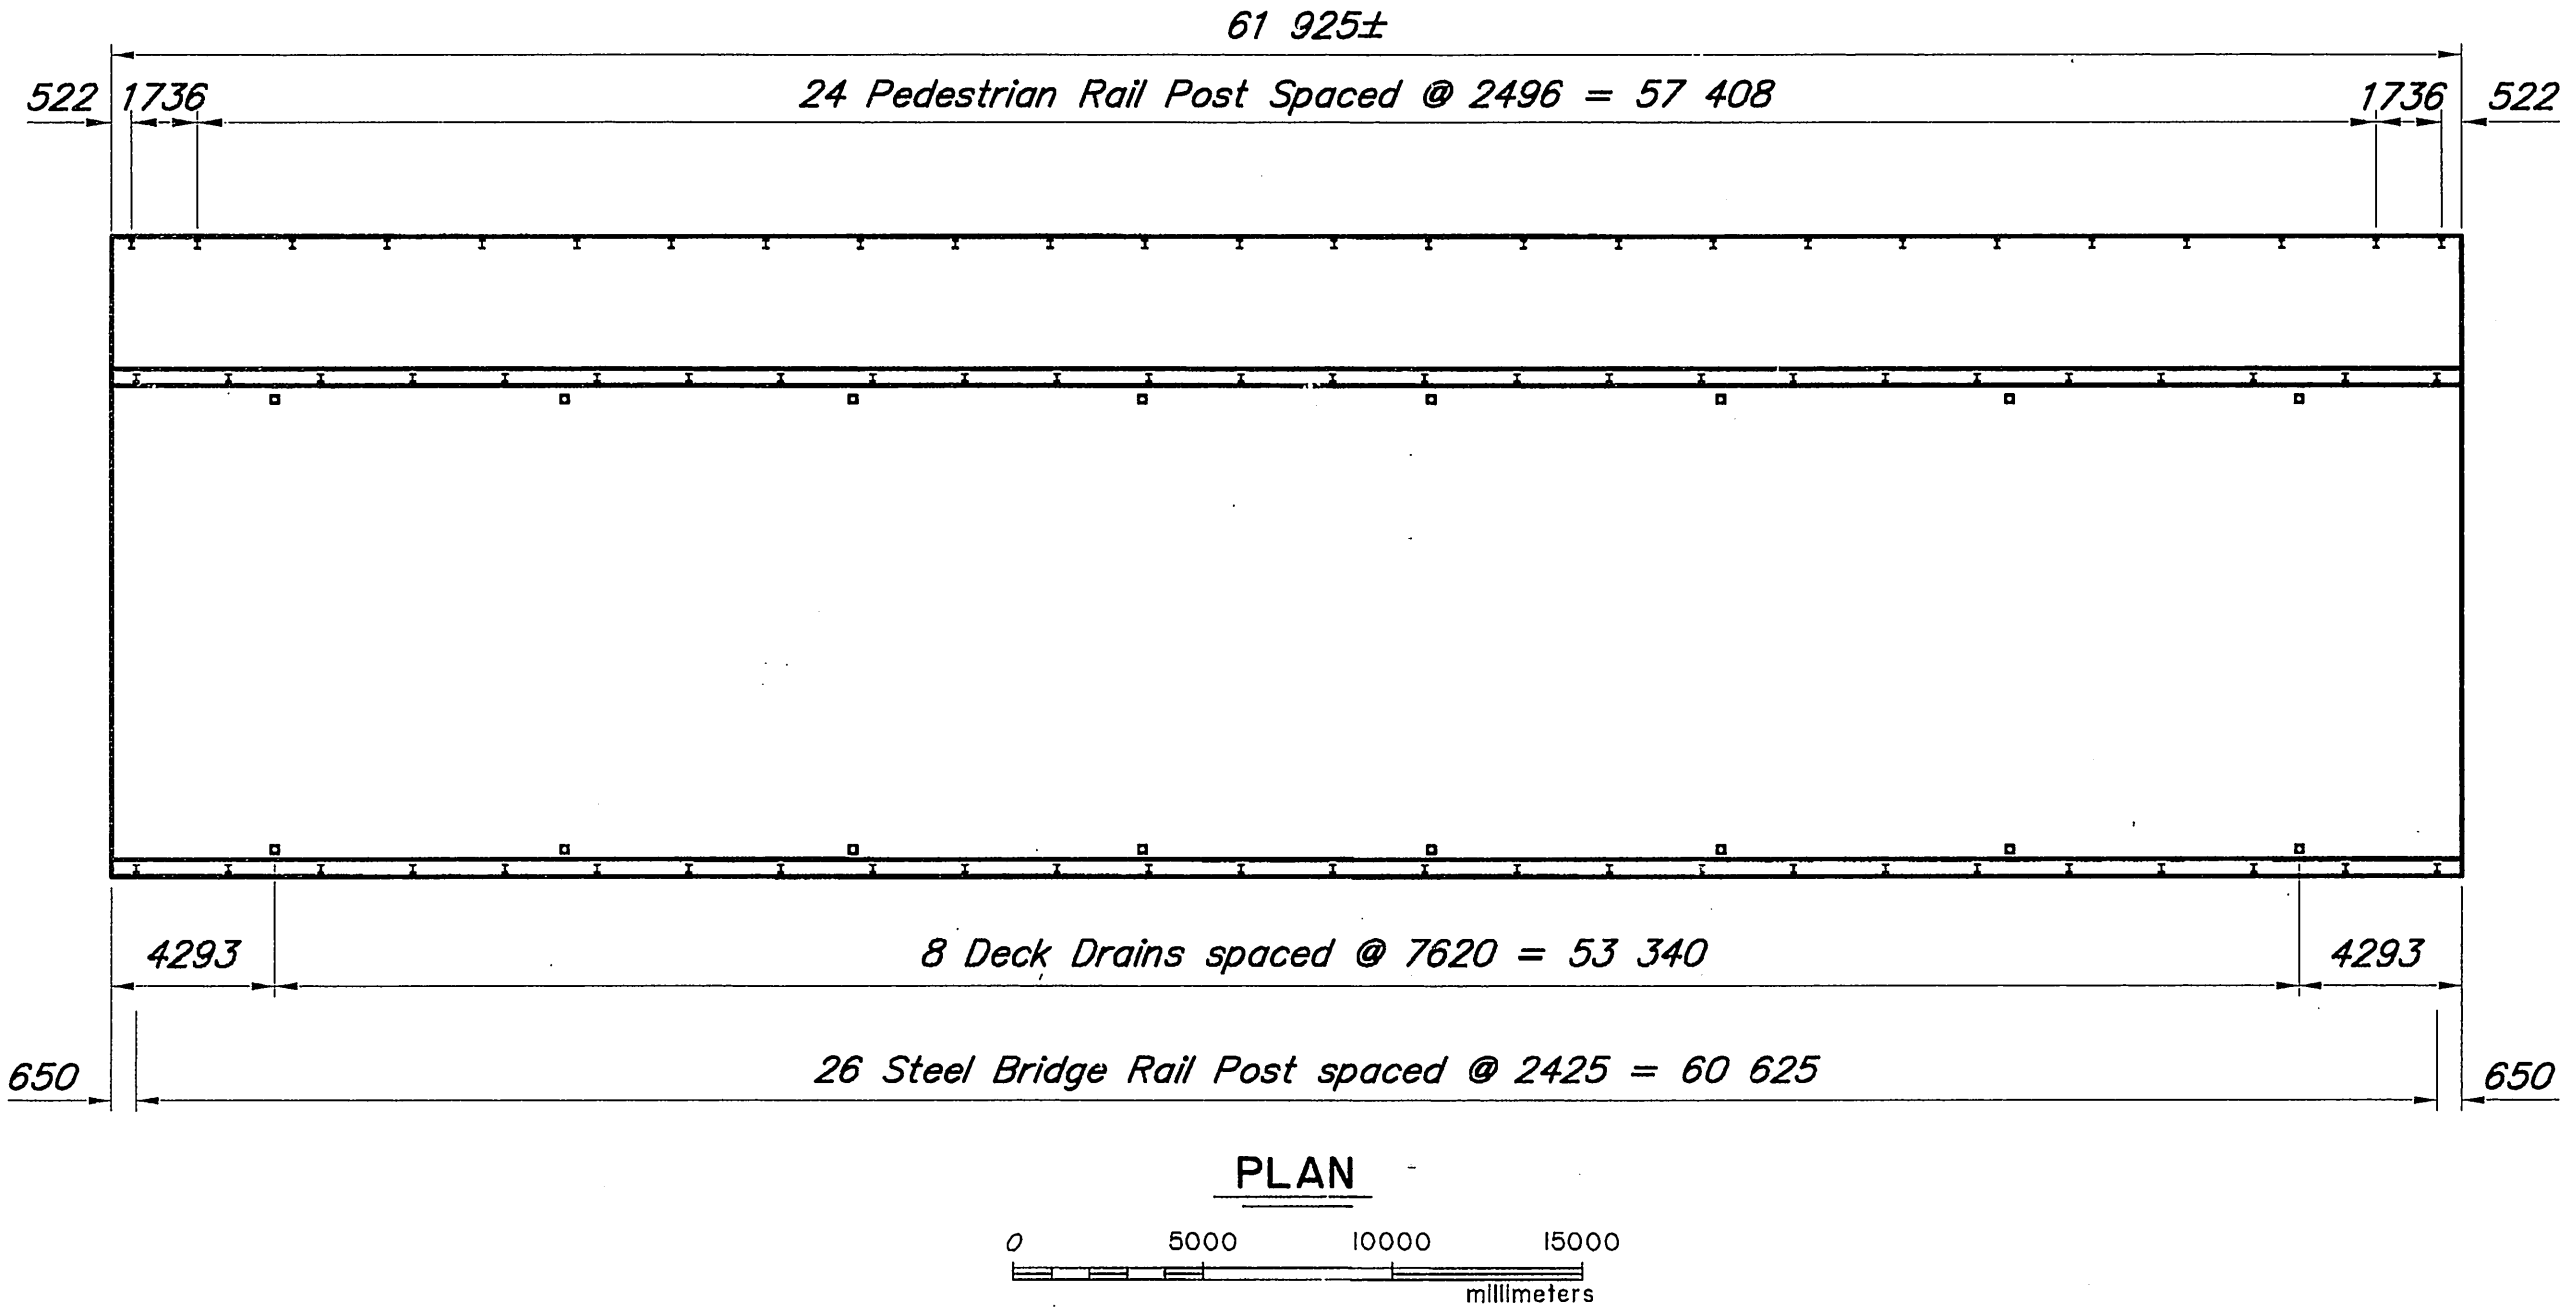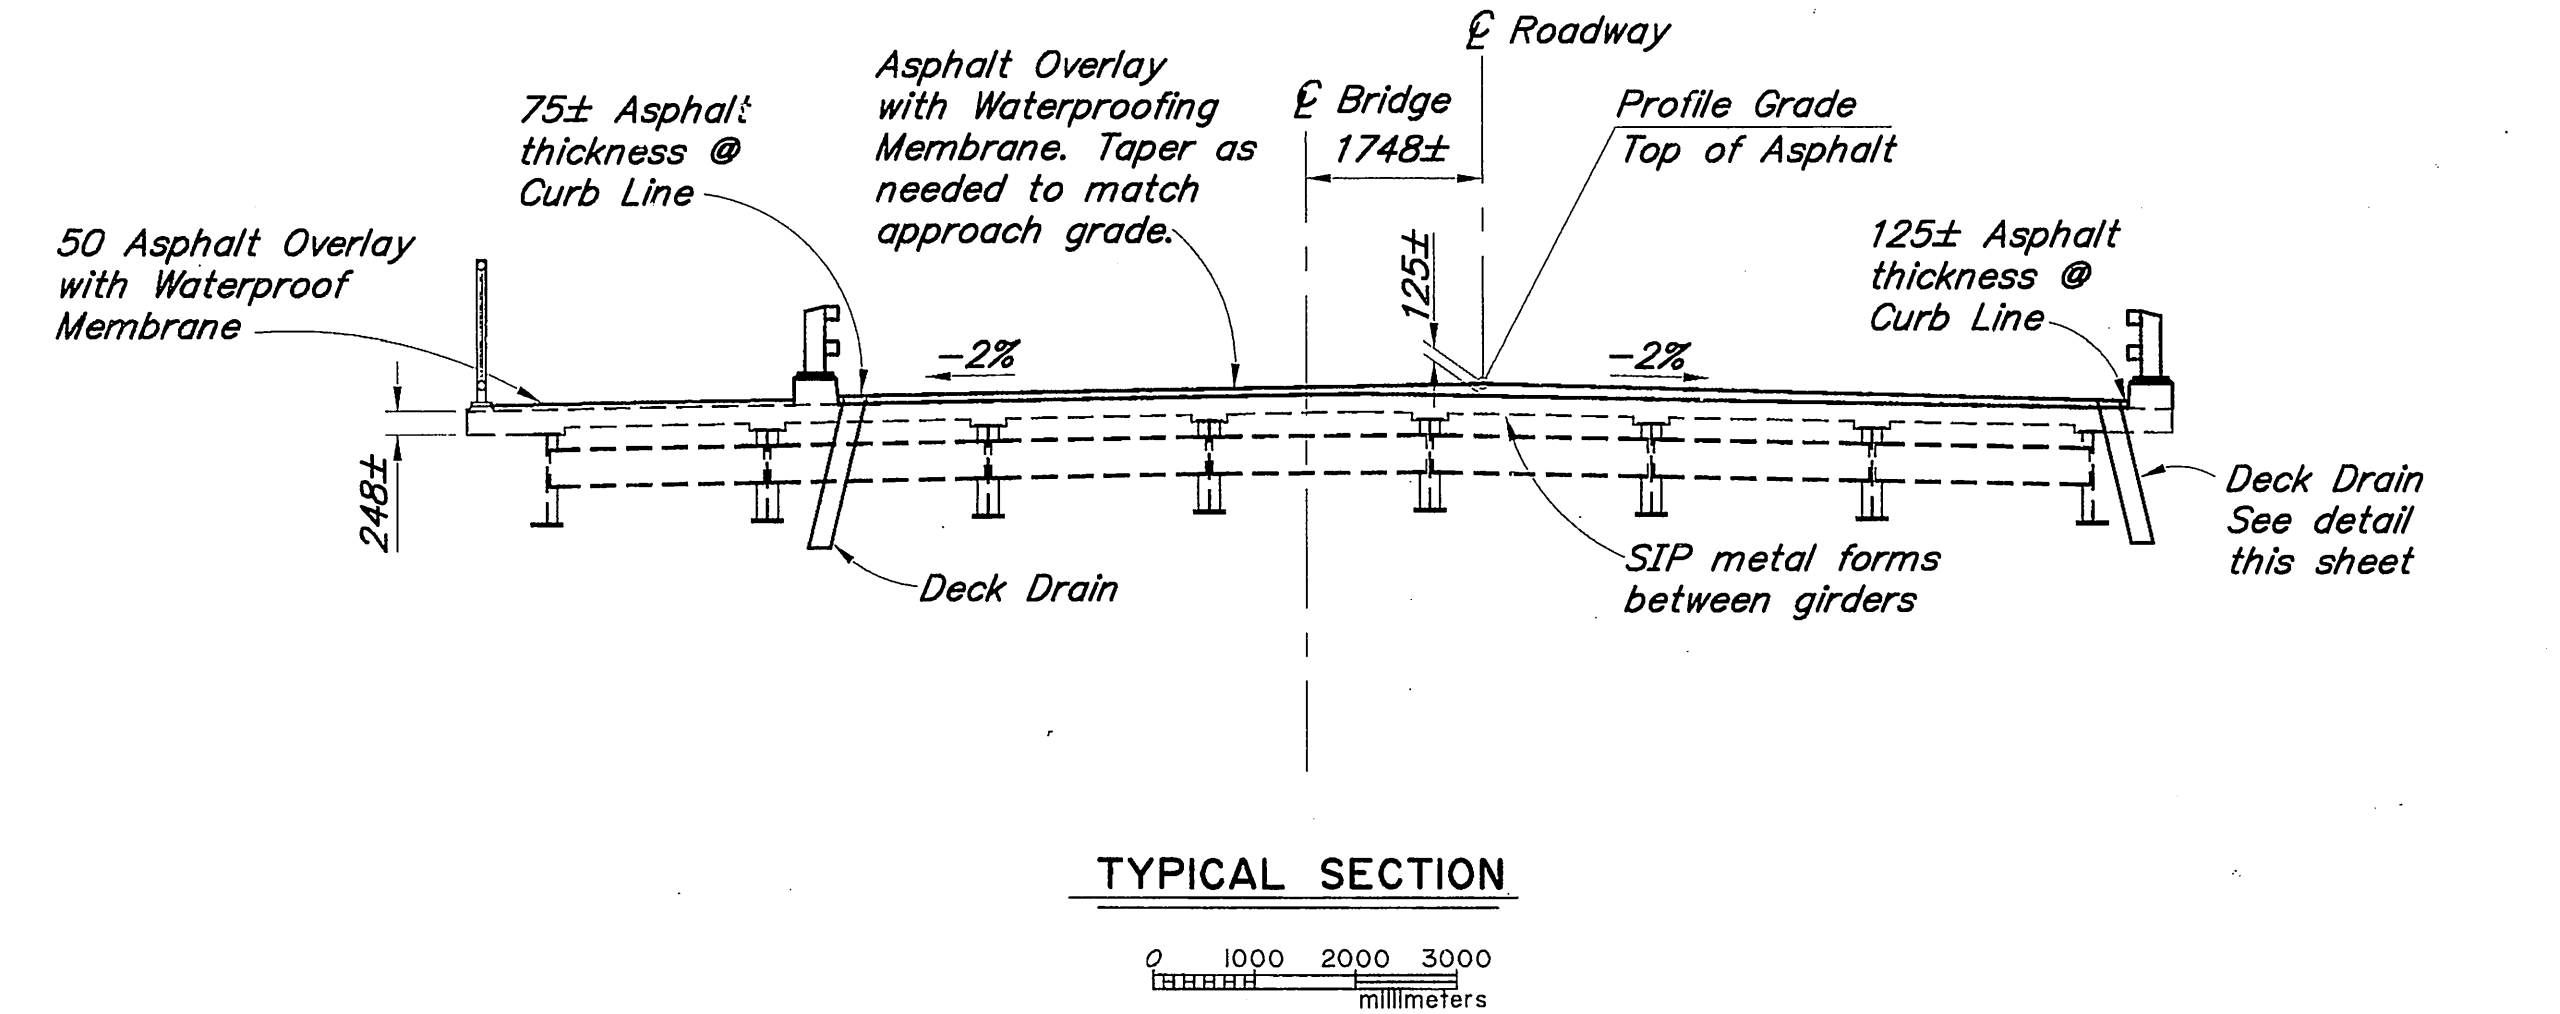

ESTIMATE OF QUANTITIES				
ITEM NO.	ITEM	UNIT	SUPERSTR.	TOTAL
202(1)	Removal of Structures & Obstructions	LS	All Req'd	All Req'd
401(1)	Asphalt Concrete, Type II, Class A	Mg	216	216
401(2)	Asphalt Cement, Grade 52-28	Mg	12	12
504(1)	Structural Steel	LS-Kg	1040	1040
507(1)	Steel Bridge Railing	m	123.85	123.85
507(2)	Pedestrian Railing	m	61.925	61.925
508(1)	Waterproofing Membrane	LS-SM	996	996
606(12)	Guardrail/Bridge Rail Connection	EA	4	4

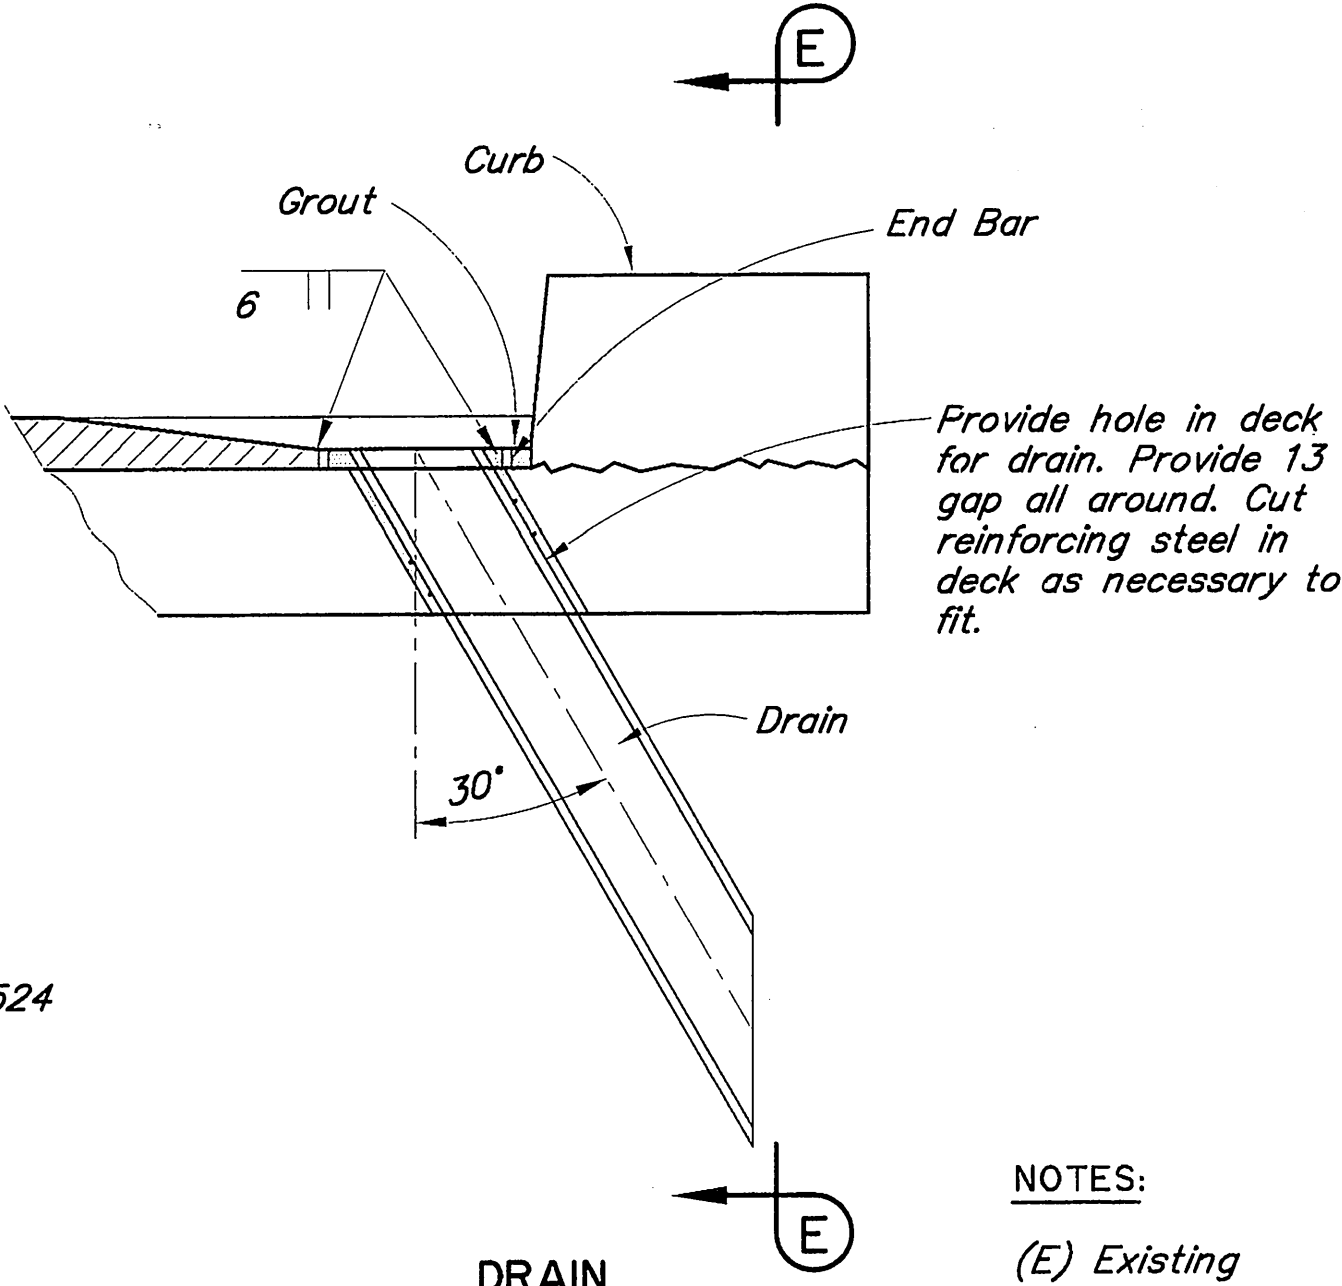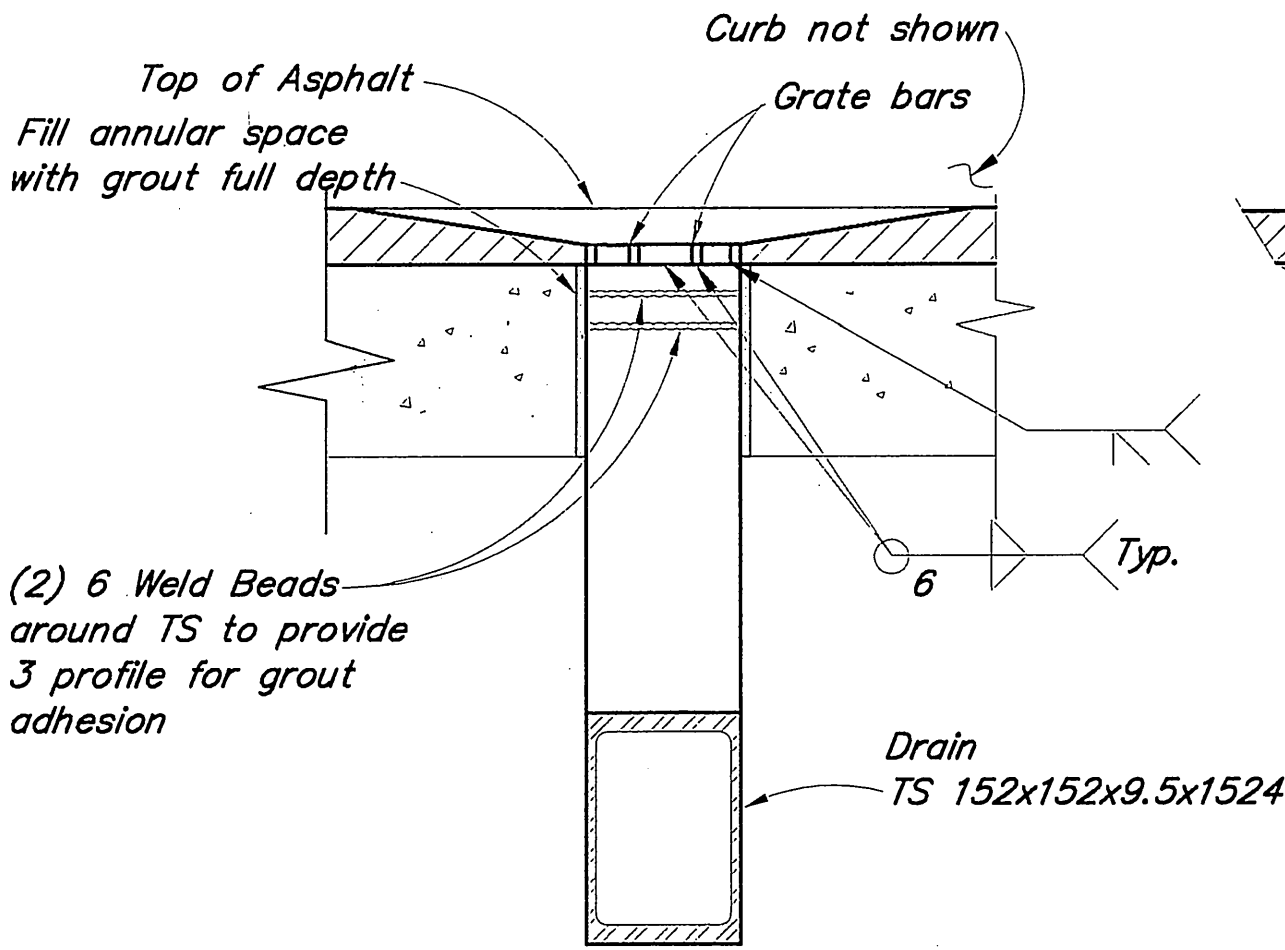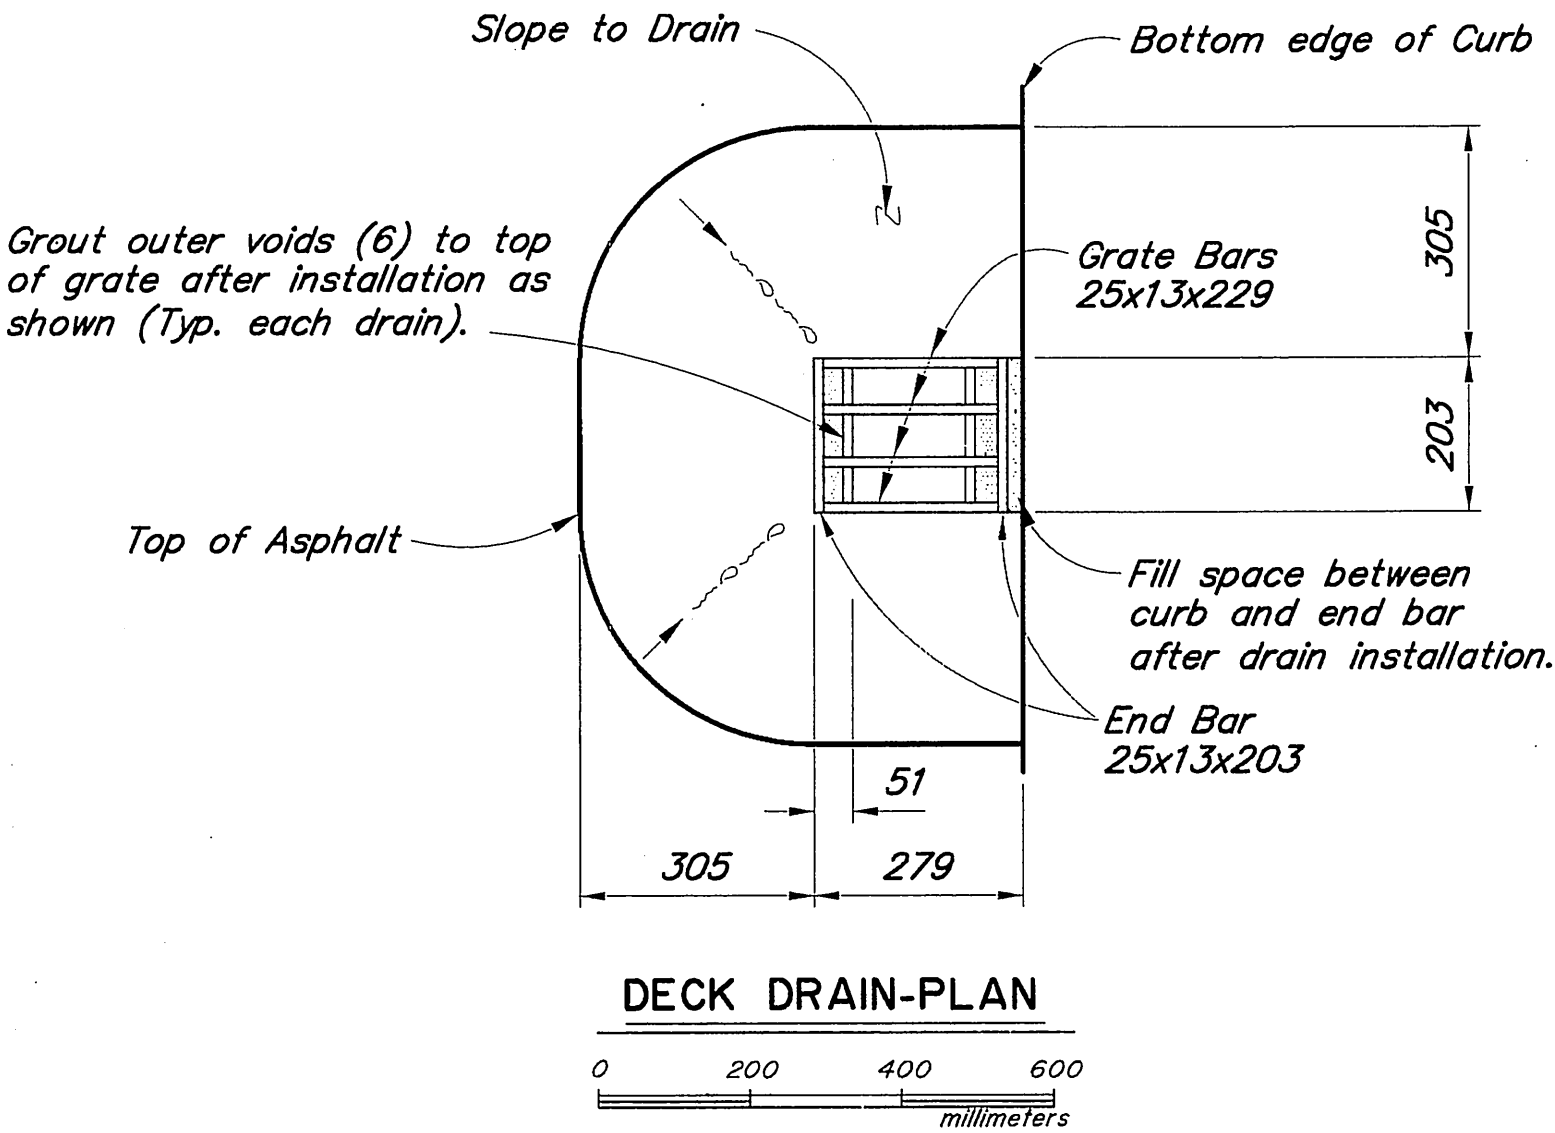

NOTES:

(E) Existing


----- Denotes Existing

————— Denotes New Construction


Elevations, Benchmarks and Dimensions are based on "AS-BUILT" plans. Contractor shall verify all controlling field dimensions before ordering or fabricating any material.

DESIGNED BY: Frank Muchmore	CHECKED: ELMER E. MARX	STATE OF ALASKA DEPARTMENT OF TRANSPORTATION AND PUBLIC FACILITIES BRIDGE SECTION		BIRD CREEK BRIDGE SEWARD HIGHWAY TYPICAL SECTION	 BRIDGE NO. 643 DWG. NO. 2
DRAWN BY: Sam S. S. S.	CHECKED: ELMER MARX				
QUANTITIES BY: Frank Muchmore	CHECKED: ELMER MARX				


STATE	PROJECT DESIGNATION	YEAR	SHEET NO.	TOTAL SHEETS
ALASKA	NH-0A3-1(28)/54433	2001	N3	N5

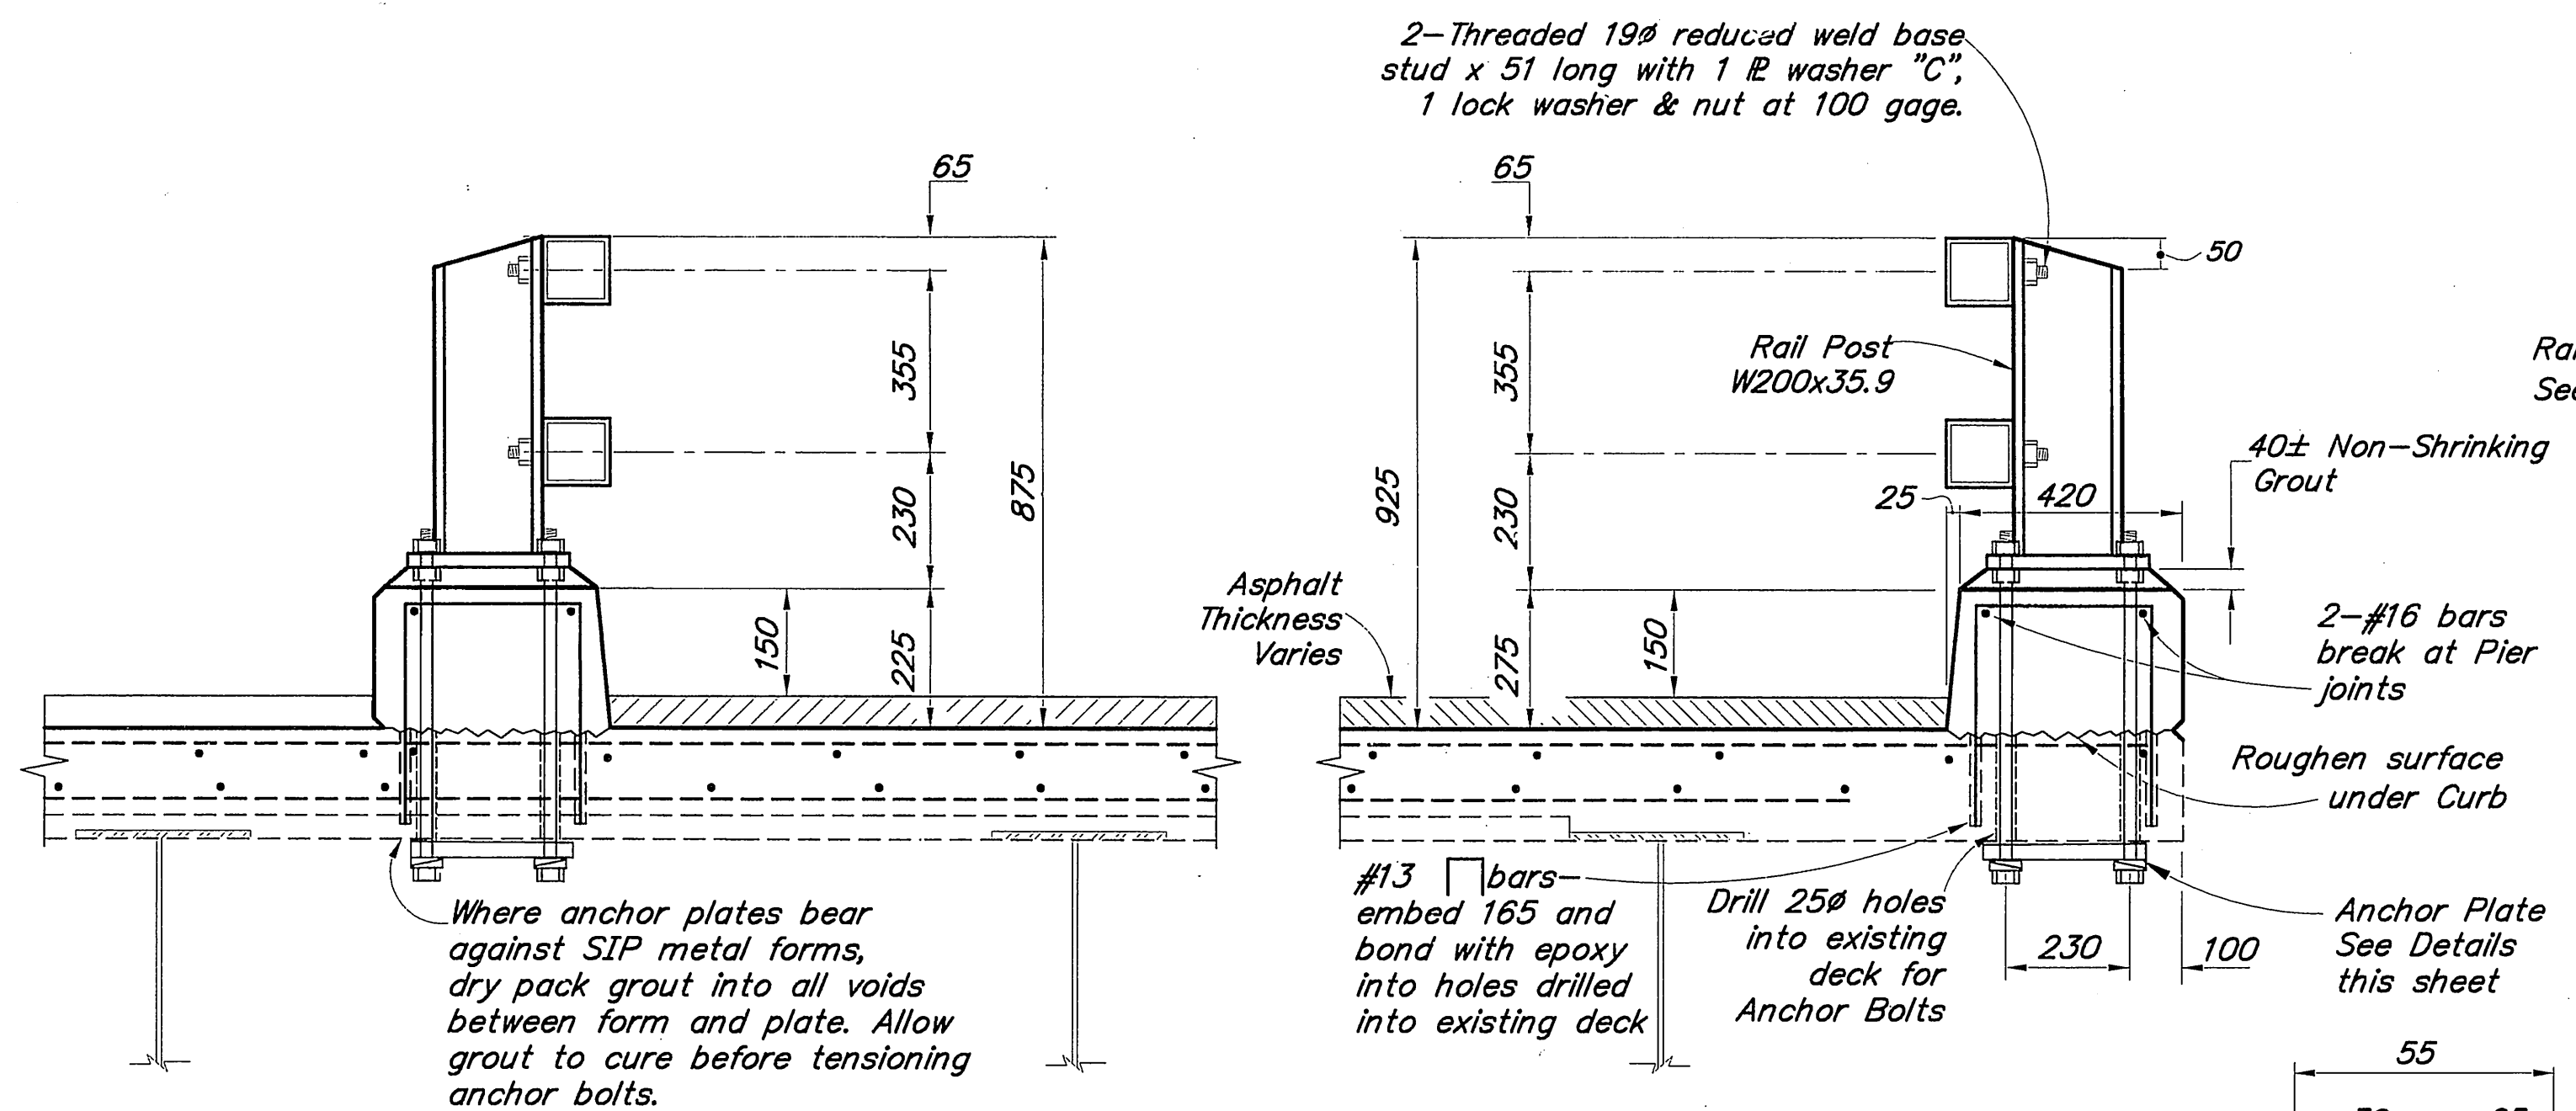

TYPICAL SECTION

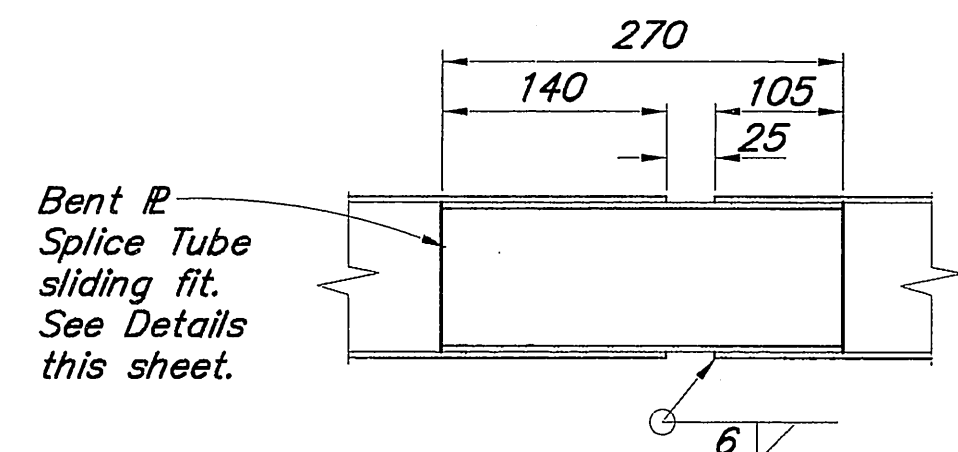

RAIL SPLICE DETAIL

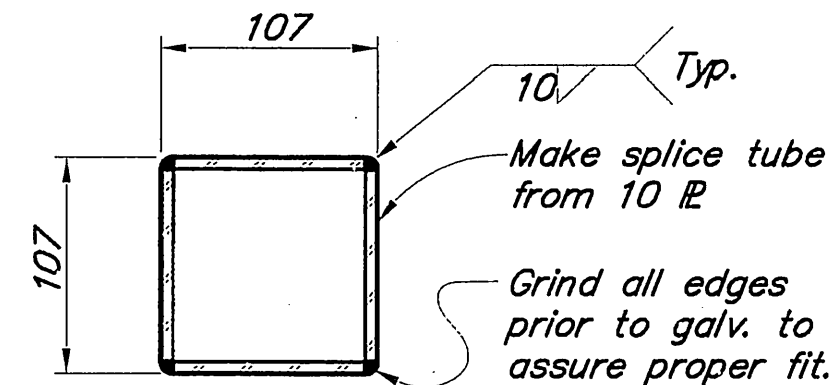

SPLICE TUBE



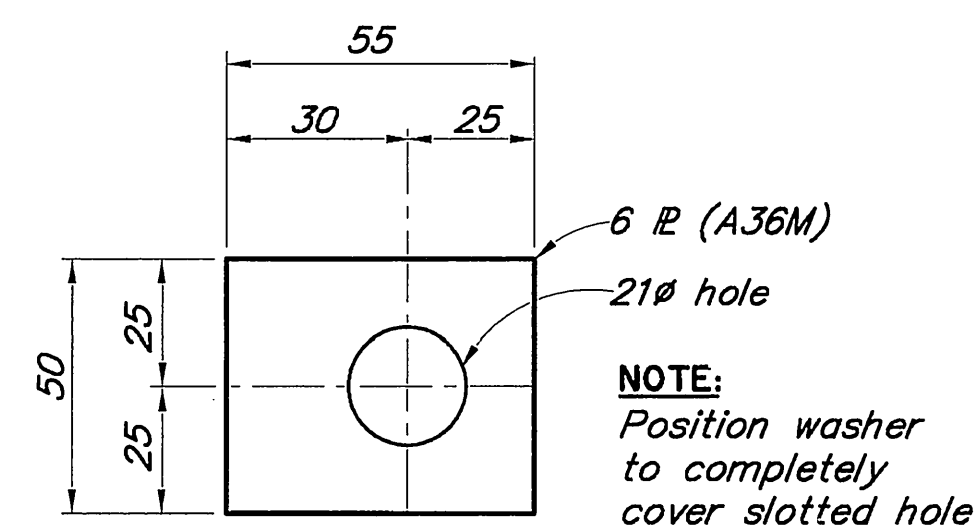



PLATE WASHER "C"

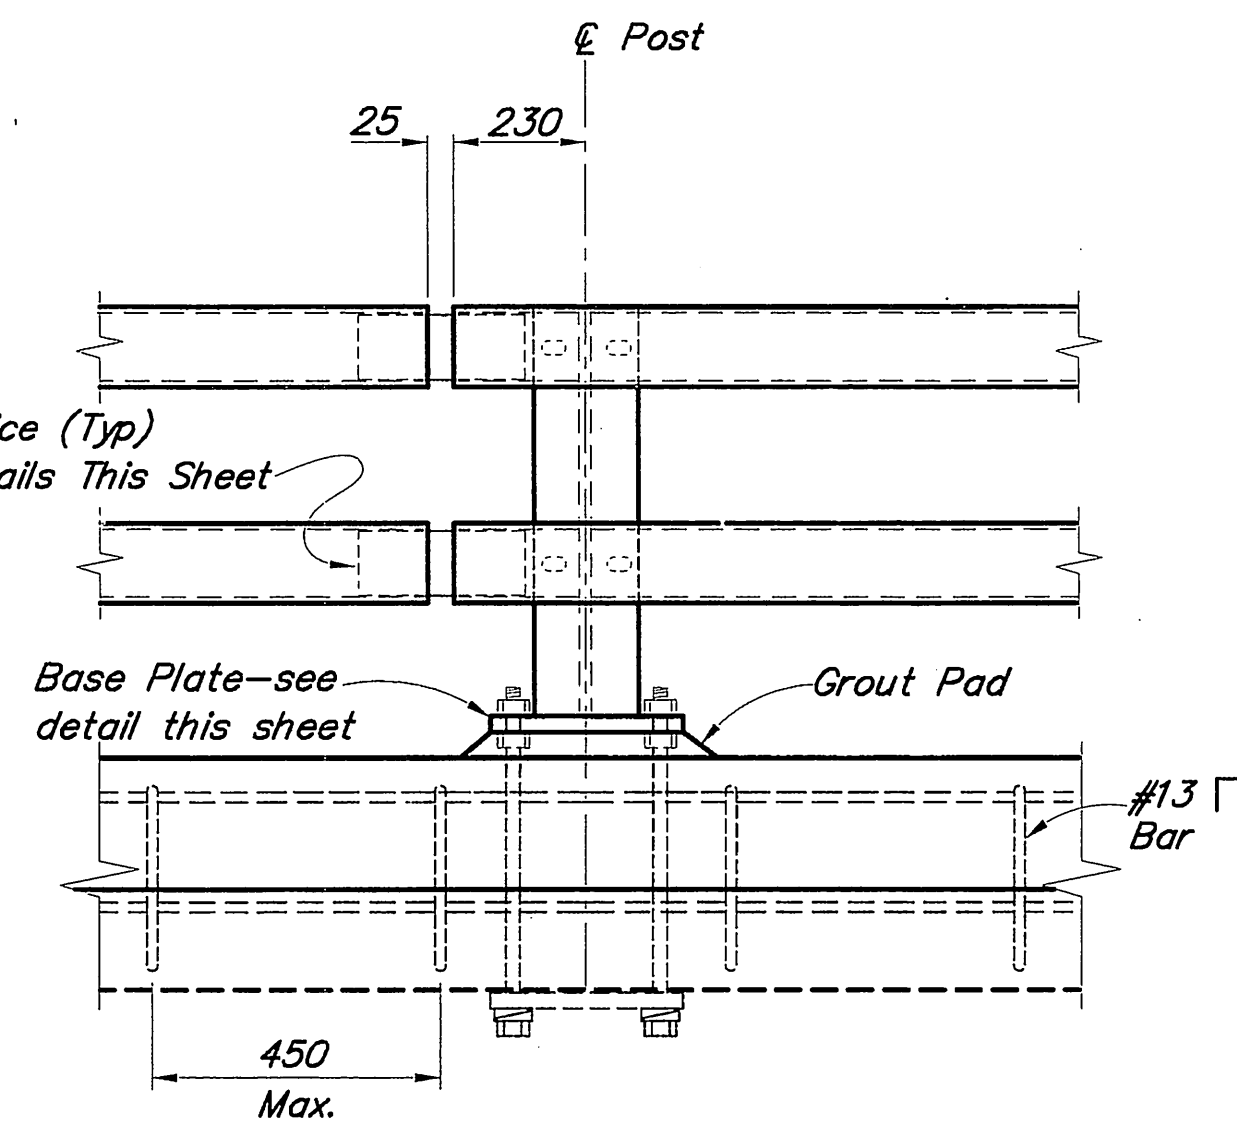


EXPANSION JOINT

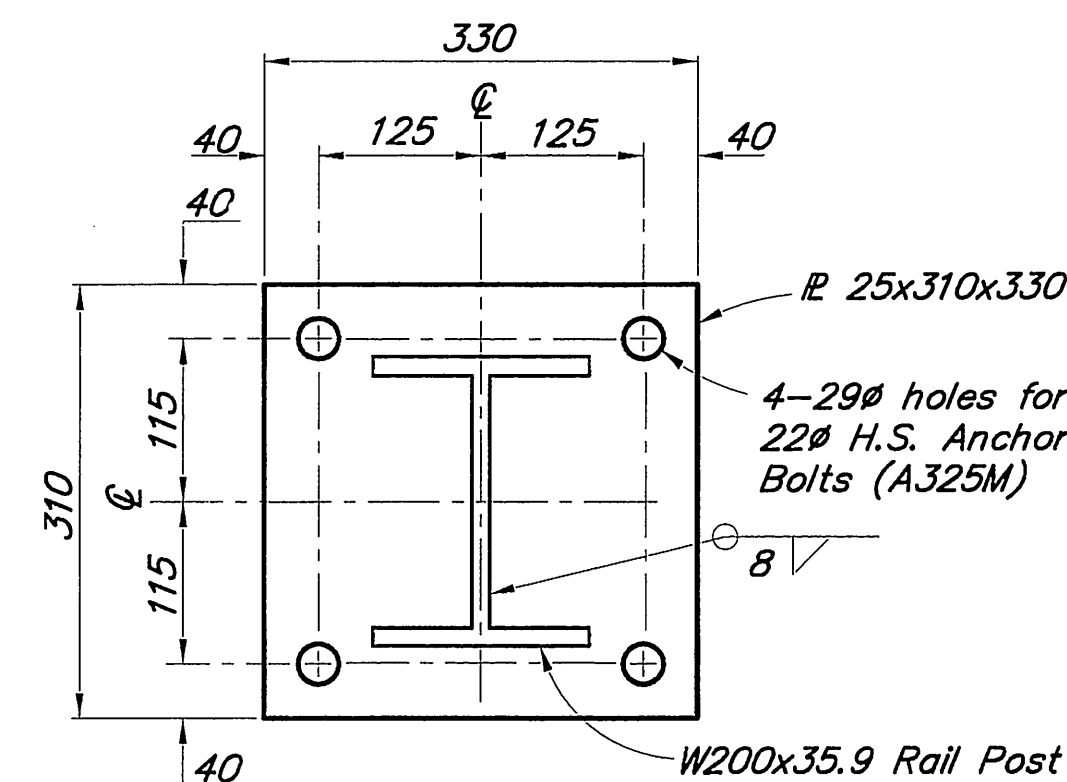

BASE PLATE DETAIL

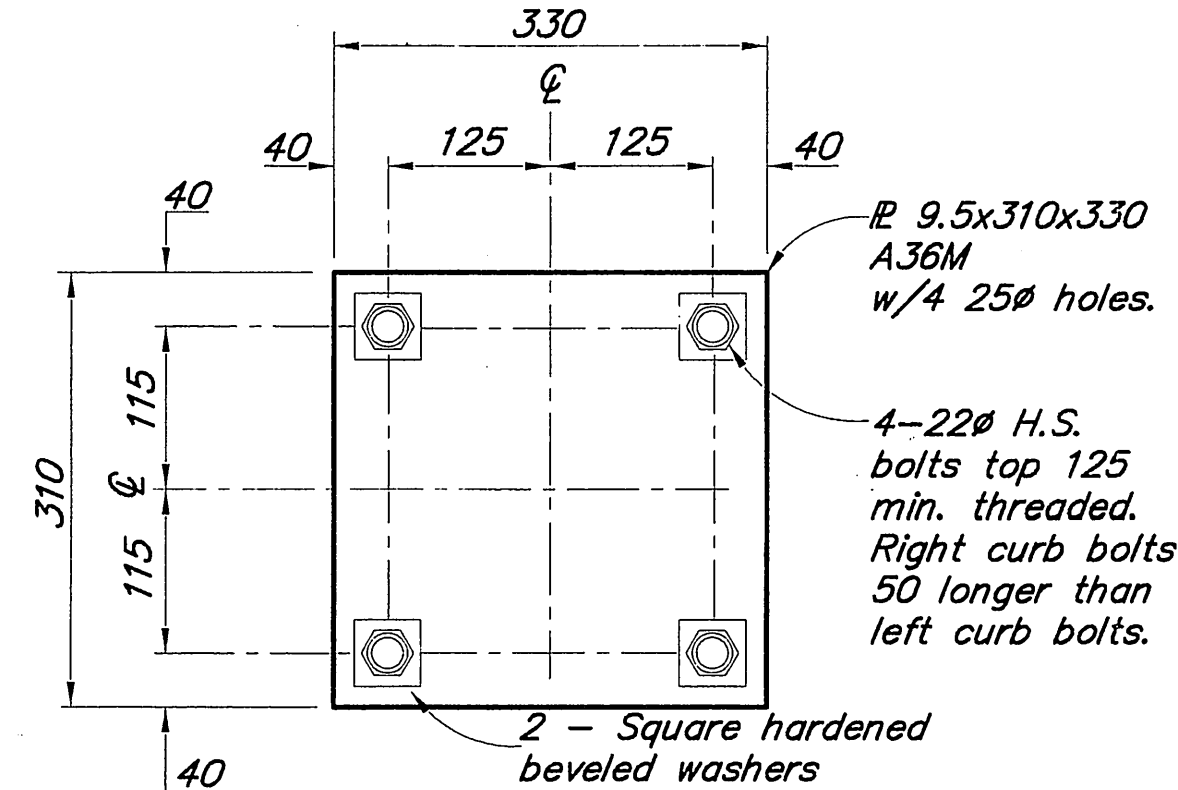


ANCHOR PLATE DETAIL

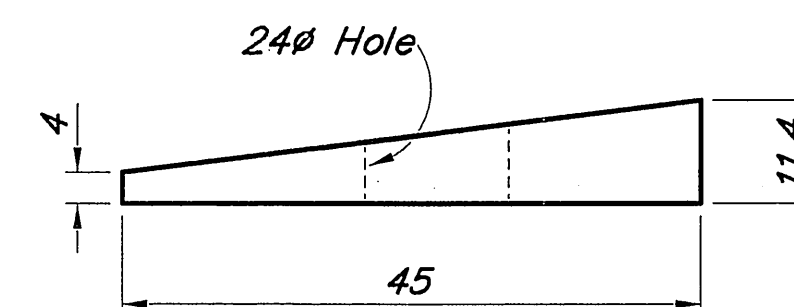

TYPE B SQUARE HARDENED BEVELED WASHER


(See Note 9)

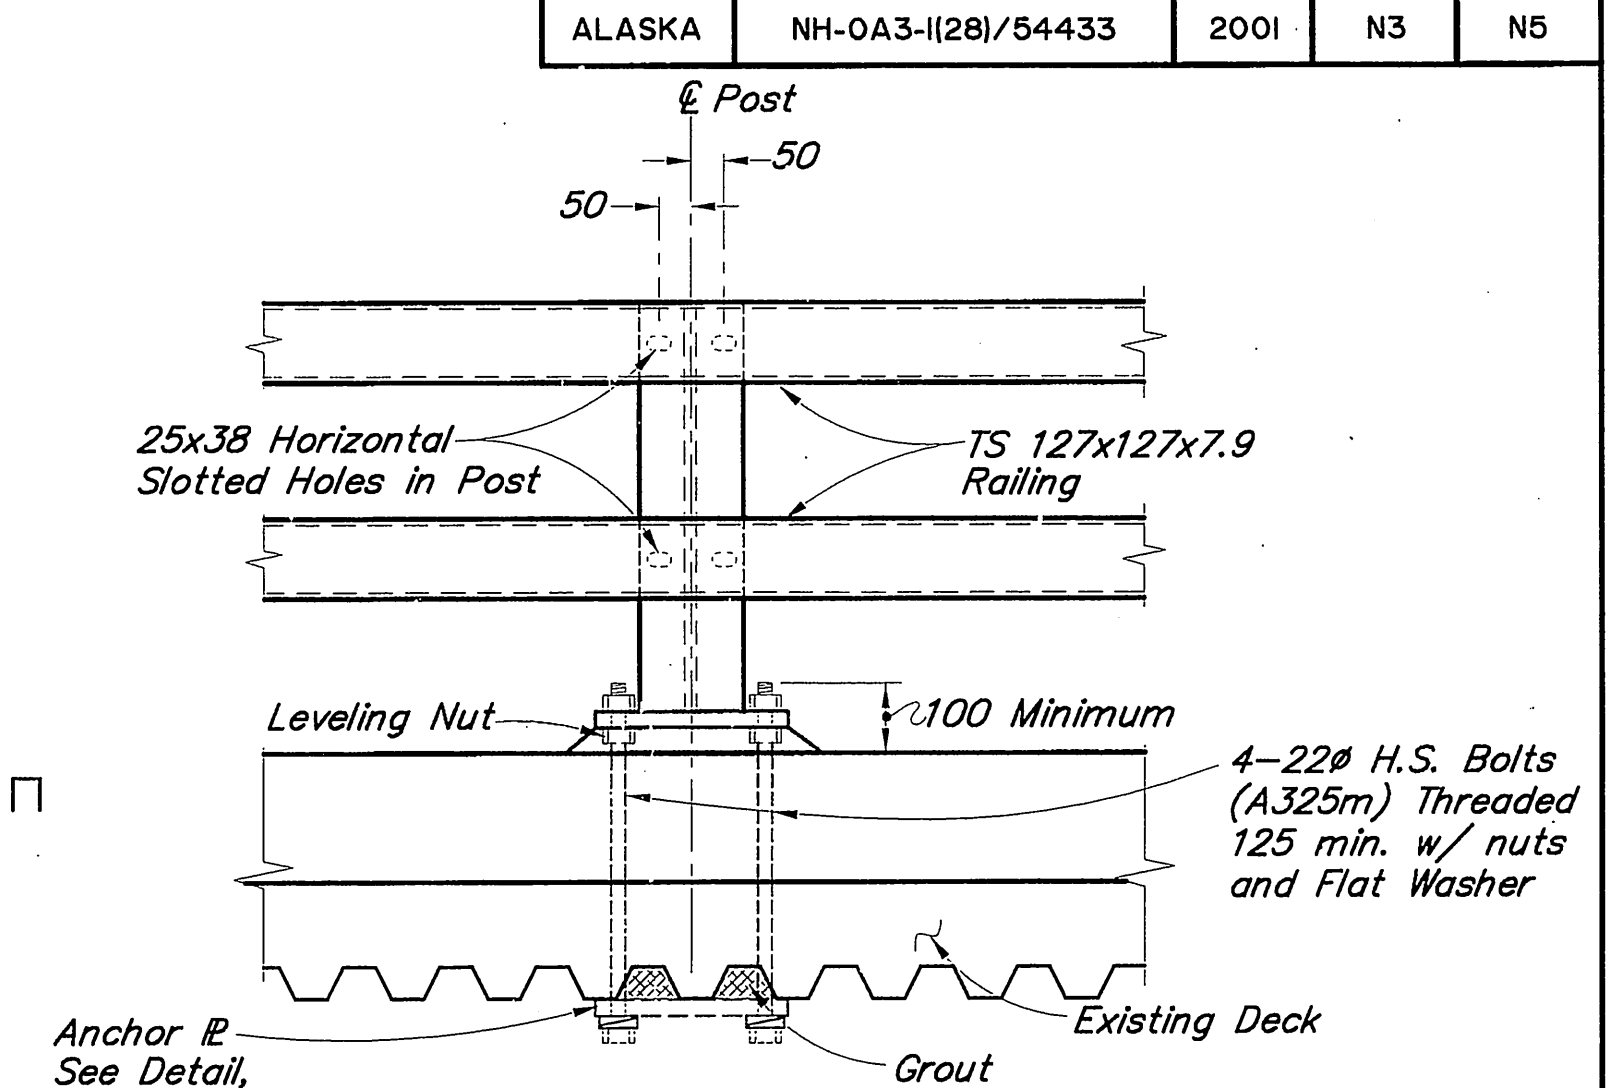


TYPICAL POST ELEVATION

NOTES

1. Remove existing bridge number plates from existing railposts. Relocate existing bridge number plates to right hand side of approaching traffic at each end as shown (2 Total). Attach bridge number plates to new post with 4-60x25 ribbed neck carriage bolts with steel tamper proof nuts (McMaster-Carr 90084A029 or approved equal), galvanized or cadmium plated.
2. All machine bolts shall have locking nuts or lock washers.
3. Railing expansion joints must be provided at 15 000 maximum intervals throughout the railing. Railing shall be continuous over 2 posts minimum.
4. Posts shall be adjusted to a plumb position.
5. Thrie beam guardrail transition "NESTED" sections shall be installed one section on each side of transition bracket, typical either end of bridge. Ref. Dwg. No. 5.
6. Grout for railposts shall conform to Section 701.
7. See "TYPICAL SECTION" drawing 5 for rail post spacing.
8. Place 13 joint filler full depth of curbs at existing deck joints.
9. Adjust 2 beveled washers so that each rail post anchor bolt is vertical and fully bearing on washers.

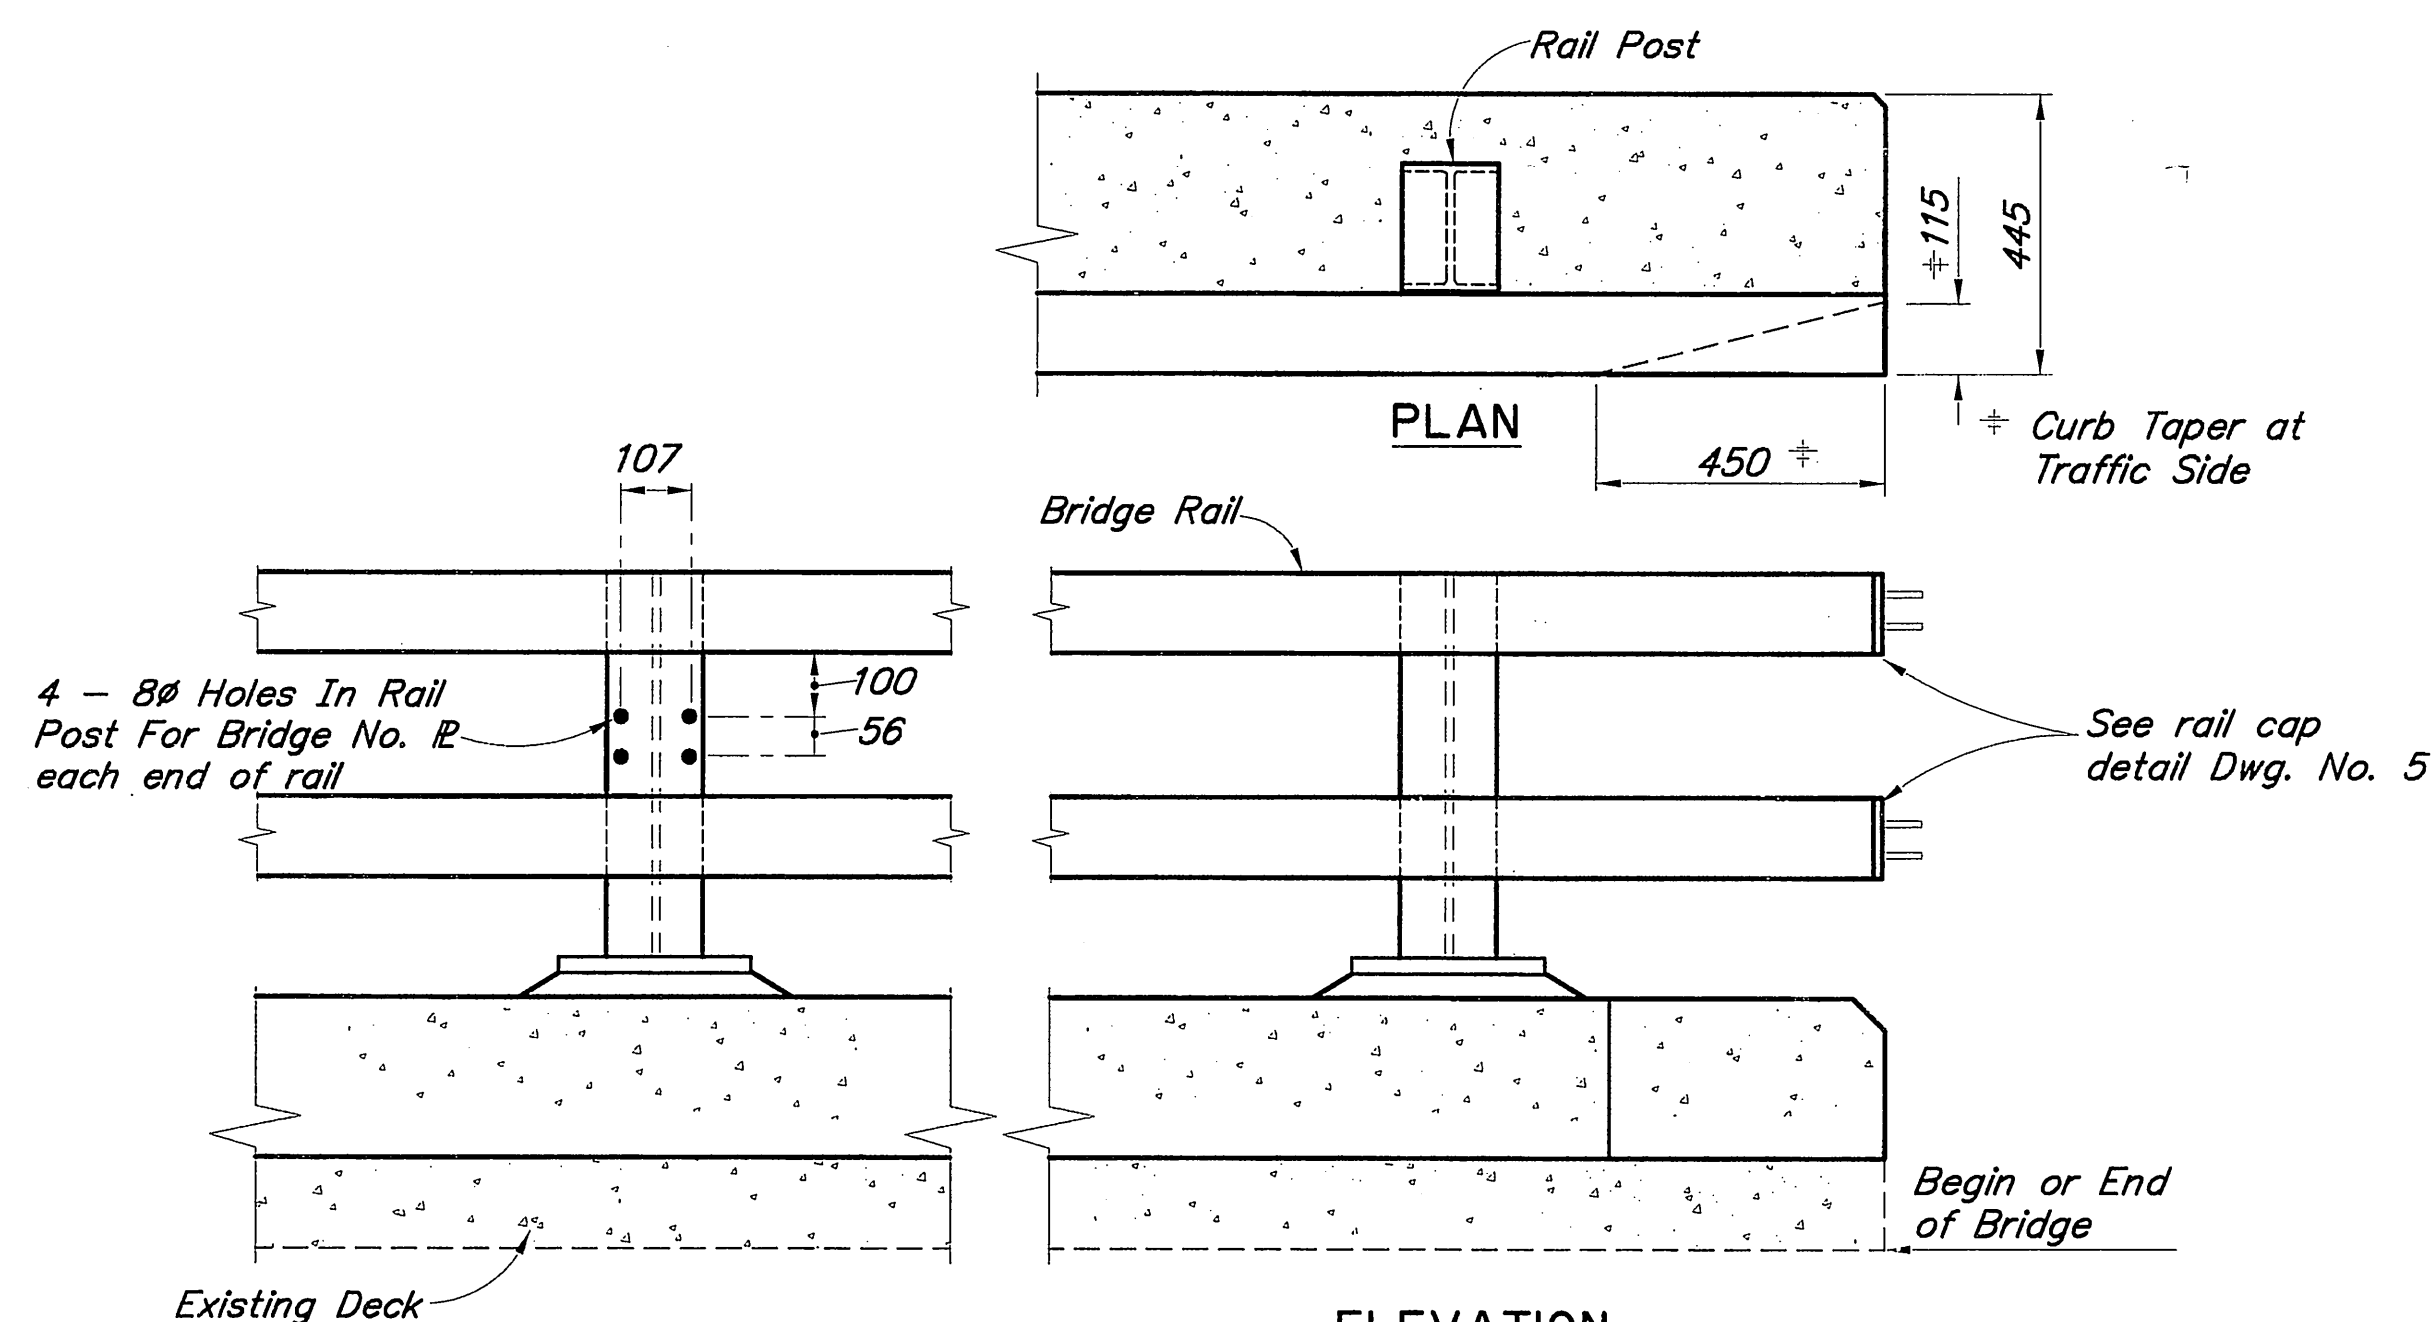

RAIL CAP ATTACHMENT TO 2-TUBE BRIDGE RAIL

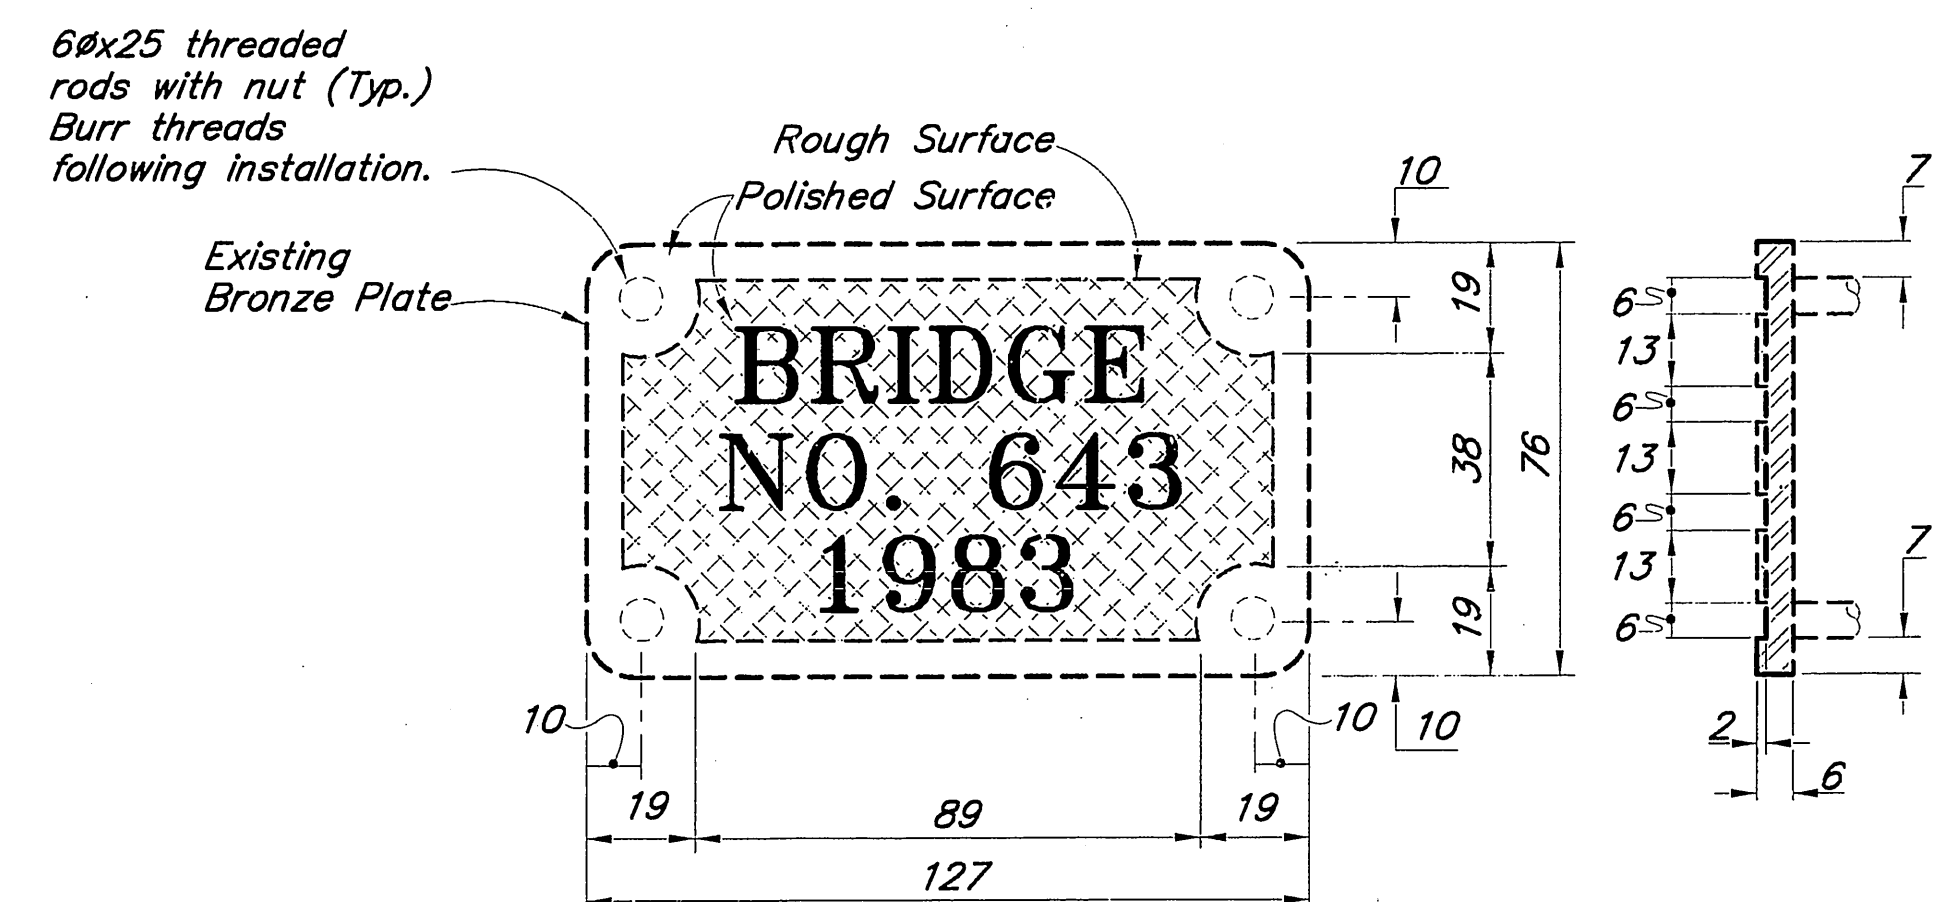


EXISTING BRONZE BRIDGE NO. PLATE


No Scale

DESIGNED BY: Frank Muchmore	CHECKED: ELMER E. MARX	STATE OF ALASKA DEPARTMENT OF TRANSPORTATION AND PUBLIC FACILITIES BRIDGE SECTION		BIRD CREEK BRIDGE SEWARD HIGHWAY STEEL BRIDGE RAILING	 BRIDGE NO. 643 DWG. NO. 3
DRAWN BY: Sa Soller	CHECKED: ELMER E. MARX				
QUANTITIES BY: Frank Muchmore	CHECKED: ELMER E. MARX				

REVISIONS			STATE	PROJECT DESIGNATION	YEAR	SHEET NO.	TOTAL SHEETS
No.	DATE	DESCRIPTION	ALASKA	NH-0A3-1(28)	2002	S1	S17

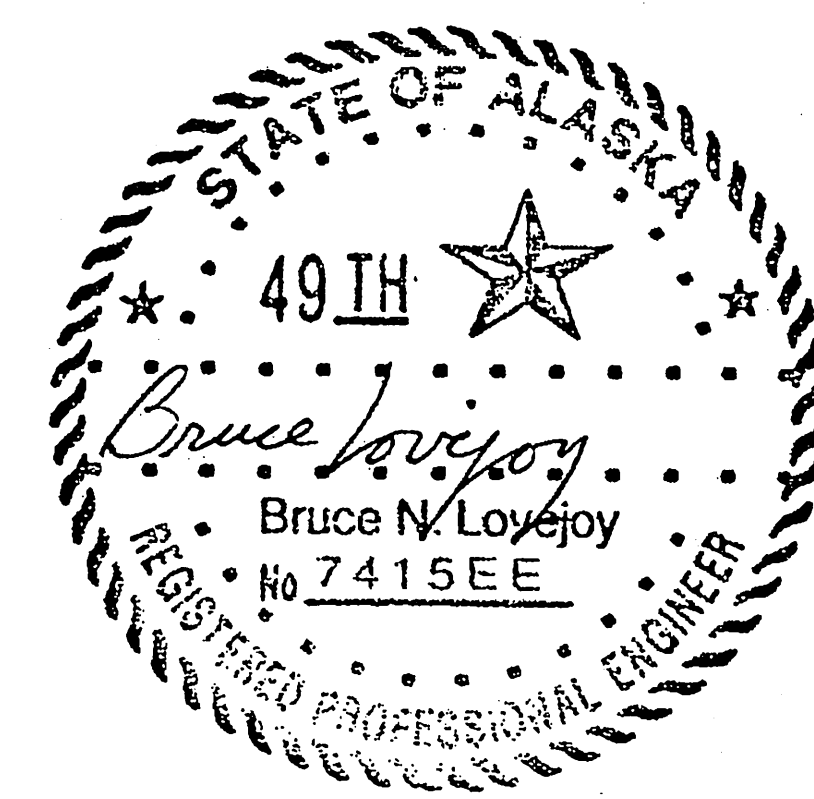

DESIGNED BY	1/29/02
CHECKED BY	CS
COMPUTER PREPARED BY	ALACAD-CAROLIE-MARE-AUDP

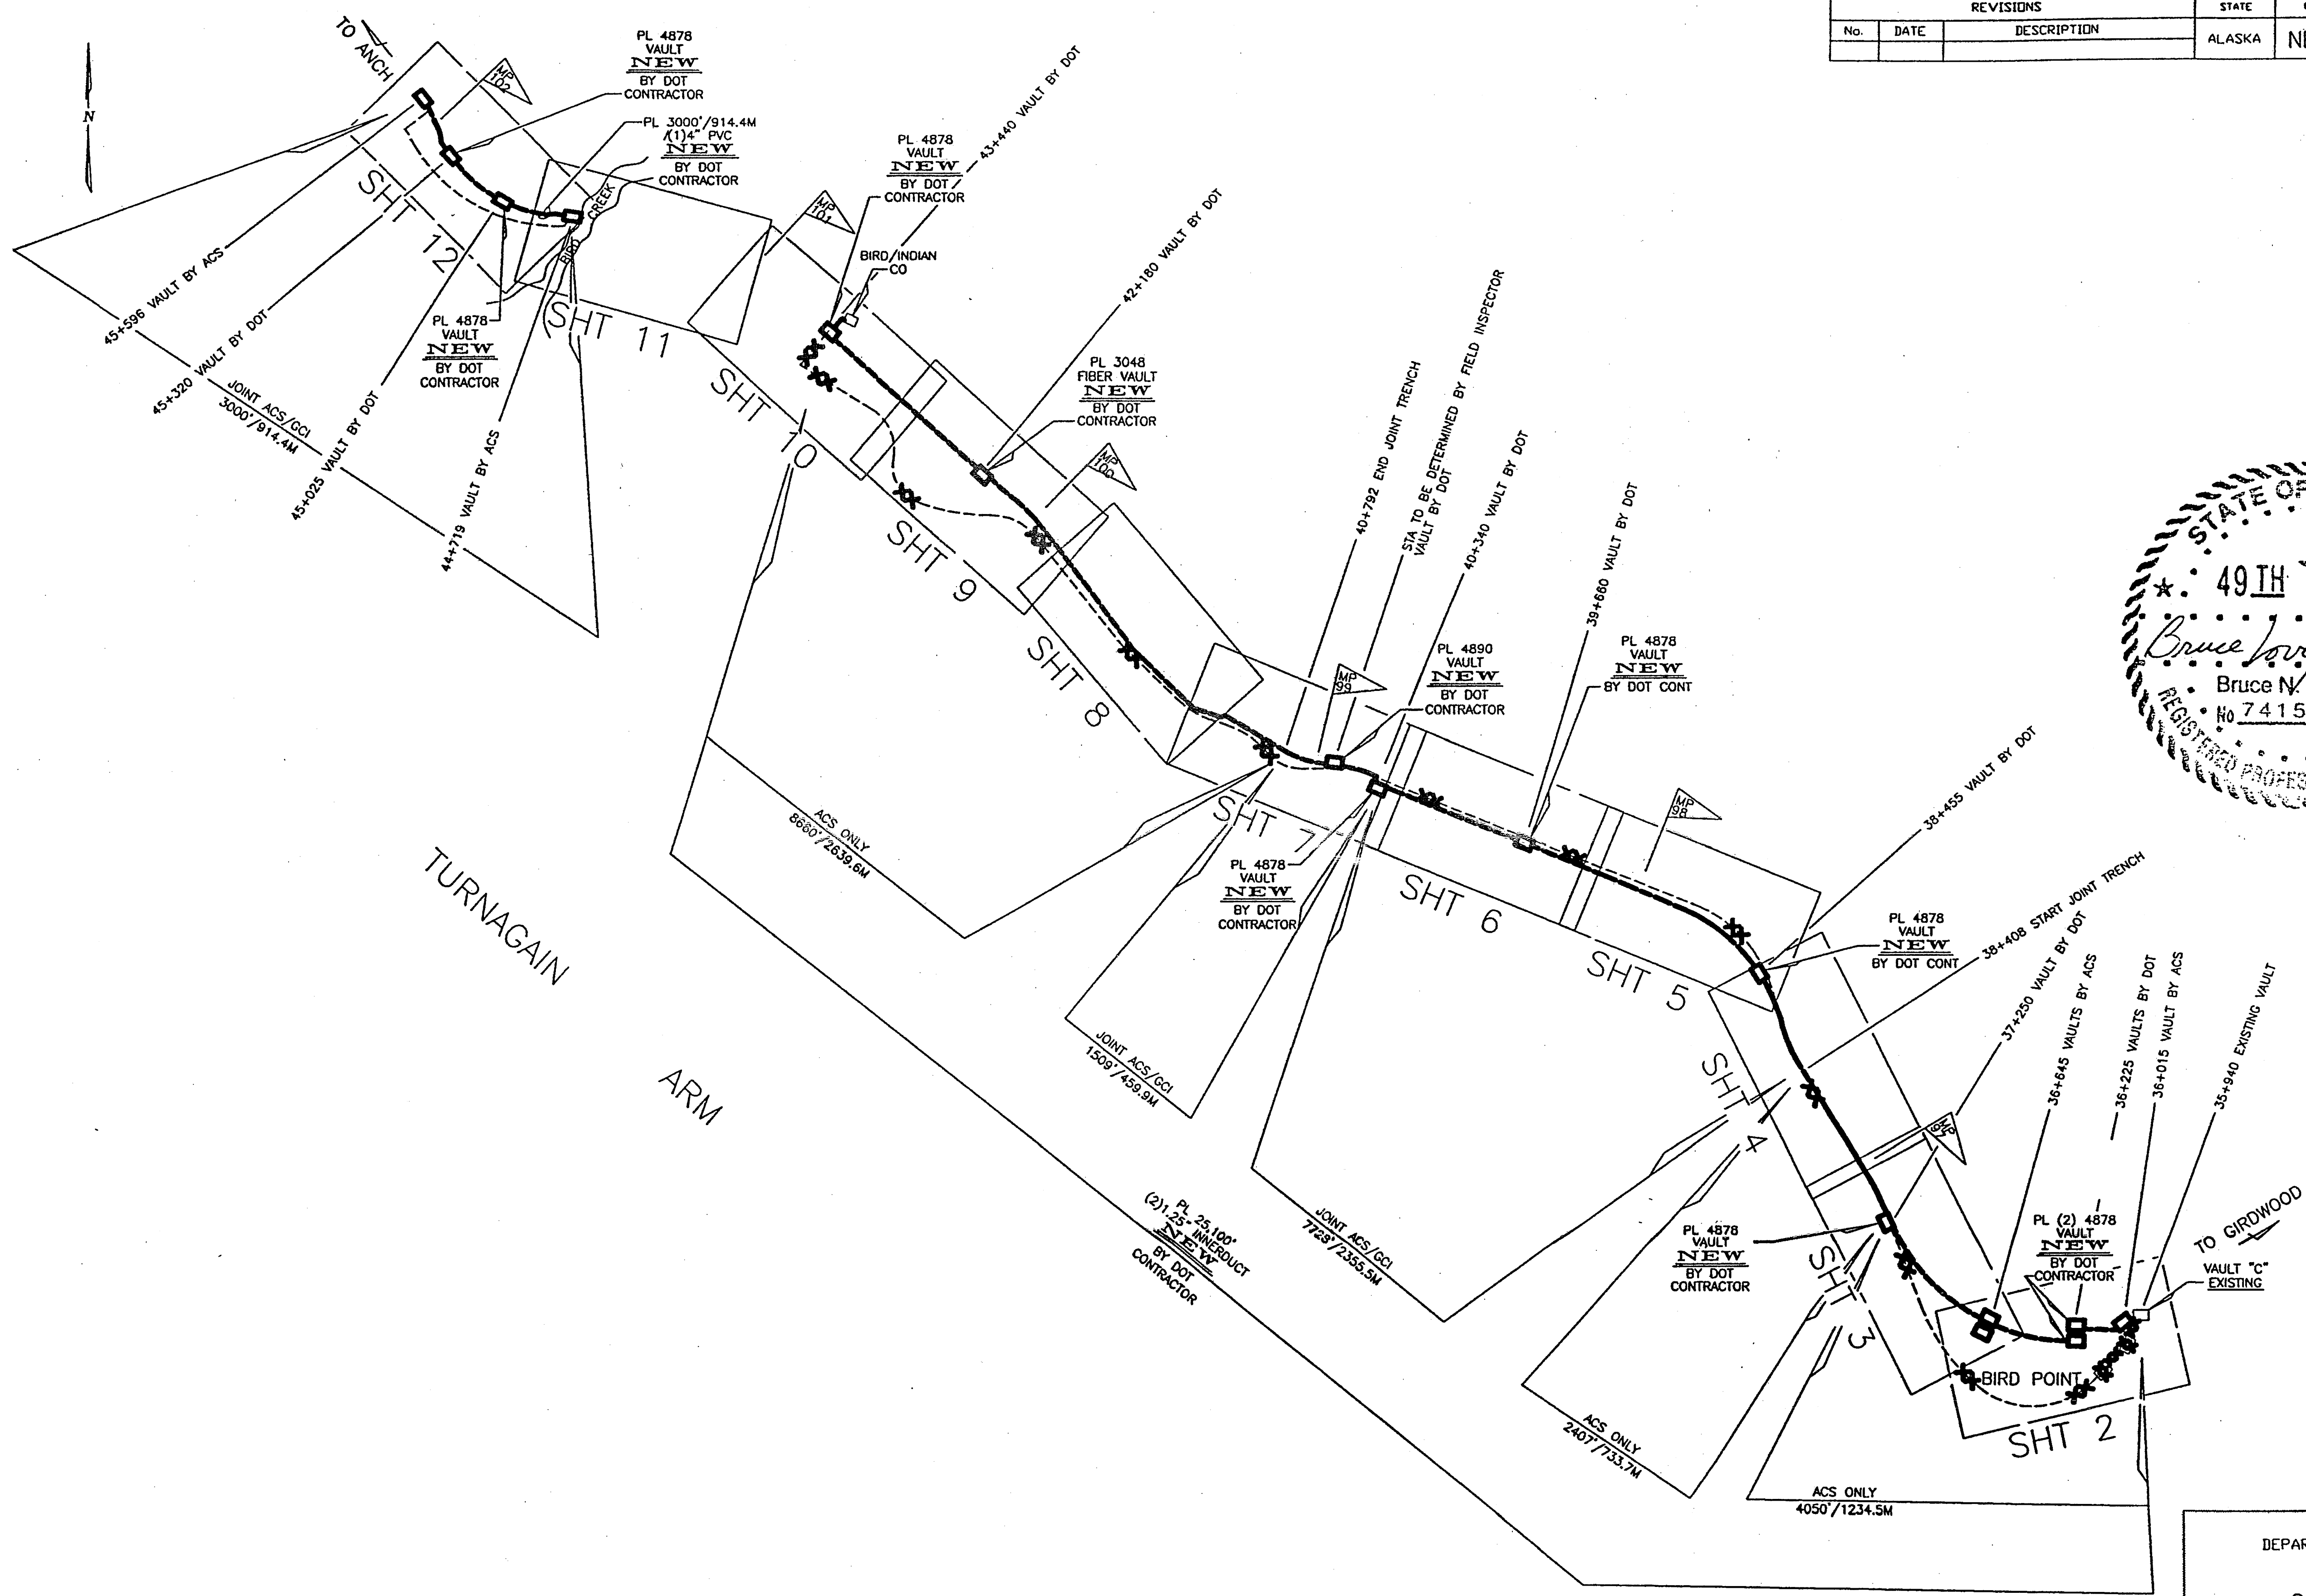

SHEETS 1-15 WORK BY DOT CONTRACTOR
SHEETS 16-30 WORK BY ACS OR ACS CONTRACTOR

TOWNSHIP ANCHORAGE		RANGE		SECTION		DA#	EFAP#	HOLD ORDER: YES NO		PERMITS: YES NO		CUTS REQ: YES NO		PRESSURE: YES NO	
ASSOCIATED WORK ORDERS		SOURCE MAPS		REVISION NUMBER-DATE-INITIALS		EXCHANGE	SR	TITLE: BIRD FLATS FIBER RELOCATION		W# (2001)		001-0519		SH. 1 OF 30 SHTS	
				REV. 01051901		CAD#		BOROUGH/CITY		SCALE: NTS		APR'D: 6-7-02			
				REV. C. CHRISTENSEN 564-1367 / 244-1191		DATE	5/29/02								
				REV. MTE											



STATE OF ALASKA
DEPARTMENT OF TRANSPORTATION
AND
PUBLIC FACILITIES
SEWARD HIGHWAY
MP 96 TO MP 102
SAFETY, ROADWAY AND
RECREATIONAL IMPROVEMENTS

STATE OF ALASKA


49TH

Bruce Lovejoy

Bruce N. Lovejoy

No. 7415EE


REGISTERED PROFESSIONAL ENGINEER

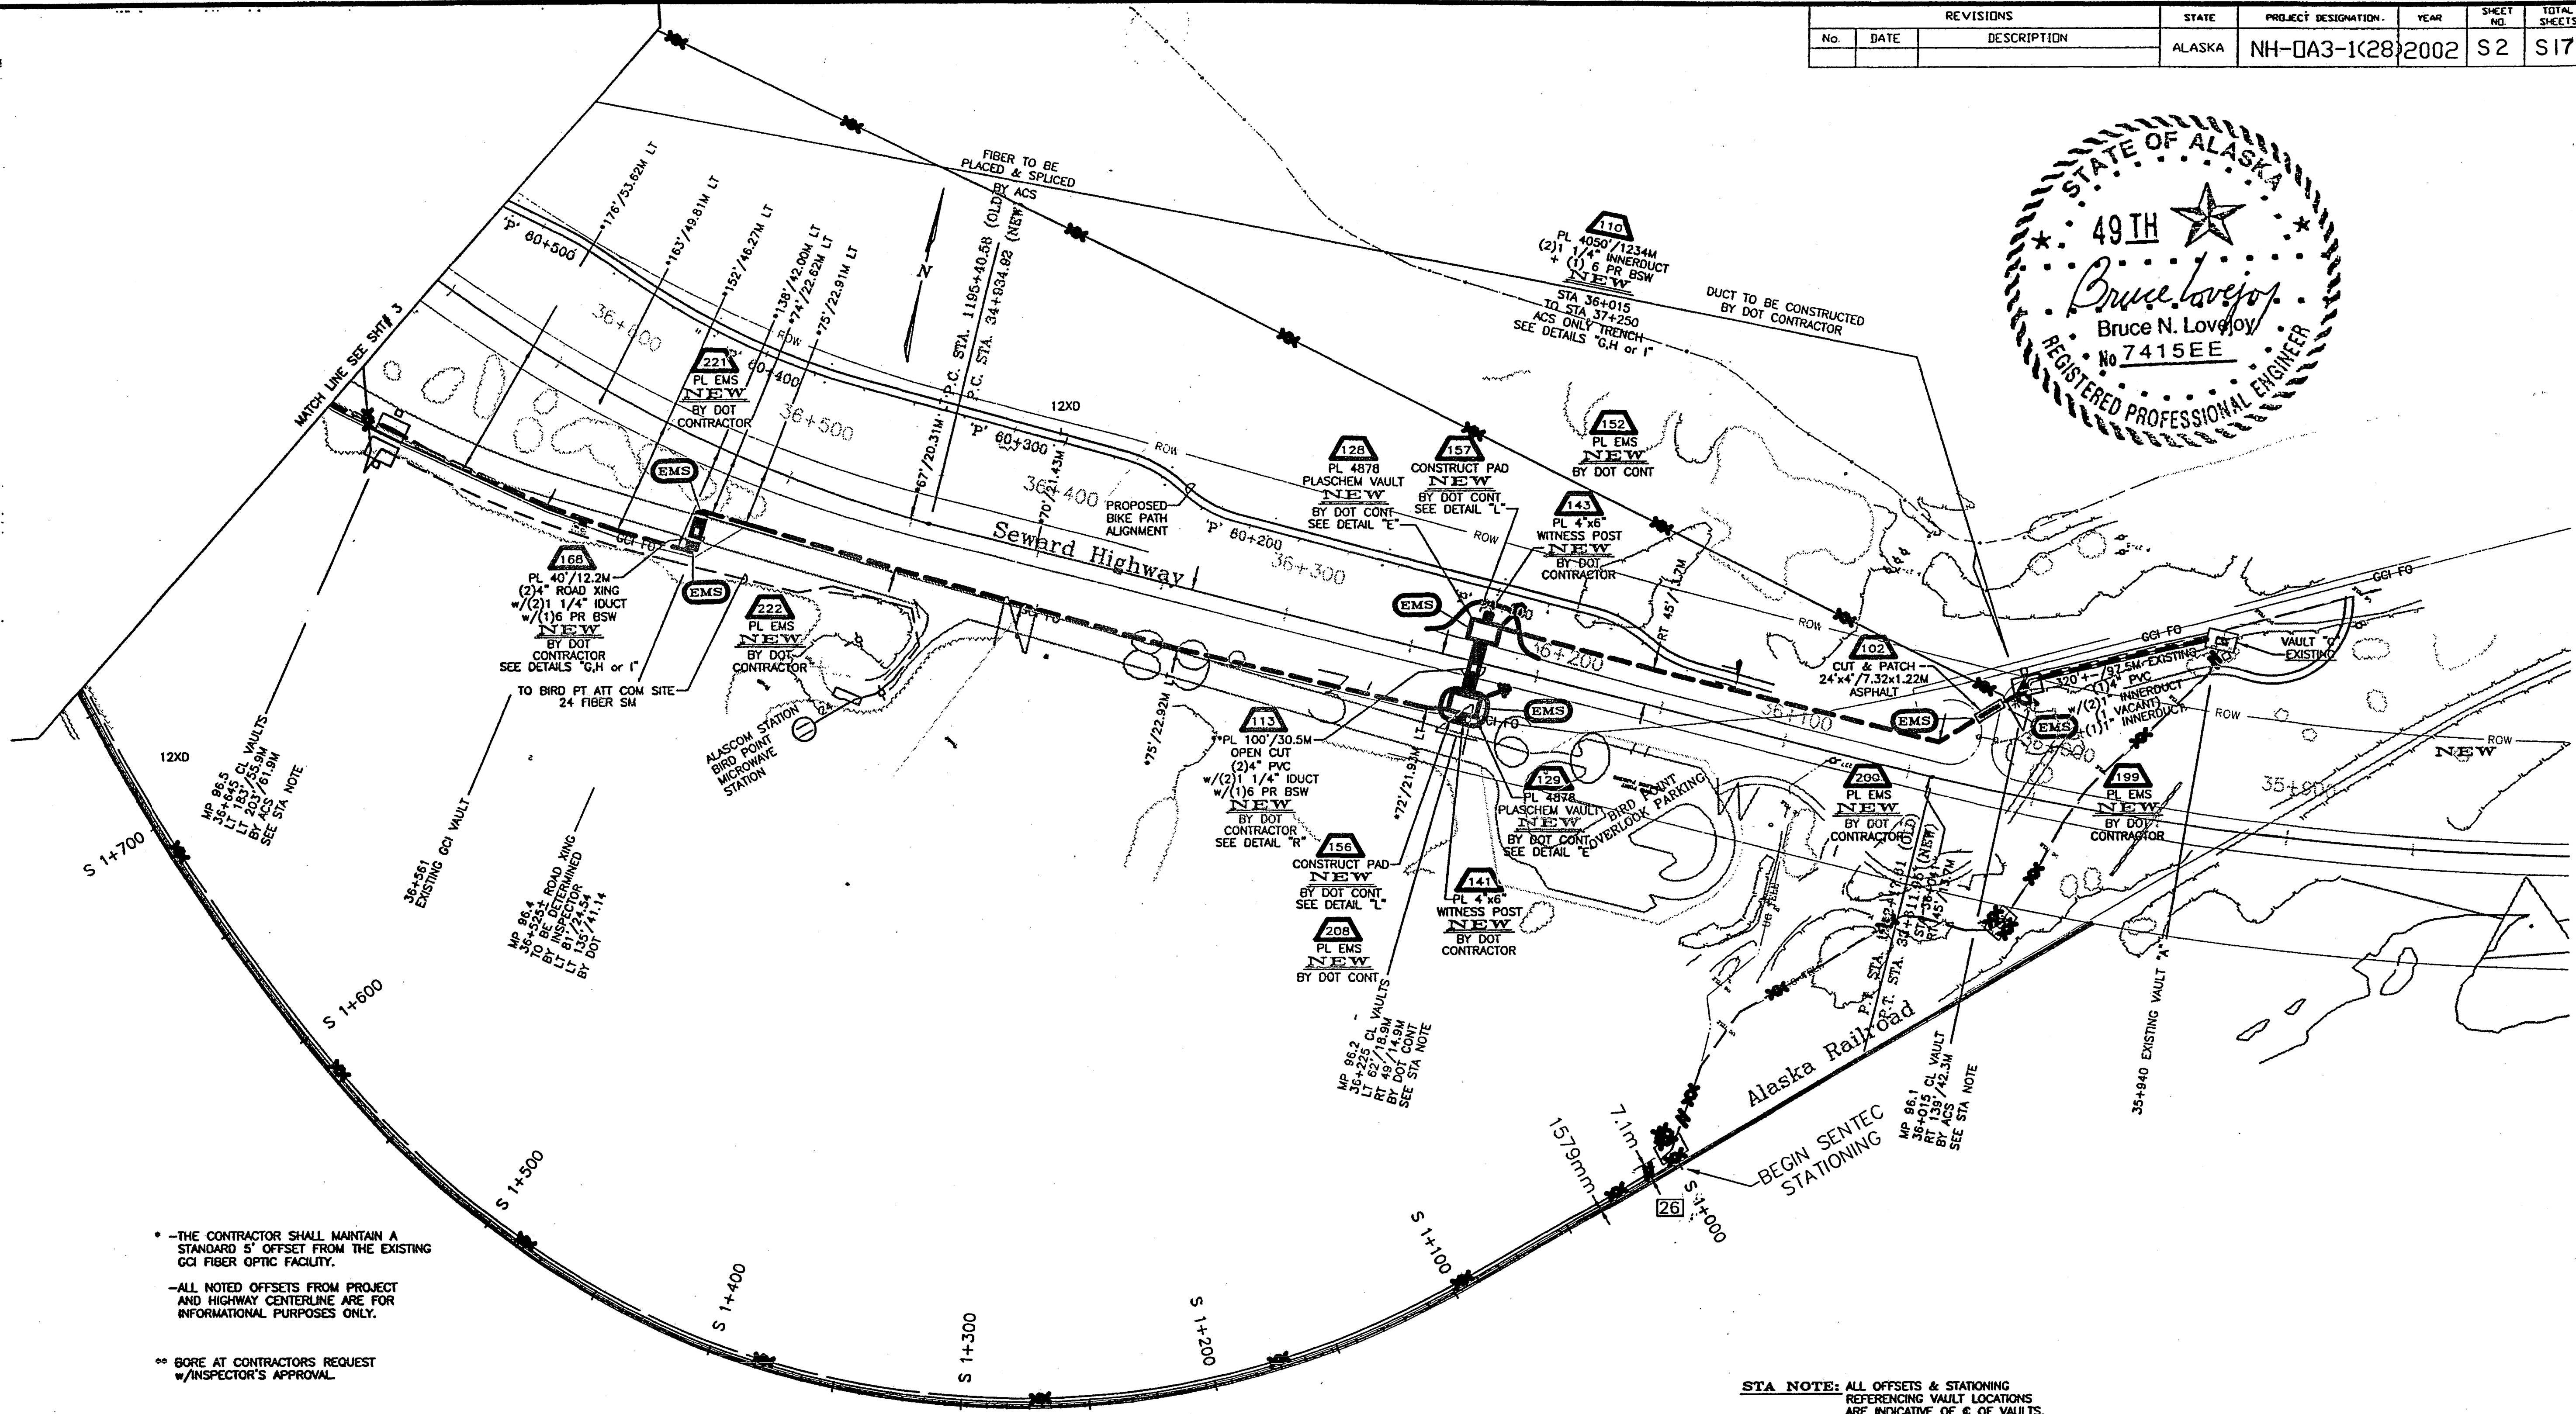

STATE OF ALASKA
DEPARTMENT OF TRANSPORTATION
AND
PUBLIC FACILITIES
SEWARD HIGHWAY
MP 96 TO MP 102
SAFETY, ROADWAY AND
RECREATIONAL IMPROVEMENTS

REVISIONS			STATE	PROJECT DESIGNATION	YEAR	SHEET NO.	TOTAL SHEETS
No.	DATE	DESCRIPTION	ALASKA	NH-0A3-1(28)	2002	S 3	S 17'

DESIGNED BY	17/29/02
CHECKED BY	
PREPARED BY	
VIEW ALL	
COMPUTER DESIGNATION	AUTOCAD-CAROLEE-MARC/ABDR

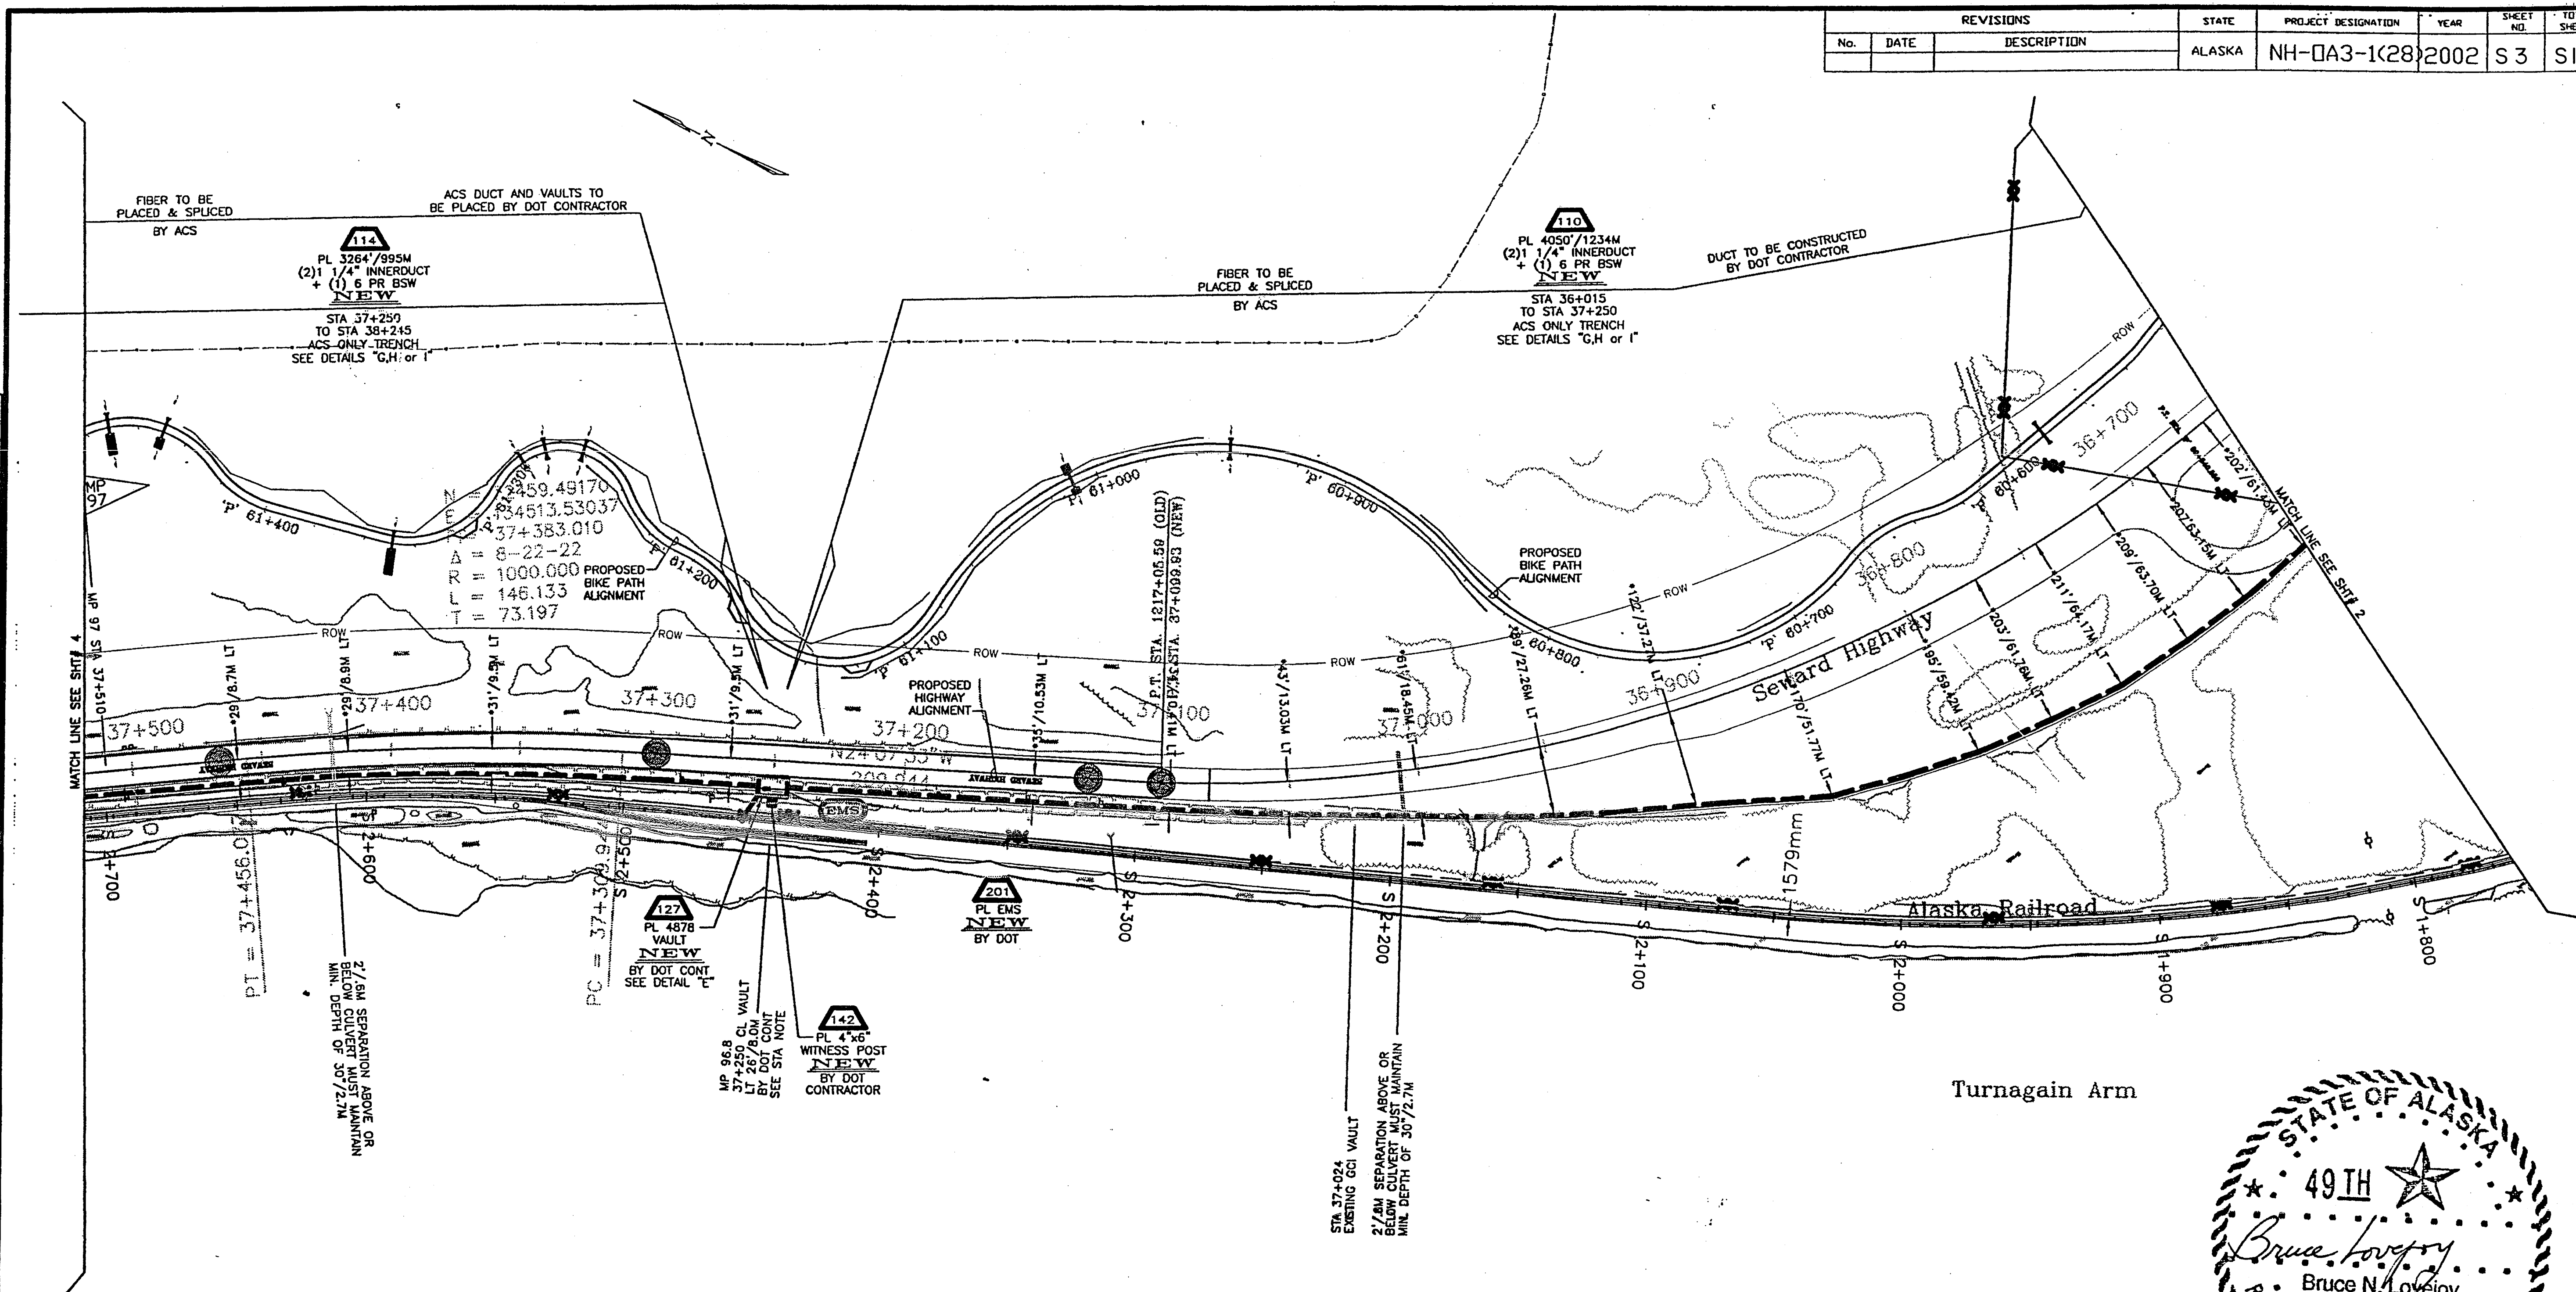


STA NOTE: ALL OFFSETS & STATIONING
REFERENCING VAULT LOCATIONS
ARE INDICATIVE OF C OF VAULTS.



METRIC BAR SCALE
1 METER = 3937/1200 U.S. SURVEY FEET

	TOWNSHIP	RANGE	SECTION	DATE	EFRA#	FIELD ORDER: YES NO	PERMITS: YES NO	CUTS REQ: YES NO	PRESSURE: YES NO
	ANCHORAGE								
	ASSOCIATED	SOURCE MAPS	REVISION	EXCHANGE	SR	TITLE: BIRD FLATS FIBER			
	WORK ORDERS		NUMBER-DATE-INITIALS	GRD		RELOCATION			
			REV.	CAO# 01051901		WOF (2001)			
			REV.	ENCR/EXT		001-0519			
			REV.	DATE 5/29/02		ISSUED 6-7-02			
						SCALE: NTS			

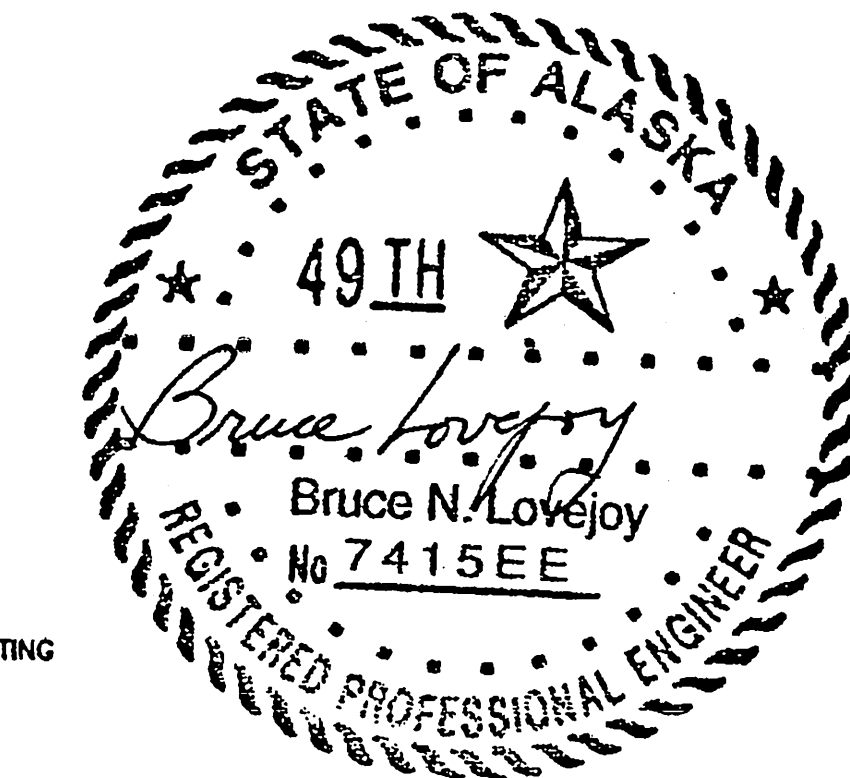


* -THE CONTRACTOR SHALL MAINTAIN A
STANDARD 5' OFFSET FROM THE EXISTING
GCI FIBER OPTIC FACILITY.

-ALL NOTED OFFSETS FROM PROJECT
AND HIGHWAY CENTERLINE ARE FOR
INFORMATIONAL PURPOSES ONLY.

STATE OF ALASKA
DEPARTMENT OF TRANSPORTATION
AND
PUBLIC FACILITIES
SEWARD HIGHWAY
MP 96 TO MP 102
SAFETY, ROADWAY AND
RECREATIONAL IMPROVEMENTS

REVISIONS			STATE	PROJECT DESIGNATION	YEAR	SHEET NO.	TOTAL SHEETS
No.	DATE	DESCRIPTION	ALASKA	NH-0A3-1(28)	2002	S 4	S 17

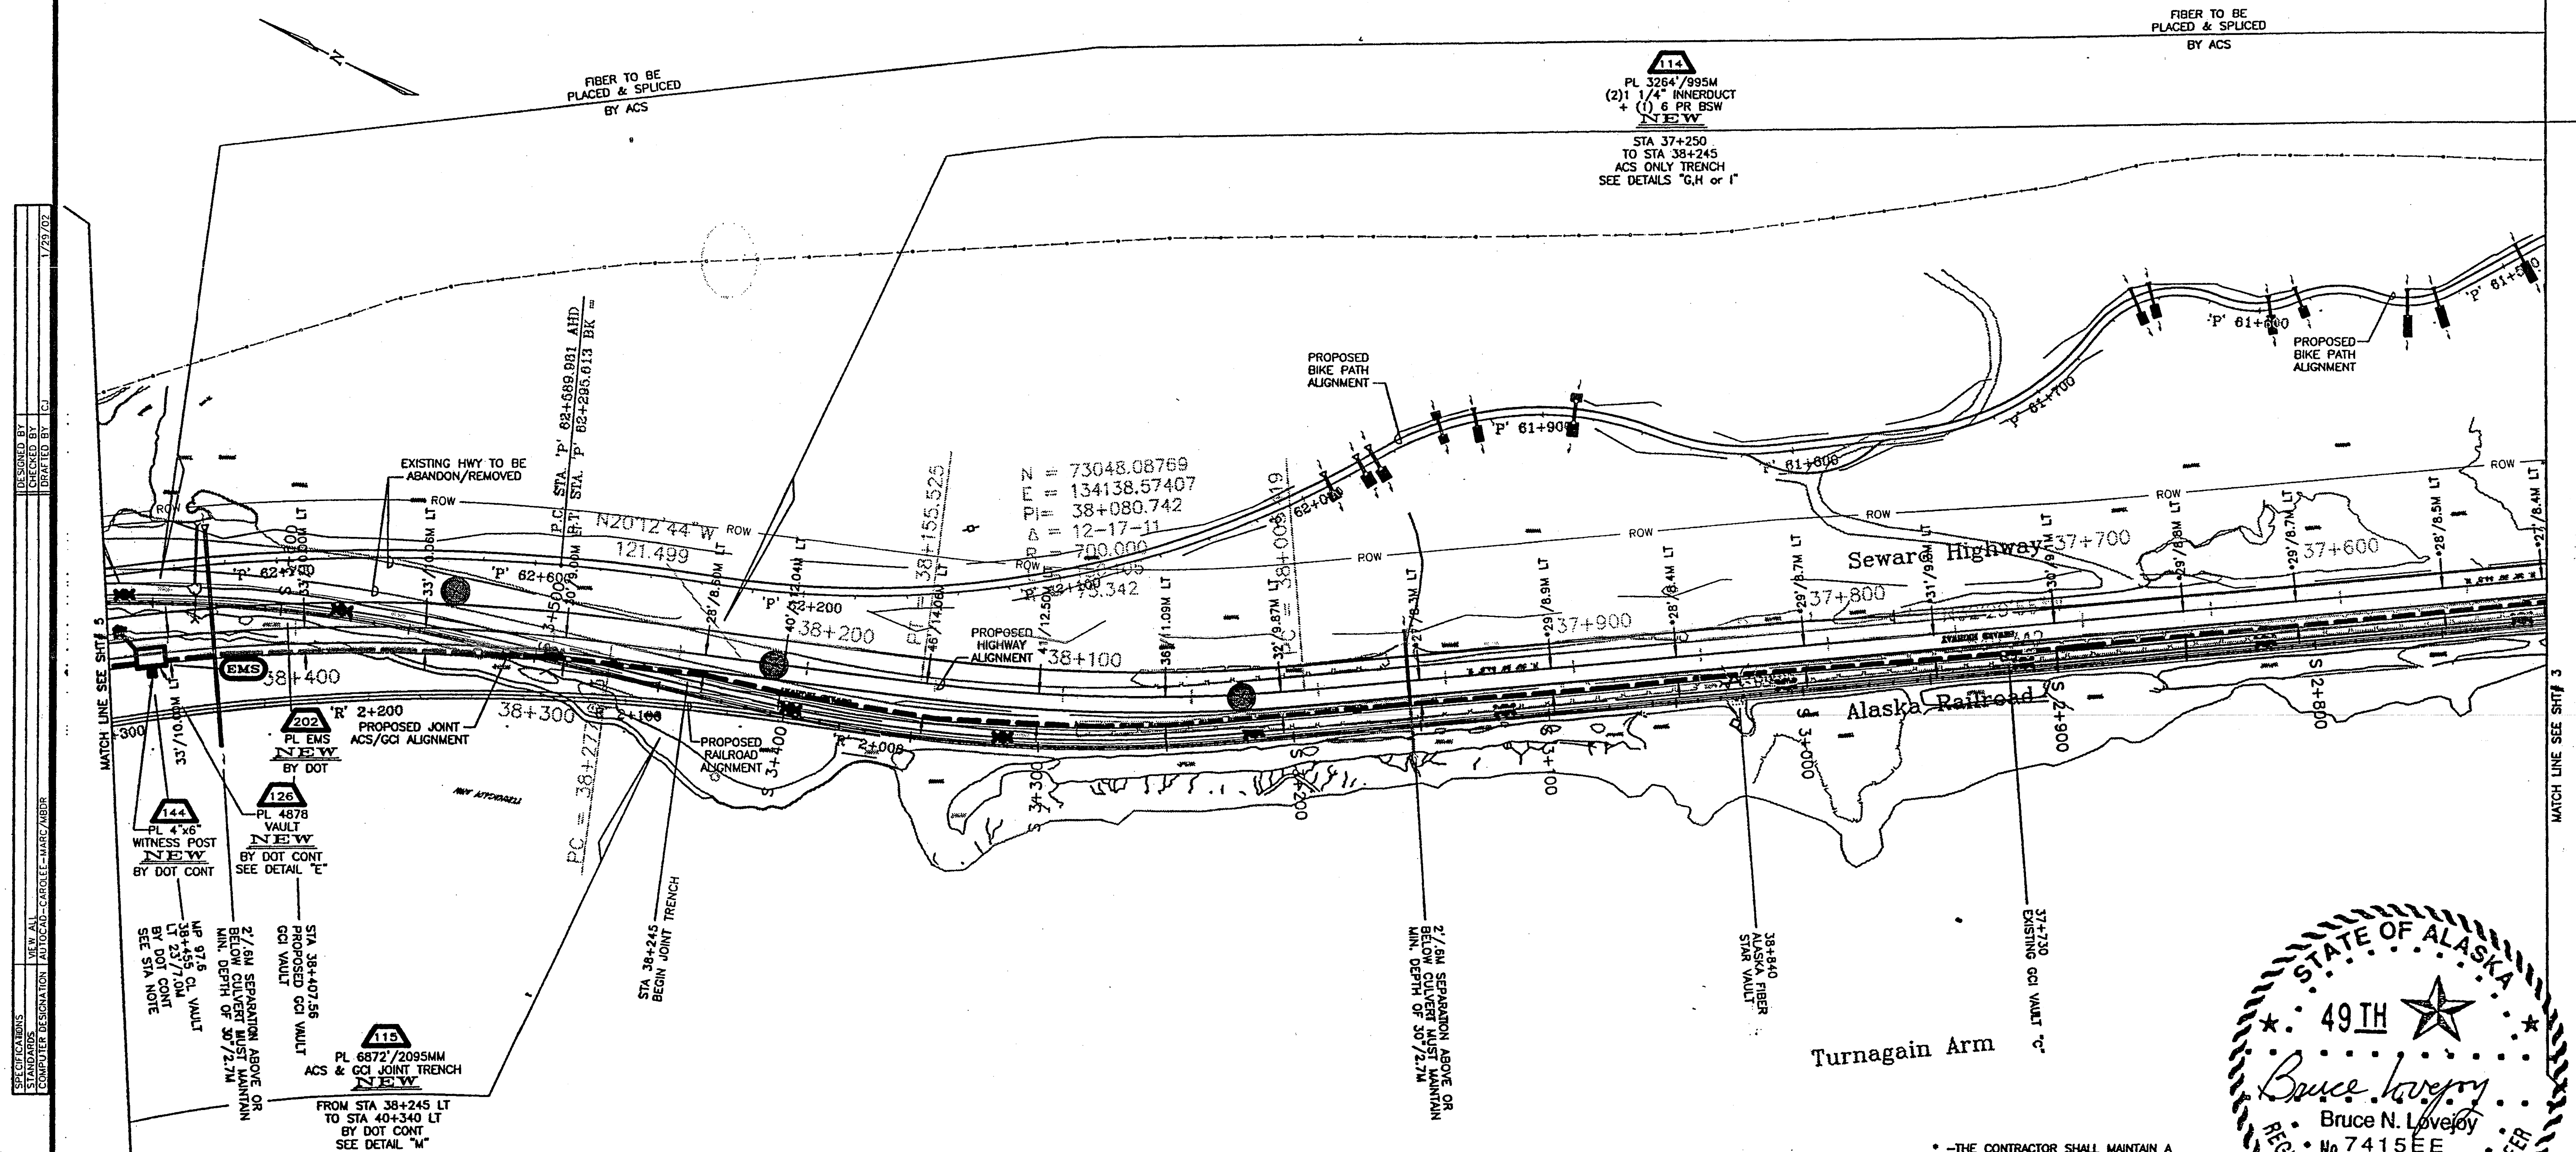


STA NOTE: ALL OFFSETS & STATIONING
REFERENCING VAULT LOCATIONS
ARE INDICATIVE OF C. OF VAULTS.




METRIC BAR SCALE
1 METER = 3937/1200 U.S. SURVEY FEET

 Alaska Communications Systems	TOWNSHIP ANCHORAGE		RANGE		SECTION		DA#		CFR#		HELD ORDER: YES ☐ NO ☐		PERMITS: YES ☐ NO ☐		CUTS REQ: YES ☐ NO ☐		PRESSURE: YES ☐ NO ☐	
	ASSOCIATED WORK ORDERS	SOURCE MAPS			REVISION NUMBER-DATE-INITIALS		EXCHANGE GND		S#		TITLE: BIRD FLATS FIBER RELOCATION BOROUGH/CITY SCALE: NTS APT'D: ISS'D: 6-7-07 SH 4 OF 10 SLDS							
					CAD# 01051901		ENR/EXT C. CHRISTENSEN 564-1567 / 244-1191											
					REV.		DATE: 5/29/07											
					REV.		VTE											


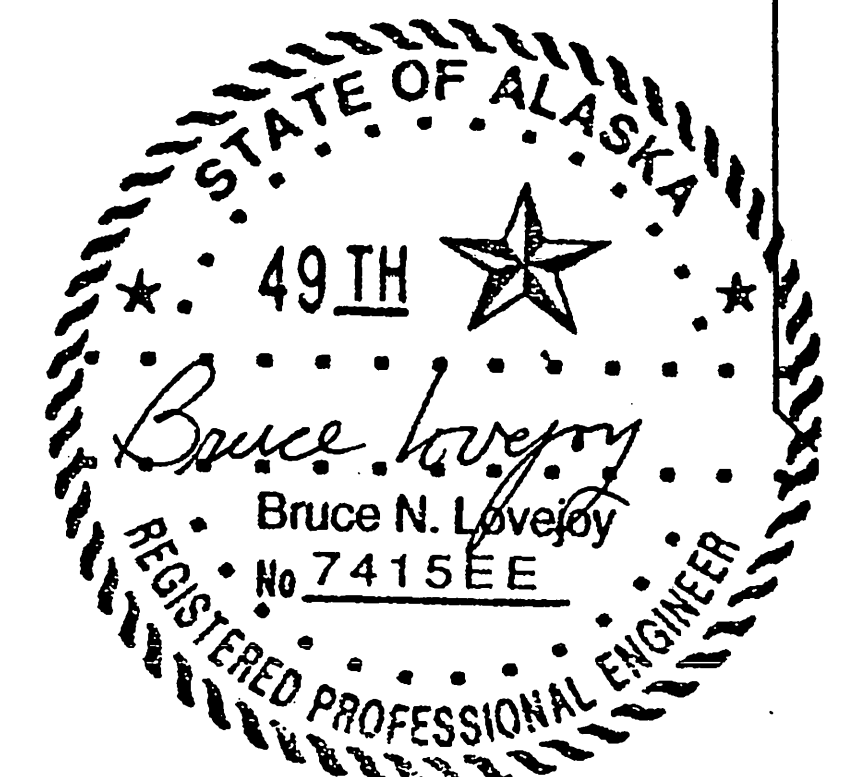


STATE OF ALASKA
DEPARTMENT OF TRANSPORTATION
AND
PUBLIC FACILITIES
SEWARD HIGHWAY
MP 96 TO MP 102
SAFETY, ROADWAY AND
RECREATIONAL IMPROVEMENTS

REVISIONS			STATE	PROJECT DESIGNATION	YEAR	SHEET NO.	TOTAL SHEETS
No.	DATE	DESCRIPTION	ALASKA	NH-0A3-1K28	2002	S 5	S 17

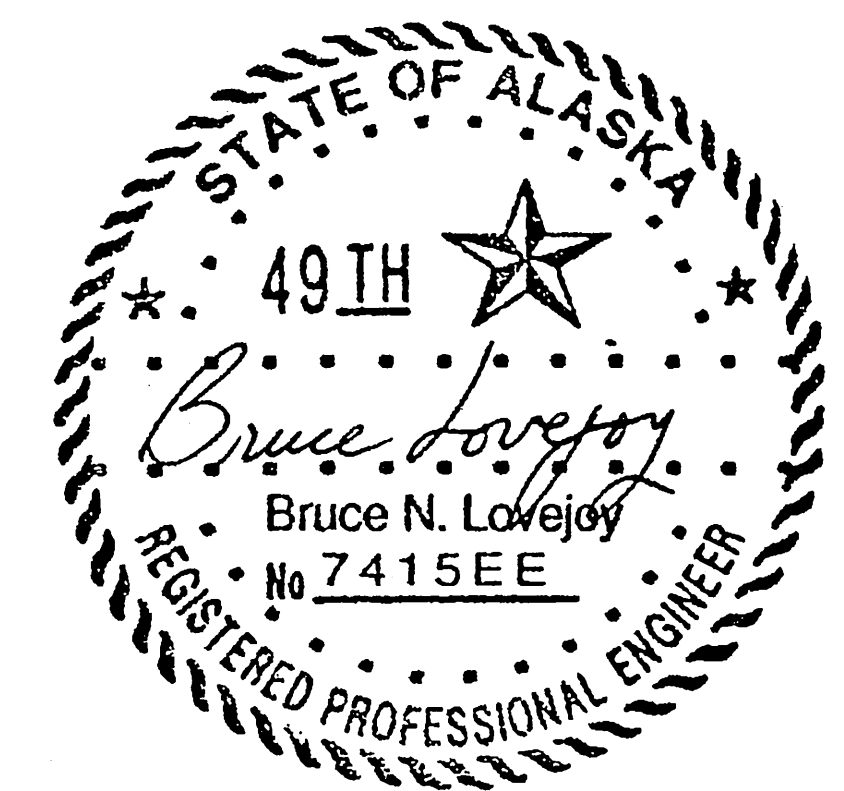


DESIGNED BY	17/29/02
CHECKED BY	
DATE	
COMPUTER DESIGNATION	NEW AL
COMPUTER DESIGNATION	AUTOCAD-CAROLEE-MARC-AUDRE

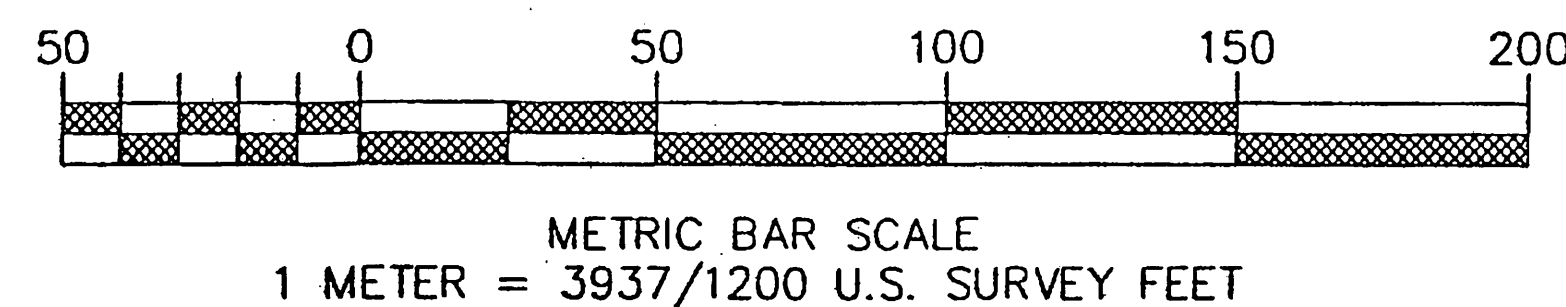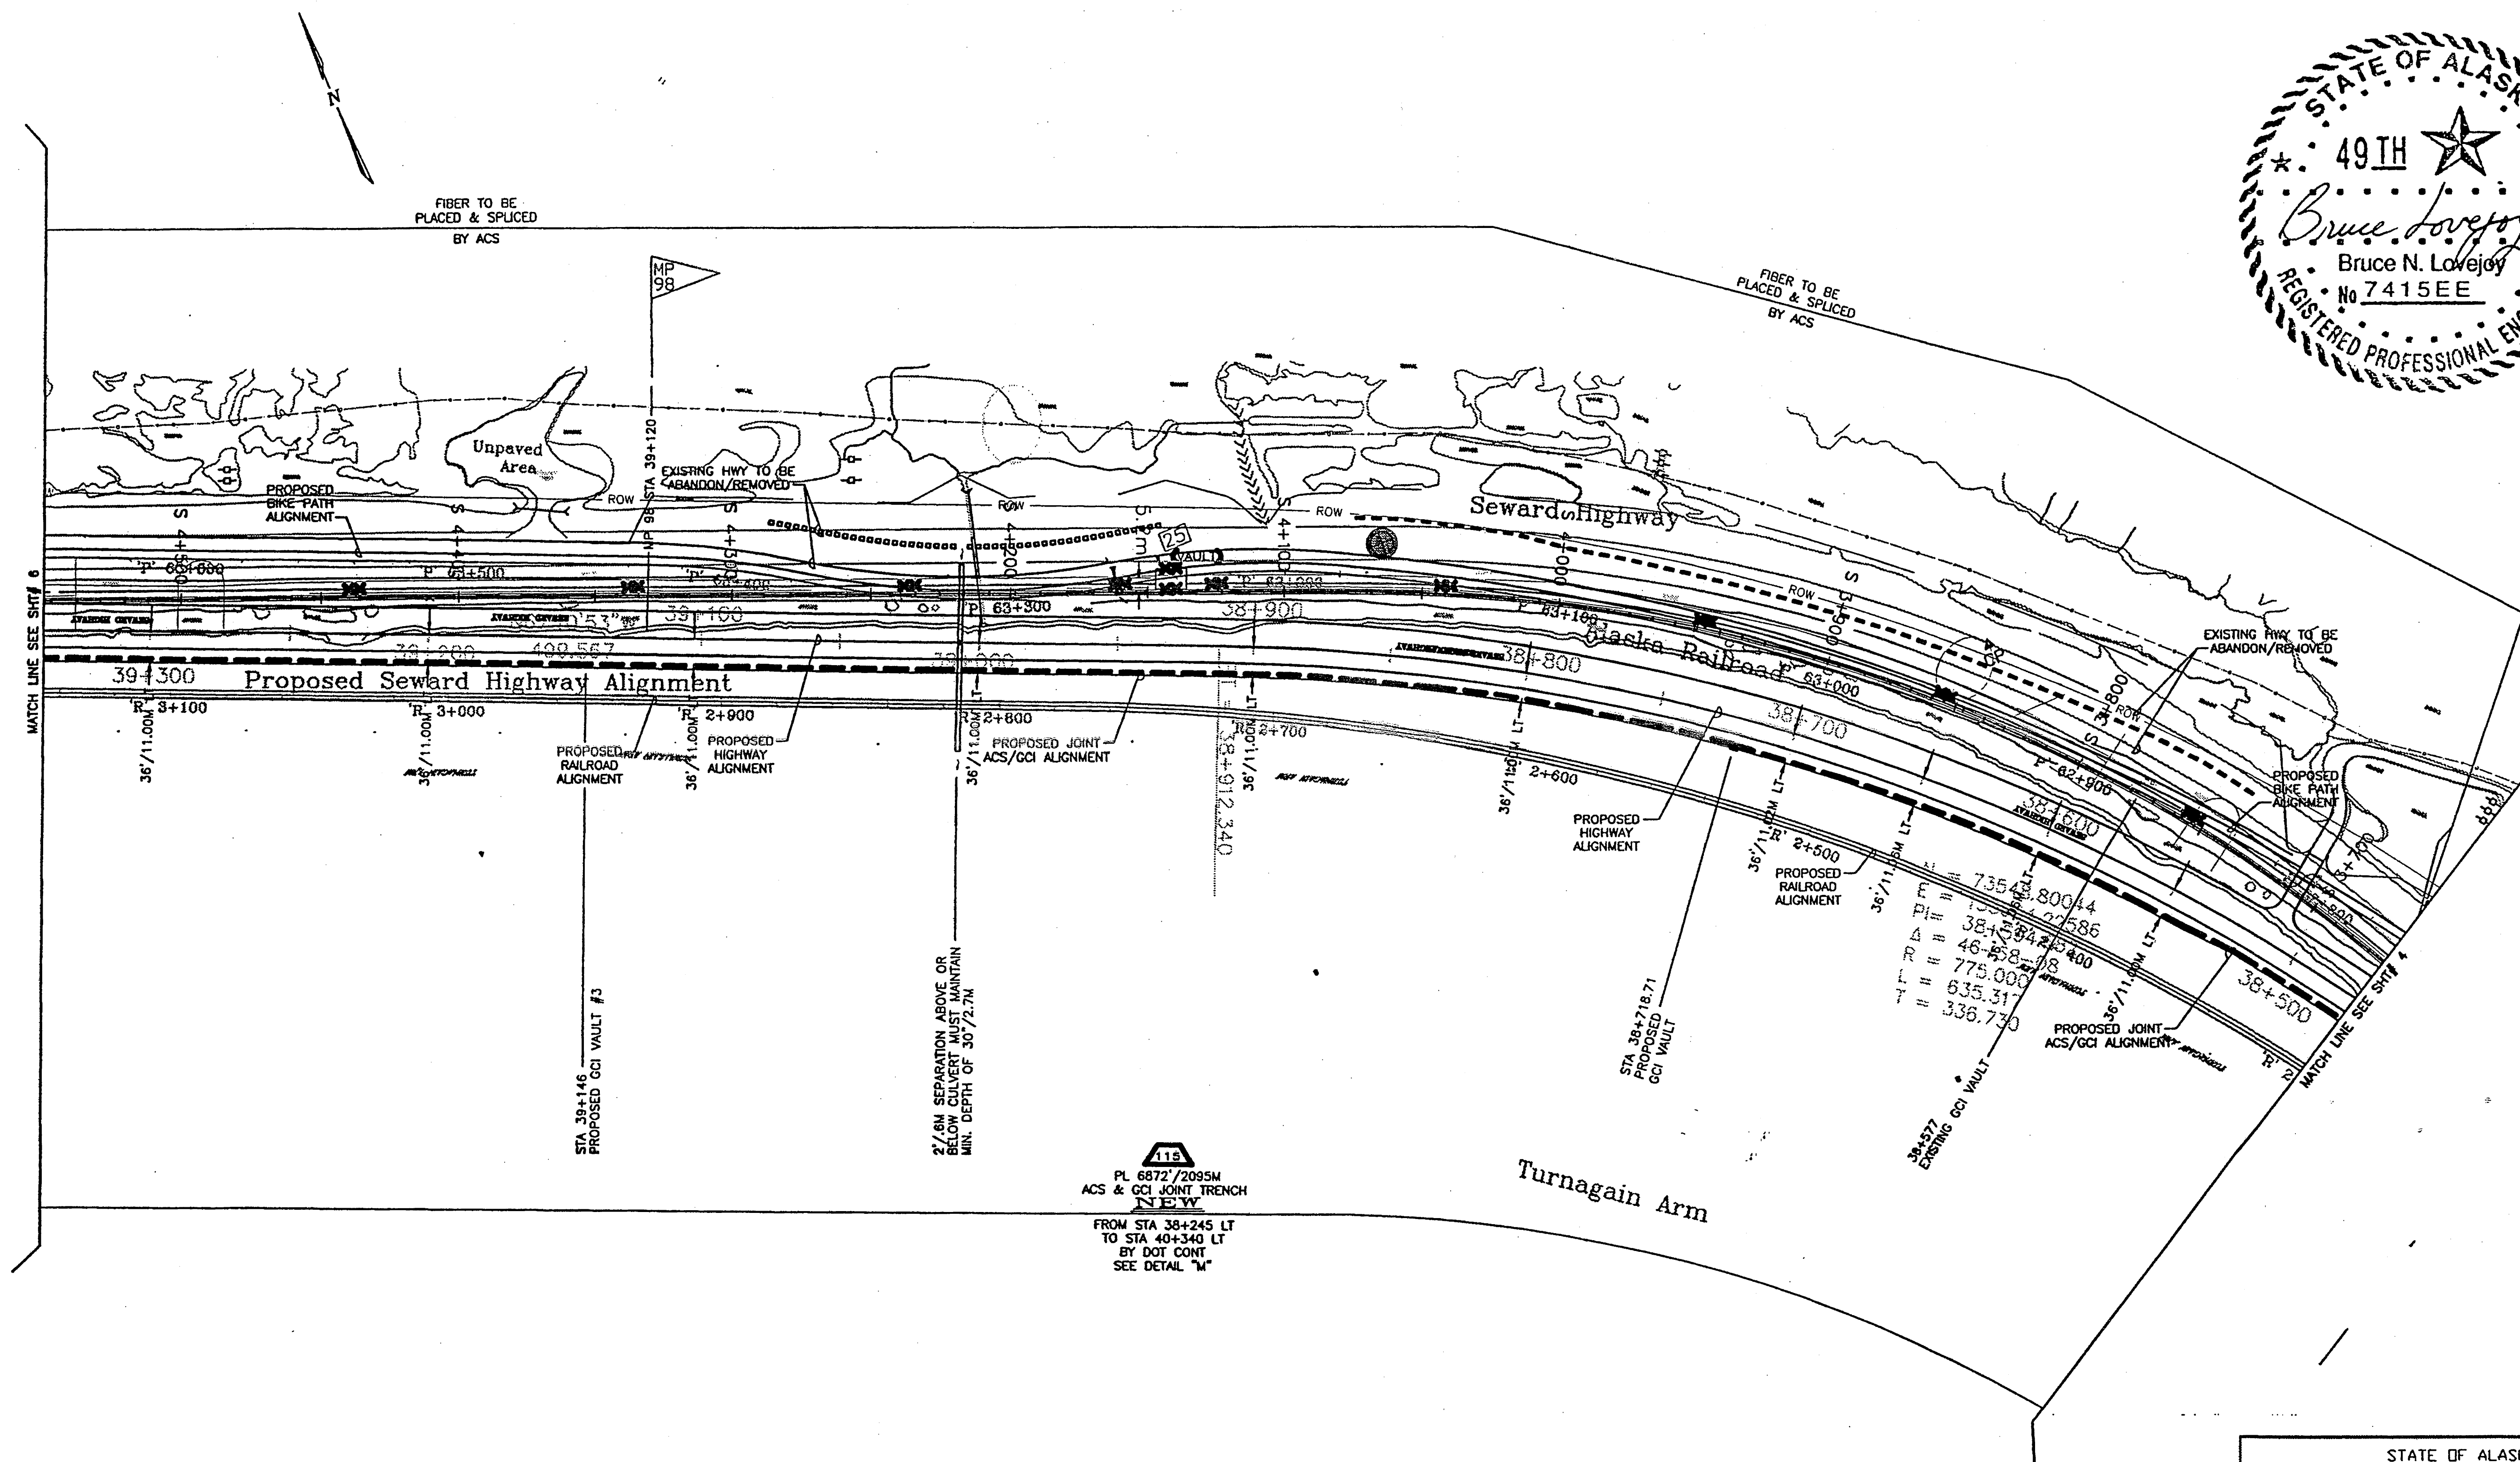


	TOWNSHIP	RANGE	SECTION	DATE	EFAP	FIELD ORDER: YES NO	PERMITS: YES NO	CUTS REQ: YES NO	PRESSURE: YES NO
	ANCHORAGE			EXCHANGE	SR				
	ASSOCIATED WORK ORDERS	SOURCE MAPS	REVISION NUMBER-DATE-INITIALS	CAD# 01051901		TITLE: BIRD FLATS FIBER RELOCATION			
			REV. ENCR/EXT. C. CHRISTENSEN 564-1367 / 244-1191	DATE: 5/29/02	BOROUGH/CITY	WOF (2001) 001-0519			
			REV. DATE: 5/29/02	SCALE: NTS	APPROD.	ISSUED: 6-7-02			

STATE OF ALASKA
DEPARTMENT OF TRANSPORTATION
AND
PUBLIC FACILITIES
SEWARD HIGHWAY
MP 96 TO MP 102
SAFETY, ROADWAY AND
RECREATIONAL IMPROVEMENTS

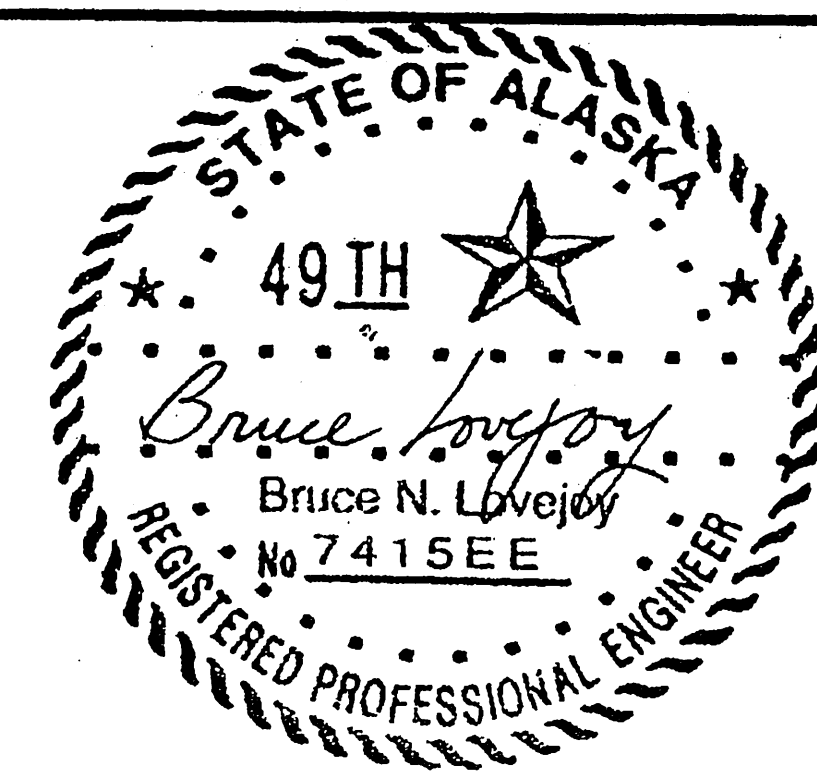

REVISIONS			STATE	PROJECT DESIGNATION	YEAR	SHEET NO.	TOTAL SHEETS
No.	DATE	DESCRIPTION	ALASKA	NH-0A3-1K28	2002	S6	S17

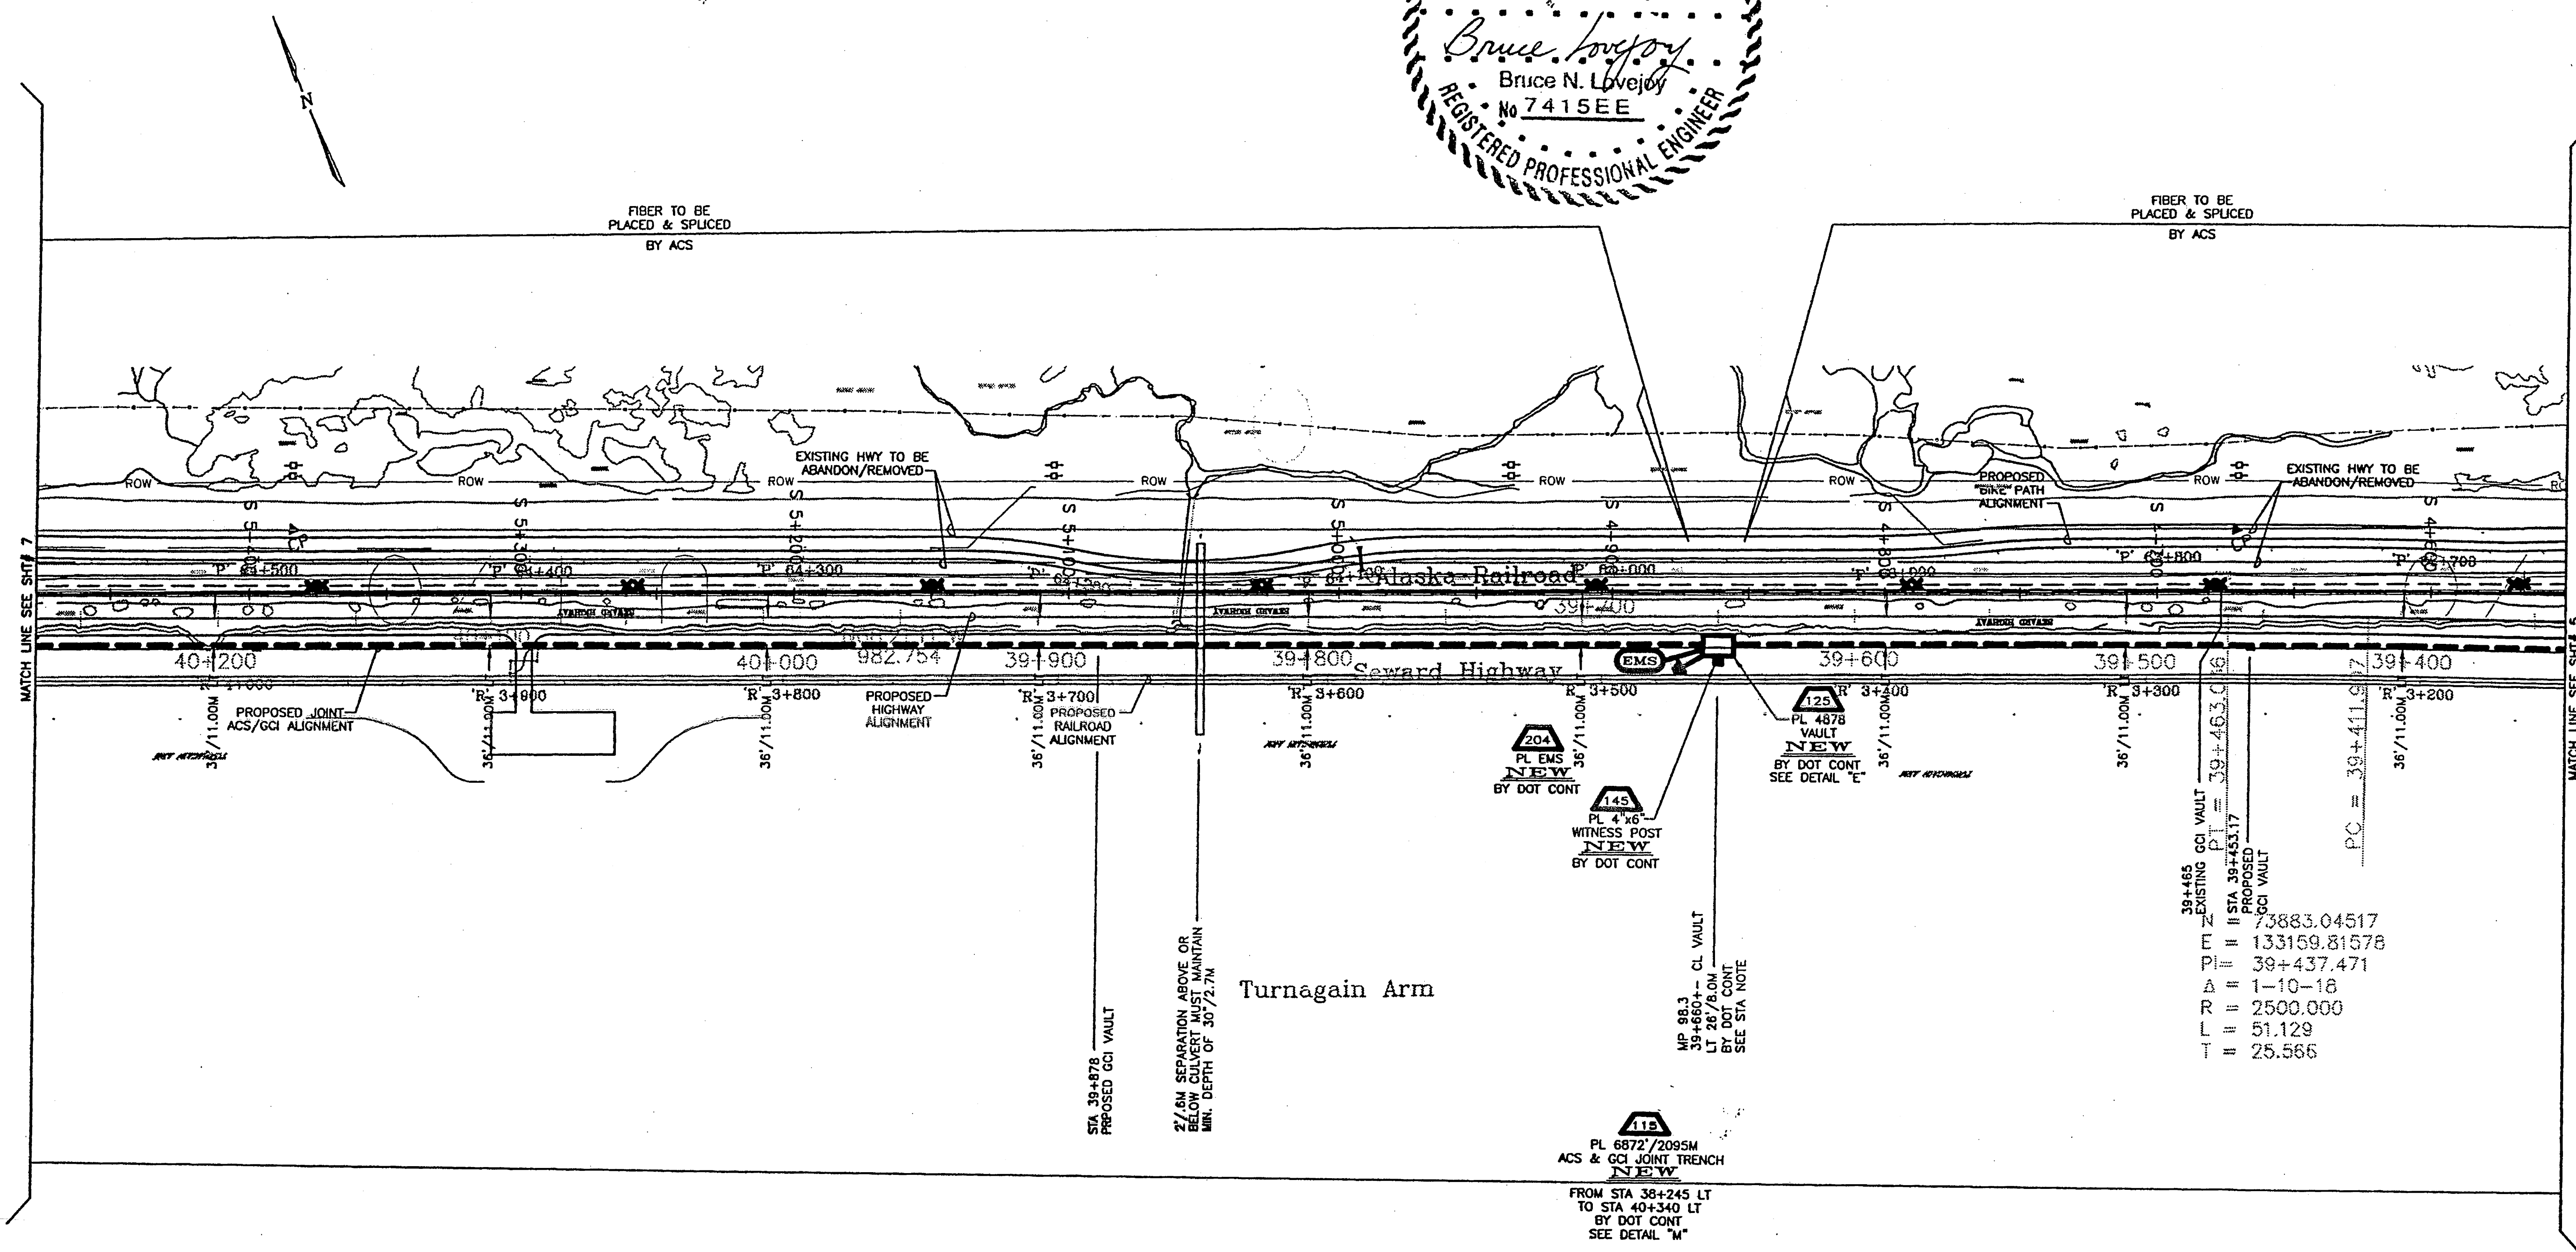


METRIC BAR SCALE
1 METER = 3937/1200 U.S. SURVEY FEET



TOWNSHIP ANCHORAGE		RANGE	SECTION	DA#	ETRAP#	HELD ORDER: YES NO	PERMITS: YES NO	CUTS REQ: YES NO	PRESSURE: YES NO
ASSOCIATED WORK ORDERS		SOURCE MAPS	REVISION NUMBER-DATE-INITIALS	EXCHANGE GRD	SI	DATE: 01031901	DATE: 01031901	DATE: 01031901	DATE: 01031901
ACR/EXT: C. CHRISTENSEN 564-1367 / 244-1191		DATE: 5/29/02	SCALE: NTS	APPRO: 6-7-02	SH. 6 OF 30 SHTS.				

STATE OF ALASKA
DEPARTMENT OF TRANSPORTATION
AND
PUBLIC FACILITIES
SEWARD HIGHWAY
MP 96 TO MP 102
SAFETY, ROADWAY AND
RECREATIONAL IMPROVEMENTS

REVISIONS			STATE	PROJECT DESIGNATION	YEAR	SHEET NO.	TOTAL SHEETS
NO.	DATE	DESCRIPTION	ALASKA	NH-0A3-1K28	2002	S7	S17

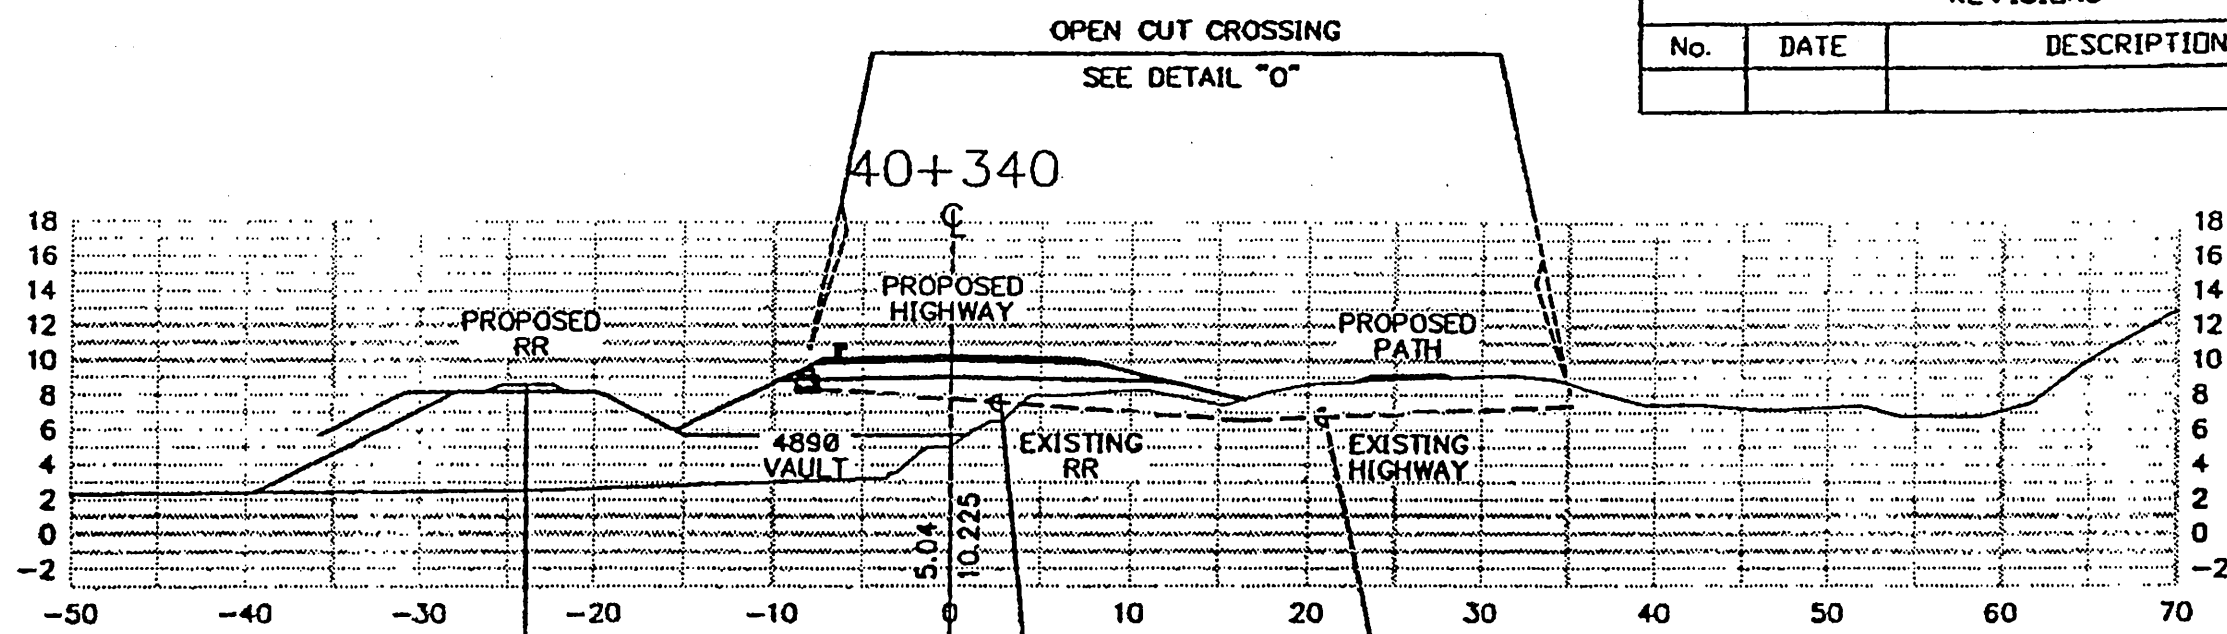


SEE ABOVE
DETAIL

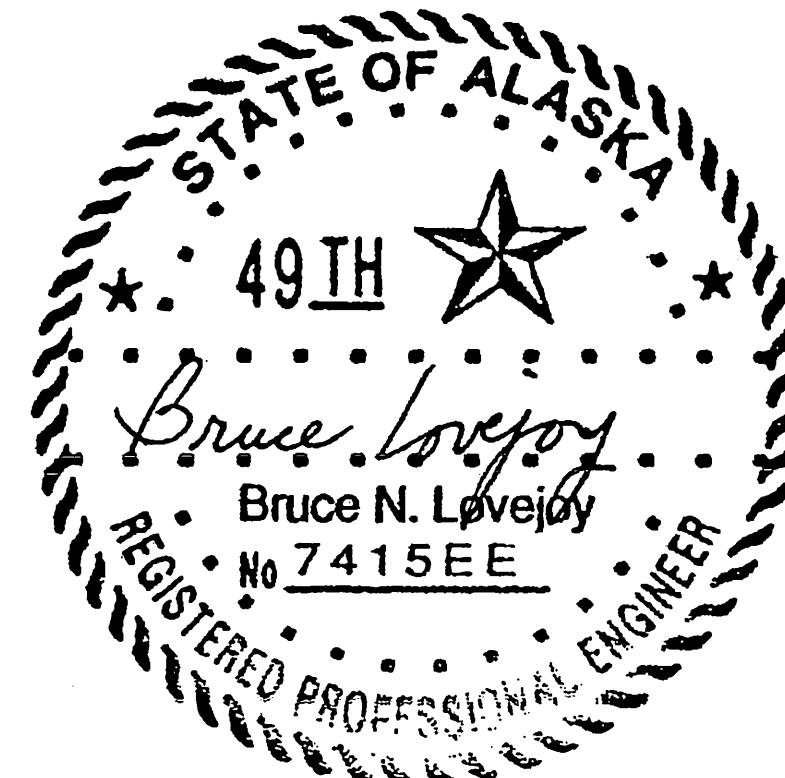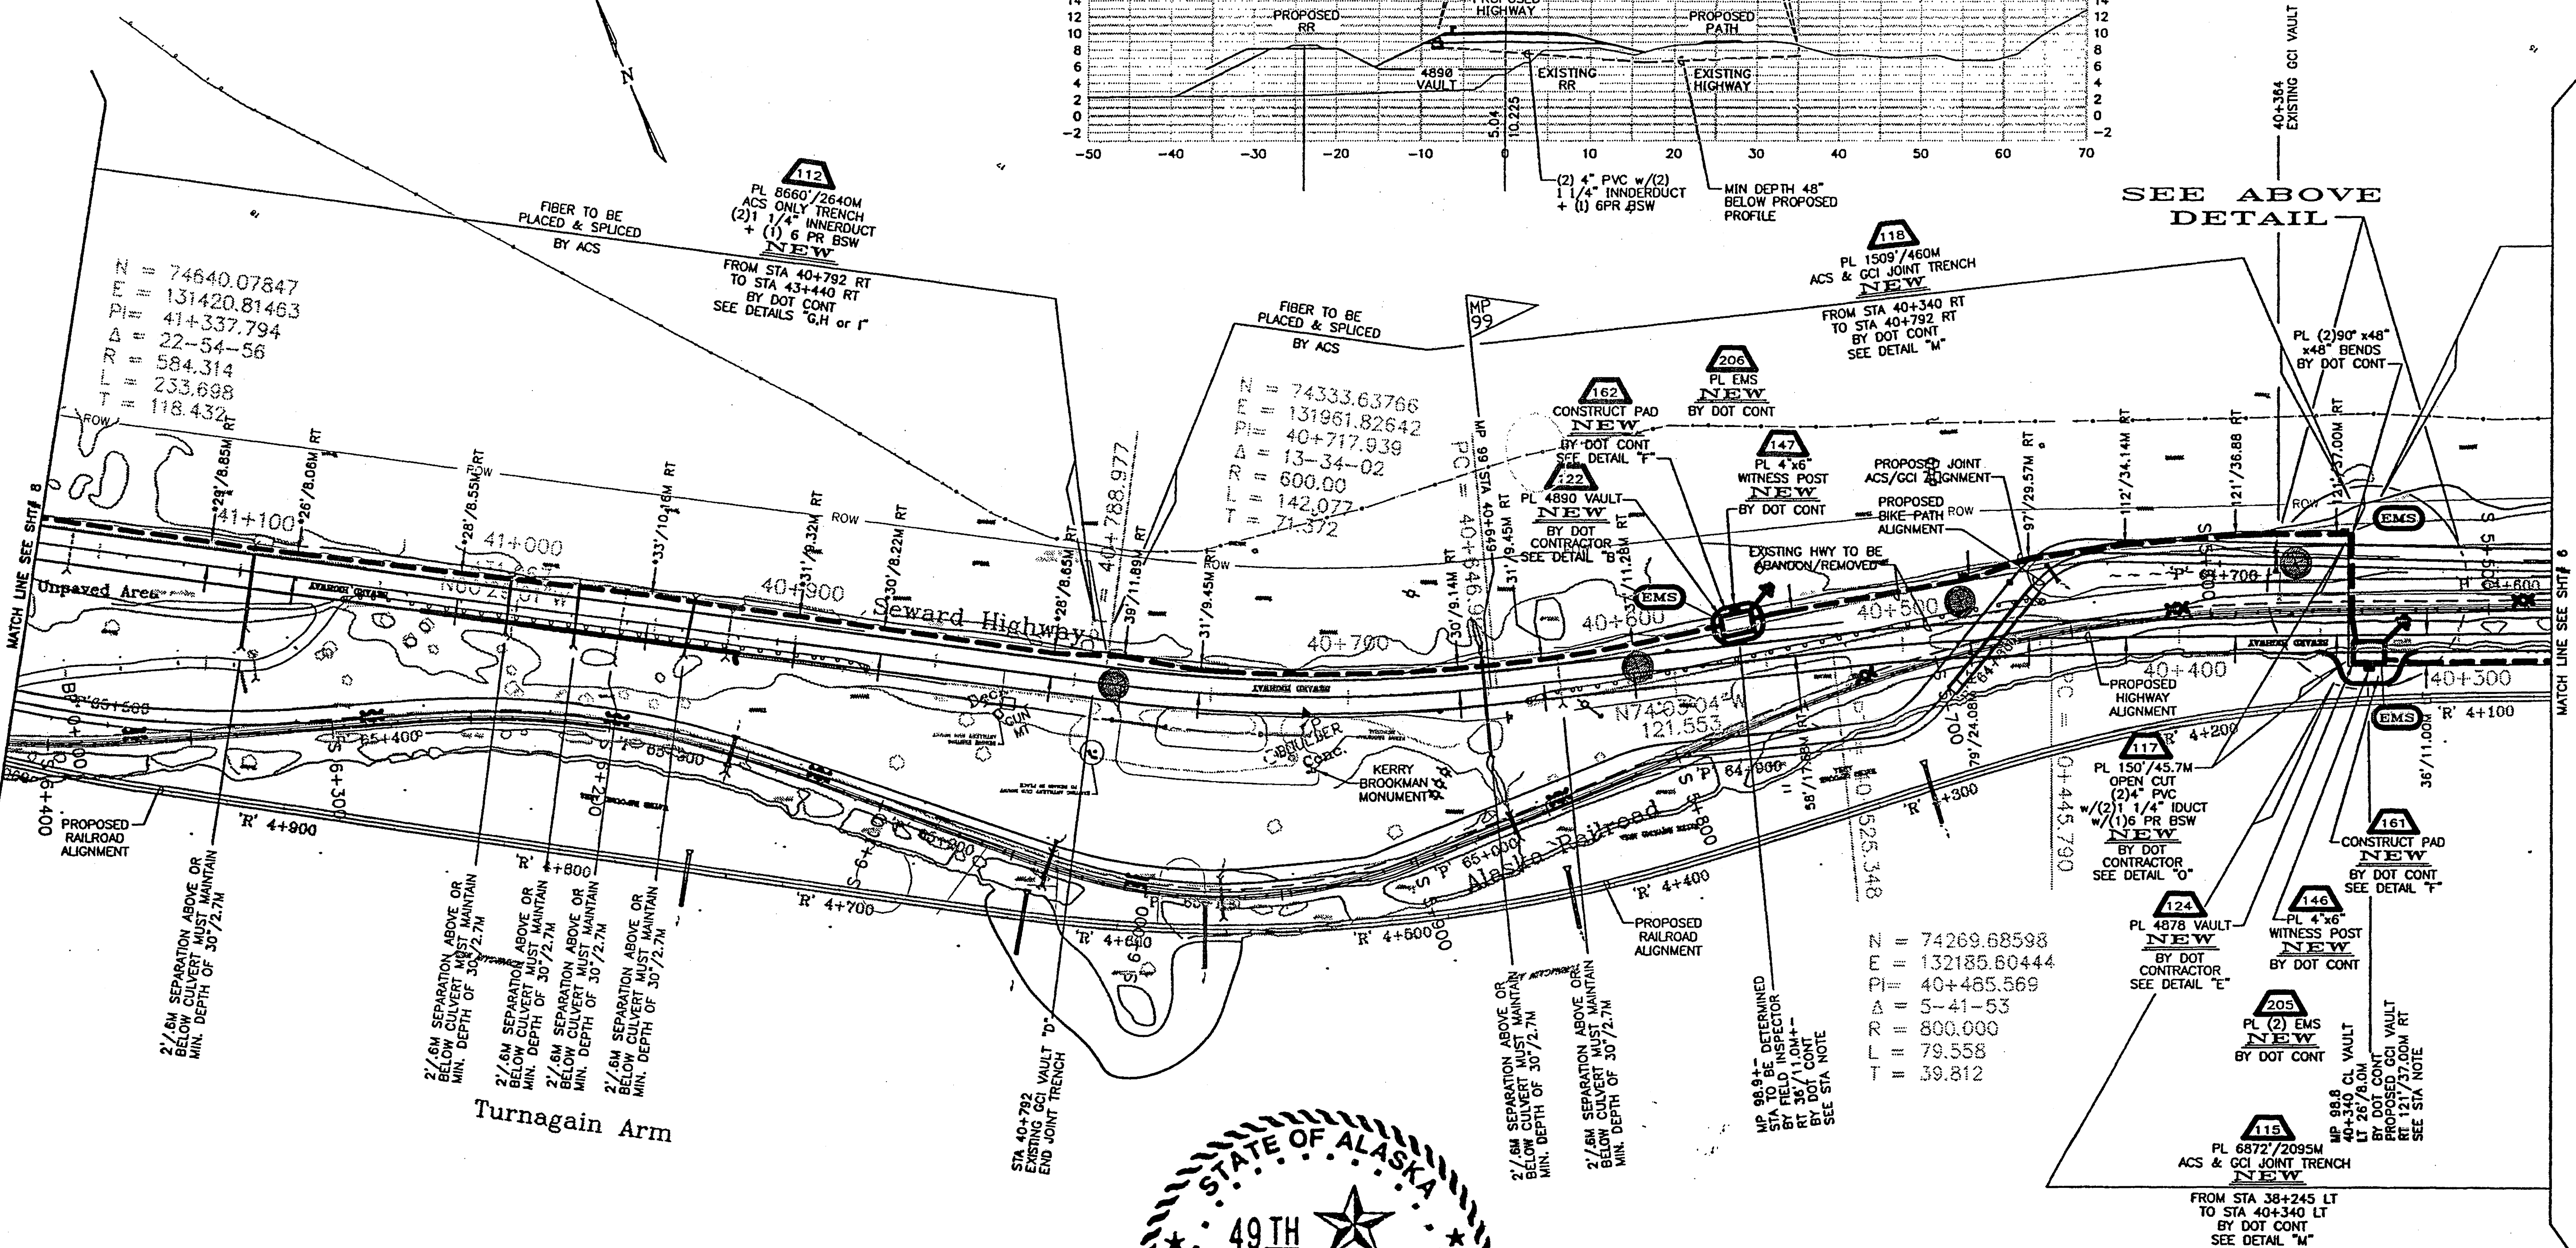

THE CONTRACTOR SHALL MAINTAIN A
STANDARD 5' OFFSET FROM THE EXISTING
GCI FIBER OPTIC FACILITY.
ALL NOTED OFFSETS FROM PROJECT
AND HIGHWAY CENTERLINE ARE FOR
INFORMATIONAL PURPOSES ONLY.

STA NOTE: ALL OFFSETS & STATIONING
REFERENCING VAULT LOCATIONS
ARE INDICATIVE OF C OF VAULTS.


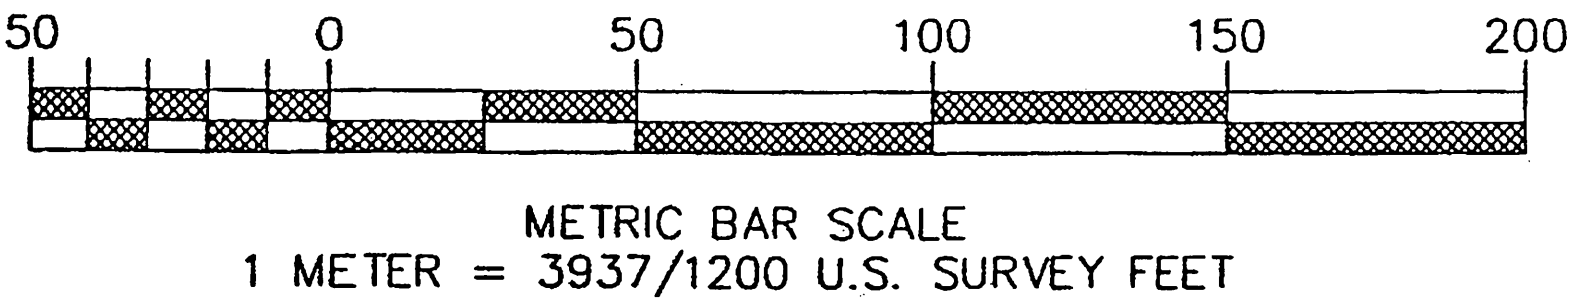


TOWNSHIP		RANGE		SECTION		DATE		HOLD ORDER		PERMITS		CUTS REQ.		PRESSURE	
ANCHORAGE		SOURCE MAPS		REVISION		EXCHANGE		YES NO		YES NO		YES NO		YES NO	
ASSOCIATED				NUMBER-DATE-INITIALS		CIR									
WORK ORDERS				REV.		CAD# 01051901									
				REV.		ENR/CITY									
				REV.		C. CHRISTENSEN 564-1367 / 244-1191		BOROUGH/CITY							
						DATE: 5/29/02		SCALE: MTS		APRD:		ISSUED: 6-7-02		SH. 7 OF 30 SHTS	

STATE OF ALASKA
DEPARTMENT OF TRANSPORTATION
AND
PUBLIC FACILITIES
SEWARD HIGHWAY
MP 96 TO MP 102
SAFETY, ROADWAY AND
RECREATIONAL IMPROVEMENTS


REVISIONS			STATE	PROJECT DESIGNATION	YEAR	SHEET NO.	TOTAL SHEETS
No.	DATE	DESCRIPTION	ALASKA	NH-0A3-1(28)	2002	S 8	S 17

DESIGNED BY: NEW ALL
 CHECKED BY: AUTOCAD-CAROL-NADEAU
 1/29/02
 COMPUTER DESIGNATION: AUTOCAD-CAROL-NADEAU

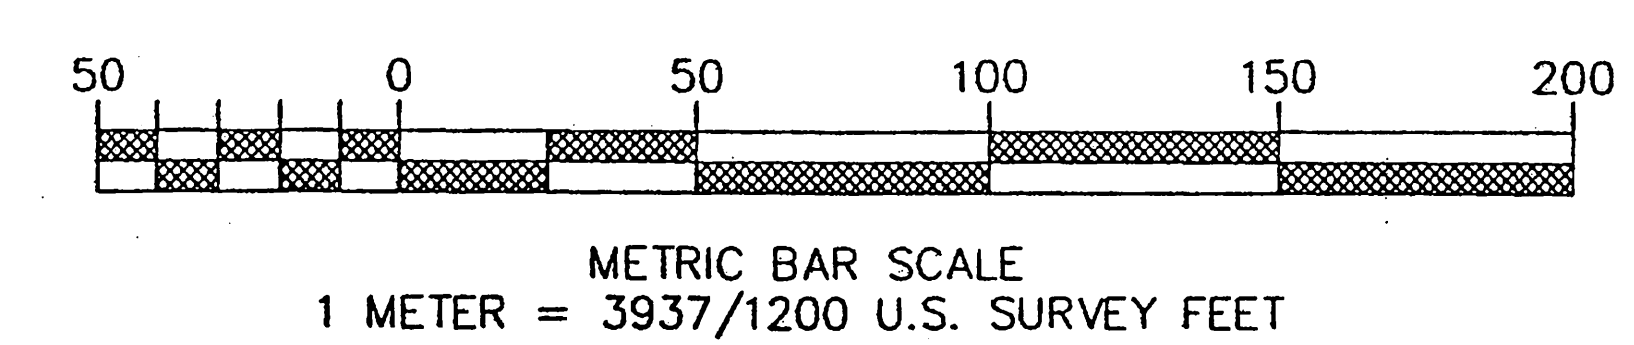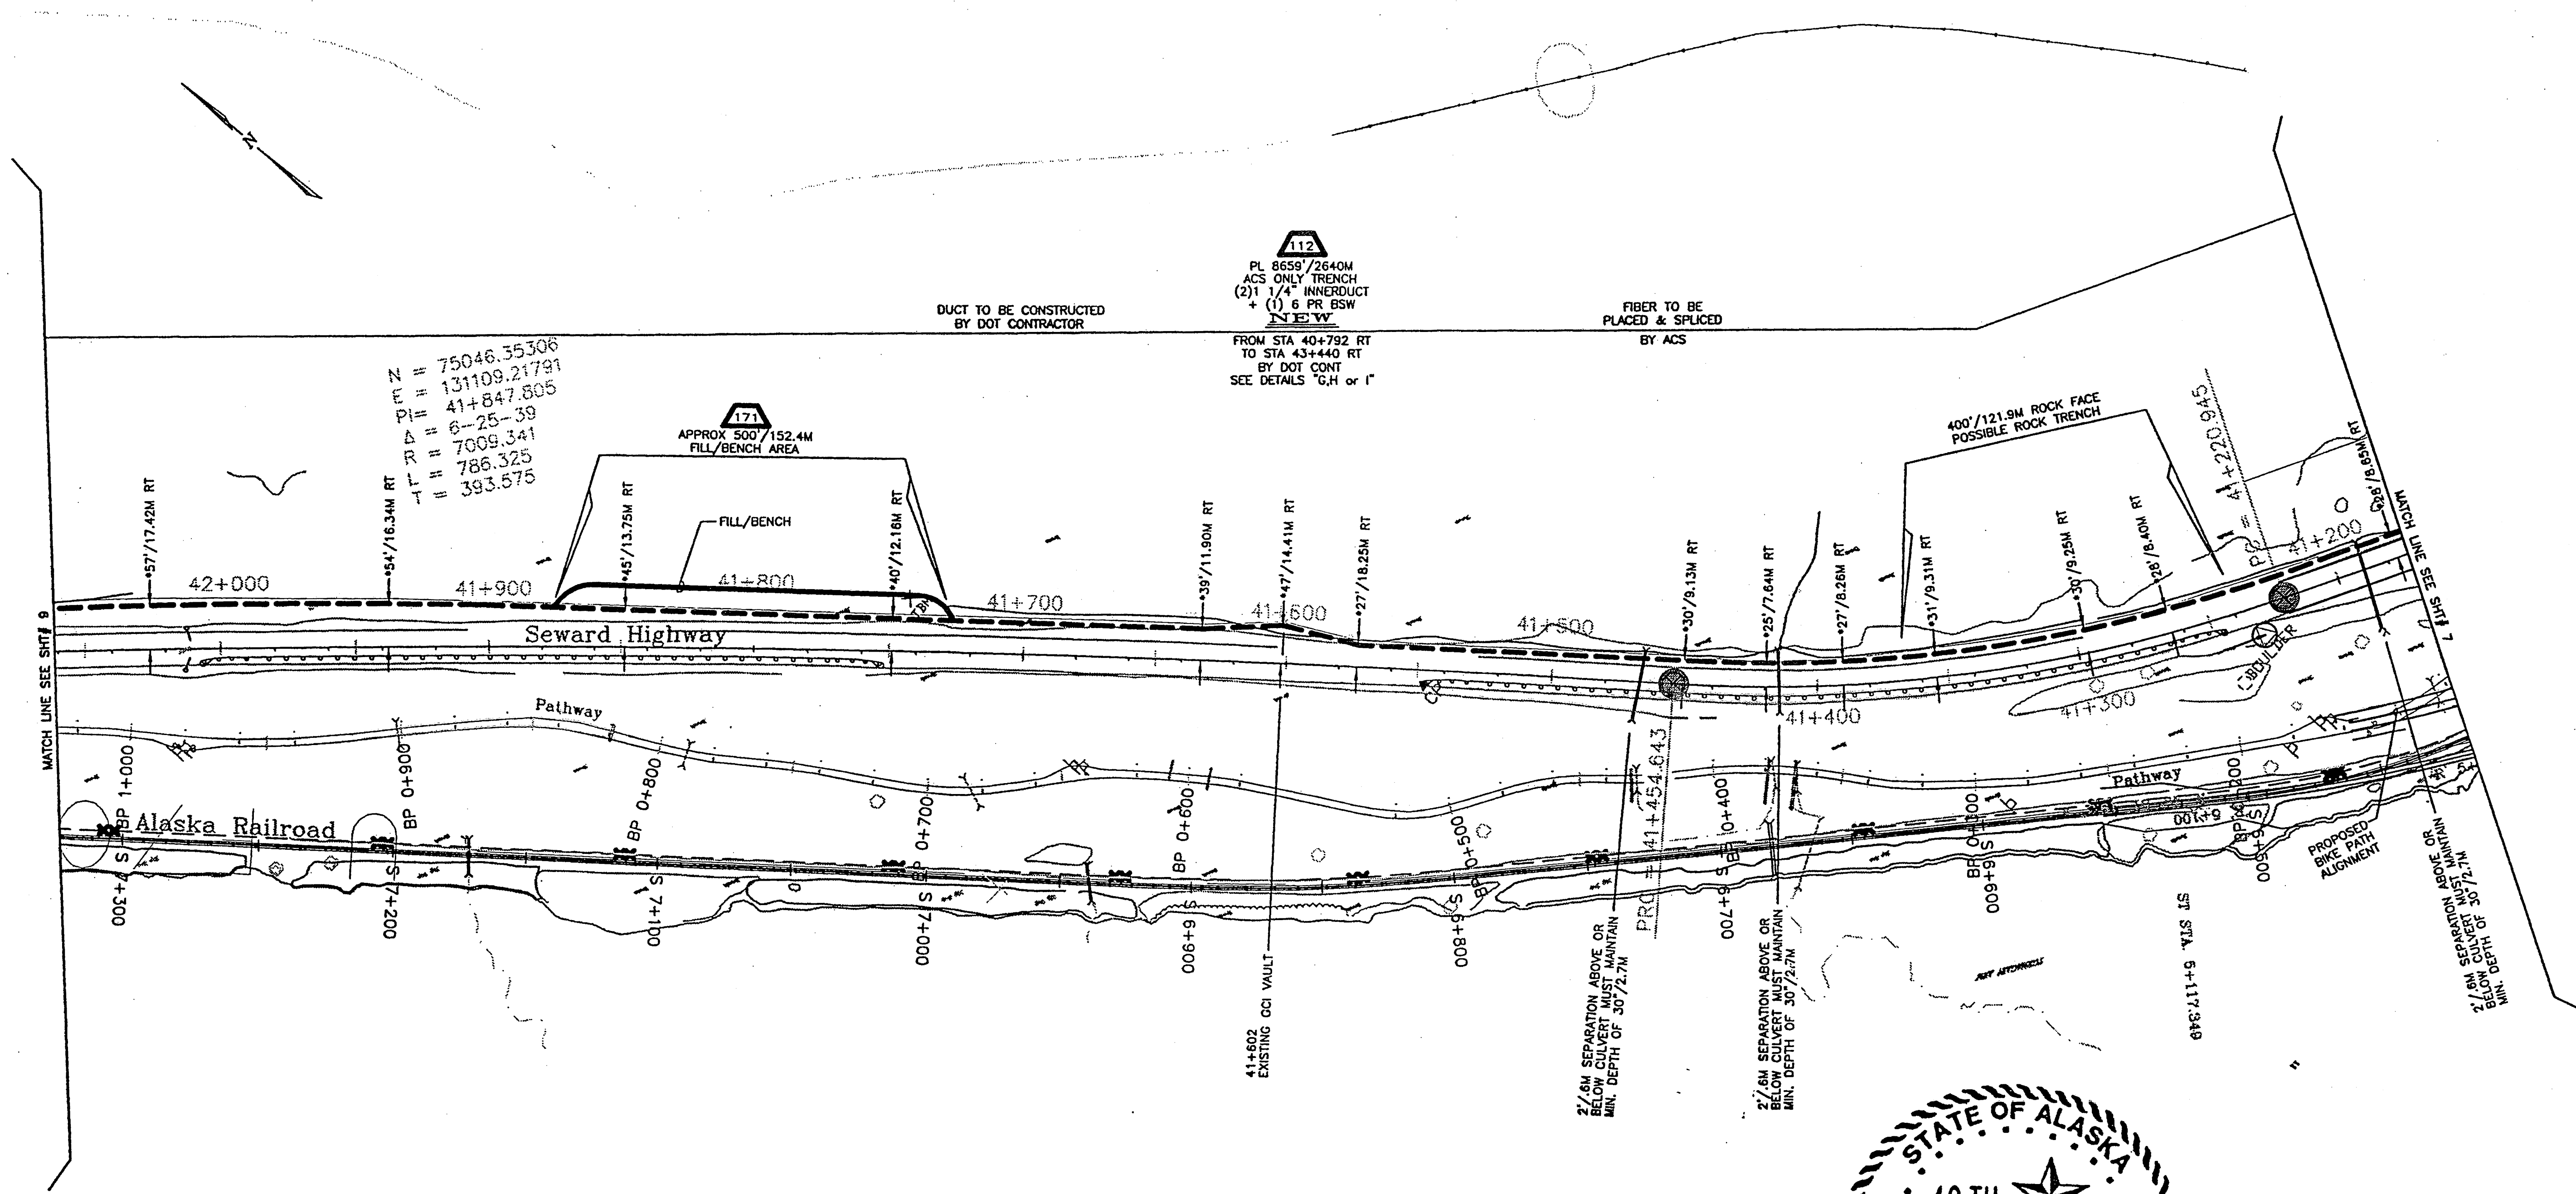

Turnagain Arm

- THE CONTRACTOR SHALL MAINTAIN A STANDARD 5' OFFSET FROM THE EXISTING GCI FIBER OPTIC FACILITY.
- ALL NOTED OFFSETS FROM PROJECT AND HIGHWAY CENTERLINE ARE FOR INFORMATIONAL PURPOSES ONLY.

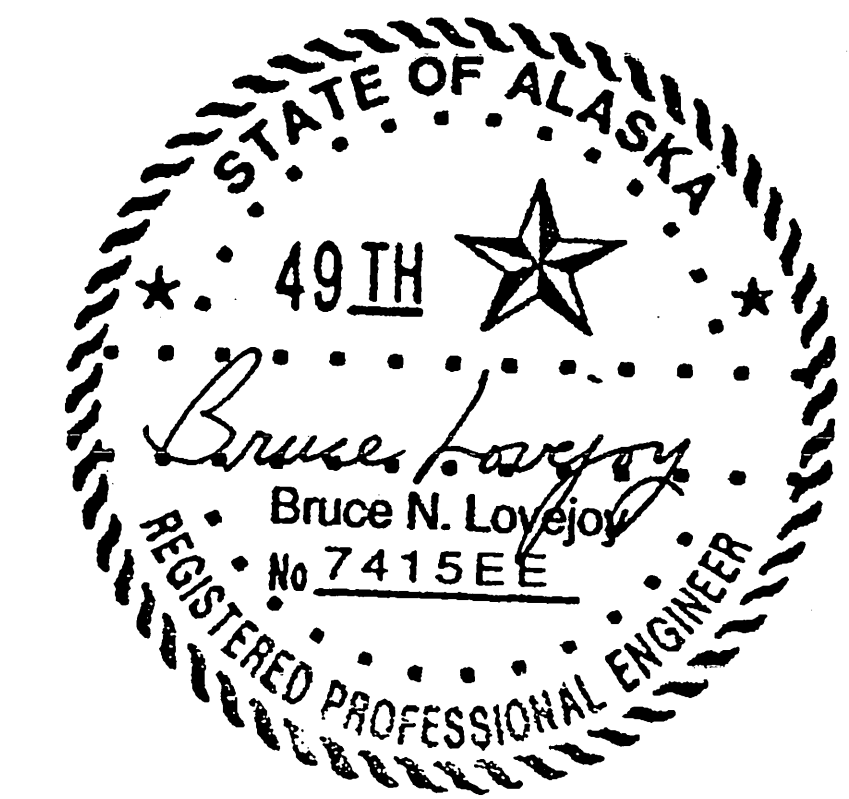


TOWNSHIP ANCHORAGE		RANGE	SECTION	DA	EFRA	HELD ORDER: YES NO	PERMITS: YES NO	CUTS REQ: YES NO	PRESSURE: YES NO
ASSOCIATED WORK ORDERS		SOURCE MAPS	REVISION NUMBER-DATE-INITIALS	EXCHANGE GIRD	S	01051901			
CAD: 01051901		ENGR/EXT: C. CHRISTENSEN 564-1367 / 244-1191	DATE: 5/29/02	SCALE: NTS	APRD:	ISSUED: 6-7-02	SH. 8	OF 30	SHTS


STATE OF ALASKA
 DEPARTMENT OF TRANSPORTATION
 AND
 PUBLIC FACILITIES
 SEWARD HIGHWAY
 MP 96 TO MP 102
 SAFETY, ROADWAY AND
 RECREATIONAL IMPROVEMENTS

REVISIONS			STATE	PROJECT DESIGNATION	YEAR	SHEET NO.	TOTAL SHEETS
No.	DATE	DESCRIPTION	ALASKA	NH-0A3-1K28	2002	S9	S17


DESIGNED BY: [blank]
 CHECKED BY: [blank]
 DRAFTED BY: [blank]
 DATE: 1/29/02
 STANDARD: [blank]
 COMPUTER DESIGNATION: AUTOCAD-CAROLE-MARY/MBR
 VIEW ALL: [blank]

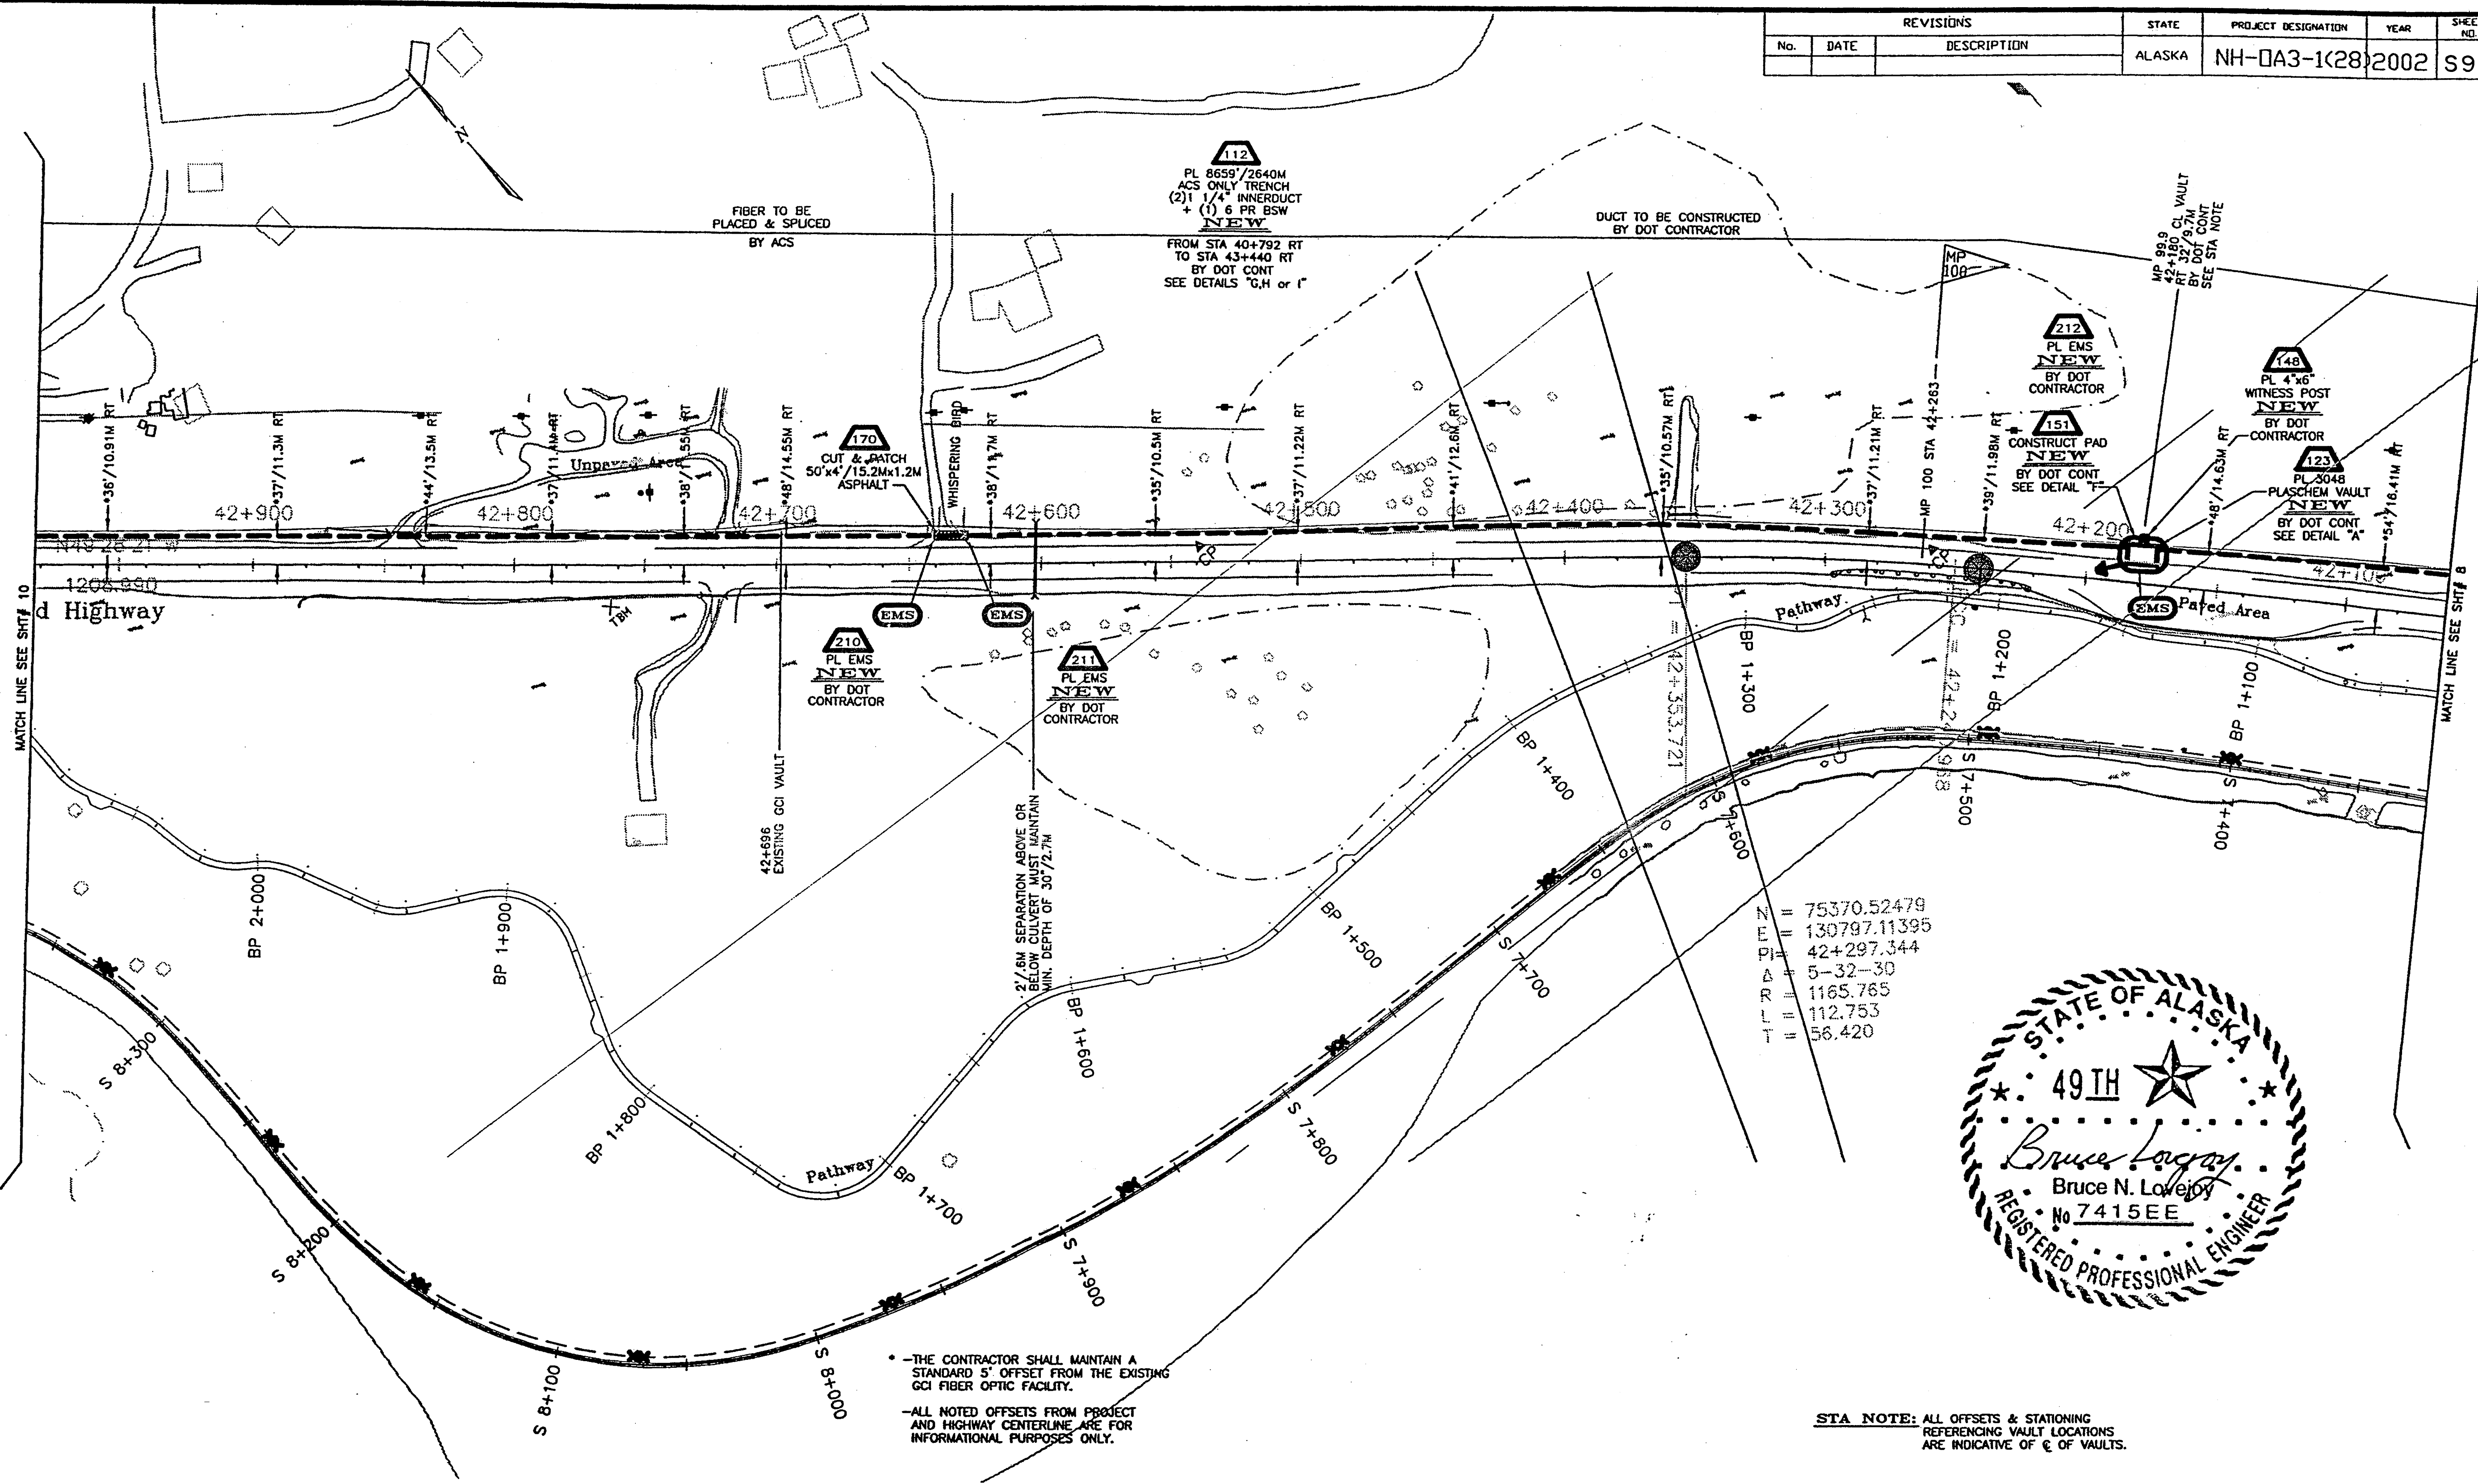

N = 75370.52479
 E = 130797.11395
 P = 42+297.344
 A = 5-32-30
 R = 1165.765
 L = 112.753
 T = 56.420

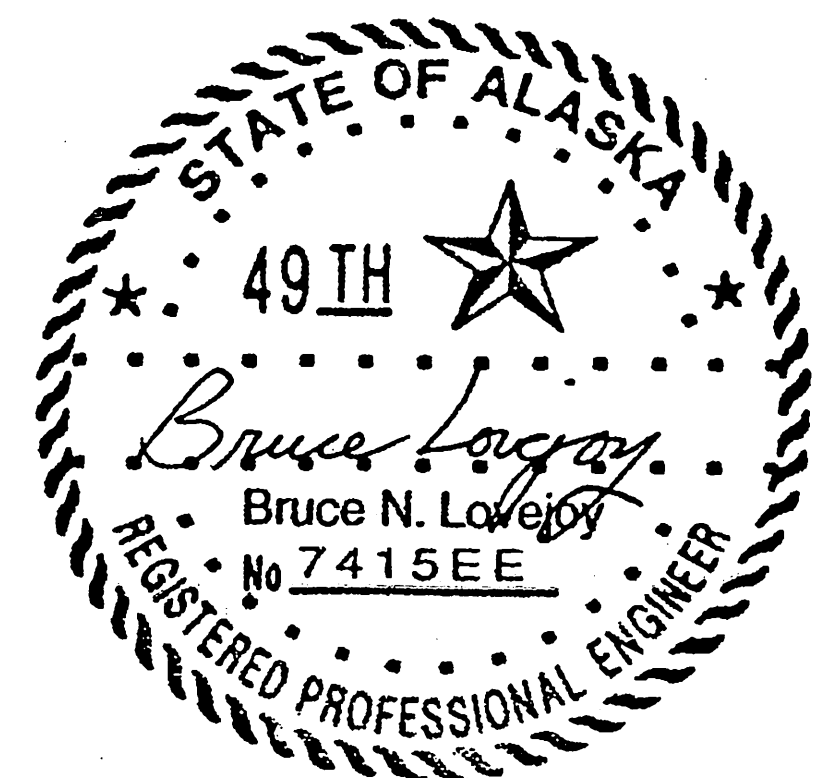

STA NOTE: ALL OFFSETS & STATIONING REFERENCING VAULT LOCATIONS ARE INDICATIVE OF C OF VAULTS.

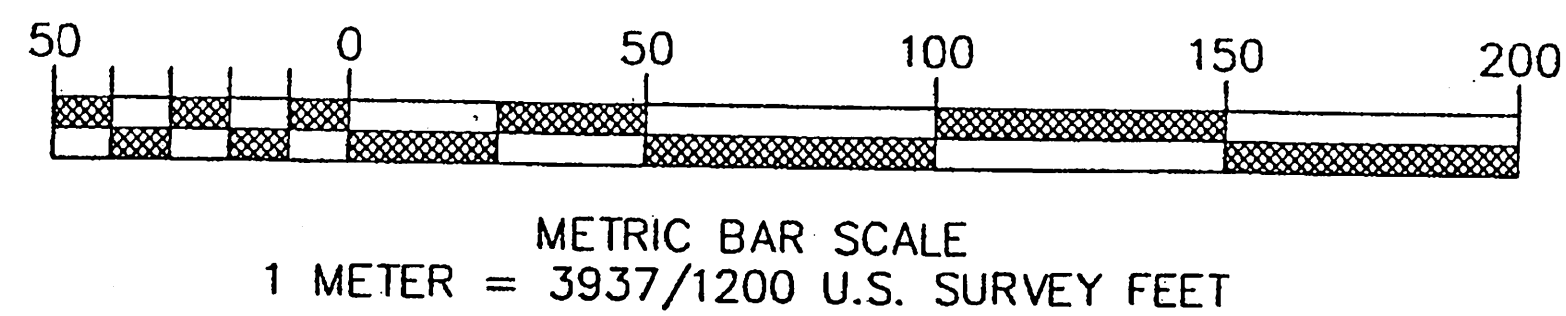


TOWNSHIP ANCHORAGE		RANGE	SECTION	DA	FRAP	HELD ORDER: YES NO	PERMITS: YES NO	CUTS REQ: YES NO	PRESSURE: YES NO
ASSOCIATED WORK ORDERS		SOURCE MAPS	REVISION NUMBER-DATE-INITIALS	EXCHANGE CARD	SJ	TITLE: BIRD FLATS FIBER RELOCATION	WOF (2001)	001-0519	SH. 9 OF 30 SHITS
			REV.	CAD 01051901		BOROUGH/CITY	SCALE: NTS	APRD: ISSUED: 6-7-07	
			REV.	ENGR/EXT: C. CHRISTENSEN 564-1367 / 244-1191					
			REV.	DWG: MTE	DATE: 5/29/02				

STATE OF ALASKA
 DEPARTMENT OF TRANSPORTATION AND PUBLIC FACILITIES
 SEWARD HIGHWAY
 MP 96 TO MP 102
 SAFETY, ROADWAY AND RECREATIONAL IMPROVEMENTS


REVISIONS			STATE	PROJECT DESIGNATION	YEAR	SHEET NO.	TOTAL SHEETS
No.	DATE	DESCRIPTION	ALASKA	NH-0A3-1K28	2002	S10	S17

DESIGNED BY	1/29/02
CHECKED BY	
DRAWN BY	
IN CHARGE	
COMPUTER DESIGNATION	
VIEW ALL	
COMPUTER DESIGNATION	

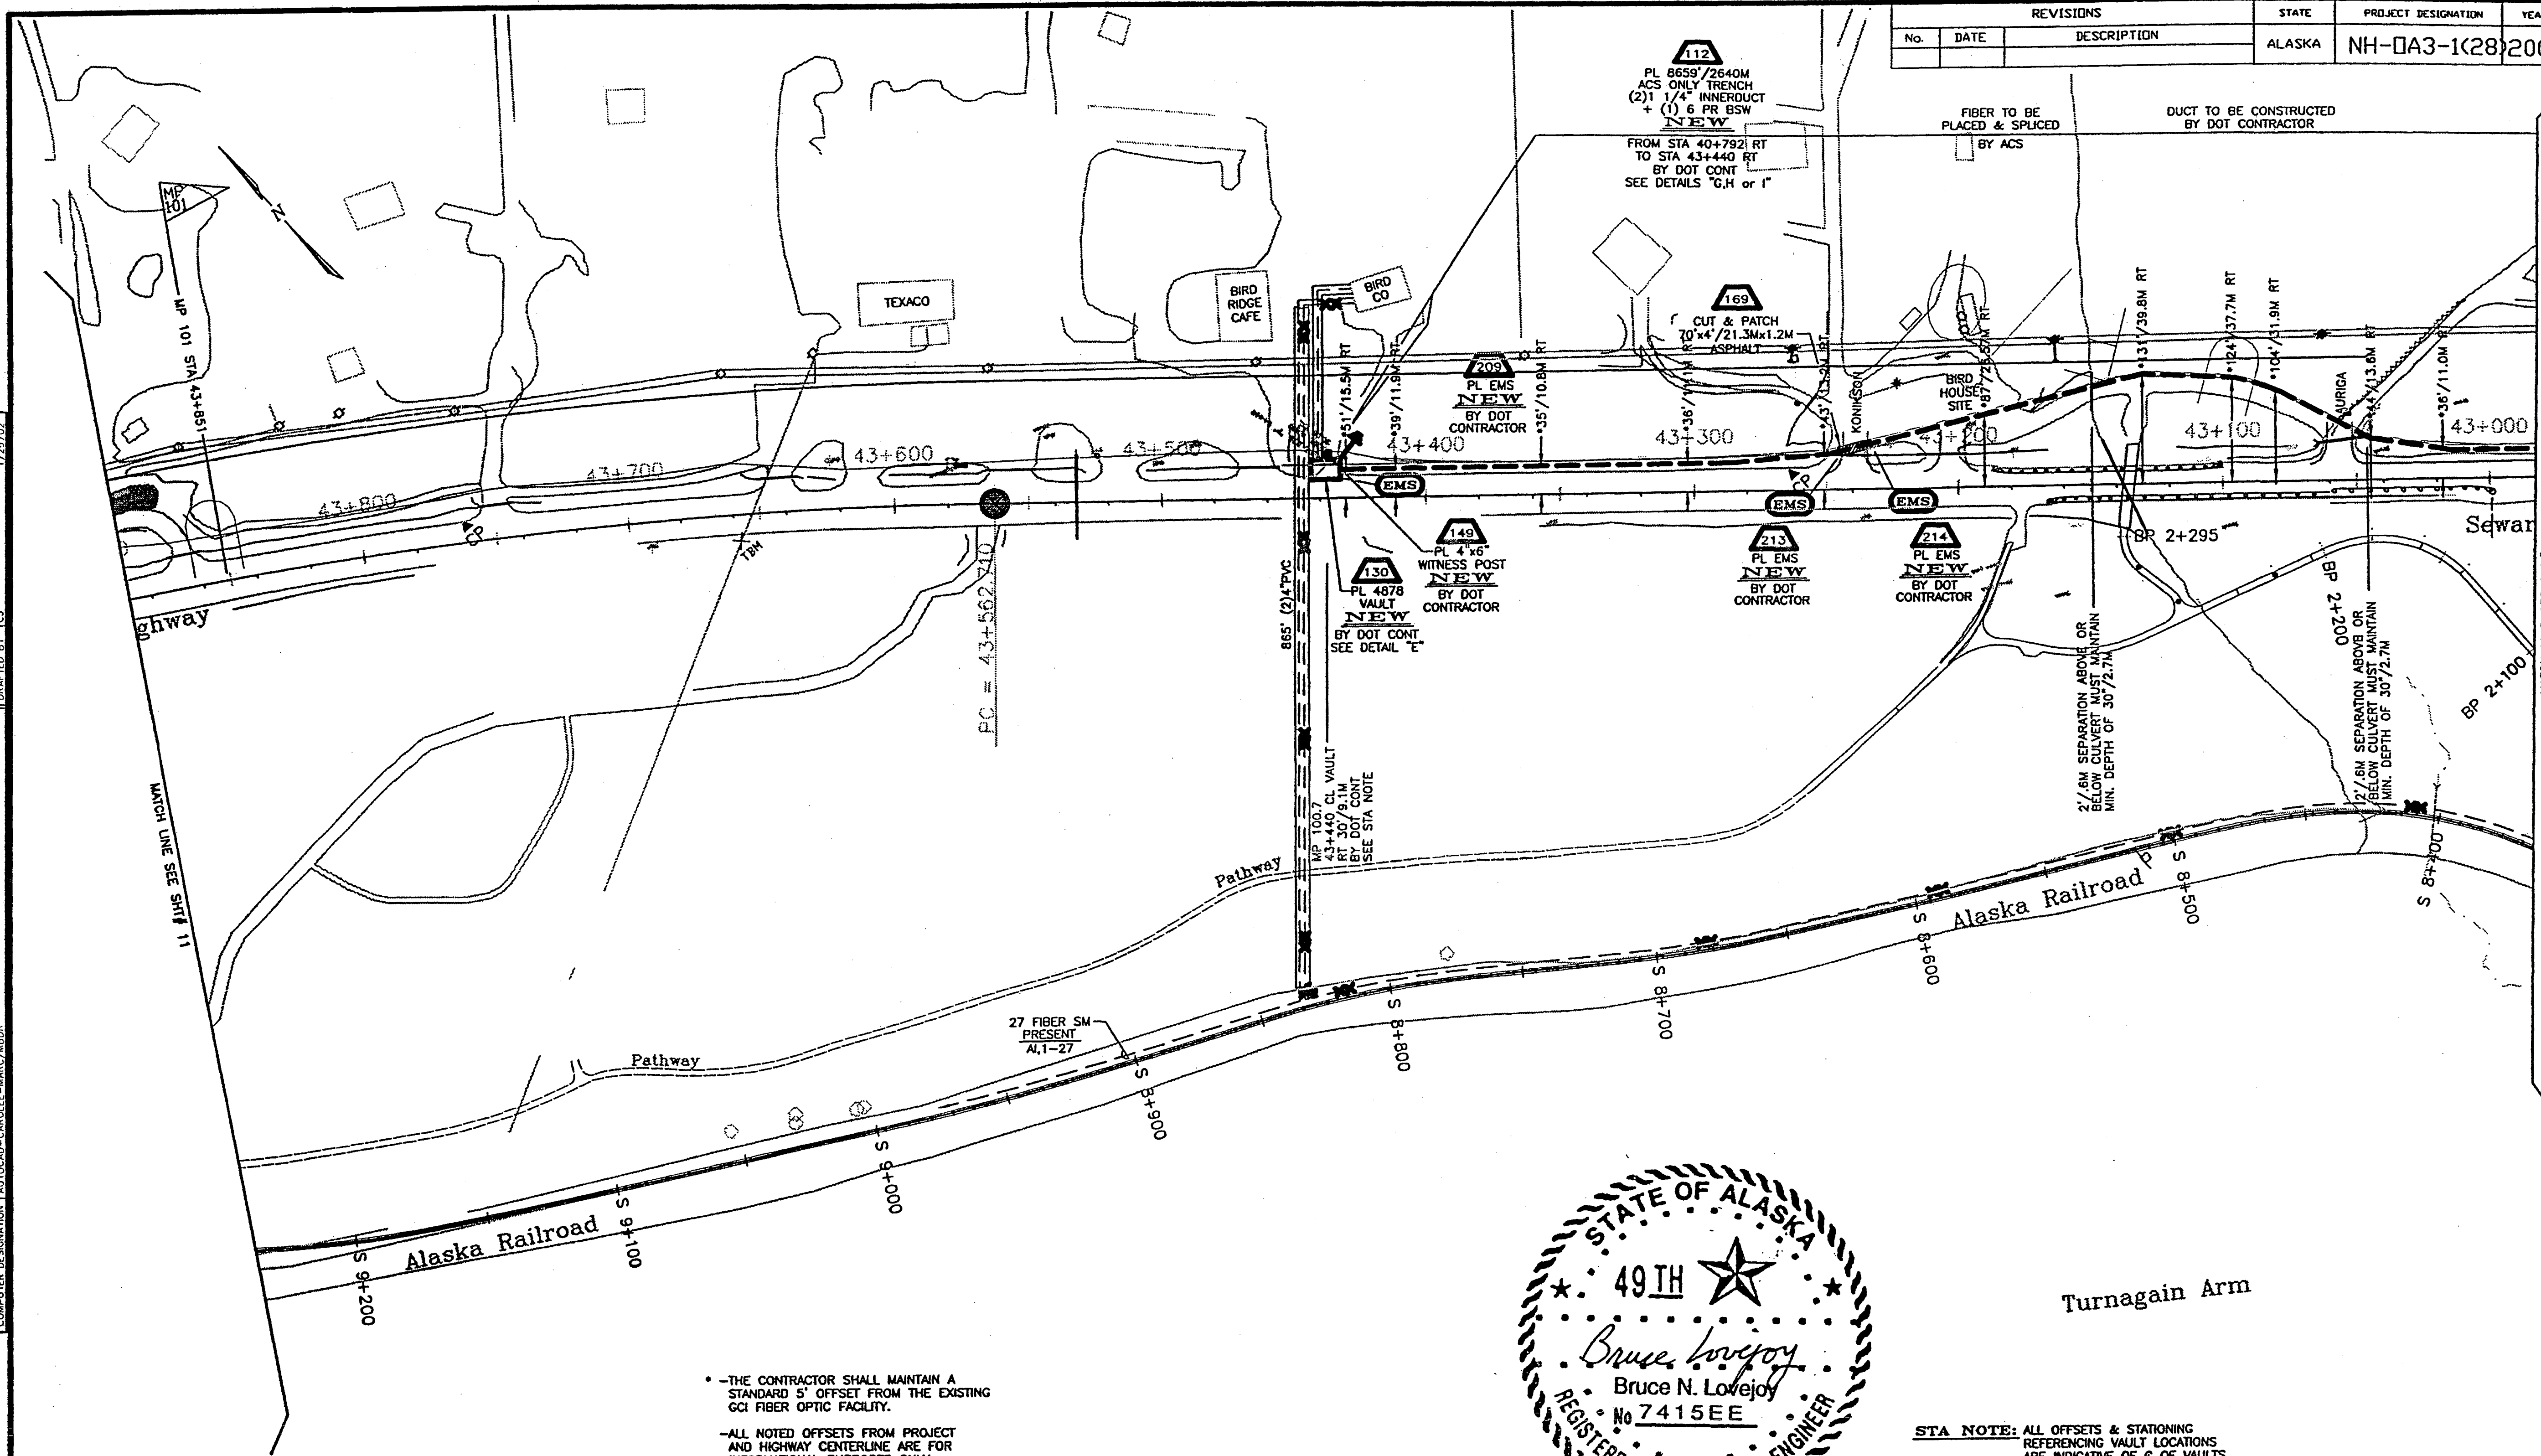


• THE CONTRACTOR SHALL MAINTAIN A STANDARD 5' OFFSET FROM THE EXISTING GCI FIBER OPTIC FACILITY.

• ALL NOTED OFFSETS FROM PROJECT AND HIGHWAY CENTERLINE ARE FOR INFORMATIONAL PURPOSES ONLY.

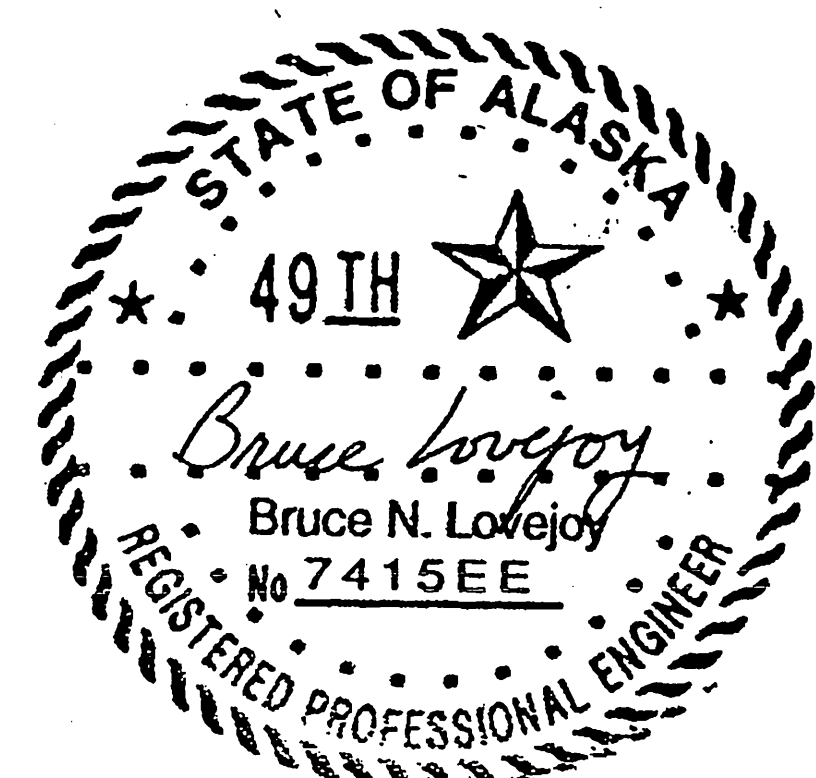


STA NOTE: ALL OFFSETS & STATIONING REFERENCING VAULT LOCATIONS ARE INDICATIVE OF C OF VAULTS.

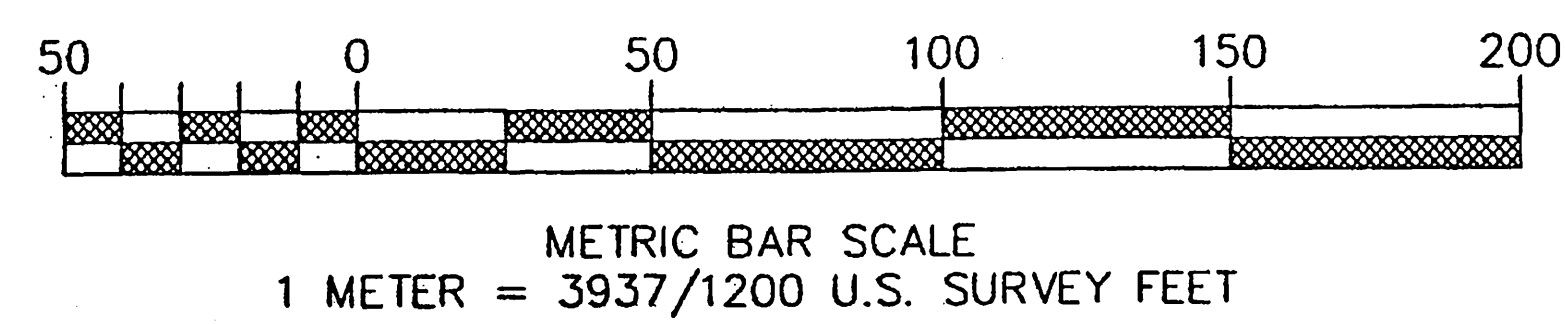

TOWNSHIP		RANGE		SECTION		DATE	
ANCHORAGE		SOURCE MAPS		REVISION		EXCHANGE	
ASSOCIATED				NUMBER-DATE-INITIALS		GIRD	
WORK ORDERS				REV.		CAD	
				REV.		ENGR/EXT	
				REV.		C. CHRISTENSEN 584-1367 / 244-1191	
						DATE 5/29/02	
						SCALE: NTS	
						APRD:	
						ISSUED: 6/7/02	
						SHEET 10 OF 30 SHEETS	

STATE OF ALASKA
DEPARTMENT OF TRANSPORTATION
AND
PUBLIC FACILITIES
SEWARD HIGHWAY
MP 96 TO MP 102
SAFETY, ROADWAY AND
RECREATIONAL IMPROVEMENTS

REVISIONS			STATE	PROJECT DESIGNATION	YEAR	SHEET NO.	TOTAL SHEETS
No.	DATE	DESCRIPTION	ALASKA	NH-0A3-1K28	2002	S11	S17

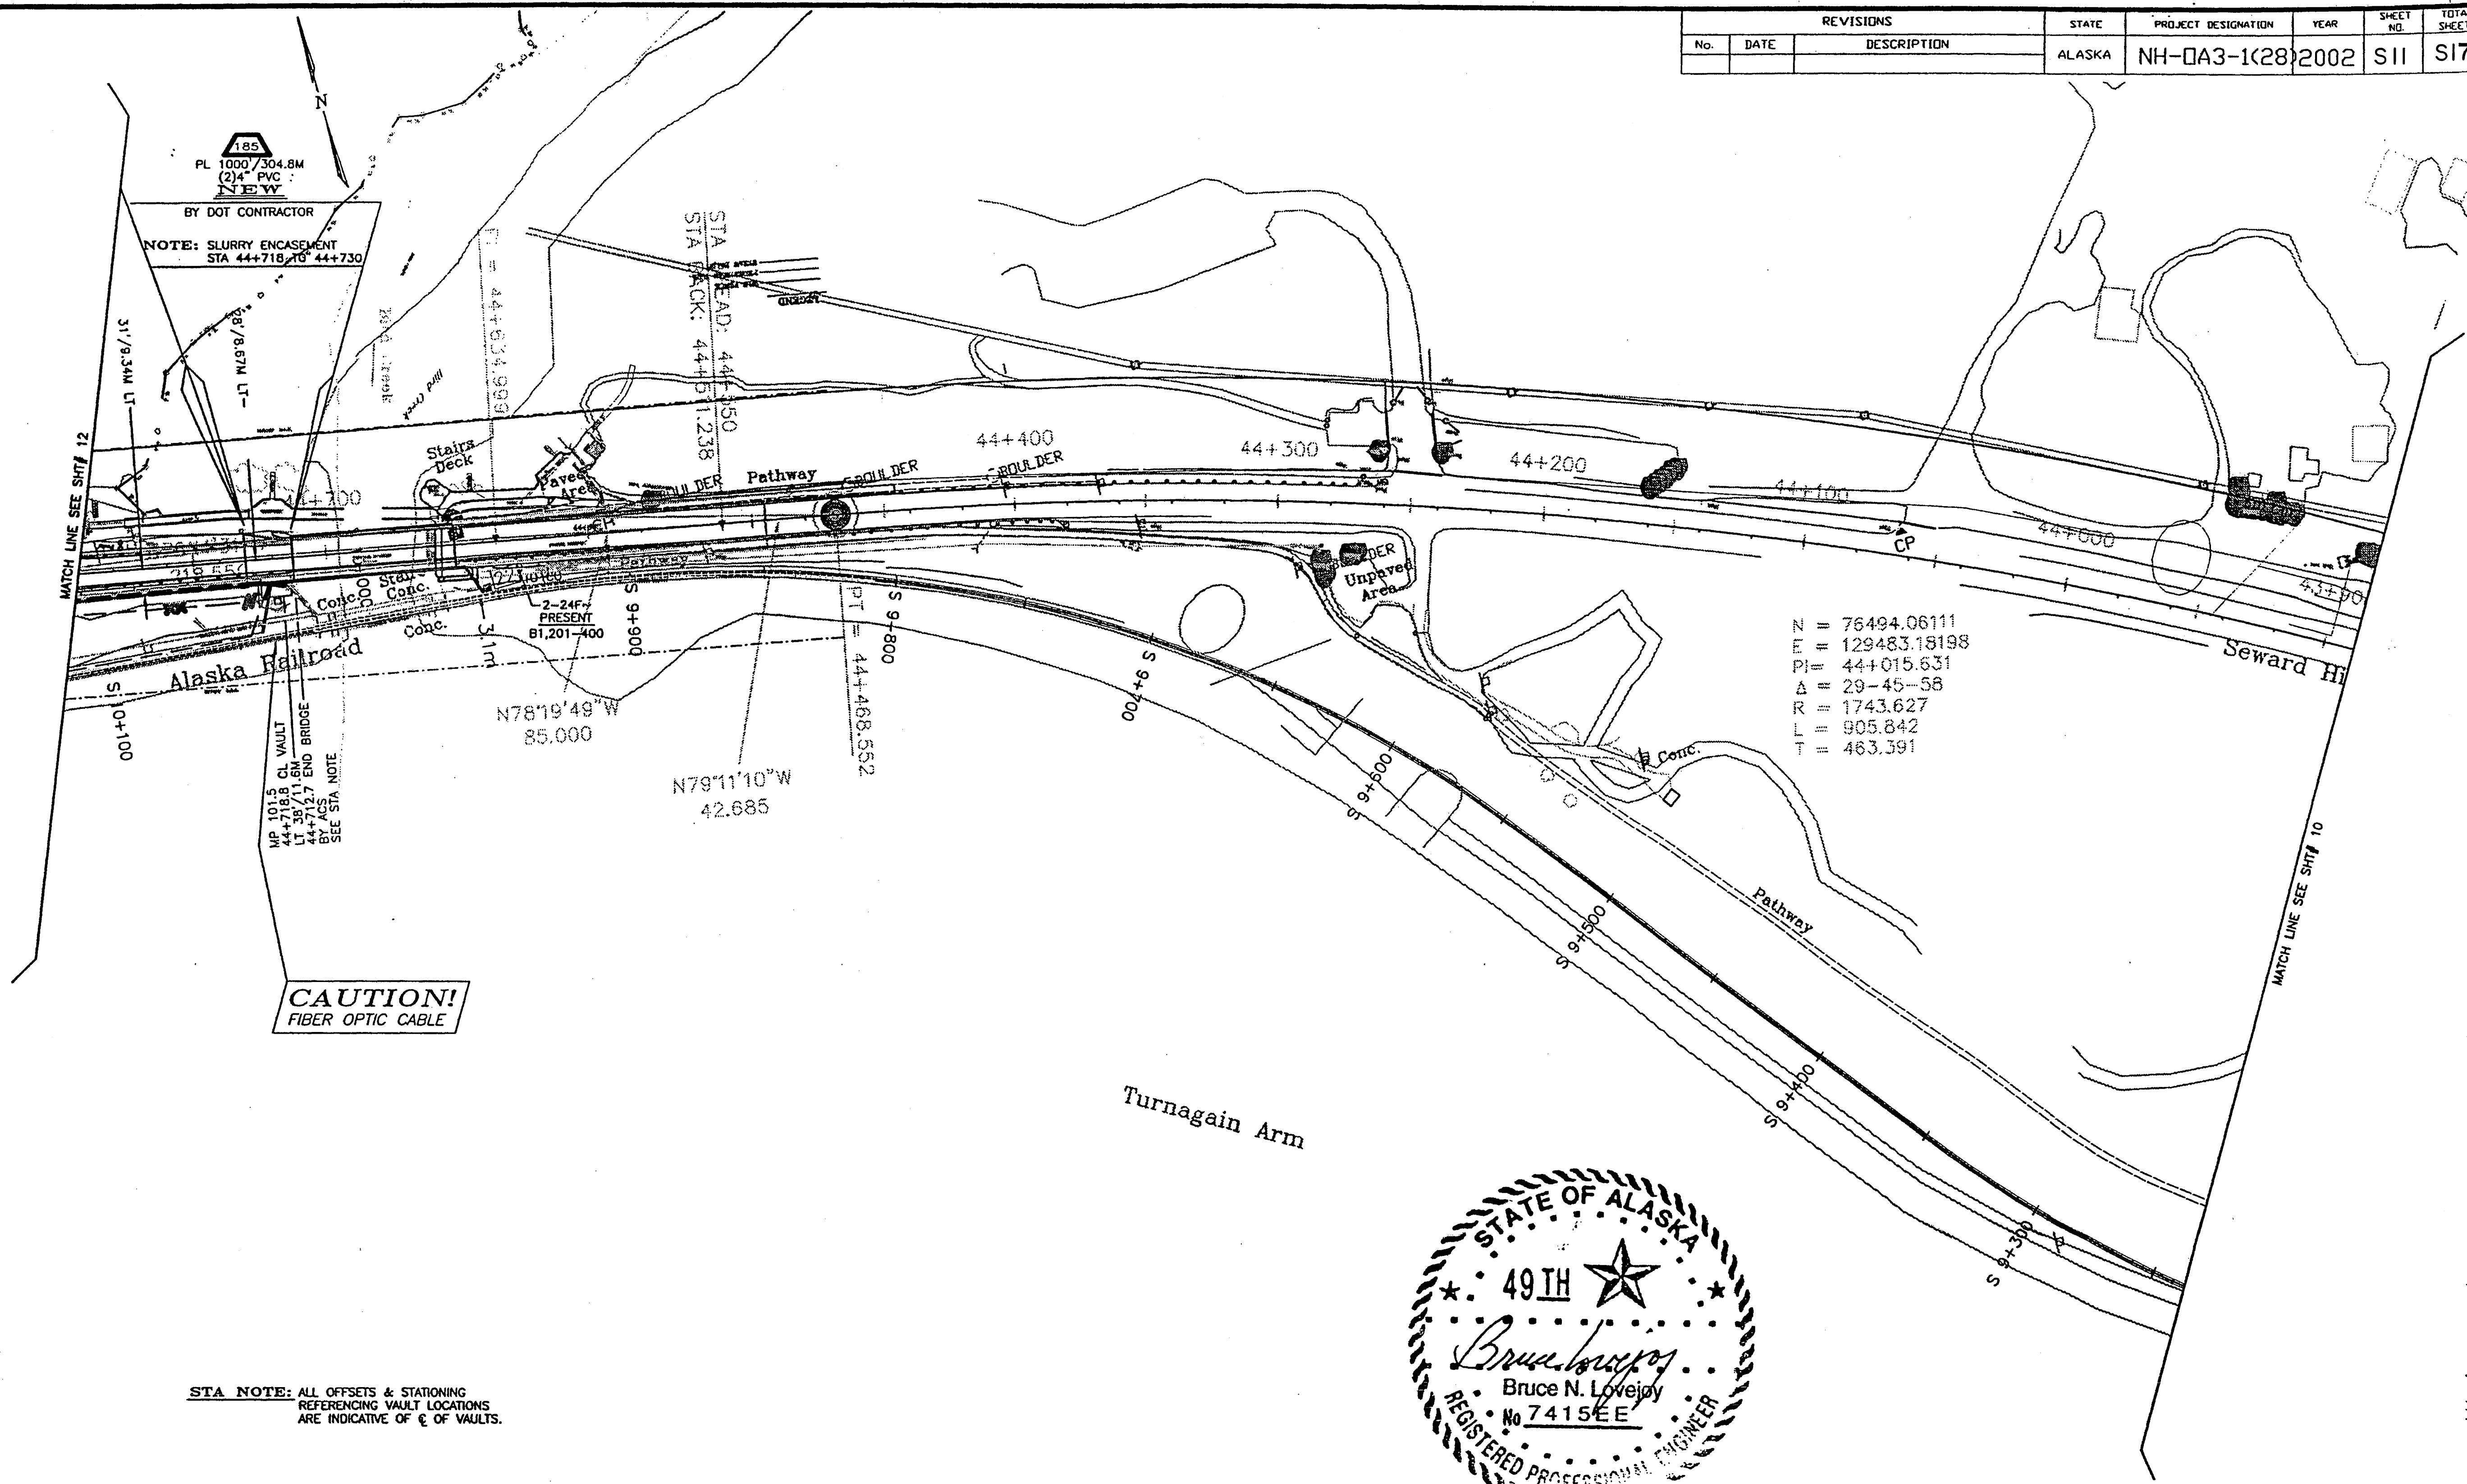

METRIC BAR SCALE
1 METER = 3937/1200 U.S. SURVEY FEET





TOWNSHIP ANCHORAGE	RANGE	SECTION	DA#	ETRAP#	HELD ORDER: YES NO	PERMITS: YES NO	CUTS REQ: YES NO	PRESSURE: YES NO
ASSOCIATED WORK ORDERS	SOURCE MAPS	REVISION NUMBER-DATE-INITIALS	EXCHANGE GIRD	SA	TITLE: BIRD FLATS FIBER RELOCATION	W# (2001)	001-0519	
		REV.	CAD# 01051901		BOROUGH/CITY			
		REV.	ENGR/EXT: C. CHRISTENSEN 564-1367 / 244-1191		SCALE: NTS	APR'D:	ISSUED: 4/17/02	SHT. 11 OF 30 SHTS.
		REV.	DATE: 4/17/02					




STATE OF ALASKA
DEPARTMENT OF TRANSPORTATION
AND
PUBLIC FACILITIES
SEWARD HIGHWAY
MP 96 TO MP 102
SAFETY, ROADWAY AND
RECREATIONAL IMPROVEMENTS




DETAIL "J"
ELIMINATED
NTS

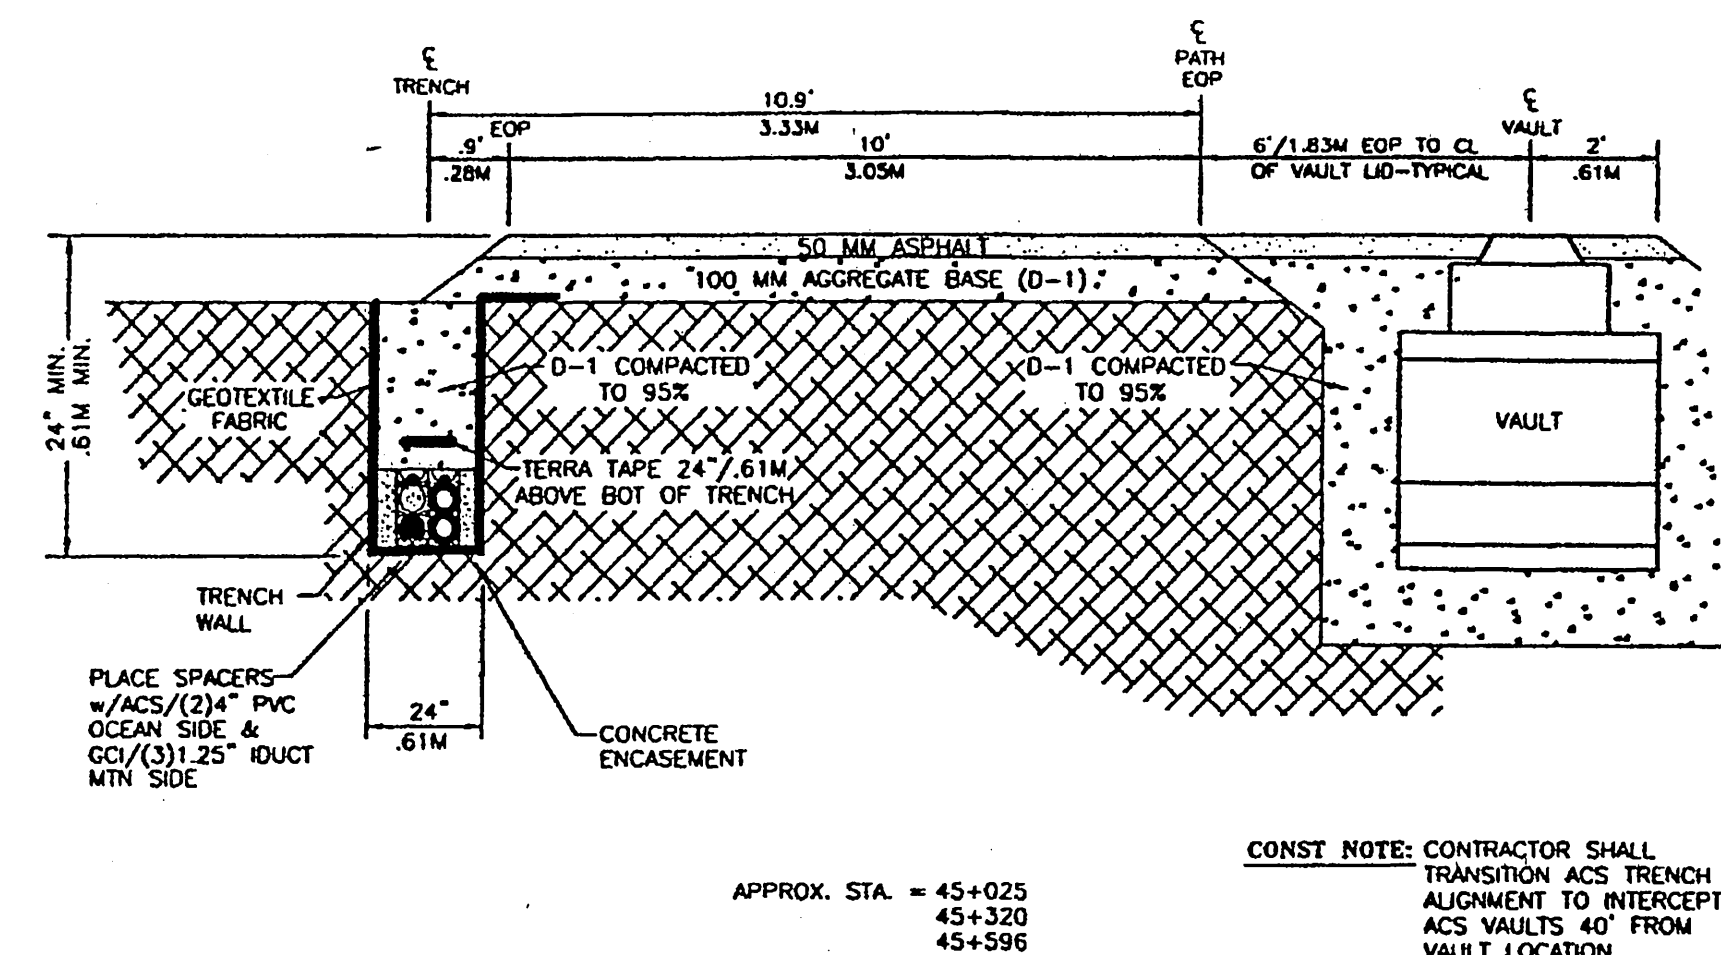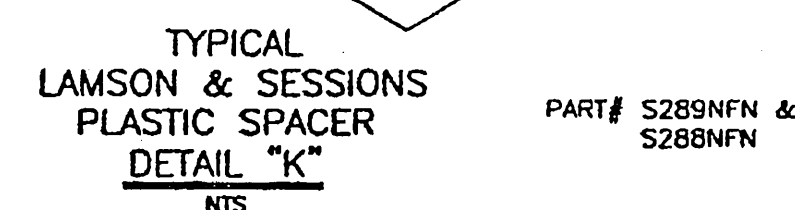

TYPICAL PATHWAY
TRENCH & MH OFFSET
DETAIL "L"
NTS

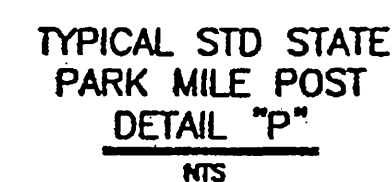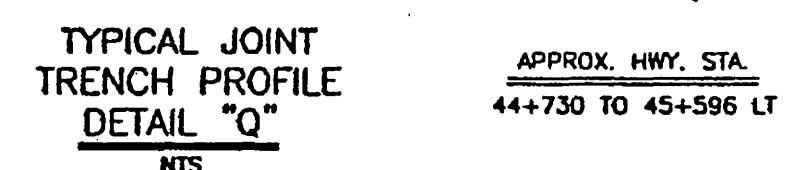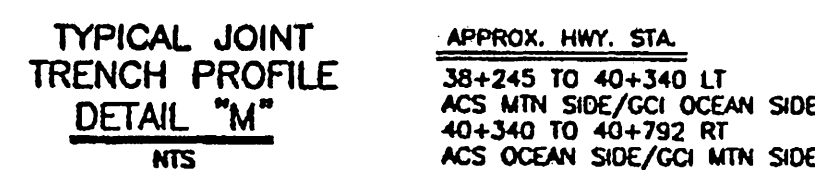

DETAIL "N"
ELIMINATED
NTS

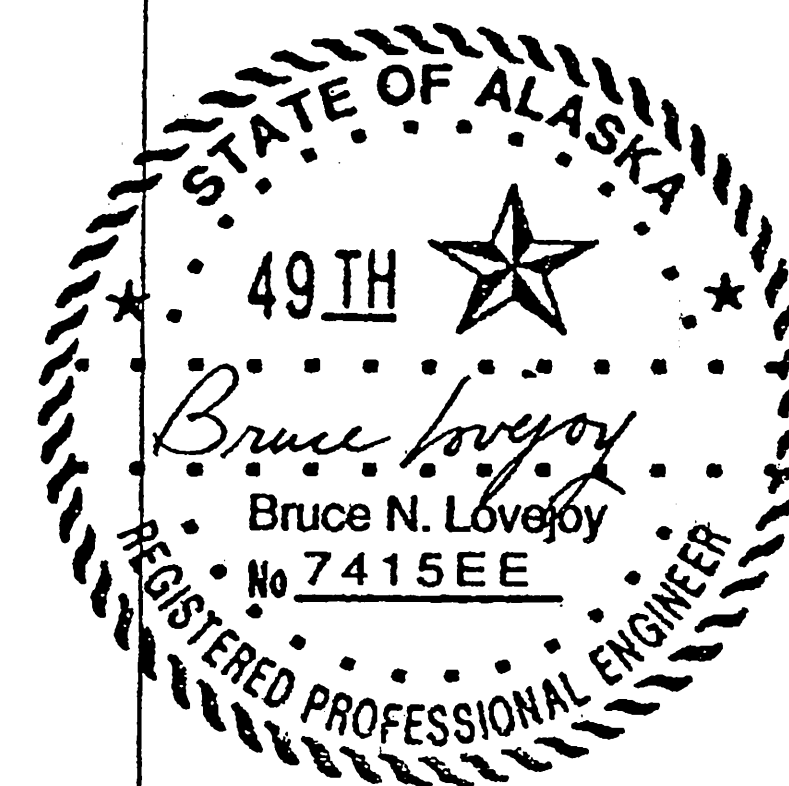

STATE OF ALASKA
DEPARTMENT OF TRANSPORTATION
AND
PUBLIC FACILITIES
SEWARD HIGHWAY
MP 96 TO MP 102
SAFETY, ROADWAY AND
RECREATIONAL IMPROVEMENTS

	TOWNSHIP ANCHORAGE	RANGE	SECTION	DATE	ETAP#	FIELD ORDER: YES NO 0 0	PERMITS: YES NO 0 0	CUTS REQ: YES NO 0 0	PRESSURE: YES NO 0 0
	ASSOCIATED WORK ORDERS	SOURCE MAPS	REVISION NUMBER-DATE-INITIALS		EXCHANGE GRD	SA	TITLE: BIRD FLATS FIBER RELOCATION		NO# (2001) 001-0519
			REV.		CAD# 01051901		BOROUGH/CITY		
			REV.		ENR/EXT. 6 CHRISTENSEN 554-1367 / 244-1191		SCALE: NTS		
			REV.		DATE: 5/29/02		APPRO: ISSUED: 6-7-02		
				DATE: 5/29/02	APPRO: ISSUED: 6-7-02		SH. 14 OF 30 SHITS		

CONSTRUCTION OPERATIONS:

OP#	ELEM	FOC	RESP	SH#	DESCRIPTION
101					
102	21	244100	DOT/CONT	2	CUT & PATCH 4'x24'/1.2x7.3M ASPHALT
103					
104					
105					
106					
107					
108					
109					
110	21	244100	DOT/CONT	2-3	PL 4050'/1234M (2)1-1/4" IDU+(1)6 PR BSW-ACS ONLY
111					
112	21	244100	DOT/CONT	7-10	PL 8660'/2640M (2)1-1/4" IDU+(1)6 PR BSW-ACS ONLY TRENCH
113	21	244100	DOT/CONT	2	PL 100'/30M (2)4" PVC+(3)1-1/4" IDU+(1)6 PR BSW
114	21	244100	DOT/CONT	3-4	PL 3264'/985M (2)1 1/4" IDU+(1)6PR BSW-ACS ONLY TRENCH
115	21	244100	DOT/CONT	4-7	PL 6872'/2095M (2)1 1/4" IDU+(1)6PR BSW+(3)GCI IDU-JOINT TR.
116					
117	21	244100	DOT/CONT	7	PL 150'/46M (2)4" PVC+(3)1-1/4" IDU+(1)6 PR BSW-JOINT OPEN CUT
118	21	244100	DOT/CONT	7	PL 1509'/460M (2)1 1/4" IDU+(1)6PR BSW+(3)GCI IDU-JOINT TR.
119					
120					
121					
122	21	244100	DOT/CONT	7	PL 4890 PLASCHEN VAULT
123	21	244100	DOT/CONT	9	PL 3048 PLASCHEN VAULT
124	21	244100	DOT/CONT	7	PL 4878 VAULT w/FRAME & COVER
125	21	244100	DOT/CONT	6	PL 4878 VAULT w/FRAME & COVER
126	21	244100	DOT/CONT	5	PL 4878 VAULT w/FRAME & COVER
127	21	244100	DOT/CONT	3	PL 4878 VAULT w/FRAME & COVER
128	21	244100	DOT/CONT	2	PL 4878 VAULT w/FRAME & COVER
129	21	244100	DOT/CONT	2	PL 4878 VAULT w/FRAME & COVER
130	21	244100	DOT/CONT	10	PL 4878 VAULT w/FRAME & COVER
131					
132					
133					
134					
135					
136					
137					
138					
139					
140					
141	21	244100	DOT/CONT	2	PL 4x6 WITNESS POST
142	21	244100	DOT/CONT	2	PL 4x6 WITNESS POST
143	21	244100	DOT/CONT	2	PL 4x6 WITNESS POST
144	21	244100	DOT/CONT	4	PL 4x6 WITNESS POST
145	21	244100	DOT/CONT	6	PL 4x6 WITNESS POST
146	21	244100	DOT/CONT	7	PL 4x6 WITNESS POST
147	21	244100	DOT/CONT	7	PL 4x6 WITNESS POST
148	21	244100	DOT/CONT	9	PL 4x6 WITNESS POST
149	21	244100	DOT/CONT	10	PL 4x6 WITNESS POST
150					
151	21	244100	DOT/CONT	9	CONSTRUCT PAD FOR VAULT
152	21	244100	DOT/CONT	2	PL EMS
153	21	244100	DOT/CONT	12	CONSTRUCT PAD FOR VAULT
154	21	244100	DOT/CONT	12	CONSTRUCT PAD FOR VAULT
155	21	244100	DOT/CONT	12	CONSTRUCT PAD FOR VAULT
156	21	244100	DOT/CONT	2	CONSTRUCT PAD FOR VAULT
157	21	244100	DOT/CONT	2	CONSTRUCT PAD FOR VAULT
158					
159					
160					
161	21	244100	DOT/CONT	7	CONSTRUCT PAD FOR VAULT
162	21	244100	DOT/CONT	7	CONSTRUCT PAD FOR VAULT
163					
164					
165					
166					
167					
168	21	244100	DOT/CONT	2	PL 40'/12.2M (2)4" PVC+(3)1-1/4" IDU+(1)6 PR BSW
169	21	244100	DOT/CONT	10	RMV & REPLACE 4'x70'/1.2x21.3M ASPHALT
170	21	244100	DOT/CONT	9	RMV & REPLACE 4'x50'/1.2x15.2M ASPHALT
171	21	244100	DOT/CONT	8	FILL AND BENCH 500'/152M
172					
173					
174					
175					
176					
177					
178					
179					
180					
181					
182					
183	12	244100	DOT/CONT	12	PL 4878 VAULT w/FRAME & COVER
184	21	244100	DOT/CONT	12	PL 4878 VAULT w/FRAME & COVER
185	21	244100	DOT/CONT	12	PL 1000'/305M (2)4" PVC
186	21	244100	DOT/CONT	12	PL 1000'/305M (2)4" PVC
187	21	244100	DOT/CONT	12	PL 1000'/305M (2)4" PVC
188					
189					
190					
191					
192					
193					
194					
195					

CONSTRUCTION OPERATIONS CONT:

OP#	ELEM	FOC	RESP	SH#	DESCRIPTION
196					
197					
198					
199	21	244100	DOT/CONT	2	PL EMS
200	21	244100	DOT/CONT	2	PL EMS
201	21	244100	DOT/CONT	3	PL EMS
202	21	244100	DOT/CONT	4	PL EMS
203					
204	21	244100	DOT/CONT	6	PL EMS
205	21	244100	DOT/CONT	7	PL EMS
206	30	244100	DOT/CONT	7	PL EMS
207					
208	21	244100	DOT/CONT	2	PL EMS
209	21	244100	DOT/CONT	10	PL EMS
210	21	244100	DOT/CONT	9	PL EMS
211	21	244100	DOT/CONT	9	PL EMS
212	21	244100	DOT/CONT	9	PL EMS
213	21	244100	DOT/CONT	10	PL EMS
214	21	244100	DOT/CONT	10	PL EMS
215					
216	21	244100	DOT/CONT	12	PL EMS
217	12	244100	DOT/CONT	12	PL EMS
218					
219					
220					
221	21	244100	DOT/CONT	2	PL EMS
222	21	244100	DOT/CONT	2	PL EMS


*ALL INNERDUCT AND SPACERS TO BE SUPPLIED BY DOT CONTRACTOR.

VAULT SCHEDULE

APPROX	ROUTE	TOTAL	DIST	PLACED	LINE	TOTAL	DIST
* STA	LENGTH	VAULTS	TYPE	BY	OP#	ROUTE	BETWEEN
35+040	0	300'	EXISTING	EXISTING	EXISTING	0	91.4M
36+015	300'	740'	4878	ACS	138	91.4M	225.6M
36+225	1,040'	100'	4878	DOT/CONT	128	317.0M	30.5M
36+225	1,140'	1,470'	4878	DOT/CONT	129	347.5M	448.1M
36+645	2,610'	0'	4878	ACS	139	795.5M	0
36+645	0'	1,984'	4878	ACS	131	0	604.7M
37+250	4,594'	3,970'	4878	DOT/CONT	127	1400.3M	1210.1M
36+50	8,664'	3,952'	4878	DOT/CONT	126	2640.6M	1204.6M
48+50	12,616'	2,230'	4878	DOT/CONT	125	3845.4M	679.7M
40+340	14,846'	875'	4878	DOT/CONT	124	4525.1M	267.9M
40+560	15,721'	5,310'	4890	DOT/CONT	122	4793.0M	1617.3M
42+180	21,031'	4,134'	3048	DOT/CONT	123	6410.3M	1260.0M
43+440	25,165'	270'	4878	DOT/CONT	130	7670.3M	82.3M
CO	25,435'		EXISTING	EXISTING	EXISTING	7752.6M	
COPPER VAULTS							
44+718			4878	ACS	75		
45+025			4878	DOT/CONT	83		
45+320			4878	DOT/CONT	84		
45+596			4878	ACS	79		

"PRECAST CONCRETE INC." 4878 VAULTS & COMPONENTS INCLUDING LIDS & CAST IRON FRAMES & COVERS TO BE SUPPLIED BY DOT CONTRACTOR.


REVISIONS			STATE	PROJECT DESIGNATION	YEAR	SHEET NO.	TOTAL SHEETS
NO.	DATE	DESCRIPTION	ALASKA	NH-0A3-1K28	2002	S15	S17

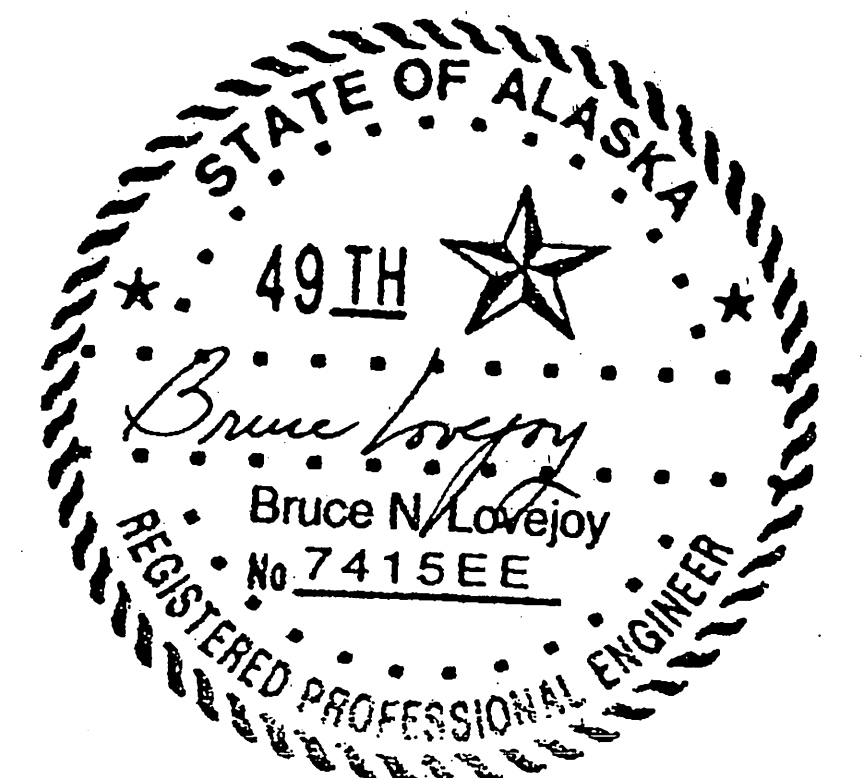

STATE OF ALASKA
DEPARTMENT OF TRANSPORTATION
AND
PUBLIC FACILITIES
SEWARD HIGHWAY
MP 96 TO MP 102
SAFETY, ROADWAY AND
RECREATIONAL IMPROVEMENTS

	TOWNSHIP	RANGE	SECTION	DAY	FRAP#	HELD ORDER: YES NO	PERMITS: YES NO	CUTS REQ: YES NO	PRESSURE: YES NO
	ANCHORAGE								
	ASSOCIATED WORK ORDERS	SOURCE MAPS	REVISION NUMBER-DATE-INITIALS	EXCHANGE	GIRD	S#	TITLE: BIRD FLATS FIBER RELOCATION		
			REV. 01051901				WOF# (2001) 001-0519		
				ENGR/EXT: C. CHRISTENSEN 564-1367 / 244-1191	BOROUGH/CITY	DATE: 5/29/02			SCALE: NTS
				DATE: 5/29/02	SCALE: NTS	APRD:	ISSUED: 6-7-02	SH. 15 OF 30 SHTS	


REVISIONS			STATE	PROJECT DESIGNATION	YEAR	SHEET NO.	TOTAL SHEETS
No.	DATE	DESCRIPTION	ALASKA	NH-0A3-1(28)	2002	S16	S17

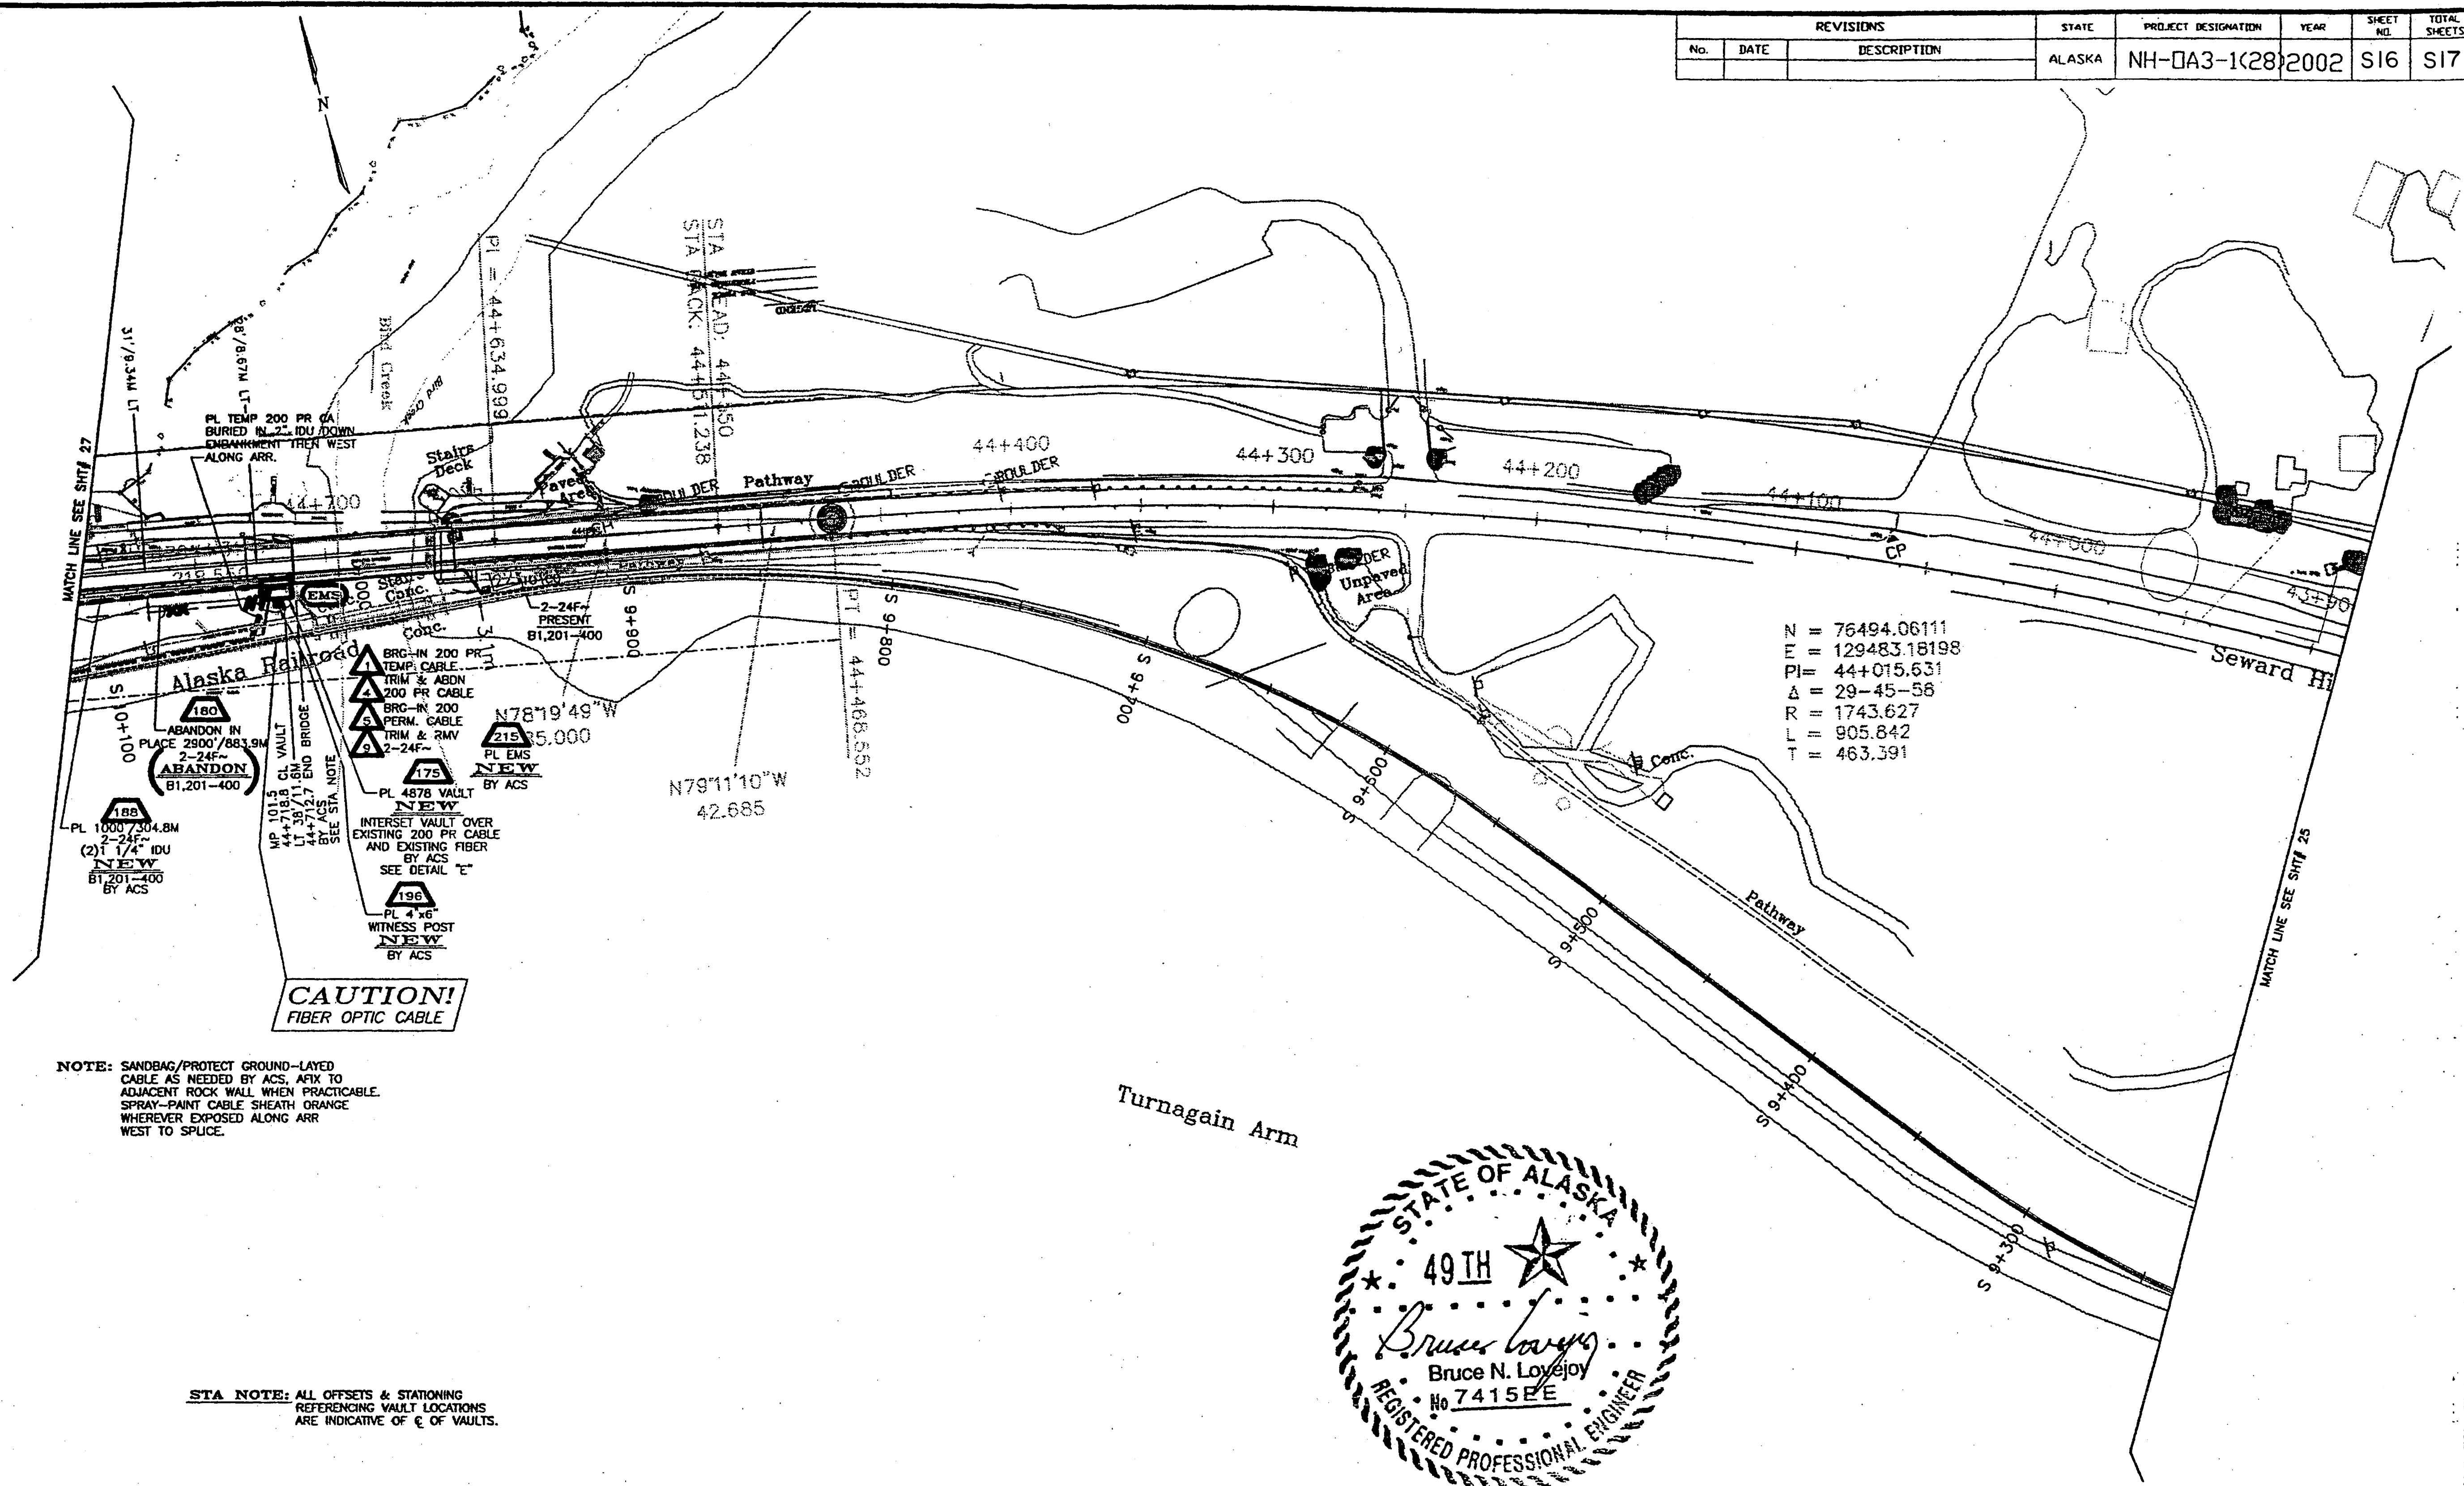


N = 76494.06111
 E = 129483.18198
 PI = 44+015.631
 Δ = 29-45-56
 R = 1743.627
 L = 905.842
 T = 463.391

NOTE: SANDBAG/PROTECT GROUND-LAYED
 CABLE AS NEEDED BY ACS. AFFIX TO
 ADJACENT ROCK WALL WHEN PRACTICABLE.
 SPRAY-PAINT CABLE SHEATH ORANGE
 WHEREVER EXPOSED ALONG ARR
 WEST TO SPUCE.

STA NOTE: ALL OFFSETS & STATIONING
 REFERENCING VAULT LOCATIONS
 ARE INDICATIVE OF E OF VAULTS.

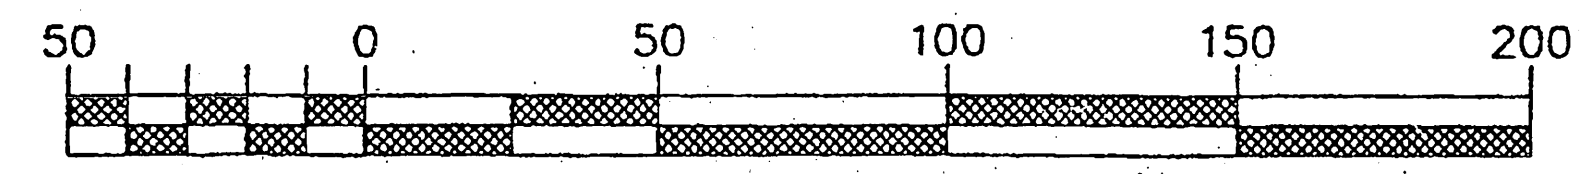

METRIC BAR SCALE
 1 METER = 3937/1200 U.S. SURVEY FEET

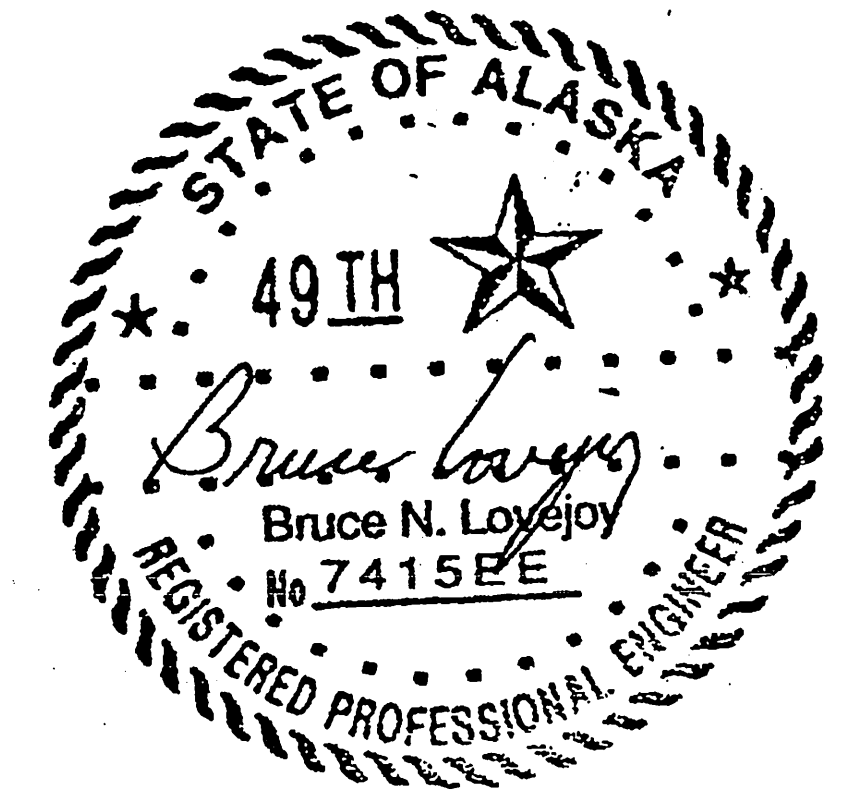


TOWNSHIP ANCHORAGE		RANGE	SECTION	DMA	UTM	HOLD ORDER: YES NO	PERMITS: YES NO	CUTS REQ: YES NO	PRESSURE: YES NO
ASSOCIATED WORK ORDERS		SOURCE MAPS	REVISION NUMBER-DATE-INITIALS	EXCHANGE GRID	SA	TITLE: BIRD FLATS FIBER RELOCATION	WID (2001)	001-0519	
ACS Alaska Communications Systems			REV. 01051901	DATE 4/17/02		SCALE: NTS	APRD: 24/02	SHEET 26 OF 30 SHEETS	


STATE OF ALASKA
 DEPARTMENT OF TRANSPORTATION
 AND
 PUBLIC FACILITIES
 SEWARD HIGHWAY
 MP 96 TO MP 102
 SAFETY, ROADWAY AND
 RECREATIONAL IMPROVEMENTS

REVISIONS			STATE	PROJECT DESIGNATION	YEAR	SHEET NO.	TOTAL SHEETS
No.	DATE	DESCRIPTION	ALASKA	NH-0A3-1(28)	2002	T1	T23

DESIGNED BY	CJ	1/29/02
CHECKED BY		
DRAFTED BY		
VIEW ALL		
AUTOCAD-CAROLEE-MARC/MBDR		
SPECIFICATIONS		
STANDARDS		
COMPUTER DESIGNATION		

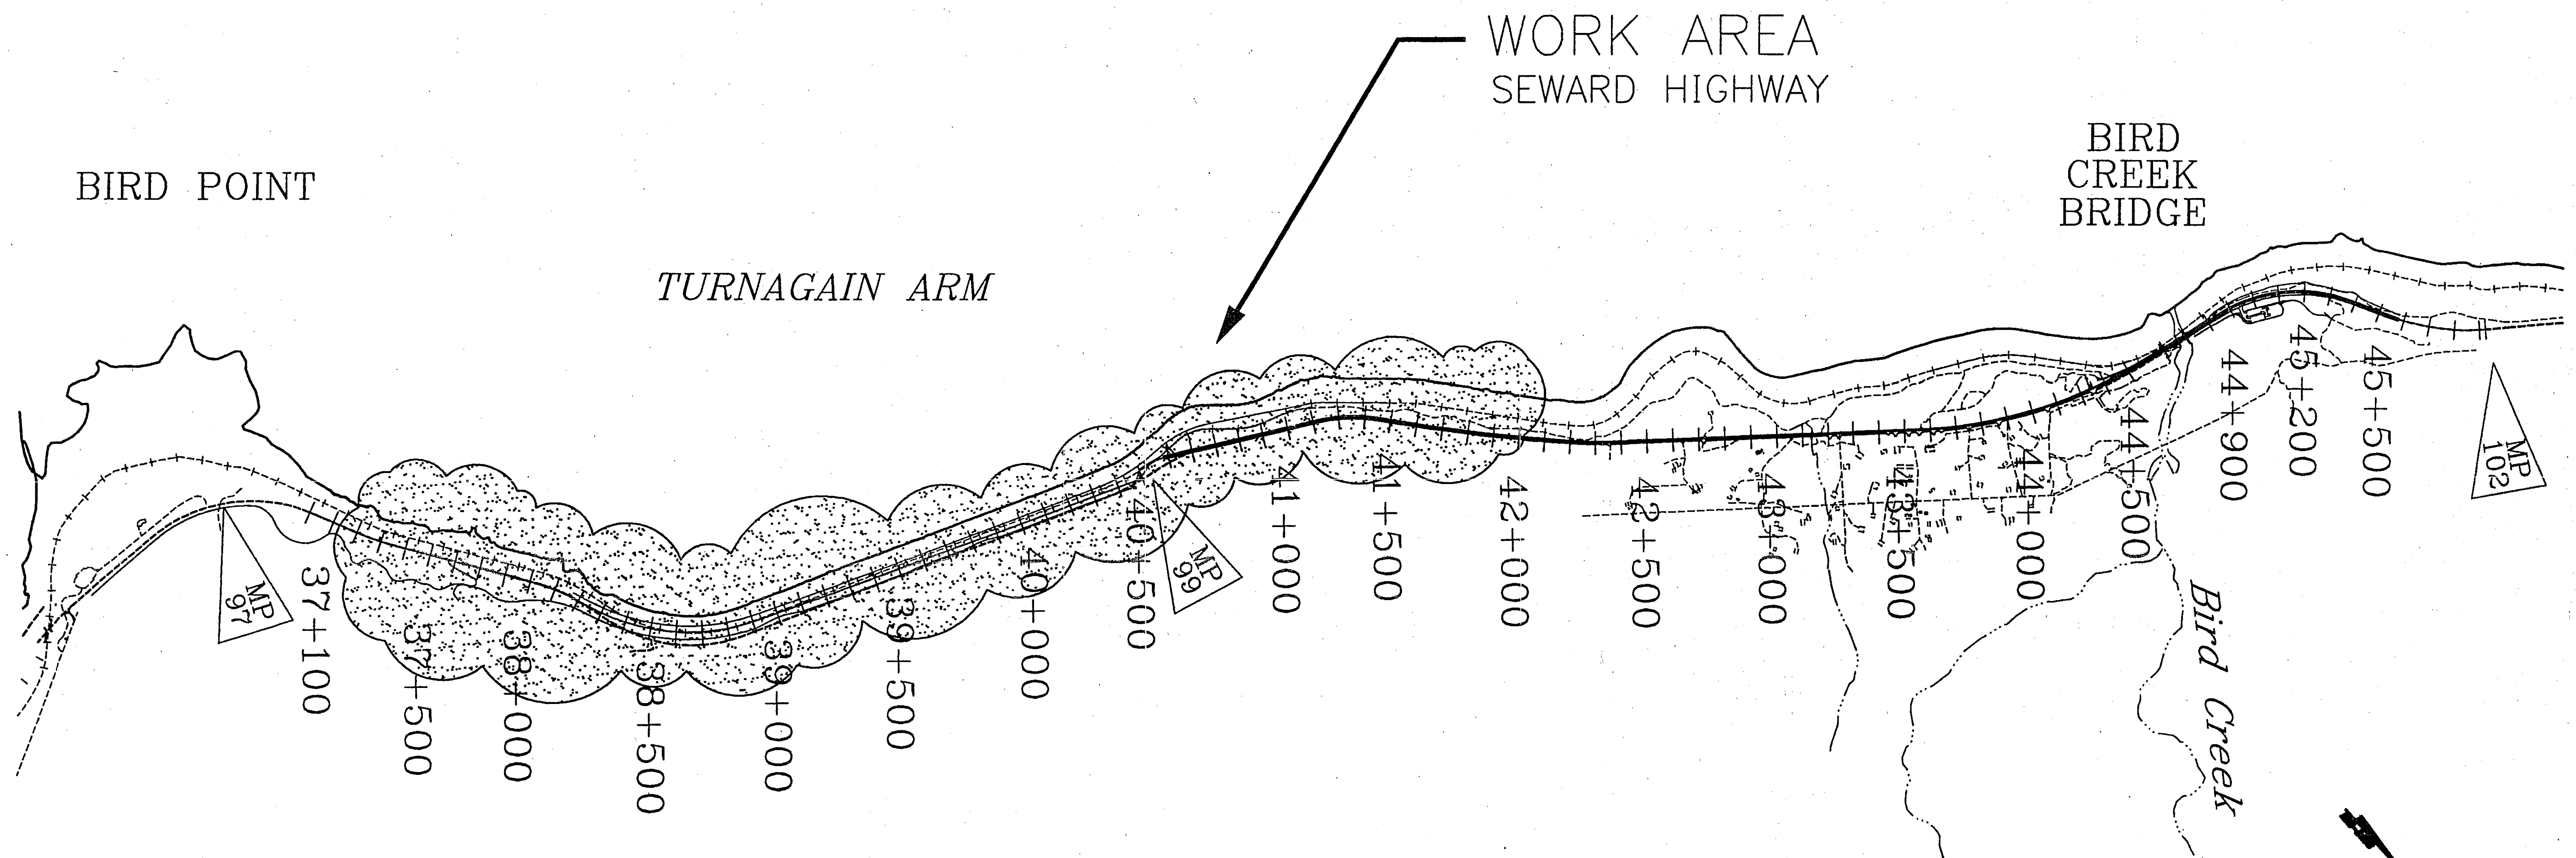


SEWARD HIGHWAY, MP 96 TO 102

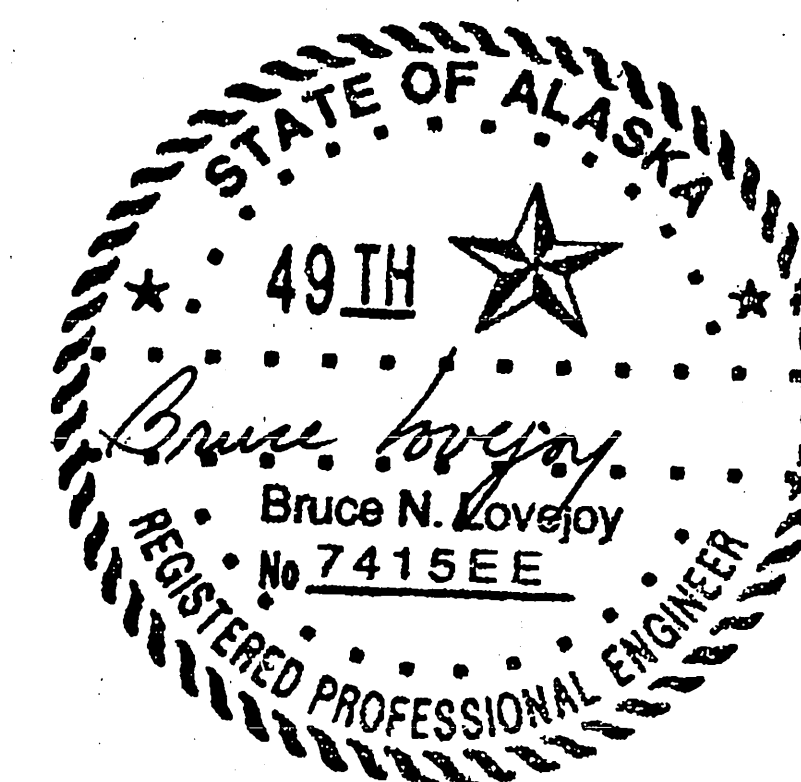


REV.	DATE	REVISIONS

TEMPTEL, INC. A SUBSIDIARY OF MID-STATE CONSULTANTS 1075 EAST 72ND AVENUE ANCHORAGE, ALASKA 99518 (907)258-7667 FAX (907)258-0616			
ALASKA FIBER STAR, LLC			
BIRD CREEK RR RELOCATE			
BIRD CREEK		ALASKA	
SCALE: N.T.S.	DATE: 4/5/02	DRAWN BY: KGS	ENGR: JG
REVISION:	SHT. 1 OF 1	DRG. NO: BIRD CREEK	

REVISONS			STATE	PROJECT DESIGNATION	YEAR	SHEET NO.	TOTAL SHEETS
No.	DATE	DESCRIPTION	ALASKA	NH-0A3-1(28)	2002	T 2	T 23

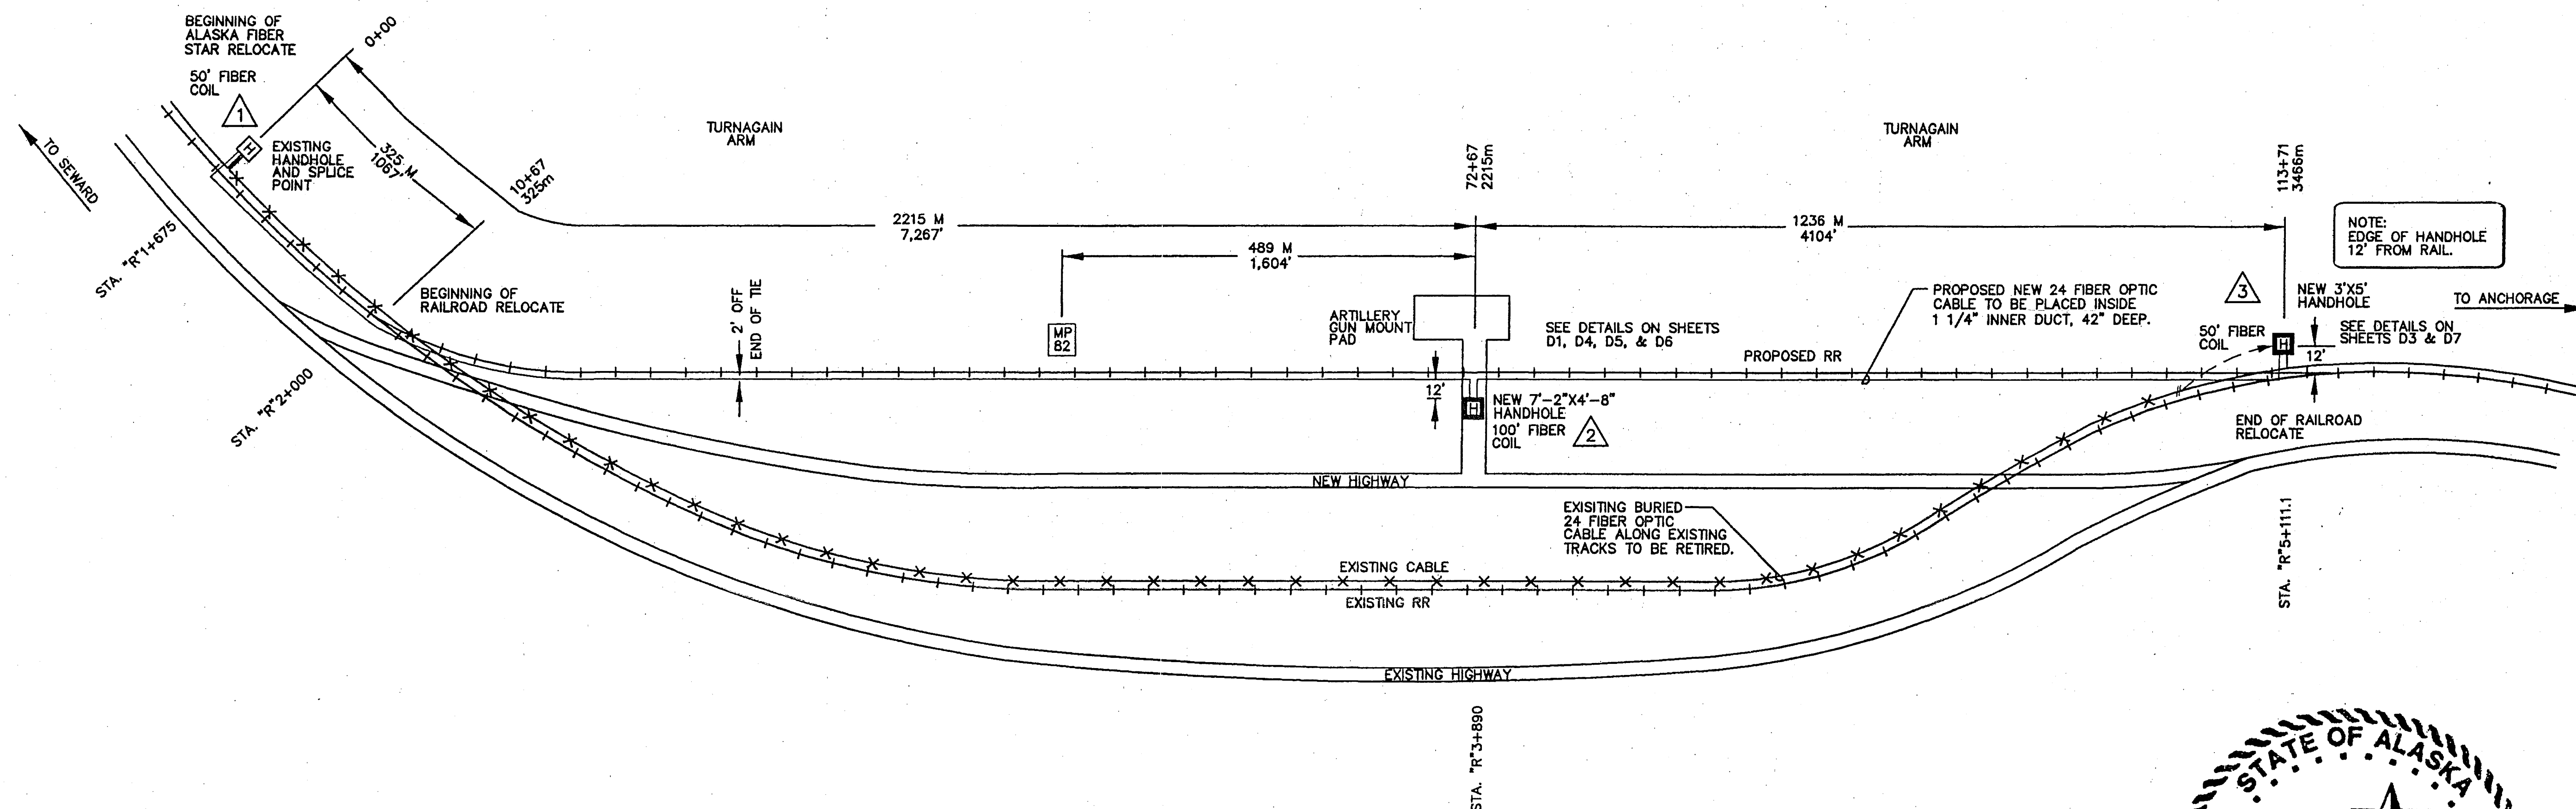




1. CONTRACTOR FOR D.O.T. DOING RR RELOCATION WILL BE REQUIRED TO PLACE NEW 1 1/4" INNER DUCT FROM HANDHOLE AT STA 1+675 TO NEW HAND HOLE AT STA. 3+890, CONTINUING ON TO NEW HANDHOLE AT R STA. 5111.1. CONTRACTOR WILL ALSO BE REQUIRED TO TRANSPORT 2 NEW HANDHOLES TO JOB SITE AND WILL BE RESPONSIBLE FOR PLACING ONE HANDHOLE AT STA 3+890.
2. MINIMUM DEPTH OF FIBER INNERDUCT BESIDE RR TRACKS 121.92cm (48"), MINIMUM DEPTH UNDER RR TRACKS 157.48cm (62"). ANY DEVIATIONS FROM PRESCRIBED DEPTHS MUST BE APPROVED BY AN AFS INSPECTOR PRIOR TO PLACEMENT.

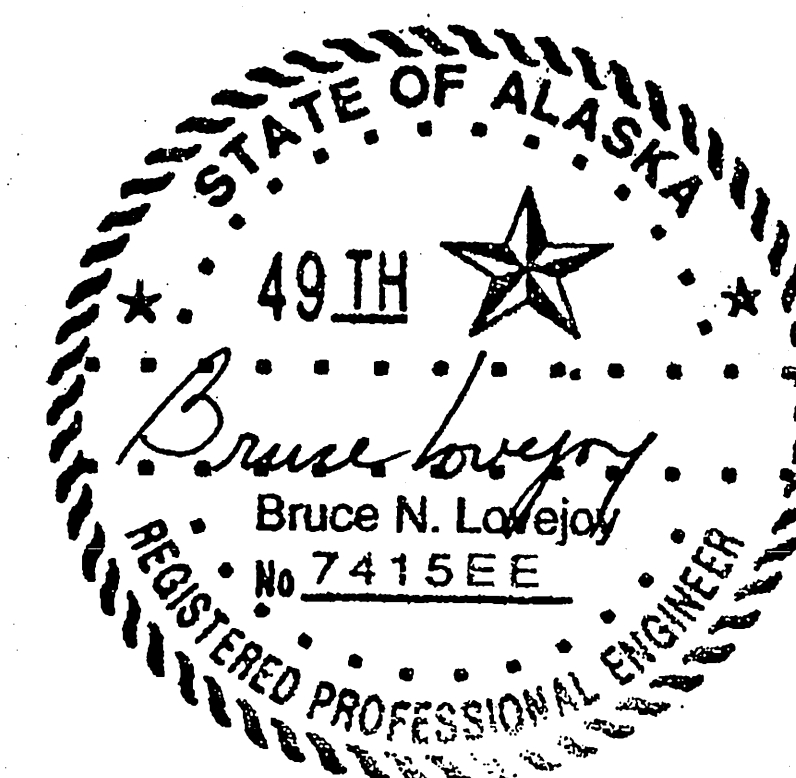

	TEMPTTEL, INC A SUBSIDIARY OF MID-STATE CONSULTANTS		
1075 EAST 72ND AVENUE ANCHORAGE, ALASKA 99518 (907)258-7667 FAX (907)258-0616			
ALASKA FIBER STAR, LLC			
BIRD CREEK RR RELOCATE			
BIRD CREEK ALASKA			
SCALE:	DATE:	DRWN BY:	ENGR:
N. T. S.	4/5/02	KGS	JG
REVISION:	SHT. 1 OF 1	DRG. NO:	BIRD

REVISIONS			STATE	PROJECT DESIGNATION	YEAR	SHEET NO.	TOTAL SHEETS
No.	DATE	DESCRIPTION	ALASKA	NH-0A3-1(28)	2002	T4	T23

TYPICAL FO CABLE
PLACEMENT DETAIL

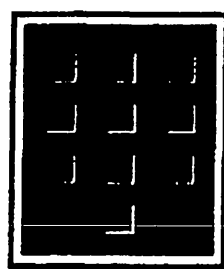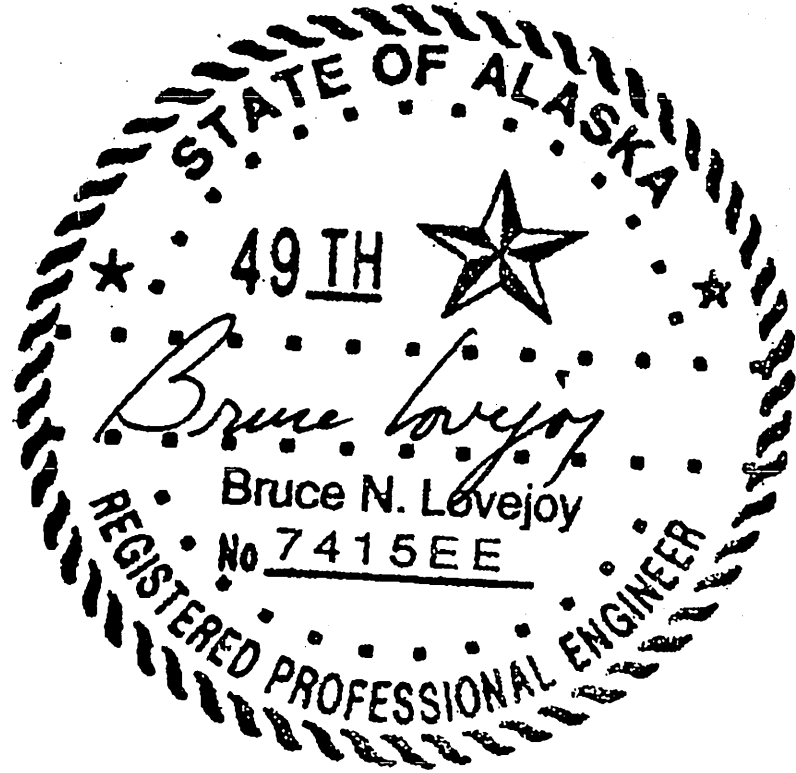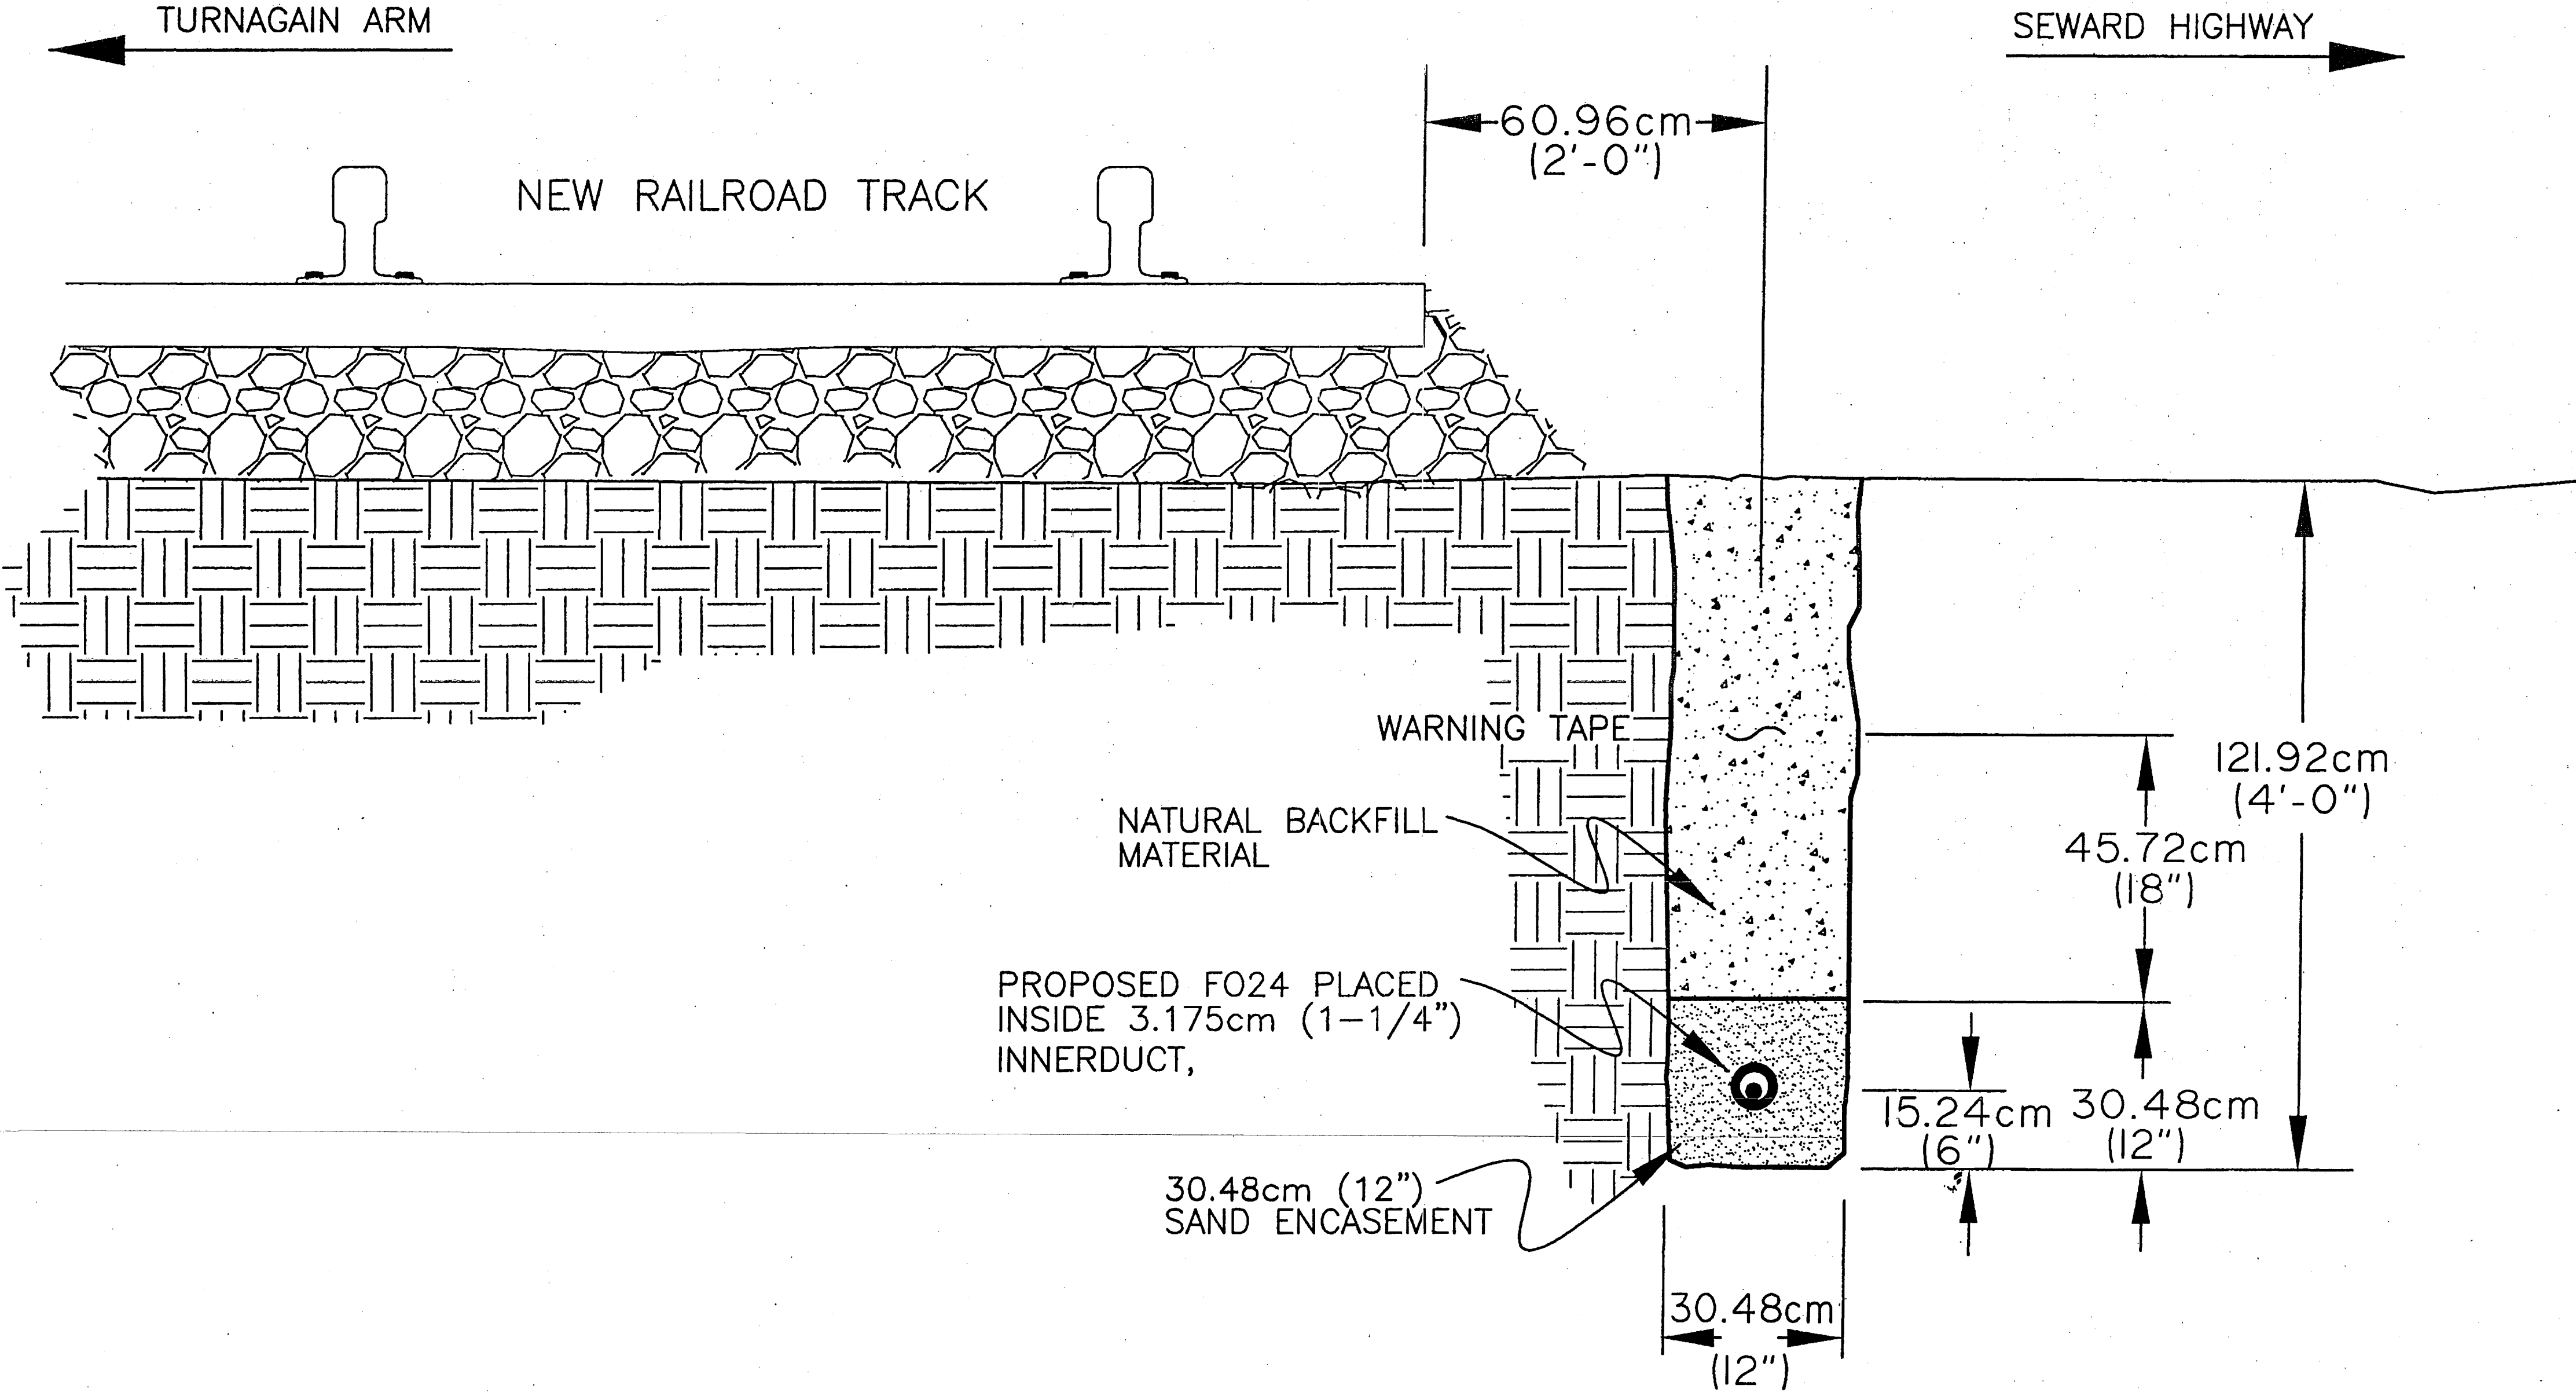

TEMPTEL, INC.

A SUBSIDIARY OF MID-STATE CONSULTANTS

1075 EAST 72ND AVENUE
ANCHORAGE, ALASKA 99518
(907)258-7867 FAX (907)258-0616

ALASKA FIBER STAR, LLC

**BIRD CREEK
RR RELOCATE**

ALASKA

BIRD CREEK

SCALE: N.T.S.

DATE: 4/5/02

DRAWN BY: KGS

ENGR: JG

REVISION:

SHT. D2 OF 7


DWG. NO:

BIRD CREEK


REV.	DATE	REVISIONS

SPECIFICATIONS	DESIGNED BY	1/29/02
STANDARDS	CHECKED BY	
COMPUTER DESIGNATION	DRAFTED BY	CJ
VIEW ALL	AUTOCAD-CAROLEE-MARC/MBDR	


DESIGNED BY	CJ	1/29/02
CHECKED BY		
DRAFTED BY		
VIEW ALL		
COMPUTER DESIGNATION	AUTOCAD-CAROLEE-MARC/MBDR	
SPECIFICATIONS		
STANDARDS		

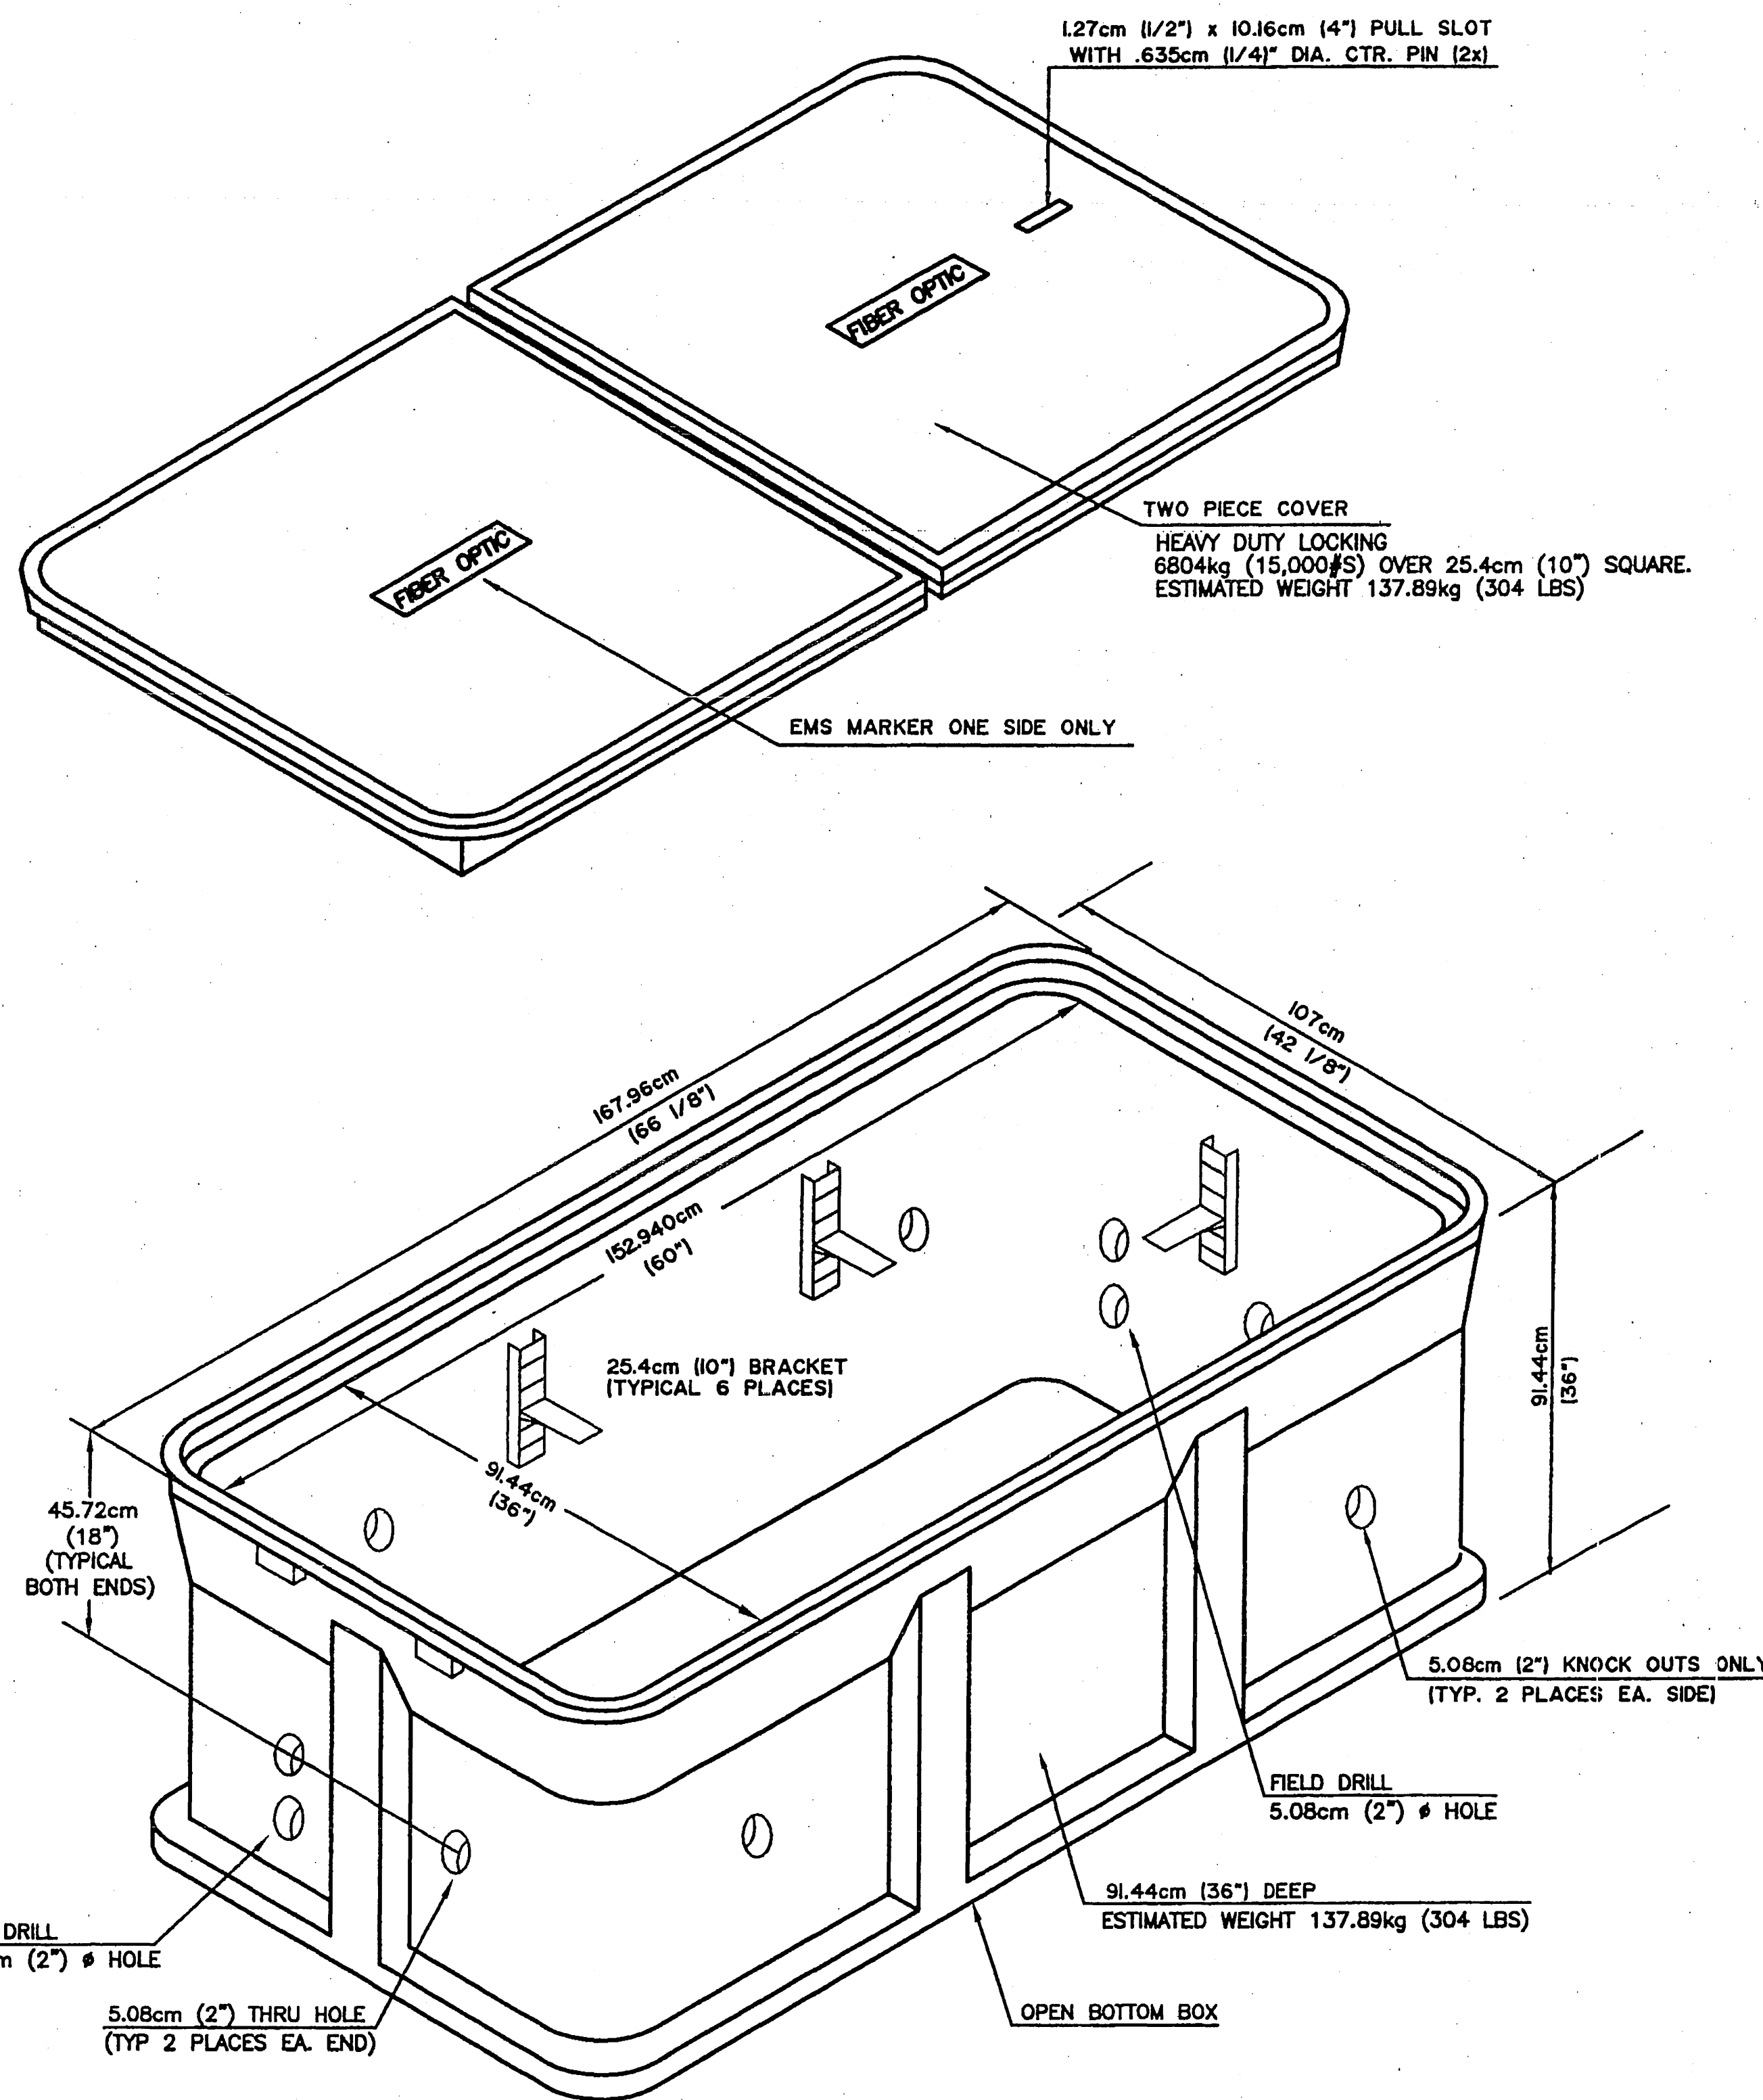


152.40cm x 91.44cm x 91.44cm HANDHOLE ASSEMBLY DETAIL
(60" x 36" x 36") STA "R"5+111.1

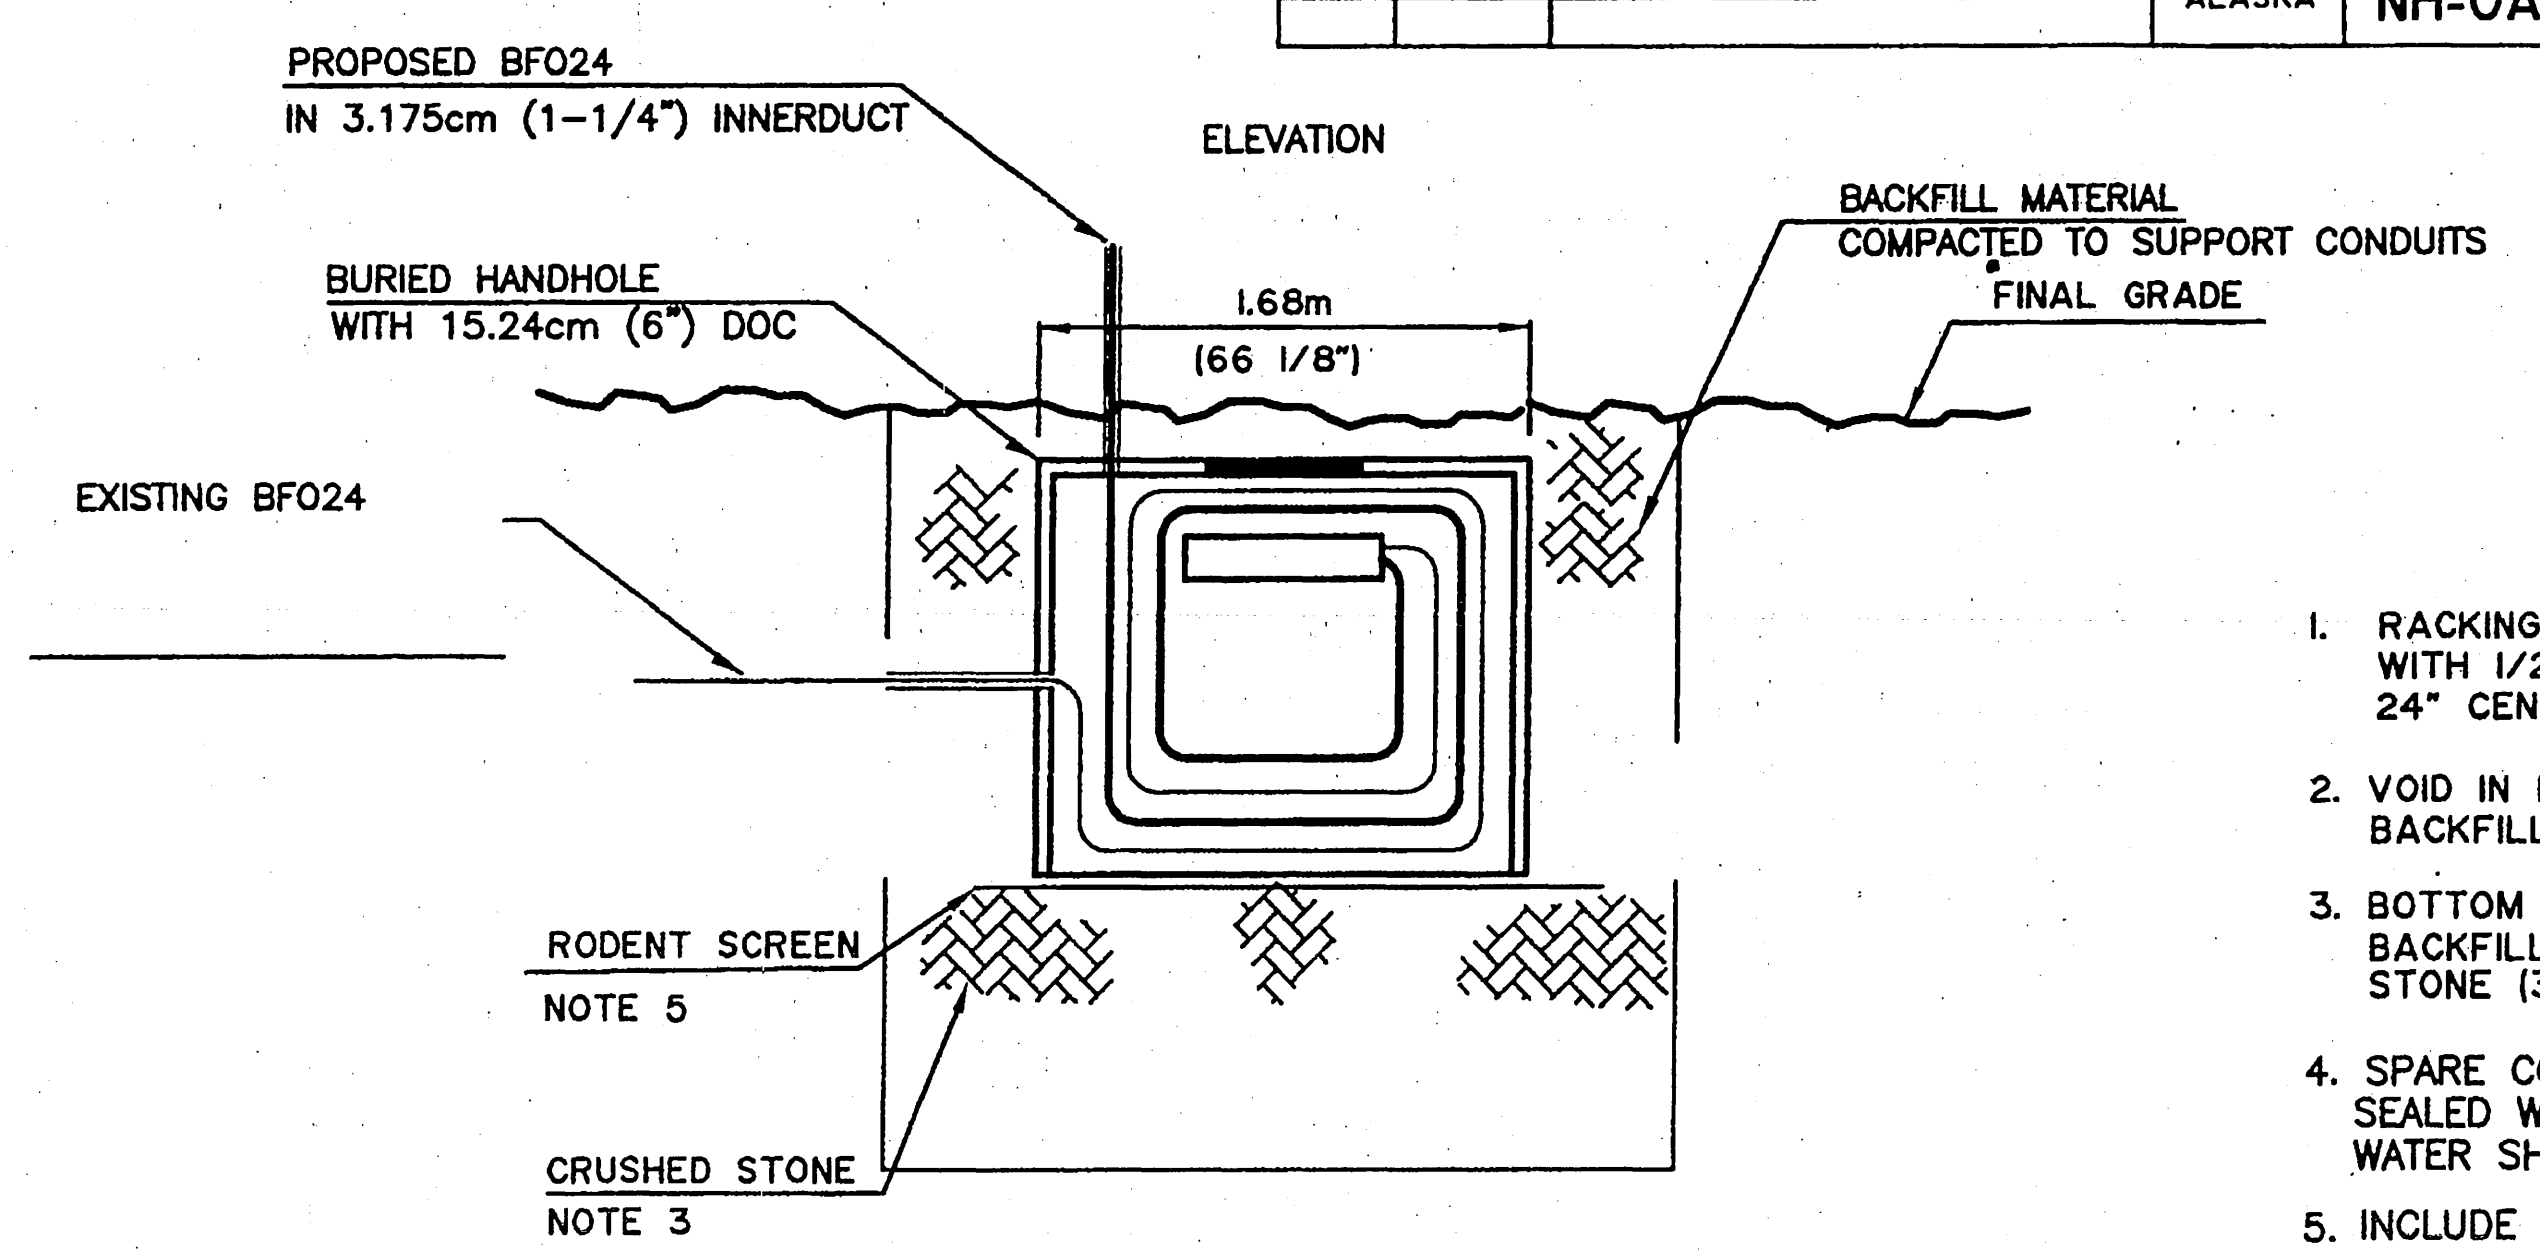

TYPICAL HANDHOLE AT BRIDGE OR SPLICE POINT
N.T.S.

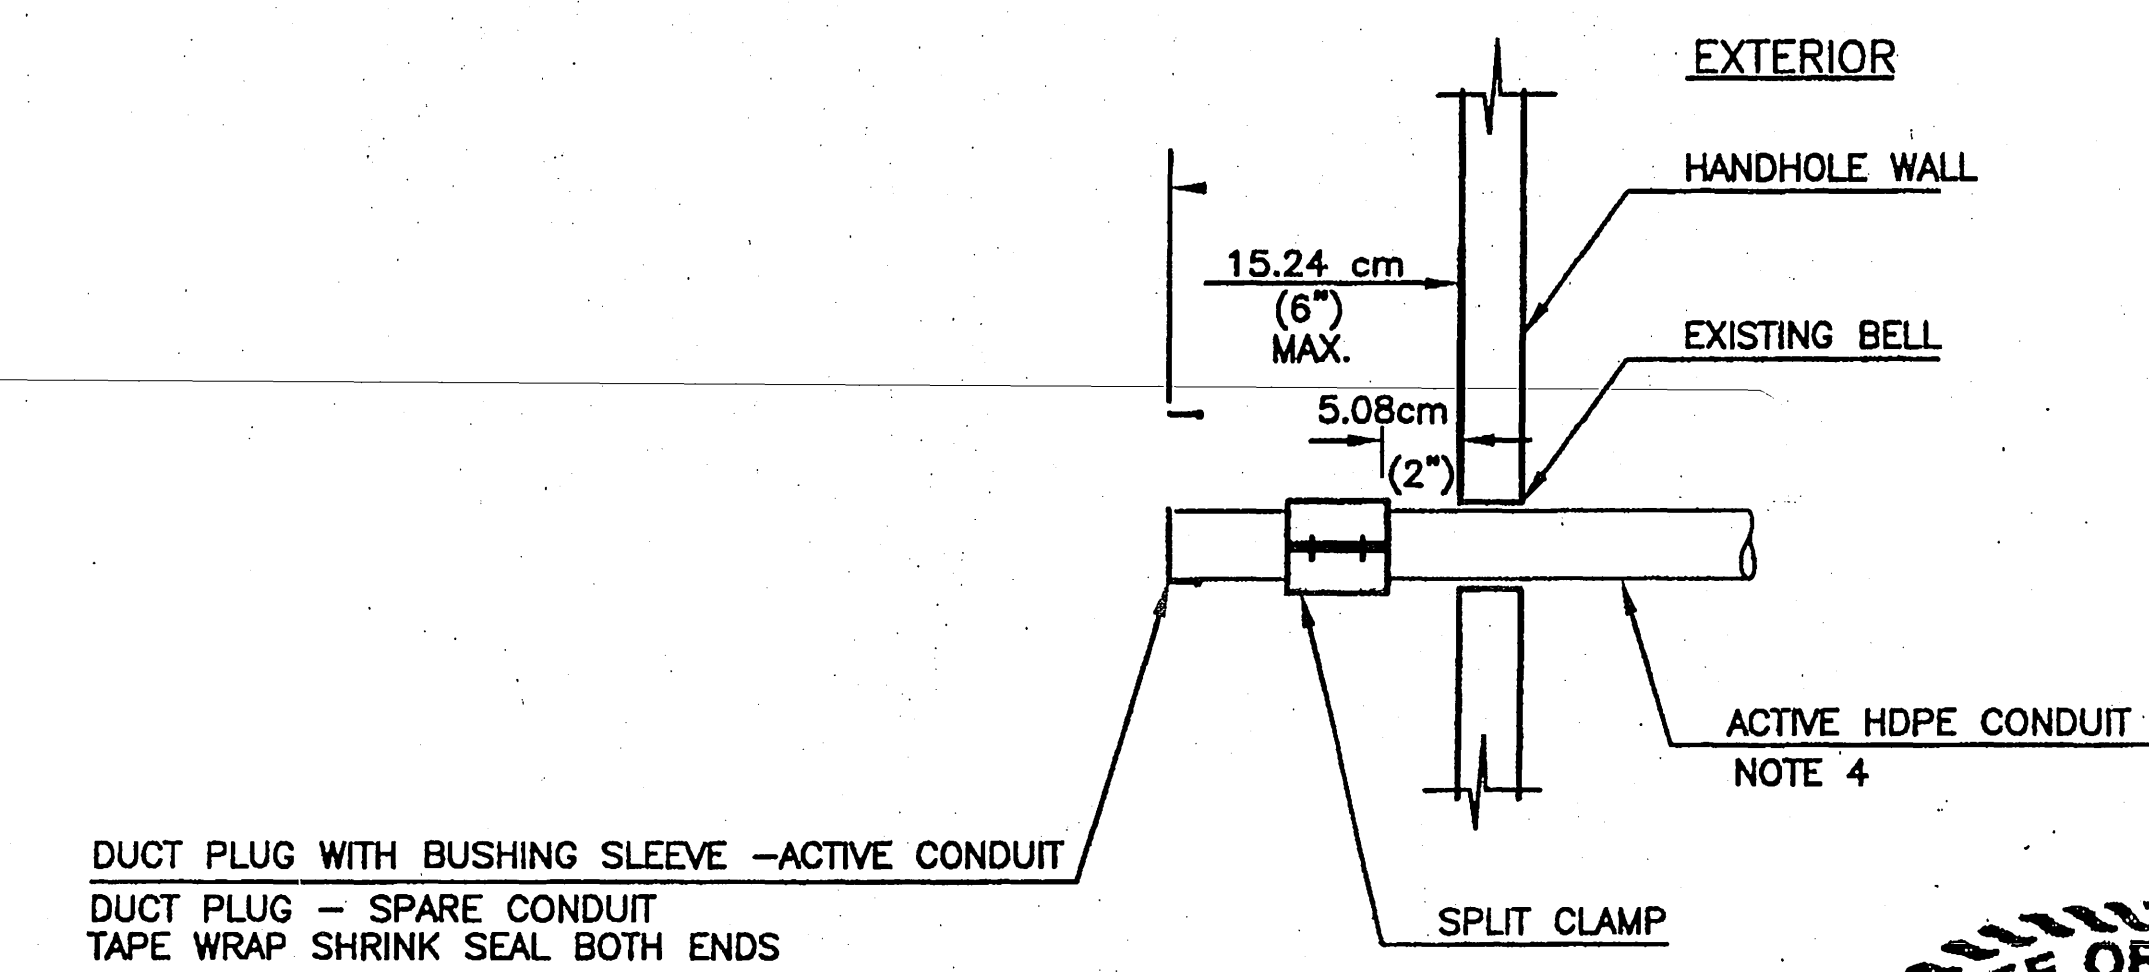


HANDHOLE WALL PENETRATION DETAIL
N.T.S.

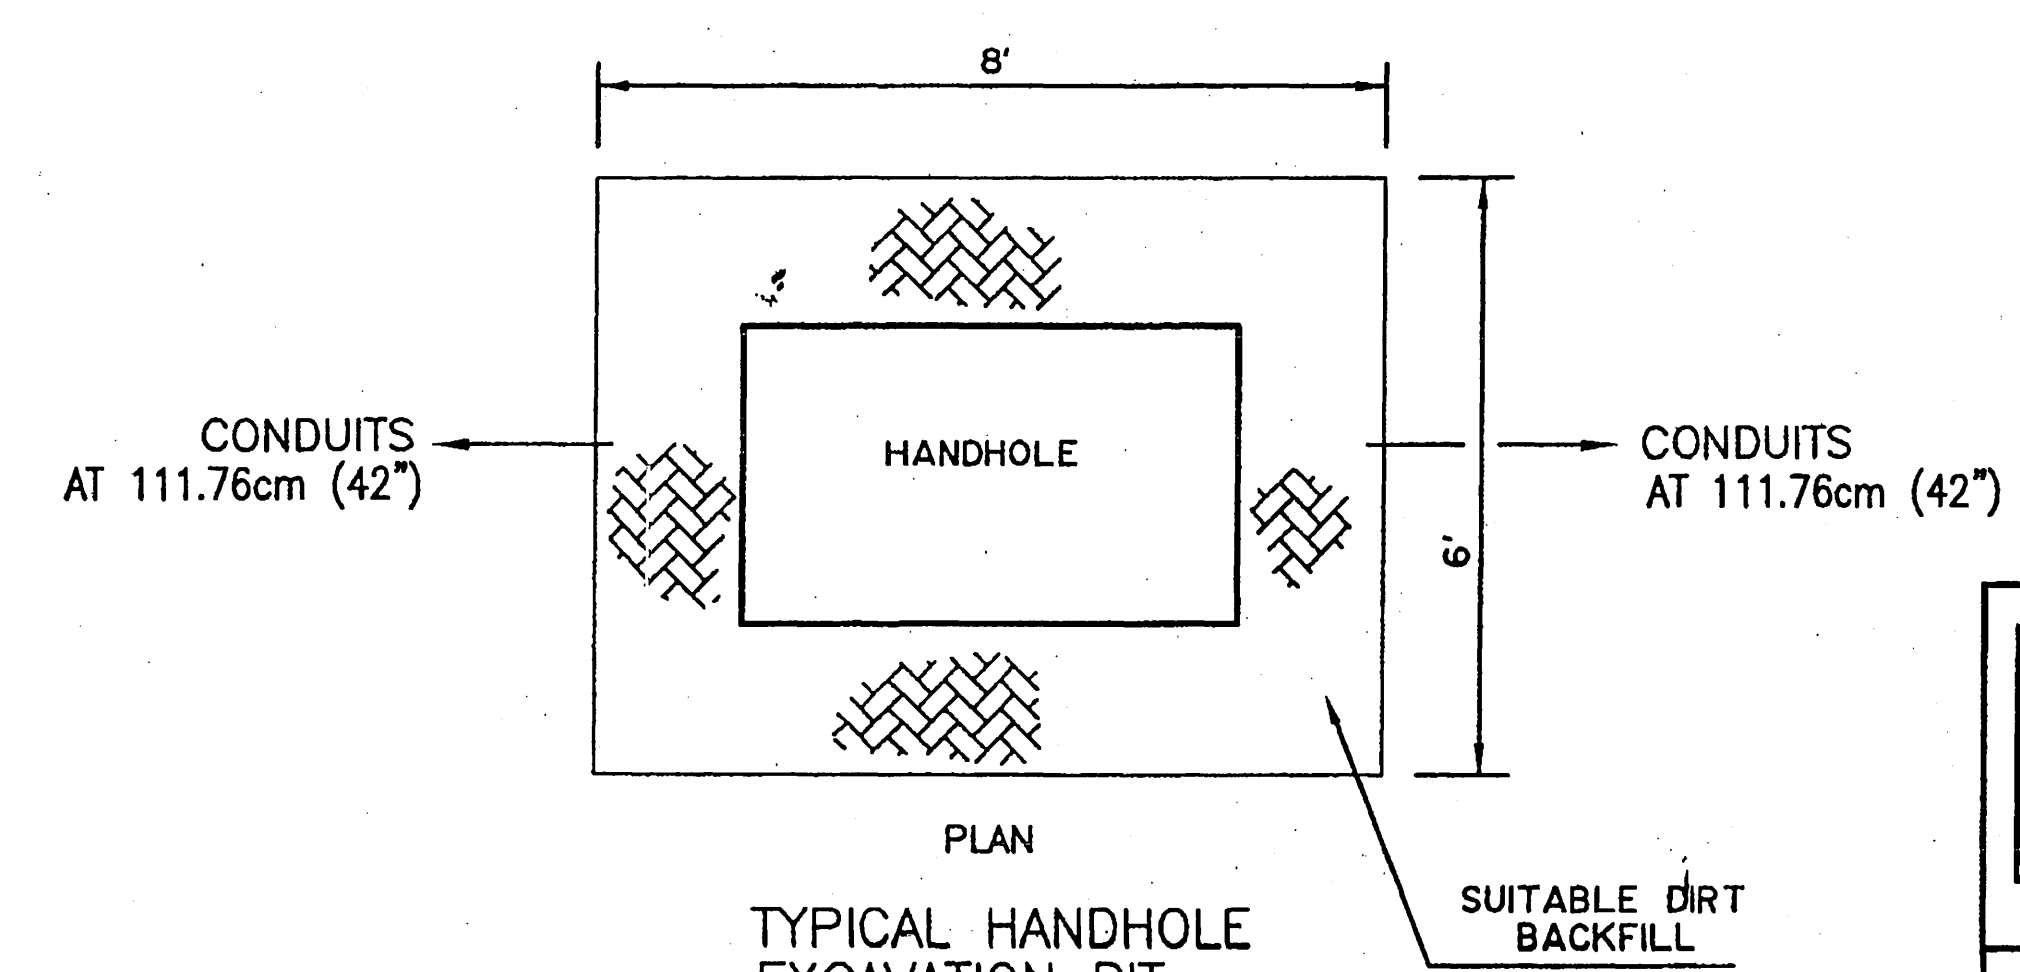

TYPICAL HANDHOLE EXCAVATION PIT
N.T.S.

- NOTES
1. RACKING 18" LONG (GALVANIZED) WITH 1/2" - 13NC S.S. INSERT ON 24" CENTERS (6-REQ'D)
 2. VOID IN EXCAVATED AREAS TO BE BACKFILLED WITH SELECT MATERIAL
 3. BOTTOM OF EXCAVATED PIT TO BE BACKFILLED WITH 12" OF CRUSHED STONE (3/4") GRADE
 4. SPARE CONDUITS TO BE PLUGGED AND SEALED WITH DUCT PLUG. NO FREE WATER SHALL BE ALLOWED INTO CONDUIT.
 5. INCLUDE RODENT SCREENS.

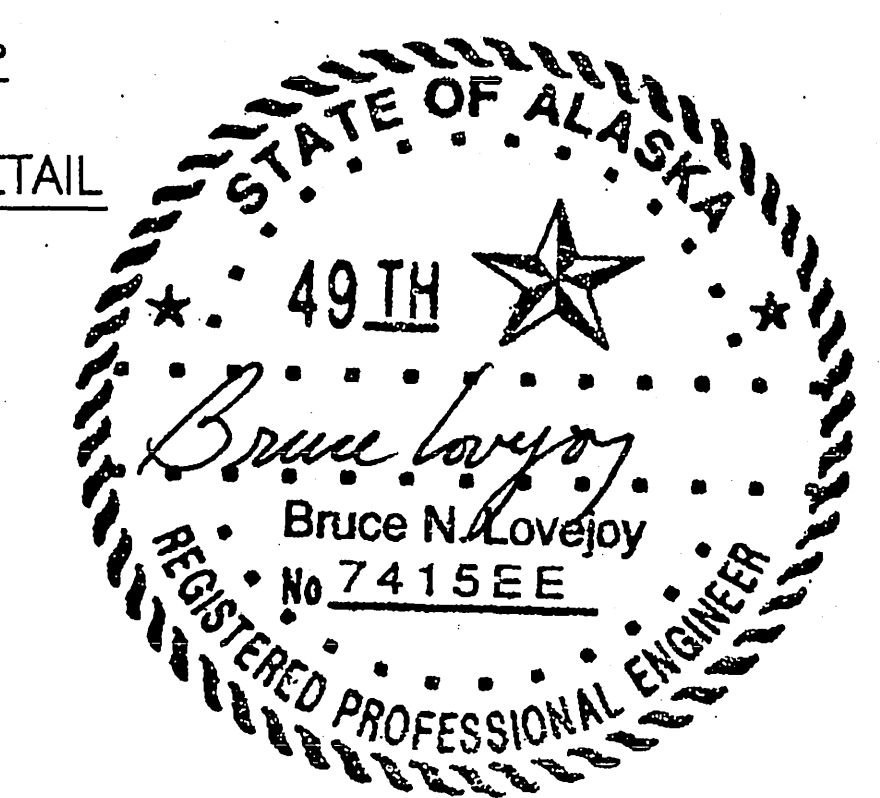

TEMPTEL, INC.
A SUBSIDIARY OF MID-STATE CONSULTANTS
1075 EAST 72ND AVENUE
ANCHORAGE, ALASKA 99518
(907)258-7887 FAX (907)258-0818

ALASKA FIBER STAR, LLC

BIRD CREEK RR RELOCATE

BIRD CREEK ALASKA

SCALE: N.T.S. DATE: 4/5/02 DRAWN BY: KGS ENGR: JG




REVISION: SHT. D3 OF 7 DRG. NO: BIRD CREEK

REV.	DATE	REVISIONS

REVISIONS			STATE	PROJECT DESIGNATION	YEAR	SHEET NO.	TOTAL SHEETS
No.	DATE	DESCRIPTION	ALASKA	NH-0A3-I(28)	2002	T 7	T 23

PLACEMENT DETAIL LOOKING NORTH RR CROSSING CONDUIT STA. 73+93 STA. "R"3+380

SPECIFICATIONS	DESIGNED BY	CJ	1/29/02
	CHECKED BY		
	DRAFTED BY		
STANDARDS	VIEW ALL		
	AUTOCAD-CAROLEE-MARC/MBDR		
	COMPUTER DESIGNATION		

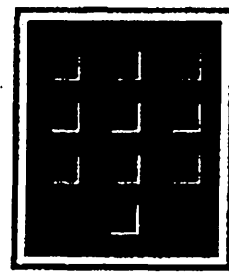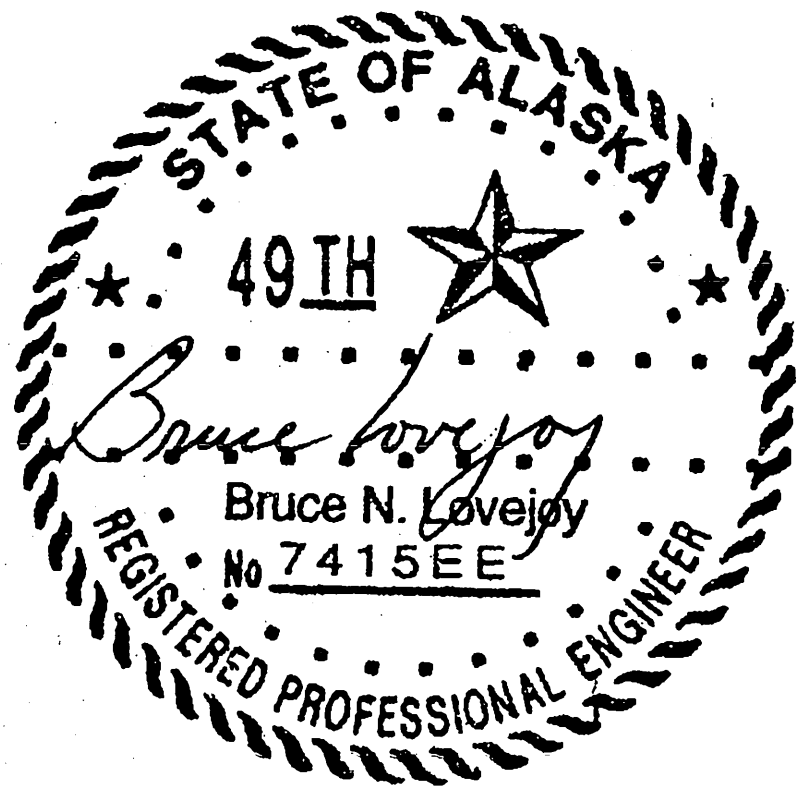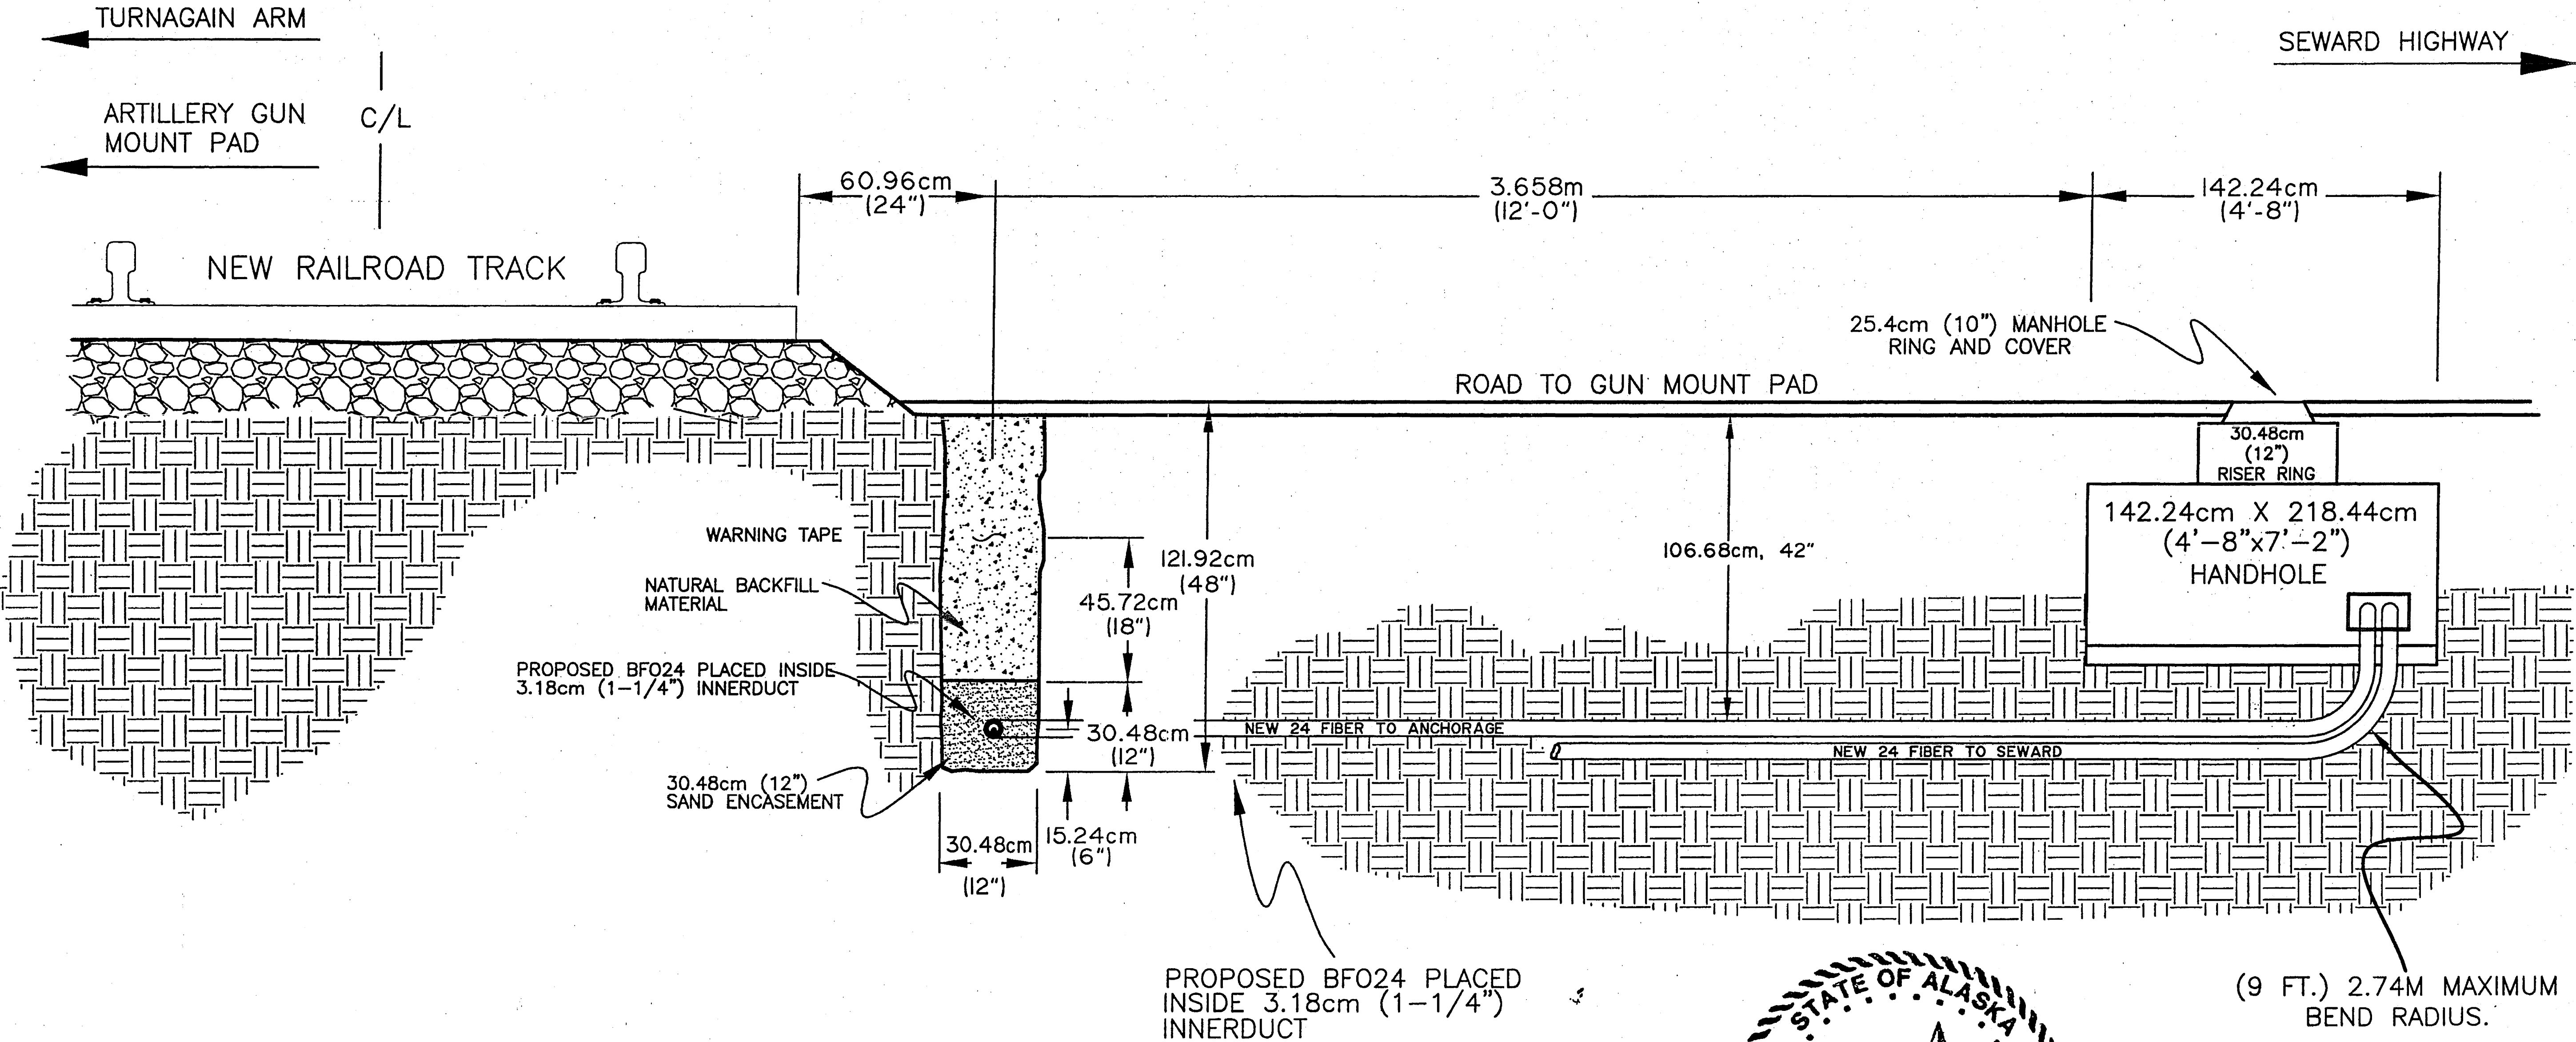

TEMPTEL, INC.
 A SUBSIDIARY OF MID-STATE CONSULTANTS
 1075 EAST 72ND AVENUE
 ANCHORAGE, ALASKA 99518
 (907)258-7667 FAX (907)258-0616

ALASKA FIBER STAR, LLC

BIRD CREEK
 RR RELOCATE

ALASKA

BIRD CREEK

SCALE: N.T.S. DATE: 4/5/02 DRAWN BY: KGS ENGR: JG

REVISION: SHT. 05 OF 7 DRG. NO: BIRD CREEK



REV.	DATE	REVISIONS

DESIGNED BY		1/29/02
CHECKED BY		
DRAFTED BY	CJ	
VIEW ALL		
AUTOCAD-CAROLEE-MARC/MBDR		
SPECIFICATIONS		
STANDARDS		
COMPUTER DESIGNATION		

4878 VAULT
PLACEMENT DETAIL
STA 73+95
STA 'R' 3+380

REVISIONS			STATE	PROJECT DESIGNATION	YEAR	SHEET NO.	TOTAL SHEETS
No.	DATE	DESCRIPTION	ALASKA	NH-0A3-I(28)	2002	T 8	T 23

NOTE:
MODIFICATIONS TO HANDHOLE FOR
PLACEMENT REQUIREMENTS SHALL BE
COMPLETED IN FIELD. DRILL AT REQUIRED
LOCATIONS WITH THE APPROVAL OF THE
AFS INSPECTOR.
SEE ASSEMBLY DETAIL SHT D4.

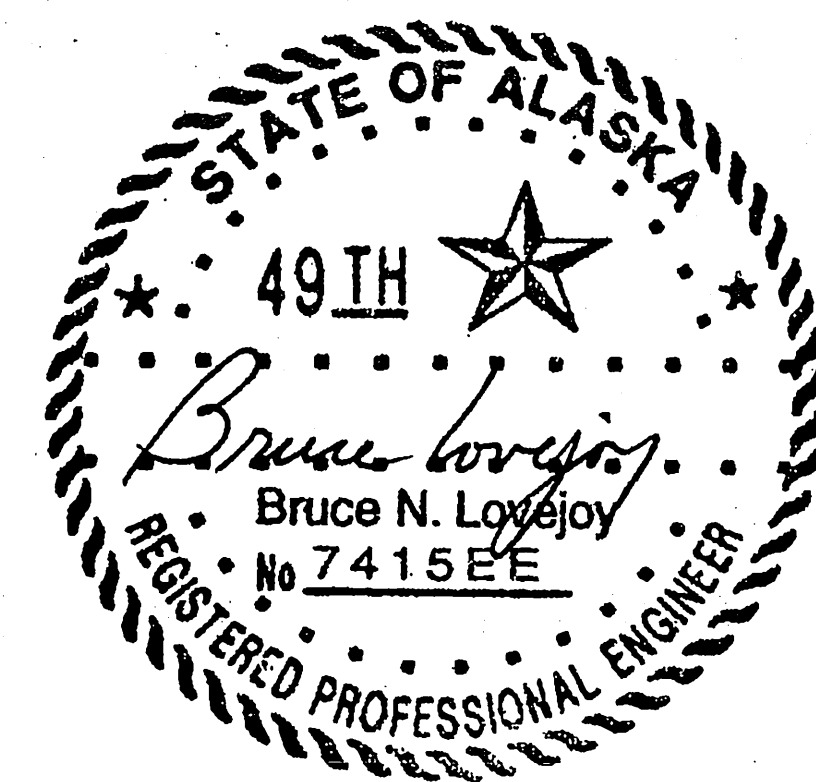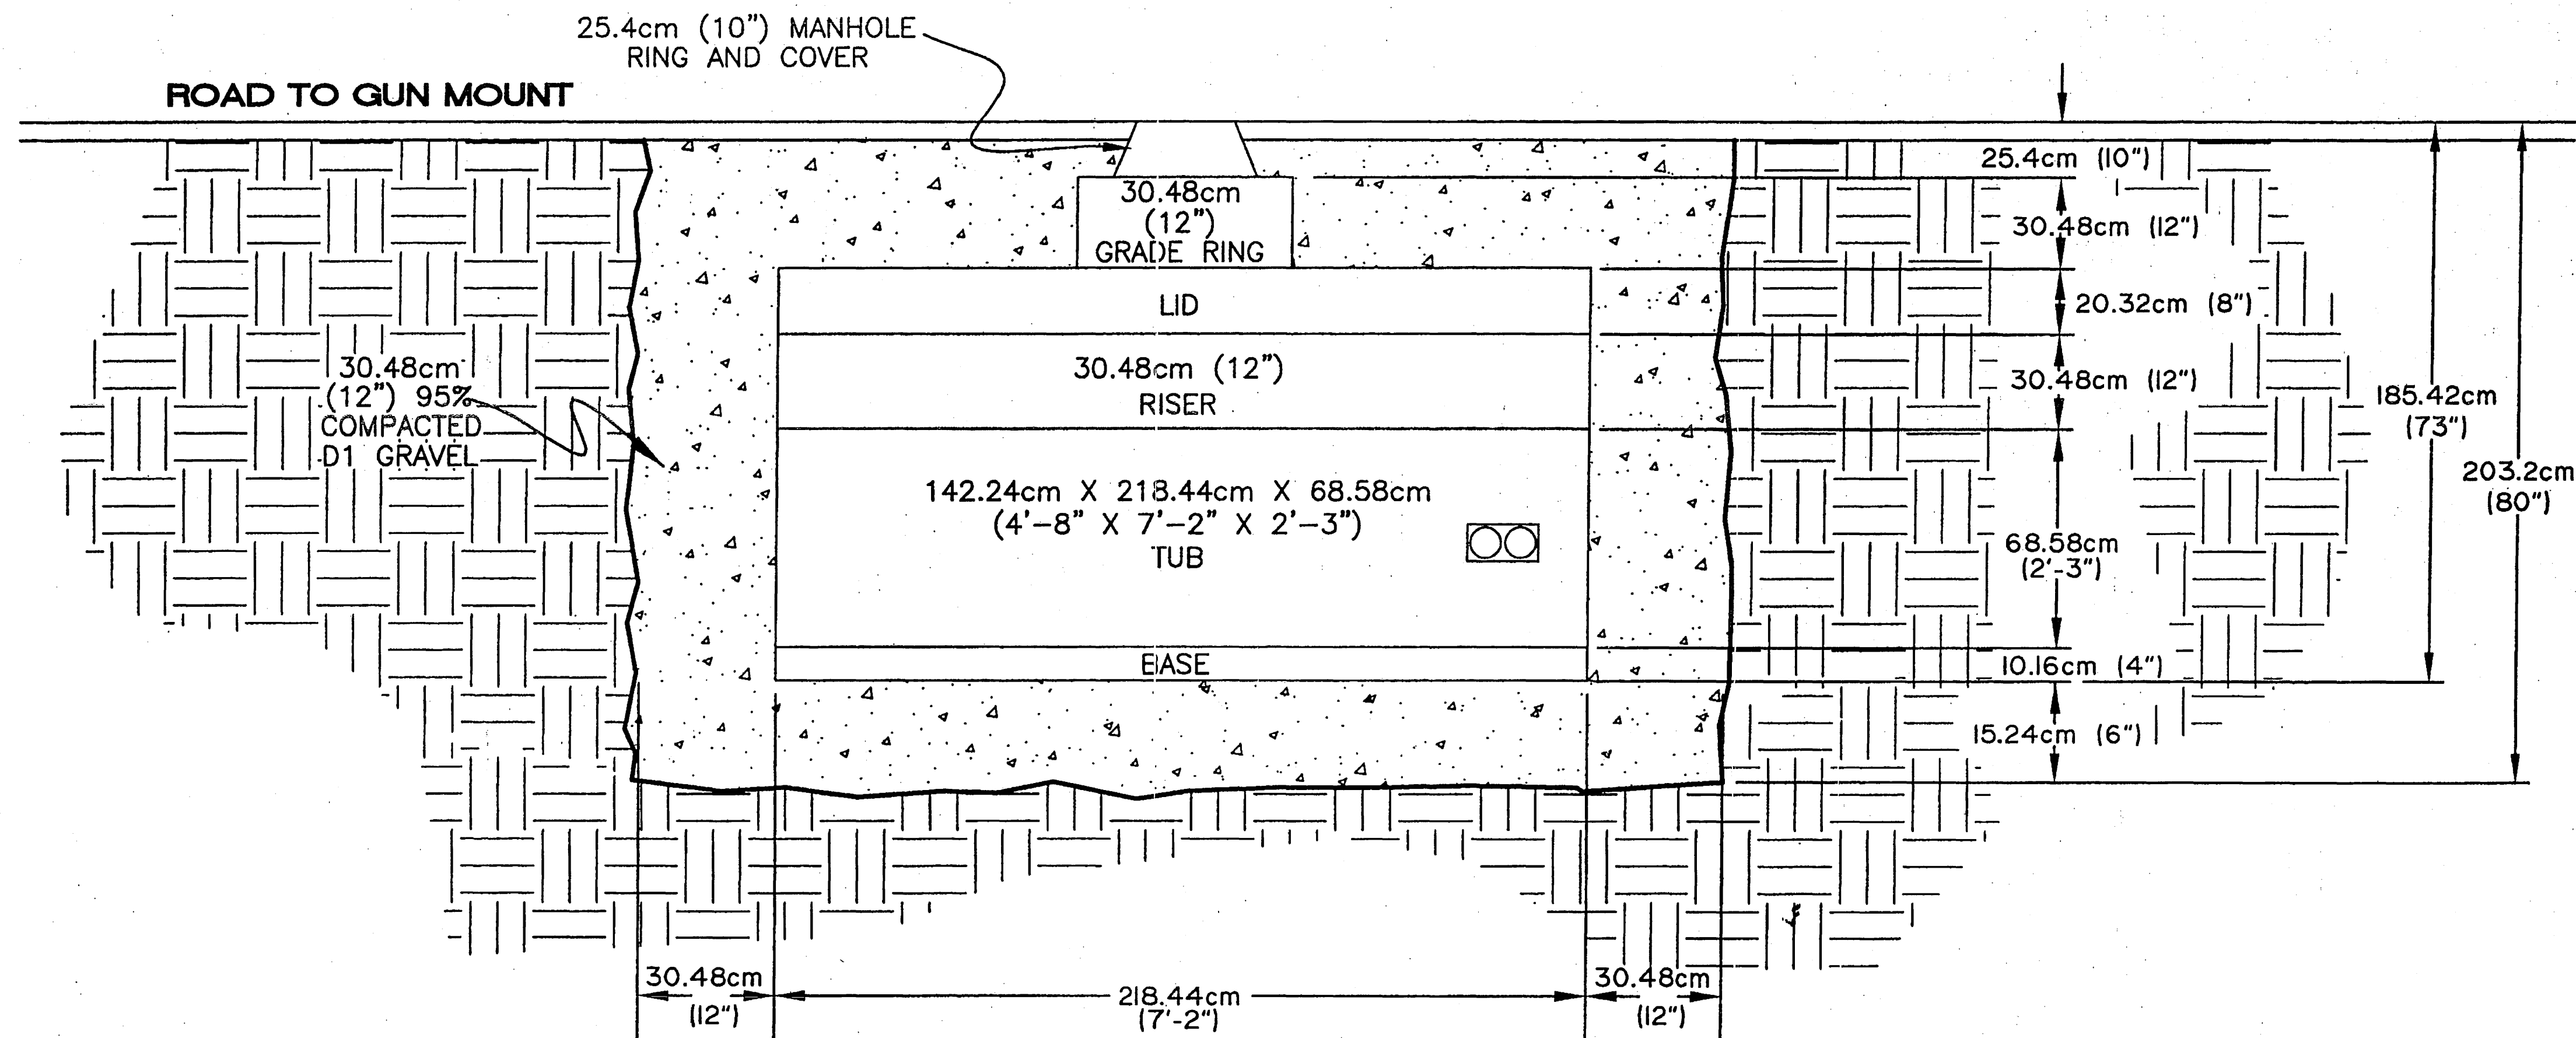

TEMPTEL, INC.
A SUBSIDIARY OF MID-STATE CONSULTANTS
1075 EAST 72ND AVENUE
ANCHORAGE, ALASKA 99518
(907)258-7867 FAX (907)258-0818

ALASKA FIBER STAR, LLC

**BIRD CREEK
RR RELOCATE**

ALASKA

SCALE: N.T.S.	DATE: 4/5/02	DRWN BY: KGS	ENGR: JG
REVISION:	SHT. 06 OF 7	DRG. NO:	BIRD CREEK

REV:	DATE:	REVISIONS

DESIGNED BY
CHECKED BY
DRAFTED BY
VIEW ALL
AUTOCAD-CAROLEE-MARC/MBDR
COMPUTER DESIGNATION
SPECIFICATIONS
STANDARDS

1/29/02

CJ

1/29/02

30.48cm
(12") 95%
COMPACTED
D1 GRAVEL

91.44cmX152.4cm
X91.44cm

(36"X60"X36")
HANDHOLE

EXISTING BFO-24

HANDHOLE TO BE PLACED BY AK
FIBERSTAR AFTER NEW FIBER IS IN
PLACE AND SPLICED TO EXISTING FIBER.

PROPOSED BBFO24 PLACED
INSIDE 3.18cm (1-1/4")
INNERDUCT.

EXPOSE APPROX. 15.2M (50')
EXISTING BFO24 TO FACILITATE
SPLICE TO NEW F024

AFTER SECTION THROW
TO NEW BFO24, COIL FO CABLE
AND SPLICE IN NEW HANDHOLE.

TURNAGAIN ARM

ABANDON OLD F.O. CABLE
IN PLACE AFTER SPLICE

30.48cm
(12")

91.44cm
(36")

3.658cm
(12'-0")

C/L

60.96cm
(24")

SEWARD HIGHWAY

NEW RAILROAD TRACK

91.44cmX152.4cmX91.44cm
(36"X60"X36")
HANDHOLE

TO BE SET BY
AK FIBERSTAR

EXACT CONDUIT ENTRANCE
TO BE DETERMINED AFTER
EXCAVATION FOR HANDHOLE
AND SPLICE IS COMPLETE.

SIDE VIEW

WARNING TAPE
NATURAL BACKFILL
MATERIAL

PROPOSED BFO24 PLACED
INSIDE 3.18cm (1-1/4")
INNERDUCT


30.48cm (12")
SAND ENCASEMENT

30.48cm
(12")

45.72cm
(18")

30.48cm
(12")

157.48cm
(62") MIN.

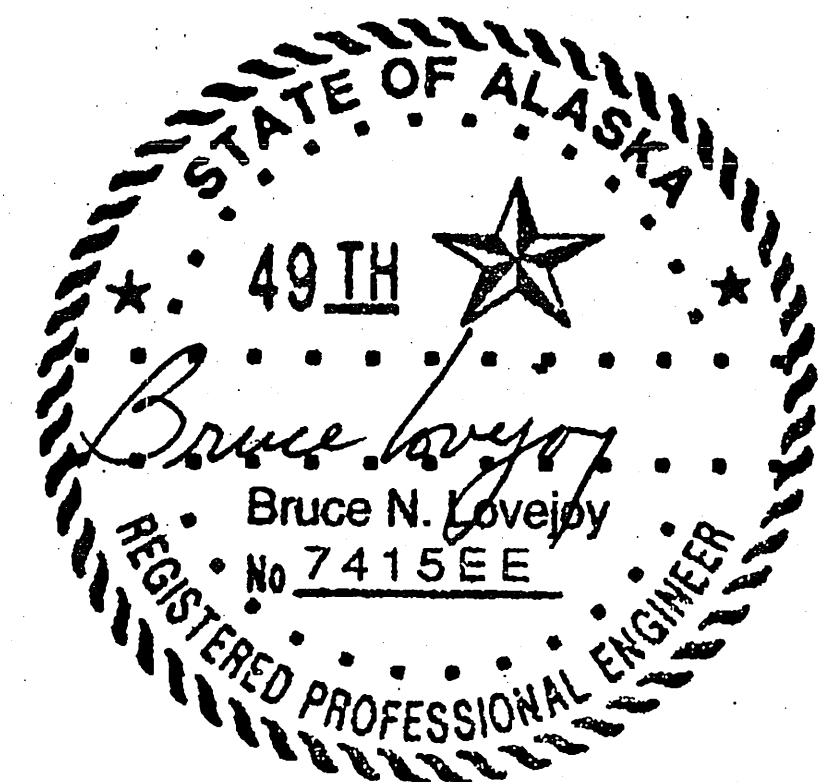

LOOKING NORTH
RR CROSSING CONDUIT
PLACEMENT DETAIL
STA. 115+23
STA. 'R'5+111.1

REV.	DATE	REVISIONS

TEMPTEL, INC.
A SUBSIDIARY OF MID-STATE CONSULTANTS
1075 EAST 72ND AVENUE
ANCHORAGE, ALASKA 99518
(907)258-7867 FAX (907)258-0616

ALASKA FIBER STAR, LLC

**BIRD CREEK
RR RELOCATE**

BIRD CREEK ALASKA



SCALE: N.T.S. DATE: 4/5/02 DRAWN BY: KGS ENGR: JG

REVISION: SHT. 07 OF 7 DRG. NO: BIRD CREEK


REVISIONS			STATE	PROJECT DESIGNATION	YEAR	SHEET NO.	TOTAL SHEETS
No.	DATE	DESCRIPTION	ALASKA	NH-0A3-1(28)	2002	T9	T23


REVISIONS			STATE	PROJECT DESIGNATION	YEAR	SHEET NO.	TOTAL SHEETS
No.	DATE	DESCRIPTION	ALASKA	NH-0A3-1(28)	2002	T II	T23

SPECIFICATIONS	DESIGNED BY	1/29/02
STANDARDS	CHECKED BY	
COMPUTER DESIGNATION	DRAFTED BY	CJ
VIEW ALL		
AUTOCAD-CAROLEE-MARC/MBDR		

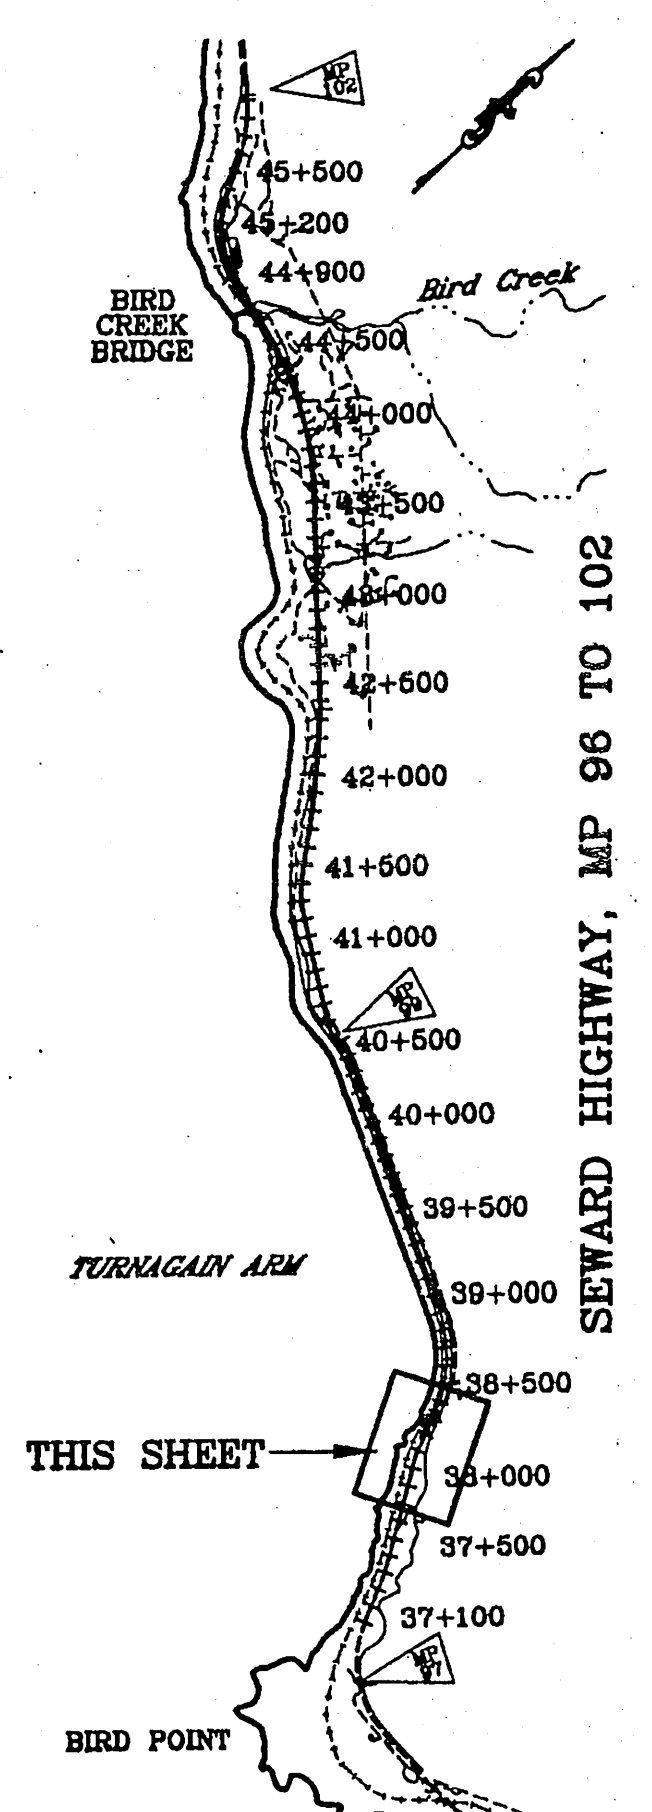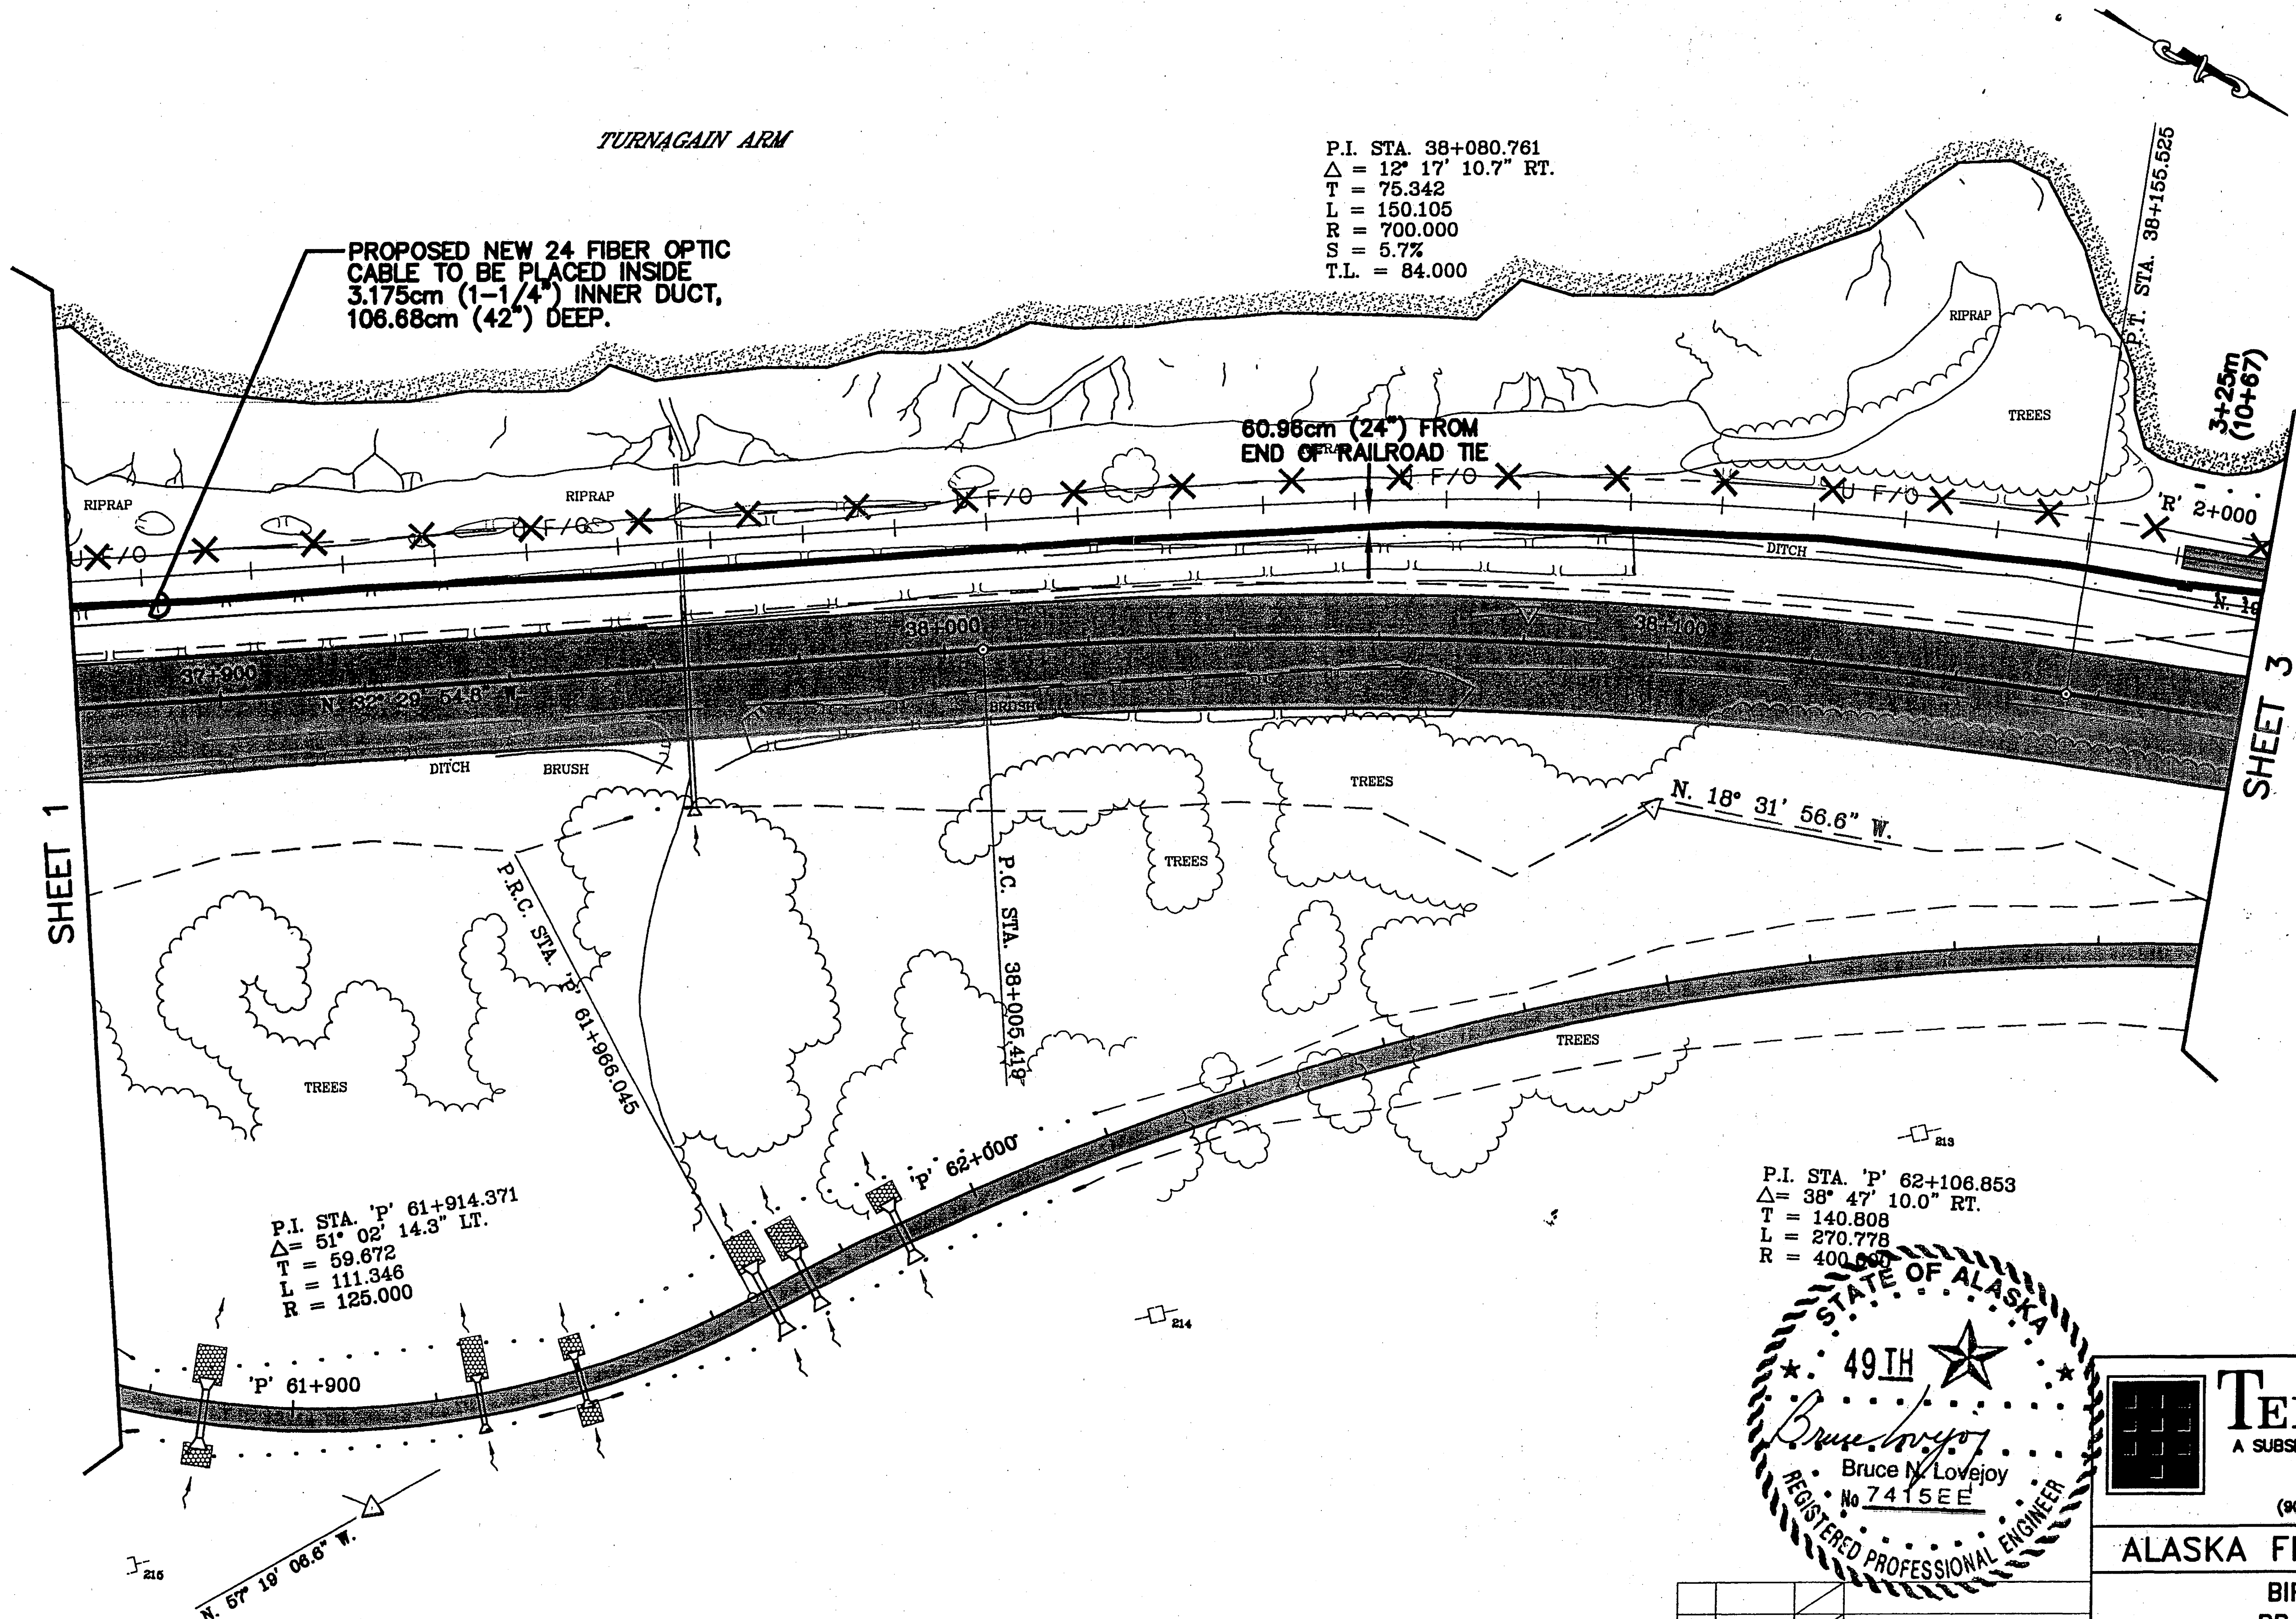

P.I. STA. 'P' 62+106.853
 $\Delta = 38^\circ 47' 10.0''$ RT.
 T = 140.808
 L = 270.778
 R = 400.000

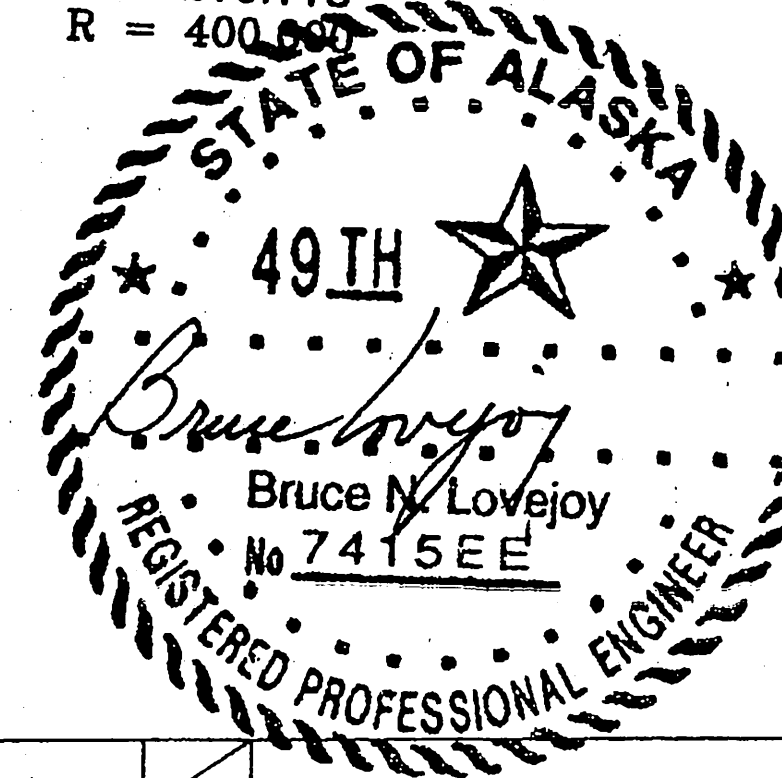

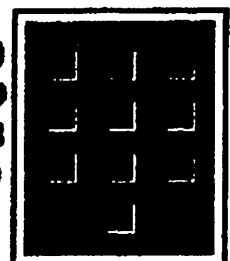

TEMPTEL, INC.

A SUBSIDIARY OF MID-STATE CONSULTANTS




1075 EAST 72ND AVENUE
 ANCHORAGE, ALASKA 99518
 (907)258-7887 FAX (907)258-0816


ALASKA FIBER STAR, LLC			
BIRD CREEK RR RELOCATE			
BIRD CREEK ALASKA			
SCALE: N.T.S.	DATE: 4/5/02	DRAWN BY: KGS	ENGR: JG
REVISION: SH. 2 OF 13	DRG. NO: BIRD CREEK		

REV.	DATE	REVISIONS

REVISIONS			STATE	PROJECT DESIGNATION	YEAR	SHEET NO.	TOTAL SHEETS
No.	DATE	DESCRIPTION					
			ALASKA	NH-0A3-1(28)	2002	T 12	T 23

SPECIFICATIONS	DESIGNED BY	1/29/02
STANDARDS	CHECKED BY	
COMPUTER DESIGNATION	DRAFTED BY	CJ
VIEW ALL		
AUTOCAD-CAROLEE-MARC/MBDR		

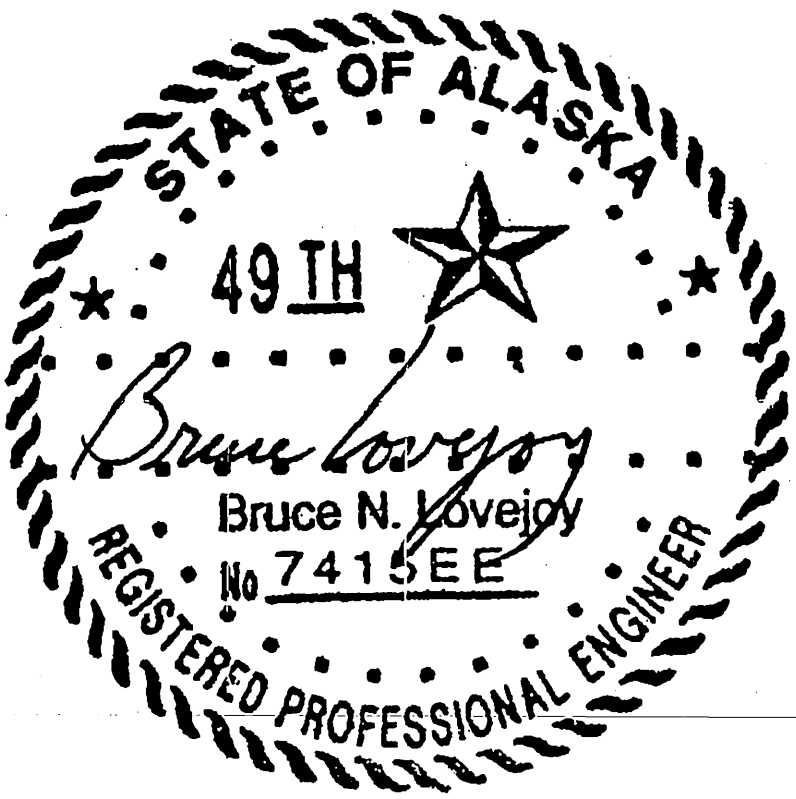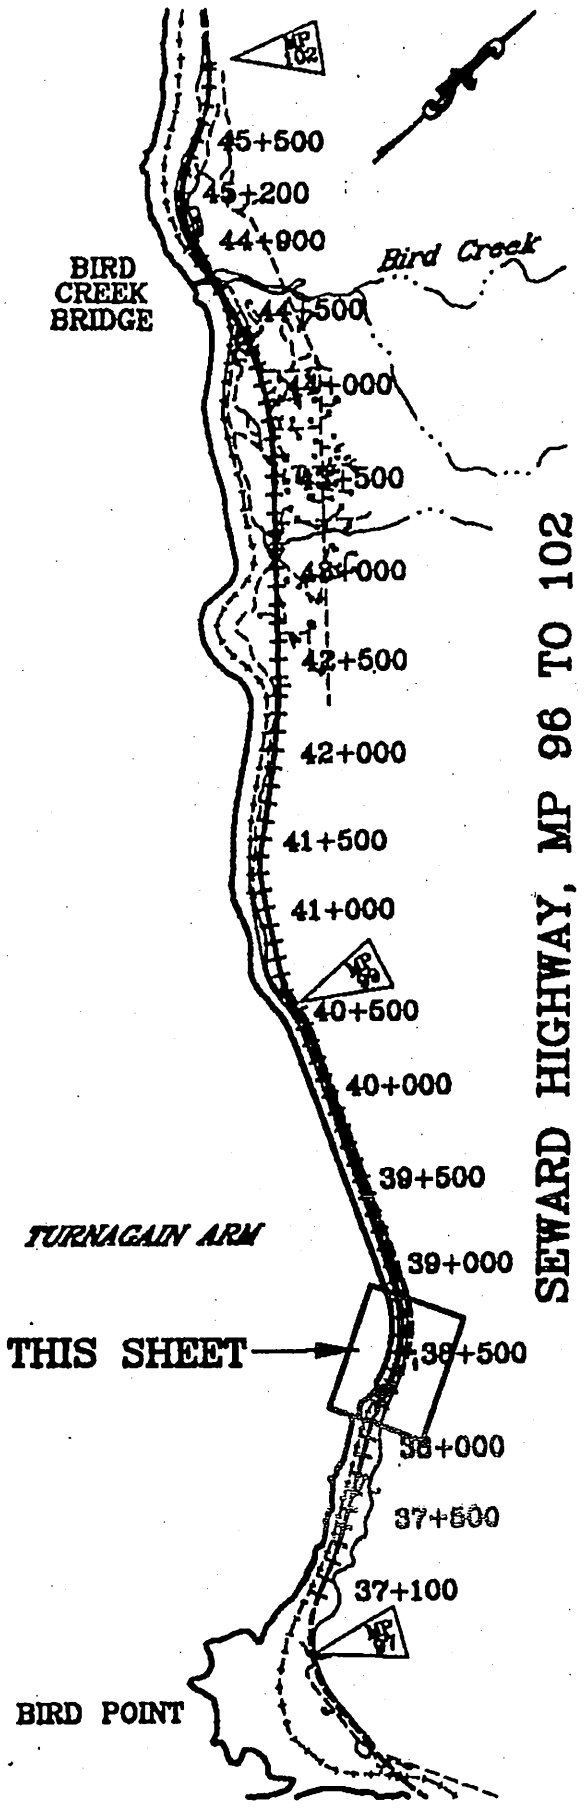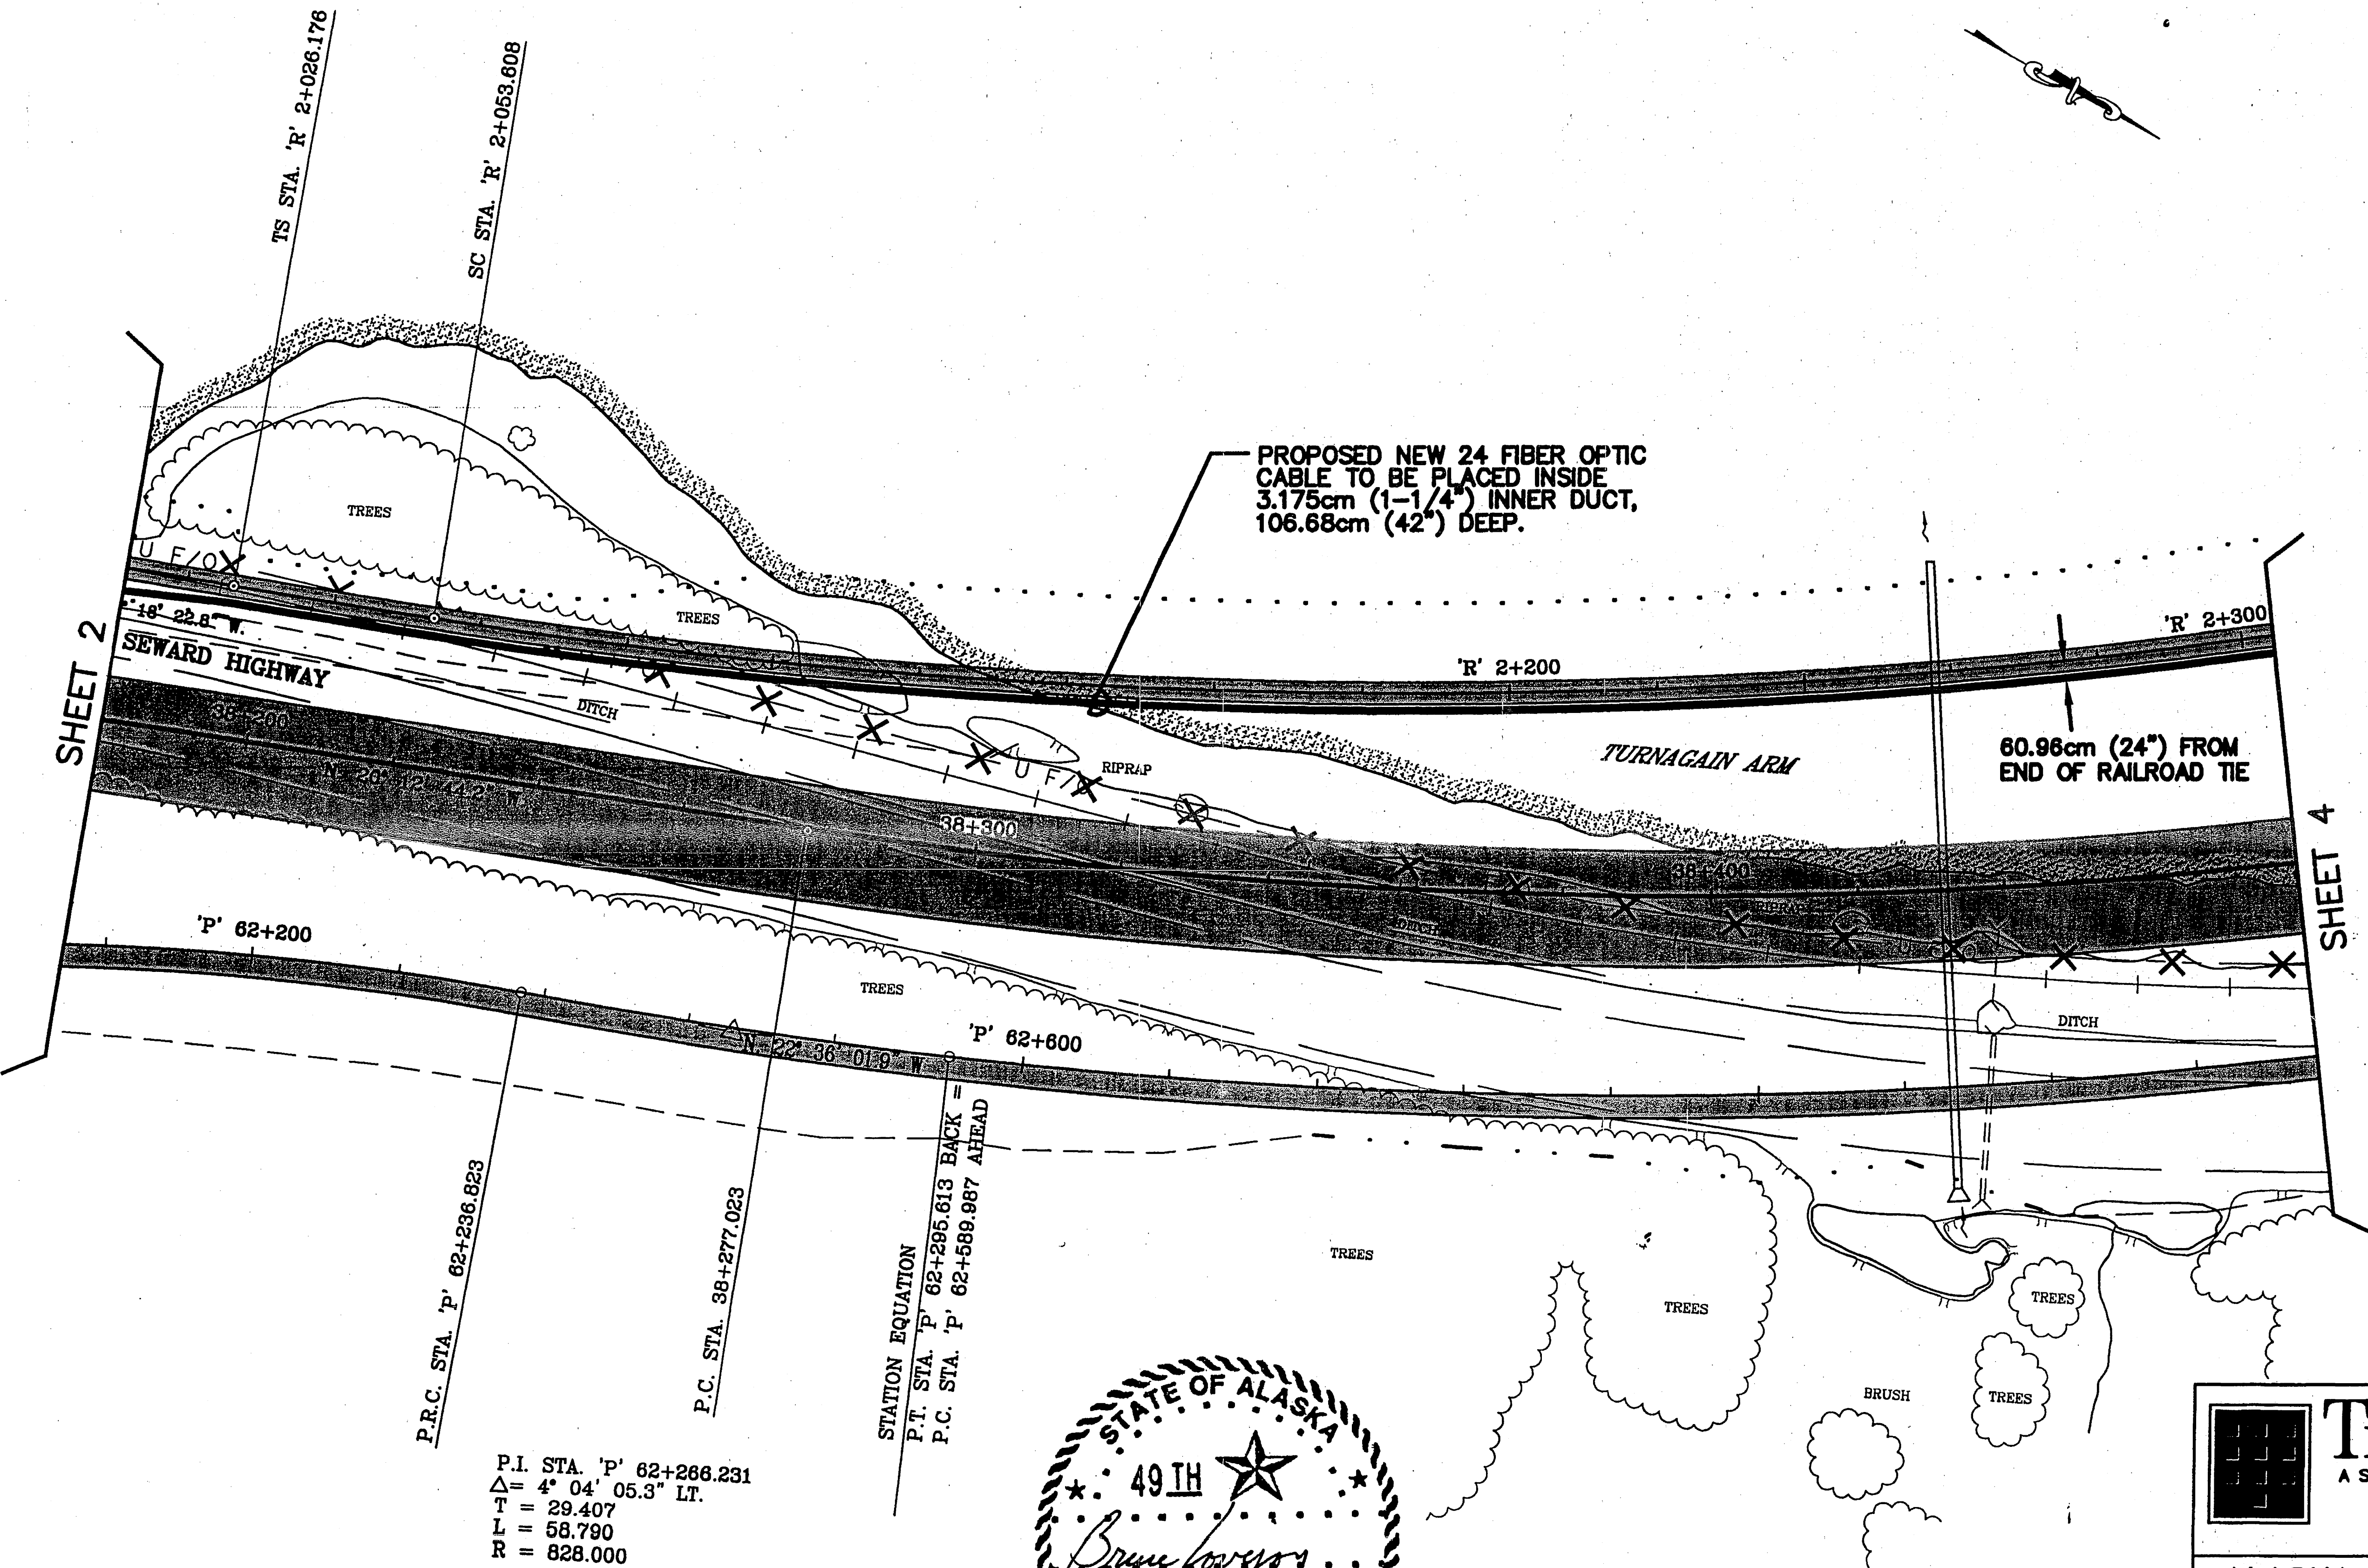

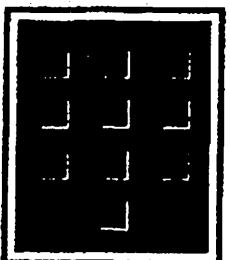
TEMPTEL, INC.
 A SUBSIDIARY OF MID-STATE CONSULTANTS
 1075 EAST 72ND AVENUE
 ANCHORAGE, ALASKA 99518
 (907)258-7867 FAX (907)258-0816



ALASKA FIBER STAR, LLC
BIRD CREEK RR RELOCATE
 BIRD CREEK ALASKA

SCALE: N.T.S.	DATE: 4/5/02	DRAWN BY: KGS	ENGR: JG
REVISION:	SHT. 3 OF 13	DRG. NO:	BIRD CREEK

REV:	DATE:	REVISIONS:

REVISIONS			STATE	PROJECT DESIGNATION	YEAR	SHEET NO.	TOTAL SHEETS
No.	DATE	DESCRIPTION	ALASKA	NH-0A3-I(28)	2002	T13	T23

SPECIFICATIONS	DESIGNED BY	1/29/02
STANDARDS	CHECKED BY	
COMPUTER DESIGNATION	DRAFTED BY	CJ
	AUTOCAD-CAROLEE-MARC/MBDR	

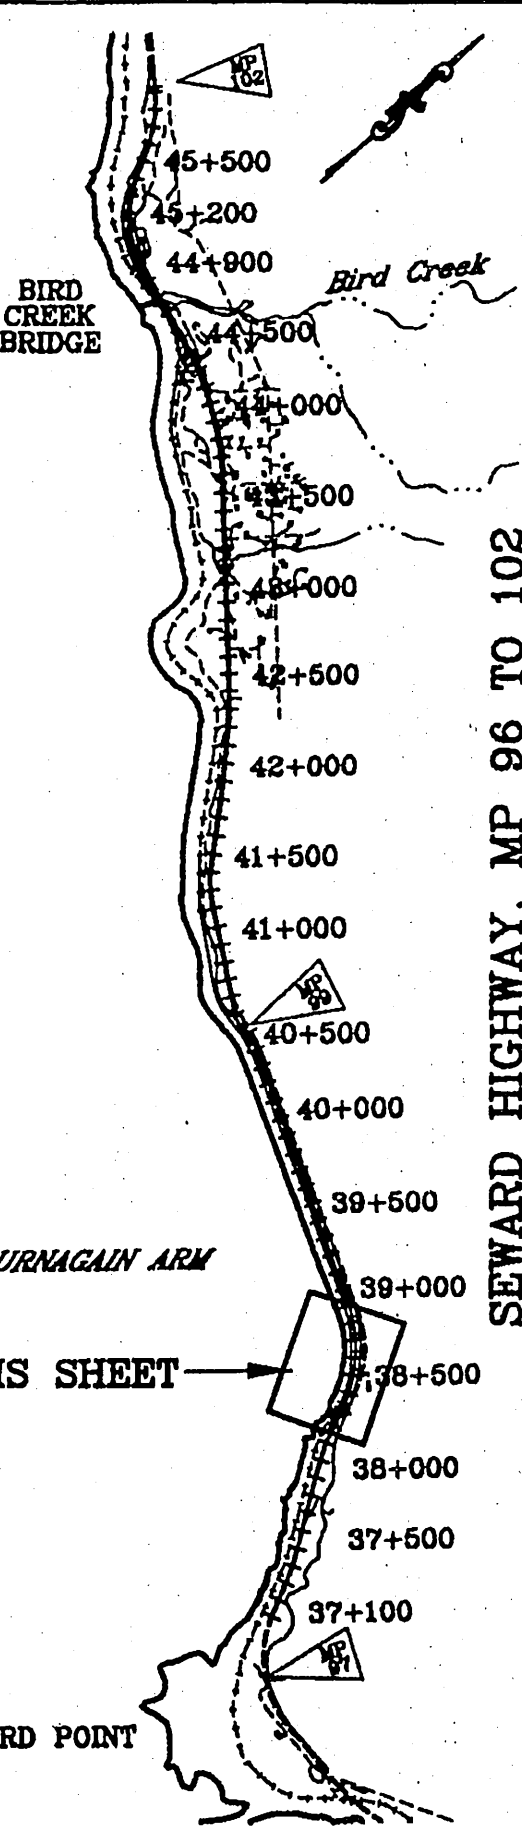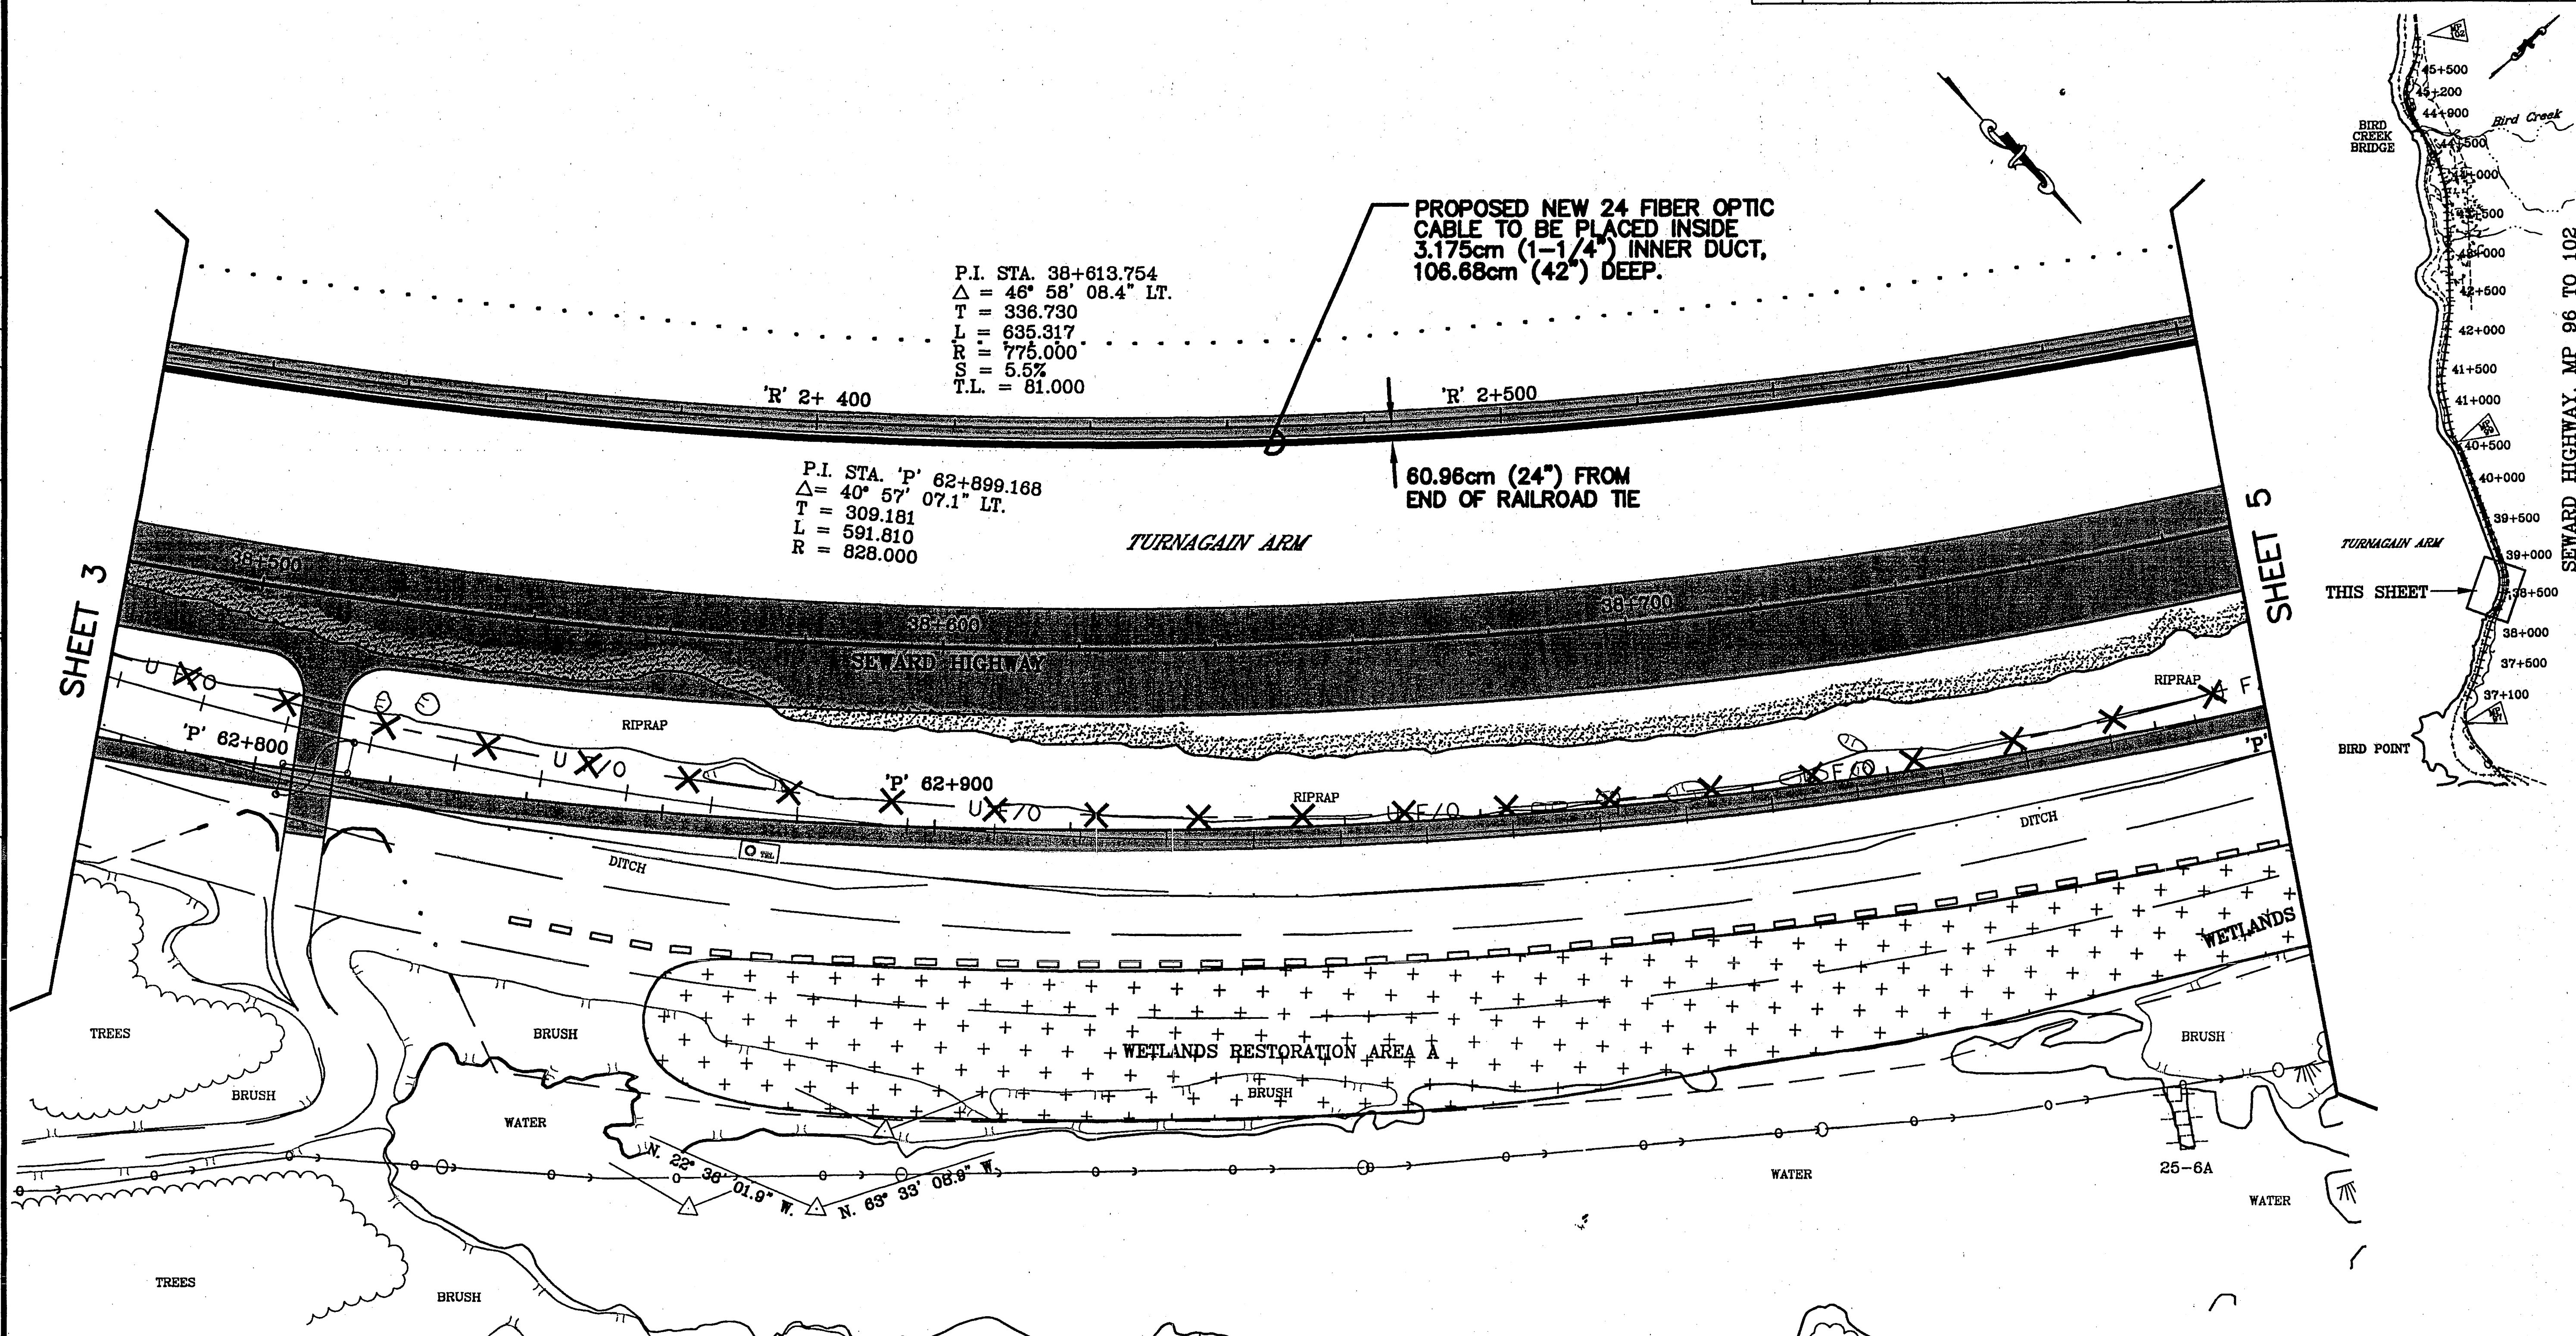

TEMPTEL, INC.
A SUBSIDIARY OF MID-STATE CONSULTANTS
1075 EAST 72ND AVENUE
ANCHORAGE, ALASKA 99518
(907)258-7887 FAX (907)258-0816

ALASKA FIBER STAR, LLC

BIRD CREEK RR RELOCATE

ALASKA

BIRD CREEK


SCALE: N.T.S. DATE: 4/5/02 DRAWN BY: KGS ENGR: JG

REVISION: SHT. 4 OF 13 DRG. NO: BIRD CREEK

REV.	DATE	REVISIONS



REVISIONS			STATE	PROJECT DESIGNATION	YEAR	SHEET NO.	TOTAL SHEETS
No.	DATE	DESCRIPTION	ALASKA	NH-0A3-1(28)	2002	T14	T23

DESIGNED BY	CJ	1/29/02
CHECKED BY		
DRAFTED BY		
SPECIFICATIONS		
STANDARDS		
COMPUTER DESIGNATION	AUTOCAD-CAROLEE-MARC/MBDR	
VIEW ALL		

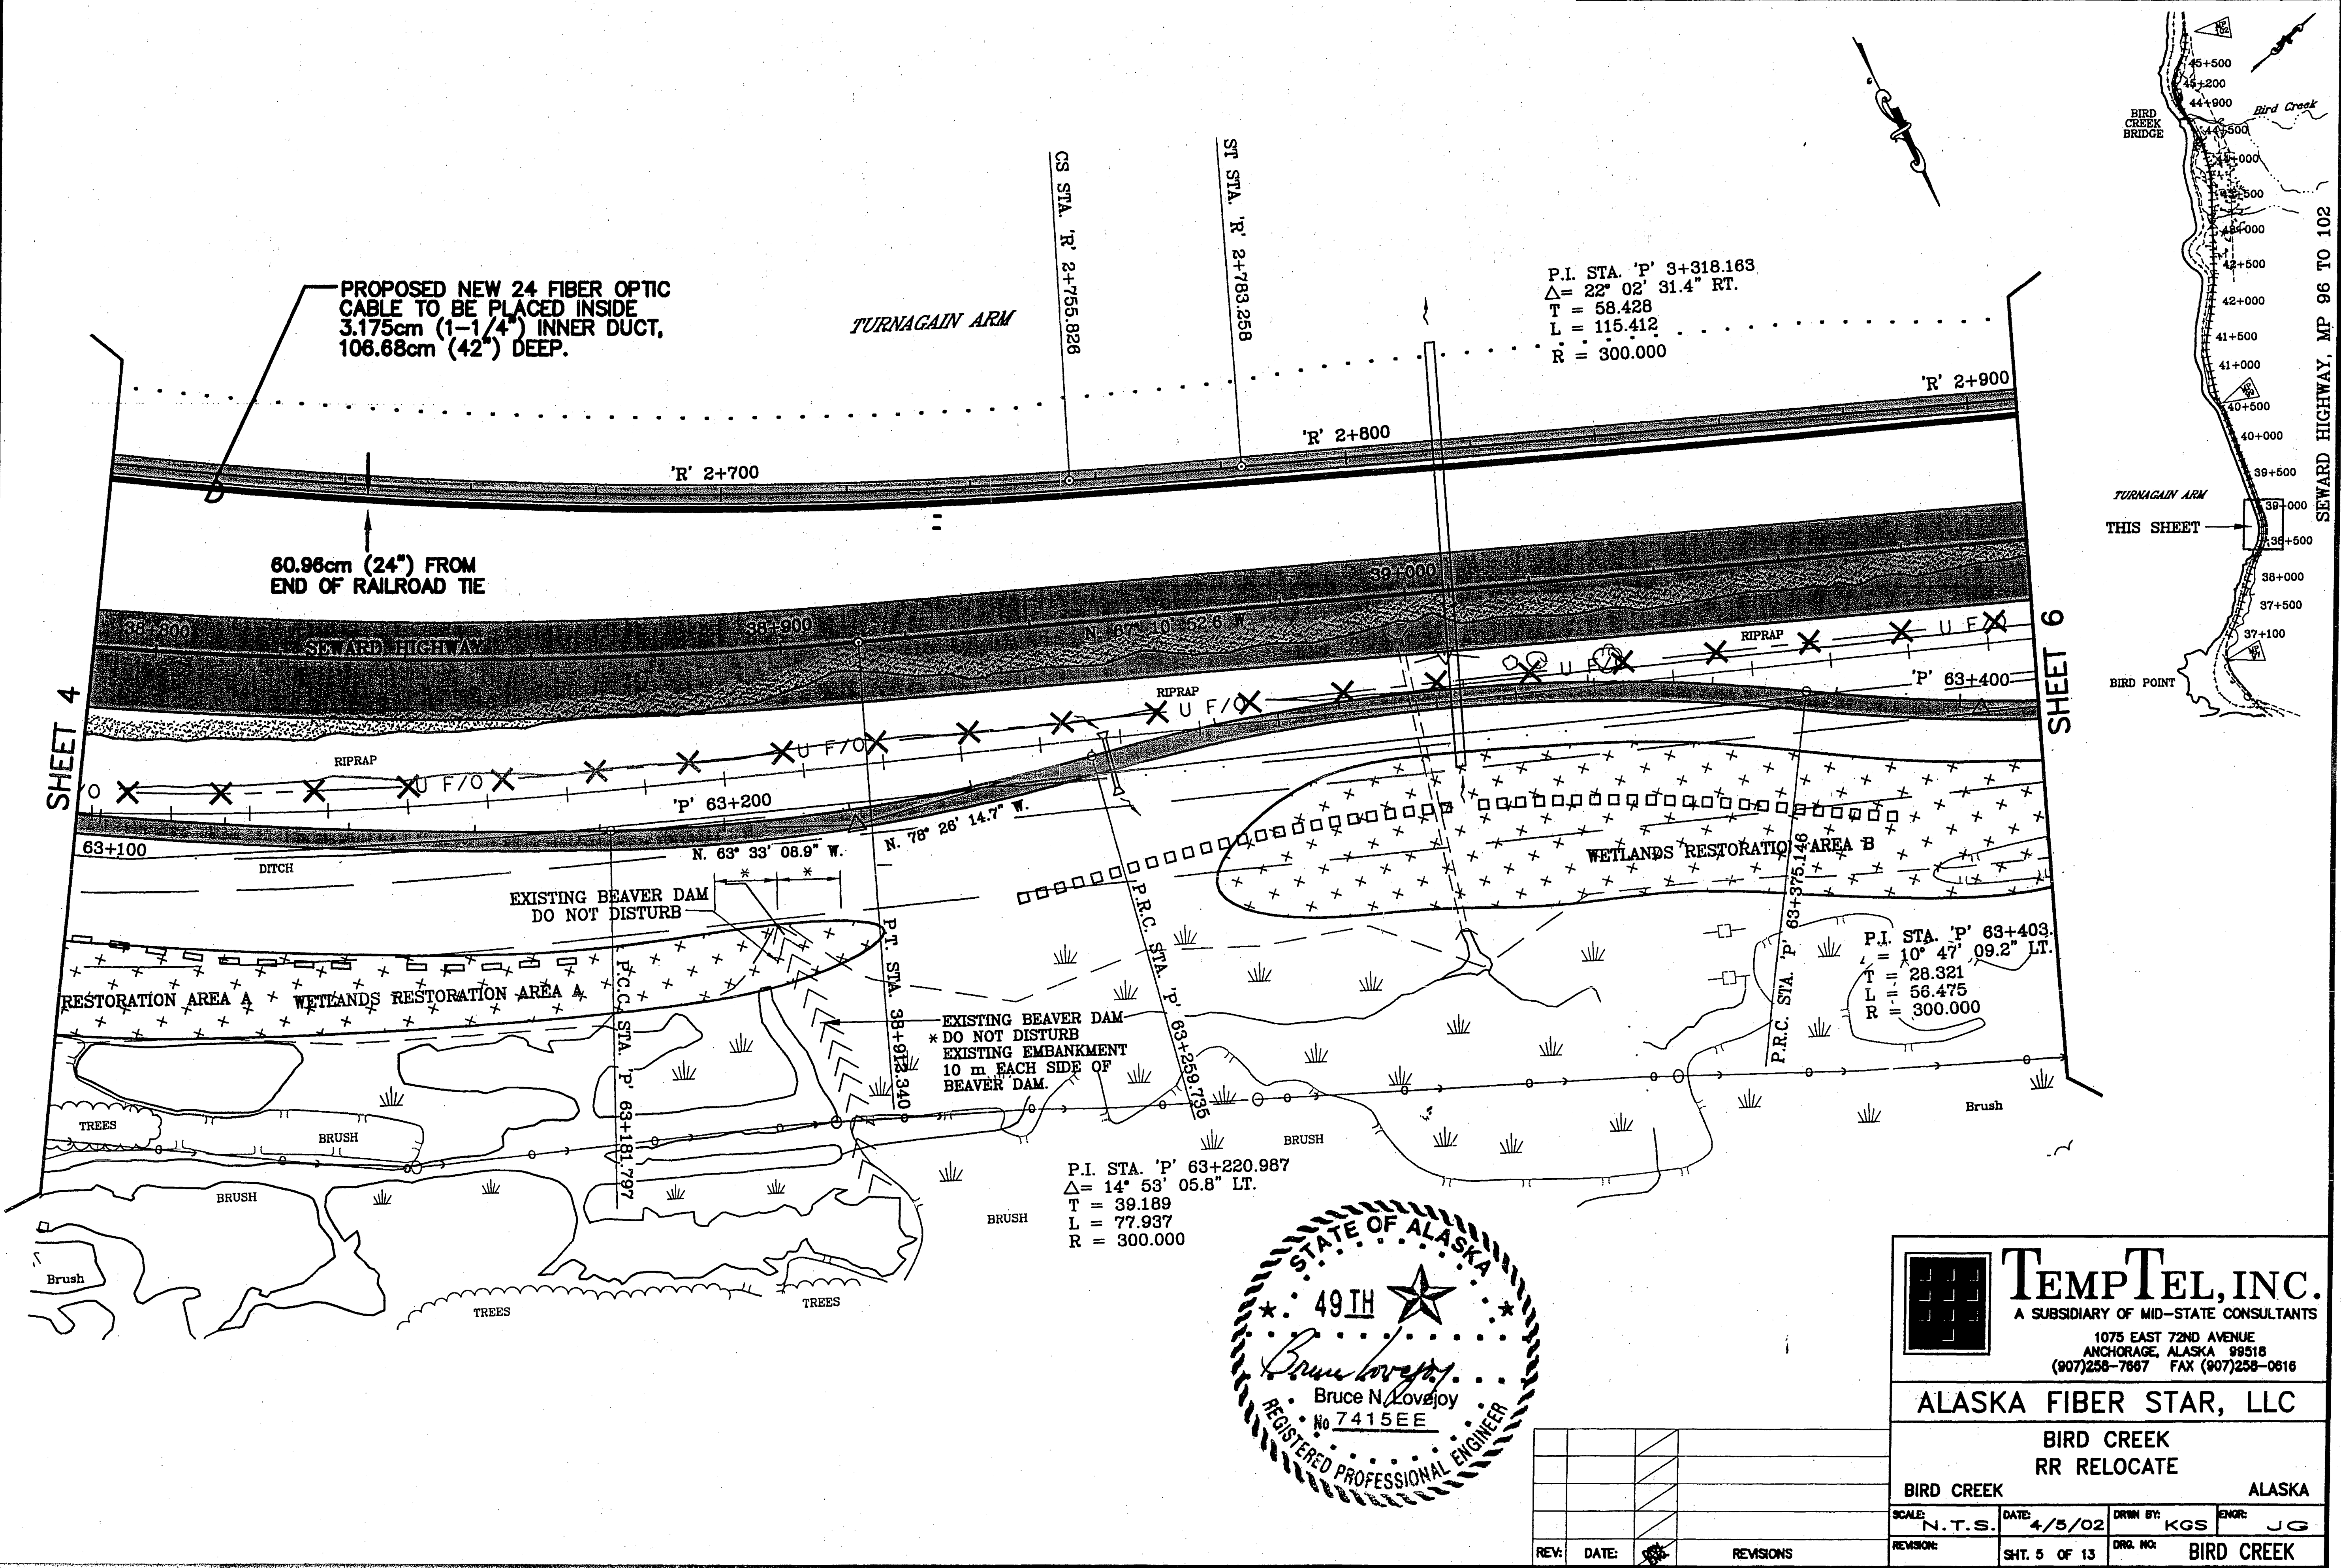

REVISIONS			STATE	PROJECT DESIGNATION	YEAR	SHEET NO.	TOTAL SHEETS
No.	DATE	DESCRIPTION	ALASKA	NH-0A3-I(28)	2002	T15	T23

SPECIFICATIONS	DESIGNED BY	1/29/02
STANDARDS	CHECKED BY	
COMPUTER DESIGNATION	DRAFTED BY	CJ
VIEW ALL		
AUTOCAD-CAROLEE-MARC/MBDR		

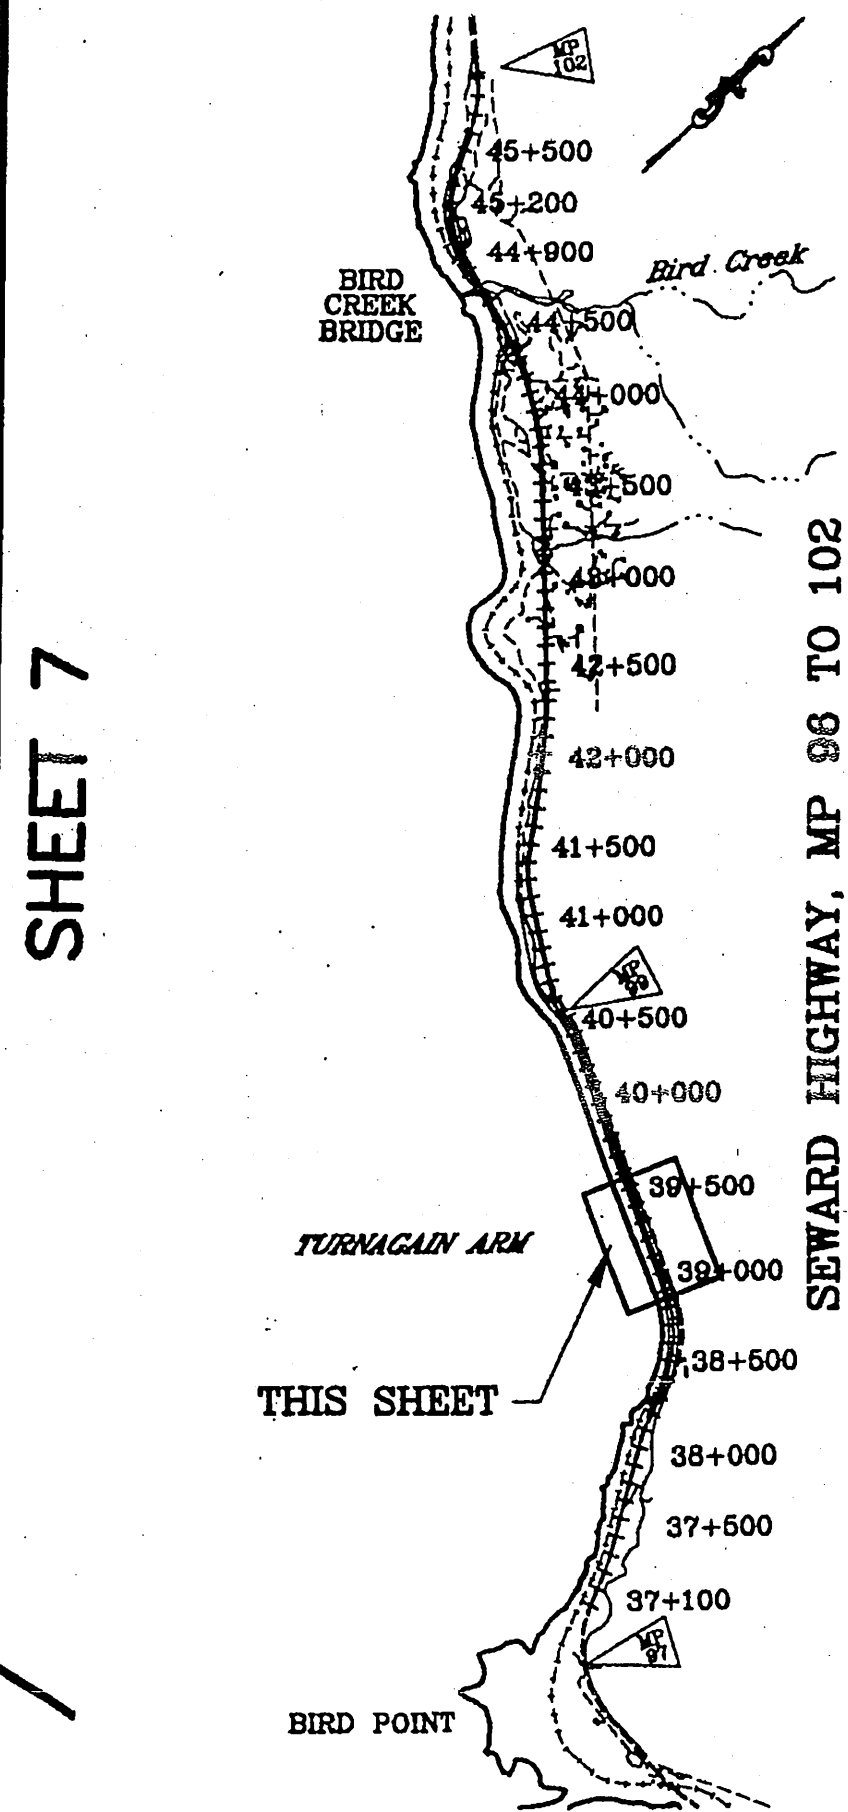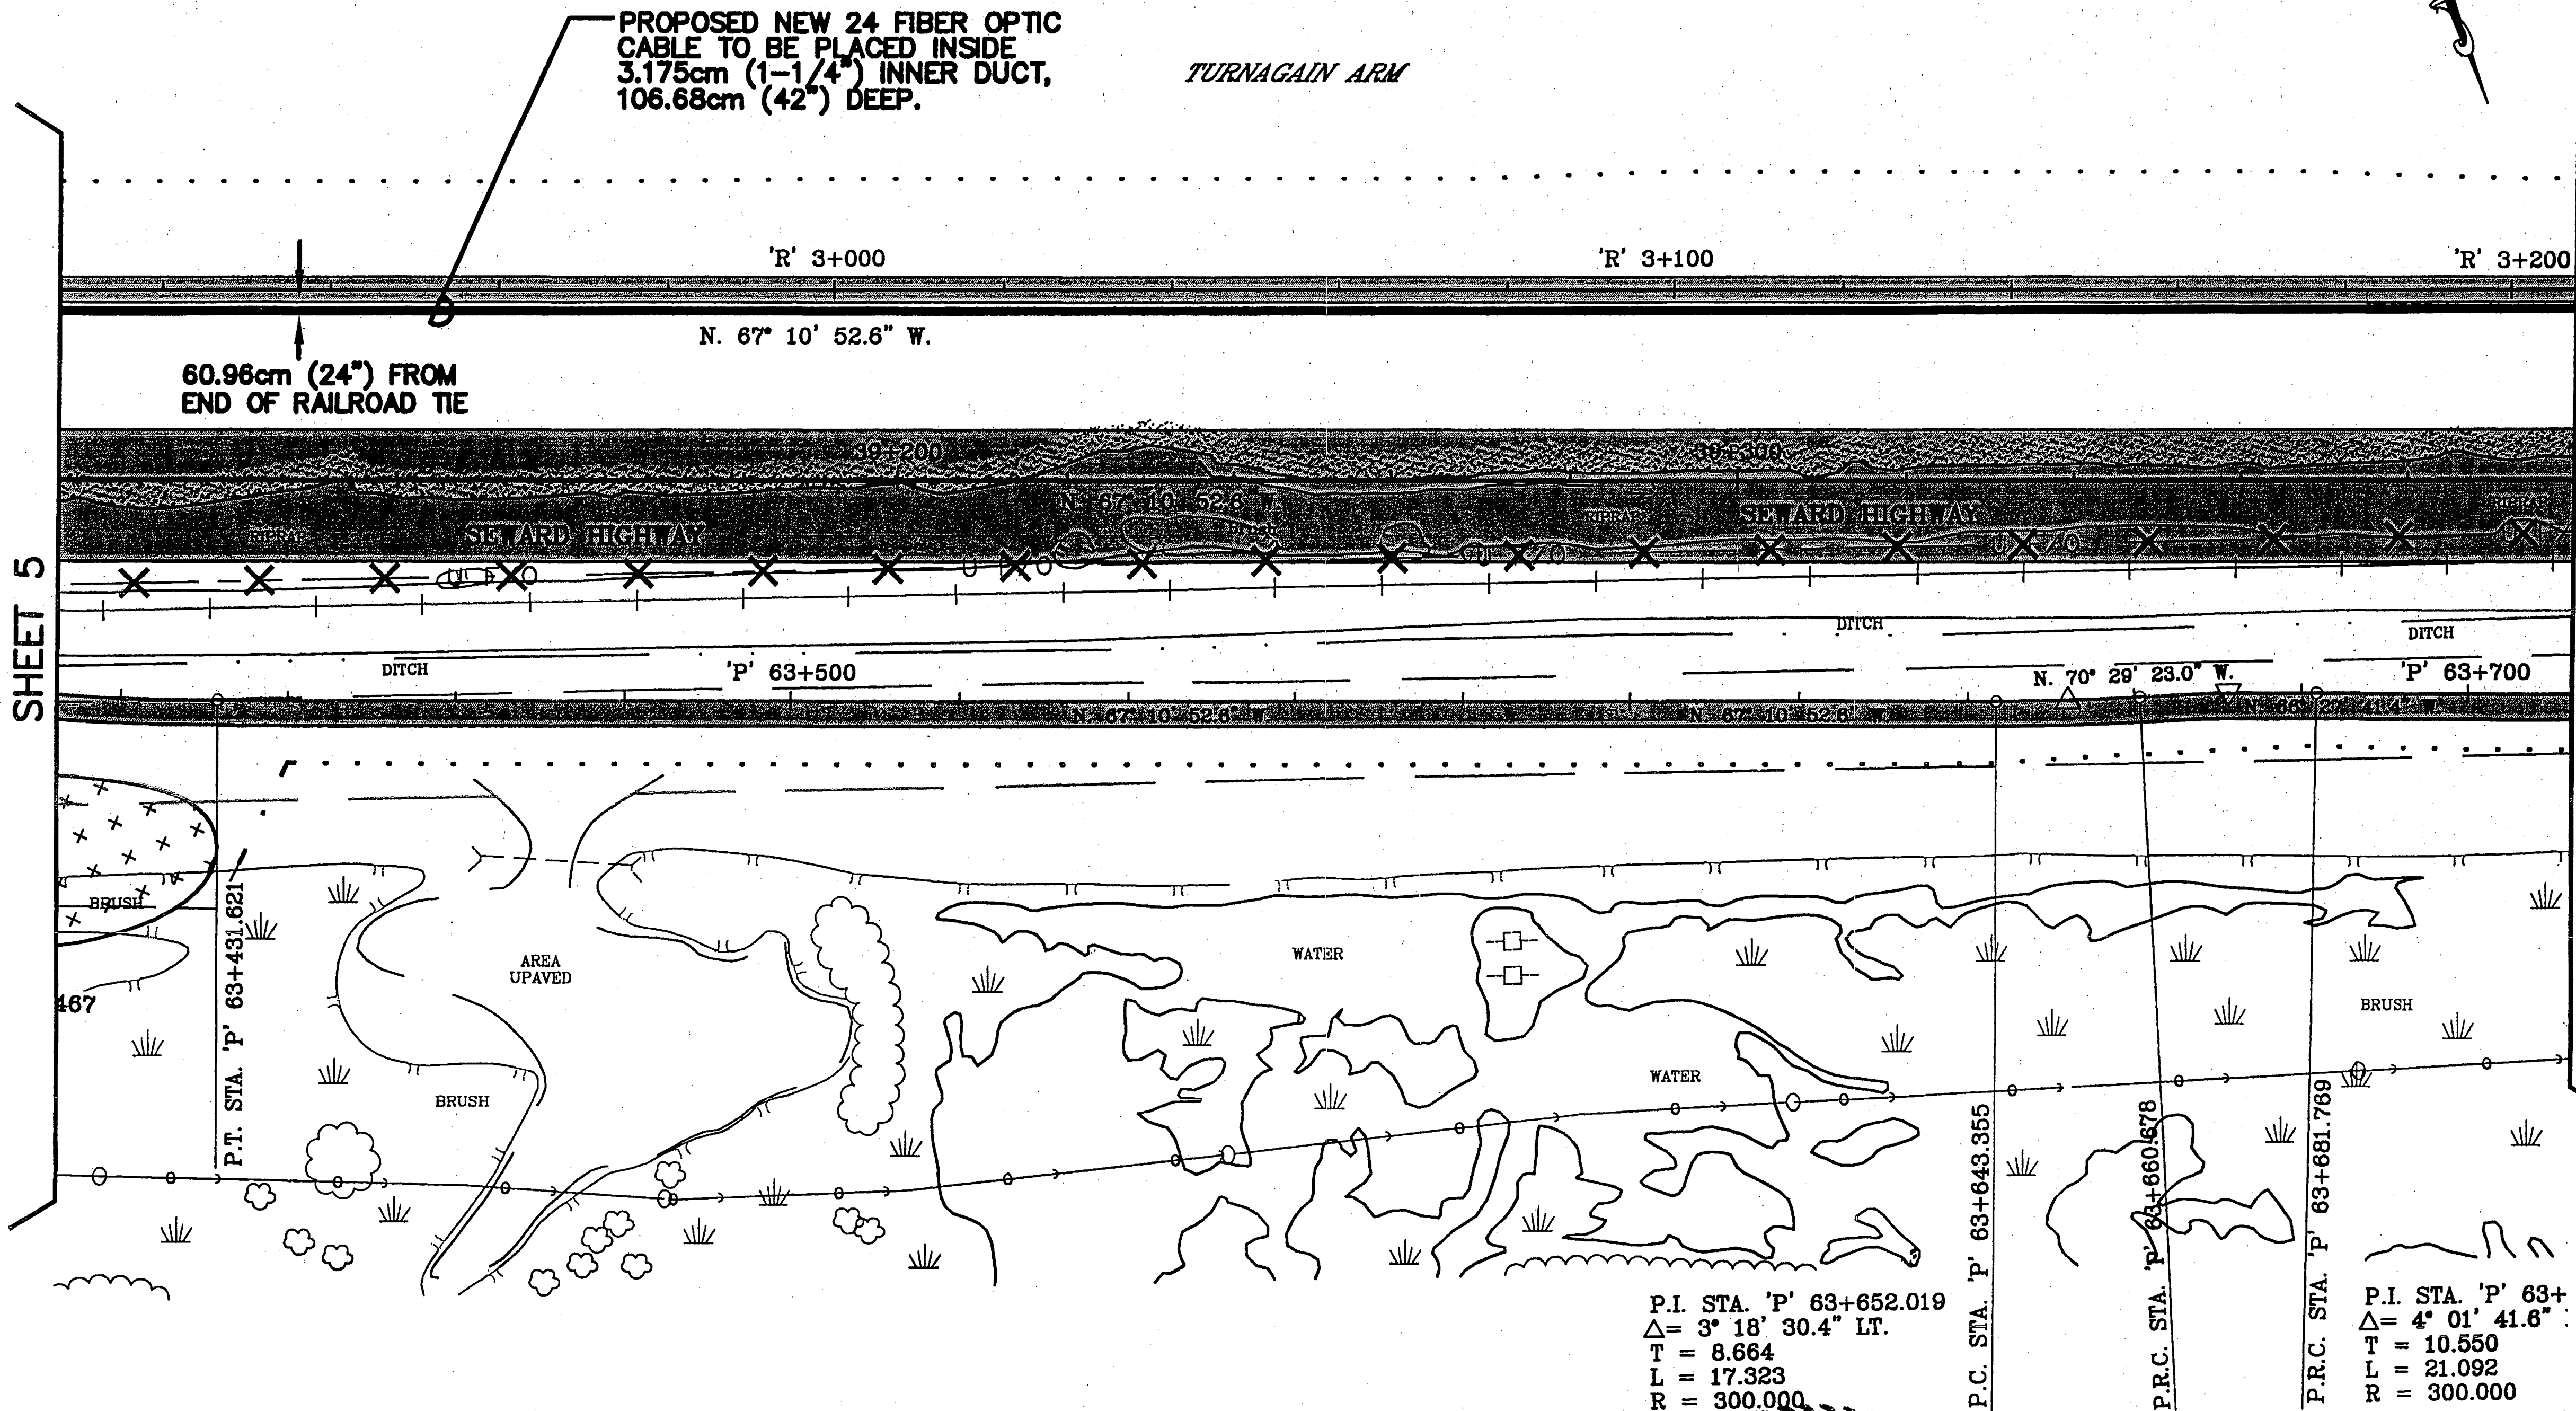

P.I. STA. 'P' 63+652.019
 $\Delta = 3^{\circ} 18' 30.4''$ LT.
 T = 8.664
 L = 17.323
 R = 300.000

P.C. STA. 'P' 63+643.355


P.R.C. STA. 'P' 63+660.678

P.R.C. STA. 'P' 63+681.769

P.I. STA. 'P' 63+
 $\Delta = 4^{\circ} 01' 41.6''$
 T = 10.550
 L = 21.092
 R = 300.000

STATE OF ALASKA
 49TH
 Bruce N. Lovejoy
 REGISTERED PROFESSIONAL ENGINEER
 No. 7415 EE

REV.	DATE	REVISIONS

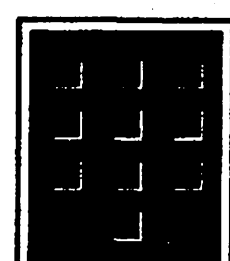

TEMPTEL, INC.
 A SUBSIDIARY OF MID-STATE CONSULTANTS
 1075 EAST 72ND AVENUE
 ANCHORAGE, ALASKA 99518
 (907)258-7667 FAX (907)258-0616

ALASKA FIBER STAR, LLC

BIRD CREEK RR RELOCATE

BIRD CREEK ALASKA

SCALE: N.T.S. DATE: 4/5/02 DRAWN BY: KGS ENGR: JG

REVISION: SHT. 6 OF 13 ORG. NO: BIRD CREEK

REVISIONS			STATE	PROJECT DESIGNATION	YEAR	SHEET NO.	TOTAL SHEETS
No.	DATE	DESCRIPTION					
				NH 0A3-1(28)	2002	T16	T23

P.I. STA. 39+437.472
 $\Delta = 01^{\circ} 10' 18.5''$ LT.
T = 25.566
L = 51.129
RRR = 2500.000
US = 2.3%
TL = 47.000

TS STA. 'R' 3+217.995
SC STA. 'R' 3+236.283
CS STA. 'R' 3+253.712
ST STA. 'R' 3+272.000

TURNAGAIN ARM

PROPOSED NEW 24 FIBER OPTIC
CABLE TO BE PLACED INSIDE
3.175cm (1-1/4") INNER DUCT,
106.68cm (42") DEEP.

'R' 3+300

N. 68° 21' 11.1" W.

'R' 3+400

'R' 3+500

P.I. STA. 'P' 63+885.920
 $\Delta = 6^{\circ} 37' 10.7''$ RT.
T = 17.349
L = 34.660 R = 300.000

60.96cm (24") FROM
END OF RAILROAD TIE

SEWARD HIGHWAY

DITCH

'P' 64+000

'P' 63+800

N. 74° 58' 21.7" W.

P.I. STA. 'P' 63+723.454
 $\Delta = 1^{\circ} 53' 29.7''$ LT.
T = 41.684
L = 83.361
R = 2525.000

P.C. STA. 39+411.907

P.T. STA. 39+463.036

P.T. STA. 'P' 63+765.131

P.C. STA. 'P' 63+833.910

P.I. STA. 'P' 63+851.259
 $\Delta = 6^{\circ} 37' 10.7''$ LT.
T = 17.349
L = 34.660
R = 300.000

P.R.C. STA. 'P' 63+868.570

P.T. STA. 'P' 63+903.231



SWAMP GRASS

SWAMP GRASS

Trees

Trees

BRUSH

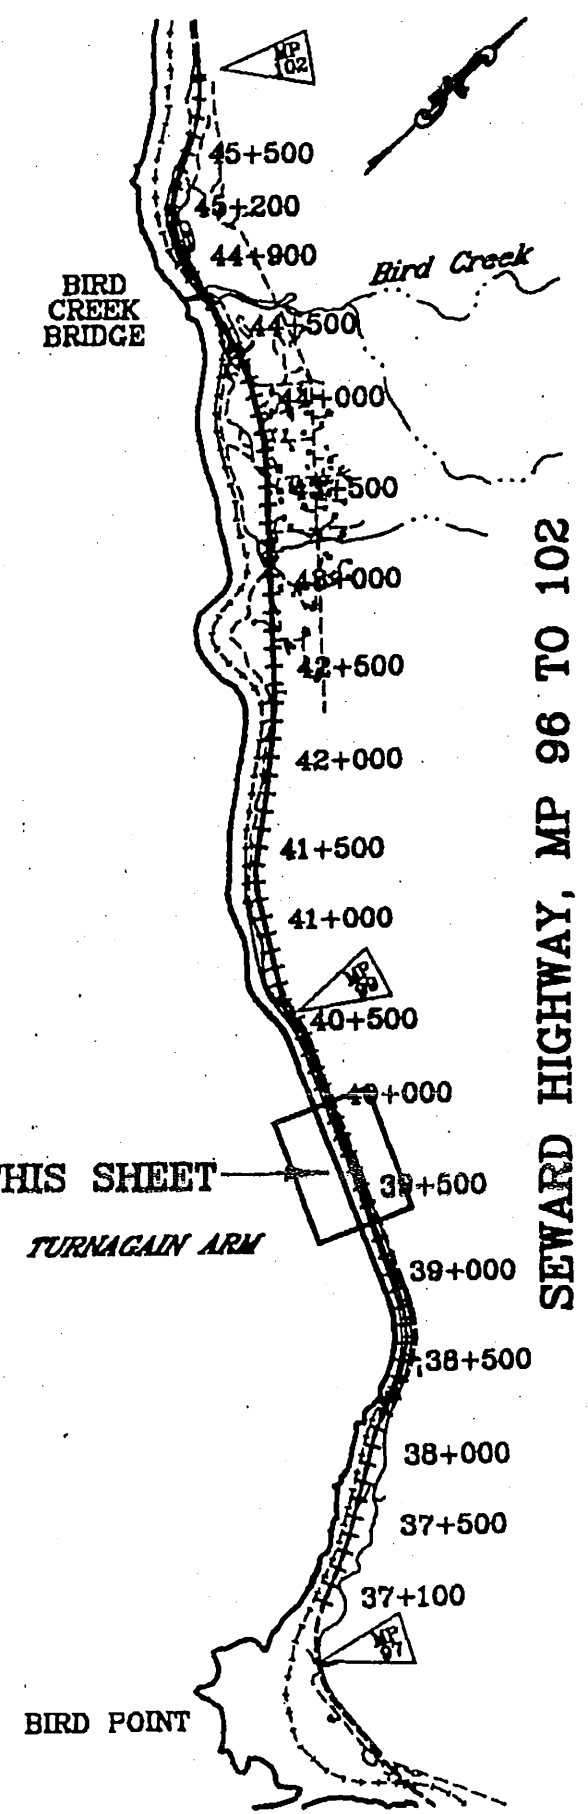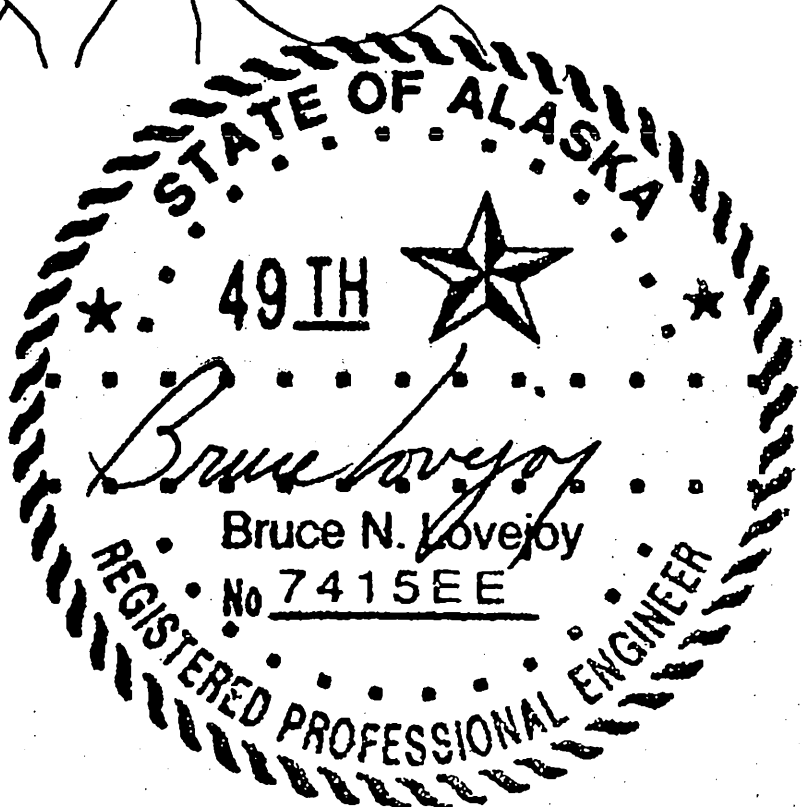

SHEET 8

SHEET 6

SPECIFICATIONS	DESIGNED BY
STANDARDS	CHECKED BY
COMPUTER DESIGNATION	DRAFTED BY
	1/29/02

TEMPTEL, INC.
A SUBSIDIARY OF MID-STATE CONSULTANTS
1075 EAST 72ND AVENUE
ANCHORAGE, ALASKA 99518
(907)258-7887 FAX (907)258-0616

ALASKA FIBER STAR, LLC

BIRD CREEK RR RELOCATE

BIRD CREEK ALASKA



SCALE: N.T.S. DATE: 4/5/02 DRAWN BY: KGS ENGR: JG

REVISION: SHT. 7 OF 13 DRG. NO. BIRD CREEK


REV.	DATE	REVISIONS

REVISIONS			STATE	PROJECT DESIGNATION	YEAR	SHEET NO.	TOTAL SHEETS
No.	DATE	DESCRIPTION	ALASKA	NH-0A3-I(28)	2002	T18	T23

SPECIFICATIONS	DESIGNED BY	1/29/02
STANDARDS	CHECKED BY	
COMPUTER DESIGNATION	DRAFTED BY	CJ
VIEW ALL		
AUTOCAD-CAROLEE-MARC/MBOR		

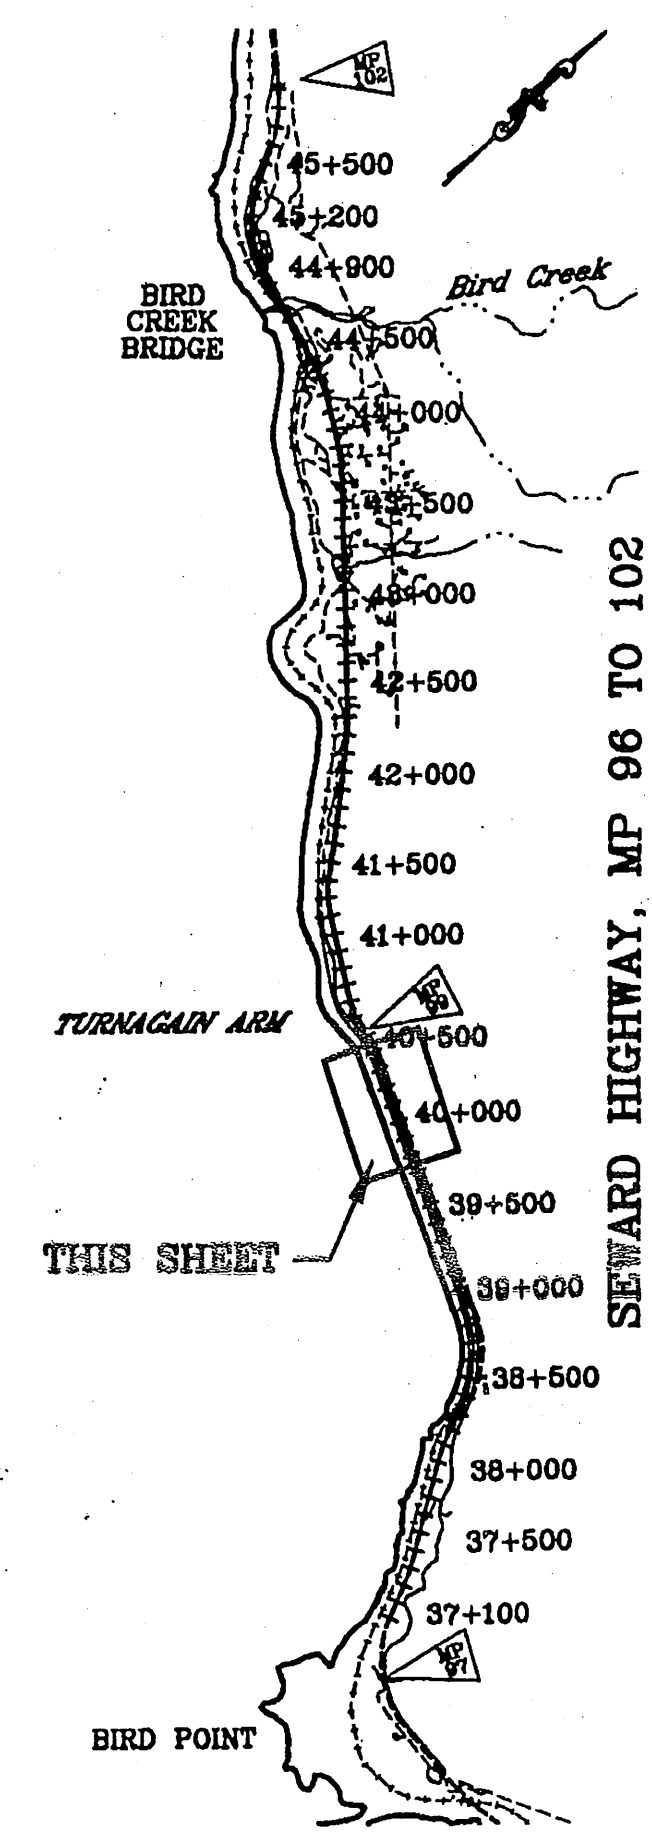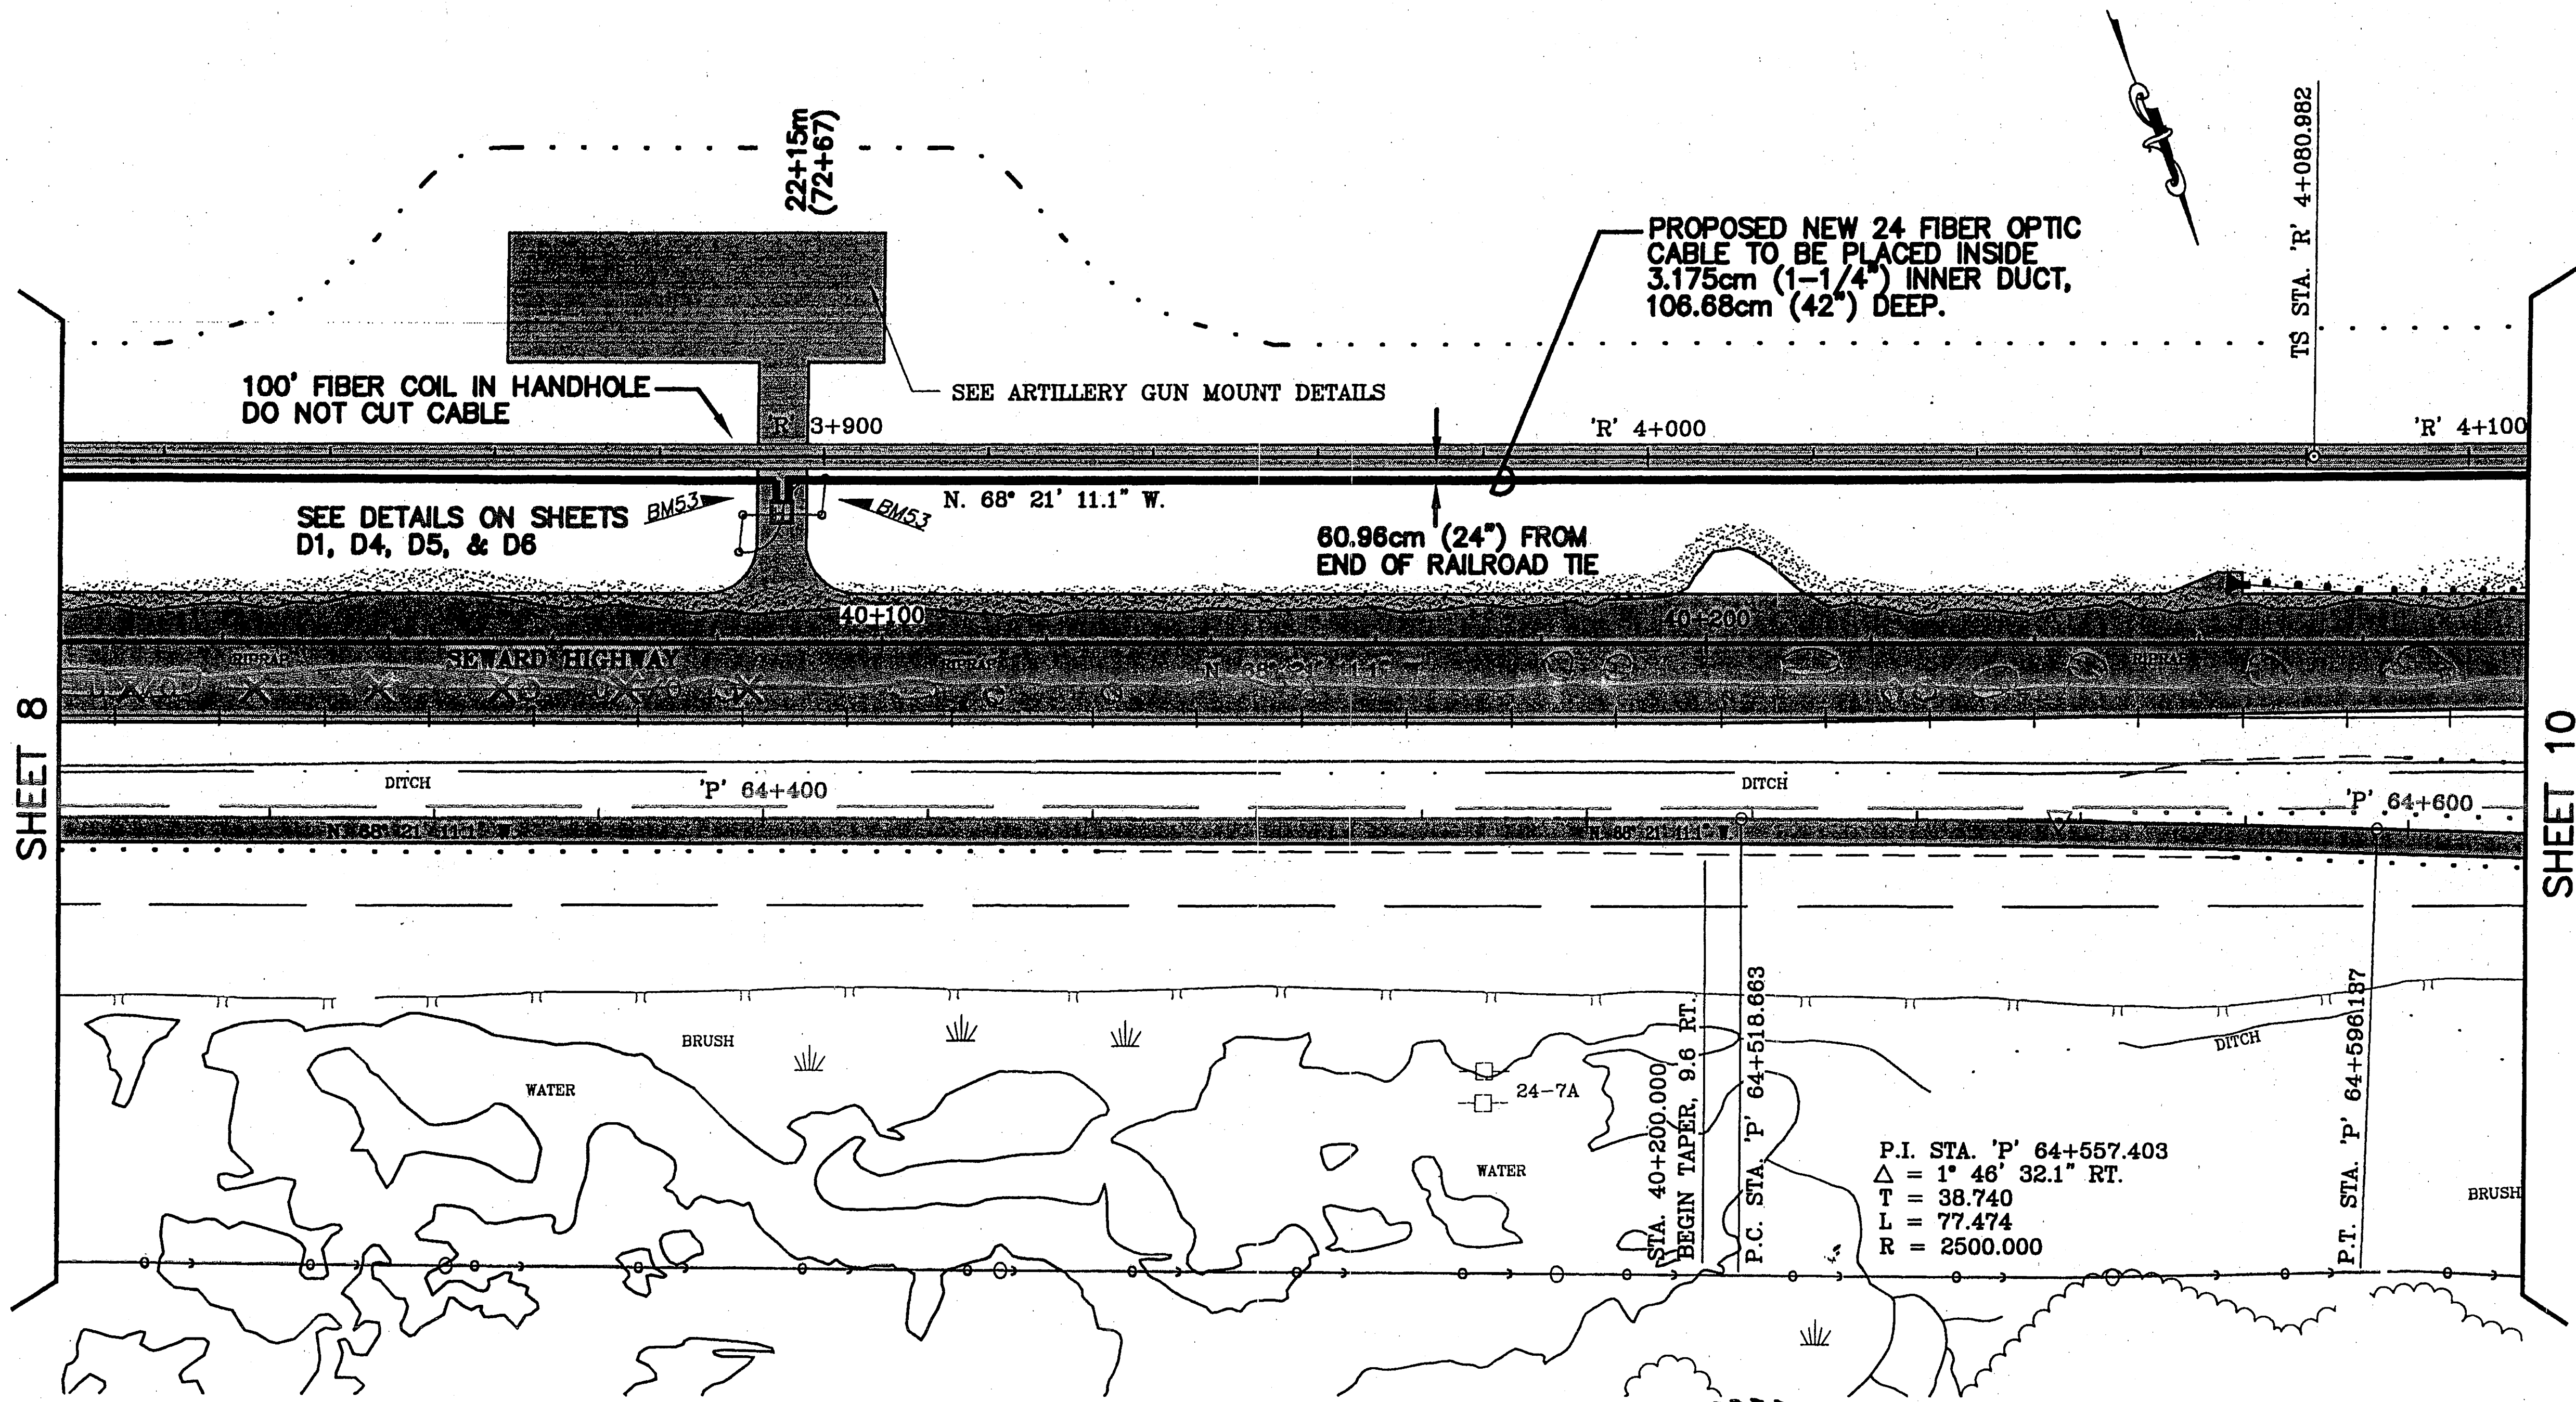



REV.	DATE	REVISIONS

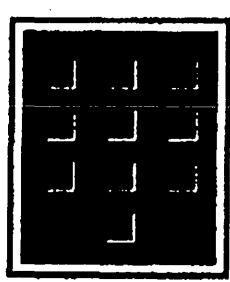
TEMPTEL, INC.
 A SUBSIDIARY OF MID-STATE CONSULTANTS
 1075 EAST 72ND AVENUE
 ANCHORAGE, ALASKA 99518
 (907)258-7667 FAX (907)258-0816


ALASKA FIBER STAR, LLC
BIRD CREEK RR RELOCATE
 BIRD CREEK ALASKA

SCALE: N.T.S.	DATE: 4/5/02	DRAWN BY: KGS	ENGR: JG
REVISION:	SHT. 9 OF 13	DWG. NO:	BIRD CREEK

REVISIONS			STATE	PROJECT DESIGNATION	YEAR	SHEET NO.	TOTAL SHEETS
No.	DATE	DESCRIPTION	ALASKA	NH-0A3-1(28)	2002	T 19	T 23

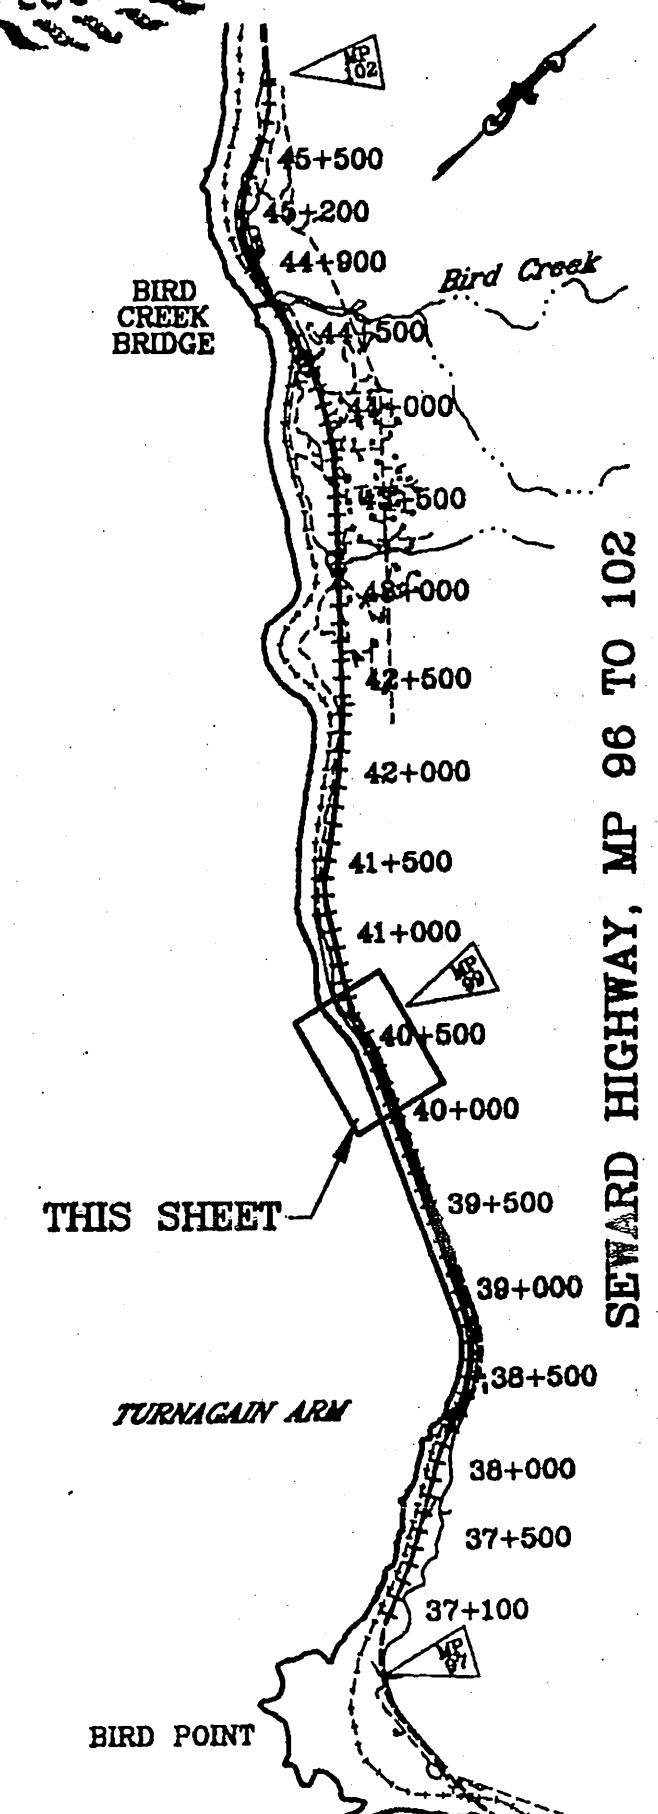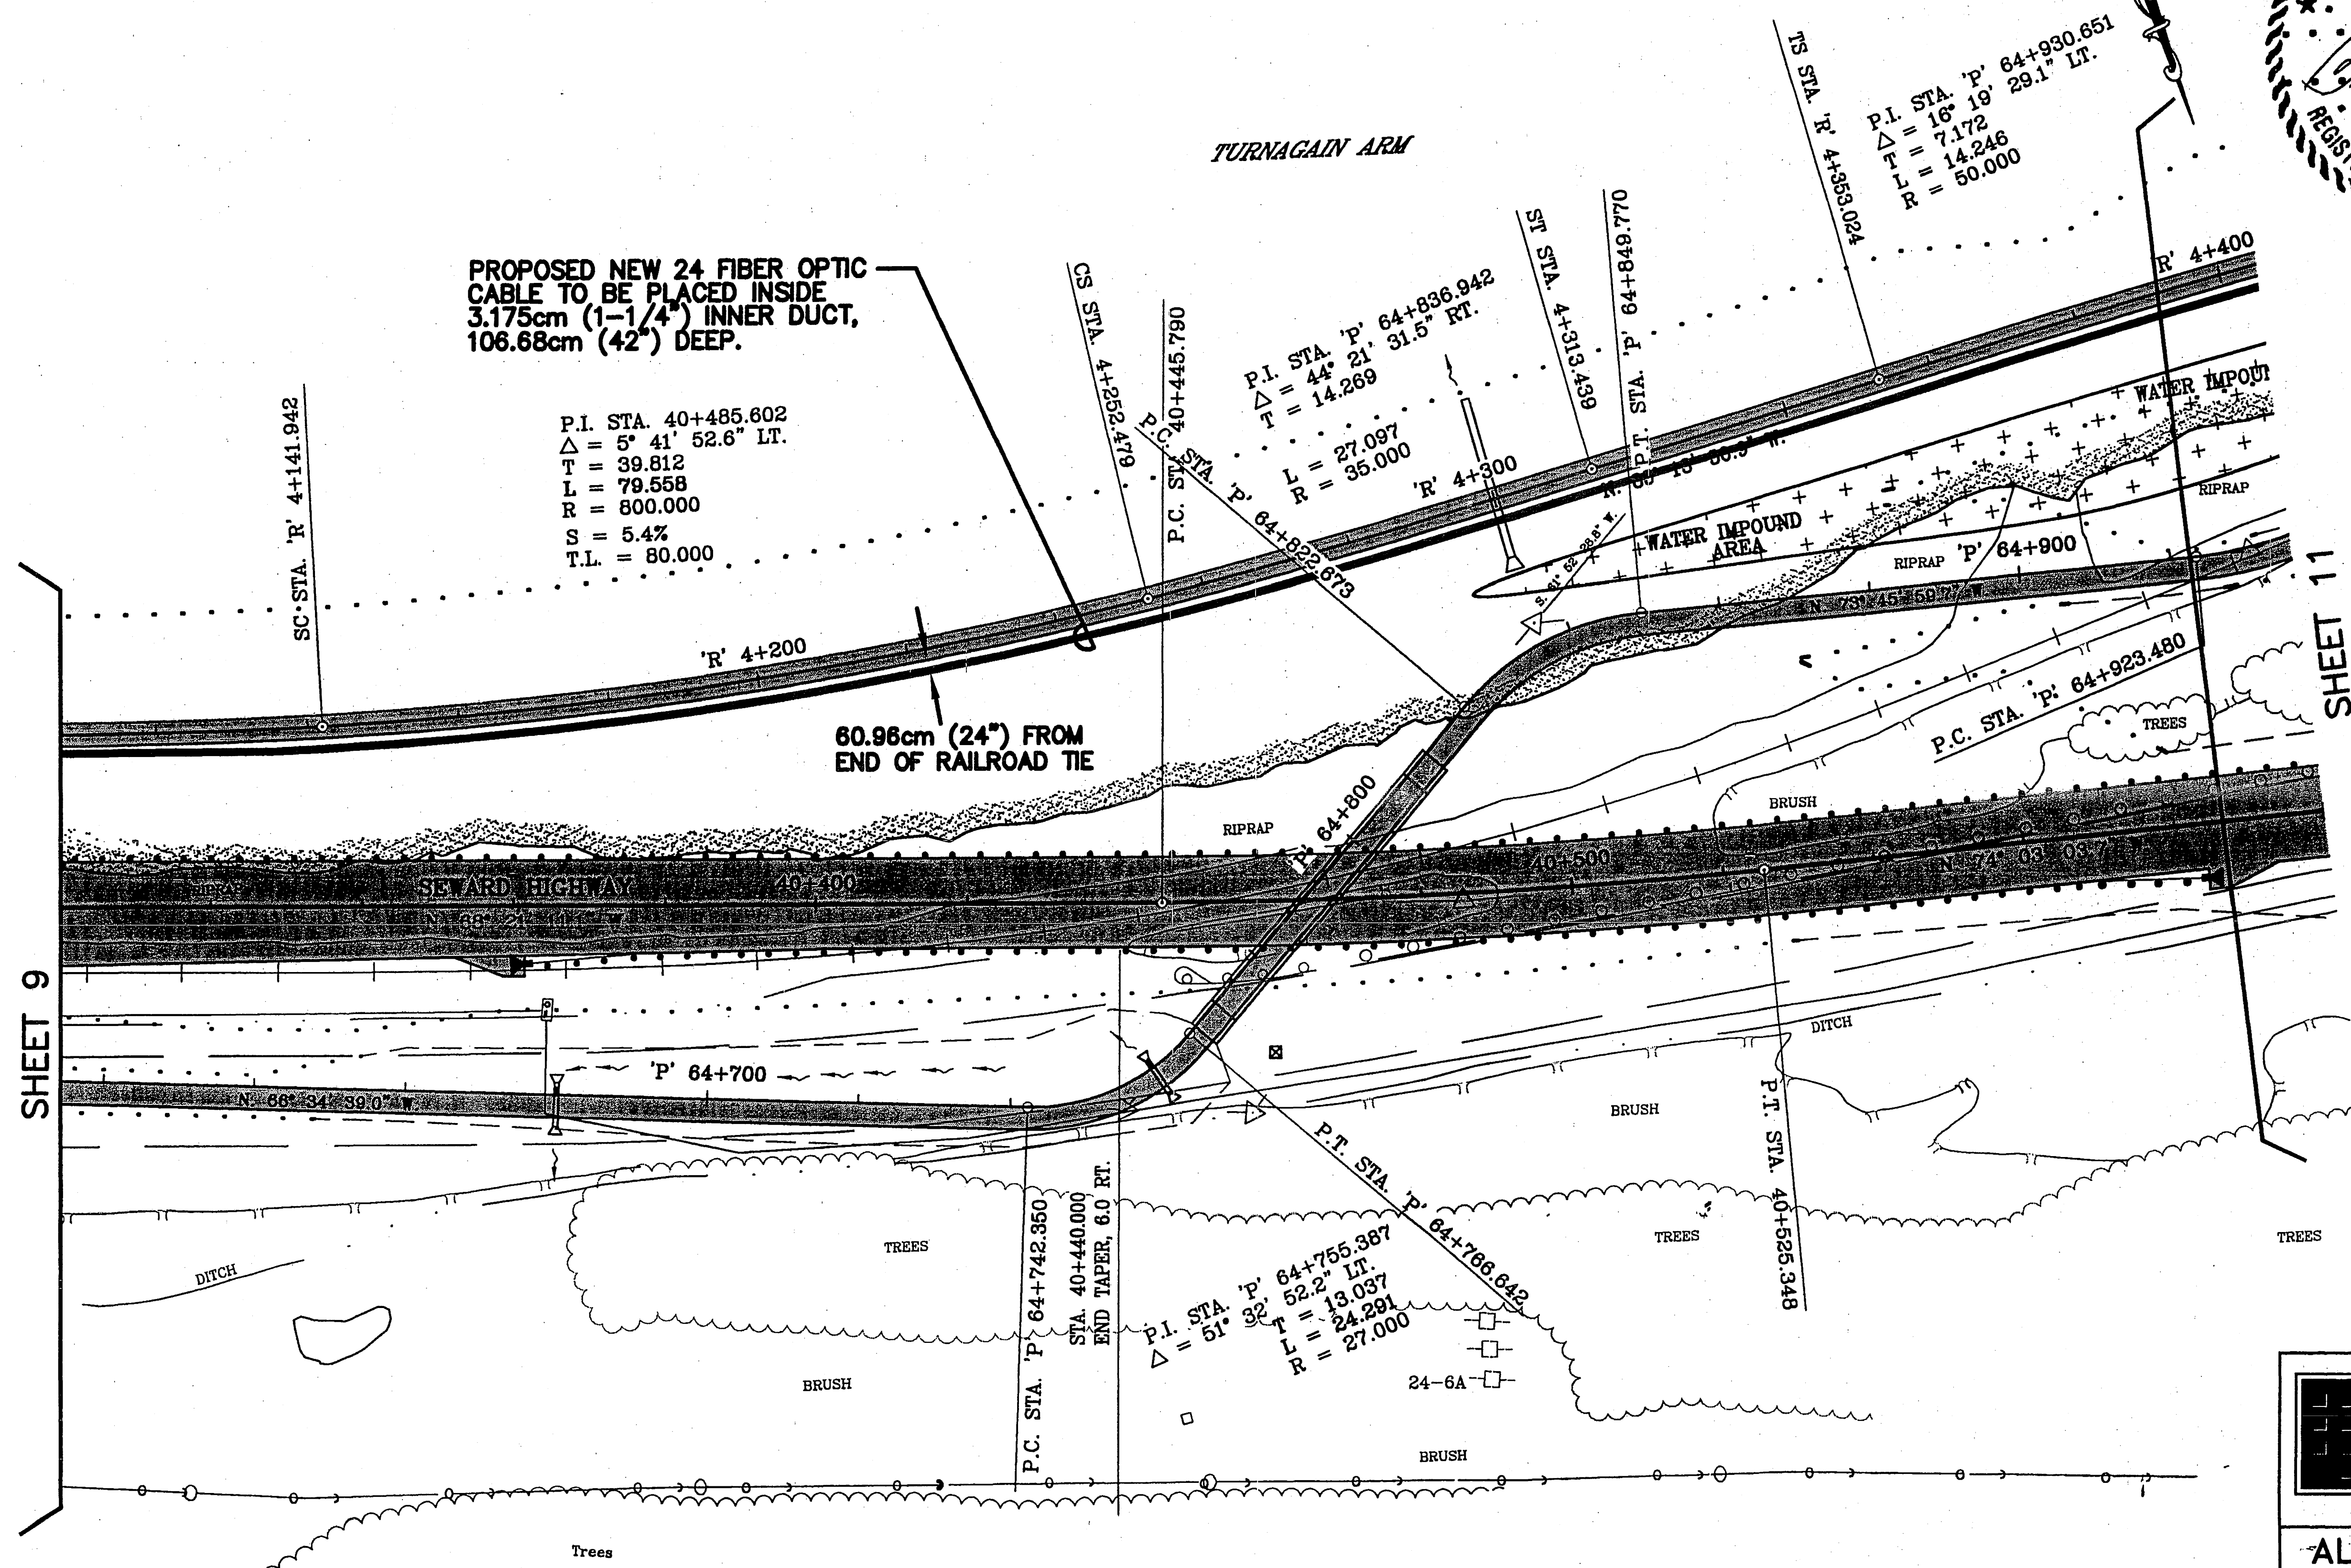



SPECIFICATIONS		DESIGNED BY	
STANDARDS		CHECKED BY	
COMPUTER DESIGNATION	VIEW ALL AUTOCAD-CAROLEE-MARC/MBDR	DRAFTED BY	CJ 1/29/02

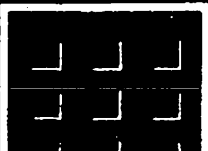	TEMPTEL, INC.		
	A SUBSIDIARY OF MID-STATE CONSULTANTS		
	1075 EAST 72ND AVENUE ANCHORAGE, ALASKA 99518 (907)258-7867 FAX (907)258-0616		
ALASKA FIBER STAR, LLC			
BIRD CREEK RR RELOCATE			
BIRD CREEK		ALASKA	
SCALE: N. T. S.	DATE: 4/5/02	DRAWN BY: KGS	ENGR: JG
REVISION:	SHT. 10 OF 13	DRG. NO. BIRD CREEK	

REV:	DATE:		REVISIONS

REVISIONS			STATE	PROJECT DESIGNATION	YEAR	SHEET NO.	TOTAL SHEETS
No.	DATE	DESCRIPTION	ALASKA	NH-0A3-II(28)	2002	T20	T23

SPECIFICATIONS	DESIGNED BY	1/29/02
STANDARDS	CHECKED BY	CJ
COMPUTER DESIGNATION	DRAFTED BY	CJ
AUTOCAD-CAROLEE-MARC/MBDR		
VIEW ALL		

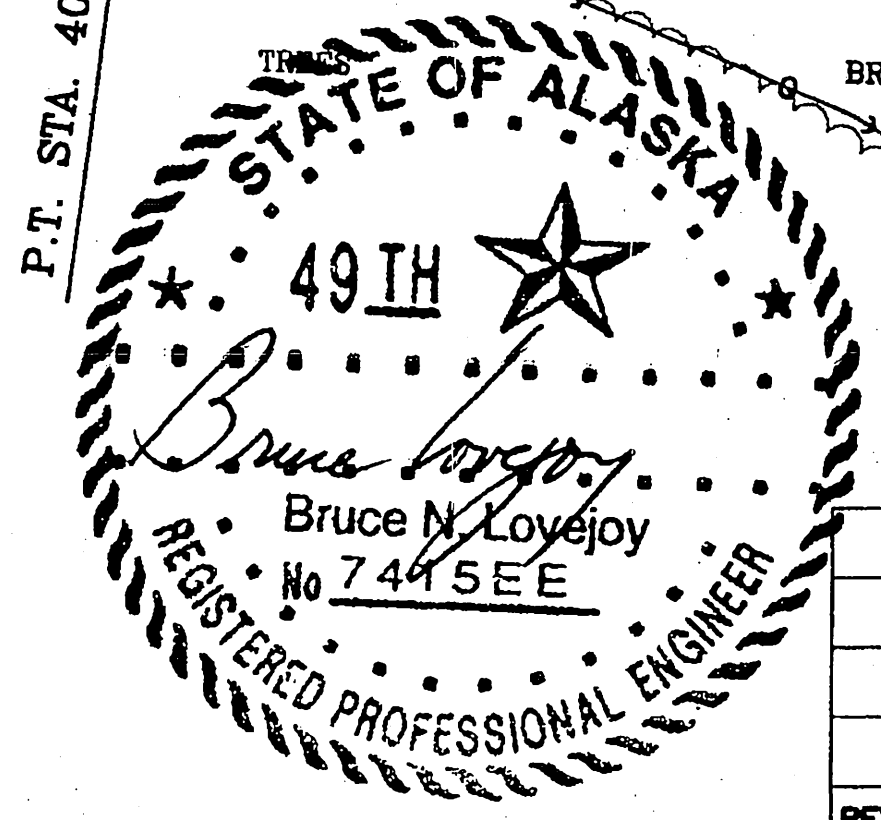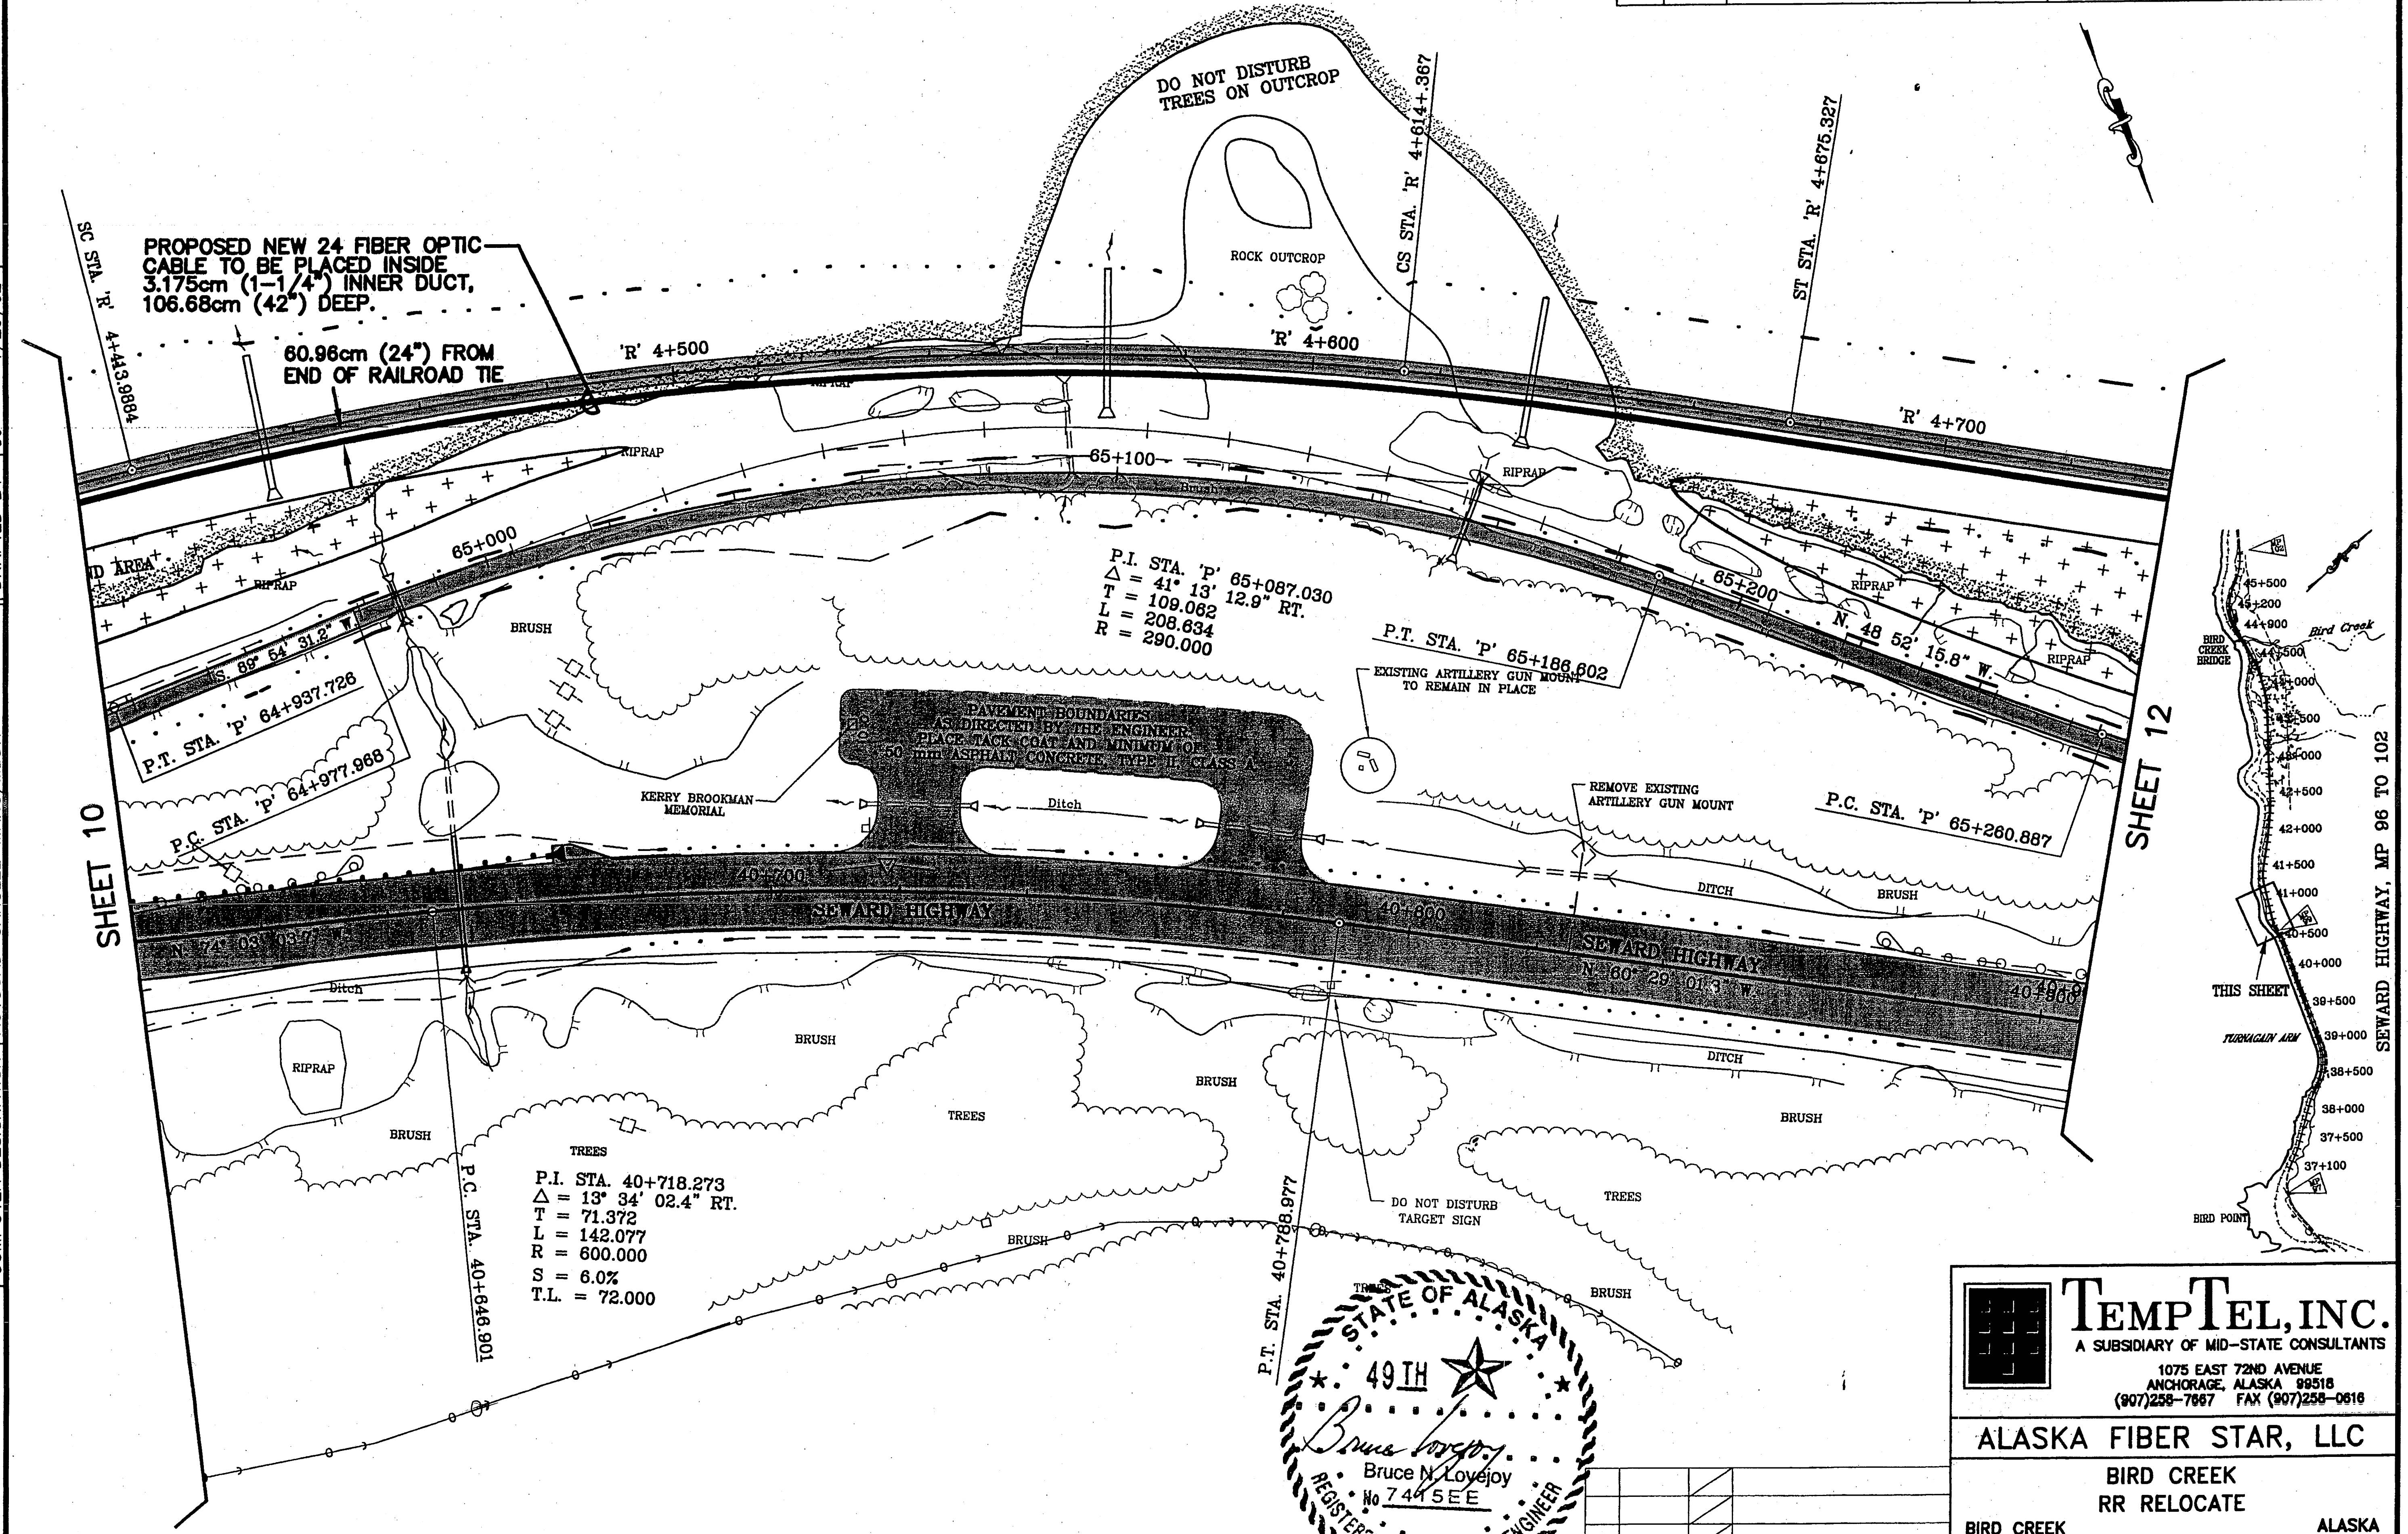

TempTel, INC.
 A SUBSIDIARY OF MID-STATE CONSULTANTS
 1075 EAST 72ND AVENUE
 ANCHORAGE, ALASKA 99518
 (907)258-7867 FAX (907)258-0816

ALASKA FIBER STAR, LLC
BIRD CREEK RR RELOCATE
 BIRD CREEK ALASKA



SCALE: N.T.S. DATE: 4/5/02 DRAWN BY: KGS ENGR: JG
 SHEET: 11 OF 13 DRG. NO: BIRD CREEK


REV.	DATE	REVISIONS

REVISIONS			STATE	PROJECT DESIGNATION	YEAR	SHEET NO.	TOTAL SHEETS
No.	DATE	DESCRIPTION	ALASKA	NH-0A3-1(28)	2002	T22	T23



SPECIFICATIONS	DESIGNED BY	CJ	1/29/02
	CHECKED BY		
	DRAFTED BY		
VIEW ALL	AUTOCAD-CAROLEE-MARC/MBDR		
COMPUTER DESIGNATION			

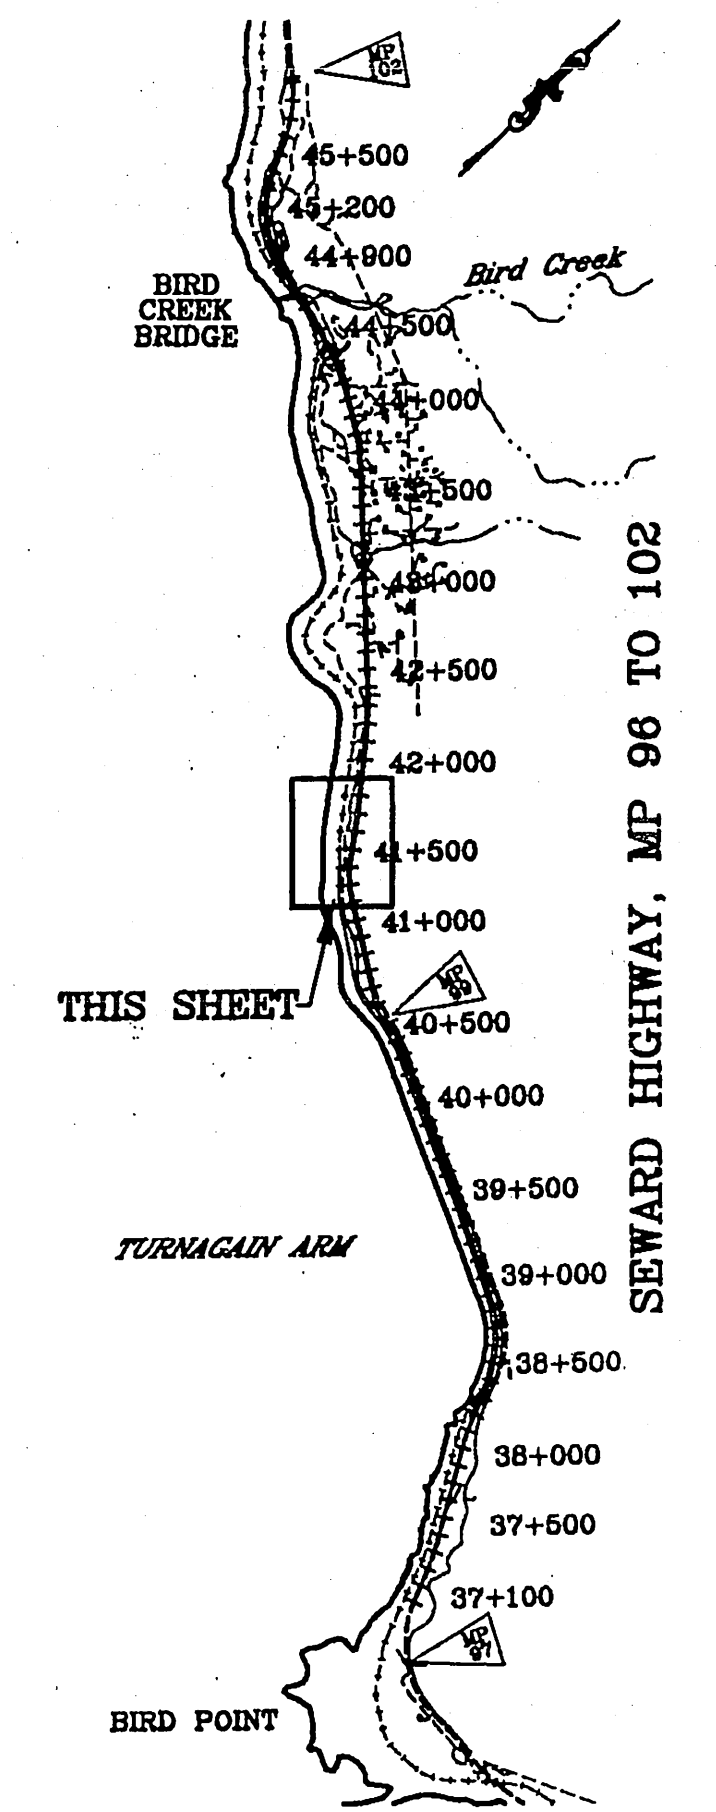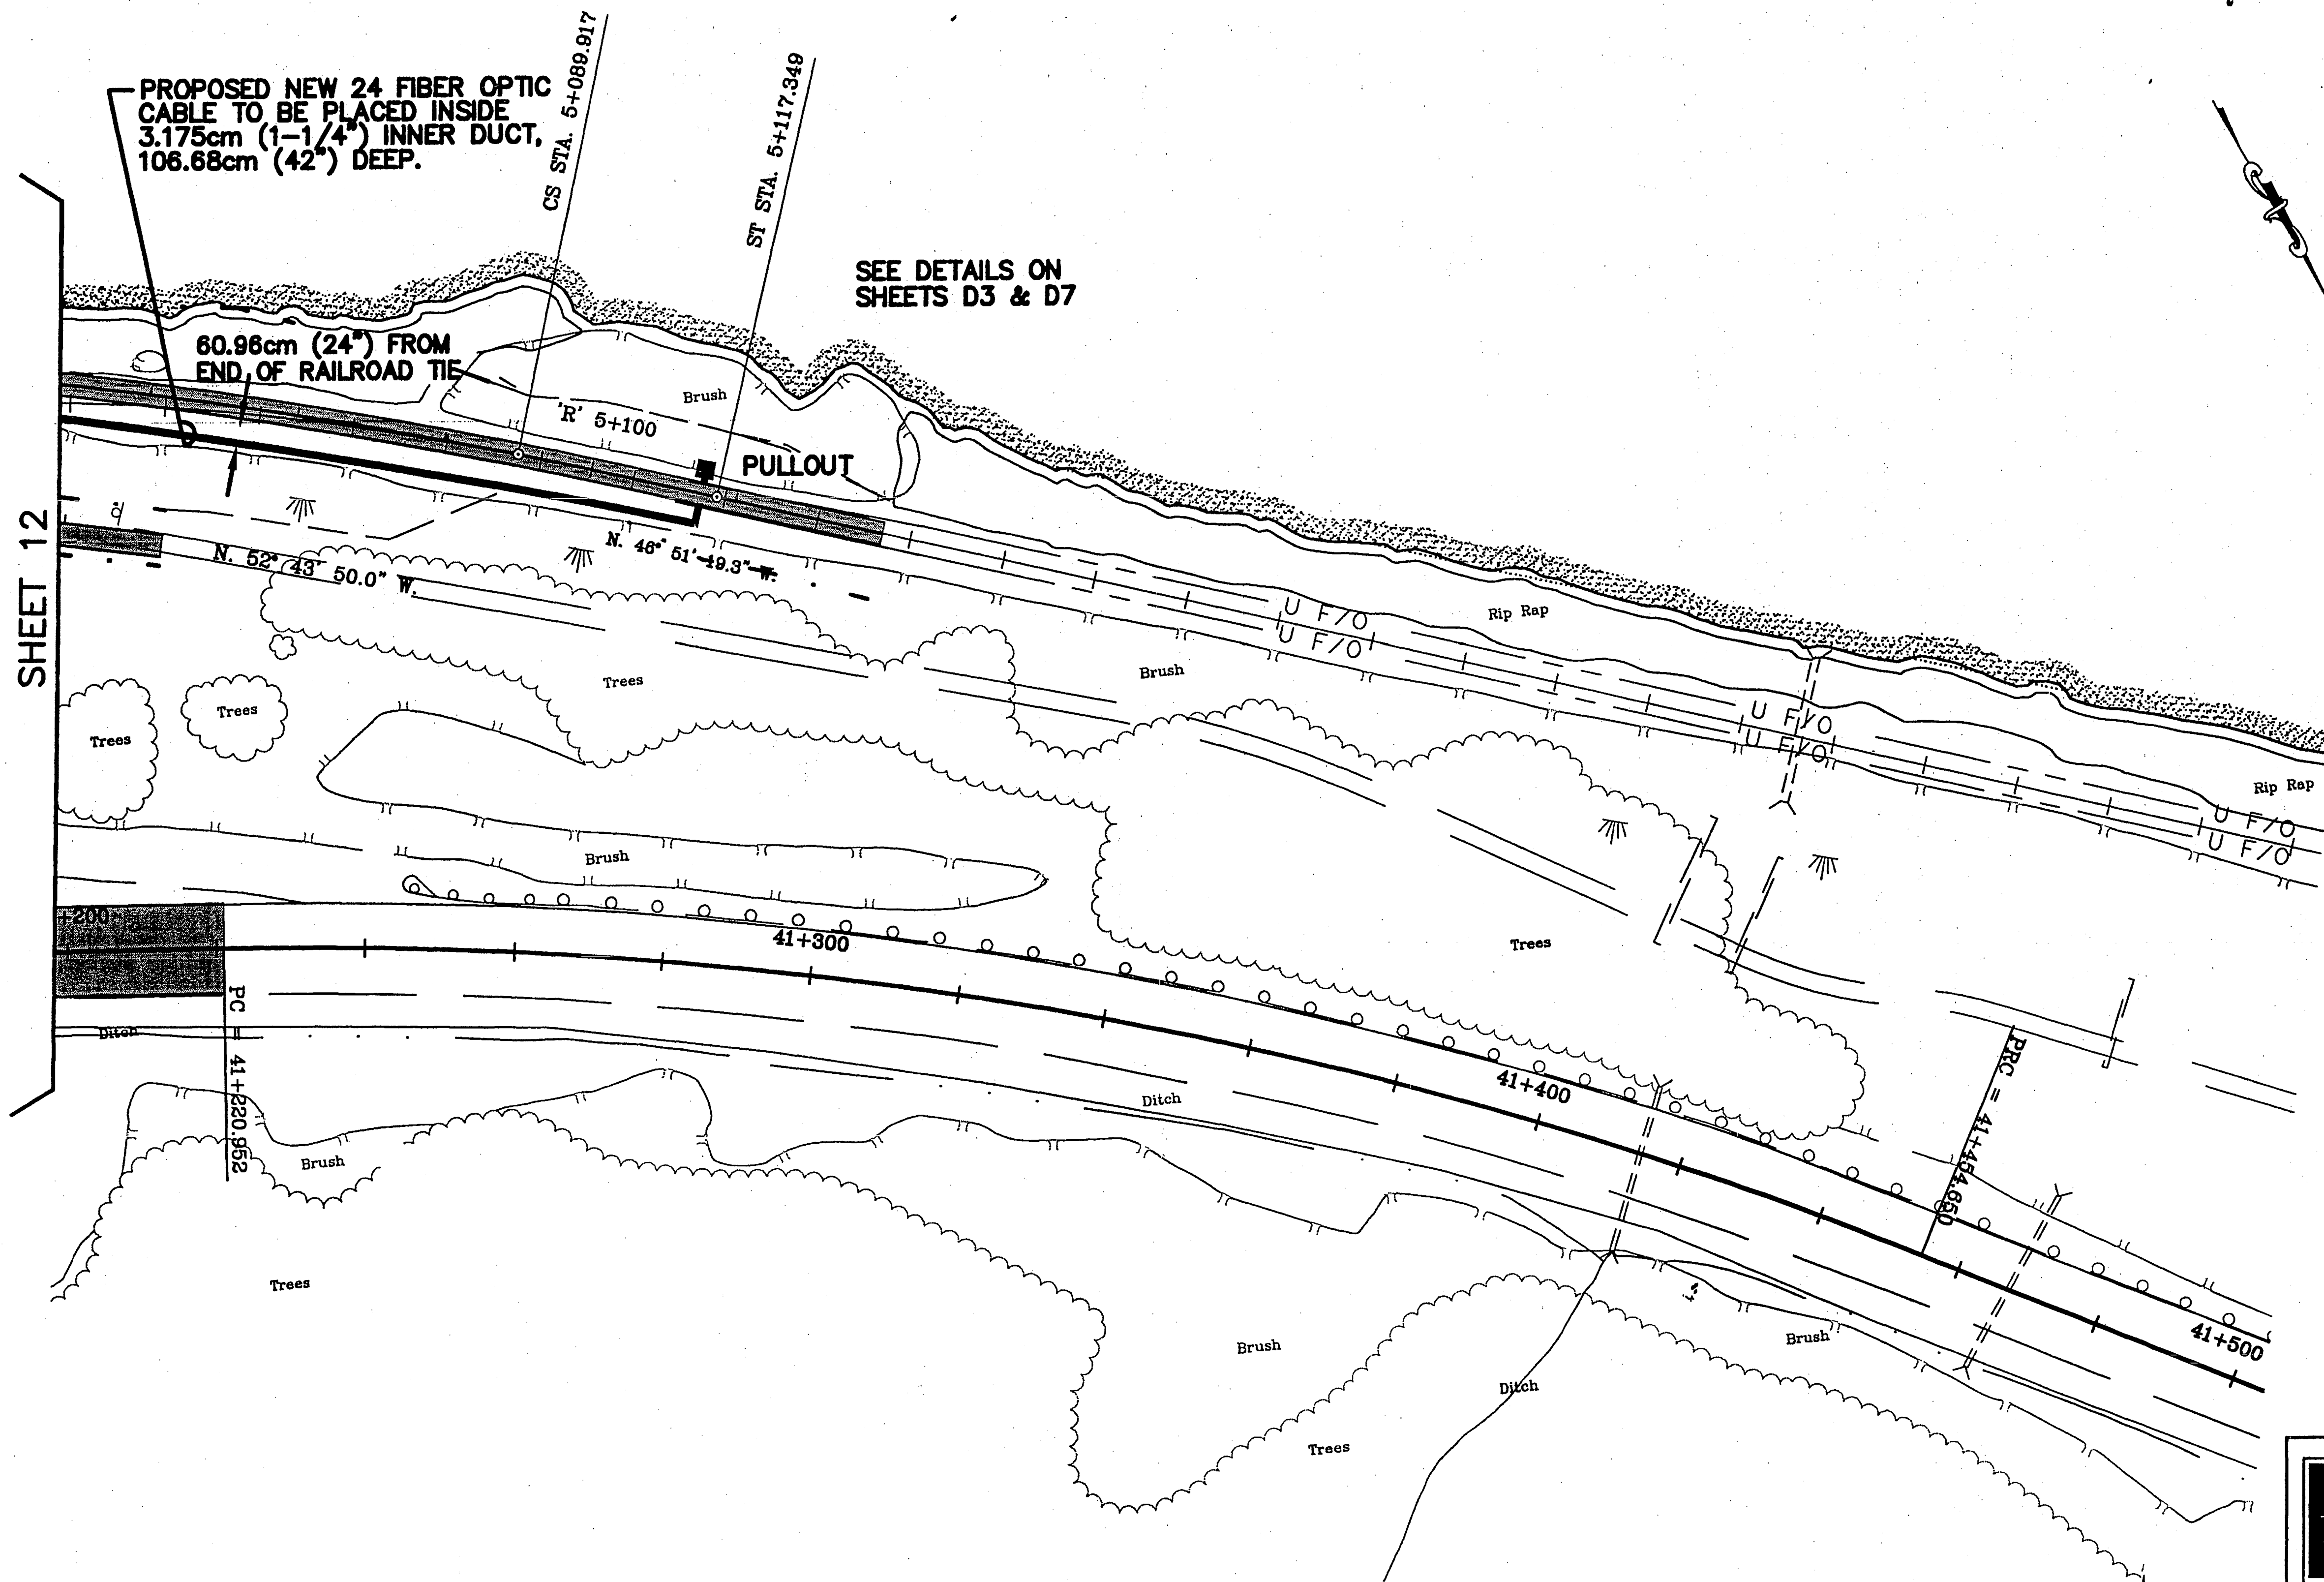

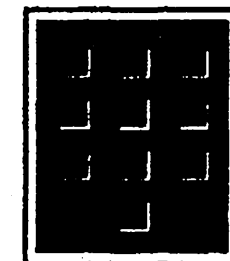

TEMPTEL, INC.

A SUBSIDIARY OF MID-STATE CONSULTANTS

1075 EAST 72ND AVENUE
ANCHORAGE, ALASKA 99518
(907)258-7667 FAX (907)258-0616

ALASKA FIBER STAR, LLC

BIRD CREEK RR RELOCATE

BIRD CREEK ALASKA

SCALE: N.T.S.

DATE: 4/5/02

DRAWN BY: KGS

ENGR: JG

REVISION: SHT. 13 OF 13

DRG. NO: BIRD CREEK

REV.	DATE	REVISIONS

TABULATION OF COMPLETED UNITS

TABULATION PERIOD, FROM: _____ TO: _____

EXCH. _____ W.O.# _____ CONTRACT# _____

CONTRACTOR _____ TEMPTTEL _____ P.O.# _____

PROJECT TITLE BIRD CREEK FIBER

PROJECT TITLE BIRD CREEK FIBER

ACTUAL CONSTRUCTION		TABBED (INITIALS/CO.)	DATE	BOOK
START DATE	COMP. DATE	JG	11-14-01	1 T 23 1
		INSP. (INITIALS/CO.)	DATE	PAGE
				1 OF 1
UNITS AGREED UPON				ISSUE
CO. CONST. SUPT.	DATE	CONTRA. SUPT.	DATE	1
				SHEET NO.
				1 OF 1


[illegible]

NOT IN CONTRACT
FOR INFORMATION ONLY

VICINITY MAP


CALL BEFORE YOU DIG!

LOCATE CALL CENTER OF ALASKA (LCCA)
ANCHORAGE AREA..... 278-3121
STATEWIDE..... 800-478-3121
ALASKA RAILROAD..... 265-2520
KULIS AIR BASE..... 249-1499
MILITARY PETROLEUM FUEL LINES..... 552-3760
STATE STORM DRAINS & STREET LIGHTS..... 333-2411

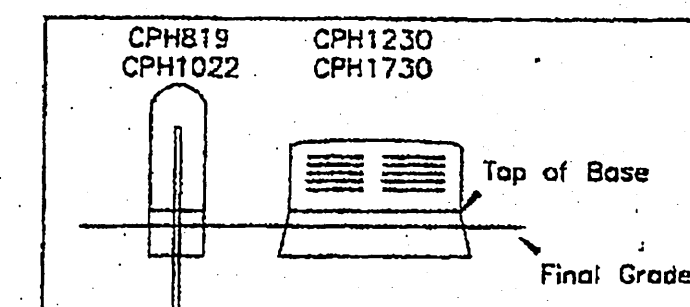

GCI Pedestal Detail

Top of base is to be 2-3 inches above final grade on all pedestals.

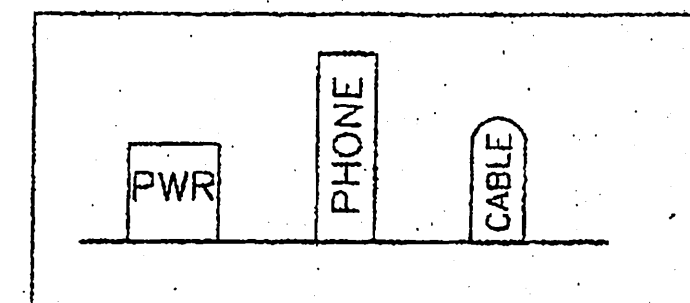

GCI Cable Ped Placement


GCI peds are to be set 2'-3' from phone peds opposite of power peds. Where there are no phone peds, GCI peds are to be minimum 6' from power.

NOT TO SCALE

NEW

EXISTING

VAULT

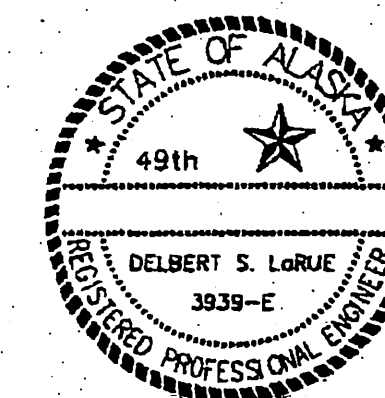

AWN BY: R. ELLWOOD		DATE: 3-7-02	
SIGNER/PROJECT ENGINEER: K. HILL		JOB #:	
DESIGN/CONSTRUCTION/ASBUILT REVISION		DWN BY/DATE	
ISSUED FOR CONSTRUCTION		RAE/4-10-02	

0	X POWER POLE	0	X SET ANCHOR	0	AERIAL SUBS EXISTING
0	⊗ JOINT USE POLE	0	X SIDEWALK ANCHOR	0	AERIAL SUBS POTENTIAL
0	⊙ CATV POLE	0	X STRUT ANCHOR	0	UG SUBS EXISTING
0	○ TELEPHONE POLE	0	X EXTENSION ARM	0	UG SUBS POTENTIAL
0	○ CONCRETE POLE	0		0	MULTI UNIT SUBS
0	△ PRIVATE POLE	0		0	TOTAL EXISTING SUBS
0	○ METAL POLE	0		0	TOTAL POTENTIAL SUBS
0	X EXISTING ANCHOR	0.00	TOTAL MILEAGE	0	COMMERCIAL SUBS



5151 Fairbanks Street
Anchorage, Alaska
99503


PROJECT NAME:	
SEWARD HIGHWAY RELOCATION MILE POST 96 TO 102 TEMPORARY F.O. RELOCATION	
GRIDS:	
DRAWING NAME: GCI-SHR-DOT	SHEET 1 OF 2

NOT IN CONTRACT
FOR INFORMATION ONLY

VICINITY MAP


CALL BEFORE YOU DIG!

LOCATE CALL CENTER OF ALASKA (LCCA)
ANCHORAGE AREA.....278-3121
STATEWIDE.....800-478-3121
ALASKA RAILROAD.....265-2520
KULUS AIR BASE.....249-1499
MILITARY PETROLEUM FUEL LINES.....552-3760
STATE STORM DRAINS & STREET LIGHTS.....333-2411

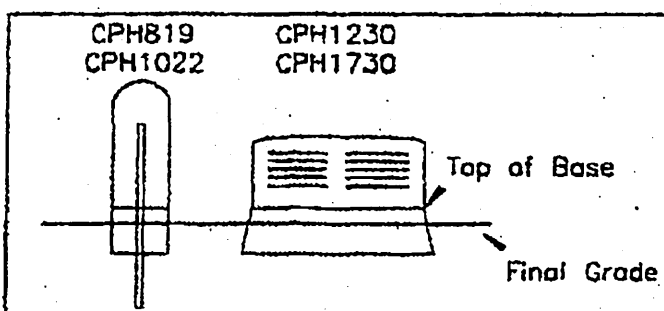

GCI Pedestal Detail

Top of base is to be 2-3 inches above final grade on all pedestals.

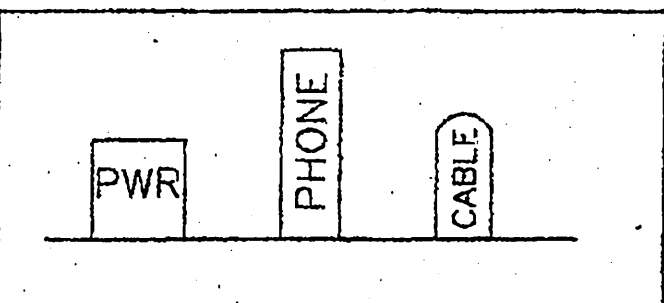


GCI Cable Ped Placement

GCI peds are to be set 2'-3' from phone peds opposite of power peds. Where there are no phone peds, GCI peds are to be minimum 5' from power.

NOT TO SCALE

NEW
EXISTING
VAULT

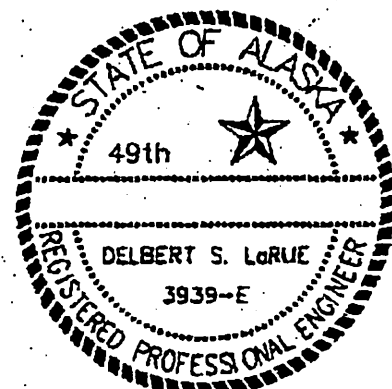

DRAWN BY: R. ELLWOOD		DATE: 3-7-02	
SIGNER/PROJECT ENGINEER: K. HILL		JOB #:	
DESIGN/CONSTRUCTION/ASBUILT REVISION		DWN BY/DATE	
ISSUED FOR CONSTRUCTION		RAE/4-10-02	

0	X POWER POLE	0	X-X SET ANCHOR	0	AERIAL SUBS EXISTING
0	⊗ JOINT USE POLE	0	X-SIDEWALK ANCHOR	0	AERIAL SUBS POTENTIAL
0	⊙ CATV POLE	0	X-STRUT ANCHOR	0	UG SUBS EXISTING
0	○ TELEPHONE POLE	0	X-EXTENSION ARM	0	UG SUBS POTENTIAL
0	○ CONCRETE POLE	0	○ AERIAL FOOTAGE	0	MULTI UNIT SUBS
0	△ PRIVATE POLE	0	○ UG FOOTAGE	0	TOTAL EXISTING SUBS
0	○ METAL POLE	0	○ TOTAL FOOTAGE	0	TOTAL POTENTIAL SUBS
0	X-X EXISTING ANCHOR	0.00	○ TOTAL MILEAGE	0	COMMERCIAL SUBS




5151 Fairbanks Street
Anchorage, Alaska
99503

PROJECT NAME:		SEWARD HIGHWAY RELOCATION	
		MILE POST 96 TO 102	
		TEMPORARY F.O. RELOCATION	
GRIDS:			
DRAWING NAME: GCI-SHR-DOT		SHEET 2 OF 2	

REVISIONS			STATE	PROJECT DESIGNATION	YEAR	SHEET NO.	TOTAL SHEETS
No.	DATE	DESCRIPTION	ALASKA	NH-0A3-1(28)	2002	U3	U23

SPECIFICATIONS
STANDARDS
COMPUTER DESIGNATION
DESIGNED BY
CHECKED BY
DRAWN BY
VIEW ALL
AUTOCAD-CAROLEE-MARC/MBDR
1/29/02

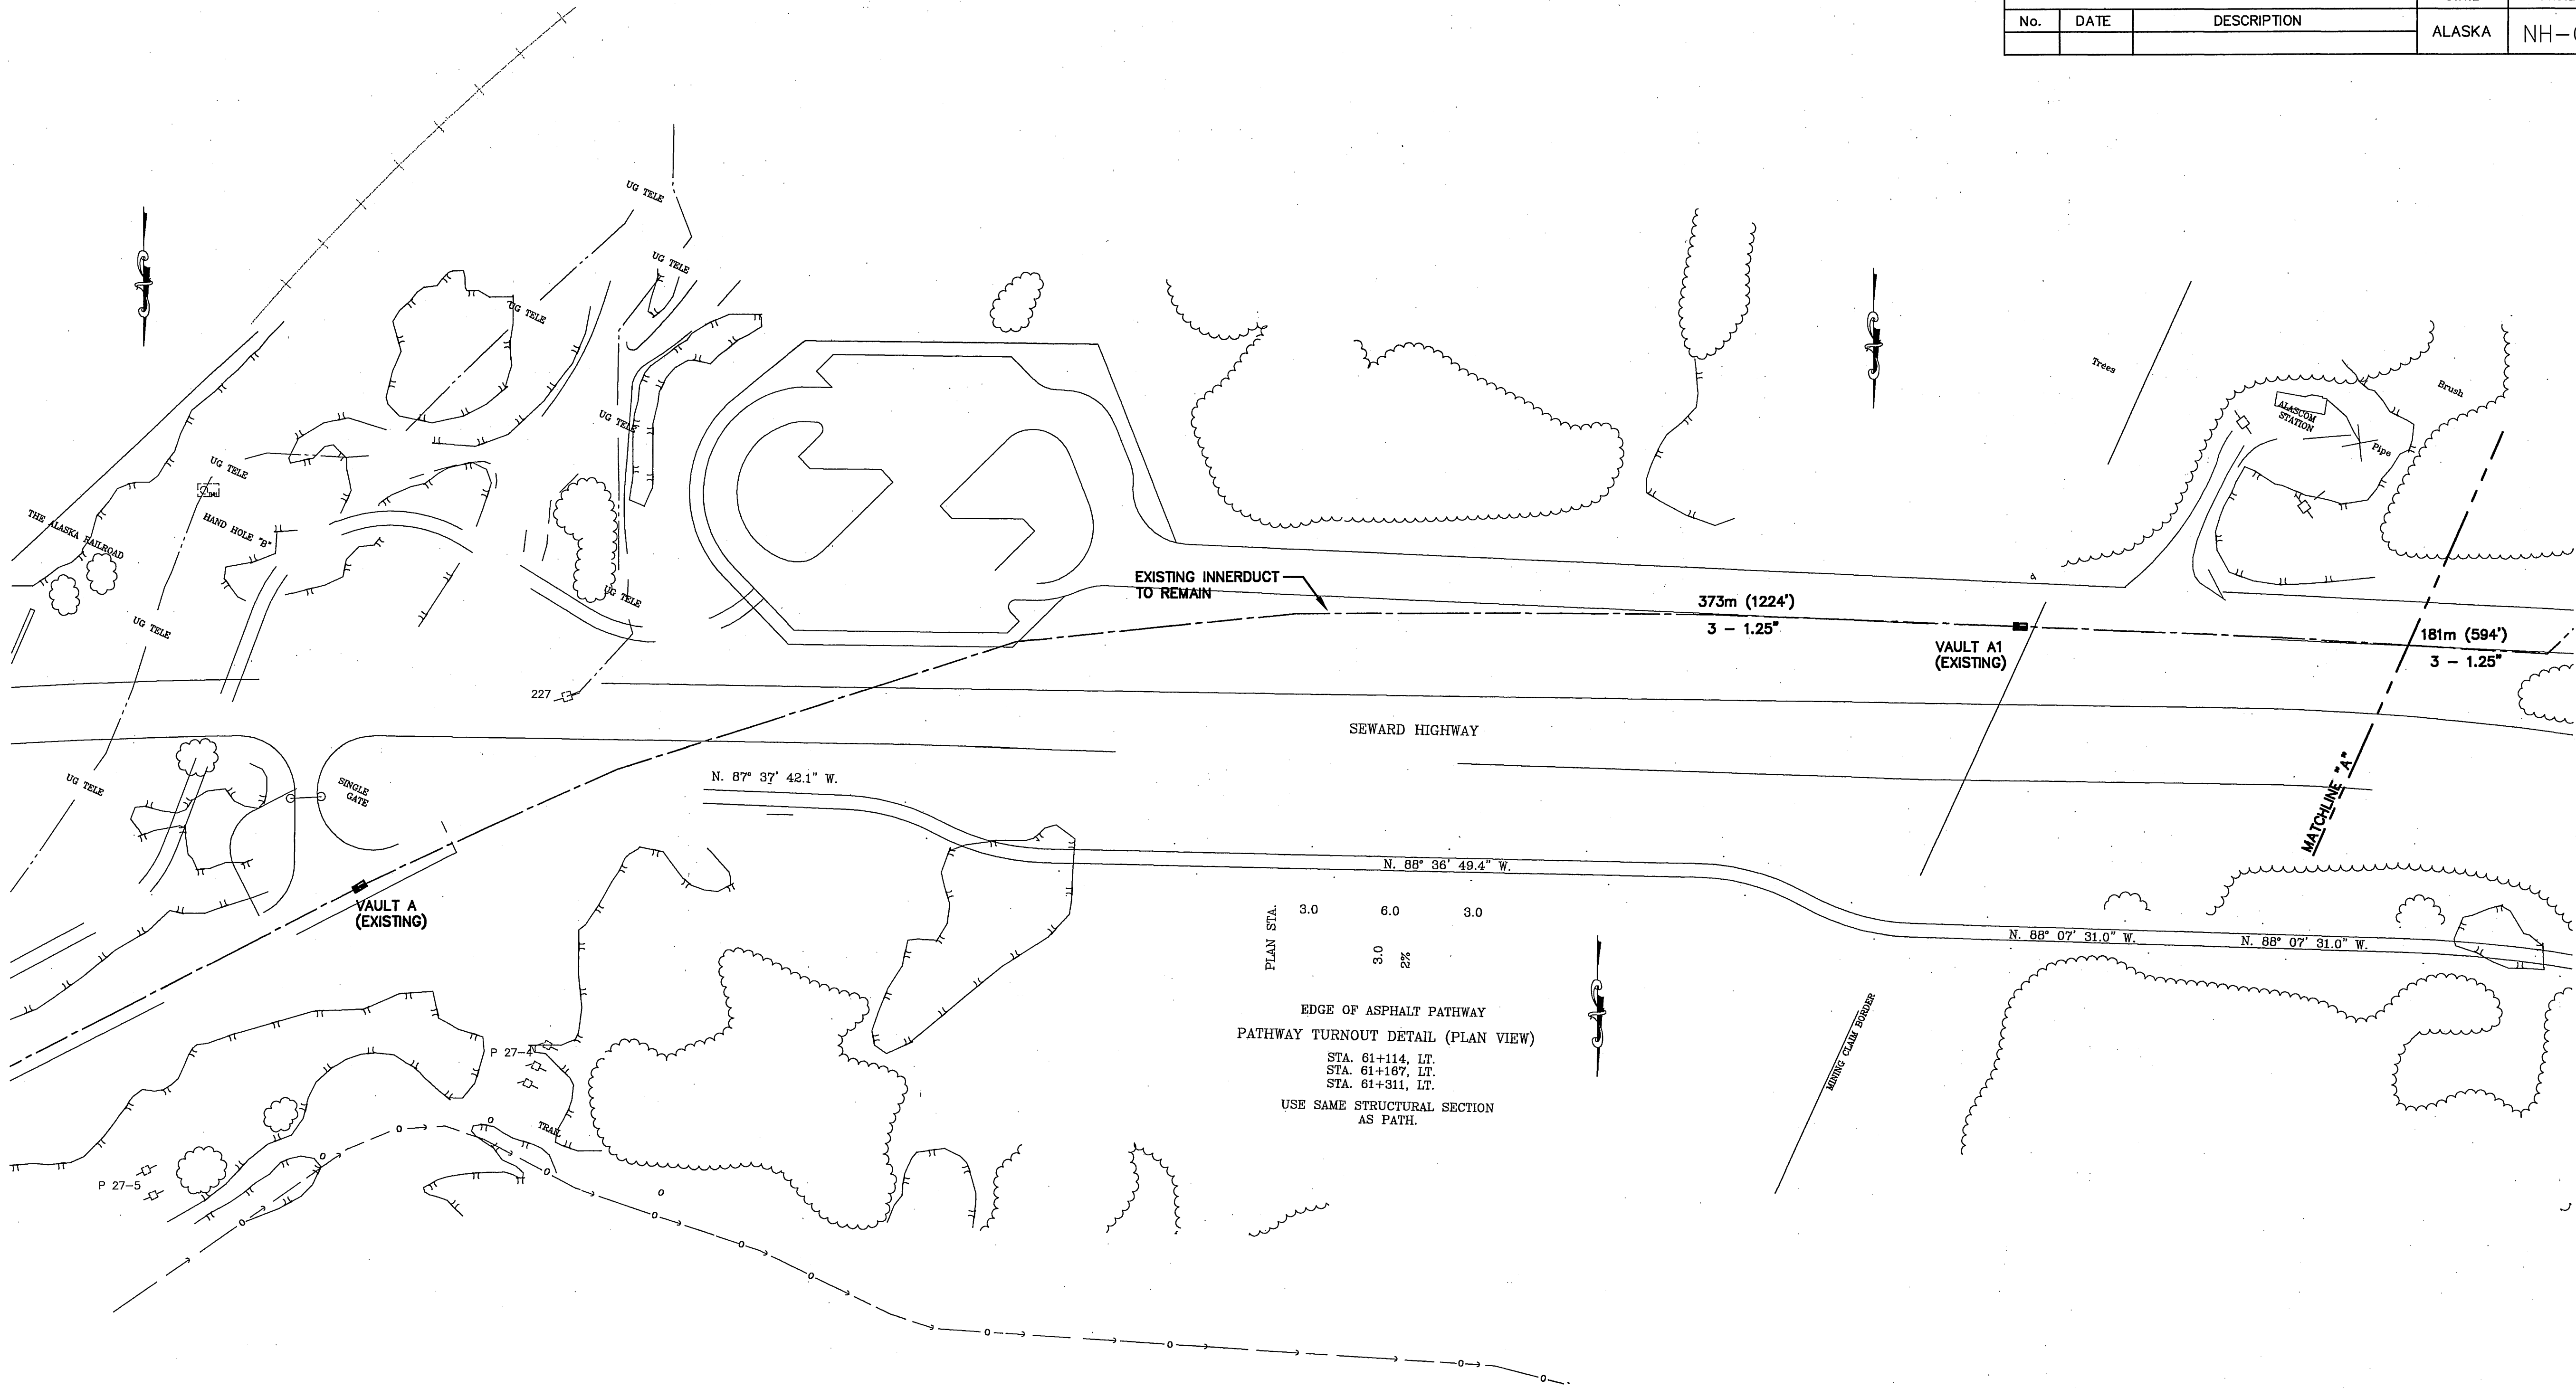

EDGE OF ASPHALT PATHWAY
PATHWAY TURNOUT DETAIL (PLAN VIEW)
STA. 61+114, LT.
STA. 61+167, LT.
STA. 61+311, LT.
USE SAME STRUCTURAL SECTION
AS PATH.




NOTE:
Offsets given are at every 50m station or 100m station unless otherwise noted
Station offset reference point

VICINITY MAP


CALL BEFORE YOU DIG!

LOCATE CALL CENTER OF ALASKA (LCCA)
ANCHORAGE AREA.....278-3121
STATEWIDE.....800-478-3121
ALASKA RAILROAD.....265-2520
KULIS AIR BASE.....249-1499
MILITARY PETROLEUM FUEL LINES.....552-3760
STATE STORM DRAINS & STREET LIGHTS.....333-2411

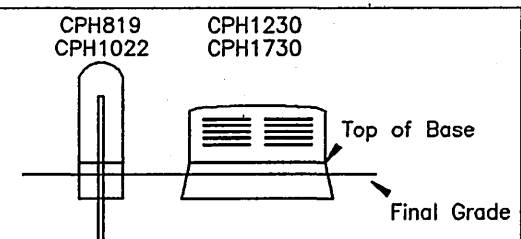

GCI Pedestal Detail


Top of base is to be 2-3 inches above final grade on all pedestals.

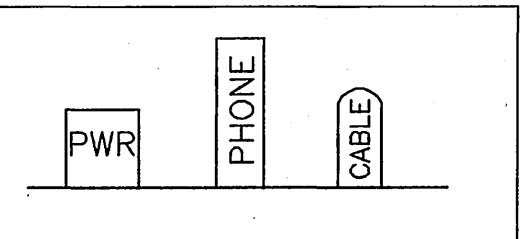

GCI Cable Ped Placement

GCI peds are to be set 2'-3' from phone peds opposite of power peds. Where there are no phone peds, GCI peds are to be minimum 6' from power.

NOT TO SCALE

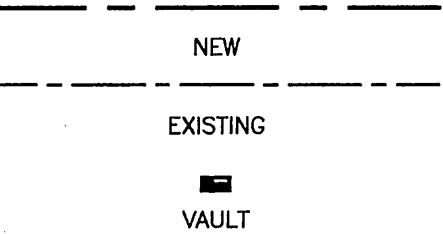

DRAWN BY: _____ DATE: _____	
DESIGNER/PROJECT ENGINEER: _____ JOB #: _____	
NO.	DESIGN/CONSTRUCTION/ASBUILT REVISION
0	ISSUED FOR CONSTRUCTION

0	X POWER POLE	0	X SET ANCHOR	0	AERIAL SUBS EXISTING
0	⊗ JOINT USE POLE	0	X SIDEWALK ANCHOR	0	AERIAL SUBS POTENTIAL
0	⊙ CATV POLE	0	X STRUT ANCHOR	0	UG SUBS EXISTING
0	○ TELEPHONE POLE	0	X EXTENSION ARM	0	UG SUBS POTENTIAL
0	○ CONCRETE POLE	0		0	MULTI UNIT SUBS
0	△ PRIVATE POLE	0		0	TOTAL EXISTING SUBS
0	○ M METAL POLE	0		0	TOTAL POTENTIAL SUBS
0	X EXISTING ANCHOR	0.00	TOTAL MILEAGE	0	COMMERCIAL SUBS




5151 Fairbanks Street
Anchorage, Alaska
99503

CABLE, INC

STATE OF ALASKA
DEPARTMENT OF TRANSPORTATION
AND
PUBLIC FACILITIES
SEWARD HIGHWAY
MP 96 TO MP 102
SAFETY, ROADWAY AND
RECREATIONAL IMPROVEMENTS

SPECIFICATIONS
STANDARDS
COMPUTER DESIGNATION
VIEW ALL
AUTOCAD-CAROL-EE-MARC/MBR
DESIGNED BY
CHECKED BY
DRAFTED BY
1/23/02


REVISIONS			STATE	PROJECT DESIGNATION	YEAR	SHEET NO.	TOTAL SHEETS
No.	DATE	DESCRIPTION	ALASKA	NH-0A3-1(28)	2002	U4	U23

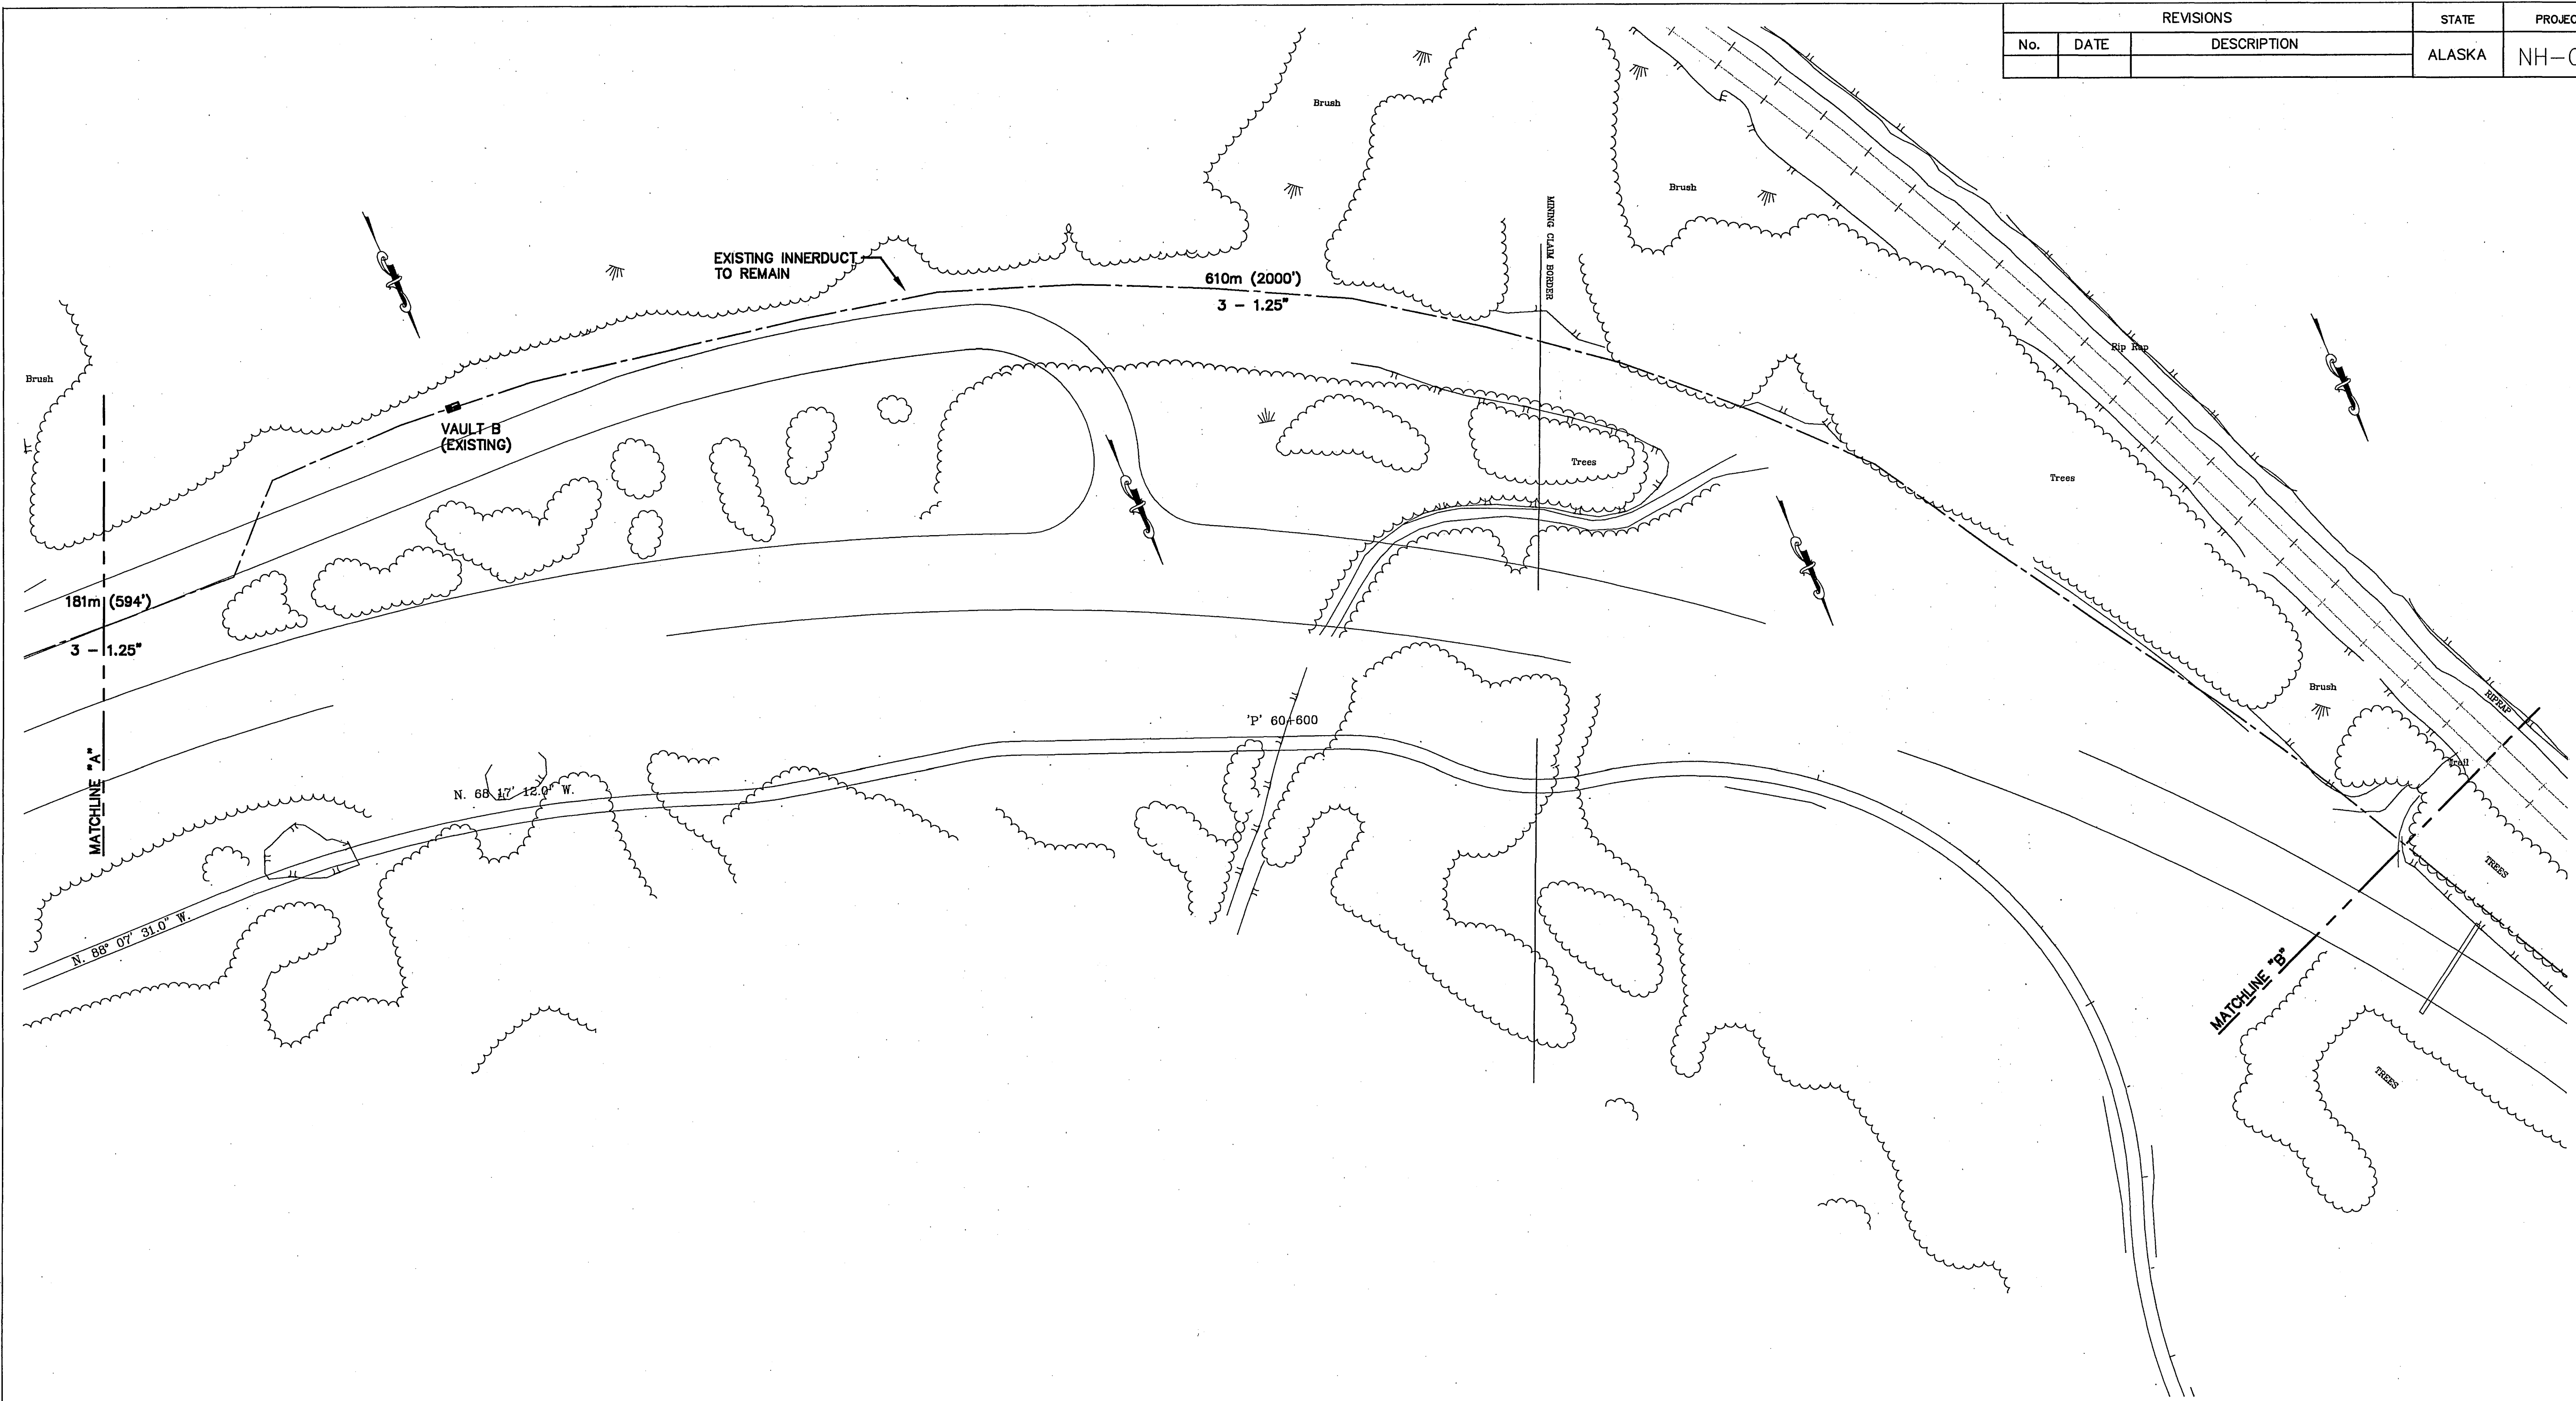

VICINITY MAP


CALL BEFORE YOU DIG!

LOCATE CALL CENTER OF ALASKA (LCCA)	278-3121
ANCHORAGE AREA	800-478-3121
STATEWIDE	265-2520
ALASKA RAILROAD	249-1499
KULIS AIR BASE	552-3760
MILITARY PETROLEUM FUEL LINES	333-2411
STATE STORM DRAINS & STREET LIGHTS	

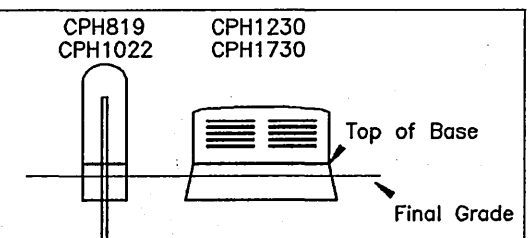

GCI Pedestal Detail



Top of base is to be 2-3 inches above final grade on all pedestals.

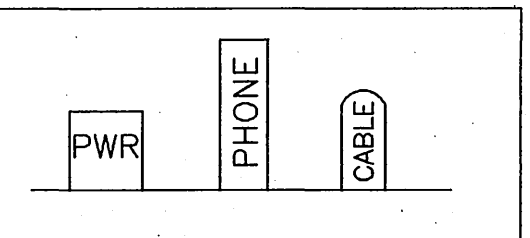

GCI Cable Ped Placement

GCI peds are to be set 2'-3" from phone peds opposite of power peds. Where there are no phone peds, GCI peds are to be minimum 6' from power.

NOT TO SCALE

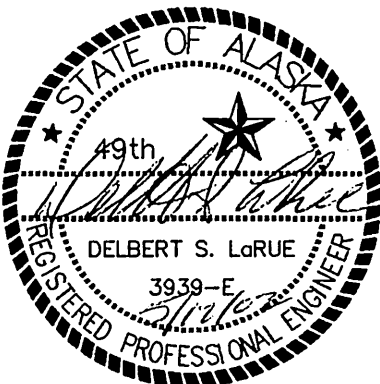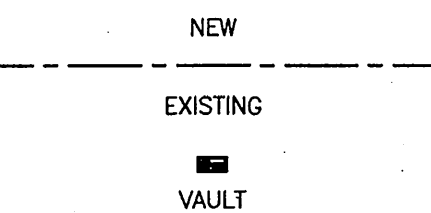

NOTE:
Offsets given are at every 50m station or 100m station unless otherwise noted

Station offset reference point 

DRAWN BY: _____ DATE: _____
DESIGNER/PROJECT ENGINEER: _____ JOB #: _____

NO.	DESIGN/CONSTRUCTION/ASBUILT REVISION	DWN BY/DATE
0	ISSUED FOR CONSTRUCTION	RAE/5-16-02


0	X POWER POLE	0	X SET ANCHOR	0	AERIAL SUBS EXISTING
0	⊗ JOINT USE POLE	0	X SIDEWALK ANCHOR	0	AERIAL SUBS POTENTIAL
0	⊙ CATV POLE	0	X STRUT ANCHOR	0	UG SUBS EXISTING
0	○ TELEPHONE POLE	0	X EXTENSION ARM	0	UG SUBS POTENTIAL
0	○ CONCRETE POLE	0	○ AERIAL FOOTAGE	0	MULTI UNIT SUBS
0	△ PRIVATE POLE	0	○ UG FOOTAGE	0	TOTAL EXISTING SUBS
0	○ M METAL POLE	0	○ TOTAL FOOTAGE	0	TOTAL POTENTIAL SUBS
0	X EXISTING ANCHOR	0.00	○ TOTAL MILEAGE	0	COMMERCIAL SUBS



5151 Fairbanks Street
Anchorage, Alaska
99503

STATE OF ALASKA
DEPARTMENT OF TRANSPORTATION
AND
PUBLIC FACILITIES
SEWARD HIGHWAY
MP 96 TO MP 102
SAFETY, ROADWAY AND
RECREATIONAL IMPROVEMENTS

REVISIONS			STATE	PROJECT DESIGNATION	YEAR	SHEET NO.	TOTAL SHEETS
No.	DATE	DESCRIPTION					
			ALASKA	NH-0A3-1(28)	2002	U5	U23

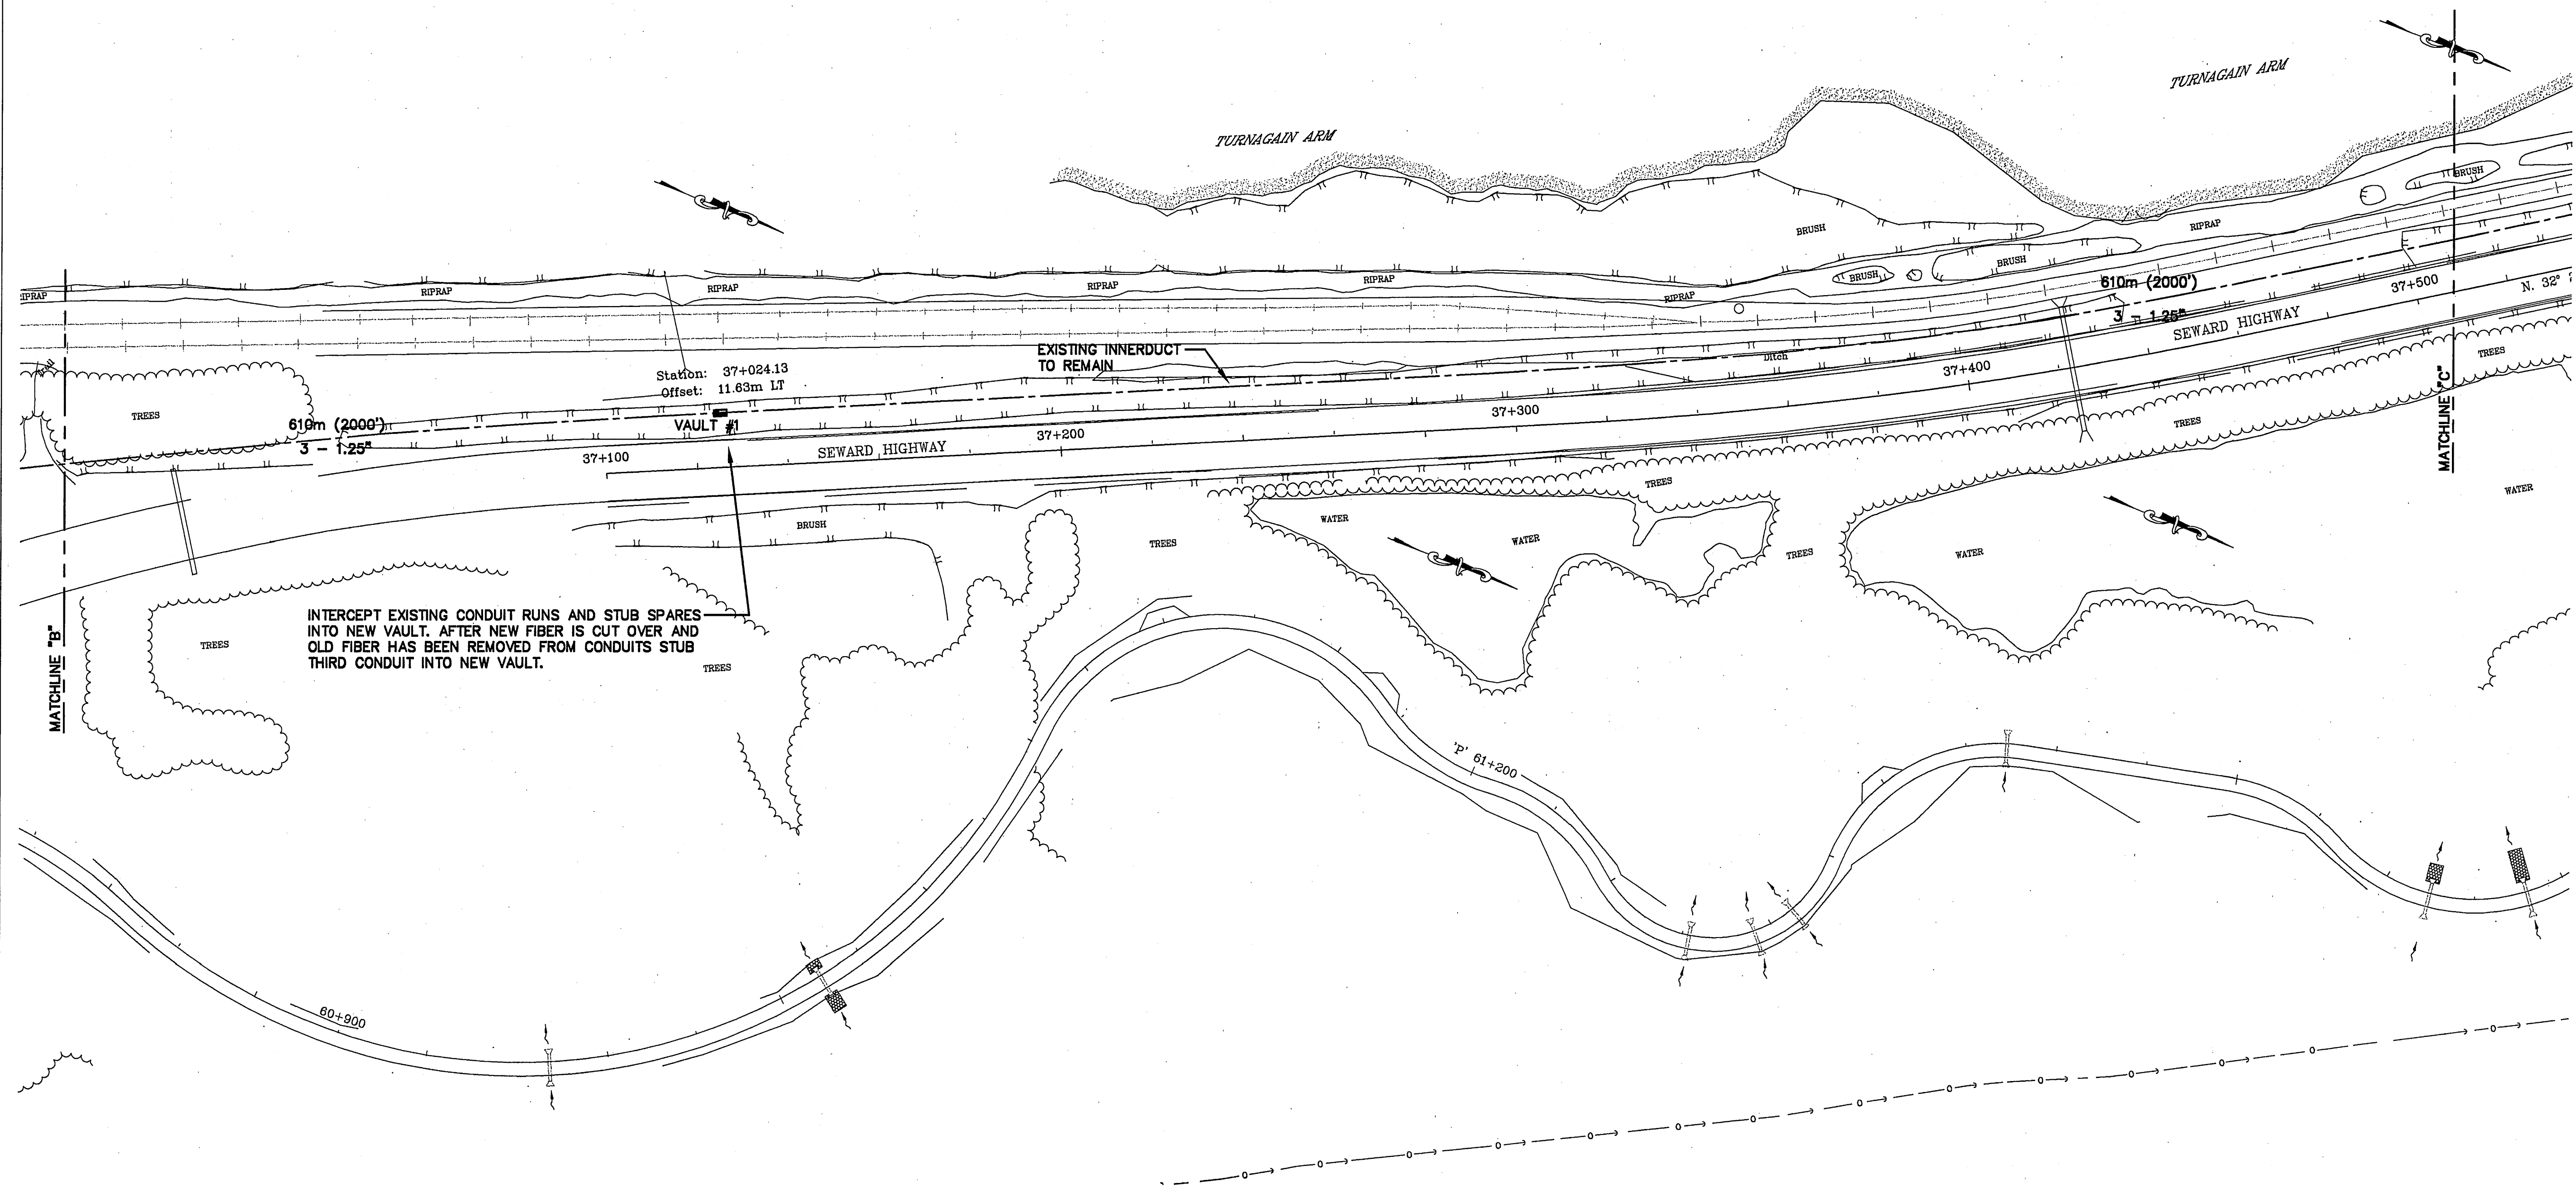

VICINITY MAP

CALL BEFORE YOU DIG!

LOCATE CALL CENTER OF ALASKA (LCCA)

ANCHORAGE AREA..... 278-3121


STATEWIDE..... 800-478-3121

ALASKA RAILROAD..... 265-2520


KULIS AIR BASE..... 249-1499

MILITARY PETROLEUM FUEL LINES..... 552-3760

STATE STORM DRAINS & STREET LIGHTS..... 333-2411

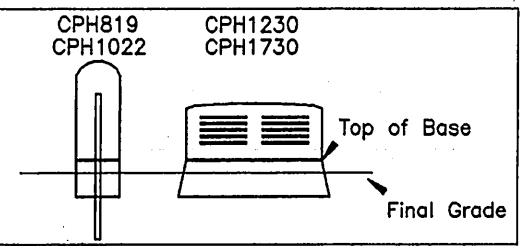



Top of base is to be 2-3 inches above final grade on all pedestals.

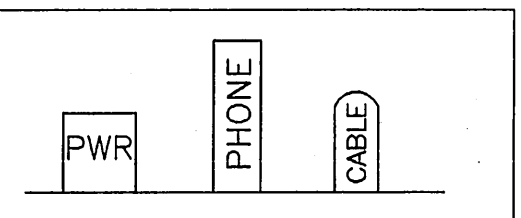

GCI Cable Ped Placement

GCI peds are to be set 2'-3' from phone peds opposite of power peds. Where there are no phone peds, GCI peds are to be minimum 6' from power.

NOT TO SCALE

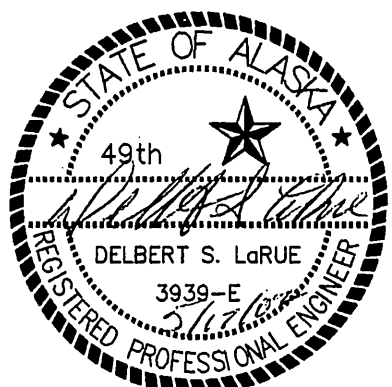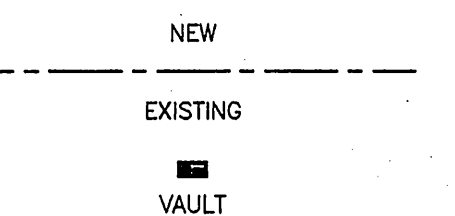

NOTE:
Offsets given are at every 50m station or 100m station unless otherwise noted

Station offset reference point

DRAWN BY: _____ DATE: _____	
DESIGNER/PROJECT ENGINEER: _____ JOB #: _____	
NO.	DESIGN/CONSTRUCTION/ASBUILT REVISION
0	ISSUED FOR CONSTRUCTION

0	X POWER POLE	0	X- SET ANCHOR	0	AERIAL SUBS EXISTING
0	⊗ JOINT USE POLE	0	X- SIDEWALK ANCHOR	0	AERIAL SUBS POTENTIAL
0	⊙ CATV POLE	0	X- STRUT ANCHOR	0	UG SUBS EXISTING
0	○ TELEPHONE POLE	0	X- EXTENSION ARM	0	UG SUBS POTENTIAL
0	○ CONCRETE POLE	0	○ AERIAL FOOTAGE	0	MULTI UNIT SUBS
0	△ PRIVATE POLE	0	○ UG FOOTAGE	0	TOTAL EXISTING SUBS
0	○ M METAL POLE	0	○ TOTAL FOOTAGE	0	TOTAL POTENTIAL SUBS
0	X- EXISTING ANCHOR	0.00	○ TOTAL MILEAGE	0	COMMERCIAL SUBS




5151 Fairbanks Street
Anchorage, Alaska
99503

STATE OF ALASKA
DEPARTMENT OF TRANSPORTATION
AND
PUBLIC FACILITIES
SEWARD HIGHWAY
MP 96 TO MP 102
SAFETY, ROADWAY AND
RECREATIONAL IMPROVEMENTS

DESIGNED BY: [blank] CHECKED BY: [blank] DRAFTED BY: [blank]
VIEW ALL: [blank] AUTO CAD: CAROL E. MARC/MDBR
SPECIFICATIONS: [blank] COMPUTER DESIGNATION: [blank]


REVISIONS			STATE	PROJECT DESIGNATION	YEAR	SHEET NO.	TOTAL SHEETS
No.	DATE	DESCRIPTION	ALASKA	NH-0A3-1(28)	2002	U6	U23

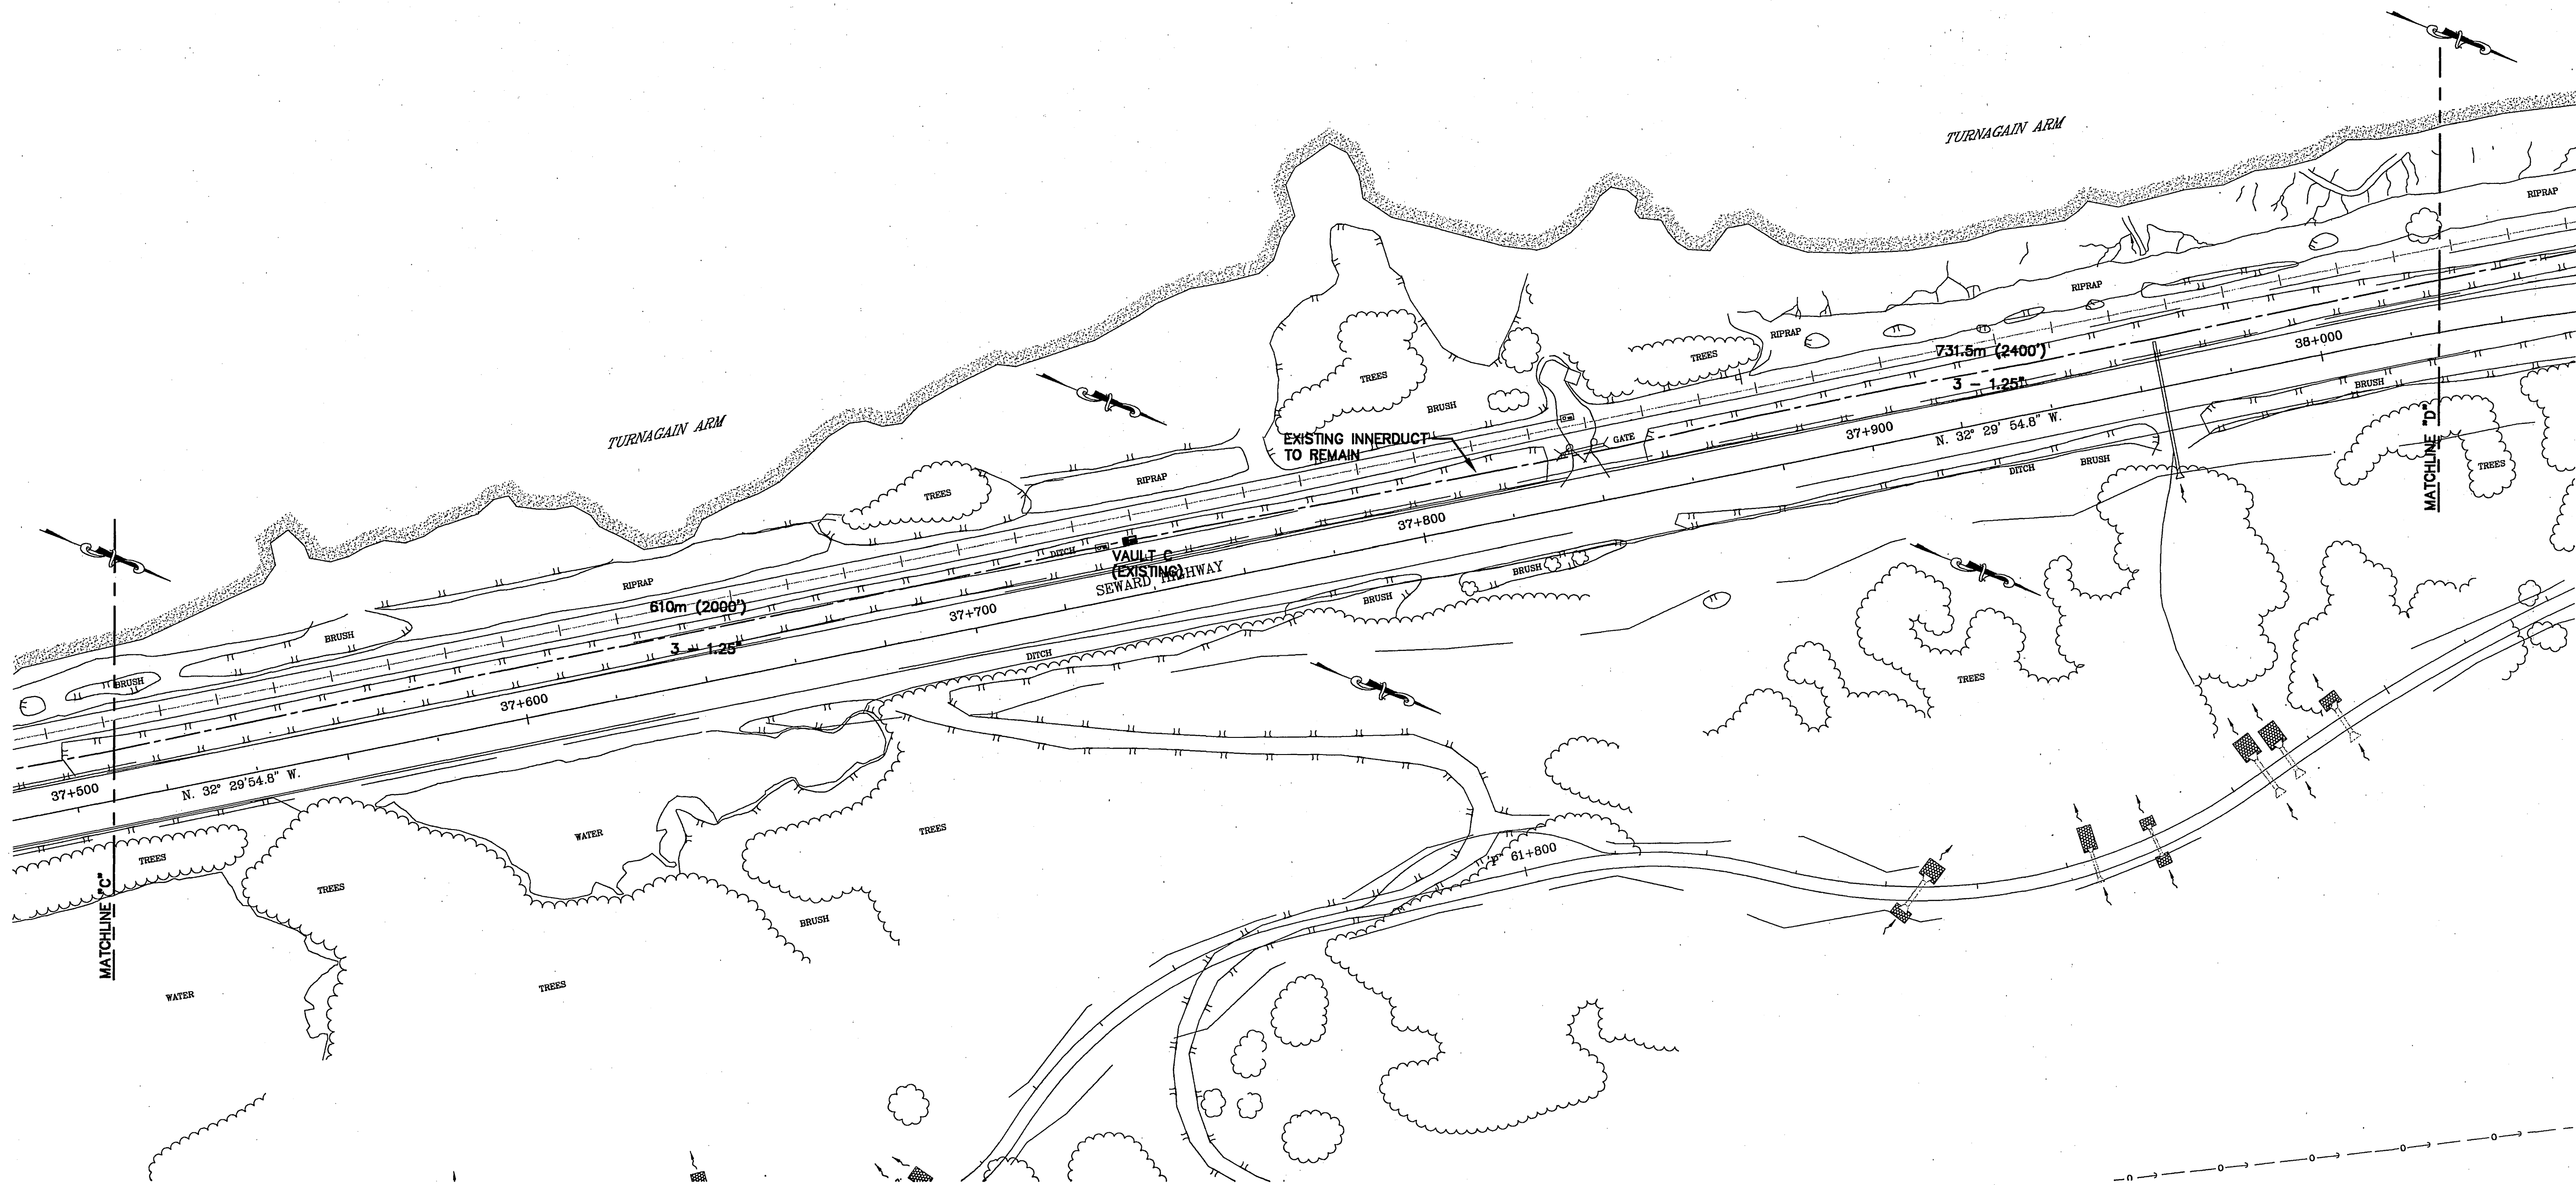

VICINITY MAP


CALL BEFORE YOU DIG!

LOCATE CALL CENTER OF ALASKA (LCCA)
ANCHORAGE AREA..... 278-3121
STATEWIDE..... 800-478-3121
ALASKA RAILROAD..... 265-2520
KULIS AIR BASE..... 249-1499
MILITARY PETROLEUM FUEL LINES..... 552-3760
STATE STORM DRAINS & STREET LIGHTS..... 333-2411

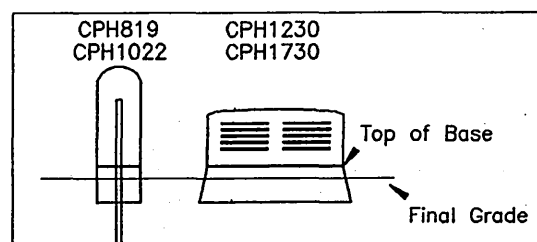

GCI Pedestal Detail



Top of base is to be 2-3 inches above final grade on all pedestals.

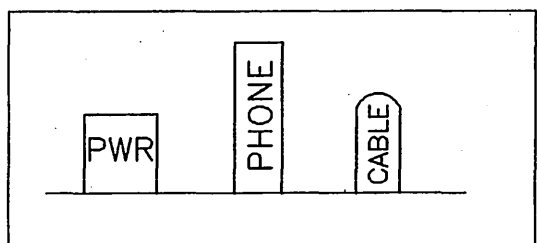

GCI Cable Ped Placement

GCI peds are to be set 2'-3' from phone peds opposite of power peds. Where there are no phone peds, GCI peds are to be minimum 6' from power.

NOT TO SCALE

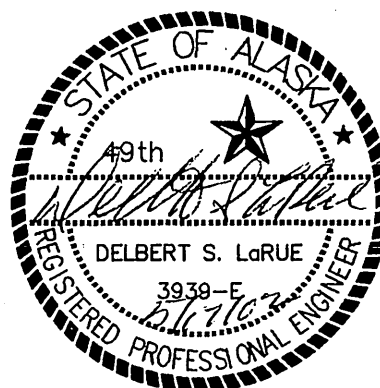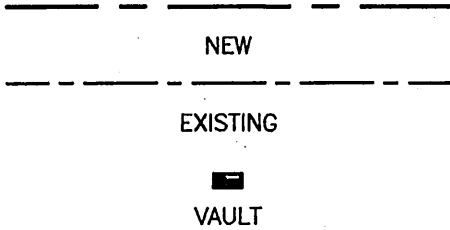

NOTE:
Offsets given are at every 50m station or 100m station unless otherwise noted

Station offset reference point

DRAWN BY: _____ DATE: _____
DESIGNER/PROJECT ENGINEER: _____ JOB #: _____

NO.	DESIGN/CONSTRUCTION/ASBUILT REVISION	DWN BY/DATE
0	ISSUED FOR CONSTRUCTION	RAE/5-16-02

0	X POWER POLE	0	X SET ANCHOR	0	AERIAL SUBS EXISTING
0	⊗ JOINT USE POLE	0	X SIDEWALK ANCHOR	0	AERIAL SUBS POTENTIAL
0	⊙ CATV POLE	0	X STRUT ANCHOR	0	UG SUBS EXISTING
0	○ TELEPHONE POLE	0	X EXTENSION ARM	0	UG SUBS POTENTIAL
0	○ CONCRETE POLE	0	○ AERIAL FOOTAGE	0	MULTI UNIT SUBS
0	△ PRIVATE POLE	0	○ UG FOOTAGE	0	TOTAL EXISTING SUBS
0	○ M METAL POLE	0	○ TOTAL FOOTAGE	0	TOTAL POTENTIAL SUBS
0	X EXISTING ANCHOR	0.00	○ TOTAL MILEAGE	0	COMMERCIAL SUBS




5151 Fairbanks Street
Anchorage, Alaska
99503

STATE OF ALASKA
DEPARTMENT OF TRANSPORTATION
AND
PUBLIC FACILITIES
SEWARD HIGHWAY
MP 96 TO MP 102
SAFETY, ROADWAY AND
RECREATIONAL IMPROVEMENTS

DESIGNED BY: VIEW ALL STANDARDS
CHECKED BY: AUTOCAD-CAROL-LEE-MARC/NBBR
DRAFTED BY: COMPUTER DESIGNATION
1/23/02


REVISIONS			STATE	PROJECT DESIGNATION	YEAR	SHEET NO.	TOTAL SHEETS
No.	DATE	DESCRIPTION	ALASKA	NH-0A3-1(28)	2002	U7	U23

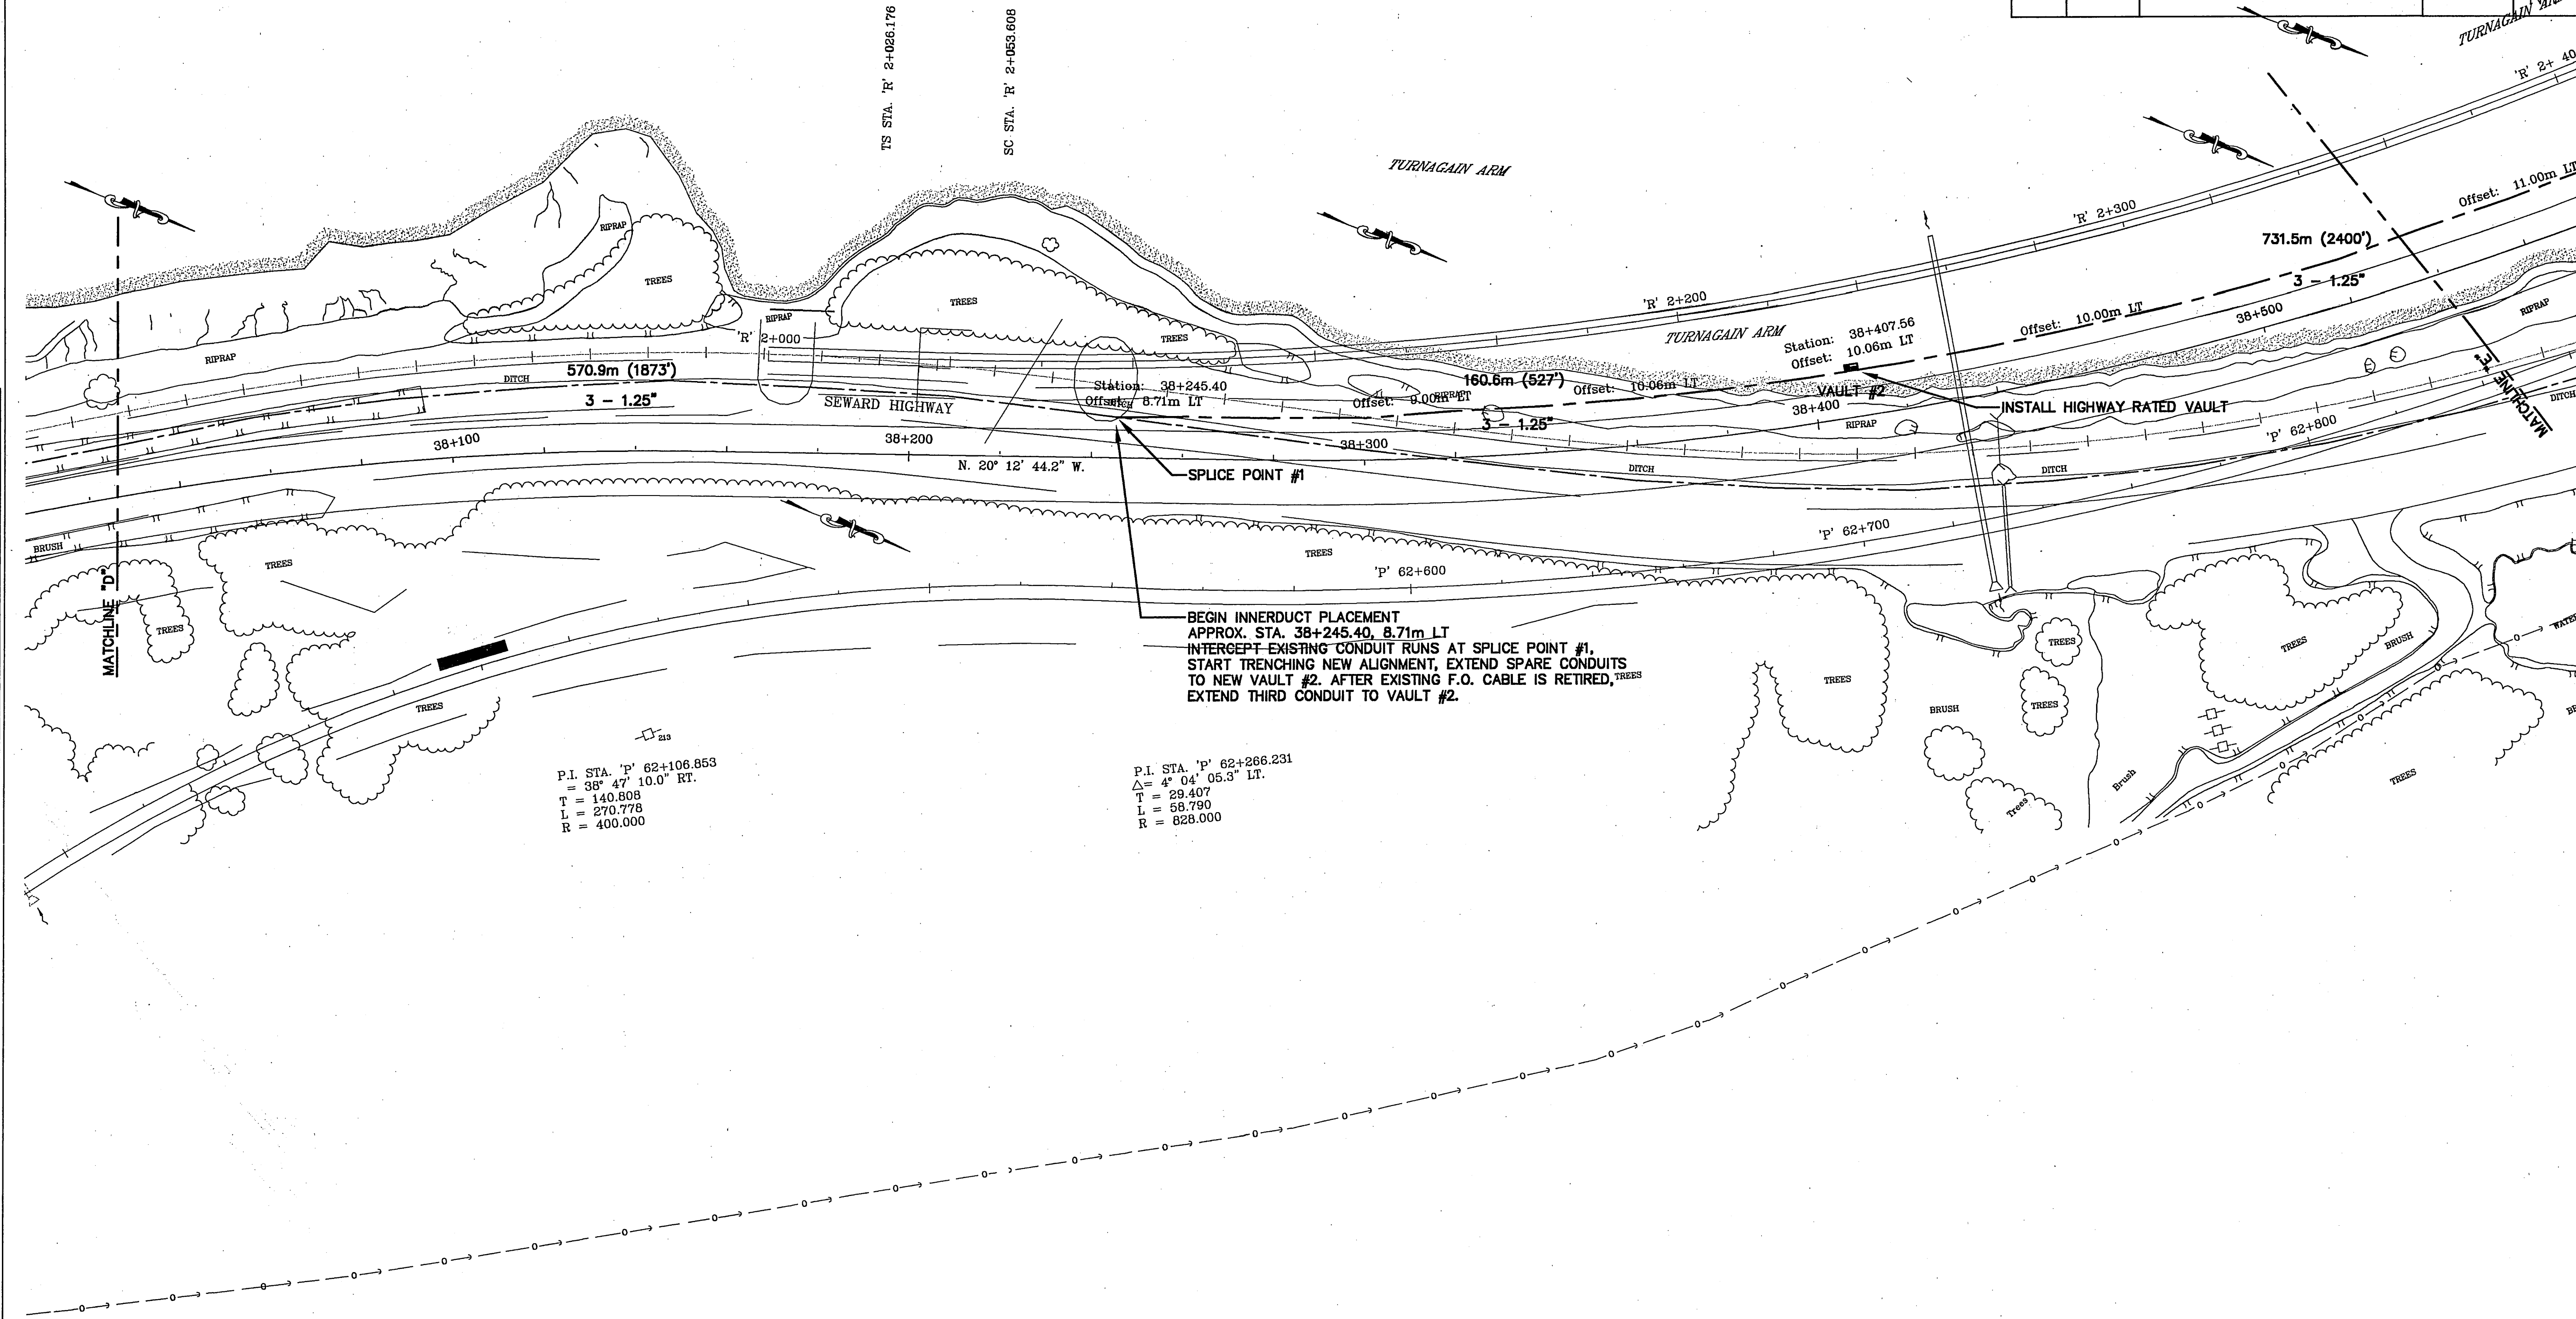

VICINITY MAP


CALL BEFORE YOU DIG!

LOCATE CALL CENTER OF ALASKA (LCCA)
ANCHORAGE AREA.....278-3121
STATEWIDE.....800-478-3121
ALASKA RAILROAD.....265-2520
KULIS AIR BASE.....249-1499
MILITARY PETROLEUM FUEL LINES.....552-3760
STATE STORM DRAINS & STREET LIGHTS.....333-2411

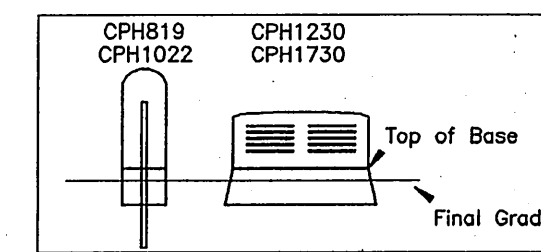

GCI Pedestal Detail


Top of base is to be 2-3 inches above final grade on all pedestals.

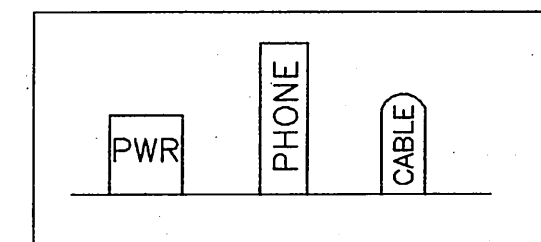

GCI Cable Ped Placement


GCI peds are to be set 2'-3' from phone peds opposite of power peds. Where there are no phone peds, GCI peds are to be minimum 6' from power.

NOT TO SCALE

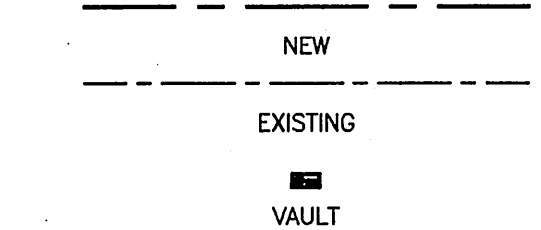

NOTE:
Offsets given are at every 50m station or 100m station unless otherwise noted

Station offset reference point →

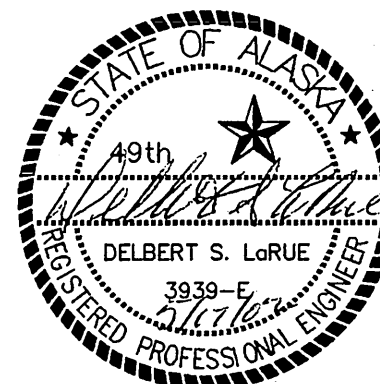

DRAWN BY: _____ DATE: _____
DESIGNER/PROJECT ENGINEER: _____ JOB #: _____

NO.	DESIGN/CONSTRUCTION/ASBUILT REVISION	DWN BY/DATE
0	ISSUED FOR CONSTRUCTION	RAE/9-16-02

0	X POWER POLE	0	X- SET ANCHOR	0	AERIAL SUBS EXISTING
0	⊗ JOINT USE POLE	0	X- SIDEWALK ANCHOR	0	AERIAL SUBS POTENTIAL
0	⊙ CATV POLE	0	X- STRUT ANCHOR	0	UG SUBS EXISTING
0	○ TELEPHONE POLE	0	X- EXTENSION ARM	0	UG SUBS POTENTIAL
0	○ CONCRETE POLE	0	○ AERIAL FOOTAGE	0	MULTI UNIT SUBS
0	△ PRIVATE POLE	0	○ AERIAL FOOTAGE	0	TOTAL EXISTING SUBS
0	○M METAL POLE	0	○ TOTAL FOOTAGE	0	TOTAL POTENTIAL SUBS
0	X- EXISTING ANCHOR	0.00	○ TOTAL MILEAGE	0	COMMERCIAL SUBS



5151 Fairbanks Street
Anchorage, Alaska
99503



STATE OF ALASKA
DEPARTMENT OF TRANSPORTATION
AND
PUBLIC FACILITIES
SEWARD HIGHWAY
MP 96 TO MP 102
SAFETY, ROADWAY AND
RECREATIONAL IMPROVEMENTS

VICINITY MAP



CALL BEFORE YOU DIG!

LOCATE CALL CENTER OF ALASKA (LCCA)

ANCHORAGE AREA.....	278-3121
STATEWIDE.....	800-478-3121
ALASKA RAILROAD.....	265-2520
KULIS AIR BASE.....	249-1499
MILITARY PETROLEUM FUEL LINES.....	652-5370
STATE STORM DRAINS & STREET LIGHTS.....	333-2411

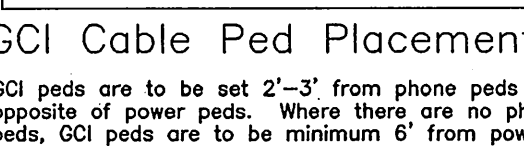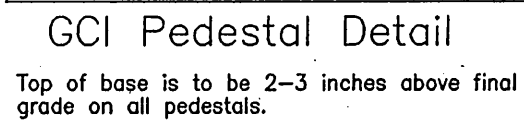

NOT TO SCALE

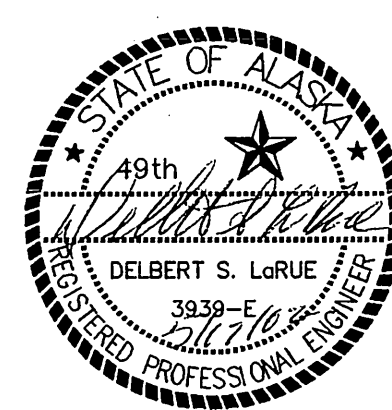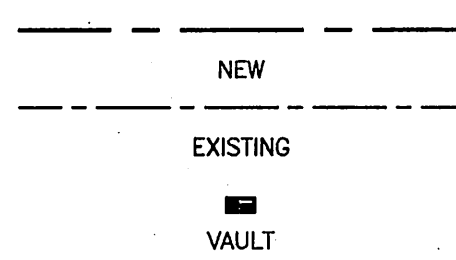

NOTE:
Offsets given are at every 50m station or 100m station unless otherwise noted

Station offset reference point $\rightarrow$ 

DRAWN BY: _____ DATE: _____			0	X POWER POLE	0	X➤ SET ANCHOR	0	AERIAL SUBS EXISTING
DESIGNER/PROJECT ENGINEER: _____ JOB #: _____			0	⊗ JOINT USE POLE	0	X➤ SIDEWALK ANCHOR	0	AERIAL SUBS POTENTIAL
NO.	DESIGN/CONSTRUCTION/ASBUILT REVISION	DWN BY/DATE	0	⊗ CATV POLE	0	X➤ STRUT ANCHOR	0	UG SUBS EXISTING
0	ISSUED FOR CONSTRUCTION	RAE/5-16-02	0	○ TELEPHONE POLE	0	X- EXTENSION ARM	0	UG SUBS POTENTIAL
			0	○ CONCRETE POLE	0	AERIAL FOOTAGE	0	MULTI UNIT SUBS
			0	△ PRIVATE POLE	0	UG FOOTAGE	0	TOTAL EXISTING SUBS
			0	○M METAL POLE	0	TOTAL FOOTAGE	0	TOTAL POTENTIAL SUBS
			0	X➤ EXISTING ANCHOR	0.00	TOTAL MILEAGE	0	COMMERCIAL SUBS



5151 Fairbanks Street
Anchorage, Alaska
99503


STATE OF ALASKA
DEPARTMENT OF TRANSPORTATION
AND
PUBLIC FACILITIES
SEWARD HIGHWAY
MP 96 TO MP 102
SAFETY, ROADWAY AND
RECREATIONAL IMPROVEMENTS

REVISIONS			STATE	PROJECT DESIGNATION	YEAR	SHEET NO.	TOTAL SHEETS
No.	DATE	DESCRIPTION	ALASKA	NH-0A3-1(28)	2002	U9	U23

VICINITY MAP


CALL BEFORE YOU DIG!

LOCATE CALL CENTER OF ALASKA (LCCA)
ANCHORAGE AREA.....278-3121
STATEWIDE.....800-478-3121
ALASKA RAILROAD265-2520
KULIS AIR BASE.....249-1499
MILITARY PETROLEUM FUEL LINES.....552-3760
STATE STORM DRAINS & STREET LIGHTS.....333-2411

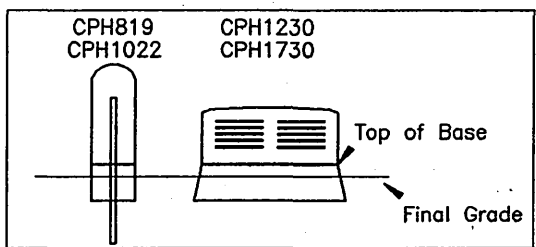

GCI Pedestal Detail




Top of base is to be 2-3 inches above final grade on all pedestals.

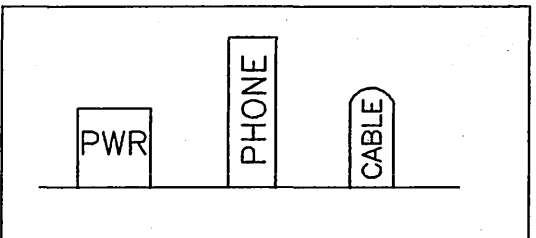

GCI Cable Ped Placement

GCI peds are to be set 2'-3' from phone peds opposite of power peds. Where there are no phone peds, GCI peds are to be minimum 6' from power.

NOT TO SCALE

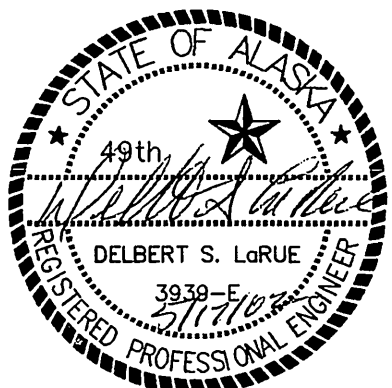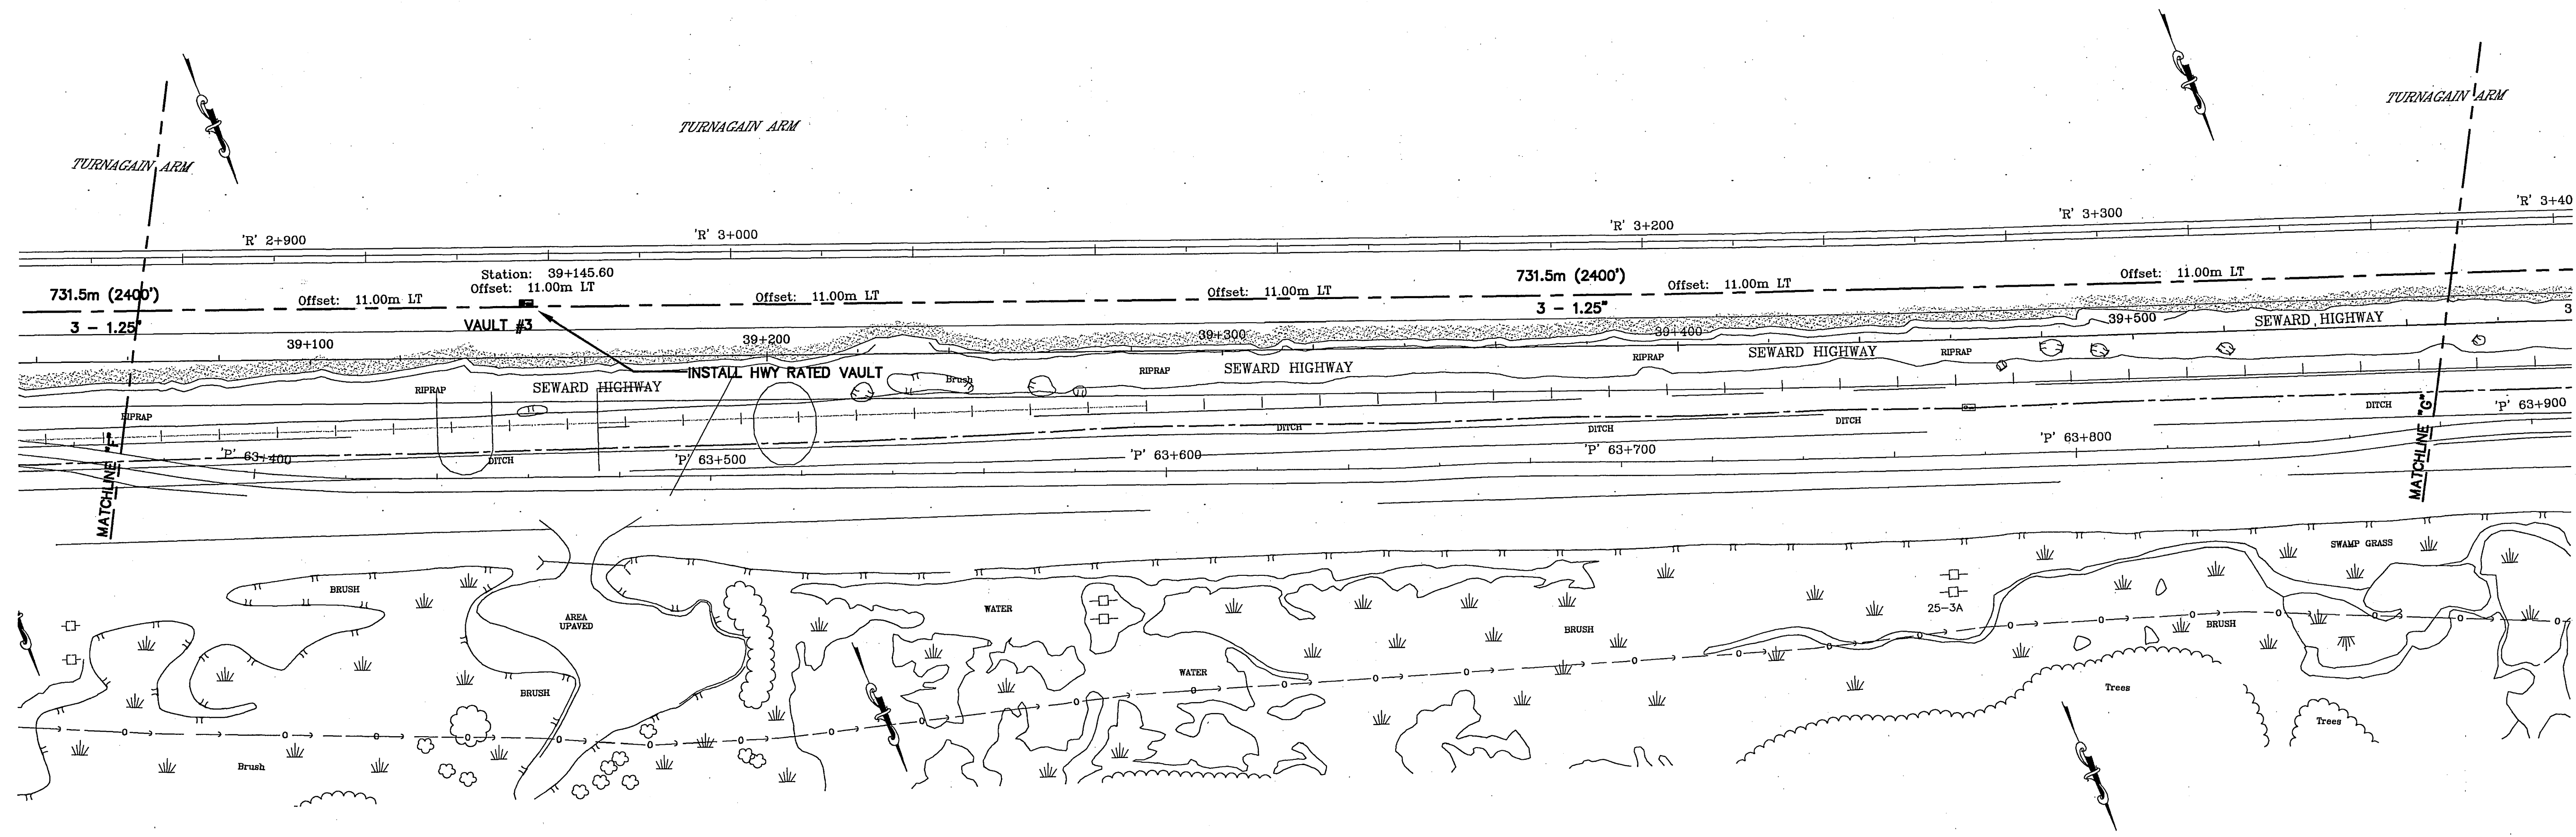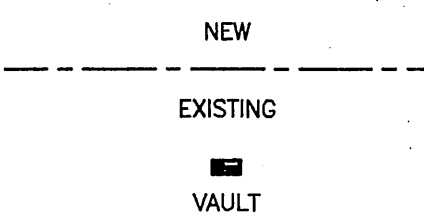

NOTE:
Offsets given are at every 50m station or 100m station unless otherwise noted

Station offset reference point

DRAWN BY: _____ DATE: _____
DESIGNER/PROJECT ENGINEER: _____ JOB #: _____

NO.	DESIGN/CONSTRUCTION/ASBUILT REVISION	DWN BY/DATE
0	ISSUED FOR CONSTRUCTION	RAE/5-16-02

0	X POWER POLE	0	X-X SET ANCHOR	0	AERIAL SUBS EXISTING
0	⊗ JOINT USE POLE	0	X-SIDEWALK ANCHOR	0	AERIAL SUBS POTENTIAL
0	⊙ CATV POLE	0	X-STRUT ANCHOR	0	UG SUBS EXISTING
0	○ TELEPHONE POLE	0	X-EXTENSION ARM	0	UG SUBS POTENTIAL
0	○ CONCRETE POLE	0	○ AERIAL FOOTAGE	0	MULTI UNIT SUBS
0	△ PRIVATE POLE	0	○ UG FOOTAGE	0	TOTAL EXISTING SUBS
0	○ M METAL POLE	0	○ TOTAL FOOTAGE	0	TOTAL POTENTIAL SUBS
0	X-X EXISTING ANCHOR	0.00	○ TOTAL MILEAGE	0	COMMERCIAL SUBS



5151 Fairbanks Street
Anchorage, Alaska
99503

STATE OF ALASKA
DEPARTMENT OF TRANSPORTATION
AND
PUBLIC FACILITIES
SEWARD HIGHWAY
MP 96 TO MP 102
SAFETY, ROADWAY AND
RECREATIONAL IMPROVEMENTS

REVISIONS			STATE	PROJECT DESIGNATION	YEAR	SHEET NO.	TOTAL SHEETS
No.	DATE	DESCRIPTION	ALASKA	NH-0A3-1(28)	2002	U11	U23

DESIGNED BY

CHECKED BY


DRAWN BY

DATE

VIEW ALL

COMPUTER DESIGNATION

RAE/5-16-02

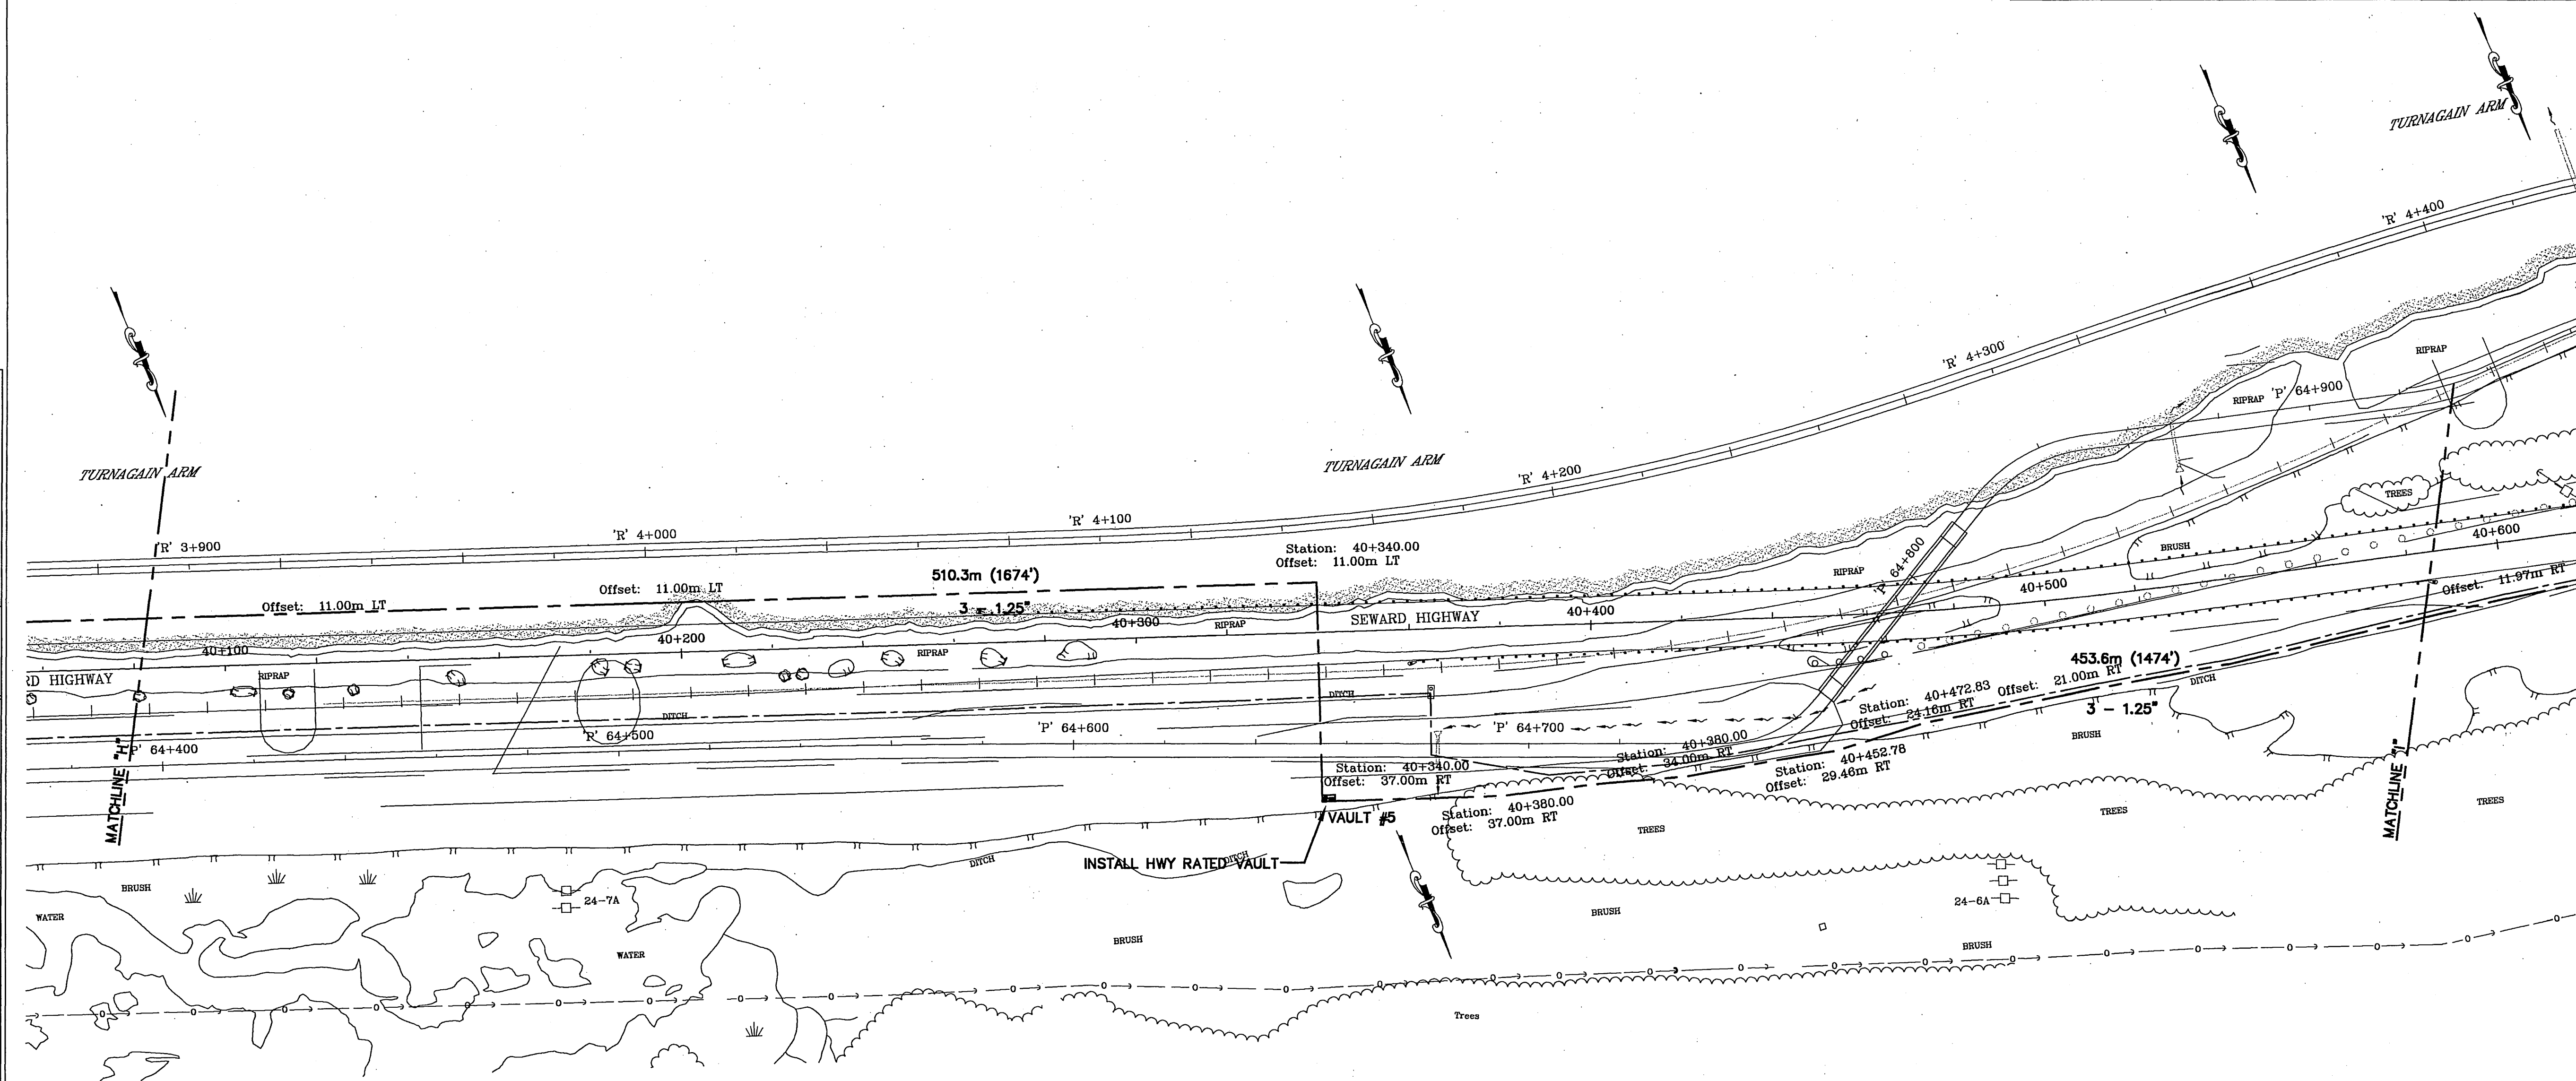

VICINITY MAP

CALL BEFORE YOU DIG!

LOCATE CALL CENTER OF ALASKA (LCCA)

ANCHORAGE AREA.....278-3121

STATEWIDE.....800-478-3121

ALASKA RAILROAD.....265-2520

KULIS AIR BASE.....249-1499

MILITARY PETROLEUM FUEL LINES.....552-3760

STATE STORM DRAINS & STREET LIGHTS.....333-2411

CPH819

CPH1022

CPH1230

CPH1730

Top of Base

Final Grade

GCI Pedestal Detail

Top of base is to be 2-3 inches above final grade on all pedestals.

PWR

PHONE

CABLE

GCI Cable Ped Placement

GCI peds are to be set 2'-3' from phone peds opposite of power peds. Where there are no phone peds, GCI peds are to be minimum 6' from power.

NOT TO SCALE

NEW

EXISTING

VAULT



NOTE:

Offsets given are at every 50m station or 100m station unless otherwise noted

Station offset reference point O ca

DRAWN BY: _____		DATE: _____	
DESIGNER/PROJECT ENGINEER: _____		JOB #: _____	
NO.	DESIGN/CONSTRUCTION/ASBUILT REVISION	DWN BY/DATE	
0	ISSUED FOR CONSTRUCTION	RAE/5-16-02	


0	X POWER POLE	0	X SET ANCHOR	0	AERIAL SUBS EXISTING
0	JOINT USE POLE	0	SIDEWALK ANCHOR	0	AERIAL SUBS POTENTIAL
0	CATV POLE	0	STRUT ANCHOR	0	UG SUBS EXISTING
0	TELEPHONE POLE	0	EXTENSION ARM	0	UG SUBS POTENTIAL
0	CONCRETE POLE	0	AERIAL FOOTAGE	0	MULTI UNIT SUBS
0	PRIVATE POLE	0	UG FOOTAGE	0	TOTAL EXISTING SUBS
0	M METAL POLE	0	TOTAL FOOTAGE	0	TOTAL POTENTIAL SUBS
0	EXISTING ANCHOR	0.00	TOTAL MILEAGE	0	COMMERCIAL SUBS



5151 Fairbanks Street
Anchorage, Alaska
99503

STATE OF ALASKA
DEPARTMENT OF TRANSPORTATION
AND
PUBLIC FACILITIES
SEWARD HIGHWAY
MP 96 TO MP 102
SAFETY, ROADWAY AND
RECREATIONAL IMPROVEMENTS


REVISIONS			STATE	PROJECT DESIGNATION	YEAR	SHEET NO.	TOTAL SHEETS
No.	DATE	DESCRIPTION	ALASKA	NH-OA3-1(28)	2002	U 12	U 23

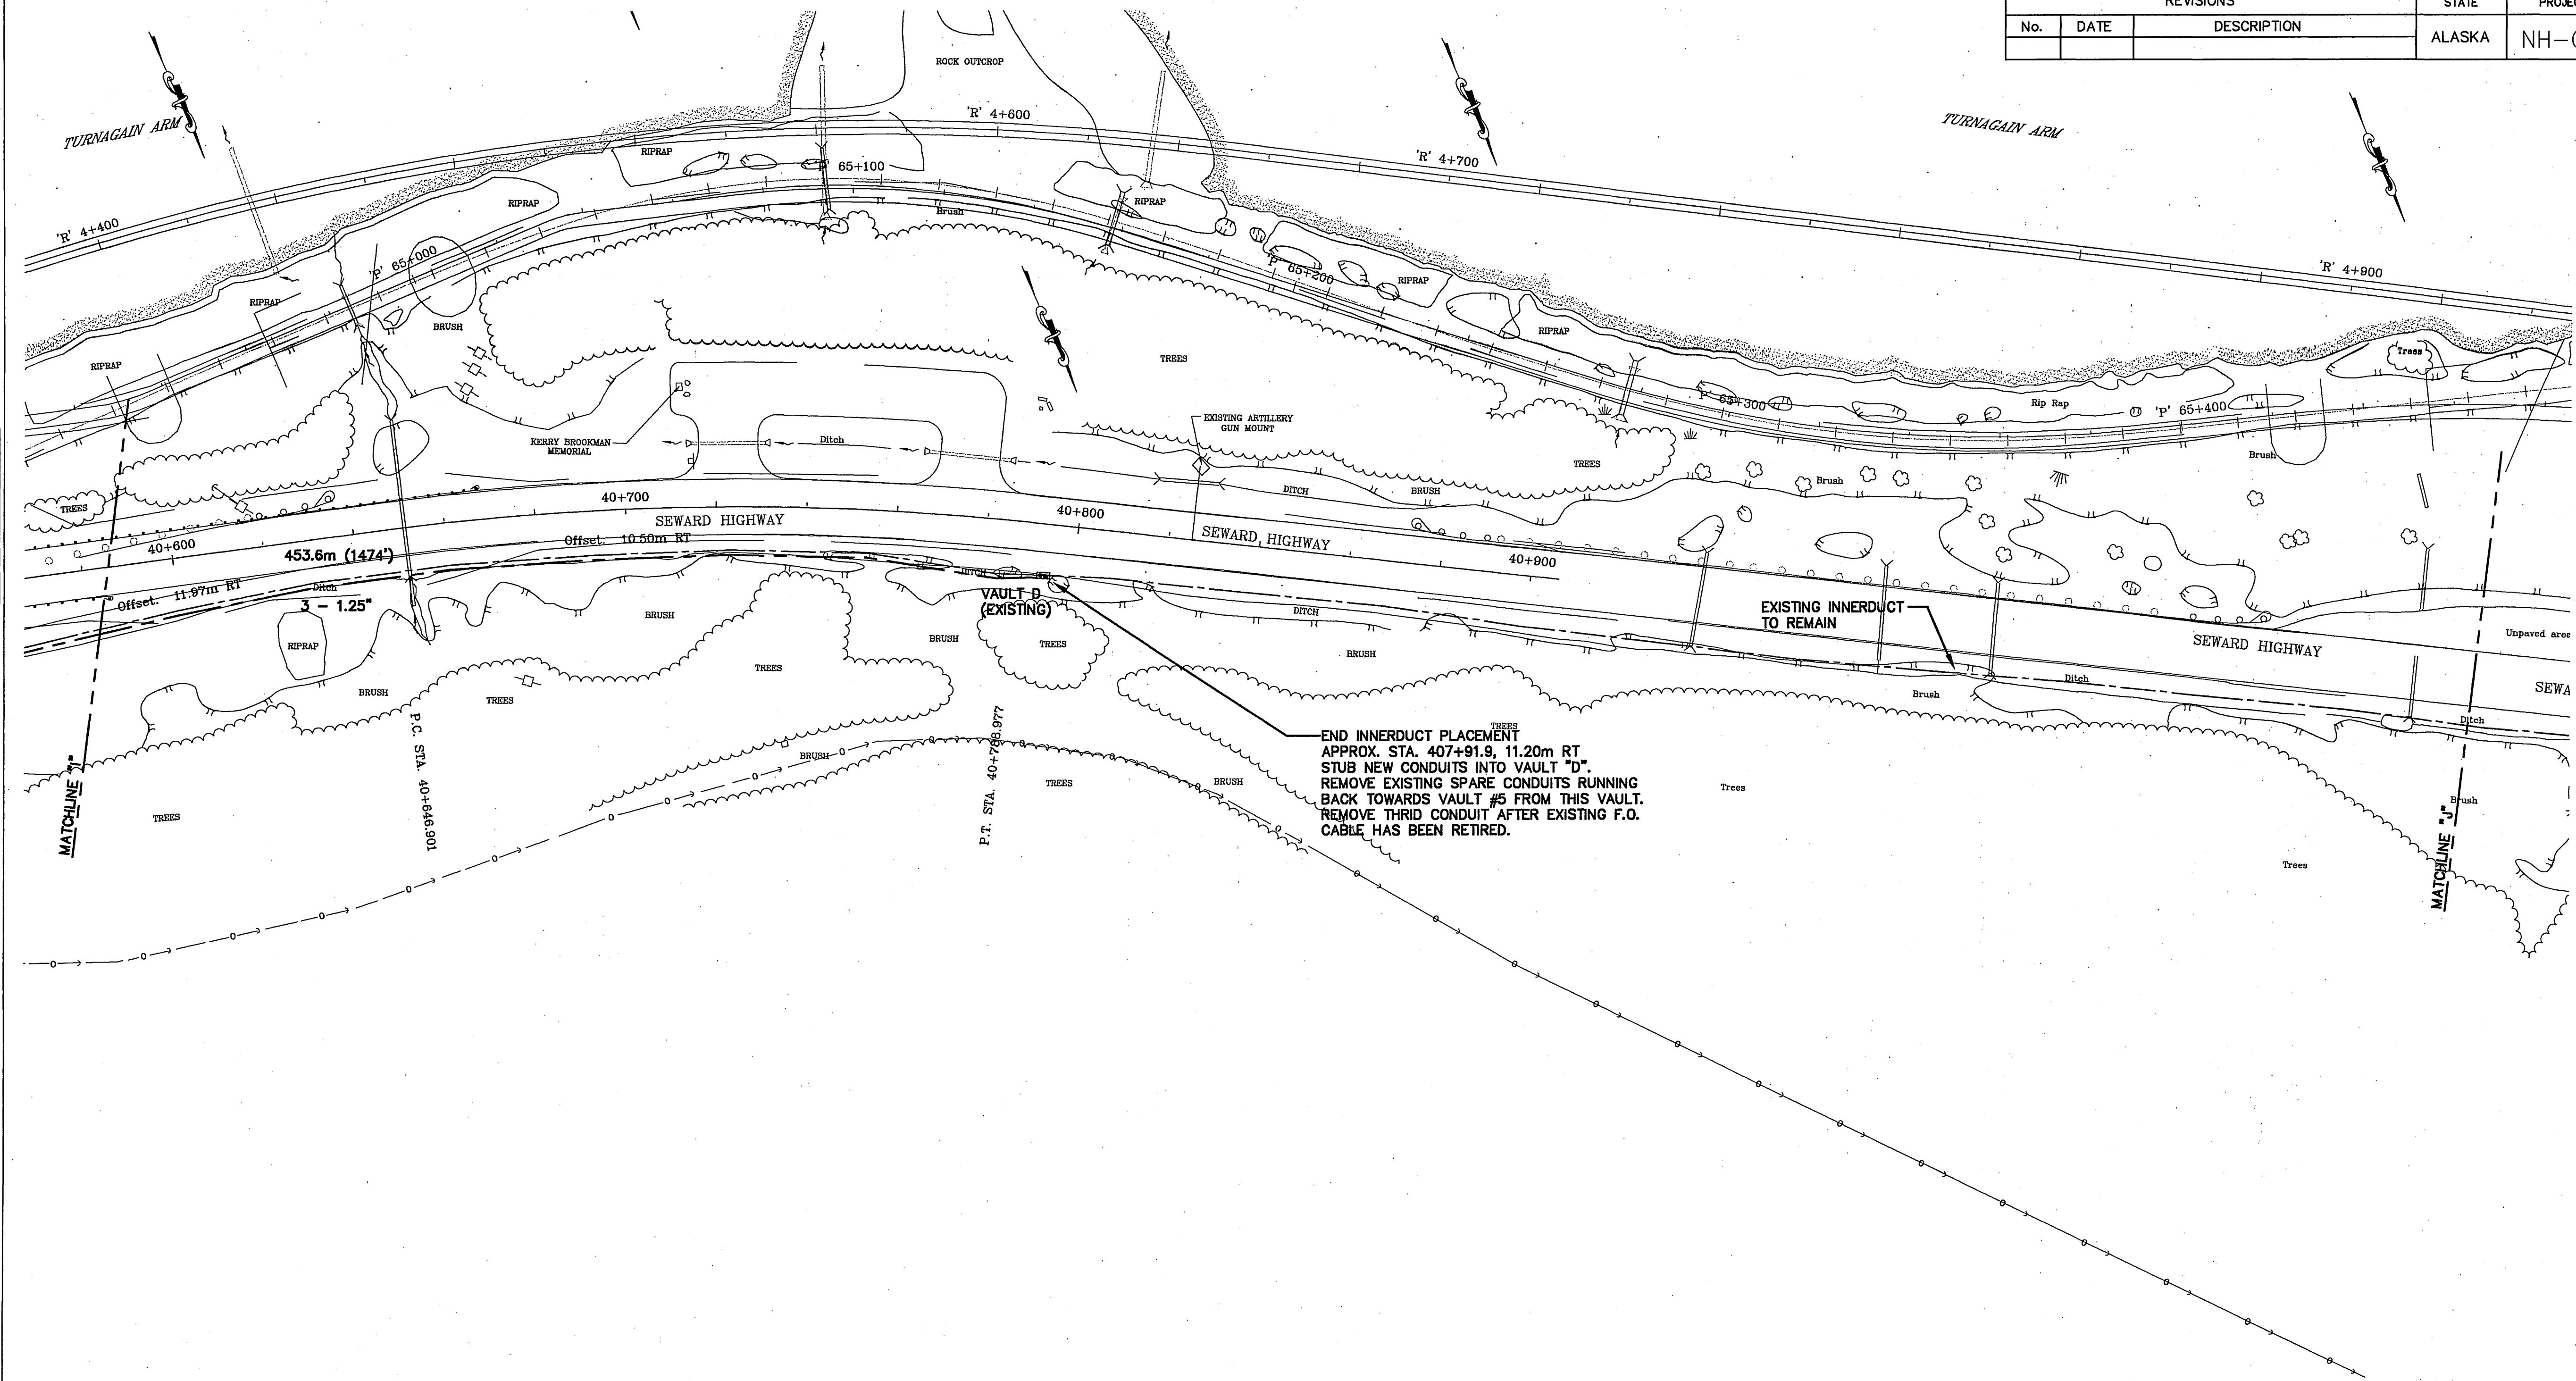

VICINITY MAP


CALL BEFORE YOU DIG!

LOCATE CALL CENTER OF ALASKA (LCCA)
ANCHORAGE AREA.....278-3121
STATEWIDE.....800-478-3121
ALASKA RAILROAD.....265-2520
KULIS AIR BASE.....249-1499
MILITARY PETROLEUM FUEL LINES.....552-3760
STATE STORM DRAINS & STREET LIGHTS.....333-2411

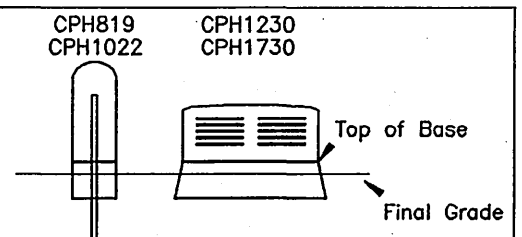

GCI Pedestal Detail



Top of base is to be 2-3 inches above final grade on all pedestals.

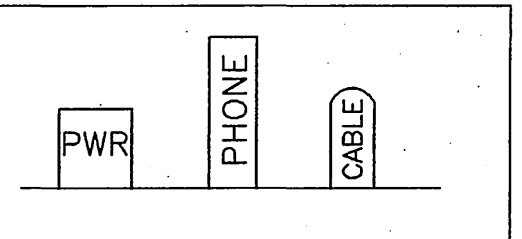

GCI Cable Ped Placement

GCI peds are to be set 2'-3' from phone peds opposite of power peds. Where there are no phone peds, GCI peds are to be minimum 6' from power.

NOT TO SCALE

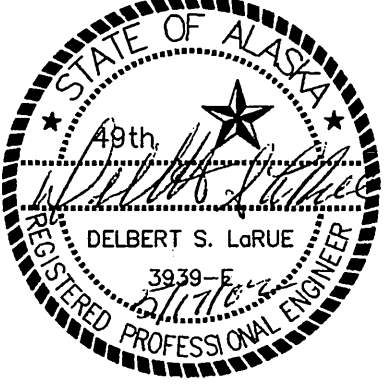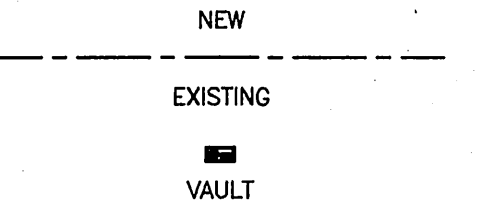

NOTE:
Offsets given are at every 50m station or 100m station unless otherwise noted

Station offset reference point →

DRAWN BY: _____ DATE: _____
DESIGNER/PROJECT ENGINEER: _____ JOB #: _____

NO.	DESIGN/CONSTRUCTION/ASBUILT REVISION	DWN BY/DATE
0	ISSUED FOR CONSTRUCTION	RAE/5-16-02


0	X POWER POLE	0	X SET ANCHOR	0	AERIAL SUBS EXISTING
0	⊗ JOINT USE POLE	0	X SIDEWALK ANCHOR	0	AERIAL SUBS POTENTIAL
0	⊙ CATV POLE	0	X STRUT ANCHOR	0	UG SUBS EXISTING
0	○ TELEPHONE POLE	0	X EXTENSION ARM	0	UG SUBS POTENTIAL
0	○ CONCRETE POLE	0	○ AERIAL FOOTAGE	0	MULTI UNIT SUBS
0	△ PRIVATE POLE	0	○ UG FOOTAGE	0	TOTAL EXISTING SUBS
0	○ M METAL POLE	0	○ TOTAL FOOTAGE	0	TOTAL POTENTIAL SUBS
0	X EXISTING ANCHOR	0.00	○ TOTAL MILEAGE	0	COMMERCIAL SUBS



5151 Fairbanks Street
Anchorage, Alaska
99503

STATE OF ALASKA
DEPARTMENT OF TRANSPORTATION
AND
PUBLIC FACILITIES
SEWARD HIGHWAY
MP 96 TO MP 102
SAFETY, ROADWAY AND
RECREATIONAL IMPROVEMENTS

SPECIFICATIONS
STANDARDS
COMPUTER DESIGNATION
DESIGNED BY
CHECKED BY
DRAFTED BY
VIEW ALL
AUTOCAD-CAROL-EE-MARC/MBDR
1/29/02

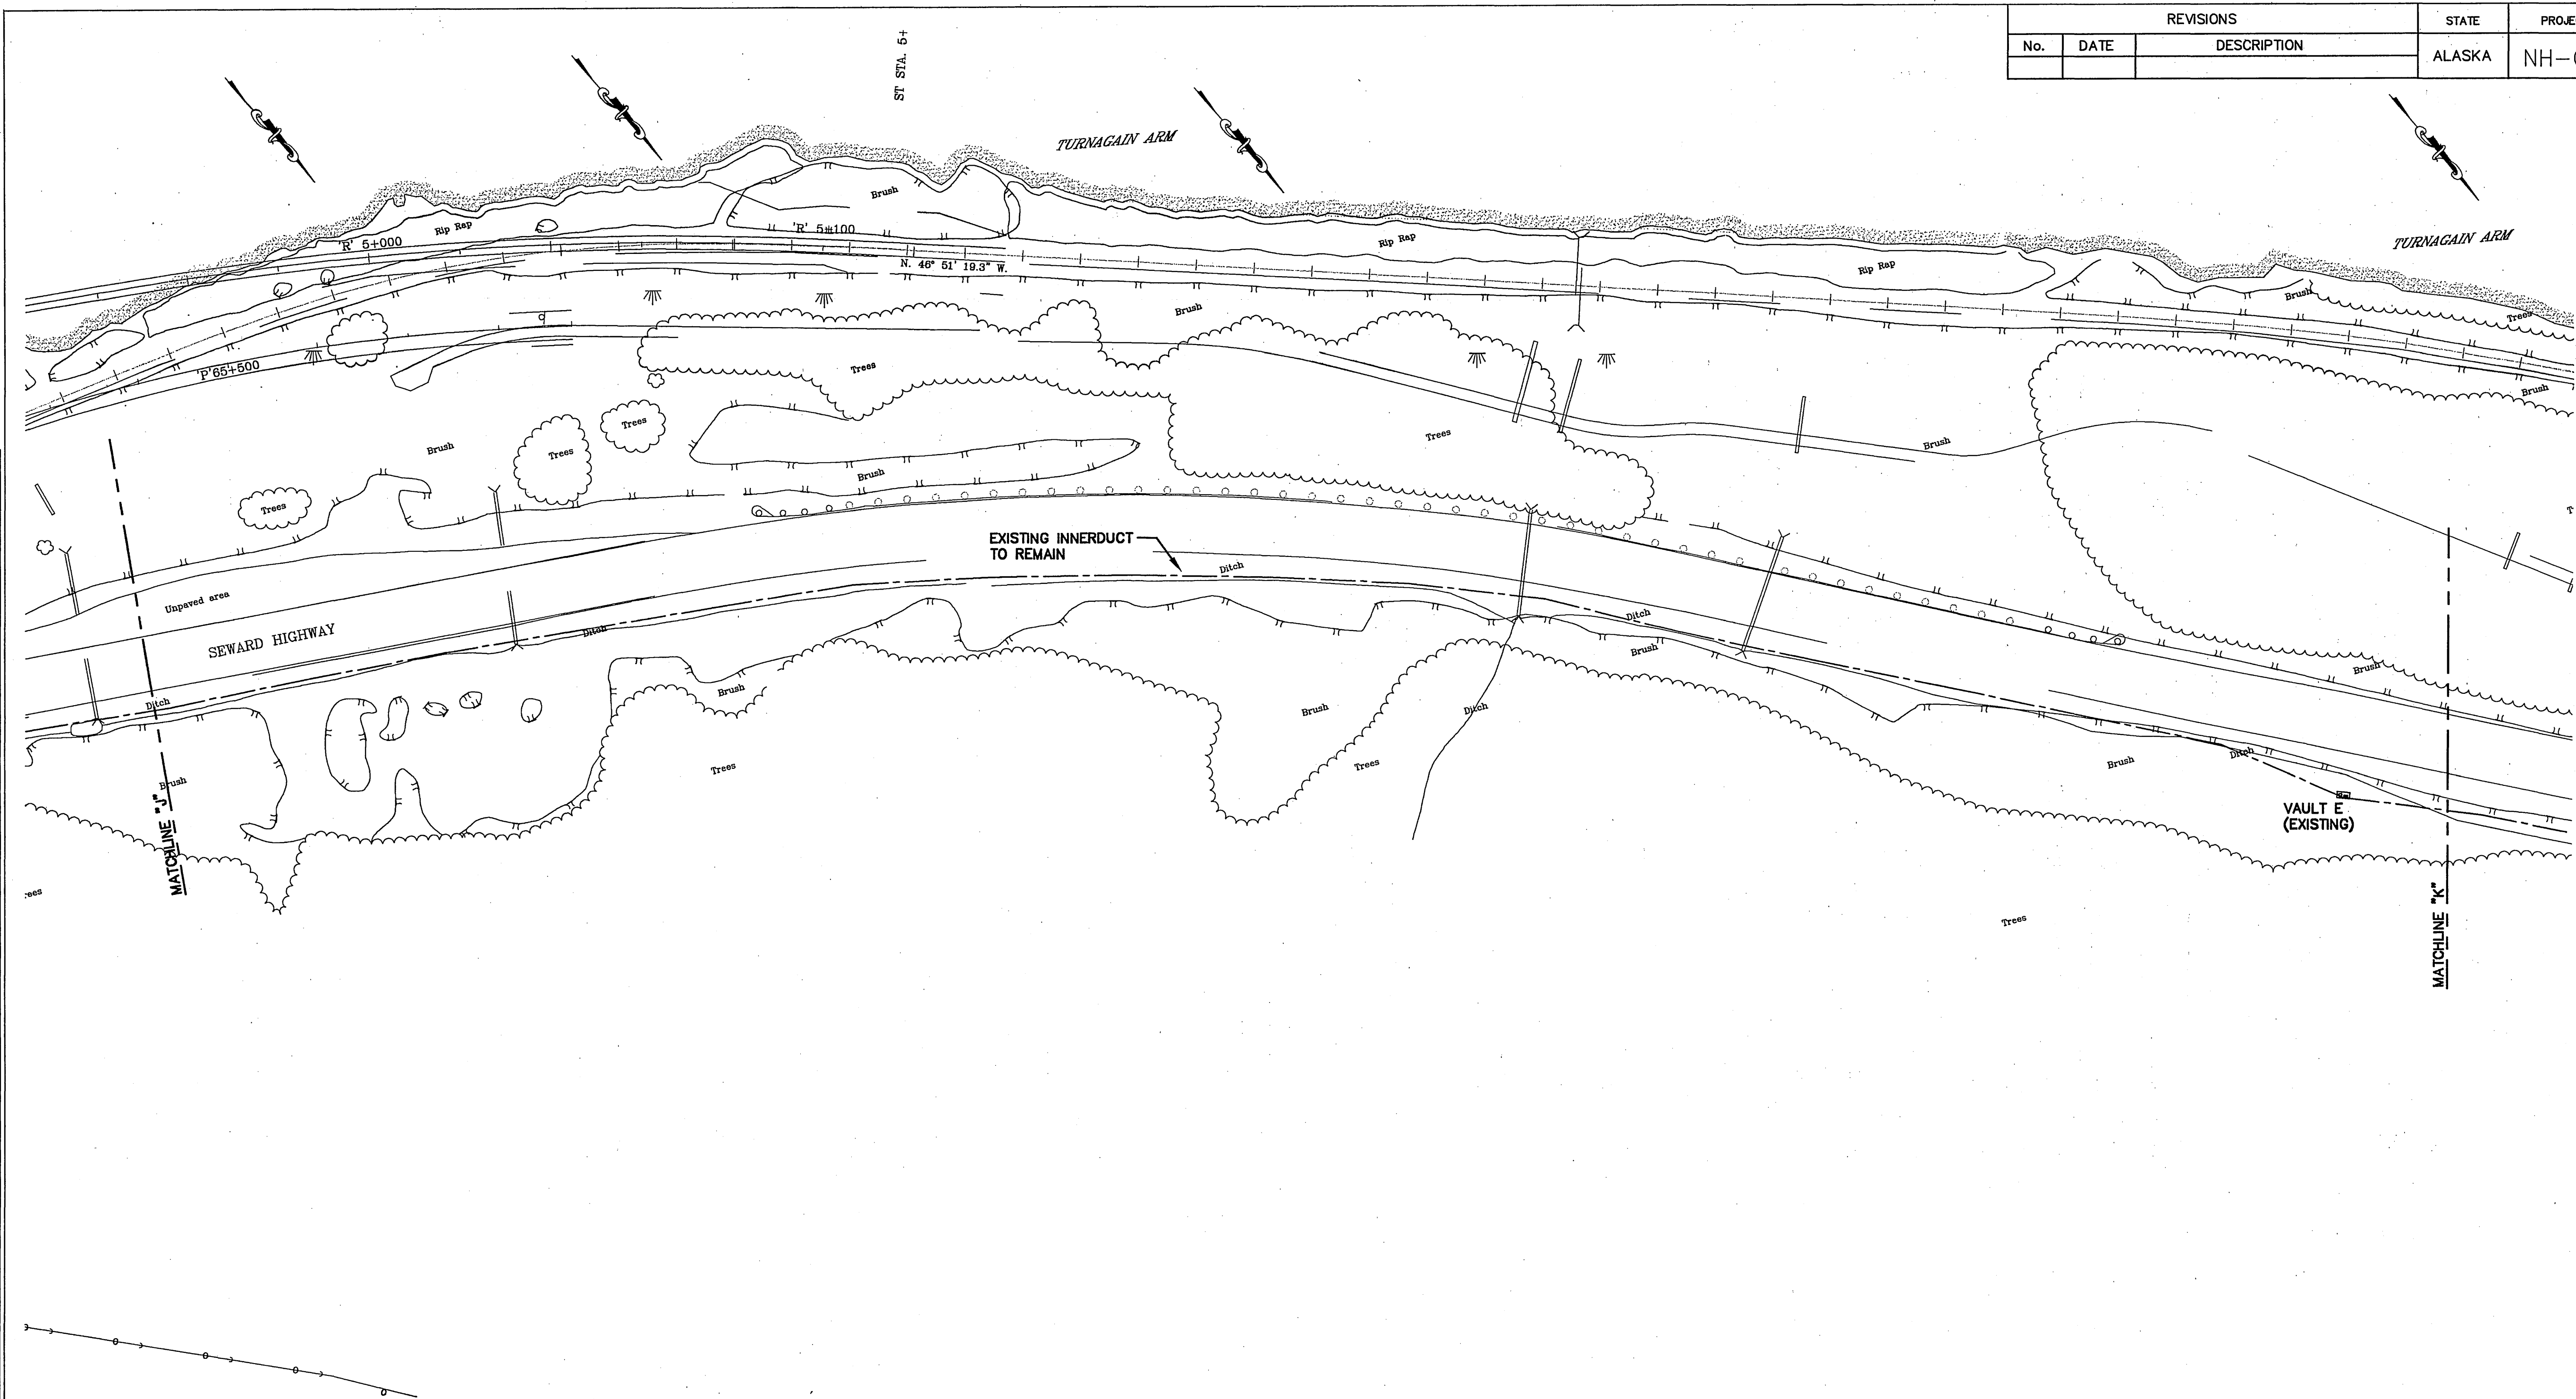


REVISIONS			STATE	PROJECT DESIGNATION	YEAR	SHEET NO.	TOTAL SHEETS
No.	DATE	DESCRIPTION	ALASKA	NH-0A3-1(28)	2002	U13	U23

VICINITY MAP


CALL BEFORE YOU DIG!

LOCATE CALL CENTER OF ALASKA (LCCA)
ANCHORAGE AREA..... 278-3121
STATEWIDE..... 800-478-3121
ALASKA RAILROAD..... 265-2520
KULIS AIR BASE..... 249-1499
MILITARY PETROLEUM FUEL LINES..... 552-3760
STATE STORM DRAINS & STREET LIGHTS..... 333-2411

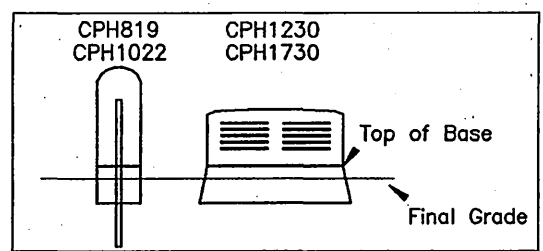

GCI Pedestal Detail



Top of base is to be 2-3 inches above final grade on all pedestals.

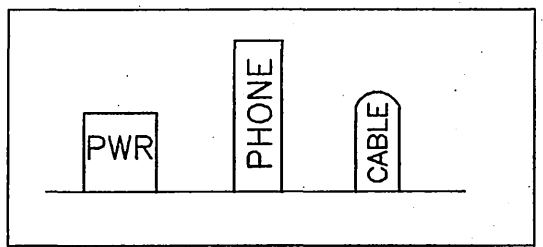

GCI Cable Ped Placement

GCI peds are to be set 2'-3' from phone peds opposite of power peds. Where there are no phone peds, GCI peds are to be minimum 6' from power.

NOT TO SCALE

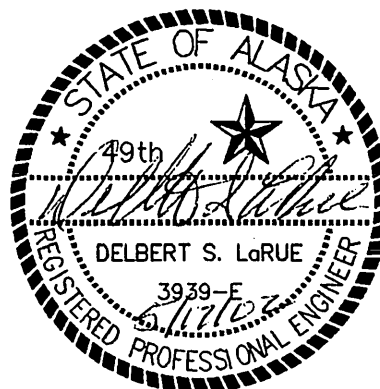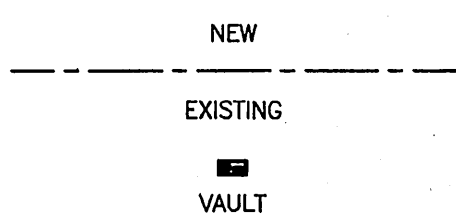

NOTE:
Offsets given are at every 50m station or 100m station unless otherwise noted

Station offset reference point

DRAWN BY: _____ DATE: _____
DESIGNER/PROJECT ENGINEER: _____ JOB #: _____

NO.	DESIGN/CONSTRUCTION/ASBUILT REVISION	DWN BY/DATE
0	ISSUED FOR CONSTRUCTION	RAE/5-16-02

0	X POWER POLE	0	X-X SET ANCHOR	0	AERIAL SUBS EXISTING
0	⊗ JOINT USE POLE	0	X-SIDEWALK ANCHOR	0	AERIAL SUBS POTENTIAL
0	⊙ CATV POLE	0	X-STRUT ANCHOR	0	UG SUBS EXISTING
0	○ TELEPHONE POLE	0	X-EXTENSION ARM	0	UG SUBS POTENTIAL
0	○ CONCRETE POLE	0	○ AERIAL FOOTAGE	0	MULTI UNIT SUBS
0	△ PRIVATE POLE	0	○ UG FOOTAGE	0	TOTAL EXISTING SUBS
0	○ M METAL POLE	0	○ TOTAL FOOTAGE	0	TOTAL POTENTIAL SUBS
0	X-EXISTING ANCHOR	0.00	○ TOTAL MILEAGE	0	COMMERCIAL SUBS




5151 Fairbanks Street
Anchorage, Alaska
99503

STATE OF ALASKA
DEPARTMENT OF TRANSPORTATION
AND
PUBLIC FACILITIES
SEWARD HIGHWAY
MP 96 TO MP 102
SAFETY, ROADWAY AND
RECREATIONAL IMPROVEMENTS


REVISIONS			STATE	PROJECT DESIGNATION	YEAR	SHEET NO.	TOTAL SHEETS
No.	DATE	DESCRIPTION	ALASKA	NH-0A3-1(28)	2002	U14	U23

SPECIFICATIONS
STANDARDS
COMPUTER DESIGNATION
DESIGNED BY
CHECKED BY
DRAWN BY
DATE
1/29/02
VIEW ALL
AUTOCAD-CAROLEE-MARC/MBOR

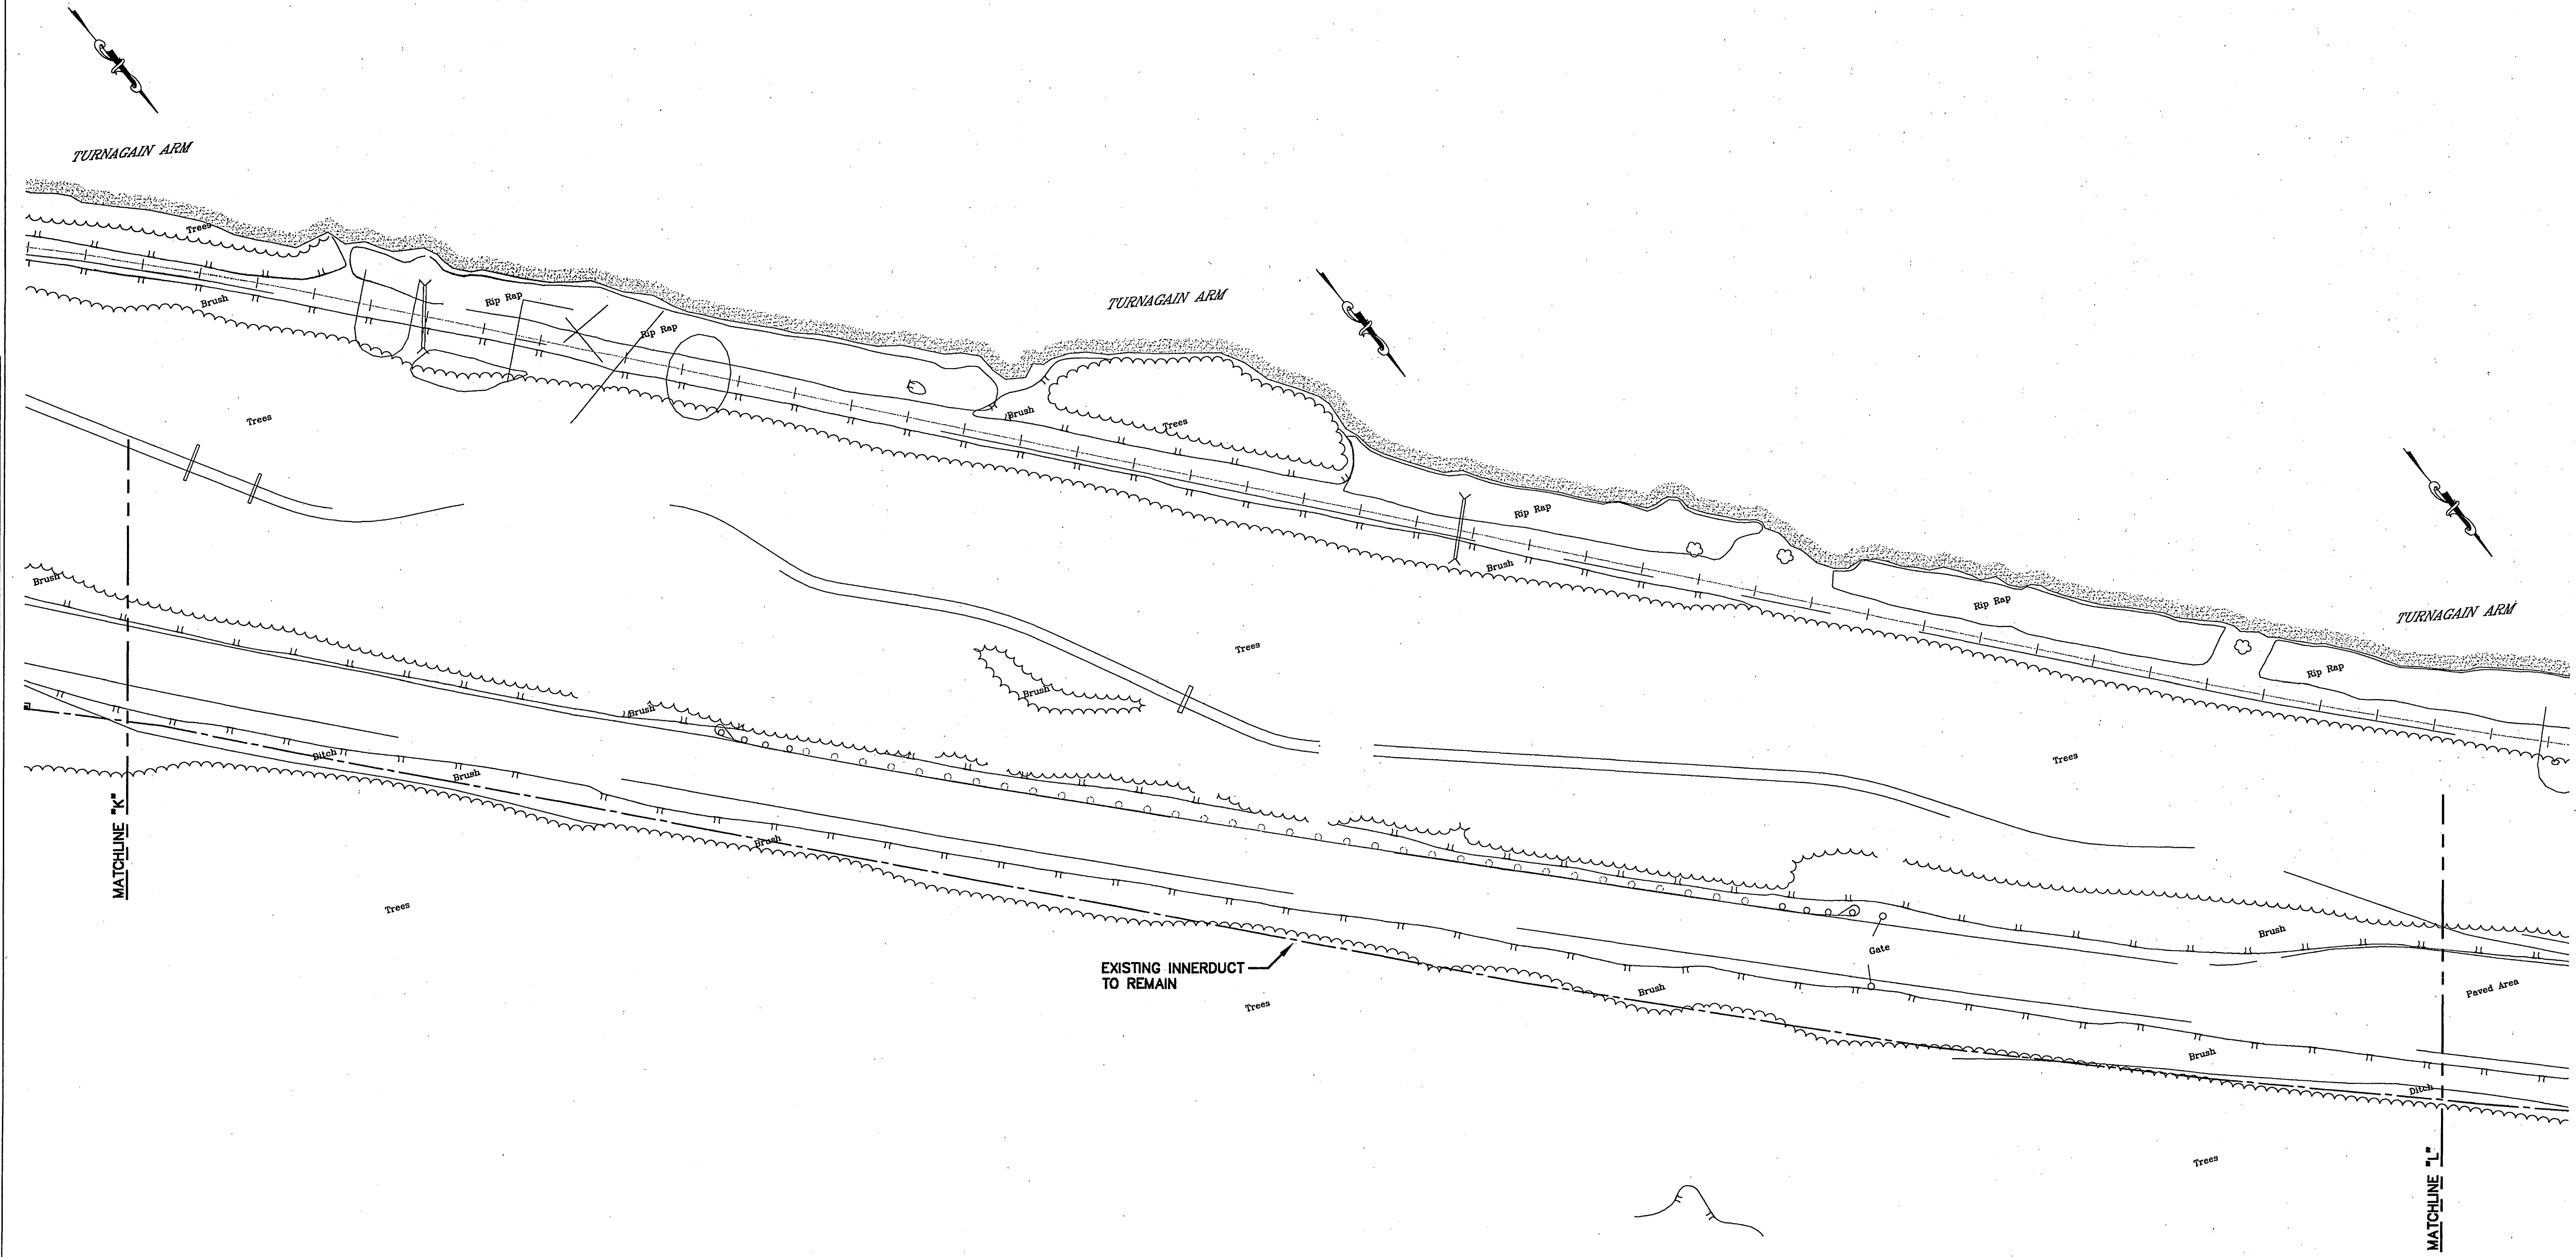


VICINITY MAP

CALL BEFORE YOU DIG!
LOCATE CALL CENTER OF ALASKA (LCCA)
ANCHORAGE AREA.....278-3121
STATEWIDE.....800-478-3121
ALASKA RAILROAD.....265-2520
KILIS AIR BASE.....249-1499
MILITARY PETROLEUM FUEL LINES.....552-3760
STATE STORM DRAINS & STREET LIGHTS.....333-2411

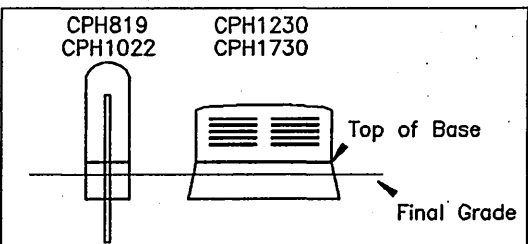


GCI Pedestal Detail
Top of base is to be 2-3 inches above final grade on all pedestals.

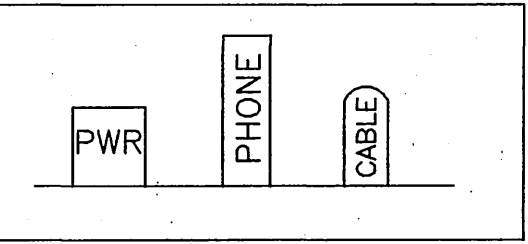

GCI Cable Ped Placement
GCI peds are to be set 2'-3' from phone peds opposite of power peds. Where there are no phone peds, GCI peds are to be minimum 6' from power.

NOT TO SCALE

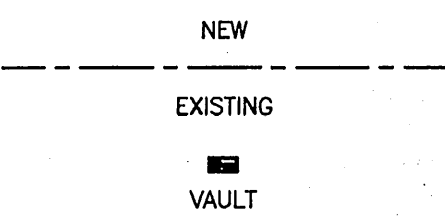

NOTE:
Offsets given are at every 50m station or 100m station unless otherwise noted

Station offset reference point →

DRAWN BY: _____		DATE: _____	
DESIGNER/PROJECT ENGINEER: _____		JOB #: _____	
NO.	DESIGN/CONSTRUCTION/ASBUILT REVISION	DWN BY/DATE	RAE/5-16-02
0	ISSUED FOR CONSTRUCTION		


0	X POWER POLE	0	X- SET ANCHOR	0	AERIAL SUBS EXISTING
0	⊗ JOINT USE POLE	0	X- SIDEWALK ANCHOR	0	AERIAL SUBS POTENTIAL
0	⊙ CATV POLE	0	X- STRUT ANCHOR	0	UG SUBS EXISTING
0	○ TELEPHONE POLE	0	X- EXTENSION ARM	0	UG SUBS POTENTIAL
0	○ CONCRETE POLE	0	○ AERIAL FOOTAGE	0	MULTI UNIT SUBS
0	△ PRIVATE POLE	0	○ UG FOOTAGE	0	TOTAL EXISTING SUBS
0	○ M METAL POLE	0	○ TOTAL FOOTAGE	0	TOTAL POTENTIAL SUBS
0	X- EXISTING ANCHOR	0.00	○ TOTAL MILEAGE	0	COMMERCIAL SUBS



5151 Fairbanks Street
Anchorage, Alaska
99503

STATE OF ALASKA
DEPARTMENT OF TRANSPORTATION
AND
PUBLIC FACILITIES
SEWARD HIGHWAY
MP 96 TO MP 102
SAFETY, ROADWAY AND
RECREATIONAL IMPROVEMENTS

SPECIFICATIONS
STANDARDS
COMPUTER DESIGNATION
DESIGNED BY
CHECKED BY
DRAWN BY
DATE
1/23/02
VIEW ALL
AUTOCAD-CAROLEE-MARC/MDBR

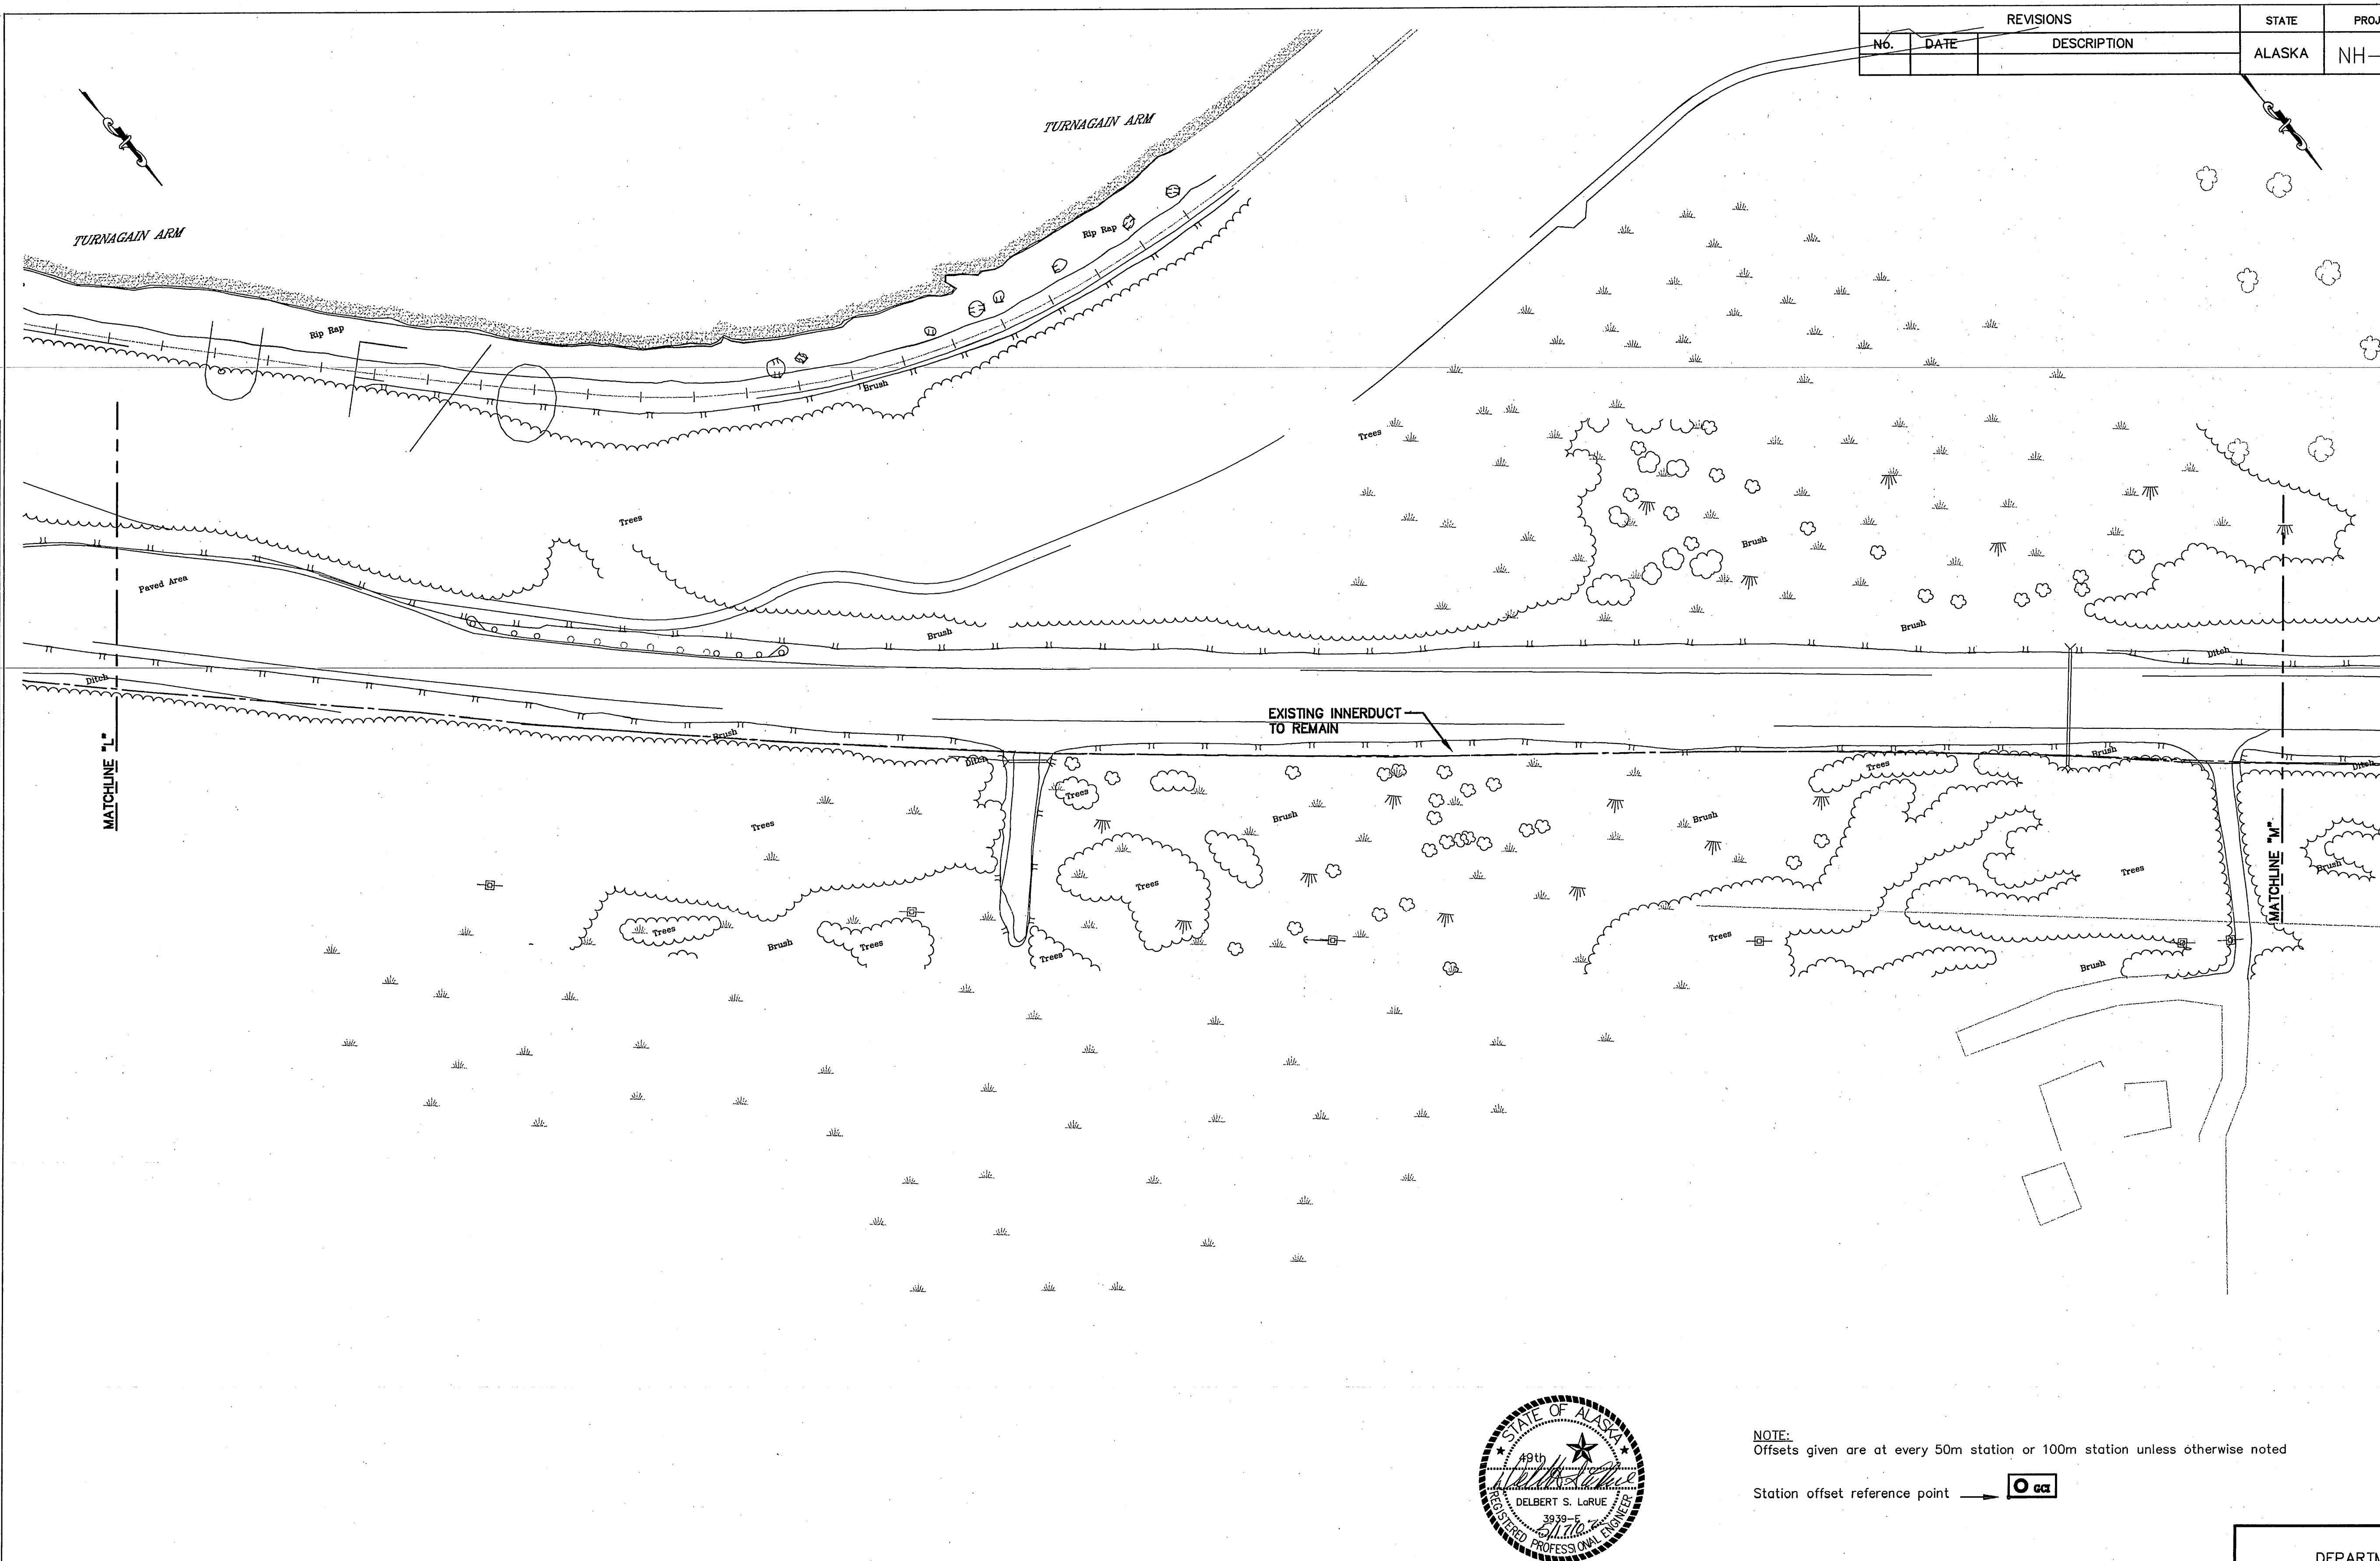


REVISIONS			STATE	PROJECT DESIGNATION	YEAR	SHEET NO.	TOTAL SHEETS
NO.	DATE	DESCRIPTION	ALASKA	NH-0A3-1(28)	2002	U15	U23


VICINITY MAP

CALL BEFORE YOU DIG!

LOCATE CALL CENTER OF ALASKA (LCCA)
ANCHORAGE AREA.....278-3121
STATEWIDE.....800-478-3121
ALASKA RAILROAD.....265-2520
KULIS AIR BASE.....249-1499
MILITARY PETROLEUM FUEL LINES.....552-3760
STATE STORM DRAINS & STREET LIGHTS.....333-2411

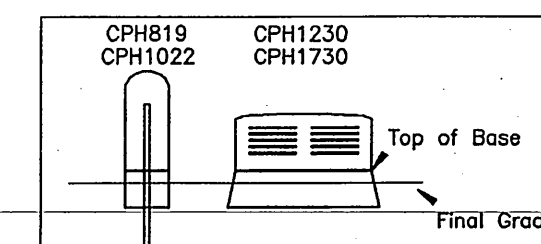


GCI Pedestal Detail
Top of base is to be 2-3 inches above final grade on all pedestals.

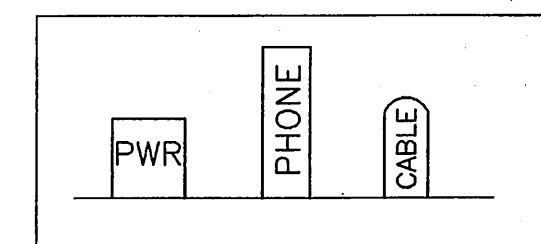

GCI Cable Ped Placement
GCI peds are to be set 2'-3' from phone peds opposite of power peds. Where there are no phone peds, GCI peds are to be minimum 6' from power.

NOT TO SCALE

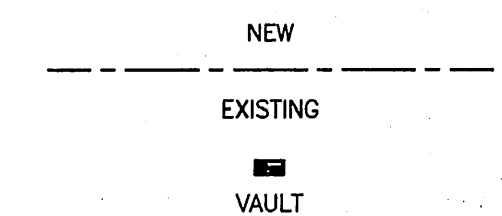

NOTE:
Offsets given are at every 50m station or 100m station unless otherwise noted

Station offset reference point →

DRAWN BY: _____ DATE: _____
DESIGNER/PROJECT ENGINEER: _____ JOB #: _____

NO.	DESIGN/CONSTRUCTION/ASBUILT REVISION	DWN BY/DATE
0	ISSUED FOR CONSTRUCTION	RAE/5-16-02


0	X POWER POLE	0	X SET ANCHOR	0	AERIAL SUBS EXISTING
0	⊗ JOINT USE POLE	0	X SIDWALK ANCHOR	0	AERIAL SUBS POTENTIAL
0	⊙ CATV POLE	0	X STRUT ANCHOR	0	UG SUBS EXISTING
0	○ TELEPHONE POLE	0	X EXTENSION ARM	0	UG SUBS POTENTIAL
0	○ CONCRETE POLE	0		0	MULTI UNIT SUBS
0	△ PRIVATE POLE	0		0	TOTAL EXISTING SUBS
0	○M METAL POLE	0		0	TOTAL POTENTIAL SUBS
0	X EXISTING ANCHOR	0.00	TOTAL FOOTAGE	0	COMMERCIAL SUBS
			TOTAL MILEAGE	0	



5151 Fairbanks Street
Anchorage, Alaska
99503

STATE OF ALASKA
DEPARTMENT OF TRANSPORTATION
AND
PUBLIC FACILITIES
SEWARD HIGHWAY
MP 96 TO MP 102
SAFETY, ROADWAY AND
RECREATIONAL IMPROVEMENTS


REVISIONS			STATE	PROJECT DESIGNATION	YEAR	SHEET NO.	TOTAL SHEETS
No.	DATE	DESCRIPTION	ALASKA	NH-0A3-1(28)	2002	U 16	U 23

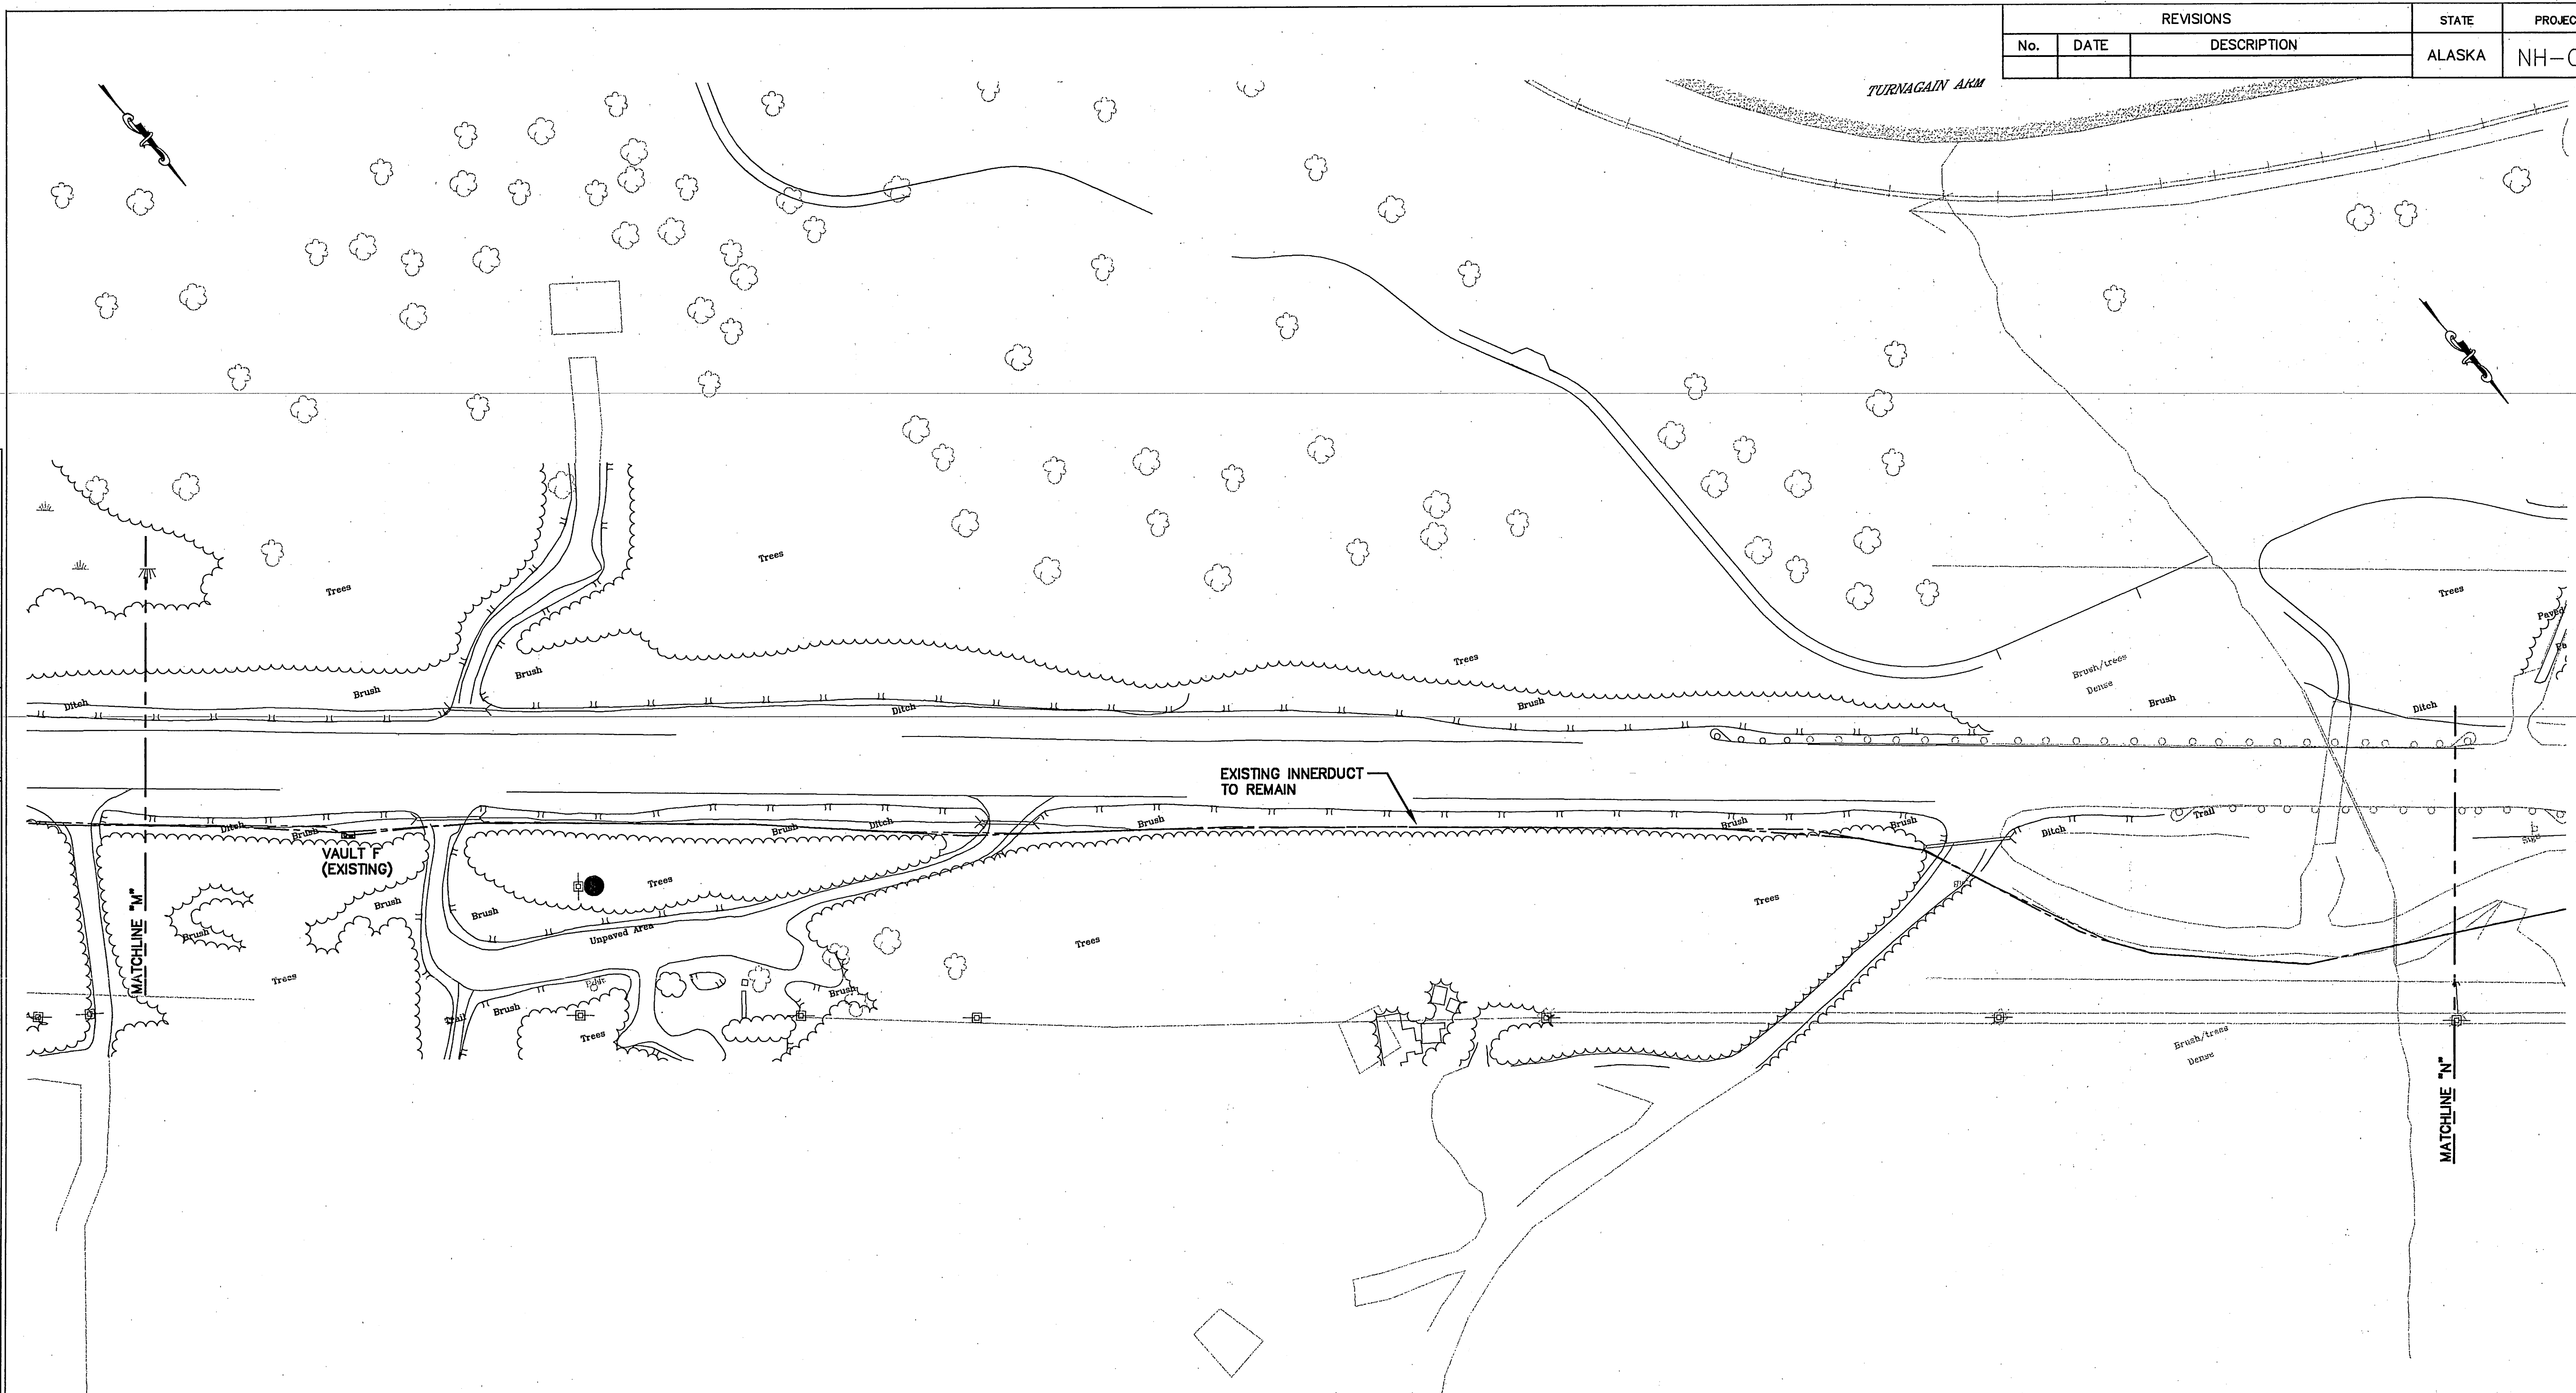

VICINITY MAP


CALL BEFORE YOU DIG!

LOCATE CALL CENTER OF ALASKA (LCCA)
ANCHORAGE AREA.....278-3121
STATEWIDE.....800-478-3121
ALASKA RAILROAD.....285-2520
KULIS AIR BASE.....249-1499
MILITARY PETROLEUM FUEL LINES.....552-3760
STATE STORM DRAINS & STREET LIGHTS.....333-2411

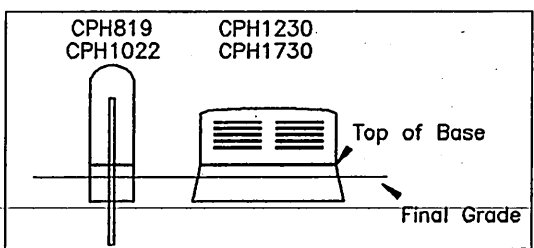

GCI Pedestal Detail



Top of base is to be 2'-3' inches above final grade on all pedestals.

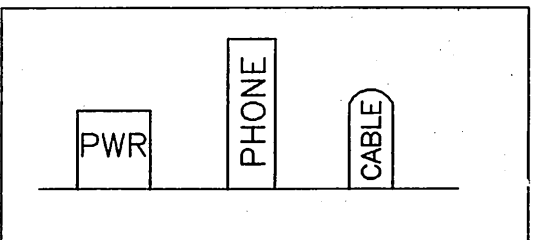

GCI Cable Ped Placement

GCI peds are to be set 2'-3' from phone peds opposite of power peds. Where there are no phone peds, GCI peds are to be minimum 6' from power.

NOT TO SCALE

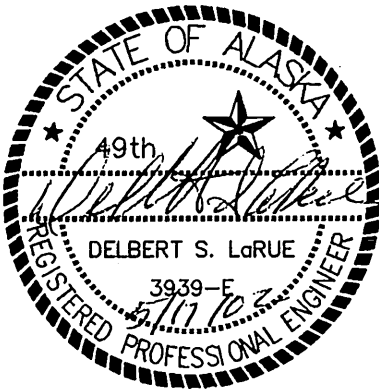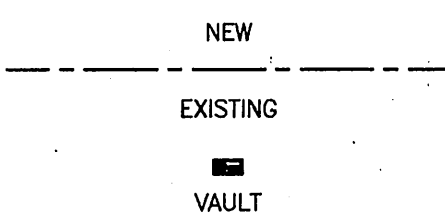

NOTE:
Offsets given are at every 50m station or 100m station unless otherwise noted

Station offset reference point →

DRAWN BY: _____ DATE: _____
DESIGNER/PROJECT ENGINEER: _____ JOB #: _____

NO.	DESIGN/CONSTRUCTION/ASBUILT REVISION	DWN BY/DATE
0	ISSUED FOR CONSTRUCTION	RAE/5-16-02

0	X POWER POLE	0	X-> SET ANCHOR	0	AERIAL SUBS EXISTING
0	⊗ JOINT USE POLE	0	X- SIDEWALK ANCHOR	0	AERIAL SUBS POTENTIAL
0	⊙ CATV POLE	0	X- STRUT ANCHOR	0	UG SUBS EXISTING
0	○ TELEPHONE POLE	0	X- EXTENSION ARM	0	UG SUBS POTENTIAL
0	○ CONCRETE POLE	0		0	MULTI UNIT SUBS
0	△ PRIVATE POLE	0		0	TOTAL EXISTING SUBS
0	○ M METAL POLE	0		0	TOTAL POTENTIAL SUBS
0	X-> EXISTING ANCHOR	0.00	TOTAL FOOTAGE	0	COMMERCIAL SUBS
			TOTAL MILEAGE	0	




5151 Fairbanks Street
Anchorage, Alaska
99503

CABLE, INC

STATE OF ALASKA
DEPARTMENT OF TRANSPORTATION
AND
PUBLIC FACILITIES
SEWARD HIGHWAY
MP 96 TO MP 102
SAFETY, ROADWAY AND
RECREATIONAL IMPROVEMENTS

DESIGNED BY
CHECKED BY
DRAFTED BY
VIEW ALL
STANDARDS
COMPUTER DESIGNATION
AUTOCAD-CAROL-EE-MARC/NBDR
1/29/02

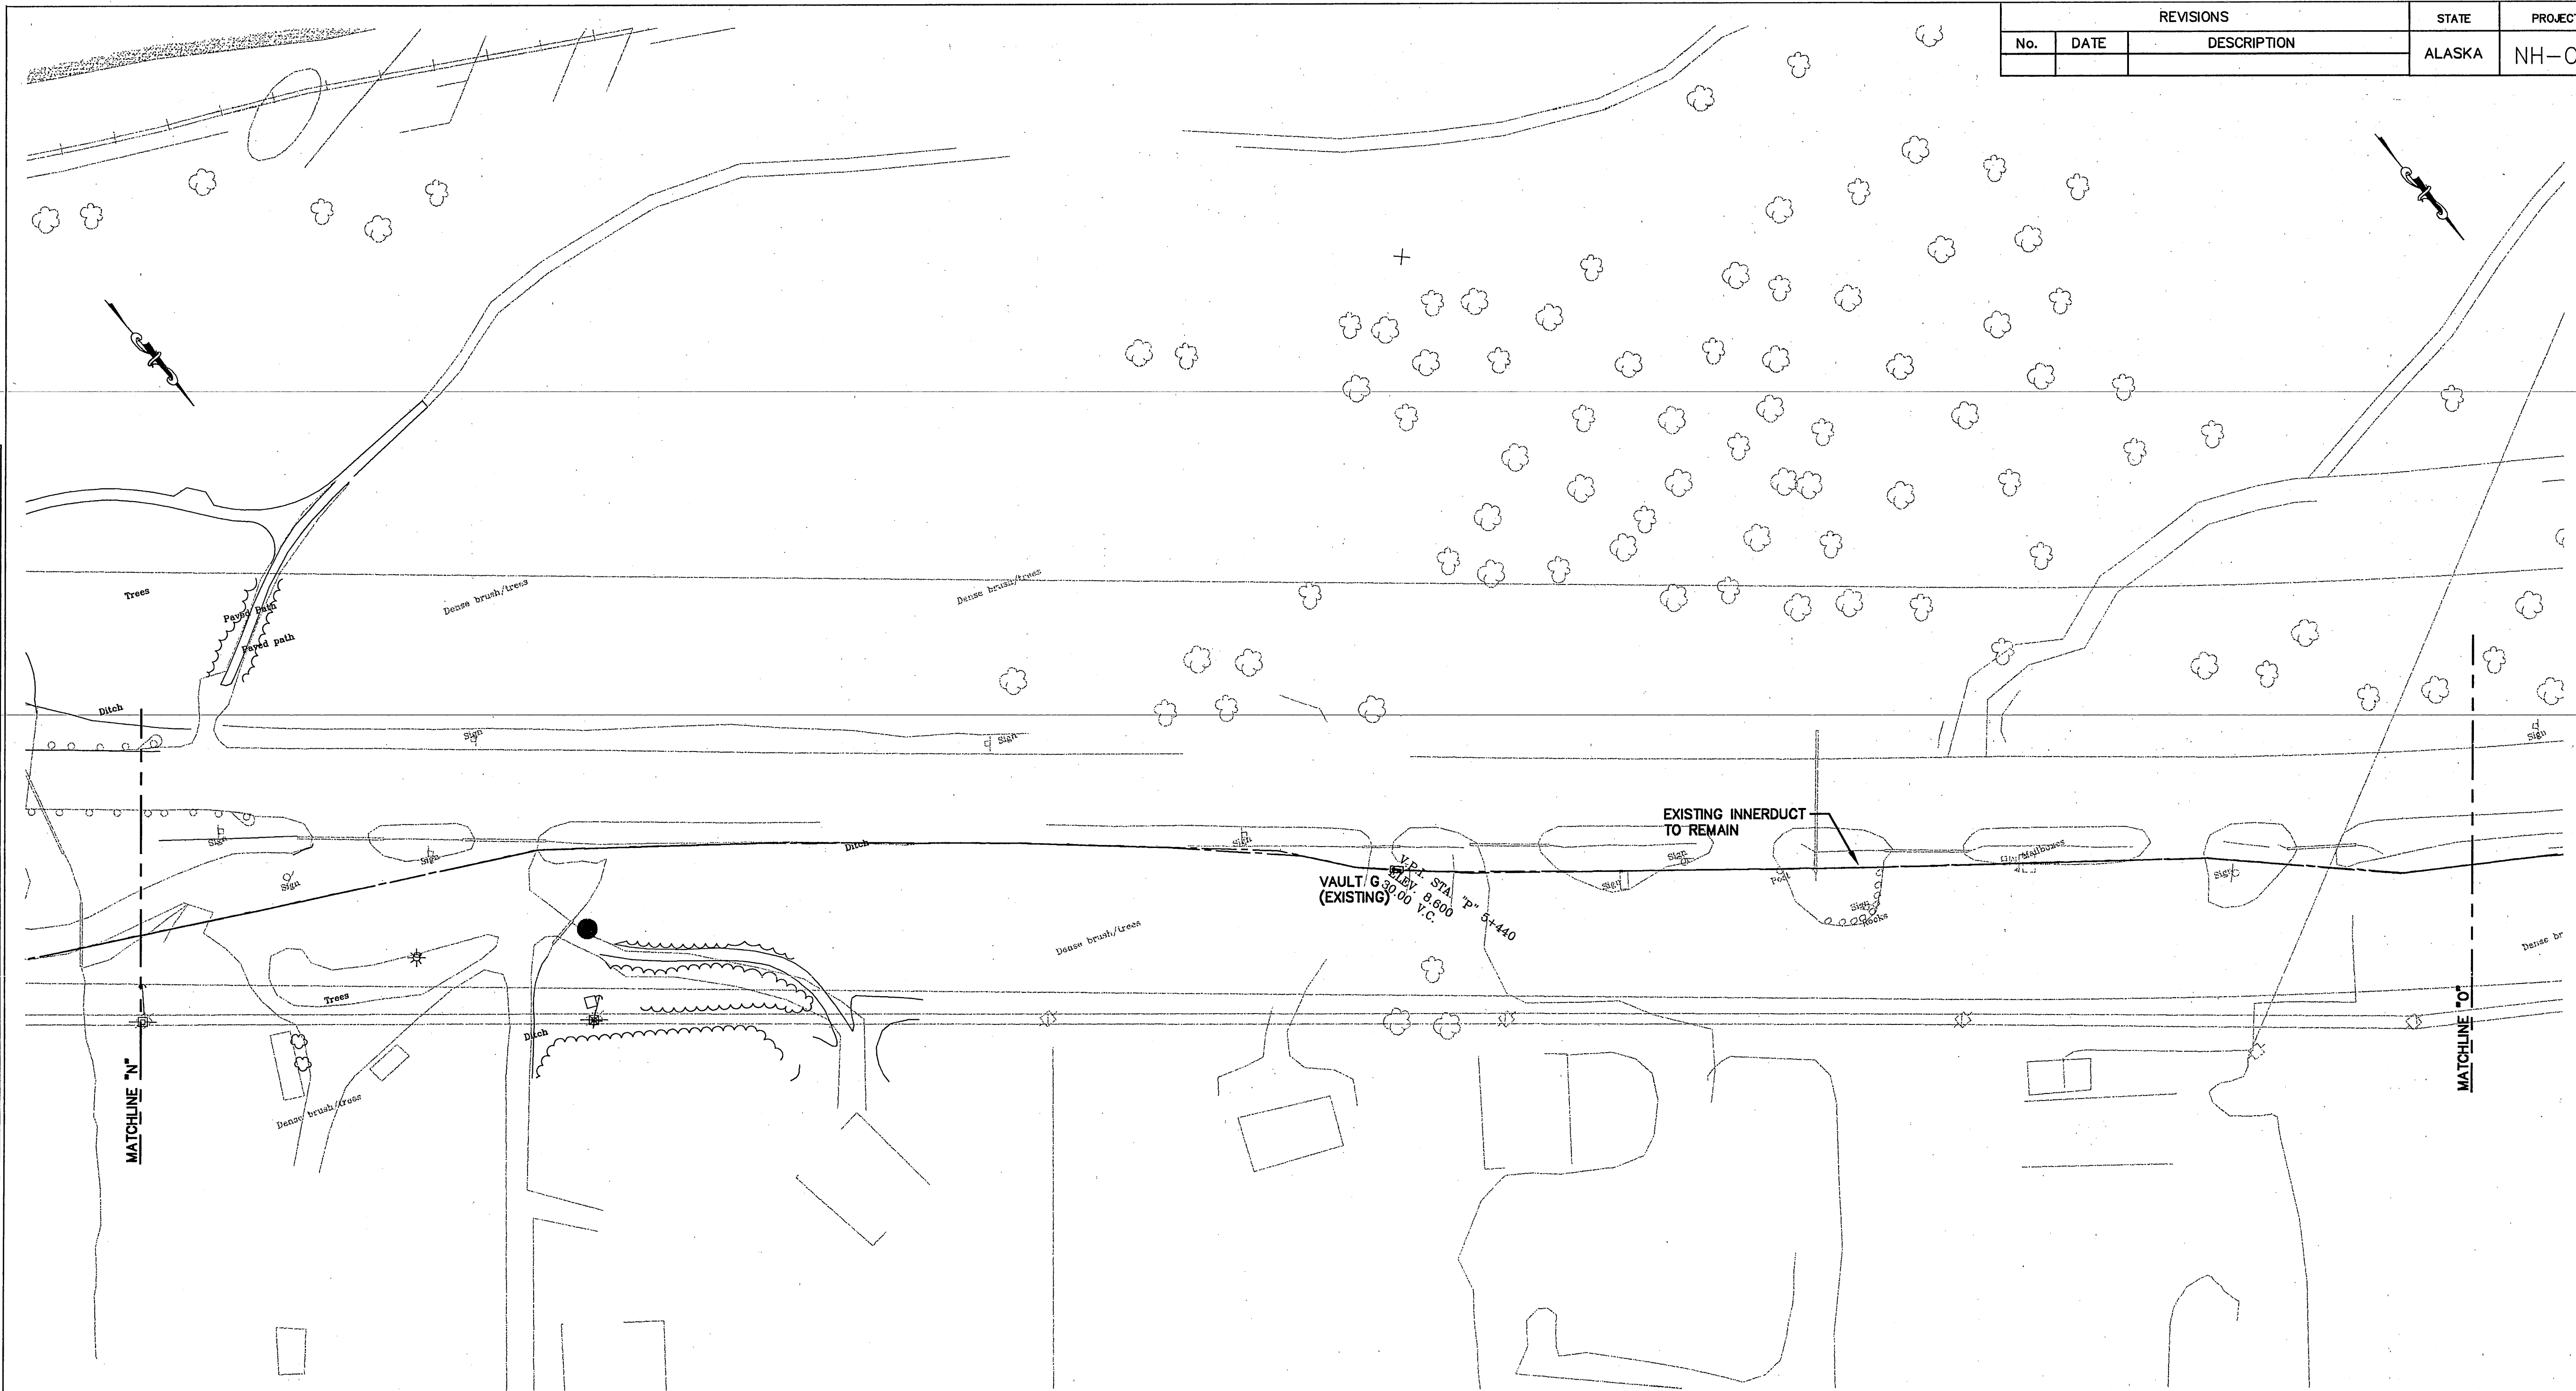


REVISIONS			STATE	PROJECT DESIGNATION	YEAR	SHEET NO.	TOTAL SHEETS
No.	DATE	DESCRIPTION	ALASKA	NH-0A3-1(28)	2002	U17	U23

VICINITY MAP


CALL BEFORE YOU DIG!

LOCATE CALL CENTER OF ALASKA (LCCA)
ANCHORAGE AREA.....278-3121
STATEWIDE.....800-478-3121
ALASKA RAILROAD.....265-2520
KULIS AIR BASE.....249-1499
MILITARY PETROLEUM FUEL LINES.....552-3760
STATE STORM DRAINS & STREET LIGHTS.....333-2411

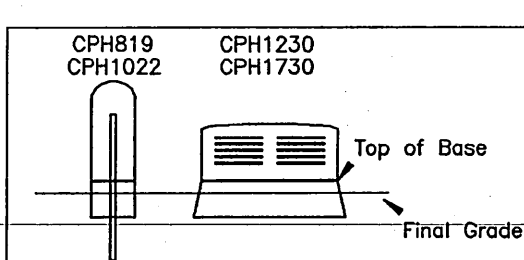

GCI Pedestal Detail



Top of base is to be 2-3 inches above final grade on all pedestals.

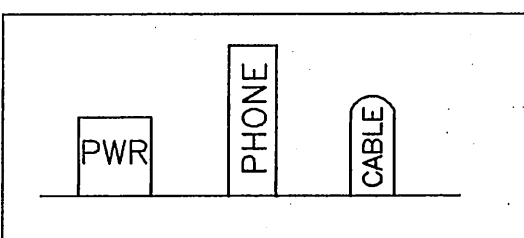

GCI Cable Ped Placement

GCI peds are to be set 2'-3' from phone peds opposite of power peds. Where there are no phone peds, GCI peds are to be minimum 6' from power.

NOT TO SCALE

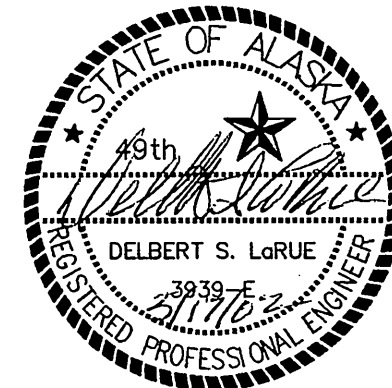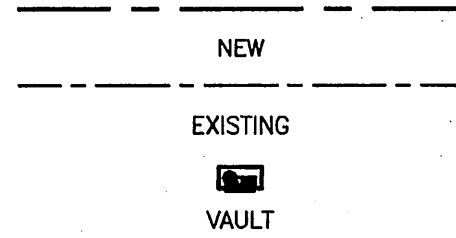

NOTE:
Offsets given are at every 50m station or 100m station unless otherwise noted

Station offset reference point →

DRAWN BY: _____ DATE: _____
DESIGNER/PROJECT ENGINEER: _____ JOB #: _____

NO.	DESIGN/CONSTRUCTION/ASBUILT REVISION	DWN BY/DATE
0	ISSUED FOR CONSTRUCTION	RAE/5-16-02

0	X POWER POLE	0	X-X SET ANCHOR	0	AERIAL SUBS EXISTING
0	⊗ JOINT USE POLE	0	X-SID WALK ANCHOR	0	AERIAL SUBS POTENTIAL
0	⊙ CATV POLE	0	X-STRUT ANCHOR	0	UG SUBS EXISTING
0	○ TELEPHONE POLE	0	X-EXTENSION ARM	0	UG SUBS POTENTIAL
0	○ CONCRETE POLE	0		0	MULTI UNIT SUBS
0	△ PRIVATE POLE	0		0	TOTAL EXISTING SUBS
0	○M METAL POLE	0		0	TOTAL POTENTIAL SUBS
0	X-EXISTING ANCHOR	0.00	TOTAL MILEAGE	0	COMMERCIAL SUBS



5151 Fairbanks Street
Anchorage, Alaska
99503

STATE OF ALASKA
DEPARTMENT OF TRANSPORTATION
AND
PUBLIC FACILITIES
SEWARD HIGHWAY
MP 96 TO MP 102
SAFETY, ROADWAY AND
RECREATIONAL IMPROVEMENTS

SPECIFICATIONS
STANDARDS
COMPUTER DESIGNATION
VIEW ALL
DESIGNED BY
CHECKED BY
DRAFTED BY
AUTOCAD-CAROLEE-MARC/MBDR
1/28/02
CJ




REVISIONS			STATE	PROJECT DESIGNATION	YEAR	SHEET NO.	TOTAL SHEETS
No.	DATE	DESCRIPTION	ALASKA	NH-0A3-1(28)	2002	U18	U23

VICINITY MAP


CALL BEFORE YOU DIG!

LOCATE CALL CENTER OF ALASKA (LCCA)
ANCHORAGE AREA.....278-3121
STATEWIDE.....800-478-3121
ALASKA RAILROAD.....265-2520
KULIS AIR BASE.....249-1499
MILITARY PETROLEUM FUEL LINES.....552-3760
STATE STORM DRAINS & STREET LIGHTS.....333-2411

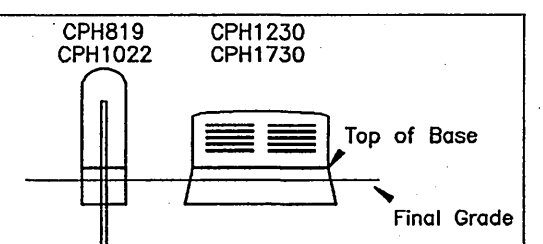

GCI Pedestal Detail


Top of base is to be 2-3 inches above final grade on all pedestals.

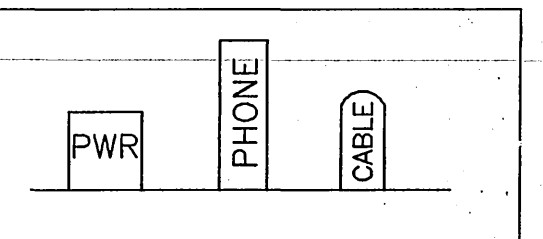

GCI Cable Ped Placement

GCI peds are to be set 2'-3' from phone peds opposite of power peds. Where there are no phone peds, GCI peds are to be minimum 6' from power.

NOT TO SCALE

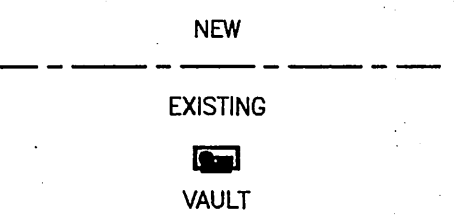

NOTE:
Offsets given are at every 50m station or 100m station unless otherwise noted

Station offset reference point →

DRAWN BY: _____ DATE: _____
DESIGNER/PROJECT ENGINEER: _____ JOB #: _____

NO.	DESIGN/CONSTRUCTION/ASBUILT REVISION	DWN BY/DATE
0	ISSUED FOR CONSTRUCTION	RAE/5-16-02

0	✕ POWER POLE	0	✕ SET ANCHOR	0	AERIAL SUBS EXISTING
0	⊗ JOINT USE POLE	0	✕ SIDEWALK ANCHOR	0	AERIAL SUBS POTENTIAL
0	⊙ CATV POLE	0	✕ STRUT ANCHOR	0	UG SUBS EXISTING
0	○ TELEPHONE POLE	0	✕ EXTENSION ARM	0	UG SUBS POTENTIAL
0	○ CONCRETE POLE	0	○ AERIAL FOOTAGE	0	MULTI UNIT SUBS
0	△ PRIVATE POLE	0	○ UG FOOTAGE	0	TOTAL EXISTING SUBS
0	○ METAL POLE	0	○ TOTAL FOOTAGE	0	TOTAL POTENTIAL SUBS
0	✕ EXISTING ANCHOR	0.00	○ TOTAL MILEAGE	0	COMMERCIAL SUBS




5151 Fairbanks Street
Anchorage, Alaska
99503

STATE OF ALASKA
DEPARTMENT OF TRANSPORTATION
AND
PUBLIC FACILITIES
SEWARD HIGHWAY
MP 96 TO MP 102
SAFETY, ROADWAY AND
RECREATIONAL IMPROVEMENTS

SPECIFICATIONS
STANDARDS
COMPUTER DESIGNATION
DESIGNED BY
CHECKED BY
DRAFTED BY
VIEW ALL
AUTOCAD-CAROL-EE-MARC-MBR
1/29/02


REVISIONS			STATE	PROJECT DESIGNATION	YEAR	SHEET NO.	TOTAL SHEETS
No.	DATE	DESCRIPTION	ALASKA	NH-0A3-1(28)	2002	U19	U23

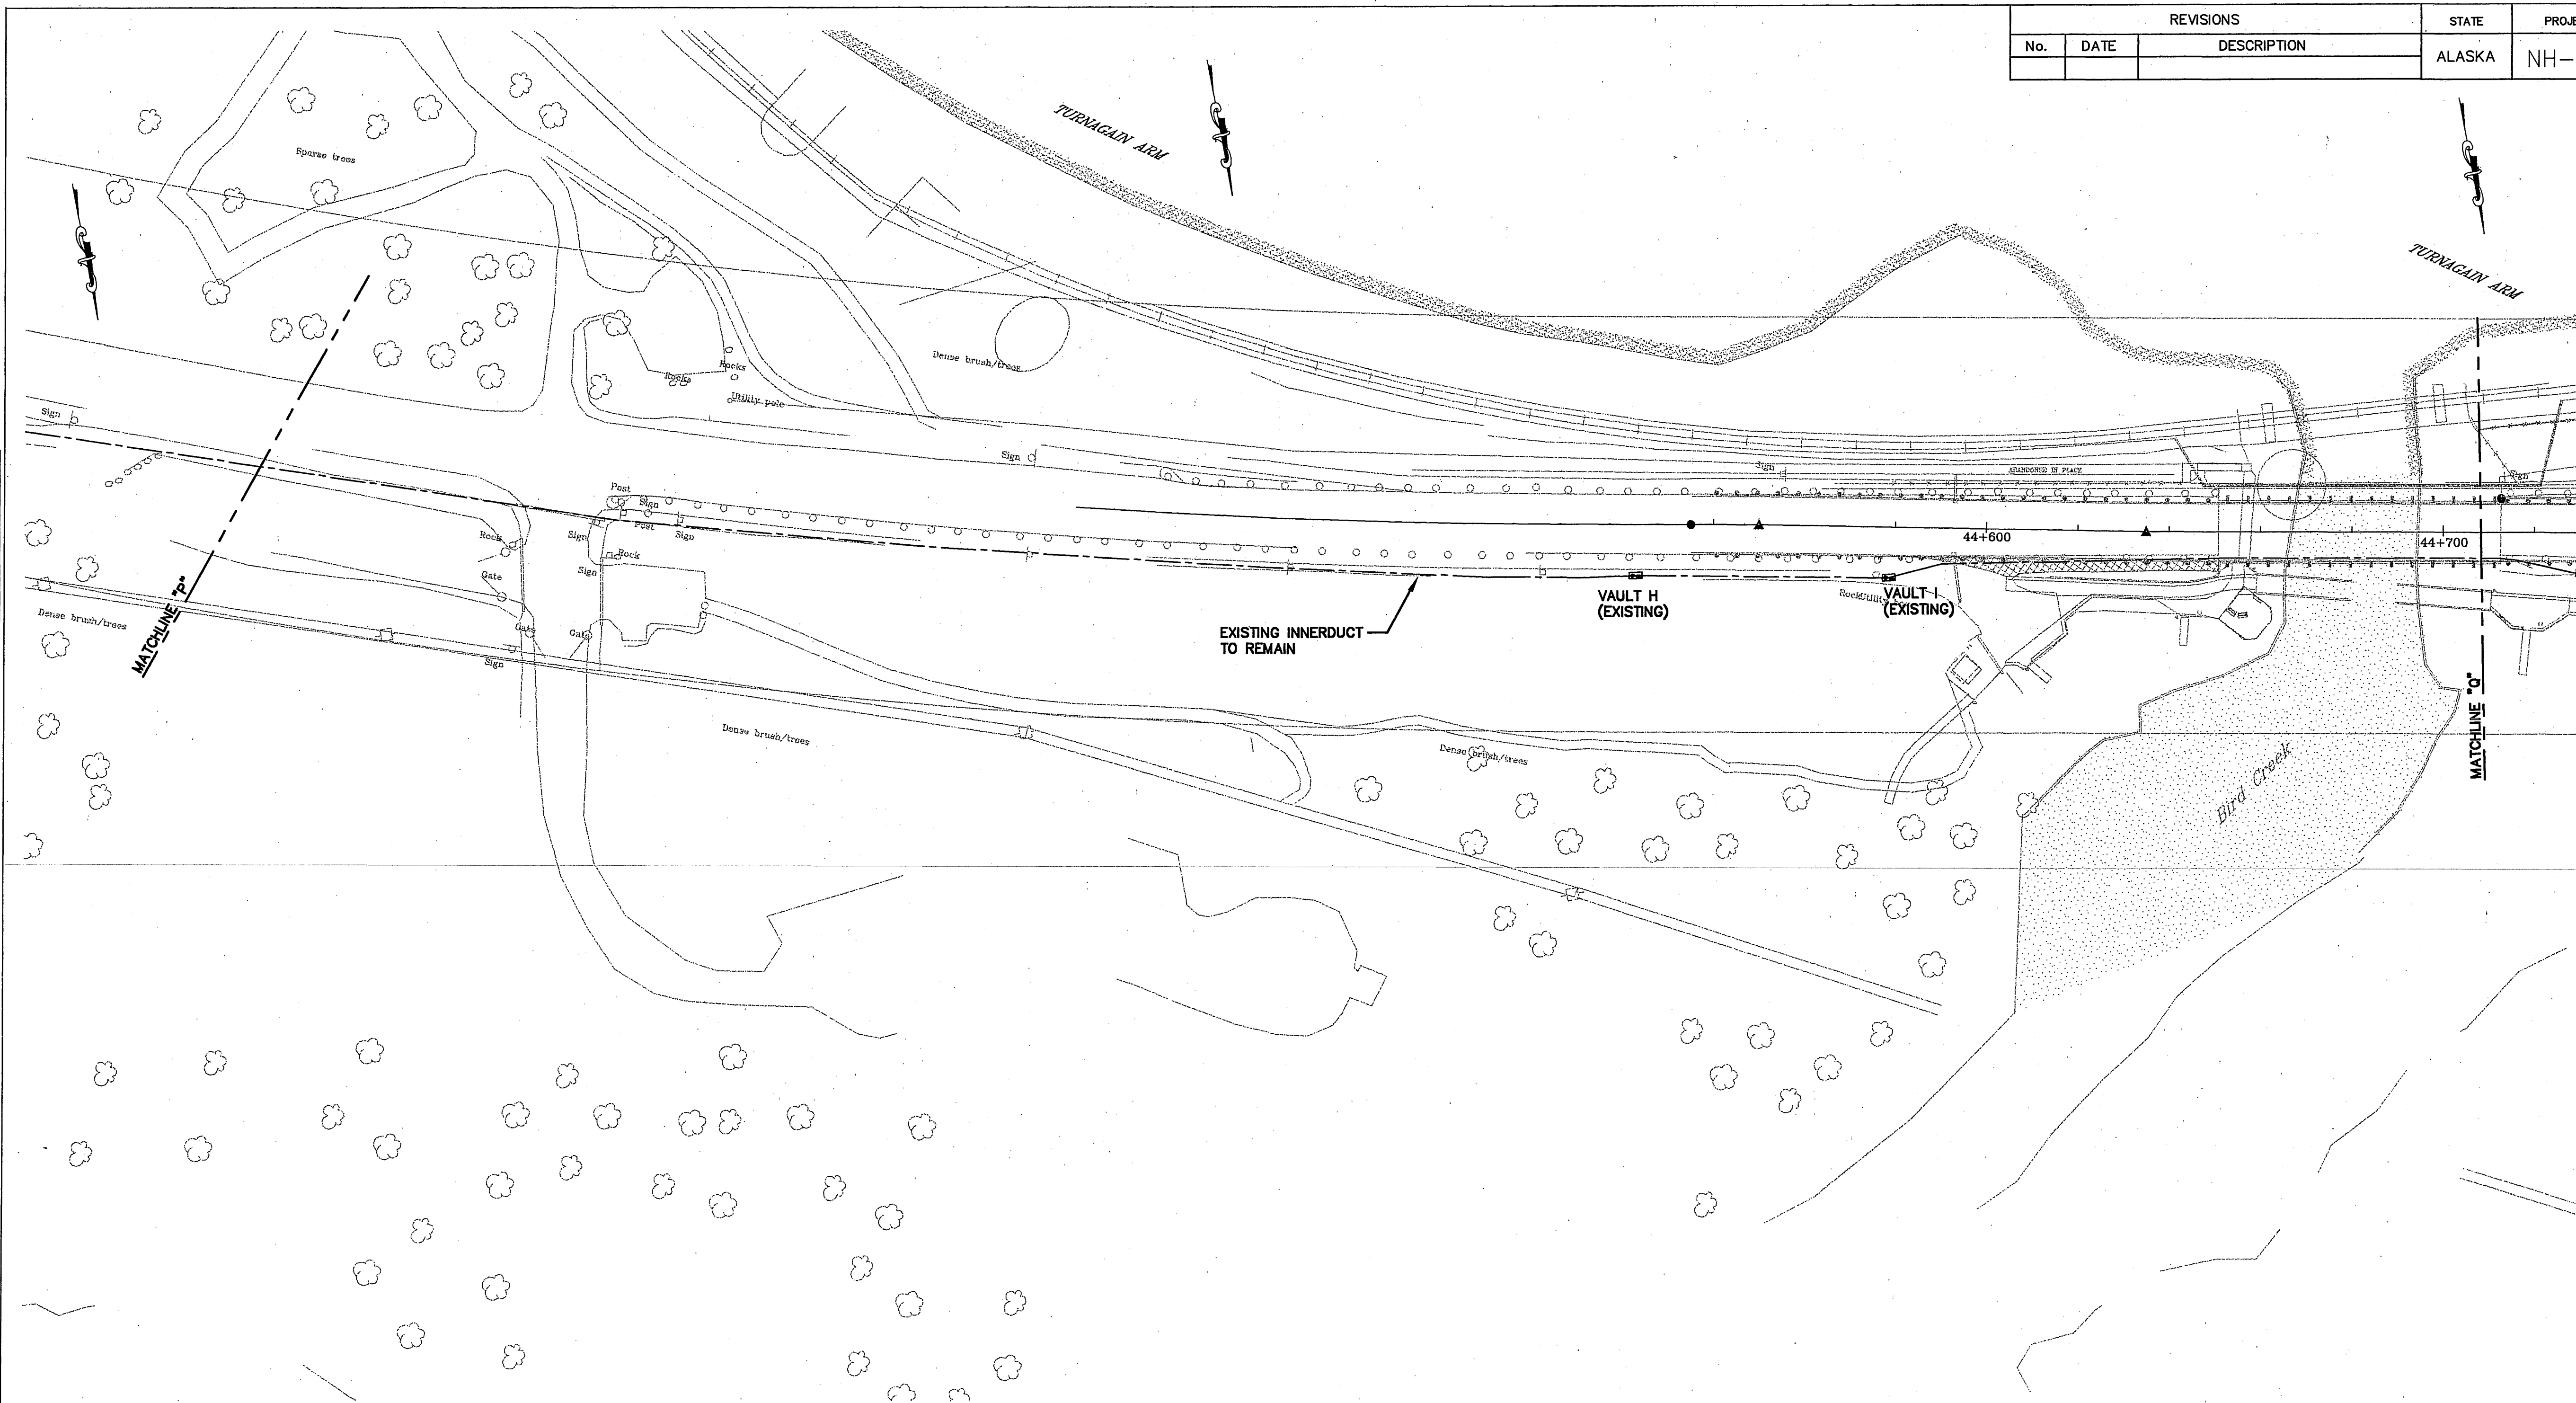

VICINITY MAP


CALL BEFORE YOU DIG!

LOCATE CALL CENTER OF ALASKA (LCCA)
ANCHORAGE AREA..... 278-3121
STATEWIDE.....800-478-3121
ALASKA RAILROAD.....265-2520
KULIS AIR BASE.....249-1499
MILITARY PETROLEUM FUEL LINES.....552-3760
STATE STORM DRAINS & STREET LIGHTS.....333-2411

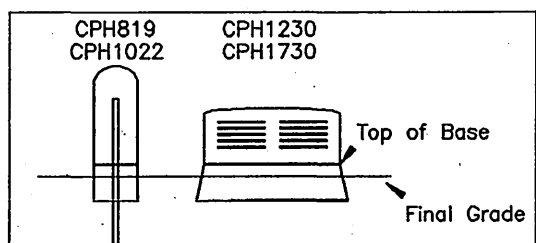

GCI Pedestal Detail



Top of base is to be 2-3 inches above final grade on all pedestals.

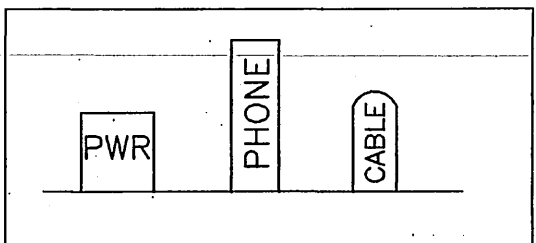

GCI Cable Ped Placement

GCI peds are to be set 2'-3' from phone peds opposite of power peds. Where there are no phone peds, GCI peds are to be minimum 6' from power.

NOT TO SCALE

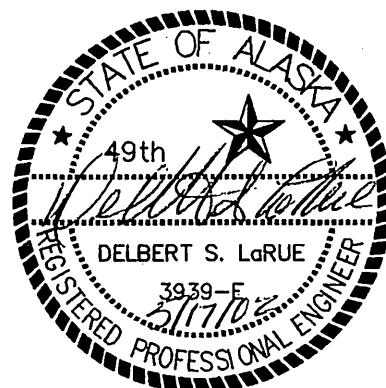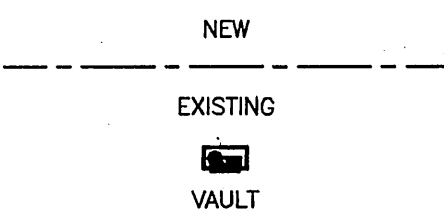

NOTE:
Offsets given are at every 50m station or 100m station unless otherwise noted

Station offset reference point

DRAWN BY: _____ DATE: _____
DESIGNER/PROJECT ENGINEER: _____ JOB #: _____

NO.	DESIGN/CONSTRUCTION/ASBUILT REVISION	DWN BY/DATE
0	ISSUED FOR CONSTRUCTION	RAE/5-16-02

0	X POWER POLE	0	X-X SET ANCHOR	0	AERIAL SUBS EXISTING
0	⊗ JOINT USE POLE	0	X- SIDEWALK ANCHOR	0	AERIAL SUBS POTENTIAL
0	⊙ CATV POLE	0	X- STRUT ANCHOR	0	UG SUBS EXISTING
0	○ TELEPHONE POLE	0	X- EXTENSION ARM	0	UG SUBS POTENTIAL
0	○ CONCRETE POLE	0	AERIAL FOOTAGE	0	MULTI UNIT SUBS
0	△ PRIVATE POLE	0	UG FOOTAGE	0	TOTAL EXISTING SUBS
0	○M METAL POLE	0	TOTAL FOOTAGE	0	TOTAL POTENTIAL SUBS
0	X- EXISTING ANCHOR	0.00	TOTAL MILEAGE	0	COMMERCIAL SUBS



5151 Fairbanks Street
Anchorage, Alaska
99503

STATE OF ALASKA
DEPARTMENT OF TRANSPORTATION
AND
PUBLIC FACILITIES
SEWARD HIGHWAY
MP 96 TO MP 102
SAFETY, ROADWAY AND
RECREATIONAL IMPROVEMENTS