

Ref. P.T. 7

ERFO-2(1)

Kenai River Bridge
to Forest Boundary

CROSS SECTION BOOK

82 0056

65.01.04 STERLING HWY: COOPER LANDING to SKILAK LAKE RD


June 65

Sta.

606+94³⁶ P.I.

602+94²³ P.C.

6/26/65
+ 52° F
C. 10000

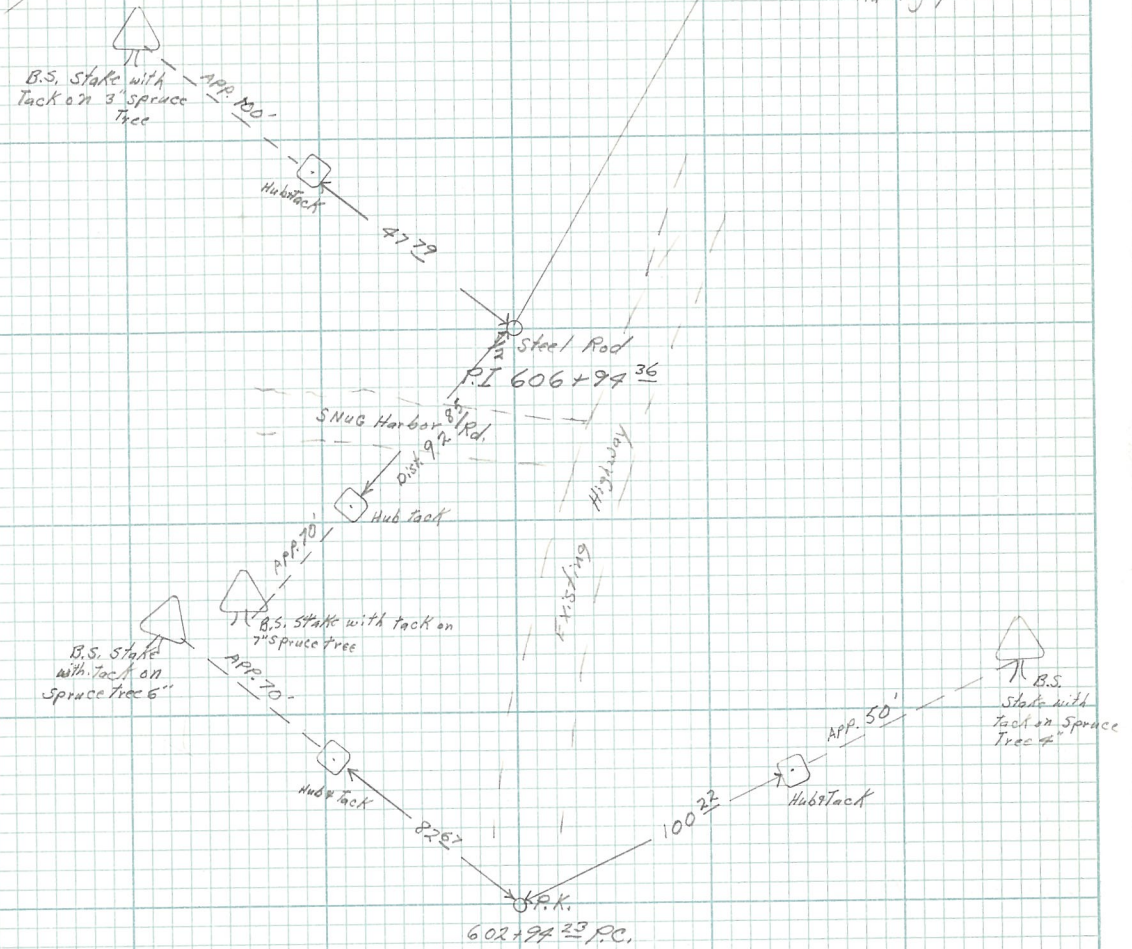

sta.


610+38.52 P.T.

6/26/65

2

Same crew

(9)

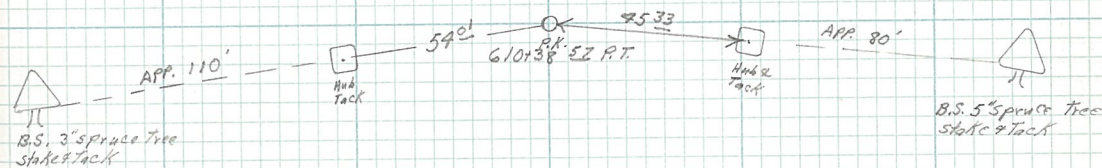


635+72²⁷ P.I.#2

631+09⁷⁵ P.C.


20

Same Crew

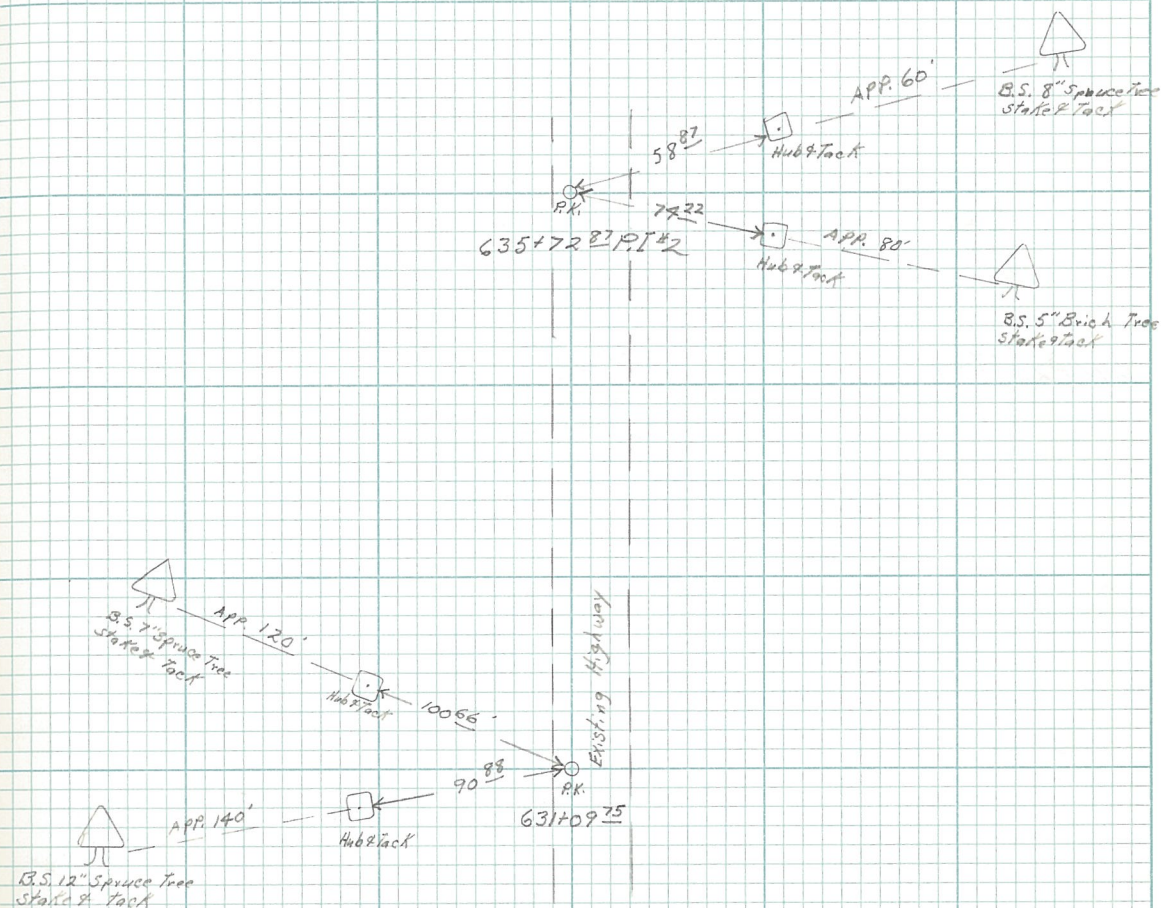

$$640 + 28 \stackrel{0.3}{=} \text{PT}$$

Same crew

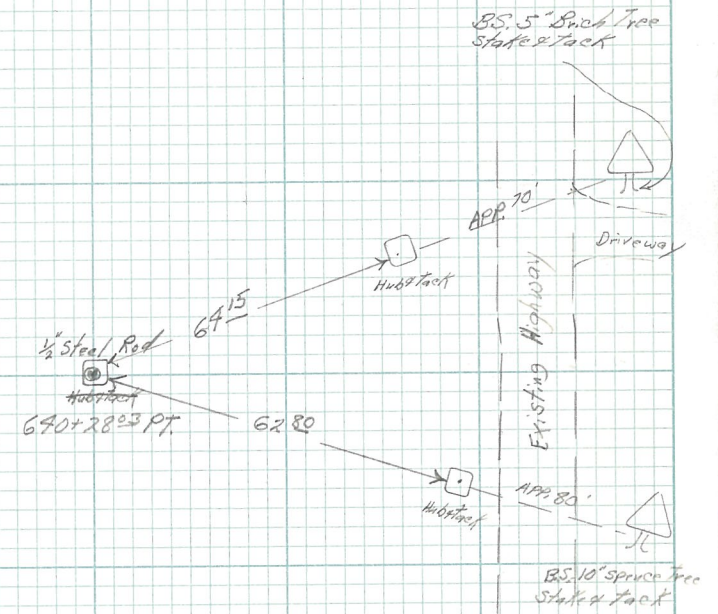


Sta.

691+54⁰³ P.O.T.

6/26/65

R

Same crew

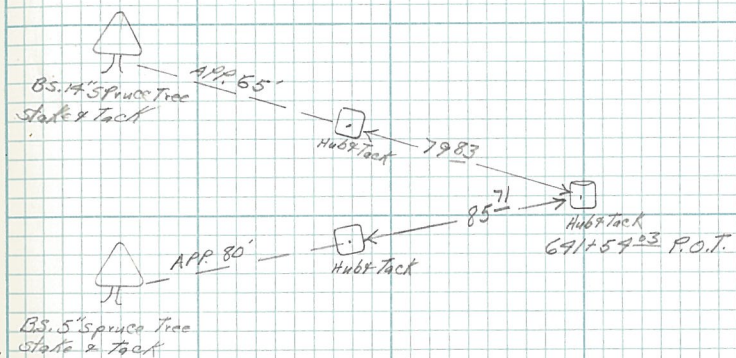

Sta


675+38th PC

6/29/65

+ 52' of
Clear

2

Huling T
Noel T
Piedra T

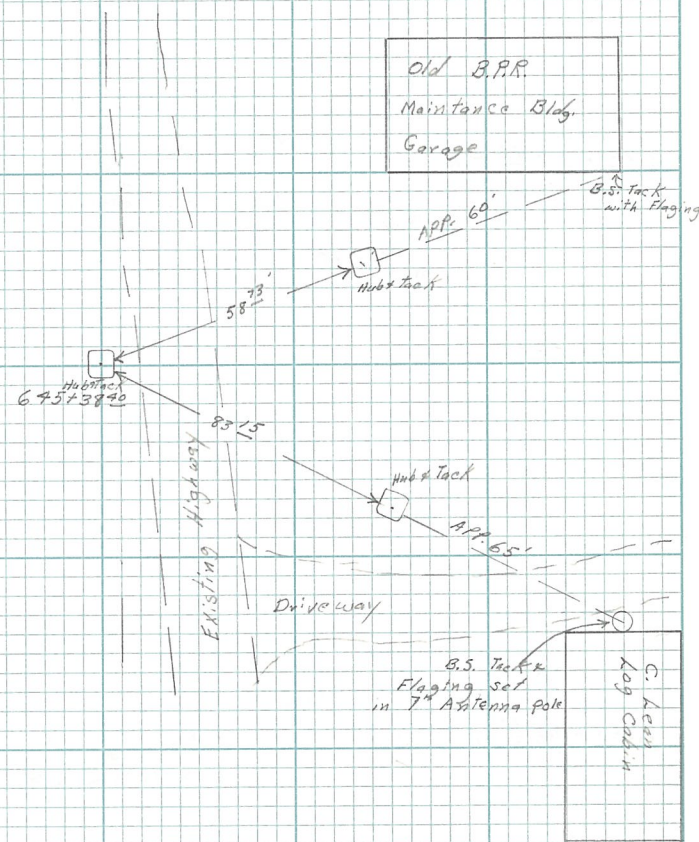

Sta.



652+09^{±3} P.T.

648+74^{±30} P.I. #3

6/28/65

R

Same Crew

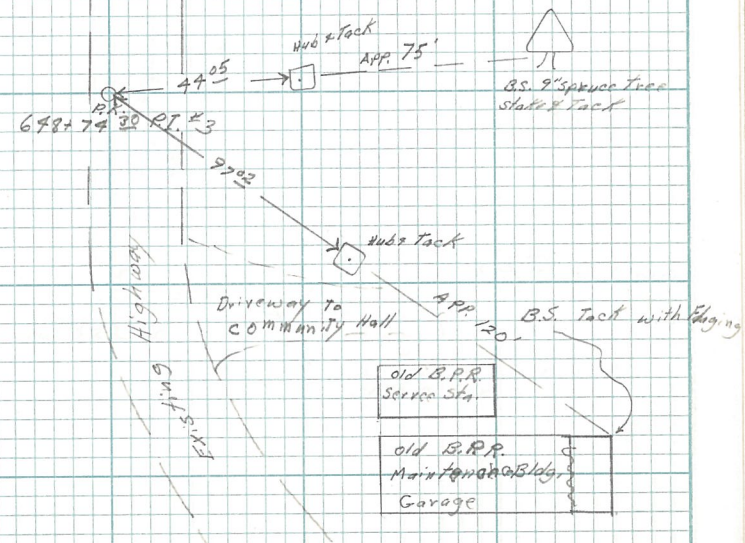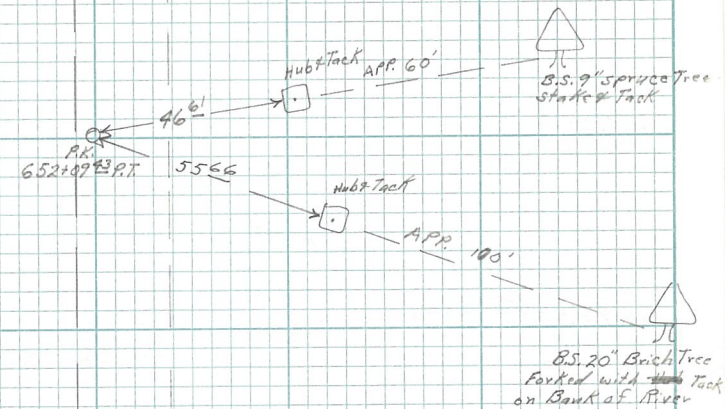


Sta

667+53.50 P.I. #4

661+52.37 P.C.

6/29/65
#5508

Same Crew

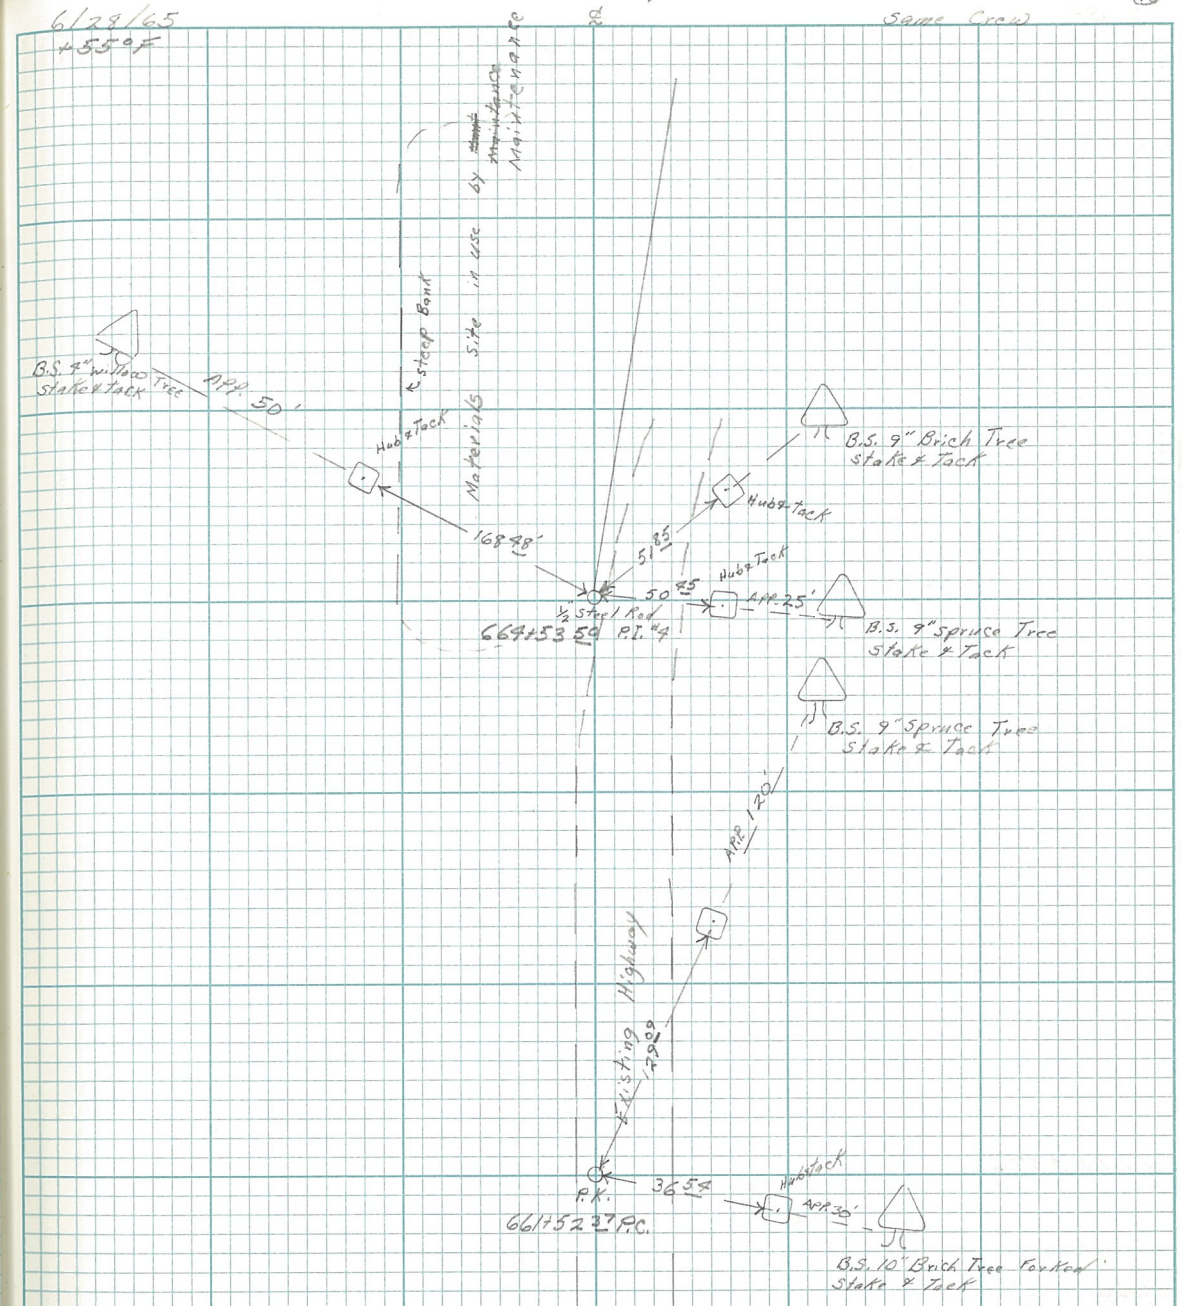

Sta

671+49²² P.O.T.


667+52⁴⁴ P.T.

6/28/65

2

Same crew

(11)

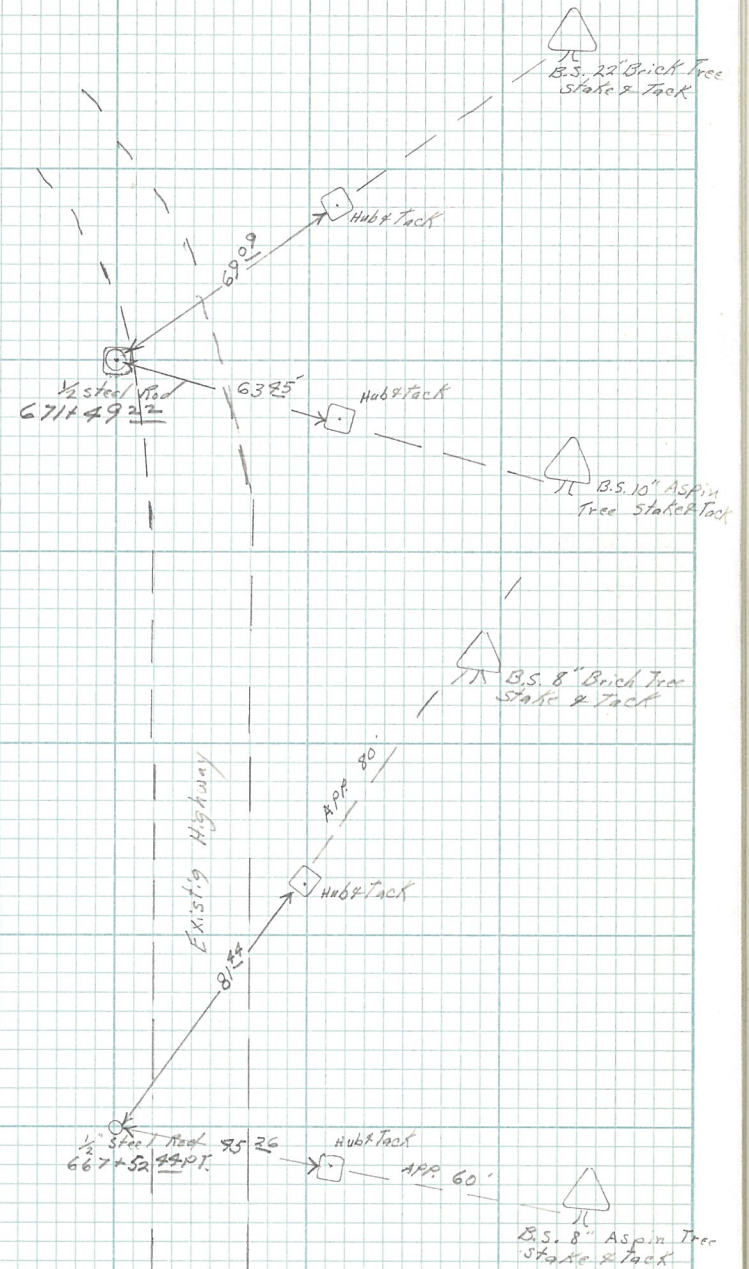


570.

676+85¹² P.O.T.

6/28/65
+60.25

Same Crew

(12)

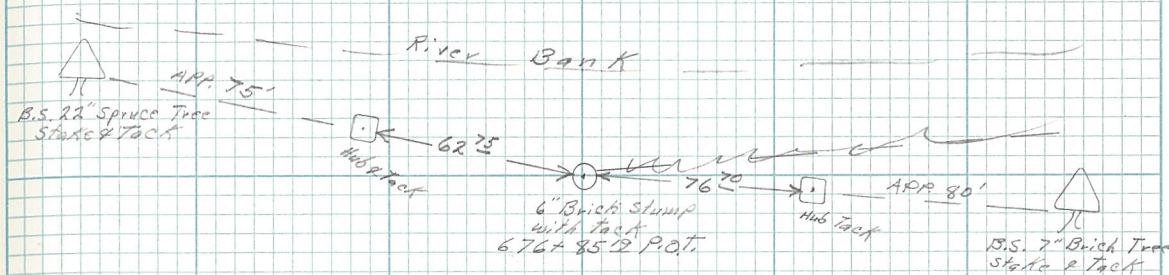

Sta.

693+38.18 P.I.


690+95.35 P.I.

6/28/65

8

same crew

(10)

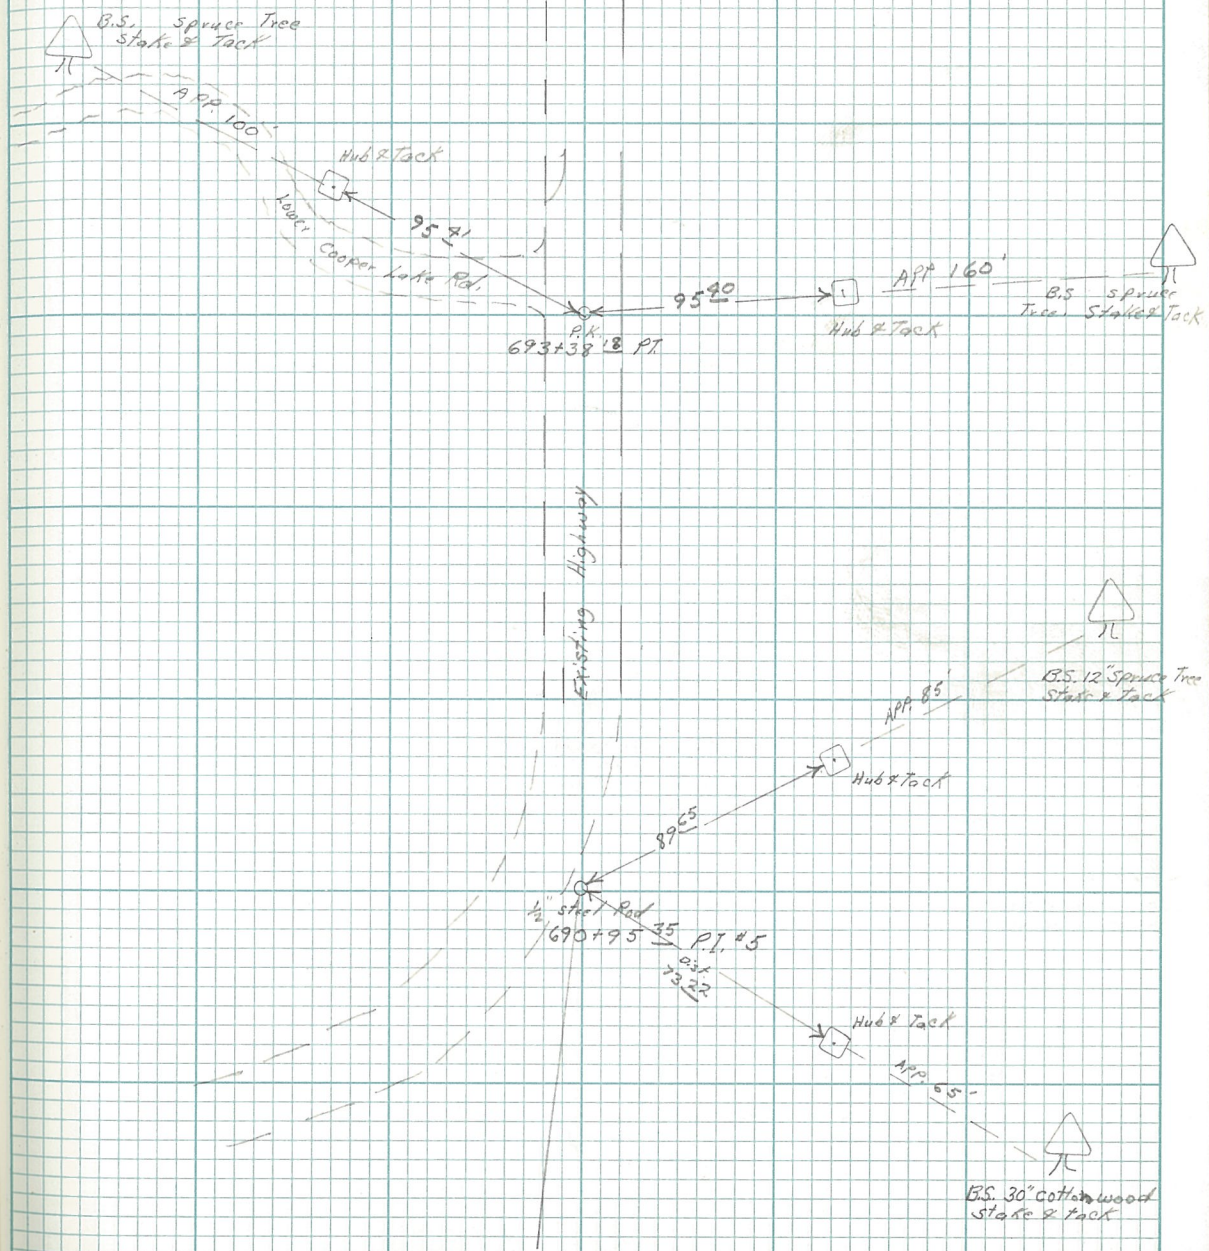

Sta


702+45.78 P.C.

6/29/65

+45°F
cloudy

R

702+45.78
Nce
702+45.78

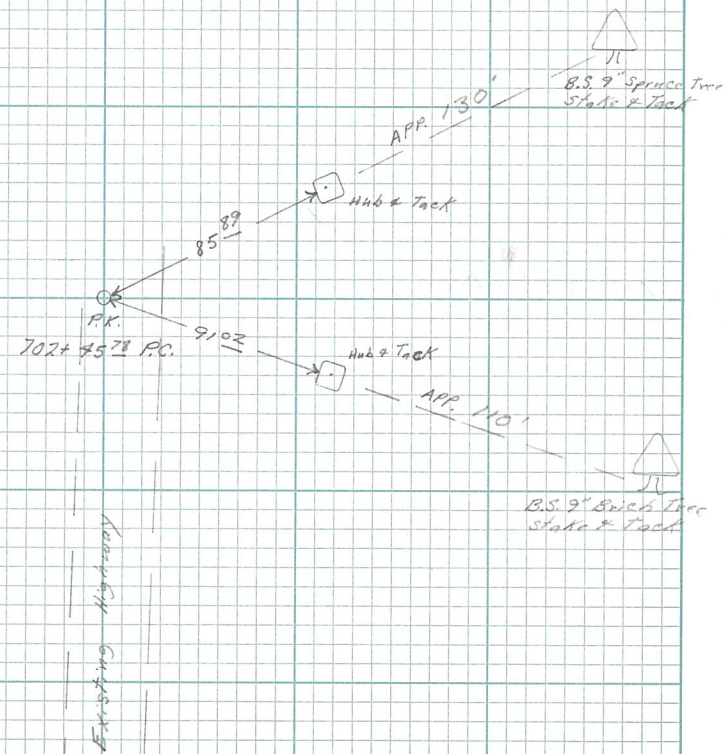

Sta.


715+28.93 P.C.

711+24.18 P.T.

6-29-65

7

Same crew

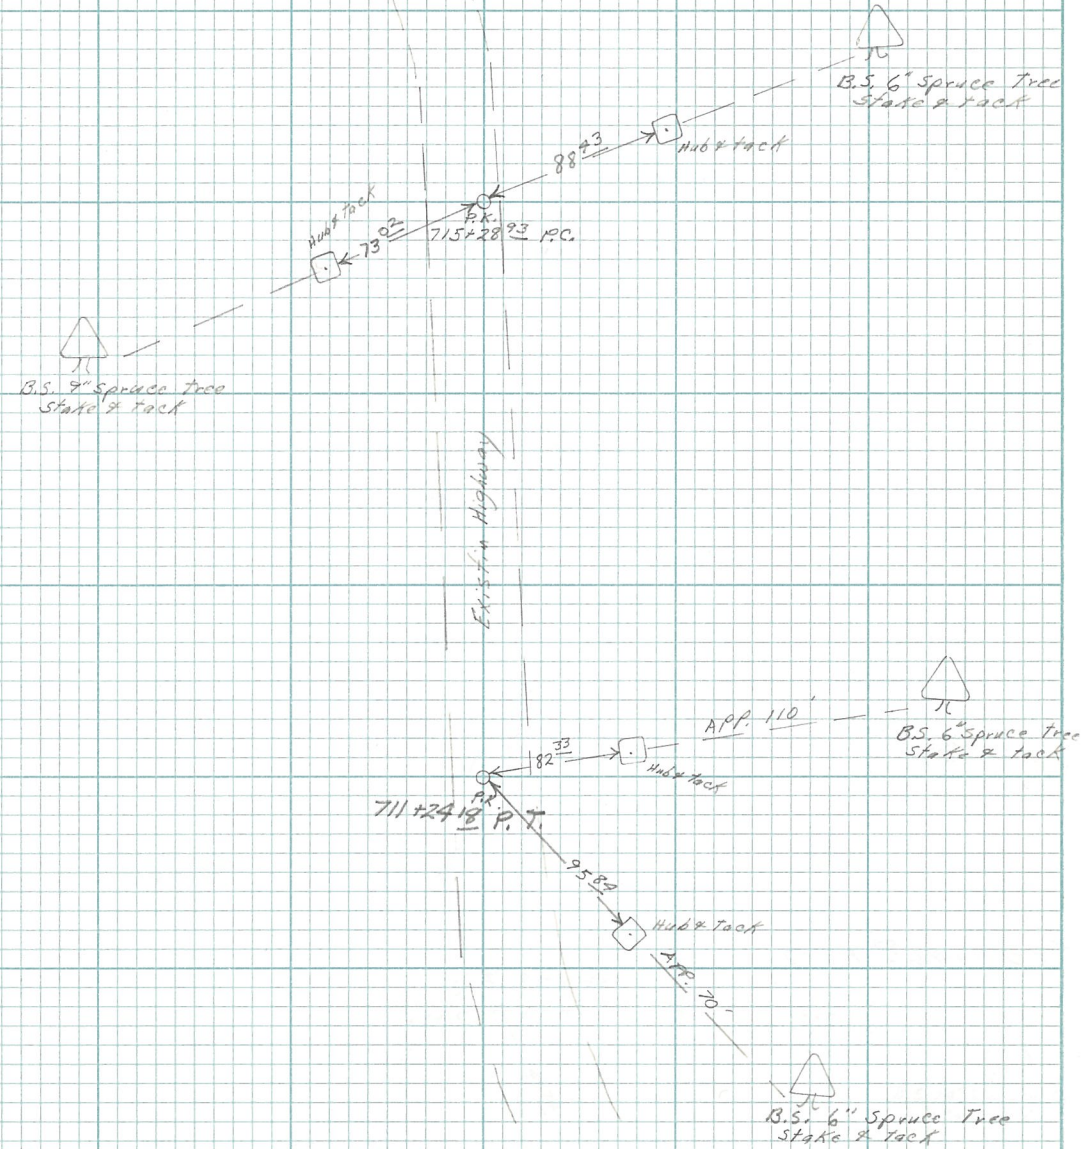

Sta


720+86²⁷ P.I. #7

6-29-65

2

same crew

10

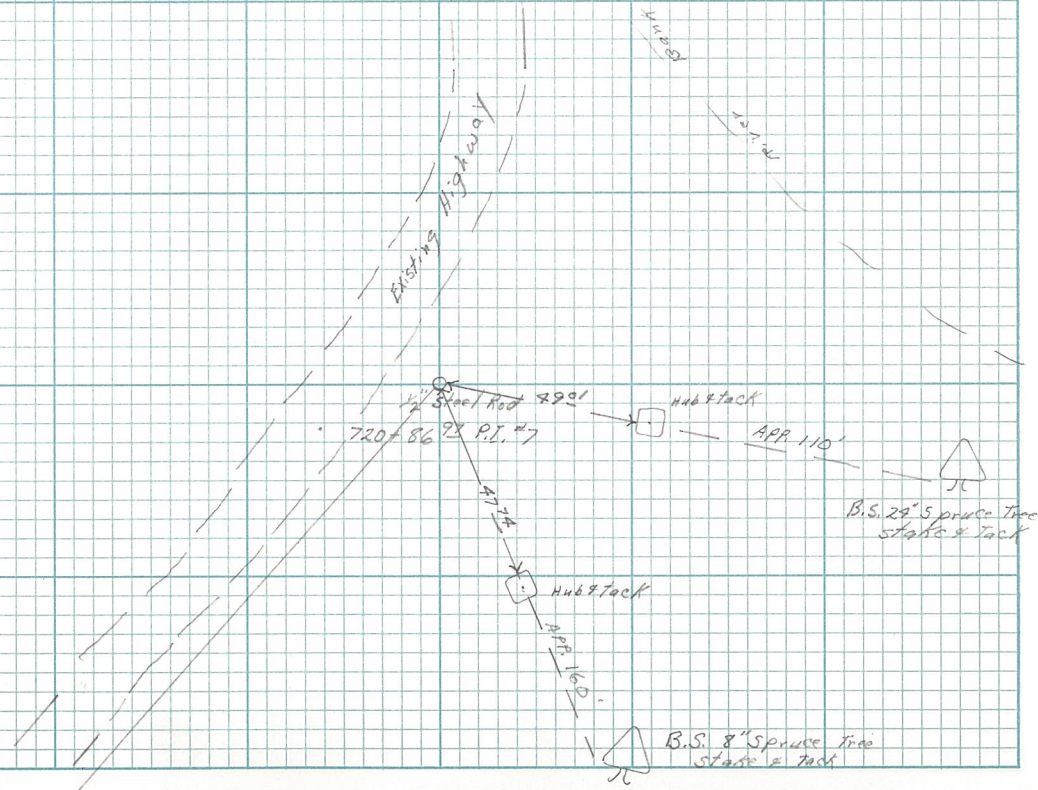

Sta.

751+15⁶⁹ P.O.T.

738+50⁷⁸ P.T.

6-29-65

SAM CRAW

(20)



B.S. 12 Spruce Tree
State & tack

APP 250'

Dump

Hub & Tack
Forest Service
Dump Rd.
13536

P.O.T. 751+15⁶⁹

5923



B.S. 32" Cottonwood Tree
State & tack



B.S. 14" Birch Tree
State & tack

APP 110'

Cooper Creek Campground Rd.
16529

Existing Highway

Hub & Tack
APP 55'



B.S. 18" Spruce Tree
State & tack

P.K.
738+50⁷⁸

Bridge

Bridge

Cooper Creek

Sta


766+50⁶⁹ P.C.

760+68⁵⁸ P.O.T.

6-29-65

same crew

(31)

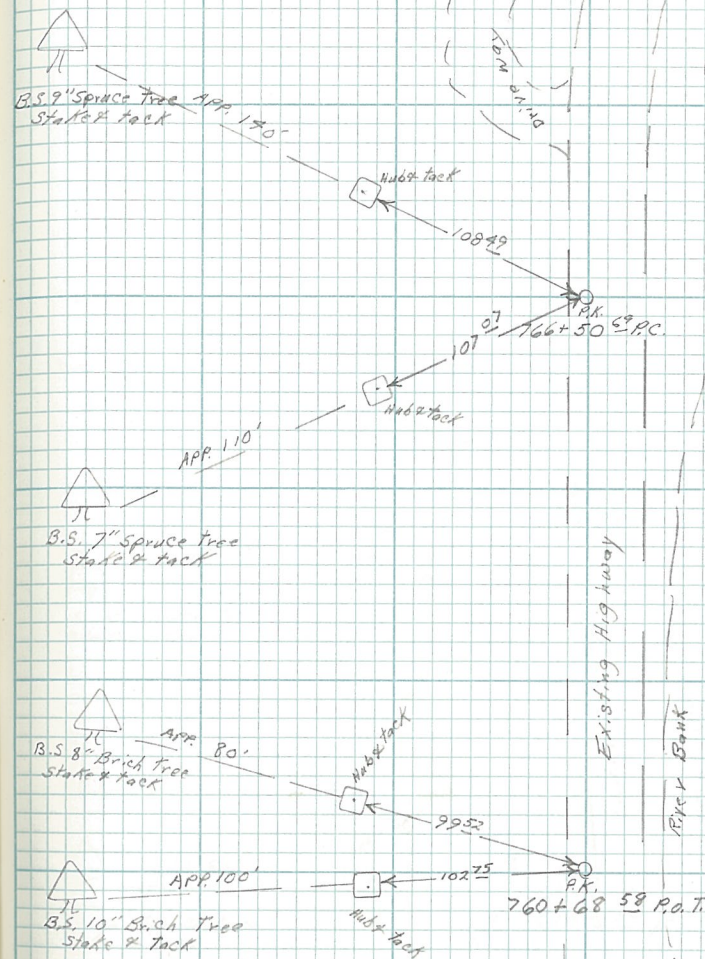

Sta.

777+51¹³ P.C.

772+98²⁸ P.T.

769+75⁵⁴ P.I.#9

6-29-65

2

Same crew

22

