


AT
PORT LIONS, ALASKA

True Meridian

Mean
Magnetic
Declination
19° E.

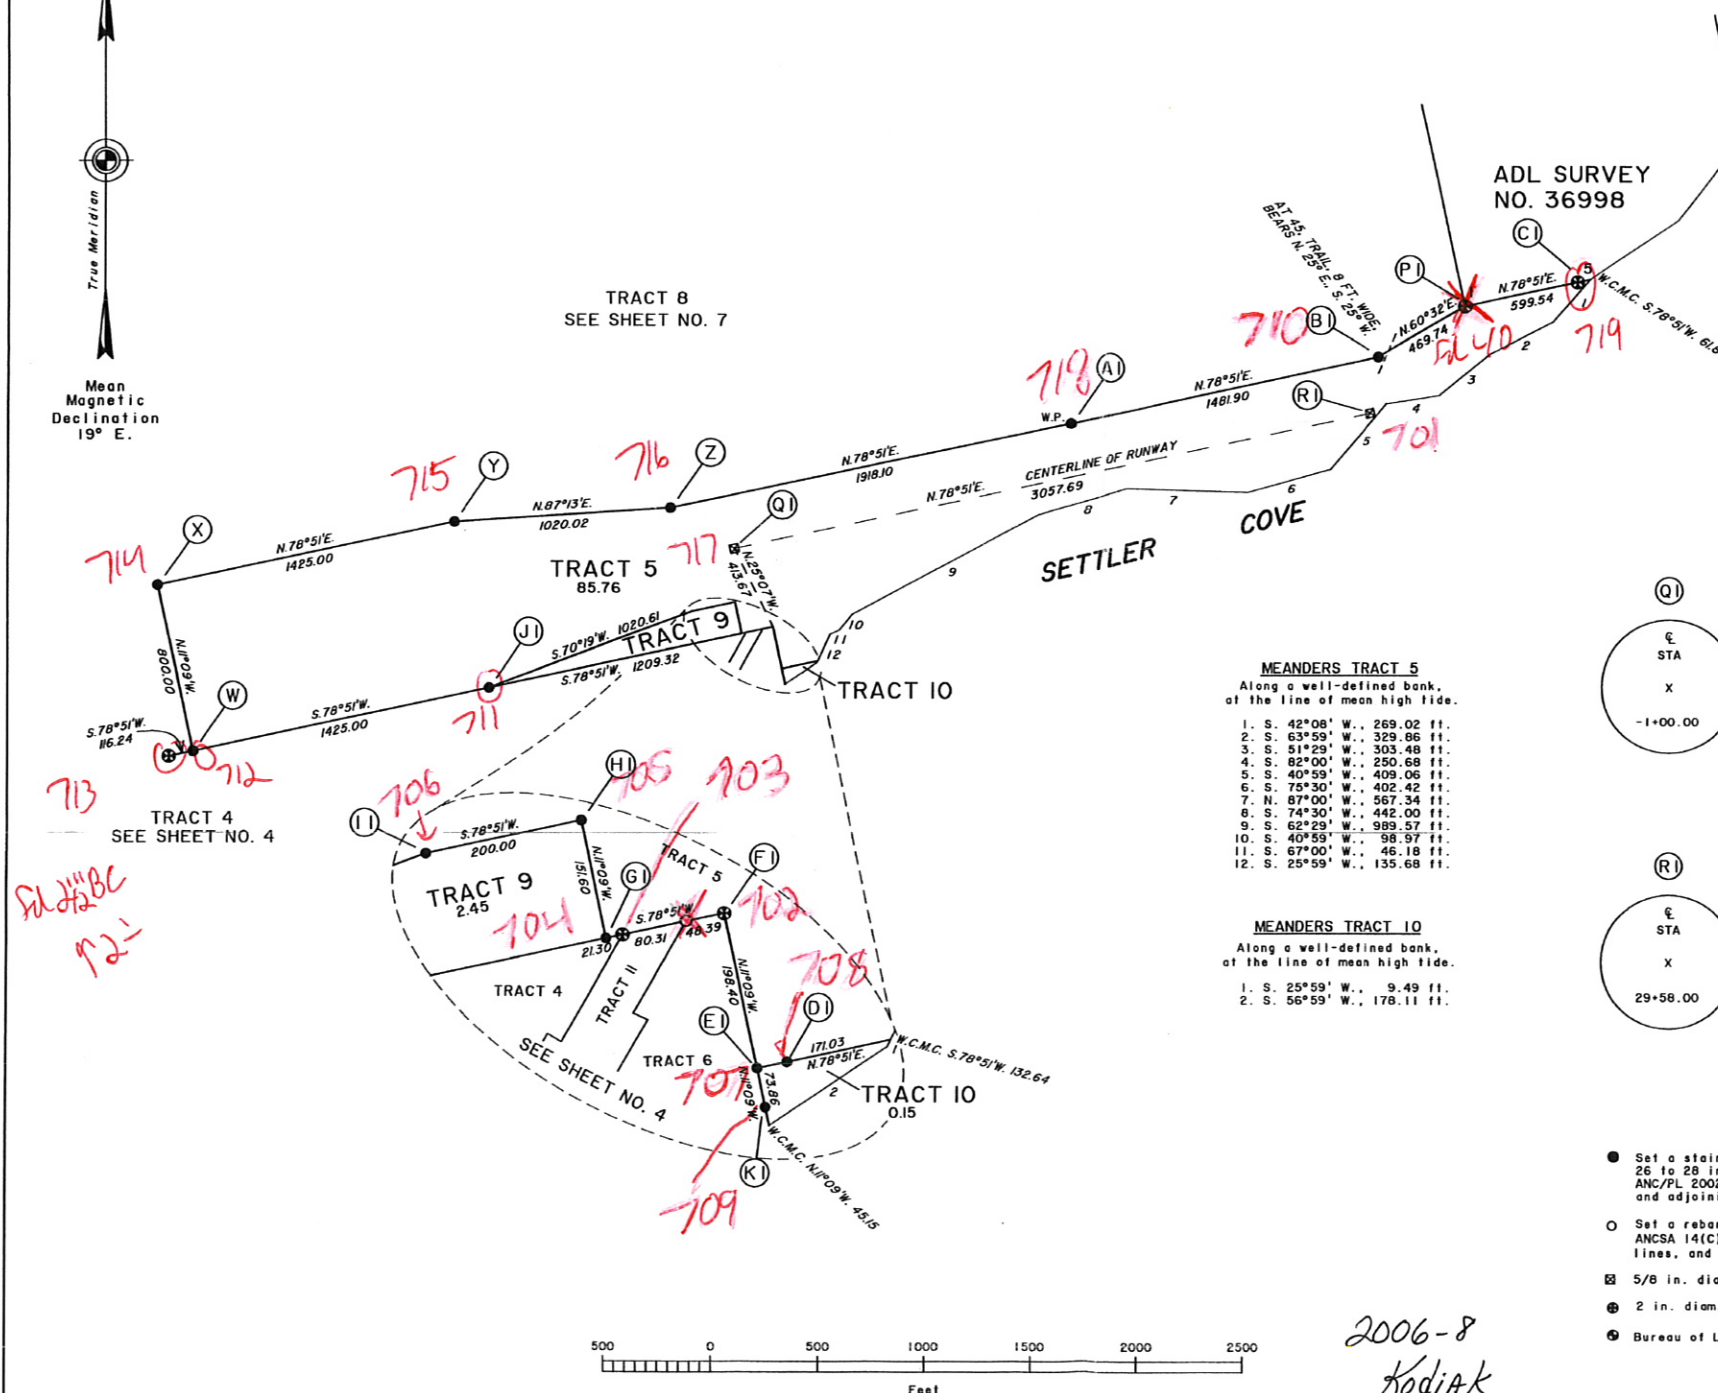

2006-8
Kodiak