

ALASKA NATIVE CLAIMS SETTLEMENT ACT
(ANCSA) SECTION 14 (c) TRACTS I THROUGH 13
AND LOTS 10B THROUGH 13B, BLOCK 16
FIRST ADDITION, PORT LIONS SUBDIVISION
P.L. 92-203 (85 STAT. 688, 702, 703)
AFOGNAK NATIVE CORPORATION
AT
PORT LIONS, ALASKA

AND
THE DEPENDENT RESURVEY OF PORTIONS
OF U.S. SURVEY NOS. 5509 AND 1736

This plat in 9 sheets contains the entire record.

This survey was executed by Kurt D. Huhta, Cadastral Surveyor, August 1 through August 21, 2002, in accordance with the principles set forth in the manual of Surveying instructions, 1973; Special Instructions dated April 12, 2002, approved April 18, 2002; the Afognak ANCSA 14(c) Map of Boundaries, accepted February 28, 2000, and Assignment instructions dated June 11, 2002.

Field assistants were:

Nathan C. Erickson, Land Surveyor
Gary L. McIntyre, Land Surveyor
Andrew M. Buck, Surveying Technician
Shanon K. Roy, Volunteer

Area: 1681.95 Acres.

The azimuth was obtained with the Global Positioning System (GPS), using static relative and real-time-kinematic (RTK) positioning techniques, and refers to the true meridian.

Preliminary to the resurvey, the lines of the prior surveys were retraced and a diligent search was made for all evidence of the original corners and other calls of record. Identified corners were re-monumented in their original positions based on the original record; lost corners were restored and monumented at proportionate positions based on the original record.

The geographic position of the northwesterly corner of Tract I, as determined from a tie to the section corner of sections 5, 6, 31 and 32, Townships 26 and 27 South, Ranges 22 West, Seward Meridian, Alaska, is:

Latitude: 57° 52' 28.63" North NAD 27
Longitude: 152° 53' 50.38" West

The mean magnetic declination was observed during the execution of this survey.

The land is rolling and forested with large diameter spruce and hemlock, with willow, alder, and salmonberry.

The soil is predominantly sandy loam.


UNITED STATES DEPARTMENT OF THE INTERIOR
BUREAU OF LAND MANAGEMENT
Anchorage, Alaska

The survey represented by this plat, sheets 1-9, having been properly executed and examined, is hereby accepted for having fulfilled the requirements of Section 14(c) of the Alaska Native Claims Settlement Act.

For the Director

John S. Soule July 5, 2006
Date

Deputy State Director for Cadastral Survey, Alaska

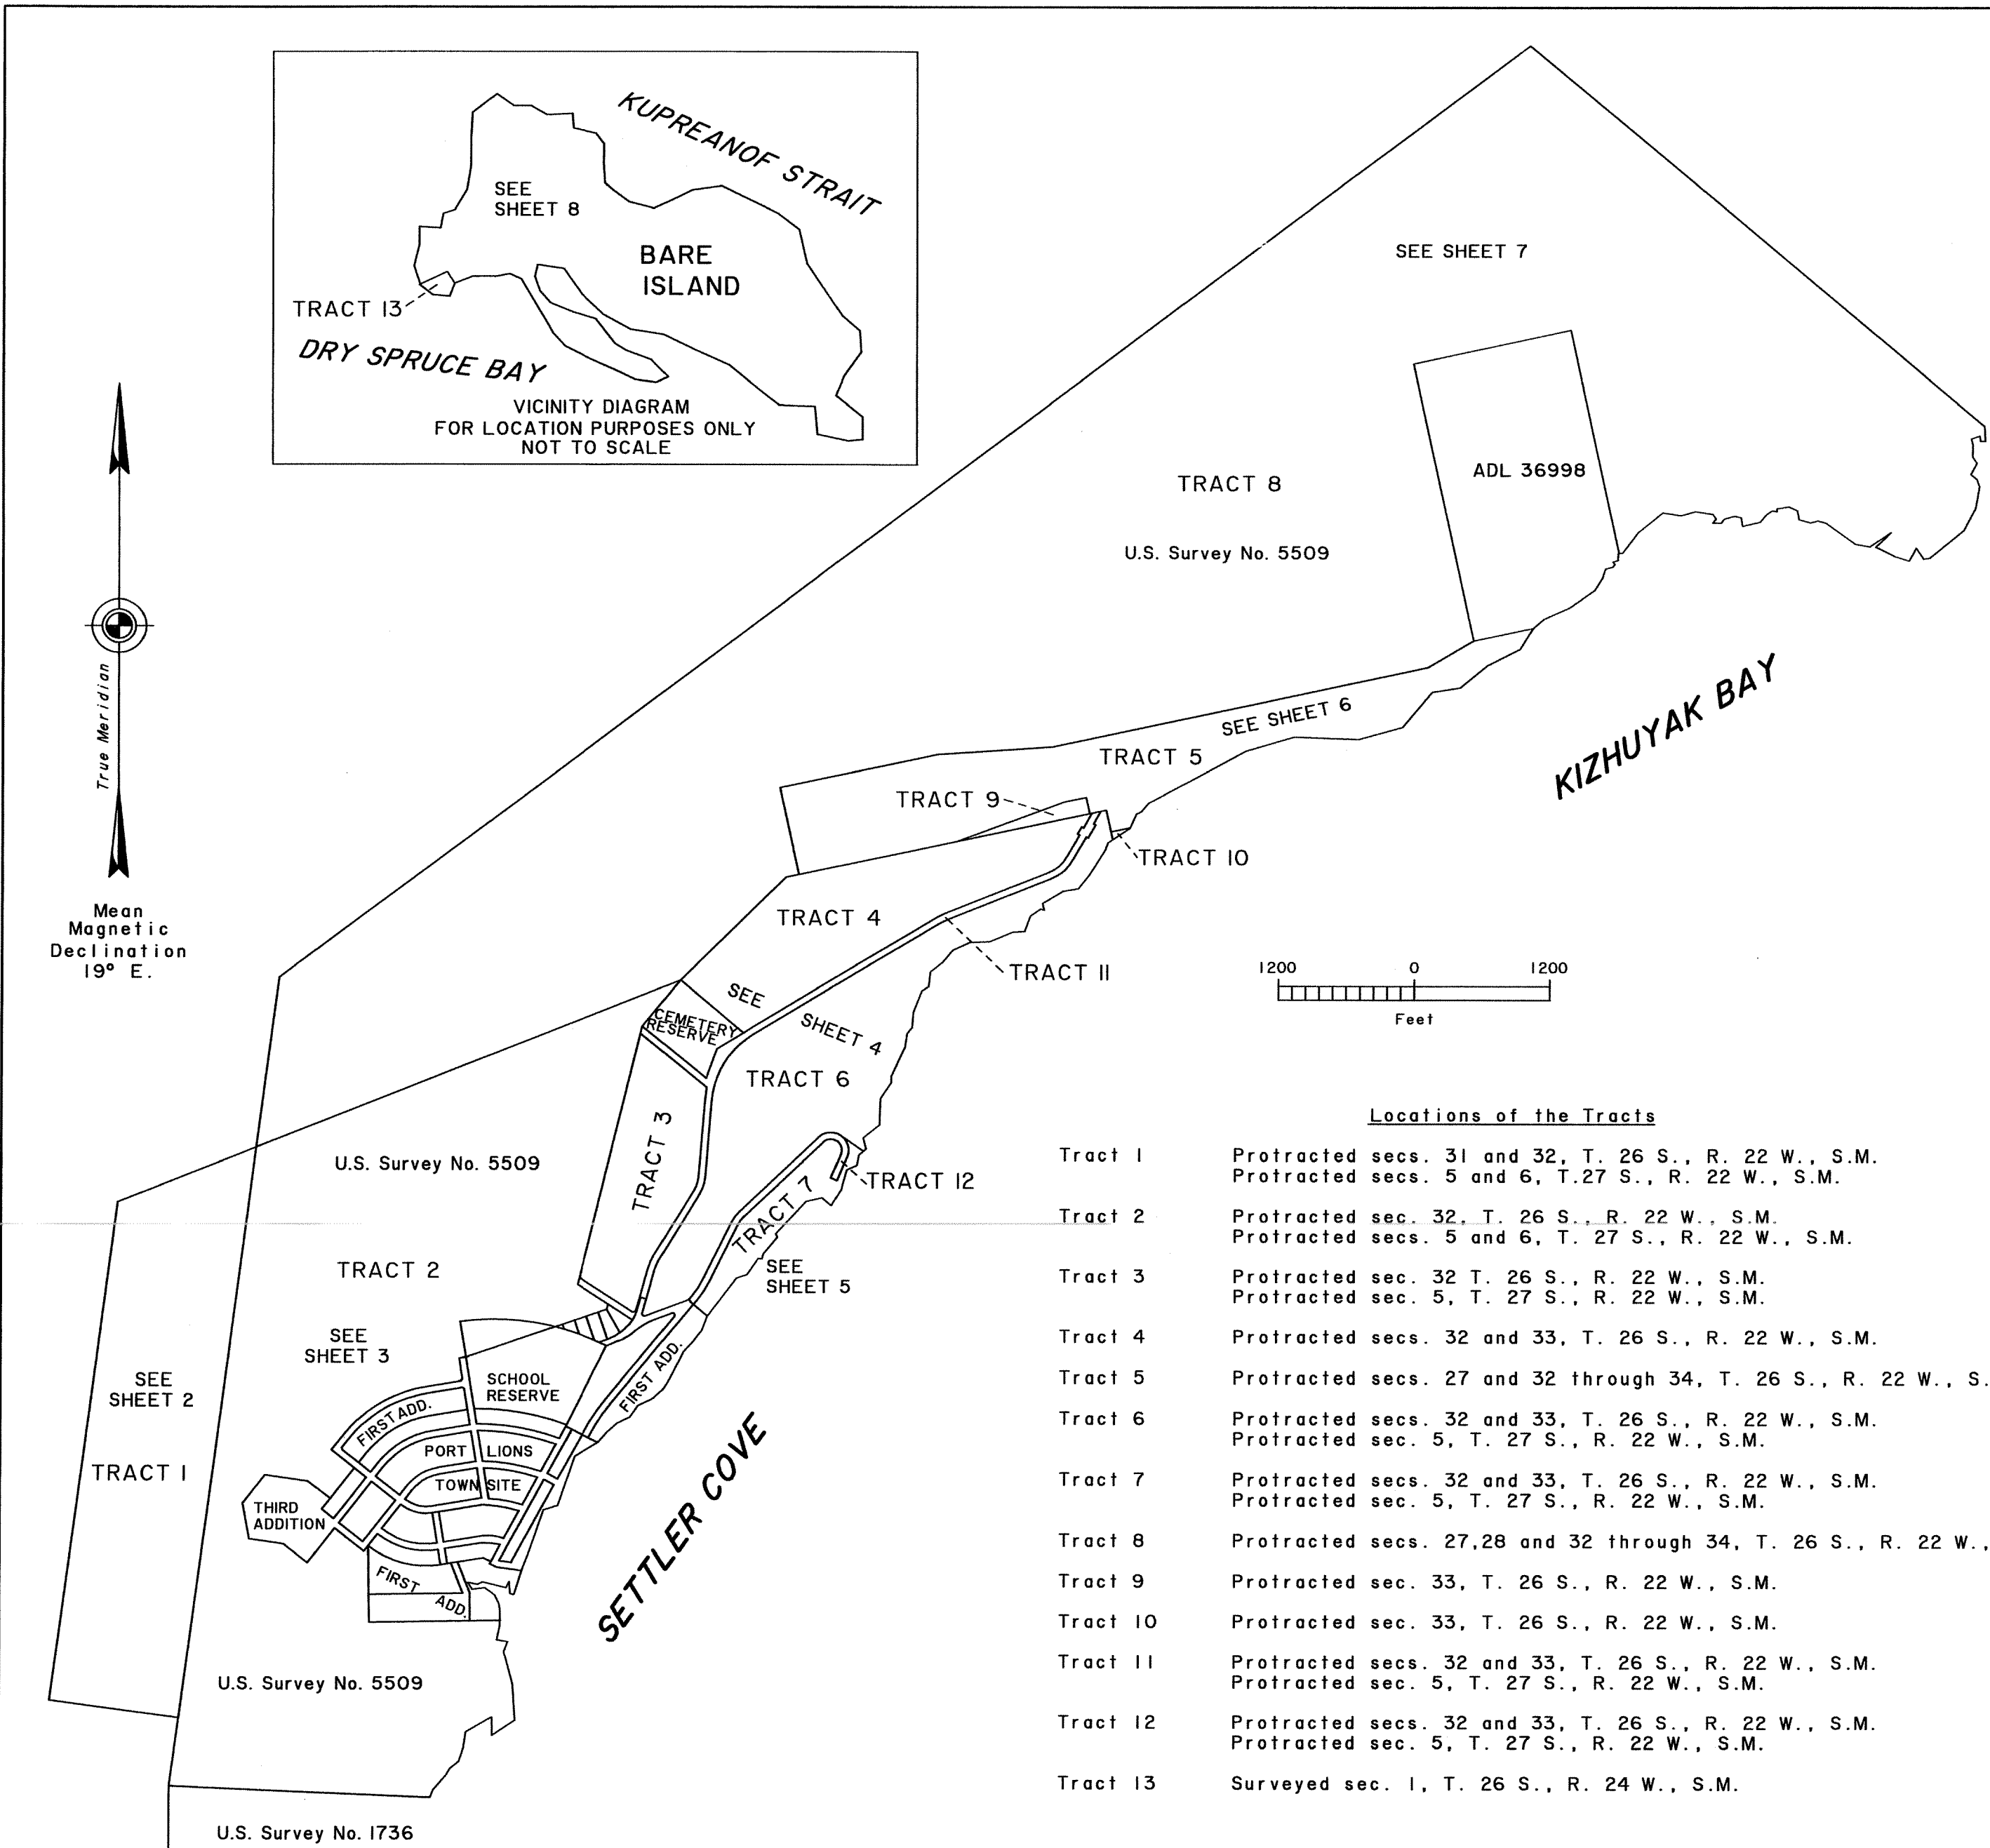

Locations of the Tracts

Tract 1	Protracted secs. 31 and 32, T. 26 S., R. 22 W., S.M. Protracted secs. 5 and 6, T. 27 S., R. 22 W., S.M.
Tract 2	Protracted sec. 32, T. 26 S., R. 22 W., S.M. Protracted secs. 5 and 6, T. 27 S., R. 22 W., S.M.
Tract 3	Protracted sec. 32 T. 26 S., R. 22 W., S.M. Protracted sec. 5, T. 27 S., R. 22 W., S.M.
Tract 4	Protracted secs. 32 and 33, T. 26 S., R. 22 W., S.M.
Tract 5	Protracted secs. 27 and 32 through 34, T. 26 S., R. 22 W., S.M.
Tract 6	Protracted secs. 32 and 33, T. 26 S., R. 22 W., S.M. Protracted sec. 5, T. 27 S., R. 22 W., S.M.
Tract 7	Protracted secs. 32 and 33, T. 26 S., R. 22 W., S.M. Protracted sec. 5, T. 27 S., R. 22 W., S.M.
Tract 8	Protracted secs. 27, 28 and 32 through 34, T. 26 S., R. 22 W., S.M.
Tract 9	Protracted sec. 33, T. 26 S., R. 22 W., S.M.
Tract 10	Protracted sec. 33, T. 26 S., R. 22 W., S.M.
Tract 11	Protracted secs. 32 and 33, T. 26 S., R. 22 W., S.M. Protracted sec. 5, T. 27 S., R. 22 W., S.M.
Tract 12	Protracted secs. 32 and 33, T. 26 S., R. 22 W., S.M. Protracted sec. 5, T. 27 S., R. 22 W., S.M.
Tract 13	Surveyed sec. 1, T. 26 S., R. 24 W., S.M.

I hereby certify that Tracts I through 13, represented on this plat of survey are on lands interim Conveyed to Afognak Native Corporation, by Interim Conveyance No. 217 issued by the United States of America; said tracts also fulfill all entitlements under the provisions of ANCSA 14(c) as requested by Afognak Native Corporation and the Afognak ANCSA 14 (c) Map of Boundaries, accepted February 28, 2000.

June 23, 2006
Date

Orville L. ...
President, Afognak Native Corporation

I, Kurt D. Huhta, Cadastral Surveyor, HEREBY CERTIFY upon honor that I have executed the ANCSA 14 (c) survey depicted on this plat, sheets 1-9, in conformity with the Special Instructions approved April 18, 2002, the principles of survey described in the Manual of Surveying Instructions, 1973, and in the specific manner described on this plat.

Feb 10, 2006
Date

Kurt D. Huhta
Cadastral Surveyor

2006-8
Kodiak

ALASKA NATIVE CLAIMS SETTLEMENT ACT
(ANCSA) SECTION 14 (c) TRACTS 1 THROUGH 13
AND LOTS 10B THROUGH 13B, BLOCK 16
FIRST ADDITION, PORT LIONS SUBDIVISION
P.L. 92-203 (85 STAT. 688, 702, 703)
AFOGNAK NATIVE CORPORATION
AT
PORT LIONS, ALASKA

REFERENCE SHOULD BE MADE
TO
SHEET No. 1
FOR SURVEY INFORMATION

U.S. Survey No. 1736 was surveyed by Fred Dahlquist U.S. Cadastral Engineer, in 1927, and a portion was dependently resurveyed by Hobart B. Hyatt, Supervisory Cadastral Surveyor, and Edward T. Prendergast, Surveying Technician, in 1968.

U.S. Survey No. 5509 was surveyed by Hobart B. Hyatt, Supervisory Cadastral Surveyor, and Edward T. Prendergast, Surveying Technician, in 1968. A supplemental plat of U.S. Survey No. 5509, showing amended lottings created by the segregation of Port Lions Alaska Subdivision, was accepted in 1994.

Port Lions Subdivision, was surveyed by Harold H. Gallieff Jr., Alaska Registered Civil Engineer No. 445, in 1965, and filed as plat No. 65-12, Kodiak Recording District, Alaska, on January 22, 1965.

First Addition, Port Lions Subdivision, was surveyed by Robert L. Tarrant, Alaska Registered Land Surveyor No. 1641, in 1967, and filed as plat No. 68-1, Kodiak Recording District, Alaska, on January 19, 1968.

Alaska Division of Lands Survey No. 36998, was surveyed by Roy A. Ecklund, Alaska Registered Land Surveyor No. 1638, in 1969, and filed as plat No. 69-6, Kodiak Recording District, Alaska, on September 29, 1969.

Port Lions Subdivision, Second Addition, was surveyed by Roy A. Ecklund, Alaska Registered Land Surveyor No. 1638, in 1969, not recorded, and received by the Kodiak Island borough Engineering Department, on September 20, 1984.

Third Addition, Port Lions Subdivision, was surveyed by Gordon Sheret, Alaska Registered Land Surveyor No. 4609, in 1979, and filed as plat No. 83-14, Kodiak Recording District, Alaska, on July 8, 1983.

The south and east boundaries of Township 26 South, Range 22 West, Seward Meridian, Alaska, were surveyed by Fredrick W. Ward, Cadastral Surveyor in 1971-1973.

The south and east boundaries of Township 27 South, Range 22 West, Seward Meridian, Alaska, were surveyed by Fredrick W. Ward, Cadastral Surveyor in 1971-1973.


The south and east boundaries of Township 26 South, Range 23 West, Seward Meridian, Alaska, were surveyed by Fredrick W. Ward, Cadastral Surveyor in 1971-1973.

The Sixth Guide Meridian West on the west boundary, a portion of the south boundary, the east boundary and the north boundary of Township 26 South, Range 24 West, Seward Meridian, Alaska, were surveyed by Frederick W. Ward, Cadastral Surveyor, in 1971-1973.

A portion of the east boundary of Township 26 South, Range 24 West, Seward Meridian, was dependently resurveyed by Charles E. Akin, Jr., Alaska Registered Land Surveyor, under contract, in 1988.

A portion of the east boundary of Township 26 South, Range 24 West, Seward Meridian, was dependently resurveyed by Willard M. Olson, Cadastral Surveyor, in 1995.

A portion of the east boundary of Township 26 South, Range 24 West, Seward Meridian, was dependently resurveyed by Marshal D. Wade, Cadastral Surveyor, in 1997-1999.

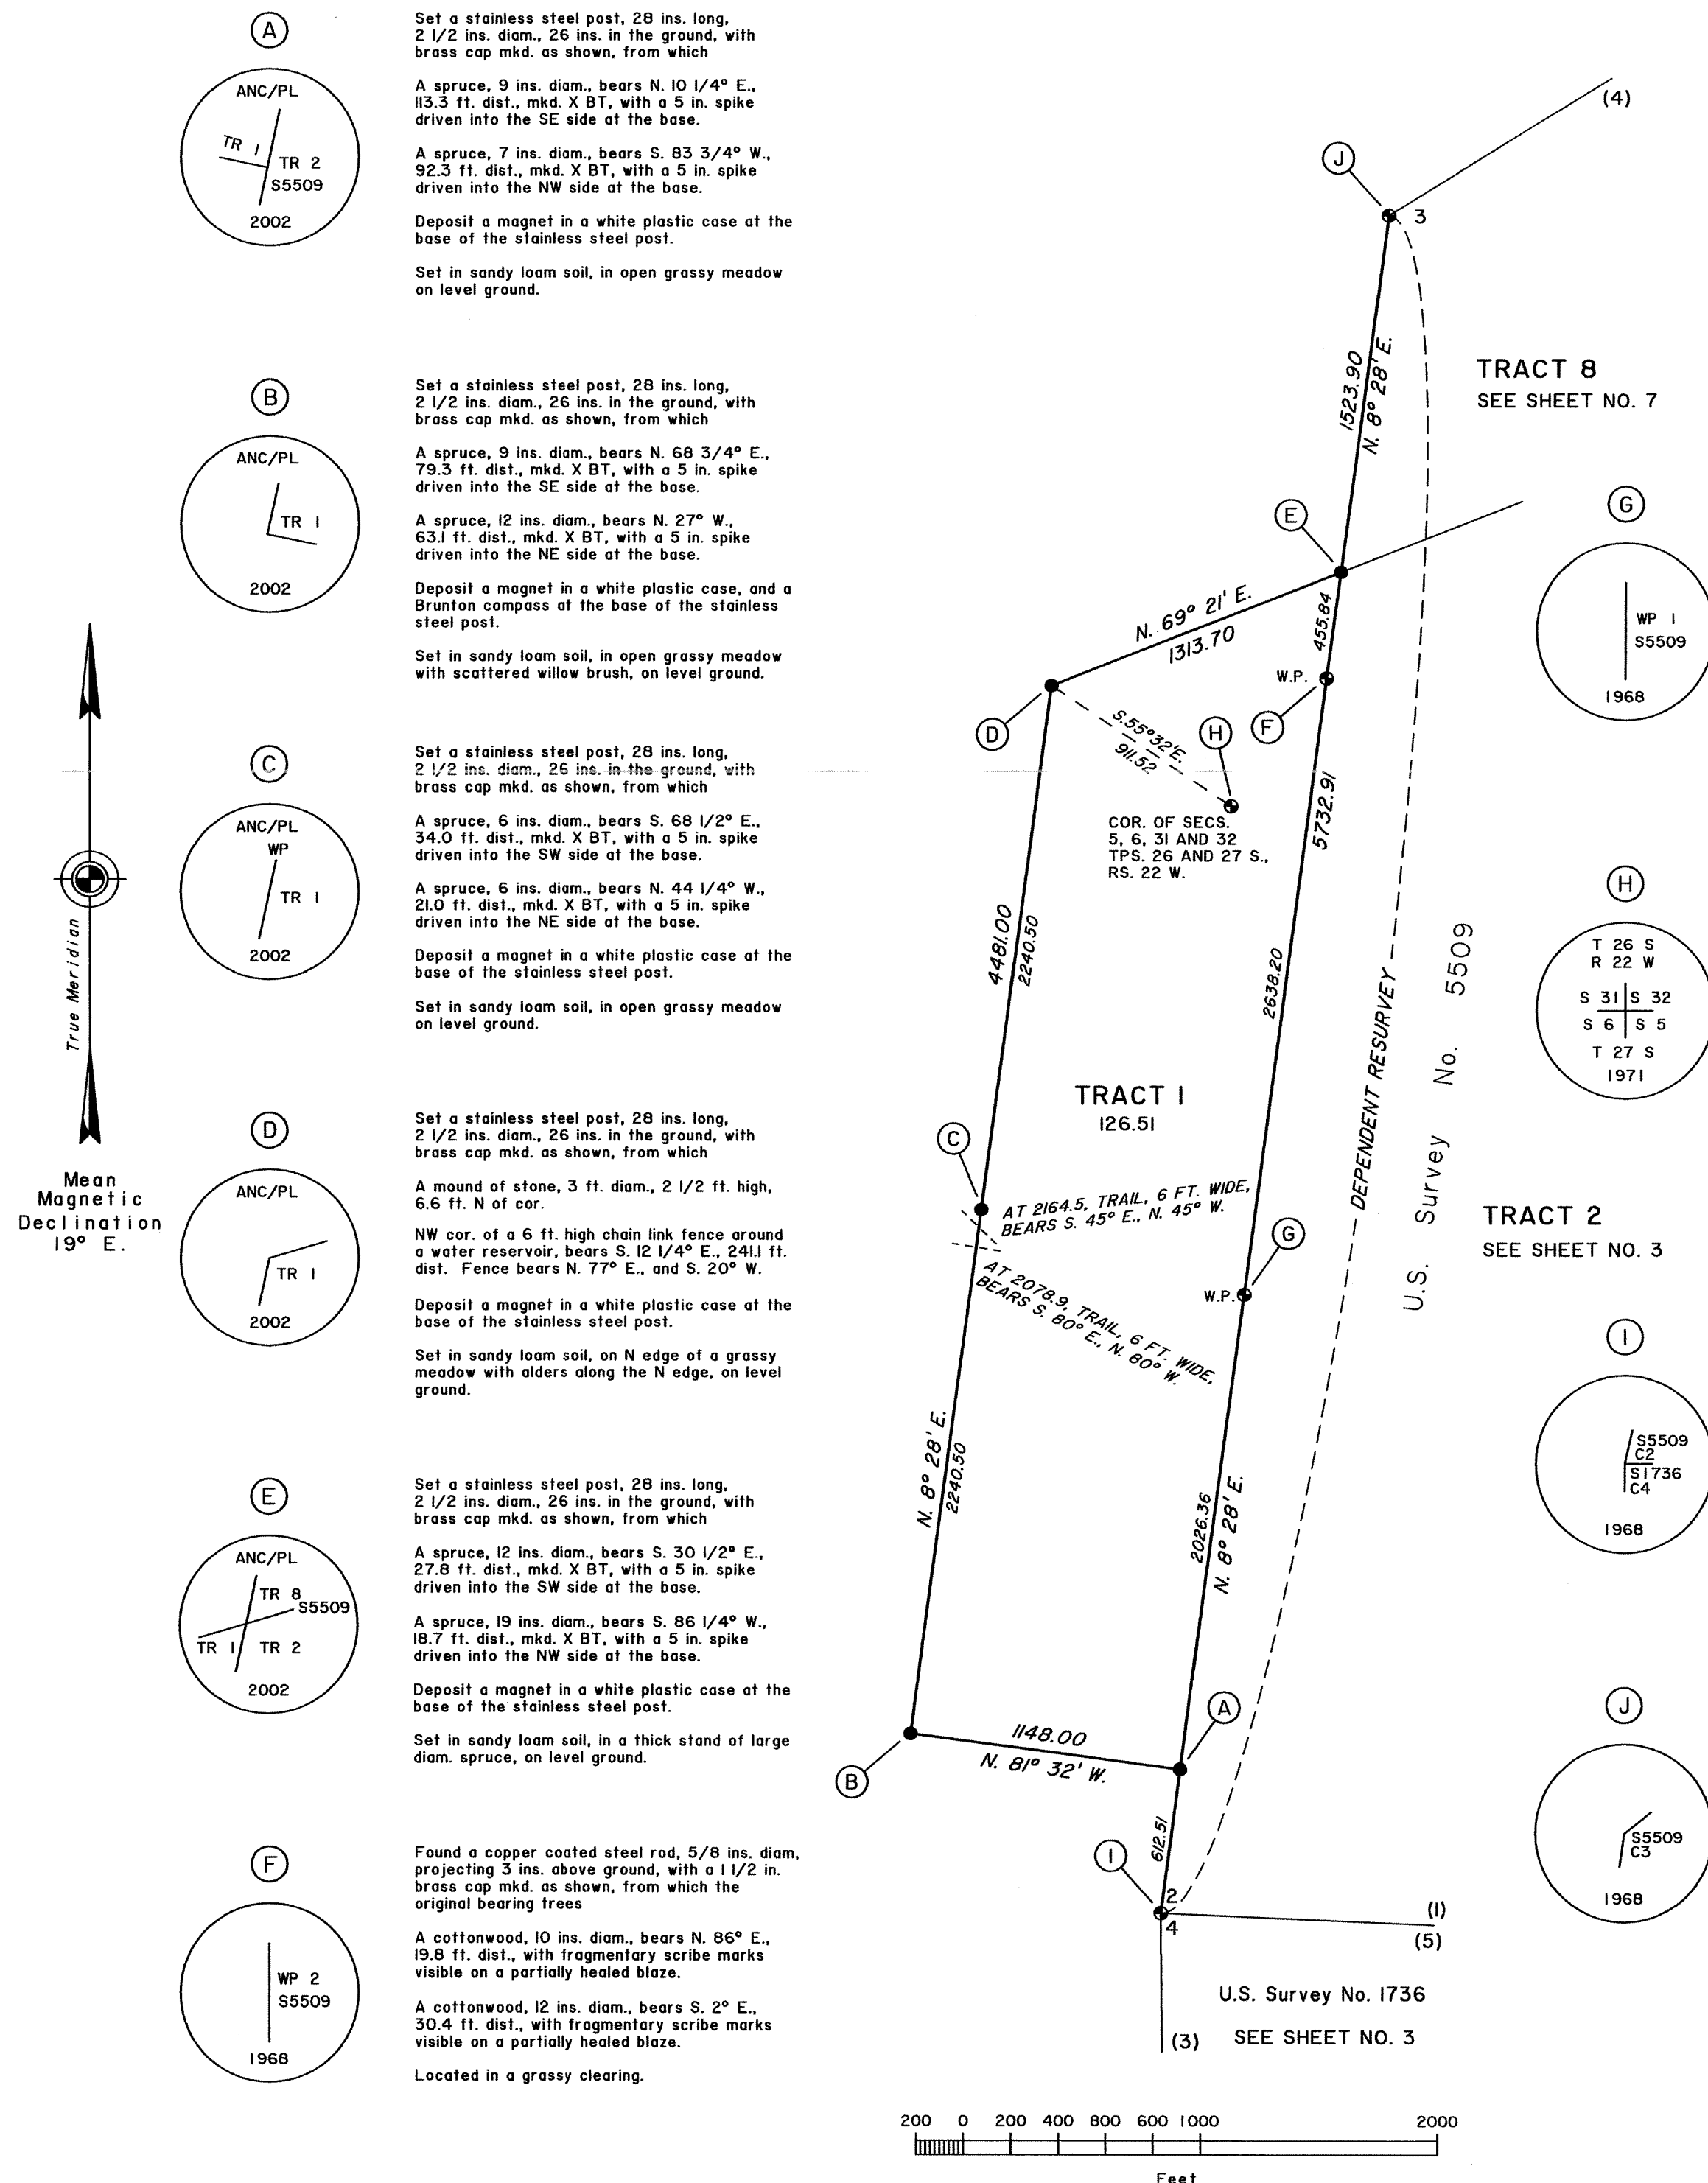


CURVE TABLE

- (C1) (R) 316.90
(L) 96.88
(L.C.) N. 42°47'24" E., 96.50
- (C2) (R) 2215.00
(L) 45.16
(L.C.) N. 64°42'03" W., 45.16
- (C3) (R) 2215.00
(L) 147.77
(L.C.) N. 67°11'47" W., 147.75
- (C4) (R) 2215.00
(L) 140.16
(L.C.) N. 70°55'15" W., 140.13
- (C5) (R) 2215.00
(L) 81.70
(L.C.) N. 73°47'25" W., 81.70
- (C6) (R) 2215.00
(L) 846.12
(L.C.) N. 85°47'33" W., 841.02
- (C7) (R) 2215.00
(L) 71.12
(L.C.) S. 63°11'48" E., 71.12
- (C8) (R) 20.00
(L) 31.42
(L.C.) S. 36°38'15" W., 28.29
- (C9) (R) 1185.68
(L) 879.50
(L.C.) S. 60°23'06" W., 859.51


ALASKA NATIVE CLAIMS SETTLEMENT ACT
(ANCSA) SECTION 14 (c) TRACTS I THROUGH 13
AND LOTS 10B THROUGH 13B, BLOCK 16
FIRST ADDITION, PORT LIONS SUBDIVISION
P.L. 92-203 (85 STAT. 688, 702, 703)
AFOGNAK NATIVE CORPORATION
AT
PORT LIONS, ALASKA

REFERENCE SHOULD BE MADE
TO
SHEET Nos. 1, 2 AND 9
FOR SURVEY INFORMATION

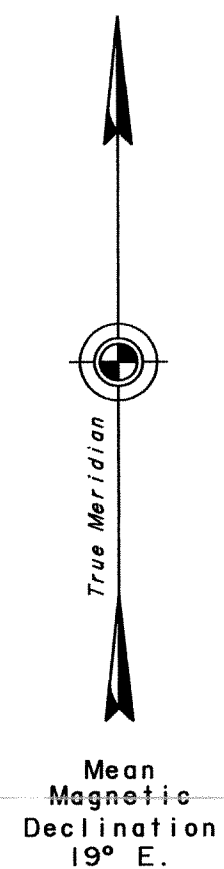

RECORD DATA FROM
THIRD ADDITION PORT LIONS SUBDIVISION
KODIAK RECORDING DISTRICT
PLAT No. 83-14

1. S. 39°09'28" W., 344.71 ft.
2. N. 50°50'46" W., 250.01 ft.
3. N. 80°50'40" W., 385.02 ft.
4. S. 39°09'28" W., 320.01 ft.
5. S. 9°50'33" E., 319.99 ft.
6. S. 80°50'40" E., 304.86 ft.
7. S. 50°50'39" E., 272.87 ft.
8. N. 39°09'08" E., 389.99 ft.
9. S. 50°50'38" E., 134.99 ft.

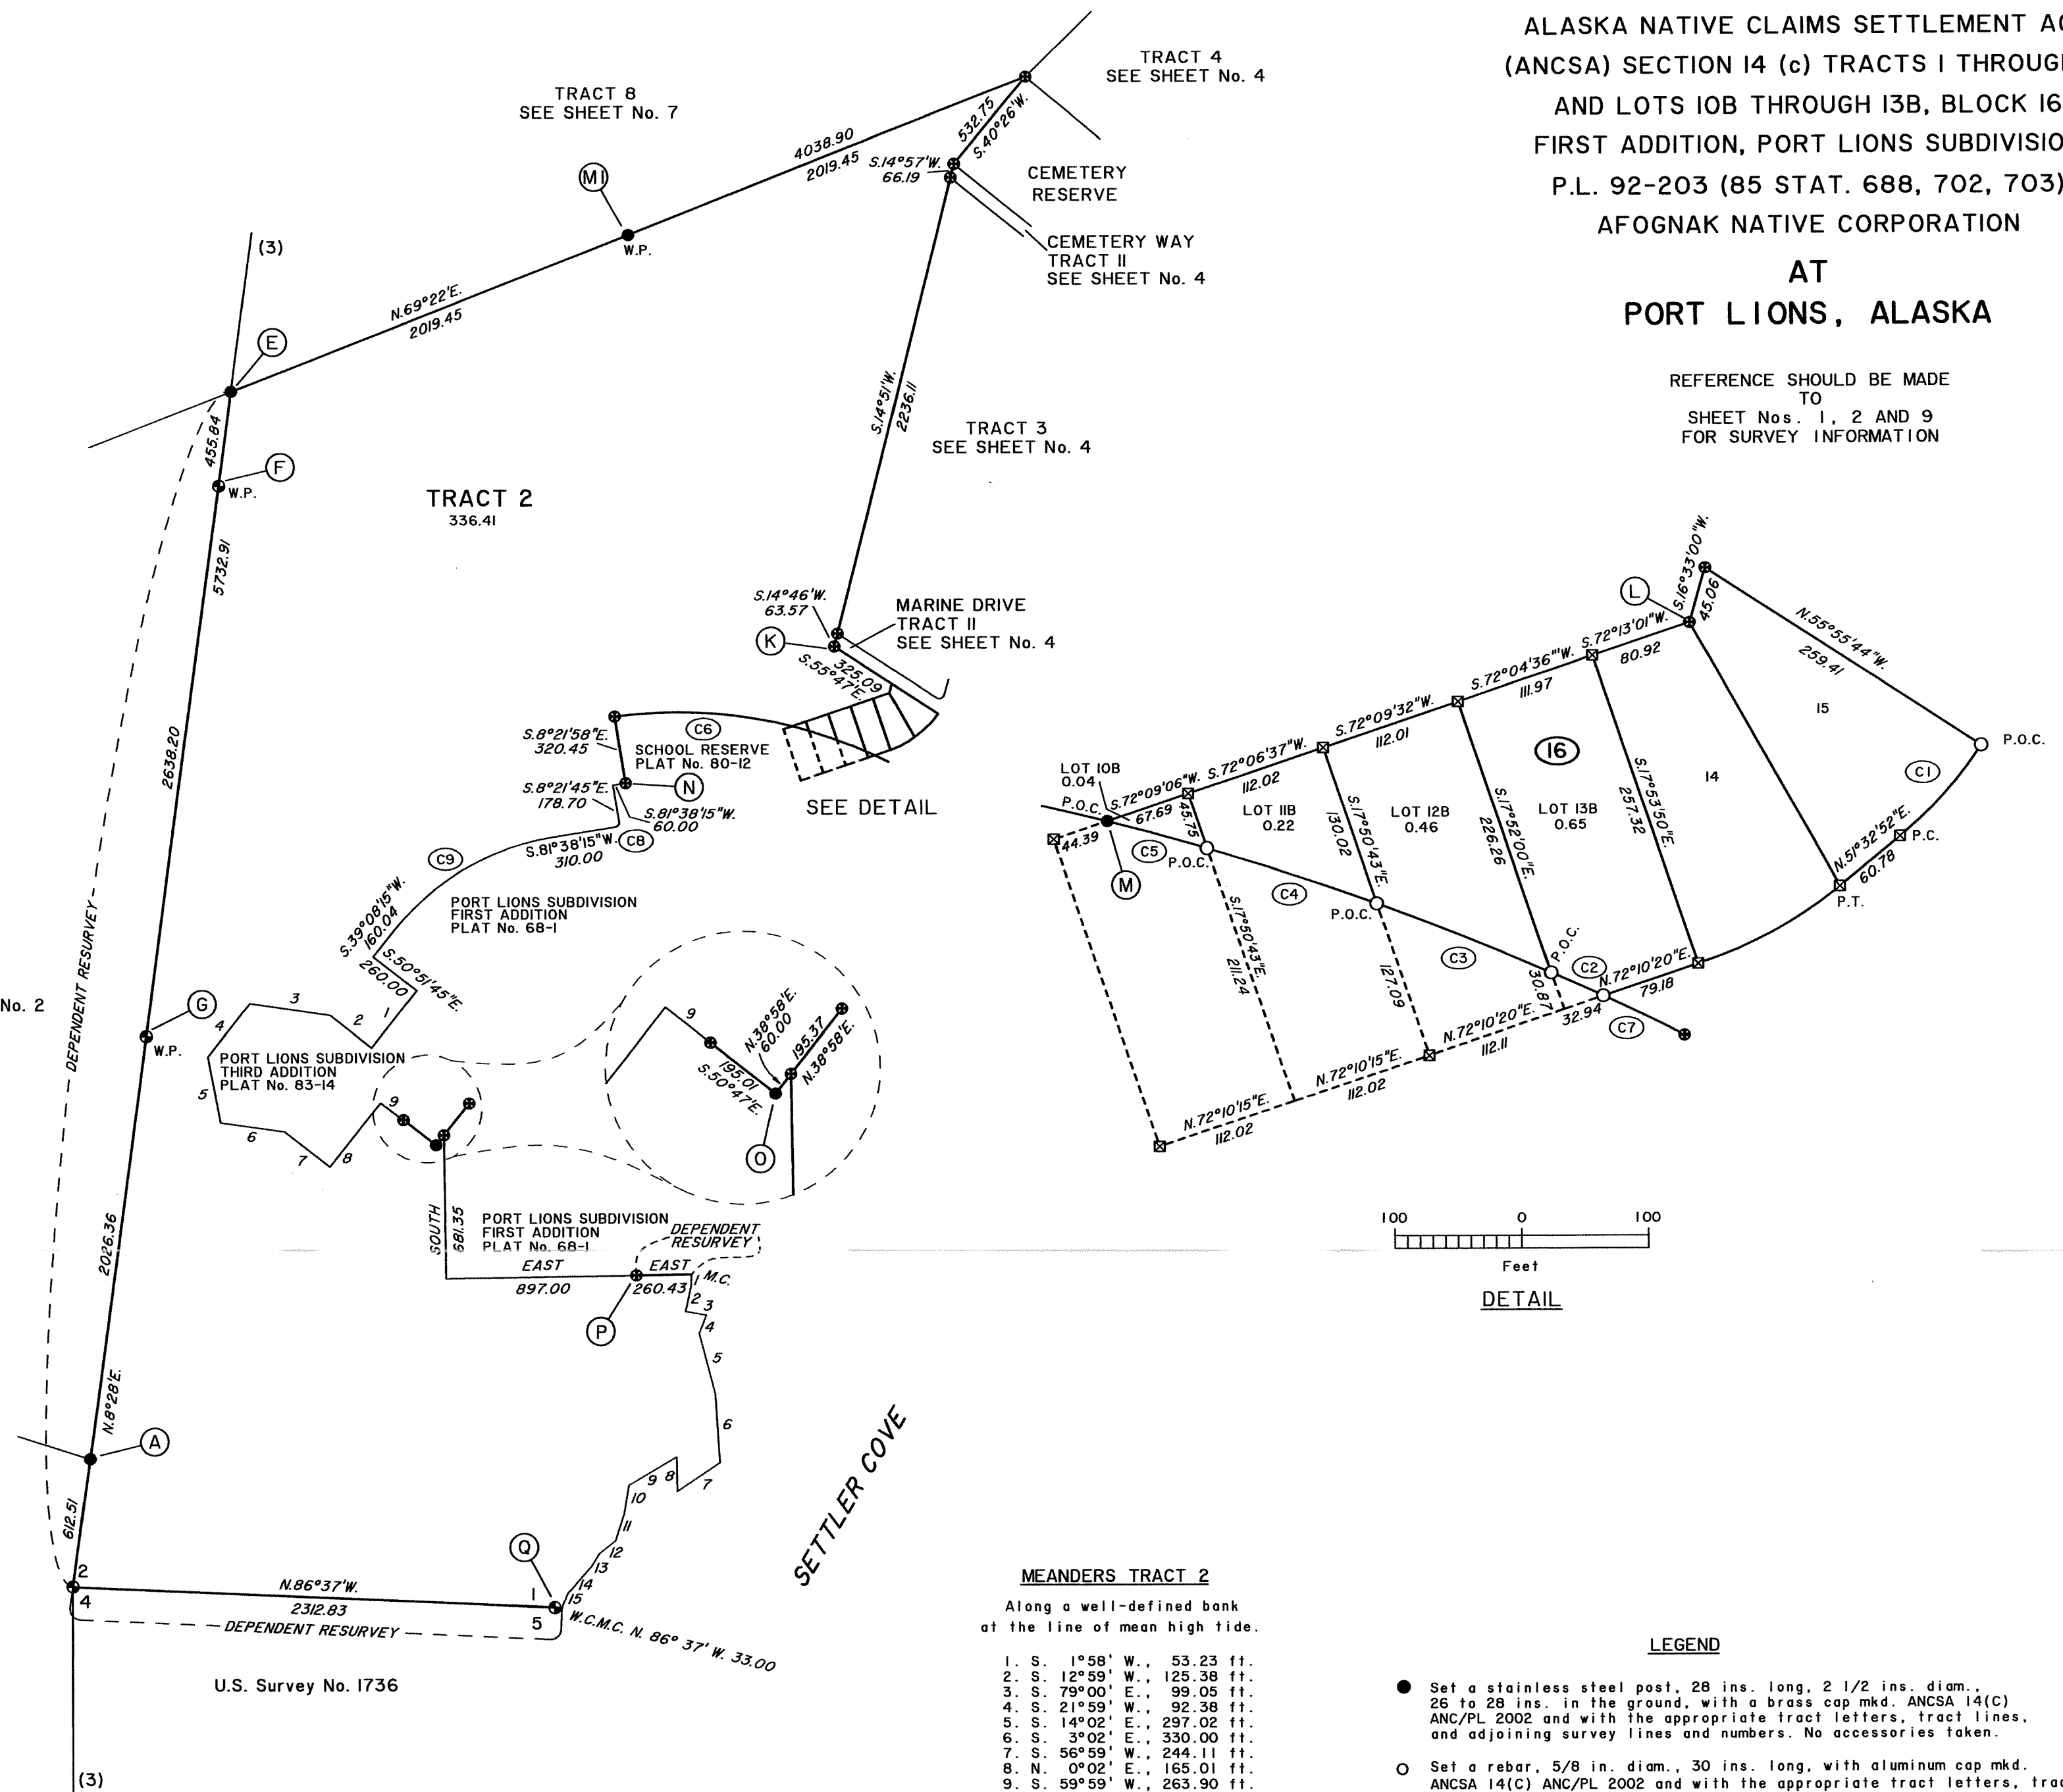

MEANDERS TRACT 2

Along a well-defined bank
at the line of mean high tide.

1. S. 1°58' W., 53.23 ft.
2. S. 12°59' W., 125.38 ft.
3. S. 79°00' E., 99.05 ft.
4. S. 21°59' W., 92.38 ft.
5. S. 14°02' E., 297.02 ft.
6. S. 3°02' E., 330.00 ft.
7. S. 56°59' W., 244.11 ft.
8. N. 0°02' E., 165.01 ft.
9. S. 59°59' W., 263.90 ft.
10. S. 9°59' W., 138.58 ft.
11. S. 18°59' W., 131.98 ft.
12. S. 51°59' W., 98.96 ft.
13. S. 32°59' W., 72.58 ft.
14. S. 41°59' W., 164.95 ft.
15. S. 23°59' W., 72.58 ft.

LEGEND

- Set a stainless steel post, 28 ins. long, 2 1/2 ins. diam., 26 to 28 ins. in the ground, with a brass cap mkd. ANCSA 14(C) ANC/PL 2002 and with the appropriate tract letters, tract lines, and adjoining survey lines and numbers. No accessories taken.
- Set a rebar, 5/8 in. diam., 30 ins. long, with aluminum cap mkd. ANCSA 14(C) ANC/PL 2002 and with the appropriate tract letters, tract lines, and adjoining survey lines and numbers. No accessories taken.
- ☒ 5/8 in. diam. rebar with alum. cap recovered this survey.
- ⊗ 2 in. diam. iron pipe, with brass cap recovered this survey.
- Bureau of Land Management monument recovered this survey.

2006-8
KODIAK

ALASKA NATIVE CLAIMS SETTLEMENT ACT
(ANCSA) SECTION 14 (c) TRACTS I THROUGH 13
AND LOTS 10B THROUGH 13B, BLOCK 16
FIRST ADDITION, PORT LIONS SUBDIVISION
P.L. 92-203 (85 STAT. 688, 702, 703)
AFOGNAK NATIVE CORPORATION

AT
PORT LIONS, ALASKA

REFERENCE SHOULD BE MADE
TO
SHEET Nos. 1 AND 2
FOR SURVEY INFORMATION



CURVE TABLE

(C1)	(R) 316.90 (L) 96.86 (L.C.) N. 25°16'30" E., 96.48
(C2)	(R) 24.66 (L) 46.36 (L.C.) N. 70°21'30" E., 39.83
(C3)	(R) 467.13 (L) 129.46 (L.C.) N. 24°26'30" E., 129.05
(C4)	(R) 299.19 (L) 139.32 (L.C.) N. 19°02'30" E., 138.07
(C5)	(R) 823.74 (L) 105.95 (L.C.) N. 9°23'30" E., 105.88
(C6)	(R) 20.00 (L) 20.77 (L.C.) N. 20°20'30" W., 19.85
(C7)	(R) 620.88 (L) 96.54 (L.C.) N. 64°23'30" E., 96.45
(C8)	(R) 335.00 (L) 224.20 (L.C.) N. 49°40'30" E., 220.05
(C9)	(R) 395.00 (L) 264.35 (L.C.) S. 49°40'30" W., 259.46
(C10)	(R) 560.88 (L) 87.21 (L.C.) S. 64°23'30" W., 87.13
(C11)	(R) 763.74 (L) 722.80 (L.C.) S. 32°49'30" W., 696.16
(C12)	(R) 359.19 (L) 167.26 (L.C.) S. 19°02'30" W., 165.76
(C13)	(R) 407.13 (L) 112.83 (L.C.) S. 24°26'30" W., 112.47
(C14)	(R) 20.00 (L) 44.08 (L.C.) S. 46°44'30" E., 35.68

LEGEND


- Set a stainless steel post, 28 ins. long, 2 1/2 ins. diam., 26 to 28 ins. in the ground, with a brass cap mkd. ANCSA 14(C) ANC/PL 2002 and with the appropriate tract letters, tract lines, and adjoining survey lines and numbers. No accessories taken.
- Set a rebar, 5/8 in. diam., 30 ins. long, with aluminum cap mkd. ANCSA 14(C) ANC/PL 2002 and with the appropriate tract letters, tract lines, and adjoining survey lines and numbers. No accessories taken.
- ⊠ 5/8 in. diam. rebar with alum. cap recovered this survey.
- ⊙ 2 in. diam. iron pipe, with brass cap recovered this survey.
- ⊕ Bureau of Land Management monument recovered this survey.

2006-P
Kodiak

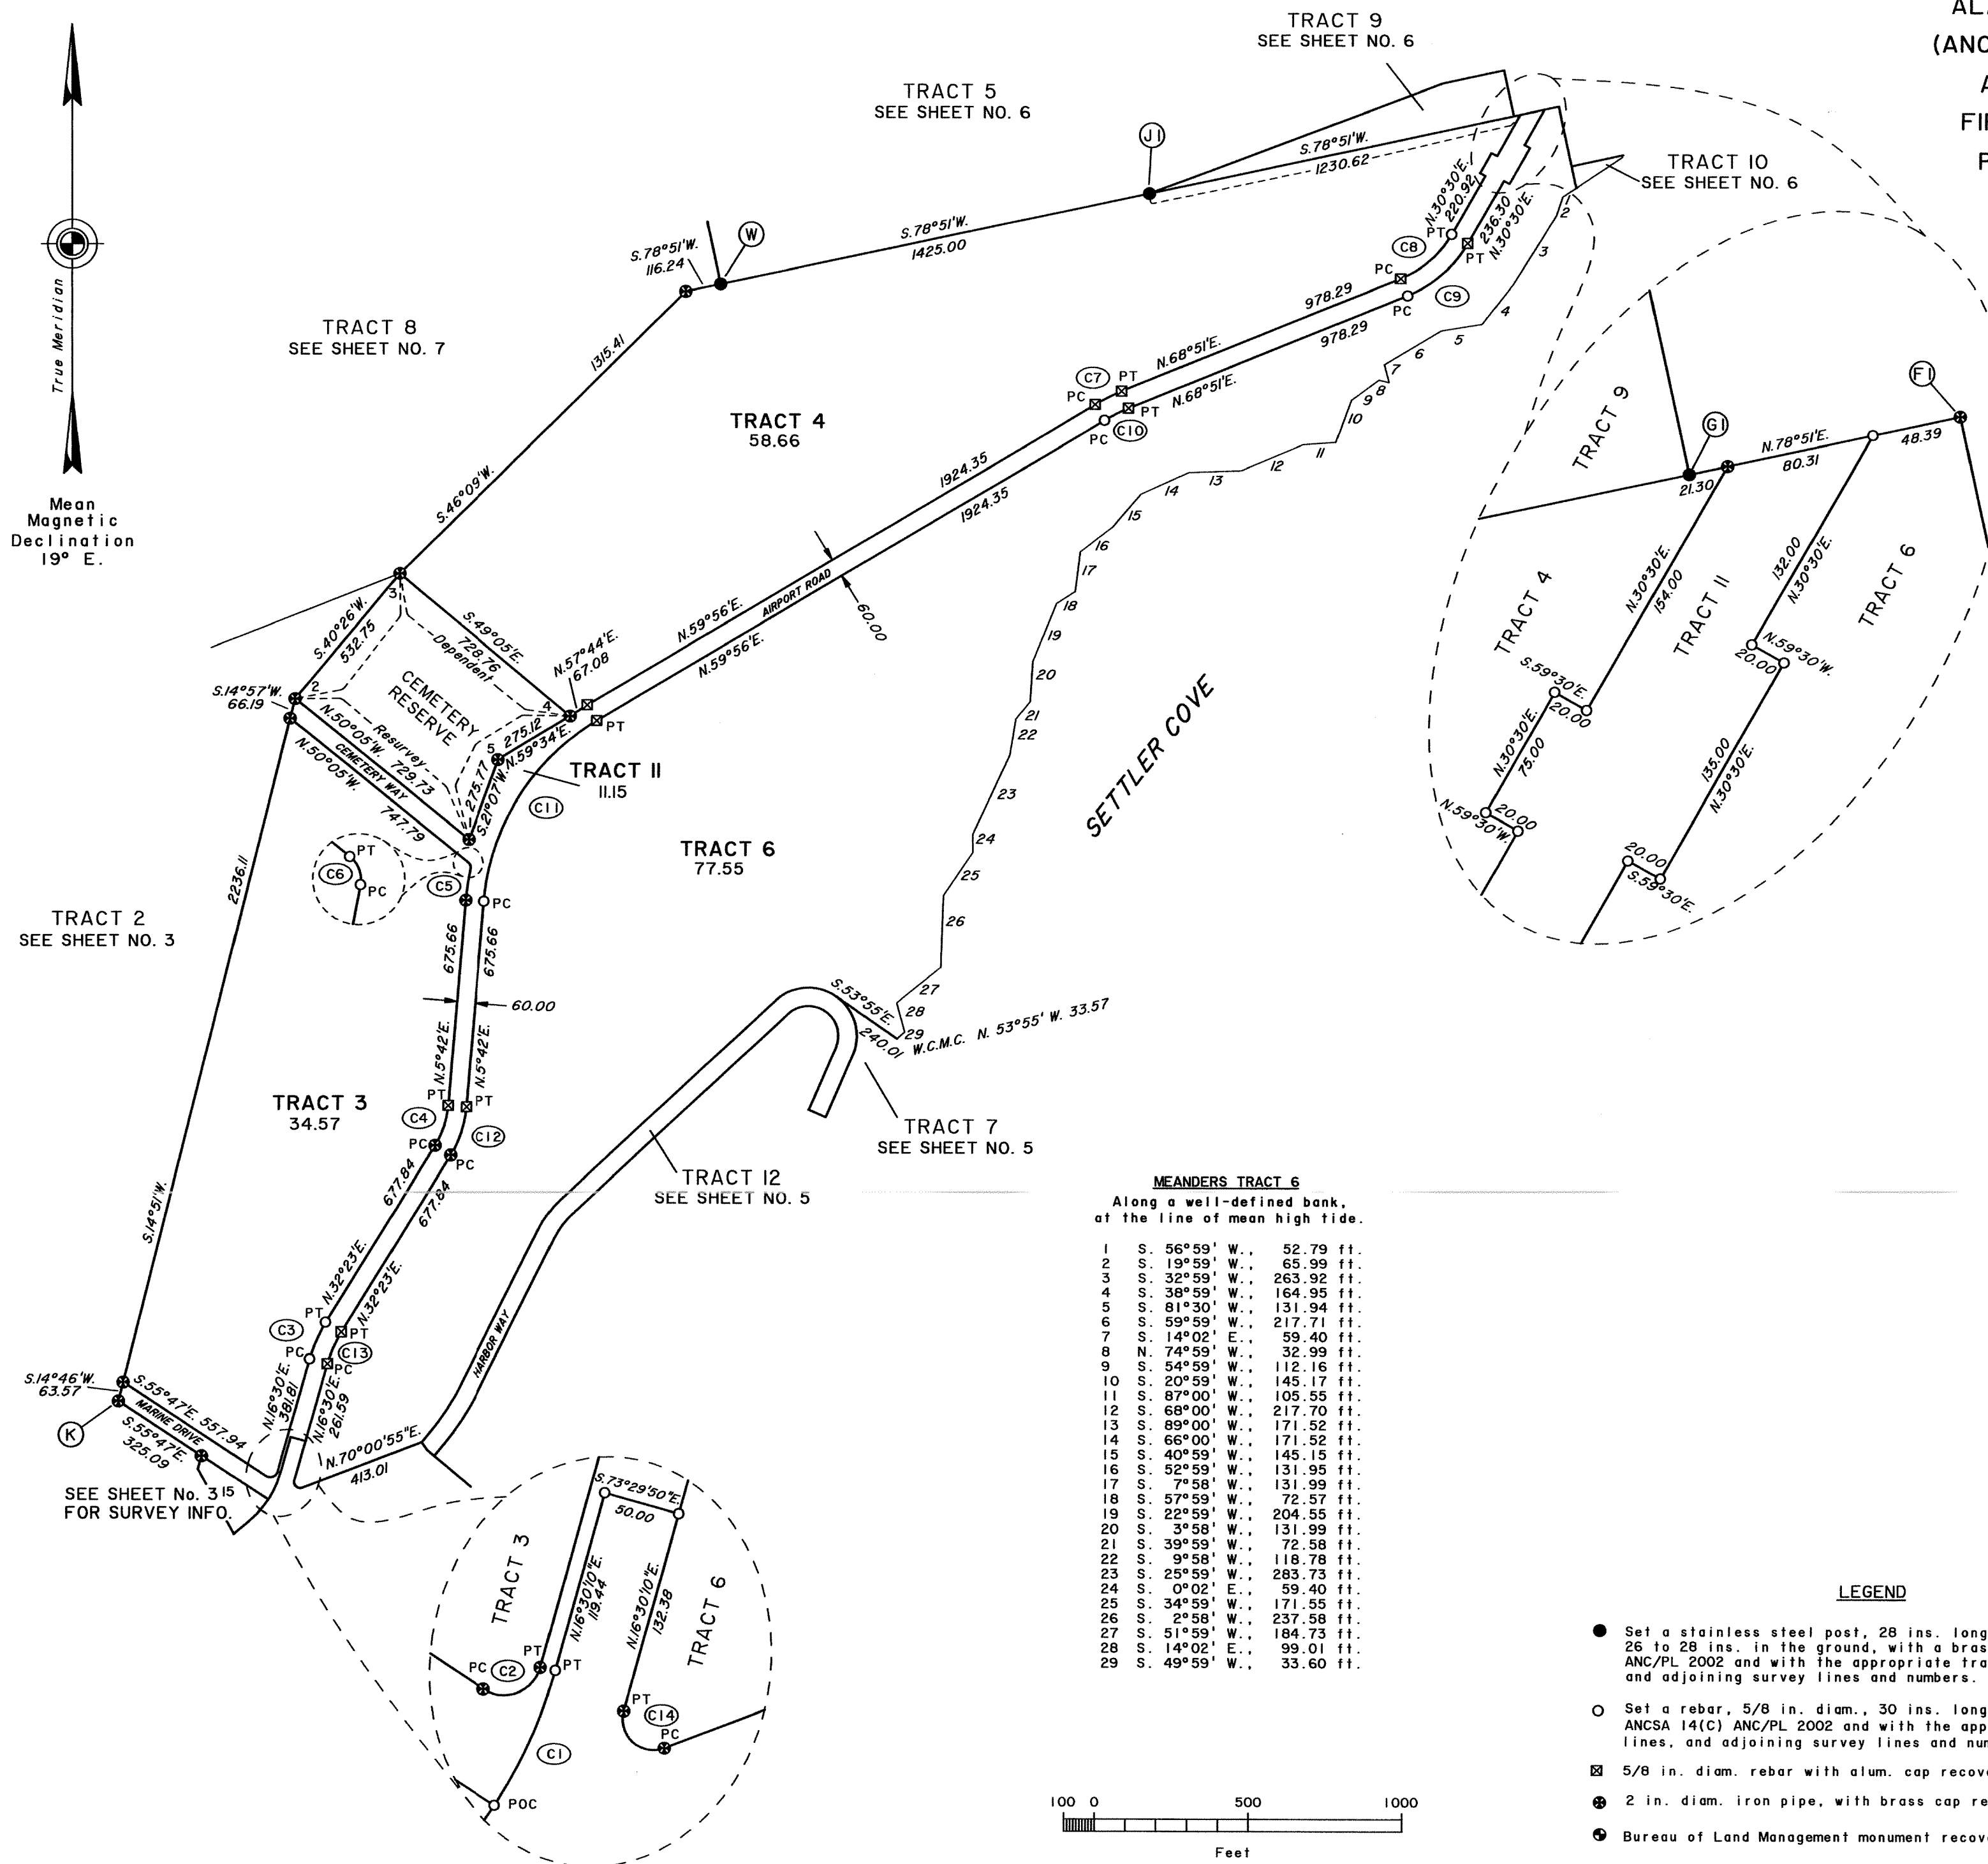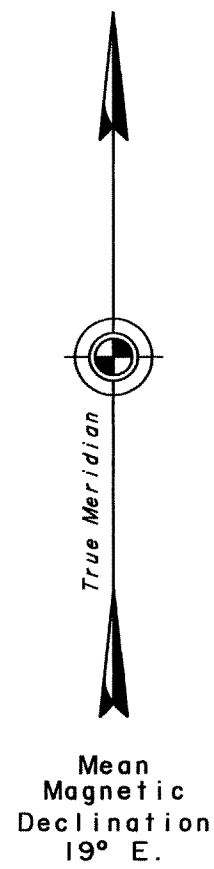

MEANDERS TRACT 6
Along a well-defined bank,
at the line of mean high tide.

1	S. 56°59' W.	52.79 ft.
2	S. 19°59' W.	65.99 ft.
3	S. 32°59' W.	263.92 ft.
4	S. 38°59' W.	164.95 ft.
5	S. 81°30' W.	131.94 ft.
6	S. 59°59' W.	217.71 ft.
7	S. 14°02' E.	59.40 ft.
8	N. 74°59' W.	32.99 ft.
9	S. 54°59' W.	112.16 ft.
10	S. 20°59' W.	145.17 ft.
11	S. 87°00' W.	105.55 ft.
12	S. 68°00' W.	217.70 ft.
13	S. 89°00' W.	171.52 ft.
14	S. 66°00' W.	171.52 ft.
15	S. 40°59' W.	145.15 ft.
16	S. 52°59' W.	131.95 ft.
17	S. 7°58' W.	131.99 ft.
18	S. 57°59' W.	72.57 ft.
19	S. 22°59' W.	204.55 ft.
20	S. 3°58' W.	131.99 ft.
21	S. 39°59' W.	72.58 ft.
22	S. 9°58' W.	118.78 ft.
23	S. 25°59' W.	283.73 ft.
24	S. 0°02' E.	59.40 ft.
25	S. 34°59' W.	171.55 ft.
26	S. 2°58' W.	237.58 ft.
27	S. 51°59' W.	184.73 ft.
28	S. 14°02' E.	99.01 ft.
29	S. 49°59' W.	33.60 ft.

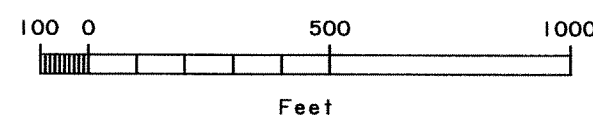


ALASKA NATIVE CLAIMS SETTLEMENT ACT
(ANCSA) SECTION 14 (c) TRACTS 1 THROUGH 13
AND LOTS 10B THROUGH 13B, BLOCK 16
FIRST ADDITION, PORT LIONS SUBDIVISION
P.L. 92-203 (85 STAT. 688, 702, 703)
AFOGNAK NATIVE CORPORATION

AT
PORT LIONS, ALASKA

REFERENCE SHOULD BE MADE
TO
SHEET Nos. 1 AND 2
FOR SURVEY INFORMATION

CURVE TABLE

(C1)	(R)	791.98
	(L)	186.39
	(L.C.)	N. 34°03'30" E., 185.97
(C2)	(R)	333.26
	(L)	119.52
	(L.C.)	N. 37°35'30" E., 117.93
(C3)	(R)	157.67
	(L)	430.50
	(L.C.)	N. 86°58' E., 198.94
(C4)	(R)	157.67
	(L)	430.50
	(L.C.)	S. 14°48' E., 198.94
(C5)	(R)	97.67
	(L)	266.67
	(L.C.)	S. 53°55' E., 191.23
(C6)	(R)	273.26
	(L)	98.00
	(L.C.)	N. 37°35'30" E., 97.48
(C7)	(R)	851.98
	(L)	200.51
	(L.C.)	N. 34°03'30" E., 200.06

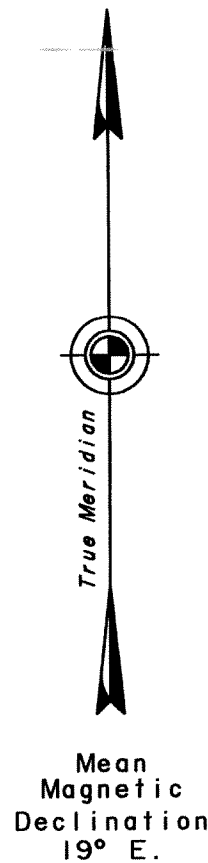


TRACT 6
SEE SHEET No. 4


TRACT 7
12.83

TRACT 12
3.37


SETTLER COVE

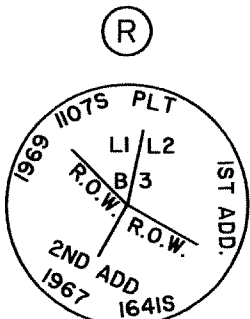


Found an iron pipe, 2 ins. diam., leaning over, 6 ins. below ground, with a brass cap cemented in flush with the pipe, mkd. as shown
At the corner point
Reset the original iron post, flush with the ground.
No accessories taken.

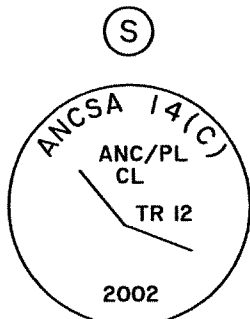

Set a stainless steel post, 28 ins. long, 2 1/2 ins. diam., 40 ins. in the ground, with brass cap mkd. as shown
No accessories taken.
Deposit a magnet in a white plastic case at the base of the stainless steel post.

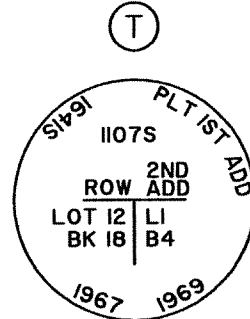


Found an iron pipe, 2 ins. diam., firmly set, projecting 2 ins. above ground, with a brass cap cemented in flush with the pipe, mkd. as shown, from which the remaining original bearing trees
A spruce, 18 ins. diam., bears S. 17° E., 4.3 ft. dist., with a healed blaze.
A spruce, 18 ins. diam., bears S. 89° E., 7.4 ft. dist., with a healed blaze.

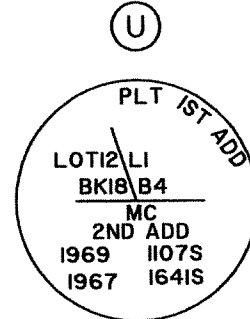

Found an iron pipe, 2 ins. diam., firmly set, projecting 2 ins. above ground, with a brass cap cemented in flush with the pipe, mkd. as shown, from which the remaining original bearing trees
A spruce, 13 ins. diam., bears N. 36° E., 34.4 ft. dist., with a healed blaze.
A spruce, 37 ins. diam., bears S. 1° W., 21.8 ft. dist., with a healed blaze.


LEGEND

- Set a stainless steel post, 28 ins. long, 2 1/2 ins. diam., 26 to 28 ins. in the ground, with a brass cap mkd. ANCSA 14(C) ANC/PL 2002 and with the appropriate tract letters, tract lines, and adjoining survey lines and numbers. No accessories taken.
- Set a rebar, 5/8 in. diam., 30 ins. long, with aluminum cap mkd. ANCSA 14(C) ANC/PL 2002 and with the appropriate tract letters, tract lines, and adjoining survey lines and numbers. No accessories taken.
- ⊗ 5/8 in. diam. rebar with alum. cap recovered this survey.
- ⊗ 2 in. diam. iron pipe, with brass cap recovered this survey.
- ⊗ Bureau of Land Management monument recovered this survey.

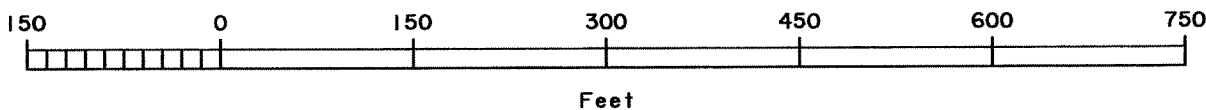


2006-P
Kodiak

REFERENCE SHOULD BE MADE
TO
SHEET Nos. 1, 2 AND 9
FOR SURVEY INFORMATION

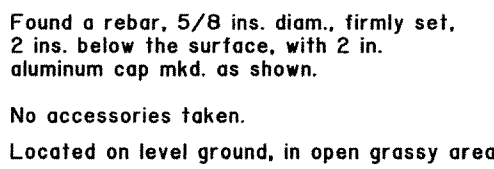

- Set a stainless steel post, 28 ins. long, 2 1/2 ins. diam., 26 to 28 ins. in the ground, with a brass cap mkd. ANCSA 14(C) ANC/PL 2002 and with the appropriate tract letters, tract lines, and adjoining survey lines and numbers. No accessories taken.
- Set a rebar, 5/8 in. diam., 30 ins. long, with aluminum cap mkd. ANCSA 14(C) ANC/PL 2002 and with the appropriate tract letters, tract lines, and adjoining survey lines and numbers. No accessories taken.
- ☒ 5/8 in. diam. rebar with alum. cap recovered this survey.
- ⊗ 2 in. diam. iron pipe, with brass cap recovered this survey.
- ⦿ Bureau of Land Management monument recovered this survey.

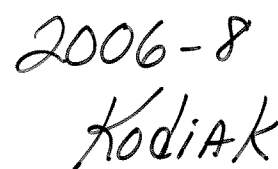


ALASKA NATIVE CLAIMS SETTLEMENT ACT
(ANCSA) SECTION 14 (c) TRACTS 1 THROUGH 13
AND LOTS 10B THROUGH 13B, BLOCK 16
FIRST ADDITION, PORT LIONS SUBDIVISION
P.L. 92-203 (85 STAT. 688, 702, 703)
AFOGNAK NATIVE CORPORATION
AT
PORT LIONS, ALASKA

REFERENCE SHOULD BE MADE
TO
SHEET Nos. 1, 2 AND 9
FOR SURVEY INFORMATION

LEGEND

- Set a stainless steel post, 28 ins. long, 2 1/2 ins. diam., 26 to 28 ins. in the ground, with a brass cap mkd. ANCSA 14(c) ANC/PL 2002 and with the appropriate tract letters, tract lines, and adjoining survey lines and numbers. No accessories taken
- Set a rebar, 5/8 in. diam., 30 ins. long, with aluminum cap mkd. ANCSA 14(c) ANC/PL 2002 and with the appropriate tract letters, tract lines, and adjoining survey lines and numbers. No accessories taken.
- ⊠ 5/8 in. diam. rebar with alum. cap recovered this survey.
- ⊙ 2 in. diam. iron pipe, with brass cap recovered this survey.
- ⊕ Bureau of Land Management monument recovered this survey.

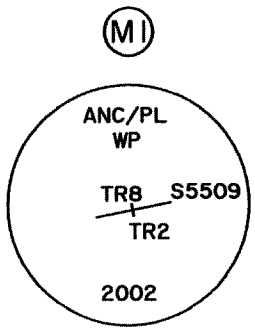



Set a stainless steel post, 28 ins. long, 2 1/2 ins. diam., 26 ins. in the ground, with brass cap mkd. as shown, from which

A spruce, 15 ins. diam., bears S. 70° E., 50.0 ft. dist., mkd. X BT, with a 5 in. spike driven into the SW side at the base.

A spruce, 32 ins. diam., bears S. 4 1/2° W., 61.5 ft. dist., mkd. X BT, with a 5 in. spike driven into the W side at the base.

Deposit a magnet in a white plastic case at the base of the stainless steel post.

Set in sandy loam soil, on gentle S facing slope in a clearing with scattered large diam. spruce along the north and south edge.

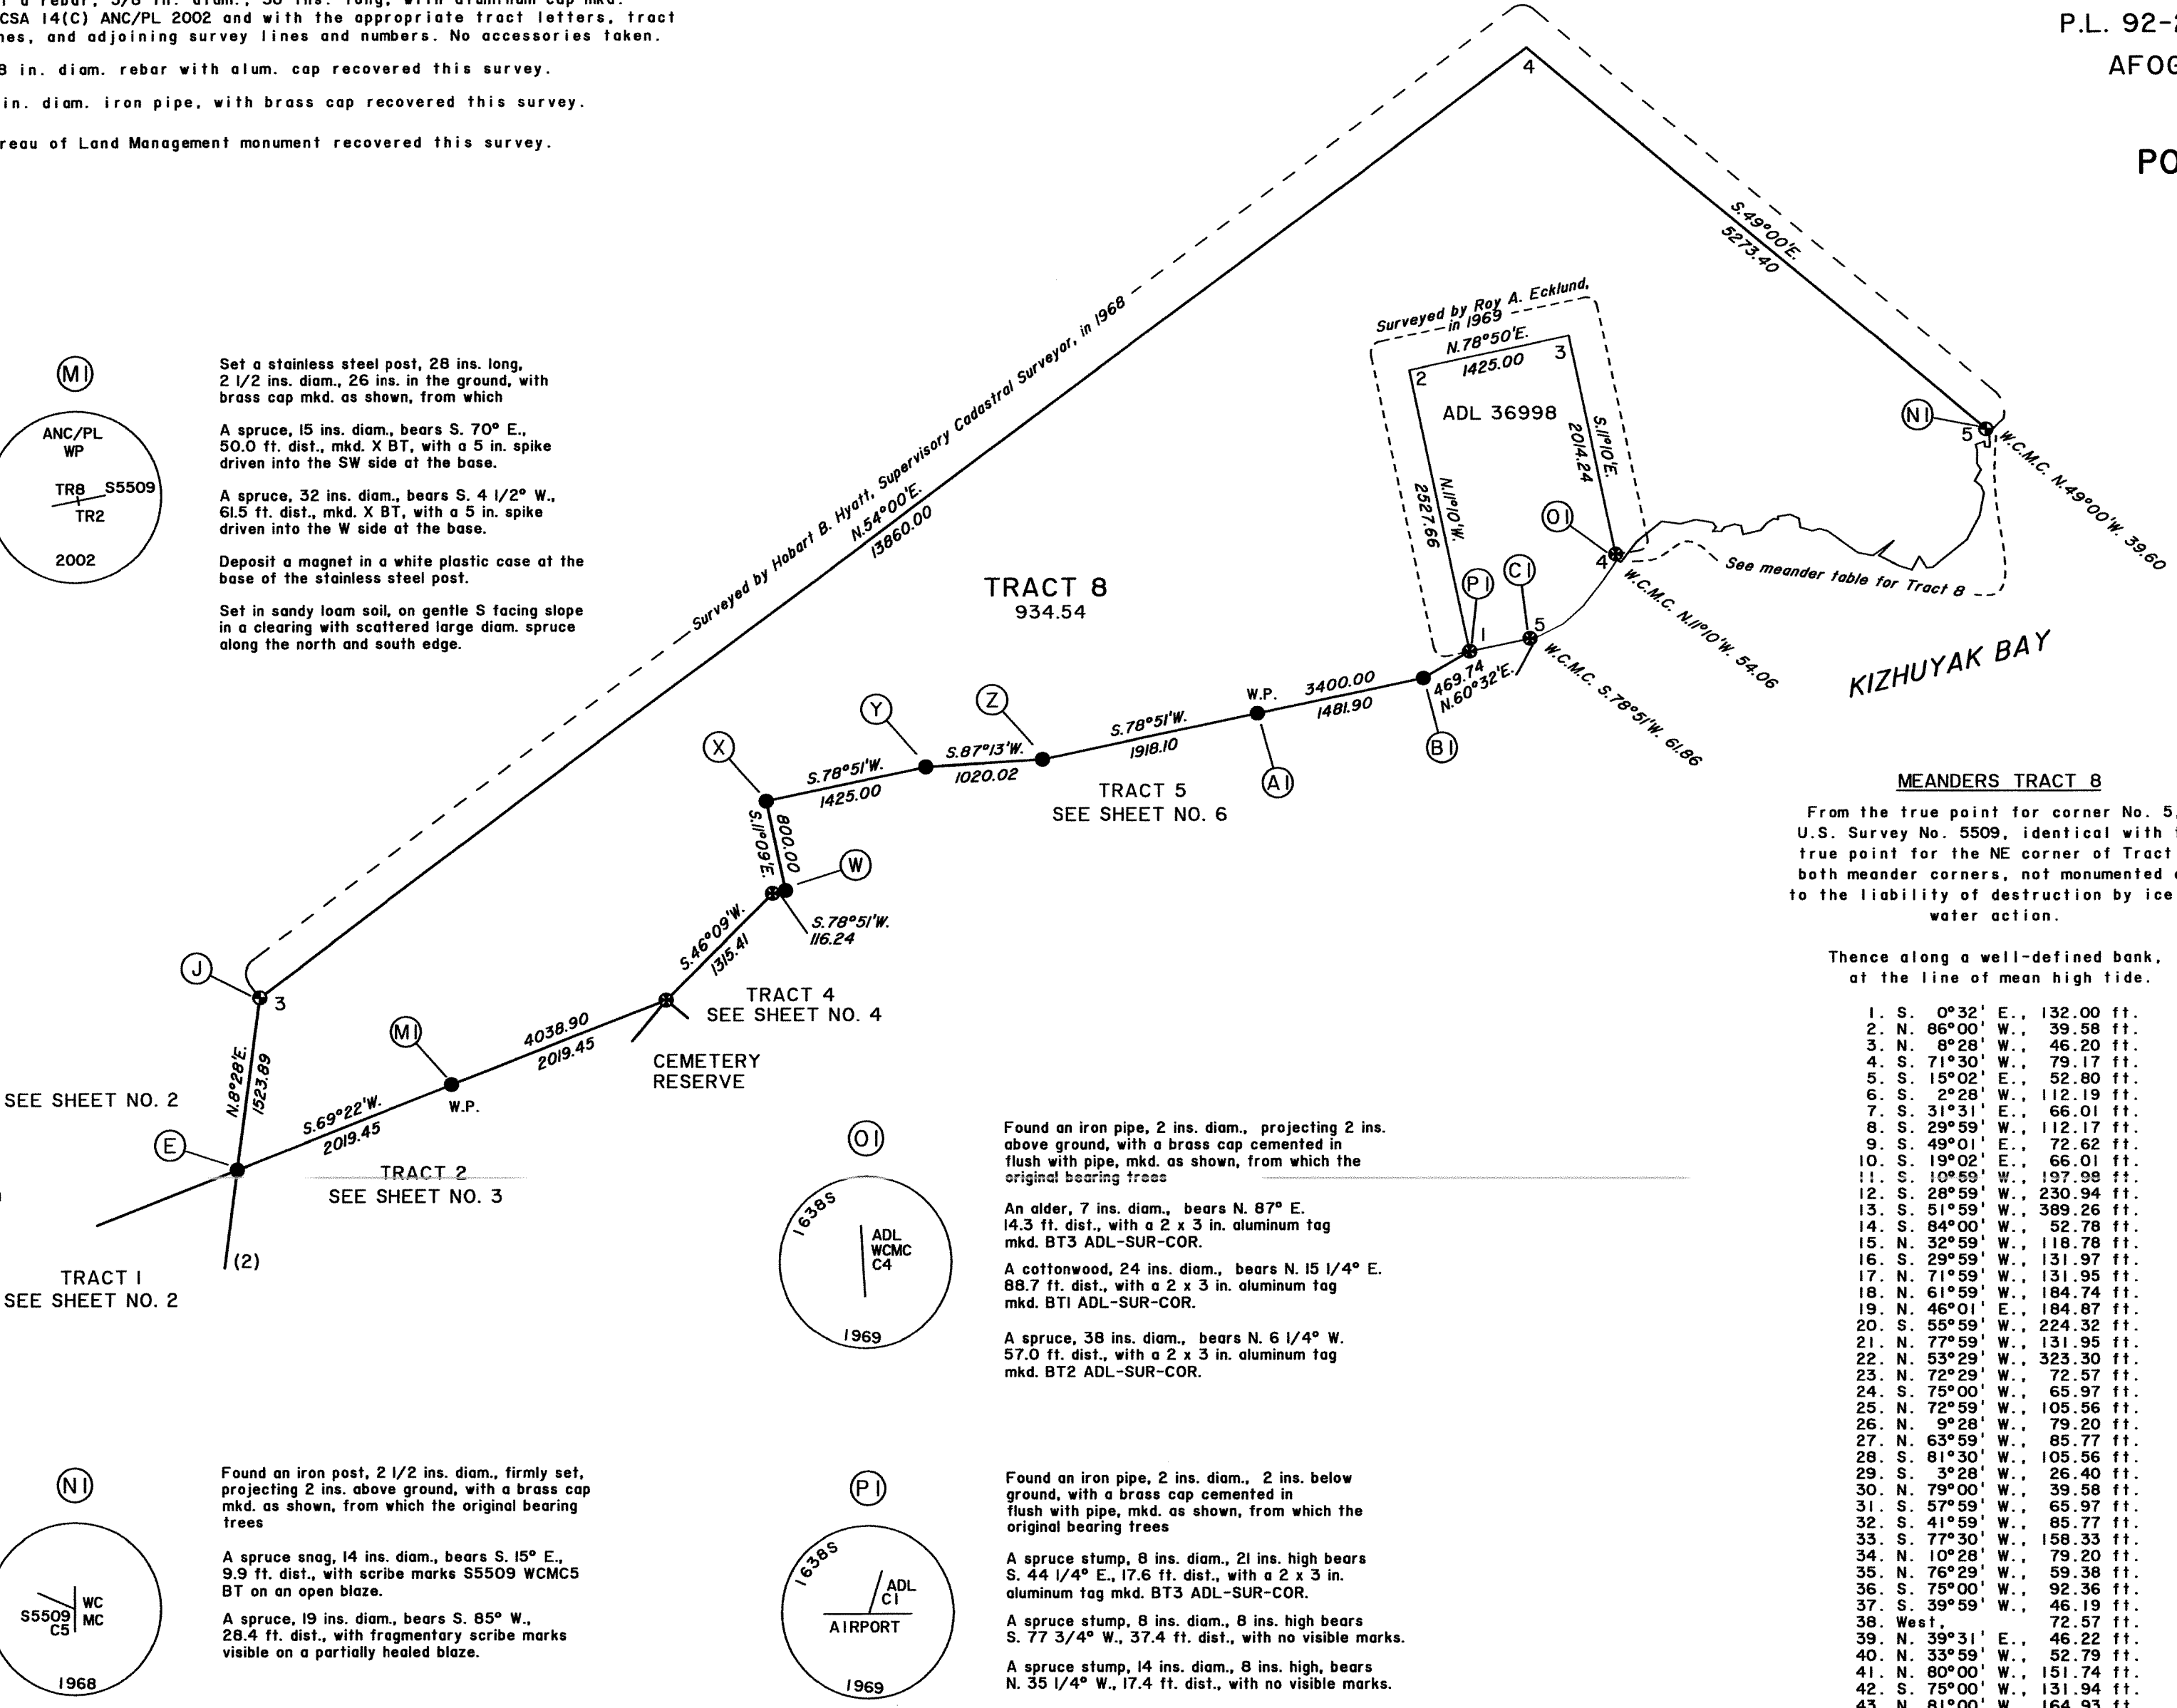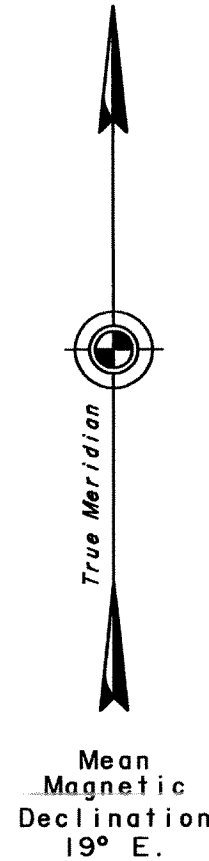

MEANDERS TRACT 8

From the true point for corner No. 5, U.S. Survey No. 5509, identical with the true point for the NE corner of Tract 8, both meander corners, not monumented due to the liability of destruction by ice and water action.

Thence along a well-defined bank, at the line of mean high tide.

- | | |
|------------------|------------|
| 1. S. 0°32' E. | 132.00 ft. |
| 2. N. 86°00' W. | 39.58 ft. |
| 3. N. 8°28' W. | 46.20 ft. |
| 4. S. 71°30' W. | 79.17 ft. |
| 5. S. 15°02' E. | 52.80 ft. |
| 6. S. 2°28' W. | 112.19 ft. |
| 7. S. 31°31' E. | 66.01 ft. |
| 8. S. 29°59' W. | 112.17 ft. |
| 9. S. 49°01' E. | 72.62 ft. |
| 10. S. 19°02' E. | 66.01 ft. |
| 11. S. 10°59' W. | 197.99 ft. |
| 12. S. 28°59' W. | 230.94 ft. |
| 13. S. 51°59' W. | 389.26 ft. |
| 14. S. 84°00' W. | 52.78 ft. |
| 15. N. 32°59' W. | 118.78 ft. |
| 16. S. 29°59' W. | 131.97 ft. |
| 17. N. 71°59' W. | 131.95 ft. |
| 18. N. 61°59' W. | 184.74 ft. |
| 19. N. 46°01' E. | 184.87 ft. |
| 20. S. 55°59' W. | 224.32 ft. |
| 21. N. 77°59' W. | 131.95 ft. |
| 22. N. 53°29' W. | 323.30 ft. |
| 23. N. 72°29' W. | 72.57 ft. |
| 24. S. 75°00' W. | 65.97 ft. |
| 25. N. 72°59' W. | 105.56 ft. |
| 26. N. 9°28' W. | 79.20 ft. |
| 27. N. 63°59' W. | 85.77 ft. |
| 28. S. 81°30' W. | 105.56 ft. |
| 29. S. 3°28' W. | 26.40 ft. |
| 30. N. 79°00' W. | 39.58 ft. |
| 31. S. 57°59' W. | 65.97 ft. |
| 32. S. 41°59' W. | 85.77 ft. |
| 33. S. 77°30' W. | 158.33 ft. |
| 34. N. 10°28' W. | 79.20 ft. |
| 35. N. 76°29' W. | 59.38 ft. |
| 36. S. 75°00' W. | 92.36 ft. |
| 37. S. 39°59' W. | 46.19 ft. |
| 38. West. | 72.57 ft. |
| 39. N. 39°31' E. | 46.22 ft. |
| 40. N. 33°59' W. | 52.79 ft. |
| 41. N. 80°00' W. | 151.74 ft. |
| 42. S. 75°00' W. | 131.94 ft. |
| 43. N. 81°00' W. | 164.93 ft. |
| 44. S. 51°59' W. | 283.70 ft. |
| 45. S. 38°29' W. | 224.33 ft. |
| 46. N. 63°09' W. | 38.15 ft. |

At end of course, the true point for corner No. 4, Alaska Division of Lands Survey No. 36998, identical with a corner of Tract 8, both meander corners, not monumented due to the liability of destruction by ice and water action.

2006-8
KODIAK

ALASKA NATIVE CLAIMS SETTLEMENT ACT
(ANCSA) SECTION 14 (c) TRACTS I THROUGH I3
AND LOTS 10B THROUGH I3B, BLOCK 16
FIRST ADDITION, PORT LIONS SUBDIVISION
P.L. 92-203 (85 STAT. 688, 702, 703)
AFOGNAK NATIVE CORPORATION

AT
PORT LIONS, ALASKA


REFERENCE SHOULD BE MADE
TO
SHEET Nos. 1 AND 2
FOR SURVEY INFORMATION

The geographic position of the witness corner to corner No. 3, a meander corner, as determined by a tie (using the Global Positioning System, utilizing static, relative positioning techniques) to the witness corner to the meander corner of sections 1 and 6, Township 26 South, Ranges 23 and 24 West, Seward Meridian, Alaska, is:

Latitude: 57° 57' 15.17" North NAD 27
Longitude: 153° 05' 08.97" West

This survey is situated on the southwesterly side of Bare Island, approximately 10 miles northwesterly of Port Lions, Alaska, within Section 1, Township 26 South, Range 24 West, Seward Meridian, Alaska.

The surveyed area is generally level, with a small bluff along the southwest shoreline. Vegetation is tall grass in the open areas with medium to large diameter hemlock and spruce in the forested areas. The soil is sandy loam.

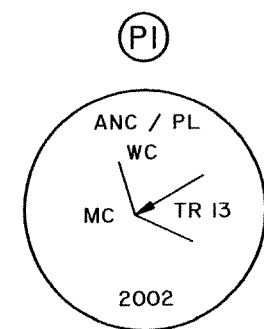


Set a stainless steel post, 28 ins. long, 2 1/2 ins. diam., 26 ins. in the ground, with brass cap mkd. as shown, from which

A spruce, 9 ins. diam., bears N. 35 1/4° E., 26.5 ft. dist., mkd. XBT, with a 5 in. spike driven into the E side at the base.

A spruce, 10 ins. diam., bears S. 33° E., 7.7 ft. dist., mkd. XBT, with a 5 in. spike driven into the E side at the base.

Deposit a magnet in a white plastic case at the base of the stainless steel post.

Located on level ground above a 15 ft. high rocky cliff bank with mixed diameter spruce.

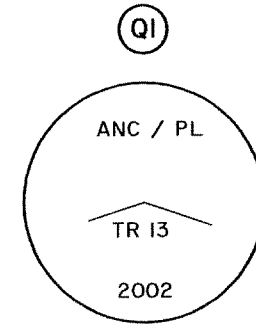



Set a stainless steel post, 28 ins. long, 2 1/2 ins. diam., 26 ins. in the ground, with brass cap mkd. as shown, from which

A spruce, 12 ins. diam., bears S. 50° W., 28.20 ft. dist., mkd. XBT, with a 5 in. spike driven into the W side at the base.

A spruce, 8 ins. diam., bears N. 46 1/2° W., 21.5 ft. dist., mkd. XBT, with a 5 in. spike driven into the W side at the base.

Deposit a magnet in a white plastic case at the base of the stainless steel post.

Located on level ground with mixed diameter spruce and no under brush.

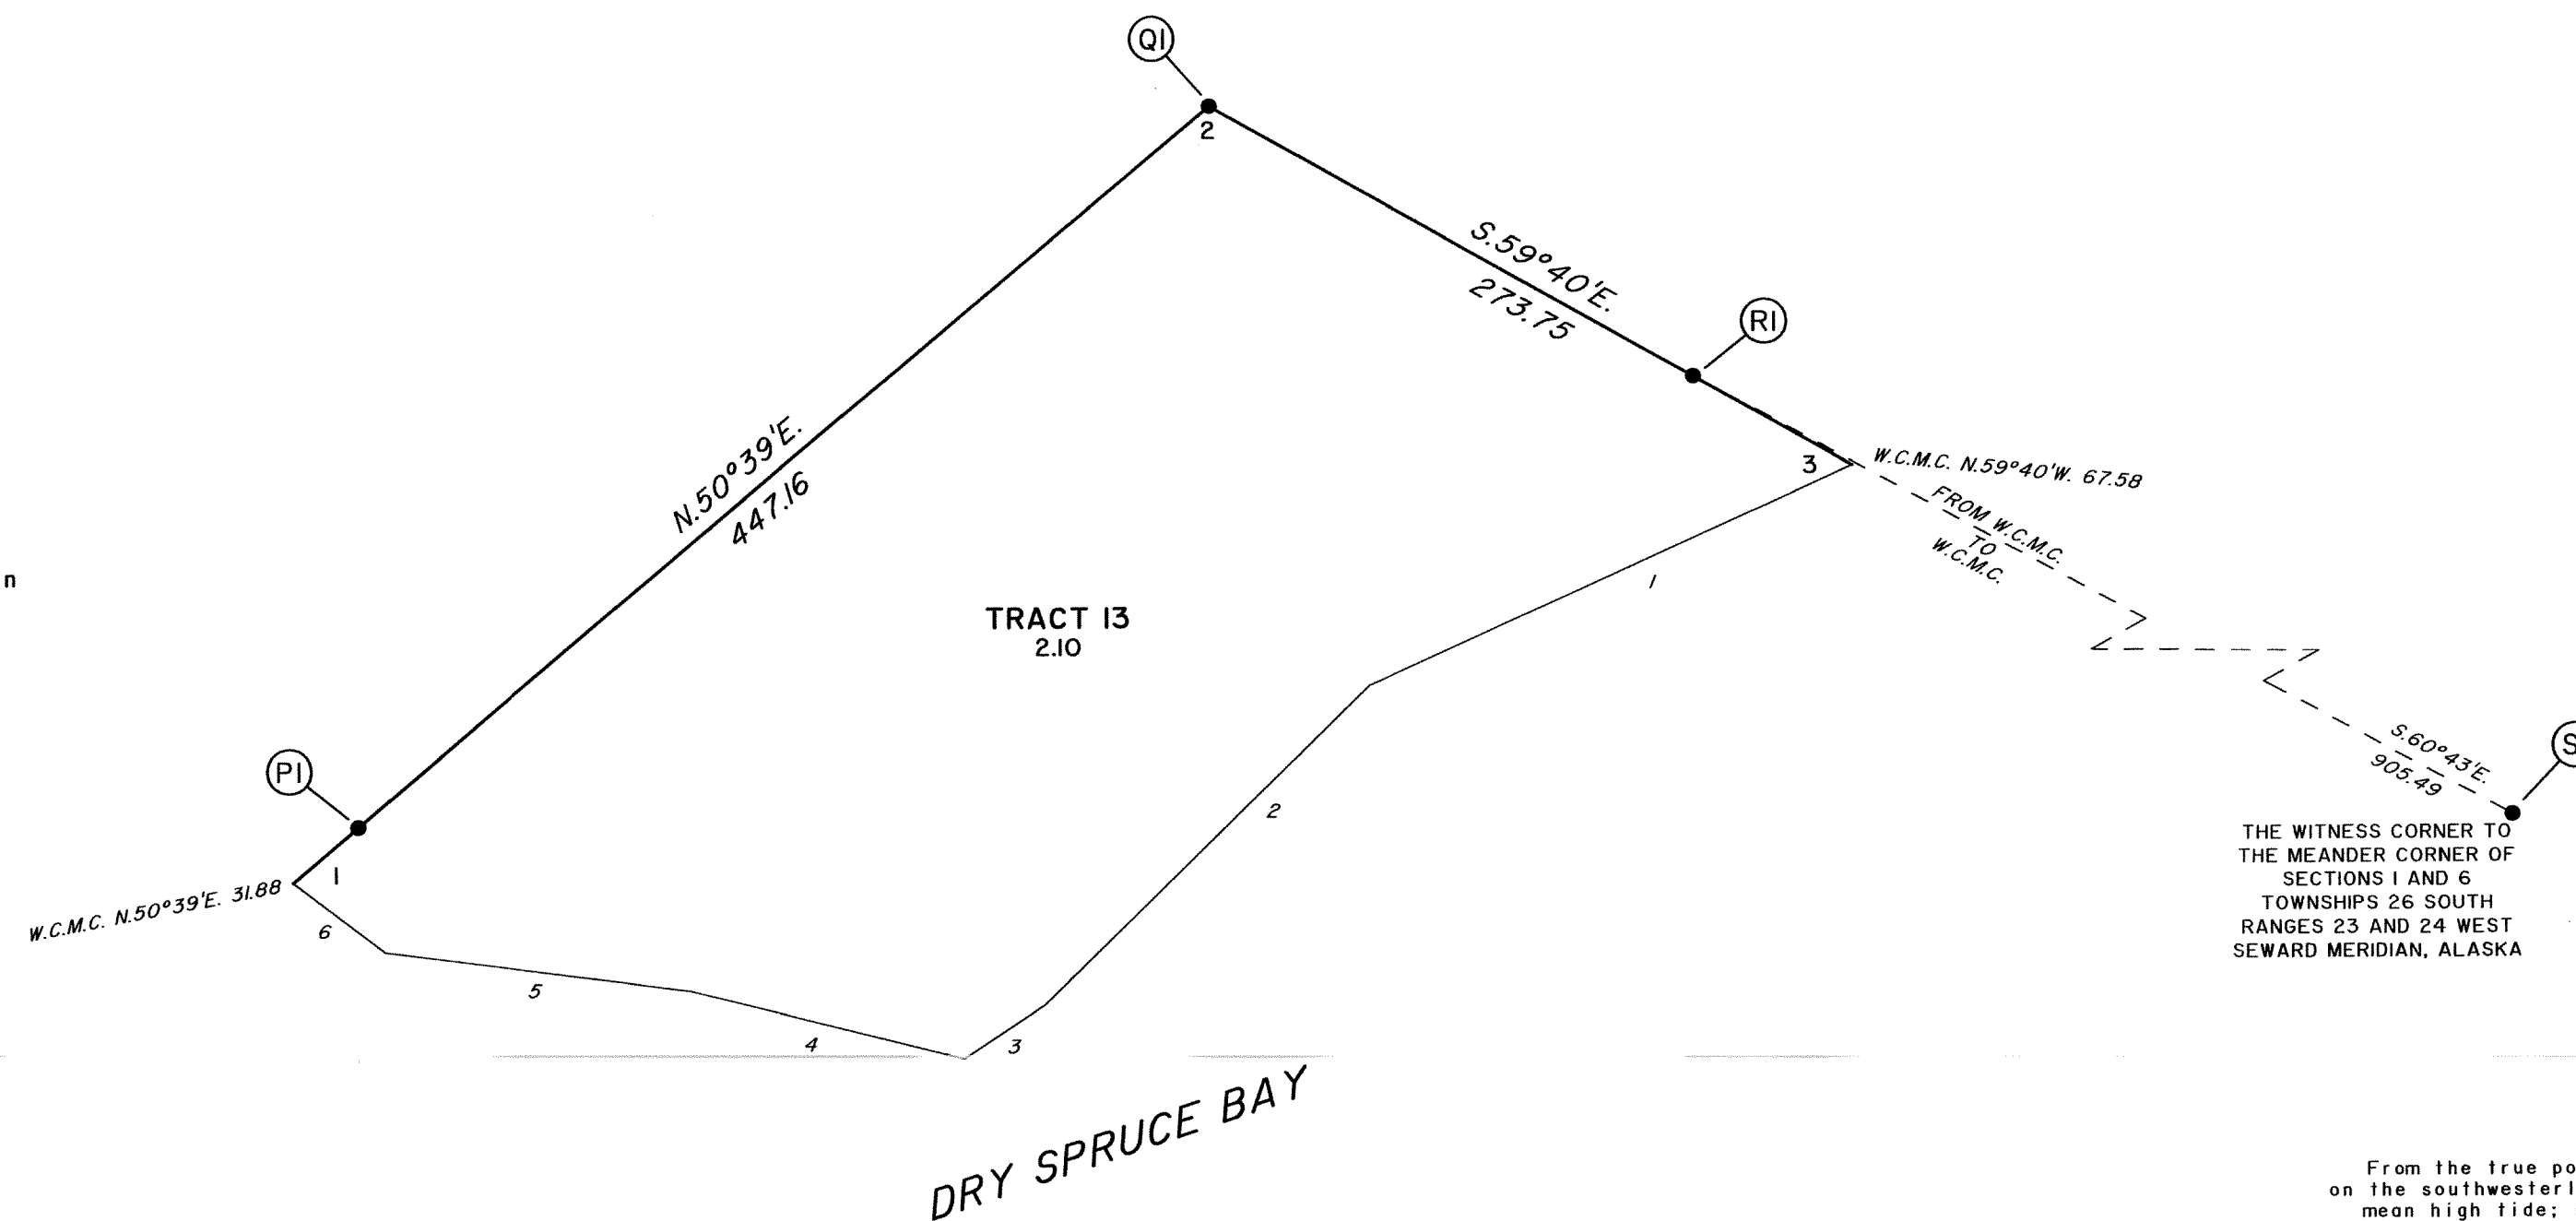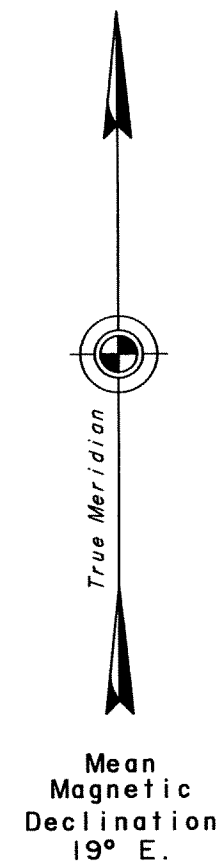

THE WITNESS CORNER TO THE MEANDER CORNER OF SECTIONS 1 AND 6 TOWNSHIPS 26 SOUTH RANGES 23 AND 24 WEST SEWARD MERIDIAN, ALASKA


MEANDERS

From the true point for cor. No. 3, a meander cor., on the southwesterly shore of Bare Island, at the line of mean high tide; not monumented due to the liability of destruction by ice and water action.

Thence with the meanders of the southwesterly shore of Bare Island, along a gently sloping gravel and rock beach, at the line of mean high tide.

- | | |
|------------------|------------|
| 1. S. 66°20' W., | 196.78 ft. |
| 2. S. 46°26' W., | 169.16 ft. |
| 3. S. 57°43' W., | 36.19 ft. |
| 4. N. 75°17' W., | 104.36 ft. |
| 5. N. 81°51' W., | 114.82 ft. |
| 6. N. 51°47' W., | 43.37 ft. |

At end of course, the true point for cor. No. 1, a meander cor.; not monumented due to the liability of destruction by ice and water action.

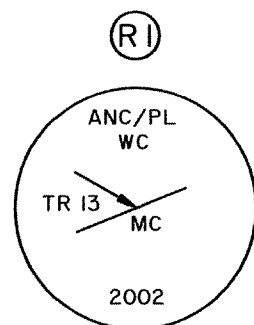


Set a stainless steel post, 28 ins. long, 2 1/2 ins. diam., 25 ins. in the ground with brass cap mkd. as shown, from which

A spruce, 21 ins. diam., bears N. 57 3/4° E., 27.7 ft. dist., mkd. XBT, with a 5 in. spike driven into the East side at the base.

A spruce, 16 ins. diam., bears N. 43° W., 24.8 ft. dist., mkd. XBT, with a 5 in. spike driven into the West side at the base.

Deposit a magnet in a white plastic case at the base of the stainless steel post.

Located on level ground above a 4 ft. high sand bank with large diameter spruce.

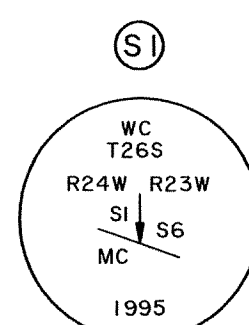


Found a stainless steel post, 2 1/2 ins. diam., firmly set, flush with the ground, with brass cap mkd. as shown, from which

A spruce, 14 ins. diam., bears S. 69° E., 27.7 ft. dist., with marks XBT visible on an open blaze.

A spruce, 7 ins. diam., bears S. 34° W., 10.6 ft. dist., with marks XBT visible on an open blaze.

Located on level ground with mixed diameter spruce.

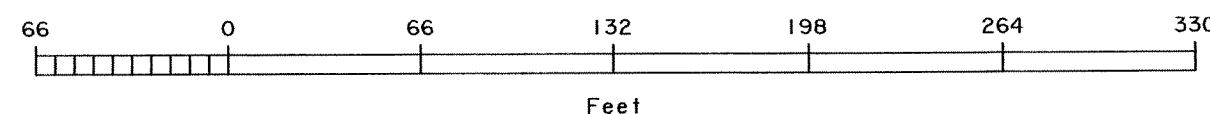

2006-8
KODIAK

ALASKA NATIVE CLAIMS SETTLEMENT ACT
(ANCSA) SECTION 14 (c) TRACTS I THROUGH 13

AND LOTS IOB THROUGH I3B, BLOCK I6
FIRST ADDITION, PORT LIONS SUBDIVISION





P.L. 92-203 (85 STAT. 688, 702, 703)

AFOGNAK NATIVE CORPORATION

60 - AT
PORT LIONS, ALASKA

REFERENCE SHOULD BE MADE
TO
SHEET Nos. 1, 2, 3, 6 AND 7
FOR SURVEY INFORMATION

2006-8
KODIAK
KODIAK REC DIST
Date 7/10/2006
Time 2:01 P
Requested By B.T.A.
Address

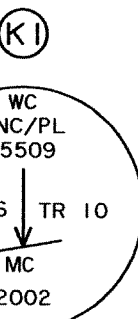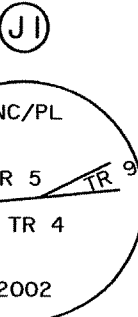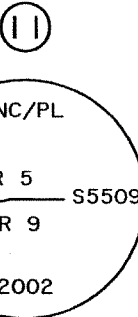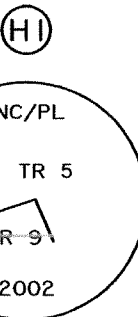

2006-8
KODIAK



Set a stainless steel post, 28 ins. long,
2 1/2 ins. diam., 26 ins. in the ground, with
brass cap mkd. as shown, from which

A spruce, 9 ins. diam., bears S. 63° W.,
68.2 ft. dist., mkd. X BT, with a 5 in. spike
driven into the NW side at the base.

A spruce, 24 ins. diam., bears N. 66 1/2° W.,
63.4 ft. dist., mkd. X BT, with a 5 in. spike
driven into the NE side at the base.

Deposit a magnet in a white plastic case at the
base of the stainless steel post.

Located on level ground, in an area forested
with scattered large diam. spruce.

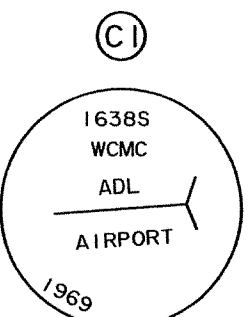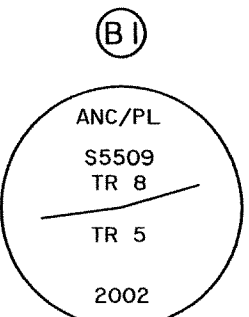


Found an iron pipe, 2 ins. diam., projecting 20 ins.
above ground, and in a mound of stone, 21 ins. at
the base, 18 ins. high, with a brass cap cemented
in flush with pipe, mkd. as shown, from which the
original bearing trees

A spruce, 14 ins. diam., bears N. 11° E., 6.6 ft.
dist., with a healed blaze where a tag was nailed.
The was no other evidence of the tag.

A spruce, 5 ins. diam., bears S. 83 3/4° W.,
15.4 ft. dist., with a 2 x 3 in. aluminum tag mkd.
BT1 ADL-SUR-COR.

A spruce, 14 ins. diam., bears N. 46 3/4° W.,
5.8 ft. dist., with a 2 x 3 in. aluminum tag mkd.
BT2 ADL-SUR-COR.

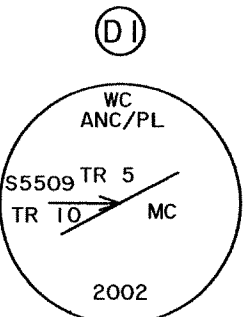


Set a stainless steel post, 28 ins. long,
2 1/2 ins. diam., 26 ins. in the ground, with
brass cap mkd. as shown, from which

A spruce, 33 ins. diam., bears N. 32 3/4° E.,
48.9 ft. dist., mkd. X BT, with a 5 in. spike
driven into the SE side at the base.

Drive a steel fence post, 6 ft. long, 3 ft. in
the ground, 3.3 ft. W of cor.

Deposit a magnet in a white plastic case at the
base of the stainless steel post.

Located on the top of a level bluff, approximately
60 ft. above mean high tide, in an area forested
with large diam. spruce, cottonwood, and alder.

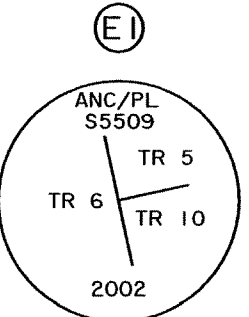


Set a stainless steel post, 28 ins. long,
2 1/2 ins. diam., 26 ins. in the ground, with
brass cap mkd. as shown, from which

A spruce, 21 ins. diam., bears N. 83 3/4° W.,
15.9 ft. dist., mkd. X BT, with a 5 in. spike
driven into the N side at the base.

Drive a steel fence post, 6 ft. long, 3 ft. in
the ground, 3.3 ft. N of cor.

Deposit a magnet in a white plastic case at the
base of the stainless steel post.

Located near the top of a steep S facing
slope, in an area forested with large diam.
spruce, cottonwood, and alder.

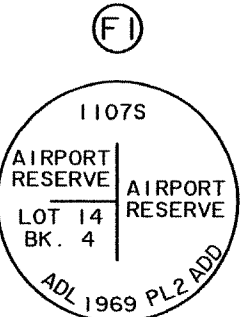


Found an iron pipe, 2 ins. diam., firmly set,
projecting 3 ins. above ground, with brass cap
3 1/4 ins. diam., mkd. as shown, from which the
same bearing trees used by Roy A. Ecklund, R.L.S.,
in a survey of the Port Lions Subdivision, Second
Addition, in 1969

A spruce, 21 ins. diam., bears S. 63 3/4° E.,
58.6 ft. dist., with a healed blaze.

A spruce, 20 ins. diam., bears S. 22° E., 75.5 ft.
dist., with a healed blaze.

A spruce, 24 ins. diam., bears S. 3 1/4° W.
76.2 ft. dist., with a healed blaze.

Found alongside a rebar with a 1 1/2 in. aluminum
cap.

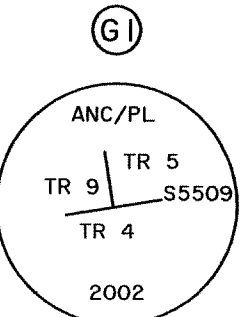

Set a stainless steel post, 28 ins. long,
2 1/2 ins. diam., 26 ins. in the ground, with
brass cap mkd. as shown, from which

A spruce, 5 ins. diam., bears S. 85° W.,
13.6 ft. dist., mkd. X BT, with a 5 in. spike
driven into the N side at the base.

A spruce, 7 ins. diam., bears N. 15° W.,
66.4 ft. dist., mkd. X BT, with a 5 in. spike
driven into the NE side at the base.

Deposit a magnet in a white plastic case at the
base of the stainless steel post.

Set in sandy loam soil, on level ground, in an
area forested with small diam. spruce and alder.


Found an iron pipe, 2 1/2 ins. diam., firmly set,
projecting 1 ins. above ground, with a brass cap
mkd. as shown, from which the original
bearing trees

A spruce, 19 ins. diam., bears N. 59 1/2° E.,
38.3 ft. dist., with fragmentary scribe marks
visible on a partially healed blaze.

A spruce, 11 ins. diam., bears S. 37° W.,
23.1 ft. dist., with a healed blaze.

A spruce, 18 ins. diam., bears N. 18 1/4° W.,
31.7 ft. dist., with a healed blaze.

A spruce stump, 15 ins. diam., 6 ft. high,
bears S. 84° E., 27.0 ft. dist., mkd.
WC SI736 MC5 BT on an open blaze.

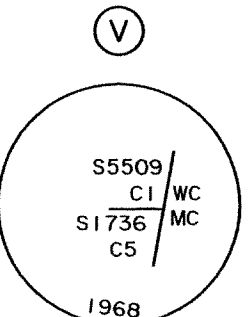


Set a stainless steel post, 28 ins. long,
2 1/2 ins. diam., 26 ins. in the ground, with
brass cap mkd. as shown, from which

A spruce, 26 ins. diam., bears N. 51 1/2° E.,
139.0 ft. dist., mkd. X BT, with a 5 in. spike
driven into the SE side of the base.

A spruce, 12 ins. diam., bears S. 4 1/2° W.,
123.2 ft. dist., mkd. X BT, with a 5 in. spike
driven into the W side at the base.

Deposit a magnet in a white plastic case at the
base of the stainless steel post.

Set in sandy loam soil, on gentle E facing slope
forested with scattered large diam. spruce, and
small diam. birch and alder.

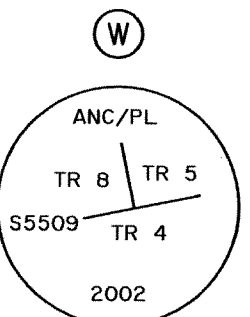


Set a stainless steel post, 28 ins. long,
2 1/2 ins. diam., 26 ins. in the ground, with
brass cap mkd. as shown, from which

A spruce, 10 ins. diam., bears N. 11 1/2° W.,
45.8 ft. dist., mkd. X BT, with a 5 in. spike
driven into the E side of the base.

Drive a steel fence post, 6 ft. long, 3 ft. in
the ground, 6.6 ft. N of cor.

Deposit a magnet in a white plastic case at the
base of the stainless steel post.

Set in sandy loam soil, in tall grass on a
gentle E facing slope.

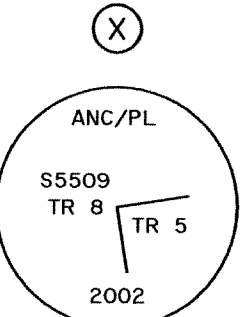


Set a stainless steel post, 28 ins. long,
2 1/2 ins. diam., 26 ins. in the ground, with
brass cap mkd. as shown, from which

A spruce, 17 ins. diam., bears N. 37° E.,
16.3 ft. dist., mkd. X BT, with a 5 in. spike
driven into the SE side at the base.

A spruce, 16 ins. diam., bears S. 78° W.,
33.9 ft. dist., mkd. X BT, with a 5 in. spike
driven into the NW side at the base.

Deposit a magnet in a white plastic case at the
base of the stainless steel post.

Set in sandy loam soil, at the base of a
16 in. spruce, in an area forested with
mixed diam. spruce with no underbrush.

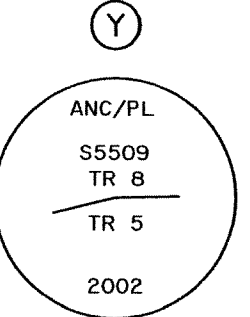


Set a stainless steel post, 28 ins. long,
2 1/2 ins. diam., 26 ins. in the ground, with
brass cap mkd. as shown, from which

A spruce, 13 ins. diam., bears S. 17° E.,
35.2 ft. dist., mkd. X BT, with a 5 in. spike
driven into the W side at the base.

A spruce, 13 ins. diam., bears S. 72° W.,
16.8 ft. dist., mkd. X BT, with a 5 in. spike
driven into the N side at the base.

Deposit a magnet in a white plastic case at the
base of the stainless steel post.

Located on level ground, in an area forested
with scattered spruce and alder.

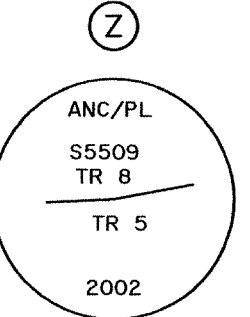


Set a stainless steel post, 28 ins. long,
2 1/2 ins. diam., 26 ins. in the ground, with
brass cap mkd. as shown, from which

A spruce, 15 ins. diam., bears N. 45° E.,
106.6 ft. dist., mkd. X BT, with a 5 in. spike
driven into the SE side at the base.

A spruce, 21 ins. diam., bears N. 56° W.,
84.0 ft. dist., mkd. X BT, with a 5 in. spike
driven into the NE side at the base.

Deposit a magnet in a white plastic case at the
base of the stainless steel post.

Located on level ground, in a small clearing
surrounded by scattered spruce and alder.

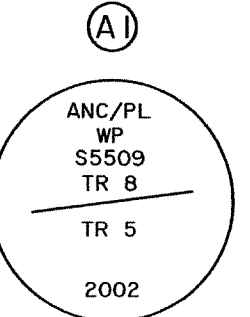


Found an iron pipe, 2 ins. diam., firmly set,
projecting 5 ins. above ground, with brass cap
3 1/4 ins. diam., mkd. as shown, from which the
same bearing trees used by Roy A. Ecklund, R.L.S.,
in a survey of the Port Lions Subdivision, Second
Addition, in 1969

A spruce, 12 ins. diam., bears S. 18° W.,
32.1 ft. dist., with a healed blaze.

A spruce, 32 ins. diam., bears S. 71 1/2° E.,
18.8 ft. dist., with a healed blaze.

A spruce, 30 ins. diam., bears N. 62 1/4° W.,
37.1 ft. dist., with a healed blaze.

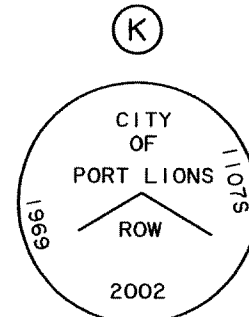


Found an iron pipe, 2 ins. diam., projecting 3 ins.
above ground, with a brass cap cemented in
flush with pipe, mkd. as shown, from which the
original bearing trees

A spruce, 24 ins. diam., bears S. 59° E.,
6.7 ft. dist., with a healed blaze.

A spruce, 20 ins. diam., bears N. 26° W.,
23.7 ft. dist., with a healed blaze.

A spruce, 20 ins. diam., bears N. 69° W.,
20.4 ft. dist., with a healed blaze.

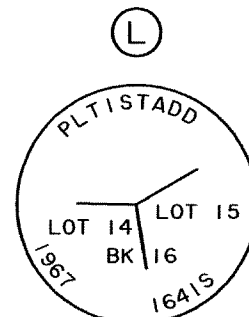


Set a stainless steel post, 28 ins. long,
2 1/2 ins. diam., 26 ins. in the ground, with
brass cap mkd. as shown, from which

A spruce, 14 ins. diam., bears S. 34° W.,
35.6 ft. dist., mkd. X BT, with a 5 in. spike
driven into the NW side at the base.

A spruce, 8 ins. diam., bears N. 11° W.,
38.0 ft. dist., mkd. X BT, with a 5 in. spike
driven into the E side of the base.

Deposit a magnet in a white plastic case at the
base of the stainless steel post.

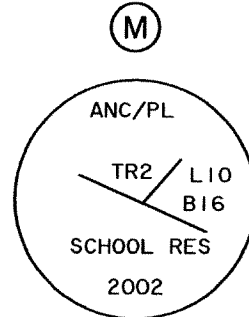


Found an iron pipe, 2 ins. diam., projecting 3 ins.
above ground, with a brass cap cemented in
flush with pipe, mkd. as shown, from which the
original bearing trees

A spruce, 19 ins. diam., bears N. 21° E.,
23.8 ft. dist., with a healed blaze.
(Record N. 19° W.)

A spruce, 24 ins. diam., bears S. 29° E.,
29.0 ft. dist., with a healed blaze.

A spruce, 20 ins. diam., bears S. 84° W.,
60.1 ft. dist., with a healed blaze.

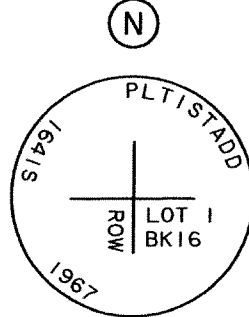


Set a stainless steel post, 28 ins. long,
2 1/2 ins. diam., 26 ins. in the ground, with
brass cap mkd. as shown, from which

A spruce, 5 ins. diam., bears S. 27 1/4° E.,
9.7 ft. dist., mkd. X BT, with a 5 in. spike
driven into the SW side of the base.

A spruce, 13 ins. diam., bears N. 87 3/4° W.,
26.0 ft. dist., mkd. X BT, with a 5 in. spike
driven into the N side at the base.

Deposit a magnet in a white plastic case at the
base of the stainless steel post.

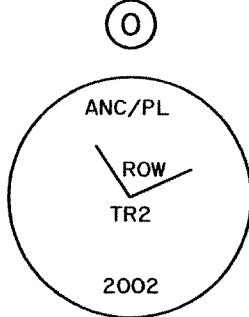

Found an iron pipe, 2 ins. diam., projecting 2 ins.
above ground, with a brass cap cemented in
flush with pipe, mkd. as shown, from which the
original bearing trees

A spruce, 24 ins. diam., bears N. 45° E.,
6.9 ft. dist., with a healed blaze.

A spruce, 30 ins. diam., bears S. 58 1/2° W.,
25.5 ft. dist., with a healed blaze.

A spruce stump, 14 ins. diam., 24 ins. high,
bears N. 19 1/2° W., 15.7 ft. dist., with no
visible marks.

