


LOCATION MAP

UNALASKA

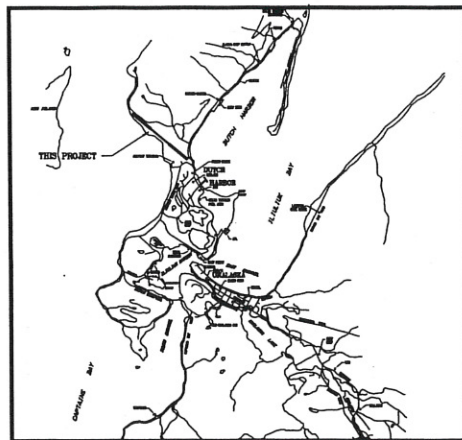

VICINITY MAP


NO SCALE
T72S, R11W
SEWARD MERIDIAN, ALASKA
USGS UNALASKA

This Land Occupancy Drawing (LO) was compiled from the previous LO dated 01/02/1986 and updated 01/26/1996, the Exhibit A dated 1/27/03 from which English stationing was derived, tenant surveys, and a CADD produced base map, which was rescaled from metric at a factor of 3.2808. Facilities may not be to exact English dimensions.

English stations on the Exhibit A noted above differs from the stationing on the previous LO.

The locations and elevations of all utilities shown are approximate only; locations have not been field verified. Additional utilities that are not shown on this LO may also exist.

DRAFT

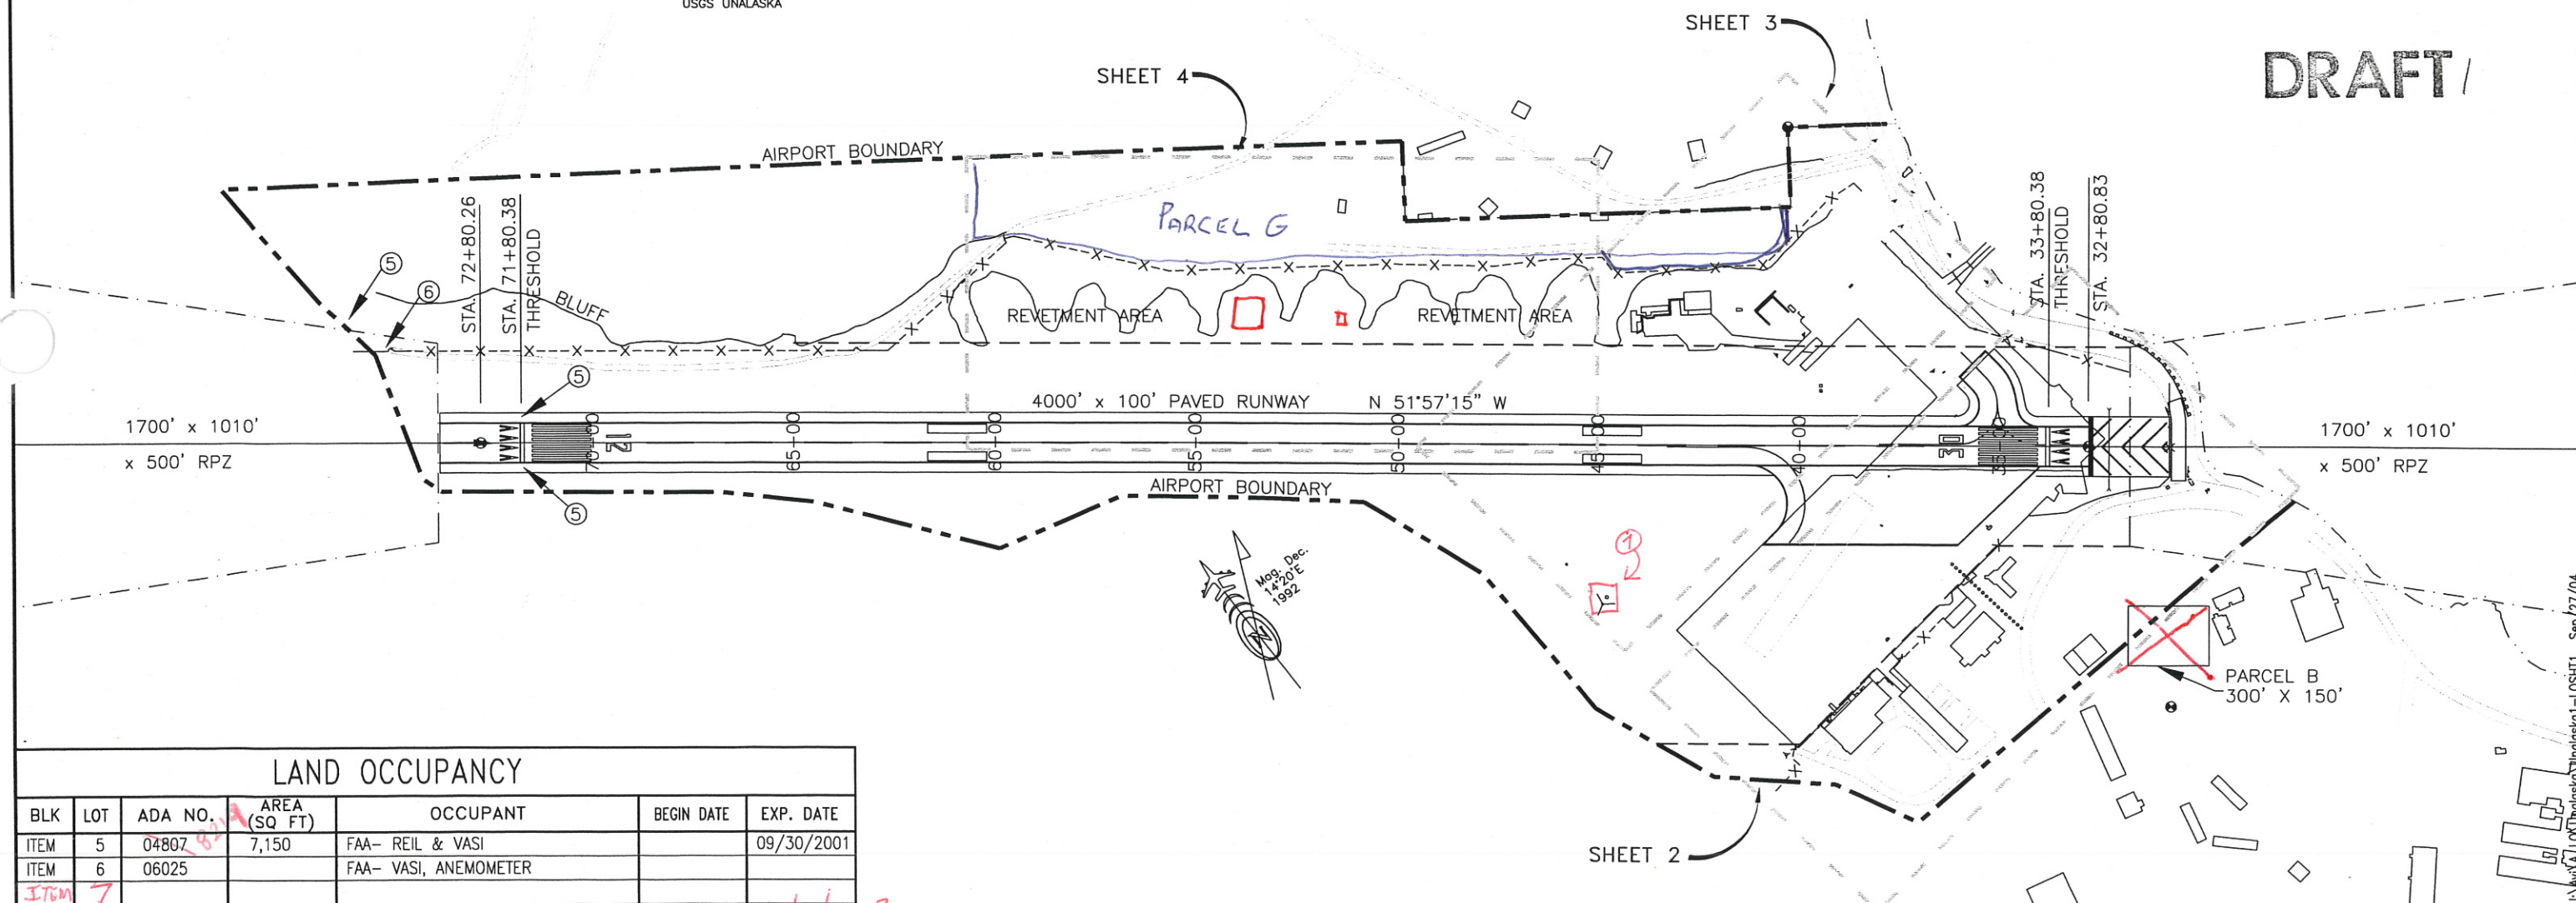

LAND OCCUPANCY

BLK	LOT	ADA NO.	AREA (SQ FT)	OCCUPANT	BEGIN DATE	EXP. DATE
ITEM 5	04807	87	7,150	FAA- REIL & VASI		09/30/2001
ITEM 6	06025			FAA- VASI, ANEMOMETER		
ITEM 7	06500		30,000	FAA- AWOS SITE		09/30/2023
PARCEL B	07707		1,000	PENINSULA AIRWAYS, INC		12/31/2004
PARCEL C	08467		299,300	WEST COAST CO		8/14/2011

LEGEND

—	EXISTING FACILITIES	C/L	= CENTERLINE	<	= TIE-DOWNS
- - -	EXISTING ROADS	LT	= LEFT	⋈	= TELEPHONE PEDESTAL
BRL	BUILDING RESTRICTION LINE	ROW	= RIGHT OF WAY	⋈FH	= FIRE HYDRANT
- - -	UG TV CABLE	RPZ	= RUNWAY PROTECTION ZONE	⋈V	= VALVE
- - -	UG TELEPHONE CABLE	RT	= RIGHT	⋈MH	= MANHOLE
- - -	UG ELECTRIC CABLE	R/W	= RUNWAY	⋈EM	= ELEC HANDHOLE
■	BUILDINGS	SREB	= SNOW REMOVAL EQUIPMENT BUILDING	⋈	= LIGHT OR LUMINAIRE
■	ABOVEGROUND FUEL TANKS	STA	= STATION	⋈	= FLOODLIGHT
⊙	PRIMARY MONUMENT	T/W	= TAXIWAY		
●	SECONDARY MONUMENT				




STATE OF ALASKA
DEPARTMENT OF TRANSPORTATION
AND PUBLIC FACILITIES
AVIATION LEASING AND AIRPORT LAND DEVELOPMENT

UNALASKA AIRPORT LAND OCCUPANCY

APPROVED
Robert L. Norton
CHIEF, AVIATION LEASING

BY	DATE	CHANGE

SCALE
1"=200'
DWN CAT
DATE 9/25/04
SHEET 1 OF 4

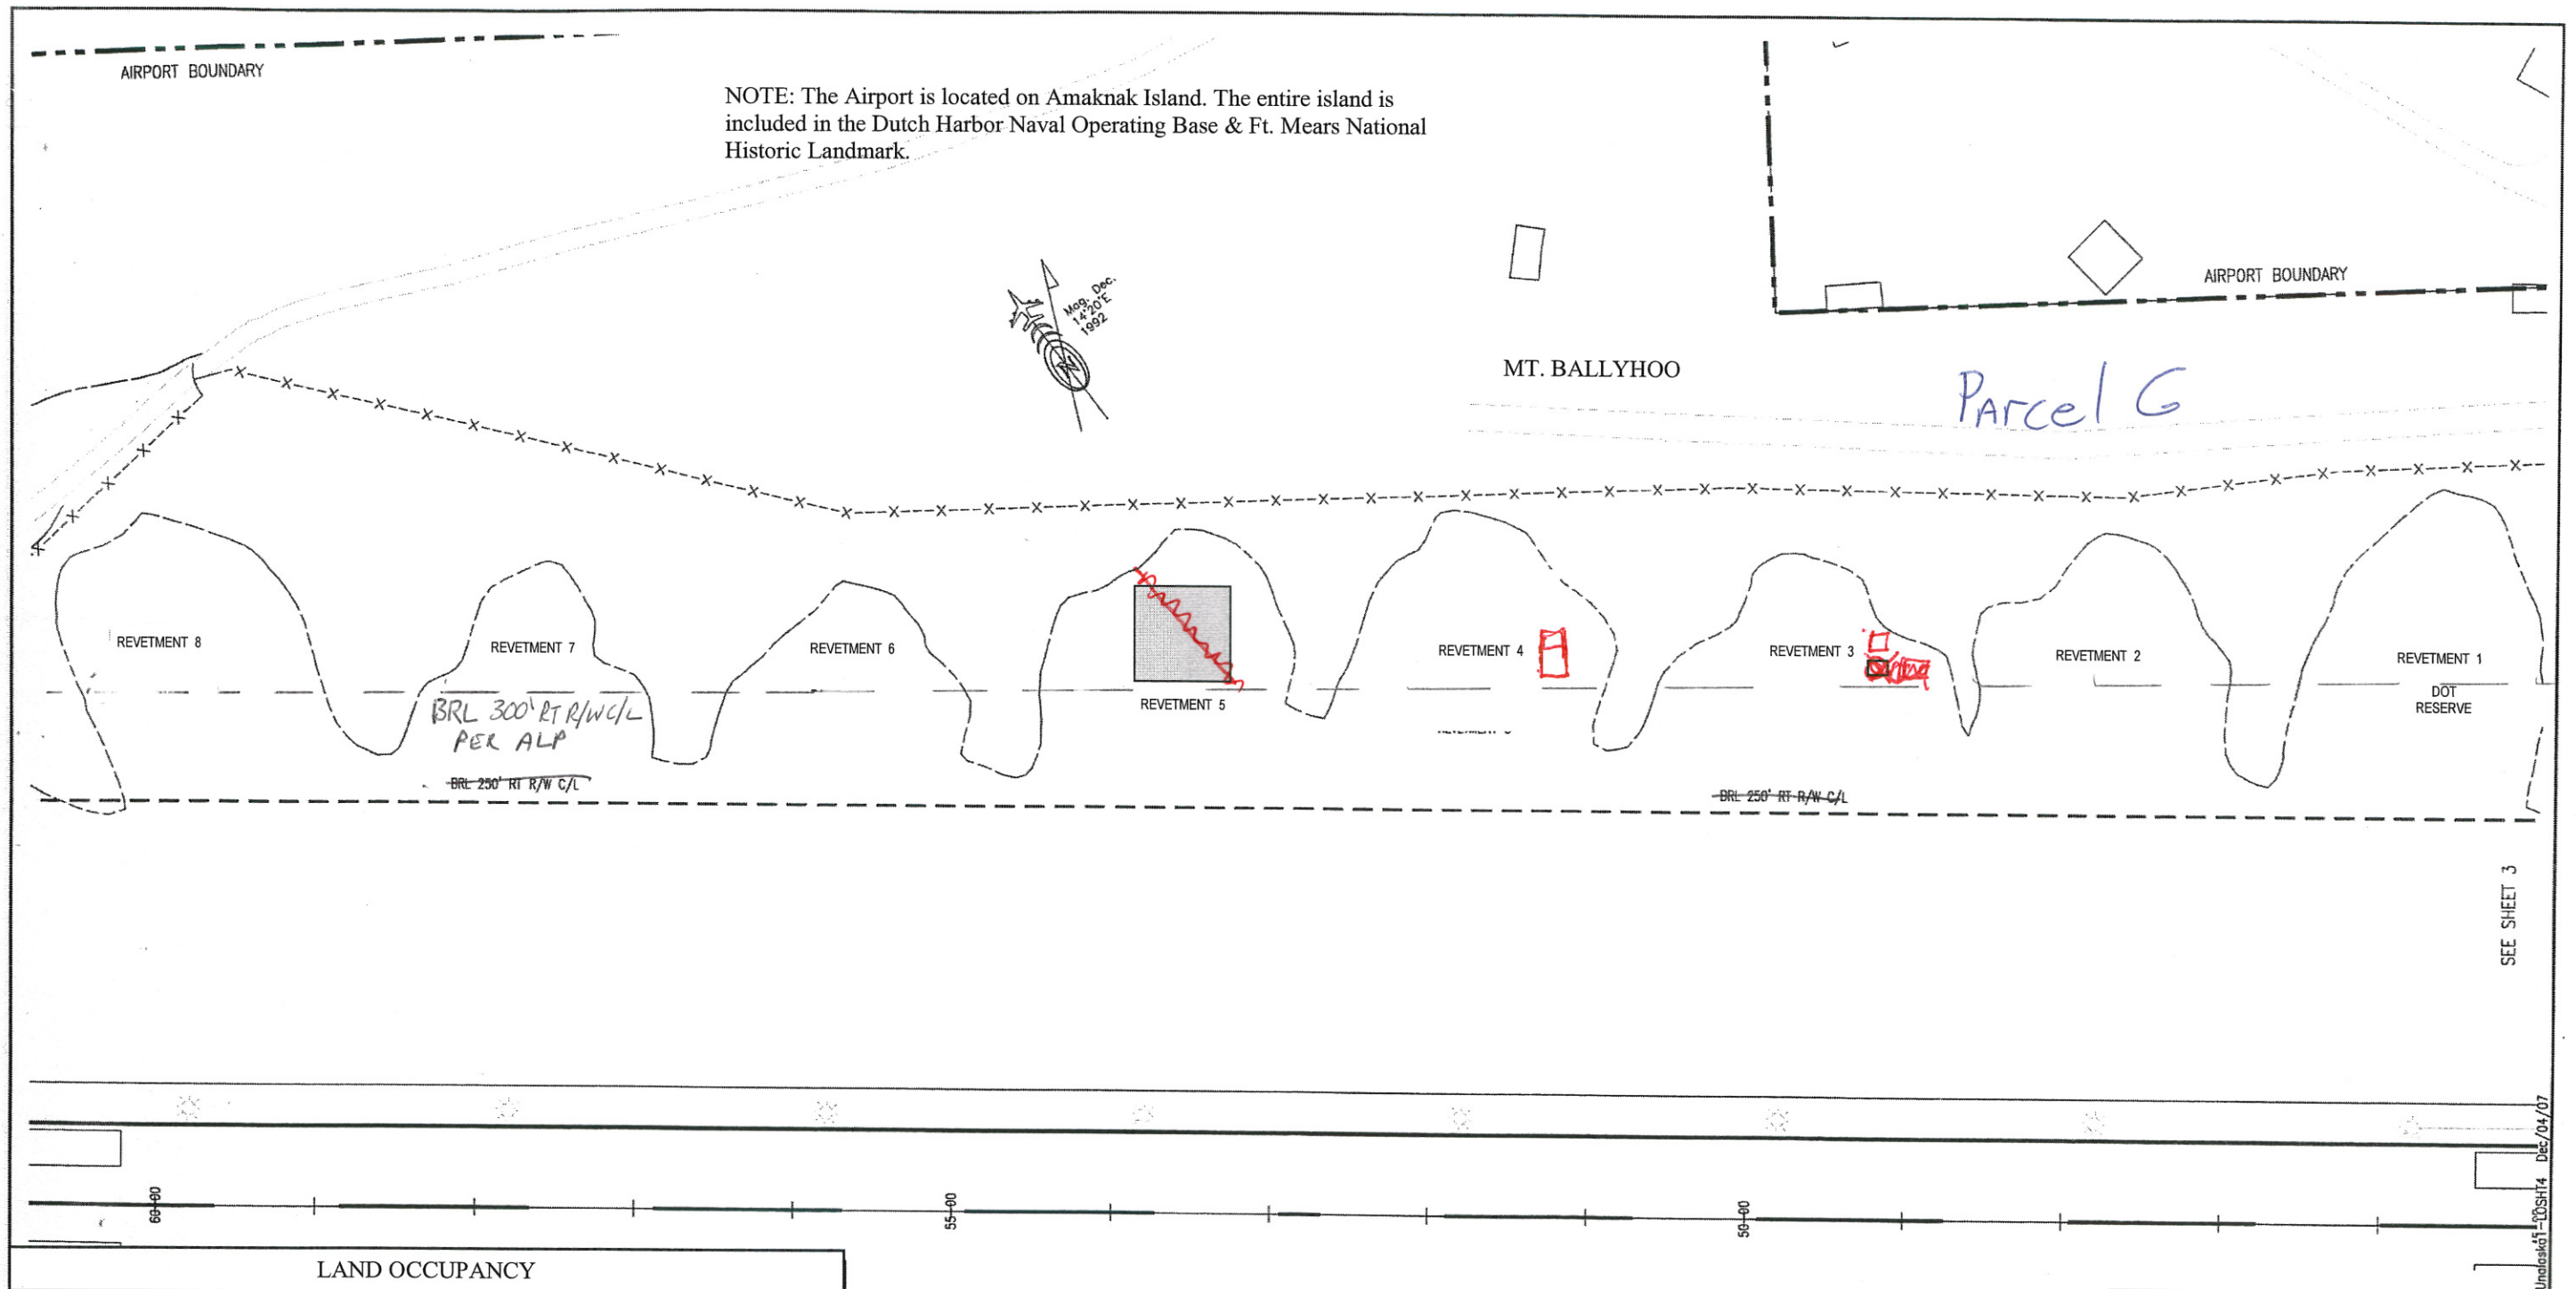

LAND OCCUPANCY

BLK	LOT	ADA	AREA SQ. FT.	OCCUPANT	TERM START	END TERM
REVT	1			DOT & PF RESERVE	RESERVE	INDEFINITE
REVT	2	08373				
REVT	3	08755	7,150	MARITIME HELICOPTERS, INC.	12/13/2010	12/12/2015
REVT	4	08314	7,150	BELL, THOMAS	07/28/2006	07/27/2011
REVT	5	08547	7,150	LEGGETT, DOUG	11/07/2007	11/06/2012
REVT	6					
REVT	7		7,150			
REVT	8		7,150			
Parcel G		08407	299,300	WEST Coast Co	08/14/2011	07/27/2016

DRAFT

The locations and elevations of all utilities shown are approximate only; locations have not been field verified. Additional utilities that are not shown on this LO may also exist.

BY	DATE	CHANGE

SCALE: NONE

STATE OF ALASKA
DEPARTMENT OF TRANSPORTATION AND
PUBLIC FACILITIES
AVIATION LEASING

UNALASKA AIRPORT
LAND OCCUPANCY

This is a graphic depiction of the Premises. It is an expression of the intent of the Parties as to the location of the Premises. If the Premises is an unsurveyed tract, its actual location must be confirmed by a land survey.

LEASING
RGH