


U.S. Sec. Cor. found  
Sec. 1, 2, 11 & 12

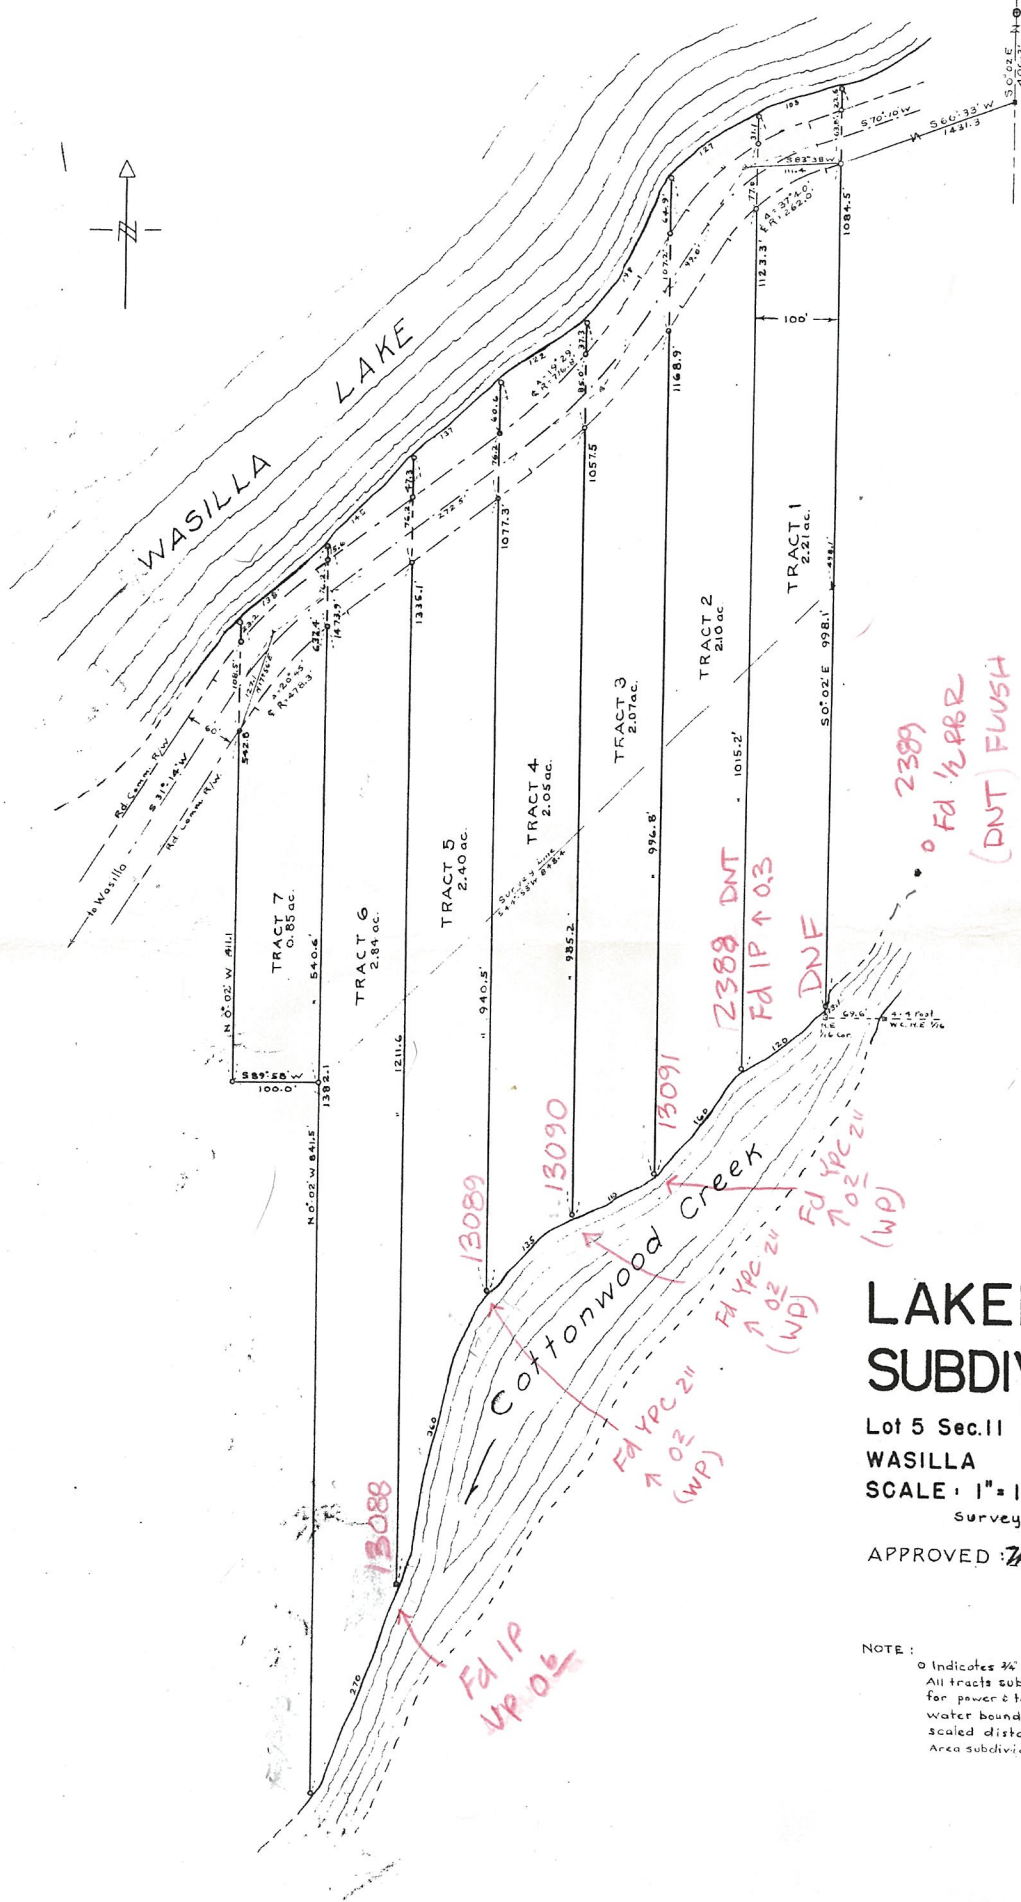

July 10 1955  
Martin Olson  
File 27  
of Plate  
May C. Carter

# LAKEBROOK SUBDIVISION

in  
Lot 5 Sec. 11 T17N RIW S.M.  
WASILLA ALASKA  
SCALE: 1" = 100' May 1955

Survey & Plat by: J.C. Baldwin

APPROVED: Martin Olson Edith Olson  
OWNER

NOTE:  
o Indicates 3/4" iron pipe.  
All tracts subject to R/W easement  
for power & telephone lines.  
Water boundaries are  
scaled distances.  
Area subdivided - 14.52 Acres

