

STATE OF ALASKA
DEPARTMENT OF TRANSPORTATION
AND
PUBLIC FACILITIES
SOUTHEAST REGION

ELFIN COVE, ALASKA

ELFIN COVE BOARDWALKS

PEDESTRIAN BOARDWALK AND
RAILING REPAIRS

PROJECT NO. STP-0003(56) ~ 67619

SHEET NO.	DESCRIPTION
1	TITLE SHEET
2	TYPICAL BOARDWALK AND HANDRAIL SECTION
3	ESTIMATE AND SUMMARY OF QUANTITIES
4	BOARDWALK PLANS - "A" LINE
5-6	BOARDWALK PLANS - "B" LINE
7	INNER HARBOR DOCK AREA PLAN
8	CONSTRUCTION DETAILS
9	TIMBER BRIDGE RECONSTRUCTION DETAILS
10	BOARDWALK RECONSTRUCTION PLAN AND DETAILS
11	MISCELLANEOUS DETAILS
12	HELICAL PIER PLAN AND DETAILS

The following Standard Drawings apply to this project :
A-1

AS-BUILT PLANS

CONTRACTOR - R.A. ENVIRONMENTAL, ANCH., AK.
PROJECT ENGINEER - JIM MAVER
NOTICE TO PROCEED - 9/1/99
BEGIN WORK - 3/21/00
COMPLETION DATE - ORIGINALLY 5/15/00
EXTENDED TO 7/10/00 BY CHANGE ORDER
ACTUAL COMPLETION DATE - 7/10/00
CONTRACT AMOUNT - \$213,162.53
ACTUAL FINAL AMOUNT - \$235,170.15



STATE OF ALASKA
DEPARTMENT OF TRANSPORTATION
AND
PUBLIC FACILITIES
SOUTHEAST REGION DESIGN SECTION

APPROVED
Regional Reconstruction Engineer

APPROVED
Director, S.E. Region Design & Construction

PROJECT NUMBER:

67619


DATE:


JUNE 1999

SHEET

1 OF 12

ENGINEER'S SEAL

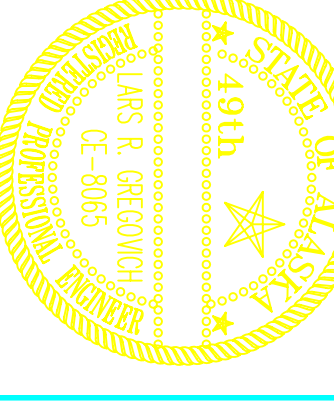

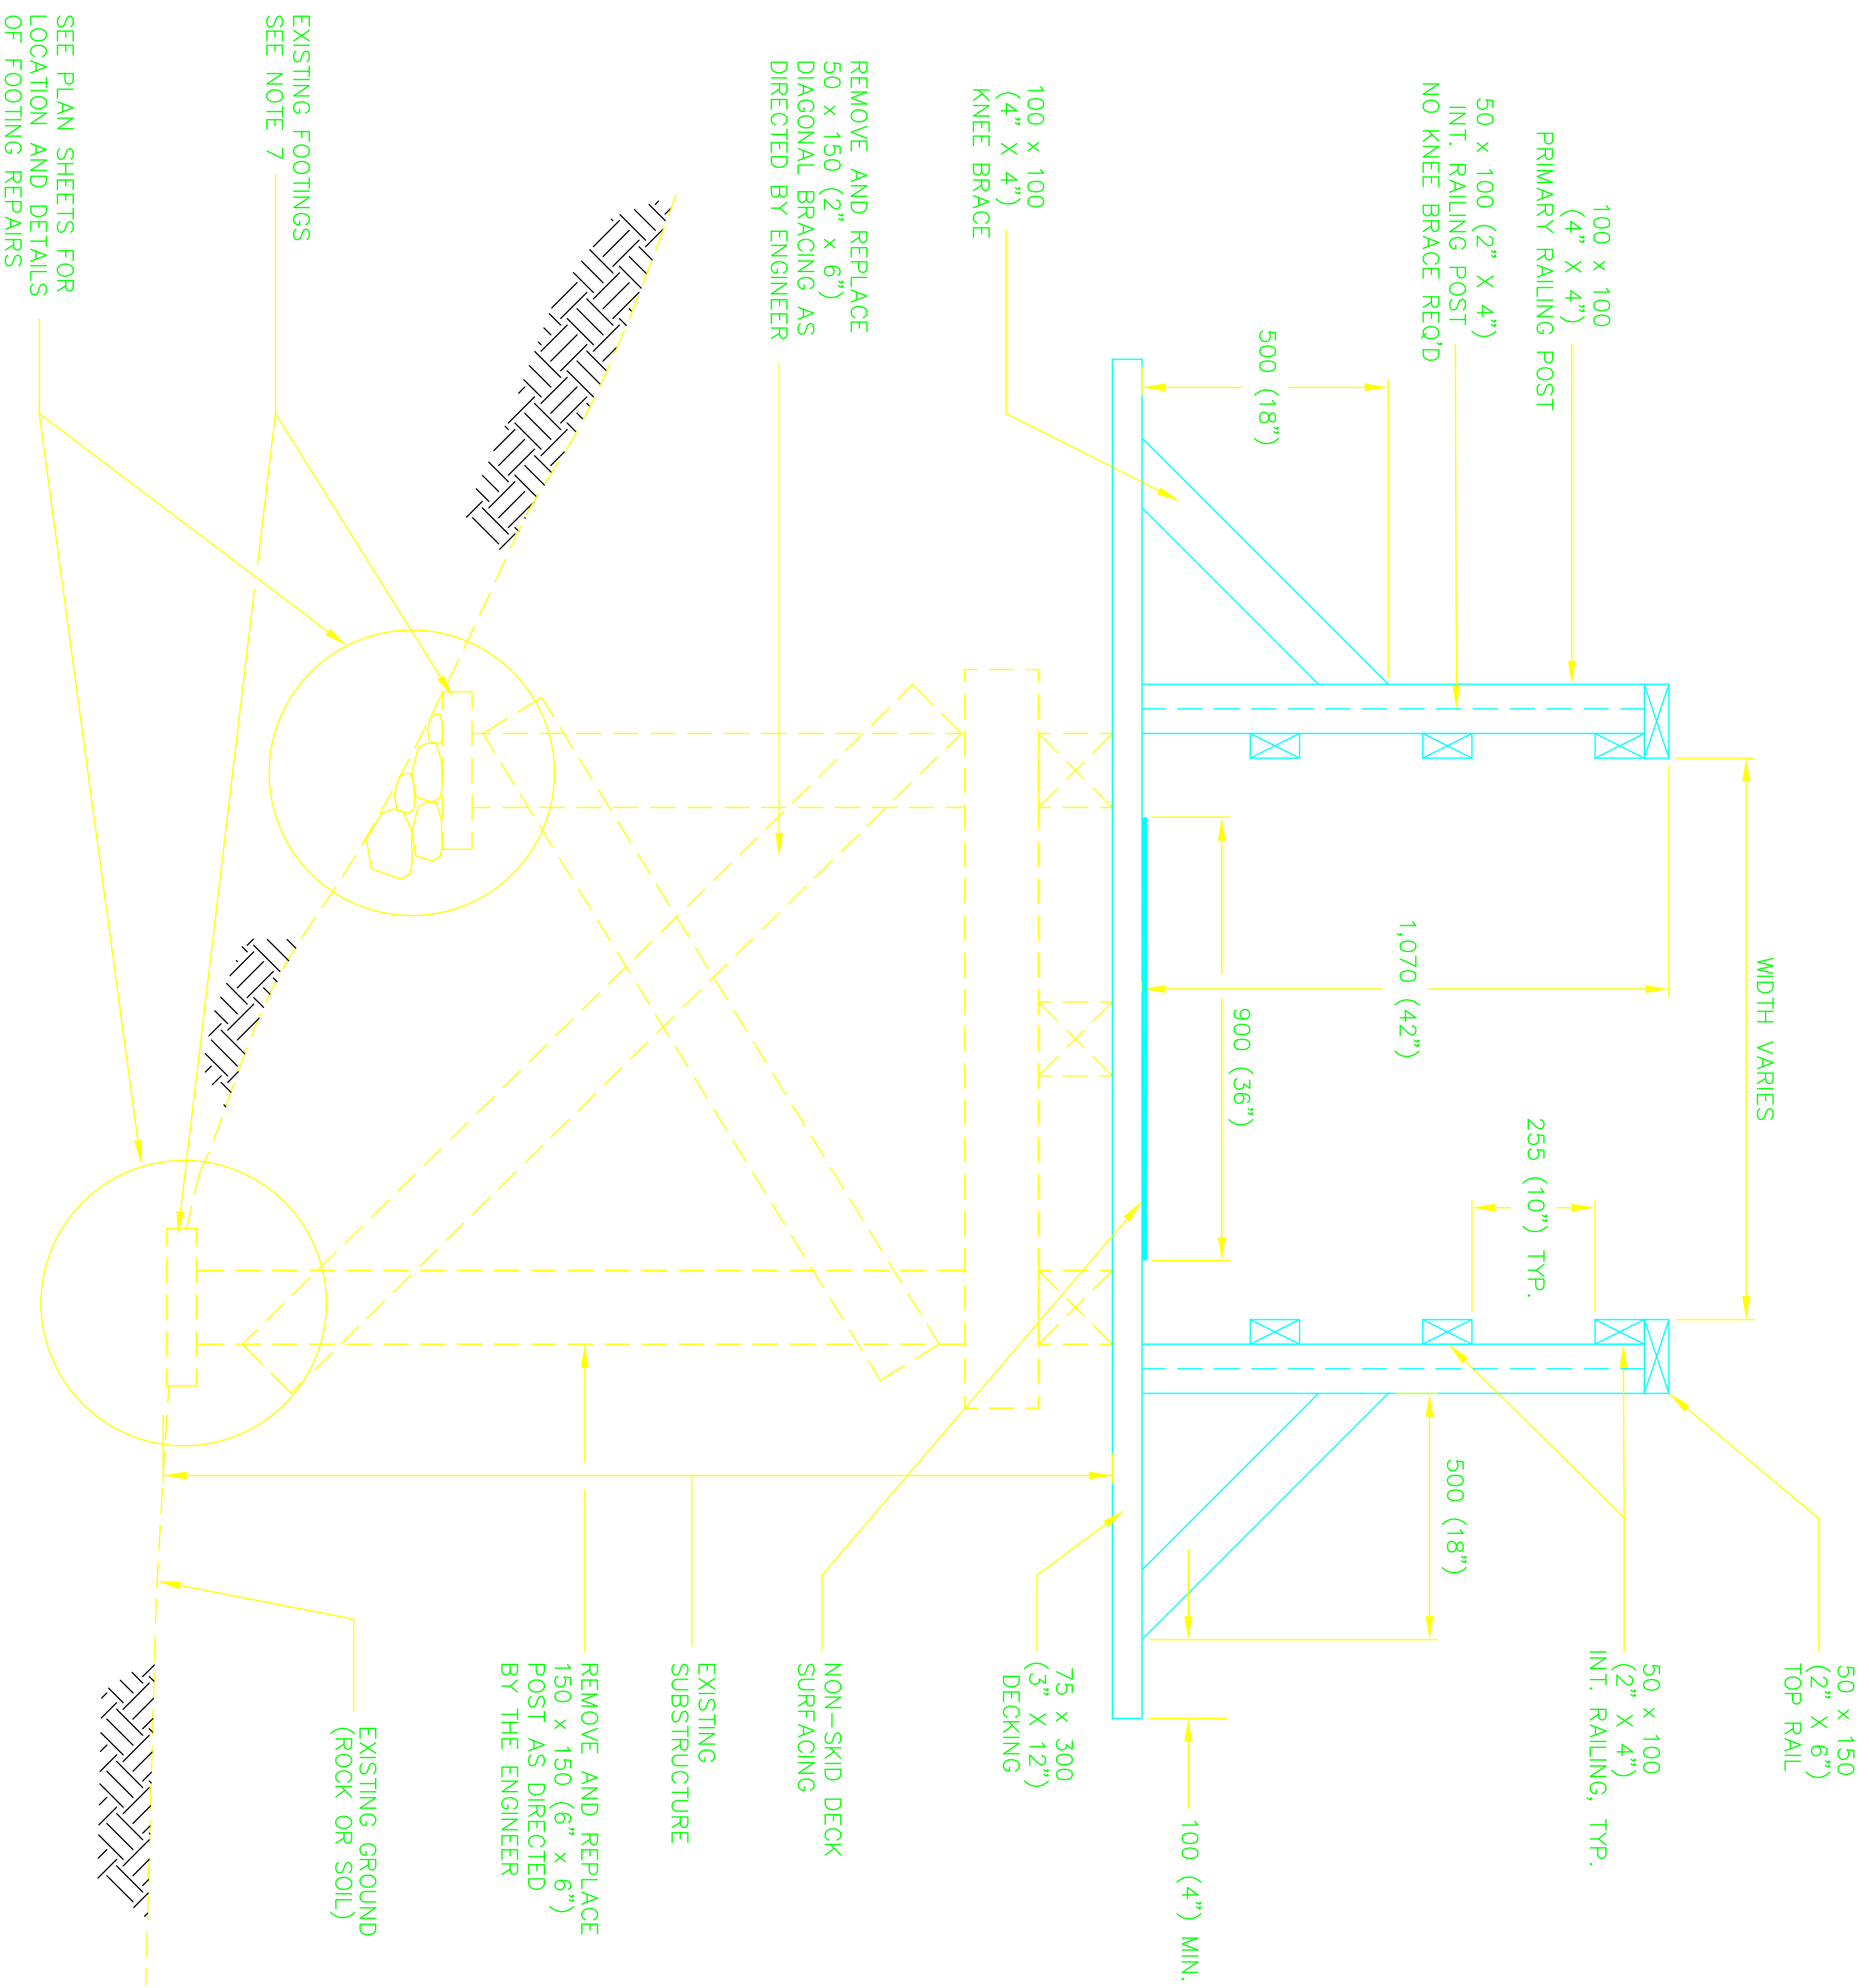

TYPICAL BOARDWALK SECTION
 ALL DIMENSIONS IN MILLIMETERS
 (ENGLISH UNITS IN PARENTHESES)

SEE PLAN SHEETS FOR LOCATION AND DETAILS OF FOOTING REPAIRS

REMOVE AND REPLACE 50 x 150 (2" x 6") DIAGONAL BRACING AS DIRECTED BY ENGINEER

EXISTING SUBSTRUCTURE

NON-SKID DECK SURFACING

REMOVE AND REPLACE 150 x 150 (6" x 6") POST AS DIRECTED BY THE ENGINEER

EXISTING GROUND (ROCK OR SOIL)

CONSTRUCTION NOTES:

- ALL DIMENSIONS GIVEN ARE NOMINAL SIZES.
- ALL REMOVED MATERIALS WILL BECOME THE PROPERTY OF THE CONTRACTOR AND SHALL BE DISPOSED OF IN AN APPROVED MANNER.
- THE BOARDWALK AND TRAIL SYSTEM ARE THE COMMUNITY OF ELEN COVE'S ONLY LAND BASED TRANSPORTATION NETWORK. BOARDWALK AND TRAIL ACCESS SHALL BE MAINTAINED THROUGH WORK ZONES AT ALL TIMES.
- THE CONTRACTOR SHALL VERIFY DIMENSIONS OF EXISTING CONSTRUCTION PRIOR TO ORDERING TIMBER MATERIALS. PRIMARY RAILING POST SPACING VARIES FROM 1650mm (5'6") TO 3800mm (12'6") WITH AN AVERAGE SPACING OF ABOUT 2600mm (8'6"). **SOME MATERIALS WERE ACCEPTED AT 0.4 PCF**
- ALL TIMBER SHALL BE HEM-FIR NO. 1 OR BETTER AND SHALL BE PRESSURE TREATED WITH ACZA TO A RETENTION OF 9.6 kg/m³ (0.6 pcf). EXCEPT 150 mm x 150 mm POSTS WHICH SHALL BE PRESSURE TREATED WITH CREOSOTE TO A RETENTION OF 400 kg/CUBIC METER (25 pcf) PER AWP A C18. ALL FIELD CUTS AND HOLES SHALL BE TREATED PER AWP A STD M4 WITH CUPRINOL OR APPROVED EQUAL.
- ALL EXISTING TIMBER TO BE REMOVED SHALL BE CONSIDERED TREATED. THE DEPARTMENT HAS TESTED WOOD FROM THE EXISTING BOARDWALK STRUCTURE FOR PRESERVATIVES AND THE RESULTS ARE CONTAINED IN APPENDIX C.
- BURNING OF CONSTRUCTION WASTES MAY REQUIRE AN OPEN BURNING APPROVAL FROM THE STATE DEPARTMENT OF ENVIRONMENTAL CONSERVATION. REFER TO THE ENVIRONMENTAL COMMITMENTS CONTAINED IN APPENDIX A FOR FURTHER INFORMATION ON OPEN BURNING.
- THE CONTRACTOR SHALL MATCH EXISTING CONSTRUCTION WHERE IT DOES NOT CONFORM TO THE TYPICALS SHOWN ON THE PLANS.
- PREDRILL 75 X 300 DECKING BOARDS WITH A 5mm (3/16") HOLE FOR 40d SPIKE TO PREVENT SPLITTING, ESPECIALLY AT ENDS OF BOARDS.
- EXISTING FOOTING CONDITIONS VARY. THE FOLLOWING FOOTING TYPES EXIST:
 - DIRECT BEARING ON BEDROCK
 - POST AND PAD BEARING ON SOIL OR ROCK - SOME PADS ARE CHINKED WITH ROCKS
 - PIER BLOCKS
- ALL BOARDWALK SHALL RECEIVE NON-SKID DECK SURFACING.

CONNECTION SCHEDULE

MEMBER	TO MEMBER	CONNECTOR	COMMENTS
75 x 300 DECKING	EXISTING 150 X 150 STRINGER	40d GALV. SPIKE	2 SPIKES PER STRINGER PREDRILL HOLES PER NOTE 6
100 x 100 KNEE BRACE	75 x 300 DECKING & 100 x 100 PRI. POST	20d GALV. COMMON NAIL	2 EACH PER MEMBER
100 x 100 PRI. POST	75 x 300 DECKING	20d GALV. COMMON NAIL	4 EACH PER CONNECTION
50 x 150 TOP RAIL OR 50 x 100 INT. RAILING	100 x 100 PRI. POST OR 50 x 100 INT. POST	16d GALV. COMMON NAIL	2 EACH PER CONNECTION
NON-SKID DECK SURFACING	75 x 300 DECKING	25mm GALV. ROOFING NAIL (1")	3 EACH PER DECK PLANK
50 x 150 DIAGONAL BRACING	150 x 150 POST	20d GALV. SPIKE	4 EACH PER CONNECTION
150 x 150 POST	EXISTING 150 x 150 PILE CAP	SIMPSON BO6 GALV. CONNECTOR	NAIL PER MANUFACTURERS RECOMMENDATION

NOTE: DO NOT SCALE FROM THESE PLANS-USE DIMENSIONS


PATH: Q:\Elf\67619\PLANS\ET\DETT
 PLOT: 1=(F) OR 1=2(H) METRIC SCALE: 1=10(F) OR 1=20(H)
 BY: DATE: DESCRIPTION OR CHANGE:

STATE OF ALASKA
 DEPARTMENT OF TRANSPORTATION
 AND PUBLIC FACILITIES
 SOUTHBAST REGION

ELEN COVE
 ELF - ELEN COVE BOARDWALKS
 STP-0003(56) ~ PROJECT NO. 67619
 TYPICAL BOARDWALK AND HANDRAIL SECTION

ALASKA
 DESIGNED BY: L. GREBOVICH
 DRAWN BY: R. SNYDER
 CHECKED BY: A. STENINGER

PROJECT NO. 67619
 DATE: JUNE 1999
 SHEET 2 OF 12

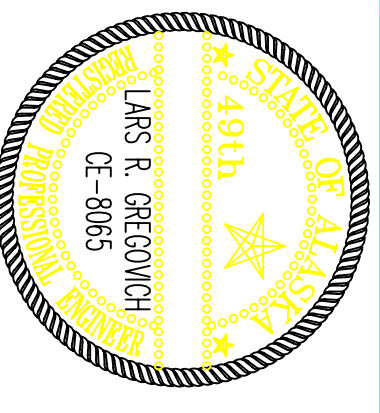

ESTIMATE OF QUANTITIES

ITEM NO.	ITEM	UNIT	QUANTITY
120(1)	DBE ADJUSTMENT	NONE	
301(5)	AGGREGATE BASE COURSE, GRADING D-1	CONTINGENT SUM	ALL REQUIRED
501(7)	CONCRETE FOOTINGS	SQUARE METER	224
501(8)	CONCRETE SLAB - CHANGE ORDER NO. 1	EACH	167
506(5)	REMOVE & REPLACE TIMBER RAILING	LUMP SUM	ALL REQUIRED
506(6)	REMOVE & REPLACE TIMBER DECKING	METER	1002.50
506(7)	REMOVE & RECONSTRUCT TIMBER BOARDWALK	SQUARE METER	295
506(8)	REMOVE & RECONSTRUCT TIMBER BRIDGE AT STA. 0+506	LUMP SUM	ALL REQUIRED
506(9)	REMOVE & RECONSTRUCT TIMBER BRIDGE AT STA. 0+843	LUMP SUM	ALL REQUIRED
506(10)	150mm X 150mm TIMBER POSTS	METER	2.5
506(11)	50mm X 150mm TIMBER BRACING	METER	212.70
506(12)	FURNISH MISCELLANEOUS TIMBER	LUMP SUM	ALL REQUIRED
506(13)	PHONE BOOTH DECKING - CHANGE ORDER NO. 1	LUMP SUM	ALL REQUIRED
506(14)	PARK BENCHES - CHANGE ORDER NO. 1	LUMP SUM	ALL REQUIRED
506(15)	TIMBER RAMPS - CHANGE ORDER NO. 1	LUMP SUM	ALL REQUIRED
506(16)	BRIDGE RECONSTRUCTION - CHANGE ORDER NO. 1	LUMP SUM	ALL REQUIRED
506(17)	ADDITIONAL DECKING - CHANGE ORDER NO. 1	LUMP SUM	ALL REQUIRED
506(18)	RAISED BOARDWALK - CHANGE ORDER NO. 2	LUMP SUM	ALL REQUIRED
628(1)	HELICAL PIERS	EACH	11
628(1)	UTILITY RELOCATION	CONTINGENT SUM	ALL REQUIRED
637(1)	NON-SKID DECK SURFACING	SQUARE METER	729
640(1)	MOBILIZATION & DEMOBILIZATION	LUMP SUM	811.80

REMOVE & REPLACE TIMBER RAILING SUMMARY

STATIONING	SIDE METERS	LOCATION	OFFSET	LENGTH
"A" 0+000 TO 0+027	RT	"A"0+000.2 to 0+017.8	ft	17.6m
"A" 0+030.5 TO 0+051	RT	"A"0+019.3 to 0+027.0	ft	7.7m
"A" 0+052 TO 0+062	RT	"A"0+029.9 to 0+031.1	ft	1.2m
"A" 0+080 TO 0+099.5	LT	"A"0+031.9 to 0+041.2	ft	9.3m
"A" 0+100 TO 0+120	LT	"A"0+045.4 to 0+054.9	ft	9.5m
MULTIPLE RAILING SEGMENTS				
"A" 0+122 TO 0+133	LT	"A"0+078.5 to 0+094.2	for ft	15.7
"A" 0+122 TO 0+133	LT	"A"0+094.9 to 0+097.0	for ft	2.9
"A" 0+122 TO 0+133	LT	"A"0+099.05 to 0+109.05	for ft	10.9m
"A" 0+122 TO 0+133	RT	"A"0+097.9, stair rail	ft	1.9m
"A" 0+135 TO 0+157.5	LT	"A"0+098.7, stair rail	ft	1.8m
"A" 0+135 TO 0+157.5	LT	"A"0+091.1 to 0+097.9	ft	6.8m
"A" 0+163.5 TO 0+185.5	LT	"A"0+100.8 to 0+109.2	ft	8.4m
"A" 0+180 TO 0+195	RT	"AB"0+101.7 ft to "A" 0+119.2 ft	ft	21.4m
"A" 0+192.5 TO 0+214.5	LT	"A"0+121.6 to 0+126.8	ft	5.4m
"A" 0+213.5 TO 0+237.5	RT	"A"0+122.0 to 0+133.5	ft	12.3m
"A" 0+266.5 TO 0+279.5	RT	"A"0+135.2 to 0+155.5	ft	20.8m
"A" 0+289.5 TO 0+300	RT	"A"0+128.7 to 0+130.2	ft	2.0m
"A" 0+315 TO 0+324	LT	"A"0+162.5 to 0+165.2	ft	3.4
"A" 0+324 TO 0+354.5	RT	"A"0+165.2 to 0+180.5	ft	15.2m
"A" 0+360.5 TO 0+394	RT	"A"0+175.6 to 0+190.4	ft	14.8m
"A" 0+441.5 TO 0+448.5	LT & RT	"A"0+188.0 to 0+205.0	ft	117.8m
FOOT BRIDGE-NON TYPICAL RAILING				
"A" 0+465 TO 0+470	RT	"A"0+208.5 to 0+232.5	ft	23.5m
REPLACE WITH TYPICAL				
"A" 0+261.3 TO 0+267.4	RT	"A"0+261.3 to 0+267.4	ft	5.6m
"A" 0+269.5 TO 0+273.5	RT	"A"0+269.5 to 0+273.5	ft	4.1m
INNER HBR. DOCK AREA				
"A" 0+280.8 TO 0+281.7	N/A	"A"0+280.8 to 0+281.7	ft	0.8m
"B" 0+000 TO 0+022	RT	"A"0+283.2 to 0+284.1	ft	1.2m
"B" 0+032 TO 0+115	RT	"A"0+285.1 to 0+294.5	ft	9.6m
"B" 0+118.5 TO 0+211	RT	"A"0+308.8 to 0+387.0	ft	79.2m
"B" 0+137.5 TO 0+176	LT	"A"0+318.9 to 0+332.0	ft	13.9m
"B" 0+184 TO 0+200	LT	"A"0+333.2 to 0+348.8	ft	15.4m
"B" 0+213.5 TO 0+284	RT	"A"0+354.3 to 0+363.6	ft	9.2m
"B" 0+253.5 TO 0+277	LT	"A"0+366.6 to 0+387.0	ft	20.0m
"B" 0+305 TO 0+311	RT	"A" Line Bridge	ft/ft	14.0m
Inner Harbor Area				
"B" 0+334.5 TO 0+341	LT	"B"0+000.0 to 0+007.5	ft	1.2m
"B" 0+344.5 TO 0+357.5	RT	"B"0+007.5 to 0+019.7	ft	9.7m
"B" 0+384 TO 0+386	RT	"B"0+029.0 to 0+075.0	ft	12.2m
SMALL FOOT BRIDGE				
"B" 0+465 TO 0+470	RT	"B"0+1075.0 to 0+112.9	ft	45.3m
"B" 0+501 TO 0+511.5	RT	"B"0+115.6 to 0+125.4	ft	37.9m
"B" 0+501 TO 0+511.5	RT	"B"0+130.8 to 0+208.5	ft	9.8m
"B" 0+501 TO 0+511.5	RT	"B"0+132.2 to 0+143.1	ft	7.5m
"B" 0+501 TO 0+511.5	RT	"B"0+144.2 to 0+176.0	ft	8.2m
"B" 0+501 TO 0+511.5	RT	"B"0+182.0 to 0+198.5	ft	30.8m
"B" 0+501 TO 0+511.5	RT	"B"0+210.9 to 0+281.7	ft	16.5m
"B" 0+501 TO 0+511.5	RT	"B"0+249.1 to 0+257.0	ft	70.1m
"B" 0+501 TO 0+511.5	RT	"B"0+258.8 to 0+273.3	ft	7.8m
"B" 0+501 TO 0+511.5	RT	"B"0+299.0 to 0+308.4	ft	14.1m
"B" 0+501 TO 0+511.5	RT	"B"0+329.2 to 0+355.2	ft	9.4m
"B" 0+501 TO 0+511.5	RT	"B"0+332.9 to 0+339.2	ft	22.3m
"B" 0+501 TO 0+511.5	RT	"B"0+464.3 to 0+468.3	ft	6.3m
"B" 0+501 TO 0+511.5	RT	"B"0+512.7 to 0+519.8	ft	4.0m
TOTAL = 968.9 m				

NON-SKID DECK SURFACING SUMMARY

STATIONING	L (m)	W (m)	AREA (m2)	LOCATION	LENGTH (m)	WIDTH (m)	AREA (m2)
"A" 0+000 TO 0+394	394	0.9	354.6	"B"0+274.9 to 0+283.0	8.1	0.9	7.3
"A" 0+441.5 TO 0+448.5	7	0.9	6.3	"A"0+000.0 to 0+384.6	384.6	0.9	346.1
"A" 0+441.5 TO 0+448.5	7	0.9	6.3	"A"0+428.8 to 0+436.1	7.3	0.9	6.6
INNER HARBOR DOCK AREAS							
"B" 0+000 TO 0+008	8	0.9	7.2	Inner Harbor Area	107.8	0.9	97.0
"B" 0+000 TO 0+008	8	0.9	7.2	Inner Harbor Area	7.0	0.9	6.3
"B" 0+333 TO 0+357.5	24.5	0.9	22.1	"B"0+0+000.0 to 0+007.0	260.0	0.9	234.0
"B" 0+384 TO 0+386	2	0.9	1.8	"B"0+013.0 to 0+273.0	24.5	0.9	21.2
"B" 0+384 TO 0+386	2	0.9	1.8	"B"0+284.4 to 0+307.9	23.5	0.9	21.8
"B" 0+397	2.0	0.9	1.8	"B"0+330.9 to 0+355.1	24.2	0.9	21.8
"B" 0+397	2.0	0.9	1.8	"B"0+381.0 to 0+382.8	1.8	0.9	1.6
"B" 0+397	2.0	0.9	1.8	"B"0+395.8 to 0+399.4	3.4	0.9	3.1
"B" 0+397	2.0	0.9	1.8	"B"0+476.7 to 0+494.4	17.7	0.9	15.9
"B" 0+397	2.0	0.9	1.8	"B"0+509.8 to 0+561.9	52.1	0.9	46.9
"B" 0+397	2.0	0.9	1.8	"B"0+815.0 to 0+816.8	1.8	0.9	1.6
"B" 0+397	2.0	0.9	1.8	"B"0+821.0 to 0+823.7	2.7	0.9	2.4
TOTAL = 254.1							

REMOVE & REPLACE TIMBER DECKING SUMMARY

STATIONING	%	W (m)	AREA (m2)	LOCATION	MEASURED LENGTH	AVERAGE WIDTH	AREA (m2)
"A" 0+210	N/A/N/A	0.93	"A"0+187	"A"0+187	0.30	2.44	0.73
"A" 0+312	N/A/N/A	2.97	"A"0+221	"A"0+221	0.30	3.04	0.91
"A" 0+312	N/A/N/A	2.97	"A"0+244	"A"0+244	0.30	2.44	0.73
"B" 0+003 TO 0+008	100	2.0	"A"0+260	"A"0+260	0.60	2.44	1.46
"B" 0+014 TO 0+032	100	2.0	"A"0+269	"A"0+269	0.30	2.44	0.73
"B" 0+073 TO 0+130.5	100	2.0	"A"0+109	"A"0+109	0.30	2.44	0.73
"B" 0+277.5 TO 0+311	100	1.7	"AB"0+003(Near School)	"A"0+310	0.91	1.83	1.67
"B" 0+277.5 TO 0+311	100	1.7	"AB"0+003(Near School)	"A"0+310	0.60	4.60	2.76
INCLUDES 2 SETS OF SMALL STAIRS -							
REPLACE STAIR TREADS ONLY							
"B" 0+478.5 TO 0+499.9	1.4	25.83	"B"0+000.0 to 0+003.3	"B"0+000.0 to 0+003.3	3.30	3.40	11.22
"B" 0+478.5 TO 0+499.9	1.4	25.83	"B"0+003.3 to 0+007.6	"B"0+003.3 to 0+007.6	4.80	1.83	8.78
"B" 0+478.5 TO 0+499.9	1.4	25.83	"B"0+014.0 to 0+029.0	"B"0+014.0 to 0+029.0	15.00	1.83	27.45
"B" 0+478.5 TO 0+499.9	1.4	25.83	"B"0+069.9 to 0+074.7	"B"0+069.9 to 0+074.7	4.80	1.83	8.78
"B" 0+478.5 TO 0+499.9	1.4	25.83	"B"0+074.7 to 0+116.0	"B"0+074.7 to 0+116.0	41.30	1.83	75.58
"B" 0+478.5 TO 0+499.9	1.4	25.83	"B"0+116.0 to 0+117.6	"B"0+116.0 to 0+117.6	0.90	1.83	2.93
"B" 0+478.5 TO 0+499.9	1.4	25.83	"B"0+117.6 to 0+118.5	"B"0+117.6 to 0+118.5	0.90	1.83	1.65
"B" 0+478.5 TO 0+499.9	1.4	25.83	"B"0+118.5 to 0+118.5	"B"0+118.5 to 0+118.5	0.90	1.83	1.65
"B" 0+478.5 TO 0+499.9	1.4	25.83	"B"0+274.2 to 0+283.0	"B"0+274.2 to 0+283.0	8.80	1.22	10.74
"B" 0+478.5 TO 0+499.9	1.4	25.83	"B"0+284.8 to 0+291.0	"B"0+284.8 to 0+291.0	6.20	1.22	7.56
"B" 0+478.5 TO 0+499.9	1.4	25.83	"B"0+291.0 to 0+309.0	"B"0+291.0 to 0+309.0	18.00	1.22	21.96
"B" 0+478.5 TO 0+499.9	1.4	25.83	"B"0+309.0 to 0+320.0	"B"0+309.0 to 0+320.0	11.20	1.22	13.66
"B" 0+478.5 TO 0+499.9	1.4	25.83	"B"0+320.0 to 0+382.0	"B"0+320.0 to 0+382.0	2.15	1.22	2.62
"B" 0+478.5 TO 0+499.9	1.4	25.83	"B"0+481.8 to 0+484.5	"B"0+481.8 to 0+484.5	2.70	1.53	4.13
"B" 0+478.5 TO 0+499.9	1.4	25.83	"B"0+484.5 to 0+484.5	"B"0+484.5 to 0+484.5	9.40	1.22	11.47
"B" 0+478.5 TO 0+499.9	1.4	25.83	"B"0+509.2 to 0+510.4	"B"0+509.2 to 0+510.4	1.20	1.22	1.46
"B" 0+478.5 TO 0+499.9	1.4	25.83	"B"0+510.4 to 0+512.3	"B"0+510.4 to 0+512.3	1.90	1.52	2.89
"B" 0+478.5 TO 0+499.9	1.4	25.83	"B"0+512.3 to 0+513.0	"B"0+512.3 to 0+513.0	0.70	1.22	0.85
"B" 0+478.5 TO 0+499.9	1.4	25.83	"B"0+513.0 to 0+540.5	"B"0+513.0 to 0+540.5	27.50	1.22	33.55
"B" 0+478.5 TO 0+499.9	1.4	25.83	"B"0+815.0 to 0+816.9	"B"0+815.0 to 0+816.9	1.90	1.22	2.32
"B" 0+478.5 TO 0+499.9	1.4	25.83	"B"0+821.0 to 0+823.9	"B"0+821.0 to 0+823.9	2.90	1.22	3.54
TOTAL = 254.10							

CONCRETE FOOTING SUMMARY


LOCATION	TYPE I	TYPE II	TYPE III
"A" LINE IN VICINITY OF NARROW ENTRANCE CHANNEL FROM STA. 0+207 TO 0+368	57	60	10
INNER HARBOR DOCK AREA			
"A" LINE FROM STA. 0+100 TO 0+180			
"A" LINE FROM STA. 0+103 TO 0+197			
"B" LINE FROM STA. 0+070 TO 0+250			
"AB" AND "AB1" LINES IN THE AREA POST OFFICE, SCHOOL, CITY SHOP AND INNER HARBOR RAMP			
TOTAL = 189 - 167			

FURNISH MISCELLANEOUS TIMBER SUMMARY


DIMENSION	LENGTH (m)	QTY
16 mm (5/8") A/C P.T. PLYWOOD	1.20m x 2.45m (4' X 8')	3 EA
50mm x 100mm (2" x 4")		20 EA
75mm x 300mm (3" x 12")		20 EA
150mm x 150mm (6" x 6") CREOSOTE		3 EA
150mm x 150mm (6" x 6") CREOSOTE		3 EA
150mm x 150mm (6" x 6") CREOSOTE		3 EA

TIMBER BRACING SUMMARY

STATION	LENGTH	STATION	LENGTH	STATION	LENGTH	STATION	LENGTH
"A"0+095	3.5m	"A"0+132	4.8m	"A"0+202	2.2m	"A"0+099	3.3m
"A"0+098	3.4m	"A"0+135	4.2m	"A"0+205	1.1m	"A"0+102	

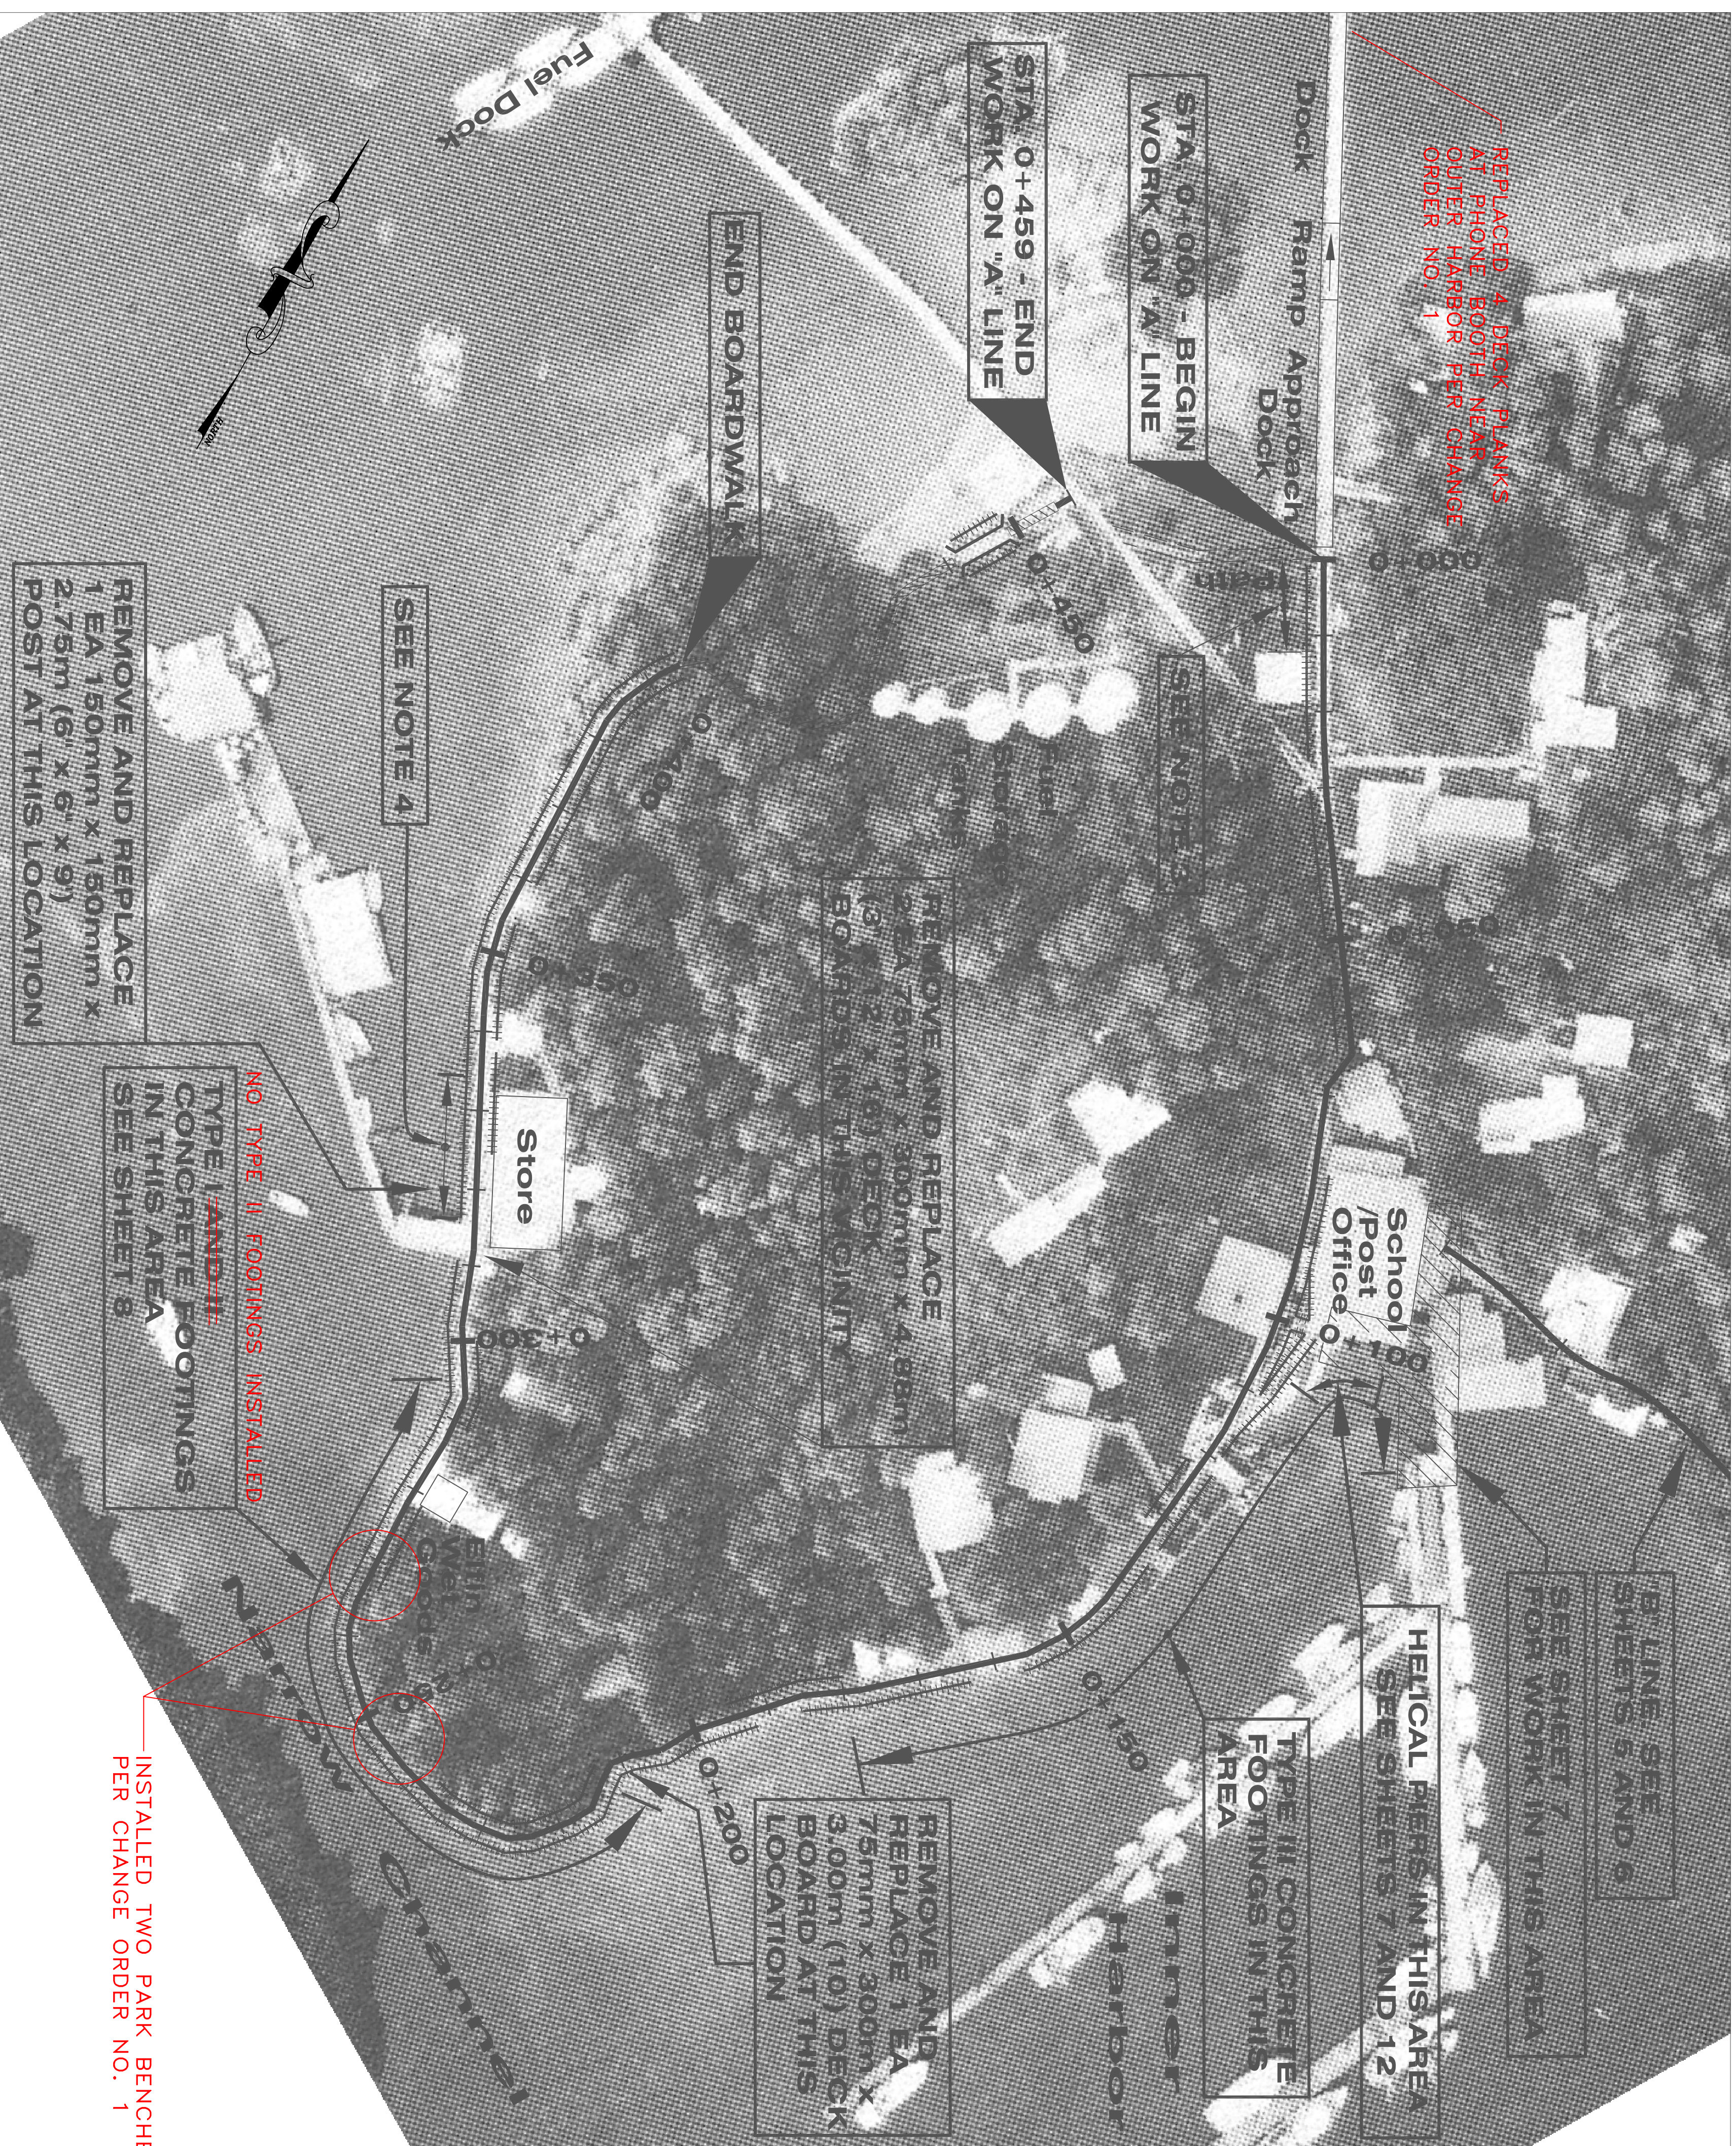

LEGEND

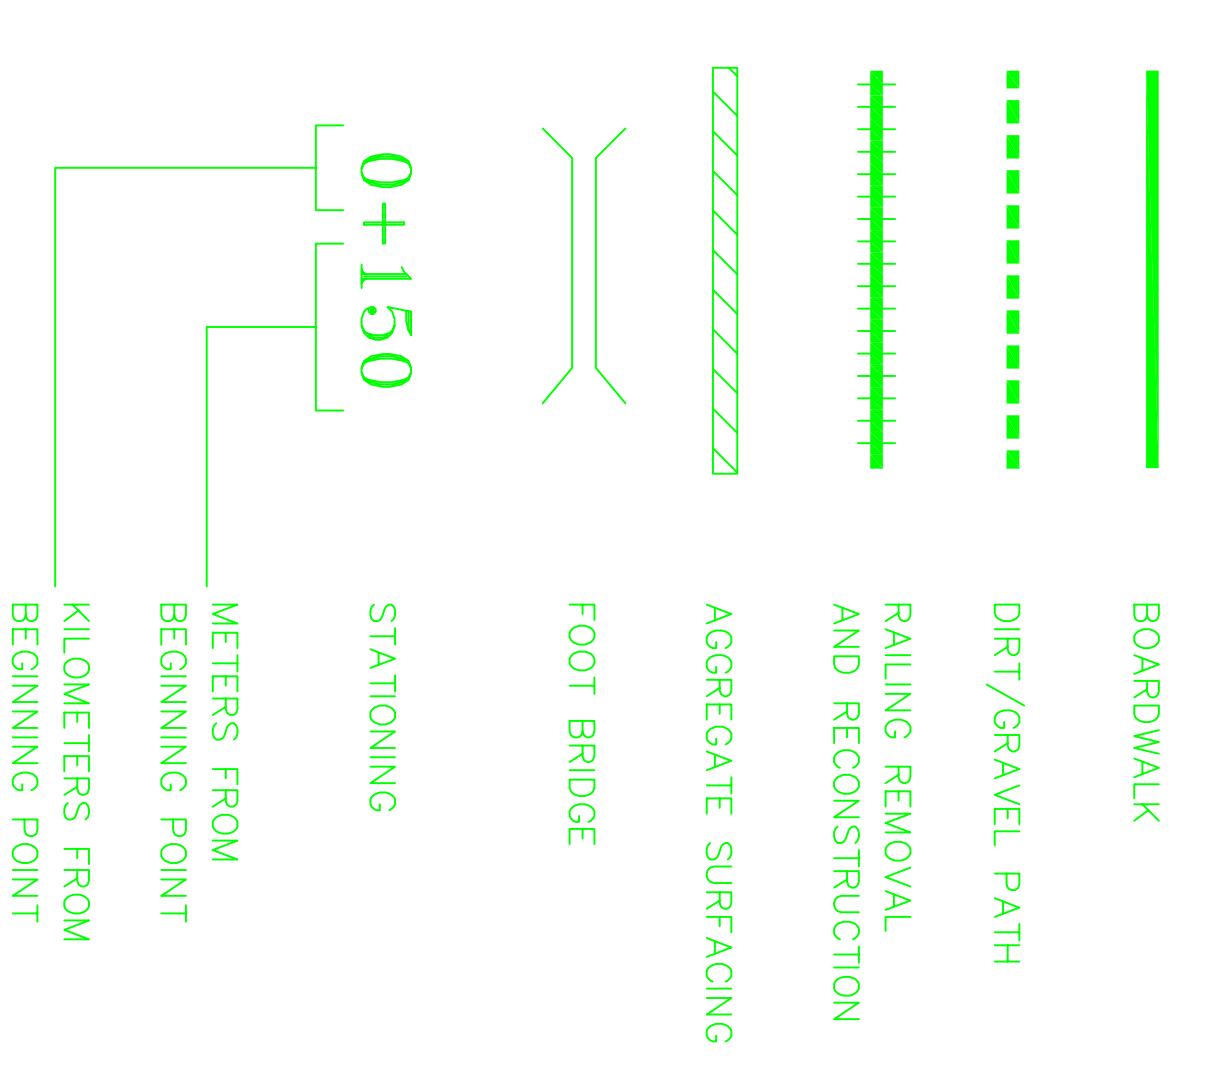

CONSTRUCTION NOTES:

1. THE IMAGE USED ON THIS PLAN SHEET WAS TAKEN FROM AN AERIAL PHOTOGRAPH TAKEN IN 1989. THIS IMAGE UNDERLAY IS BEING USED TO PROVIDE THE CONTRACTOR WITH A REASONABLE DEPICTION OF WHERE THE WORK IS LOCATED IN RELATION TO MAJOR TOPOGRAPHICAL FEATURES AND OTHER IMPROVEMENTS. NO ATTEMPT HAS BEEN MADE TO UPDATE THIS INFORMATION.
2. THE LOCATION OF THE WORK INDICATED IS APPROXIMATE ONLY AND SHALL BE VERIFIED WITH THE ENGINEER PRIOR TO BEGINNING WORK.
3. REMOVE AND REINSTALL CHAINLINK FENCE ATTACHED TO RAILING.
4. INSTALL TEMPORARY RAILING IN THIS LOCATION. THIS WORK IS A PRIORITY ITEM.

ASBUILT\ELFIN-PLAN-2


PATH:	Q:\ELF\67619\PLANS\ELFIN-PLAN-2-	V.P. ZOOM 0.162 XP
PILOT:	METRIC SCALE: 1=(1/F) OR 1=2(H)	
BY:	DATE:	DESCRIPTION OF CHANGE:


STATE OF ALASKA
 DEPARTMENT OF TRANSPORTATION
 AND PUBLIC FACILITIES
 SOUTHEAST REGION

ELFIN COVE
 ELF - ELFIN COVE BOARDWALKS
 STP-0009(56) ~ PROJECT NO. 67619
 BOARDWALK PLANS - "A" LINE

NOTE: DO NOT SCALE FROM THESE PLANS-USE DIMENSIONS


DESIGNED BY:	L. GREGOVICH	PROJECT NO.	67619
DRAWN BY:	R. SVYDER	DATE:	JUNE 1999
CHECKED BY:	A. STEININGER	SHEET	4 OF 12

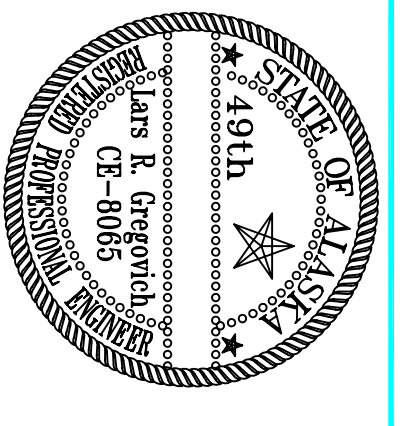

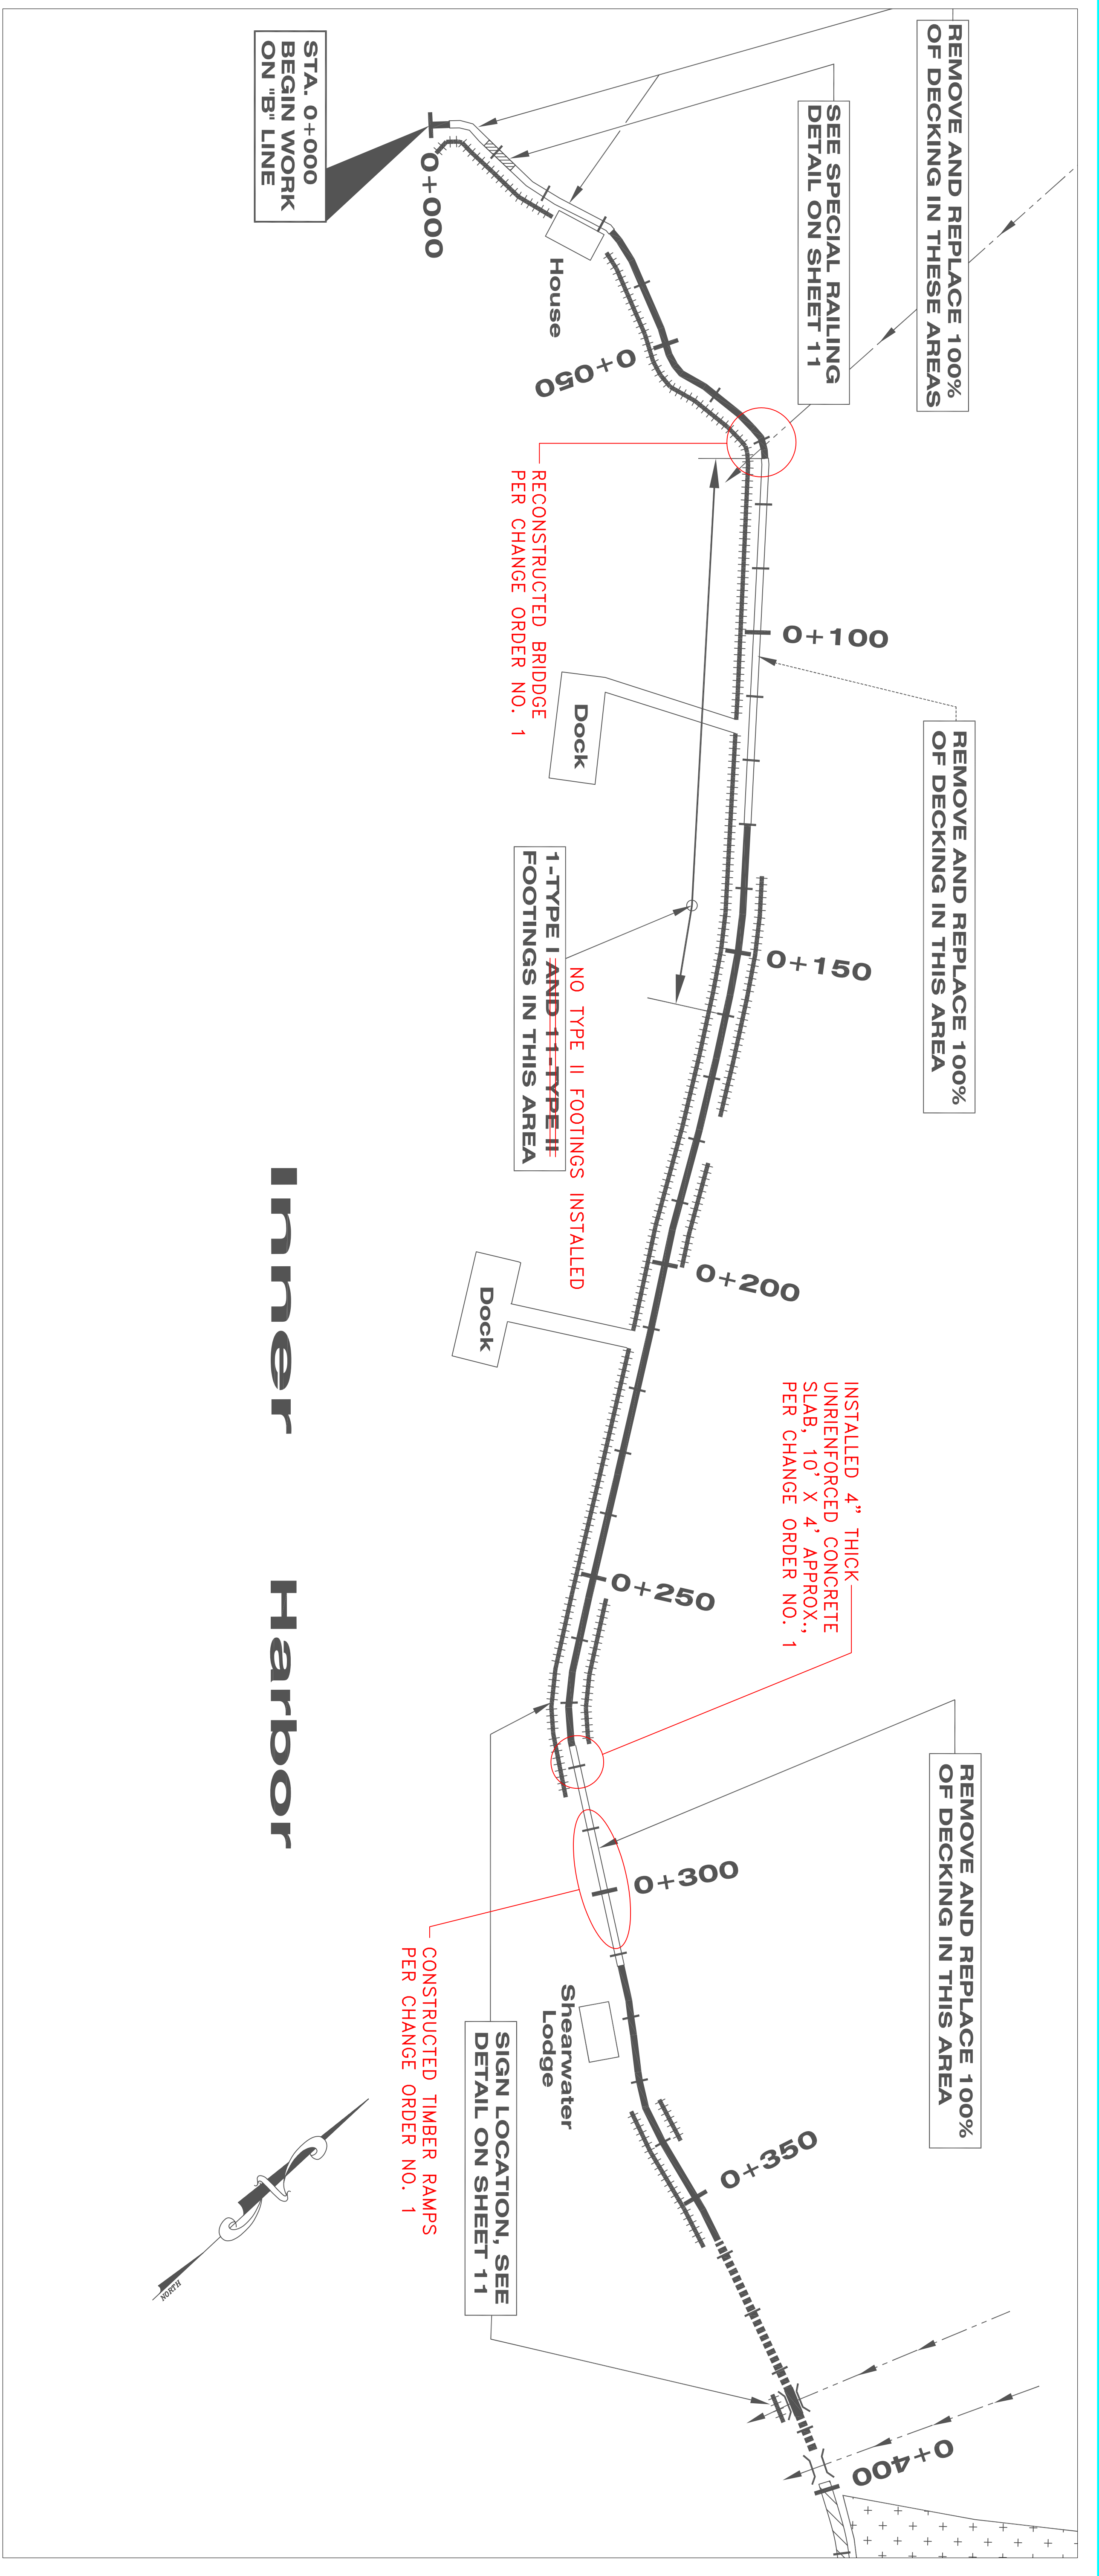

Inner Harbor

LEGEND

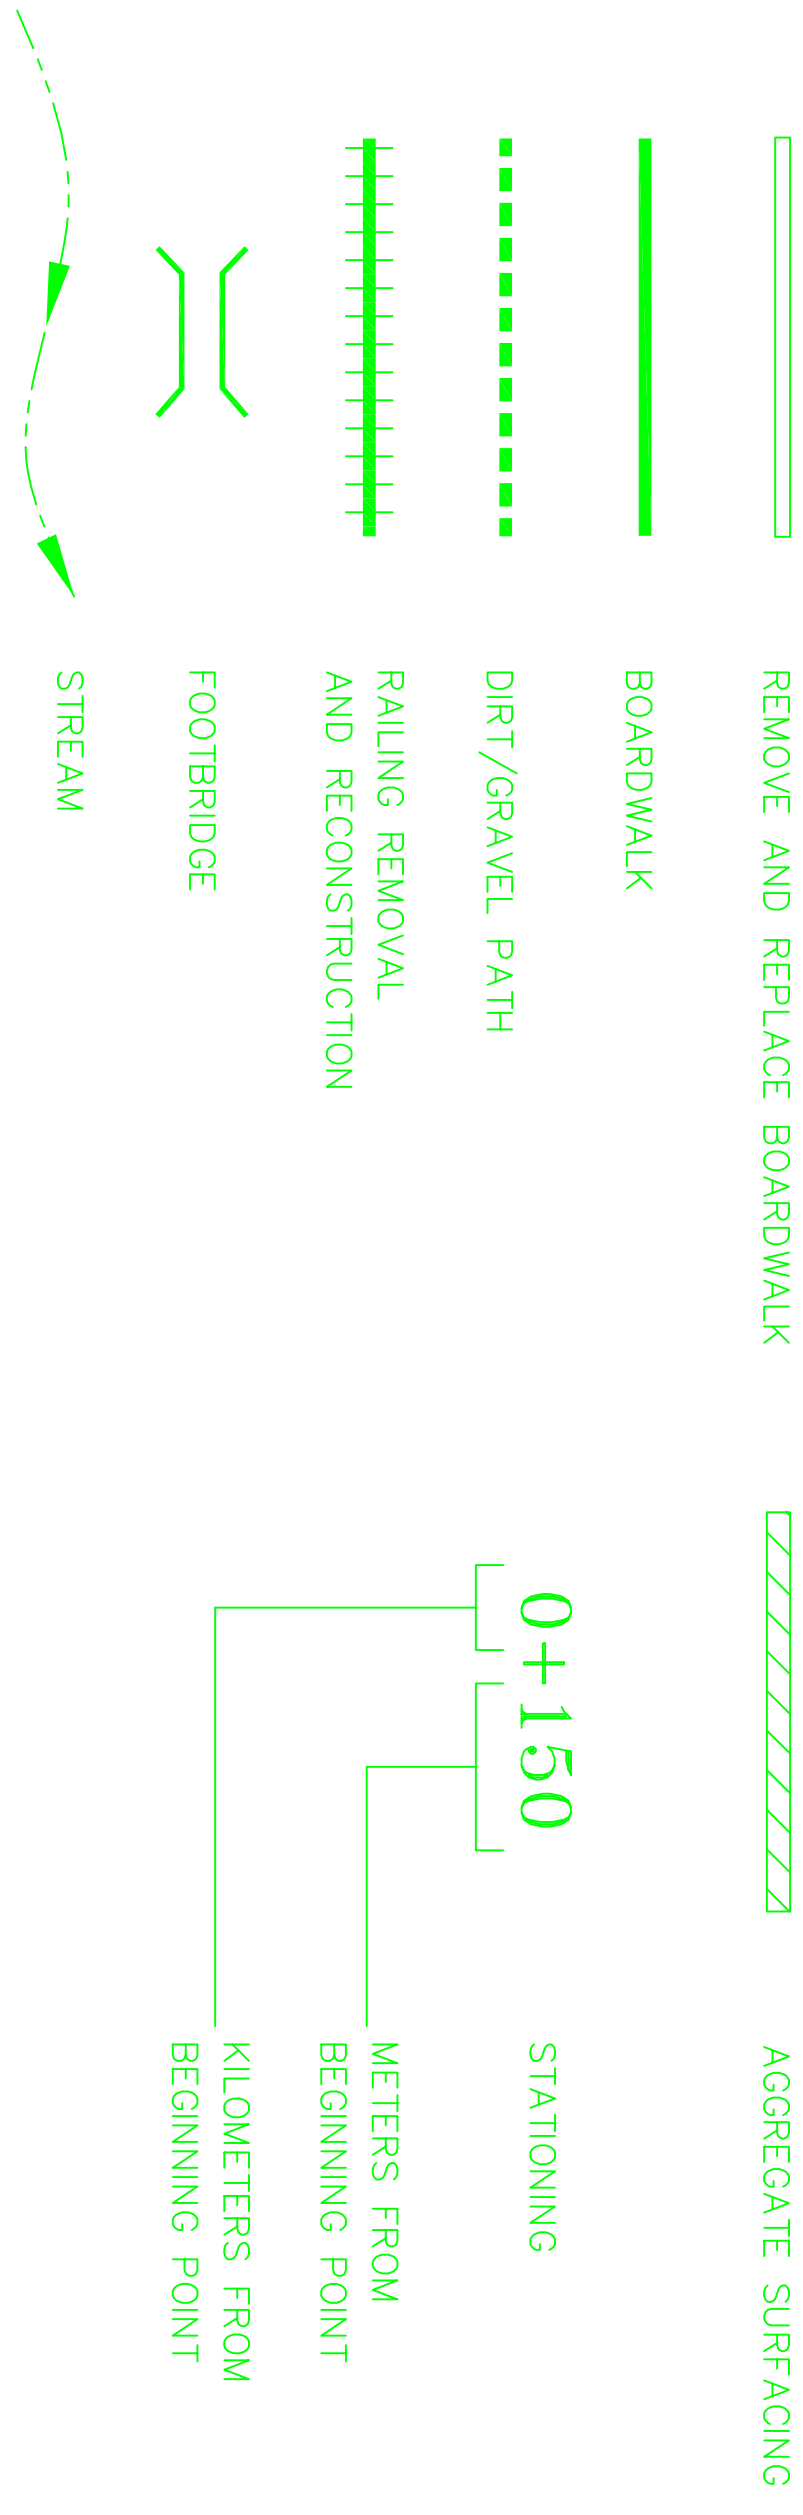

CONSTRUCTION NOTES:

1. THE IMAGE USED ON THIS PLAN SHEET WAS TAKEN FROM AN AERIAL PHOTOGRAPH TAKEN IN 1985. THIS IMAGE OVERLAY IS BEING USED TO PROVIDE THE CONTRACTOR WITH A REASONABLE DEPICTION OF WHERE THE WORK IS LOCATED IN RELATION TO MAJOR TOPOGRAPHICAL AND OTHER IMPROVEMENTS. NO ATTEMPT HAS BEEN MADE TO UPDATE THIS INFORMATION.
2. THE LOCATION OF THE WORK INDICATED IS APPROXIMATE ONLY AND SHALL BE VERIFIED WITH THE ENGINEER PRIOR TO BEGINNING WORK.
3. HANDRAIL IN THIS AREA IS NON-TYPICAL. CONTRACTOR SHALL MATCH EXISTING CONSTRUCTION.

NOTE: DO NOT SCALE FROM THESE PLANS-USE DIMENSIONS


ASBUILT\ELFIN-PLAN-1


PATH:	Q:\Elf\67619\PLANS\ELFIN-PLAN-1
PILOT:	METRIC SCALE: 1=1(F) OR 1=2(H)
BY:	DATE:
DESCRIPTION OF CHANGE:	V.P. ZOOM 0.270 XP

STATE OF ALASKA
DEPARTMENT OF TRANSPORTATION
AND PUBLIC FACILITIES
SOUTHDAST REGION

ELFIN COVE
ELF - ELFIN COVE BOARDWALKS
STP-0009(66) ~ PROJECT NO. 67619

DESIGNED BY:	L. GREGOVICH	PROJECT NO.	67619
DRAWN BY:	R. SNYDER	DATE:	JUNE 1999
CHECKED BY:	A. STENNINGER	SHEET	5 OF 12

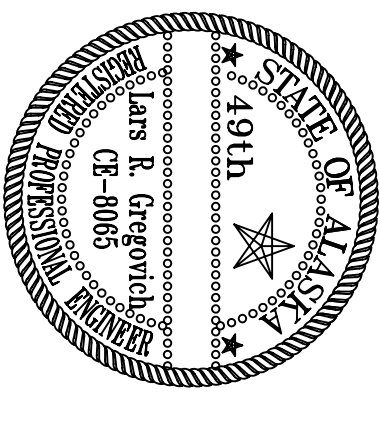

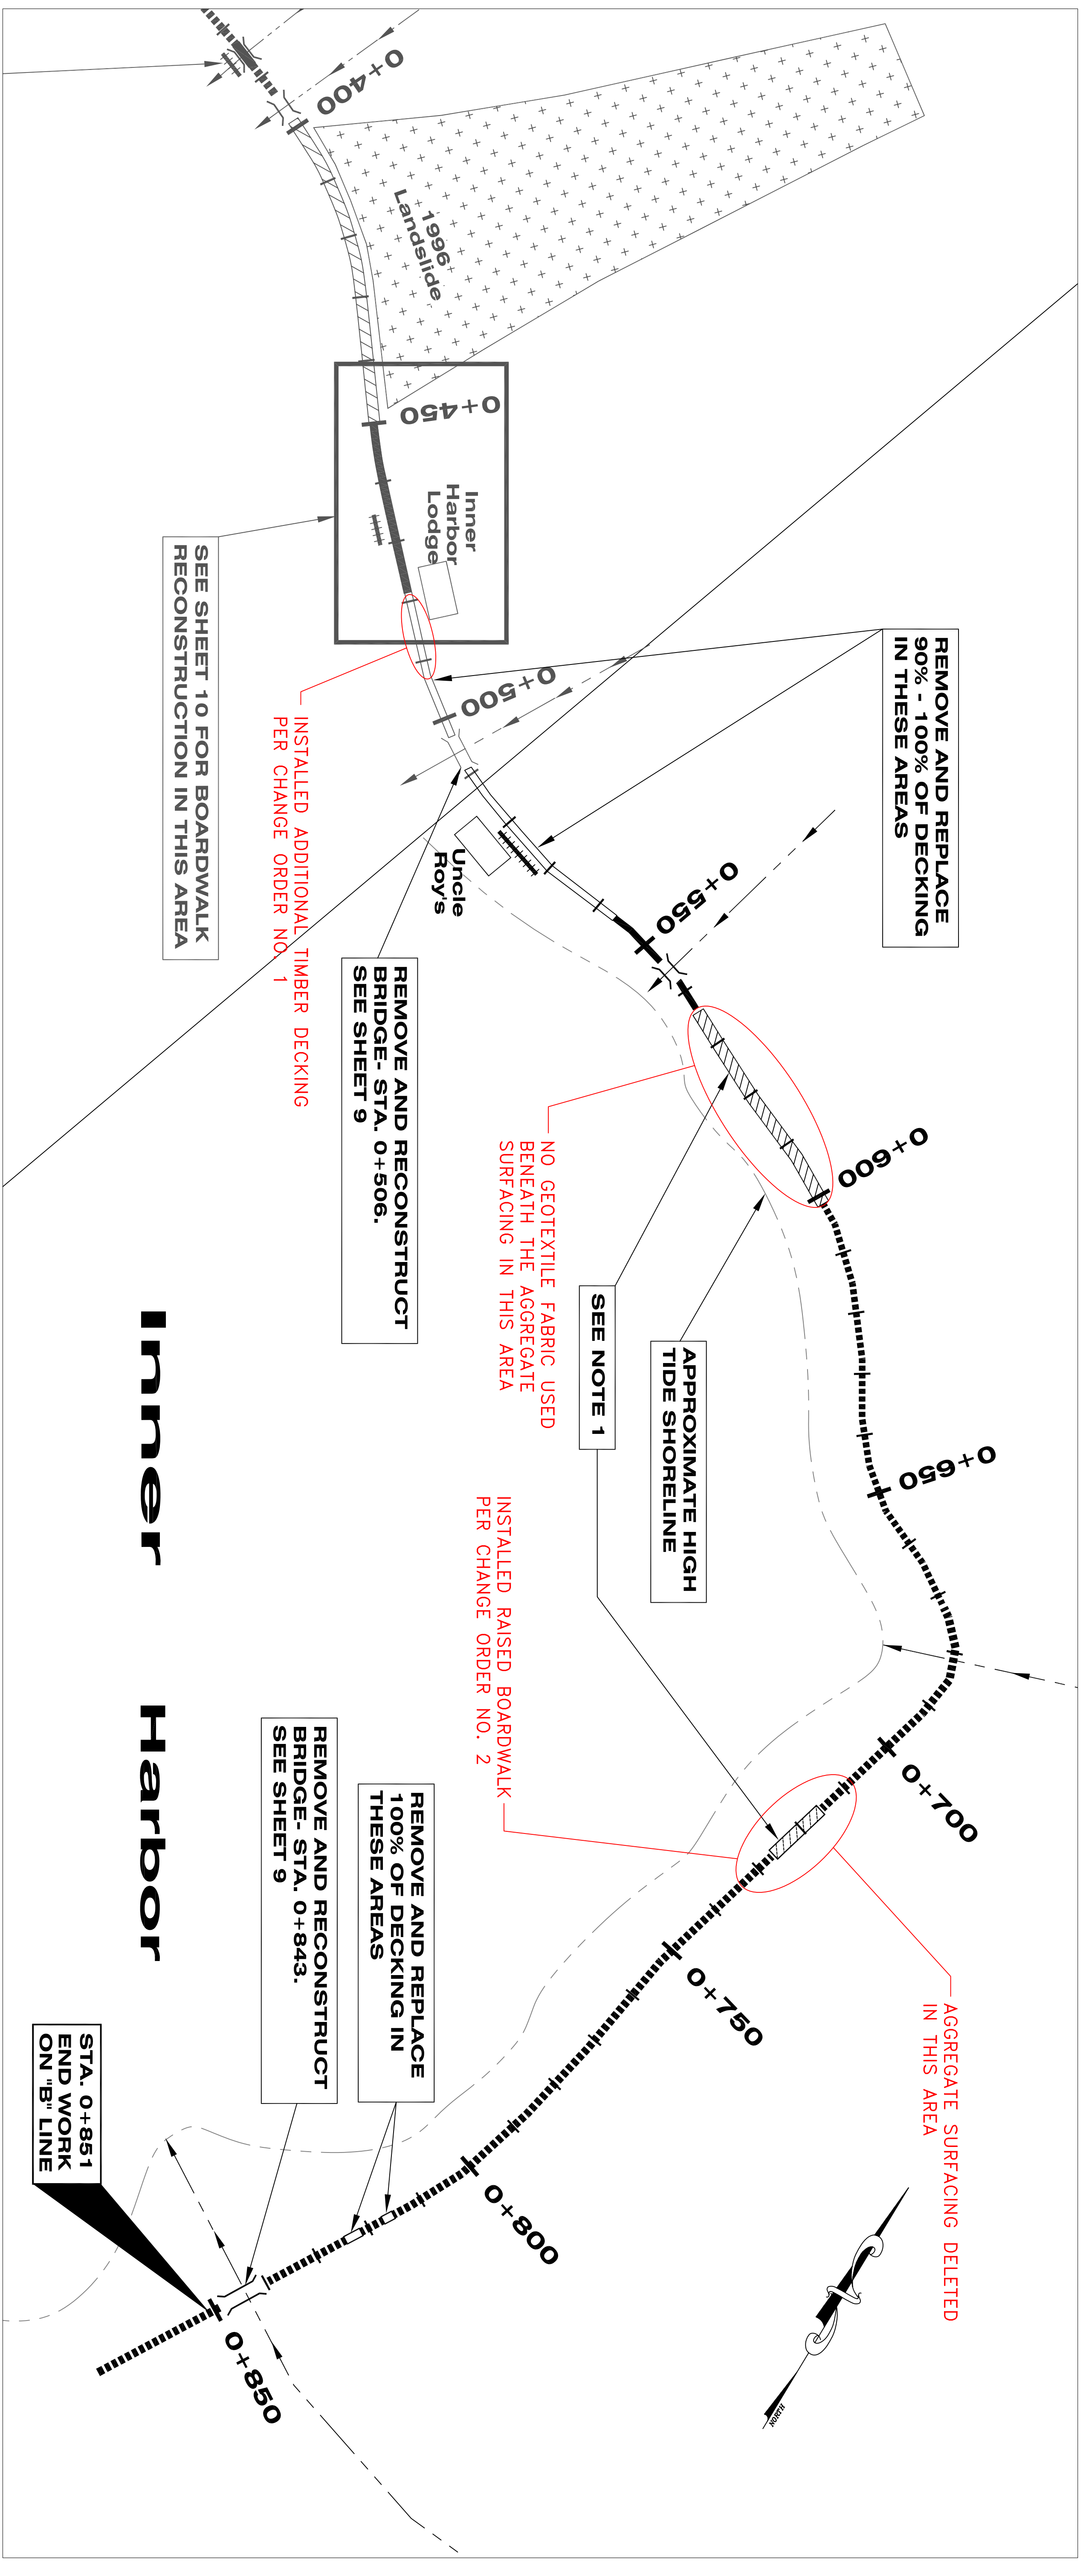

LEGEND

- REMOVE AND REPLACE BOARDWALK
 - BOARDWALK
 - DIRT/GRAVEL PATH
 - RAILING REMOVAL AND RECONSTRUCTION
 - FOOTBRIDGE
 - STREAM
 - AGGREGATE SURFACING
 - STATIONING
- 0+150 METERS FROM BEGINNING POINT
KILOMETERS FROM BEGINNING POINT

CONSTRUCTION NOTES:

1. REMOVE LOOSE COBBLES AND BOULDERS AND CUT PROJECTING TREE ROOTS PRIOR TO PLACING AGGREGATE SURFACING IN THIS AREA.

NOTE: DO NOT SCALE FROM THESE PLANS-USE DIMENSIONS


ASBUILT\ELFIN-PLAN-1


PATH:	Q:\ELF\67619\PLANS\ELFIN-PLAN-1
PLOT:	METRIC SCALE: 1=1(F) OR 1=2(H)
DATE:	V.P. ZOOM 0.270 XP
DESCRIPTION OF CHANGE:	

STATE OF ALASKA
DEPARTMENT OF TRANSPORTATION
AND PUBLIC FACILITIES
SOUTHEAST REGION

ELFIN COVE
ELF - ELFIN COVE BOARDWALKS
STP-0009(66) ~ PROJECT NO. 67619

DESIGNED BY:	L. GREGOVICH	PROJECT NO.	67619
DRAWN BY:	R. SNYDER	DATE:	JUNE 1999
CHECKED BY:	A. STEININGER	SHEET	6 OF 12

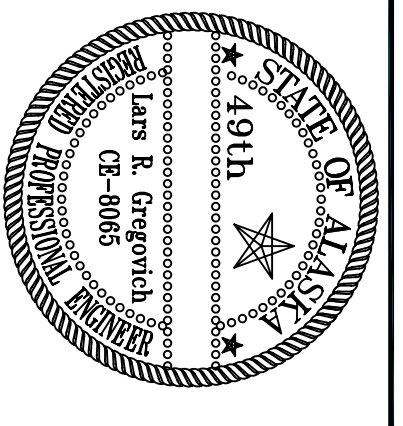


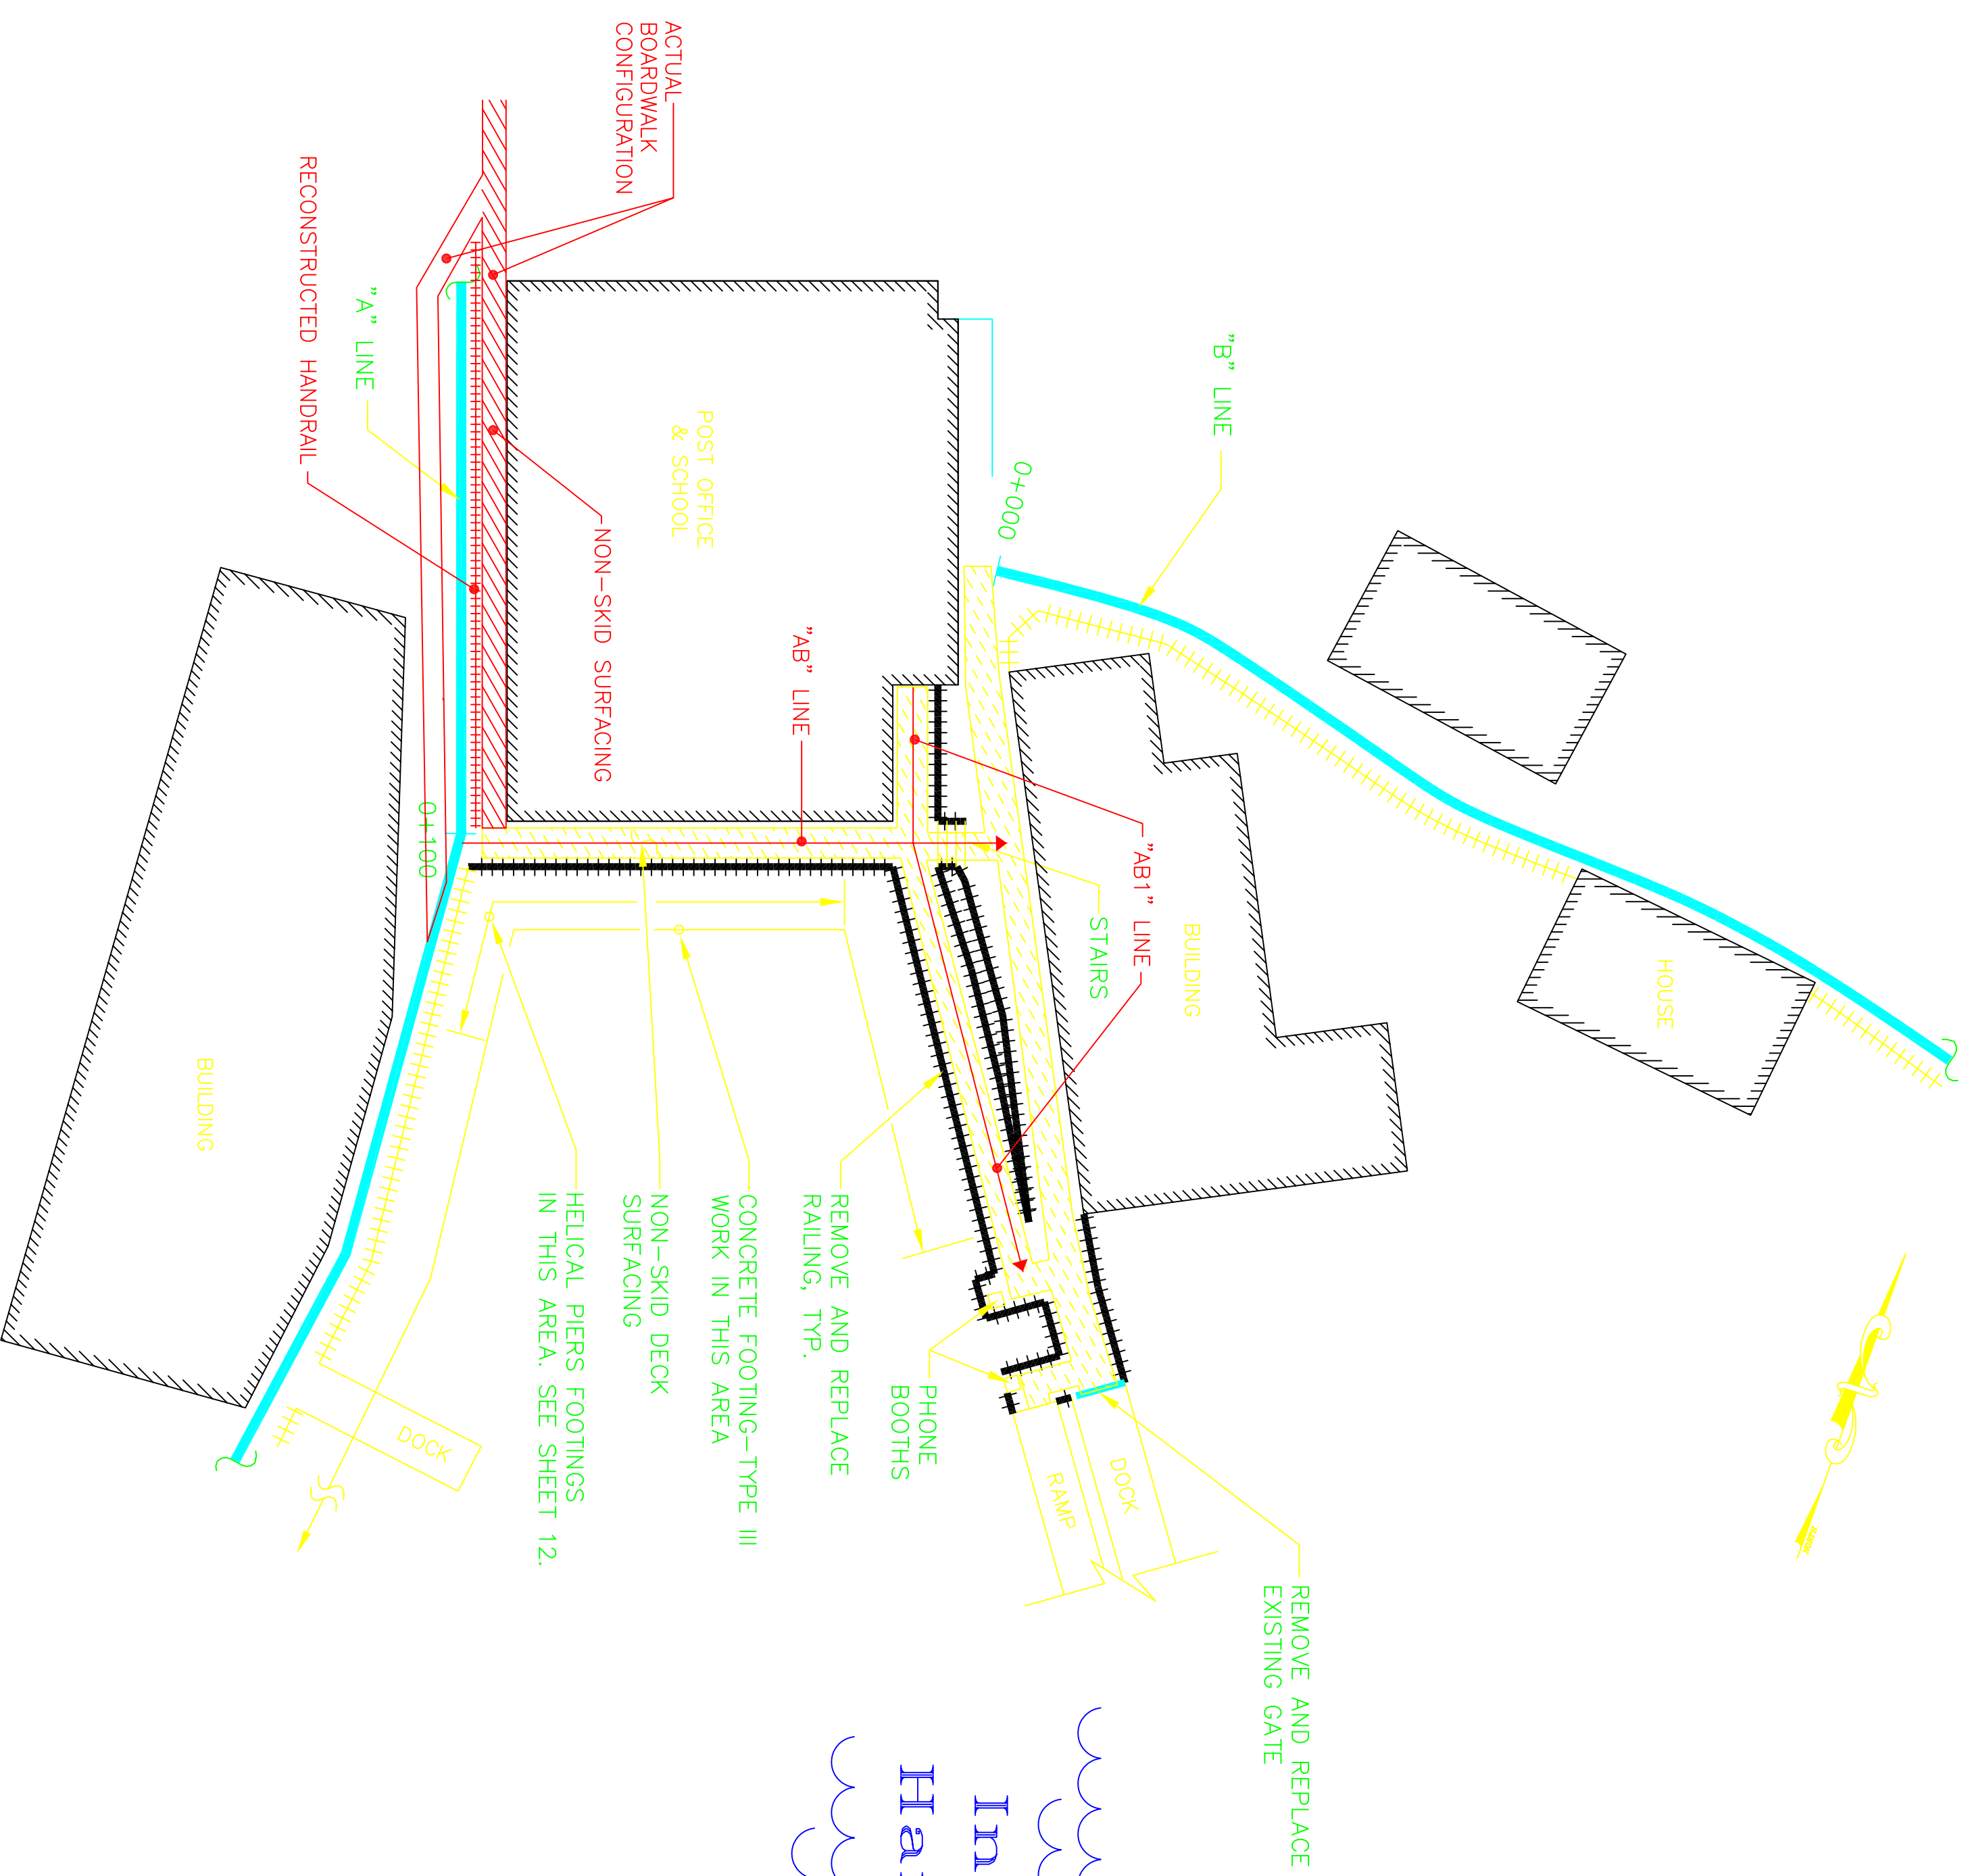

Inner Harbor

CONSTRUCTION NOTES:

1. THIS SHEET INTENDED TO SHOW WORK IN THE INNER HARBOR DOCK AREA ONLY. SEE OTHER PLAN SHEETS FOR WORK ON "A" AND "B" LINE BOARDWALKS.
2. NON-SKID DECK SURFACING SHALL BE APPLIED IN THIS WORK AREA AS DIRECTED BY THE ENGINEER.
3. RAILING SHALL CONFORM TO THAT SHOWN ON THE TYPICAL BOARDWALK SECTION. NON-TYPICAL RECONSTRUCTION SHALL MATCH EXISTING CONSTRUCTION.
4. SEE SPECIAL PROVISIONS FOR PAYMENT METHOD FOR REMOVAL AND REPLACEMENT OF THE EXISTING GATE.
5. MOST OF THE CONCRETE FOOTING WORK IS LOCATED IN THE INTERTIDAL ZONE. THE CONTRACTOR SHALL SCHEDULE THE WORK DURING FAVORABLE TIDES AND SHALL NOT POUR CONCRETE IN SEA WATER NOR WHEN WAVE ACTION MAY DAMAGE FRESHLY POURED CONCRETE.
6. THE CONTRACTOR SHALL PROVIDE TEMPORARY SHORING OF THE BOARDWALK WHILE FOOTINGS ARE BEING CONSTRUCTED. THE BOARDWALK SHALL BE LEVELED IN AREAS WHERE THE EXISTING FOOTINGS HAVE SETTLED, OR WHERE BOARDWALK DECK IS NOT LEVEL.
7. EXISTING DIAGONAL BRACING MAY NEED TO BE REMOVED AND REATTACHED AND A SLIGHTLY DIFFERENT ANGLE TO PERFORM THE FOOTING WORK.
8. TYPE III CONCRETE FOOTINGS MAY BE CIRCULAR ~~OR SQUARE~~ CIRCULAR USED
9. EXISTING POSTS SHALL BE CUT TO REMOVE PREVIOUSLY DRILLED HOLES. SOME POSTS ARE DIMENSIONAL AND SHALL BE TRIMMED TO FIT POST BASE CONNECTOR. ALL FIELD CUT SHALL BE TREATED PER NOTE 5 ON SHEET 2.

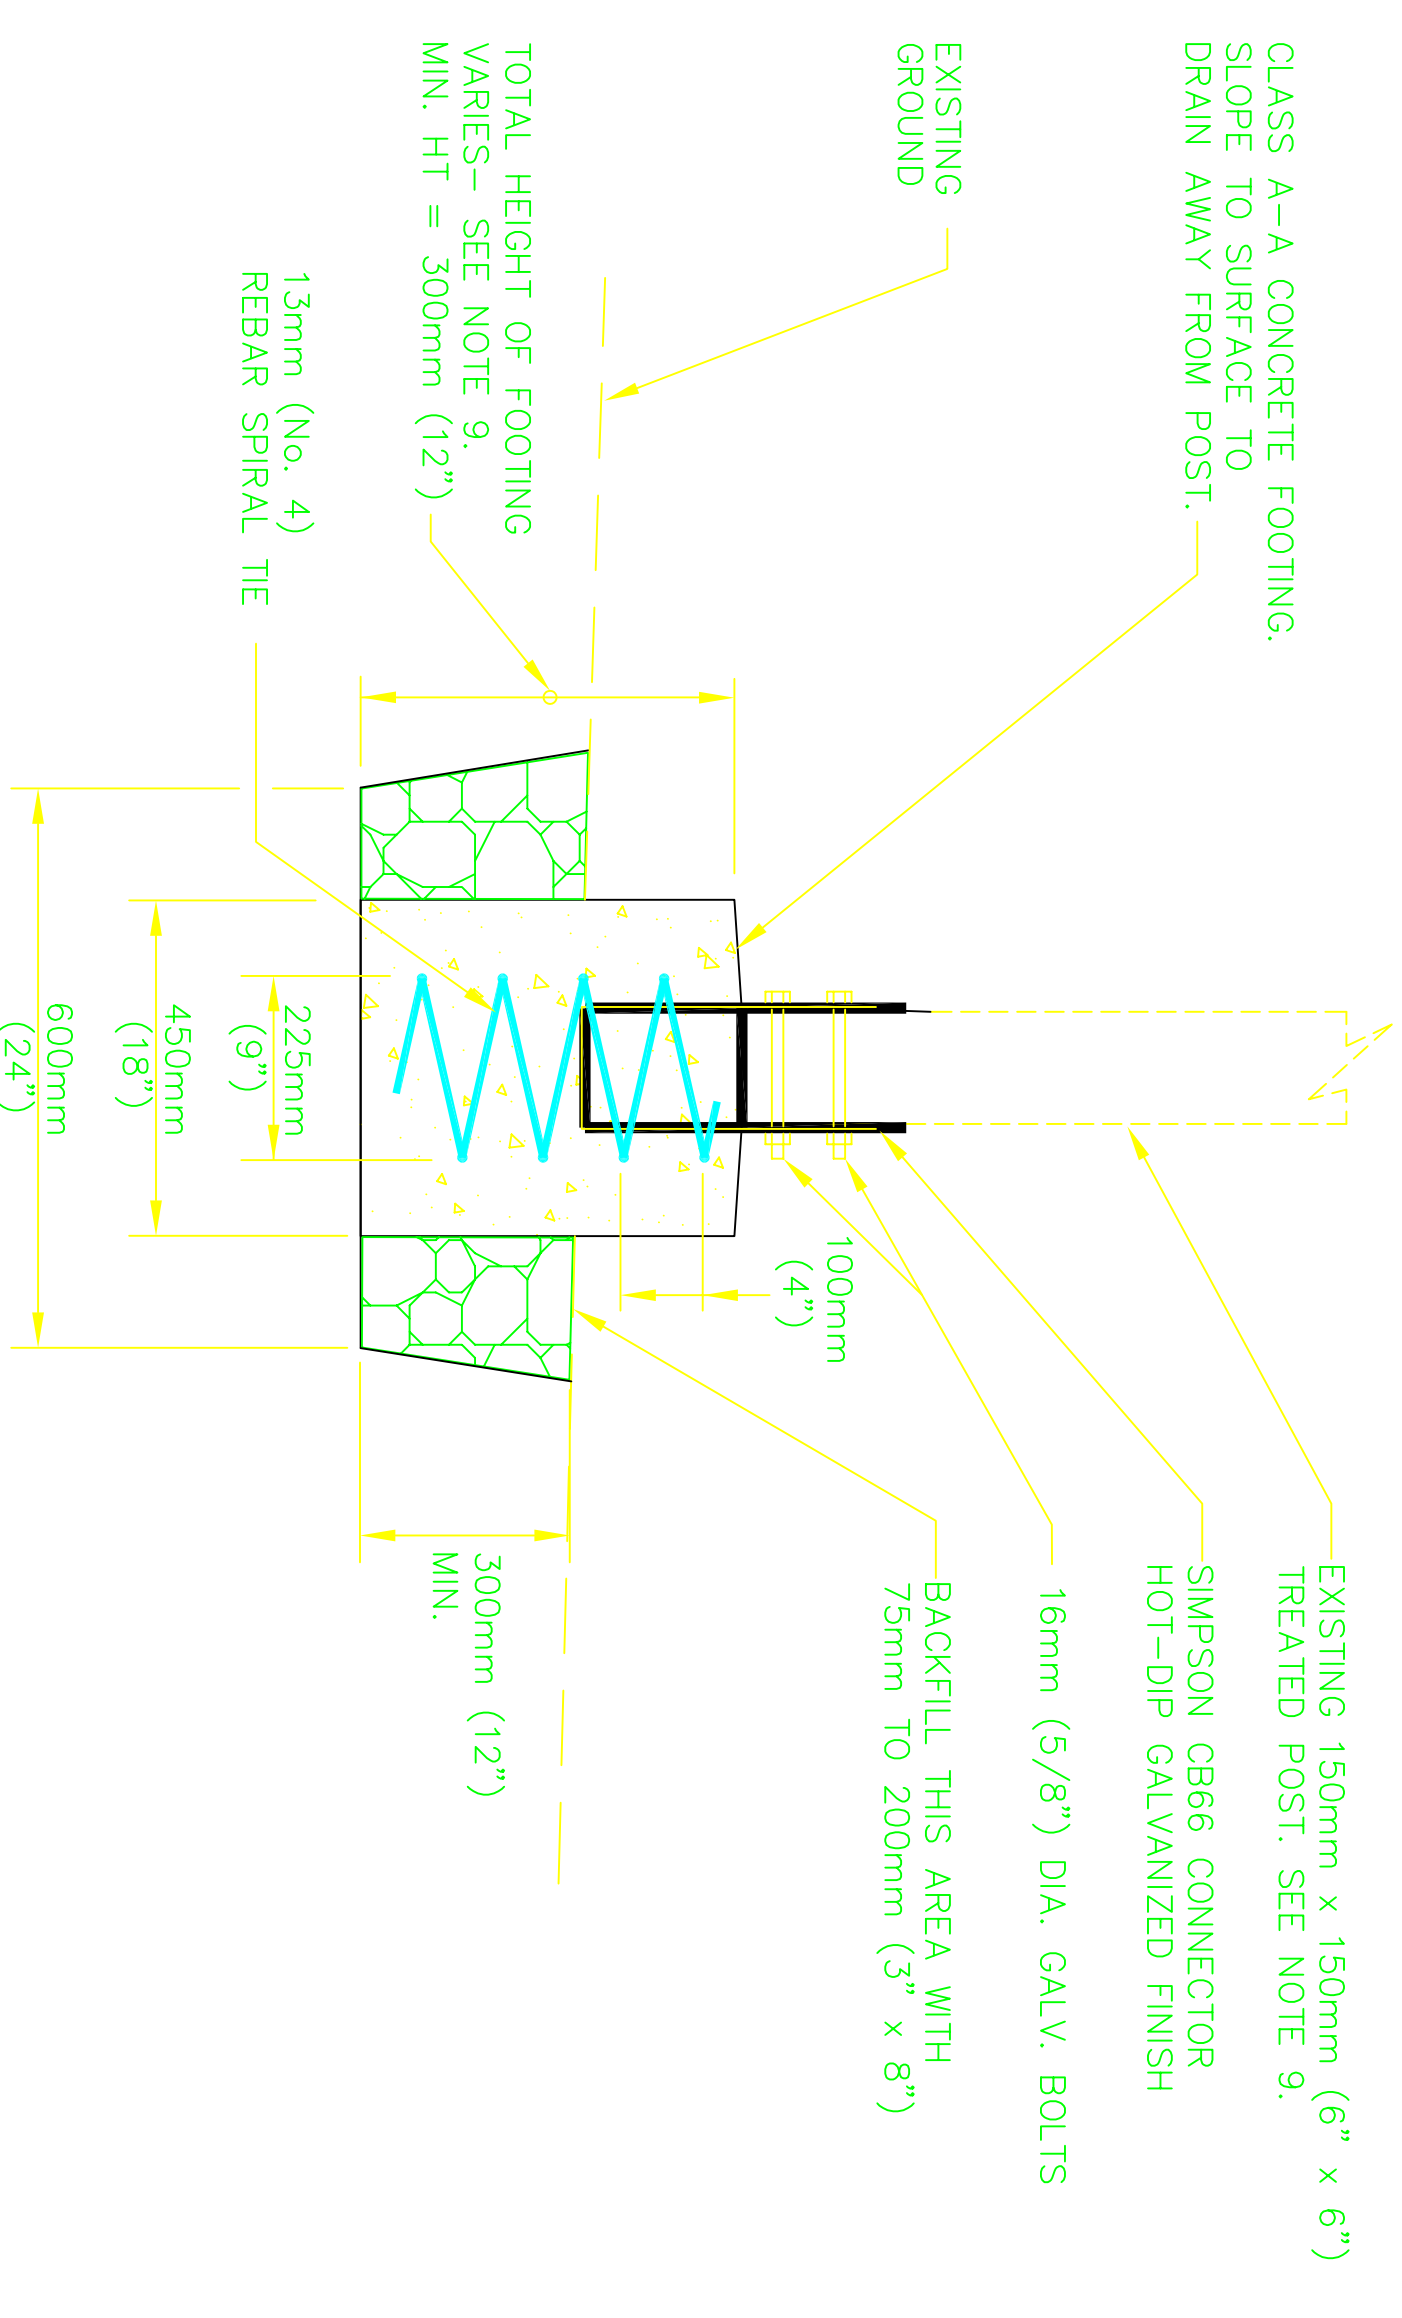

CONCRETE FOOTING - TYPE III

NOTE: DO NOT SCALE FROM THESE PLANS-USE DIMENSIONS

BOARDWALK RAILING RECONSTRUCTION PLAN

INNER HARBOR DOCK AREA

VASBULL\BOARDRAIL

PATH:	Q:\ELF\67619\PLANS\SET\DWG\10044R004.dwg	VIEW:	P1
PILOT:	1=1(F) OR 1=2(H)		
BY:	DATE:	DESCRIPTION OF CHANGE:	

STATE OF ALASKA
DEPARTMENT OF TRANSPORTATION
AND PUBLIC FACILITIES
SOUTHEAST REGION


ELFIN COVE


ELF - ELFIN COVE BOARDWALKS
STP-0003(56) ~ PROJECT NO. 67619
INNER HARBOR DOCK AREA PLAN

ALASKA

DESIGNED BY:	L. GREGOVICH
DRAWN BY:	R. SNYDER
CHECKED BY:	A. STEININGER


PROJECT NO.	67619
DATE:	JUNE 1999
SHEET	7 OF 12

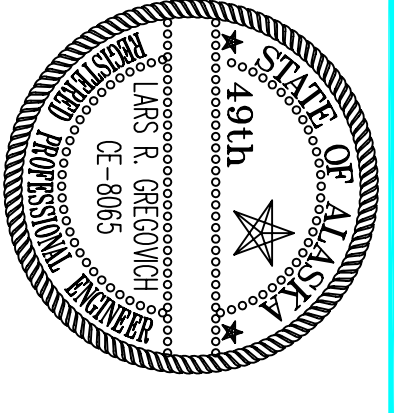

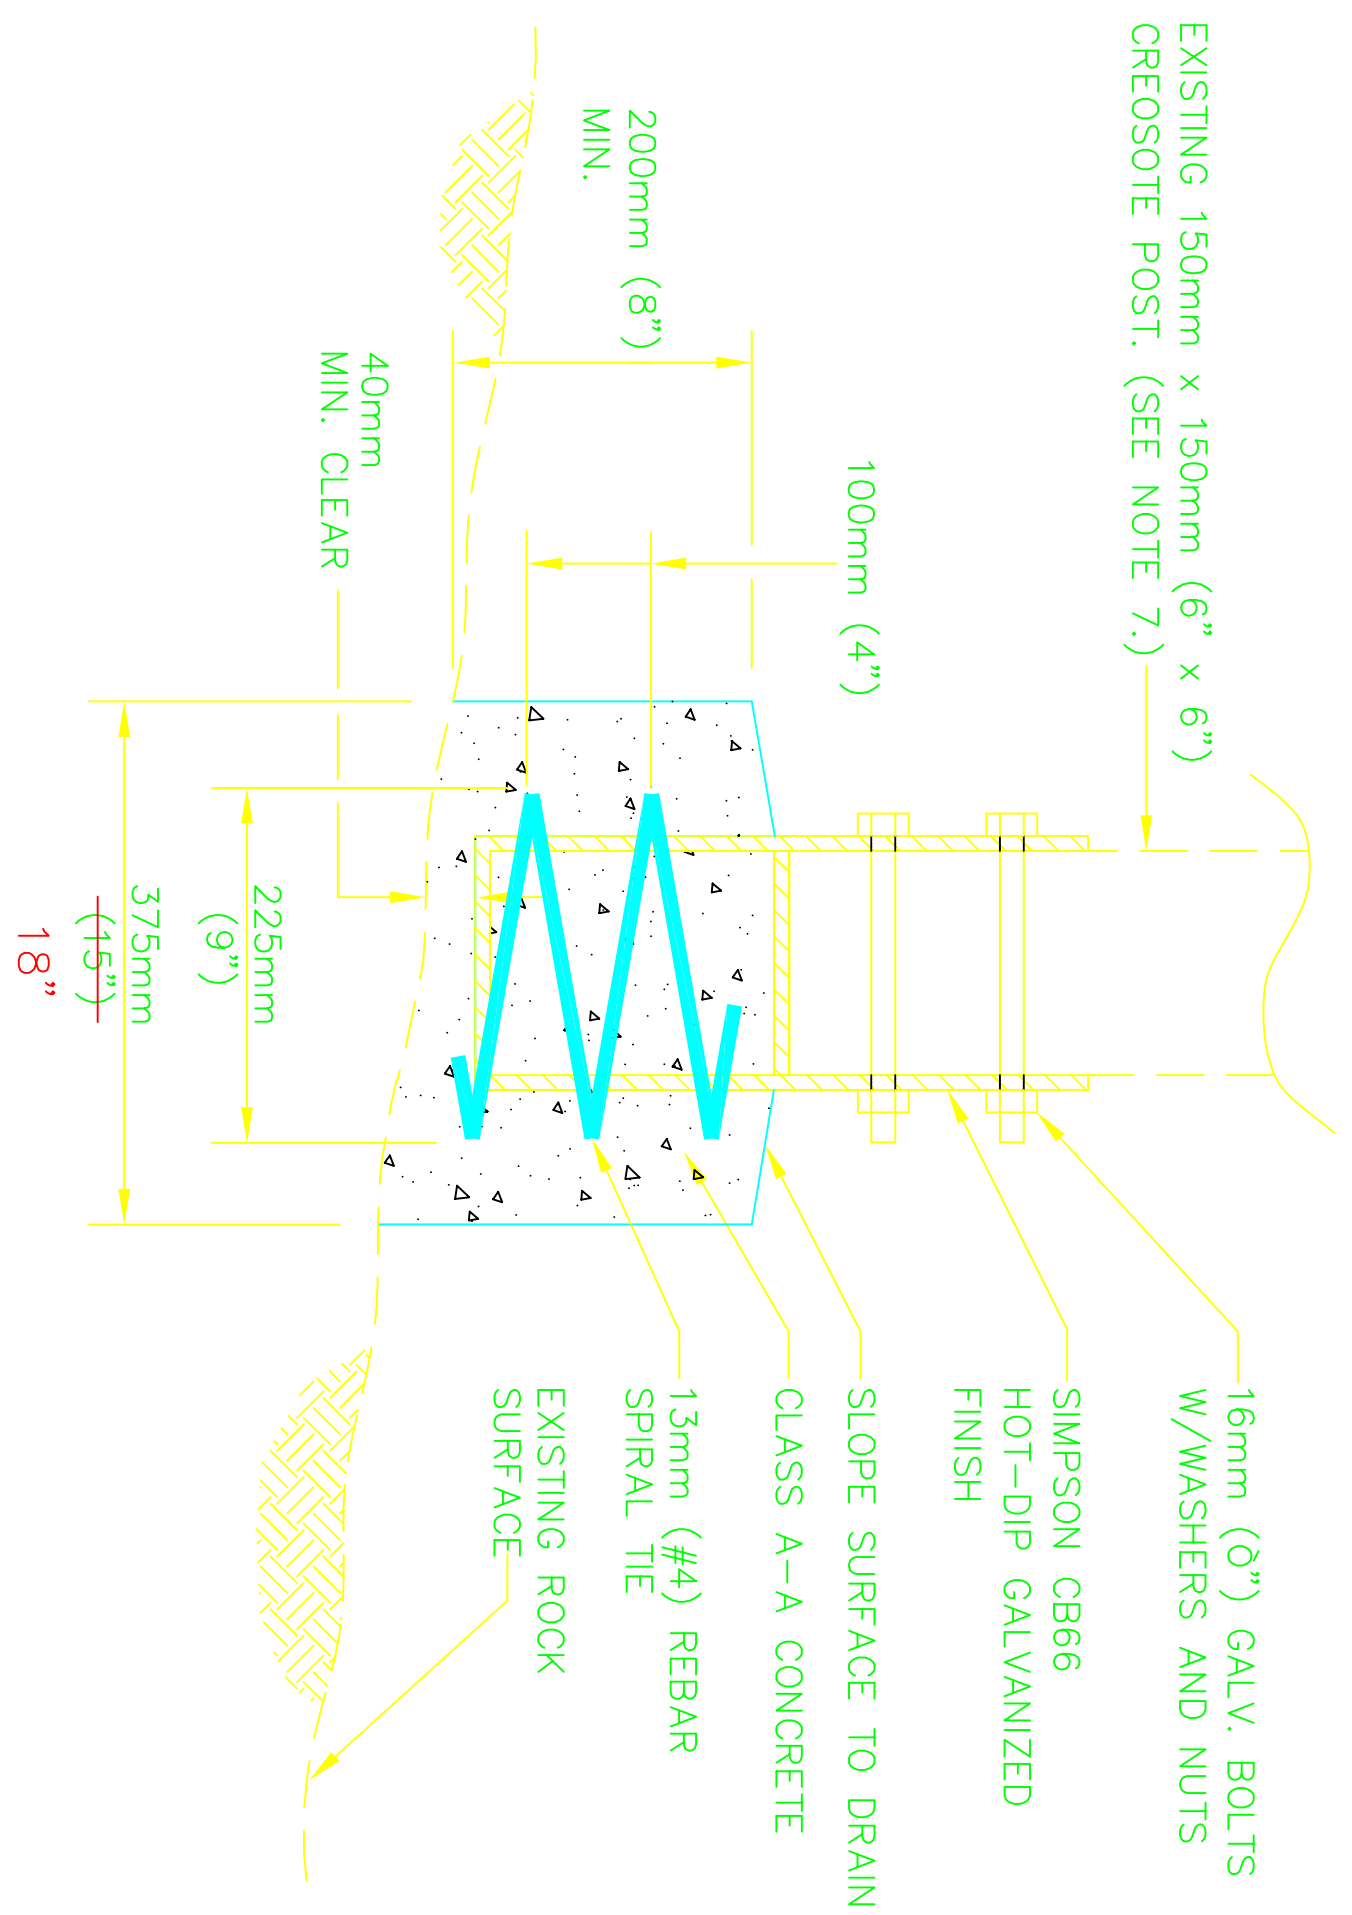


CONCRETE FOOTING - TYPE I

(TO BE USED ON SLOPES LESS THAN 30°)

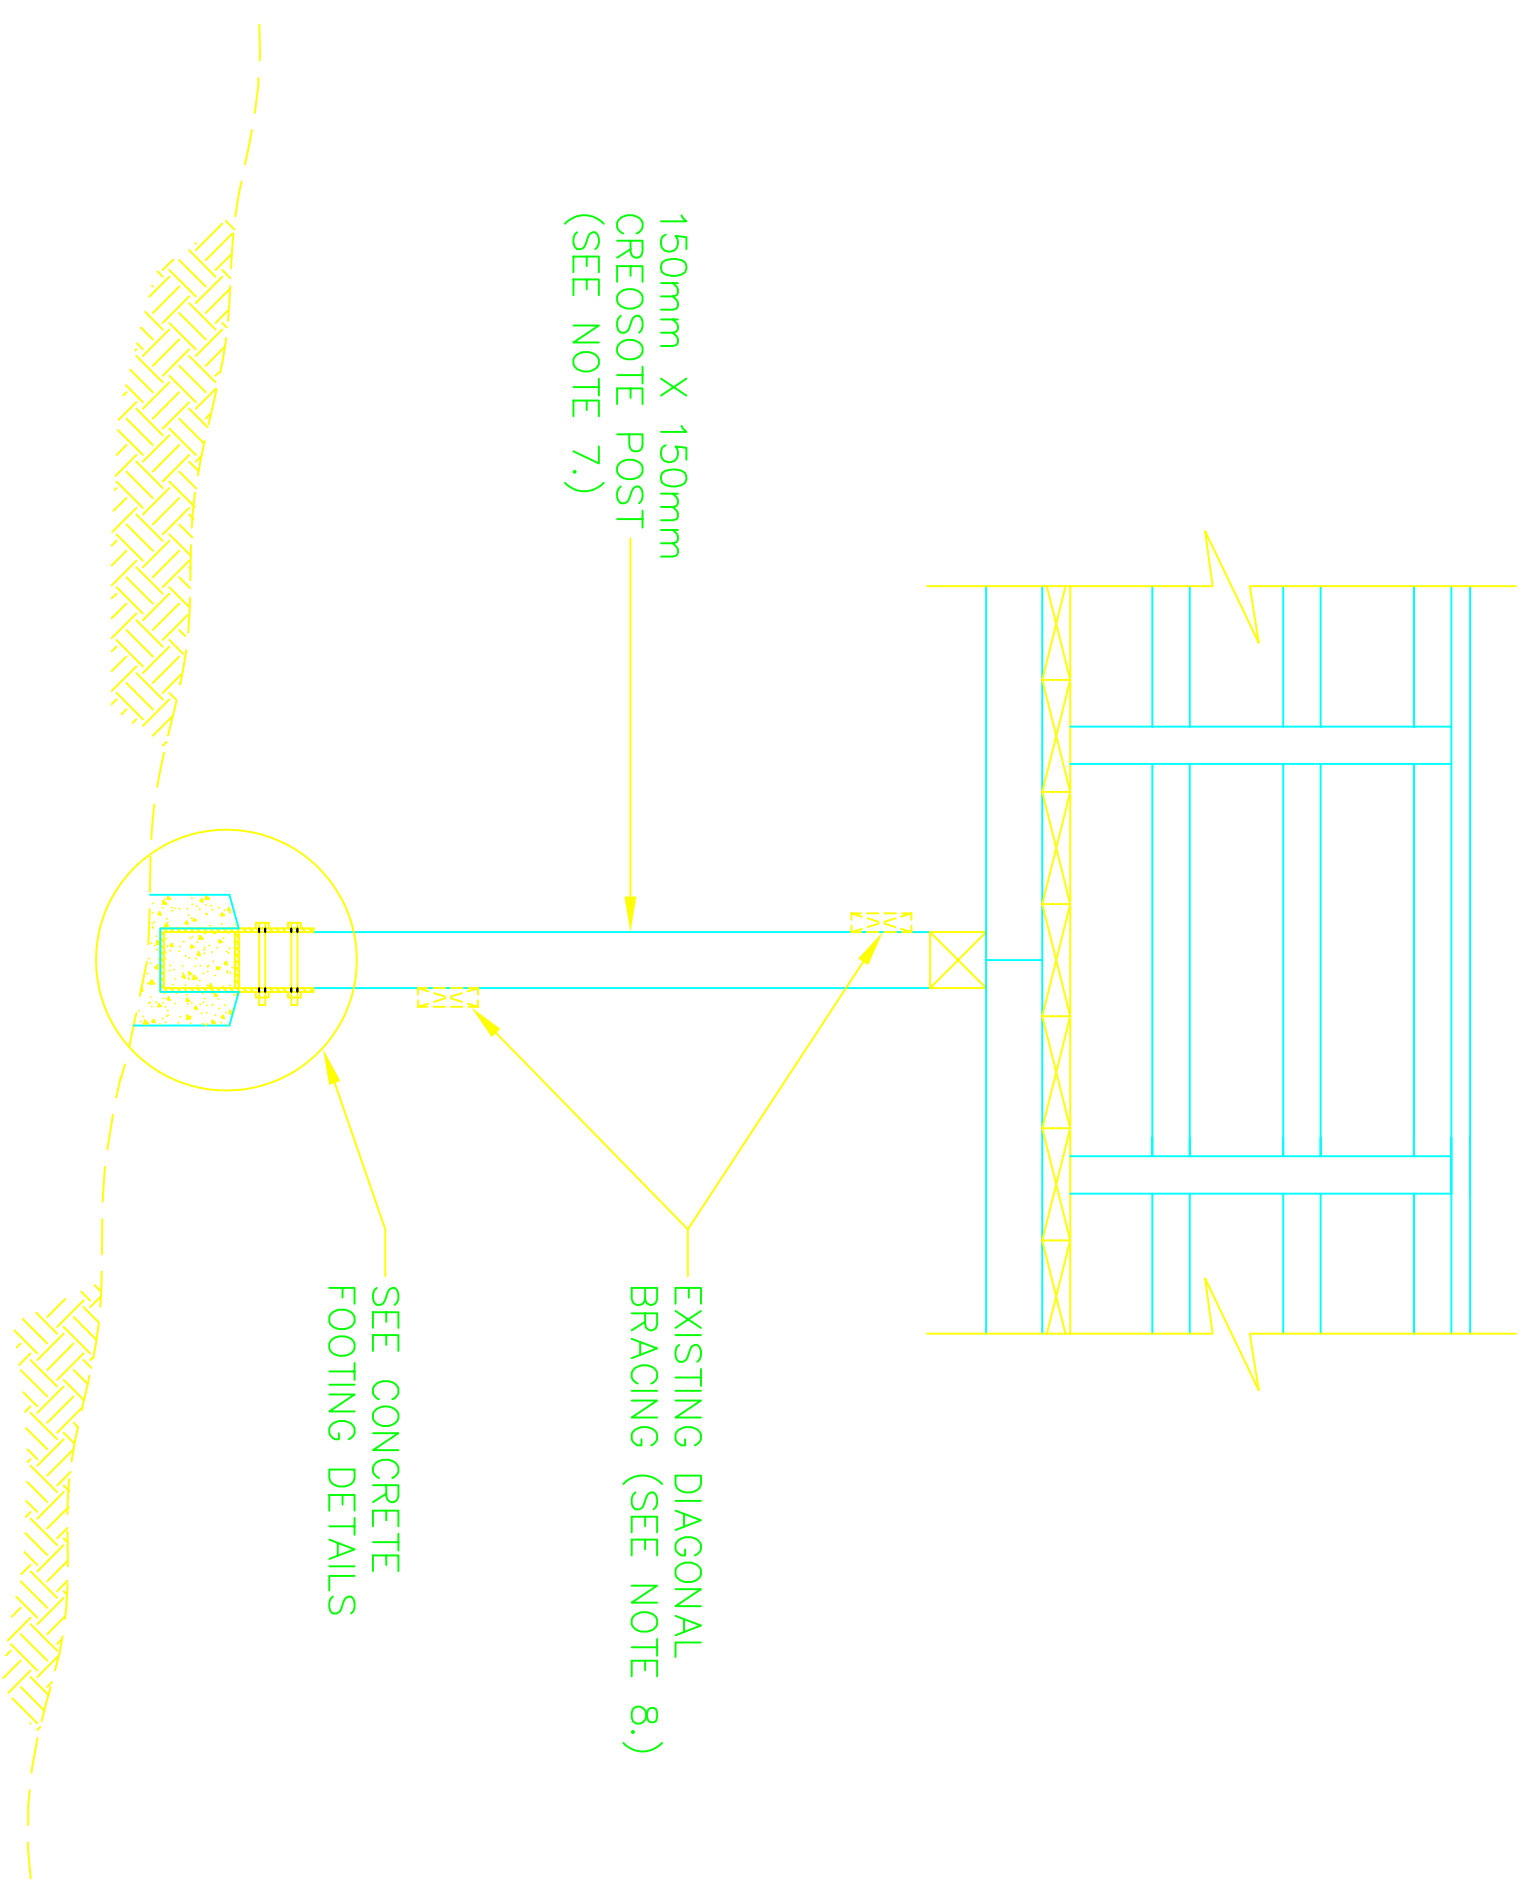


TYPICAL BOARDWALK SUPPORT

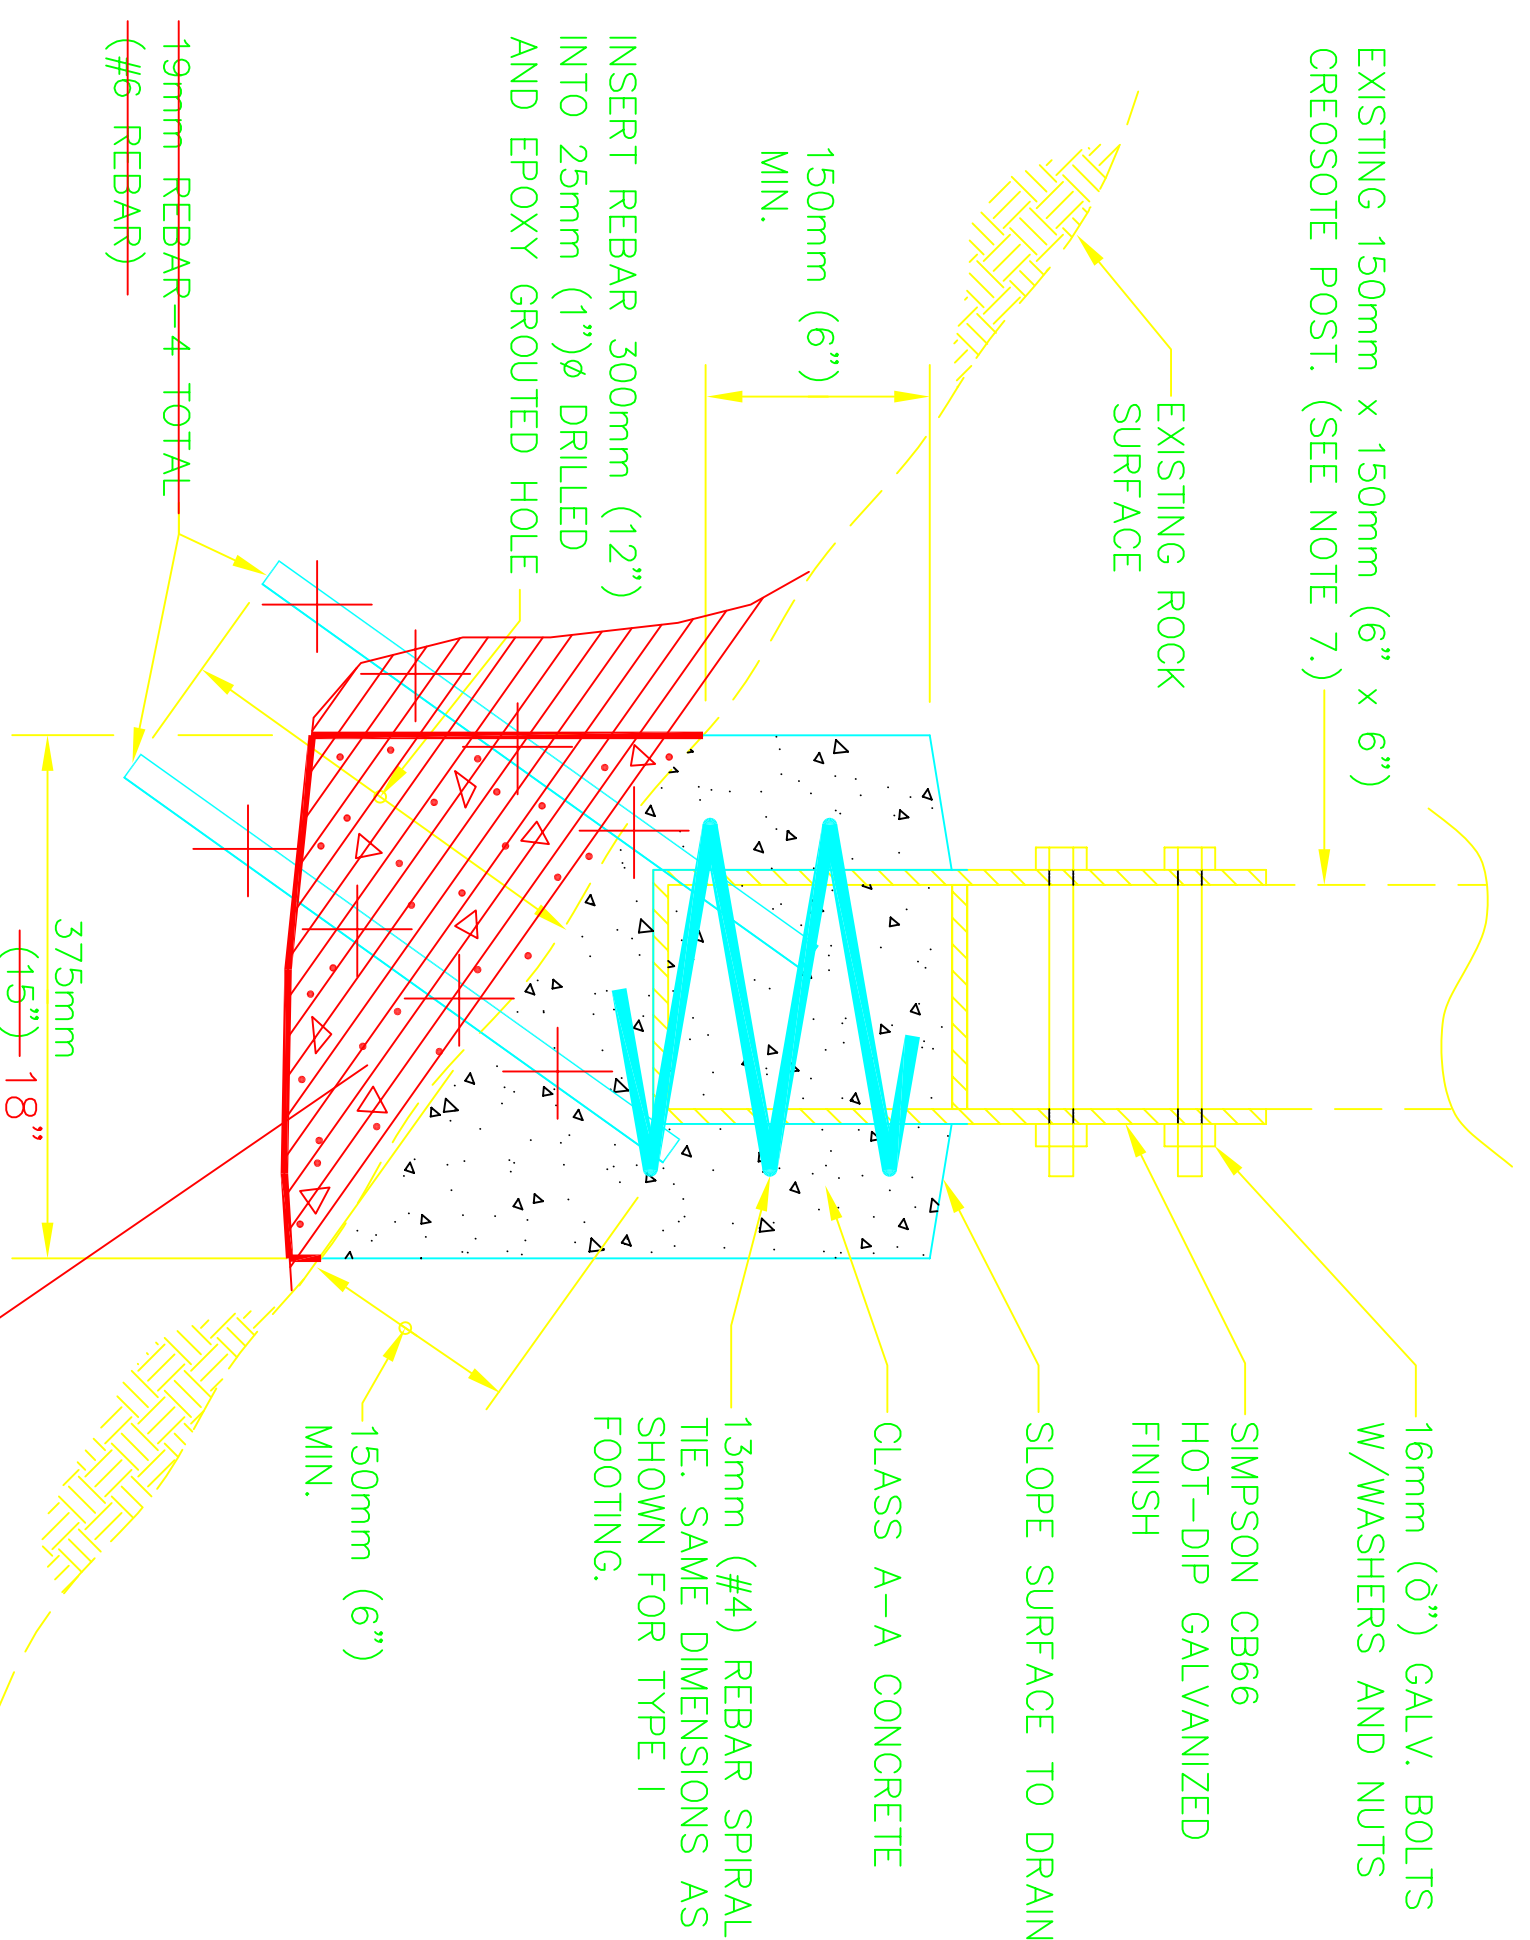

CONCRETE FOOTING - TYPE II

(TO BE USED ON SLOPES GREATER THAN 30°)

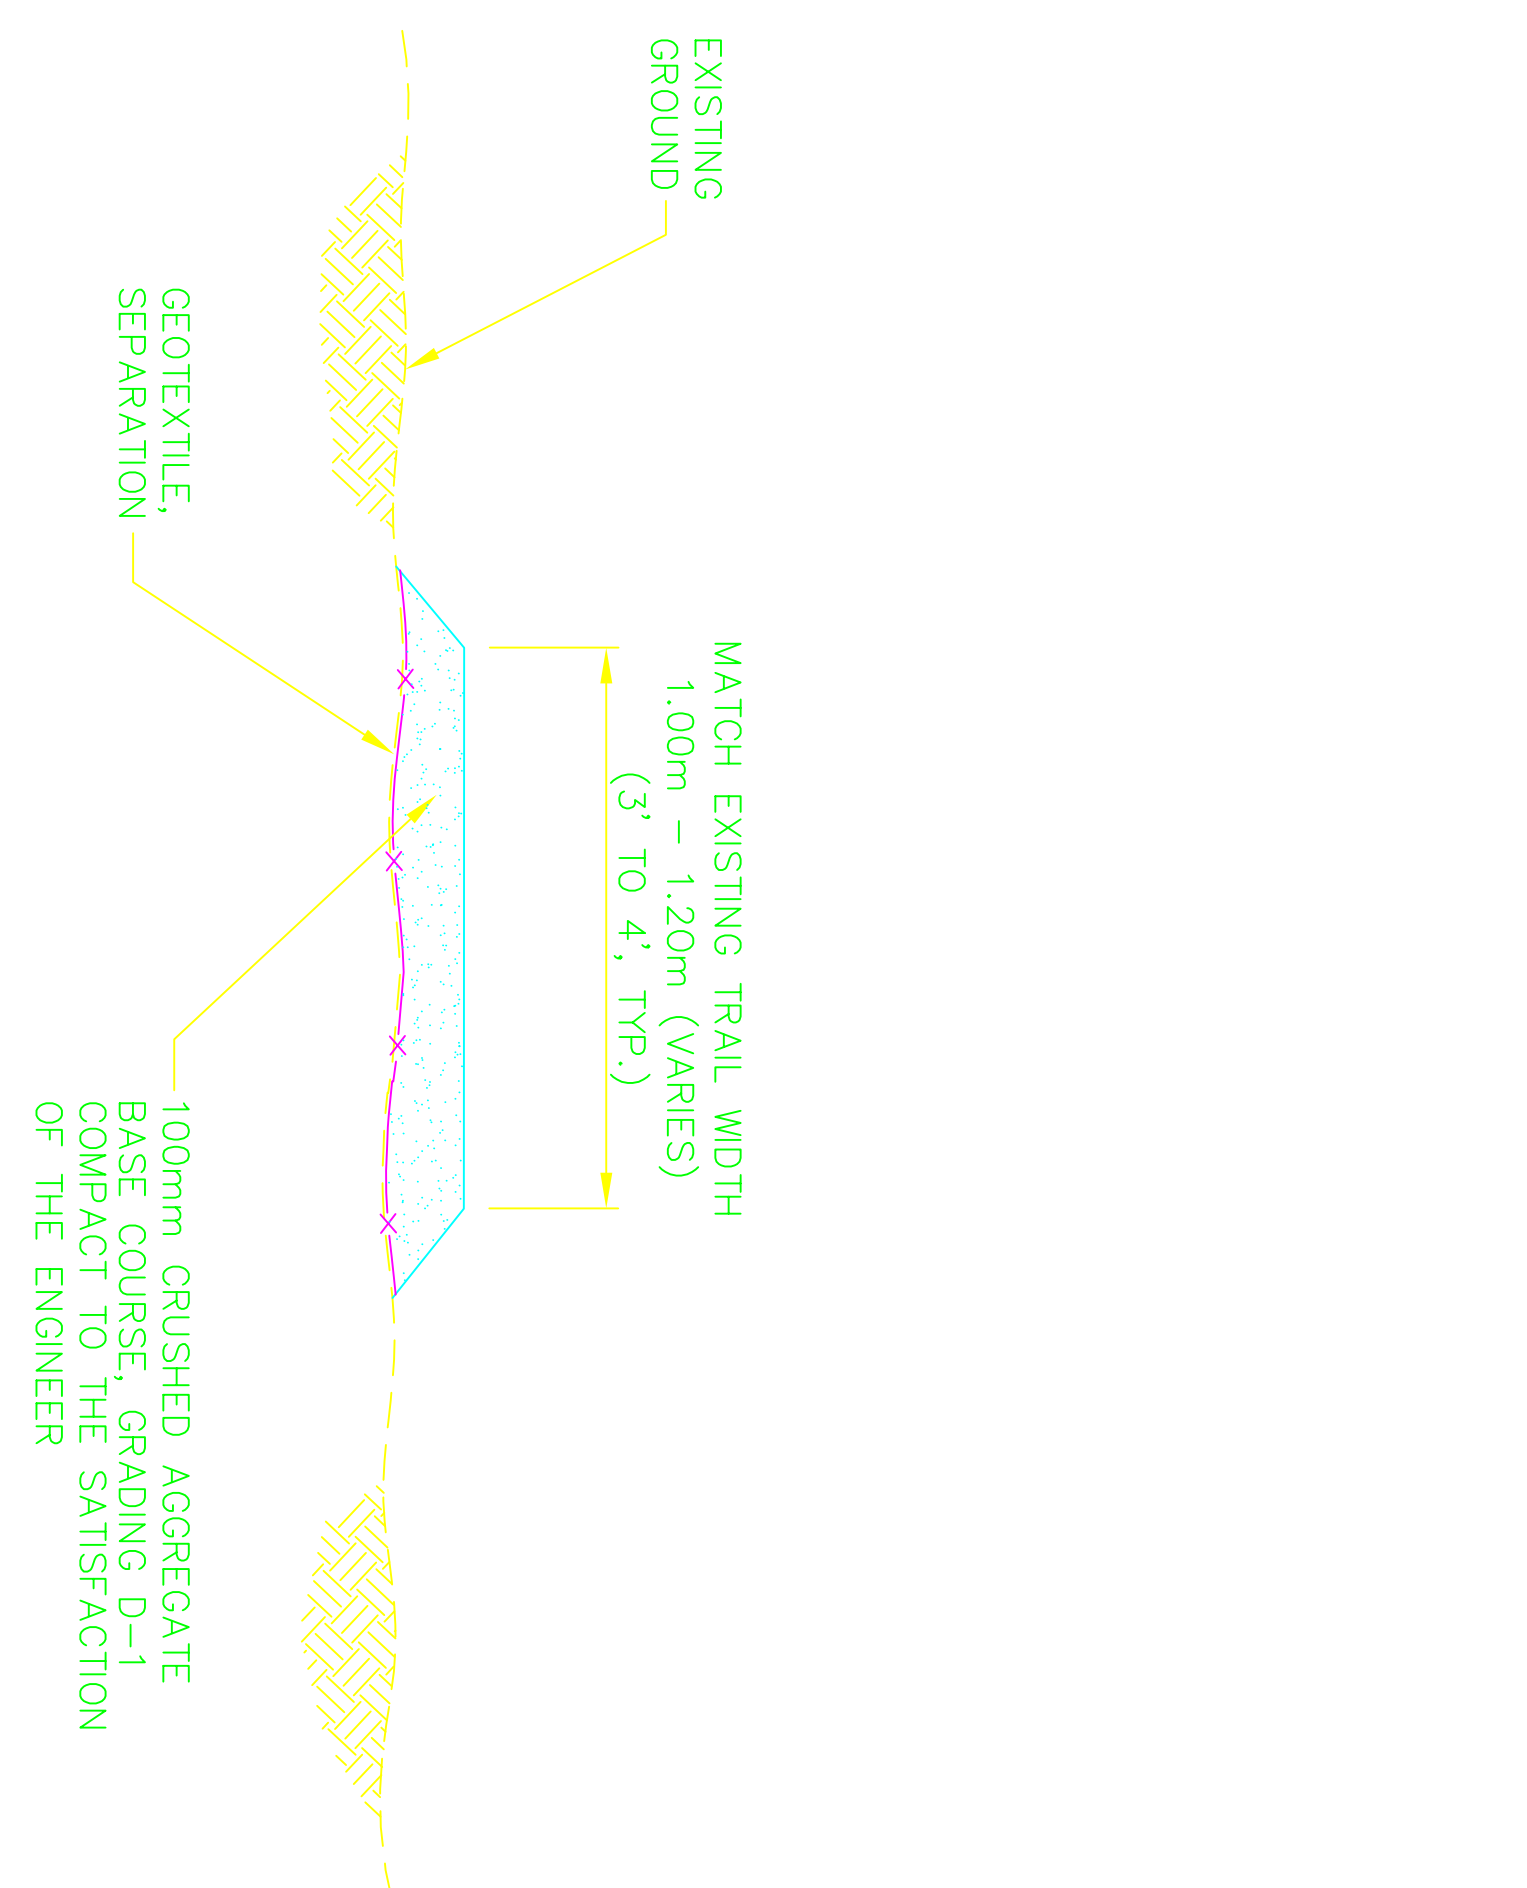

AGGREGATE SURFACING DETAIL

CONSTRUCTION NOTES:

1. MOST OF THE CONCRETE FOOTING WORK IS LOCATED IN THE INTERTIDAL ZONE. THE CONTRACTOR SHALL SCHEDULE THE WORK DURING FAVORABLE TIDES AND SHALL NOT POUR CONCRETE IN SEA WATER NOR WHEN WAVE ACTION MAY DAMAGE FRESHLY POURED CONCRETE.
2. ALL LOOSE ROCK AND THIN SOILS SHALL BE REMOVED DOWN TO BEDROCK PRIOR TO FORMING TYPE I OR II FOOTINGS. IF BEDROCK IS NOT FOUND WITHIN 300mm OF THE EXISTING GROUND SURFACE, A TYPE III FOOTING SHALL BE USED.
3. THE CONTRACTOR SHALL PROVIDE TEMPORARY SHORING OF THE BOARDWALK WHILE FOOTINGS ARE BEING CONSTRUCTED. THE BOARDWALK SHALL BE LEVELED IN AREAS WHERE THE EXISTING FOOTINGS HAVE SETTLED.
4. THE CONTRACTOR SHALL ATTEMPT TO USE THE EXISTING SUPPORT POST WHEN POSSIBLE. WHEN A NEW POST IS REQUIRED, THE CONTRACTOR SHALL RECYCLE A CREOSOTE POST FROM ANOTHER AREA; OTHERWISE, A NEW CREOSOTE POST WILL BE REQUIRED AND PAID FOR. SEE SPECIAL PROVISIONS FOR PAYMENT ON RECYCLED POSTS.
5. EXISTING DIAGONAL BRACING MAY NEED TO BE REMOVED AND REATTACHED AND A SLIGHTLY DIFFERENT ANGLE TO PERFORM THE CONCRETE FOOTING WORK.
6. CIRCULAR OR SQUARE FORMS MAY BE USED. **CIRCULAR USED**
7. EXISTING POSTS SHALL BE SQUARELY CUT TO REMOVE PREVIOUSLY DRILLED HOLES. FIELD CUTS SHALL BE TREATED PER NOTE 5 ON SHEET 2. EXISTING POSTS WERE IN GOOD SHAPE. HOLES WERE NOT DETRIMENTAL.
8. DIAGONAL BRACING SHALL BE REMOVED AND REPLACED PER THE DIRECTION OF THE ENGINEER.
9. ACTUAL HEIGHT OF CONCRETE FOOTINGS WILL DEPEND ON LENGTH OF POST CUT OFF PER NOTE 7.

LOOSE ROCK WAS EXCAVATED, HARD ROCK WAS CHIPPED OUT. THIS ENABLED THE CONTRACTOR TO AVOID DRILLING FOR THE REBAR PINS, ELIMINATED THE REBAR PINS AND ALLOWED FOR THE INSTALLATION OF TYPE I FOOTINGS IN AREAS THAT WERE >30 DEGREES. NO TYPE II FOOTINGS WERE INSTALLED UNDER THIS PROJECT


NOTE: DO NOT SCALE FROM THESE PLANS-USE DIMENSIONS


PATH: Q:\ELF\67619\Asbuilt\Det2		VIEWS: P1, P2, P3, P4	
PILOT: 1=1(F) OR 1=2(H)	DATE:	DESCRIPTION OF CHANGE:	
RECORD OF REVISIONS			

STATE OF ALASKA
DEPARTMENT OF TRANSPORTATION
AND PUBLIC FACILITIES
SOUTHEAST REGION

ELFIN COVE
ELF - ELFIN COVE BOARDWALKS
STP-0009(56) ~ PROJECT NO. 67619
CONSTRUCTION DETAILS

DESIGNED BY:	L. GREGOVICH	PROJECT NO.	67619
DRAWN BY:	R. SNYDER	DATE:	JUNE 1999
CHECKED BY:	A. STEININGER	SHEET	8 OF 12

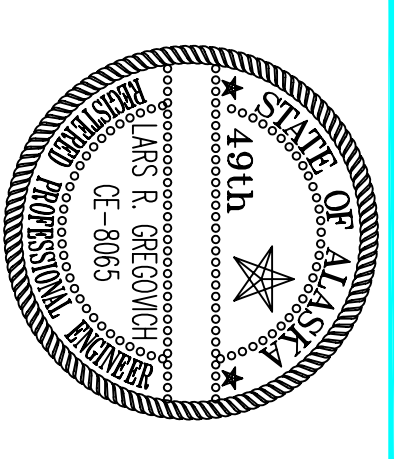

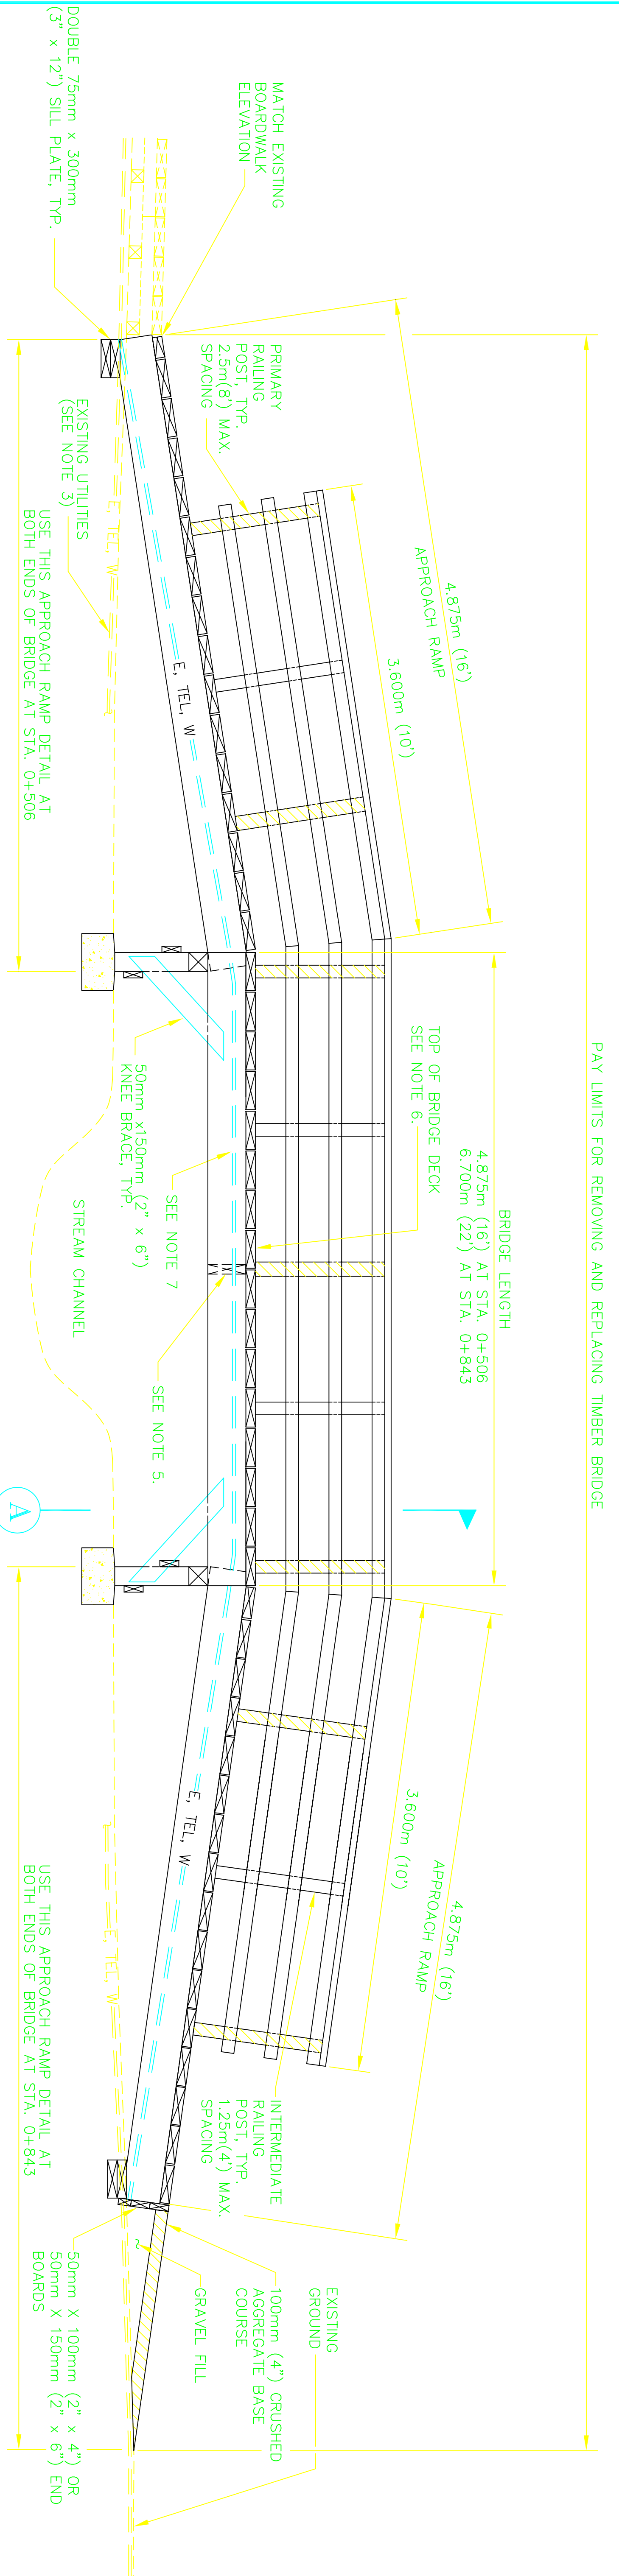


PAY LIMITS FOR REMOVING AND REPLACING TIMBER BRIDGE

TYPICAL TIMBER BRIDGE RECONSTRUCTION

STA. 0+506 AND STA. 0+843

CONSTRUCTION NOTES:

1. THE STATIONING OF THE BRIDGES IS APPROXIMATE ONLY. THE EXACT LOCATION SHOULD BE CENTERED ON THE EXISTING STREAM CHANNEL AND SHALL BE APPROVED BY THE ENGINEER.
2. ALL TIMBER SHALL BE HEM-FIR NO. 1 OR BETTER AND SHALL BE PRESSURE TREATED WITH ACZA TO A RETENTION OF 9.6 kg/m³ (0.6 pcf). ALL FIELD CUTS AND HOLES SHALL BE TREATED PER NOTE 5 ON SHEET 2.
3. EXISTING POWER, WATER AND TELEPHONE CONDUIT EXIST ADJACENT TO THE BOARDWALK AND ATTACHED TO BRIDGES. THE CONTRACTOR SHALL PERFORM LOCATES, IF NECESSARY, TO DETERMINE IF PLANNED OR SILL PLATE LOCATIONS WILL REQUIRE MINOR UTILITY ADJUSTMENTS.
4. FOOTINGS MAY BE ROUND OR SQUARE AND MAY BE PRECAST. **ROUND USED**
5. BLOCKING SHALL BE INSTALLED AT MID-SPAN FOR 4.875m (16') BRIDGE LENGTH AND 1/3 SPAN POINTS FOR 6.700m(22') BRIDGE LENGTH.
6. THE DESIRED BRIDGE ELEVATION RAISE MEASURED FROM TOP OF BRIDGE DECK, IS 0.45m (1'6") AT STA. 0+506 AND 0.75m(2'6") AT STA. 0+843.
7. THE EXISTING UTILITIES ARE SECURED TO THE EXISTING BRIDGES USING VARIOUS METHODS. THE UTILITIES SHALL BE ADJUSTED AND RESECURED TO THE RECONSTRUCTED BRIDGES. POWER CABLES SHALL BE DE-ENERGIZED PRIOR TO HANDLING. IF THE POWER CABLE REQUIRES A DIFFERENT METHOD OF SECURING IT TO THE BRIDGE, THEN AN ELECTRICIAN WITH A CERTIFICATE OF FITNESS SHALL PERFORM THE WORK. THE ENGINEER SHALL PROVIDE A WRITTEN DIRECTIVE IF AN ELECTRICIAN IS REQUIRED TO REATTACH THE POWER CABLE AND THE CONTRACTOR SHALL BE COMPENSATED FOR THIS WORK UNDER SECTION 629 - UTILITY RELOCATIONS. **NO WORK WAS REQUIRED UNDER PAY ITEM 629(1), UTILITY RELOCATION**

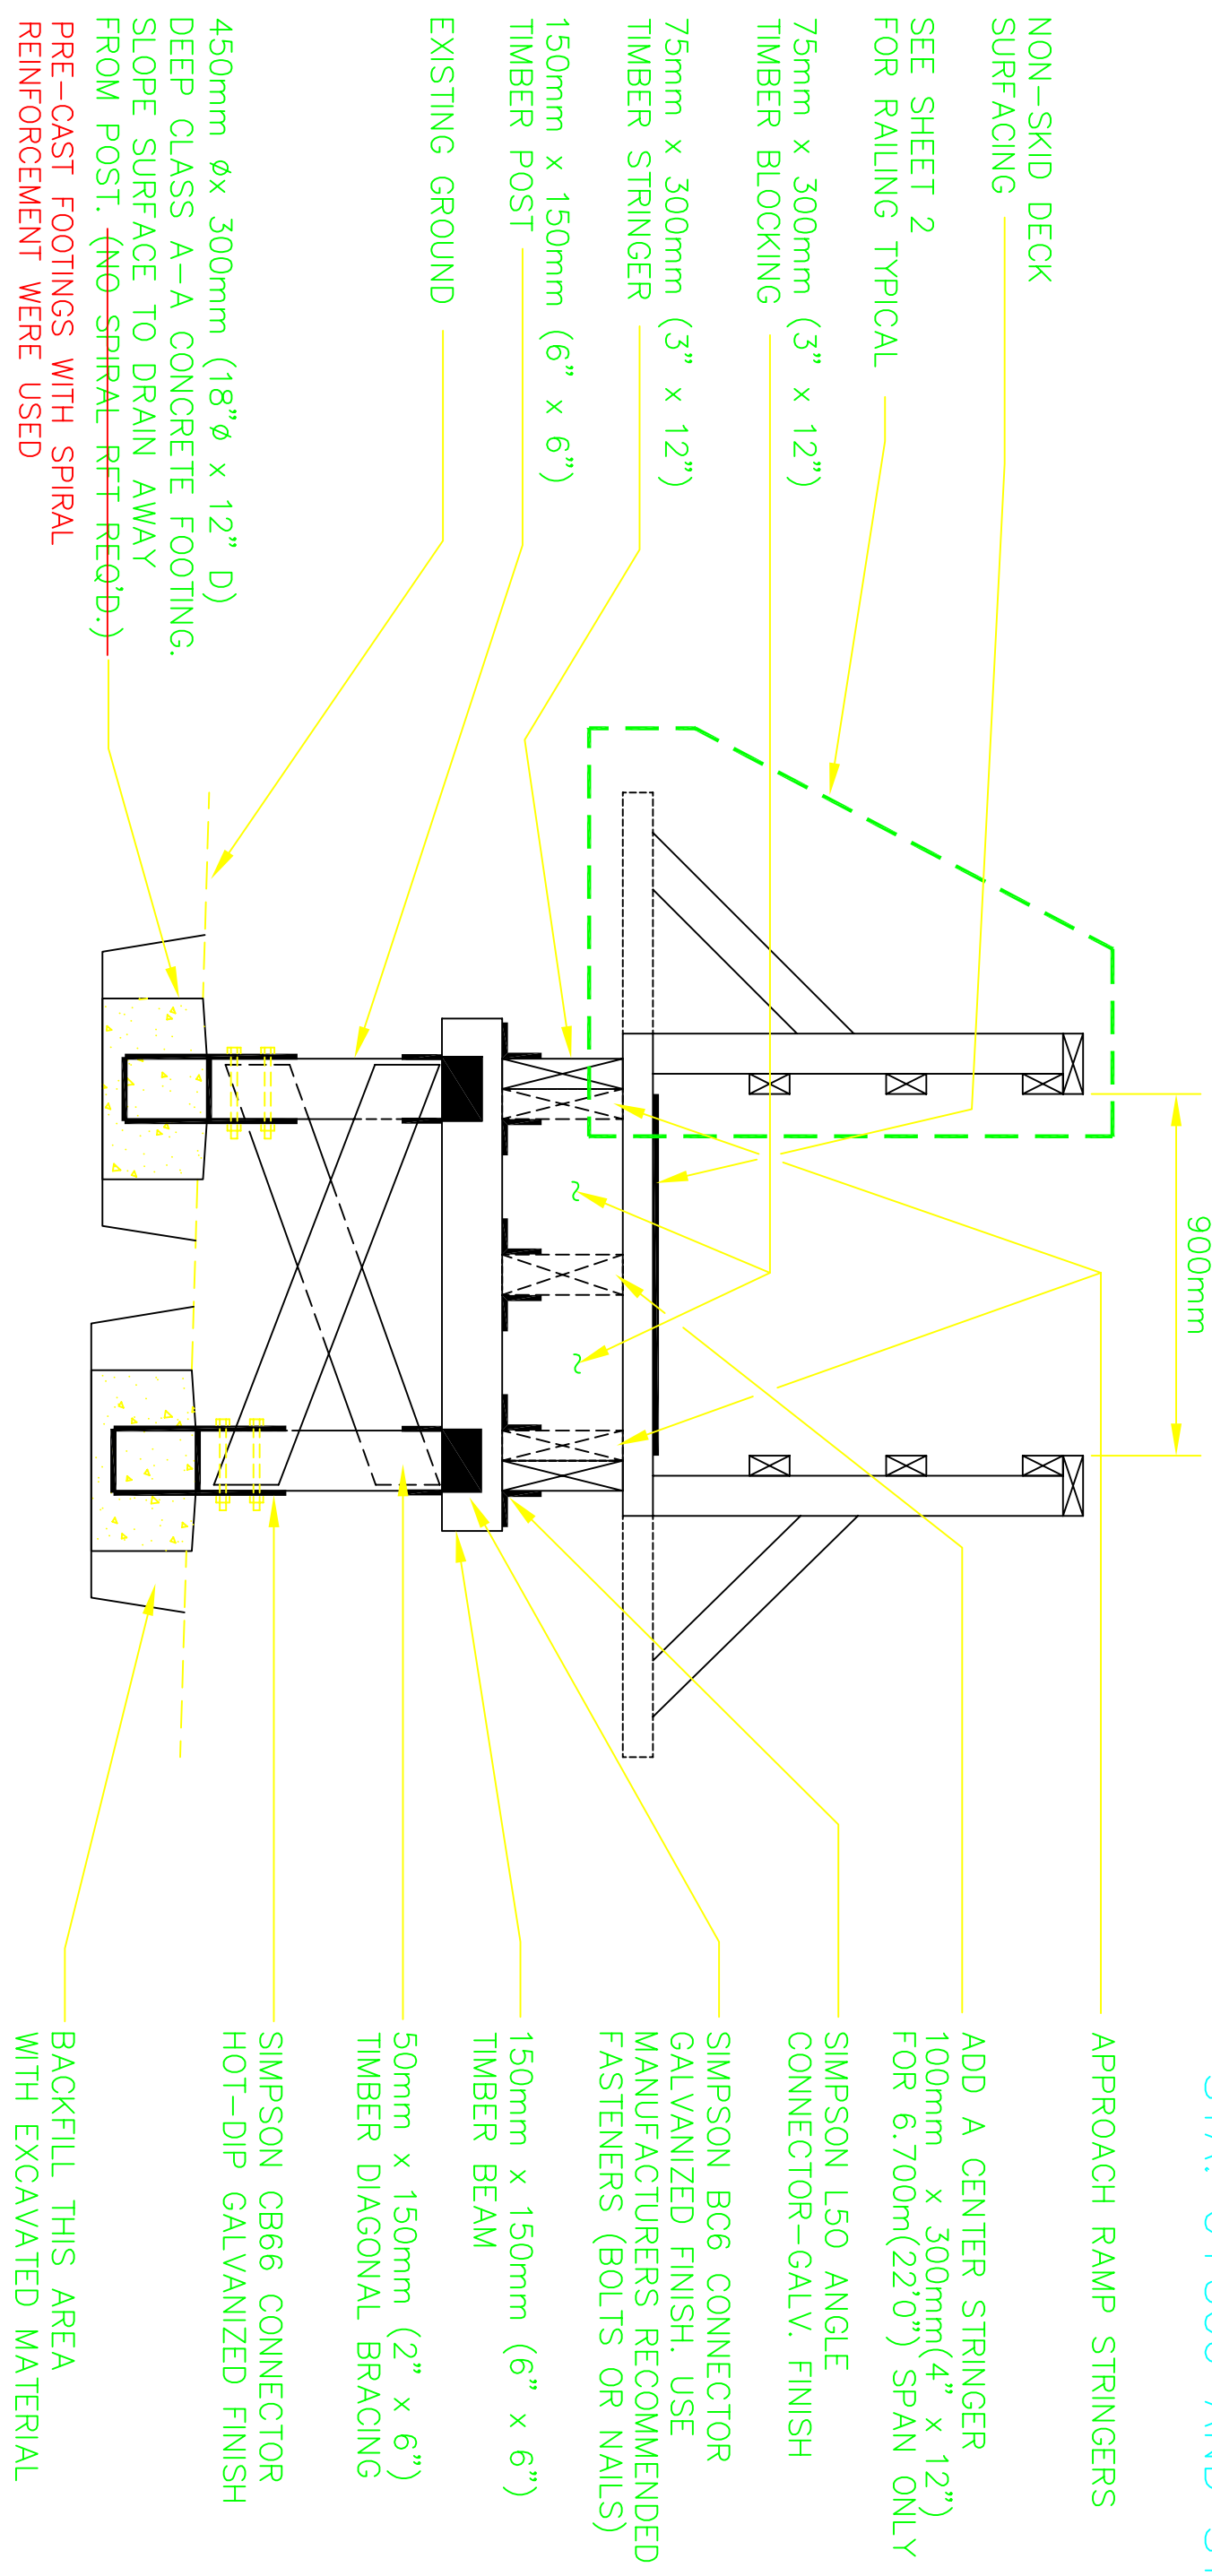

TYPICAL BRIDGE SECTION A


ASBUILT BRIDGE-1

PATH:	Q:\ELF\67619\ASBUILT\BRIDGE-1	VIEW:	P1
PLOT:	1=1(F) OR 1=2(H)	METRIC SCALE:	1=10(F) OR 1=20(H)
BY:	DATE:	DESCRIPTION OR CHANGE:	

STATE OF ALASKA
DEPARTMENT OF TRANSPORTATION
AND PUBLIC FACILITIES
SOUTHDAST REGION


ELFIN COVE
ELF - ELFIN COVE BOARDWALKS
STP-0009(56) ~ PROJECT NO. 67619

ALASKA
DESIGNED BY: L. GREGOVICH
DRAWN BY: R. SNYDER
CHECKED BY: A. STEININGER
PROJECT NO. 67619
DATE: JUNE 1999
SHEET 9 OF 12

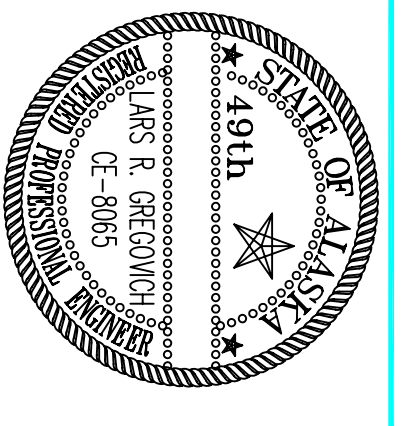

NOTE: DO NOT SCALE FROM THESE PLANS-USE DIMENSIONS


RECORD OF REVISIONS

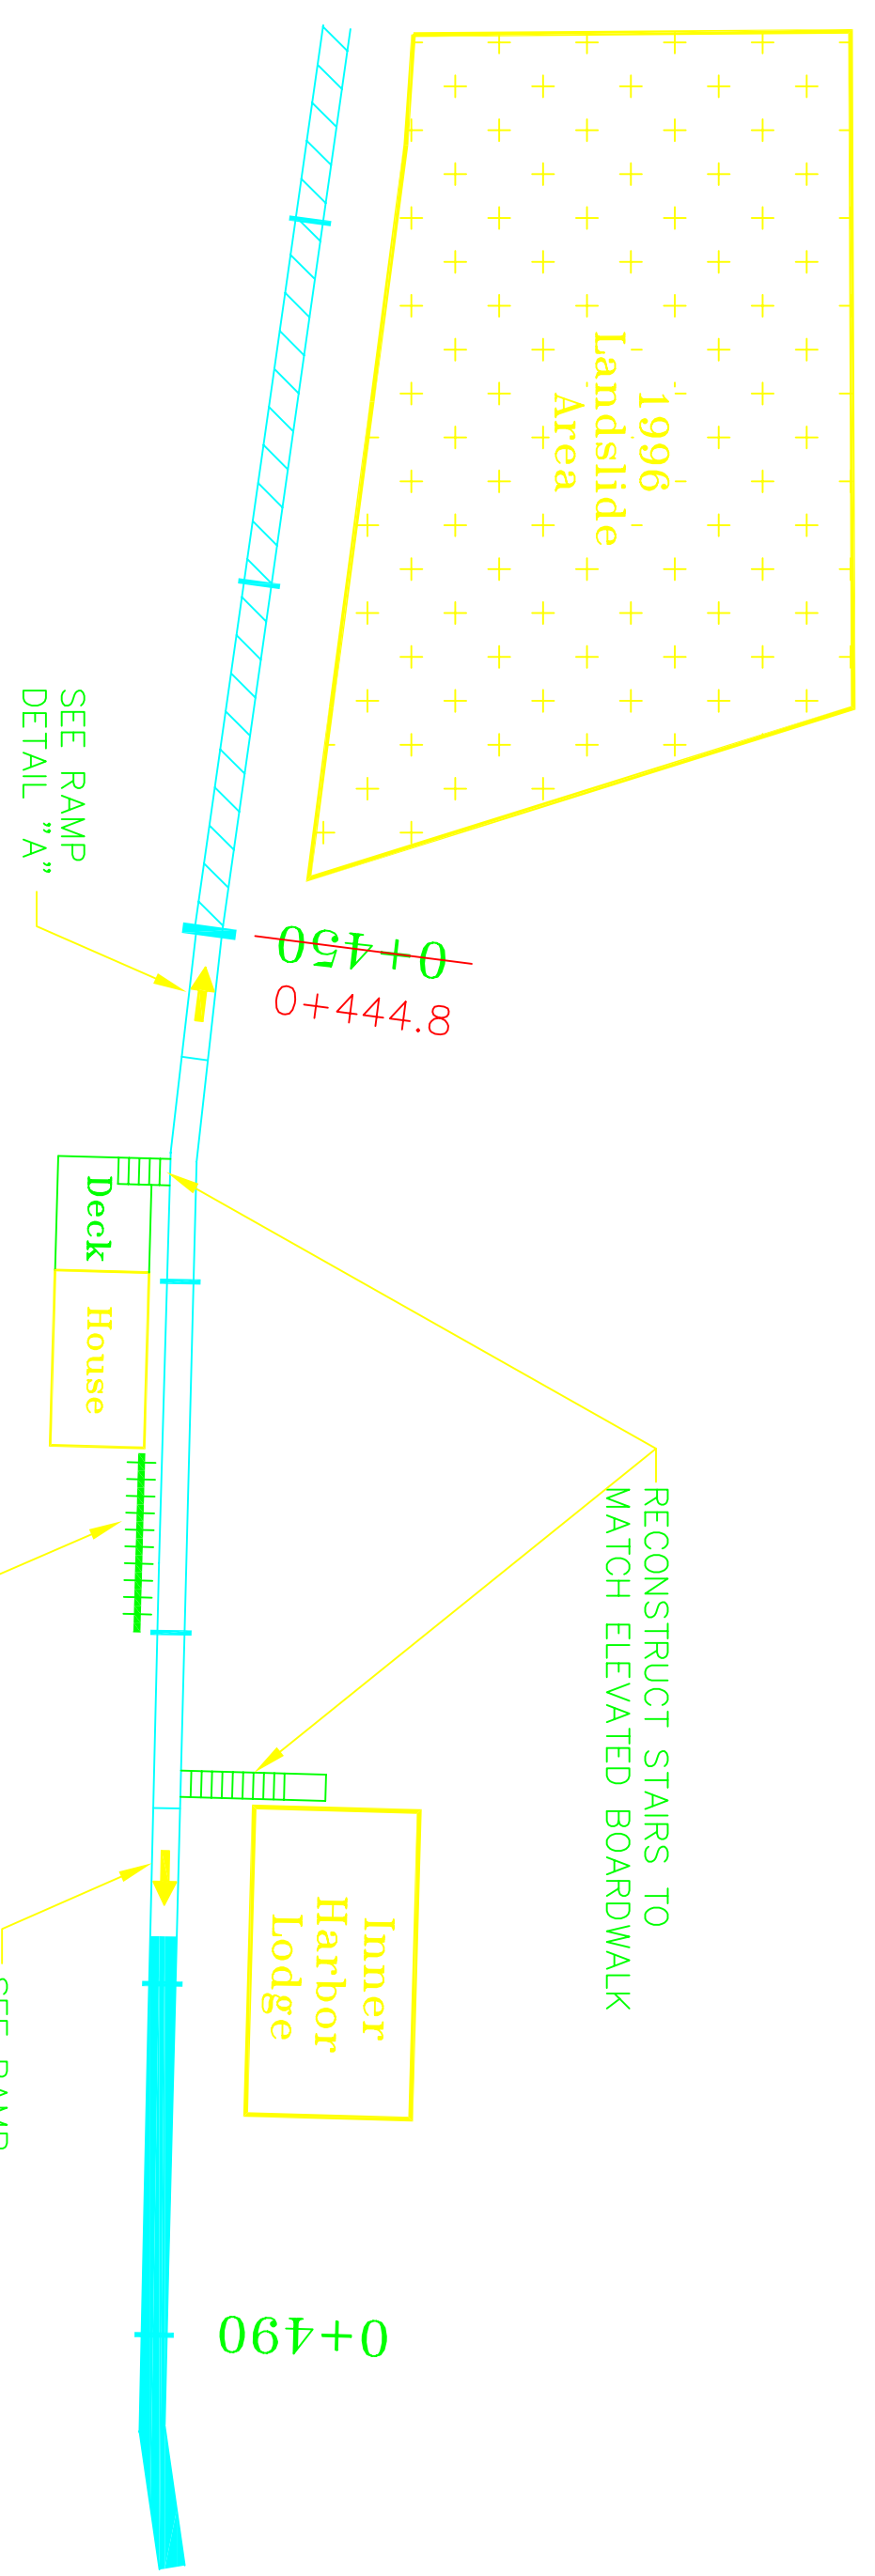


BOARDWALK RECONSTRUCTION PLAN

CONSTRUCTION NOTES:

1. ALL TIMBER SHALL BE HEM-FIR NO. 1 OR BETTER AND SHALL BE PRESSURE TREATED WITH ACZA TO A RETENTION OF 9.6 kg/m³ (0.6 pcf). ALL FIELD CUTS AND HOLES SHALL BE FIELD TREATED IN ACCORDANCE WITH NOTE 5 ON SHEET 2.
2. EXISTING POWER, TELEPHONE AND WATER CONDUITS RUN PARALLEL AND ADJACENT TO THE BOARDWALK. THE CONTRACTOR SHALL PROTECT AND PRESERVE THESE UTILITIES. THESE UTILITIES ARE SECURED TO THE HANDRAIL FROM STA. 0+465 TO 0+470 AND SHALL BE RESECURED WITH HANGERS, STRAPS OR OTHER METHODS AFTER RECONSTRUCTION OF THIS HANDRAIL. SEE NOTES 3 AND 7 ON SHEET 9.
3. BOARDWALK SUPPORTS ON THE RAMP TRANSITIONS AT EITHER END WILL VARY IN HEIGHT. THE CONTRACTOR SHALL CONSTRUCT SUITABLE SUPPORTS TO FIT THE TERRAIN AND VARIABLE HEIGHTS.

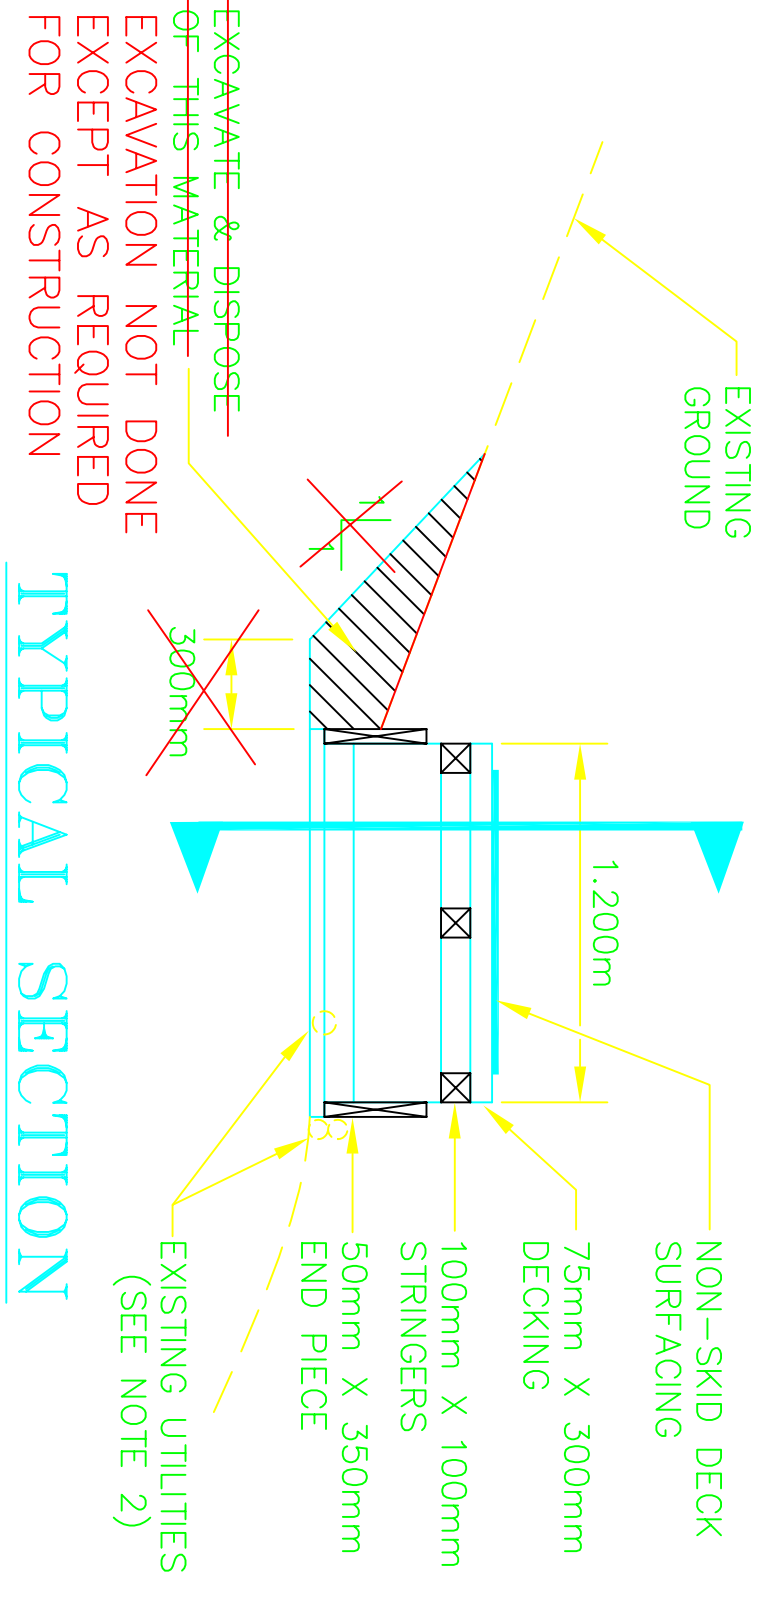


TYPICAL SECTION

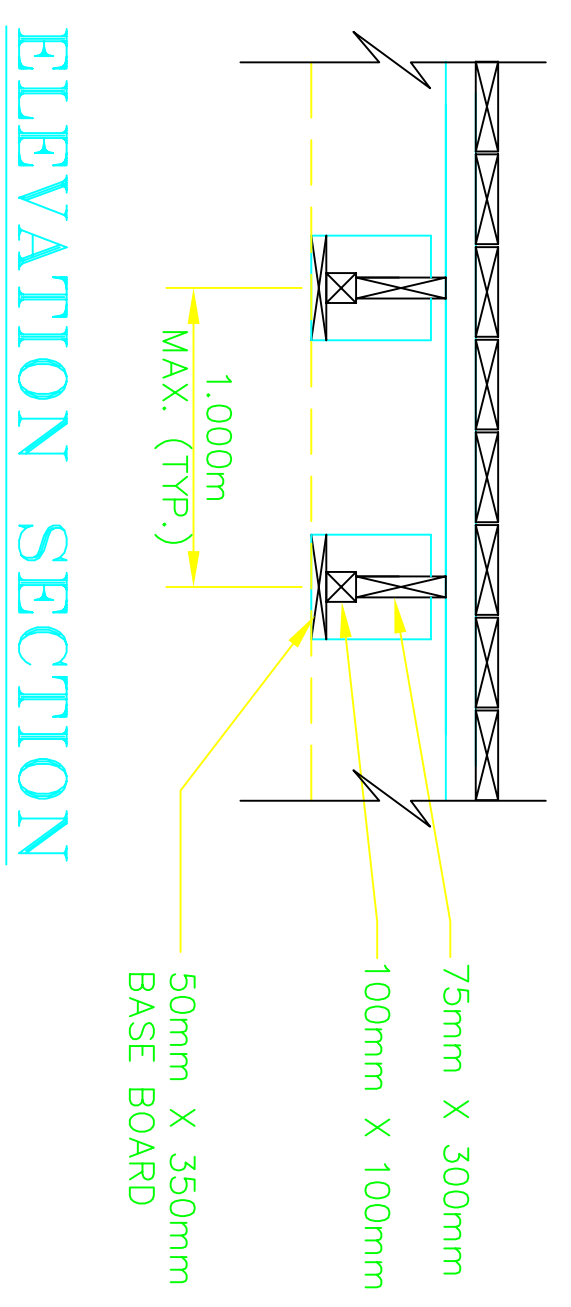

ELEVATION SECTION

MEMBER	TO	MEMBER	CONNECTOR	COMMENTS
75mm X 300mm DECKING		100mm X 100mm STRINGER	40d GALVANIZED SPIKE	SEE NOTE 4 ON SHEET 2 ON PREDRILLING
100mm X 100mm STRINGER		75mm X 300mm SUPPORT	40d GALVANIZED SPIKE	PREDRILL STRINGER TO PREVENT SPLITTING
75mm X 300mm SUPPORT		50mm X 350mm SIDE BOARD	16d GALVANIZED SPIKE	3 EACH PER CONNECTION
50mm X 350mm SIDE BOARD		50mm X 350mm BASE BOARD	16d GALVANIZED SPIKE	4 EACH PER CONNECTION
50mm X 350mm BASE BOARD		100mm X 100mm BOARD	16d GALVANIZED SPIKE	4 EACH
100mm X 100mm BOARD		50mm X 350mm SIDE BOARD	16d GALVANIZED SPIKE	1 EACH
NON-SKID DECK SURFACING		75mm X 300mm DECKING	25mm GALVANIZED ROOFING NAILS	

CONNECTION SCHEDULE

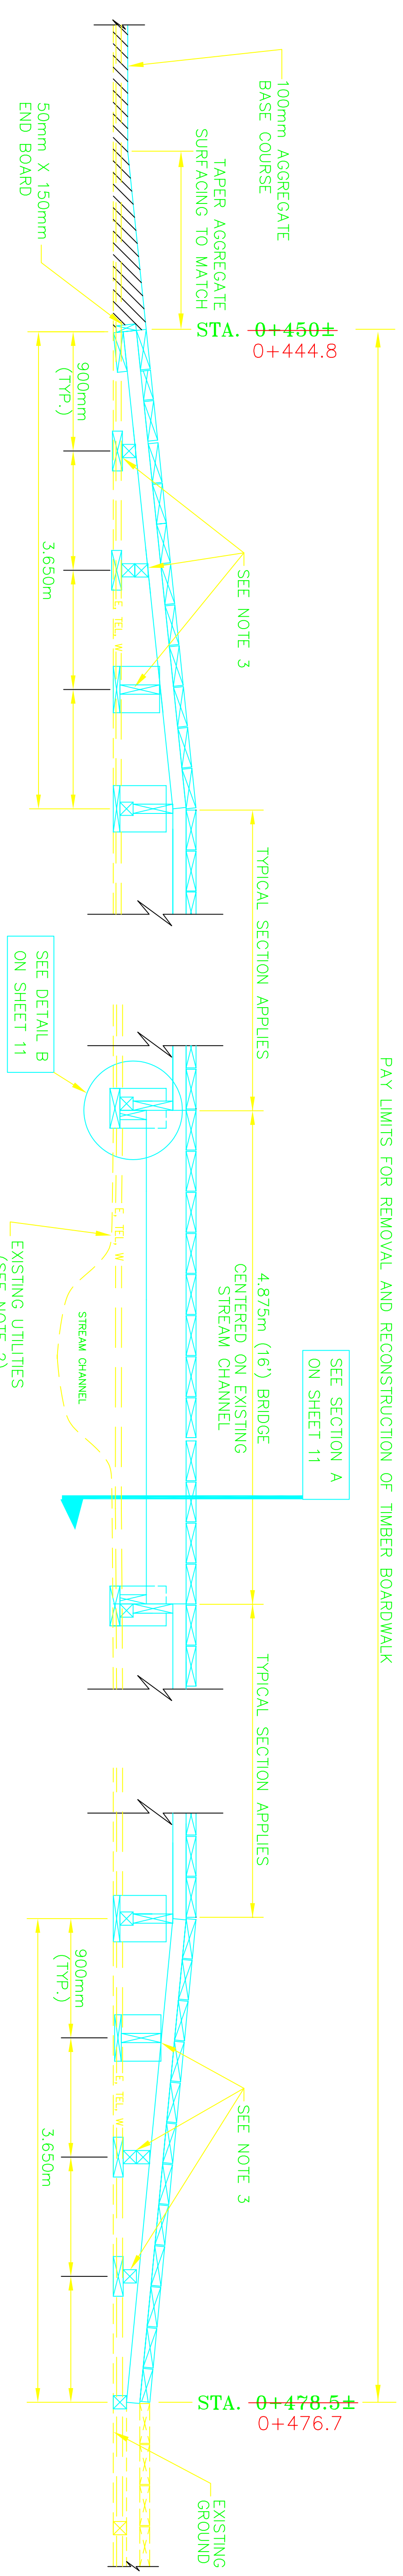

RAMP DETAIL A

RAMP DETAIL B


NOTE: DO NOT SCALE FROM THESE PLANS-USE DIMENSIONS


PATH: Q:\ELF\67619\PLANS\ASBUILT\RAILDET VIEW: P1, P2, P3, P4
 PLOT: 1=1(F) OR 1=2(H)
 BY: DATE: DESCRIPTION OF CHANGE:
 RECORD OF REVISIONS

STATE OF ALASKA
 DEPARTMENT OF TRANSPORTATION
 AND PUBLIC FACILITIES
 SOUTHBAST REGION


ELFIN COVE
 ELF - ELFIN COVE BOARDWALKS
 STP-0009(56) ~ PROJECT NO. 67619

ALASKA
 DESIGNED BY: L. GREBOVICH
 DRAWN BY: R. SNYDER
 CHECKED BY: A. STENINGER
 PROJECT NO. 67619
 DATE: JUNE 1999
 SHEET 10 OF 12

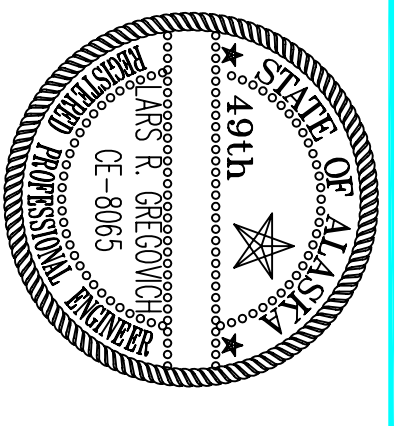

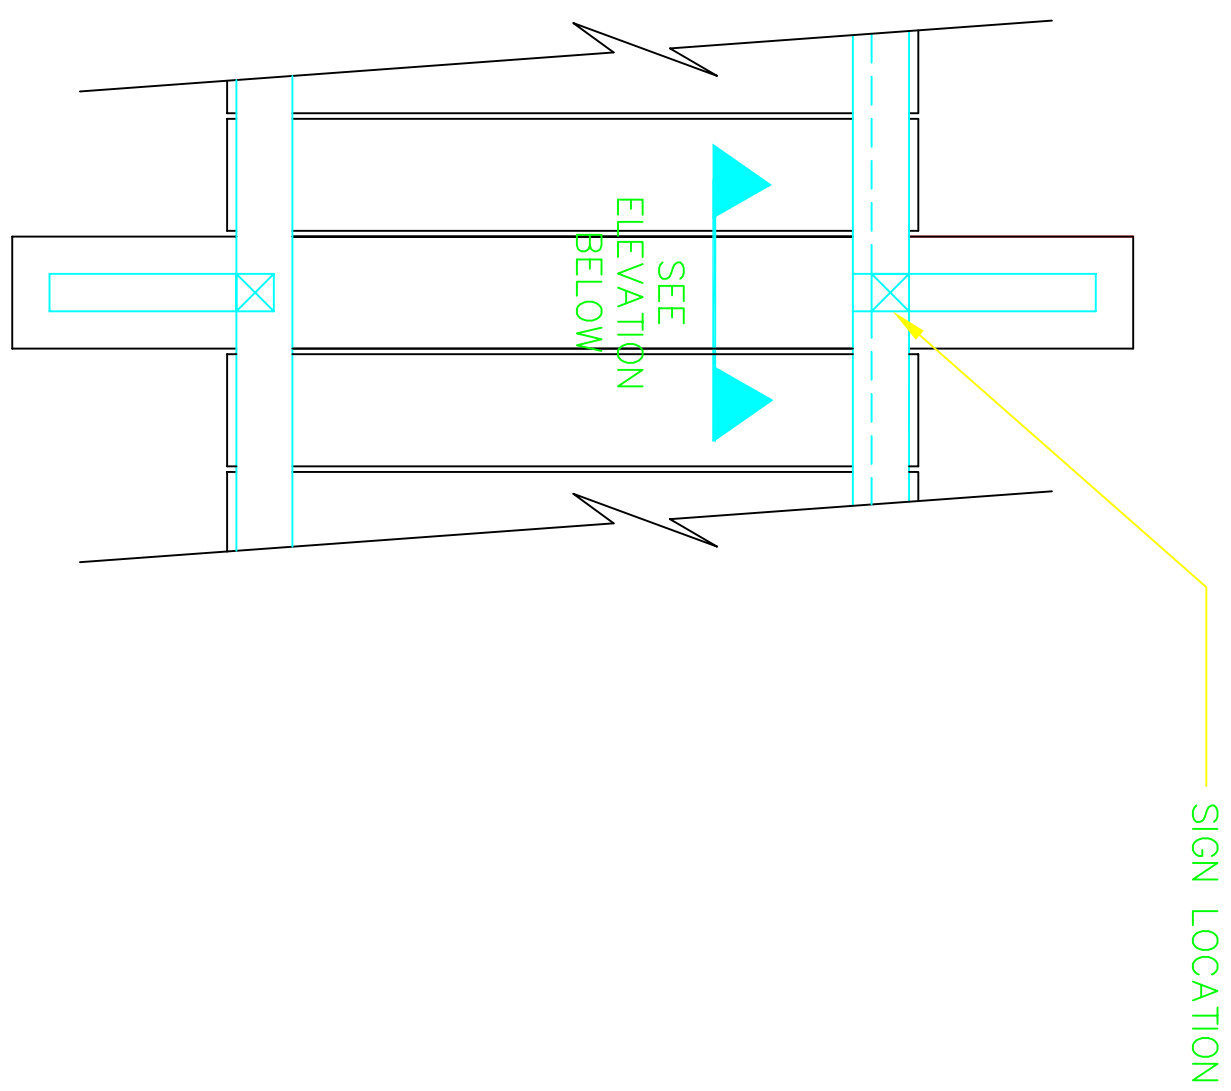

PLAN

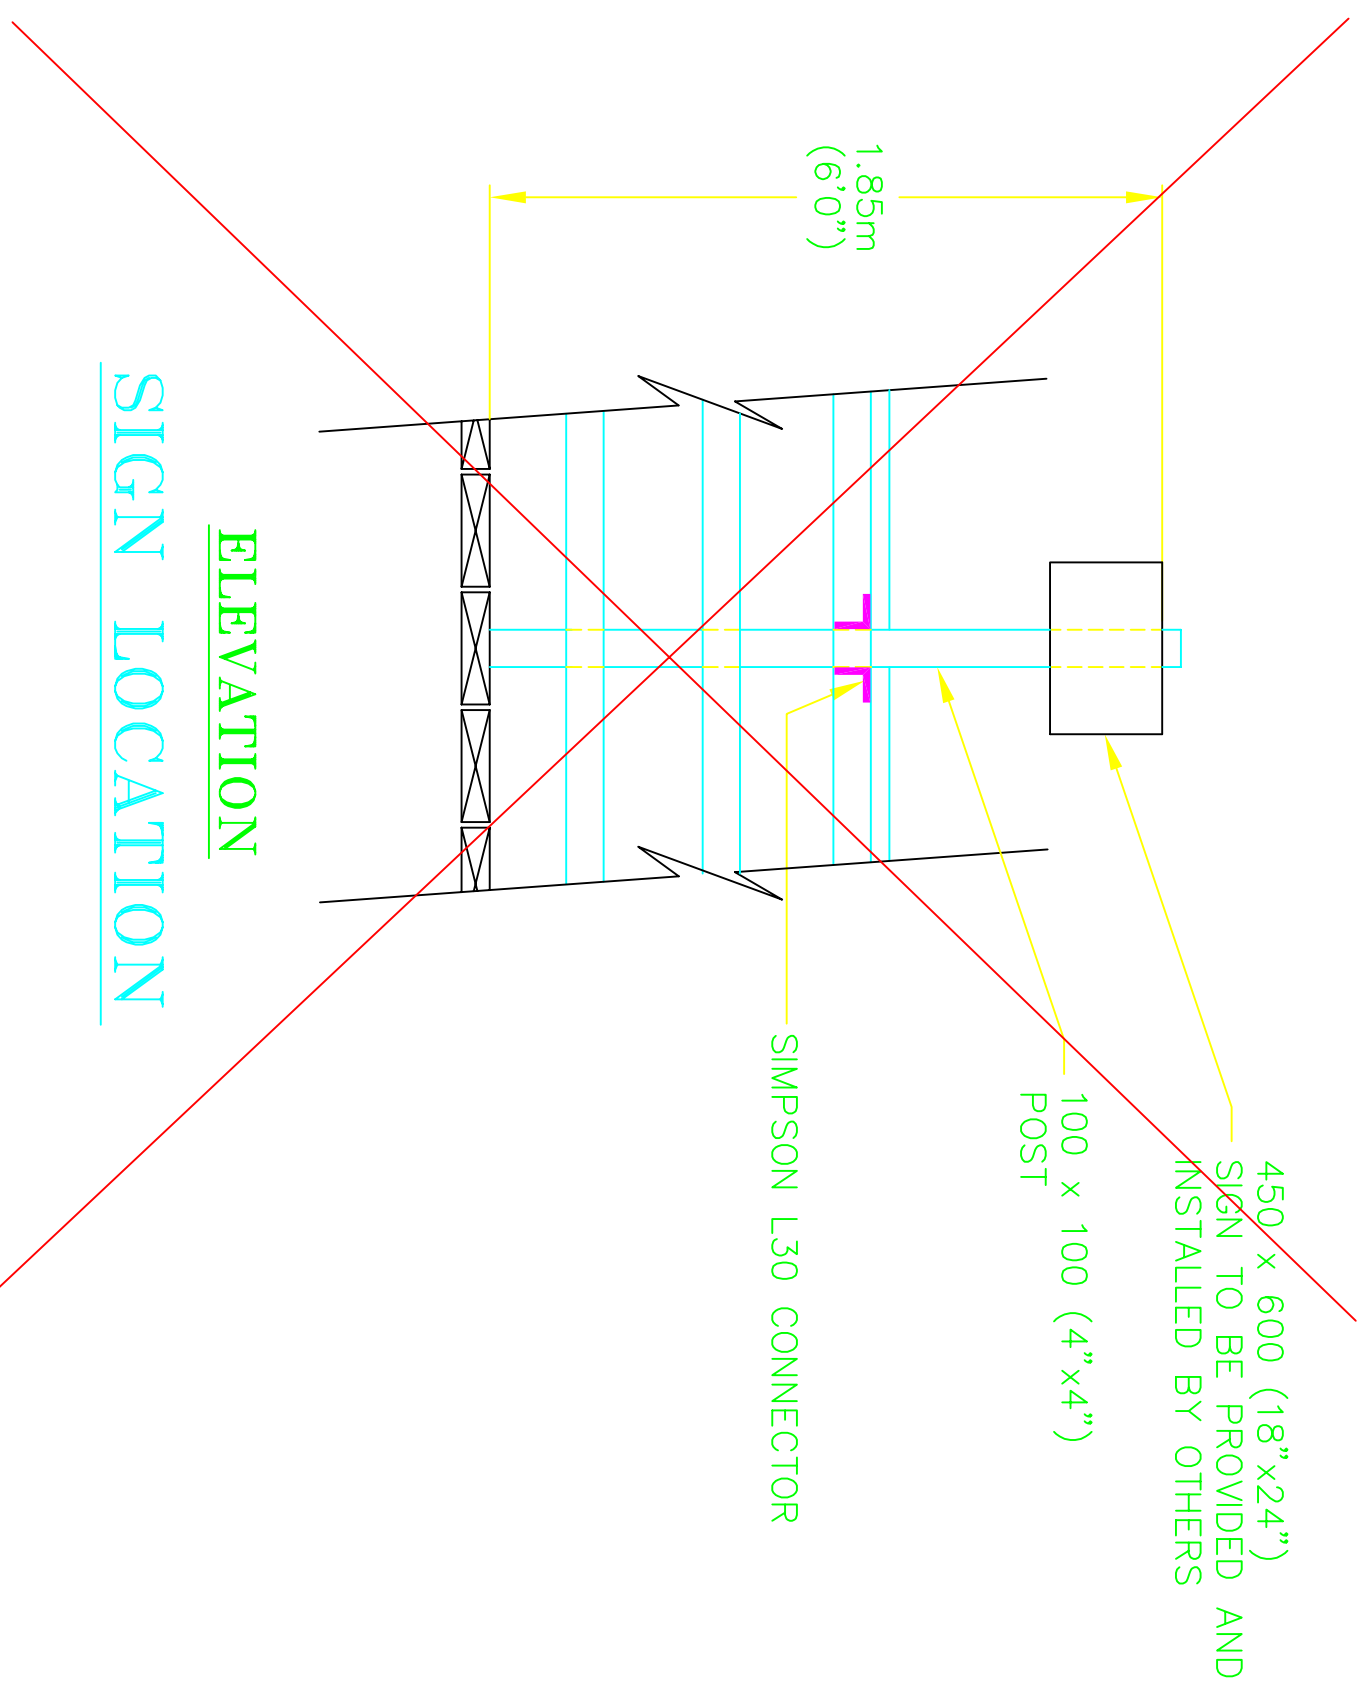

ELEVATION

SIGN LOCATION

THE COMMUNITY OF ELFIN COVE INSTALLED THE SIGNS USING A DIFFERENT MANNER OF CONSTRUCTION THAN DETAILED HERE. THEY DID THIS WORK PRIOR TO THE CONTRACTOR'S INSTALLATION OF THESE SIGN POSTS. THE SIGNS WERE IMMEDIATELY VANDALIZED AND DESTROYED.

VASBUILT.DET3

PATH: Q:\Elf\67619\PLANS\ET\DWG\DET3-
 PLOT: 1=1(F) OR 1=2(H)
 BY: DATE: DESCRIPTION OF CHANGE:

RECORD OF REVISIONS

STATE OF ALASKA
 DEPARTMENT OF TRANSPORTATION
 AND PUBLIC FACILITIES
 SOUTHBAST REGION


ELFIN COVE

JNU-GLACIER HIGHWAY
 EGAN DRIVE TO MENDENHALL LOOP ROAD
 FED. NO. STP-0003(56) ~ PROJECT NO. 67619
 MISCELLANEOUS DETAILS


ALASKA

DESIGNED BY: L. GREGOVICH
 DRAWN BY: R. SNYDER
 CHECKED BY: A. STEININGER

PROJECT NO. 67619
 DATE: JUNE 1999
 SHEET 11 OF 12

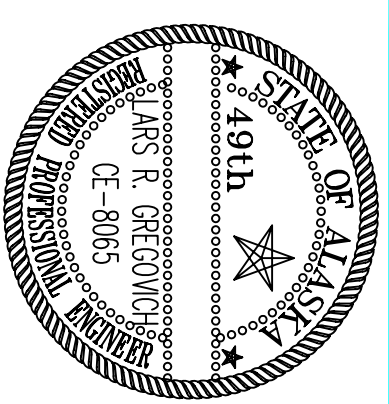


SPECIAL RAILING DETAIL
 APPLIES FROM STA. 0+008 TO 0+014

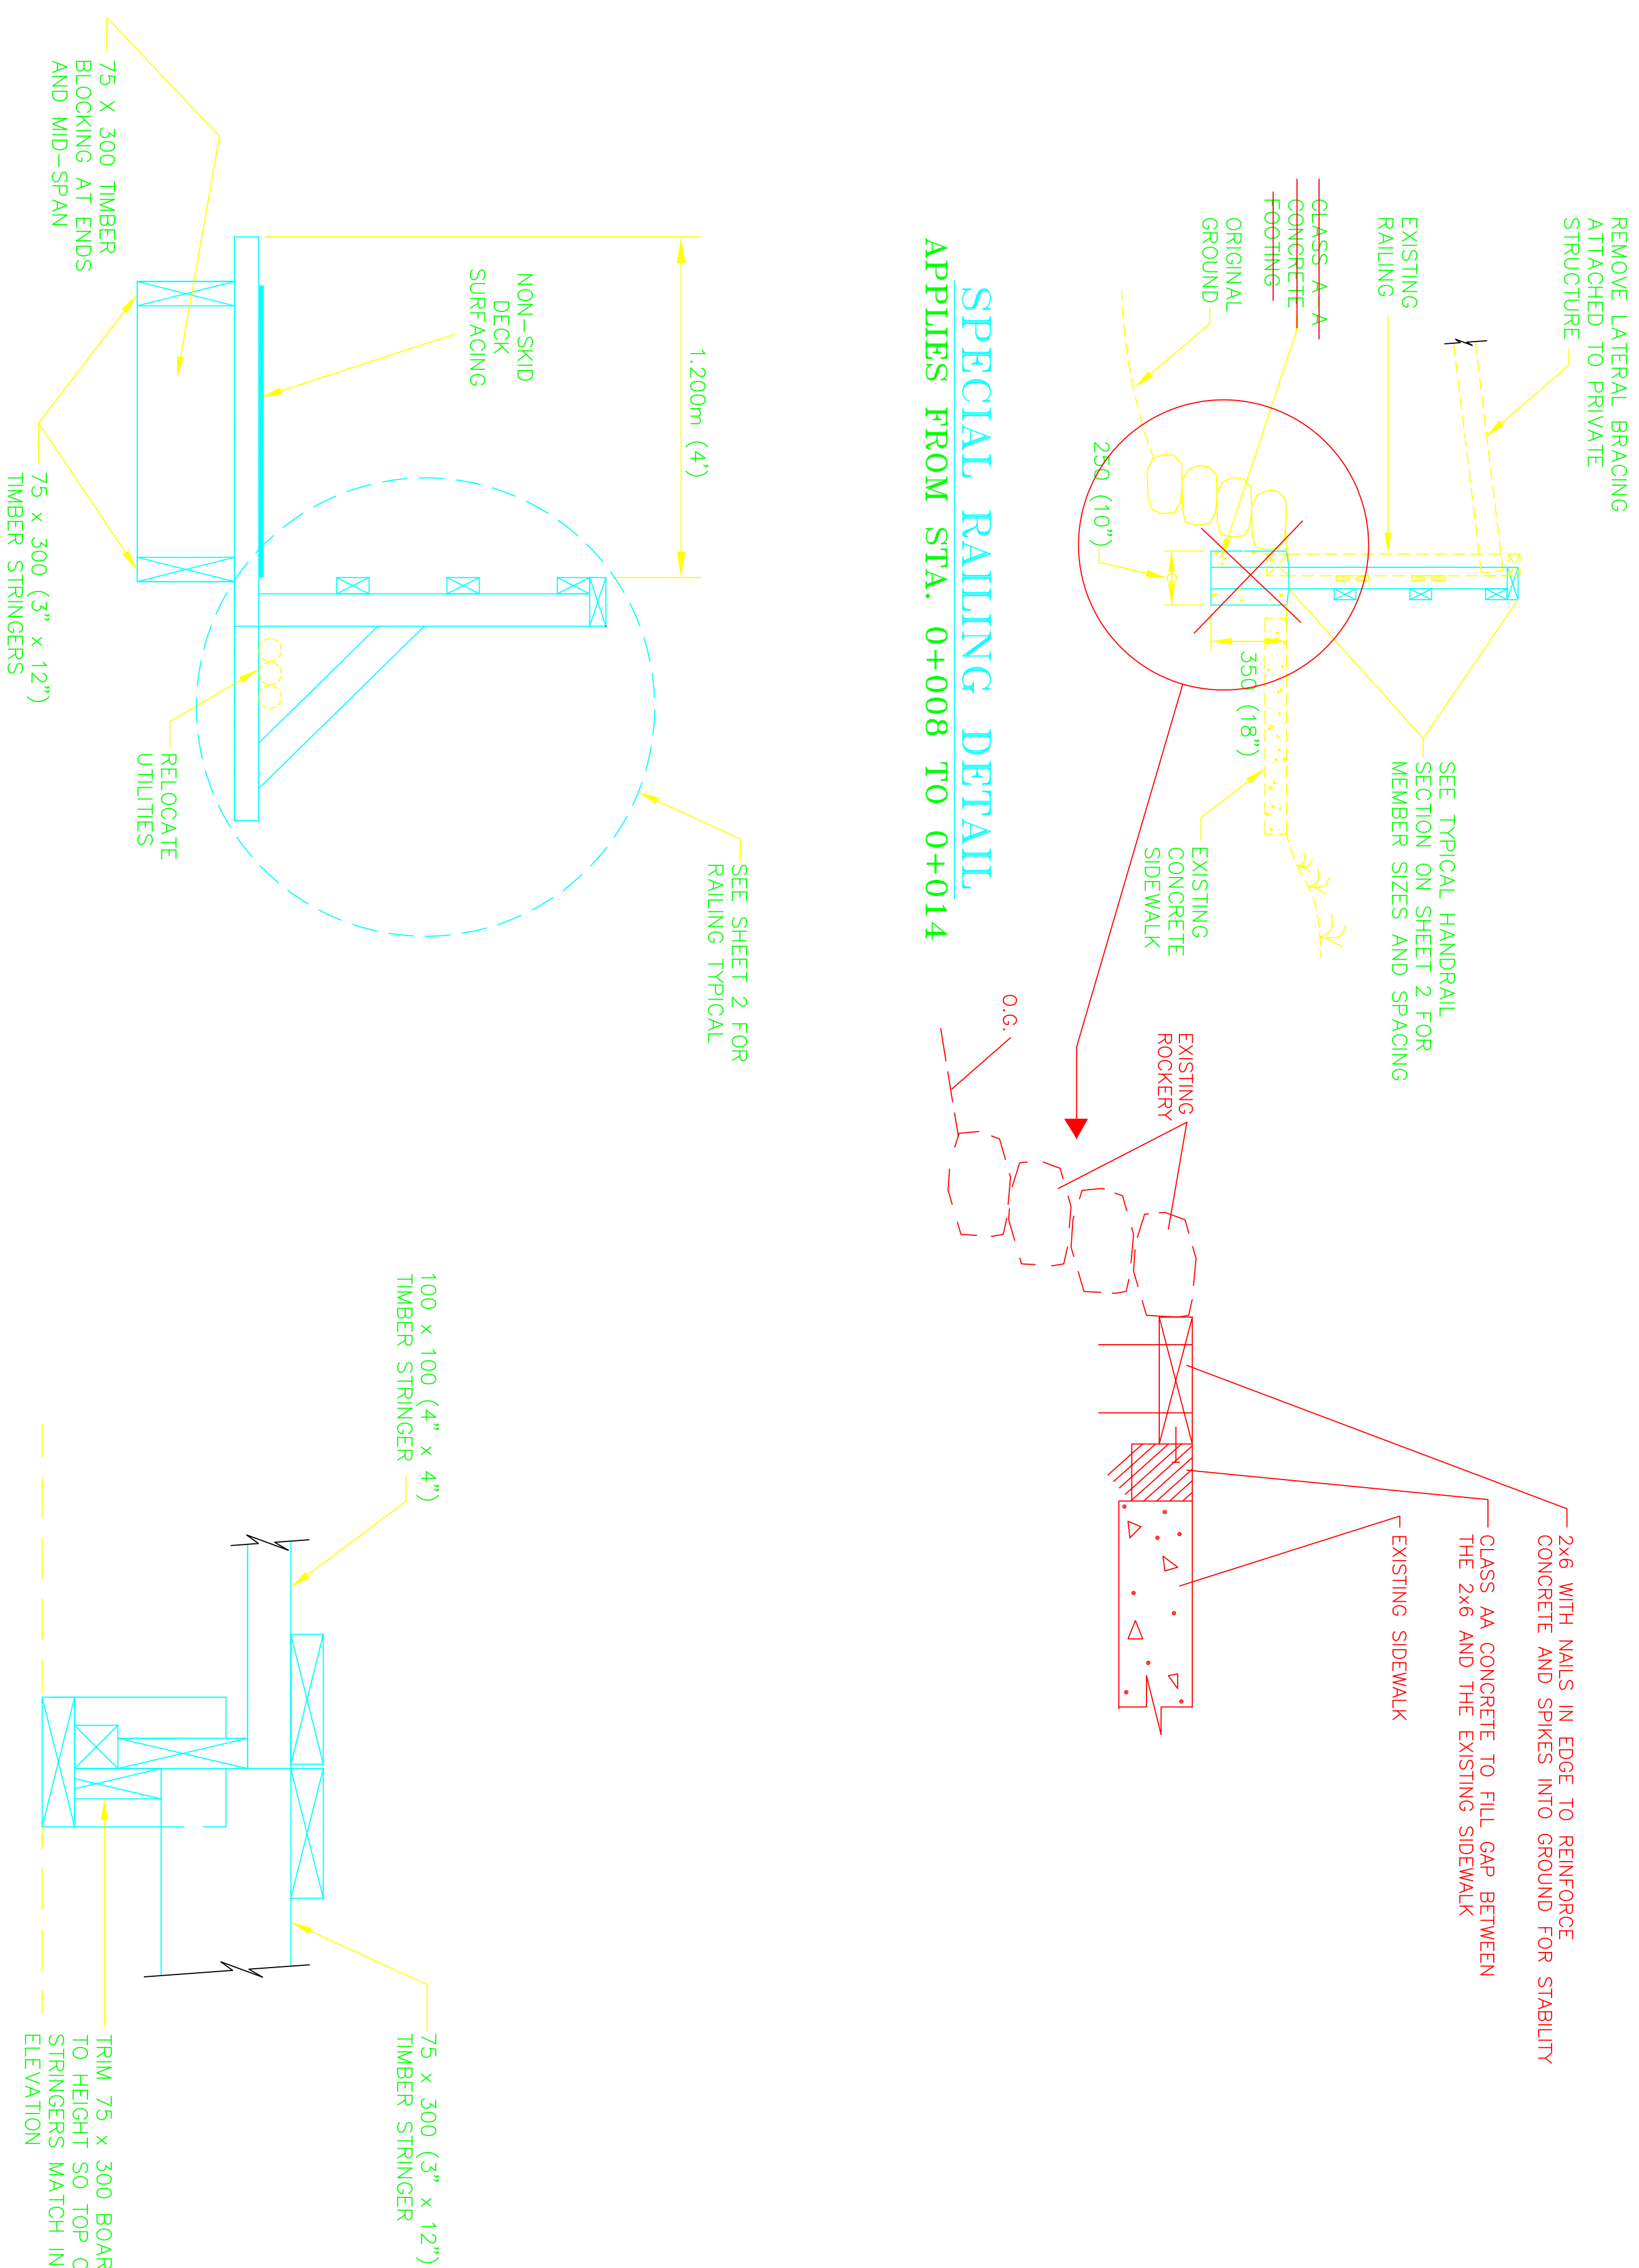


A SECTION


B SPECIAL FOOTING DETAIL

NOTE:
 SPECIAL FOOTING SIMILAR TO THAT SHOWN IN ELEVATED SECTION ON SHEET 10. USE CONNECTIONS LISTED ON THAT SHEET.

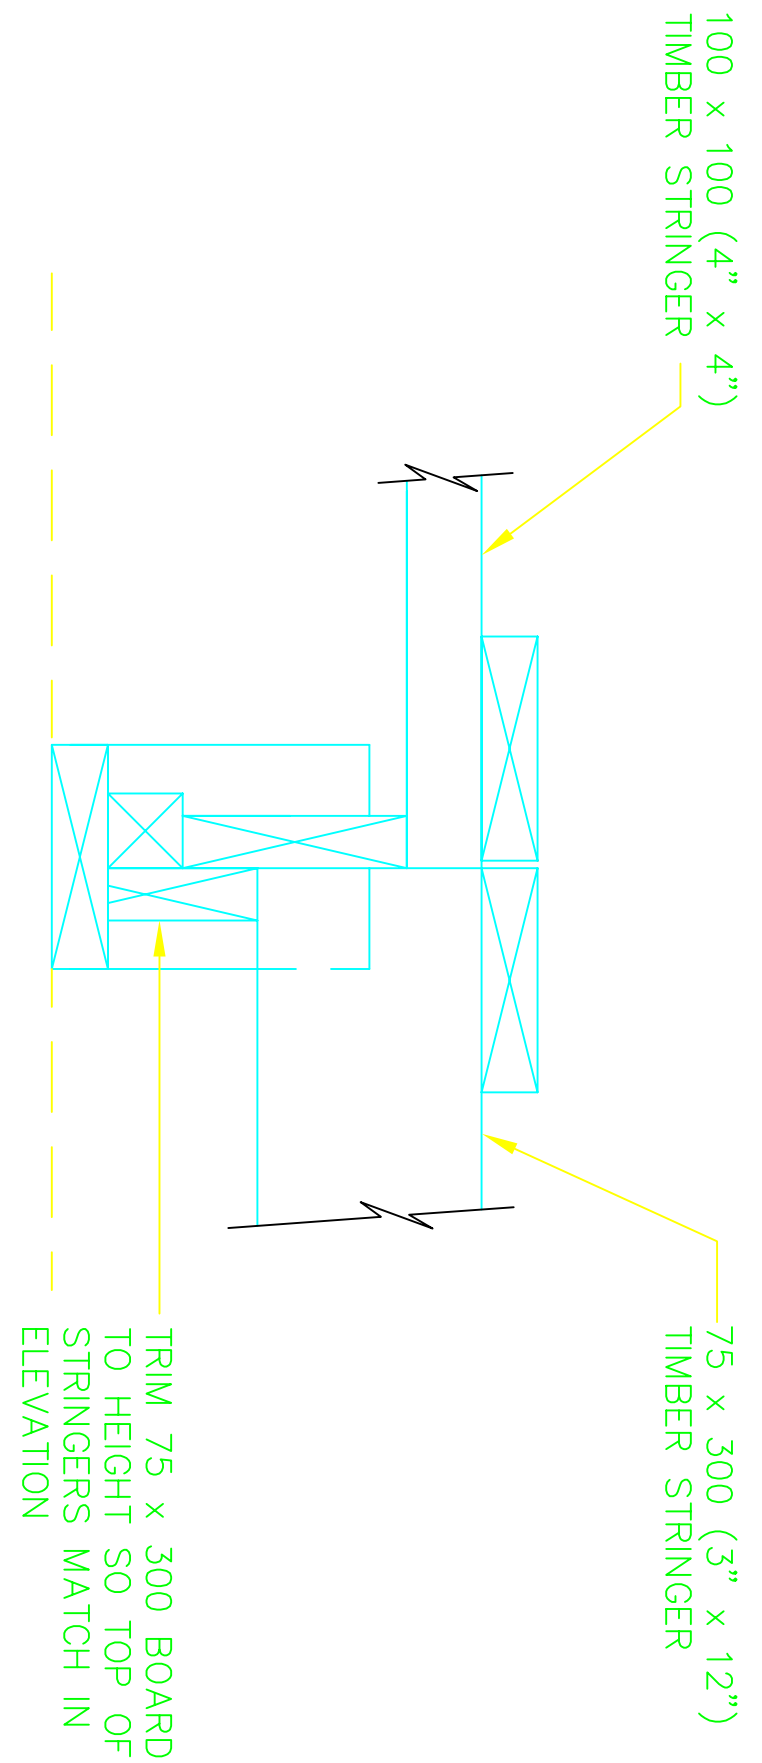


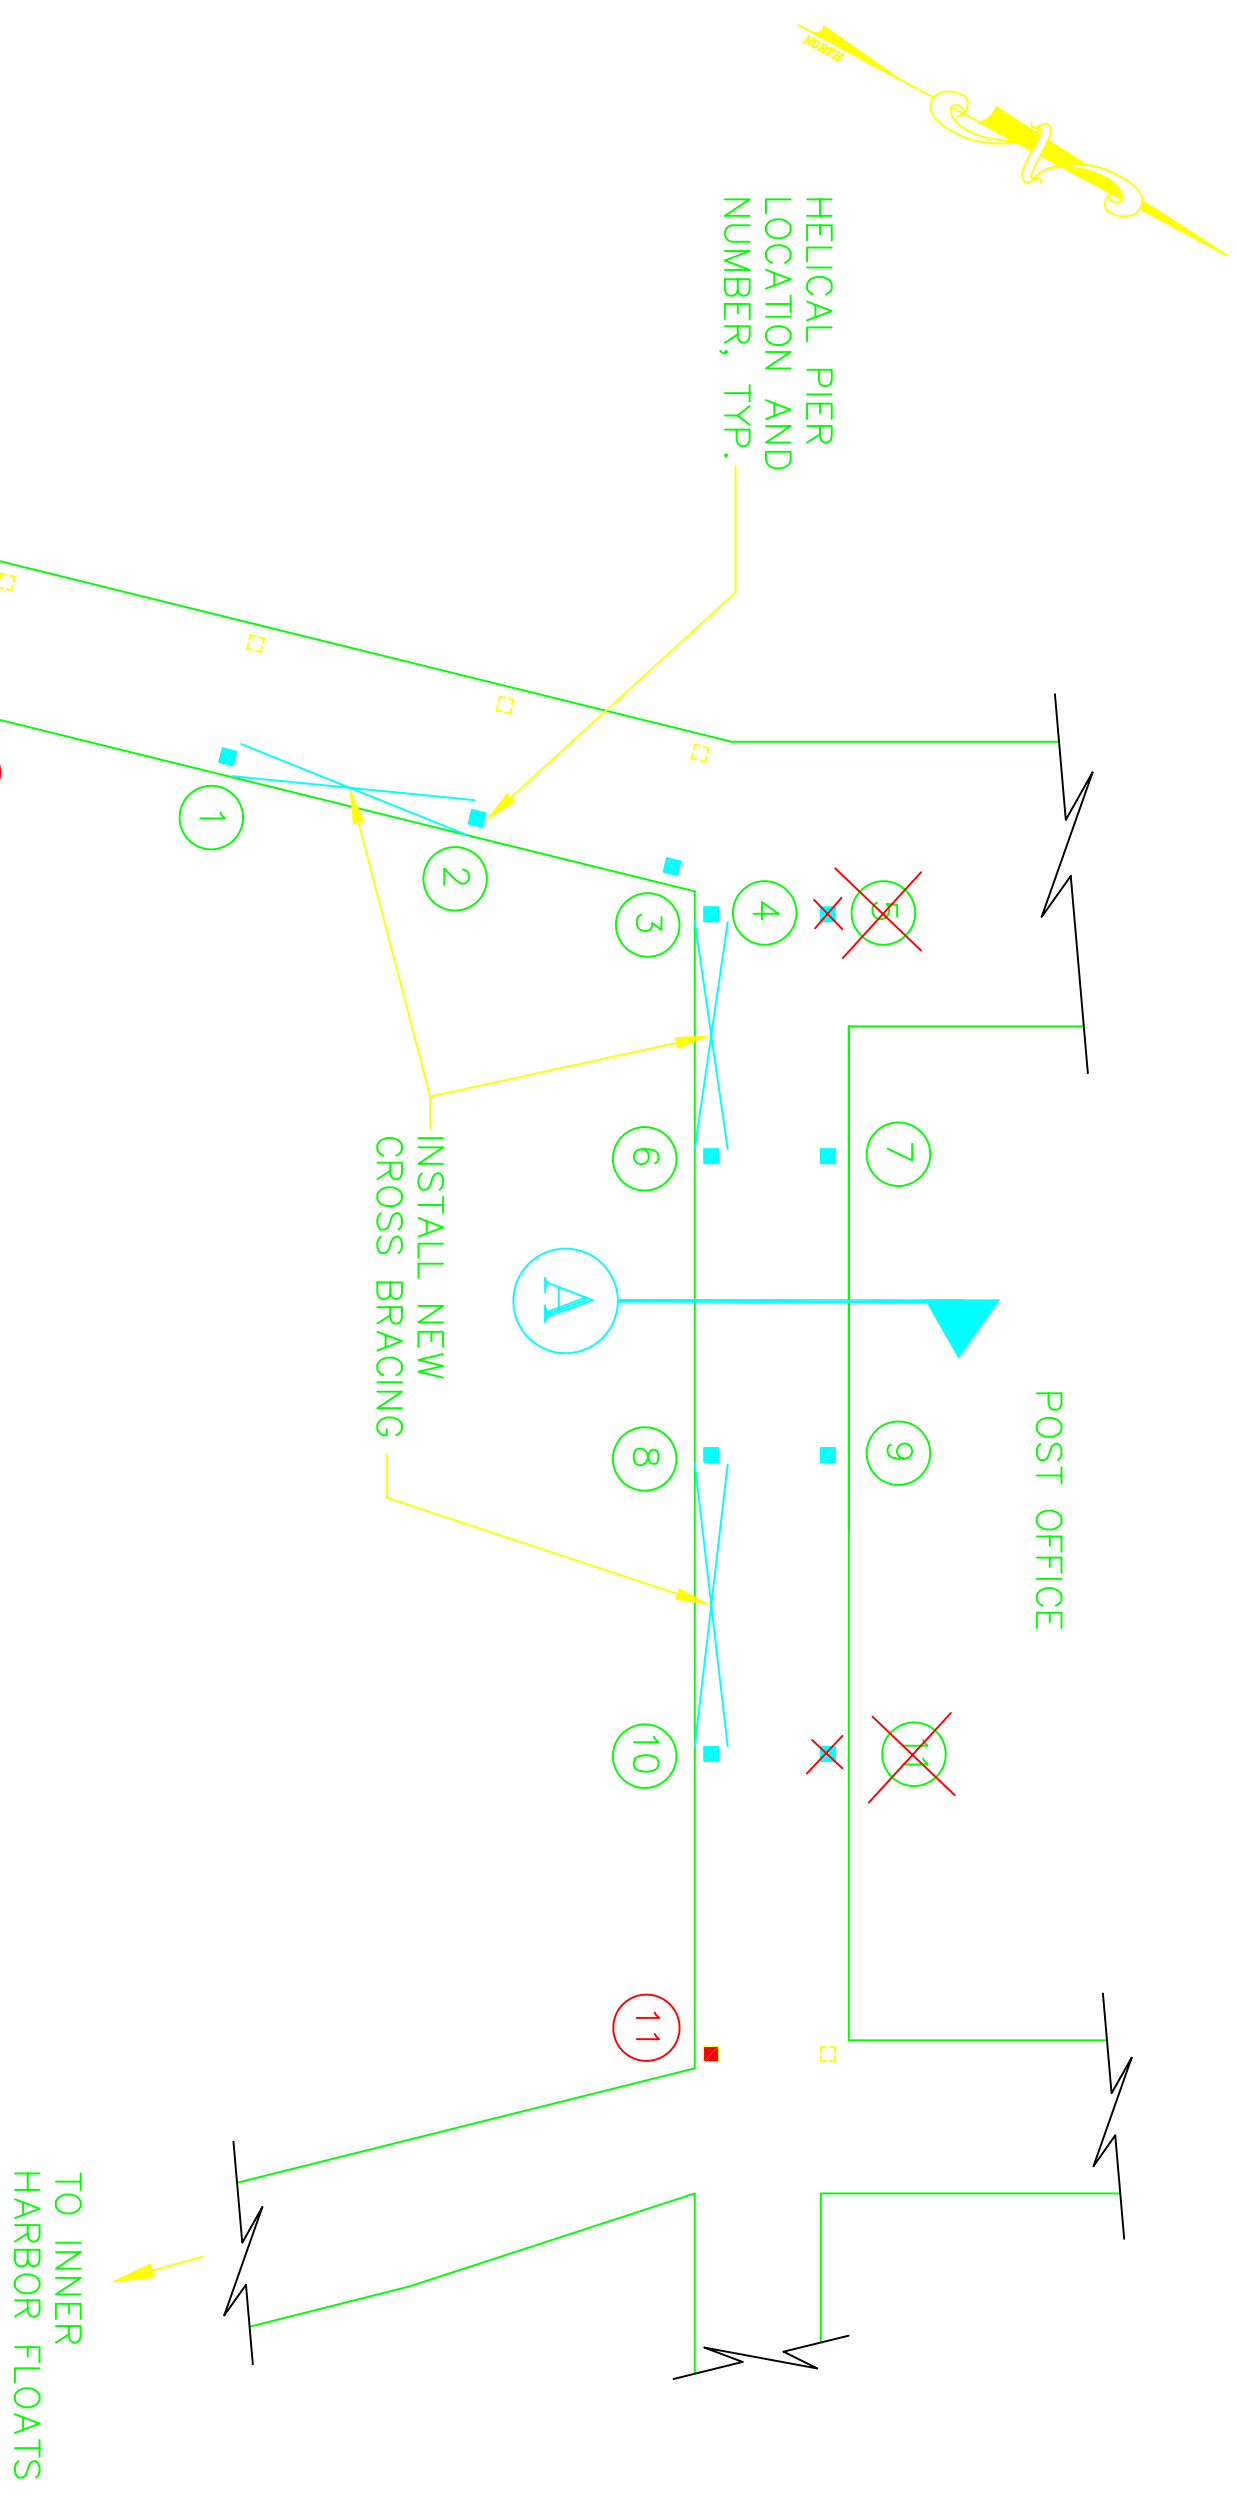


HELICAL PIER PLAN

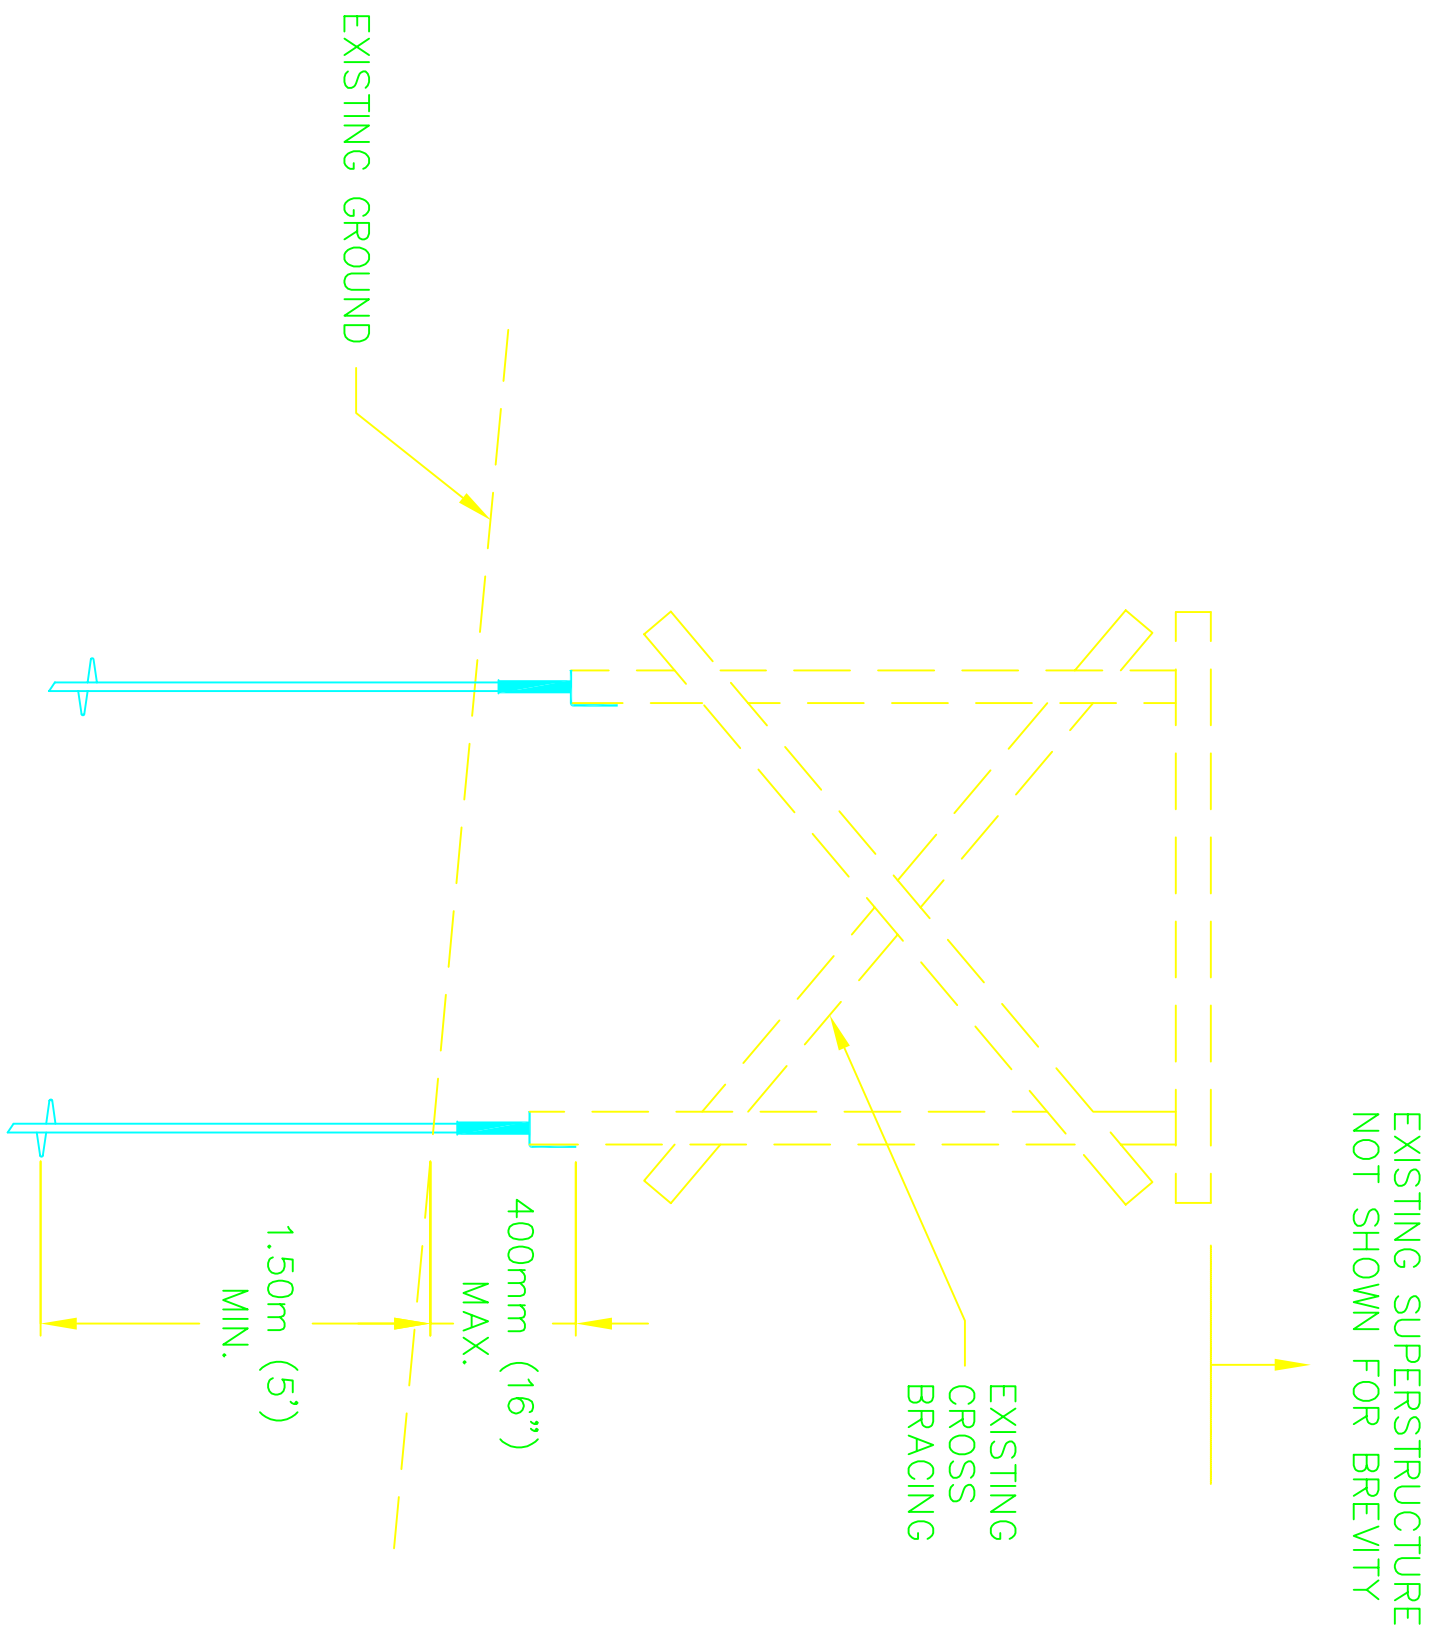

SECTION A

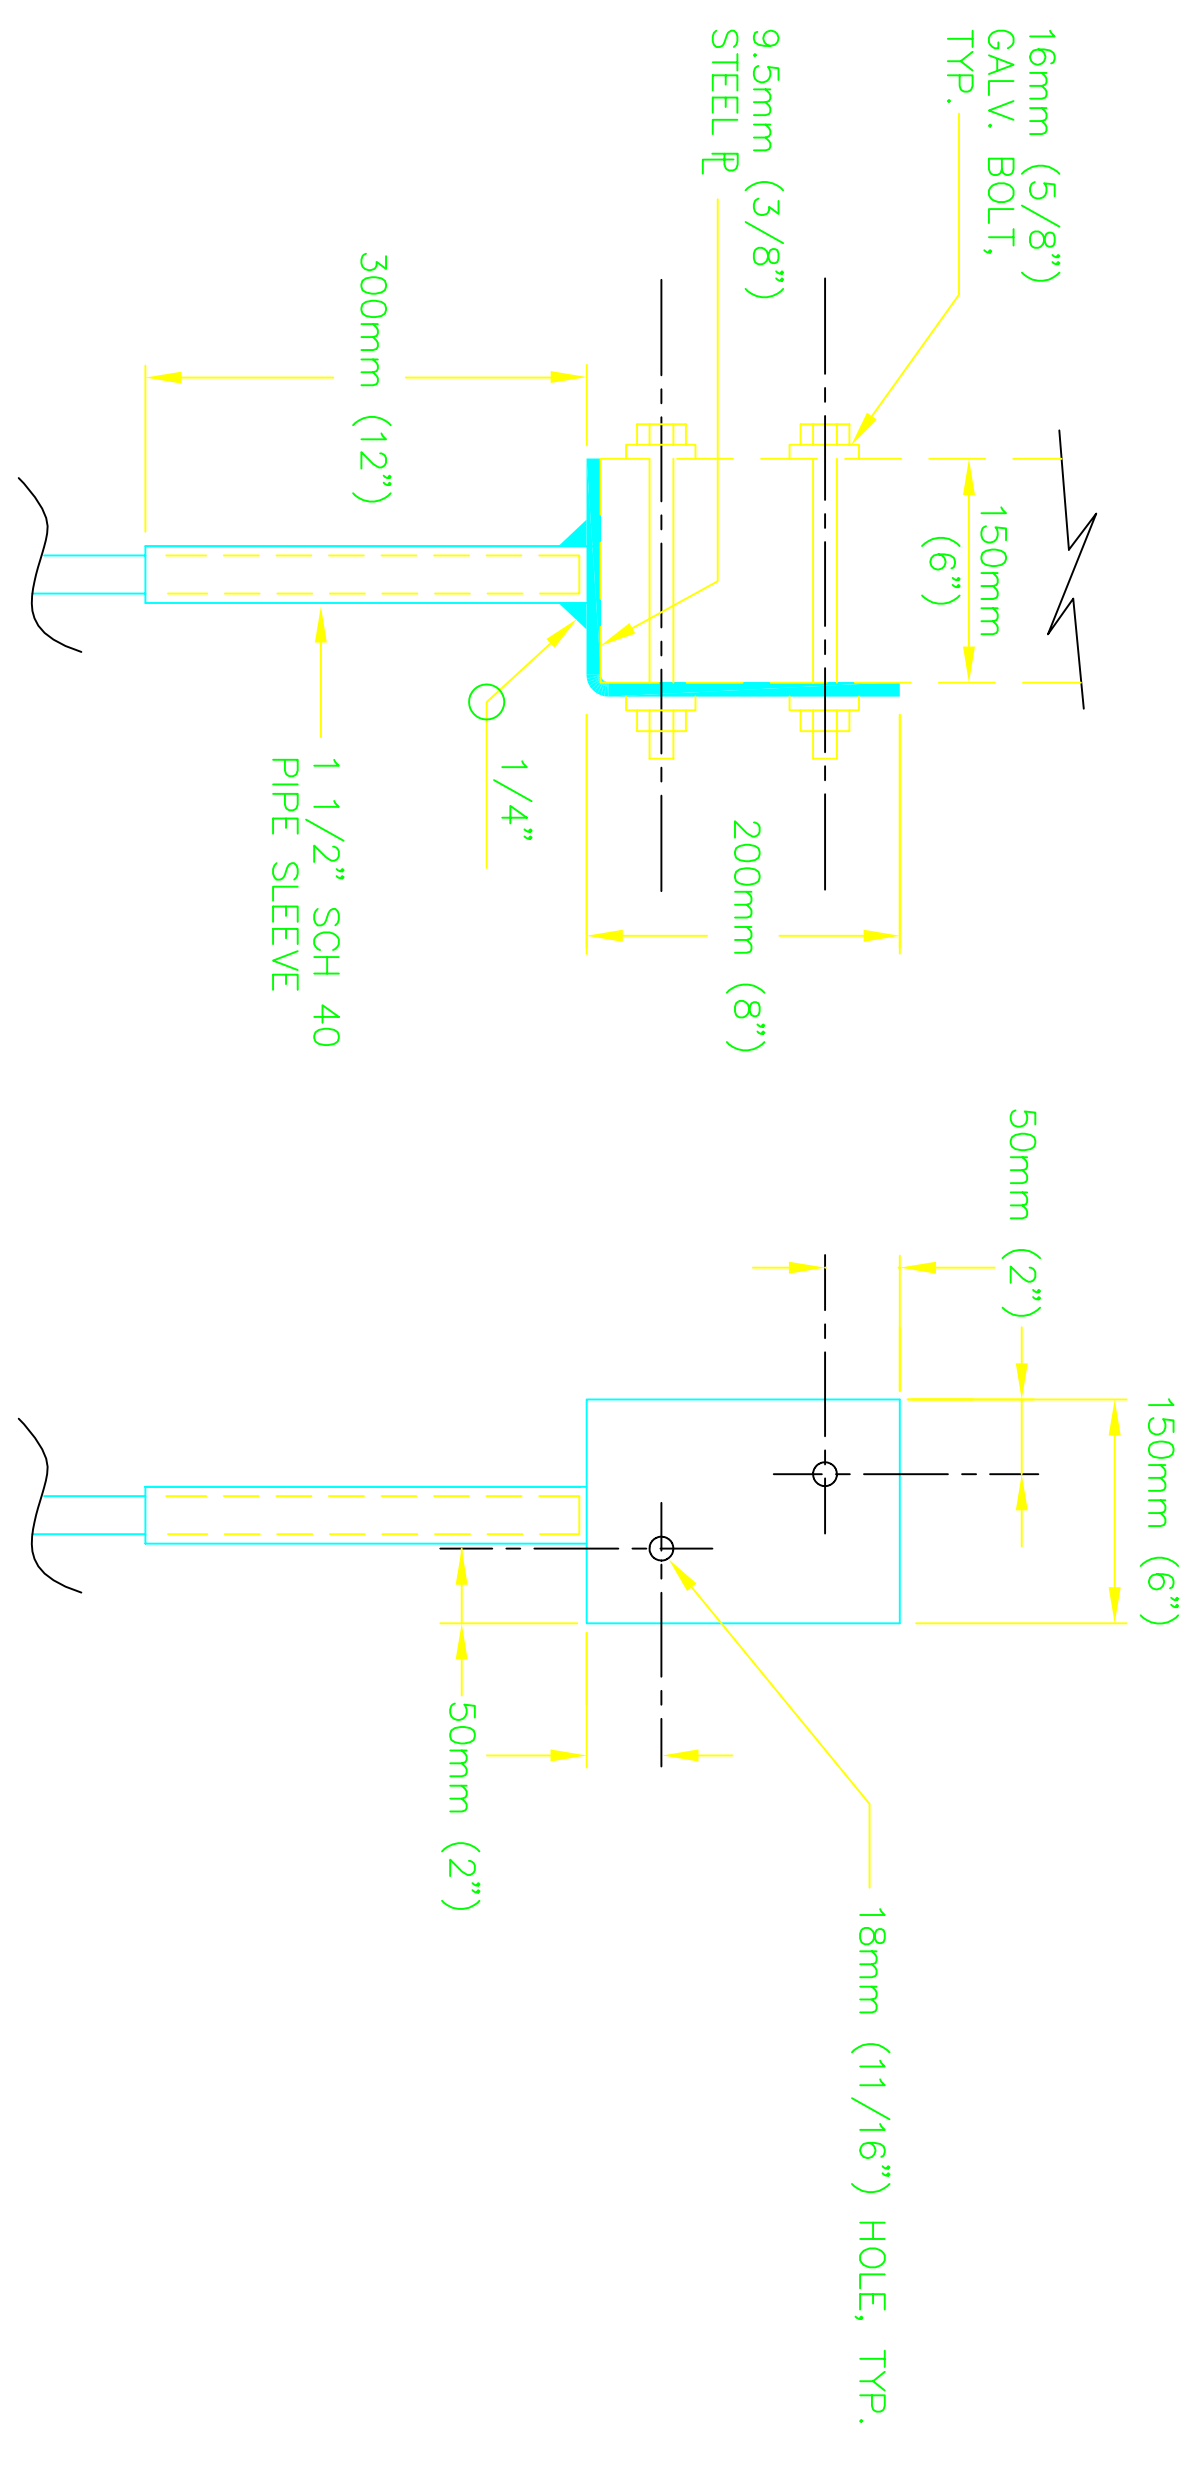

POST BRACKET DETAIL

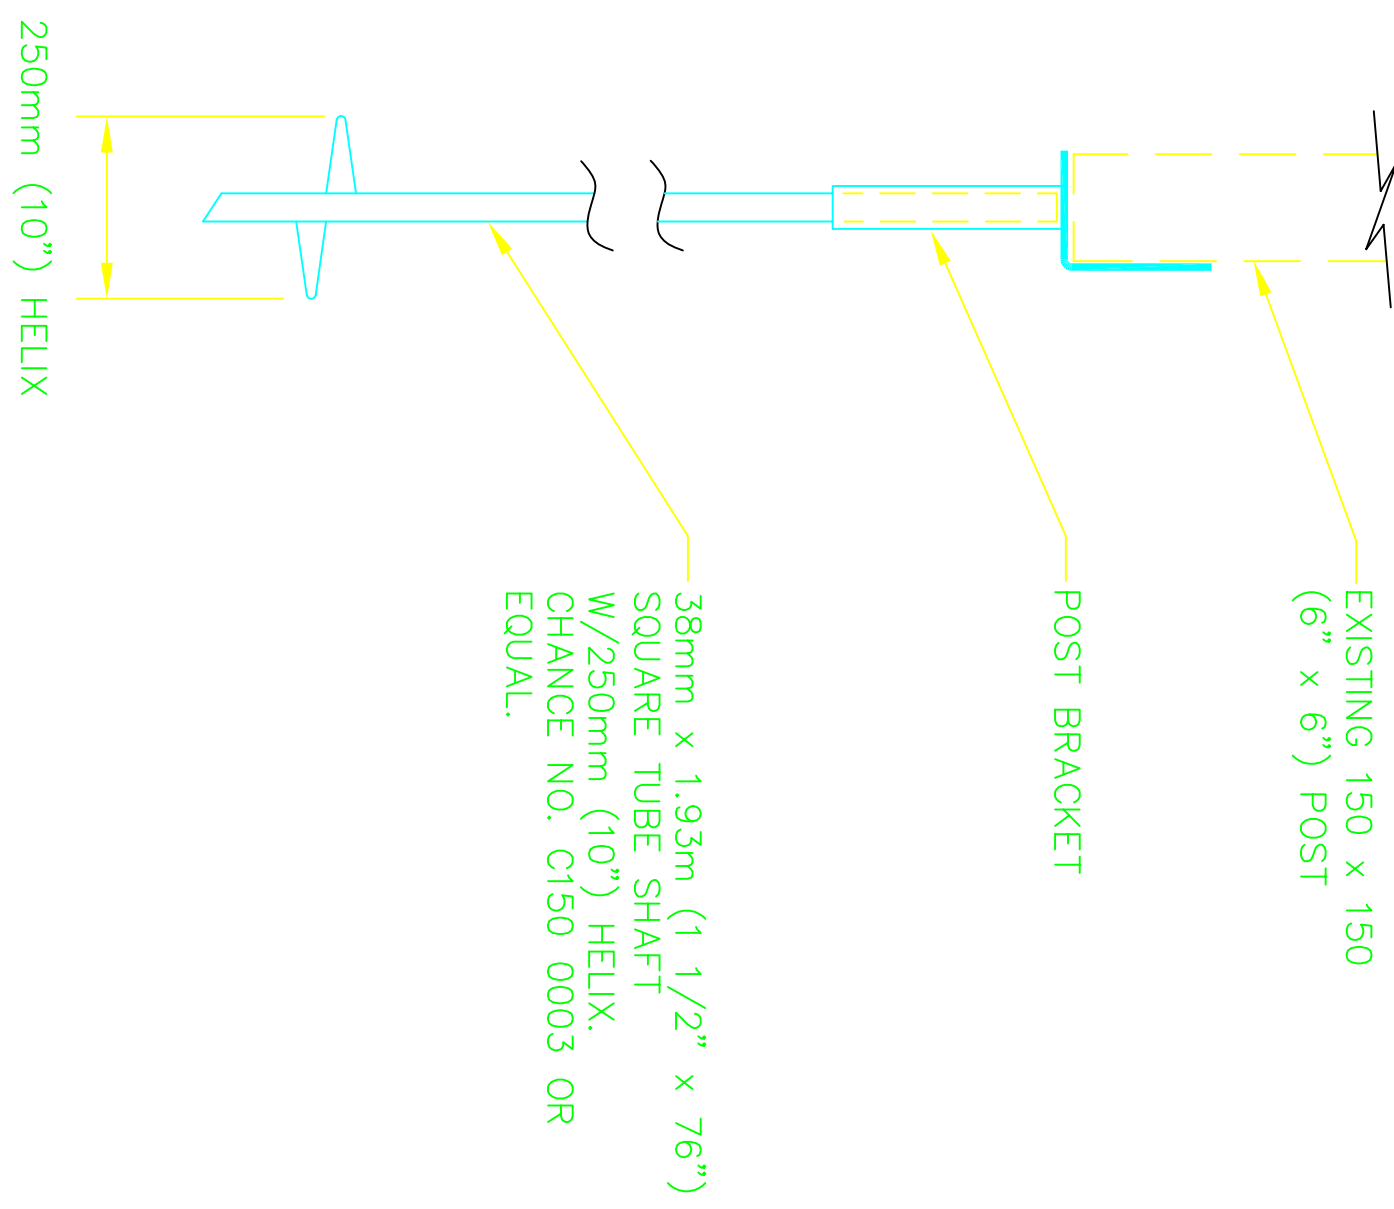

HELICAL PIER DETAIL

CONSTRUCTION NOTES:

1. SEE SECTION 628 IN THE SPECIAL PROVISIONS FOR FULL SPECIFICATIONS ON HELICAL PIER MATERIALS, INSTALLATION EQUIPMENT AND INSTALLATION PROCEDURES.
2. A GEOTECHNICAL INVESTIGATION WAS PERFORMED IN THE VICINITY WHERE THE HELICAL PIERS ARE TO BE INSTALLED. THIS REPORT IS CONTAINED IN APPENDIX B.

ASBUILT\DETS

PATH:	Q:\ELF\67619\PLANS\ASBUILT\DETS
PILOT:	1=1(F) OR 1=2(H)
BY:	DATE:
	DESCRIPTION OF CHANGE:

STATE OF ALASKA
 DEPARTMENT OF TRANSPORTATION
 AND PUBLIC FACILITIES
 SOUTHDAST REGION

ELLEN COVE
 JUNO-GLACIER HIGHWAY
 EGAN DRIVE TO MENDENHALL LOOP ROAD
 FED. NO. STP-0003(56) ~ PROJECT NO. 67619

DESIGNED BY:	L. GREGOVICH	PROJECT NO.	67619
DRAWN BY:	R. SNYDER	DATE:	JUNE 1999
CHECKED BY:	A. STEININGER	SHEET	12 OF 12

