

REGIONAL MAP

STATE OF ALASKA
 DEPARTMENT OF TRANSPORTATION
 AND
 PUBLIC FACILITIES
 SOUTHEAST REGION
 DESIGN AND CONSTRUCTION DIVISION

A PROJECT AT
GUSTAVUS, ALASKA

GUSTAVUS CAUSEWAY REPLACEMENT

BR-0003(53)

PROJECT NO. 67599

INDEX OF SHEETS



REFERENCE NO.	SHEET NO.	DESCRIPTION
G01	01	Title Sheet
G02	02	Estimate of Quantities
G03	03	Survey Control
G04 - G05	04 - 05	Site Plan / Marine Site Plan
G06 - G08	06 - 08	Signs & Anodes
S01-S02	09 - 10	Staging Area
AP01-AP23	11 - 33	Approach
AP24-AP41	34 - 51	Approach Transition
D01-D18	52 - 69	Dock
P01-P03	70 - 72	Pontoon Layouts
P04-P09	73 - 78	Pontoon Restraint
P10-P20	79 - 90	Pontoon Platforms
P21	91	Harbor Float Relocation
T01-T21	92 - 102	Bridge
RA01-RA14	103 - 116	Ramp & Apron
M01-M06	117 - 122	Mooring Structures
E1-E11	123 - 133	Electrical
AB01-AB05	134 - 138	As-Builts

AS-BUILTS
 CONTRACTOR: WESTERN MARINE CONSTRUCTION, INC.
 PROJECT ENGINEER: STEVE MIELKE
 BEGIN DATE: May 21, 2009
 END DATE: OCTOBER 16, 2013

- The following Standard Drawings apply to this project:
- F-01.01
 - F-03.01
 - G-00.01
 - G-04.06S
 - ~~G-10.00-10.01~~
 - ~~G-45.01~~
 - S-05.01
 - ~~S-20.00-20.01~~
 - S-30.03 (Soil Embedment)

Note: "For dimensions, details and notes of Jersey Barriers located at Staging Area and Fuel Line Header, refer to Attachment A of Addendum #2."

Record Drawings have been reviewed by the Project Engineer, and represent to the best of my knowledge, the project as constructed.
 PE: *[Signature]* Date: 5/21/13

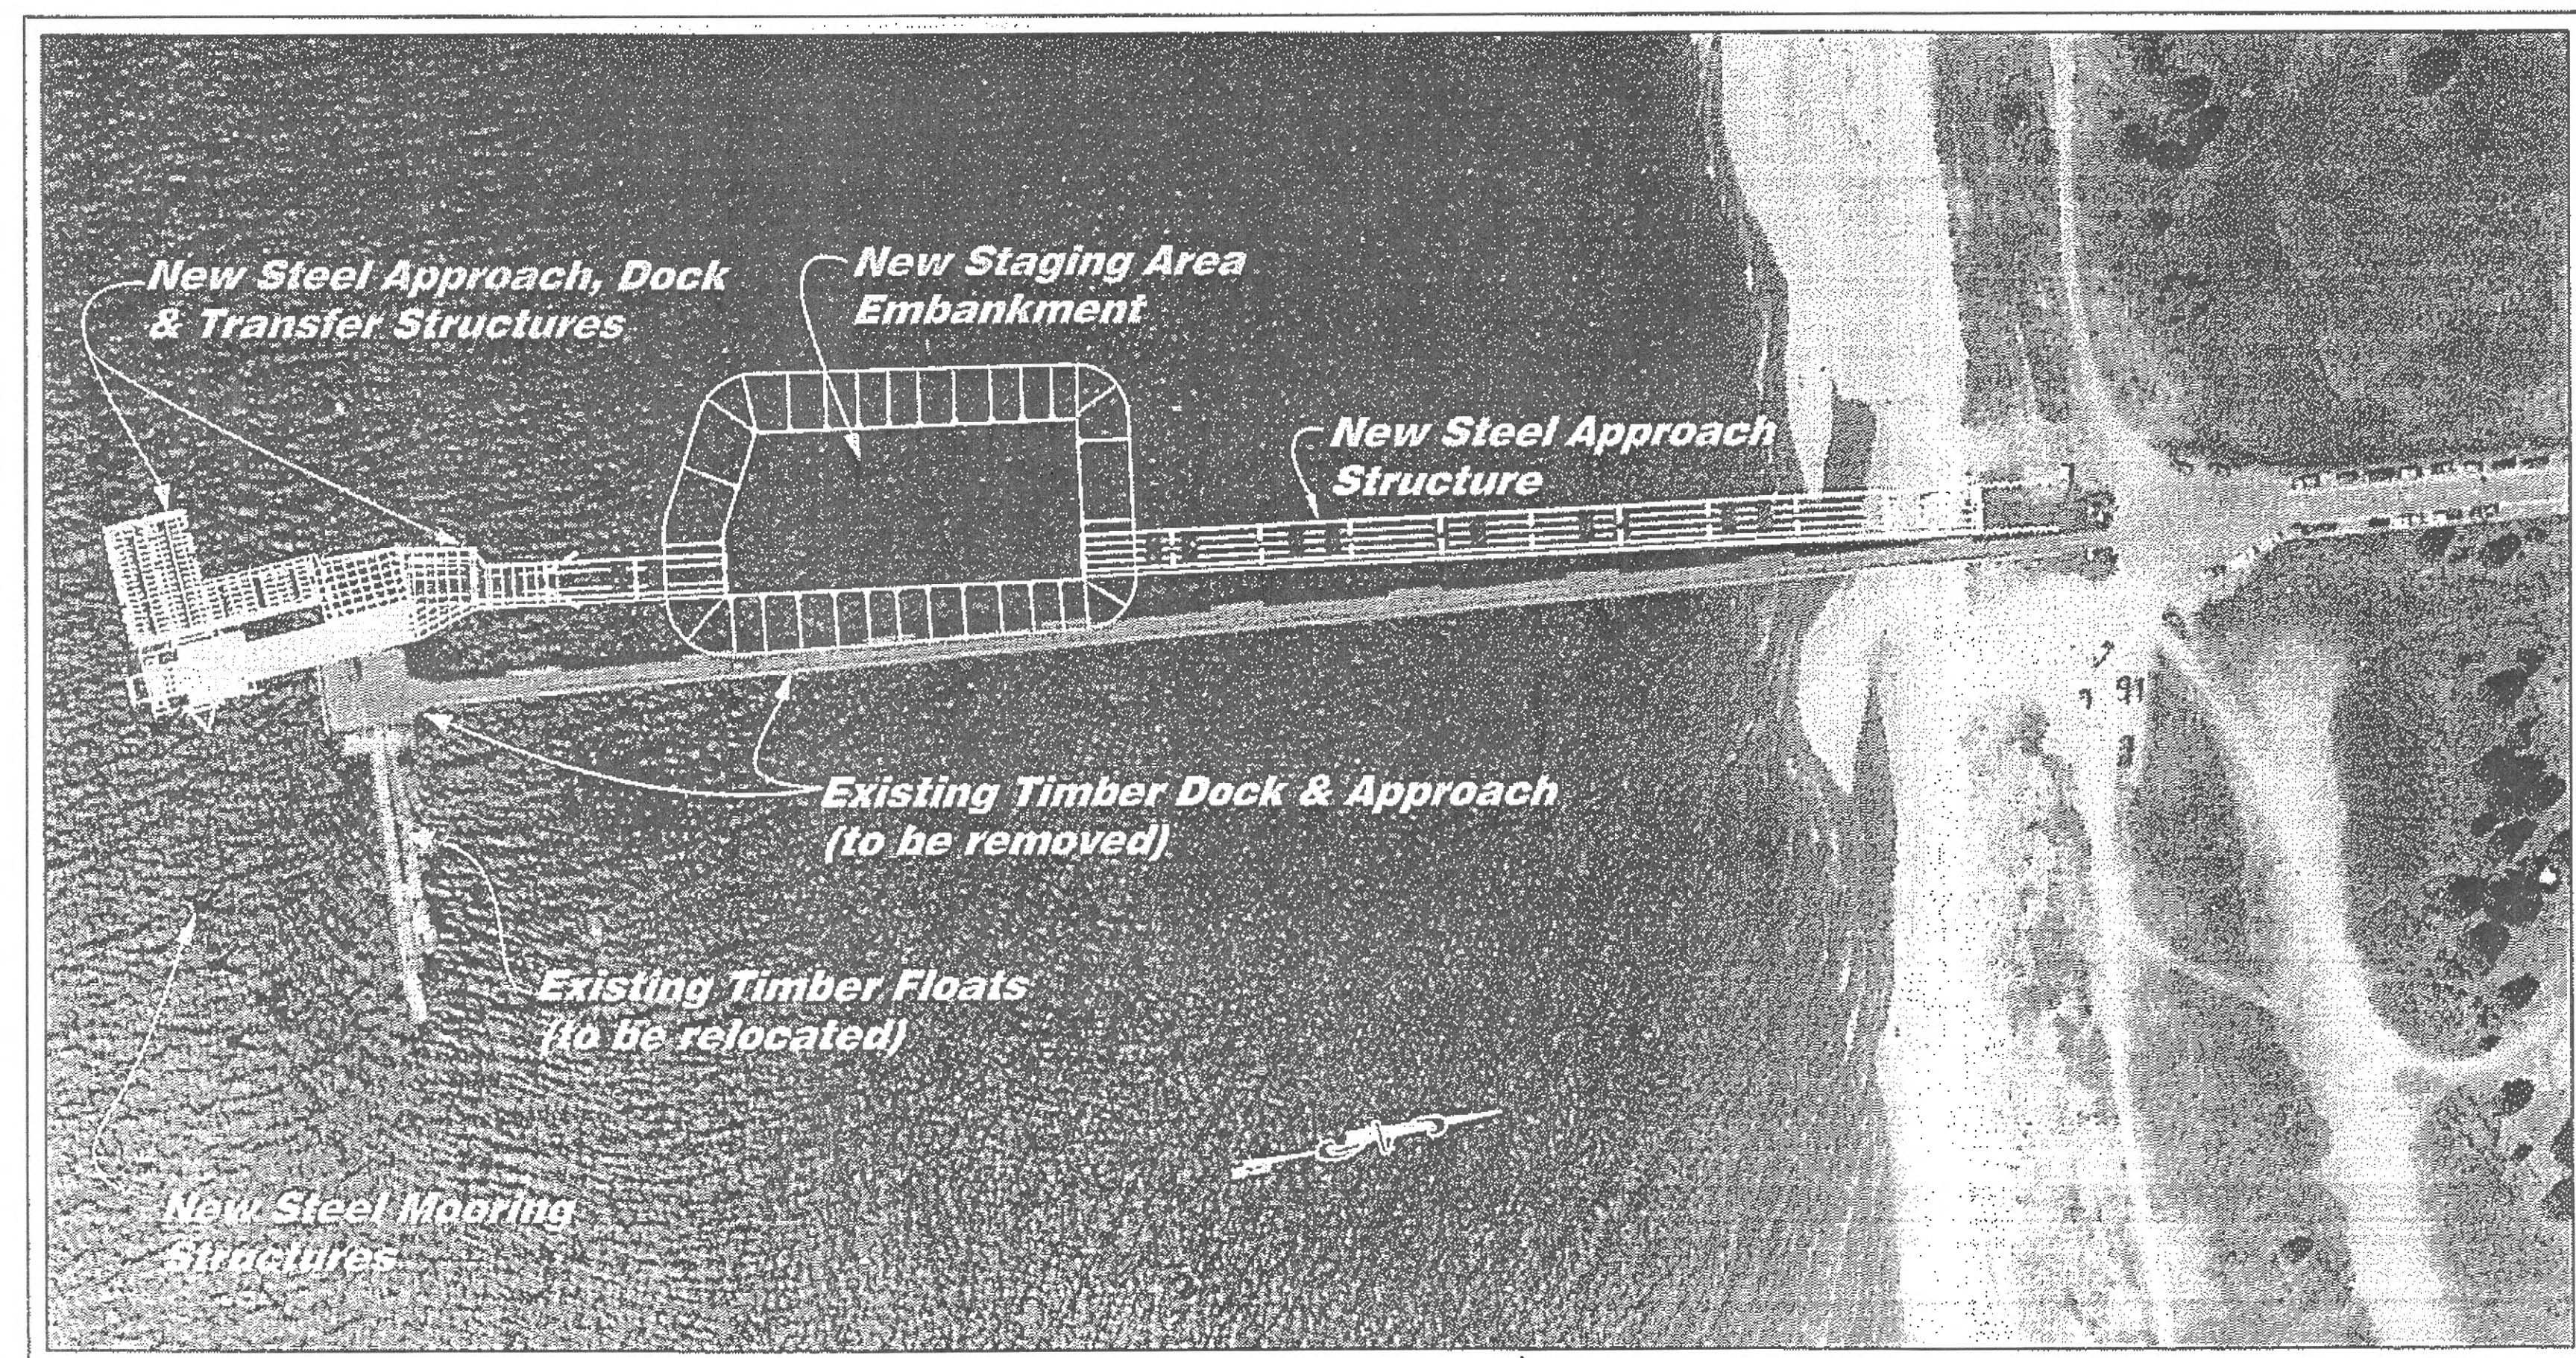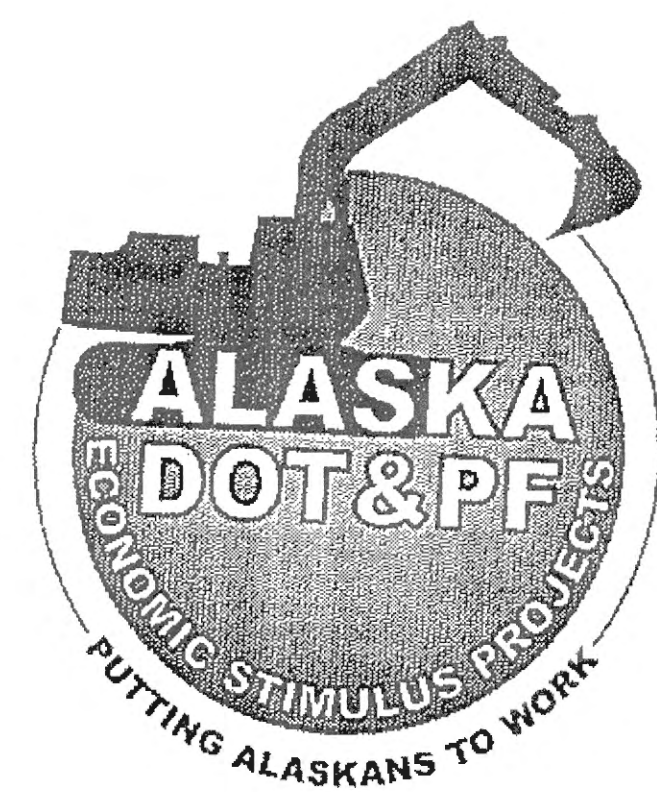

STATE OF ALASKA
 DEPARTMENT OF TRANSPORTATION
 AND
 PUBLIC FACILITIES
 SOUTHEAST REGION

APPROVED
[Signature] Date: 1-12-09
 Regional Preconstruction Engineer
 Victor E. Winters, P.E.

APPROVED
[Signature] Date: 1-12-09
 Director, S.E. Region

CERTIFIED TRUE & CORRECT AS-BUILT OF ACTUAL FIELD CONDITION:

Construction Project Manager: _____ Date: _____

PROJECT NUMBER:
 67599/BR-0003(53)

DATE: 2008

REF: G01

SHEET 01 OF 138

ESTIMATE OF QUANTITIES

ITEM NO.	ITEM	EST. UNIT	ESTIMATE QUANTITY
BASIC BID			
202(02)	Remove, Relocate and Re-install Harbor Structures, Piles and New Transitions	L.S.	ALL REQUIRED
203(19)	Approach & Staging Area Embankment	L.S.	ALL REQUIRED
304(04)	Sub-base, Grading C	L.S.	ALL REQUIRED
504(01)	Steel Approach, Abuts, Backwalls, Abut Retaining Wall & Transition	L.S.	ALL REQUIRED
504(02)	Steel Dock, Dock Fender & Wave Barrier Framing	L.S.	ALL REQUIRED
504(03)	Transfer Bridge Abutment	L.S.	ALL REQUIRED
504(04)	Transfer Bridge	L.S.	ALL REQUIRED
504(05)	Transfer Ramp & Apron System	L.S.	ALL REQUIRED
504(06)	Transfer Bridge Pontoon, Platforms & Pedestrian Ramps	L.S.	ALL REQUIRED
504(07)	Transfer Bridge Pontoon Restraint Fender Systems	L.S.	ALL REQUIRED
504(08)	Transfer Bridge Pontoon Restraint Fender Dolphins	L.S.	ALL REQUIRED
504(09A)	Mooring Structure E1 & E2 and Fender Systems	L.S.	ALL REQUIRED
504(10A)	Mooring Structure W1 and Fender	L.S.	ALL REQUIRED
504(11A)	Anodes and Cables for Structures	L.S.	ALL REQUIRED
* See pile driving records for quantities.			
505(01)	36" DIA. X 1/2" WALL PIPE PILES, FURNISHED, CO 27	L.F.	140-180
505(02)	36" DIA. X 1/2" WALL PIPE PILES, DRIVEN	EACH	1
505(03)	30" DIA. X 1/2" WALL PIPE PILES, FURNISHED, CO 27	L.F.	280-373.0
505(04)	30" DIA. X 1/2" WALL PIPE PILES, DRIVEN	EACH	2
505(05)	24" DIA. X 1/2" WALL PIPE PILES, FURNISHED, CO 27, 1, 3, 14	L.F.	50-13-84.30
505(06)	24" DIA. X 1/2" WALL PIPE PILES, DRIVEN, CO 1, 3, 14, 27	EACH	38 41
505(07)	18" DIA. X 1/2" WALL PIPE PILES, FURNISHED, CO 1, 3, 12, 14, 15, 27	L.F.	757-1981.50
505(08)	18" DIA. X 1/2" WALL PIPE PILES, DRIVEN, CO 1, 3, 12, 14, 15, 27	EACH	59 23
505(09)	Sheet Piles, Furnished & Driven for Wave Barrier	L.S.	ALL REQUIRED
505(10)	Treated Timber Fender Piles, Furnished, CO 27	L.F.	4845
505(11)	Treated Timber Fender Piles, Driven	EACH	57
640(1)	MOBILIZATION & DEMOBILIZATION	L.S.	ALL REQUIRED
640(4)	WORKER MEALS AND LODGING, or PER DIEM	L.S.	ALL REQUIRED
641(1)	EROSION & POLLUTION CONTROL ADMINISTRATION	L.S.	ALL REQUIRED
641(2)	TEMPORARY EROSION AND POLLUTION CONTROL	C.S.	ALL REQUIRED
642(1)	CONSTRUCTION SURVEYING BY THE CONTRACTOR	L.S.	ALL REQUIRED
644(1)	FIELD OFFICE	L.S.	ALL REQUIRED
644(6)	VEHICLE & SKIFF	L.S.	ALL REQUIRED
645(1)	Training Program for 1 Trainee/Apprentice	MH	500
662(1)	ELECTRICAL POWER & LIGHTING SYSTEM	L.S.	ALL REQUIRED
ADDITIVE ALTERNATE "A"			
202(01)	Removal of Structures & Obstructions	L.S.	ALL REQUIRED
504(09B)	Mooring Structure E3 & E4 and Fender Systems	L.S.	ALL REQUIRED
504(10B)	Mooring Structure E5 and Fender	L.S.	ALL REQUIRED
504(11B)	Anodes and Cables for Structures	L.S.	ALL REQUIRED
505(1A)	36" DIA. X 1/2" WALL PIPE PILES, FURNISHED, CO 27	L.F.	140-200.10
505(2A)	36" DIA. X 1/2" WALL PIPE PILES, DRIVEN	EACH	1
505(3A)	30" DIA. X 1/2" WALL PIPE PILES, FURNISHED, CO 27	L.F.	280-373.0
505(4A)	30" DIA. X 1/2" WALL PIPE PILES, DRIVEN	EACH	2
505(5A)	24" DIA. X 1/2" WALL PIPE PILES, FURNISHED	L.F.	336
505(6A)	24" DIA. X 1/2" WALL PIPE PILES, DRIVEN	EACH	2
505(7A)	18" DIA. X 1/2" WALL PIPE PILES, FURNISHED, CO 27	L.F.	630-636.20
505(8A)	18" DIA. X 1/2" WALL PIPE PILES, DRIVEN	EACH	4
680(01)	Design and Build New Bulk Fuel System Piping - Dock to Shore Abut of Approach, DELETED CO 5	L.S.	ALL REQUIRED

GENERAL NOTES

Specifications: Per Contract Documents for Project No. BR-0003(53) ~ 67599
 Construction: Per Contract Documents for Project No. BR-0003(53) ~ 67599
 Design: AKDOT/PF & Southeast Region Marine Engineering Design
 Standards: Standards & AISC ASD for Marine Structures and Dock, AASHTO ASD for Approach, Approach Transition and Transfer Bridge.
 Design Loads: Mooring and Fender Structures: Side Berth Vessel Berthing @ 30ft-k service
 Side Berth Mooring Load @ 50 kips line load
 Design Vessels: Petro-Marine Fuel Barge, AML/NSI Mainline Barge
 Alaska Marine Highway System - M/V LeConte Class & M/V Fairweather class
 Approach and Transition - LL Vehicle: AASHTO HS 20 (two lanes loaded) Pedestrian Walkway: 85 psf (ADTT < 1, Design Speed < 15 mph and Impact Factor = 0.27, LL Defl = L/1000 max)
 - EQ = 0.5 W (Pier bearings provided with restraints)
 Transfer Bridge, Ramp & Apron - LL Vehicle: AASHTO HS 20 (one lane)
 (ADTT < 1, Design Speed < 15 mph and Impact Factor = 0.27, LL Defl = L/1000 max)
 Approach and Transition to Dock - LL Vehicle: Lift Truck with empty forks (Cat 972H)
 Dock - LL Vehicle: Lift Truck with 30 k payload + 10 k flat on forks
 (See Dock Live Load Layout this sheet)
 Dock - Wave Barrier: 75' wave impingement = 7 ft at 5.2 second period
 90' wave impingement = 5.5 ft at 4.5 second period
 Max wave loading = 10 ft static water height

Materials

Concrete: All concrete shall be Class A with compressive strength on 4000 psi
 Reinforcement: Grade 60, Fy = 60 ksi
Steel Shapes & Plates: W 33, W 40 & W 24 Shapes (Main Members) - ASTM A992 (Gr. 50) unless otherwise noted
 W 33, W 36 & W 24 Shapes (Secondary Members) - ASTM A36 (Gr. 36) unless otherwise noted
 Transfer Bridge Plates and Stiffeners - ASTM A709 Gr. 50 or ASTM A572 Gr. 50 unless otherwise noted
 All other Shapes and Plates - ASTM A36 unless otherwise noted
 Tube Sections - ASTM A500 Grade B
 Pipe - ASTM A53, Grade B, Type E or S
 Stainless Steel - ASTM A 276 Type 316
 Charpy Zone 2 impact requirements shall apply where noted on Plans.
Piling: Steel pipe - ASTM A252 Grade 2 with A36 chemistry and mechanical properties
 Spiral or straight seamed, at Contractor's option
 Size - As noted on Plans and Pile Tables
Steel Ped Grating: Welded bar type, serrated top, thickness & bar spacings as noted on Plans.
Steel Veh Grating: 5 3/16" deep bearing bars HS loading and 50 ksi yield material for Approach & Approach Transition, 36 ksi yield material for Dock, Transfer Bridge and Pontoon Platform.
UHMW: Ultra High Molecular Weight Plastic, ASTM D4020
Hardware: ASTM A325, ASTM F593 316 Alloy
Aluminum Plates & Shapes: ASTM 6061-T6

Protective Coatings:



All steel and weldments: Galvanized after fabrication per Spec's, unless otherwise noted.
Approach: Galvanized after fabrication per Spec's.
Barge/Float/Pontoon: Exterior coating per Spec's, System 1 - See also Bridge Support Pontoon Layout sheet.
Platforms, Weldments, Mooring Structures and Fenders: Galvanized after fabrication per Spec's.
Transfer Bridge: Shop painted during and after fabrication per Spec's, System 5.
Apron: Galvanized after fabrication per Spec's.
Non-Skid Coating For Steel: For portions of galvanized apron and galvanized transition plates subject to pedestrian traffic (and as shown on the plans), blast clean as required after galvanizing and apply 10 mils of spray metallized zinc, followed by 2-3 mils of spray metallized (large particle size) non-skid. [Optionally fabricator may use large particle size steel spray metallizing prior to galvanizing.]
 Timber shall be dual creosote ACZA/CCA treated to min 12 pcf retention for creosote.

Piling:


Materials & Size: Per above and as per Pile Tables. Timber piles to have 18" min butt diameter.
Pile Tips: Reinforced tips / Drive Shoes Required on all piling
Coating Requirements: Pipe Piles shall be galvanized from cut-off to 20 feet below existing ground surface minimum.
 Timber Piles shall be dual creosote ACZA/CCA treated to min 12 pcf retention for creosote.
 Sheet piles shall be bare steel.

Driving

Requirements: See Pile Layout Sheets, Tables and Spec's
 Piles shall be driven to estimated tip or for sheets or timber piles to min. penetration with a vibratory hammer, unless otherwise noted. Two selected vertical pipe piles shall be initially driven to within 10 feet of estimated tip by vibratory hammer. Final driving for these selected piles shall be accomplished with an impact hammer of the min. specified size and energy after a waiting period of at least 7 days. All other piles to be driven to estimated tip with vibratory hammer. Selected piles driven with impact hammer will be instrumented for dynamic driving analysis, per specifications.

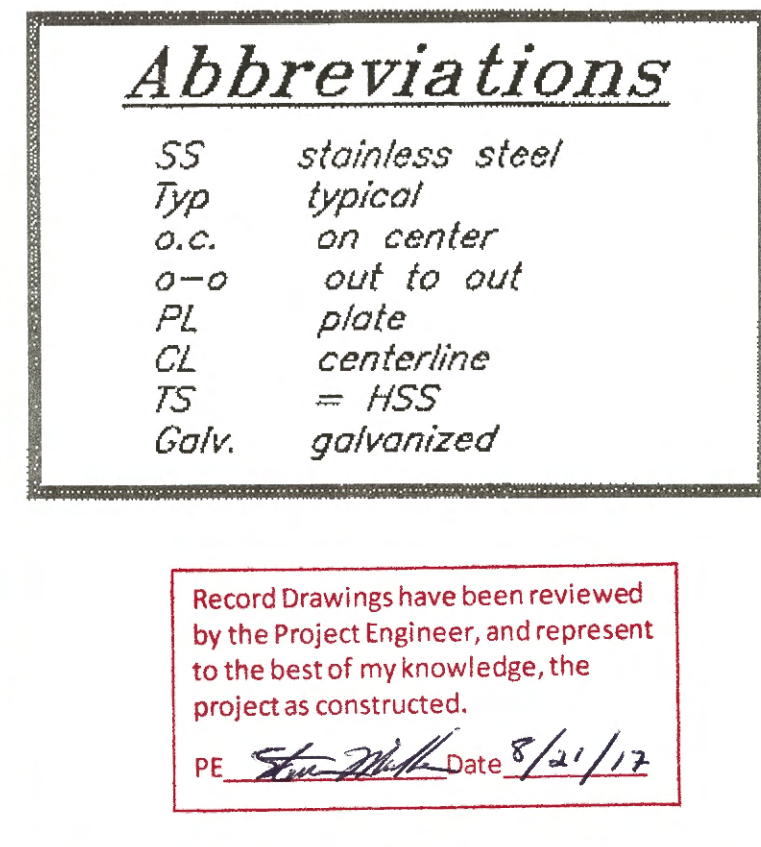
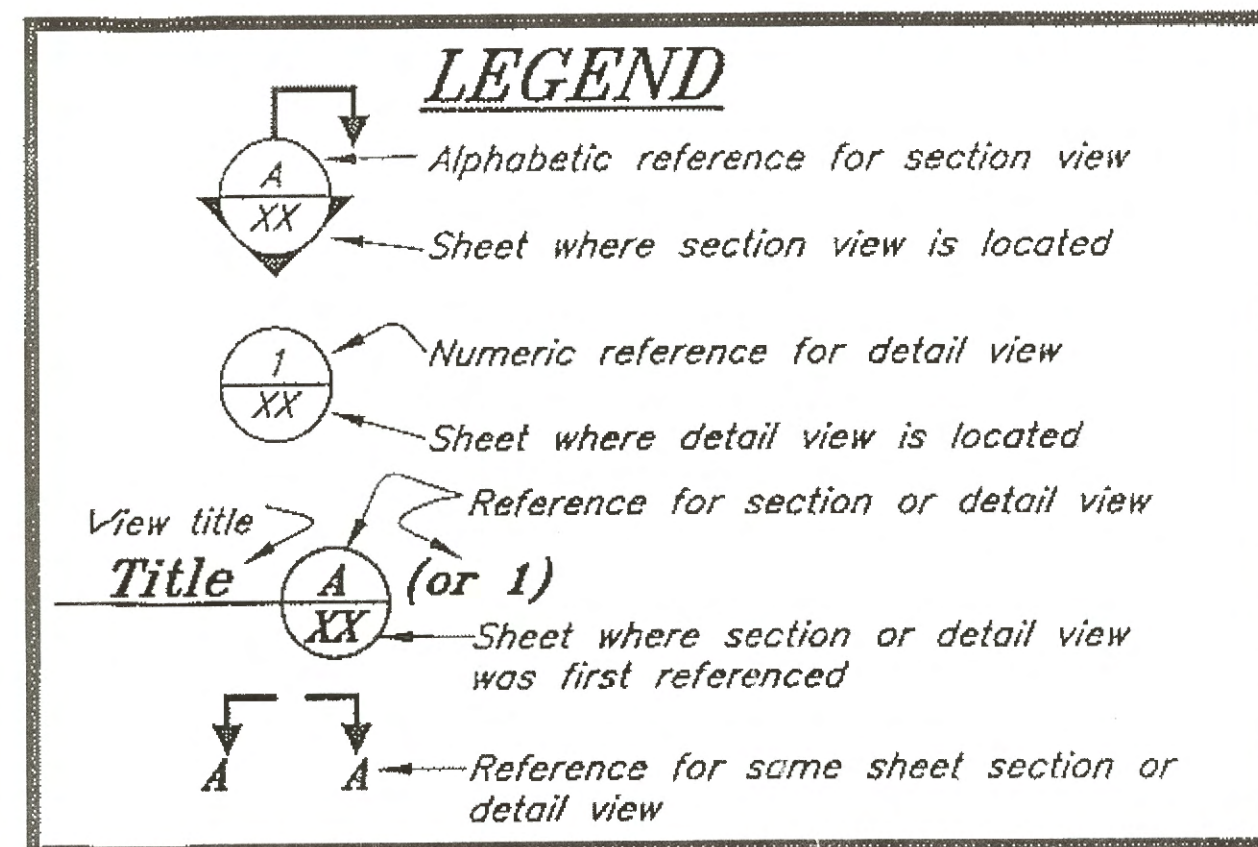


Under the "Estimate of Quantities" Table add the following:
 *Notes: 1. For the Lump Sum Item 203(19) the following are considered to be included or subsidiary -
 On-shore approach embankment:
 Embankment materials (as per 203-2.01-6) = approximately 200 CY
 Excavation in existing soils (to key in sub-base) = approximately 70 CY
 Excavation for structure in front of abutment seaward = approximately 50 CY
 Class I riprap slope protection = approximately 60 CY
 Fencing = approximately 26 LF
 Curbing = approximately 84 LF
 Guardrail and posts = approximately 40 LF standard rail and 51 LF of ET-2000 and rail
 Sheet Pile retaining wall is subsidiary to Item 504(01)
 Signs and posts/foundations are subsidiary to other items of work
 Sub-base is to be paid for under Item No. 304(04)
 Off-shore staging area embankment:
 Embankment materials (as per 203-2.01-6) below EL +12 = approximately 21,500 CY
 Embankment materials (as per 203-2.01-6) above EL +12 = approximately 11,500 CY
 Class I riprap slope protection = approximately 650 CY
 Class III riprap slope protection = approximately 2000 CY
 Class IV riprap slope protection = approximately 4500 CY
 Fencing = approximately 240 LF
 Curbing = approximately 228 LF
 Pre-cast barrier sections = 20 EA
 Guardrail and posts = approximately 57 LF standard rail, 2 terminal end sections & 2 space end sections
 Geotextile = approximately 2500 SY (not counting laps on edges and ends)
 Electrical items are paid for under Item No. 662(1)
 Fuel System is to be paid for under Item 680(01)
 Signs and posts/foundations are subsidiary to other items of work
 Sub-base is to be paid for under Item No. 304(04)
 2. For the Lump Sum Item 304(04) the following are considered to be included or subsidiary -
 On-shore approach embankment:
 Sub-base Grading C = Approximately 120 CY
 Off-shore staging area embankment:
 Sub-base Grading C = approximately 1050 CY

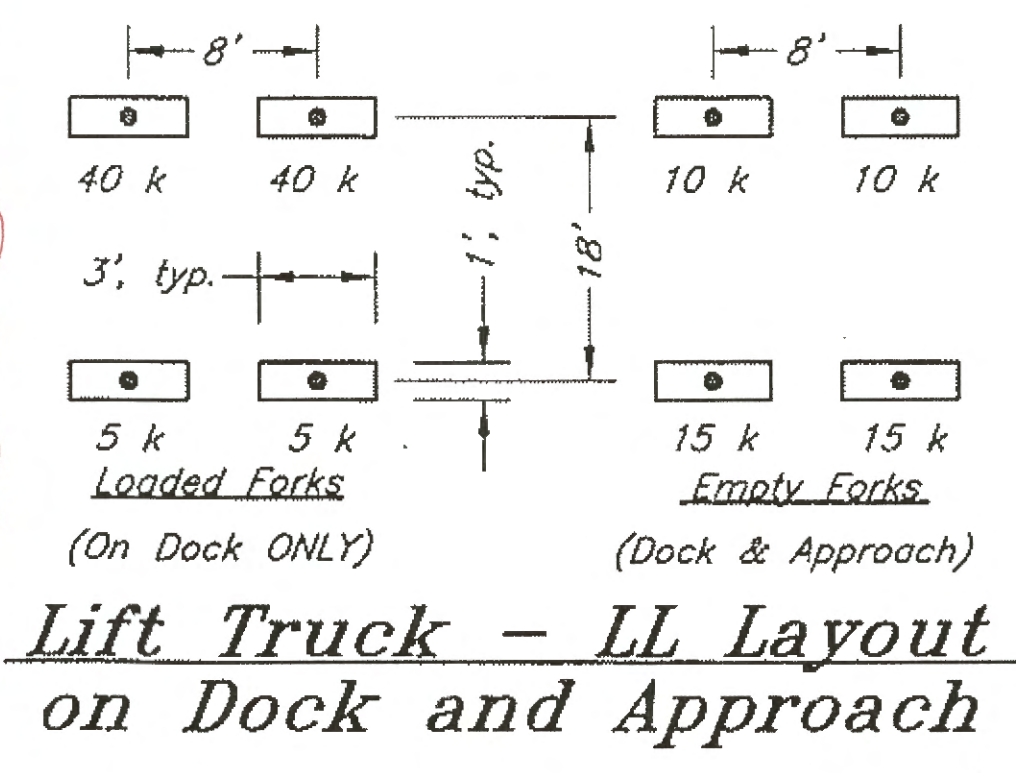

DO NOT SCALE FROM THESE DRAWINGS USE DIMENSIONS

DESIGNED BY: J. Scott	STATE OF ALASKA DEPARTMENT OF TRANSPORTATION & PUBLIC FACILITIES DESIGN & ENGINEERING SERVICES DIVISION-SOUTHEAST REGION	Gustavus Causeway Replacement
Estimate of Quantities		
G02		
CHECKED BY: B. Sovikko	11-26-08	
DRAWN BY: G. Fuman, W. Hickok	PROJECT DESIGNATION	
BR-0003(53)/67599		
YEAR		
2008		
SHEET NO.		
02		
TOTAL SHEETS		
138		

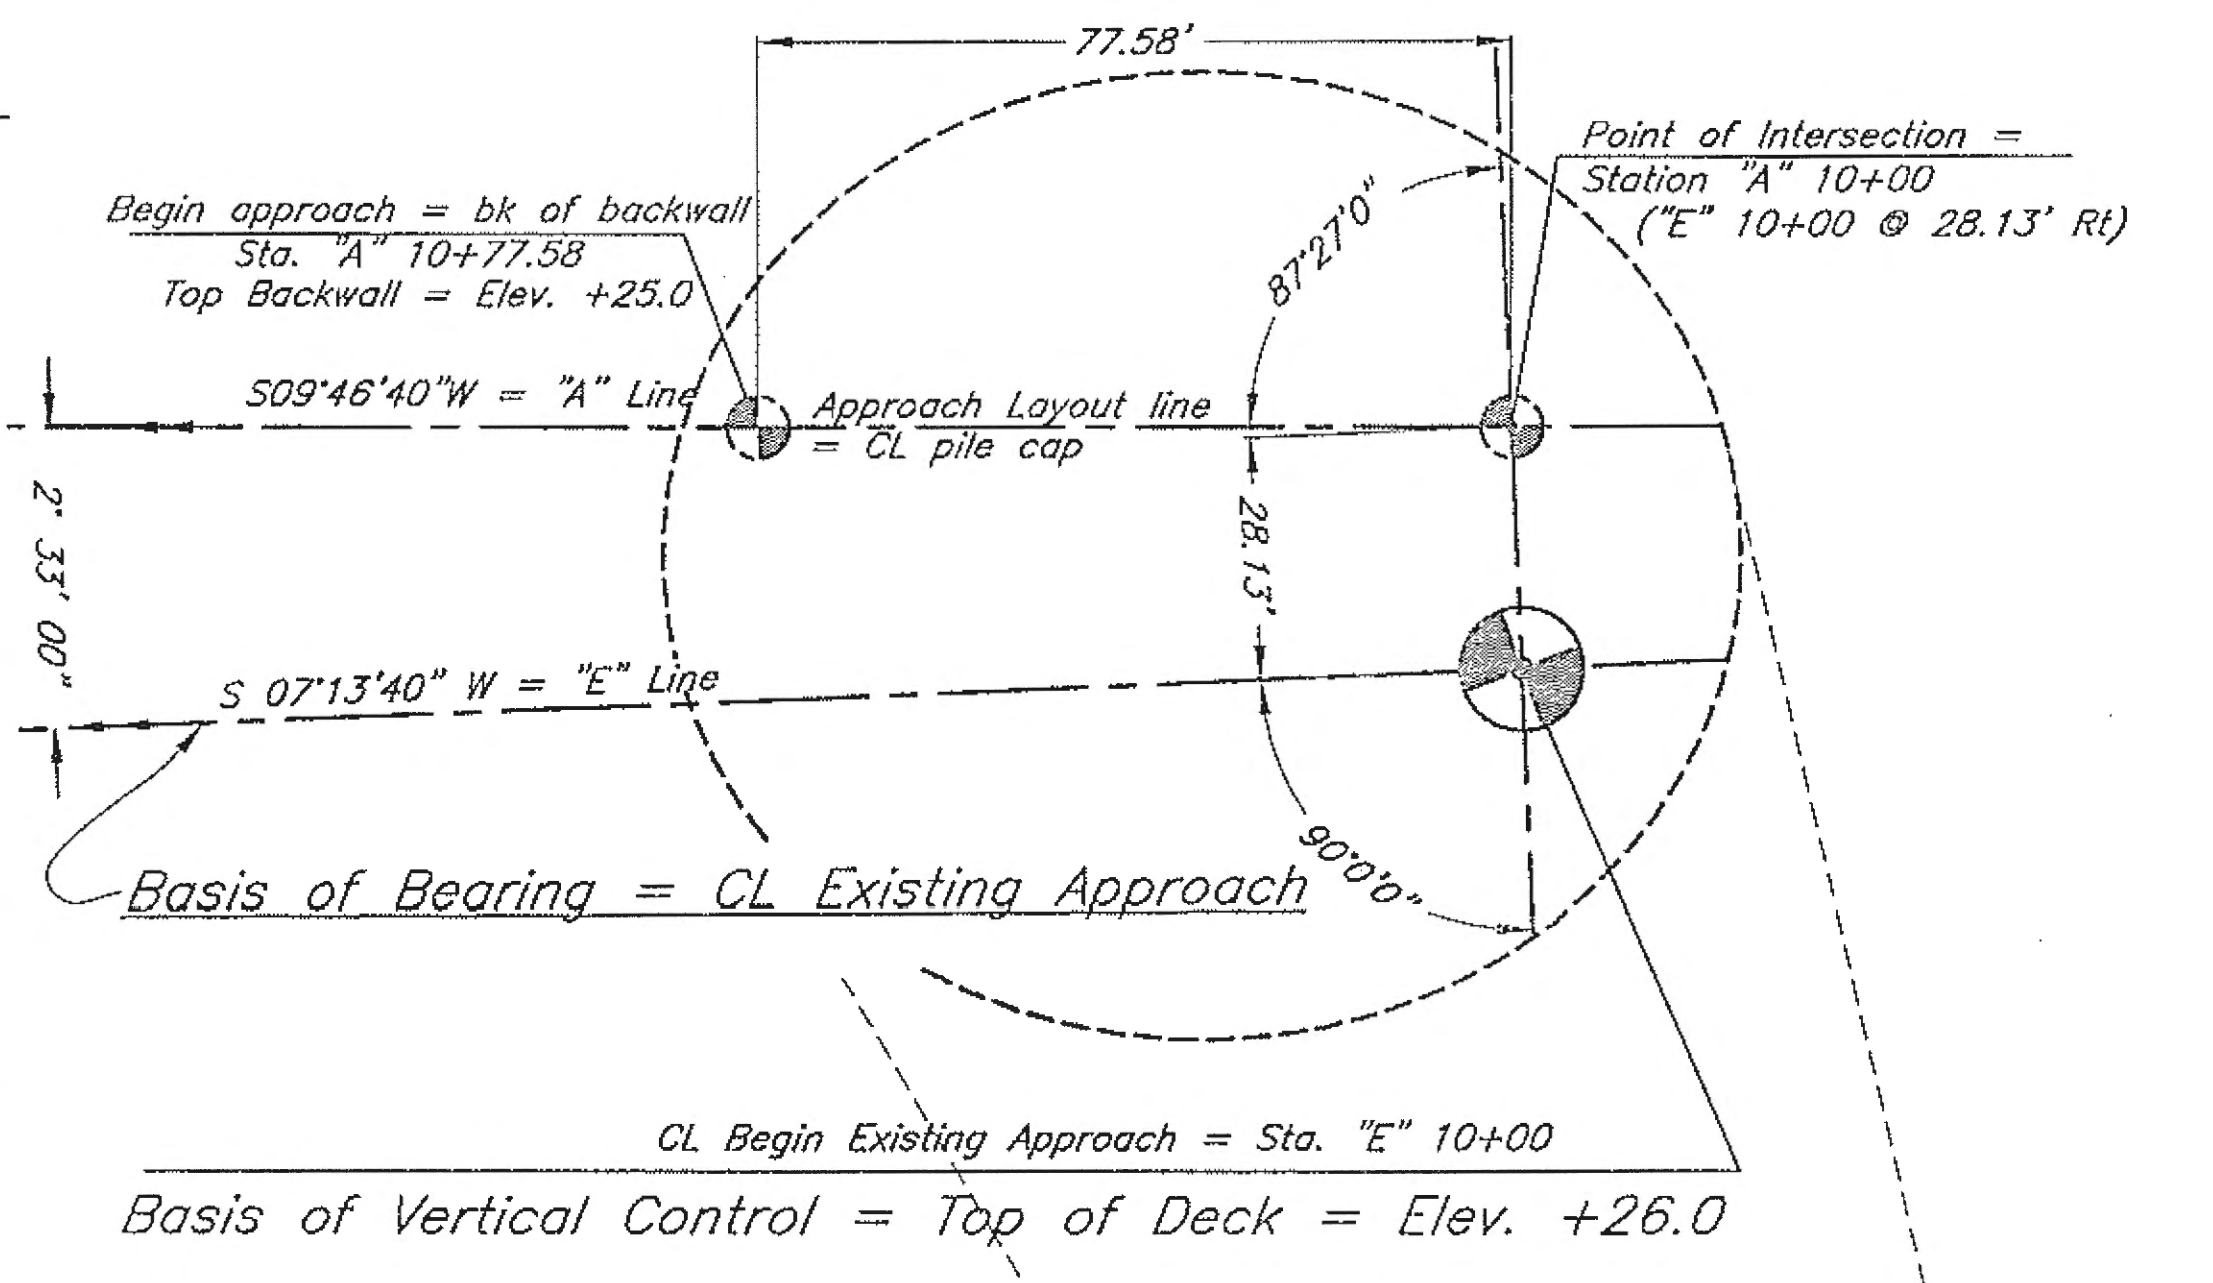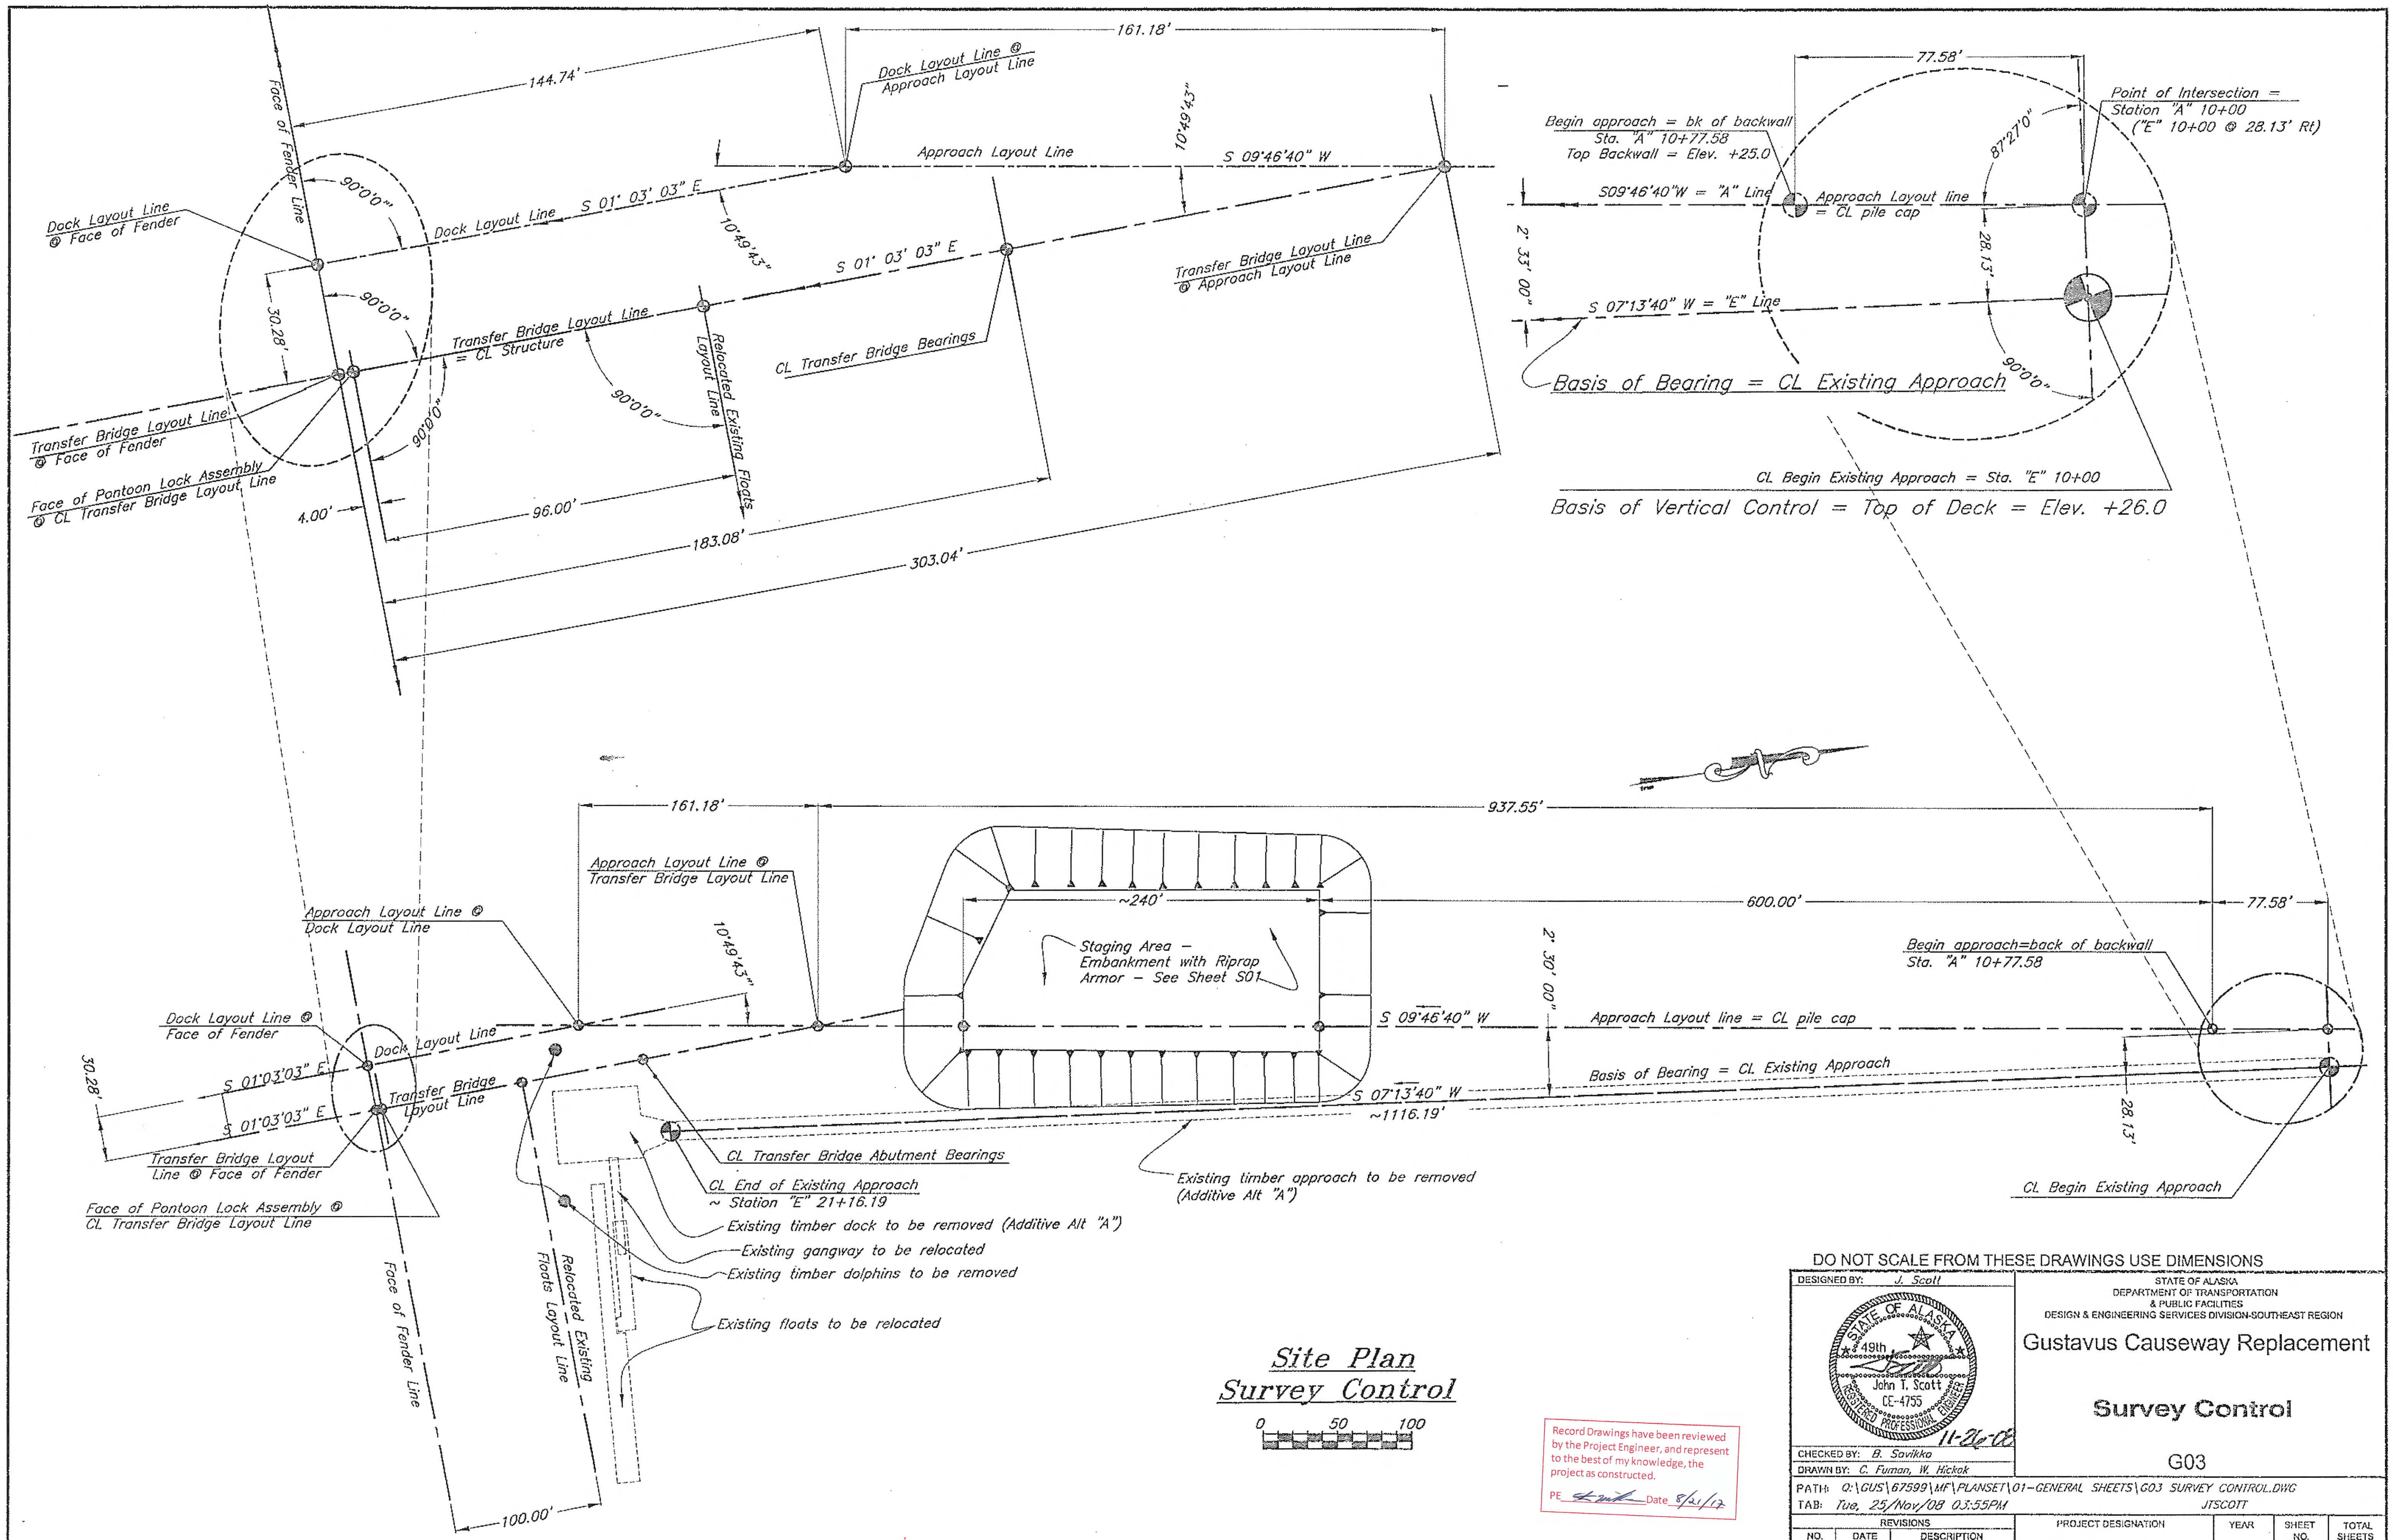


**Site Plan
Survey Control**



Record Drawings have been reviewed by the Project Engineer, and represent to the best of my knowledge, the project as constructed.
PE *[Signature]* Date 8/21/12

DO NOT SCALE FROM THESE DRAWINGS USE DIMENSIONS

DESIGNED BY: J. Scott		STATE OF ALASKA DEPARTMENT OF TRANSPORTATION & PUBLIC FACILITIES DESIGN & ENGINEERING SERVICES DIVISION-SOUTHEAST REGION				
		Gustavus Causeway Replacement				
		Survey Control				
CHECKED BY: B. Savikko		G03				
DRAWN BY: C. Fuman, W. Hickok		PATH: Q:\GUS\67599\MF\PLANSET\01-GENERAL SHEETS\G03 SURVEY CONTROL.DWG				
TAB: Tue, 25/Nov/08 03:55PM		JISCOTT				
REVISIONS		PROJECT DESIGNATION	YEAR	SHEET NO.	TOTAL SHEETS	
NO.	DATE	DESCRIPTION	BR-0003(53)/67599	2008	03	138

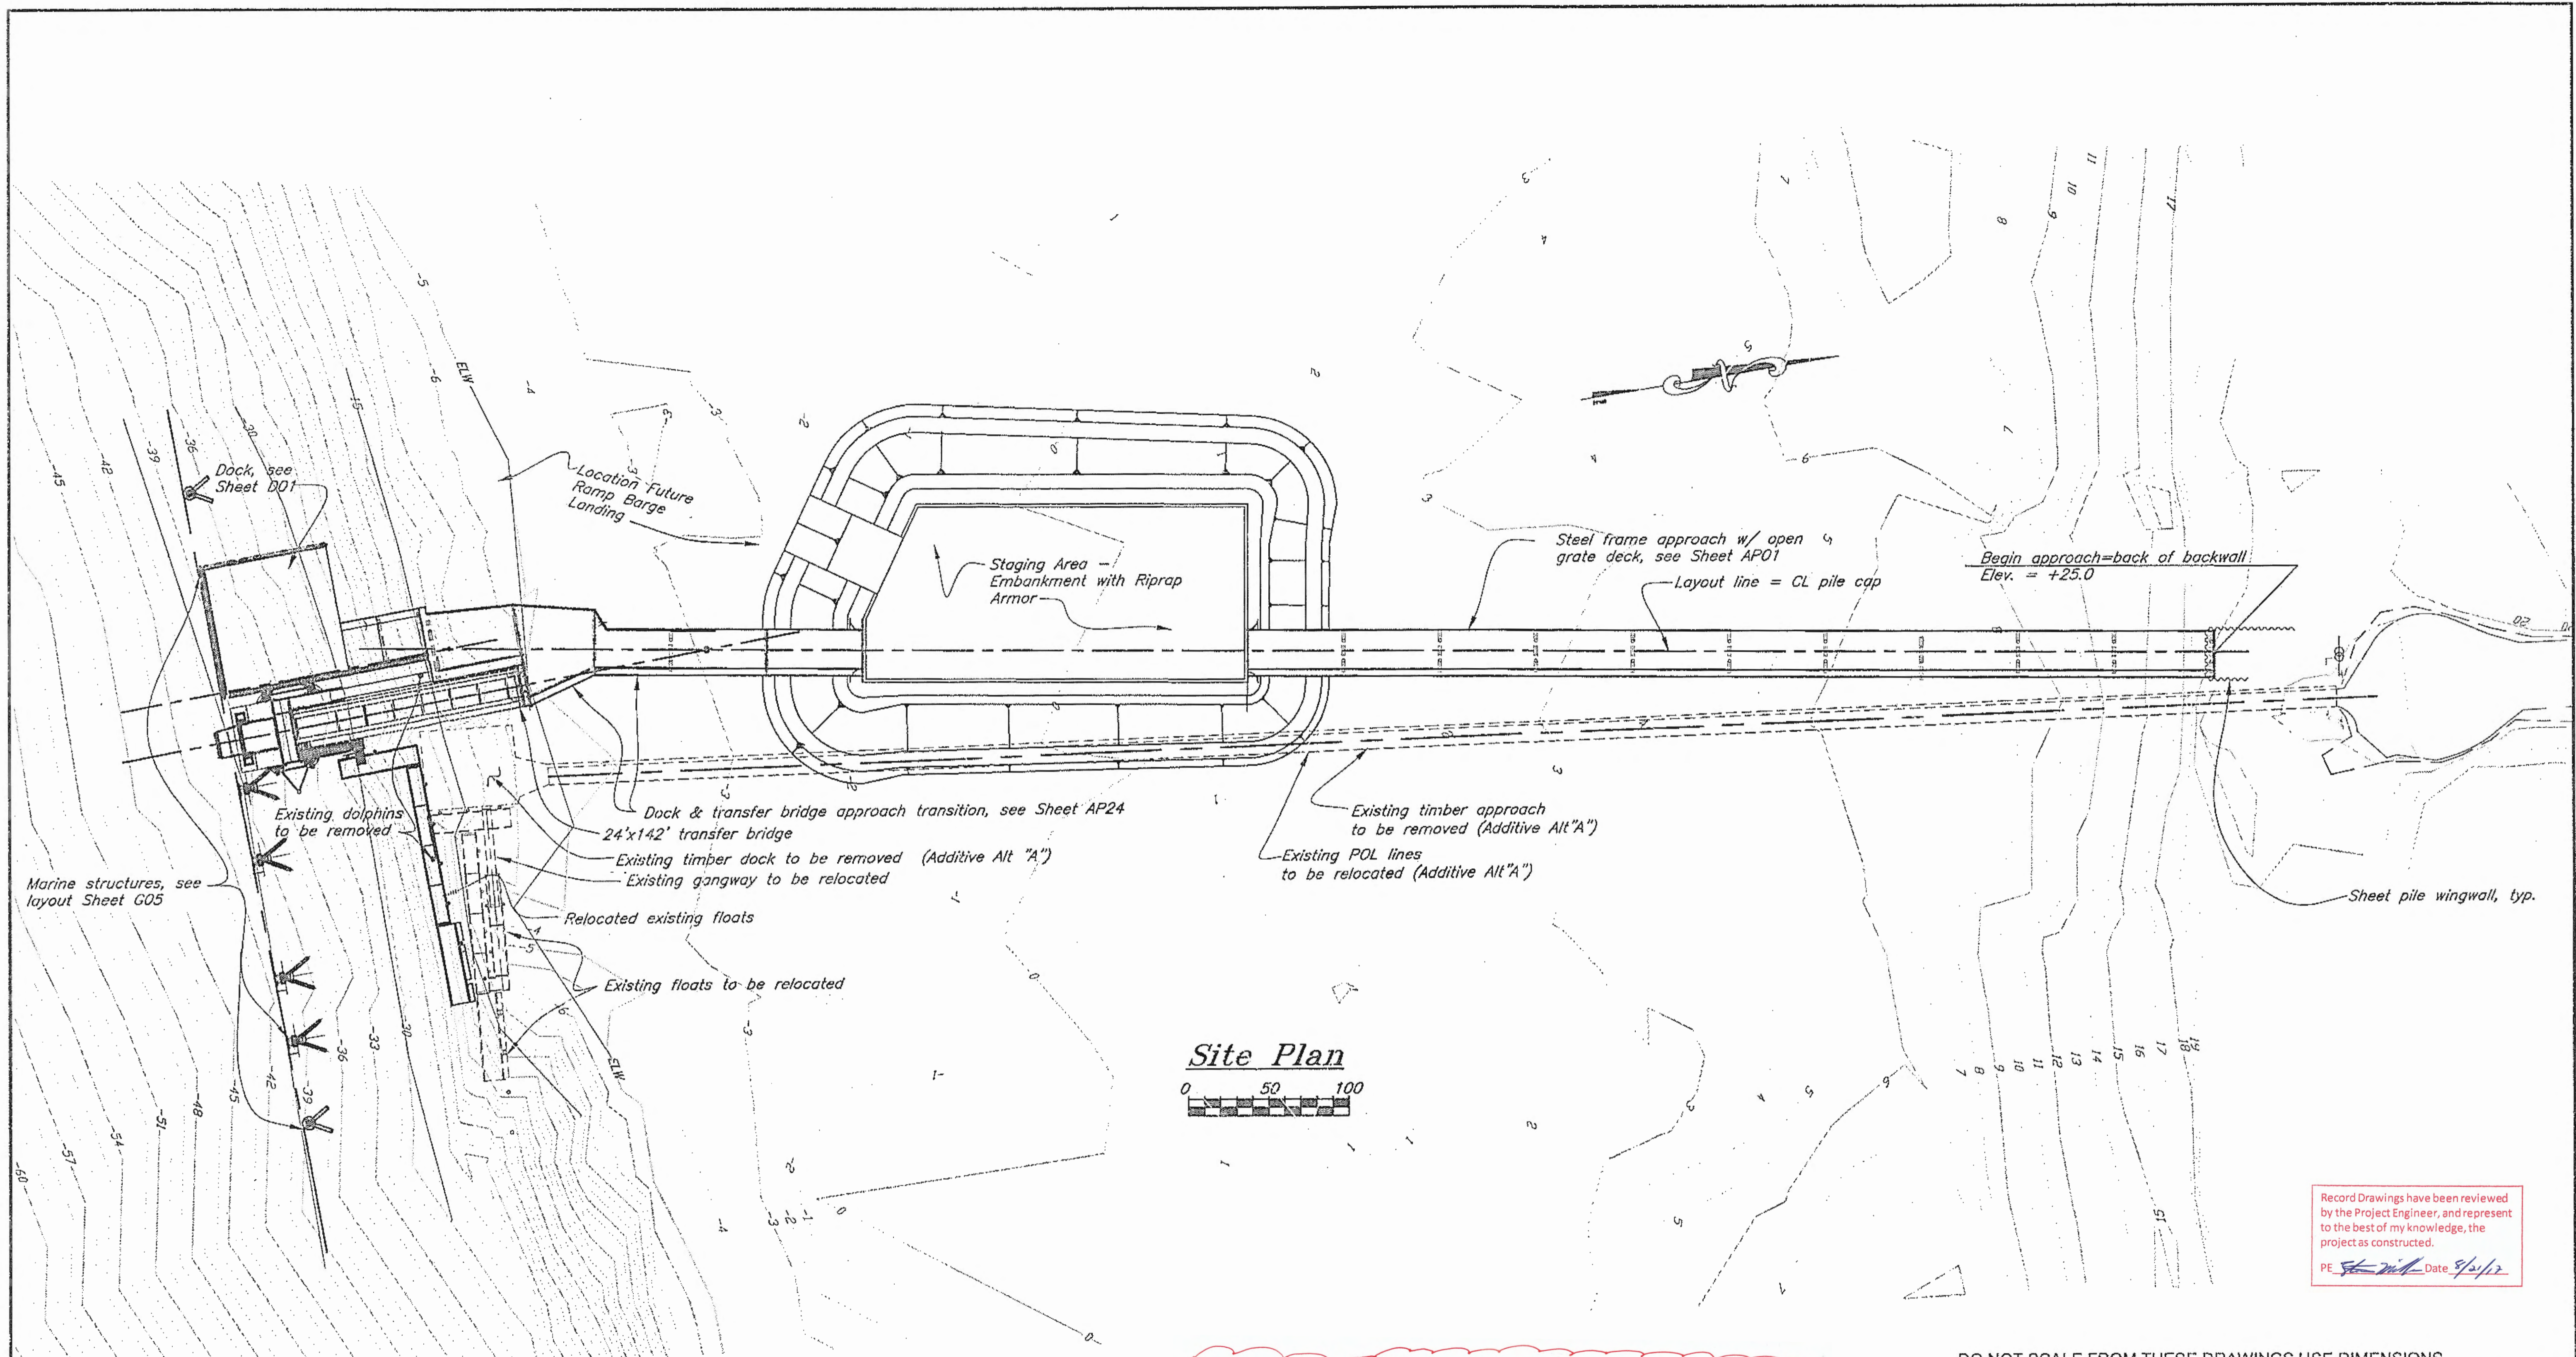

Site Plan
0 50 100

Record Drawings have been reviewed by the Project Engineer, and present to the best of my knowledge, the project as constructed.
PE *[Signature]* Date 4/2/12

Note: Several cut-off piling stubs are visible at lower tide stages seaward of the existing abutment toe of slope. These stubs are to remain and are not included in the scope of work under Section 202.

Tidal Data	
HTL	= +20.0
MHW	= +13.7
MLLW	= 0.0
ELW (Est.)	= -5.0

DO NOT SCALE FROM THESE DRAWINGS USE DIMENSIONS

DESIGNED BY: *J. Scott*

STATE OF ALASKA
DEPARTMENT OF TRANSPORTATION & PUBLIC FACILITIES
DESIGN & ENGINEERING SERVICES DIVISION-SOUTHEAST REGION


Gustavus Causeway Replacement

Site Plan G04

CHECKED BY: *B. Savikko*
DRAWN BY: *C. Fuman, W. Hickok*
PATH: Q:\GUS\67599\MF\PLANSET\01--GENERAL SHEETS\G04 SITE PLAN.DWG
TAB: Tue, 25/Nov/08 03:57PM JISCOIT

11-26-08
John T. Scott
CE-4755
REGISTERED PROFESSIONAL ENGINEER

REVISIONS		PROJECT DESIGNATION	YEAR	SHEET NO.	TOTAL SHEETS
NO.	DATE				
		BR-0003(53)/67599	2008	04	138

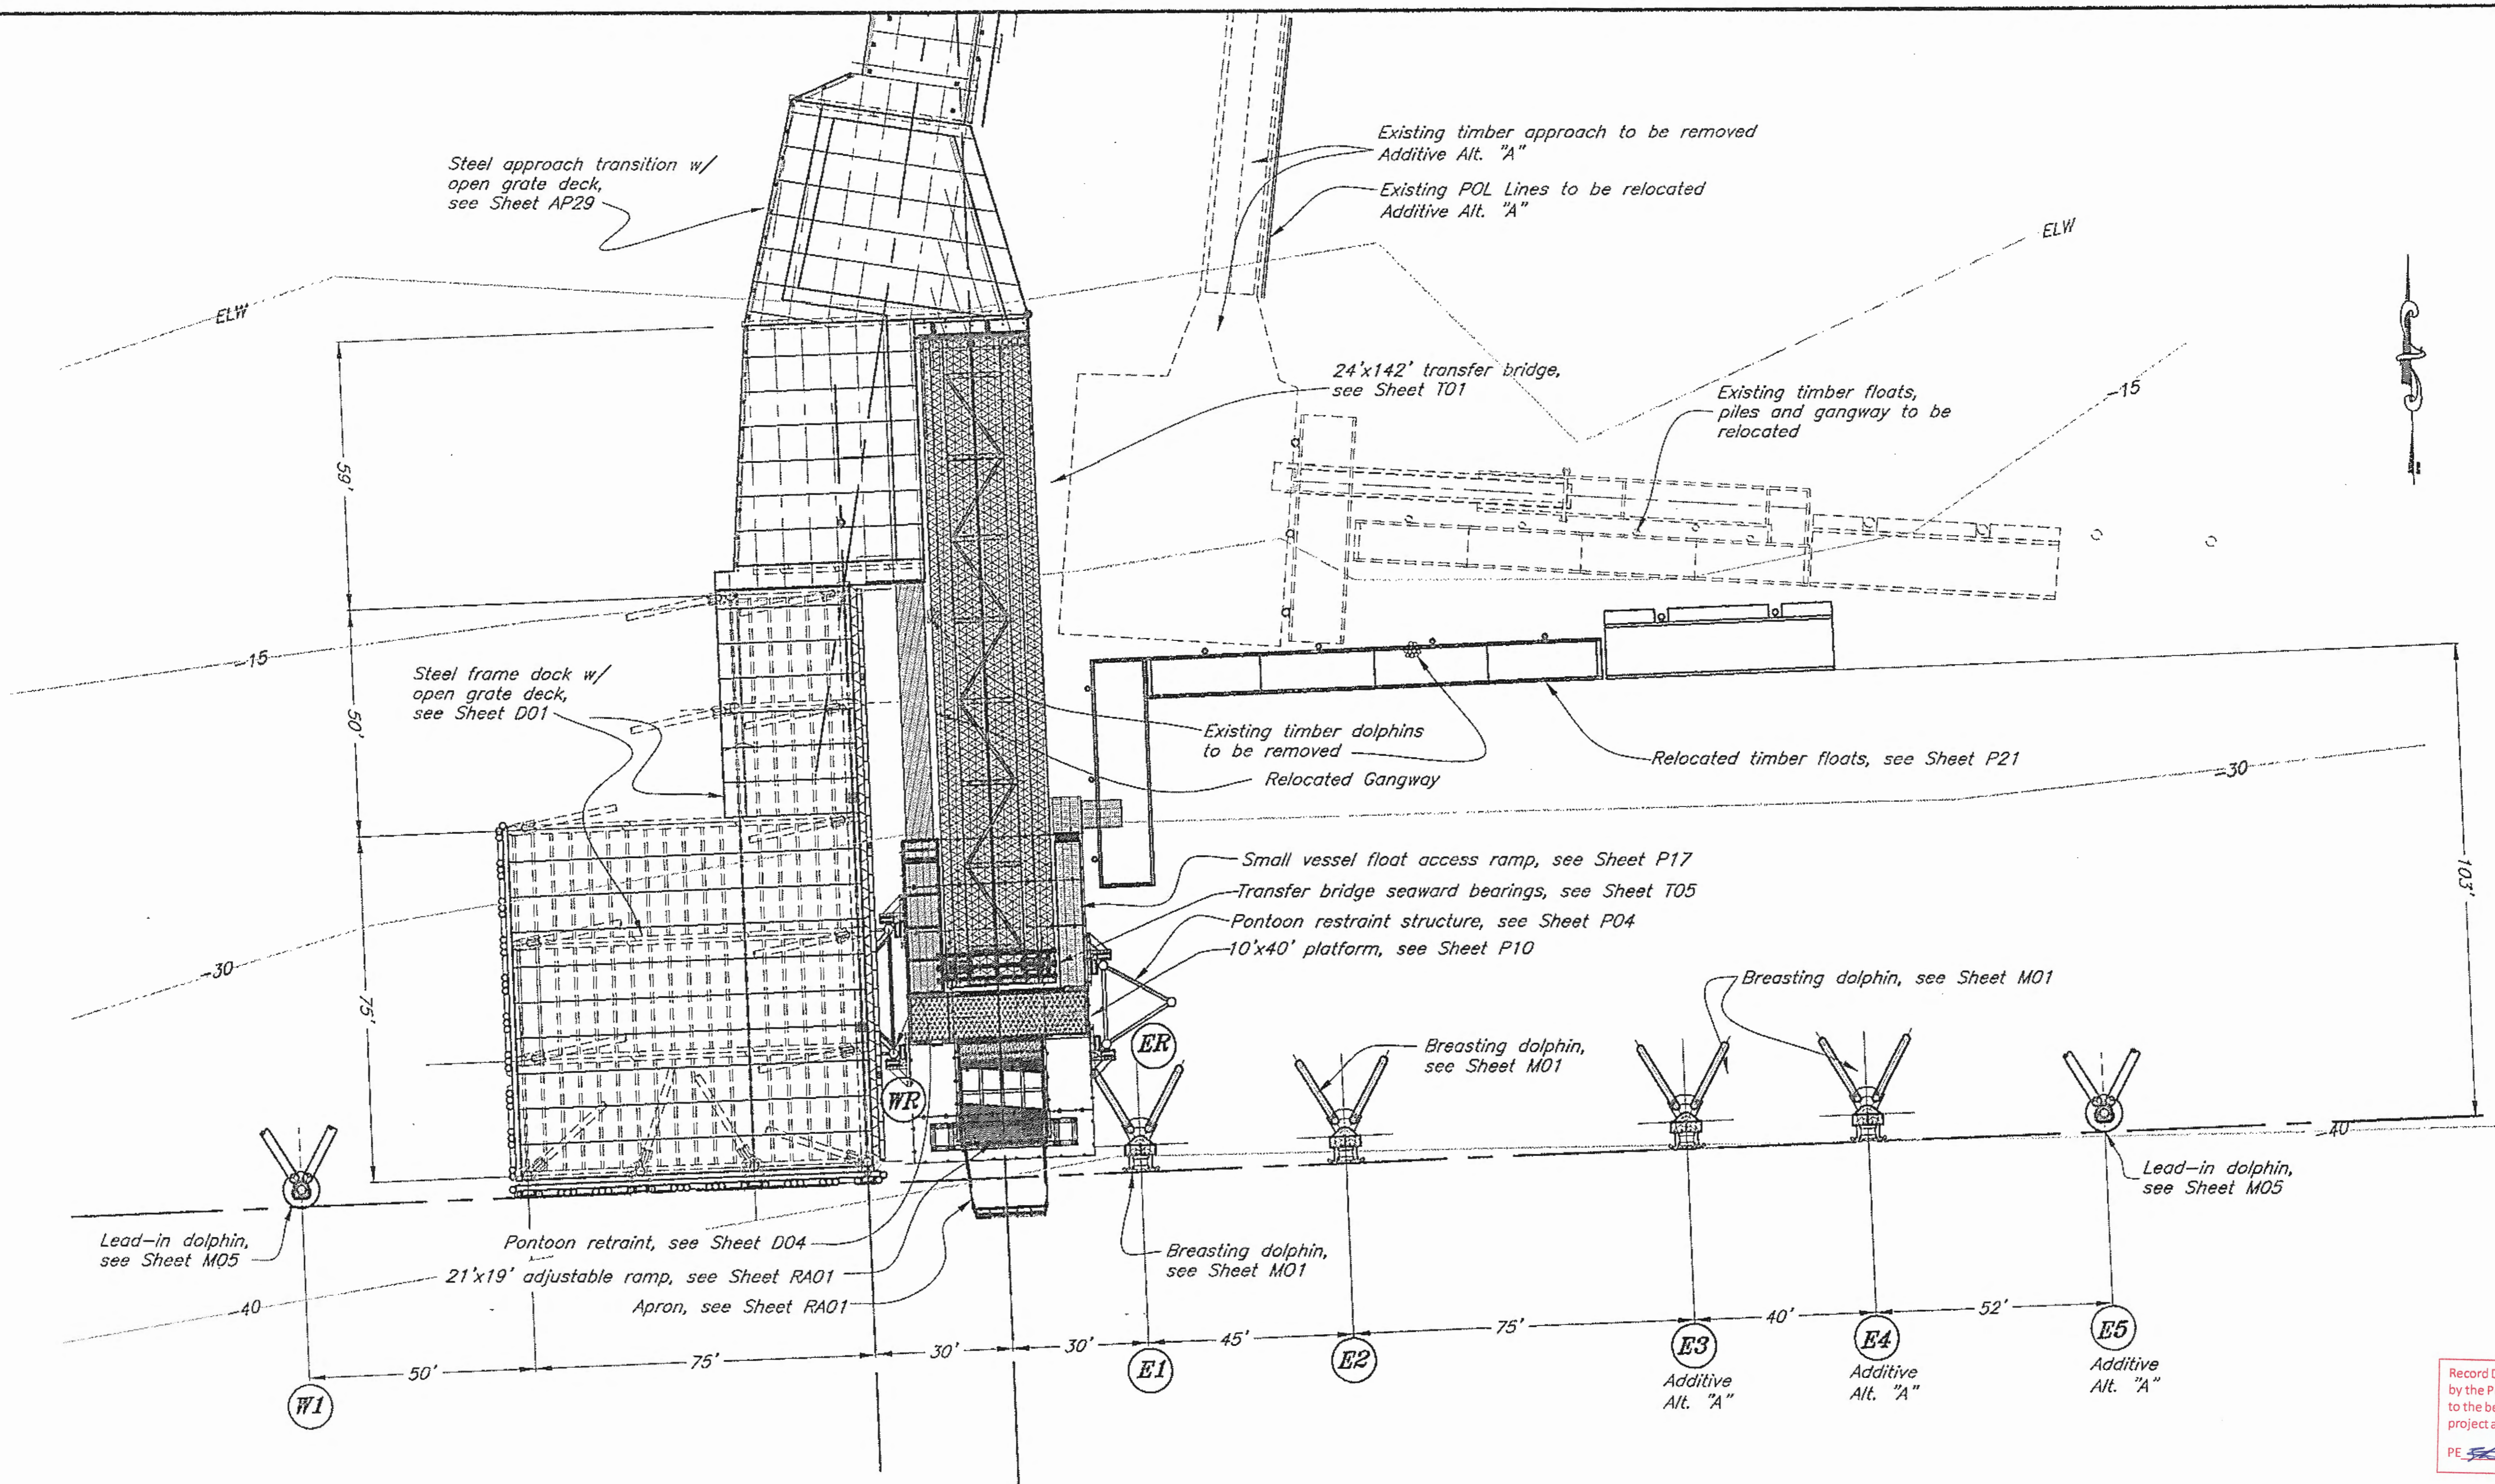




Record Drawings have been reviewed by the Project Engineer, and represent to the best of my knowledge, the project as constructed.
 PE *[Signature]* Date 9/21/12

Marine Layout
 0 10 20 30 40


Tidal Data	
HTL =	+20.0
MHW =	+13.7
MLLW =	0.0
ELW (Est.) =	-5.0

DO NOT SCALE FROM THESE DRAWINGS USE DIMENSIONS


DESIGNED BY: J. Scott	STATE OF ALASKA DEPARTMENT OF TRANSPORTATION & PUBLIC FACILITIES DESIGN & ENGINEERING SERVICES DIVISION-SOUTHEAST REGION					
	Gustavus Causeway Replacement					
	Marine Site Plan G05					
CHECKED BY: B. Savikko	11-26-08					
DRAWN BY: C. Fuman, W. Hickok						
PATH: Q:\GUS\67599\MF\PLANSET\01-GENERAL SHEETS\G05 MARINE SITE PLAN.DWG						
TAB: Tue, 25/Nov/08 03:58PM	JTSCOTT					
REVISIONS		PROJECT DESIGNATION	YEAR	SHEET NO.	TOTAL SHEETS	
NO.	DATE	DESCRIPTION	BR-0003(53)/67599	2008	05	138

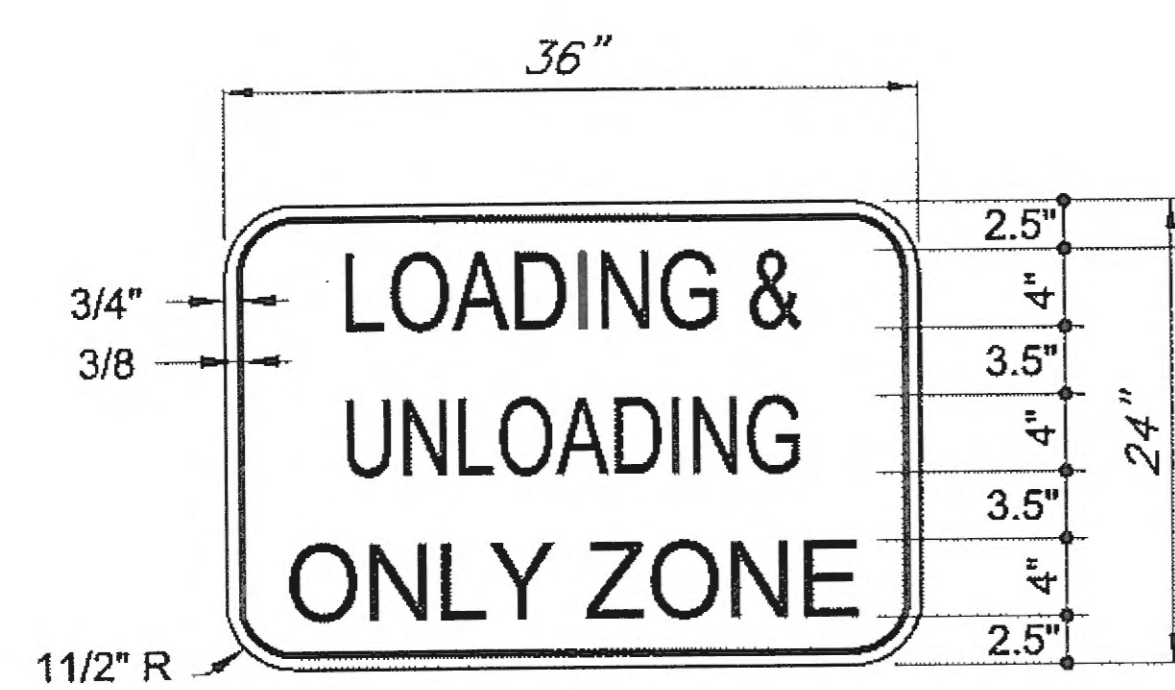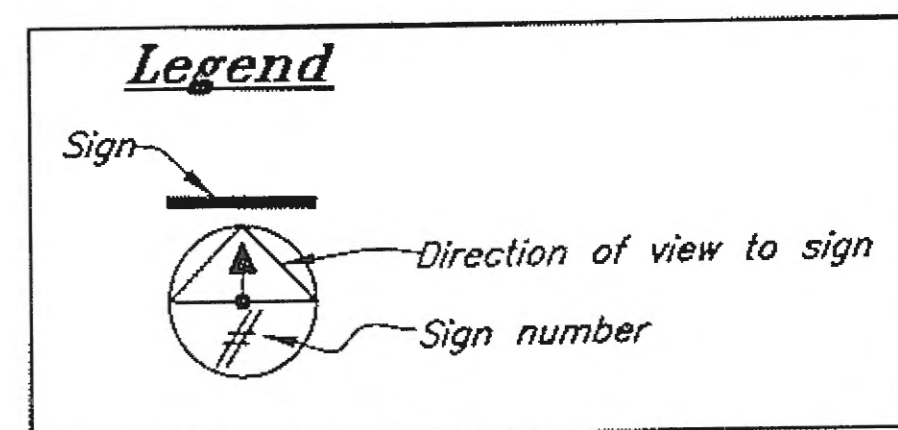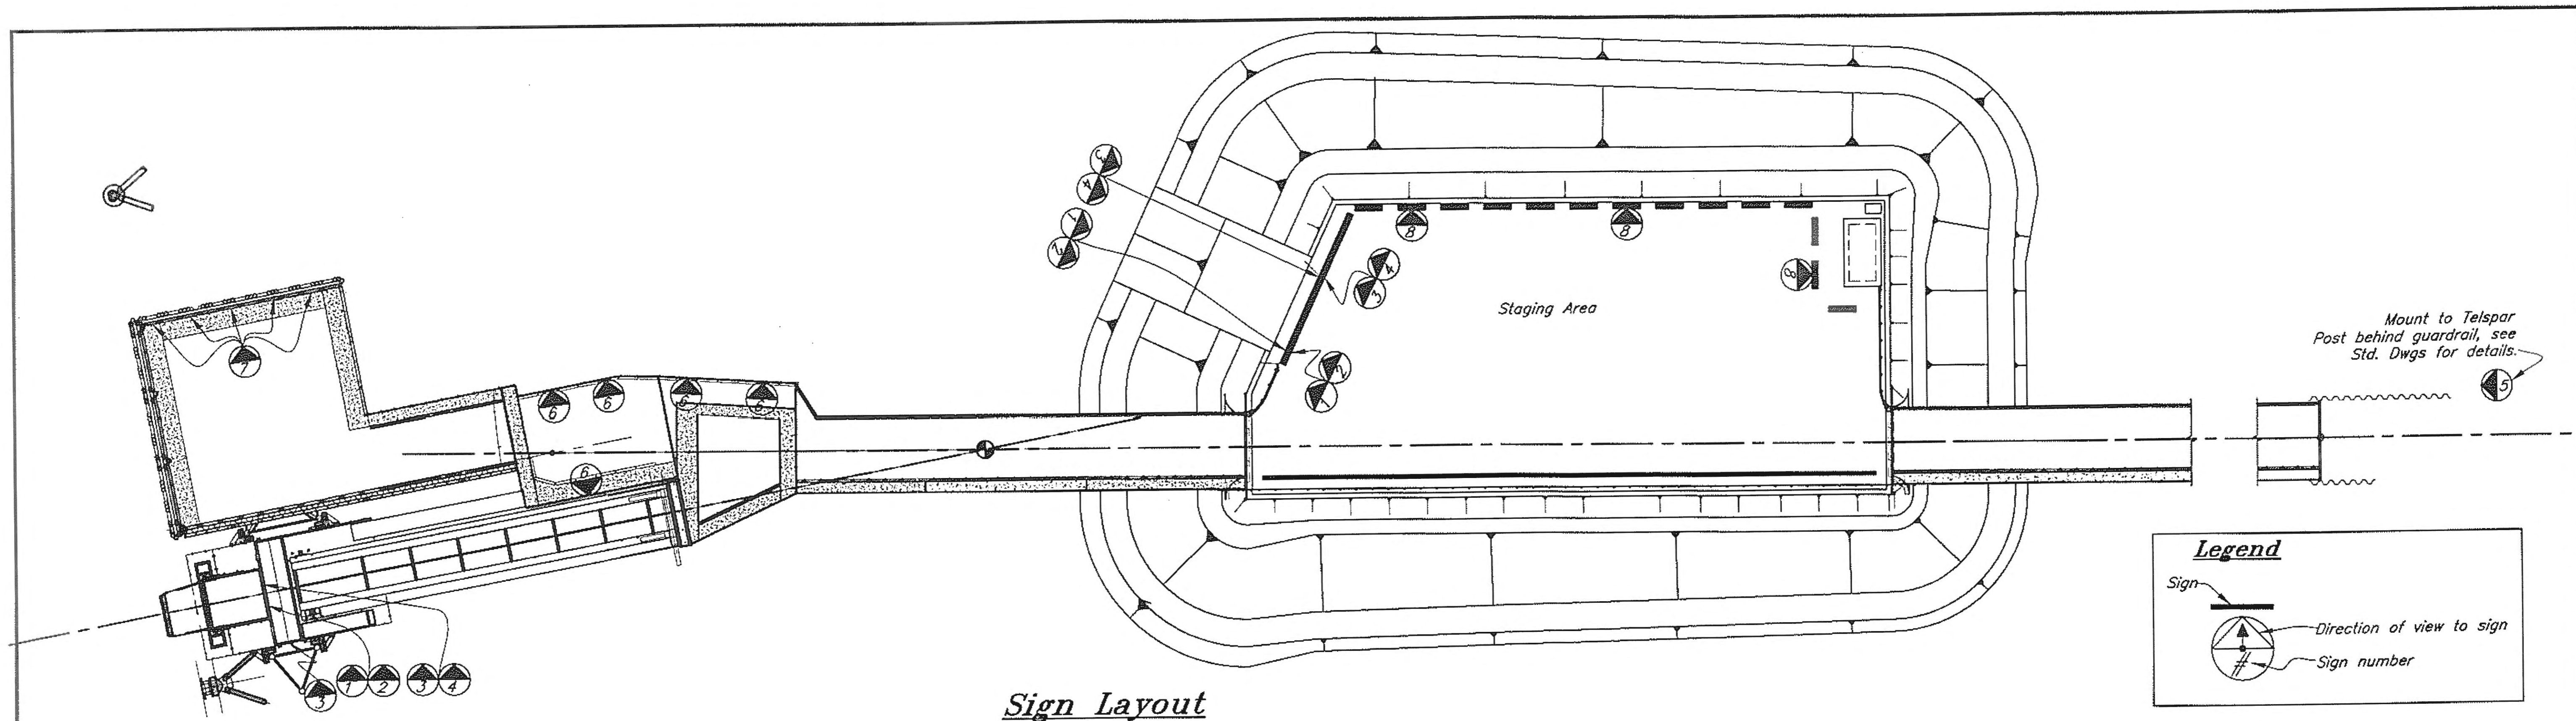

6 SPECIAL SIGN
DETAIL
(4 Req'd)

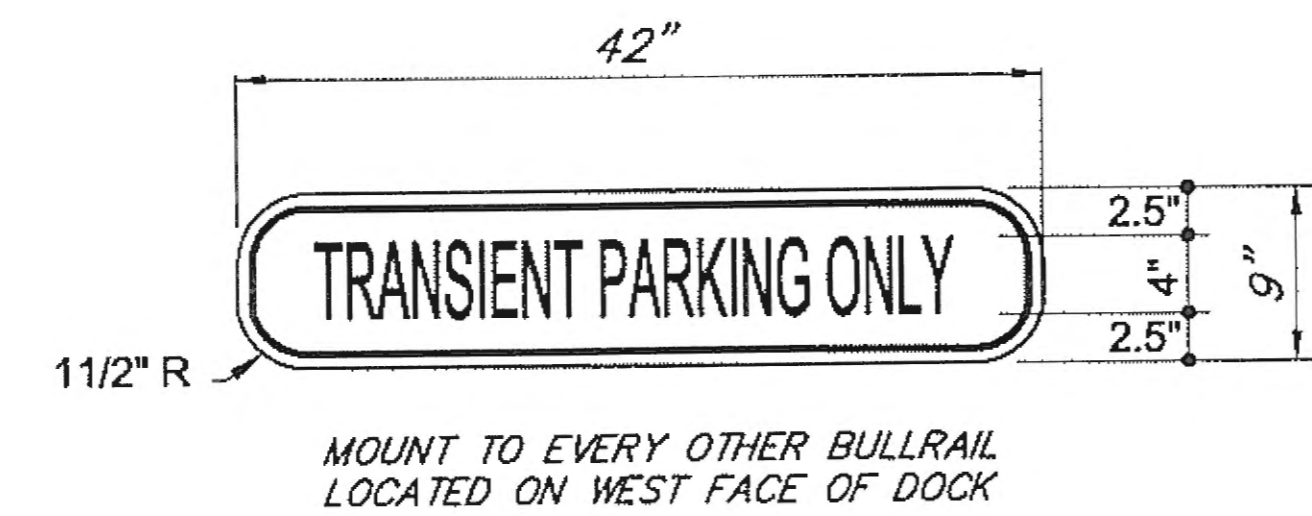

7 SPECIAL SIGN
DETAIL
(5 Req'd)

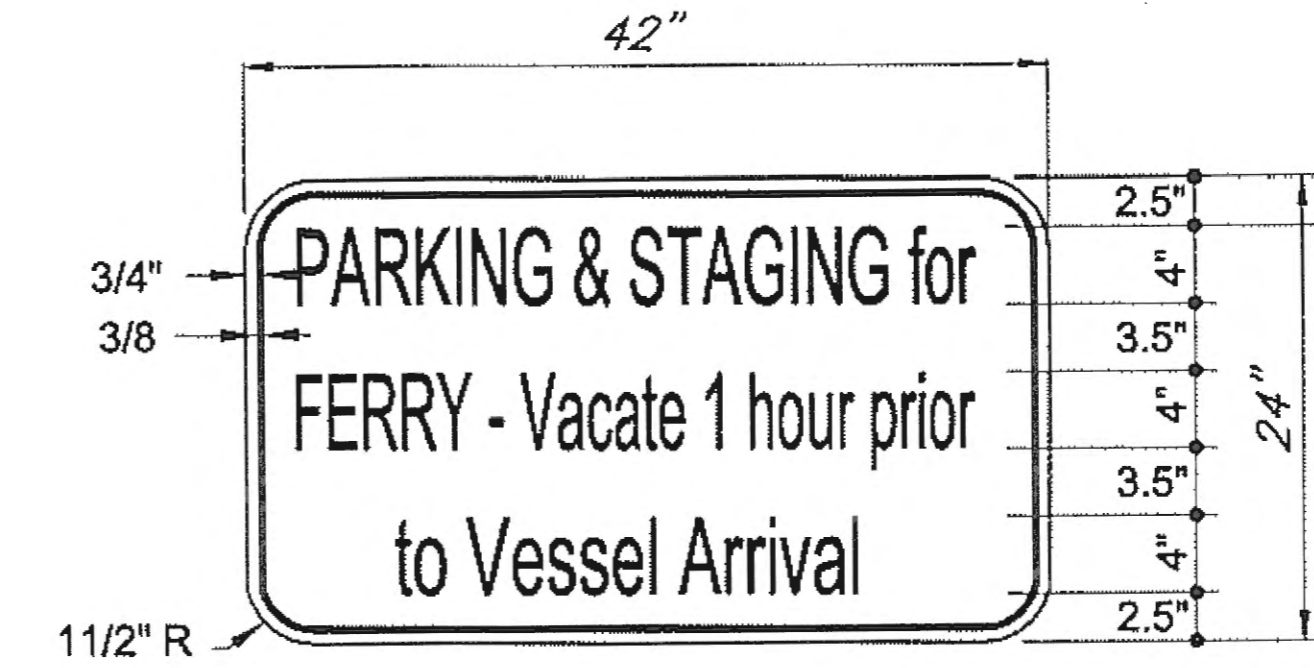



8 SPECIAL SIGN
DETAIL
(5 Req'd)

- SPECIAL SIGN NOTES:**
1. SPECIAL SIGNS 6-9: BORDER, LEGEND AND LETTERING ARE GREEN WITH BACKGROUND WHITE.
 2. CENTER TEXT ON ALL SIGNS.
 3. SIGNS ARE INCIDENTAL TO OTHER ITEMS OF WORK.
 4. MOUNT SIGNS TO FENCE FABRIC (HOG RINGS @ EACH CORNER) OR FENCE POSTS (U-BOLTS AND HARDWARE), AS REQUIRED

Record Drawings have been reviewed by the Project Engineer, and represent to the best of my knowledge, the project as constructed.
PE *[Signature]* Date 8/21/12


DO NOT SCALE FROM THESE DRAWINGS USE DIMENSIONS

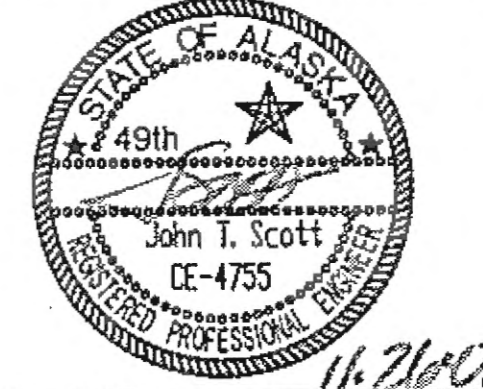DESIGNED BY: <i>J. Scott</i>  CHECKED BY: <i>B. Savikko</i> DRAWN BY: <i>C. Fuman, W. Hickey</i>	STATE OF ALASKA DEPARTMENT OF TRANSPORTATION & PUBLIC FACILITIES DESIGN & ENGINEERING SERVICES DIVISION-SOUTHEAST REGION Gustavus Causeway Replacement Signs & Sign Locations G06
PATH: O:\GUS\67599\MF\PLANSET\01-GENERAL SHEETS\G06 SIGN LOCATION.DWG TAB: Tue, 25/Nov/08 04:00PM PROJECT DESIGNATION: BR-0003(53)/67599 YEAR: 2008 SHEET NO.: 06 TOTAL SHEETS: 138	

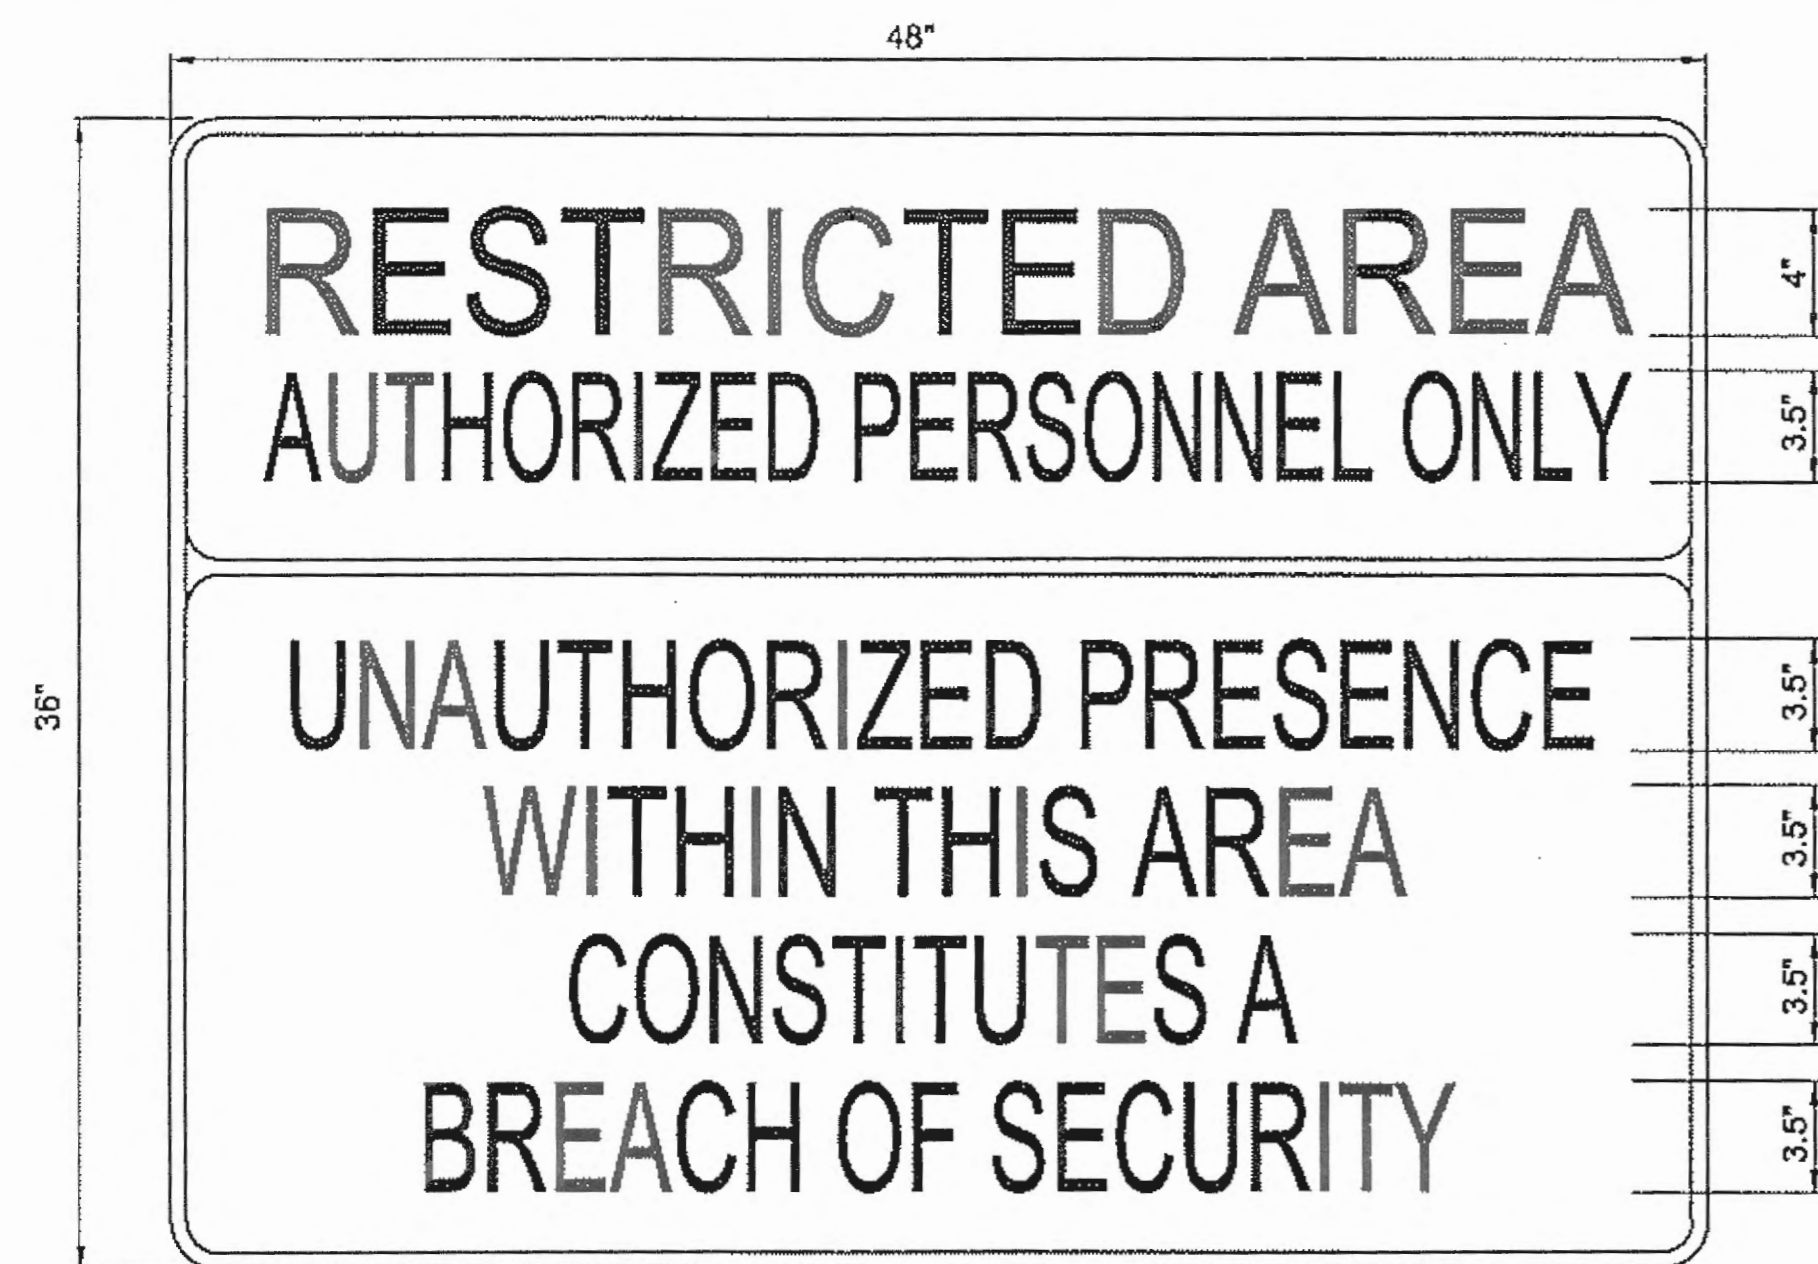


.080 ALUMINUM PANEL
(WHITE LETTERING ON A RED BACKGROUND)

1 SPECIAL LARGE RESTRICTED AREA SIGN DETAILS
(3 Req'd.)

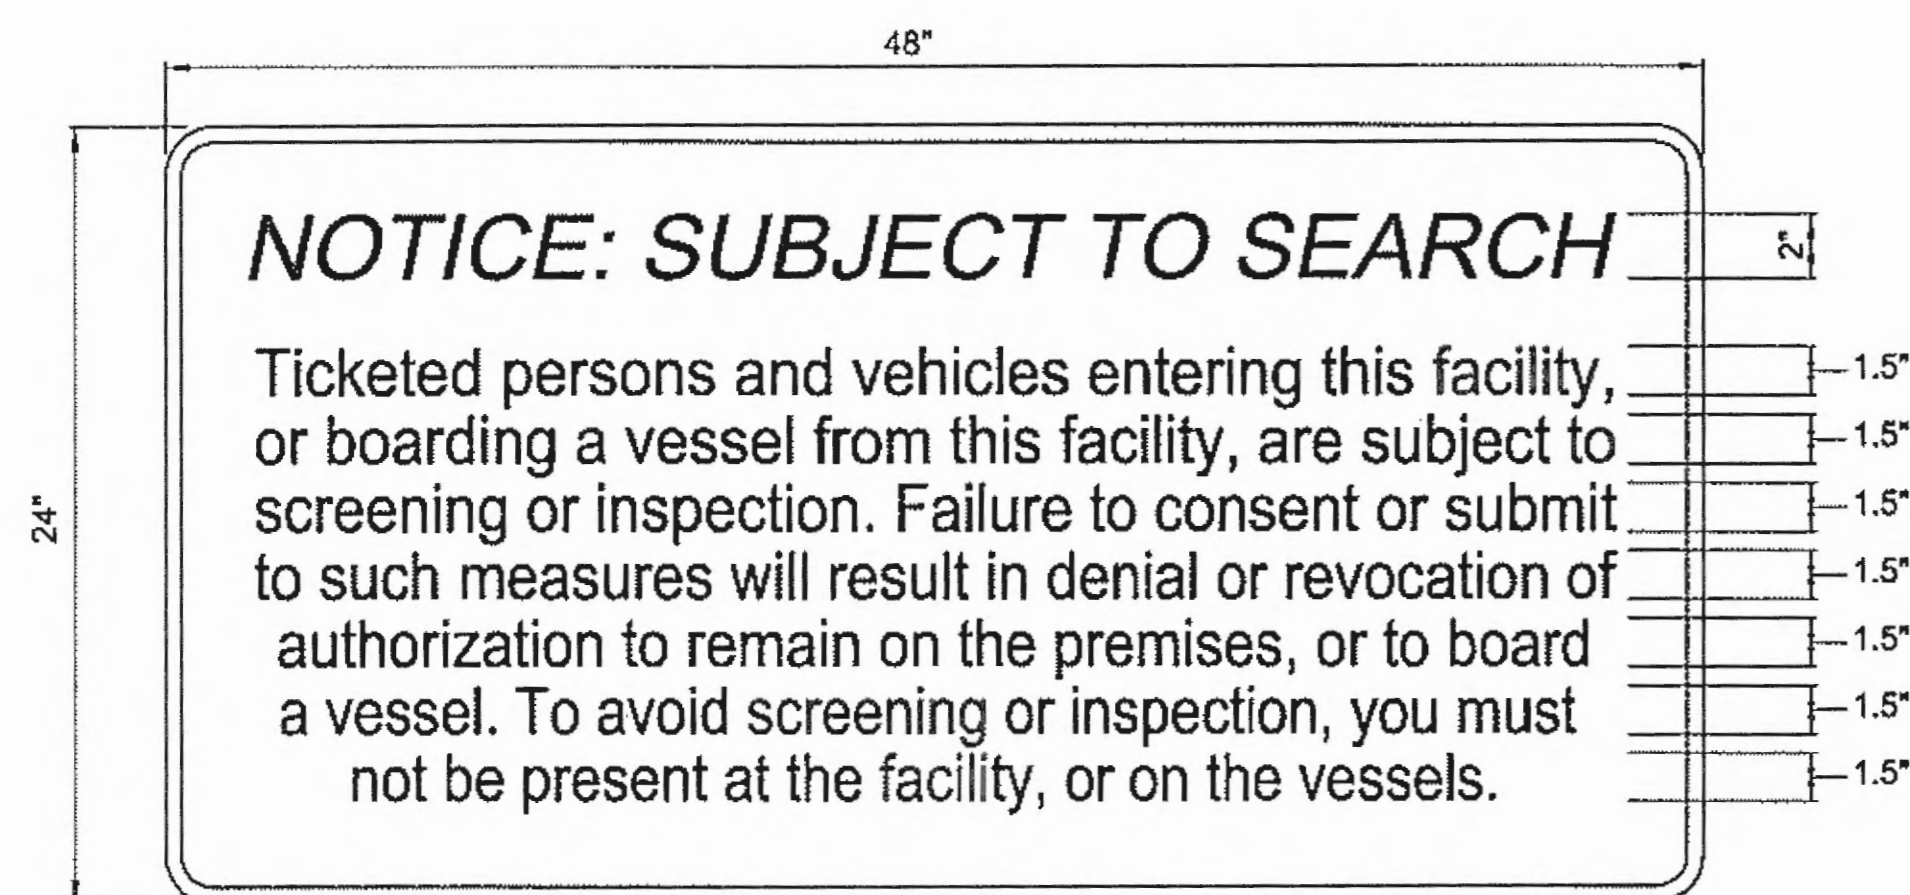


.080 ALUMINUM PANEL
(WHITE LETTERING ON A RED BACKGROUND)

2 SPECIAL SUBJECT TO SEARCH SIGN DETAILS
(3 Req'd.)

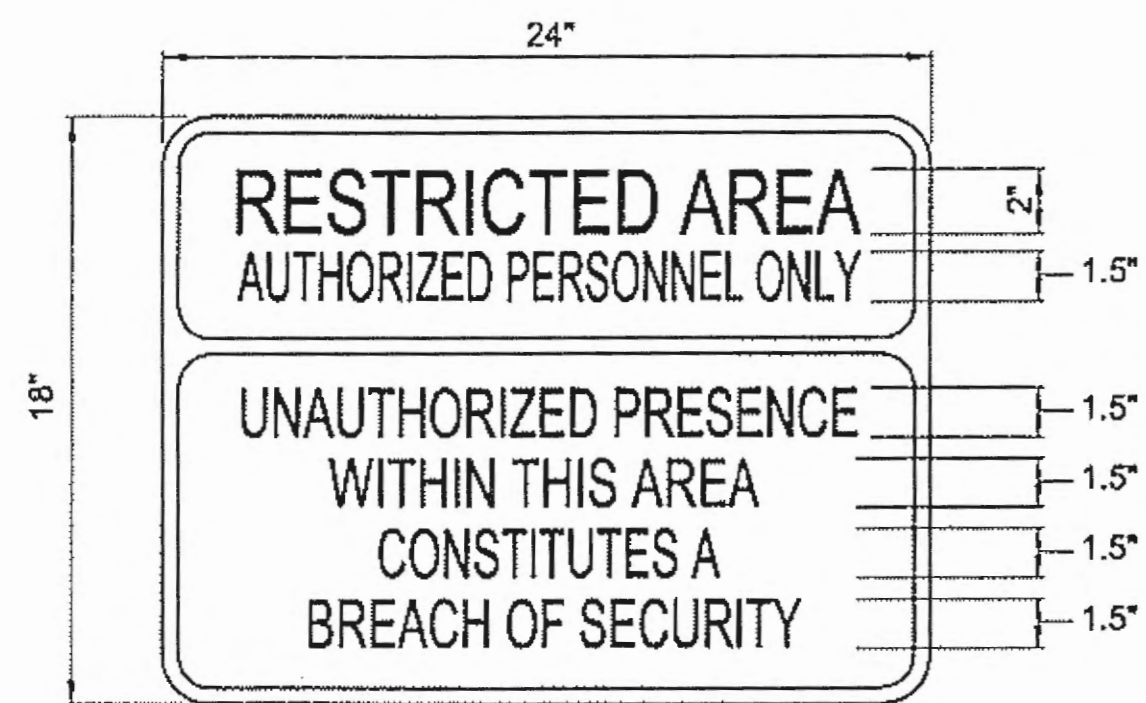


.080 ALUMINUM PANEL
(WHITE LETTERING ON A RED BACKGROUND)

3 SPECIAL SMALL RESTRICTED AREA SIGN DETAILS
(4 Req'd.)

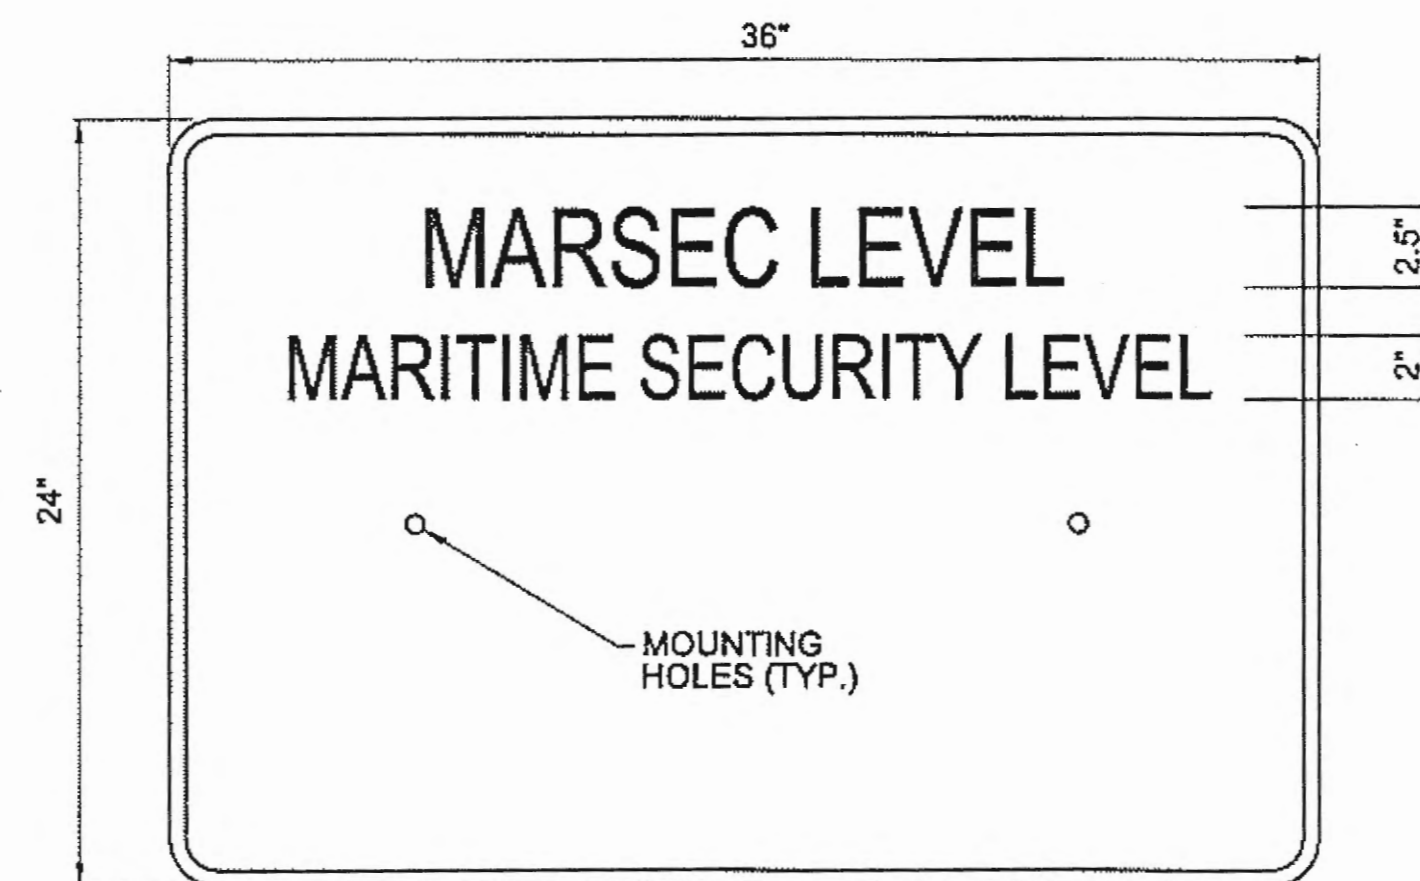


.080 ALUMINUM PANEL
(WHITE LETTERING ON A GREEN BACKGROUND)

4 MARSEC SIGN DETAILS
(3 Req'd.)

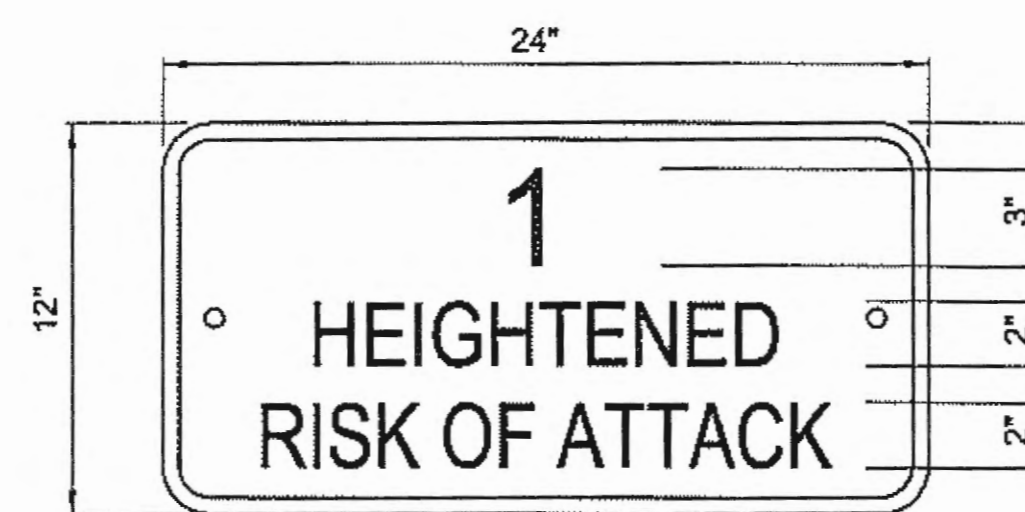


.040 ALUMINUM PANEL
(BLACK LETTERING ON A YELLOW BACKGROUND)

A (3 Req'd.)

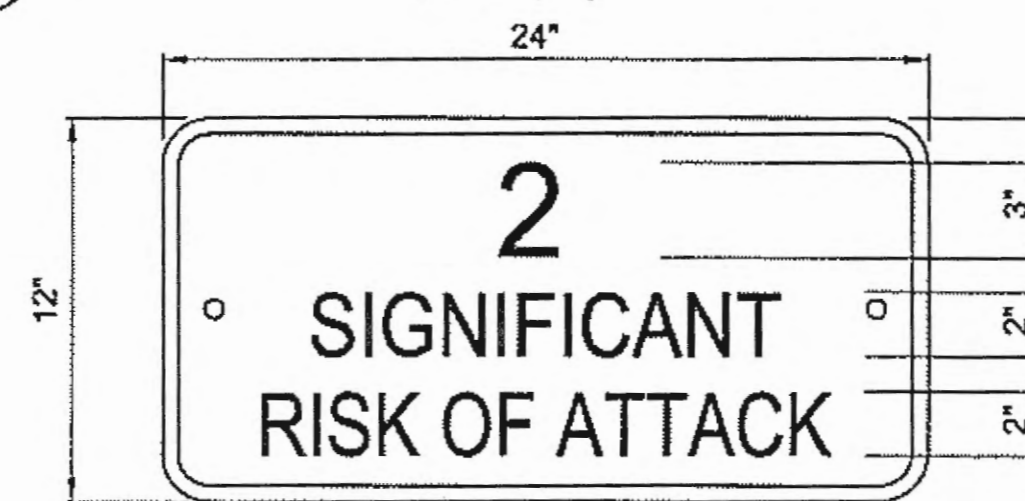


.040 ALUMINUM PANEL
(BLACK LETTERING ON A ORANGE BACKGROUND)

B (3 Req'd.)

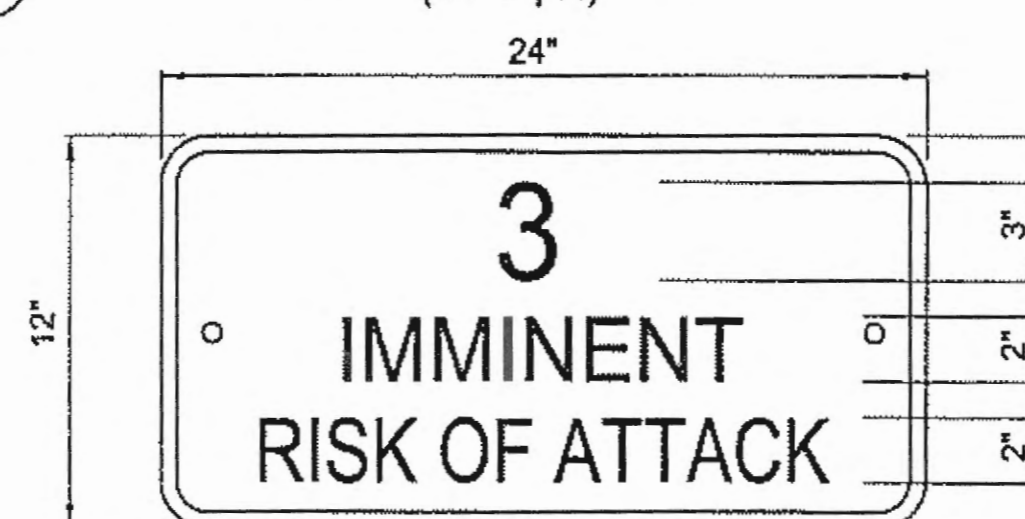

.040 ALUMINUM PANEL
(WHITE LETTERING ON A RED BACKGROUND)

C (3 Req'd.)

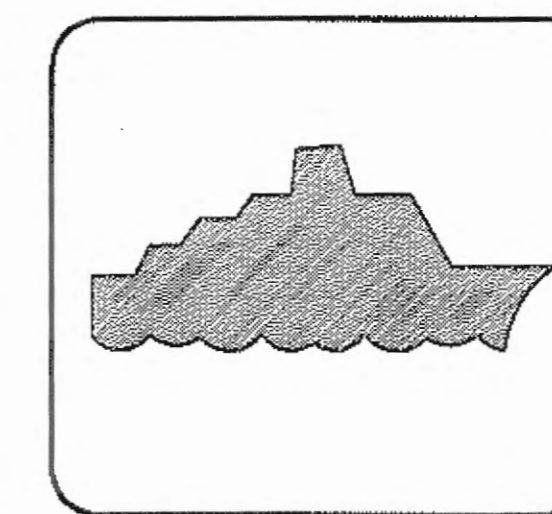

24"x21"




21"x6"

5 SPECIAL SIGN DETAILS
(1 Req'd.)

Record Drawings have been reviewed by the Project Engineer, and represent to the best of my knowledge, the project as constructed.
PE *[Signature]* Date *11/12*


DO NOT SCALE FROM THESE DRAWINGS USE DIMENSIONS

DESIGNED BY: <i>J. Scott</i>		STATE OF ALASKA DEPARTMENT OF TRANSPORTATION & PUBLIC FACILITIES DESIGN & ENGINEERING SERVICES DIVISION-SOUTHEAST REGION			
		Gustavus Causeway Replacement			
		Signs G07			
CHECKED BY: <i>B. Savikko</i>		PROJECT DESIGNATION			
DRAWN BY: <i>C. Fuman, W. Hickok</i>		YEAR			
PATH: <i>O:\GUS\67599\MF\PLANSET\01-GENERAL SHEETS\G07 SIGNS.DWG</i>		SHEET NO.			
TAB: <i>Tue, 25/Nov/08 04:02PM</i>		TOTAL SHEETS			
REVISIONS		PROJECT DESIGNATION			
NO.	DATE	DESCRIPTION	YEAR	SHEET NO.	TOTAL SHEETS
			BR-0003(53)/67599	2008	07
					138

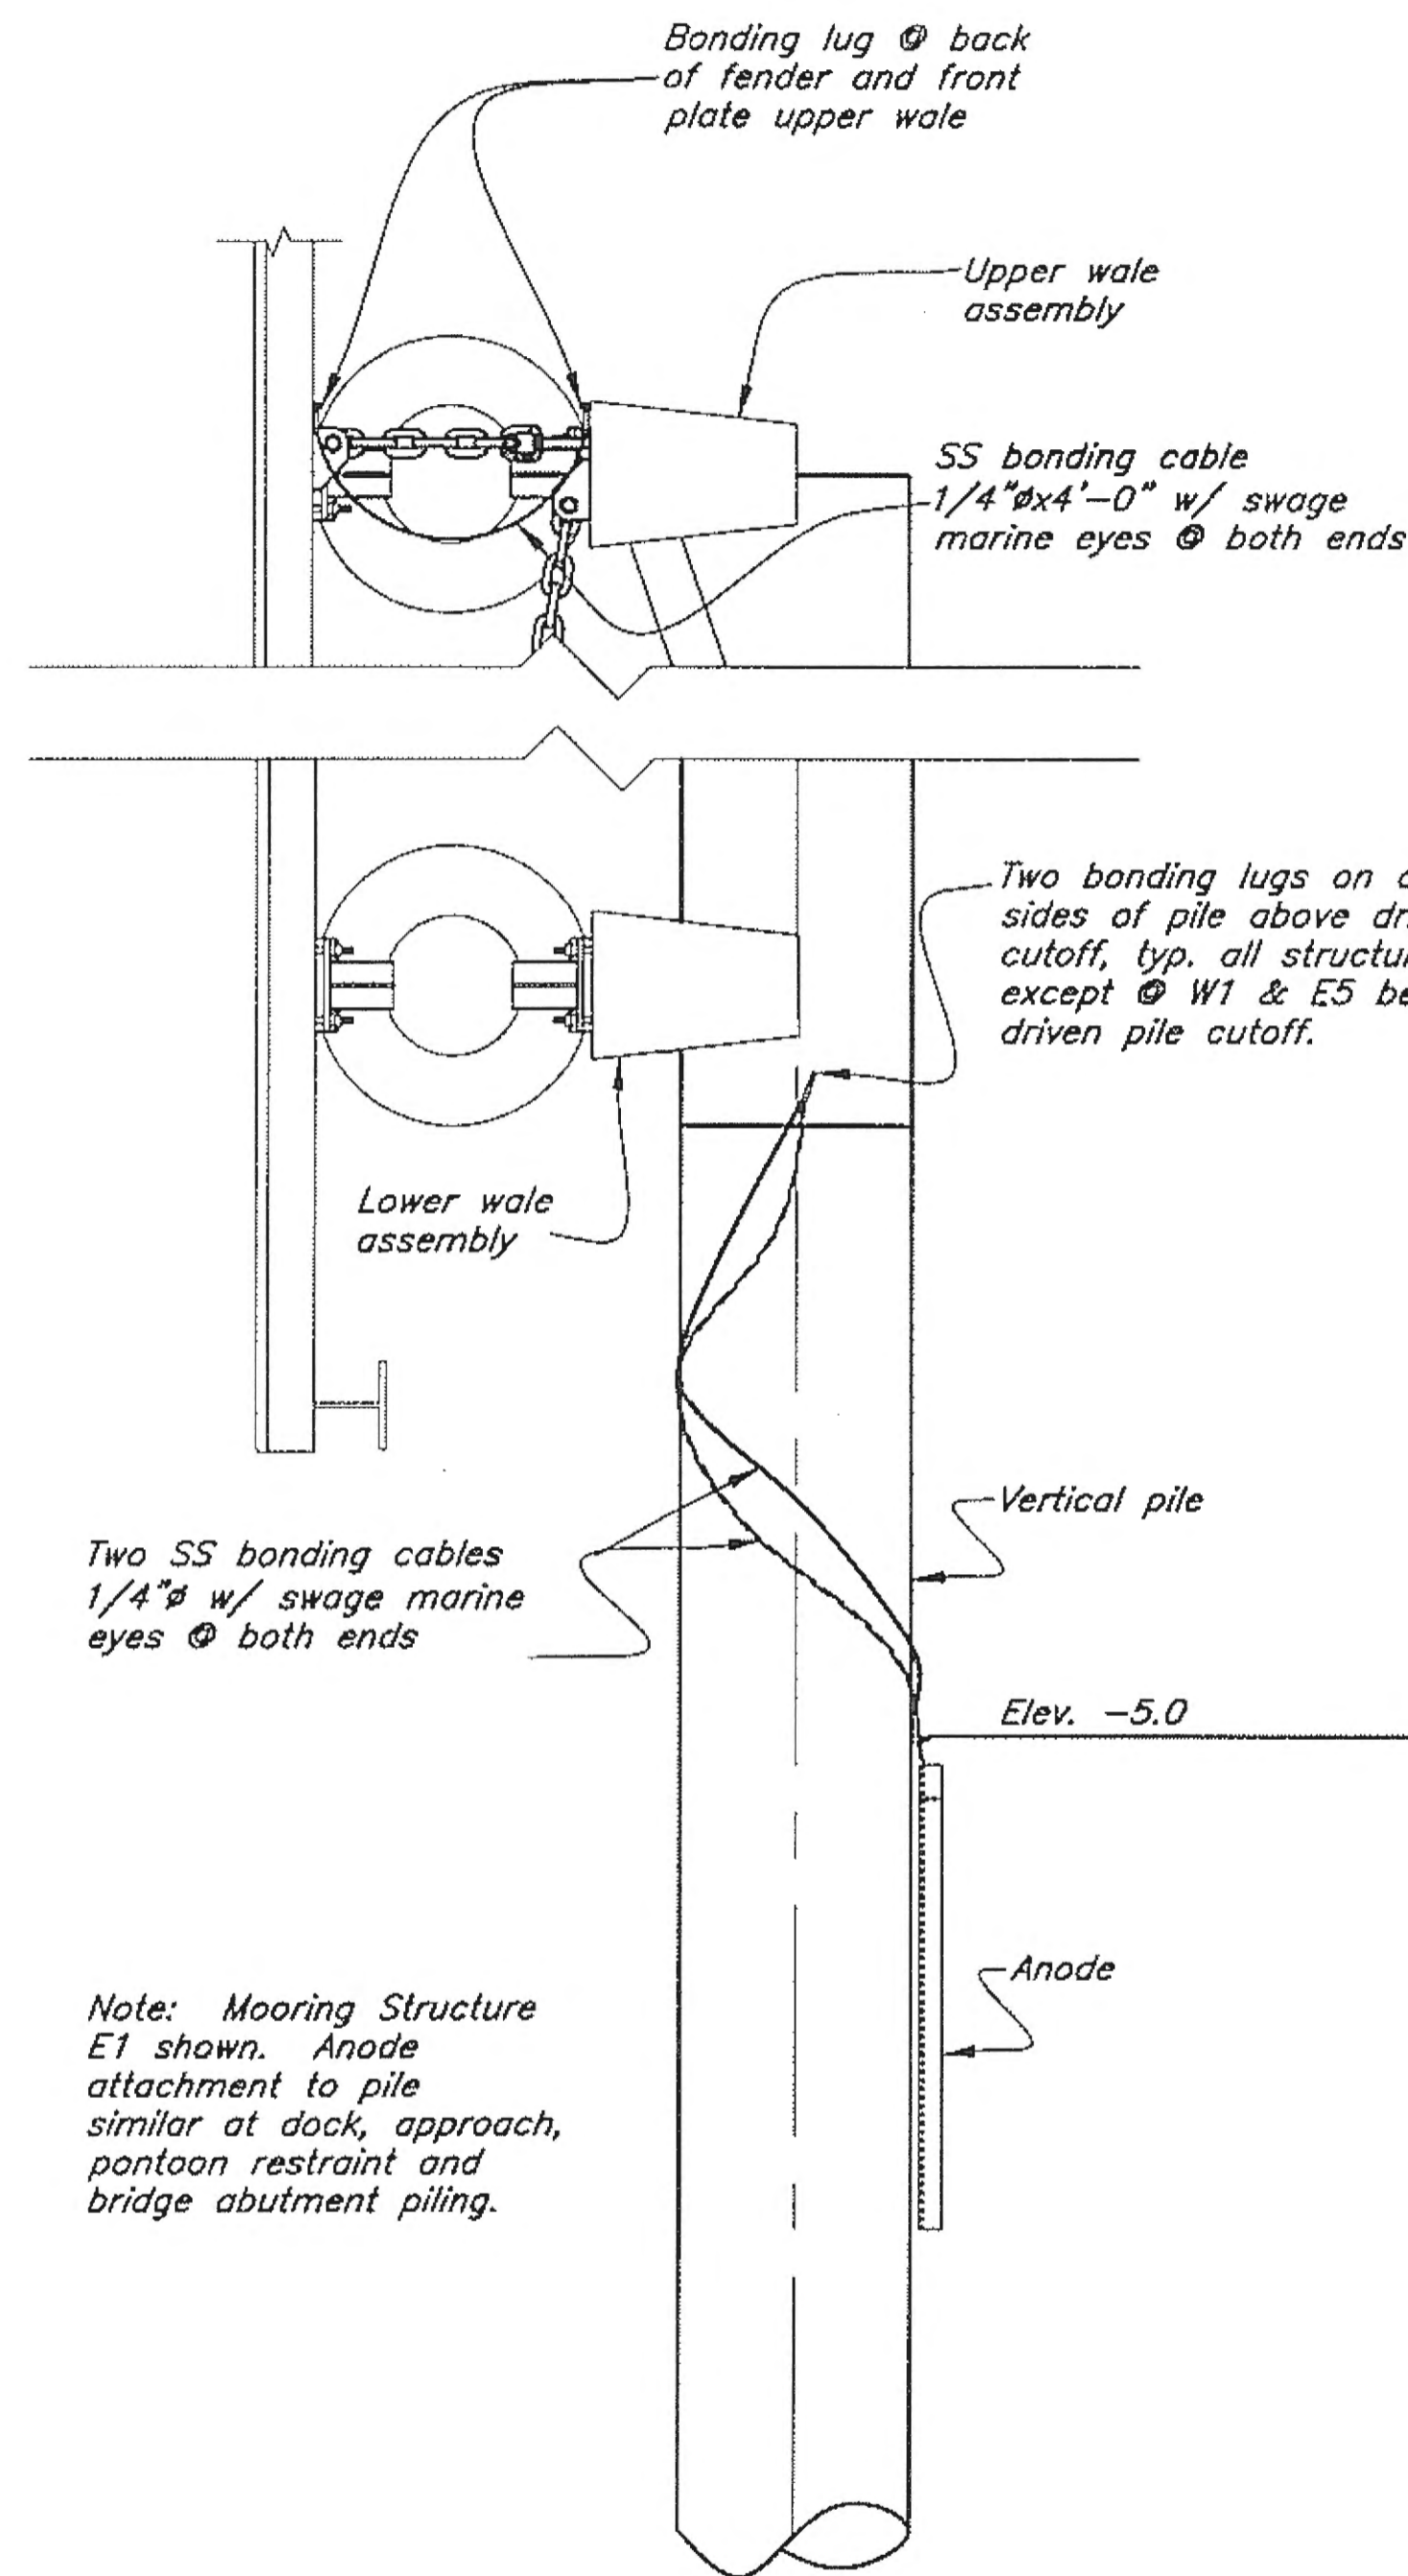


Anode Installation Elevation
Mooring Structure shown

Note: Mooring Structure E1 shown. Anode attachment to pile similar at dock, approach, pontoon restraint and bridge abutment piling.

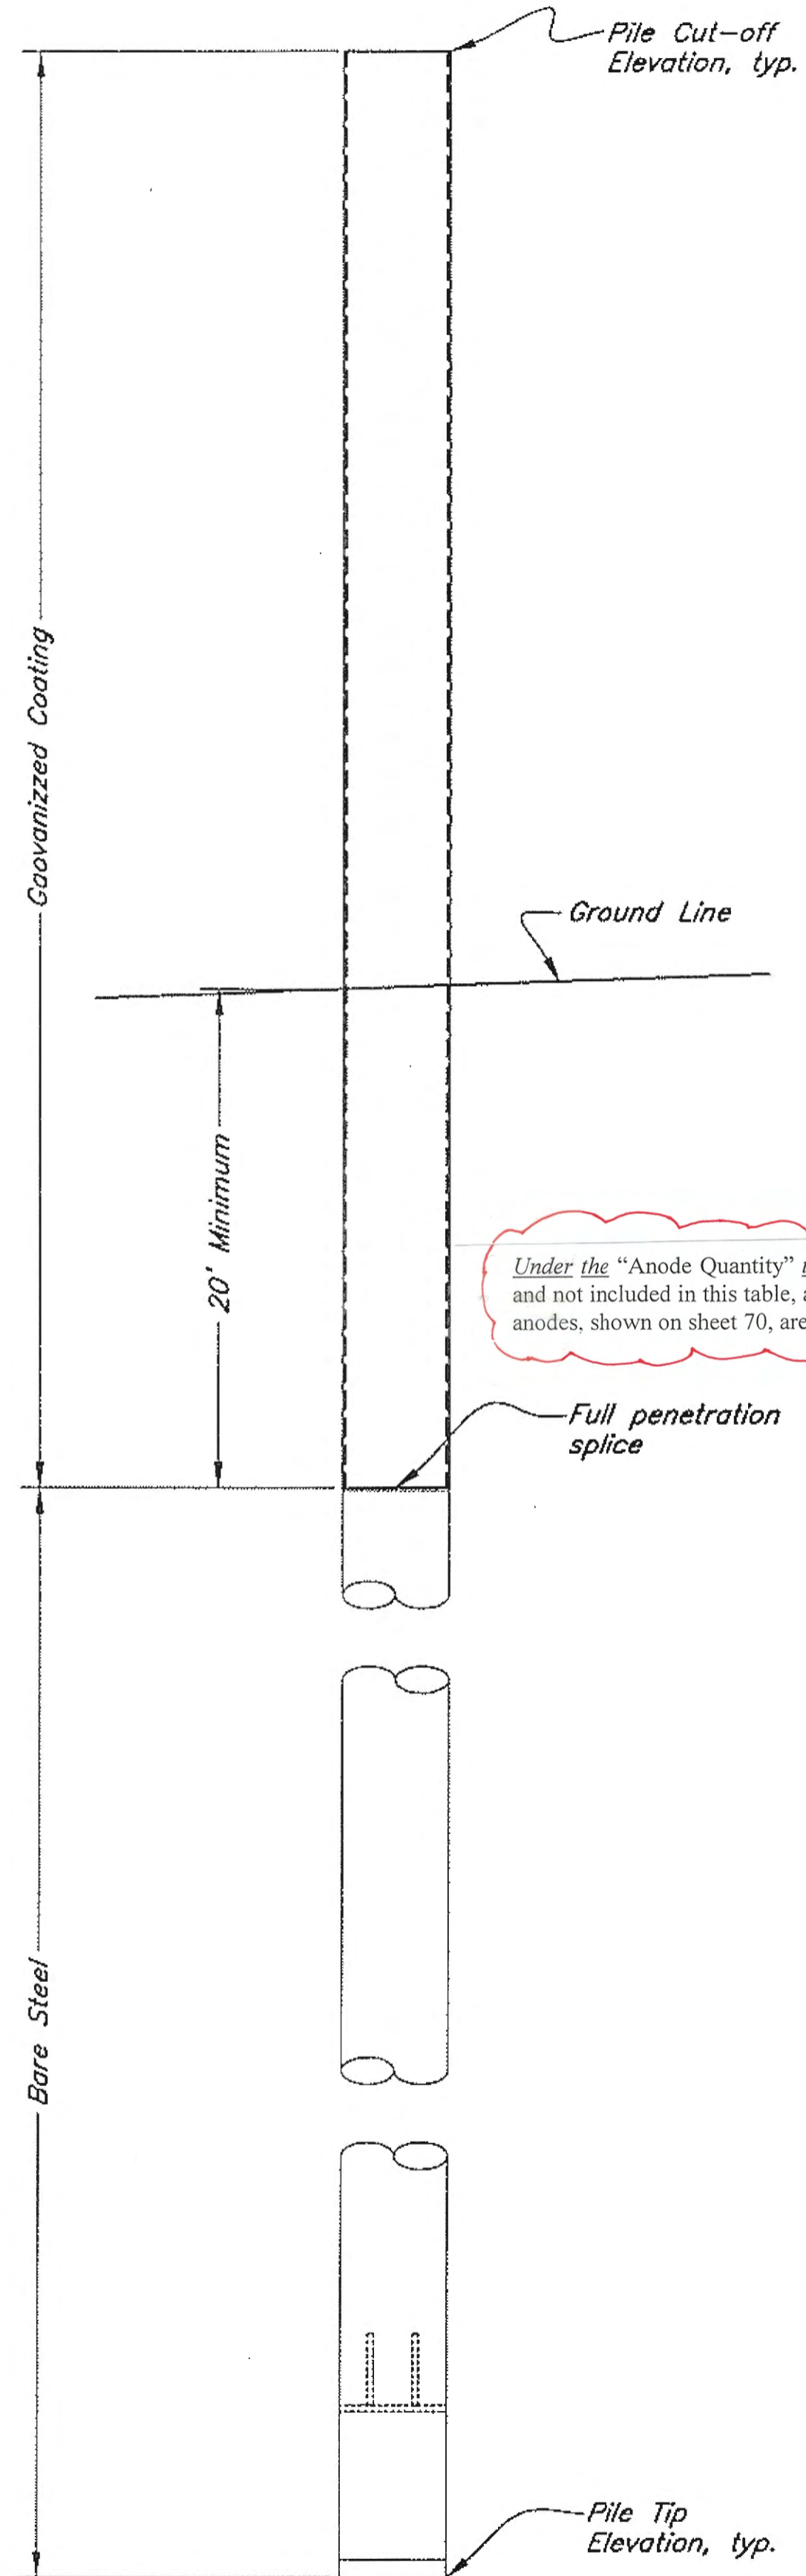


Galvanize Coating - Elevation
Vertical Pile shown

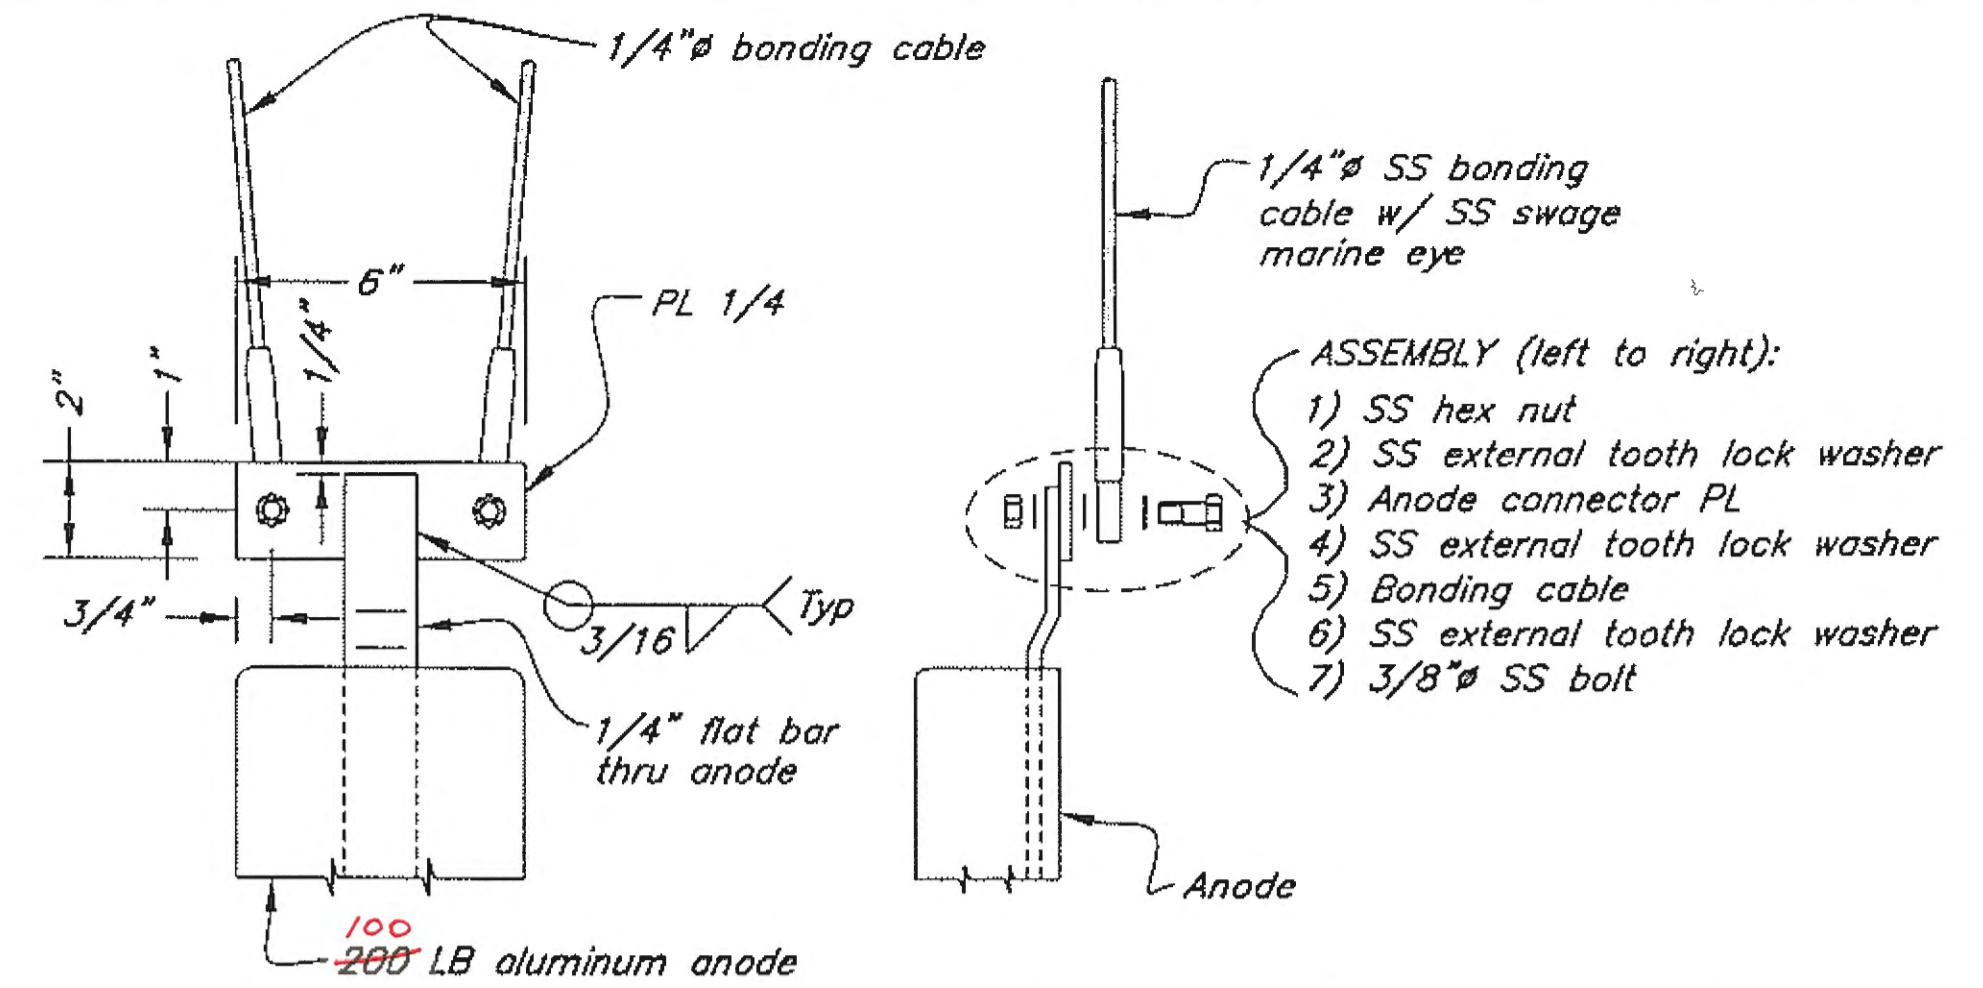

Anode & Cable Connection Detail

Anode Quantities	
Structure	Number Req'd
Bent 16	5
Bridge Abutment	2
Bent 17	3
Dock	20
Mooring Structures	6
Pontoon Restraint	1
ER (East Pile)	37

Under the "Anode Quantity" table add the following: "Note: Wave Barrier 415# anodes, shown on sheet 56 and not included in this table, are also included in the Basic Bid under Item 504(11A). The 37 each 25# Pontoon anodes, shown on sheet 70, are included in the Basic Bid but are subsidiary to Item 504(06)."

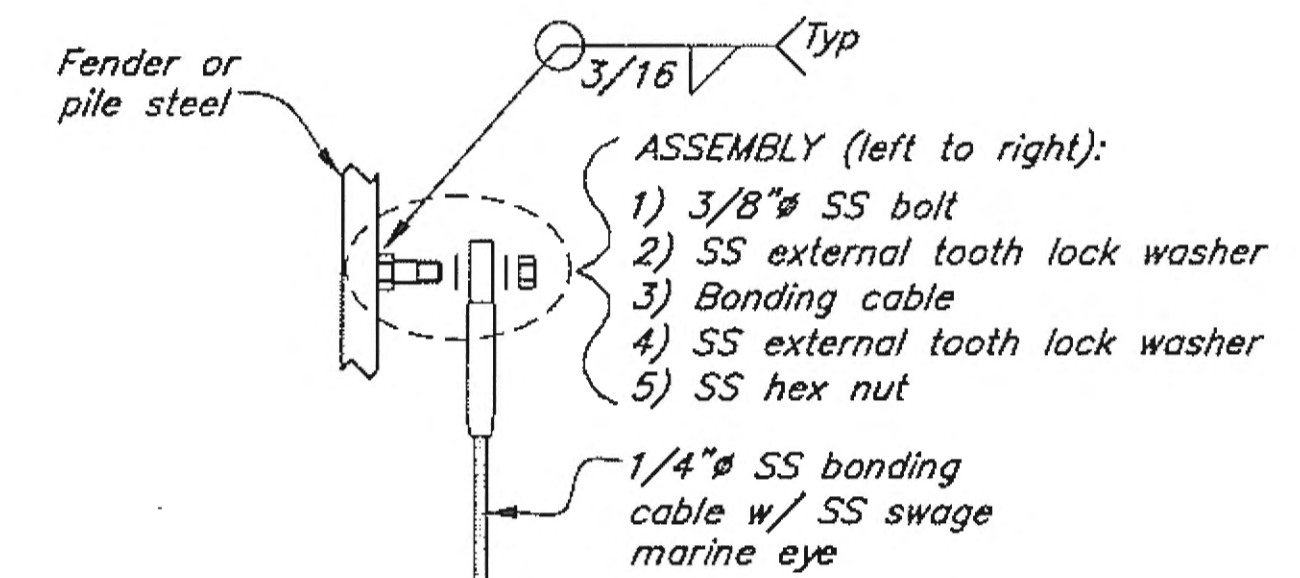

Bonding Lug Connection Detail

GENERAL NOTES:

1. Install one 100# anode on each vertical pile at Bent 16 and seaward, except one pile only at ER and omit at WR.
2. Anode connection details may vary from those indicated. Submit alternate details to the engineer for approval.
3. Std swaged fittings for bond cables may be replaced with 1/4" SS plate w/ 9/16" hole for direct connection to 1/2" bond lugs on piles (cold-weld 1/4" SS cable directly to plate in lieu of swaged fitting & 3/8" bolts).
4. Anode materials shall be aluminum alloy conforming to the following minimum requirements:
Current Capacity = 1,100 amp hours/lb
Efficiency = 85%
Min Voltage Potential = 1.1 volts (CU/CU SO4 reference electrode in seawater).
Nominal dimensions of anodes are 6" wide by 6" thick.
5. Unless otherwise noted, all bond cables, bond lugs, fastener plates and connection hardware shall be stainless steel, Type 316.
6. Repair all field welds and damaged coatings in accordance with Section 504 of the Contract Specifications.

DO NOT SCALE FROM THESE DRAWINGS USE DIMENSIONS

DESIGNED BY: J. Scott

STATE OF ALASKA
DEPARTMENT OF TRANSPORTATION & PUBLIC FACILITIES
DESIGN & ENGINEERING SERVICES DIVISION-SOUTHEAST REGION
Gustavus Causeway Replacement


Anodes G08

CHECKED BY: B. Savikko
DRAWN BY: C. Furman, W. Hickok
PATH: O:\GUS\67599\MF\PLANSET\01-GENERAL SHEETS\G08 ANODES.DWG
TAB: Tue, 25/Nov/08 04:02PM JTSCOTT


NO.	DATE	REVISIONS DESCRIPTION	PROJECT DESIGNATION	YEAR	SHEET NO.	TOTAL SHEETS
			BR-0003(53)/67599	2008	08	138

Record Drawings have been reviewed by the Project Engineer, and represent to the best of my knowledge, the project as constructed.
PE [Signature] Date 8/1/12


C.O. # 9, New Item 203(20)
Barge Landing Surface Replacement
(See Attachments)

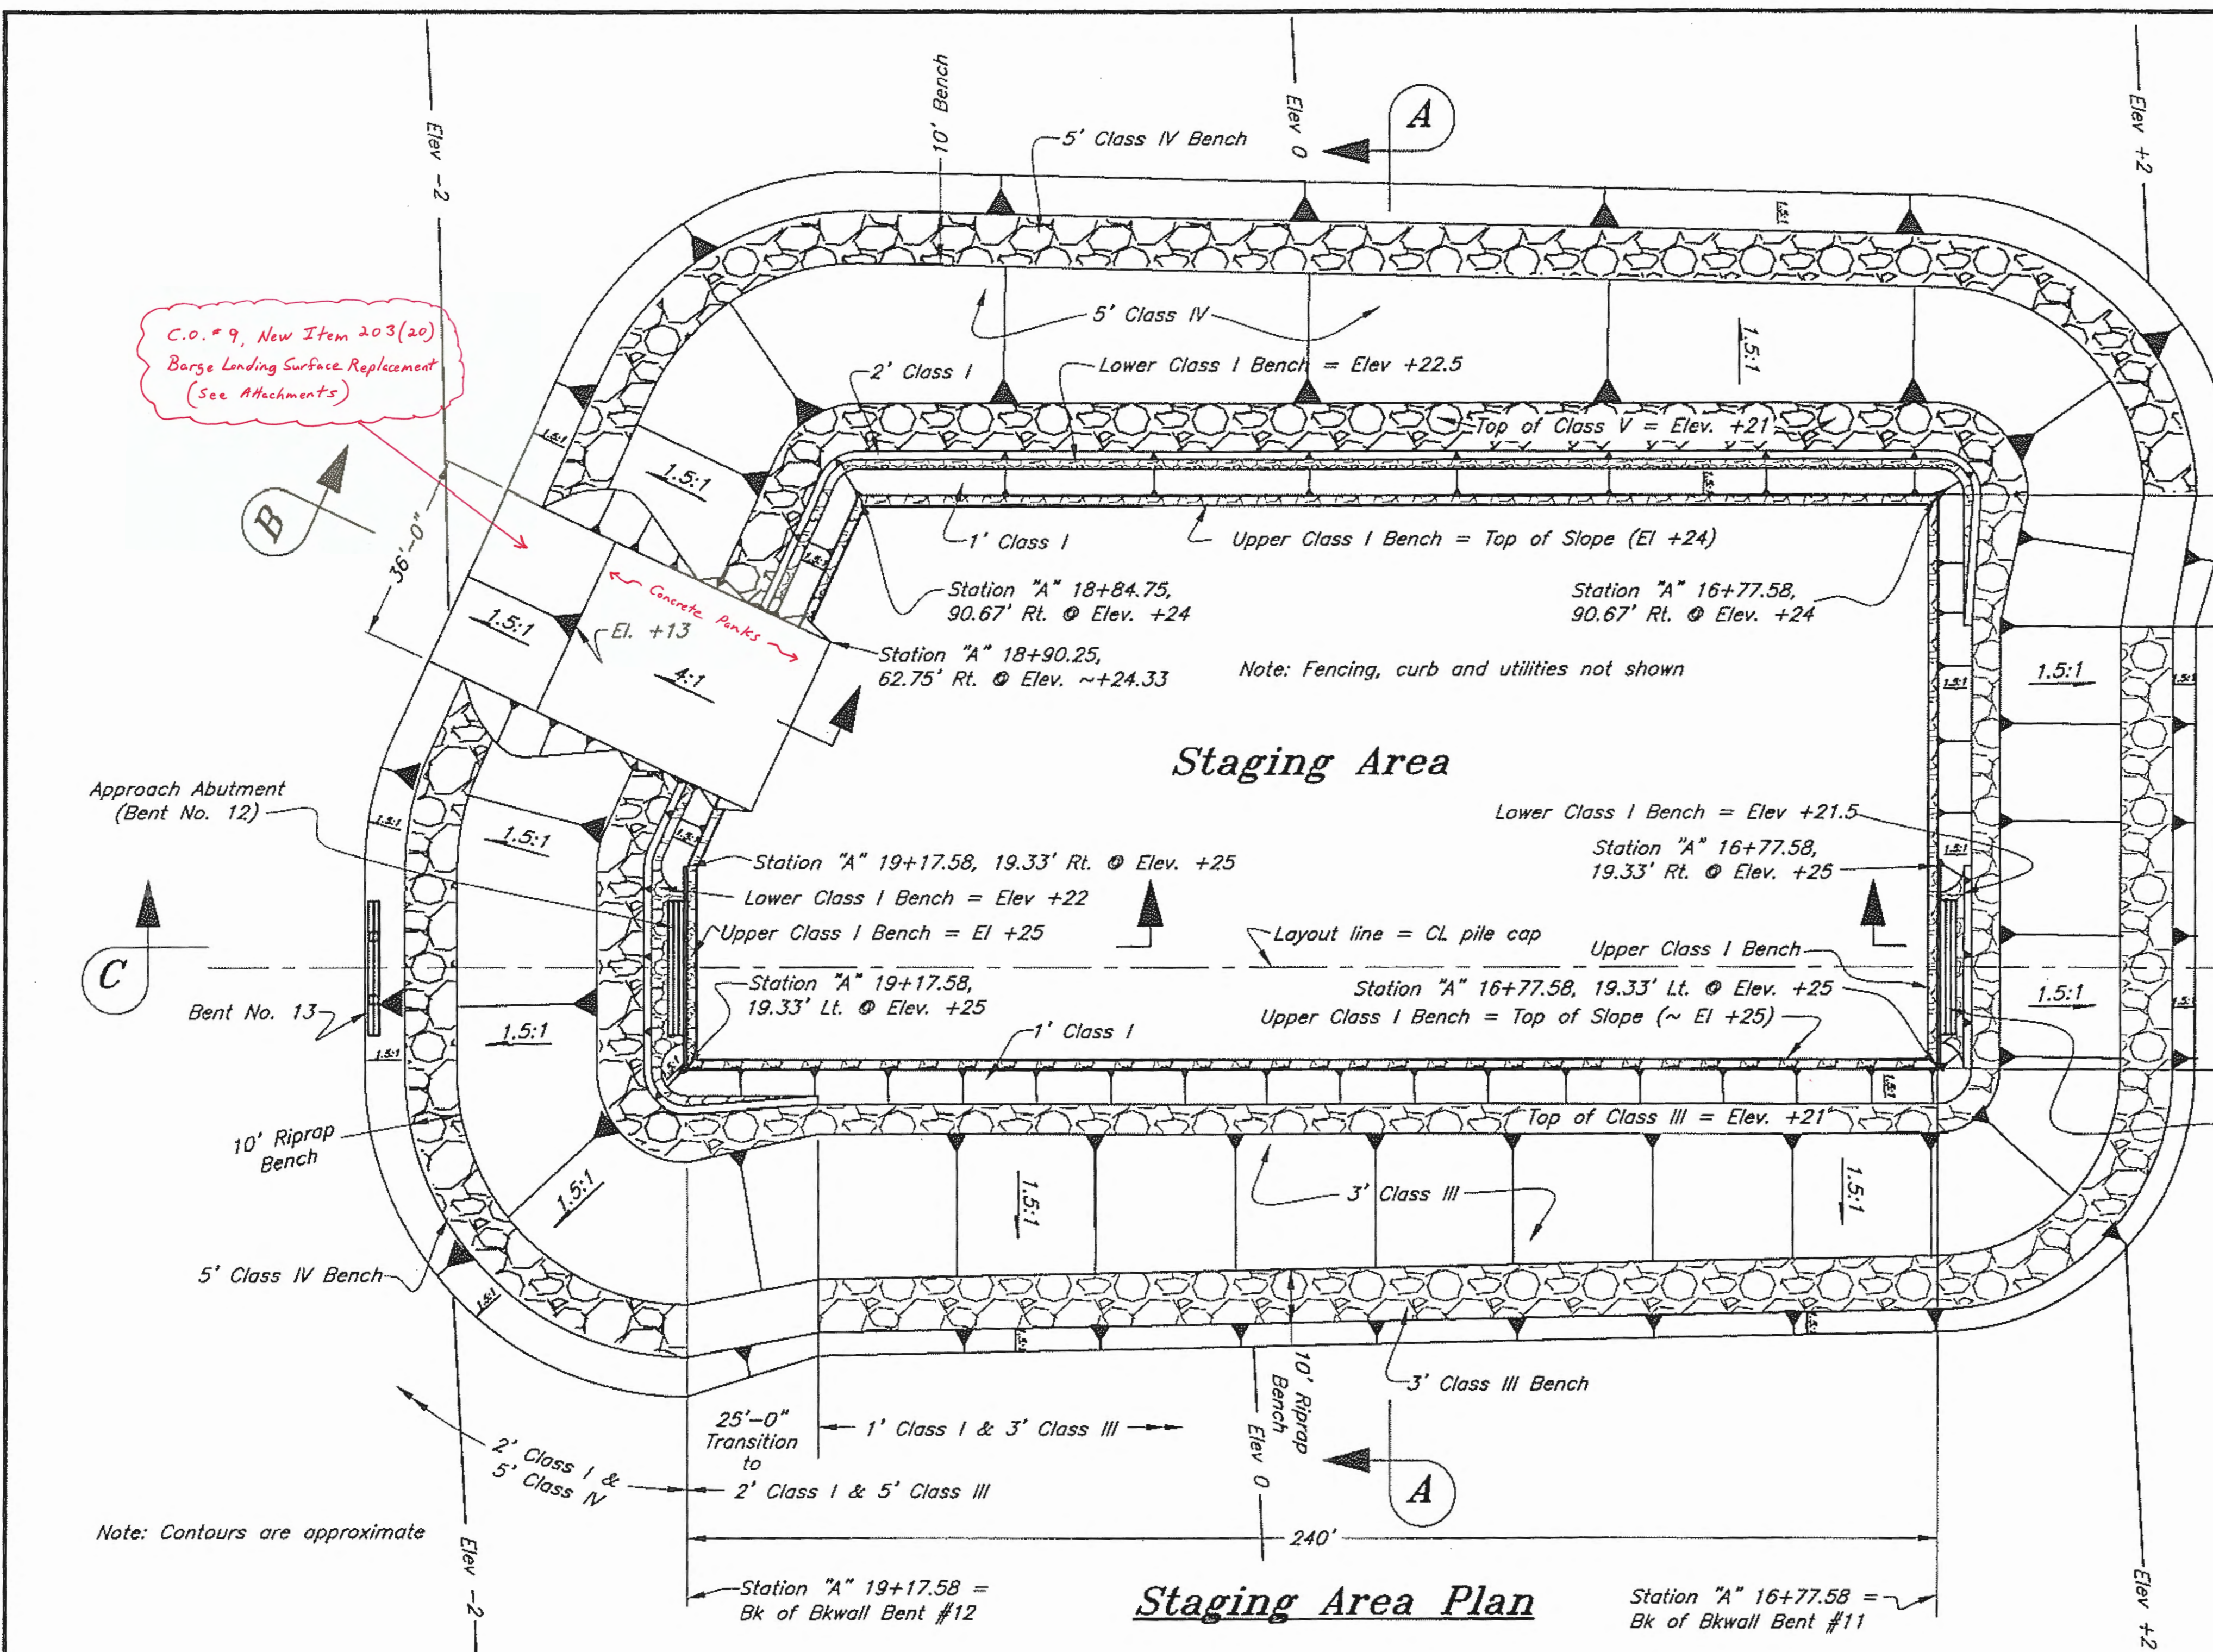


Staging Area Plan

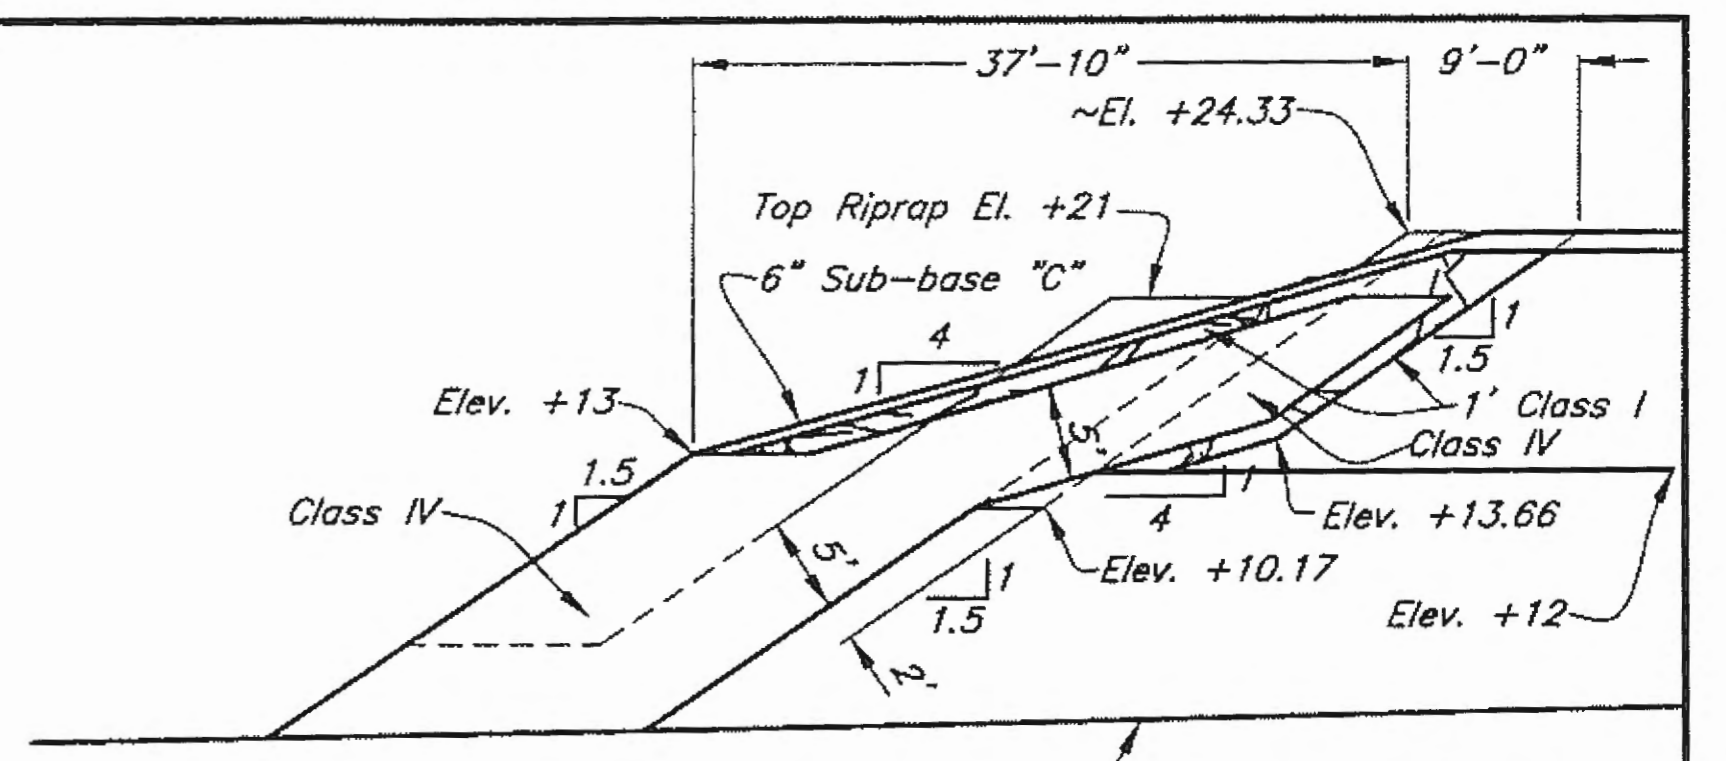

Section B

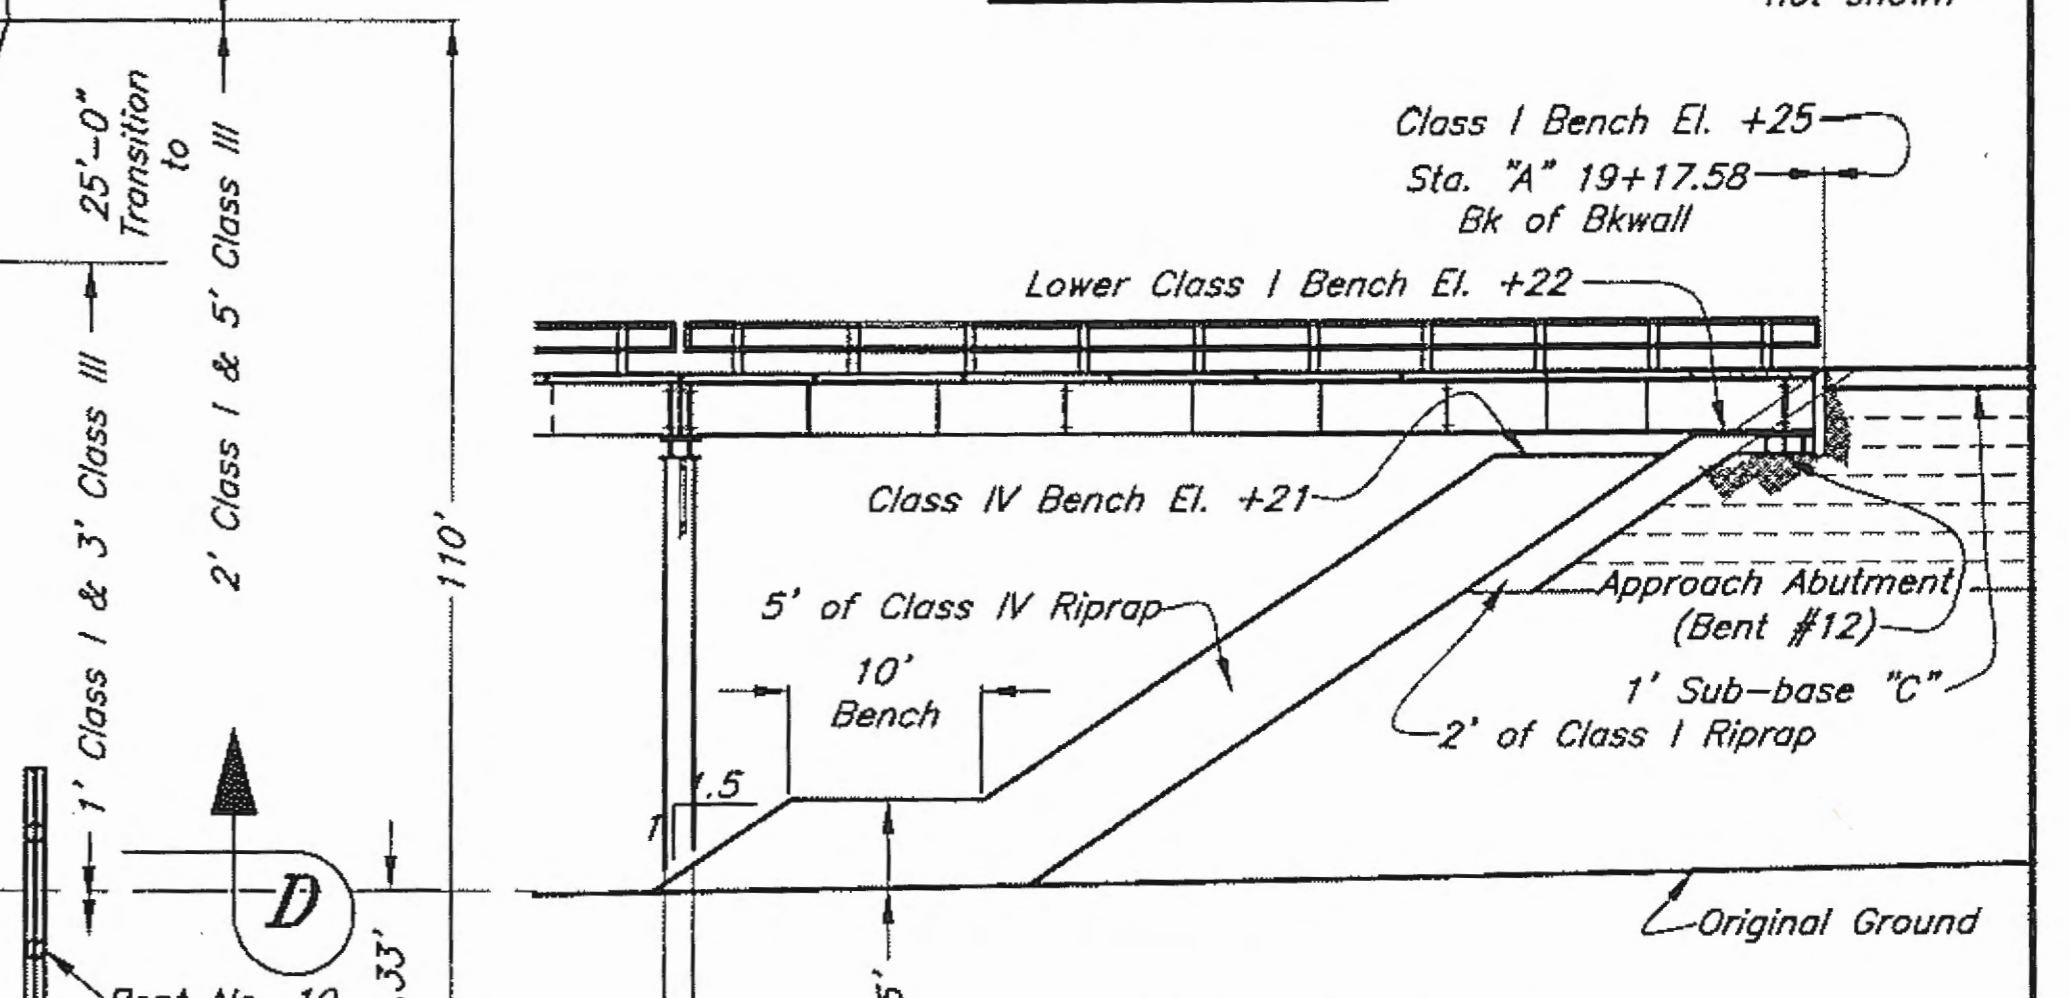


Section C

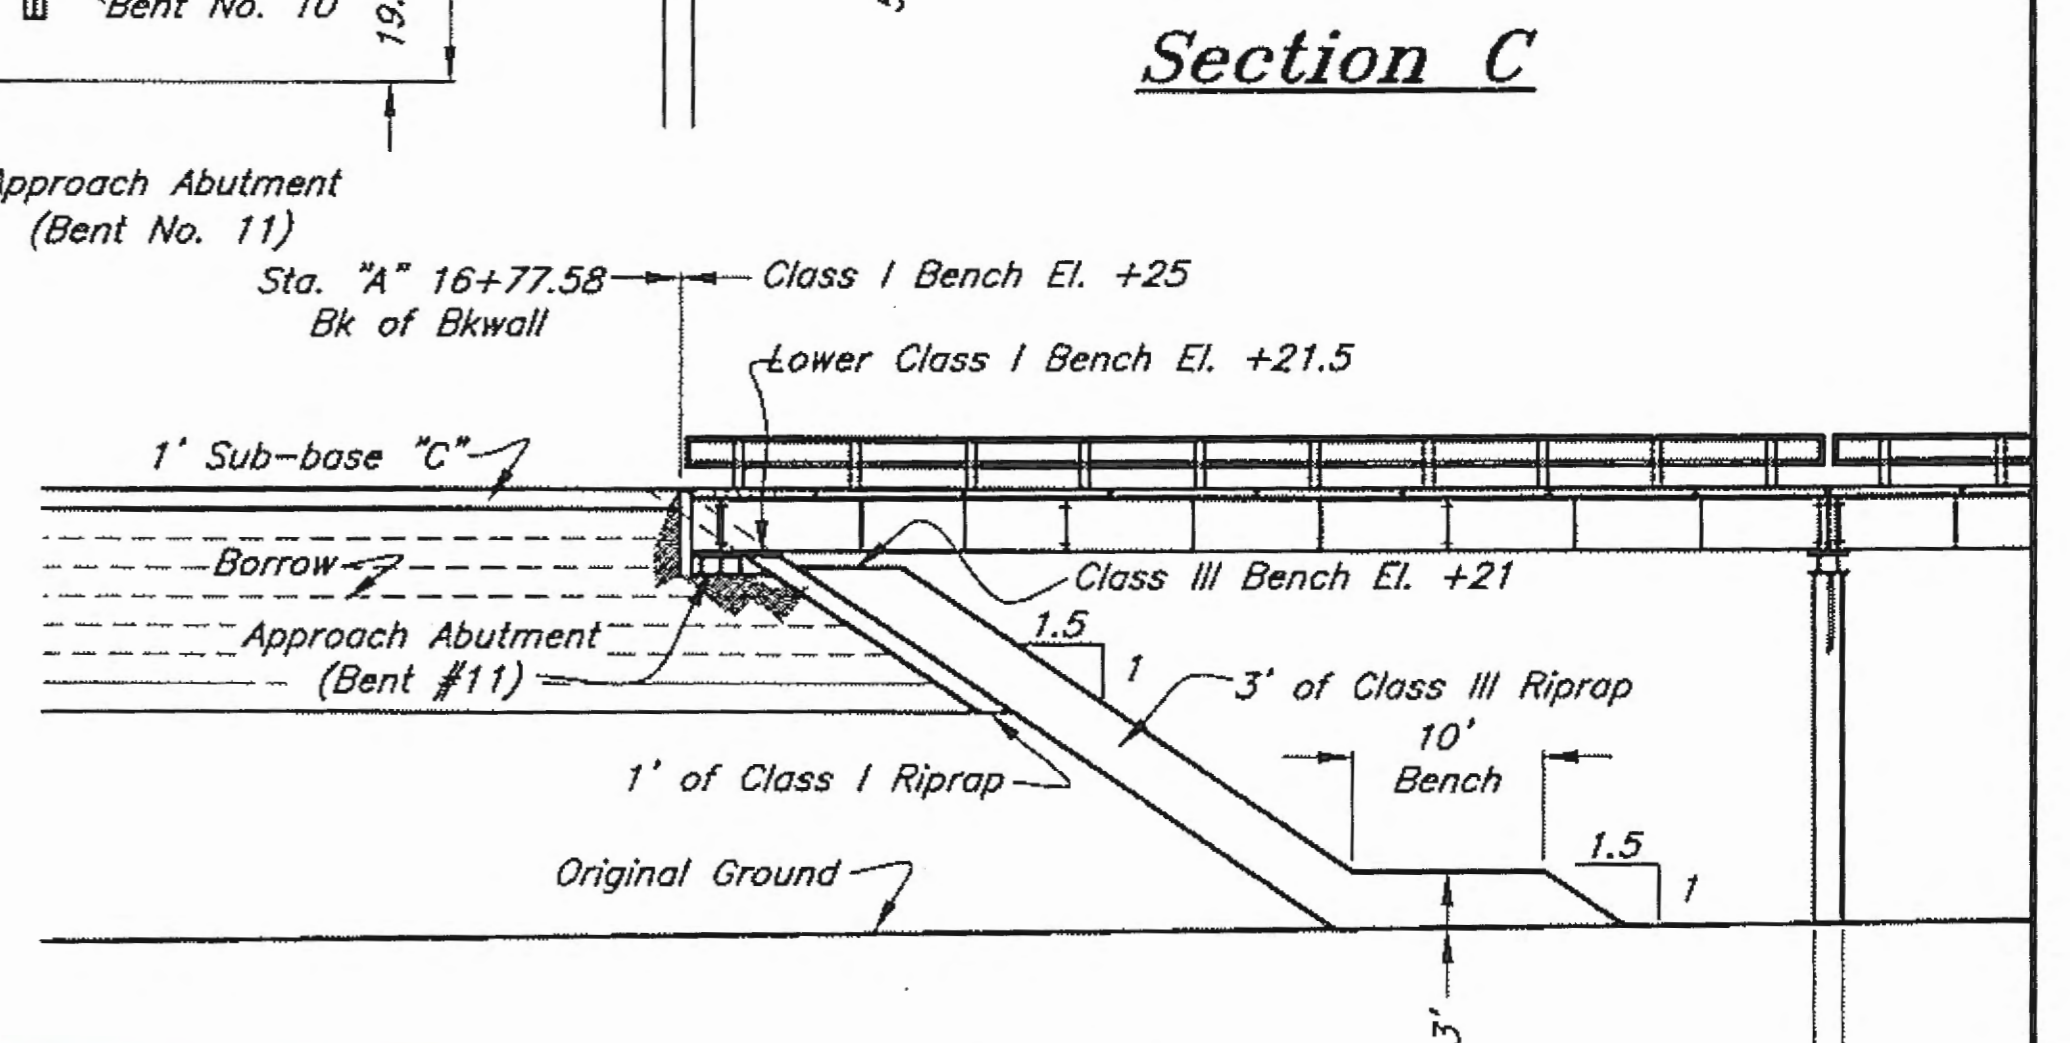

Section D

Record Drawings have been reviewed by the Project Engineer, and represent to the best of my knowledge, the project as constructed.
PE *[Signature]* Date 4/1/12

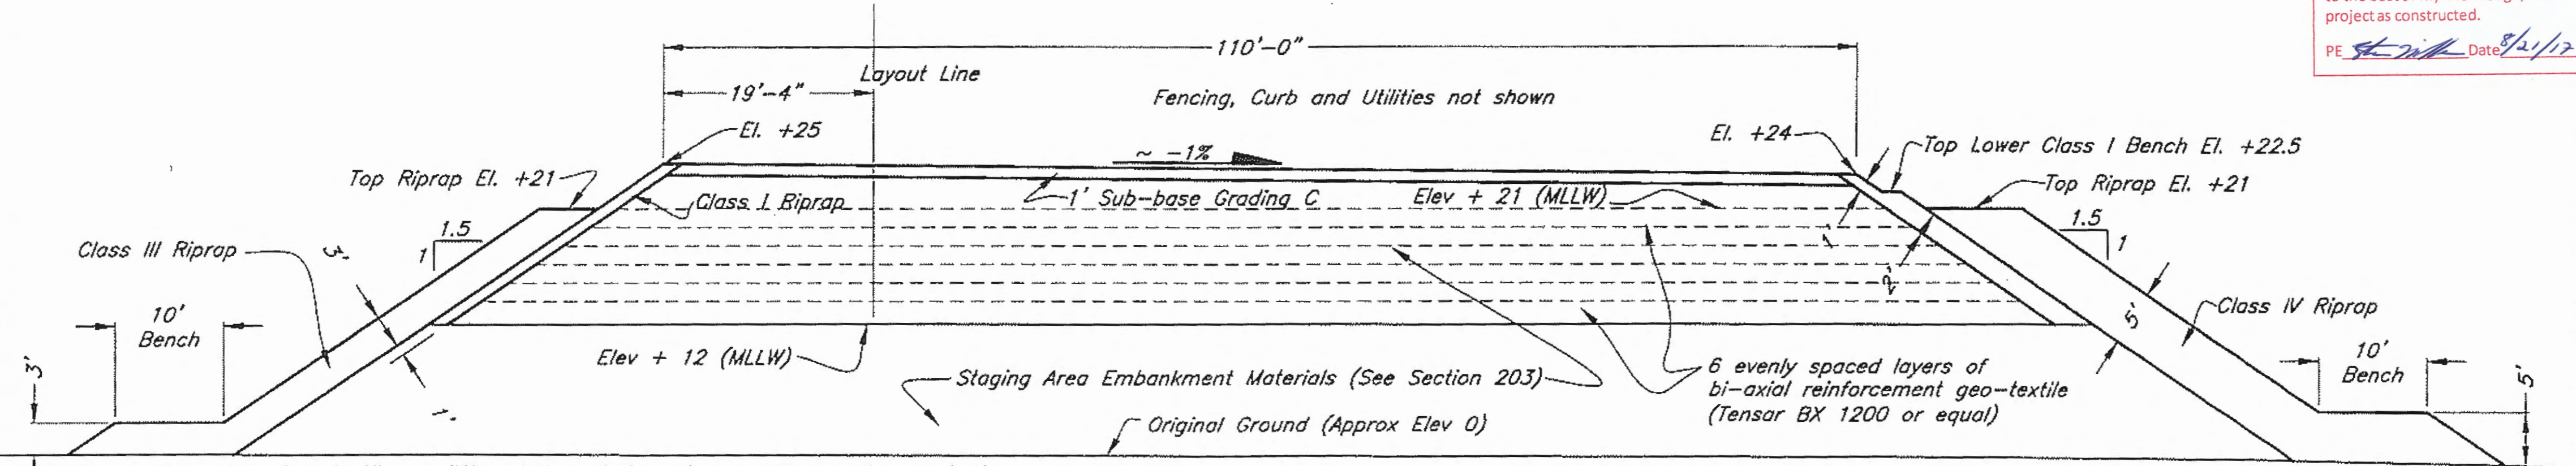


Section A-A


Note 1. Separation Geo-textile or differential gradation of materials may be required between Riprap, Borrow and Sub-base "C" materials.
2. Separation Geotextiles/differential graded materials not shown and to be incidental.

DO NOT SCALE FROM THESE DRAWINGS USE DIMENSIONS

DESIGNED BY: J. Scott	STATE OF ALASKA DEPARTMENT OF TRANSPORTATION & PUBLIC FACILITIES DESIGN & ENGINEERING SERVICES DIVISION-SOUTHEAST REGION	
	Gustavus Causeway Replacement	
	Staging Area Plan S01	
CHECKED BY: B. Savikko	DATE: 4-26-08	
DRAWN BY: C. Fuman, W. Hickey	PATH: O:\GUS\67599\MF\PLANSET\02-STAGING AREA\S01 STAGING AREA LAYOUT.DWG	
TAB: Tue, 25/Nov/08 04:08PM		JISCOTT
REVISIONS		PROJECT DESIGNATION
NO.	DATE	DESCRIPTION
		BR-0003(53)/67599
		2008
		09
		138

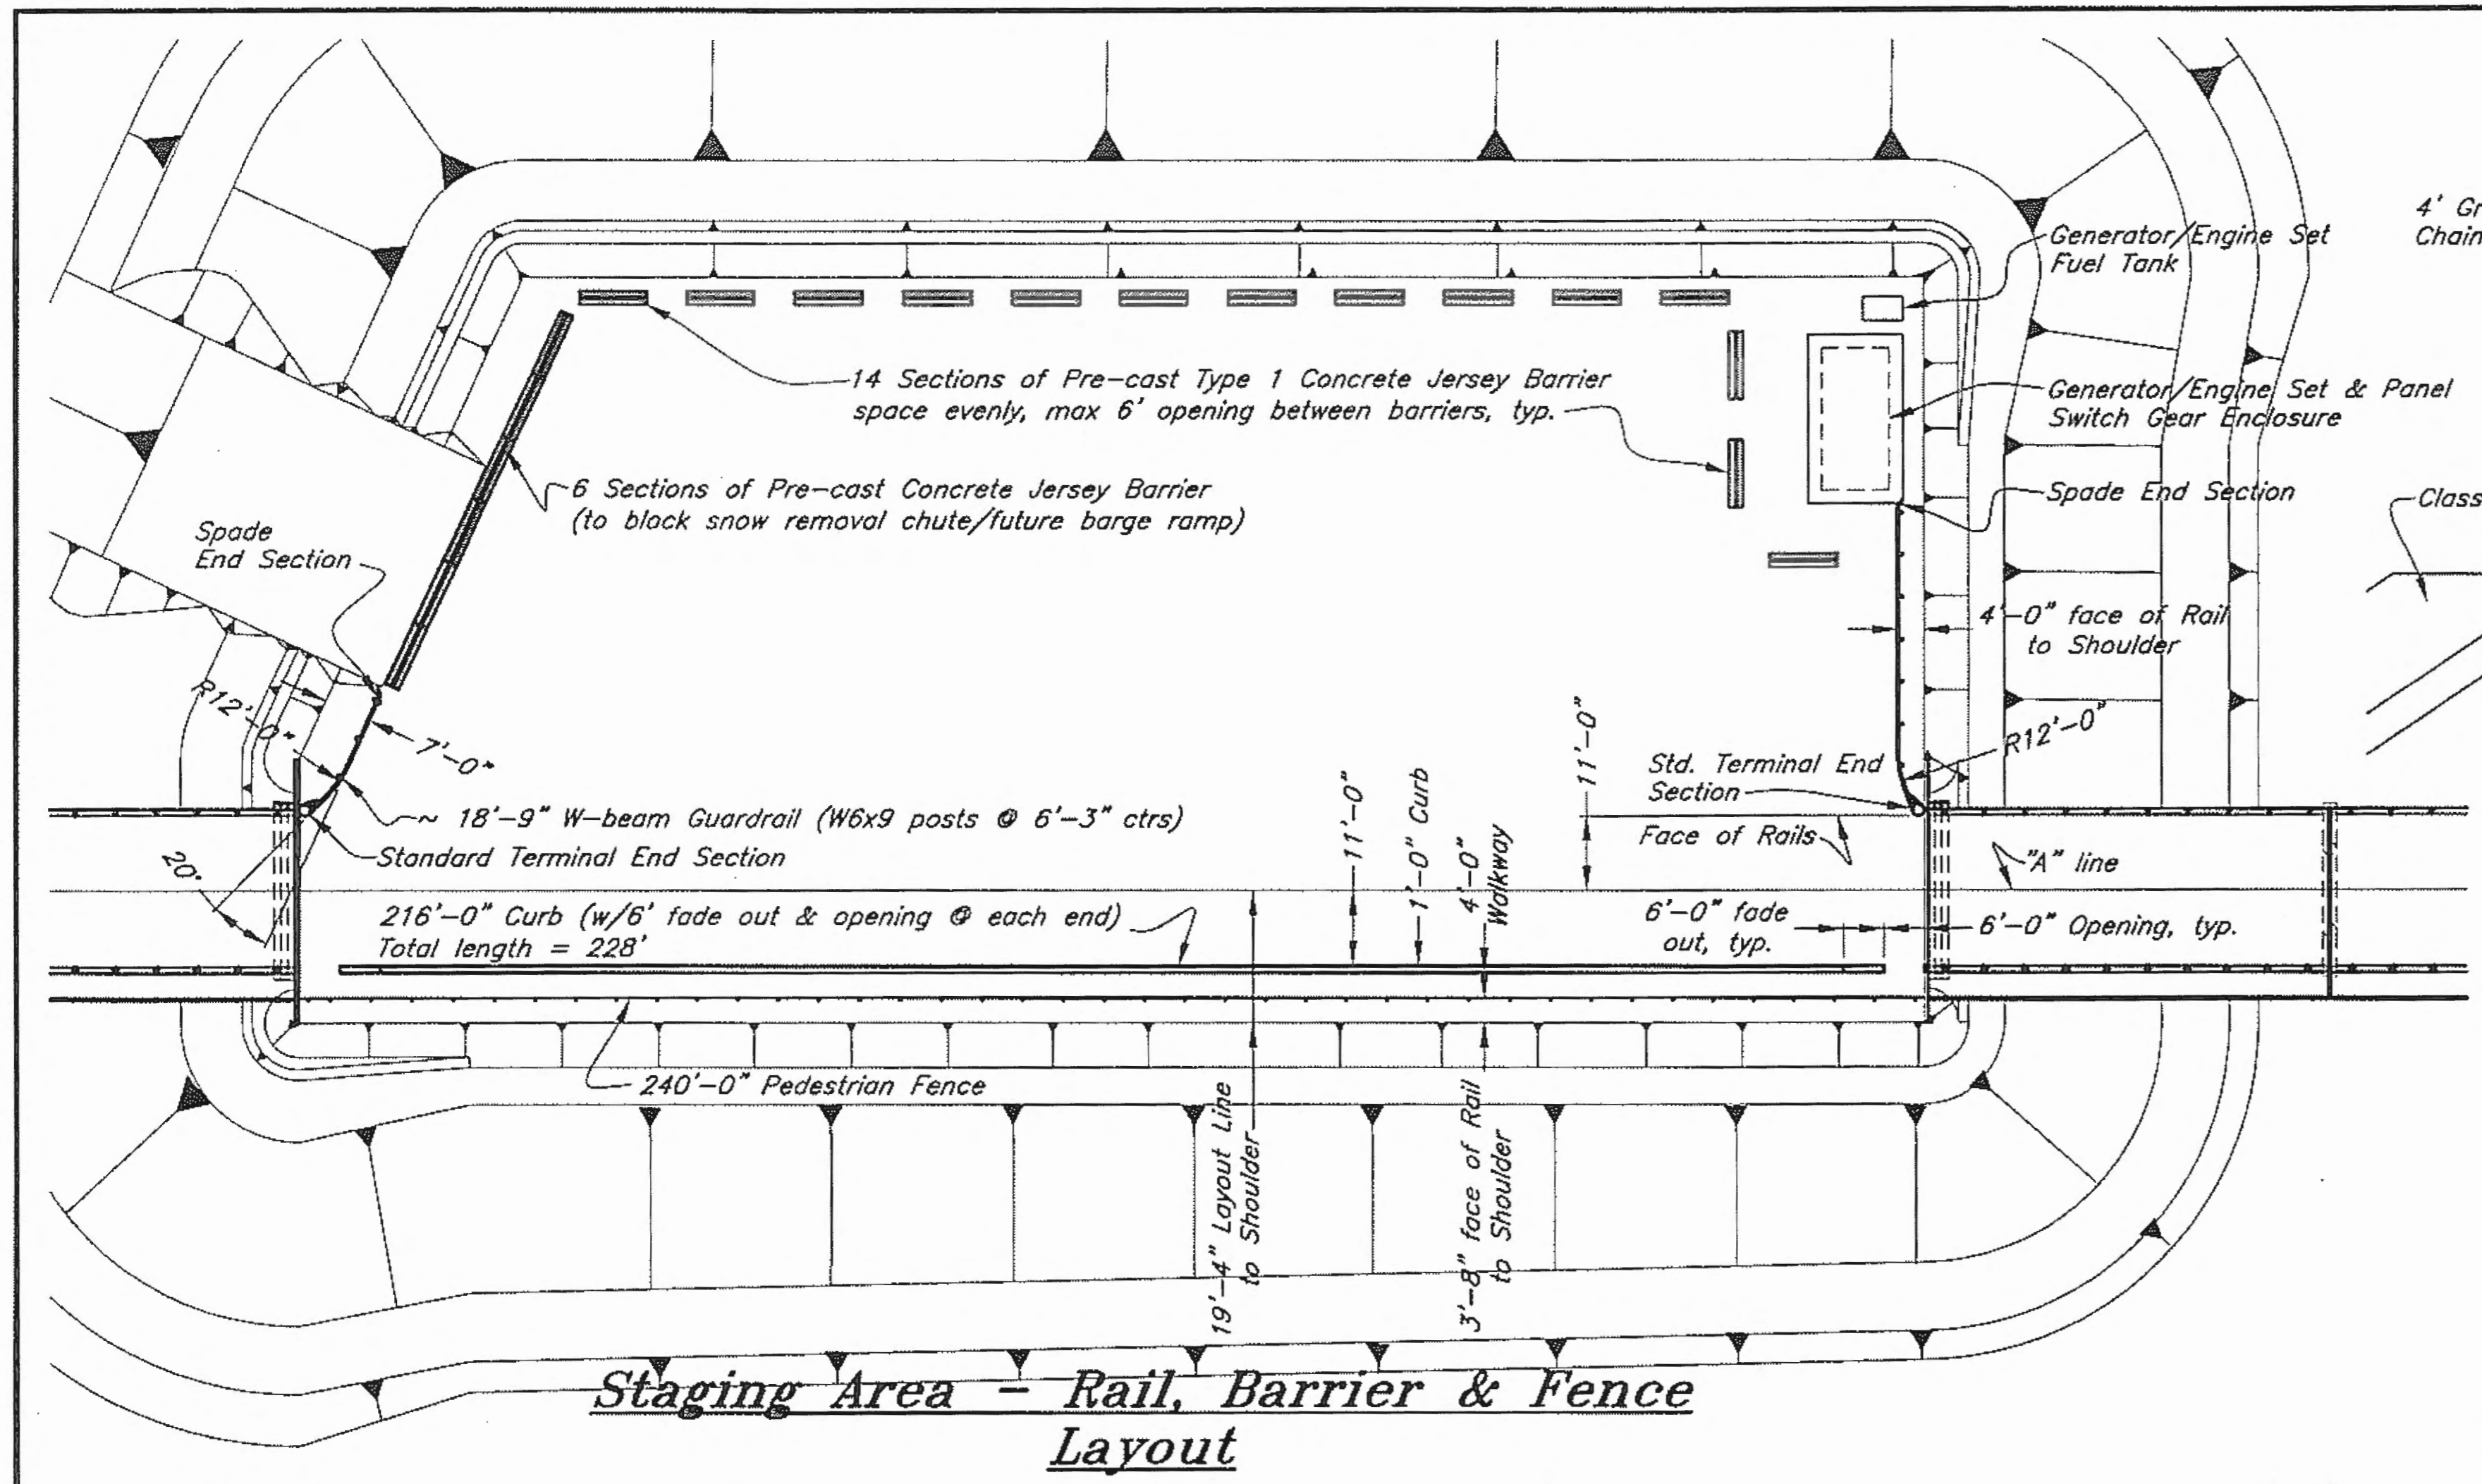


Staging Area - Rail, Barrier & Fence Layout

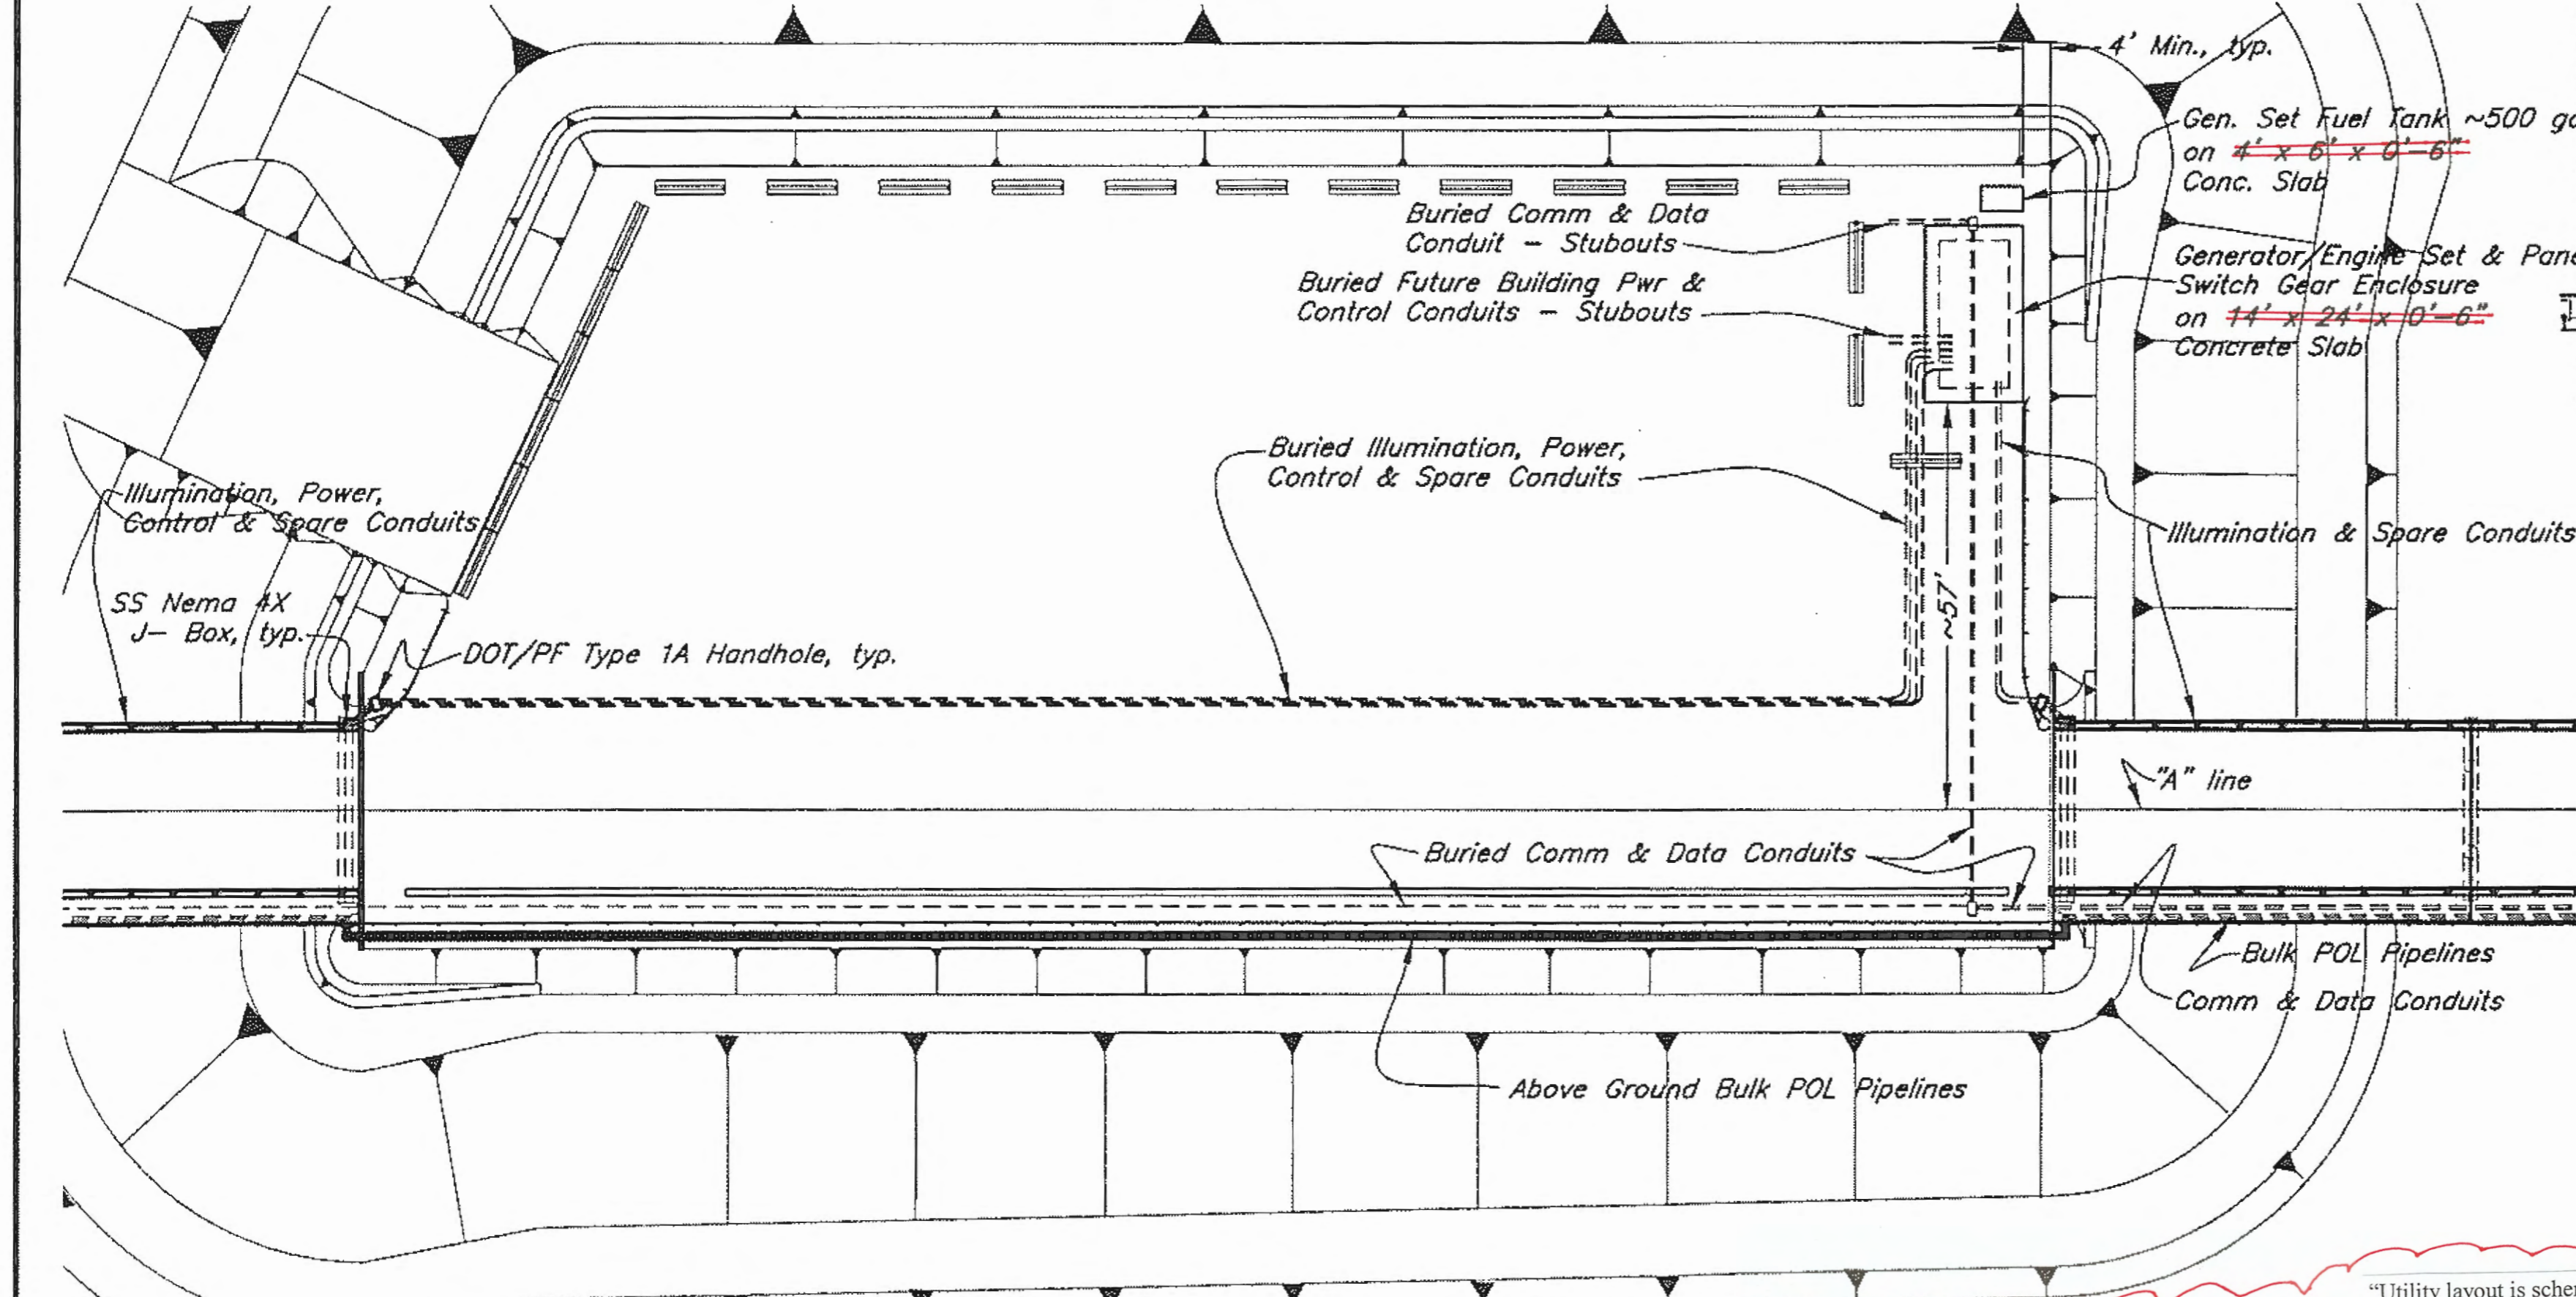


Staging Area - Utility Layout

(Note: locations shown are schematic, refer to Electrical and POL line plans)


Utility layout is schematic only and See Sheets E1 - E11 and Section 662 of the specifications for Electrical and to the Plans prepared as per Section 680 of the specifications for the Bulk Fuel System piping.

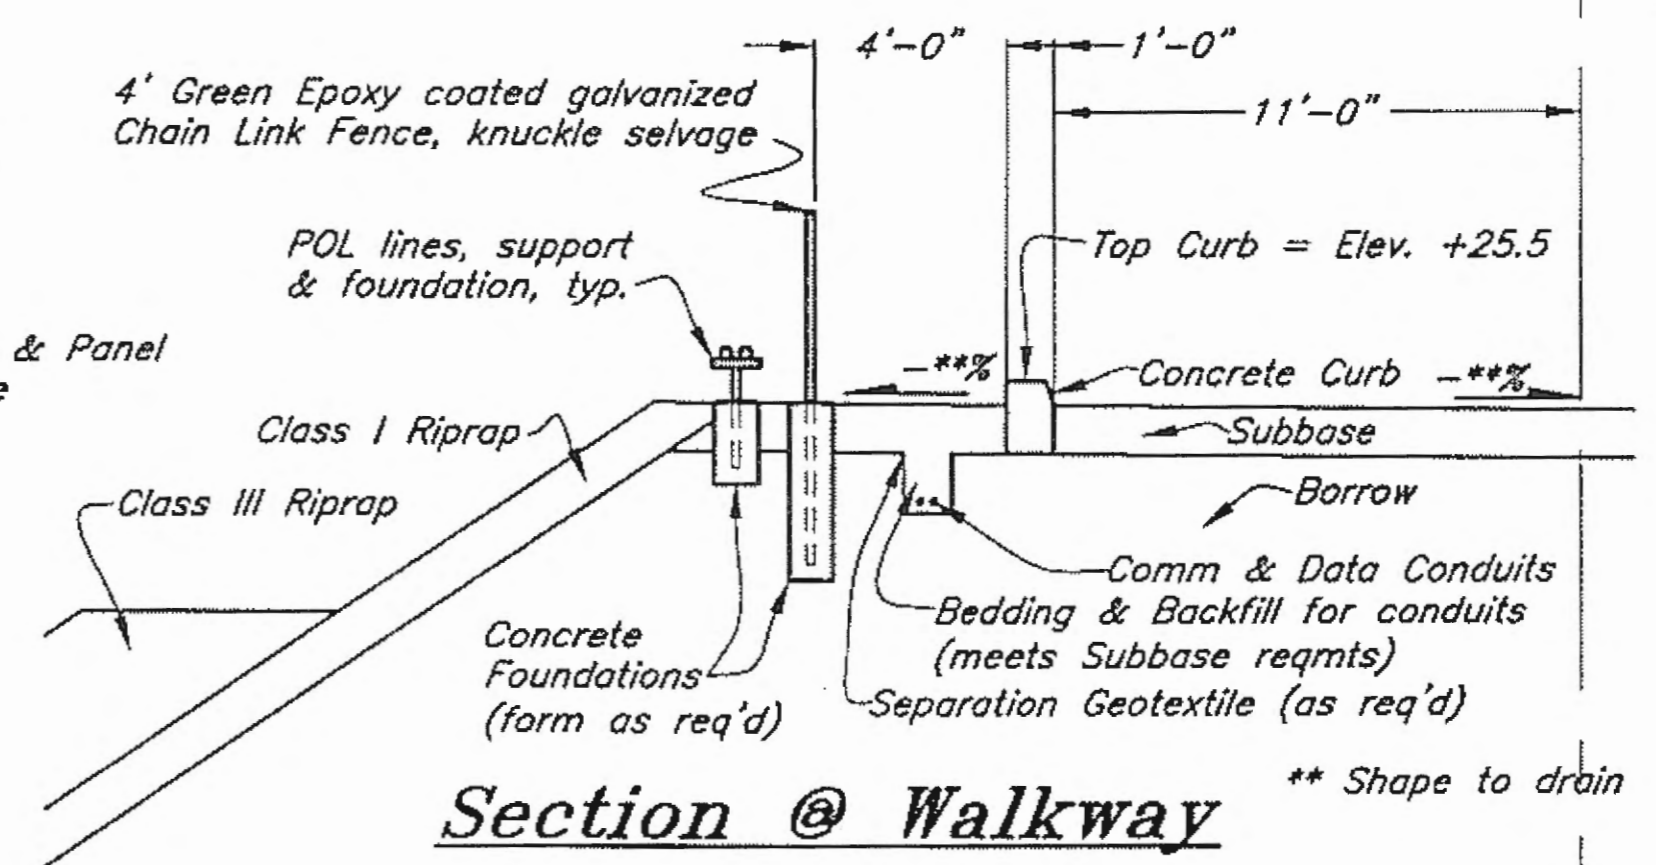

Section @ Walkway

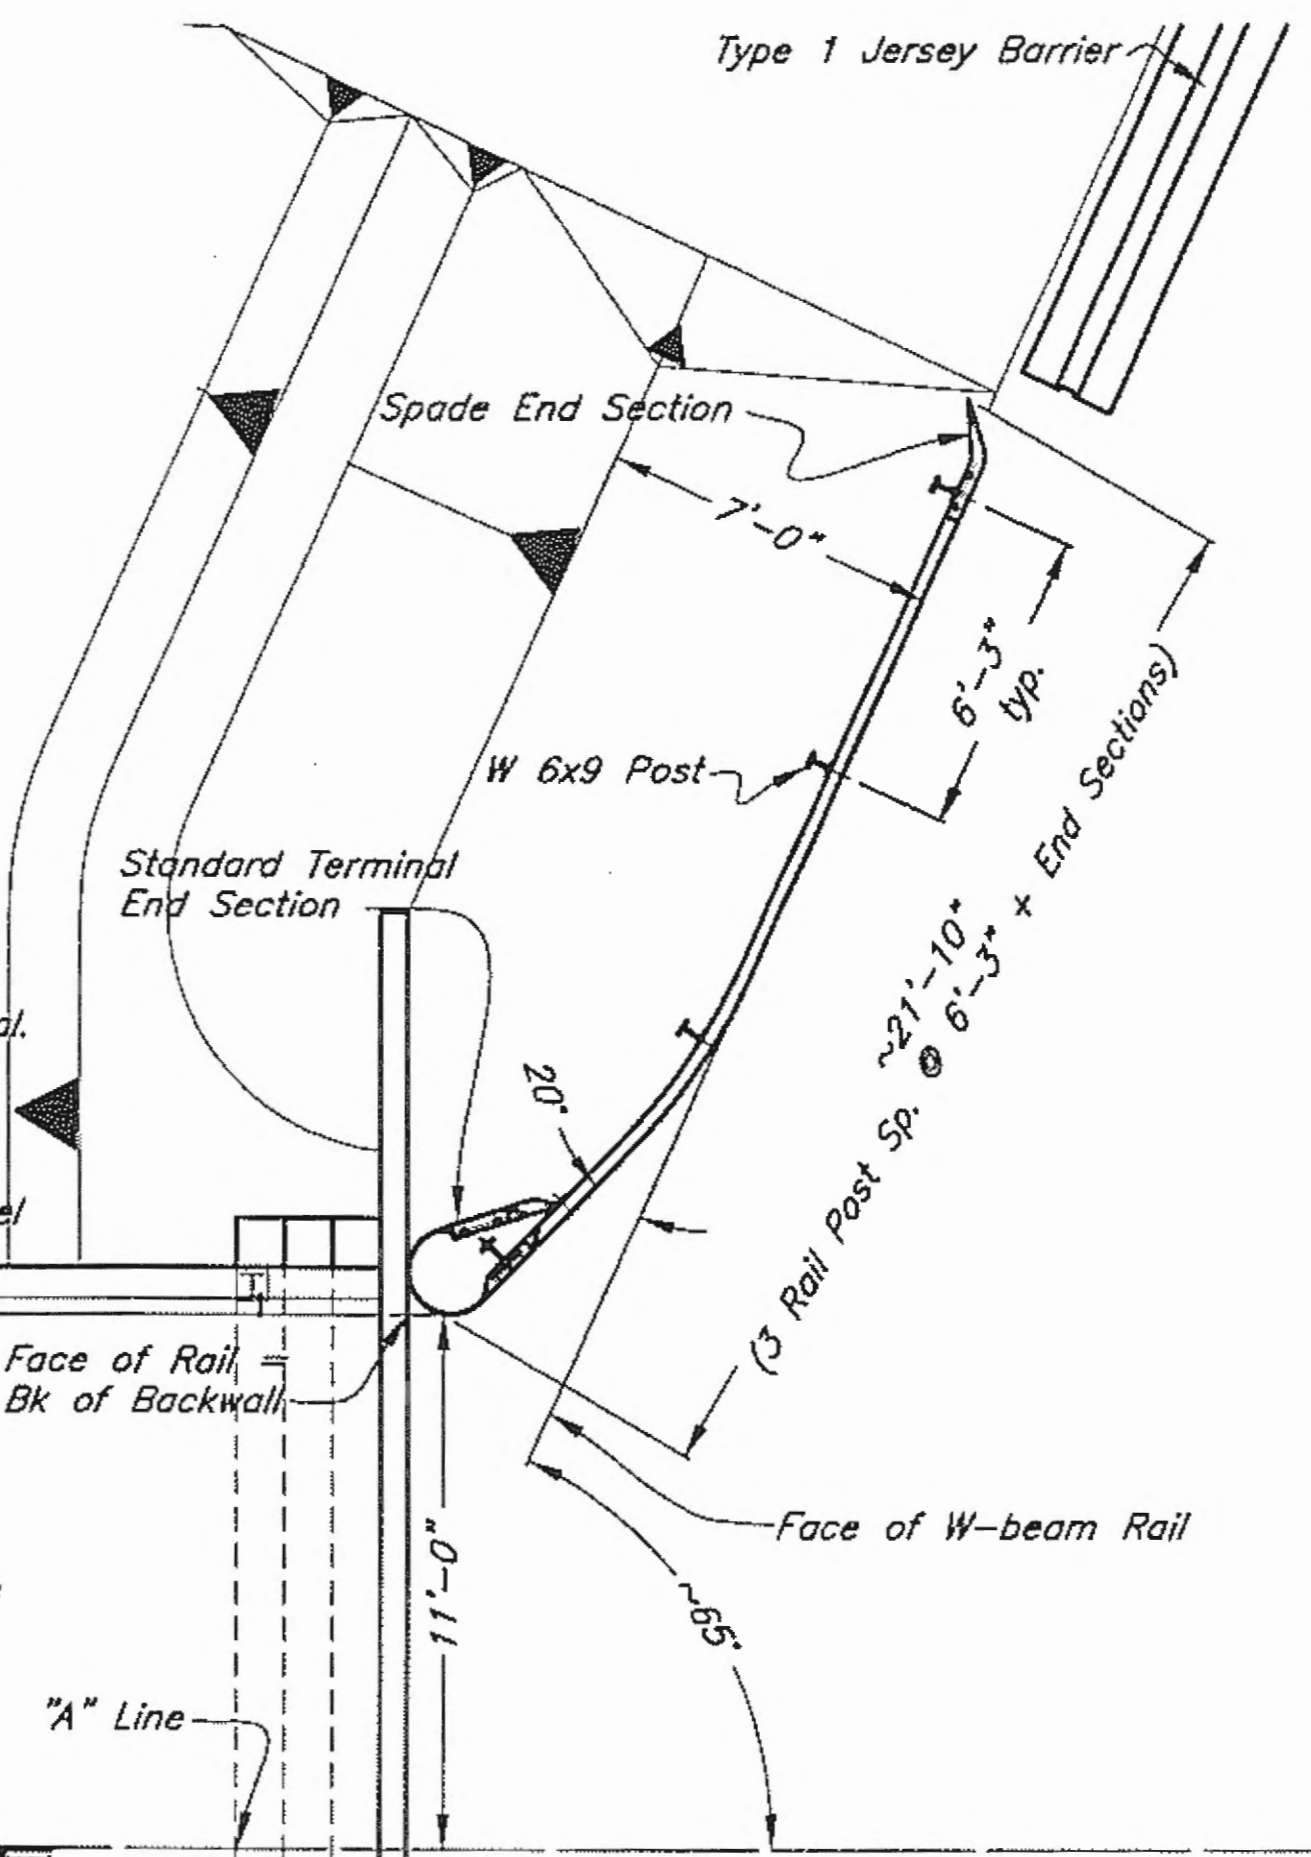

Plan @ Bent 12

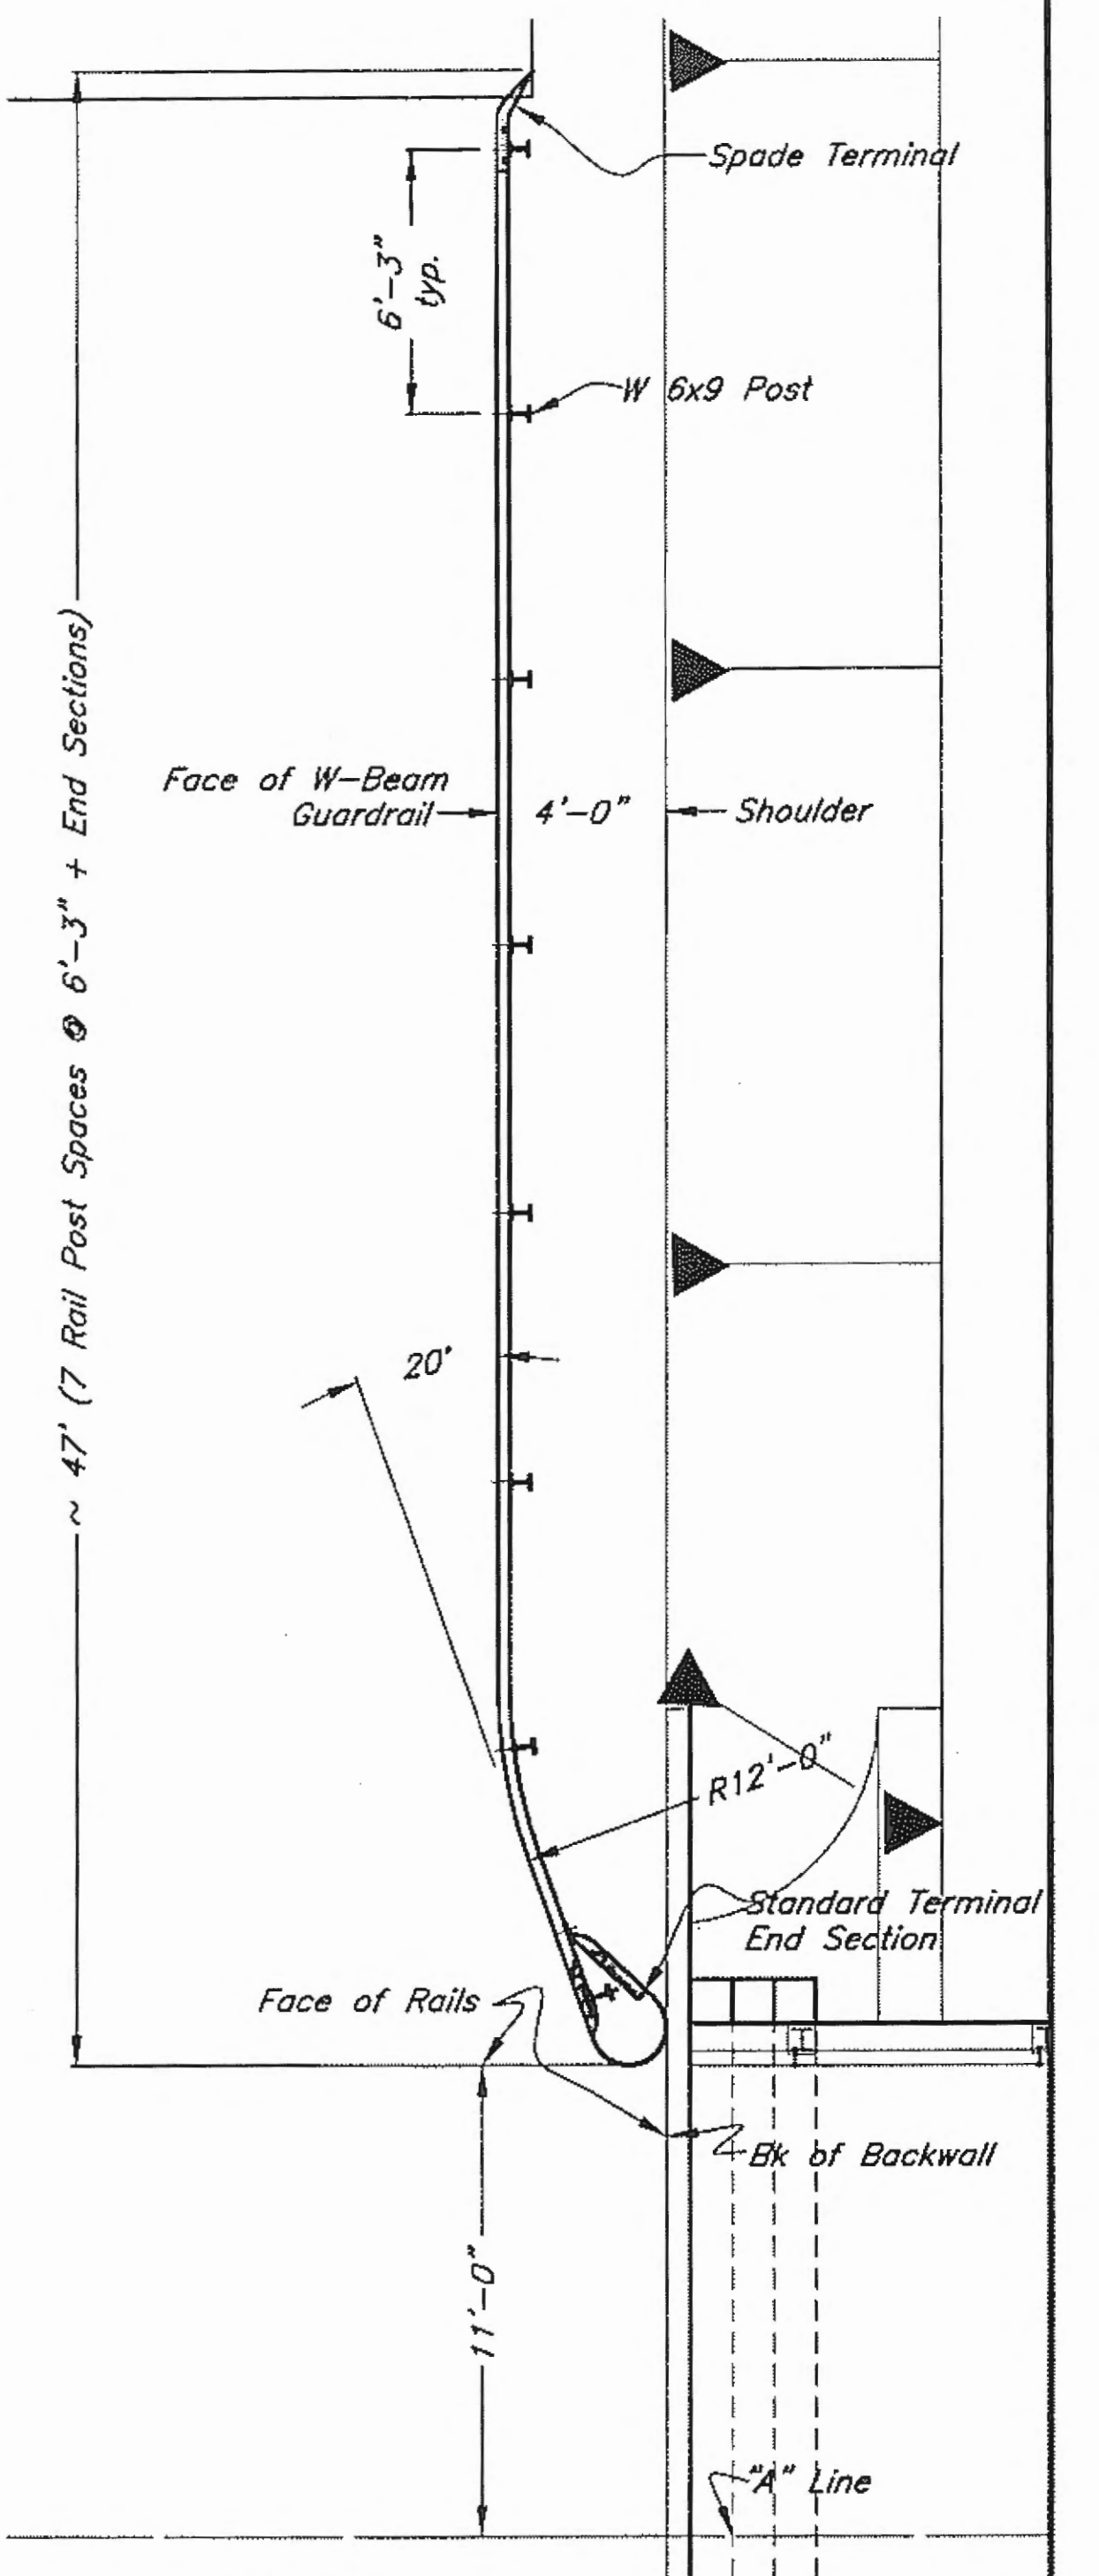

Plan @ Bent 11

Note: Fence curb rails, jersey barrier, & guard rail are incidental.

Record Drawings have been reviewed by the Project Engineer, and represent to the best of my knowledge, the project as constructed.
PE [Signature] Date 8/14/12

DO NOT SCALE FROM THESE DRAWINGS USE DIMENSIONS

DESIGNED BY: J. Scott

STATE OF ALASKA
DEPARTMENT OF TRANSPORTATION & PUBLIC FACILITIES
DESIGN & ENGINEERING SERVICES DIVISION-SOUTHEAST REGION



Gustavus Causeway Replacement

Staging Area Fence & Utility Layout

S02

CHECKED BY: B. Savikka
DRAWN BY: C. Fuman, W. Hickok
PATH: Q:\GUS\67599\MP\PLANSET\02-STAGING AREA\S02 STAGING AREA DETAILS 10-24-08.DWG
TAB: Tue, 25/Nov/08 04:09PM
JTS/COIT


REVISIONS			PROJECT DESIGNATION	YEAR	SHEET NO.	TOTAL SHEETS
NO.	DATE	DESCRIPTION				
			BR-0003(53)/67599	2008	10	138

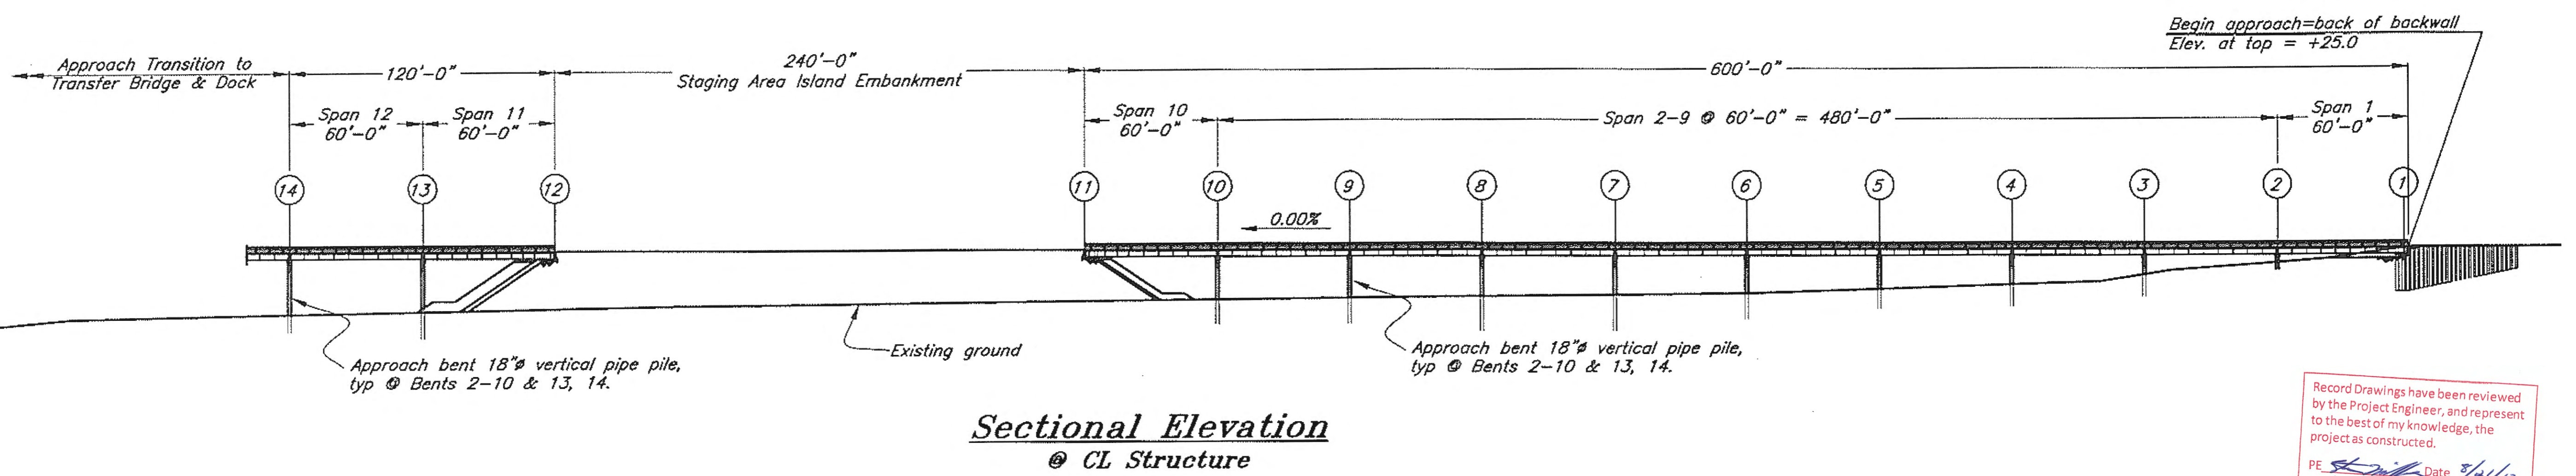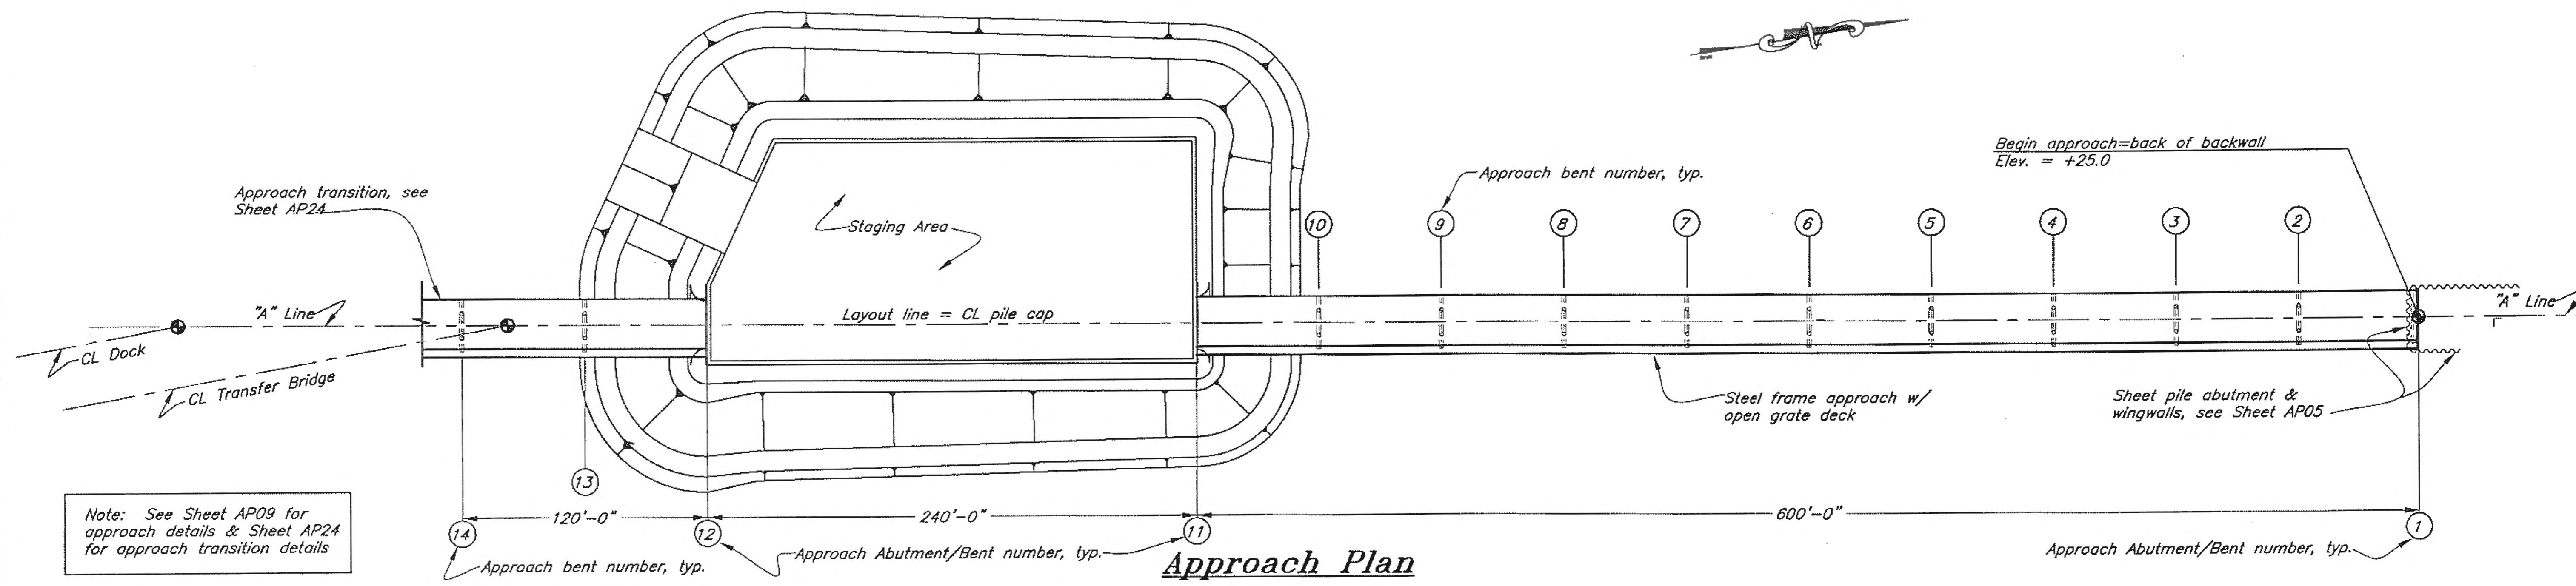


Record Drawings have been reviewed by the Project Engineer, and represent to the best of my knowledge, the project as constructed.
PE *[Signature]* Date 7/21/12

DO NOT SCALE FROM THESE DRAWINGS USE DIMENSIONS


DESIGNED BY: J. Scott	STATE OF ALASKA DEPARTMENT OF TRANSPORTATION & PUBLIC FACILITIES DESIGN & ENGINEERING SERVICES DIVISION-SOUTHEAST REGION								
	Gustavus Causeway Replacement								
	Approach Plan & Elevation AP01								
CHECKED BY: B. Savikko	PROJECT DESIGNATION	YEAR	SHEET NO.						
DRAWN BY: G. Fuman, W. Hickok	BR-0003(53)/67599	2008	11						
PATH: D:\GUS\67599\MF\PLANSET\03-APPROACH\AP01 APPROACH LAYOUT.DWG TAB: Tue, 25/Nov/08 04:15PM JTSCOTT		TOTAL SHEETS	138						
<table border="1"> <thead> <tr> <th>NO.</th> <th>DATE</th> <th>DESCRIPTION</th> </tr> </thead> <tbody> <tr> <td> </td> <td> </td> <td> </td> </tr> </tbody> </table>				NO.	DATE	DESCRIPTION			
NO.	DATE	DESCRIPTION							

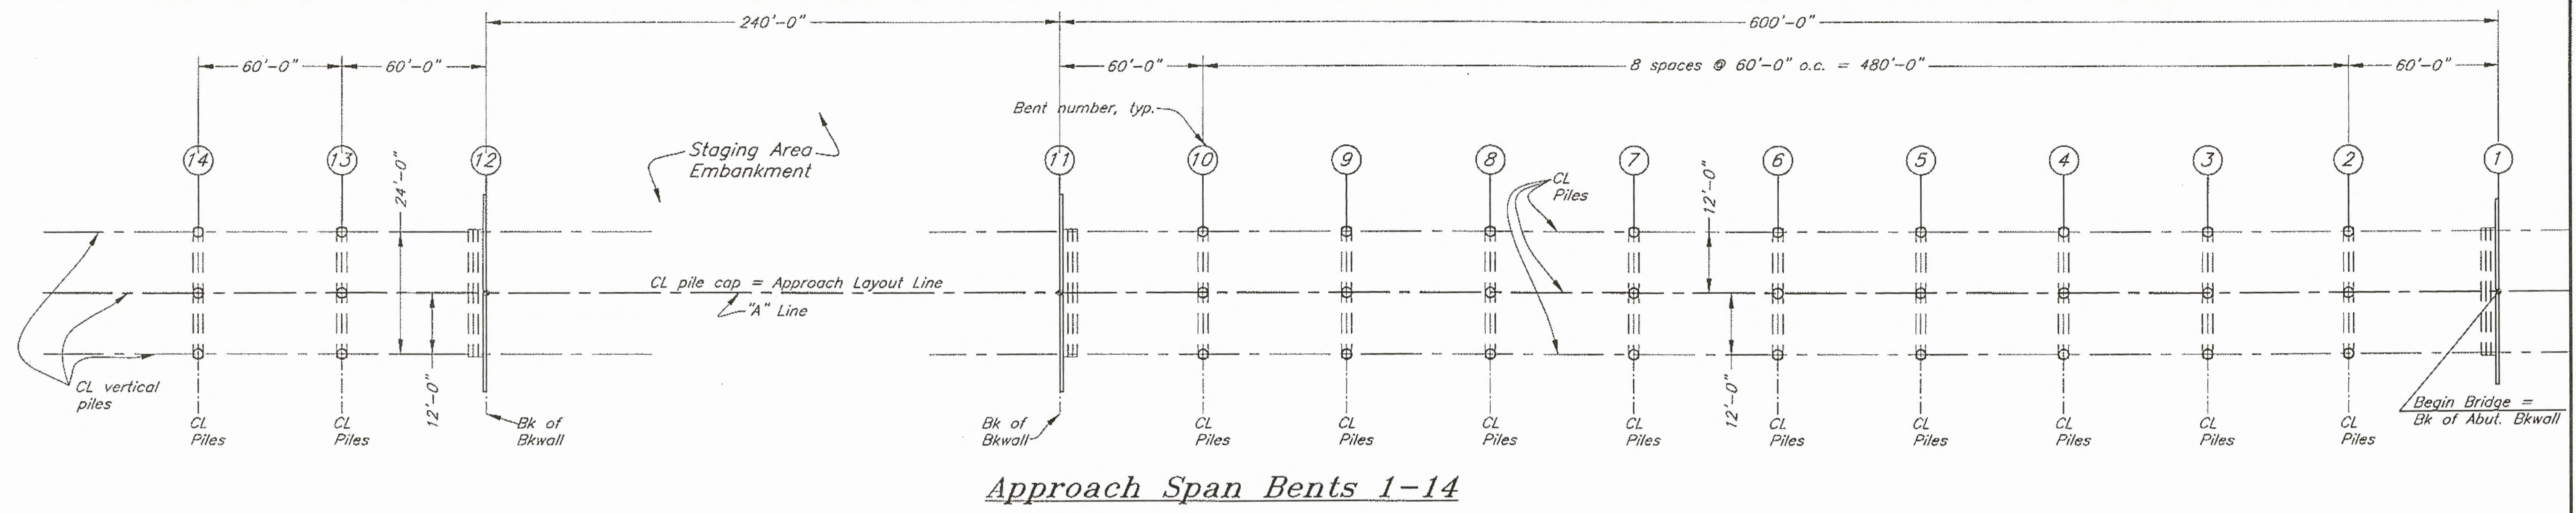

Approach Span Bents 1-14

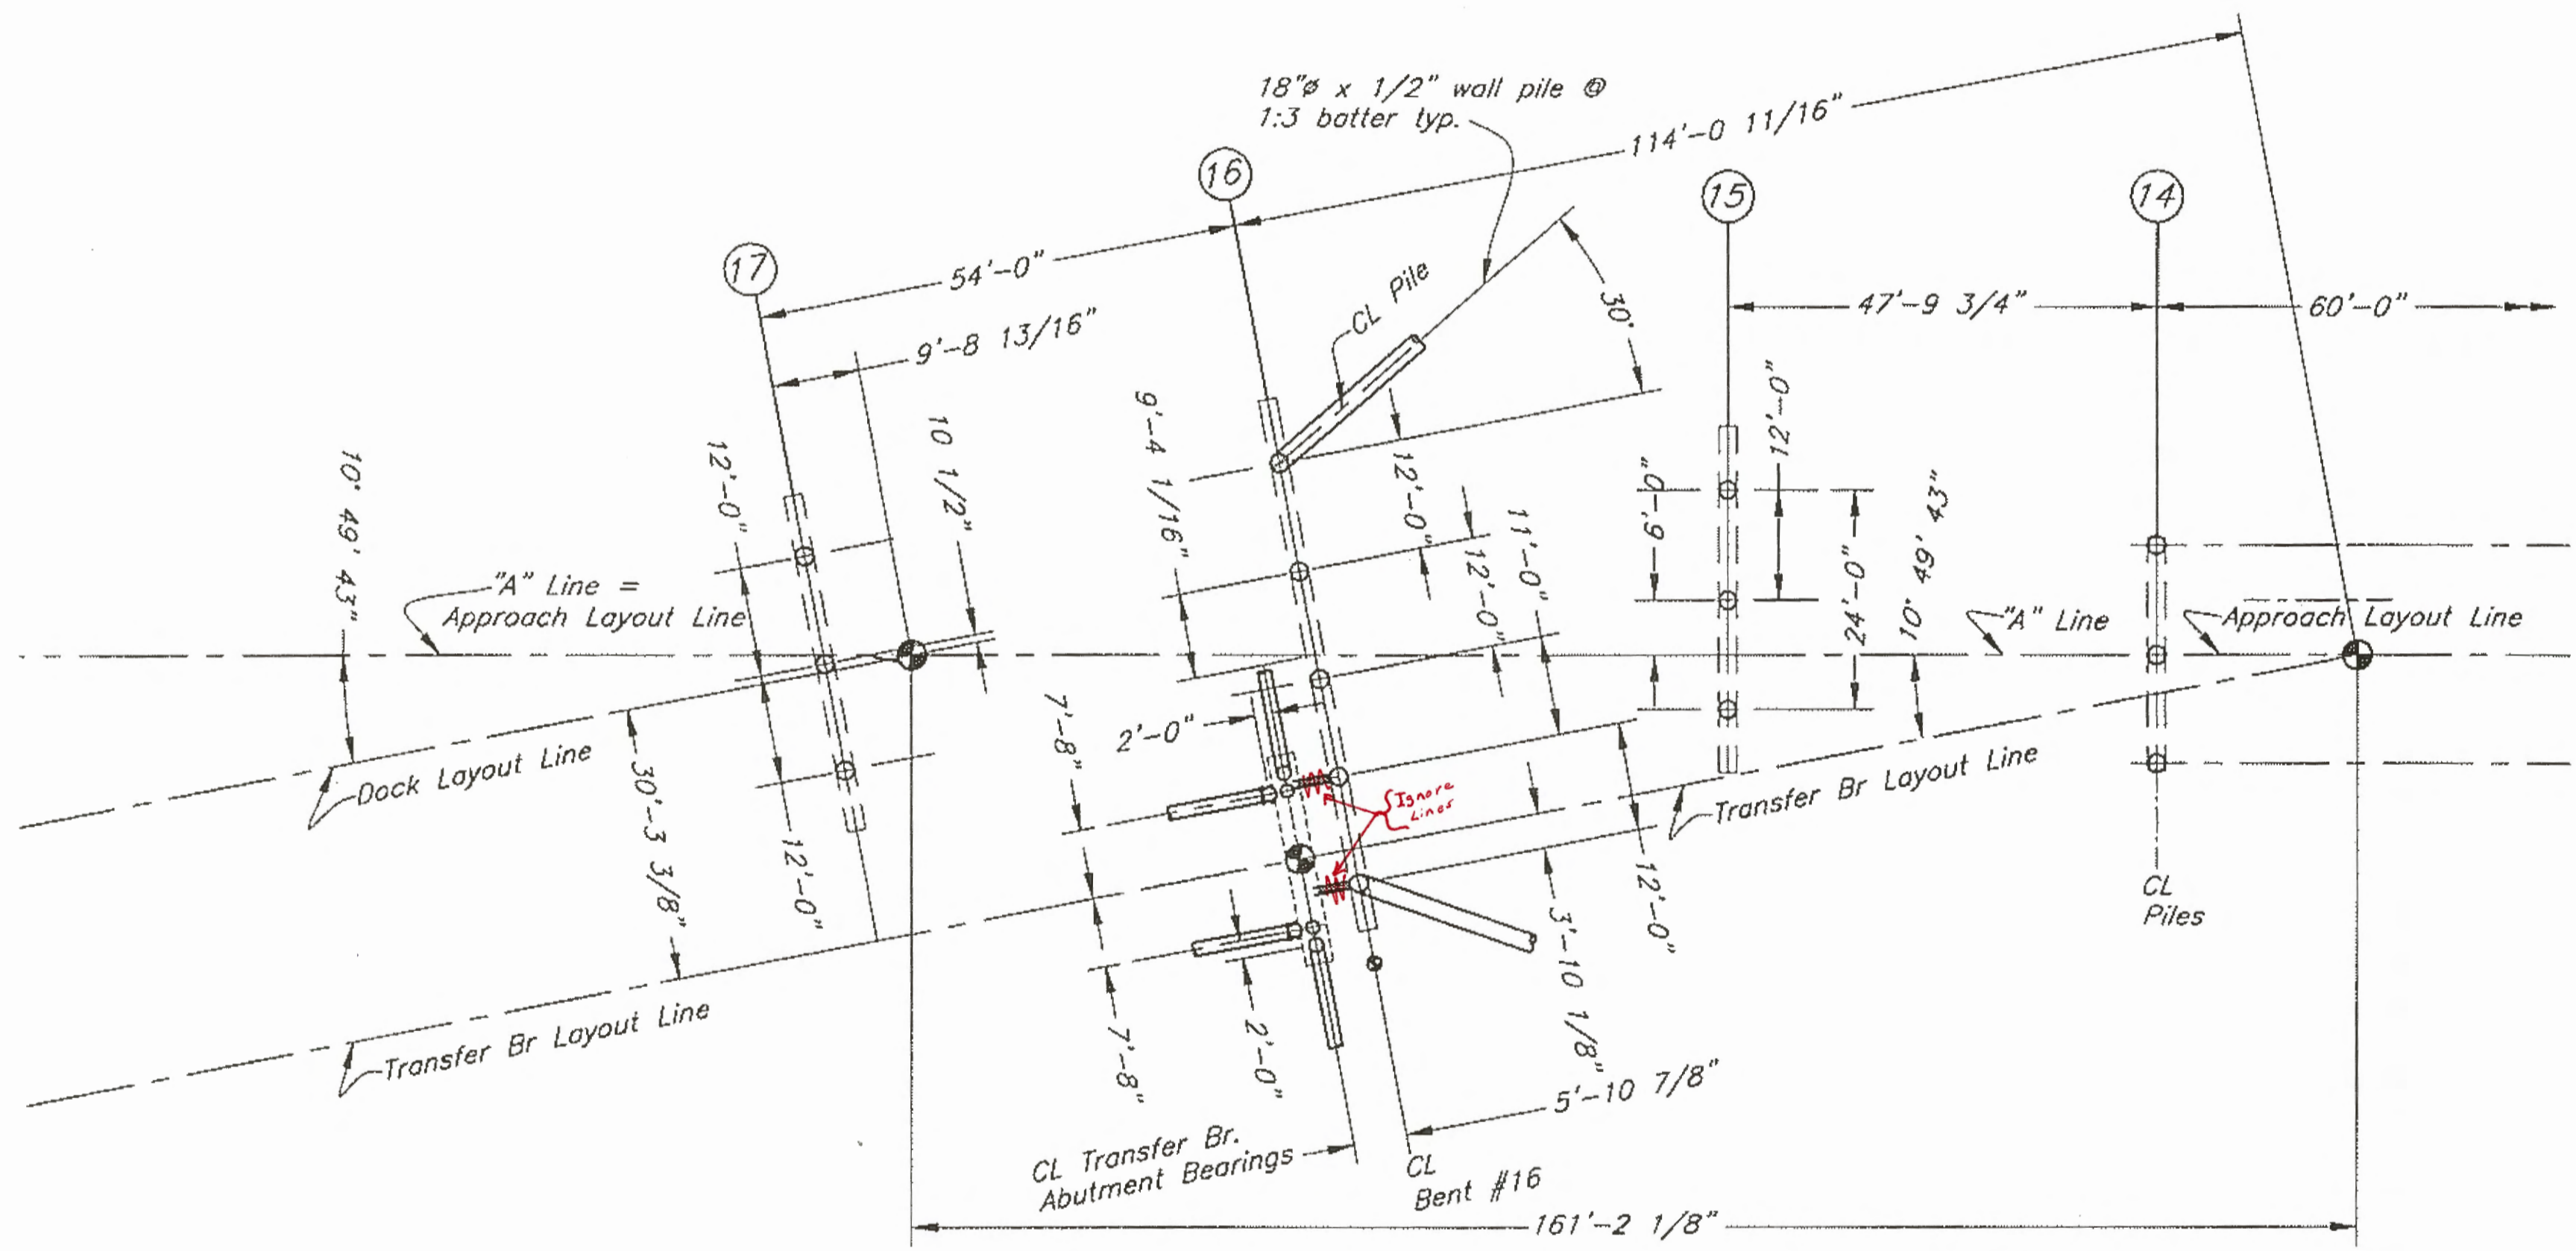

Approach Transition Bents 14-17

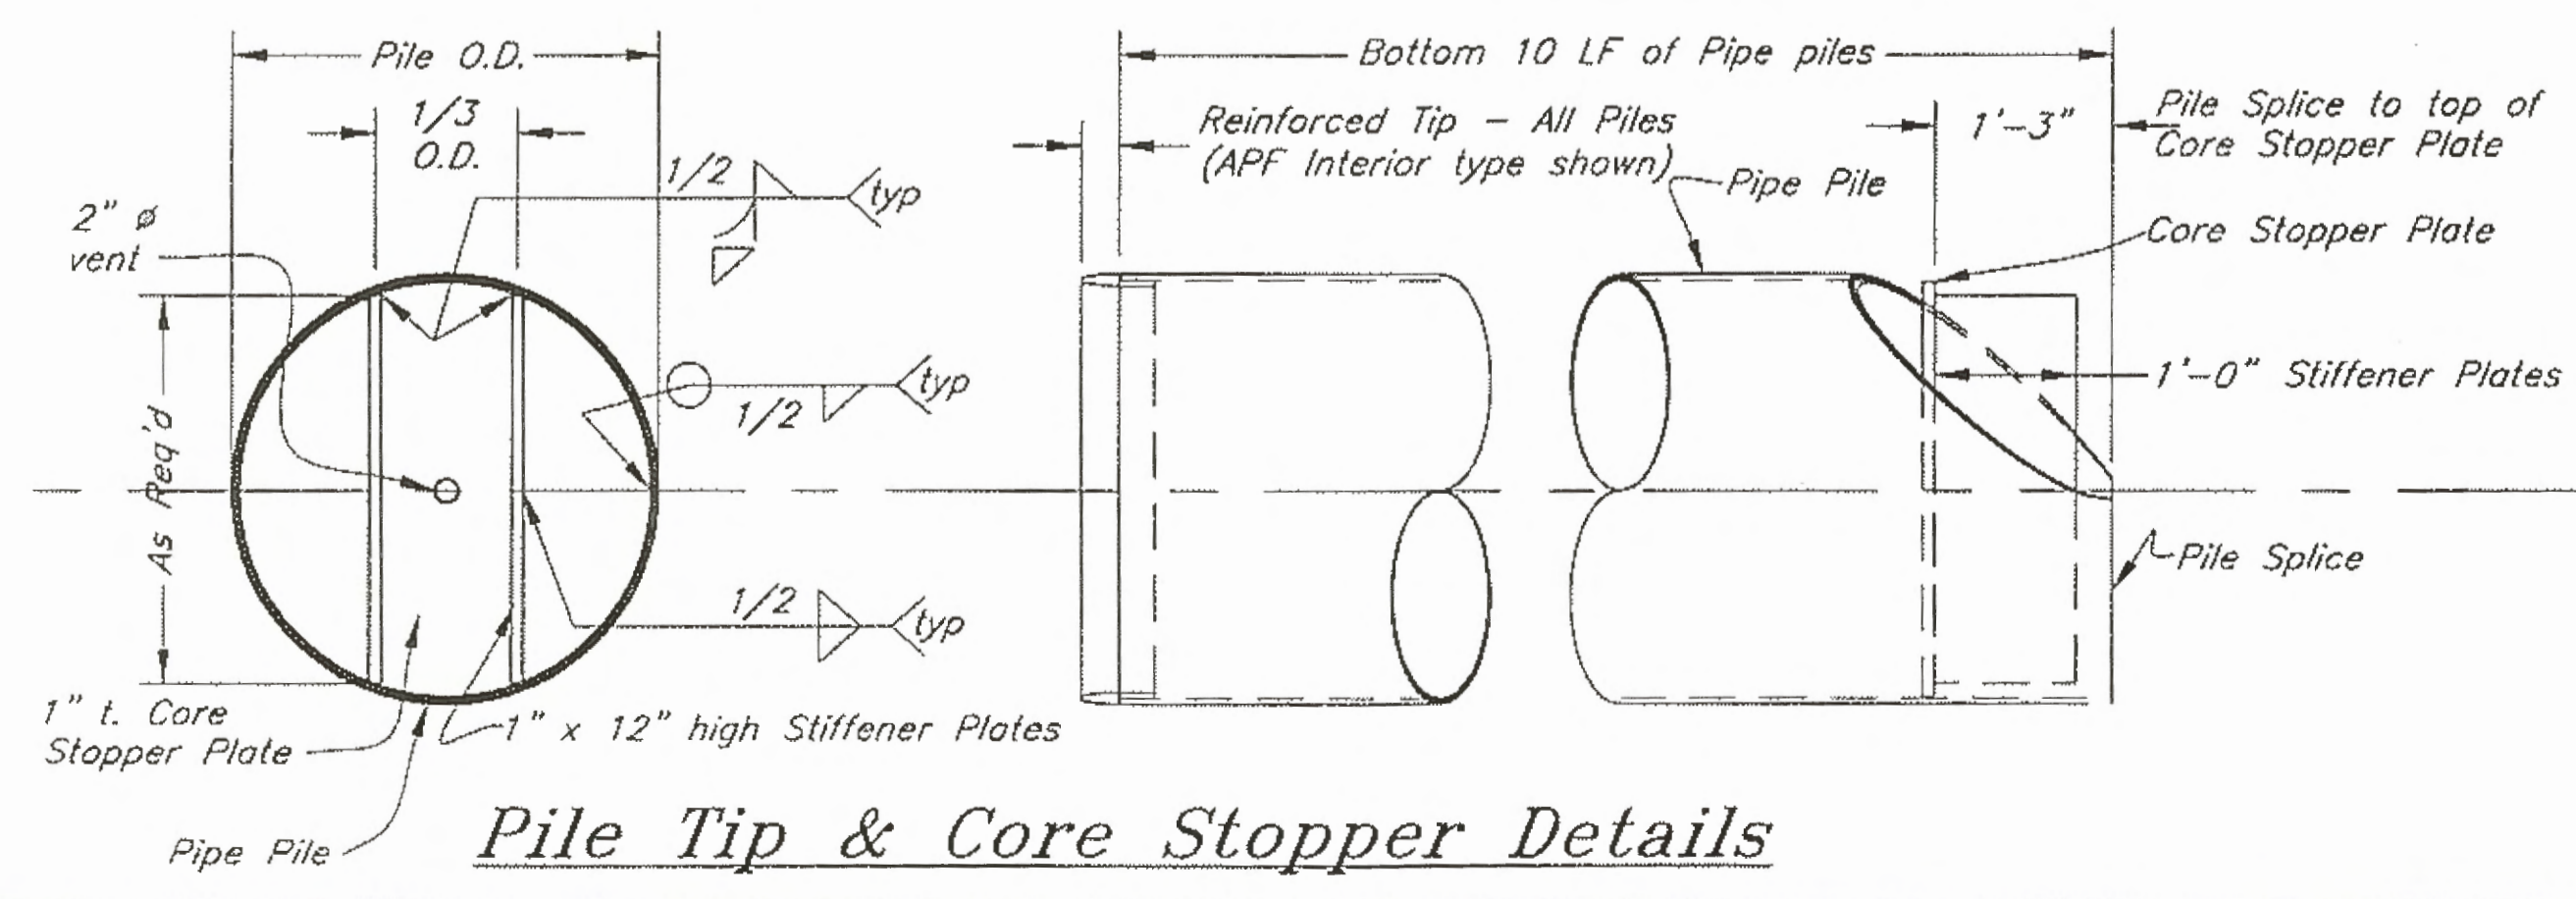

Pile Tip & Core Stopper Details

STRUCTURE & PILE LOCATION	Plugged	ORIENTATION	No. of PILES	DIA. Inches	DESIGN CAPACITY (TONS)		ELEVATIONS			EST. LGT. 24" dia	EST. LGT. 18" dia
					BEARING	UPLIFT	~ O.G.	CUT-OFF	ESTIMATED TIP		
Approach Abut. Bent #1		None	N/A	N/A	-	-	-	-	-	-	-
Approach Bent #2	Y	Vertical	2-3	24	50	-	13	14.04	-87	2.04	306
Approach Bent #3	Y	Vertical	2-3	24	50	-	8	14.04	-92	2.14	321
Approach Bent #4	Y	Vertical	2-3	24	50	-	7	14.04	-93	2.15	322
Approach Bent #5	Y	Vertical	2-3	24	50	-	5.5	14.04	-94	2.17	326
Approach Bent #6	Y	Vertical	2-3	24	50	-	4.5	14.04	-95	2.20	329
Approach Bent #7	Y	Vertical	2-3	24	50	-	3.5	14.04	-96	2.21	331
Approach Bent #8	Y	Vertical	2-3	24	50	-	2.7	14.04	-97	2.23	335
Approach Bent #9	Y	Vertical	2-3	24	50	-	2.3	14.04	-98	2.25	337
Approach Bent #10	Y	Vertical	2-3	24	50	-	1.5	14.04	-99	2.27	341
Approach Abut. Bent #11		None	N/A	N/A	50	-	-	-	-	-	-
Approach Abut. Bent #12		None	N/A	N/A	-	-	-	-	-	-	-
Approach Bent #13	Y	Vertical	2-3	24	50	-	-2.5	14.04	-103	2.35	353
Approach Bent #14	Y	Vertical	2-3	24	50	-	-3.5	14.04	-104	2.37	356
Approach Transition Bent #15	Y	Vertical	3	24	50	-	-4.5	14.04	-105	359	-
Approach Transition Bent #16	Y	Vertical	5	24	50	-	-5	14.04	-105	598	-
		N Batter 1:3	2	18	50	50	-4.5	21.04	-105	-	267
Approach Transition Bent #17	Y	Vertical	3	24	50	-	-15	14.04	-115	389	-
Transfer Bridge Abutment	Y	Vertical	2	18	50	-	-5	16.61	-105	-	243
Abut Transverse Batters	Y	Batter 1:3	2	18	50	50	-5	19.65	-105	-	262
Abut. Longitudinal Batters	Y	Batter 1:3	2	18	50	50	-10	19.65	-110	-	273
TOTAL BASIC Furn.										3,784 LF	1,045 LF
TOTAL BASIC Driven										33 Each	8 Each

- Note:
1. All piles 1/2" wall thickness and provided with reinforced tips.
 2. Approach Batter piles driven open ended
 3. Approach & Tr. Br. Abutment Vertical piles driven with plugged bottom section, see Detail this sheet
 4. Tr. Br. Abutment Batter piles driven with plugged bottom section, see Detail this sheet
 5. For purposes of Dynamic Pile Driving Analysis Ultimate Capacity = Design Capacity x 2.25

Record Drawings have been reviewed by the Project Engineer, and represent to the best of my knowledge, the project as constructed.
 PE: [Signature] Date: 8/2/12

DO NOT SCALE FROM THESE DRAWINGS USE DIMENSIONS

DESIGNED BY: J. Scott

STATE OF ALASKA
 DEPARTMENT OF TRANSPORTATION & PUBLIC FACILITIES
 DESIGN & ENGINEERING SERVICES DIVISION-SOUTHEAST REGION

Gustavus Causeway Replacement

Approach & Approach Transition Pile Layout
 AP02


CHECKED BY: B. Savikko
 DRAWN BY: C. Tuman, W. Hickok

49th
 John I. Scott
 CL-4755
 REGISTERED PROFESSIONAL ENGINEER

11-26-08

PATH: O:\CUS\67599\MF\PLANSET\03-APPROACH\AP02 PILE LAYOUT APP AND TRANS.DWG
 TAB Tue, 25/Nov/08 04:22PM JTSOTT

REVISIONS		PROJECT DESIGNATION	YEAR	SHEET NO.	TOTAL SHEETS
NO.	DATE				
		BR-0003(53)67599	2008	12	138

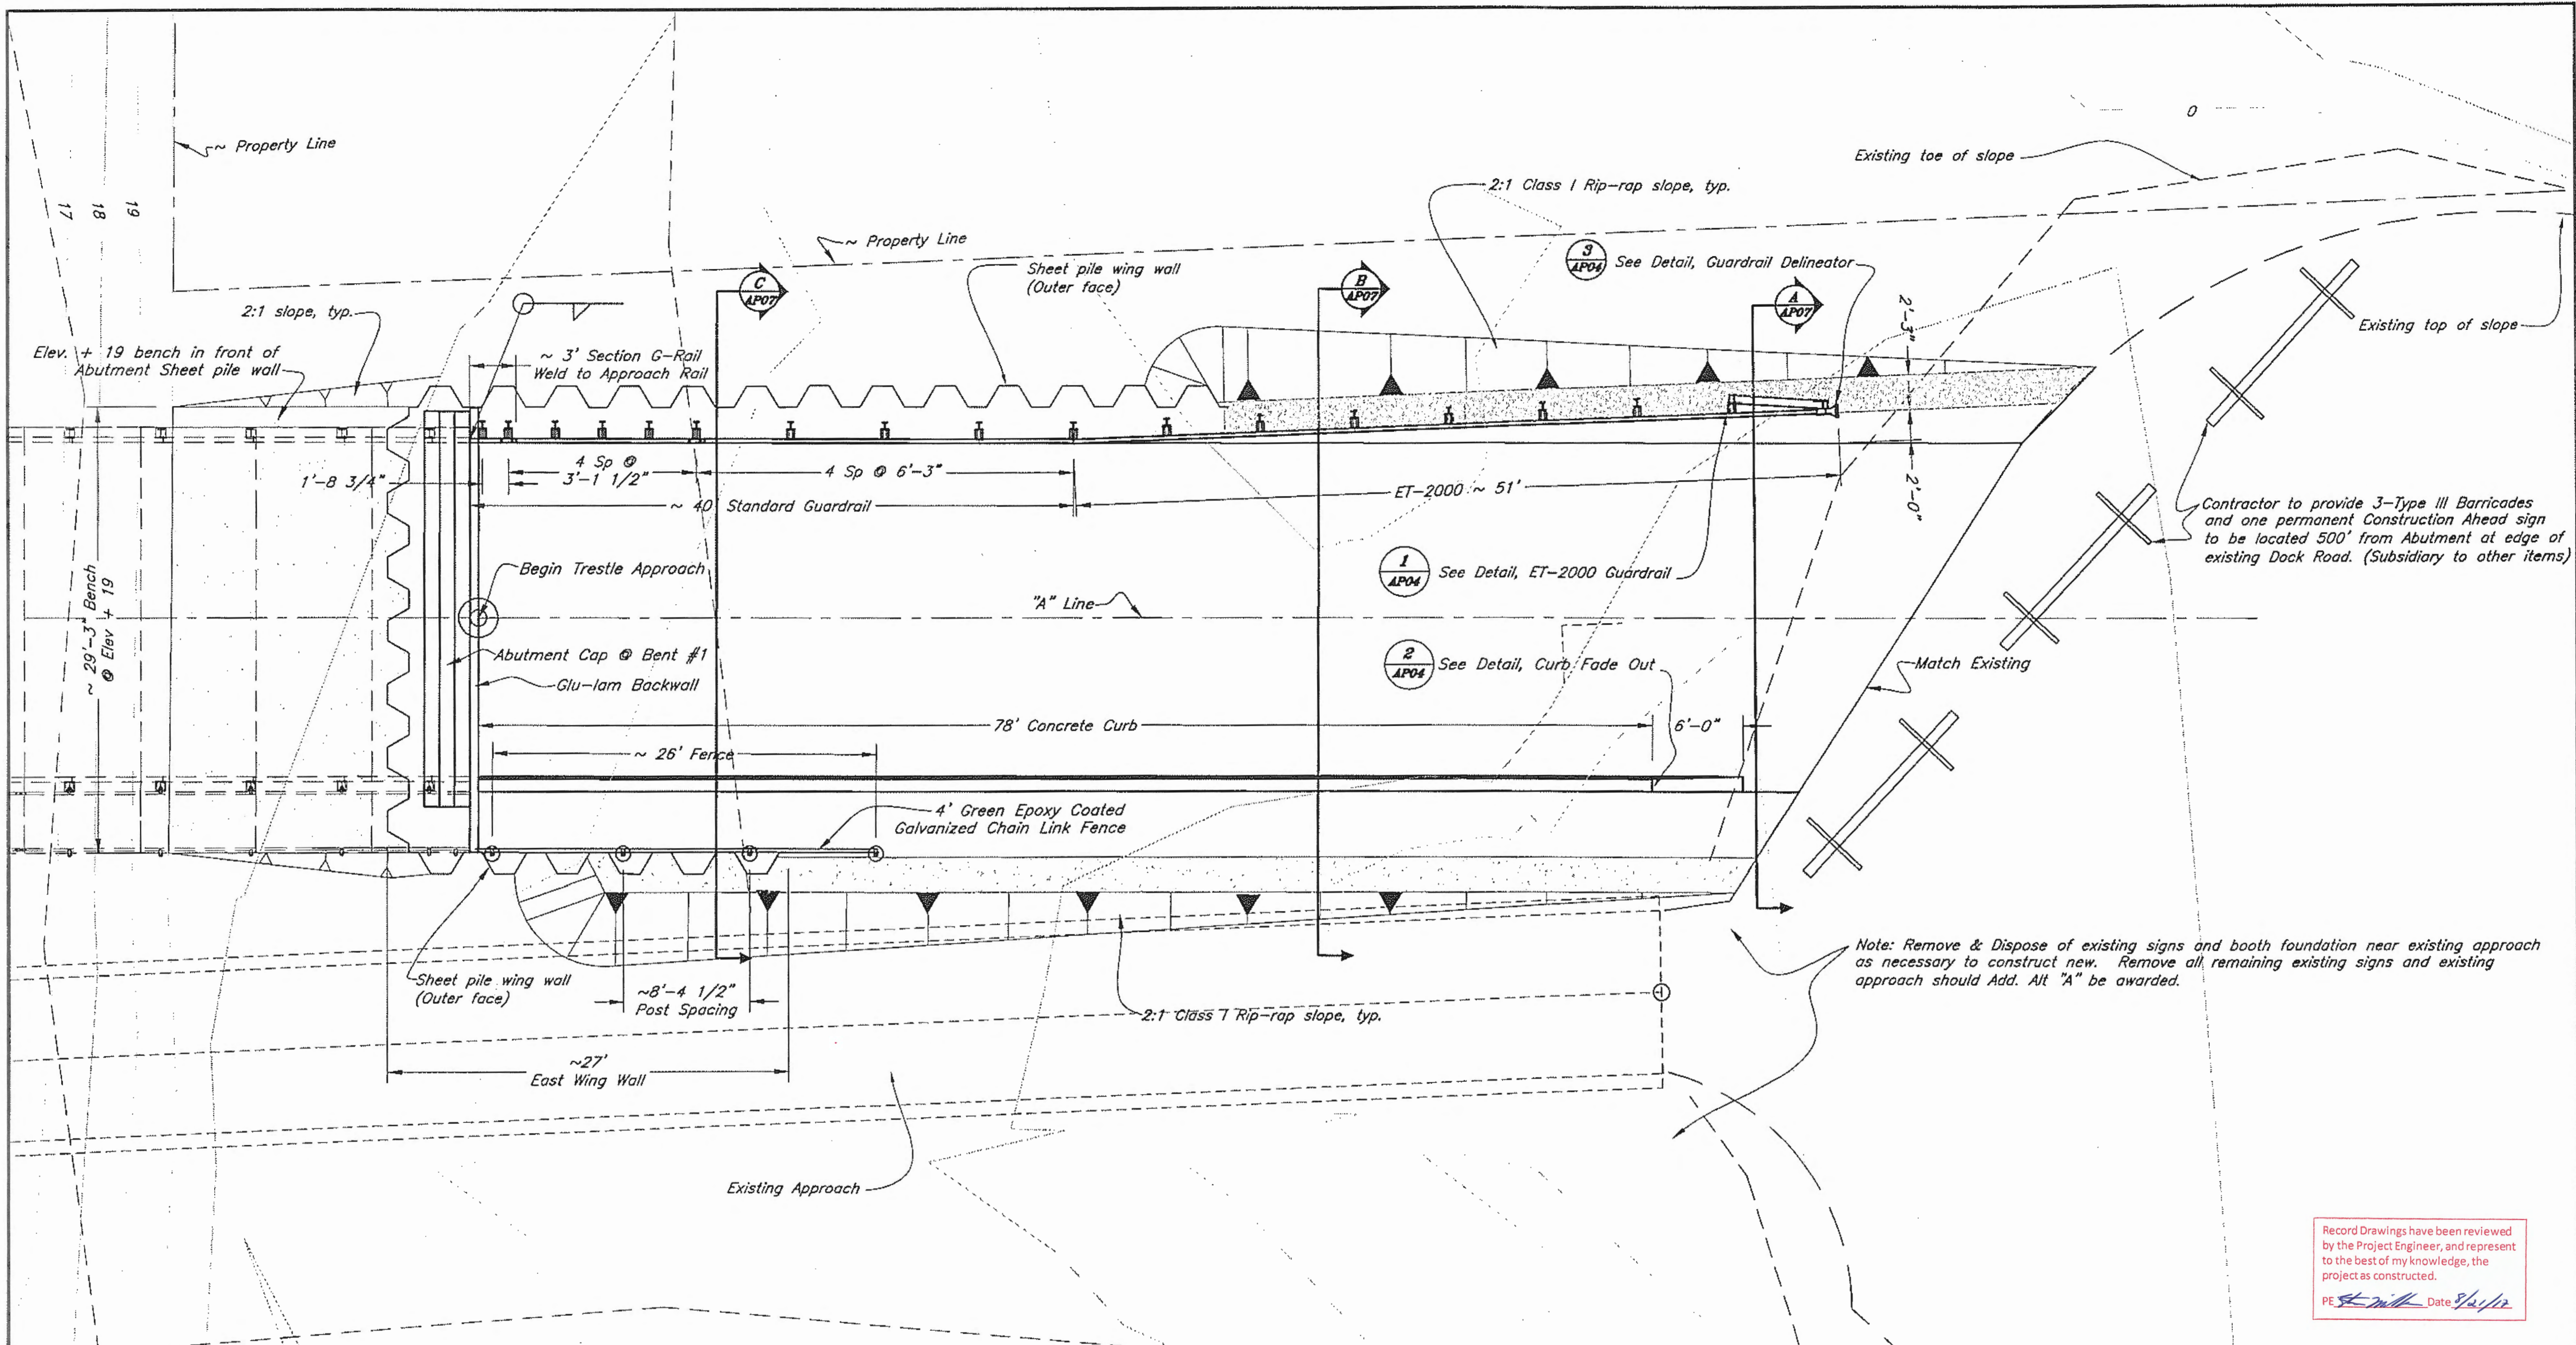


Record Drawings have been reviewed by the Project Engineer, and represent to the best of my knowledge, the project as constructed.
 PE *[Signature]* Date *11/26/08*

DO NOT SCALE FROM THESE DRAWINGS USE DIMENSIONS

DESIGNED BY: <i>J. Scott</i>		STATE OF ALASKA DEPARTMENT OF TRANSPORTATION & PUBLIC FACILITIES DESIGN & ENGINEERING SERVICES DIVISION-SOUTHEAST REGION									
		Gustavus Causeway Replacement Approach Shore Embankment & Abutment @ Bent #1 AP03									
				CHECKED BY: <i>B. Savikko</i> DRAWN BY: <i>C. Fuman, W. Hickok</i> PATH: <i>O:\GUS\67599\MF\PLANSET\03-APPROACH\AP03 ABUTMENT AREA LAYOUT.DWG</i> TAB: <i>Wed, 26/Nov/08 02:08PM Wed, 26/Nov/08 02:08PM JTS/SCOTT</i>							
<table border="1"> <thead> <tr> <th>NO.</th> <th>DATE</th> <th>DESCRIPTION</th> </tr> </thead> <tbody> <tr> <td> </td> <td> </td> <td> </td> </tr> </tbody> </table>		NO.	DATE	DESCRIPTION				PROJECT DESIGNATION	YEAR	SHEET NO.	TOTAL SHEETS
NO.	DATE	DESCRIPTION									
		BR-0003(53)/67599	2008	13	138						

White post with one 3"x9" high intensity silver reflector strip facing oncoming traffic

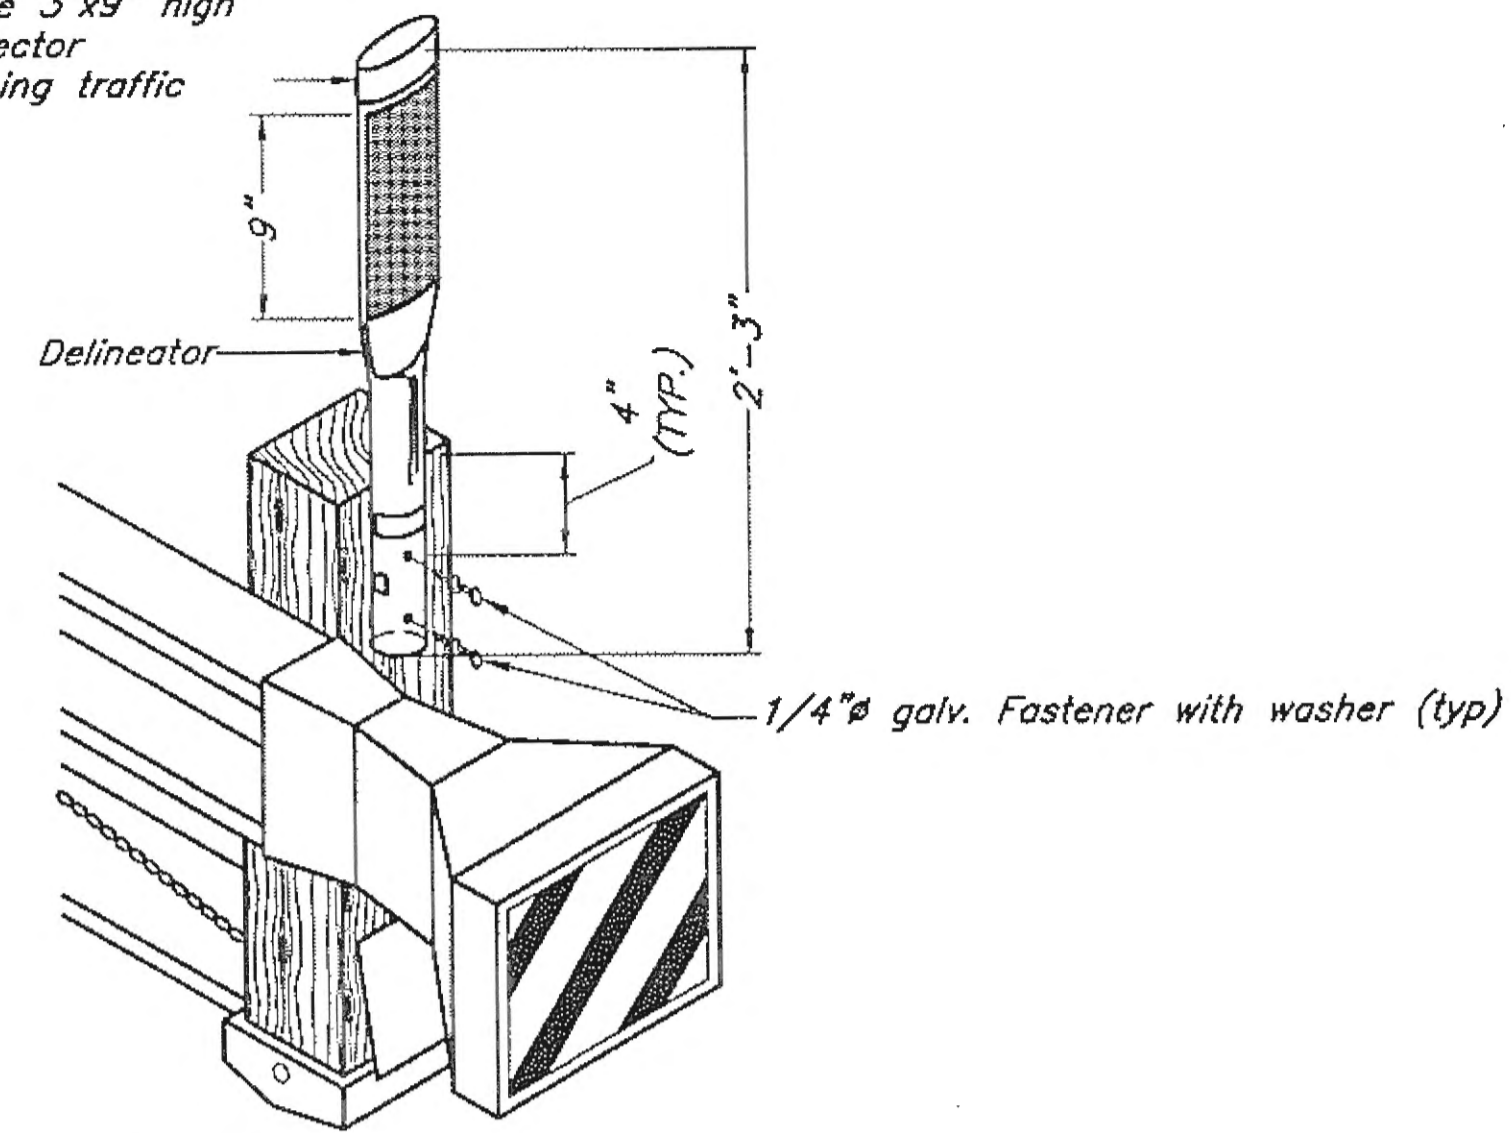


Delineator notes:

1. Each ET-2000 guardrail end shall have one delineator.
2. Delineator shall have white reflective sheeting.
3. Steel post guardrail shall be pre-drilled prior to securing delineator with self-tapping screws.
4. Delineator shall be incidental


Flexible Guardrail Delineator

No scale


3
AP03

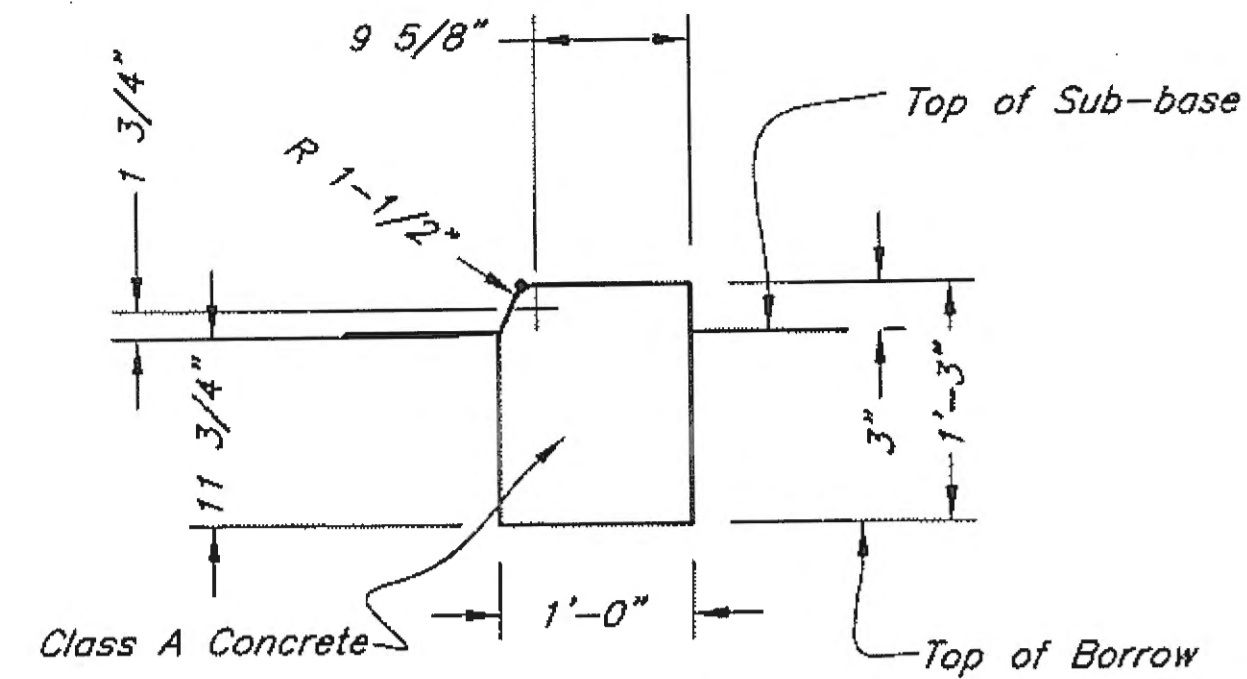

Curb Section @ 1/2 Height

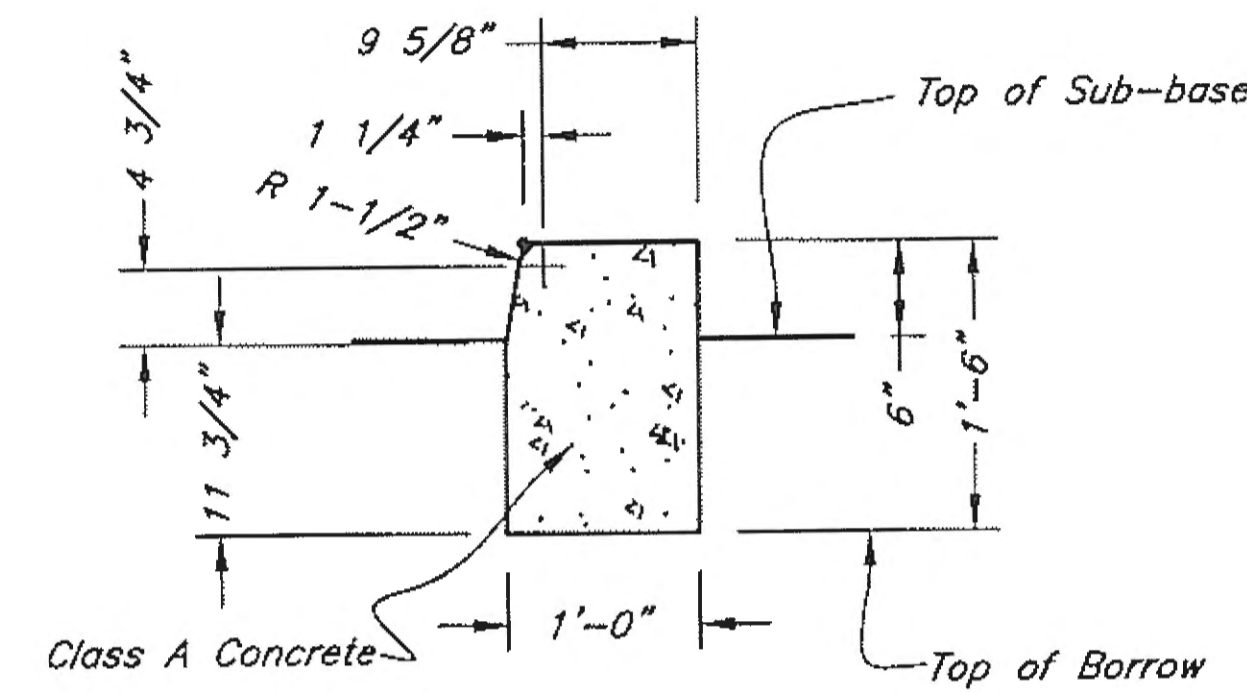


Curb - Typical Section

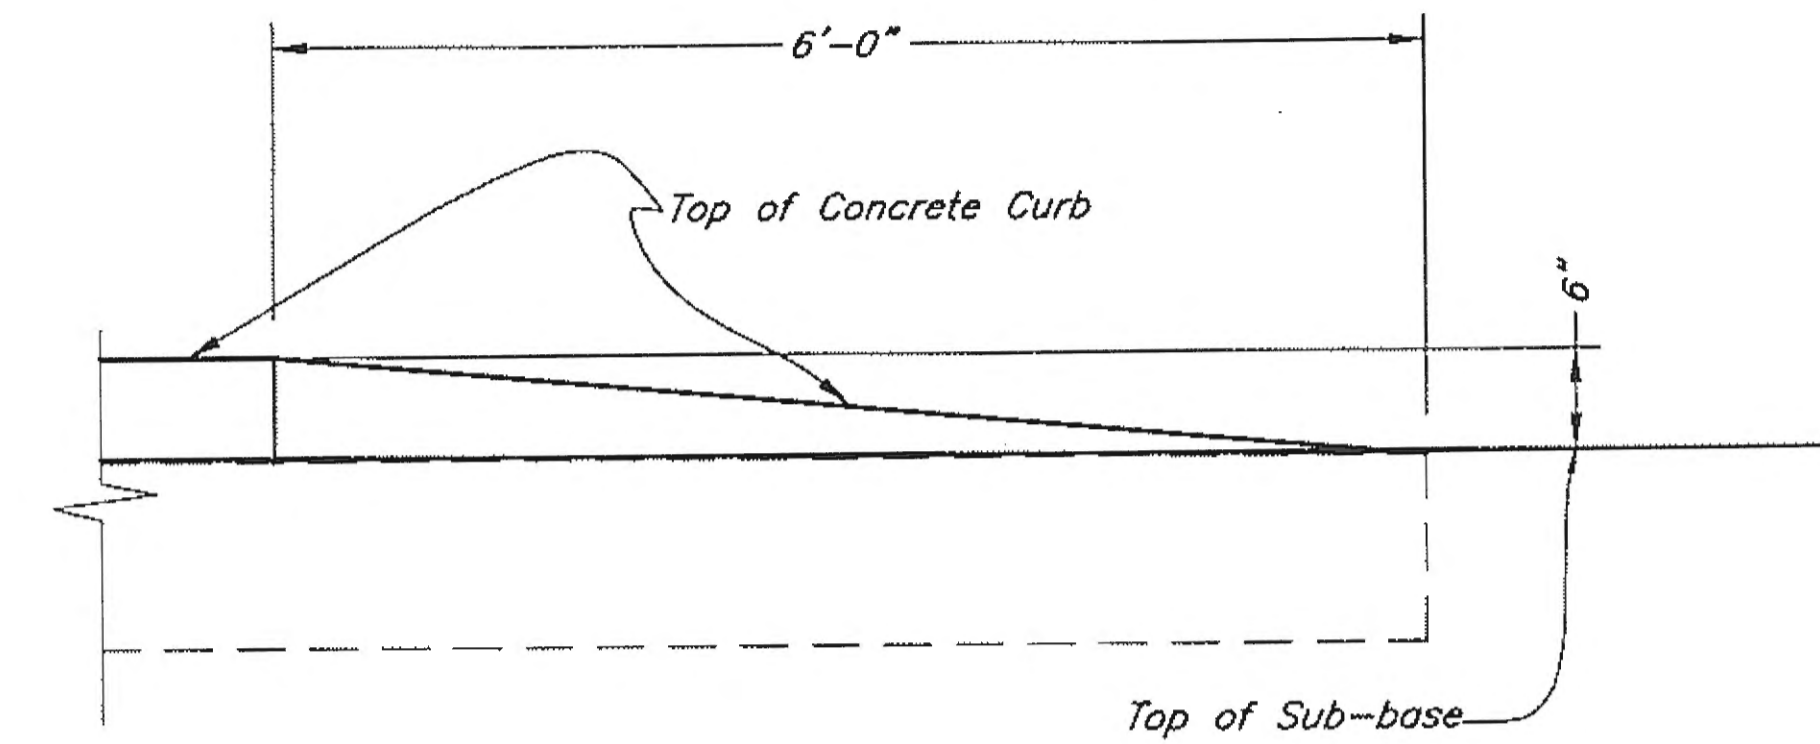

Curb Fade out Detail

2
AP03

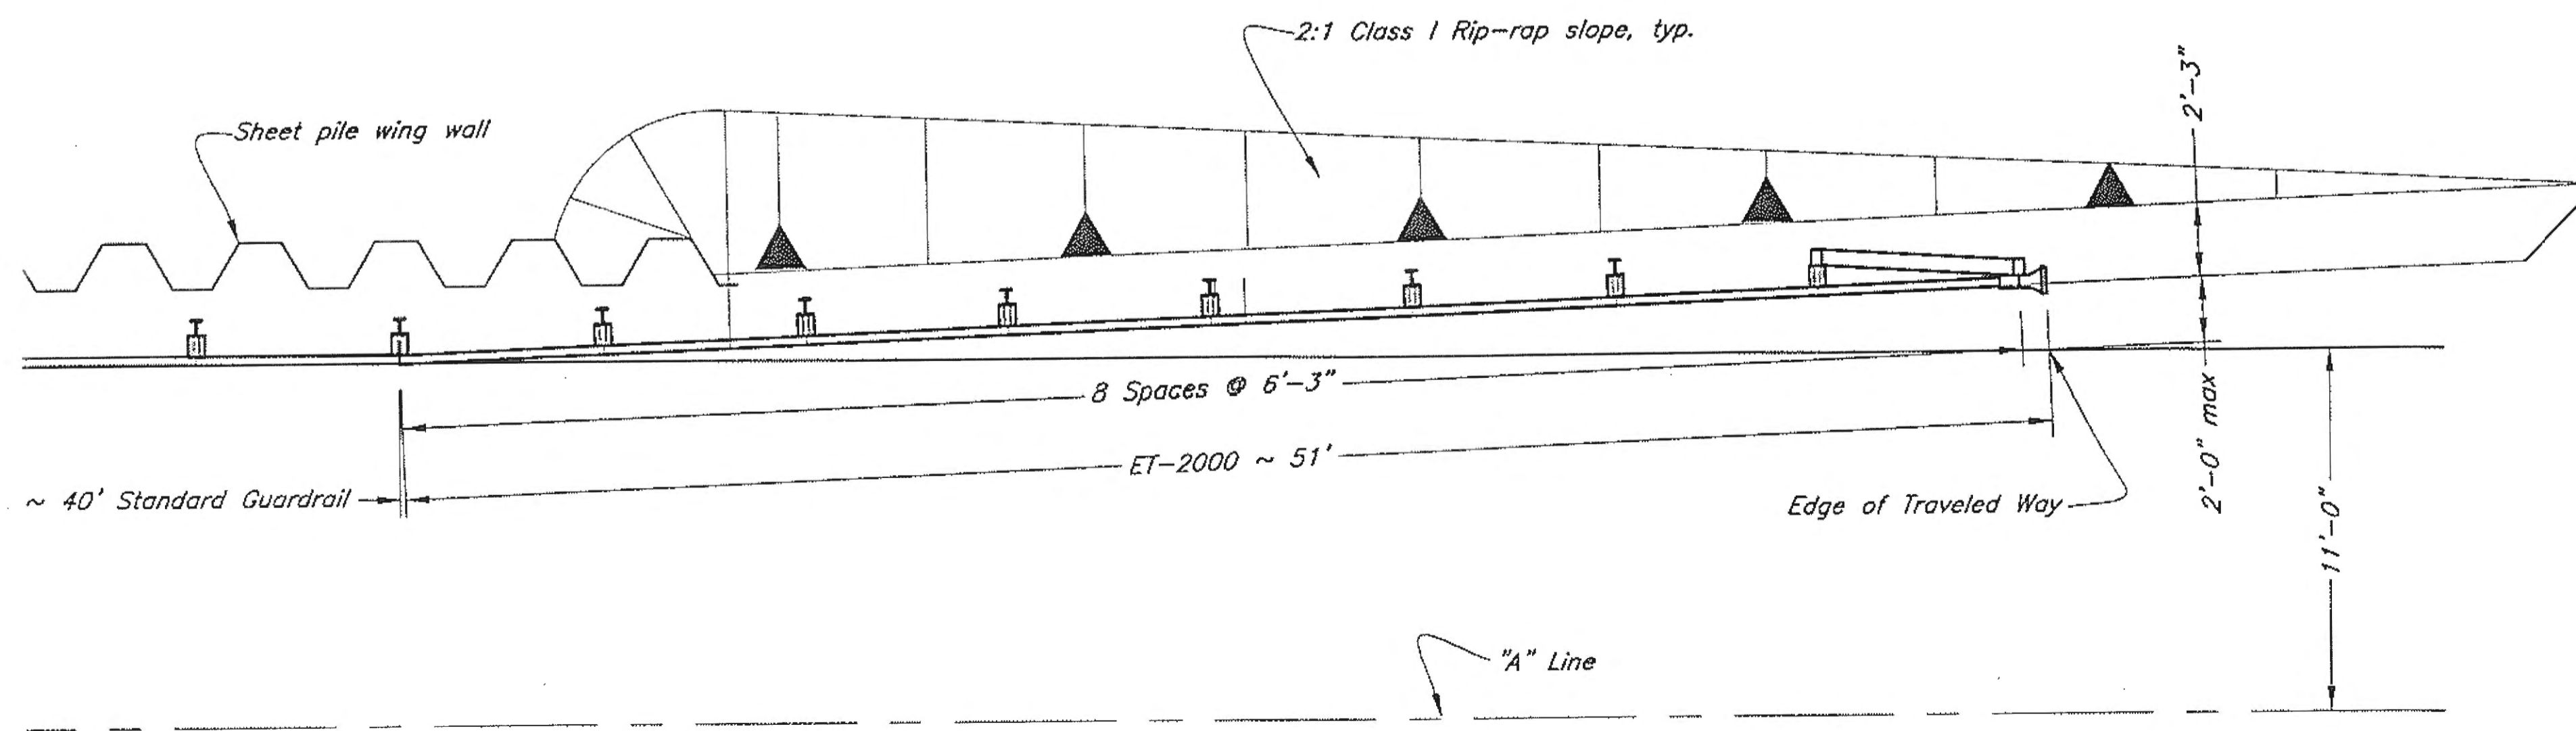


ET-2000 Layout Detail

1
AP03


Record Drawings have been reviewed by the Project Engineer, and represent to the best of my knowledge, the project as constructed.
PE: *[Signature]* Date: 5/21/12

DO NOT SCALE FROM THESE DRAWINGS USE DIMENSIONS


DESIGNED BY: J. Scott 		STATE OF ALASKA DEPARTMENT OF TRANSPORTATION & PUBLIC FACILITIES DESIGN & ENGINEERING SERVICES DIVISION-SOUTHEAST REGION	
CHECKED BY: B. Savikko DRAWN BY: C. Furman, W. Hickok		Gustavus Causeway Replacement Approach Shore Embankment Details AP04	
PATH: Q:\GUS\67599\MF\PLANSET\03-APPROACH\A04 ABUTMENT AREA DETAILS.DWG TAB: Wed, 26/Nov/08 02:10PM JTS/OT		PROJECT DESIGNATION BR-0003(53)/67599	YEAR 2008
REVISIONS NO. DATE DESCRIPTION	SHEET NO. 14	TOTAL SHEETS 138	

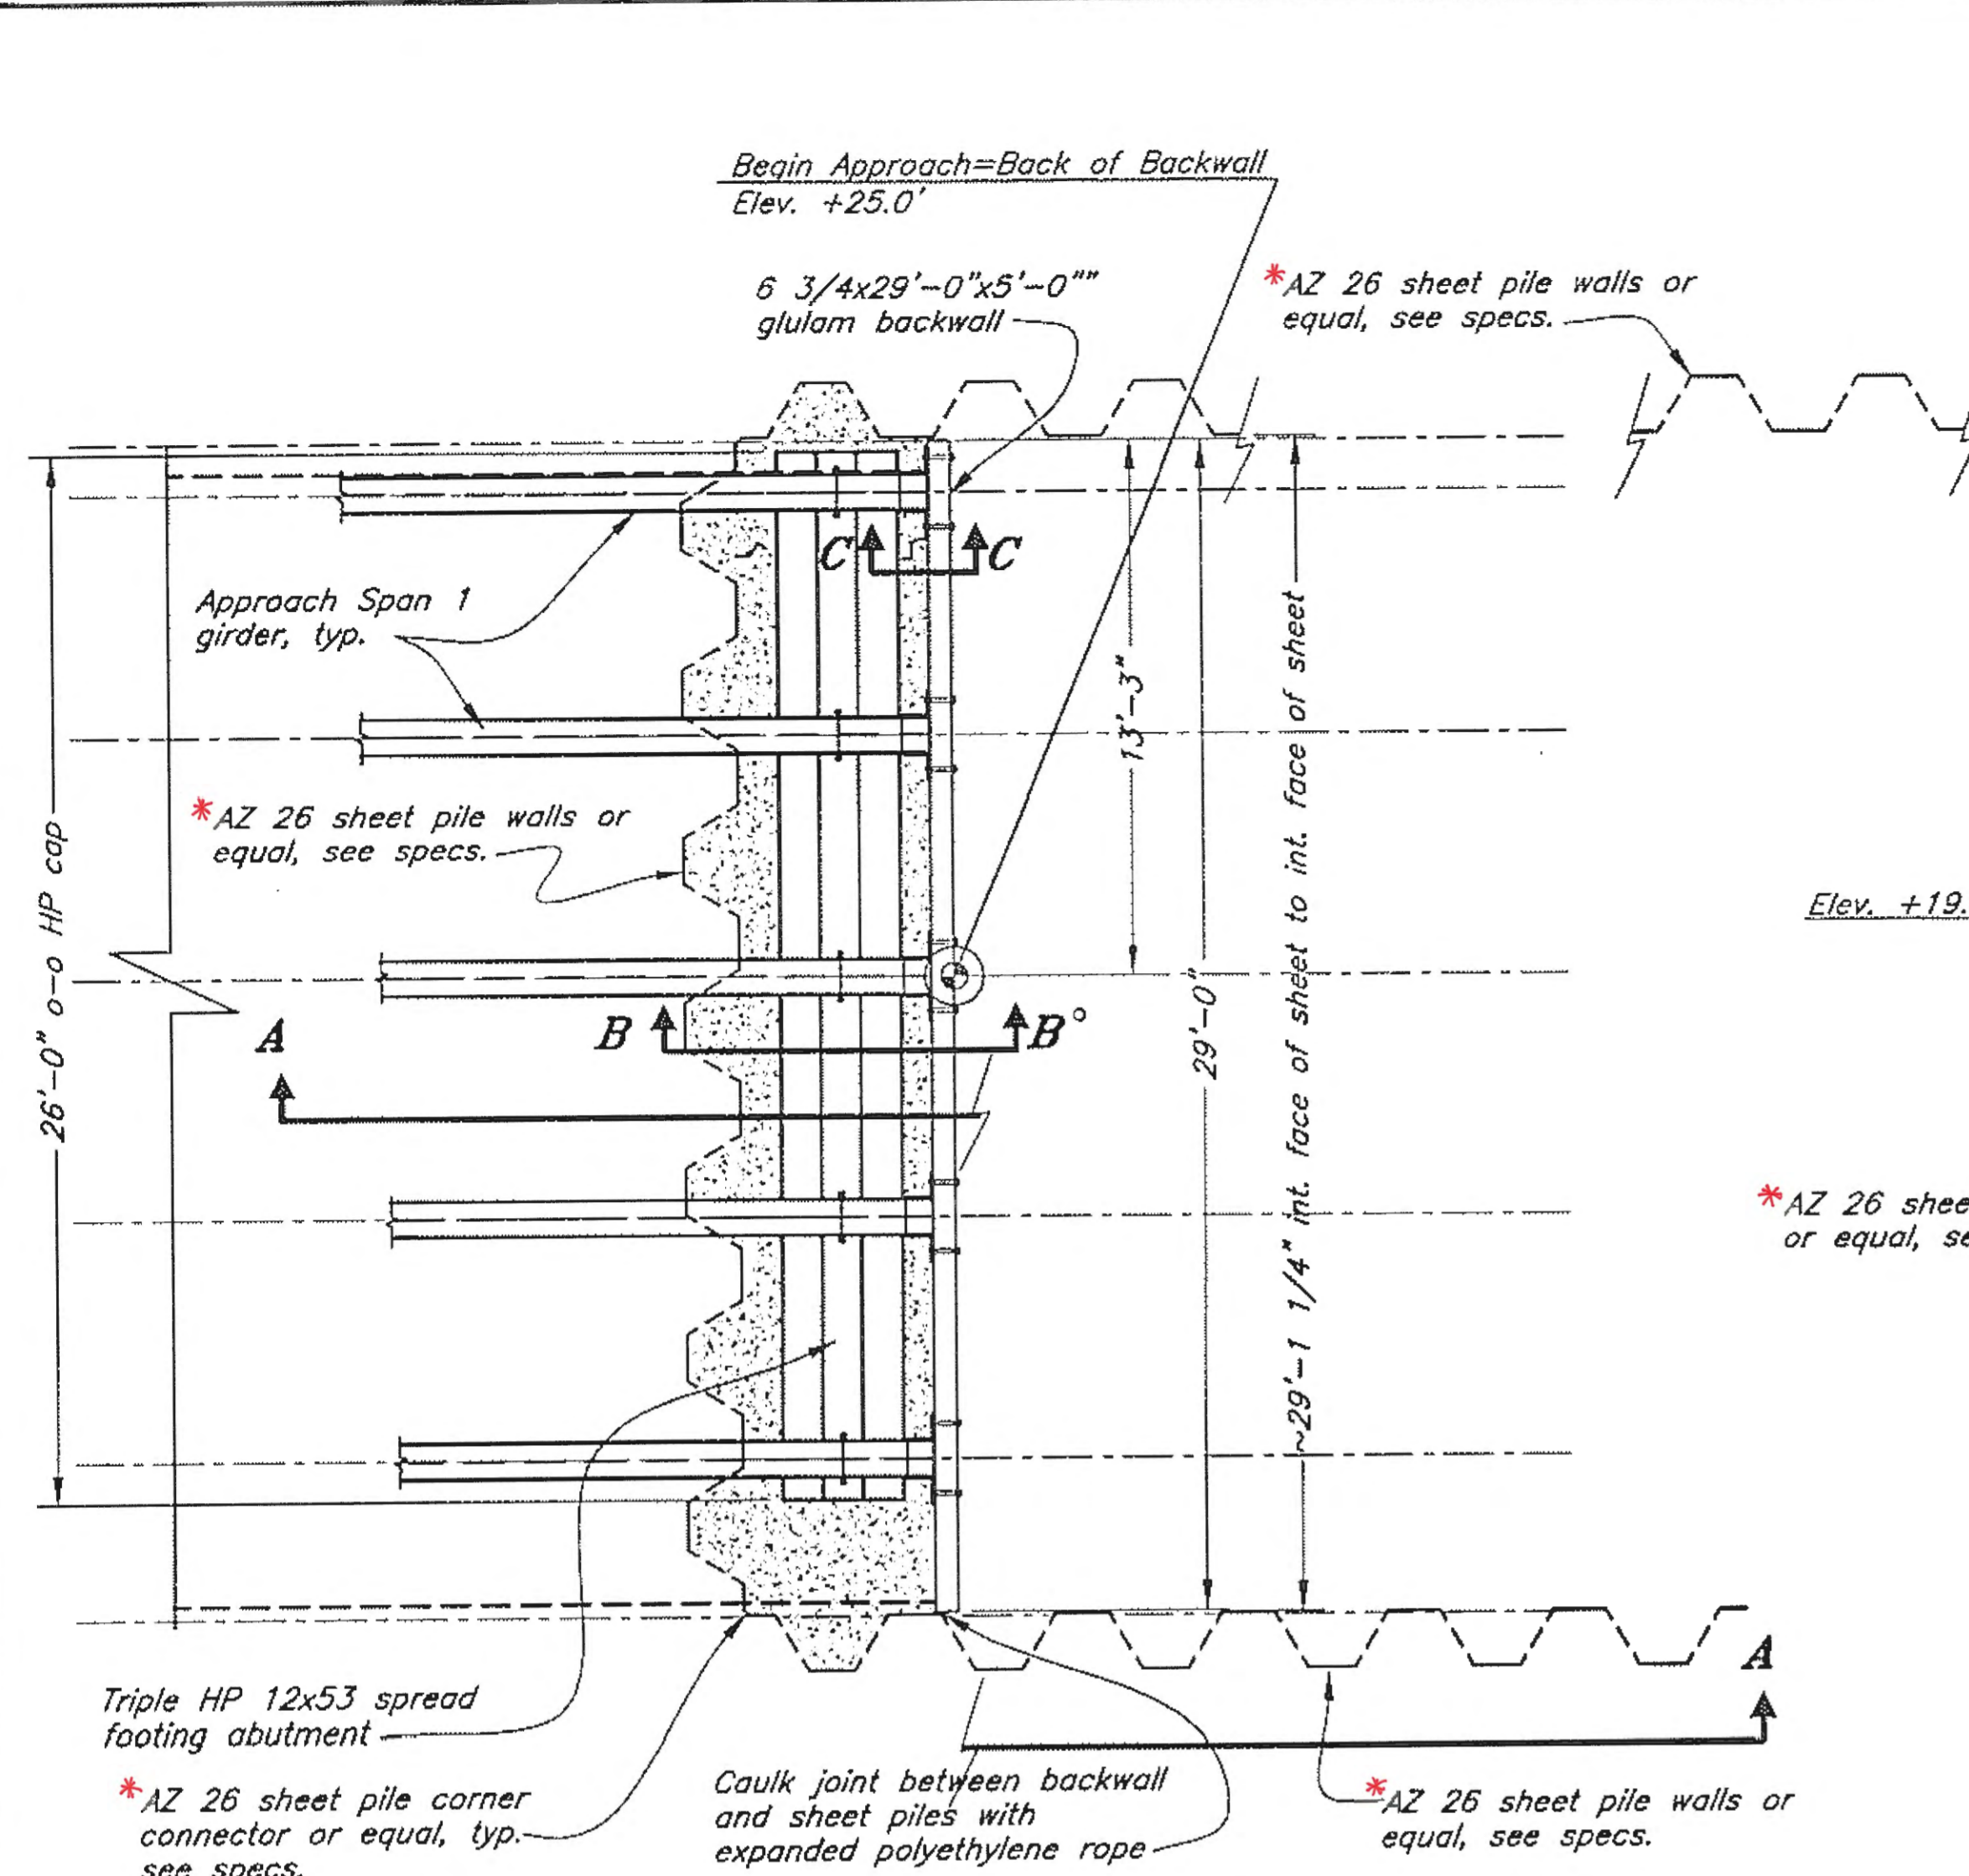


Abutment Plan - Bent #1

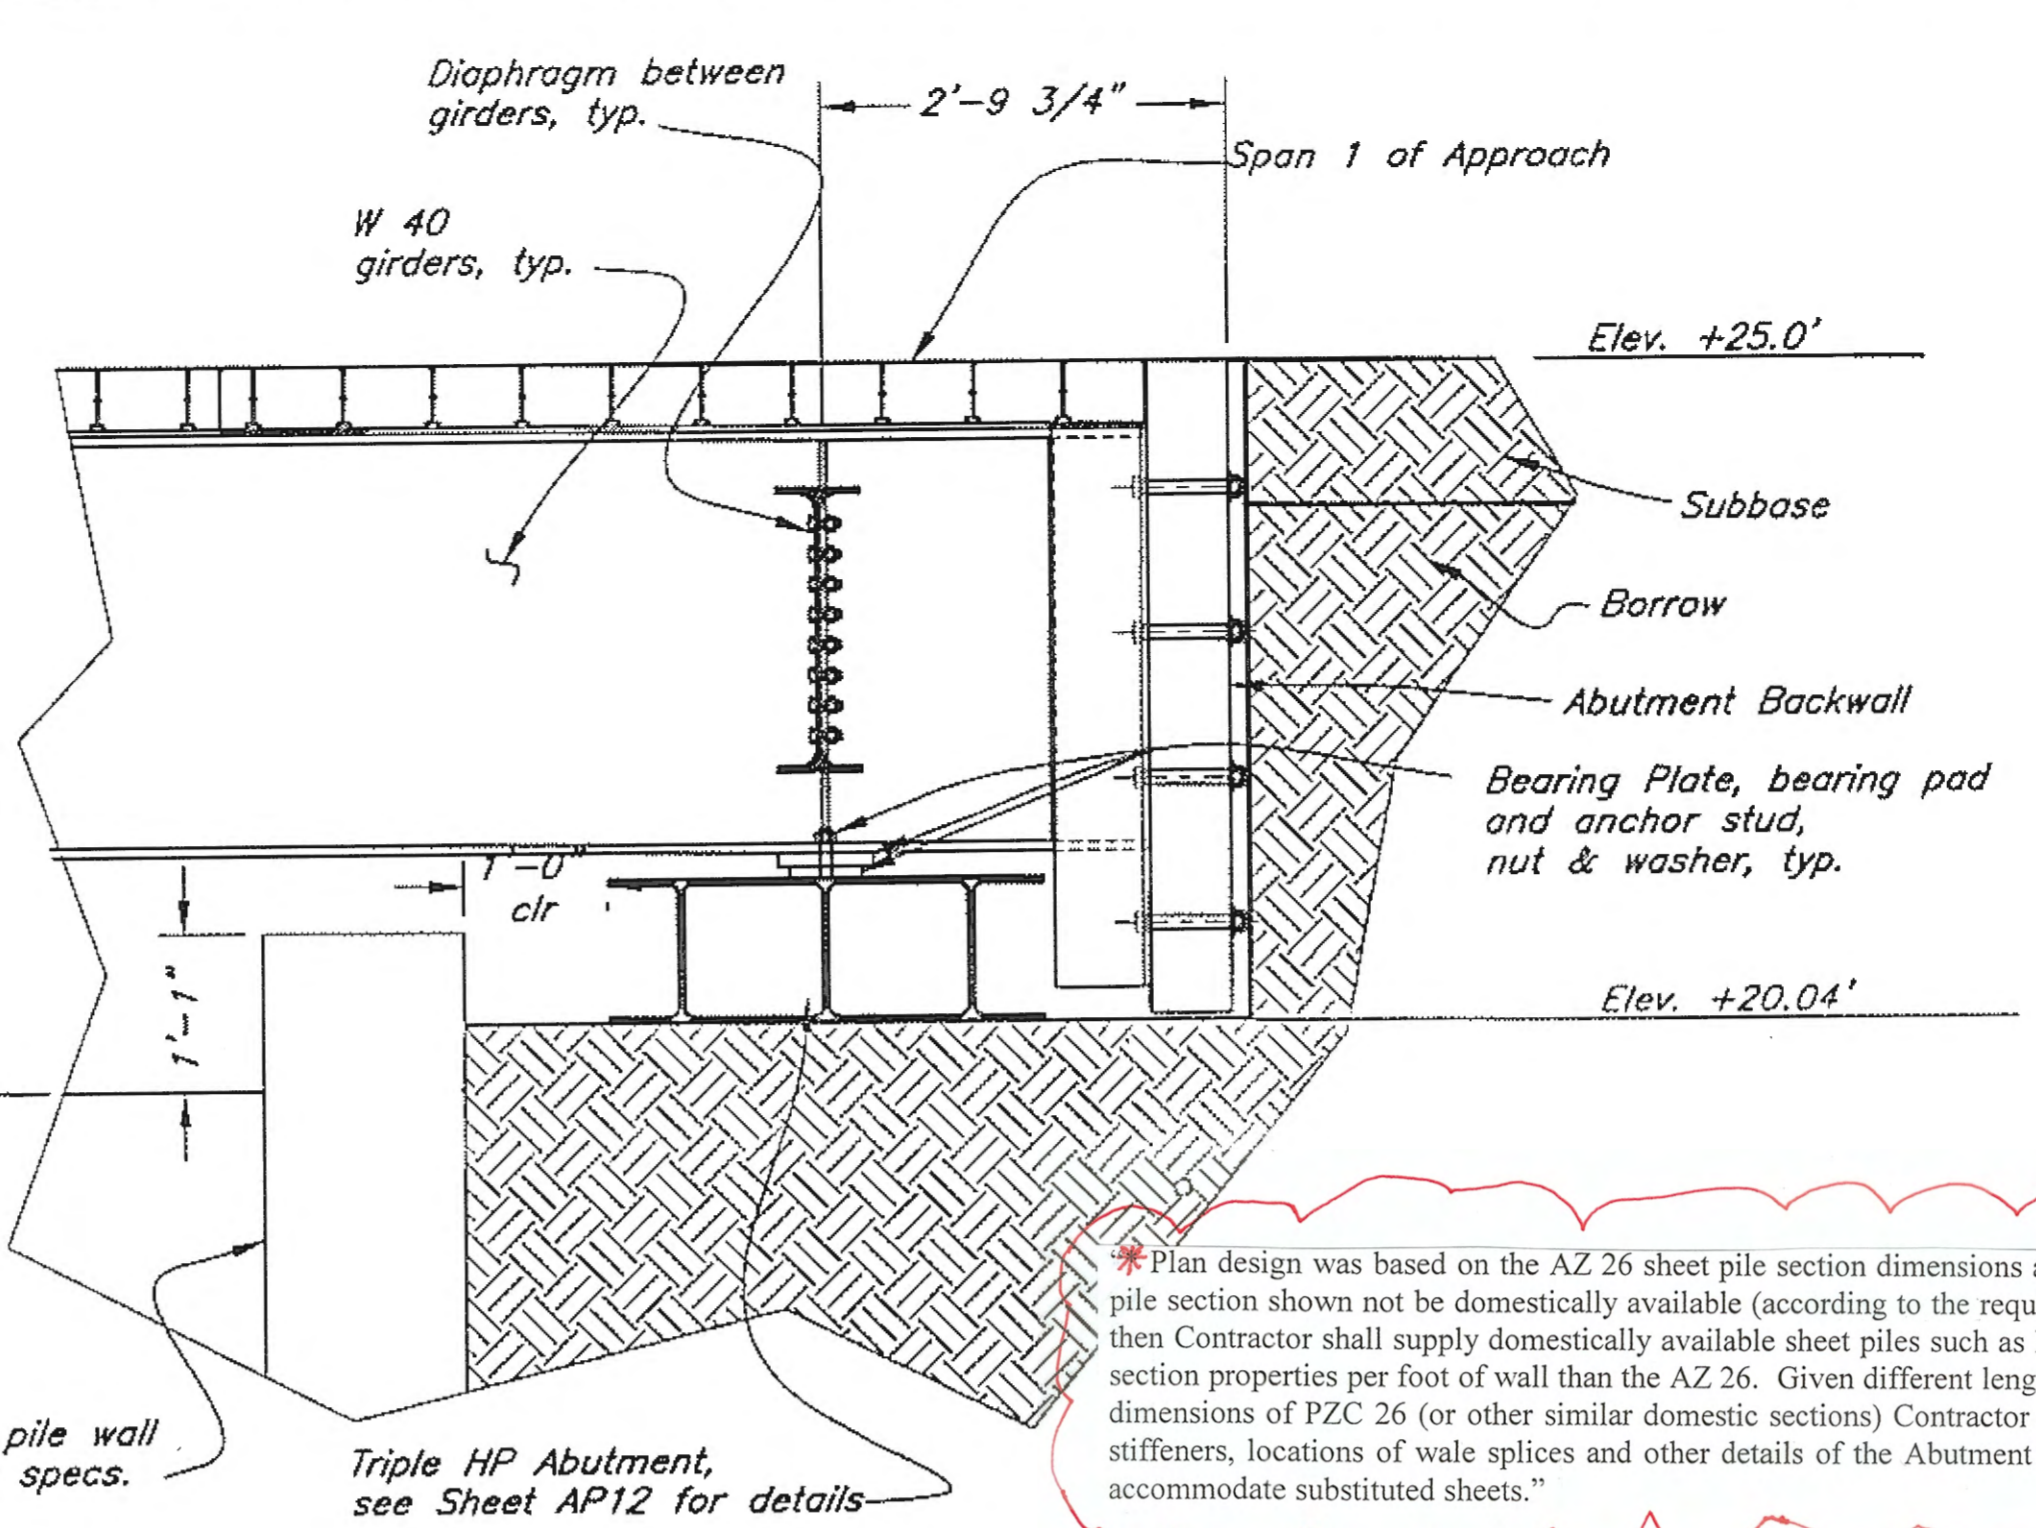

**Section B-B
(Bent 1 shown)**

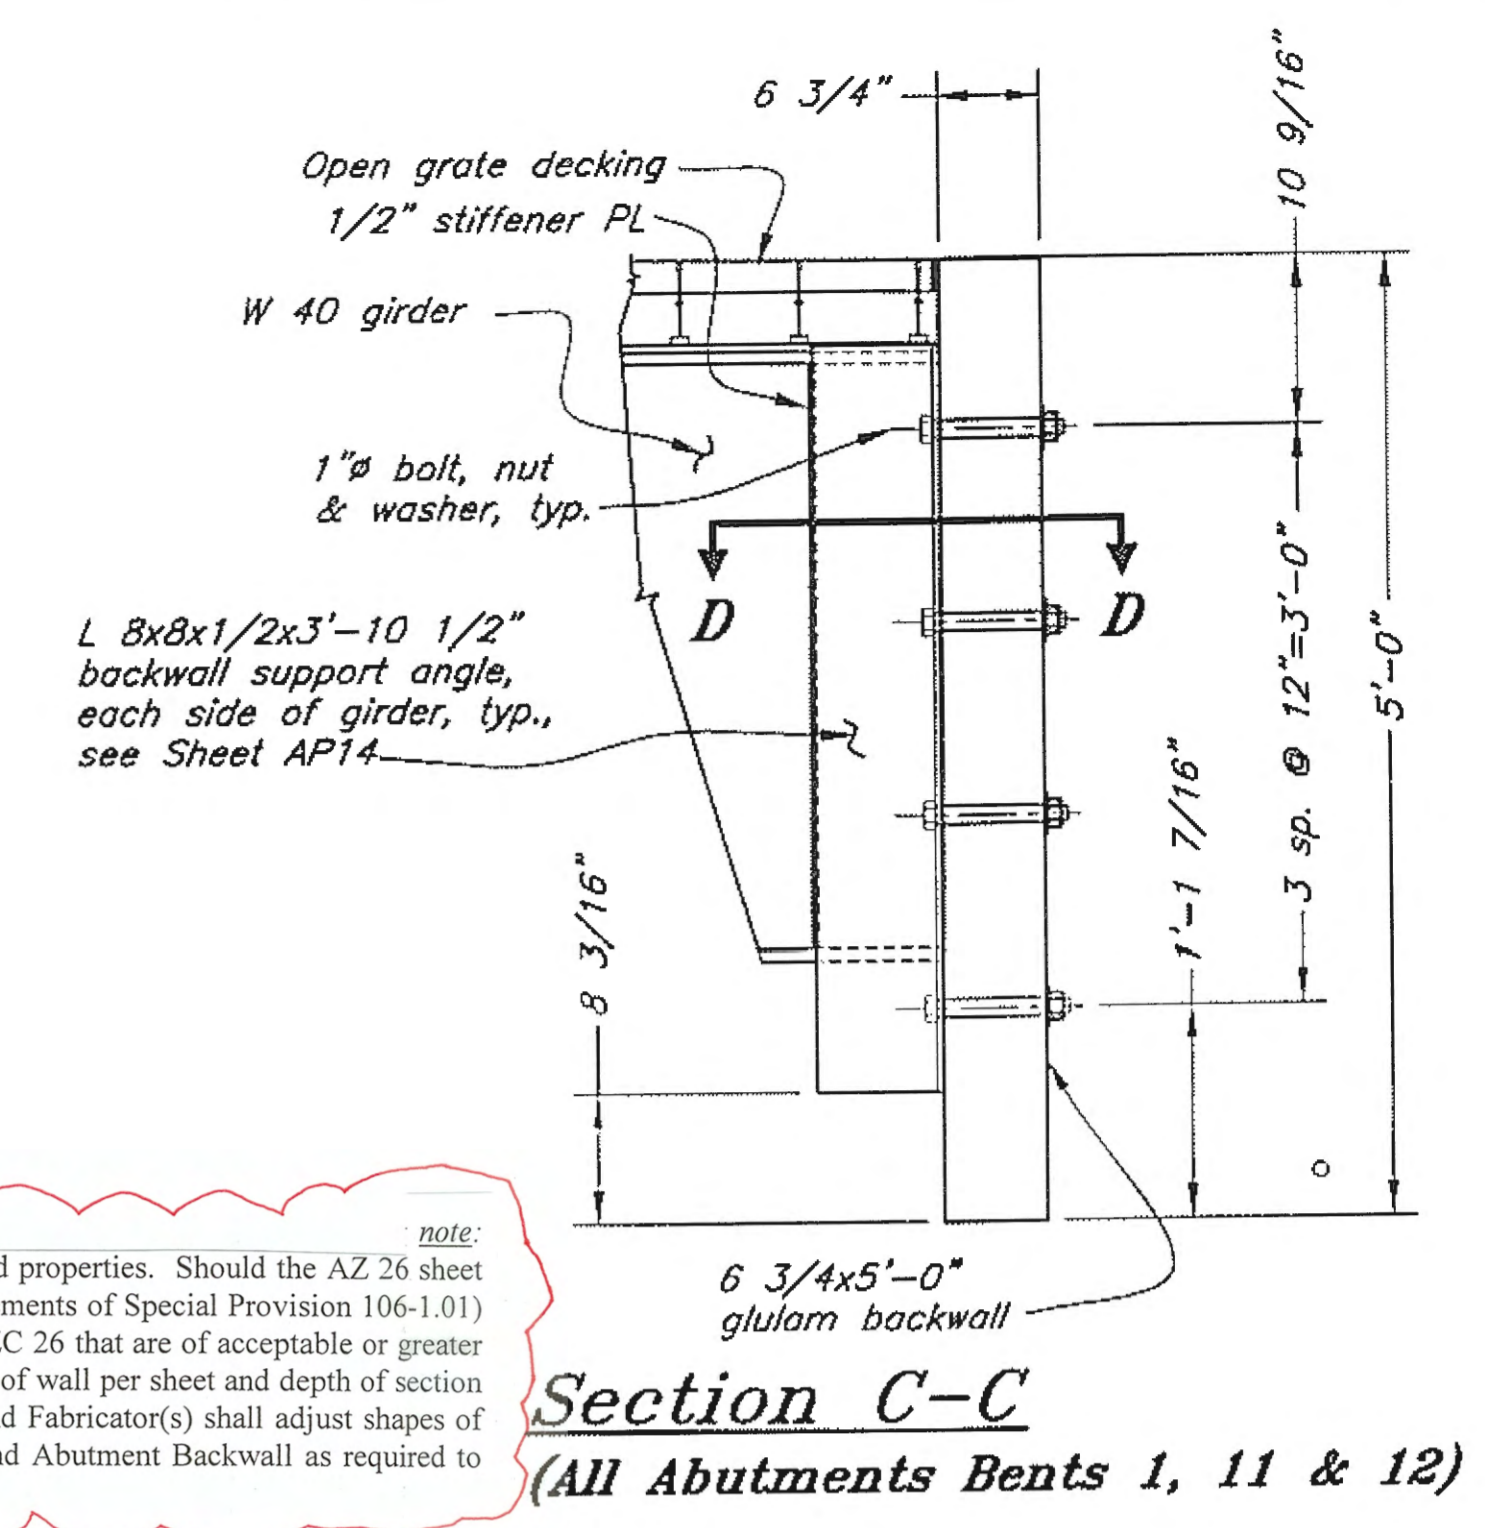


**Section C-C
(All Abutments Bents 1, 11 & 12)**

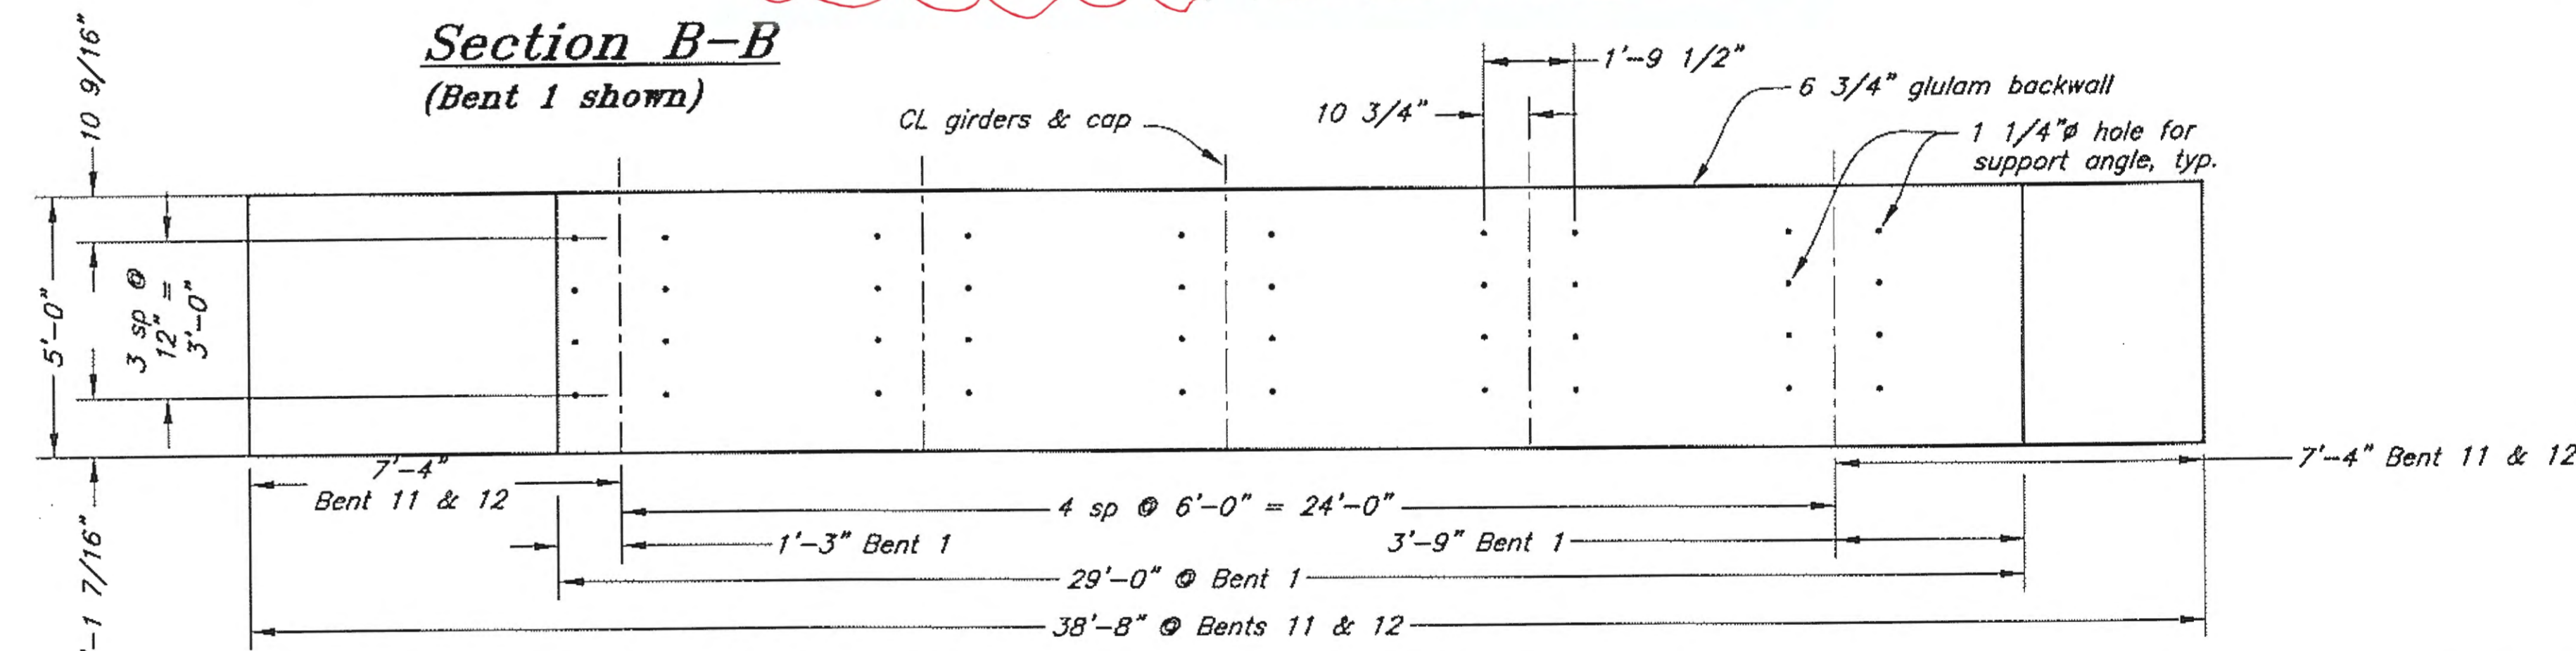


**Elevation Abutment Backwall
(Looking North - all abutment bents)**

Note: Holes thru abutment backwall necessary to POL and Electrical/Comm conduits not shown.

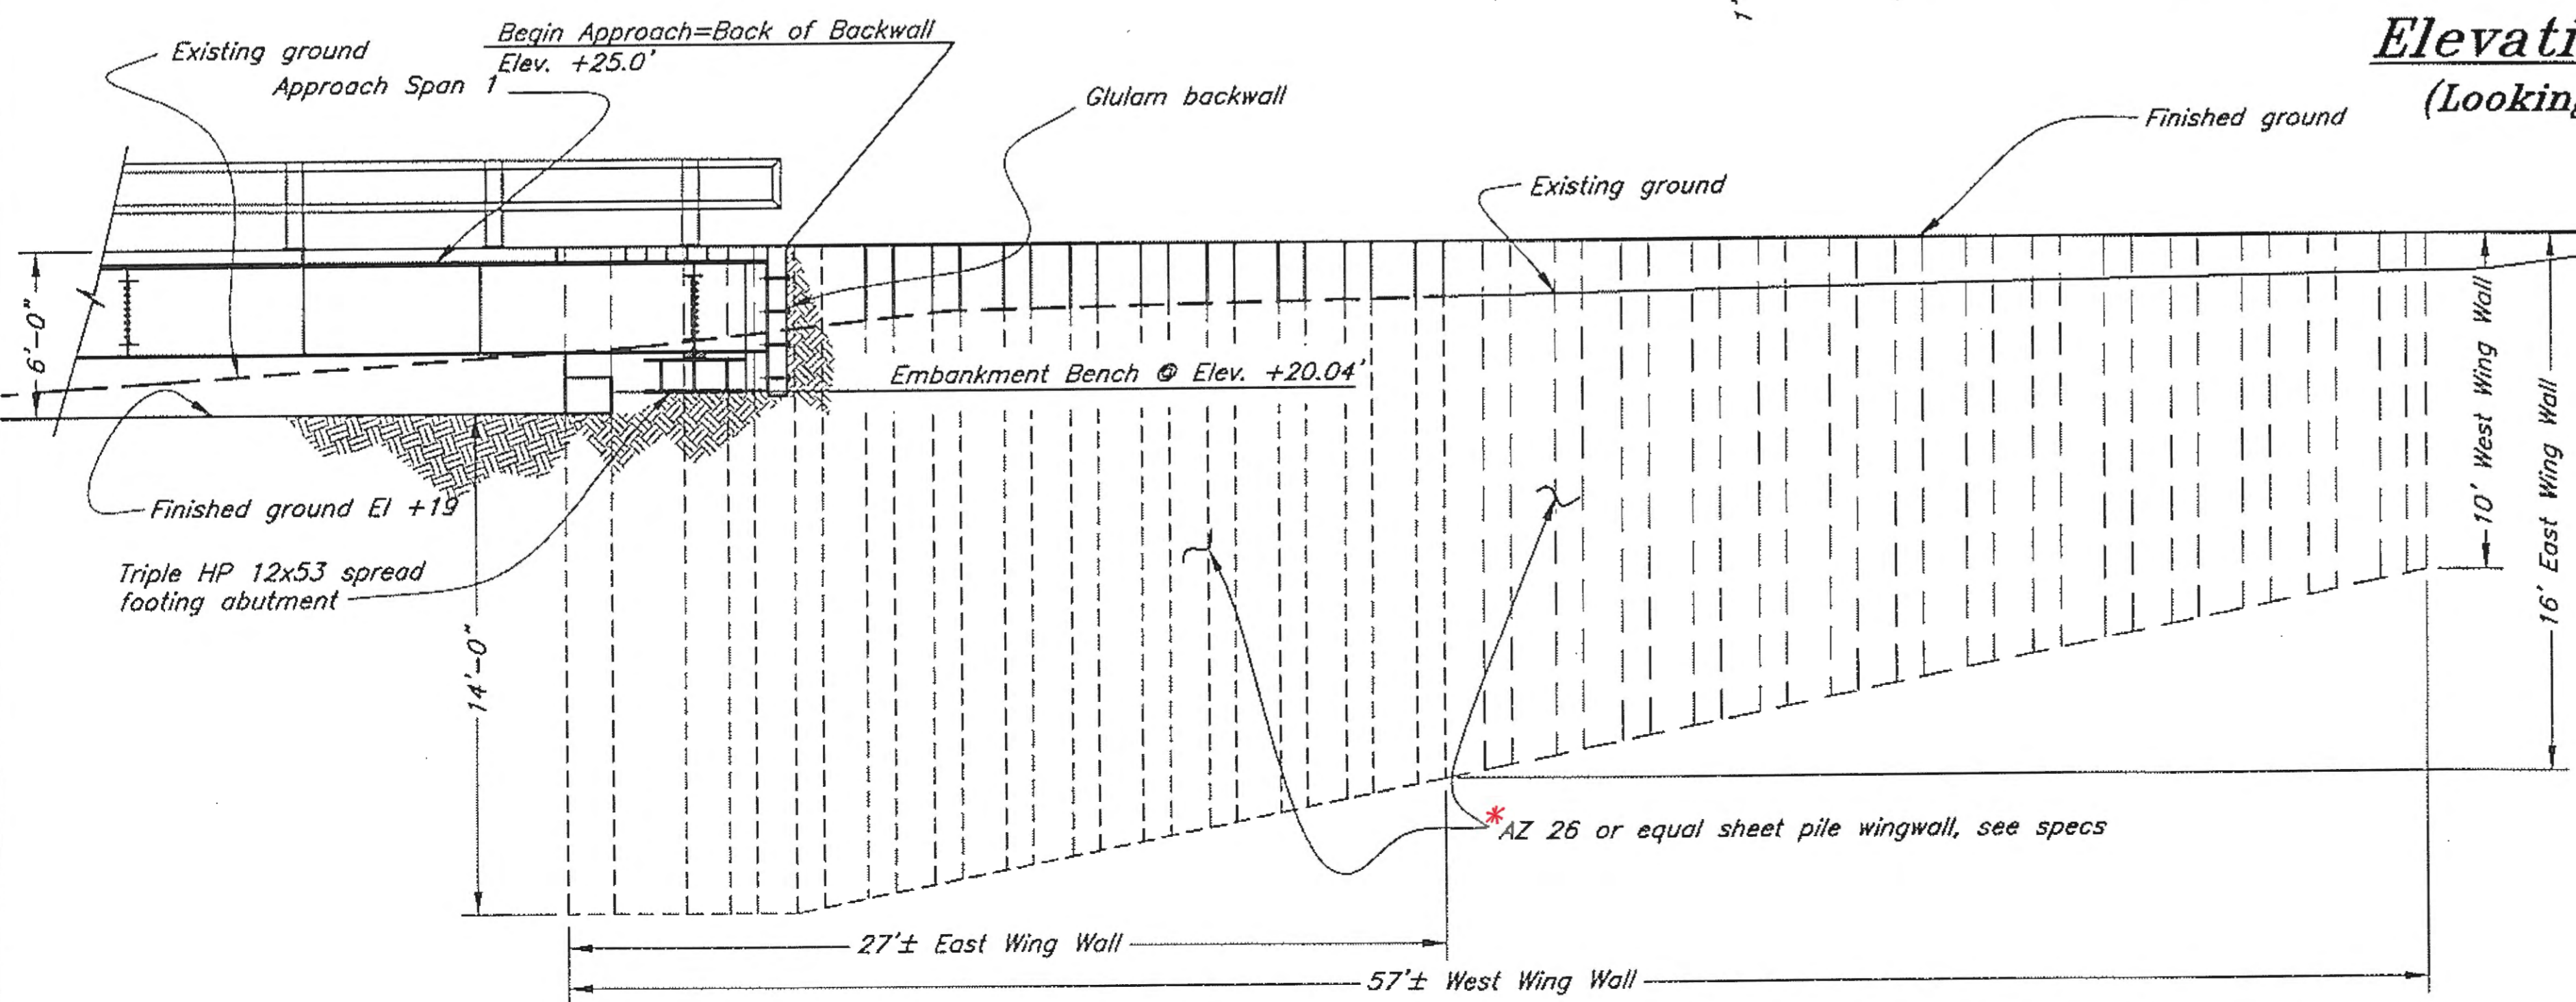

Sectional Elevation A-A

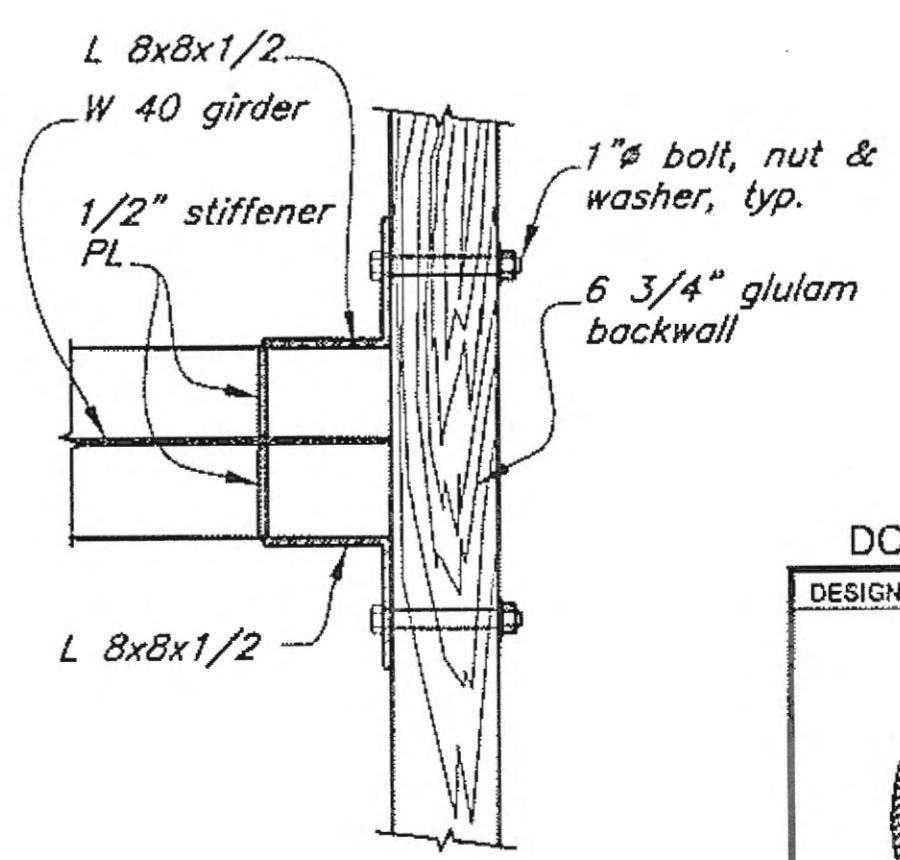

Section D-D

Record Drawings have been reviewed by the Project Engineer, and represent to the best of my knowledge, the project as constructed.
PE *[Signature]* Date 3/1/12

DO NOT SCALE FROM THESE DRAWINGS USE DIMENSIONS

DESIGNED BY: J. Scott

CHECKED BY: B. Savikko

DRAWN BY: C. Fuman, W. Hickey

PATH: D:\GUS\67599\MF\PLANSET\03-APPROACH\AP05 ABUTMENT & BACKWALL.DWG
TAB: Thu, 04/Dec/08 10:18AM

STATE OF ALASKA
DEPARTMENT OF TRANSPORTATION & PUBLIC FACILITIES
DESIGN & ENGINEERING SERVICES DIVISION-SOUTHEAST REGION

Gustavus Causeway Replacement

Abutment & Backwall Details

AP05

REVISIONS

NO.	DATE	DESCRIPTION


PROJECT DESIGNATION: BR-0003(53)/67599

YEAR: 2008


SHEET NO.: 15

TOTAL SHEETS: 138

Note: "POL and Bulk Fuel Line plan, elevation and detail layout shown here and on Sheet 69 are schematic and Bulk Fuel System Piping shall be constructed in accordance with the Plans and specifications prepared as per Section 680 of the project specifications."

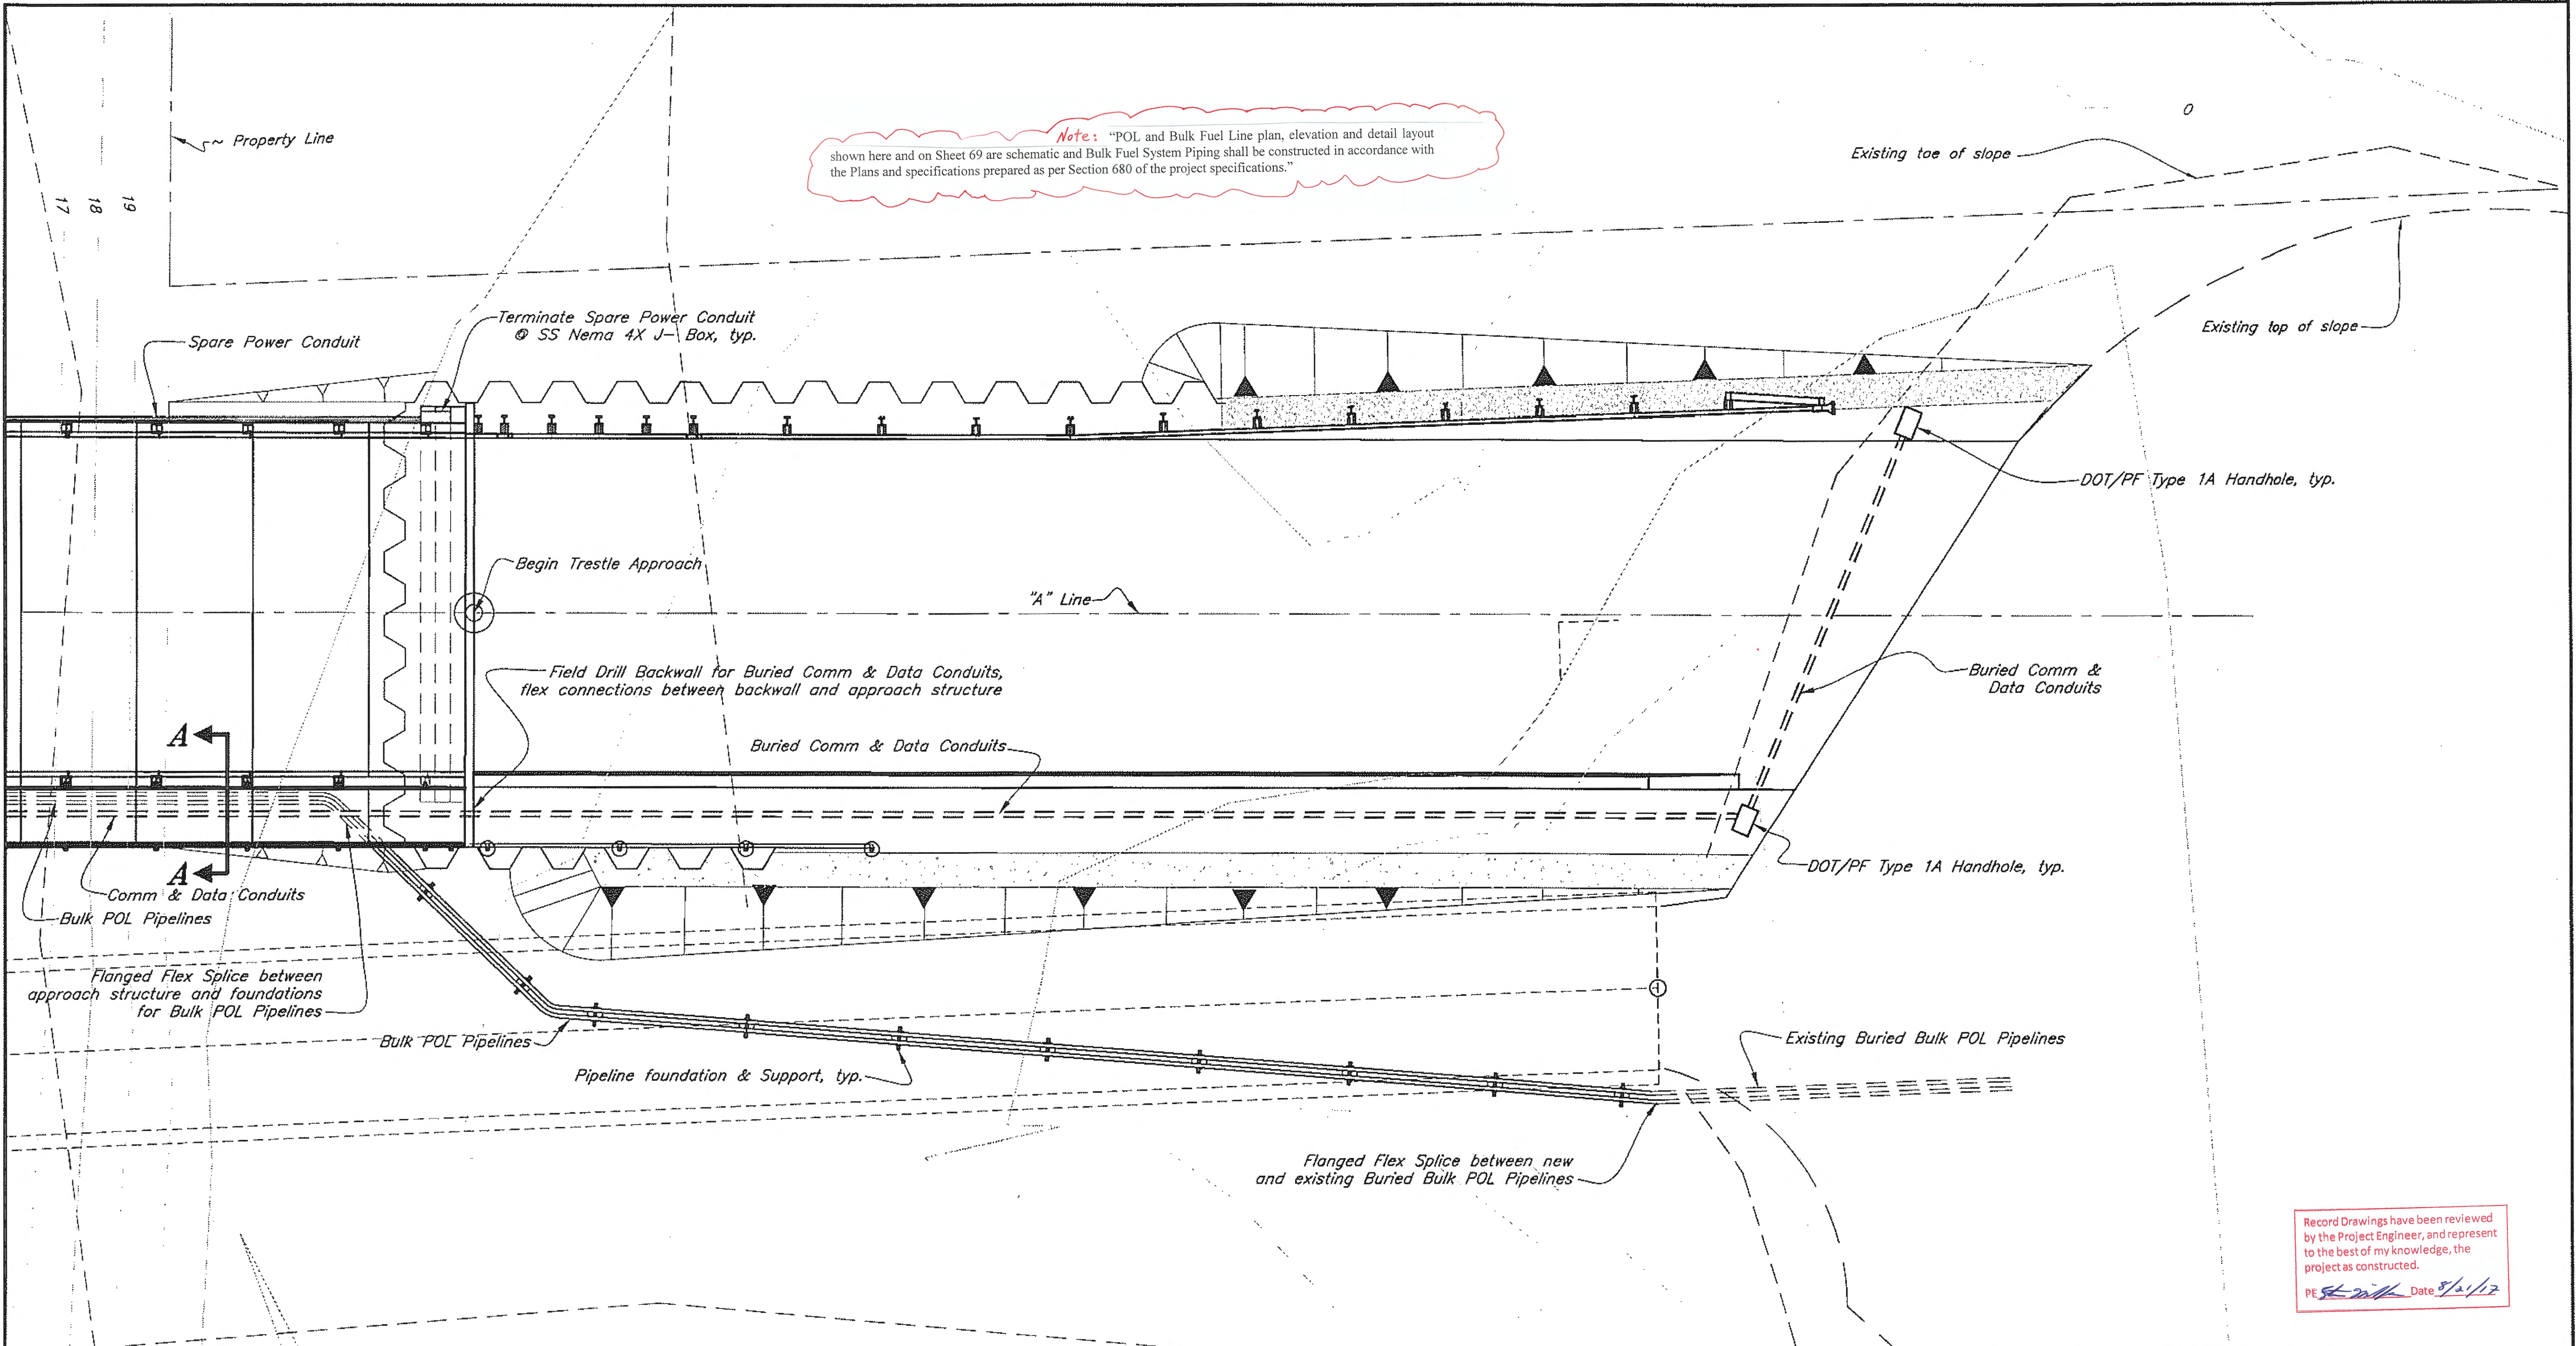

Record Drawings have been reviewed by the Project Engineer, and represent to the best of my knowledge, the project as constructed.
 PE *[Signature]* Date 8/2/12

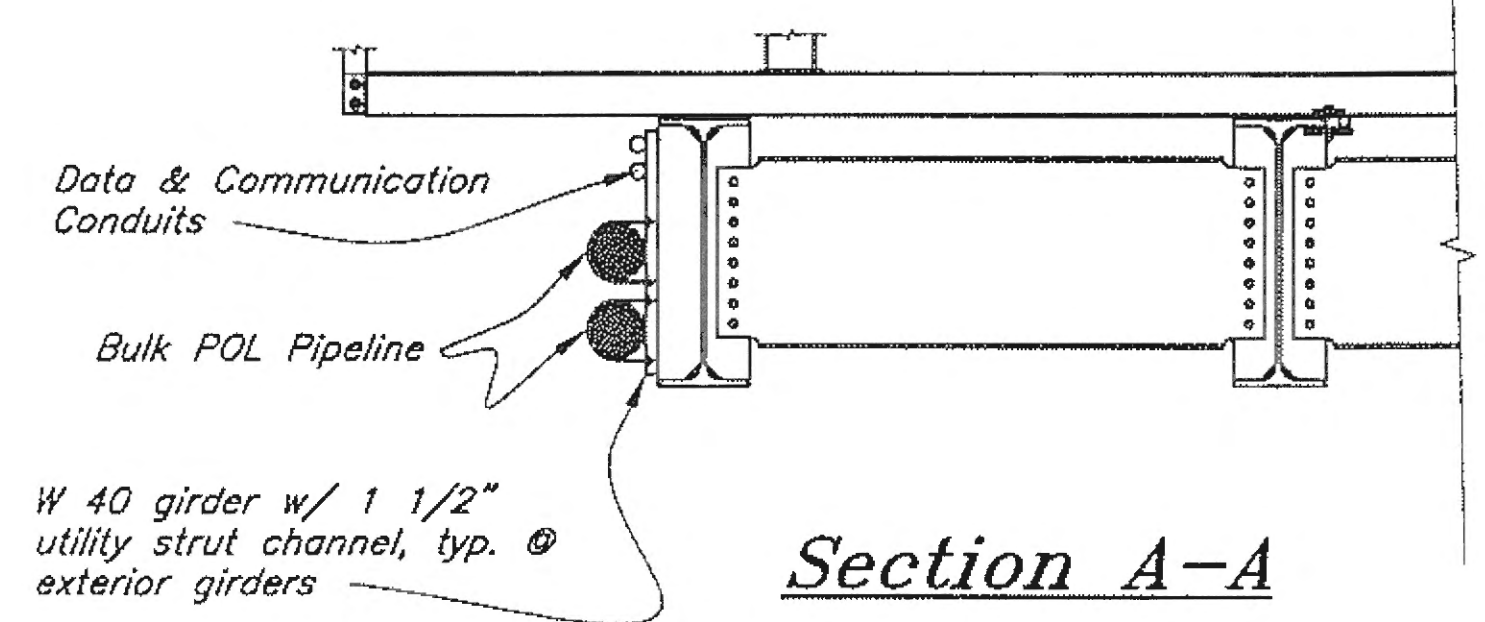

Section A-A

DO NOT SCALE FROM THESE DRAWINGS USE DIMENSIONS

DESIGNED BY: J. Scott

STATE OF ALASKA
 DEPARTMENT OF TRANSPORTATION & PUBLIC FACILITIES
 DESIGN & ENGINEERING SERVICES DIVISION-SOUTHEAST REGION


Gustavus Causeway Replacement
Approach Shore Embankment Utilities Layout
 AP06

CHECKED BY: B. Savikko
 DRAWN BY: C. Furman, W. Hickok


STATE OF ALASKA
 49th
 John I. Scott
 CE-4755
 REGISTERED PROFESSIONAL ENGINEER
 11/26/08

PATH: Q:\GUS\67599\MF\PLANSET\03-APPROACH\AP06 EMBANKMENT UTILITIES LAYOUT.DWG
 TAB: Tue, 25/Nov/08 05:26PM Tue, 25/Nov/08 05:26PM JTSCOTT


REVISIONS			PROJECT DESIGNATION	YEAR	SHEET NO.	TOTAL SHEETS
NO.	DATE	DESCRIPTION				
			BR-0003(53)/67599	2008	16	138

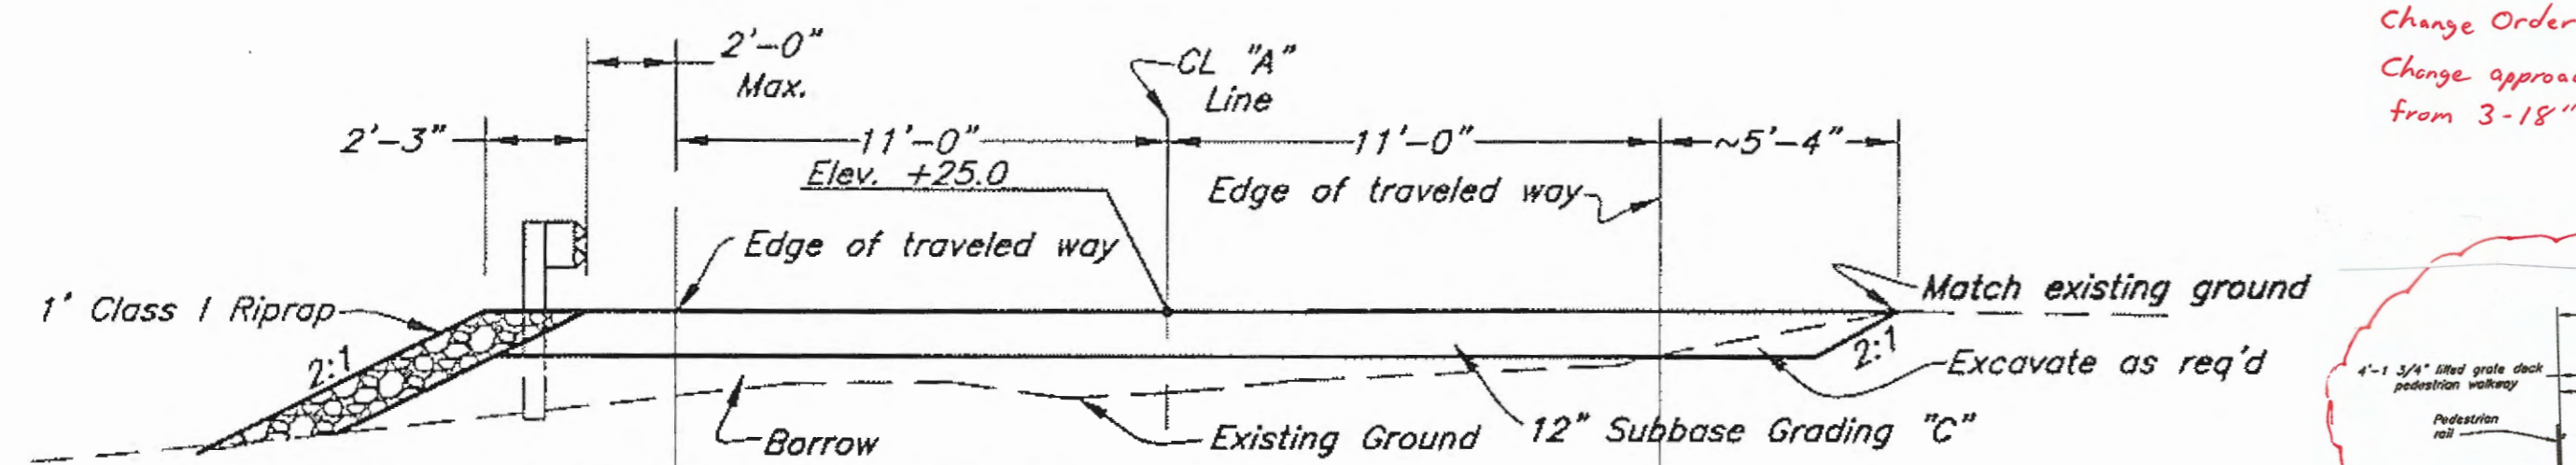

Sta. "A" 9+90 Section A
AP03

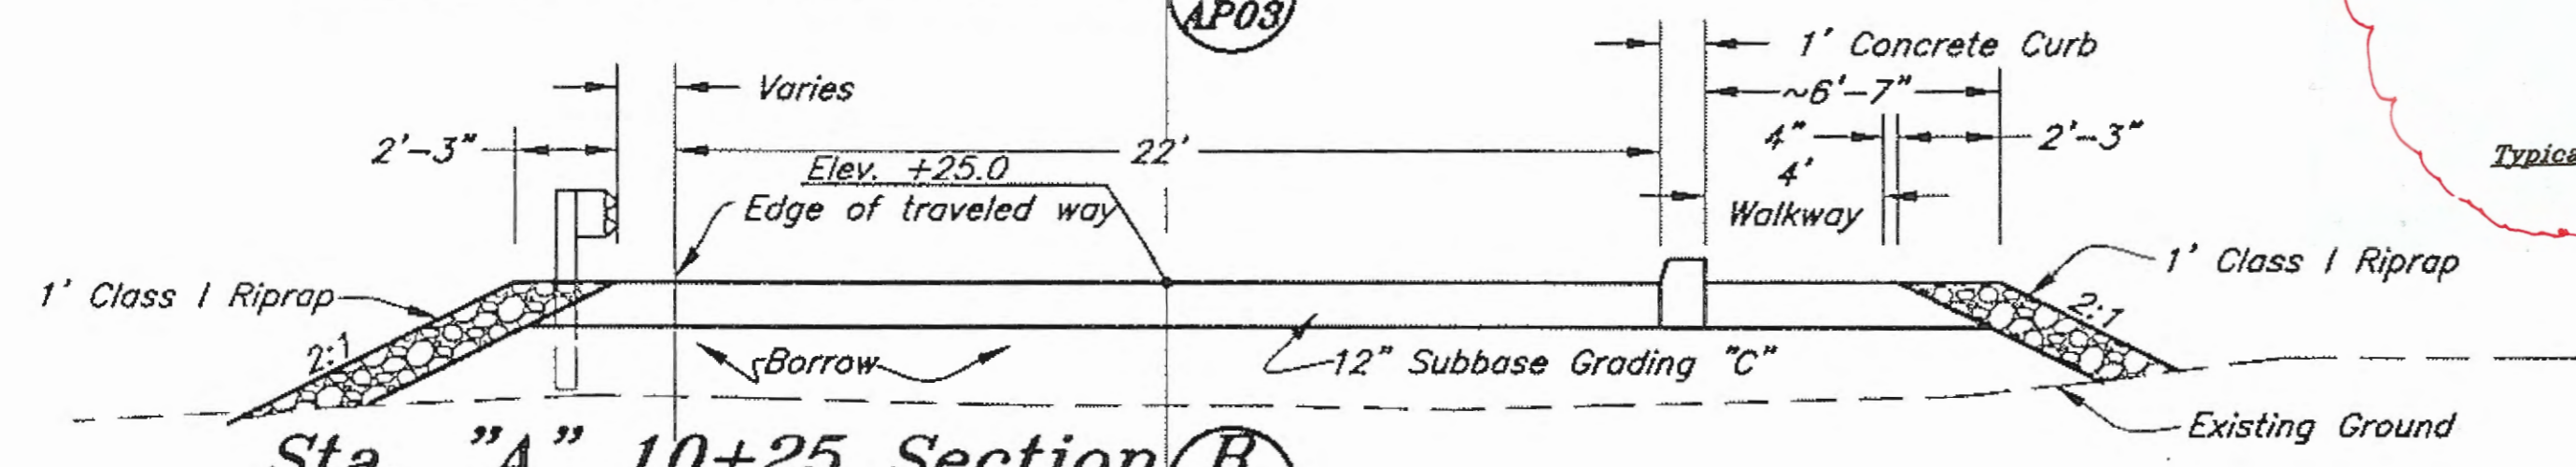


Sta. "A" 10+25 Section B
AP03

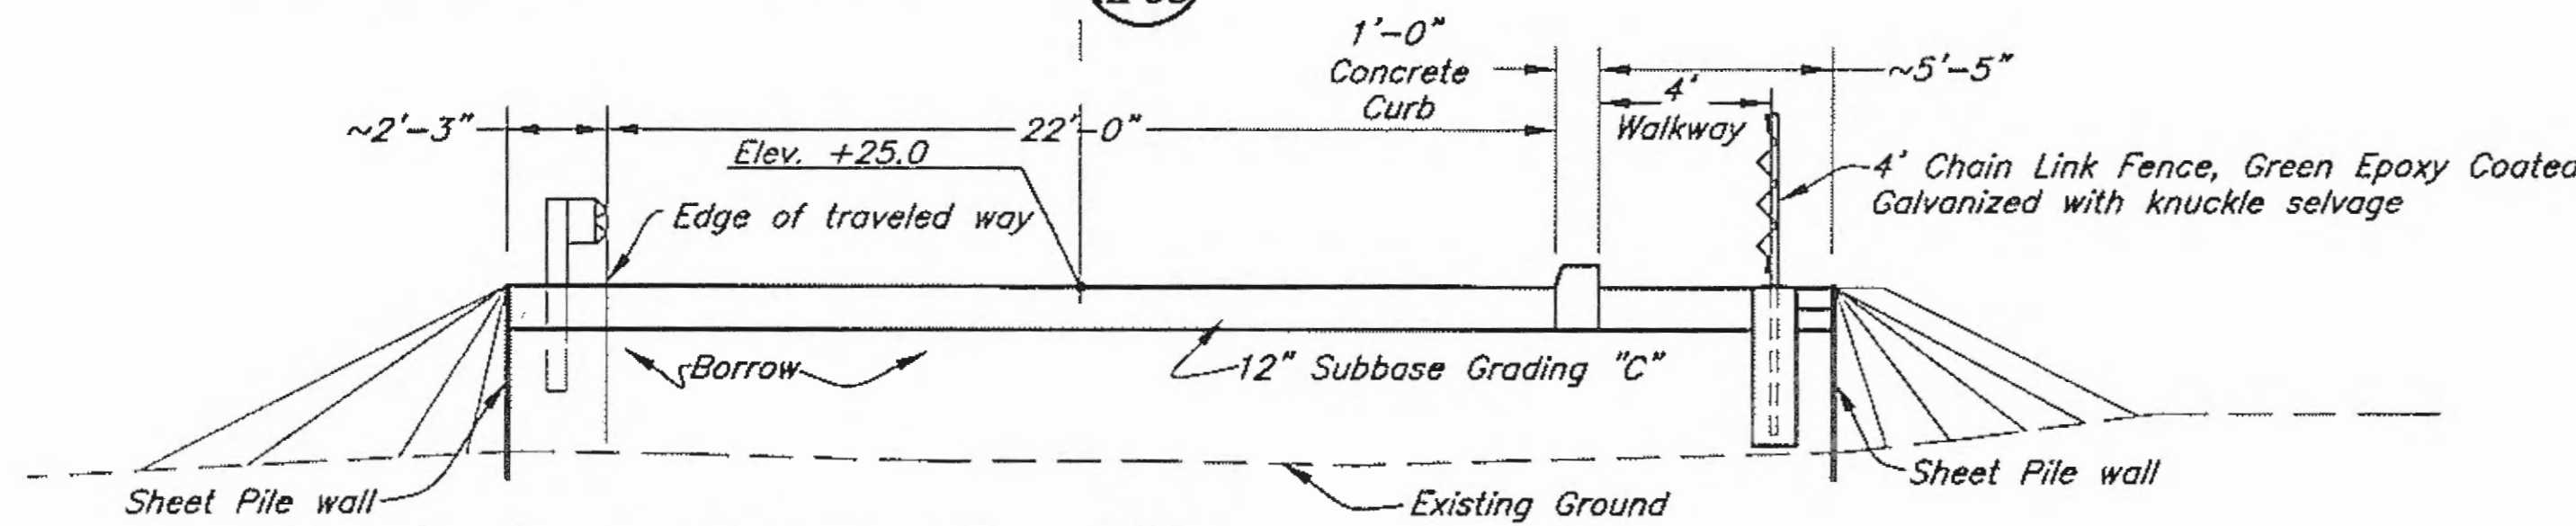


Sta. "A" 10+60 Section C
AP03


Change Order #1
Change approach piles in bents 2 through 10, 13 and 14
from 3-18" dia pile to 2-24" dia pile.

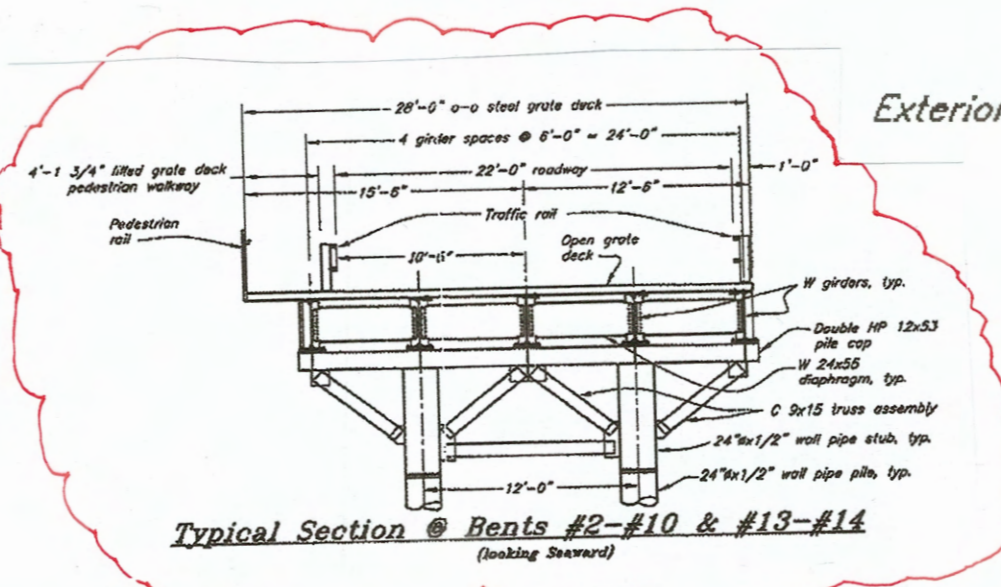


Typical Section @ Bents #2-#10 & #13-#14
(looking Seaward)

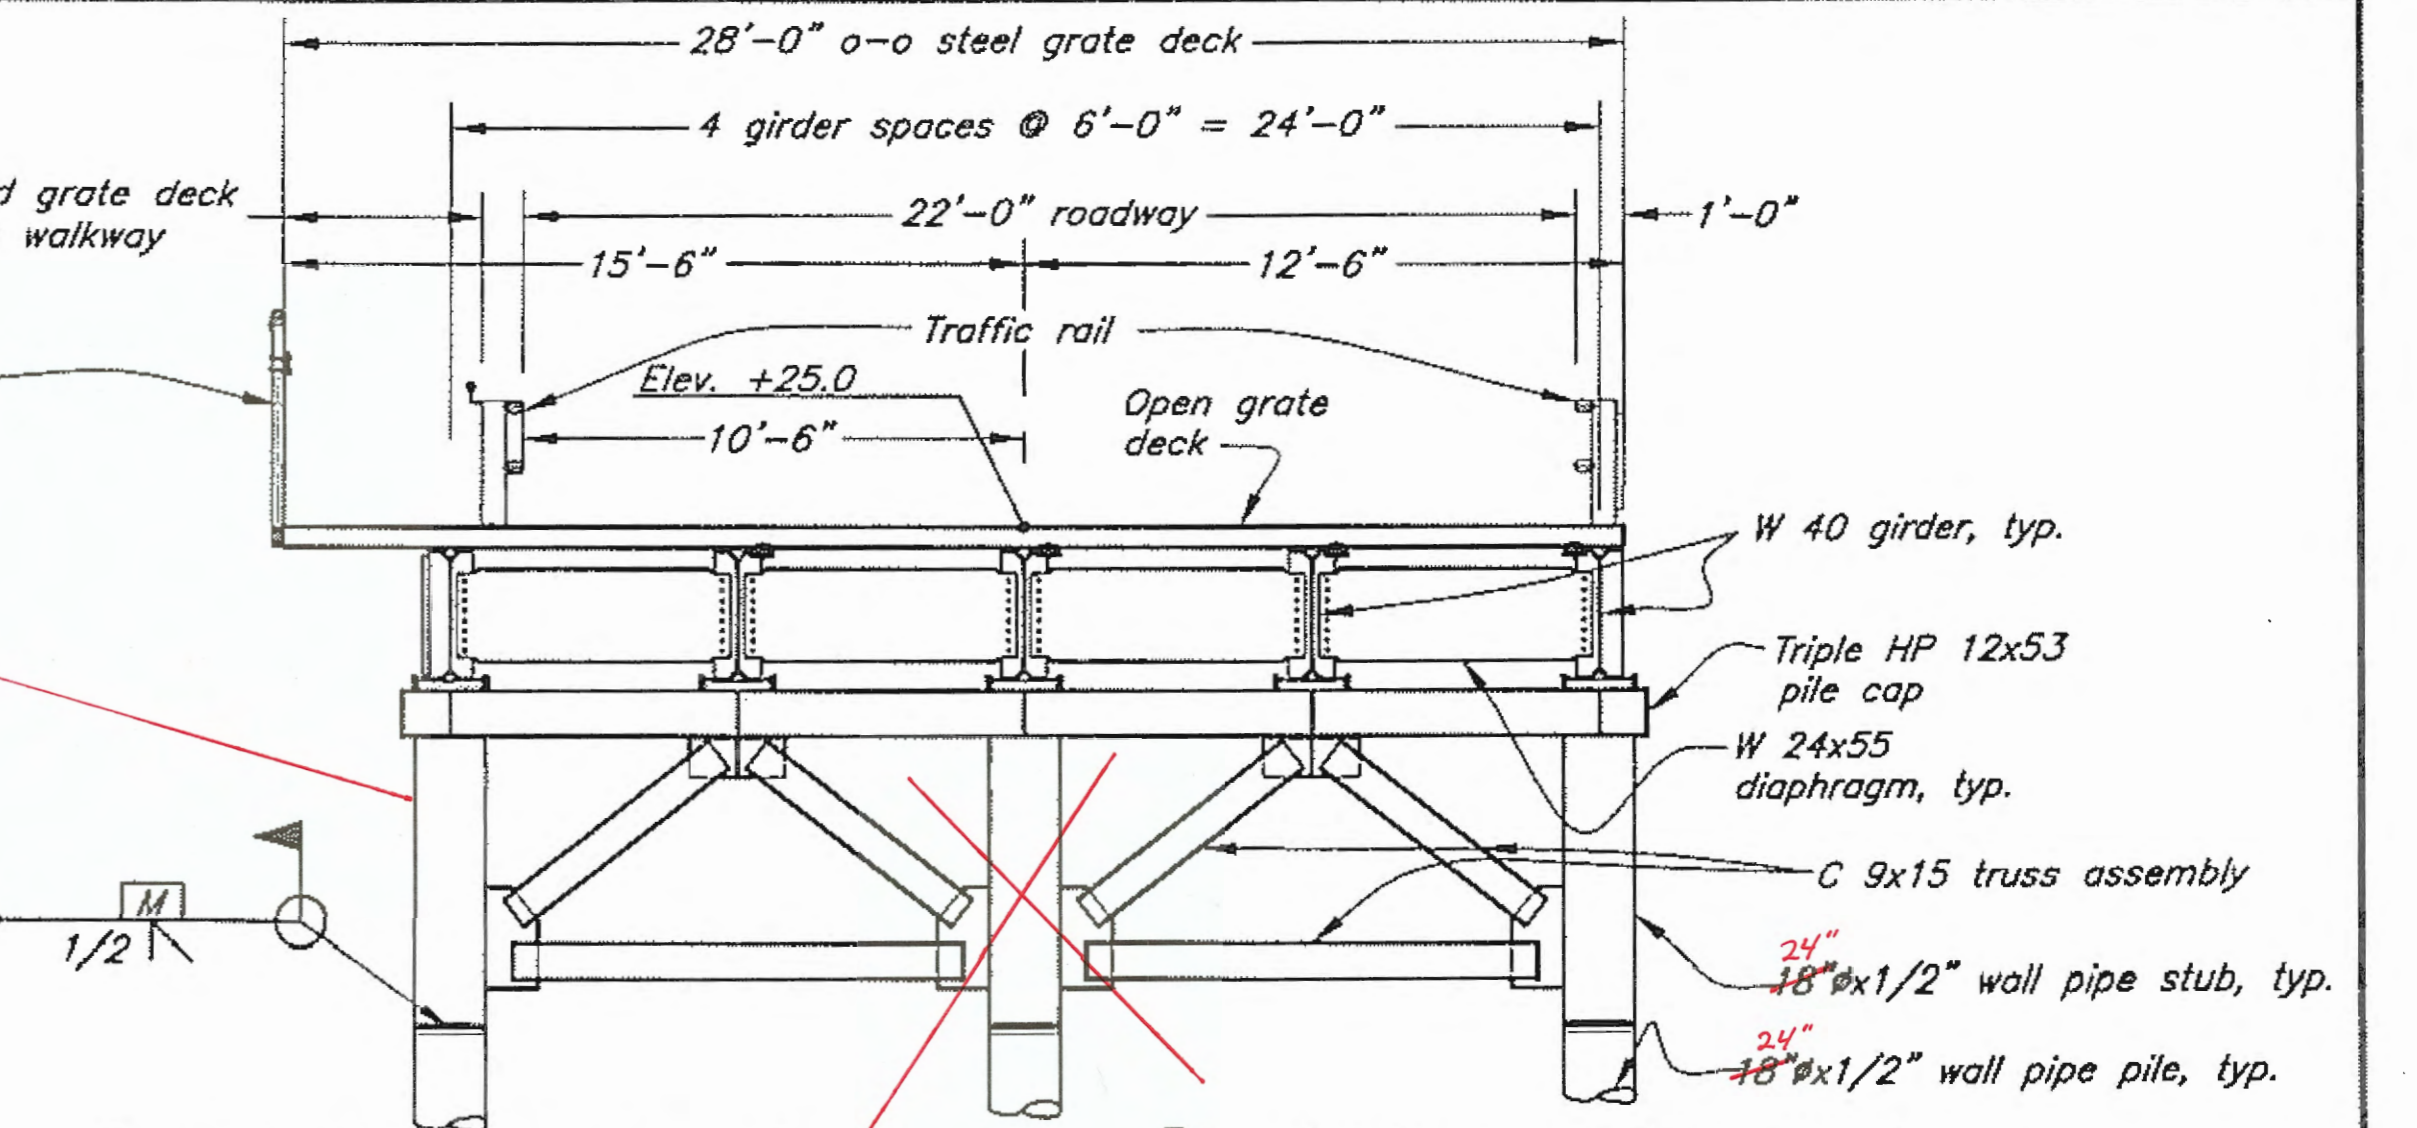


Typical Section @ Bents #2-#10 & #13-#14
(looking Seaward)

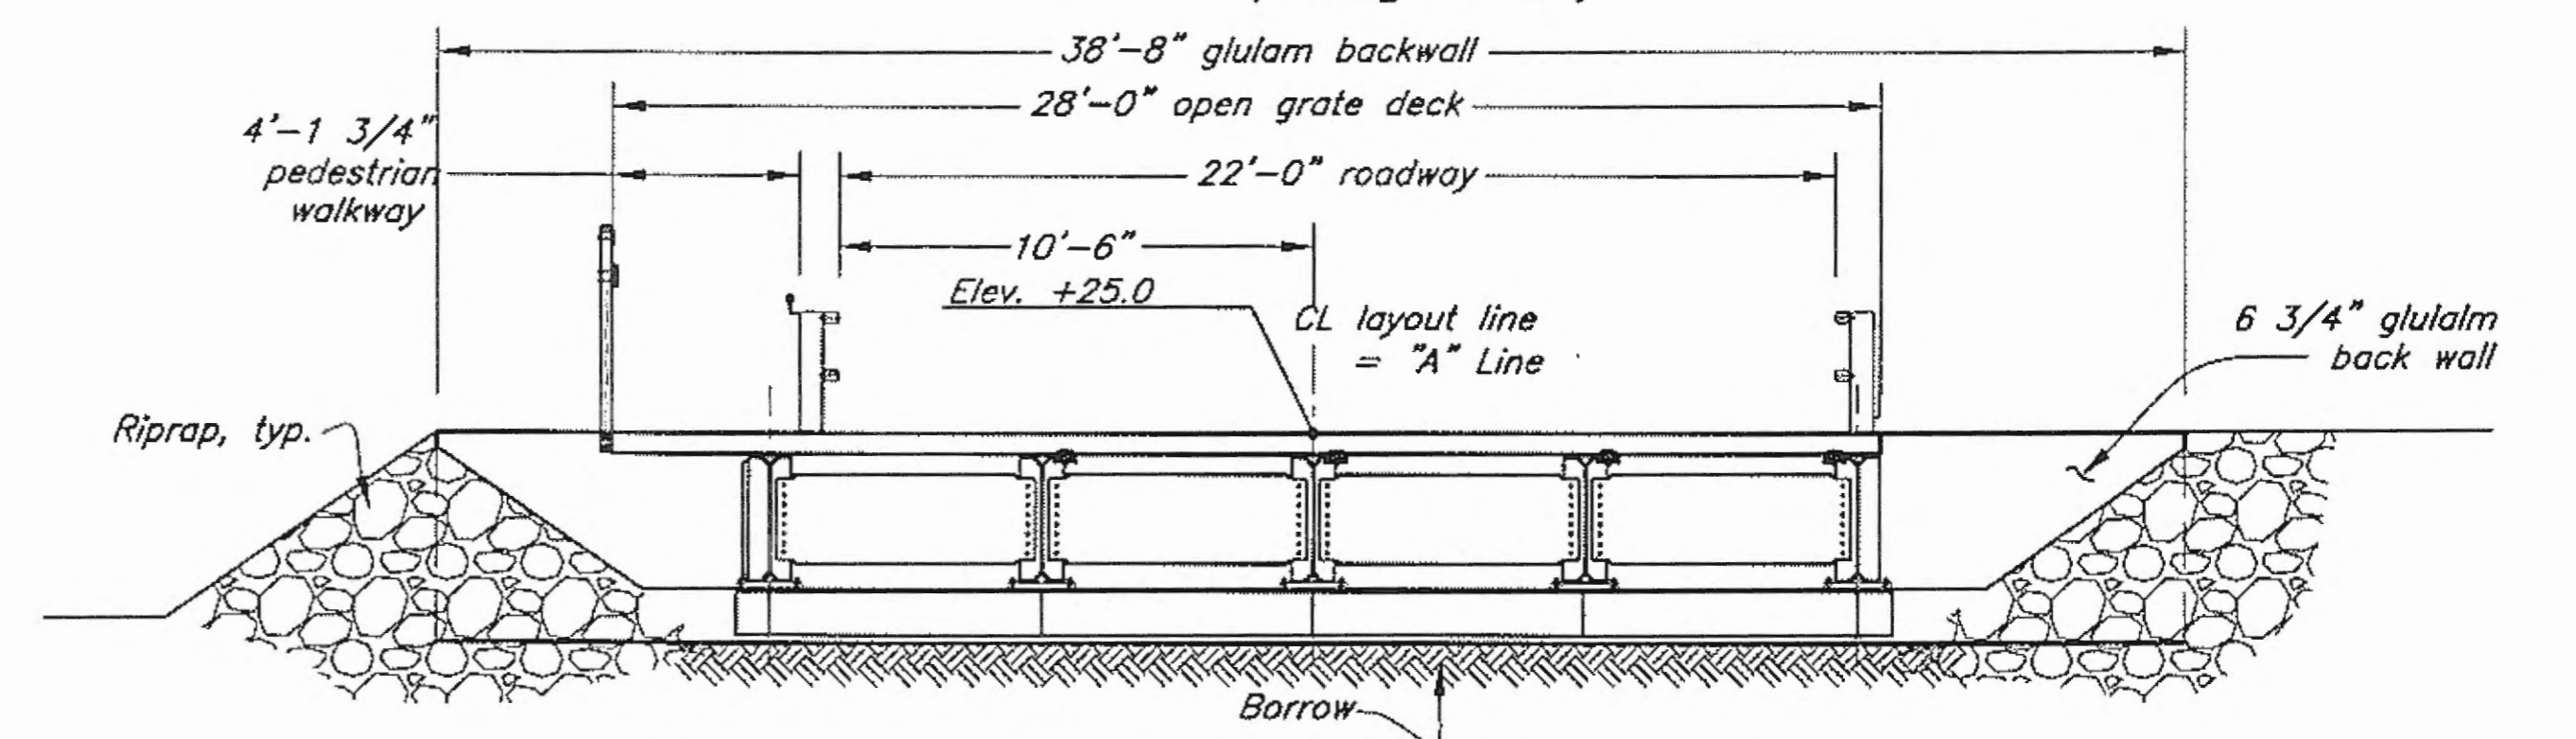


Typ. Section @ Bent #11 Abutment Cap
(looking Seaward)

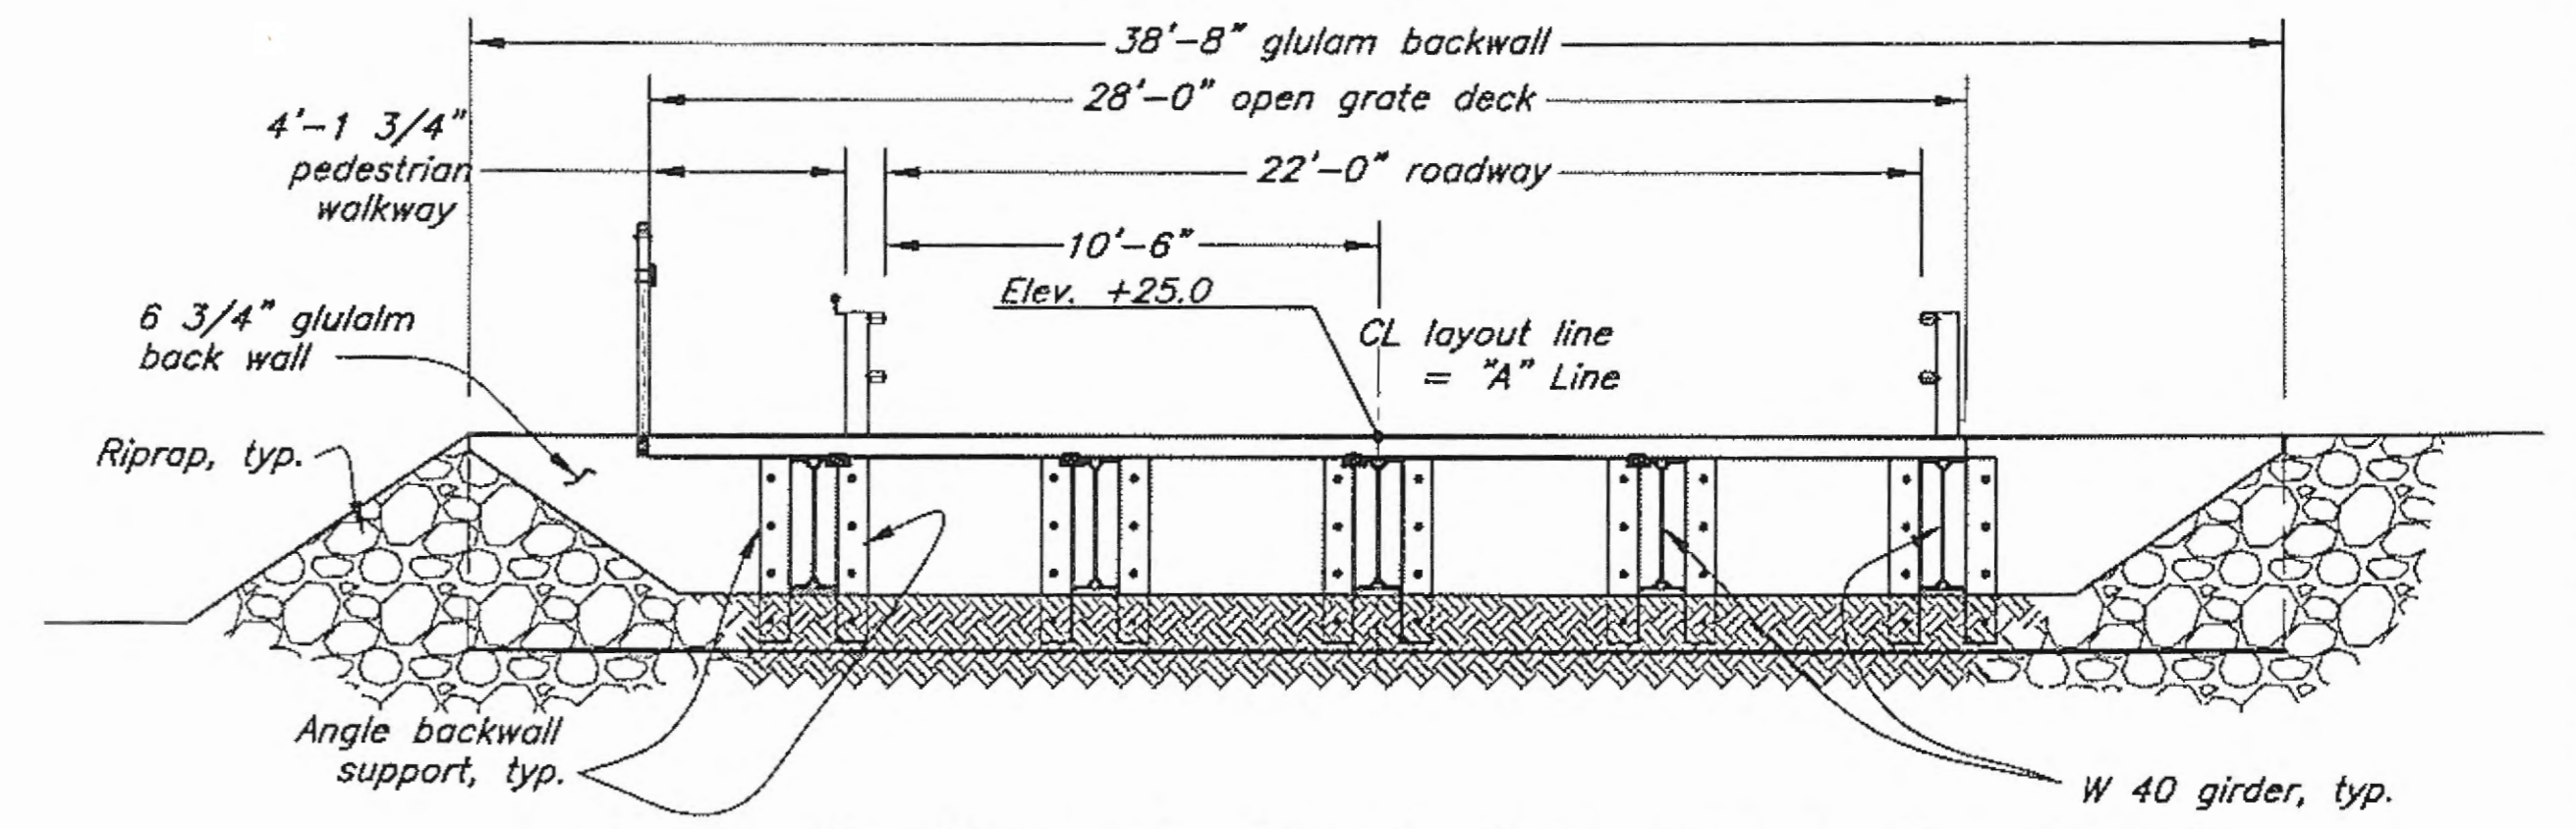

Typ. Section @ Bent #11 Abut. Backwall
(looking Seaward)

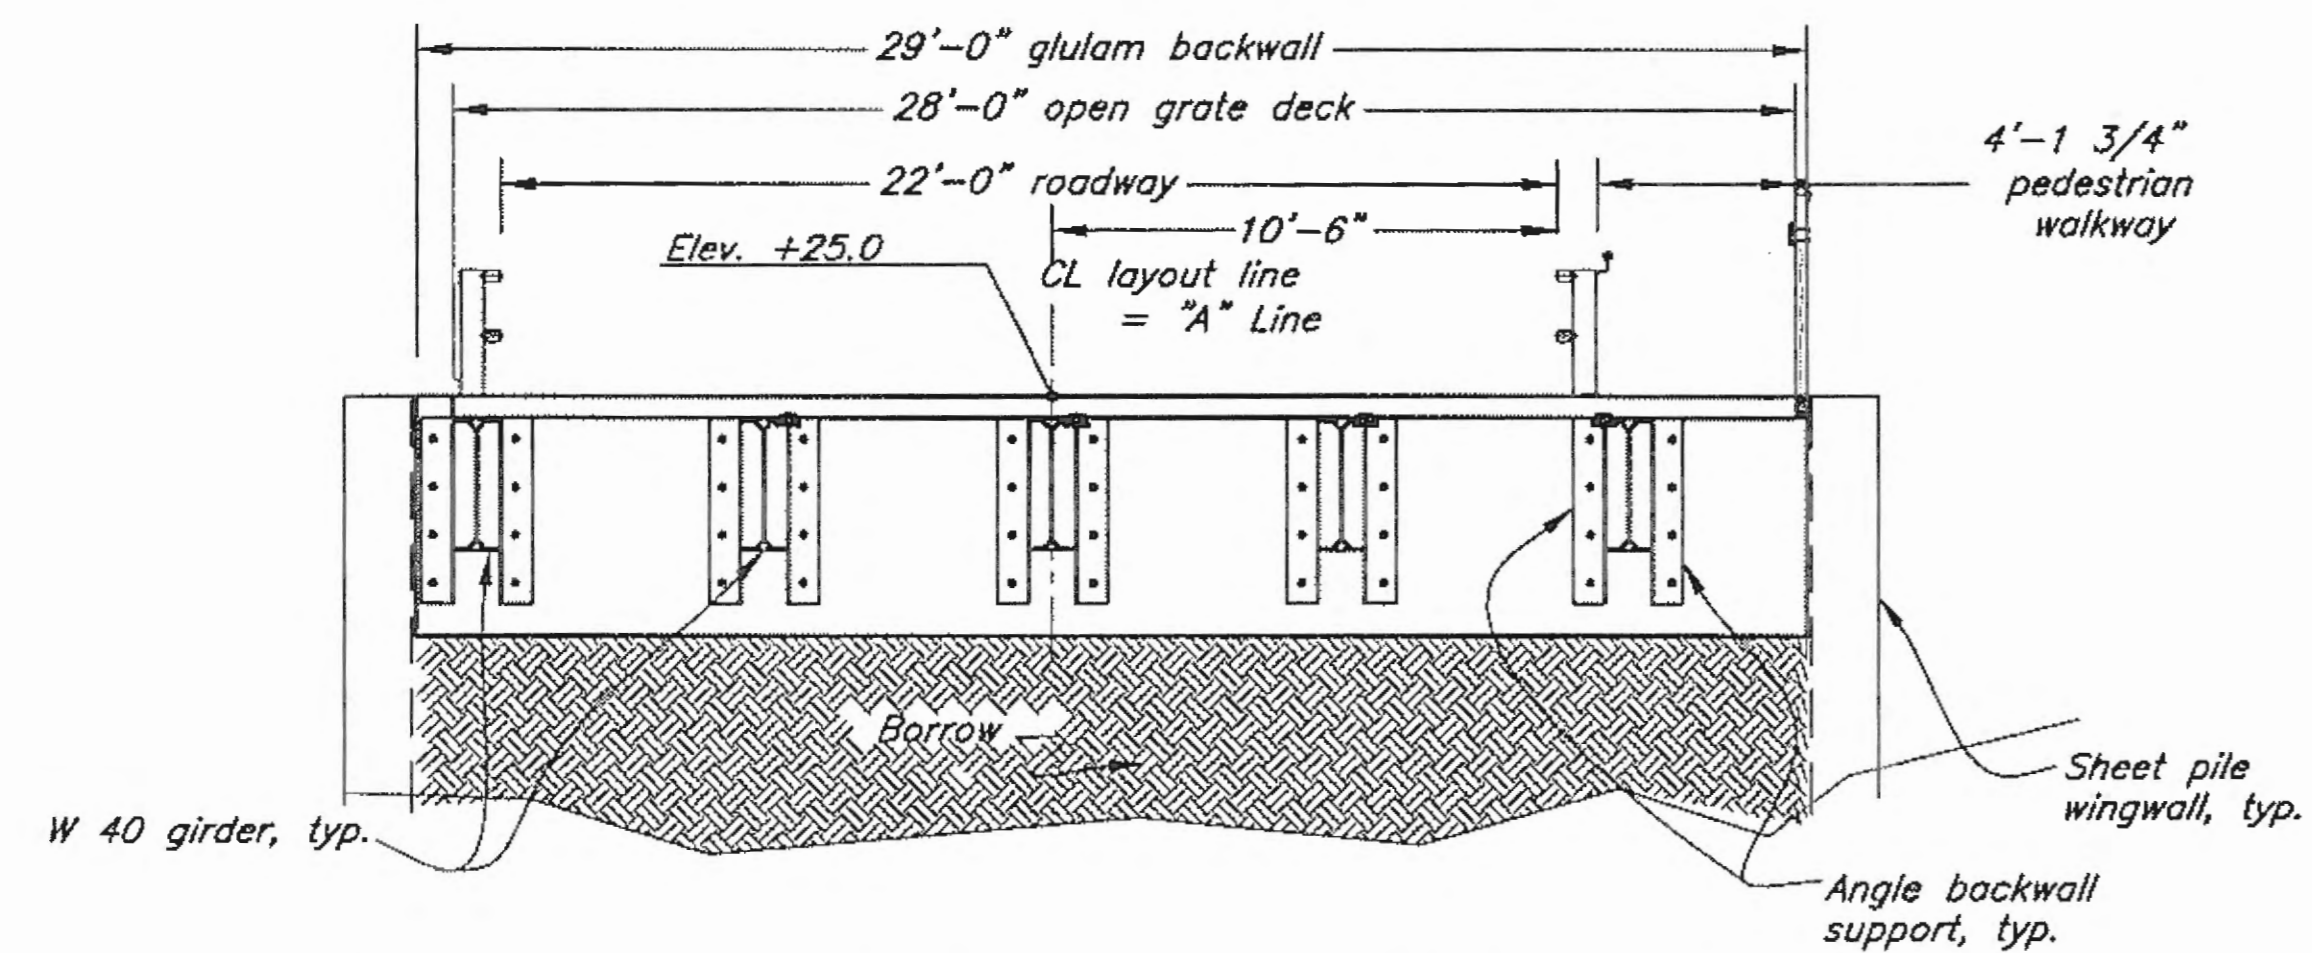

Typ. Section @ Bent #1 Abut. Backwall
(looking Shoreward)

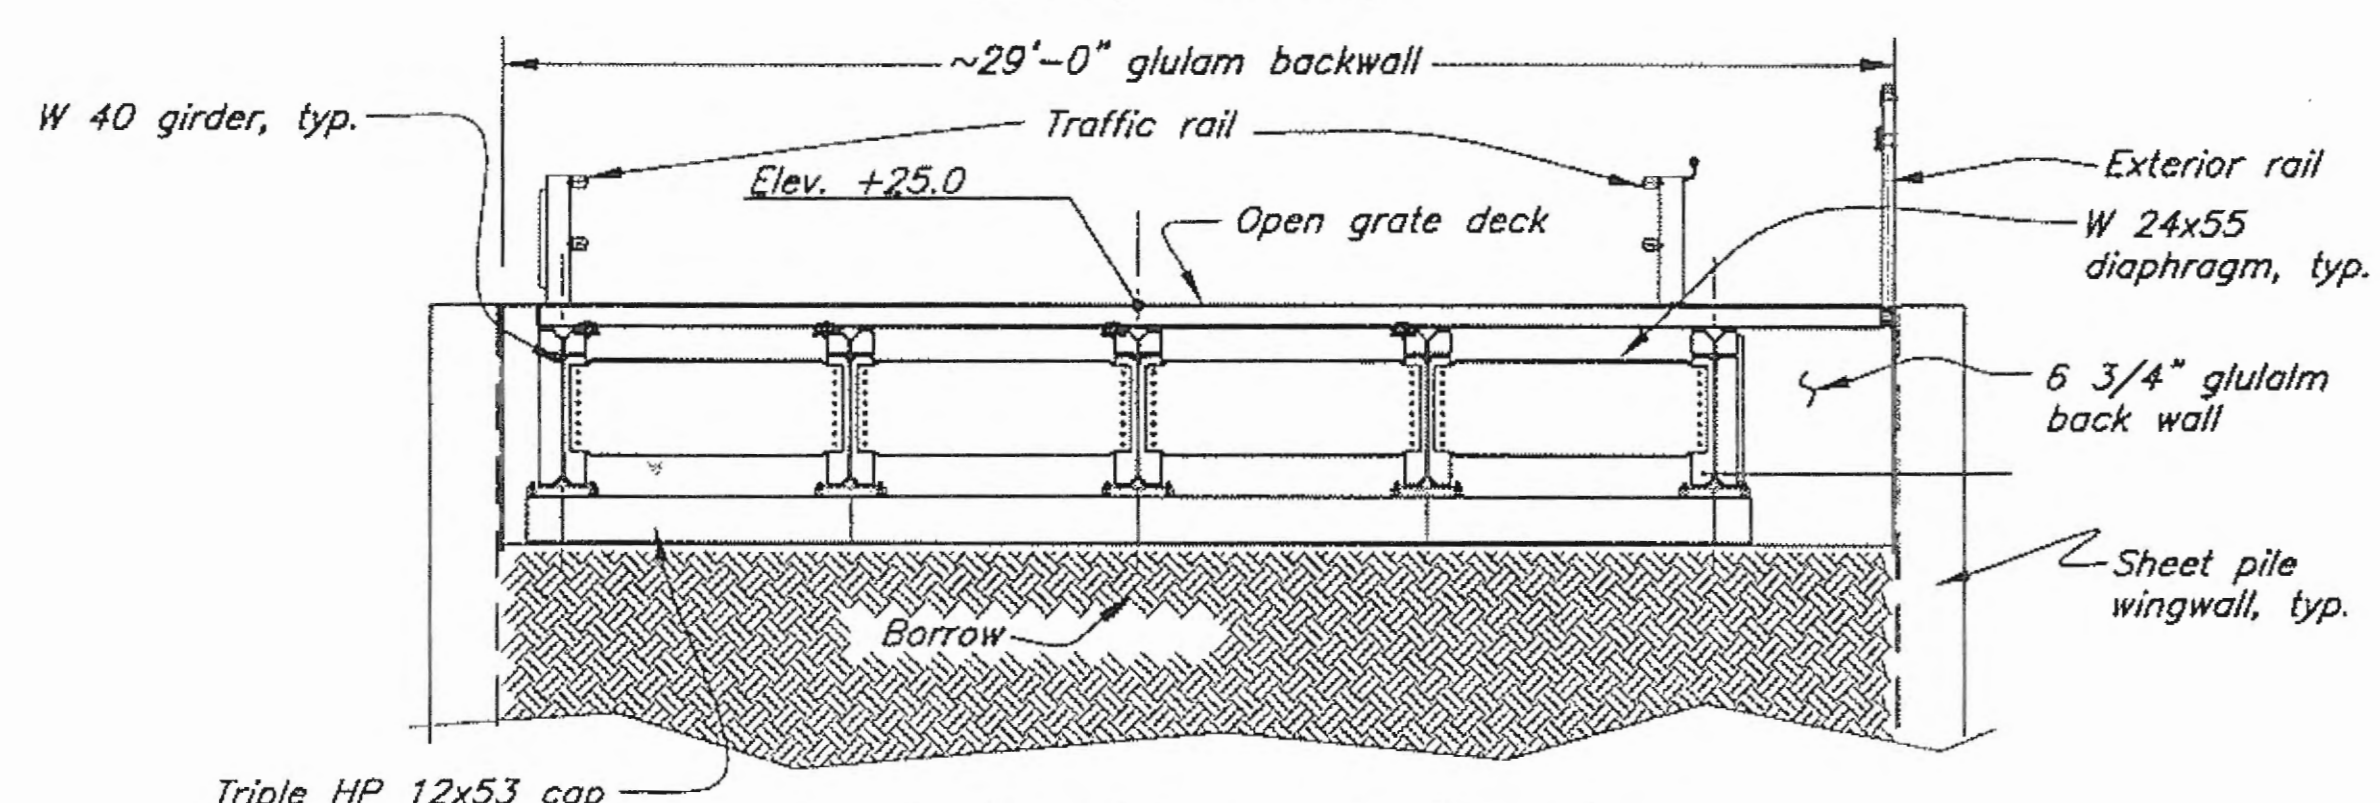

Typical Section @ Bent 1
(looking Shoreward)

Record Drawings have been reviewed by the Project Engineer, and represent to the best of my knowledge, the project as constructed.
PE: [Signature] Date: 9/21/12

DO NOT SCALE FROM THESE DRAWINGS USE DIMENSIONS

DESIGNED BY: J. Scott

CHECKED BY: B. Savikko

DRAWN BY: C. Fuman, W. Hickok

PATH: Q:\GUS\67599\MF\PLANSET\03-APPROACH\AP07 TYP SECTIONS.DWG

TAB: Tue, 25/Nov/08 07:00PM


PROJECT DESIGNATION: BR-0003(53)/67599

YEAR: 2008


SHEET NO.: 17

TOTAL SHEETS: 138


STATE OF ALASKA
DEPARTMENT OF TRANSPORTATION & PUBLIC FACILITIES
DESIGN & ENGINEERING SERVICES DIVISION-SOUTHEAST REGION
Gustavus Causeway Replacement
Approach Typical Sections
AP07

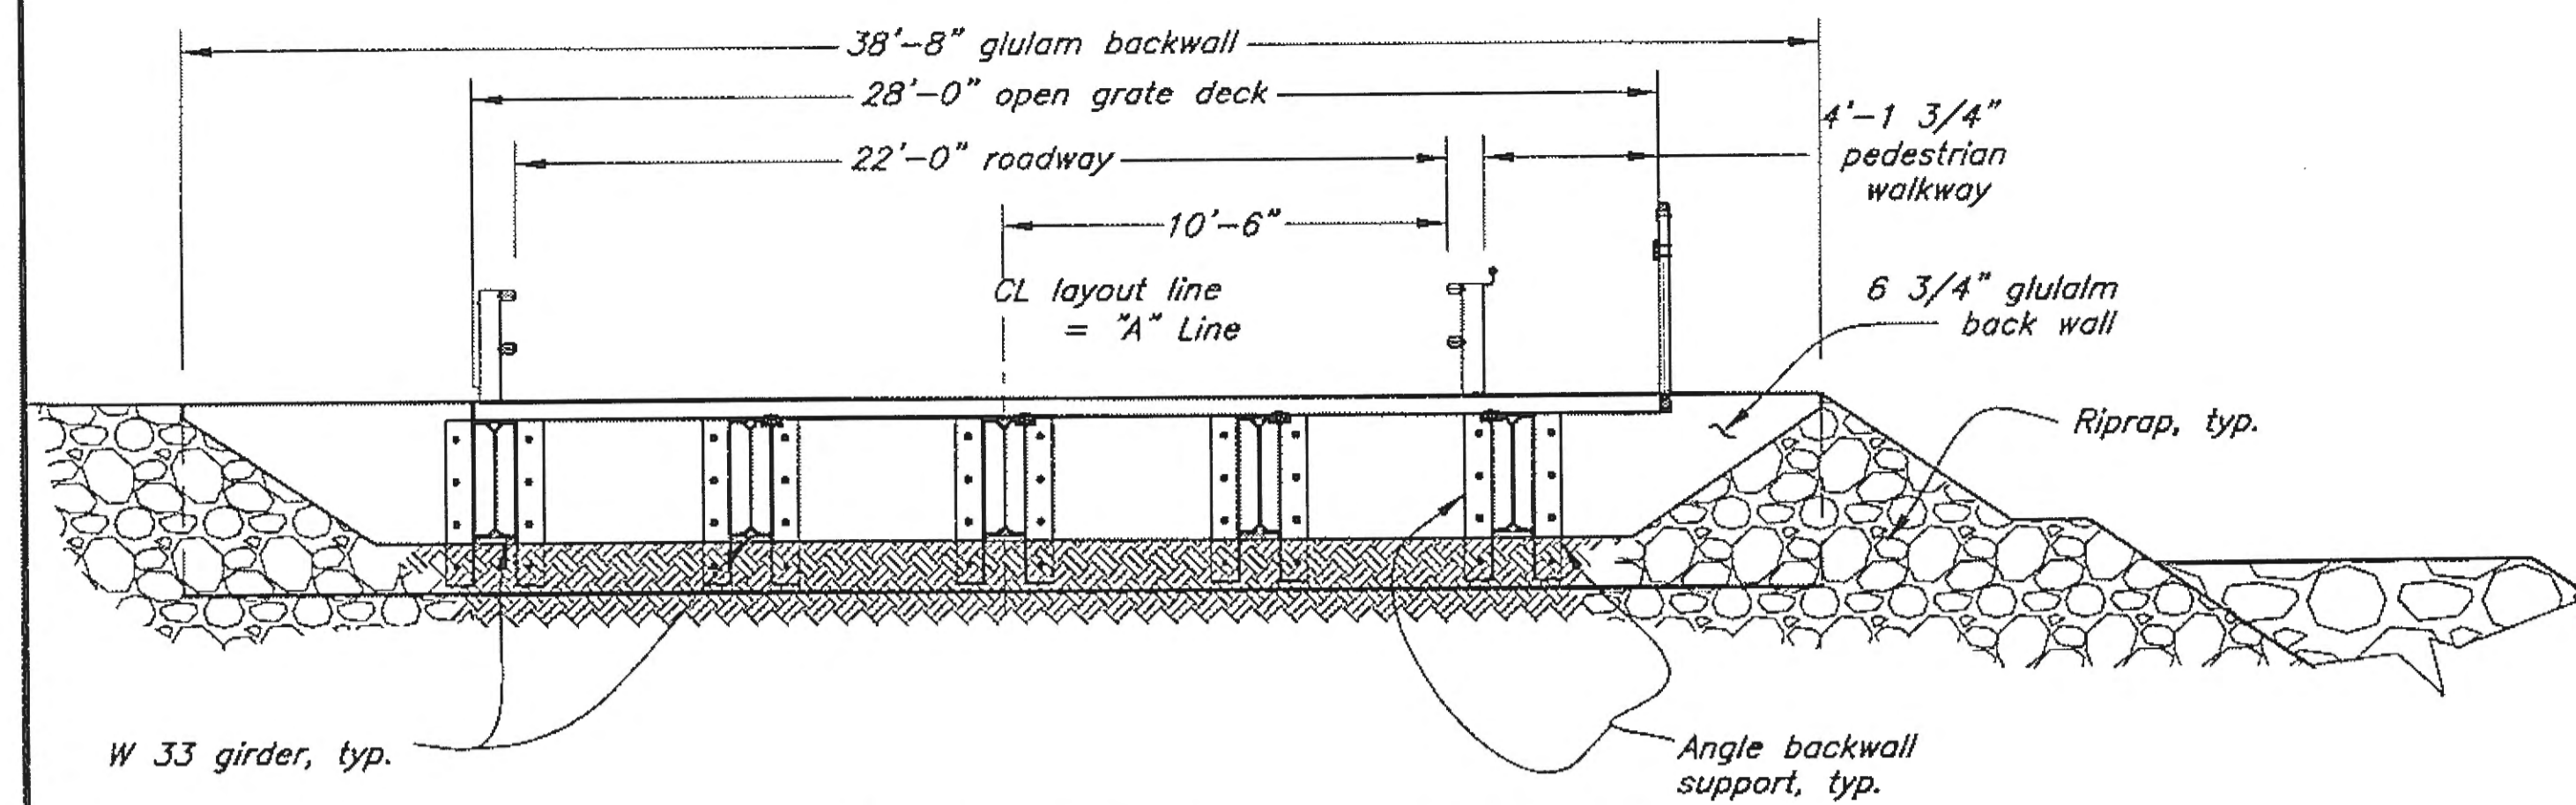


Typ. Section @ Bent #12 Abut. Backwall
(looking Shoreward)

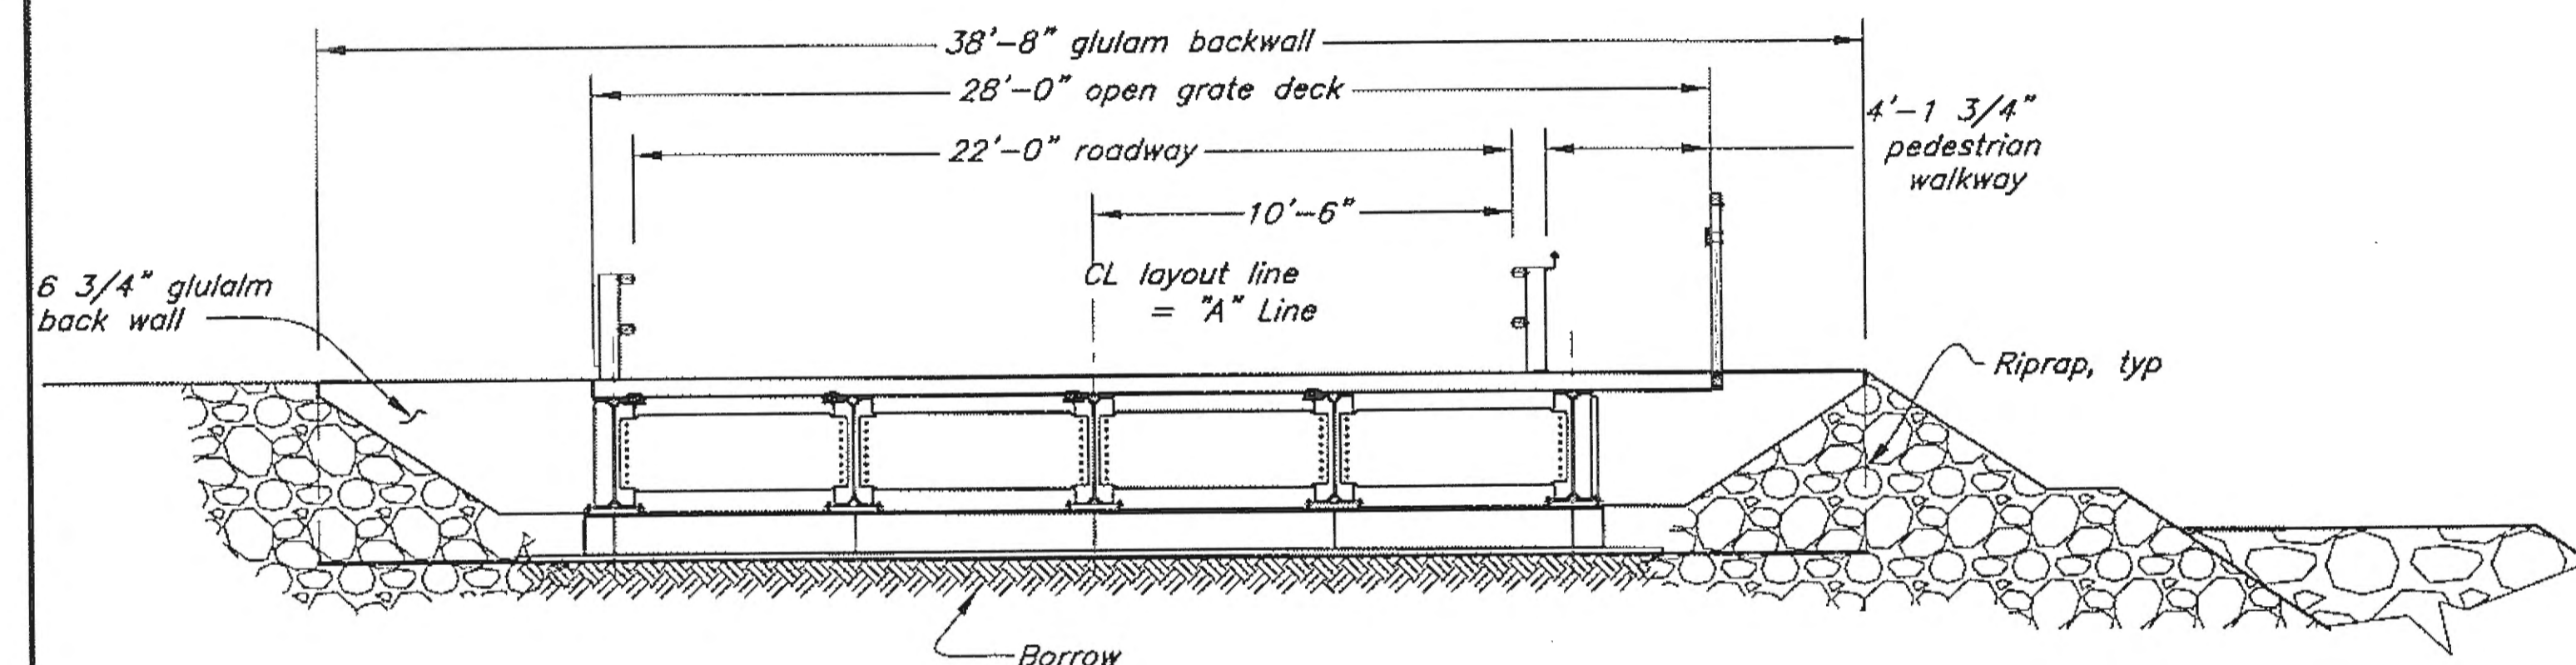


Typ. Section @ Bent #12 Abutment Cap
(looking Shoreward)

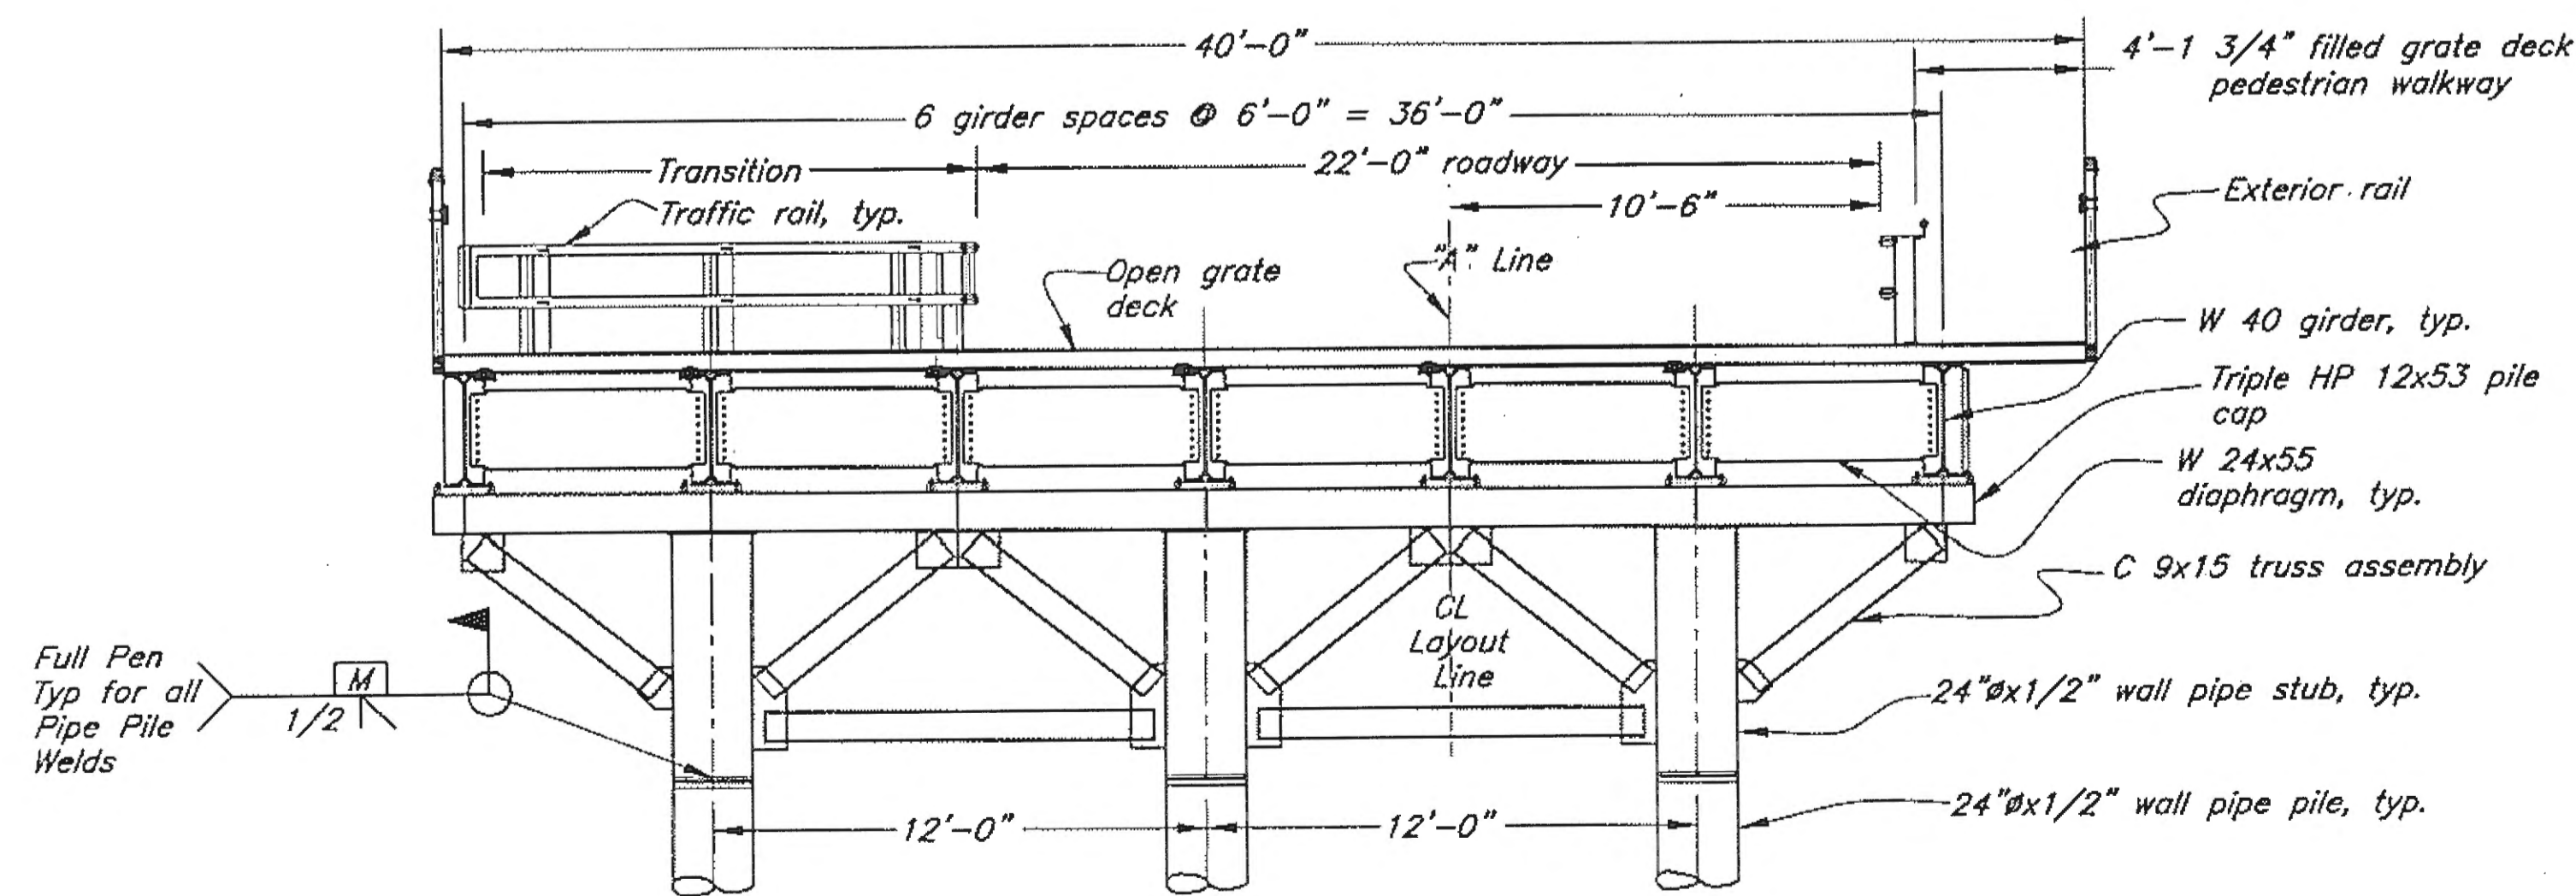

Typical Section @ Bent #15
(looking Shoreward)

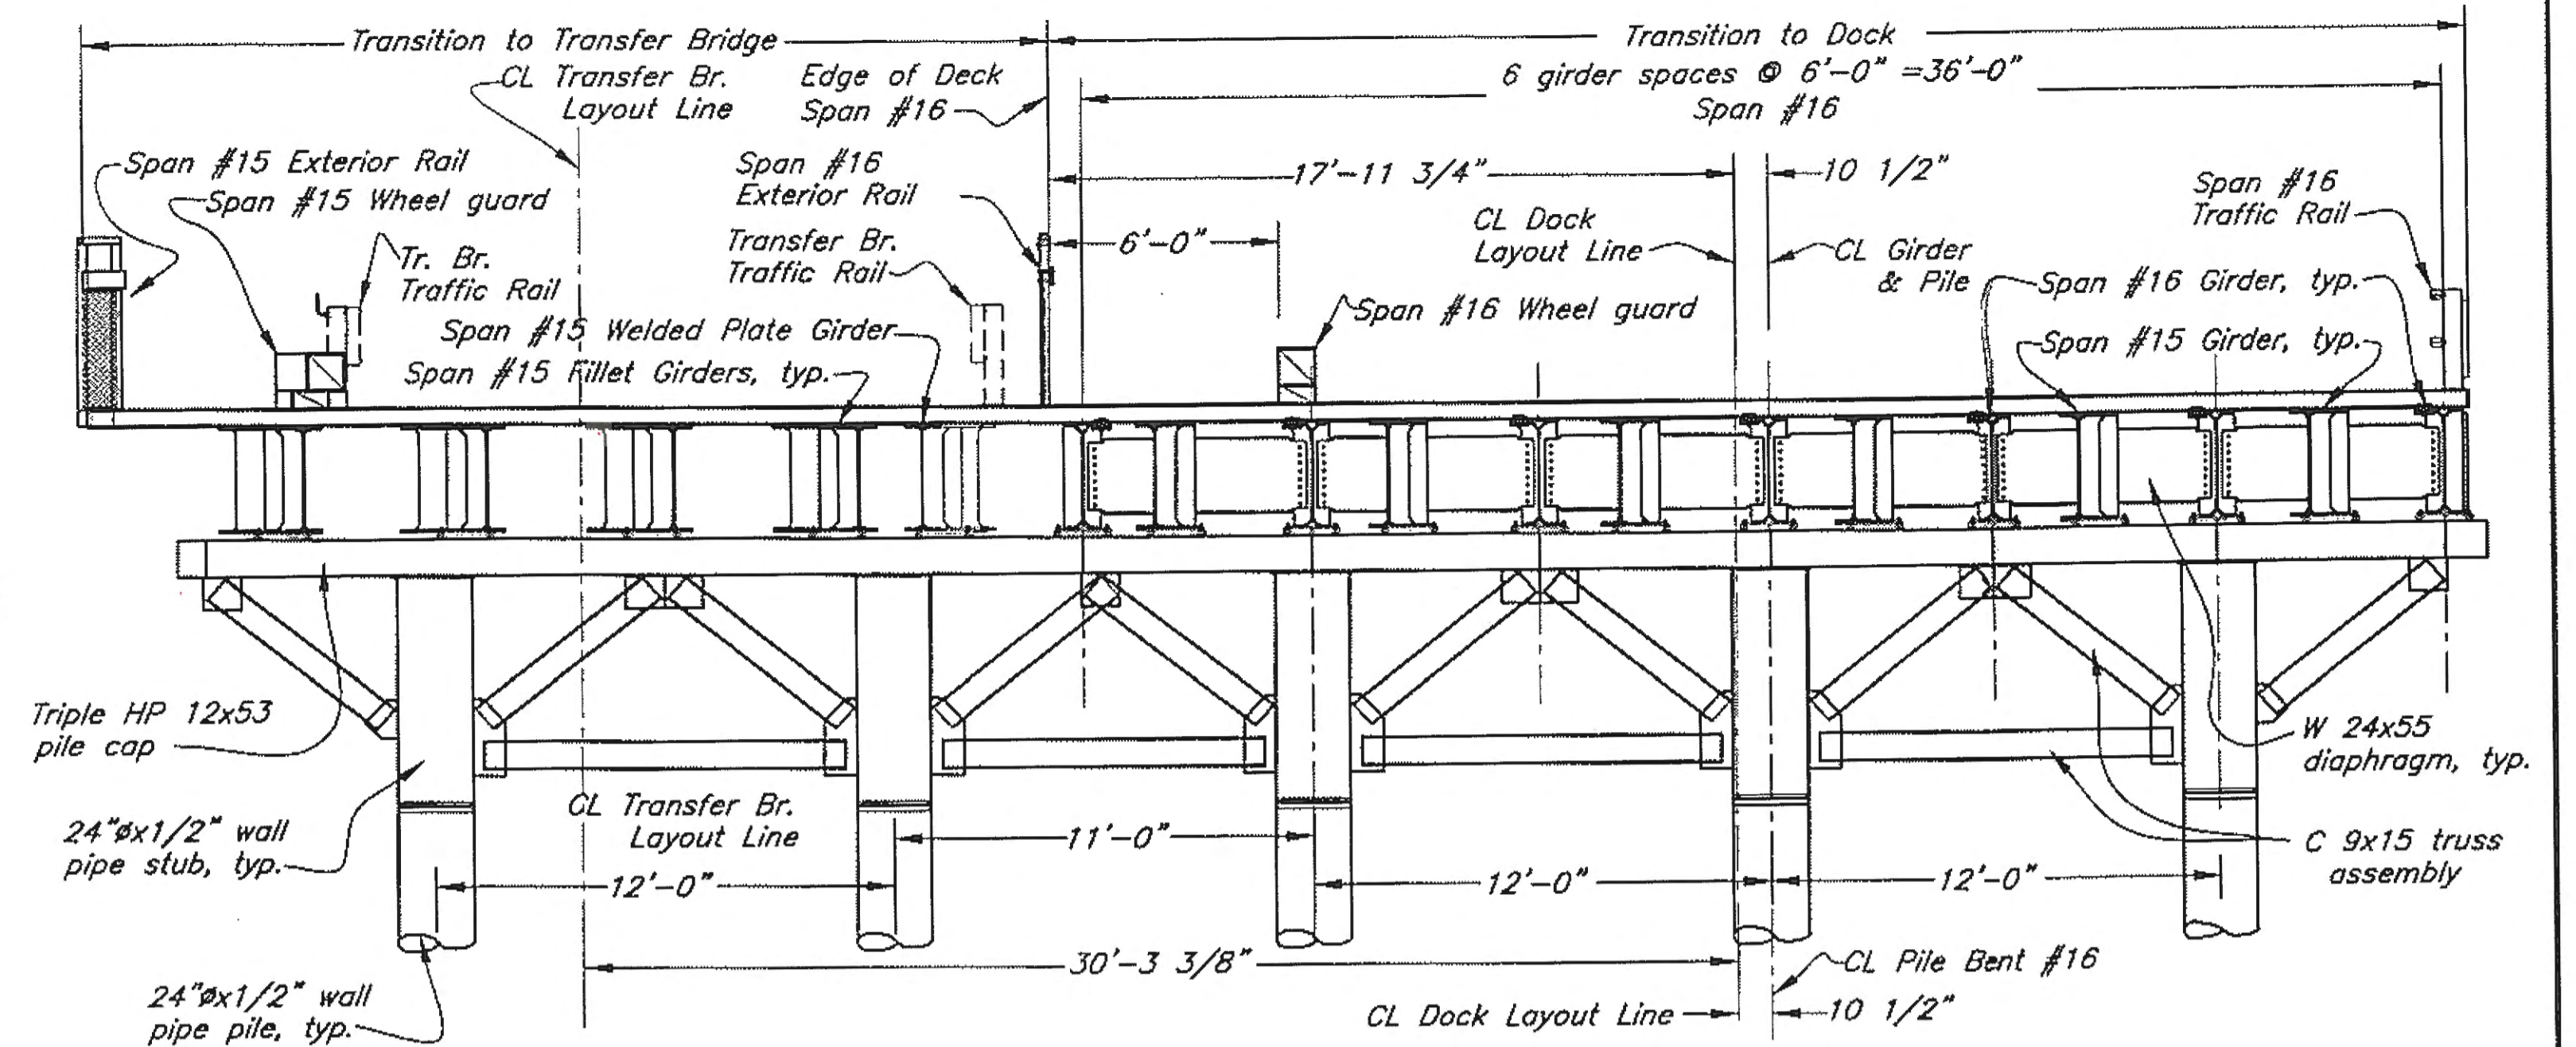

Typical Section @ Bent #16
(looking Seaward along CL Transfer Br & CL Dock)

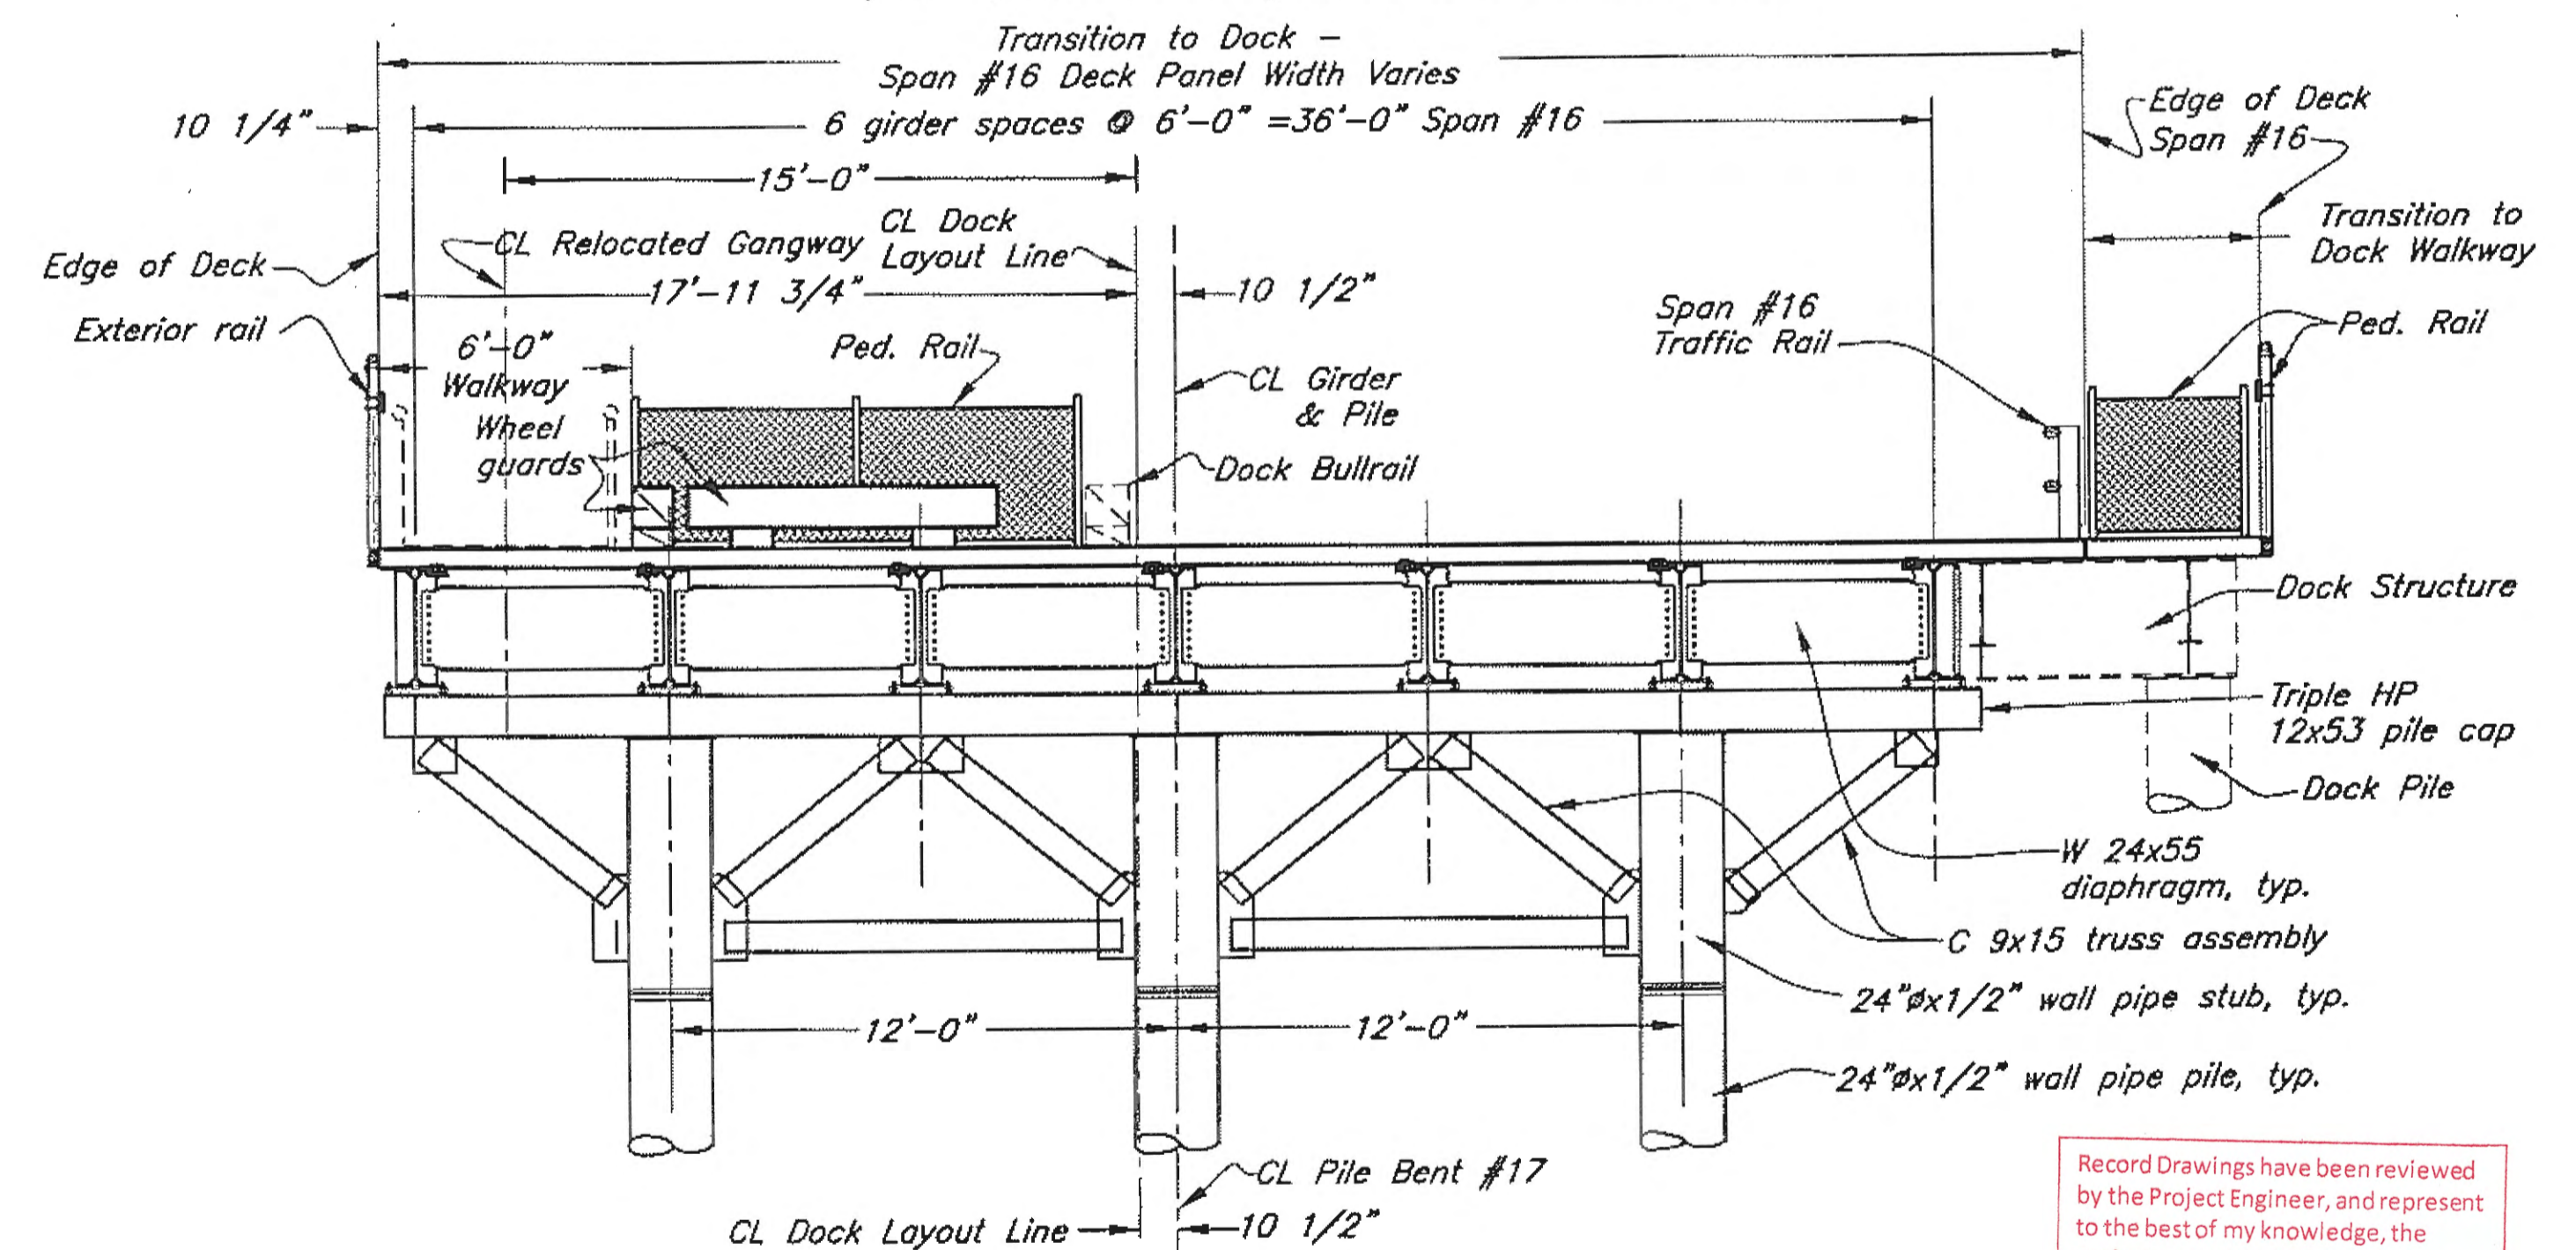

Typical Section @ Bent #17
(looking Seaward along CL Dock)

Record Drawings have been reviewed by the Project Engineer, and represent to the best of my knowledge, the project as constructed.
PE [Signature] Date 8/21/12

DO NOT SCALE FROM THESE DRAWINGS USE DIMENSIONS

DESIGNED BY: J. Scott

CHECKED BY: B. Savikko

DRAWN BY: C. Fuman, W. Hickok

PATH: Q:\GUS\67599\MP\PLANSET\03-APPROACH\AP08 TYP SECTIONS TRANSITION.DWG

TAB: Tue, 25/Nov/08 06:34PM

STATE OF ALASKA
DEPARTMENT OF TRANSPORTATION & PUBLIC FACILITIES
DESIGN & ENGINEERING SERVICES DIVISION-SOUTHEAST REGION


Gustavus Causeway Replacement

Approach Transition Typical Sections


AP08

11-26-08


REVISIONS			PROJECT DESIGNATION	YEAR	SHEET NO.	TOTAL SHEETS
NO.	DATE	DESCRIPTION	BR-0003(53)/67599	2008	18	138

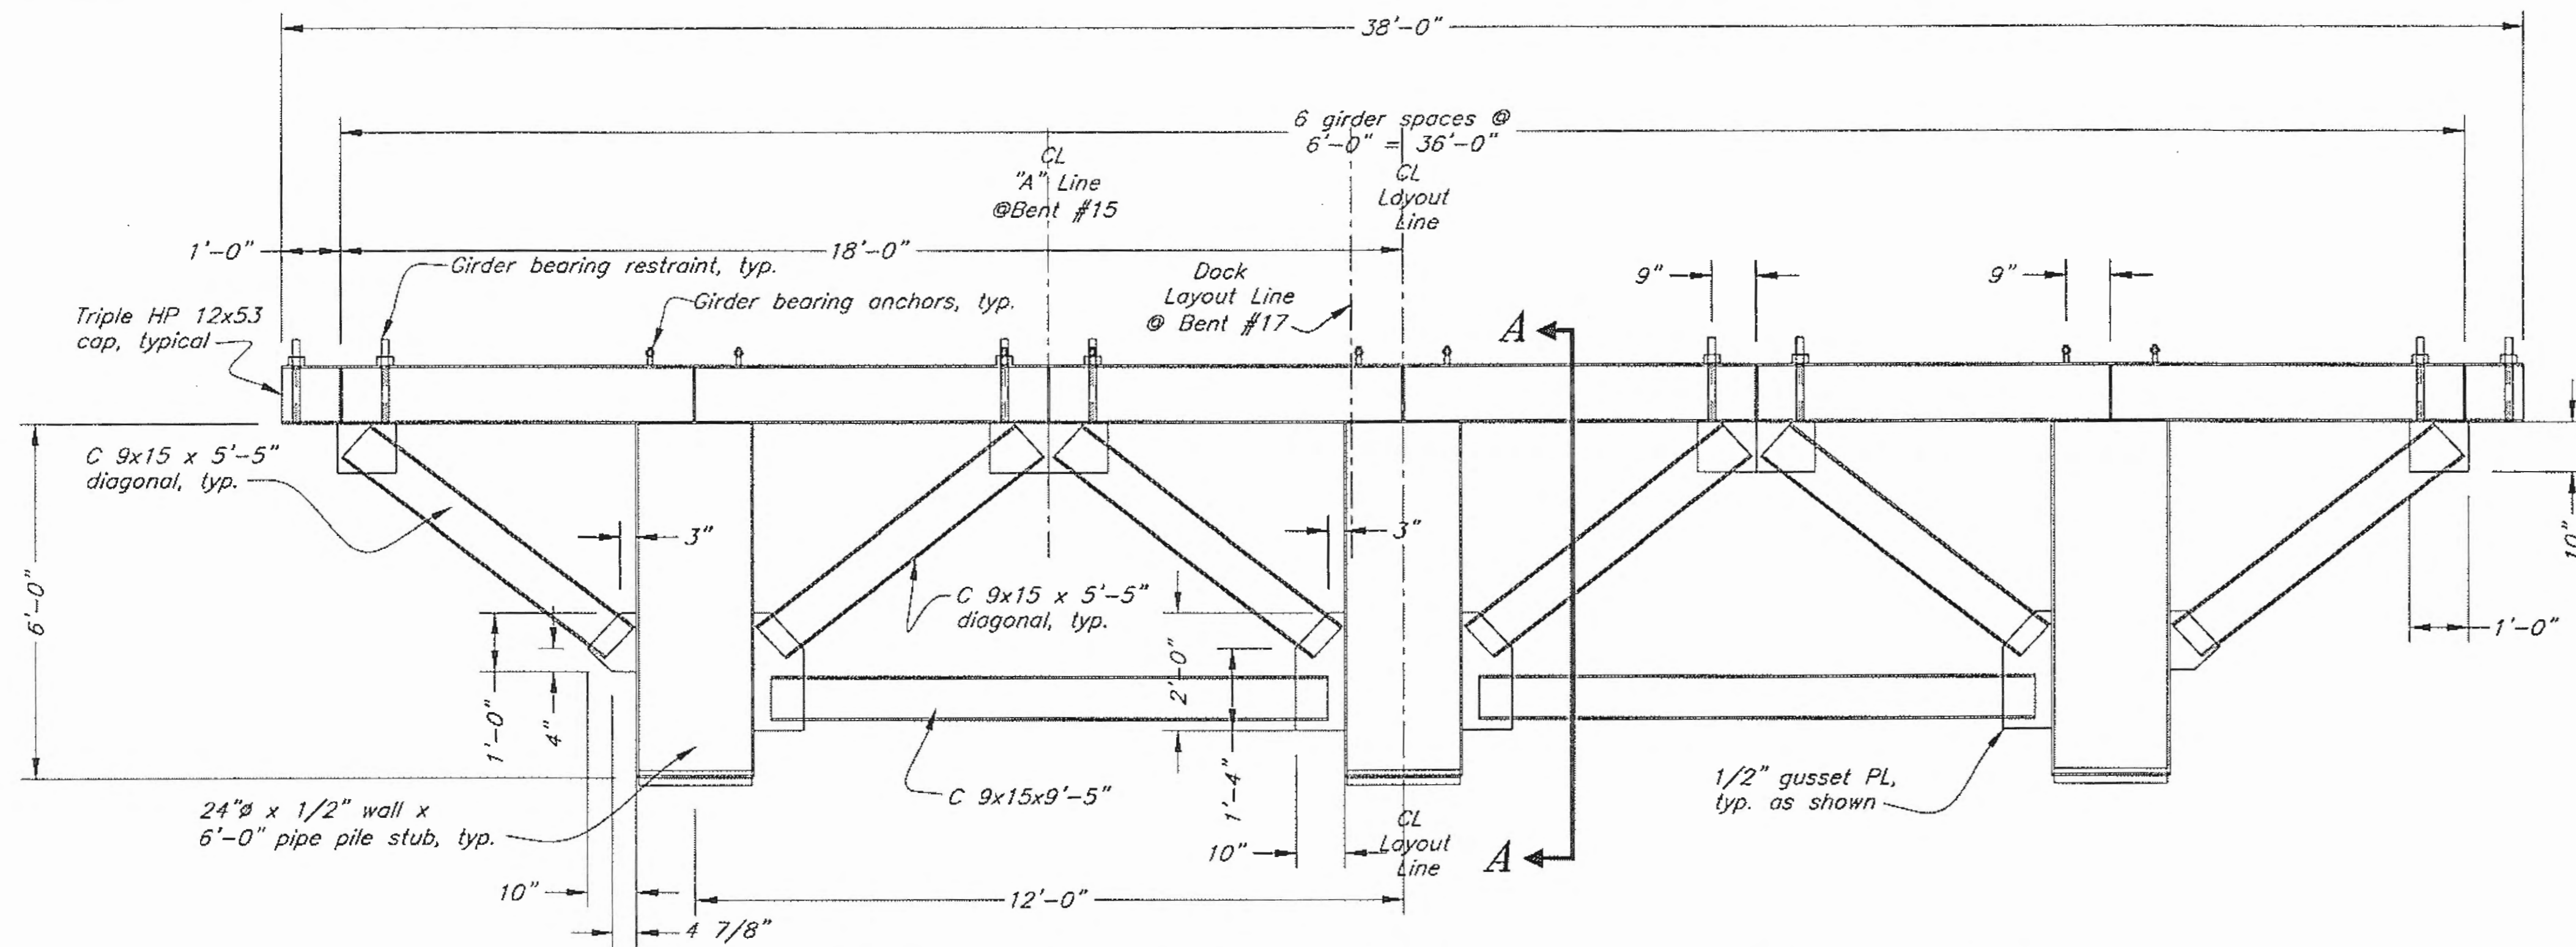


Approach Pier Cap Assembly Elevation Bents 15 & 17

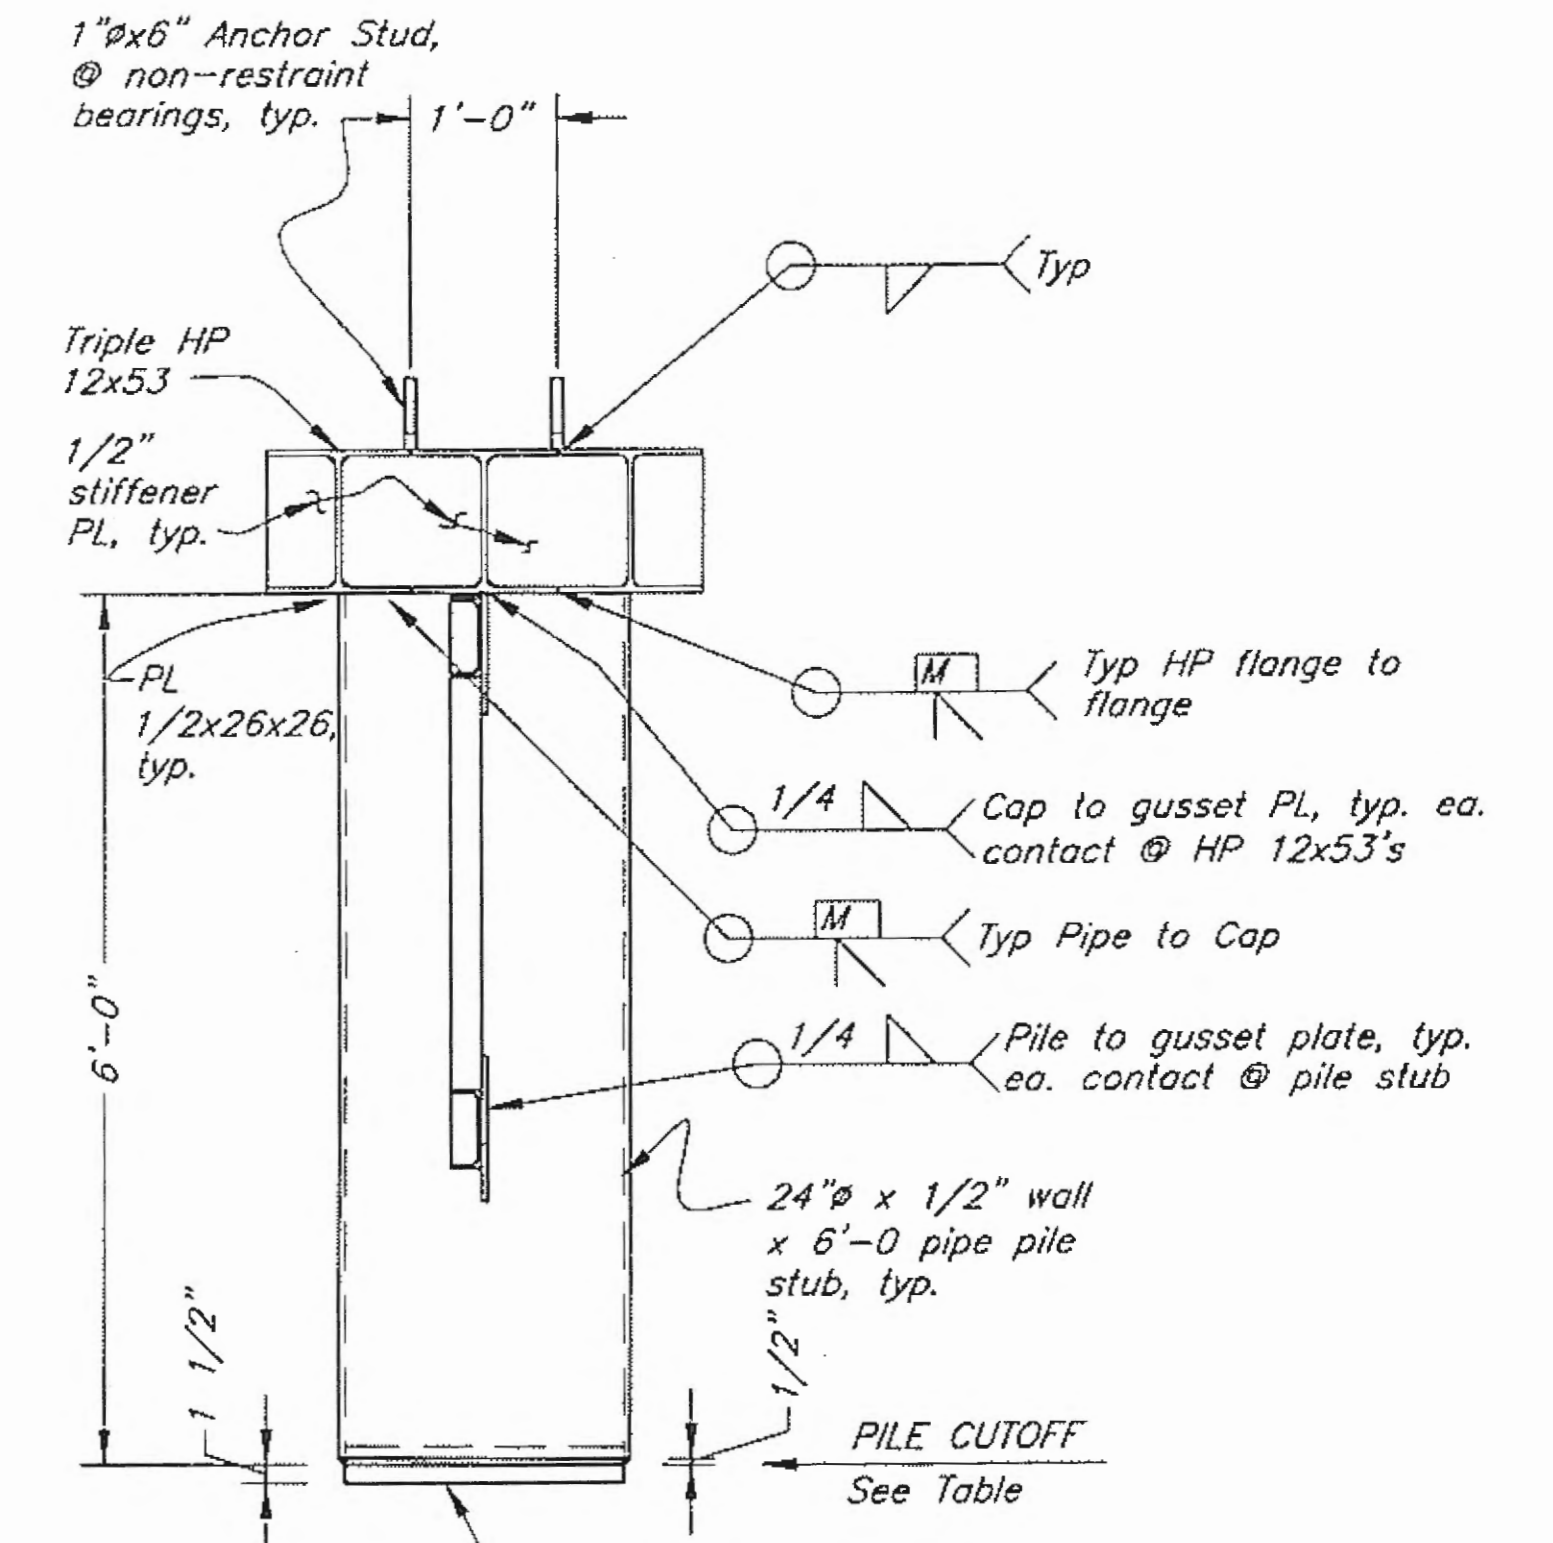

Section A-A

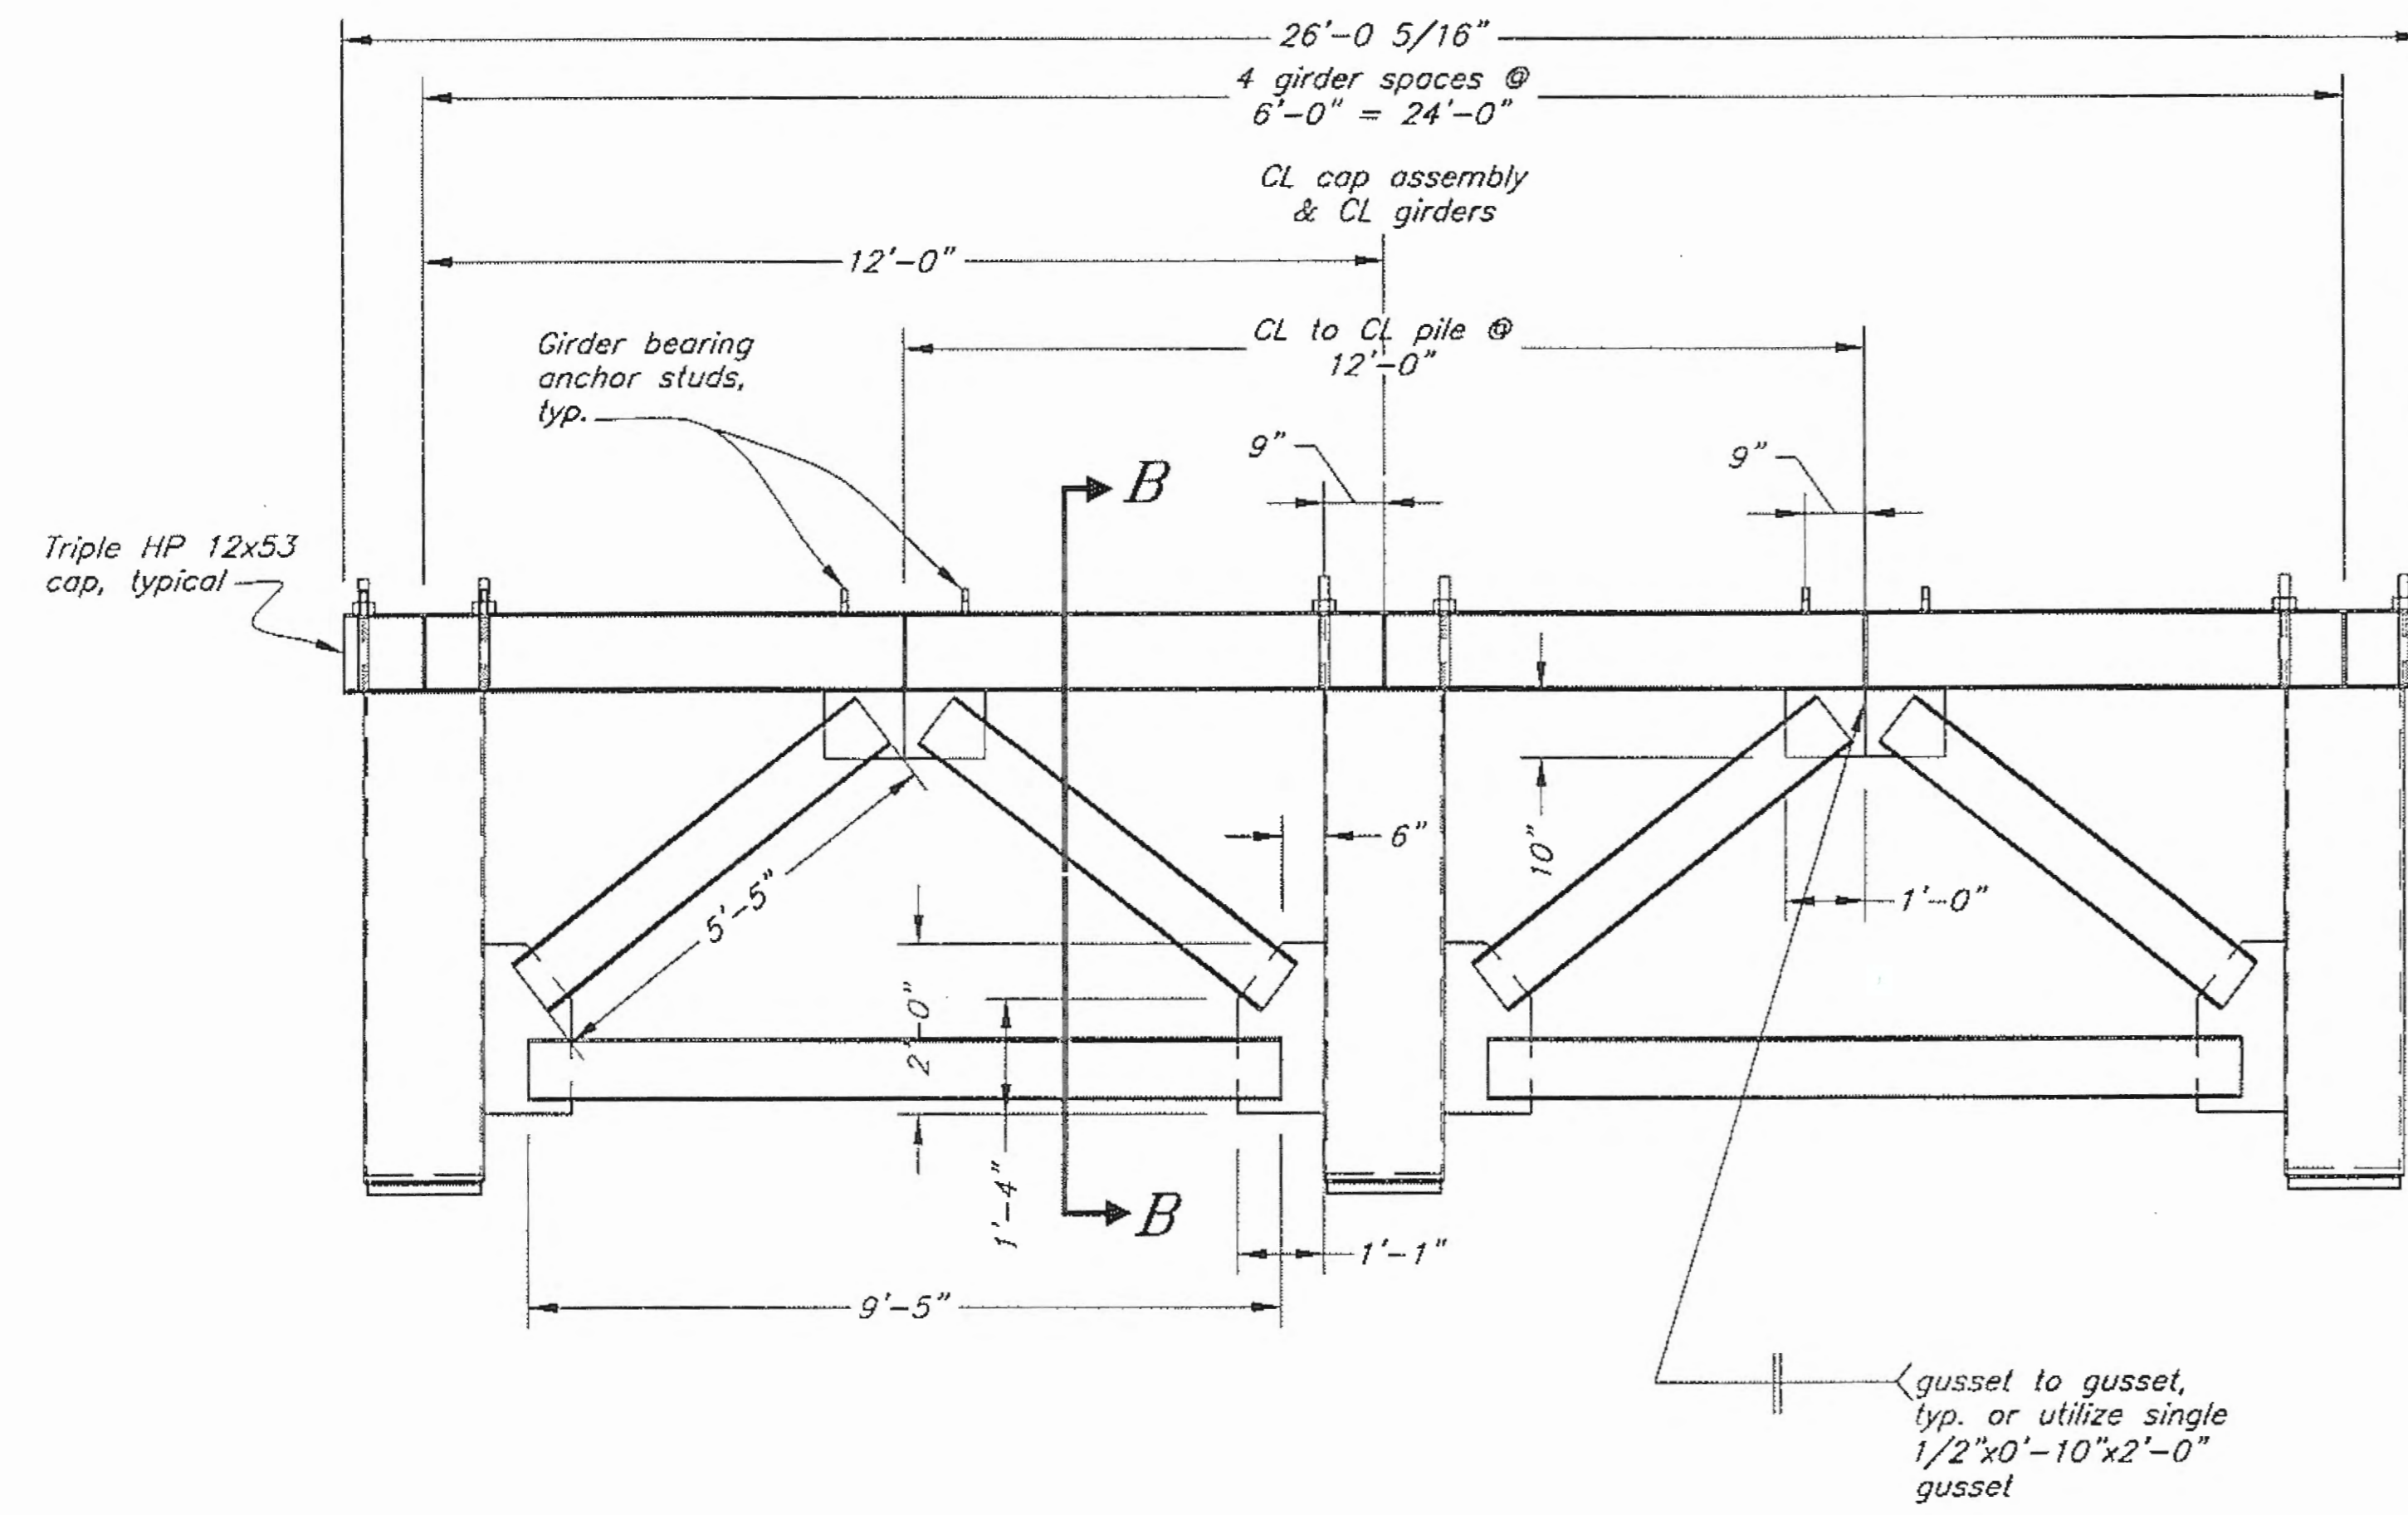


Approach Pier Cap Assembly Elevation Bents 2-10 & 13, 14

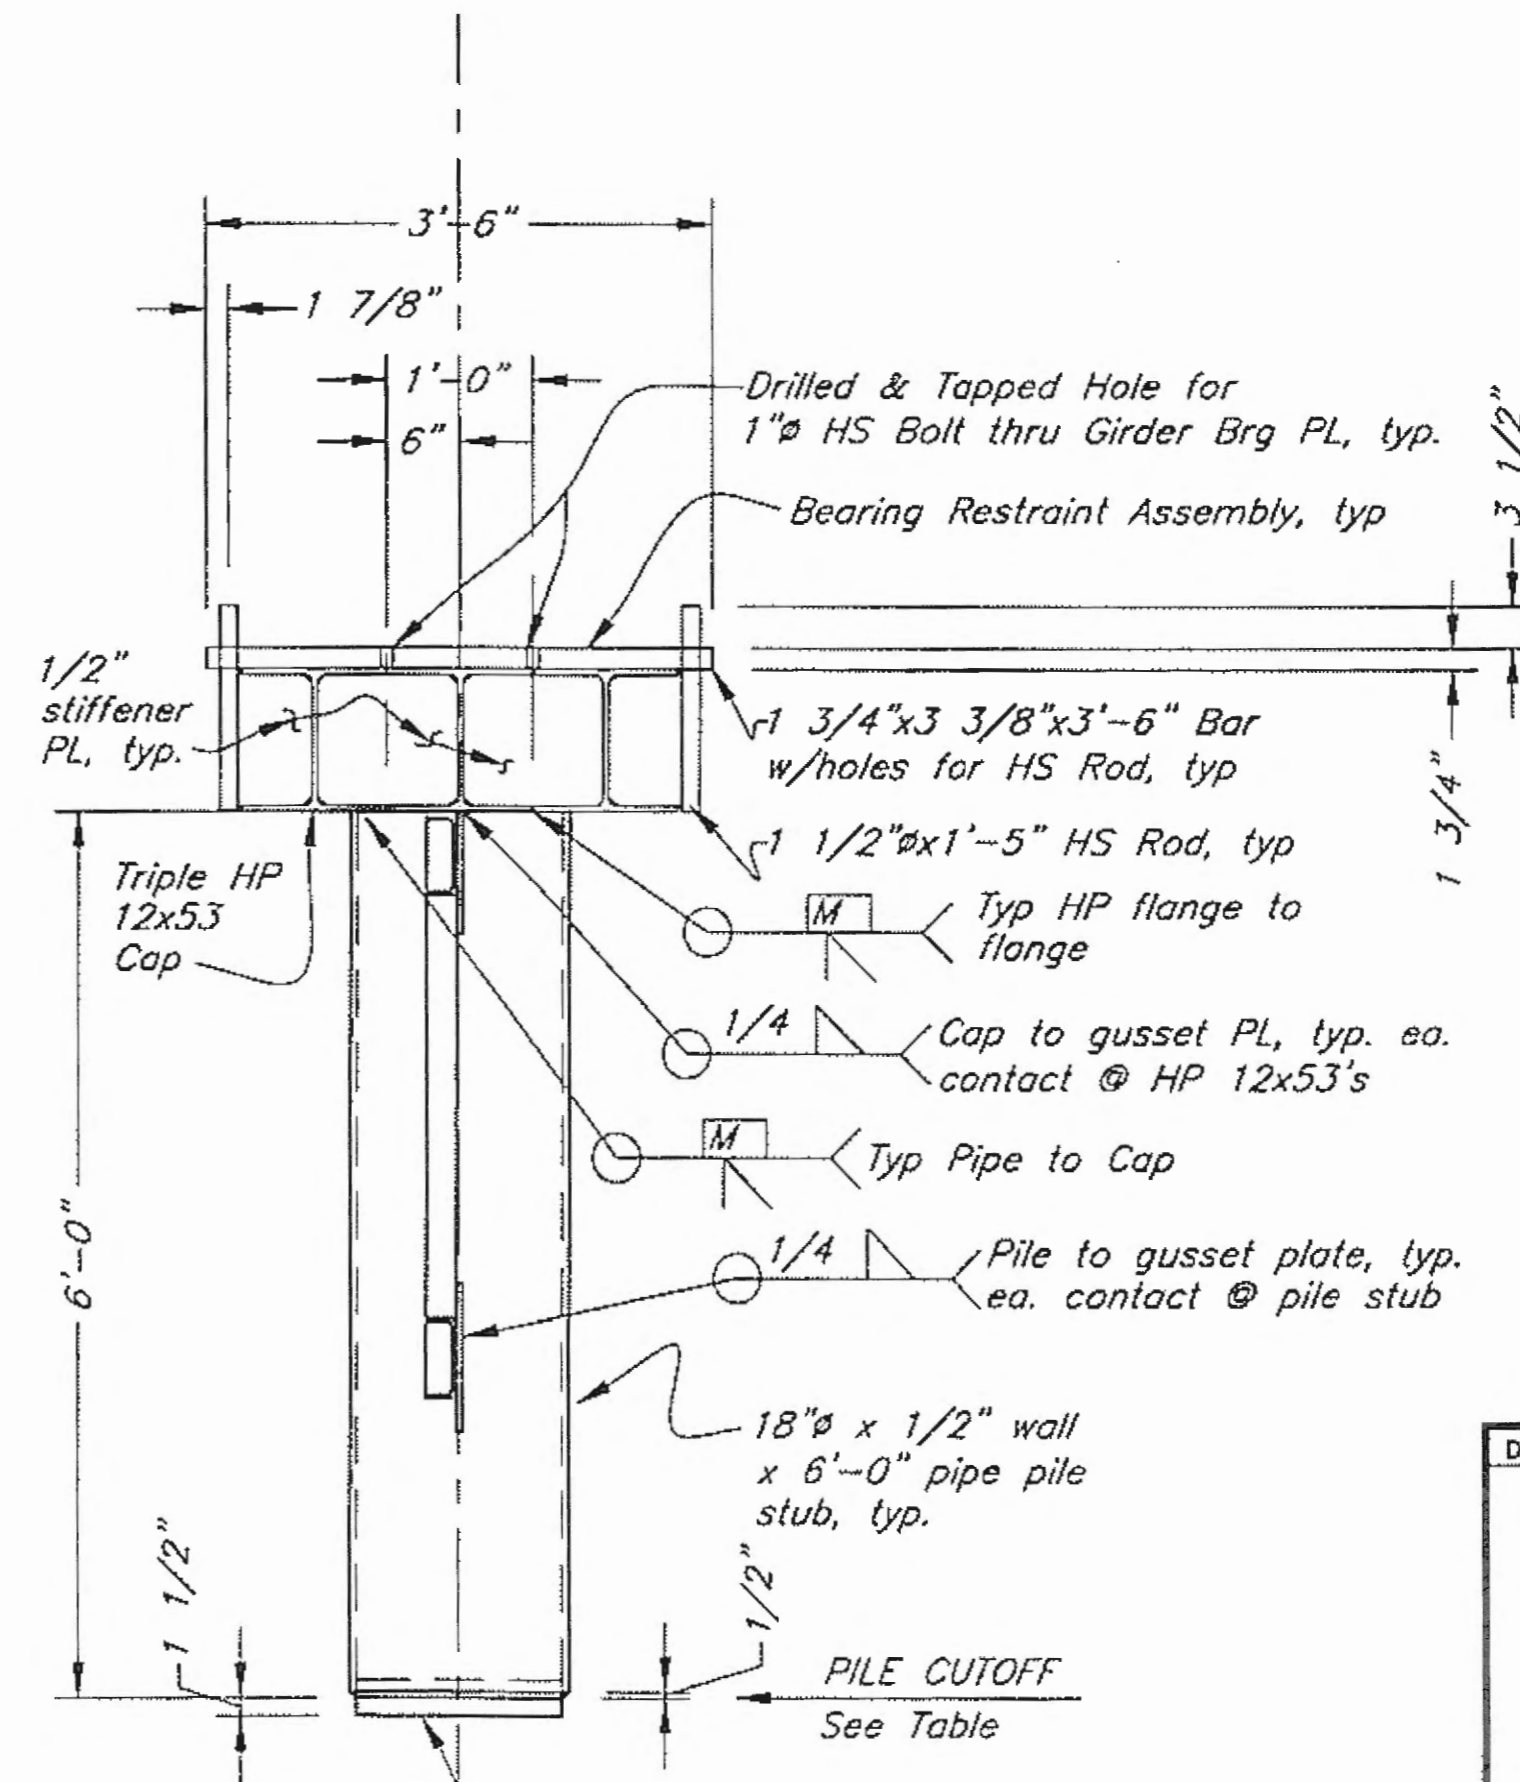


Record Drawings have been reviewed by the Project Engineer, and represent to the best of my knowledge, the project as constructed.
PE *[Signature]* Date 8/21/12

DO NOT SCALE FROM THESE DRAWINGS USE DIMENSIONS

DESIGNED BY: J. Scott	STATE OF ALASKA DEPARTMENT OF TRANSPORTATION & PUBLIC FACILITIES DESIGN & ENGINEERING SERVICES DIVISION-SOUTHEAST REGION		
Gustavus Causeway Replacement			
Approach Cap Layout & Elevation			
AP09			
CHECKED BY: B. Savikko	PROJECT DESIGNATION		
DRAWN BY: C. Fuman, W. Hickok	BR-0003(53)/67599		
DATE: Tue, 25/Nov/08 06:35PM	YEAR: 2008	SHEET NO.: 19	TOTAL SHEETS: 138

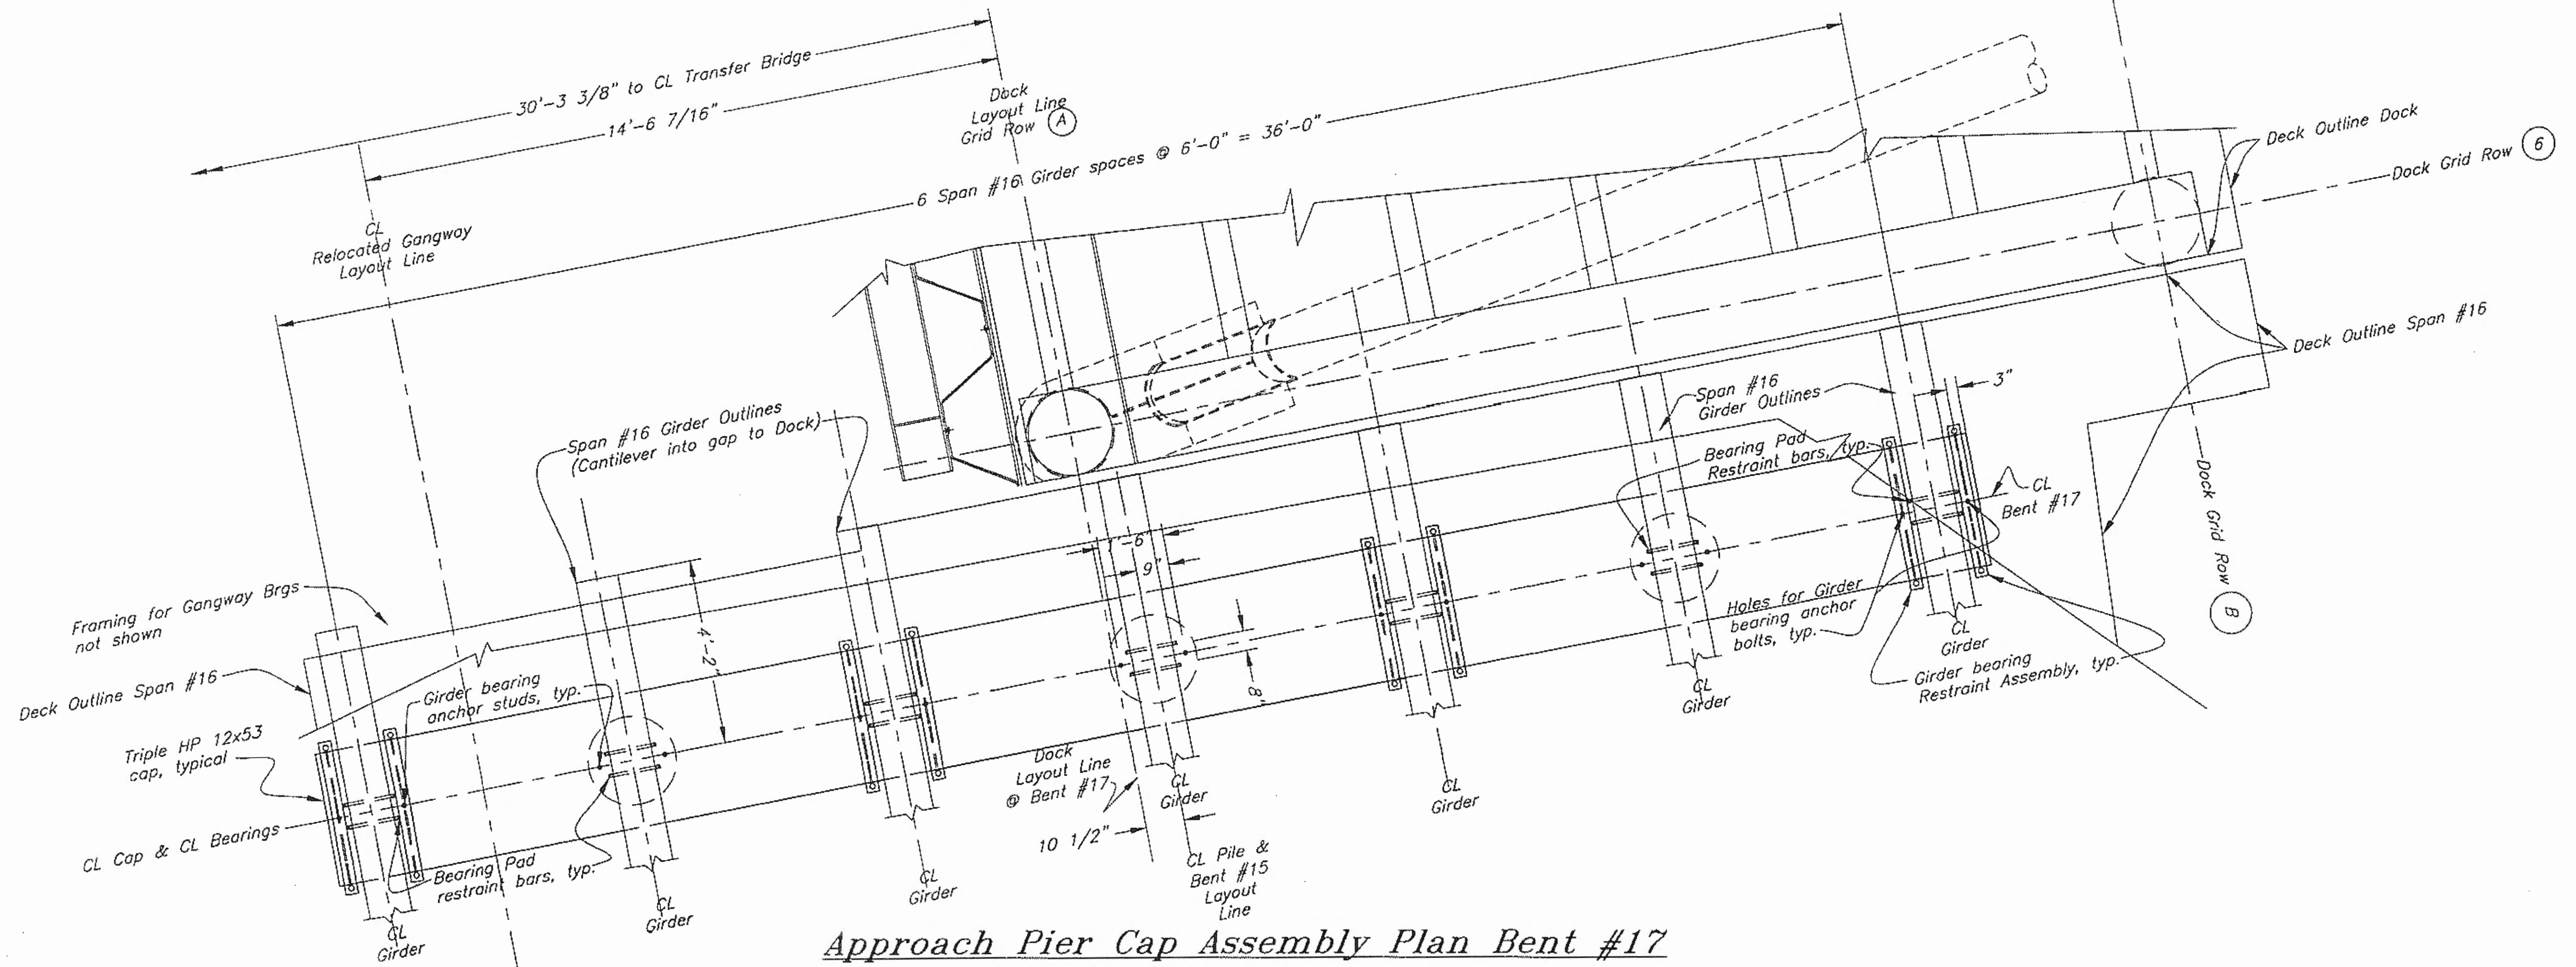

Approach Pier Cap Assembly Plan Bent #17
 (Expansion Bearings for Span #16 Girders)

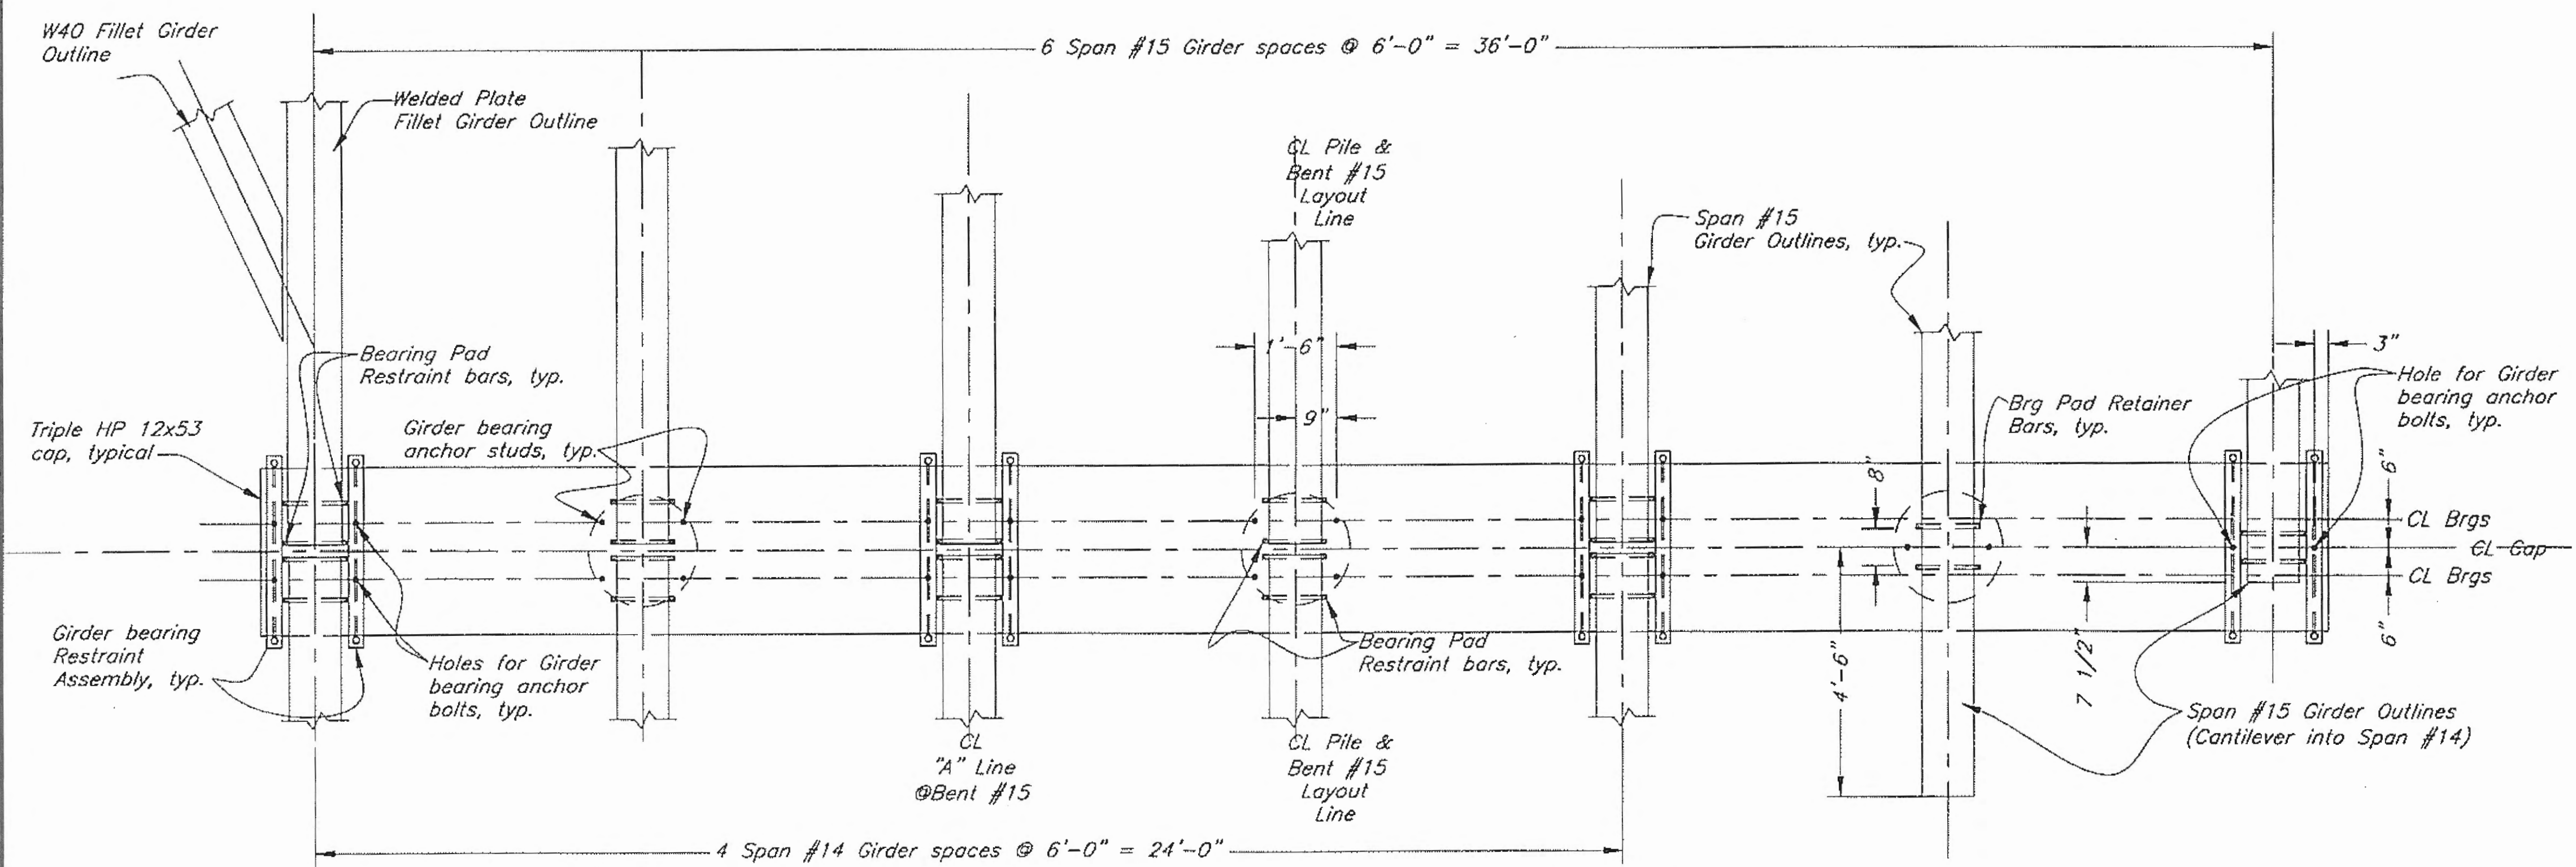

Approach Pier Cap Assembly Plan Bent #15
 (Expansion Bearings for - Span #14 & #15 Girders)

Record Drawings have been reviewed by the Project Engineer, and represent to the best of my knowledge, the project as constructed.
 PE *[Signature]* Date 8/21/12

DO NOT SCALE FROM THESE DRAWINGS USE DIMENSIONS

DESIGNED BY: J. Scott

CHECKED BY: B. Savikko

DRAWN BY: C. Fuman, W. Hickok

PATH: O:\GUS\67599\MF\PLANSET\03-APPROACH\AP10 APPROACH CAP & LAYOUT ELEV 15&17.DWG

TAB Tue, 25/Nov/08 06:37PM


STATE OF ALASKA
 DEPARTMENT OF TRANSPORTATION & PUBLIC FACILITIES
 DESIGN & ENGINEERING SERVICES DIVISION-SOUTHEAST REGION

Gustavus Causeway Replacement


Approach Cap Layout - Bents #15 & #17

AP10

REVISIONS			PROJECT DESIGNATION	YEAR	SHEET NO.	TOTAL SHEETS
NO.	DATE	DESCRIPTION				
			BR-0003(53)/67599	2008	20	138

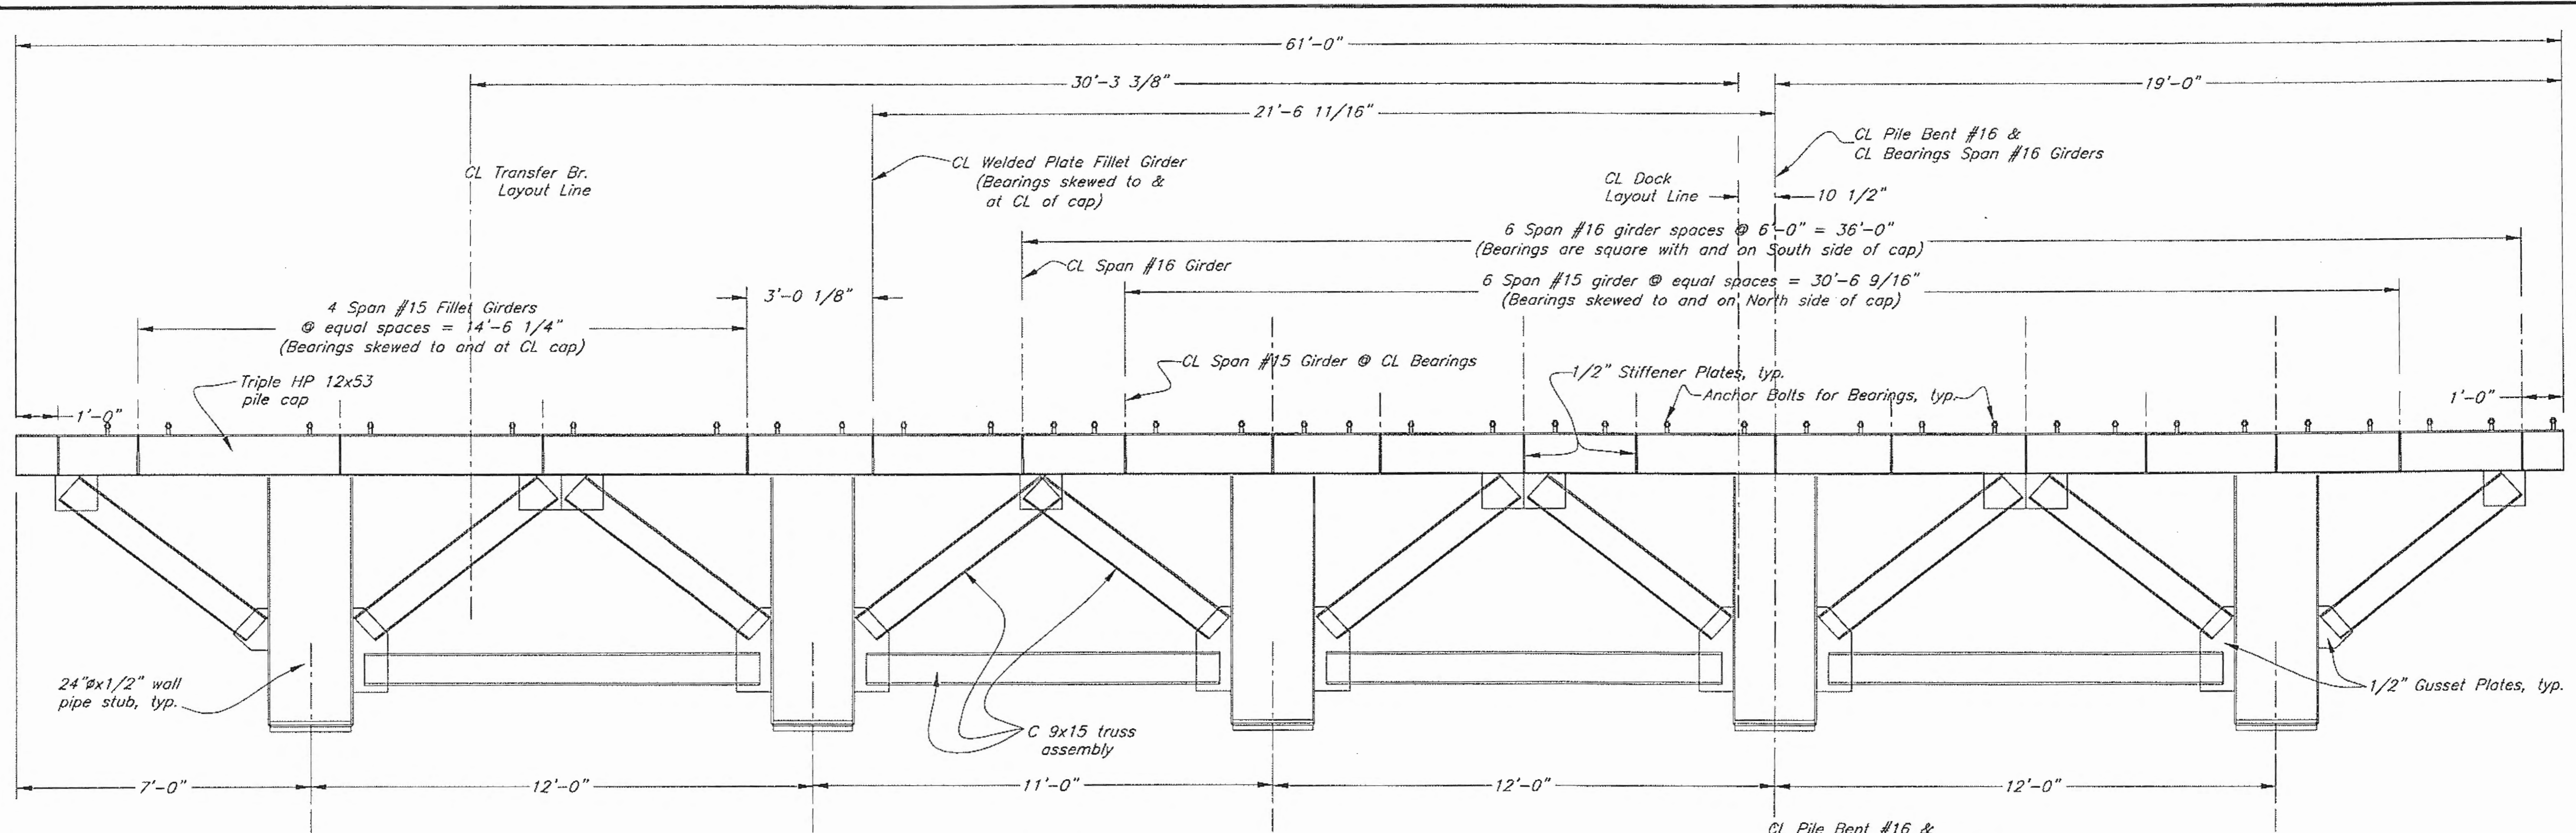

Elevation View

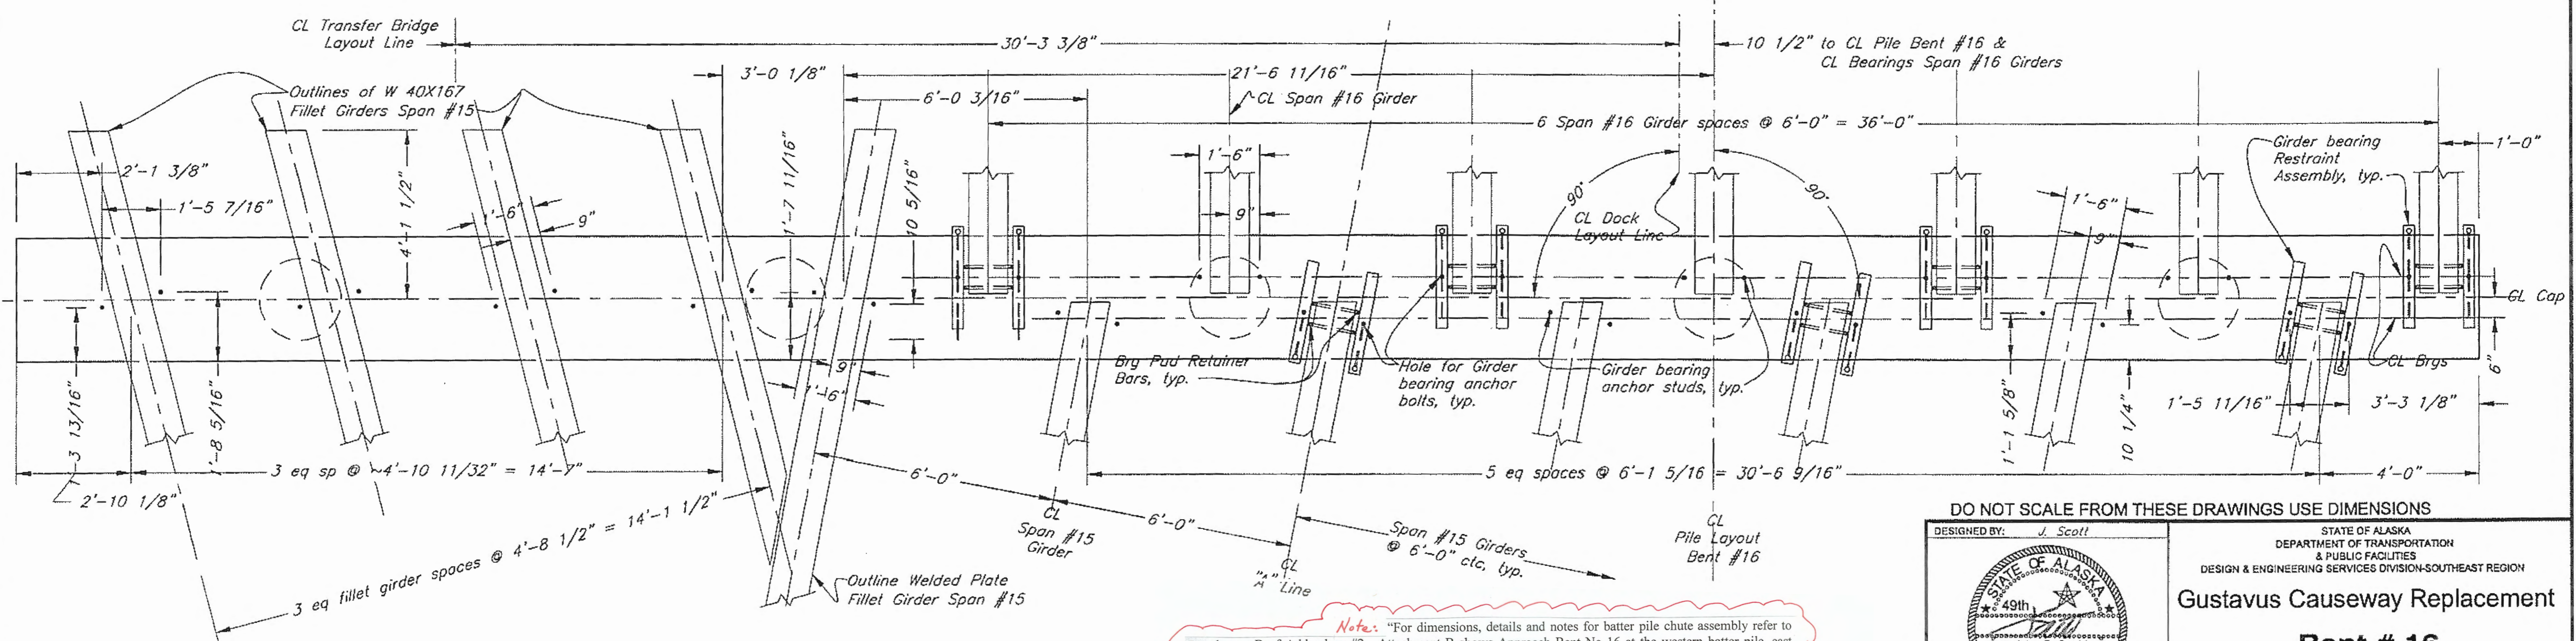

Plan View

Approach Pier Cap Assembly Bent #16
 (Rotational Bearings for - Span #15 & #16 Girders)

Note: "For dimensions, details and notes for batter pile chute assembly refer to Attachment B of Addendum #2. Attachment B shows Approach Bent No 16 at the western batter pile, east batter pile chute assembly is opposite hand."

Record Drawings have been reviewed by the Project Engineer, and represent to the best of my knowledge, the project as constructed.
 PE [Signature] Date 11/21/08

DO NOT SCALE FROM THESE DRAWINGS USE DIMENSIONS

DESIGNED BY: J. Scott

CHECKED BY: B. Savikko

DRAWN BY: G. Fuman, W. Hiskok

STATE OF ALASKA
 DEPARTMENT OF TRANSPORTATION & PUBLIC FACILITIES
 DESIGN & ENGINEERING SERVICES DIVISION-SOUTHEAST REGION

Gustavus Causeway Replacement

Bent # 16 Approach Cap Plan & Elev.


AP11

YEAR 2008 SHEET NO. 21 TOTAL SHEETS 138


PROJECT DESIGNATION: BR-0003(53)/67599

PATH: O:\GUS\67599\MF\PLANSET\03-APPROACH\AP11 APPROACH CAP & LAYOUT ELEV 16.DWG
 TAB: Tue, 25/Nov/08 07:03PM JTSCOTT


NO.	DATE	DESCRIPTION

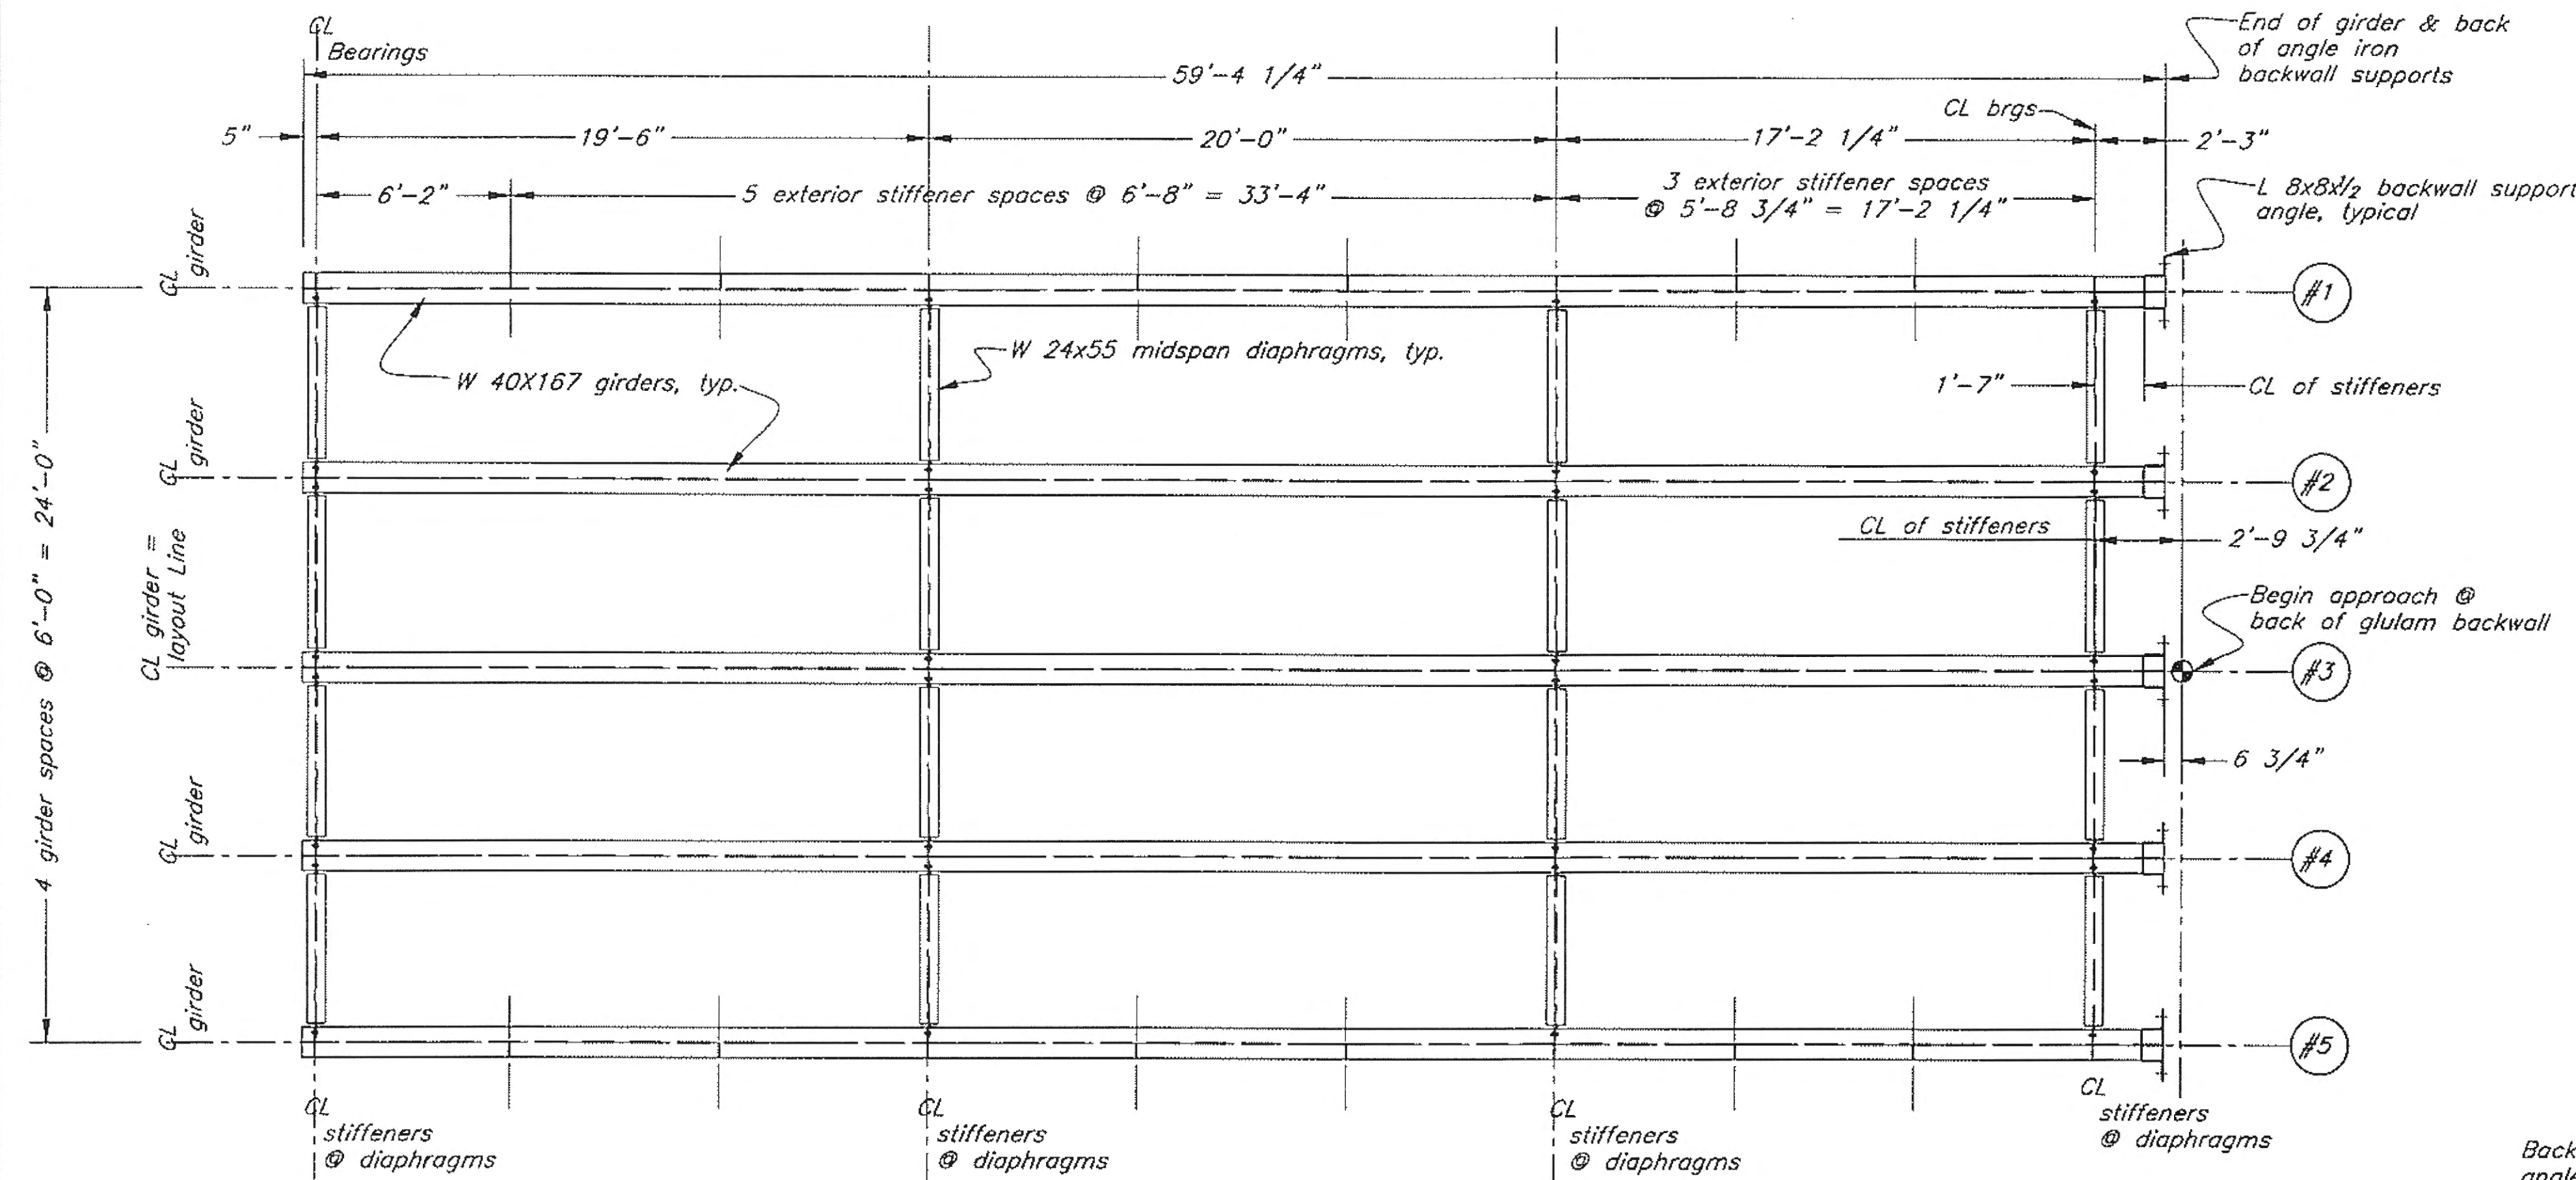


Framing Layout - Span 1 & 11 shown
Span 10 - mirror image

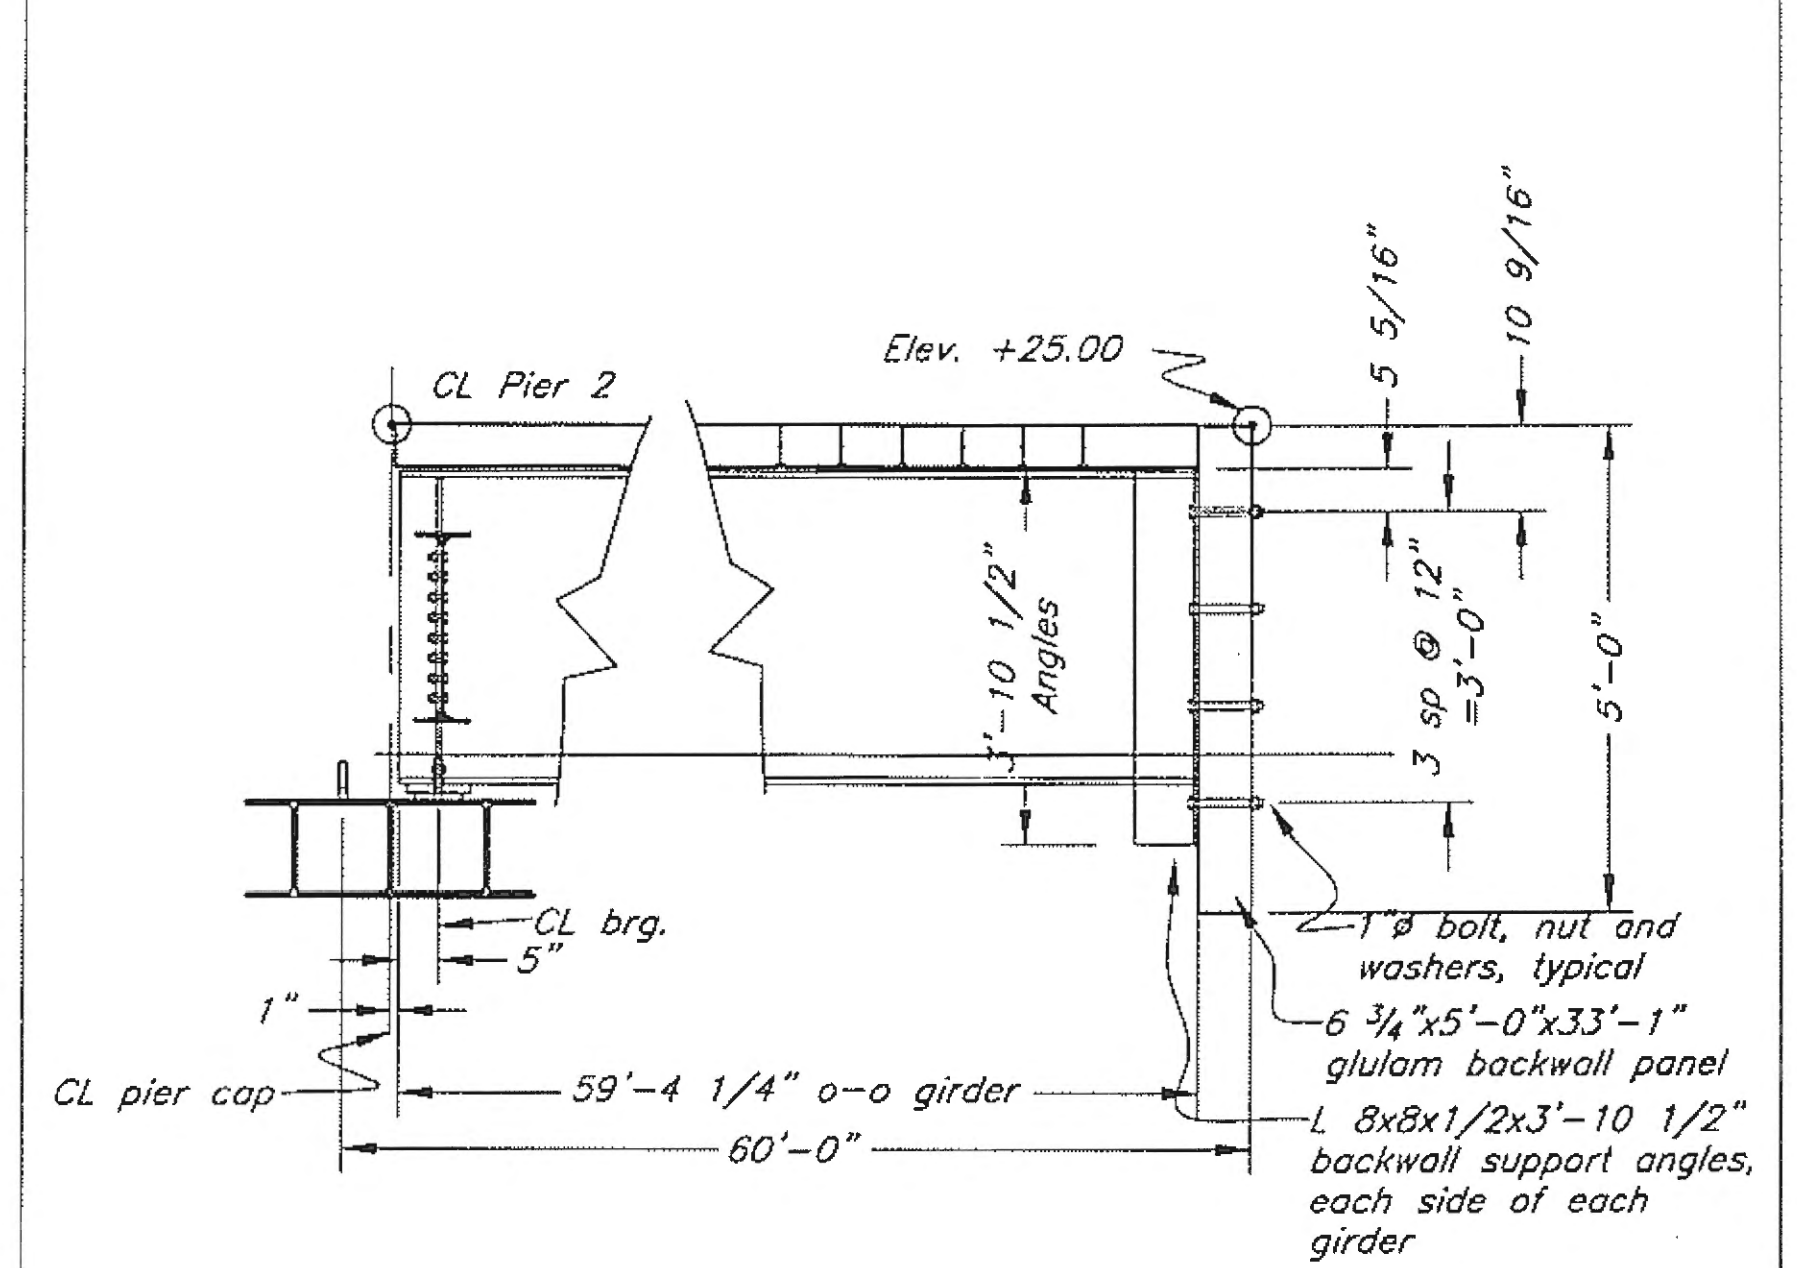

Section thru Span 1

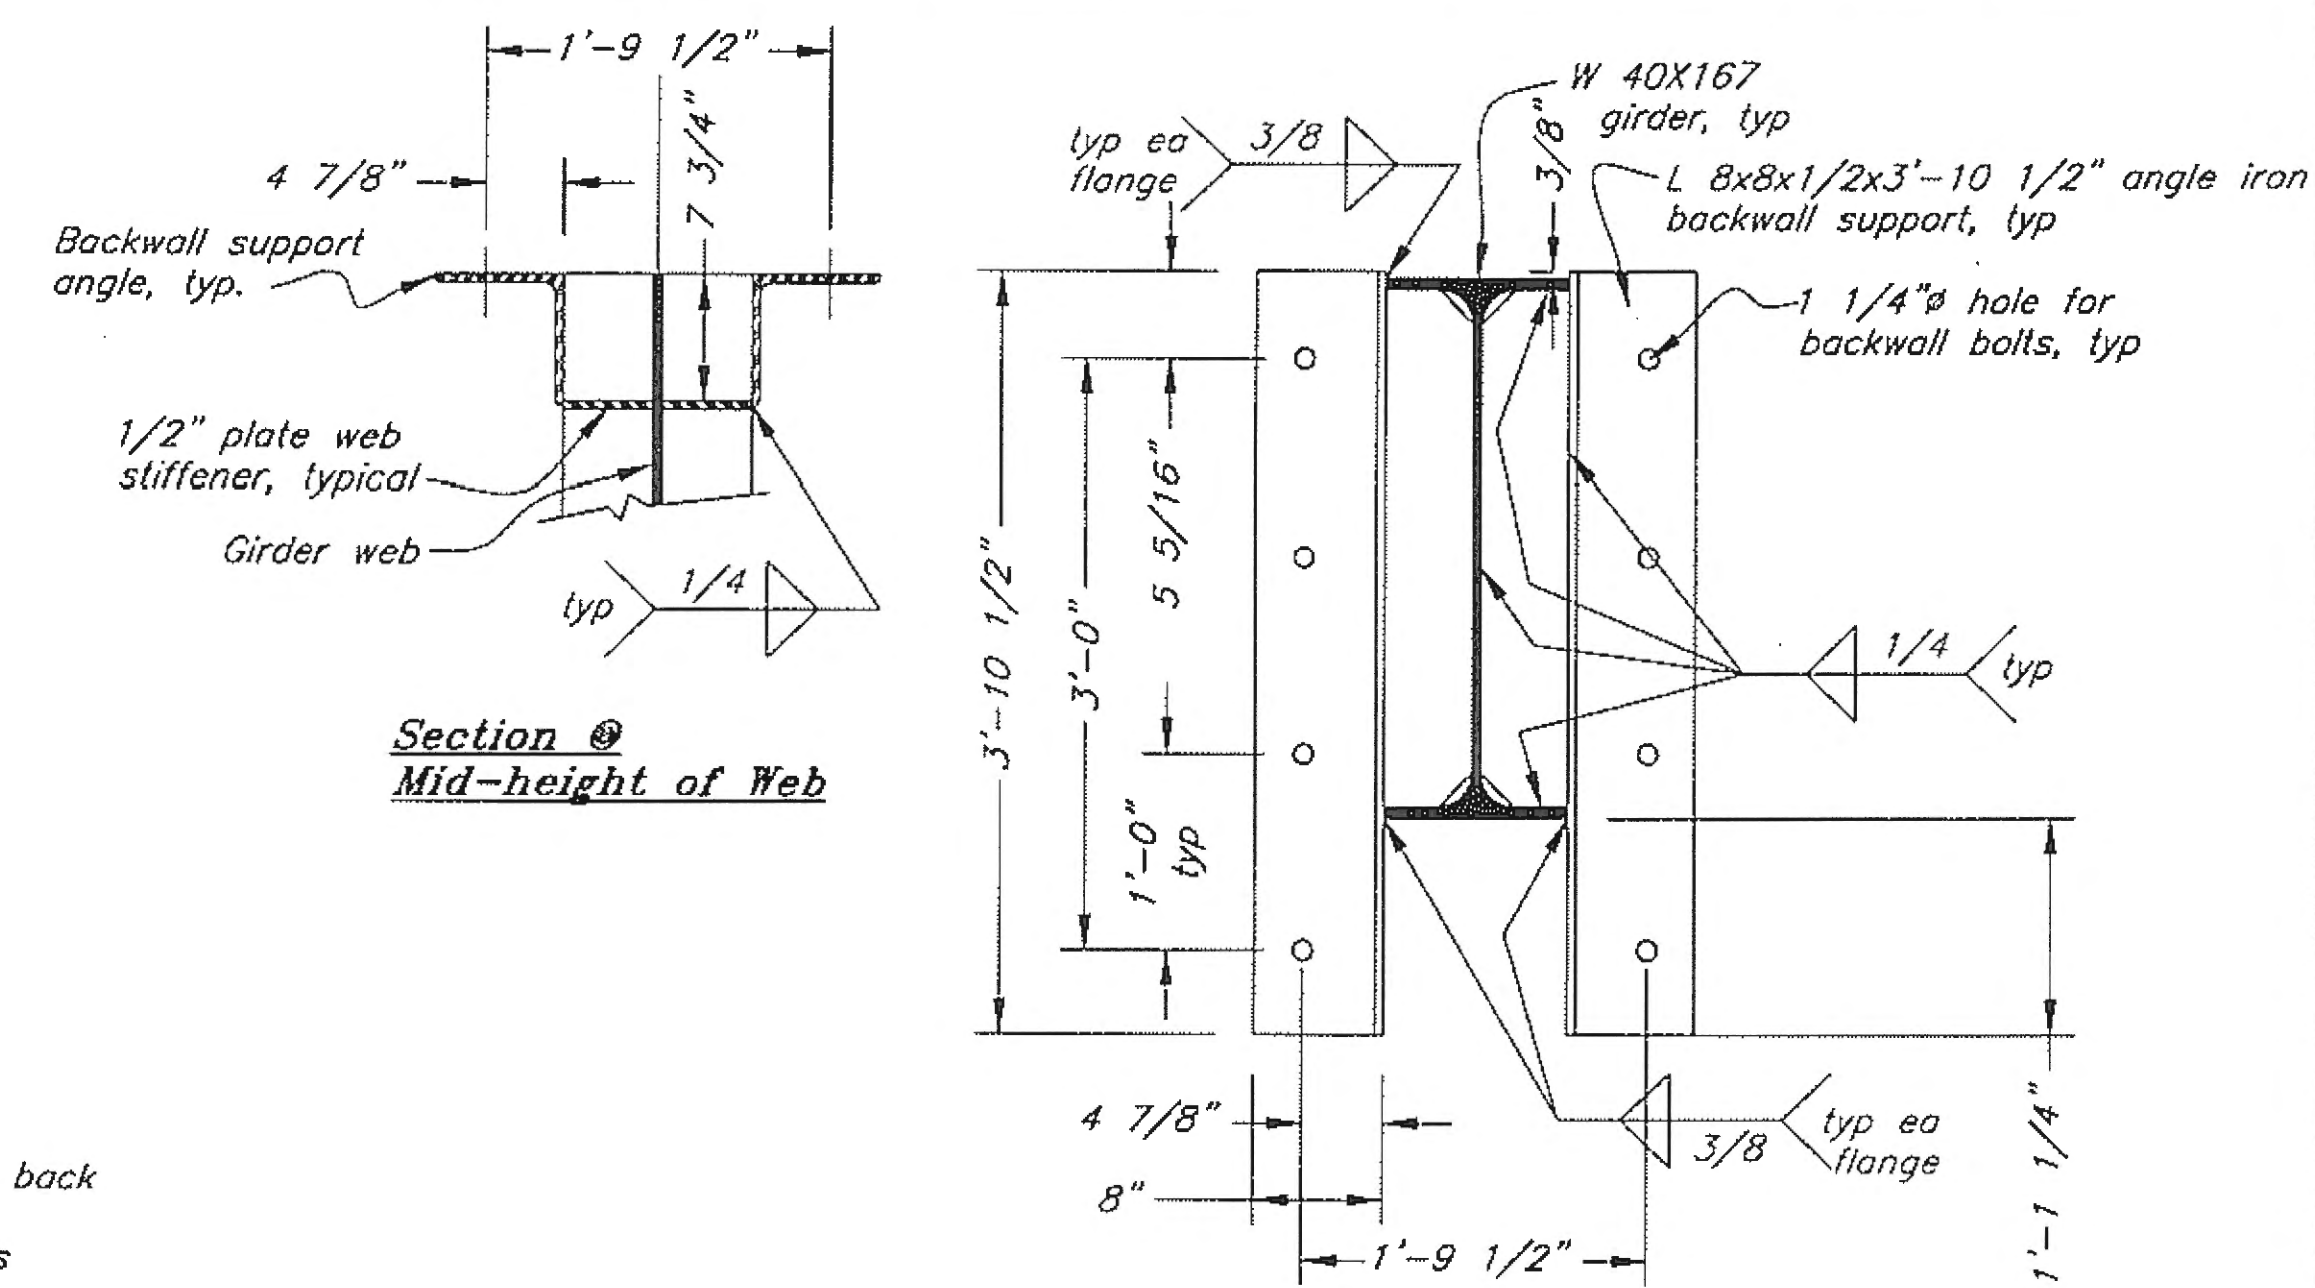

Section Thru Girder
(looking back at abutment)
Backwall Support Angle Attachment & Stiffeners

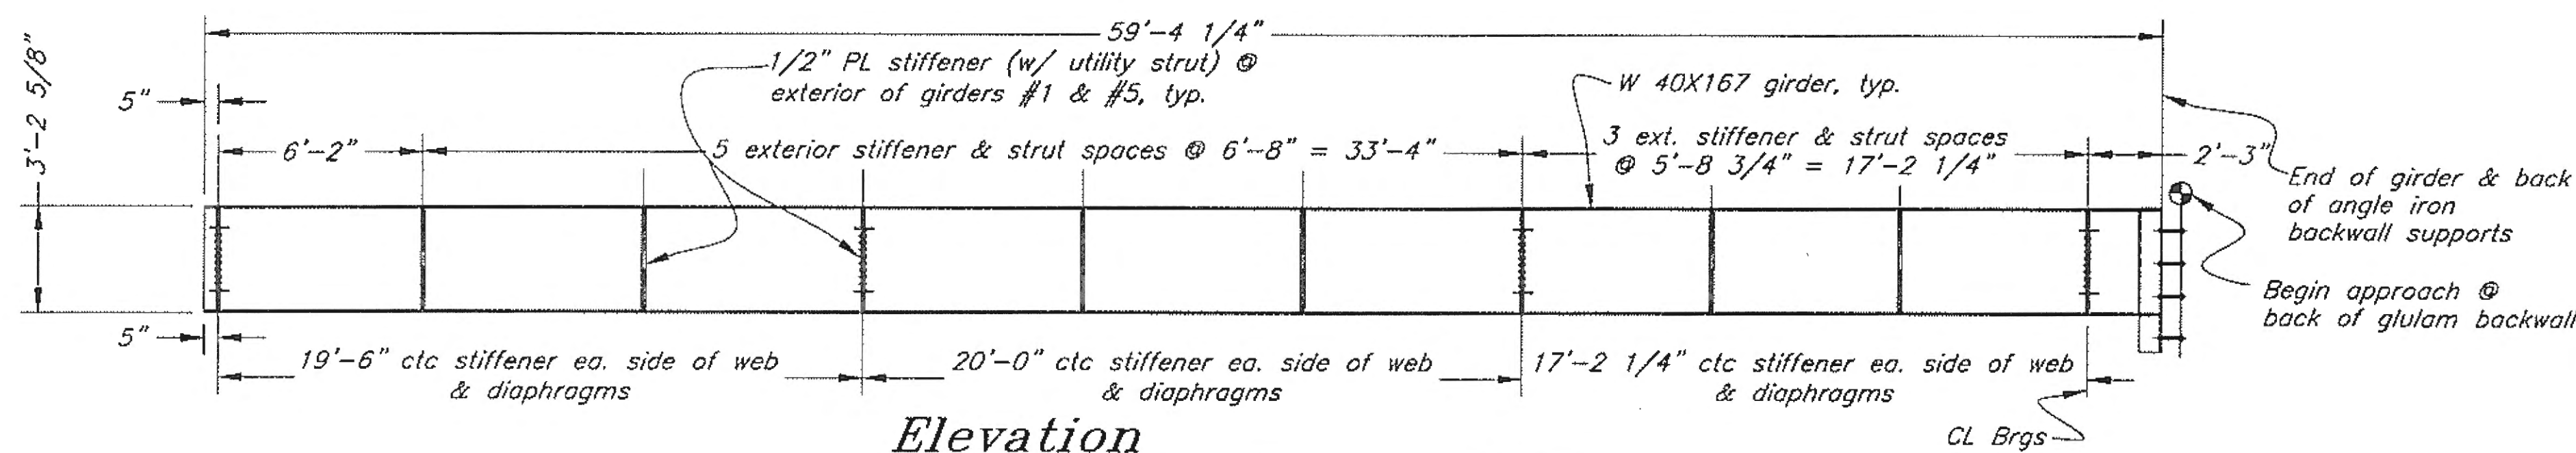

Elevation
Girder #5, Span 1 & 11
(Girder #1 opposite hand of Girder #5)

Record Drawings have been reviewed by the Project Engineer, and represent to the best of my knowledge, the project as constructed.
PE [Signature] Date 8/21/11

DO NOT SCALE FROM THESE DRAWINGS USE DIMENSIONS

DESIGNED BY: J. Scott

CHECKED BY: B. Savikko

DRAWN BY: C. Fuman, W. Hickok


PATH: O:\GUS\67599\MF\PLANS\03-APPROACH\AP14 APPROACH FRAMING SPAN 1.DWG

TAB: Tue, 25/Nov/08 07:43PM


STATE OF ALASKA
DEPARTMENT OF TRANSPORTATION & PUBLIC FACILITIES
DESIGN & ENGINEERING SERVICES DIVISION-SOUTHEAST REGION

Gustavus Causeway Replacement
APPROACH FRAMING
SPAN 1 & 11,
Span 10 (mirror image)
AP14


NO.	DATE	REVISIONS DESCRIPTION	PROJECT DESIGNATION	YEAR	SHEET NO.	TOTAL SHEETS
			BR-0003(53)/67599	2008	24	138

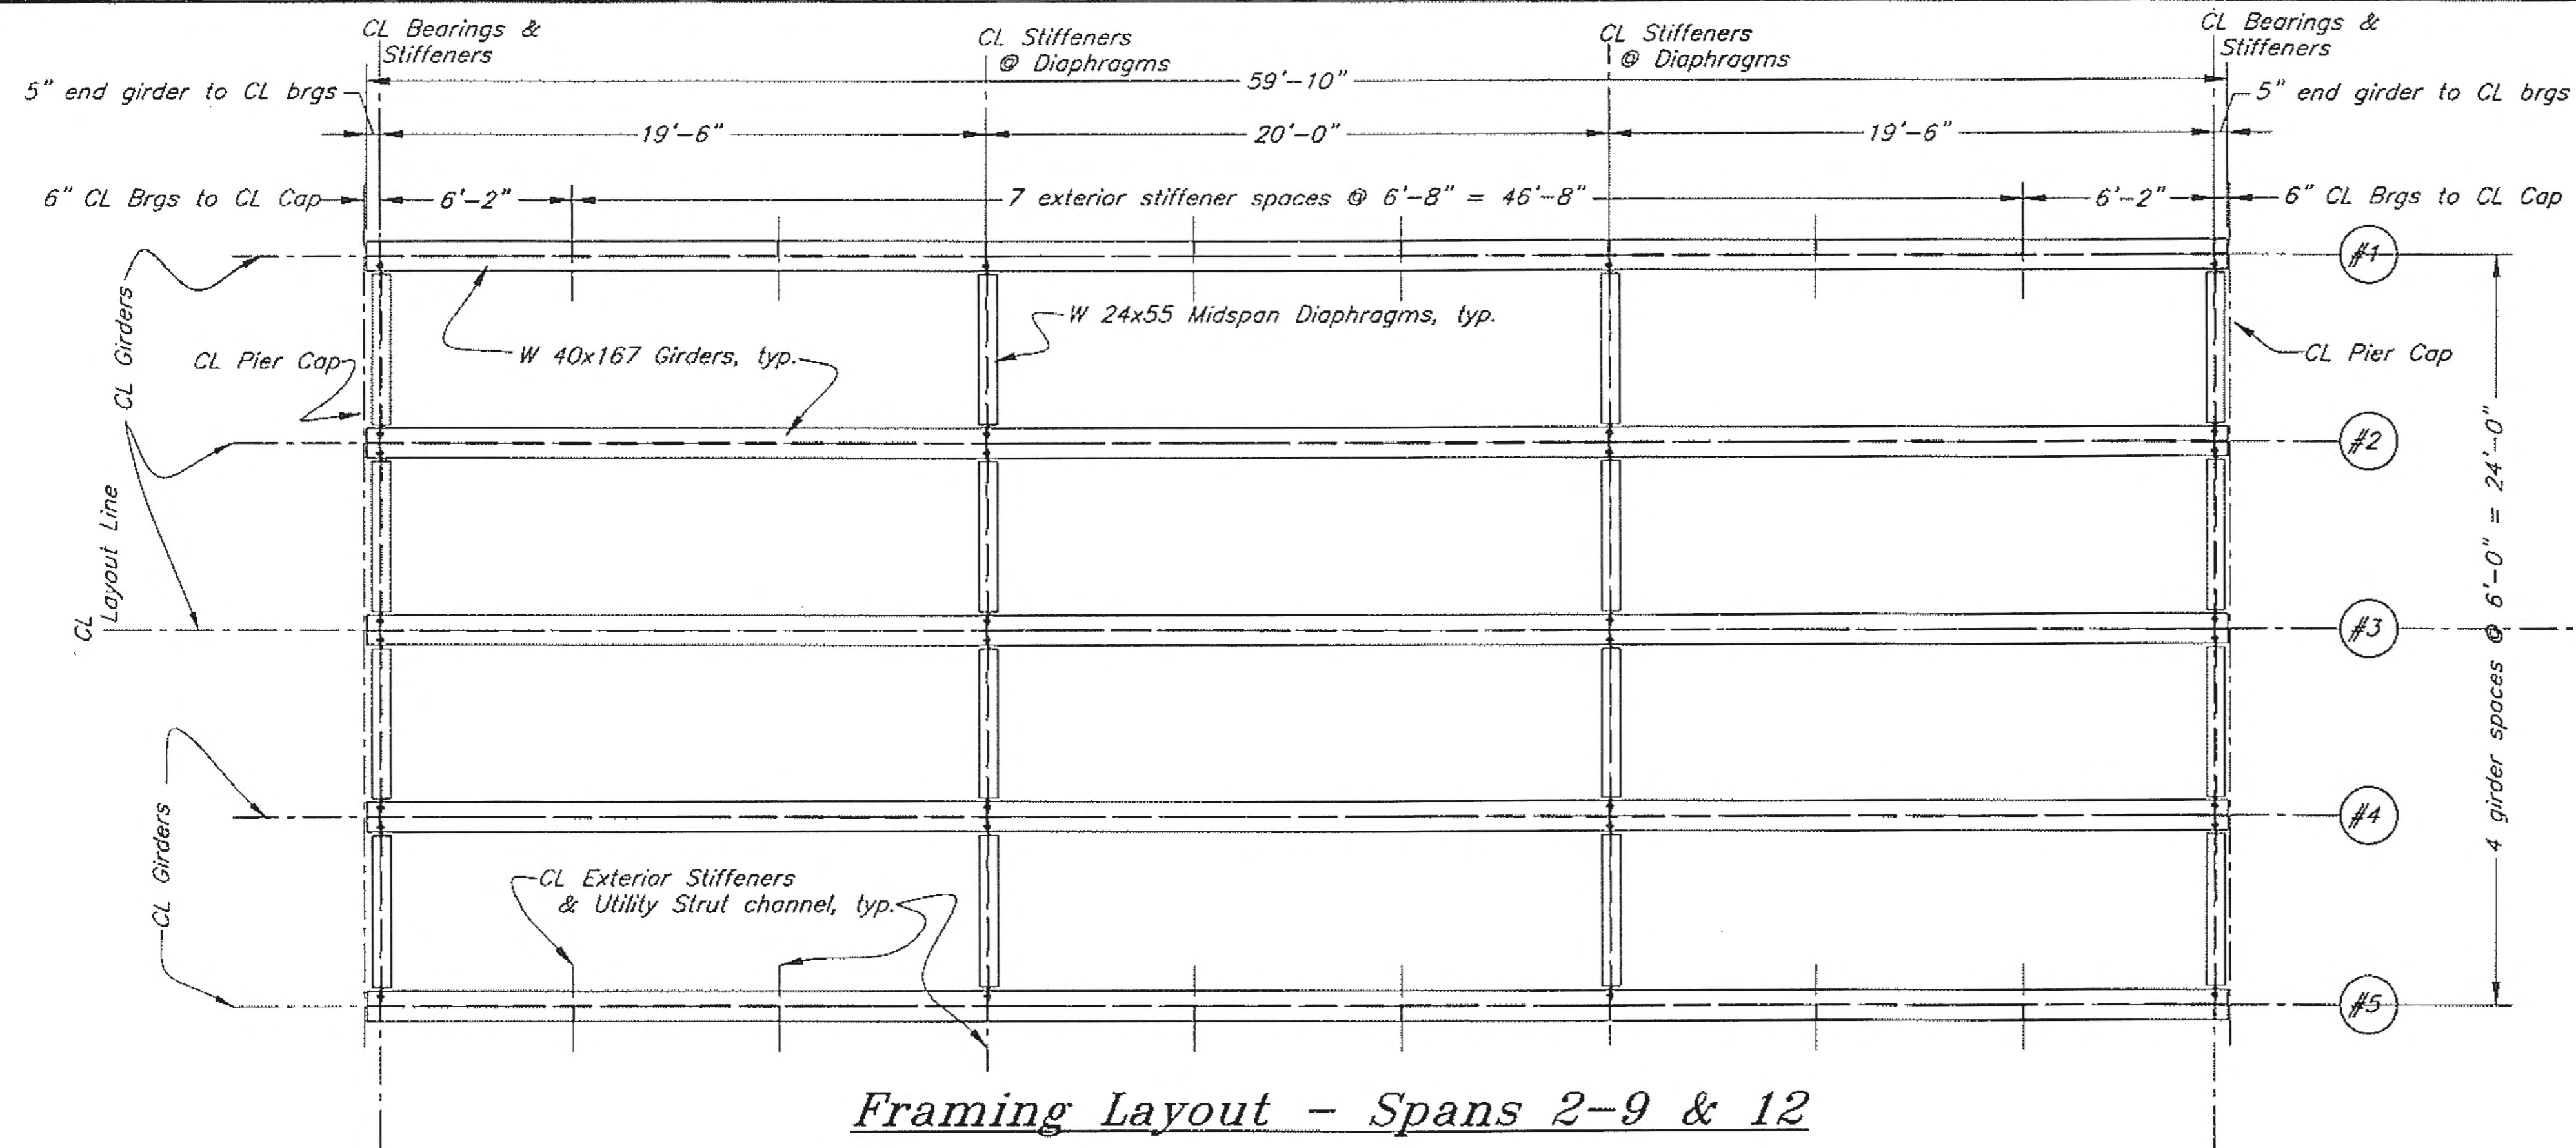


Framing Layout - Spans 2-9 & 12

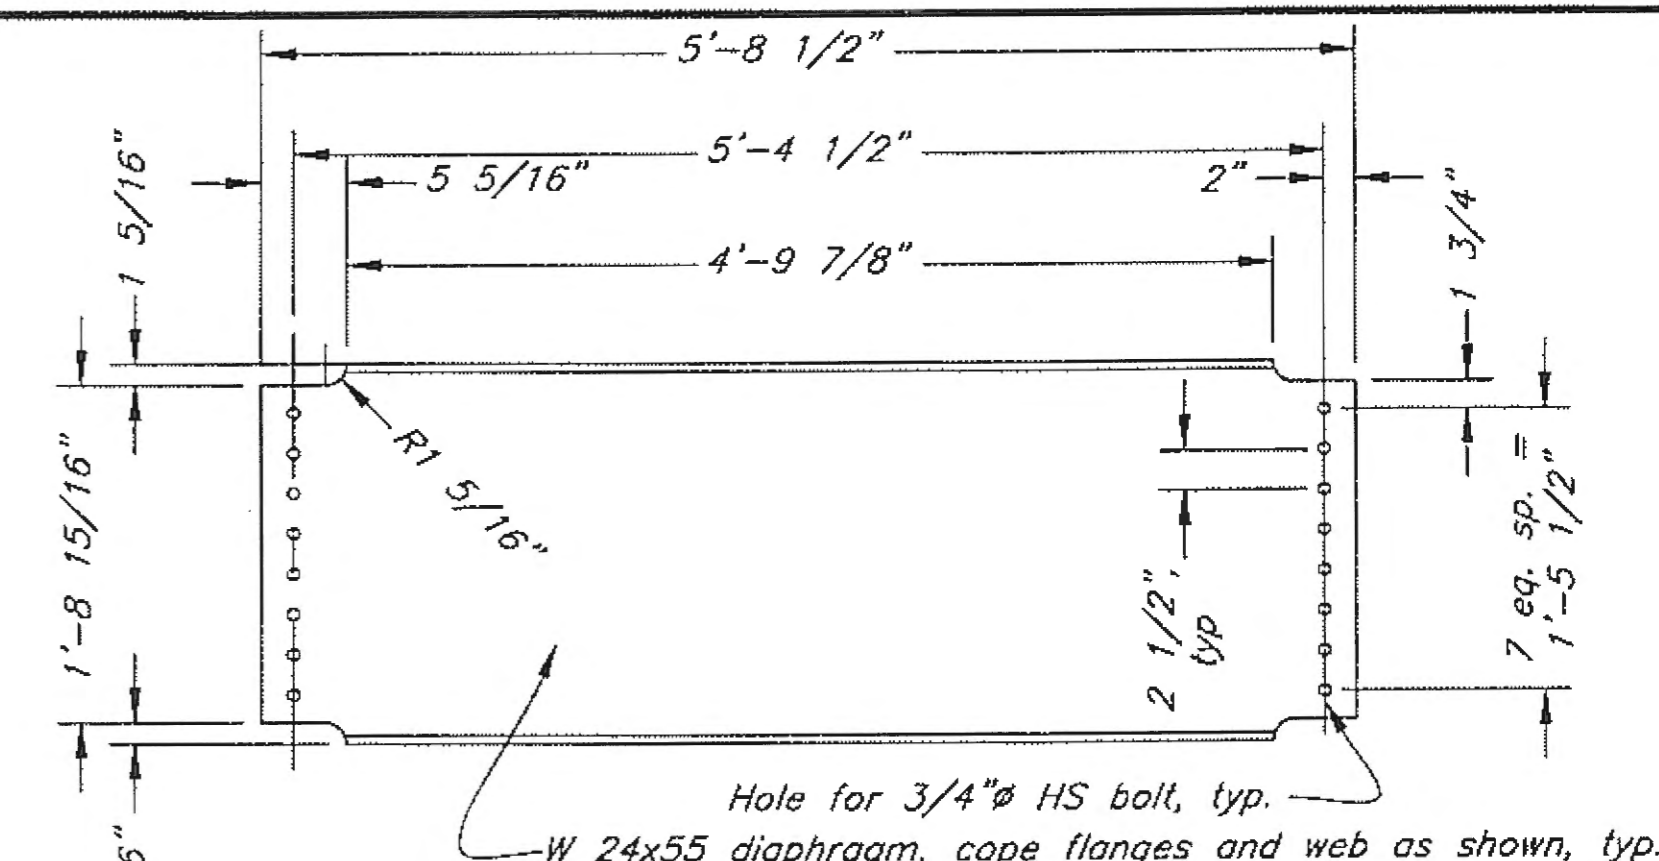


Elevation W 24x55 Diaphragm

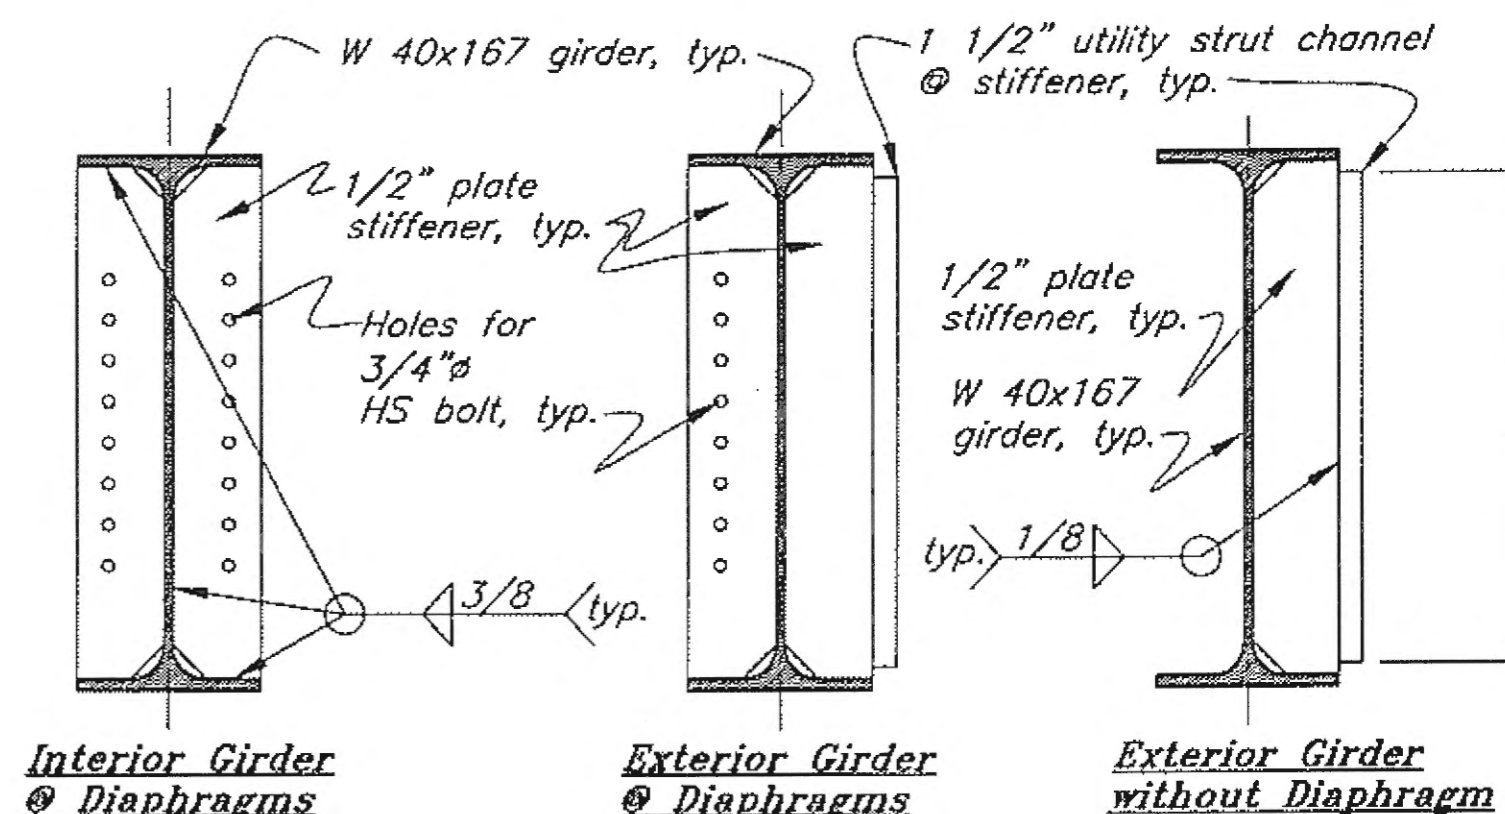


Section Views of W 40x167 Girders

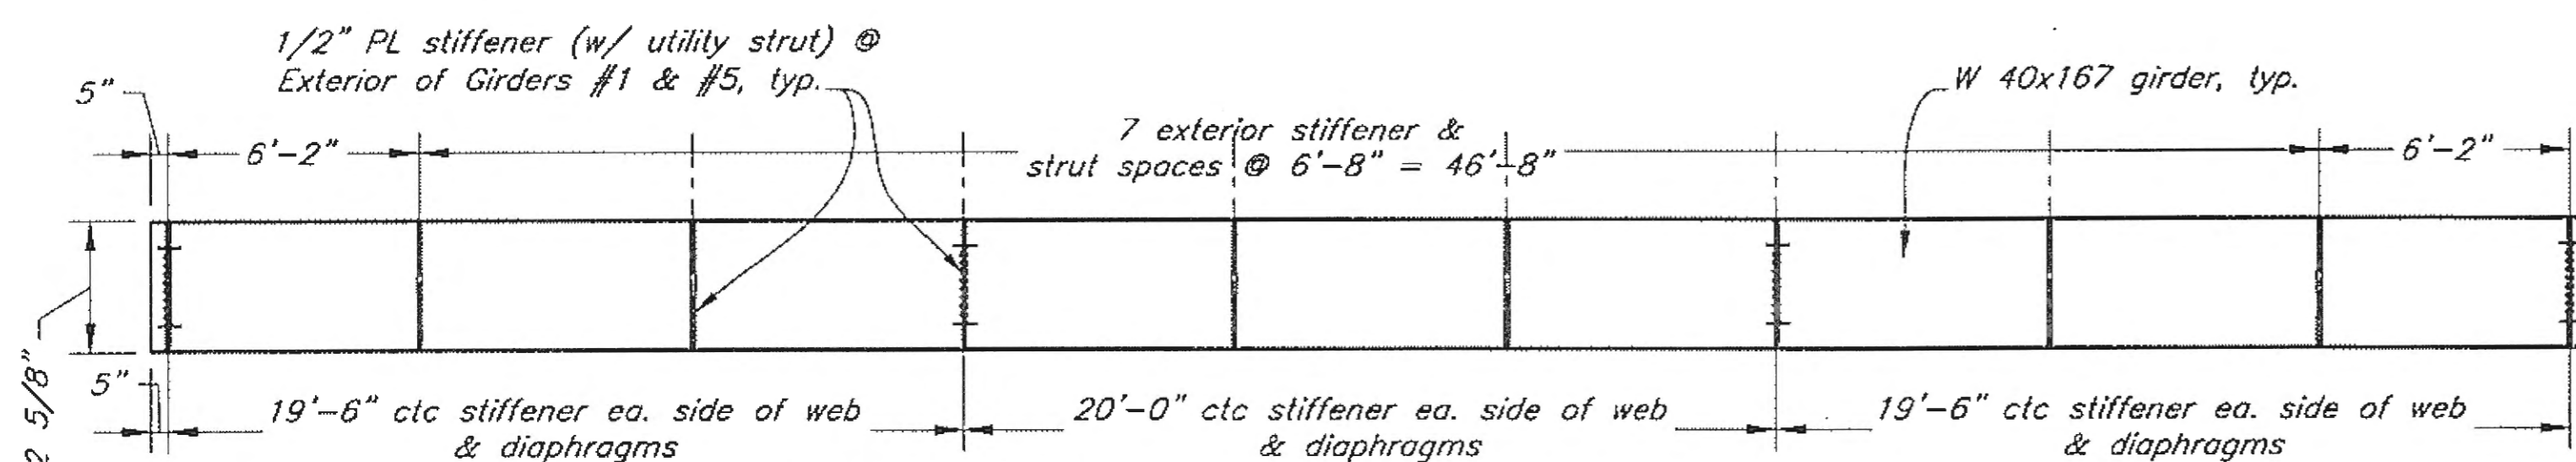


Elevation Girder #5, Spans 2-9 & 12 (Girder #1 opposite hand of Girder #5)

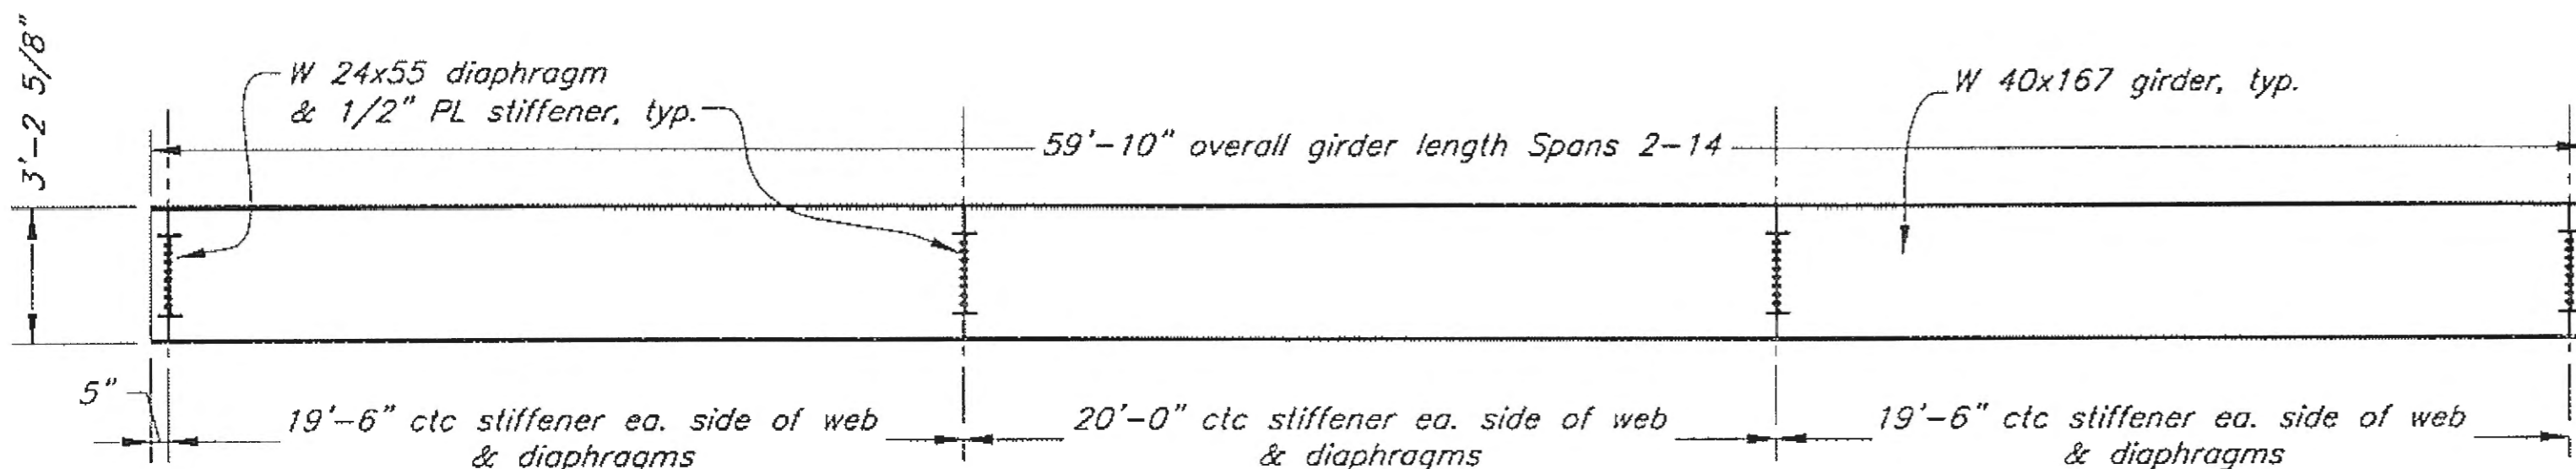

Elevation Girders #2 - #4, Spans 2-9 & 12 (Girder #1 opposite hand of Girder #5)

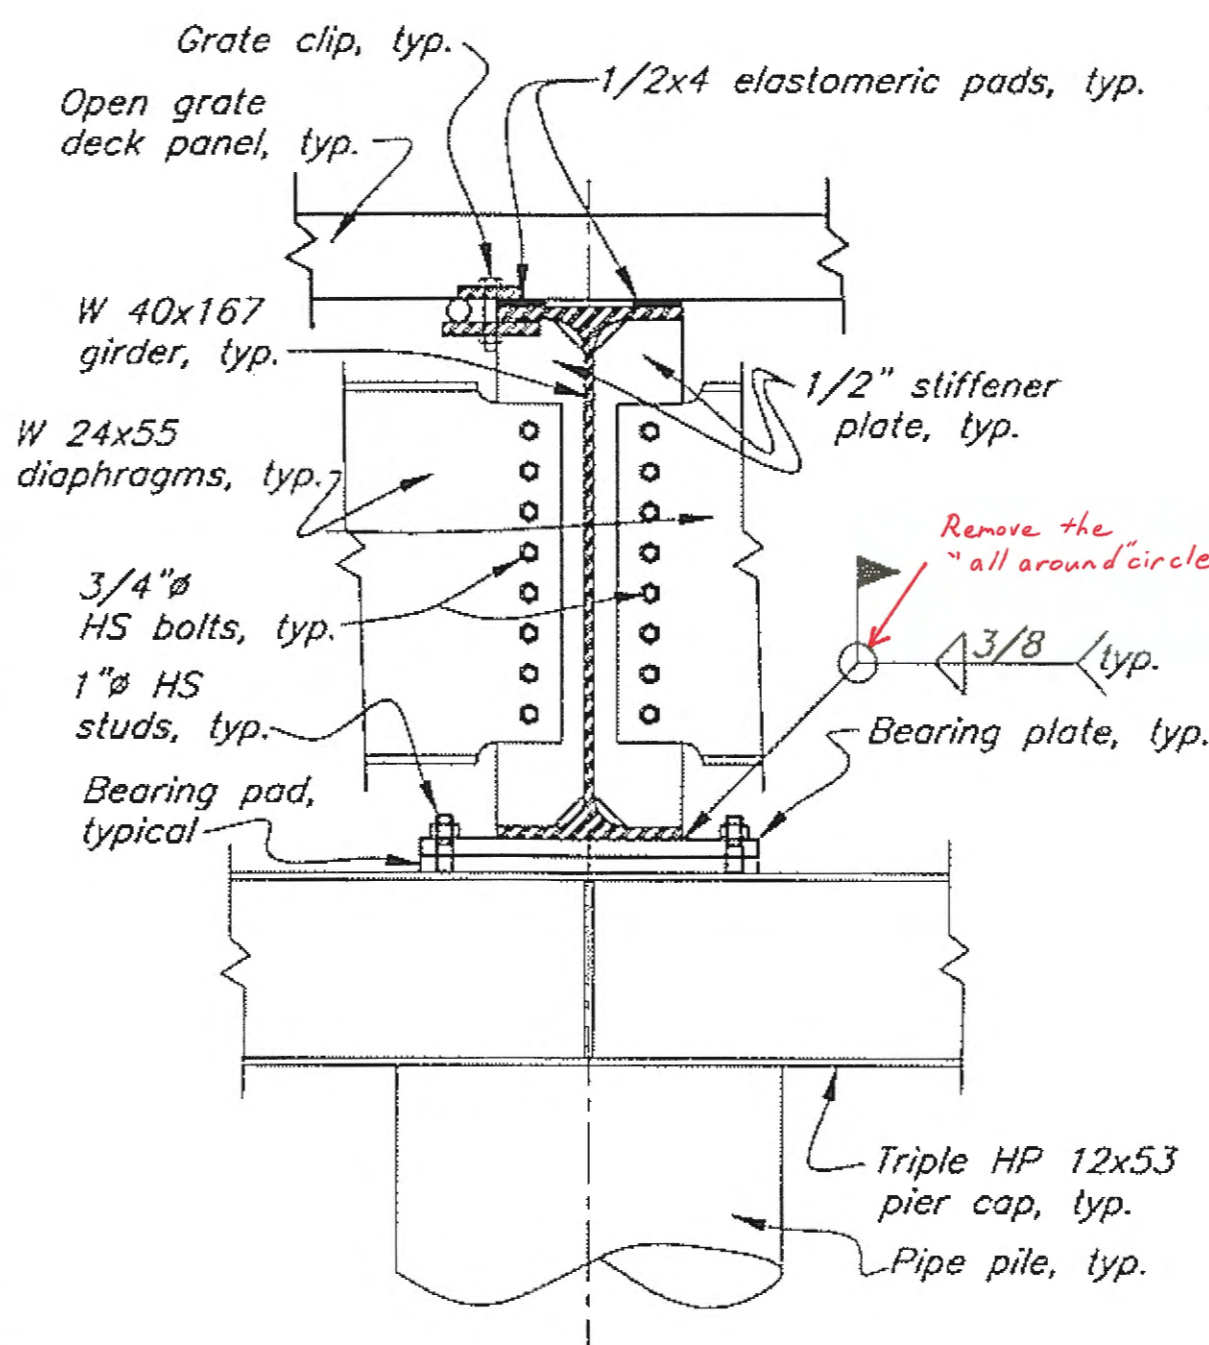

Section View @ Bearings of W 40x167 Girders

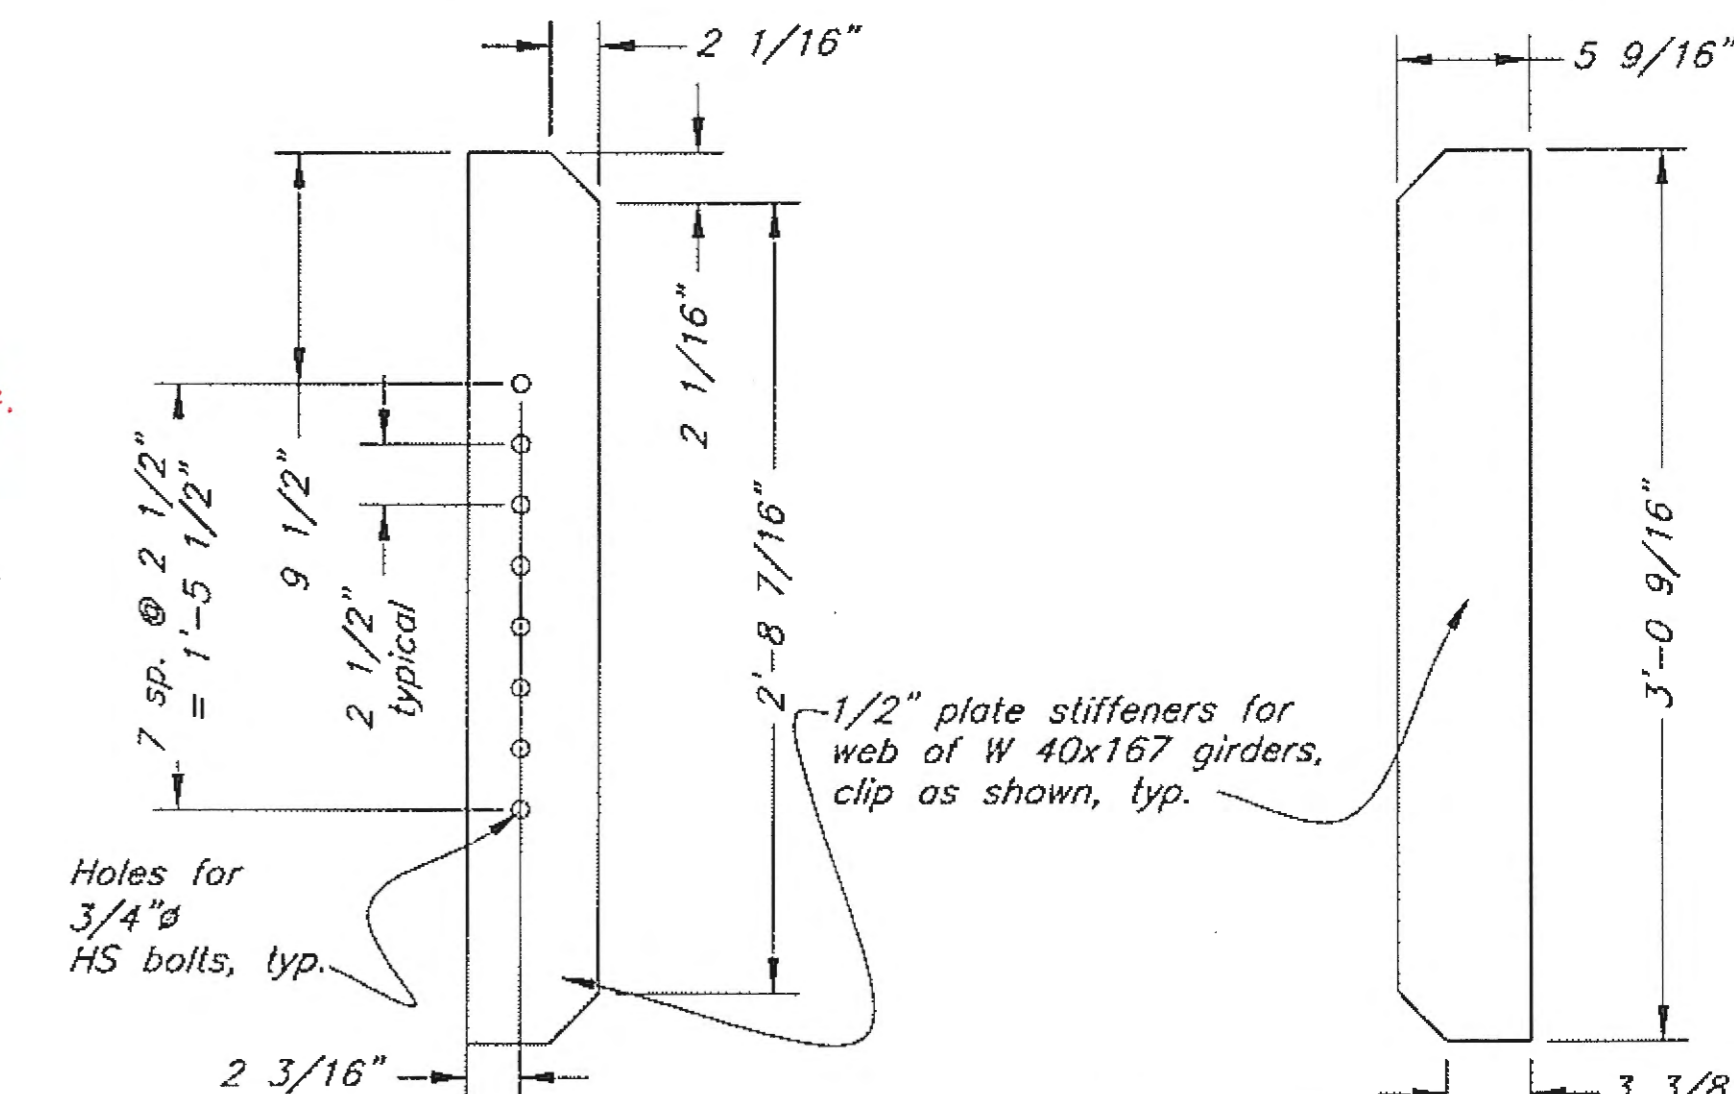

Stiffener Details

Record Drawings have been reviewed by the Project Engineer, and represent to the best of my knowledge, the project as constructed.
PE *[Signature]* Date 8/2/12

DO NOT SCALE FROM THESE DRAWINGS USE DIMENSIONS

DESIGNED BY: J. Scott

CHECKED BY: E. Savikko

DRAWN BY: C. Fuman, W. Hickok

PATH: Q:\CUS\67599\MF\PLANSET\03-APPROACH\AP15 APPROACH TYPICAL FRAMING.DWG

TAB: Wed, 26/Nov/08 02:13PM




STATE OF ALASKA
DEPARTMENT OF TRANSPORTATION & PUBLIC FACILITIES
DESIGN & ENGINEERING SERVICES DIVISION-SOUTHEAST REGION

Gustavus Causeway Replacement

AP15

AP15

BR-0003(53)/67599 2008 25 138

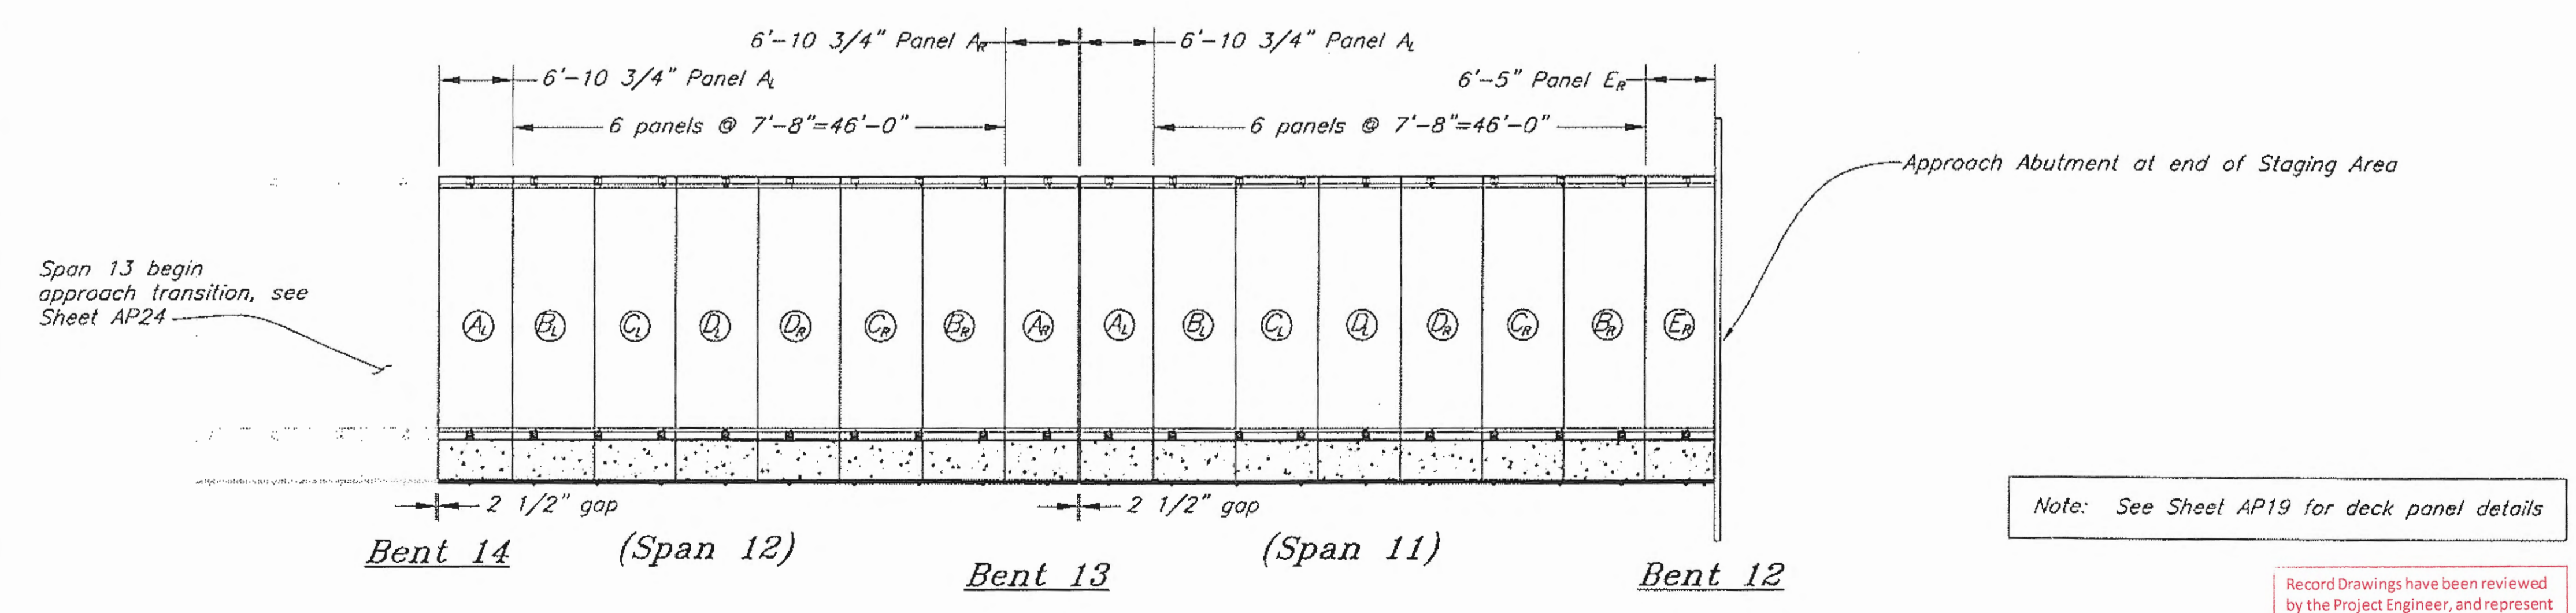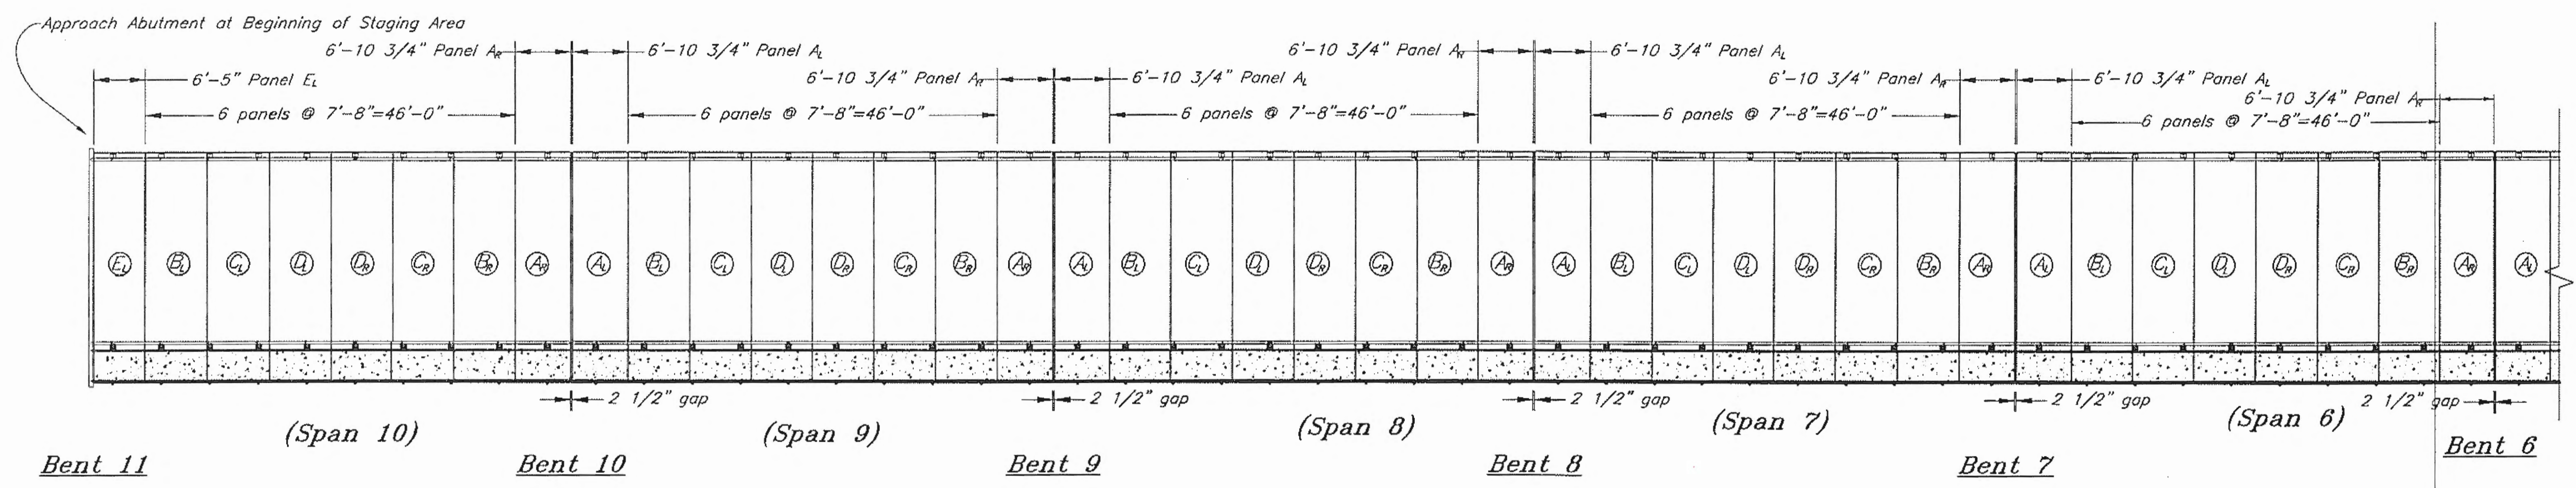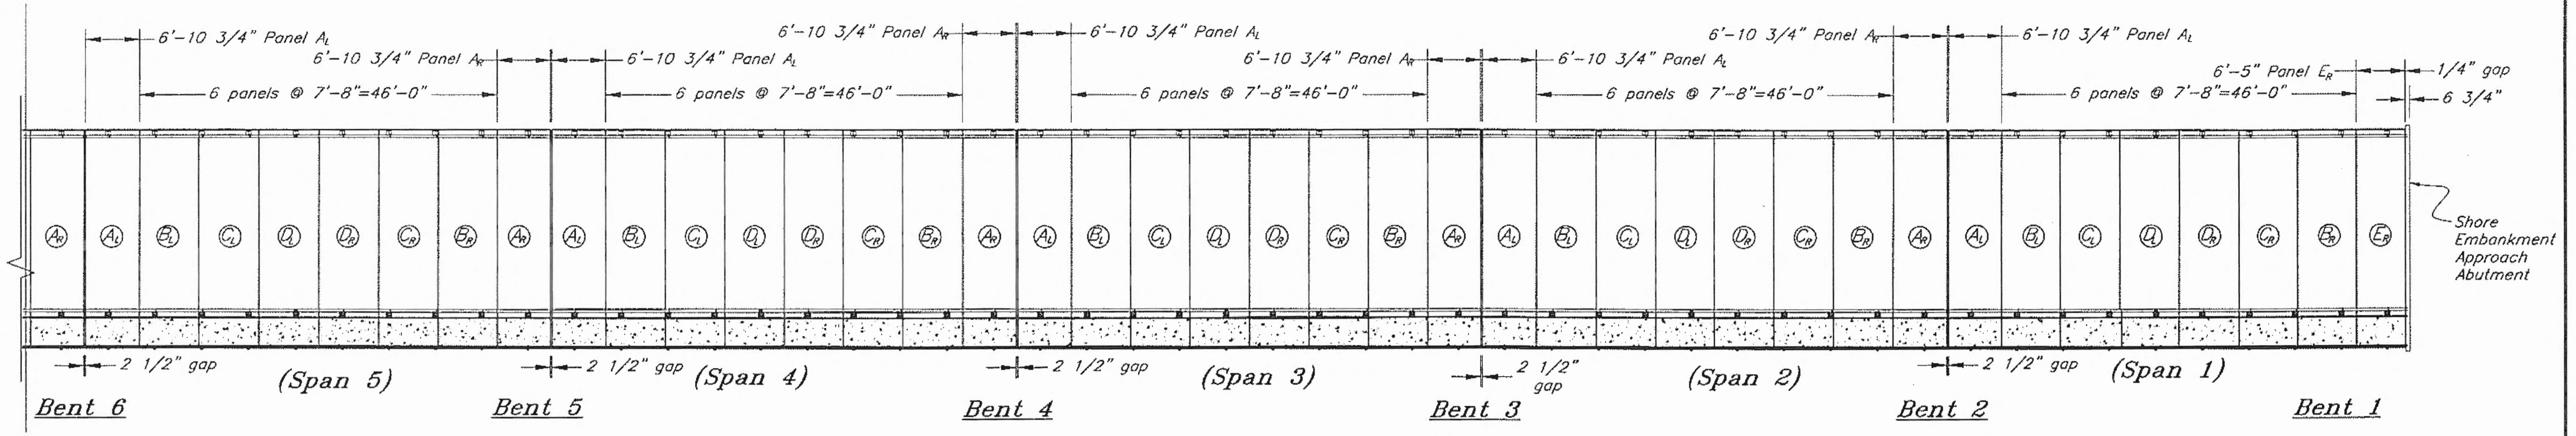

Note:
Grating panels are 5" nominal thickness, galvanized, open grate steel w/ main bearing bars 5.52#/ft @ 7 1/2" centers & 1/4" supplemental cross bars @ 3 3/4" centers & 1/4" @ 1" bent truss bars. Actual thickness = 5 3/16" Fy req'd = 50 ksi

Grate Manufacturers include but are not limited to:
Bailey Bridges, Interlocking Deck Systems Int'l & LB Foster

DO NOT SCALE FROM THESE DRAWINGS USE DIMENSIONS

DESIGNED BY: J. Scott
STATE OF ALASKA
DEPARTMENT OF TRANSPORTATION & PUBLIC FACILITIES
DESIGN & ENGINEERING SERVICES DIVISION-SOUTHEAST REGION
Gustavus Causeway Replacement
Approach Deck Panel Layout
AP16

CHECKED BY: B. Savikko
DRAWN BY: C. Tuman, W. Hickok
John I. Scott
CE-4755
11-26-08


PATH: O:\GUS\67599\MF\PLANSET\03-APPROACH\AP16 APPROACH DECK PANEL LAYOUT DWG
TAB: Tue, 25/Nov/08 08:13PM
JISCOTT

NO.	DATE	REVISIONS DESCRIPTION	PROJECT DESIGNATION	YEAR	SHEET NO.	TOTAL SHEETS
			BR-0003(53)/67599	2008	26	138

Note: See Sheet AP19 for deck panel details

Record Drawings have been reviewed by the Project Engineer, and represent to the best of my knowledge, the project as constructed.
Date 8/4/12

Span 13 begin approach transition, see Sheet AP24

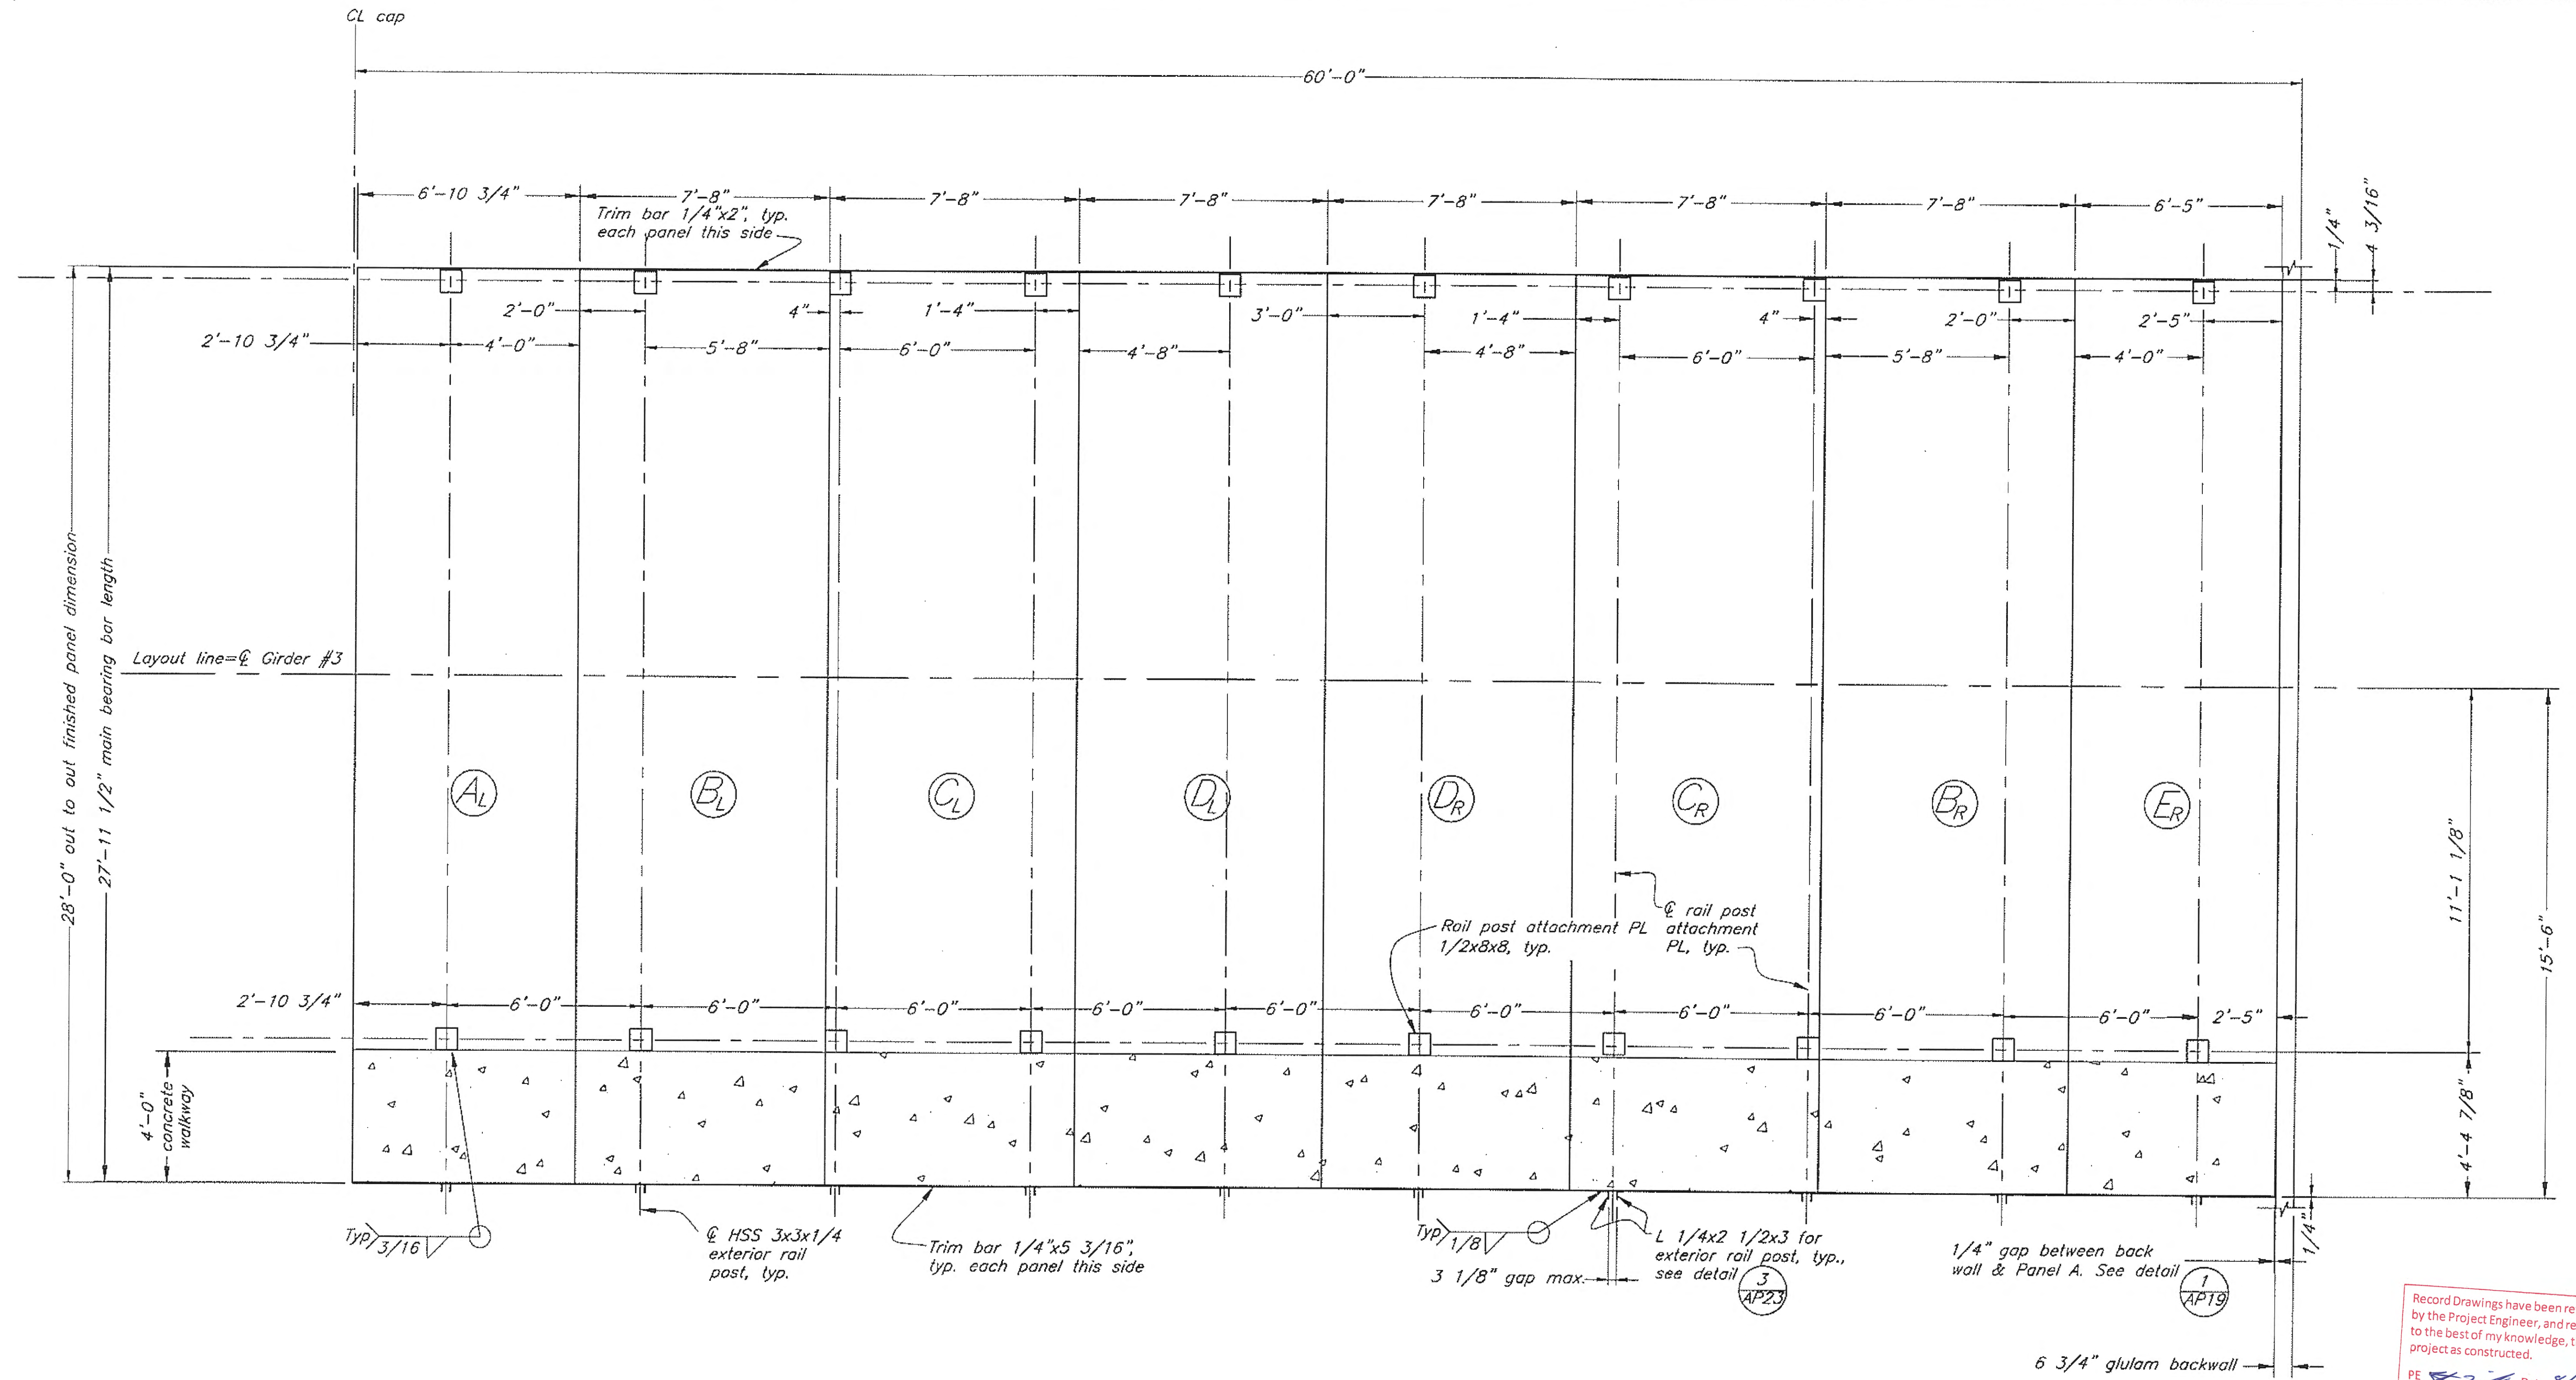

Note: See Panel Layout Sheet AP16 for Span 10 panel callout

Deck Panel A, B, C, D & E
Span 1 & 11 (shown)
Span 10 - mirror image

DO NOT SCALE FROM THESE DRAWINGS USE DIMENSIONS


DESIGNED BY: J. Scott

CHECKED BY: B. Savikko
 DRAWN BY: C. Fuman, W. Hickok

STATE OF ALASKA
 DEPARTMENT OF TRANSPORTATION
 & PUBLIC FACILITIES
 DESIGN & ENGINEERING SERVICES DIVISION-SOUTHEAST REGION

Gustavus Causeway Replacement
Spans 1, 10 & 11
Approach Deck
Panels
 AP17

REVISIONS			PROJECT DESIGNATION	YEAR	SHEET NO.	TOTAL SHEETS
NO.	DATE	DESCRIPTION				
			BR-0003(53)/67599	2008	27	138

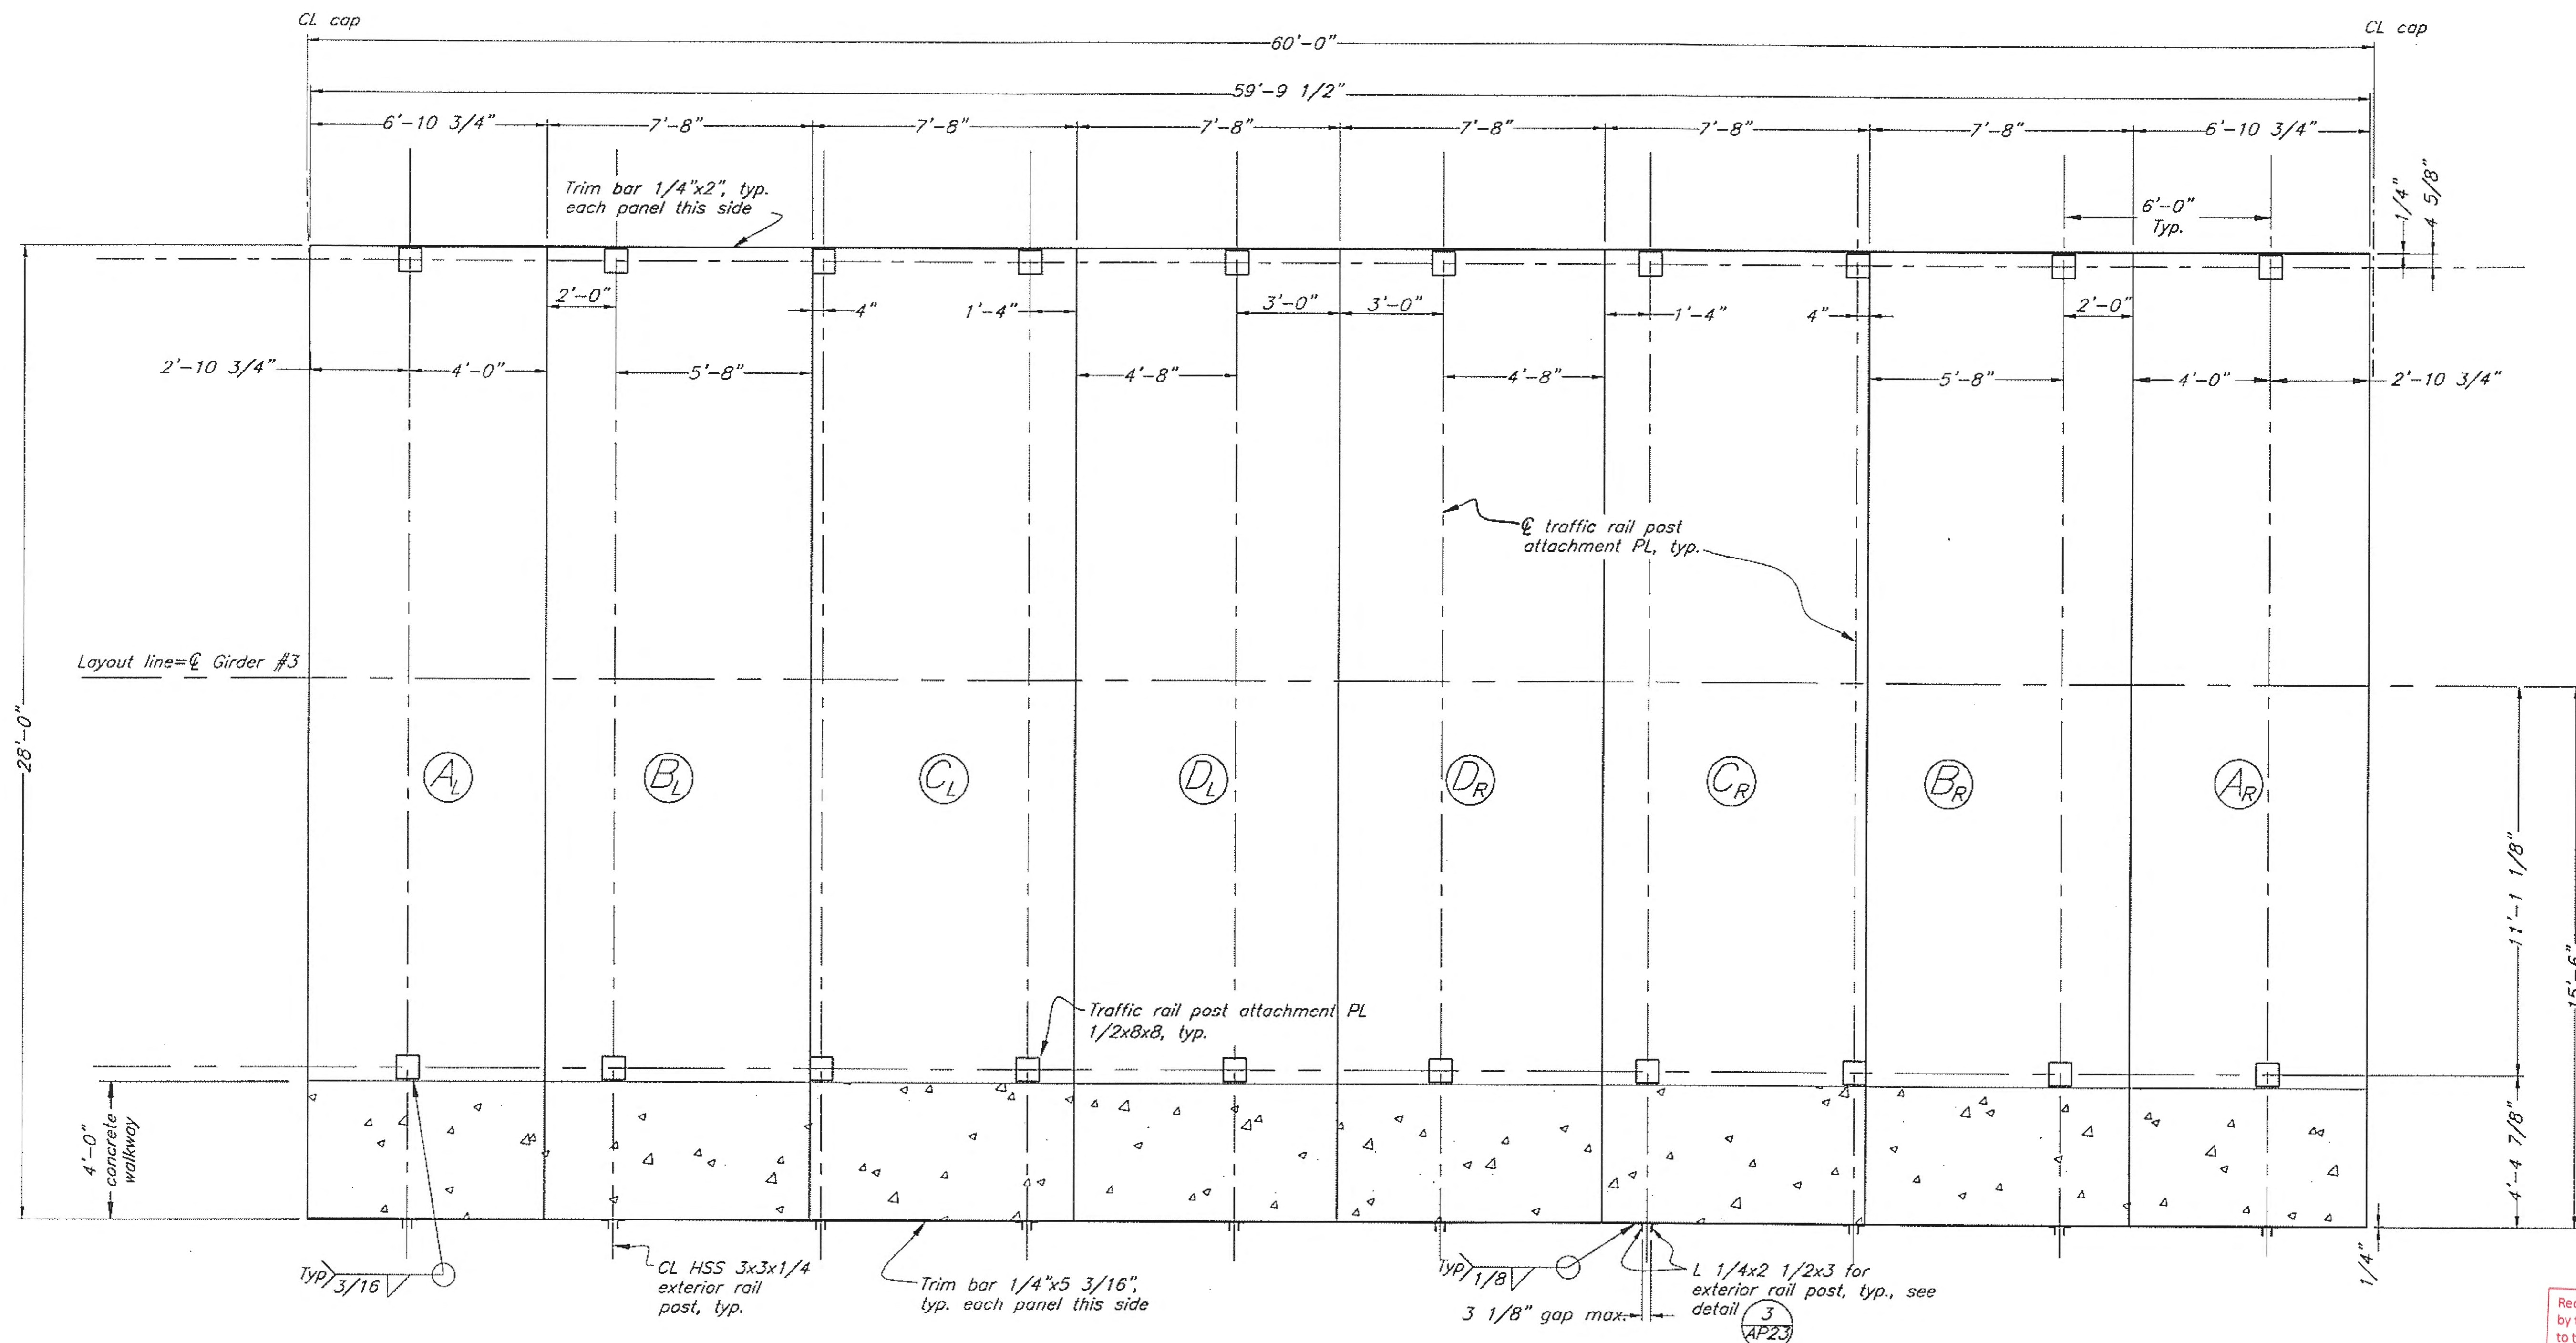


Record Drawings have been reviewed by the Project Engineer, and represent to the best of my knowledge, the project as constructed.
 PE *[Signature]* Date 8/2/12


Deck Panels A, B, C, & D
Spans 2-9 & 12

DO NOT SCALE FROM THESE DRAWINGS USE DIMENSIONS



DESIGNED BY: J. Scott	STATE OF ALASKA DEPARTMENT OF TRANSPORTATION & PUBLIC FACILITIES DESIGN & ENGINEERING SERVICES DIVISION-SOUTHEAST REGION			
	Gustavus Causeway Replacement			
	Spans 2-9 & 12 Approach Deck Panels			
CHECKED BY: B. Savikko	AP18			
DRAWN BY: C. Fuman, W. Hickok	PROJECT DESIGNATION			
PATH: Q:\GUS\67599\MF\PLANSET\03-APPROACH\AP18 APPROACH DECK PANELS SPAN 2-9 & 12		YEAR	SHEET NO.	TOTAL SHEETS
TAB: Tue, 25/Nov/08 08:15PM		2008	28	138
REVISIONS		PROJECT DESIGNATION		
NO.	DATE	DESCRIPTION	BR-0003(53)/67599	

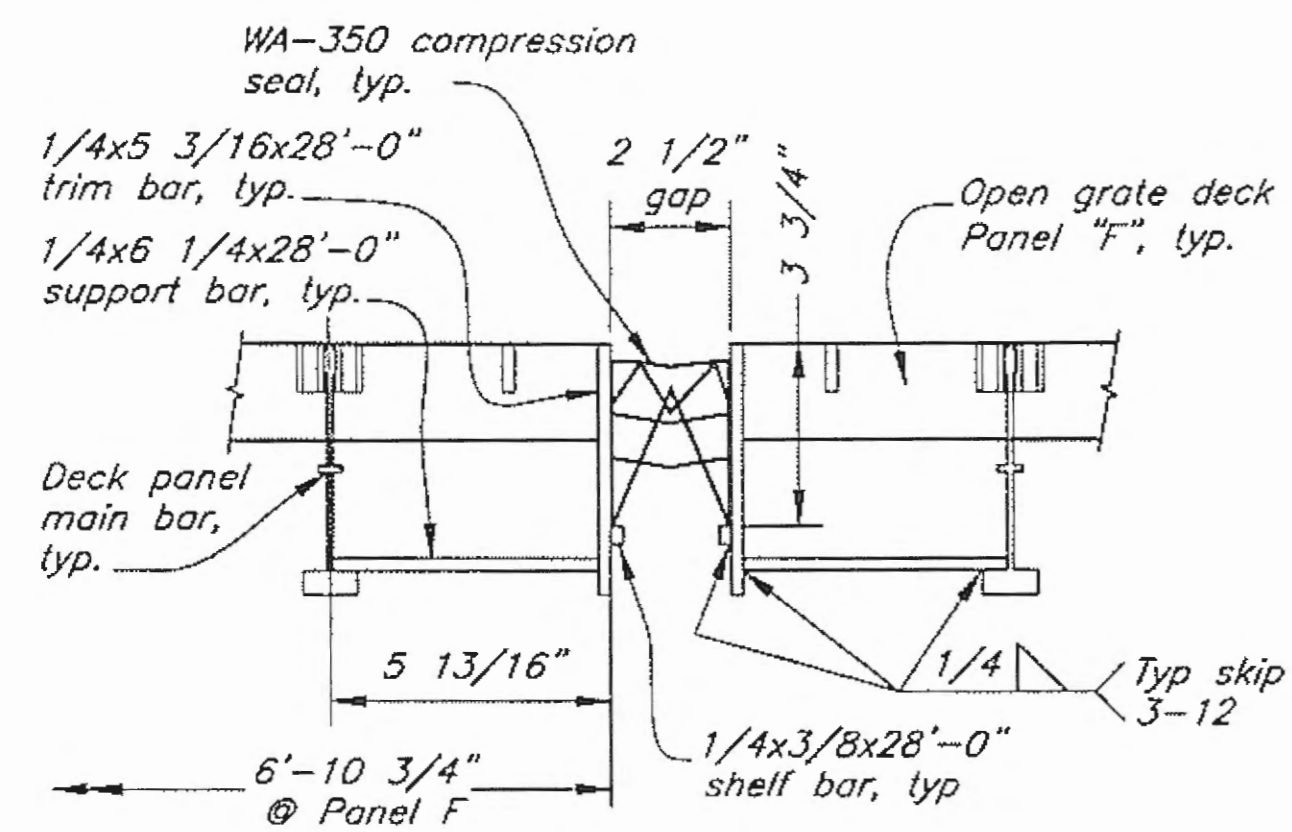


Panel Gap Detail @ Bents

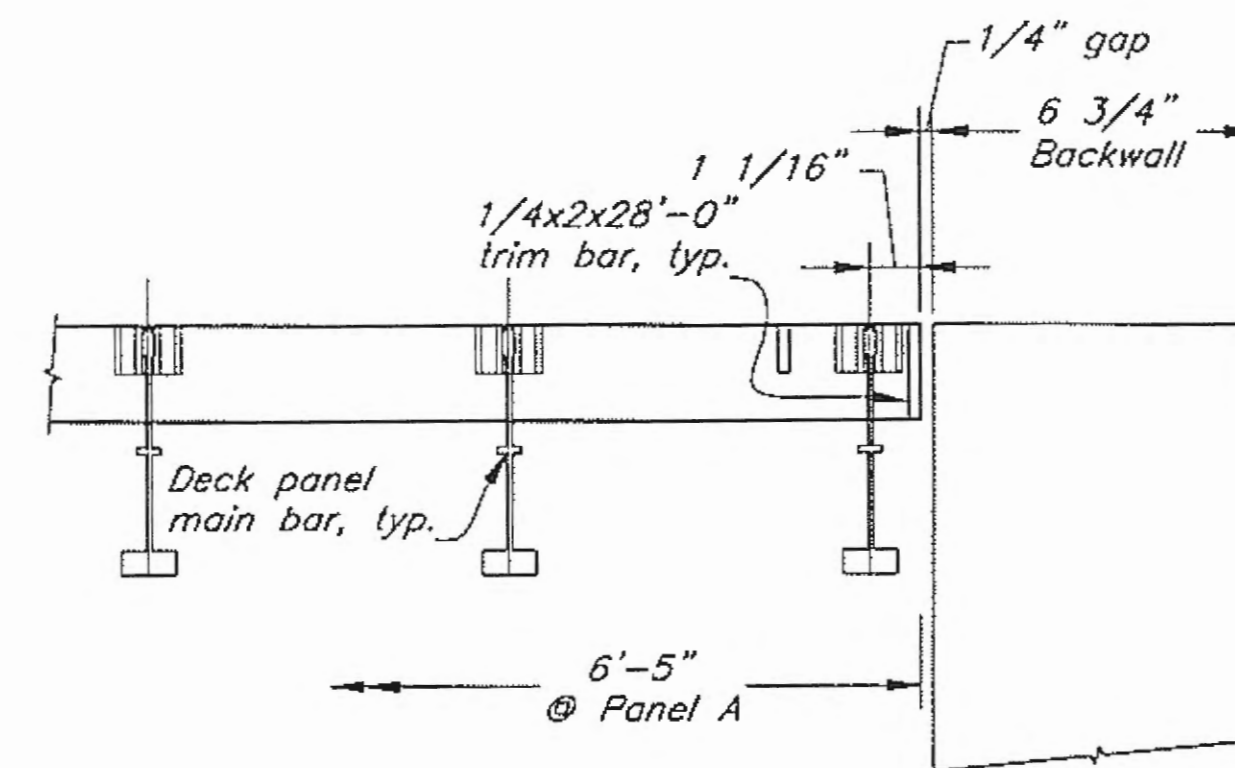


Panel Gap Detail @ Abutment 1
AP17

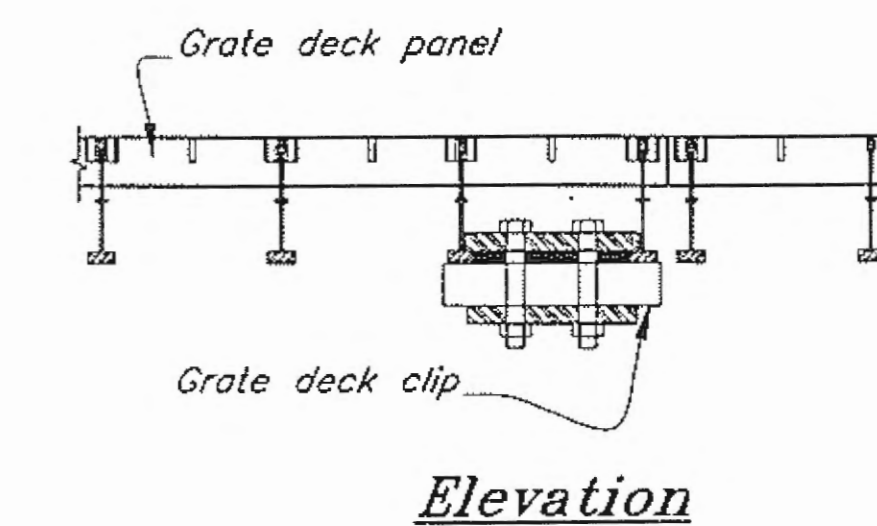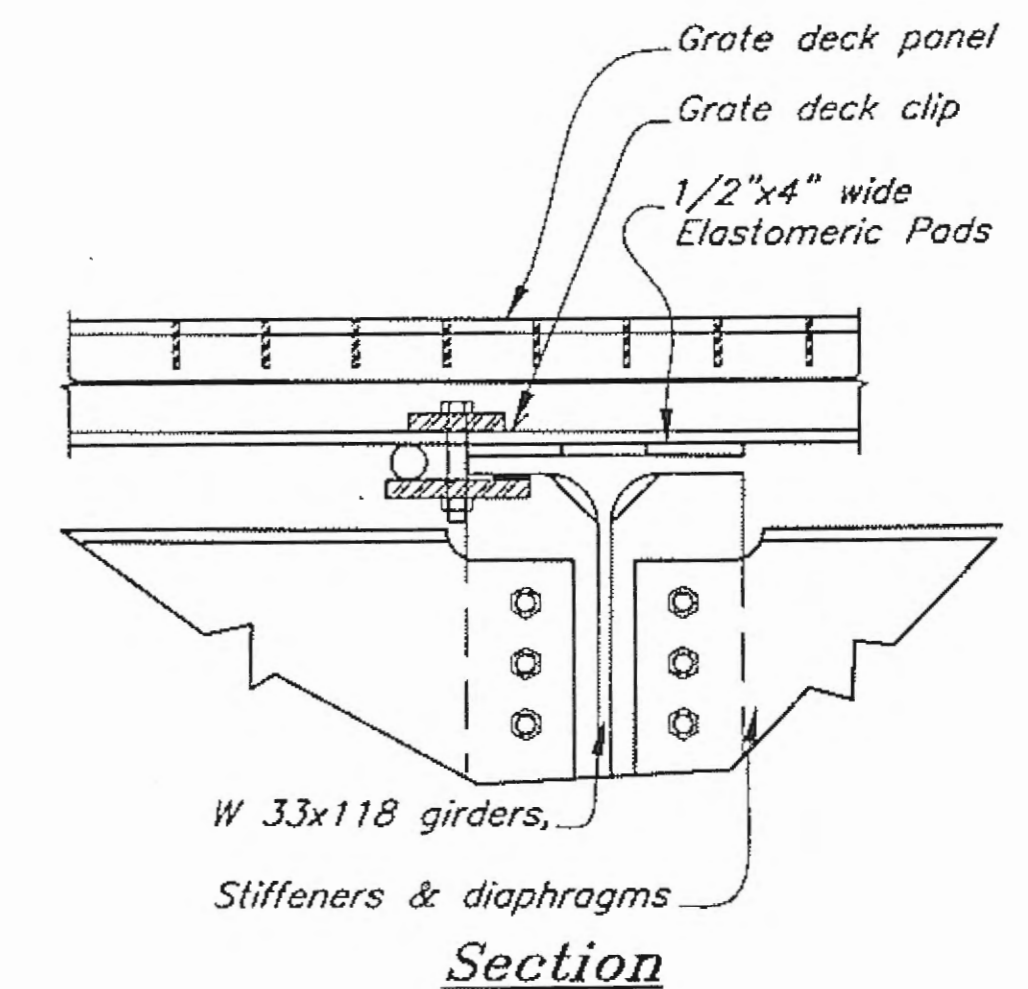


Approach & Transition Deck Clip Assemblies

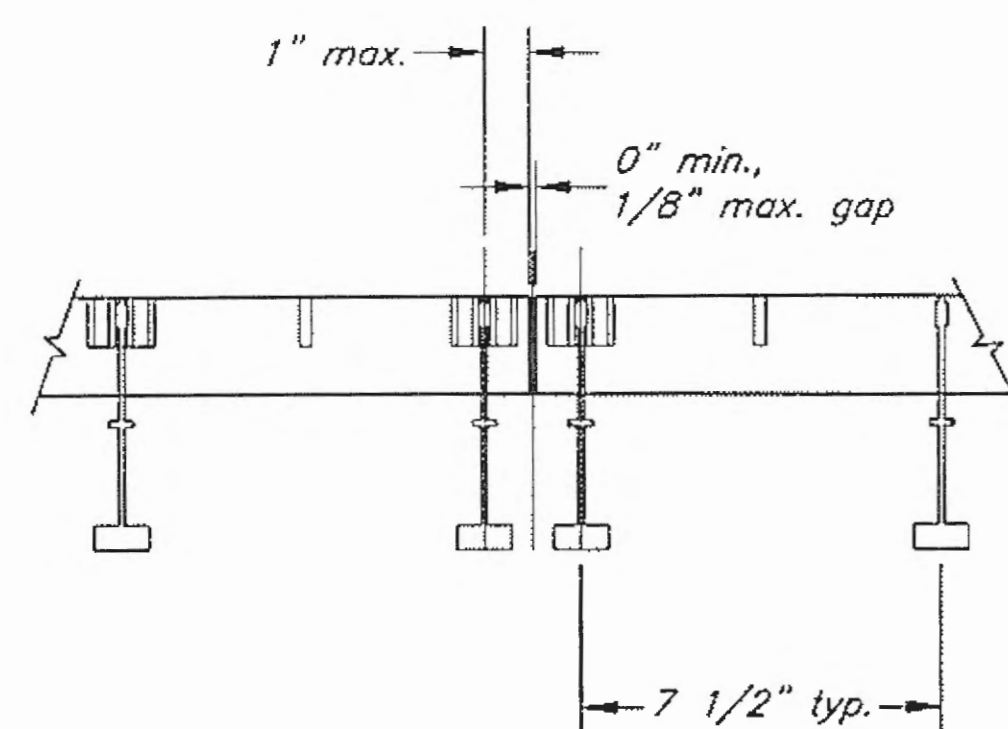

Typical Grating Joint

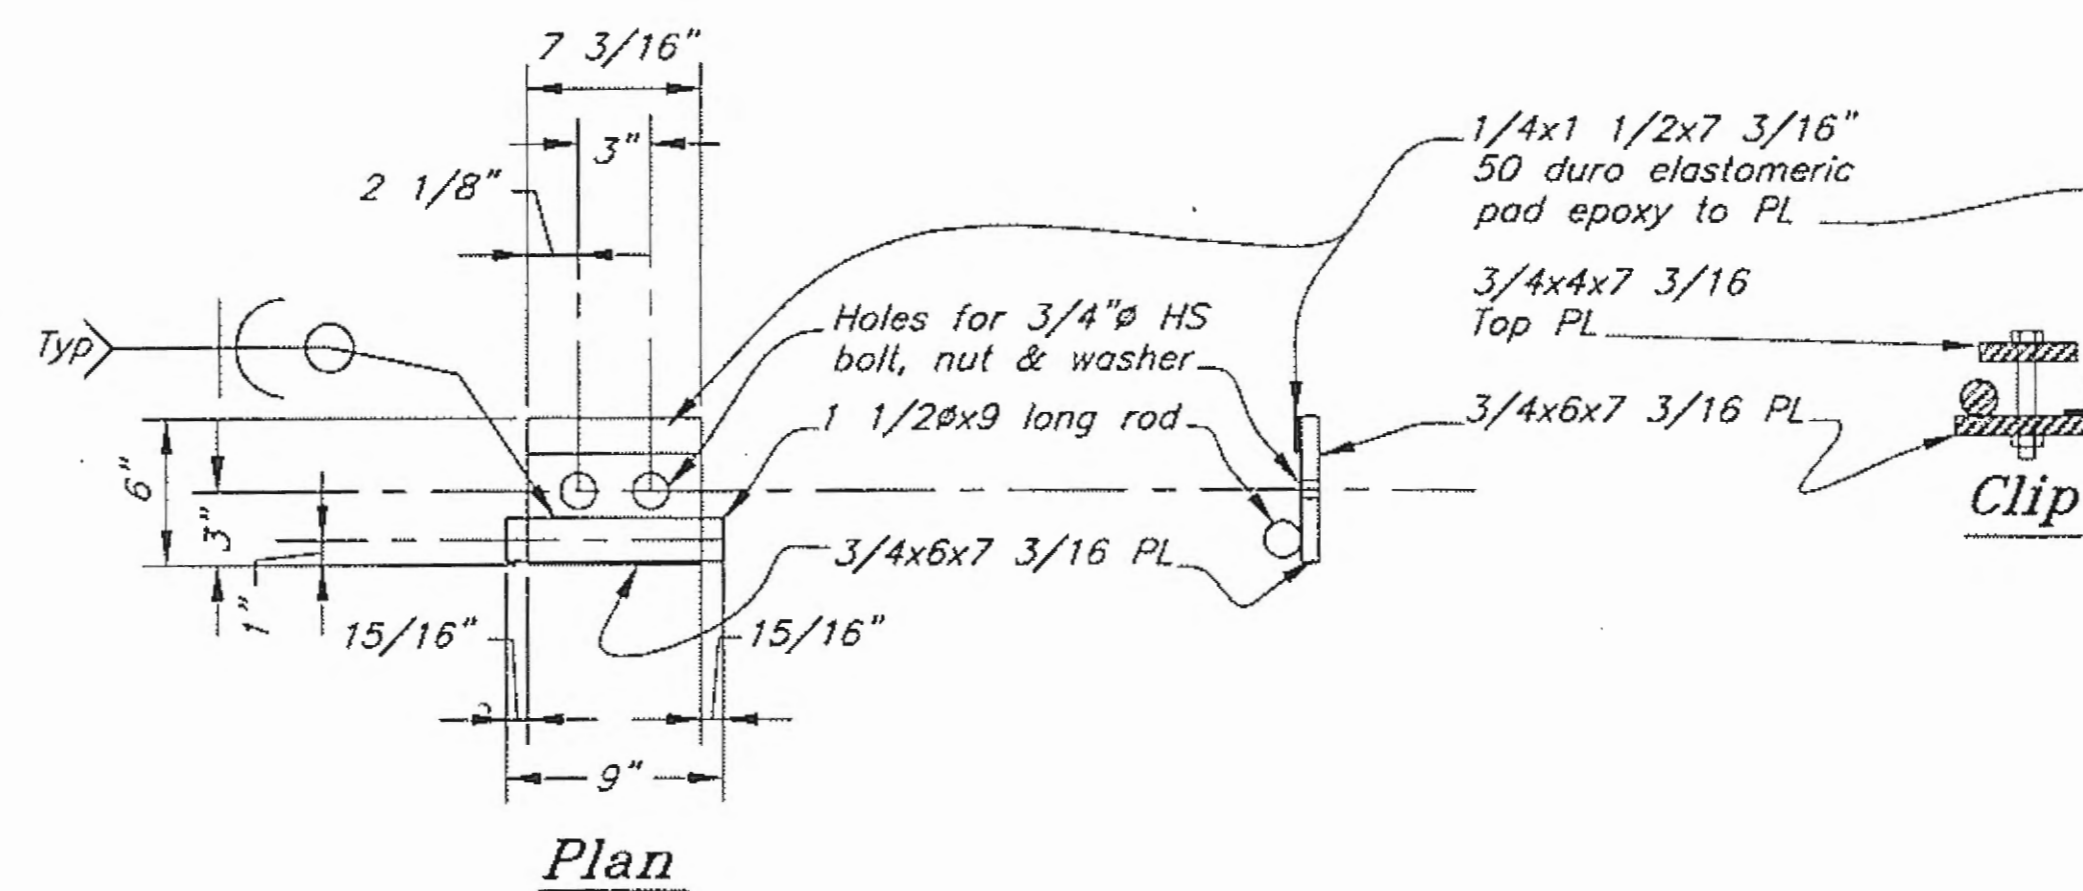


Plan

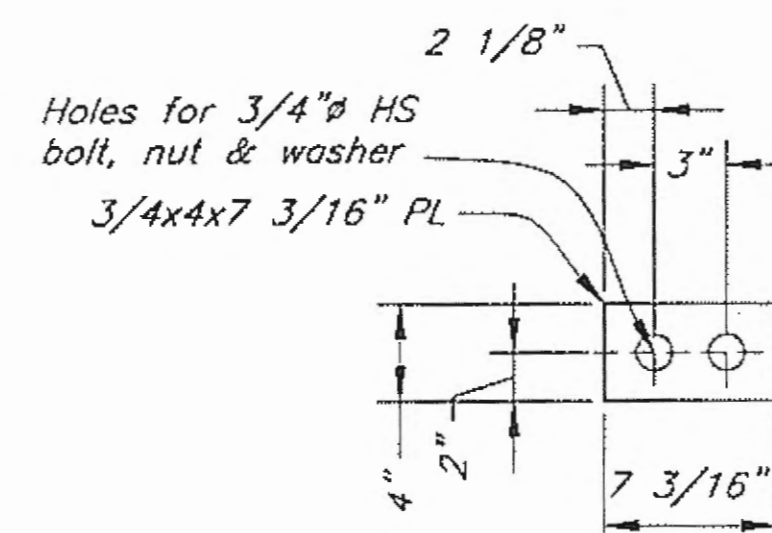

Top Plate

Clip Assembly for Grate Decking

(2 clip sets per Girder per Panel)

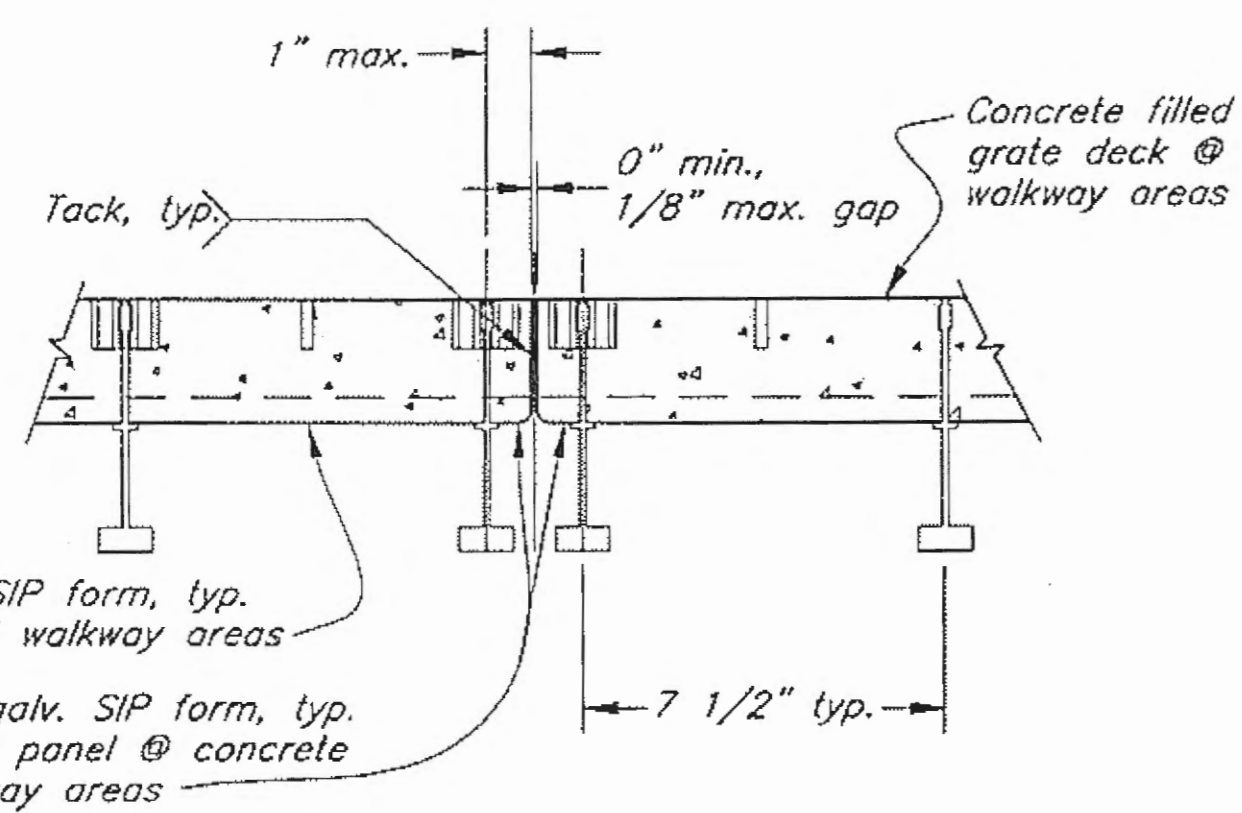

20 gauge galv. SIP form, typ. at concrete filled walkway areas


12 gauge galv. SIP form, typ. at edge of panel @ concrete filled walkway areas

Grating Joint @ Concrete Walkway


Record Drawings have been reviewed by the Project Engineer, and represent to the best of my knowledge, the project as constructed.
 PE *[Signature]* Date 8/1/12

DO NOT SCALE FROM THESE DRAWINGS USE DIMENSIONS


DESIGNED BY: J. Scott	STATE OF ALASKA DEPARTMENT OF TRANSPORTATION & PUBLIC FACILITIES DESIGN & ENGINEERING SERVICES DIVISION-SOUTHEAST REGION														
	Gustavus Causeway Replacement														
	Approach Deck Panel Details														
CHECKED BY: B. Savikko	AP19														
DRAWN BY: C. Furman, W. Hickok	BR-0003(53)/67599														
PATH: O:\GUS\67599\MF\PLANSET\03-APPROACH\AP19 APPROACH DECK PANEL DETAILS.DWG	YEAR	SHEET NO.	TOTAL SHEETS												
TAB Wed, 26/Nov/08 02:22PM	2008	29	138												
<table border="1"> <thead> <tr> <th colspan="4">REVISIONS</th> </tr> <tr> <th>NO.</th> <th>DATE</th> <th>DESCRIPTION</th> <th></th> </tr> </thead> <tbody> <tr> <td> </td> <td> </td> <td> </td> <td> </td> </tr> </tbody> </table>				REVISIONS				NO.	DATE	DESCRIPTION					
REVISIONS															
NO.	DATE	DESCRIPTION													

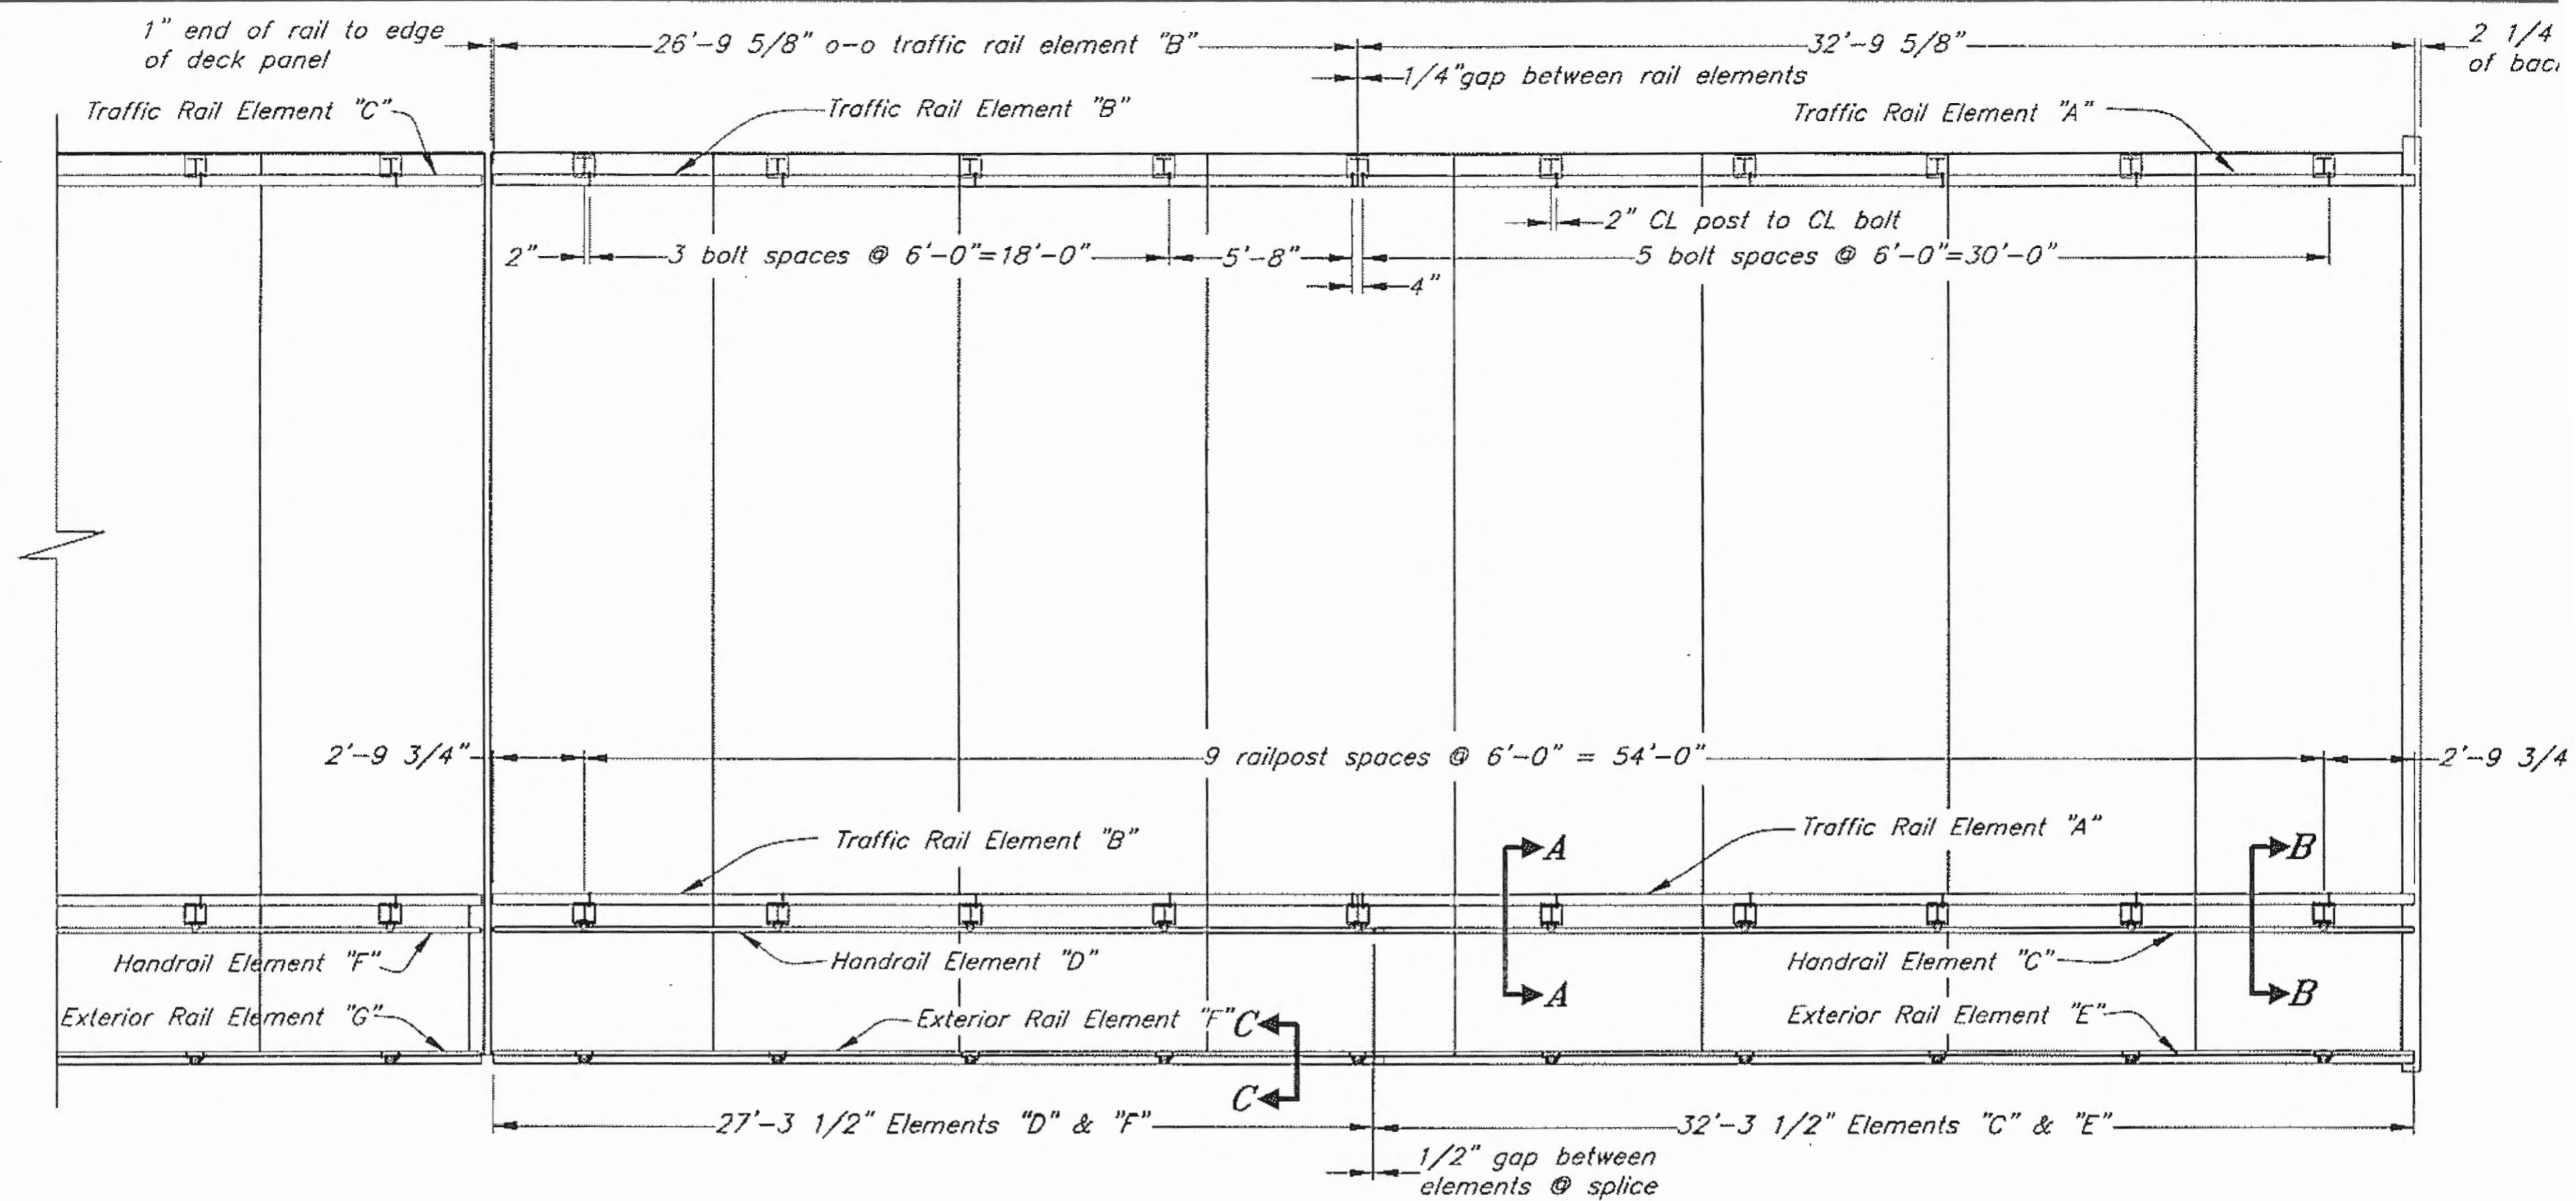


*Approach Rails - Span 1 & 11
Span 10 (mirror image @ CL Pier)*

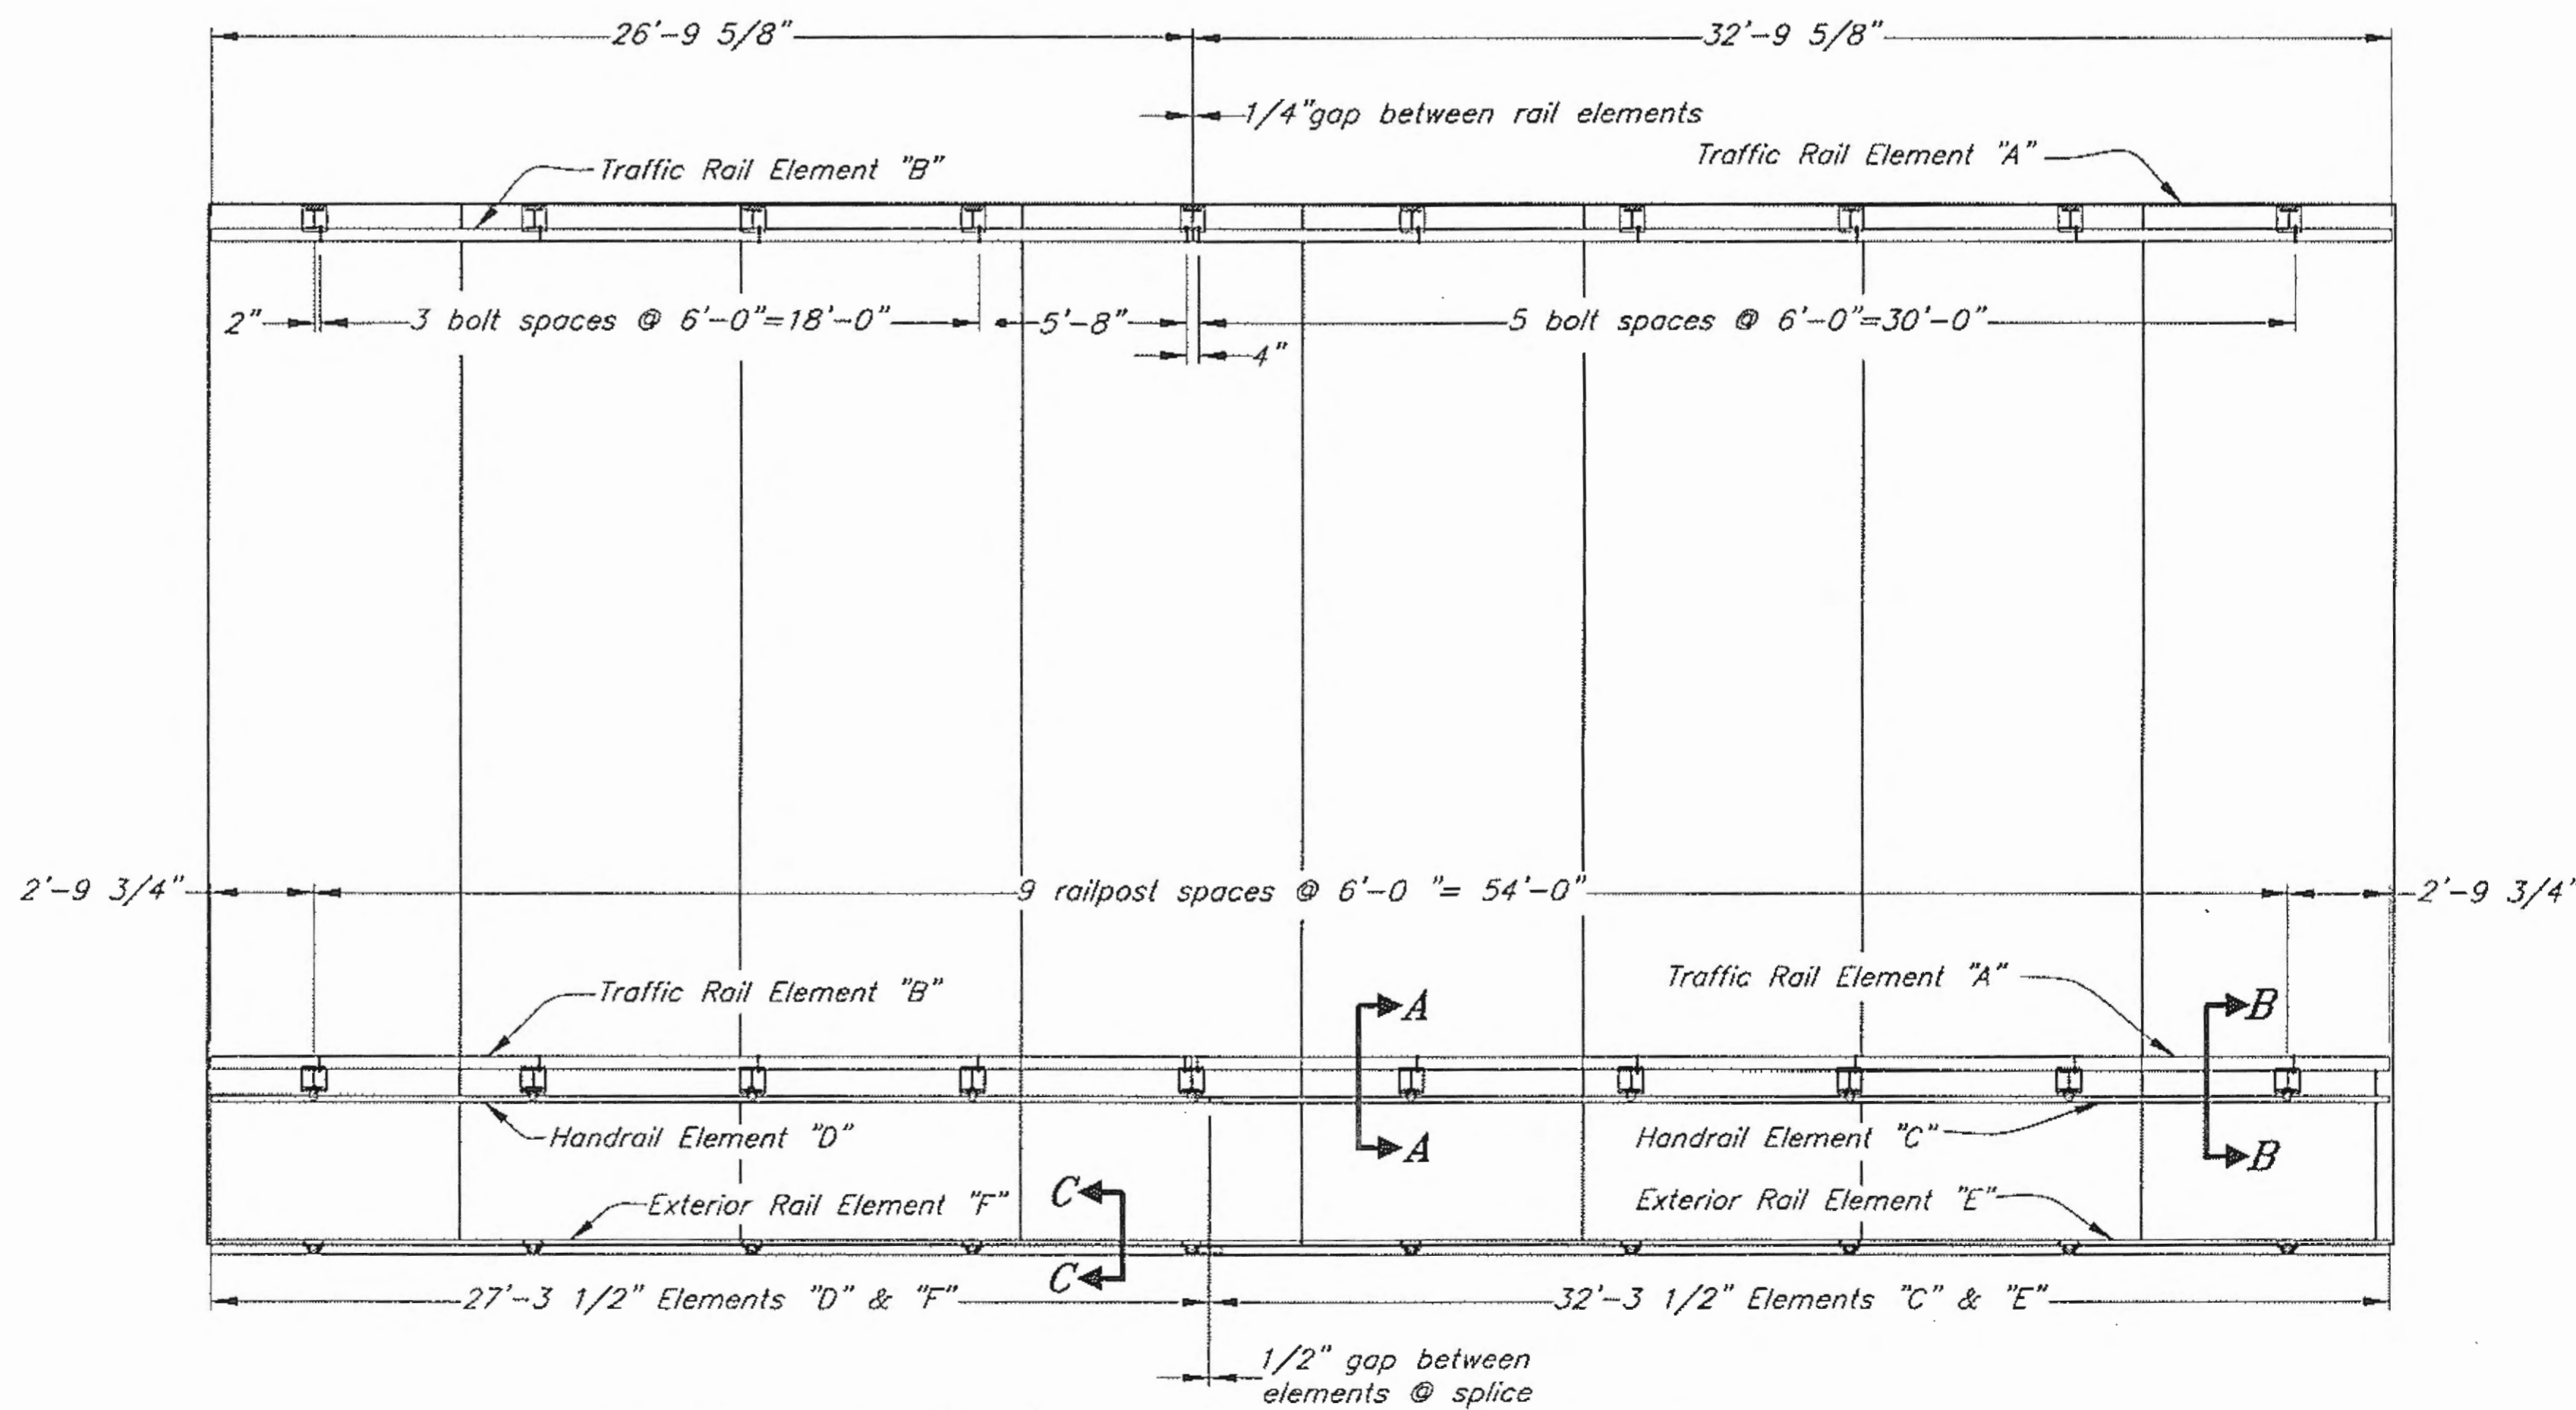


Approach Rails - Spans 2-9 & 12

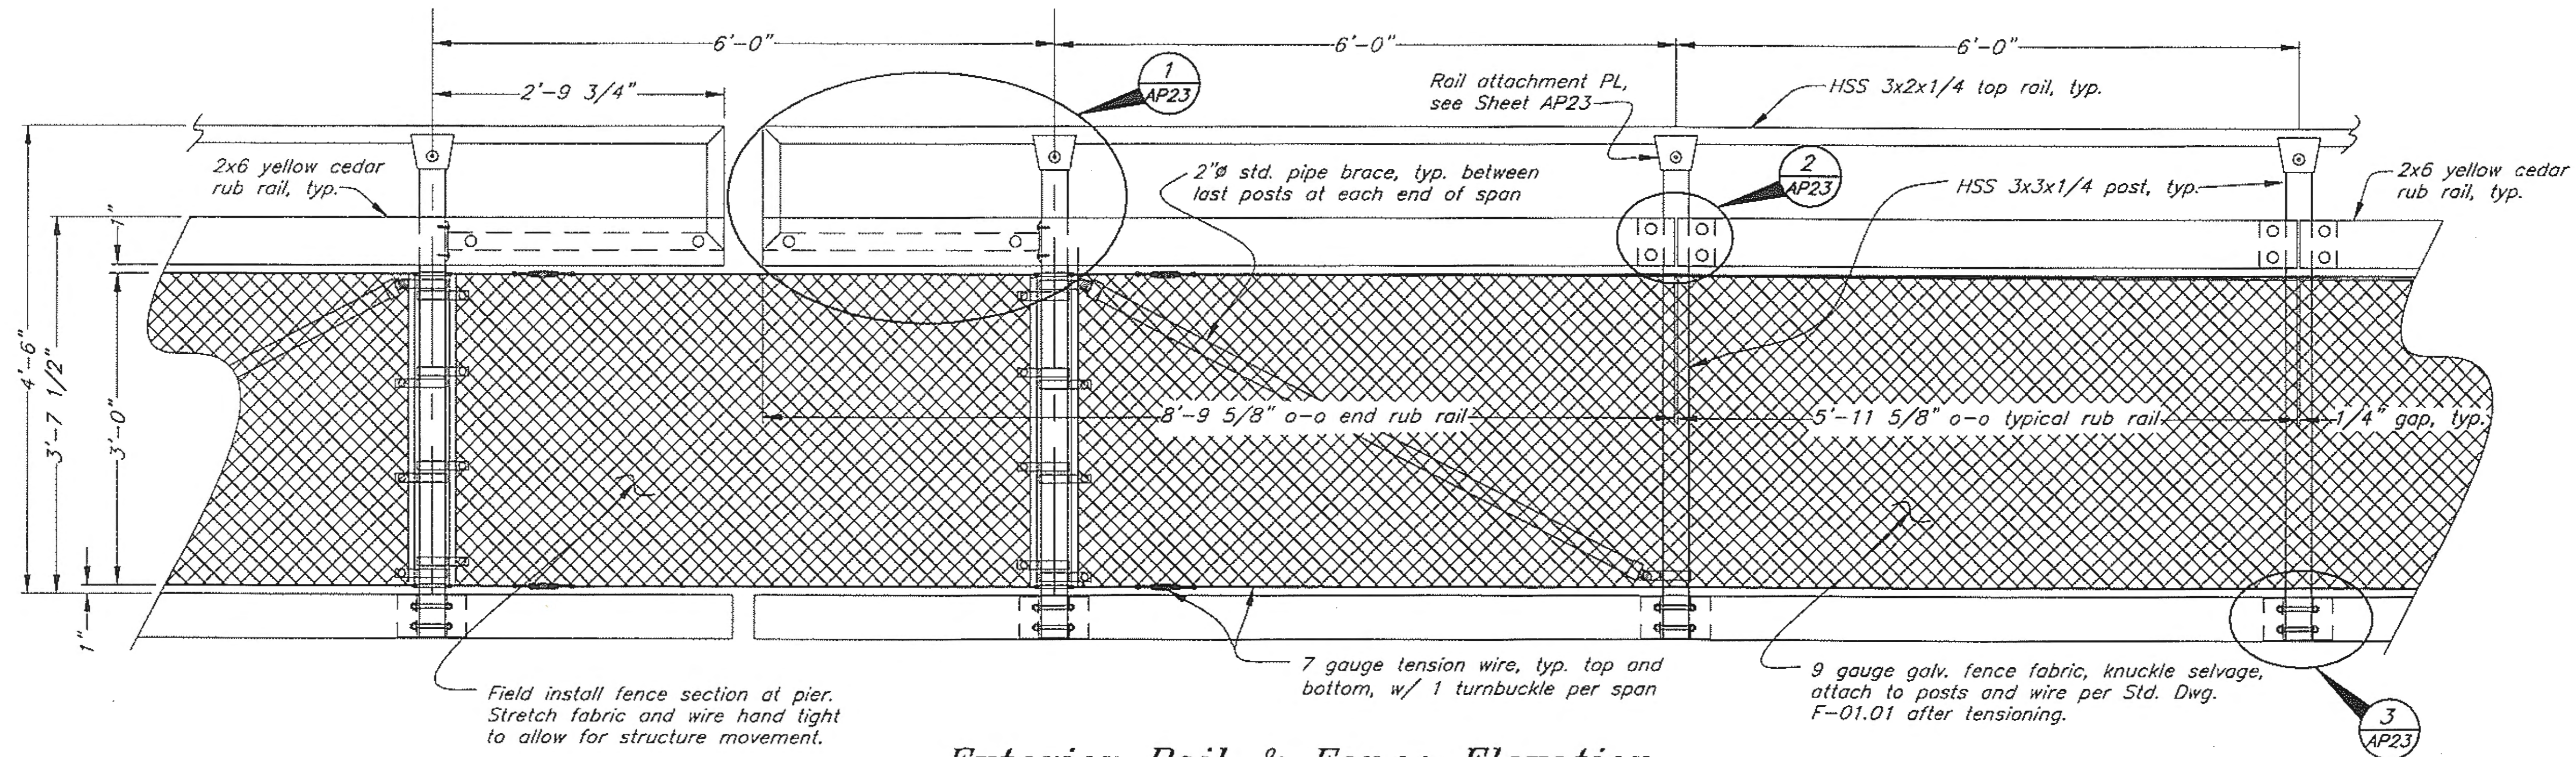

**Exterior Rail & Fence Elevation
(from inside)**

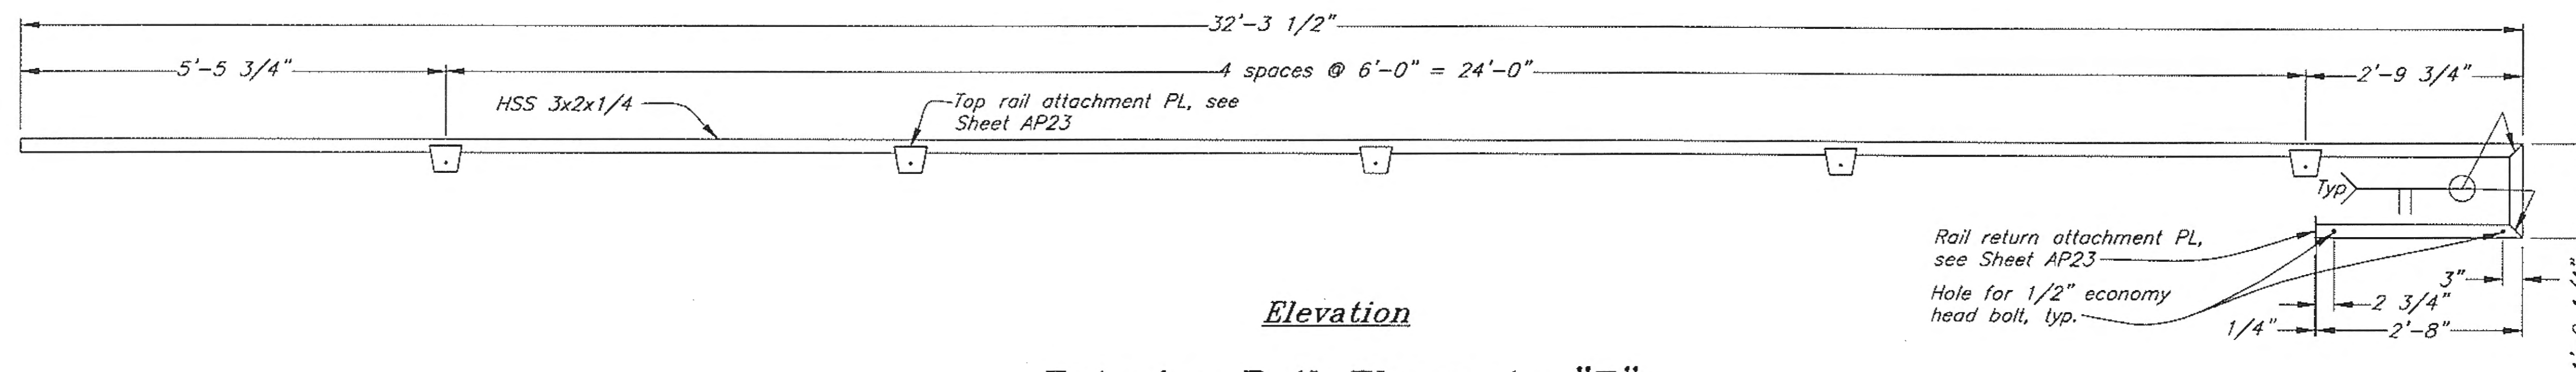

**Elevation
Exterior Rail Elements "E"**



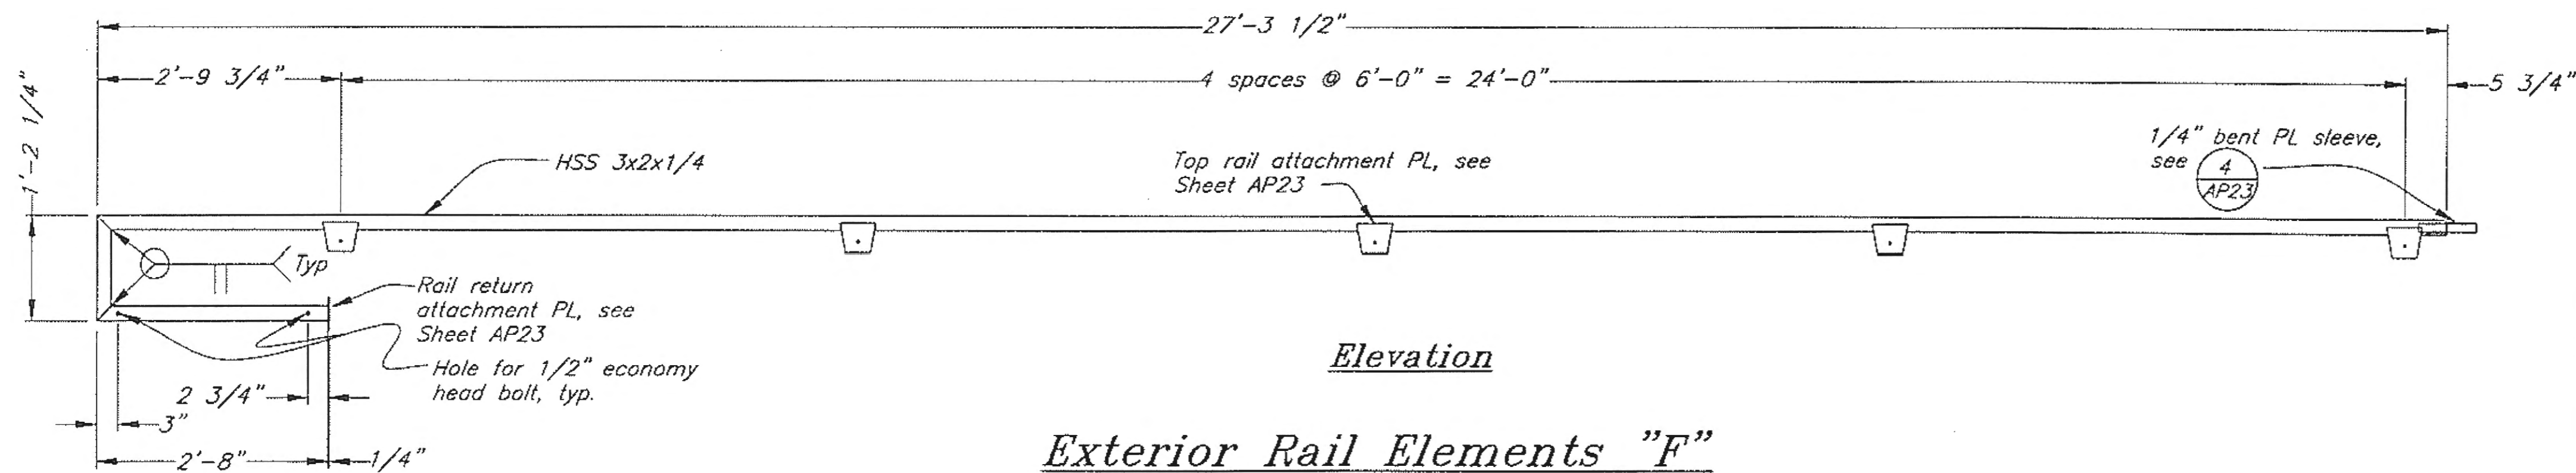


**Elevation
Exterior Rail Elements "F"**




Record Drawings have been reviewed by the Project Engineer, and represent to the best of my knowledge, the project as constructed.
PE: *[Signature]* Date: 5/21/12

DO NOT SCALE FROM THESE DRAWINGS USE DIMENSIONS


DESIGNED BY: J. Scott	STATE OF ALASKA DEPARTMENT OF TRANSPORTATION & PUBLIC FACILITIES DESIGN & ENGINEERING SERVICES DIVISION-SOUTHEAST REGION					
	Gustavus Causeway Replacement					
	Exterior Rail and Fence					
CHECKED BY: B. Savitko	AP22					
DRAWN BY: C. Fuman, W. Hickok	PATH: O:\GUS\67599\MF\PLANSET\03-APPROACH\AP22 EXTERIOR RAIL ELEMENTS.DWG					
TAB: Tue, 25/Nov/08 08:19PM	JTSCOTT					
REVISIONS		PROJECT DESIGNATION	YEAR	SHEET NO.	TOTAL SHEETS	
NO.	DATE	DESCRIPTION	BR-0003(53)/67599	2008	32	138

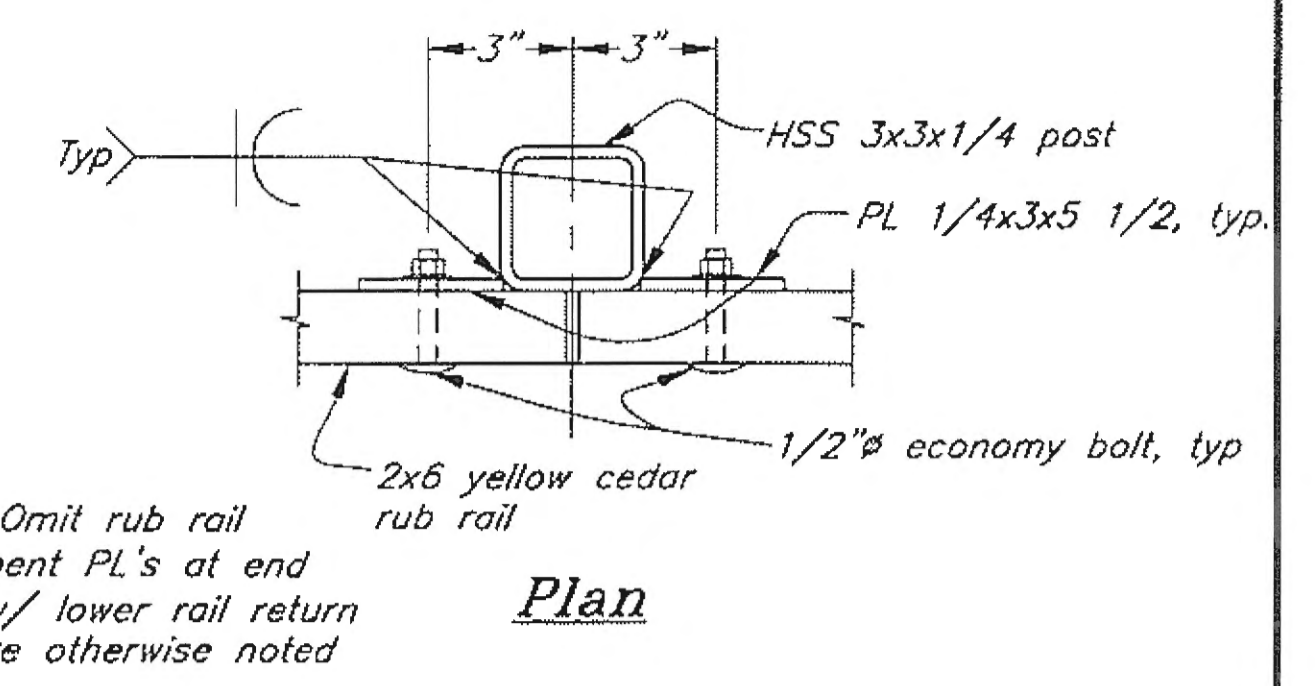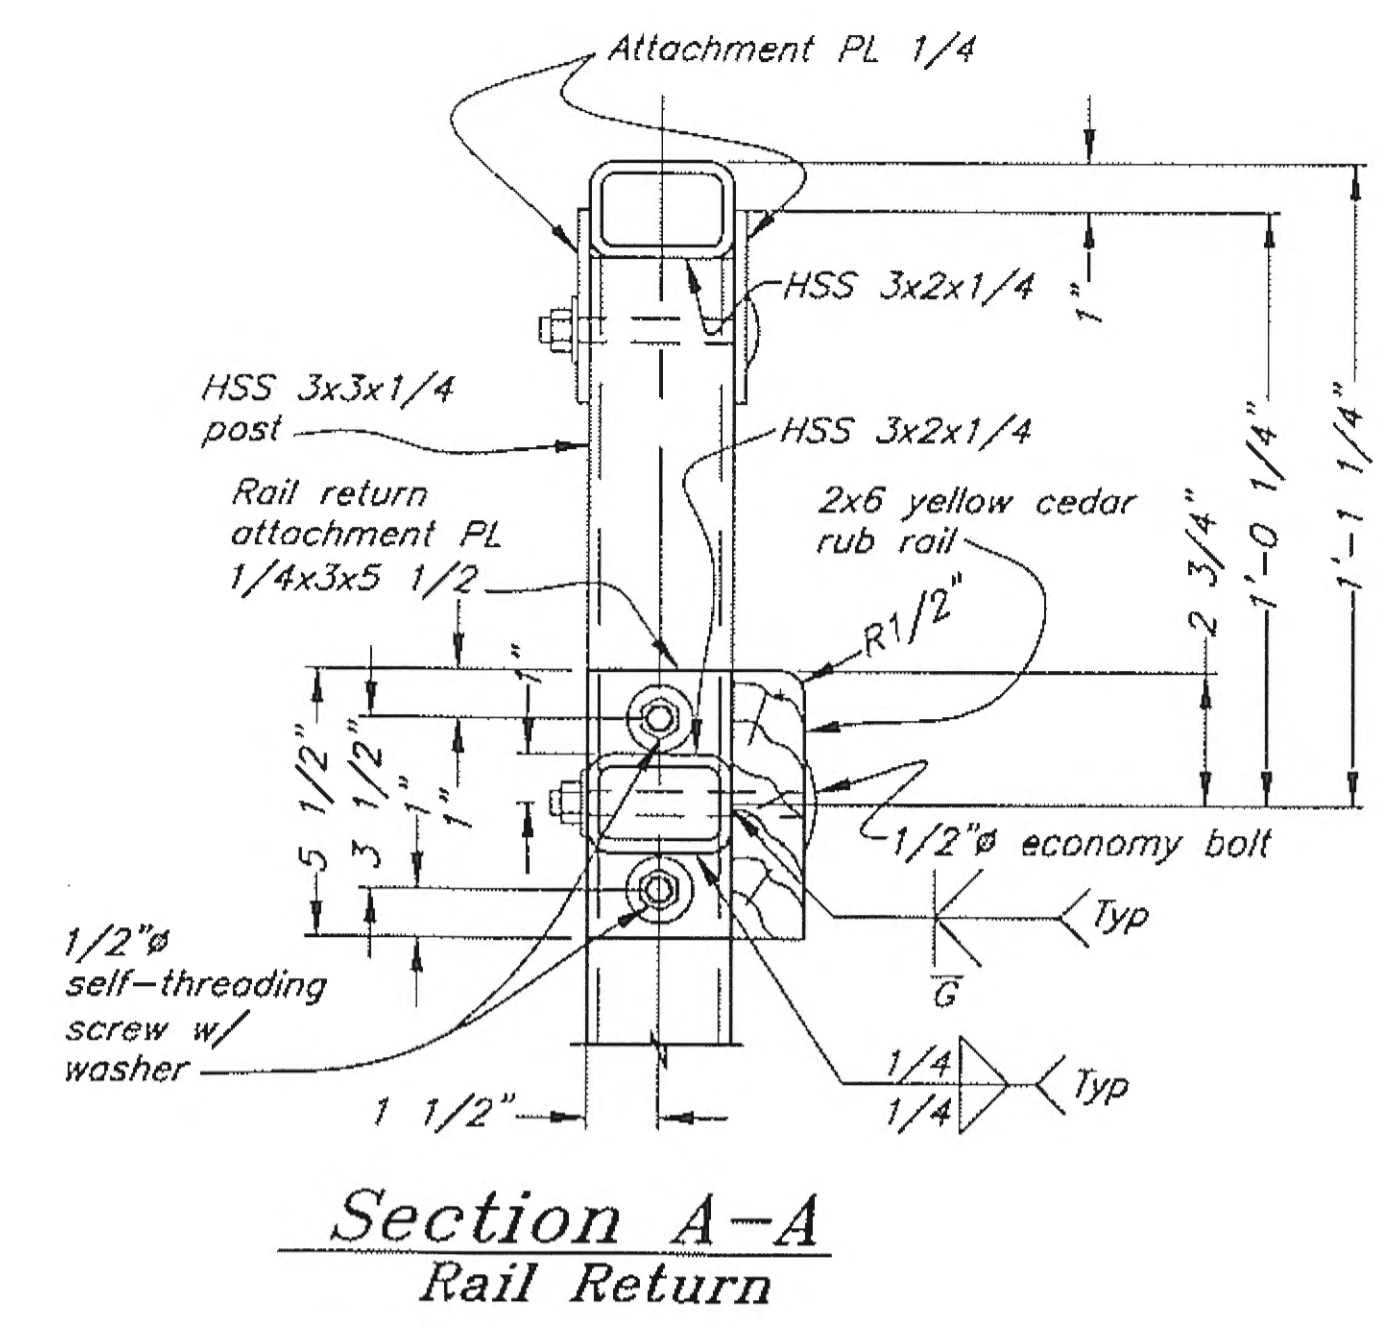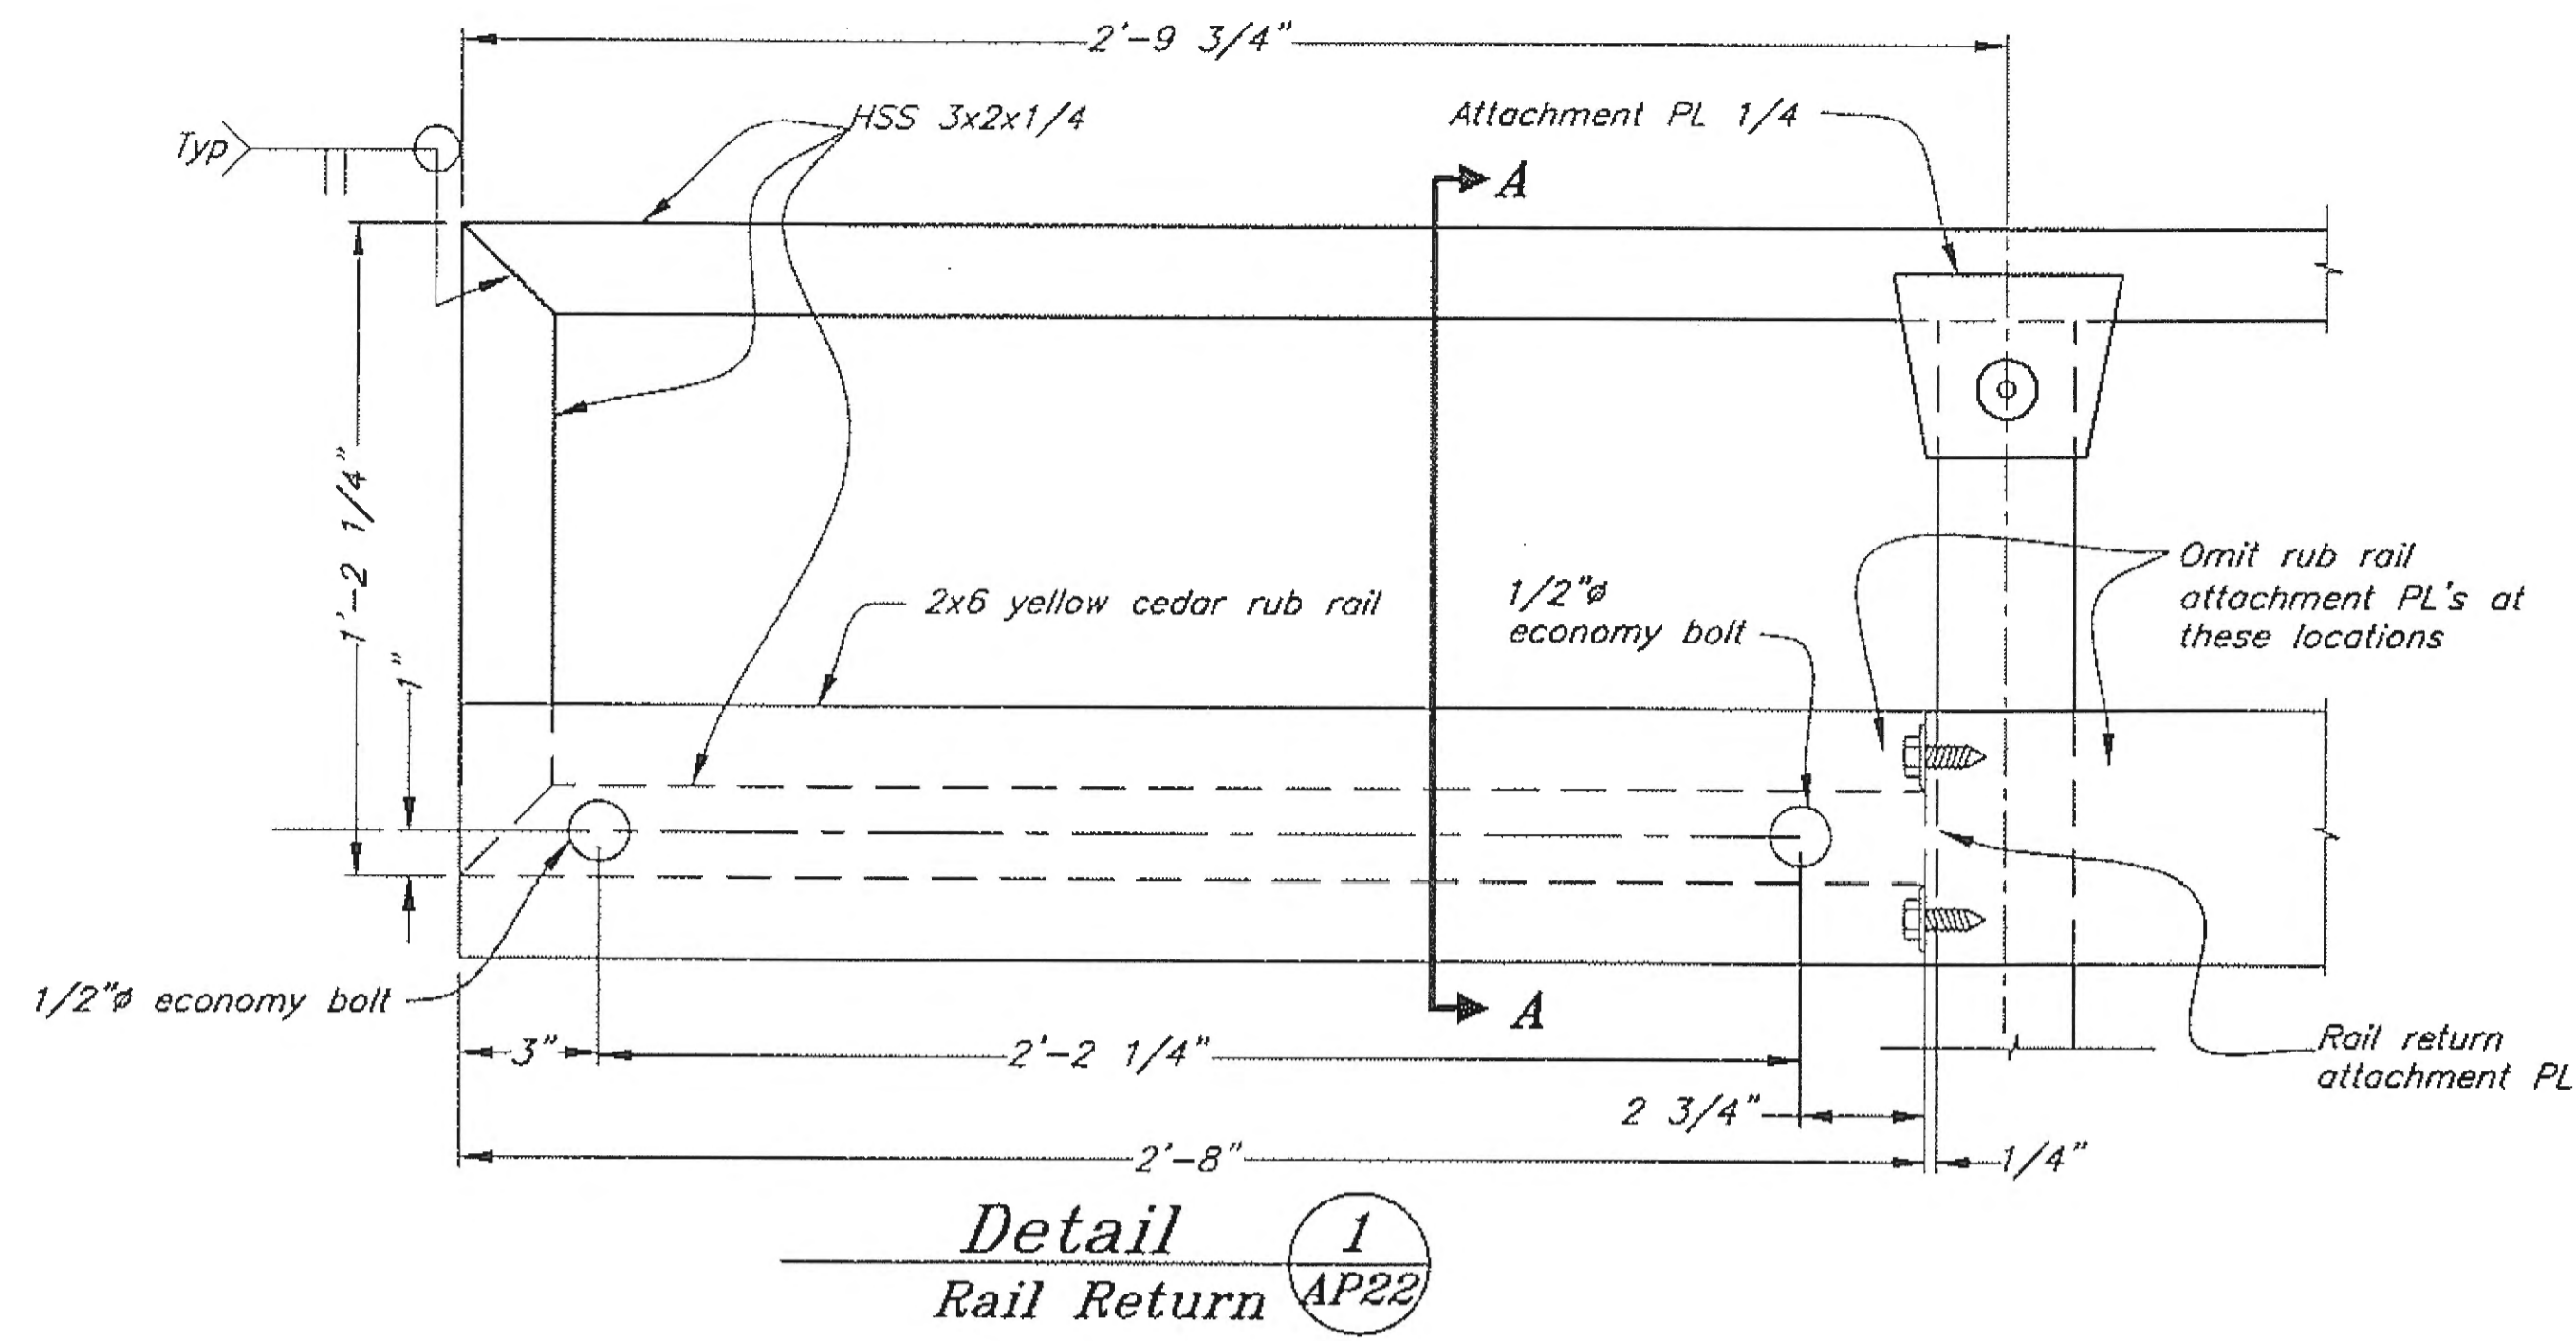

Note: Omit rub rail attachment PL's at end posts w/ lower rail return or where otherwise noted

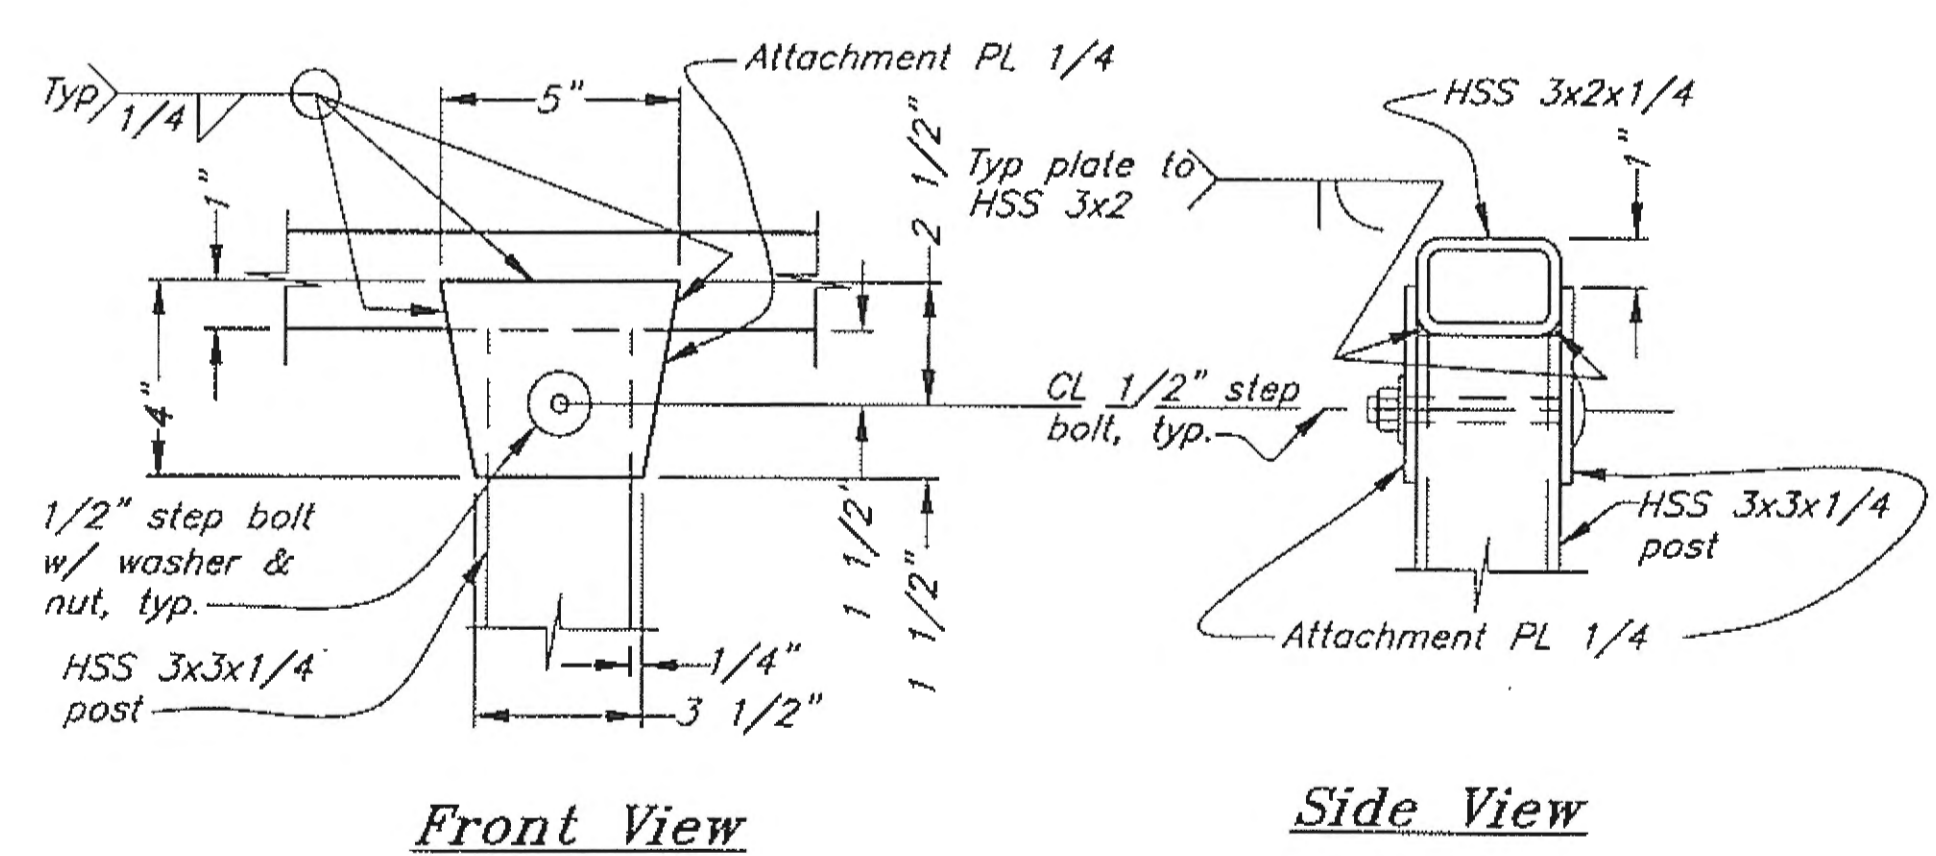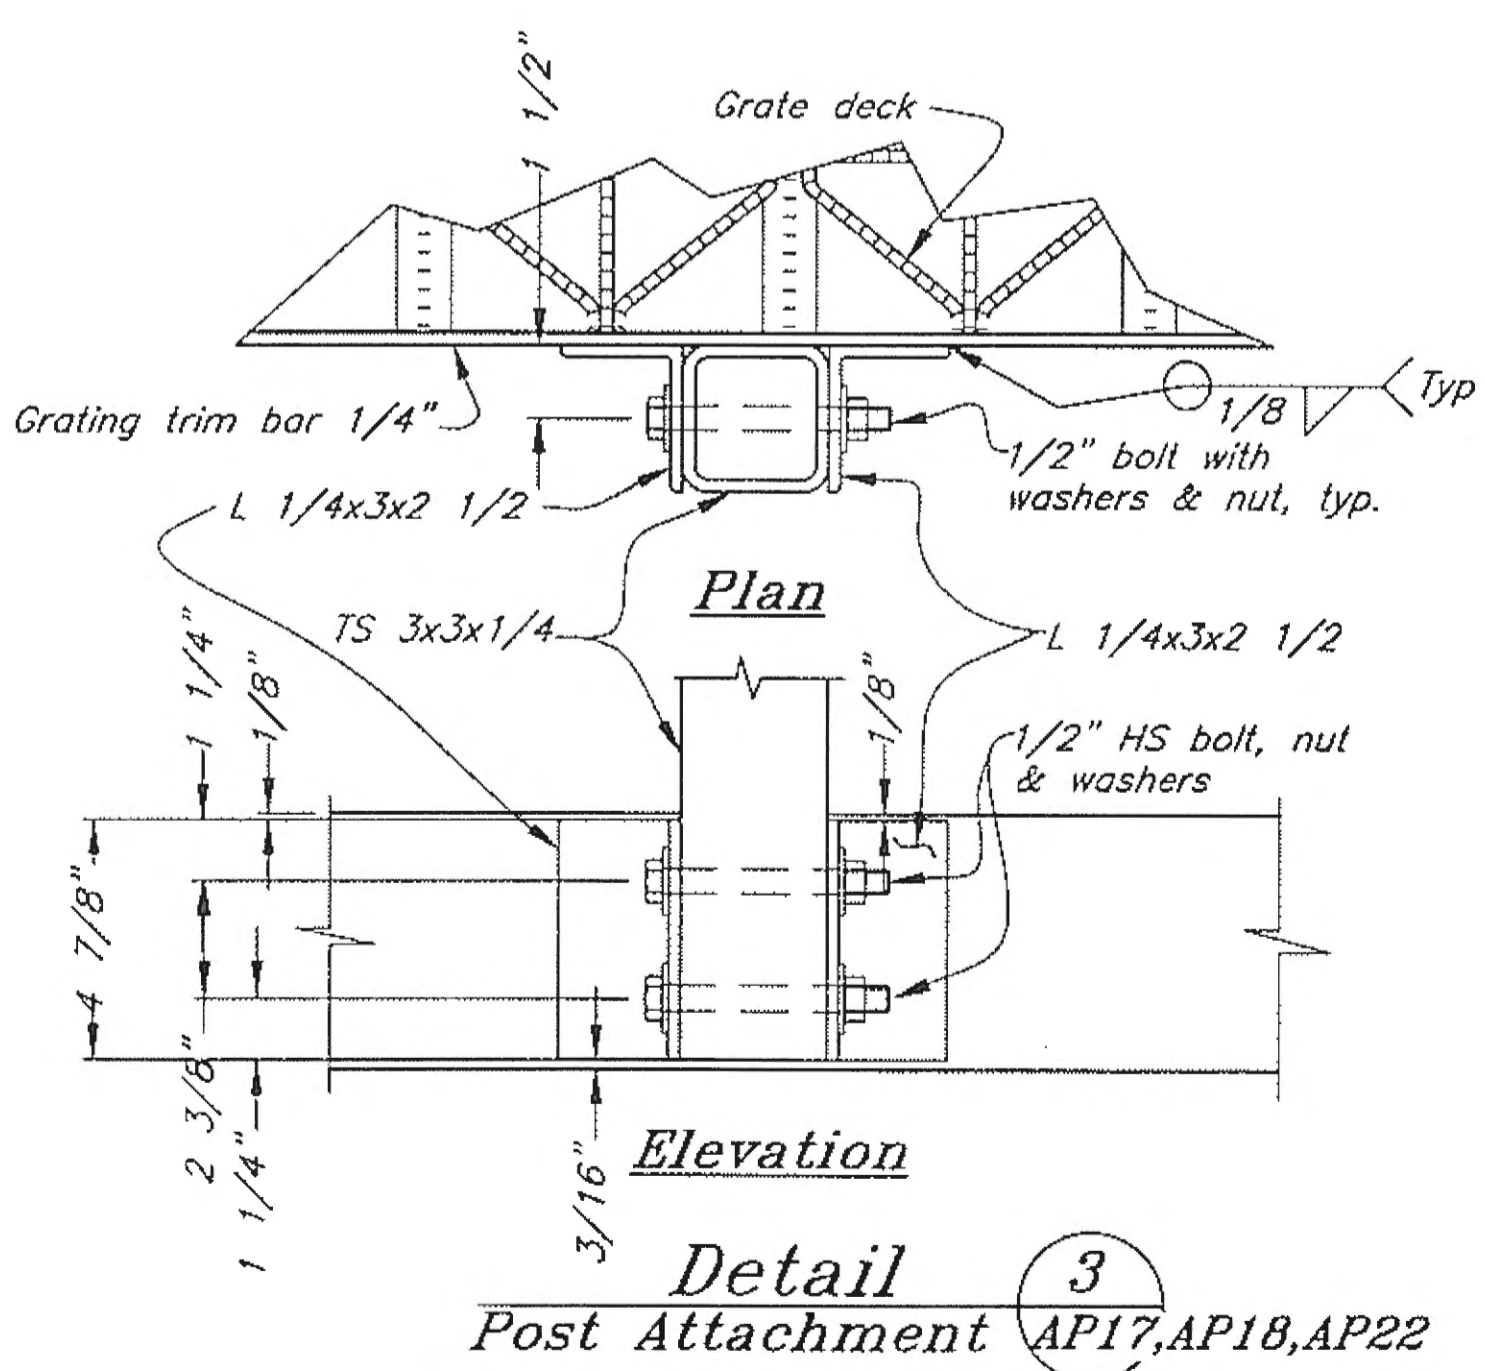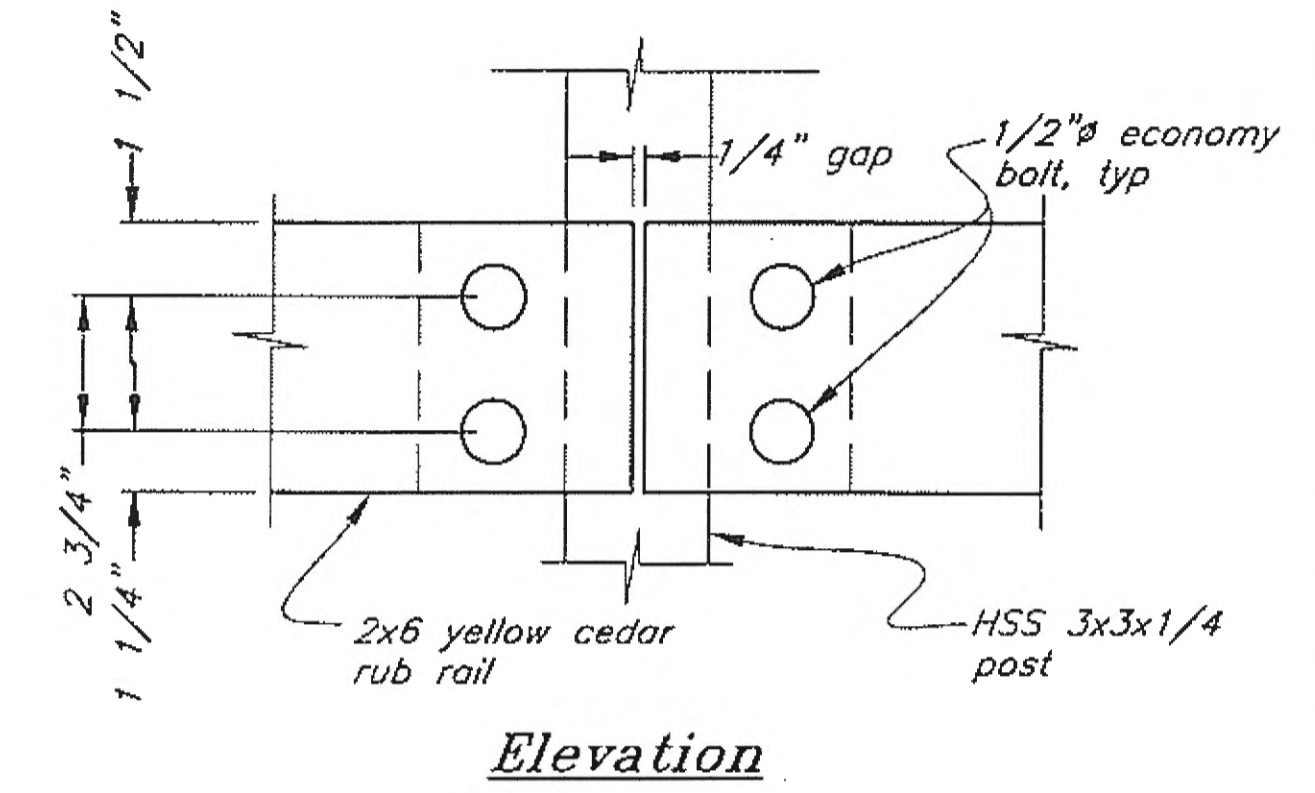

Front View
Side View
Exterior Rail Attachment Plate

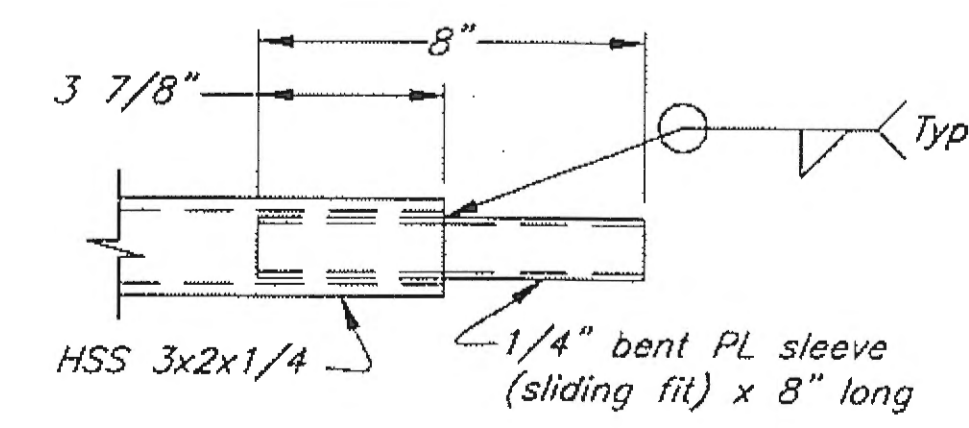


Top Rail Splice Sleeve

Record Drawings have been reviewed by the Project Engineer, and represent to the best of my knowledge, the project as constructed.
PE: *John I. Scott* Date: 8/21/17

DO NOT SCALE FROM THESE DRAWINGS USE DIMENSIONS


DESIGNED BY: <i>J. Scott</i>	STATE OF ALASKA DEPARTMENT OF TRANSPORTATION & PUBLIC FACILITIES DESIGN & ENGINEERING SERVICES DIVISION-SOUTHEAST REGION				
	Gustavus Causeway Replacement				
	Exterior Rail and Fence Details				
CHECKED BY: <i>B. Savikko</i>	AP23				
DRAWN BY: <i>C. Fuman, W. Hickok</i>	PATH: <i>Q:\GUS\67599\MF\PLANSET\03-APPROACH\AP23 EXTERIOR RAIL DETAILS.DWG</i>				
TAB: <i>Tue, 25/Nov/08 08:20PM</i>	JITSCOTT				
REVISIONS		PROJECT DESIGNATION	YEAR	SHEET NO.	TOTAL SHEETS
NO.	DATE	DESCRIPTION	BR-0003(53)/67599	2008	33
					138

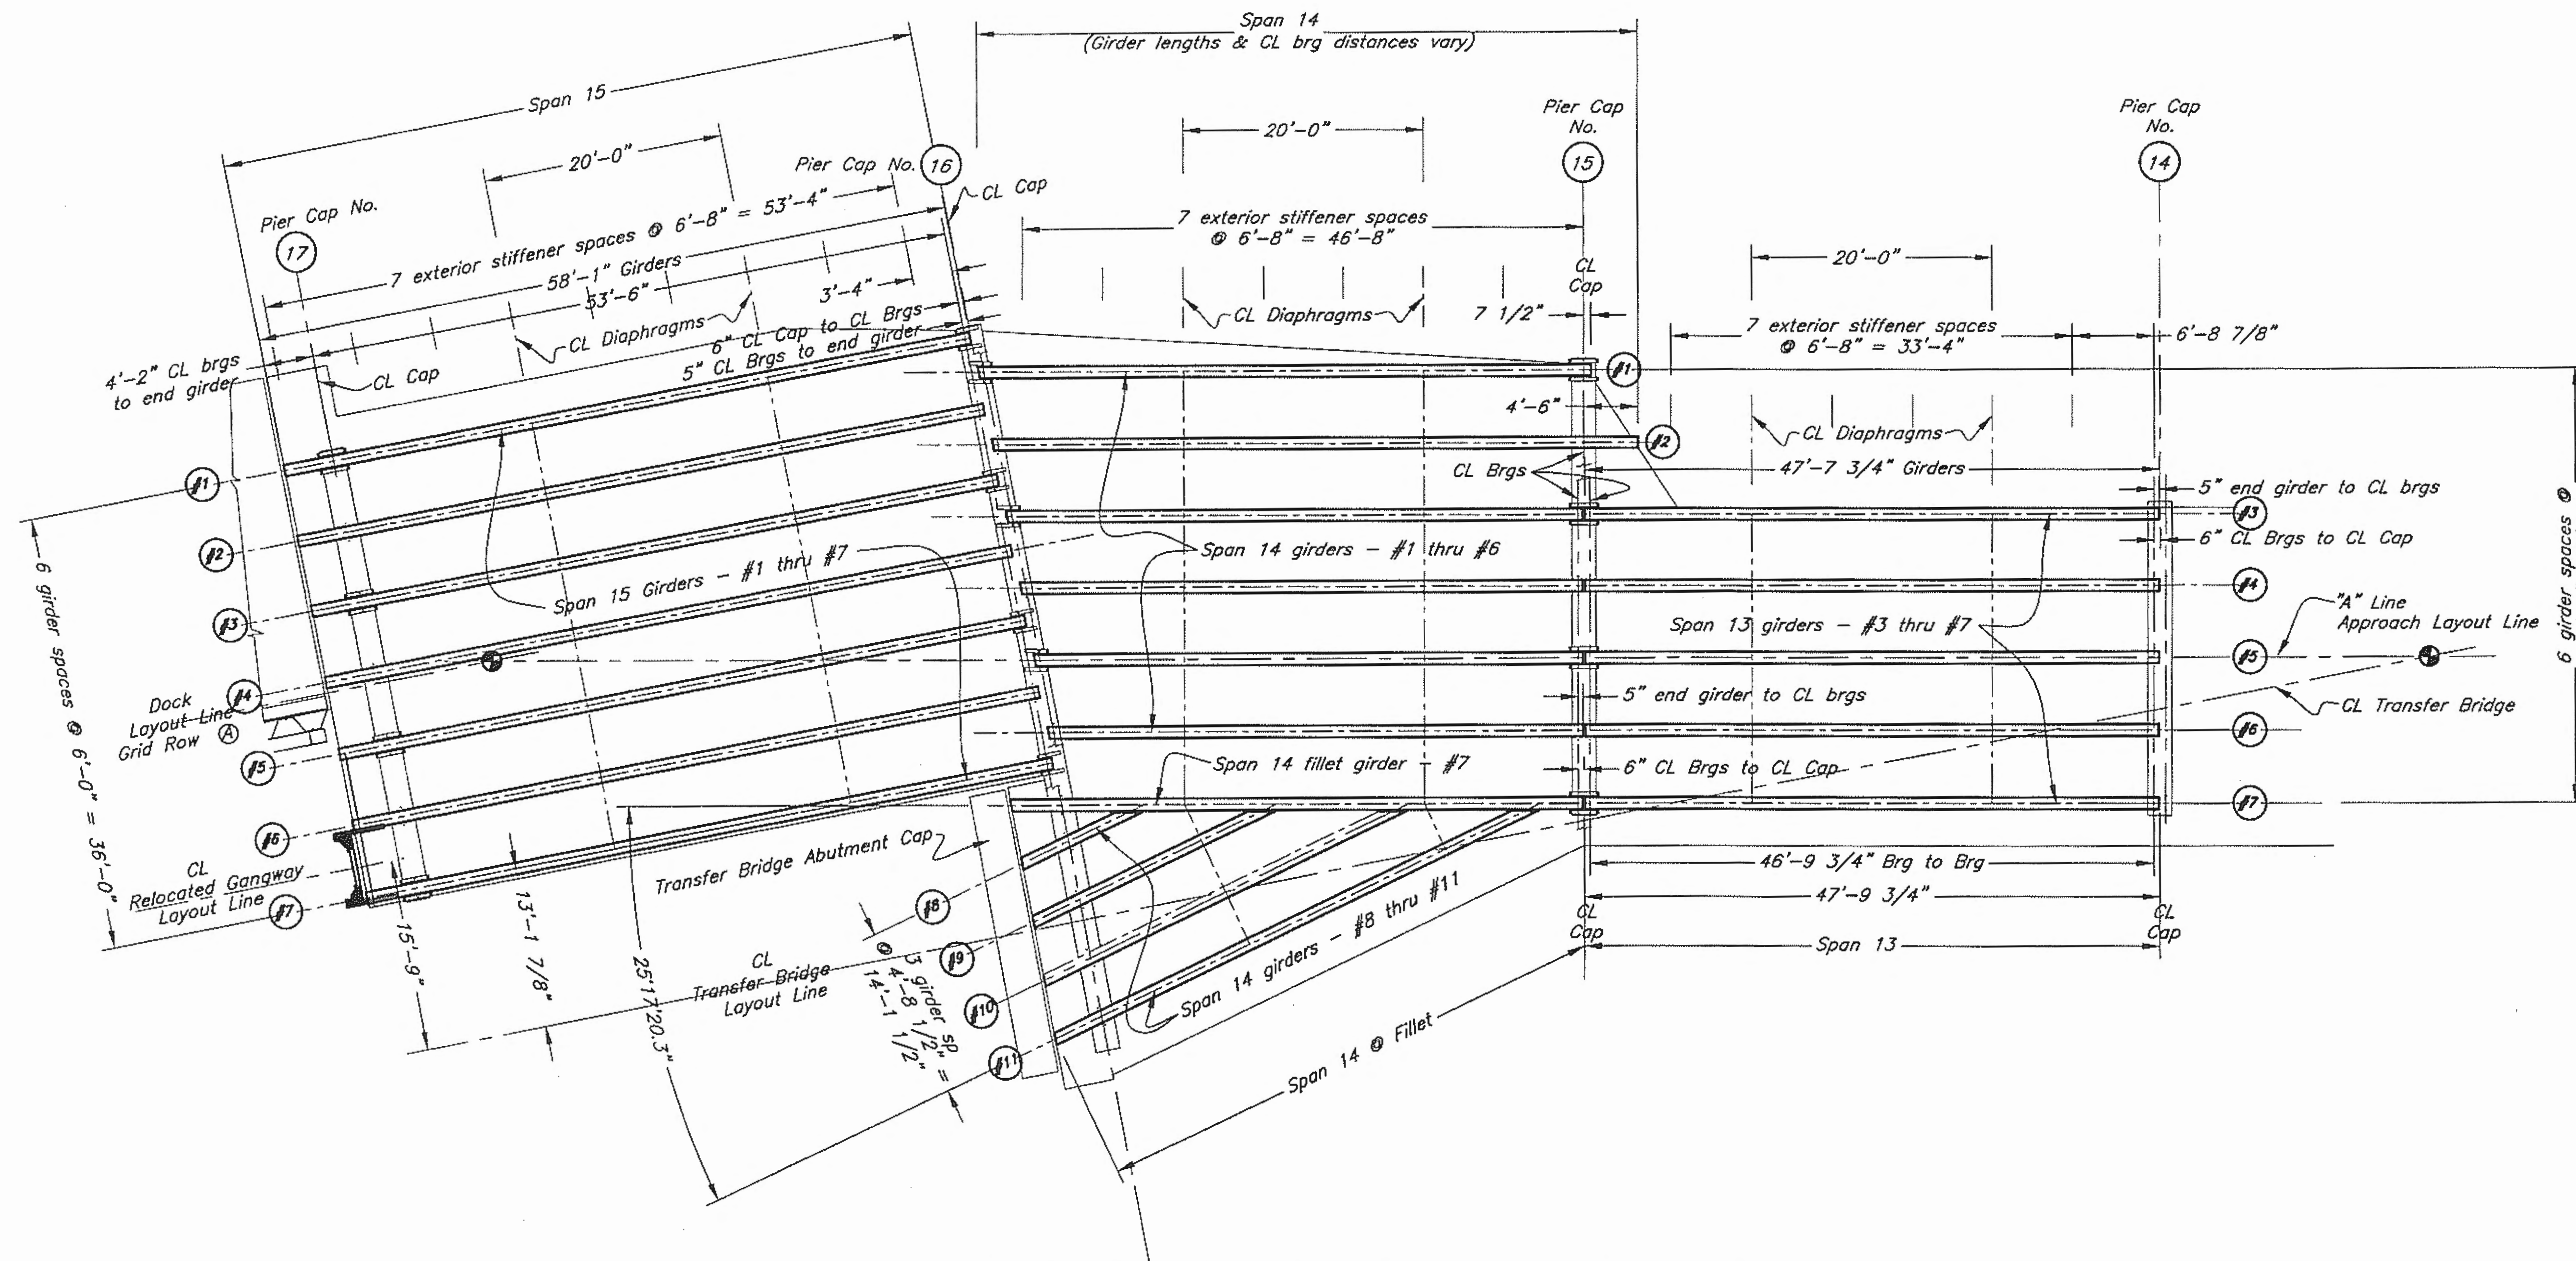


Approach Transition Framing Layout


Record Drawings have been reviewed by the Project Engineer, and represent to the best of my knowledge, the project as constructed.
 PE *John T. Scott* Date 8/21/12

DO NOT SCALE FROM THESE DRAWINGS USE DIMENSIONS

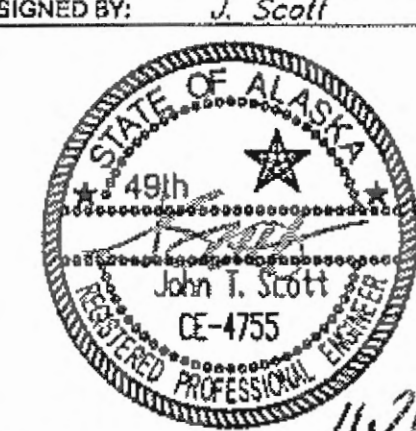
DESIGNED BY: J. Scott 		STATE OF ALASKA DEPARTMENT OF TRANSPORTATION & PUBLIC FACILITIES DESIGN & ENGINEERING SERVICES DIVISION-SOUTHEAST REGION	
		Gustavus Causeway Replacement Approach Transition Framing Layout AP24	
CHECKED BY: B. Savikko DRAWN BY: C. Fuman, W. Hickok			
PATH: Q:\GUS\67599\MF\PLANSET\03-APPROACH\AP24 TRANSITION FRAMING LAYOUT.DWG TAB: Tue, 25/Nov/08 08:21PM		JTSCOTT	
REVISIONS NO. DATE DESCRIPTION		PROJECT DESIGNATION BR-0003(53)/67599	YEAR 2008
		SHEET NO. 34	TOTAL SHEETS 138

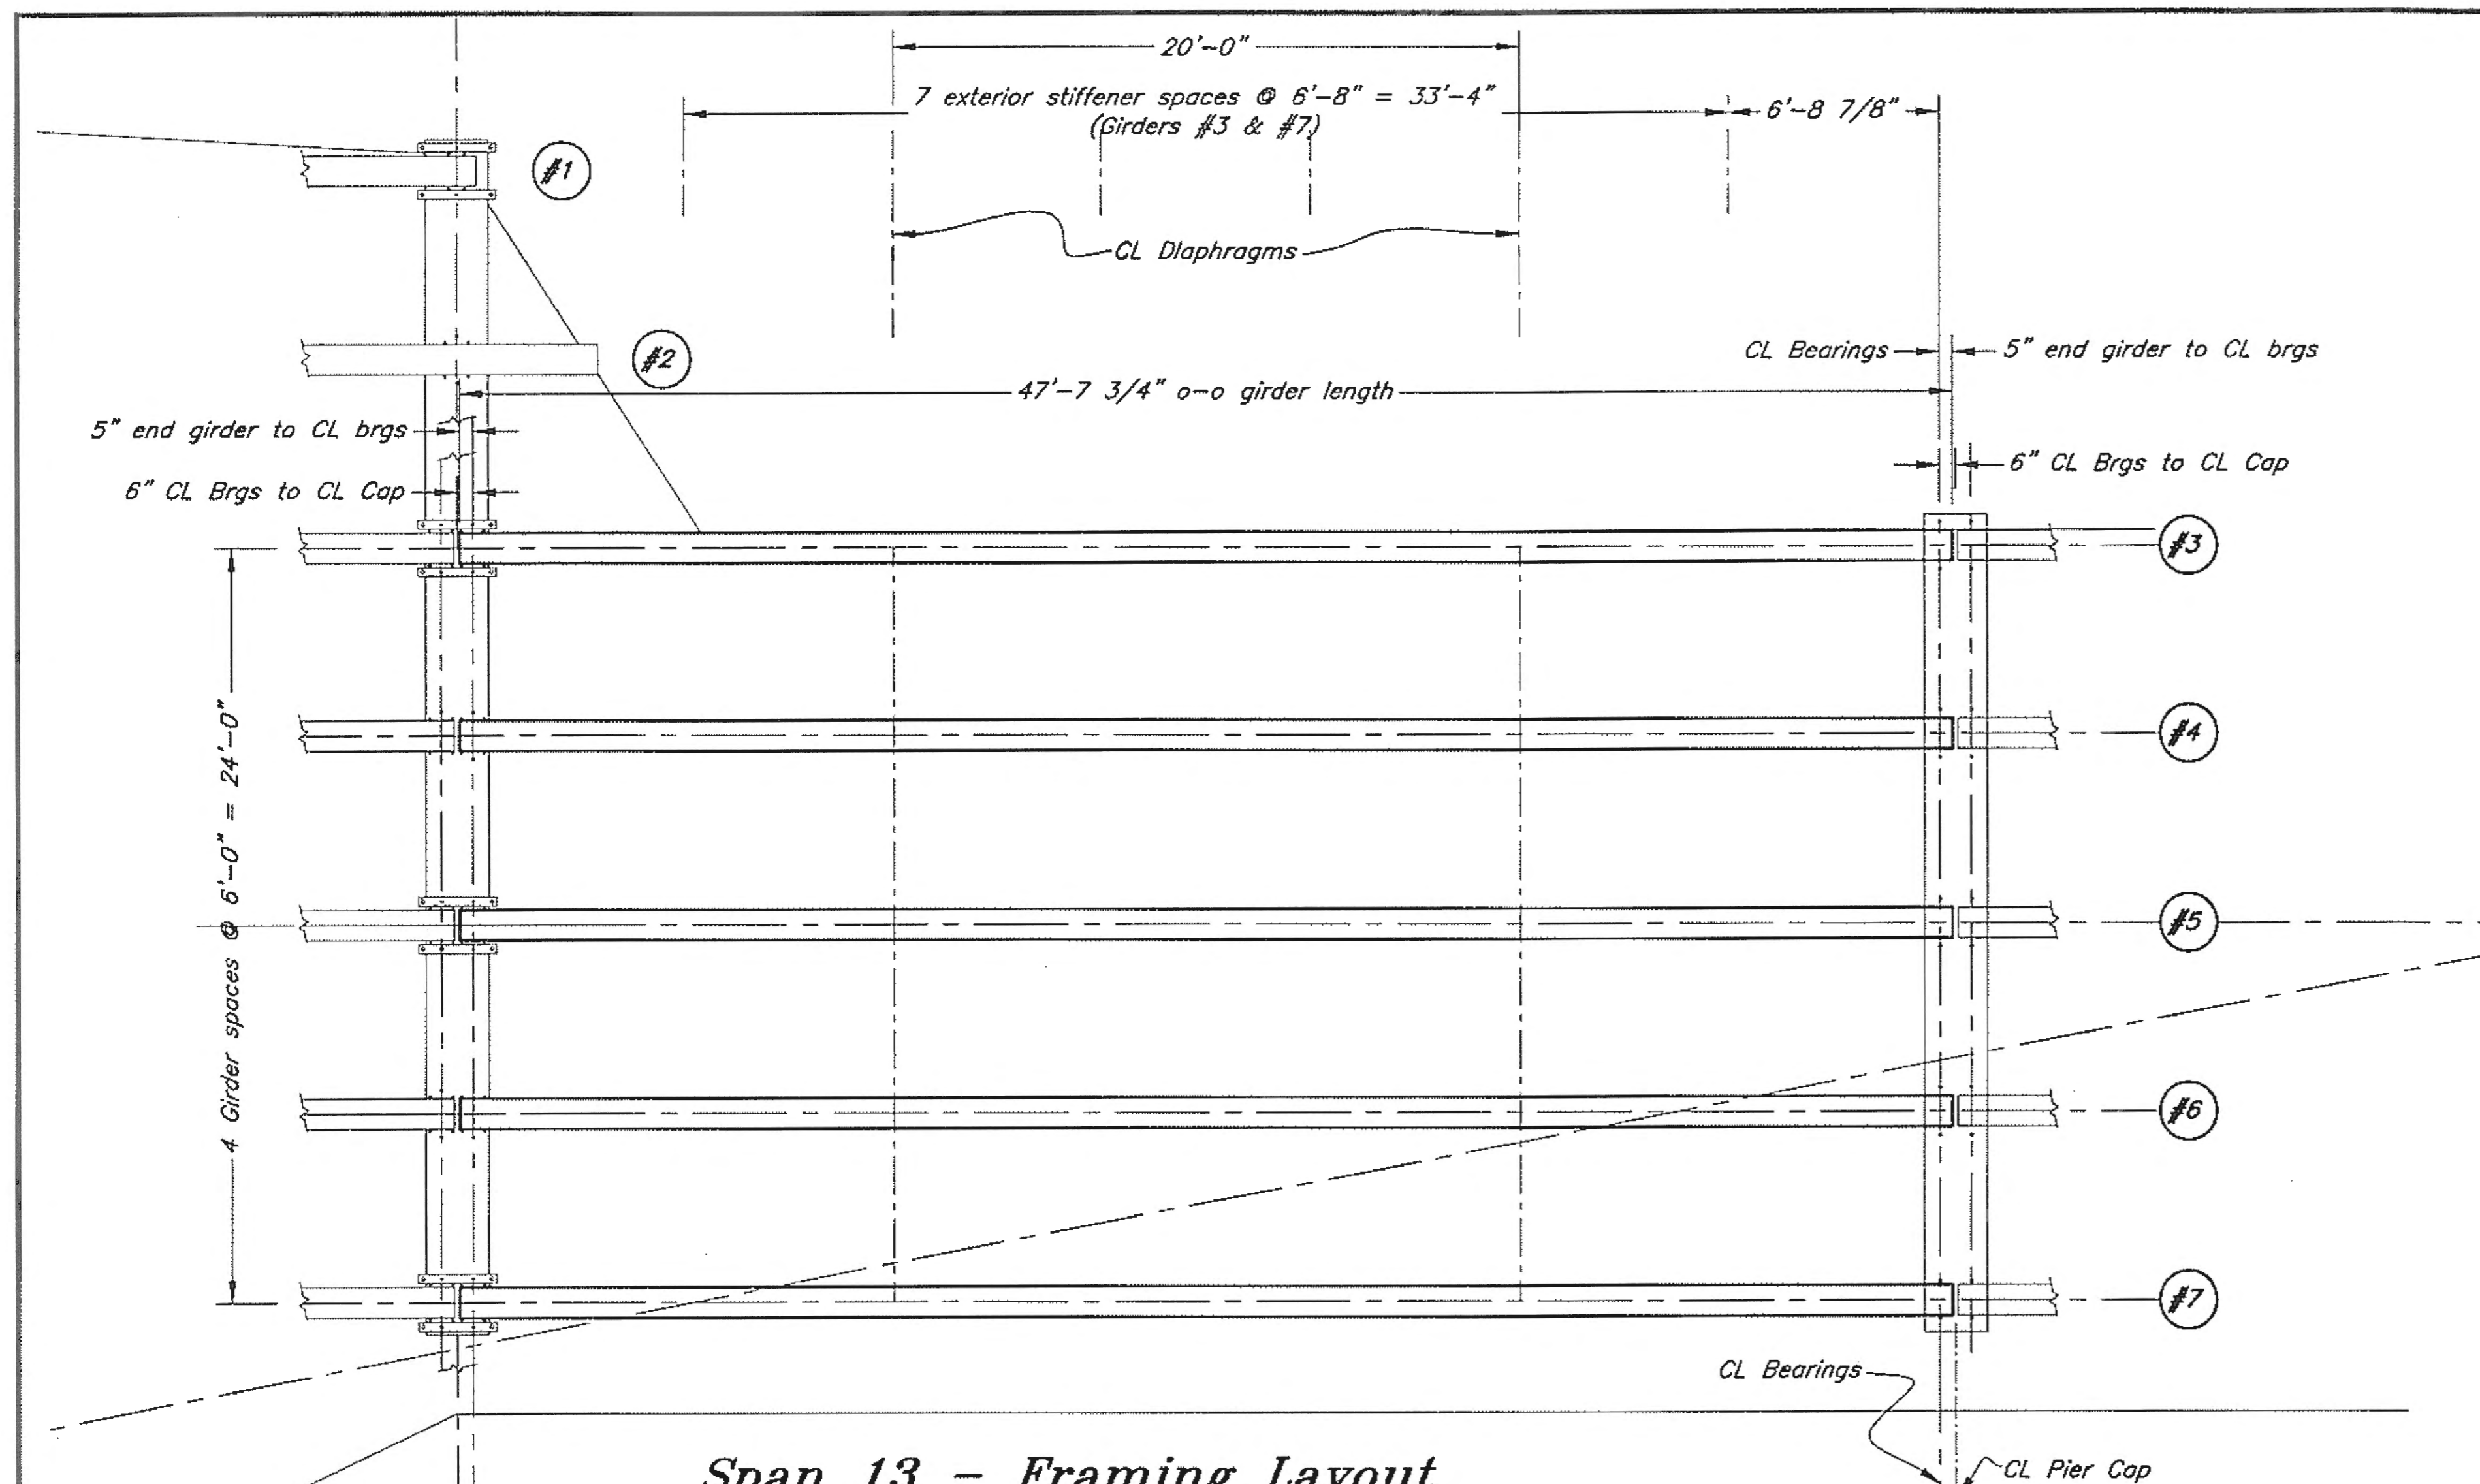

Span 13 - Framing Layout

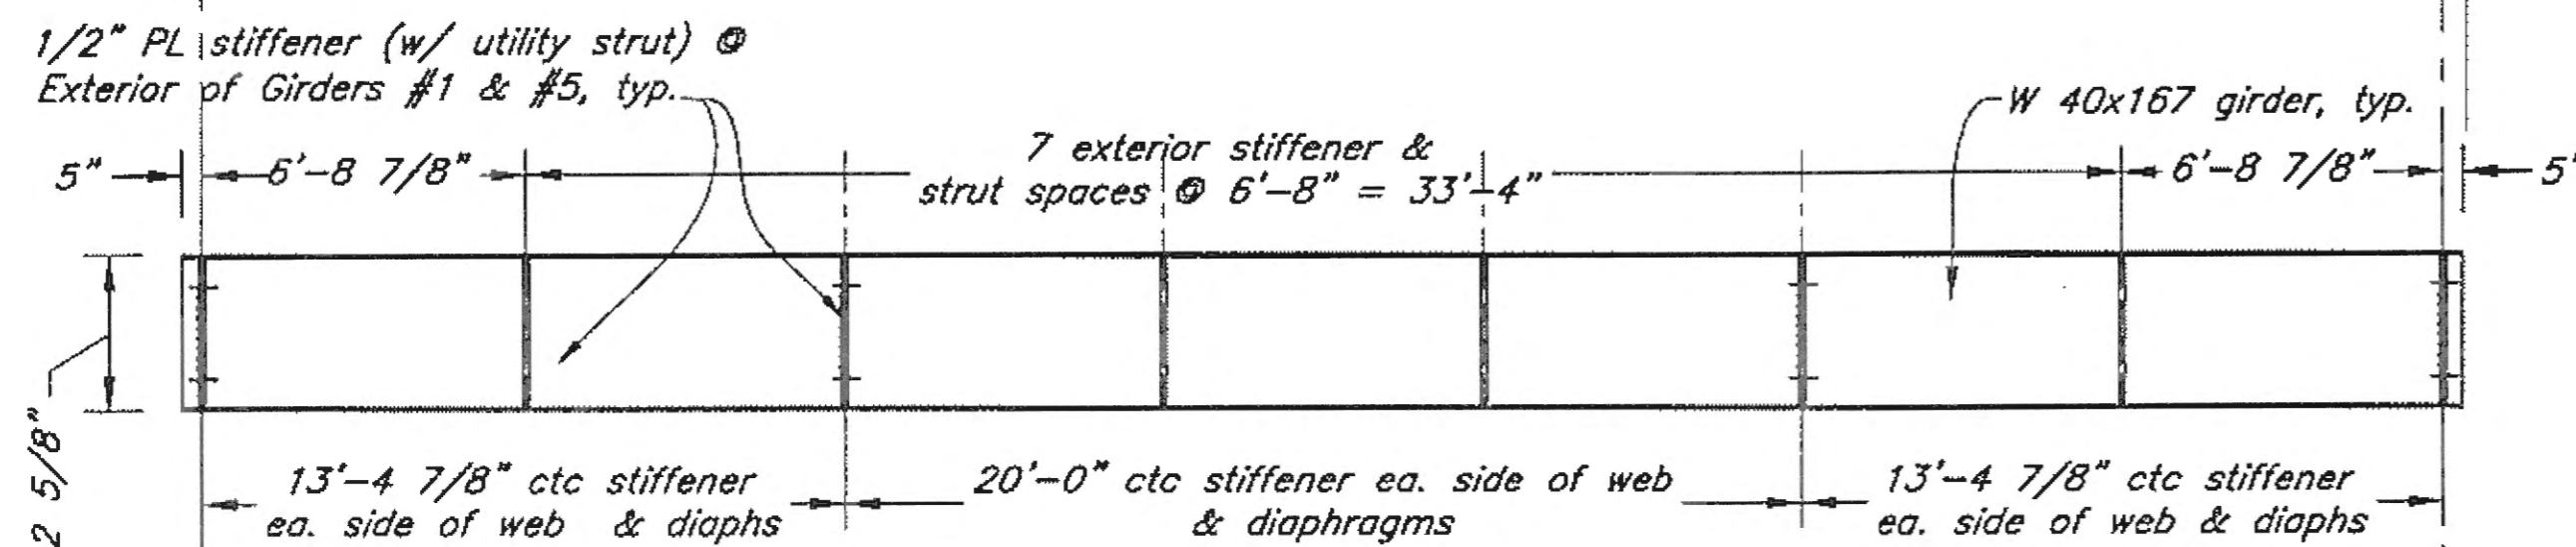

**Elevation
Girder #7 @ Span 13
(Girder #3 opposite hand of Girder #7)**

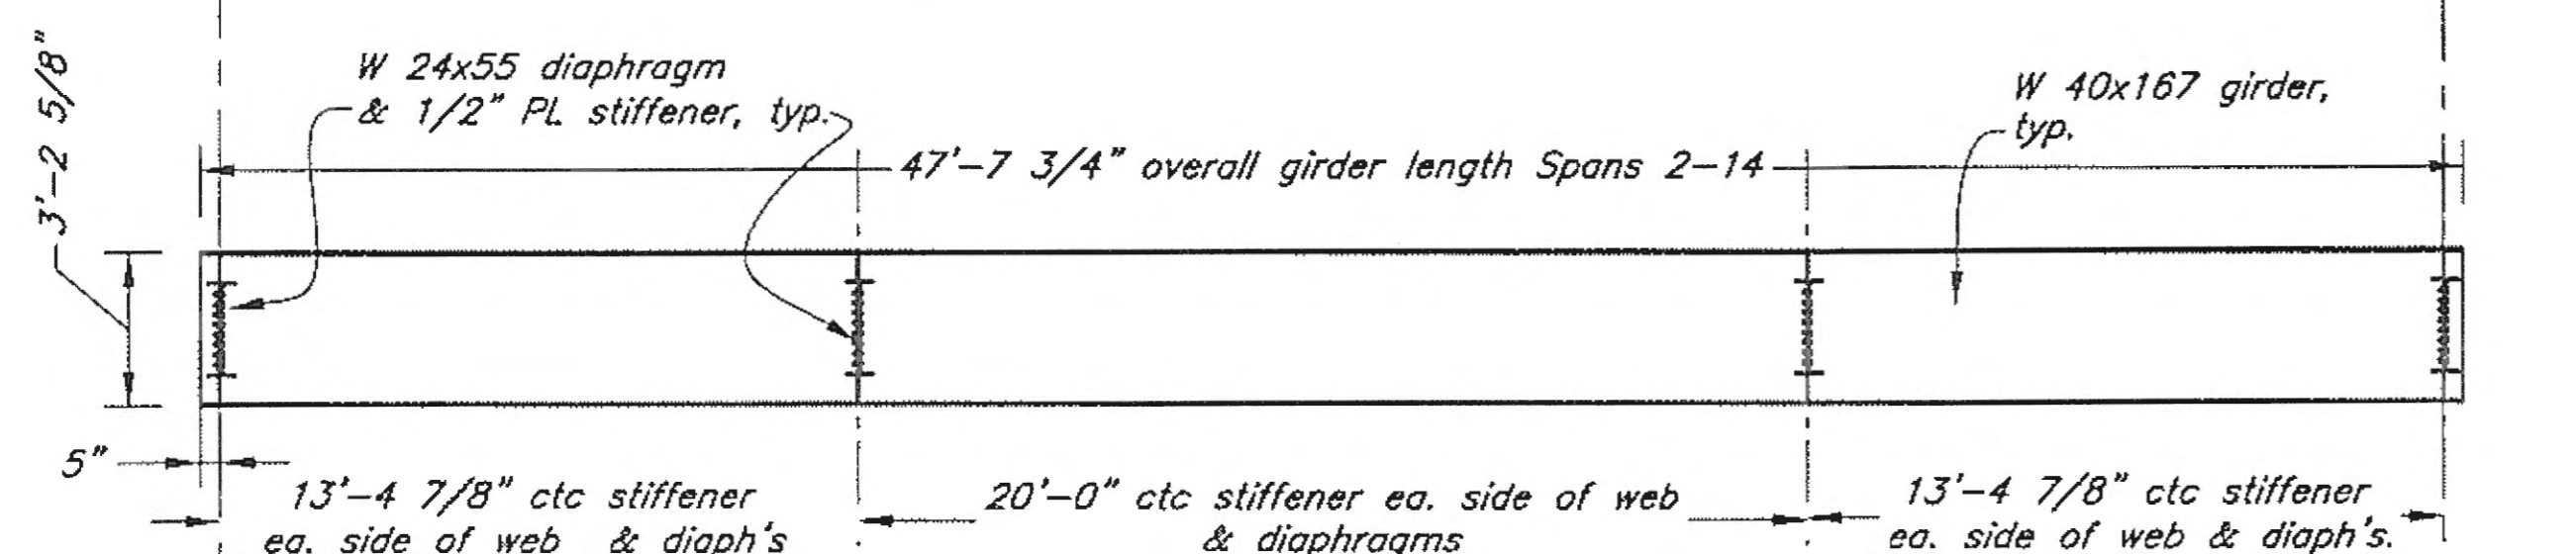


**Elevation
Girders #4 - #6, Span 13
(Girder #3 opposite hand of Girder #7)**






Record Drawings have been reviewed by the Project Engineer, and represent to the best of my knowledge, the project as constructed.
PE *Stan Miller* - Date 8/21/12

DO NOT SCALE FROM THESE DRAWINGS USE DIMENSIONS

DESIGNED BY: <i>J. Scott</i>	STATE OF ALASKA DEPARTMENT OF TRANSPORTATION & PUBLIC FACILITIES DESIGN & ENGINEERING SERVICES DIVISION-SOUTHEAST REGION										
	Gustavus Causeway Replacement										
	Approach Transition Framing Span 13										
CHECKED BY: <i>B. Sawikko</i>	AP25										
DRAWN BY: <i>C. Fuman, W. Hickok</i>	PATH: Q:\GUS\67599\MF\PLANSET\03-APPROACH\AP25 TRANSITION FRAMING SPAN 13.DWG TAB: Wed, 26/Nov/08 10:09AM JTSCOTT										
<table border="1"> <thead> <tr> <th>NO.</th> <th>DATE</th> <th>DESCRIPTION</th> </tr> </thead> <tbody> <tr> <td> </td> <td> </td> <td> </td> </tr> </tbody> </table>		NO.	DATE	DESCRIPTION				PROJECT DESIGNATION	YEAR	SHEET NO.	TOTAL SHEETS
NO.	DATE	DESCRIPTION									
		BR-0003(53)/67599	2008	35	138						

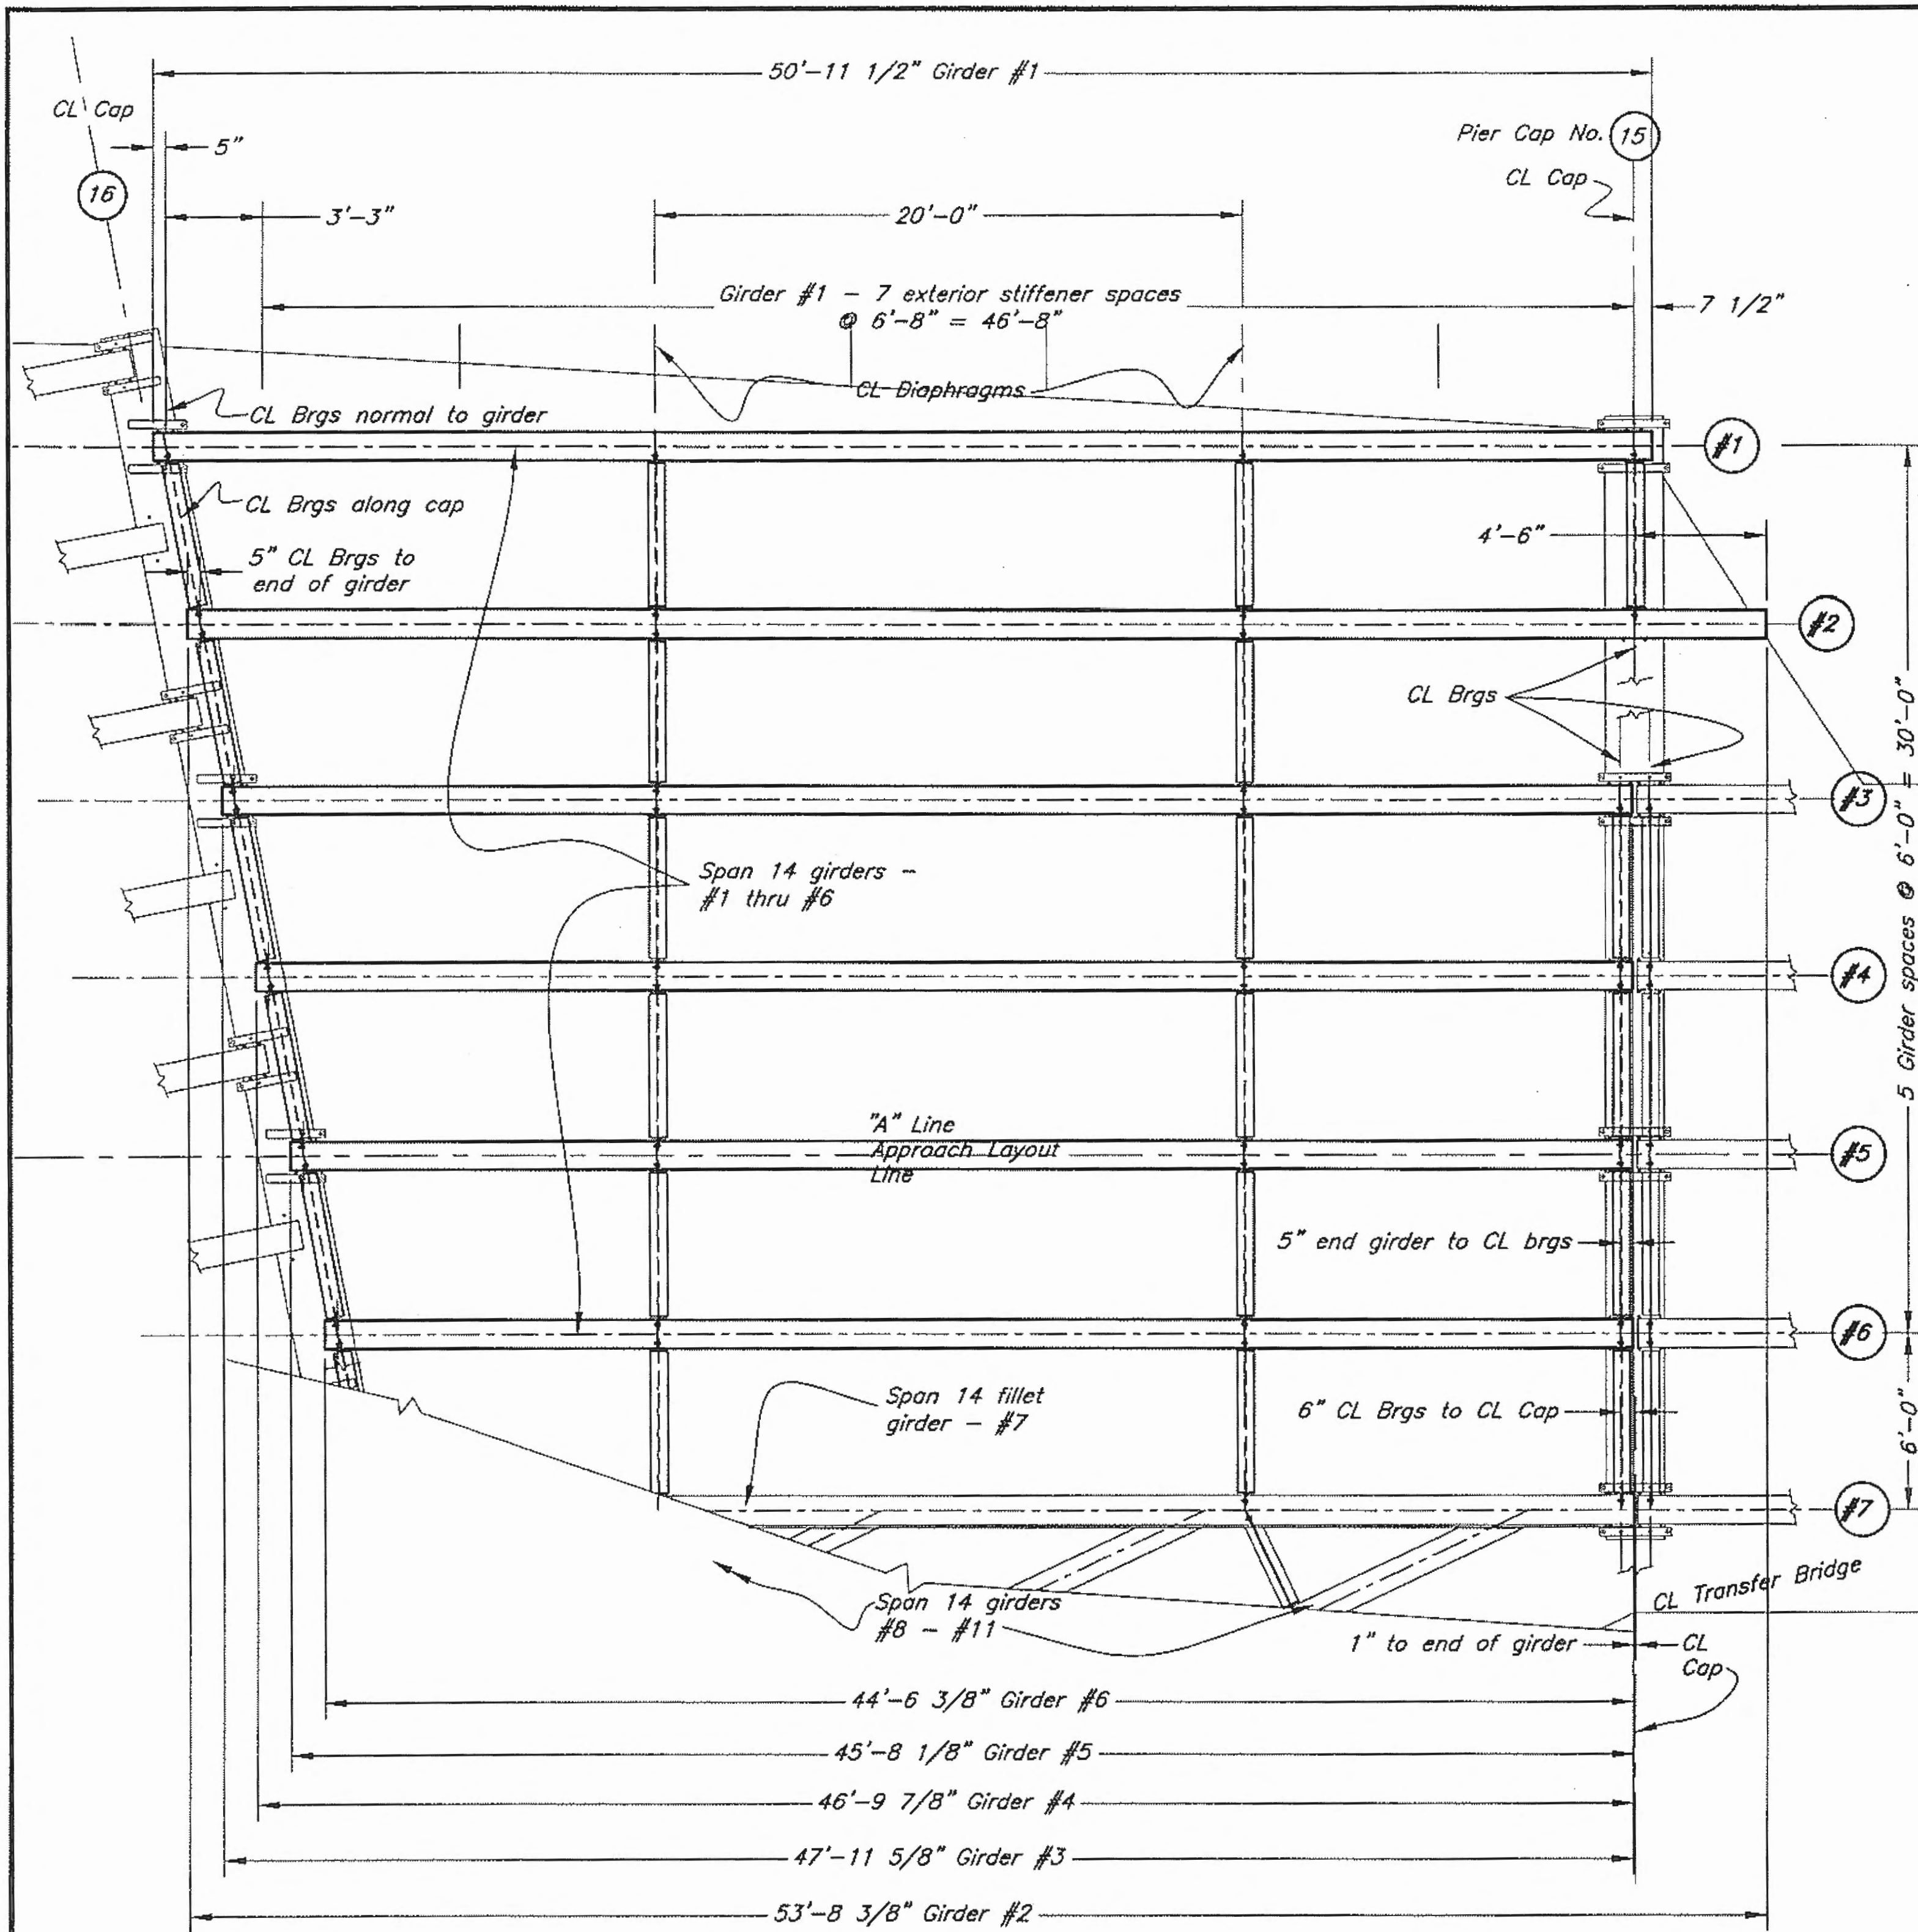

Span 14 - Framing Layout

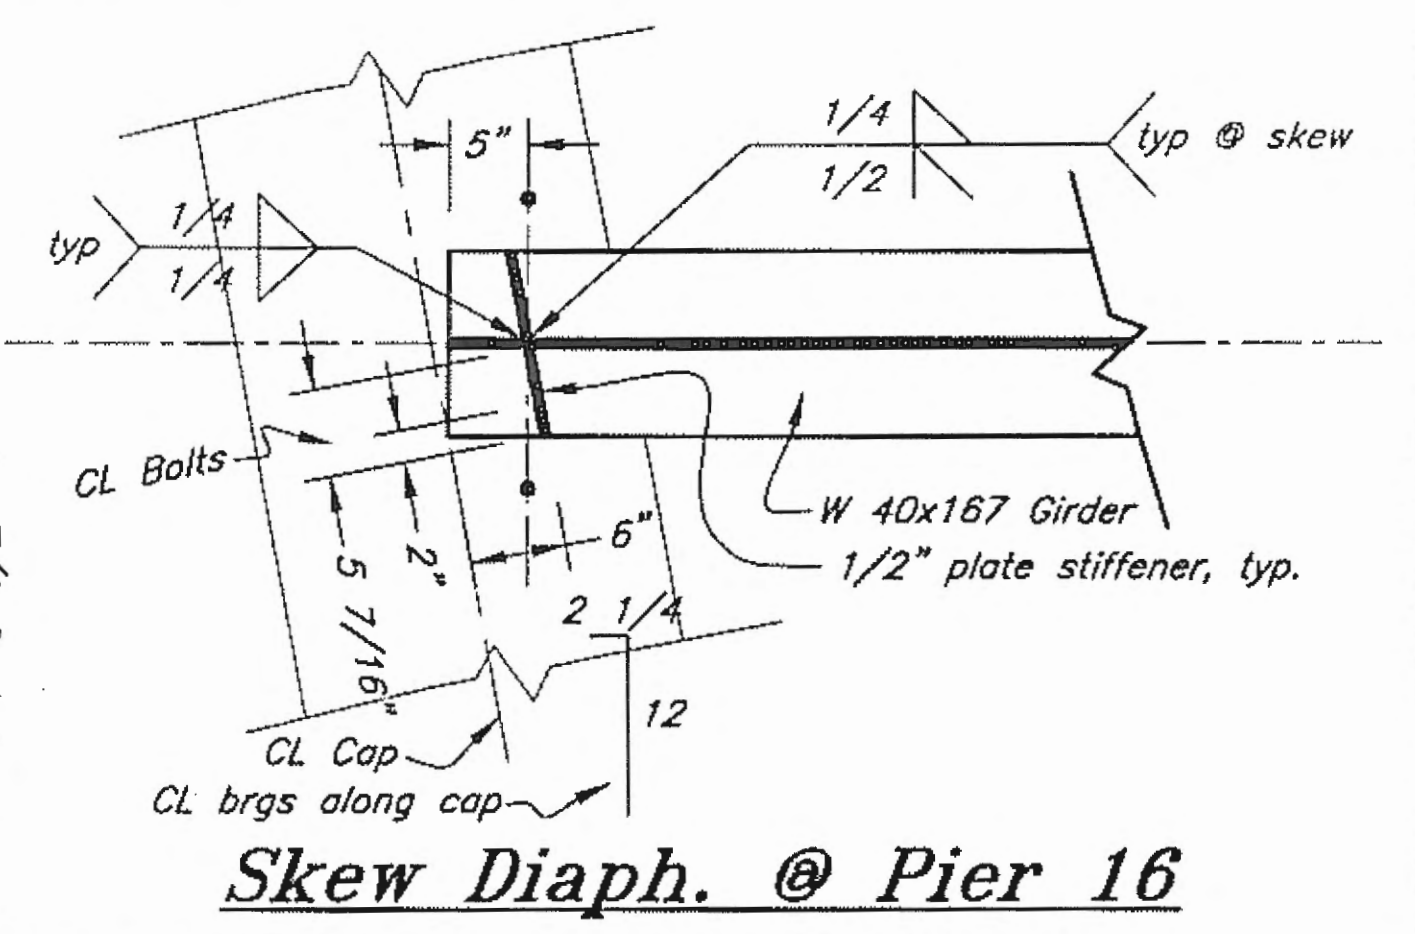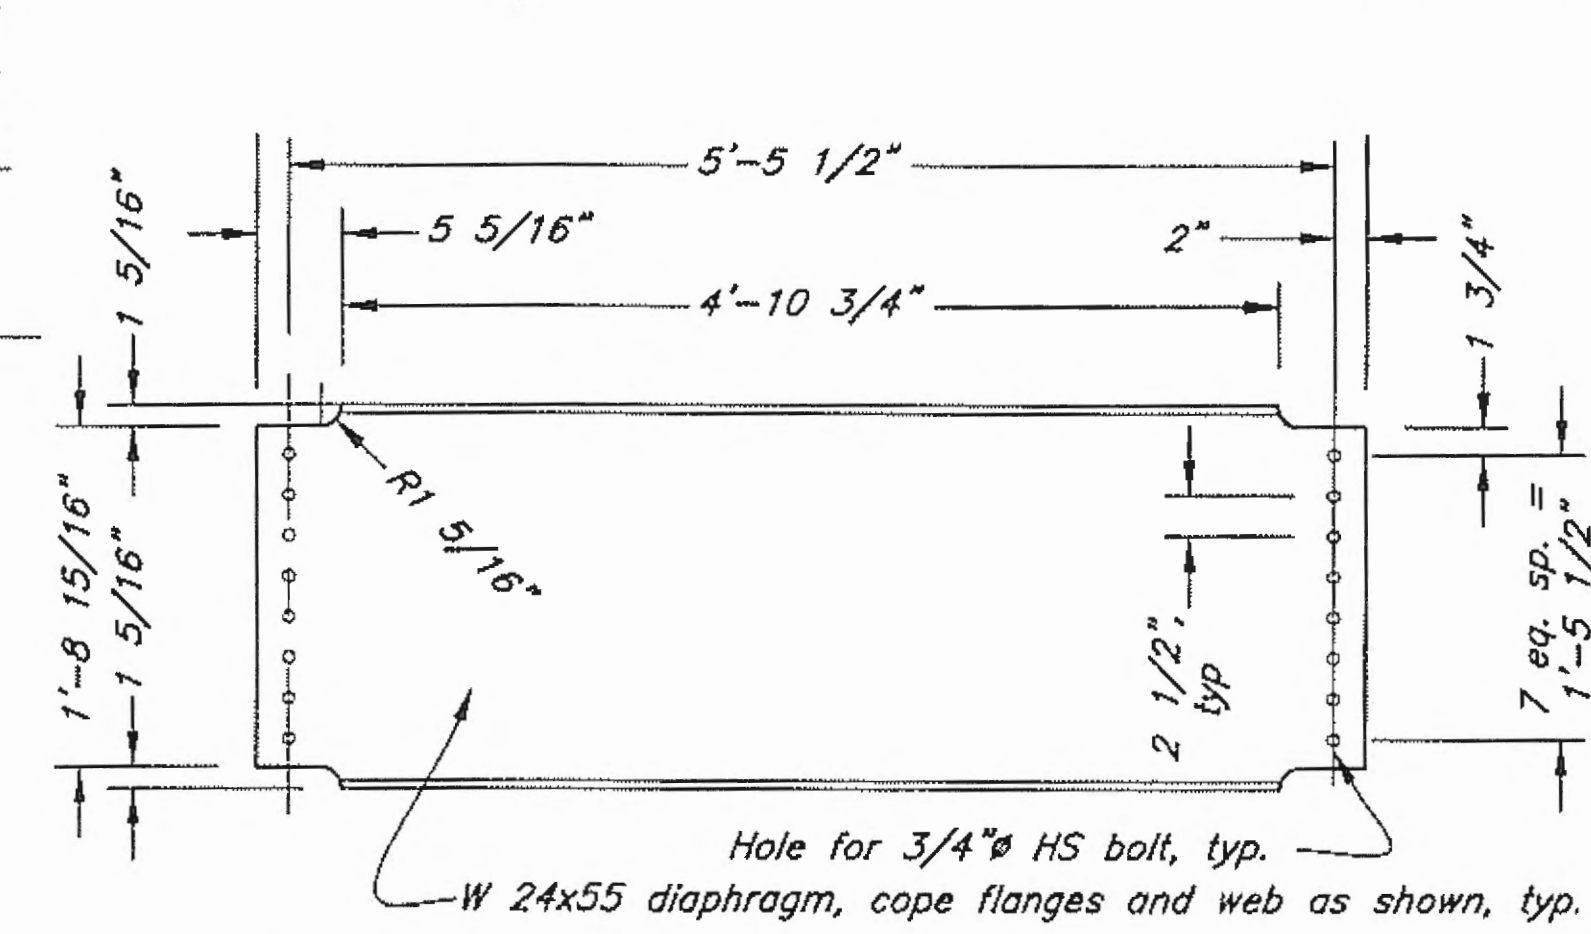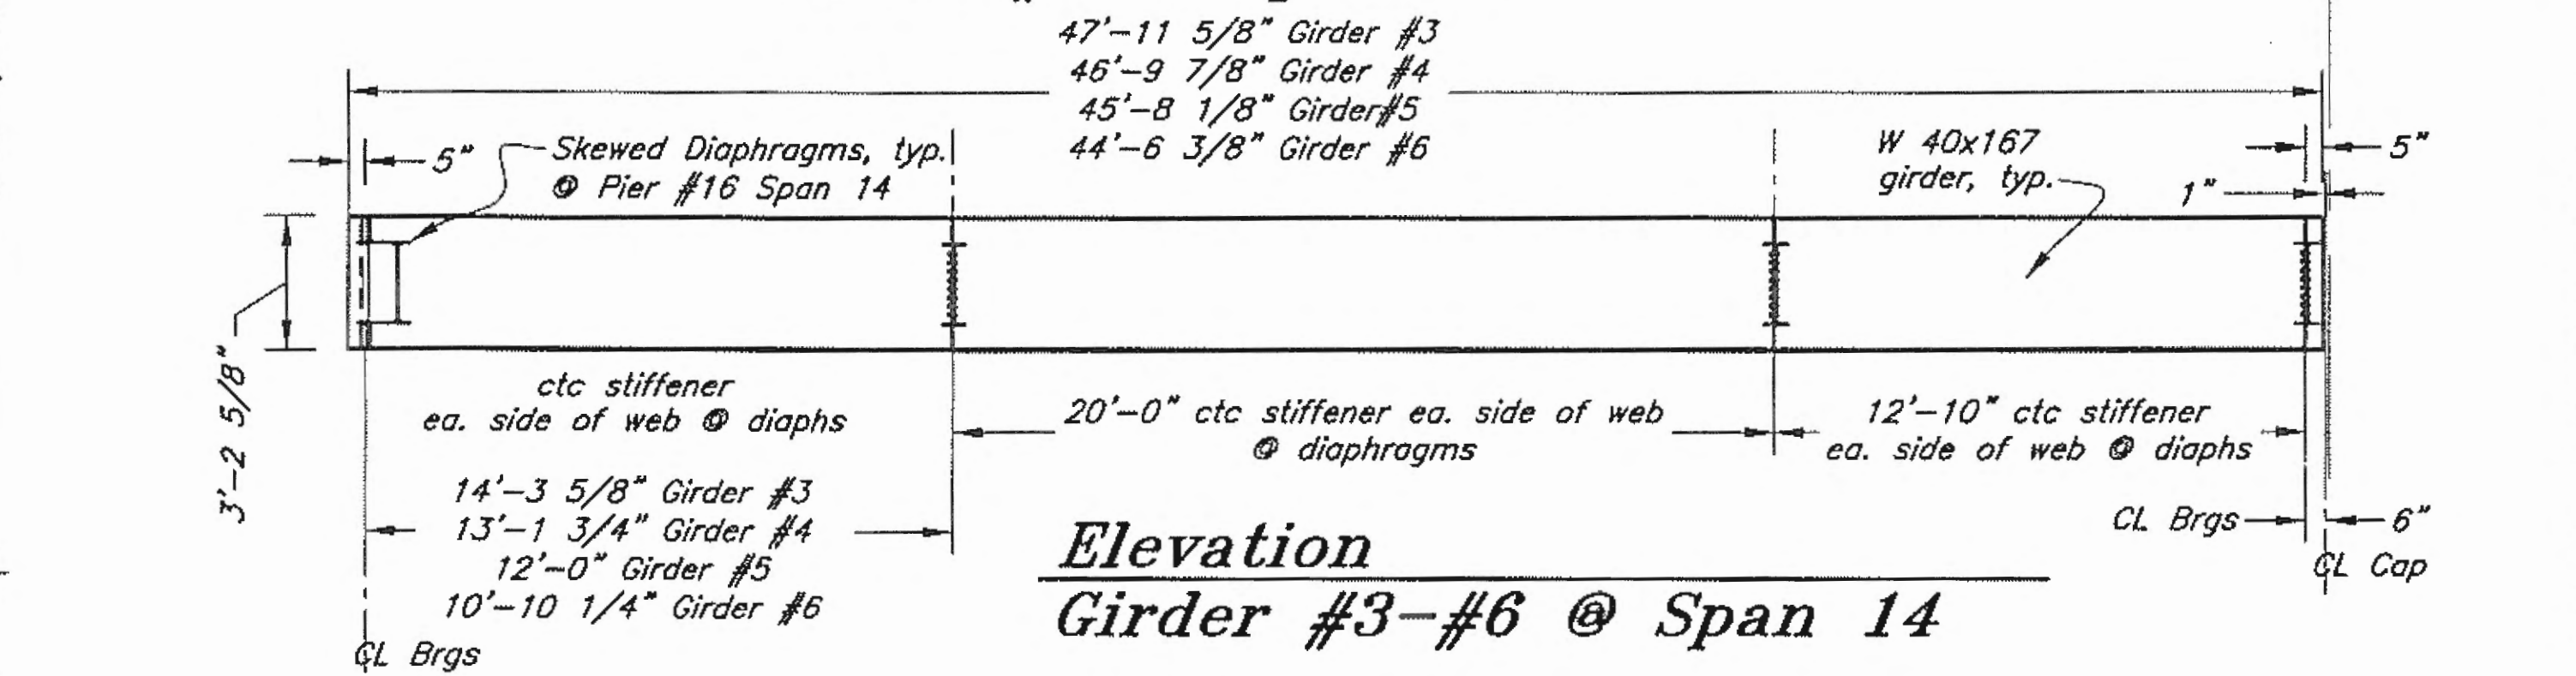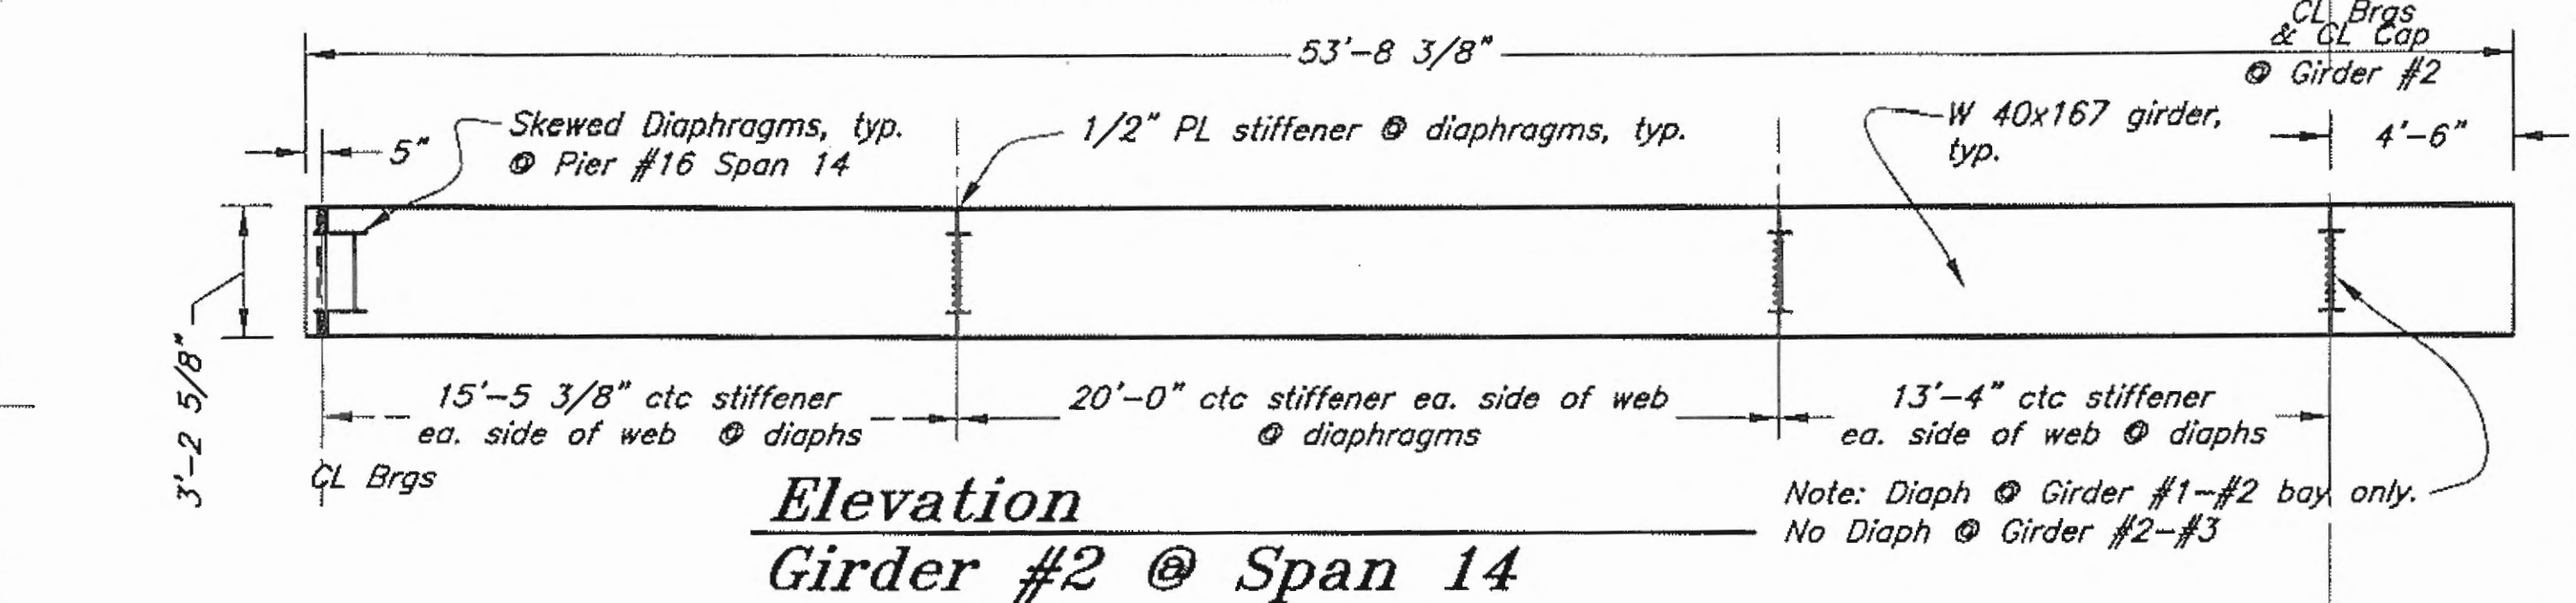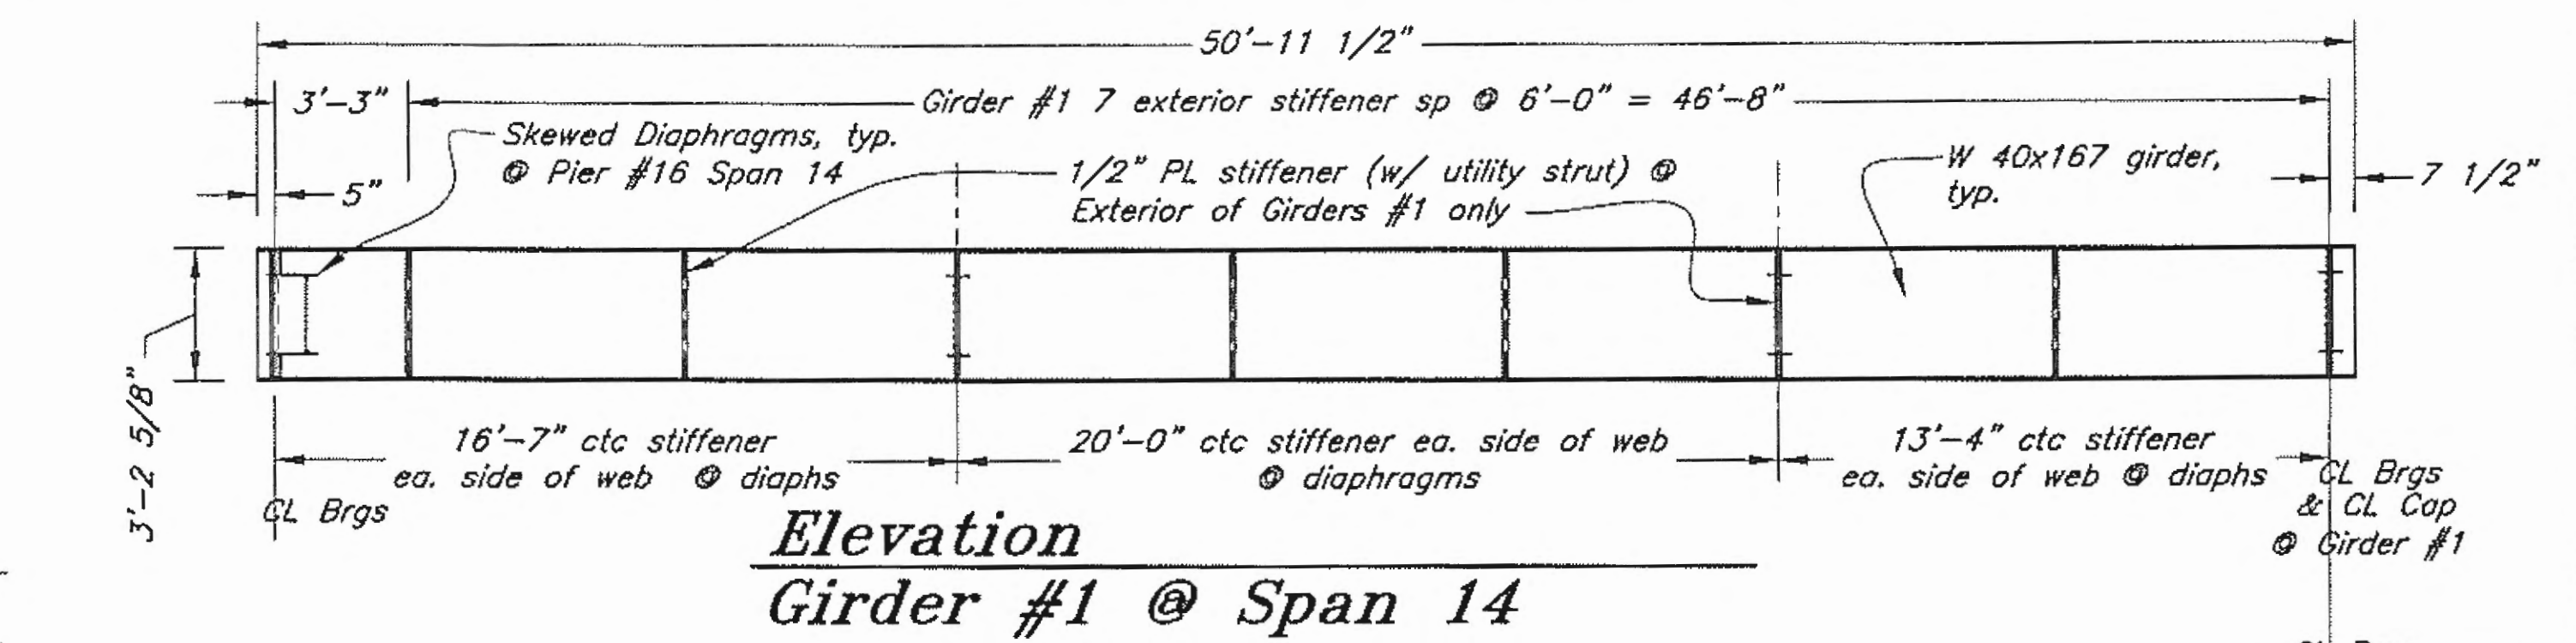

Elevation Skewed W 24x55 Diaphragm @ Pier 16

DO NOT SCALE FROM THESE DRAWINGS USE DIMENSIONS

DESIGNED BY: J. Scott


STATE OF ALASKA
DEPARTMENT OF TRANSPORTATION
& PUBLIC FACILITIES
DESIGN & ENGINEERING SERVICES DIVISION-SOUTHEAST REGION

Gustavus Causeway Replacement
Approach Transition Framing Span 14
AP26


CHECKED BY: B. Savikko
DRAWN BY: C. Fuman, W. Hickok
PATH: O:\GUS\67599\WF\PLANSET\03-APPROACH\AP26 TRANSITION FRAMING SPAN 14-1.DWG
TAB: Wed, 26/Nov/08 10:16AM JTS/SCOTT

REVISIONS			PROJECT DESIGNATION	YEAR	SHEET NO.	TOTAL SHEETS
NO.	DATE	DESCRIPTION	BR-0003(53)/67599	2008	36	138


Record Drawings have been reviewed by the Project Engineer, and represent to the best of my knowledge, the project as constructed.
Date 8/1/12

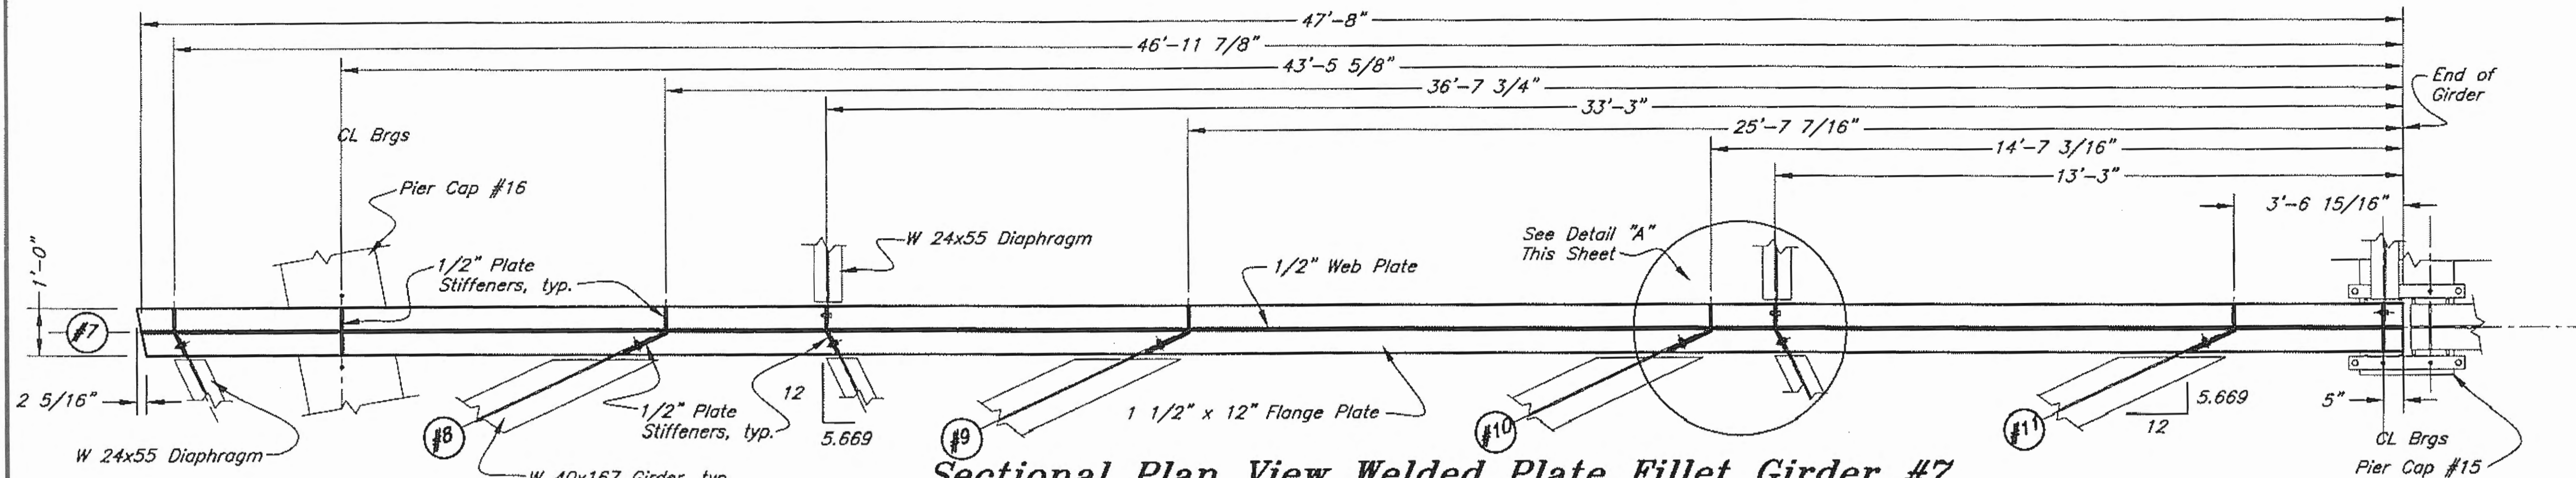


Sectional Plan View Welded Plate Fillet Girder #7
 (Section @ mid-height of web plate)

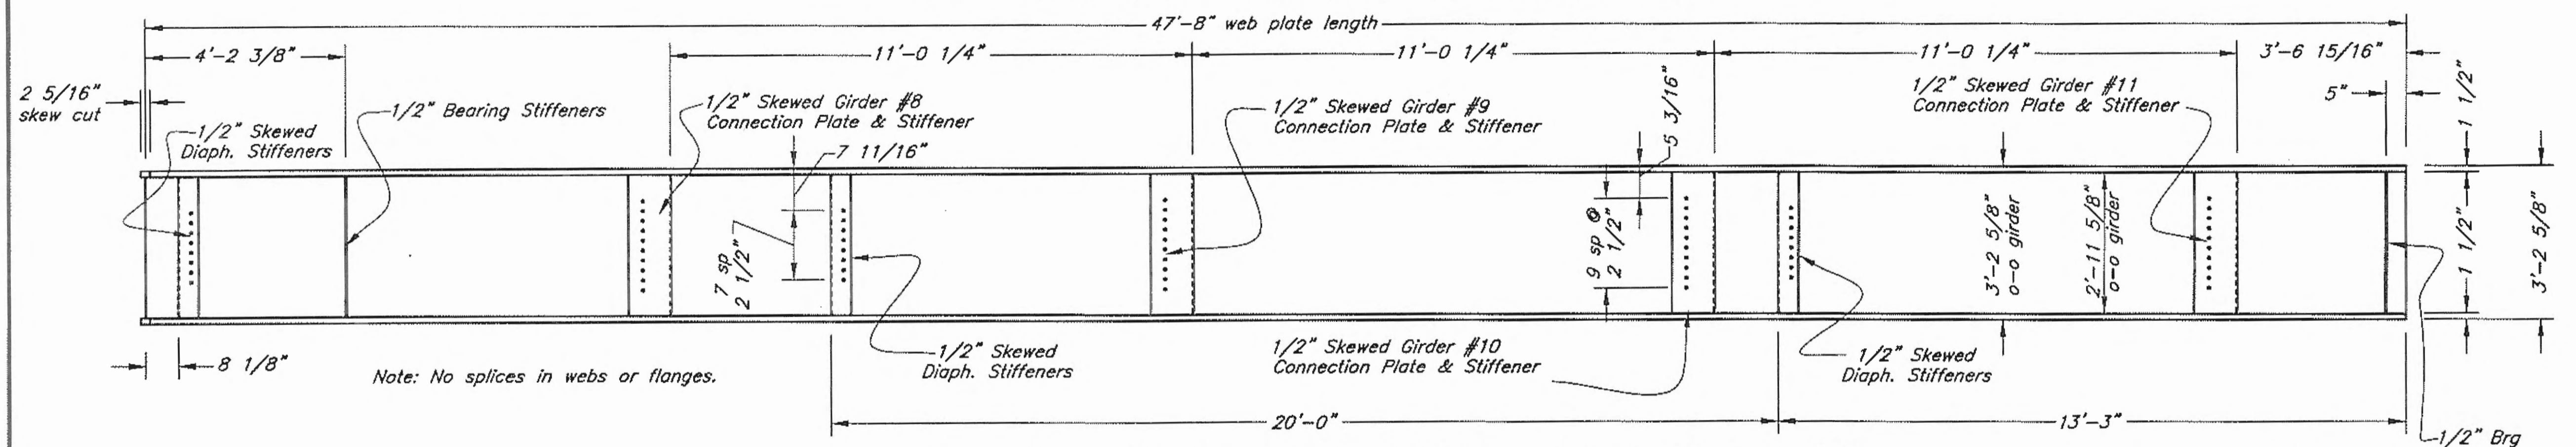

Elevation View Welded Plate Fillet Girder #7
 (looking Westward)

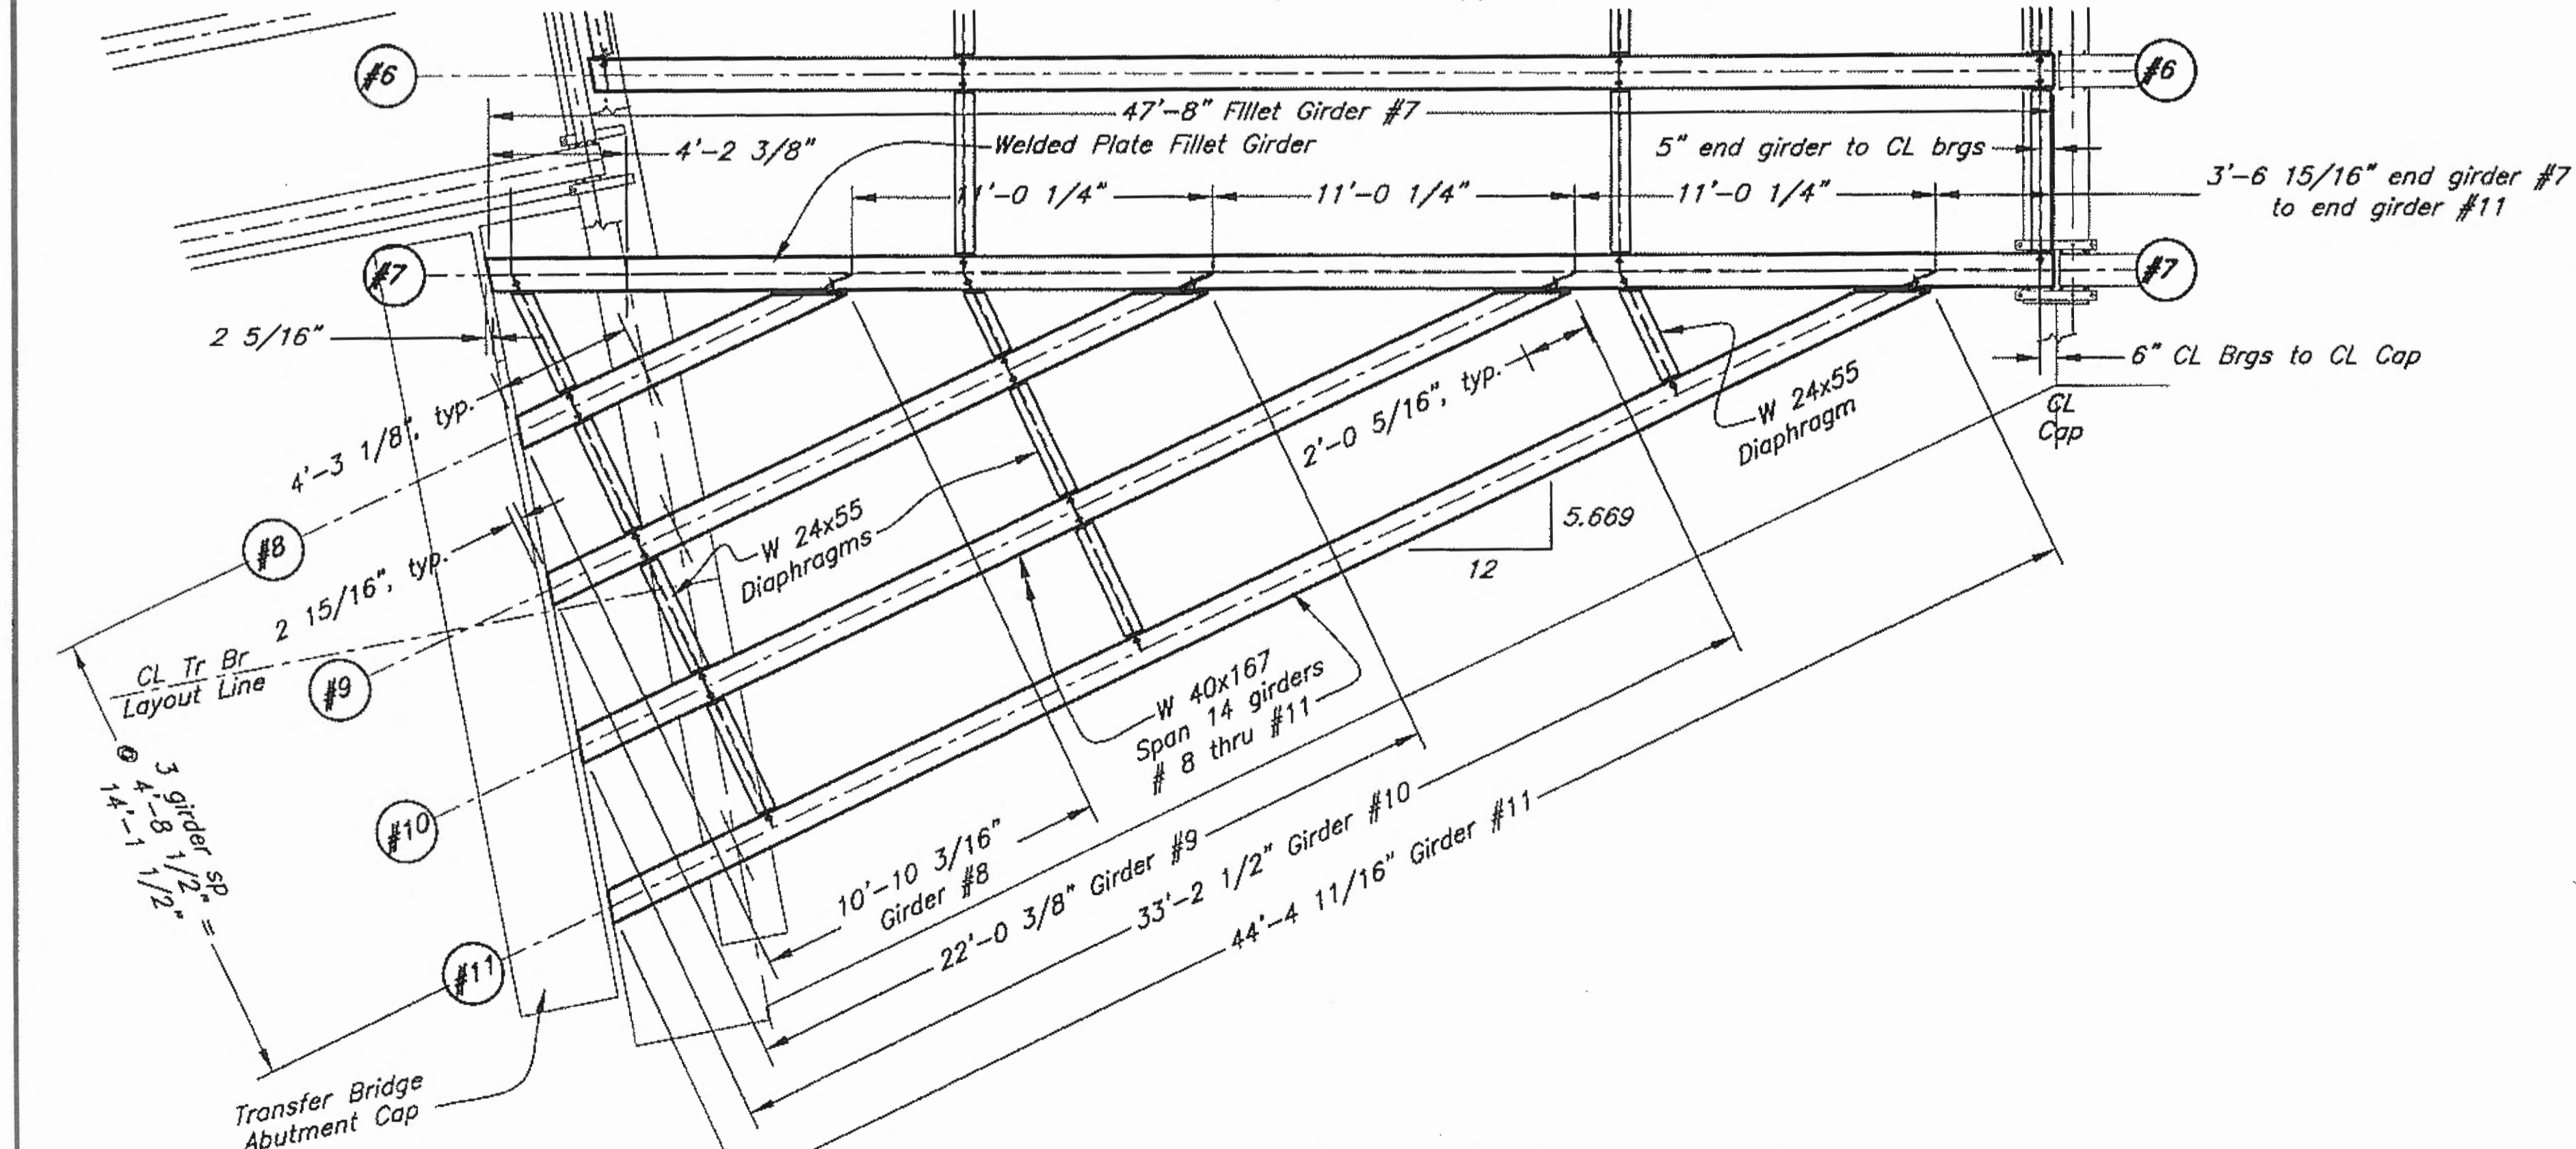


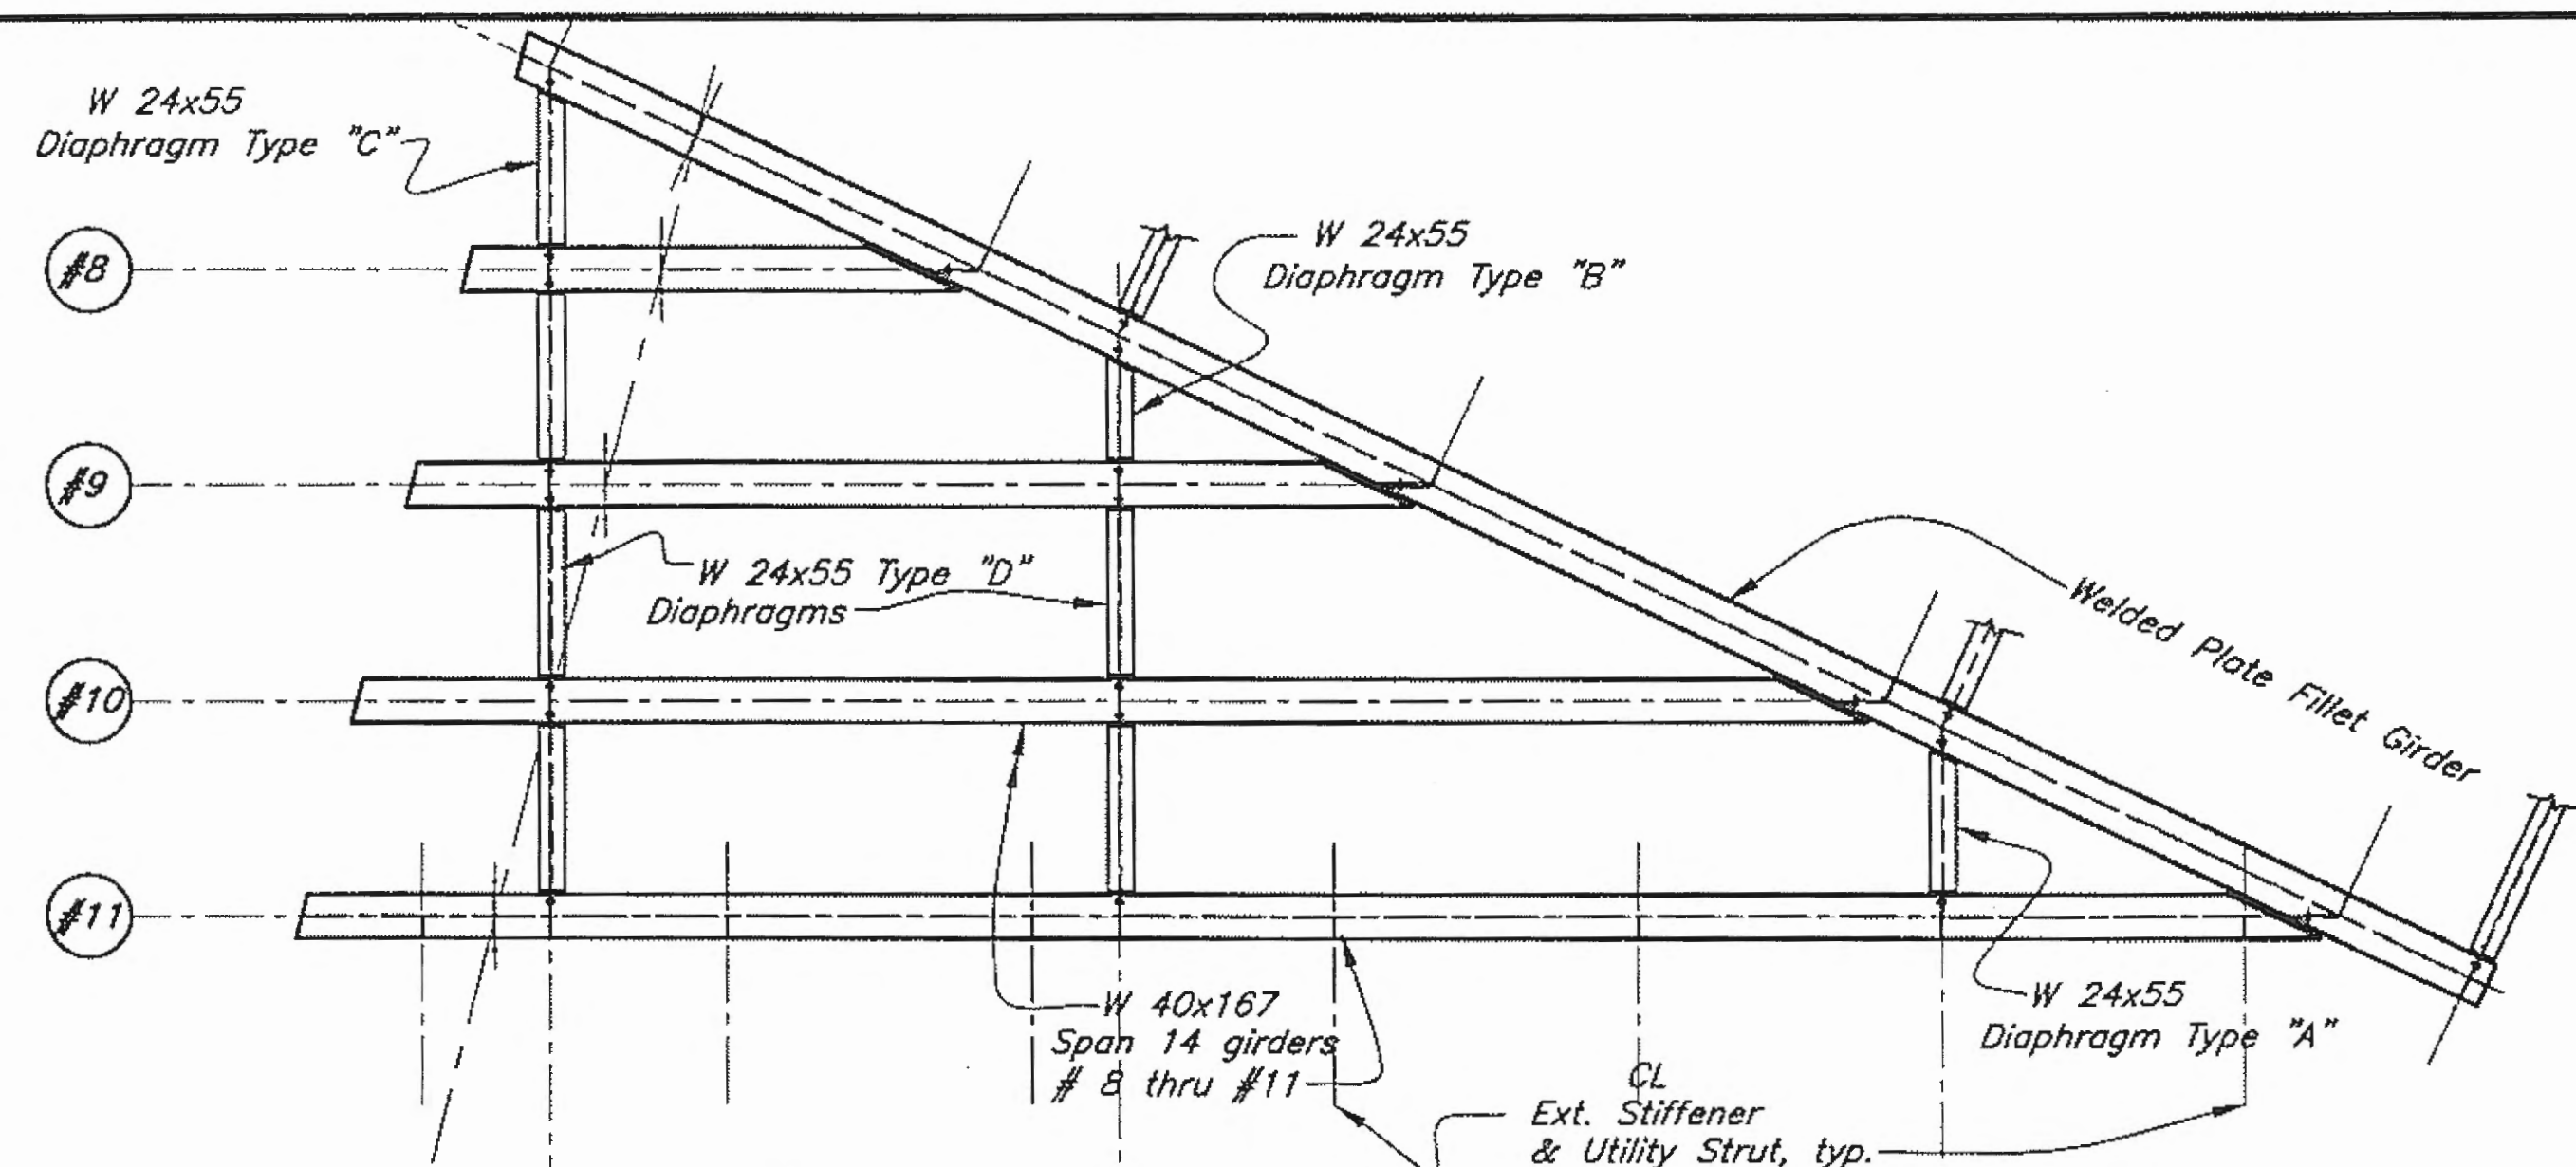
Span 14 Fillet Girder #7 - #11

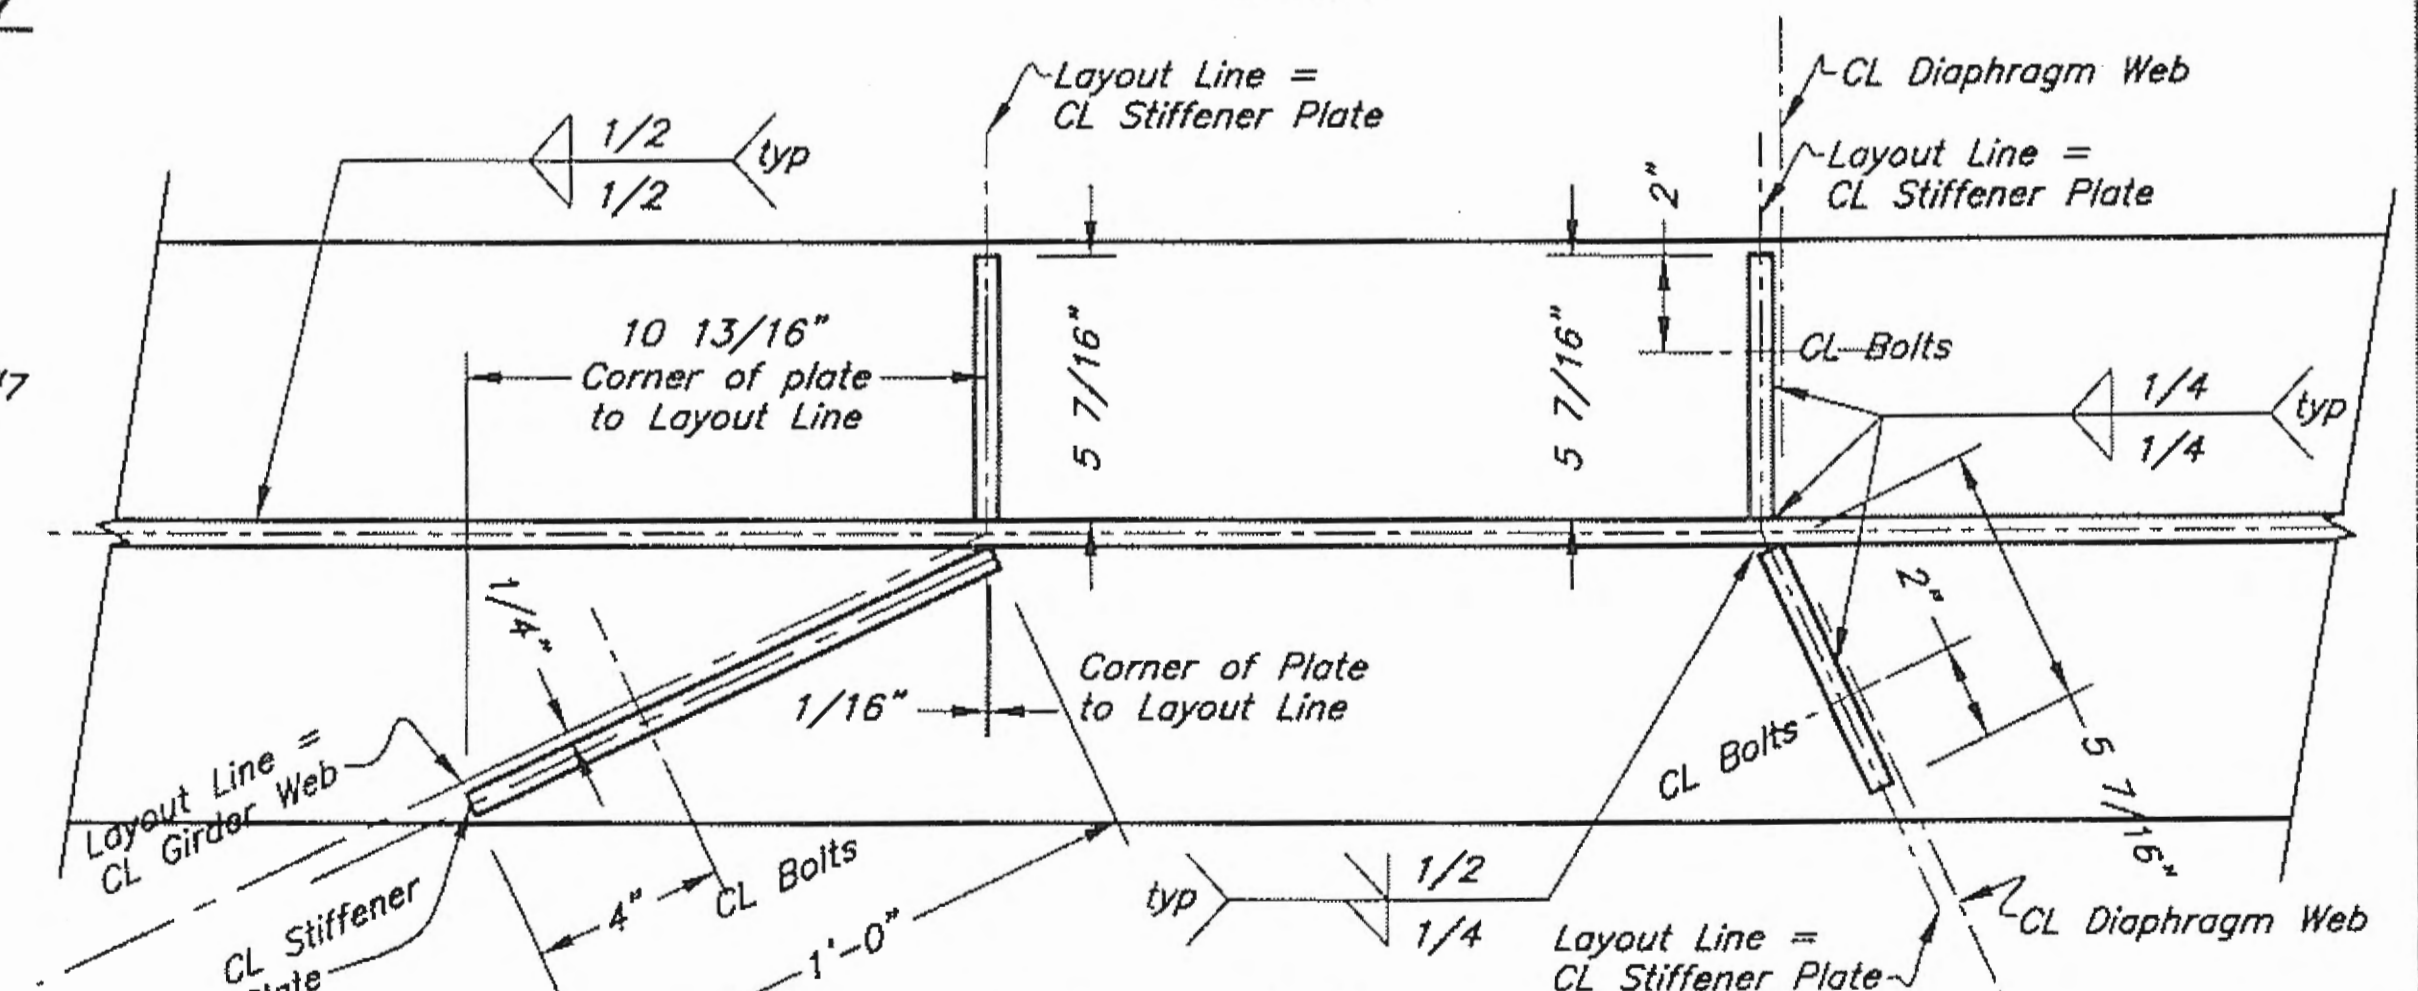


Detail "A"
 DO NOT SCALE FROM THESE DRAWINGS USE DIMENSIONS

Record Drawings have been reviewed by the Project Engineer, and represent to the best of my knowledge, the project as constructed.
 PE [Signature] Date 8/21/17


DESIGNED BY: J. Scott  CHECKED BY: B. Savikko DRAWN BY: C. Fuman, W. Hickok		STATE OF ALASKA DEPARTMENT OF TRANSPORTATION & PUBLIC FACILITIES DESIGN & ENGINEERING SERVICES DIVISION-SOUTHEAST REGION Gustavus Causeway Replacement Approach Transition Framing Span 14 Fillet AP27			
PATH: Q:\GUS\67599\MF\PLANSET\03-APPROACH\AP27 TRANSITION FRAMING SPAN 14-2.DWG TAB: Wed, 26/Nov/08 10:28AM JTS/COIT		PROJECT DESIGNATION BR-0003(53)/67599	YEAR 2008	SHEET NO. 37	TOTAL SHEETS 138




Layout Girders #8 - #11 @ Span 14

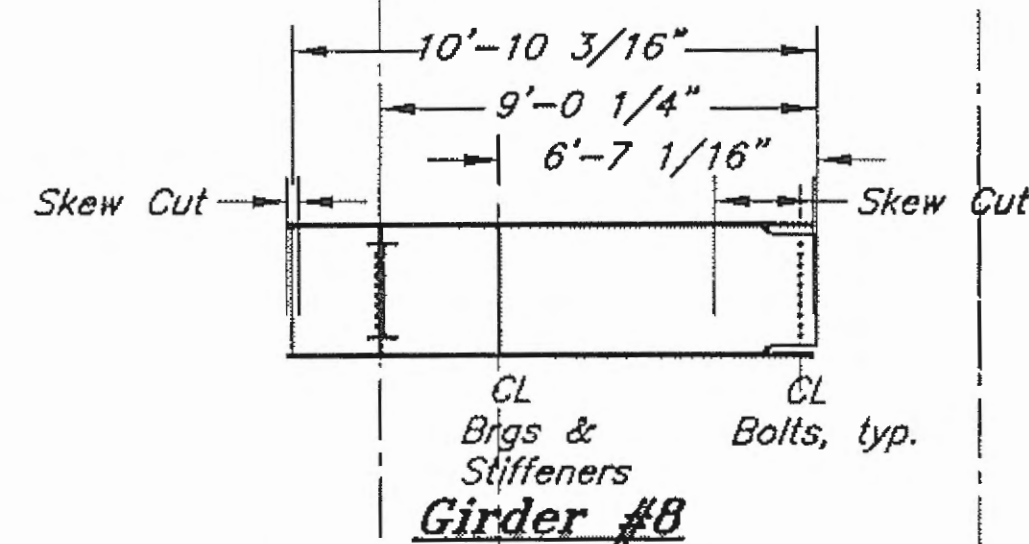


Girder #8

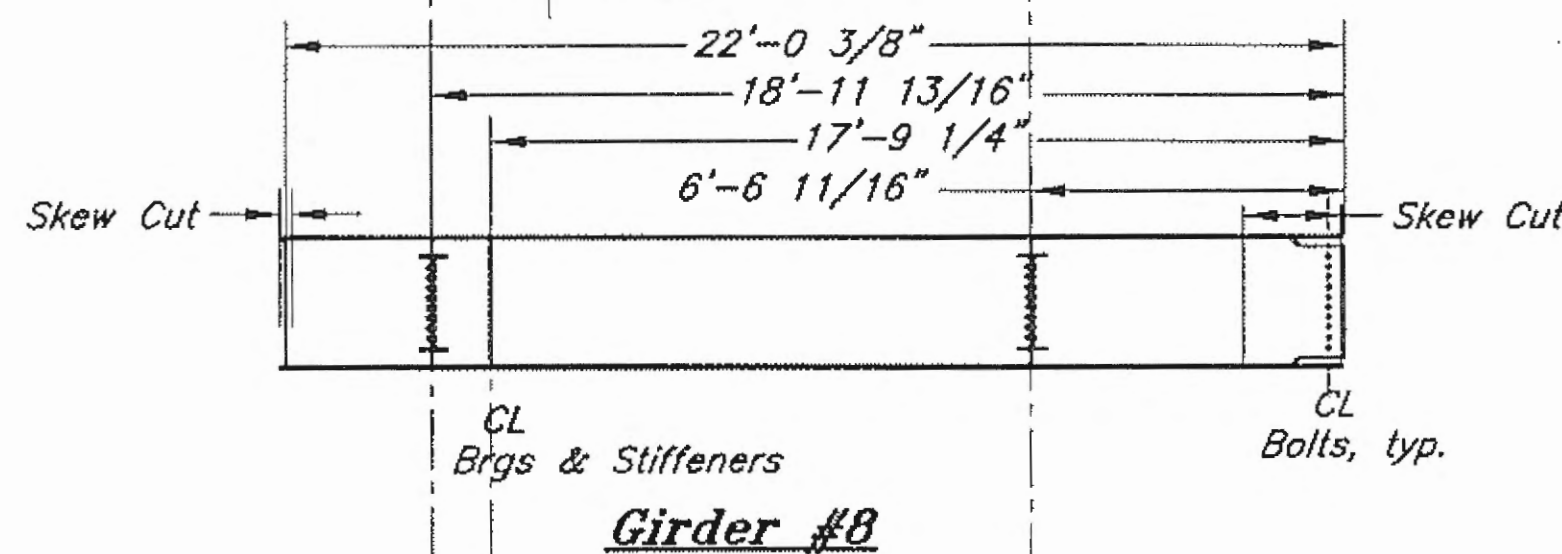

Girder #8

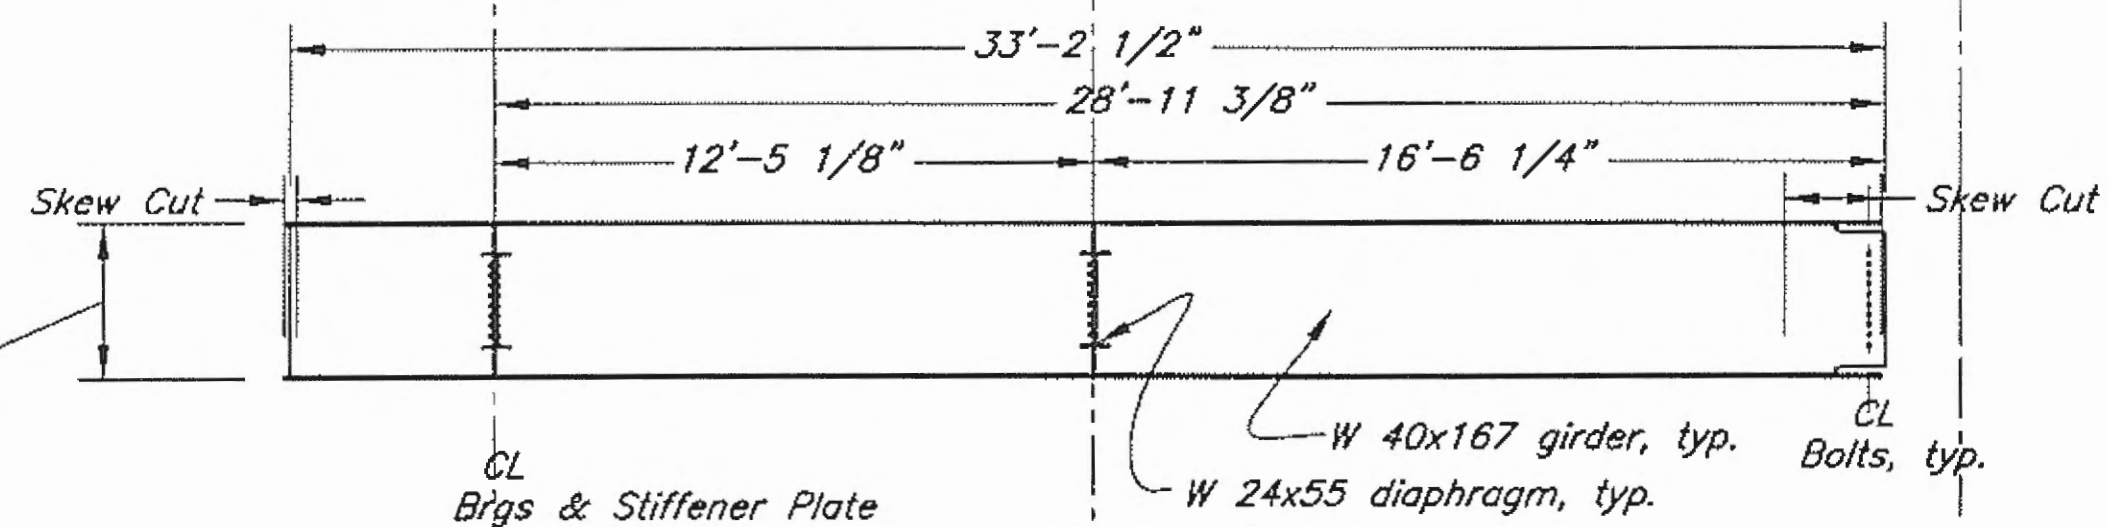


Girder #8

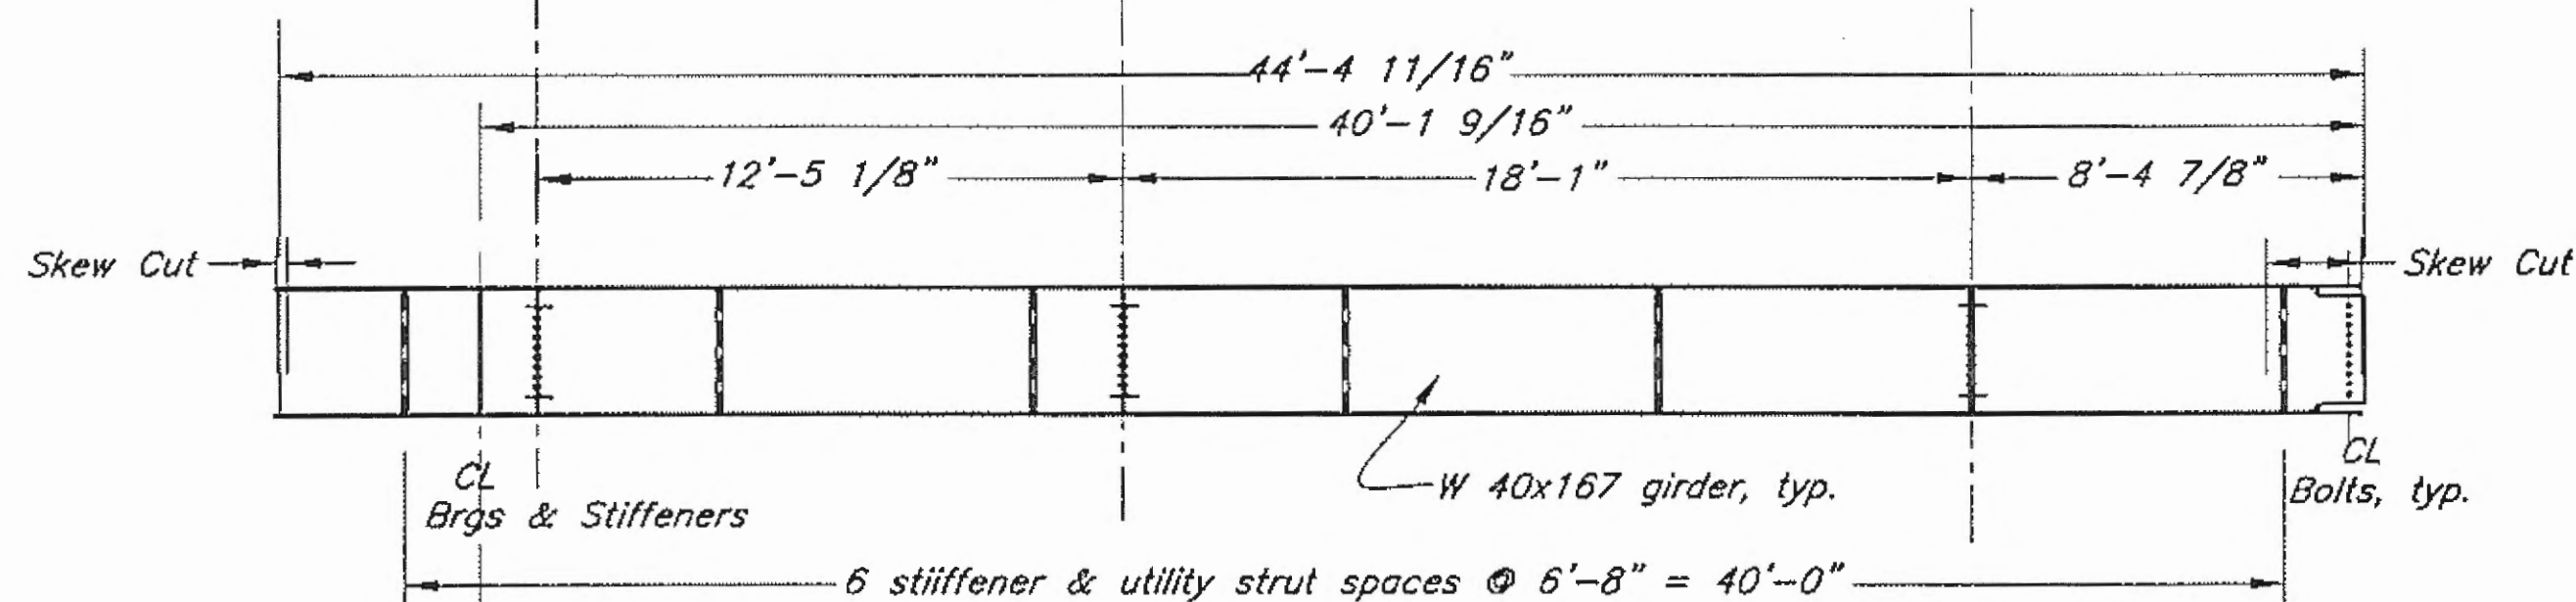


Girder #8

Elevation Girders #8 - #11 @ Span 14

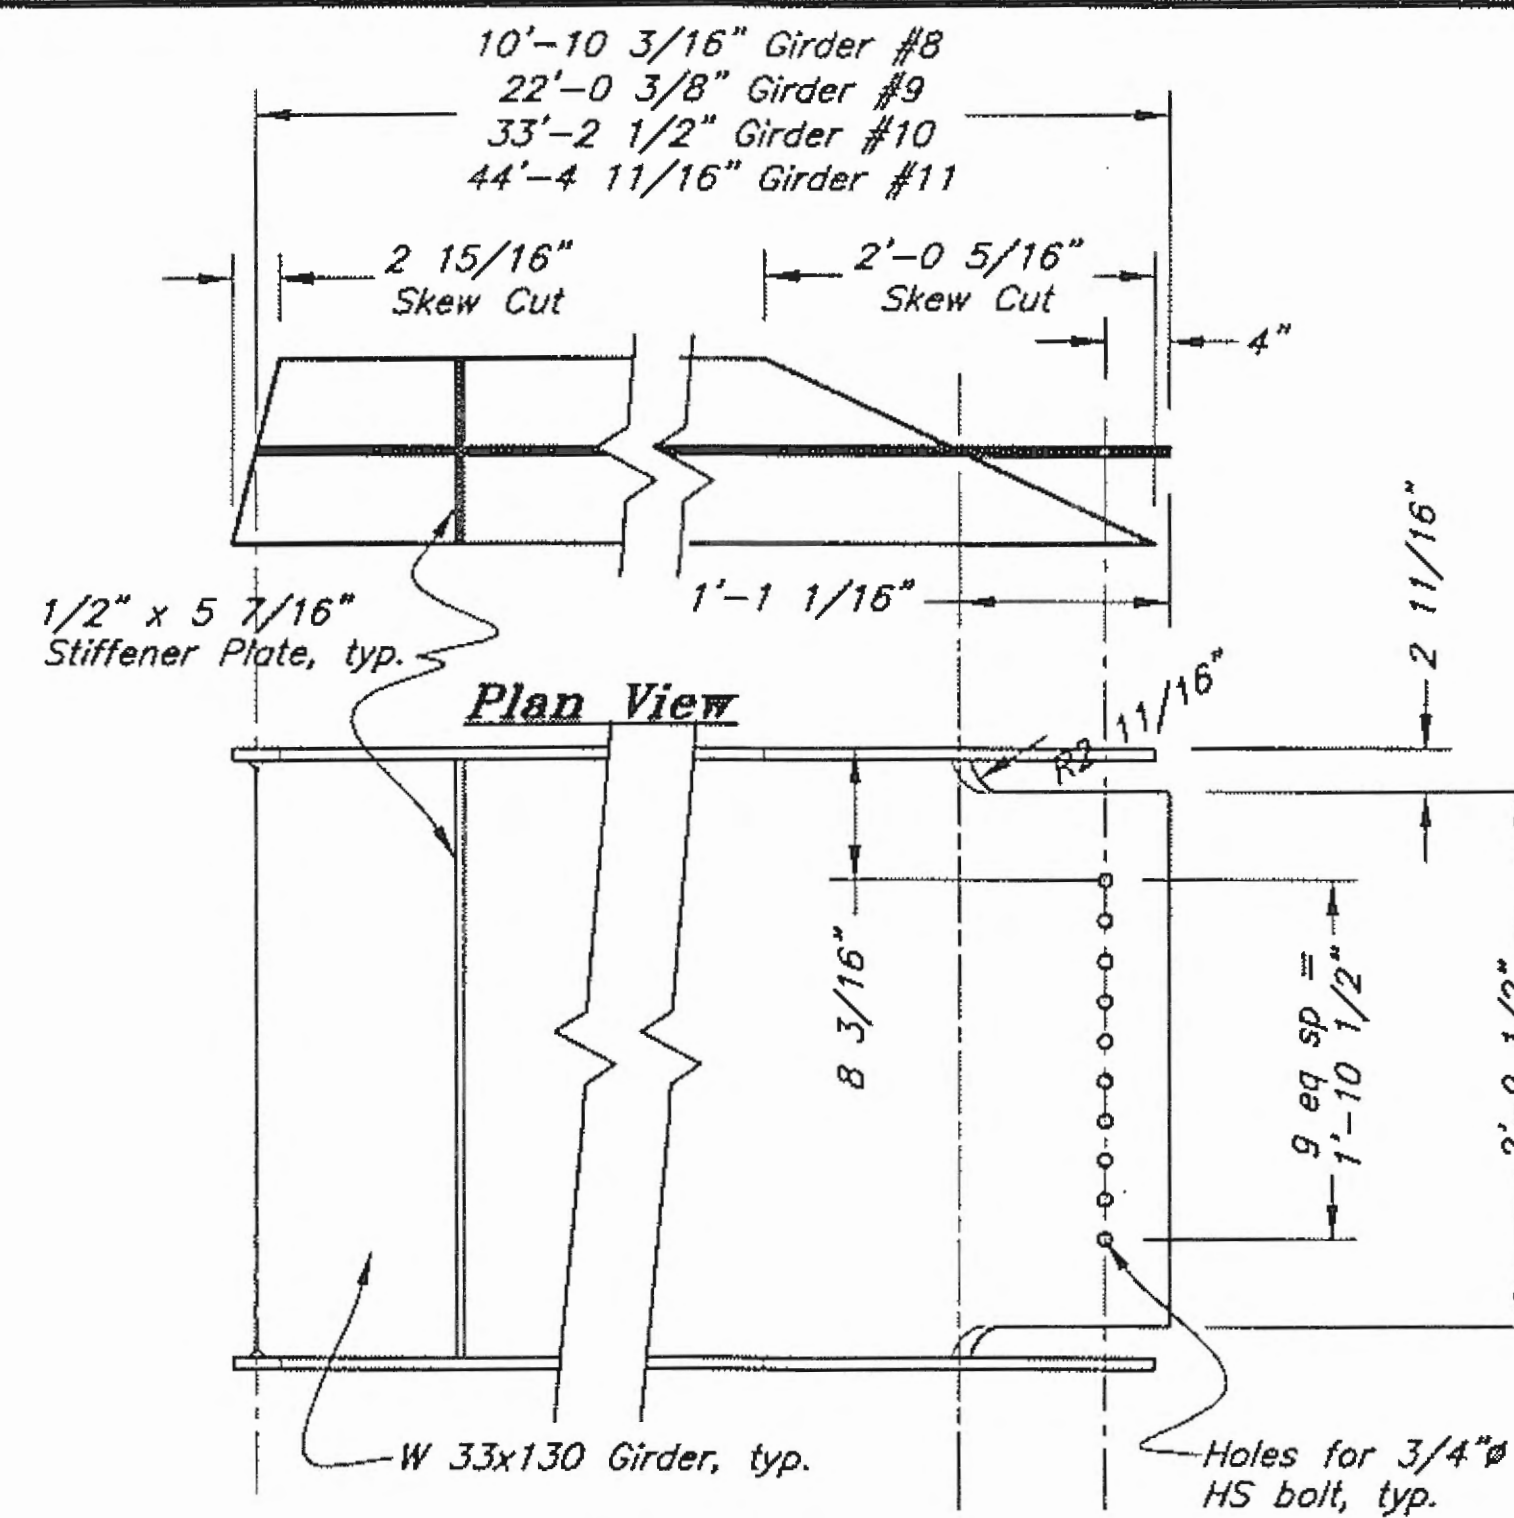

Plan View

Elevation View

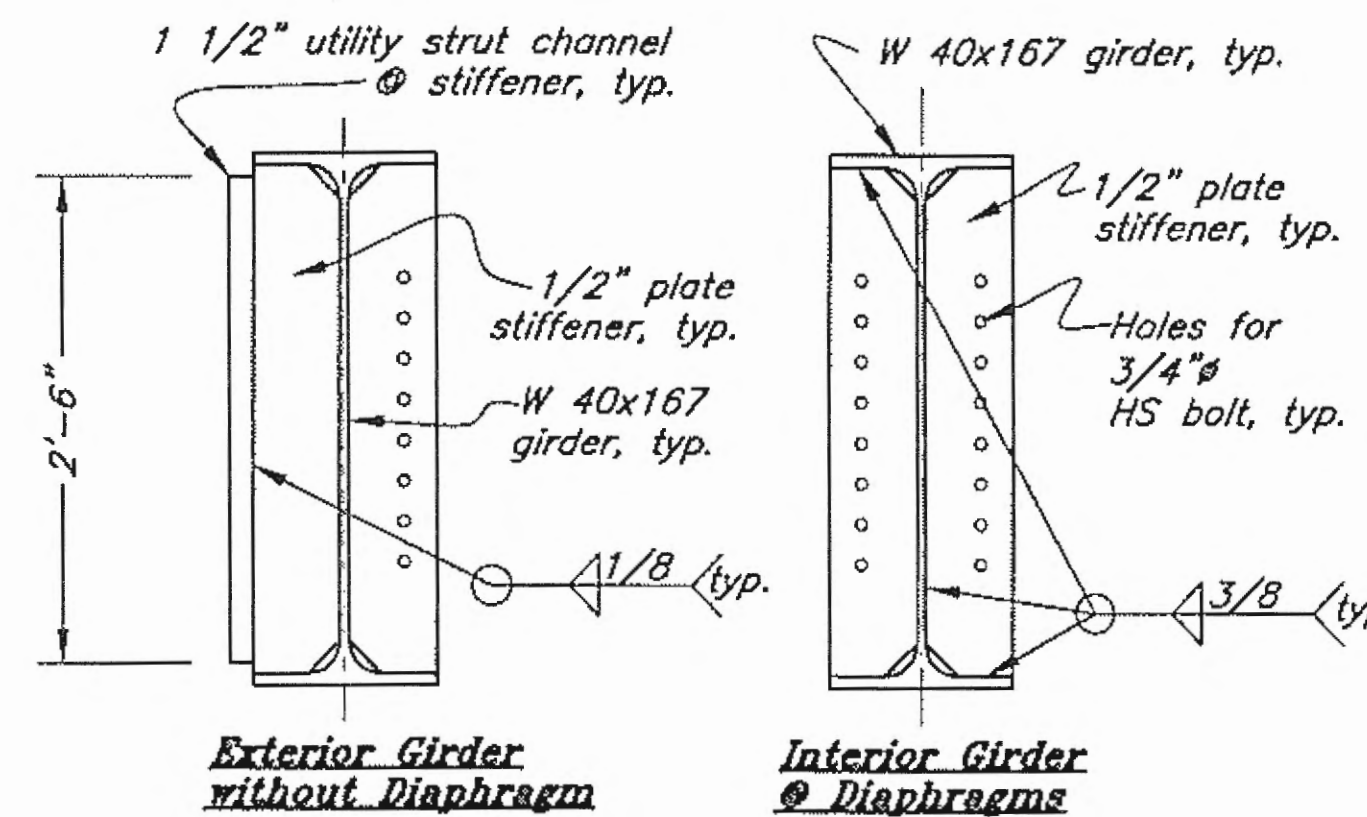


Exterior Girder without Diaphragm

Interior Girder @ Diaphragms

Section Views

Skewed Girders #8 - #11

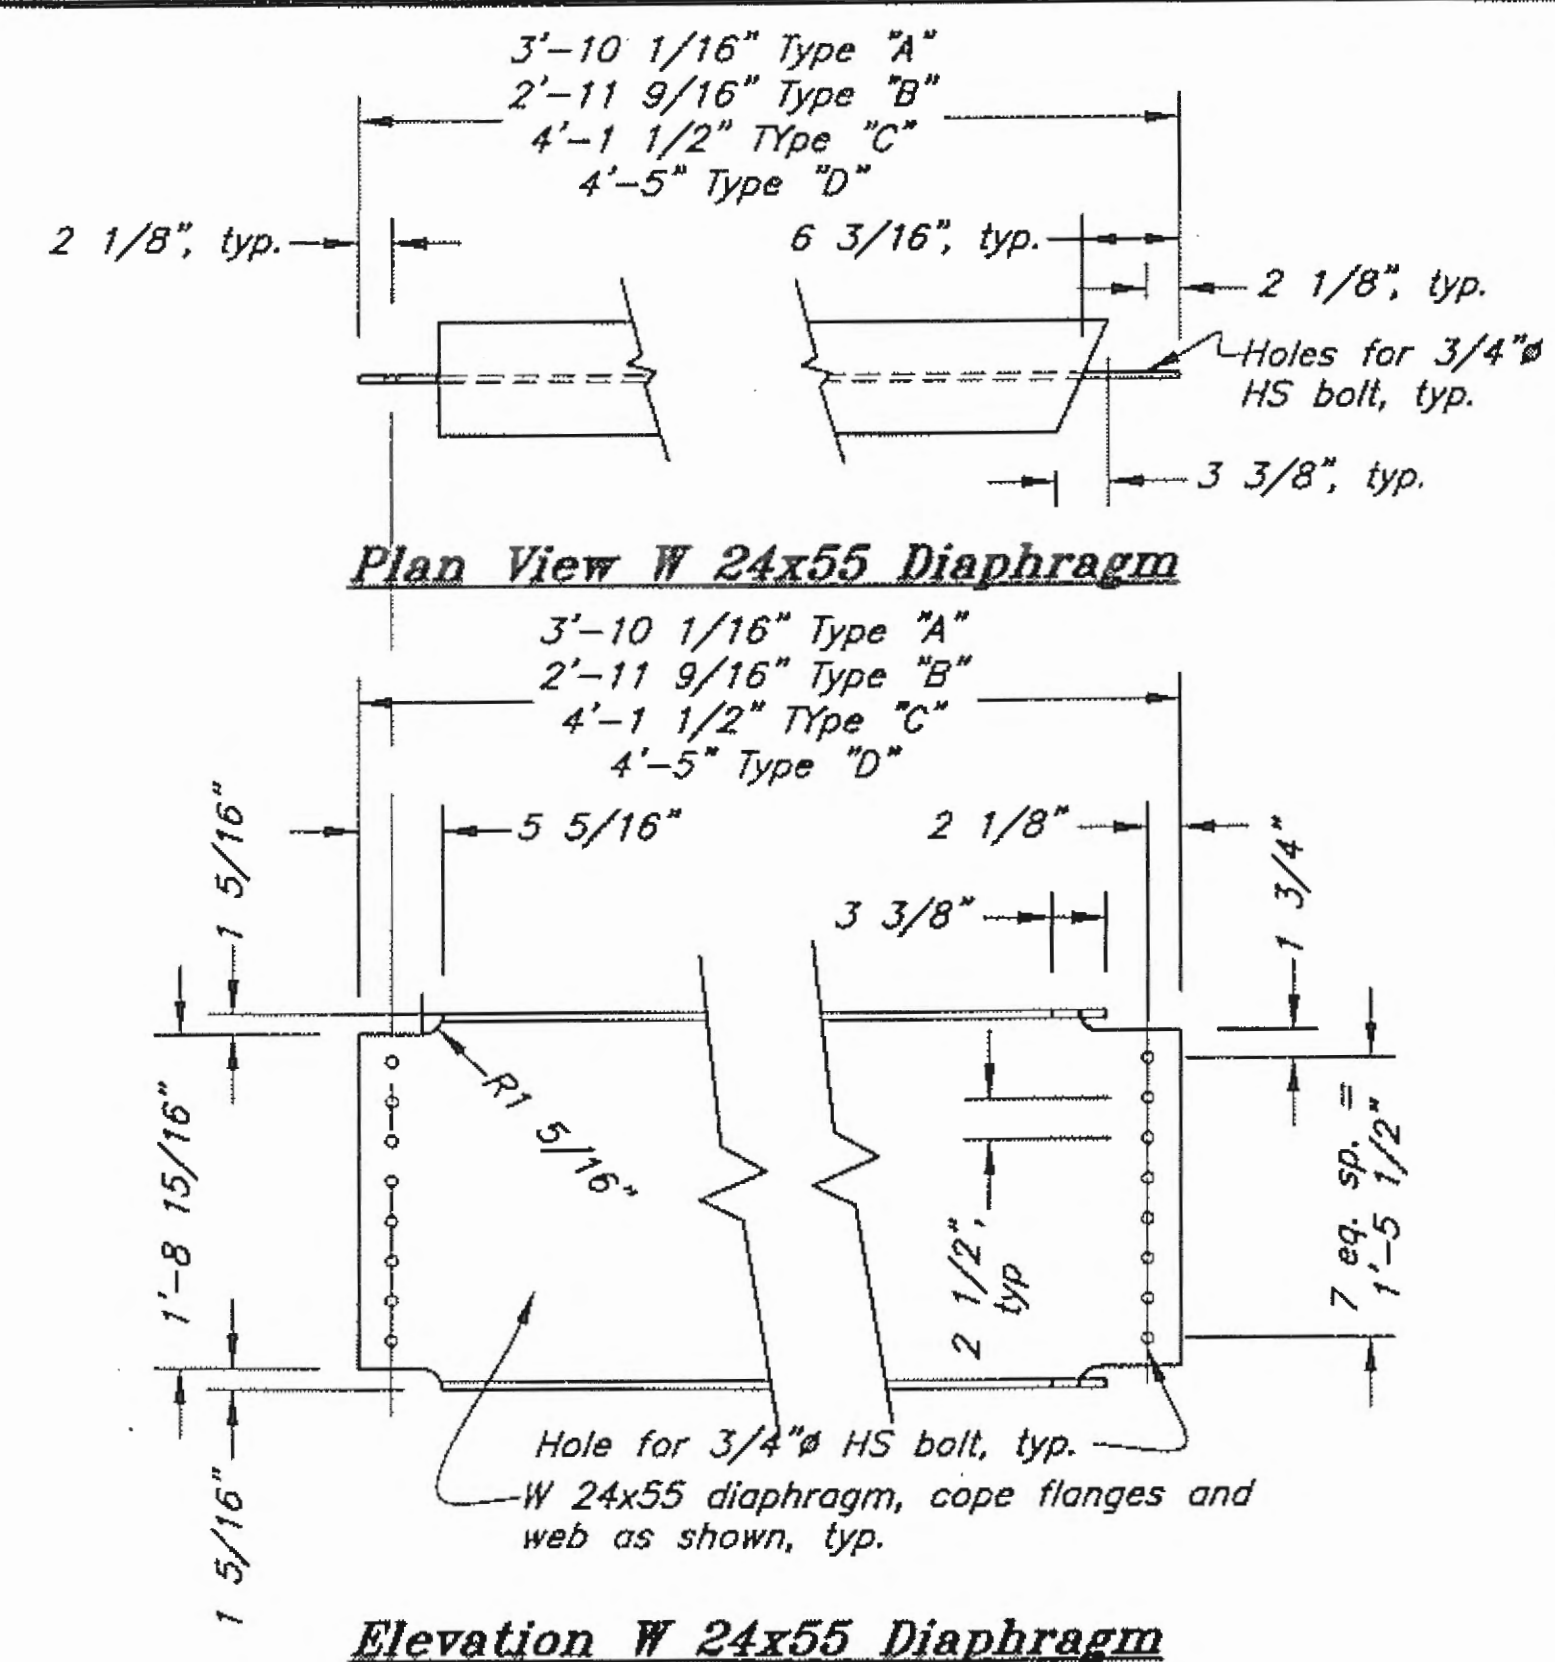

Plan View W 24x55 Diaphragm

Elevation W 24x55 Diaphragm

W 24x55 Diaphragms between Skewed Girders #8 - #11

Record Drawings have been reviewed by the Project Engineer, and represent to the best of my knowledge, the project as constructed.
 PE *[Signature]* Date 8/21/12

DO NOT SCALE FROM THESE DRAWINGS USE DIMENSIONS

DESIGNED BY: J. Scott

STATE OF ALASKA
 DEPARTMENT OF TRANSPORTATION & PUBLIC FACILITIES
 DESIGN & ENGINEERING SERVICES DIVISION-SOUTHEAST REGION

Gustavus Causeway Replacement
 Approach
 Transition Framing
 Span 14 Details



AP28

CHECKED BY: B. Savikko
 DRAWN BY: C. Fuman, W. Hickok

STATE OF ALASKA
 49th
 John T. Scott
 CE-4755
 REGISTERED PROFESSIONAL ENGINEER
 11-26-08

PATH: Q:\GUS\67599\MF\PLANSET\03-APPROACH\AP28 TRANSITION FRAMING SPAN 14-3.DWG
 TAB: Wed, 26/Nov/08 02:24PM JISCOIT

REVISIONS			PROJECT DESIGNATION	YEAR	SHEET NO.	TOTAL SHEETS
NO.	DATE	DESCRIPTION				
			BR-0003(53)/67599	2008	38	138

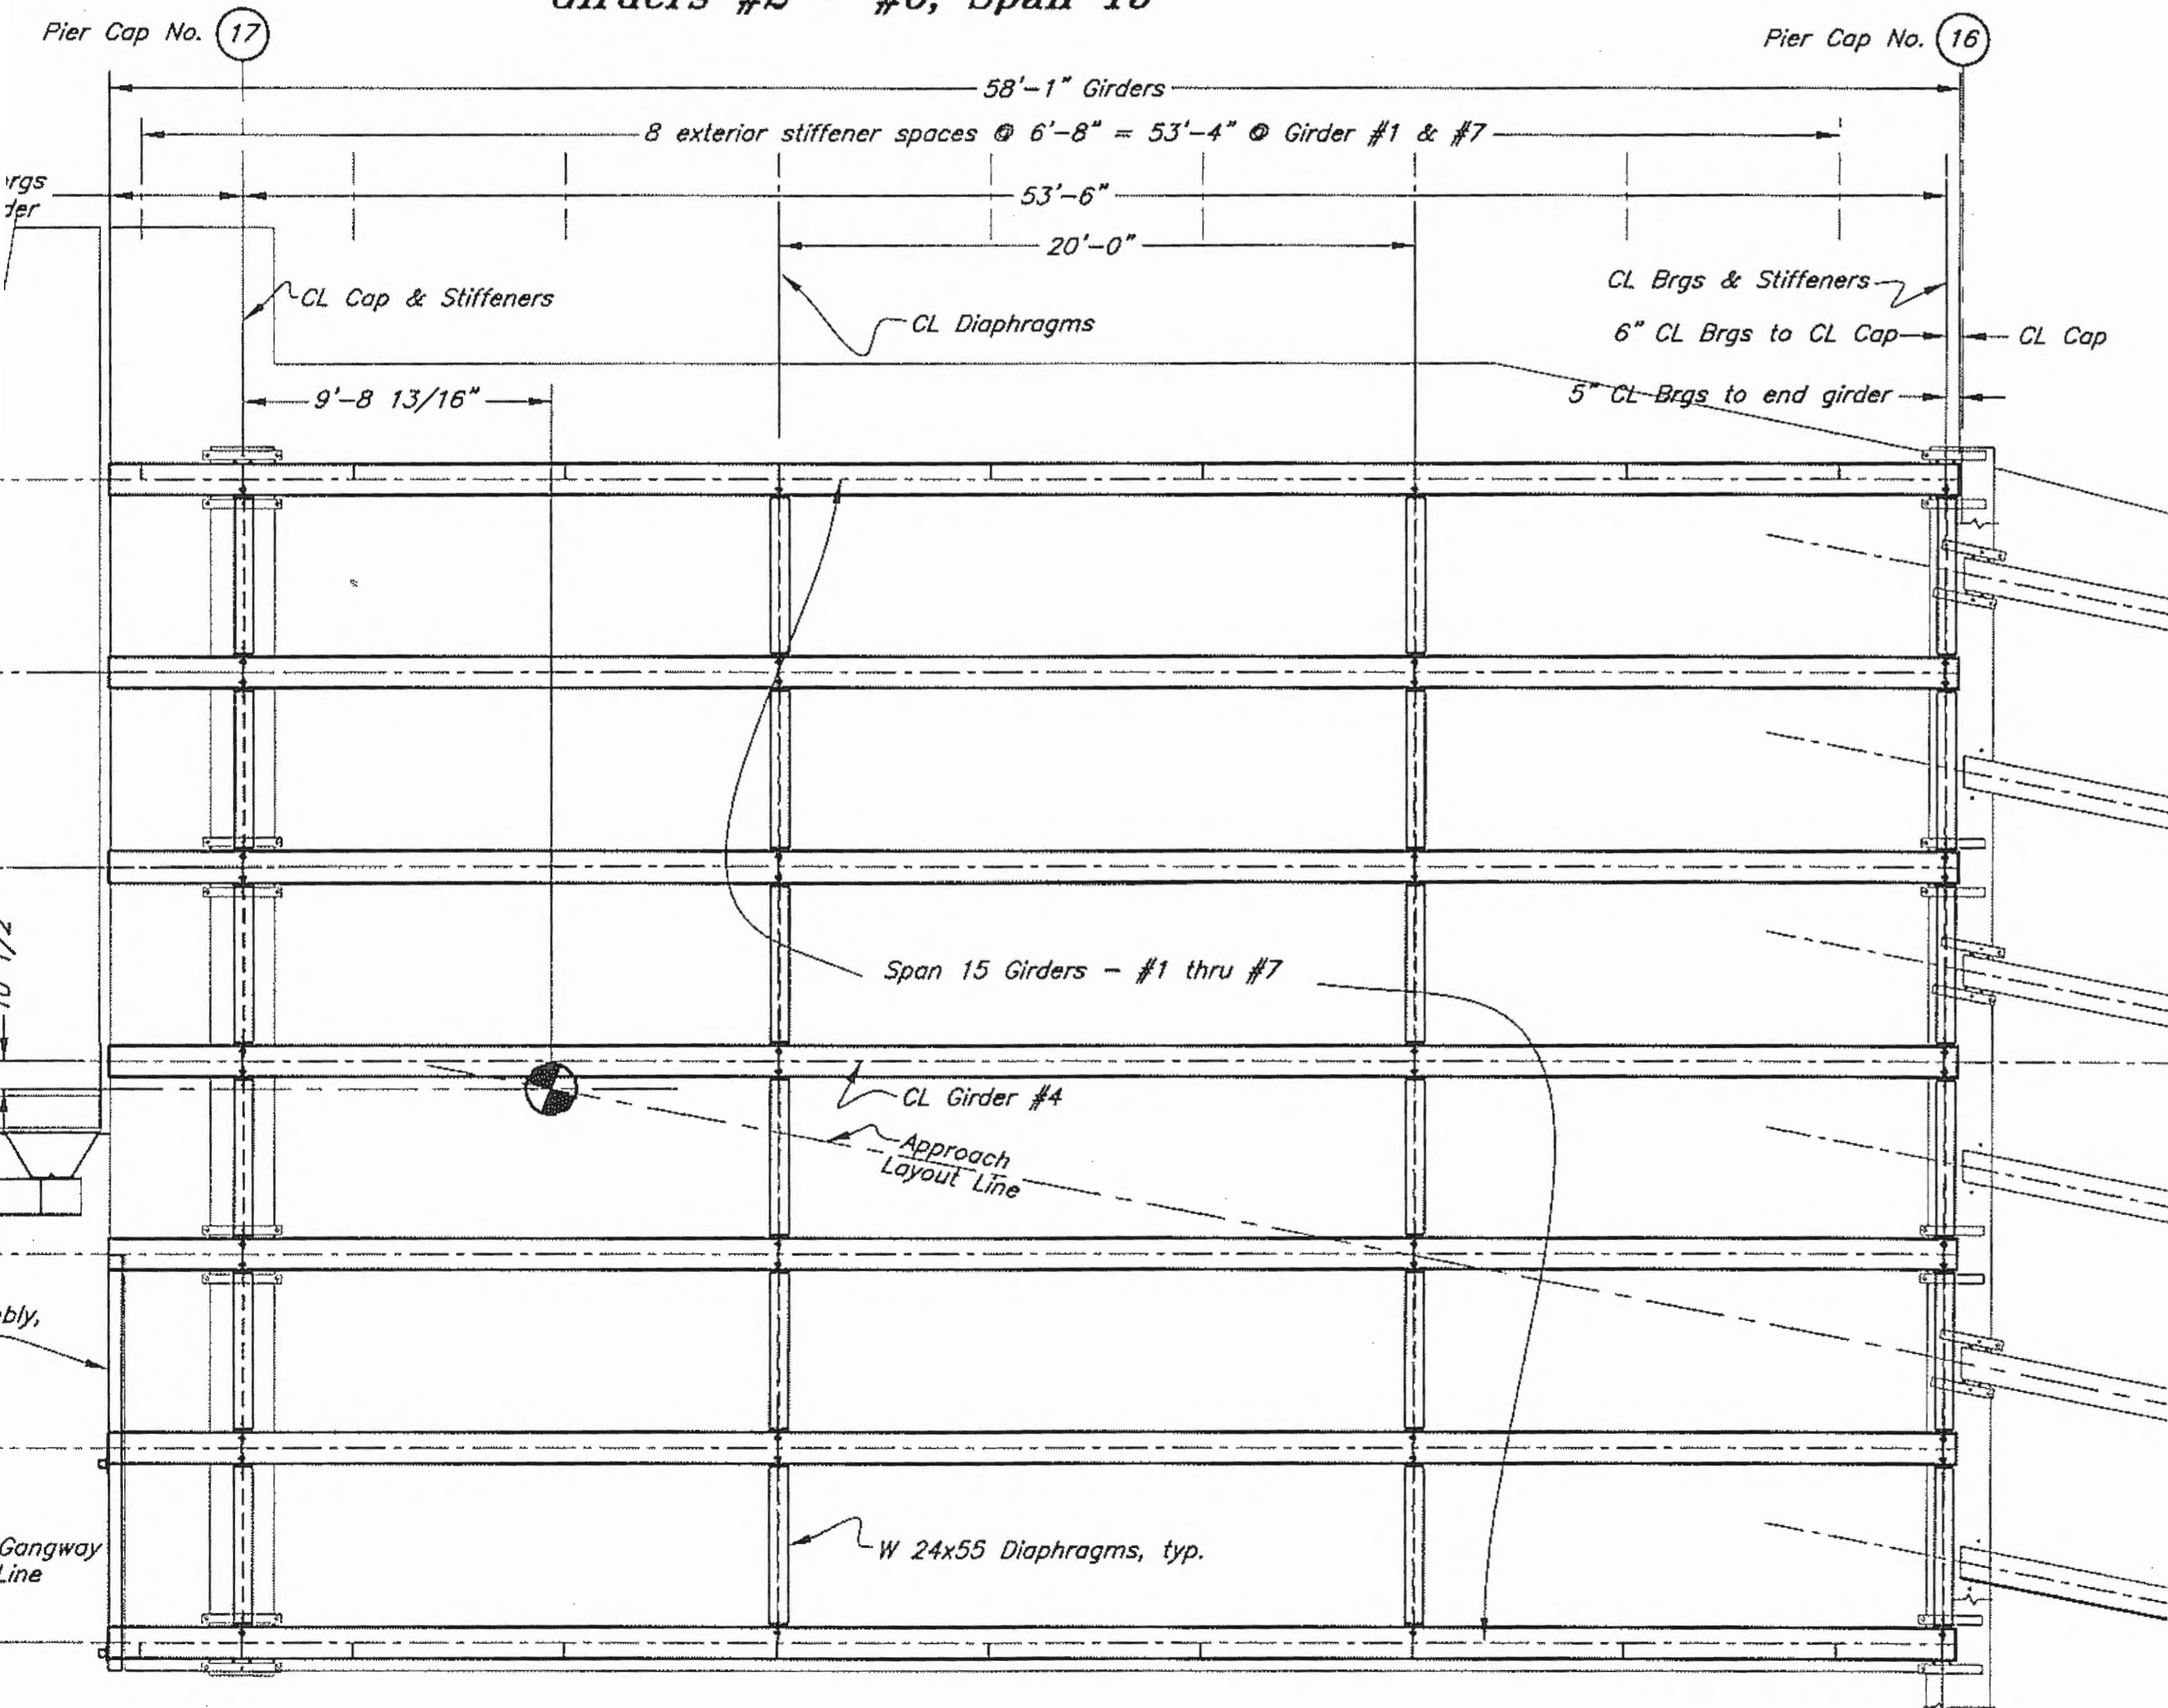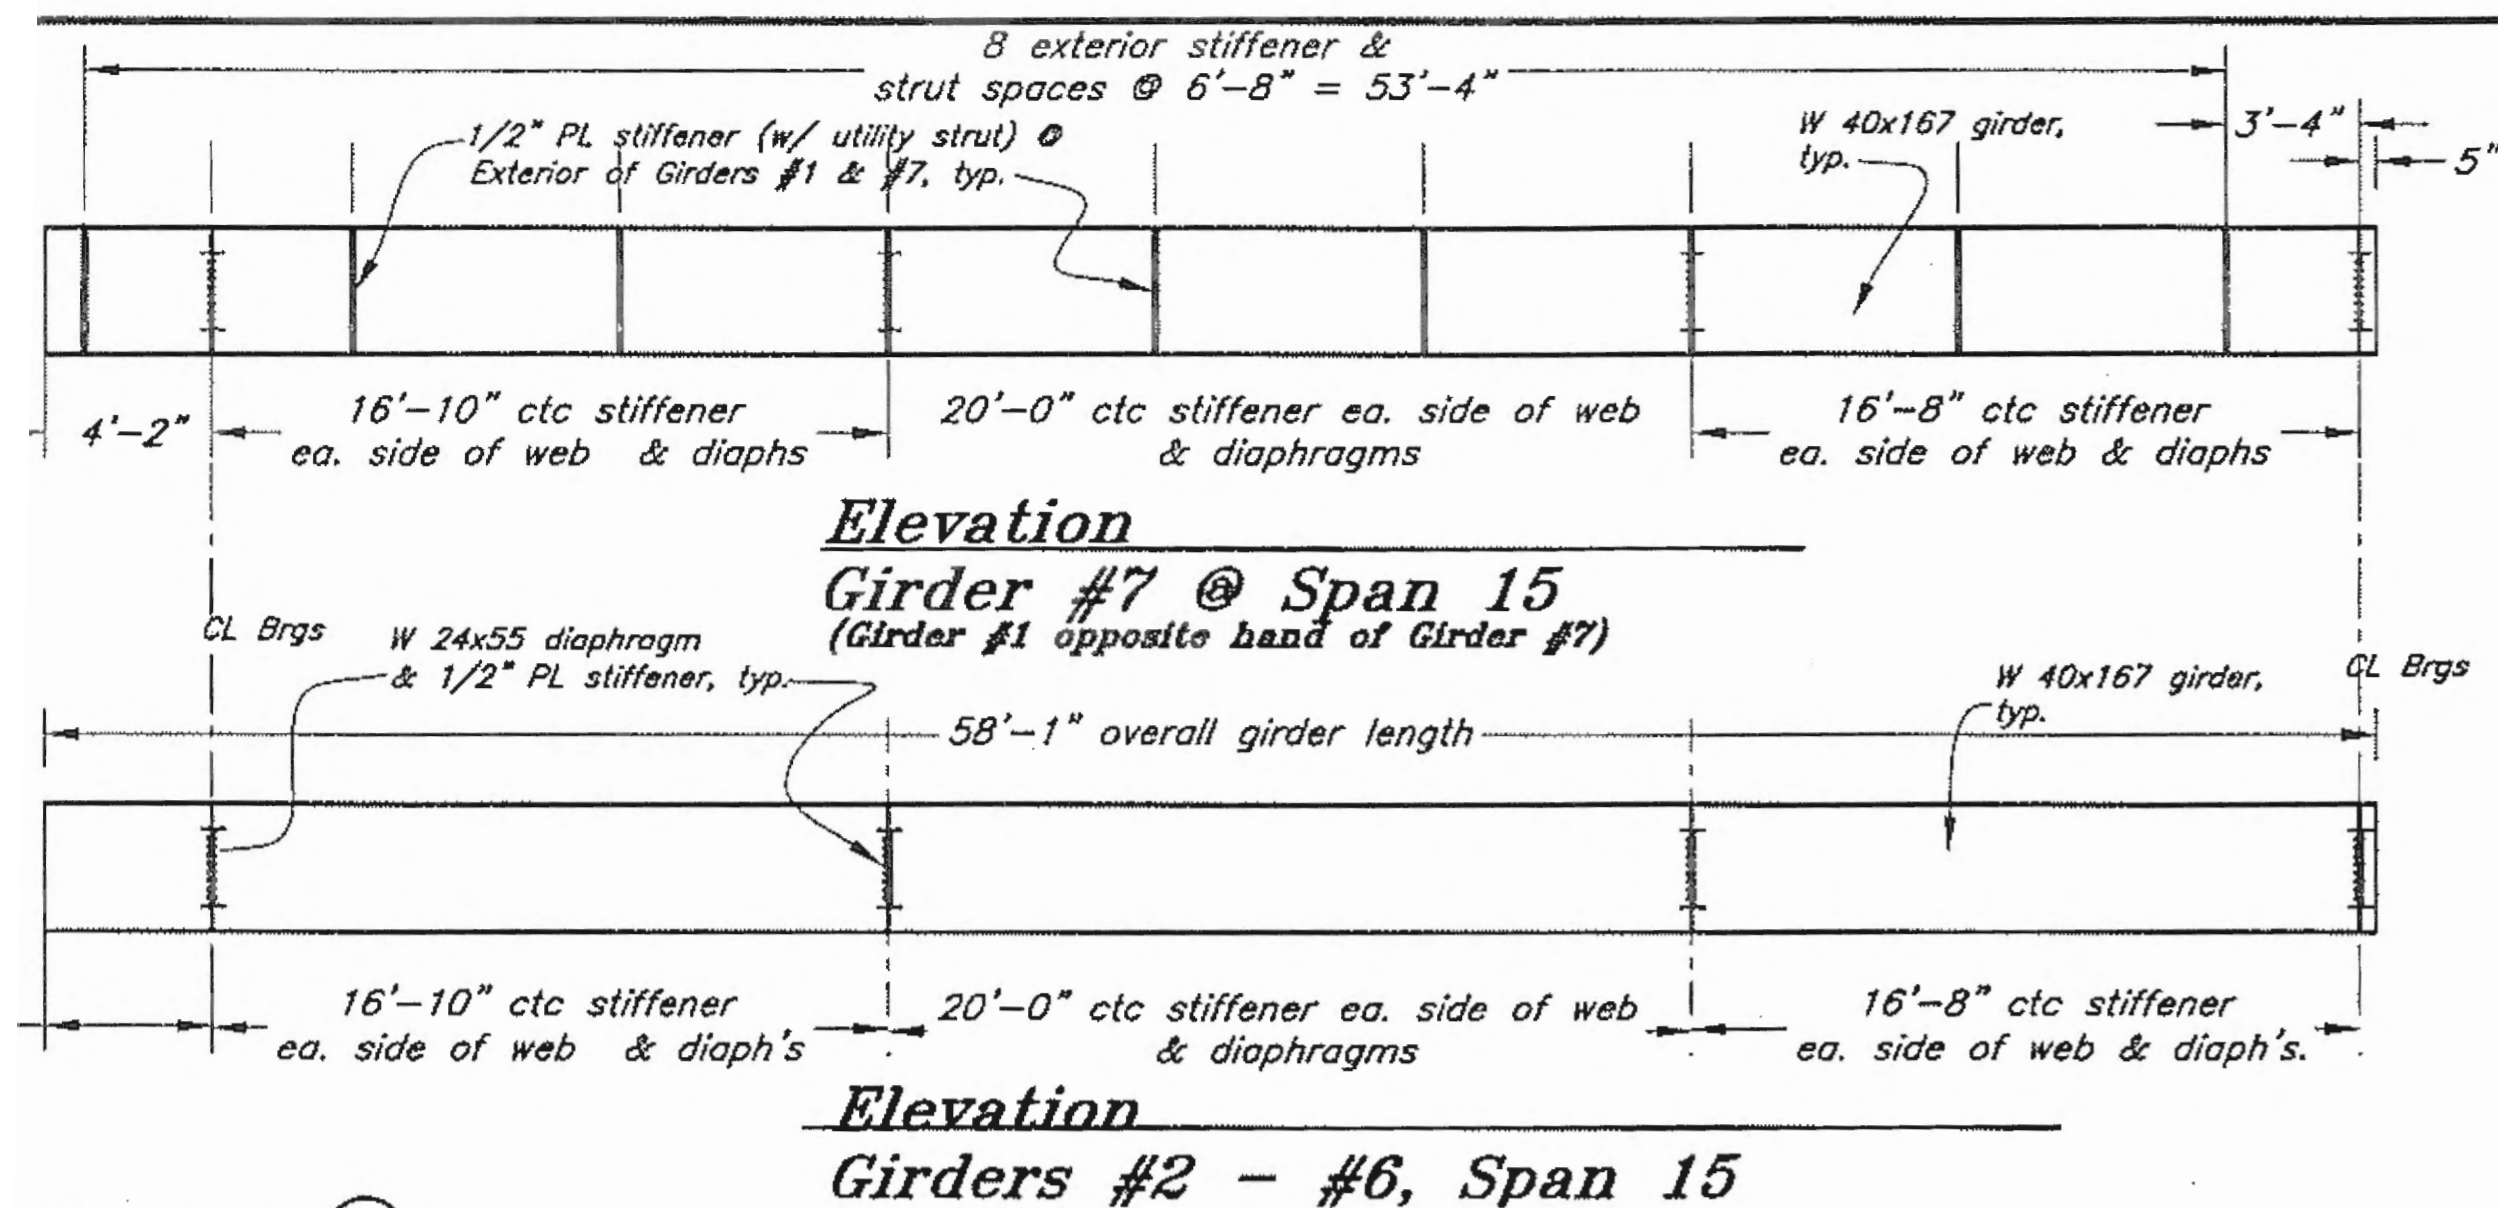

Record Drawings have been reviewed by the Project Engineer, and represent to the best of my knowledge, the project as constructed.
 PE *[Signature]* Date 8/21/12

Span 15 - Framing Layout

DO NOT SCALE FROM THESE DRAWINGS USE DIMENSIONS

DESIGNED BY: *J. Scott*

CHECKED BY: *B. Savikko*

DRAWN BY: *C. Fuman, W. Hickok*

PATH: *Q:\GUS\67599\MF\PLANSET\03-APPROACH\AP29 TRANSITION FRAMING SPAN 15.DWG*

TAB: *Wed, 26/Nov/08 10:37AM*

REVISIONS

NO.	DATE	DESCRIPTION

PROJECT DESIGNATION: BR-0003(53)/67599

YEAR: 2008

SHEET NO.: 39

TOTAL SHEETS: 138


STATE OF ALASKA
 DEPARTMENT OF TRANSPORTATION & PUBLIC FACILITIES
 DESIGN & ENGINEERING SERVICES DIVISION-SOUTHEAST REGION

Gustavus Causeway Replacement

Approach Transition Framing Span 15

AP29

11-26-08

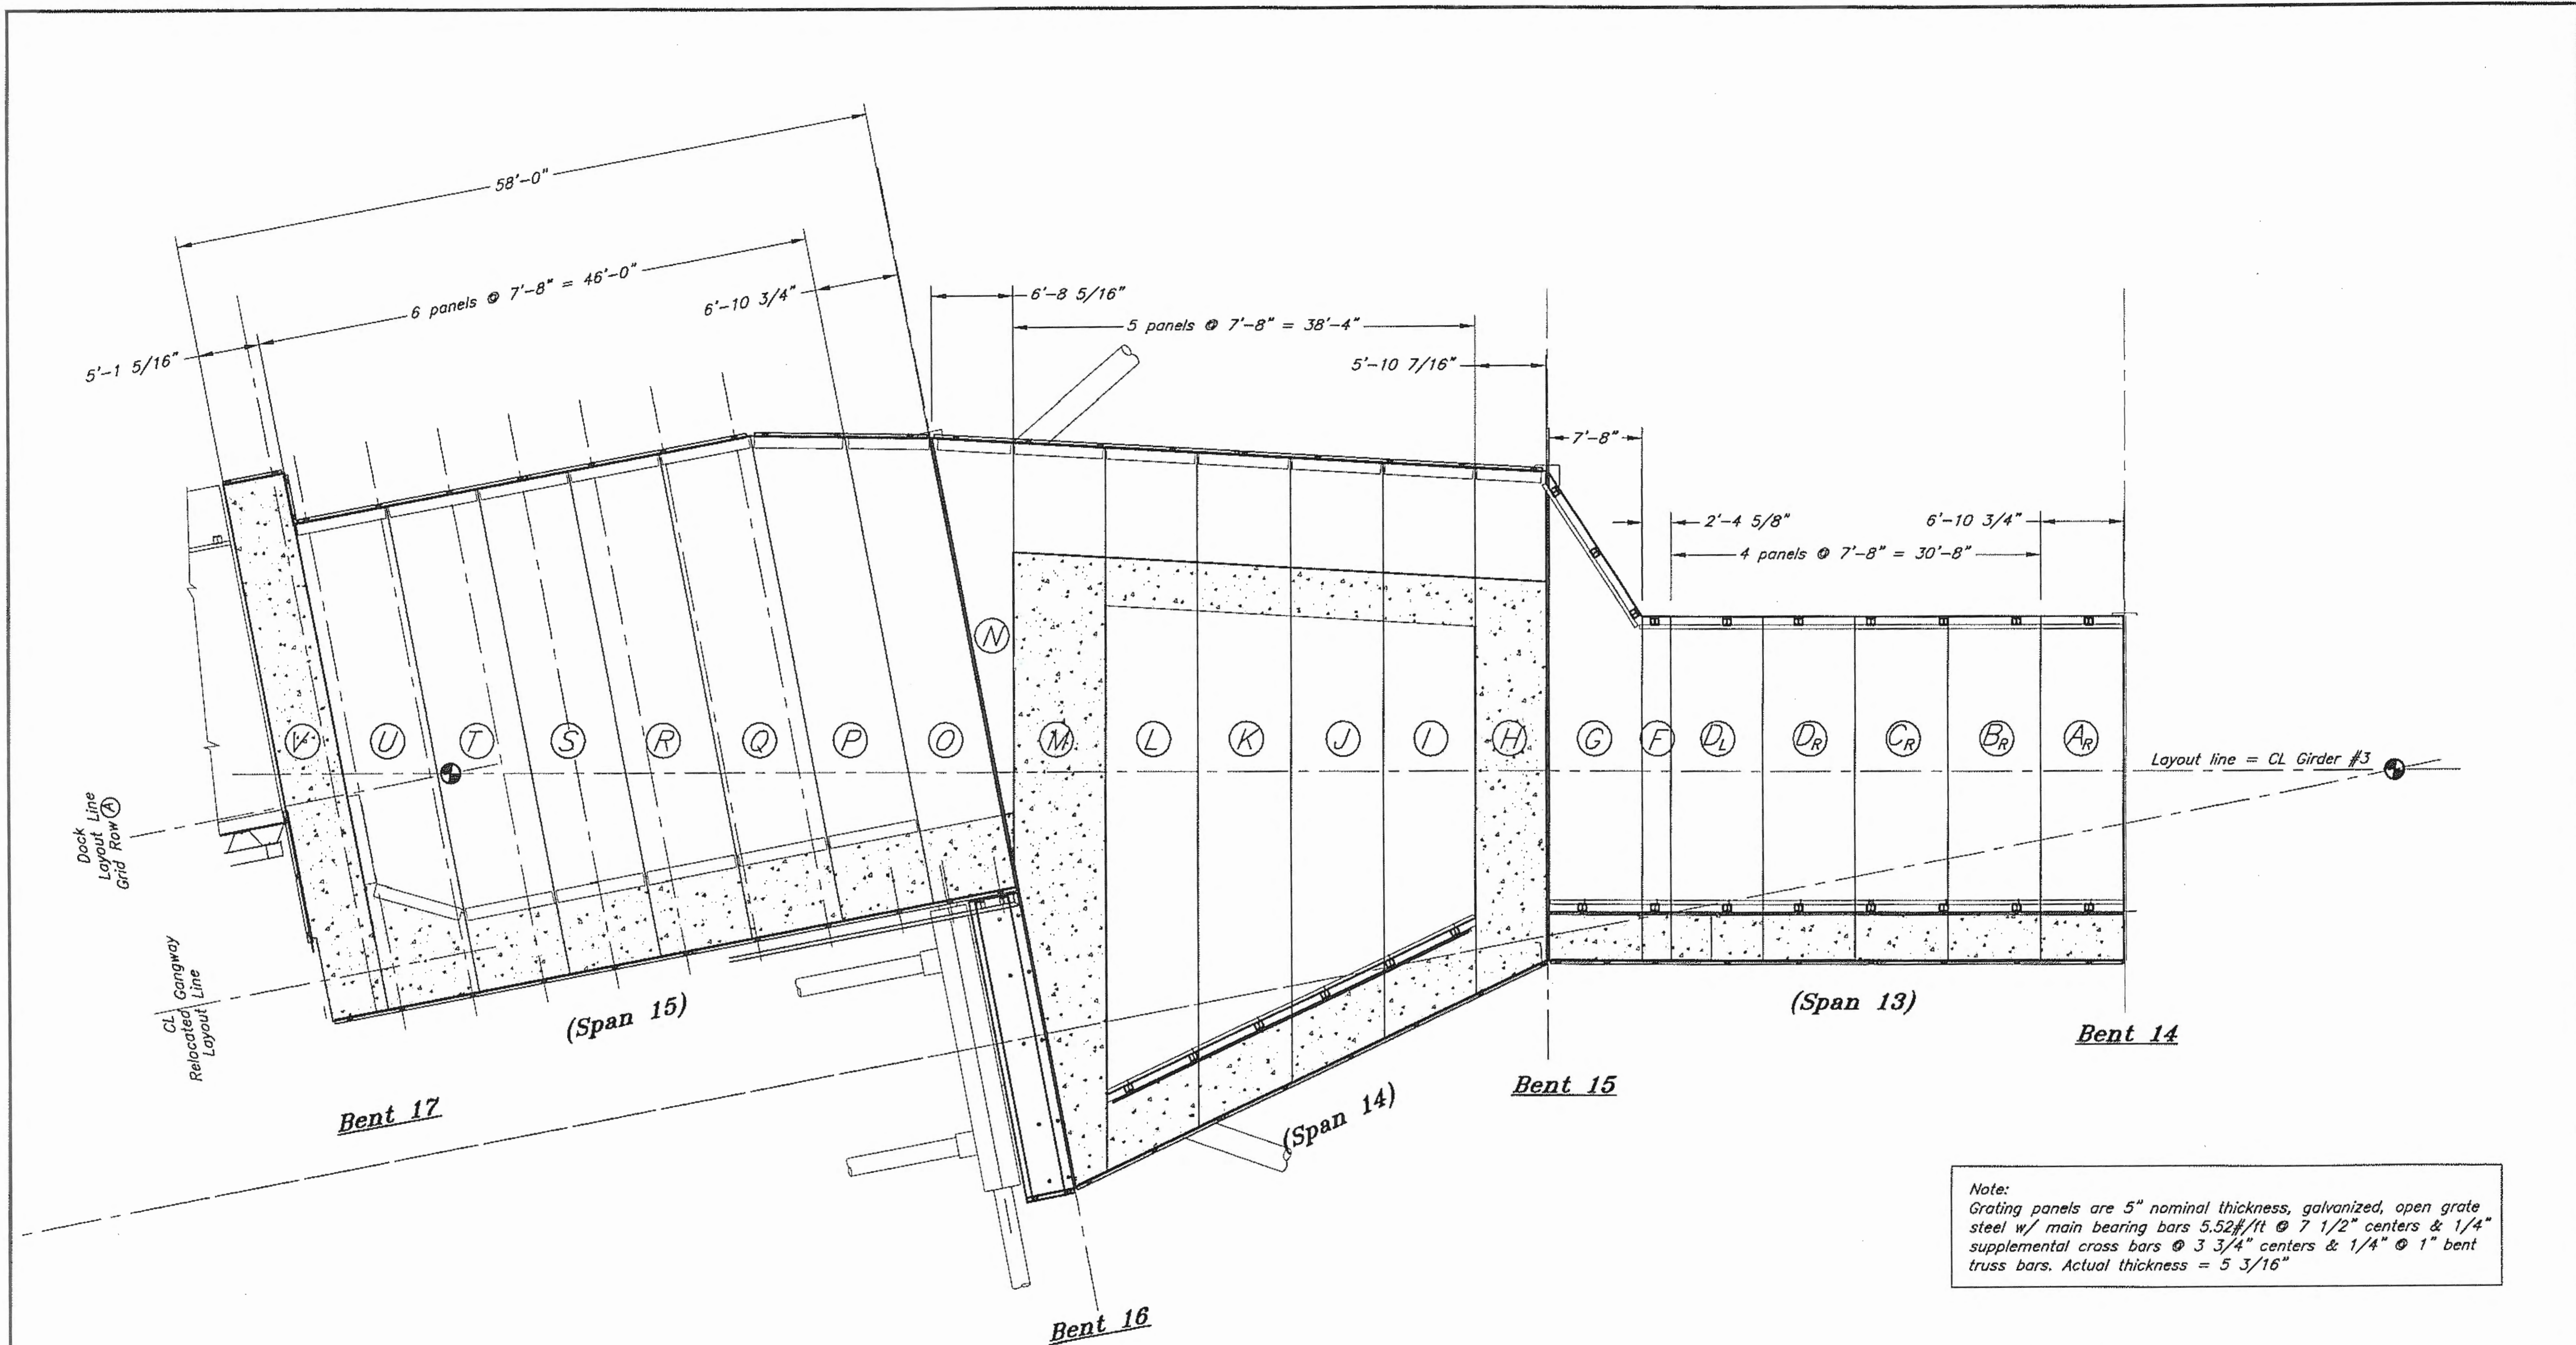


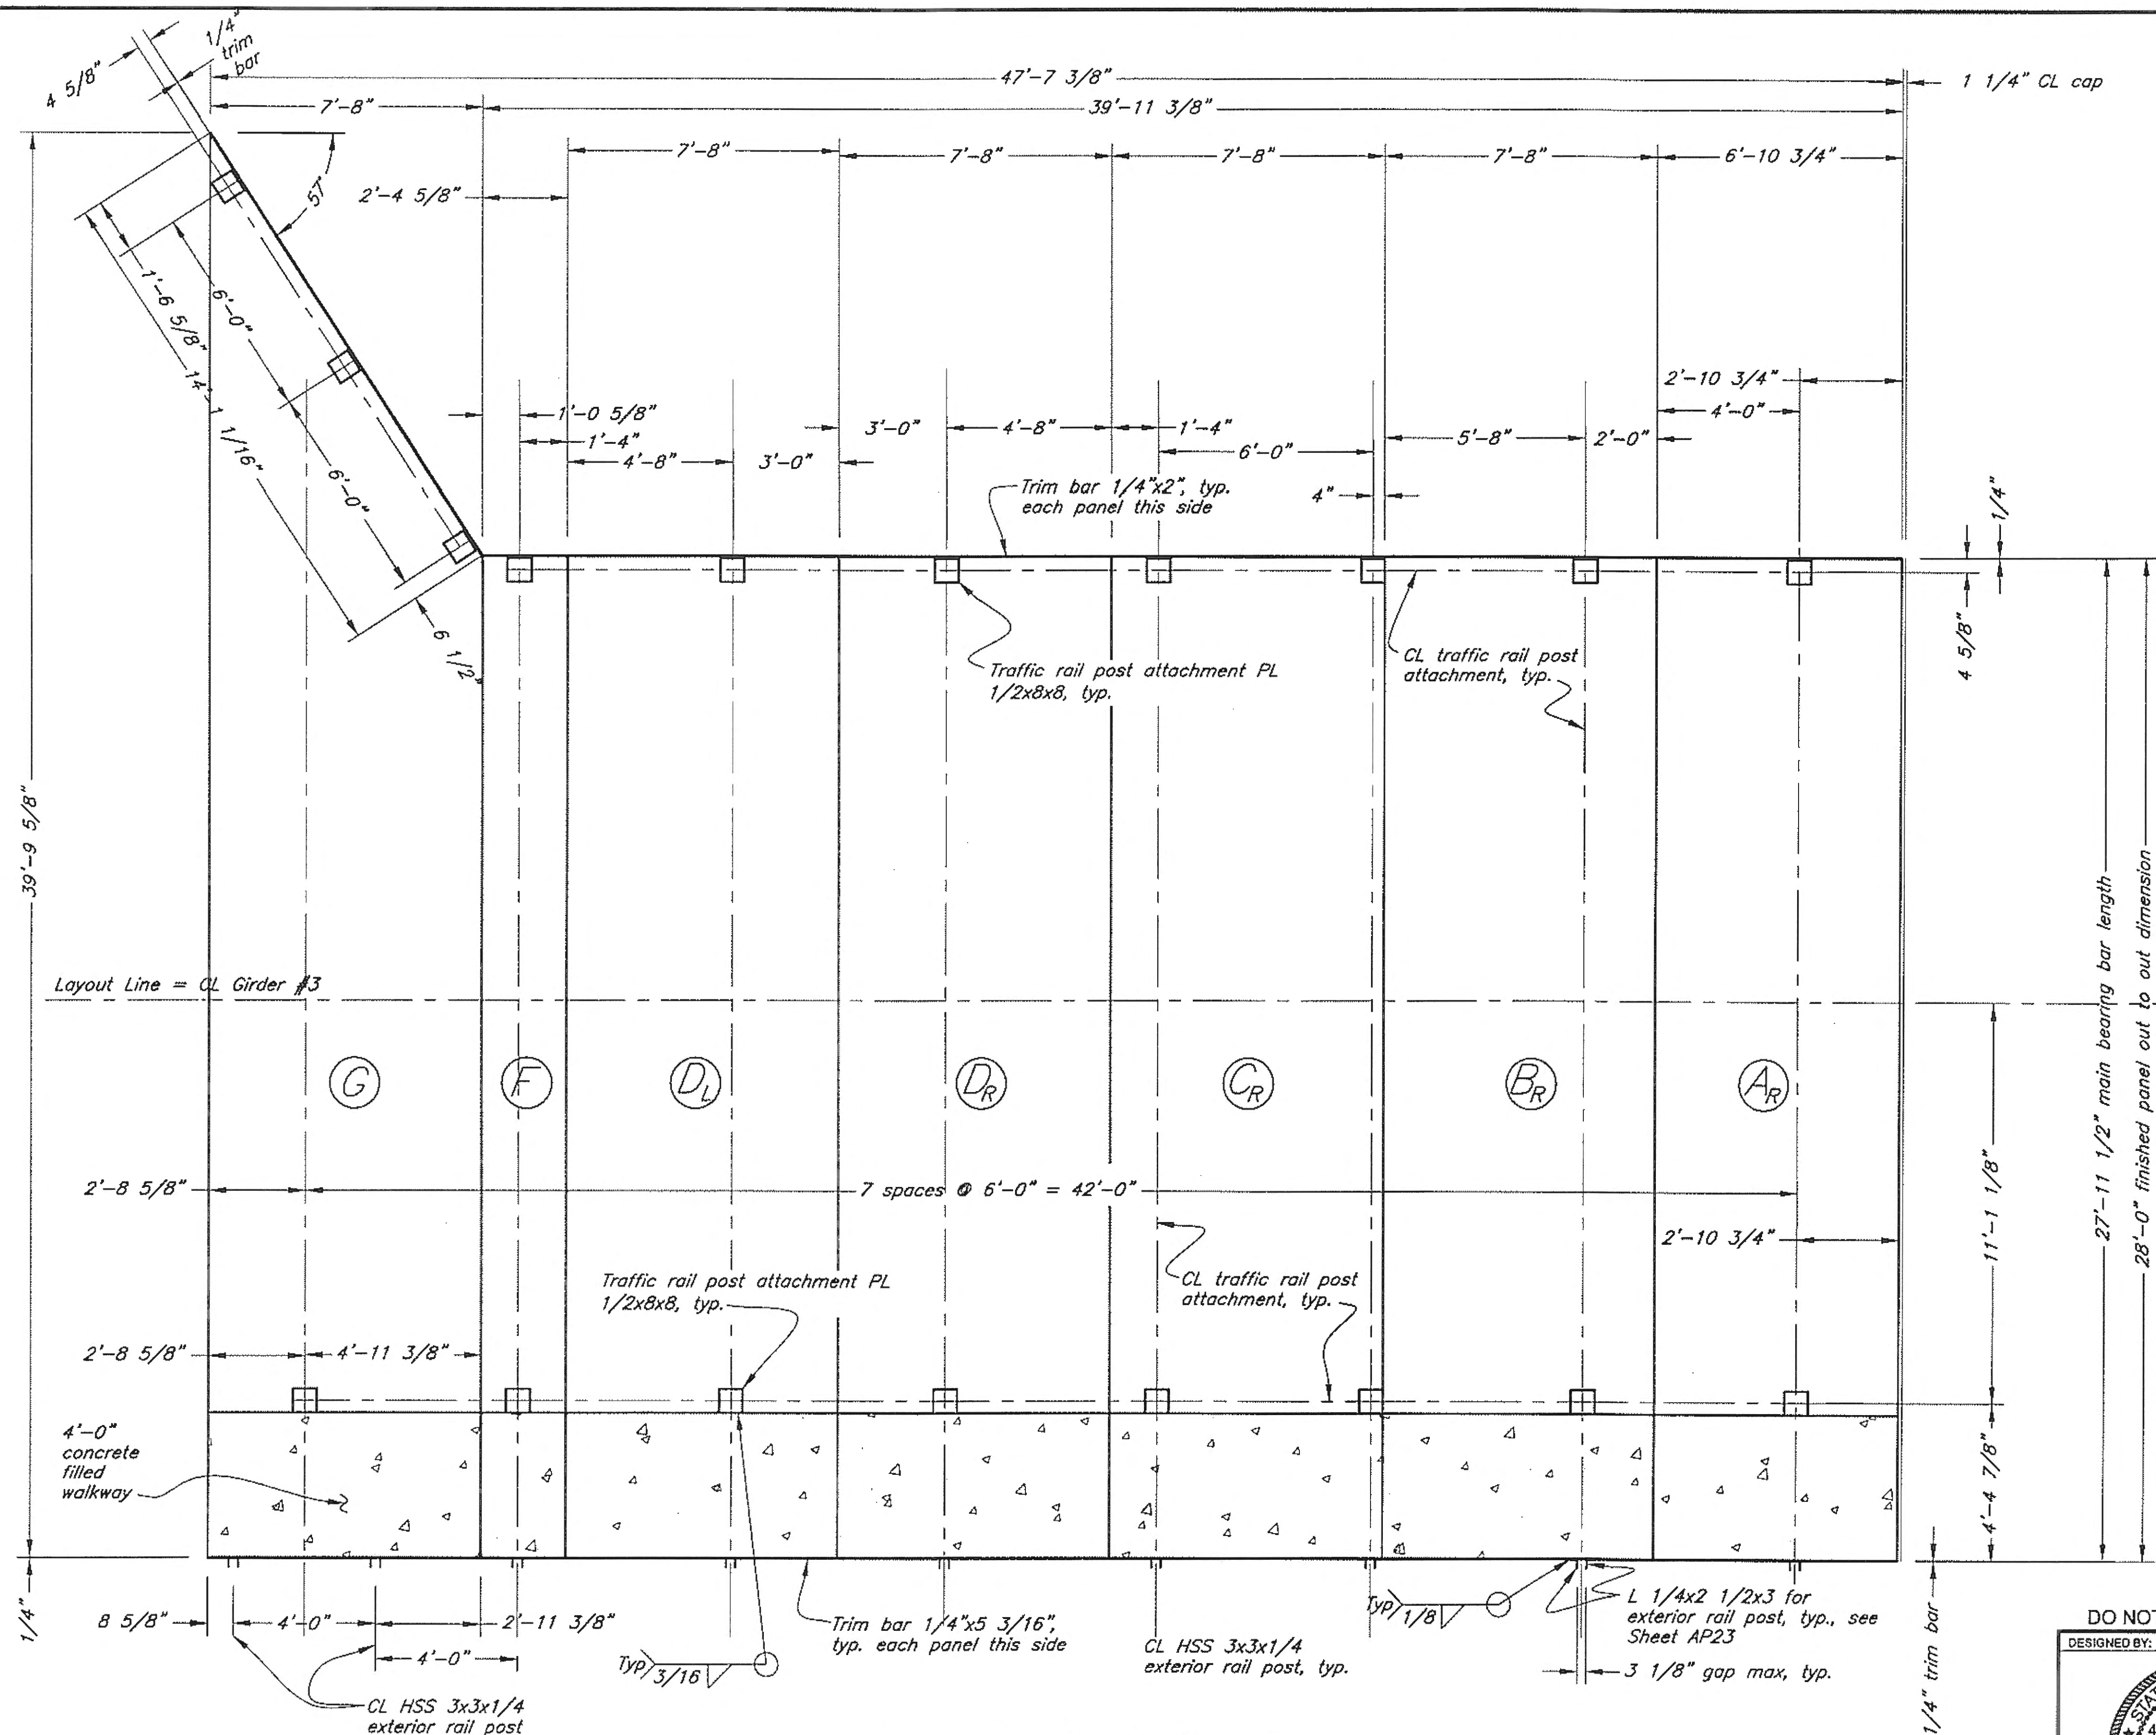
**Approach Transition Deck Panel Layout
Spans 13, 14, & 15**

Note:
Grating panels are 5" nominal thickness, galvanized, open grate steel w/ main bearing bars 5.52#/ft @ 7 1/2" centers & 1/4" supplemental cross bars @ 3 3/4" centers & 1/4" @ 1" bent truss bars. Actual thickness = 5 3/16"

Record Drawings have been reviewed by the Project Engineer, and represent to the best of my knowledge, the project as constructed.
PE: *[Signature]* Date: 5/2/17

DO NOT SCALE FROM THESE DRAWINGS USE DIMENSIONS

DESIGNED BY: <i>J. Scott</i>  CHECKED BY: <i>B. Savikko</i> DRAWN BY: <i>C. Fuman, W. Hickok</i>	STATE OF ALASKA DEPARTMENT OF TRANSPORTATION & PUBLIC FACILITIES DESIGN & ENGINEERING SERVICES DIVISION-SOUTHEAST REGION Gustavus Causeway Replacement Approach Transition Deck Panel Layout AP30									
	PATH: <i>O:\GUS\67599\MF\PLANSET\03-APPROACH\AP30-TRANSITION DECK PANEL LAYOUT.DWG</i> TAB: <i>Wed, 26/Nov/08 10:45AM</i>									
<table border="1"> <thead> <tr> <th>NO.</th> <th>DATE</th> <th>DESCRIPTION</th> </tr> </thead> <tbody> <tr> <td> </td> <td> </td> <td> </td> </tr> </tbody> </table>	NO.	DATE	DESCRIPTION				PROJECT DESIGNATION BR-0003(53)/67599	YEAR 2008	SHEET NO. 40	TOTAL SHEETS 138
NO.	DATE	DESCRIPTION								




**Span 13 Deck Panels
Panels A, B, C, D, F & G**

Record Drawings have been reviewed by the Project Engineer, and represent to the best of my knowledge, the project as constructed.
PE *[Signature]* Date 8/21/12

DO NOT SCALE FROM THESE DRAWINGS USE DIMENSIONS


DESIGNED BY: J. Scott		STATE OF ALASKA DEPARTMENT OF TRANSPORTATION & PUBLIC FACILITIES DESIGN & ENGINEERING SERVICES DIVISION-SOUTHEAST REGION		
		Gustavus Causeway Replacement		
		Approach Transition Span 13 Deck Panels AP31		
CHECKED BY: B. Savikko	PROJECT DESIGNATION: BR-0003(53)/67599			
DRAWN BY: C. Fuman, W. Hickok	YEAR: 2008	SHEET NO.: 41	TOTAL SHEETS: 138	
PATH: Q:\GUS\67599\MF\PLANSET\03-APPROACH\AP31-TRANSITION SPAN 13 DECK PANELS.DWG		TAB: Wed, 26/Nov/08 10:46AM		
REVISIONS		JTS/SCOTT		
NO.	DATE	DESCRIPTION		


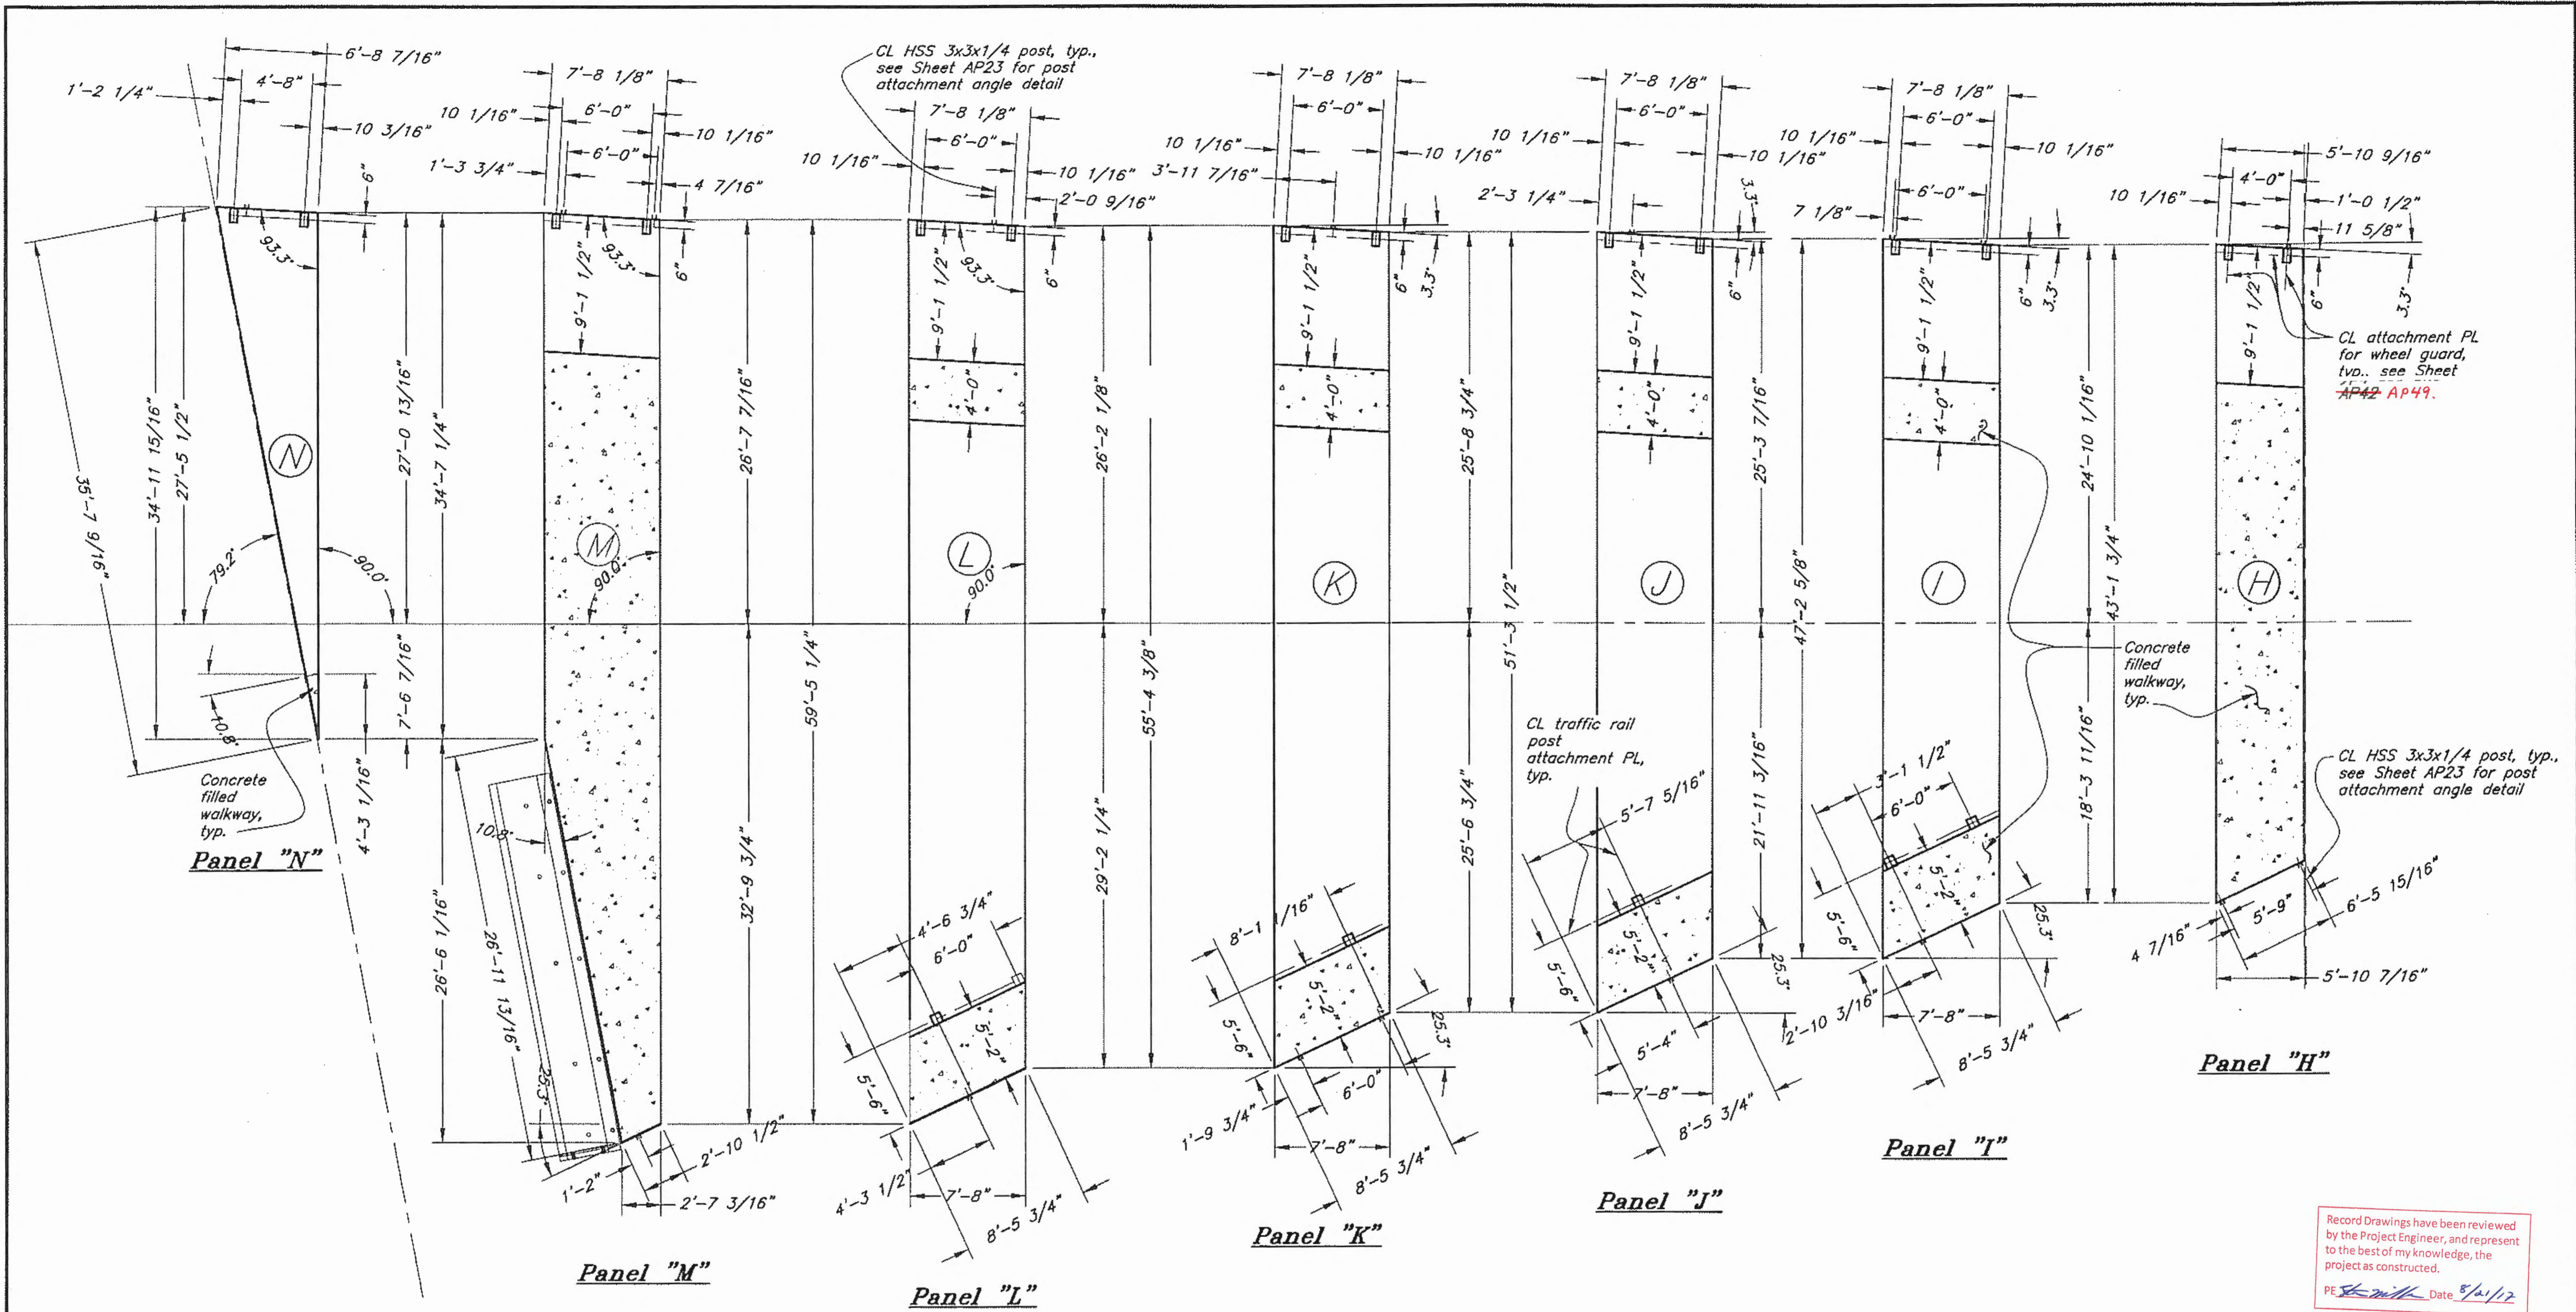


**Approach Transition Deck Panels H, I, J, K, L, M & N
Span 14**

Record Drawings have been reviewed by the Project Engineer, and represent to the best of my knowledge, the project as constructed.
PE *[Signature]* Date 5/21/12

DO NOT SCALE FROM THESE DRAWINGS USE DIMENSIONS

DESIGNED BY: <i>J. Scott</i>		STATE OF ALASKA DEPARTMENT OF TRANSPORTATION & PUBLIC FACILITIES DESIGN & ENGINEERING SERVICES DIVISION-SOUTHEAST REGION							
		Gustavus Causeway Replacement							
		Approach Transition Span 14 Deck Panels AP32							
CHECKED BY: <i>B. Savikko</i>		PROJECT DESIGNATION	YEAR						
DRAWN BY: <i>C. Fuman, W. Hickok</i>		BR-0003(53)/67599	2008						
PATH: <i>D:\GUS\67599\MF\PLANS\03-APPROACH\AP32-TRANSITION SPAN 14 DECK PANELS.DWG</i>		SHEET NO.	TOTAL SHEETS						
TAB: <i>Wed, 26/Nov/08 10:47AM</i>		42	138						
<table border="1"> <thead> <tr> <th>NO.</th> <th>DATE</th> <th>DESCRIPTION</th> </tr> </thead> <tbody> <tr> <td> </td> <td> </td> <td> </td> </tr> </tbody> </table>		NO.	DATE	DESCRIPTION				JTS/COIT	
NO.	DATE	DESCRIPTION							

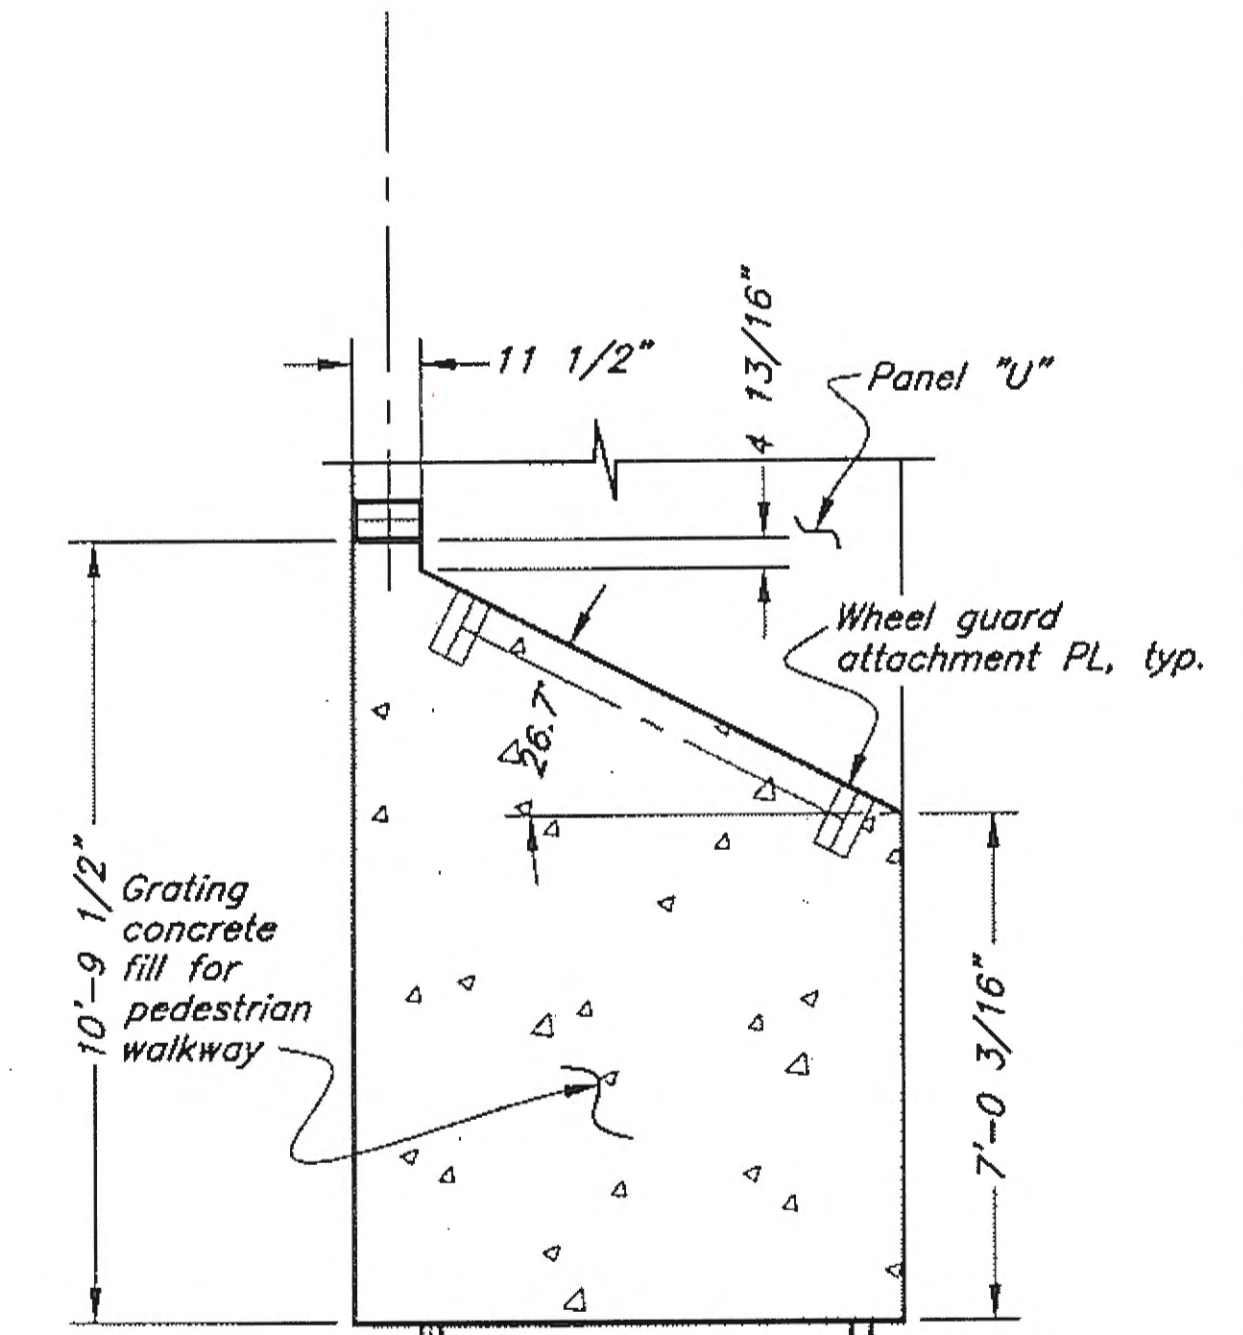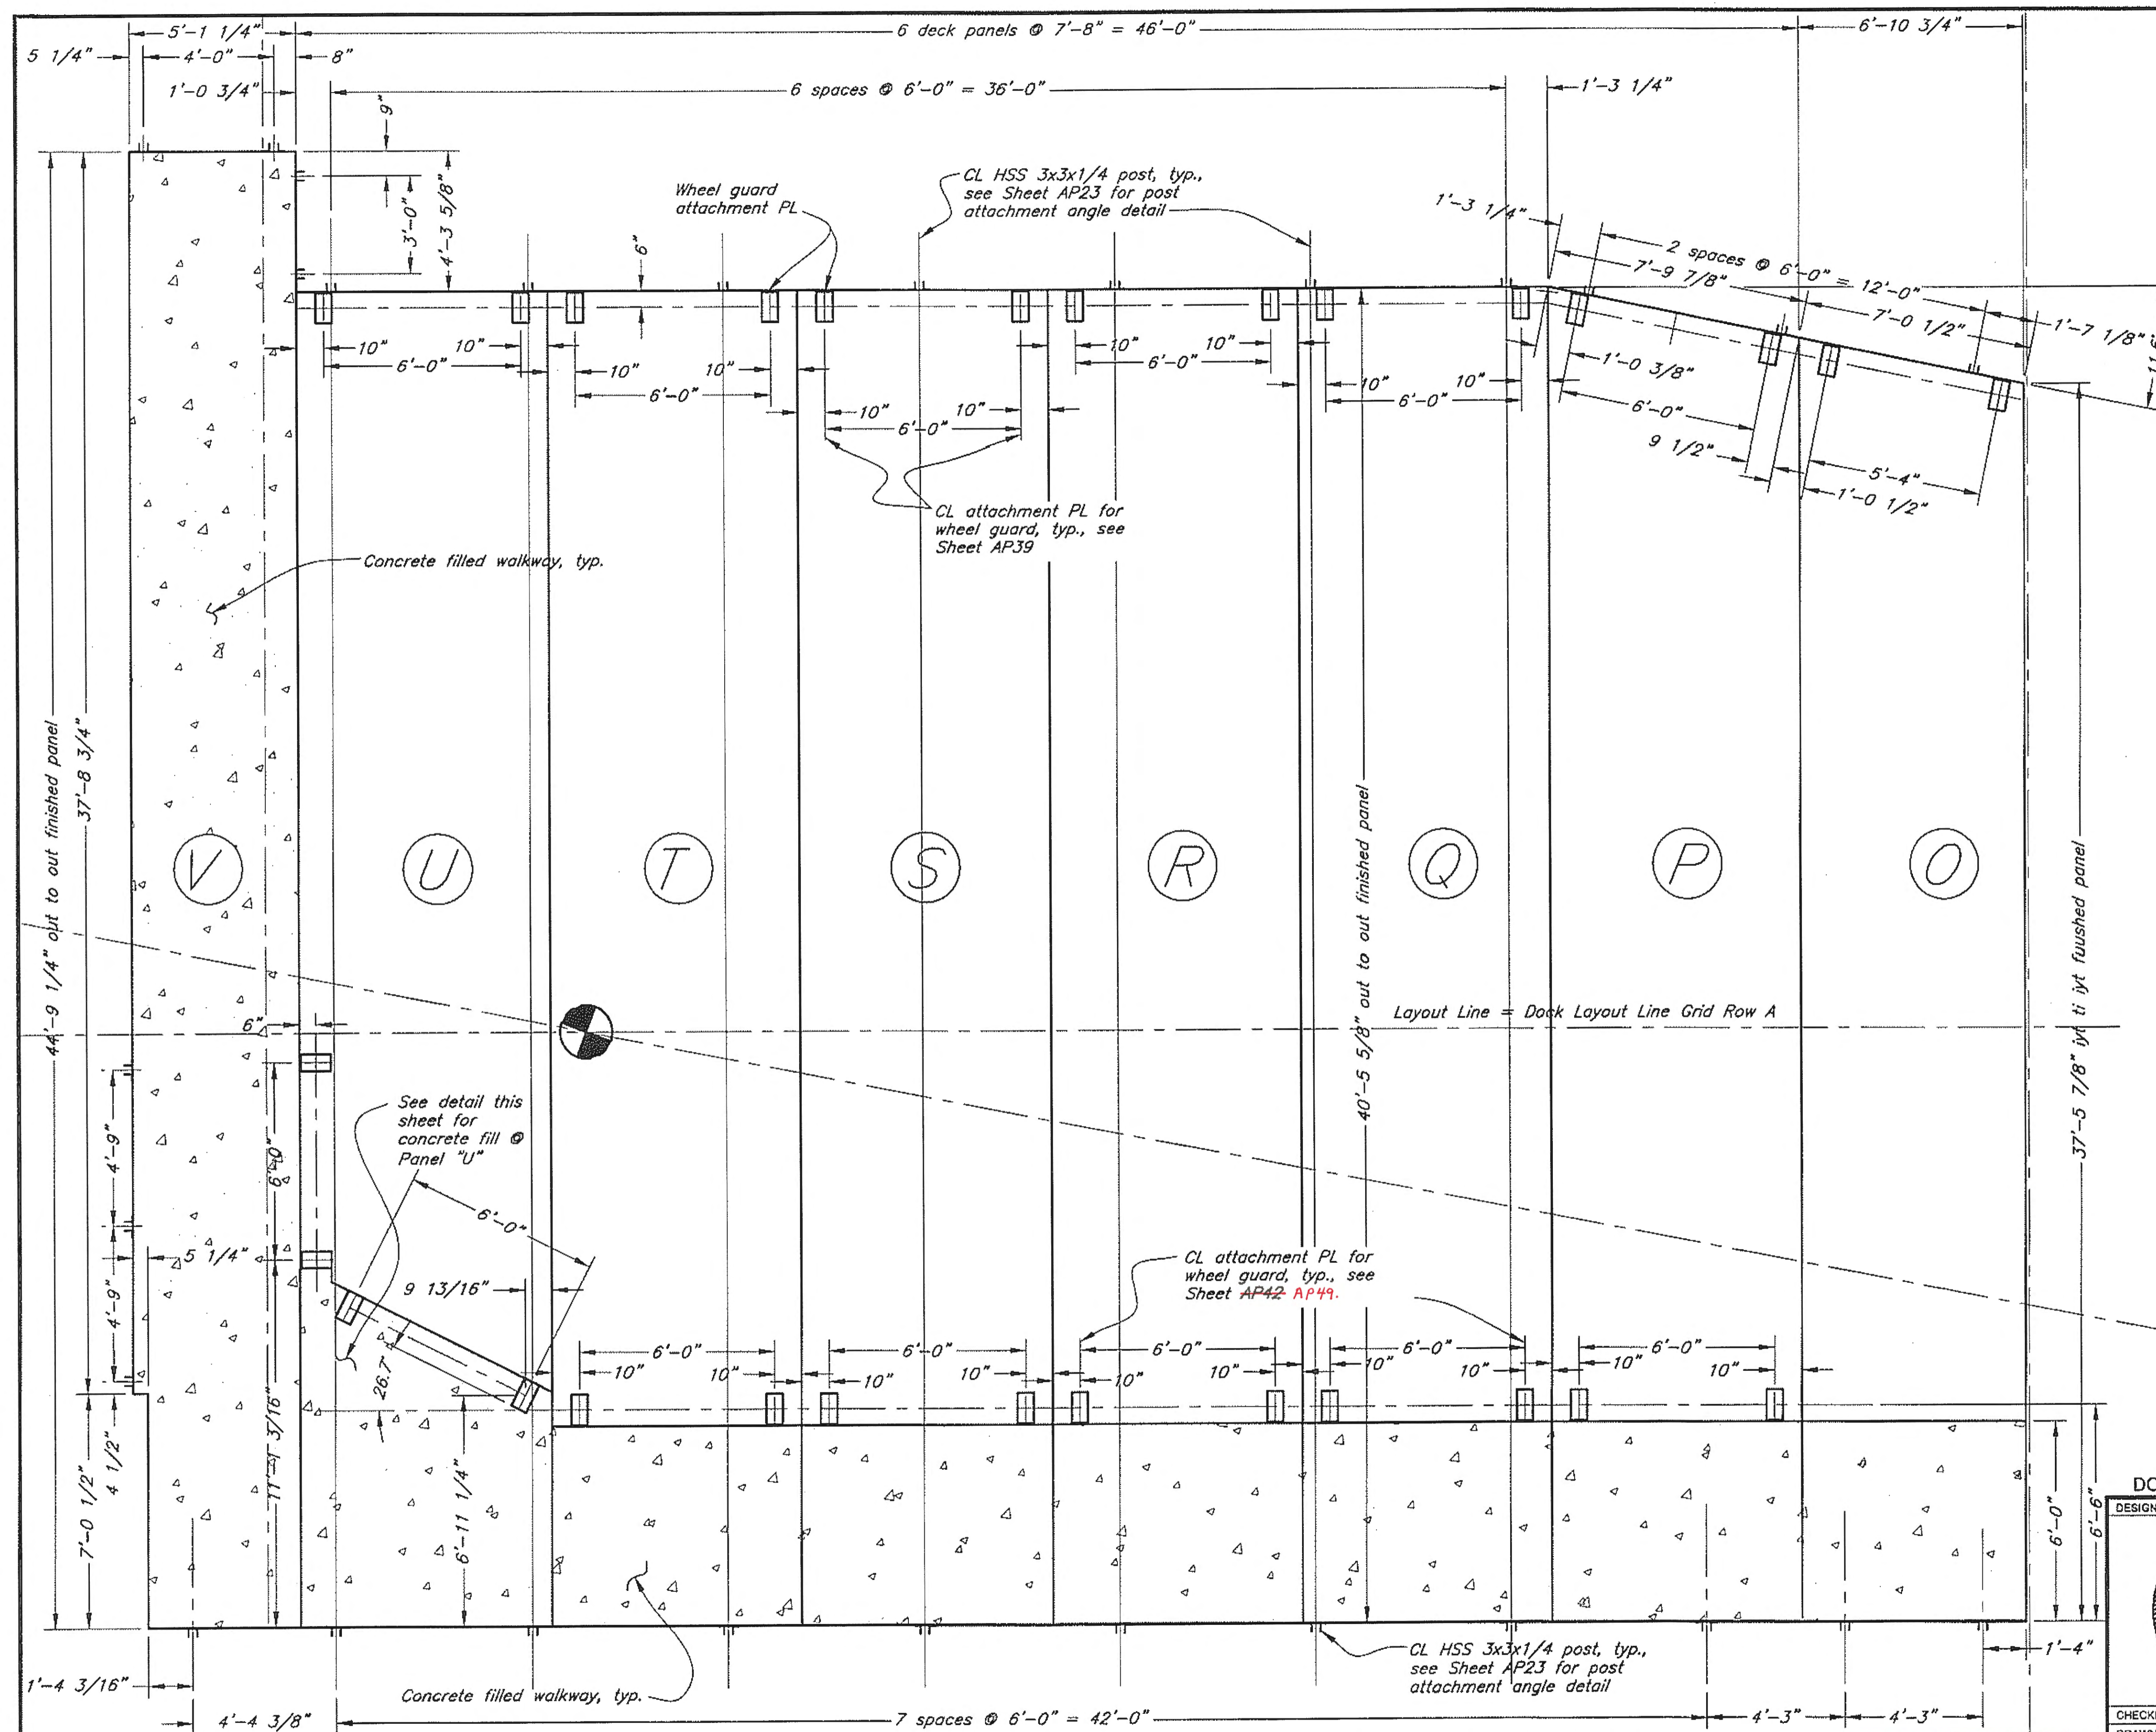


Panel "U" Concrete Fill

Note: Out to out panel lengths include 1/4" trim bar both sides

**Approach Transition Deck Panels O, P, Q, R, S, T, U & V
Span 15**

Record Drawings have been reviewed by the Project Engineer, and represent to the best of my knowledge, the project as constructed.
PE *Stan Miller* Date *8/24/12*

DO NOT SCALE FROM THESE DRAWINGS USE DIMENSIONS					
DESIGNED BY: <i>J. Scott</i>	STATE OF ALASKA DEPARTMENT OF TRANSPORTATION & PUBLIC FACILITIES DESIGN & ENGINEERING SERVICES DIVISION-SOUTHEAST REGION				
	Gustavus Causeway Replacement				
	Approach Transition Span 15 Deck Panels				
AP33					
CHECKED BY: <i>B. Savikko</i>	REVISIONS		PROJECT DESIGNATION	YEAR	SHEET NO.
DRAWN BY: <i>C. Furman, W. Hickok</i>	PATH: Q:\GUS\67599\MF\PLANSET\03-APPROACH\AP33-TRANSITION SPAN 15 DECK PANELS.DWG TAB: Wed, 26/Nov/08 10:48AM JTS/COIT		BR-0003(53)/67599	2008	43
NO. DATE DESCRIPTION			TOTAL SHEETS	138	

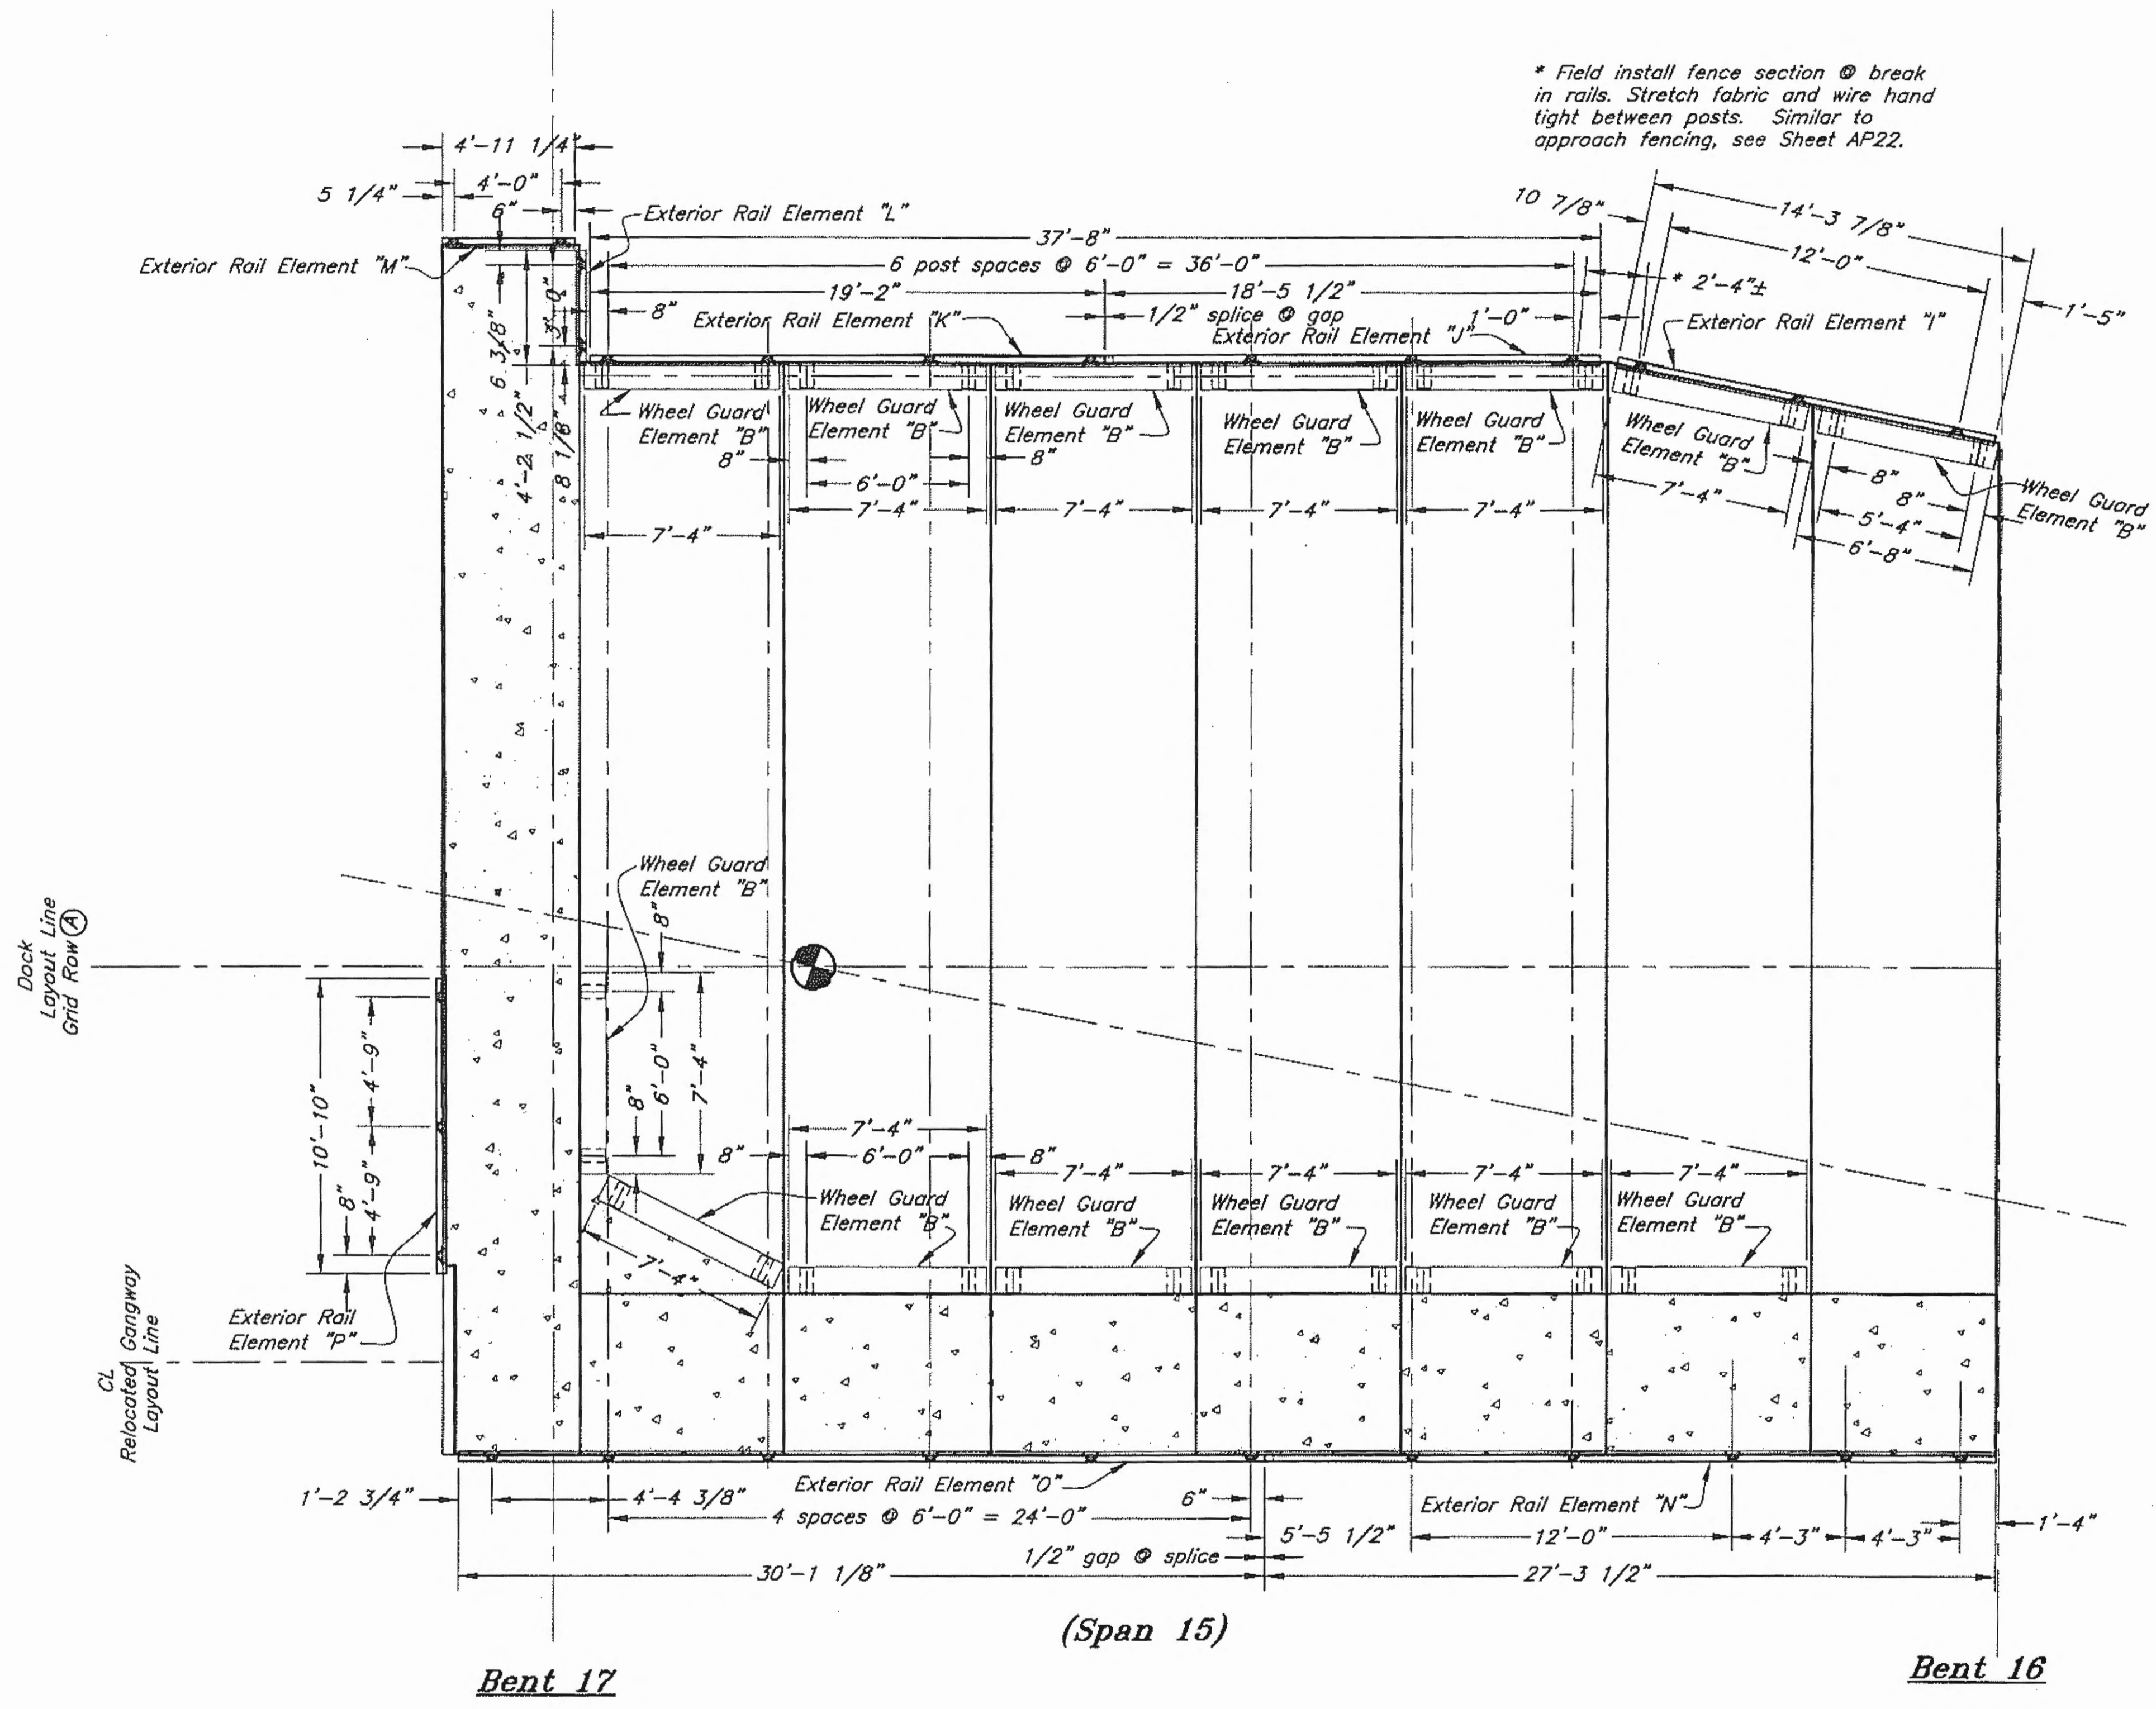


* Field install fence section @ break in rails. Stretch fabric and wire hand tight between posts. Similar to approach fencing, see Sheet AP22.

Record Drawings have been reviewed by the Project Engineer, and represent to the best of my knowledge, the project as constructed.
 PE *[Signature]* Date 8/21/12

Span 15 Rail Element Layout


DO NOT SCALE FROM THESE DRAWINGS USE DIMENSIONS

DESIGNED BY: J. Scott		STATE OF ALASKA DEPARTMENT OF TRANSPORTATION & PUBLIC FACILITIES DESIGN & ENGINEERING SERVICES DIVISION-SOUTHEAST REGION				
		Gustavus Causeway Replacement				
		Approach Transition Span 15 Railings				
CHECKED BY: B. Savikko		AP35				
DRAWN BY: C. Fuman, W. Hickey		PATH: Q:\GUS\67599\MF\PLANSET\03-APPROACH\AP35-TRANSITION RAILS SPAN 15.DWG				
TAB: Wed, 26/Nov/09 10:49AM		JTSCOTT				
NO.	DATE	REVISIONS DESCRIPTION	PROJECT DESIGNATION	YEAR	SHEET NO.	TOTAL SHEETS
			BR-0003(53)/67599	2008	45	138

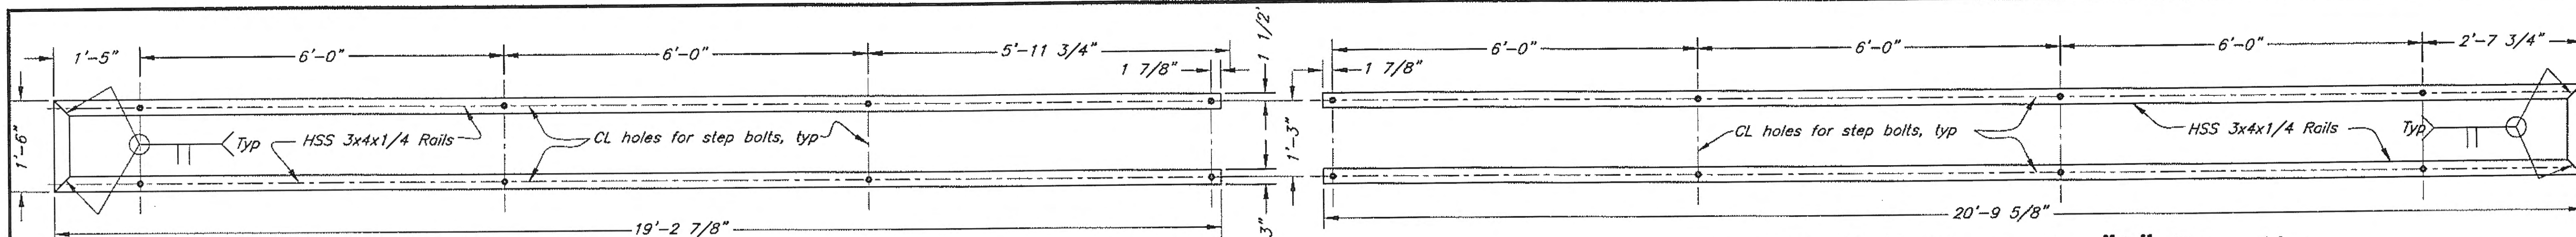


Traffic Rail Element "D" Elevation


Traffic Rail Elements "C" Elevation

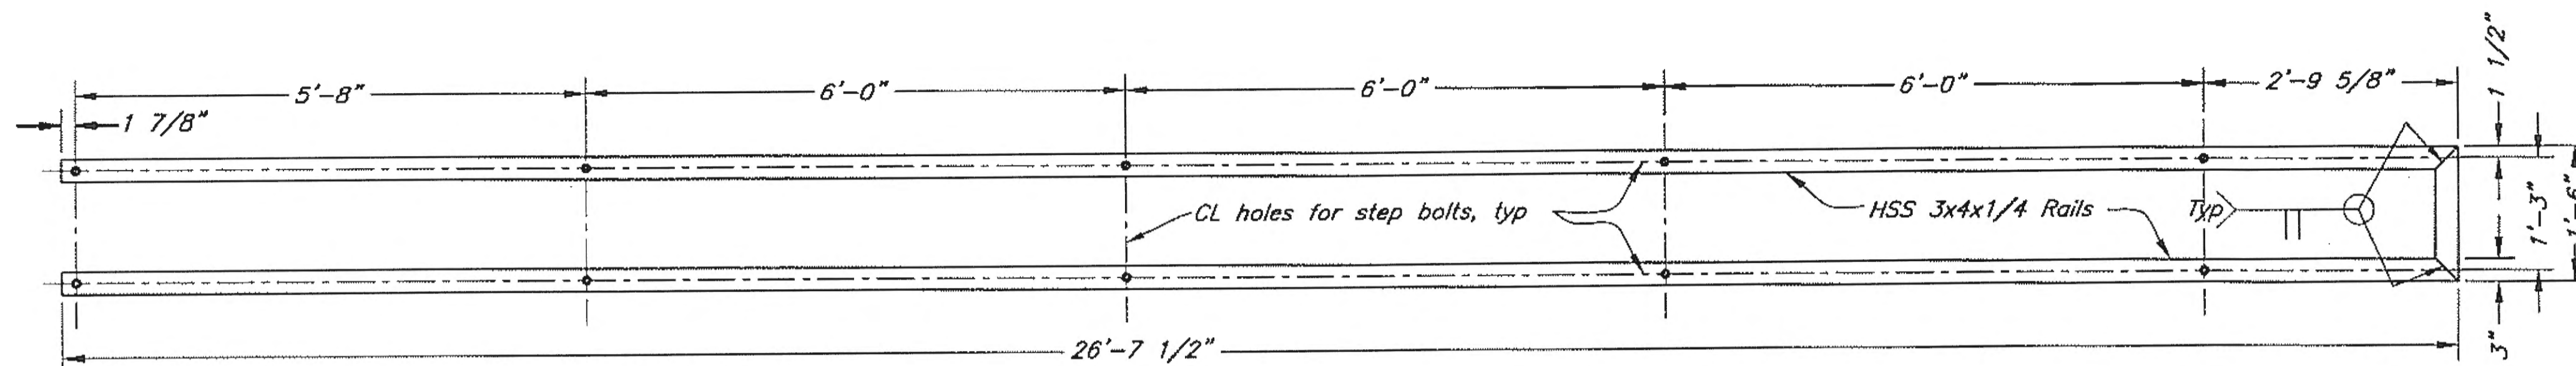

Traffic Rail Element "E" Elevation

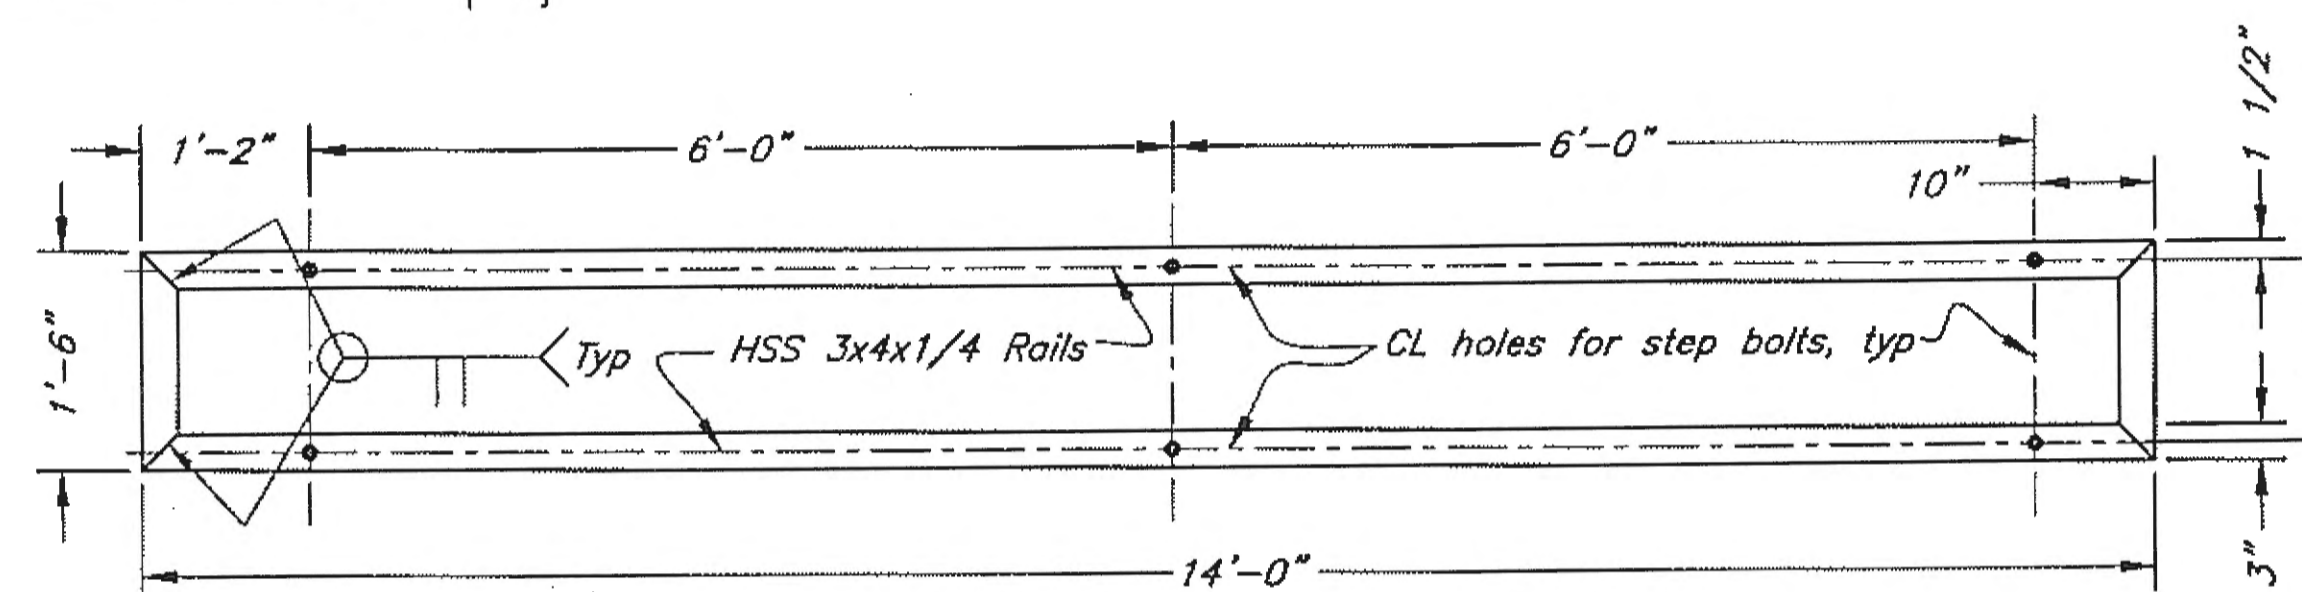

Traffic Rail Element "F" Elevation

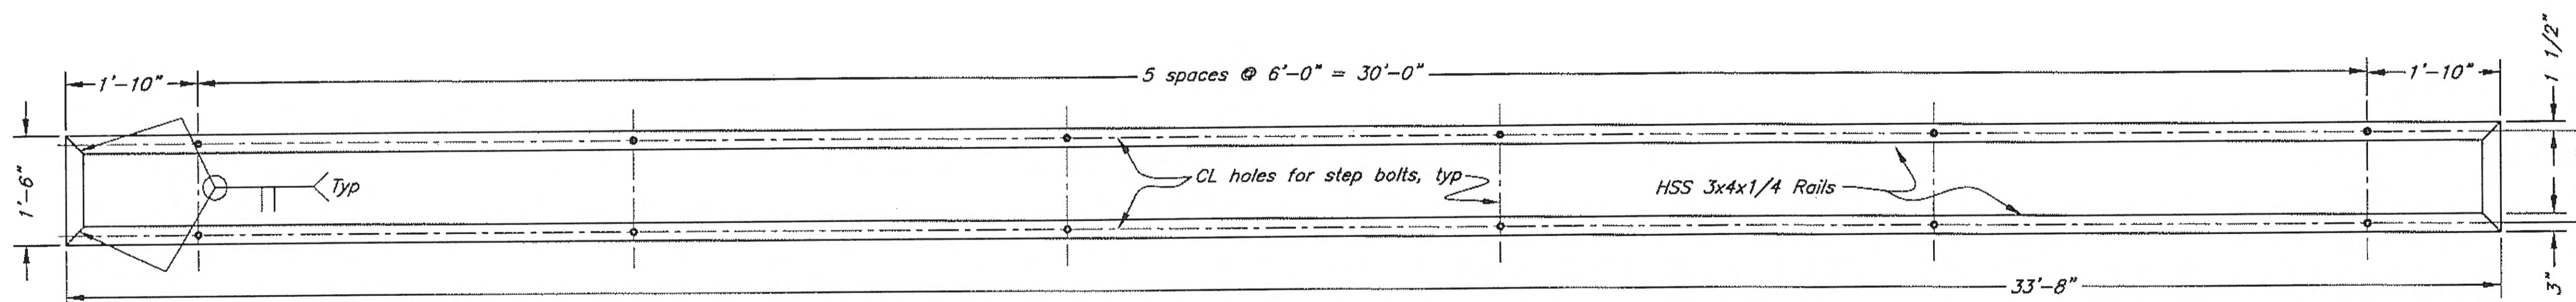


Traffic Rail Element "G" Elevation

Record Drawings have been reviewed by the Project Engineer, and represent to the best of my knowledge, the project as constructed.
 PE *[Signature]* Date 8/24/12


Note: Approach Transition traffic rails are similar to Approach traffic rails. See Sheet AP20 for details.

DO NOT SCALE FROM THESE DRAWINGS USE DIMENSIONS


DESIGNED BY: <i>J. Scott</i>		STATE OF ALASKA DEPARTMENT OF TRANSPORTATION & PUBLIC FACILITIES DESIGN & ENGINEERING SERVICES DIVISION-SOUTHEAST REGION															
		Gustavus Causeway Replacement															
		Approach Transition Traffic Rail Elements AP36															
CHECKED BY: <i>B. Savikka</i>	<table border="1"> <thead> <tr> <th>NO.</th> <th>DATE</th> <th>REVISIONS DESCRIPTION</th> <th>PROJECT DESIGNATION</th> <th>YEAR</th> <th>SHEET NO.</th> <th>TOTAL SHEETS</th> </tr> </thead> <tbody> <tr> <td></td> <td></td> <td></td> <td>BR-0003(53)/67599</td> <td>2008</td> <td>46</td> <td>138</td> </tr> </tbody> </table>			NO.	DATE	REVISIONS DESCRIPTION	PROJECT DESIGNATION	YEAR	SHEET NO.	TOTAL SHEETS				BR-0003(53)/67599	2008	46	138
NO.	DATE	REVISIONS DESCRIPTION	PROJECT DESIGNATION	YEAR	SHEET NO.	TOTAL SHEETS											
			BR-0003(53)/67599	2008	46	138											
DRAWN BY: <i>C. Fuman, W. Hickok</i>		PATH: O:\GUS\67599\MF\PLANSET\03-APPROACH\AP36-TRANSITION TRAFFIC RAIL ELEMENTS.DWG TAB: <i>Wed, 26/Nov/08 10:50AM</i>															

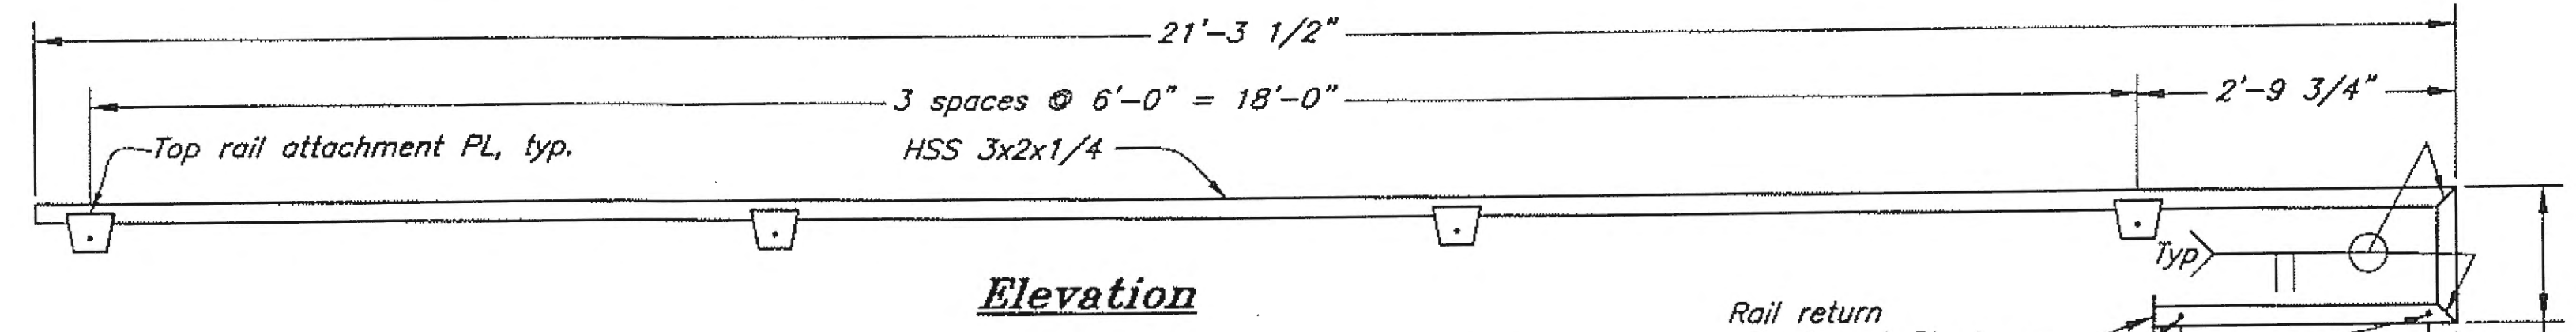


Exterior Rail Element "C"

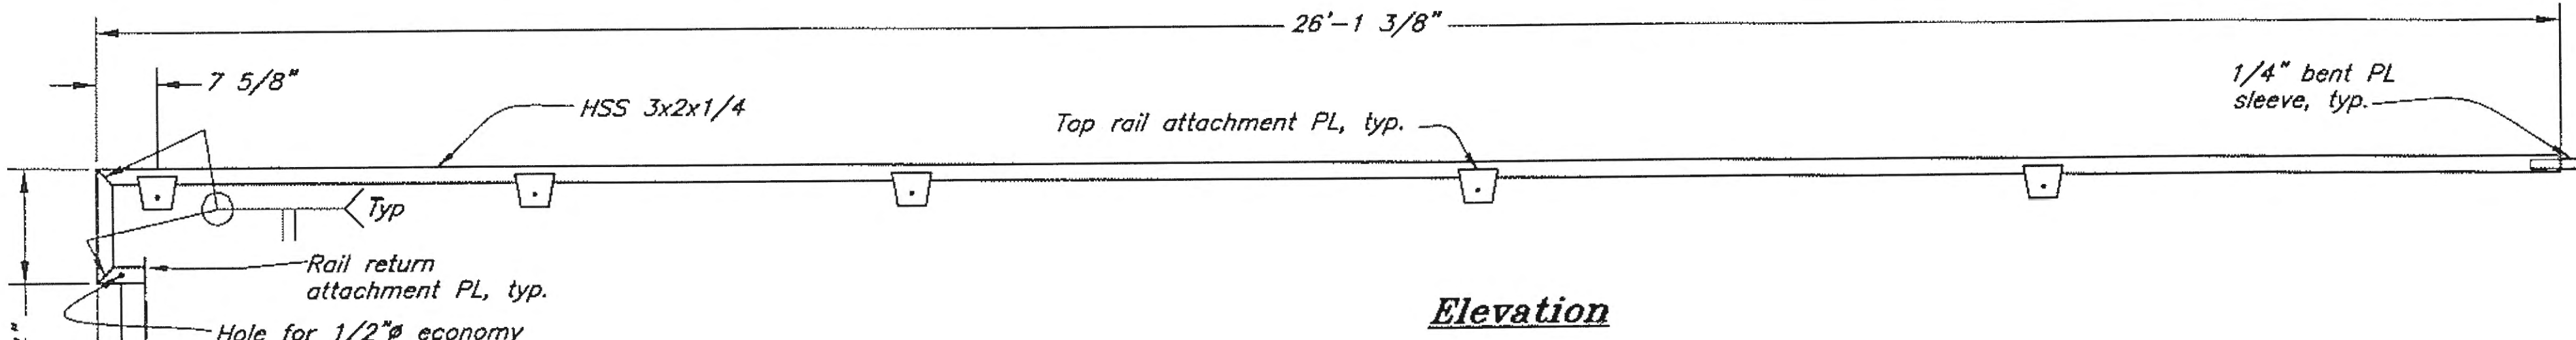


Exterior Rail Element "D"

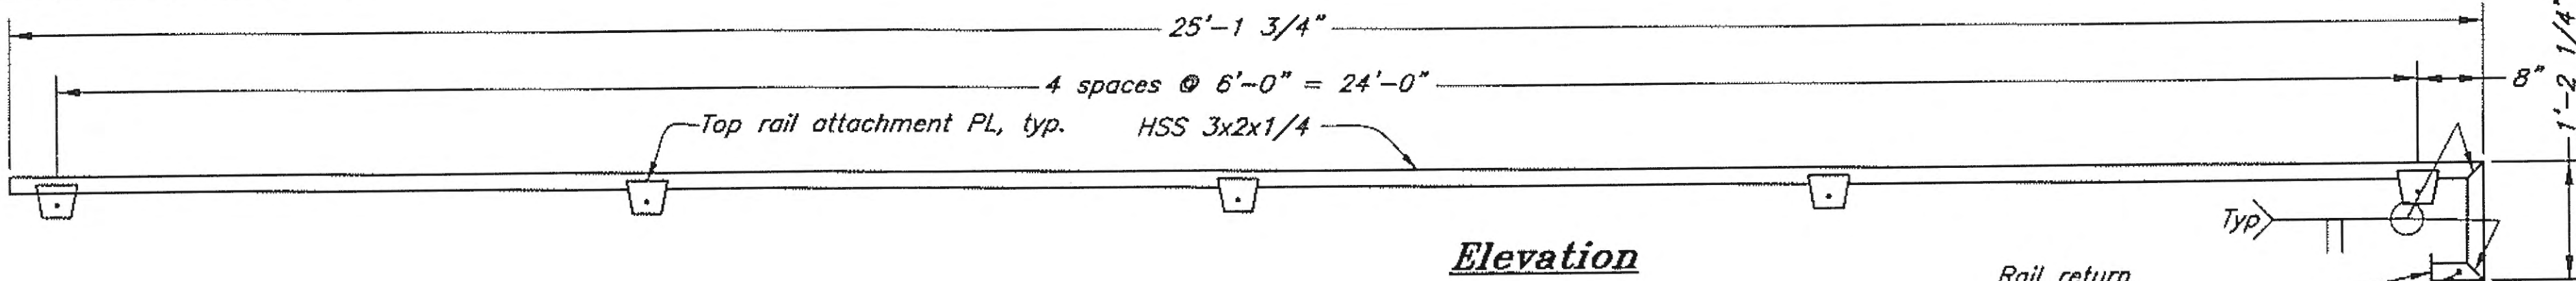


Exterior Rail Element "E"

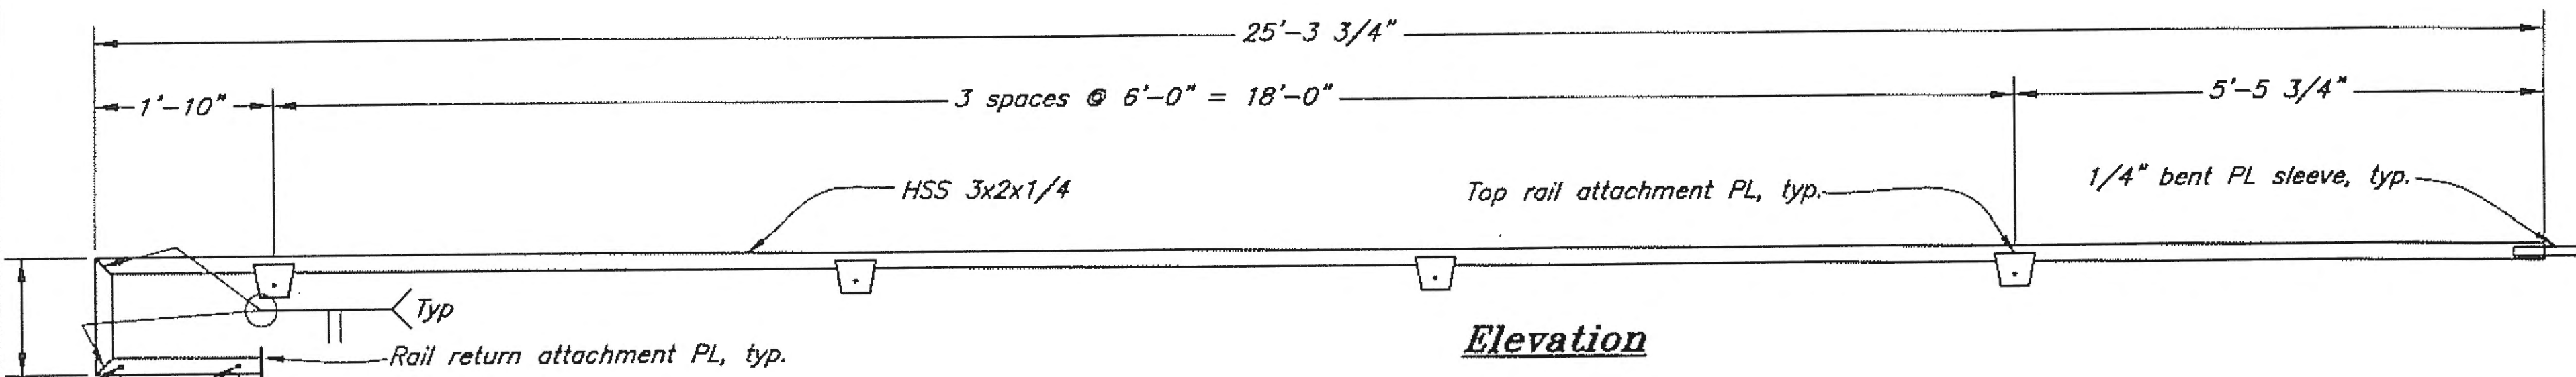

Exterior Rail Element "F"

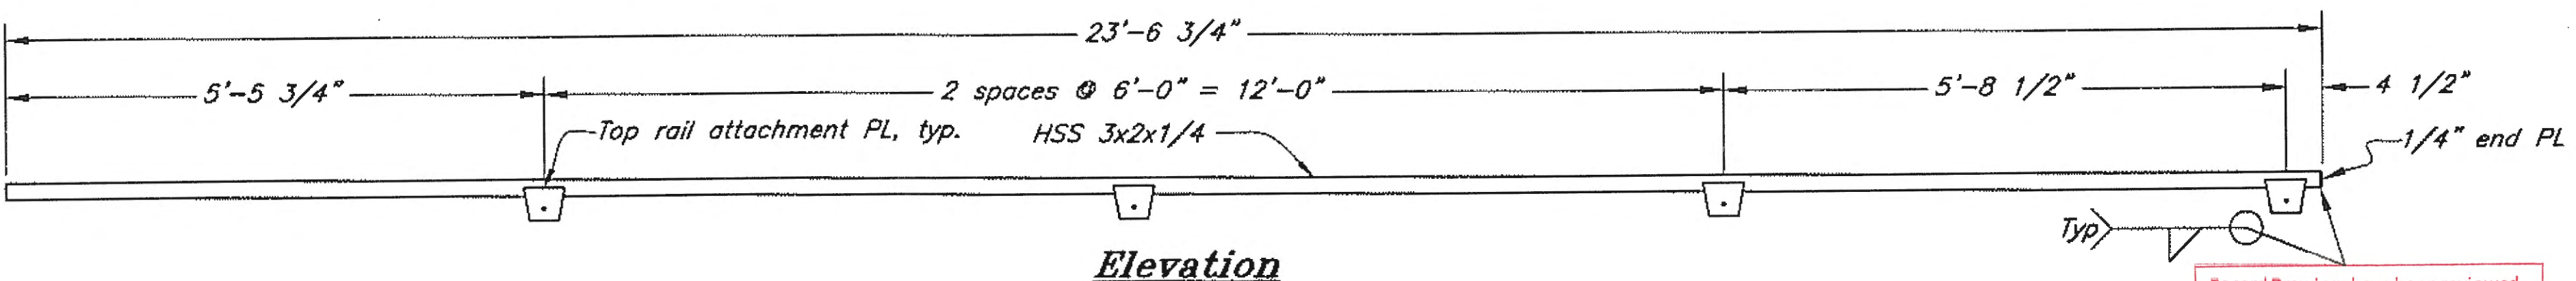

Exterior Rail Element "G"

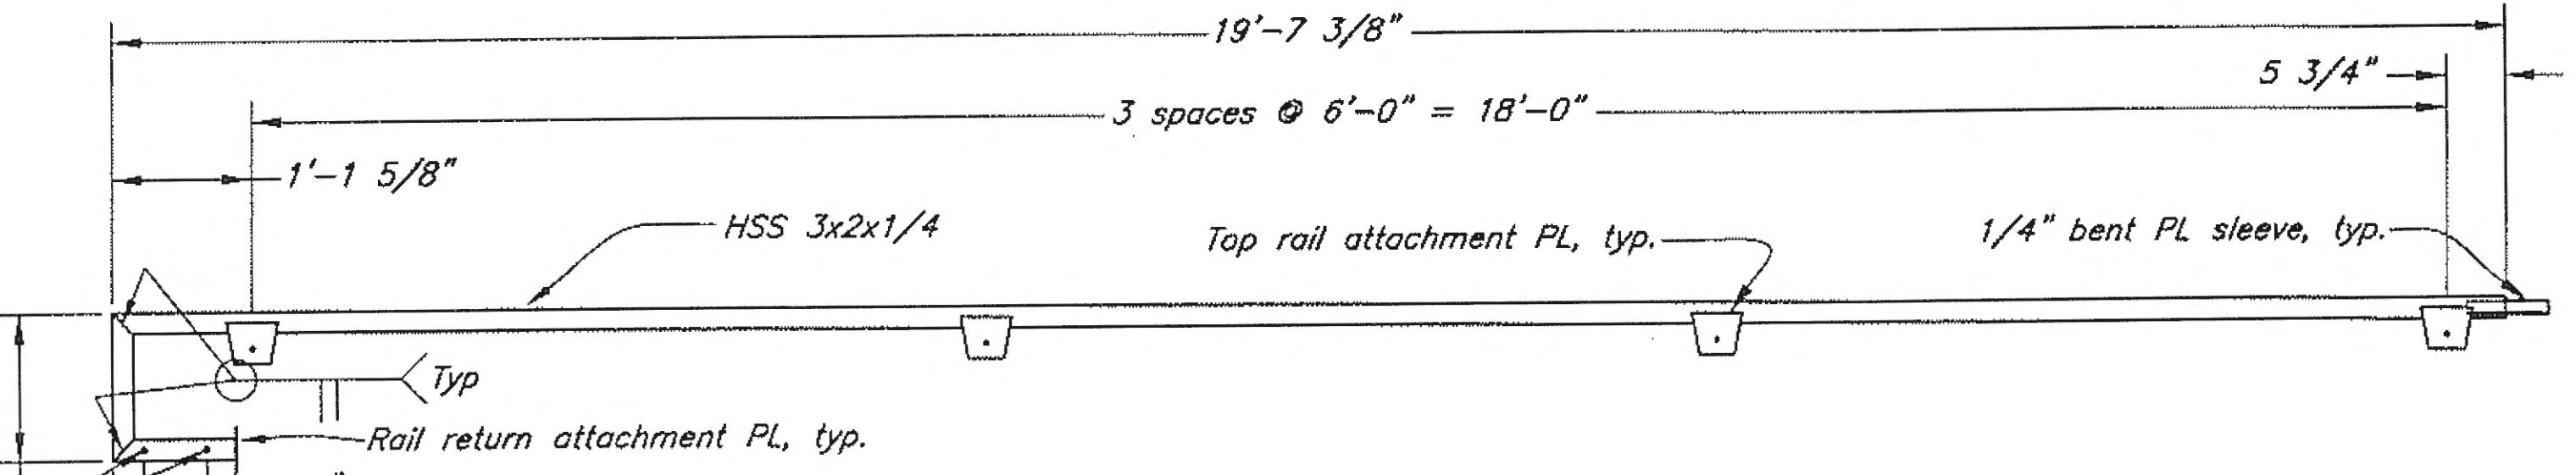

Exterior Rail Element "H"

Record Drawings have been reviewed by the Project Engineer, and represent to the best of my knowledge, the project as constructed.
PE *Steve Will* Date 8/2/12

Note: Approach transition exterior rails are similar to approach exterior rails. See Sheets AP22 & AP23 for rub rail, fencing, sleeve, and attachment details.

DO NOT SCALE FROM THESE DRAWINGS USE DIMENSIONS

DESIGNED BY: J. Scott

STATE OF ALASKA
DEPARTMENT OF TRANSPORTATION & PUBLIC FACILITIES
DESIGN & ENGINEERING SERVICES DIVISION-SOUTHEAST REGION

Gustavus Causeway Replacement

Approach Transition Exterior Rail Elements

AP37






CHECKED BY: B. Savikko
DRAWN BY: C. Fuman, W. Hickey

STATE OF ALASKA
4911
John I. Scott
CE-4755
REGISTERED PROFESSIONAL ENGINEER

11.26.08

PATH: O:\GUS\67599\MF\PLANSET\03-APPROACH\AP37-TRANSITION EXT RAIL ELEMENTS 1.DWG
TAB: Wed, 26/Nov/08 10:51AM JTSCOTT

REVISIONS		PROJECT DESIGNATION	YEAR	SHEET NO.	TOTAL SHEETS
NO.	DATE DESCRIPTION				
		BR-0003(53)/67599	2008	47	138

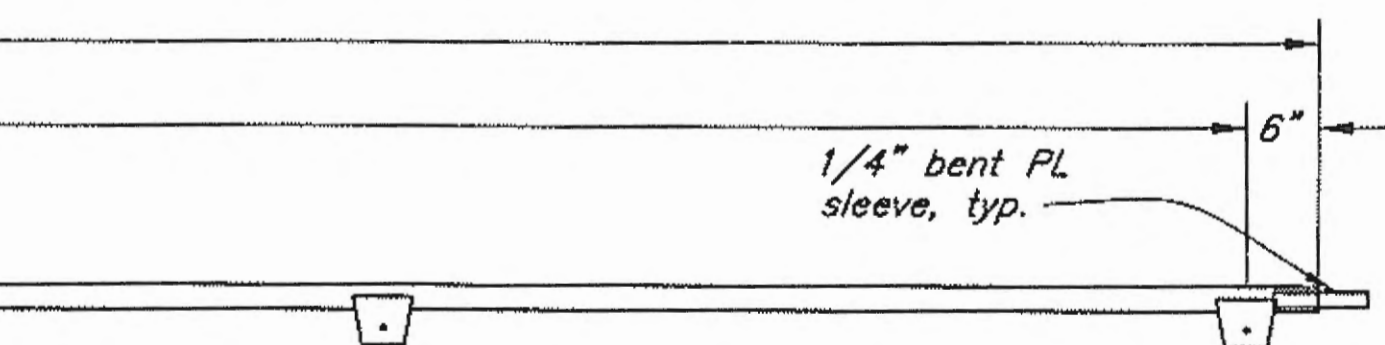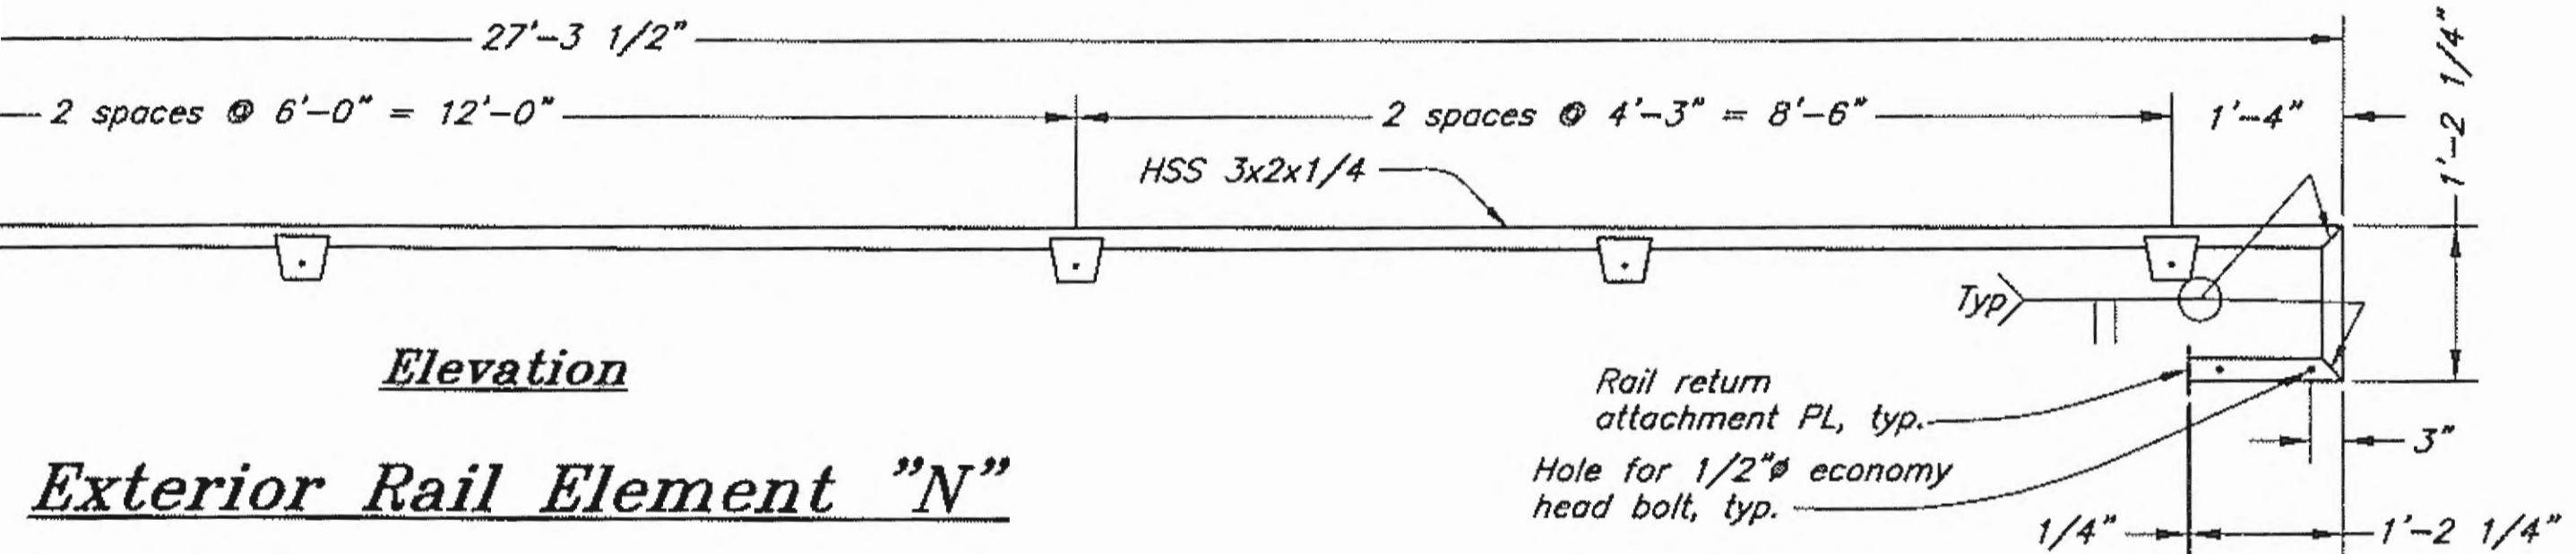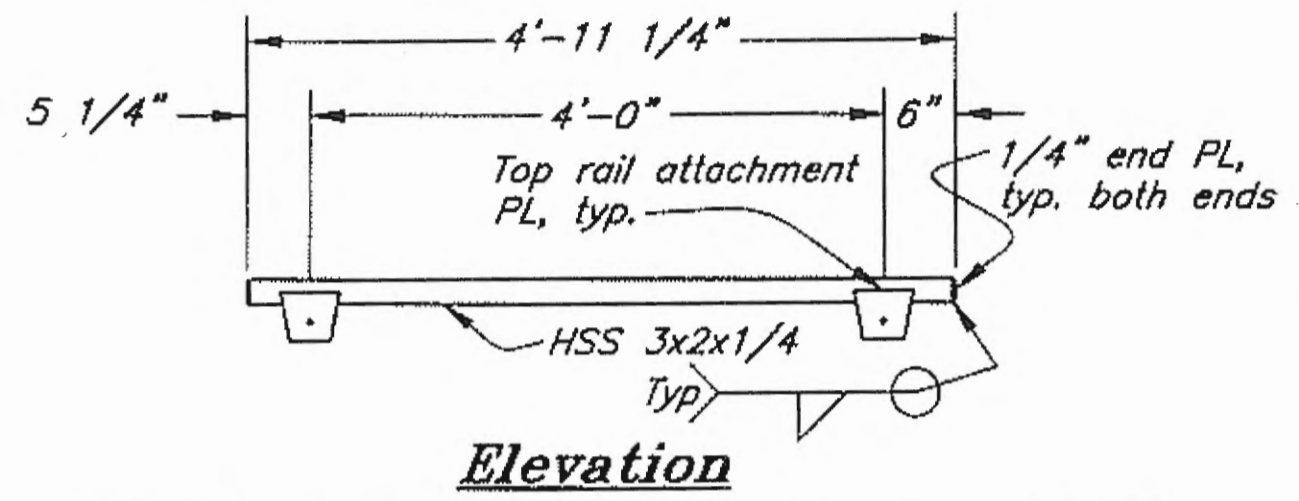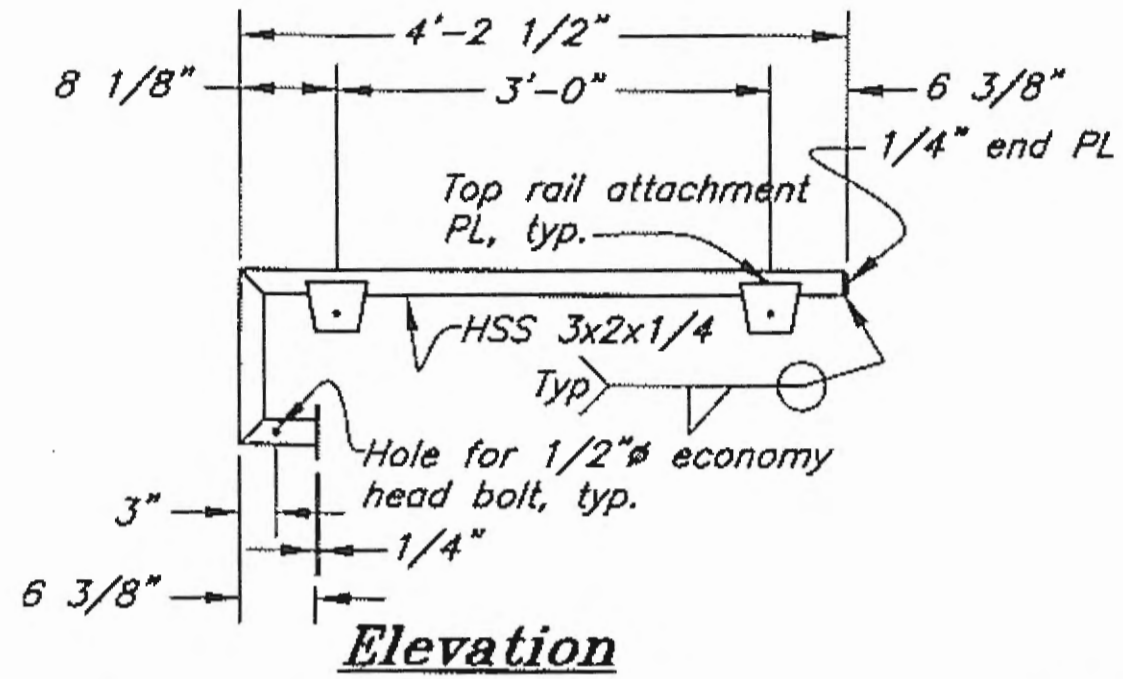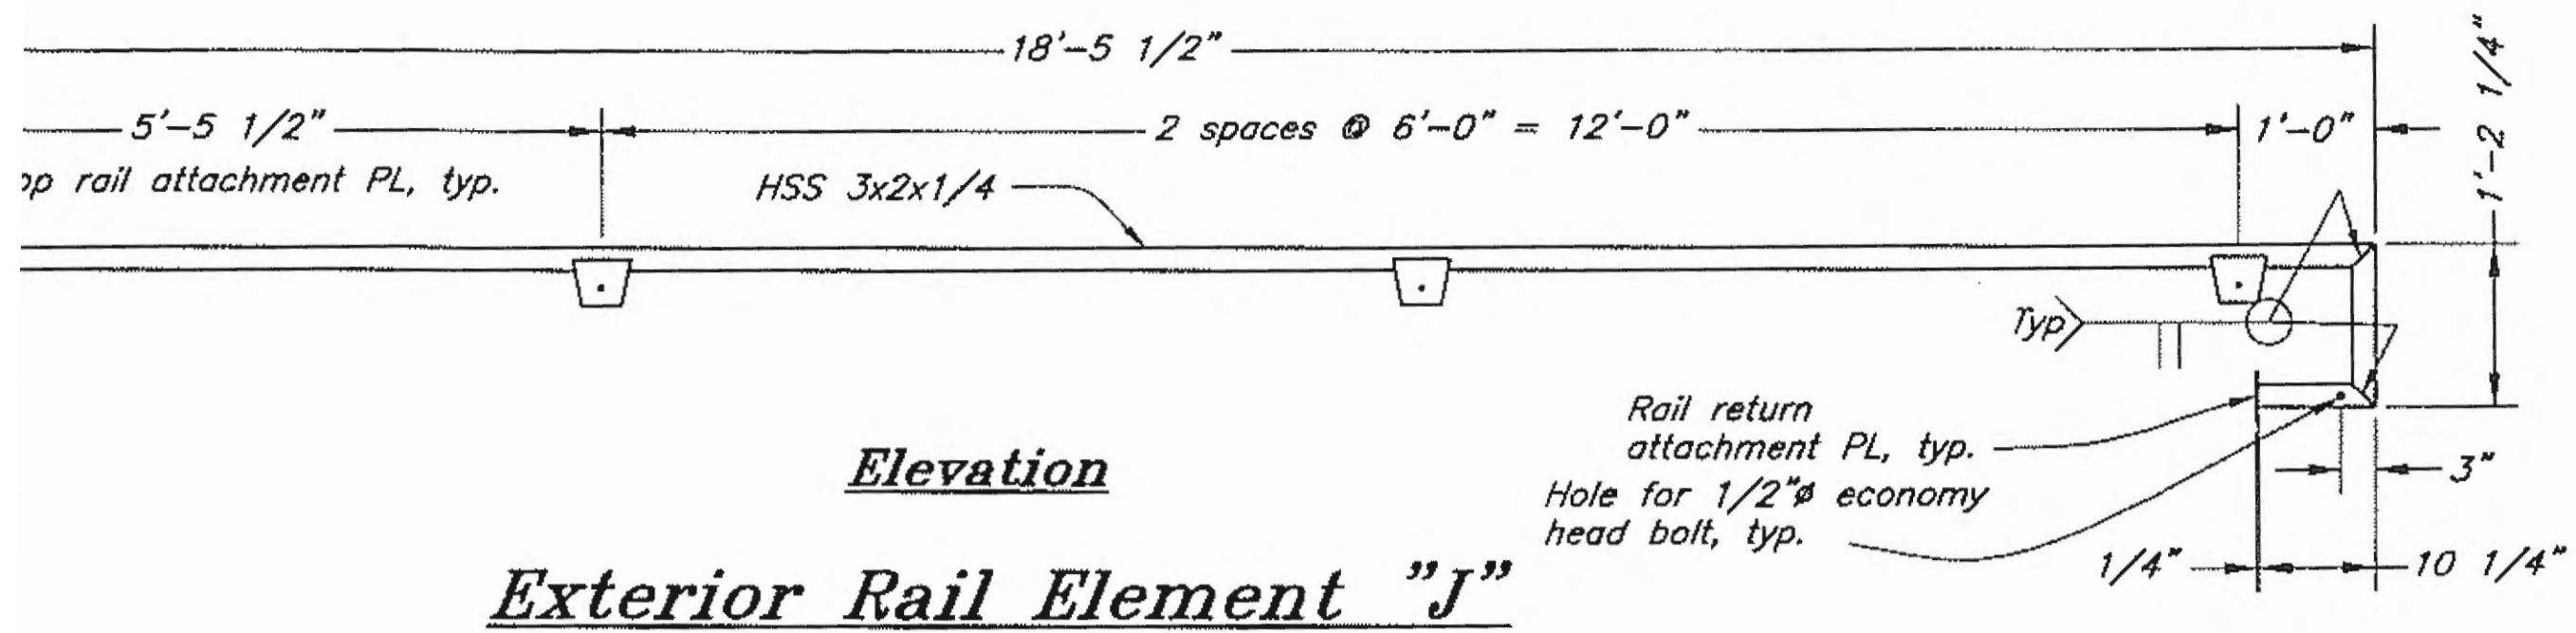


Record Drawings have been reviewed by the Project Engineer, and represent to the best of my knowledge, the project as constructed.
 PE Steve Will Date 8/21/12


DO NOT SCALE FROM THESE DRAWINGS USE DIMENSIONS

DESIGNED BY: <u>J. Scott</u>		STATE OF ALASKA DEPARTMENT OF TRANSPORTATION & PUBLIC FACILITIES DESIGN & ENGINEERING SERVICES DIVISION-SOUTHEAST REGION			
		Gustavus Causeway Replacement			
		Approach Transition Exterior Rail Elements 2			
CHECKED BY: <u>B. Savikko</u>		AP38			
DRAWN BY: <u>C. Fuman, W. Hickok</u>					
PATH: <u>O:\GUS\67599\MF\PLANSET\03-APPROACH\AP38-TRANSITION EXT RAILS - 2.DWG</u>		JTSCOTT			
TAB: <u>Wed, 26/Nov/08 10:52AM</u>					
REVISIONS		PROJECT DESIGNATION		YEAR	SHEET NO.
NO.	DATE	DESCRIPTION			TOTAL SHEETS
			BR-0003(53)/67599		138
			2008	48	


Note: Approach transition handrails are similar to approach handrails. See Sheets AP20 & AP21 for details.

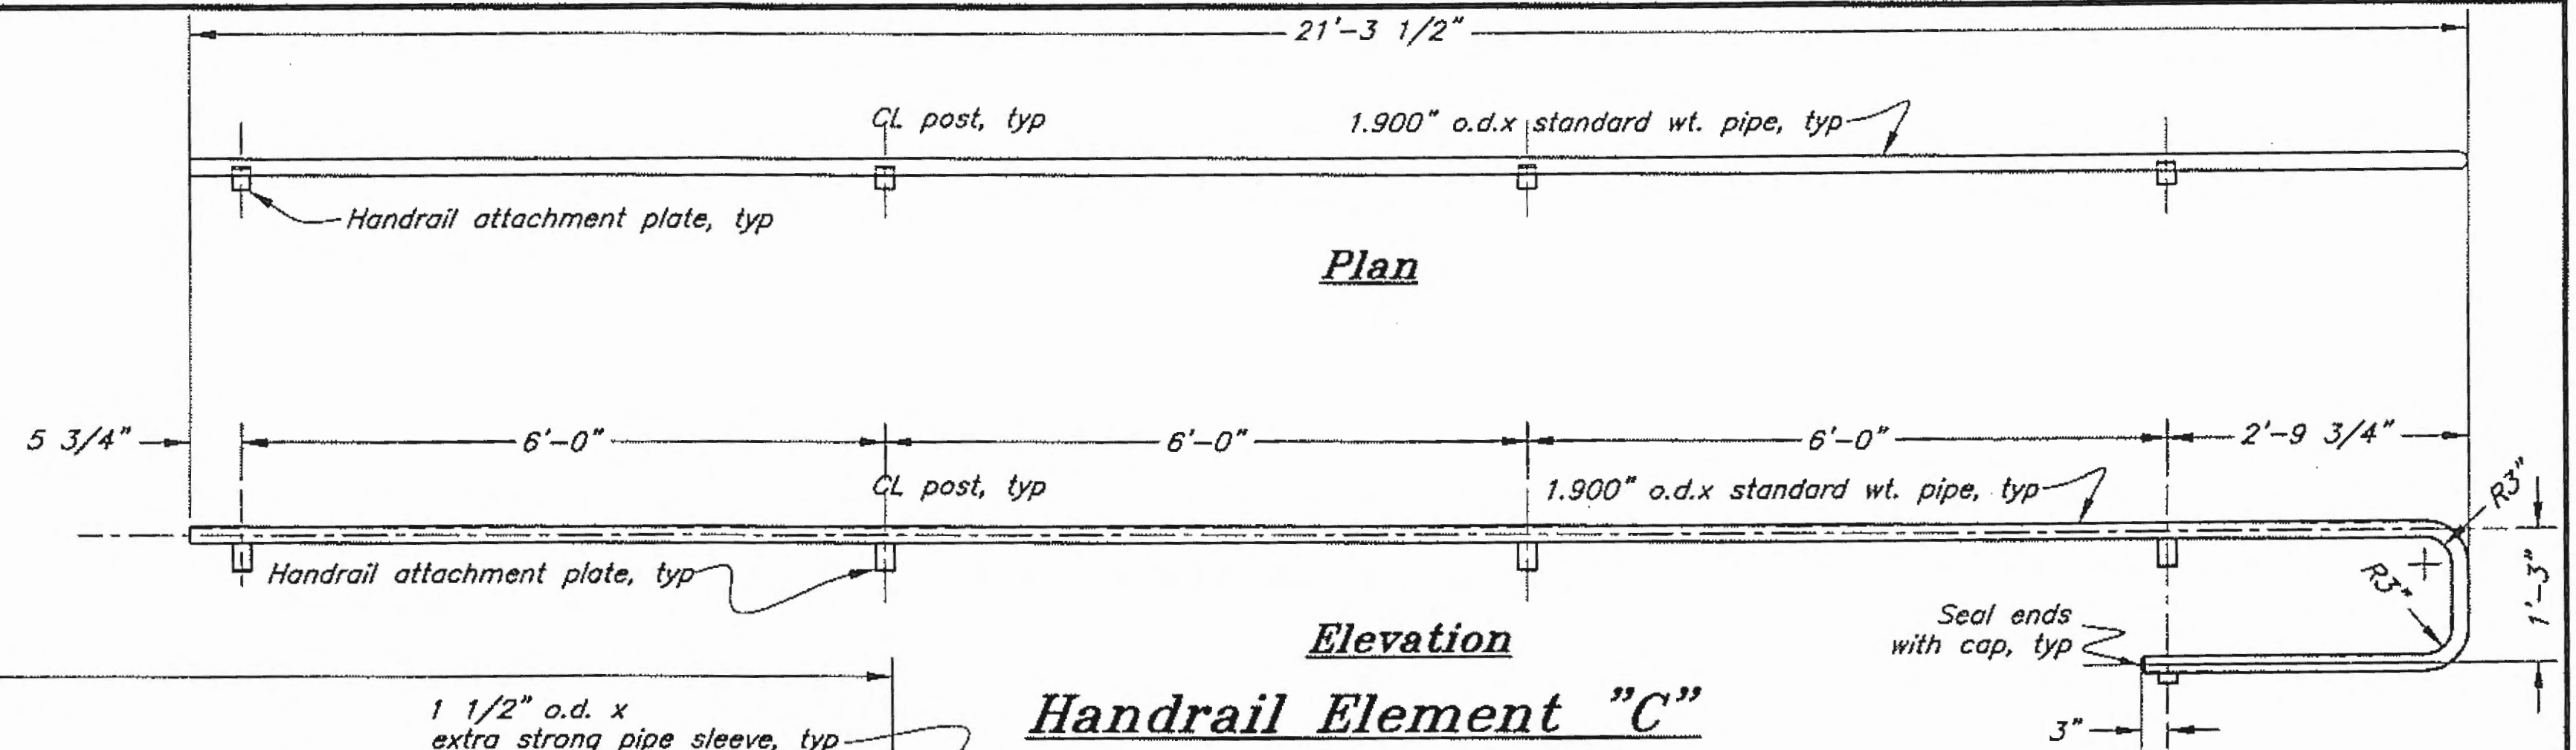


Handrail Element "C"

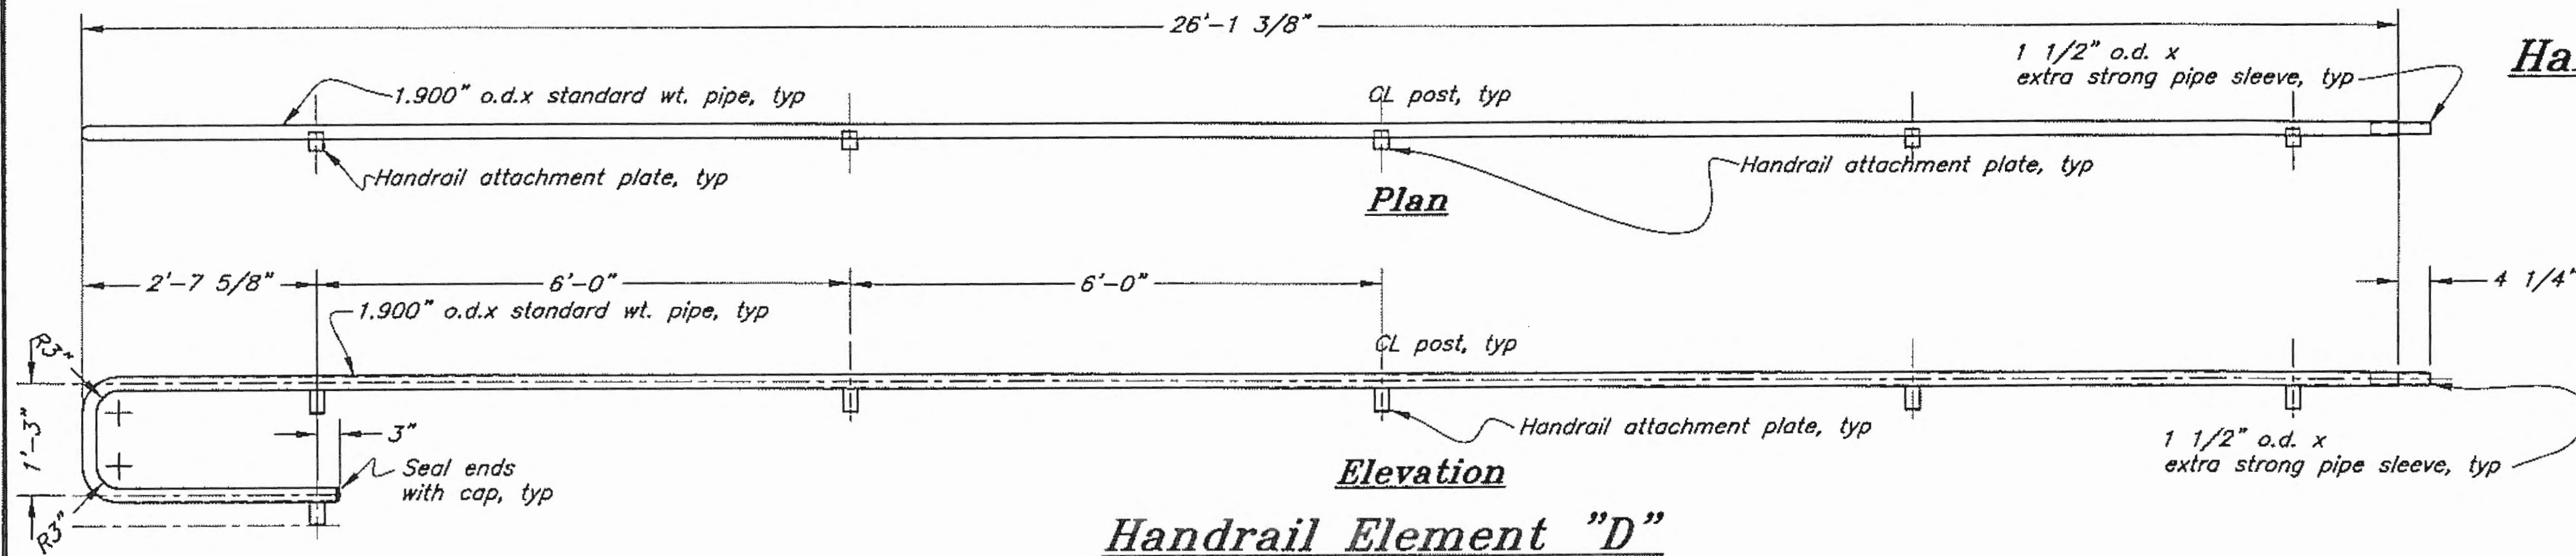

Handrail Element "D"

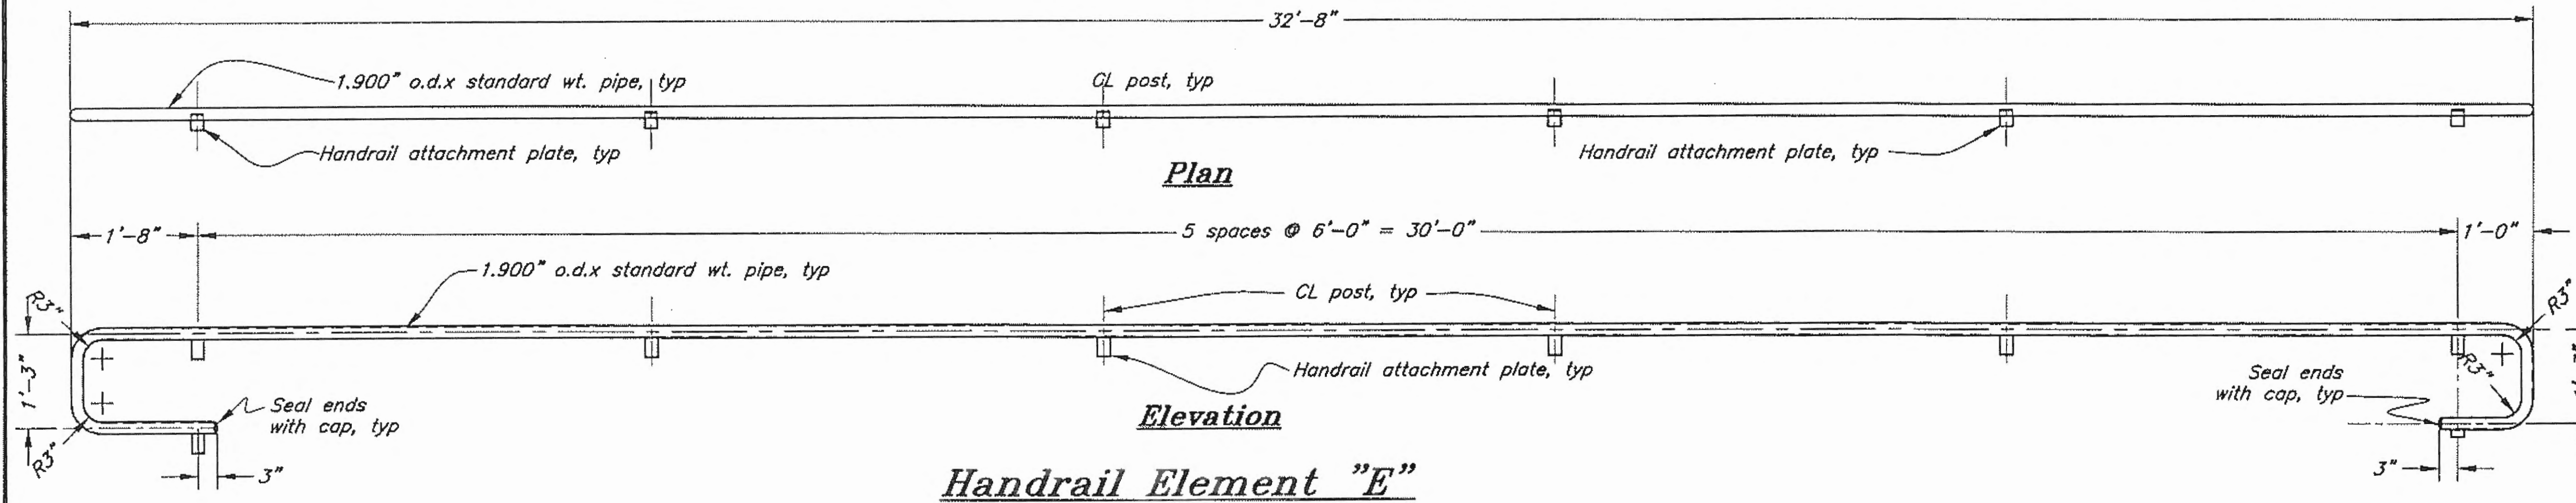


Handrail Element "E"

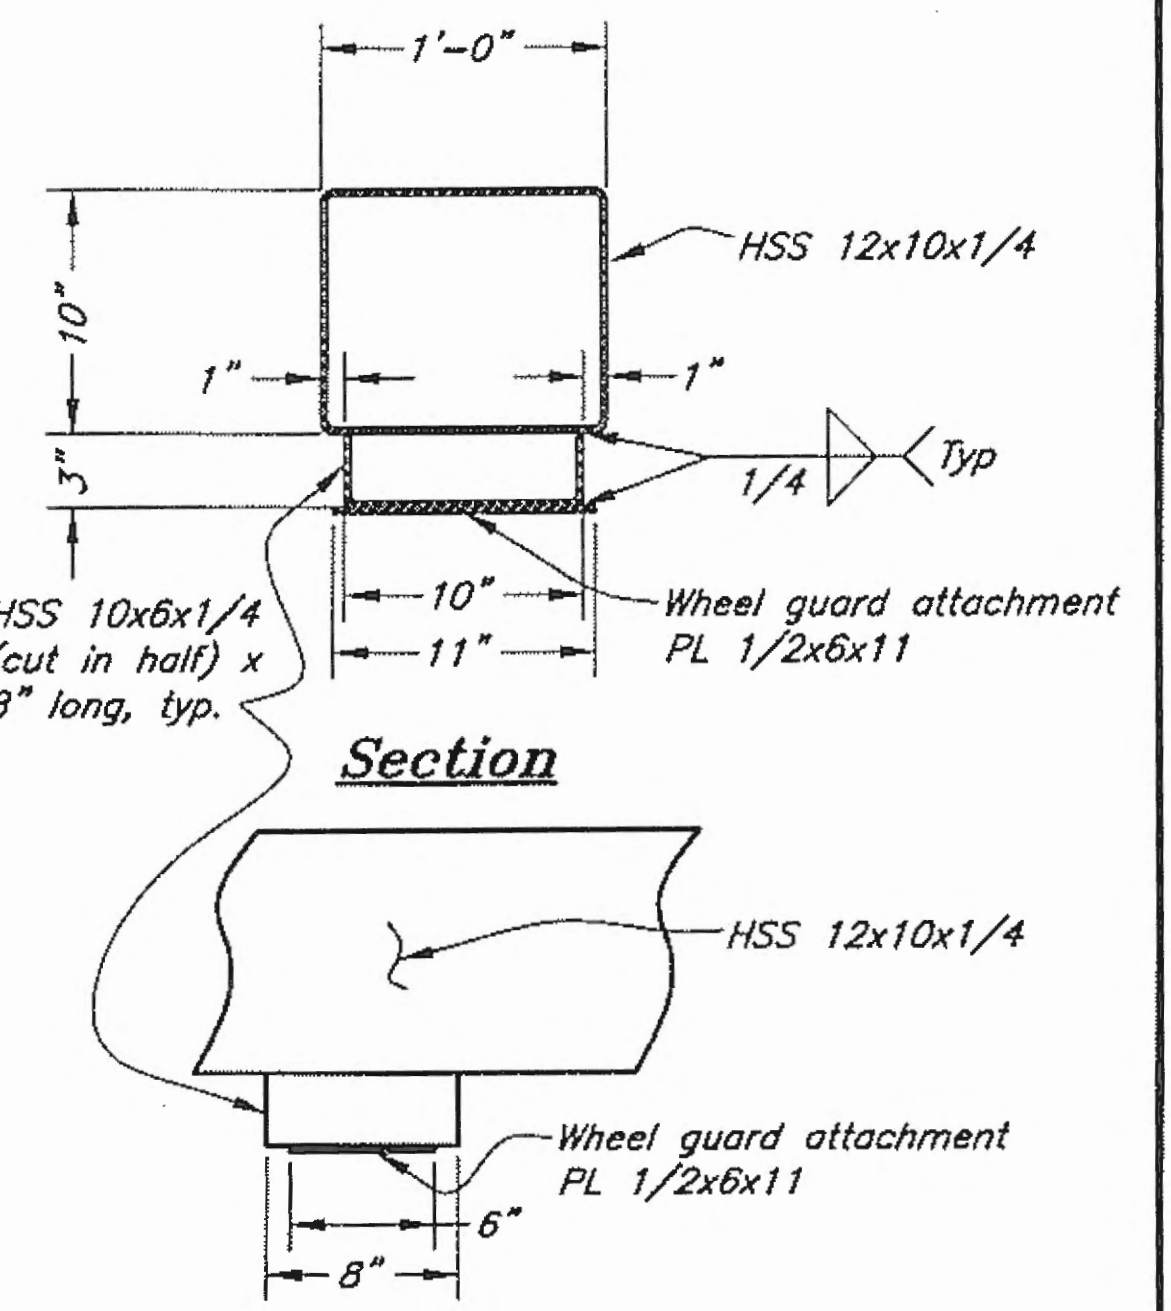


Wheel Guard Detail


Record Drawings have been reviewed by the Project Engineer, and represent to the best of my knowledge, the project as constructed.
PE *[Signature]* Date 8/21/17

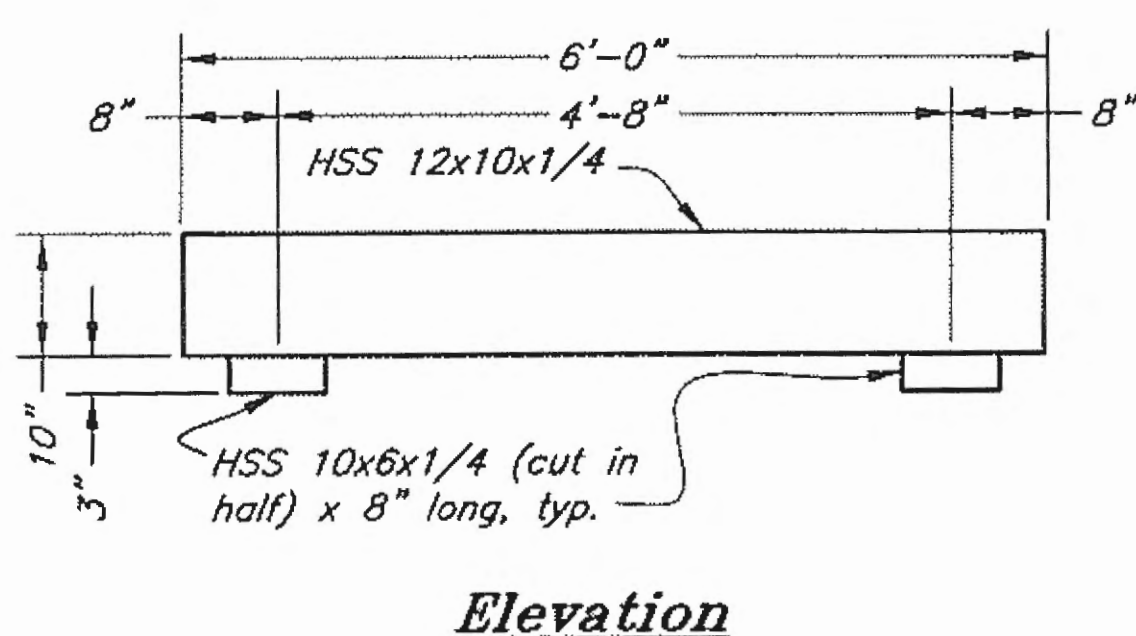

Wheel Guard Element "C"

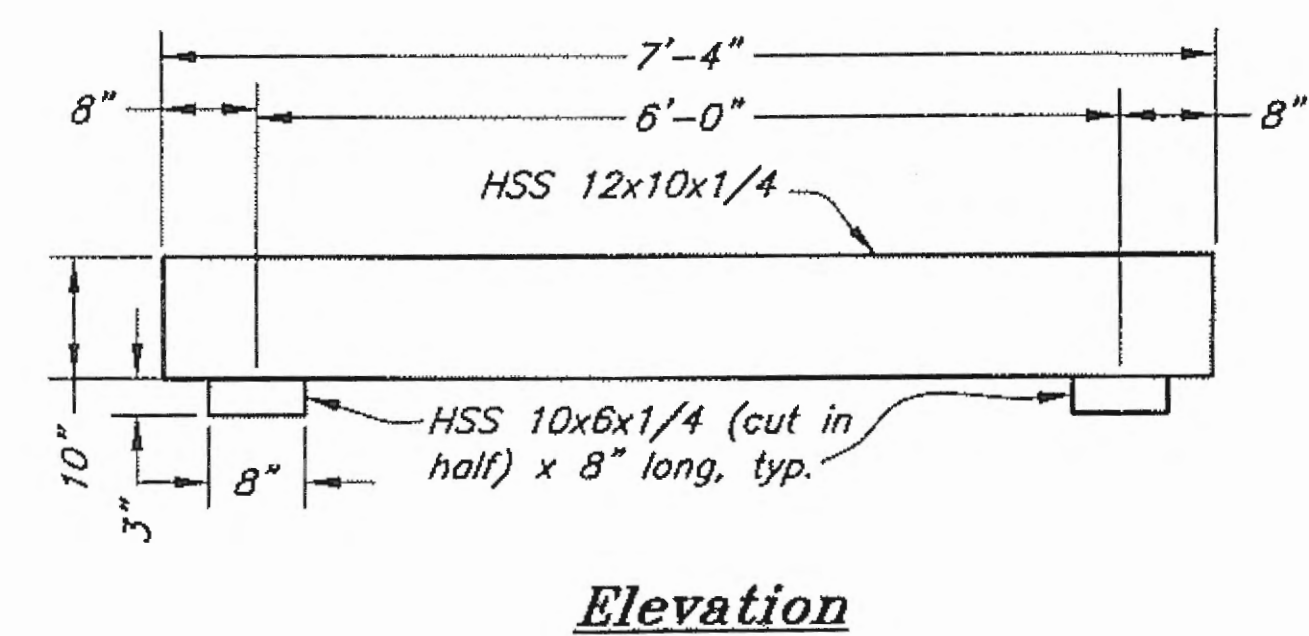

Wheel Guard Elements "B"

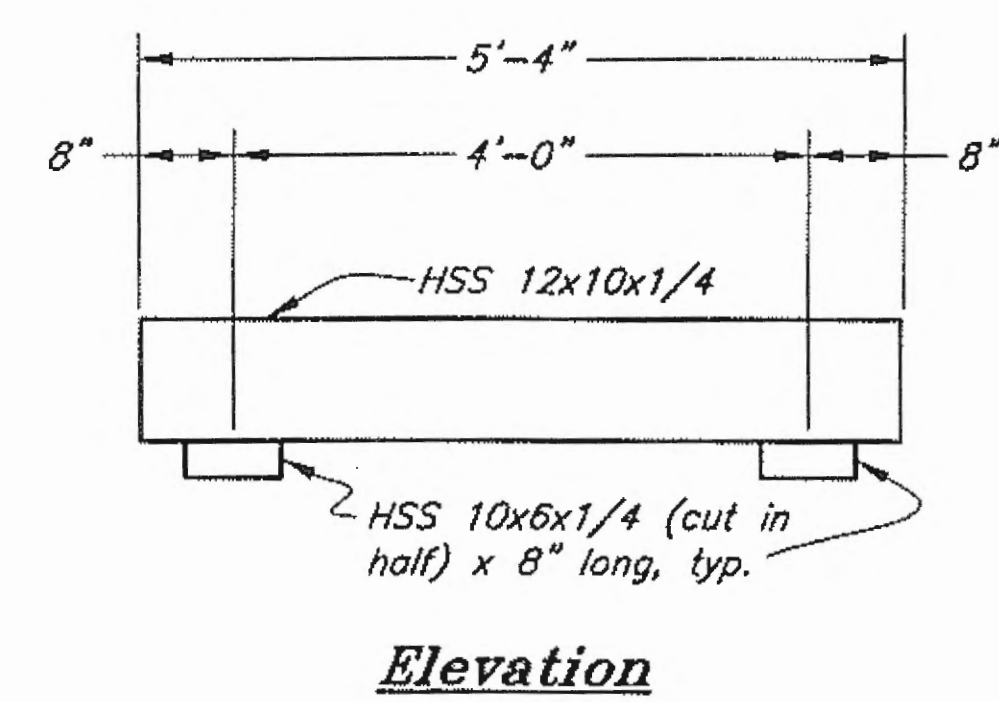

Wheel Guard Element "A"

DO NOT SCALE FROM THESE DRAWINGS USE DIMENSIONS

DESIGNED BY: J. Scott

STATE OF ALASKA
DEPARTMENT OF TRANSPORTATION & PUBLIC FACILITIES
DESIGN & ENGINEERING SERVICES DIVISION-SOUTHEAST REGION

Gustavus Causeway Replacement
Approach Transition Handrail & Wheel Guard Elements
AP39


CHECKED BY: B. Savikko
DRAWN BY: C. Fuman, W. Hickok

STATE OF ALASKA
49th
John T. Scott
CE-4755
REGISTERED PROFESSIONAL ENGINEER



11-26-08

PATH: Q:\GUS\67599\MF\PLANSET\03-APPROACH\AP39-TRANSITION HANDRAIL & WHEELGUARDS - 2.
TAB: Wed, 26/Nov/08 10:55AM JTSCOTT


REVISIONS		PROJECT DESIGNATION	YEAR	SHEET NO.	TOTAL SHEETS
NO.	DATE DESCRIPTION				
		BR-0003(53)/67599	2008	49	138

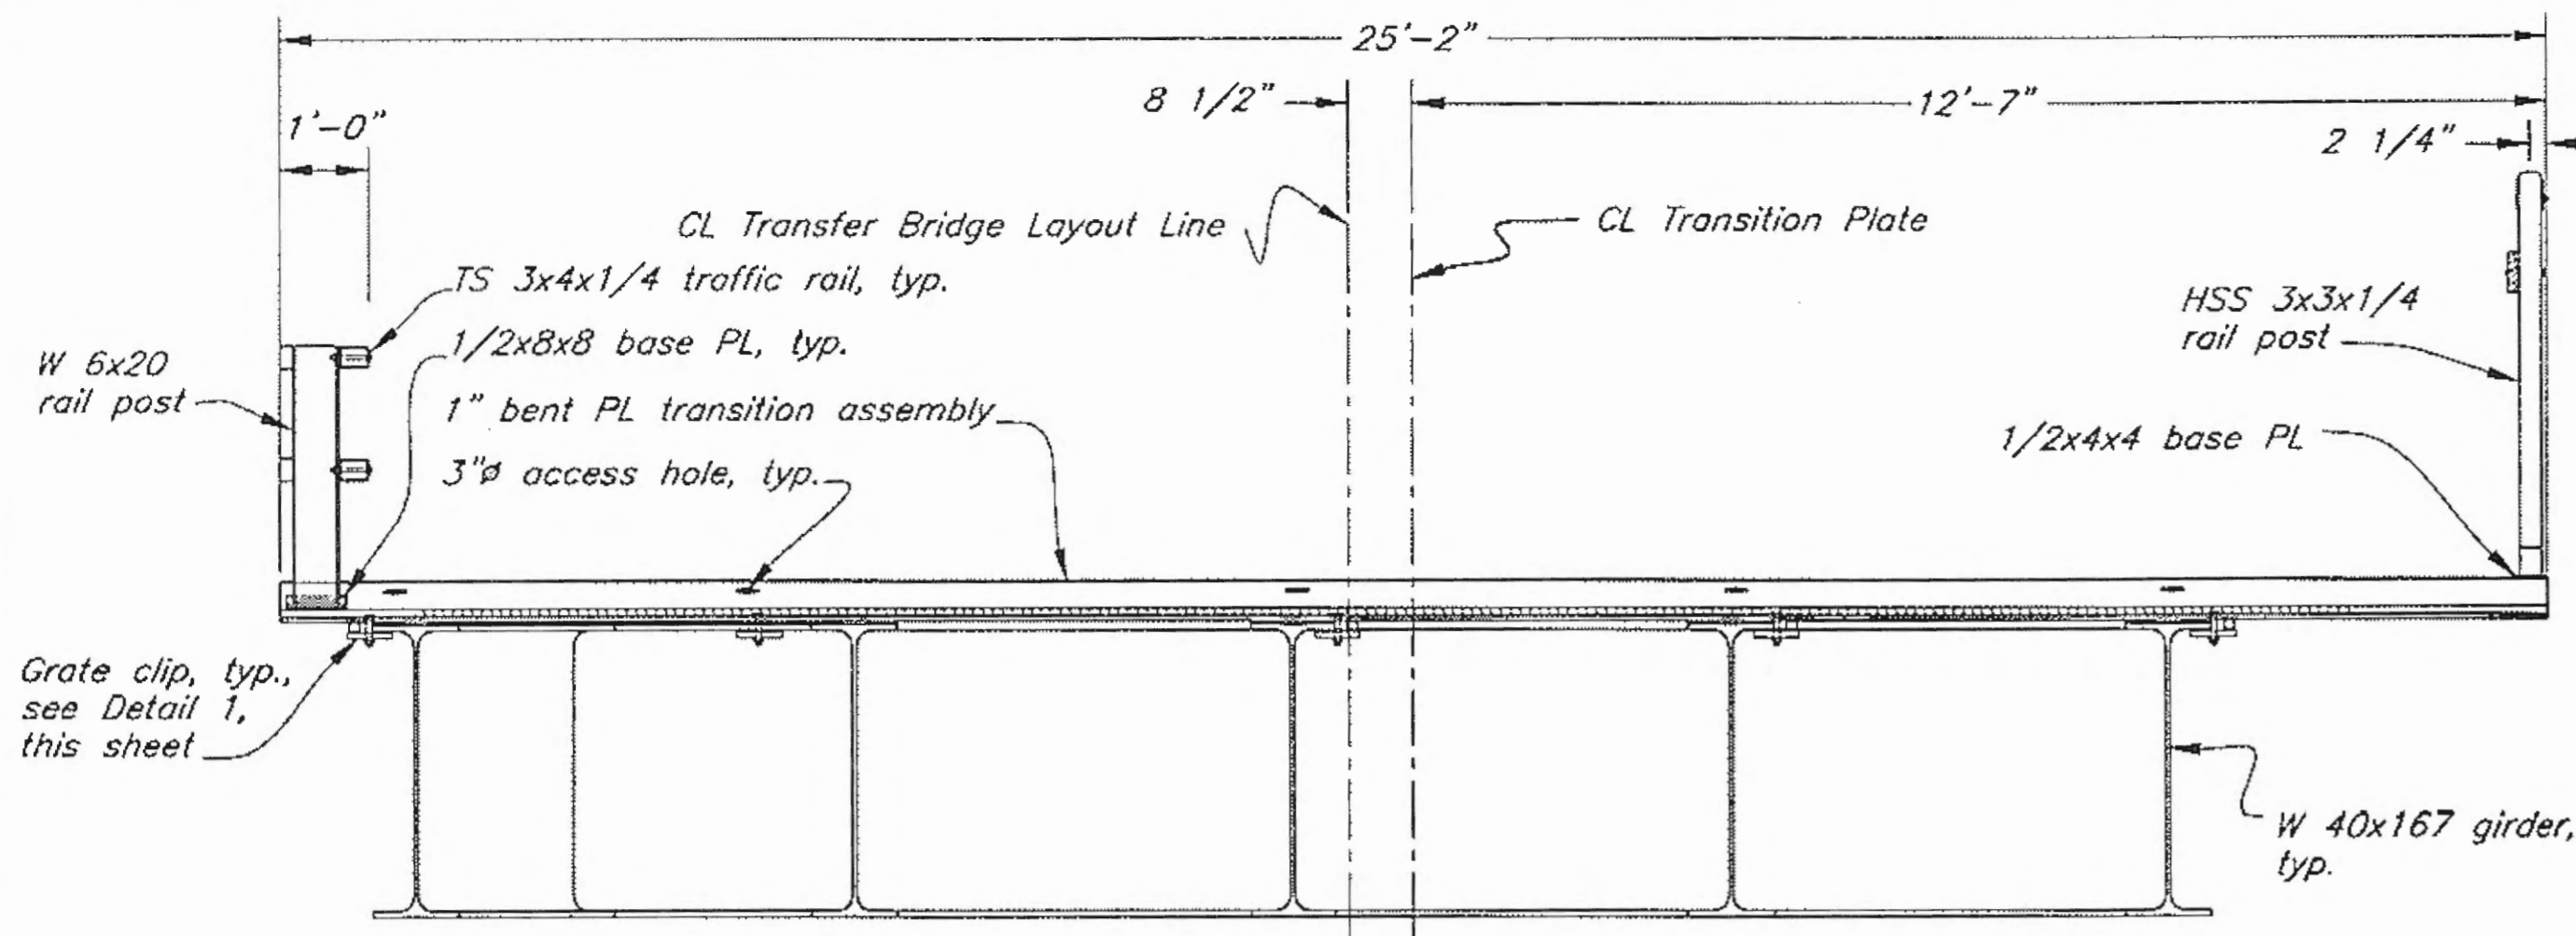


**Sectional Elevation
Transition Plate Assembly
(Looking Shoreward)**

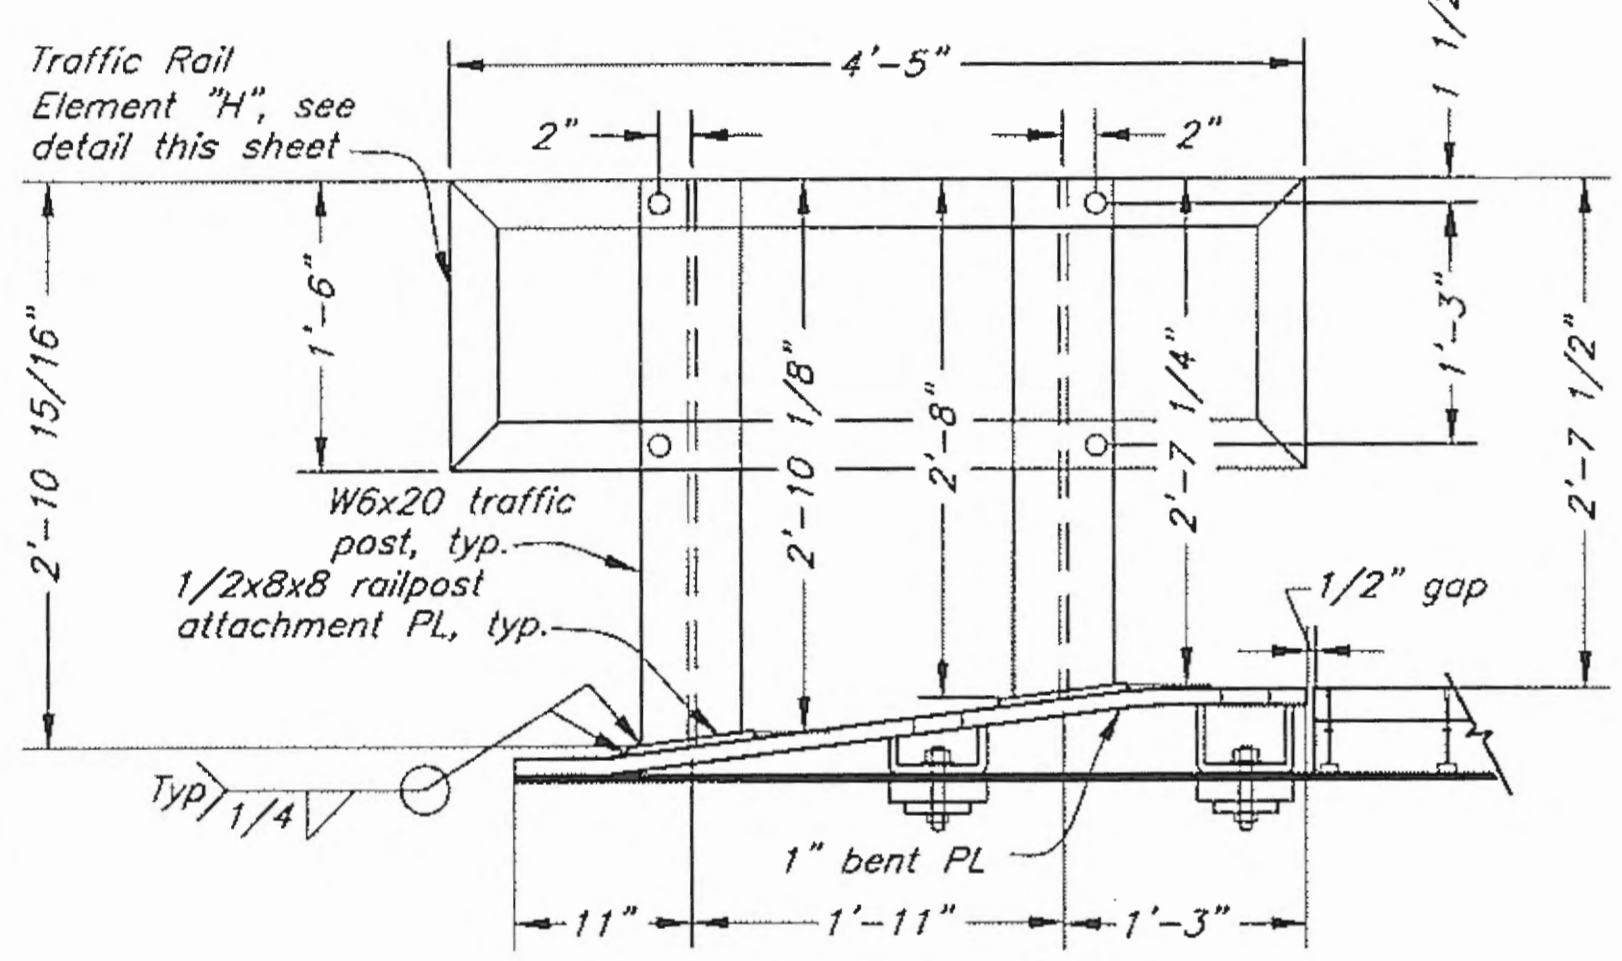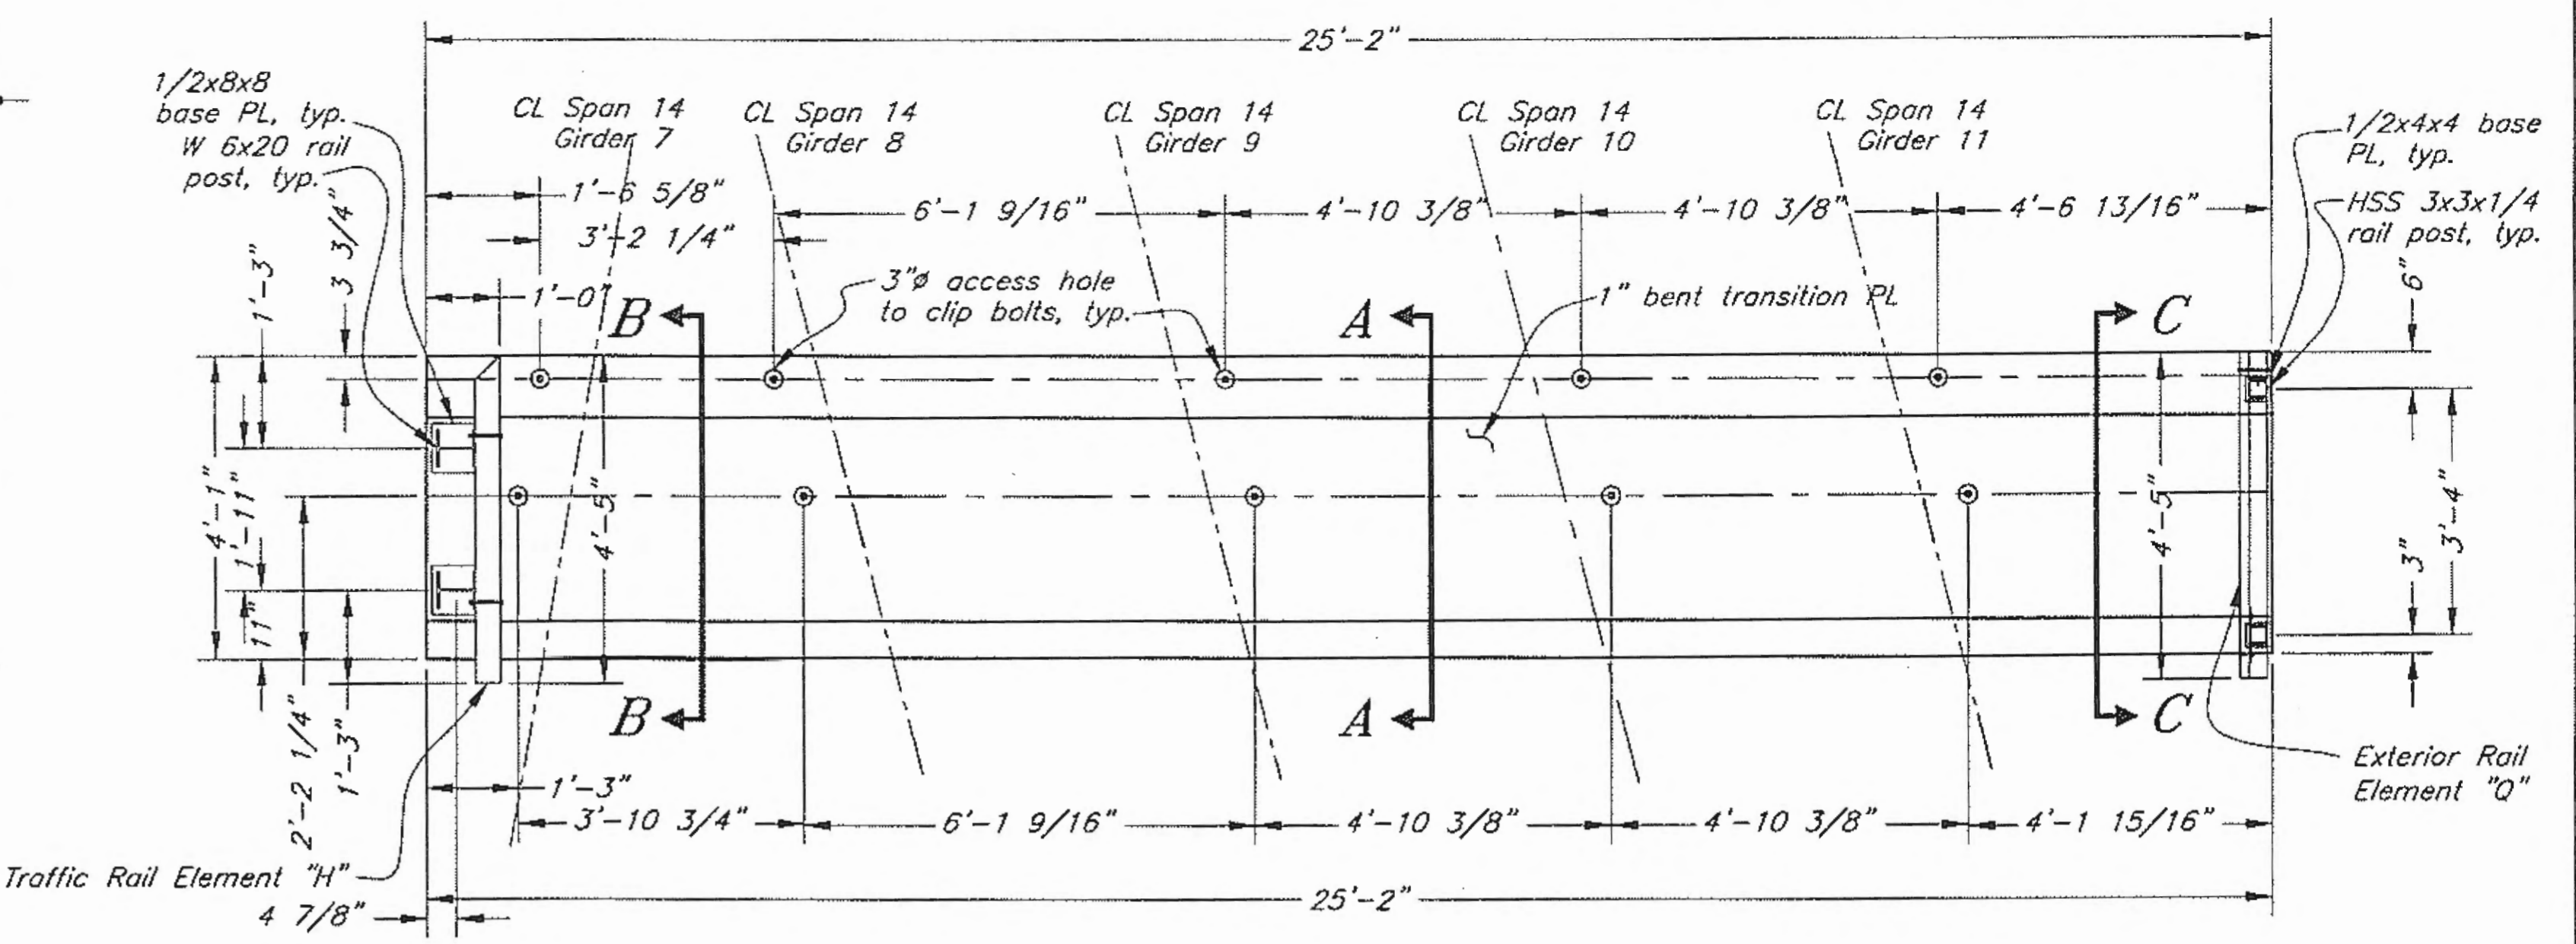


Section B-B

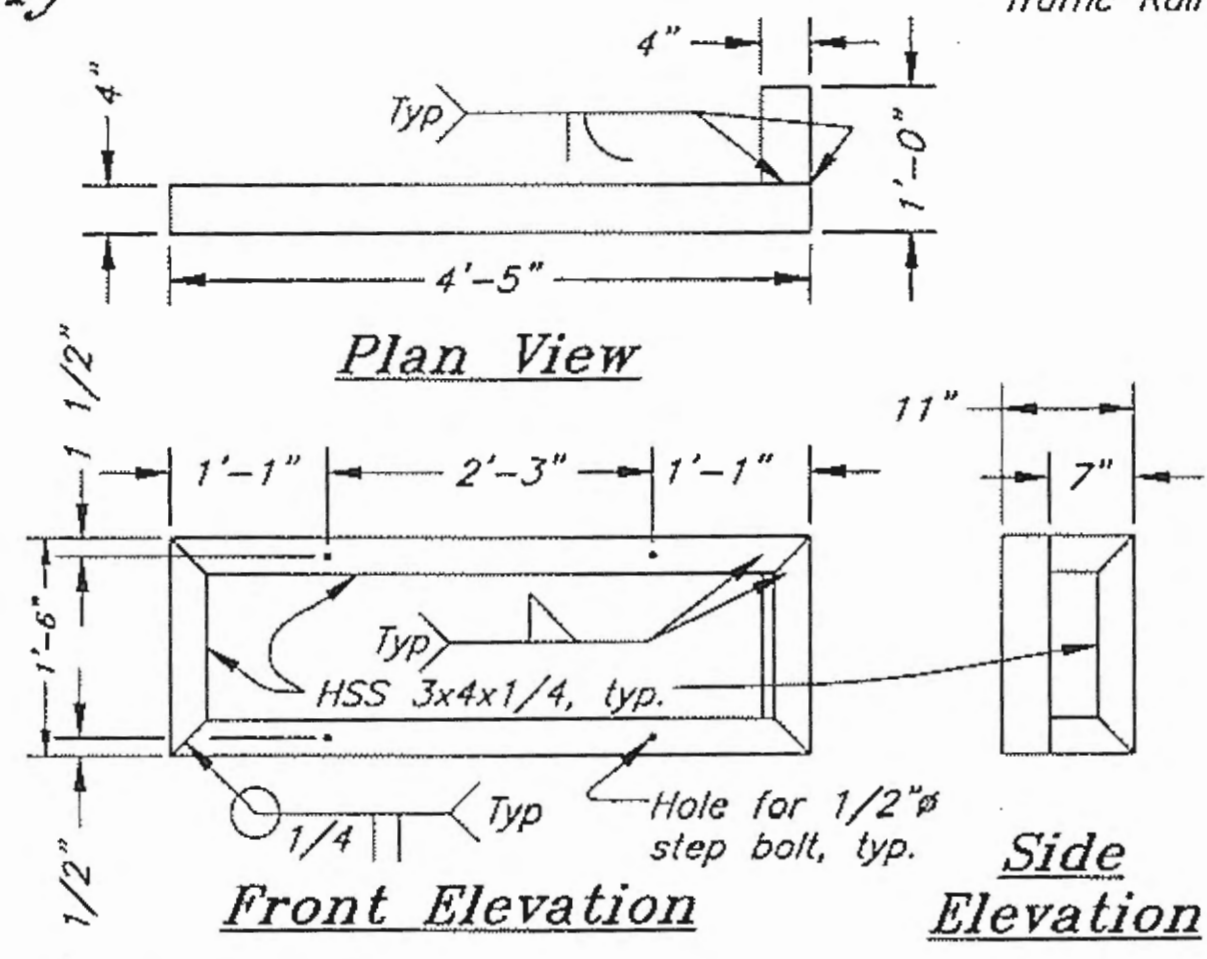


**Plan View
Front Elevation
Traffic Rail Element 'H'**

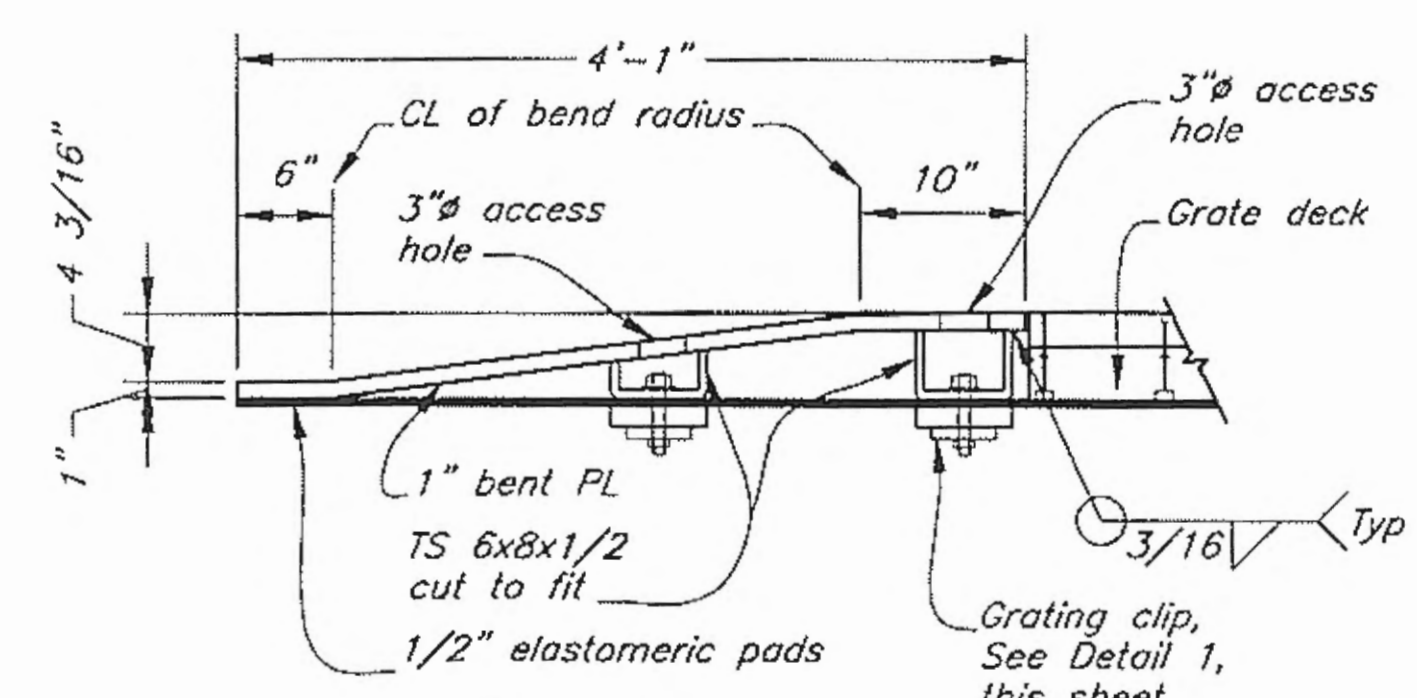


Section A-A

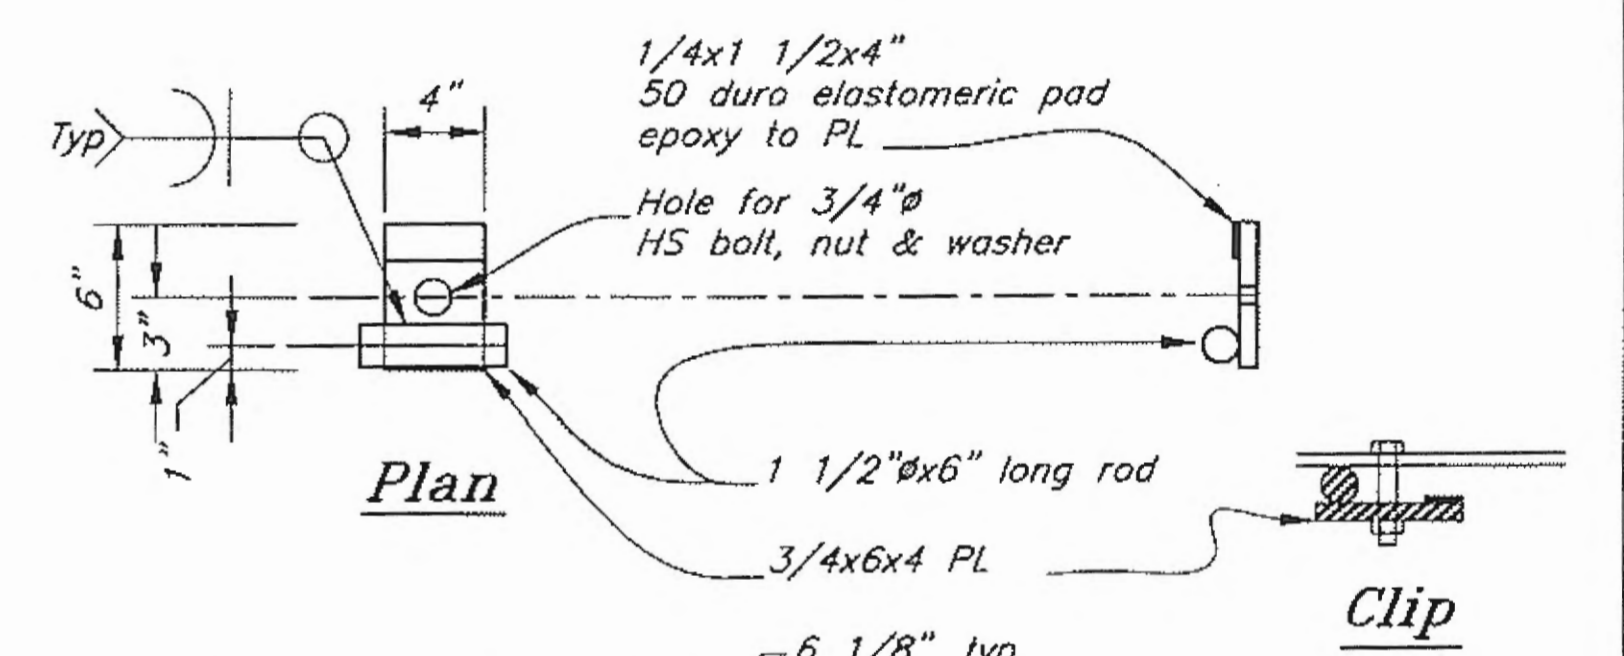


**Plan
Clip**

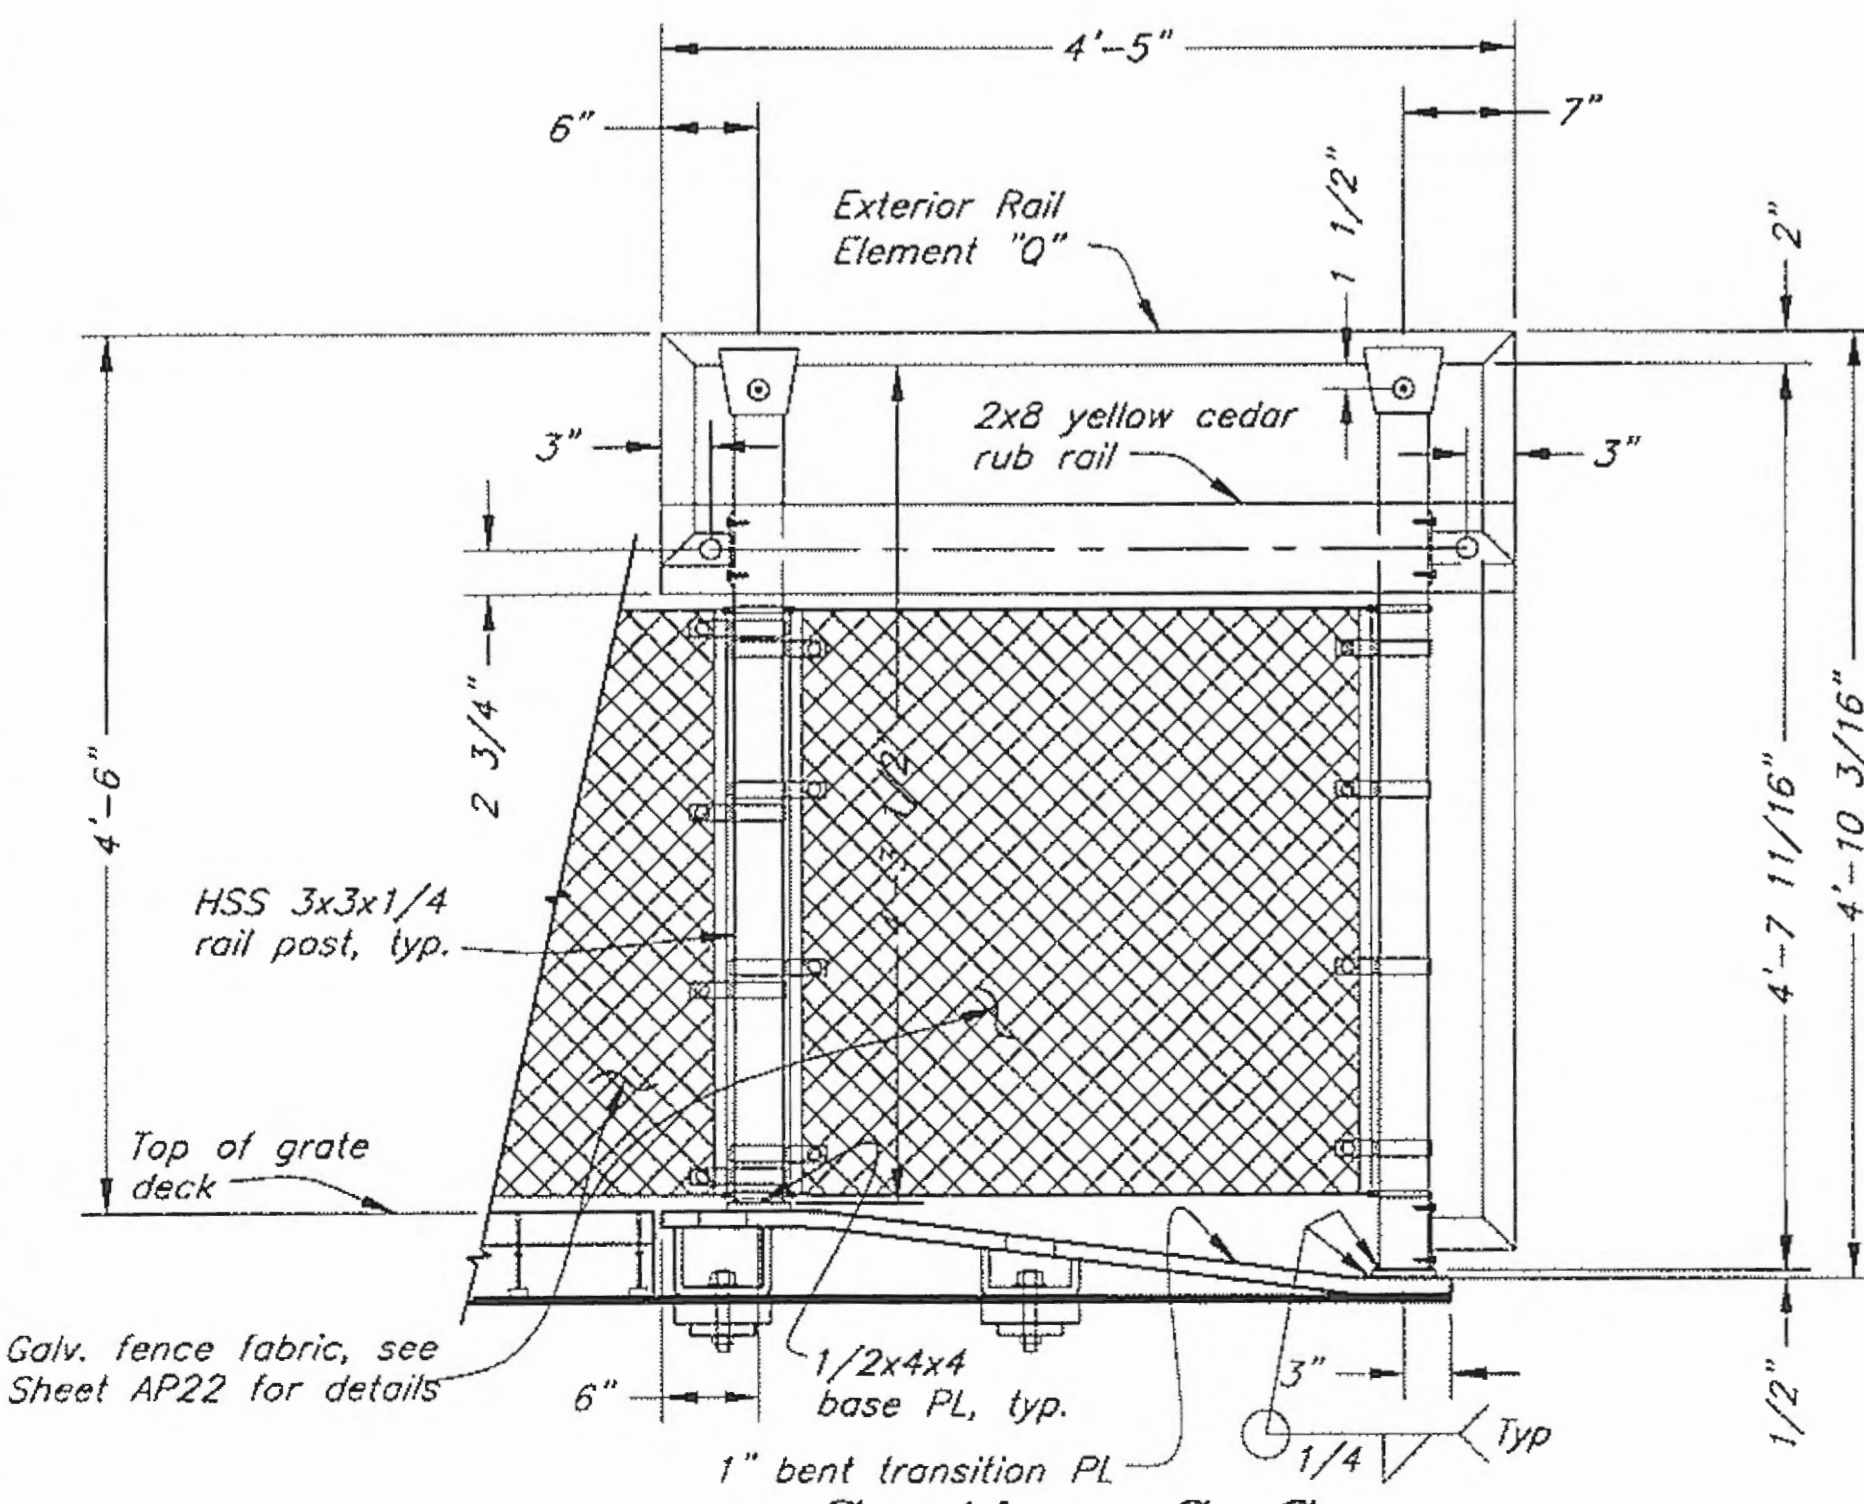

Section C-C

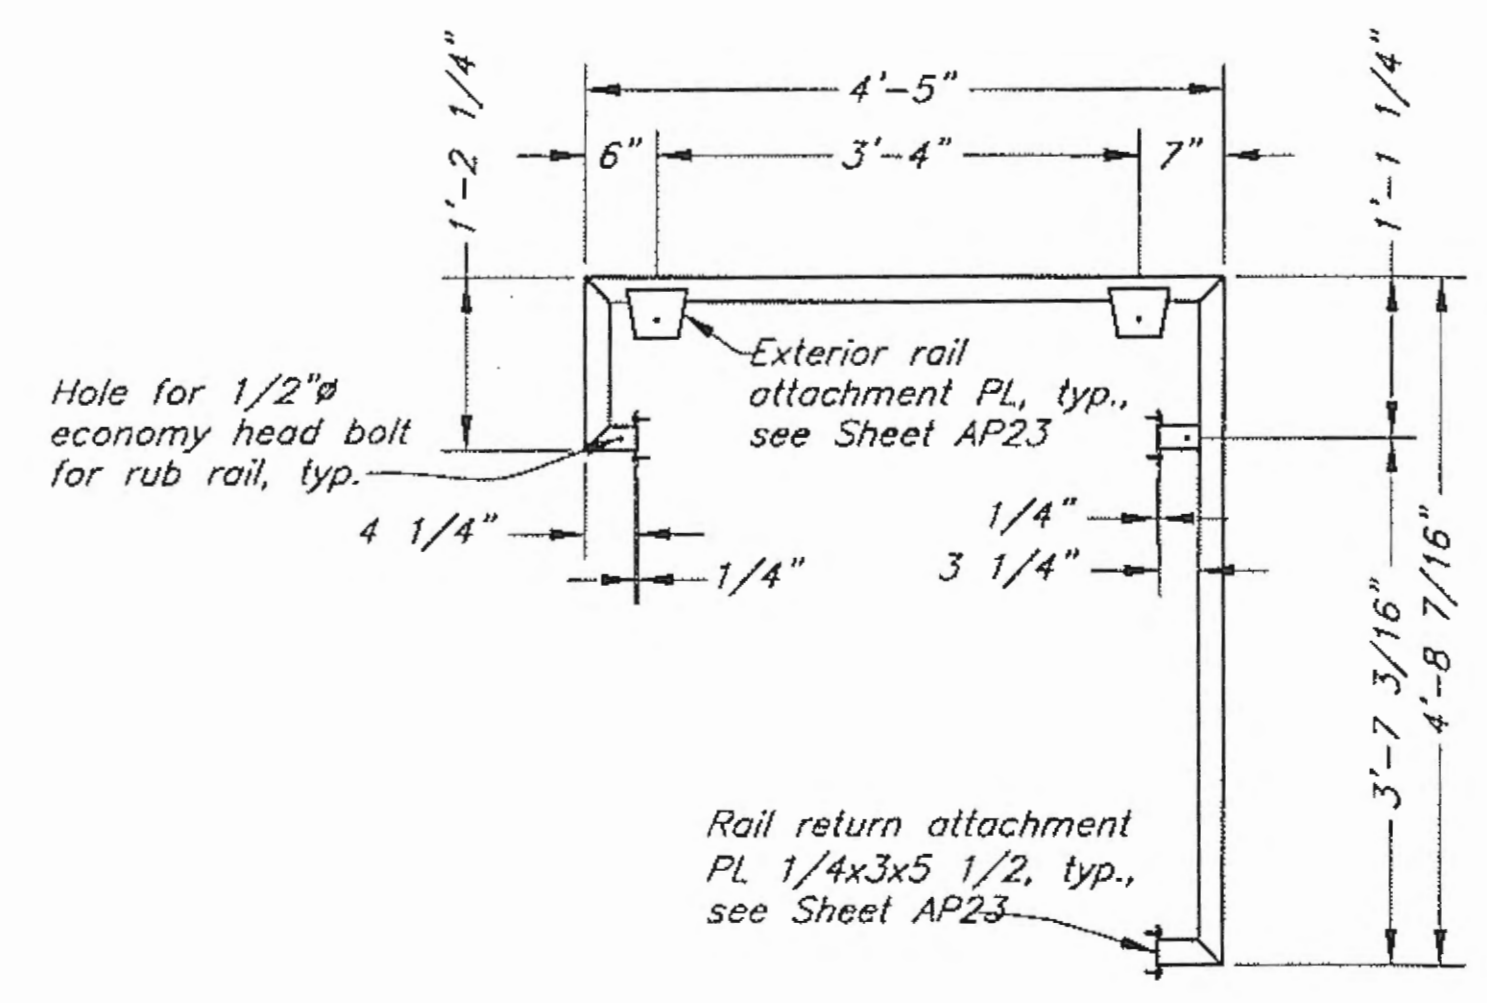

Exterior Rail Element 'Q'

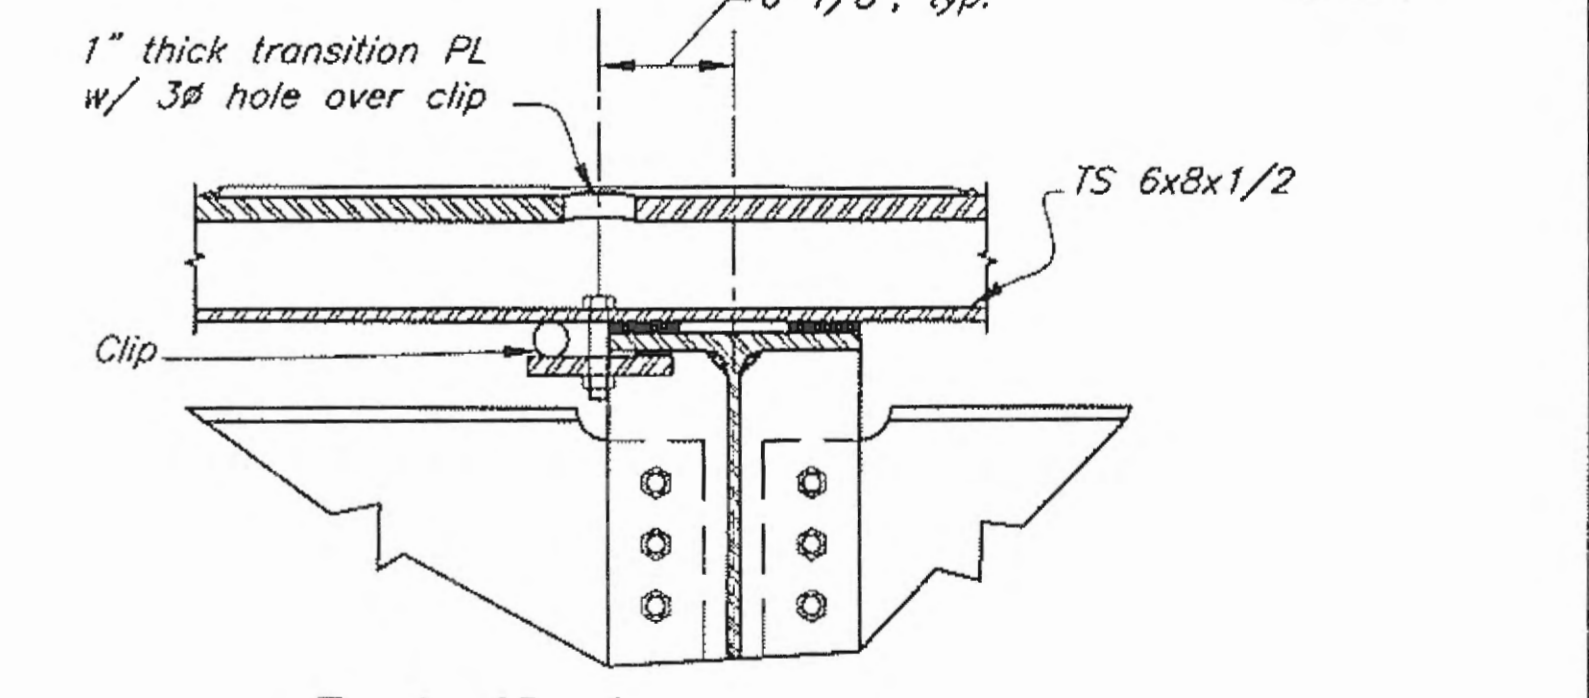

**Detail 1
Grating Clip Assembly**

Record Drawings have been reviewed by the Project Engineer, and represent to the best of my knowledge, the project as constructed.
PE *[Signature]* Date 8/24/17


DO NOT SCALE FROM THESE DRAWINGS USE DIMENSIONS

DESIGNED BY: J. Scott
STATE OF ALASKA
DEPARTMENT OF TRANSPORTATION
& PUBLIC FACILITIES
DESIGN & ENGINEERING SERVICES DIVISION-SOUTHEAST REGION


**Gustavus Causeway Replacement
Approach Transition
Transition Plate
Assembly Details**
AP40

CHECKED BY: B. Savikko
DRAWN BY: C. Fuman, W. Hickok
PATH: Q:\GUS\67599\MF\PLANSET\03-APPROACH\AP40-TRANSITION PLATE ASSEMBLY.DWG
TAB: Wed, 26/Nov/08 10:59AM JTSCOTT


REVISIONS		PROJECT DESIGNATION	YEAR	SHEET NO.	TOTAL SHEETS
NO.	DATE	DESCRIPTION			
		BR-0003(53)/67599	2008	50	138

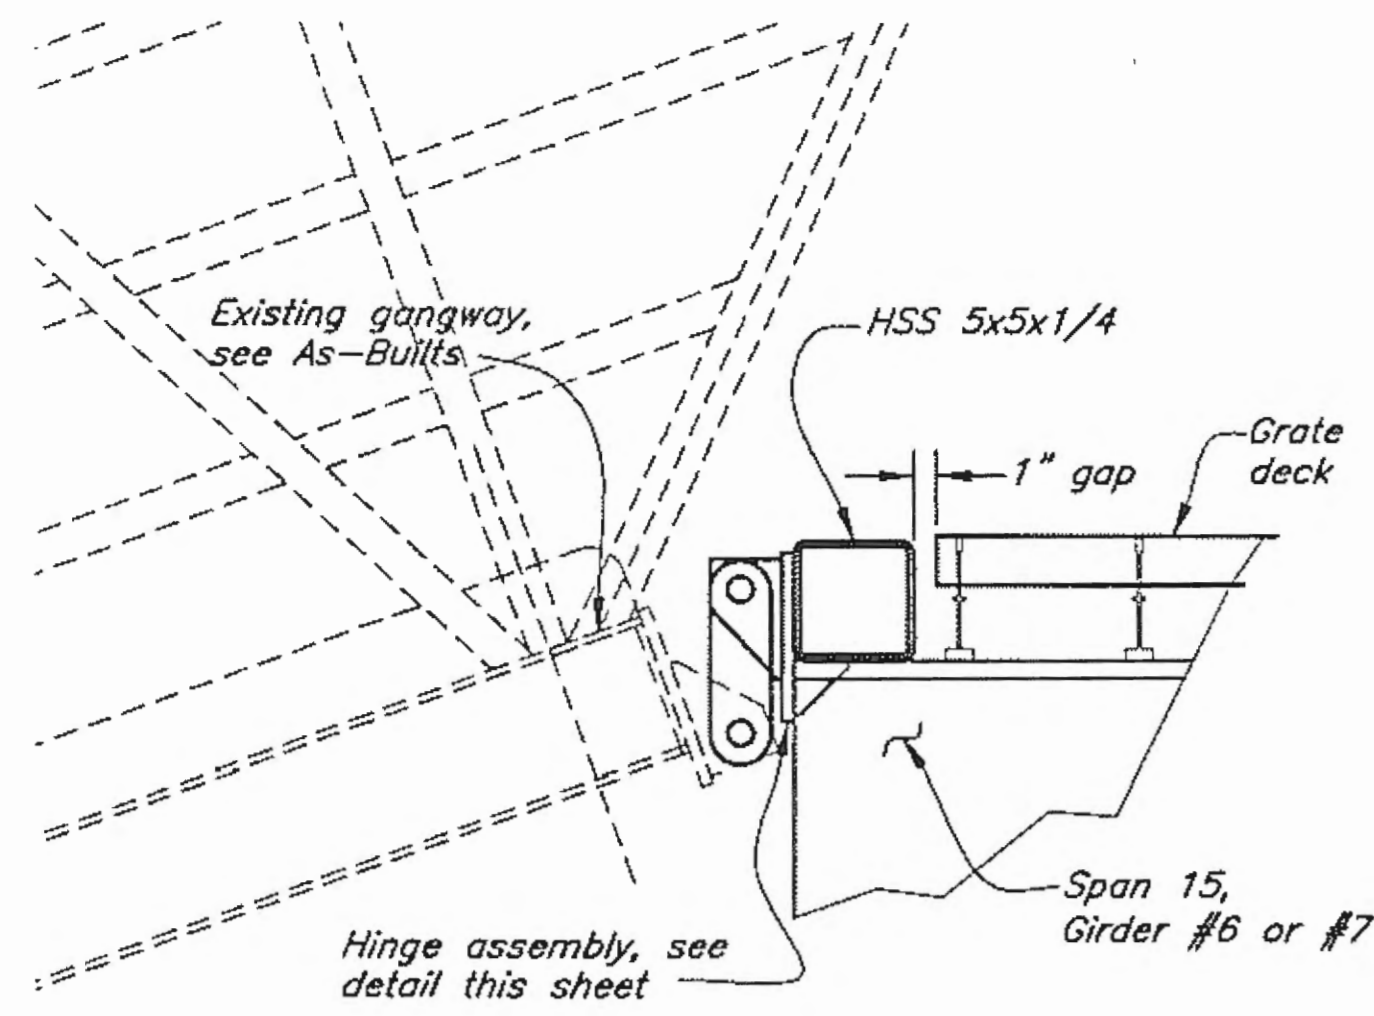


Gangway Hinge Elevation

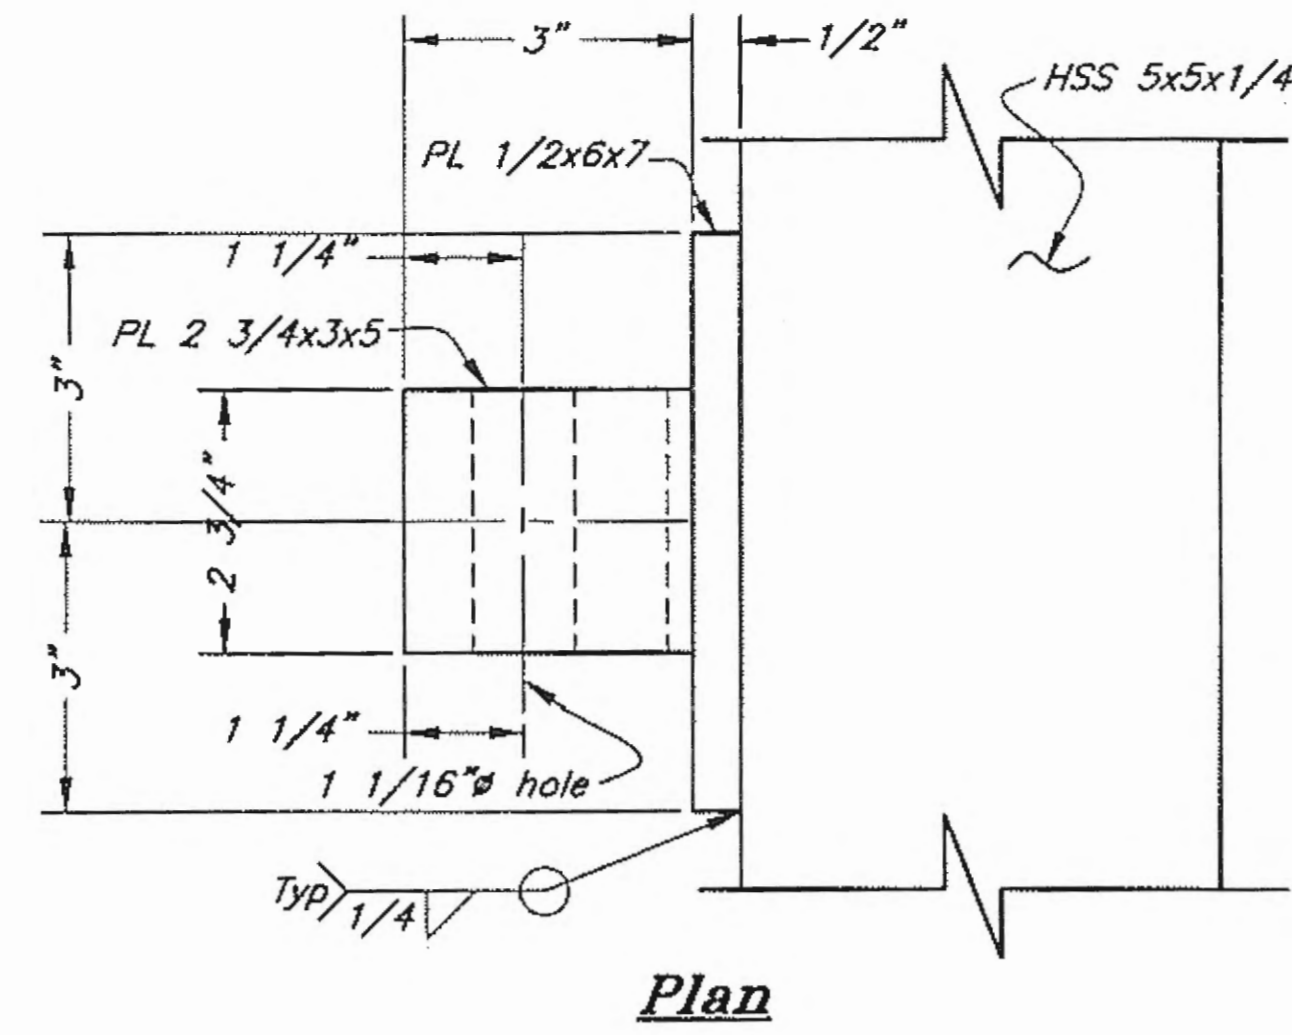


Plan

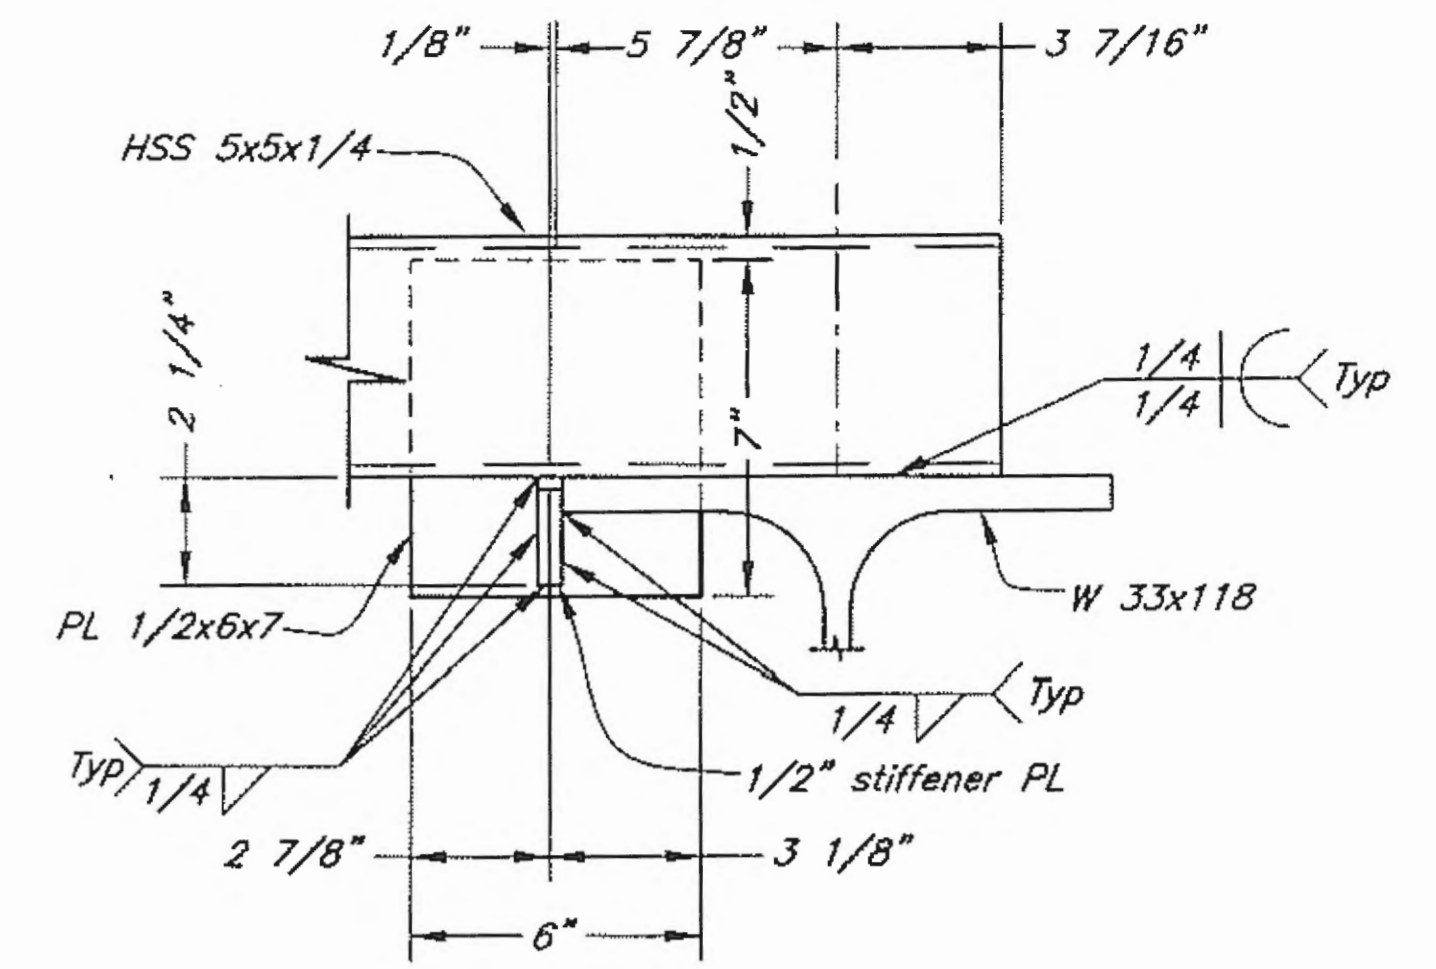


Section B-B

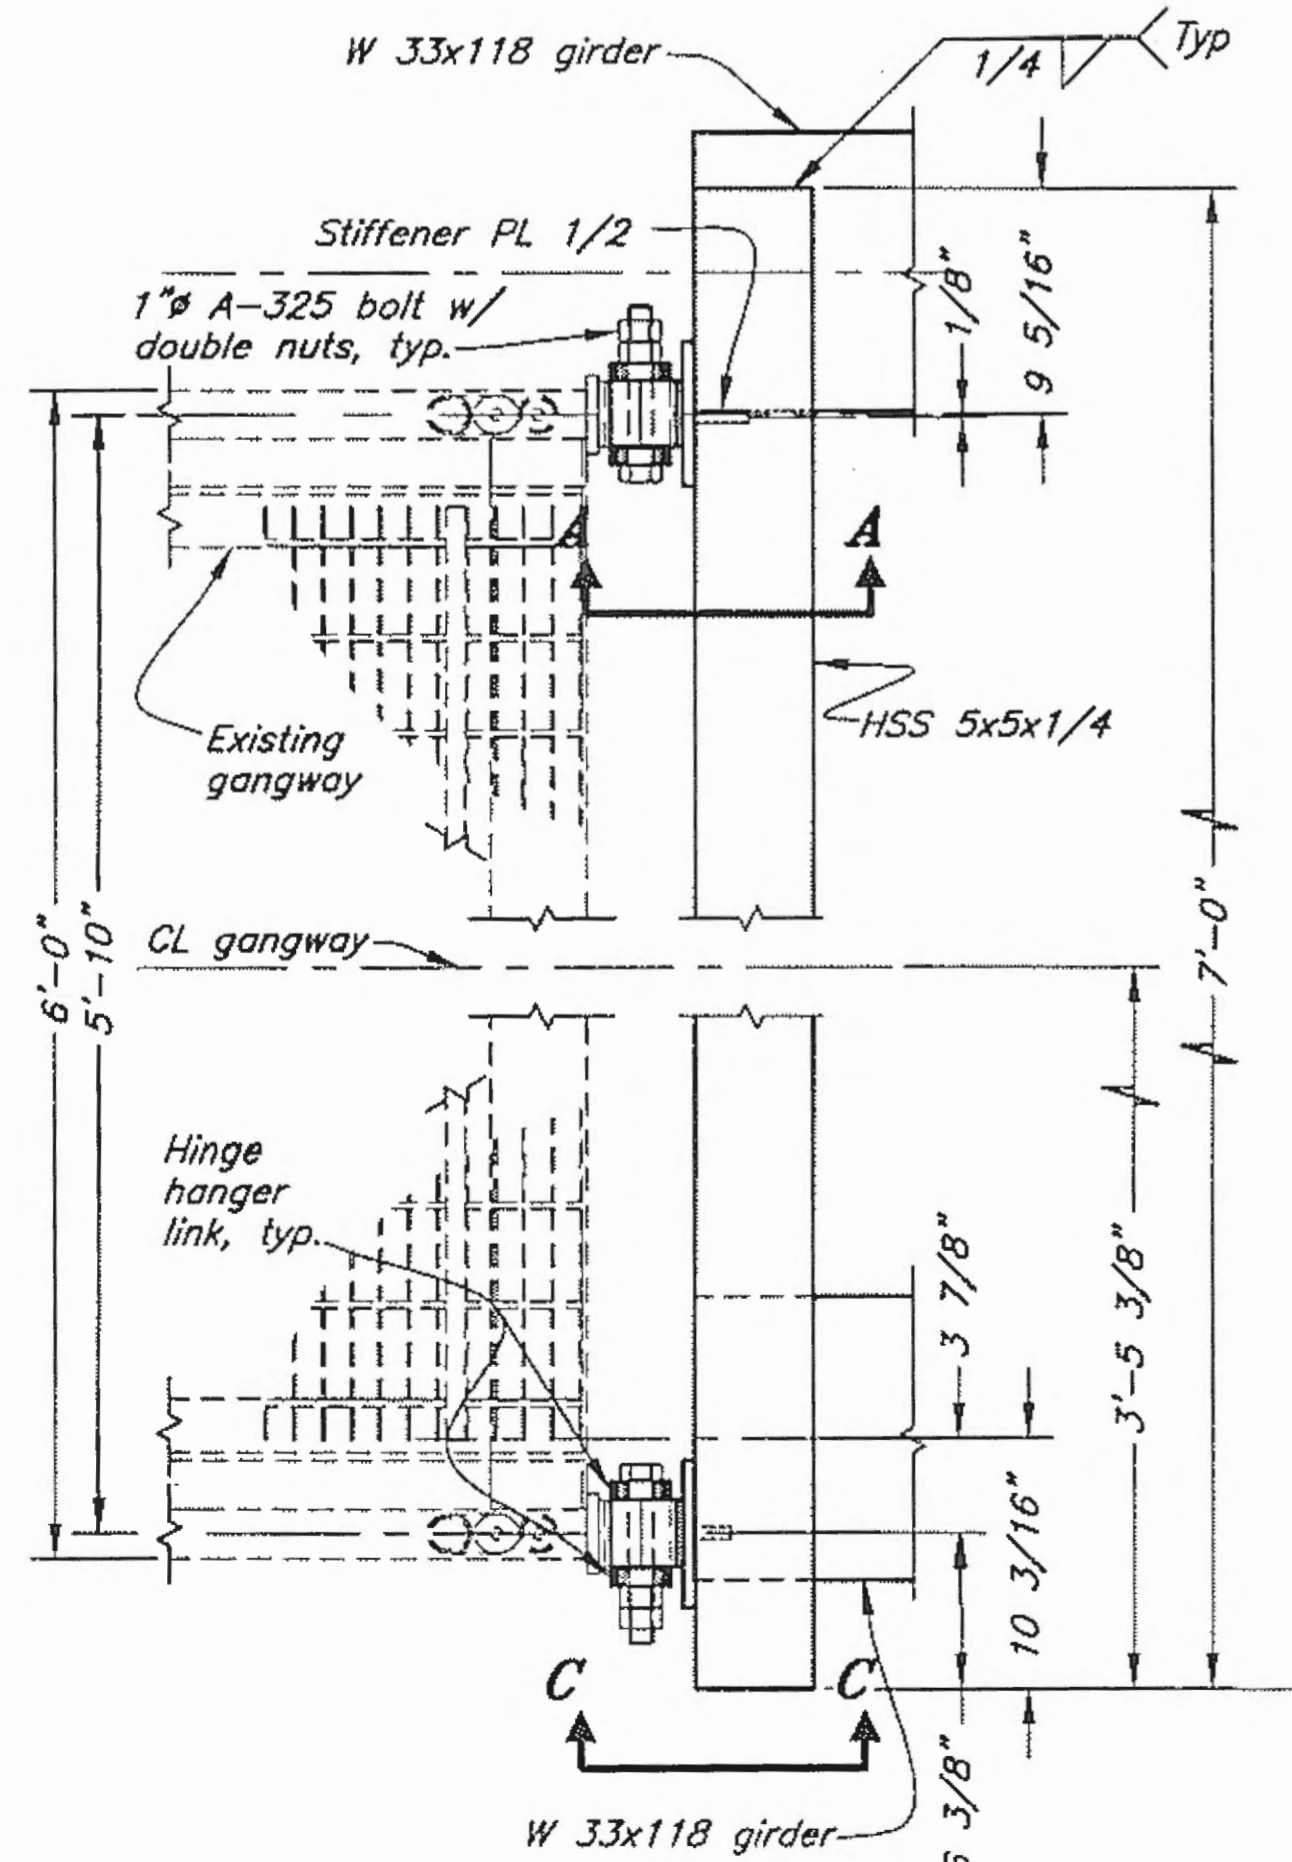


Gangway Hinge Plan

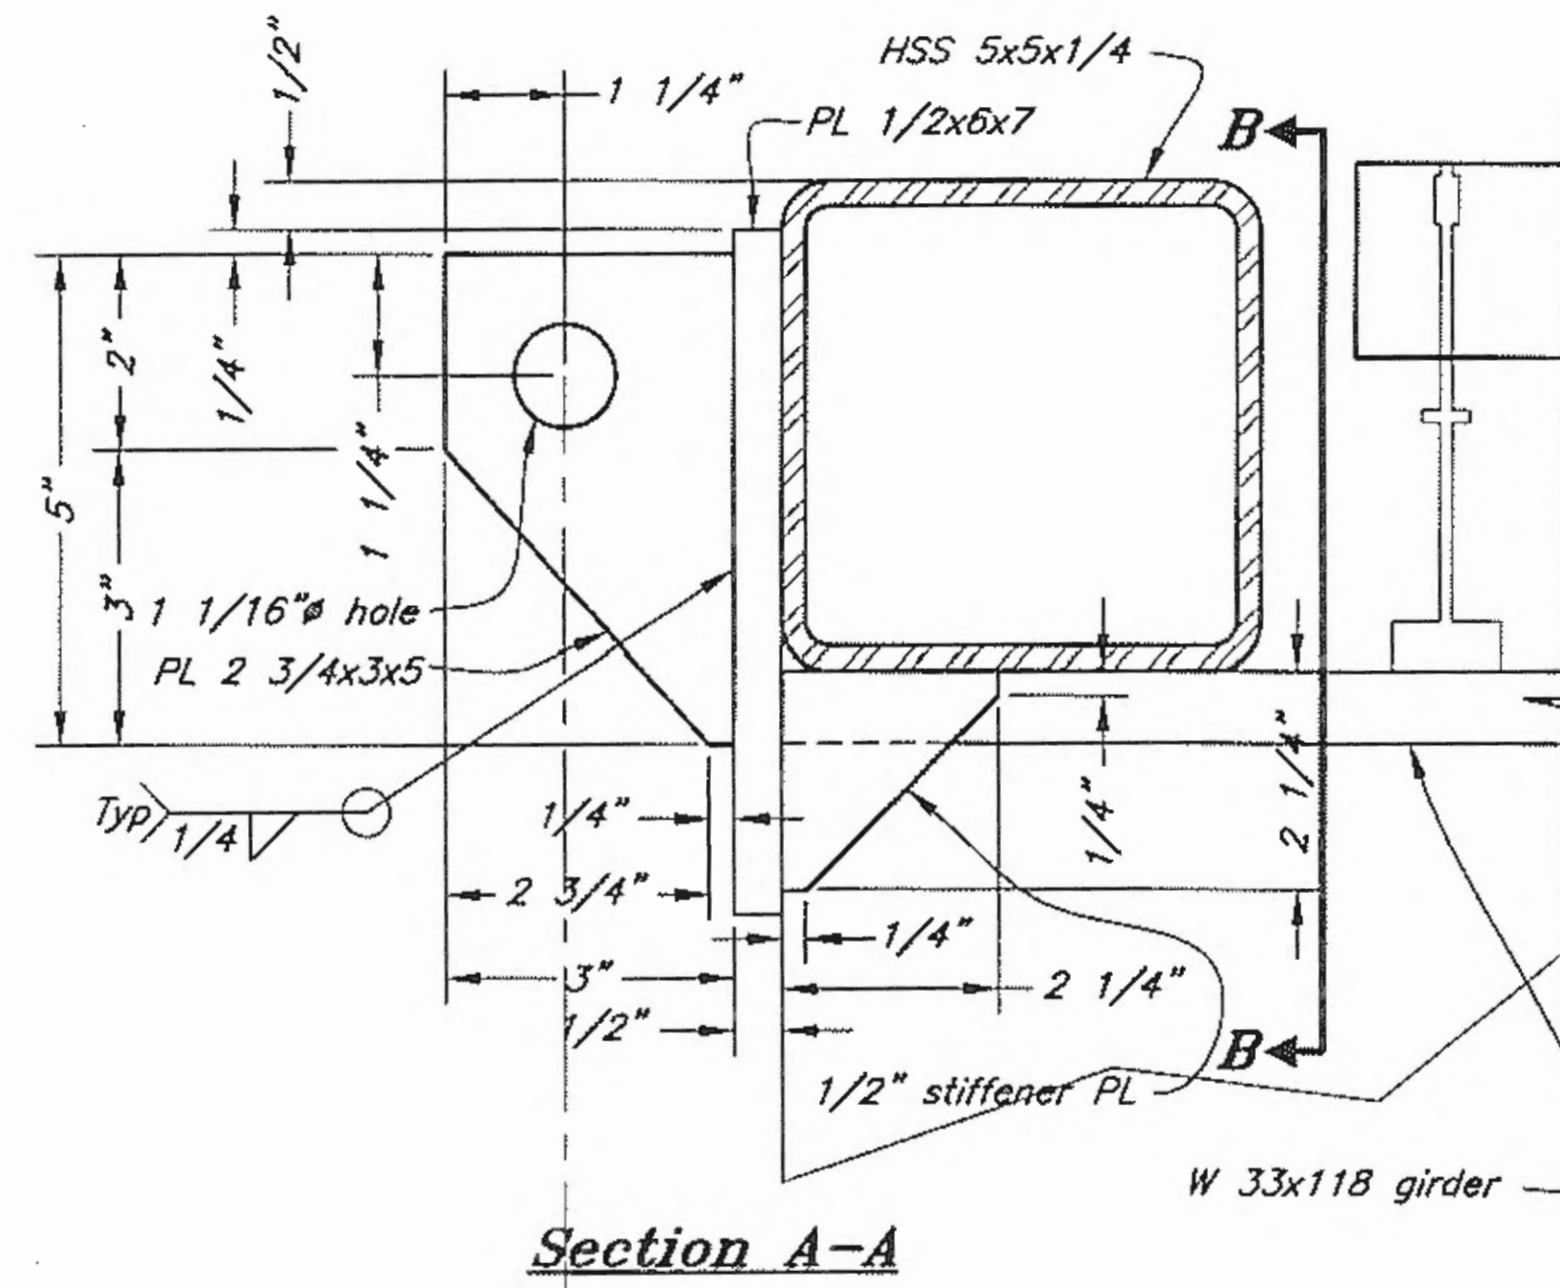

Section A-A

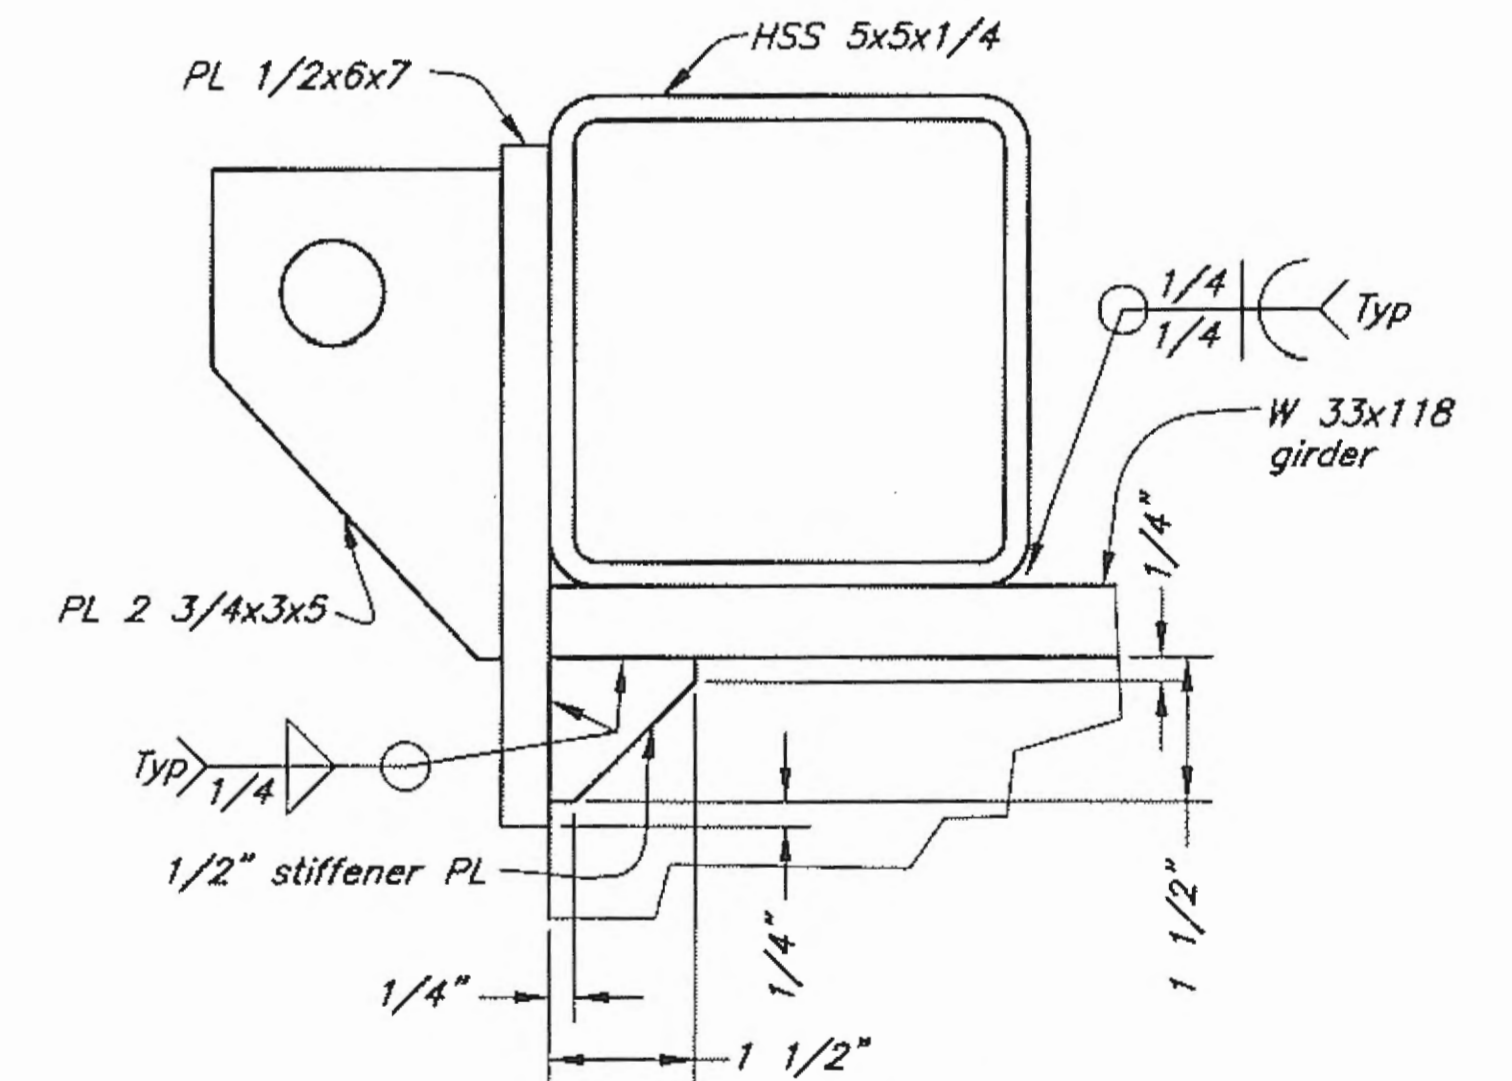

Section C-C

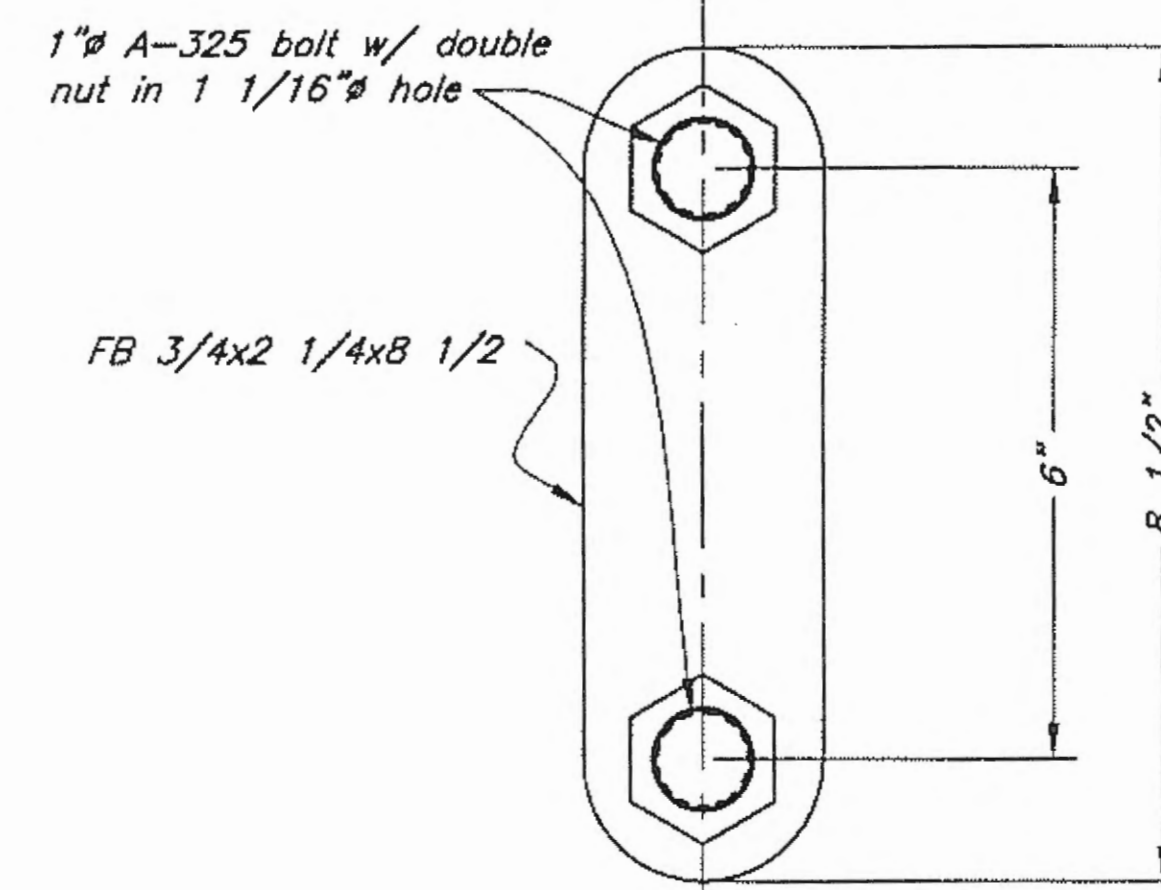

Hinge Hanger Link

Hinge Assembly

Record Drawings have been reviewed by the Project Engineer, and represent to the best of my knowledge, the project as constructed.
 PE *Steve Smith* Date 5/21/12

DO NOT SCALE FROM THESE DRAWINGS USE DIMENSIONS

DESIGNED BY: J. Scott

STATE OF ALASKA
 DEPARTMENT OF TRANSPORTATION & PUBLIC FACILITIES
 DESIGN & ENGINEERING SERVICES DIVISION-SOUTHEAST REGION


Gustavus Causeway Replacement

Gangway Hinge Assembly

AP41

CHECKED BY: B. Savikko
 DRAWN BY: C. Fuman, W. Hickok
 PATH: O:\GUS\67599\AF\PLANSET\03-APPROACH\AP41 GANGWAY HINGE ASSEMBLY.DWG
 TAB: Wed, 26/Nov/08 11:00AM JISCOIT

NO.	DATE	DESCRIPTION	PROJECT DESIGNATION	YEAR	SHEET NO.	TOTAL SHEETS
			BR-0003(53)/67599	2008	51	138

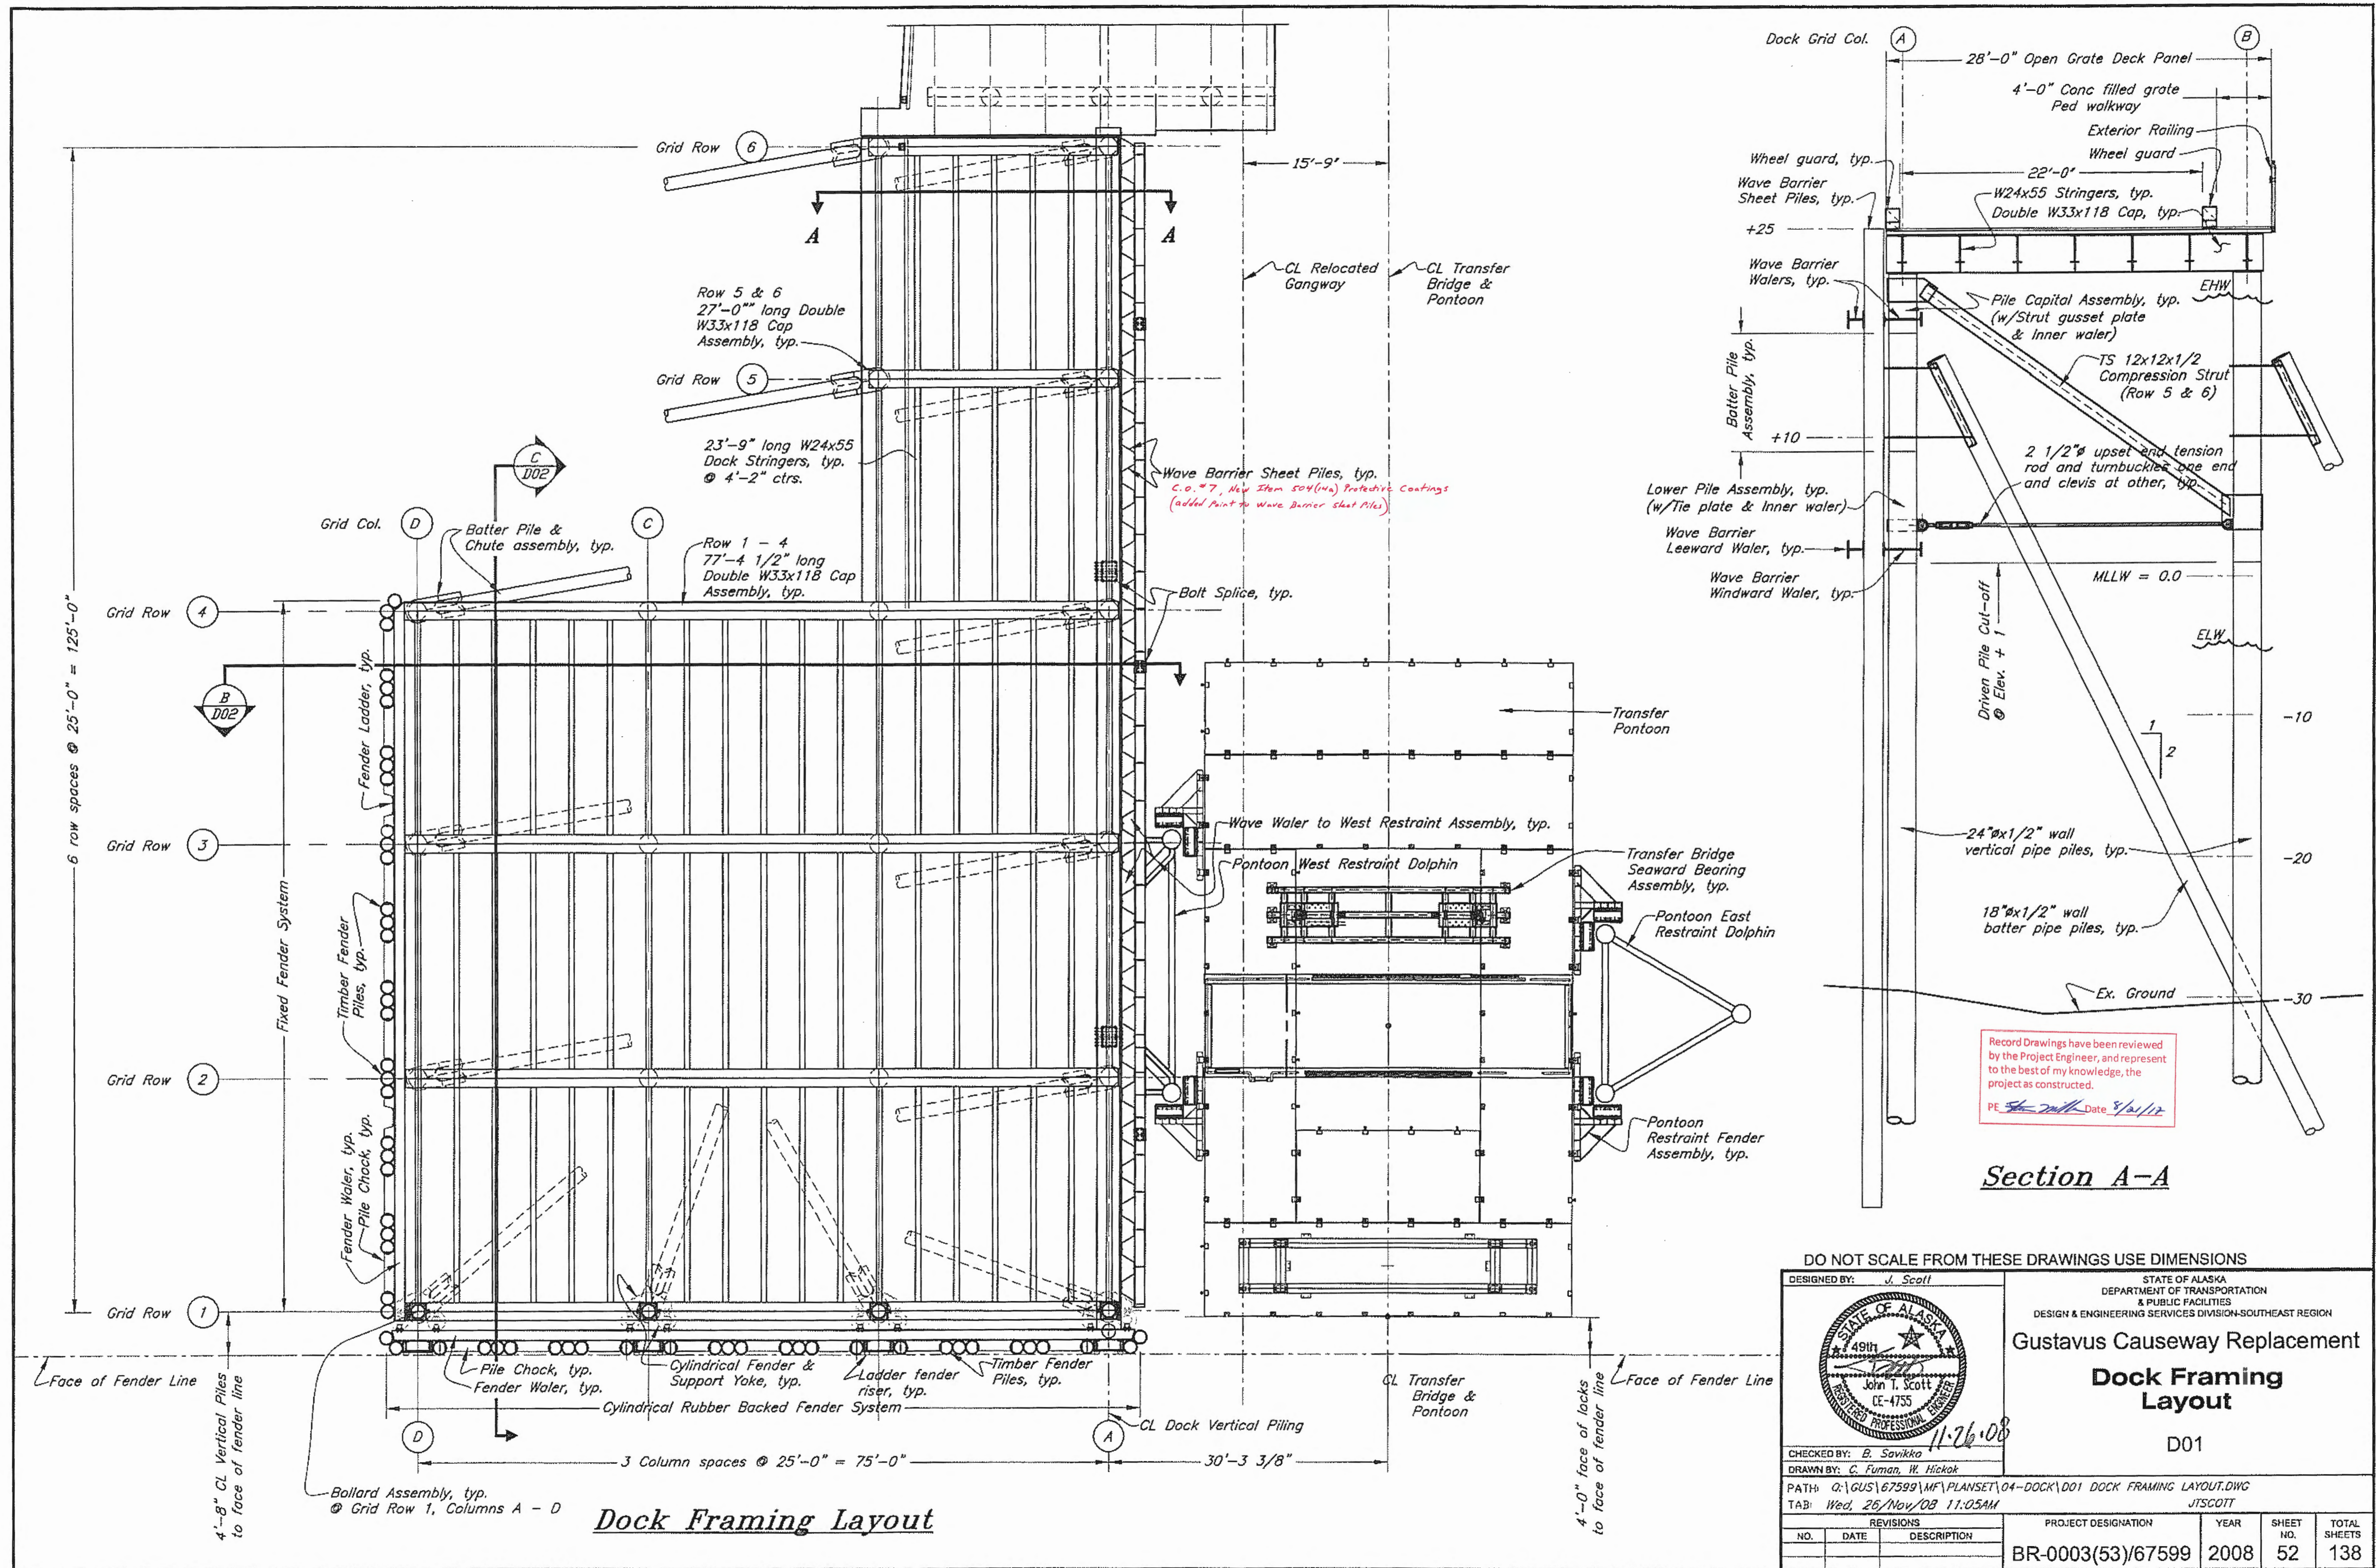

Dock Framing Layout

Section A-A

DO NOT SCALE FROM THESE DRAWINGS USE DIMENSIONS

DESIGNED BY: J. Scott

STATE OF ALASKA
DEPARTMENT OF TRANSPORTATION
& PUBLIC FACILITIES
DESIGN & ENGINEERING SERVICES DIVISION-SOUTHEAST REGION

Gustavus Causeway Replacement

Dock Framing Layout

D01


CHECKED BY: B. Savikko

DRAWN BY: C. Fuman, W. Hickok

PATH: Q:\GUS\67599\MF\PLANSET\04-DOCK\001 DOCK FRAMING LAYOUT.DWG

TAB: Wed, 26/Nov/08 11:05AM JTSCOTT


NO.	DATE	REVISIONS DESCRIPTION	PROJECT DESIGNATION	YEAR	SHEET NO.	TOTAL SHEETS
			BR-0003(53)/67599	2008	52	138

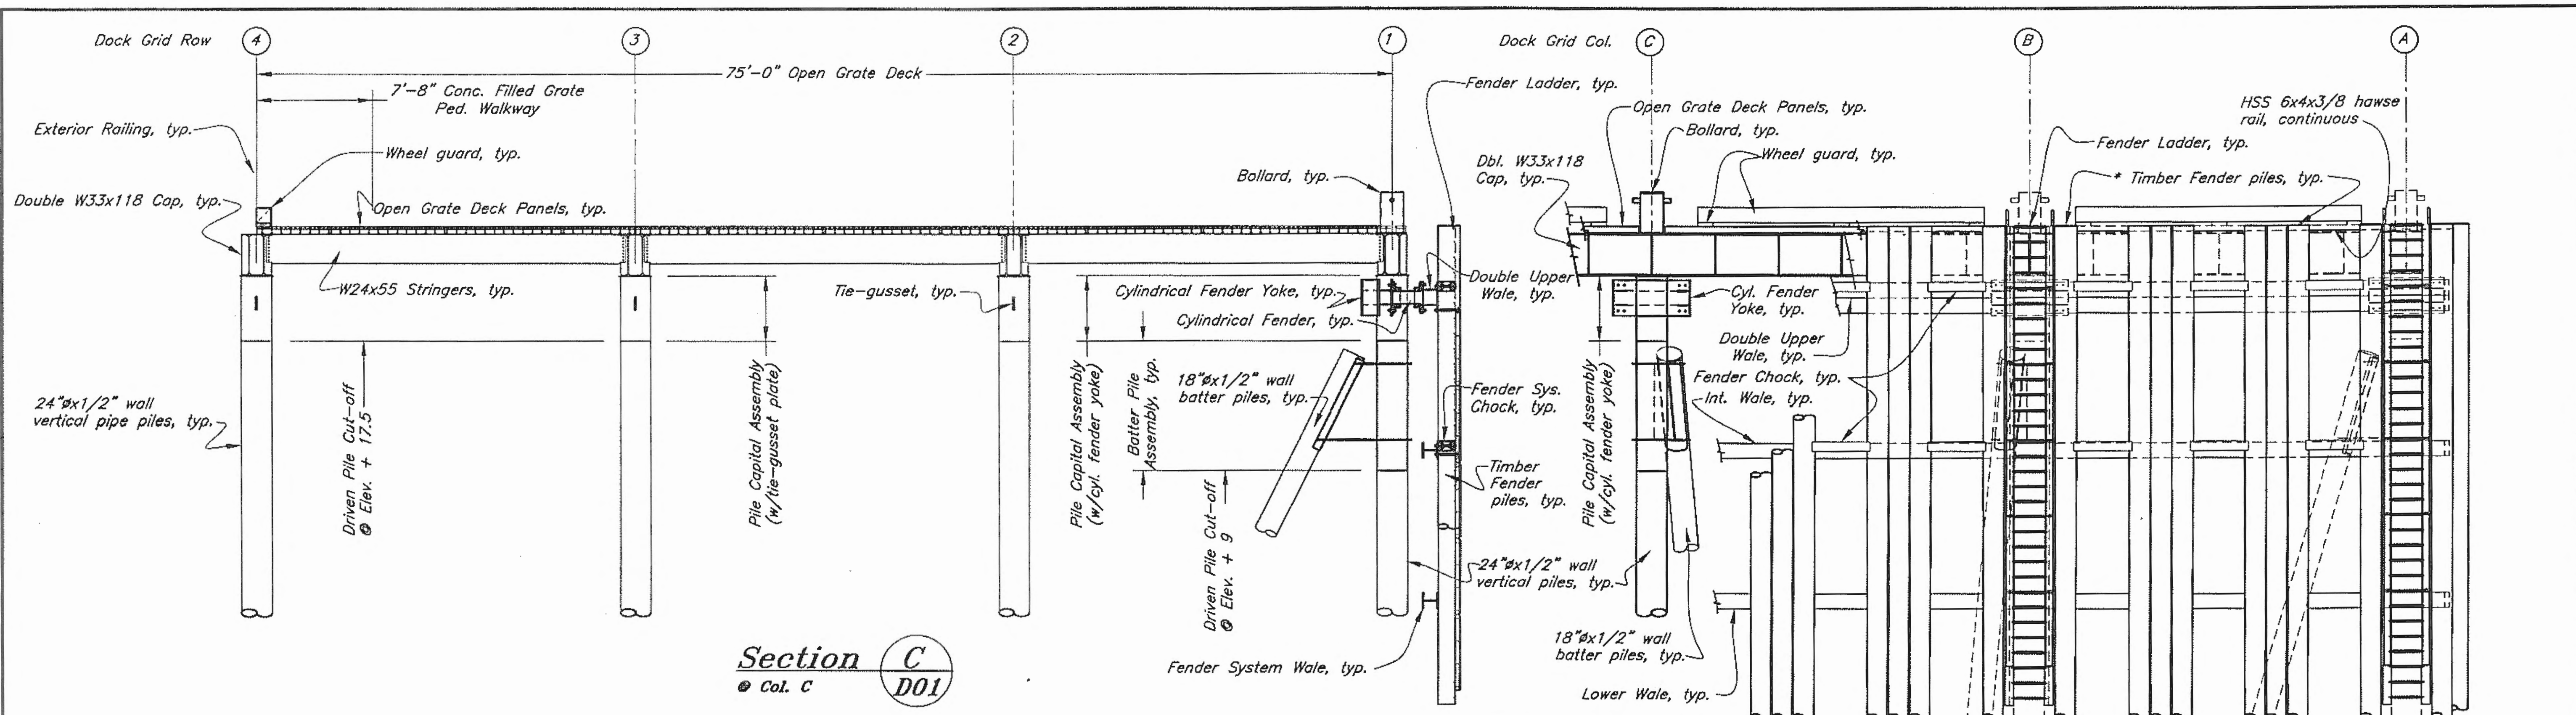


Section C
@ Col. C
D01

* Note: Timber fender piles shall be driven tip down to a penetration of 15' below mudline, typ.

Sectional Elevation
@ Grid Row 1 - Face of Fender Line, looking North

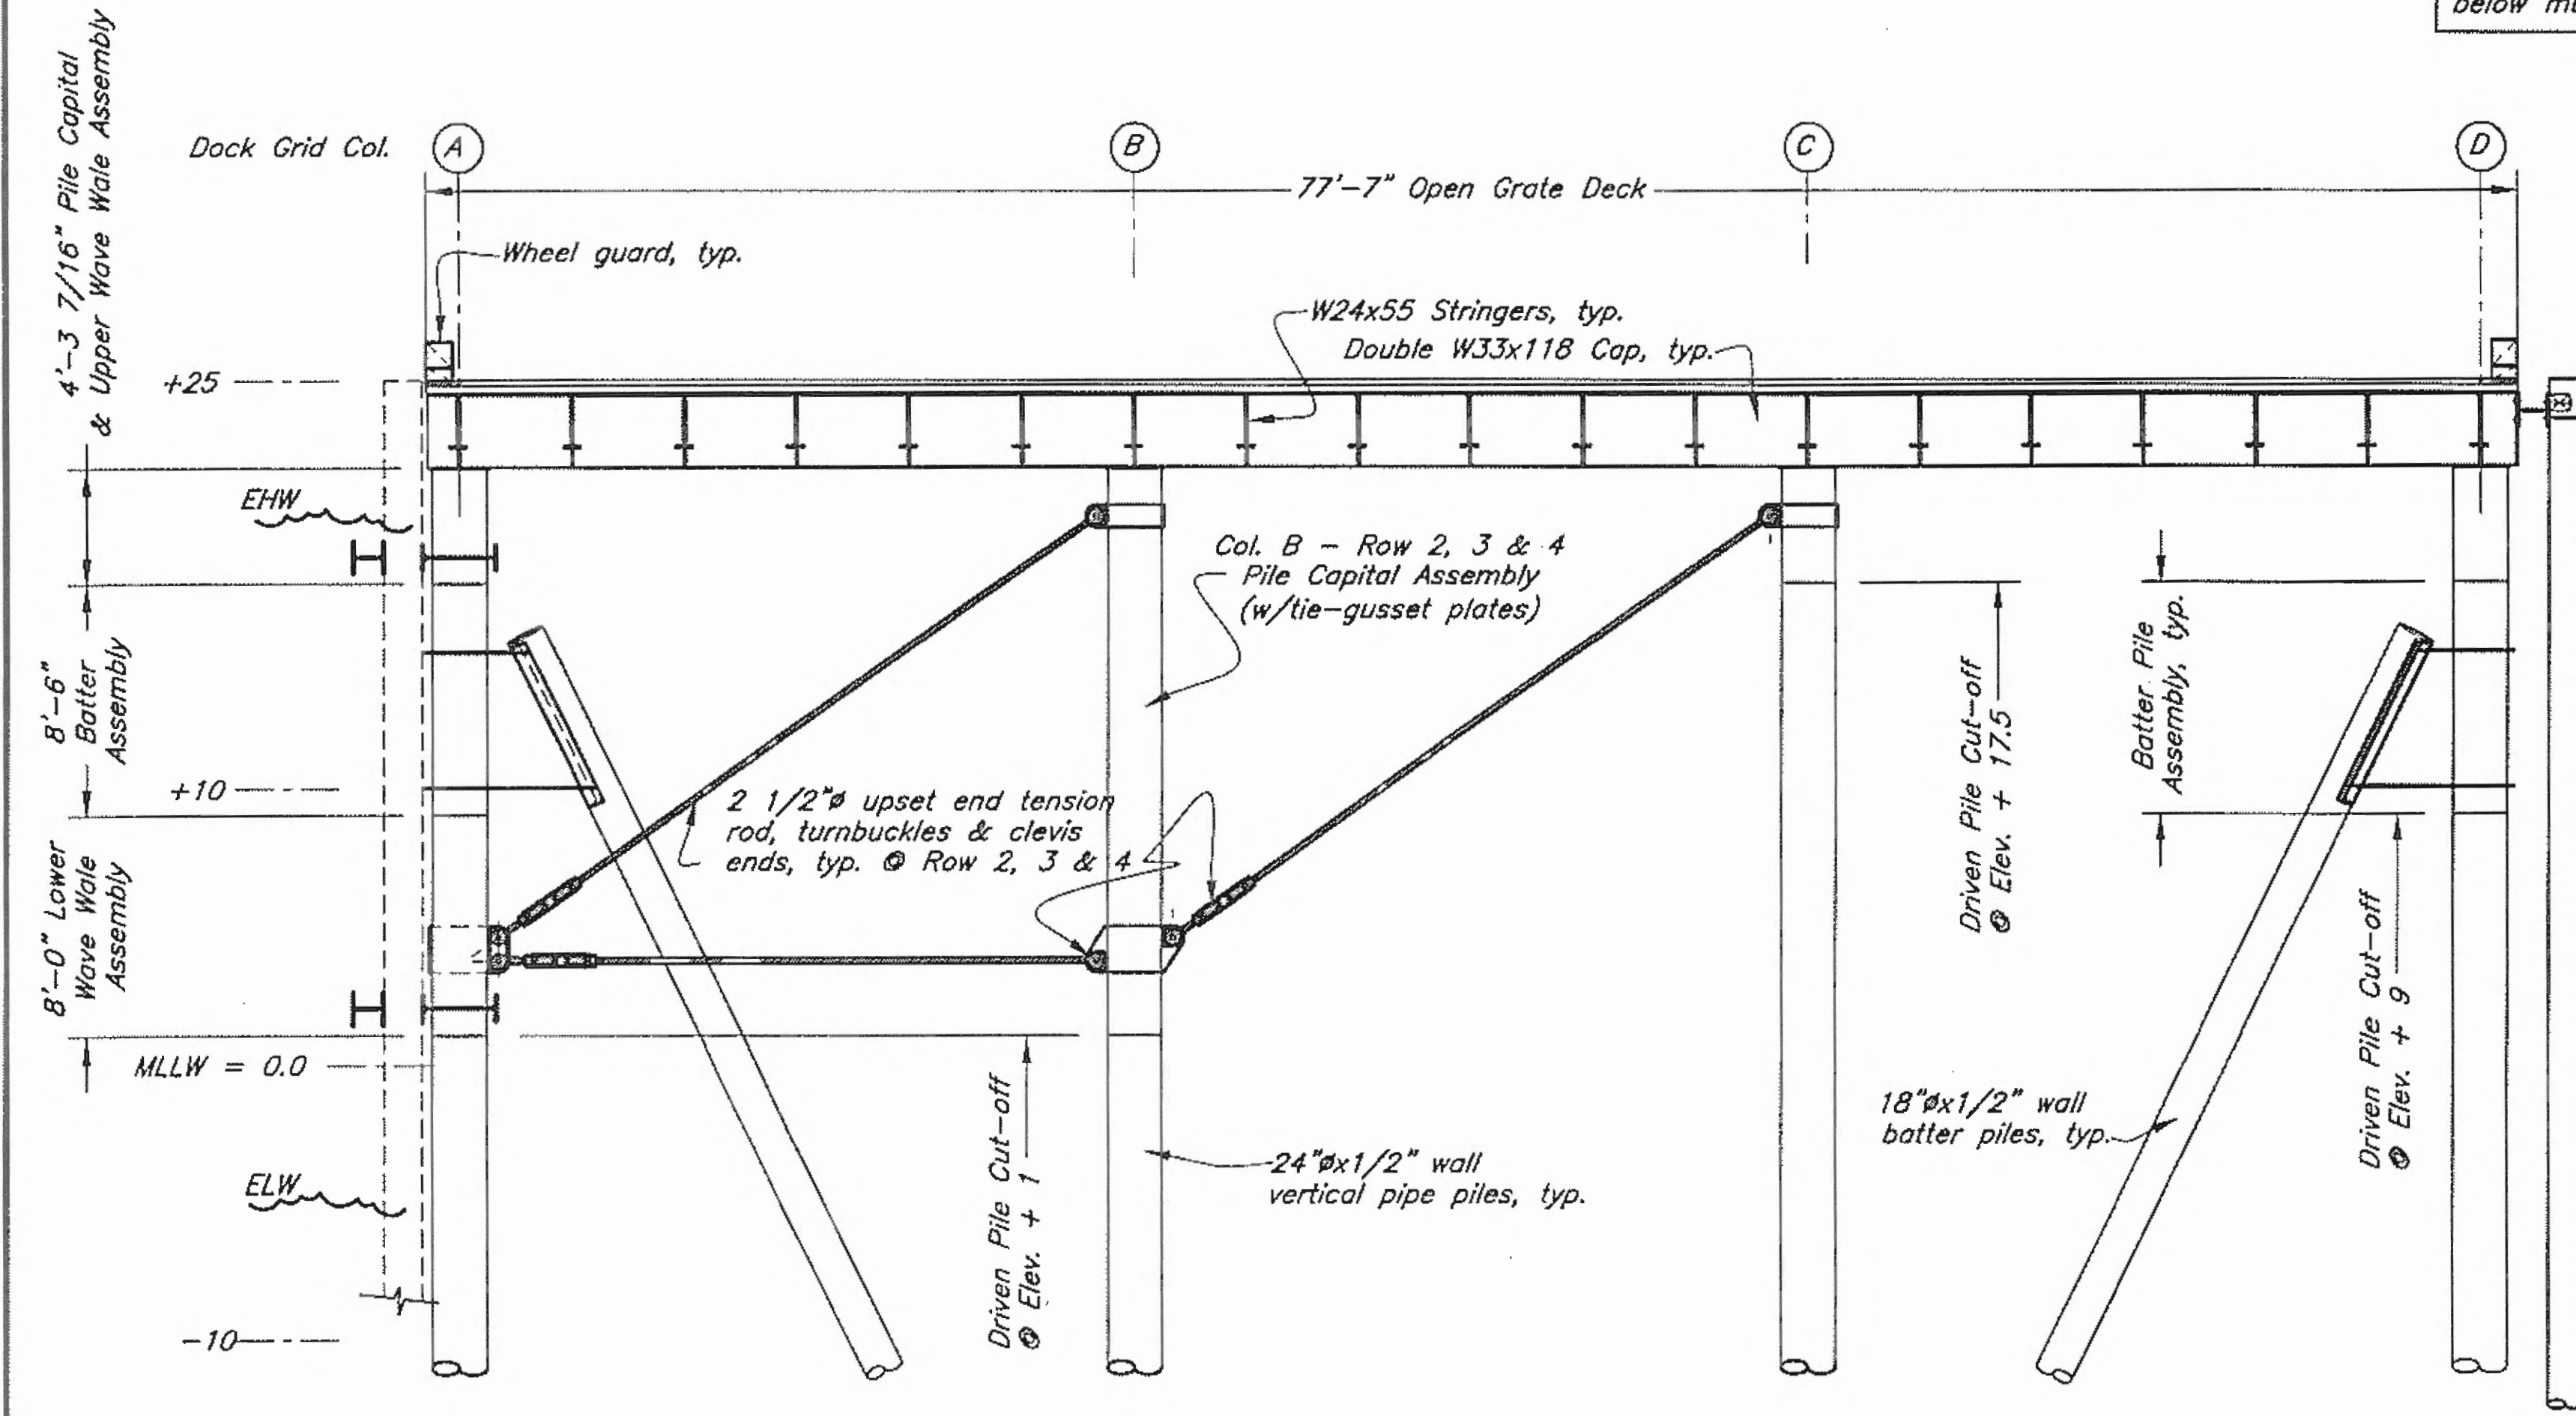

Section B
@ Row 2, 3 & 4
D01

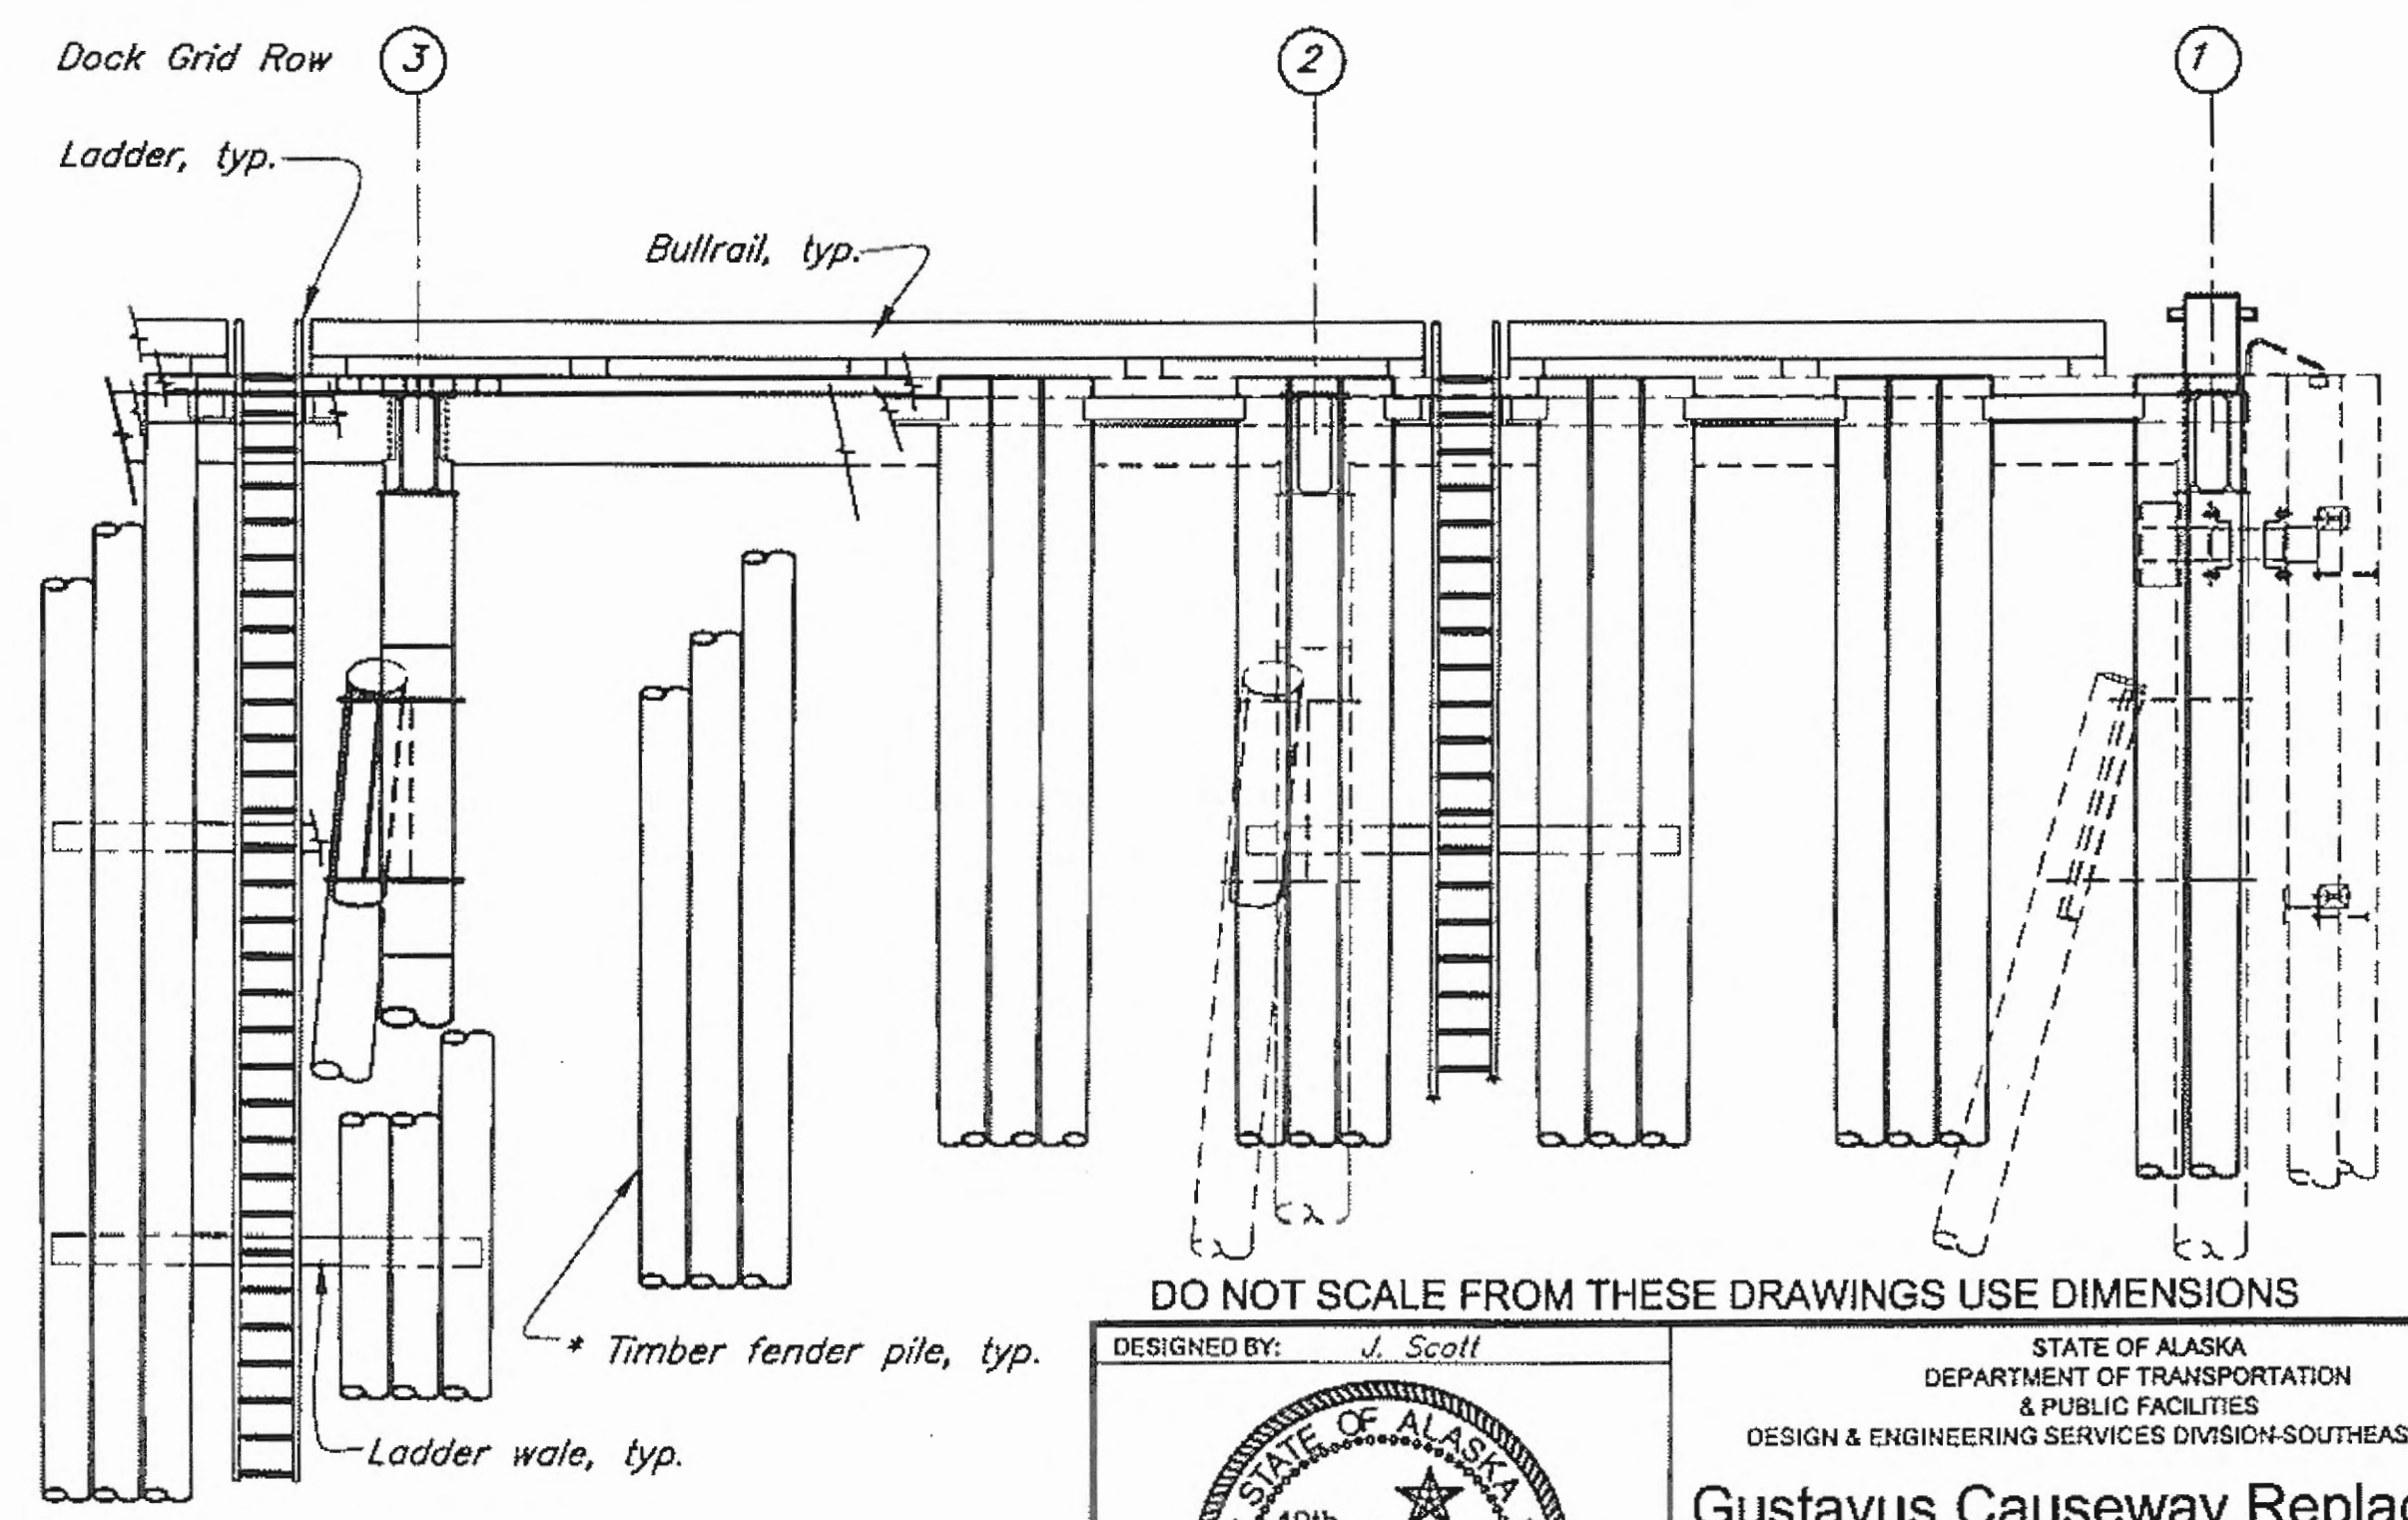

Sectional Elevation
@ Grid Col. D - Face of Fender Line, looking East

DO NOT SCALE FROM THESE DRAWINGS USE DIMENSIONS

DESIGNED BY: J. Scott

STATE OF ALASKA
DEPARTMENT OF TRANSPORTATION & PUBLIC FACILITIES
DESIGN & ENGINEERING SERVICES DIVISION-SOUTHEAST REGION

Gustavus Causeway Replacement

Dock Typical Sections

D02

CHECKED BY: B. Savikko
DRAWN BY: C. Fuman, W. Hieck

PATH: O:\GUS\67590\MF\PLANSET\04-DOCK\DO2 DOCK TYPICAL SECTIONS.DWG
TAB: Wed, 26/Nov/08 11:06AM JTS/SCOTT

NO.	DATE	DESCRIPTION	PROJECT DESIGNATION	YEAR	SHEET NO.	TOTAL SHEETS
			BR-0003(53)/67599	2008	53	138

Record Drawings have been reviewed by the Project Engineer, and represent to the best of my knowledge, the project as constructed.
PE: *Stu* Date: 8/24/17

PILE TABLE - Dock and Pontoon Restraints



Pile Location/Grid/Orientation (Vertical or Batter)	Size Dia.	Design Bearing Uplift	Elevations			Furn. Length		Driven			
			O.G.	Cut	Tip	18"φ	24"φ	18"φ	24"φ		
A6, B6 Vertical	24"φ	60T	20T	-10	+1	-110	---	222	---	2	---
B6, A6 Batter	18"φ	50T	40T	-10	+15.67	-110	280	---	---	2	---
A5, B5 Vertical	24"φ	60T	20T	-15	+1	-115	---	232	---	2	---
B5, A5 Batter	18"φ	50T	40T	-15	+15.67	-115	292	---	---	2	---
A4, A3, A2 Vertical	24"φ	60T	20T	-30	+1	-130	---	393	---	3	---
A4, A3, A2 Batter	18"φ	50T	40T	-30	+15.67	-130	490	---	---	3	---
B4, B3, B2 Vertical	24"φ	60T	20T	-30	+1	-130	---	393	---	3	---
C4, C3, C2 Vertical	24"φ	60T	20T	-30	+17.5	-130	---	443	---	3	---
D4, D3, D2 Vertical	24"φ	60T	20T	-30	+9	-130	---	417	---	3	---
D4, D3, D2 Batter	18"φ	50T	40T	-30	+15.67	-130	490	---	---	3	---
B1, C1, D1 Vertical	24"φ	60T	20T	-38	+9	-138	---	441	---	3	---
A1, A2, A3, A4 Batter	18"φ	50T	40T	-38	+15.67	-138	687	---	---	4	---
A1 Vertical	24"φ	60T	20T	-38	+1	-138	---	139	---	1	---
WR-N, WR-S Vertical	24"φ	50T	50T	-30	+1	-130	---	262	---	2	---
ER-N, ER-S, ER-E Vertical	24"φ	50T	50T	-30	+1	-129.5	---	393	---	3	---
BASIC						Total 18"φ x 1/2" wall pipe piles	2,239 LF			14 Ea.	
BID						Total 24"φ x 1/2" wall pipe piles	3,335 LF			25 Ea.	

PILE Assembly TABLE - Dock

Pile Assembly Type	Column A				Column B				Col. C				Col. D				Quantity
	1	2	3	4	1	2	3	4	1	2	3	4	1	2	3	4	
Plain Capital																	5 each
Capital w/single tie																	3 each
Capital w/upper wale & upper strut gusset																	2 each
Capital w/upper sq tie & lower dbl opposing tie																	4 each
Capital w/upper wale and yoke																	1 each
Capital w/upper wale																	3 each
Capital w/yoke & single tie																	3 each
Batter Pile Assembly																	14 each
Lower wale and double paired tie																	4 each
Lower dbl opposing tie																	1 each
Capital with strut & tie gusset																	2 each
Lower wale and single tie																	2 each

Note:

- All piles 1/2" wall thickness and provided with reinforced tips.
- All Dock & Pontoon Restraint piles driven with plugged bottom section, see Detail this sheet.
- For purposes of Dynamic Pile Driving Analysis Ultimate Capacity = Design Capacity x 2.25

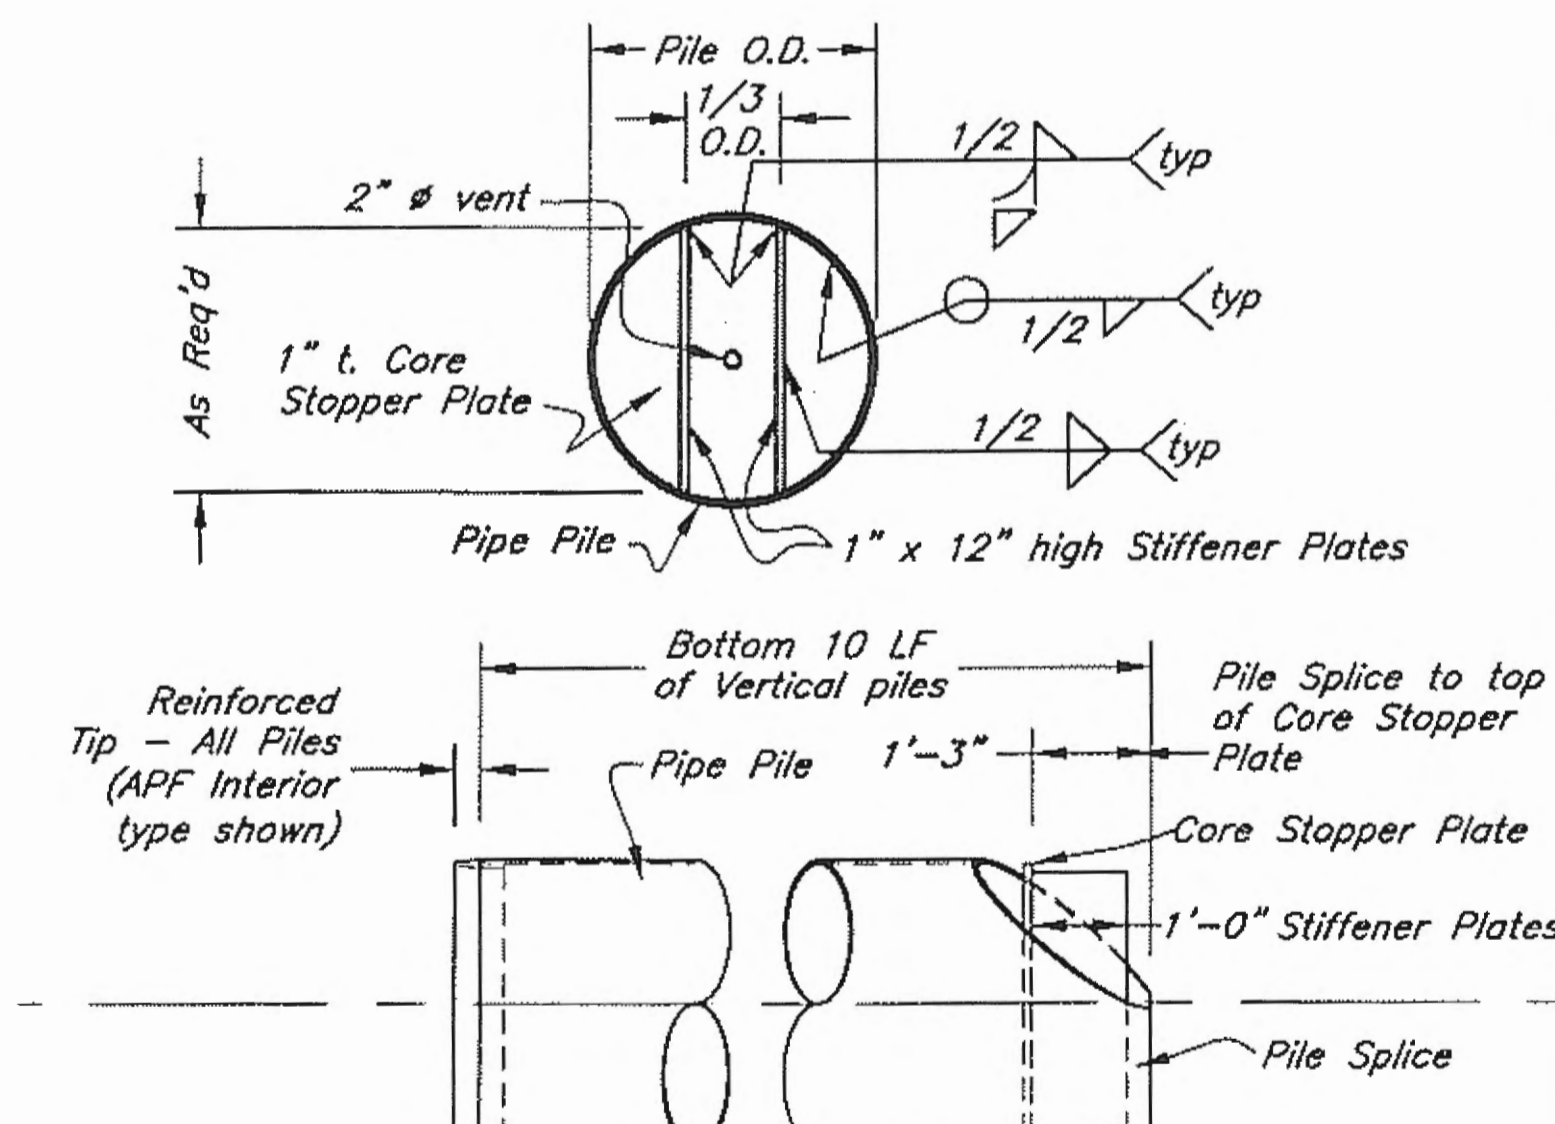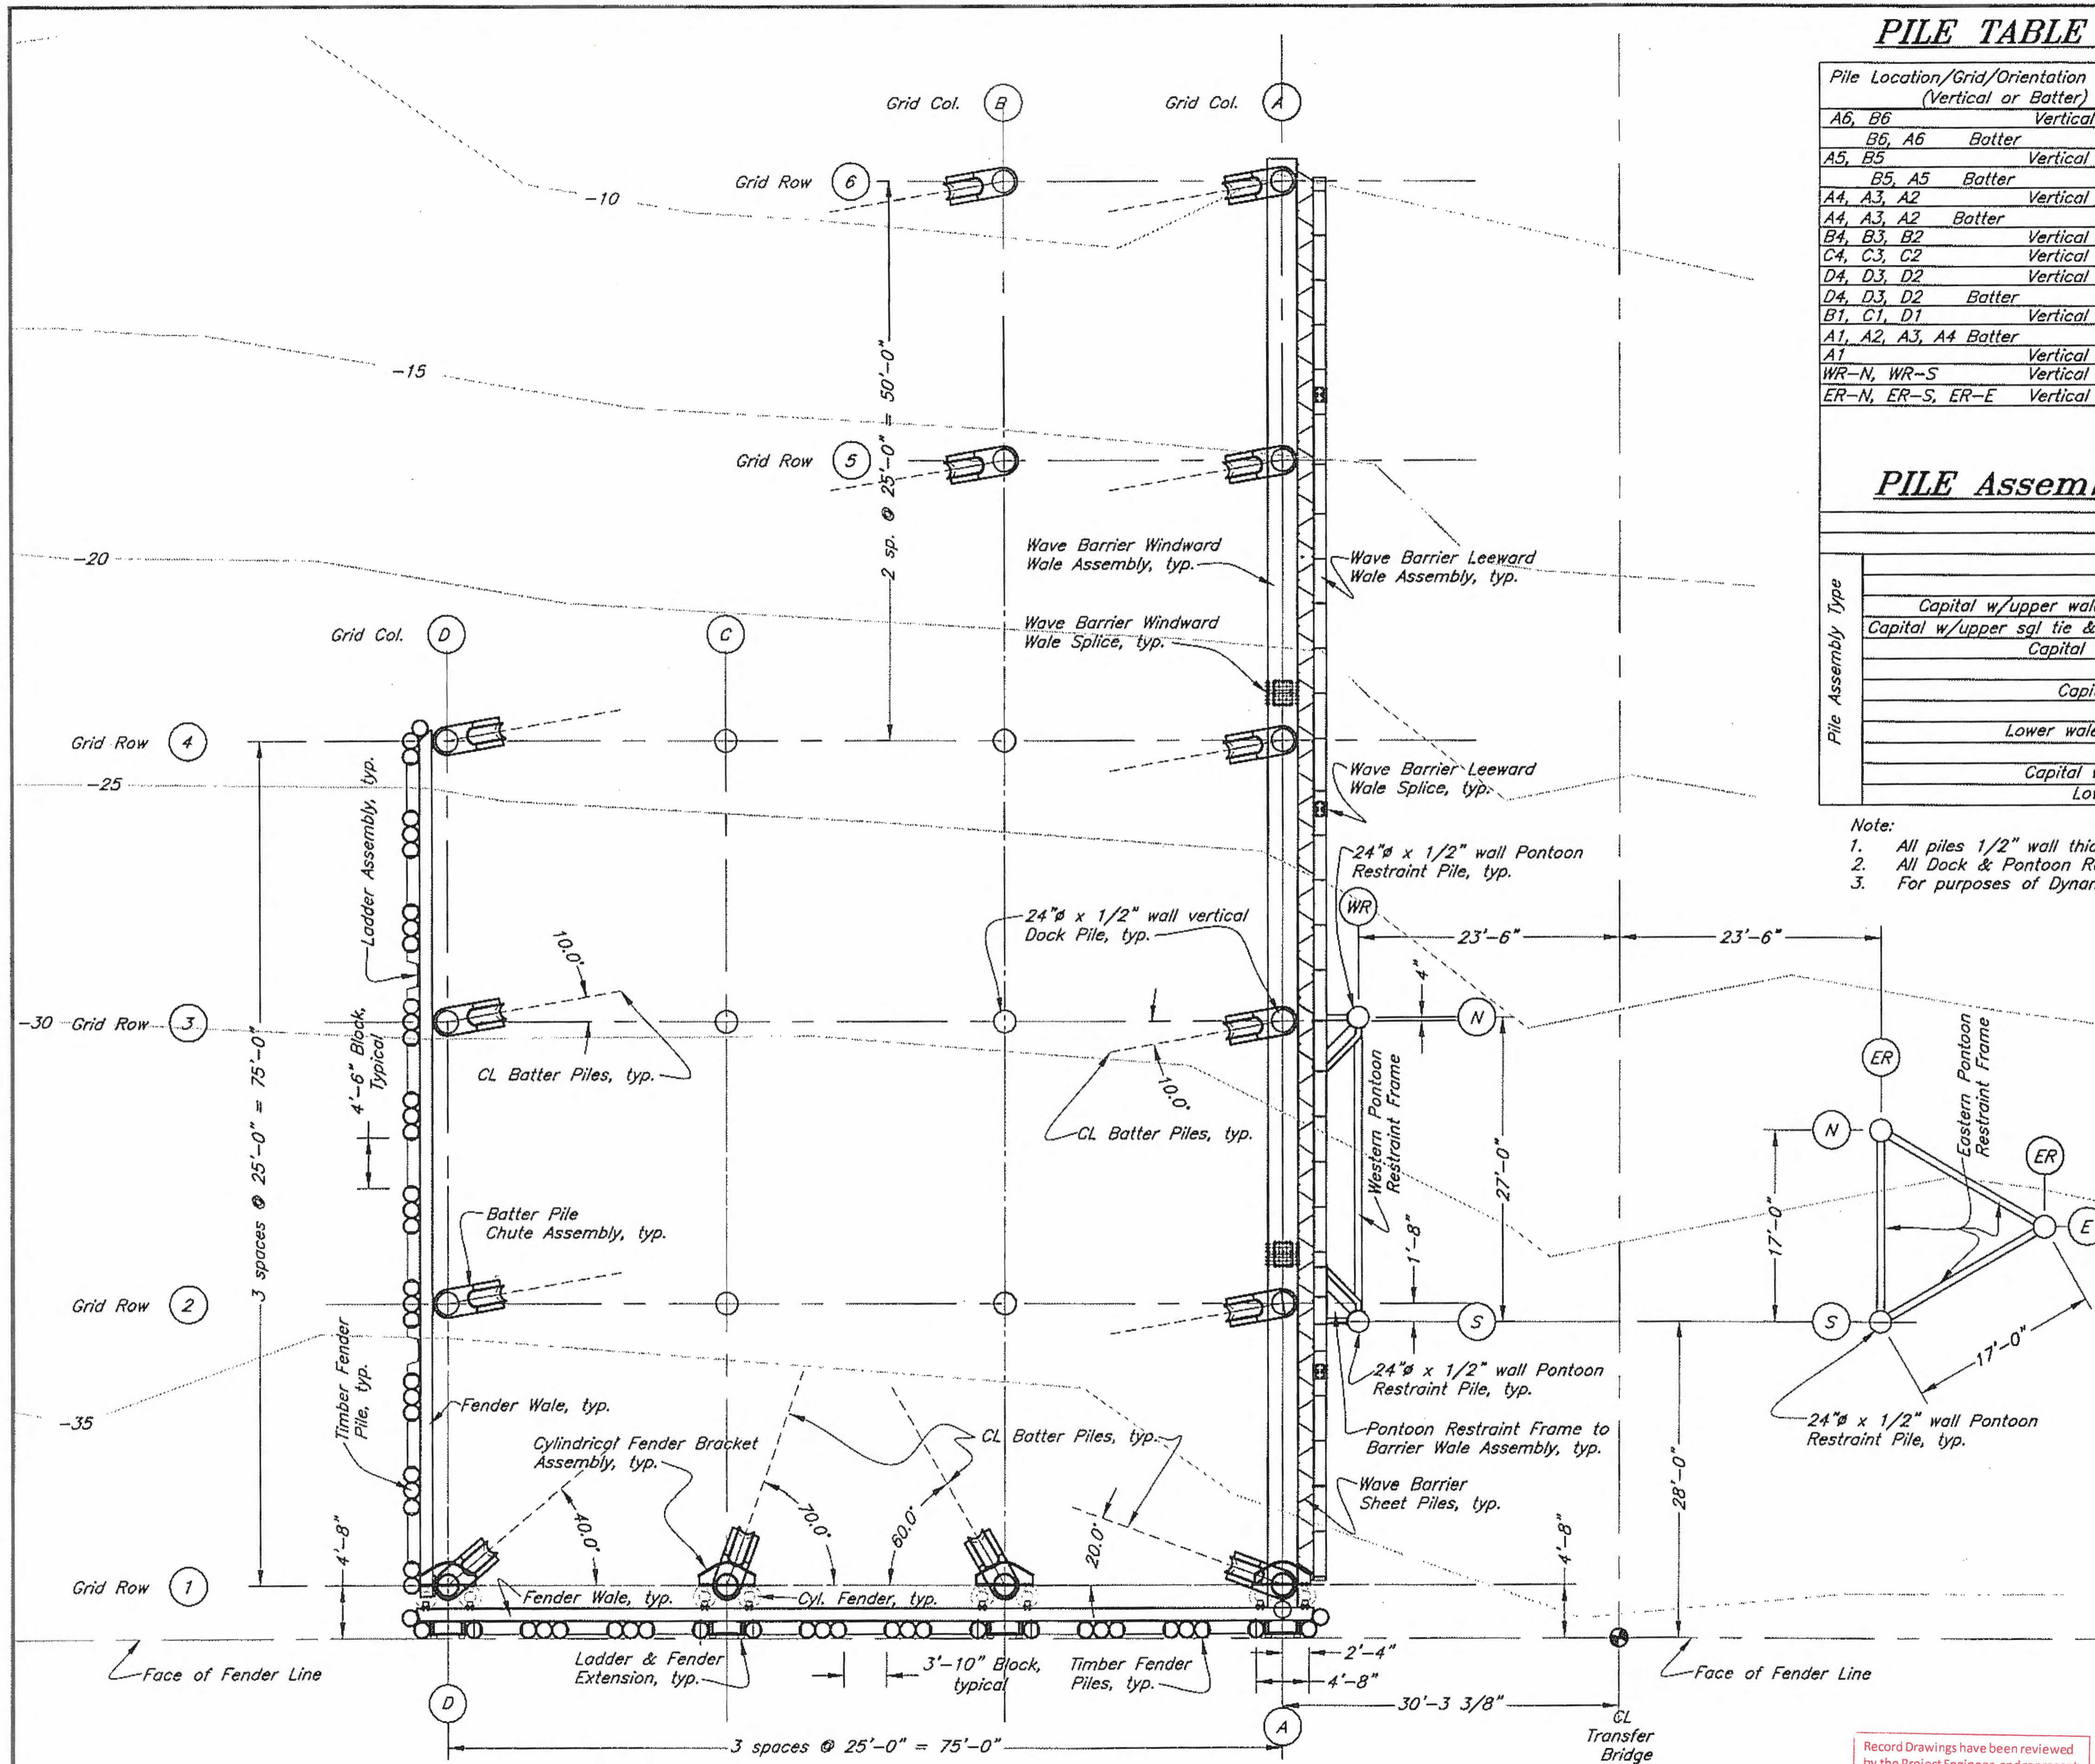


Pile Tip & Core Stopper Details

DO NOT SCALE FROM THESE DRAWINGS USE DIMENSIONS

DESIGNED BY: J. Scott	STATE OF ALASKA DEPARTMENT OF TRANSPORTATION & PUBLIC FACILITIES DESIGN & ENGINEERING SERVICES DIVISION-SOUTHEAST REGION	
	Gustavus Causeway Replacement Dock & Pontoon Restraint Pile Layout	
	D03	
CHECKED BY: B. Savikko	YEAR: 2008	TOTAL SHEETS: 138
DRAWN BY: C. Fuman, W. Hickok	PROJECT DESIGNATION: BR-0003(53)/67599	SHEET NO.: 54
PATH: Q:\GUS\67599\MF\PLANSET\04-DOCK\003 DOCK PILE LAYOUT.DWG	DATE: Wed, 26/Nov/08 11:07AM	JTSCOTT
TAB: REVISIONS	NO.	DATE
DESCRIPTION		

Dock and Pontoon Restraint Pile Layout

Record Drawings have been reviewed by the Project Engineer, and represent to the best of my knowledge, the project as constructed.
PE [Signature] Date 8/21/17

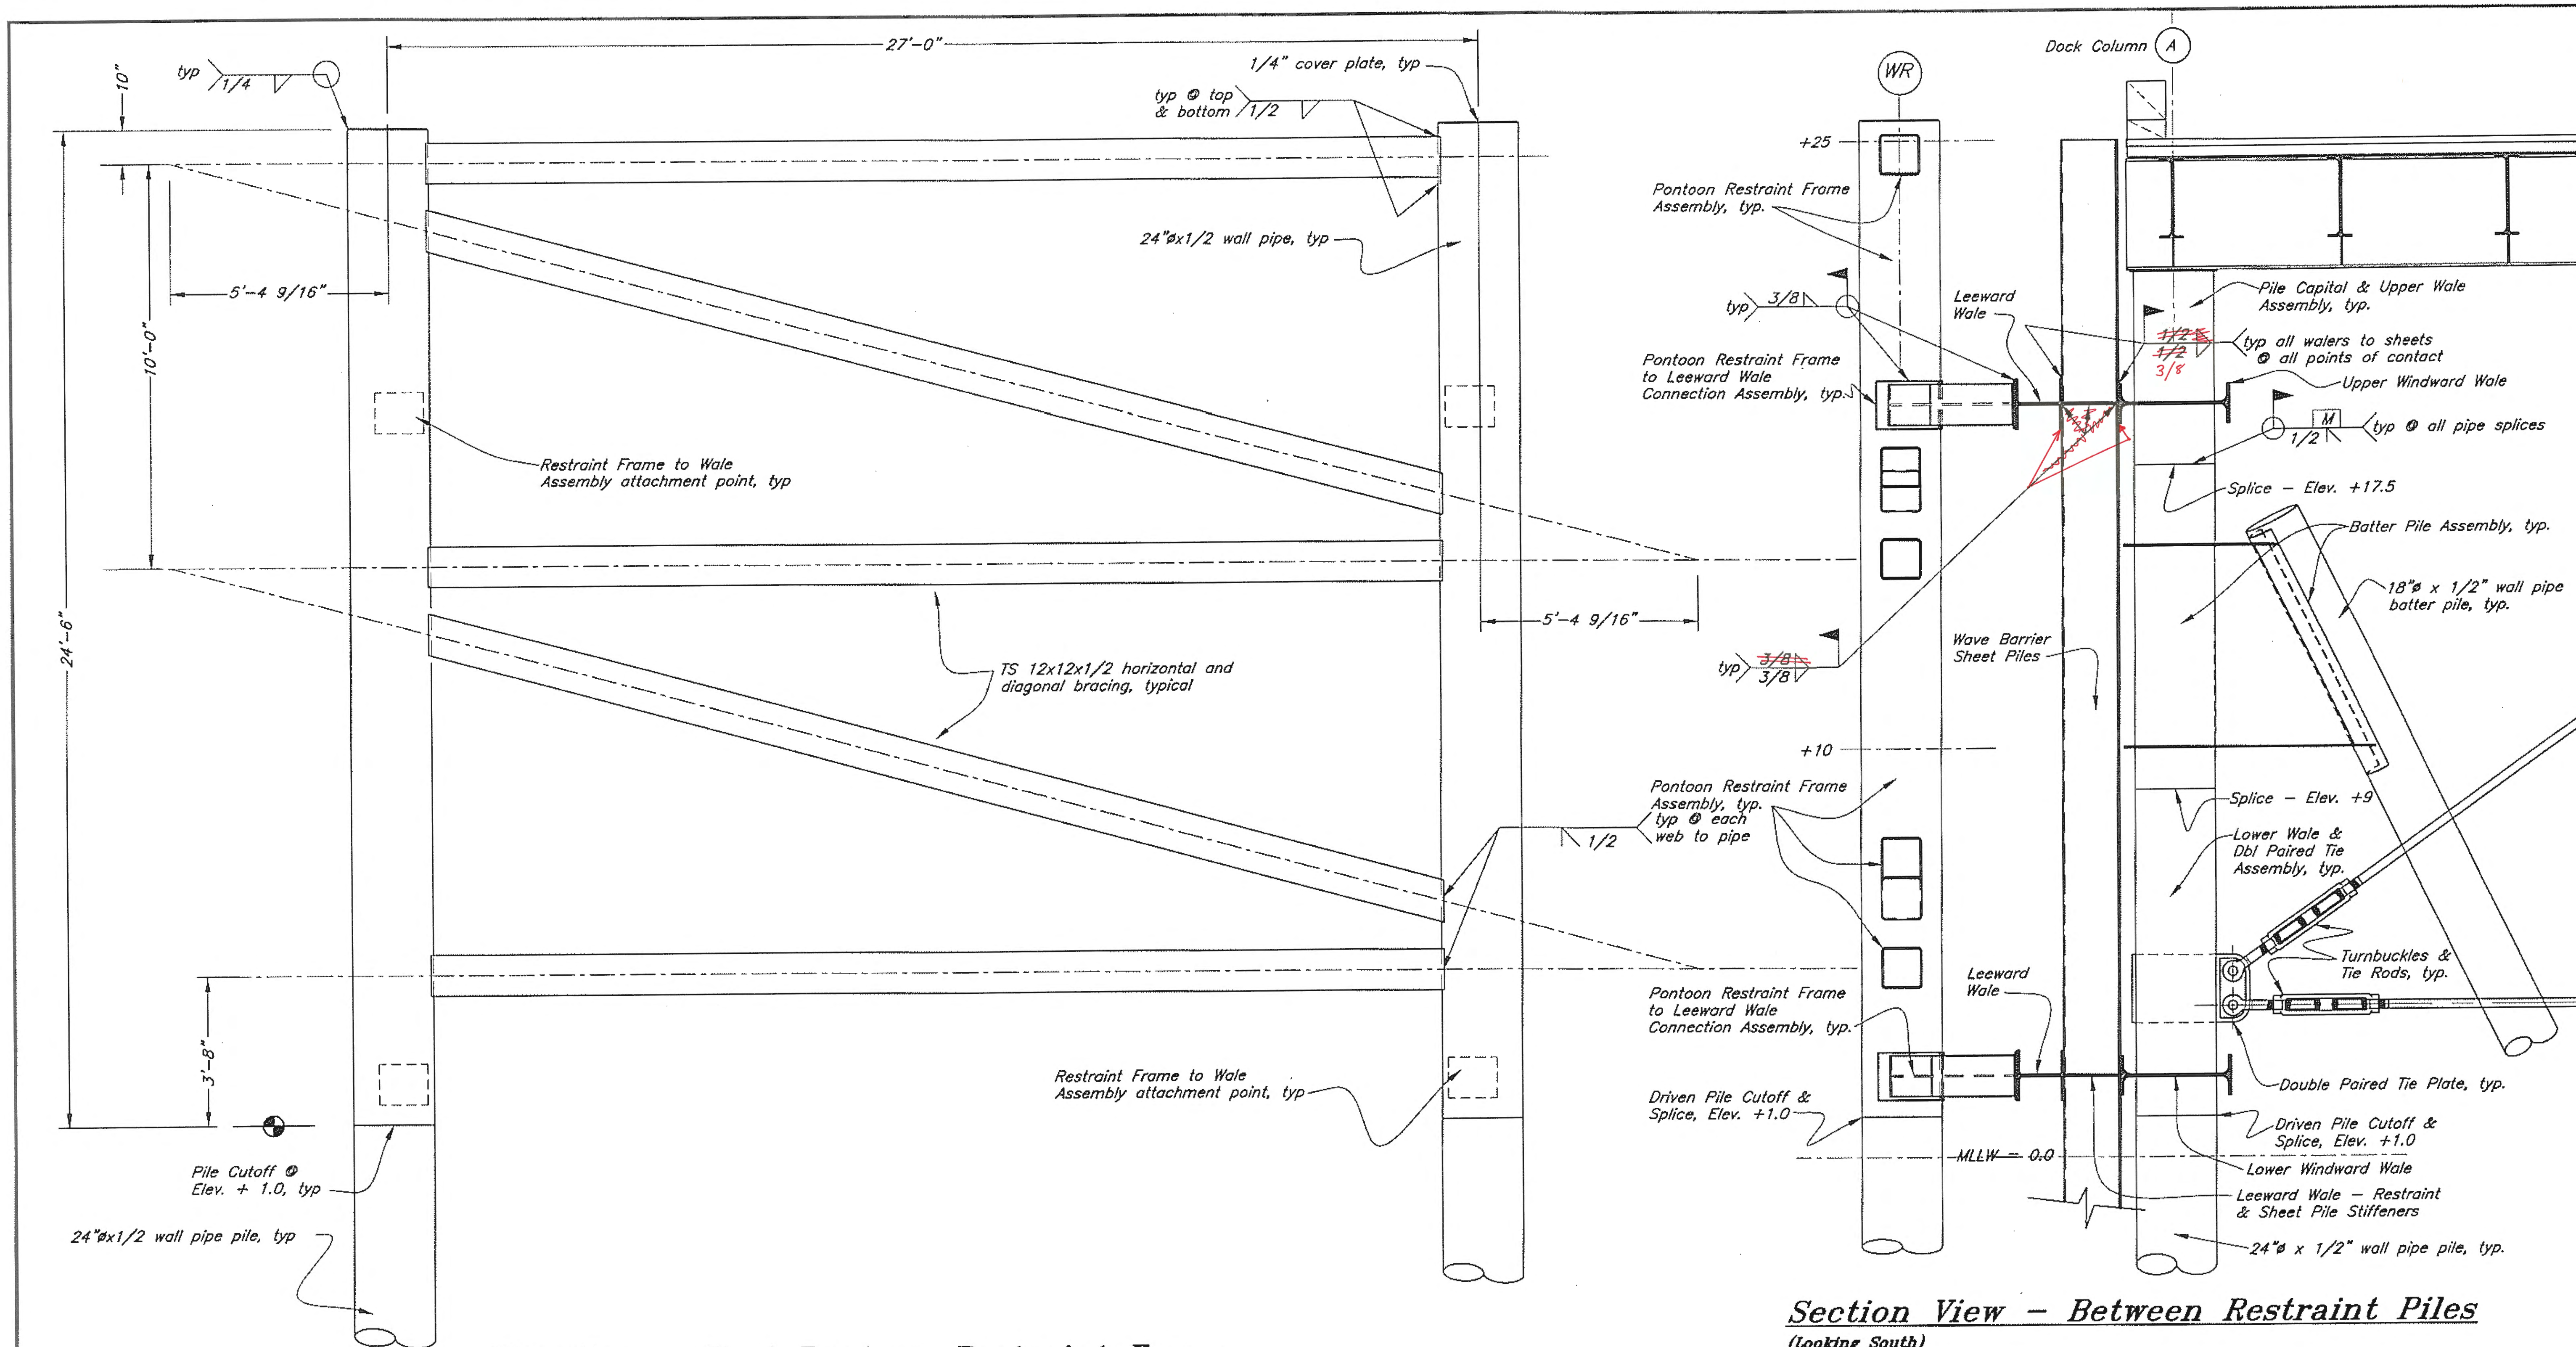


Elevation - West Pontoon Restraint Frame
(WR shown Looking West)

Section View - Between Restraint Piles
(Looking South)

Record Drawings have been reviewed by the Project Engineer, and represent to the best of my knowledge, the project as constructed.
PE *Steve Smith* Date 8/2/17


DO NOT SCALE FROM THESE DRAWINGS USE DIMENSIONS

DESIGNED BY: <i>J. Scott</i>  CHECKED BY: <i>B. Savikka</i> DRAWN BY: <i>C. Fuman, W. Hickok</i> PATH: O:\GUS\67599\MF\PLANSET\04-DOCK\04 DOCK AT RESTRAINT.DWG TAB: Wed, 26/Nov/08 11:08AM JTS/SCOTT		STATE OF ALASKA DEPARTMENT OF TRANSPORTATION & PUBLIC FACILITIES DESIGN & ENGINEERING SERVICES DIVISION-SOUTHEAST REGION Gustavus Causeway Replacement Dock/Pontoon Restraint West Frame D04		
PROJECT DESIGNATION BR-0003(53)/67599		YEAR 2008	SHEET NO. 55	TOTAL SHEETS 138



Sheet 56. Add the following notes to this sheet: "Leeward wale, leeward wale stiffeners, sheet pile stiffeners and sheet piles shall be bare steel. WR Pontoon Restraint (see Sheet 55), the pontoon restraint frame to leeward wale connection assembly (see Sheet 57), the upper and lower W 33 windward wales, windward wale pipes and all assemblies above pipe pile cutoff elevations (see table Sheet 54) shall be galvanized."
 *** Note: Add the following note to "Upper & Lower Windward Wale": "1/2" thick plate web stiffeners are located top and bottom - opposite each sheet pile joint that contacts the windward wales. 1/4" fillet weld each side of each stiffener to flanges and stiffener to web contact, typical."

Sheet 56. Under the "AZ 26 Properties" table add the following note: "Plan design was based on the AZ 26 sheet pile section dimensions and properties. Should the AZ 26 sheet pile section shown not be domestically available (according to the requirements of Special Provision 106-1.01) then Contractor shall supply domestically available sheet piles such as PZC 26 that are equal or greater section properties per foot of wall. Given different length of wall per sheet and depth of section dimensions of PZC 26 (or other similar domestic sections) Contractor and Fabricator(s) shall adjust shapes of stiffeners, locations of wale splices and other details of the Wave Barrier or Dock Framing as required to accommodate substituted sheets."
 *** Note: Under the "AZ 26 Properties" table add the following note: "Plan design was based on the AZ 26 sheet pile section dimensions and properties. Should the AZ 26 sheet pile section shown not be domestically available (according to the requirements of Special Provision 106-1.01) then Contractor shall supply domestically available sheet piles such as PZC 26 that are equal or greater section properties per foot of wall. Given different length of wall per sheet and depth of section dimensions of PZC 26 (or other similar domestic sections) Contractor and Fabricator(s) shall adjust shapes of stiffeners, locations of wale splices and other details of the Wave Barrier or Dock Framing as required to accommodate substituted sheets."

AZ 26 Properties		
Mass lb/ft of single pile	Section Modulus in ³ /ft.	Moment of Inertia in ⁴ /ft.
65.72	100.1	840.2

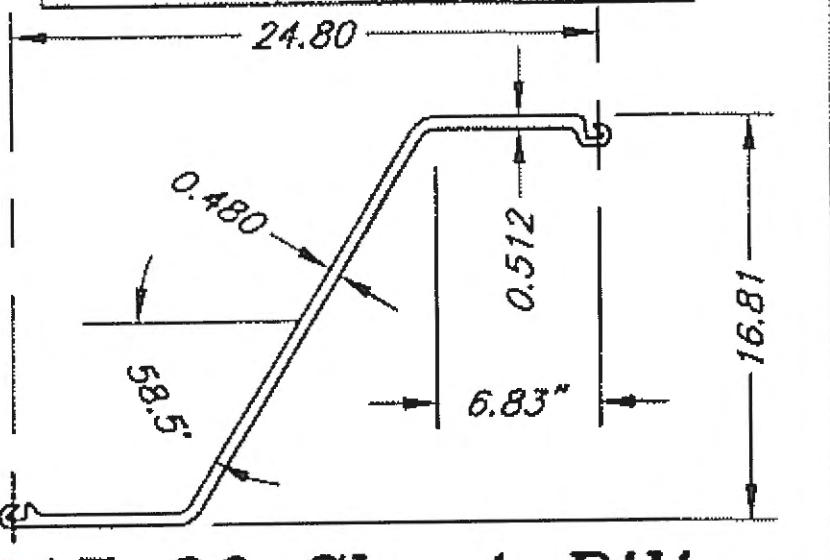


AZ 26 Sheet Piling
 * See Note in left margin.

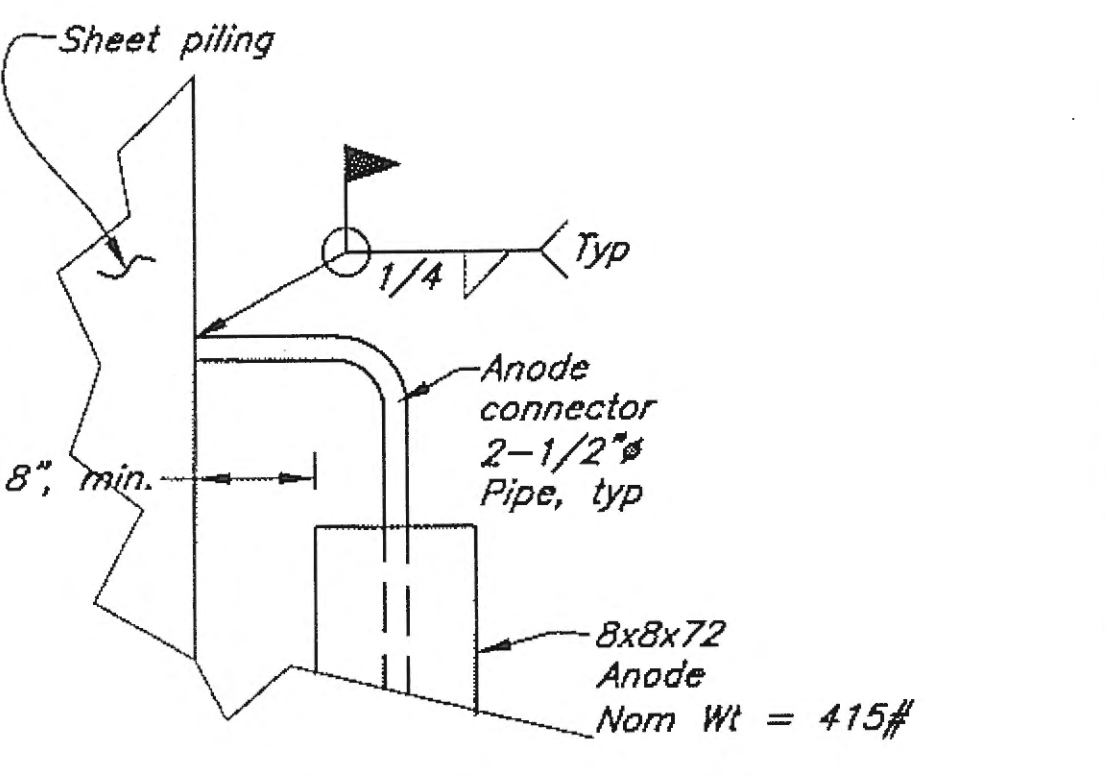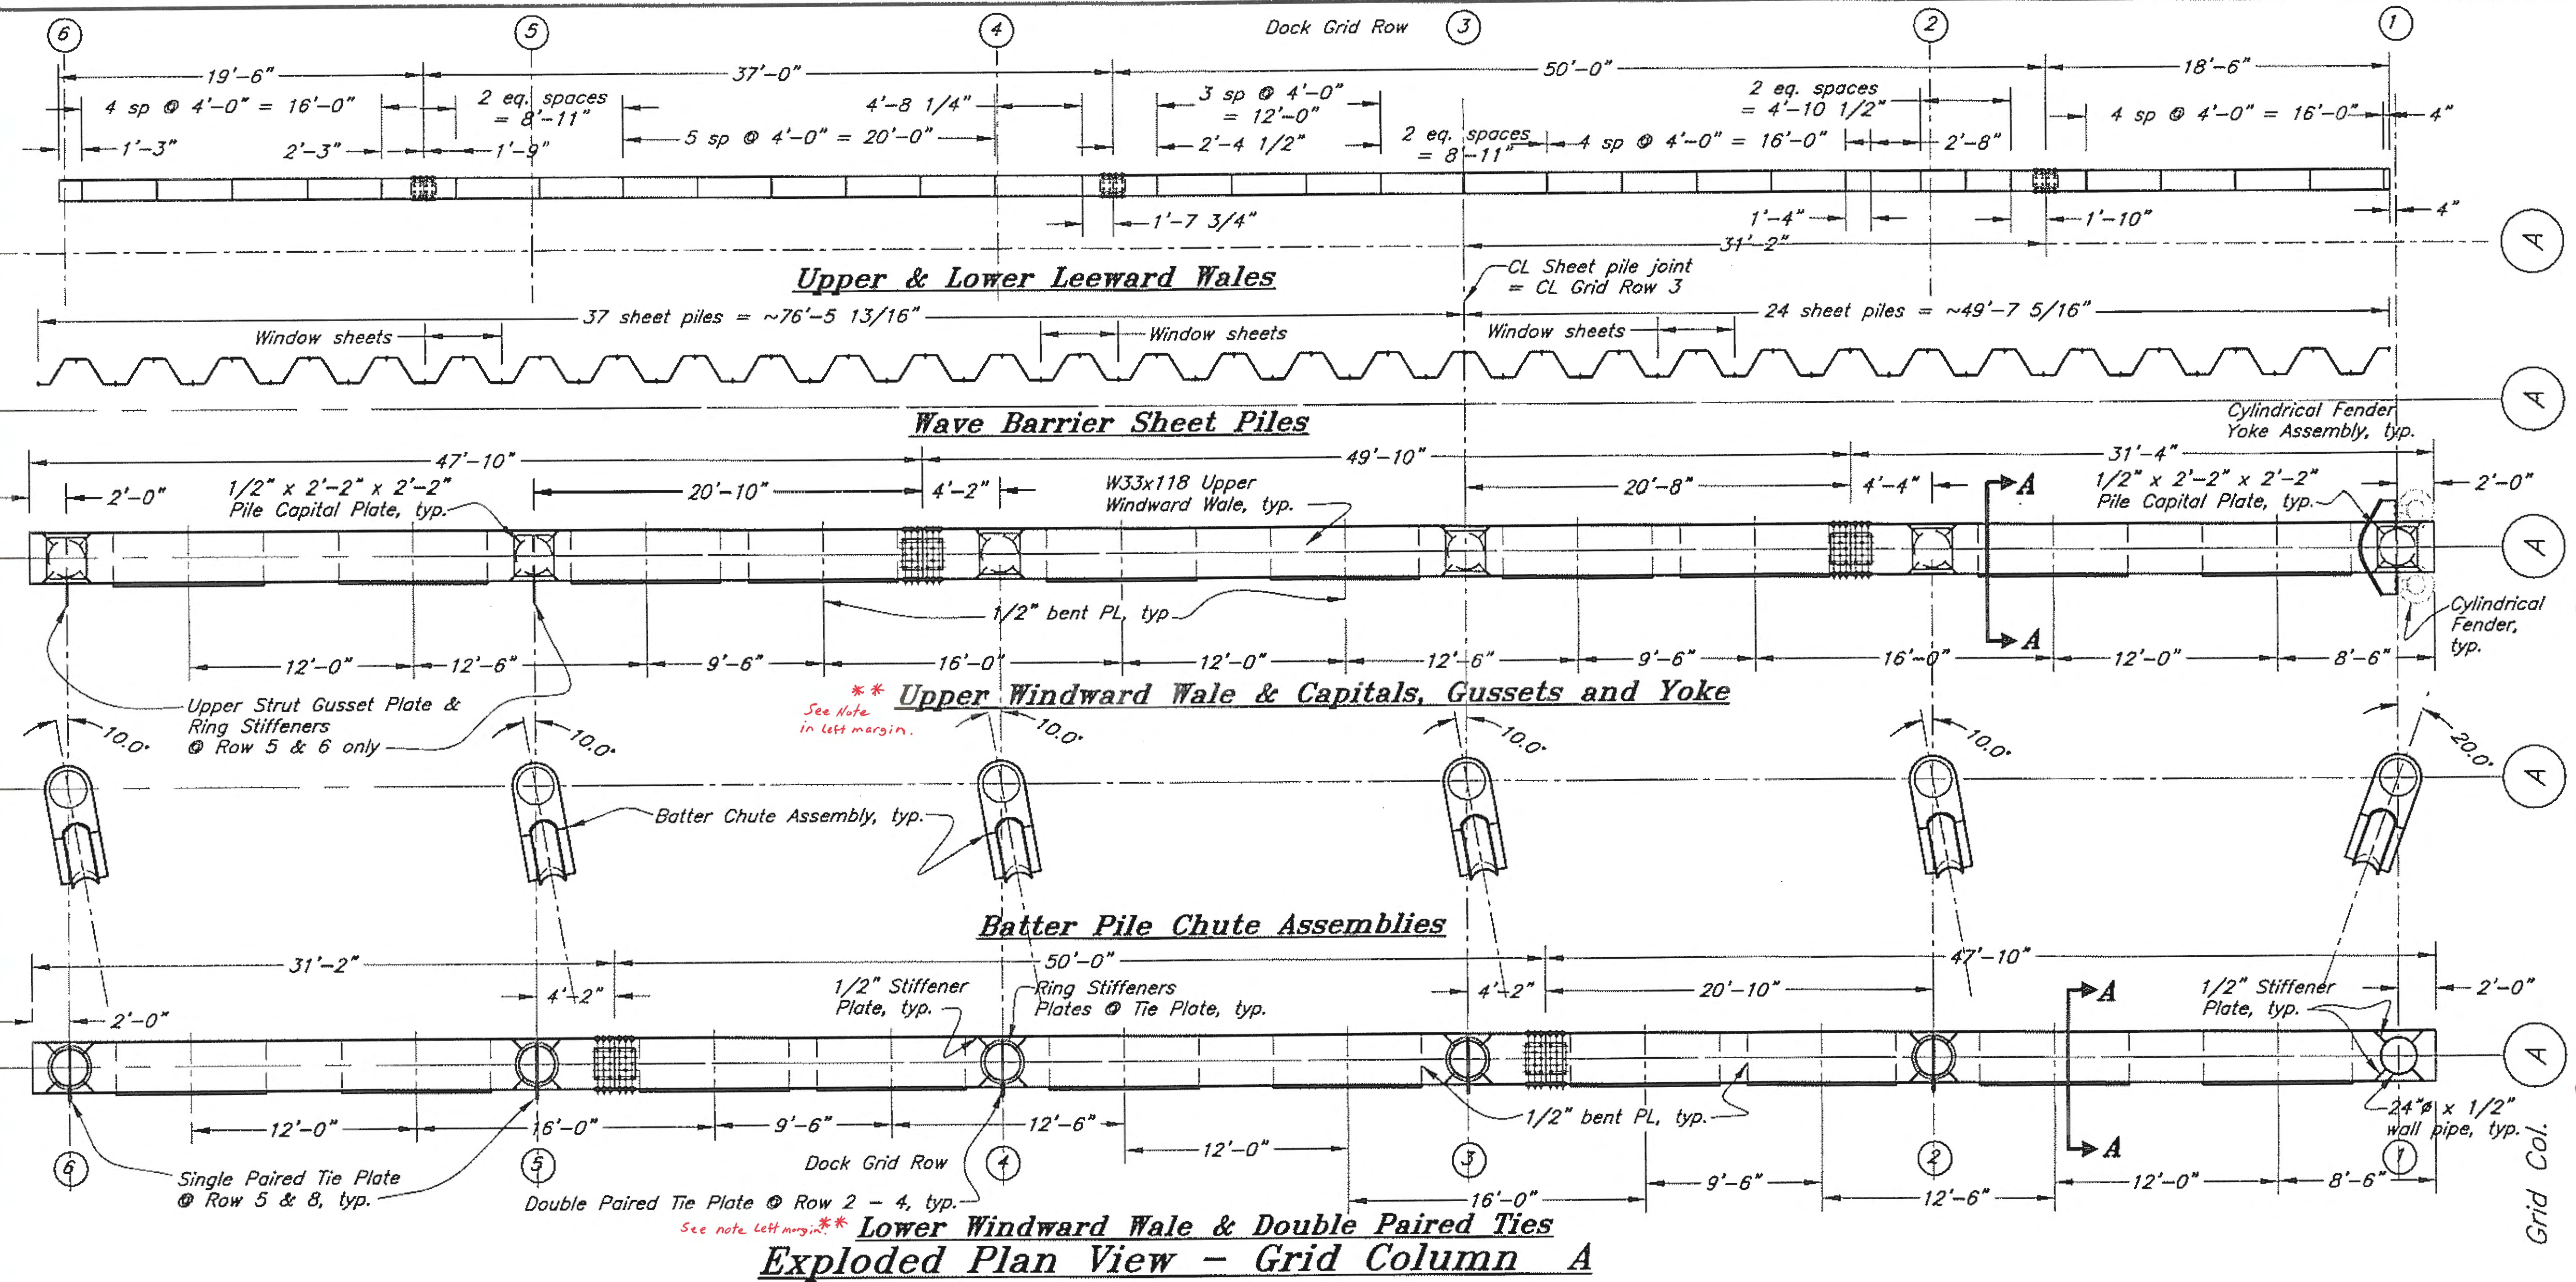


Anode Details


Note: "Section A-A": "1/2" bent Plate shown between windward wale flange and sheet piles is 8'-0" long, typical."

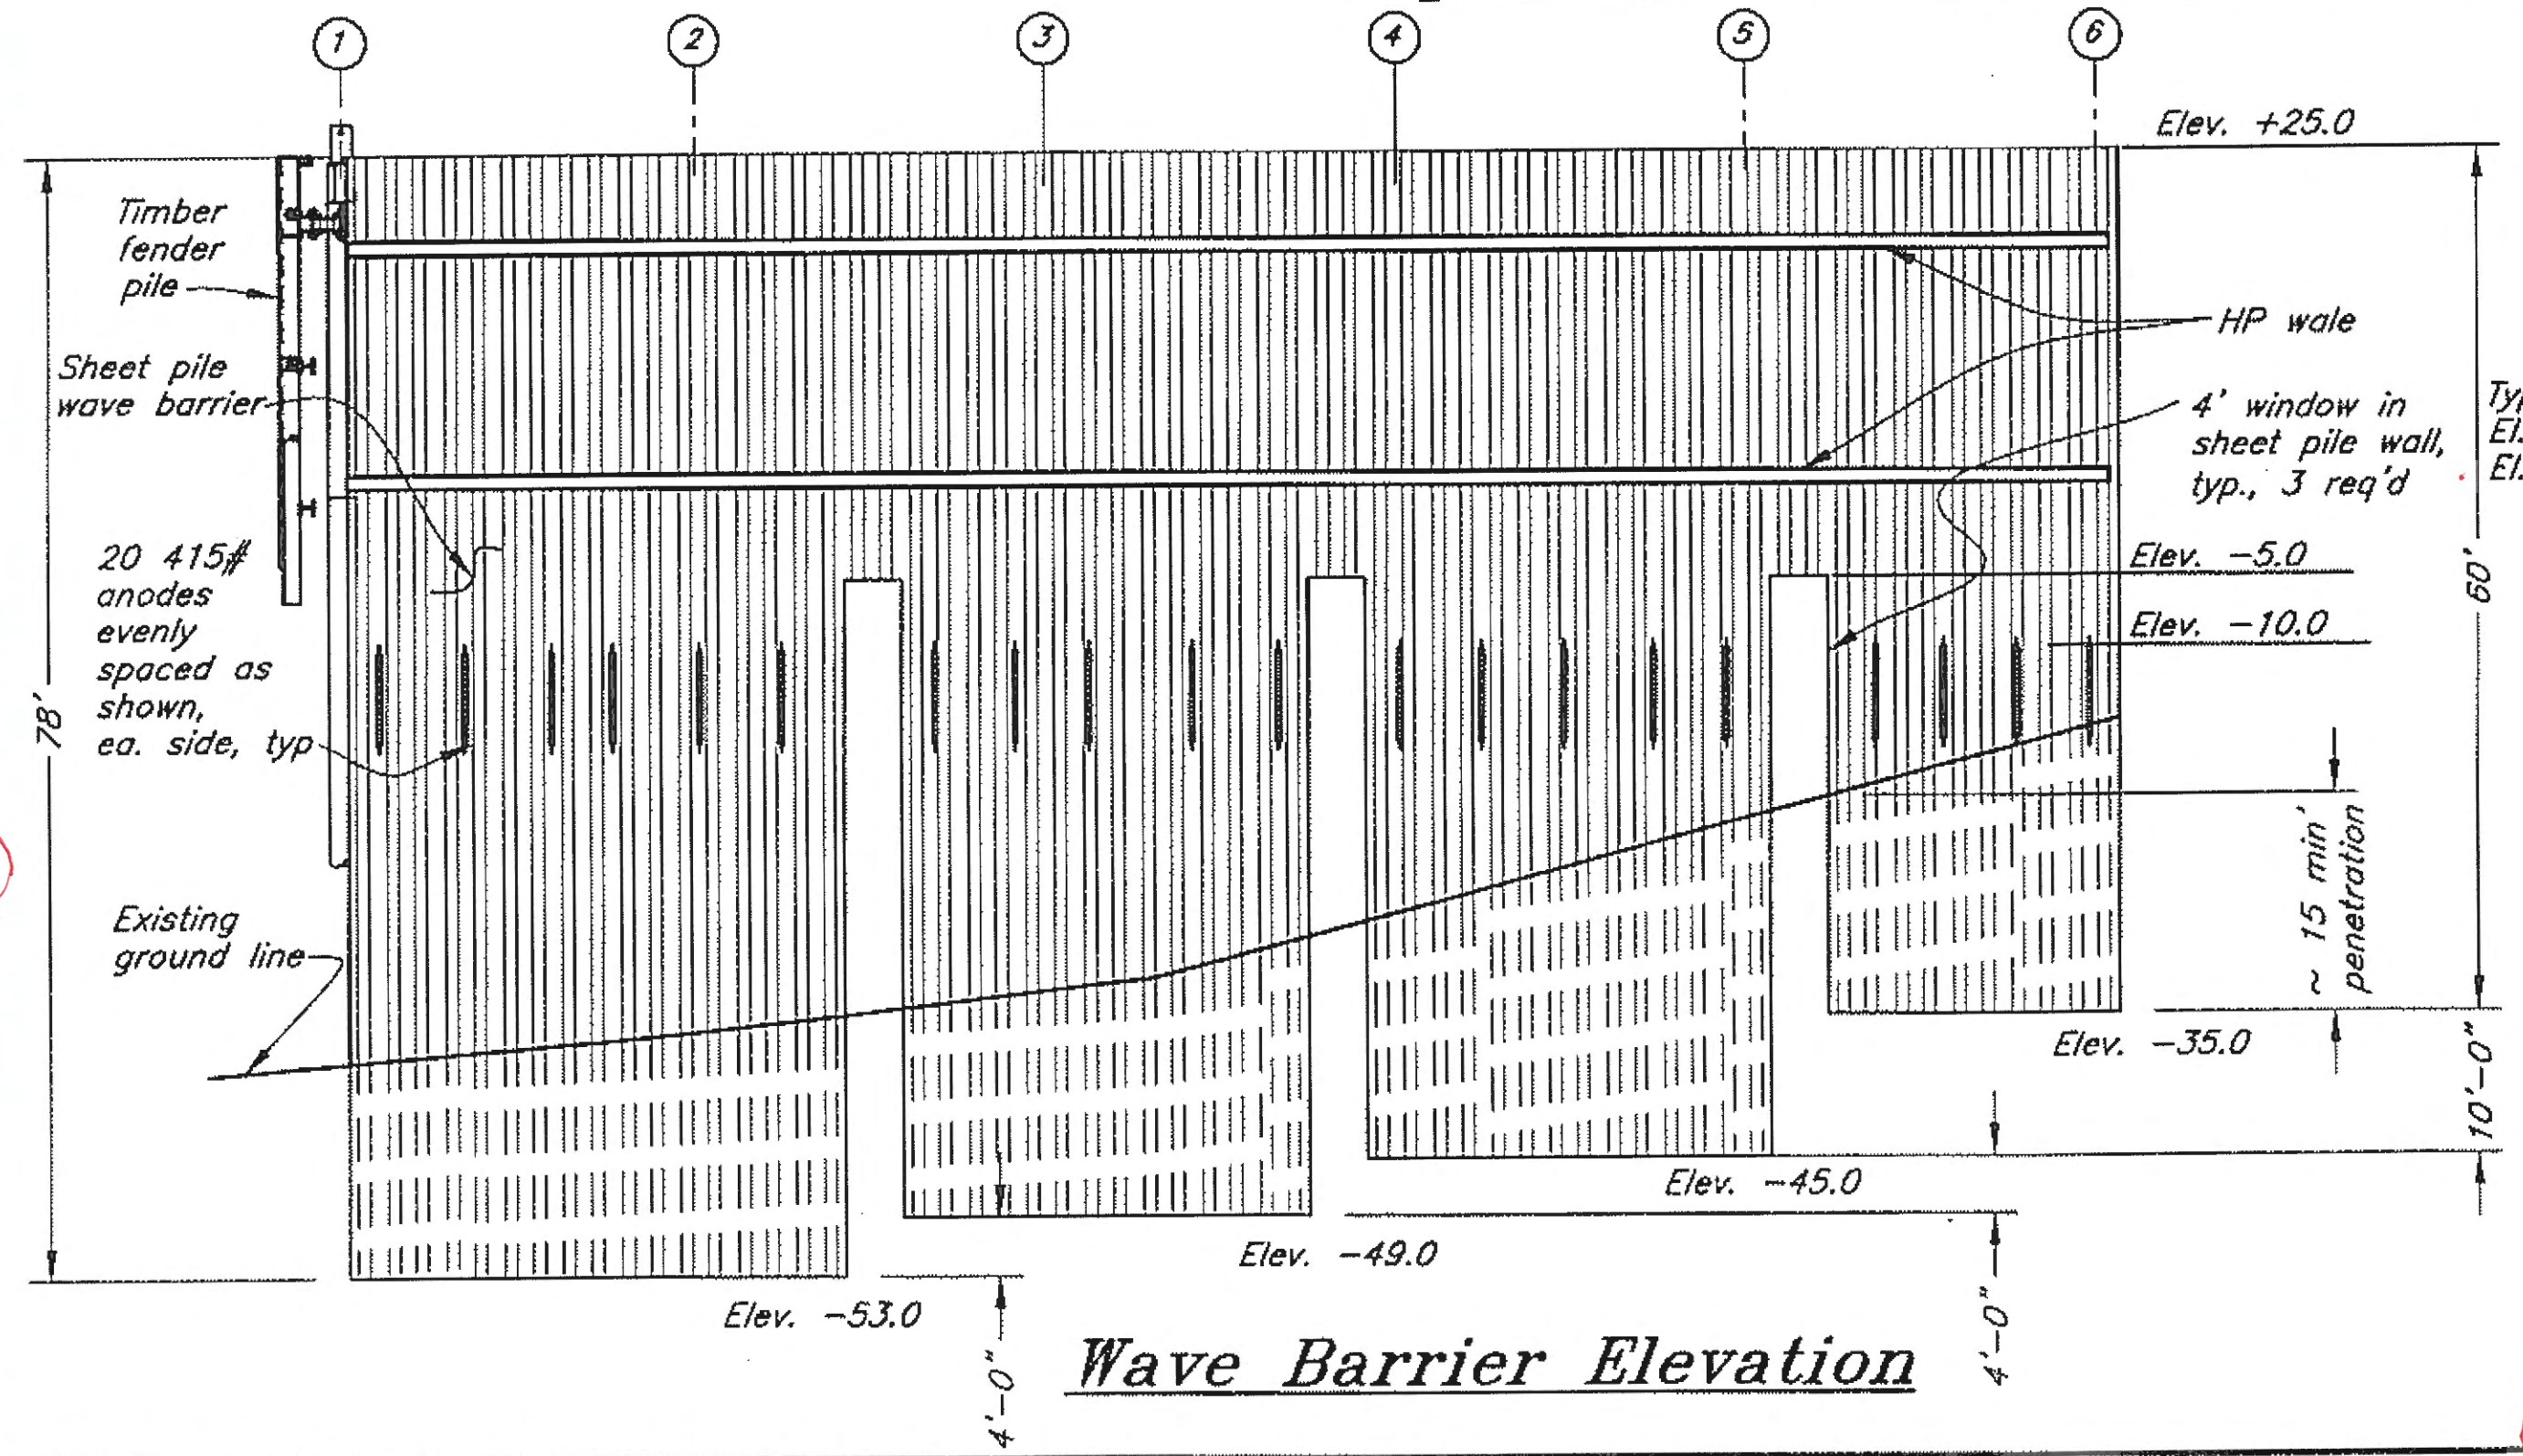

Wave Barrier Elevation

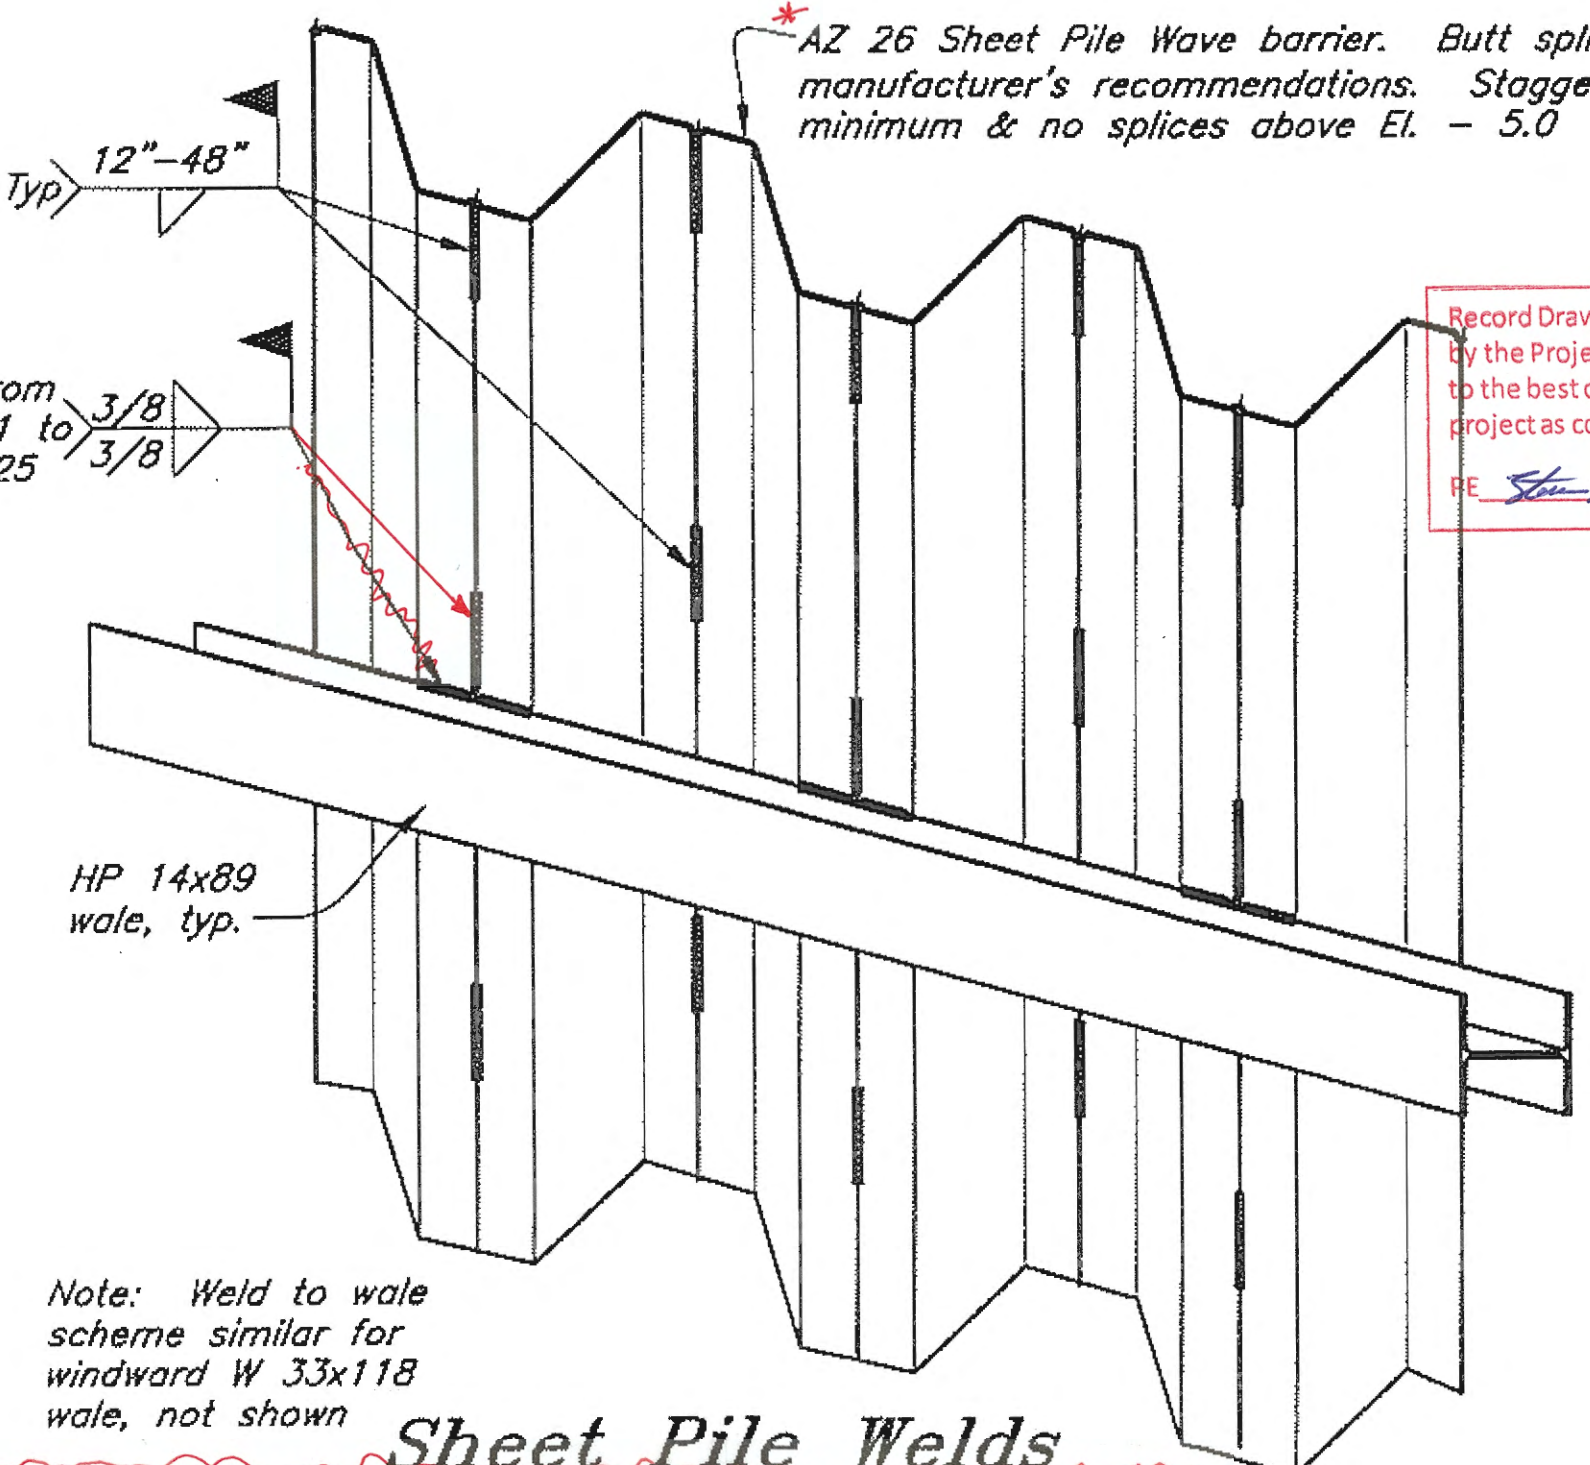

Sheet Pile Welds
 Note: The sheet to sheet weld is assumed to be equivalent to a 3/8" single pass fillet weld.

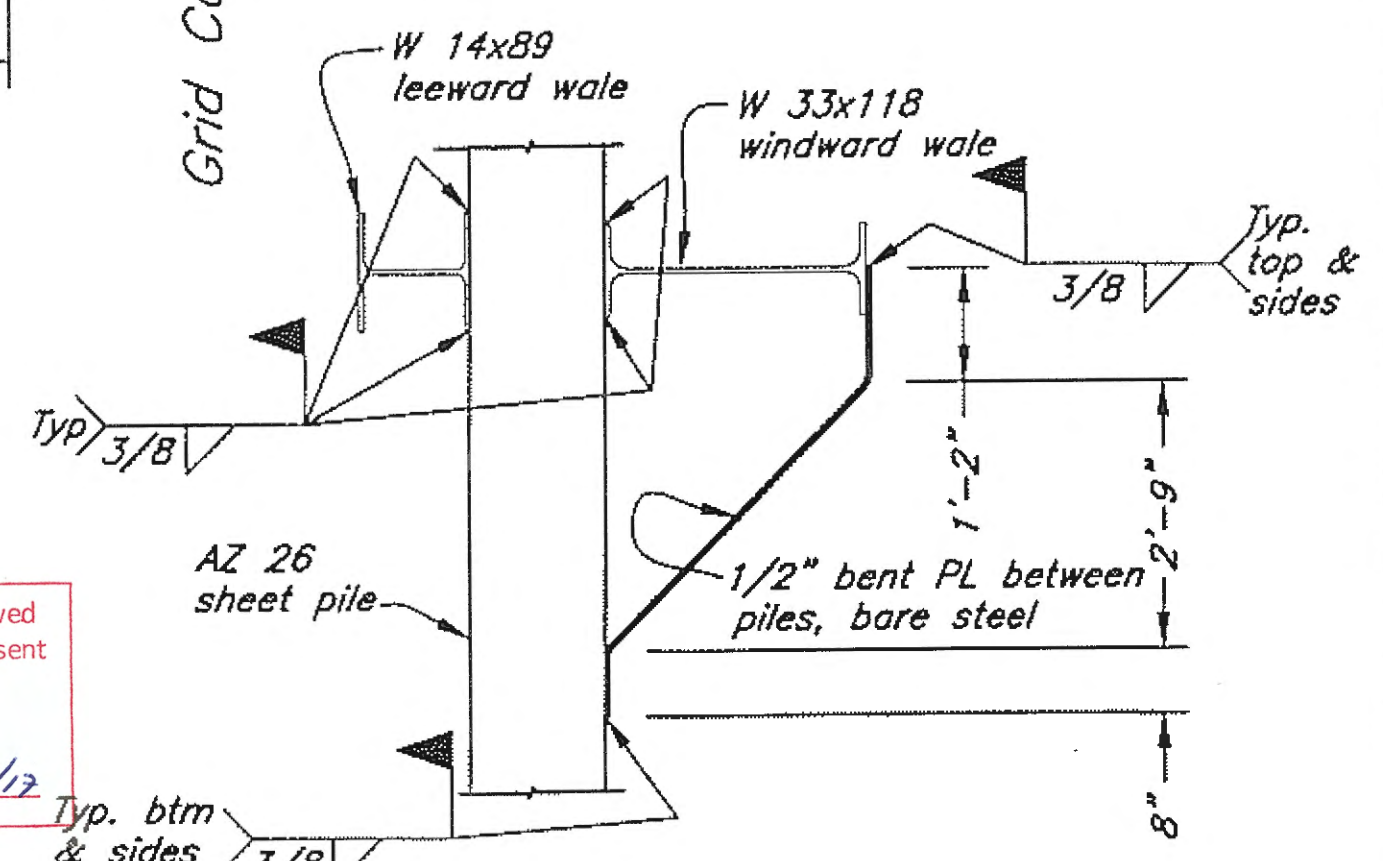

Section A-A

DO NOT SCALE FROM THESE DRAWINGS USE DIMENSIONS

DESIGNED BY: J. Scott


STATE OF ALASKA
 DEPARTMENT OF TRANSPORTATION & PUBLIC FACILITIES
 DESIGN & ENGINEERING SERVICES DIVISION-SOUTHEAST REGION

Gustavus Causeway Replacement
Dock/Pontoon West Restraint Wale & Wave Barrier
 D05


CHECKED BY: B. Savikka
 DRAWN BY: C. Fuman, W. Hickey
 PATH: O:\GUS\67599\MF\PLANSET\04-DOCK\D05 DOCK WAVE BARRIER PLAN.DWG
 TAB: Wed, 25/Nov/08 11:20AM JTS/SCOTT

NO.	DATE	DESCRIPTION	PROJECT DESIGNATION	YEAR	SHEET NO.	TOTAL SHEETS
			BR-0003(53)/67599	2008	56	138


Record Drawings have been reviewed by the Project Engineer, and represent to the best of my knowledge, the project as constructed.
 J. Scott, Date 8/21/12

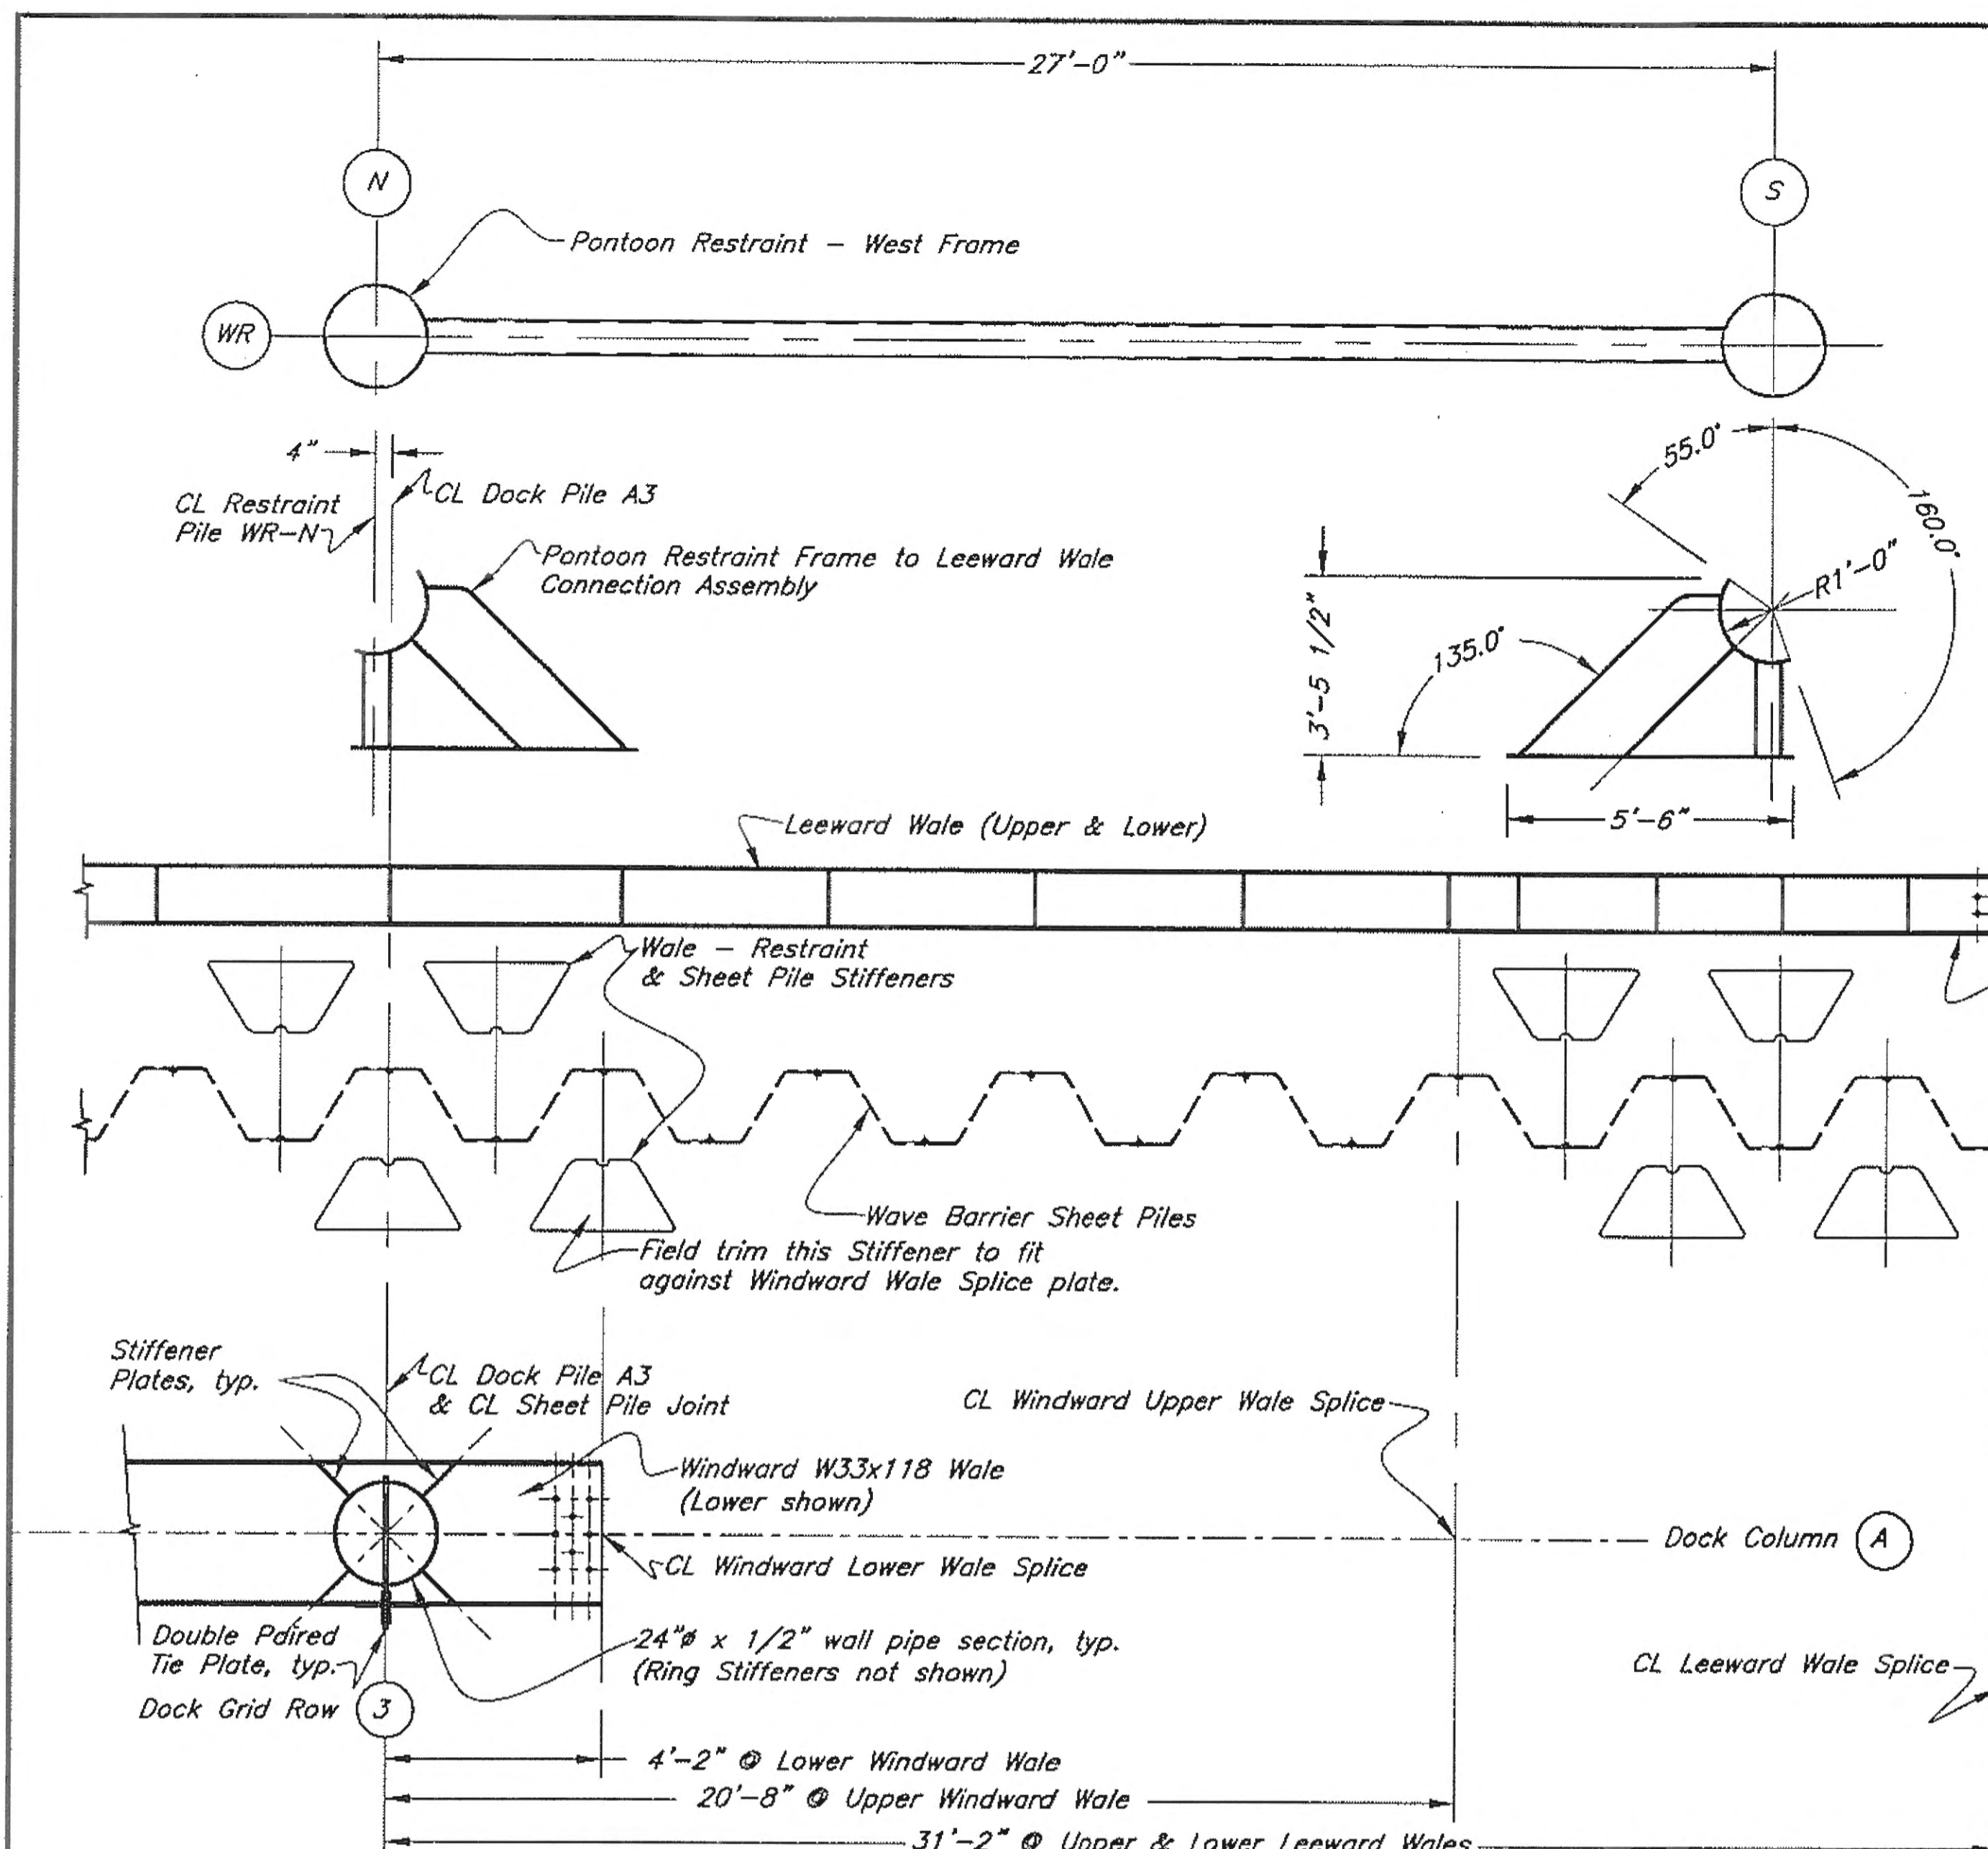


Exploded Plan View - Restraint to Wale Connection
(shown at lower wale connection, upper wale connection similar)

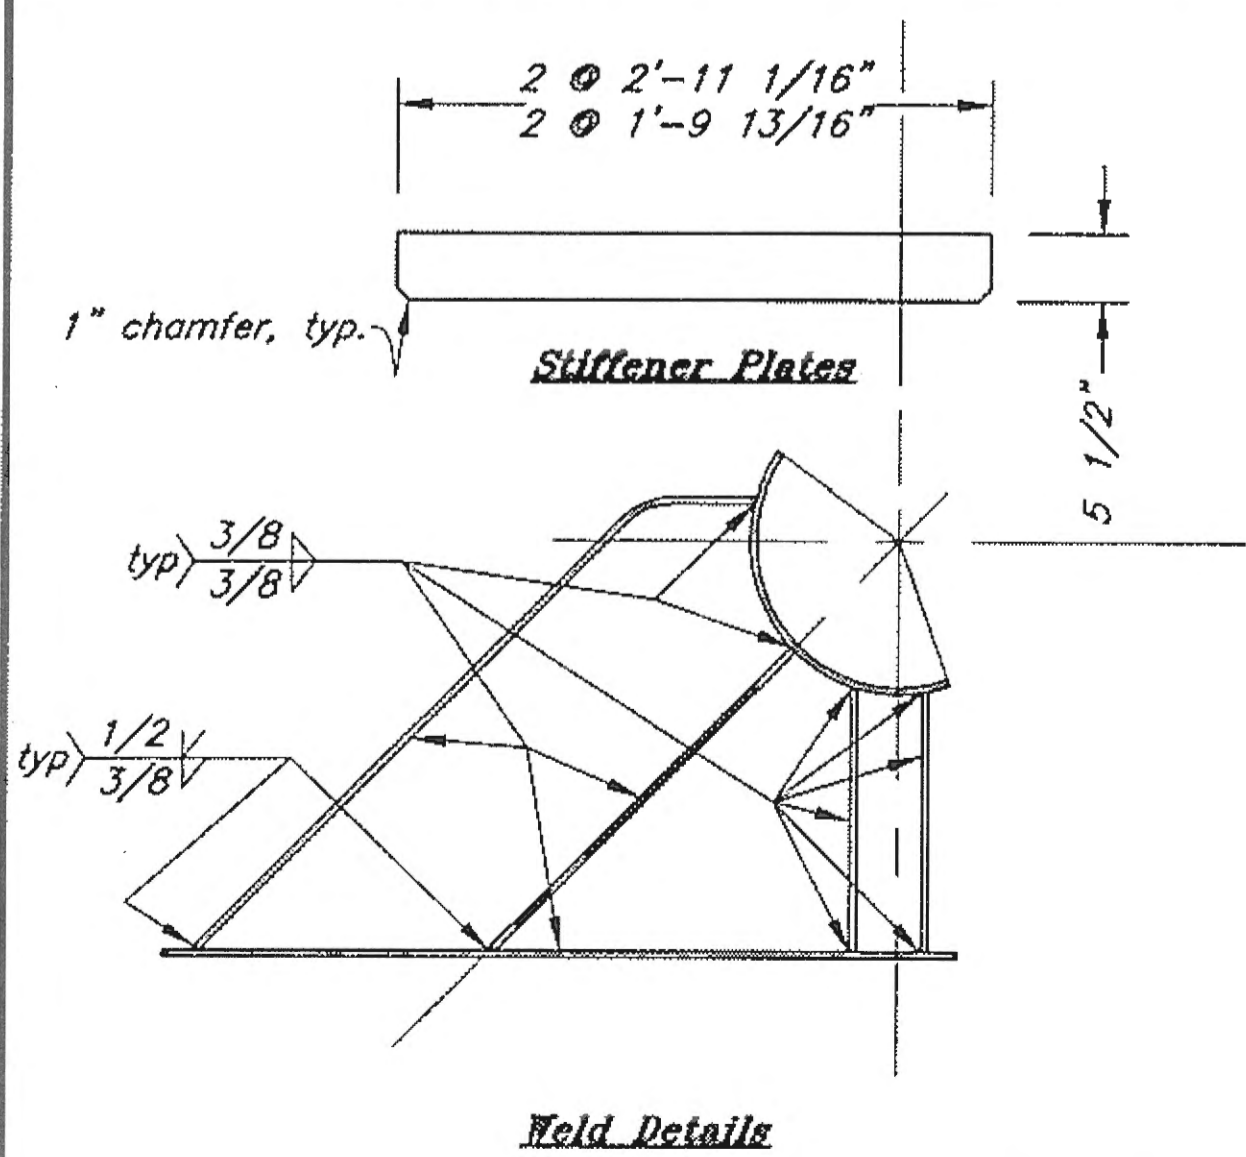

Weld Details

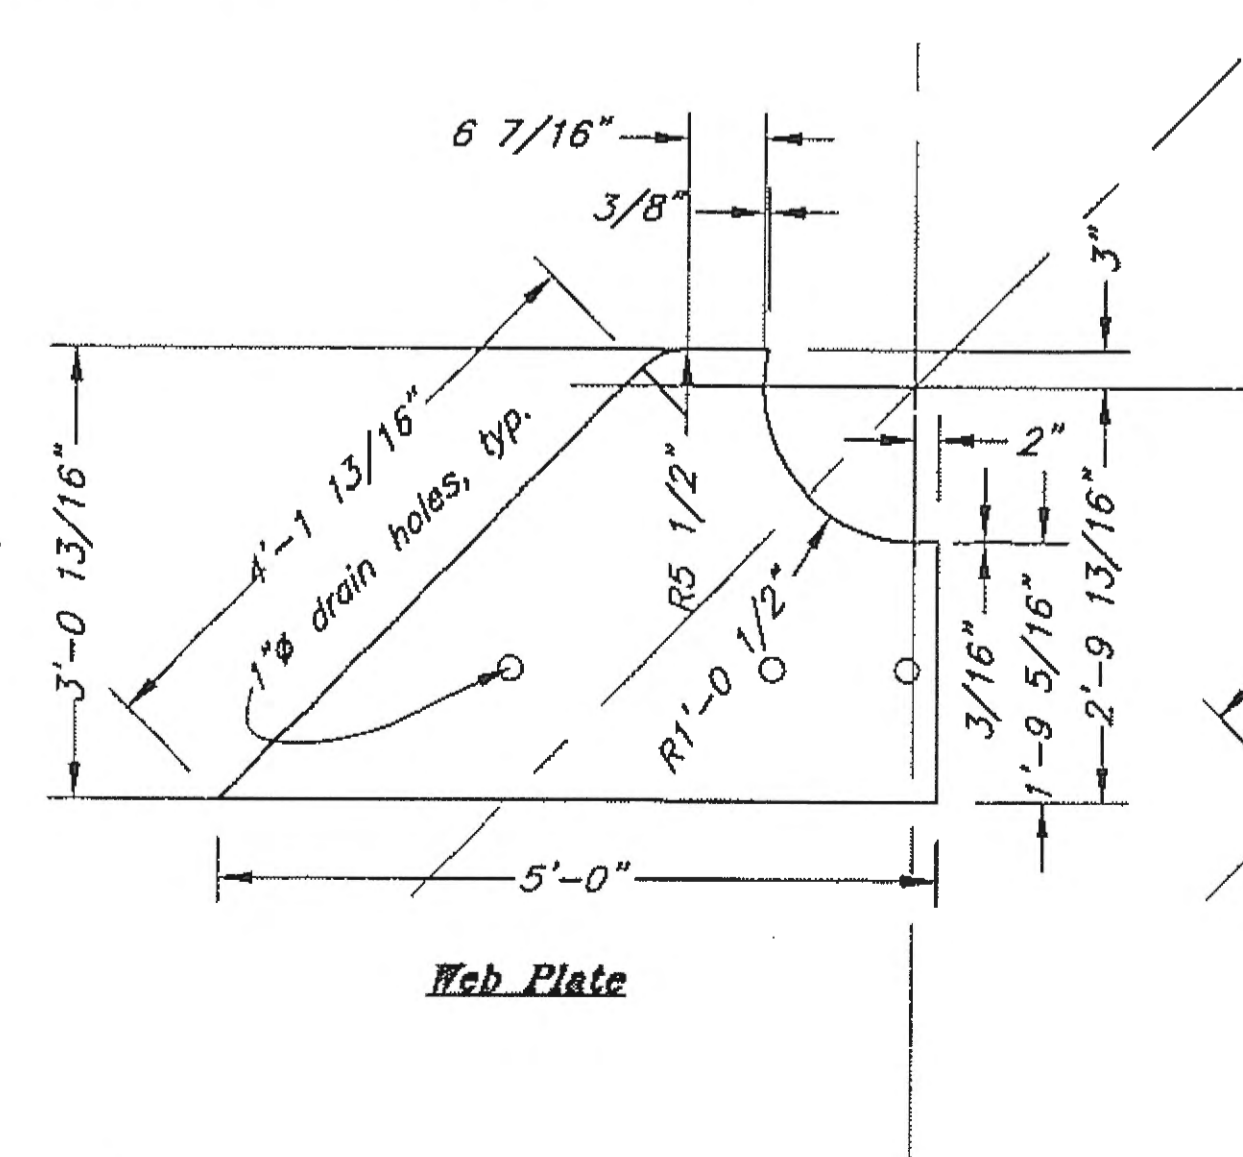


Web Plate

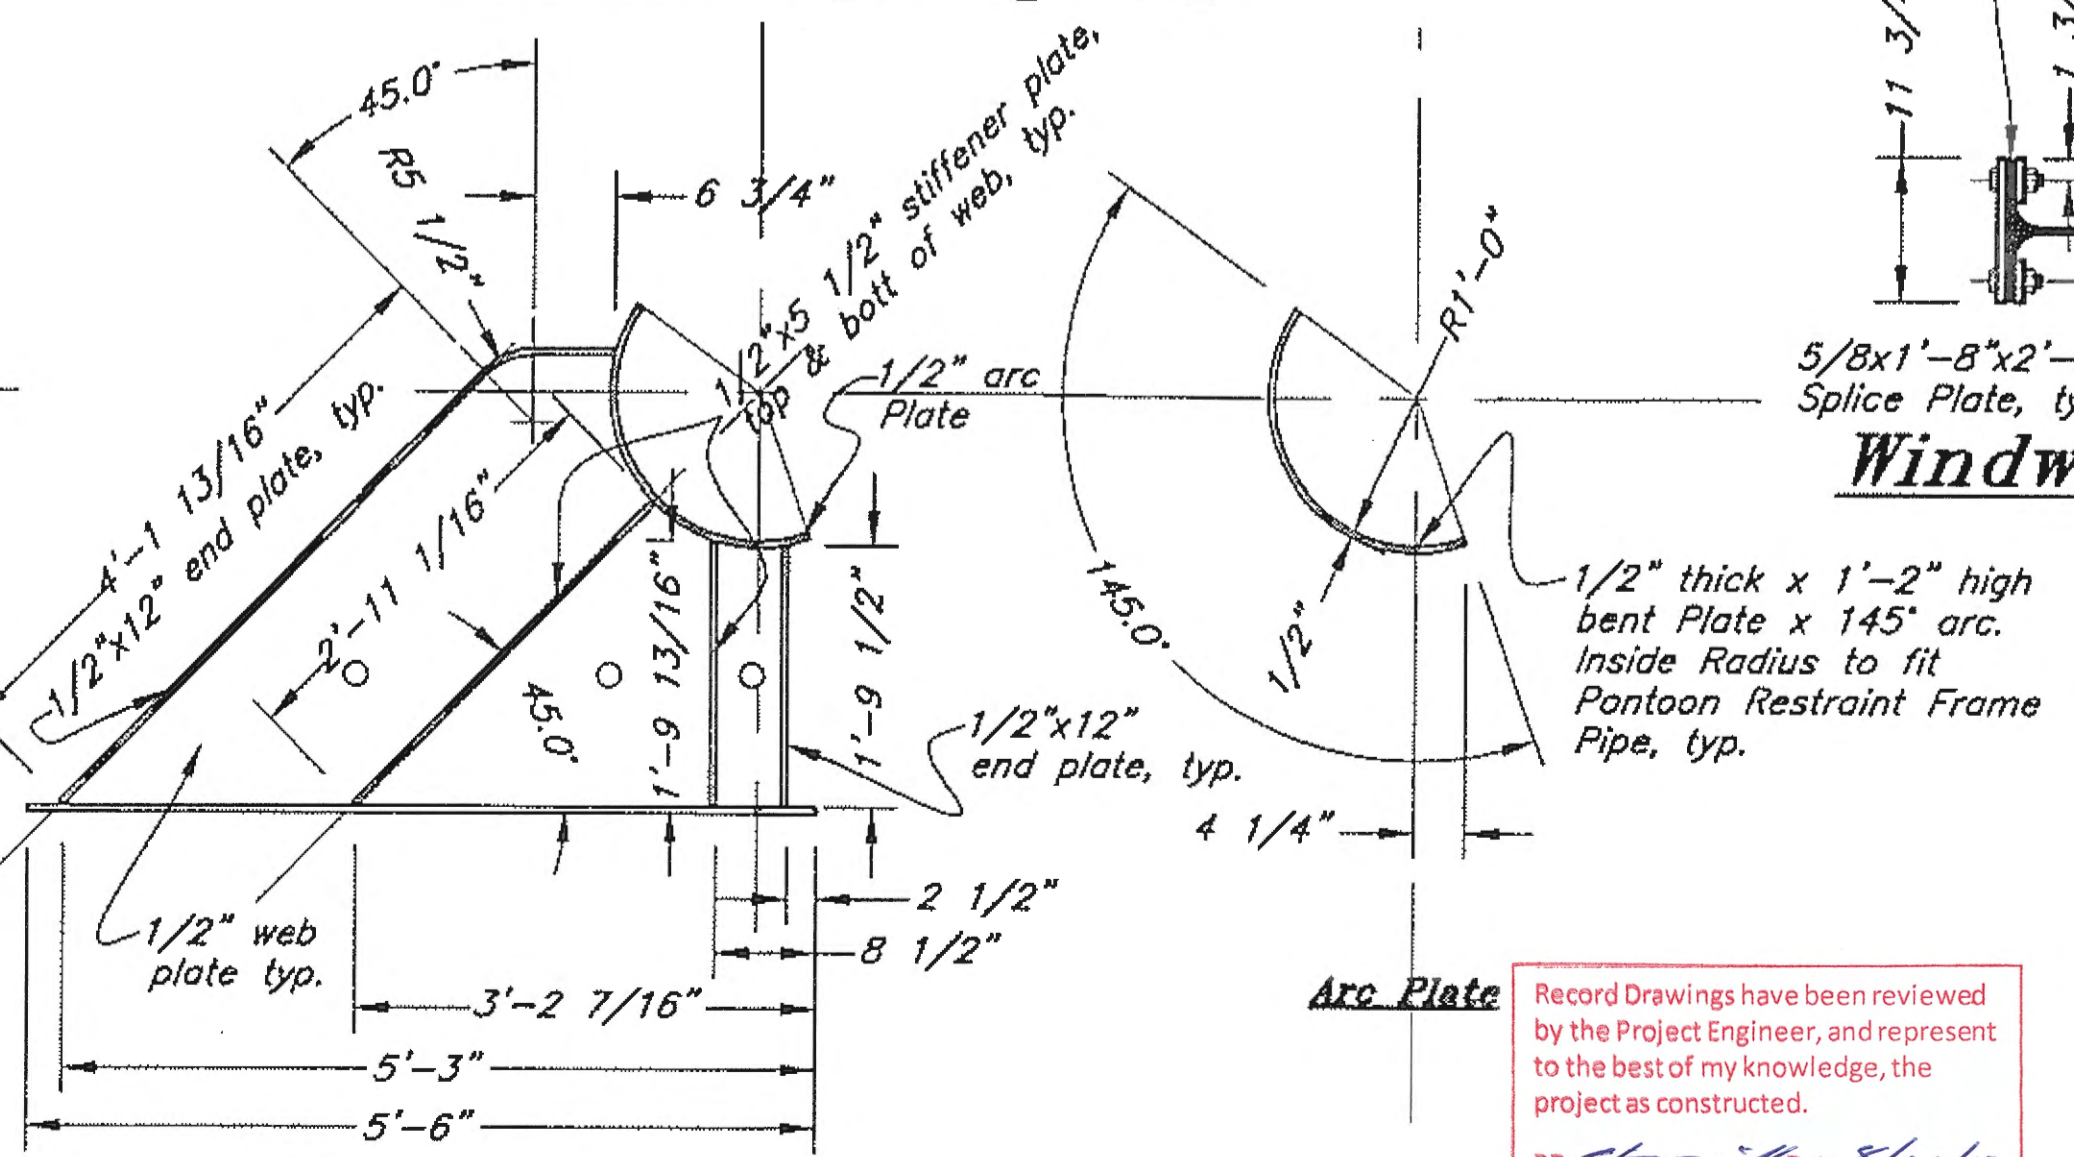


Leeward Wale Splice



Sheet Pile Stiffeners - Restraint to Wales

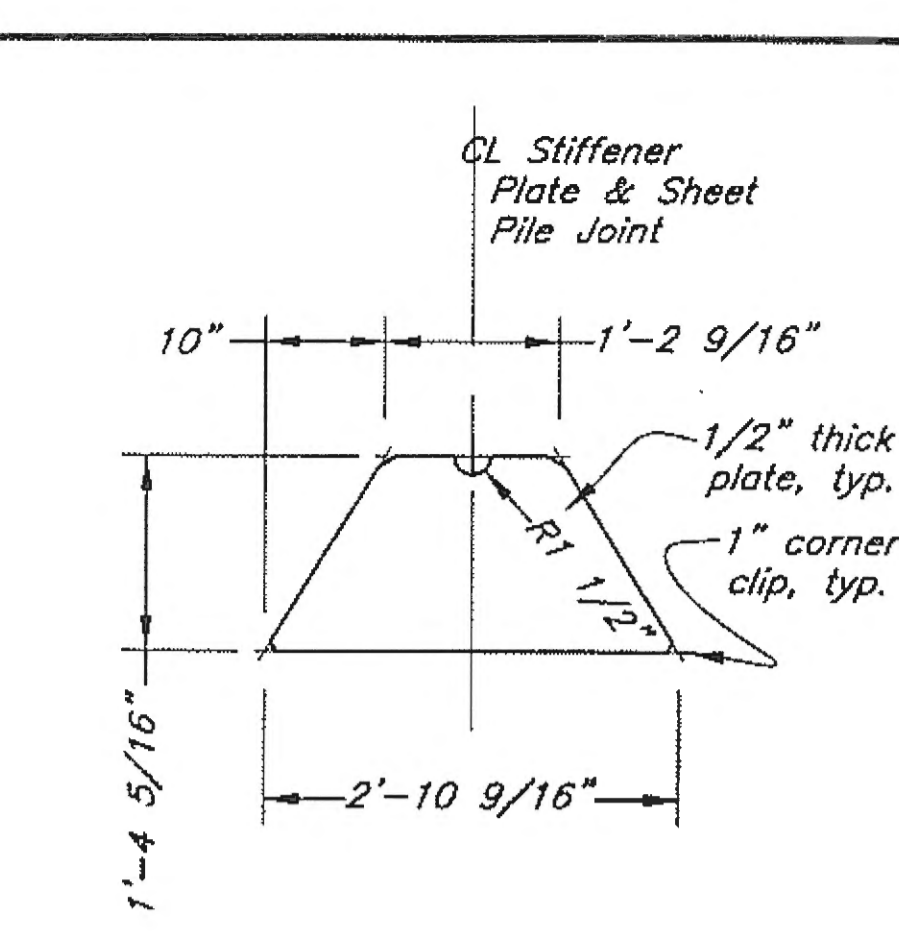


Double Paired Tie Plate

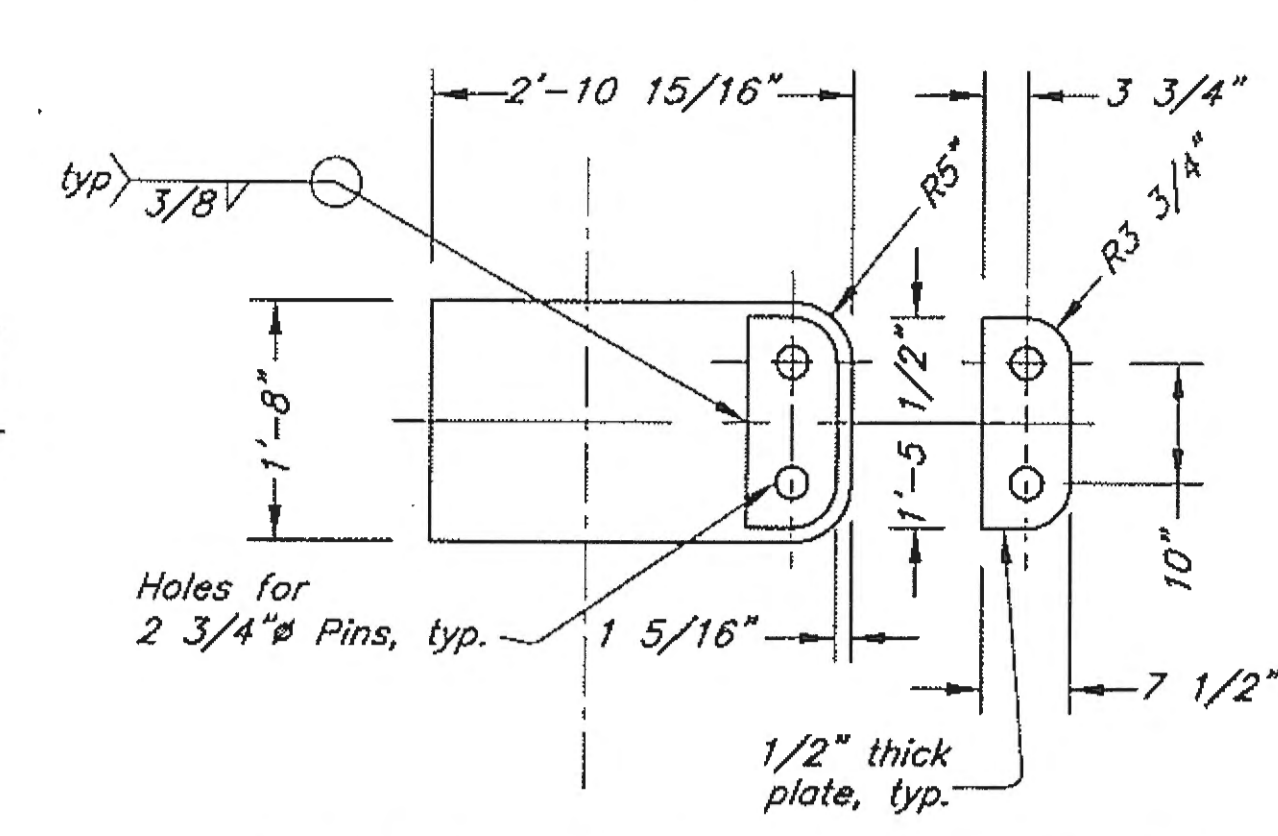

Pile Ring Stiffeners @ Ties & Gussets

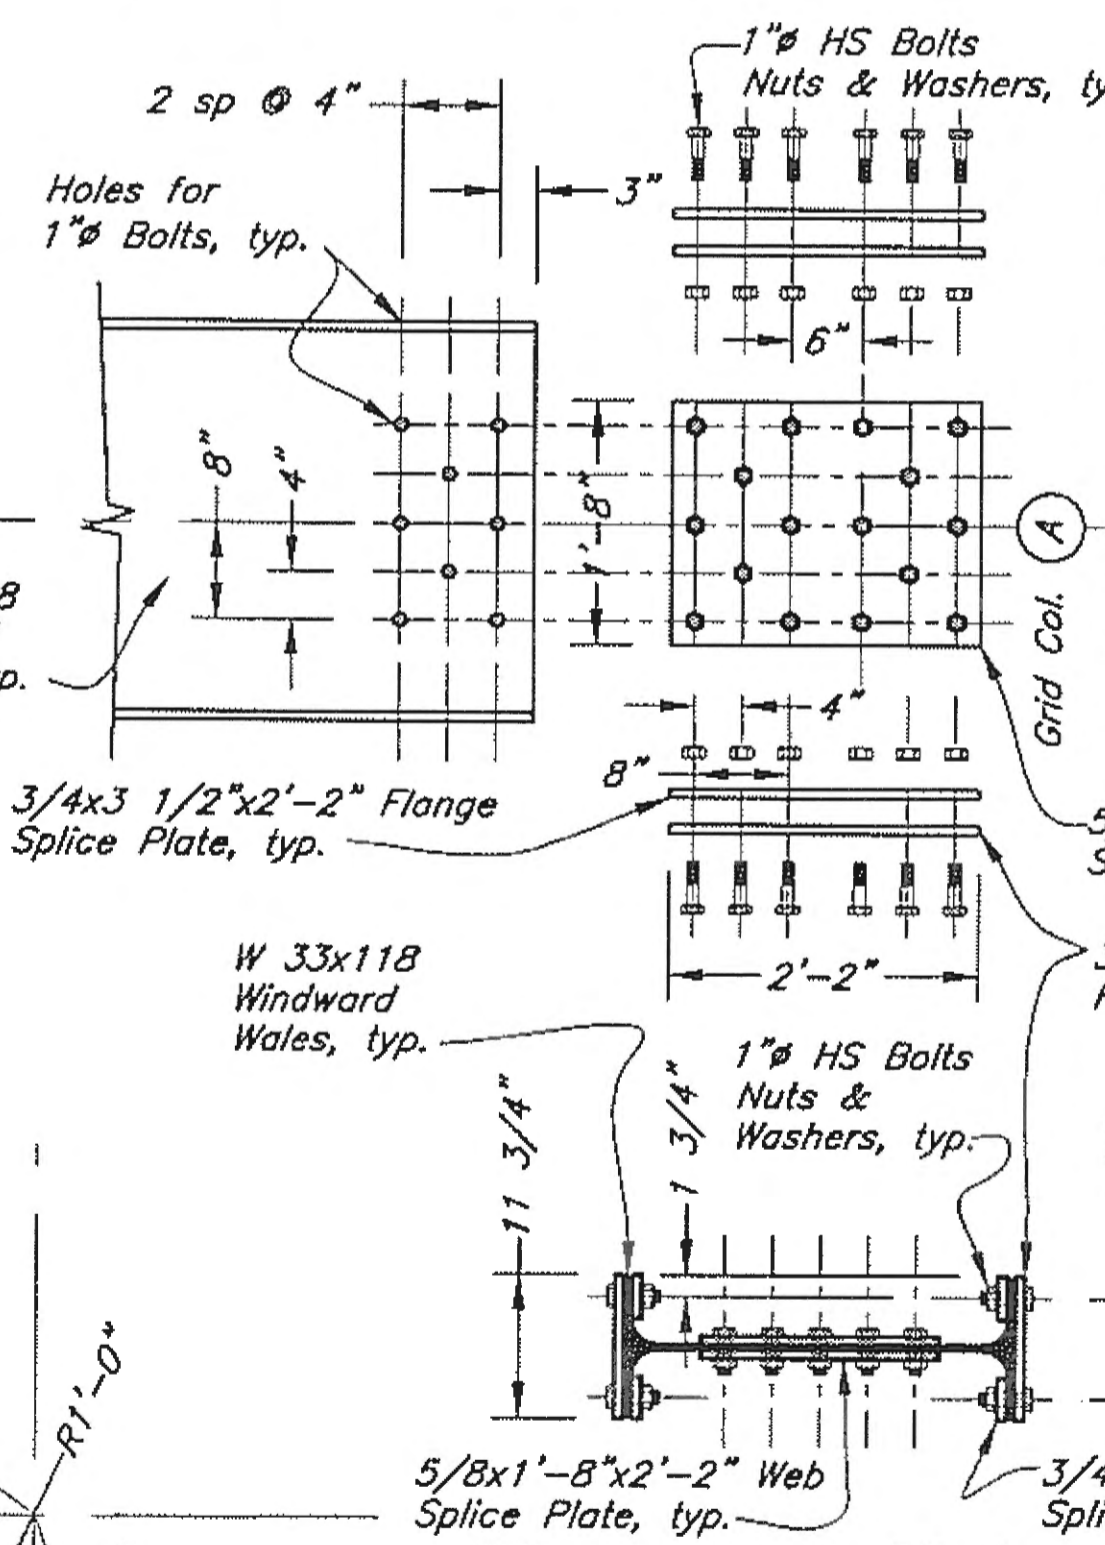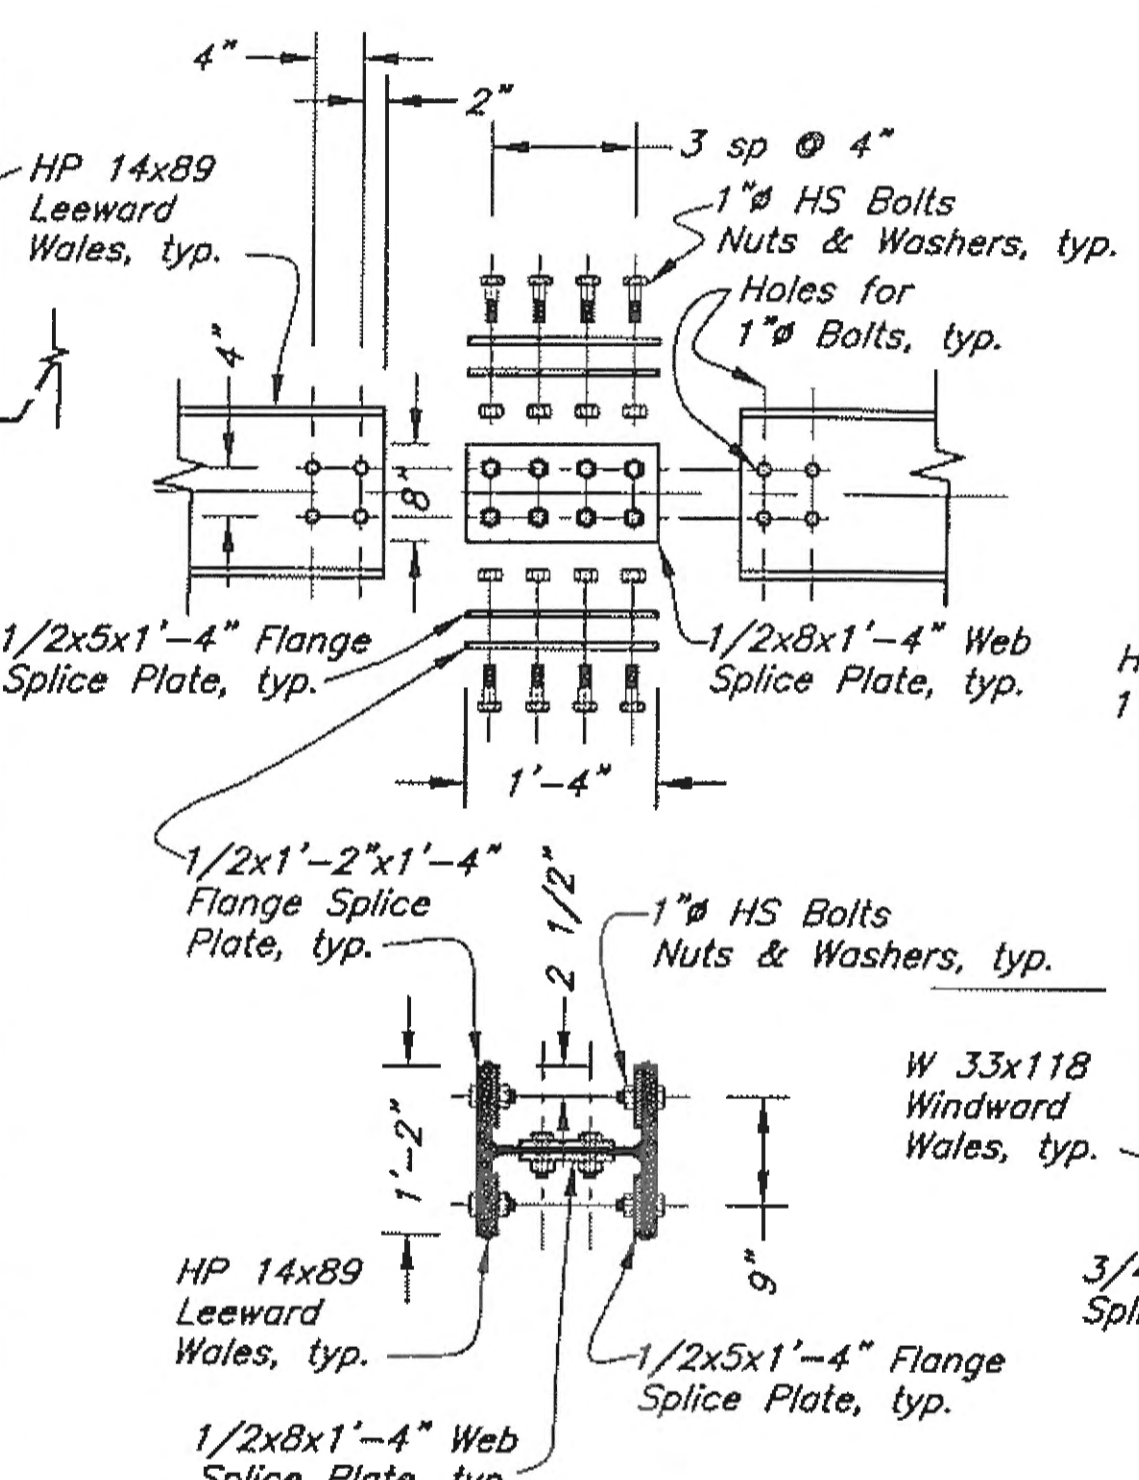

Windward Wale Splice

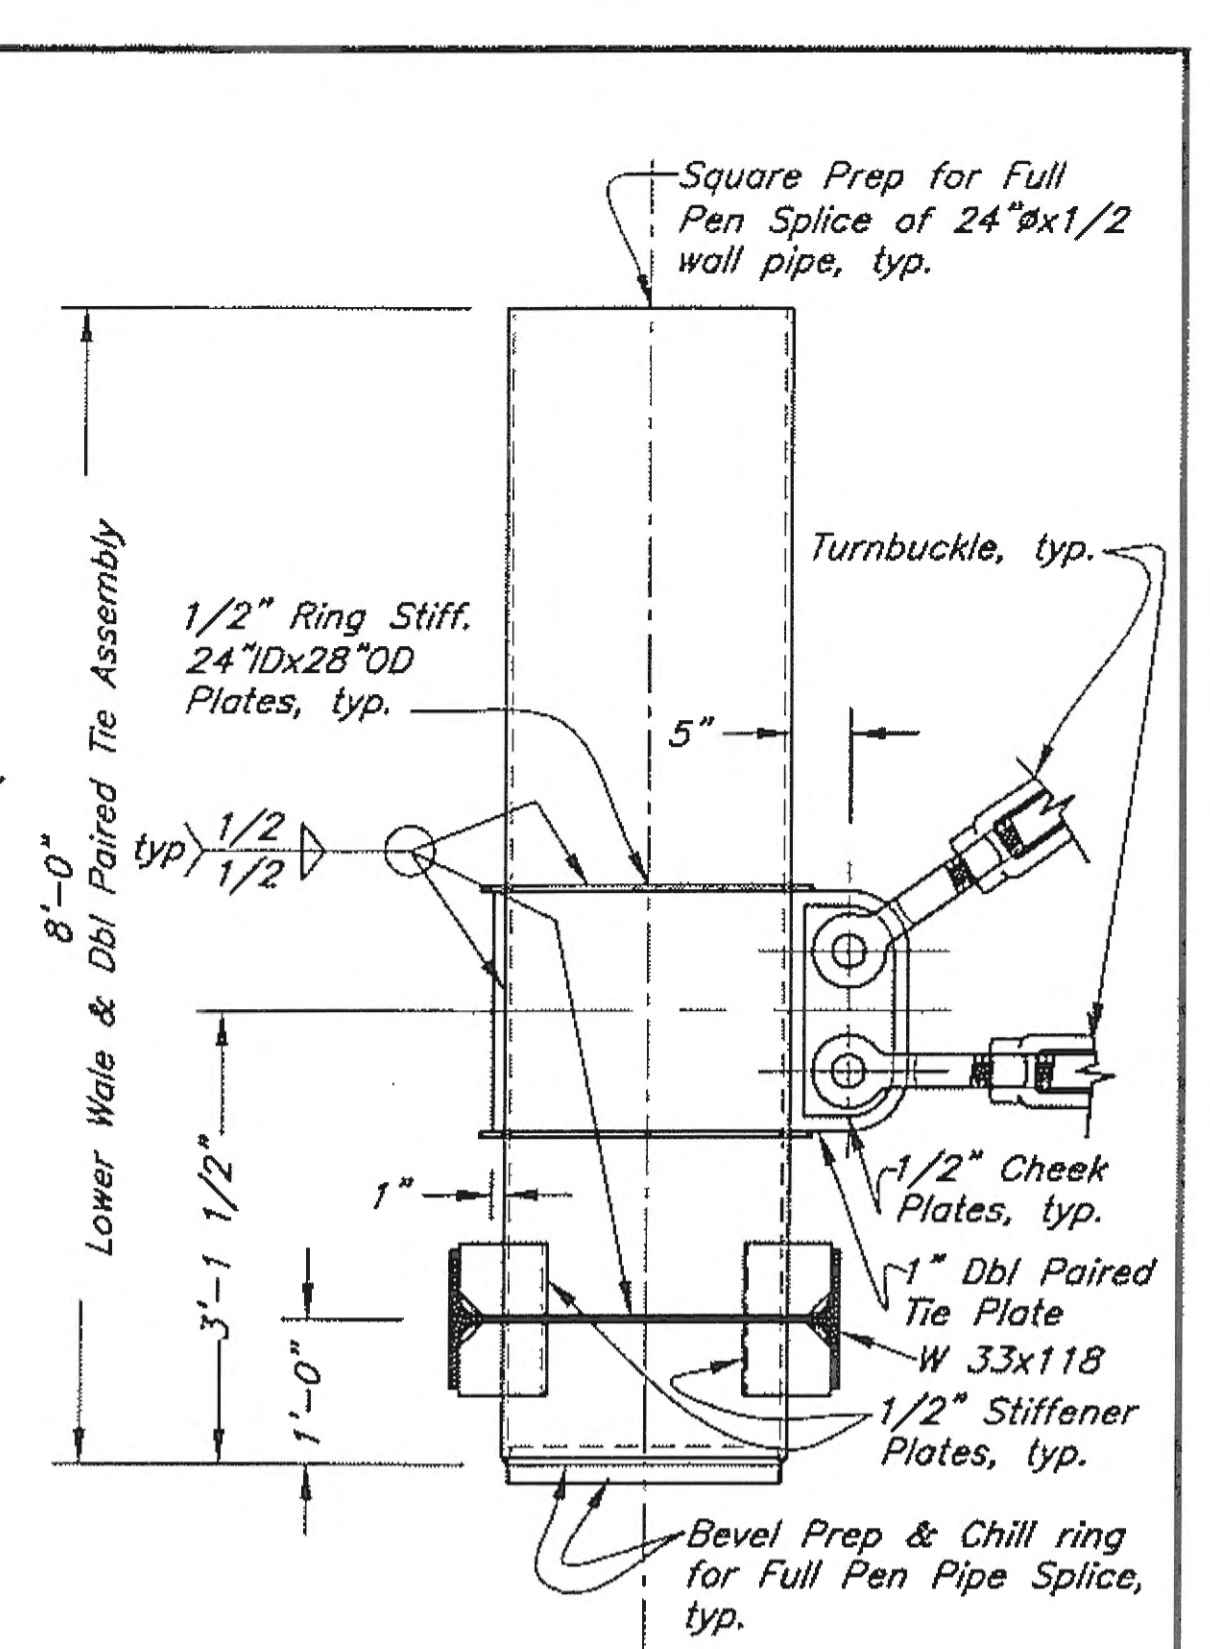

Lower Wale & Double Paired Tie Assembly

DO NOT SCALE FROM THESE DRAWINGS USE DIMENSIONS

DESIGNED BY: J. Scott

CHECKED BY: B. Savikko

DRAWN BY: C. Fuman, W. Hickok

PATH: O:\GUS\67599\MF\PLANSET\04-DOCK\006 DOCK WAVE BARRIER WALES.DWG

TAB: Wed, 26/Nov/08 11:21AM

REVISIONS

NO.	DATE	DESCRIPTION

PROJECT DESIGNATION: BR-0003(53)/67599

YEAR: 2008

SHEET NO.: 57

TOTAL SHEETS: 138

STATE OF ALASKA
DEPARTMENT OF TRANSPORTATION & PUBLIC FACILITIES
DESIGN & ENGINEERING SERVICES DIVISION-SOUTHEAST REGION


Gustavus Causeway Replacement

Dock/Pontoon West Restraint Details


D06

11.26.08


Pontoon Restraint Frame to Leeward Wale Connection Assembly

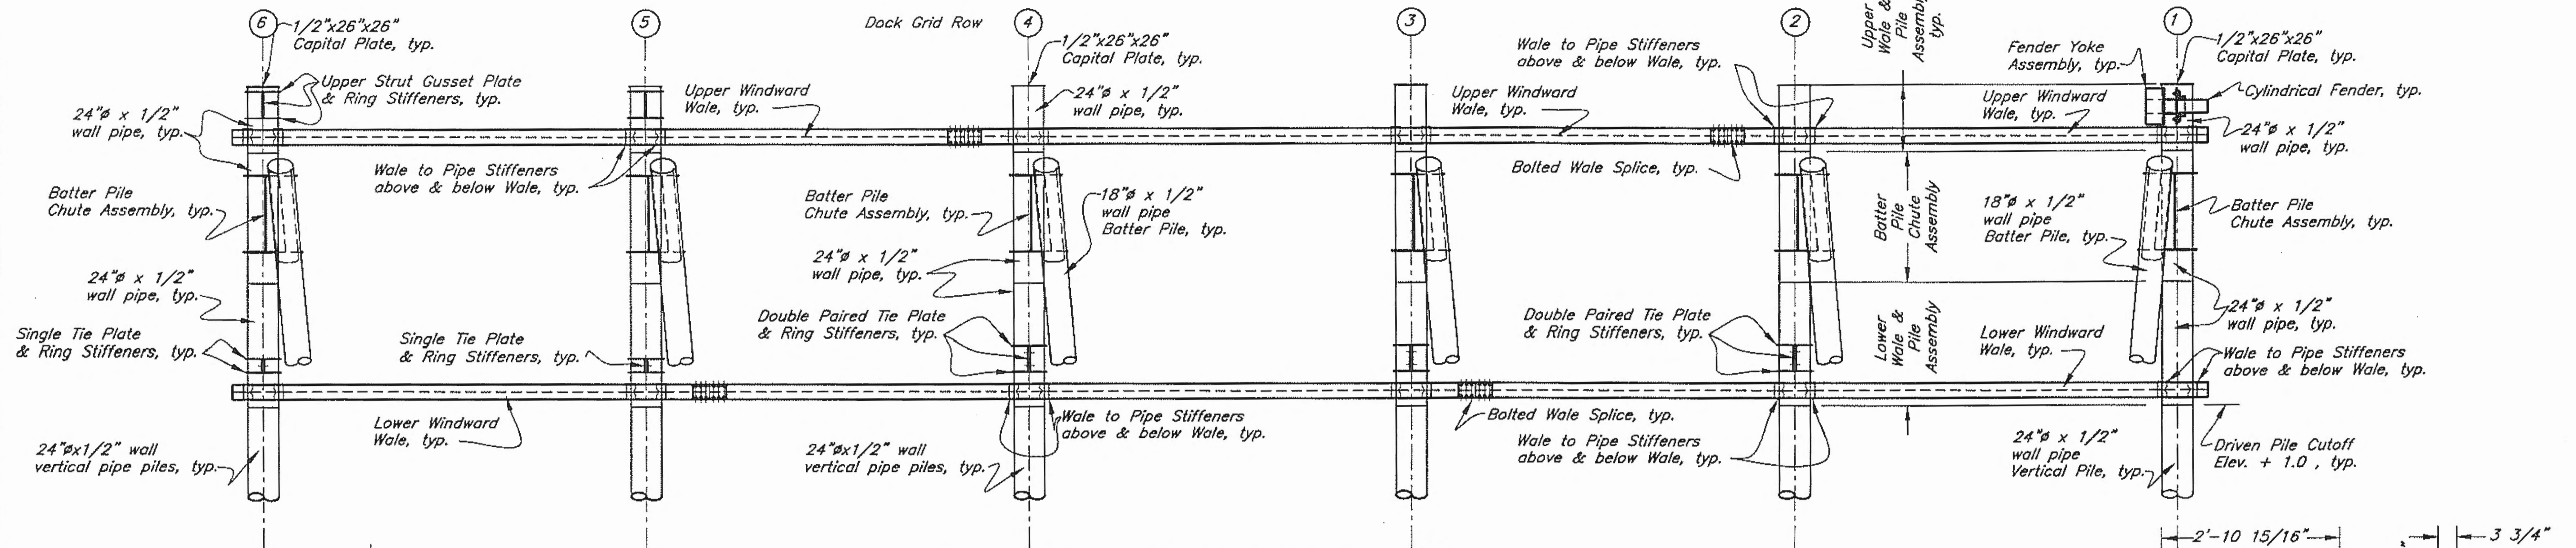


Elevation - Grid Column A
(Looking East - Wave Barrier Sheets not shown)

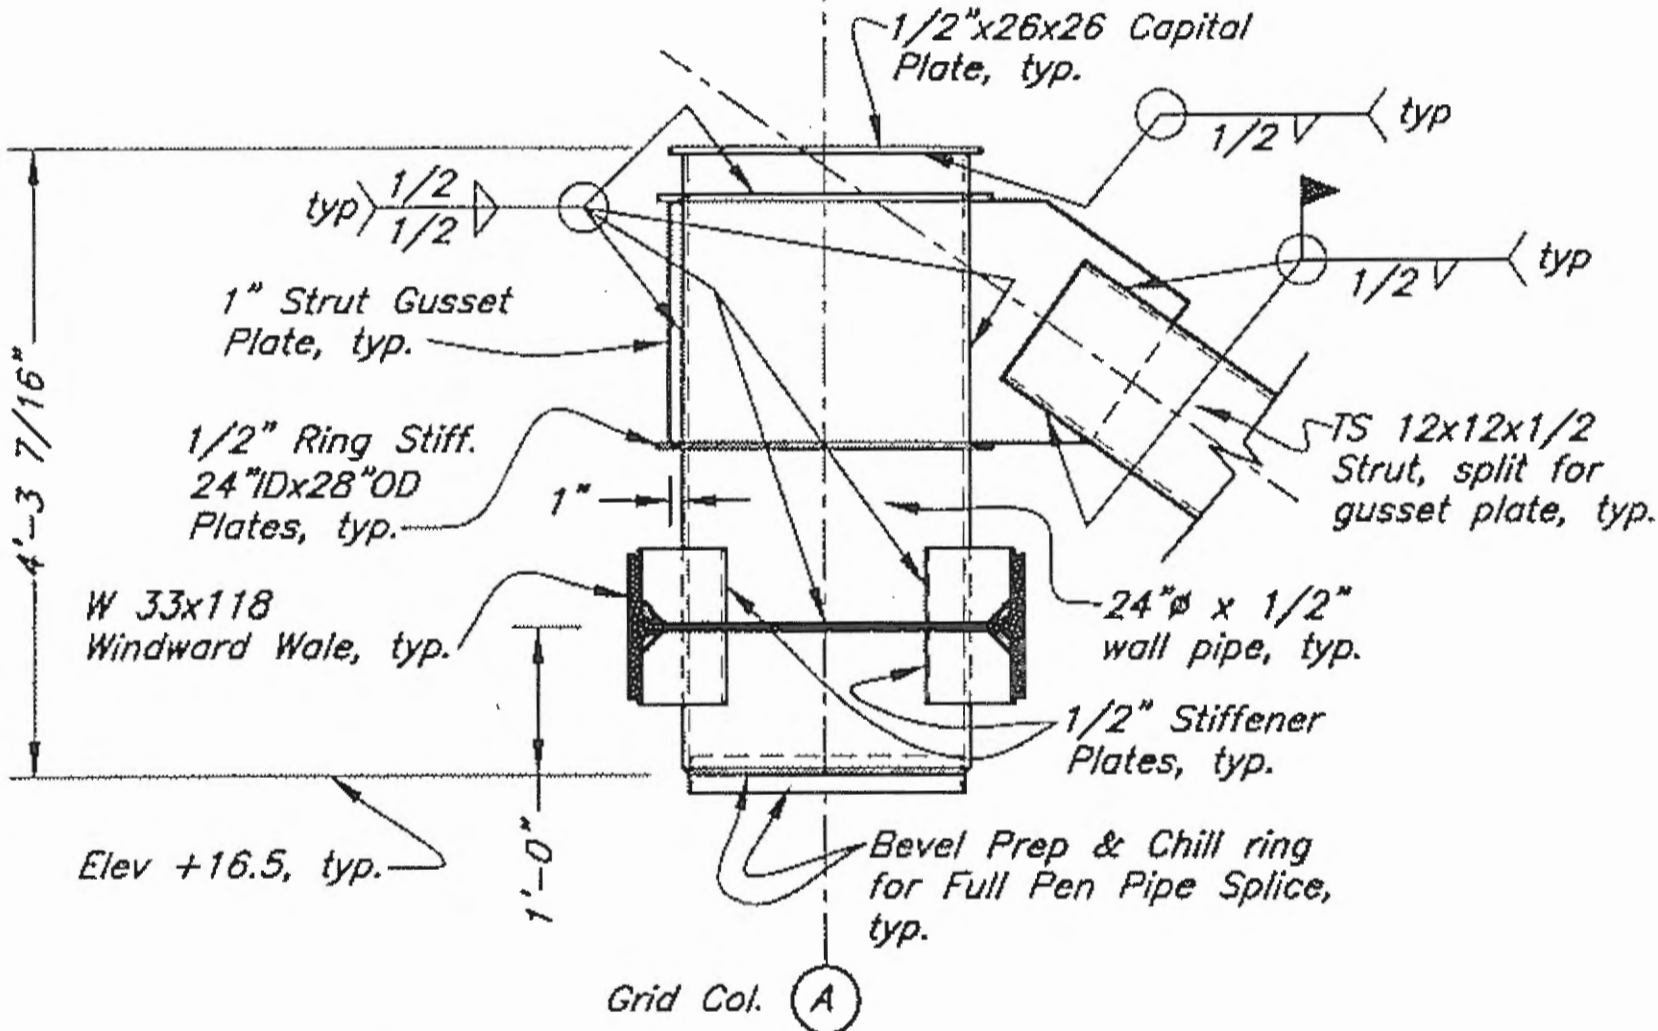


Capital with Upper Wale & Strut Gusset Assembly

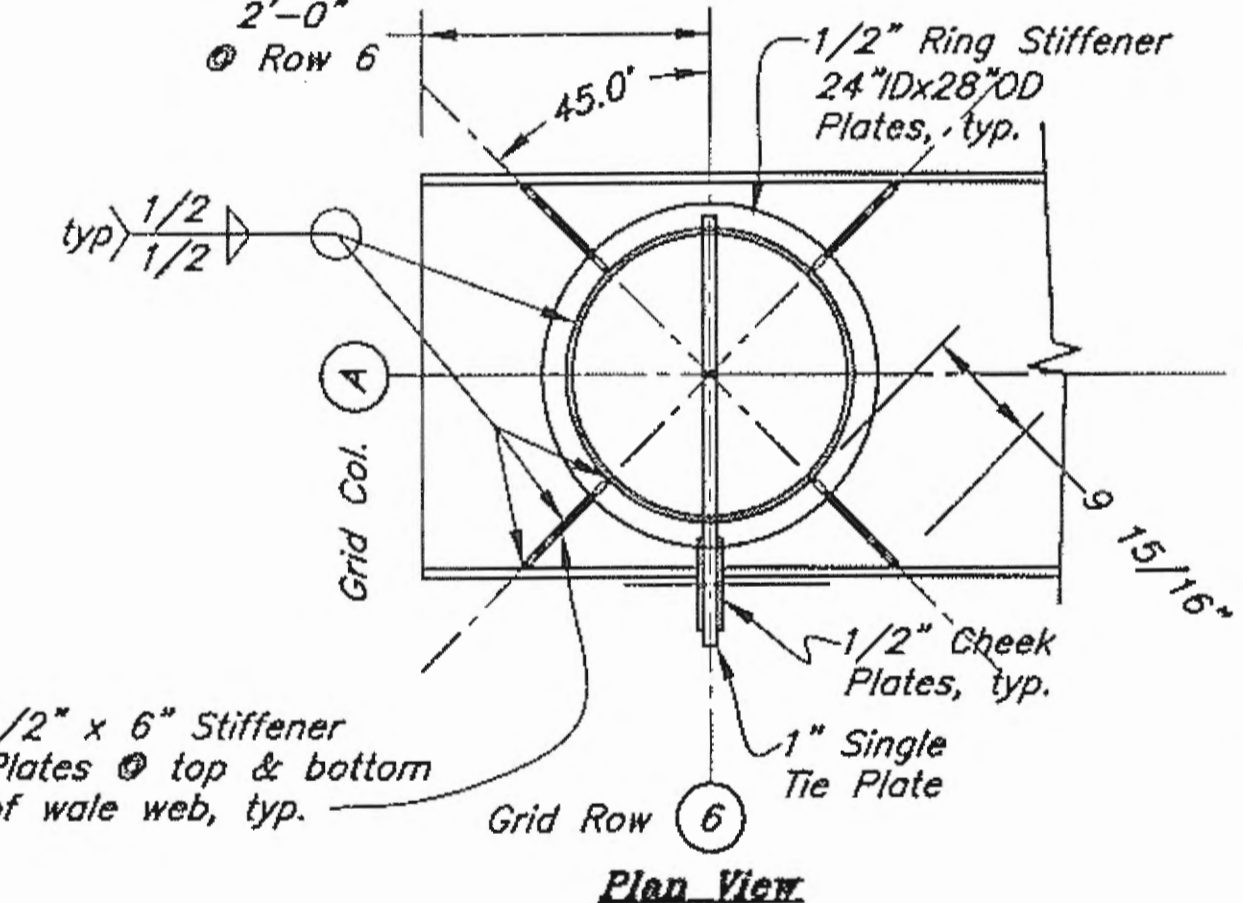


Plan View

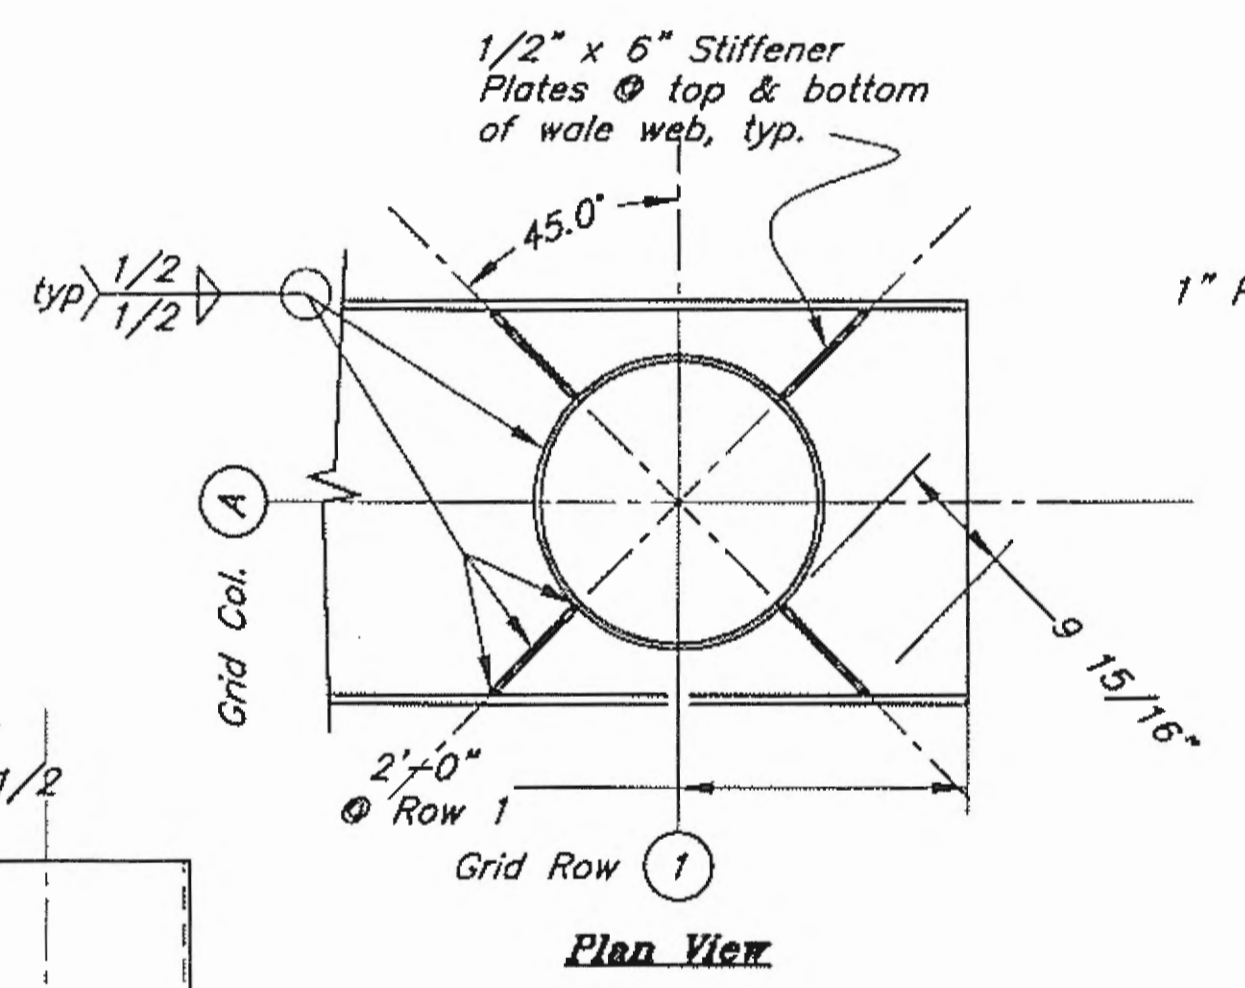


Single Tie Plate

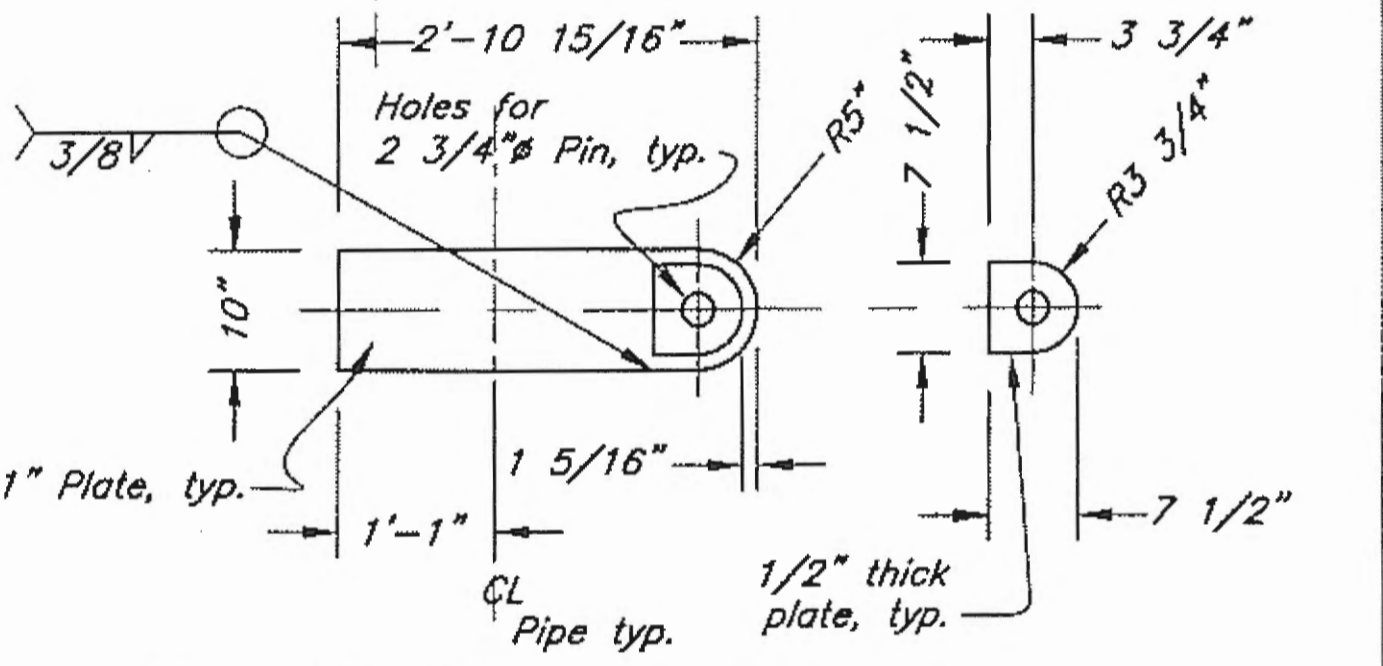


Strut Gusset Plate @ Upper Wale

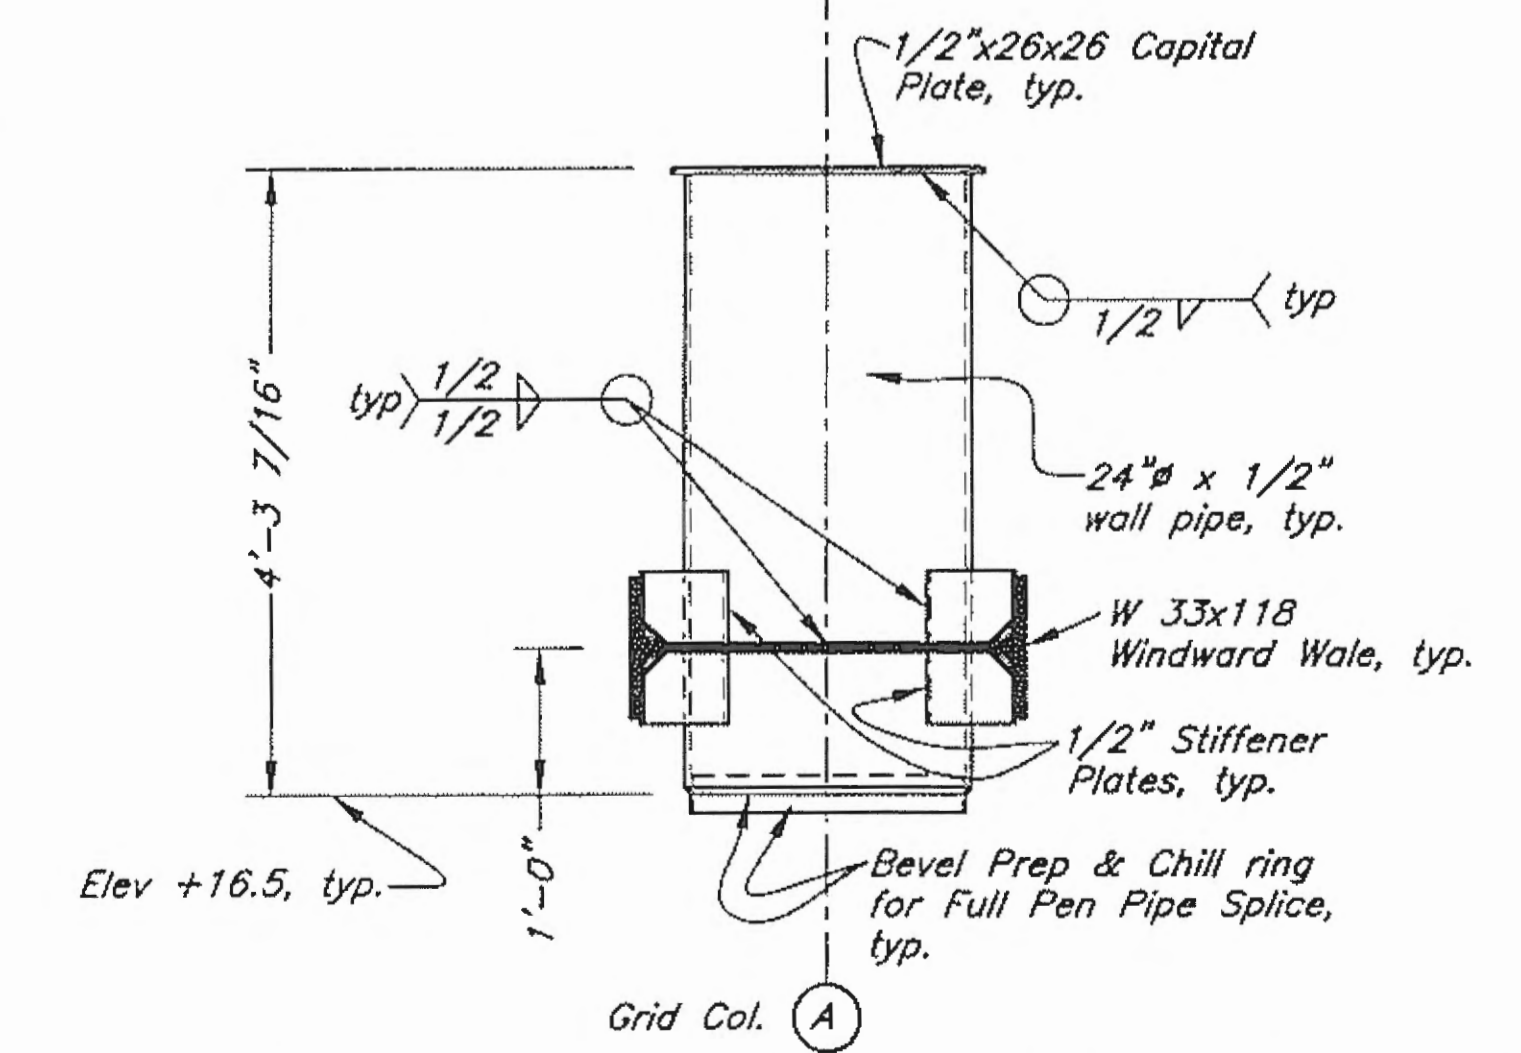

Capital with Upper Wale Assembly

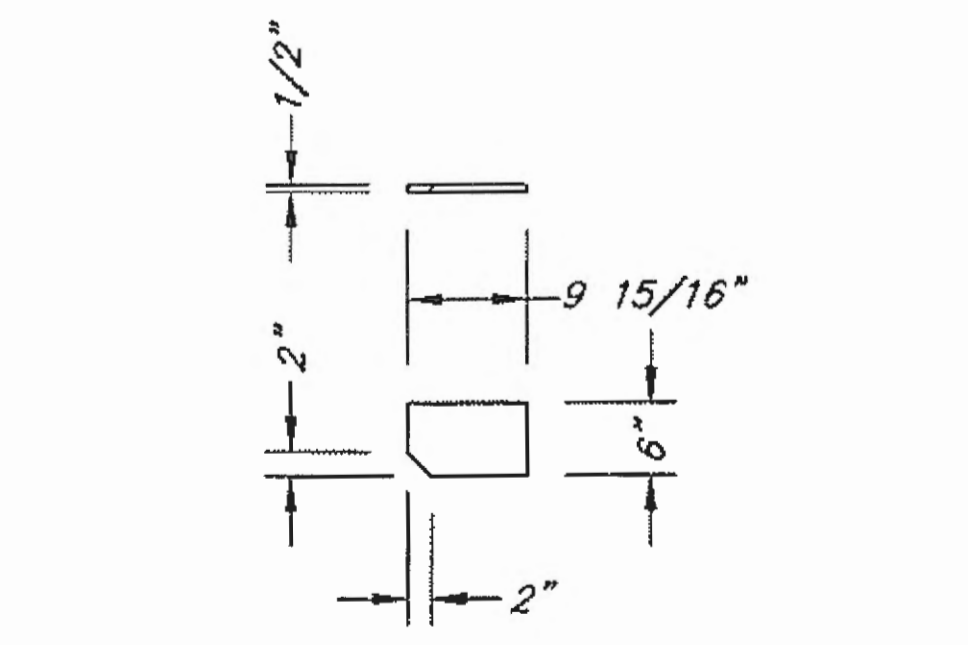

Wale to Pipe Stiffeners

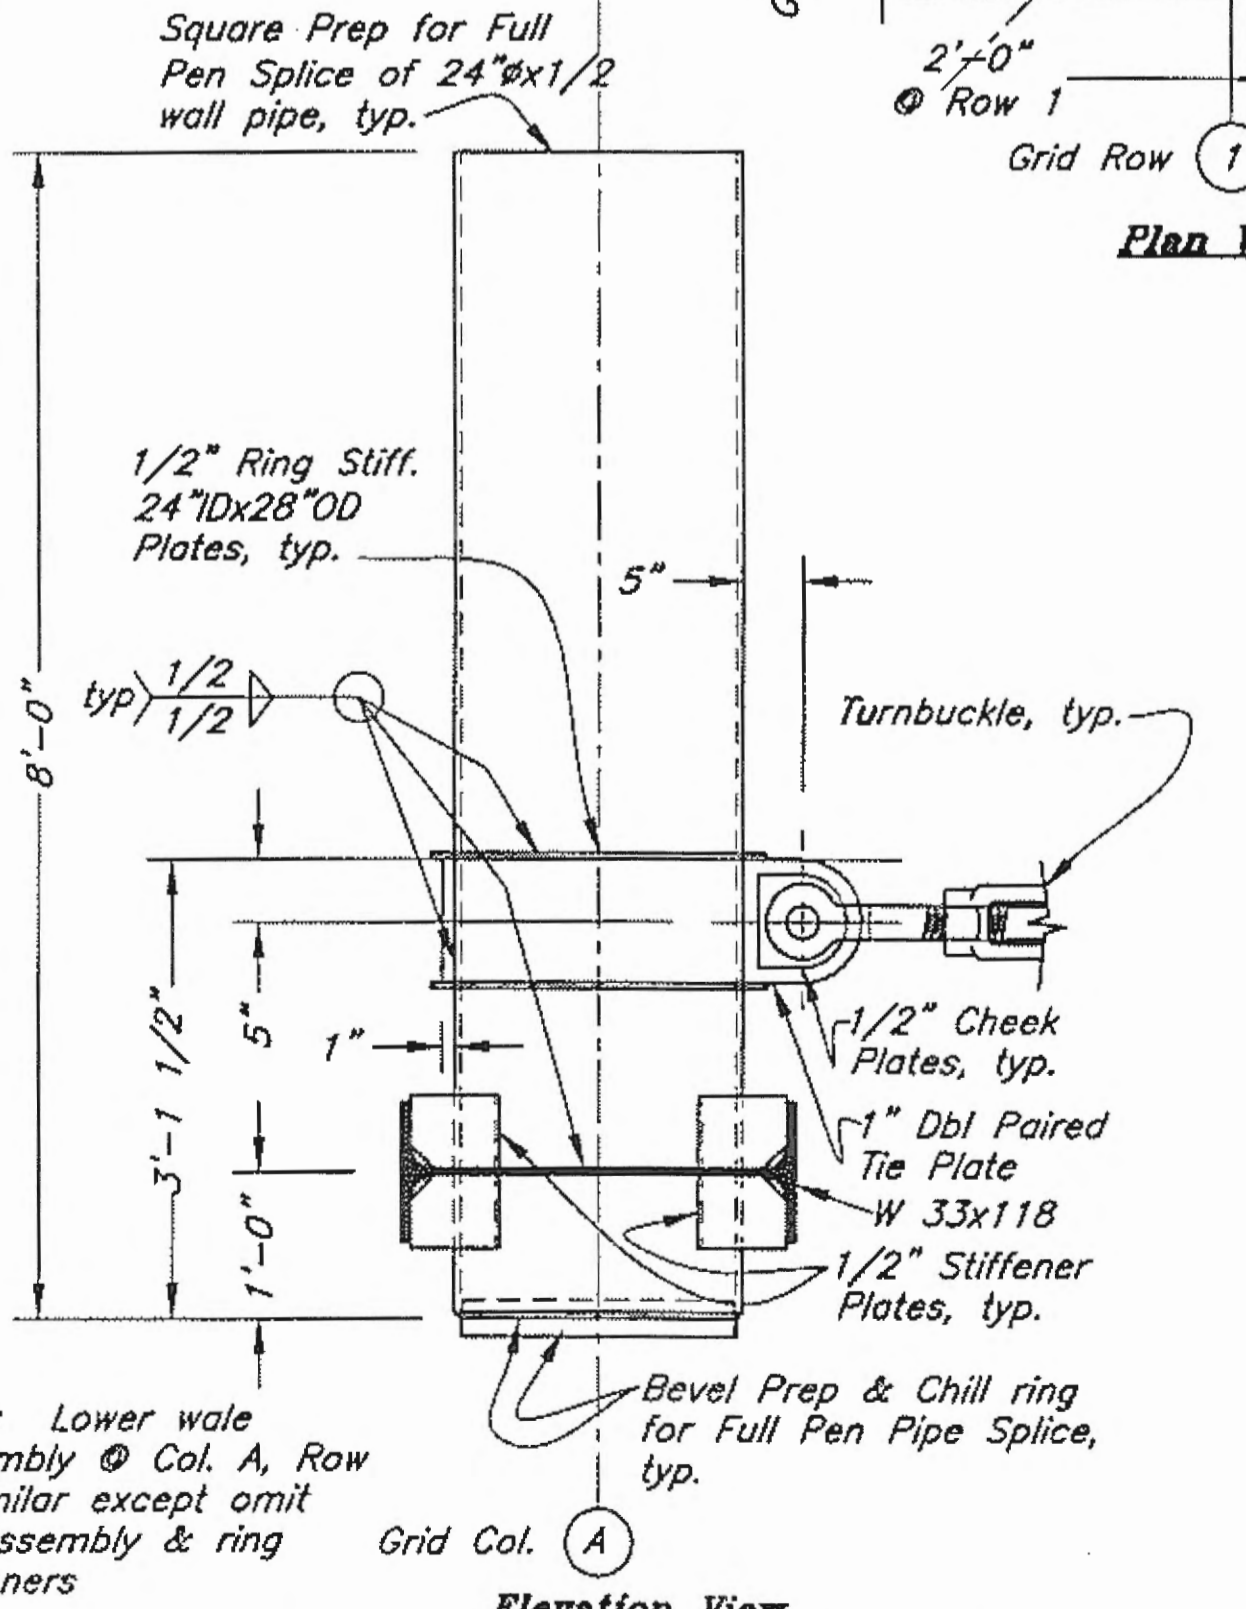


Lower Wale & Single Tie Assembly


Note: Lower wale assembly @ Col. A, Row 1 similar except omit tie assembly & ring stiffeners

Record Drawings have been reviewed by the Project Engineer, and represent to the best of my knowledge, the project as constructed.
PE: *[Signature]* Date: 8/21/12


DO NOT SCALE FROM THESE DRAWINGS USE DIMENSIONS		DESIGNED BY: J. Scott	
		STATE OF ALASKA DEPARTMENT OF TRANSPORTATION & PUBLIC FACILITIES DESIGN & ENGINEERING SERVICES DIVISION-SOUTHEAST REGION Gustavus Causeway Replacement Dock Capitals Assemblies (1) D07	
CHECKED BY: B. Savikko		PROJECT DESIGNATION	
DRAWN BY: C. Fuman, W. Hickok		YEAR	
PATH: Q:\GUS\67599\MF\PLANSET\04-DOCK\007 DOCK CAPITALS 1.DWG		SHEET NO.	
TAB: Wed, 26/Nov/08 11:23AM		TOTAL SHEETS	
REVISIONS NO. DATE DESCRIPTION		BR-0003(53)/67599 2008 58 138	

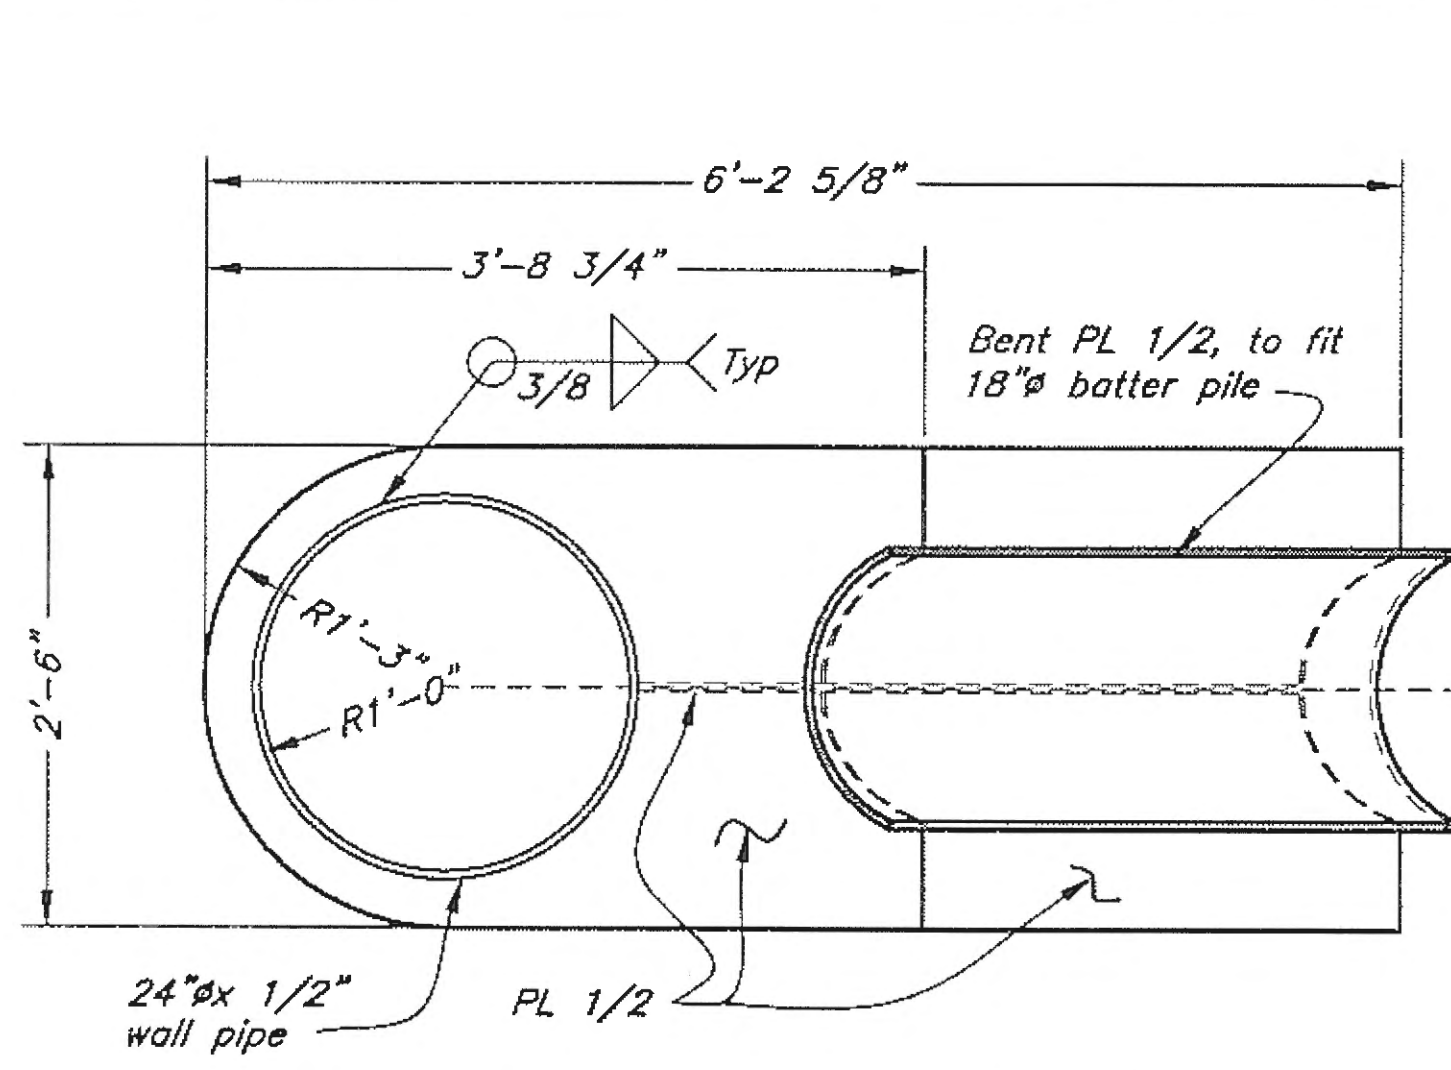


Batter Pile Assembly Plan

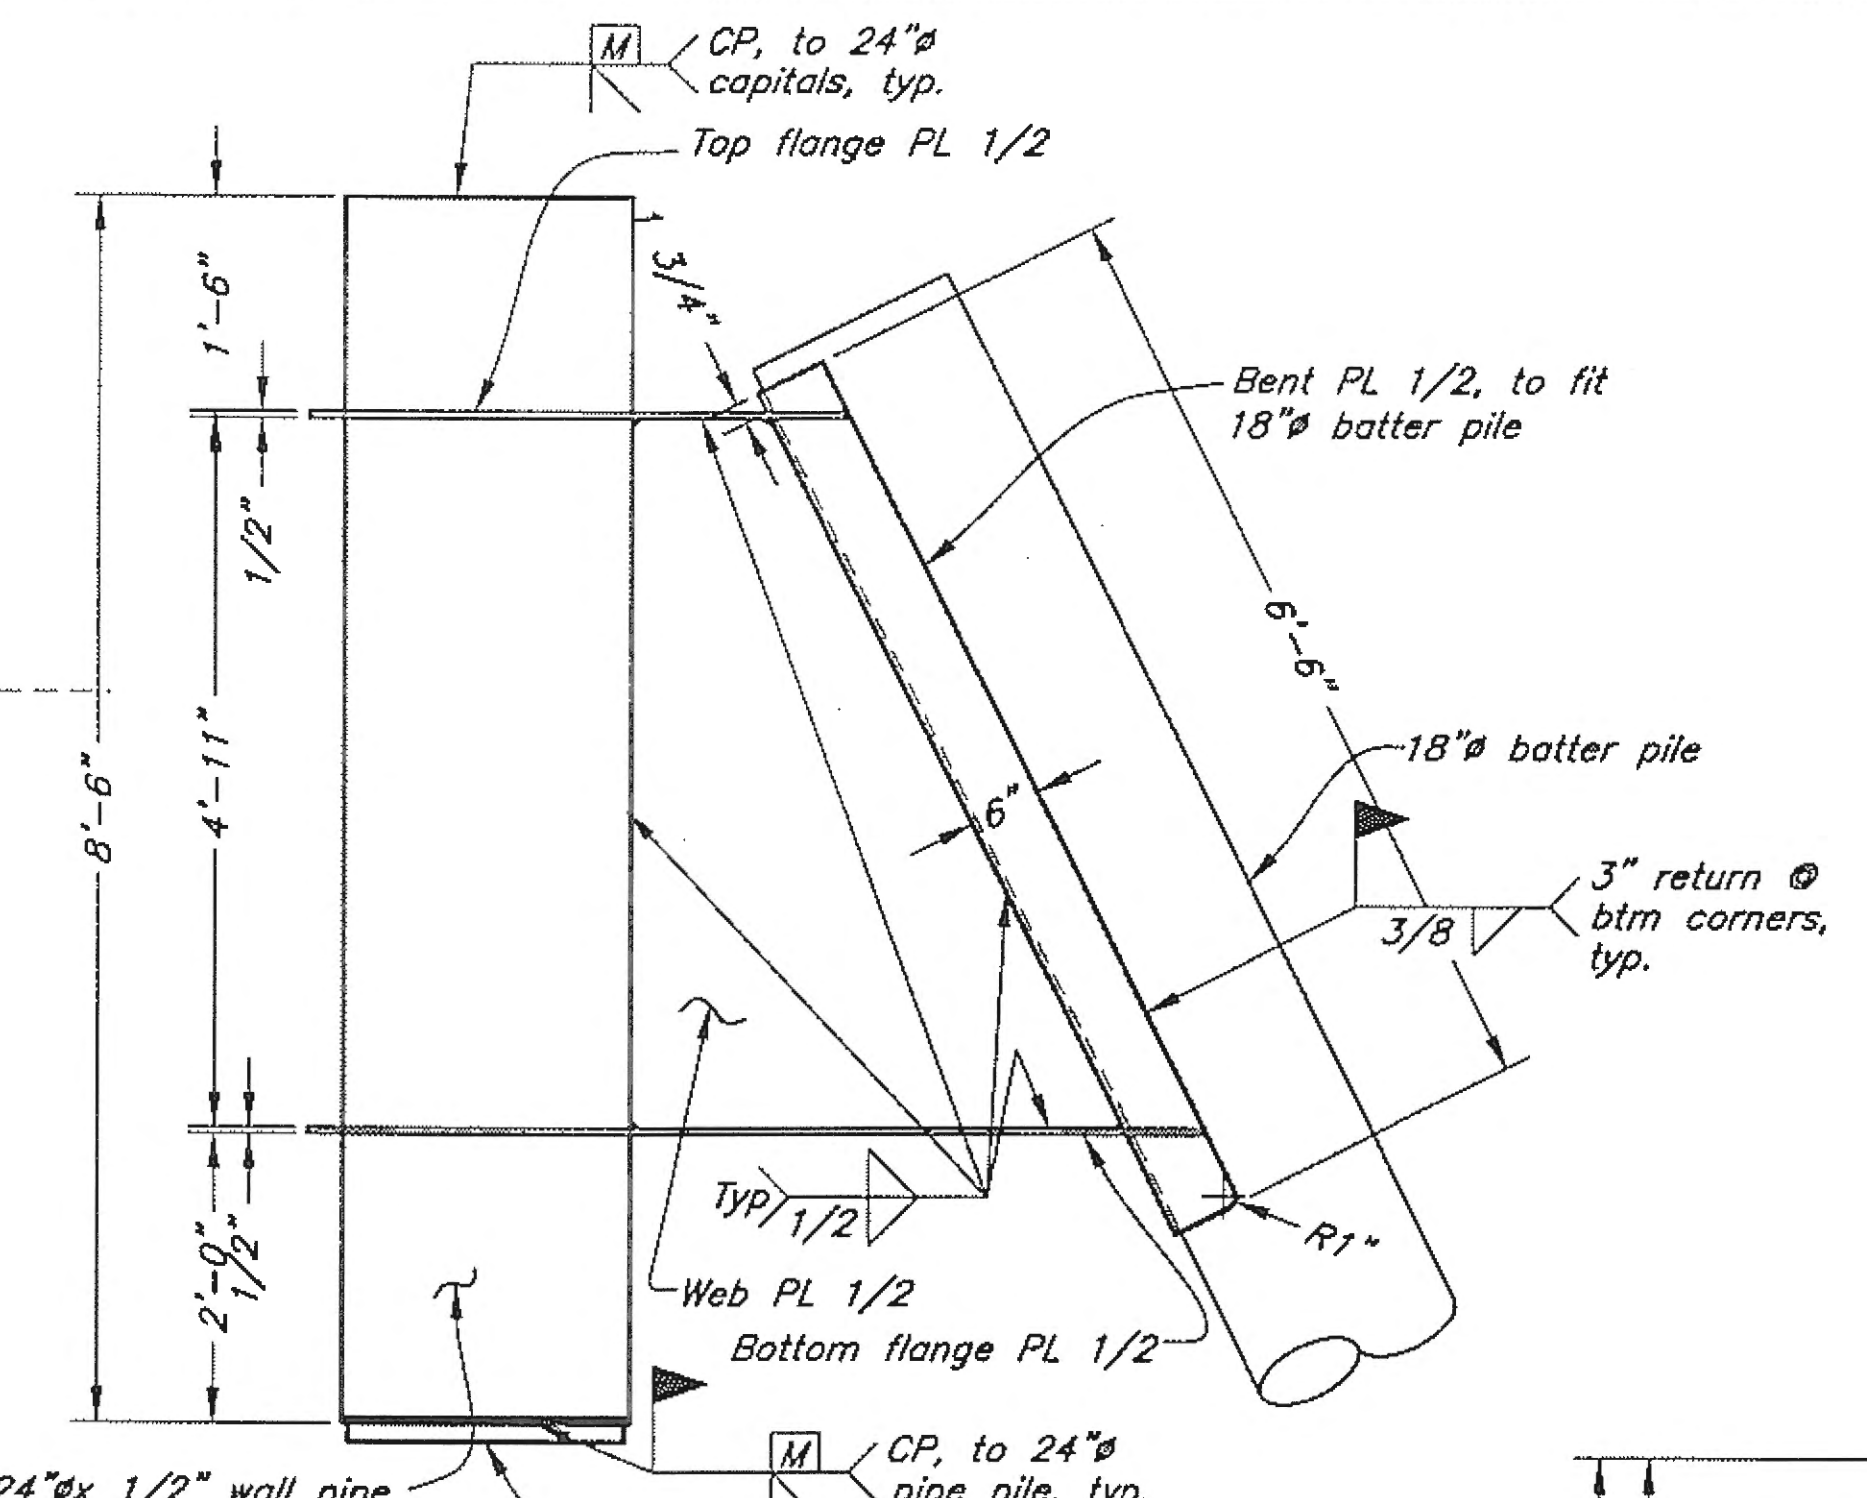


Batter Pile Assembly Elevation

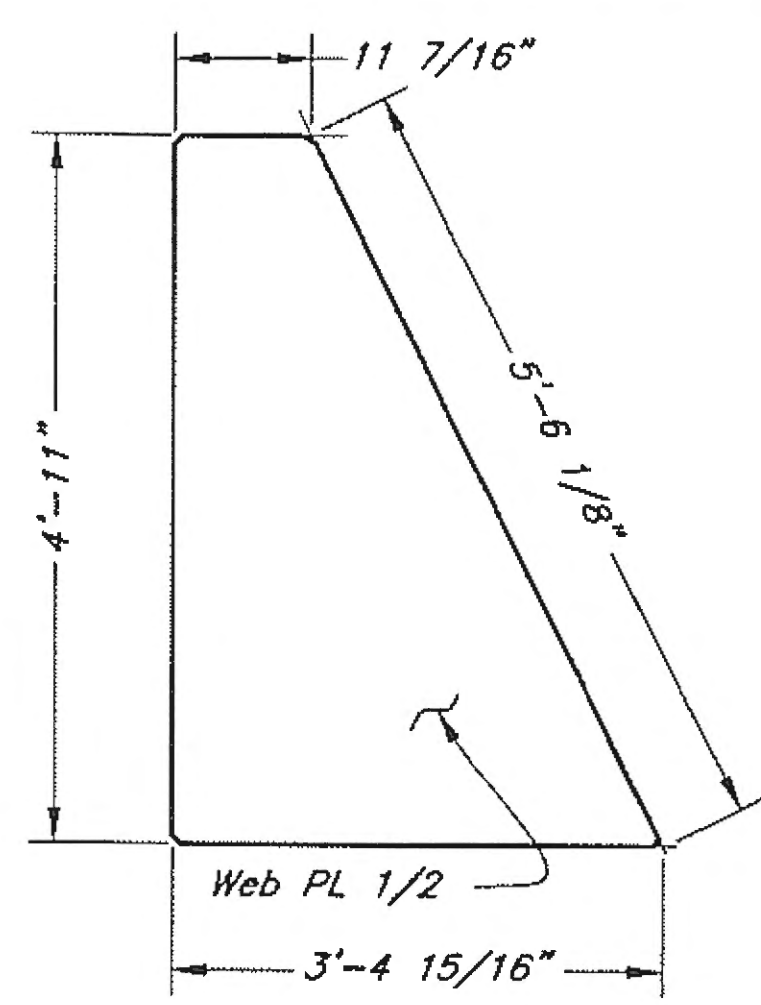


Batter Pile Assembly Web PL

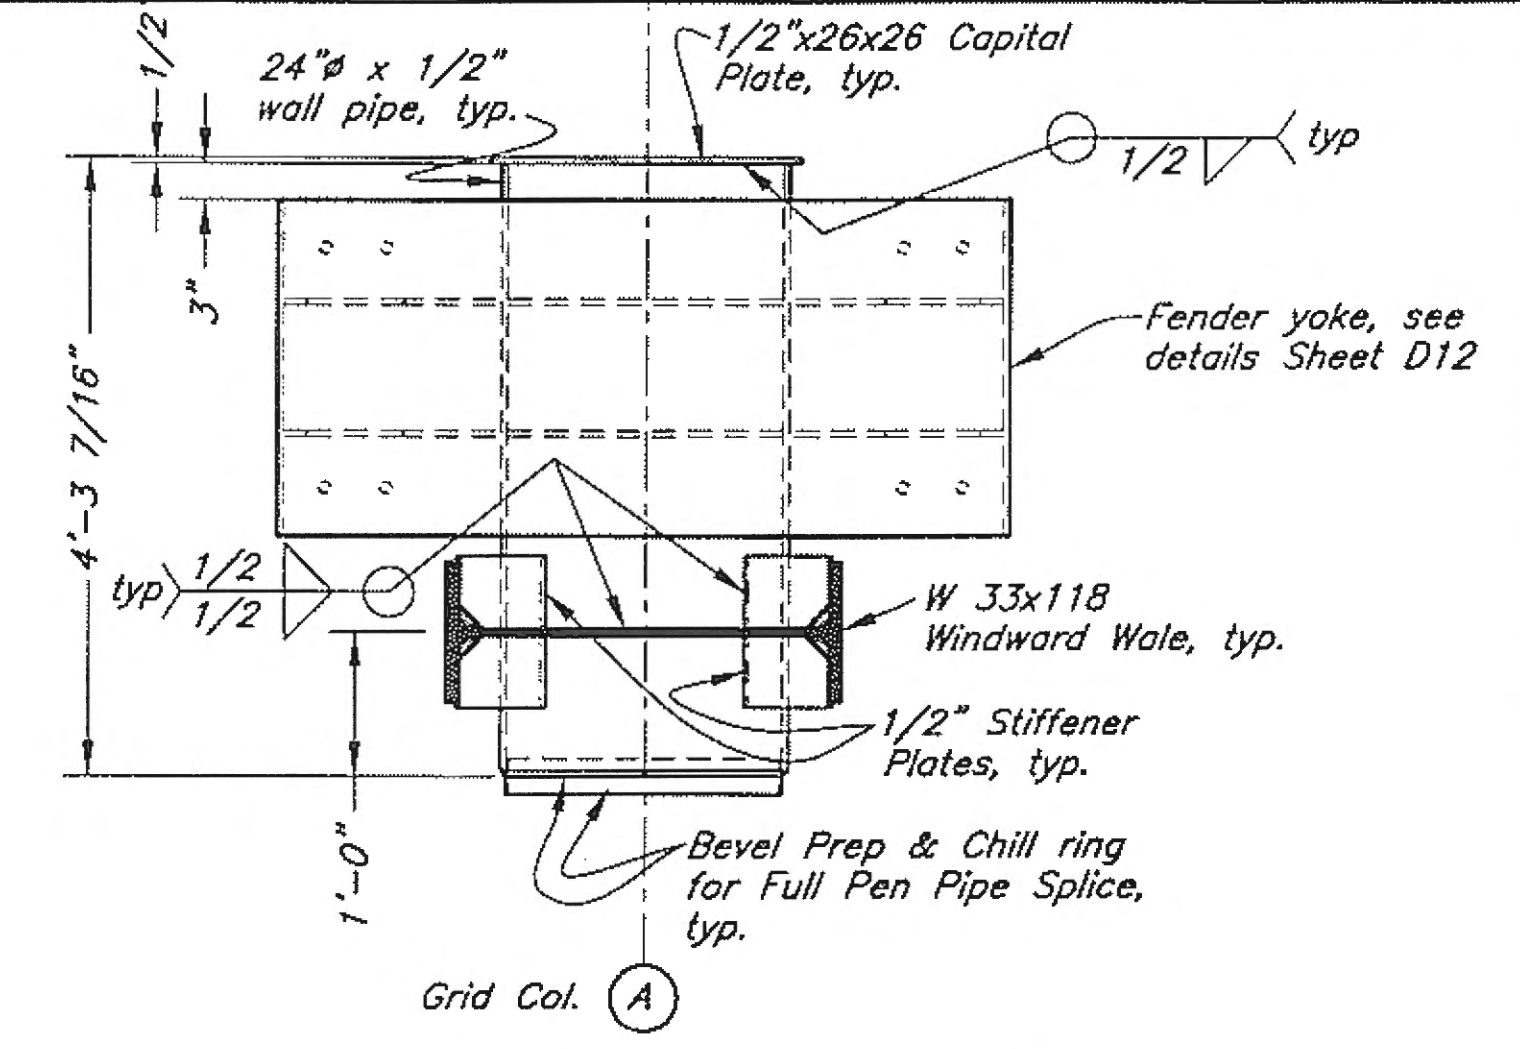


Capital with Upper Wale & Fender Yoke

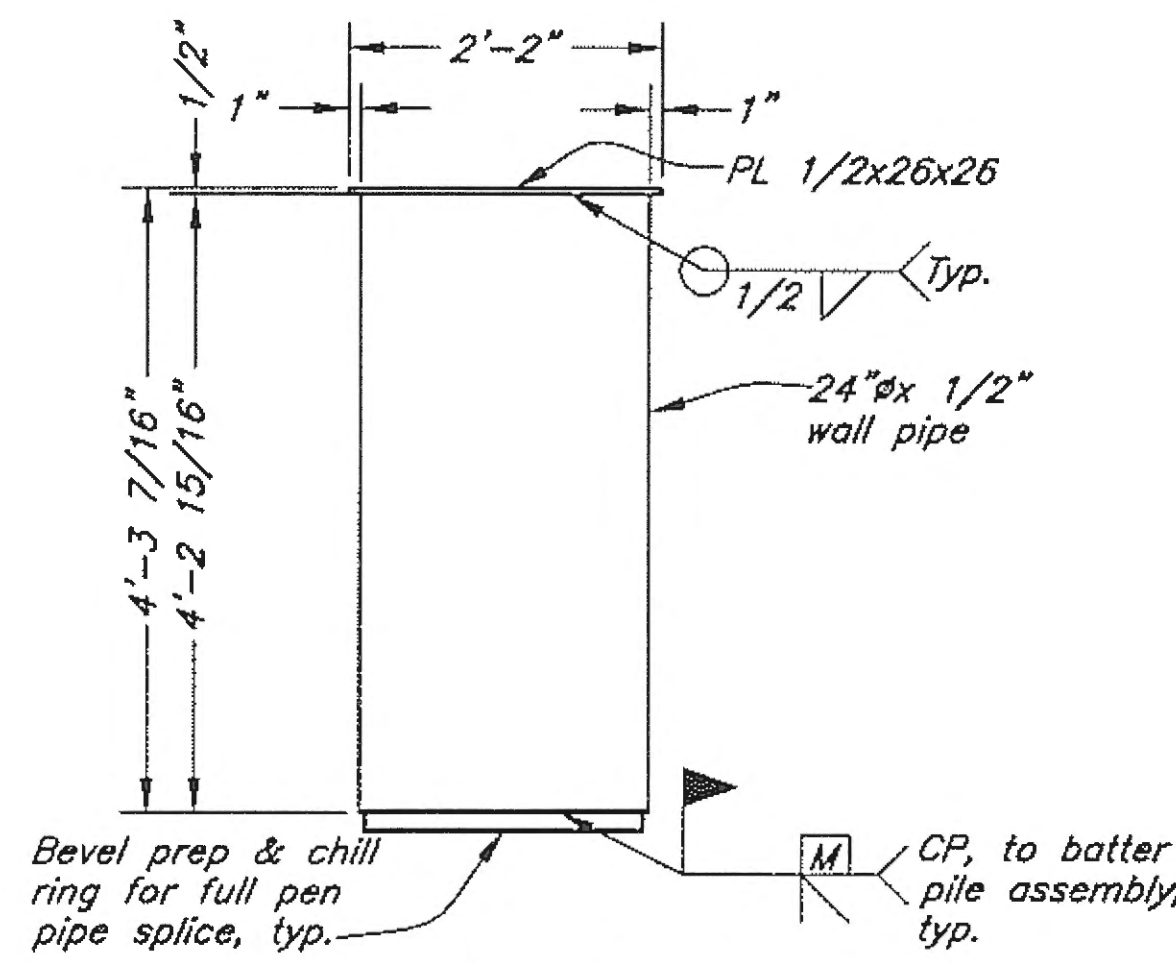


Plain Capital

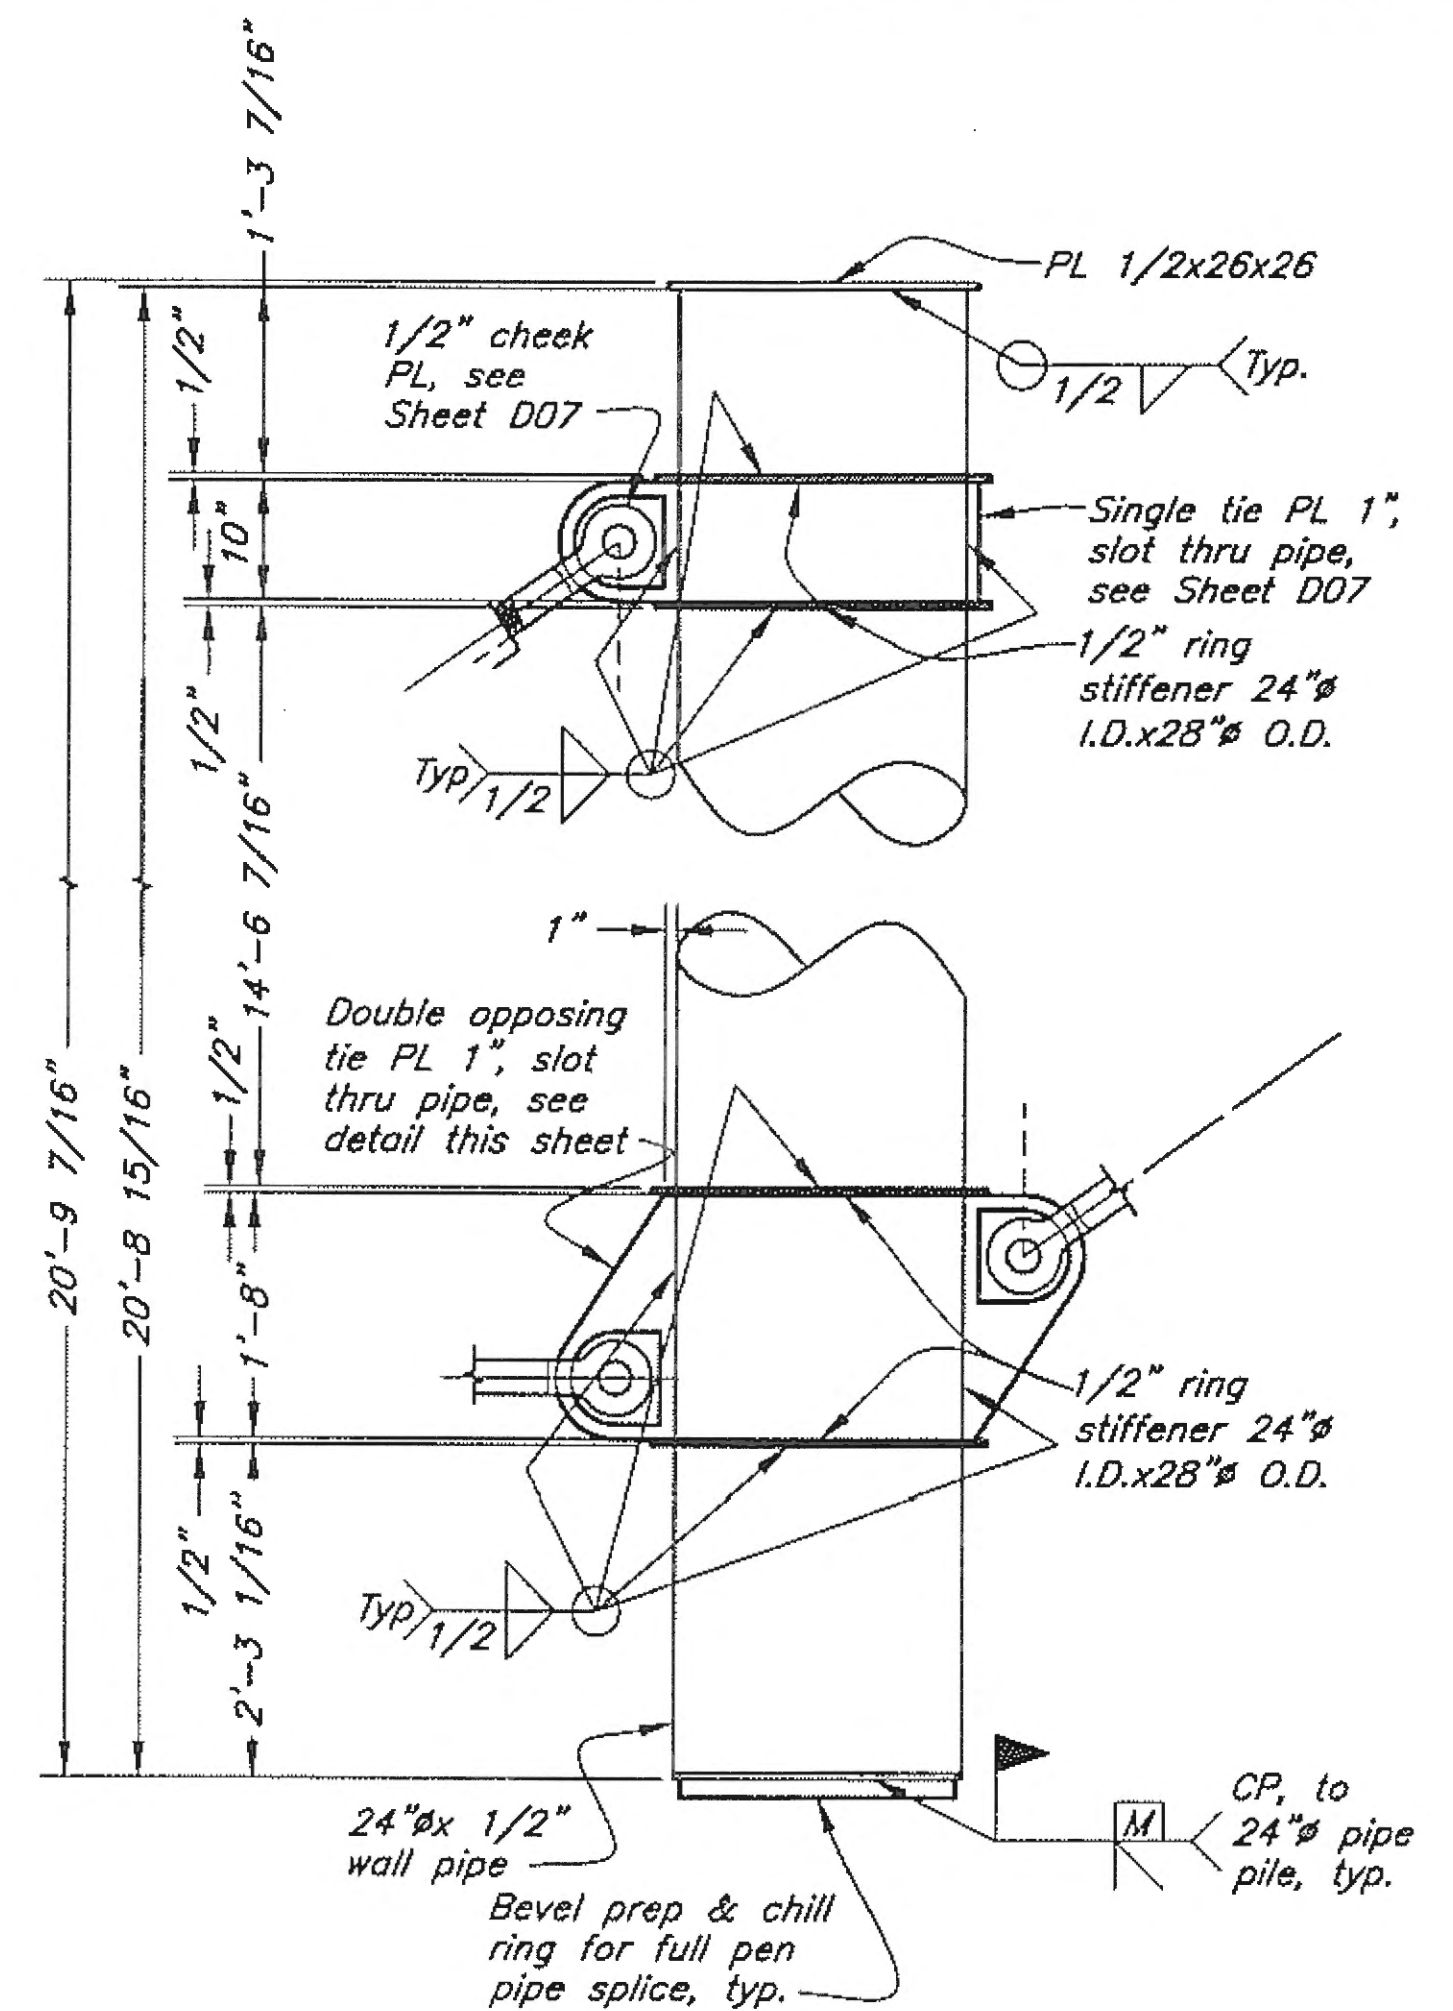


Capital w/ Single & Double Opposing Tie

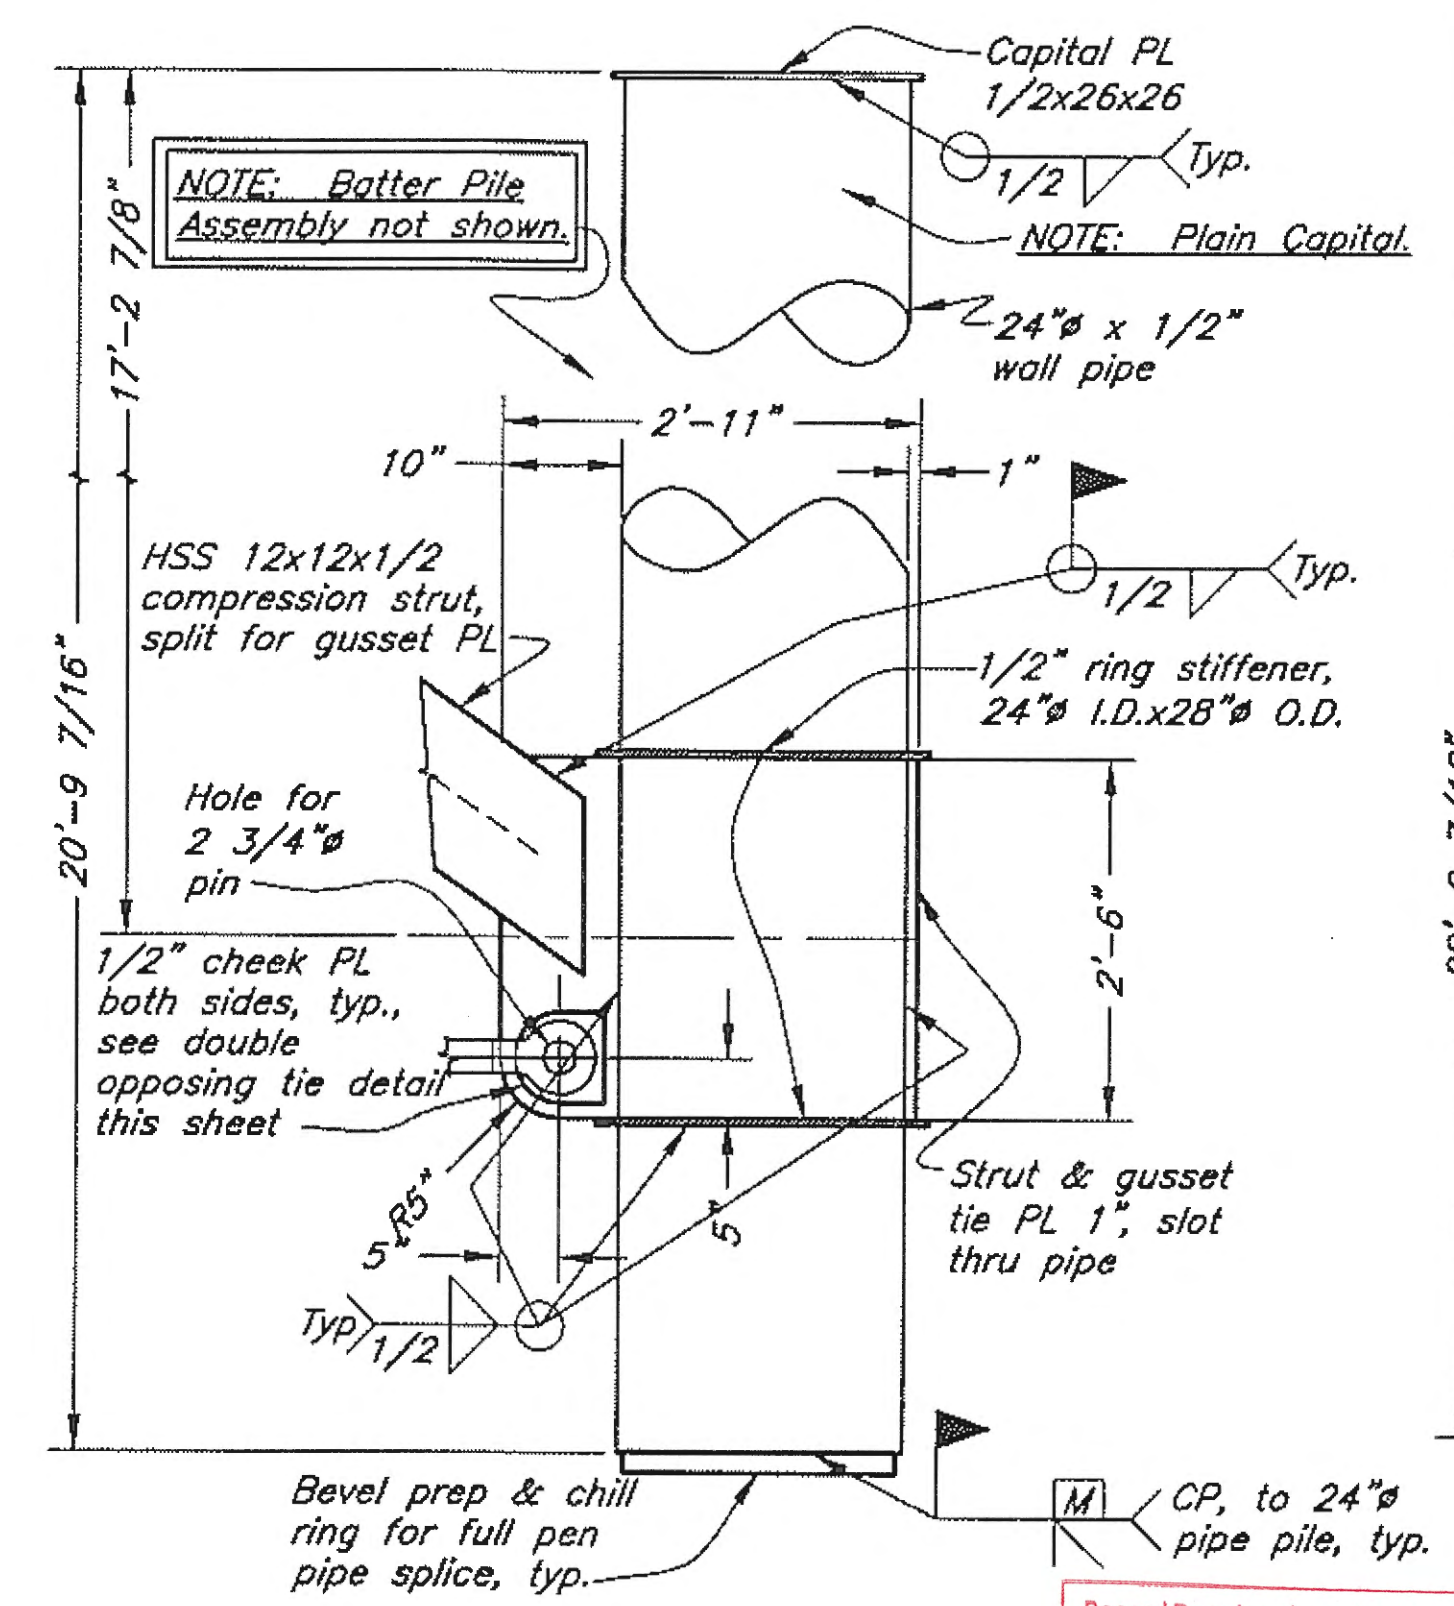


Capital w/ Strut & Tie Gusset

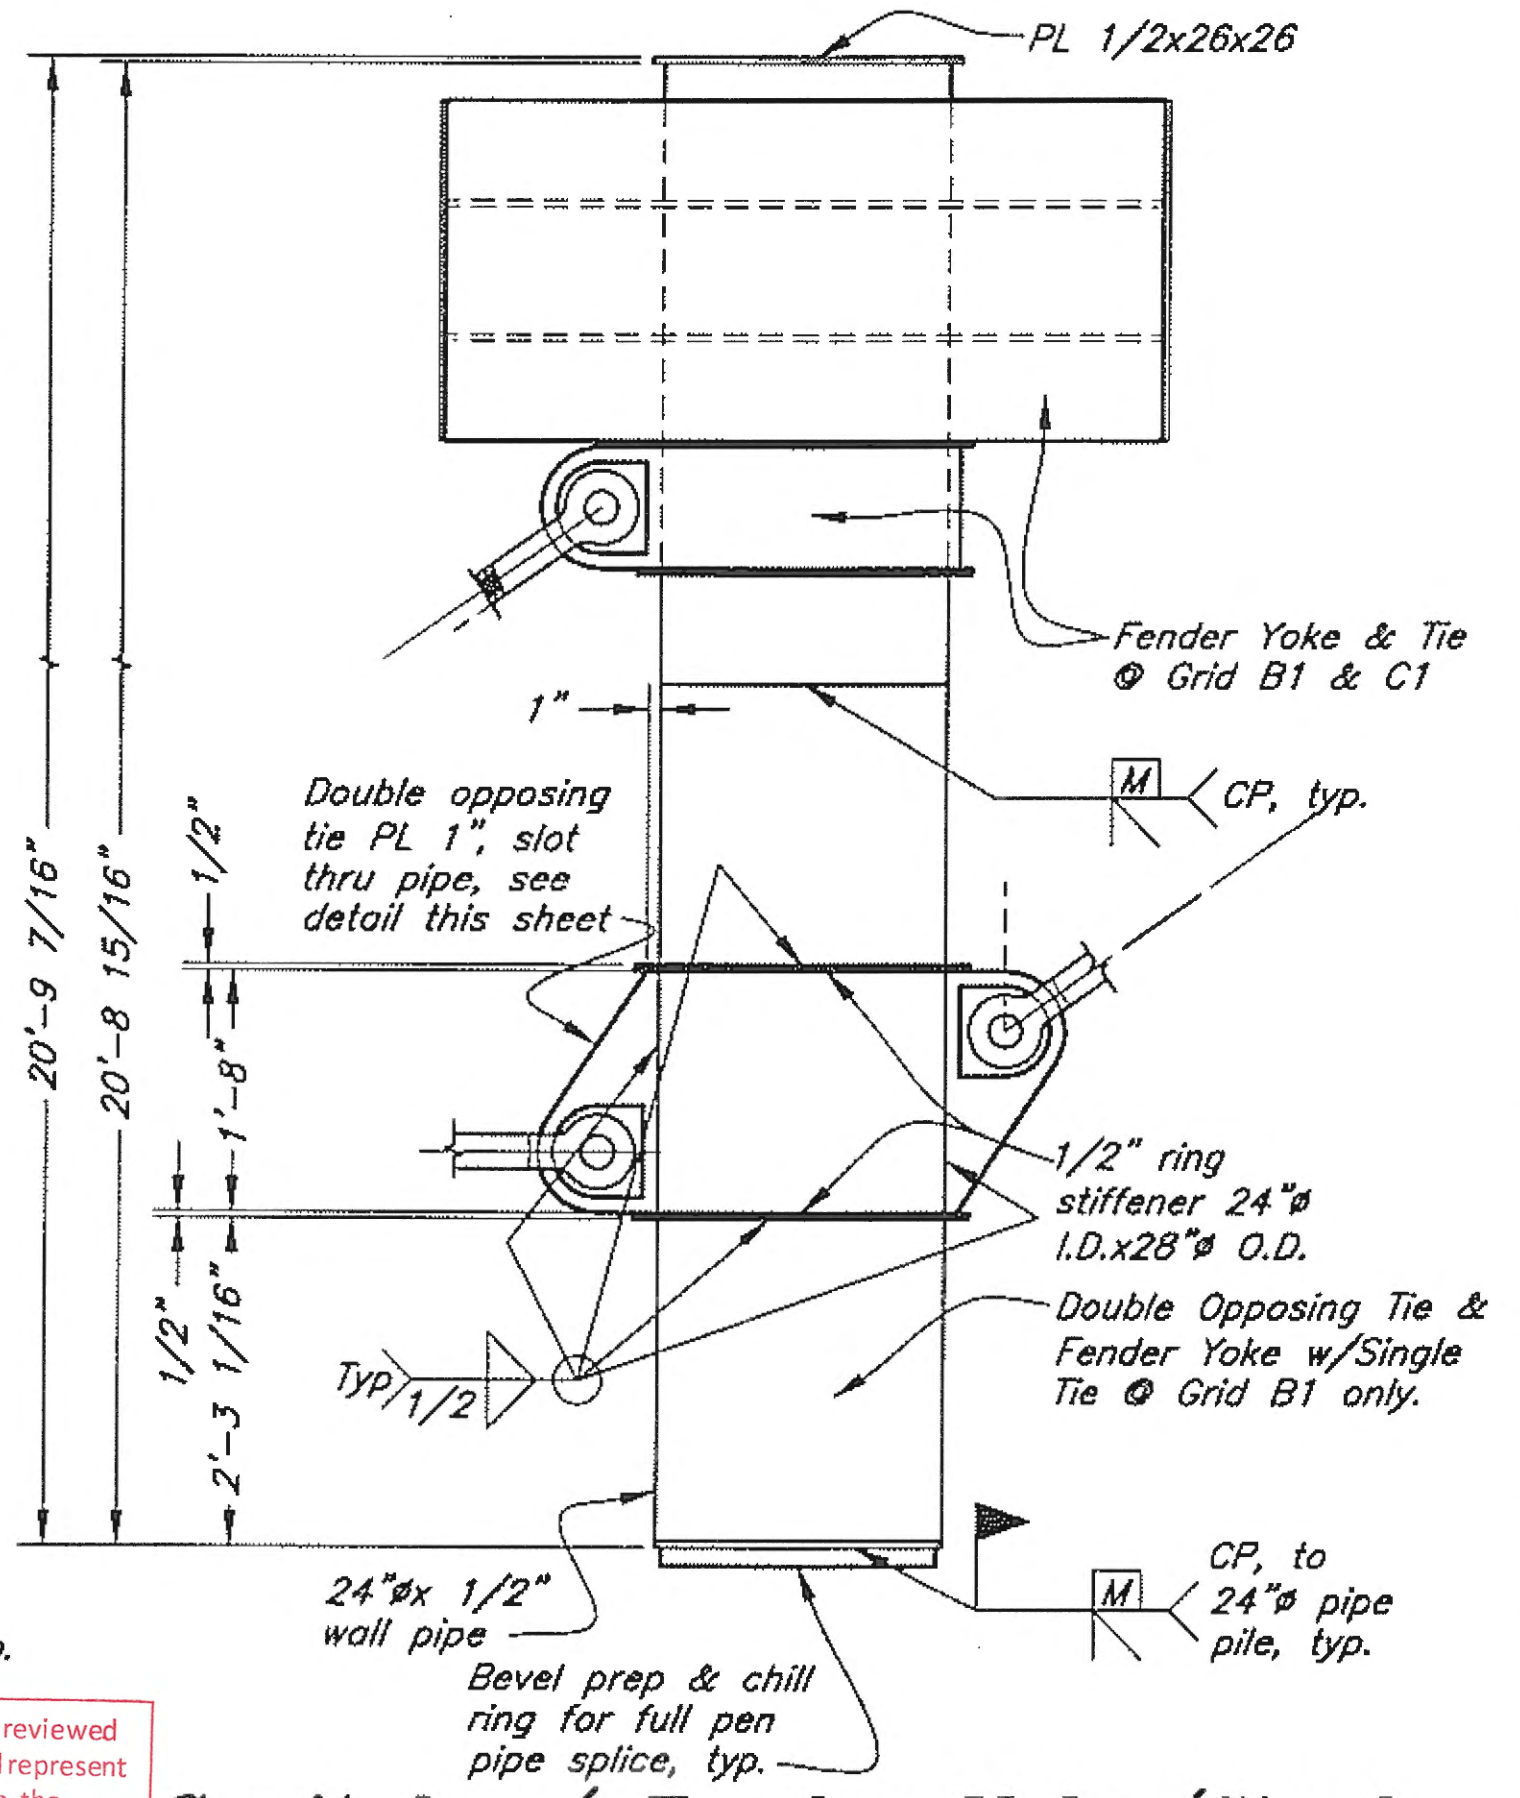

Capital w/ Fender Yoke/Single & Double Opposing Tie

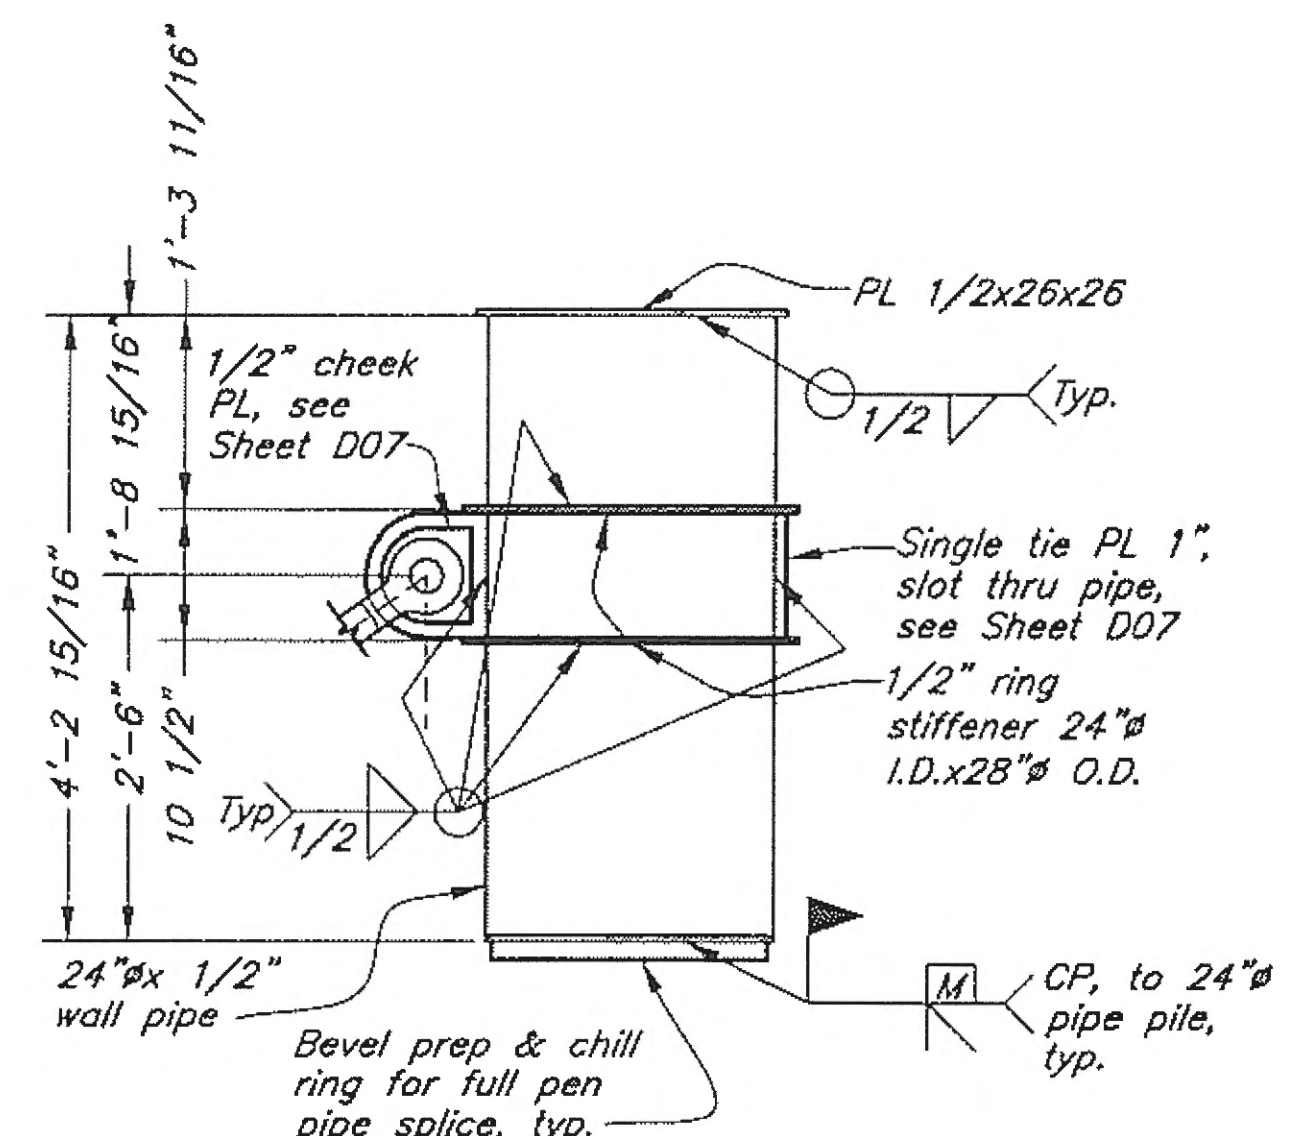

Capital w/ Single Tie

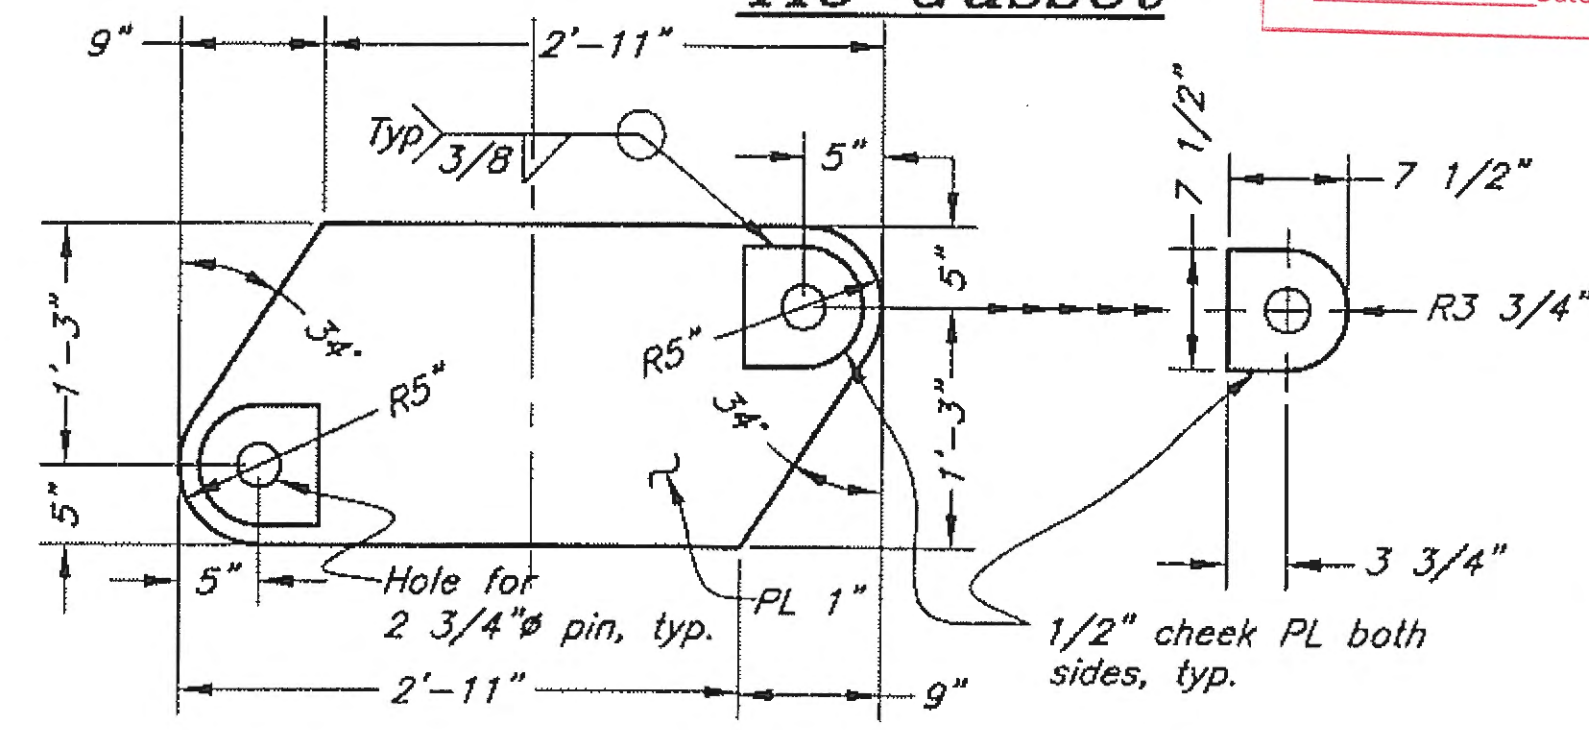

Double Opposing Tie Plate

Record Drawings have been reviewed by the Project Engineer, and represent to the best of my knowledge, the exact as constructed.
 PE *John T. Scott* Date 8/22/12

DO NOT SCALE FROM THESE DRAWINGS USE DIMENSIONS

DESIGNED BY: J. Scott


STATE OF ALASKA
 DEPARTMENT OF TRANSPORTATION & PUBLIC FACILITIES
 DESIGN & ENGINEERING SERVICES DIVISION-SOUTHEAST REGION
 Gustavus Causeway Replacement

Dock Capital Assemblies (2)


D08

CHECKED BY: B. Savikko
 DRAWN BY: C. Fumen, W. Hickok
 PATH: G:\GUS\67599\MF\PLANSET\04-DOCK\DOB DOCK CAPITALS 2.DWG
 TAB: Wed, 26/Nov/08 11:24AM JSCOTT

NO.	DATE	DESCRIPTION	PROJECT DESIGNATION	YEAR	SHEET NO.	TOTAL SHEETS
			BR-0003(53)/67599	2008	59	138

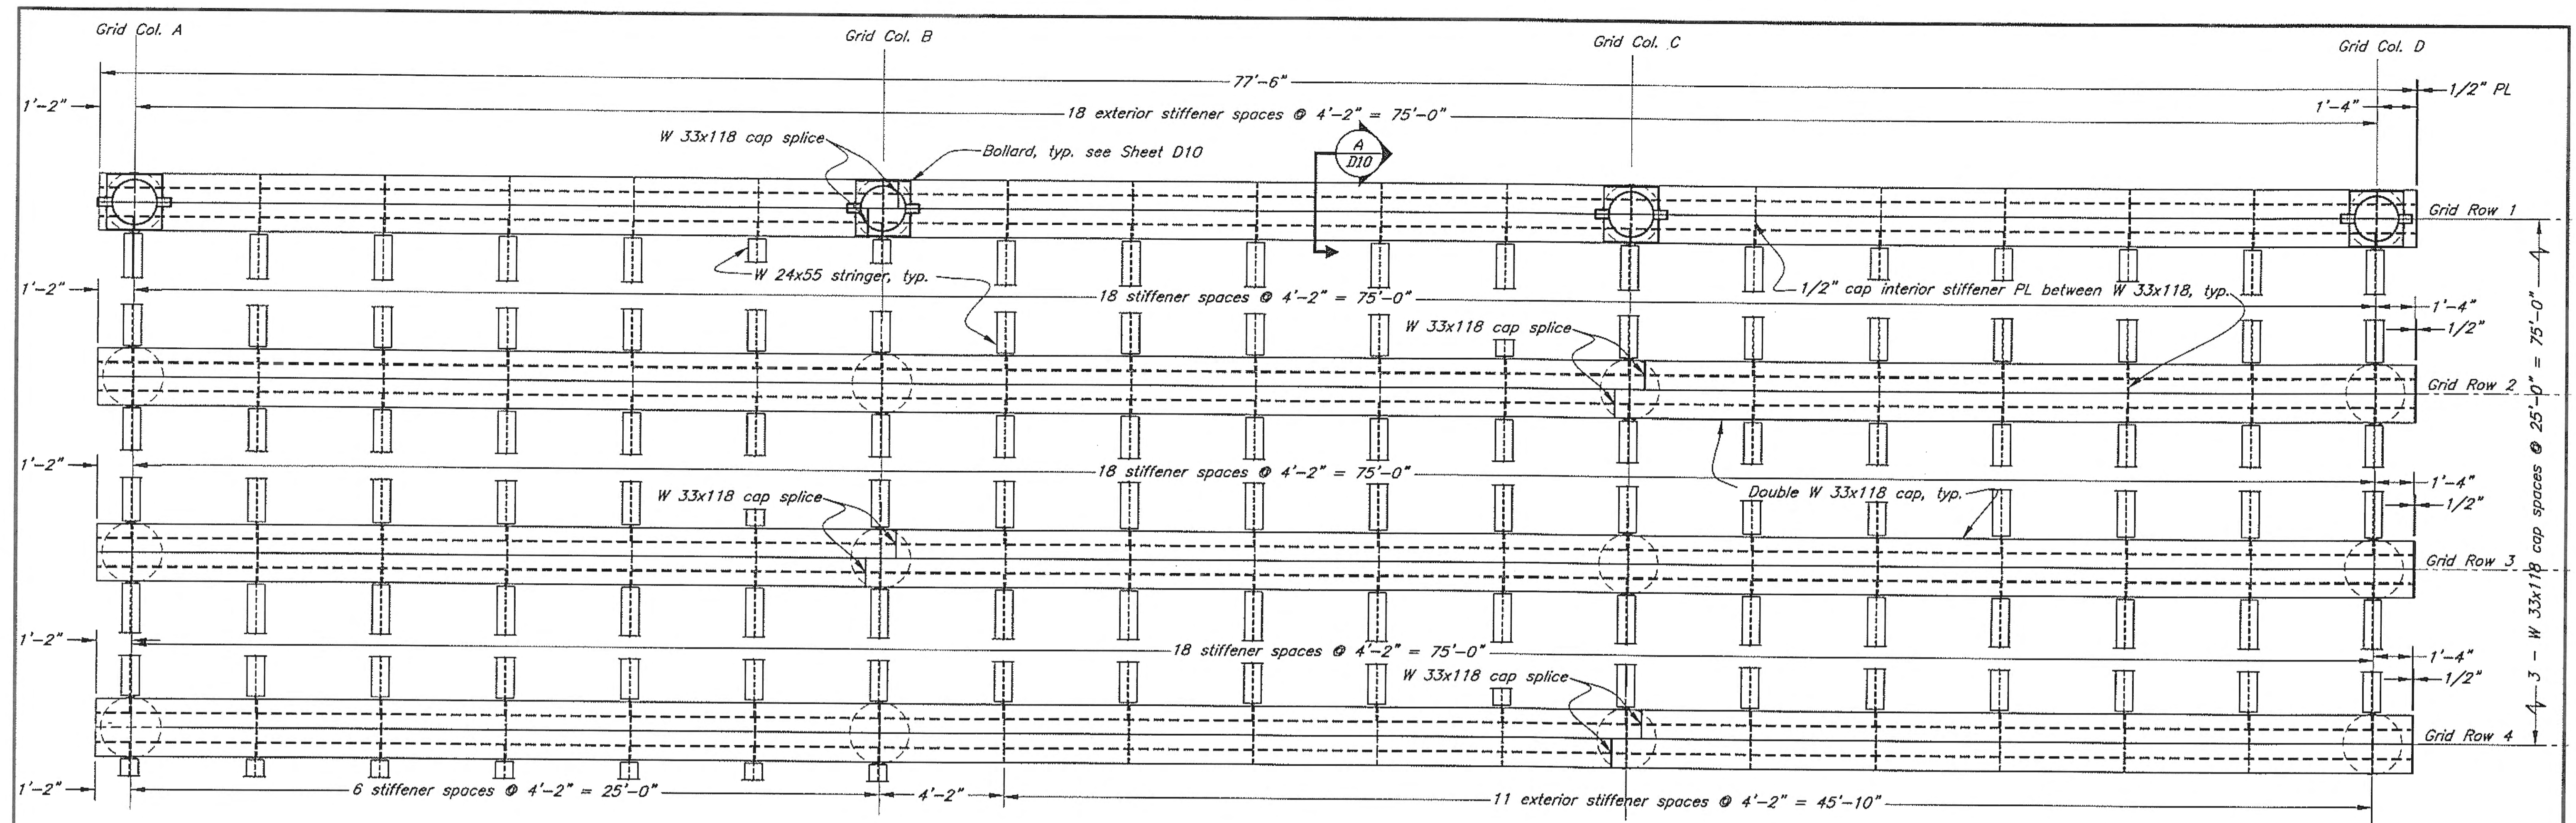

Dock Framing Plan

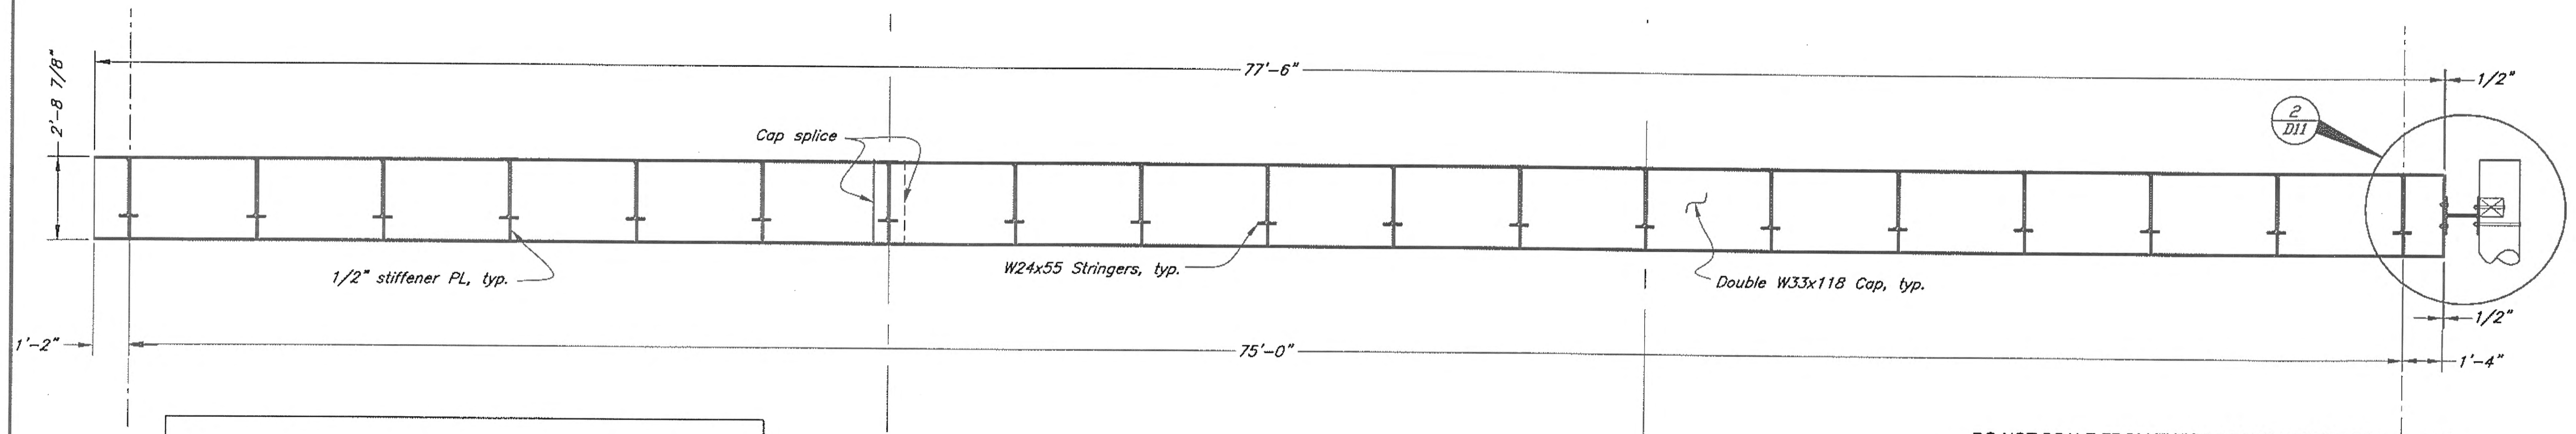

Grid Row 3 Cap Elevation

Note: Grid Rows 1, 2, & 4 similar except as shown on plan view

Record Drawings have been reviewed by the Project Engineer, and represent to the best of my knowledge, the project as constructed.
 PE *[Signature]* Date 8/2/17

DO NOT SCALE FROM THESE DRAWINGS USE DIMENSIONS

DESIGNED BY: J. Scott

CHECKED BY: B. Savikko

DRAWN BY: C. Fuman, W. Hekok

PATH: Q:\GUS\67599\MF\PLANSET\04-DOCK\009 DOCK FRAMING PLAN.DWG

TAB: Wed, 25/Nov/09 11:25AM

STATE OF ALASKA
 DEPARTMENT OF TRANSPORTATION & PUBLIC FACILITIES
 DESIGN & ENGINEERING SERVICES DIVISION-SOUTHEAST REGION



Gustavus Causeway Replacement

Dock Framing Plan


D09

BR-0003(53)/67599 2008 60 138

NO.	DATE	DESCRIPTION	PROJECT DESIGNATION	YEAR	SHEET NO.	TOTAL SHEETS
			BR-0003(53)/67599	2008	60	138

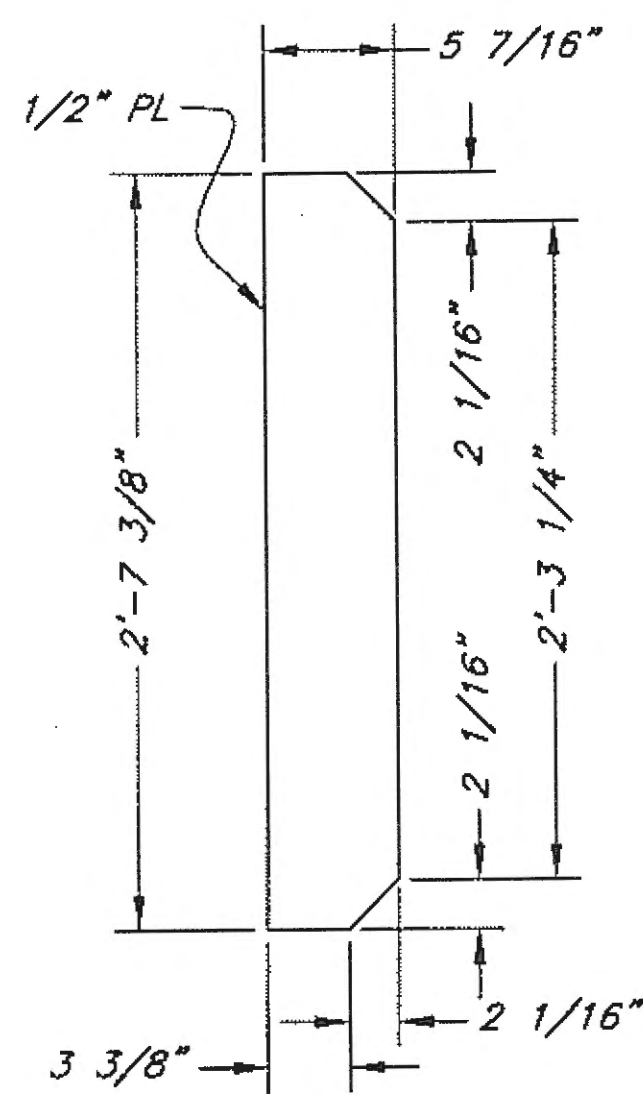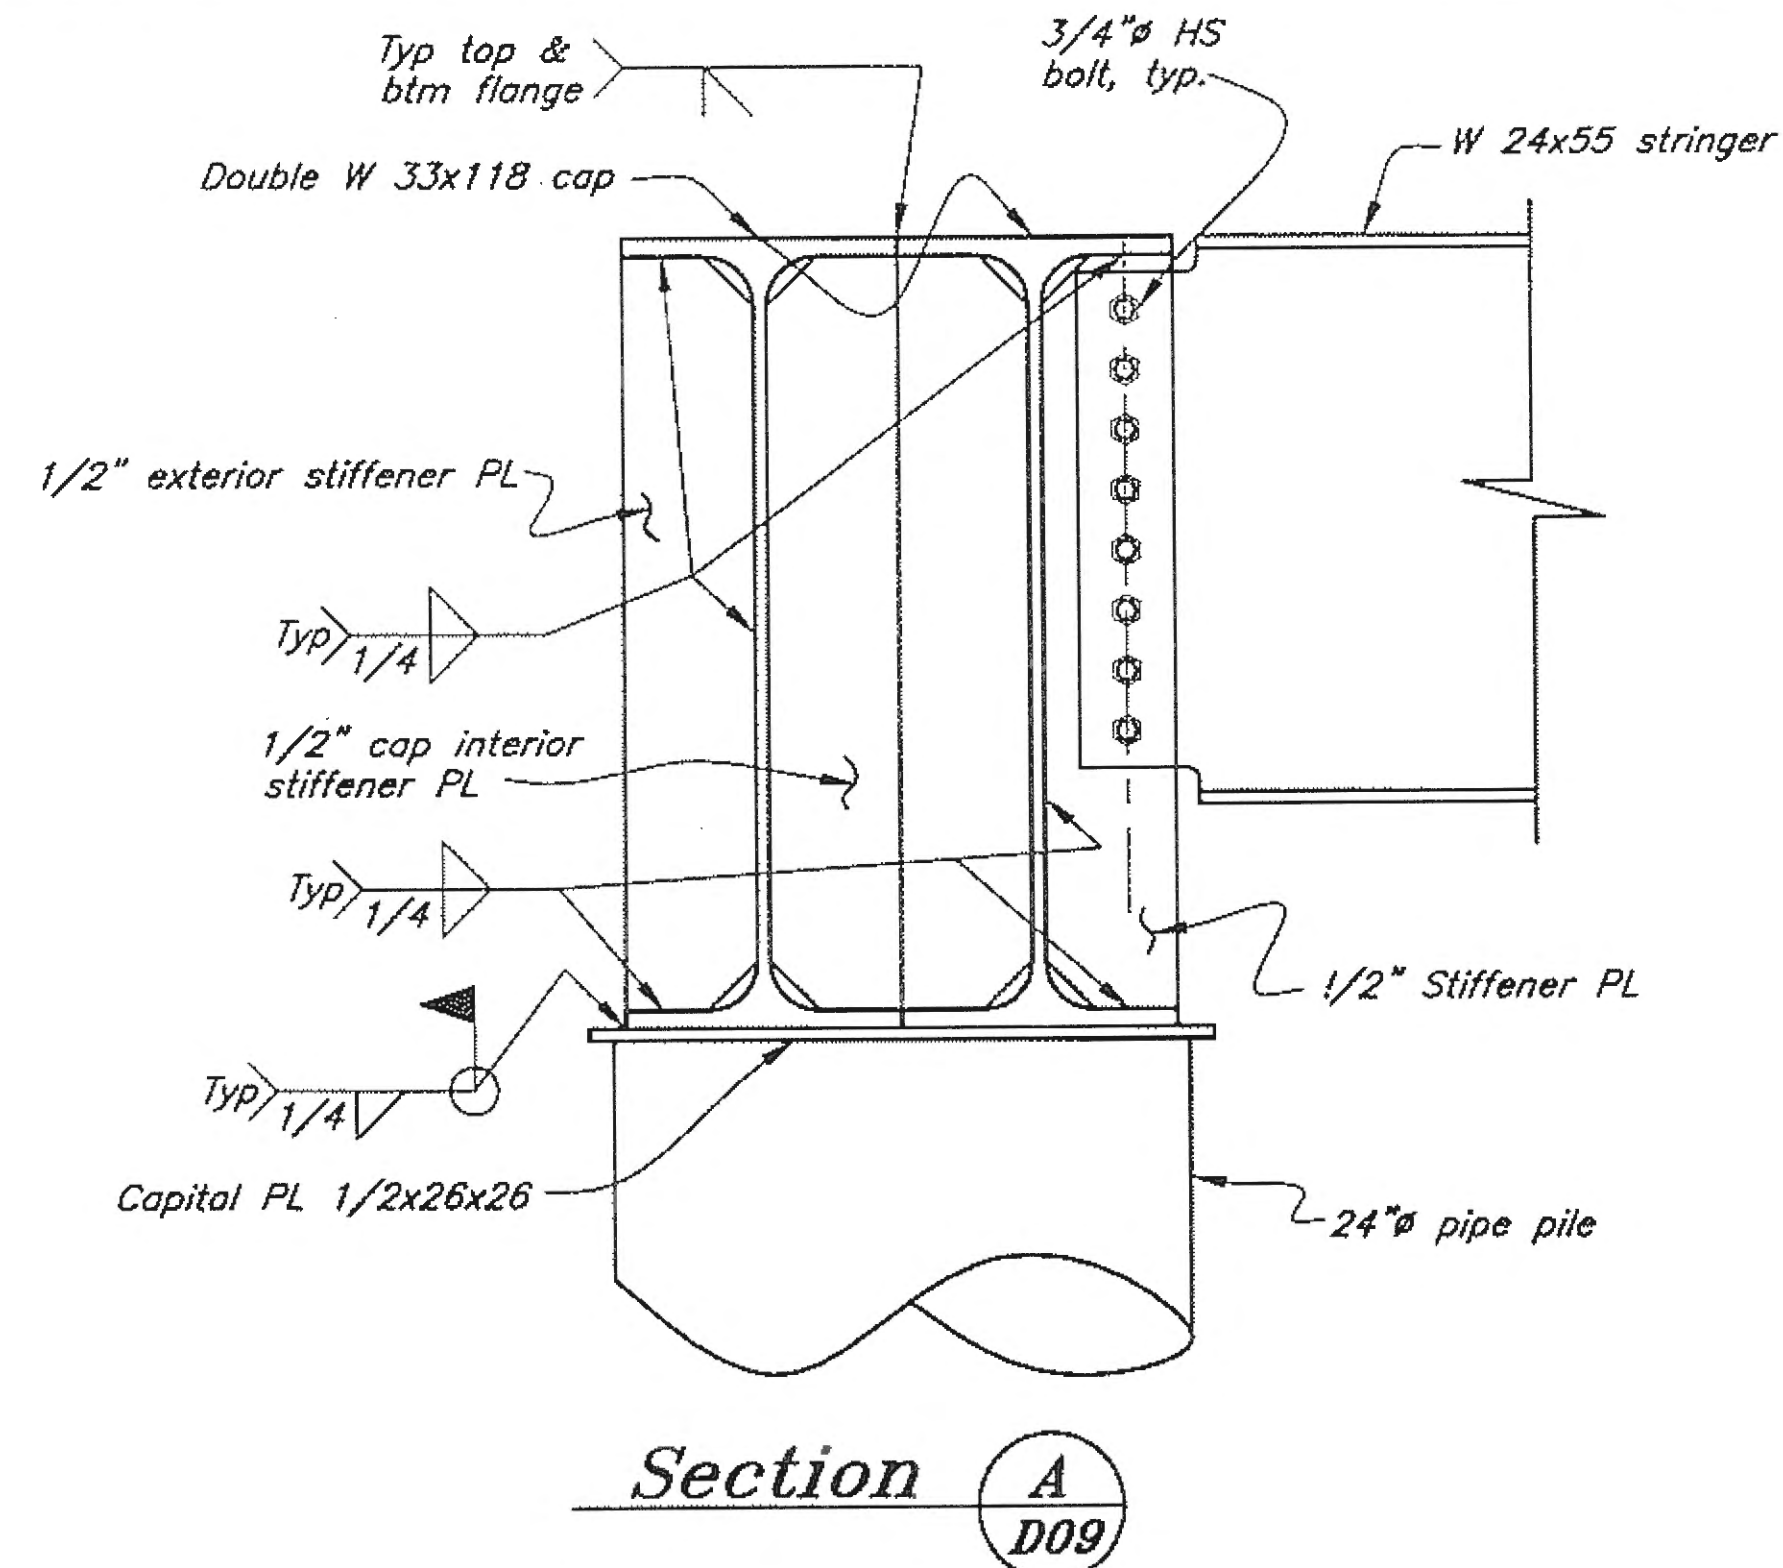


Stiffener PL

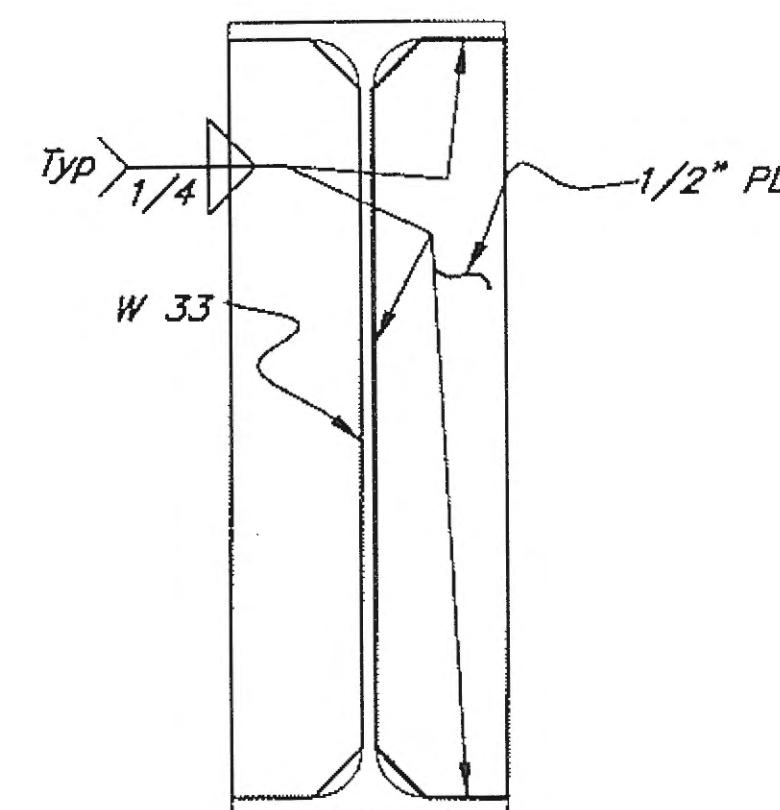


**Cap Interior Stiffener PL's
(between double W 33's)**


Stiffener Plates

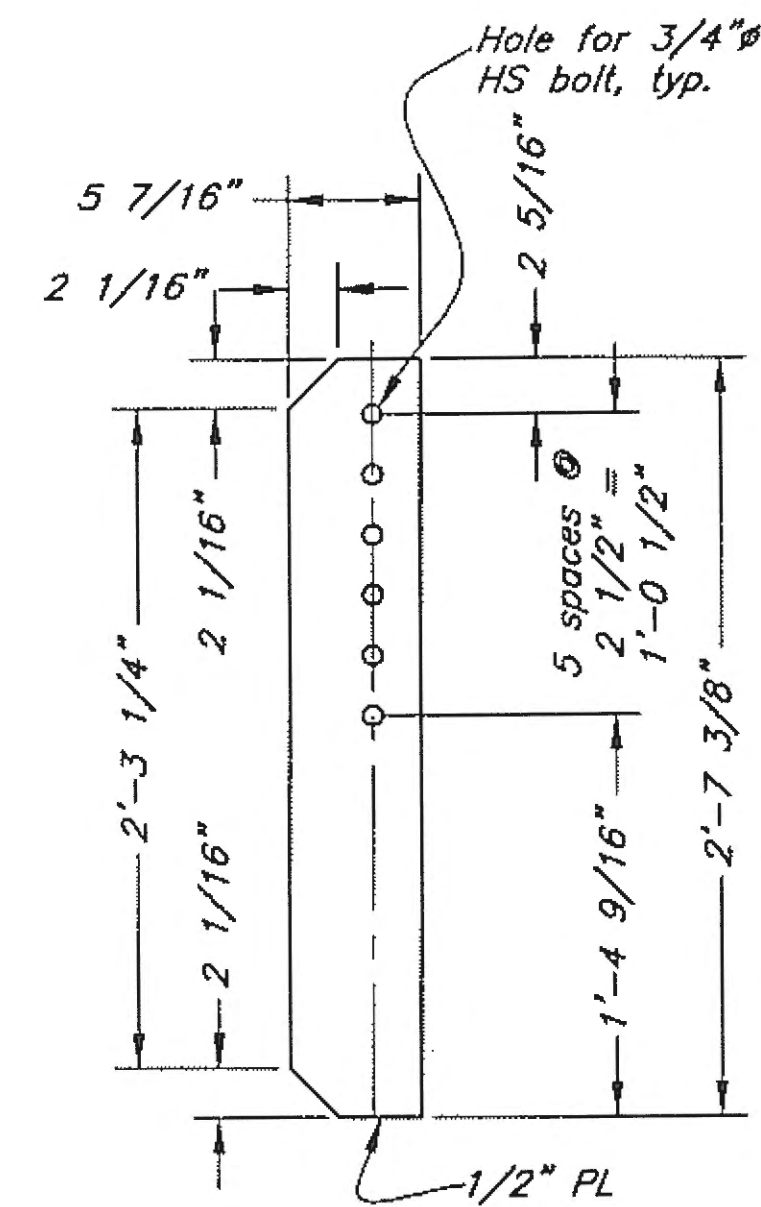

**Stiffener Plate
@ Stringer Connections**

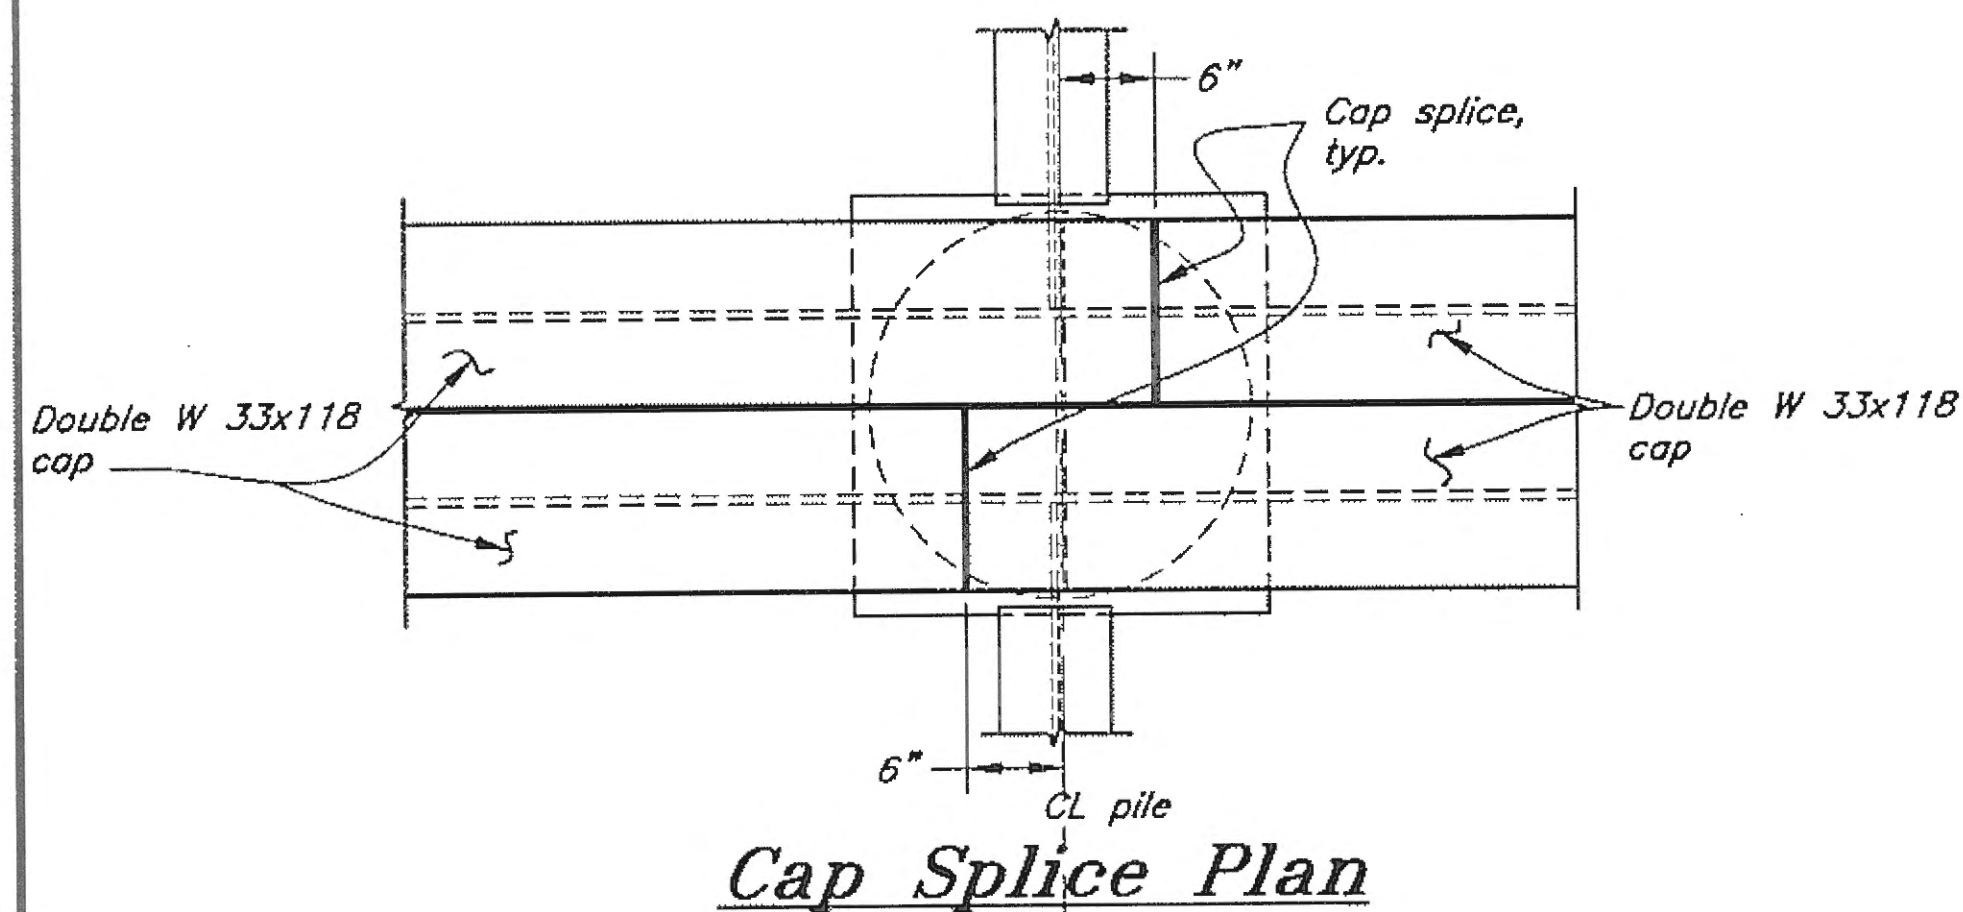


Cap Splice Plan

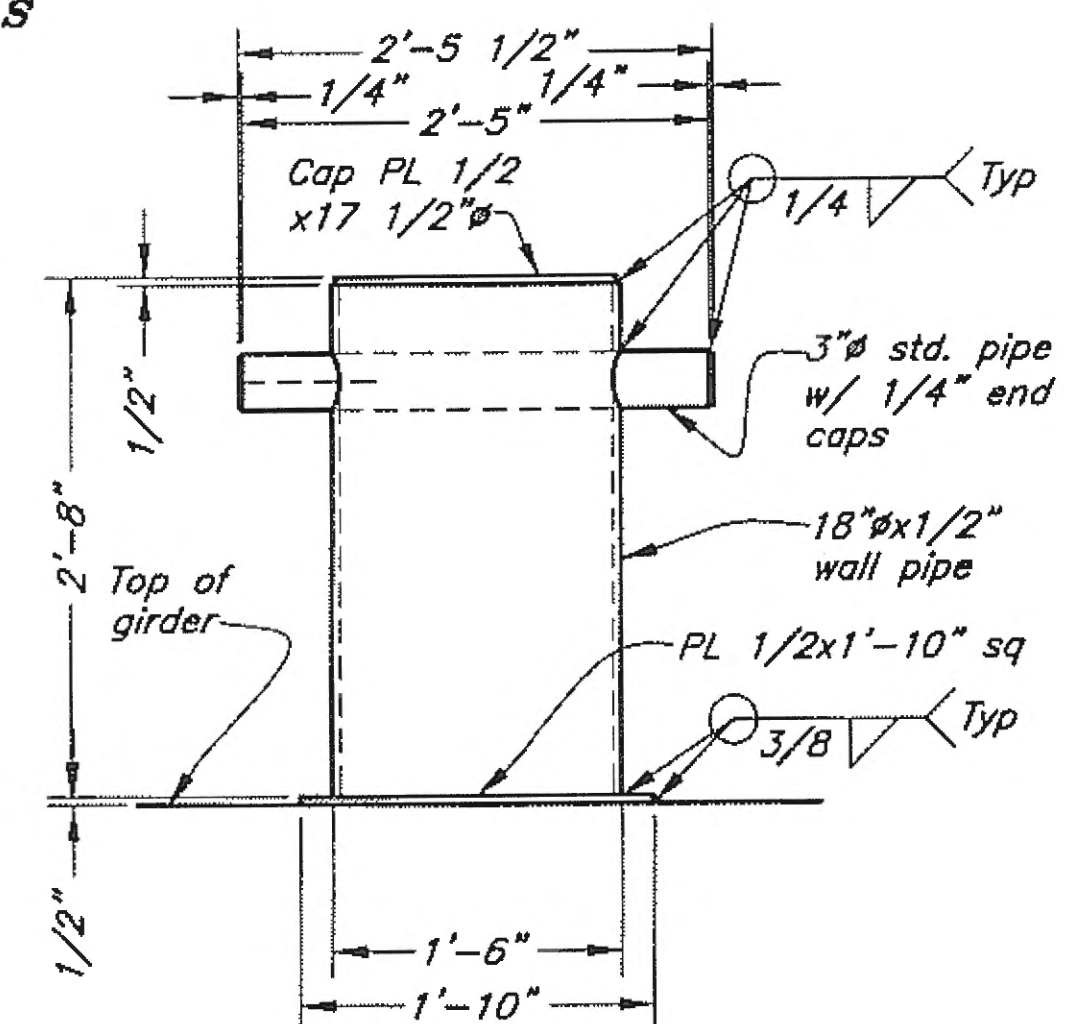


Bollard Elevation

Note: See Sheet D09 for splice locations

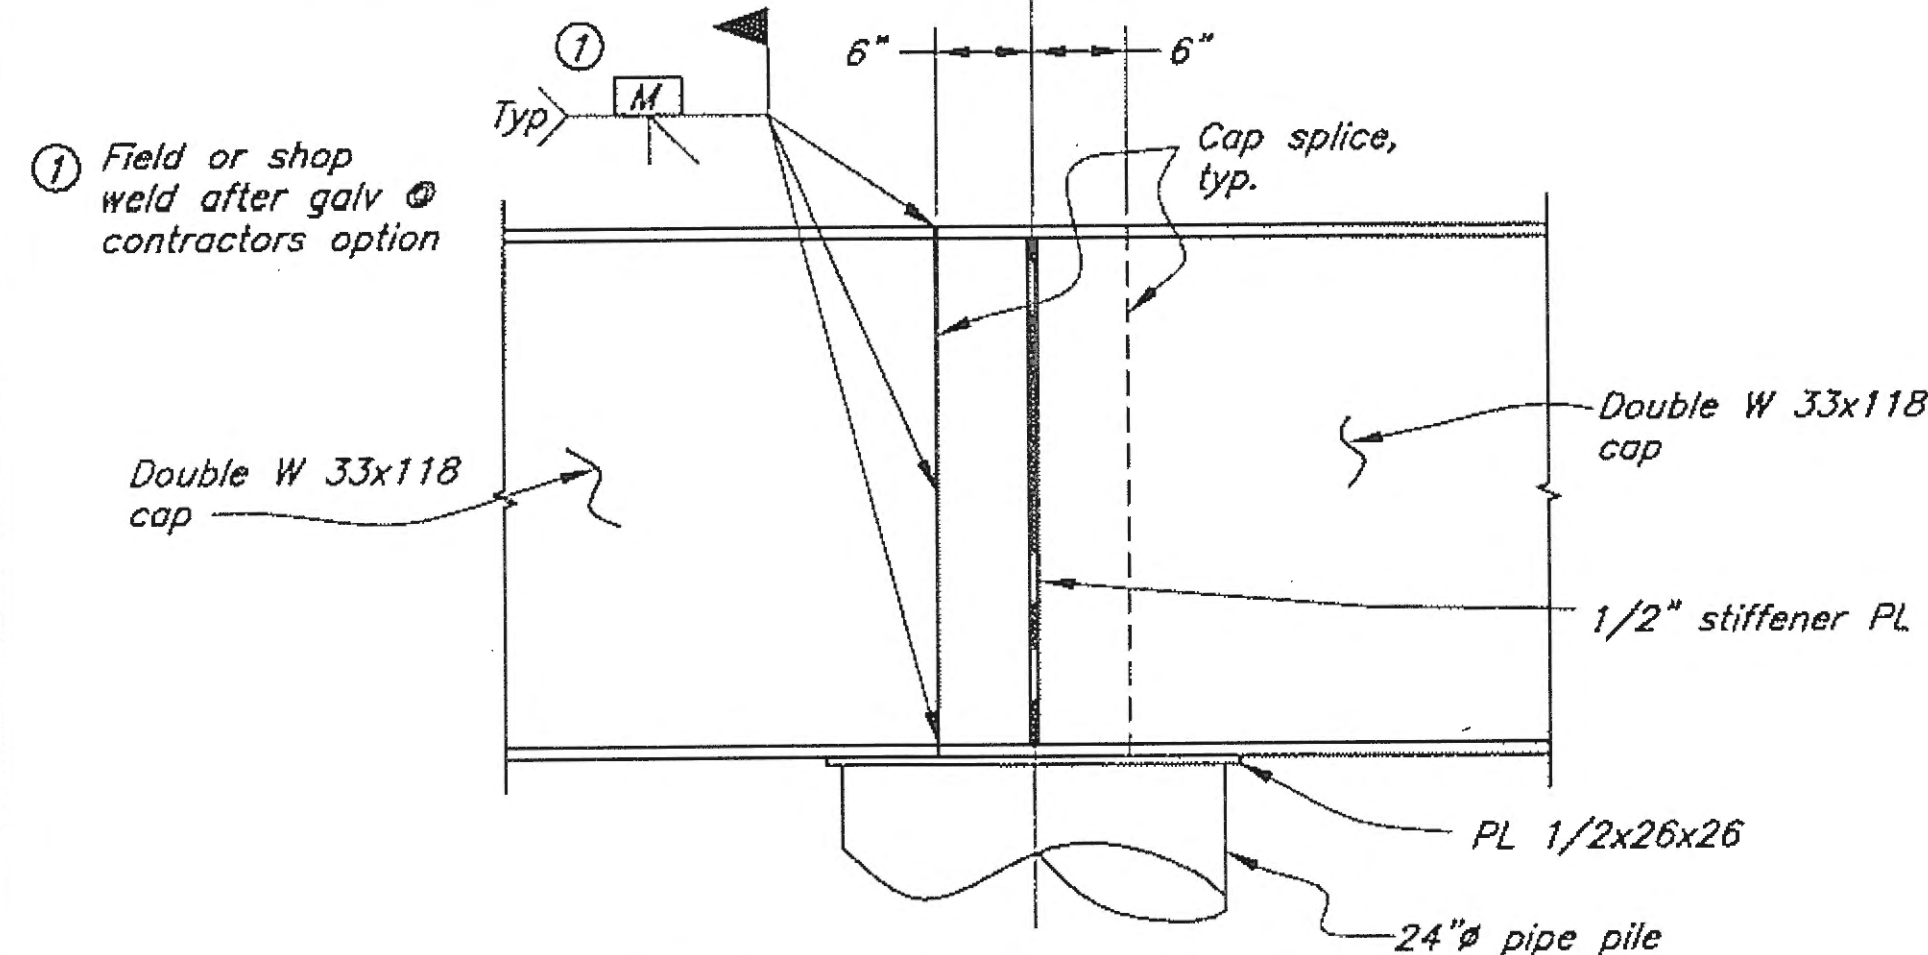

Cap Splice Elevation

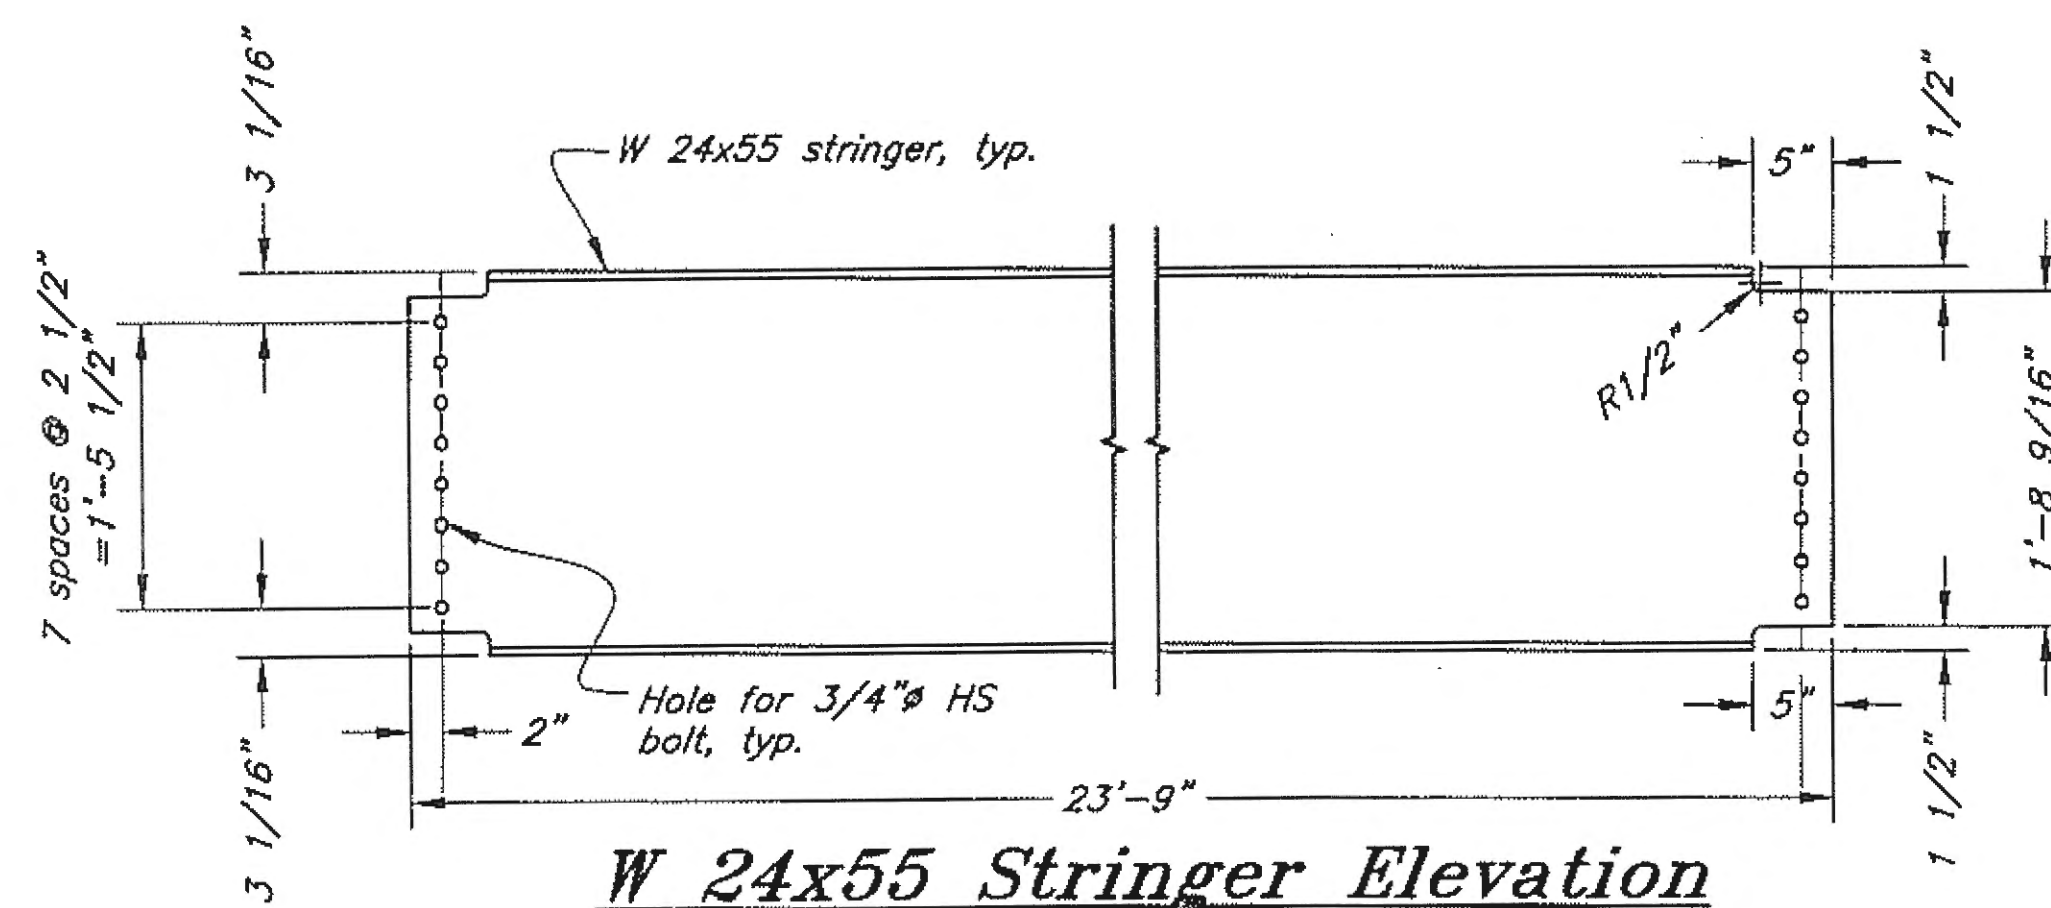

W 24x55 Stringer Elevation

Record Drawings have been reviewed by the Project Engineer, and represent to the best of my knowledge, the project as constructed.
PE: *John I. Scott* Date: 8/21/12

DO NOT SCALE FROM THESE DRAWINGS USE DIMENSIONS

DESIGNED BY: J. Scott

CHECKED BY: B. Savikko

DRAWN BY: C. Fuman, W. Hickok

PATH: O:\GUS\67599\MF\PLANSET\04-DOCK\D10 DOCK FRAMING DETAILS.DWG

TAB: Wed, 26/Nov/08 11:26AM JTSCOTT


STATE OF ALASKA
DEPARTMENT OF TRANSPORTATION & PUBLIC FACILITIES
DESIGN & ENGINEERING SERVICES DIVISION-SOUTHEAST REGION

Gustavus Causeway Replacement


Dock Framing Details

D10


REVISIONS			PROJECT DESIGNATION	YEAR	SHEET NO.	TOTAL SHEETS
NO.	DATE	DESCRIPTION	BR-0003(53)/67599	2008	61	138

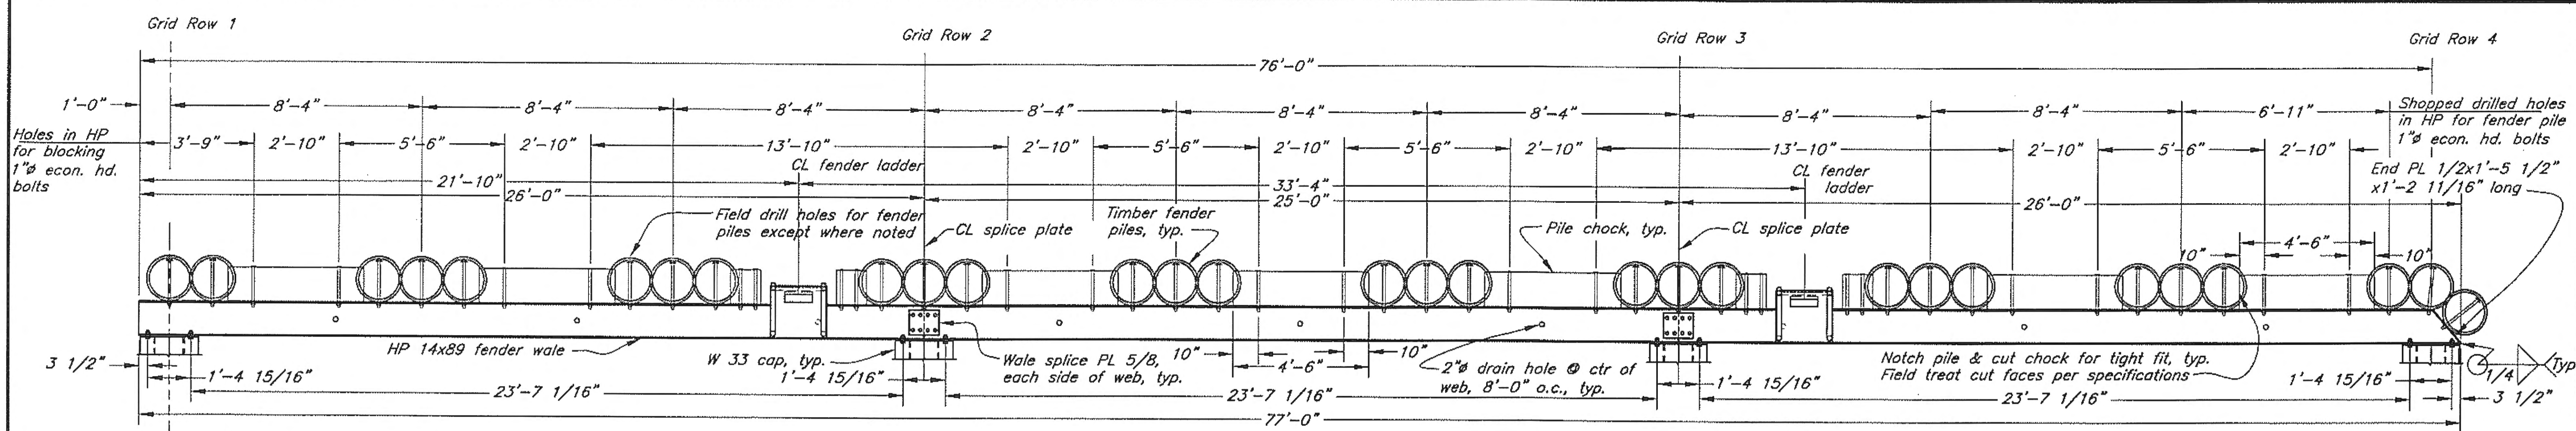


Fixed Fender Plan

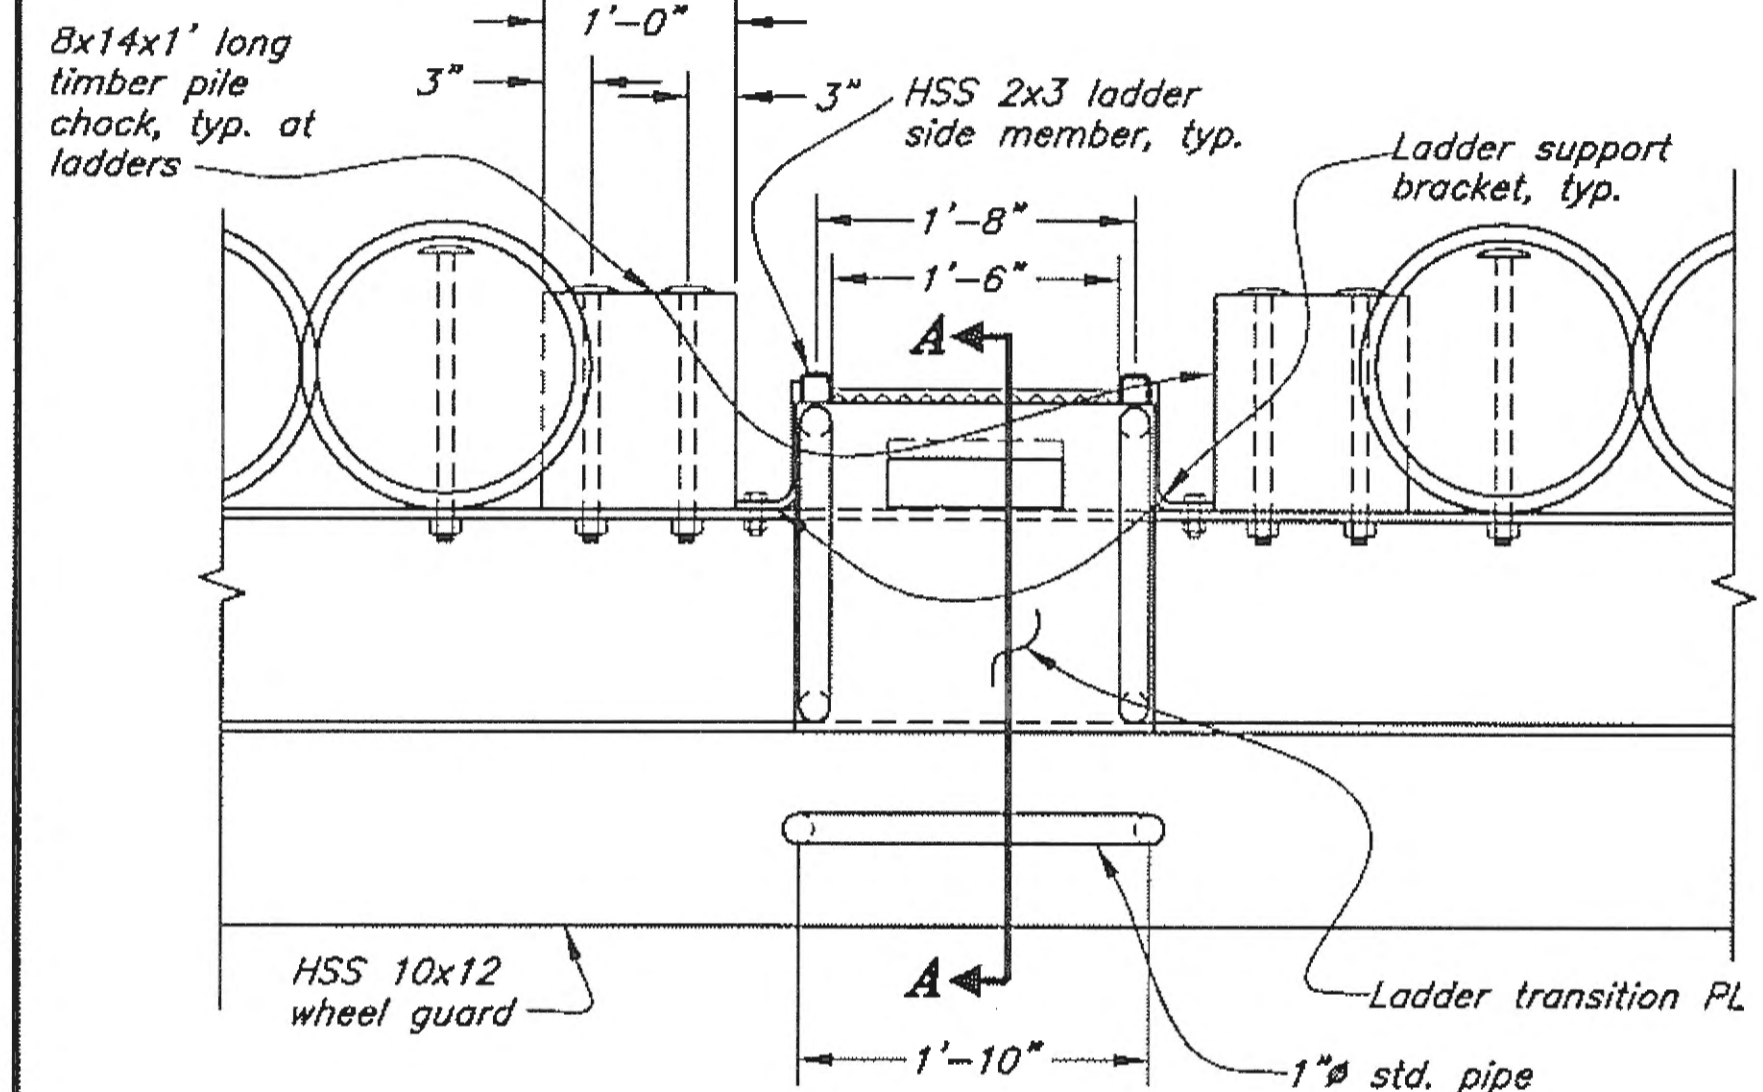


Ladder Plan

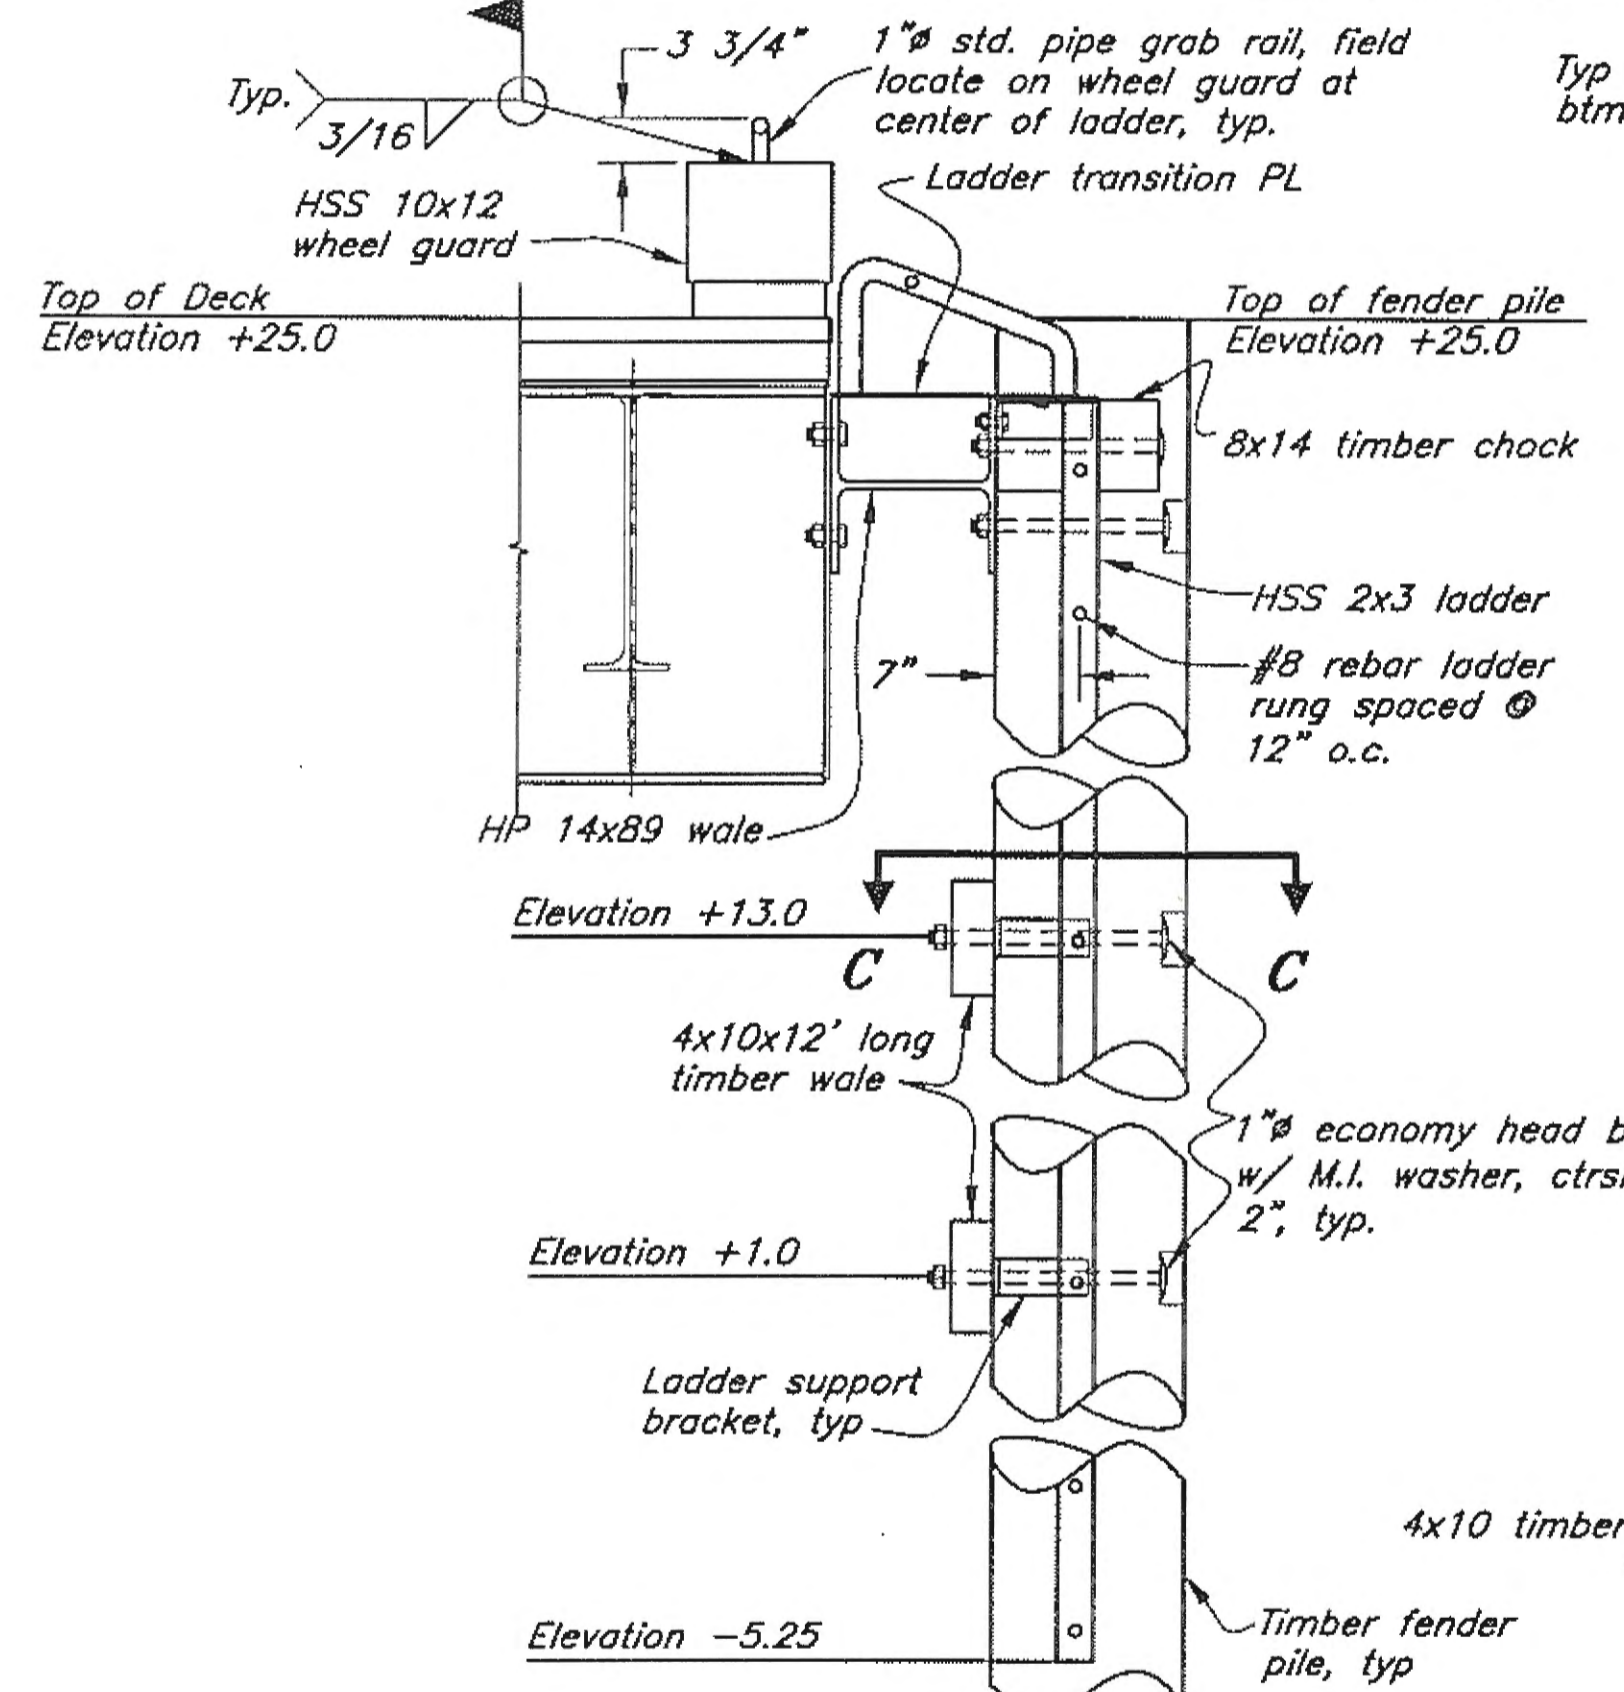


Section A-A

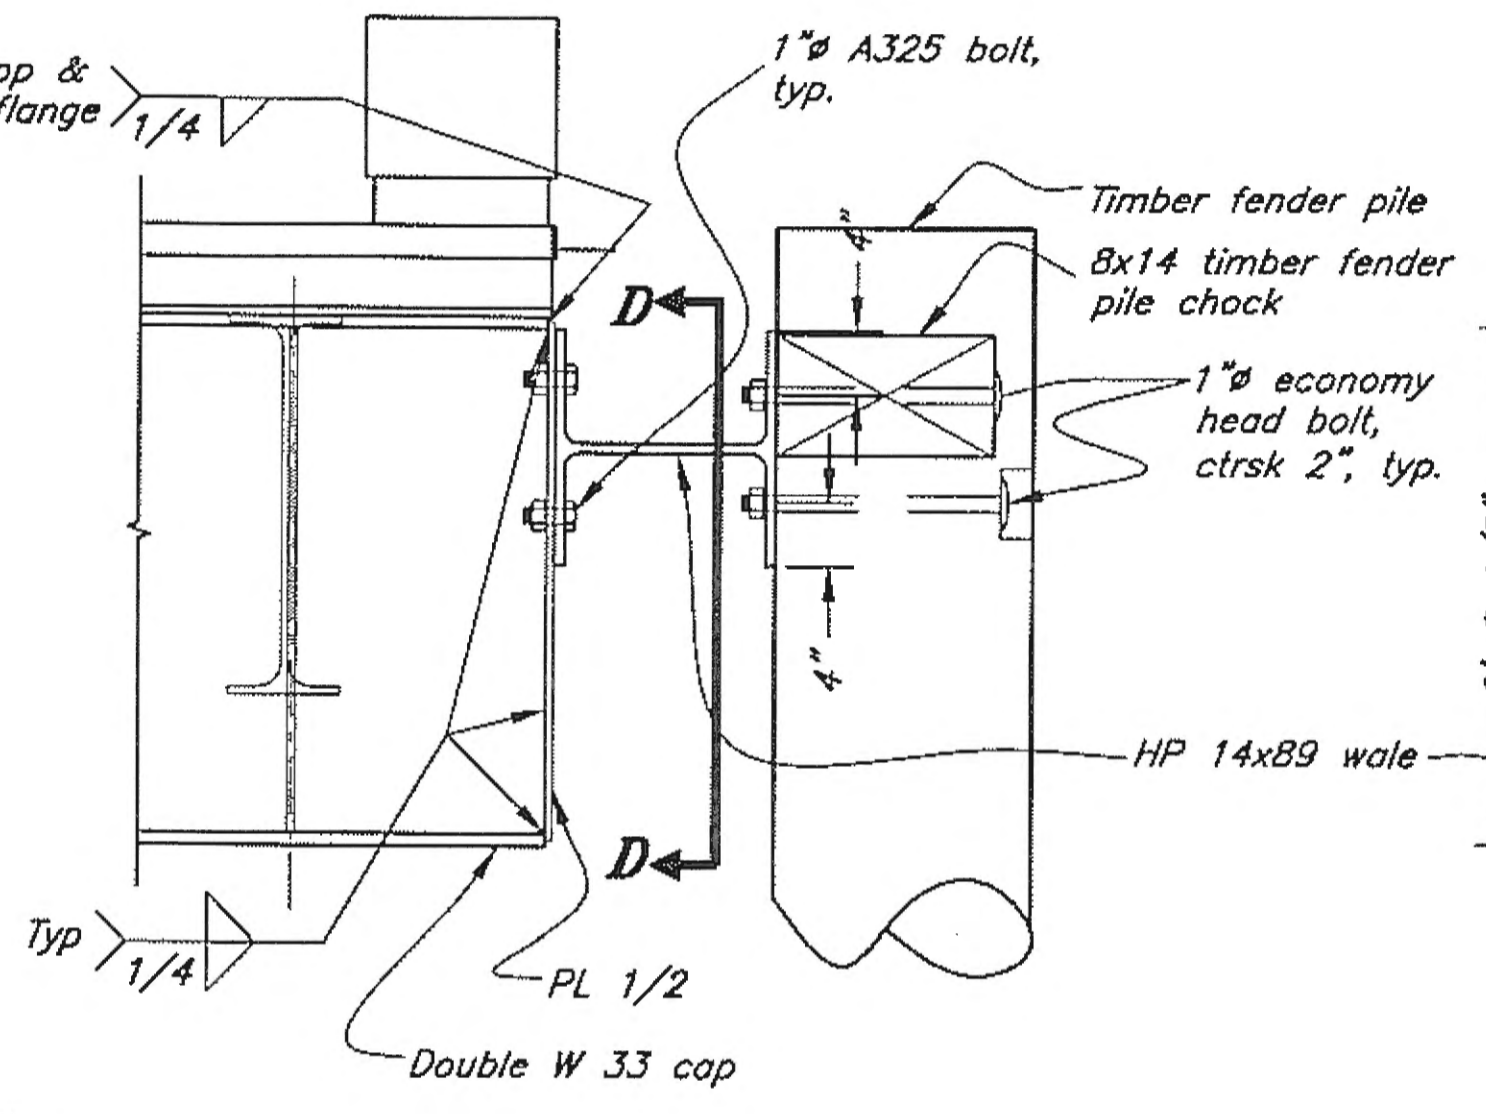


Detail 2
D02

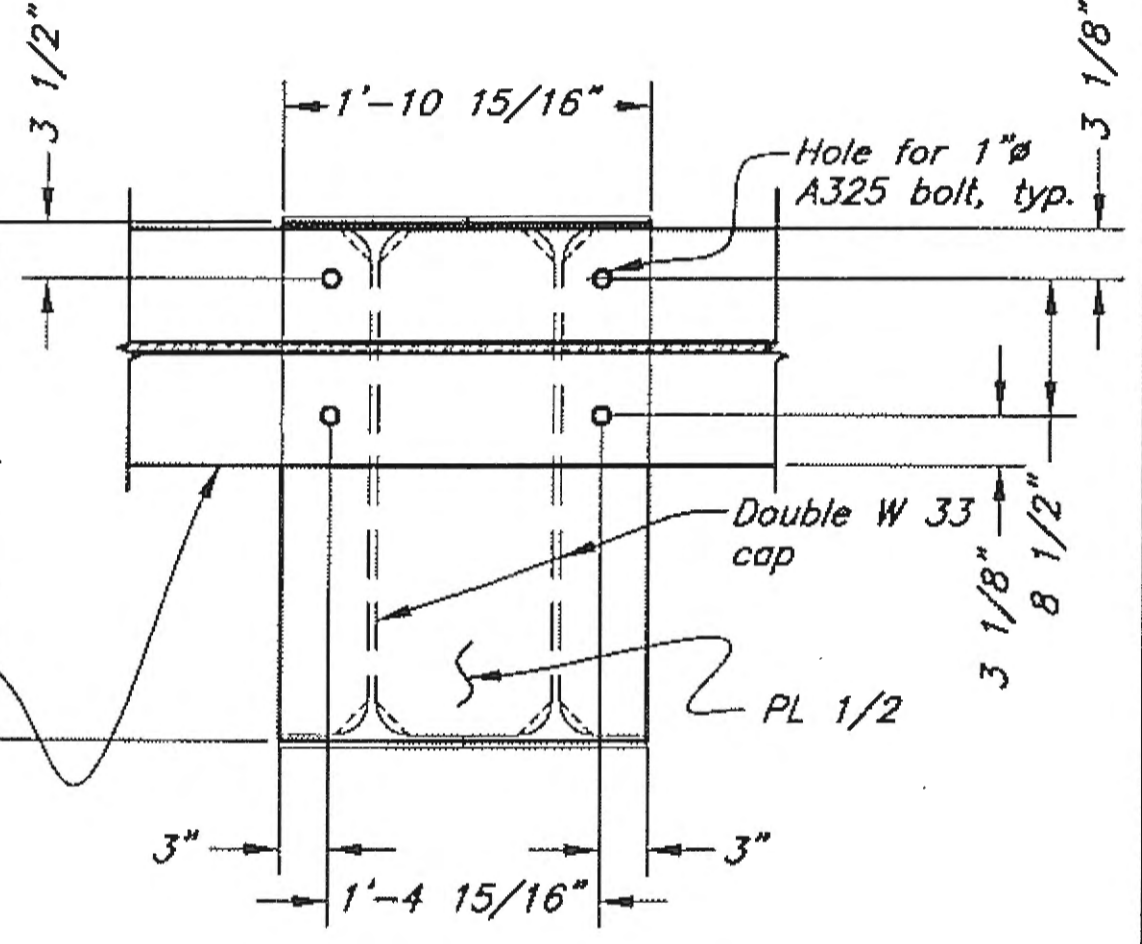


Section D-D

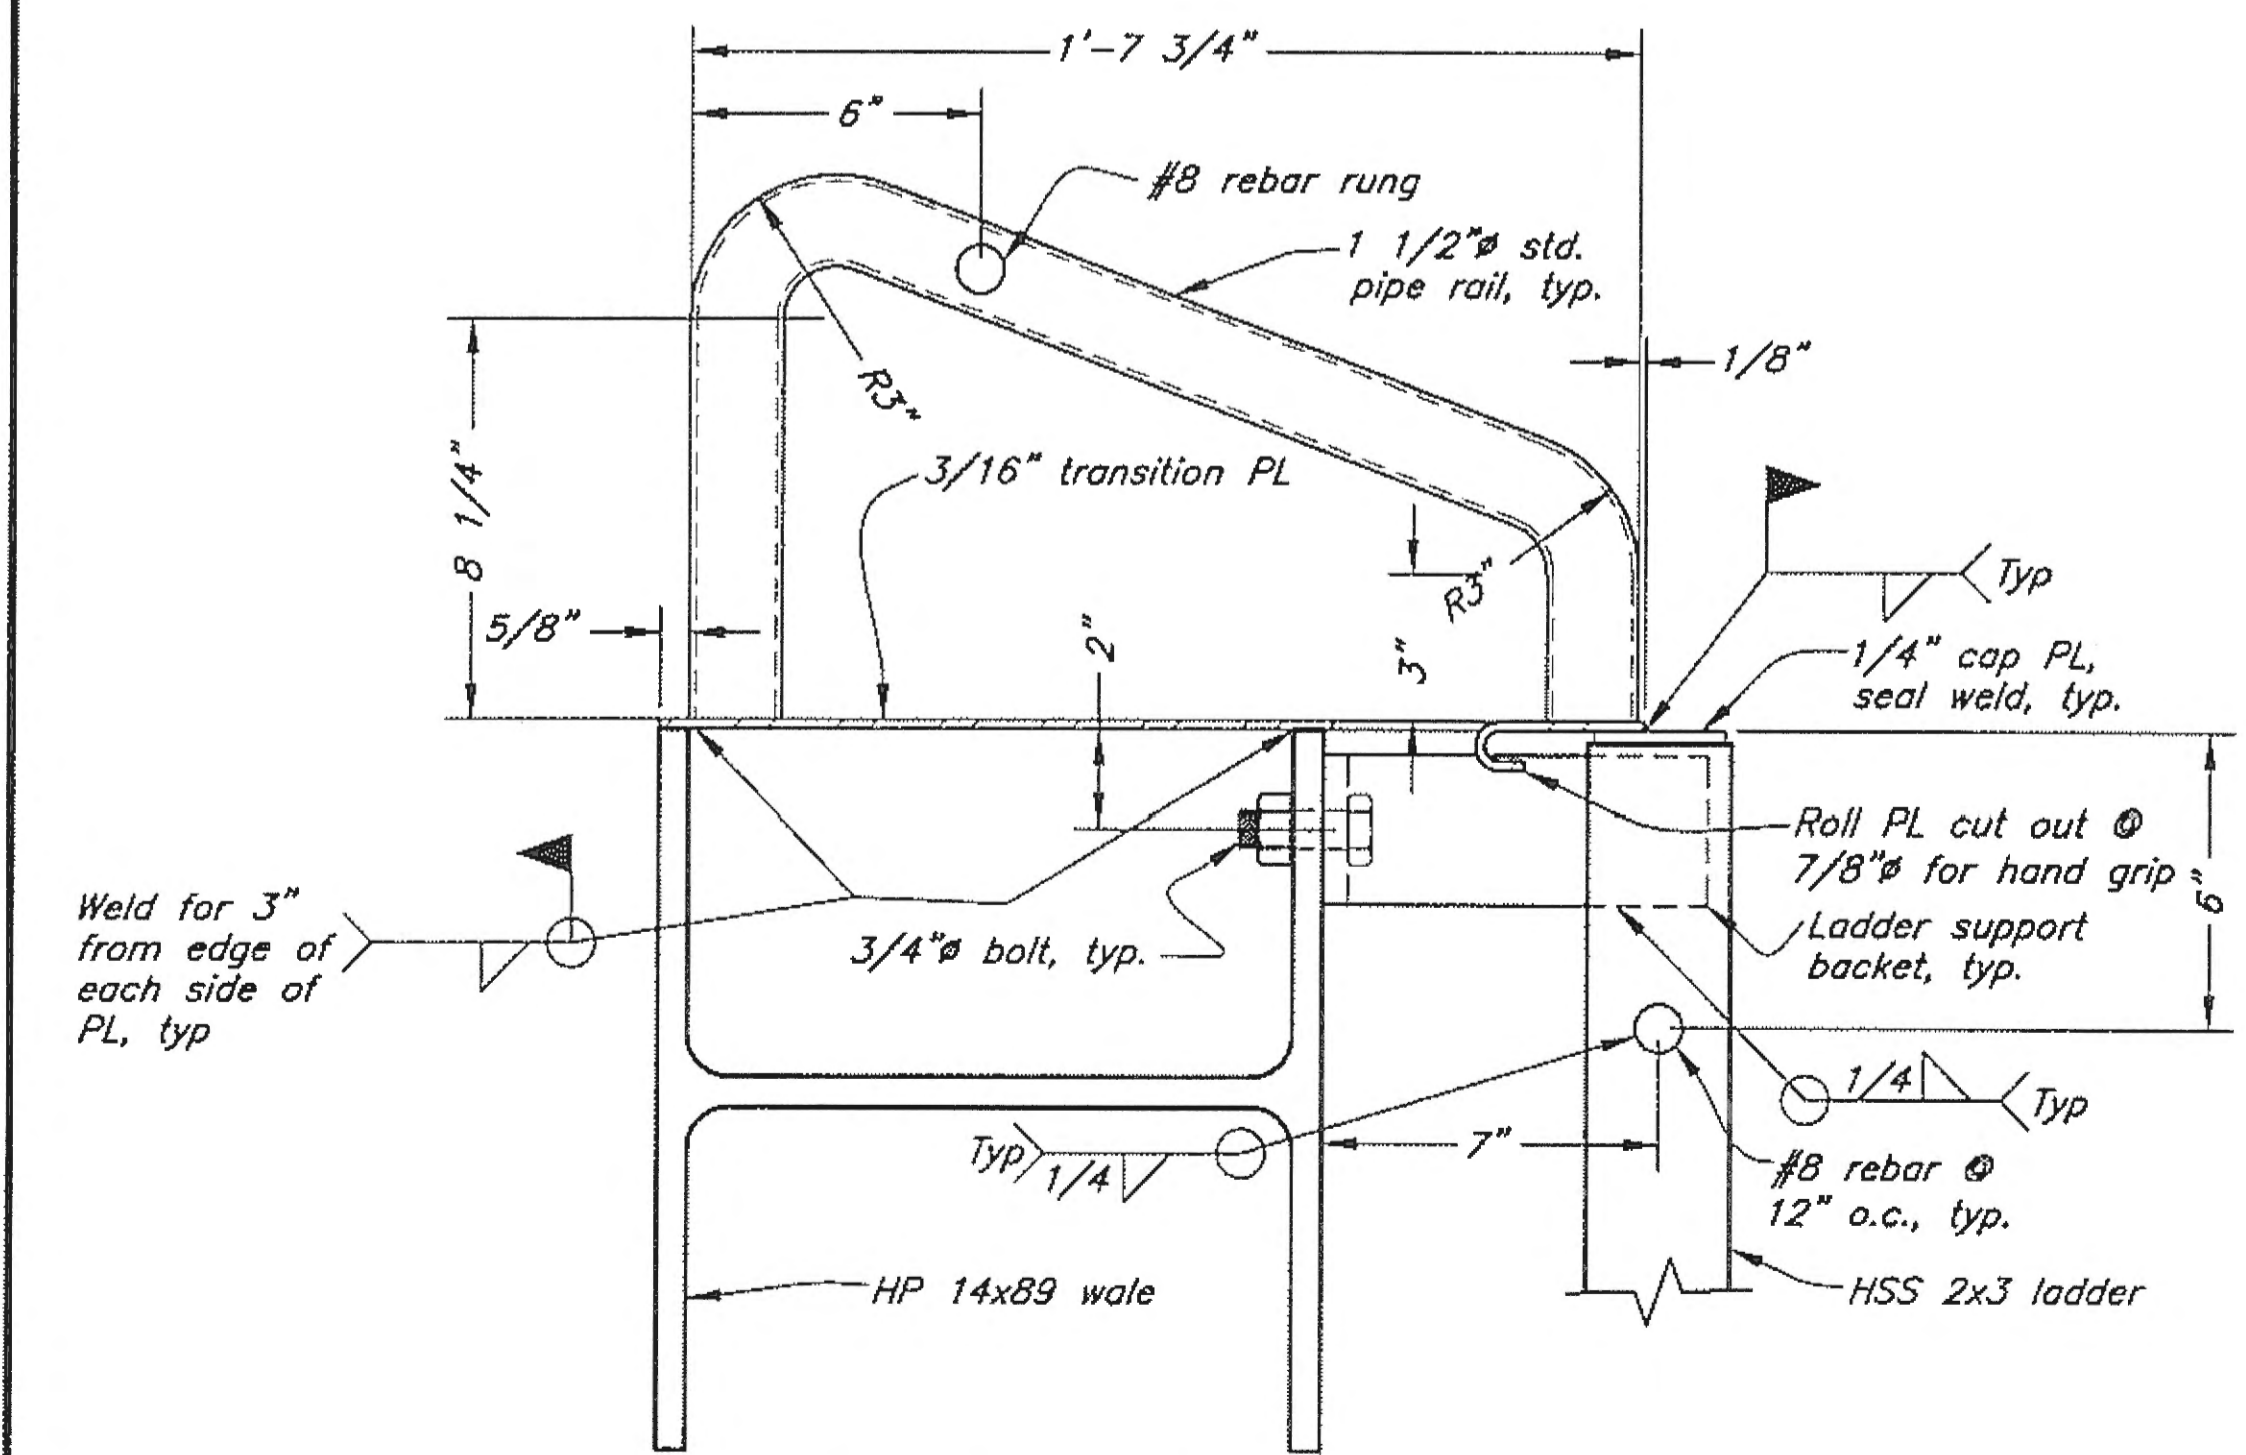


Section B-B

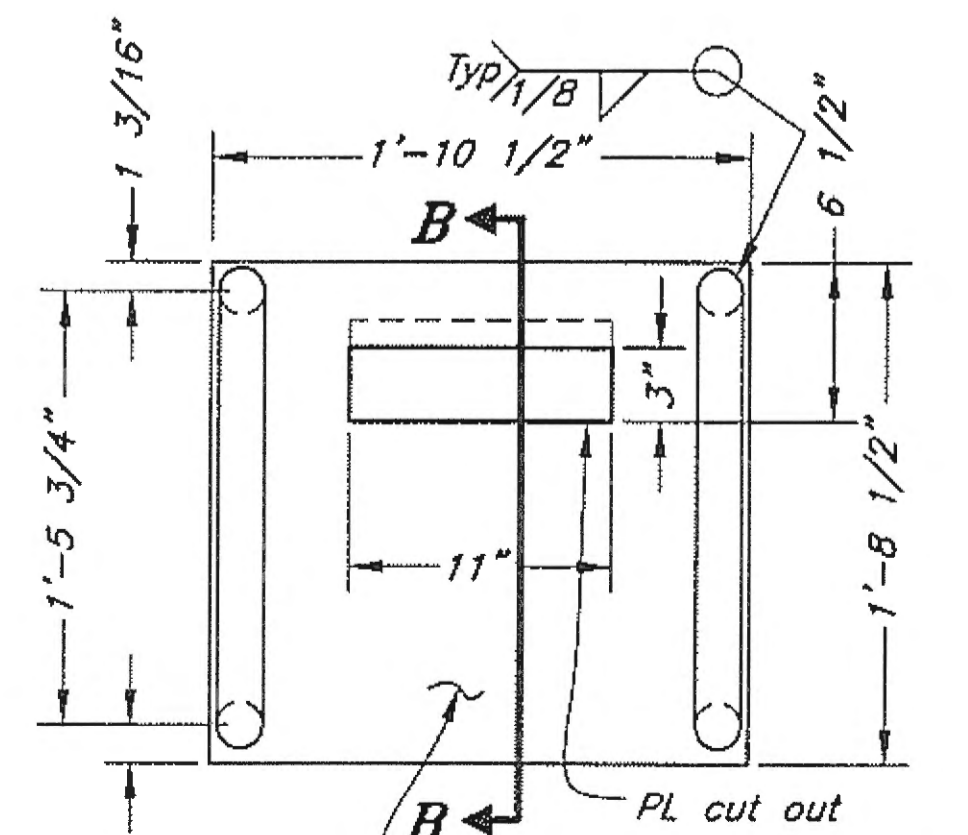


Transition PL Plan

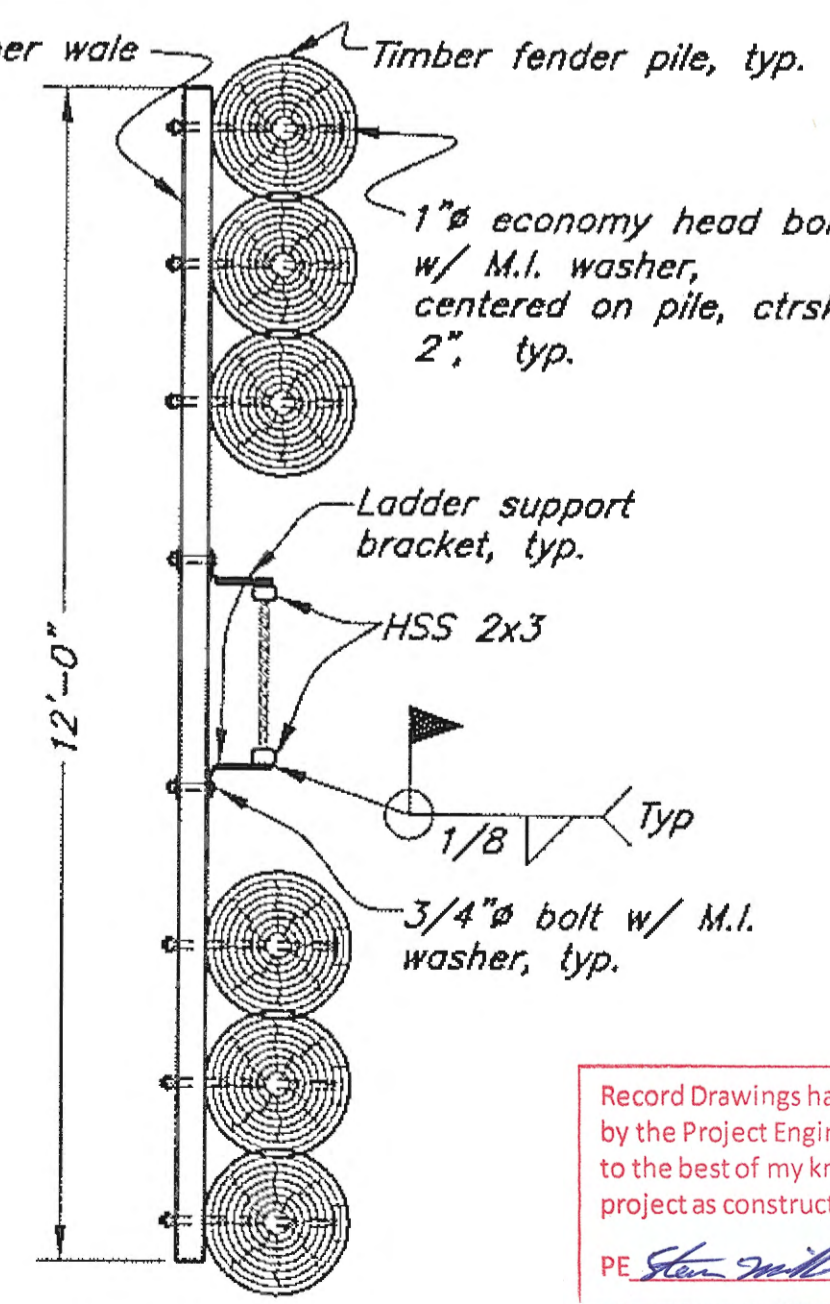

Section C-C

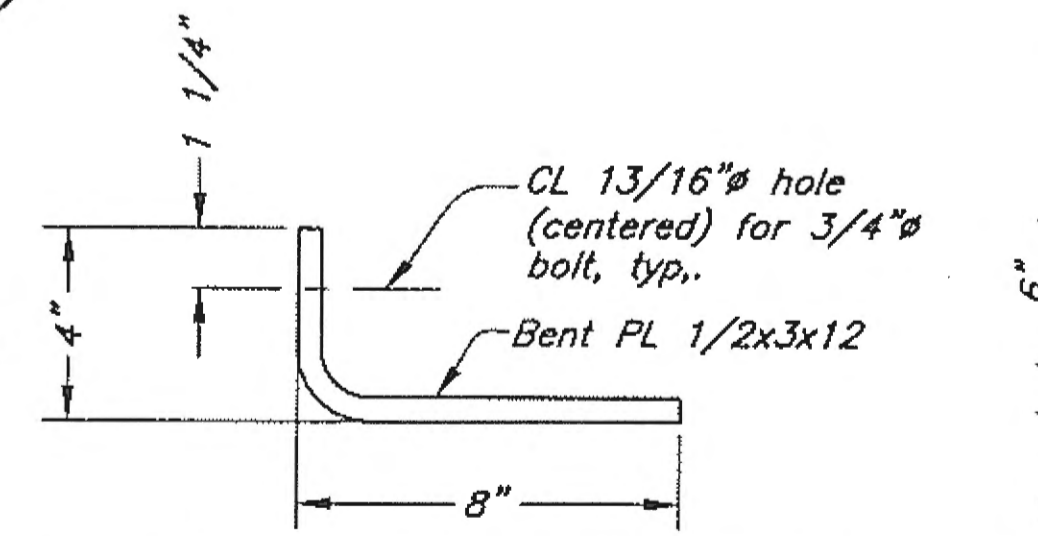

Ladder Support Bracket

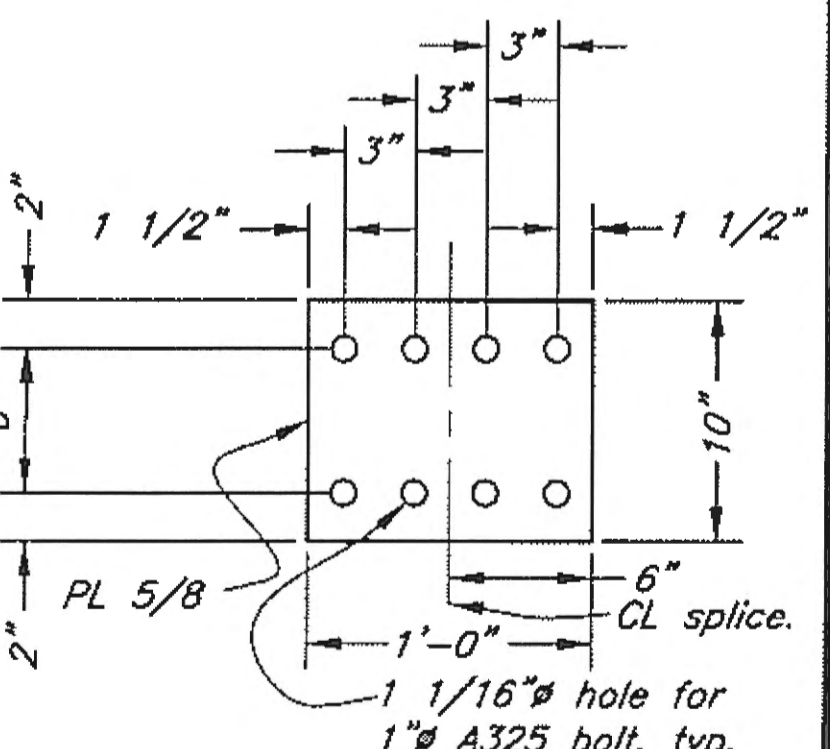

Wale Splice PL

Record Drawings have been reviewed by the Project Engineer, and represent to the best of my knowledge, the project as constructed.
PE [Signature] Date 11/17

DO NOT SCALE FROM THESE DRAWINGS USE DIMENSIONS

DESIGNED BY: J. Scott

CHECKED BY: B. Savikko

DRAWN BY: G. Fuman, W. Hickok

PATH: Q:\GUS\67599\MF\PLANSET\04-DOCK\D11 DOCK FIXED FENDER.DWG

TAB: Wed, 26/Nov/08 11:27AM

REVISIONS

NO.	DATE	DESCRIPTION

PROJECT DESIGNATION: BR-0003(53)/67599

YEAR: 2008

SHEET NO.: 62

TOTAL SHEETS: 138


STATE OF ALASKA
DEPARTMENT OF TRANSPORTATION & PUBLIC FACILITIES
DESIGN & ENGINEERING SERVICES DIVISION-SOUTHEAST REGION

Gustavus Causeway Replacement


Dock Fixed Fender Details

D11


11-26-08

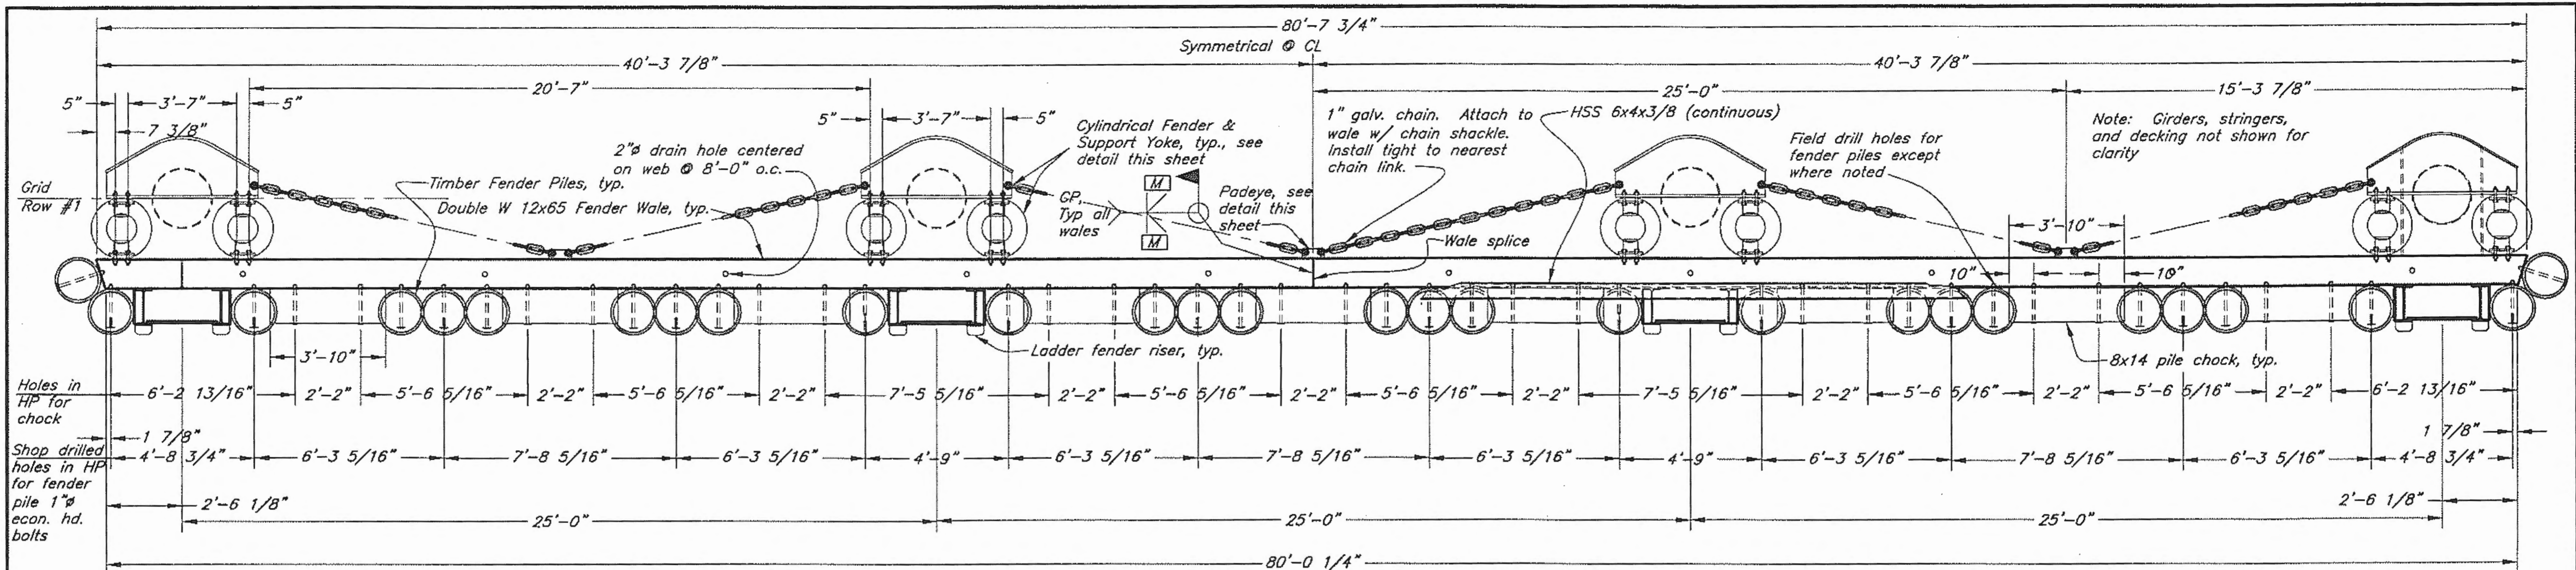


Grid Row #1 Fender Plan

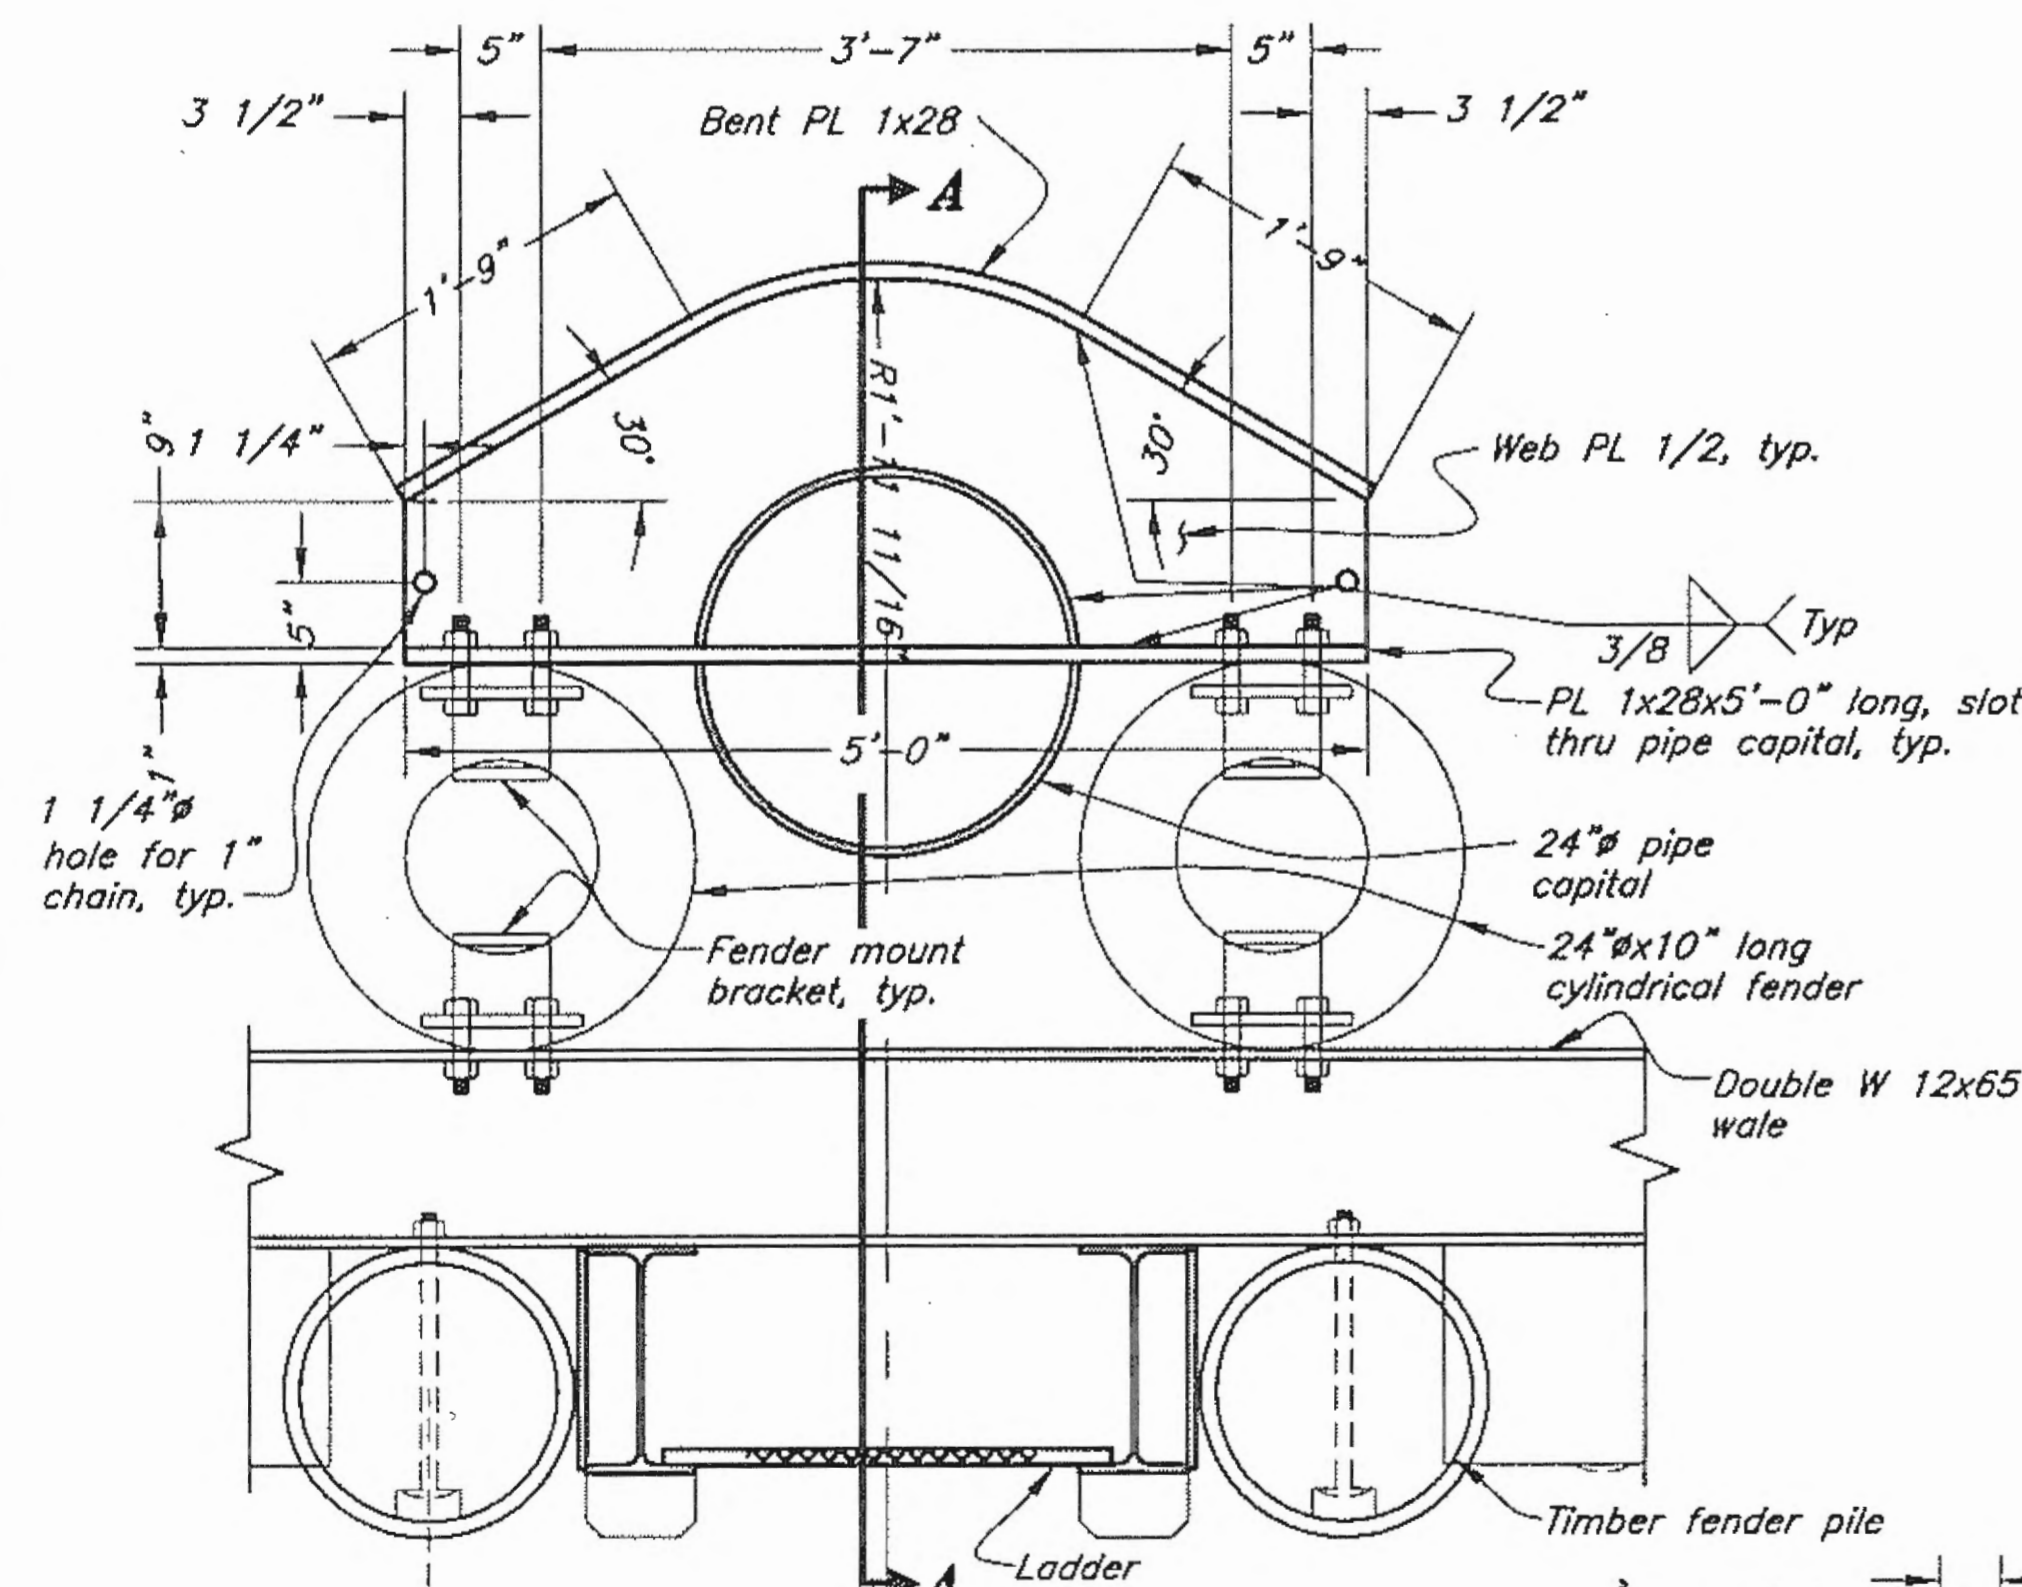


Fender & Fender Yoke Plan

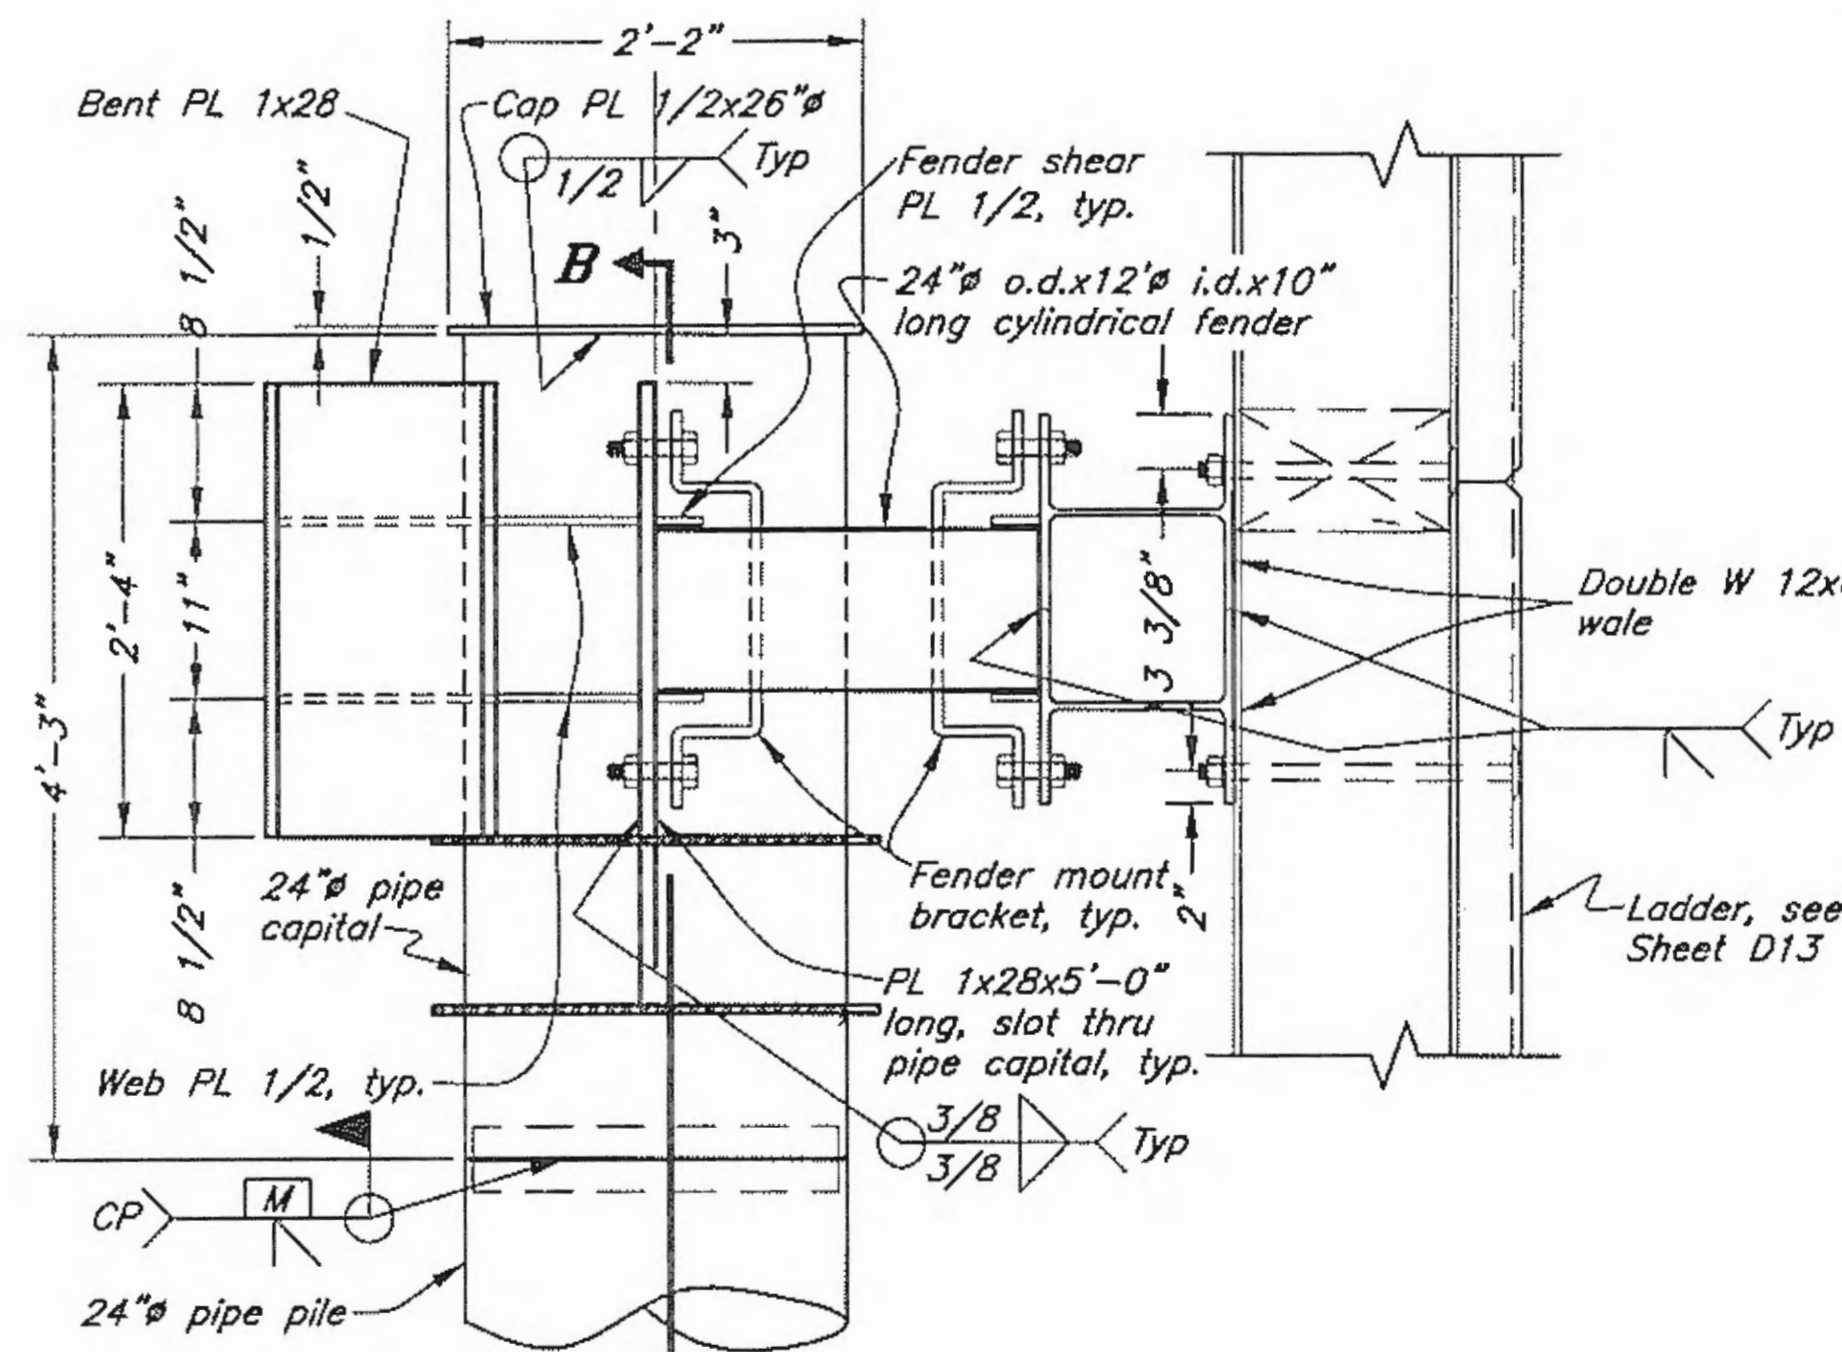


Section A-A Capital w/ Yoke

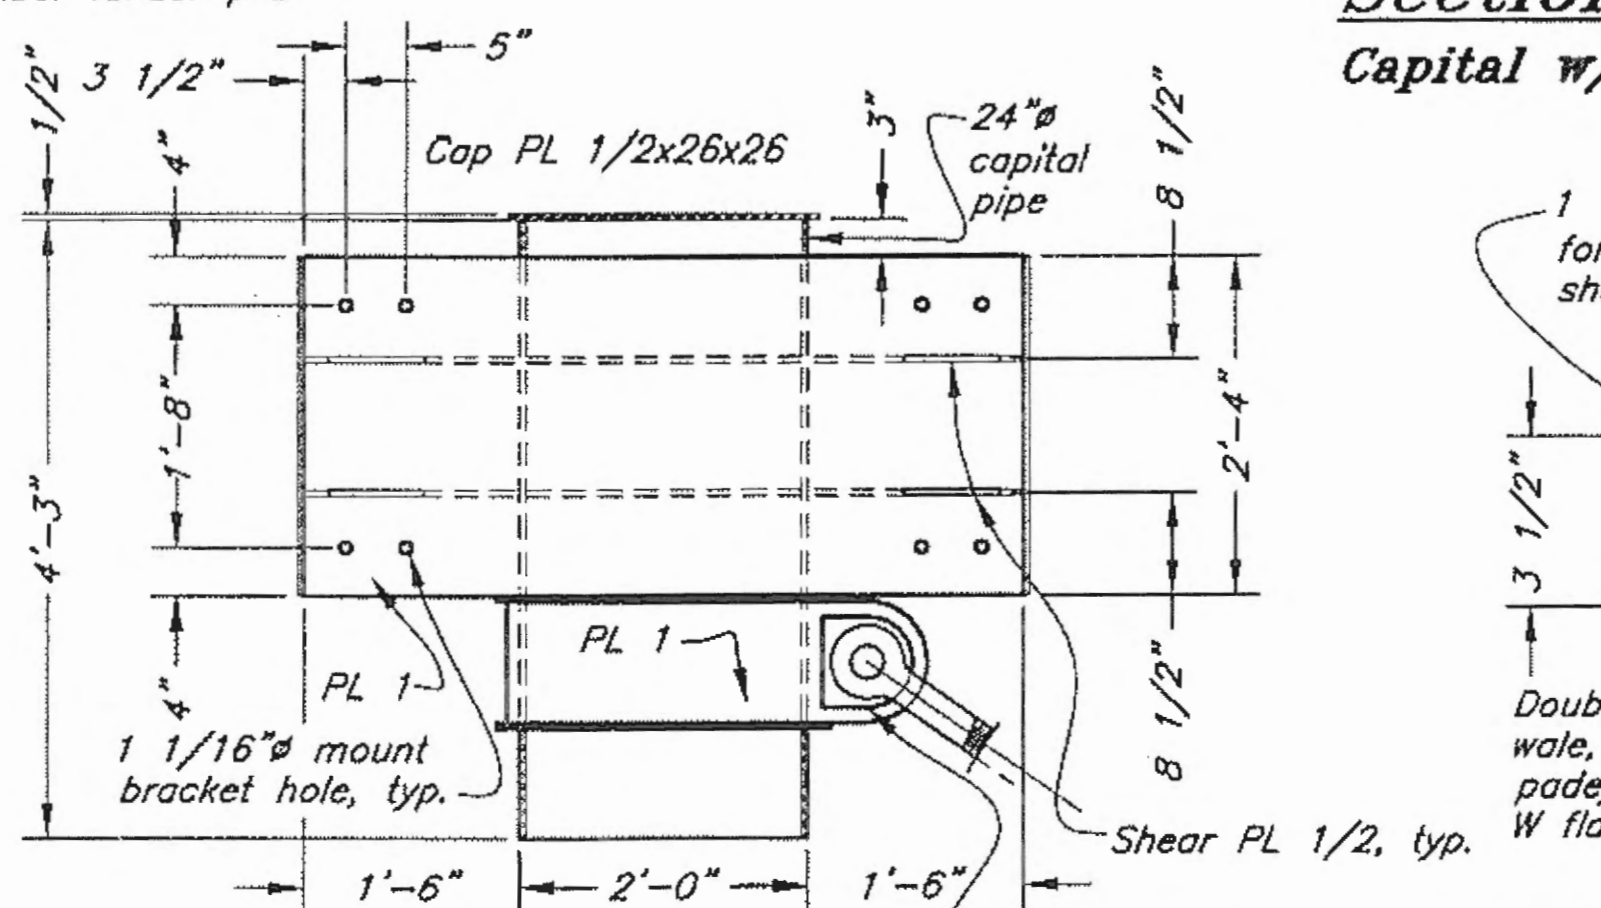

Section B-B

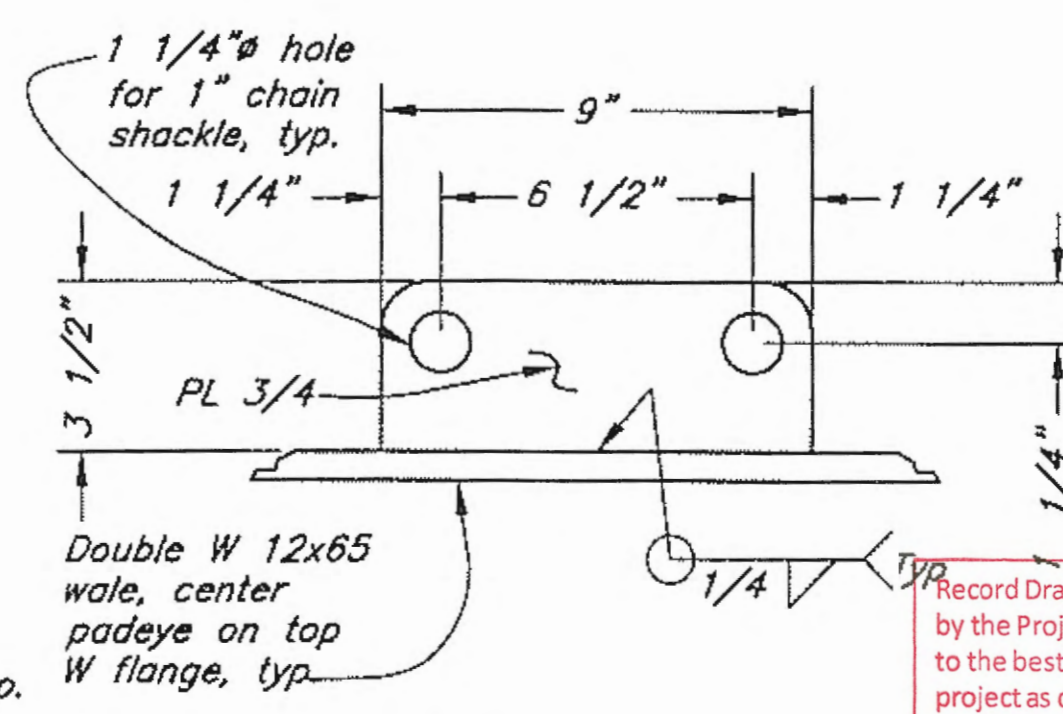








Chain Padeye

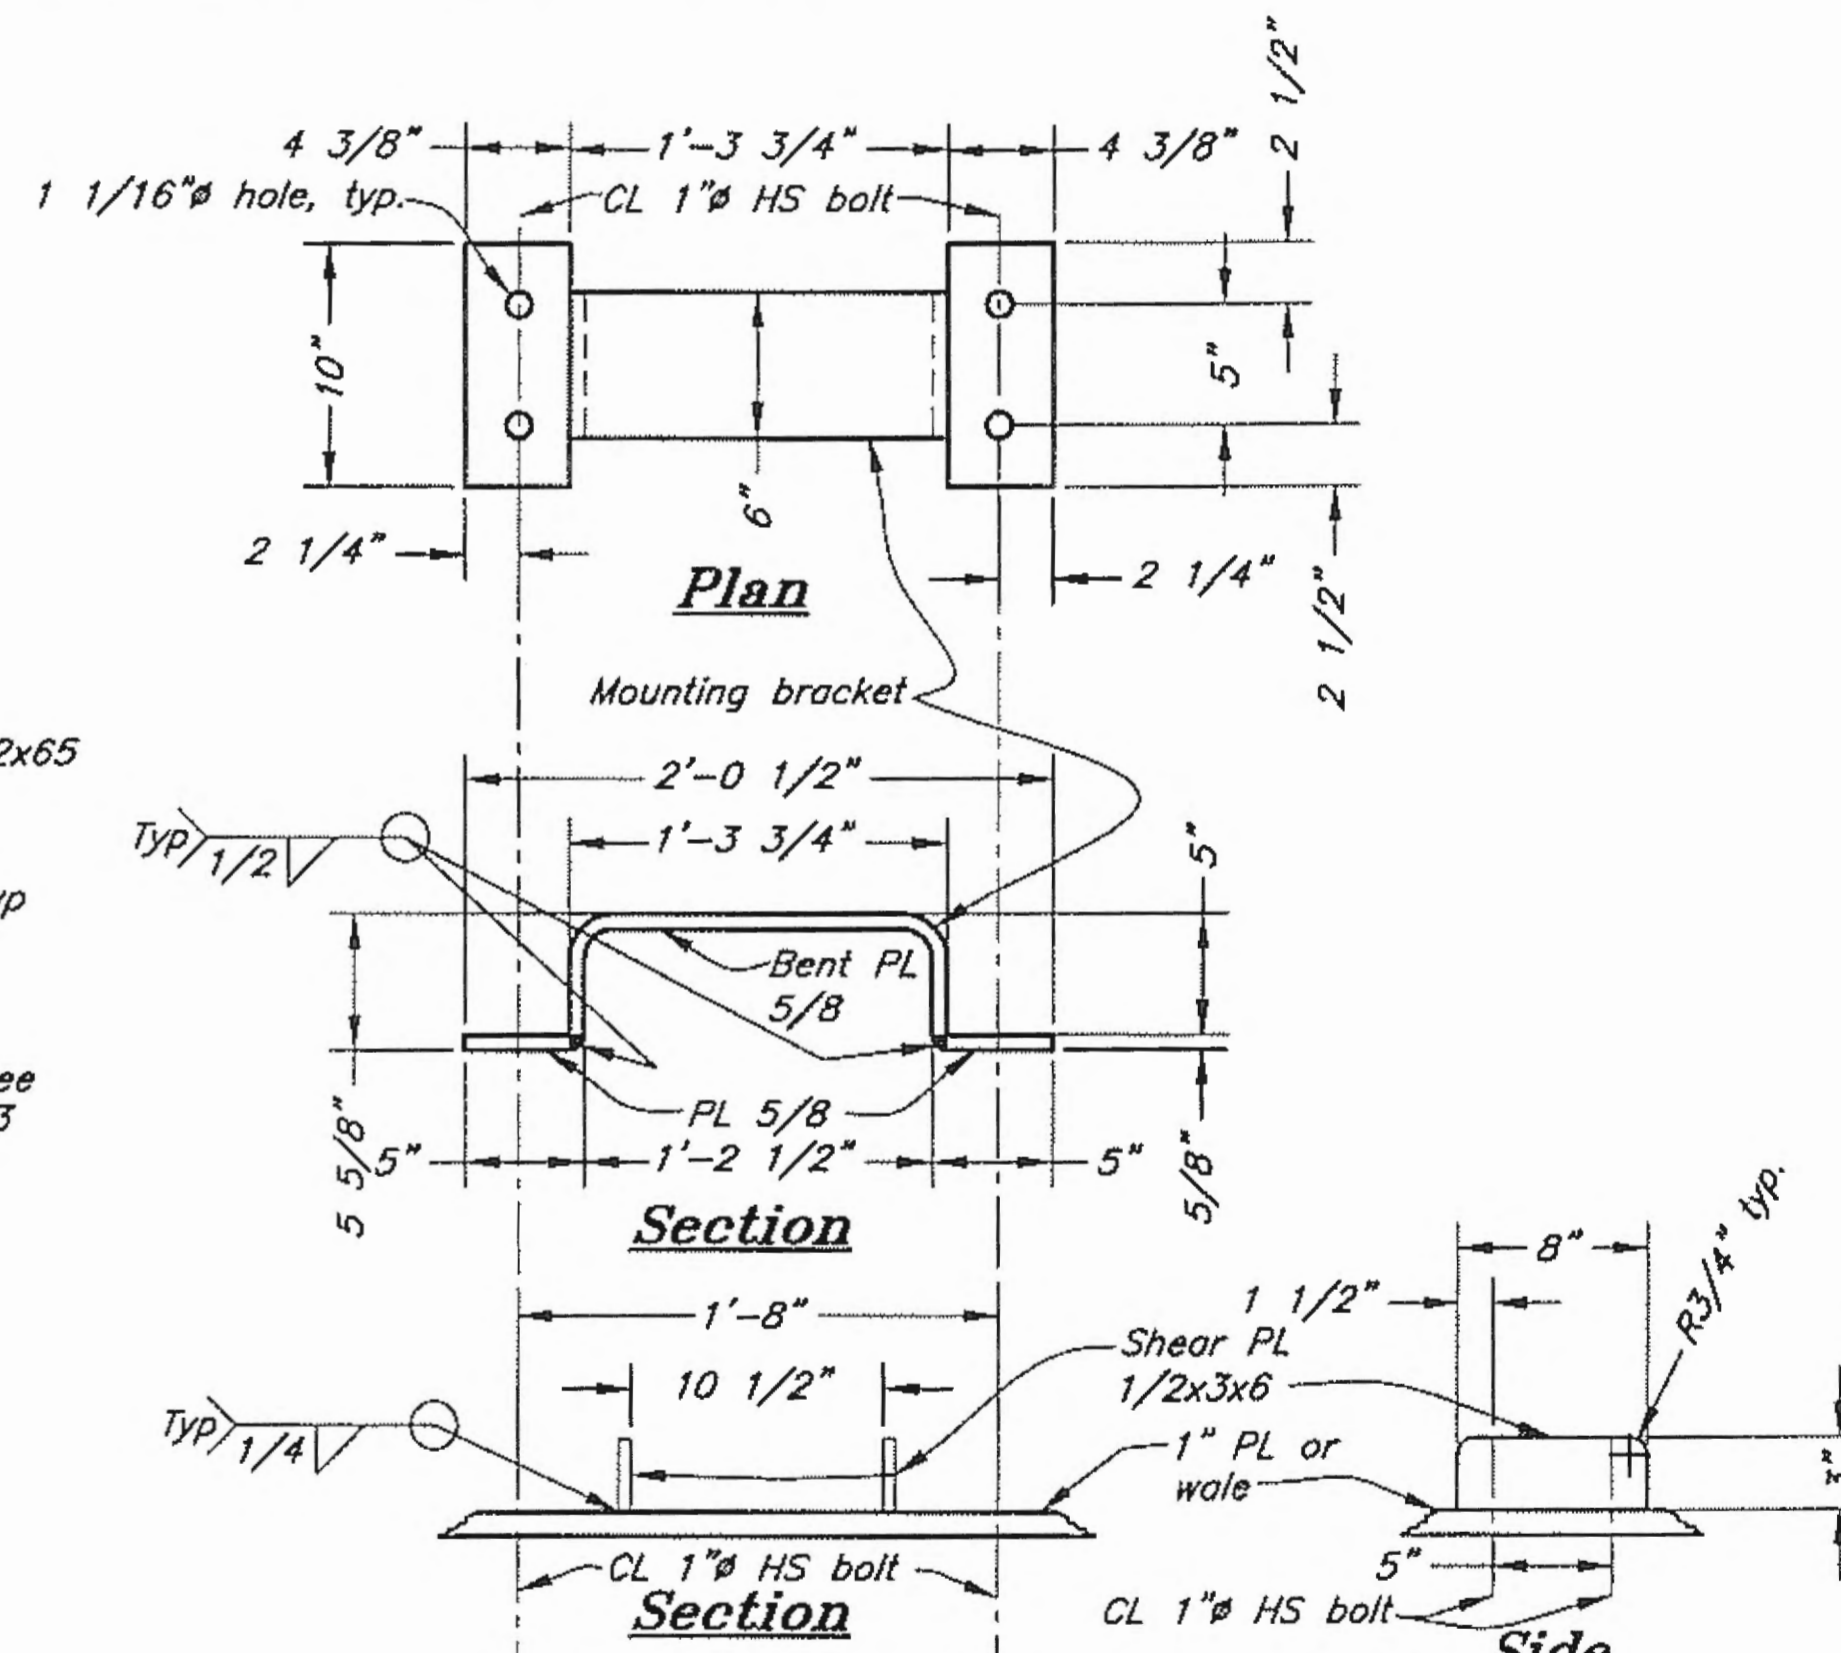

Fender Mount Bracket & Mounting Details

DO NOT SCALE FROM THESE DRAWINGS USE DIMENSIONS

DESIGNED BY: J. Scott	STATE OF ALASKA DEPARTMENT OF TRANSPORTATION & PUBLIC FACILITIES DESIGN & ENGINEERING SERVICES DIVISION-SOUTHEAST REGION
CHECKED BY: B. Savikko	Gustavus Causeway Replacement Dock Front Fender Details (Grid Row #1)
DRAWN BY: C. Fuman, W. Hickok	D12
PATH: Q:\GUS\67599\MF\PLANSET\04-DOCK\D12 DOCK FRONT FENDER.DWG	REVISIONS
TAB: Wed, 26/Nov/08 11:30AM	NO. DATE DESCRIPTION
	PROJECT DESIGNATION YEAR SHEET NO. TOTAL SHEETS
	BR-0003(53)/67599 2008 63 138

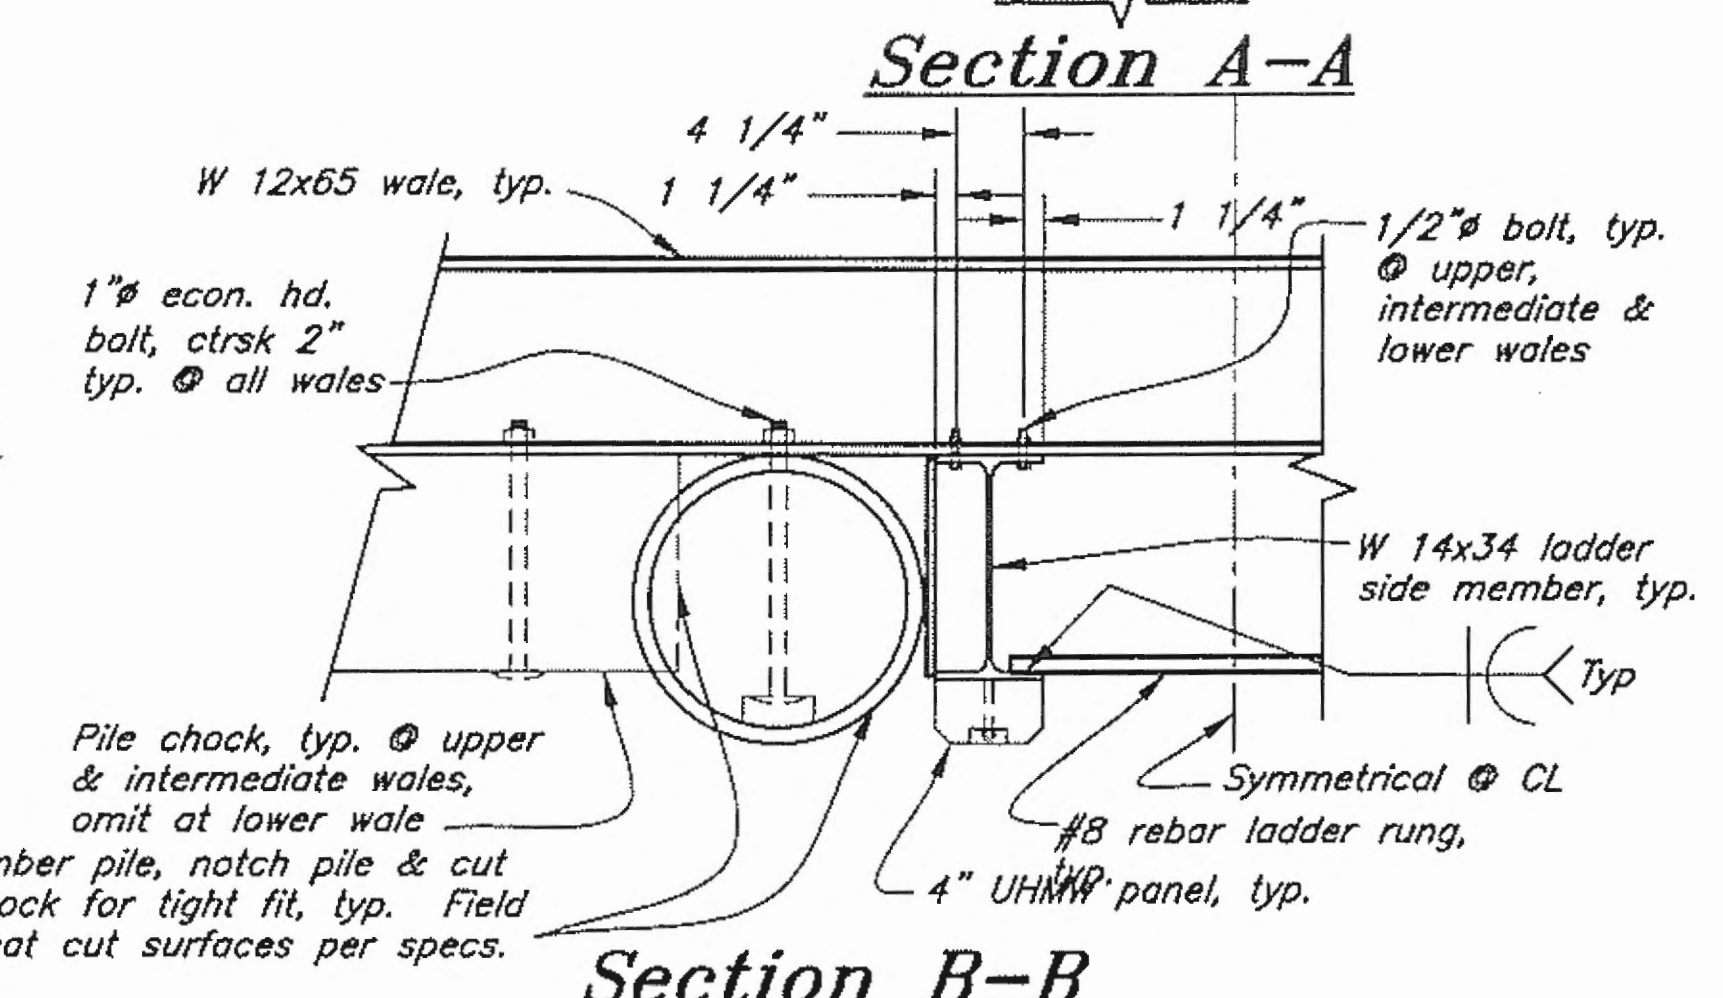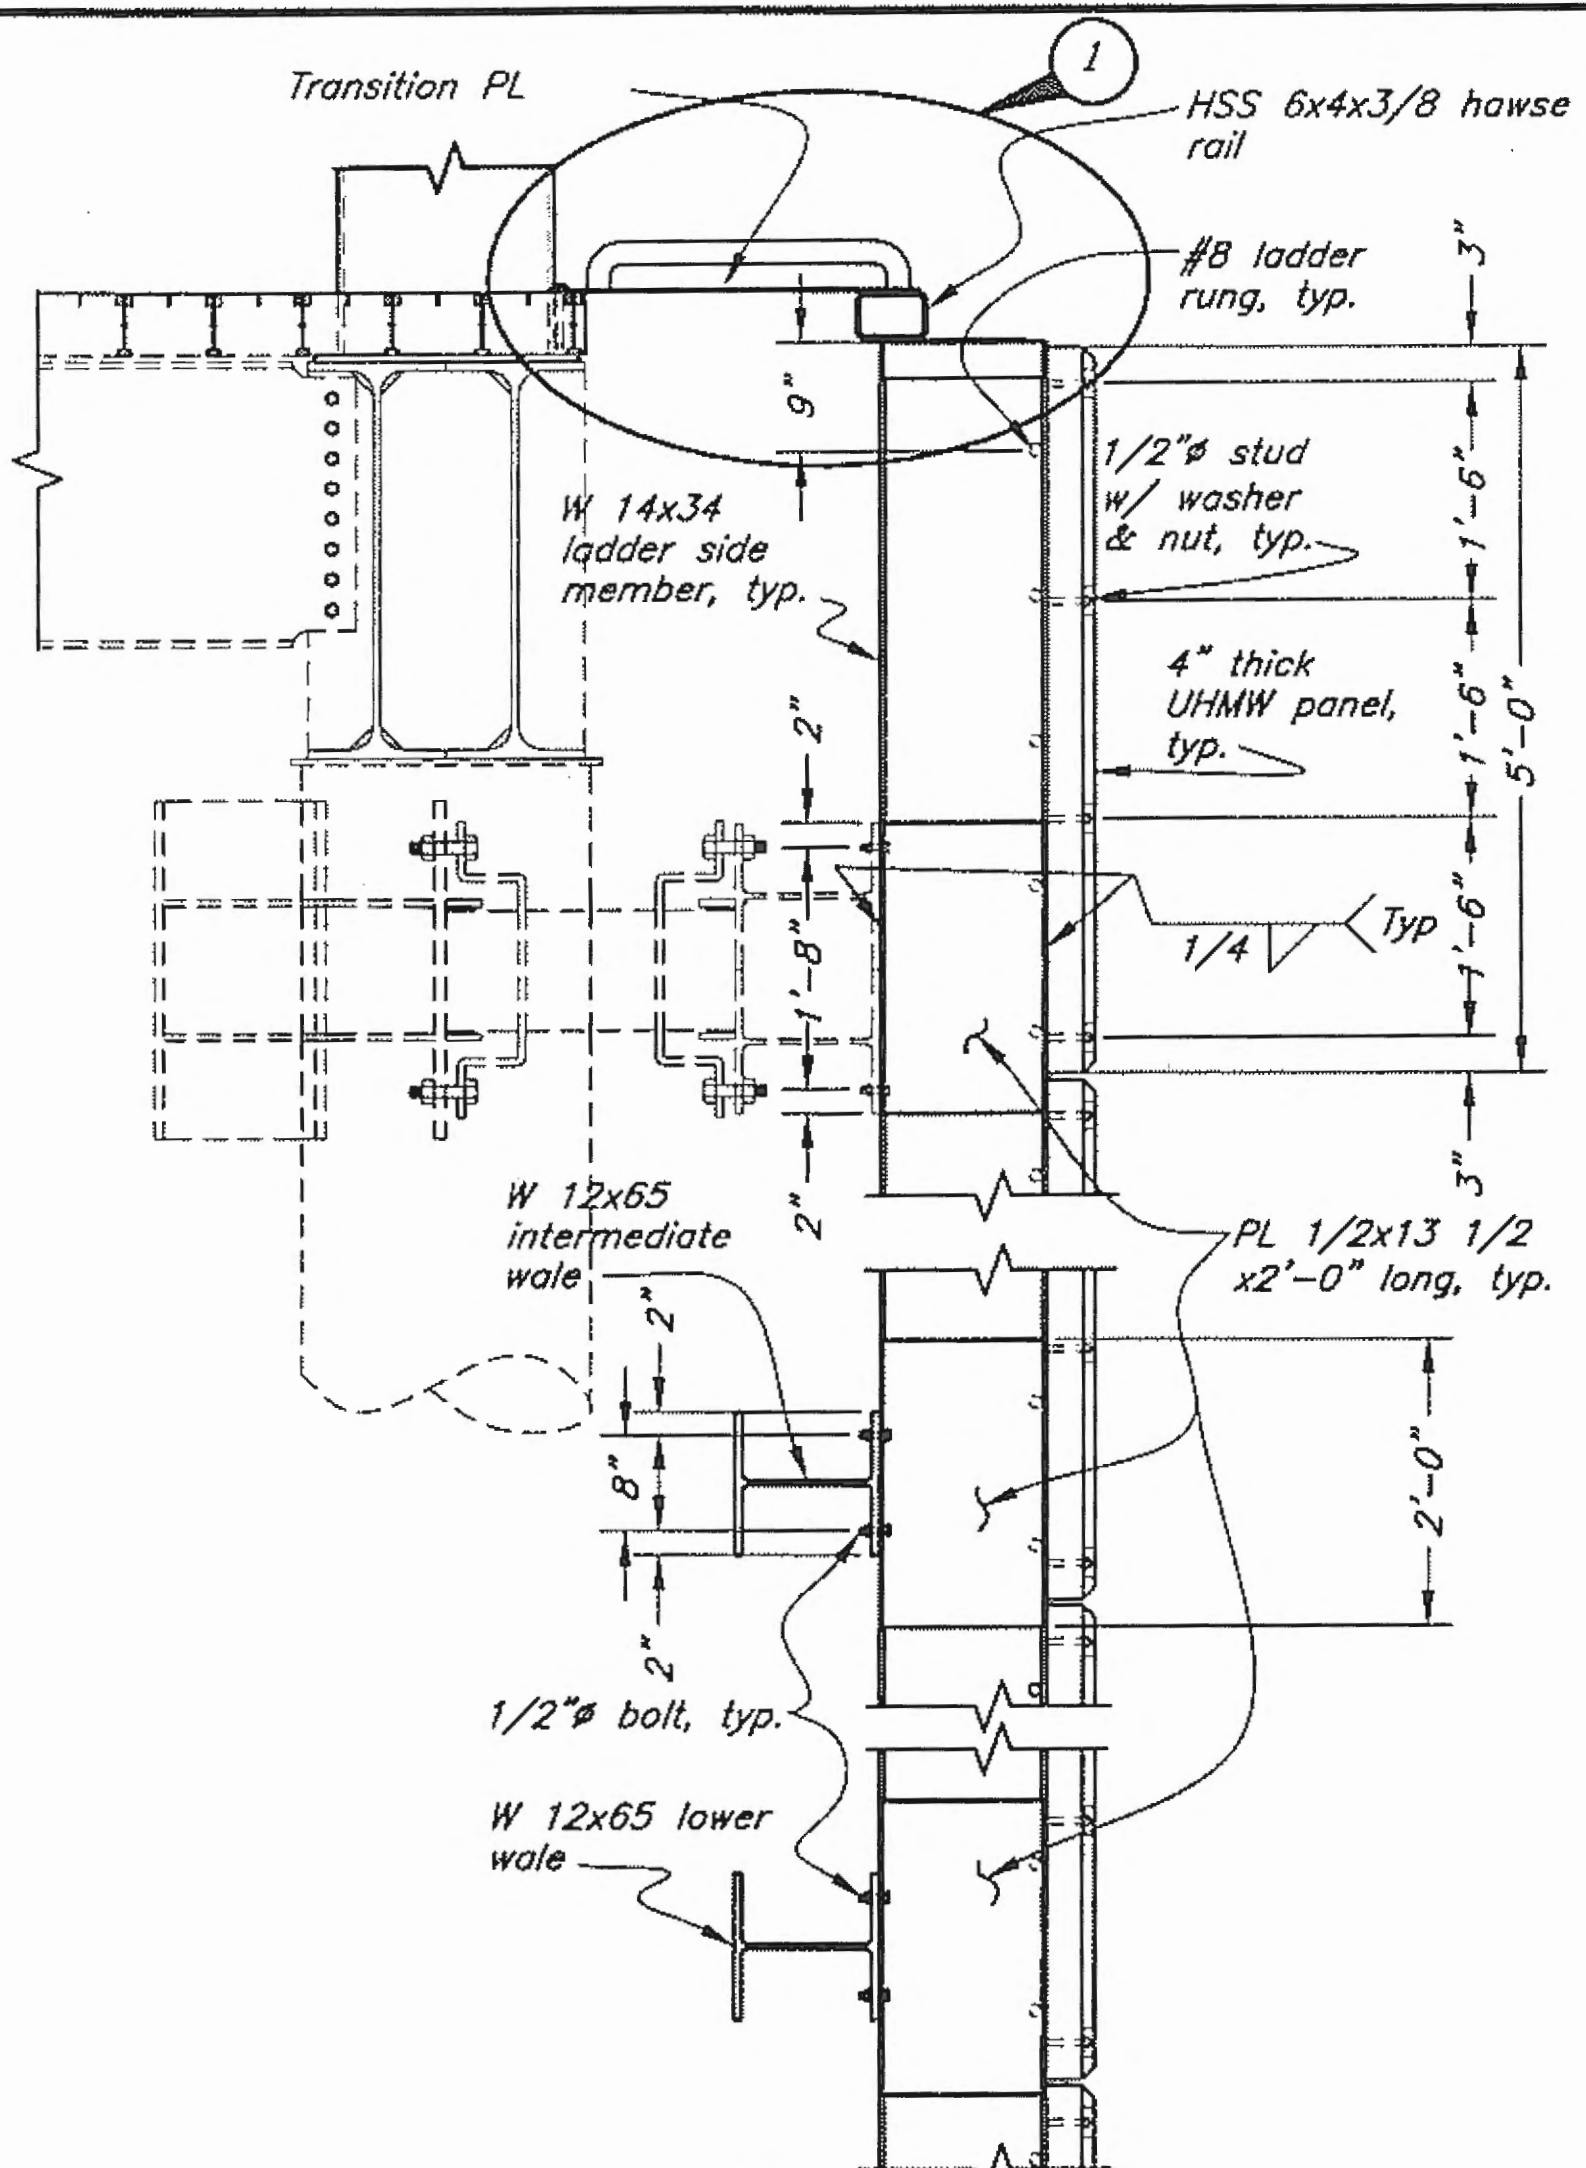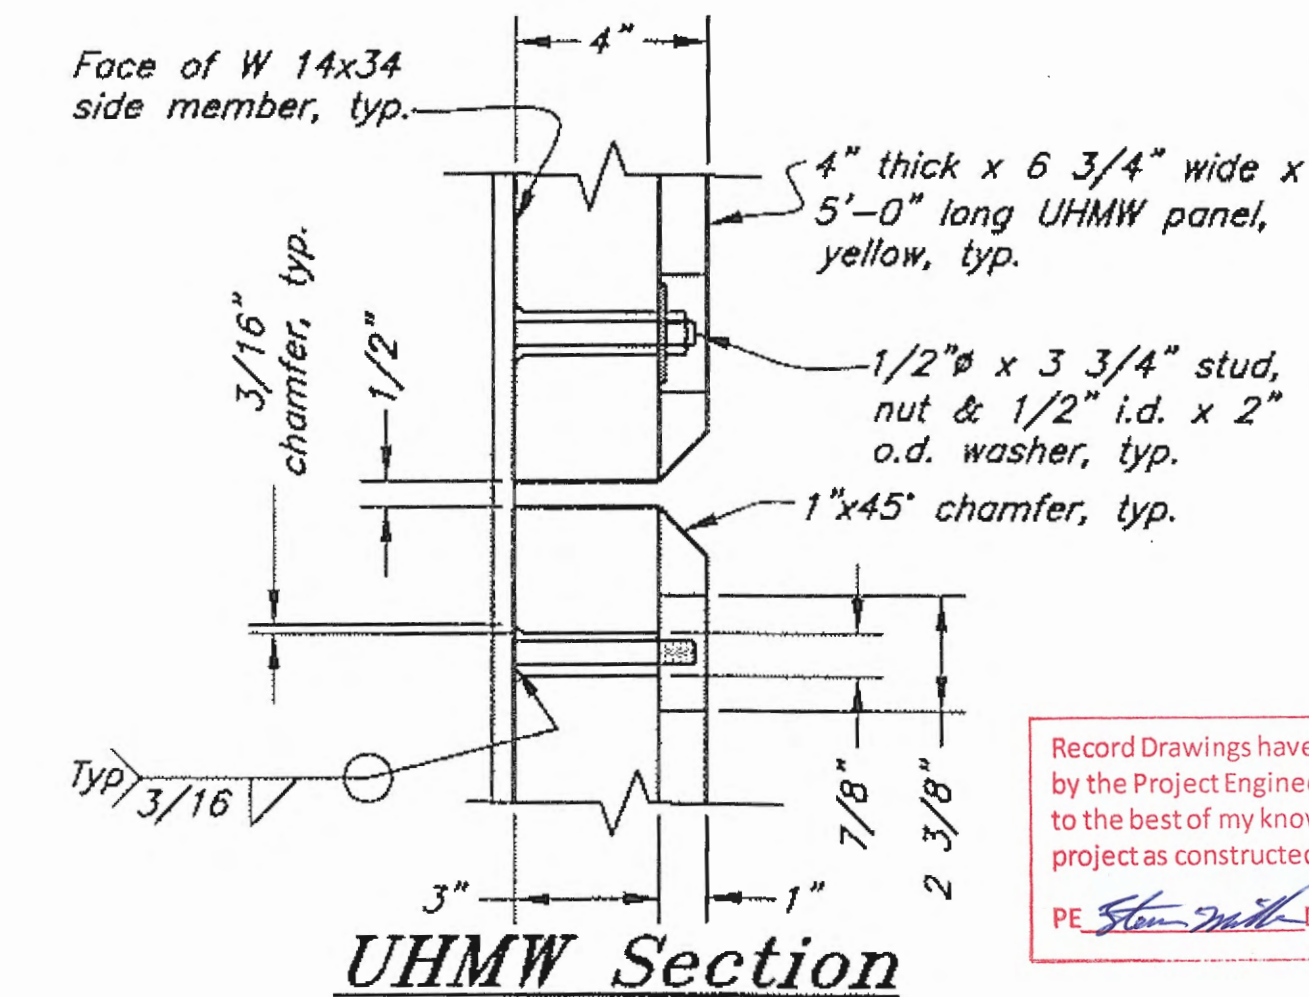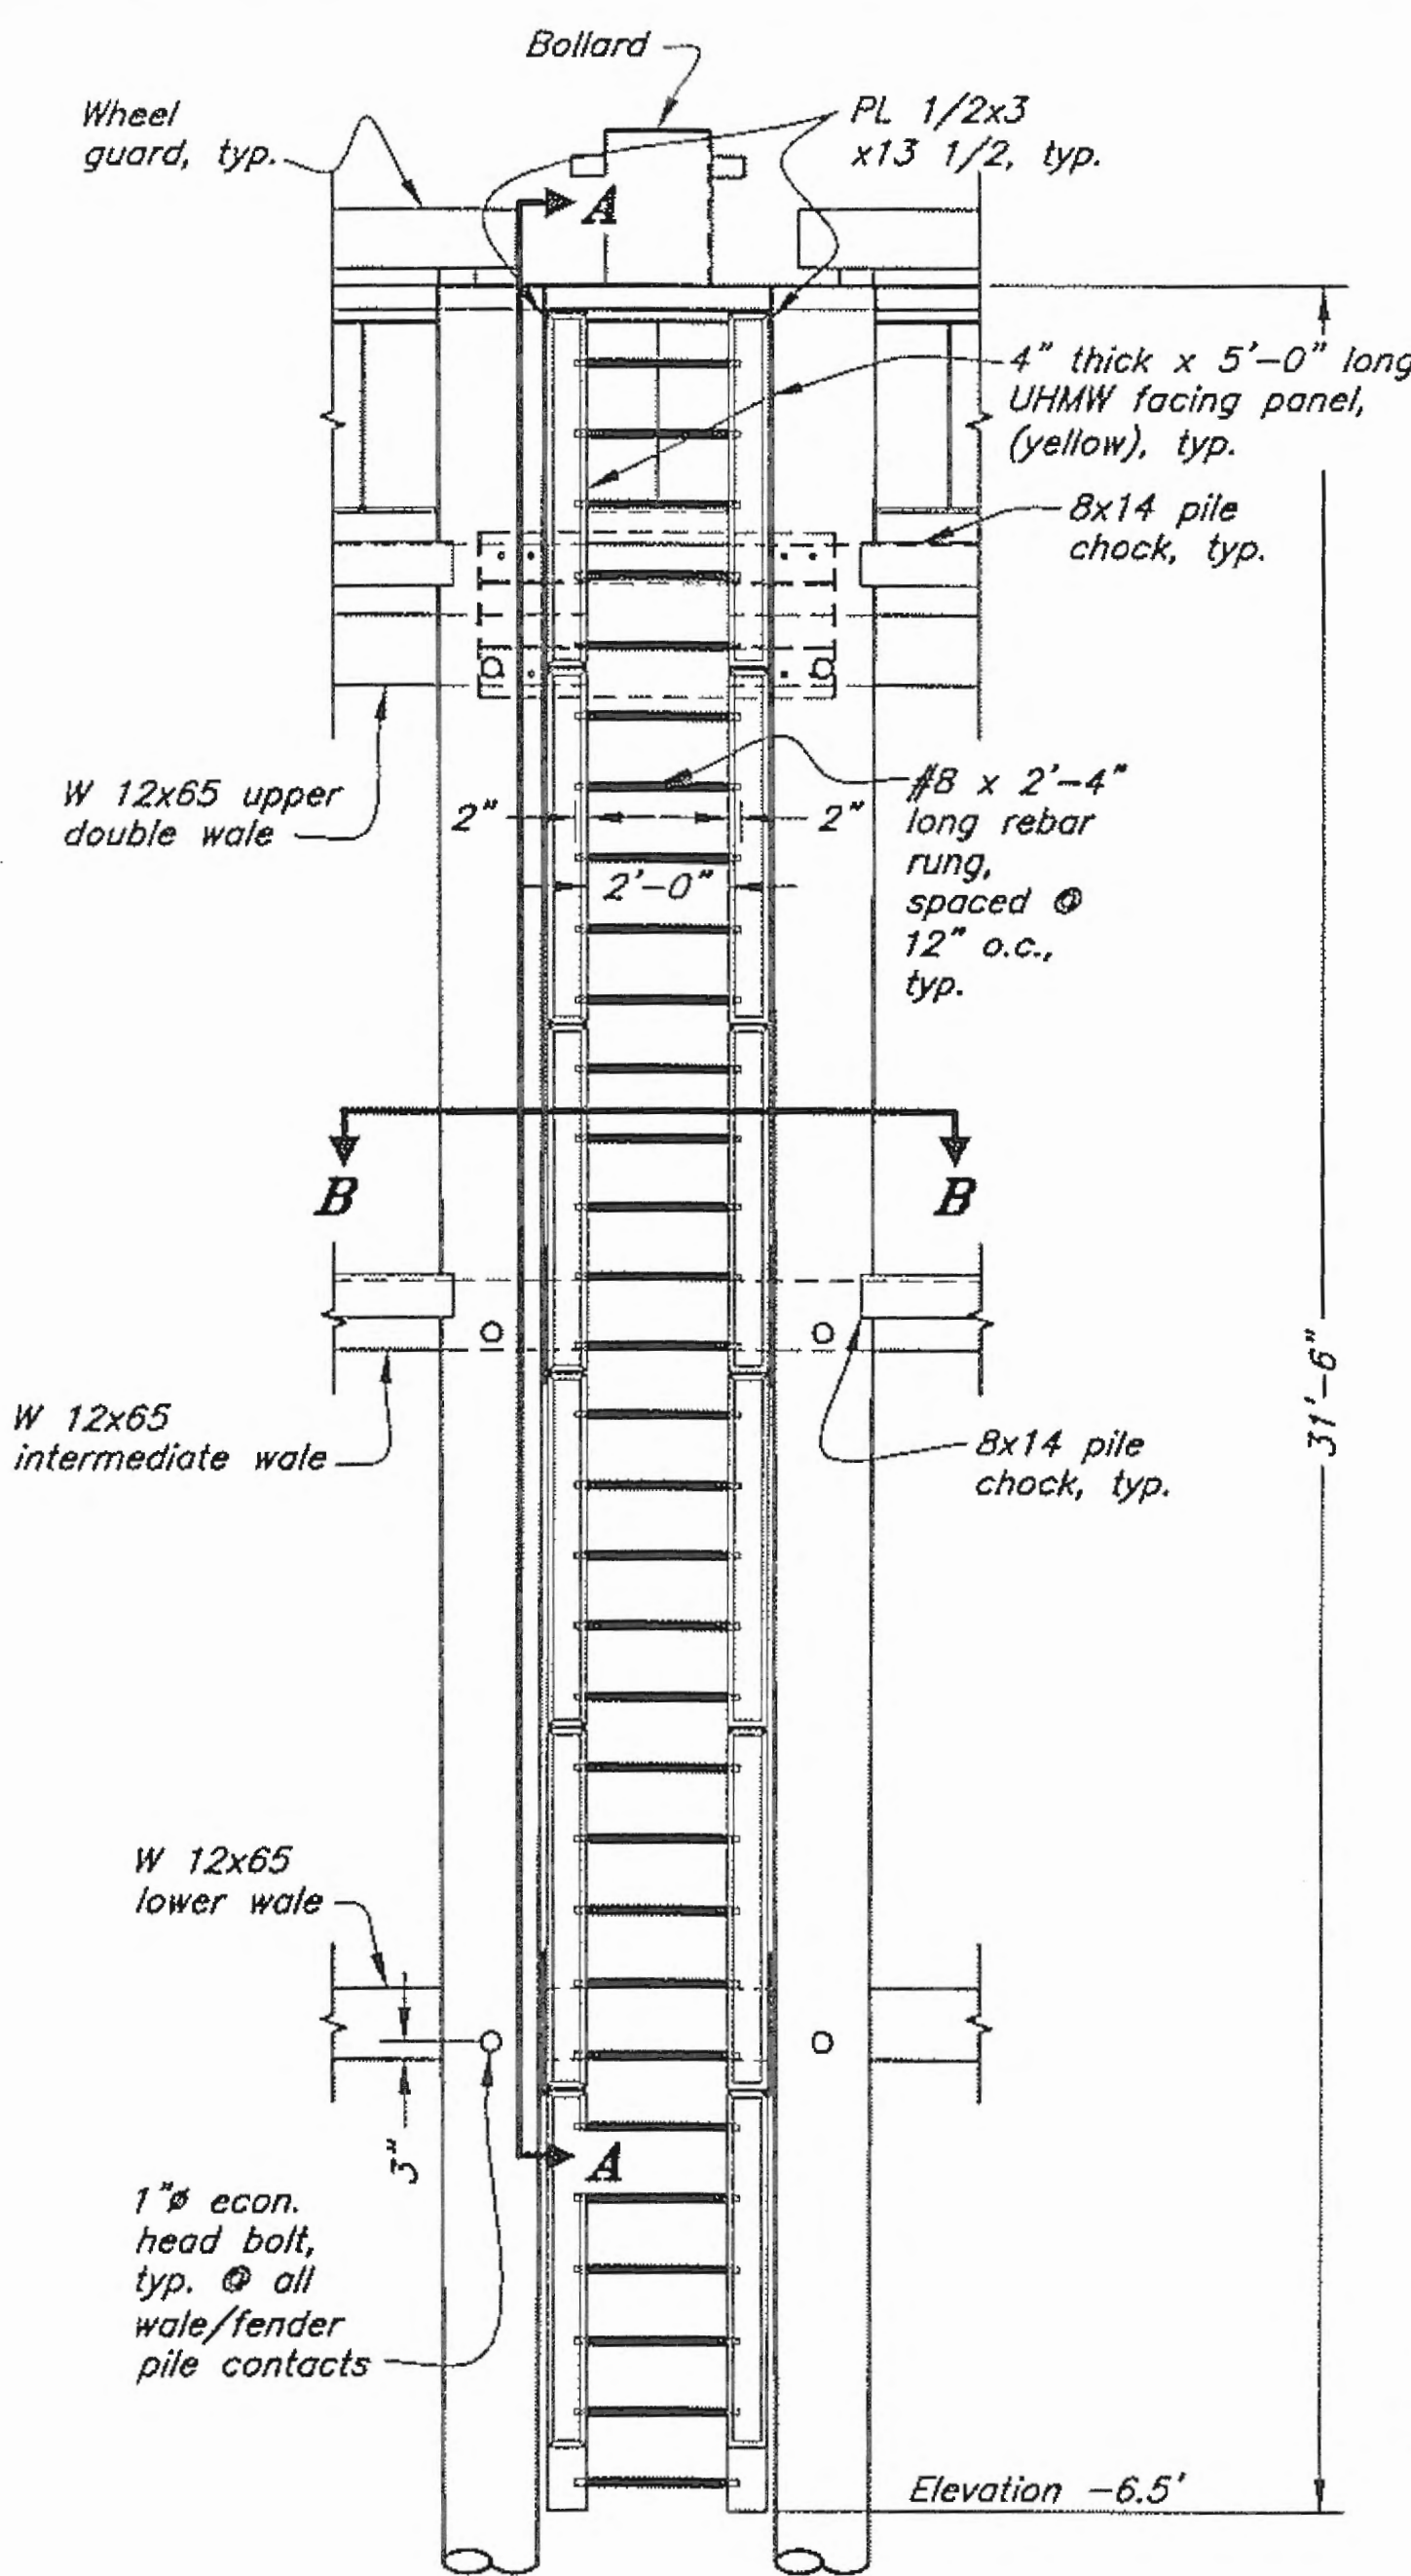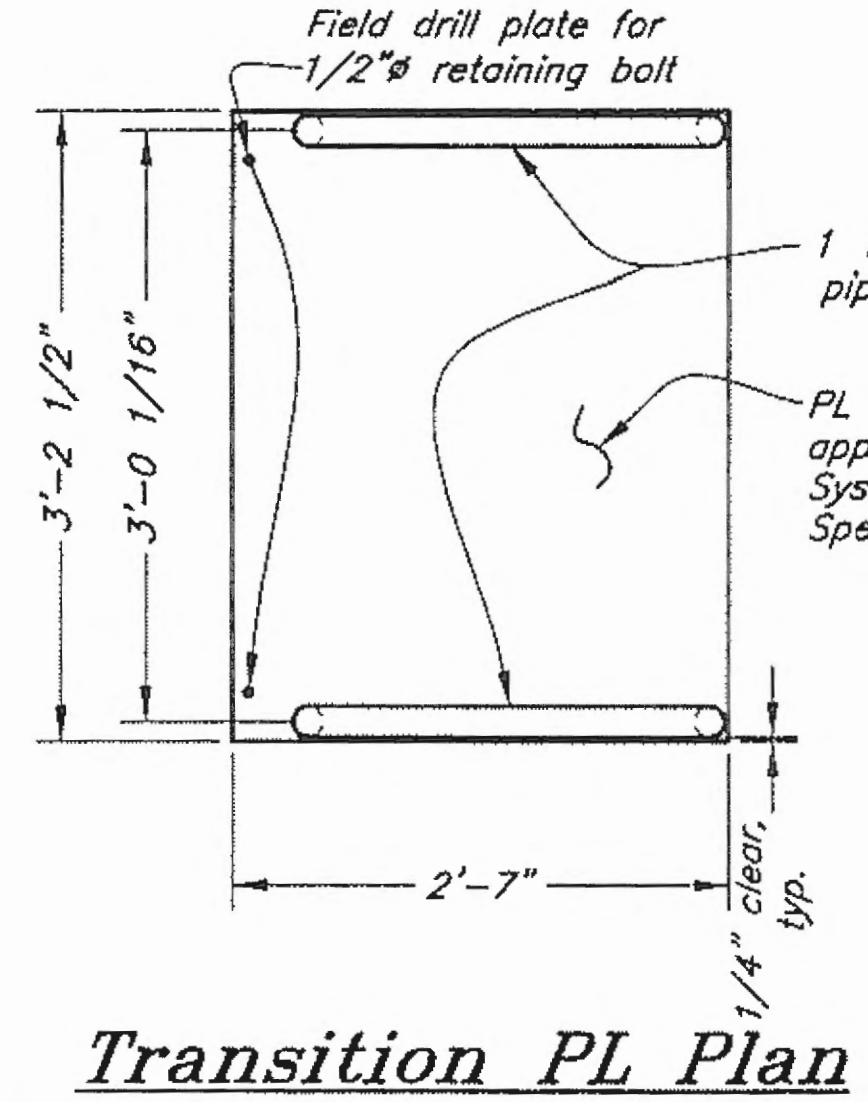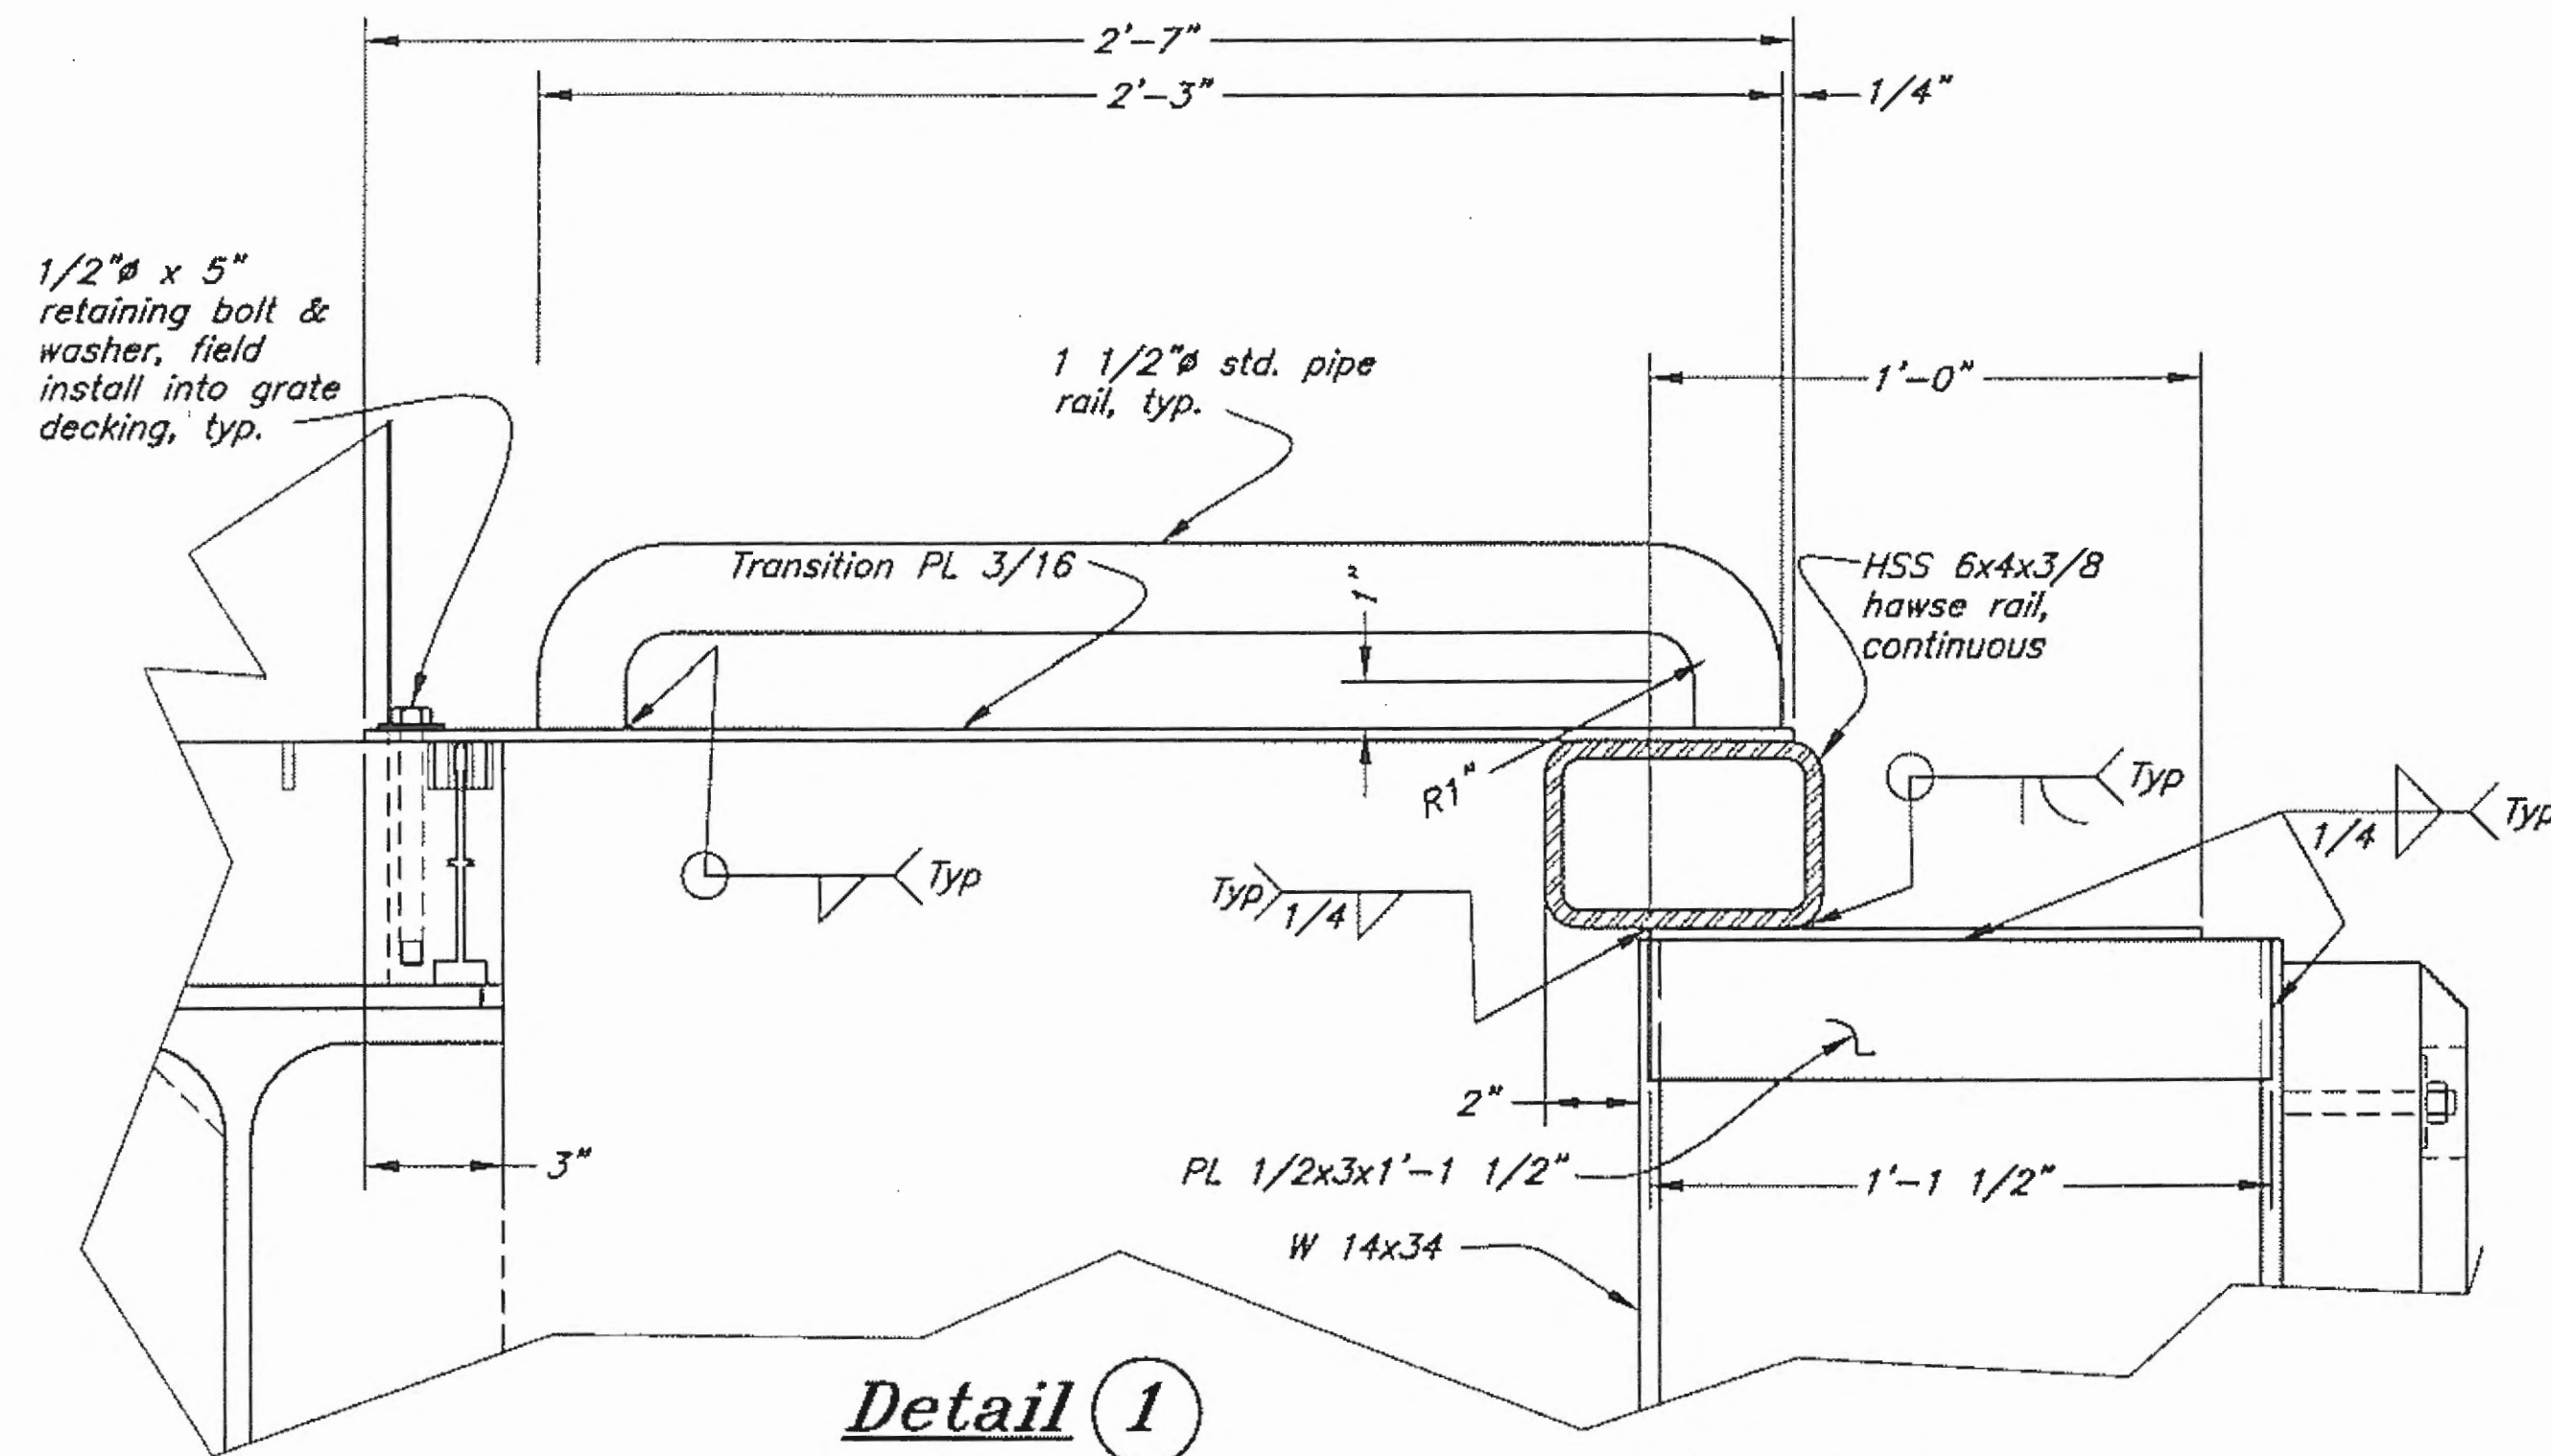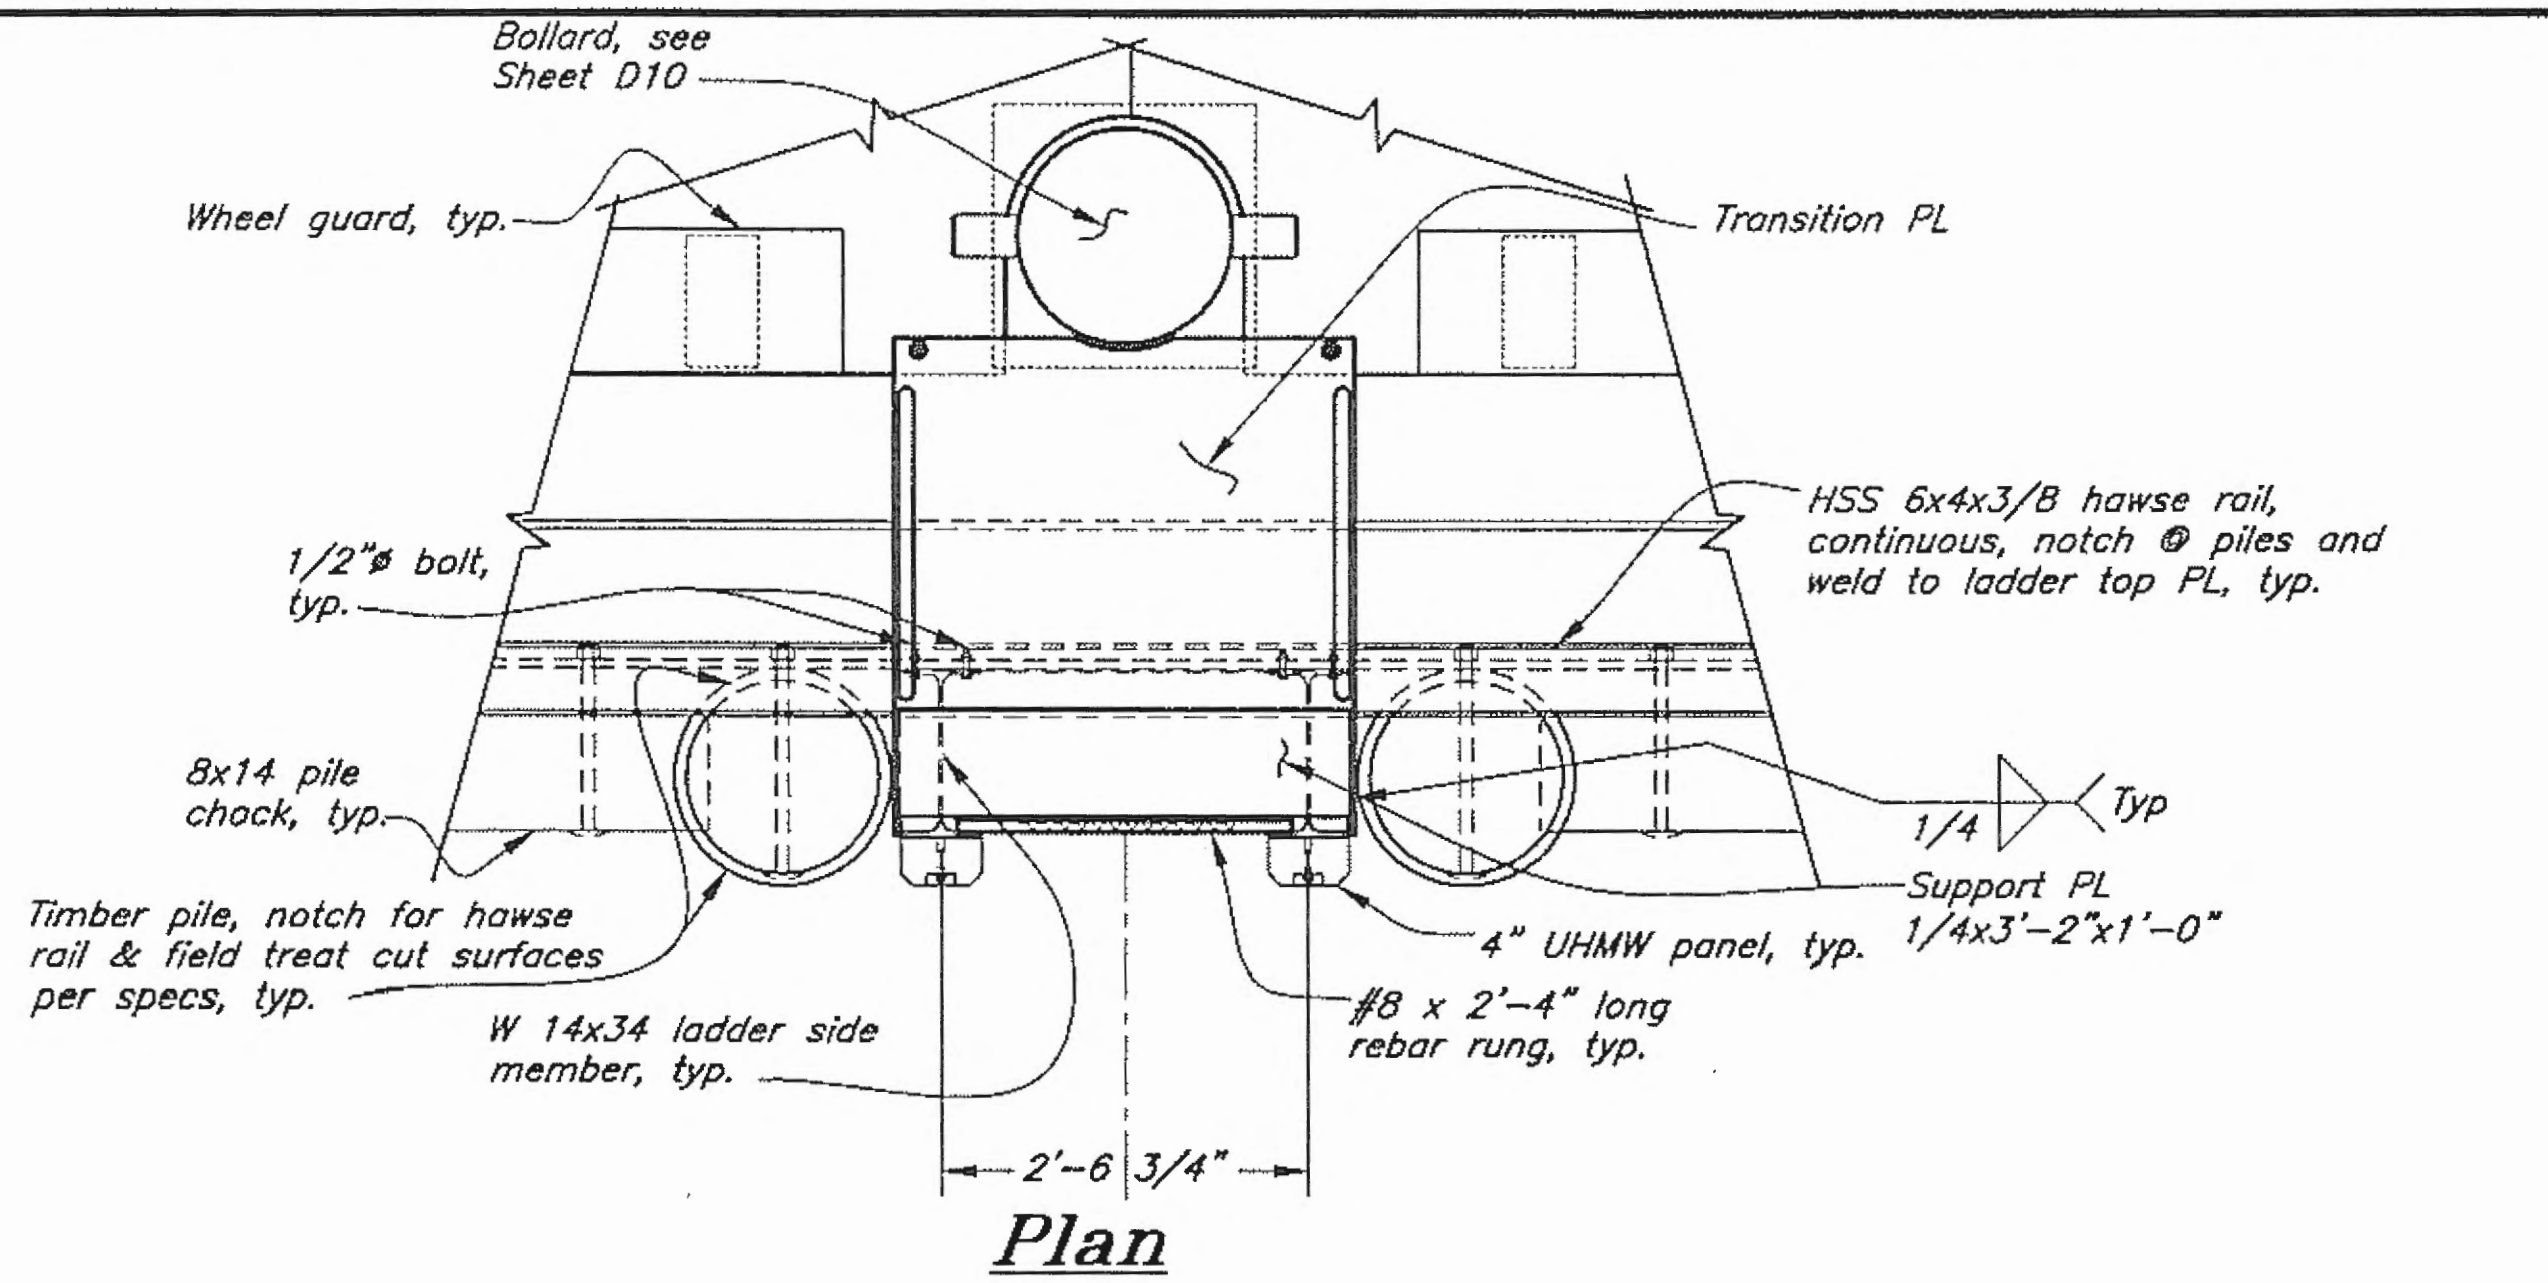

Record Drawings have been reviewed by the Project Engineer, and represent to the best of my knowledge, the project as constructed.
 PE: *[Signature]* Date: 5/21/17

DO NOT SCALE FROM THESE DRAWINGS USE DIMENSIONS

DESIGNED BY: J. Scott

CHECKED BY: B. Sovikko

DRAWN BY: C. Fuman, W. Hickey

PATH: Q:\GUS\67599\MF\PLANSET\04-DOCK\D13 DOCK FRONT FENDER LADDER & TP.DWG

TAB: Wed, 26/Nov/08 11:31AM

STATE OF ALASKA
 DEPARTMENT OF TRANSPORTATION & PUBLIC FACILITIES
 DESIGN & ENGINEERING SERVICES DIVISION-SOUTHEAST REGION

Gustavus Causeway Replacement
 Dock Front Fender Ladder & Transition Plate

D13

REVISIONS


NO.	DATE	DESCRIPTION

PROJECT DESIGNATION: BR-0003(53)/67599

YEAR: 2008

SHEET NO.: 64

TOTAL SHEETS: 138

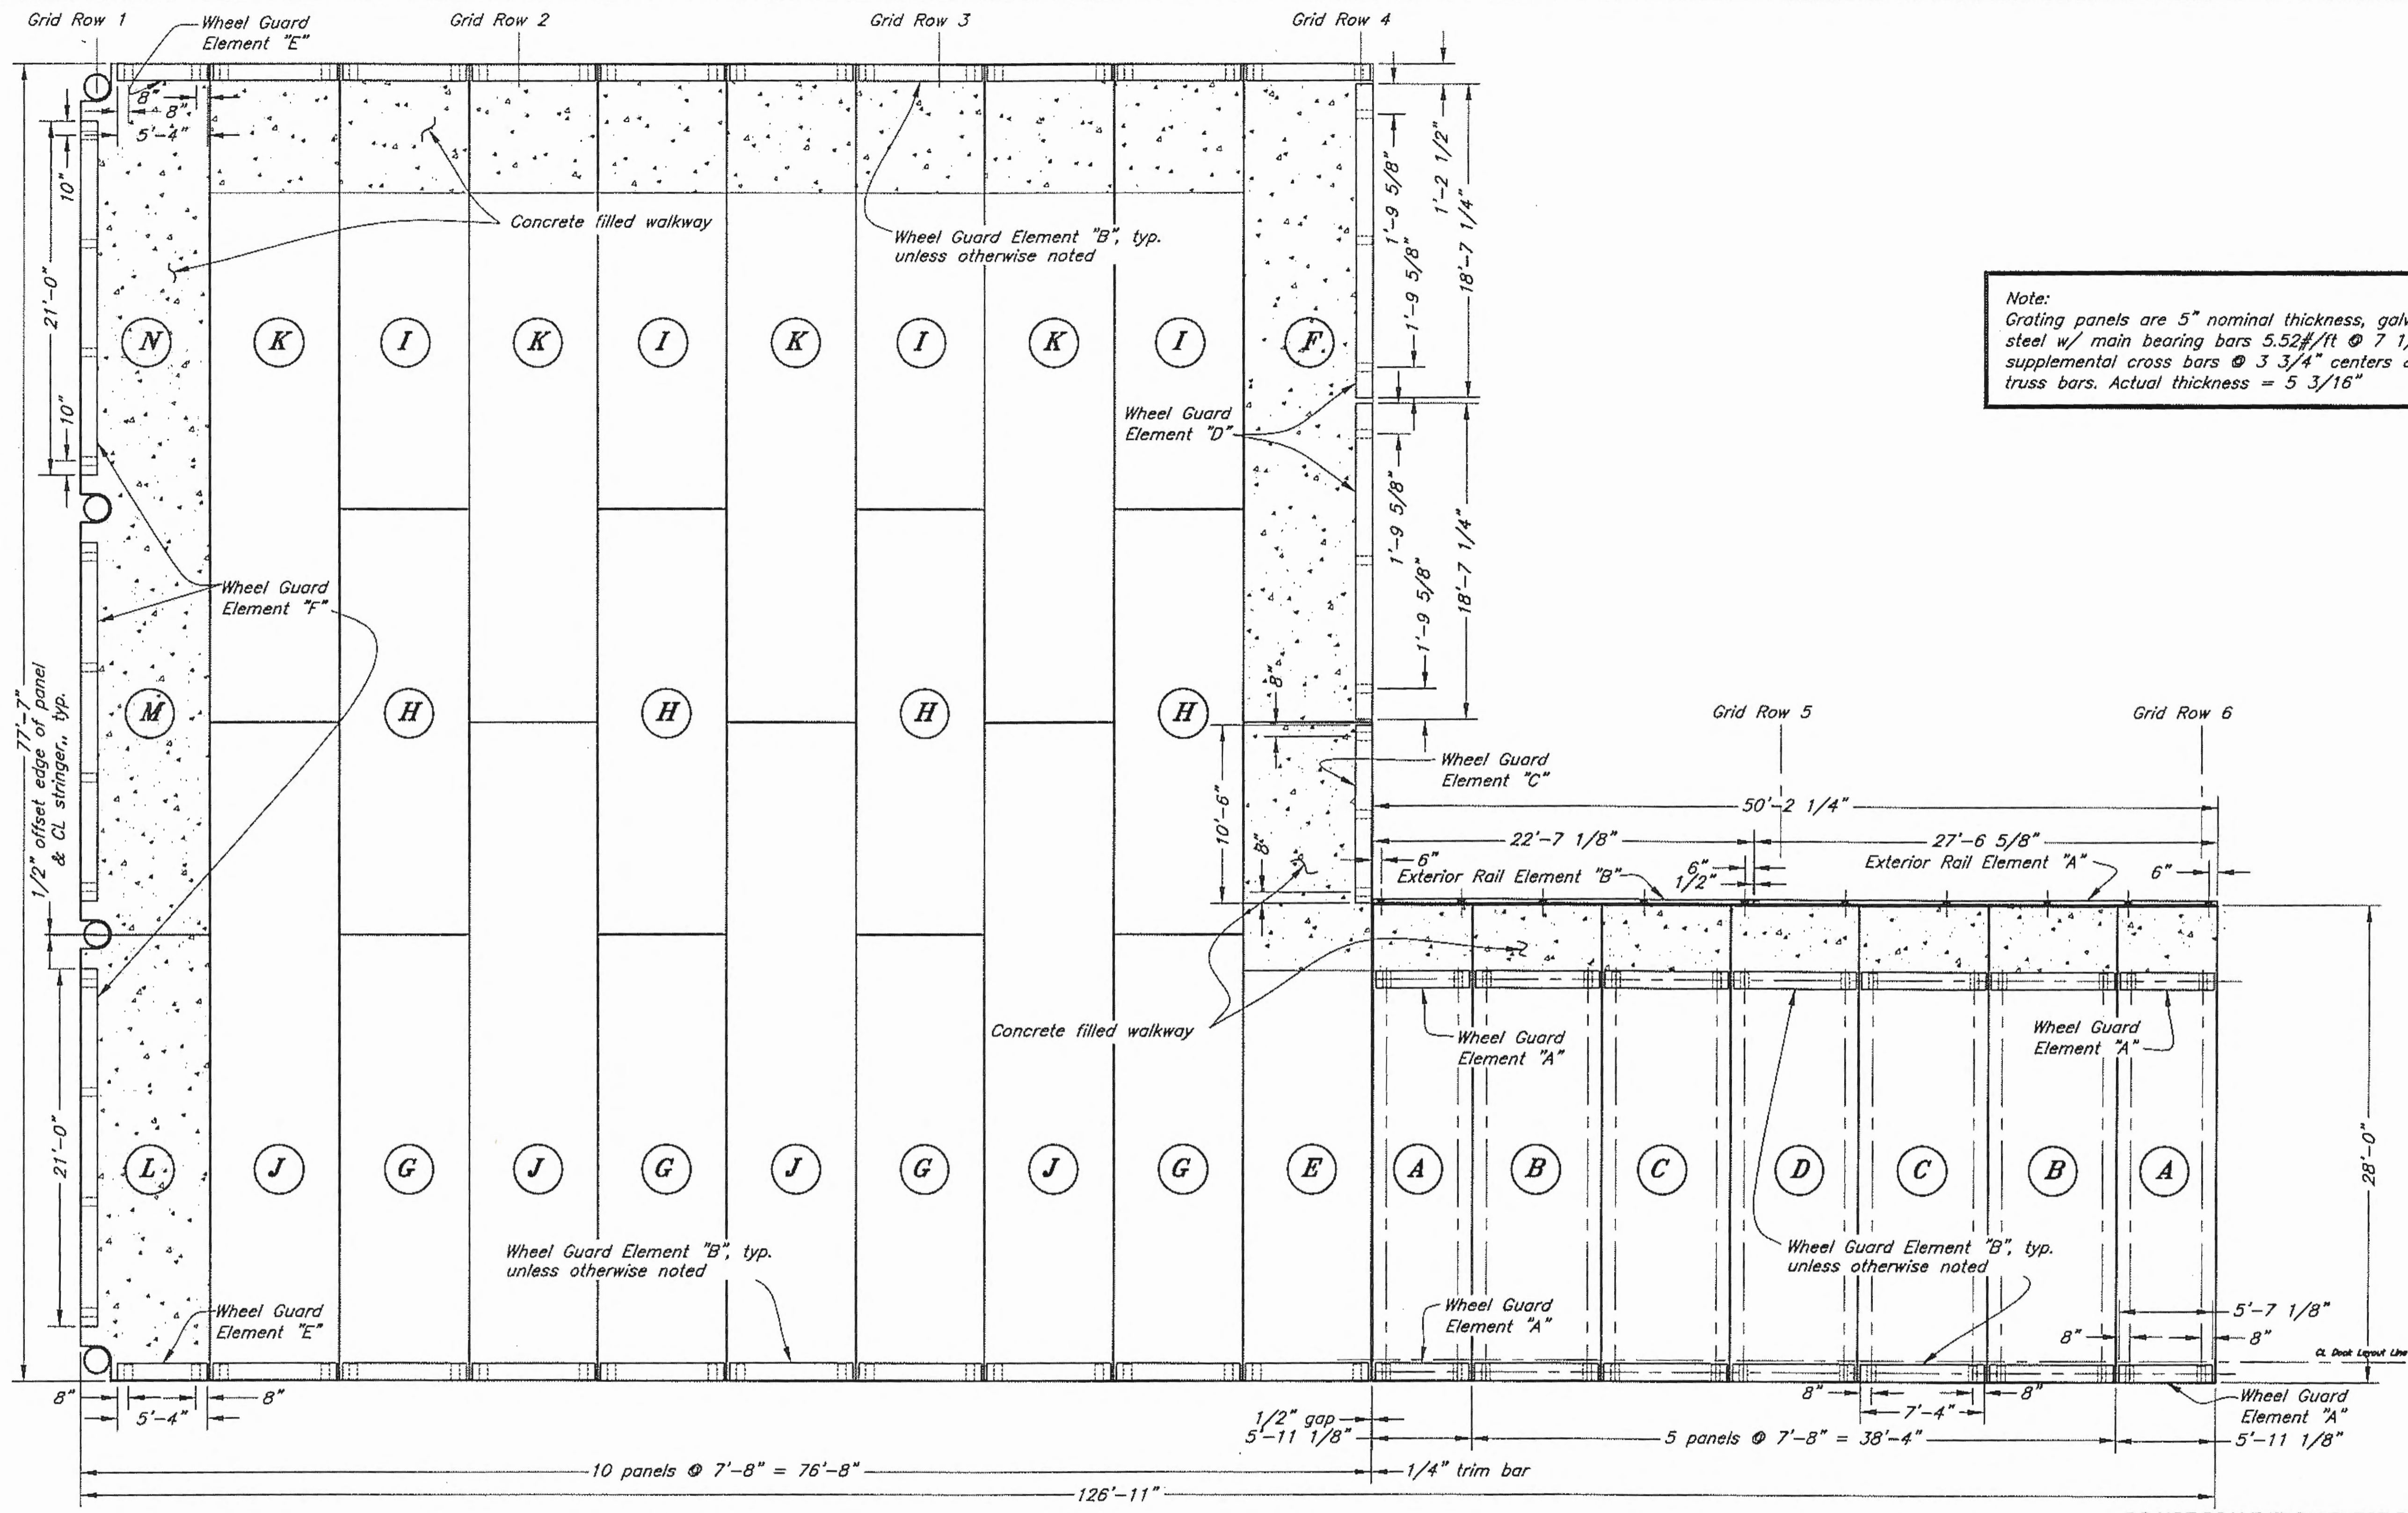

Note:
 Grating panels are 5" nominal thickness, galvanized, open grate steel w/ main bearing bars 5.52#/ft @ 7 1/2" centers & 1/4" supplemental cross bars @ 3 3/4" centers & 1/4" @ 1" bent truss bars. Actual thickness = 5 3/16"

Record Drawings have been reviewed by the Project Engineer, and represent to the best of my knowledge, the project as constructed.
 PE *[Signature]* Date 8/24/12

Dock Deck Panel Layout

DO NOT SCALE FROM THESE DRAWINGS USE DIMENSIONS

DESIGNED BY: J. Scott





STATE OF ALASKA
 DEPARTMENT OF TRANSPORTATION & PUBLIC FACILITIES
 DESIGN & ENGINEERING SERVICES DIVISION-SOUTHEAST REGION

Gustavus Causeway Replacement
Dock Deck Panel Layout


D14

CHECKED BY: B. Sovikko
 DRAWN BY: C. Fuman, W. Hickok
 PATH: G:\GUS\67599\MF\PLANS\04-DOCK\14 DOCK DECK PANELS LAYOUT.DWG
 TAB: Wed, 26/Nov/08 11:32AM


NO.	DATE	DESCRIPTION	PROJECT DESIGNATION	YEAR	SHEET NO.	TOTAL SHEETS
			BR-0003(53)/67599	2008	65	138

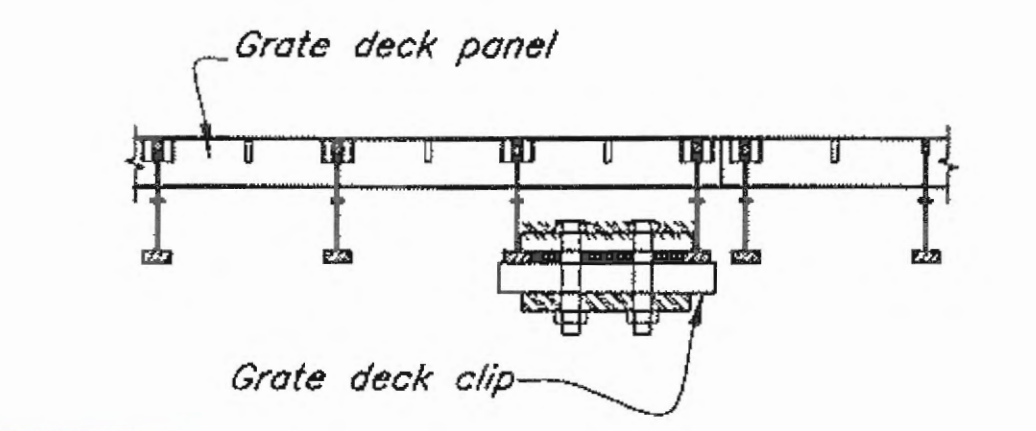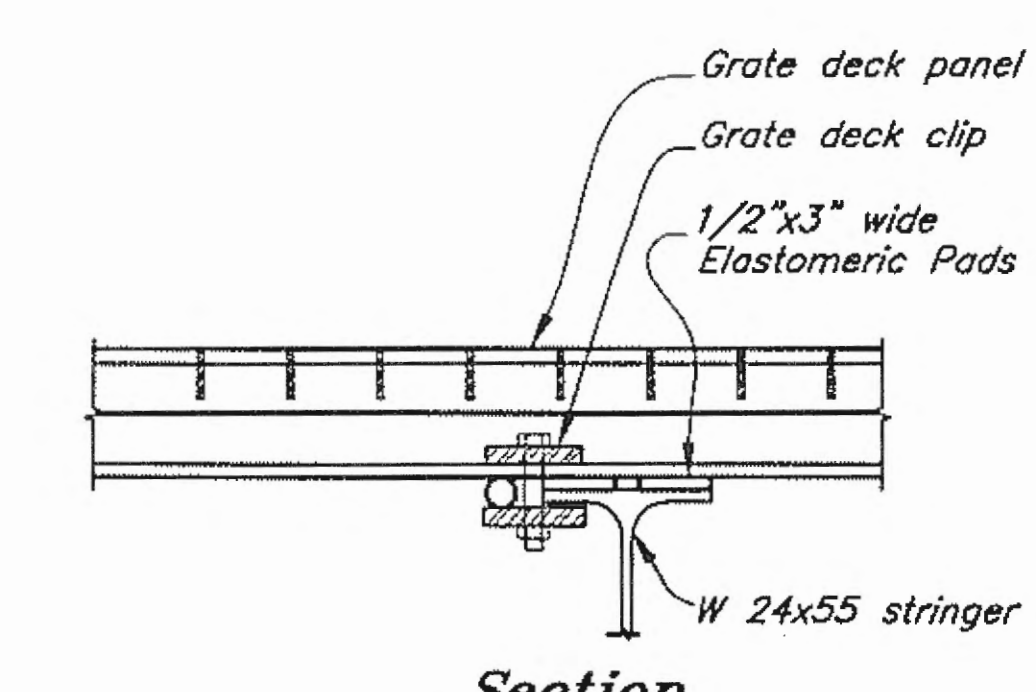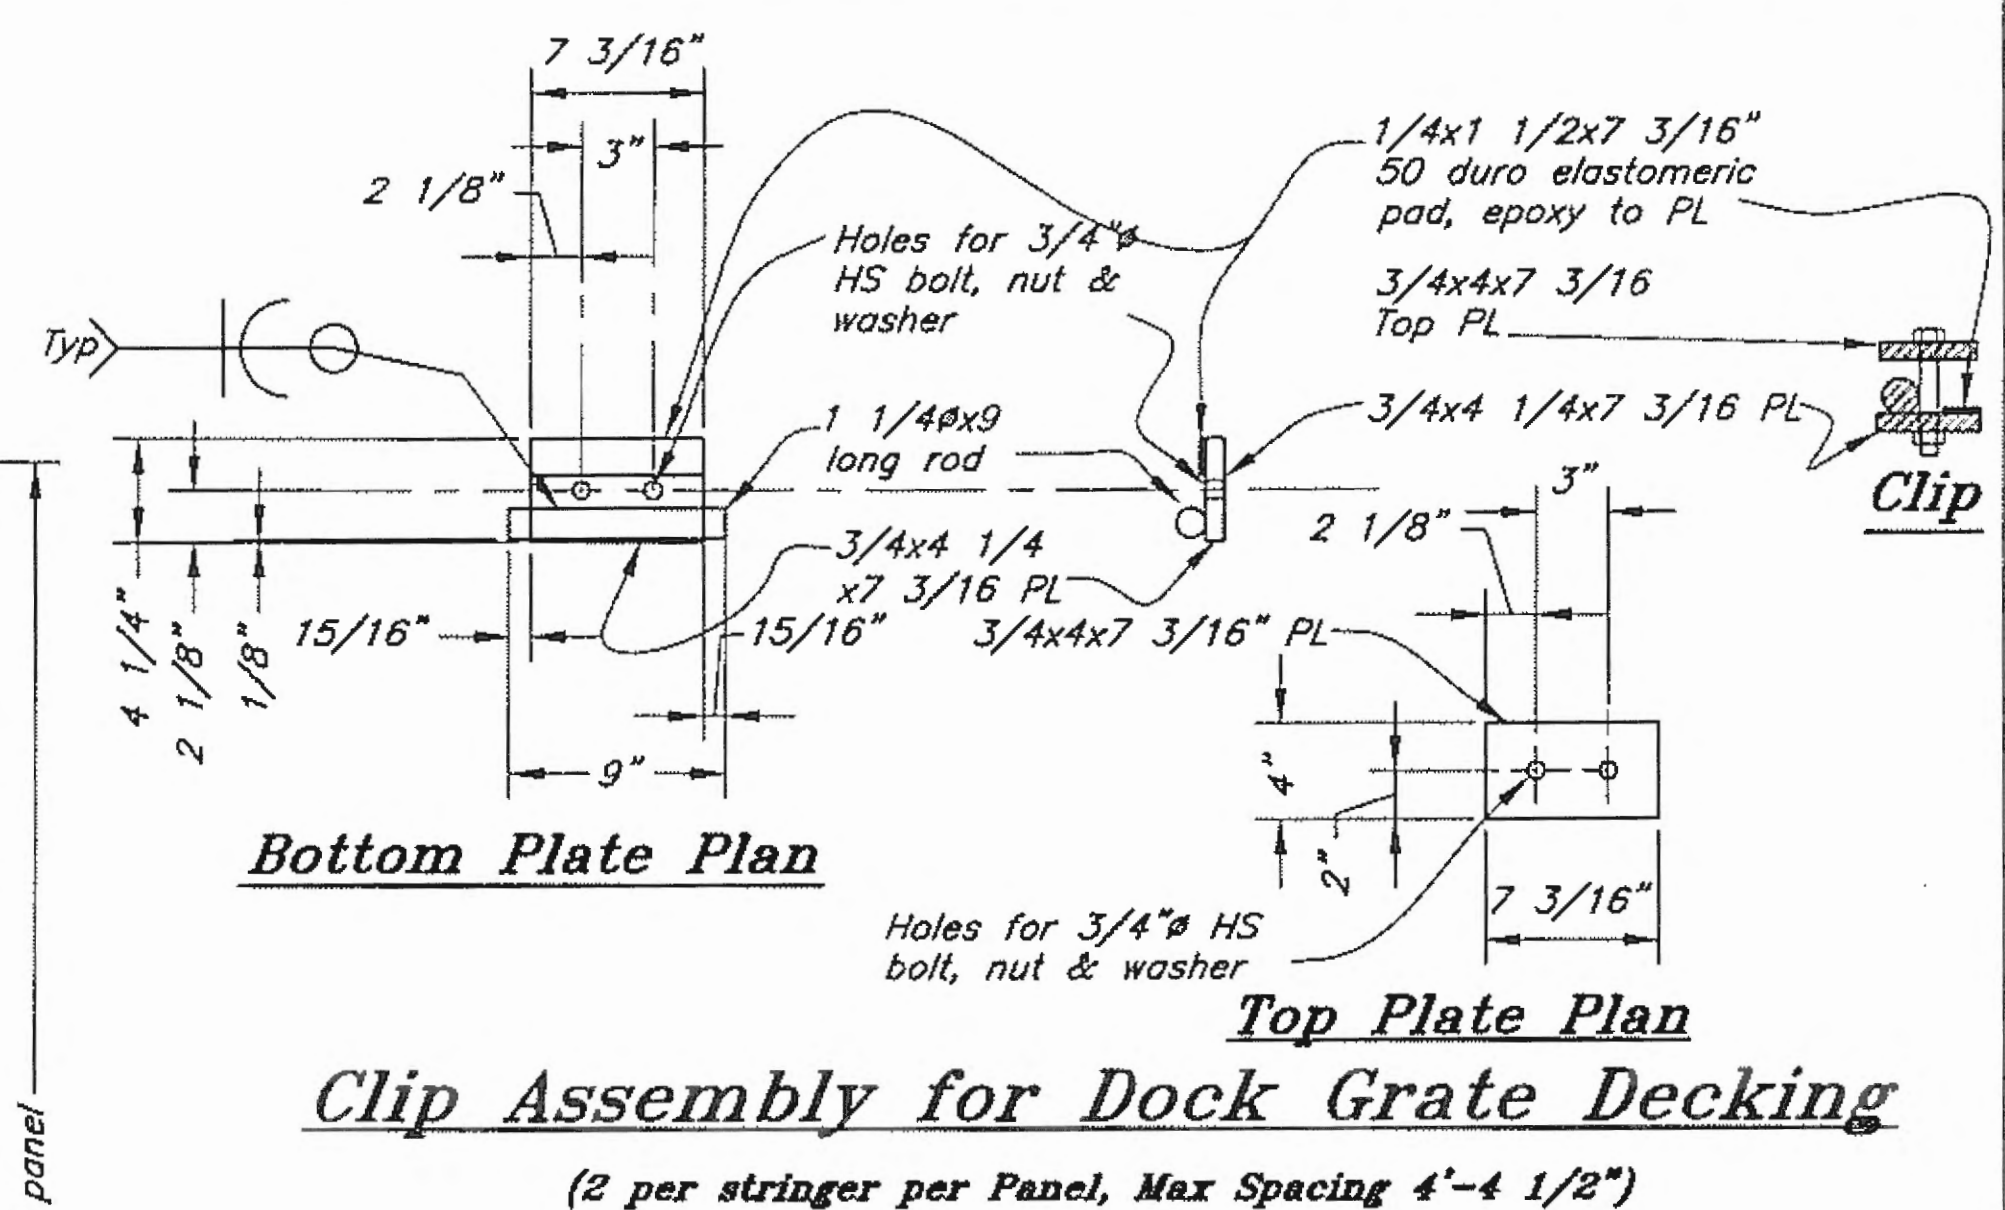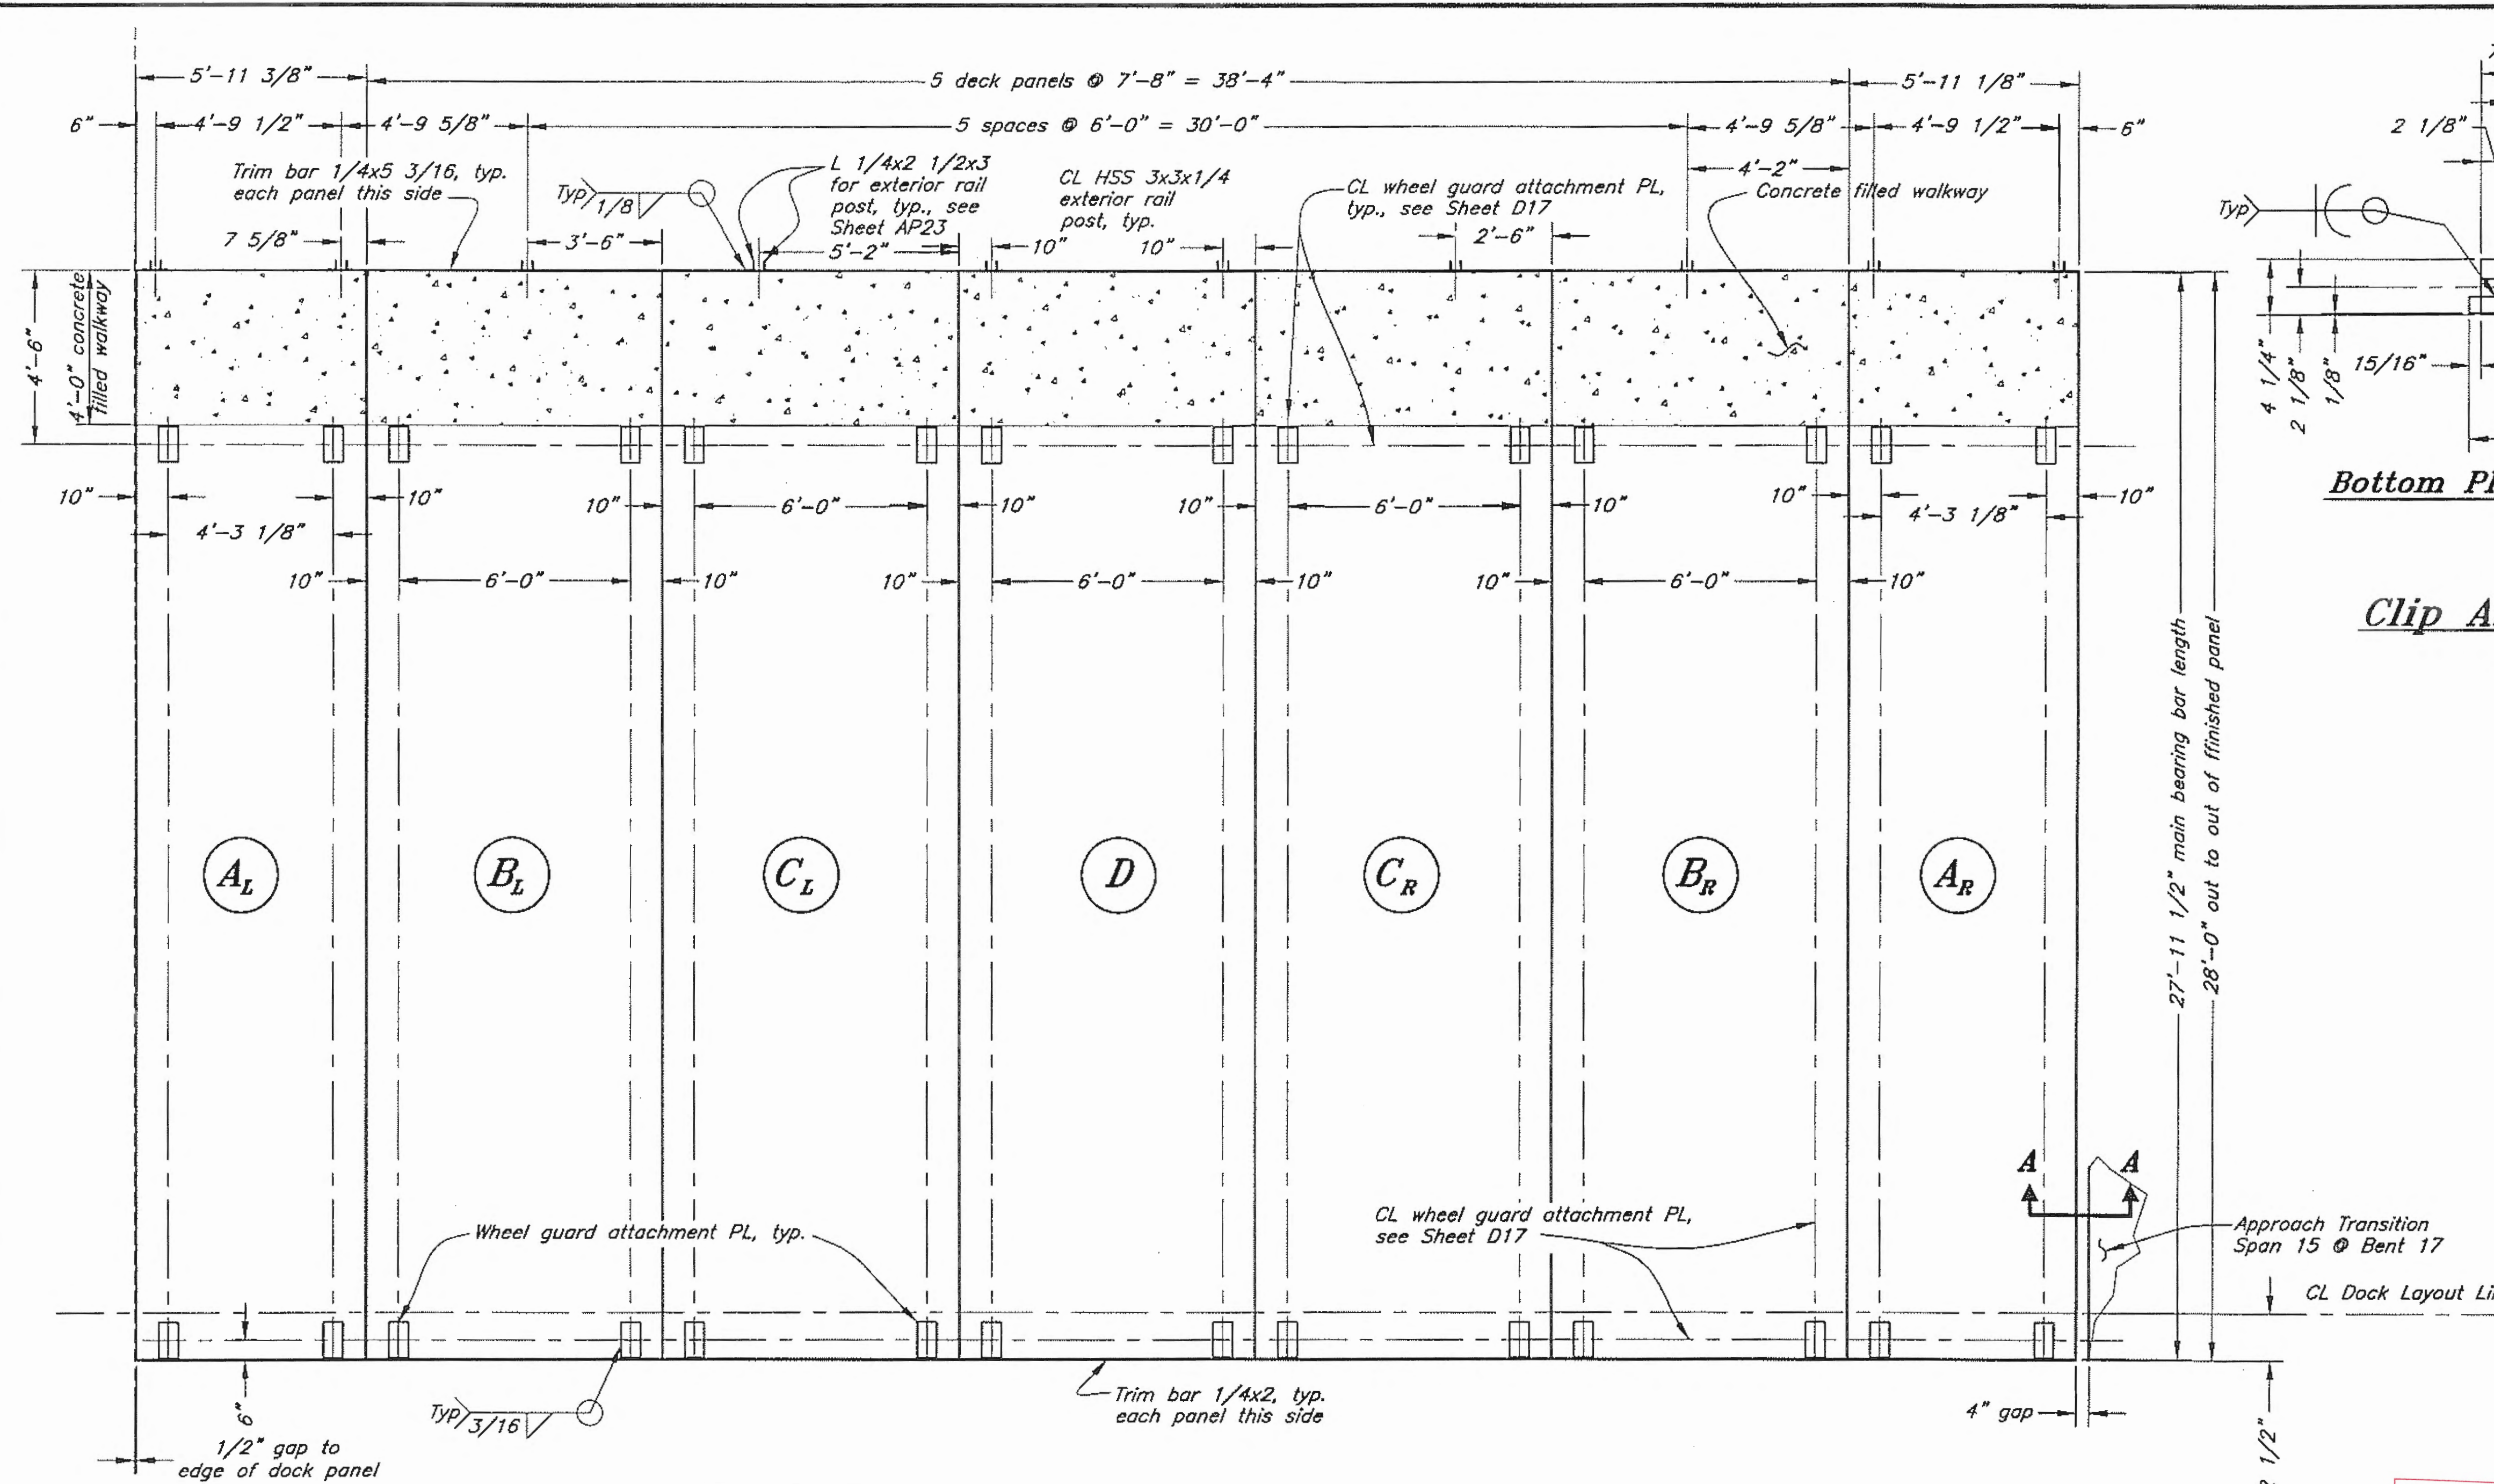


Dock Access Deck Panels Grid Rows 4-6

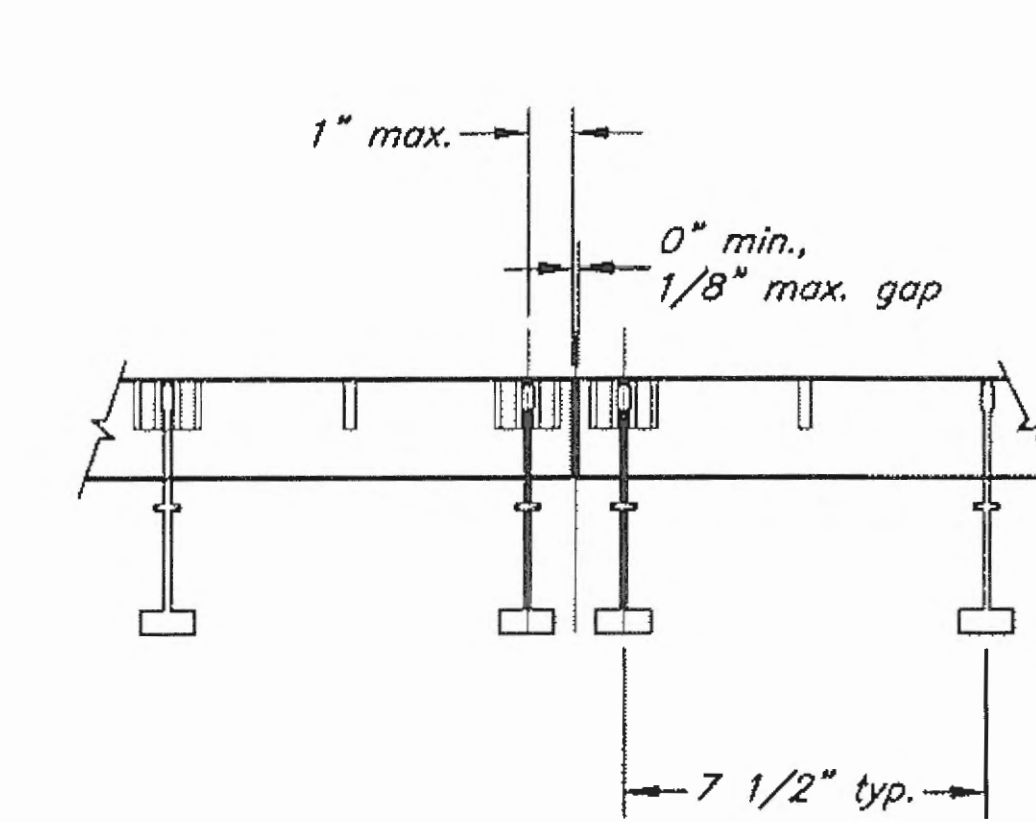

Typical Grating Joint

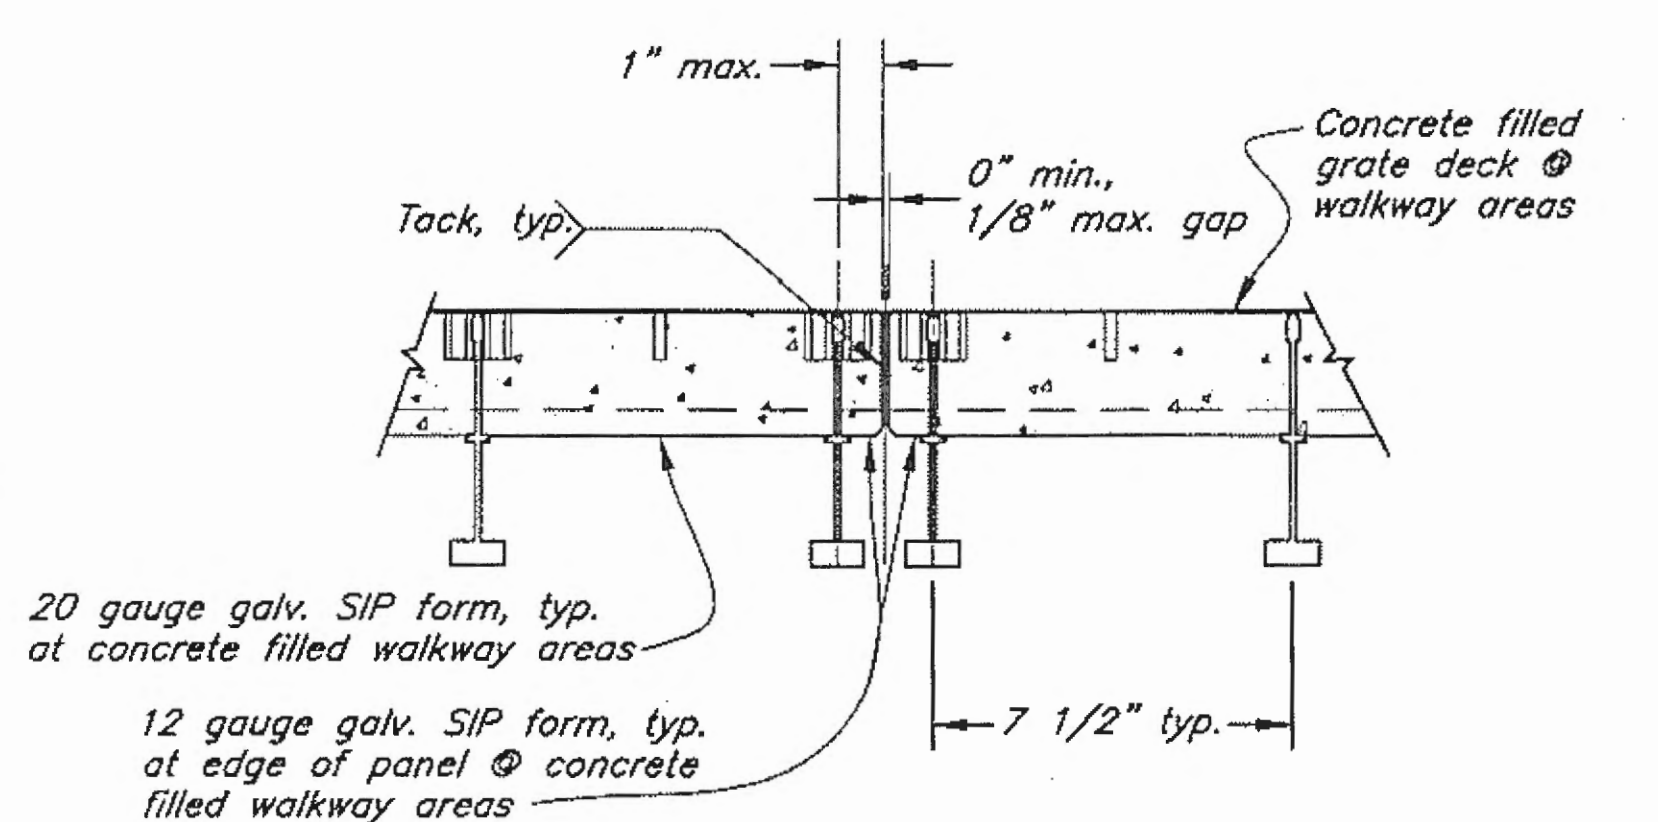

Grating Joint @ Concrete Walkway

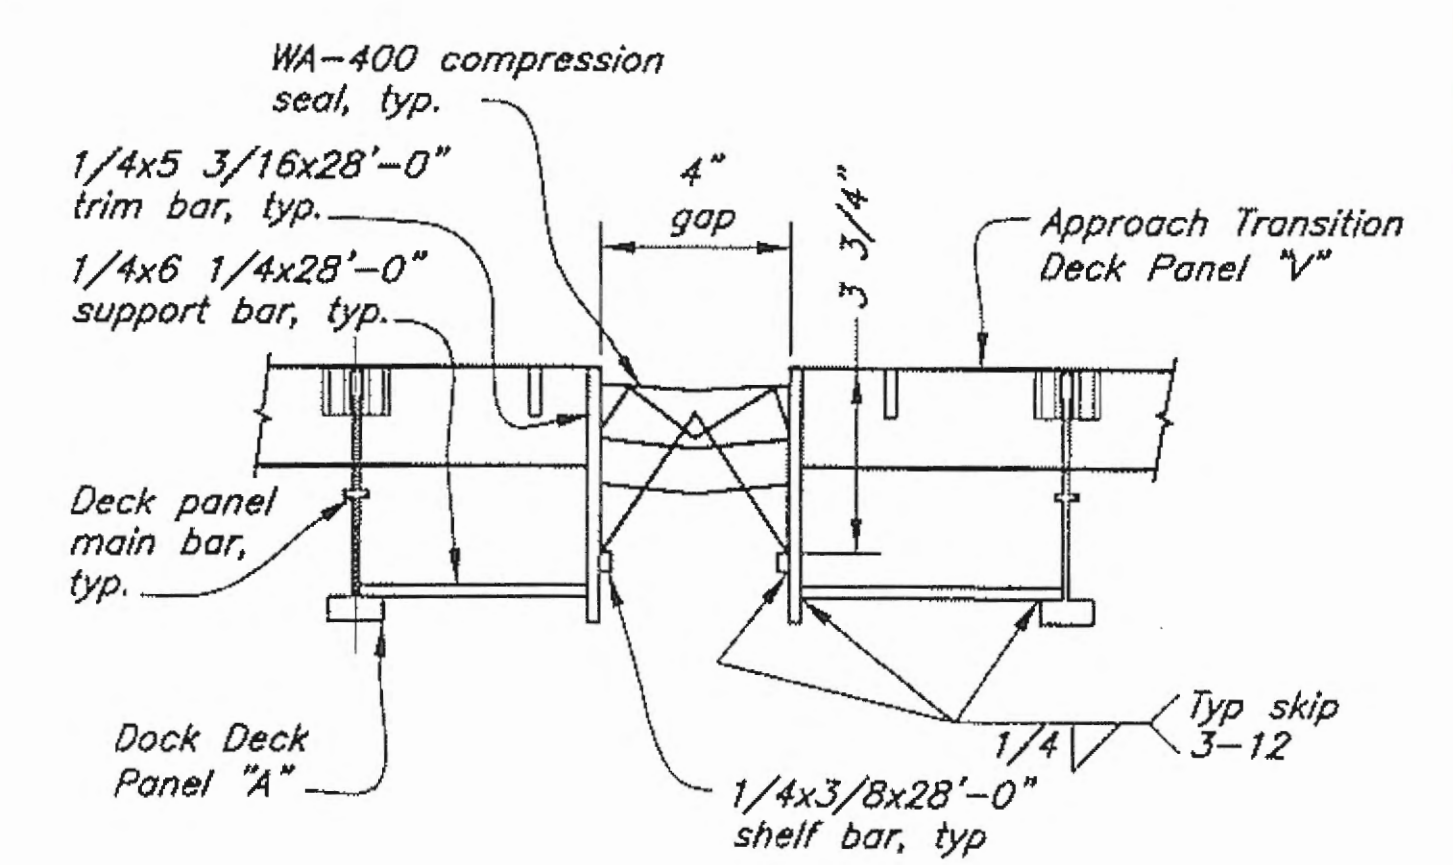

Section A-A (Gap @ Bent 17)

Record Drawings have been reviewed by the Project Engineer, and represent to the best of my knowledge, the project as constructed.
PE [Signature] Date 3/21/12

DO NOT SCALE FROM THESE DRAWINGS USE DIMENSIONS

DESIGNED BY: J. Scott


STATE OF ALASKA
DEPARTMENT OF TRANSPORTATION & PUBLIC FACILITIES
DESIGN & ENGINEERING SERVICES DIVISION-SOUTHEAST REGION

Gustavus Causeway Replacement
Dock Access Deck Panels Grid Rows 4 - 6

D15

CHECKED BY: B. Savikko
DRAWN BY: C. Fuman, W. Hickok
PATH: Q:\GUS\67599\MF\PLANSET\04-DOCK\015 DOCK ACCESS PANELS.DWG
TAB: Wed, 26/Nov/08 11:33AM JTSCOTT

NO.	DATE	REVISIONS DESCRIPTION	PROJECT DESIGNATION	YEAR	SHEET NO.	TOTAL SHEETS
			BR-0003(53)/67599	2008	66	138

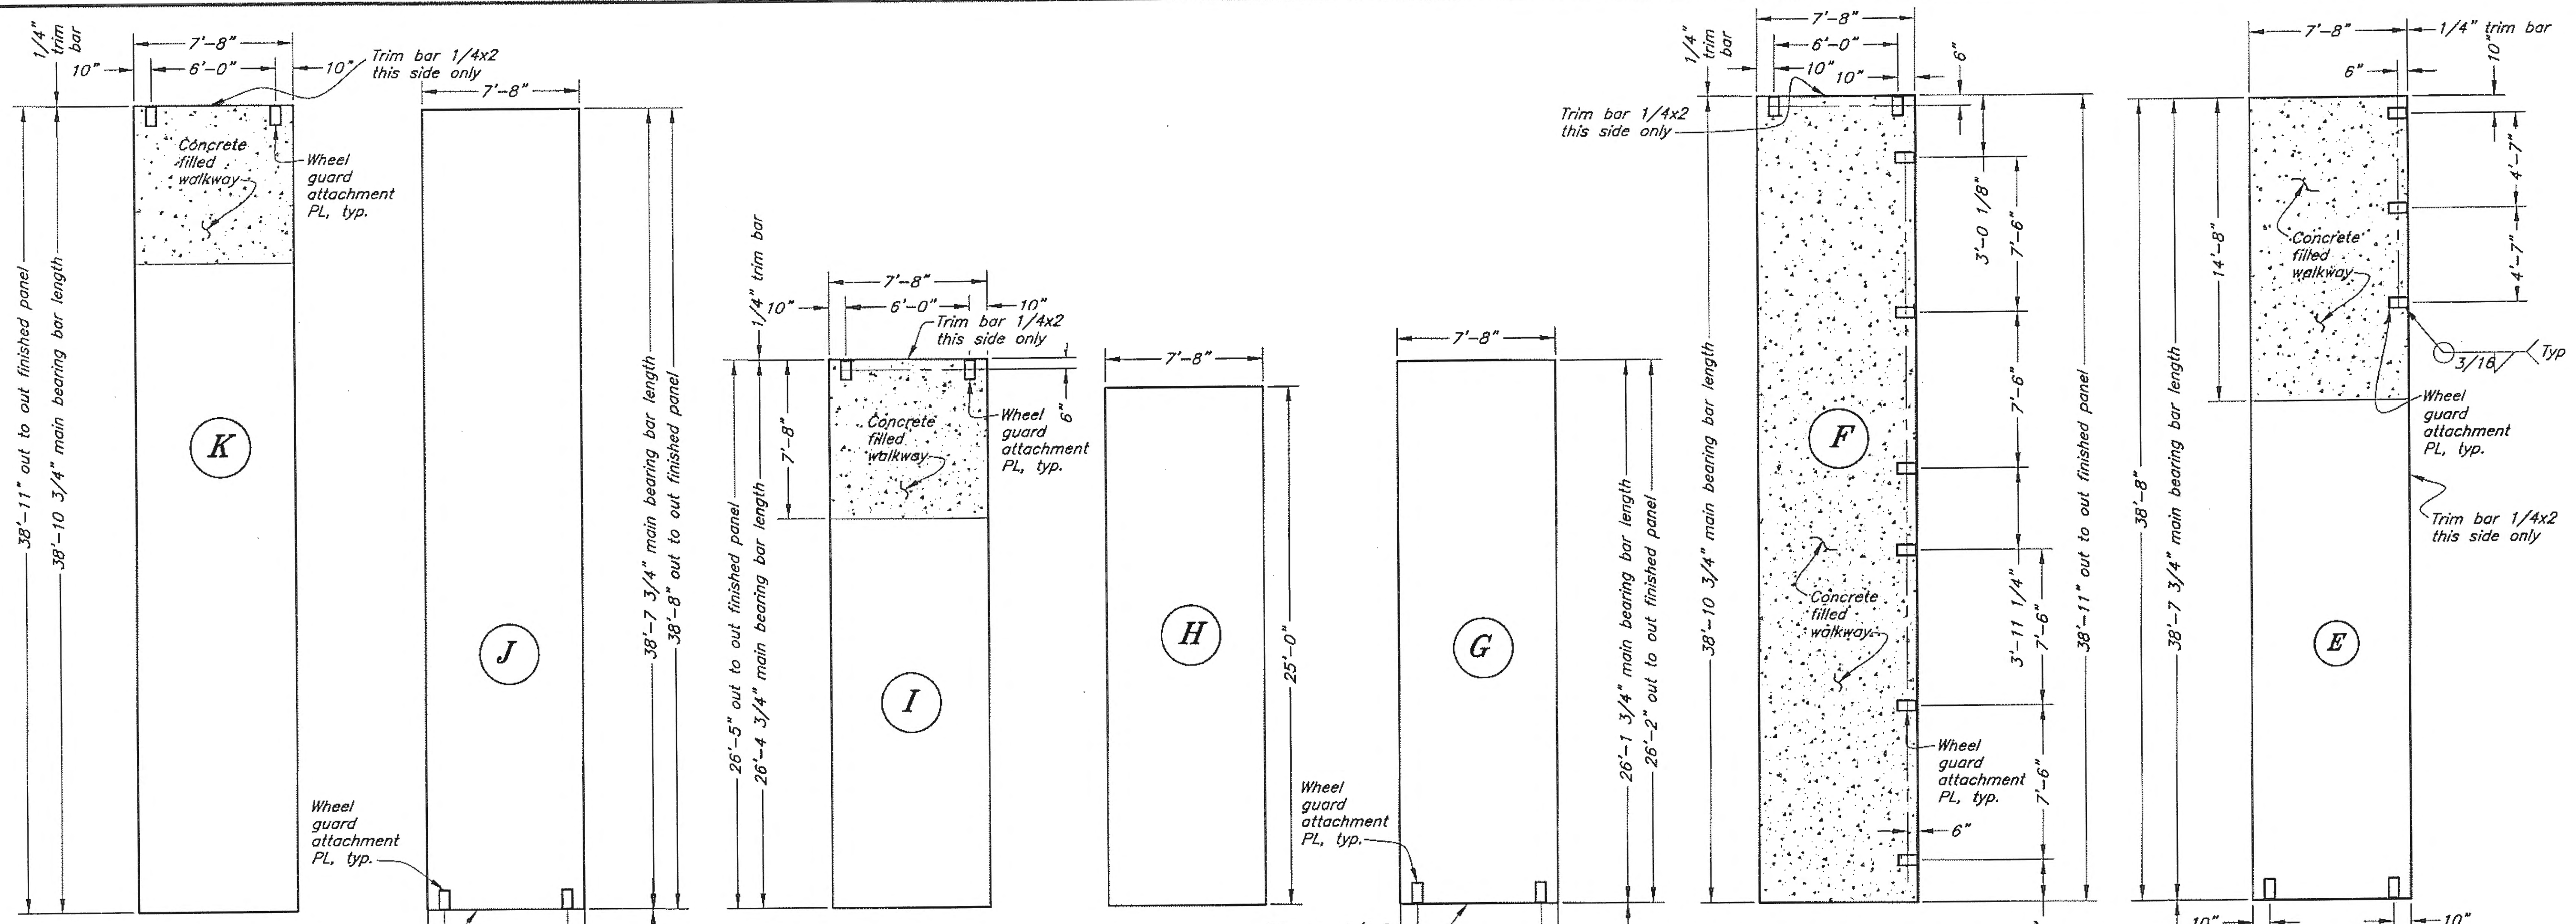

Panel K

Panel J


Panel I

Panel H


Panel G

Panel F


Panel E

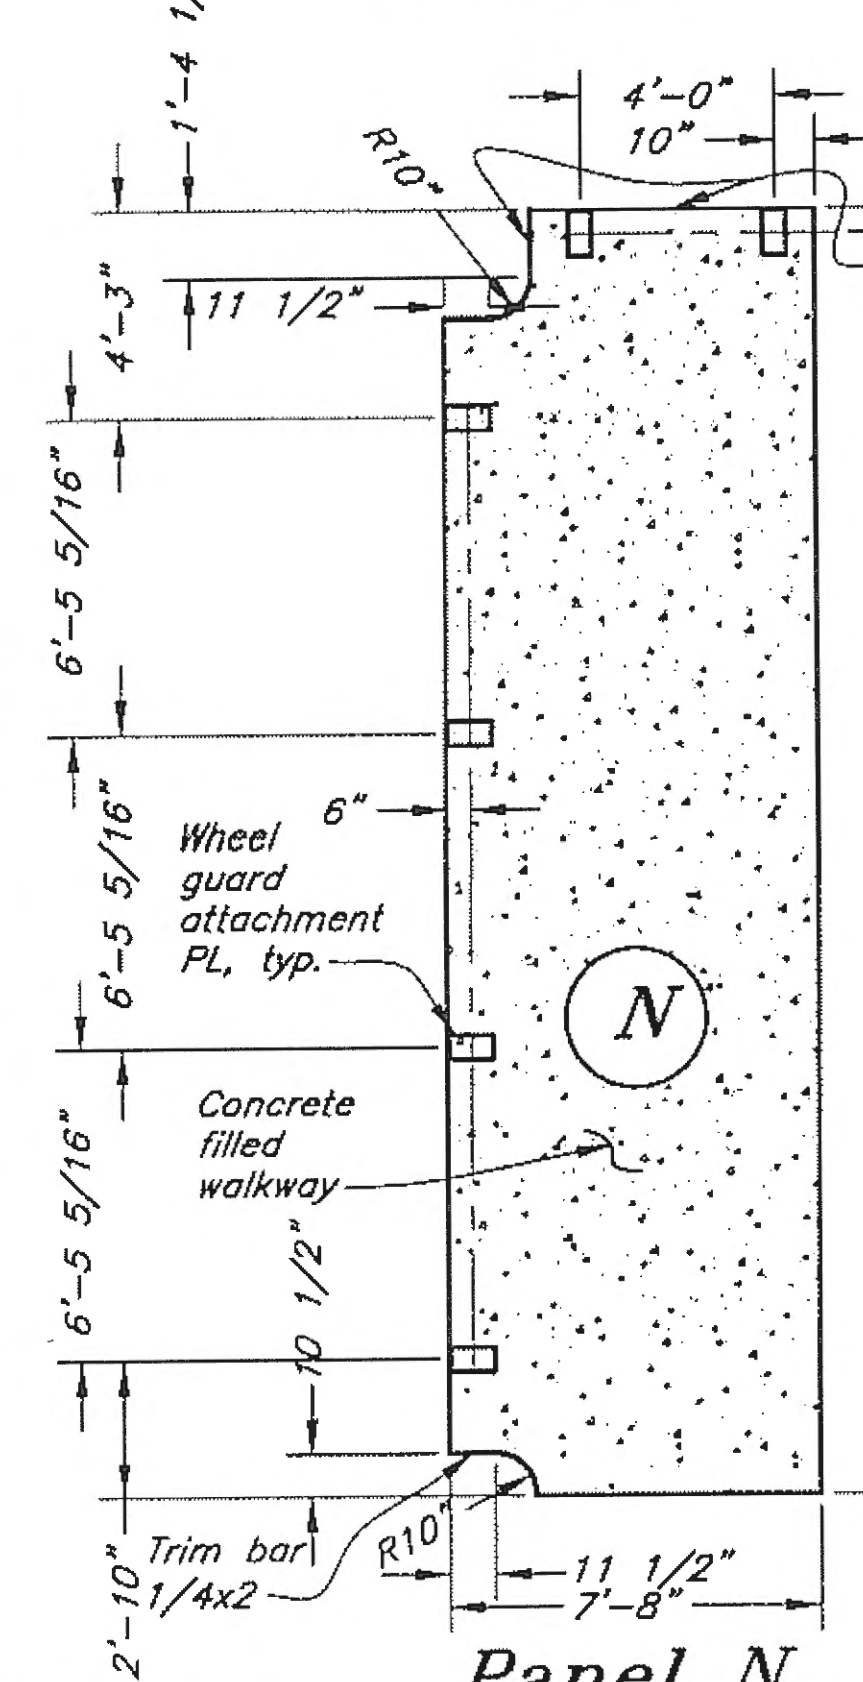

Panel N

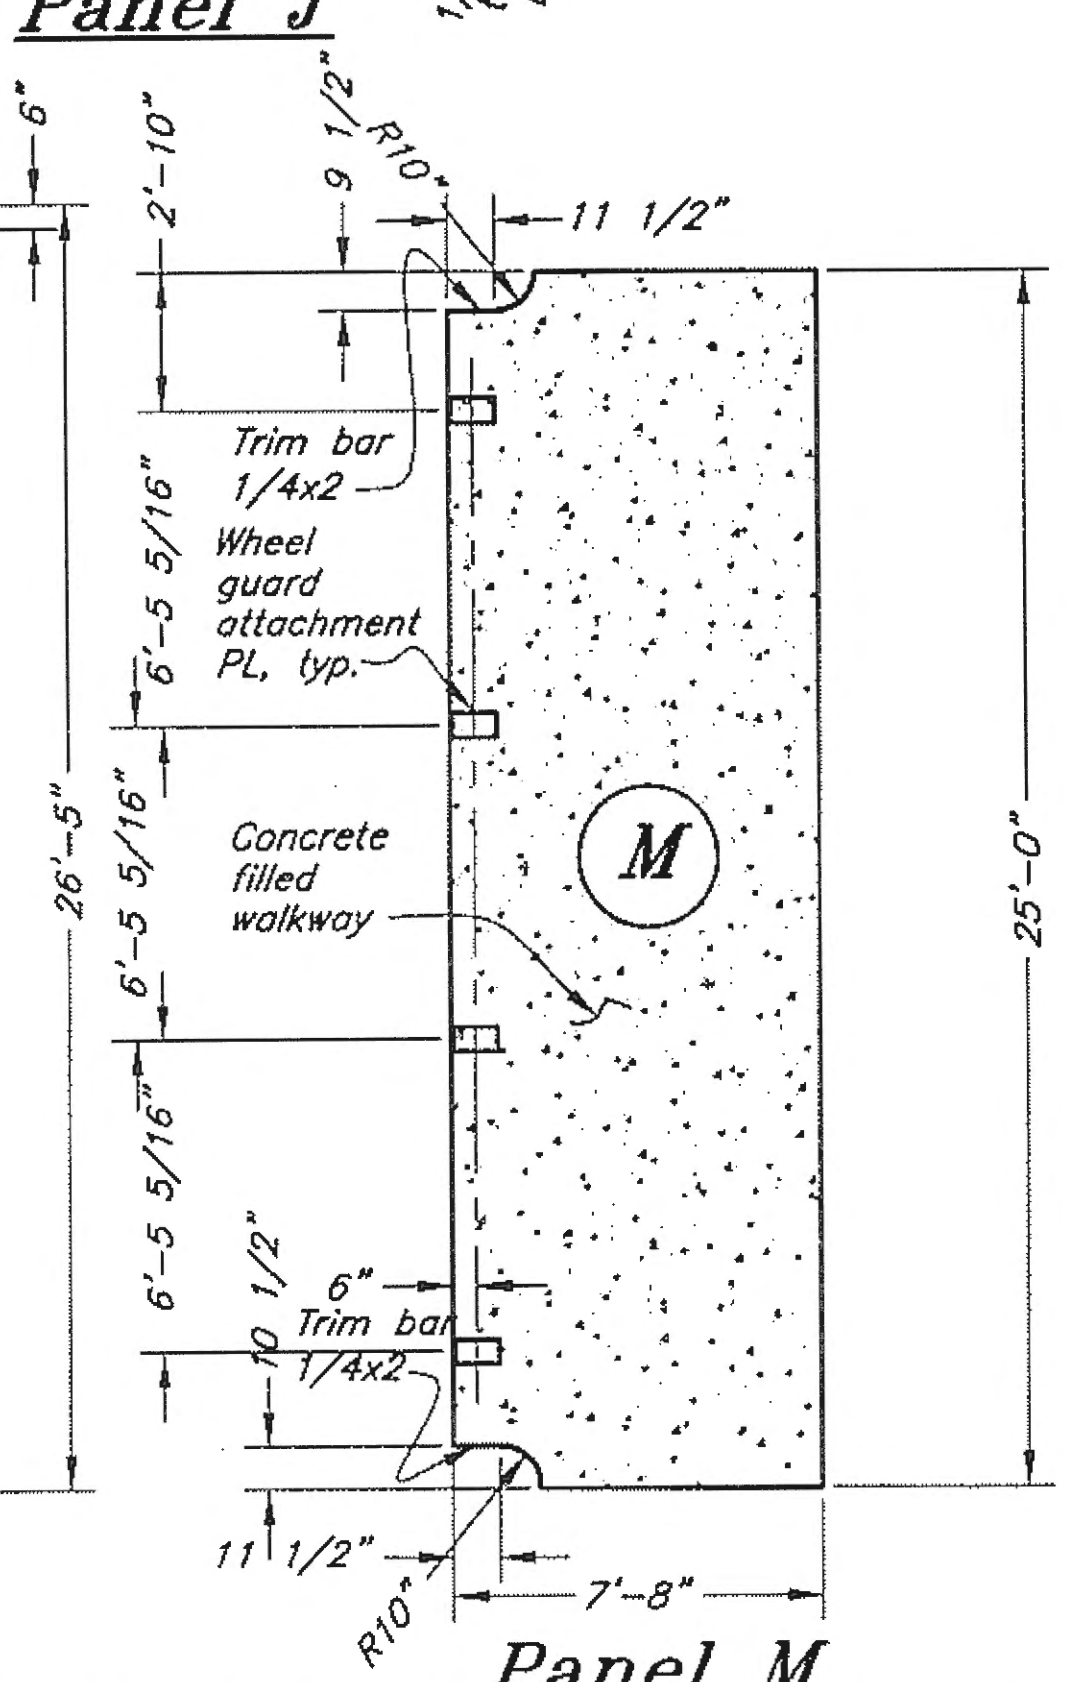

Panel M

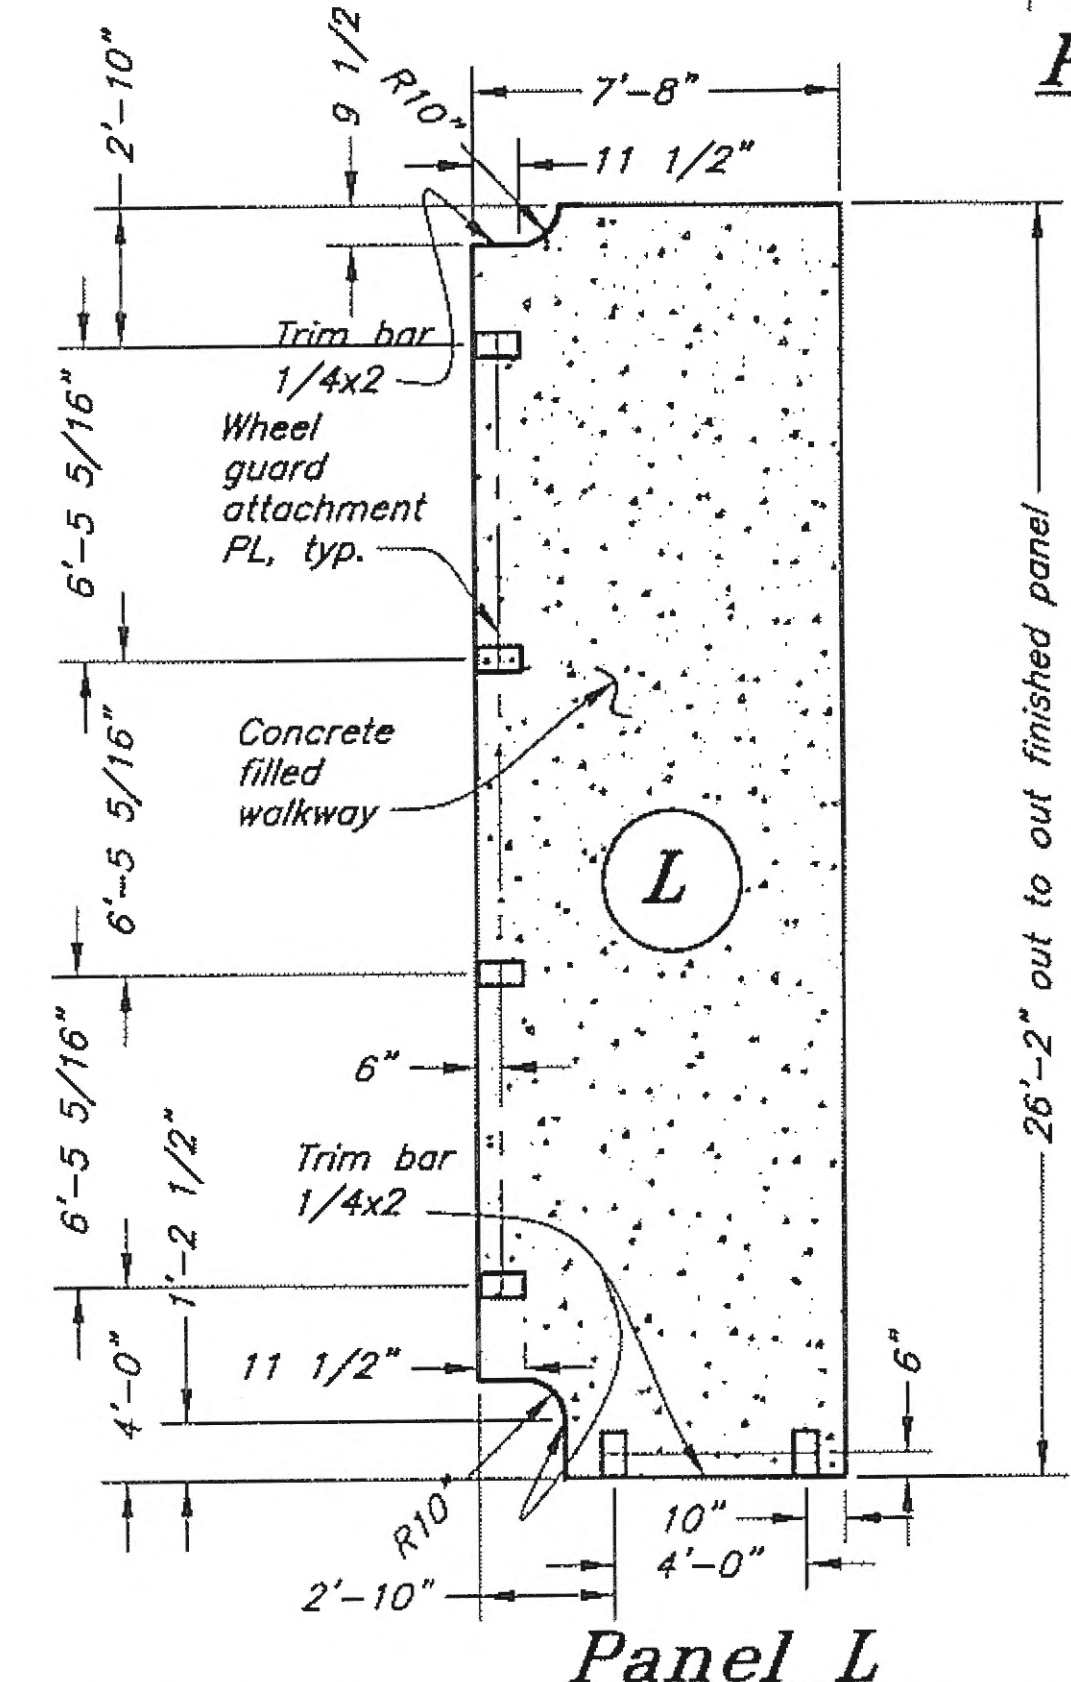

Panel L

Record Drawings have been reviewed by the Project Engineer, and represent to the best of my knowledge, the project as constructed.
 PE *[Signature]* Date 3/21/12

DO NOT SCALE FROM THESE DRAWINGS USE DIMENSIONS

DESIGNED BY: J. Scott

STATE OF ALASKA
 DEPARTMENT OF TRANSPORTATION & PUBLIC FACILITIES
 DESIGN & ENGINEERING SERVICES DIVISION-SOUTHEAST REGION

Gustavus Causeway Replacement
Dock Deck Panels
Grid Rows 1-4

D16

CHECKED BY: B. Savikko
 DRAWN BY: C. Fuman, W. Hickok


STATE OF ALASKA
 49th
 John I. Scott
 CE-4755
 REGISTERED PROFESSIONAL ENGINEER

11.20.08

PATH: Q:\GUS\67599\MF\PLANSET\04-DOCK\D16 DOCK PANELS.DWG
 TAB: Wed, 25/Nov/08 11:30AM JTSCOTT


REVISIONS		PROJECT DESIGNATION	YEAR	SHEET NO.	TOTAL SHEETS
NO.	DATE DESCRIPTION				
		BR-0003(53)/67599	2008	67	138

Note: Dock exterior rails similar to approach exterior rails. See Sheet AP23 for details.

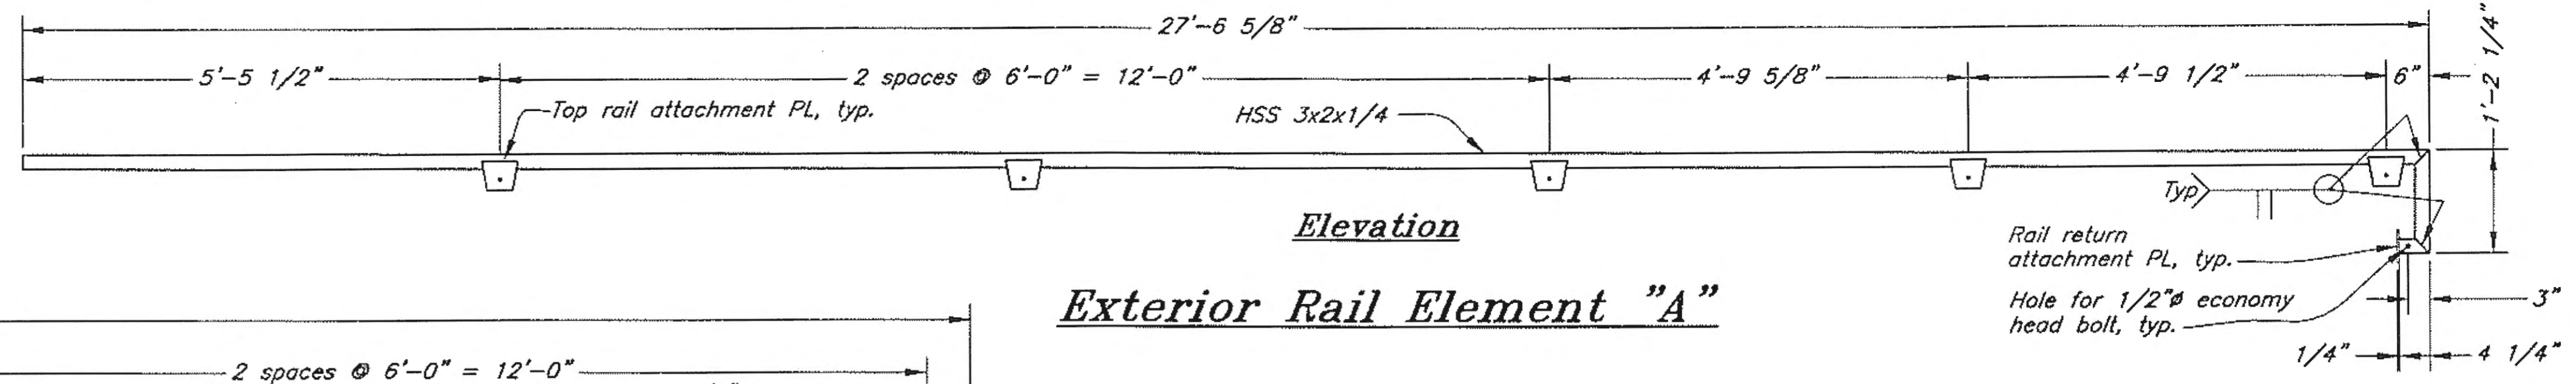


Elevation

Exterior Rail Element "A"

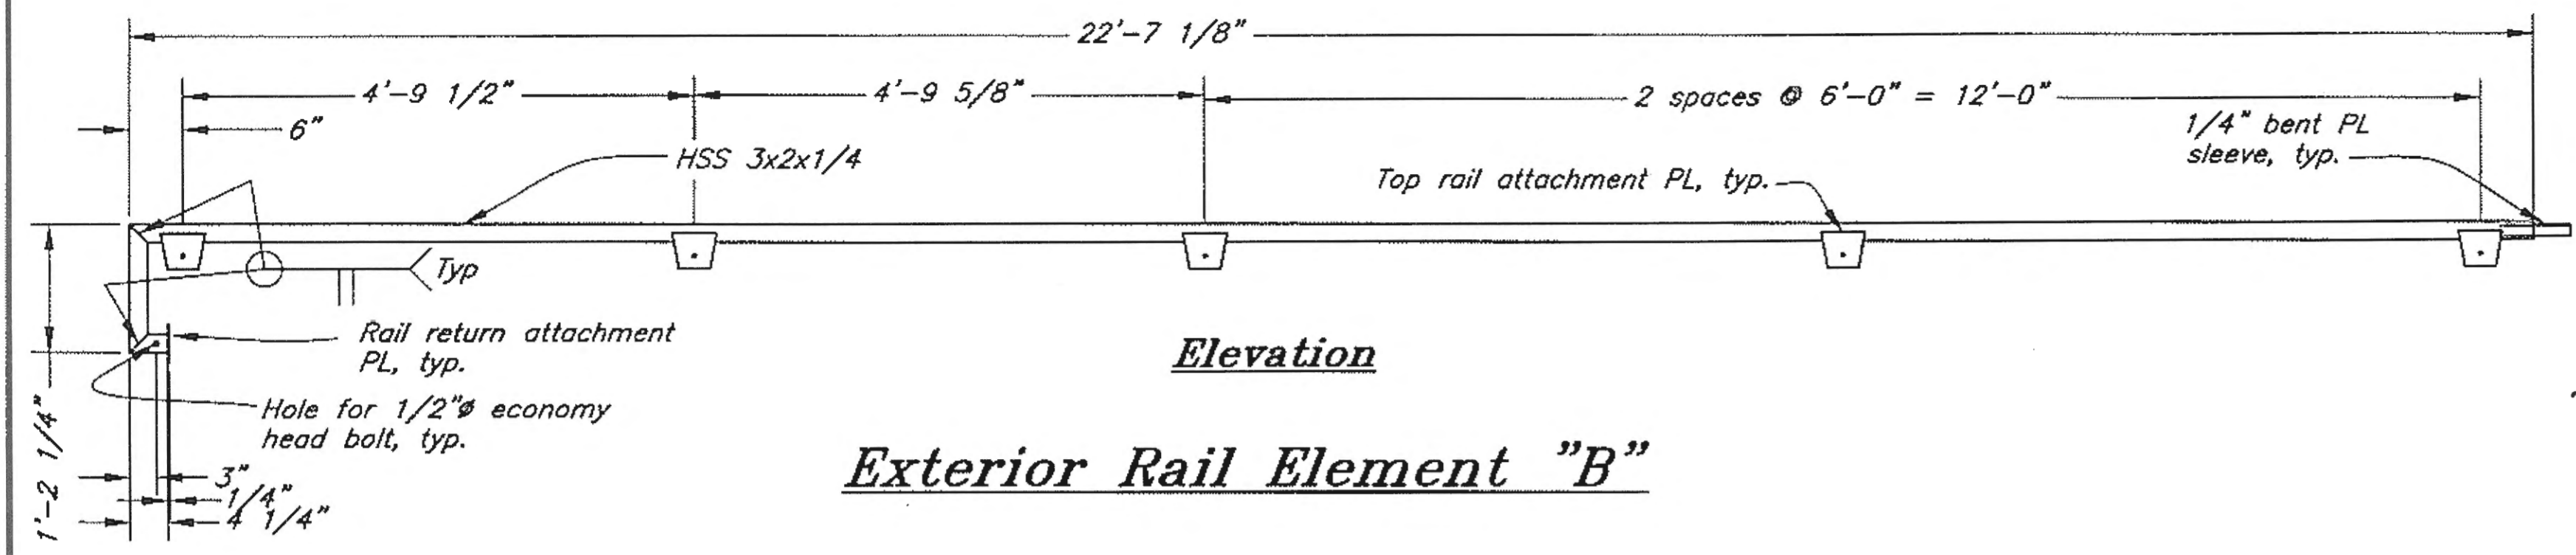


Elevation

Exterior Rail Element "B"

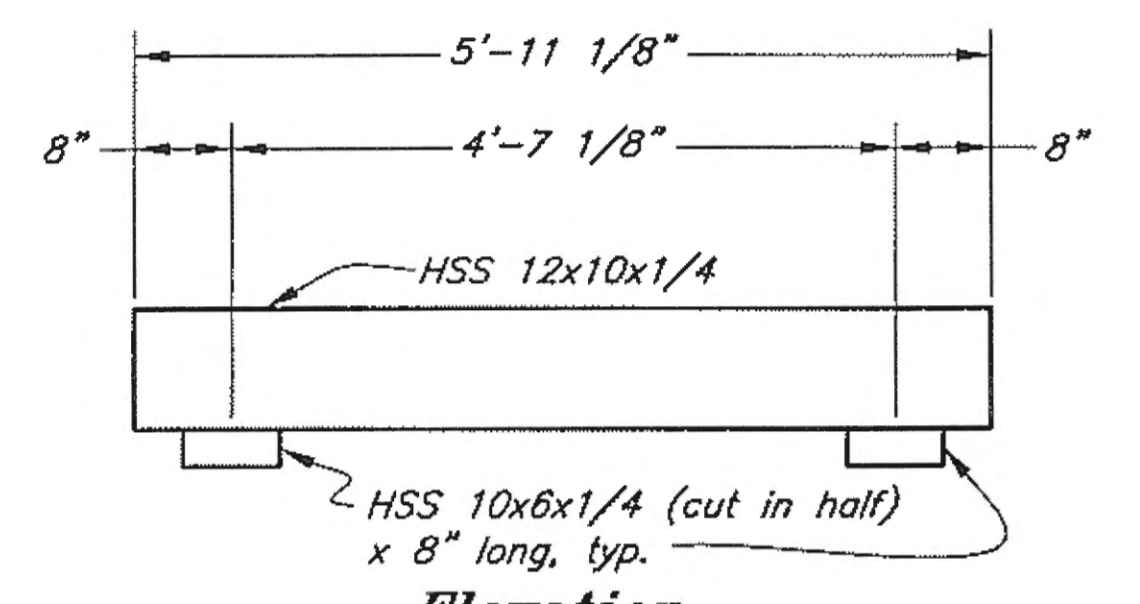


Elevation

Wheel Guard Elements "A"

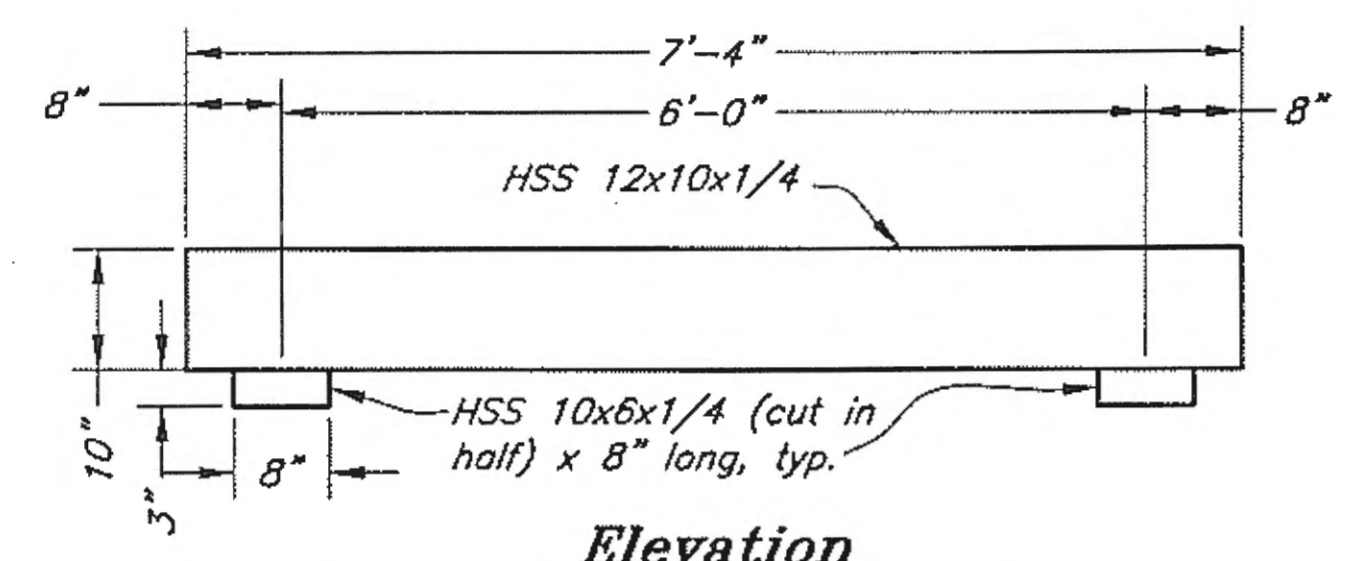


Elevation

Wheel Guard Elements "B"

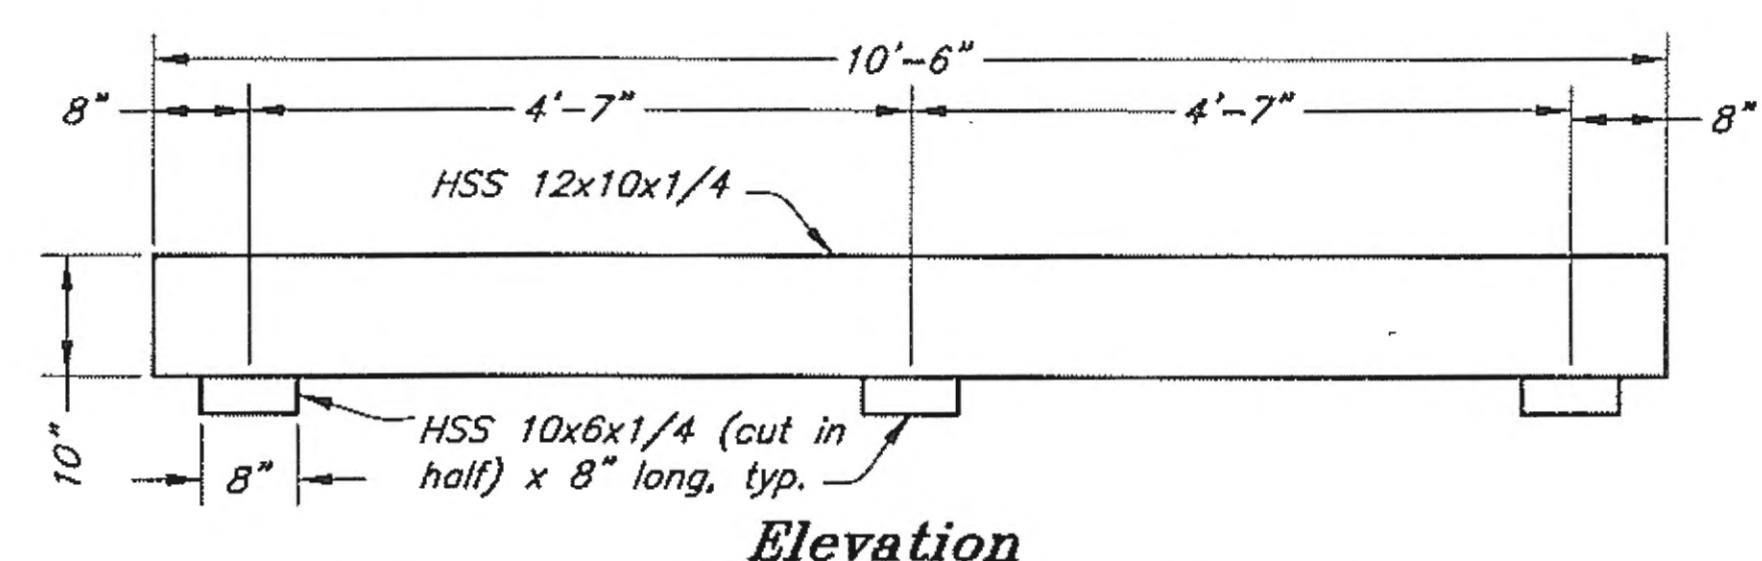


Elevation

Wheel Guard Elements "C"

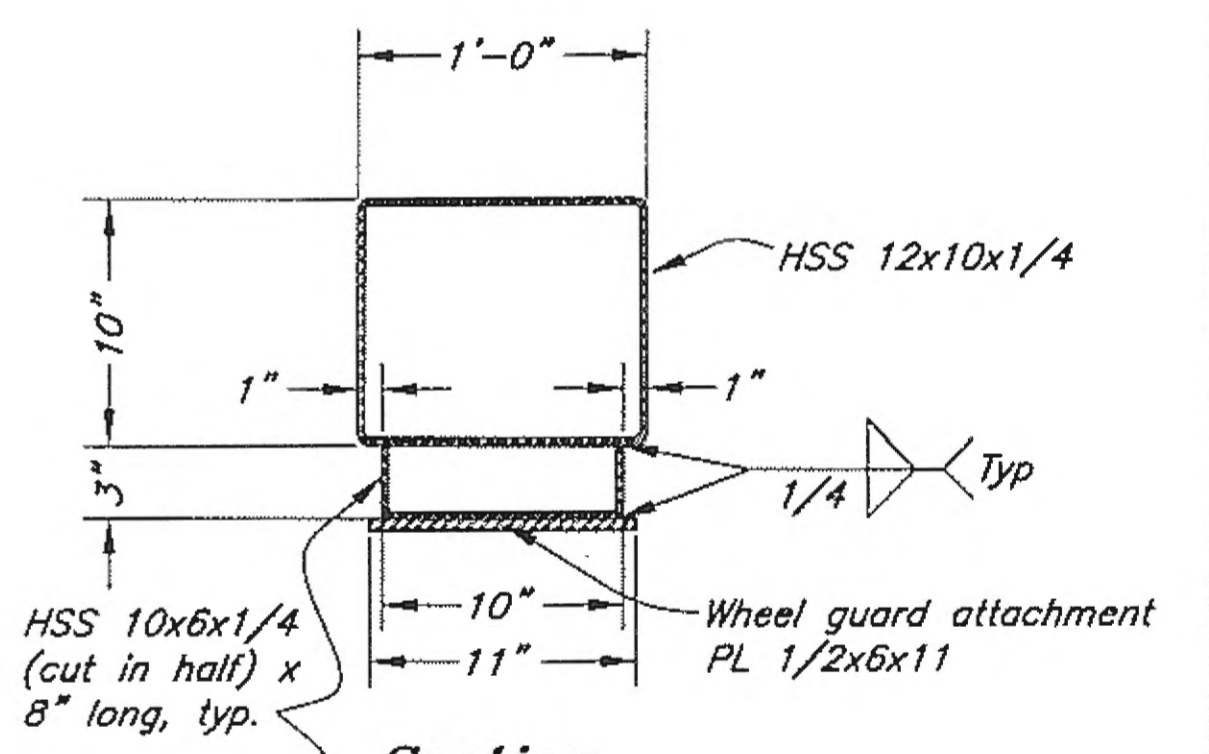


Section

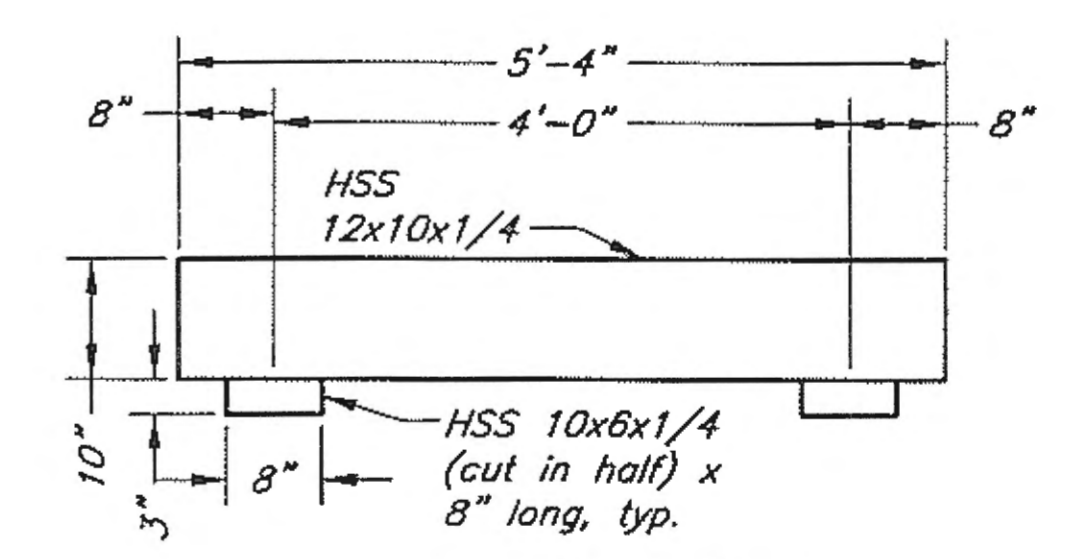

Elevation

Wheel Guard Elements "E"

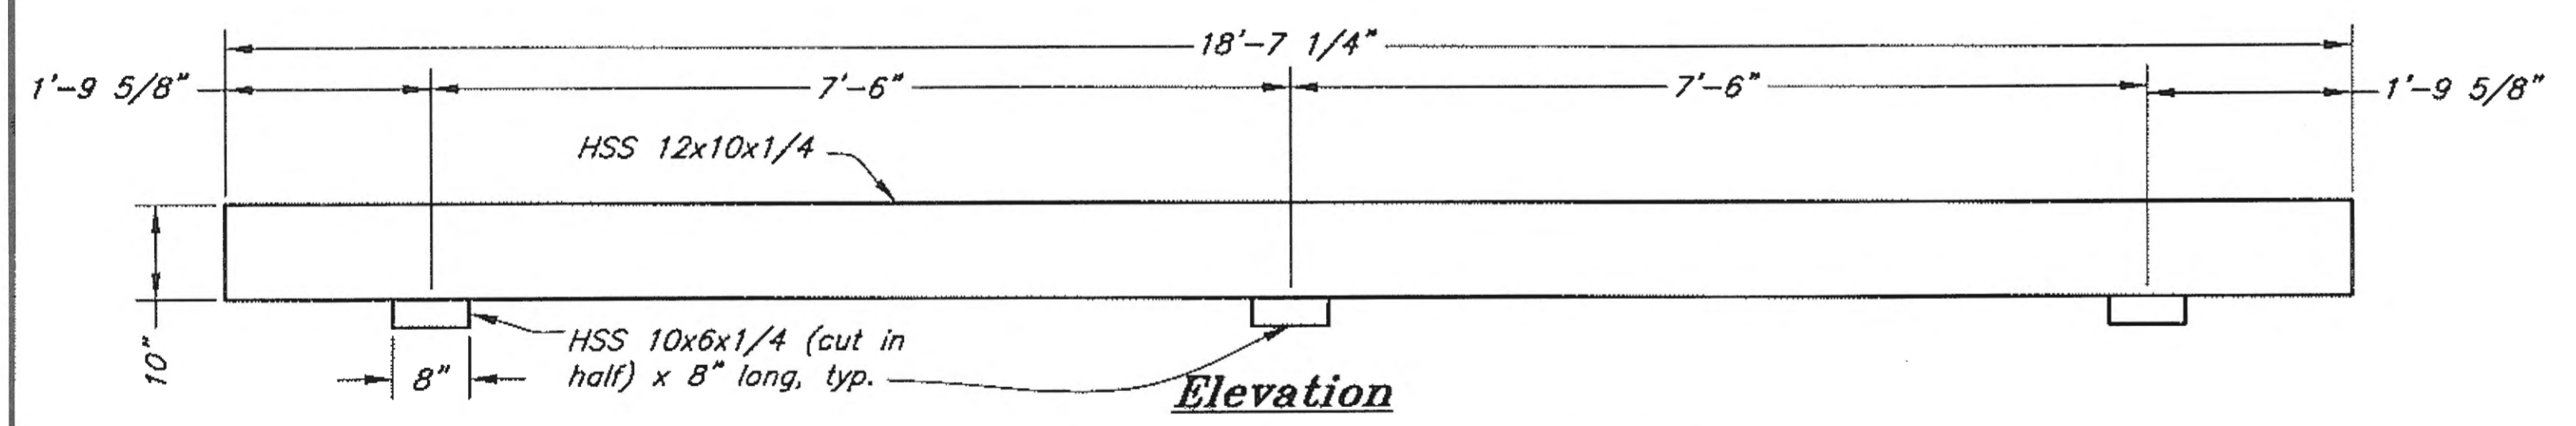

Wheel Guard Elements "D"

Elevation
Wheel Guard Detail

DO NOT SCALE FROM THESE DRAWINGS USE DIMENSIONS


DESIGNED BY: J. Scott

STATE OF ALASKA
DEPARTMENT OF TRANSPORTATION & PUBLIC FACILITIES
DESIGN & ENGINEERING SERVICES DIVISION-SOUTHEAST REGION
Gustavus Causeway Replacement
Dock Rail Elements
D17

CHECKED BY: B. Sawikka
DRAWN BY: C. Fuman, W. Hickey
PATH: G:\GUS\67599\AF\PLANSET\04-DOCK\17 DOCK RAILS.DWG
TAB: Wed, 26/Nov/08 11:35AM
REVISIONS
NO. DATE DESCRIPTION
PROJECT DESIGNATION
YEAR
SHEET NO.
TOTAL SHEETS


11.26.08
11.26.08
11.26.08
BR-0003(53)/67599 2008 68 138

Record Drawings have been reviewed by the Project Engineer, and represent to the best of my knowledge, the project as constructed.
PE [Signature] Date 3/21/17

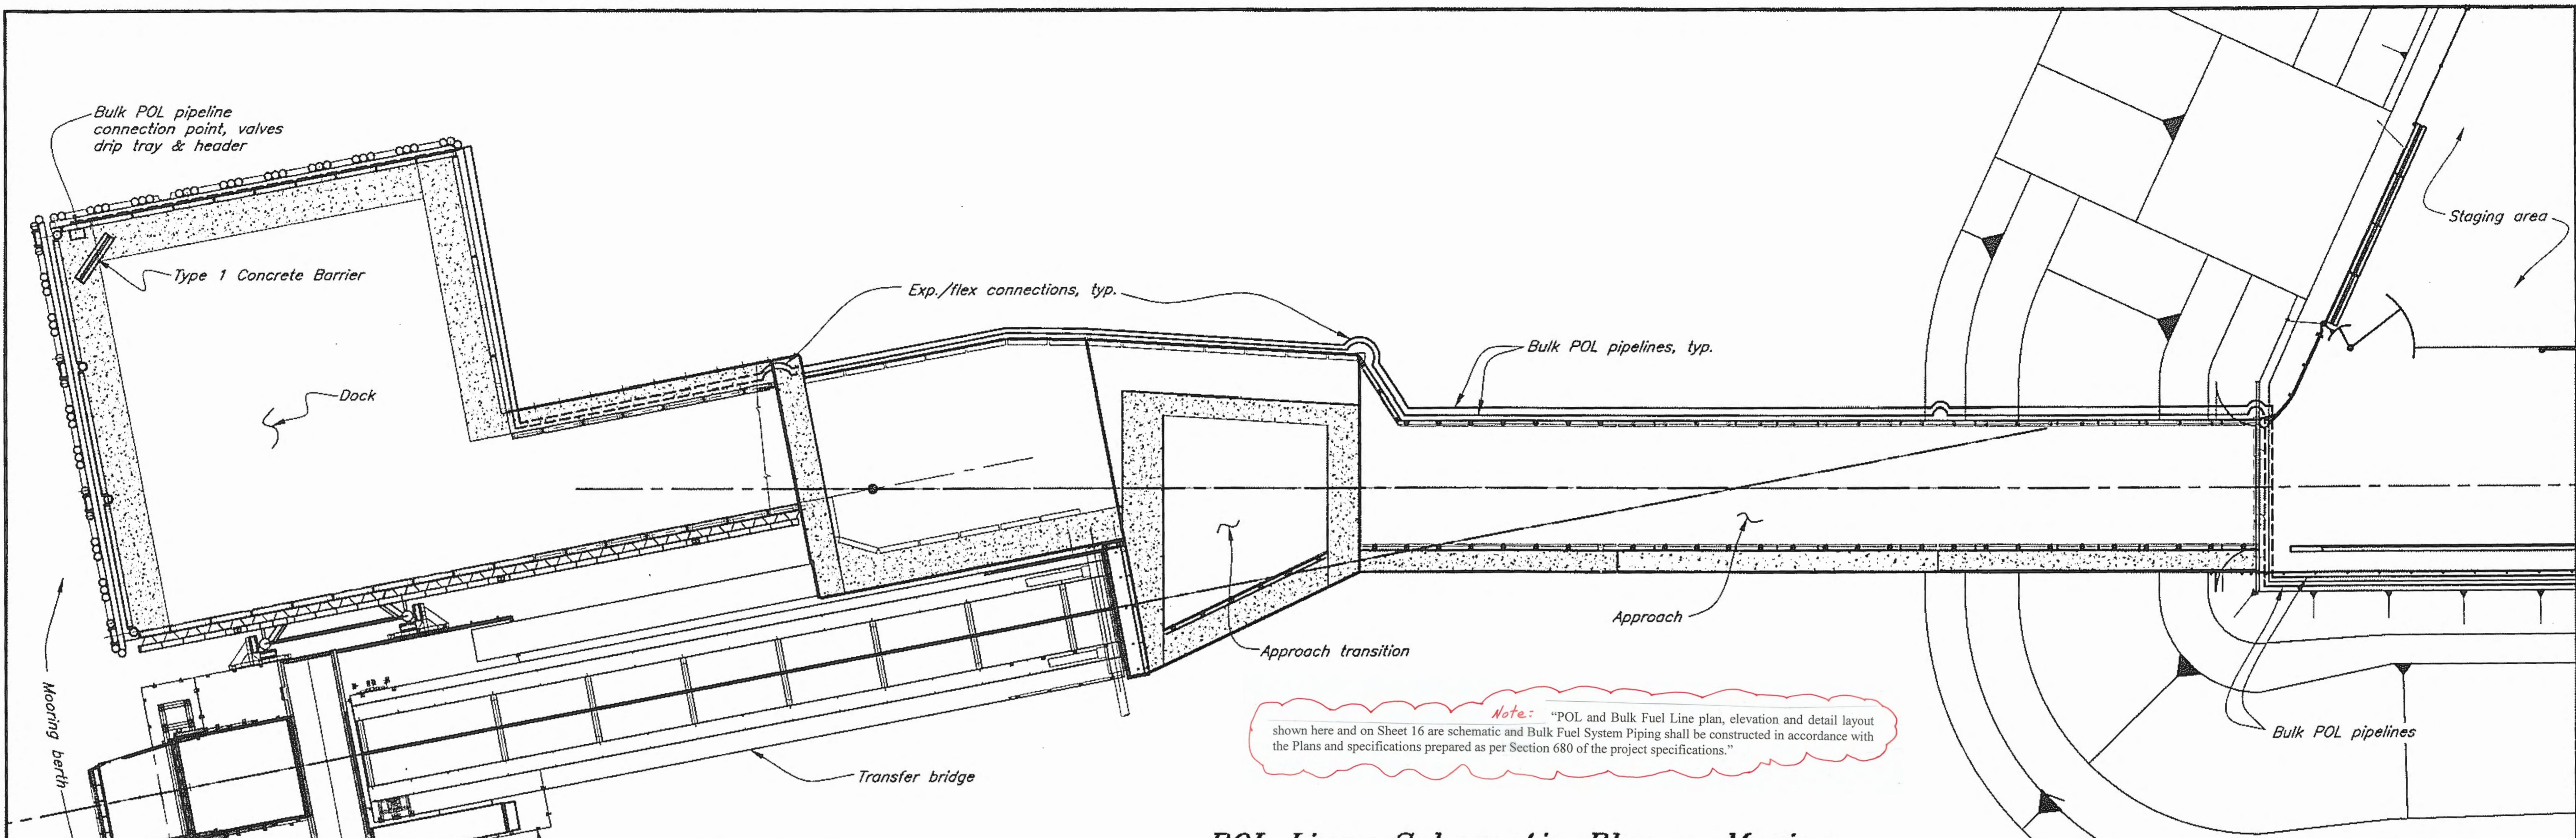


Note: "POL and Bulk Fuel Line plan, elevation and detail layout shown here and on Sheet 16 are schematic and Bulk Fuel System Piping shall be constructed in accordance with the Plans and specifications prepared as per Section 680 of the project specifications."

POL Lines Schematic Plan - Marine

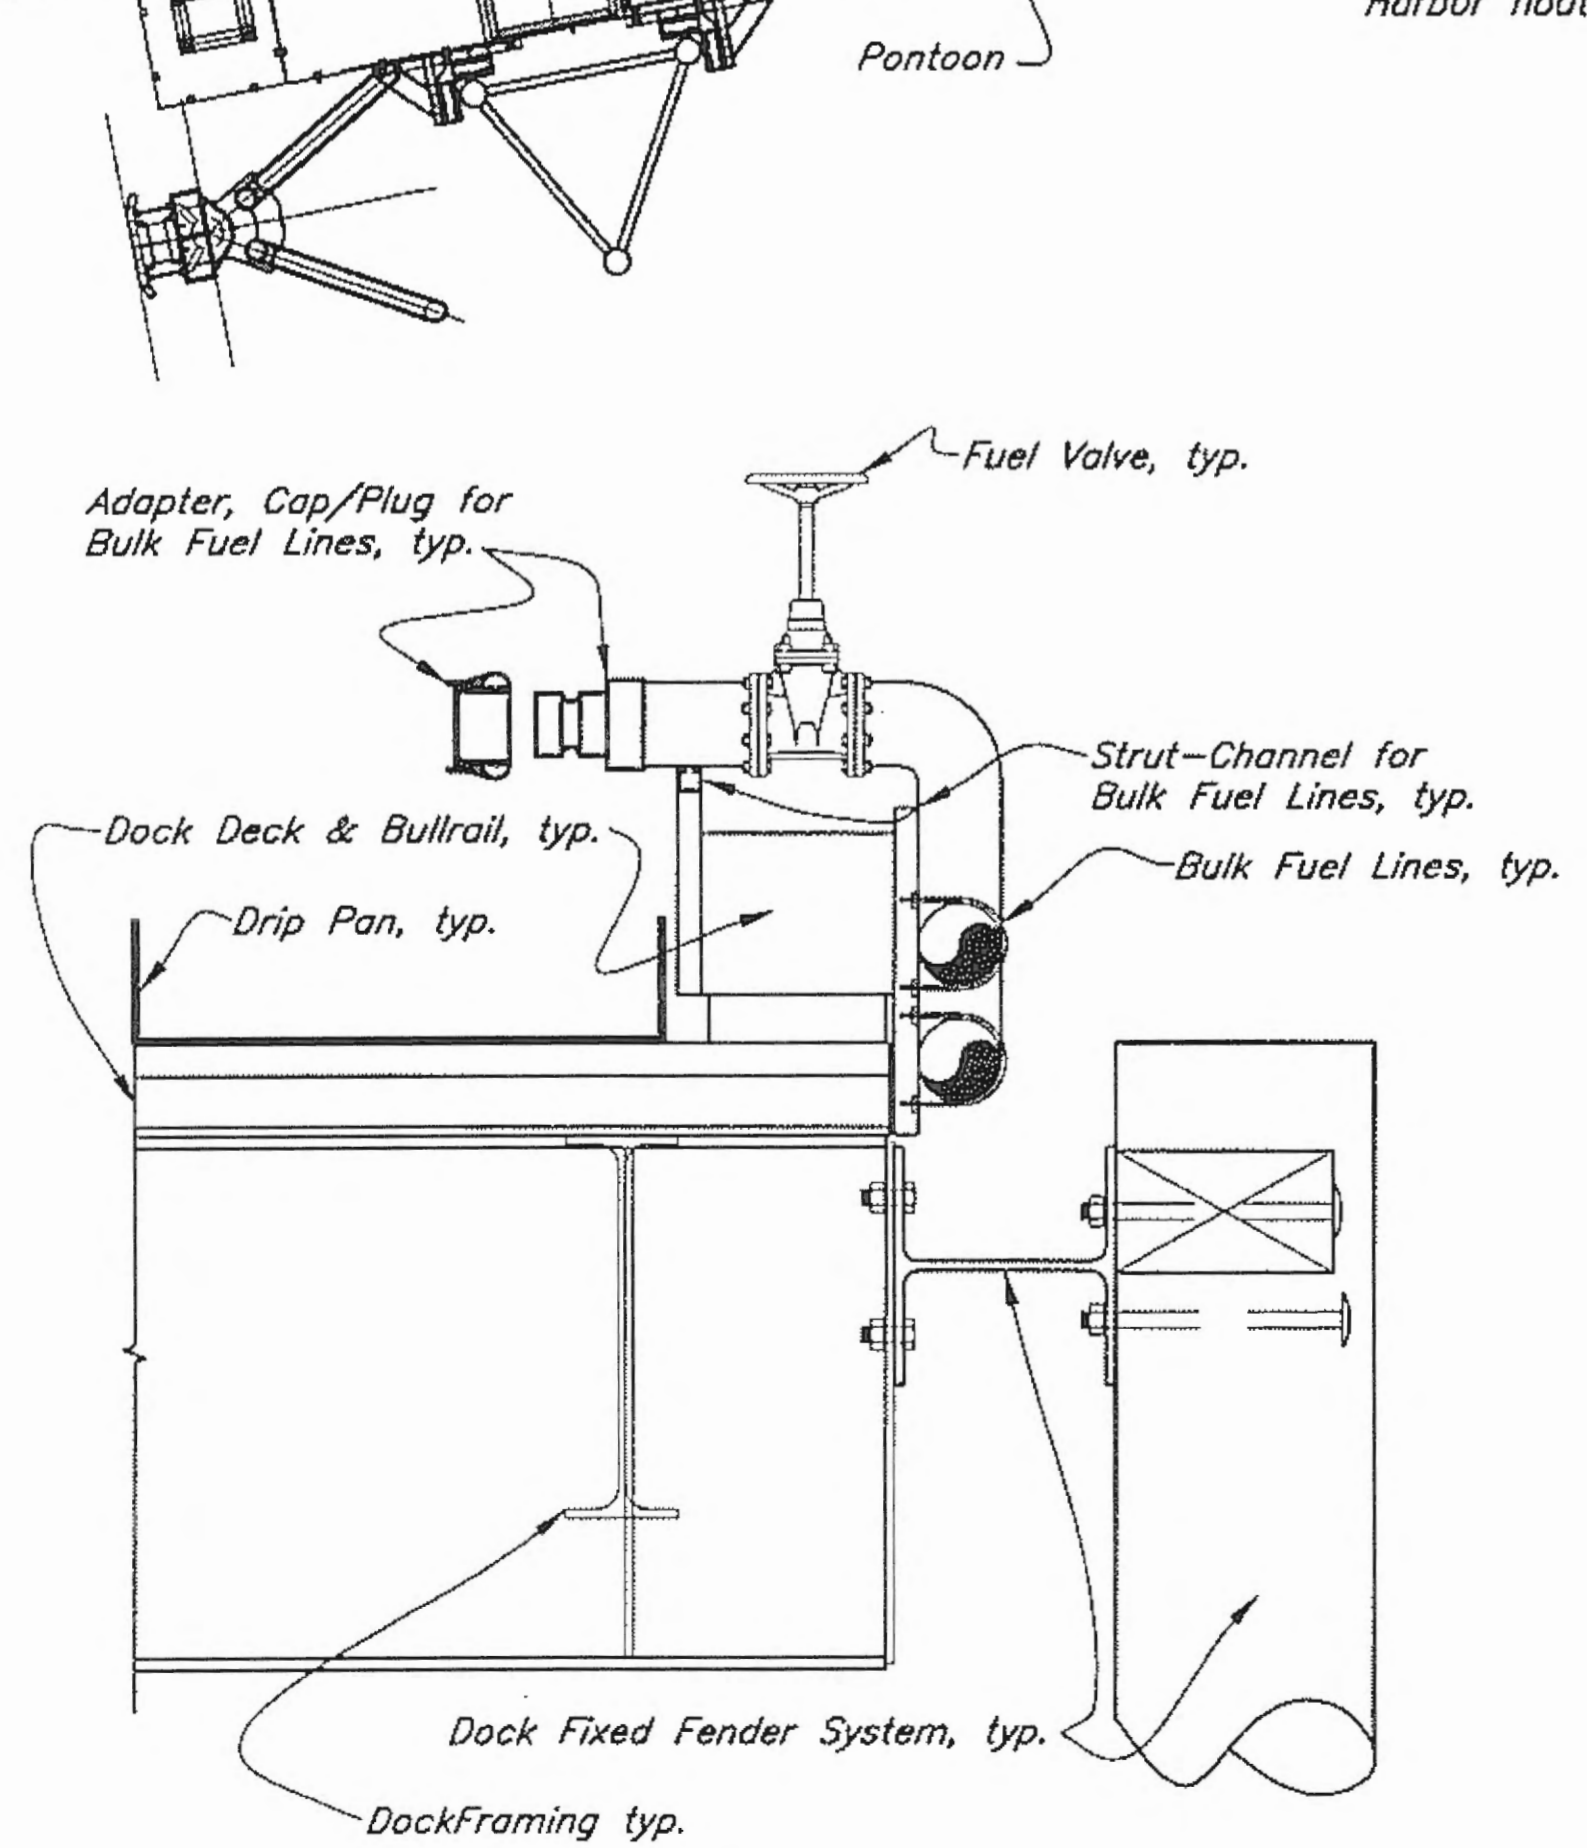

Elevation @ Fuel Line Header

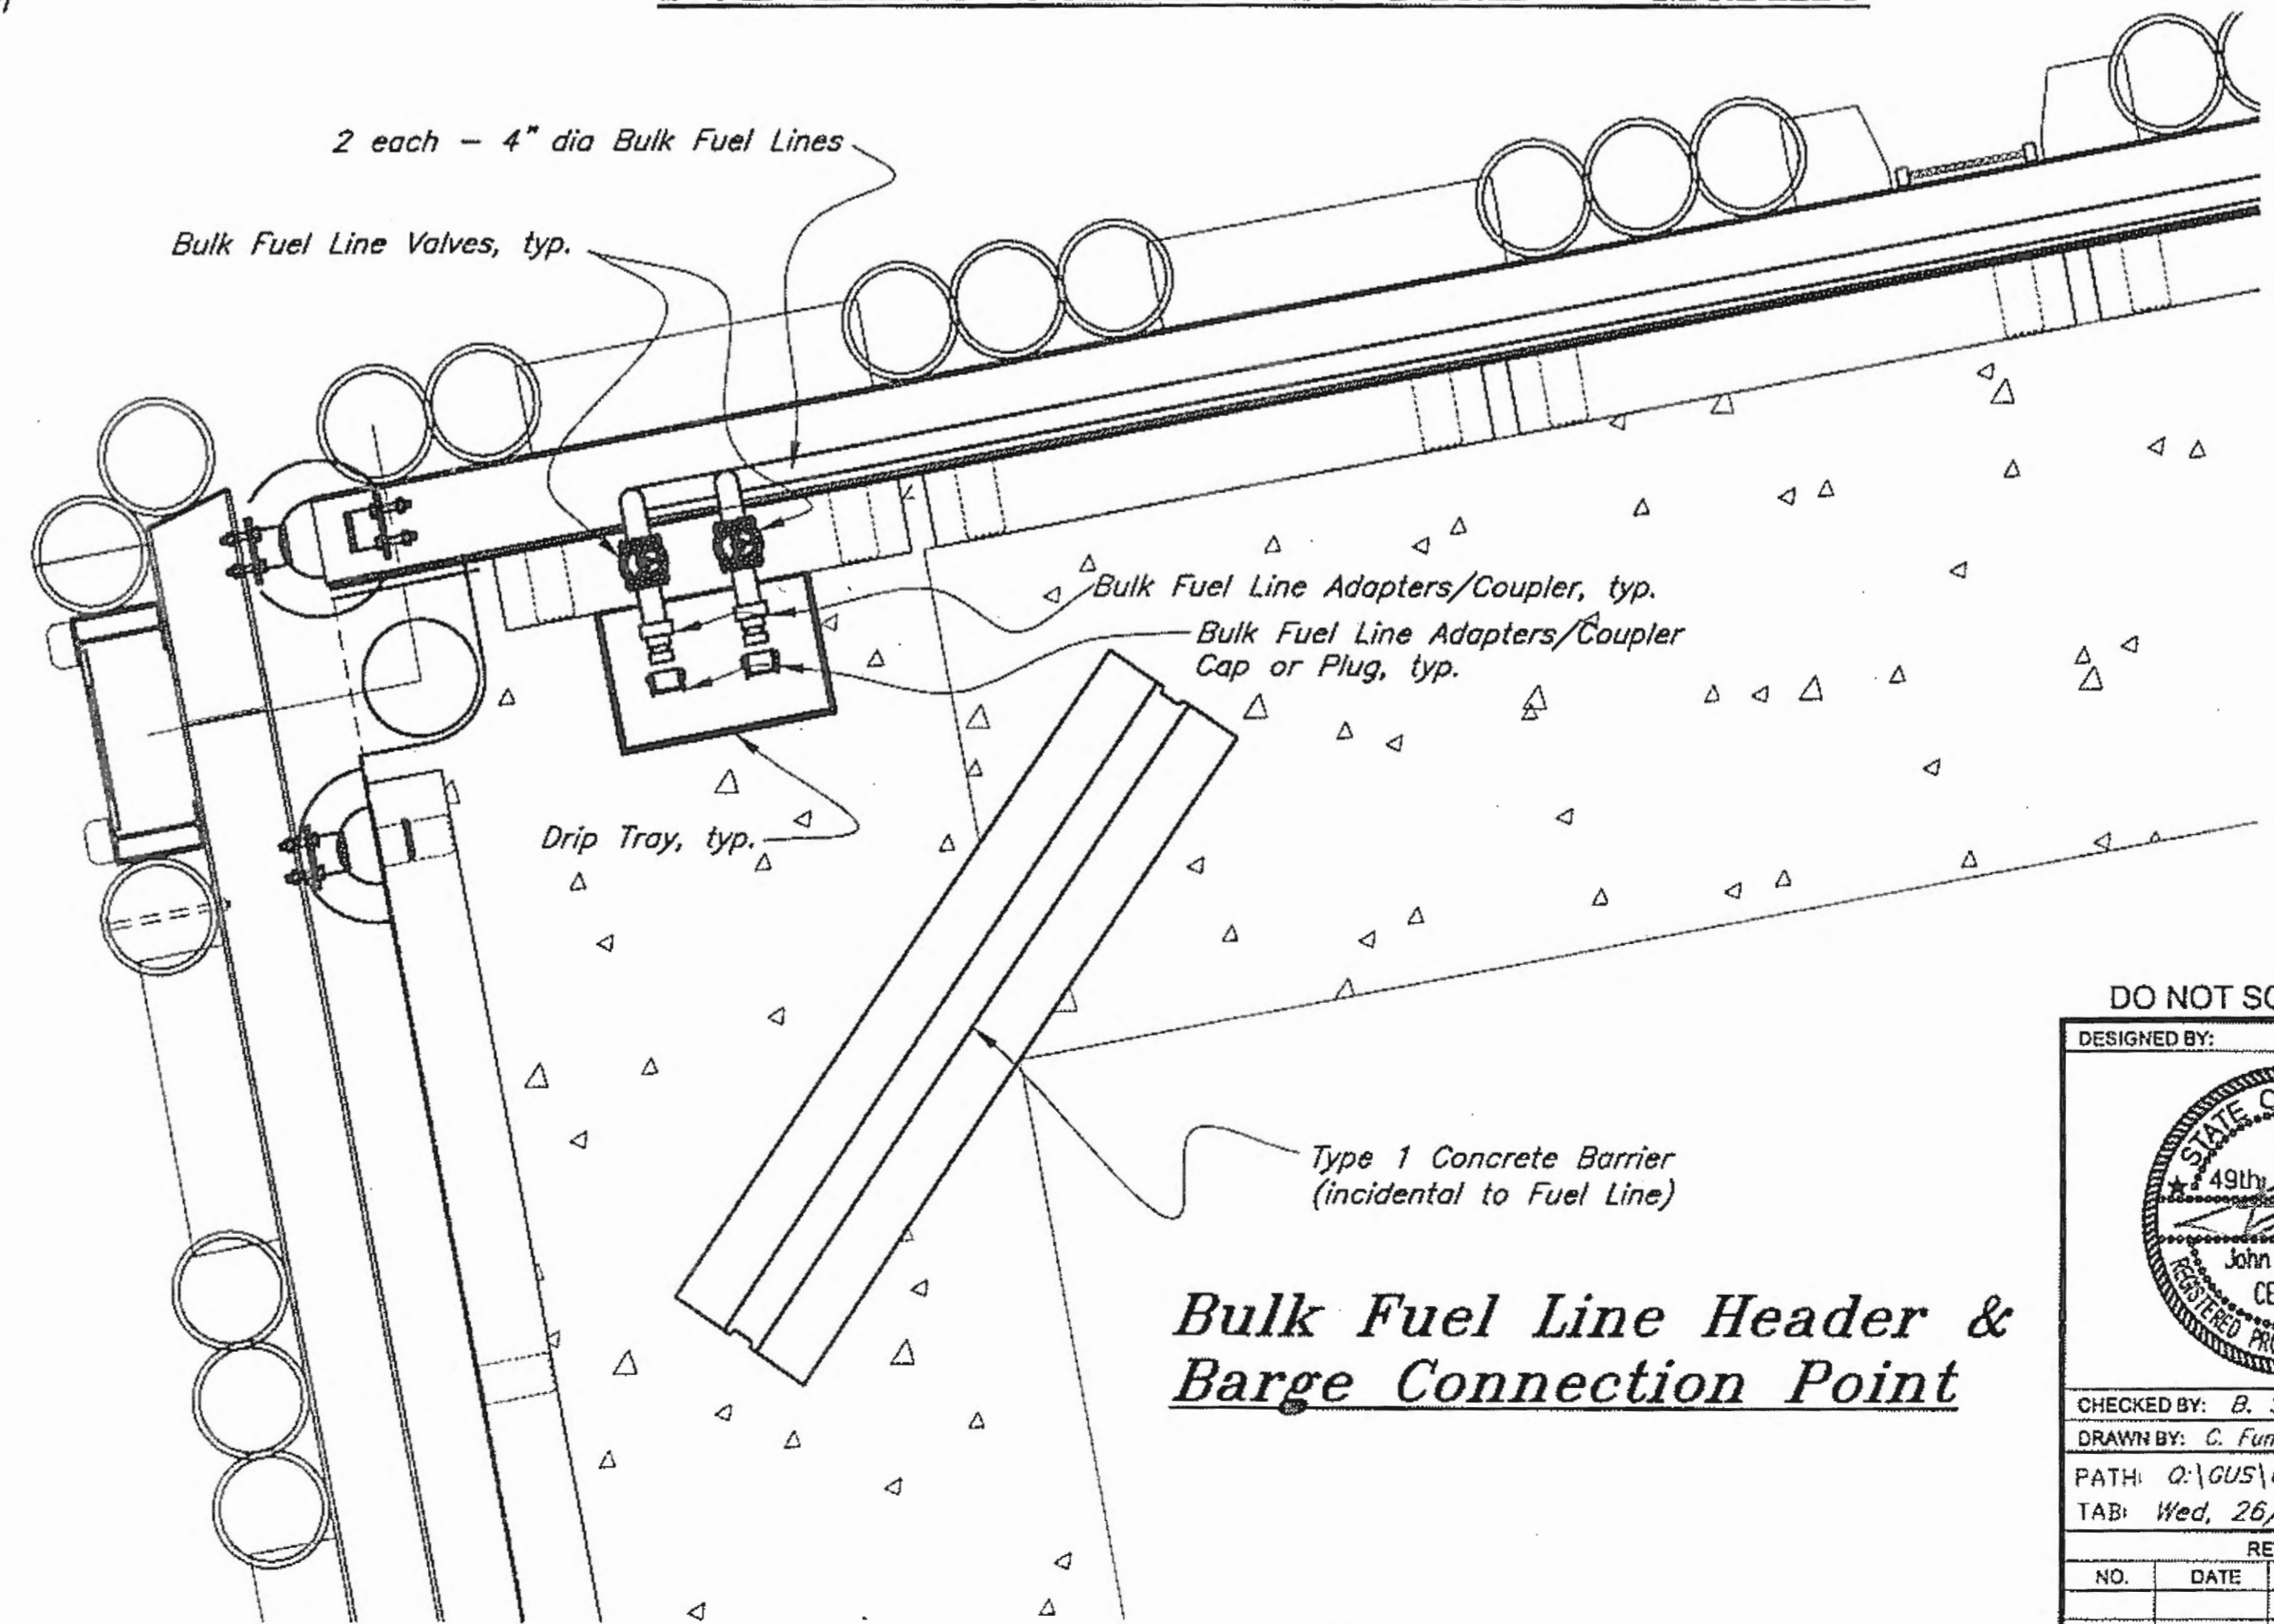

Bulk Fuel Line Header & Barge Connection Point

Record Drawings have been reviewed by the Project Engineer, and represent to the best of my knowledge, the project as constructed.
 PE *John T. Scott* Date 8/2/12

DO NOT SCALE FROM THESE DRAWINGS USE DIMENSIONS

DESIGNED BY: *J. Scott*

STATE OF ALASKA
 DEPARTMENT OF TRANSPORTATION & PUBLIC FACILITIES
 DESIGN & ENGINEERING SERVICES DIVISION-SOUTHEAST REGION

**Gustavus Causeway Replacement
 Bulk POL Pipelines
 @ Dock & Approach
 Transition**

D18

CHECKED BY: *B. Savikko*

DRAWN BY: *C. Furman, W. Hickok*

PATH: Q:\GUS\67599\MF\PLANSET\04-DOCK\D18 FUEL LINE @ DOCK.DWG

TAB: Wed, 26/Nov/08 11:37AM JTS/COIT

NO.	DATE	REVISIONS DESCRIPTION	PROJECT DESIGNATION	YEAR	SHEET NO.	TOTAL SHEETS
			BR-0003(53)/67599	2008	69	XX