


State of Alaska

Department of Transportation
and Public Facilities
Southeast Region


HAINES, ALASKA OLD HAINES HIGHWAY

OLD HAINES HIGHWAY SIDEWALK 3rd AVENUE TO
ALLEN ROAD
PROJECT No. SRTS-0987(007) ~ 67555

AS BUILT DRAWINGS
CONTRACTOR: SOUTHEAST ROAD BUILDERS, INC
PROJECT ENGINEER: JEREMY L. STEPHENS
NOTICE TO PROCEED: JULY 9, 2013
START DATE: JULY 27, 2013
END DATE: OCTOBER 11, 2013

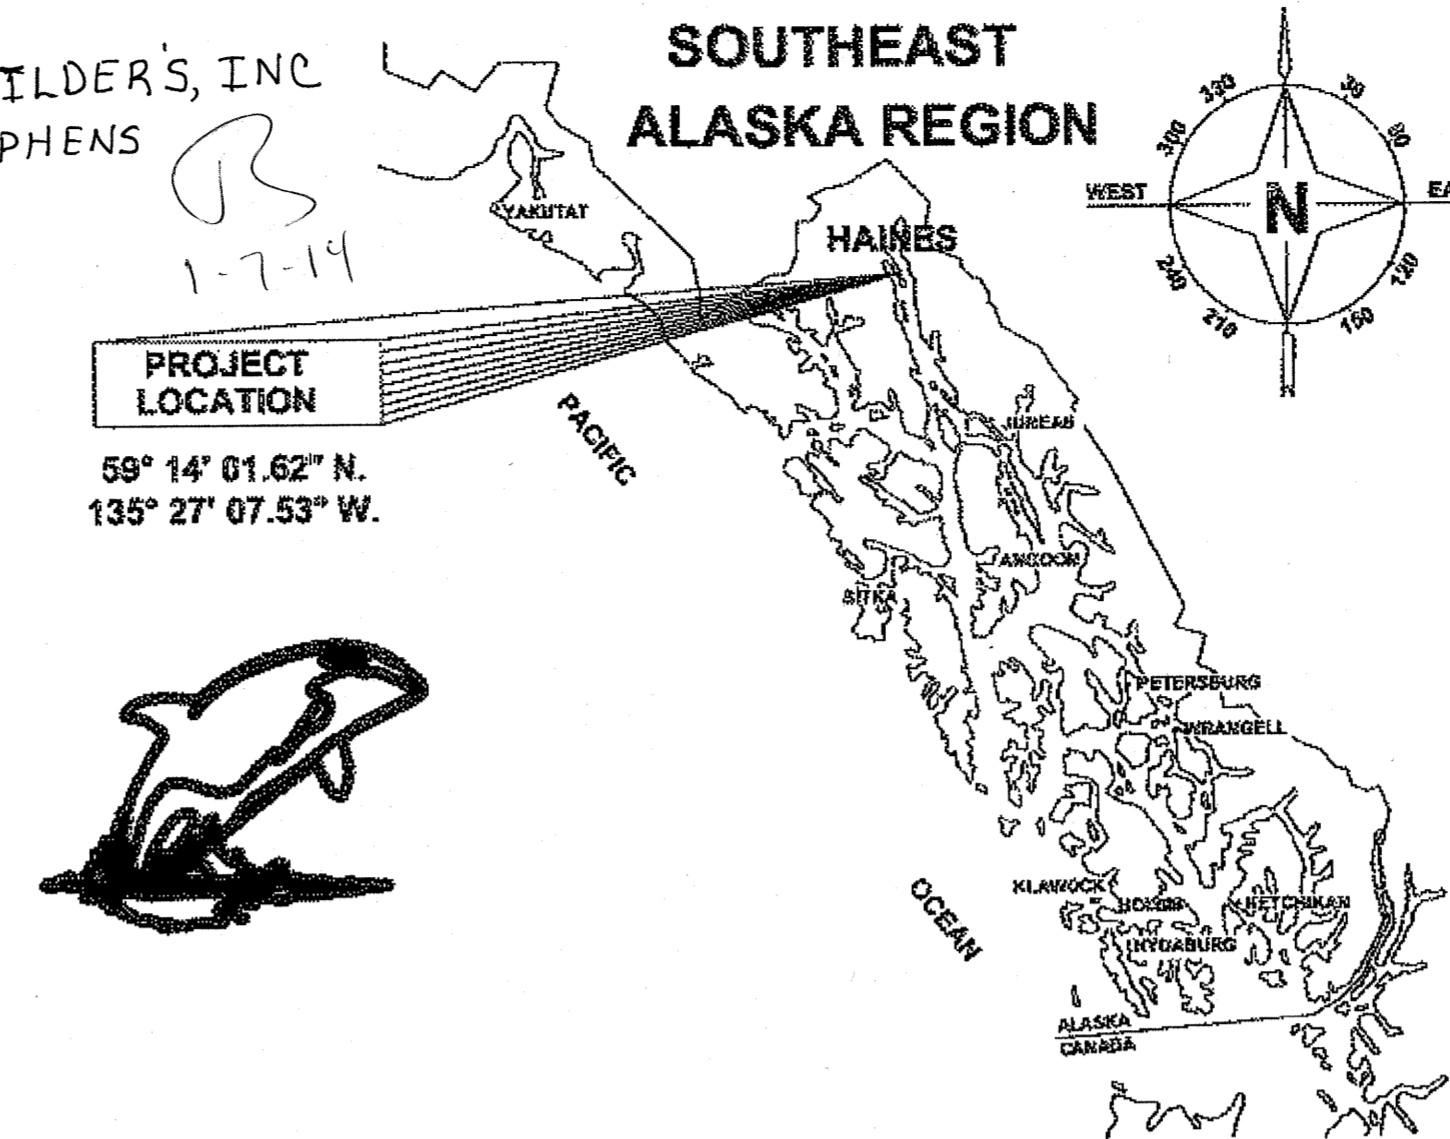

INDEX	
SHEET NO.	DESCRIPTION
A1	TITLE SHEET
A2-A3	SURVEY CONTROL SHEETS
B1-B3	TYPICAL SECTIONS
C1-C3	ESTIMATE OF QUANTITIES
D1	SIGN SUMMARY
F1-F4	PLAN & PROFILE SHEETS
G1-G2	PROFILE SHEETS
J1-J3	MISC DETAILS
P1-P4	EROSION AND SEDIMENT CONTROL PLANS
P5	EROSION AND SEDIMENT CONTROL DETAILS
R1-R4	SIGNING & STRIPING PLAN
S1	TRAFFIC CONTROL PLAN

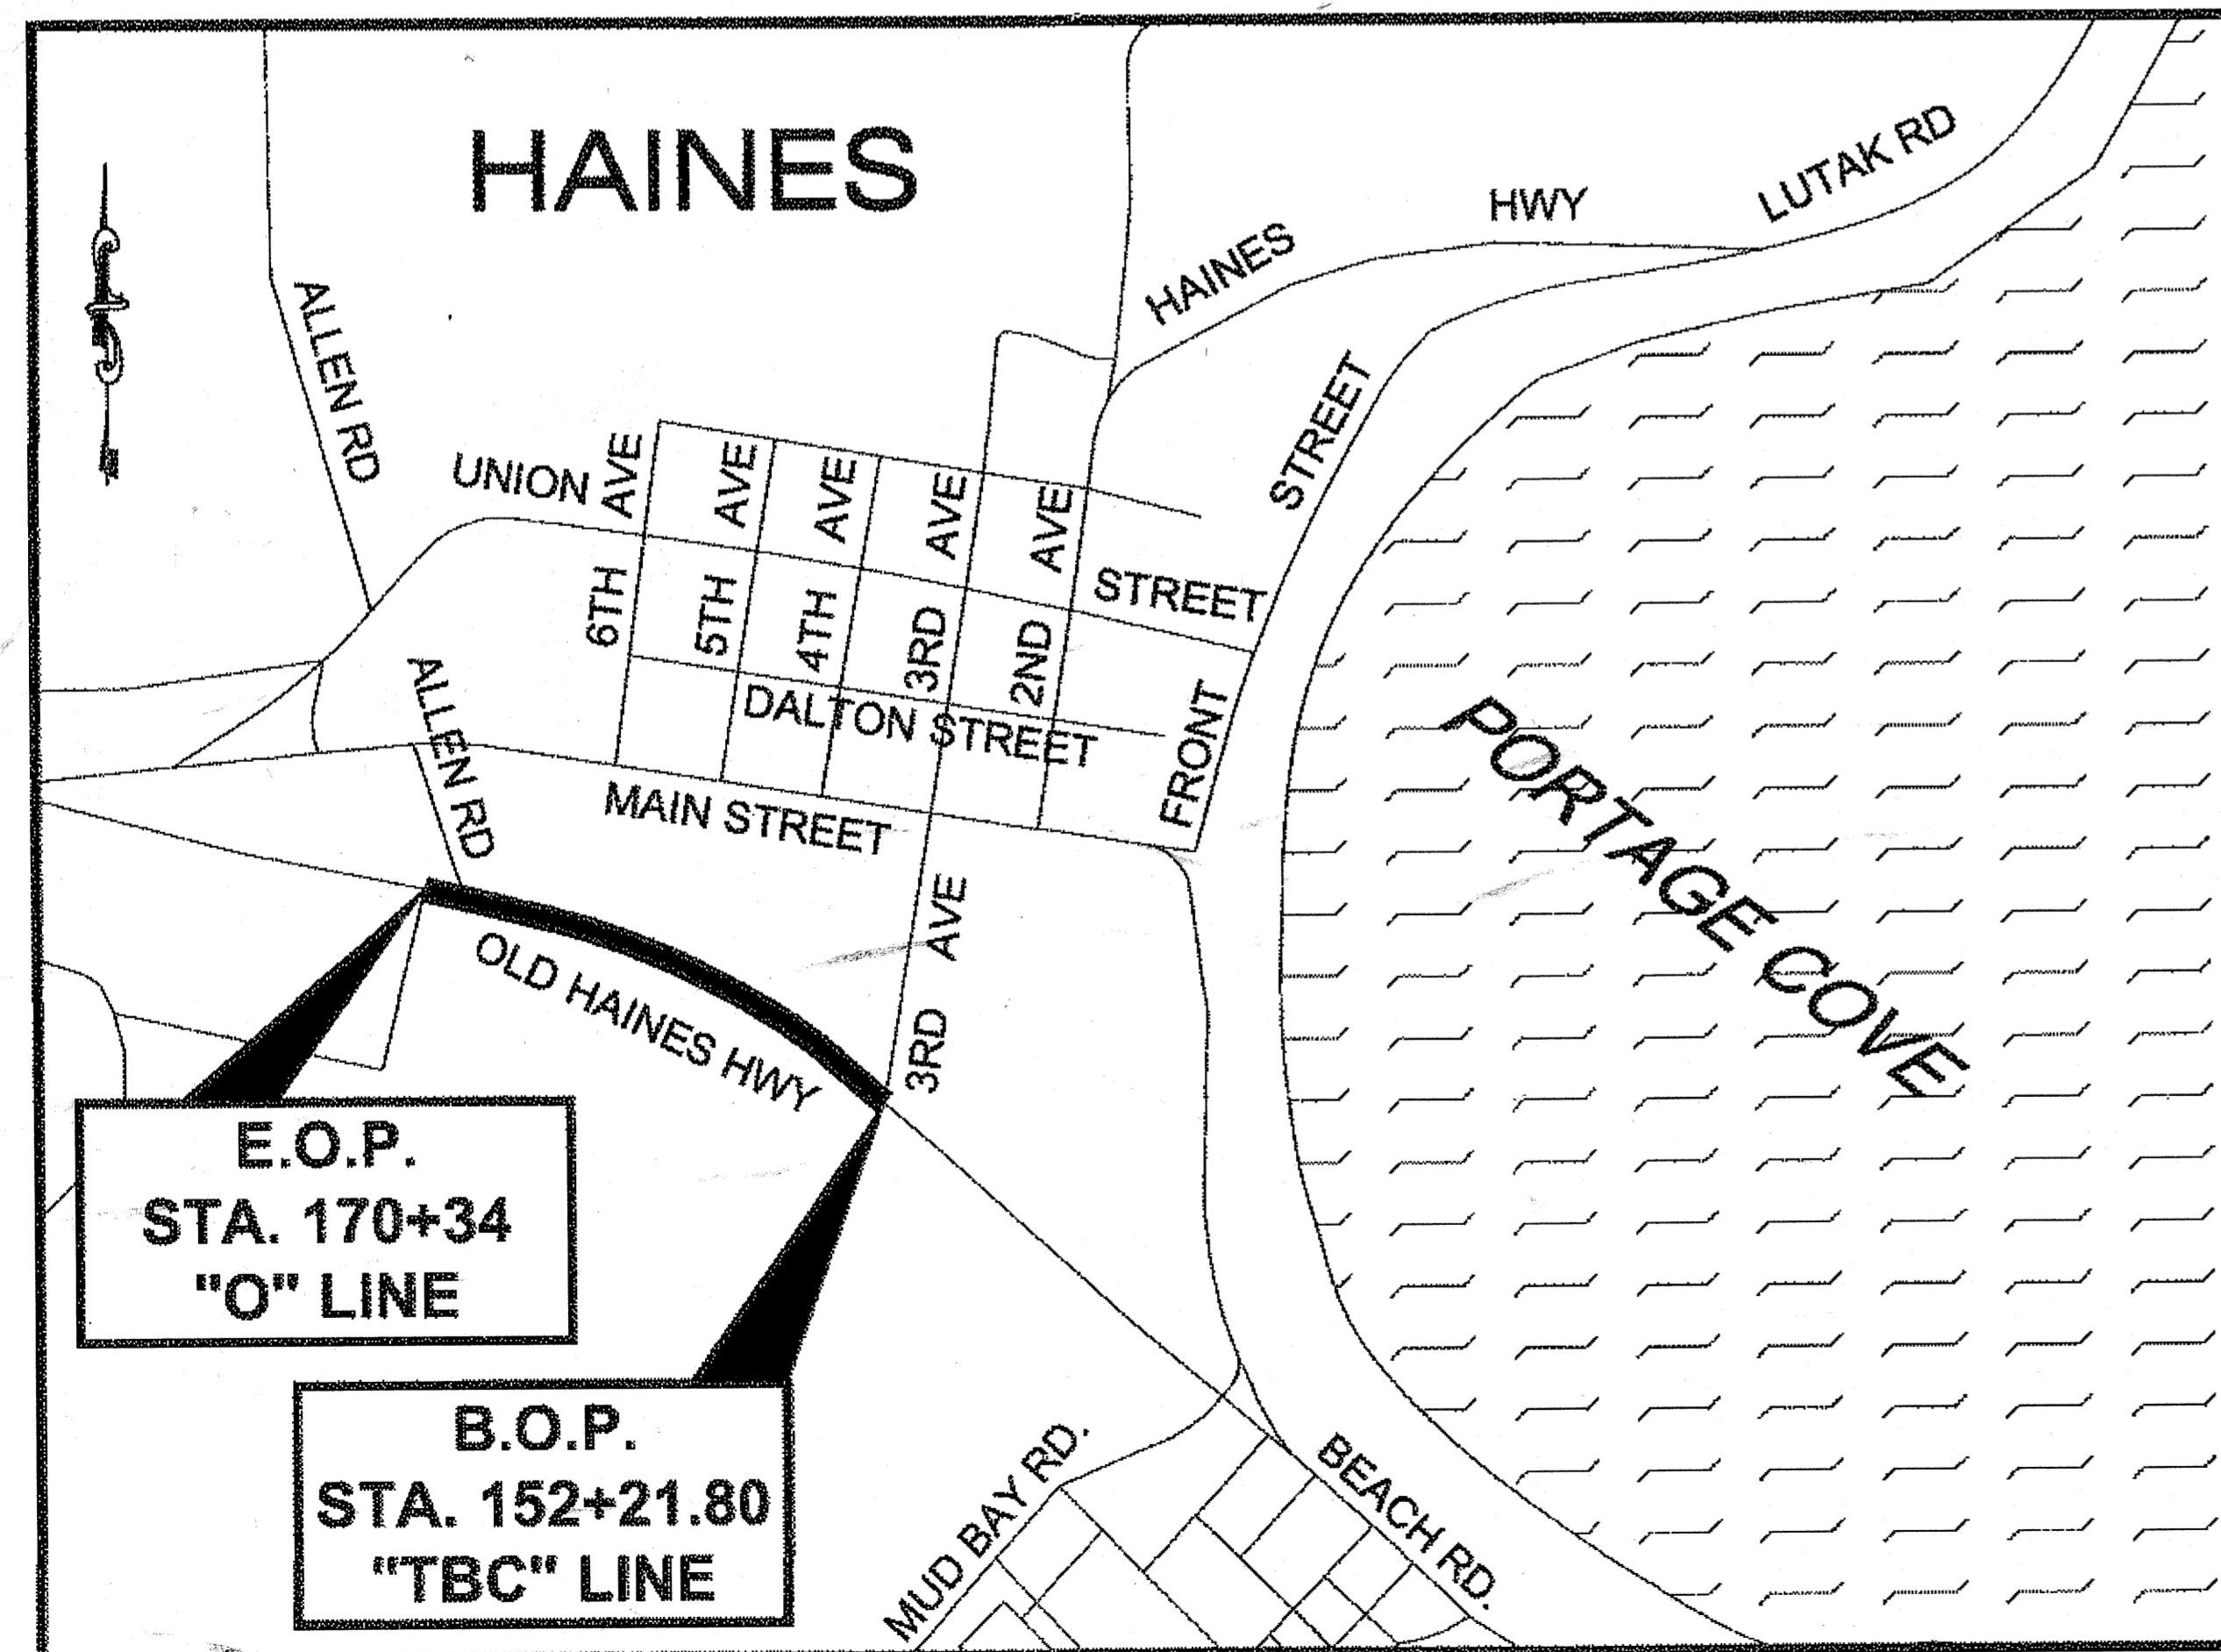

VICINITY MAP
N.T.S.

DESIGN DESIGNATION

FUNCTIONAL CLASSIFICATION	=	RURAL MAJOR COLLECTOR
A.D.T. 2011 (LAST YEAR WITH DATA)	=	1740
A.D.T. 2014 (YEAR AFTER CONSTRUCTION)	=	1770
A.D.T. 2024 (MID-LIFE YEAR)	=	1860
A.D.T. 2034 (FUTURE YEAR)	=	1950
D.H.V. (14.2%) 2034	=	280
% T	=	9.9%
V	=	20 M.P.H. SCHOOL ZONE, 35 M.P.H. POSTED
E.A.L.	=	300,000
DESIGN VEHICLES FOR TURNING	=	WB-50

PROJECT SUMMARY

CDS ROUTE NO.	=	298020
CDS MILEPOINT	=	0.286 TO 0.635
LENGTH OF PROJECT	=	0.349 MILES
LENGTH OF SIDEWALK	=	0.349 MILES
WIDTH OF SIDEWALK	=	5 FT
HALF WIDTH OF ROADWAY	=	12 FT. TRAVEL LANE, 4 FT. SHOULDER

THE FOLLOWING STANDARD DRAWINGS APPLY TO THIS PROJECT:

A-1	D-01.02	E-13.00	S-00.11	T-20.03
C-03.10	D-22.01	I-20.14	S-01.00	T-21.03
C-04.12	D-24.00	I-21.02	S-05.01	T-23.00
	D-23.01		S-30.03	
	D-26.02			

CDS MILEPOINT	CDS ROUTE #	START	END
	298020	0.635 THIRD AVE. (BOP)	0.286 FAIR DRIVE (EOP)

PATH: Q:\MS67555\ENDOUG'S FILE\A_TITLE_SHT.DWG TAB:A1
Tuesday, October 30, 2012 11:12:04 AM
PLOT: PSPACE OR MSPACE: 1=1(F)

STATE OF ALASKA
DEPARTMENT OF TRANSPORTATION
& PUBLIC FACILITIES
SOUTHEAST REGION

APPROVED: *Chuck Correa* 4/26/13
REGIONAL PRE-CONSTRUCTION ENGINEER
CHUCK CORREA, P.E. DATE

APPROVED: *Chuck Correa* 4/26/13
DIRECTOR, SOUTHEAST REGION
ALBERT H. CLOUGH, CPG DATE


CERTIFIED TRUE & CORRECT AS-BUILT OF ACTUAL FIELD CONDITION:

Margaret A. Hansen 3-19-14
CONSTRUCTION PROJECT MANAGER DATE


STATE	PROJECT DESIGNATION	YEAR	SHEET NO.	TOTAL SHEETS
ALASKA	SRTS-0987(007) ~ 67555	2013	A1	29

JS
1-7-14

ADDENDUM NUMBER		
ATTACHMENT NUMBER		
RECORD OF REVISIONS		
No.	DATE	DESCRIPTION

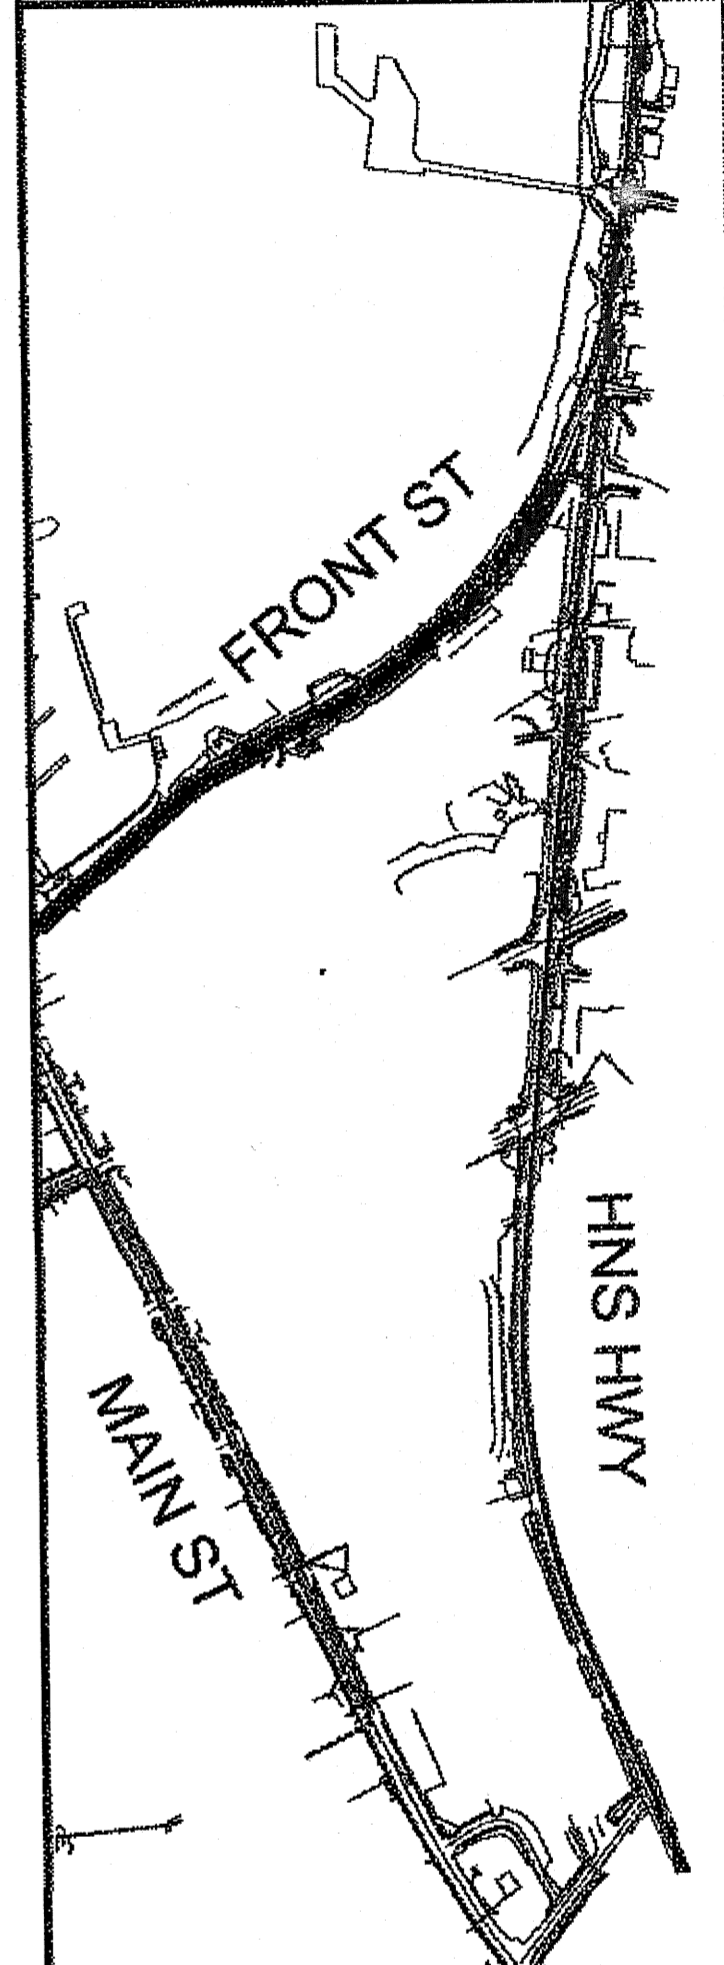

CHECKED BY: D.IGNOTOV

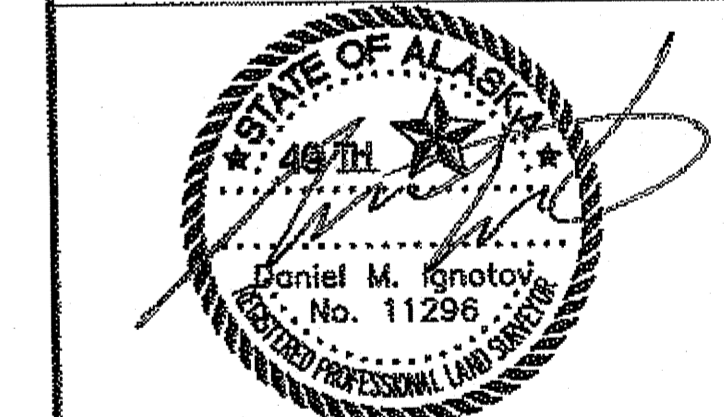

DESIGNED BY: J.PAPOI
DRAWN BY: J.PAPOI

STATE OF ALASKA
DEPARTMENT OF TRANSPORTATION
& PUBLIC FACILITIES
DESIGN & ENGINEERING SERVICES
DIVISION-SOUTHEAST REGION

HNS-OLD HAINES HIGHWAY
SIDEWALK 3rd AVENUE
TO ALLEN ROAD
PROJECT #67555

SURVEY CONTROL	
PROJECT DESIGNATION	
67555	
STATE	YEAR
ALASKA	2013
SHEET NUMBER	TOTAL SHEETS
A2	29

HORIZONTAL & VERTICAL BASIS
Haines Alaska Project # 67555
Old Haines Highway New Sidewalk 3rd Avenue to Allen Road

HORIZONTAL CONTROL

The basis of horizontal control is "HNS-D", a Primary Airport Control Station, 3.5" Brass Cap located in bedrock adjacent to Haines Highway near the northwesterly end of the airport access road.

NGS published coordinates NAD83 (1992)
Latitude : N 59°14'53.13661", Longitude : W 135°32'03.05281" ,Ellipsoid Ht: 16.353m

The basis of bearing for this project is the geodetic bearing of S 50°56'51" E from HNS-D to HNS-A. This bearing was derived from GPS and conventional observations plus the applied convergence angle of -1°34'03.84" described below.

The Haines 4-24 Grid is based about NGS monument HNS-A, a 3.5" Brass Cap located in a 6'x3' concrete pad near the hold bar on taxiway B. The Grid system relates to AKSPC zone 1 NAD83(1992) through the following parameters:

Zone = NAD83(92) AKSPC ZONE 1 Grid Scale = 0.99995319 Convergence = -1°34'03.84"
Translation about HNS-A as follows:
AKSPC Northing = 2711876.83845 FT US AKSPC Easting = 2337586.75087 FT
US Local Northing = 500000.0000 FT US Local Easting = 700000.0000 FT US

PROJECT SPECIFIC HORIZONTAL CONTROL

HNS-D :
HNS-Grid N 501107.9682 FT US, E 698634.3273 FT US
AKSPC N 2713021.7013 FT US, E 2336251.9644 FT US
HNS-A :
HNS-Grid N 500000.0000 FT US, E 700000.0000 FT US
AKSPC N 2711876.8384 FT US, E 2337586.7509 FT US


VERTICAL CONTROL

The basis of vertical control is the 3 1/4" Brass Cap USACE benchmark "HH-1" with a published elevation of **25.63' above MLLW**. Source of elevation is Corps of Engineers harbor plat 2509-08. Monument is located approximately 80' back from end of north Harbor Jetty.


MONUMENT NOTES:

1. If any pair of control points disagrees from published value by more than 1:10,000 horizontally or vertically then a third network point must be tied to ascertain which point is in error or has been disturbed.
2. Whether listed or not, all monuments, property markers, or accessories that will be disturbed or buried shall be referenced prior to being disturbed, and re-established in their original position and a record of monument form in accordance with A.S.34.65.040 shall be submitted to the construction engineer for review prior to recording. Coordinate values listed are for informational purposes and should be used to reset monuments only as a last resort.

No.	DATE	DESCRIPTION

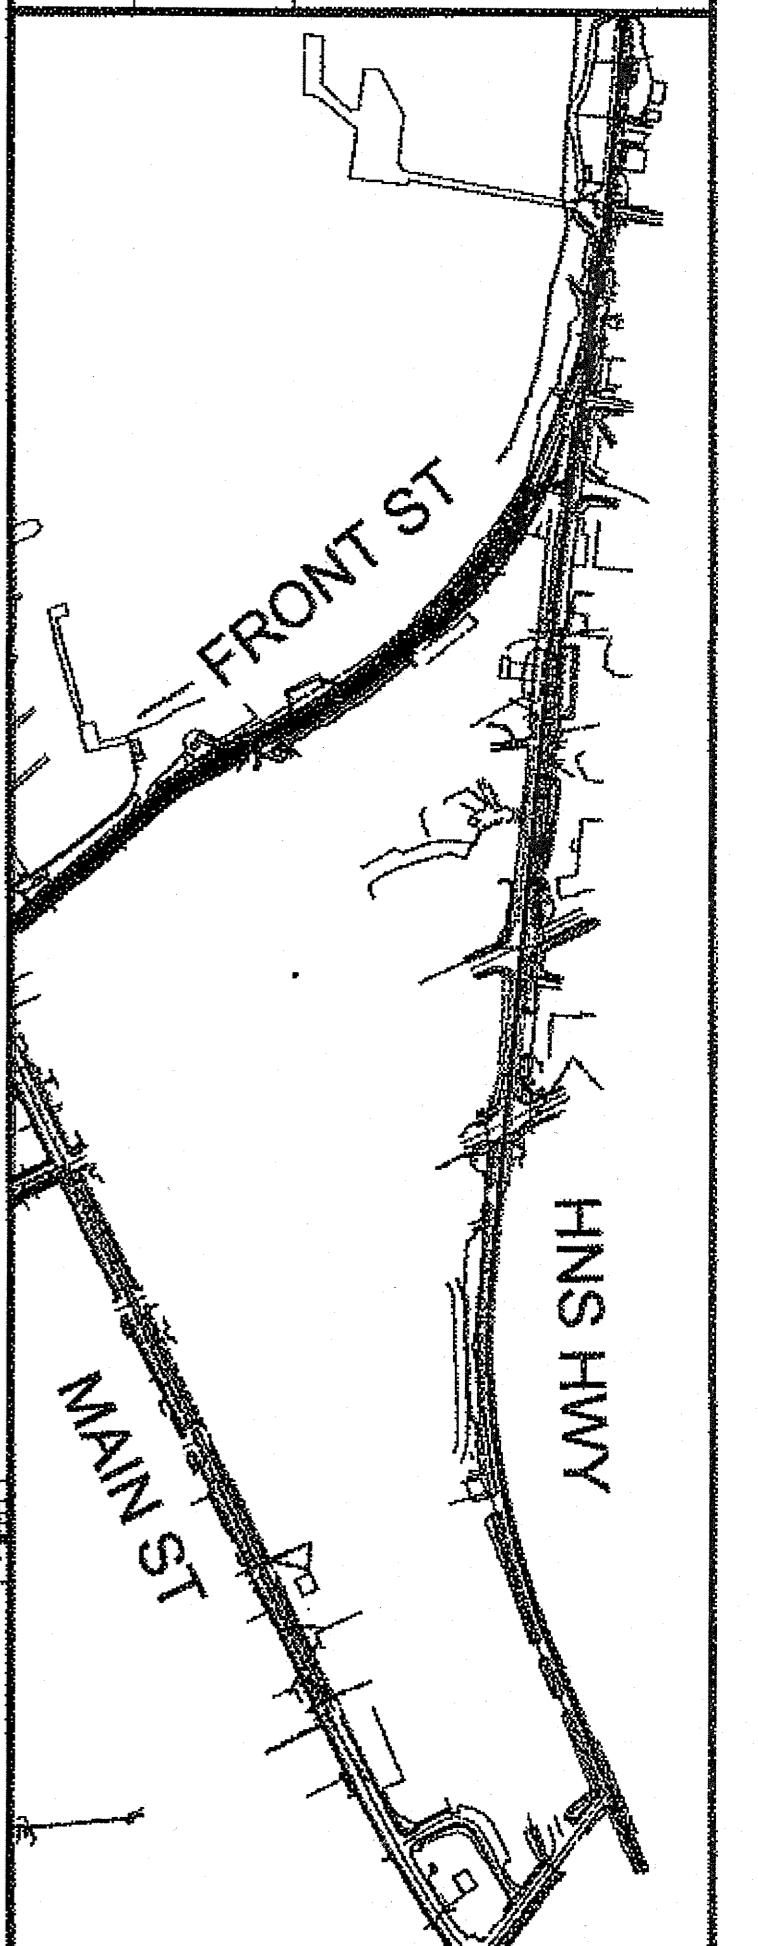

CHECKED BY: D.IGNOTOV

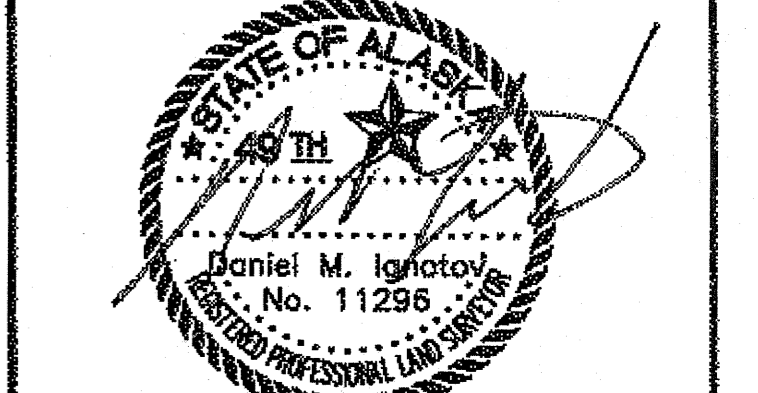

DESIGNED BY: J.PAPOI

DRAWN BY: J.PAPOI

STATE OF ALASKA
DEPARTMENT OF TRANSPORTATION
& PUBLIC FACILITIES
DESIGN & ENGINEERING SERVICES
DIVISION-SOUTHEAST REGION

HNS-OLD HAINES HIGHWAY
SIDEWALK 3rd AVENUE
TO ALLEN ROAD
PROJECT #67555

SURVEY CONTROL

PROJECT DESIGNATION


67555

STATE YEAR

ALASKA 2013

SHEET NUMBER TOTAL SHEETS

A3 29

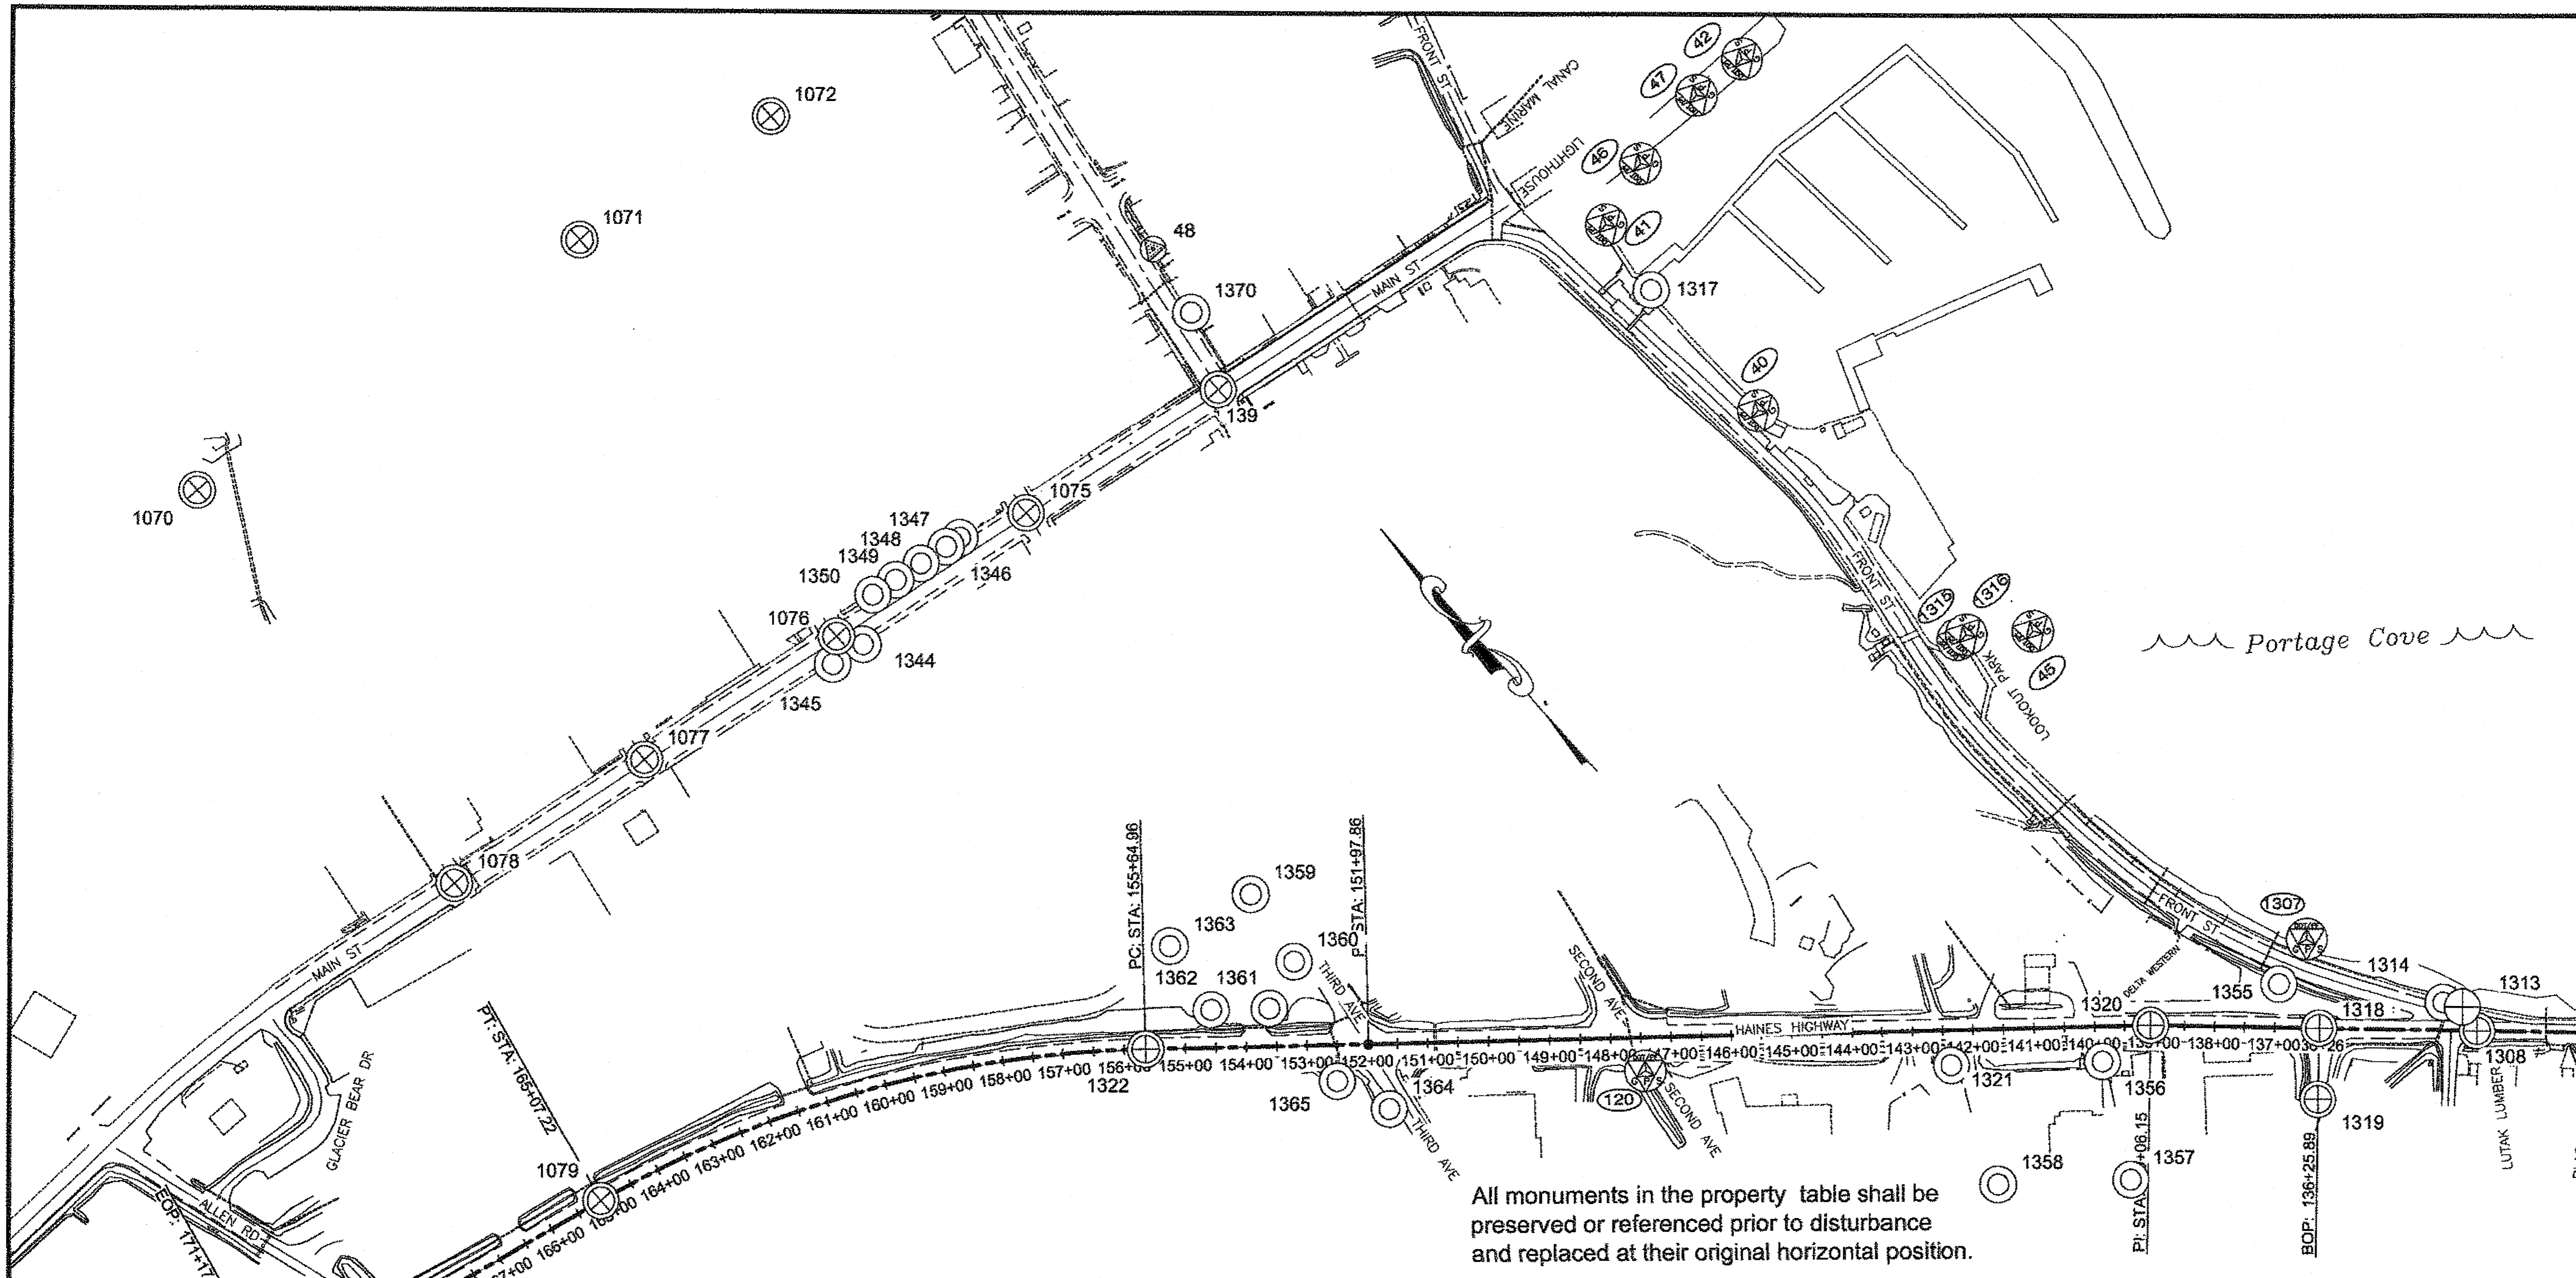

All monuments in the property table shall be preserved or referenced prior to disturbance and replaced at their original horizontal position.

All monuments in this table are provided strictly for survey control. Should any of them be destroyed during construction they shall not be replaced.

CONTROL OLD HAINES HIGHWAY						
CONTROL #	Northing	Easting	Elevation	Description	STATION	OFFSET
40	495717.04	715915.80	33.55	GPS_BC3.25"_USACE_HH-21	145+30.01	1024.97R
41	496111.84	715931.62	32.24	GPS_BC3.25"_USACE_HH-20	147+74.34	1335.48R
42	496163.65	716281.18	25.63	GPS_BC3.25"_USACE_HH-1	145+42.16	1601.87R
45	495143.96	716012.37	24.57	GPS_BC3.5"_USACE_HH-5	140+84.44	651.86R
46	496148.19	716040.86	18.05	GPS_ALCAP2"_TONER-NRDLNG	147+14.88	1434.07R
47	496170.04	716185.00	26.96	GPS_ALCAP2"_DOWL-HKM	146+19.45	1544.27R
48	496579.89	715349.53	97.78	USC&GS_BC3.75"_BM-A141	155+21.02	1313.52R
120	495034.46	715051.71	49.87	GPS_SURVSPIKE_PND	147+43.90	55.23L
1307	494464.50	716012.61	30.48	GPS_USCGS_BM_No.5	136+48.96	146.22R
1315	495217.02	715910.71	35.61	GPS_BC3.25"_USACE_HH-23	142+09.20	641.41R
1316	495213.03	715926.92	35.57	GPS_BC3.25"_DOT_HNS-7	141+94.28	648.90R


PROPERTY OLD HAINES HIGHWAY						
CONTROL #	Northing	Easting	Elevation	Description	STATION	OFFSET
139	496337.64	715274.85	81.49	CL_MON_BC2.5"_RTK	154+20.44	1080.72R
1070	497333.14	713908.41	61.33	CL_MON_RTK	165+06.55	1340.44R
1071	497221.56	714652.83	91.18	CL_MON_RTK	160+79.70	1472.05R
1072	497162.19	715023.75	102.83	CL_MON_RTK	158+82.86	1593.52R
1075	496396.20	714904.38	78.09	CL_MON_RTK	156+84.37	890.19R
1076	496454.86	714534.14	71.14	CL_MON_RTK	159+23.82	735.76R
1077	496513.45	714163.81	66.34	CL_MON_RTK	161+88.31	627.82R
1078	496571.91	713793.42	61.29	CL_MON_RTK	164+70.41	572.45R
1079	496022.59	713626.96	53.58	CL_MON_RTK	165+07.22	0.00R
1308	494164.17	716121.12	36.98	CL_MON_DOH	N/A	N/A
1313	494209.76	716128.98	38.55	ALPRIM3.25"_MC2_S735_WCMC_S2716_ALS	N/A	N/A
1314	494236.34	716110.56	39.46	ALSEC2"_NO-MRKS	N/A	N/A
1317	495982.47	715915.48	31.79	ALSEC2"_TONER-NRDLNG	147+02.61	1226.61R
1318	494341.69	715929.97	50.47	CL_MON_DOH	136+25.89	0.00R
1319	494256.02	715850.10	54.65	CL_MON_DOH	136+26.09	117.12L
1320	494532.46	715724.66	56.32	CL_MON_DOH	139+06.15	0.00R
1321	494703.63	715435.15	49.66	ALSEC2.5"_PO_SITE	142+37.48	57.82L
1322	495609.62	714463.17	53.58	CL_MON_DOH	155+64.96	0.00R

PROPERTY OLD HAINES HIGHWAY						
CONTROL #	Northing	Easting	Elevation	Description	STATION	OFFSET
1344	496415.64	714558.30	71.96	ALCAP2"_ROW/LB_6277S	158+94.44	713.95R
1345	496424.98	714499.02	71.13	ALCAP2"_ROW/L7_6277S	159+35.34	692.47R
1347	498443.31	714767.58	75.98	IP1.25"	157+79.55	849.20R
1348	496450.81	714718.04	74.77	PLASCAP1.5"_5713S	158+11.07	628.08R
1349	496458.80	714668.43	74.04	PLASCAP1.25"_3650S	158+43.30	808.09R
1350	496466.05	714624.13	73.13	PLASCAP1"_1410S	158+72.51	791.01R
1356	494541.93	715624.84	57.85	ALCAP2"_3650S_RTK	139+88.22	57.62L
1357	494366.09	715530.27	60.29	ALCAP2"_3650S_RTK	139+45.85	252.75L
1358	494506.66	715361.93	55.99	ALCAP2"_3650S_RTK	141+65.25	255.17L
1359	495684.79	714761.53	54.70	ALCAP2"_L3_6277S_RTK	153+86.88	250.91R
1360	495554.84	714741.06	52.64	REBAR5/8"_SPINHOLE_RTK	153+18.06	138.79R
1361	495524.64	714659.02	52.05	REBAR5/8"_RTK	153+60.84	62.55R
1362	495586.66	714586.26	52.47	REBAR5/8"_SPINHOLE_RTK	154+56.46	62.49R
1363	495709.36	714606.01	55.54	PLASCAP1.5"_3650S_RTK	165+21.10	168.61R
1364	495268.82	714696.86	49.84	REBAR5/8"_RTK	151+65.94	107.42L
1365	495360.55	714682.94	46.64	PLASCAP1.5"_9234S_RTK	152+51.30	59.69L
1370	498460.98	715326.09	86.77	PLASCAP1.5"_5713S	154+61.56	1207.79R

B
1-7-14



TYPICAL SECTION

"TBC" LINE
 STA. 152+21.80 TO STA. 164+58.38
 &
 STA. 200+00 TO STA. 200+96.74 (EOP)
 N.T.S.

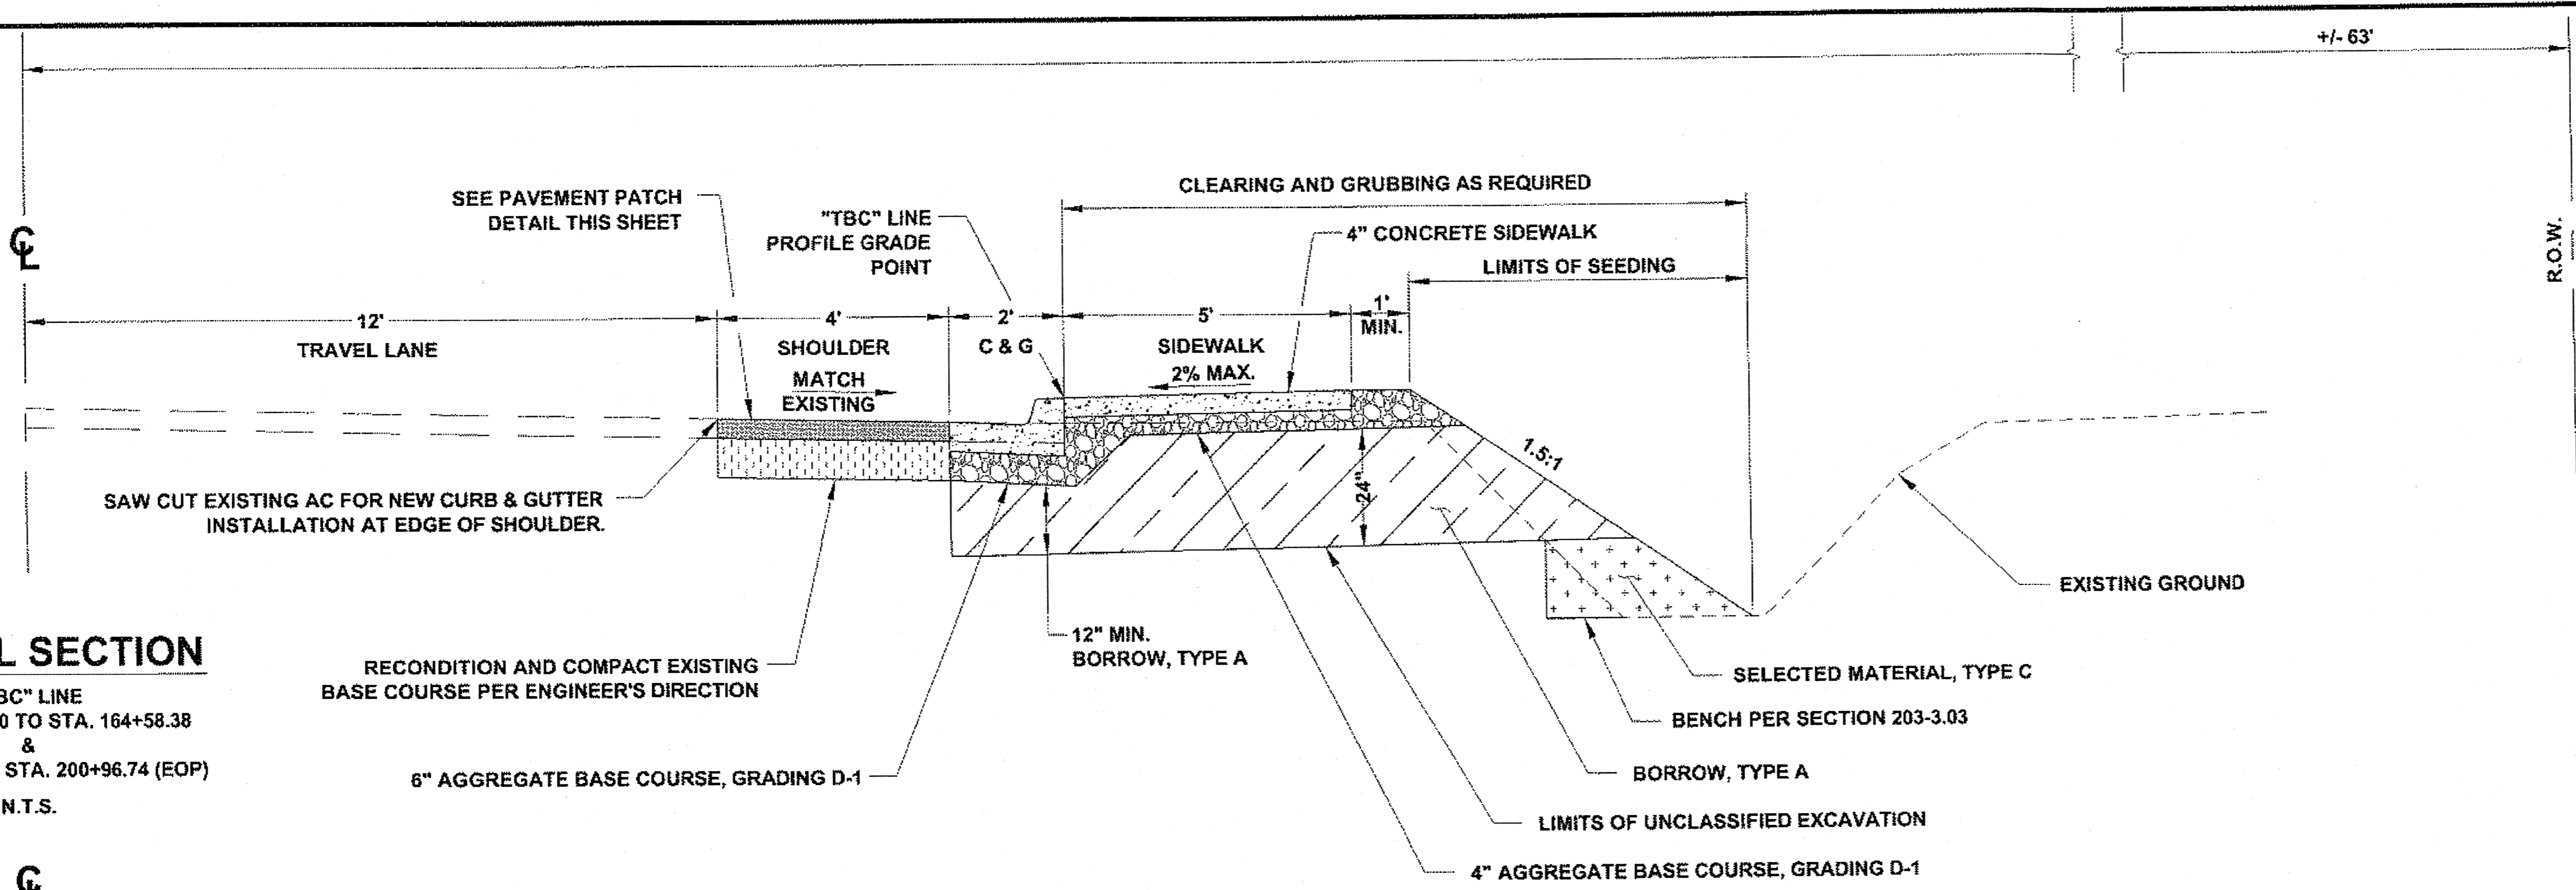

TYPICAL SECTION

"TBC" LINE
 STA. 164+58.38 TO STA. 169+01.31
 N.T.S.

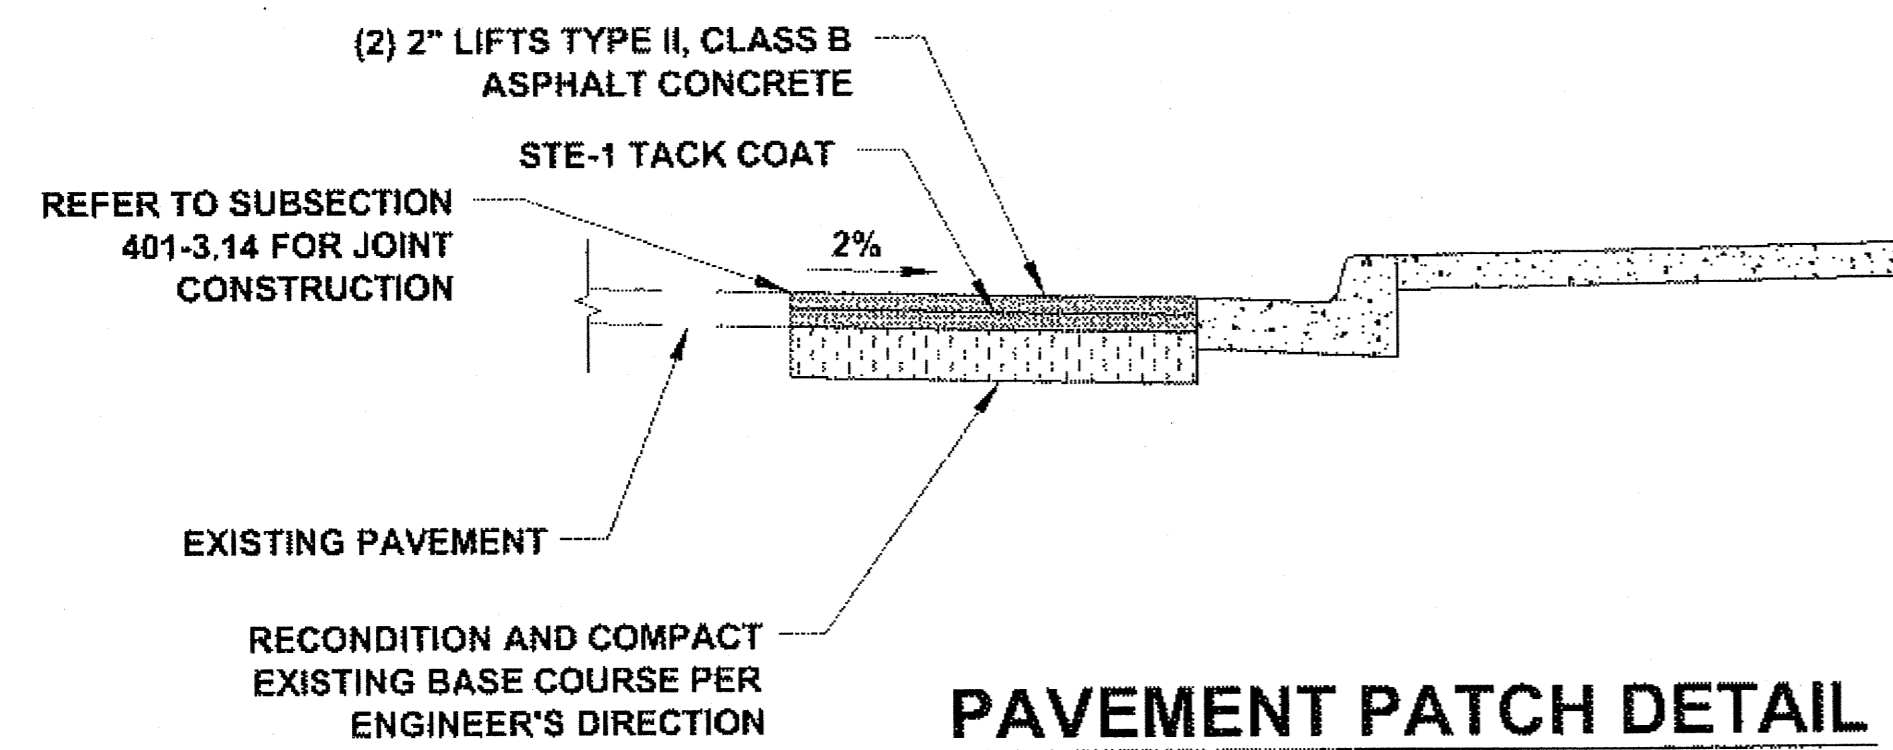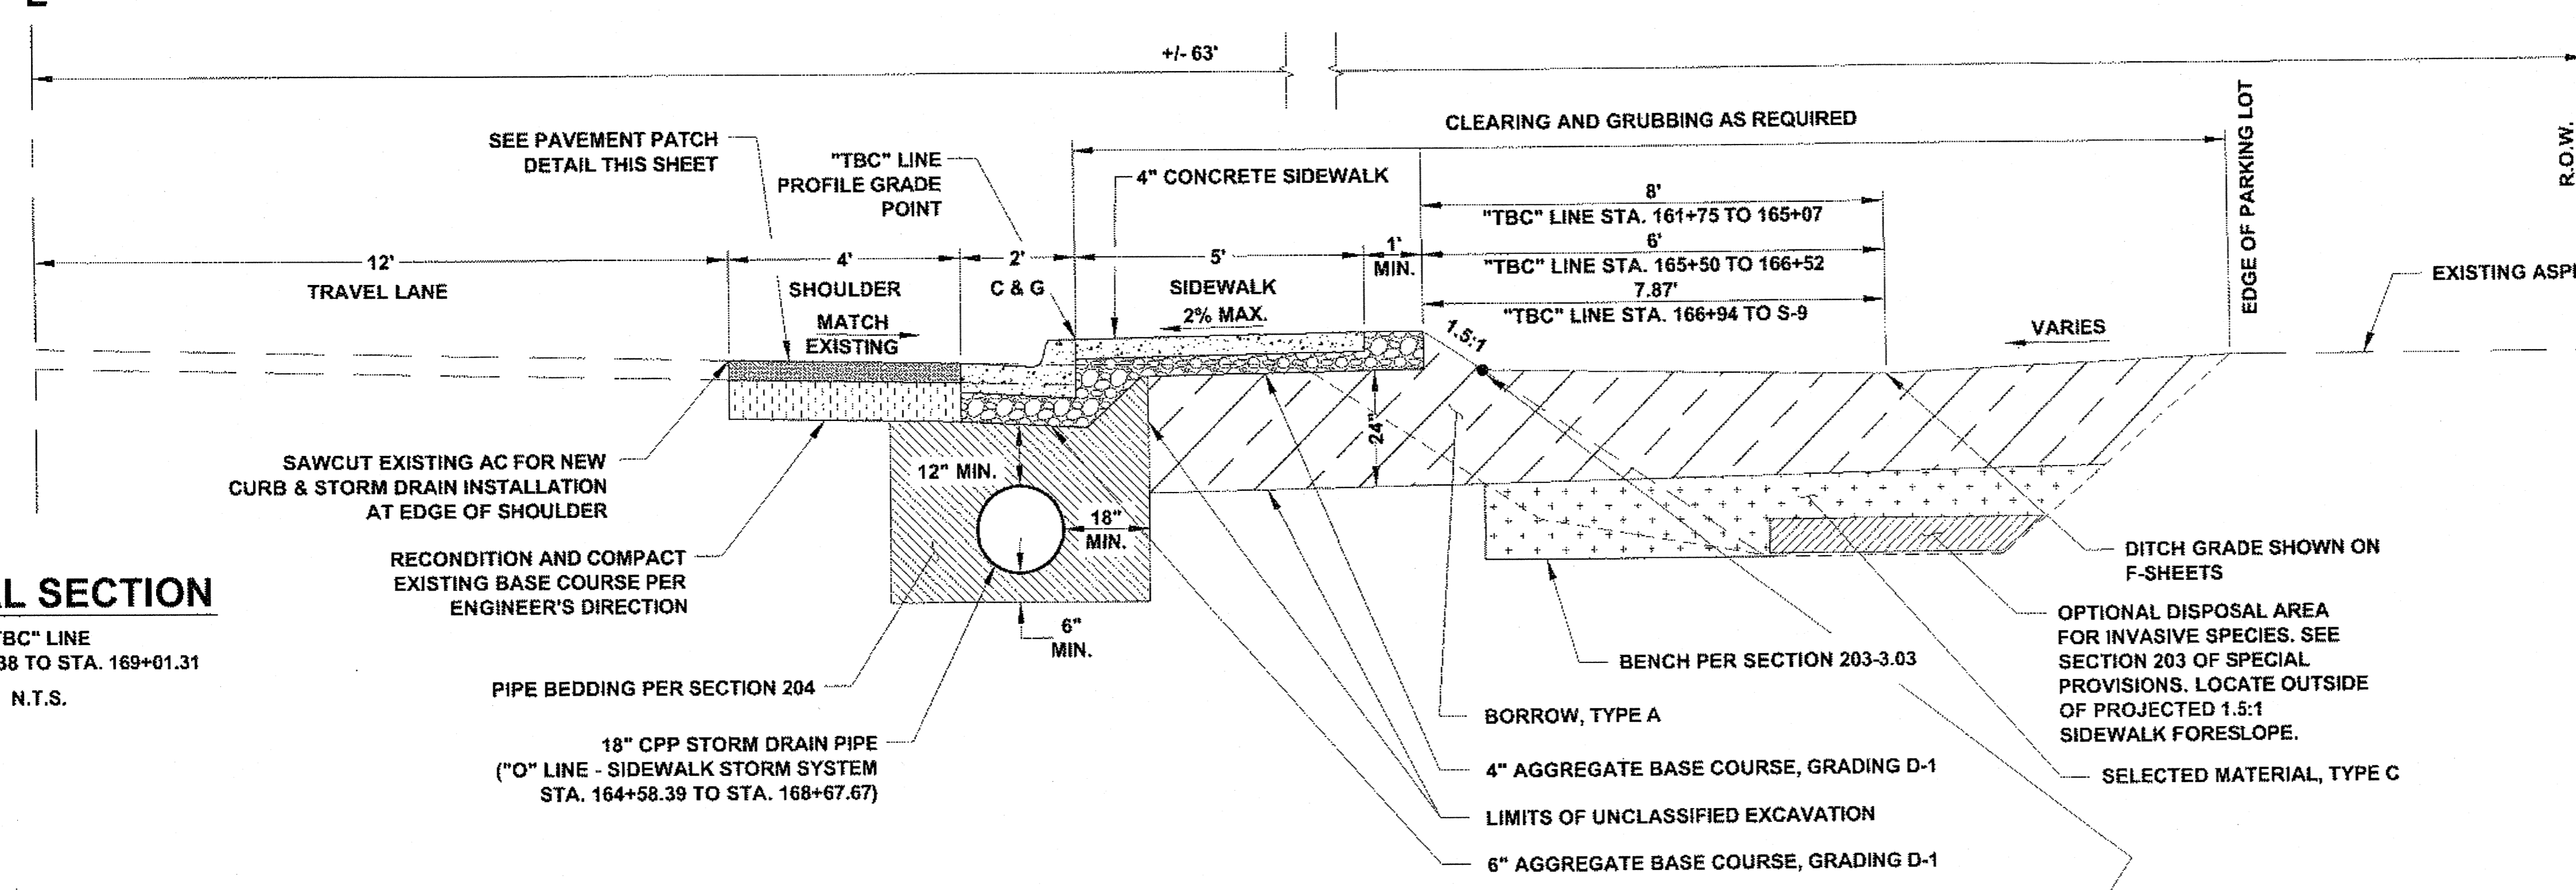

PAVEMENT PATCH DETAIL
 N.T.S.

TOE HINGE POINT		
"TBC" LINE STATION	OFFSET FROM TBC	ELEV.
14' FROM TBC OFFSET SECTION		
162+00	16.50'	54.79
162+50	10.40'	54.66
163+00	10.22'	54.53
163+50	9.57'	54.40
164+00	9.23'	54.28
165+07	10.08'	53.58
13.87' FROM TBC OFFSET SECTION		
167+00	7.66'	51.67
167+50	7.53'	51.08
168+00	7.62'	50.47
168+50	7.86'	49.86

DO NOT SCALE FROM THESE DRAWINGS USE DIMENSIONS

CHECKED BY: K. KARPSTEIN

STATE OF ALASKA
 DEPARTMENT OF TRANSPORTATION & PUBLIC FACILITIES
 SOUTHEAST REGION

HNS-OLD HAINES HIGHWAY
 SIDEWALK 3rd AVENUE
 TO ALLEN ROAD
 PROJECT #67555

TYPICAL SECTIONS


DESIGNED BY: D. MULLINER
 DRAWN BY: D. MULLINER

DATE: Wednesday, May 22, 2013 10:35:52 AM

GRANTHAM, RICK L. (DOT)

REVISIONS			PROJECT DESIGNATION	YEAR	SHEET NO.	TOTAL SHEETS
NO.	DATE	DESCRIPTION				
			SRTS-0987(007) ~ 67555	2013	B1	29

OB
 1-7-14

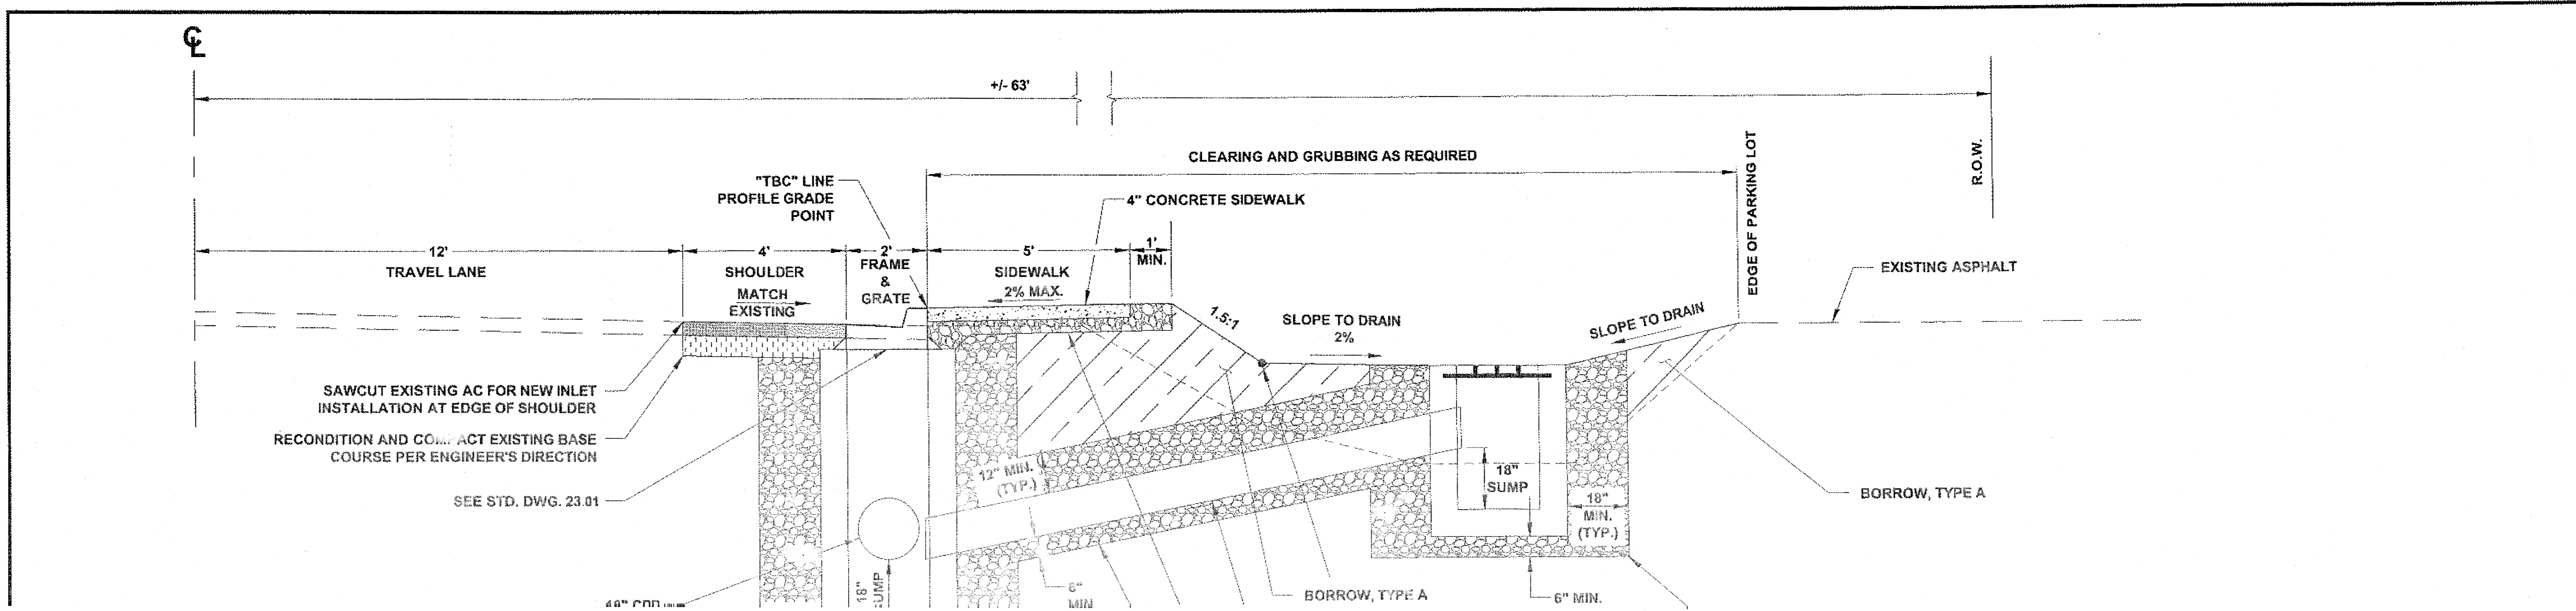


50

40

10

20


30

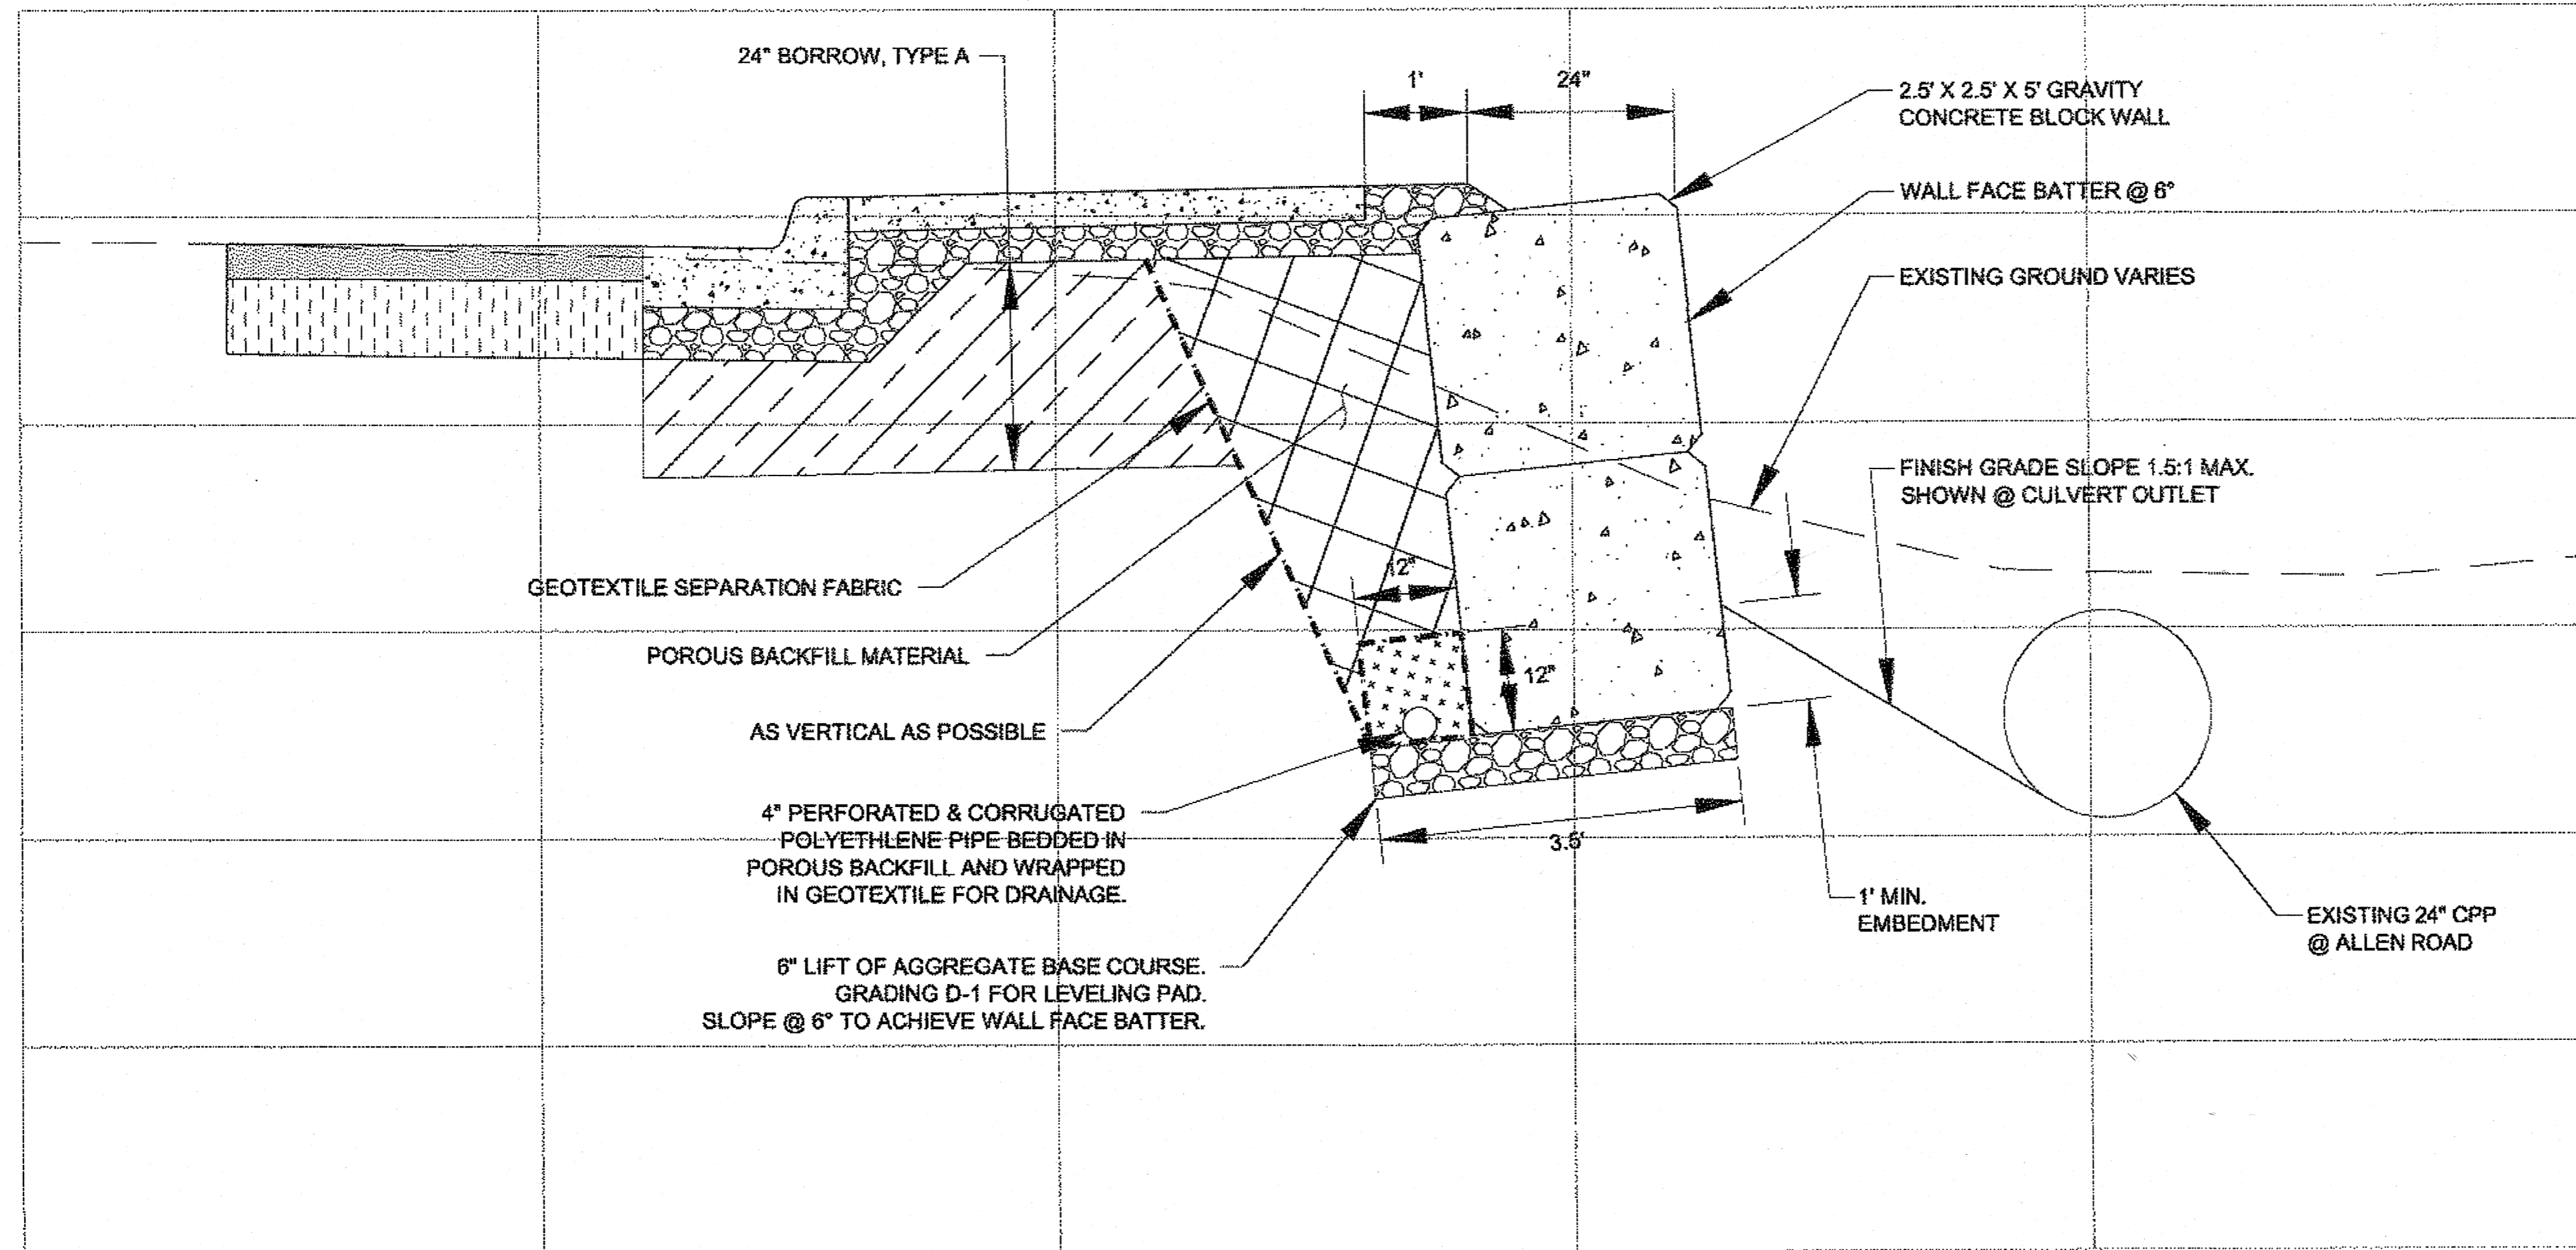

GRAVITY BLOCK WALL
 ("TBC" LINE - STA. 200+03.86 TO STA. 200+21.74)

N.T.S.

DO NOT SCALE FROM THESE DRAWINGS USE DIMENSIONS

CHECKED BY: K. KARPSTEIN 		STATE OF ALASKA DEPARTMENT OF TRANSPORTATION & PUBLIC FACILITIES SOUTHEAST REGION	
DESIGNED BY: D. MULLINER DRAWN BY: D. MULLINER		HNS-OLD HAINES HIGHWAY SIDEWALK 3rd AVENUE TO ALLEN ROAD PROJECT #67555	
PATH: Q:\HNS\67555\EN\DOUG'S FILE\B_TYP_SHT.DWG TAB: B3		WEDNESDAY, APRIL 24, 2013 2:43:10 PM MULLINER, DOUGLAS J (DOT)	
REVISIONS NO. DATE DESCRIPTION		PROJECT DESIGNATION SRTS-0987(007) ~ 67555	YEAR 2013
		SHEET NO. B3	TOTAL SHEETS 29

B3
1-7-14

ESTIMATE OF QUANTITIES-BASIC BID			
ITEM NO.	ITEM DESCRIPTION	PAY UNIT	QUANTITY
201(3B)	CLEARING AND GRUBBING	LUMP SUM	ALL REQUIRED
202(2)	REMOVAL OF PAVEMENT	SQUARE YARD	1451 1850
202(4)	REMOVAL OF CULVERT PIPE	LINEAR FOOT	199 207
203(3)	UNCLASSIFIED EXCAVATION	CUBIC YARD	1175 1890
203(6)-A	BORROW, TYPE A	TON	3281 4120
203(6)-C	BORROW, TYPE C	TON	1163 3110
203(19)	CONTROL OF INVASIVE SPECIES	LUMP SUM	ALL REQUIRED
301(1)	AGGREGATE BASE COURSE, GRADING D-1	TON	1202 700
303(4)	DITCH RECONDITIONING	LINEAR FOOT	216 200
401(1)	ASPHALT CONCRETE, TYPE II, CLASS B	TON	294 90
401(2)	ASPHALT CEMENT, GRADE PG 58-28	TON	16 5
402(1)	STE-1 ASPHALT FOR TACK COAT	TON	0.4 1
530 (1)	GRAVITY BLOCK WALL	SQUARE FEET	71 75
603(21)-12	12 INCH CORRUGATED POLYETHYLENE PIPE	LINEAR FOOT	60 81
603(21)-18	18 INCH CORRUGATED POLYETHYLENE PIPE	LINEAR FOOT	789 781
603(21)-24	24 INCH CORRUGATED POLYETHYLENE PIPE	LINEAR FOOT	48 46
604 (4)	ADJUST EXISTING MANHOLE	EACH	1
604(5)	INLET, TYPE A	EACH	8
604 (8)	36" X 36" FIELD INLET	EACH	1
608(1A)	CONCRETE SIDEWALK, 4 INCHES THICK	SQUARE YARD	856 840
608(1B)	CONCRETE SIDEWALK, 6 INCHES THICK	SQUARE YARD	113 110
608(6)	CURB RAMP	EACH	4
609(2)	CURB AND GUTTER, TYPE 1	LINEAR FOOT	1763 1780
611(1)	RIPRAP, CLASS I	CUBIC YARD	7.5 25
615(1)	STANDARD SIGN	SQUARE FOOT	193 195
618(2)	SEEDING	POUND	50 40
639(3)	DRIVEWAY	EACH	4
640(1)	MOBILIZATION AND DEMOBILIZATION	LUMP SUM	ALL REQUIRED
640(4)	WORKER MEALS AND LODGING, OR PER DIEM	LUMP SUM	ALL REQUIRED
641(1)	EROSION, SEDIMENT AND POLLUTION CONTROL ADMINISTRATION	LUMP SUM	ALL REQUIRED
641(3)	TEMPORARY EROSION, SEDIMENT AND POLLUTION CONTROL	LUMP SUM	ALL REQUIRED
641(5)	TEMPORARY EROSION, SEDIMENT AND POLLUTION CONTROL BY DIRECTIVE	CONTINGENT SUM	ALL REQUIRED
641(6)	WITHOLDING	CONTINGENT SUM	ALL REQUIRED
642(1)	CONSTRUCTION SURVEYING	LUMP SUM	ALL REQUIRED
643(2)	TRAFFIC MAINTENANCE	LUMP SUM	ALL REQUIRED
643(3)	PERMANENT CONSTRUCTION SIGNS	LUMP SUM	ALL REQUIRED
643(15)	FLAGGING	CONTINGENT SUM	ALL REQUIRED
643(23)	TRAFFIC PRICE ADJUSTMENT	CONTINGENT SUM	ALL REQUIRED
643(25)	TRAFFIC CONTROL	CONTINGENT SUM	ALL REQUIRED
644(8)	VEHICLES	LUMP SUM	ALL REQUIRED
646(1)	CPM SCHEDULING	LUMP SUM	ALL REQUIRED
670(1)	PAINTED TRAFFIC MARKINGS	LUMP SUM	ALL REQUIRED


204(1A) Relocation of Utilities C.O.1 Lumpsum All Required

BASIS OF ESTIMATE - BASIC BID		
ITEM NO.	ITEM	ESTIMATING FACTOR
201 (3B)	CLEARING AND GRUBBING	0.8 ACRES
203 (6)	BORROW, TYPE A & C	2.5 TONS/CY COMPACTED IN PLACE
301 (1)	AGGREGATE BASE COURSE GRADING D-1	2.5 TON/CY
401 (1)	ASPHALT CONCRETE	124 LBS/SY/IN
401 (2)	ASPHALT CEMENT, GRADE PG 58-28	6% OF ITEM 401 (1)
402 (1)	STE-1 TACK COAT	0.1 GAL./S.Y. (243 GAL/TON)
618 (1)	SEEDING	50 LB/AC

UTILITY POINTS OF CONTACT			
ELECTRIC	AP&T	DANNY GONCE	766-6500
TELEPHONE	AP&T	BRUCE MESSERSCHMIDT	766-6500
SEWER	HAINES BOROUGH	CARLOS JIMENEZ	766-2257
WATER	HAINES BOROUGH	CARLOS JIMENEZ	766-2257
CABLE	HAINES CABLE TV	PATTY CAMPBELL	766-2337

DO NOT SCALE FROM THESE DRAWINGS USE DIMENSIONS

CHECKED BY: K. KARPSTEIN



DESIGNED BY: D. MULLINER
DRAWN BY: D. MULLINER

STATE OF ALASKA
DEPARTMENT OF TRANSPORTATION & PUBLIC FACILITIES
SOUTHEAST REGION

HNS-OLD HAINES HIGHWAY
SIDEWALK 3rd AVENUE
TO ALLEN ROAD
PROJECT #67555

ESTIMATE OF QUANTITIES

PATH: Q:\HNS\67555\HNS\DOUG'S FILE\ESTIMATE OF QUANTITIES SHT.DWG
TAB: C1 Wednesday, May 22, 2013 11:39:35 AM MULLINER, DOUGLAS J. (DOT)

REVISIONS			PROJECT DESIGNATION	YEAR	SHEET NO.	TOTAL SHEETS
NO.	DATE	DESCRIPTION				
			SRTS-0987(007) ~ 67555	2013	C1	29


03
1-7-14

202(2) REMOVAL OF PAVEMENT			
"TBC" LINE STATION		AREA (SY)	REMARKS
TO	FROM		
152+22	169+01	1800	INCLUDES DRIVEWAY REMOVAL BEHIND SIDEWALK
200+00	200+97	50	

202(4) REMOVAL OF CULVERT PIPE				
"TBC" LINE STATION		DIAMETER (IN)	LENGTH (FT)	REMARKS
TO	FROM			
153+60	154+06	18	46	DRIVEWAY CULVERT
161+20	161+80	24	60	DRIVEWAY CULVERT
161+19	-	12	± 4'	SEE NOTE ON SHEET F2
165+03	165+54	18	51	DRIVEWAY CULVERT
166+47	166+97	18	50	DRIVEWAY CULVERT

603 CULVERT INSTALLATION										
PIPE	INLET			OUTLET			LENGTH (FT)	SIZE	REMARKS	APPROX GRADE
	"TBC" LINE STATION	OFFSET	INVERT	"TBC" LINE STATION	OFFSET	INVERT				
P-1	S-1	TBC	50.02	153+00	14' RT	48.17	14	12" CPP		13.21%
P-2	154+06.43	13.50' RT	48.20	153+60.43	13.50' RT	47.65	46	24" CPP	DRIVEWAY CULVERT	1.20%
P-3	S-2	TBC	51.15	154+50	14' RT	49.62	14	12" CPP		10.93%
P-4	161+21.06	16' RT	51.75	S-4	14' RT	49.50	340	18" CPP		0.66%
P-5	S-4	13' RT	49.50	S-3	TBC	49.33	15	18" CPP		1.13%
P-6	S-3	-	49.33	S-5	-	48.58	150	18" CPP		0.50%
P-7	S-6	11' RT	49.25	S-5	TBC	48.58	13	12" CPP		5.15%
P-8	S-5	-	48.58	S-7	-	47.83	150	18" CPP		0.50%
P-9	S-7	-	47.83	S-8	-	45.51	116	18" CPP		2.00%
P-10	S-8	-	45.51	S-9	12.56' RT	44.82	20	18" CPP		3.45%
P-11	"O" LINE 168+97.10	"O" LINE 43.08' RT	45.22	"O" LINE 168+79.90	"O" LINE 32.87' RT	44.82	20	12" CPP		2.00%

DO NOT SCALE FROM THESE DRAWINGS USE DIMENSIONS

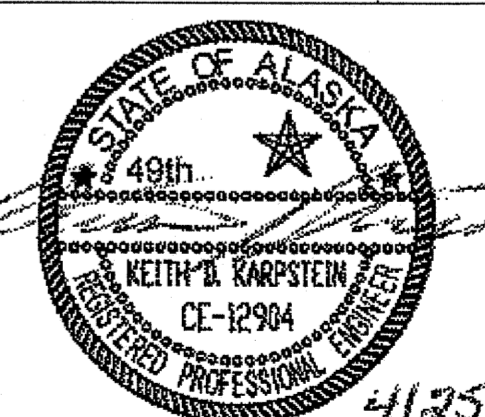CHECKED BY: K. KARPSTEIN	STATE OF ALASKA DEPARTMENT OF TRANSPORTATION & PUBLIC FACILITIES SOUTHEAST REGION
	HNS-OLD HAINES HIGHWAY SIDEWALK 3rd AVENUE TO ALLEN ROAD PROJECT #67555
DESIGNED BY: D. MULLINER DRAWN BY: D. MULLINER	ESTIMATE OF QUANTITIES
PATH: Q:\HNS\67555\ENDOU'S FILE\ESTIMATE OF QUANTITIES SHT.DWG TAB: C2 Wednesday, April 24, 2013 4:56:33 PM MULLINER, DOUGLAS J (DOT)	
REVISIONS	PROJECT DESIGNATION
NO. DATE DESCRIPTION	YEAR SHEET NO. TOTAL SHEETS
	SRTS-0987(007) ~ 67555 2013 C2 29

4/25/13

604(5) INLET, TYPE A & 604(8) 36" X 36" FIELD INLET					
STRUCT. NO.	"TBC" LINE STATION	OFFSET	TOP BACK OF CURB ELEV./FIELD INLET GRATE ELEV.	STRUCT. TYPE	REMARKS
S-1	153+00	TBC	52.84 (TBC)	A	CURB INLET
S-2	154+50	TBC	53.89 (TBC)	A	CURB INLET
S-3	164+58.39	TBC	55.49 (TBC)	A	CURB INLET
S-4	164+58.39	14' RT	53.00	A	FIELD INLET
S-5	166+08.93	TBC	53.63 (TBC)	A	CURB INLET
S-6	166+08.93	12' RT	51.00	A	FIELD INLET
S-7	167+58.93	TBC	51.89 (TBC)	A	CURB INLET
S-8	168+74.89	TBC	50.96 (TBC)	A	CURB INLET
S-9	168+92.91	13.54' RT	49.30	-36" X 36"	FIELD INLET

CATCH BASIN NOTES

- ENTIRE KNOCKOUT IS TO BE REMOVED AND SEALED SHUT AROUND PIPE. ALL PIPES ARE TO EXTEND MIN. 1" AND MAX. 2" INTO CATCH BASIN. GROUT INTERIOR AND EXTERIOR BETWEEN FRAME, SECTIONS AND CATCH BASIN.
- GRATE MUST BE OF A TYPE THAT WILL NOT CREATE A HAZARD OF BICYCLE TRAFFIC.
- MINIMUM SUMP DEPTH SHALL BE 18".

608(1B) CONCRETE SIDEWALK 6 INCHES THICK				
"TBC" LINE STATION	DW WIDTH (FT)	6" CONC. WIDTH (FT)	AREA (SY)	REMARKS
153+84	34	49	28	
161+50.67	34	49	28	
165+28.32	34	49	28	
166+72.81	34	49	28	

608(6) CURB RAMP	
"TBC" LINE STATION	REMARKS
152+48	SEE DETAIL SHT. J1
168+92	SEE DETAIL SHT. J1
200+06	SEE DETAIL SHT. J1
200+84	SEE DETAIL SHT. J1

72" MAN HOLE WITH CIRCULAR FRAME AND GRATE


608(1A) CONCRETE SIDEWALK 4 INCHES THICK				
"TBC" LINE STATION FROM	"TBC" LINE STATION TO	LENGTH (FT)	AREA (SY)	REMARKS
152+22	152+35	14	7	
152+60	153+59	100	55	
154+08	161+26	720	400	
161+75	165+03	330	184	
165+52	166+48	96	54	
166+97	168+76	181	101	
200+18	200+84	67	37	

609(2) CURB AND GUTTER, TYPE 1			
"TBC" LINE STATION		LENGTH (LF)	REMARKS
FROM	TO		
152+22	169+02	1680	
200+00	200+97	100	

639(3) DRIVEWAY			
"TBC" LINE STATION	WIDTH (FT)	LENGTH (FT)	REMARKS
153+84	49	10	
161+50.67	49	10	
165+28.32	49	10	
166+72.81	49	10	

604(4) ADJUST EXISTING MANHOLE		
"TBC" LINE STATION	OFFSET	REMARKS
165+72	37.42' RT	FG = +/- 53.72


DO NOT SCALE FROM THESE DRAWINGS USE DIMENSIONS

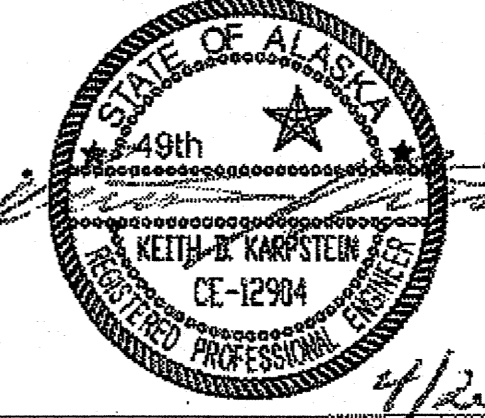	STATE OF ALASKA DEPARTMENT OF TRANSPORTATION & PUBLIC FACILITIES SOUTHEAST REGION	
	HNS-OLD HAINES HIGHWAY SIDEWALK 3rd AVENUE TO ALLEN ROAD PROJECT #67555	
DESIGNED BY: D. MULLINER DRAWN BY: D. MULLINER	ESTIMATE OF QUANTITIES	
PATH: Q:\HNS\67555\END\DOUG'S FILE\ESTIMATE OF QUANTITIES SHT.DWG TAB: CS Wednesday, April 24, 2013 3:40:10 PM MULLINER, DOUGLAS J (DOT)		
REVISIONS NO. DATE DESCRIPTION	PROJECT DESIGNATION SRTS-0987(007) ~ 67555	YEAR SHEET NO. TOTAL SHEETS 2013 C3 29


615(1) STANDARD SIGN SUMMARY

SIGN #	LEGEND	"O" LINE STATION	OFFSET	ASDS CODE	WIDTH (IN)	HEIGHT (IN)	AREA (SF)	POST	EMBEDDED DEPTH	SIGN FACING	COMMENTS
1	ADVANCE SCHOOL CROSSING (SYMBOL)	151+16	LT	S1-1	36	36	9.00	2.5 PST	4'-6"	NB	
2	ADVANCE SCHOOL CROSSING (SYMBOL)	151+37	LT	S1-1	36	36	9.00	2.5 PST	4'-6"	EB	
3	DIAGONAL PLATE LEFT (SAME COLOR AS SIGN #1)	151+37	LT	W16-7PL	24	12	2.00	-	-	EB	MOUNT BELOW SIGN #2
4	ADVANCE SCHOOL CROSSING (SYMBOL)	151+61	RT	S1-1	36	36	9.00	2.5 PST	4'-6"	WB	
5	DIAGONAL PLATE LEFT (SAME COLOR AS SIGN #4)	151+61	RT	W16-7PL	24	12	2.00	-	-	WB	MOUNT BELOW SIGN #4
6	STOP	152+60	RT	R1-1	30	30	6.25	2.5 PST	4'-6"	SB	
7	Old Haines Hwy	152+60	RT	D3-1	42	8	2.33	-	-	EB/WB	(USE FONT SERIES C, 4" LETTER HEIGHT) MOUNT ABOVE SIGN #6
8	3rd Ave	152+60	RT	D3-1	42	12	3.50	-	-	NB/SB	(USE FONT SERIES C, 6" LETTER HEIGHT) MOUNT ABOVE SIGN #7
9	ADVANCE SCHOOL CROSSING (SYMBOL)	152+93	110' RT	S1-1	36	36	9.00	2.5 PST	4'-6"	SB	
10	SPEED LIMIT 35	153+15	RT	R2-1	30	36	7.50	2.5 PST	4'-6"	WB	
11	SCHOOL	153+15	RT	S4-3	36	12	3.00	-	-	WB	MOUNT BELOW SIGN #10
12	SPEED LIMIT 20	153+15	RT	R2-1	30	36	7.50	-	-	WB	MOUNT BELOW SIGN #11
13	WHEN CHILDREN ARE PRESENT	153+15	RT	S4-2	36	18	4.50	-	-	WB	MOUNT BELOW SIGN #12
14	FIRE TRUCK (SYMBOL)	154+50	LT	W11-8	36	36	9.00	2.5 PST	4'-6"	EB	
15	FIRE STATION	154+50	LT	W11-8A	36	36	9.00	-	-	EB	MOUNT BELOW SIGN #14
16	ADVANCE SCHOOL CROSSING (SYMBOL)	169+68	RT	S1-1	36	36	9.00	2.5 PST	4'-6"	SB	
17	SE. STATE FAIR ←	169+88	RT	CUSTOM	12	42	3.5	2.5 PST	4'-6"	WB	
18	ADVANCE SCHOOL CROSSING (SYMBOL)	170+18	RT	S1-1	36	36	9.00	2.5 PST	4'-6"	WB	
19	DIAGONAL PLATE LEFT (SAME COLOR AS SIGN #18)	170+18	RT	W16-7PL	24	12	2.00	-	-	WB	MOUNT BELOW SIGN #18
20	STOP	170+31	LT	R1-1	30	30	6.25	2.5 PST	4'-6"	SB	
21	Old Haines Hwy	170+31	LT	D3-1	42	8	2.33	-	-	EB/WB	(USE FONT SERIES C, 4" LETTER HEIGHT) MOUNT ABOVE SIGN #20
22	Fair Dr	170+31	LT	D3-1	42	12	3.50	-	-	NB/SB	(USE FONT SERIES C, 6" LETTER HEIGHT) MOUNT ABOVE SIGN #21
23	ADVANCE SCHOOL CROSSING (SYMBOL)	170+31	LT	S1-1	36	36	9.00	2.5 PST	4'-6"	NB	
24	ADVANCE SCHOOL CROSSING (SYMBOL)	170+32	LT	S1-1	36	36	9.00	2.5 PST	4'-6"	EB	
25	DIAGONAL PLATE LEFT (SAME COLOR AS SIGN #24)	170+32	LT	W16-7PL	24	12	2.00	-	-	EB	MOUNT BELOW SIGN #24
26	SCHOOL	170+72	LT	S4-3	36	12	3.00	2.5 PST	4'-6"	EB	
27	SPEED LIMIT 20	170+72	LT	R2-1	30	36	7.50	-	-	EB	MOUNT BELOW SIGN #26
28	WHEN CHILDREN ARE PRESENT	170+72	LT	S4-2	36	18	4.50	-	-	EB	MOUNT BELOW SIGN #27
29	SE. STATE FAIR →	171+12	LT	CUSTOM	12	42	3.5	2.5 PST	4'-6"	EB	
30	SPEED LIMIT 35	171+12	RT	R2-1	30	36	7.5	2.5 PST	4'-6"	WB	
31	END SCHOOL ZONE	171+12	RT	S5-2	24	30	5	-	-	WB	MOUNT BELOW SIGN #30
32	ADVANCE SCHOOL CROSSING (SYMBOL)	171+76	LT	S1-1	36	36	9.00	2.5 PST	4'-6"	EB	
33	AHEAD	171+76	LT	W16-9P	36	18	4.5	-	-	EB	MOUNT BELOW SIGN #32

DO NOT SCALE FROM THESE DRAWINGS USE DIMENSIONS

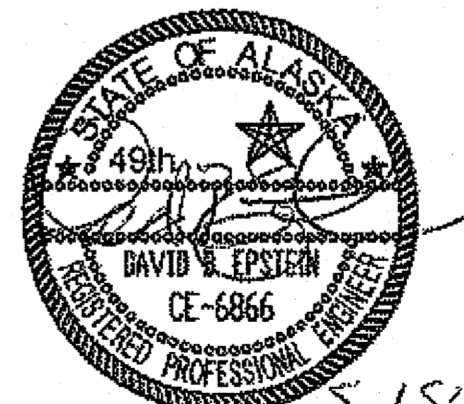CHECKED BY: D. EPSTEIN  DESIGNED BY: D. MULLINER DRAWN BY: D. MULLINER		STATE OF ALASKA DEPARTMENT OF TRANSPORTATION & PUBLIC FACILITIES SOUTHEAST REGION HNS-OLD HAINES HIGHWAY SIDEWALK 3rd AVENUE TO ALLEN ROAD PROJECT #67555	
		SIGN SUMMARY	
PATH: Q:\HNS\67555\EN\DOUG'S FILED_SIGN SUMMARY SHT.DWG TAB: D1 Wednesday, May 15, 2013 11:08:37 AM MULLINER, DOUGLAS J (DOT)			
REVISIONS NO. DATE DESCRIPTION		PROJECT DESIGNATION SRTS-0987(007)-67555	YEAR 2013
		SHEET NO. D1	TOTAL SHEETS 29

1-7-14

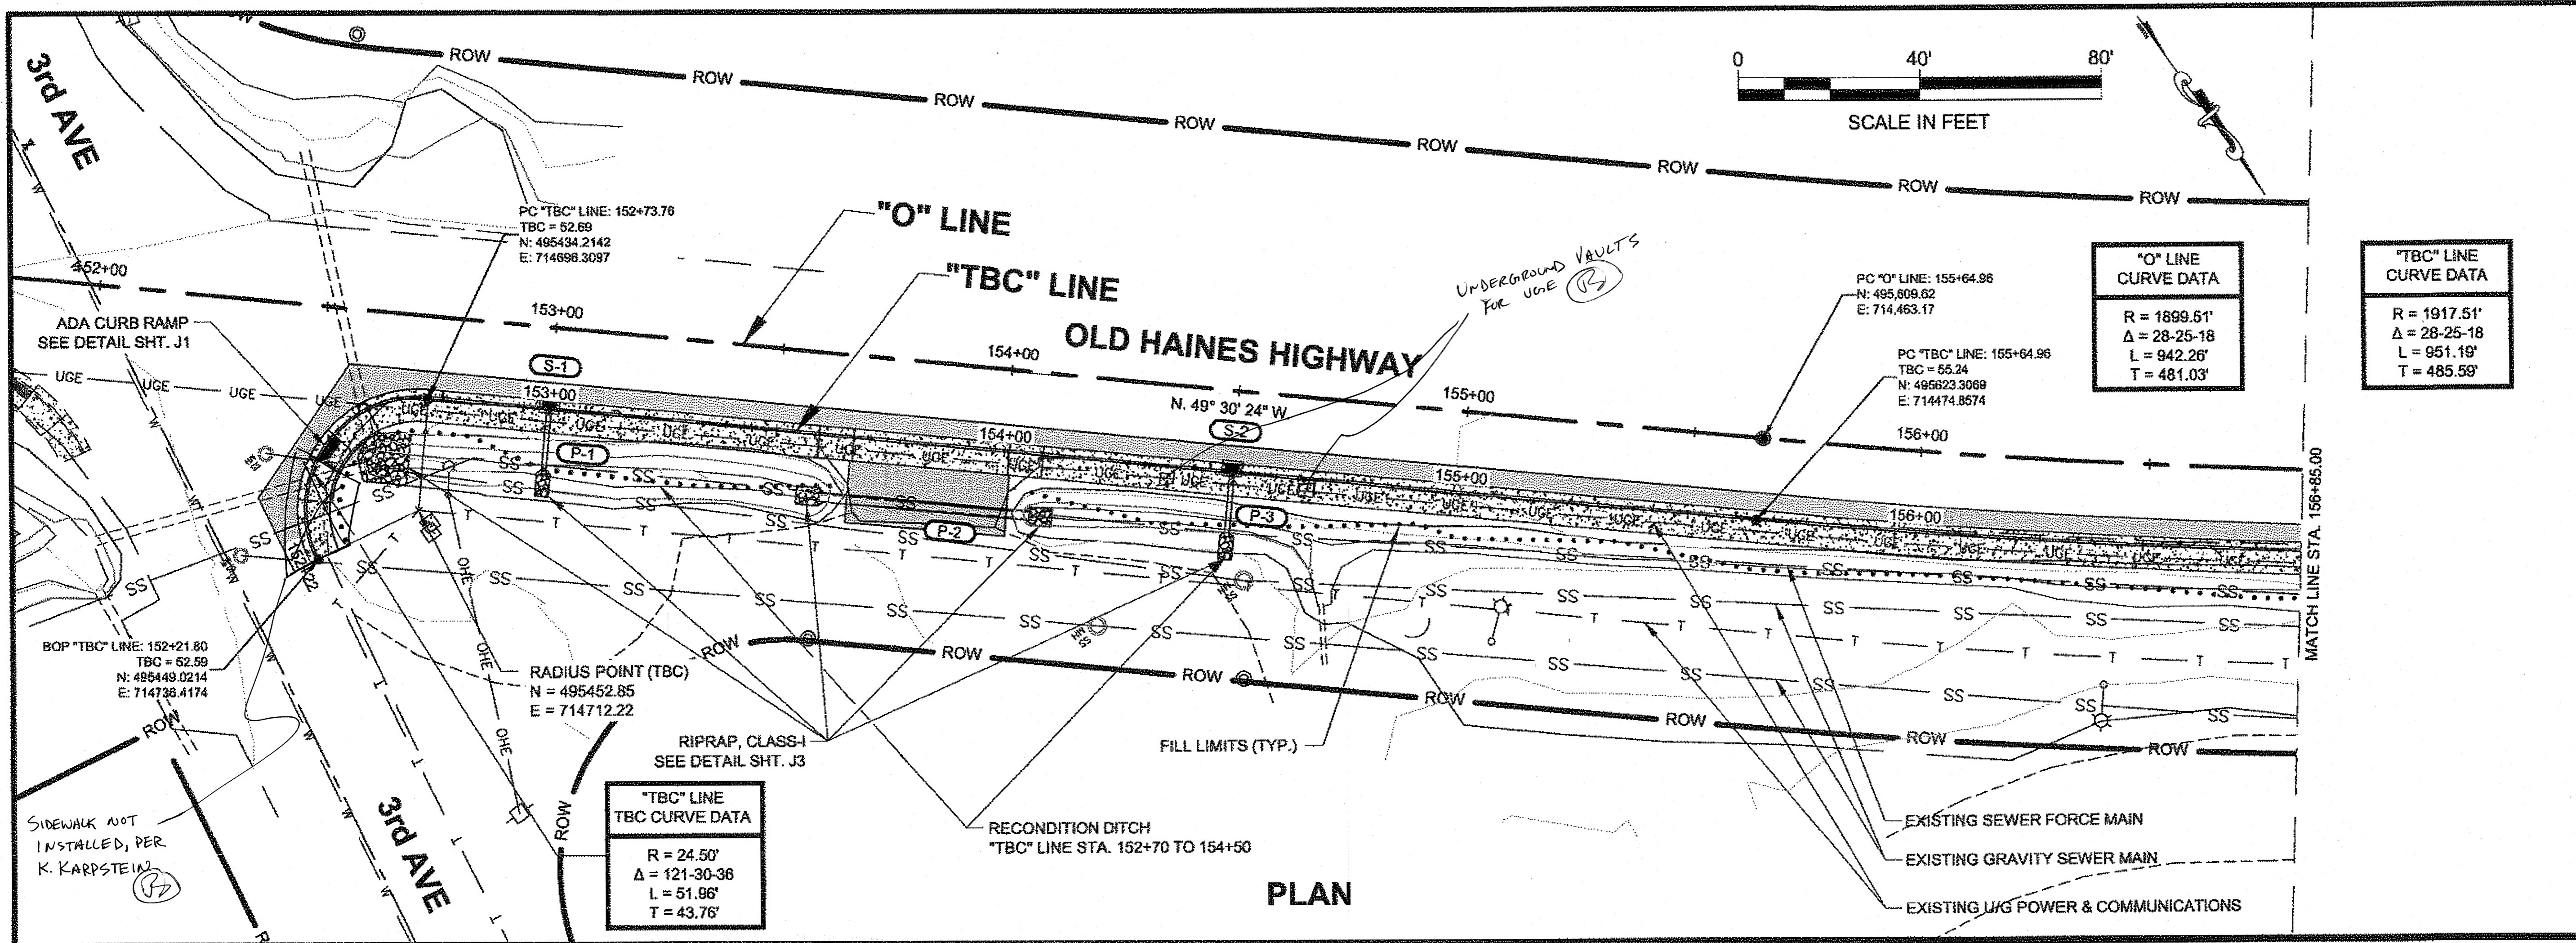

PATH: Q:\HNS\67556\END\DOUG'S FILE\F_PLAN_SHT.DWG


MULLINER, DOUGLAS J (DOT)
TAB: F1 Wednesday, May 15, 2013 8:27:02 AM

ADDENDUM NUMBER

ATTACHMENT NUMBER

RECORD OF REVISIONS

No.	DATE	DESCRIPTION

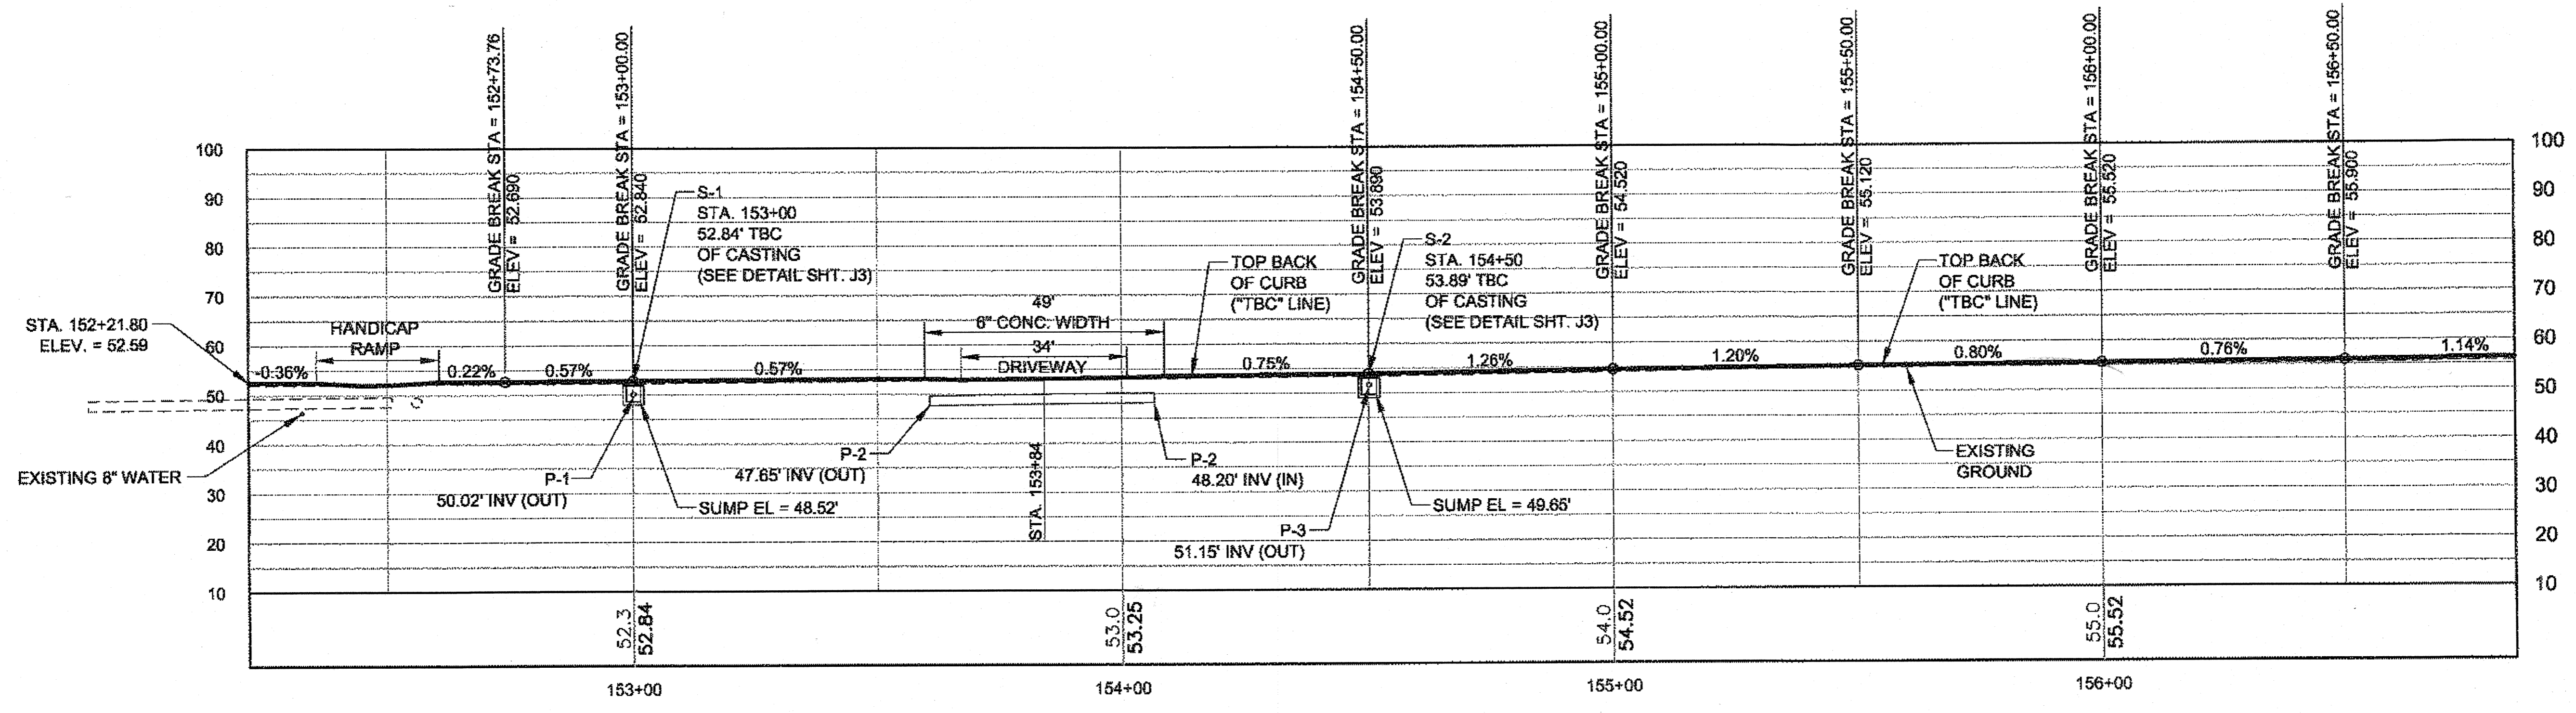

NOTE:
UNDERGROUND UTILITIES SHOWN ON THIS DRAWING INDICATE EXISTENCE ONLY AND DO NOT SUBSTITUTE FOR FIELD LOCATES. CONTACT UTILITY COMPANIES PRIOR TO ANY ON-SITE WORK.

TBC STATIONING PROFILE

DO NOT SCALE FROM THESE DRAWINGS USE DIMENSIONS

PLAN LEGEND

CHECKED BY: K. KARPSTEIN

DESIGNED BY: D. MULLINER

DRAWN BY: D. MULLINER

STATE OF ALASKA
DEPARTMENT OF TRANSPORTATION & PUBLIC FACILITIES
SOUTHEAST REGION

**HNS-OLD HAINES HIGHWAY
SIDEWALK 3rd AVENUE
TO ALLEN ROAD
PROJECT #67555**

PLAN VIEW


PROJECT DESIGNATION
SRTS-0987(007) ~ 67555

STATE	YEAR
ALASKA	2013

SHEET NUMBER	TOTAL SHEETS
F1	29


1-7-14

No.	DATE	DESCRIPTION

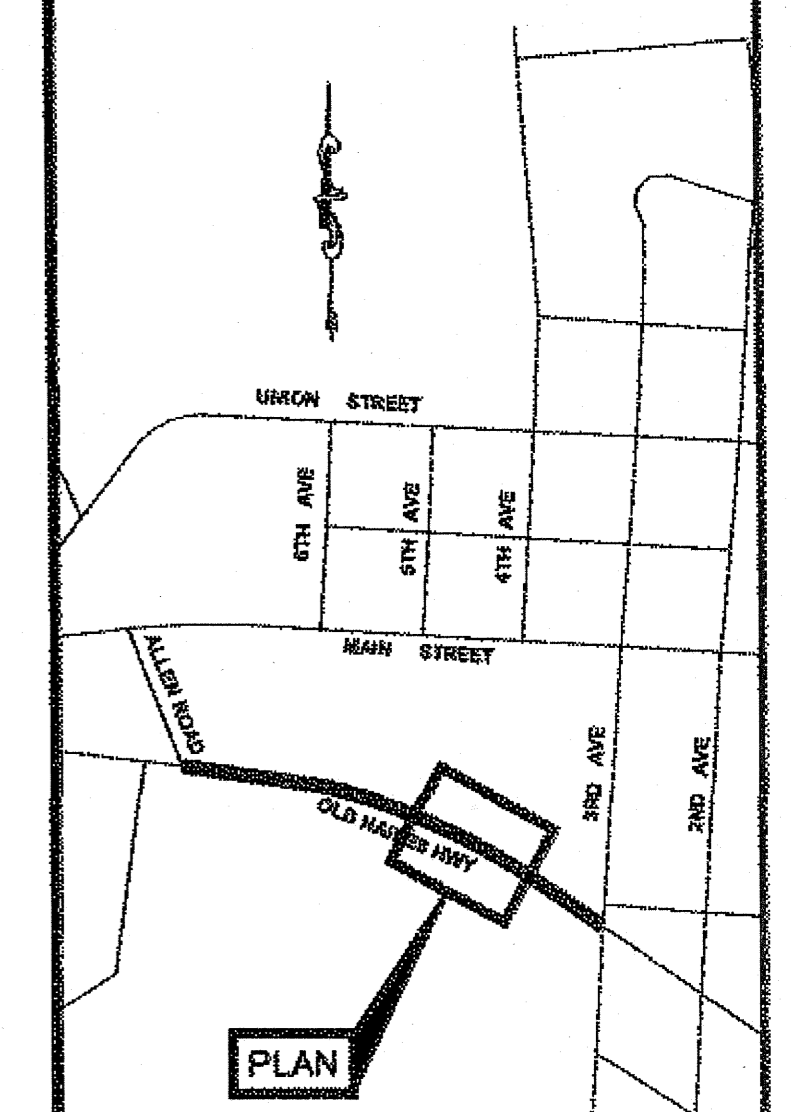

PLAN LEGEND

CHECKED BY: K. KARPSTEIN

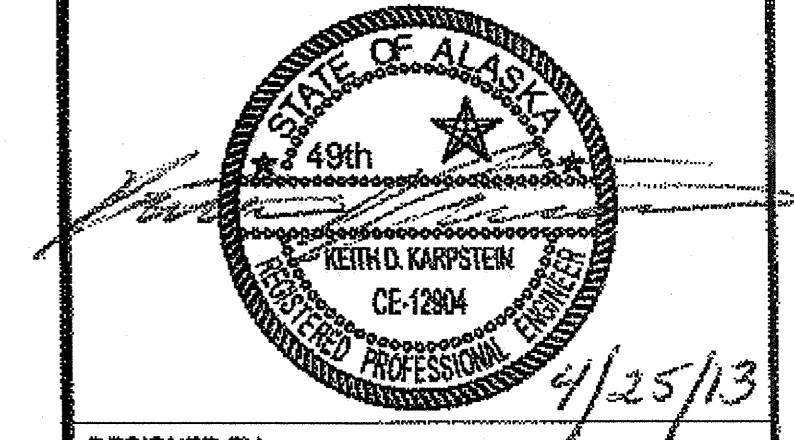

DESIGNED BY: D. MULLINER
 DRAWN BY: D. MULLINER



STATE OF ALASKA
 DEPARTMENT OF TRANSPORTATION
 & PUBLIC FACILITIES
 SOUTHEAST REGION
 HNS-OLD HAINES HIGHWAY
 SIDEWALK 3rd AVENUE
 TO ALLEN ROAD
 PROJECT #67555

PLAN VIEW

PROJECT DESIGNATION
SRTS-0987(007) ~ 67555

STATE	YEAR
ALASKA	2013

SHEET NUMBER	TOTAL SHEETS
F2	29

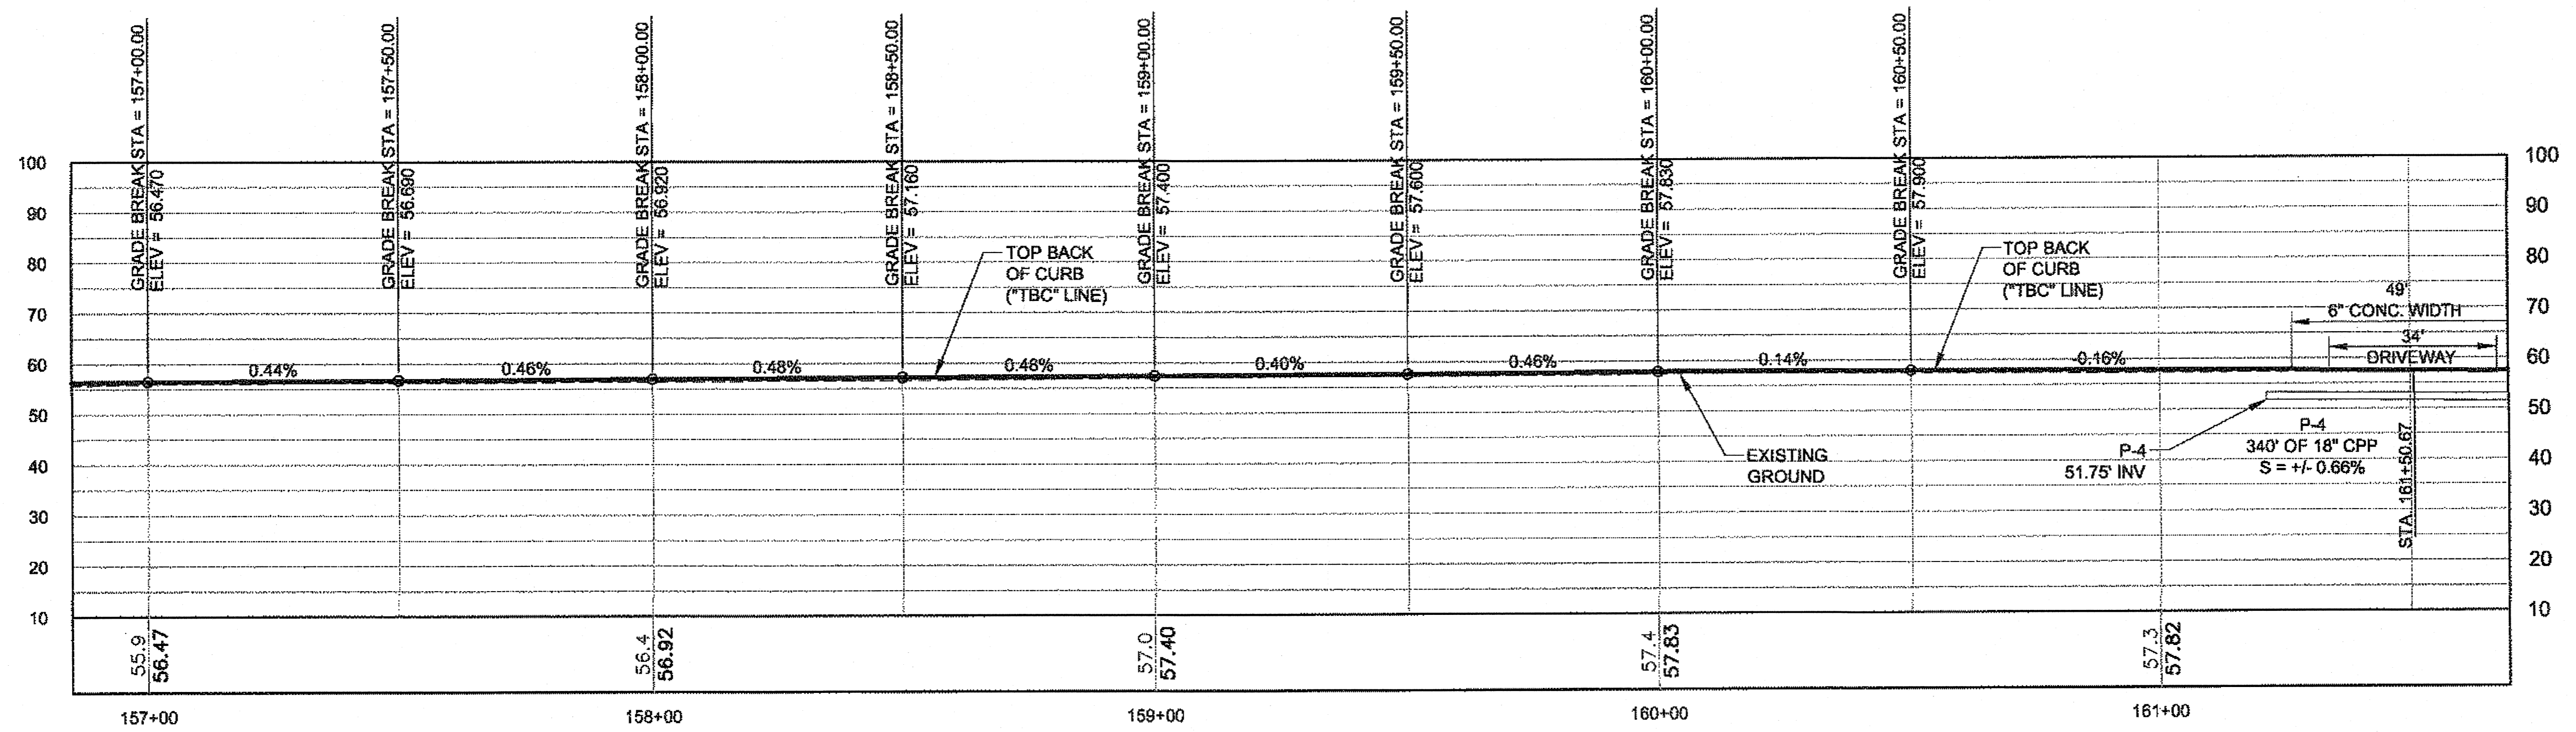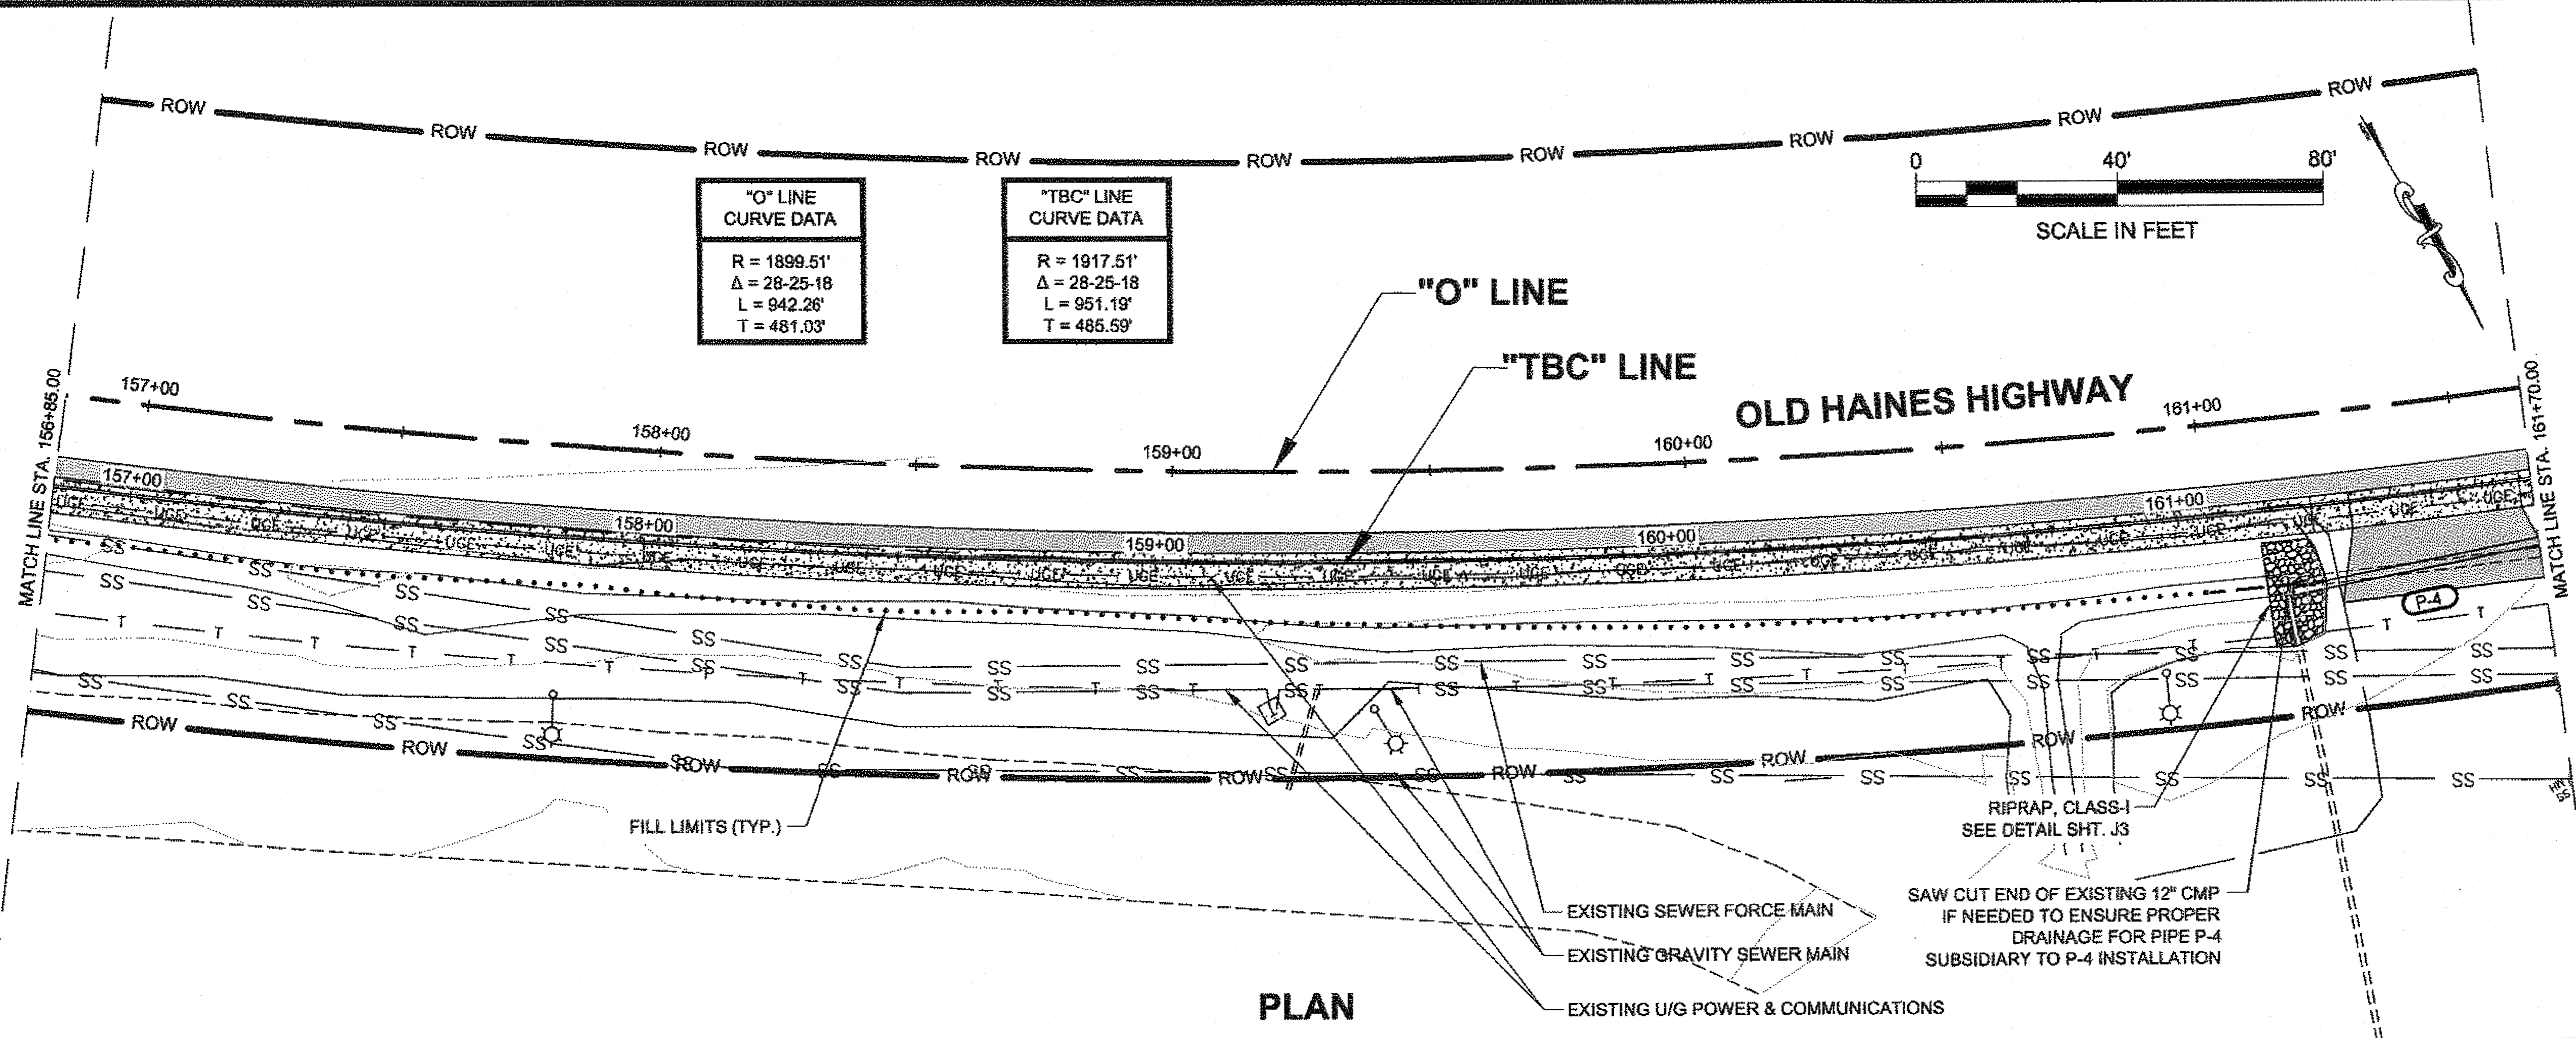


(DIAL BEFORE YOU DIG)

NOTE:
 UNDERGROUND UTILITIES SHOWN ON THIS DRAWING
 INDICATE EXISTENCE ONLY AND DO NOT SUBSTITUTE FOR
 FIELD LOCATES. CONTACT UTILITY COMPANIES PRIOR TO
 ANY ON-SITE WORK.

**TBC STATIONING
 PROFILE**

DO NOT SCALE FROM THESE DRAWINGS USE DIMENSIONS

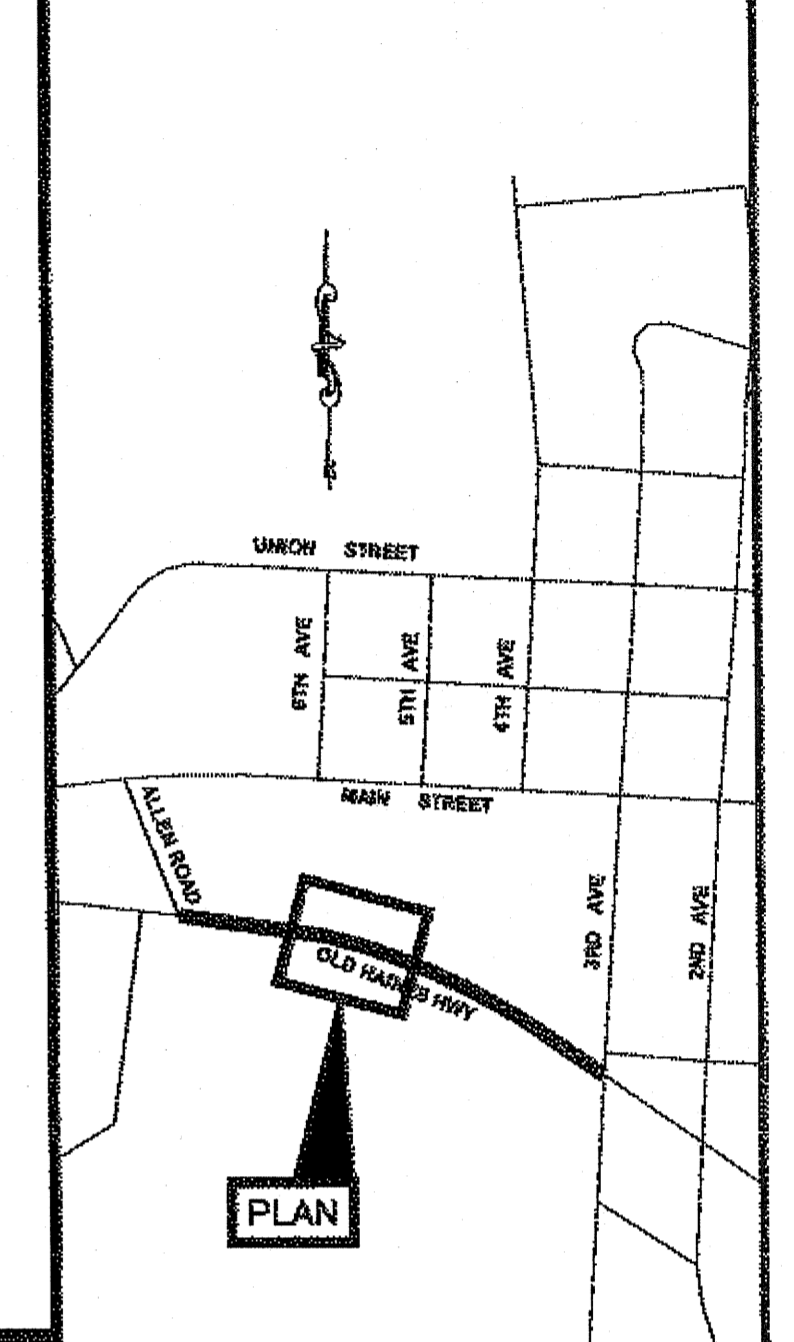

PLAN LEGEND

CHECKED BY: K. KARPSTEIN

DESIGNED BY: D. MULLINER
 DRAWN BY: D. MULLINER


STATE OF ALASKA
 DEPARTMENT OF TRANSPORTATION
 & PUBLIC FACILITIES
 SOUTHEAST REGION

HNS-OLD HAINES HIGHWAY
 SIDEWALK 3rd AVENUE
 TO ALLEN ROAD
 PROJECT #67555


PLAN VIEW

PROJECT DESIGNATION
SRTS-0987(007) ~ 67555

STATE	YEAR
ALASKA	2013
SHEET NUMBER	TOTAL SHEETS
F3	29

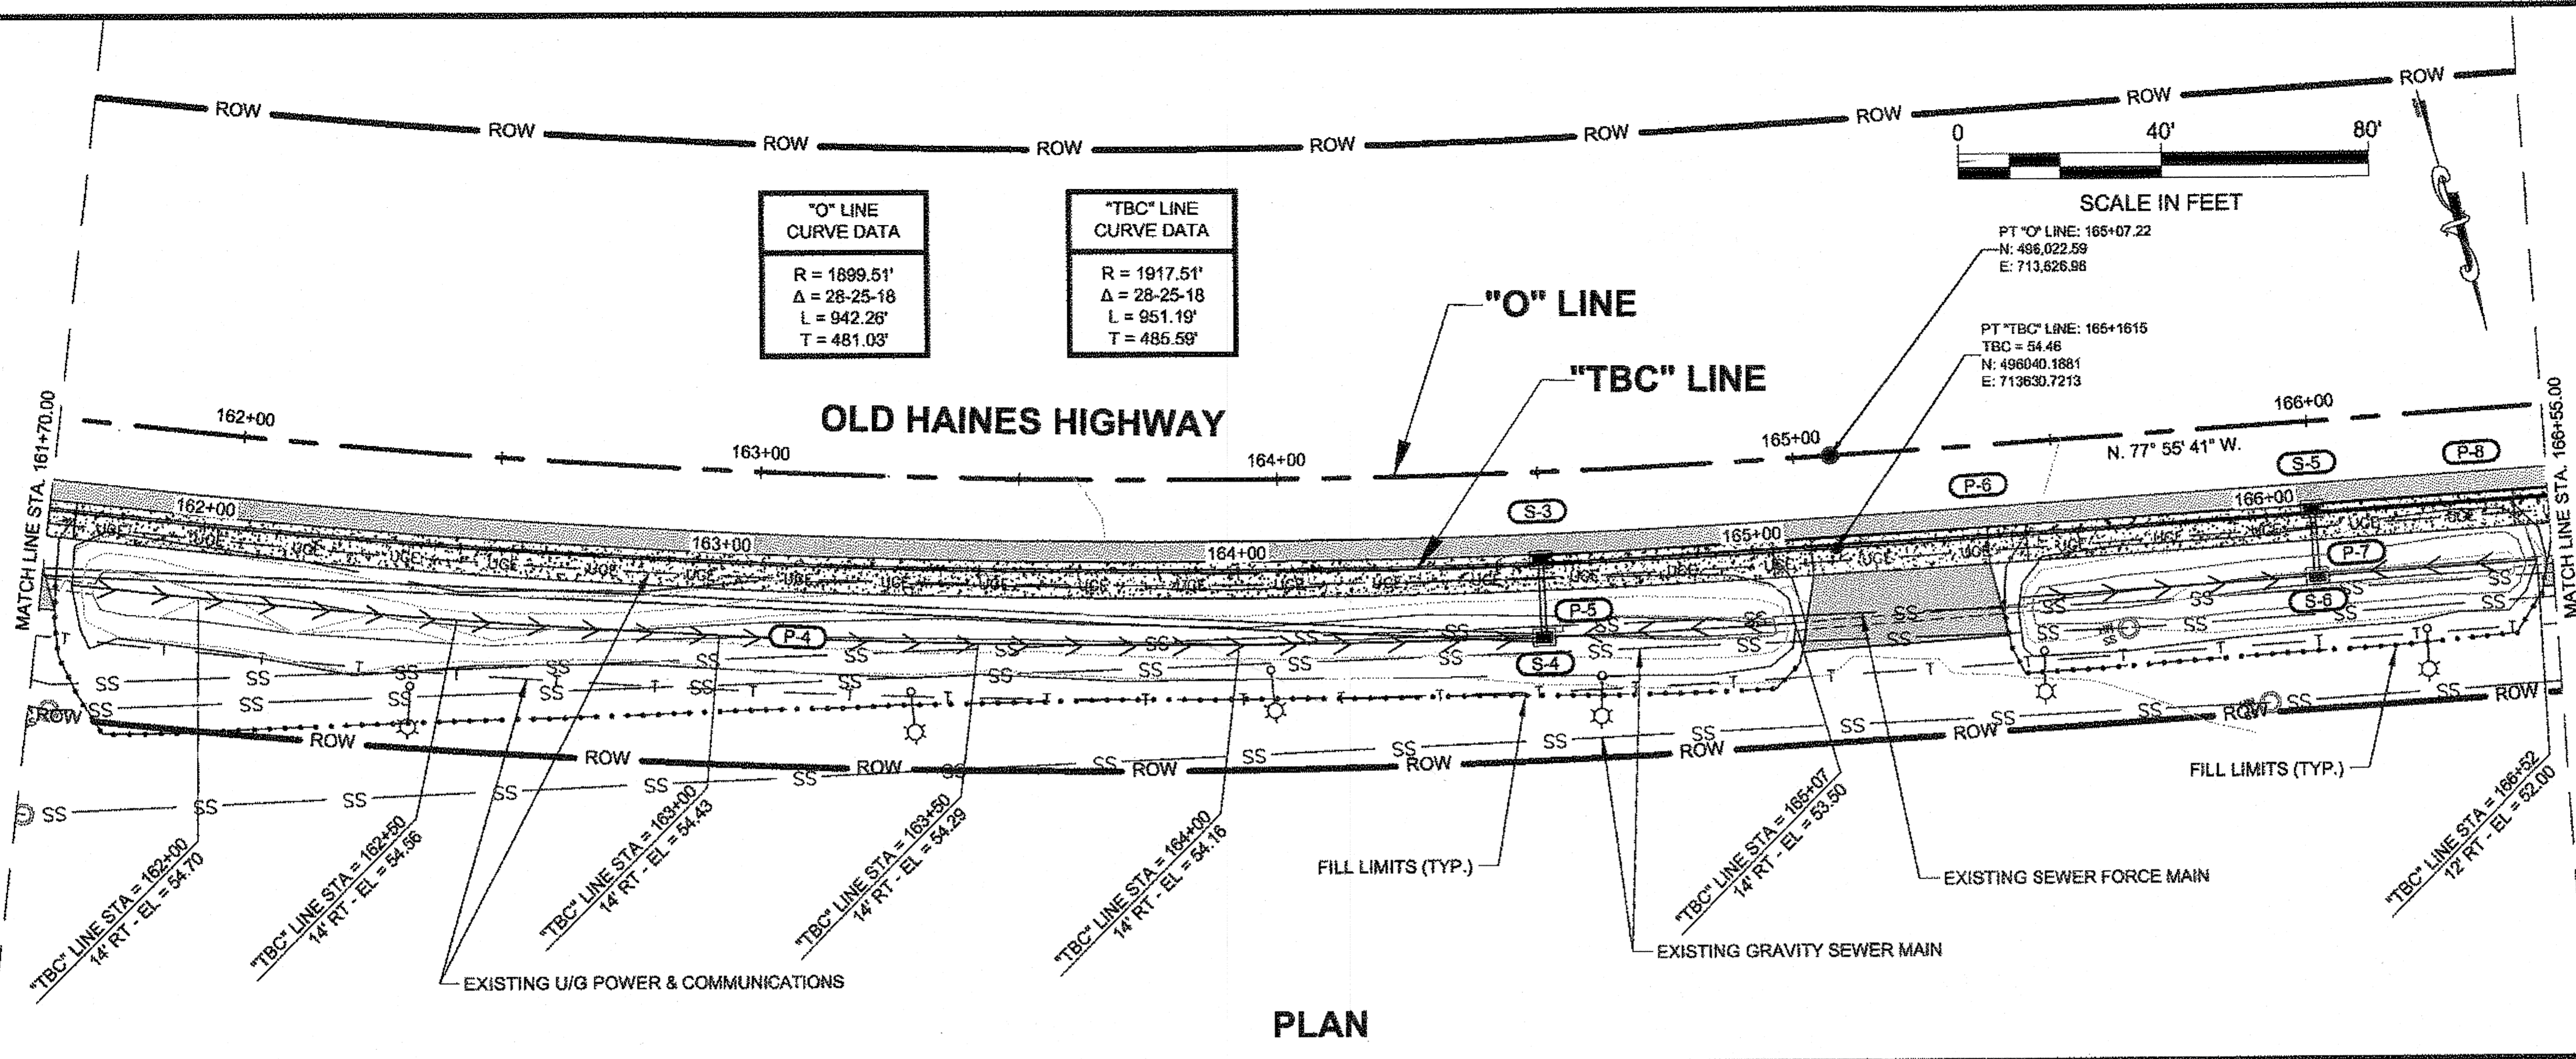

PLAN

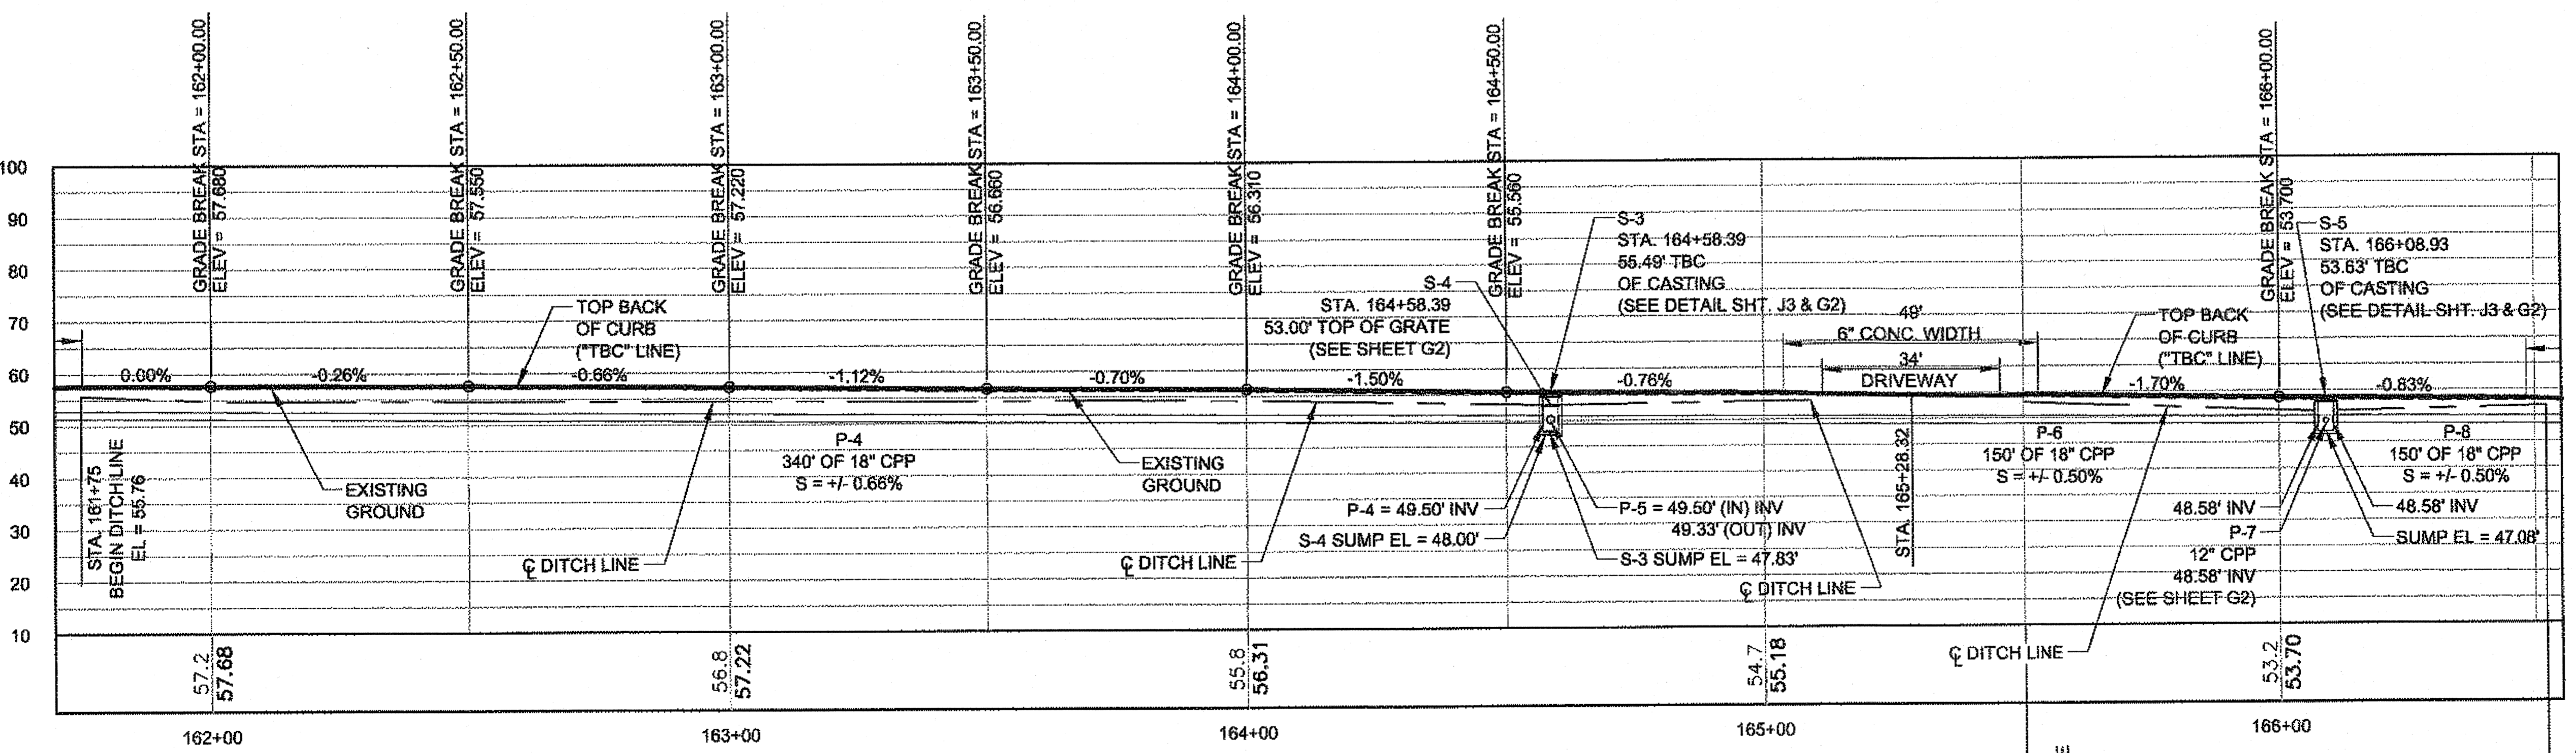

TBC STATIONING PROFILE

PROFILE




DO NOT SCALE FROM THESE DRAWINGS USE DIMENSIONS

NOTE:
 UNDERGROUND UTILITIES SHOWN ON THIS DRAWING
 INDICATE EXISTENCE ONLY AND DO NOT SUBSTITUTE FOR
 FIELD LOCATES. CONTACT UTILITY COMPANIES PRIOR TO
 ANY ON-SITE WORK.

(DIAL BEFORE YOU DIG)

1-7-14

ADDENDUM NUMBER		
ATTACHMENT NUMBER		
RECORD OF REVISIONS		
No.	DATE	DESCRIPTION

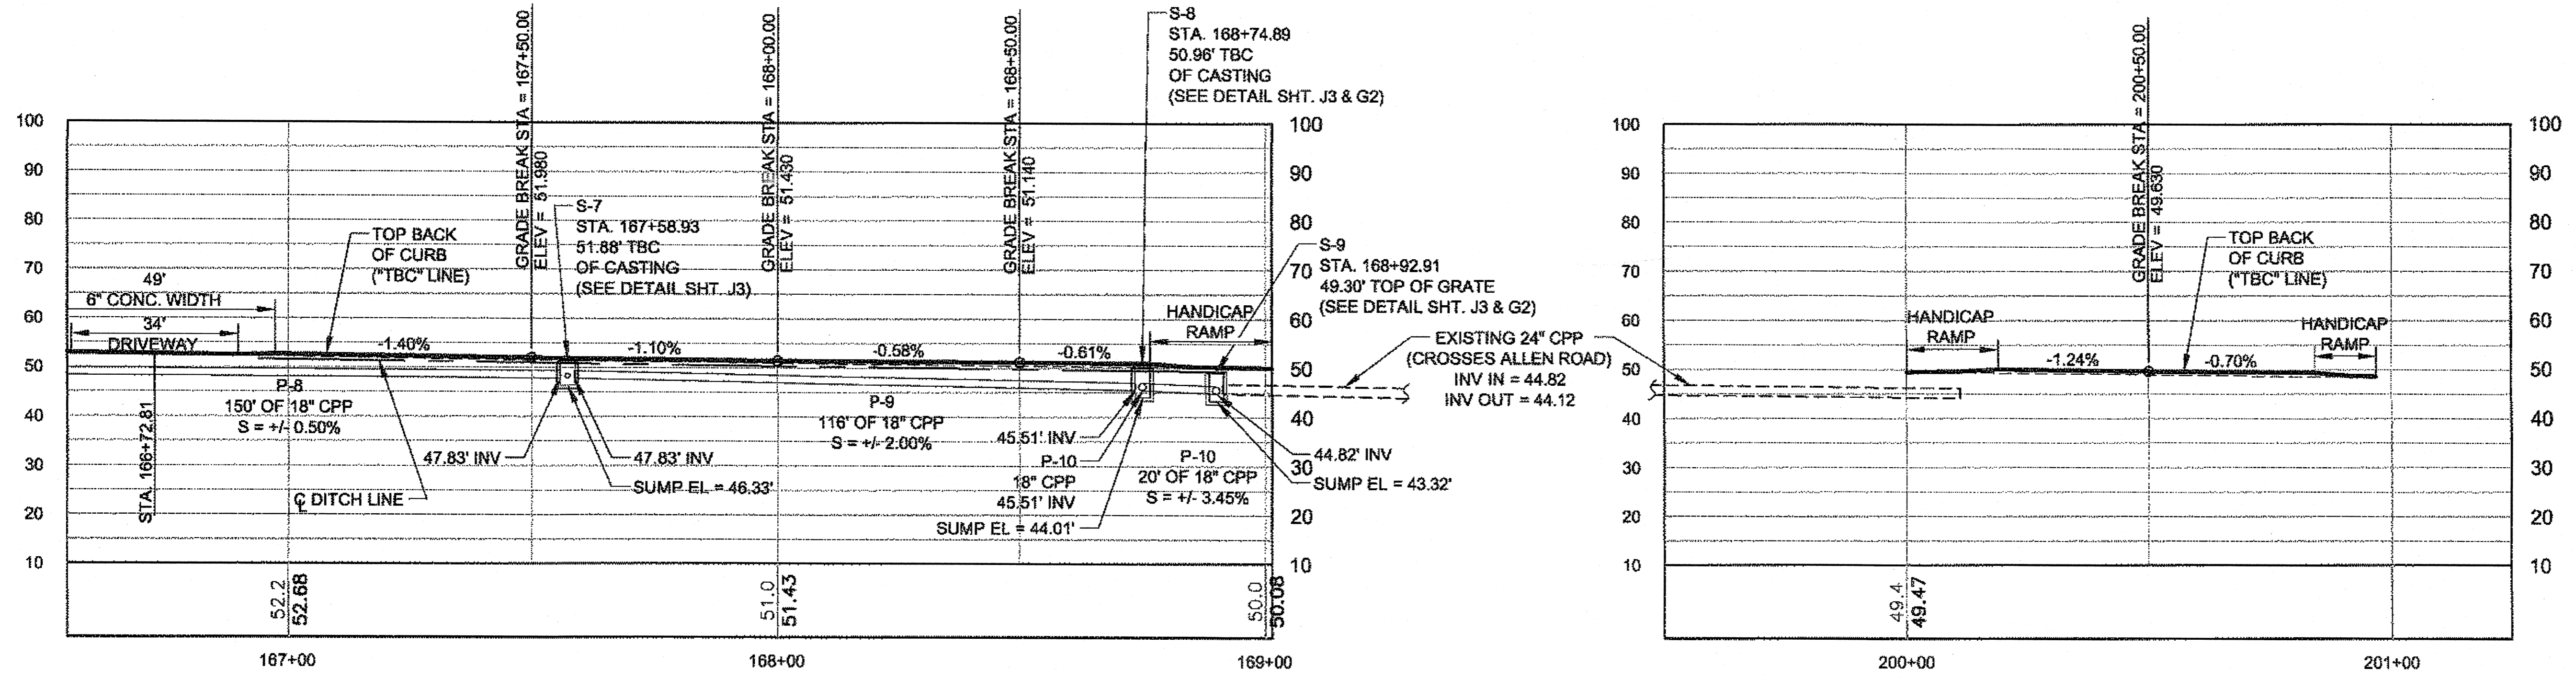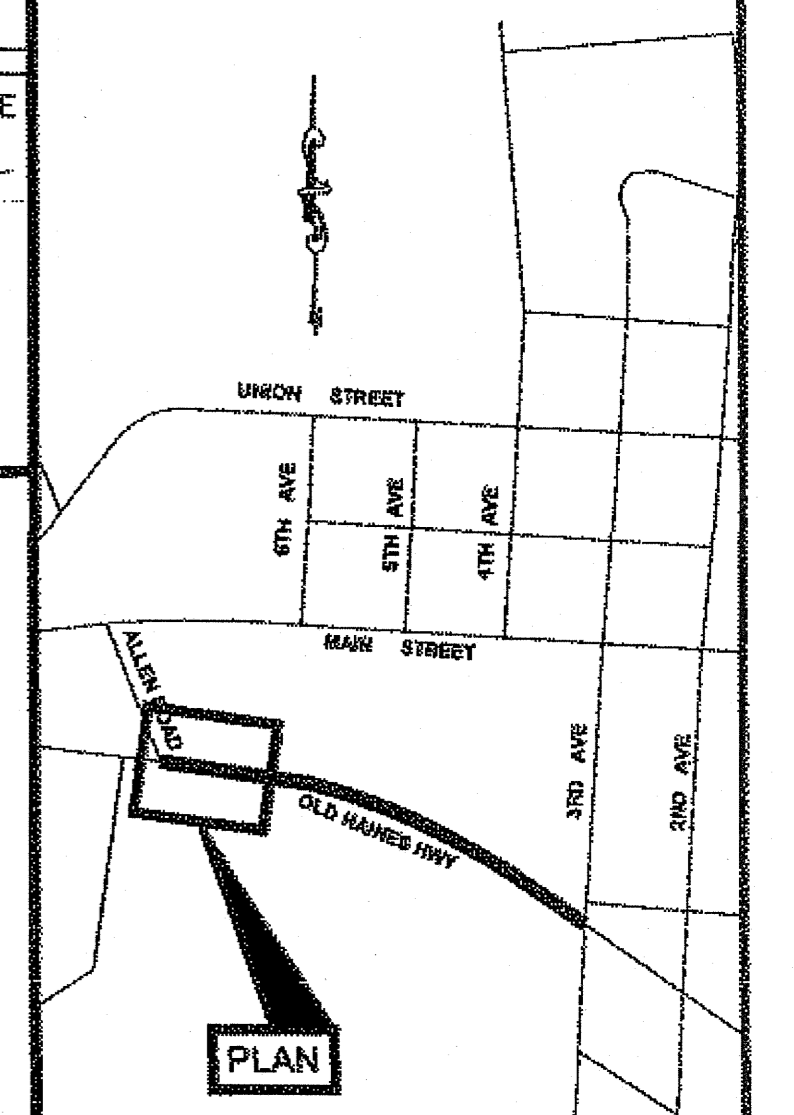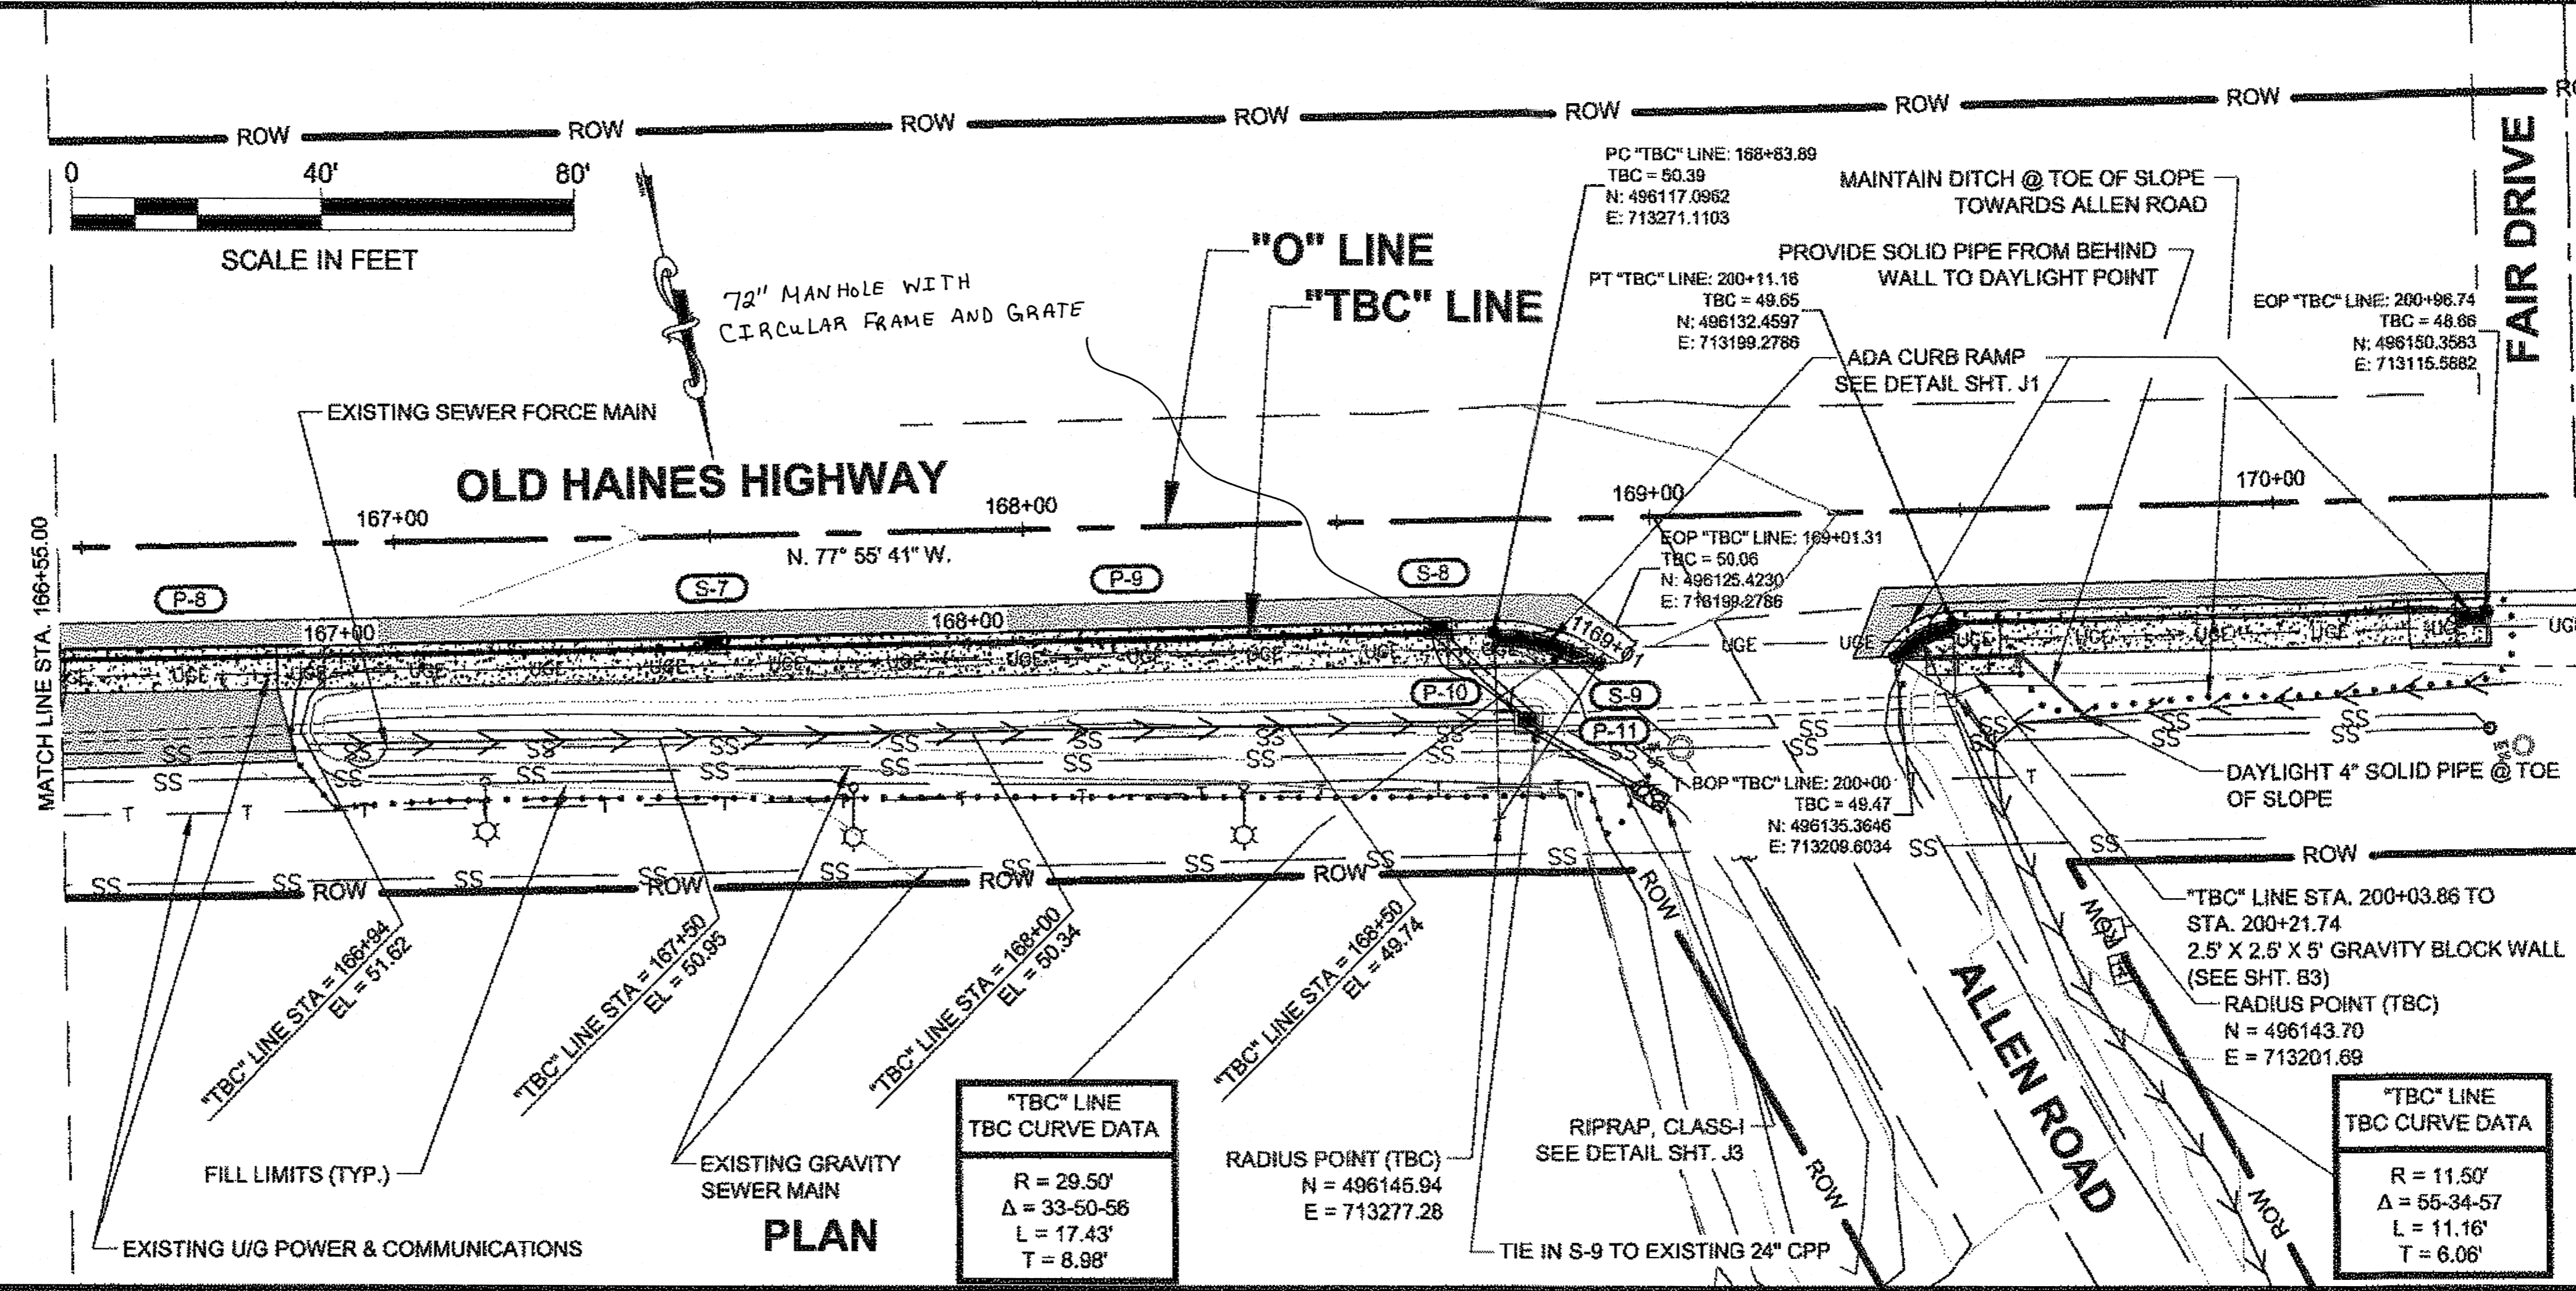

TBC STATIONING PROFILE

DO NOT SCALE FROM THESE DRAWINGS USE DIMENSIONS

PLAN VIEW

PROJECT DESIGNATION
SRTS-0987(007) ~ 67555

STATE	YEAR
ALASKA	2013
SHEET NUMBER	TOTAL SHEETS
F4	29


"O" LINE & "TBC" LINE - STA'S/ELEV'S/NORTHINGS/EASTINGS					
STA "O" LINE	STA "TBC" LINE	TBC ELEV.	"TBC" LINE NORTHING	"TBC" LINE EASTING	REMARKS
152+52.87	152+21.80	52.59	495449.0214	714736.4174	BOP
152+49.26	152+35.59	52.54	495436.9824	714730.8878	BEGIN RAMP
152+51.04	152+44.67	51.99	495431.1235	714723.5466	RAMP LANDING
152+54.09	152+50.92	52.09	495428.9669	714717.8943	RAMP LANDING
152+61.01	152+60.35	52.66	495428.6567	714708.3343	END RAMP
152+73.76	152+73.76	52.69	495434.2142	714696.3097	PC
153+00	153+00	52.84	495451.2534	714676.3546	S-1
153+50	153+50	53.14	495483.7213	714638.3304	
153+59.50	153+59.50	53.18	495489.8902	714631.1058	TOP DRIVEWAY
153+67	153+67	52.92	495494.753	714625.4108	BOTTOM DRIVEWAY
154+01	154+01	53.26	495516.8312	714599.5544	BOTTOM DRIVEWAY
154+08.50	154+08.50	53.58	495521.7087	714593.8422	TOP DRIVEWAY
154+50	154+50	53.89	495548.6571	714562.282	S-2
155+00	155+00	54.52	495581.1249	714524.258	
155+50	155+50	55.12	495613.5928	714486.2338	
155+64.96	155+64.96	55.24	495623.3069	714474.8574	PC
155+99.67	156+00	55.52	495645.8162	714448.0034	
156+49.20	156+50	55.90	495677.0771	714408.9827	
156+98.73	157+00	56.47	495707.3101	714369.1603	
157+48.26	157+50	56.69	495736.4945	714328.5631	
157+97.79	158+00	56.92	495764.6105	714287.2189	
158+47.32	158+50	57.16	495791.639	714245.1556	
158+96.86	159+00	57.40	495817.5617	714202.402	
159+46.39	159+50	57.60	495842.3608	714158.987	
159+95.92	160+00	57.83	495866.0195	714114.9401	
160+45.45	160+50	57.90	495888.5218	714070.2915	
160+94.98	161+00	57.84	495909.8524	714025.0713	
161+20.90	161+26.17	57.78	495920.5373	714001.1918	TOP DRIVEWAY
161+28.32	161+33.67	57.49	495923.5474	713994.3166	BOTTOM DRIVEWAY
161+62.01	161+67.67	57.41	495936.828	713963.018	BOTTOM DRIVEWAY
161+69.44	161+75.17	57.68	495939.6828	713956.0825	TOP DRIVEWAY
161+94.04	162+00	57.67	495948.934	713933.0369	
162+43.57	162+50	57.55	495966.6725	713886.2908	

"O" LINE & "TBC" LINE - STA'S/ELEV'S/NORTHINGS/EASTINGS					
STA "O" LINE	STA "TBC" LINE	TBC ELEV.	"TBC" LINE NORTHING	"TBC" LINE EASTING	REMARKS
162+93.10	163+00	57.22	495983.1791	713839.0956	
163+42.63	163+50	56.66	495998.4496	713791.4861	
163+92.16	164+00	56.31	496012.4736	713743.4945	
164+41.69	164+50	55.56	496025.2416	713695.1537	
164+50	164+58.39	55.49	496027.2595	713687.0135	S-3
164+91.22	165+00	55.19	496036.7448	713646.4964	
164+95.01	165+03.82	55.15	496037.5718	713642.7656	TOP DRIVEWAY
165+02.44	165+11.32	54.83	496039.1731	713635.4385	BOTTOM DRIVEWAY
165+07.22	165+16.15	54.46	496040.1881	713630.7213	PT
165+36.39	165+45.32	54.30	496046.2897	713602.1916	BOTTOM DRIVEWAY
165+43.89	165+52.82	54.50	496047.8582	713594.8575	TOP DRIVEWAY
165+91.07	166+00	53.70	496057.7251	713548.7222	
166+00	166+08.93	53.63	496059.5924	713539.9908	S-5
166+39.38	166+48.31	53.30	496067.8281	713501.4825	TOP DRIVEWAY
166+46.88	166+55.81	52.89	496069.3966	713494.1483	BOTTOM DRIVEWAY
166+80.88	166+89.81	52.49	496076.5073	713460.9002	BOTTOM DRIVEWAY
166+88.38	166+97.31	52.72	496078.0759	713453.566	TOP DRIVEWAY
166+91.07	167+00	52.67	496078.6389	713450.9336	
167+41.07	167+50	51.98	496089.0958	713402.0393	
167+50	167+58.93	51.89	496090.9631	713393.3079	S-7
167+91.07	168+00	51.43	496099.5527	713353.145	
168+41.07	168+50	51.14	496110.0096	713304.2506	
168+65.96	168+74.89	51.00	496115.2149	713279.9114	S-8
168+67.46	168+76.39	50.98	496115.5286	713278.4446	BEGIN RAMP
168+74.96	168+83.89	50.39	496117.0962	713271.1103	PC (BEGIN RAMP LANDING)
168+91.39	169+01.31	50.06	496125.423	713256.0882	END RAMP LANDING @ TBC
169+38.93	200+00	49.47	496135.3646	713209.6034	BOP
169+48.42	200+11.16	49.65	496132.4597	713199.2786	PT (END RAMP LANDING)
169+55.92	200+18.66	50.02	496134.0278	713191.9465	END RAMP LANDING @ TBC
169+87.26	200+50	49.63	496140.5829	713161.2958	
170+21.50	200+84.24	49.39	496147.7441	713127.8118	BEGIN RAMP
170+29.00	200+91.74	48.74	496149.3126	713120.4777	BEGIN RAMP LANDING
170+34.00	200+96.74	48.66	496150.3583	713115.5882	EOP


NOTE:

CONTRACTOR SHALL VERIFY ALL ELEVATIONS IN THE FIELD PRIOR TO SETTING FORMS. TBC ELEVATIONS SHALL BE ESTABLISHED BASED ON EXISTING PAVEMENT SURFACE ELEVATIONS AND TYPICAL SECTIONS.

DO NOT SCALE FROM THESE DRAWINGS USE DIMENSIONS


CHECKED BY: K. KARPSTEIN	STATE OF ALASKA DEPARTMENT OF TRANSPORTATION & PUBLIC FACILITIES SOUTHEAST REGION					
	HNS-OLD HAINES HIGHWAY SIDEWALK 3rd AVENUE TO ALLEN ROAD PROJECT #67555					
DESIGNED BY: D. MULLINER	PROFILE					
DRAWN BY: D. MULLINER						
PATH: Q:\HNS\67555\END\DOUG'S FILE\G_PROFILE SHT.DWG						
TAB: G1	Friday, April 19, 2013 11:33:33 AM					
MULLINER, DOUGLAS J (DOT)						
NO.	DATE	DESCRIPTION	PROJECT DESIGNATION	YEAR	SHEET NO.	TOTAL SHEETS
			SRTS-0987(007) ~ 67555	2013	G1	29

4/25/13

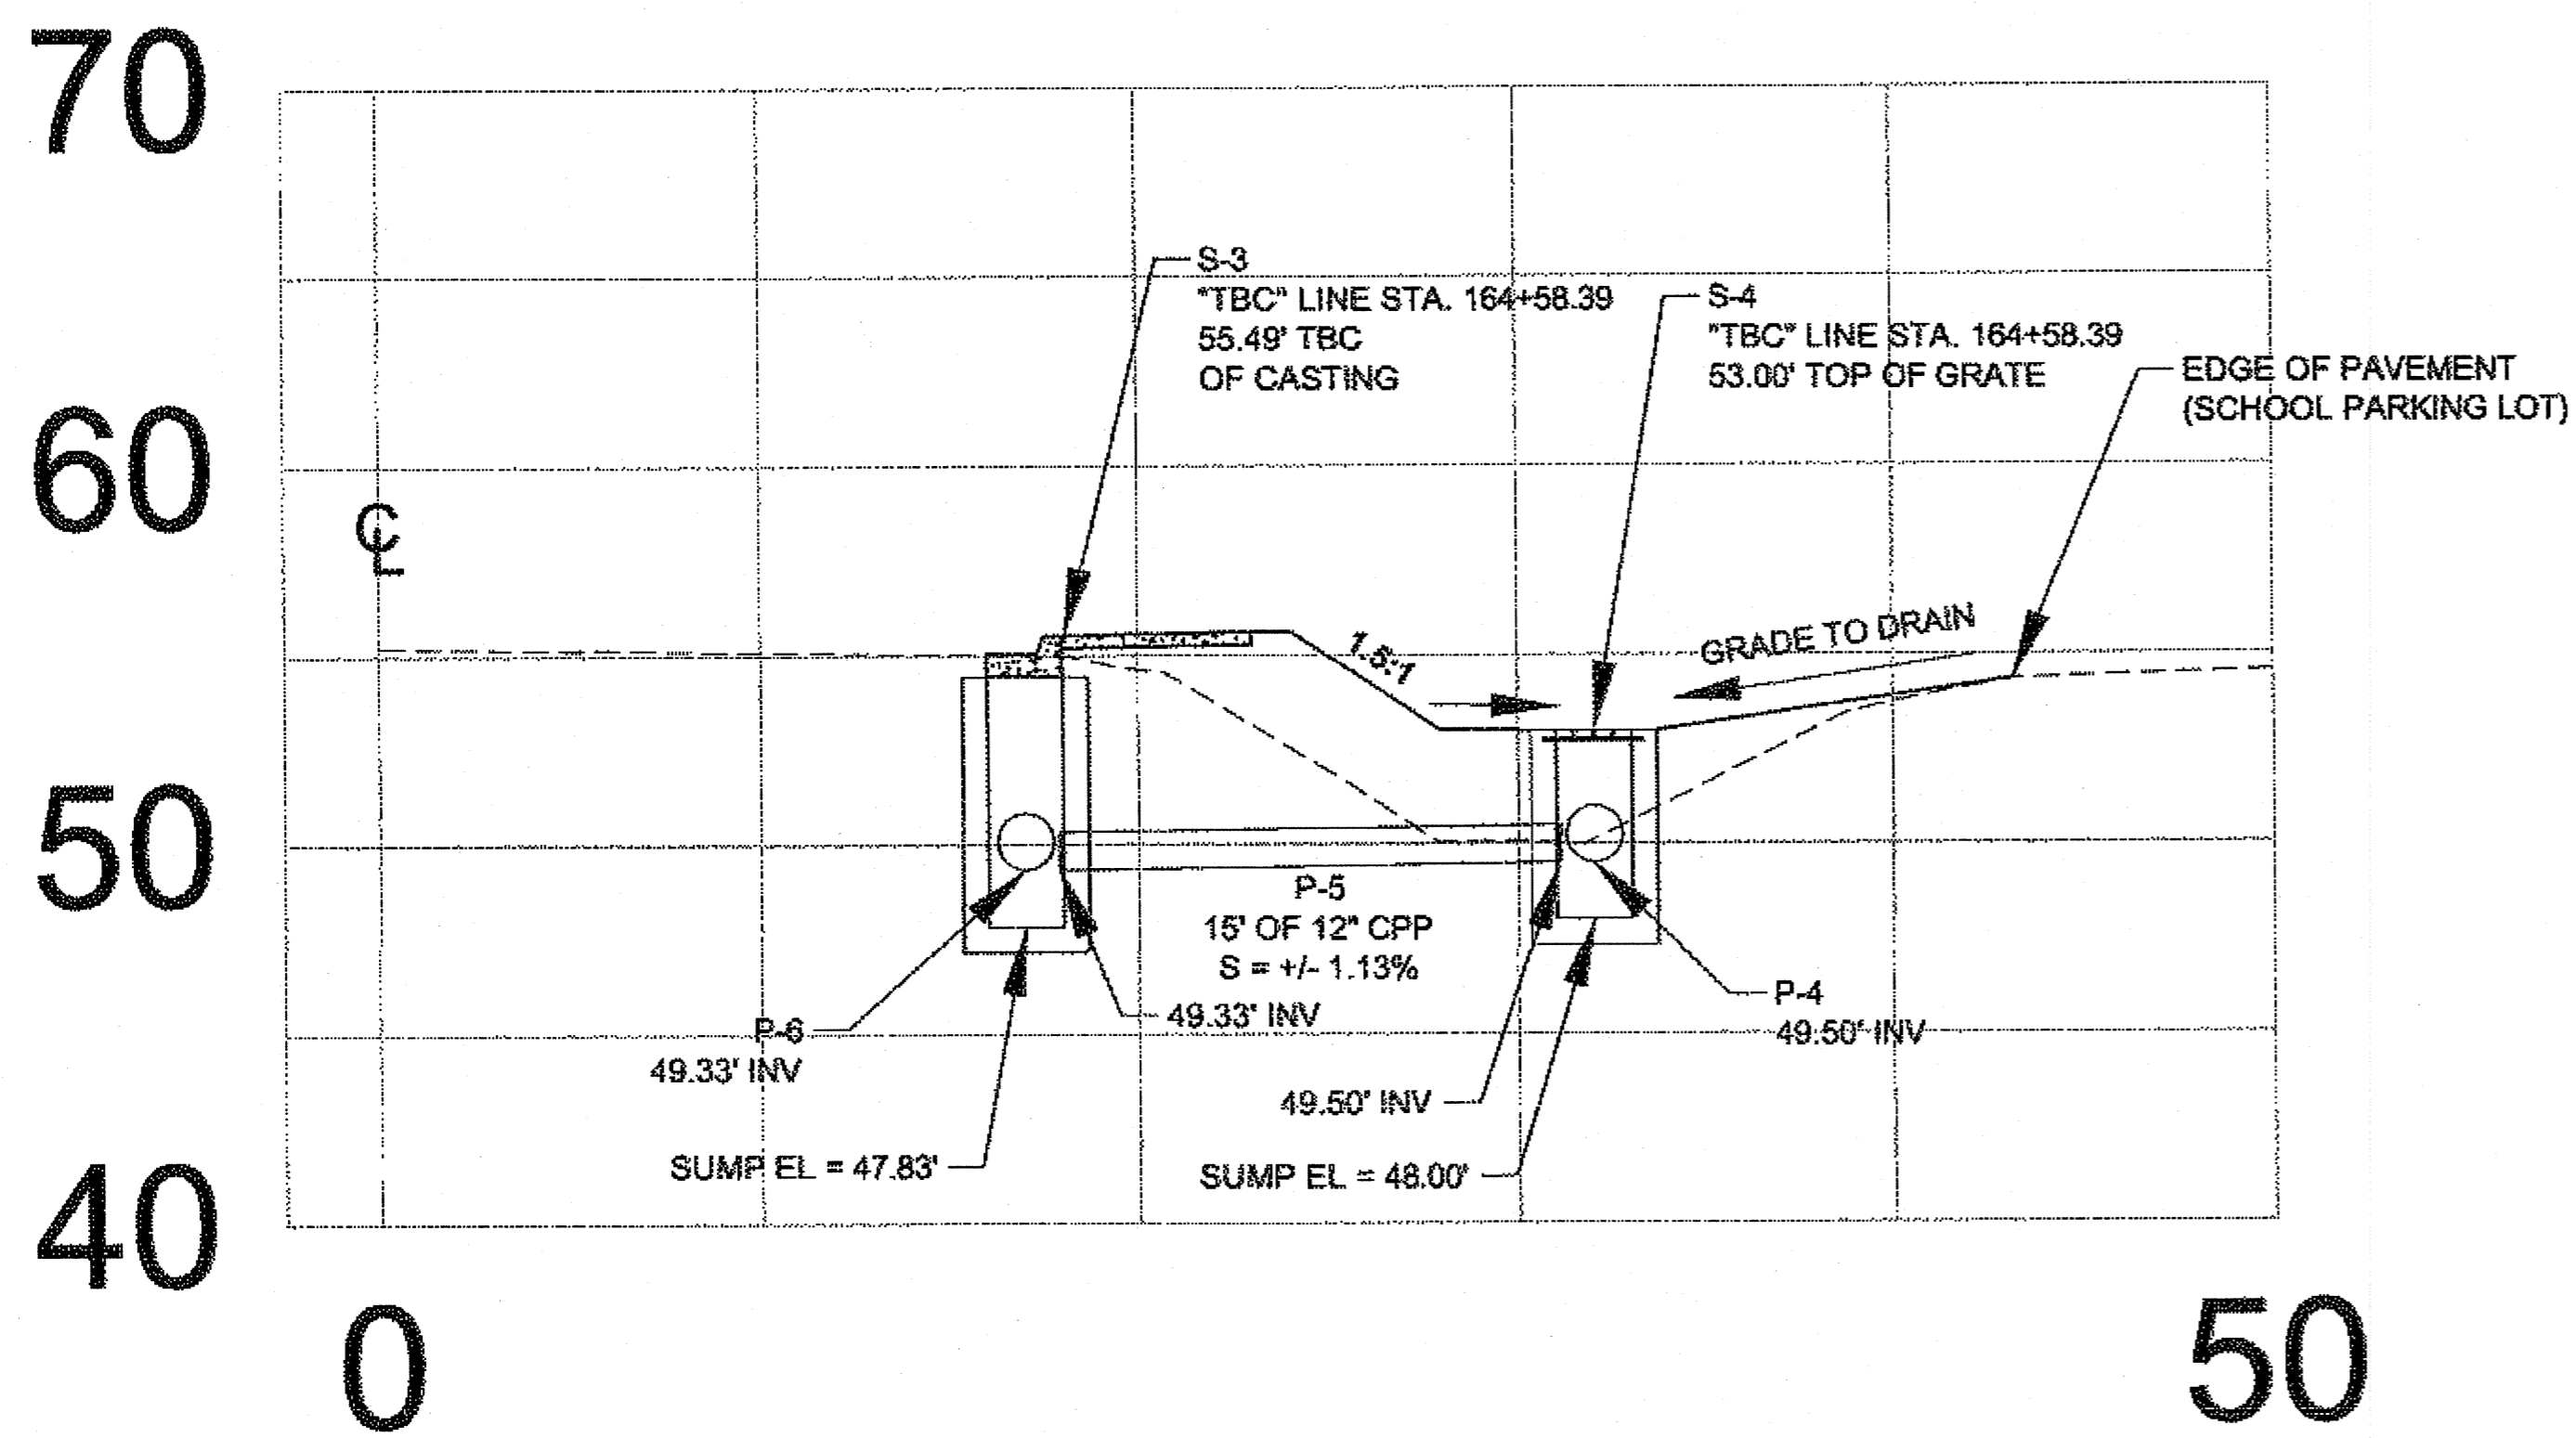


CATCH BASINS S-3 & S-4

N.T.S.

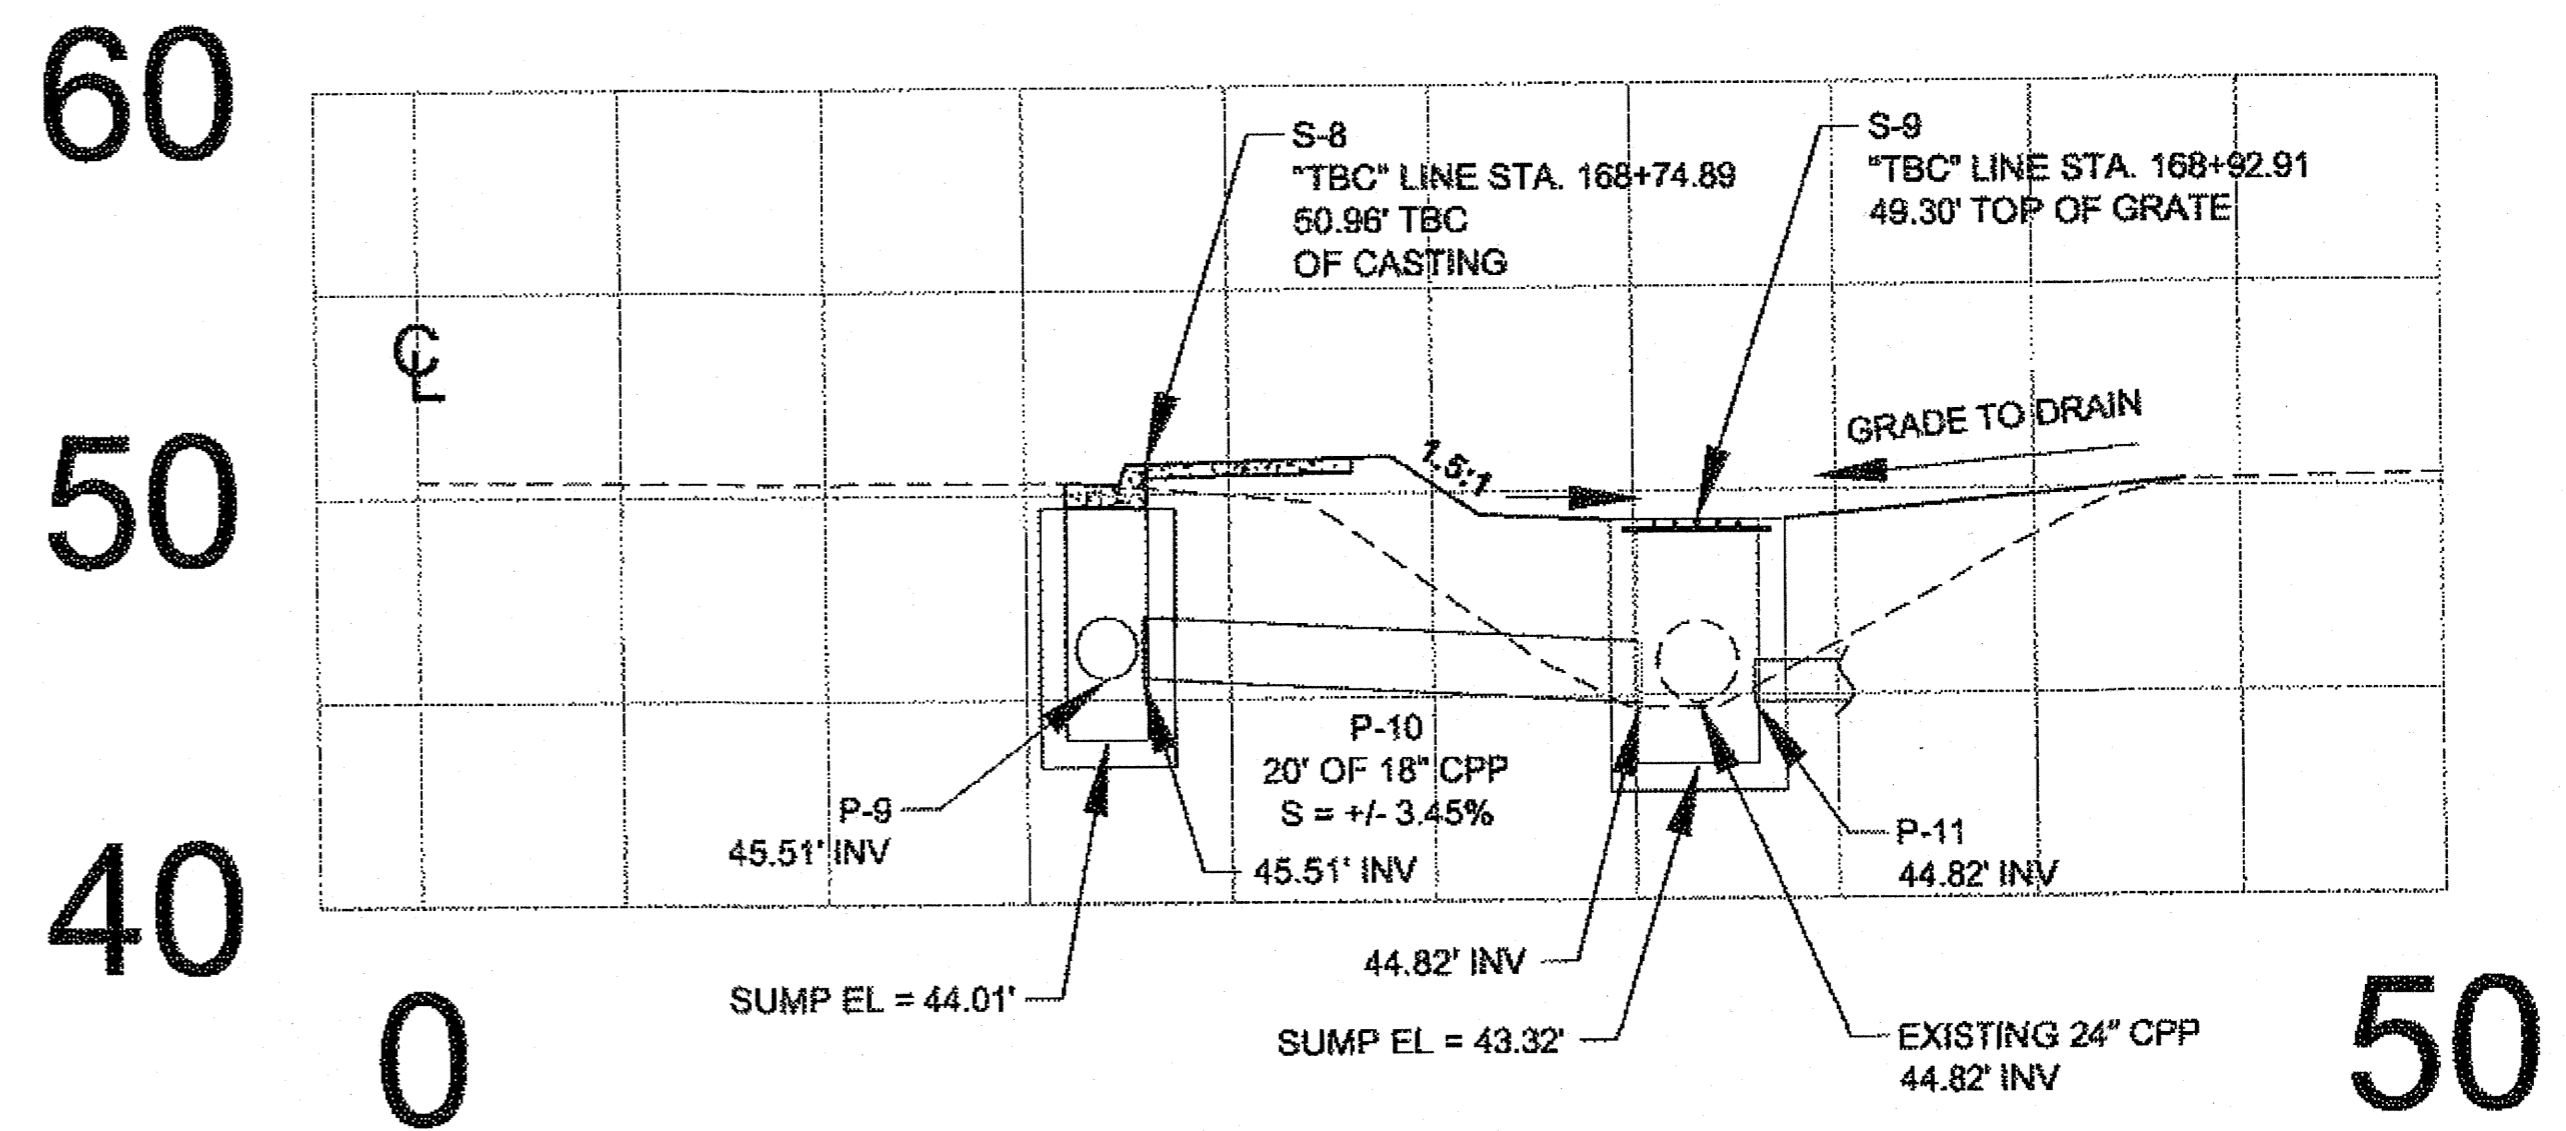

CATCH BASINS S-8 & S-9

N.T.S.

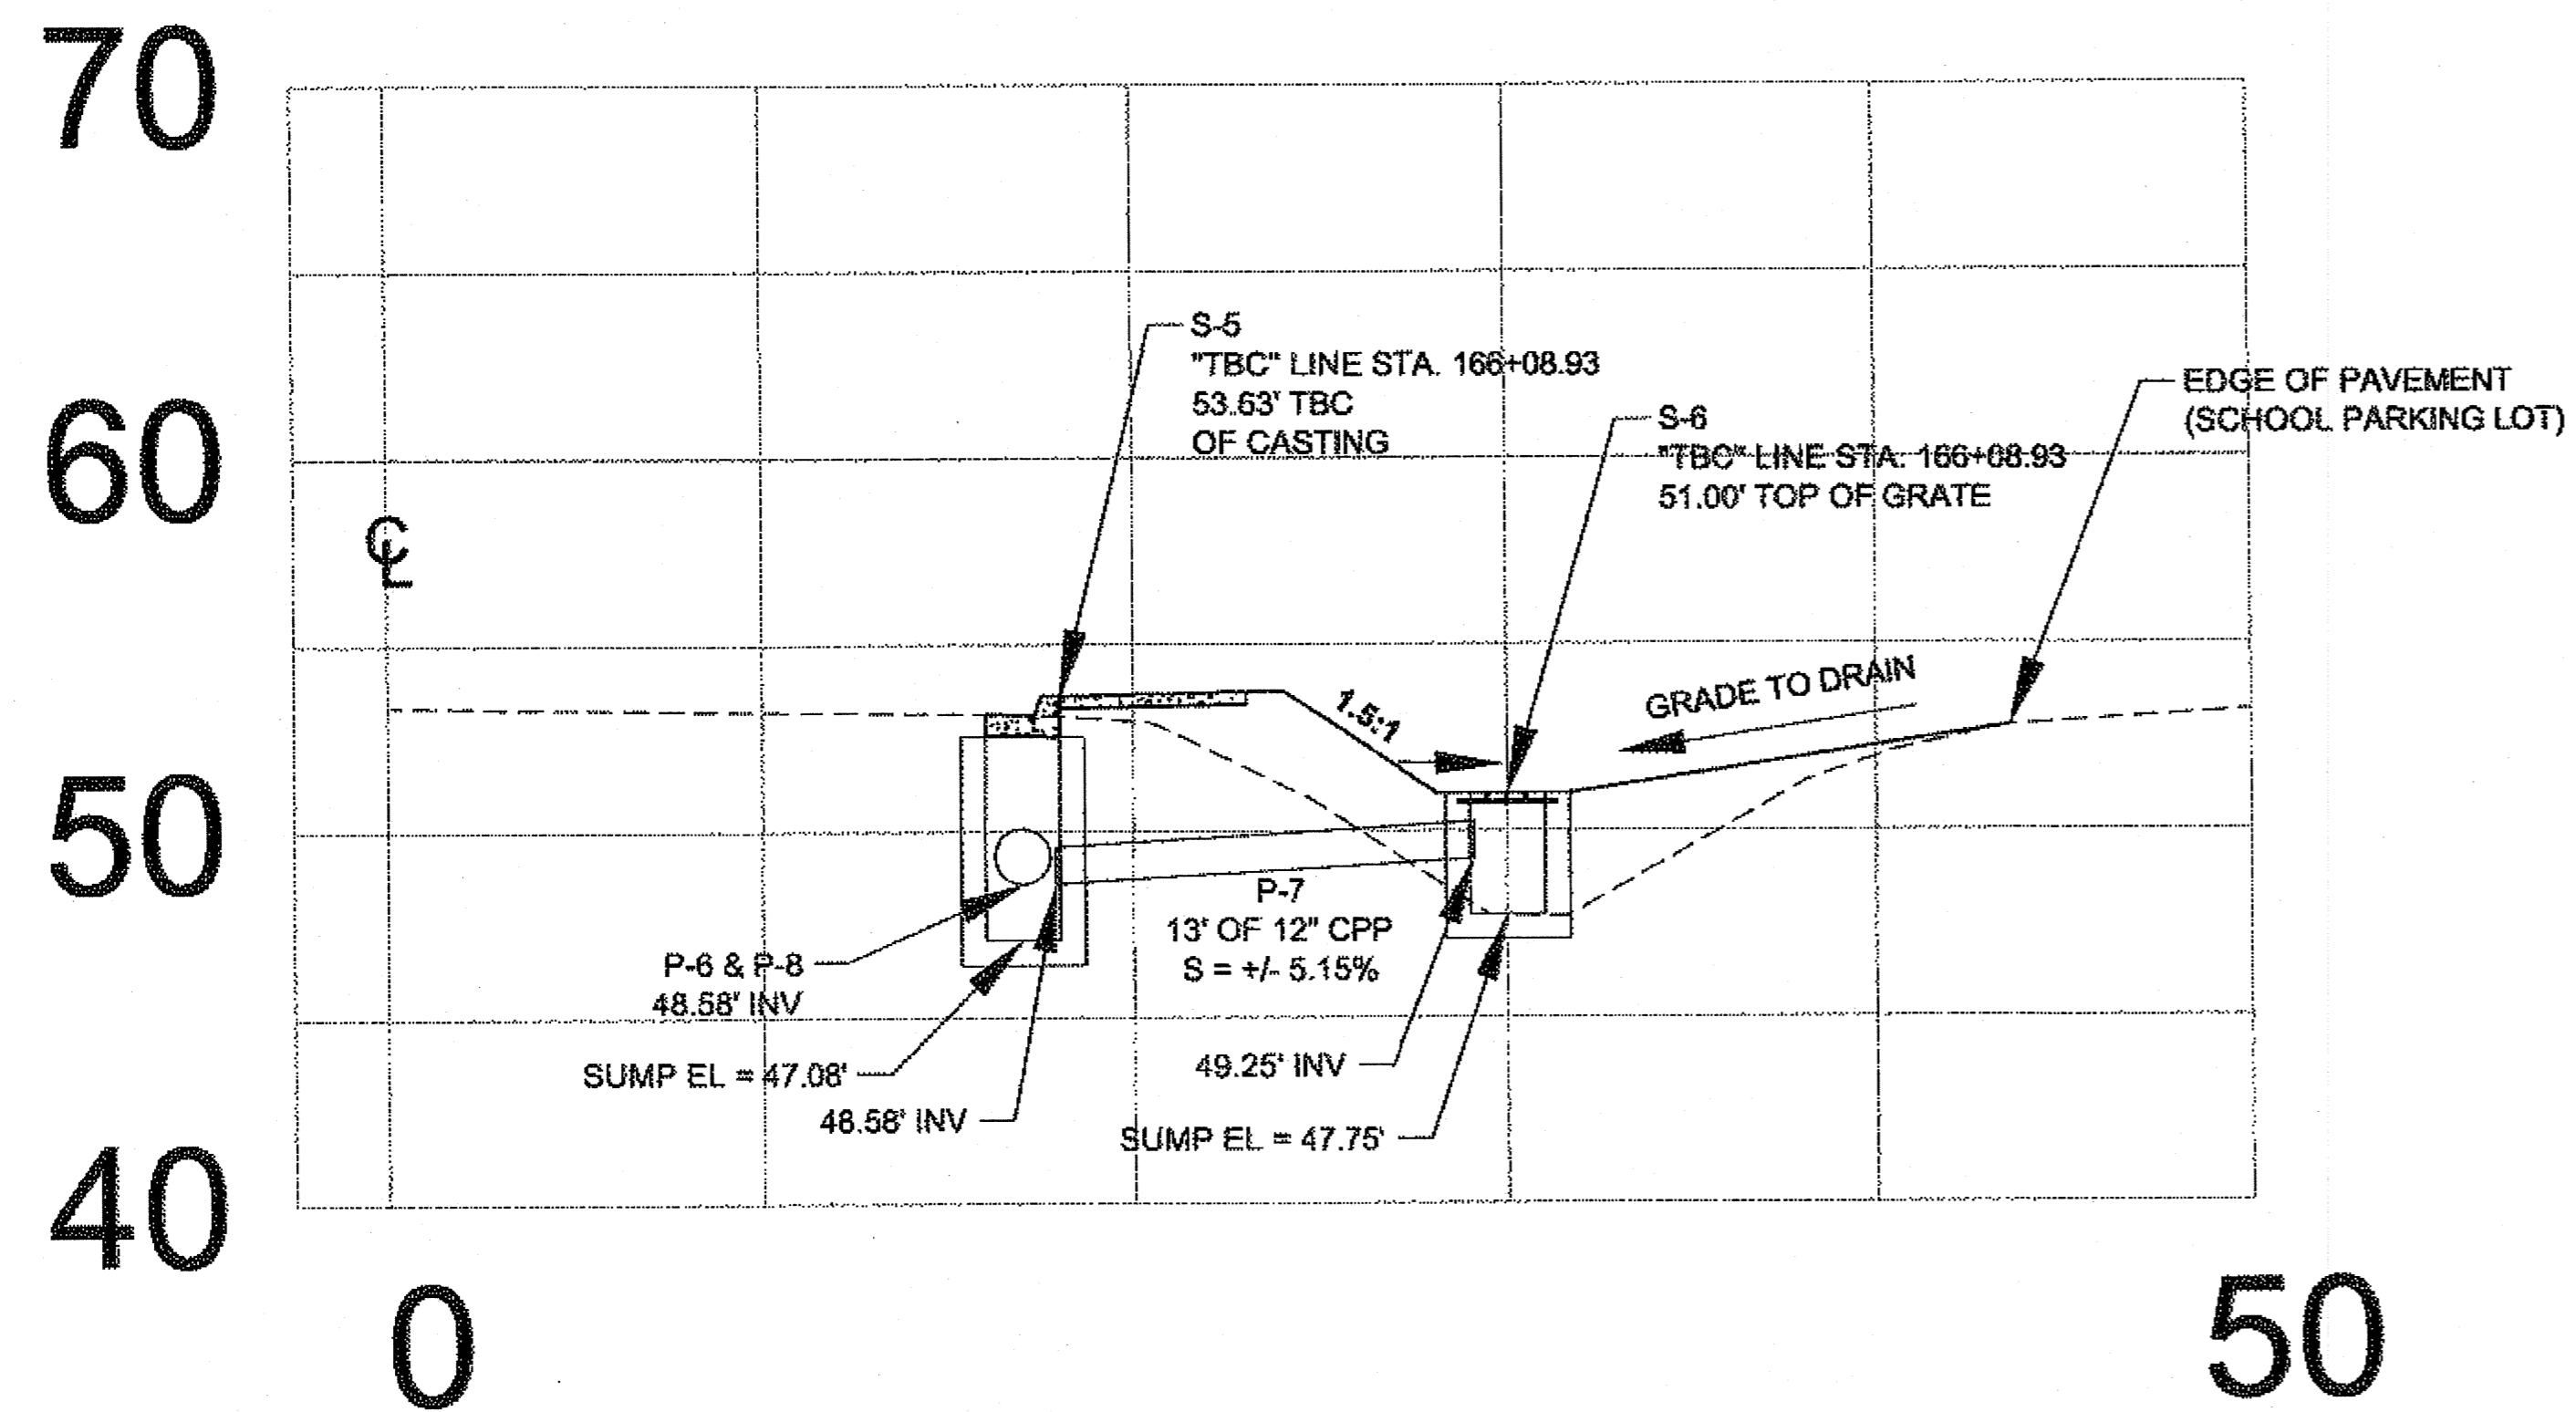


CATCH BASINS S-5 & S-6

N.T.S.


DO NOT SCALE FROM THESE DRAWINGS USE DIMENSIONS

CHECKED BY: K. KARPSTEIN 		STATE OF ALASKA DEPARTMENT OF TRANSPORTATION & PUBLIC FACILITIES SOUTHEAST REGION												
DESIGNED BY: D. MULLINER DRAWN BY: D. MULLINER		HNS-OLD HAINES HIGHWAY SIDEWALK 3rd AVENUE TO ALLEN ROAD PROJECT #67555												
PATH: Q:\HNS\67555\EN\DOUG'S FILE\G_PROFILE SHY.DWG TAB: G2		MULLINER, DOUGLAS J (DOT)												
<table border="1"> <thead> <tr> <th colspan="3">REVISIONS</th> </tr> <tr> <th>NO.</th> <th>DATE</th> <th>DESCRIPTION</th> </tr> </thead> <tbody> <tr> <td> </td> <td> </td> <td> </td> </tr> </tbody> </table>		REVISIONS			NO.	DATE	DESCRIPTION				PROJECT DESIGNATION SRTS-0987(007) ~ 67555	YEAR 2013	SHEET NO. G2	TOTAL SHEETS 29
REVISIONS														
NO.	DATE	DESCRIPTION												


B
1-7-14

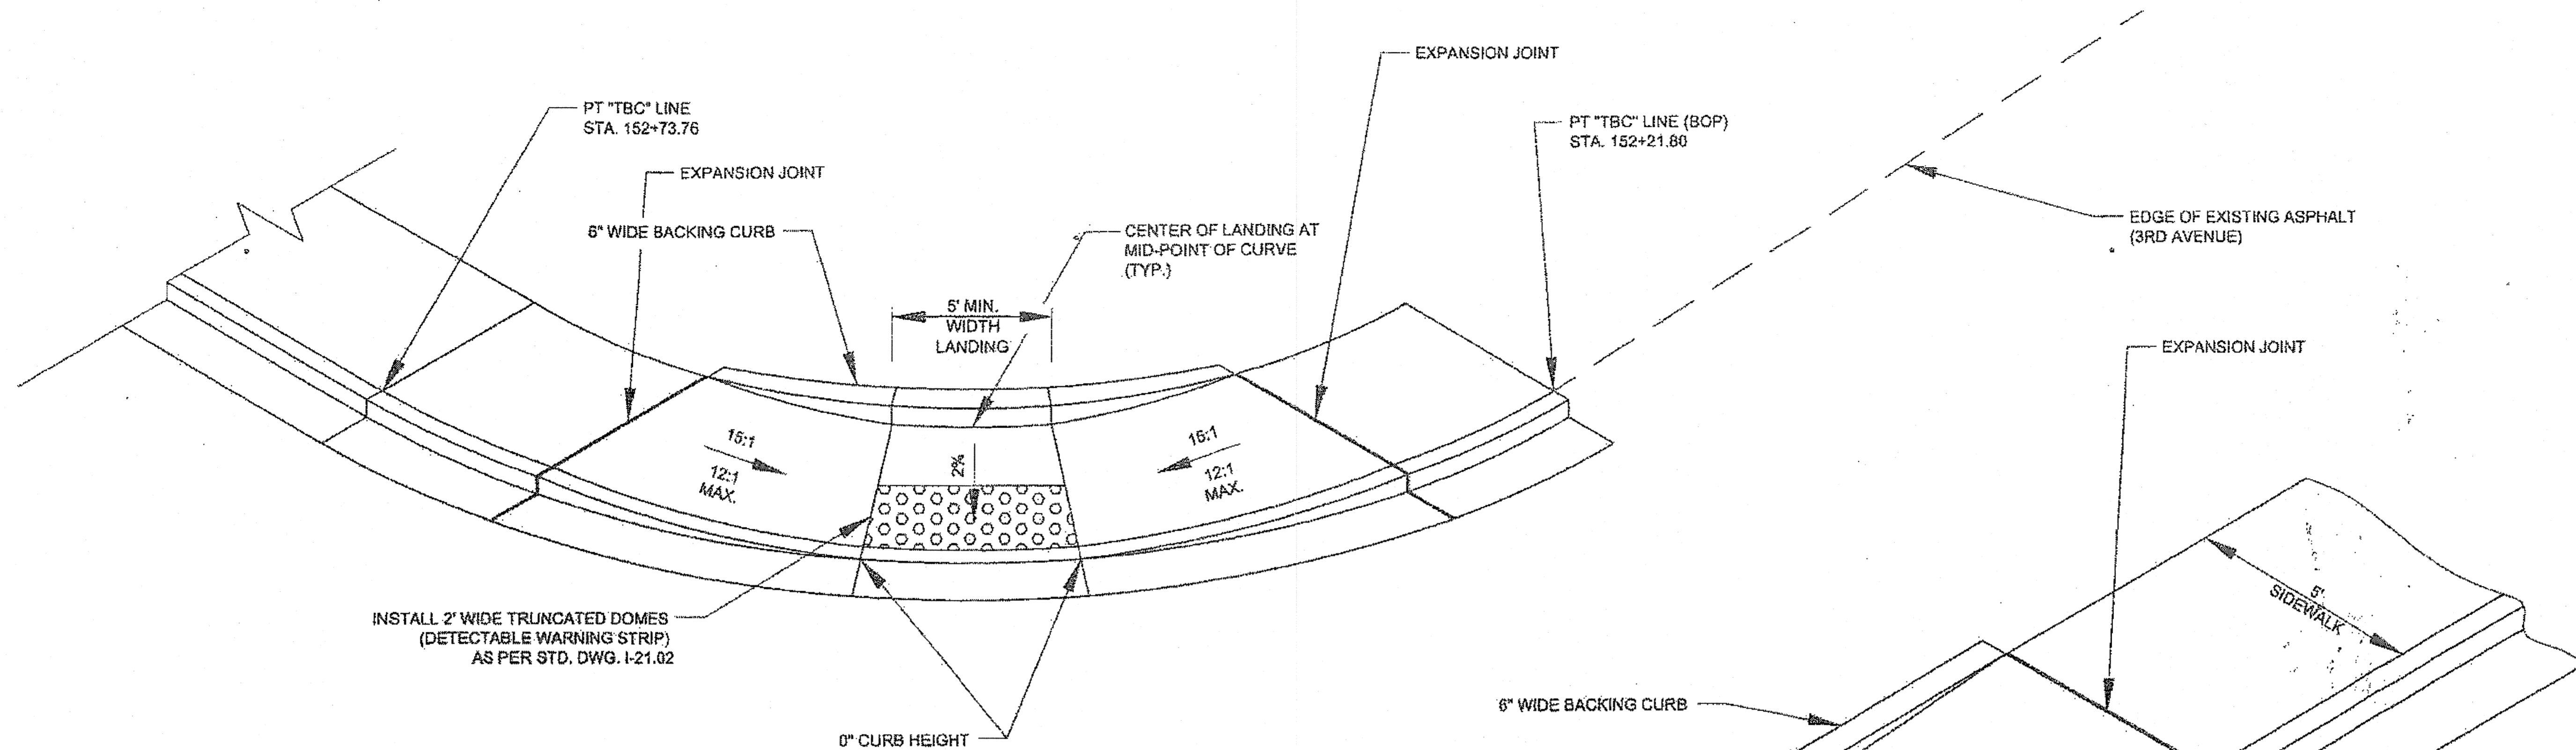

CURB RAMP DETAIL
("TBC" LINE STA. 152+48)
 N.T.S.

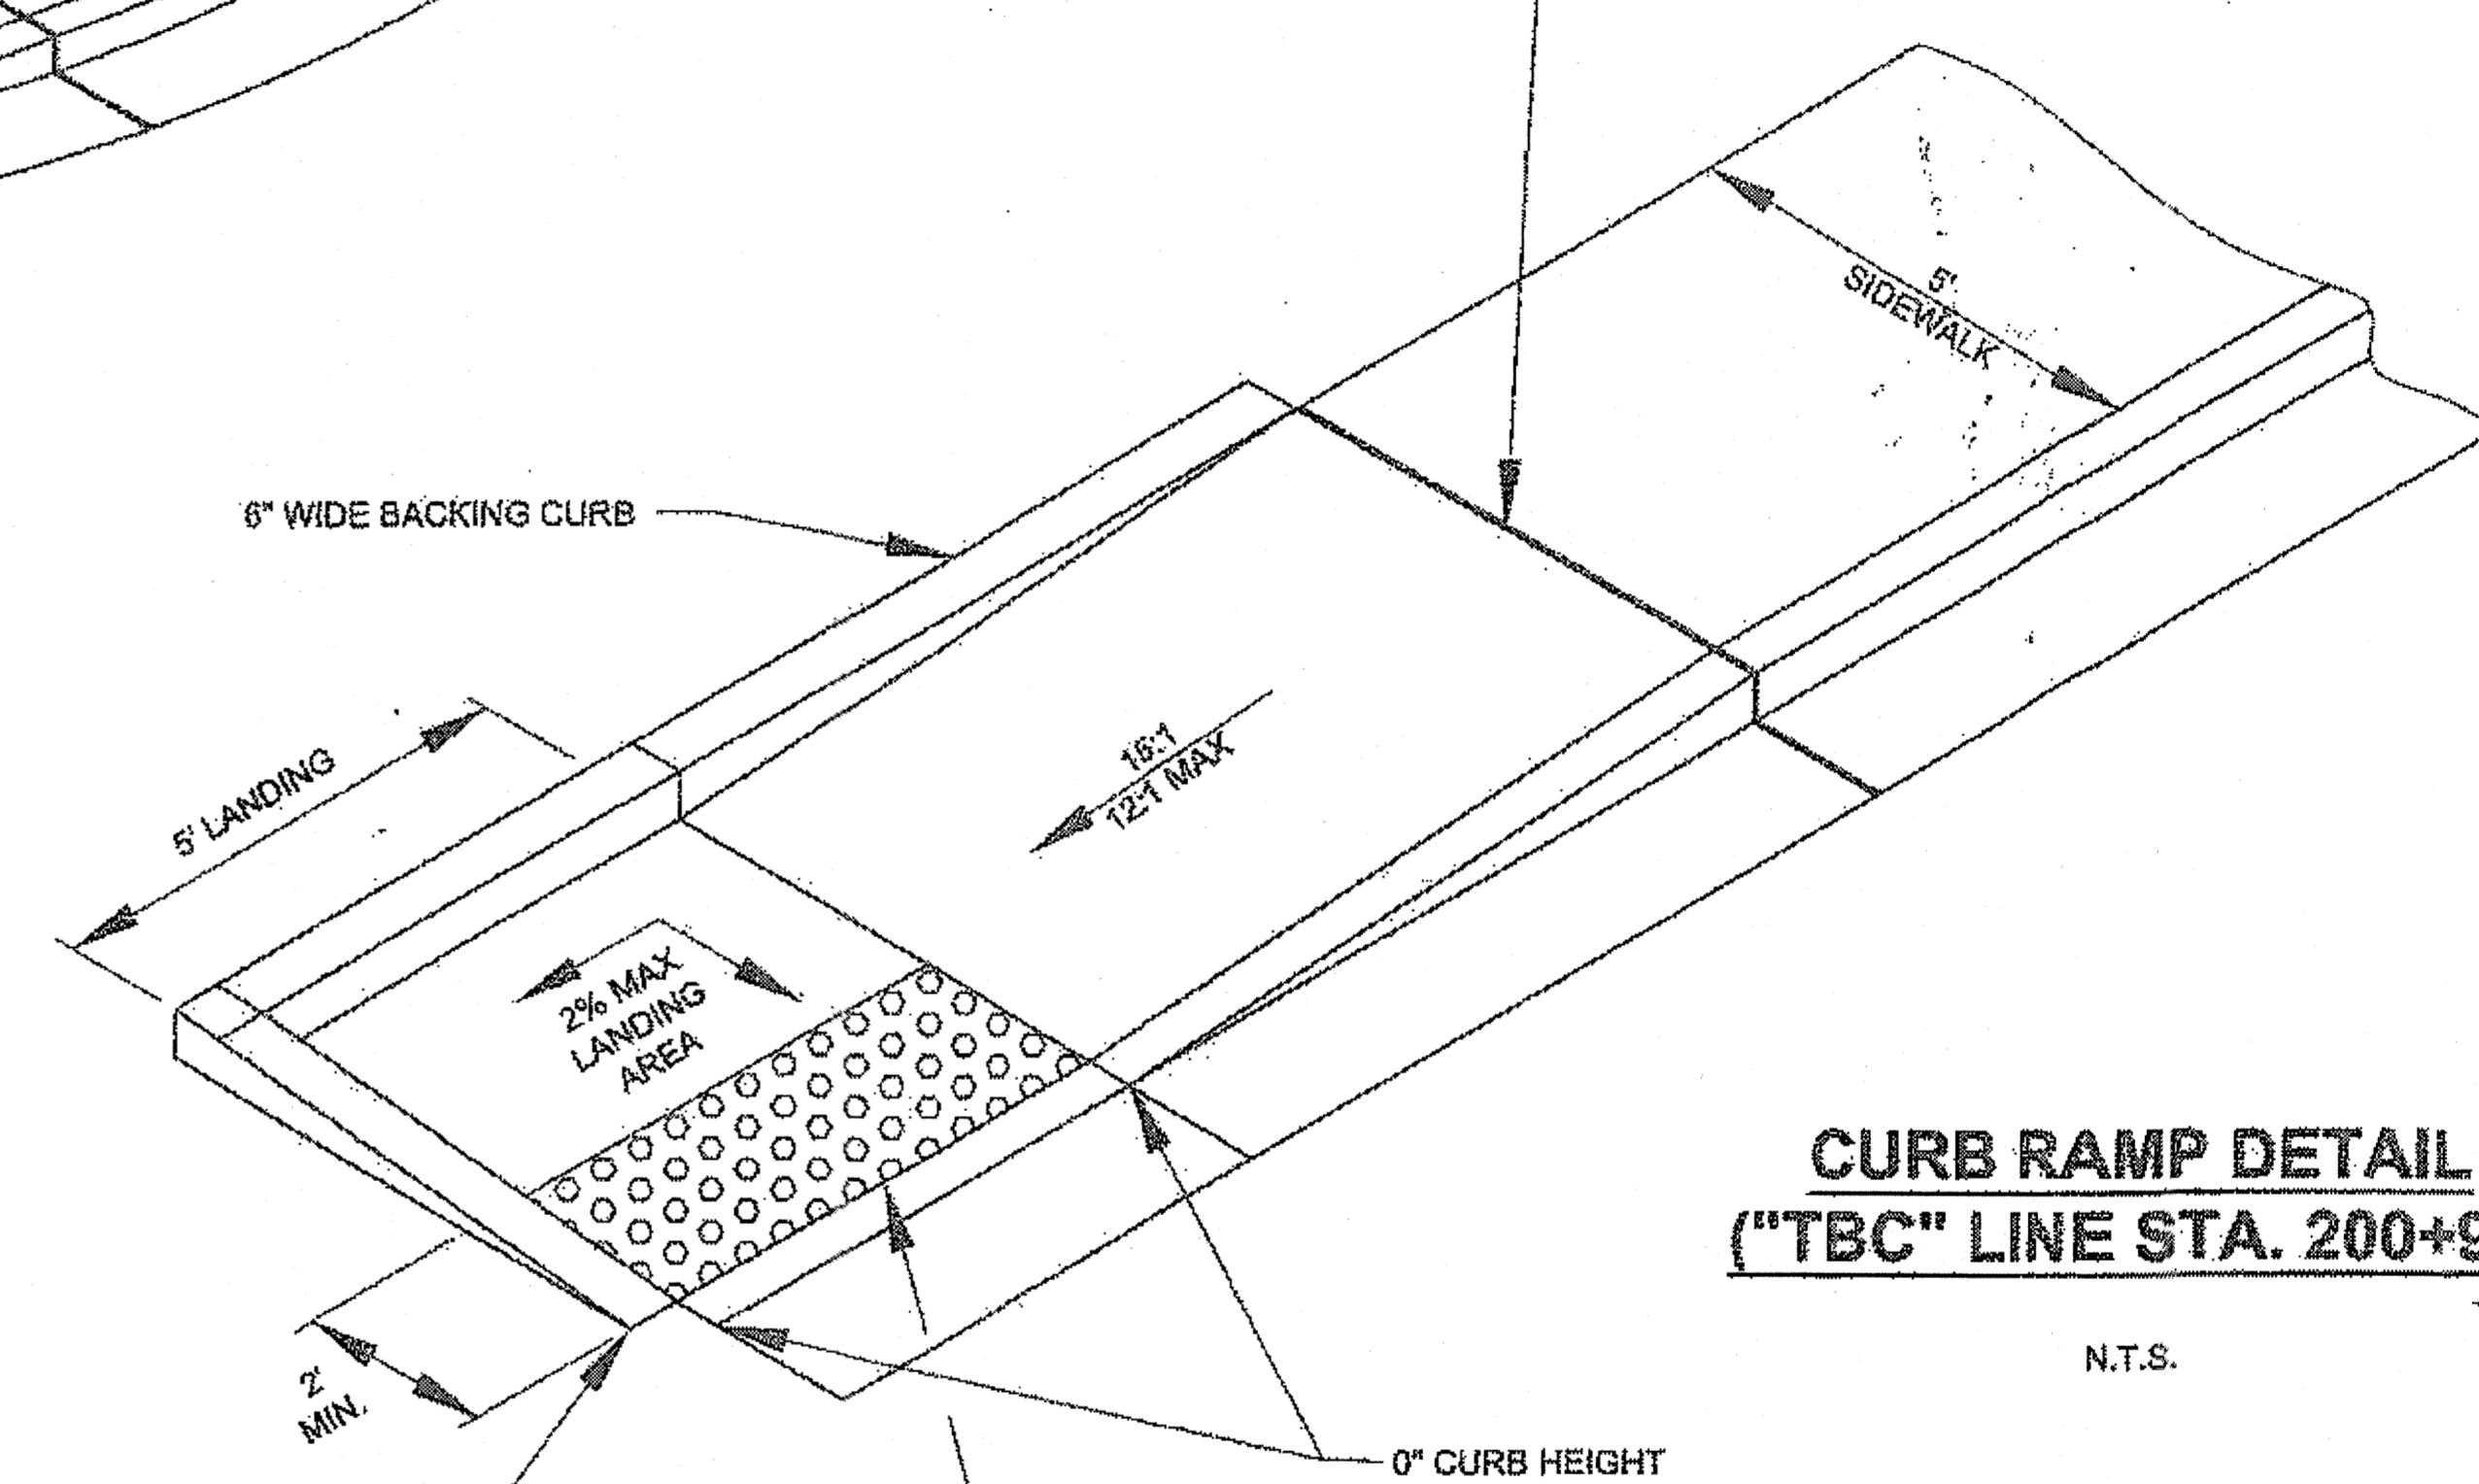


CURB RAMP DETAIL
("TBC" LINE STA. 200+94)
 N.T.S.

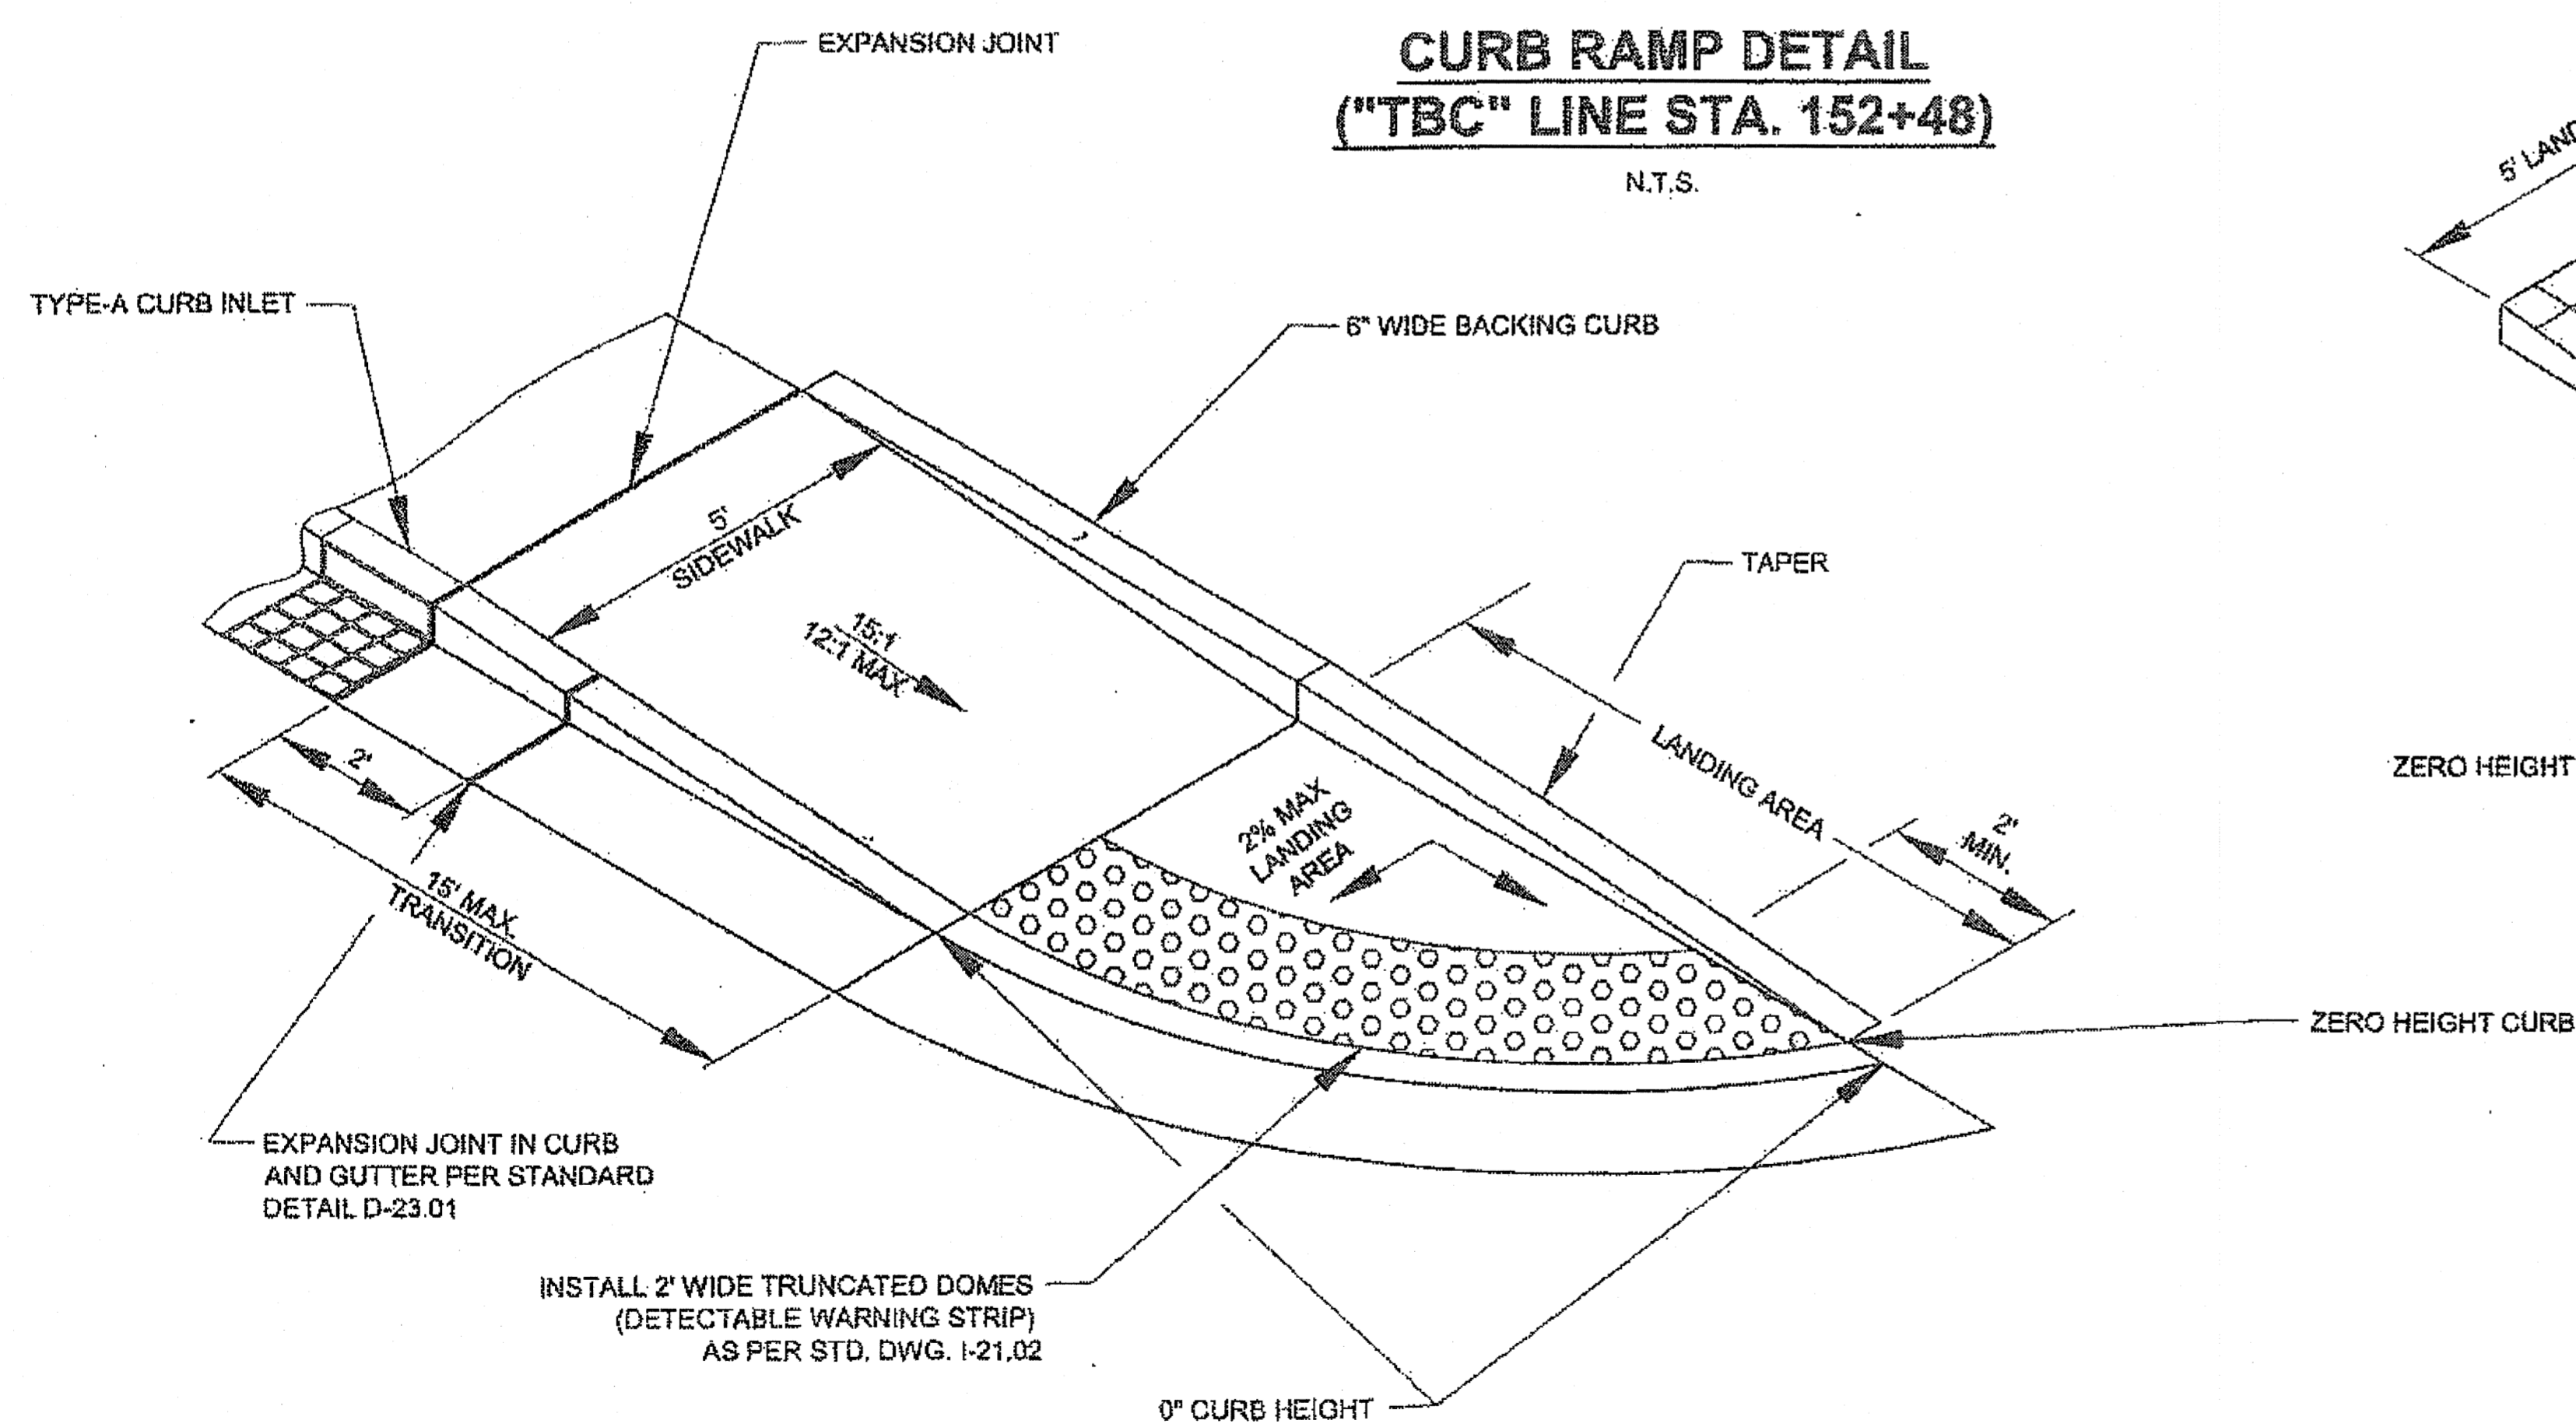


ONE WAY DIRECTIONAL CURB RAMP
("TBC" LINE STA. 168+92 & 200+06)
 N.T.S.

DO NOT SCALE FROM THESE DRAWINGS USE DIMENSIONS

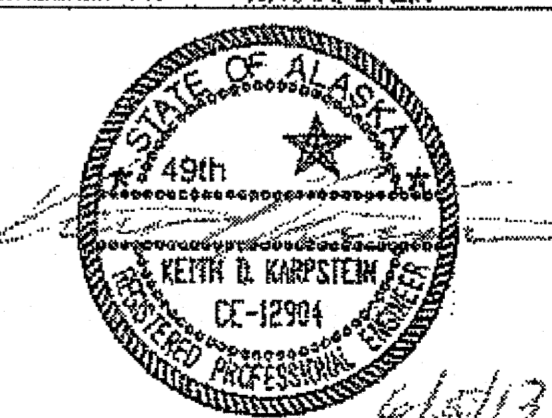
CHECKED BY: K. KARPSTEIN 		STATE OF ALASKA DEPARTMENT OF TRANSPORTATION & PUBLIC FACILITIES SOUTHEAST REGION																						
DESIGNED BY: D. MULLINER DRAWN BY: D. MULLINER		HNS-OLD HAINES HIGHWAY SIDEWALK 3rd AVENUE TO ALLEN ROAD PROJECT #67555																						
PATH: Q:\HNS\67555\EN\DOUG'S FILE\DETAIL 5HT.DWG TAB: J1 Wednesday, June 05, 2013 11:16:55 AM		MULLINER, DOUGLAS J (DOT)																						
<table border="1"> <thead> <tr> <th colspan="3">REVISIONS</th> <th>PROJECT DESIGNATION</th> <th>YEAR</th> <th>SHEET NO.</th> <th>TOTAL SHEETS</th> </tr> <tr> <th>NO.</th> <th>DATE</th> <th>DESCRIPTION</th> <th></th> <th></th> <th></th> <th></th> </tr> </thead> <tbody> <tr> <td></td> <td></td> <td></td> <td>SRTS-0987(007) ~ 67555</td> <td>2013</td> <td>J1</td> <td>29</td> </tr> </tbody> </table>		REVISIONS			PROJECT DESIGNATION	YEAR	SHEET NO.	TOTAL SHEETS	NO.	DATE	DESCRIPTION								SRTS-0987(007) ~ 67555	2013	J1	29		
REVISIONS			PROJECT DESIGNATION	YEAR	SHEET NO.	TOTAL SHEETS																		
NO.	DATE	DESCRIPTION																						
			SRTS-0987(007) ~ 67555	2013	J1	29																		

1-7-14

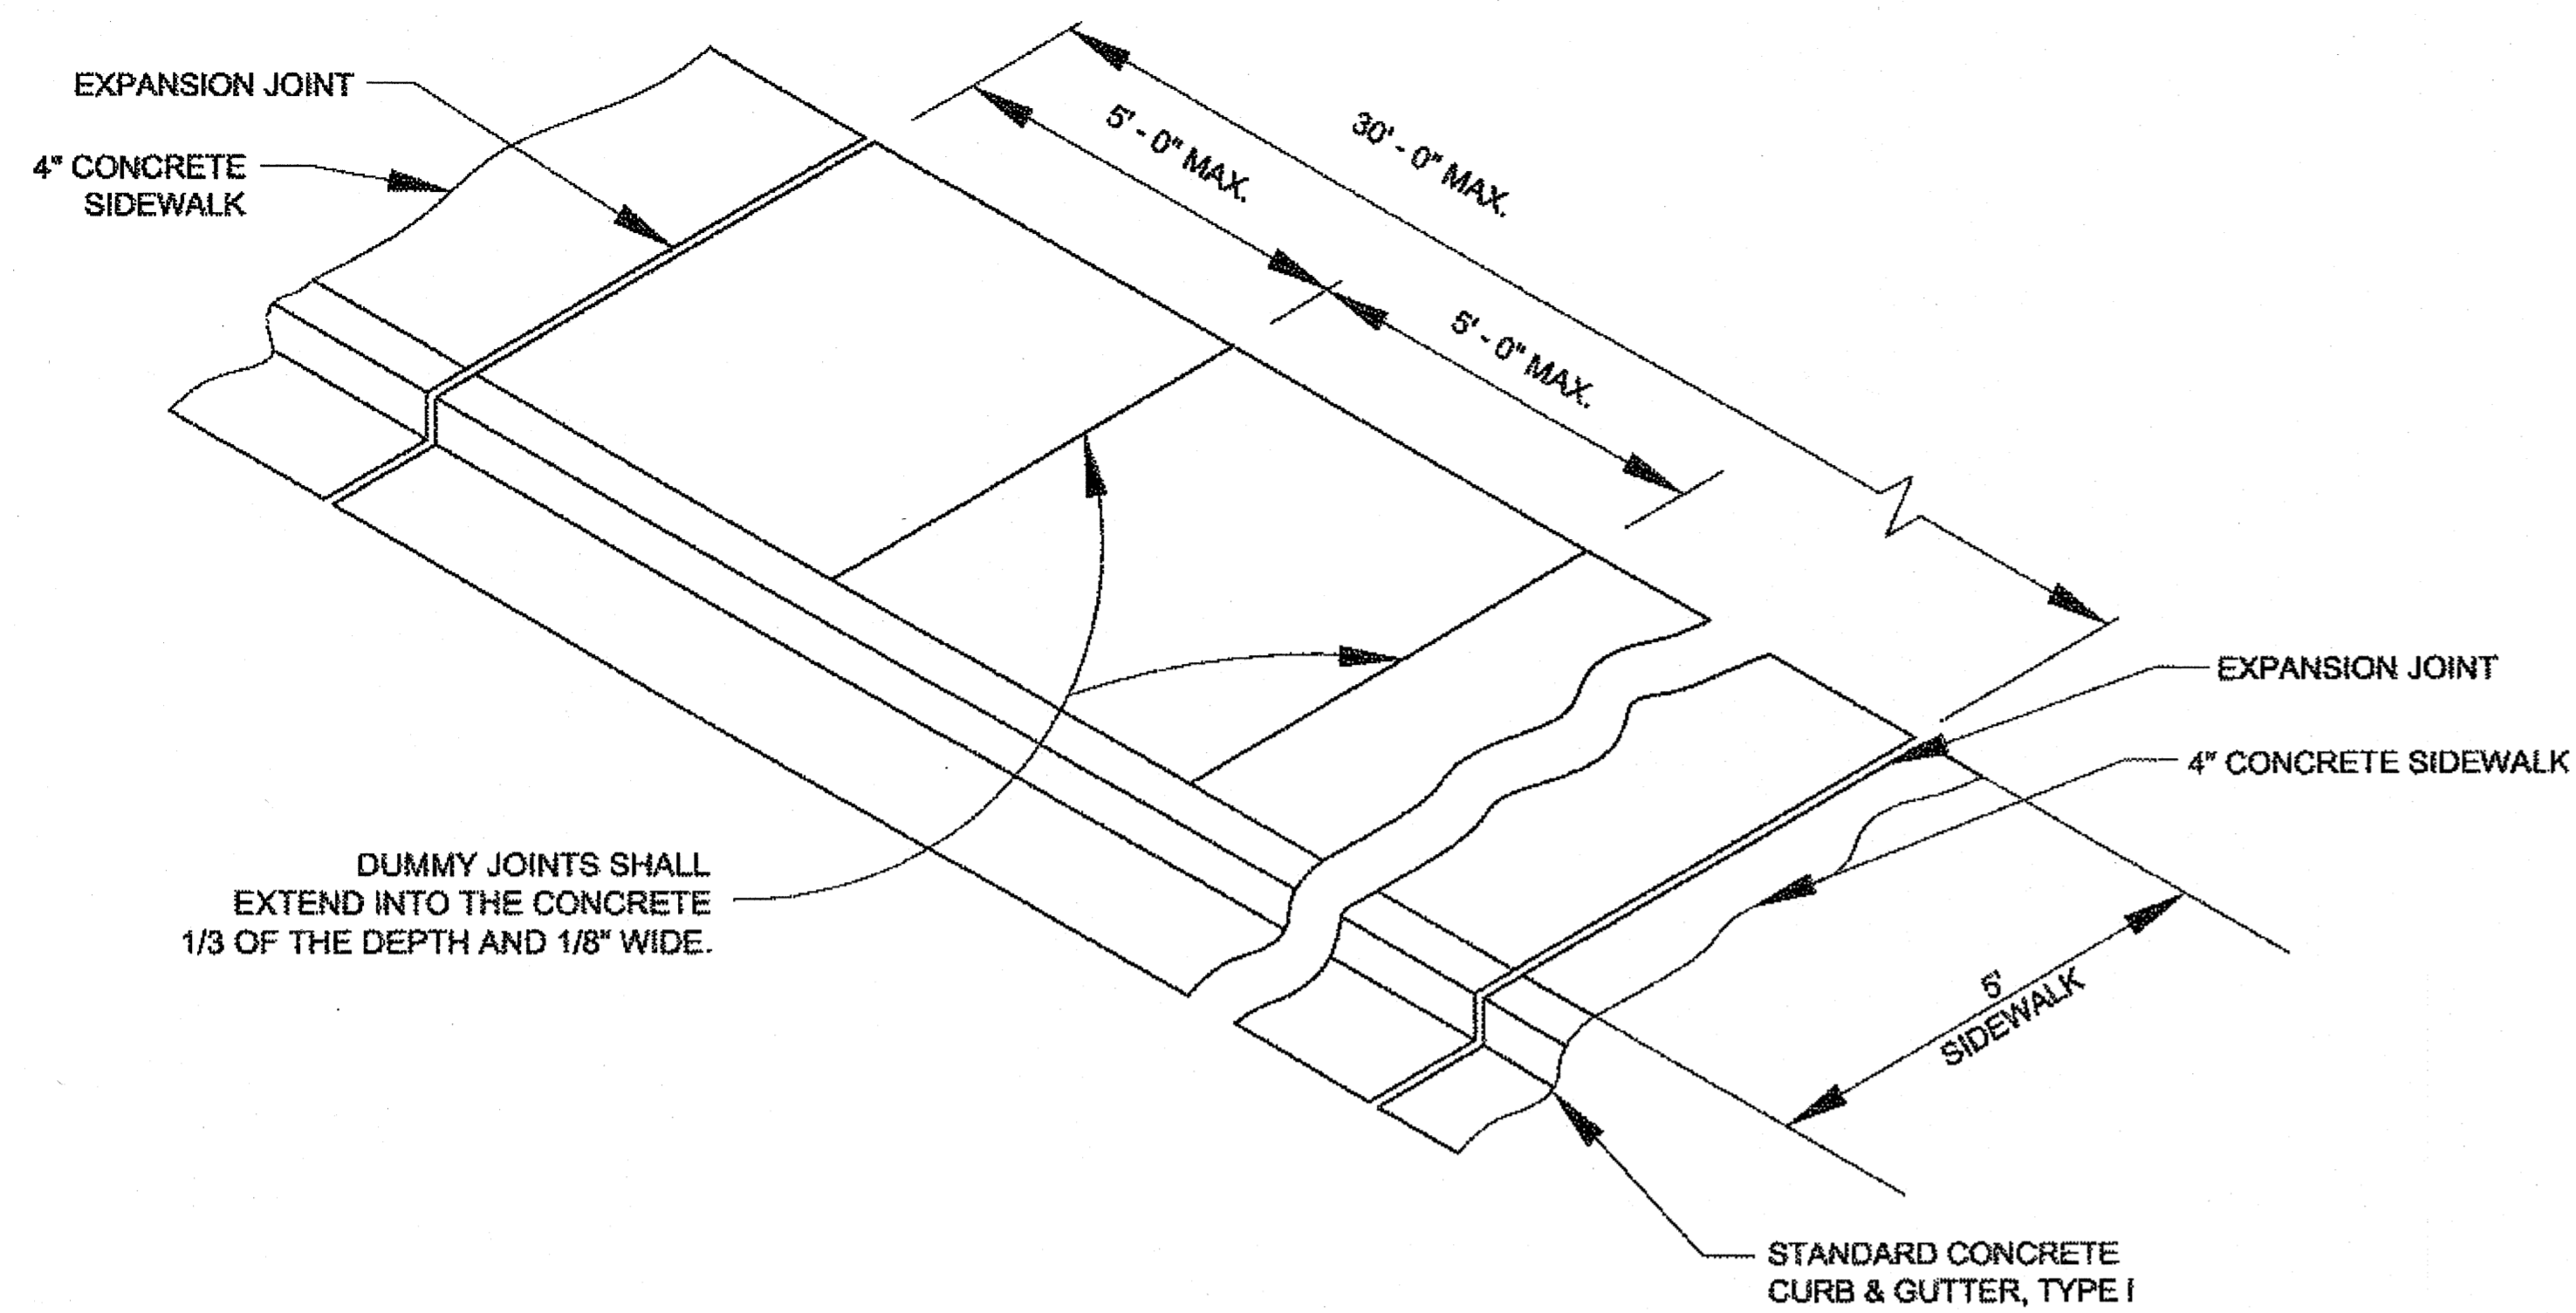


TYPICAL SIDEWALK, CURB & GUTTER DETAIL

N.T.S.

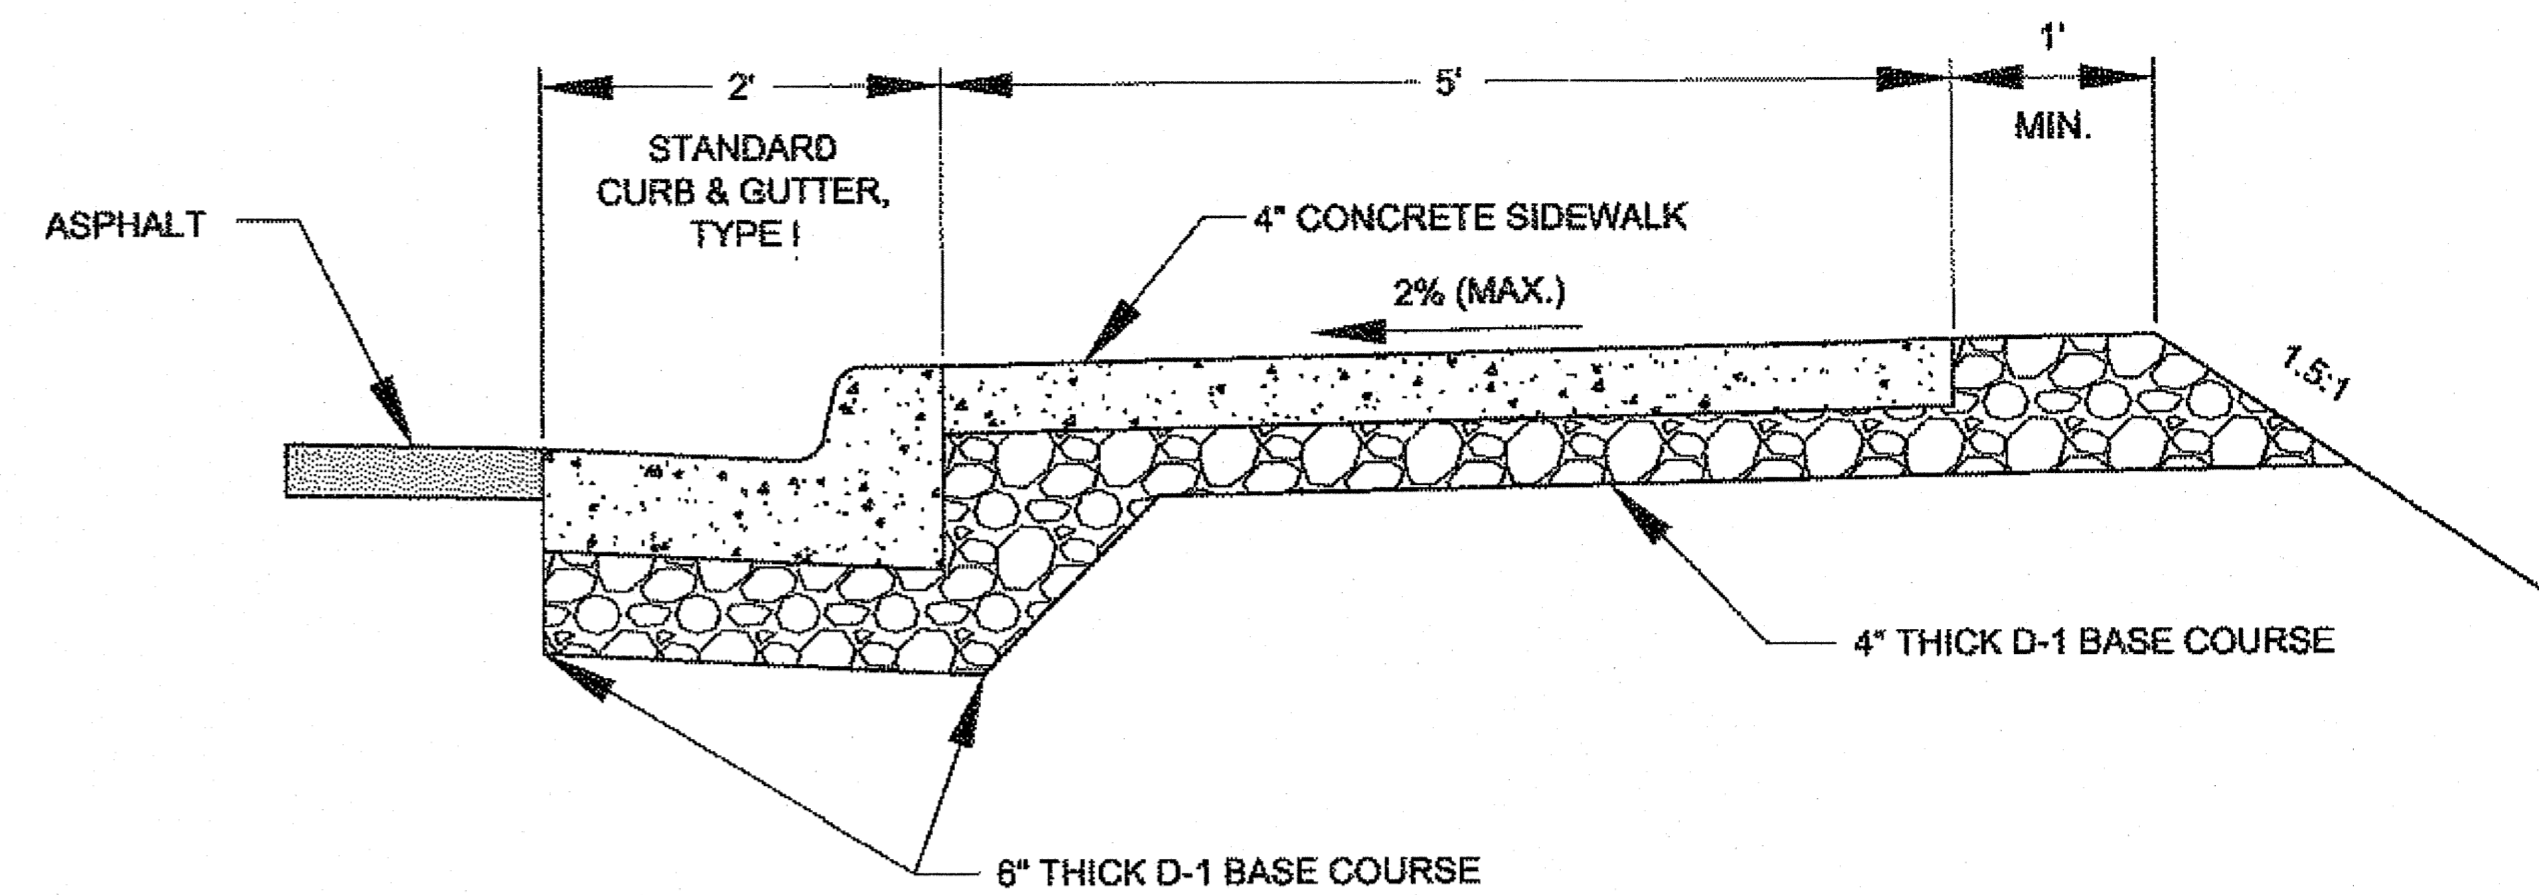


SIDEWALK DETAIL

N.T.S.

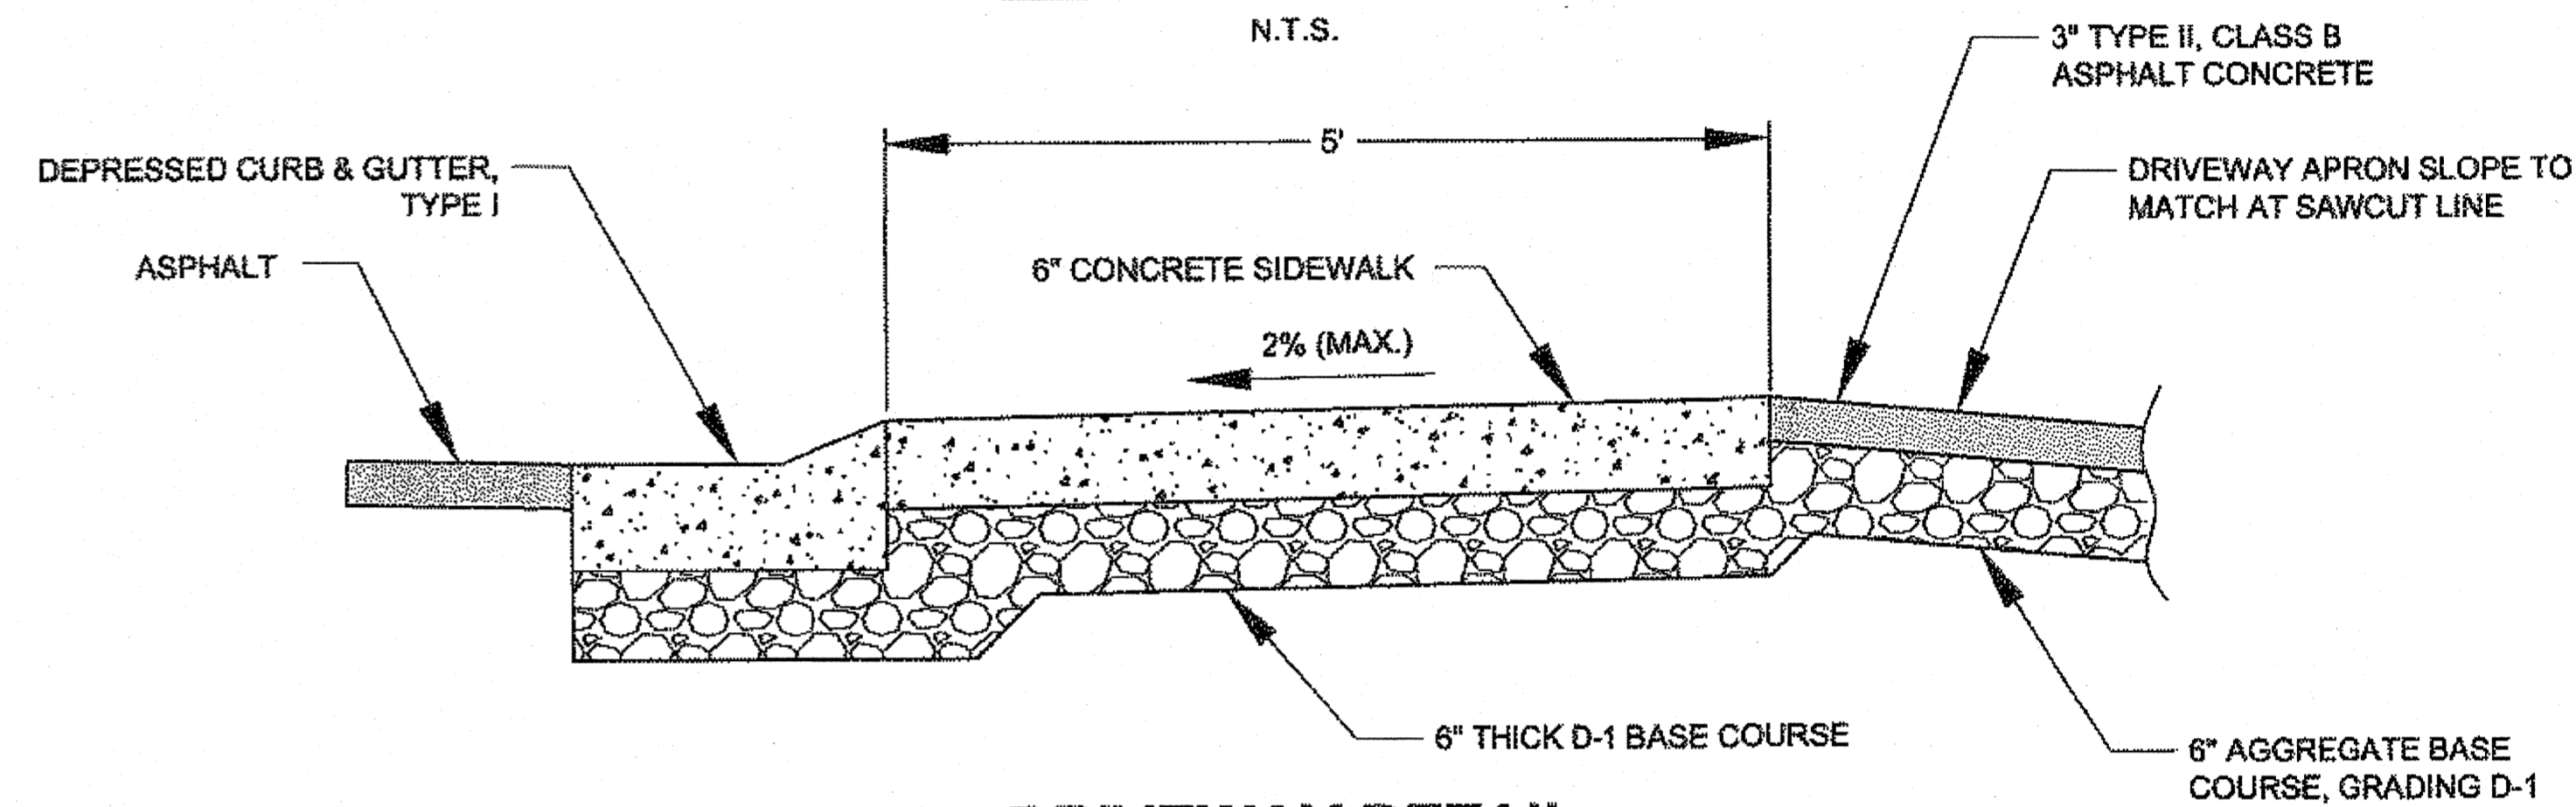


DRIVEWAY DETAIL

N.T.S.

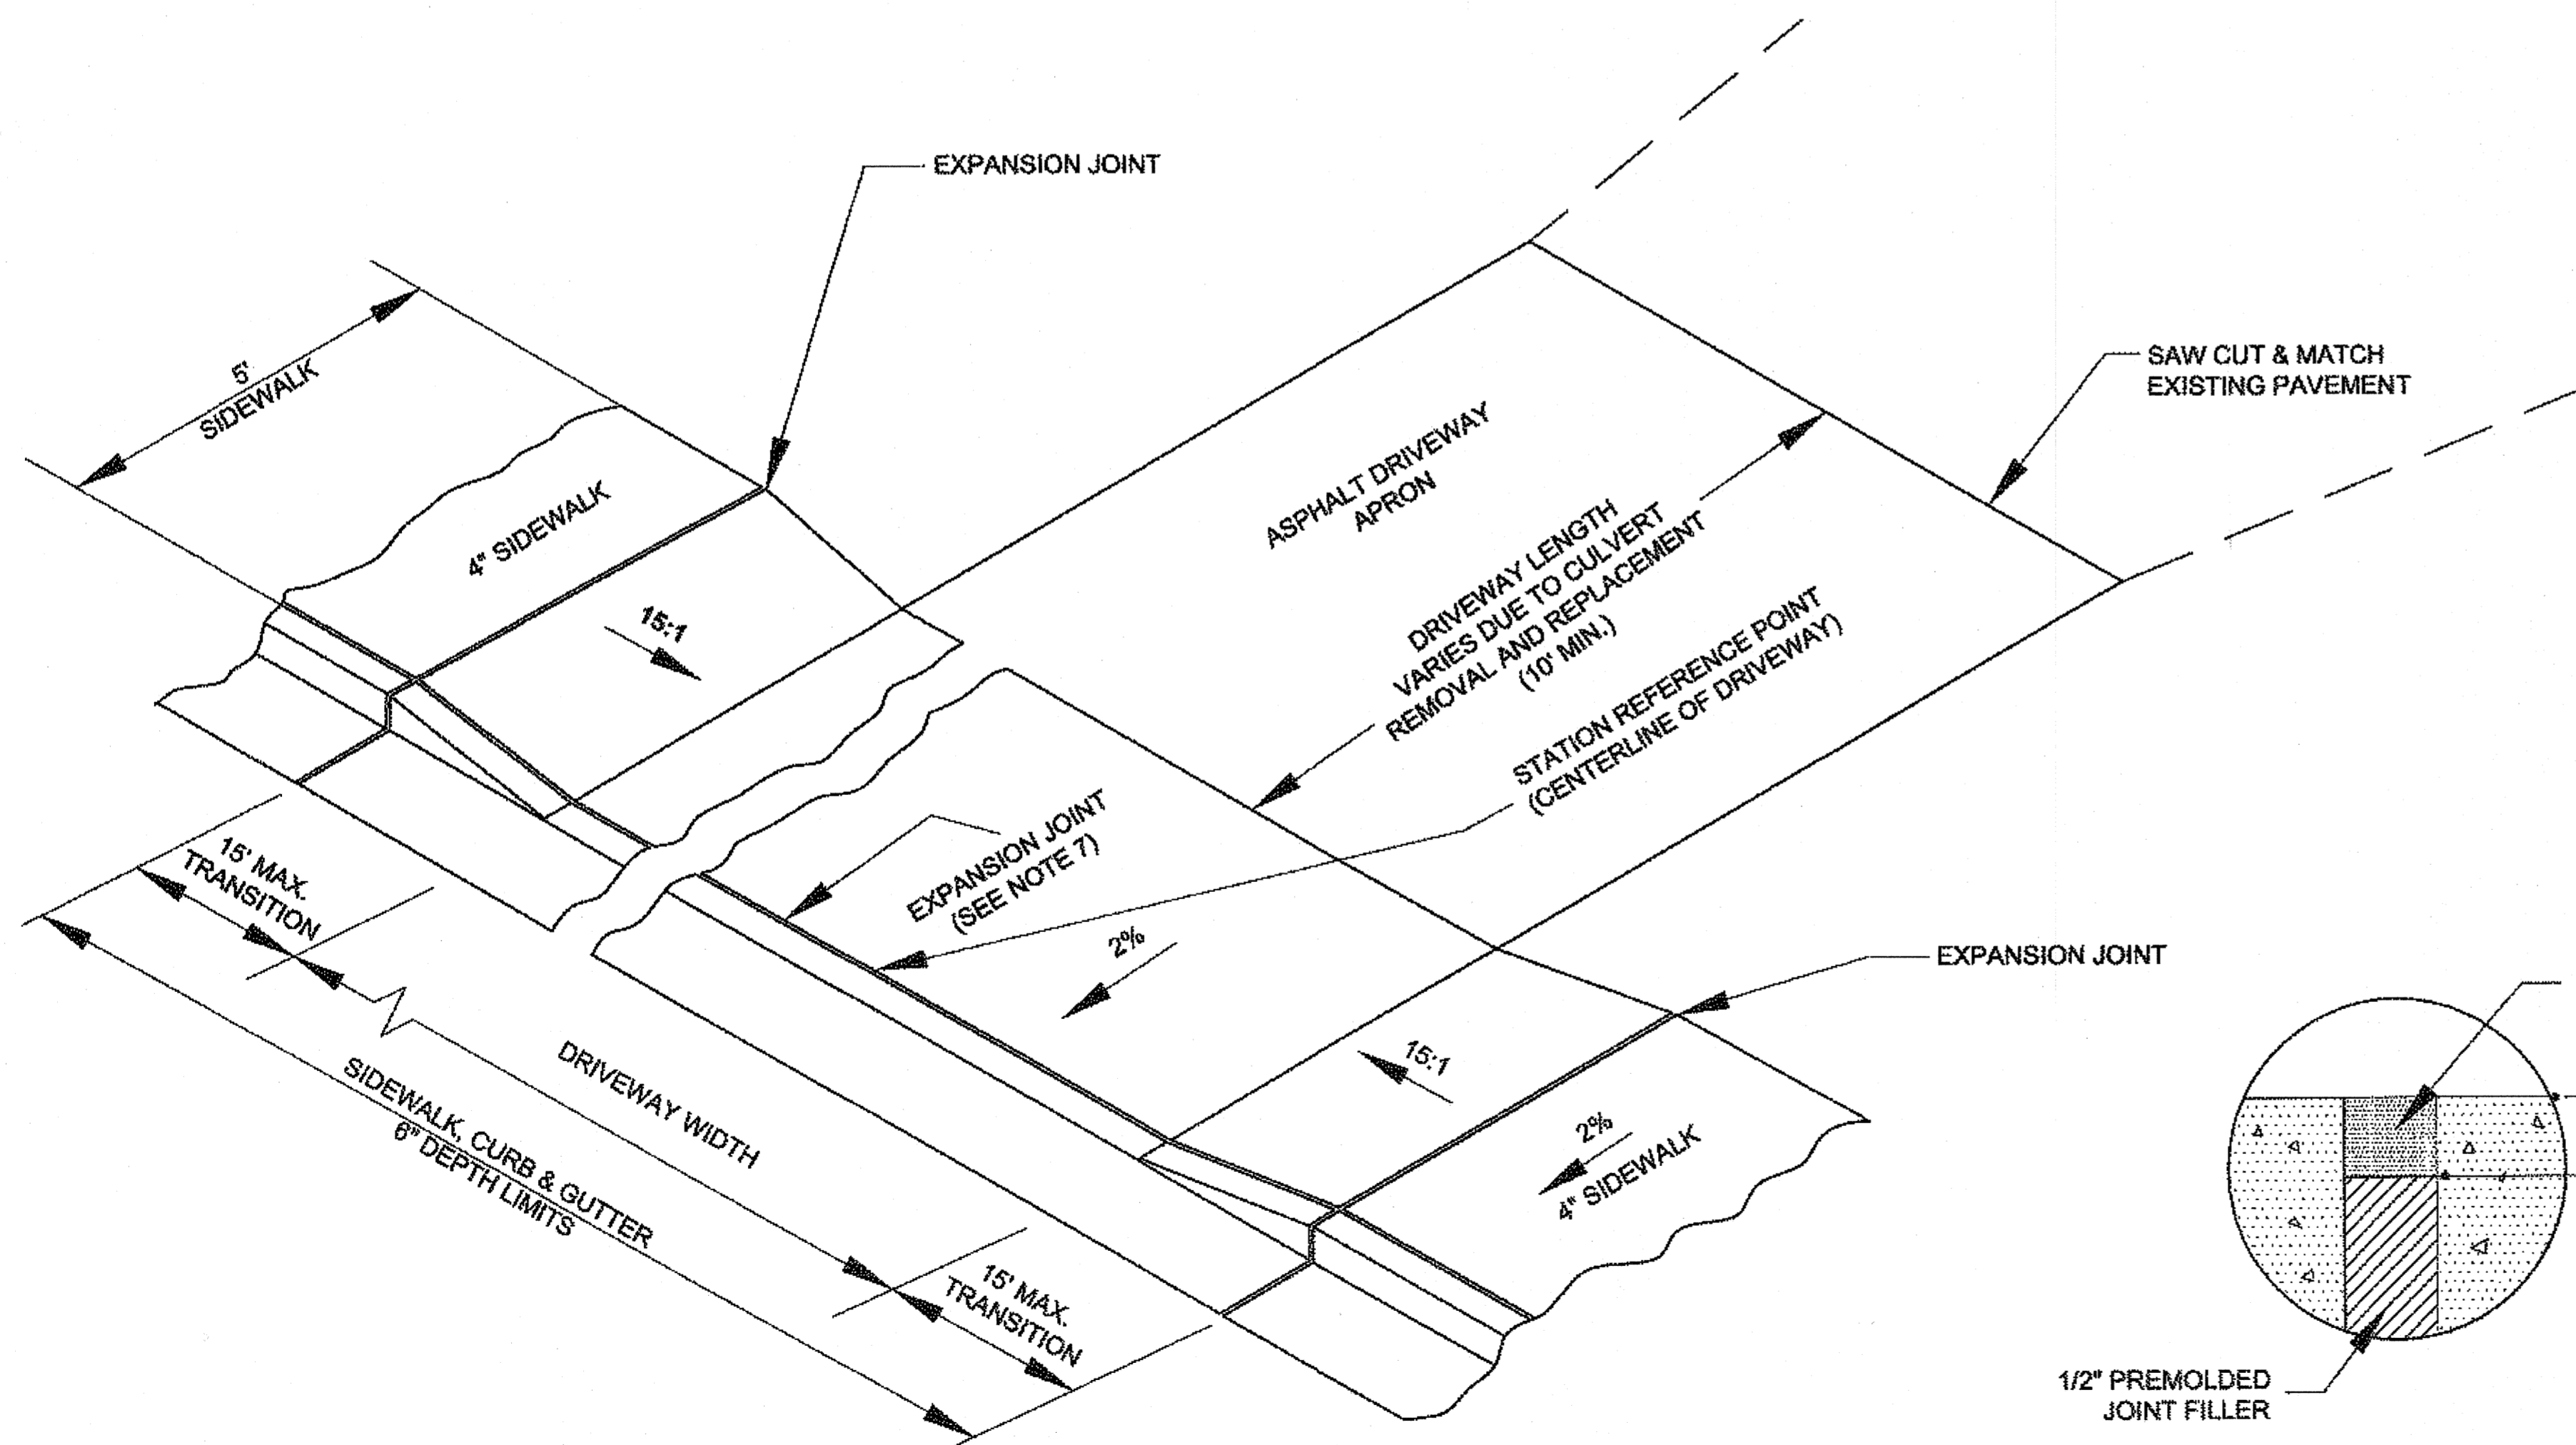

DRIVEWAY RAMP DETAIL

N.T.S.

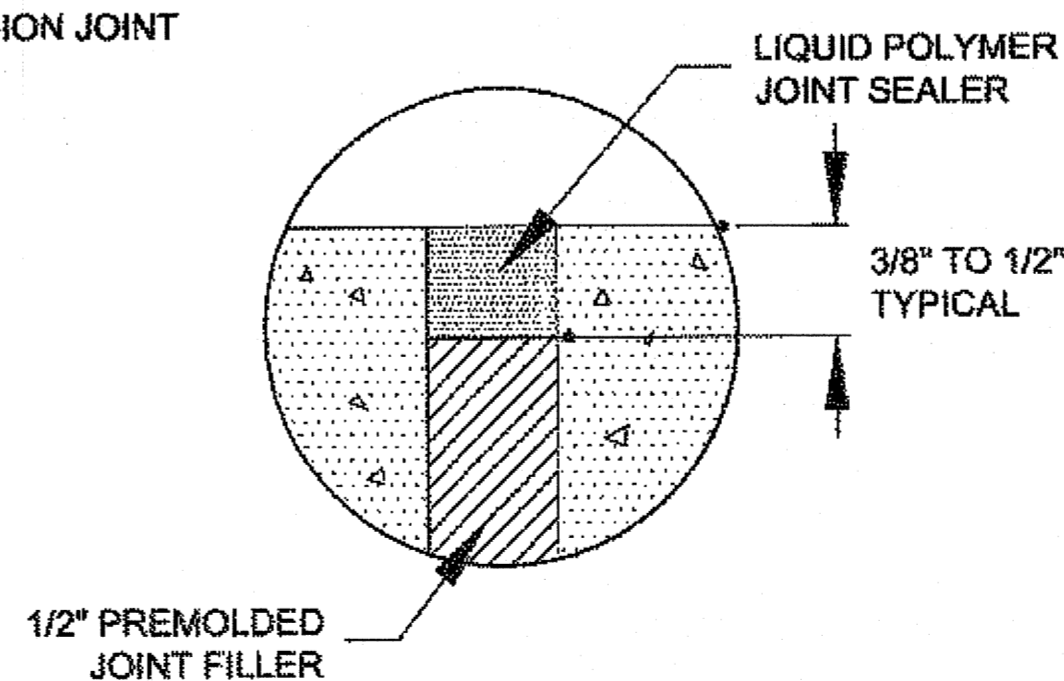

EXPANSION JOINT DETAIL

N.T.S.


SIDEWALK, CURB & GUTTER NOTES

1. CONCRETE SIDEWALKS, CURB & GUTTER EXPANSION JOINTS SHALL BE PLACED IMMEDIATELY PRECEDING AND FOLLOWING ALL CURB AND SIDEWALK CUTS. THEREAFTER, THEY SHALL BE PLACED AT 30' MAXIMUM.
2. CONCRETE SIDEWALKS DUMMY JOINTS SHALL EXTEND INTO CONCRETE 1/3 THE DEPTH AND 1/8 WIDE AT 5' MAXIMUM INTERVALS BETWEEN EXPANSION JOINTS. FOR CURBS, DUMMY JOINTS SHALL HAVE 10' MAXIMUM SPACING.
3. ALL JOINTS AND SEAMS SHALL BE EDGED.
4. STEEL TROWELING FINISH REQUIRED PRIOR TO BROOM FINISHING ON ALL SURFACES.
5. CURING COMPOUND SHALL BE APPLIED TO THE CONCRETE. APPLICATION SHALL CONFORM TO THE MANUFACTURER'S RECOMMENDATIONS.
6. CURB AND GUTTER CONSTRUCTION SHALL MAINTAIN EXISTING FLOW LINE.
7. EXPANSION JOINT REQUIRED BETWEEN SIDEWALK AND DRIVEWAY, AND BETWEEN SIDEWALK AND CURB.
8. ALL CONCRETE WITHIN THE CURB CUT LIMITS FOR DRIVEWAYS SHALL BE 6" THICK AND SHALL BE POURED ON A 6" D-1 BASE COURSE COMPACTED TO 95% OF ITS MAXIMUM DENSITY.
9. FOR RAMPS, WHEN "CHASING GRADE", RAMP LENGTH NEED NOT EXCEED 15', BUT SLOPE MUST BE UNIFORM.

DO NOT SCALE FROM THESE DRAWINGS USE DIMENSIONS


CHECKED BY: K. KARPSTEIN 		STATE OF ALASKA DEPARTMENT OF TRANSPORTATION & PUBLIC FACILITIES SOUTHEAST REGION HNS-OLD HAINES HIGHWAY SIDEWALK 3rd AVENUE TO ALLEN ROAD PROJECT #67555	
DESIGNED BY: D. MULLINER DRAWN BY: D. MULLINER		MISC. DETAILS	
PATH: Q:\HNS\67555\ENDOU\G'S FILE\J DETAIL SHT.DWG TAB: J2 Wednesday, April 24, 2013 5:16:47 PM		MULLINER, OGOGLAS J (DOT)	
REVISIONS NO. DATE DESCRIPTION	PROJECT DESIGNATION SRTS-0987(007) ~ 67555	YEAR 2013	SHEET NO. J2
			TOTAL SHEETS 29

1-7-14

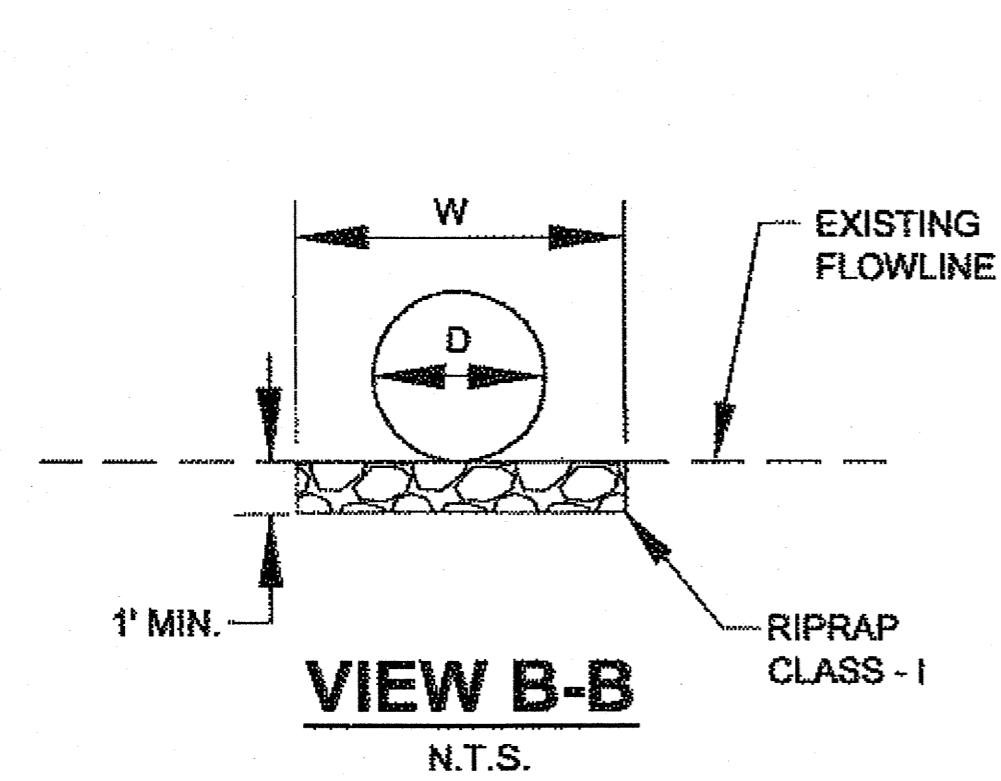







NOTES:

1. FOR CULVERT LOCATIONS AND REPLACEMENT SEE SHEET C-2.
2. CONSTRUCT RIPRAP APRON MINIMUM 3' BEYOND OUTLET UNLESS OTHERWISE SHOWN ON PLANS.

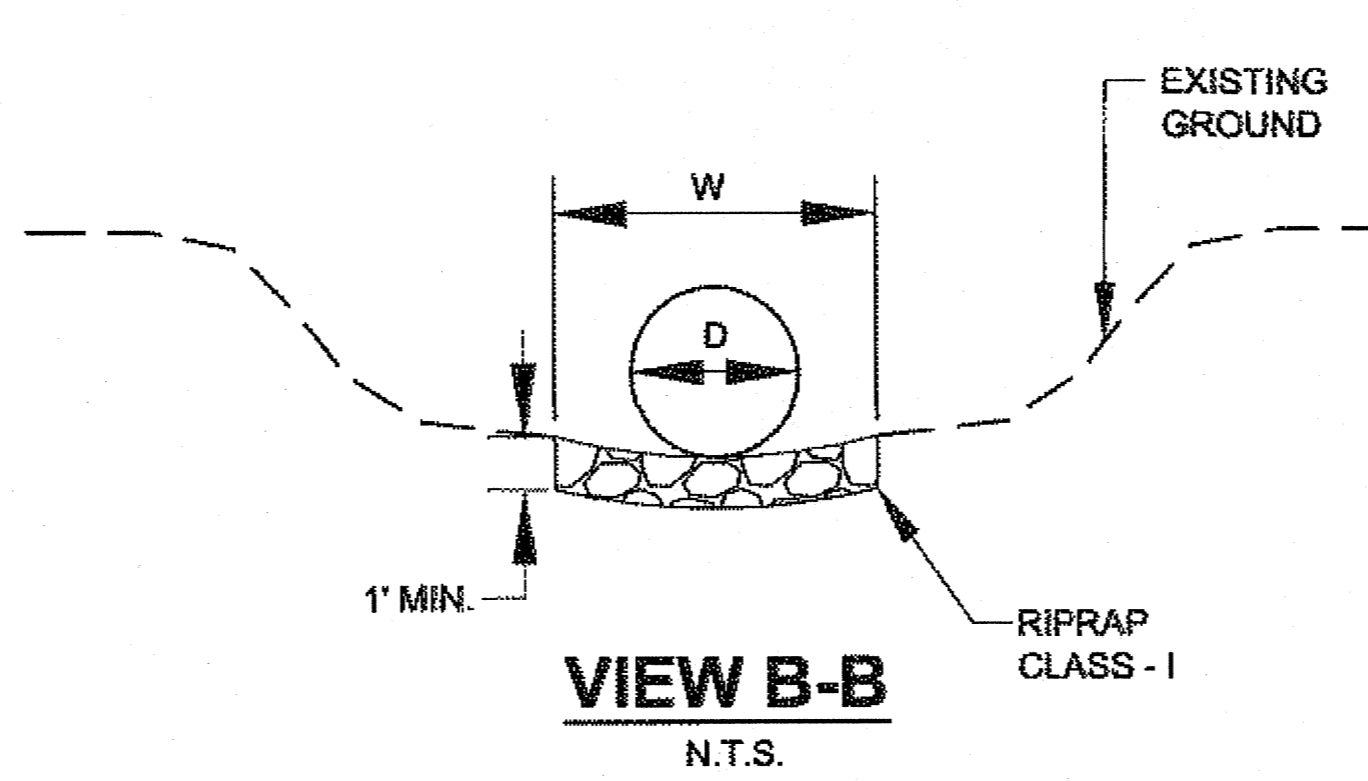

NOTES:

1. FOR CULVERT LOCATIONS AND REPLACEMENT SEE SHEET C-2.
2. CONSTRUCT RIPRAP APRON MINIMUM 5' BEYOND OUTLET UNLESS OTHERWISE SHOWN ON PLANS.

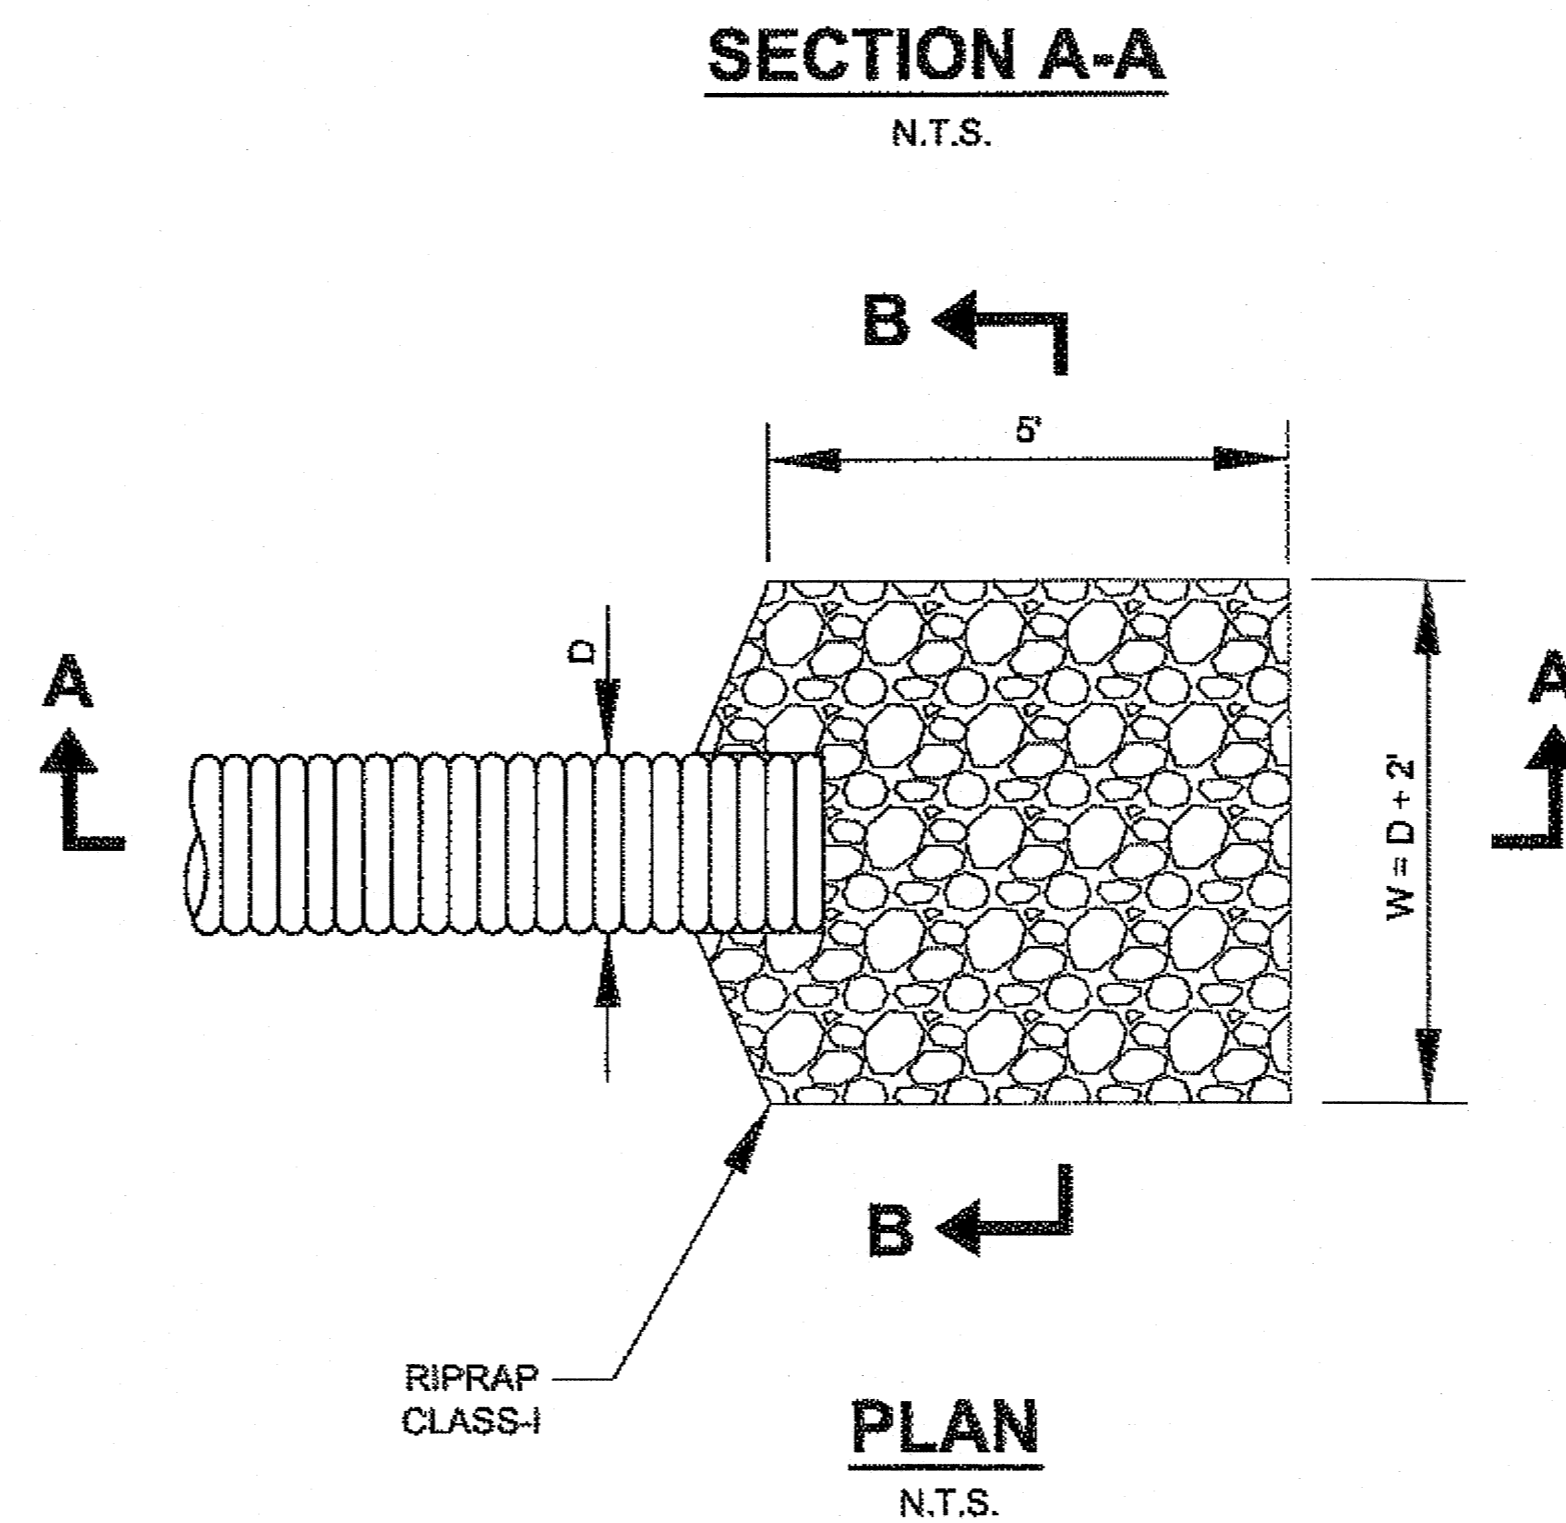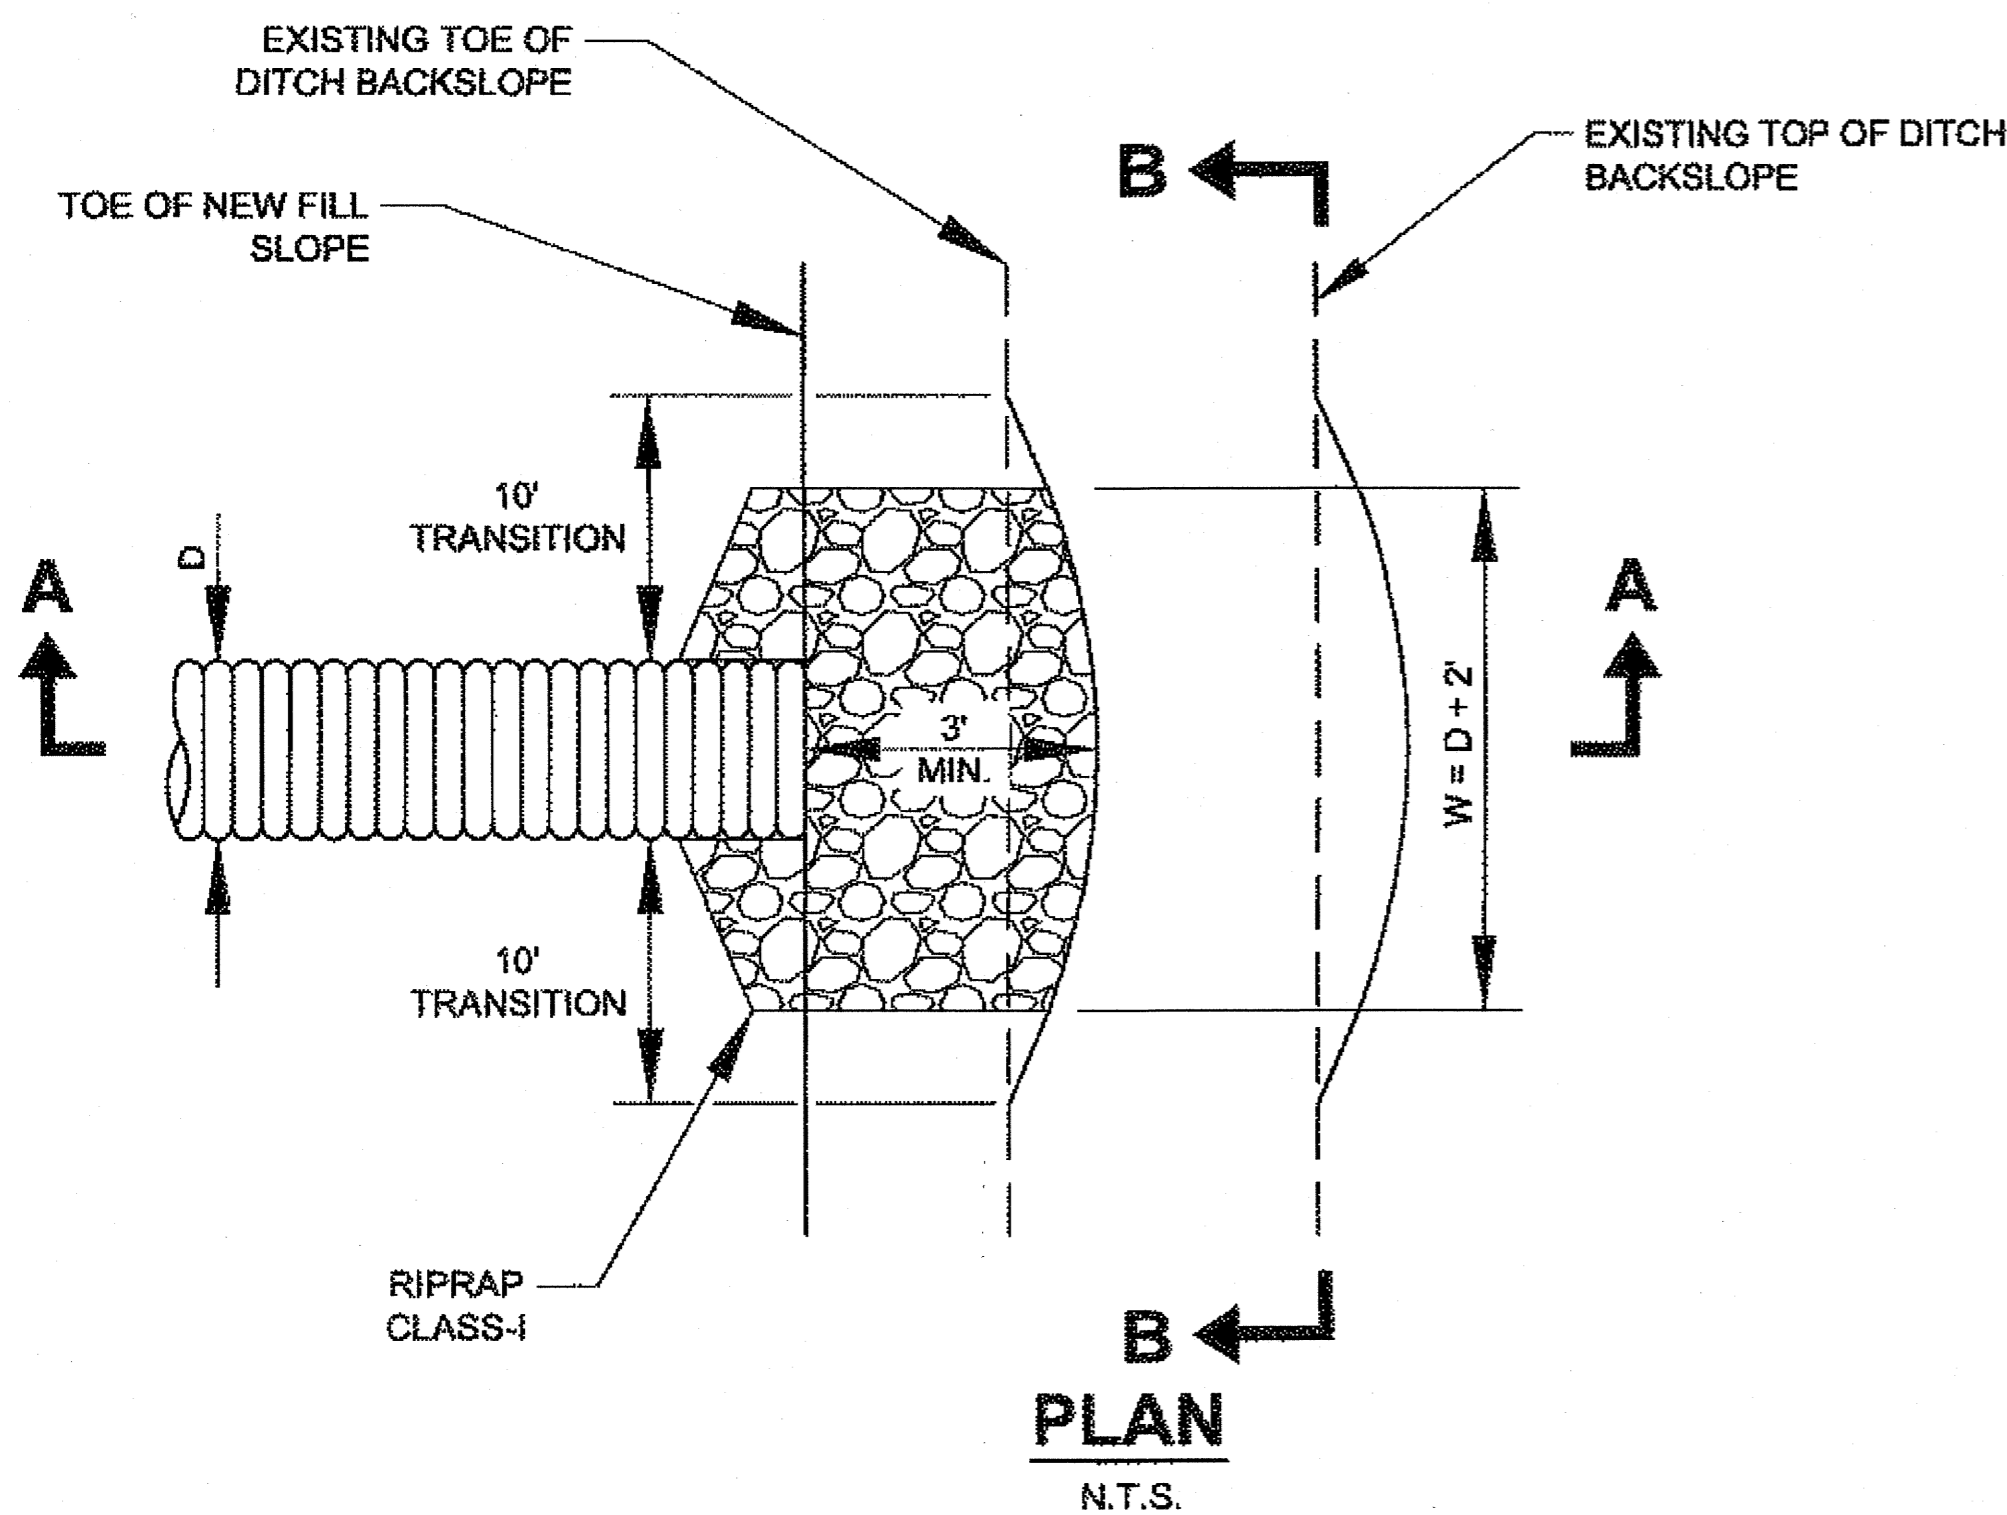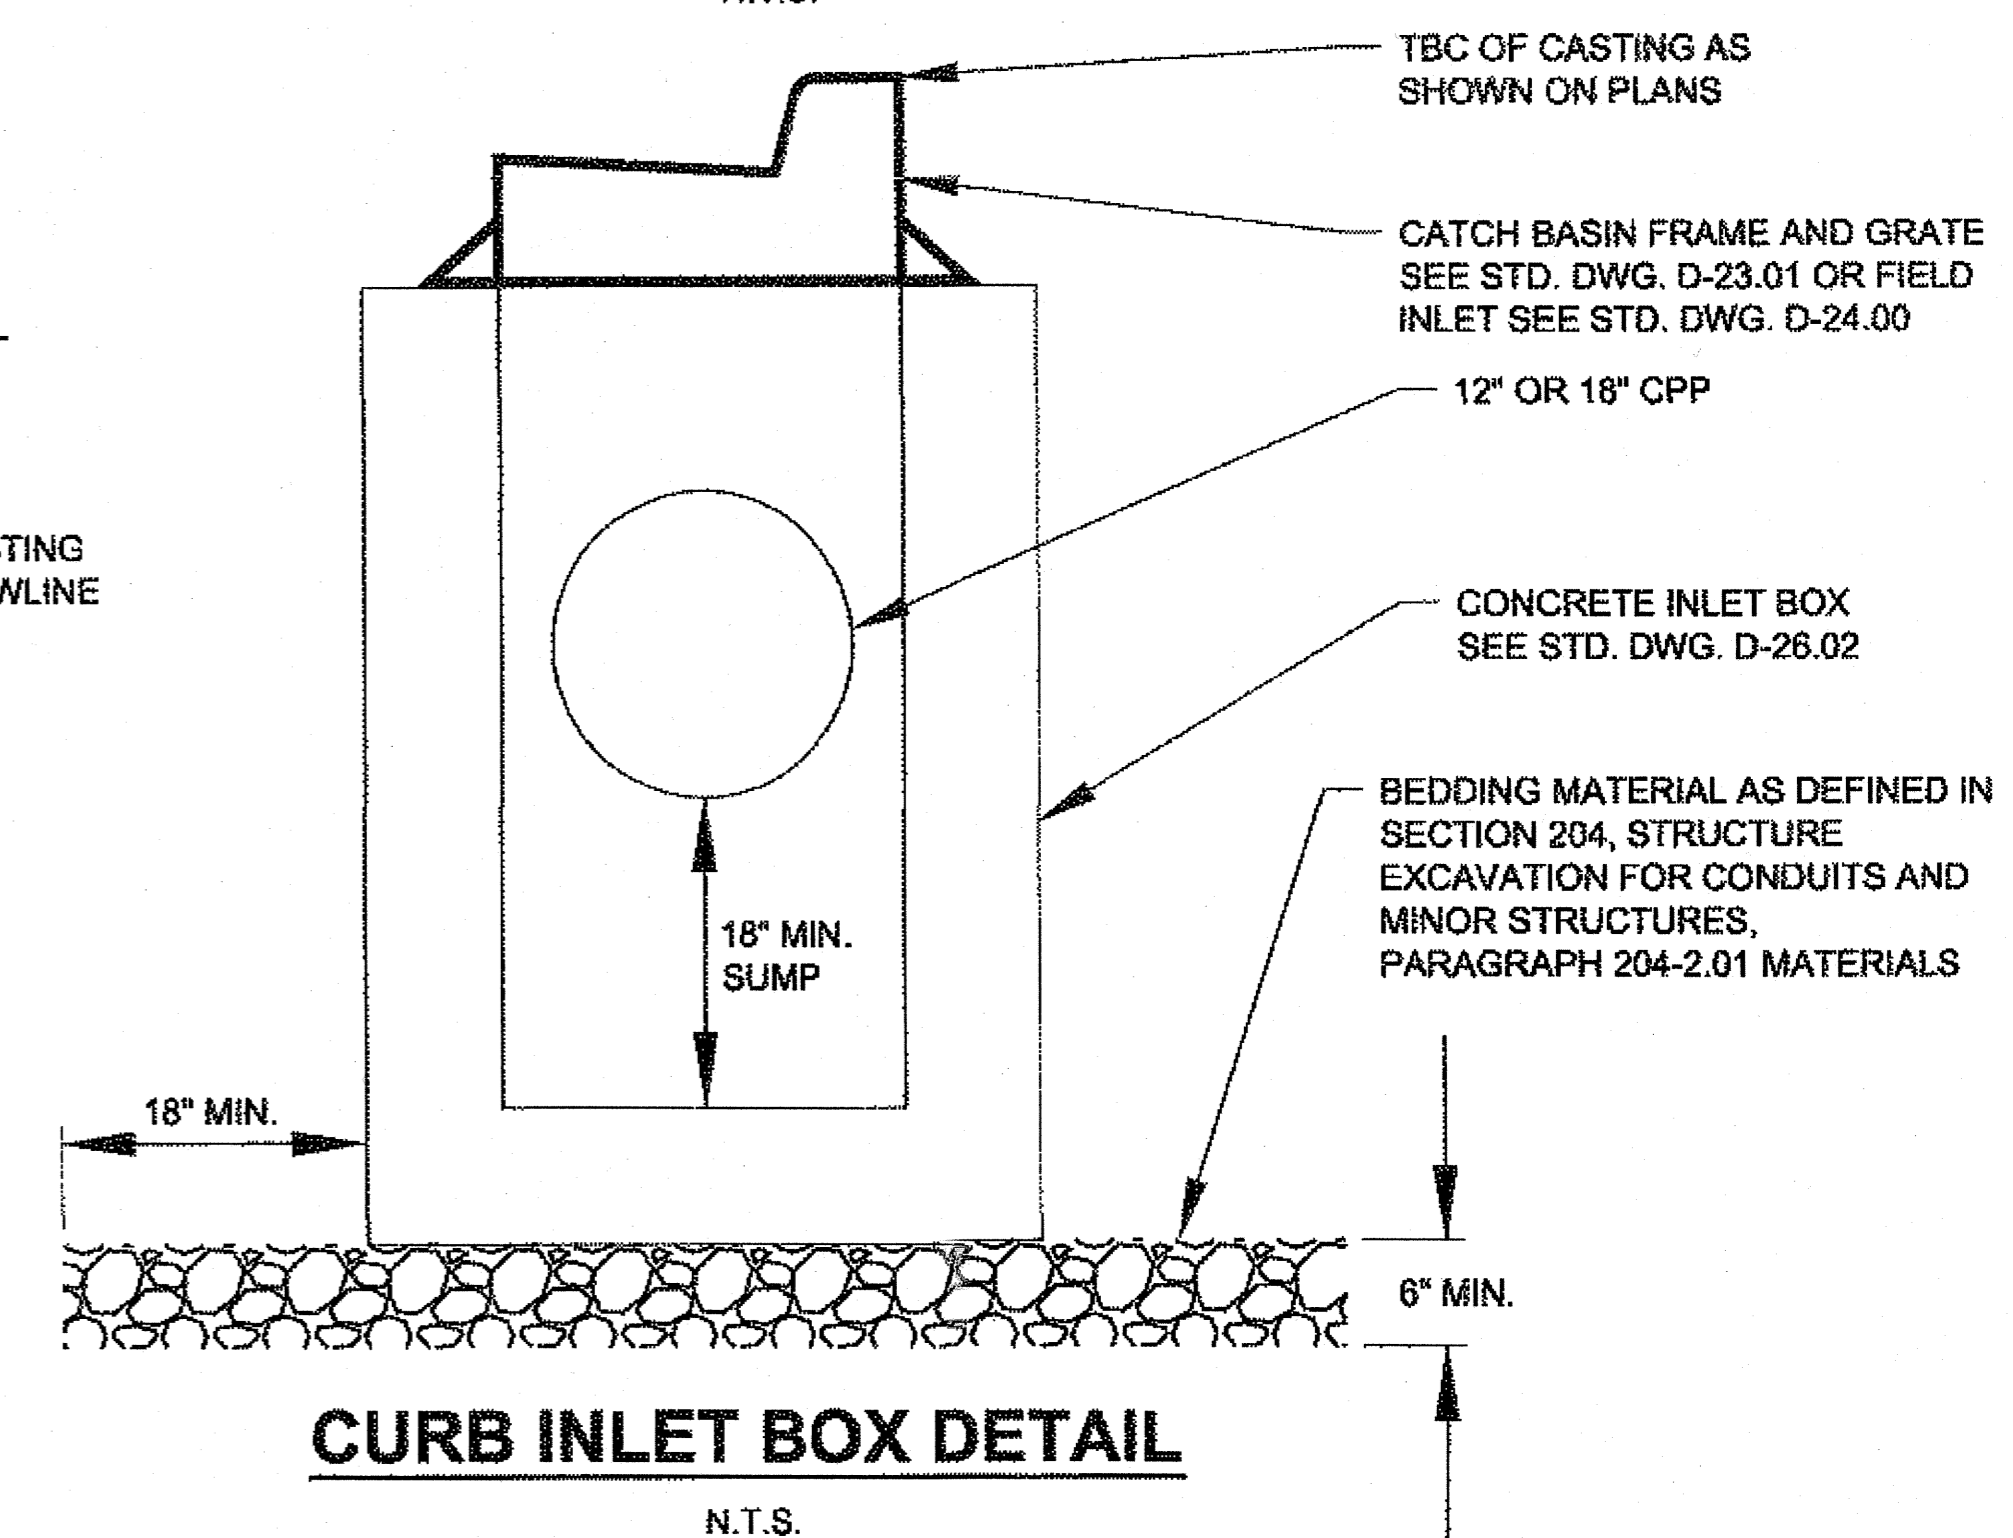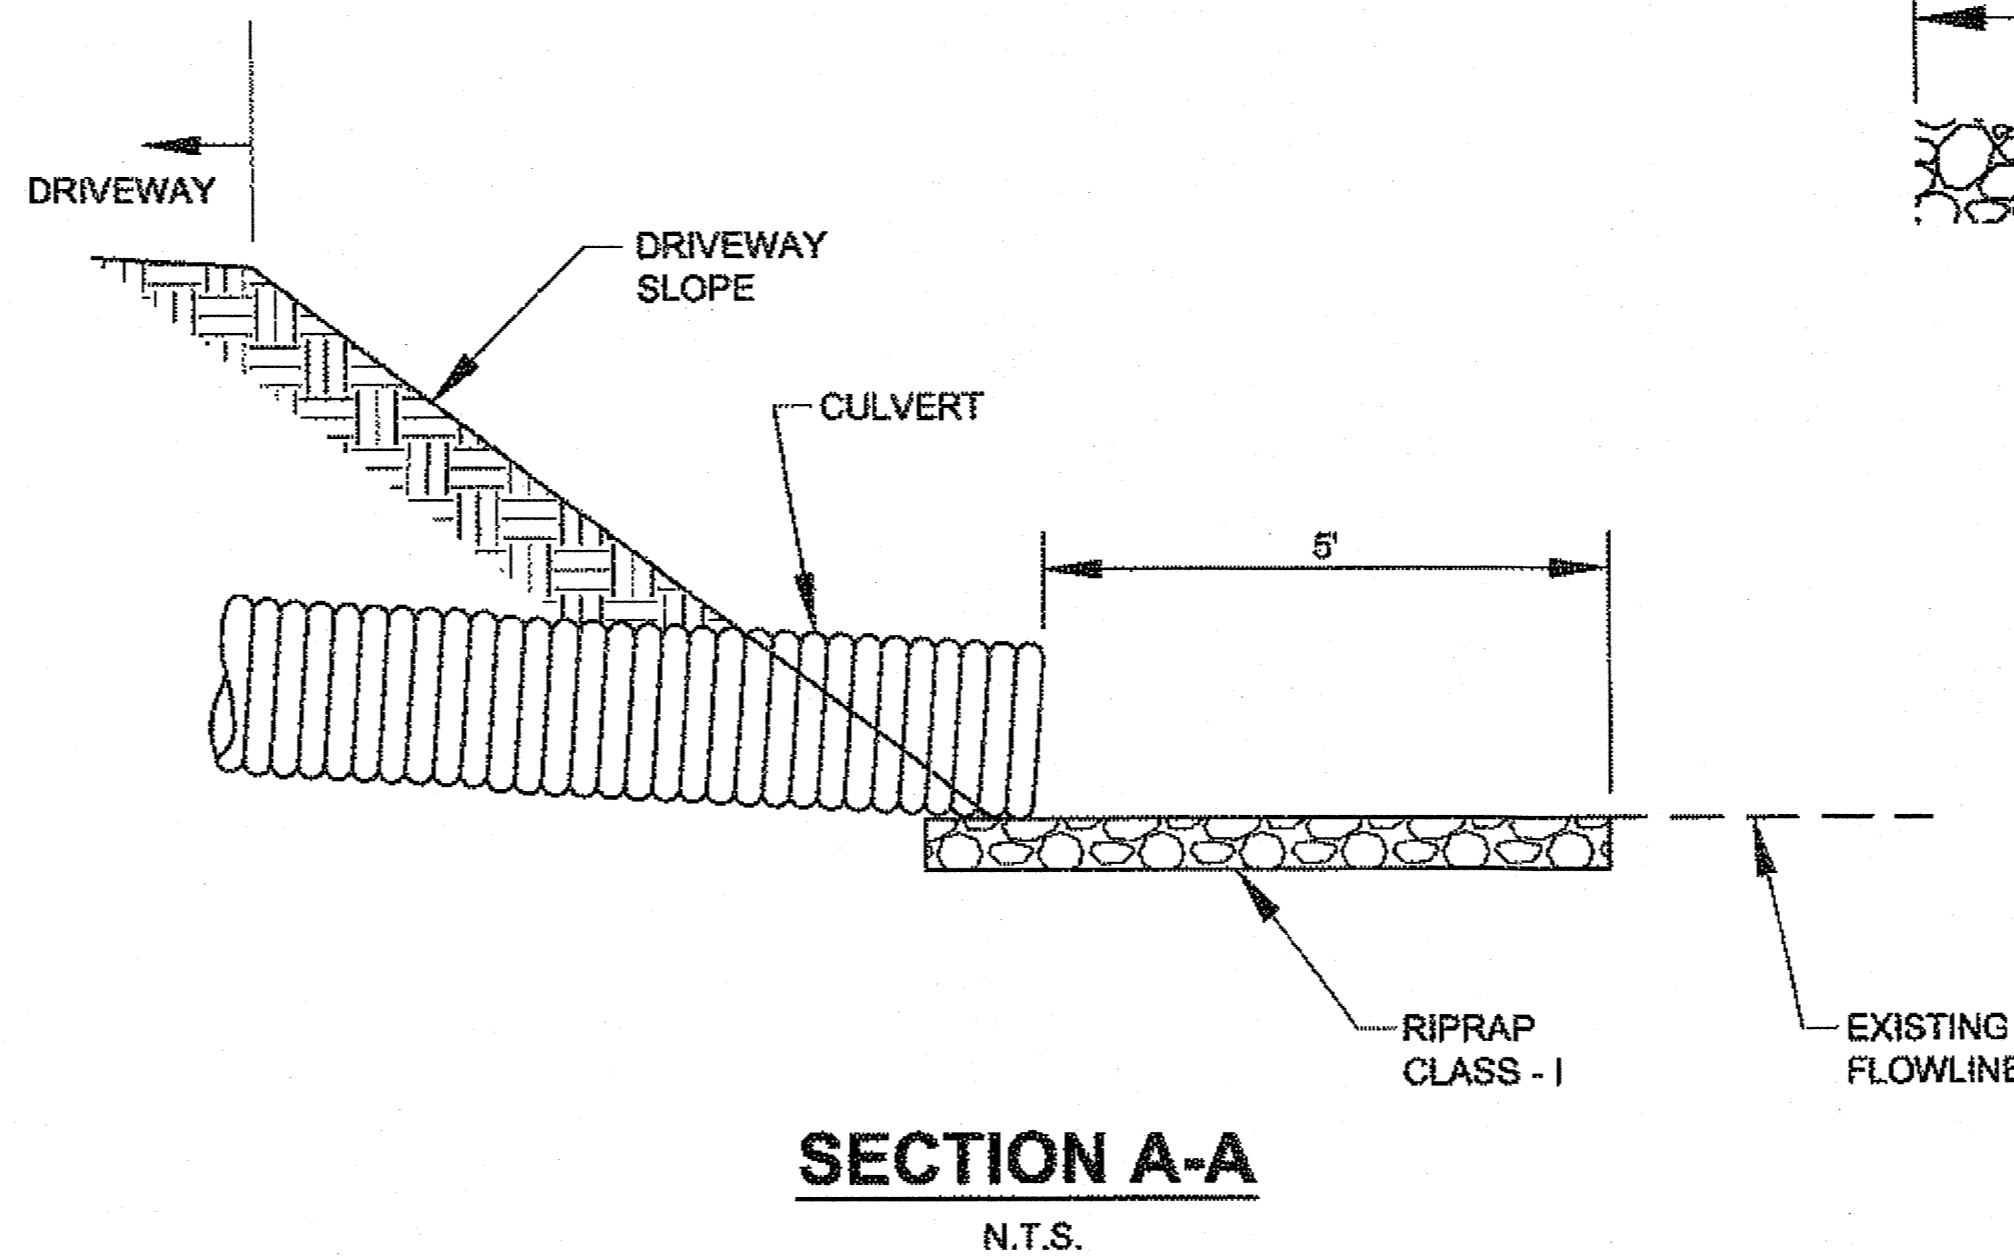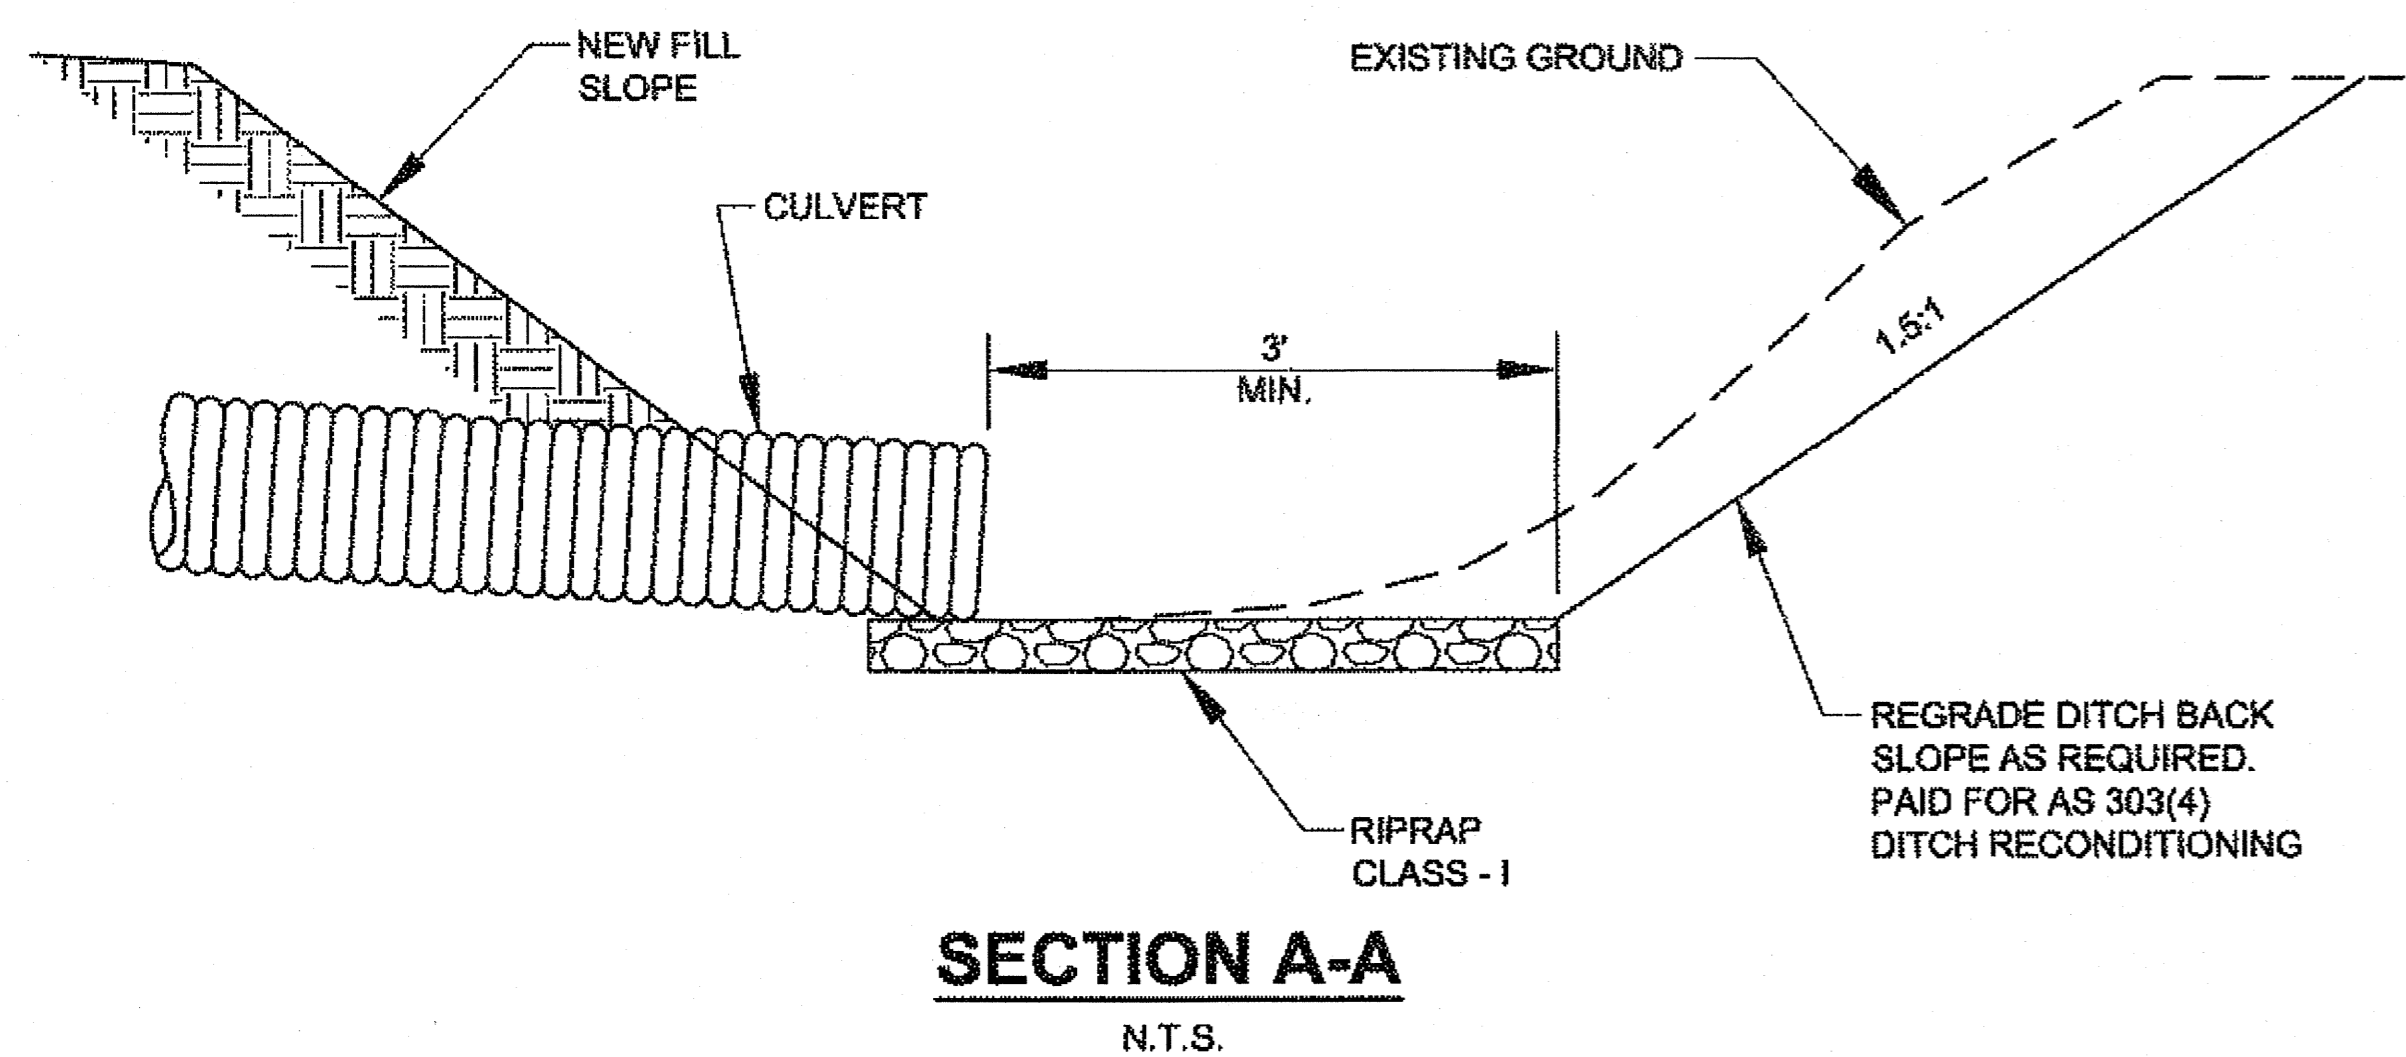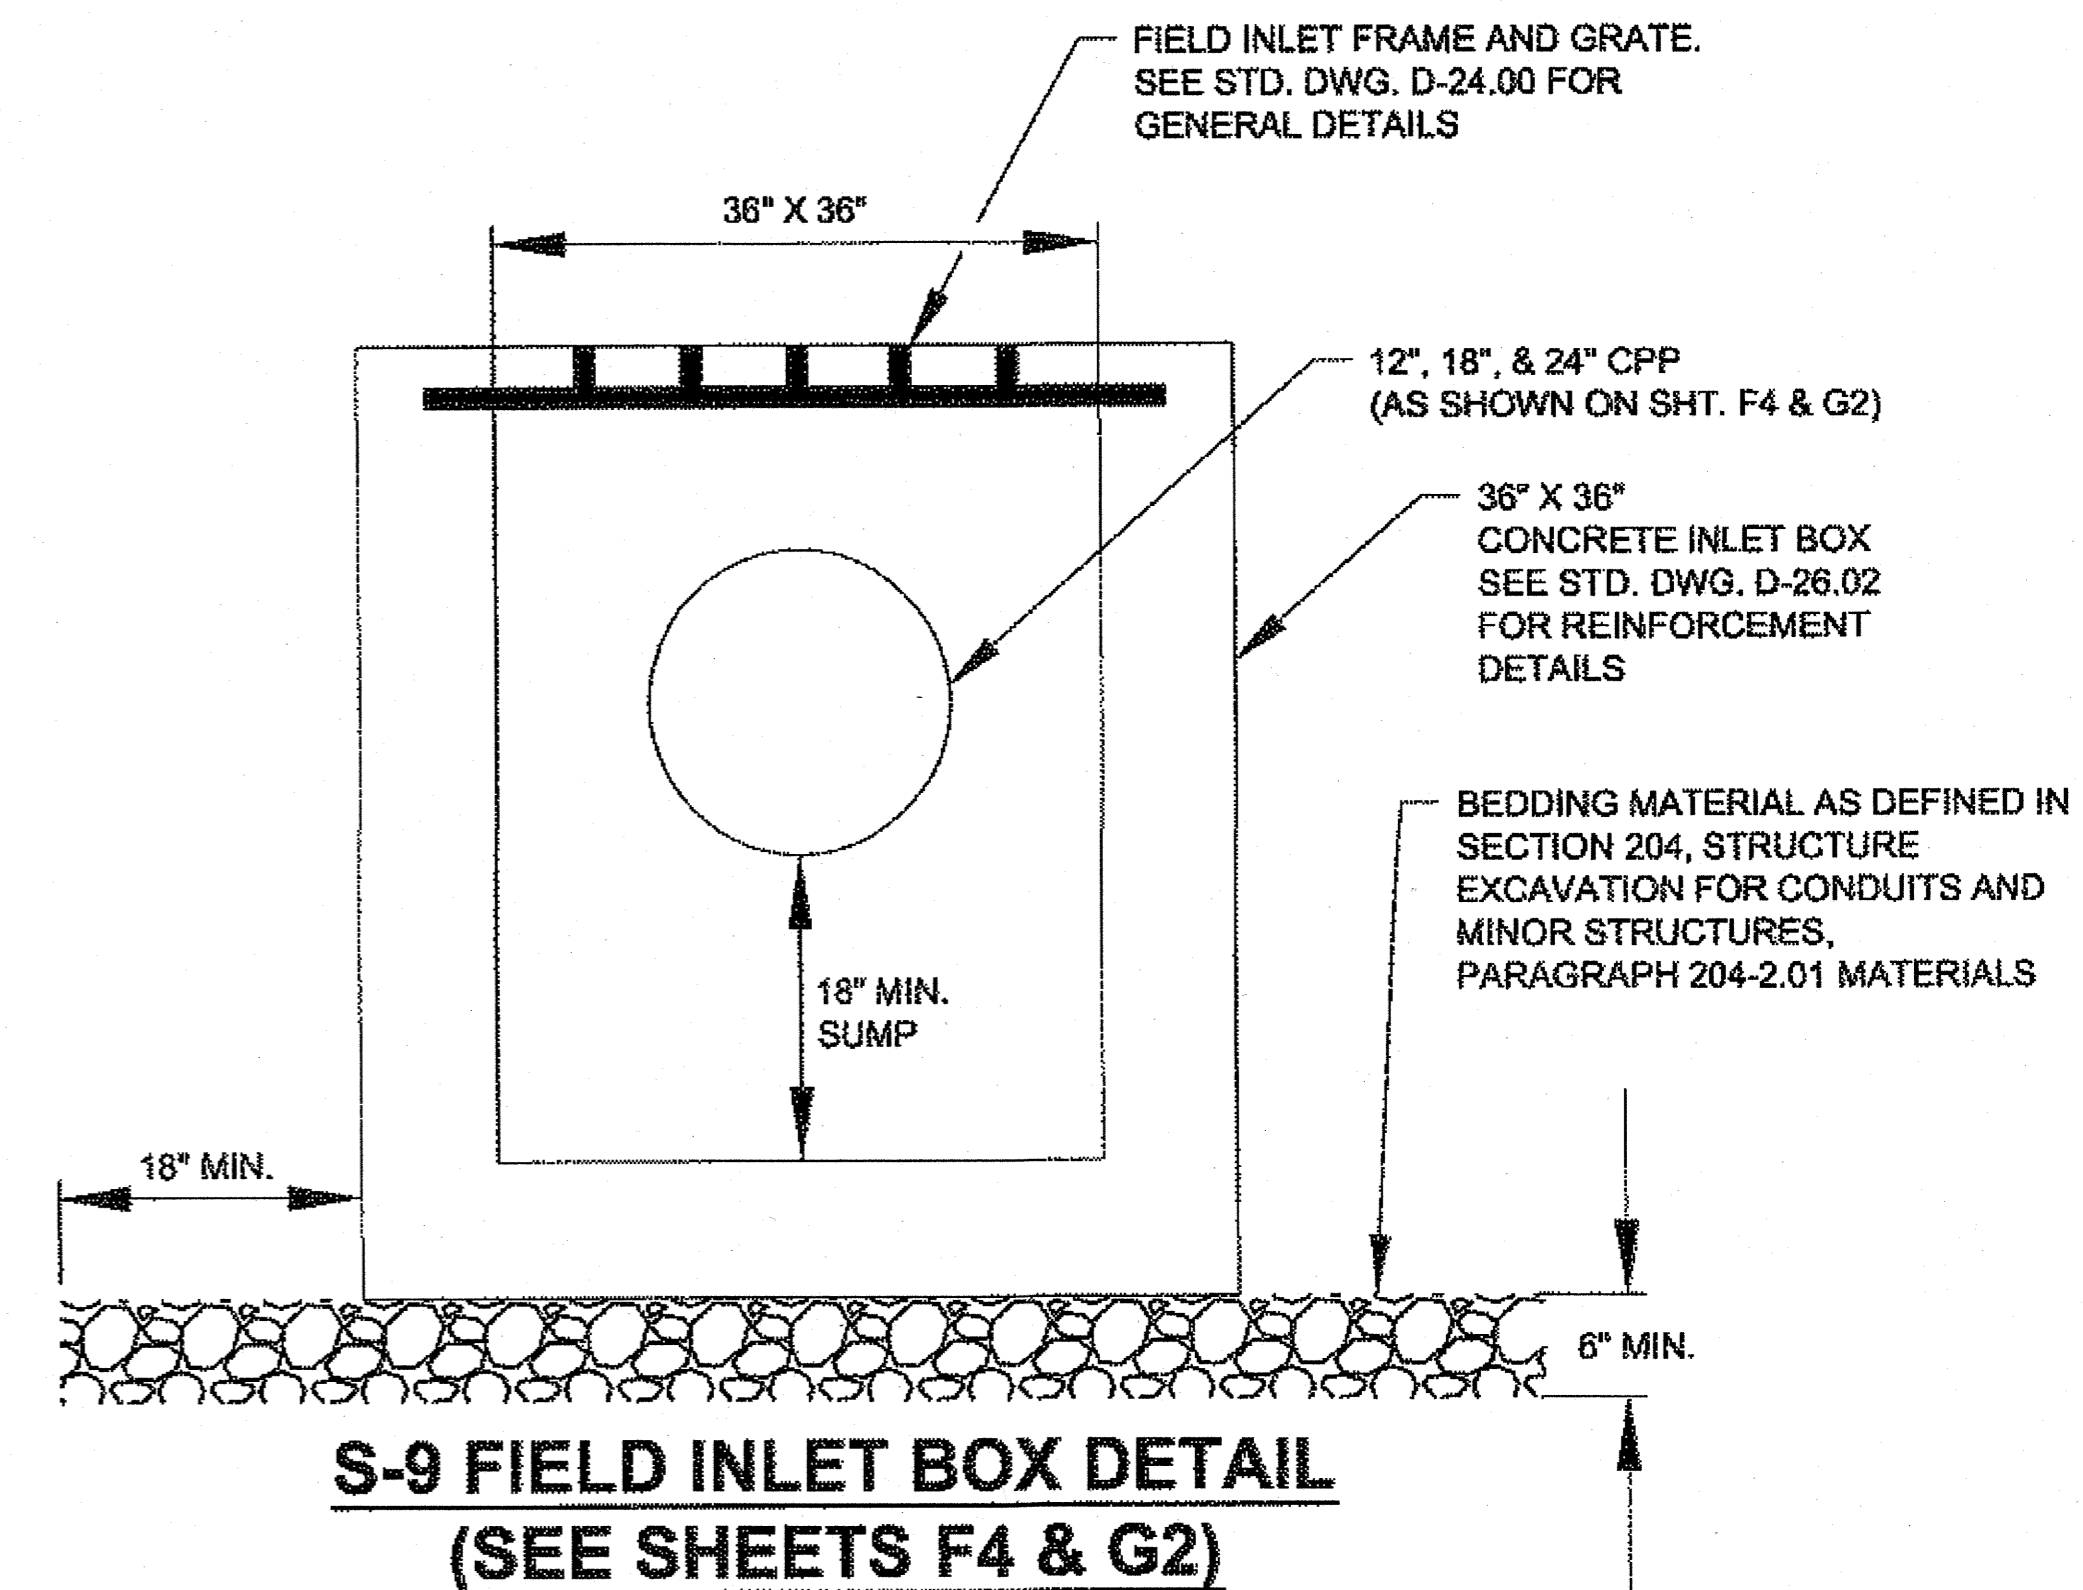


RIPRAP LINED OUTLET APRON DETAIL (INLET OUTFALLS)
N.T.S.

RIPRAP LINED OUTLET / INLET APRON DETAIL (DRIVEWAY CULVERTS)
N.T.S.

DO NOT SCALE FROM THESE DRAWINGS USE DIMENSIONS

CHECKED BY: K. KARPSTEIN		STATE OF ALASKA DEPARTMENT OF TRANSPORTATION & PUBLIC FACILITIES SOUTHEAST REGION	
DESIGNED BY: D. MULLINER		HNS-OLD HAINES HIGHWAY SIDEWALK 3RD AVENUE TO ALLEN ROAD PROJECT #67555	
DRAWN BY: D. MULLINER		MISC. DETAILS	
PATH: Q:\HNS\67555\EN\DOUG'S FILE\DETAIL SHT.DWG		MULLINER, DOUGLAS J (DOT)	
TAB: J3 Wednesday, April 24, 2013 11:02:47 AM			
REVISIONS		PROJECT DESIGNATION	YEAR
NO.	DATE	DESCRIPTION	SHEET NO.
			TOTAL SHEETS
		SRTS-0987(007) ~ 67555	2013 J3 29

1-7-14

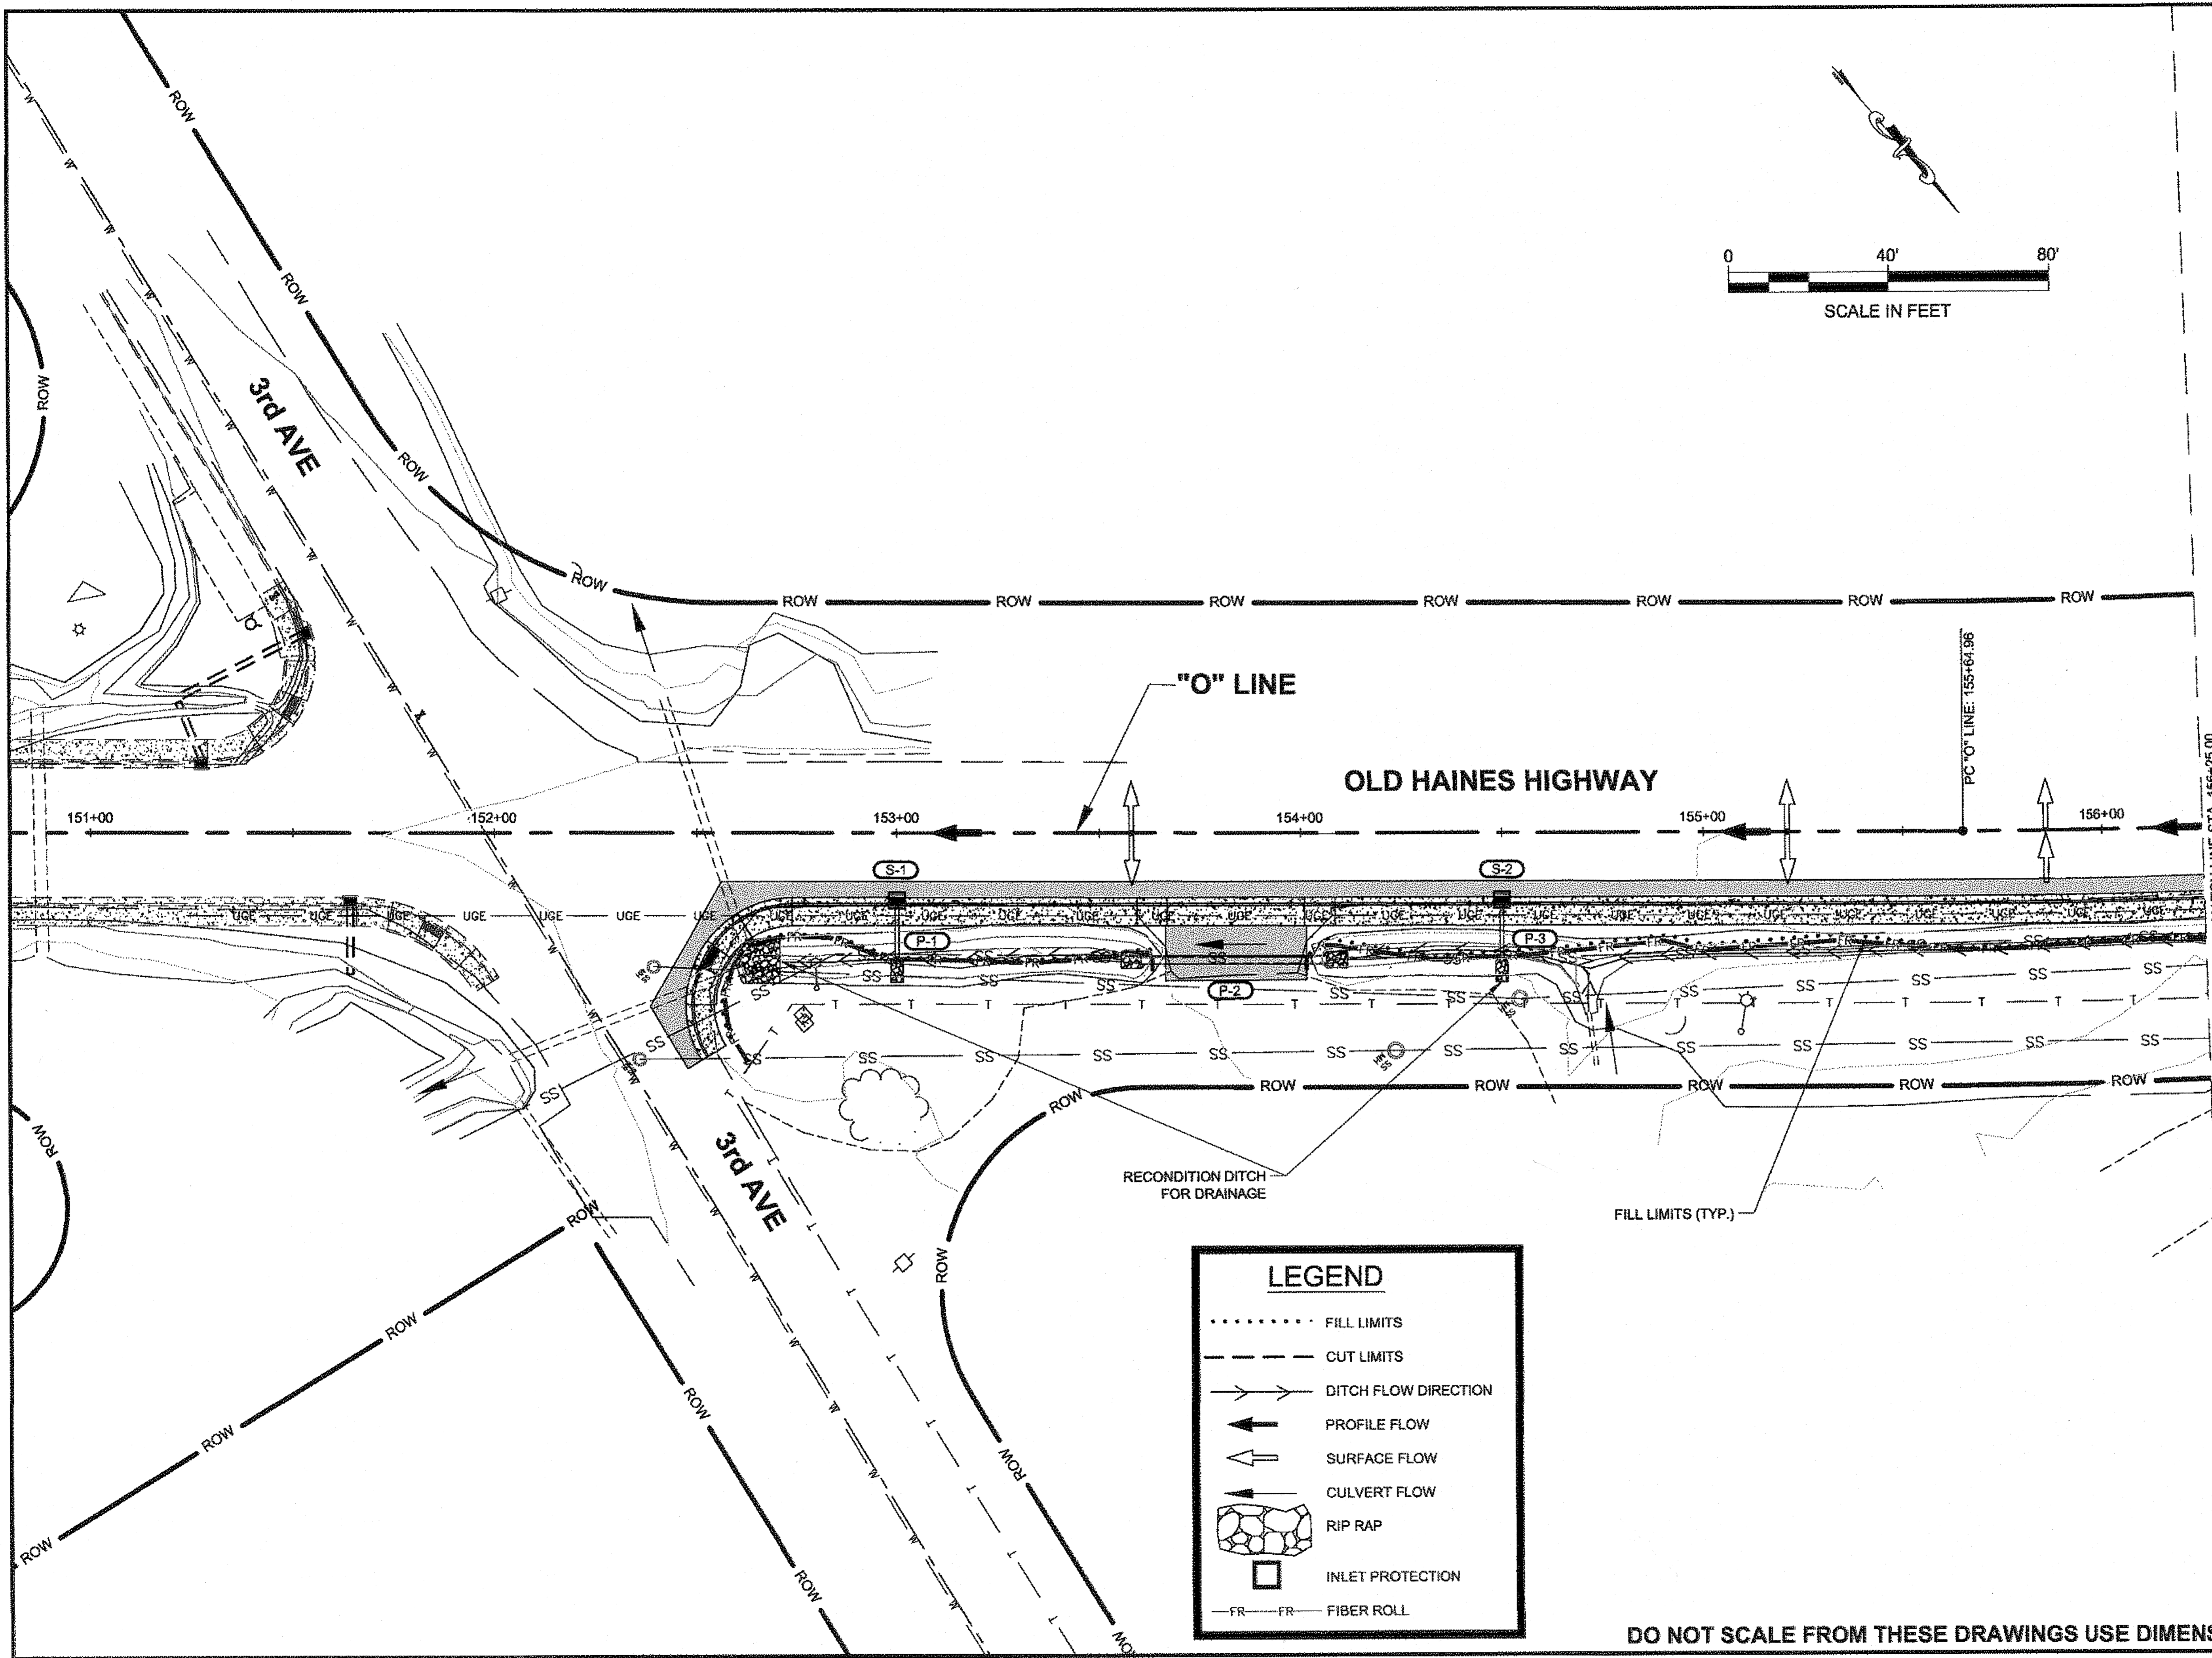

LEGEND

- FILL LIMITS
- CUT LIMITS
- DITCH FLOW DIRECTION
- ← PROFILE FLOW
- ← SURFACE FLOW
- ← CULVERT FLOW
- ▣ RIP RAP
- ▣ INLET PROTECTION
- FR—FR— FIBER ROLL

DO NOT SCALE FROM THESE DRAWINGS USE DIMENSIONS

PATH: Q:\HNS\67555\ENDOUG'S FILE\ESC_SHT.DWG


MULLINER, DOUGLAS J (DOT)
 TAB: P1 Wednesday, May 15, 2013 10:52:32 AM

ADDENDUM NUMBER

ATTACHMENT NUMBER

RECORD OF REVISIONS

No.	DATE	DESCRIPTION

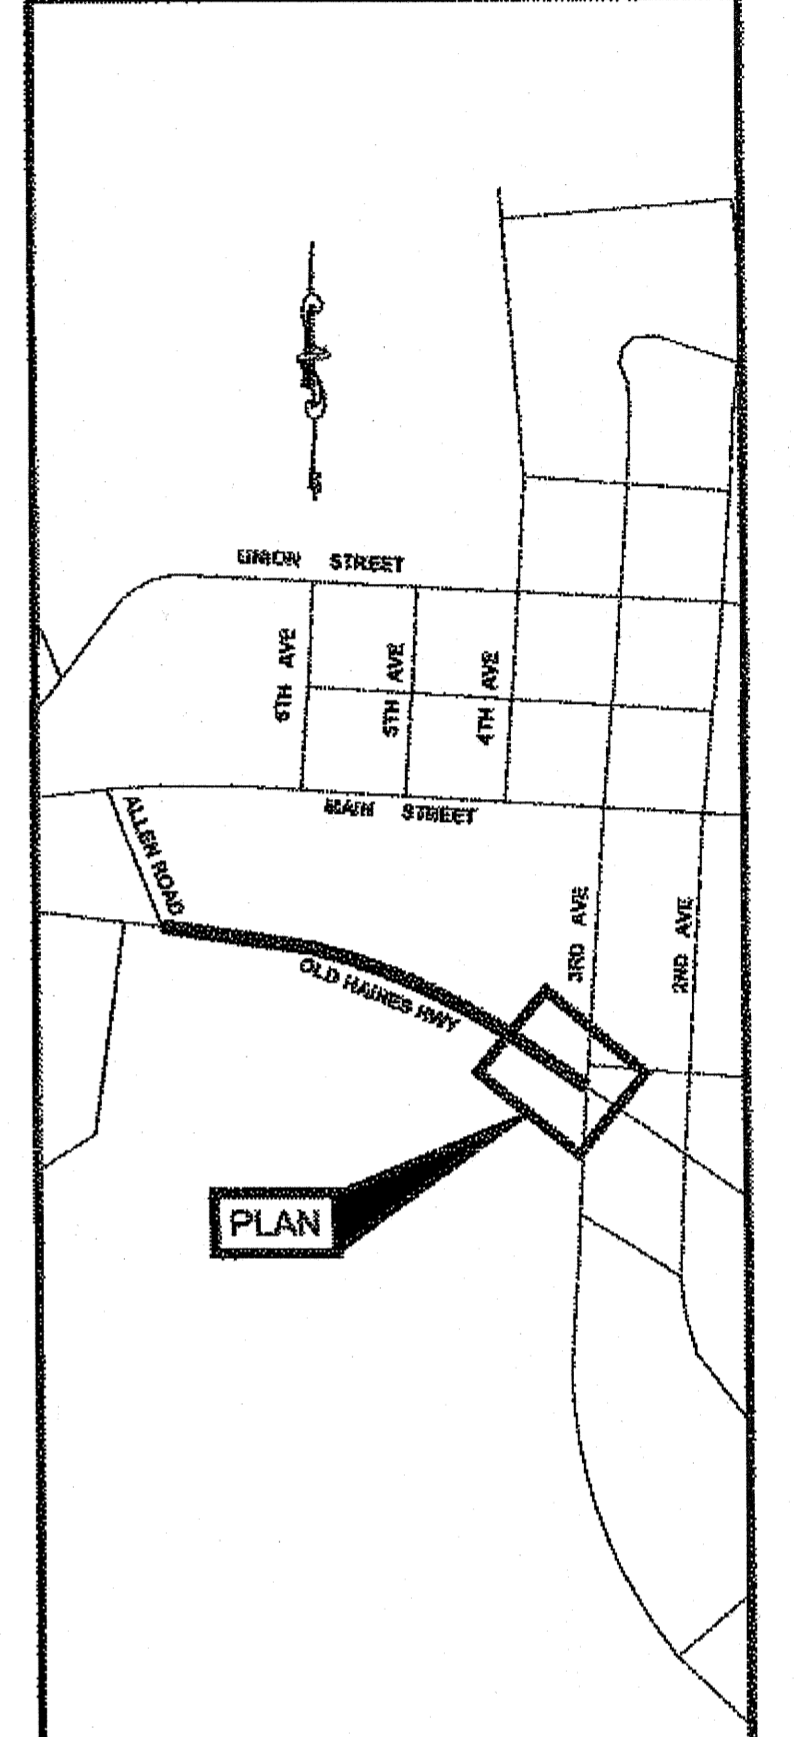

PLAN LEGEND

CHECKED BY: K. KARPSTEIN

DESIGNED BY: D. MULLINER
 DRAWN BY: D. MULLINER

STATE OF ALASKA
 DEPARTMENT OF TRANSPORTATION
 & PUBLIC FACILITIES
 SOUTHEAST REGION

**HNS-OLD HAINES HIGHWAY
 SIDEWALK 3rd AVENUE
 TO ALLEN ROAD
 PROJECT #67555**


**EROSION & SEDIMENT
 CONTROL PLAN**

PROJECT DESIGNATION
SRTS-0987(007) ~ 67555

STATE	YEAR
ALASKA	2013
SHEET NUMBER	TOTAL SHEETS
P1	29

OS
 1-7-14

No.	DATE	DESCRIPTION

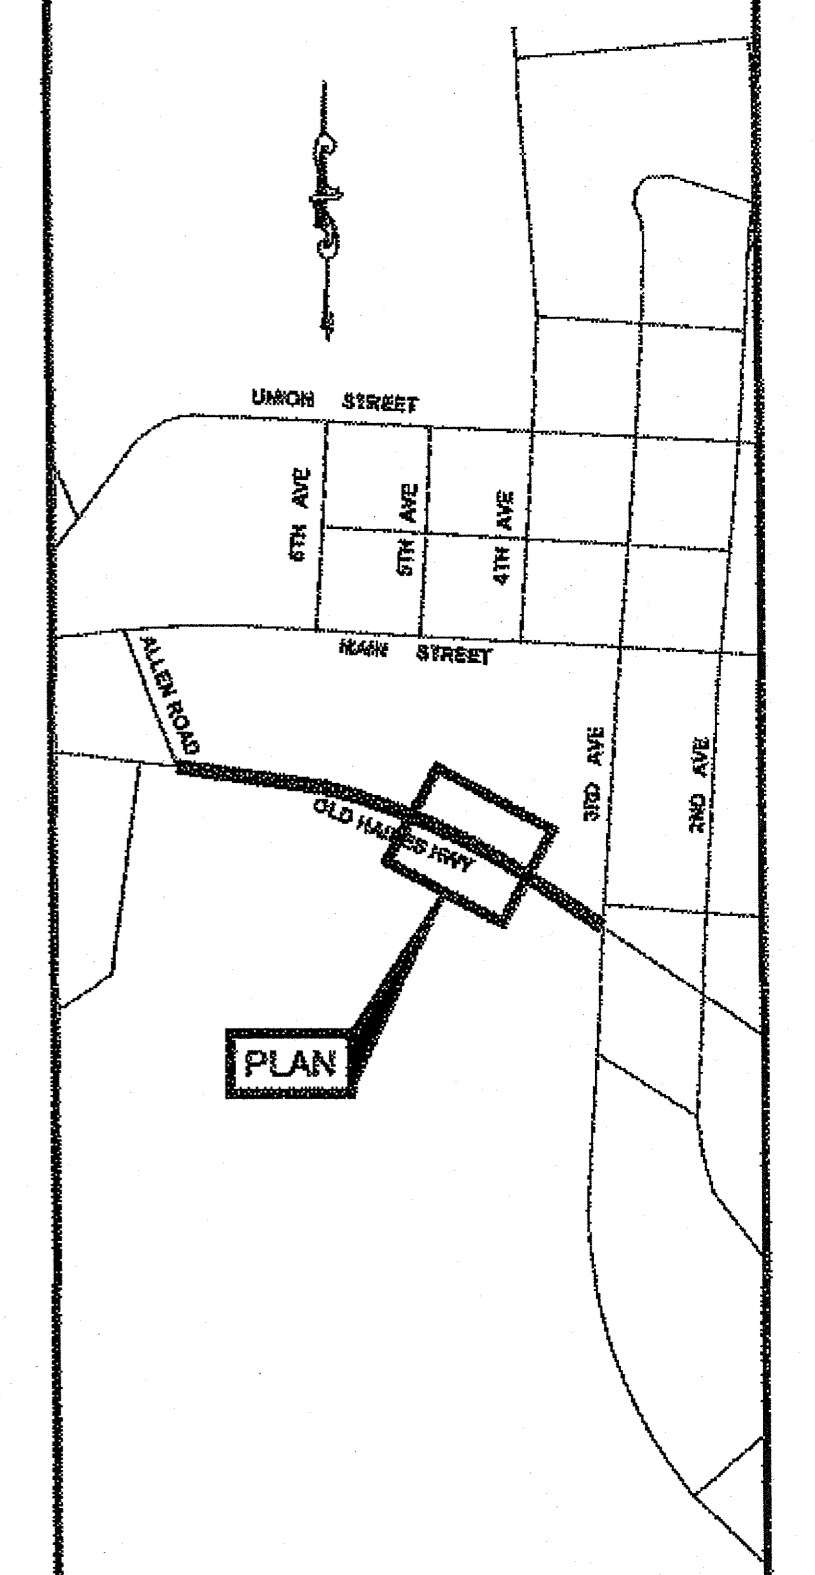

PLAN LEGEND

CHECKED BY: K. KARPSTEIN

DESIGNED BY: D. MULLINER

DRAWN BY: D. MULLINER

STATE OF ALASKA
 DEPARTMENT OF TRANSPORTATION
 & PUBLIC FACILITIES
 SOUTHEAST REGION

HNS-OLD HAINES HIGHWAY
 SIDEWALK 3rd AVENUE
 TO ALLEN ROAD
 PROJECT #67555



EROSION & SEDIMENT CONTROL PLAN

PROJECT DESIGNATION

SRTS-0987(007) ~ 67555

STATE	YEAR
ALASKA	2013

SHEET NUMBER	TOTAL SHEETS
P2	29


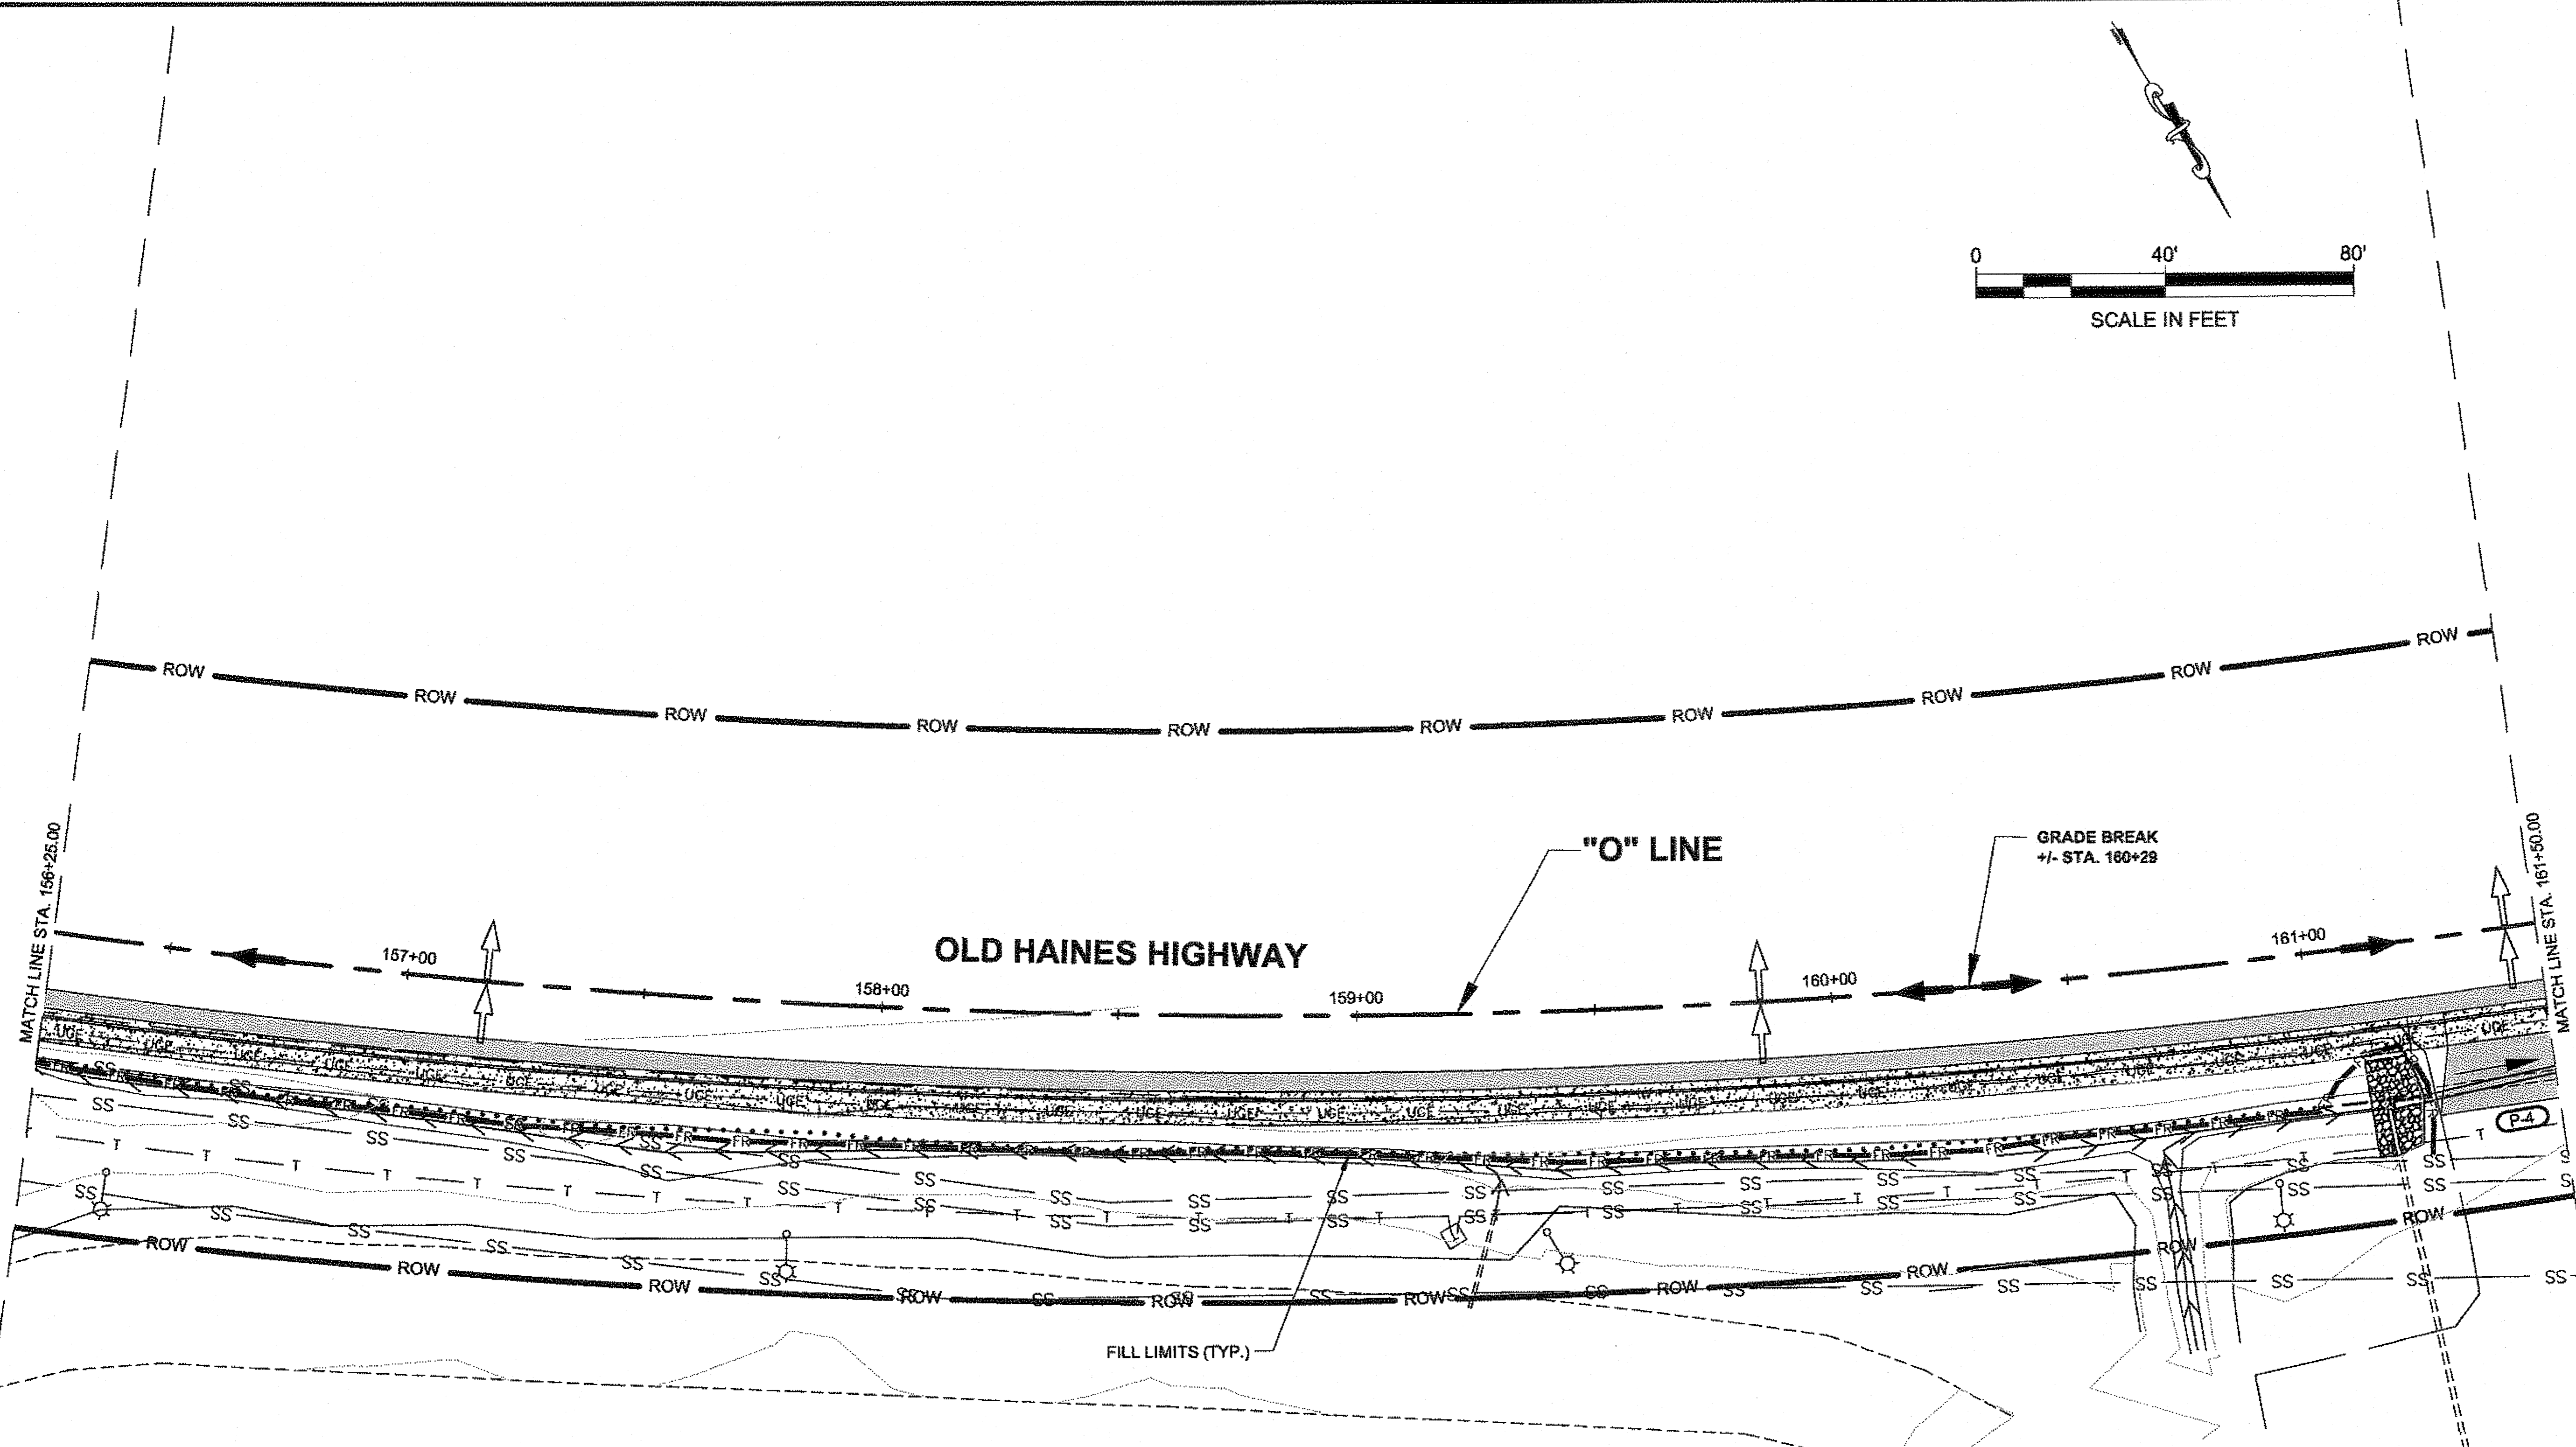
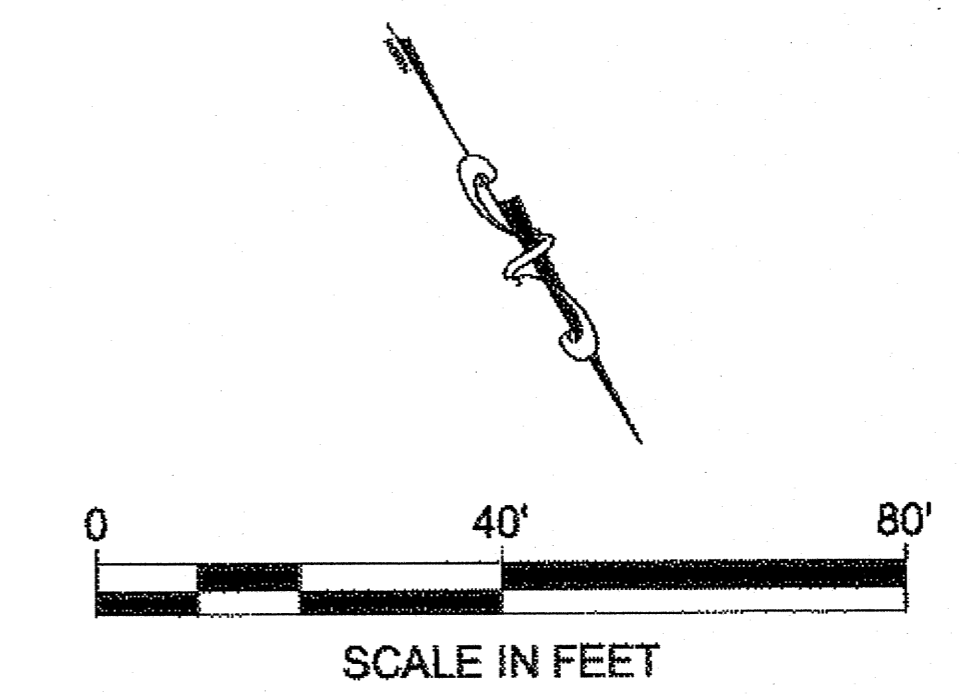


LEGEND

- FILL LIMITS
- - - - - CUT LIMITS
- → → DITCH FLOW DIRECTION
- ← ← ← PROFILE FLOW
- ↑ ↑ ↑ SURFACE FLOW
- ↓ ↓ ↓ CULVERT FLOW
- ▣ RIP RAP
- ▣ INLET PROTECTION
- FR- FR- FIBER ROLL

DO NOT SCALE FROM THESE DRAWINGS USE DIMENSIONS

DS
 1-7-14

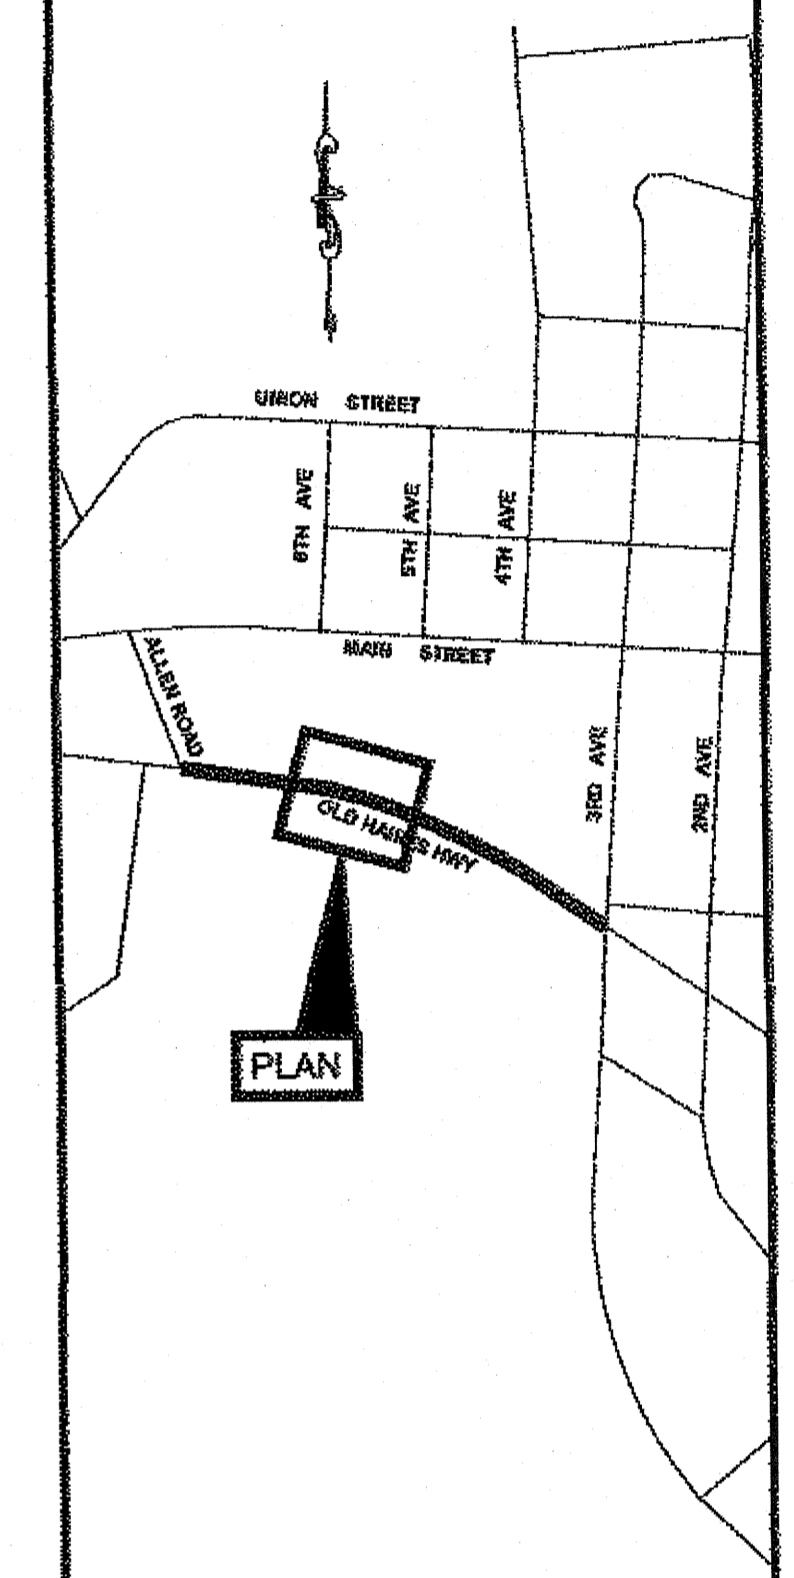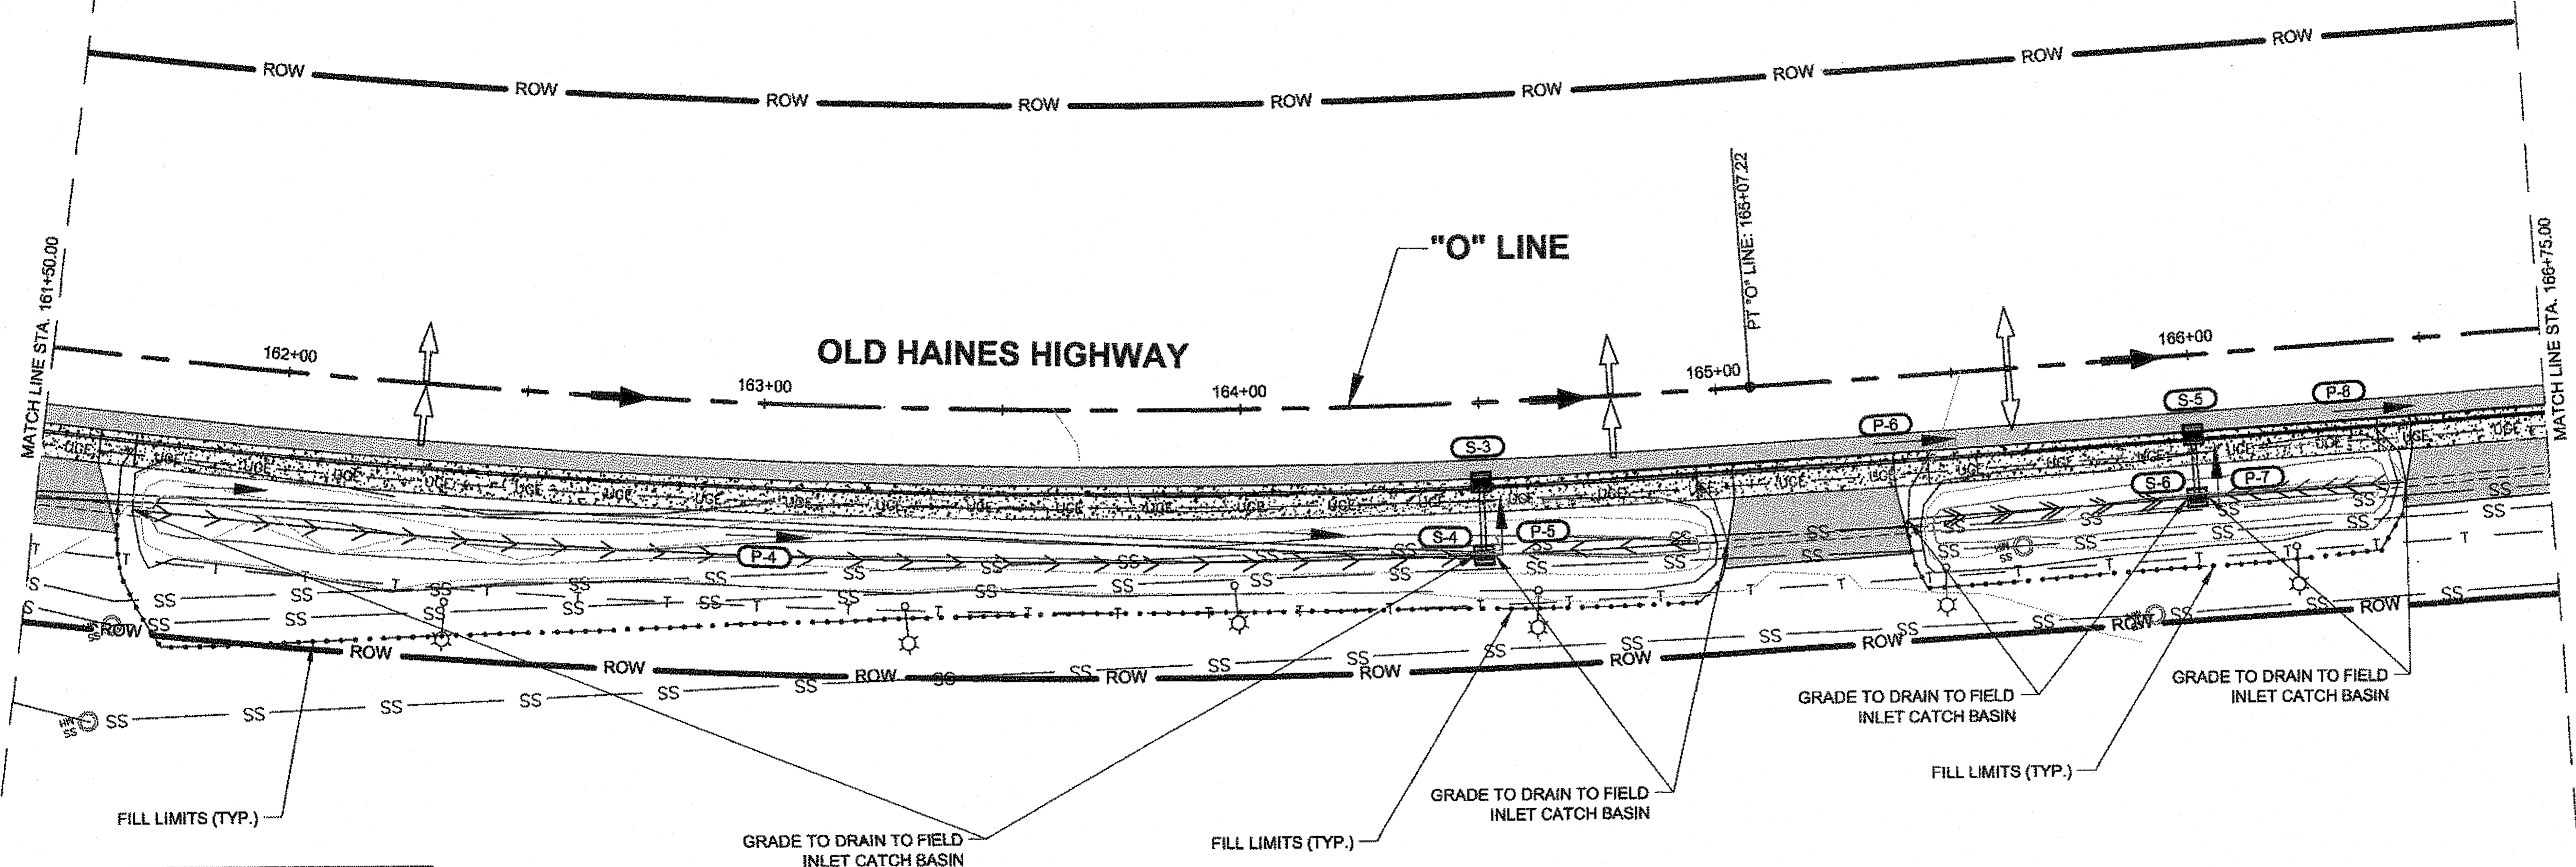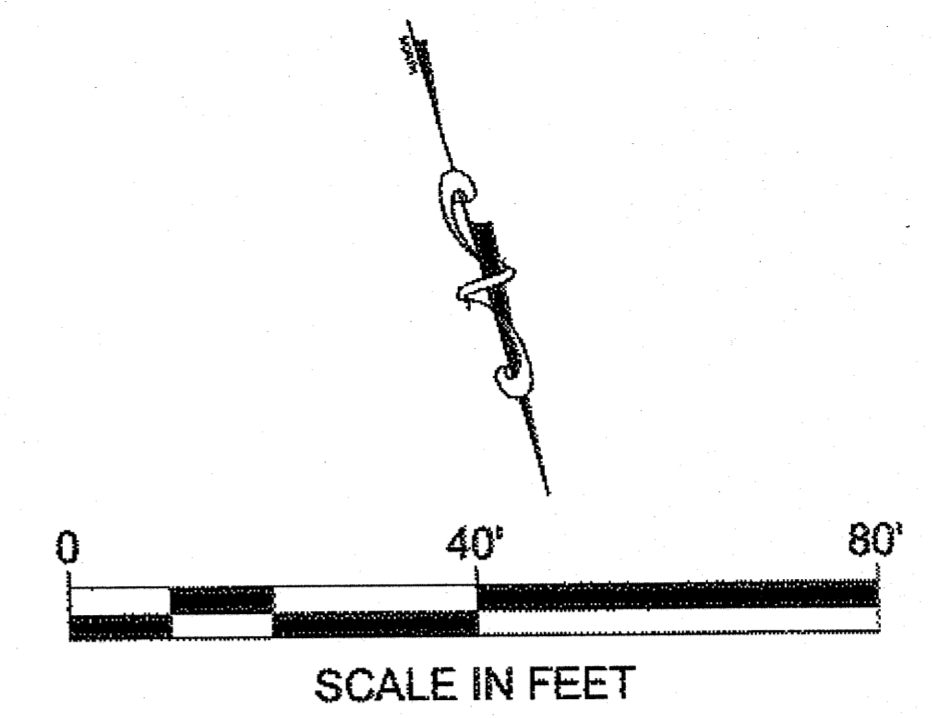

PLAN LEGEND

CHECKED BY: K. KARPSTEIN
 DESIGNED BY: D. MULLINER
 DRAWN BY: D. MULLINER

STATE OF ALASKA
 DEPARTMENT OF TRANSPORTATION
 & PUBLIC FACILITIES
 SOUTHEAST REGION
**HNS-OLD HAINES HIGHWAY
 SIDEWALK 3rd AVENUE
 TO ALLEN ROAD
 PROJECT #67555**

**EROSION & SEDIMENT
 CONTROL PLAN**

PROJECT DESIGNATION
SRTS-0987(007) ~ 67555

STATE	YEAR
ALASKA	2013
SHEET NUMBER	TOTAL SHEETS
P3	29


LEGEND

- FILL LIMITS
- - - - - CUT LIMITS
- DITCH FLOW DIRECTION
- ↑ PROFILE FLOW
- ↖ SURFACE FLOW
- CULVERT FLOW
- ⬢ RIP RAP
- INLET PROTECTION
- FR- FR- FIBER ROLL

DO NOT SCALE FROM THESE DRAWINGS USE DIMENSIONS

1-7-14

RECORD OF REVISIONS		
No.	DATE	DESCRIPTION

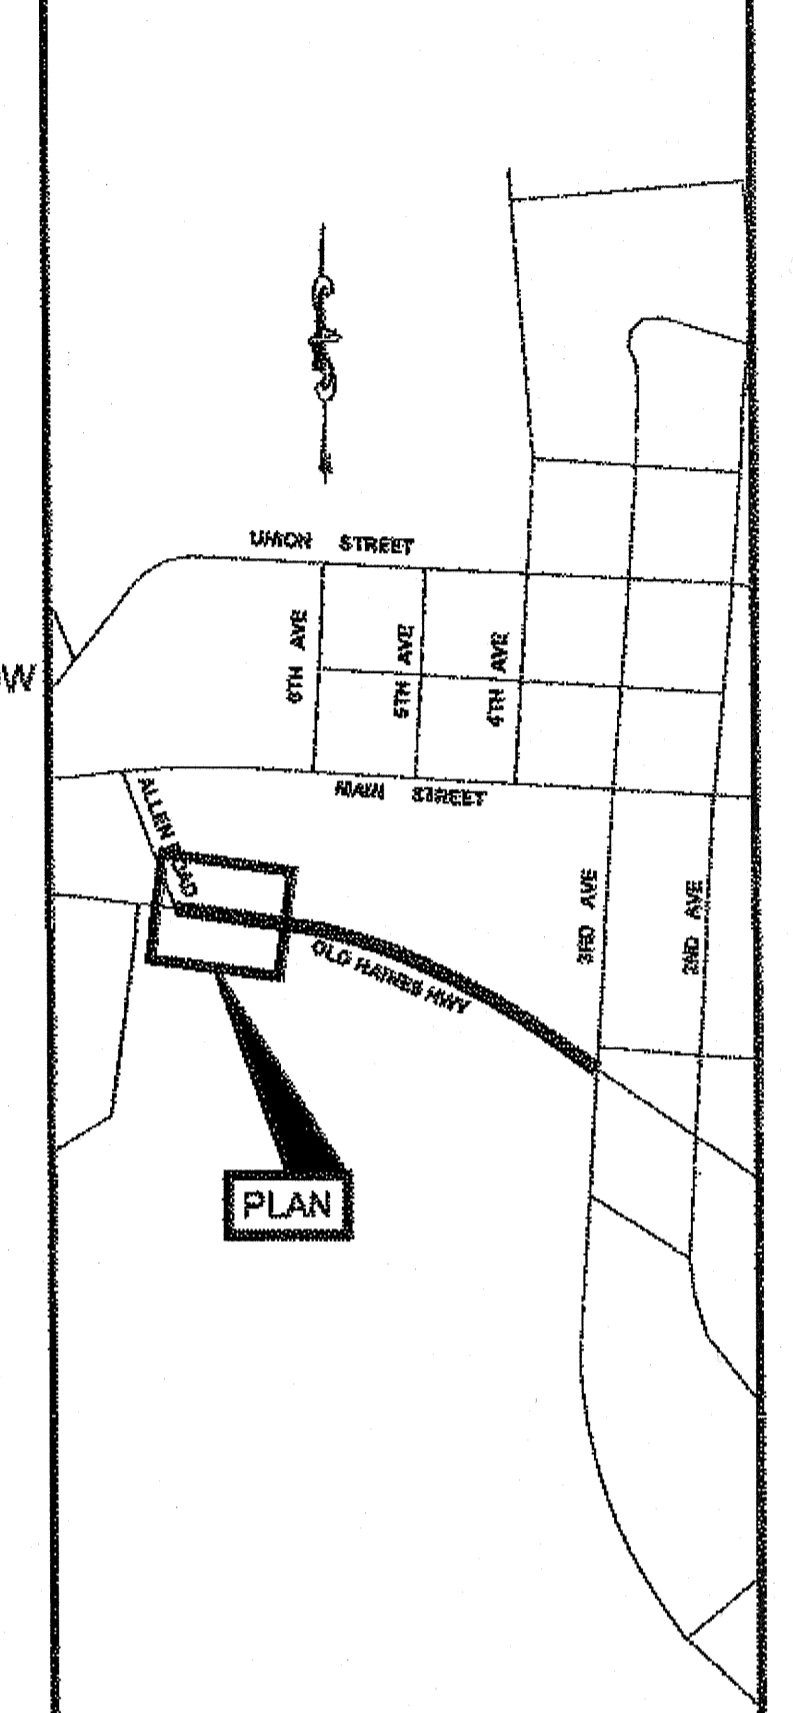

PLAN LEGEND

CHECKED BY: K. KARPSTEIN

DESIGNED BY: D. MULLINER
 DRAWN BY: D. MULLINER



STATE OF ALASKA
 DEPARTMENT OF TRANSPORTATION
 & PUBLIC FACILITIES
 SOUTHEAST REGION

HNS-OLD HAINES HIGHWAY
 SIDEWALK 3rd AVENUE
 TO ALLEN ROAD
 PROJECT #67555

EROSION & SEDIMENT CONTROL PLAN

PROJECT DESIGNATION
SRTS-0987(007) ~ 67555

STATE	YEAR
ALASKA	2013
SHEET NUMBER	TOTAL SHEETS
P4	29

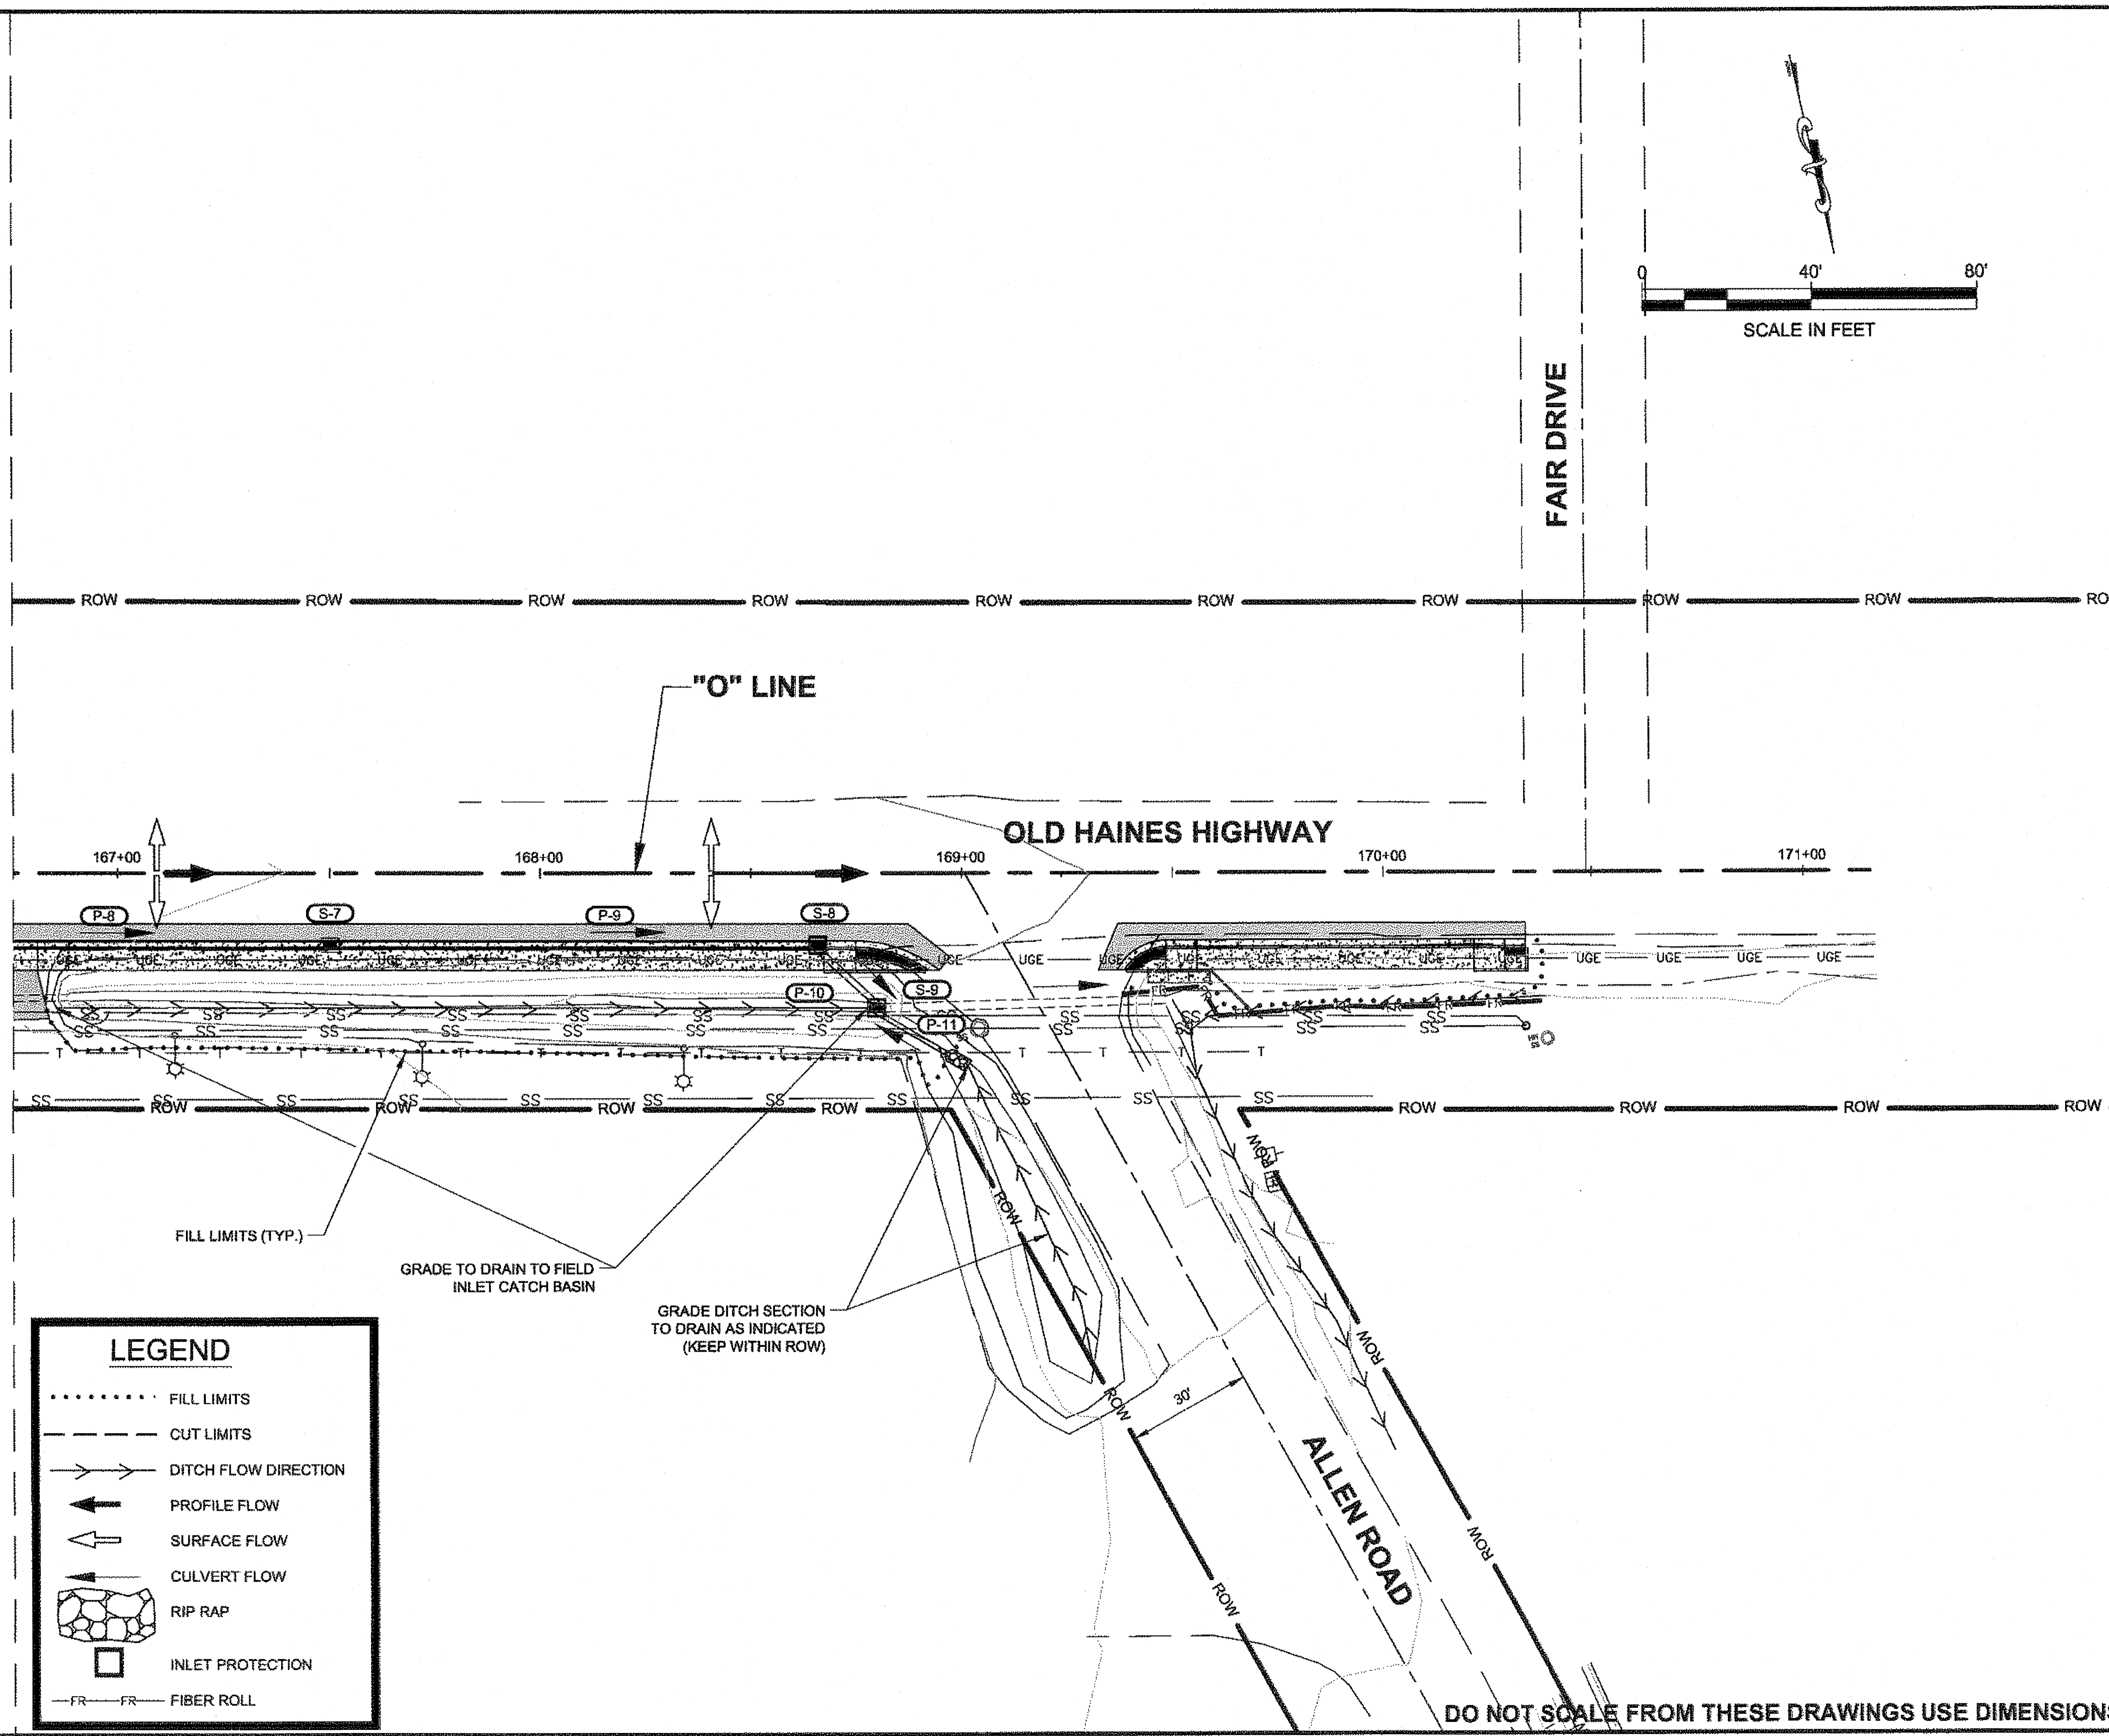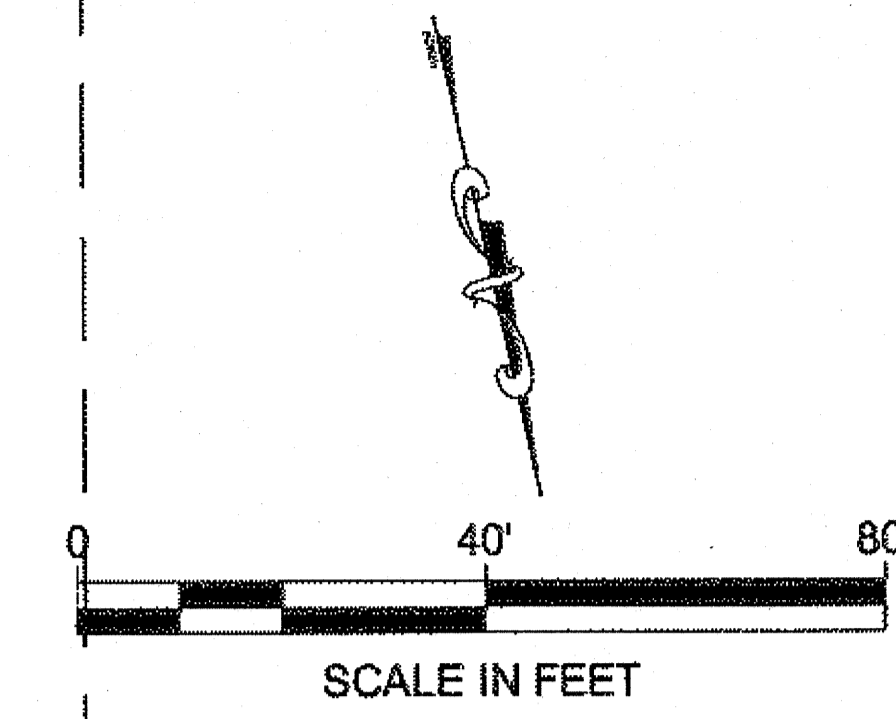


LEGEND

- FILL LIMITS
- - - - - CUT LIMITS
- → → DITCH FLOW DIRECTION
- ← ← ← PROFILE FLOW
- ← ← ← SURFACE FLOW
- ← ← ← CULVERT FLOW
- ▢ RIP RAP
- ▢ INLET PROTECTION
- FR- FR- FIBER ROLL

DO NOT SCALE FROM THESE DRAWINGS USE DIMENSIONS

BS
 1-7-14

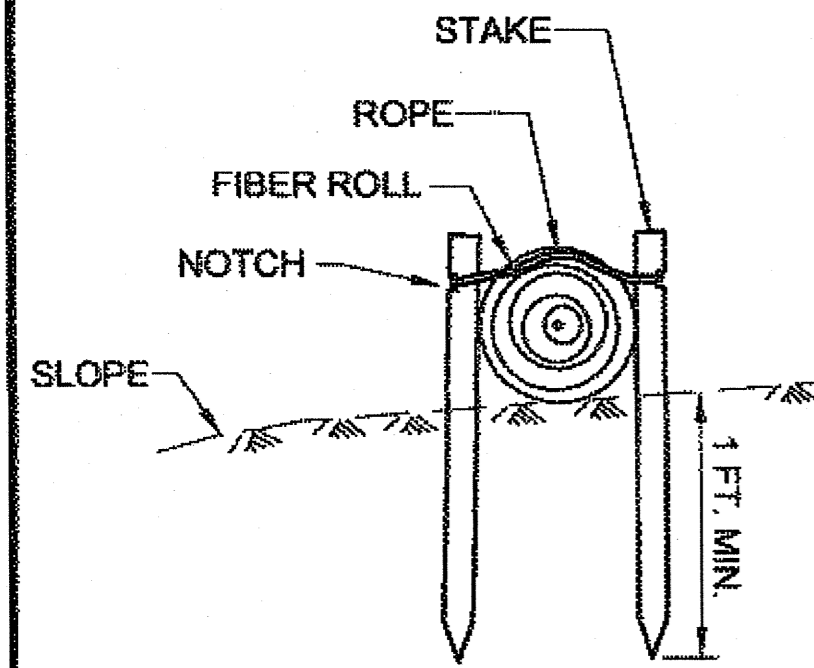

SECTION

FIBER ROLL (TYPE 2)


N.T.S.



PERSPECTIVE

FIBER ROLL (TYPE 2)


N.T.S.

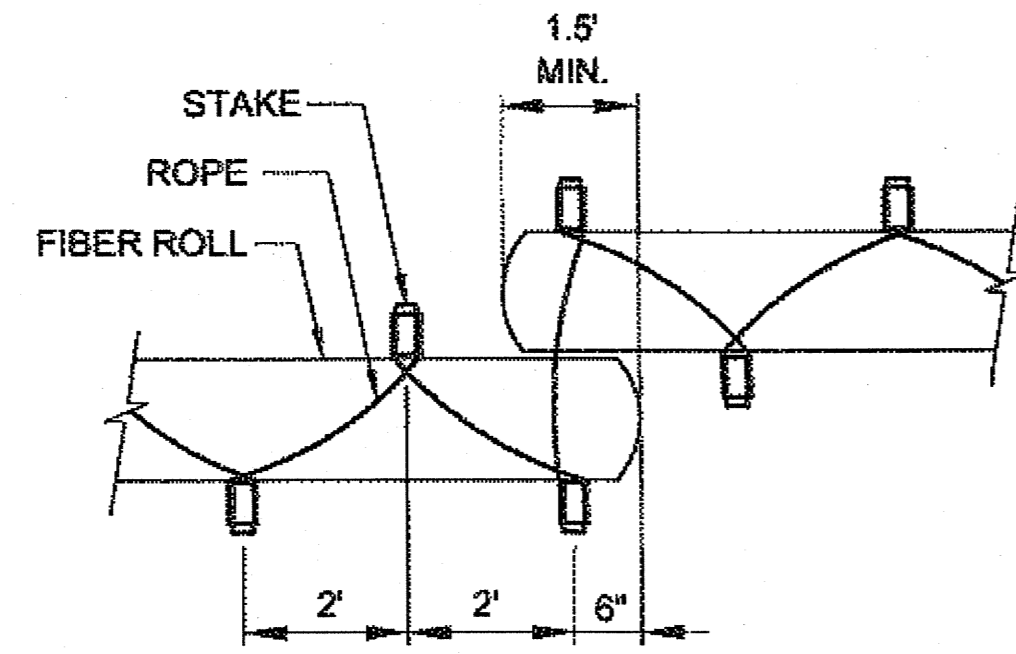


PLAN

TYPICAL FIBER ROLL DETAIL

N.T.S.

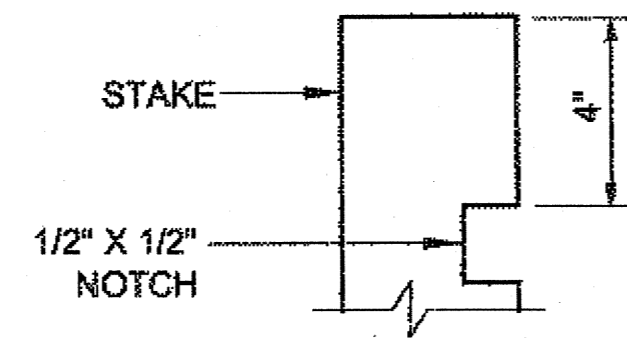


STAKE TYPE 2

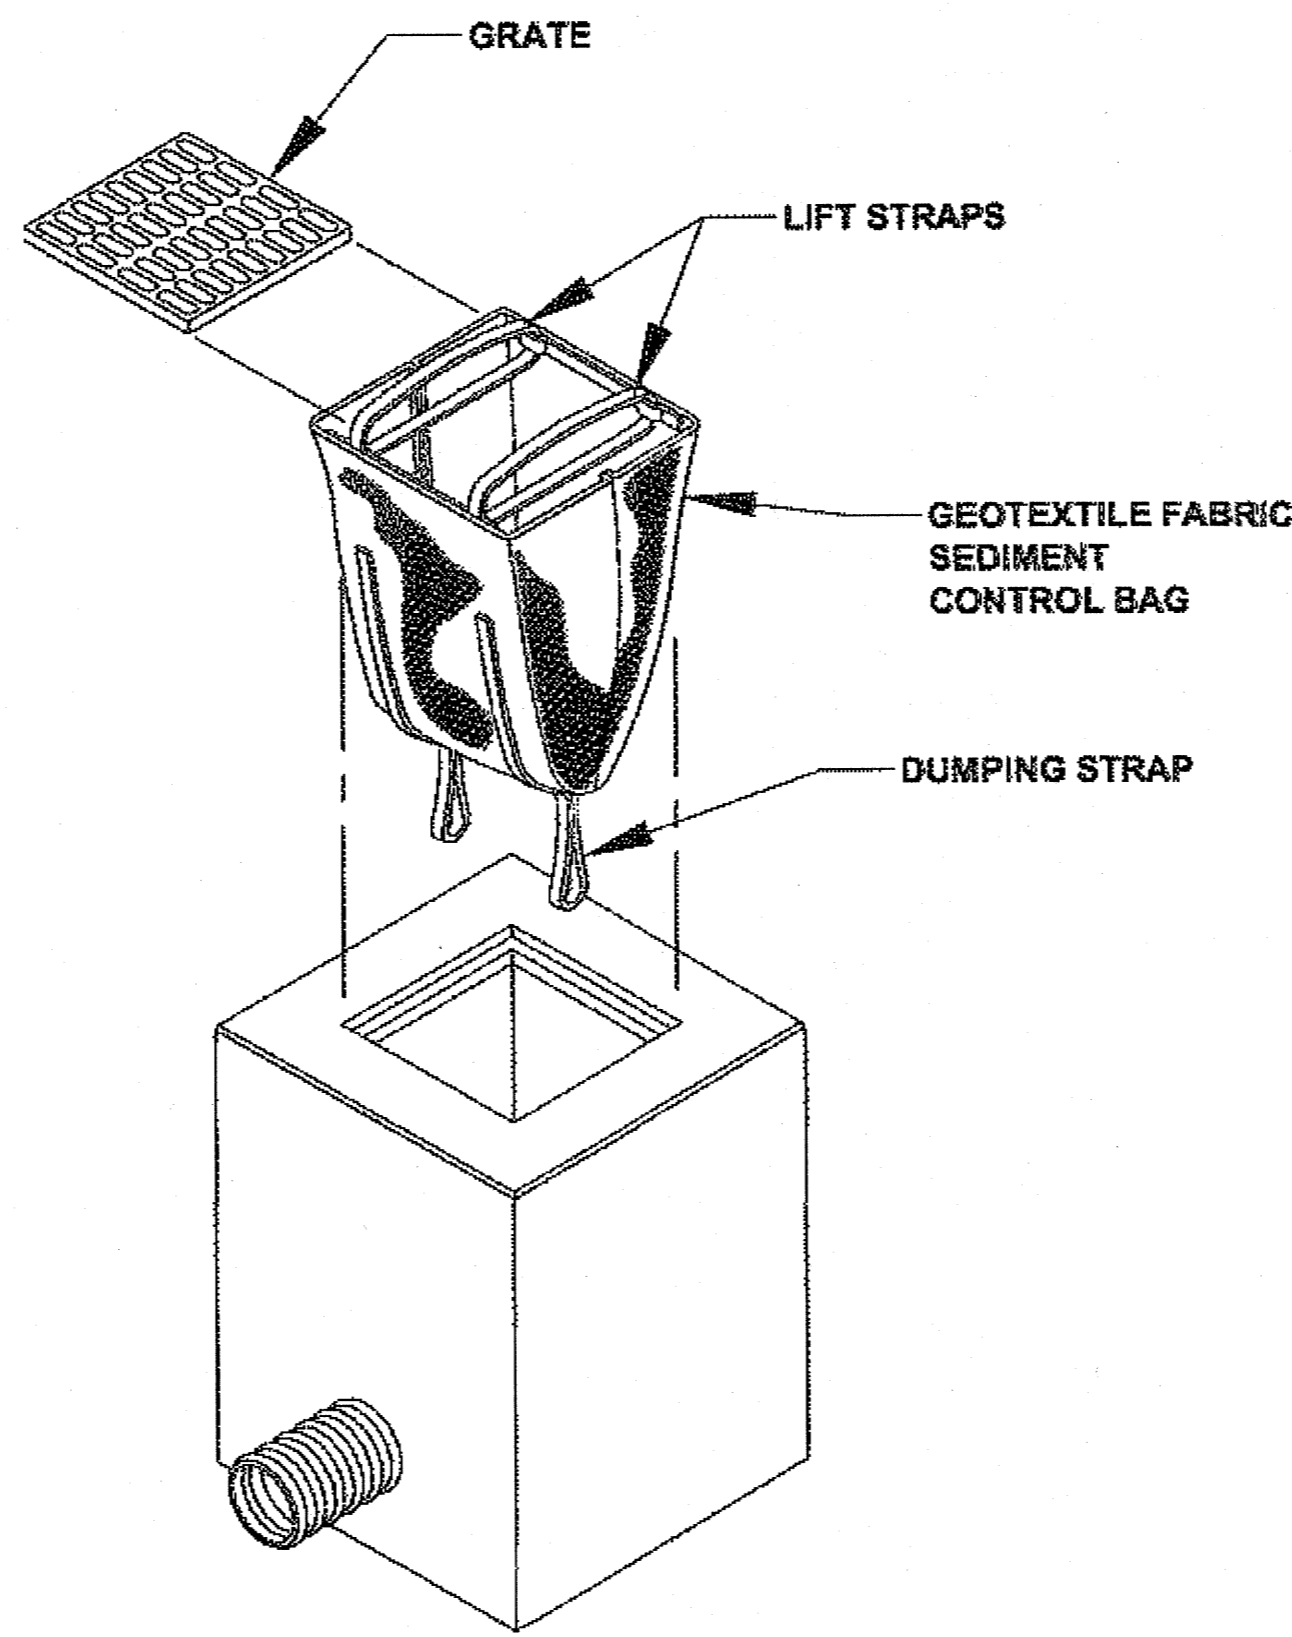


INLET PROTECTION DETAIL

N.T.S.

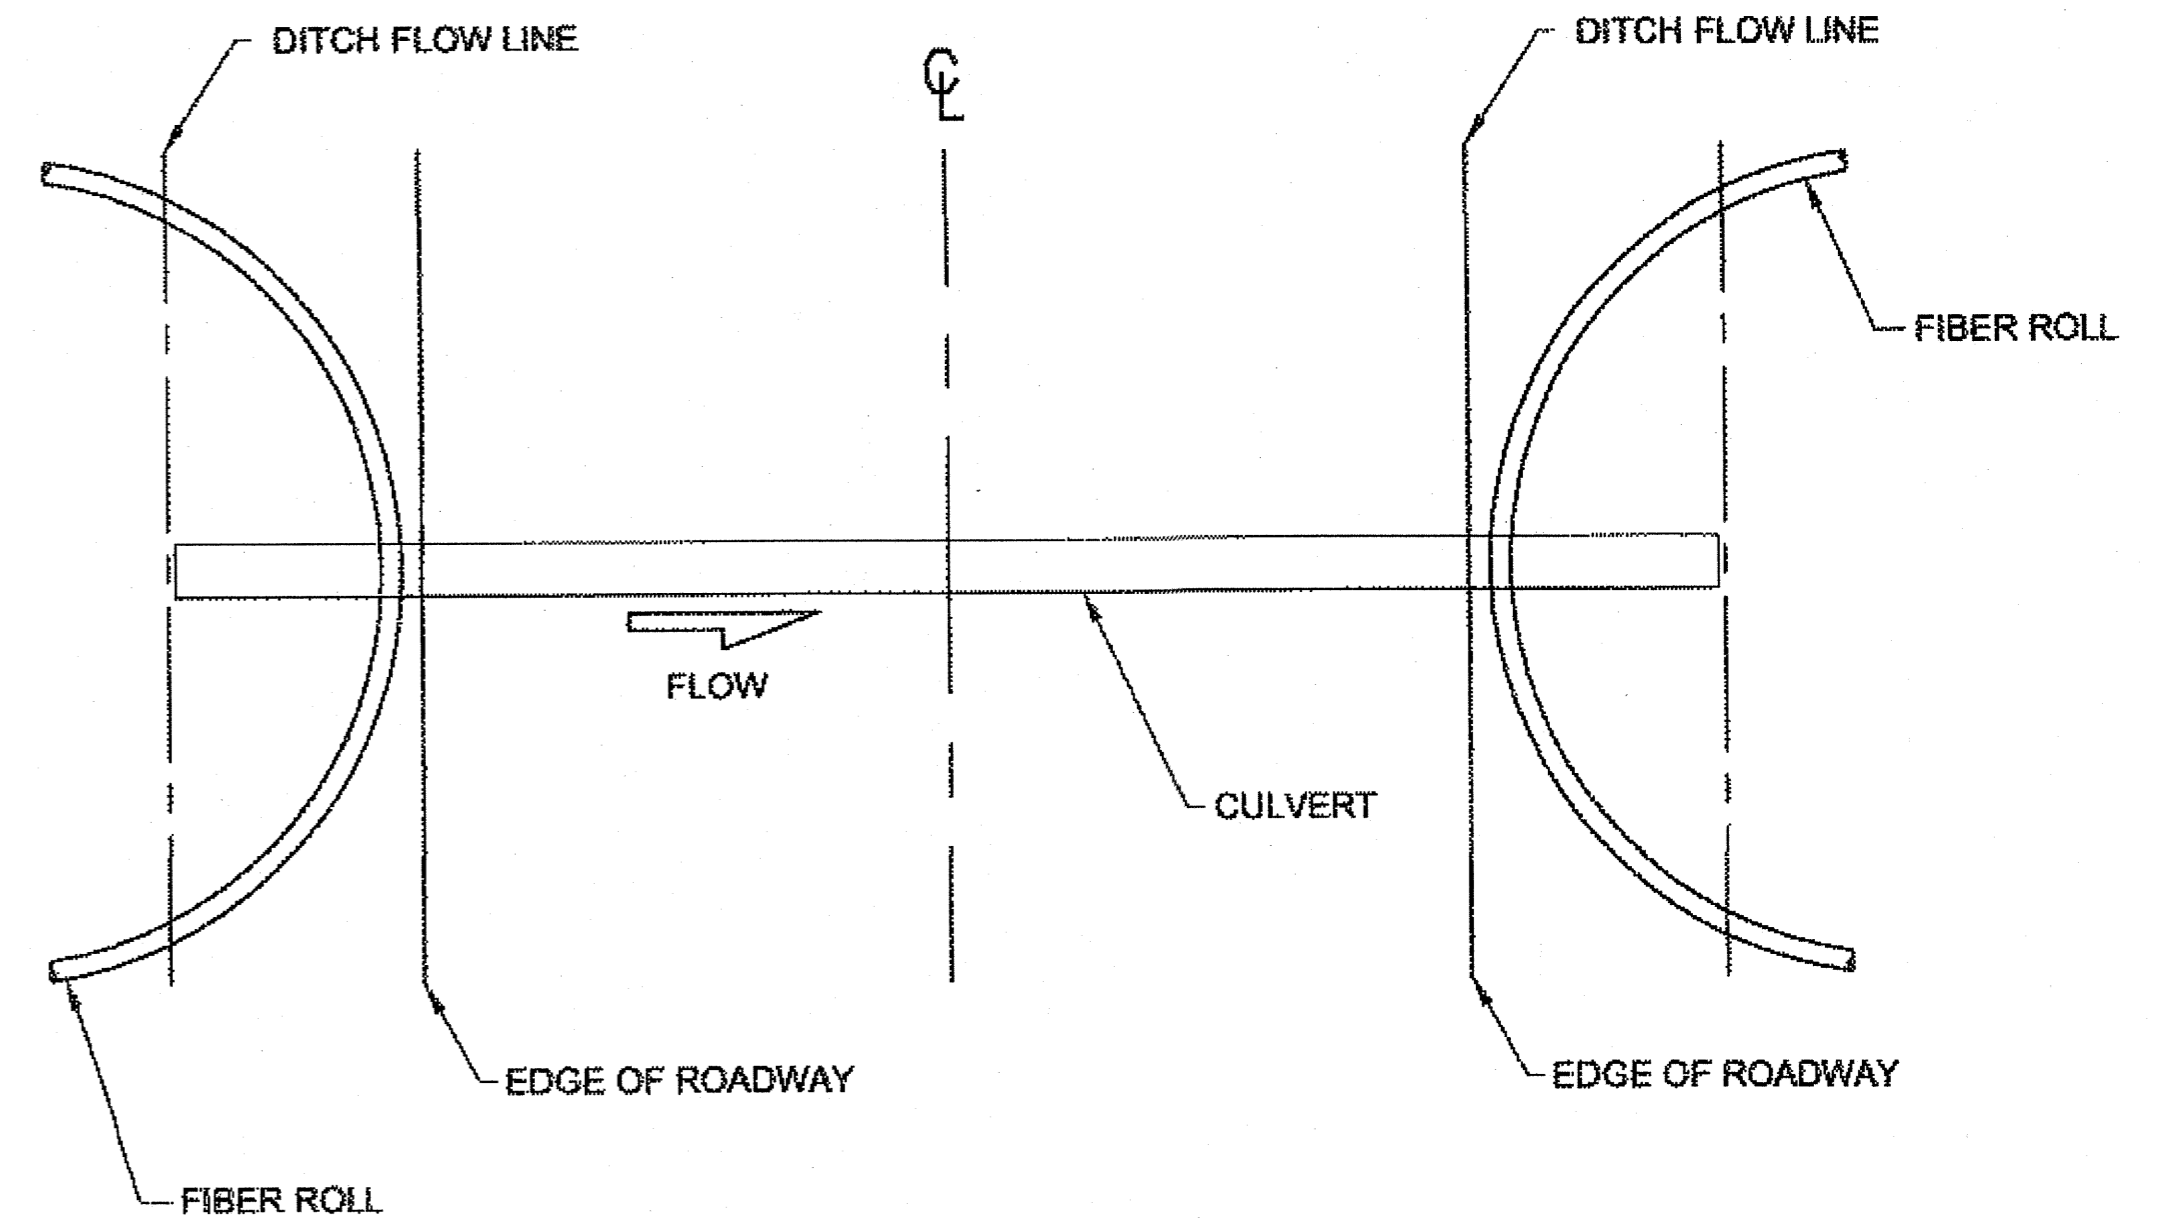

FIBER ROLL PLACEMENT AT CULVERTS

N.T.S.

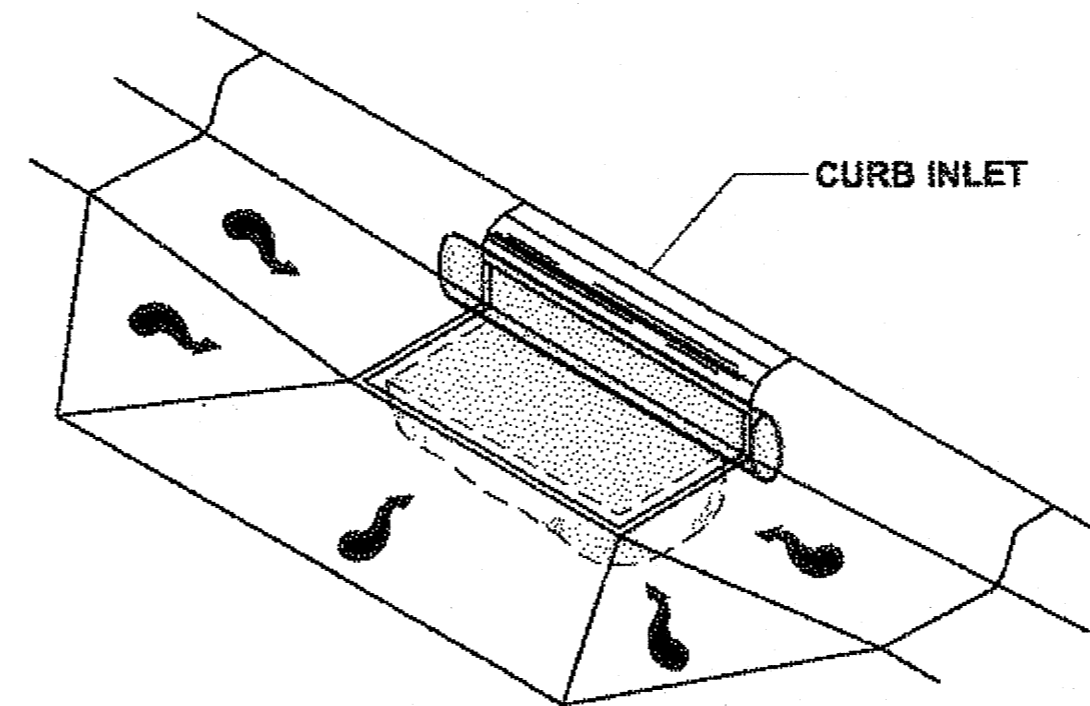

INLET PROTECTION DETAIL

N.T.S.

NOTES:

1. THE LOCATION AND LENGTH OF FIBER ROLLS IS DEPENDENT ON THE CONDITION OF THE SITE.
2. LAP ADJACENT FIBER ROLLS TO PREVENT SEDIMENT BYPASS.
3. ANCHOR AS NECESSARY TO FIRMLY SECURE FIBER ROLLS AND PROVIDE CONTINUOUS CONTACT WITH THE SURFACE ON WHICH IT IS INSTALLED.

EROSION & SEDIMENT CONTROL NOTES:

1. REFER TO APPENDIX B OF THE CONTRACT DOCUMENTS FOR THE ENVIRONMENTAL COMMITMENTS.
2. THE LOCATIONS OF TEMPORARY EROSION & SEDIMENT POLLUTION CONTROLS SHOWN ON F-SHEETS ARE RECOMMENDATIONS. IT IS THE RESPONSIBILITY OF THE CONTRACTOR TO PREPARE AND IMPLEMENT A WATER QUALITY CONTROL PLAN (WQCP) ACCORDING TO SECTION 641 OF THE SPECS.
3. INSTALL EROSION AND SEDIMENT CONTROL DEVICES BEFORE BEGINNING EARTH DISTURBING ACTIVITIES AND COLD PLANING OR AS SPECIFIED ELSEWHERE.
4. IF INSPECTION REVEALS SEDIMENT IS DISCHARGED BEYOND THE PROJECT WORK LIMITS. IMMEDIATELY IMPLEMENT CORRECTIVE ACTION. ADDITIONAL BMP'S MAY BE REQUIRED.

INLET PROTECTION INSTALLATION AND MAINTENANCE

1. **INSTALLATION:** REMOVE THE GRATE FROM CATCH BASIN. IF USING OPTIONAL OIL ABSORBENTS; PLACE ABSORBENT PILLOW IN UNIT. STAND THE GRATE ON END. MOVE THE TOP LIFTING STRAPS OUT OF THE WAY AND PLACE THE GRATE INTO THE SEDIMENT BAG SO THAT THE GRATE IS BELOW THE TOP STRAPS AND ABOVE THE LOWER STRAPS. HOLDING THE LIFTING DEVICES, INSERT THE GRATE INTO THE INLET.
2. **MAINTENANCE:** REMOVE ALL ACCUMULATED SEDIMENT AND DEBRIS FROM VICINITY OF UNIT AFTER EACH STORM EVENT. AFTER EACH STORM EVENT AND AT REGULAR INTERVALS, LOOK INTO THE SEDIMENT BAG. IF THE CONTAINMENT AREA IS MORE THAN 1/3 FULL OF SEDIMENT, THE UNIT MUST BE EMPTIED. TO EMPTY UNIT, LIFT THE UNIT OUT OF THE INLET USING THE LIFTING STRAPS AND REMOVE THE GRATE. IF USING OPTIONAL OIL ABSORBENTS; REPLACE ABSORBENT WHEN NEAR SATURATION.
3. **INSTALL INLET PROTECTION AT LOCATIONS PRIOR TO EARTH DISTURBING ACTIVITIES AND COLD PLANING.**


DO NOT SCALE FROM THESE DRAWINGS USE DIMENSIONS

CHECKED BY: K. KARPSTEIN		STATE OF ALASKA DEPARTMENT OF TRANSPORTATION & PUBLIC FACILITIES SOUTHEAST REGION			
DESIGNED BY: D. MULLINER		HNS-OLD HAINES HIGHWAY SIDEWALK 3rd AVENUE TO ALLEN ROAD PROJECT #67555 EROSION AND SEDIMENT CONTROL DETAILS			
DRAWN BY: D. MULLINER					
PATH: Q:\HNS\67555\ENDOU\G'S FILE\P_ESCP_DETAIL_SHT.DWG					
TAB: P5 Thursday, April 25, 2013 9:37:23 AM MULLINER, DOUGLAS J (DOT)					
REVISIONS		PROJECT DESIGNATION	YEAR	SHEET NO.	TOTAL SHEETS
NO.	DATE	DESCRIPTION			
SRTS-0987(007) ~ 67555			2013	P5	29

1-7-14

ATTACHMENT - 2

PATH: Q:\HNS\67555\ENR\DOUG'S FILE\R_SIGN & STRIPING SH1.DWG
 MULLINER, DOUGLAS J (DOT)
 TAB: R1 Wednesday, June 05, 2013 10:48:16 AM
 ADDENDUM NUMBER
 ATTACHMENT NUMBER
 RECORD OF REVISIONS

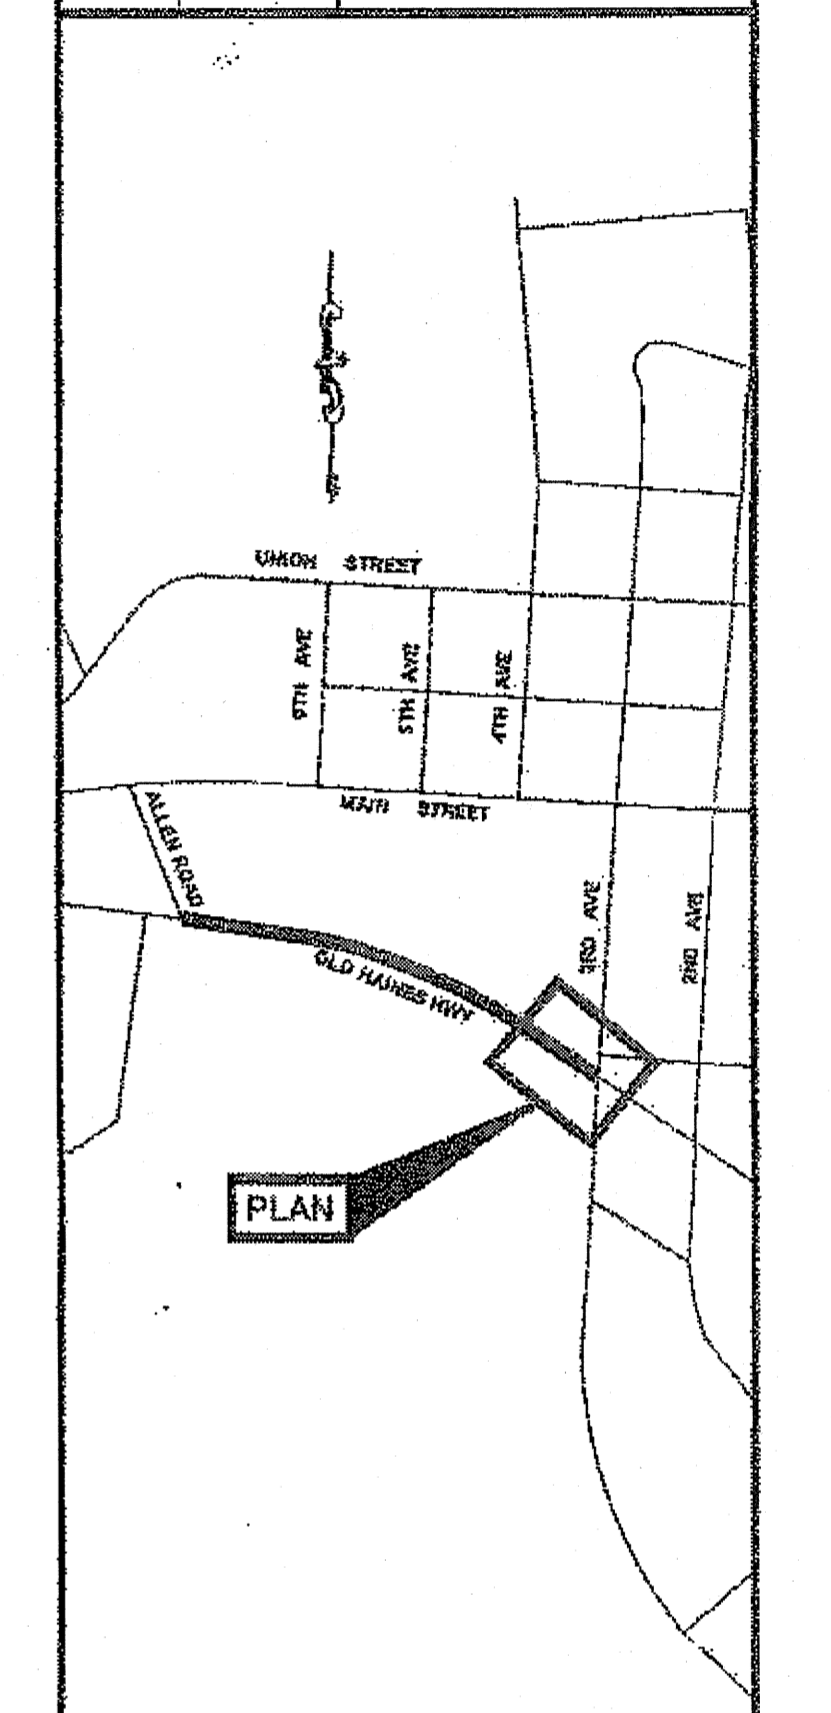

PLAN LEGEND

CHECKED BY: D. EPSTEIN



 DESIGNED BY: D. MULLINER
 DRAWN BY: D. MULLINER

STATE OF ALASKA
 DEPARTMENT OF TRANSPORTATION & PUBLIC FACILITIES
 SOUTHEAST REGION
**HNS-OLD HAINES HIGHWAY
 SIDEWALK 3rd AVENUE
 TO ALLEN ROAD
 PROJECT #67555**

SIGNING & STRIPING



PROJECT DESIGNATION
SRTS-0987(007) ~ 67555

STATE	YEAR
ALASKA	2013
SHEET NUMBER	TOTAL SHEETS
R1	29

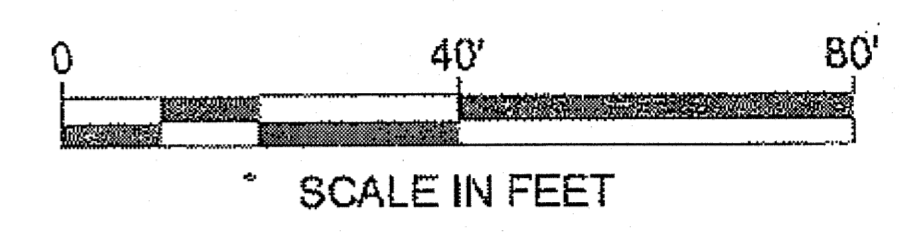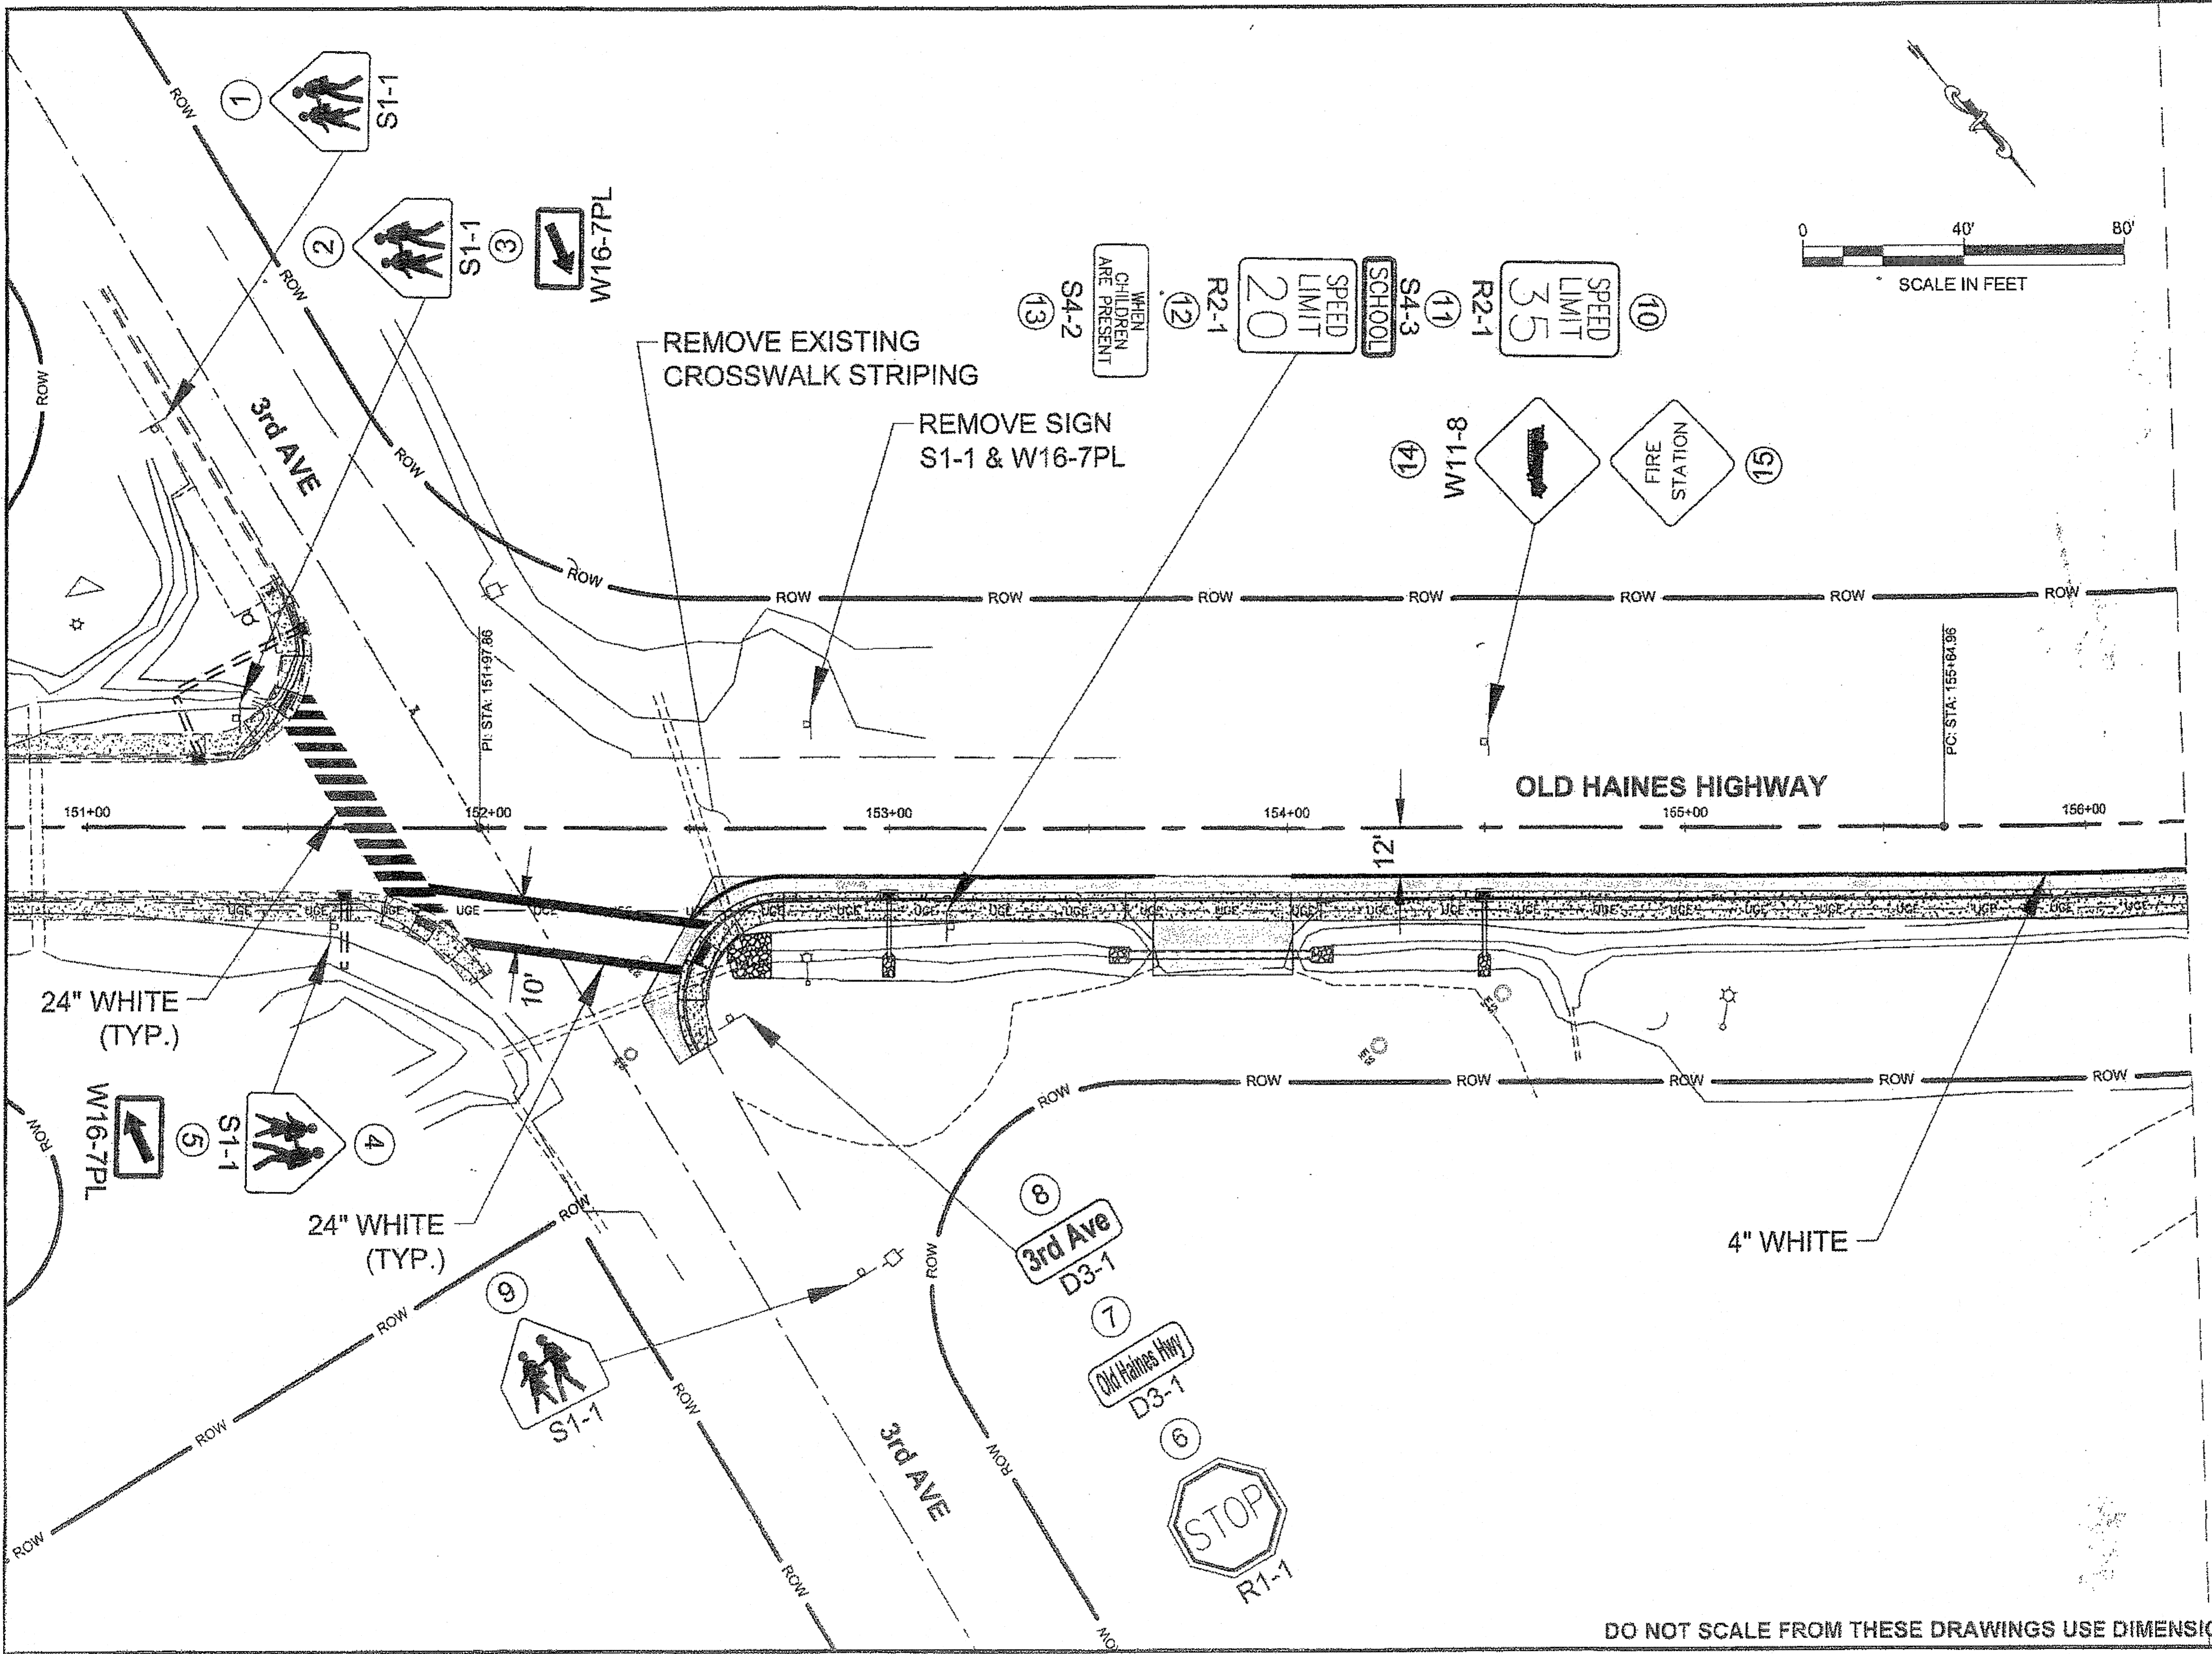

DO NOT SCALE FROM THESE DRAWINGS USE DIMENSIONS

1-7-14

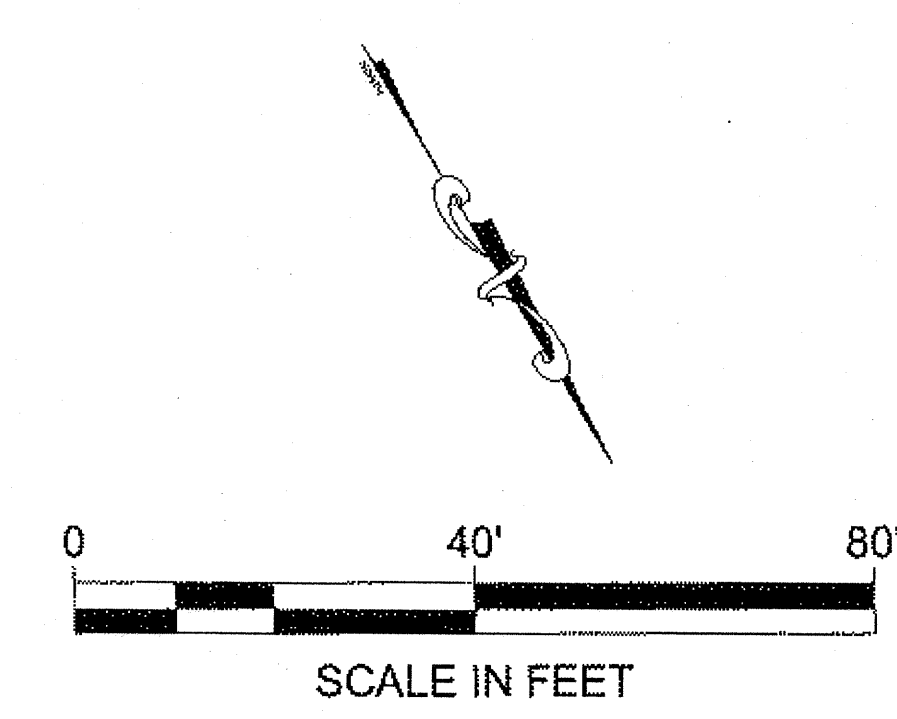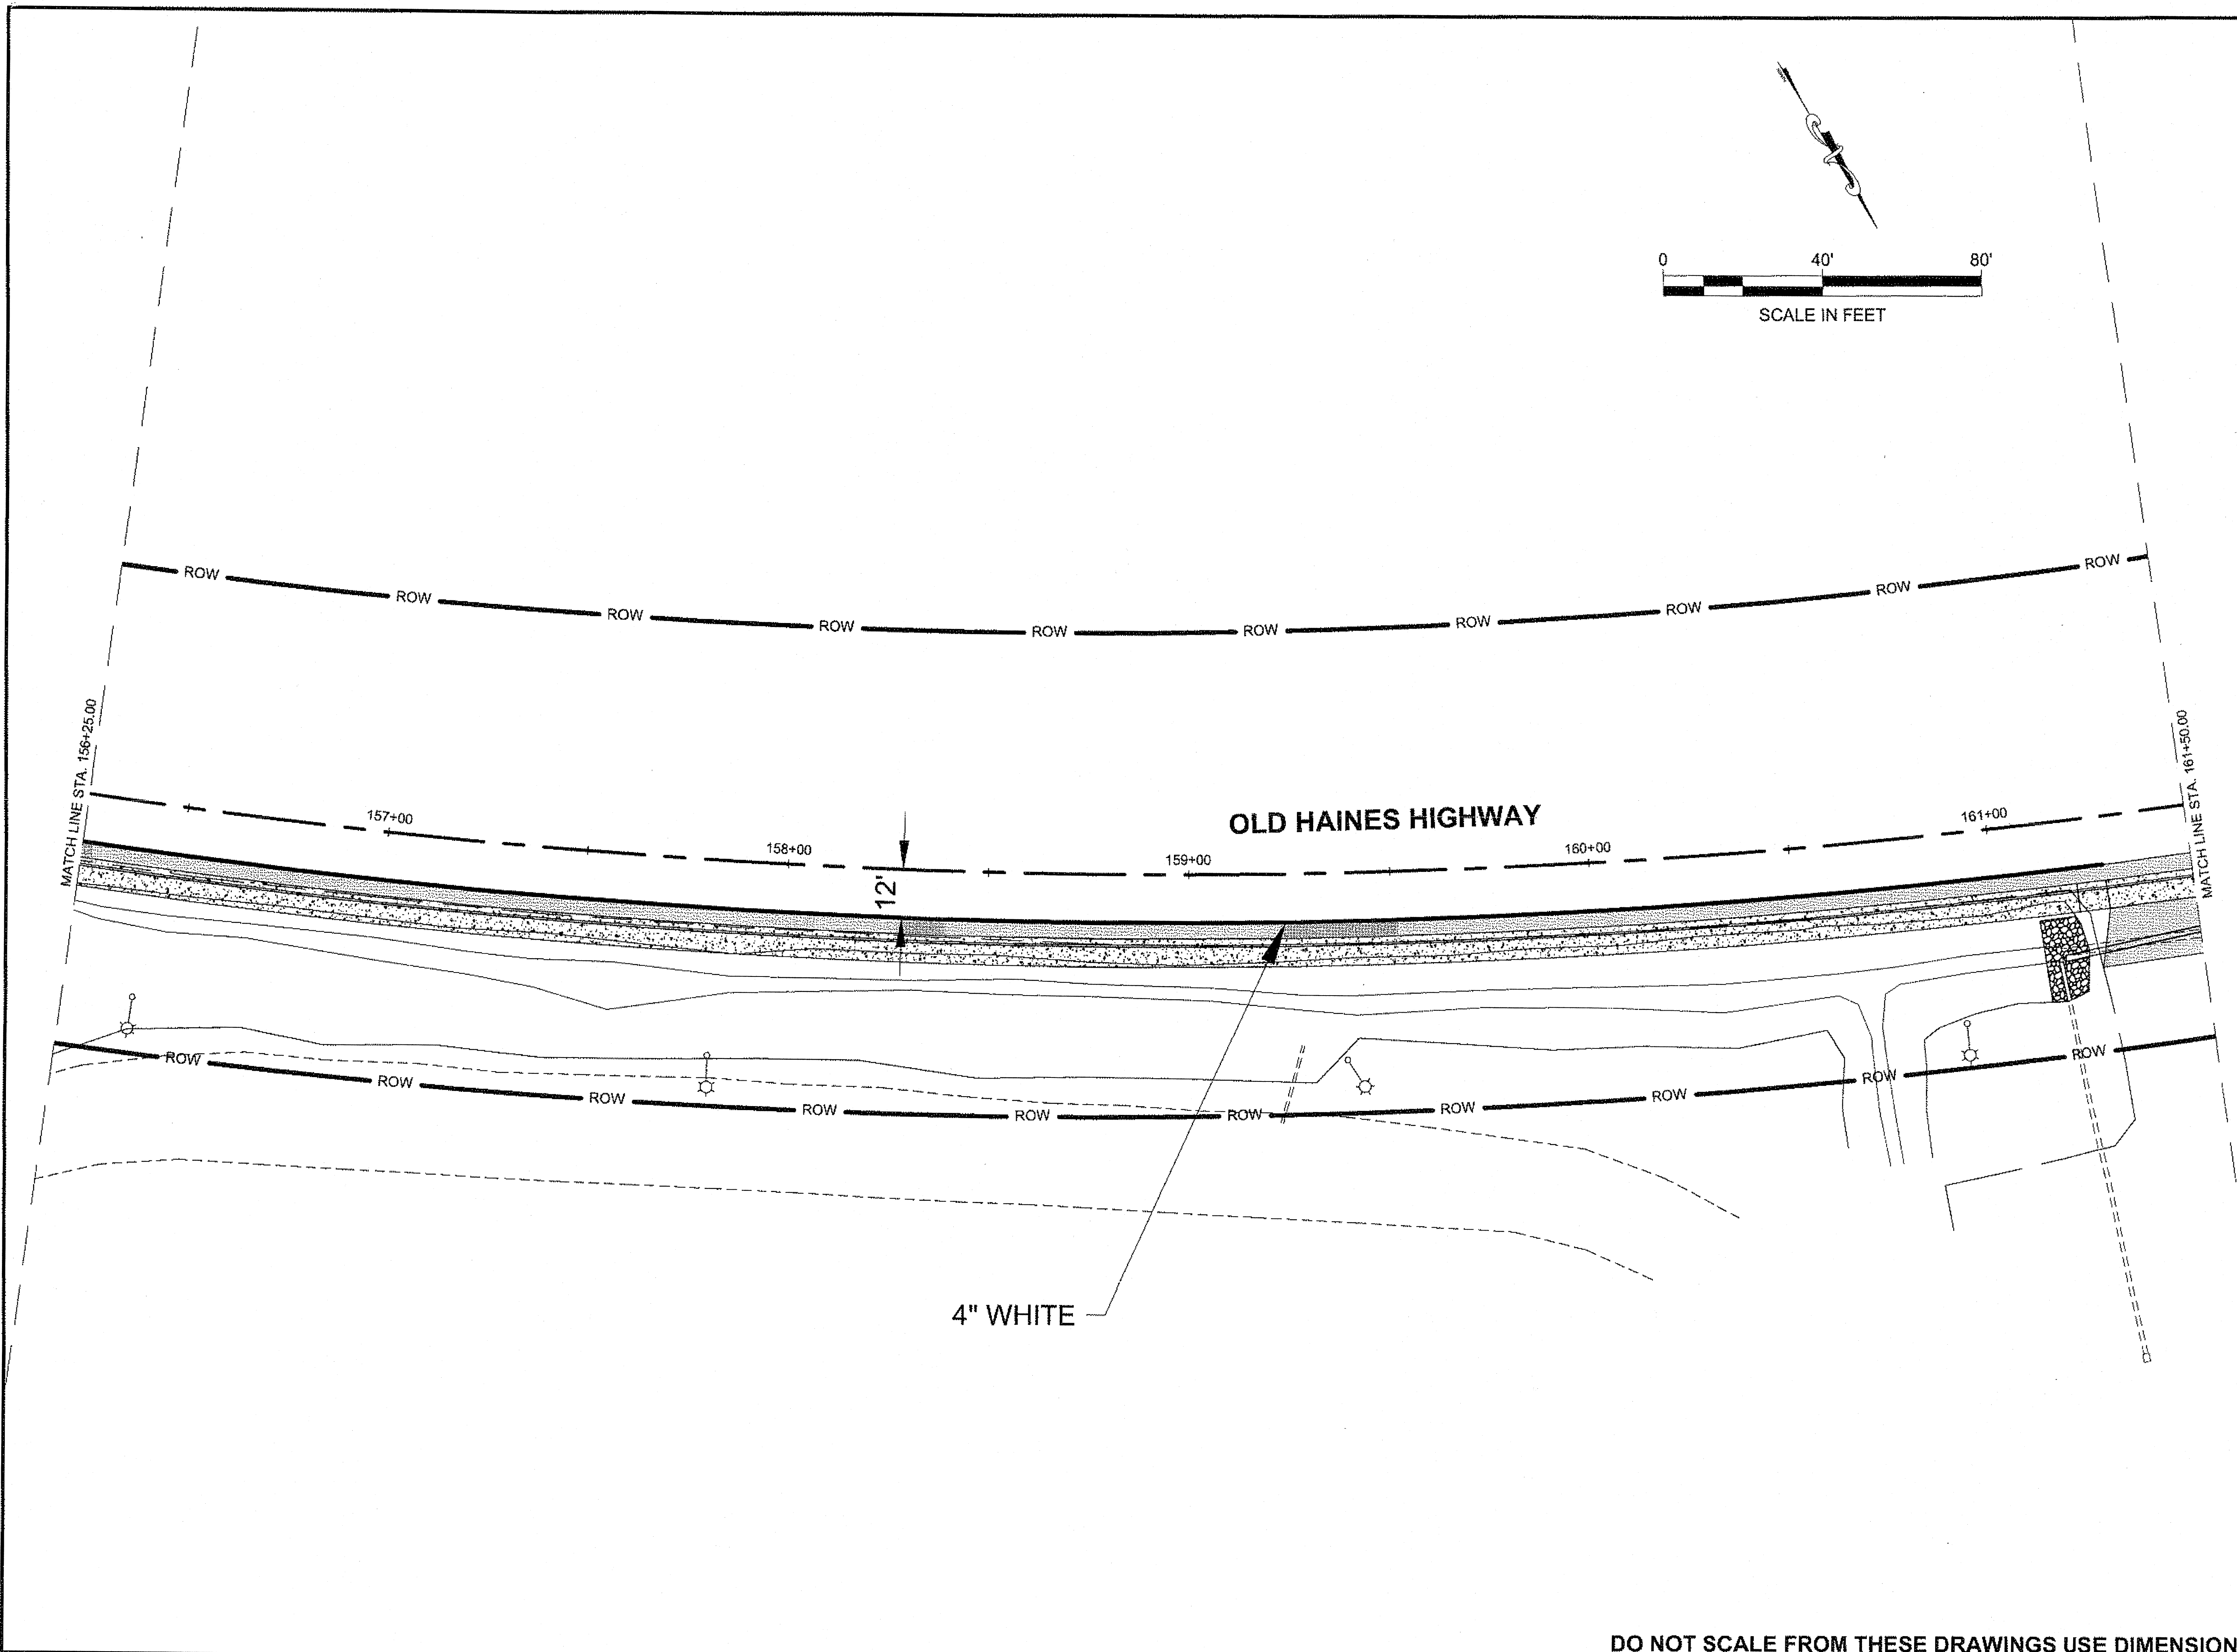

PATH: Q:\HNS\67555\EN\DOUG'S FILE\R_SIGN & STRIPING SHT.DWG


MULLINER, DOUGLAS J (DOT)
 TAB: R2 Friday, April 19, 2013 10:20:29 AM

ADDENDUM NUMBER

ATTACHMENT NUMBER


RECORD OF REVISIONS

No.	DATE	DESCRIPTION

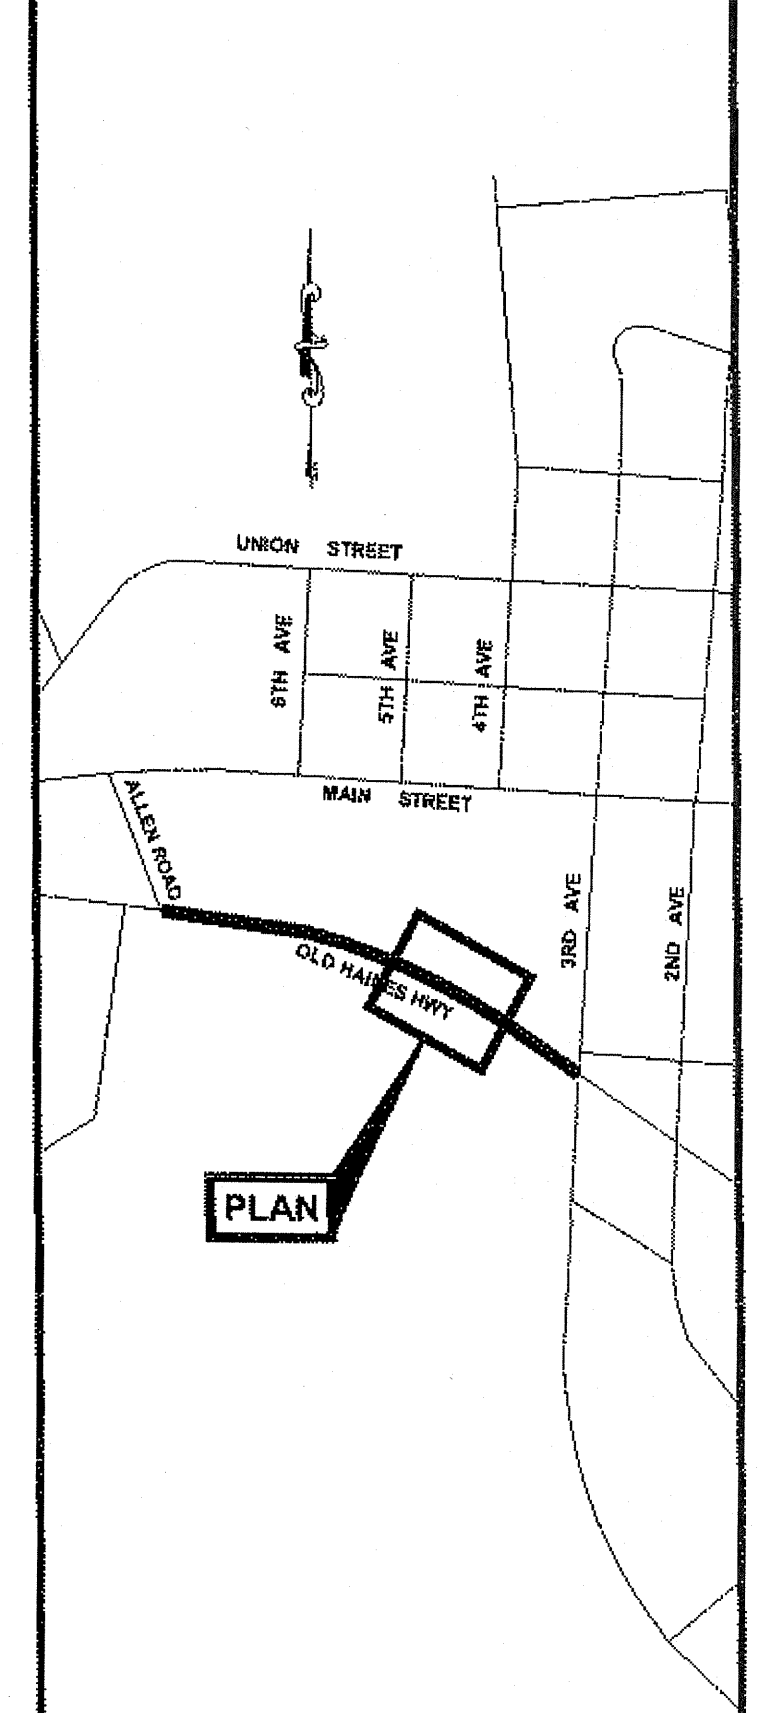

PLAN LEGEND

CHECKED BY: D. EPSTEIN

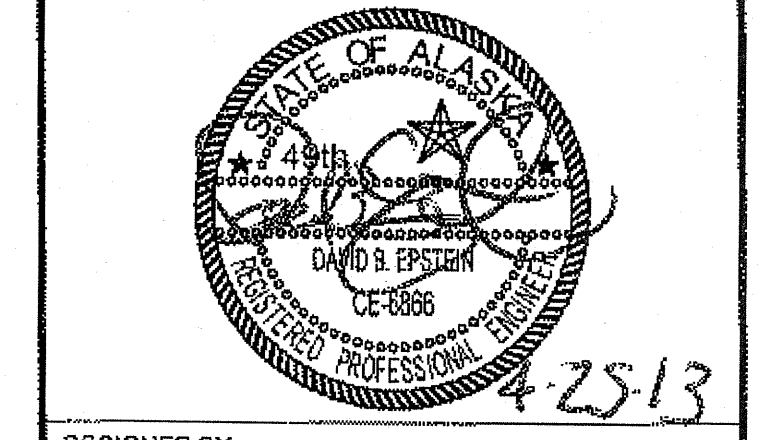

DESIGNED BY: D. MULLINER
 DRAWN BY: D. MULLINER

STATE OF ALASKA
 DEPARTMENT OF TRANSPORTATION
 & PUBLIC FACILITIES
 SOUTHEAST REGION

**HNS-OLD HAINES HIGHWAY
 SIDEWALK 3rd AVENUE
 TO ALLEN ROAD
 PROJECT #67555**

**SIGNING &
 STRIPING**


PROJECT DESIGNATION

SRTS-0987(007) ~ 67555

STATE	YEAR
ALASKA	2013
SHEET NUMBER	TOTAL SHEETS
R2	29

DO NOT SCALE FROM THESE DRAWINGS USE DIMENSIONS

1-7-14

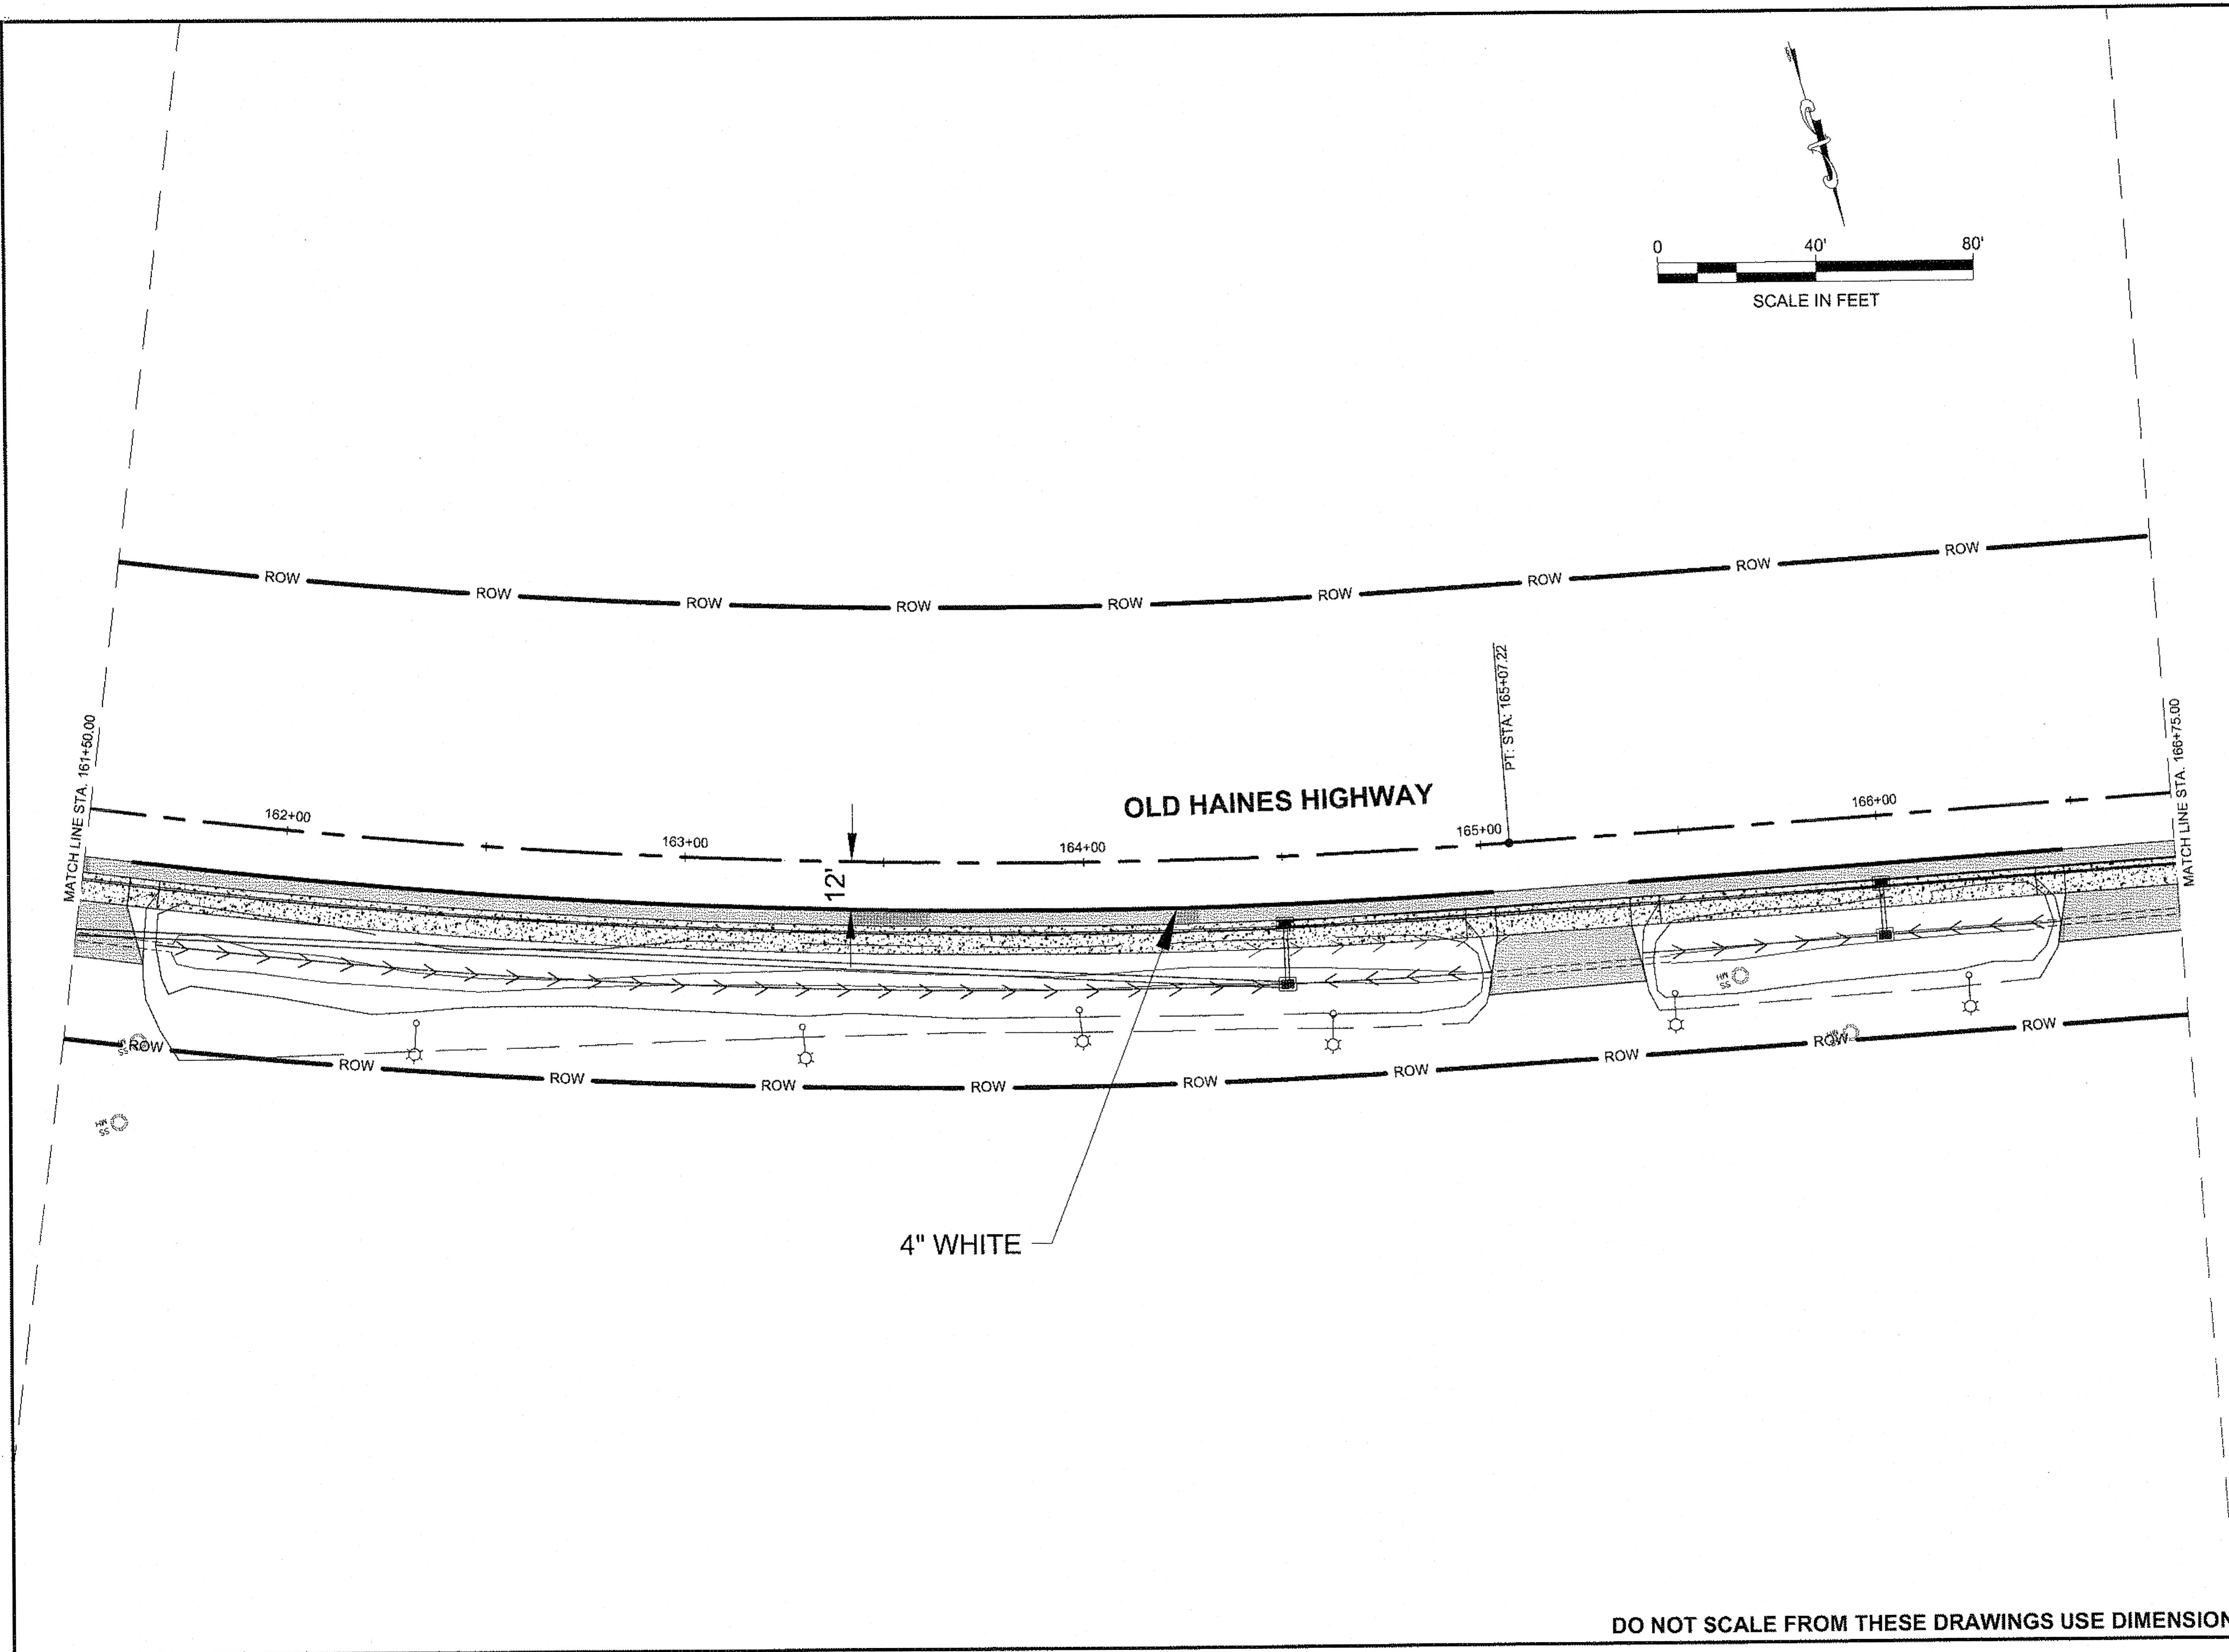

PATH: Q:\HNS\67555\EN\DOUG'S FILE\R_SIGN & STRIPING SHT.DWG


MULLINER, DOUGLAS J (DOT)
 TAB: R3 Friday, April 19, 2013 10:20:39 AM

ADDENDUM NUMBER

ATTACHMENT NUMBER

RECORD OF REVISIONS

No.	DATE	DESCRIPTION

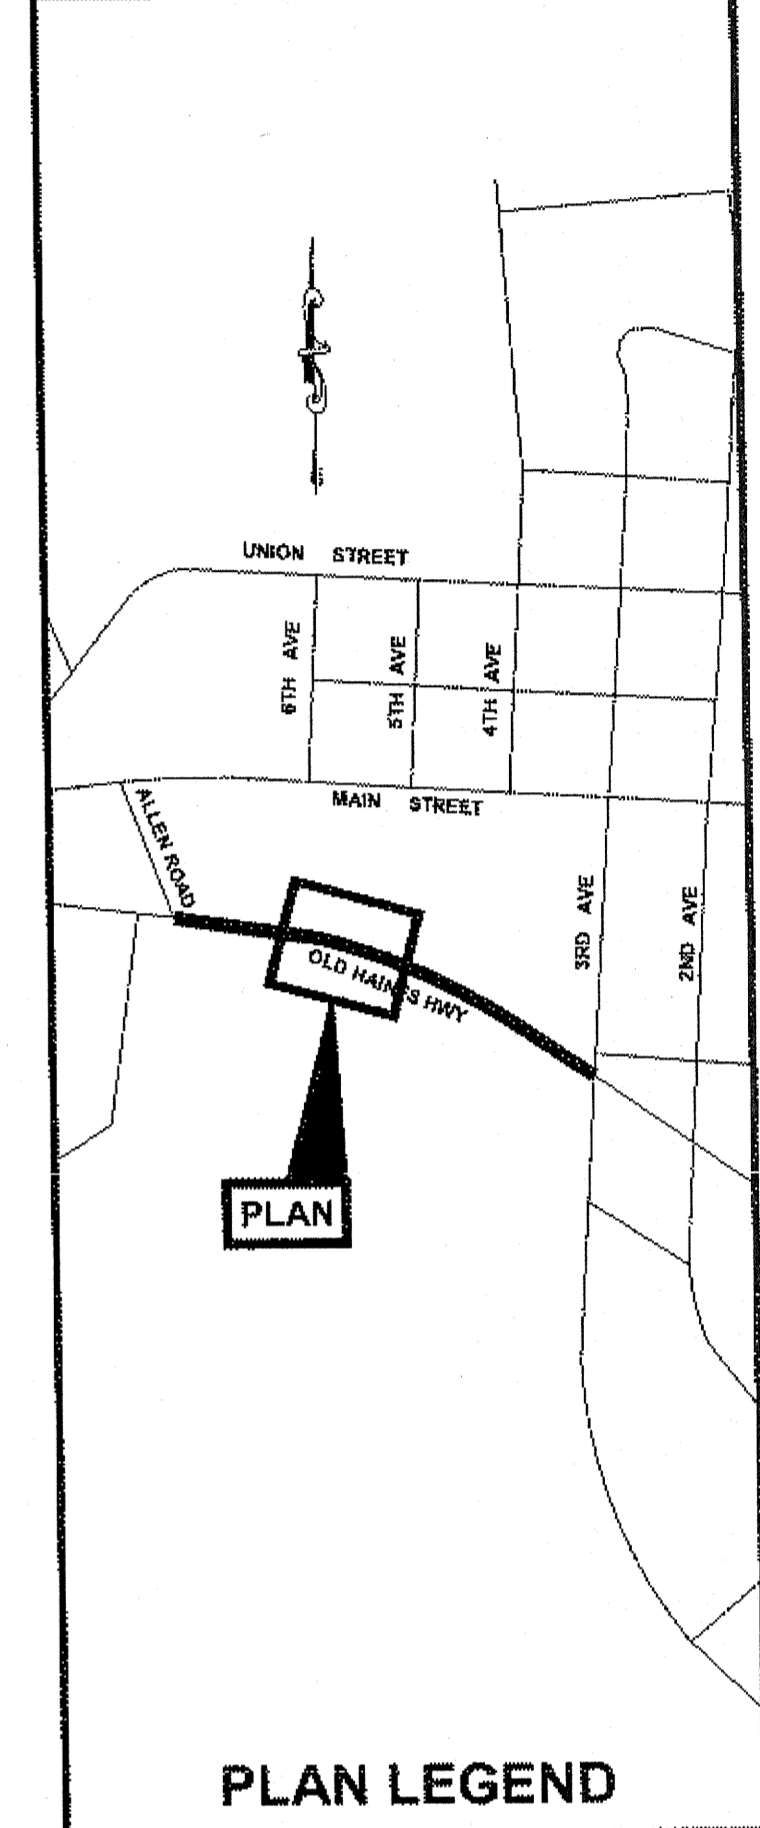

PLAN LEGEND

CHECKED BY: D. EPSTEIN

DESIGNED BY: D. MULLINER

DRAWN BY: D. MULLINER

STATE OF ALASKA
 DEPARTMENT OF TRANSPORTATION
 & PUBLIC FACILITIES
 SOUTHEAST REGION

HNS-OLD HAINES HIGHWAY
 SIDEWALK 3rd AVENUE
 TO ALLEN ROAD
 PROJECT #67555

SIGNING & STRIPING














PROJECT DESIGNATION

SRTS-0987(007) ~ 67555

STATE	YEAR
ALASKA	2013
SHEET NUMBER	TOTAL SHEETS
R3	29

DO NOT SCALE FROM THESE DRAWINGS USE DIMENSIONS

BS
1-7-14

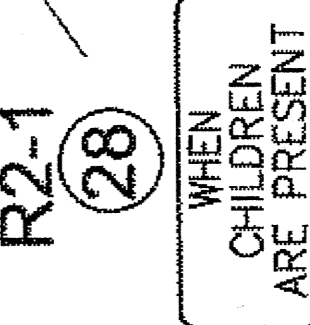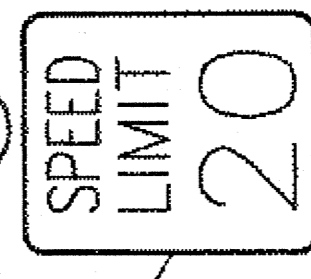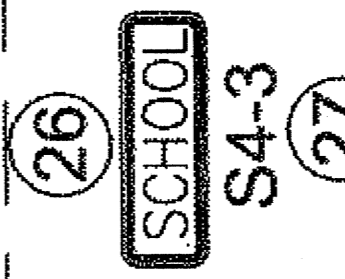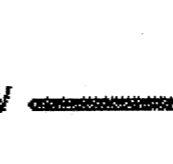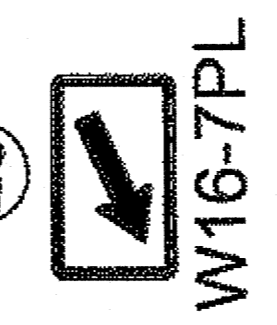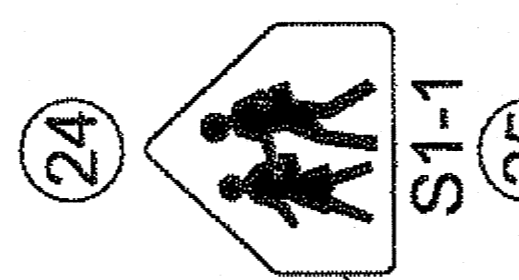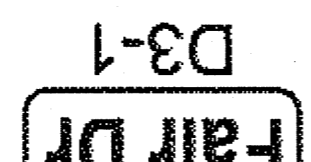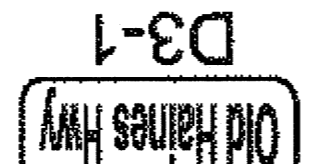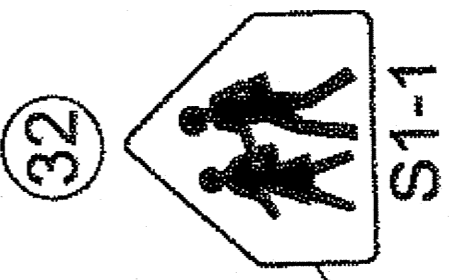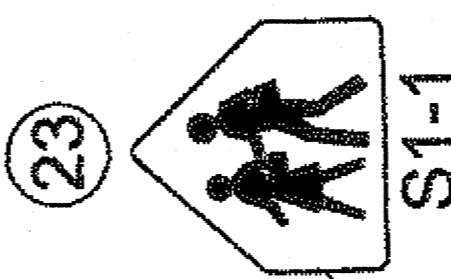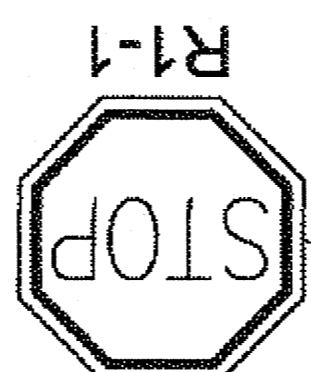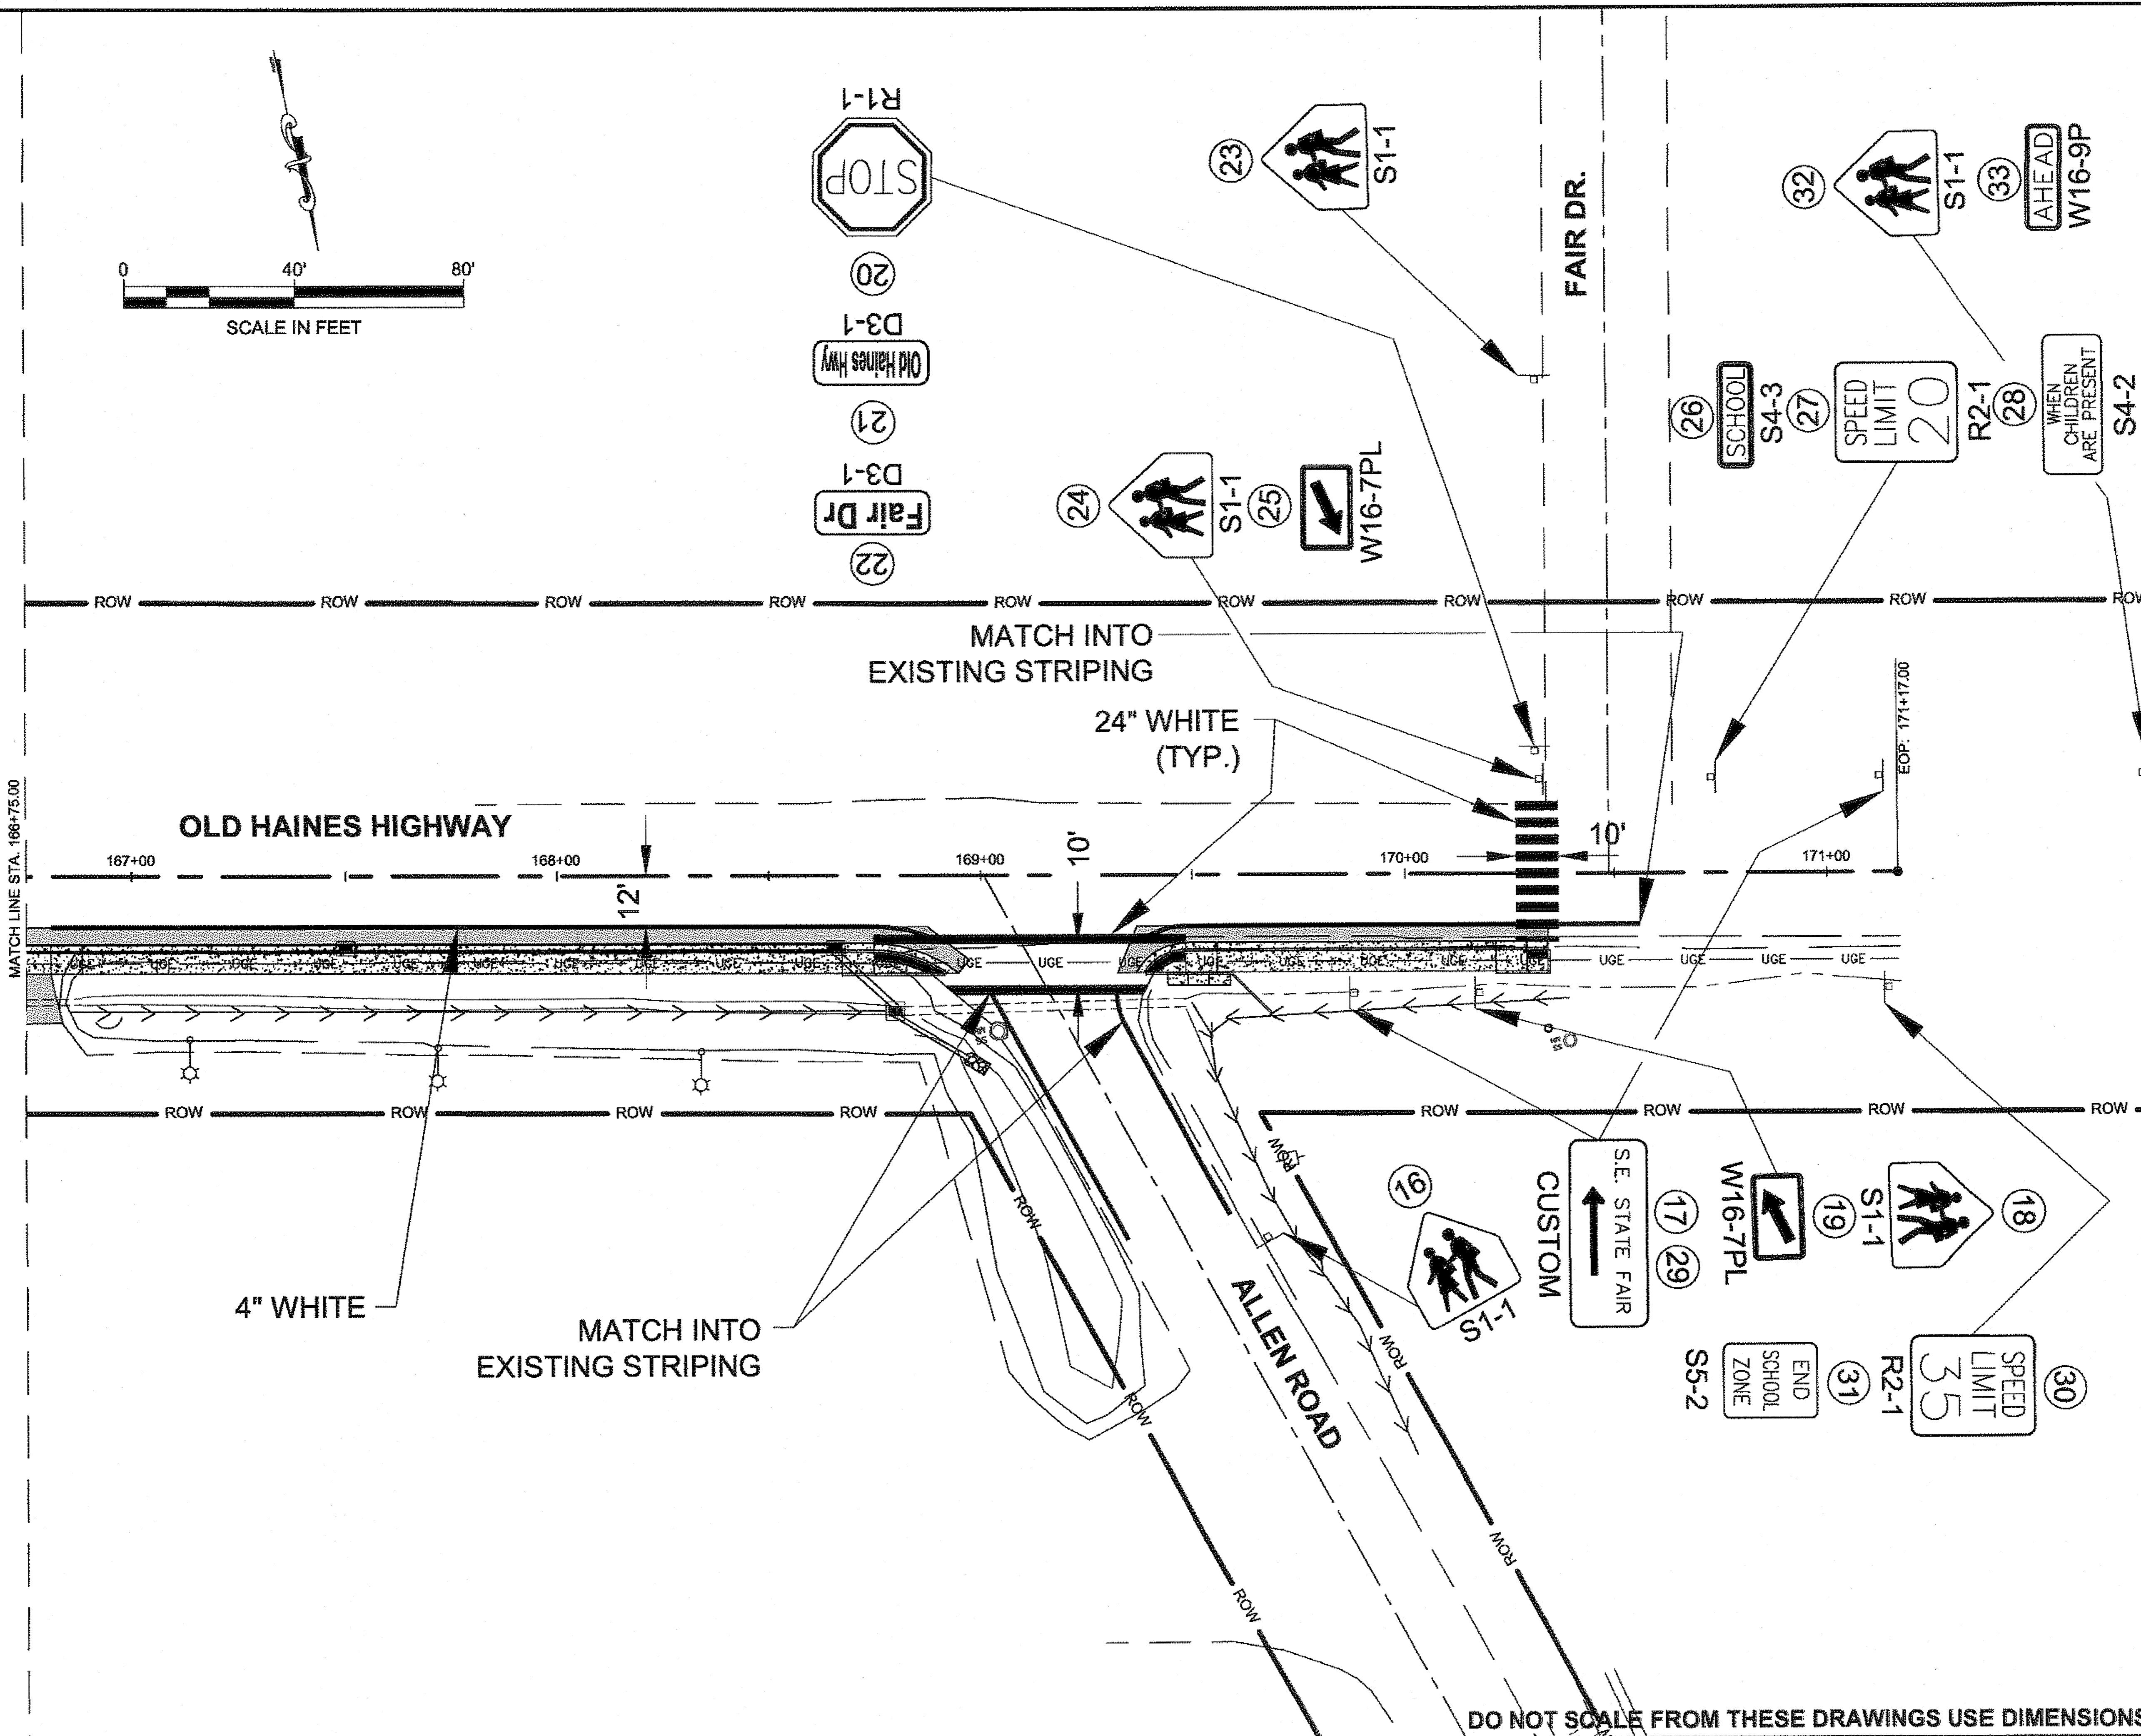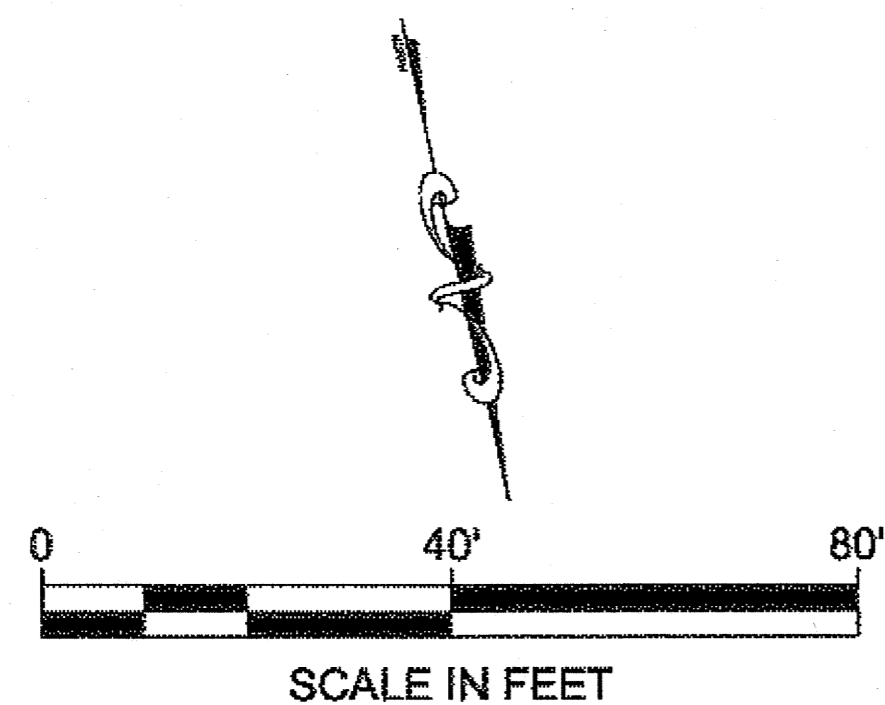


MATCH LINE STA. 166+75.00

PATH: Q:\HNS\67555\END\DOUG'S FILE\SIGN & STRIPING SHT.DWG

MULLINER, DOUGLAS J (DOT)
TAB: R4 Wednesday, May 15, 2013 10:48:28 AM


ADDENDUM NUMBER
ATTACHMENT NUMBER

RECORD OF REVISIONS		
No.	DATE	DESCRIPTION

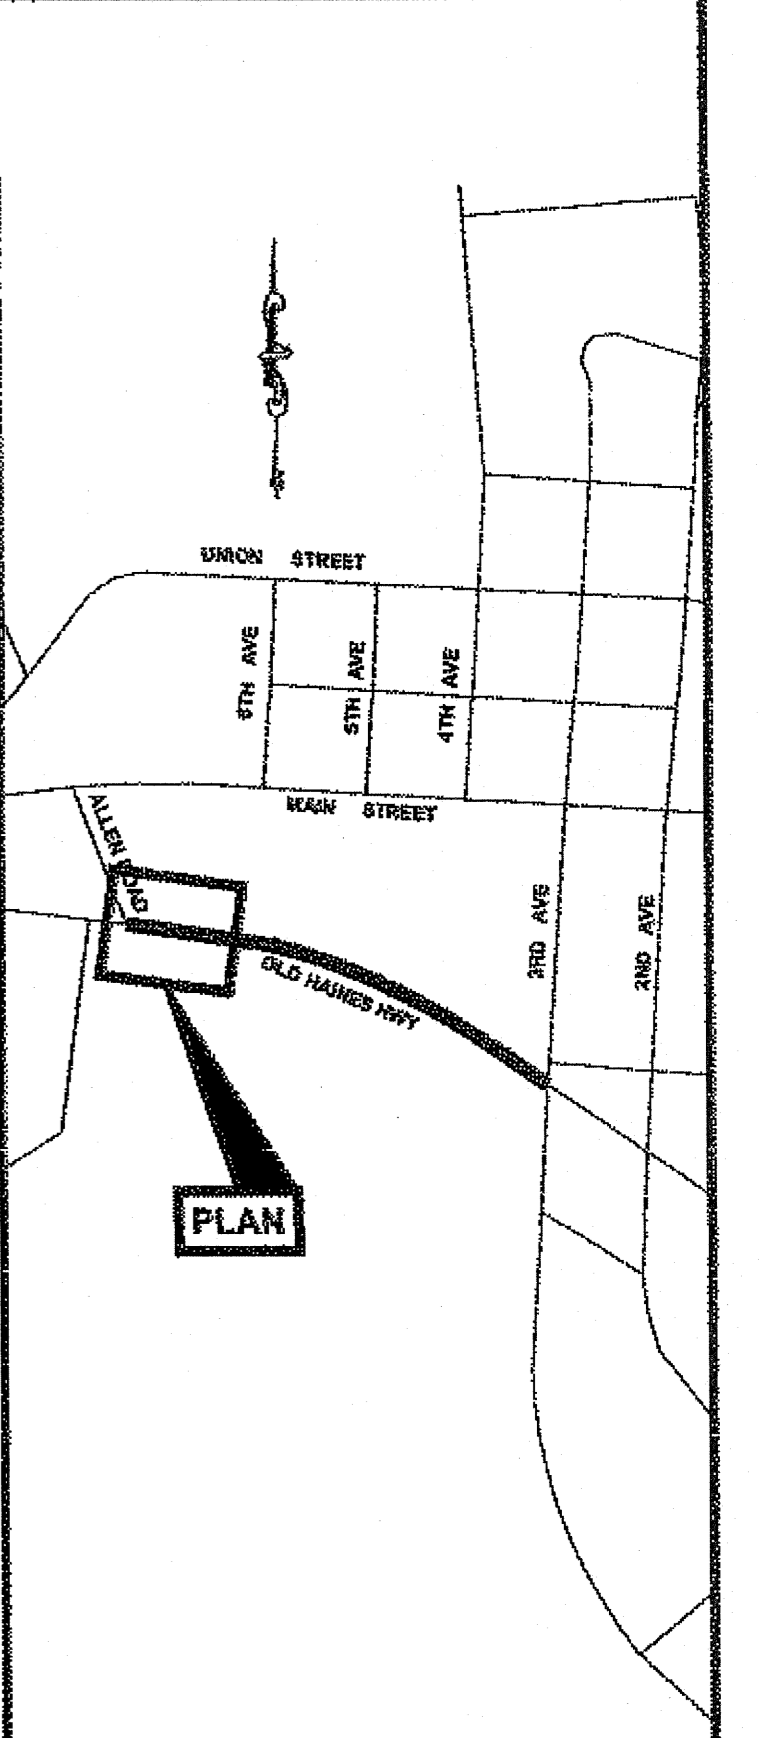

PLAN LEGEND

CHECKED BY: D. EPSTEIN

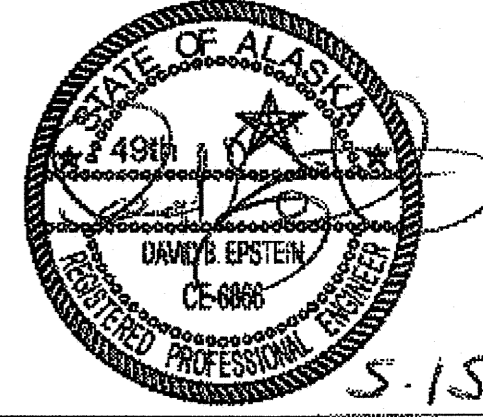

DESIGNED BY: D. MULLINER
DRAWN BY: D. MULLINER


STATE OF ALASKA
DEPARTMENT OF TRANSPORTATION & PUBLIC FACILITIES
SOUTHEAST REGION
HNS-OLD HAINES HIGHWAY
SIDEWALK 3rd AVENUE
TO ALLEN ROAD
PROJECT #67555

SIGNING & STRIPING

PROJECT DESIGNATION
SRTS-0987(007) ~ 67555


STATE	YEAR
ALASKA	2013
SHEET NUMBER	TOTAL SHEETS
R4	29

1-7-14

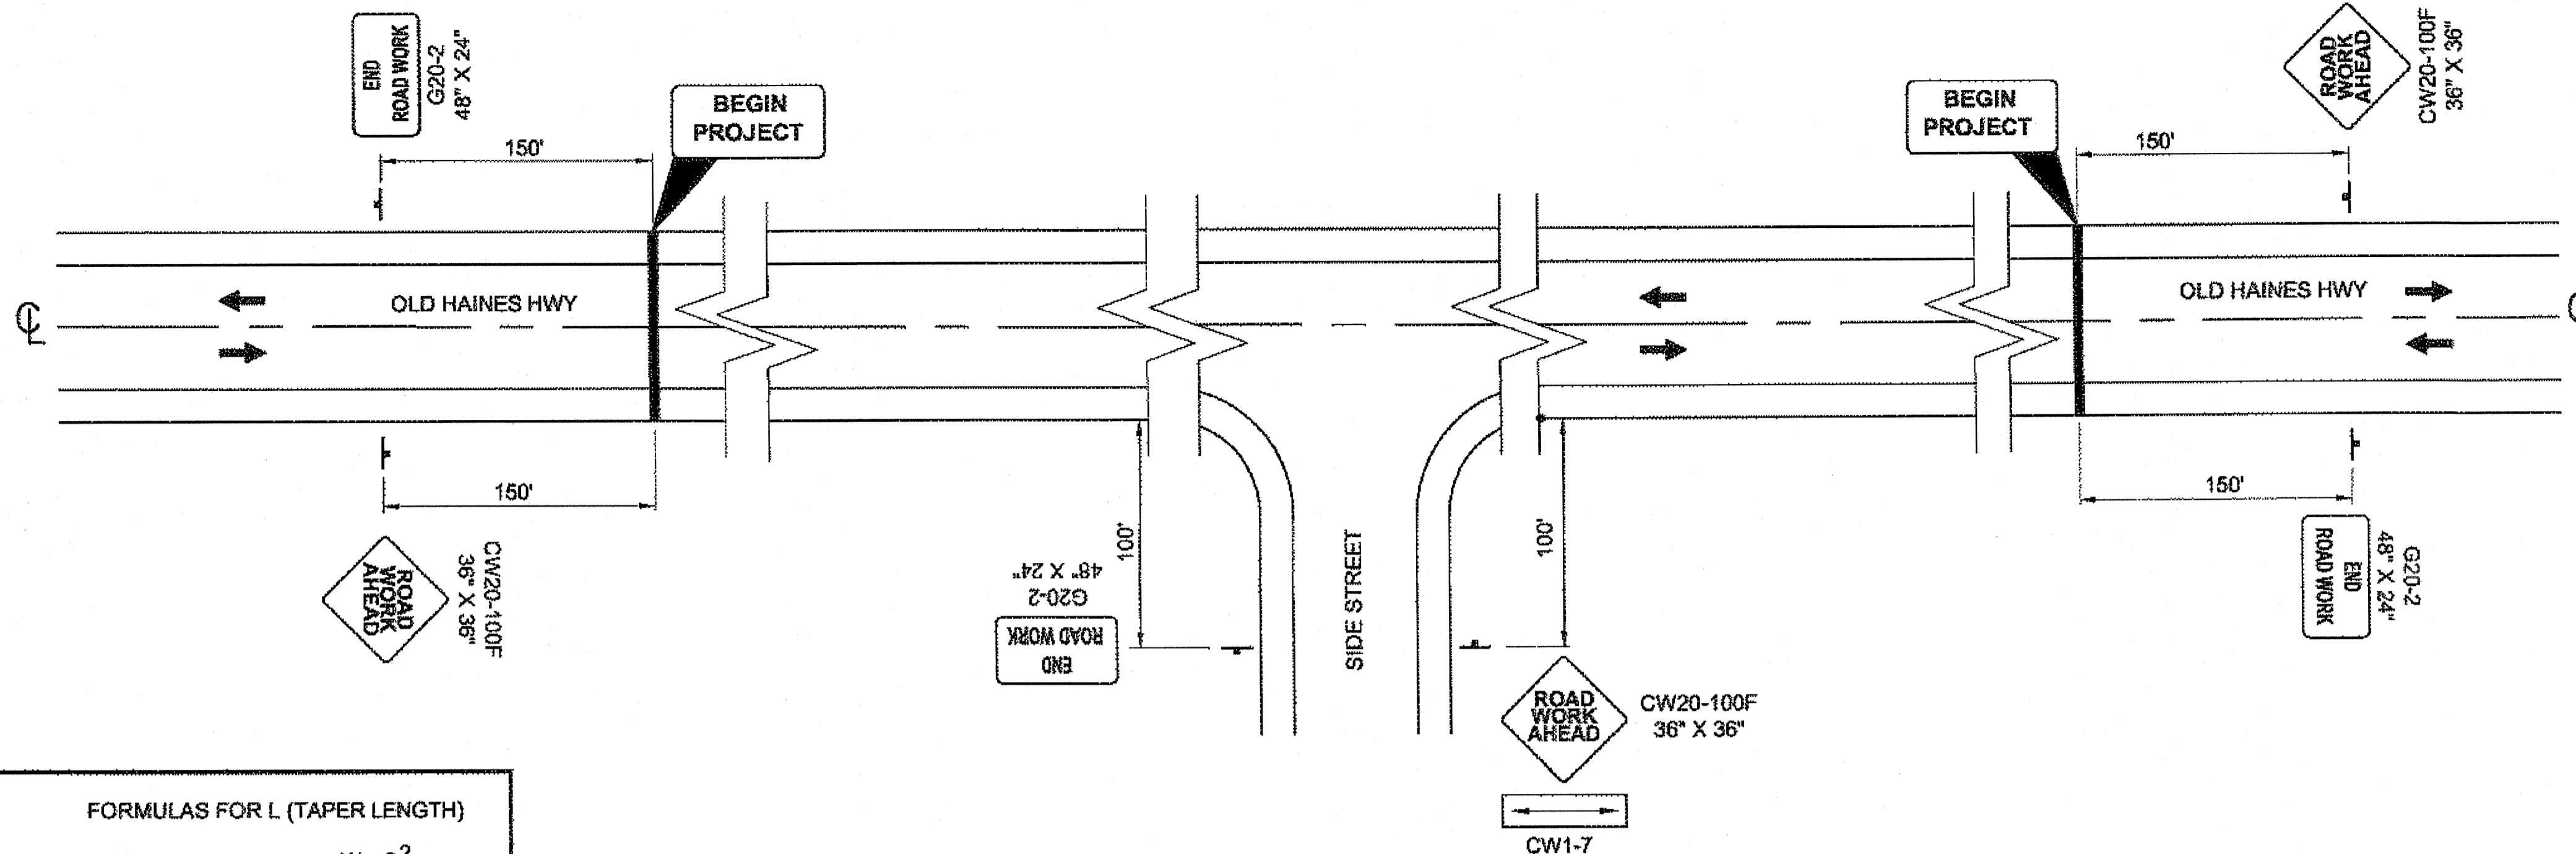

PERMANENT CONSTRUCTION SIGNING

N.T.S.

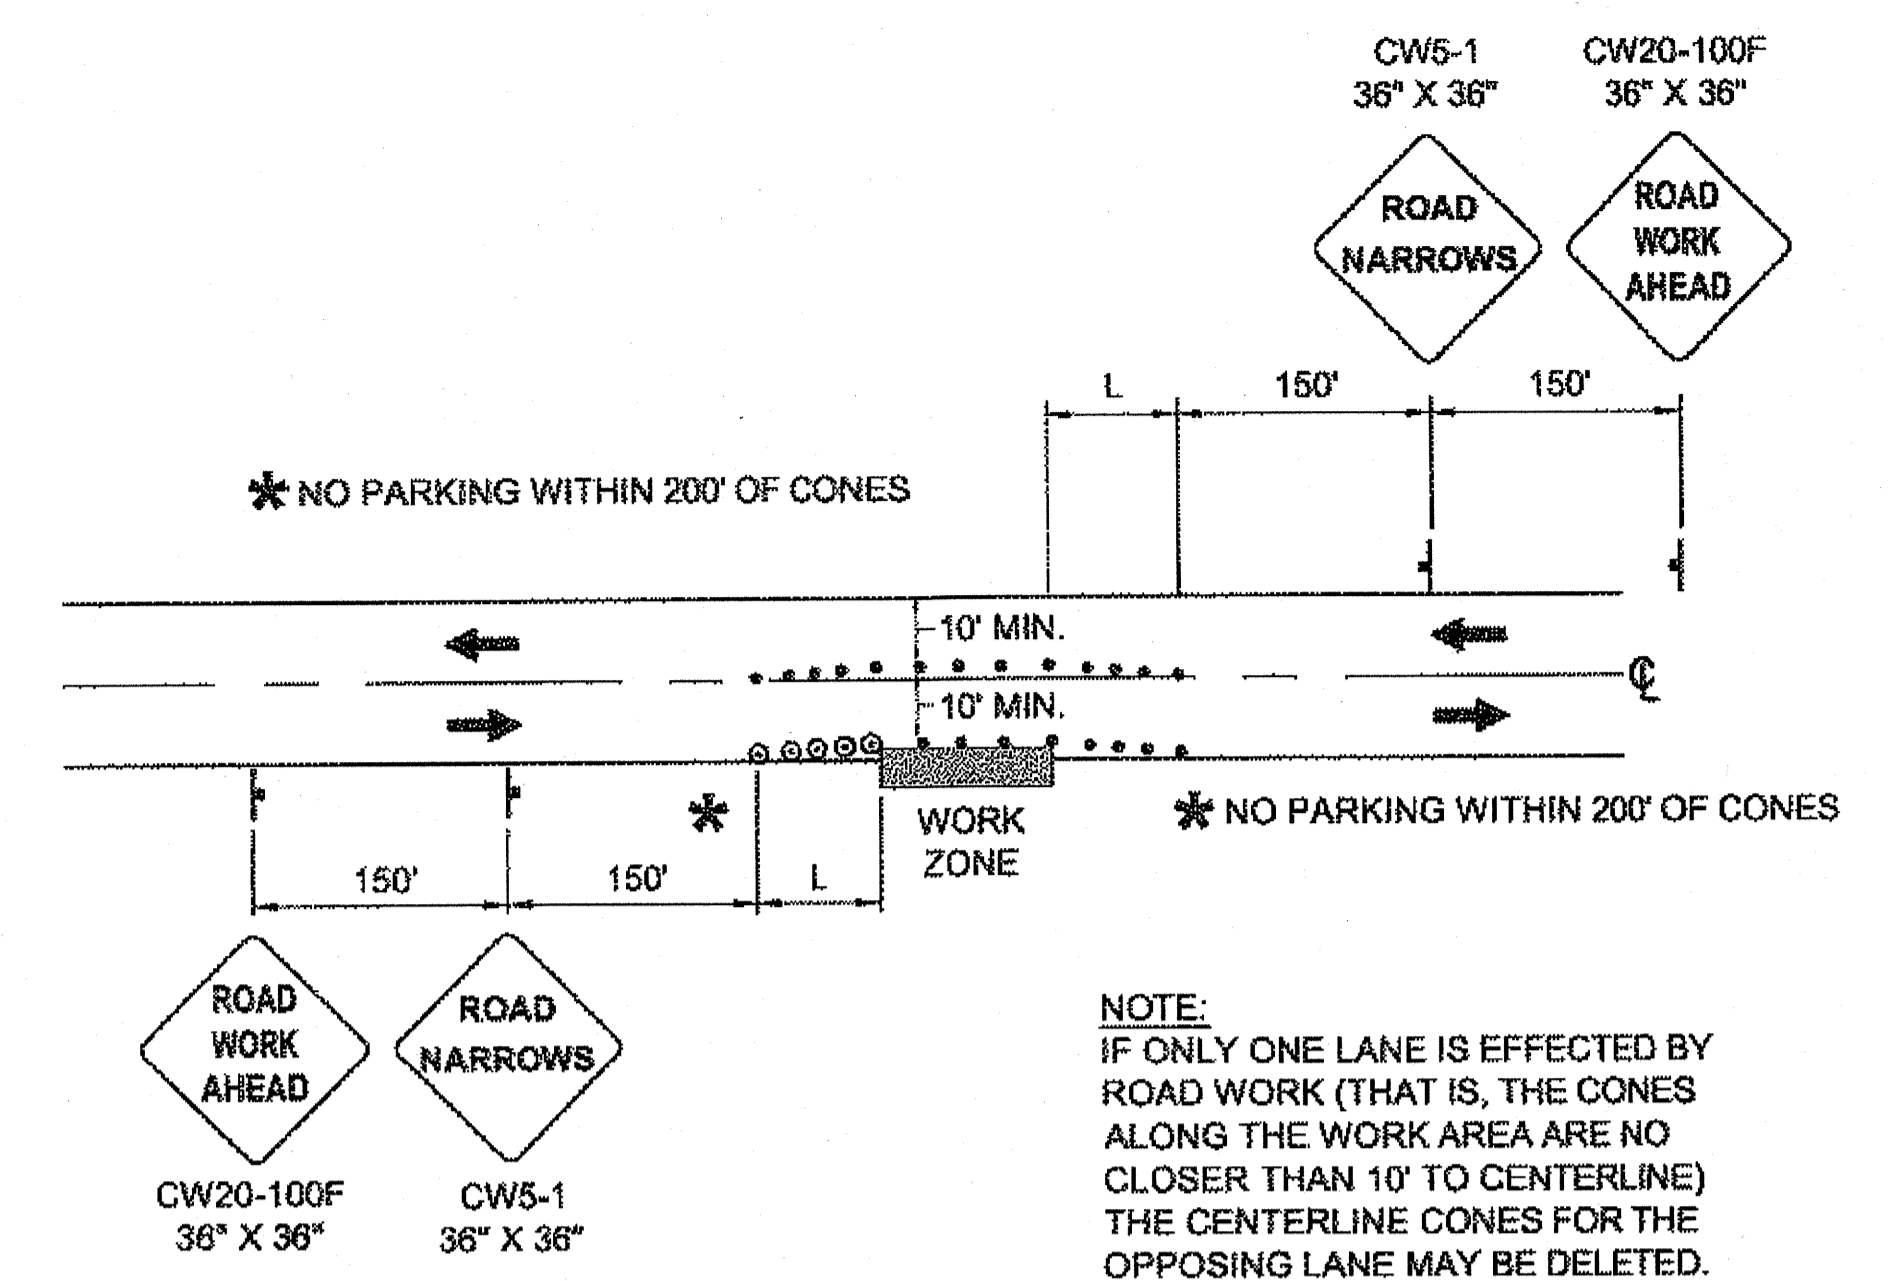

ROADWAY ENCROACHMENT

N.T.S.

FORMULAS FOR L (TAPER LENGTH)

40 MPH OR LESS $L = \frac{W \times S^2}{80}$

45 MPH OF GREATER $L = W \times S$


WHERE W=WIDTH OF OFFSET
S= POSTED SPEED LIMIT

TCP SETUP TABLE

SPEED (MPH)	MIN MERGING TAPER LENGTH (L) IN FEET WIDTH OF OFFSET (W) IN FEET			MIN NUMBER OF DEVICES WIDTH OF OFFSET (W) IN FEET			MAX DEVICE SPACING IN FEET		BUFFER SPACE (FT)
	10'	11'	12'	10'	11'	12'	ALONG TAPER	ALONG TANGENT	
25 OR BELOW	105	115	125	6	6	6	25	50	155
30	150	165	180	6	7	7	30	60	200
35	205	225	245	7	8	8	35	70	250
40	270	295	320	8	9	9	40	80	305
45	450	495	540	11	12	13	45	90	360
50	500	550	600	11	12	13	50	100	425
55	550	605	660	11	12	13	55	110	495
60	600	660	720	11	12	13	60	120	570

TRAFFIC CONTROL NOTES:

- IT IS THE INTENT OF THIS TRAFFIC CONTROL PLAN (TCP) TO ILLUSTRATE SOME BUT NOT ALL OF THE TRAFFIC CONTROL CONFIGURATIONS THAT WILL BE REQUIRED BY THIS PROJECT. TRAFFIC CONTROL PLANS FOR CONFIGURATION NOT COVERED BY THIS TCP SHALL BE DEVELOPED BY THE CONTRACTOR AND SUBMITTED TO THE ENGINEER FOR APPROVAL PRIOR TO USE.
- A MINIMUM OF ONE LANE SHALL BE MAINTAINED AT ALL TIMES IN WORK AREAS.
- TWO LANES SHALL BE MAINTAINED AT ALL TIMES WITHIN THE PROJECT LIMITS IN NON-WORK AREAS AND DURING NON-WORKING HOURS.
- DRIVING LANES SHALL BE A MINIMUM WIDTH OF 10'.
- TRAFFIC DELAYS SHALL NOT EXCEED 10 MINUTES.
- THE UNEVEN LANES (W8-11) SIGN SHOULD BE USED DURING OPERATIONS THAT CREATE A GREATER THAN 1" DIFFERENCE IN ELEVATION ON A VERTICAL OR NEAR-VERTICAL EDGE BETWEEN ADJACENT LANES THAT ARE OPEN TO TRAVEL.
- FLAGGER STATIONS NEED TO BE ILLUMINATED AT NIGHT.
- THE CONTRACTOR SHALL KEEP THE PUBLIC INFORMED OF HIS/HER CONSTRUCTION ACTIVITIES THROUGH THE USE OF THE LOCAL NEWS MEDIA. NEWS RELEASES SHALL BE APPROVED BY THE PROJECT ENGINEER PRIOR TO THEIR RELEASE. NEWS RELEASES WILL BE REQUIRED BUT NOT LIMITED TO, THE ONSET OF WORK, GRINDING, PAVING AND CHANGES IN THE LANE CONFIGURATIONS.
- FOR LOCATION OF DOUBLE TRAFFIC FINE SIGNS SEE ALASKA STANDARD DRAWING C-04.12.
- FOR LOCATION OF PEDESTRIAN TRAFFIC CONTROL SIGNS SEE ALASKA STANDARD DRAWING C-03.10

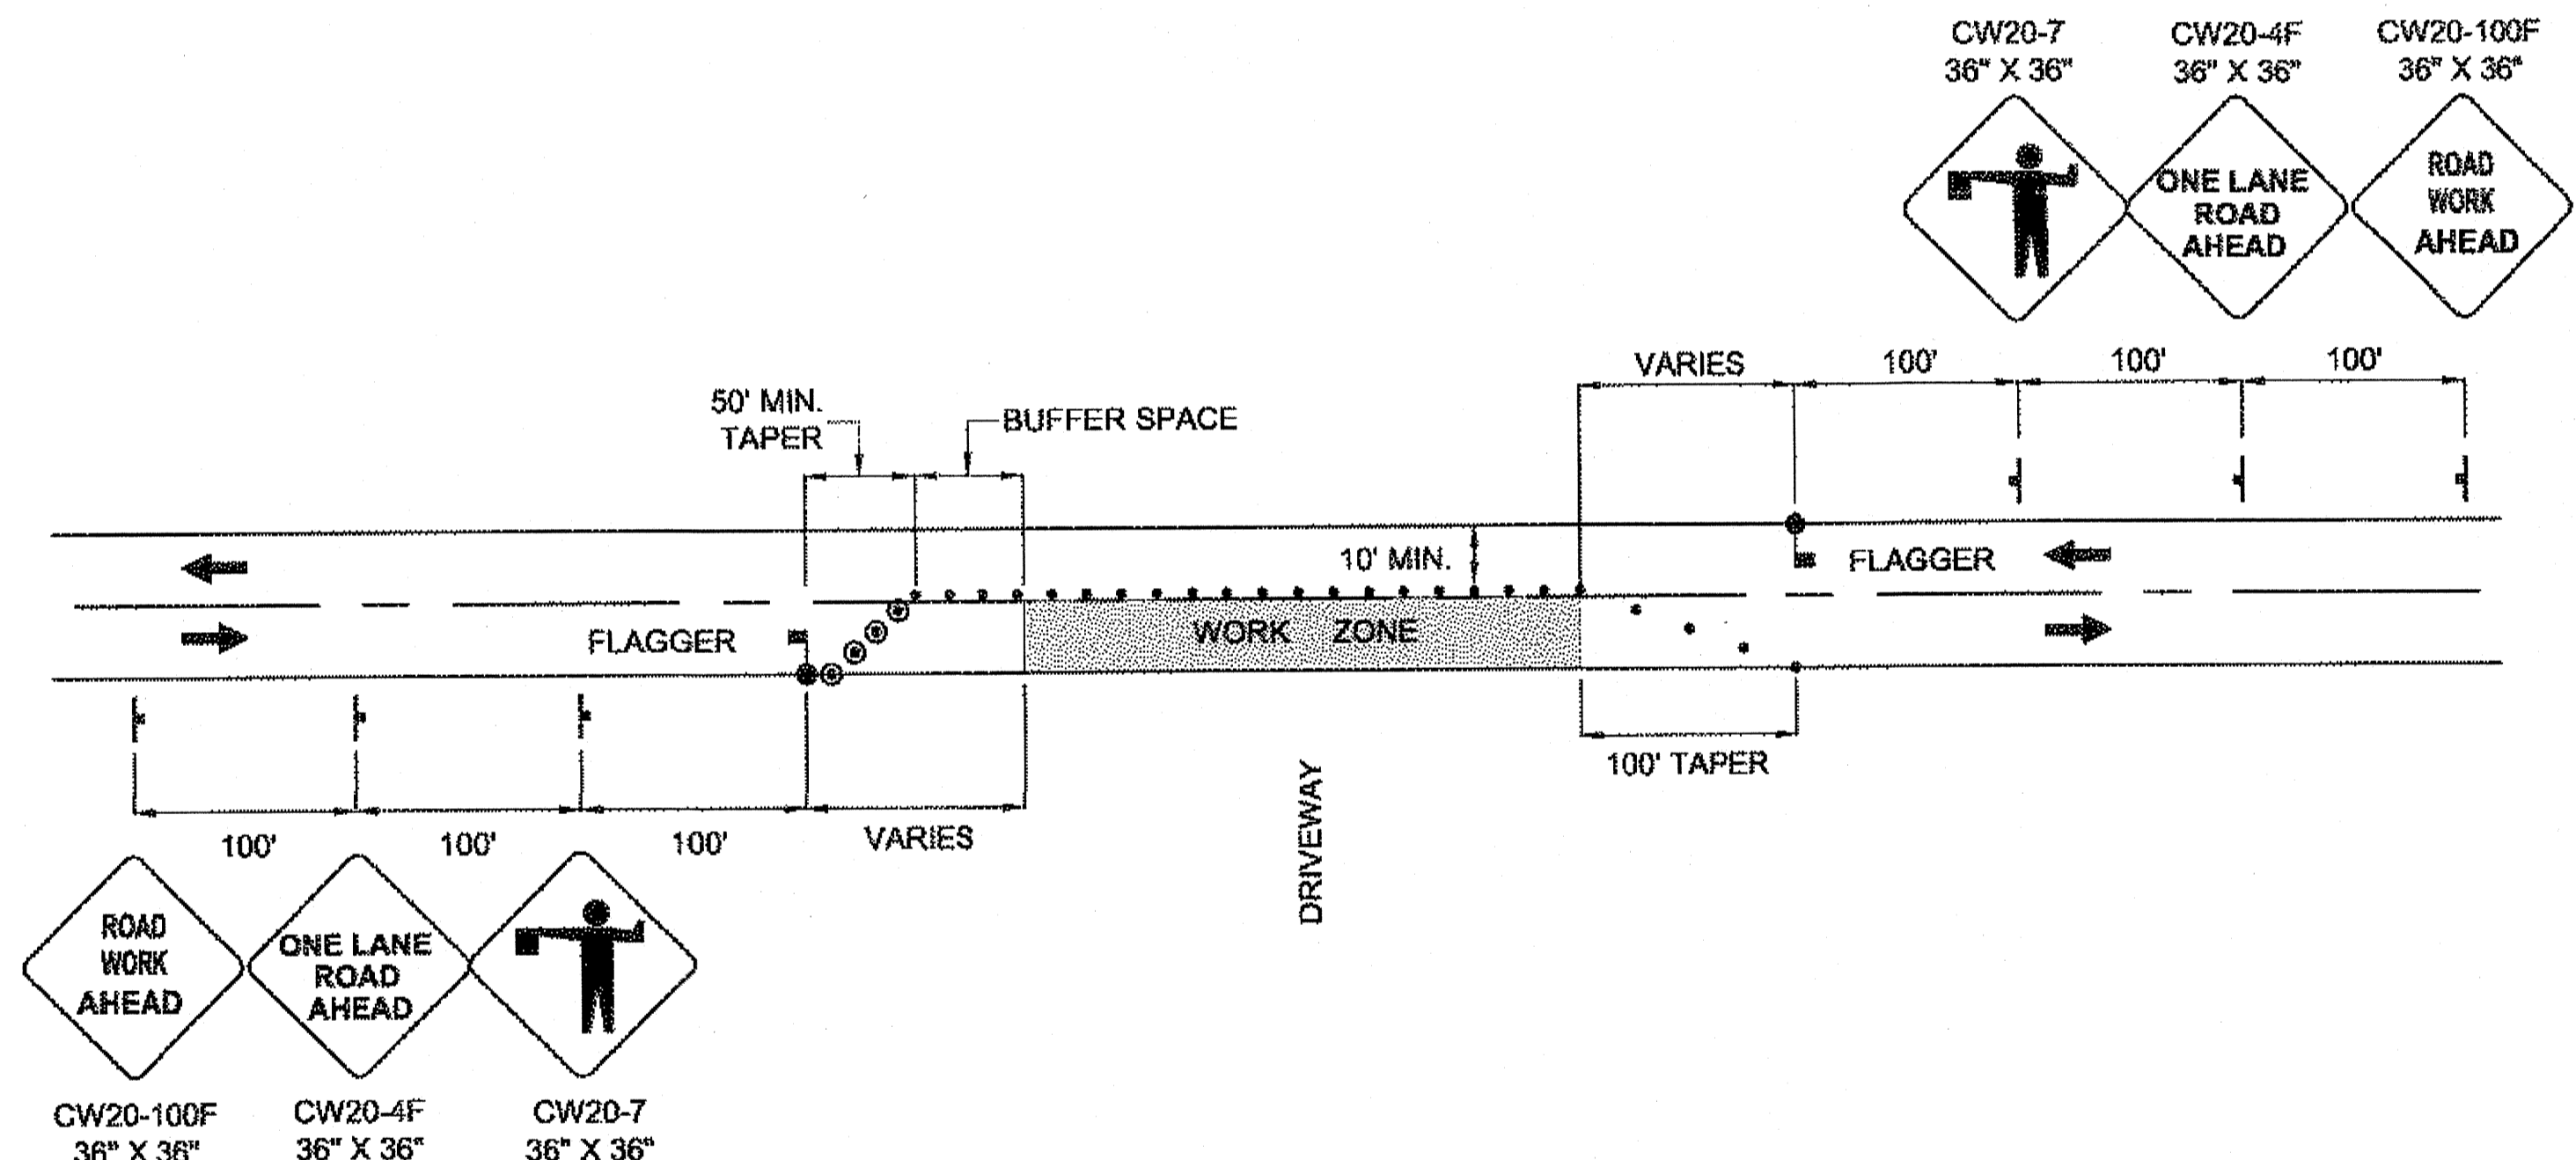

TWO LANE ROADWAY-SINGLE LANE CLOSURE

N.T.S.

LEGEND

	SIGN
	CONE
	DRUM
	TYPE III BARRICADE
	FLAGGING STATION

DO NOT SCALE FROM THESE DRAWINGS USE DIMENSIONS

CHECKED BY: D. EPSTEIN	STATE OF ALASKA DEPARTMENT OF TRANSPORTATION & PUBLIC FACILITIES SOUTHEAST REGION			
DESIGNED BY: D. MULLINER	HNS-OLD HAINES HIGHWAY SIDEWALK 3rd AVENUE TO ALLEN ROAD PROJECT #67555			
DRAWN BY: D. MULLINER	TRAFFIC CONTROL PLAN			
PATH: Q:\HNS\67555\ENDOU\G'S FILES_TOP SHT.DWG	REVISIONS	PROJECT DESIGNATION	YEAR	SHEET NO.
TAB: S1	NO. DATE DESCRIPTION	SRTS-0987(007)-67555	2013	S1
Wednesday, April 24, 2013 8:38:42 AM				TOTAL SHEETS
				29

1-7-14