

State of Alaska

Department of Transportation
and Public Facilities

Southeast Region

HAINES, ALASKA


SEA NOVEMBER 2005 STORM PERMANENT REPAIRS

69236 / ER-0079(2)


HAINES HIGHWAY

PERMANENT TRAFFIC RECORDER

NH-095-6(31) / 67778

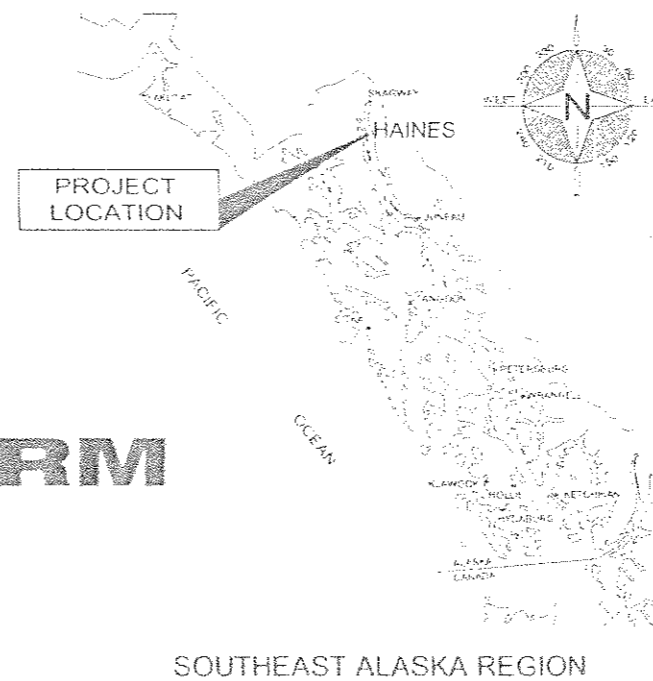

INDEX	
SHEET NO.	DESCRIPTION
A1	TITLE SHEET
A2-A7	SURVEY DATA SHEETS
B1-B2	TYPICAL SECTIONS
C1	ESTIMATE OF QUANTITIES
D1	SUMMARY SHEETS
E1	MISCELLANEOUS DETAILS
F1-F6	PLAN AND PROFILE SHEETS
H1-H9	DRAINAGE DETAILS
Q1-Q3	HNS. HWY. PTR REPLACEMENT PLANS
S1-S2	TRAFFIC CONTROL PLANS
T1-T3	EROSION & SEDIMENT CONTROL PLAN
T4	ESCP DETAILS
<p><i>AS Builts</i> Contractor: Southeast Road Builders Project Engineer: Allen Culbreath Begin Date: 9-21-08 End Date: 8-24-09</p>	
<p>Project As-Built Drawings have been reviewed by the Project Engineer and represent to the best of my knowledge, the project as constructed. PE <i>Allen Culbreath</i> Date <u>4/29/2011</u></p>	

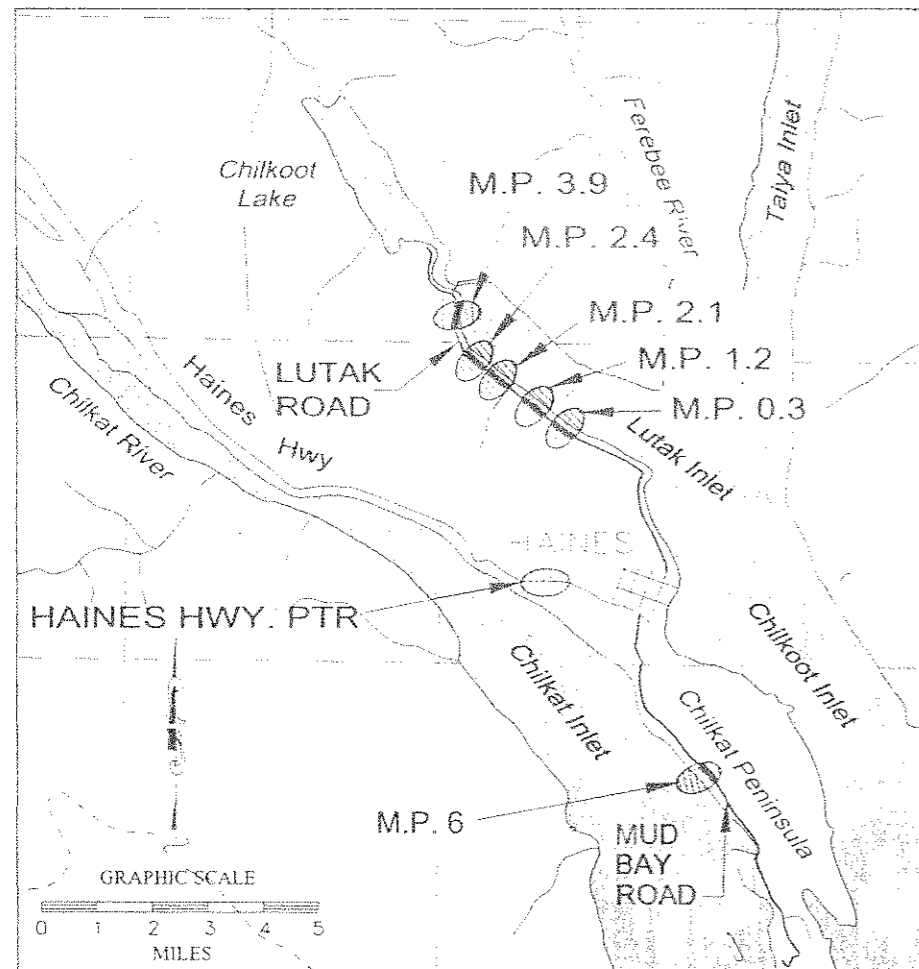

HAINES VICINITY MAP

PROJECT SUMMARY


LENGTH OF GRADING	=	2415.00 ft. (0.46 mi.)
LENGTH OF PAVING	=	2415.00 ft. (0.46 mi.)
LUTAK ROAD SPEED LIMIT	=	40 MPH
LUTAK ROAD ADT	=	829

THE FOLLOWING STANDARD DRAWINGS APPLY TO THIS PROJECT:

A-1	E-00.00	G-15.10
D-01.02	E-13.00	G-20.10
D-04.21	G-00.01	G-28.00
D-07.00	G-04.07W	G-31.00
D-30.01	G-10.01	I-81.00

ROUTE: _____ MILEPOINT: _____
 PATH: Q:\SEA\69236\Plans\Tsh1.dwg
 Thu, 19/Jun/08 11:04AM dastevens
 PLOT: PSPACE OR MSPACE TAB: TSHT


STATE OF ALASKA
 DEPARTMENT OF TRANSPORTATION
 & PUBLIC FACILITIES
 SOUTHEAST REGION

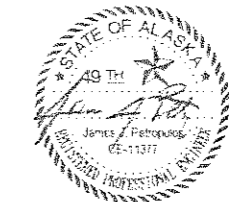

APPROVED: *Victor Winters* 6/20/08
 REGIONAL PRE-CONSTRUCTION ENGINEER
 VICTOR WINTERS, P.E. DATE

APPROVED: *Malcolm A. Menzies* 6/20/08
 DIRECTOR, SOUTHEAST REGION
 MALCOLM A. MENZIES, P.E., U.S.
 CERTIFIED TRUE & CORRECT AS-BUILT OF ACTUAL FIELD CONDITION

STATE	PROJECT DESIGNATION	YEAR	SHEET NO.	TOTAL SHEETS
ALASKA	69236 / ER-0079(2)	2008	A1	36

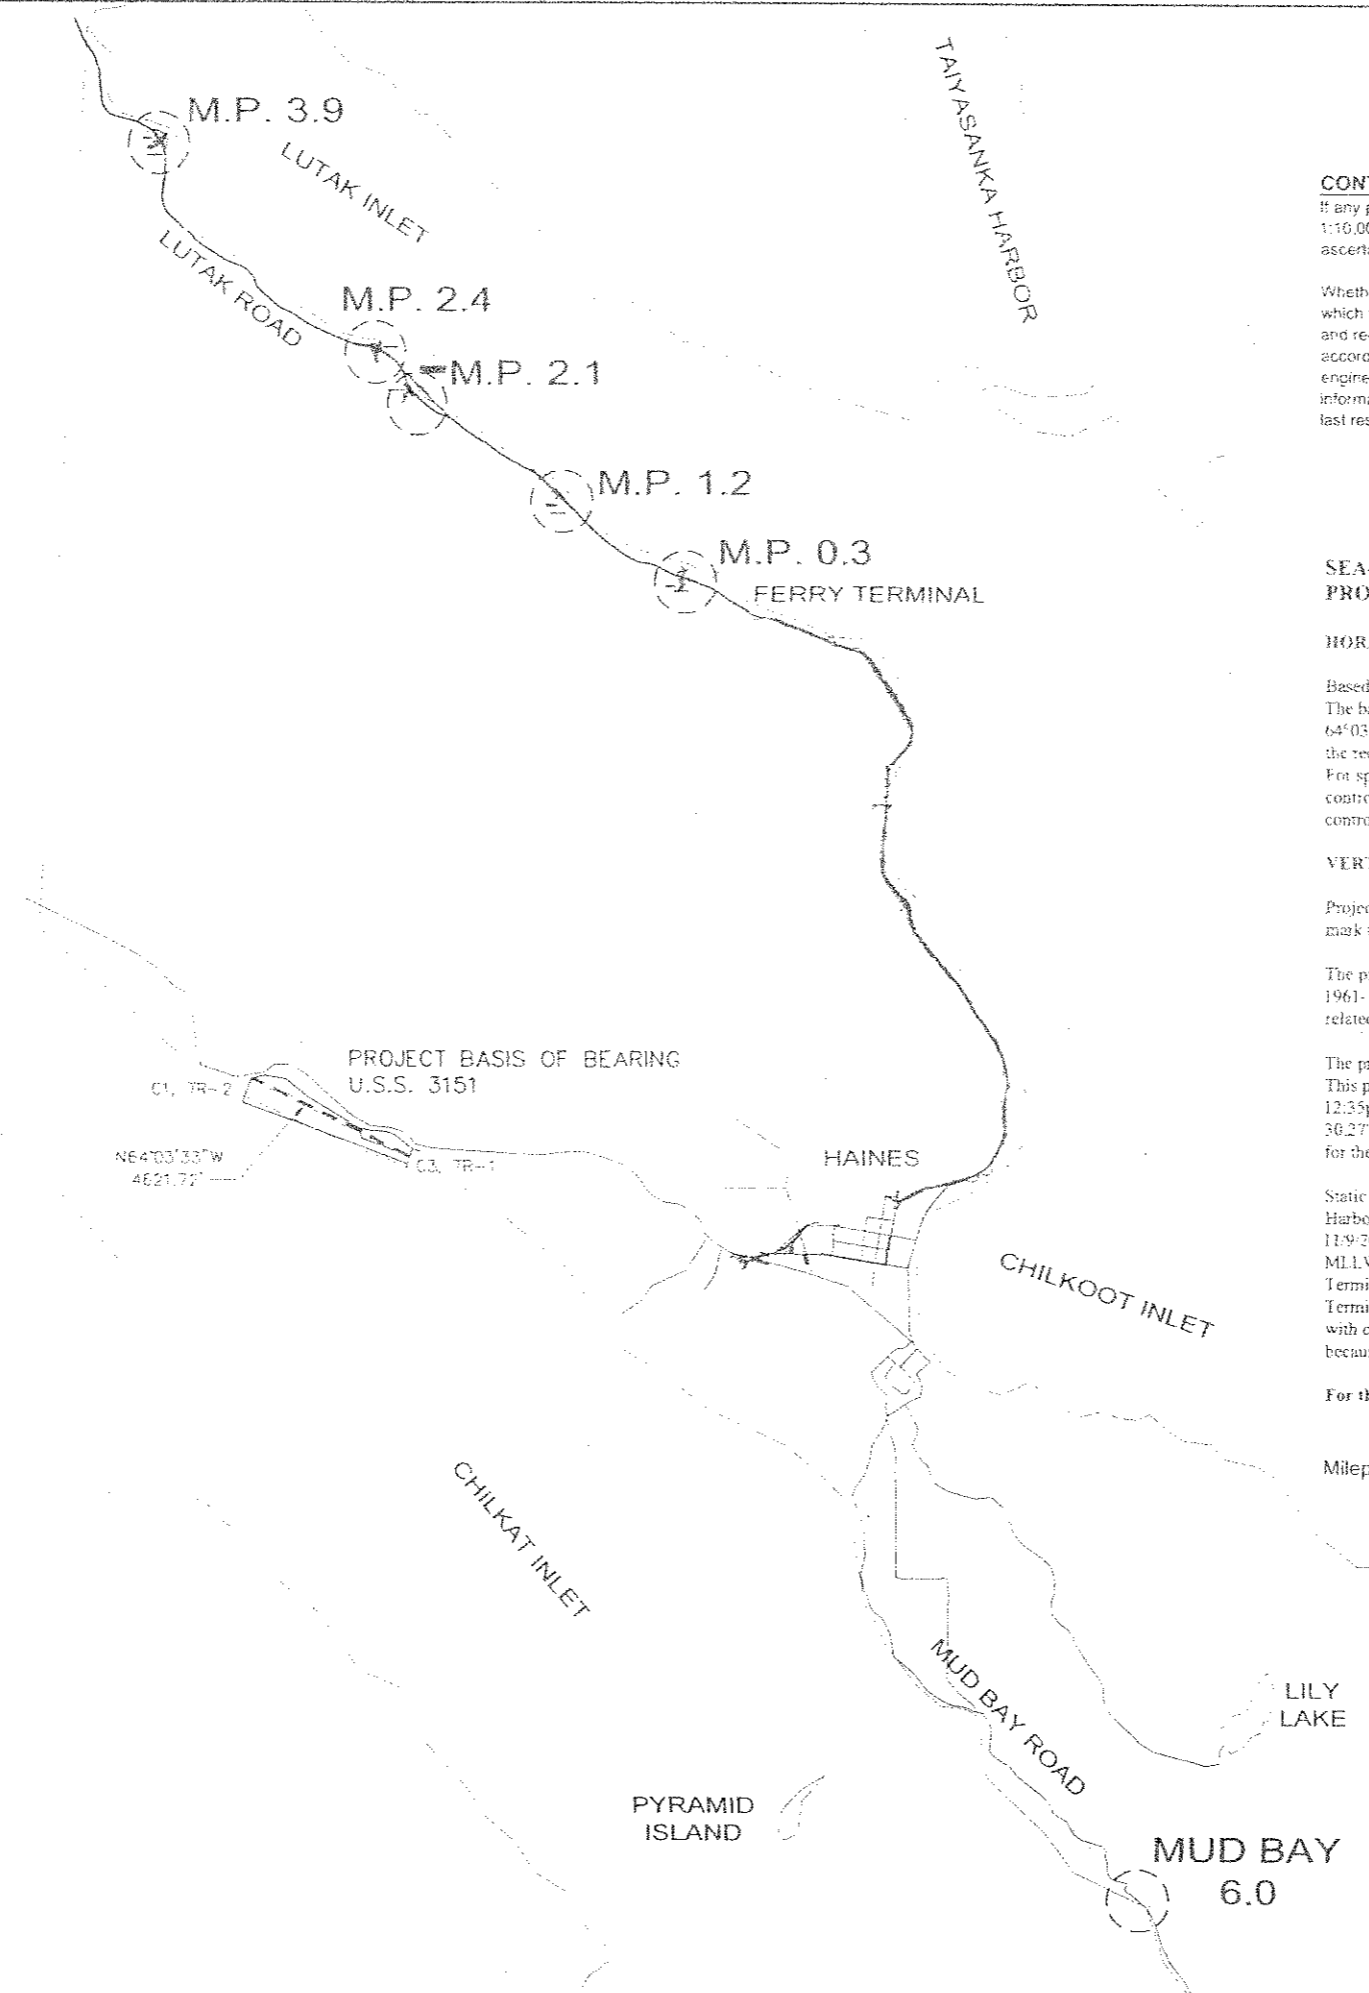

LEGEND	
	HUB & TACK
	2" ALUMINUM CAP ON ALUMINUM DRIVE ROD

CONTROL NOTE:

If any pair of control points disagrees from published value by more than 1:10,000 horizontally or vertically then a third network point must be tied to ascertain which point is in error or has been disturbed.

Whether listed or not, all monuments or property markers or accessions which will be disturbed or buried shall be referenced prior to being disturbed and re-established in their original position and a record of monument form in accordance with A.S. 34.65.040 shall be submitted to the construction engineer for review prior to recording. Coordinate values listed are for informational purposes and should be used to reset monuments only as a last resort.

SEA-Storm Repair PROJECT #69236

HORIZONTAL CONTROL

Based entirely on Ferry Terminal to Union job, project #72170. The basis of bearing on Union to Airport is the record bearing of N 64°03'33" W from the recovered monument for C3 Tract 1 USS 3151, to the recovered monument for C1 Tract 2 USS 3151. For spot improvements at each culvert replacement area, GPS pairs of control were set in relation to the site. See control diagram for isolated control points at each site.

VERTICAL CONTROL

Project elevations are based on an adjusted elevation for USCGGS bench mark #5 with a 5.61 published elevation of 27.60' above MLLW. The predicted glacial rebound for the Haines area is 2.3 cm per year. 1961-1997 is 26.5 years at 2.5cm/yr, or a 2.75' rise in ground elevations related to sea level. The predicted 1997 elevation of BM #5 is 30.35' above MLLW. This predicted elevation was verified with a single tide shot on 10/31/97 at 12:35pm. The predicted high tide of 18.4' produced a tidal elevation of 30.27', only 0.08' different than the rebound adjusted elevation computed for the point.

Static GPS ties to NOS benchmarks 2454-A and 2454-B in Tuvasanka Harbor (series 9452454) were performed in 9/2001. Publication date 11/9/2000 holding "A" at 22.59' above MLLW and "B" at 26.48' above MLLW. These ties were used specifically for work at the Haines Ferry Terminal and indicate that the predicted rebound elevation used for Ferry Terminal to Union Street control file needs to be raised 0.36' to correspond with current tidal conditions. However this adjustment has not been made because the referenced project is still in design phase.

For this project, the adjusted elevation for BM #5 held at 30.35'

Milepoints listed on Lutak Road are from Ferry Terminal.


DATE: 01/24/2008 10:56:00 AM DRAWN BY: T. REED/V. STEVENS PROJECT DESIGNATION NUMBER: 69236 / ER-0079(2) SHEET NUMBER: A2 TOTAL SHEETS: 36	
APPENDIX NUMBER:	
ATTACHMENT NUMBER:	
METHOD OF READING:	
DATE OF READING:	
DESCRIPTION:	
SEA NOVEMBER 2005 STORM PERMANENT REPAIRS 69236 / ER-0079(2)	
LOCATION MAP SURVEY DATA SHEET	
DESIGNED BY: T. REED	
DRAWN BY: T. REED/V. STEVENS	
STATE OF ALASKA DEPARTMENT OF TRANSPORTATION & PUBLIC FACILITIES SOUTHEAST REGION	
SEA NOVEMBER 2005 STORM PERMANENT REPAIRS	
LOCATION MAP SURVEY DATA SHEET	
PROJECT DESIGNATION NUMBER: 69236 / ER-0079(2)	
STATE: ALASKA	YEAR: 2008
SHEET NUMBER: A2	TOTAL SHEETS: 36

PLOT
 D:\SEA\69236\ER-0079(2)\LUTAK.DWG
 PLOT DATE: 08/10/2008
 PLOT TIME: 10:22AM
 PLOT BY: T. REED
 PLOT SCALE: 1/8" = 100'-0"
 PLOT TYPICALS


APPENDIX NUMBER
 ATTACHMENT NUMBER
 POLYLINE REVISIONS
 NO. DATE DESCRIPTION

SEA NOVEMBER 2005
 STORM PERMANENT REPAIRS
 69236 / ER-0079(2)

LUTAK RD. 0.3 MILE
 SURVEY DATA SHEET

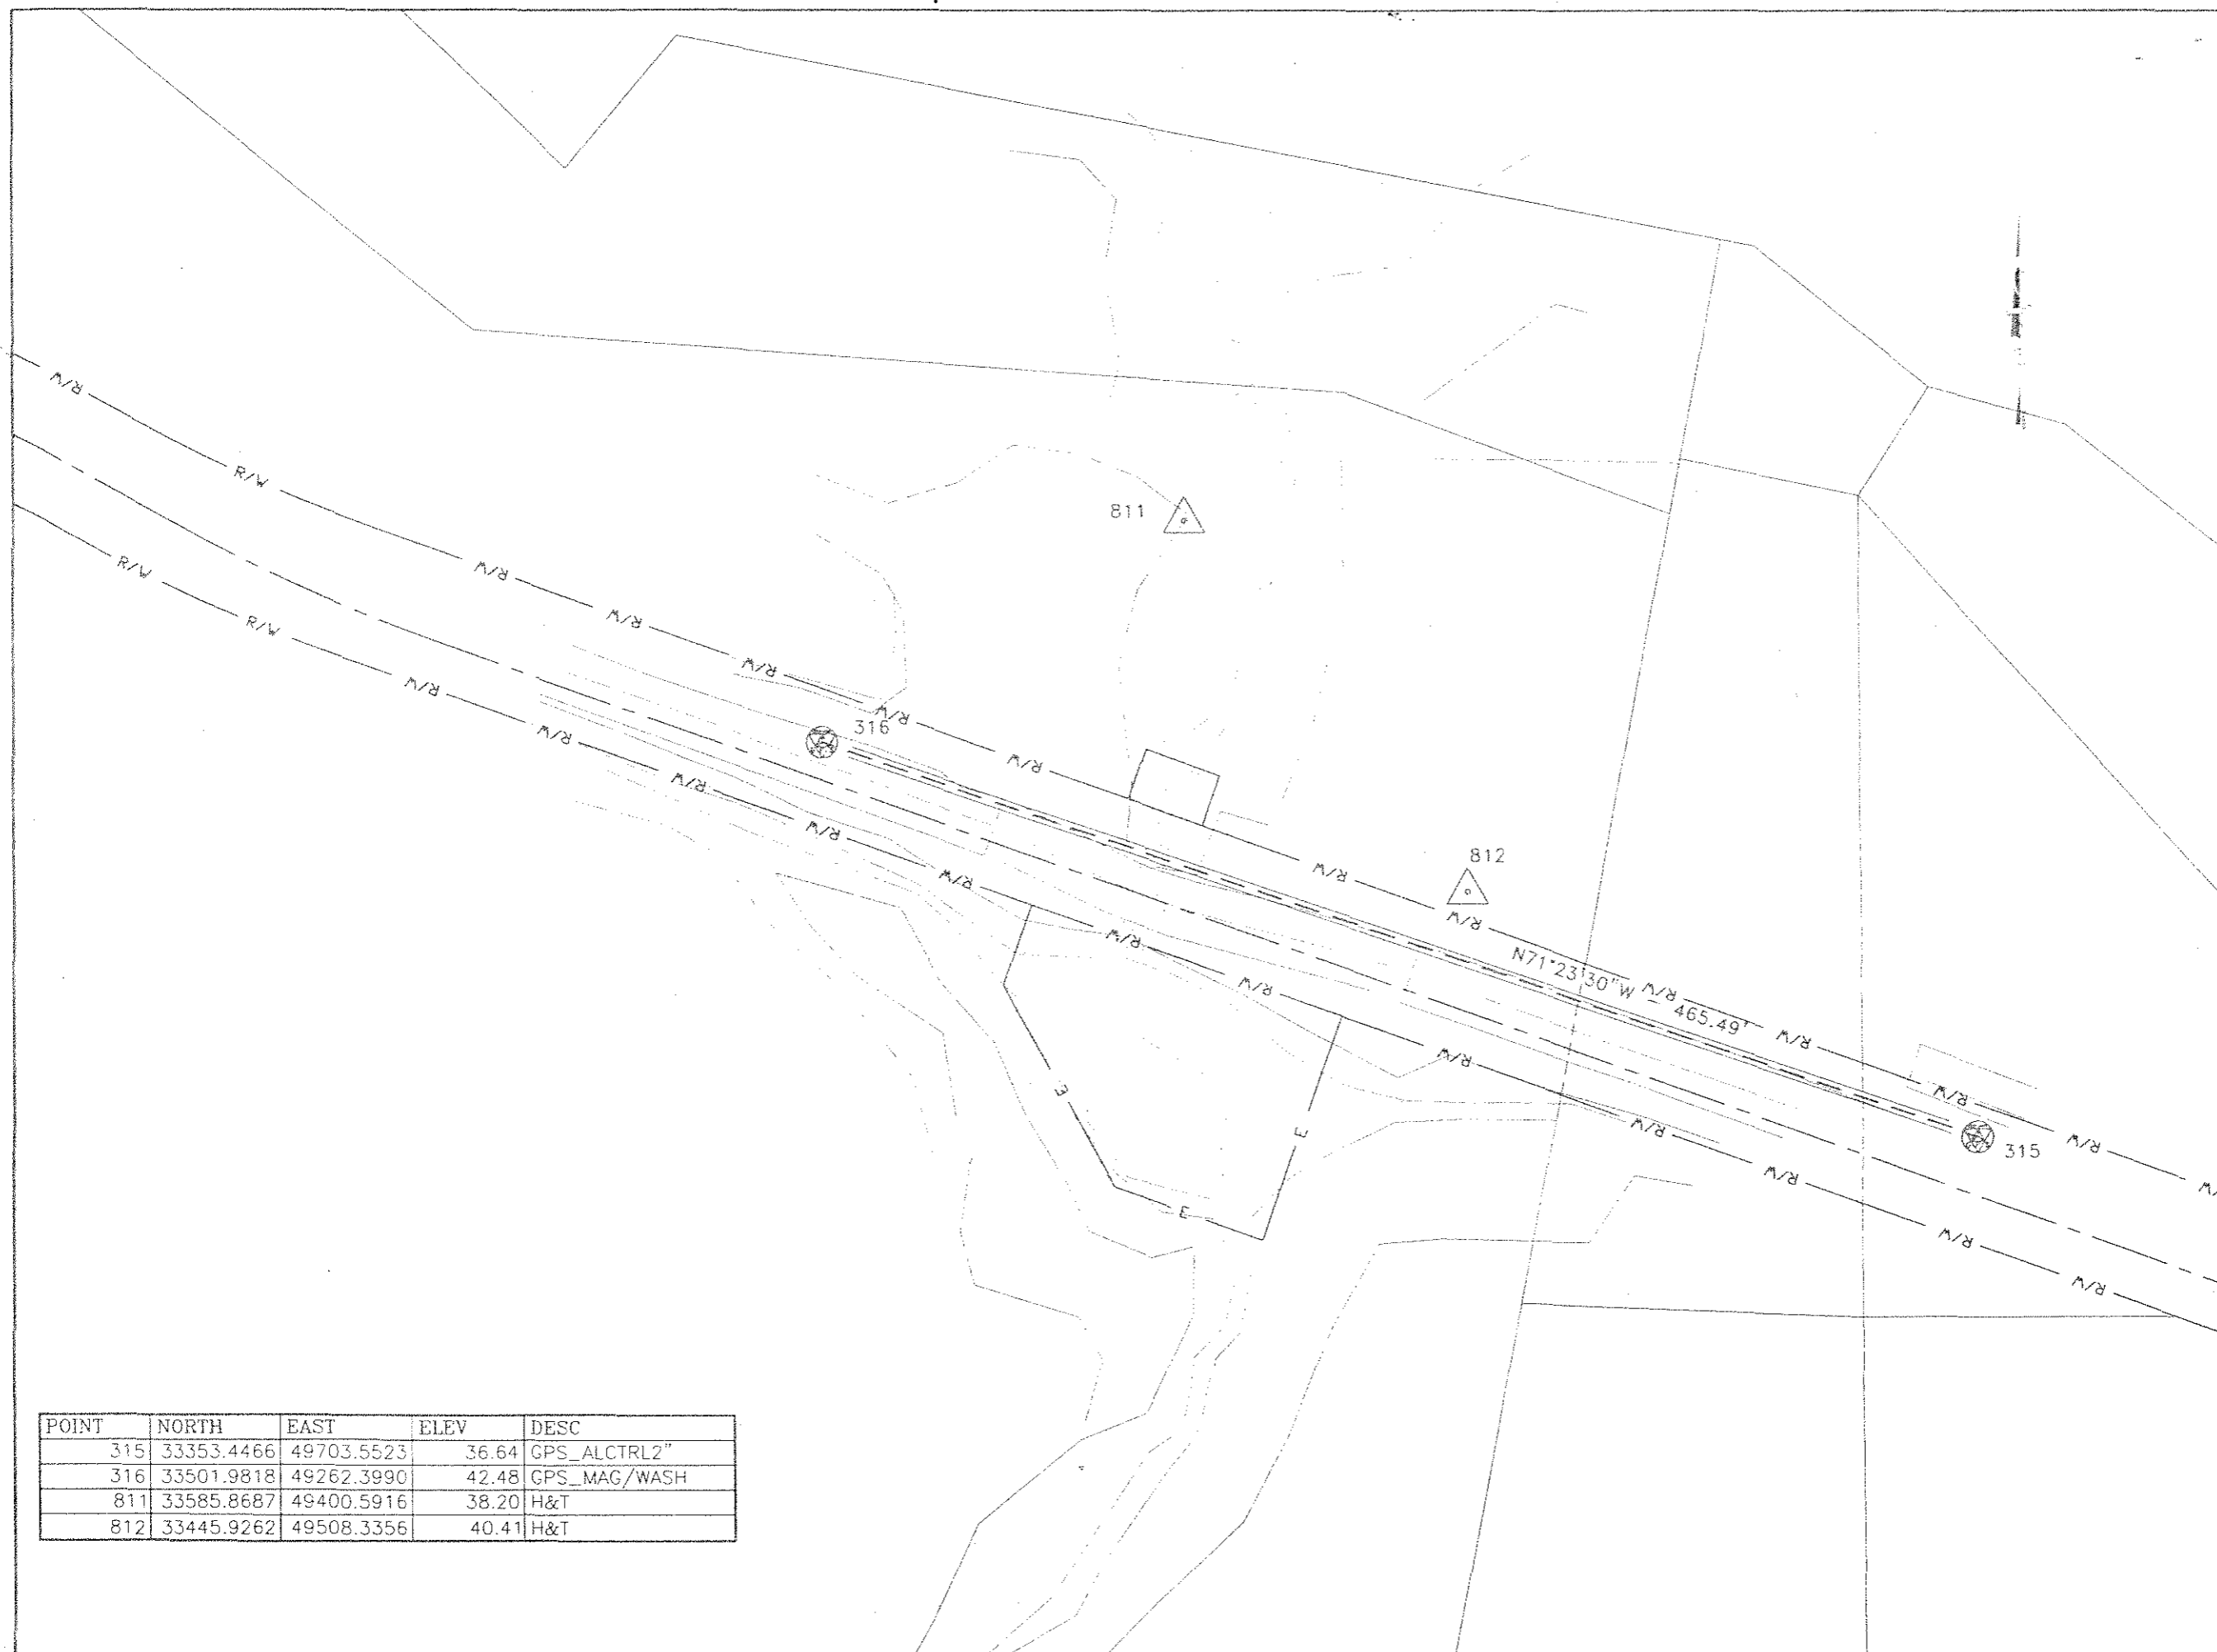

POINT	NORTH	EAST	ELEV	DESC
315	33353.4466	49703.5523	36.64	GPS_ALCTRL2"
316	33501.9818	49262.3990	42.48	GPS_MAG/WASH
811	33585.8687	49400.5916	38.20	H&T
812	33445.9262	49508.3356	40.41	H&T

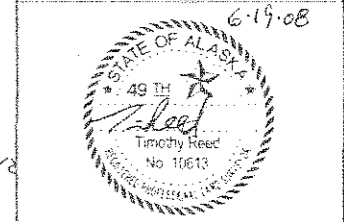


DESIGNED BY: T. REED
 DRAWN BY: T. REED/D. SPENCER
 STATE OF ALASKA
 DEPARTMENT OF TRANSPORTATION
 & PUBLIC FACILITIES
 SOUTHWEST REGION

SEA NOVEMBER 2005
 STORM PERMANENT REPAIRS

LUTAK RD. 0.3 MILE
 SURVEY DATA SHEET

PROJECT DESIGNATION NUMBER	
69236 / ER-0079(2)	
STATE	YEAR
ALASKA	2008
SHEET NUMBER	TOTAL SHEETS
A3	36

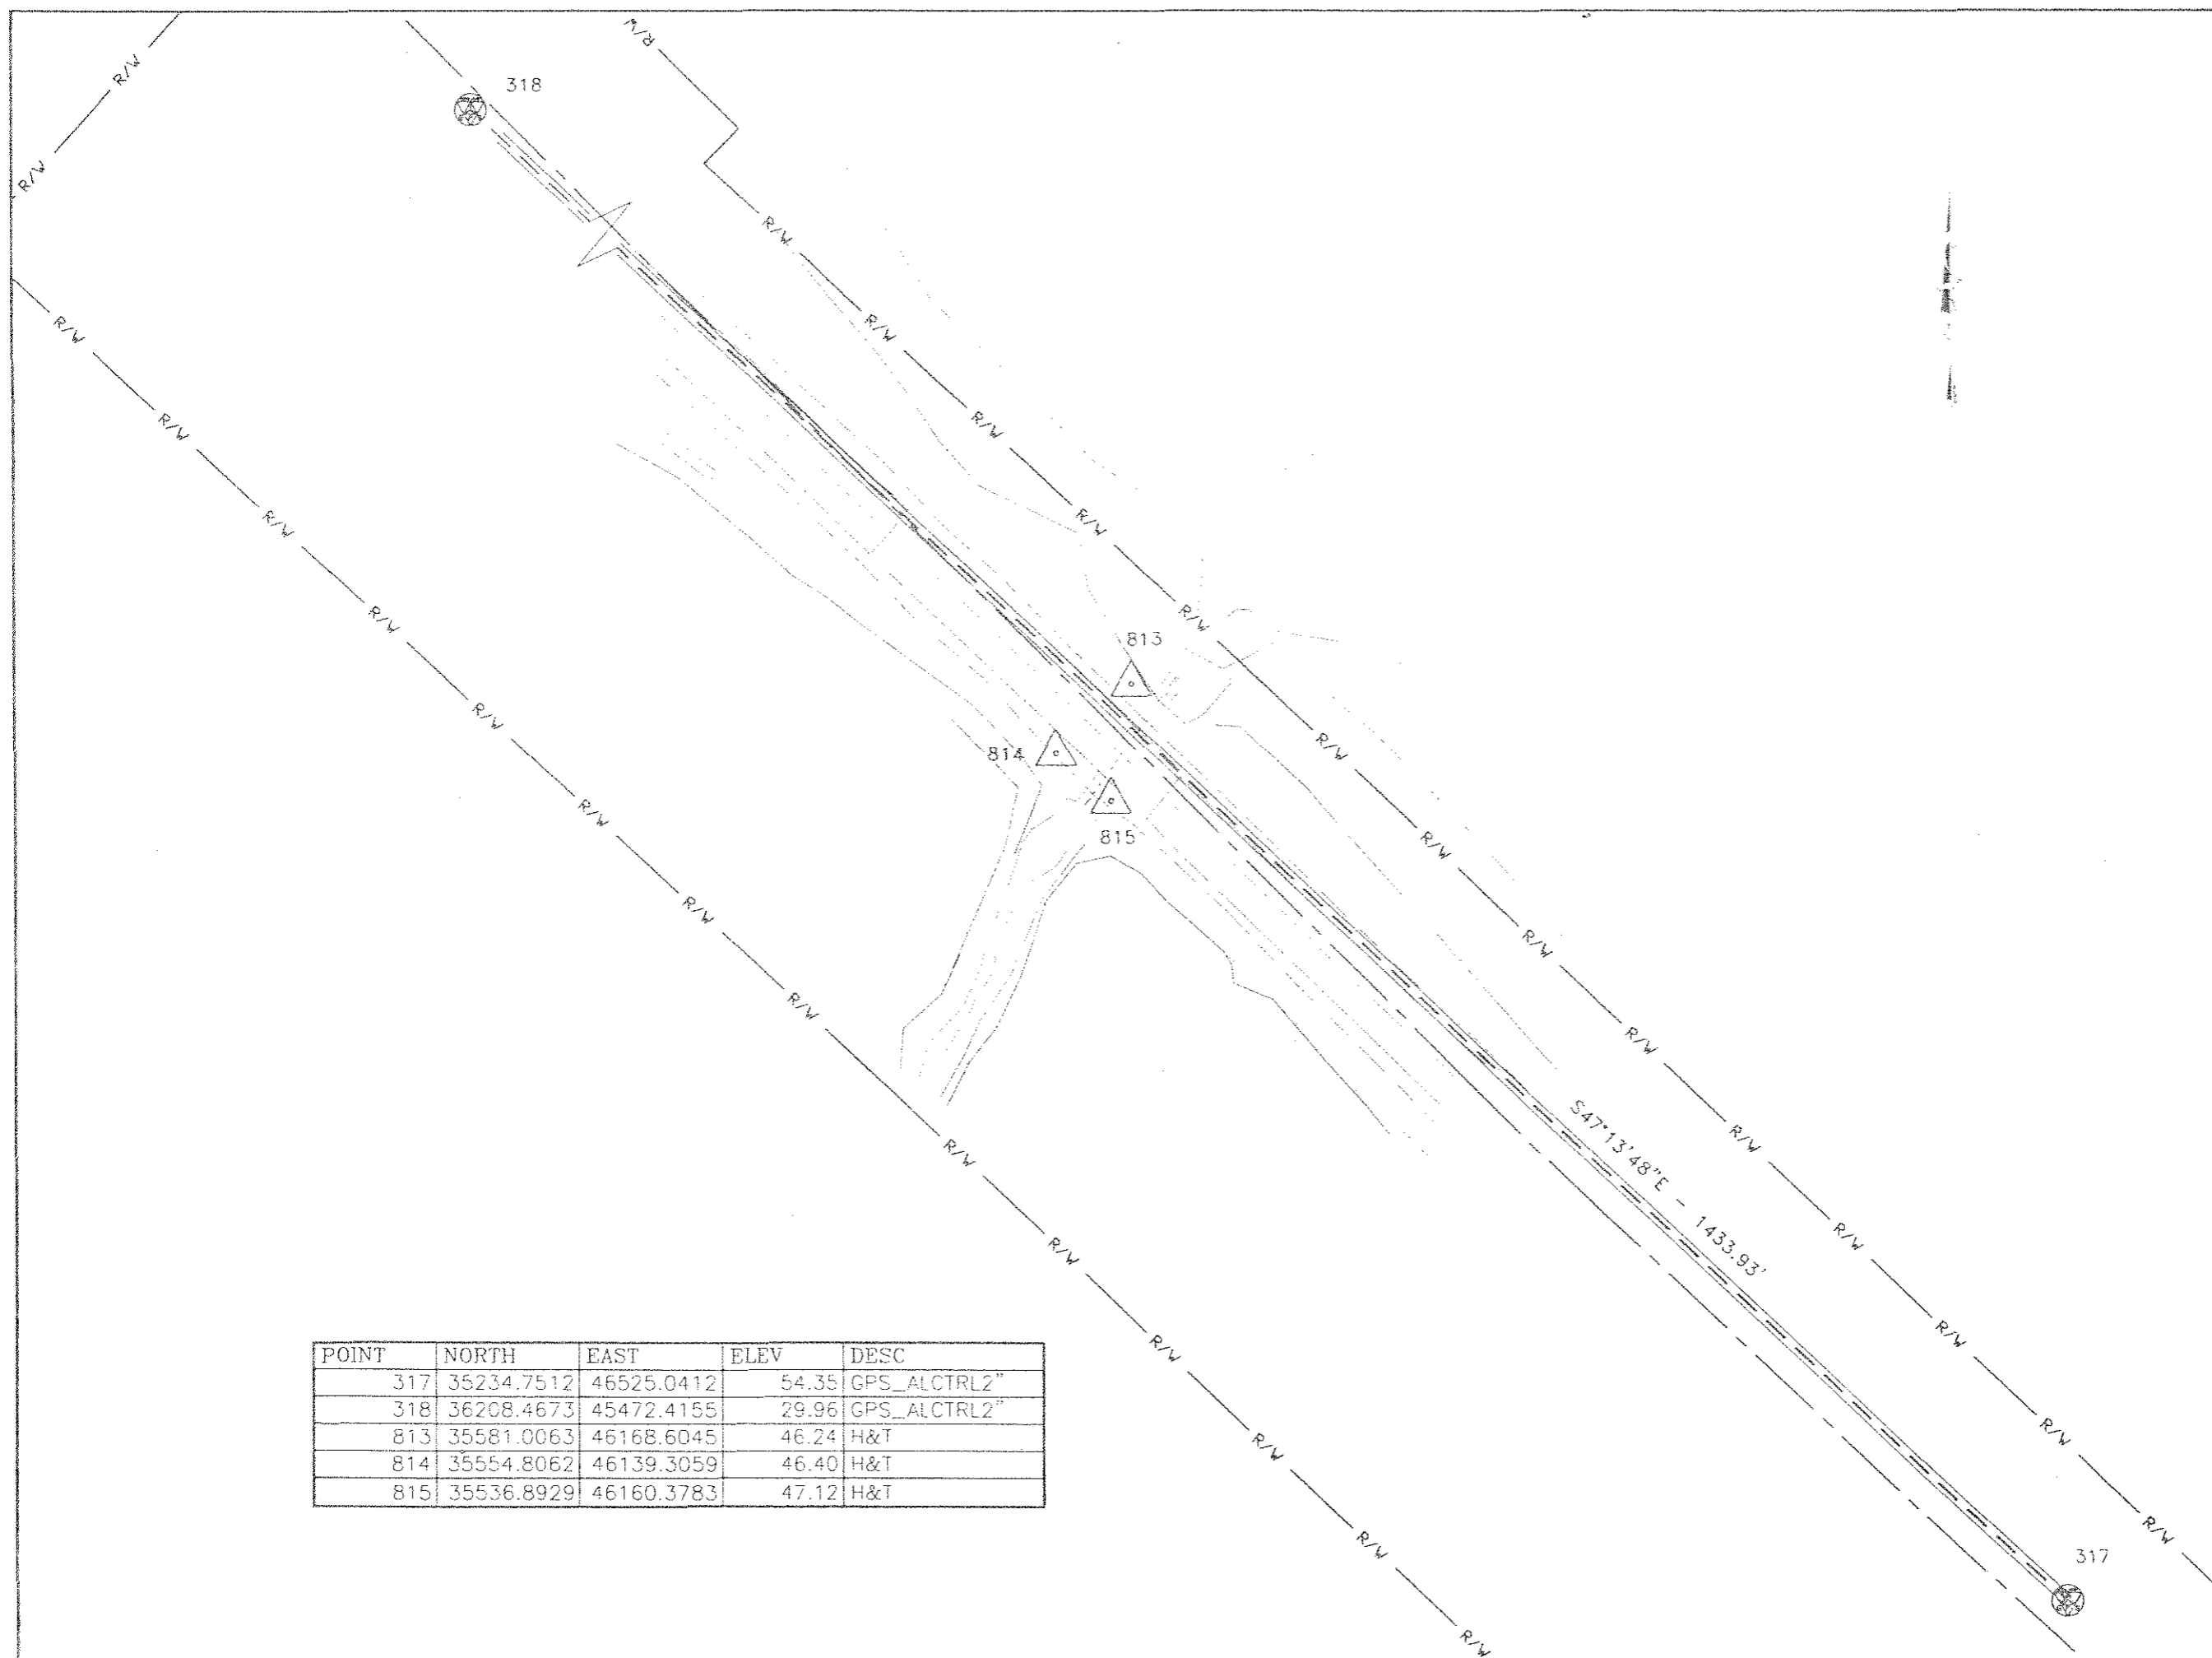


POINT	NORTH	EAST	ELEV	DESC
317	35234.7512	46525.0412	54.35	GPS_ALCTRL2"
318	36208.4673	45472.4155	29.96	GPS_ALCTRL2"
813	35581.0063	46168.6045	46.24	H&T
814	35554.8062	46139.3059	46.40	H&T
815	35536.8929	46160.3783	47.12	H&T

DATE: 03/28/08
 DRAWN BY: J. REED/C. STEVENS
 CHECKED BY: J. REED/C. STEVENS
 PROJECT DESIGNATION NUMBER: 69236 / ER-0079(2)
 SHEET NUMBER: A4

SEA NOVEMBER 2005
 STORM PERMANENT REPAIRS
 69236 / ER-0079(2)

LUTAK RD. 1.2 MILE
 SURVEY DATA SHEET

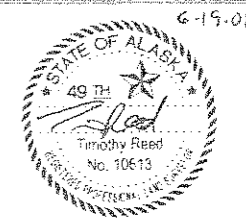


DESIGNED BY: T. REED
 DRAWN BY: T. REED/C. STEVENS
 STATE OF ALASKA
 DEPARTMENT OF TRANSPORTATION
 & PUBLIC FACILITIES
 SOUTHEAST REGION

SEA NOVEMBER 2005
 STORM PERMANENT REPAIRS

LUTAK RD. 1.2 MILE
 SURVEY DATA SHEET


PROJECT DESIGNATION NUMBER	
69236 / ER-0079(2)	
STATE	YEAR
ALASKA	2008
SHEET NUMBER	TOTAL SHEETS
A4	36

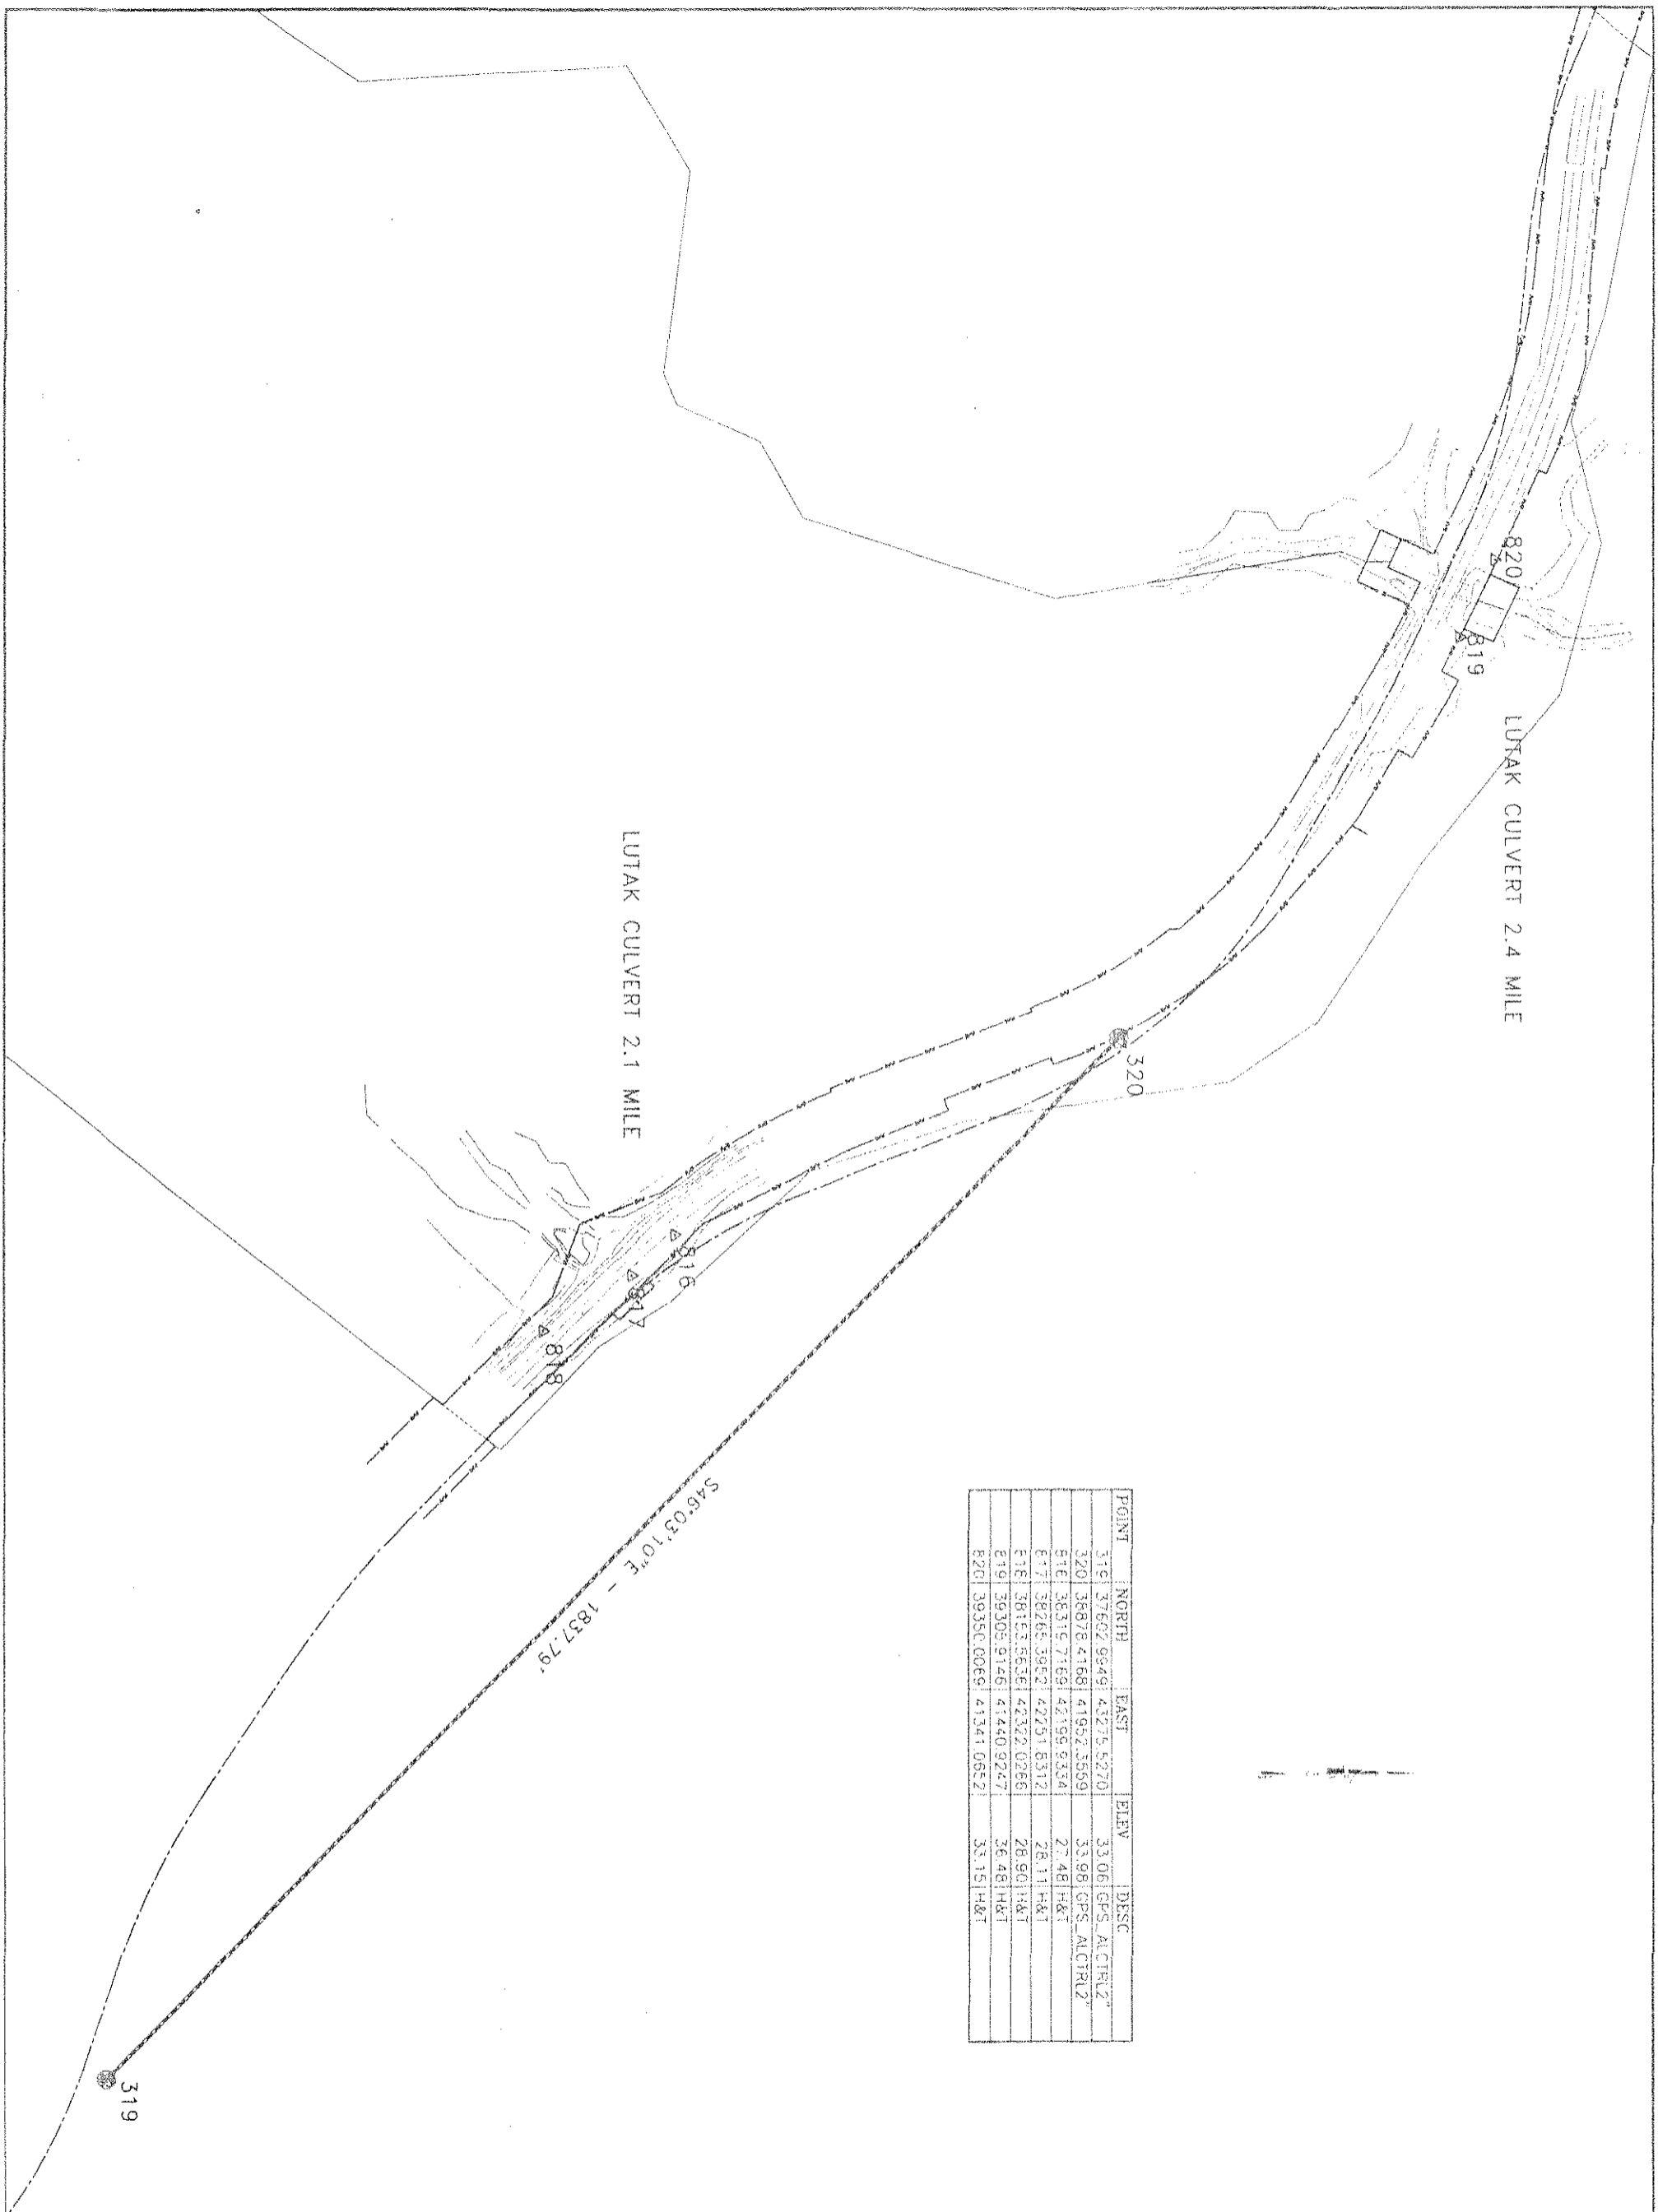

POINT	NORTH	EAST	ELEV	DESC
319	37662.9949	43275.5270	33.06	GPS ALTR/L2*
320	38678.4168	41952.3559	33.98	GPS ALTR/L2*
816	38315.7169	42159.9334	27.48	H&I
817	38266.3952	42251.8312	26.11	H&I
818	38153.8636	42322.0266	28.90	H&I
819	39305.9146	41440.9247	36.48	H&I
820	39350.0069	41341.0652	33.15	H&I

SEA NOVEMBER 2005
 STORM PERMANENT REPAIRS
 69236 / ER-0079(2)

LUTAK RD. 2.1 MILE AND
 LUTAK RD. 2.4 MILE
 SURVEY DATA SHEET

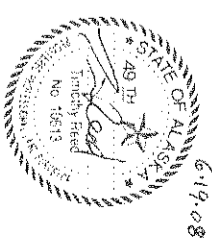

PROJECT DESIGNATION NUMBER
 69236 / ER-0079(2)

STATE ALASKA YEAR 2008

SHEET NUMBER TOTAL SHEETS
 A5 36

SEA NOVEMBER 2005
 STORM PERMANENT REPAIRS
 LUTAK RD. 2.1 MILE AND
 LUTAK RD. 2.4 MILE
 SURVEY DATA SHEET

POINT	NORTH	EAST	ELEV	DESC
321	44418.5183	35867.9791	32.04	GPS_ALCTRL2"
322	44922.8419	35532.0554	30.11	GPS_ALCTRL2"
821	44631.0030	35766.2159	30.05	H&T


N33°40'02"W
605.96'

DATE: 05/24/08
DRAWN BY: T. REED
CHECKED BY: T. REED / D. STEVENS
SCALE: AS SHOWN

PROJECT NUMBER:
ATTACHMENT NUMBER:
REGION OF RESPONSIBILITY:
SHEET NUMBER: 36 OF 36

SEA NOVEMBER 2005
STORM PERMANENT REPAIRS
69236 / ER-0079(2)

LUTAK RD. 3.9 MILE
SURVEY DATA SHEET

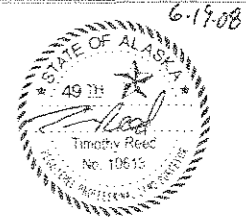

DESIGNED BY: T. REED
DRAWN BY: T. REED / D. STEVENS
STATE OF ALASKA
DEPARTMENT OF TRANSPORTATION
& PUBLIC FACILITIES
SOUTHWEST REGION

SEA NOVEMBER 2005
STORM PERMANENT REPAIRS

LUTAK RD. 3.9 MILE
SURVEY DATA SHEET


PROJECT DESIGNATION NUMBER:
69236 / ER-0079(2)

STATE	YEAR
ALASKA	2008
SHEET NUMBER	TOTAL SHEETS
A6	36

SHEET
 69236/ER-0079(2)
 PROJECT DESIGNATION NUMBER
 69236 / ER-0079(2)
 STATE ALASKA
 YEAR 2008
 SHEET NUMBER B1
 TOTAL SHEETS 36

SEA NOVEMBER 2005
 STORM PERMANENT REPAIRS
 69236 / ER-0079(2)

TYPICAL SECTIONS

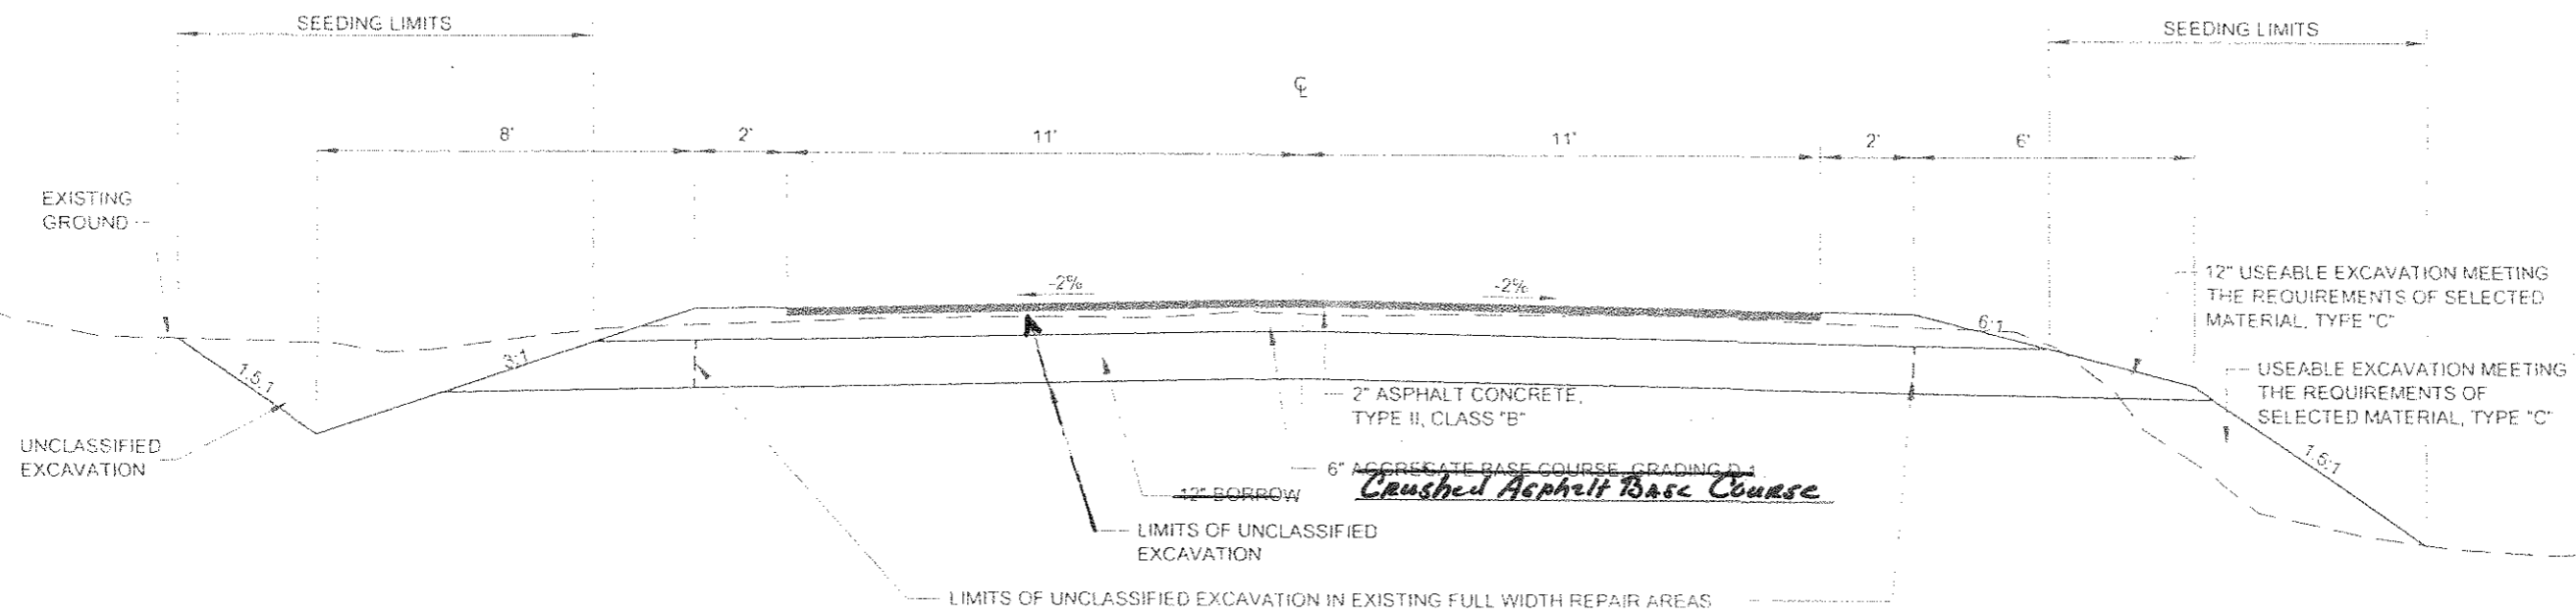

NOTE:
 1 BORROW WILL MEET THE REQUIREMENTS OF SELECTED MATERIAL, TYPE "A". *Not Needed*

TYPICAL SECTION
 LUTAK ROAD
 STA. 271+70 TO STA. 272+05
 STA. 311+00 TO STA. 311+40
 STA. 358+85 TO STA. 359+50
 STA. 372+80 TO STA. 373+65
 STA. 458+30 TO STA. 458+80




DESIGNED BY J. PETROPOULOS
 DRAWN BY D. STEVENS
 STATE OF ALASKA
 DEPARTMENT OF TRANSPORTATION
 & PUBLIC SAFETY
 SOUTHWEST REGION
 SEA NOVEMBER 2005
 STORM PERMANENT REPAIRS

TYPICAL SECTIONS

PROJECT DESIGNATION NUMBER
 69236 / ER-0079(2)
 STATE ALASKA
 YEAR 2008
 SHEET NUMBER B1
 TOTAL SHEETS 36

Project As-Built Drawings have been reviewed by the Project Engineer and represent to the best of my knowledge, the project as constructed.
 PE *Ally Culbert* Date *4-29-2011*

DATE	05/24/07	
PROJECT	SEA NOVEMBER 2005 STORM PERMANENT REPAIRS	
SCALE	AS SHOWN	
APPENDIX NUMBER		
ATTACHMENT NUMBER		
REVISIONS		
NO.	DATE	DESCRIPTION

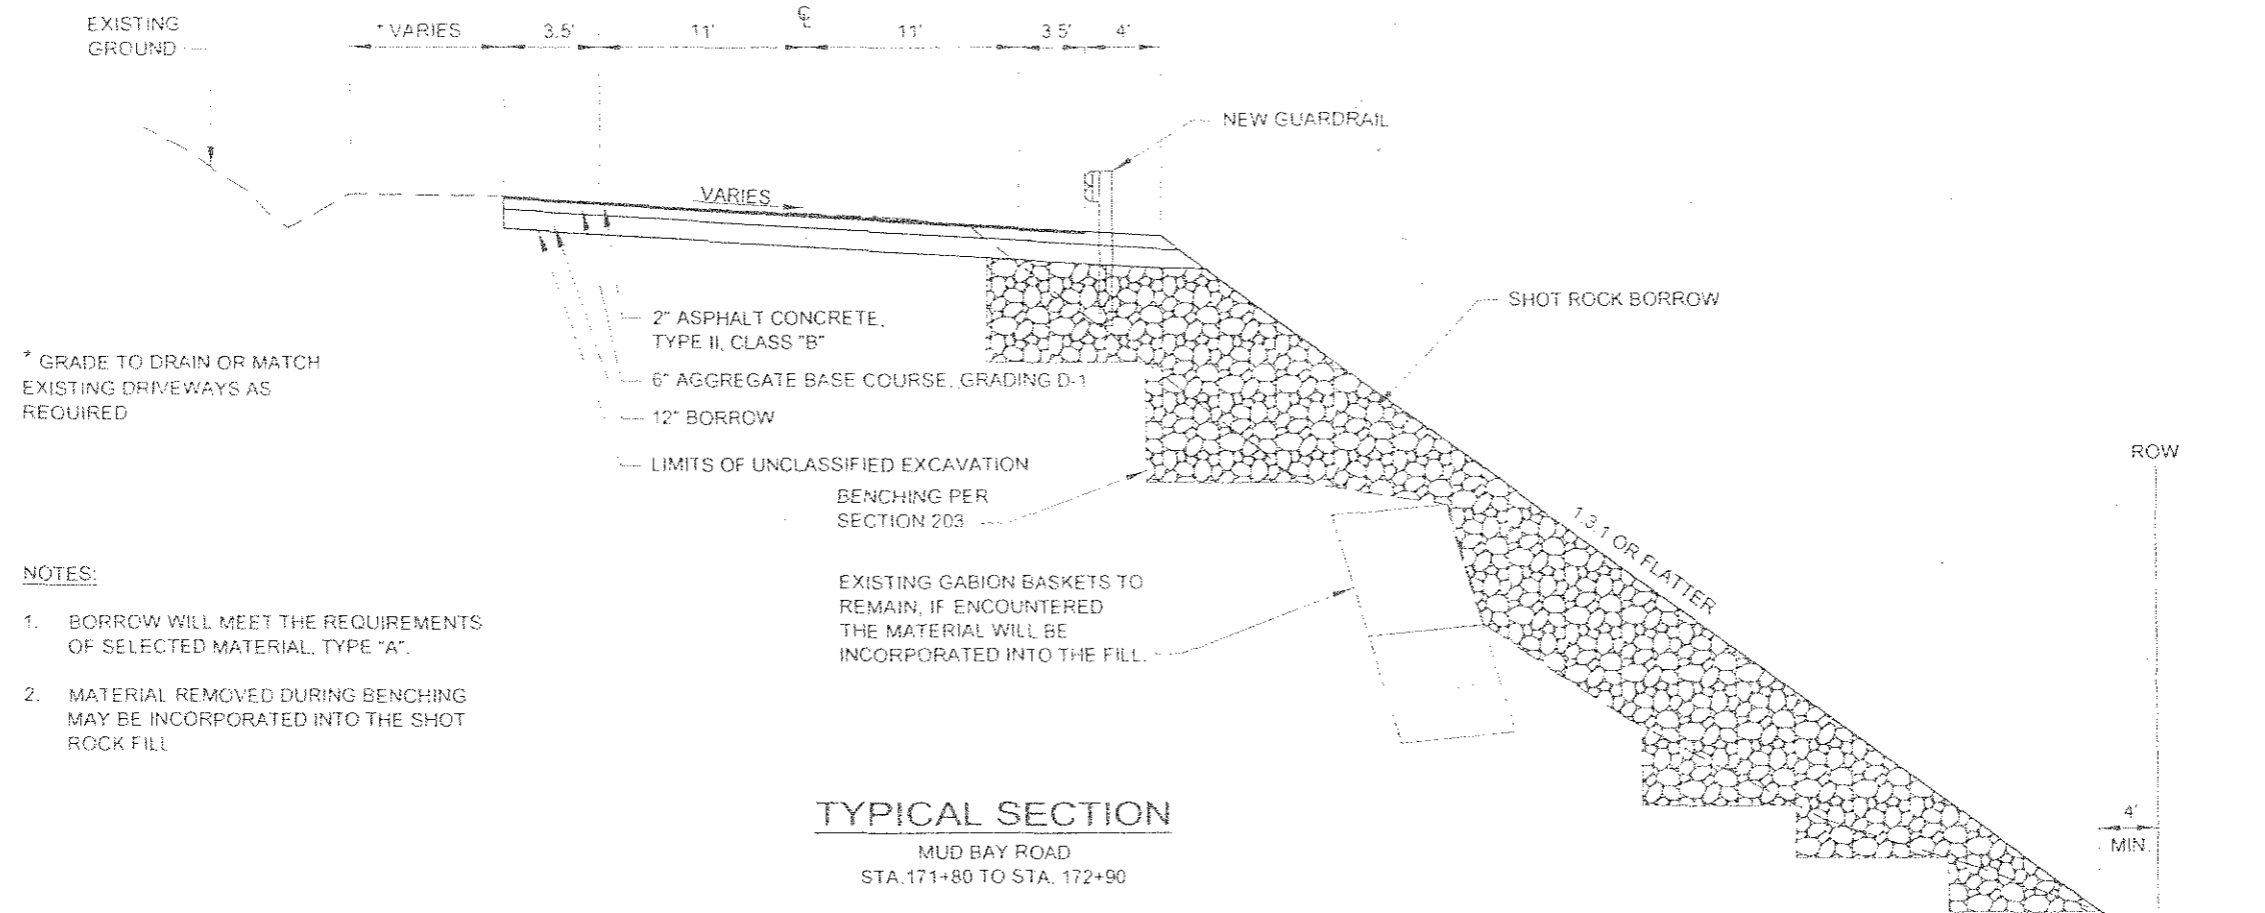


* GRADE TO DRAIN OR MATCH EXISTING DRIVEWAYS AS REQUIRED

NOTES:


- BORROW WILL MEET THE REQUIREMENTS OF SELECTED MATERIAL, TYPE "A".
- MATERIAL REMOVED DURING BENCHING MAY BE INCORPORATED INTO THE SHOT ROCK FILL

TYPICAL SECTION
MUD BAY ROAD
STA. 171+80 TO STA. 172+90

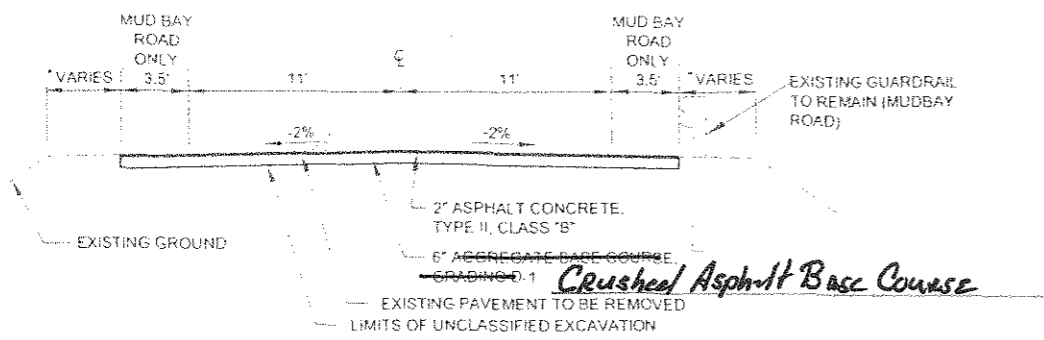

TYPICAL SECTION

LUTAK ROAD
STA. 270+80 TO STA. 271+70
STA. 272+05 TO STA. 273+35
STA. 310+00 TO STA. 311+00
STA. 311+40 TO STA. 313+00
STA. 357+60 TO STA. 358+85
STA. 359+50 TO STA. 360+25
STA. 369+80 TO STA. 372+80
STA. 373+65 TO STA. 379+00
STA. 457+00 TO STA. 458+30
STA. 458+80 TO STA. 460+50
MUD BAY ROAD
STA. 170+50 TO STA. 171+80
STA. 172+90 TO STA. 173+75

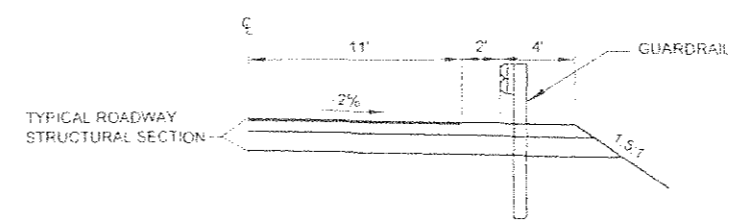


LUTAK RD. GUARDRAIL TYPICAL
TYP. BOTH SIDES OF ROADWAY

Project As-Built Drawings have been reviewed by the Project Engineer and represent to the best of my knowledge, the project as constructed.
PE *[Signature]* Date 4/29/08

SEA NOVEMBER 2005
STORM PERMANENT REPAIRS
69236 / ER-0079(2)

TYPICAL SECTIONS

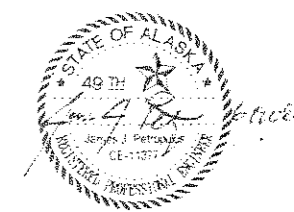

DESIGNED BY J. PETROPULOS
DRAWN BY J. STEVENS
STATE OF ALASKA
DEPARTMENT OF TRANSPORTATION
& PUBLIC FACILITIES
SOUTHEAST REGION
SEA NOVEMBER 2005
STORM PERMANENT REPAIRS

TYPICAL SECTIONS

PROJECT DESIGNATION NUMBER	
69236 / ER-0079(2)	
STATE	YEAR
ALASKA	2008
SHEET NUMBER	TOTAL SHEETS
B2	36

ESTIMATE OF QUANTITIES

ITEM NUMBER	ITEM DESCRIPTION	PAY UNIT	QUANTITY		
			69236	67778	TOTAL
201 (6)	SELECTIVE TREE REMOVAL	EACH	19		19
202 (1)	REMOVAL OF STRUCTURES AND OBSTRUCTIONS	LUMP SUM	ALL REQUIRED		ALL REQUIRED
202 (2)	REMOVAL OF PAVEMENT	SQUARE YARD	6630 6060.9	520	6550
202 (4)	REMOVAL OF CULVERT PIPE	LINEAR FOOT	699 718		699
203 (3)	UNCLASSIFIED EXCAVATION	CUBIC YARD	2400 2098.8		2400
203 (6)	BORROW	TON	1200 N/A		1200
203 (9)	SHOT ROCK BORROW	CUBIC YARD	150 378.30		150
301 (1) <i>C.O. #2</i>	AGGREGATE BASE COURSE, GRADING D-1 <i>Crushed Asphalt Base Course</i>	TON	2964	64	2964
401 (1)	ASPHALT CONCRETE, TYPE II, CLASS B	TON	770 967.28	163	933
401 (2)	ASPHALT CEMENT, GRADE PG 56-28	TON	46 50.46	9	55
402(1)	STE-1 ASPHALT FOR TACK COAT	TON		0.2	0.2
501 (1)	CLASS A CONCRETE	LUMP SUM	ALL REQUIRED		ALL REQUIRED
503 (1)	REINFORCING STEEL	LUMP SUM	ALL REQUIRED		ALL REQUIRED
503 (2)	EPOXY-COATED REINFORCING STEEL	LUMP SUM	ALL REQUIRED		ALL REQUIRED
602 (1)	STRUCTURAL PLATE PIPE, 12'-0" DIA., 0.250" GAGE	LINEAR FOOT	152 5		152
603 (9-48)	48 INCH CORRUGATED ALUMINUM PIPE	LINEAR FOOT	180		180
603 (9-60)	60 INCH CORRUGATED ALUMINUM PIPE	LINEAR FOOT	132 131.4		132
603 (9-64)	84 INCH CORRUGATED ALUMINUM PIPE	LINEAR FOOT	96		96
603 (10)	57" x 36" CORRUGATED ALUMINUM PIPE ARCH	LINEAR FOOT	116 119		116
606 (1)	W-BEAM GUARDRAIL	LINEAR FOOT	500 406.5		500
606 (10)	SLOTTED RAIL TERMINAL (SRT-350)	EACH	1		1
606 (11)	EXTRUDER TERMINAL (ET-PLUS)	EACH	7		7
611 (1A)	RIPRAP, CLASS II	CUBIC YARD	230 307.1		230
611 (1B)	RIPRAP, CLASS III	CUBIC YARD	150 149.63		150
618 (1)	SEEDING	ACRE	0.5 2.40		0.5
630 (1)	GEOTEXTILE, SEPARATION	SQUARE YARD	560 200		560
633 (1)	SILT FENCE	LINEAR FOOT	2000 785		2000
640 (1)	MOBILIZATION AND DEMOBILIZATION	LUMP SUM	ALL REQUIRED	ALL REQUIRED	ALL REQUIRED
640 (4)	WORKER MEALS AND LODGING, OR PER DIEM	LUMP SUM	ALL REQUIRED	ALL REQUIRED	ALL REQUIRED
641 (1)	EROSION AND POLLUTION CONTROL ADMINISTRATION	LUMP SUM	ALL REQUIRED	ALL REQUIRED	ALL REQUIRED
641 (3)	TEMPORARY EROSION AND POLLUTION CONTROL	LUMP SUM	ALL REQUIRED	ALL REQUIRED	ALL REQUIRED
641 (5)	PRELIMINARY SEEDING	ACRE	0.5		0.5
641 (6)	TEMPORARY ROCK CHECK DAM	EACH	18 10		18
641 (7)	EROSION AND POLLUTION CONTROL PRICE ADJUSTMENT	CONTINGENT SUM	ALL REQUIRED		ALL REQUIRED
642 (1)	CONSTRUCTION SURVEYING	LUMP SUM	ALL REQUIRED		ALL REQUIRED
642 (3)	THREE PERSON SURVEY PARTY	HOUR	25		25
643 (2)	TRAFFIC MAINTENANCE	LUMP SUM	ALL REQUIRED	ALL REQUIRED	ALL REQUIRED
643 (3)	PERMANENT CONSTRUCTION SIGNS	LUMP SUM	ALL REQUIRED	ALL REQUIRED	ALL REQUIRED
643 (15)-A	FLAGGING	CONTINGENT SUM	ALL REQUIRED	ALL REQUIRED	ALL REQUIRED
643 (25)	TRAFFIC CONTROL	CONTINGENT SUM	ALL REQUIRED	ALL REQUIRED	ALL REQUIRED
667 (1)	PERMANENT TRAFFIC RECORDER, COMPLETE	LUMP SUM	ALL REQUIRED	ALL REQUIRED	ALL REQUIRED
670 (1)	PAINTED TRAFFIC MARKINGS	LUMP SUM	ALL REQUIRED	ALL REQUIRED	ALL REQUIRED
662 (1)	ELECTRICAL CONDUIT	LUMP SUM	ALL REQUIRED		ALL REQUIRED

BASIS OF ESTIMATE

ITEM	PAY ITEM	ESTIMATING FACTOR
203(5)	BORROW, SELECTED MATERIAL, TYPE A & C	2.2 TON/CY
301(1)	AGGREGATE BASE COURSE, GRADING D-1	2.2 TON/CY
401(1)	ASPHALT CONCRETE, TYPE II, CLASS B	125 LB/SY/IN
401(2)	ASPHALT CEMENT, GRADE PG 56-28	6.0% OF ITEM 401 (1)
402(1)	STE-1 ASPHALT FOR TACK COAT	0.1 GAL/S.Y., 253 GAL/TON

GENERAL NOTES

- VERTICAL AND HORIZONTAL ALIGNMENTS SHOWN ON THE SE PLANS ARE SUBJECT TO MINOR REVISIONS. SEE SECTION 203 OF THE SPECIFICATIONS.
- THE SUPERELEVATION SHALL BE ROTATED ABOUT THE ROADWAY CENTERLINE. THE RATE OF SUPERELEVATION AND OTHER SUPERELEVATION DETAILS ARE SHOWN ON THE PLAN AND PROFILE SHEETS.

DATE: 01/29/2011 10:04 AM
 PROJECT: SEA NOVEMBER 2005 STORM PERMANENT REPAIRS
 SHEET: 69236 / ER-0079(2)
 SCALE: AS SHOWN
 REVISIONS:
 NO. DATE DESCRIPTION

SEA NOVEMBER 2005
 STORM PERMANENT REPAIRS
 69236 / ER-0079(2)

Estimate of Quantities



DESIGNED BY: J. PERDOPULOE
 DRAWN BY: C. STEVENS
 STATE OF ALASKA
 DEPARTMENT OF TRANSPORTATION
 & PUBLIC SAFETY
 SOUTHEAST REGION
 SEA NOVEMBER 2005
 STORM PERMANENT REPAIRS

Estimate of Quantities

PROJECT DESIGNATION NUMBER:
 69236 / ER-0079(2)

STATE	YEAR
ALASKA	2008
SHEET NUMBER	TOTAL SHEETS
C1	36

Project As-Built Drawings have been reviewed by the Project Engineer and represent to the best of my knowledge, the project as constructed.
 PE *Oliver Caldwell* Date *4/29/2011*

CULVERT SUMMARY

WORK AREA	STATION	SIZE				RIPRAP (C.Y.)		CONCRETE HEADWALL	COMMENTS
		48"	60"	84"	OTHER	CLASS II	CLASS III		
LUTAK RD. 0.3 MILE	271+87	60							
LUTAK RD. 0.3 MILE	271+93	60					1	STEP BEVEL INLET END OF PIPES AND CONSTRUCT SLOPED CONCRETE HEADWALL PER THE DETAILS ON SHEET H8.	
LUTAK RD. 0.3 MILE	271+99	60							
LUTAK RD. 1.2 MILE	311+19		66			85	1	STEP BEVEL INLET END OF PIPES AND CONSTRUCT SLOPED CONCRETE HEADWALL PER THE DETAILS ON SHEET H8. PLACE CLASS II RIPRAP AT OUTLET.	
LUTAK RD. 1.2 MILE	311+26		66						
LUTAK RD. 2.1 MILE	358+93				60	23	1	57"x38" ALUMINUM PIPE ARCH. STEP BEVEL INLET END OF PIPE AND CONSTRUCT SLOPED CONCRETE HEADWALL PER THE DETAILS ON SHEET H8. PLACE CLASS II RIPRAP AT OUTLET.	
LUTAK RD. 2.1 MILE	359+34				58	17	1	57"x38" ALUMINUM PIPE ARCH. STEP BEVEL INLET END OF PIPE AND CONSTRUCT SLOPED CONCRETE HEADWALL PER THE DETAILS ON SHEET H8. PLACE CLASS II RIPRAP AT OUTLET.	
LUTAK RD. 2.4 MILE	373+35				78	60	2	12'-0" ALUMINUM STRUCTURAL PLATE PIPE W/REINFORCING RIBS. SEE SECTION 602 OF THE SPECIFICATIONS. STEP BEVEL ENDS OF PIPE AND CONSTRUCT CONCRETE STEM WALLS AND SLOPE COLLARS PER THE DETAILS ON SHEET H7.	
LUTAK RD. 3.9 MILE	458+49				74.6	45	2	12'-0" ALUMINUM STRUCTURAL PLATE PIPE W/REINFORCING RIBS. SEE SECTION 602 OF THE SPECIFICATIONS. STEP BEVEL ENDS OF PIPE AND CONSTRUCT CONCRETE STEM WALLS AND SLOPE COLLARS PER THE DETAILS ON SHEET H7.	
MUD BAY RD. 6.0 MILE	172+40			96		150	2	STEP BEVEL ENDS OF PIPE AND CONSTRUCT SLOPED CONCRETE HEADWALLS PER THE DETAILS ON SHEET H8. PLACE CLASS III RIPRAP AT OUTLET.	
TOTALS		180	122 131.4	96	270	230	150	10	

GUARDRAIL INSTALLATION SUMMARY

WORK AREA	STATION TO STATION	OFFSET		W-BEAM LENGTH (L.F.)	END SECTIONS REQ'D	COMMENTS
		LT.	RT.			
LUTAK RD. - 2.4 MILE	371+96 TO 373+68	X		100 24.5	2	SEE STANDARD DRAWING G-28.00, LONG SPAN W-BEAM GUARDRAIL, CASE "A", FOR INSTALLATION OF GUARDRAIL OVER THIS CULVERT. AN SRT-350 END SECTION SHALL BE INSTALLED AT STA. 373+67, 31' LT. ALL OTHER END SECTIONS SHALL BE ET-PLUS. CONTRACTOR MUST PROVIDE EMBANKMENT AS SHOWN IN STANDARD DRAWING G-20.10 FOR ET-PLUS.
LUTAK RD. - 2.4 MILE	372+55 TO 374+04		X	75.44'	2	
LUTAK RD. - 3.9 MILE	457+73 TO 459+23	X	X	150'	4	SEE STANDARD DRAWING G-28.00, LONG SPAN W-BEAM GUARDRAIL, CASE "A", FOR INSTALLATION OF GUARDRAIL OVER THIS CULVERT. CONTRACTOR MUST PROVIDE EMBANKMENT AS SHOWN IN STANDARD DRAWING G-20.10 FOR ET-PLUS.
MUD BAY RD. - 6.0 MILE	171+50 TO 173+25		X	188 175	0	REMOVE AND DISPOSE OF DAMAGED POSTS AND RAIL ELEMENTS, AND INSTALL NEW W-BEAM GUARDRAIL AFTER NEW EMBANKMENT IS PLACED. CONNECT TO EXISTING ON BOTH ENDS.
TOTAL				500 406.5	8	

REMOVAL OF STRUCTURES AND OBSTRUCTIONS

WORK AREA	STATION	OFFSET		DESCRIPTION	COMMENTS
		LT.	RT.		
LUTAK RD. 2.4 MILE	373+40		X	DAMAGED CULVERT PIPE	CLEANUP OF EXISTING STORM DEBRIS
LUTAK RD. 3.9 MILE	458+40 TO 458+71		X	TYPE 1 CONCRETE HEADWALL AT CULVERT PIPES INLETS	
MUD BAY RD. 6.0 MILE	172+00		X	DAMAGED CULVERT PIPE AND GUARDRAIL ELEMENTS	CLEANUP OF EXISTING STORM DEBRIS

CULVERT REMOVAL SUMMARY

WORK AREA	STATION	LENGTH (FT.)	COMMENTS
LUTAK RD. 0.3 MILE	271+84	36	DEADMAN ANCHOR(S) MAY BE ENCOUNTERED
LUTAK RD. 0.3 MILE	271+93	40	DEADMAN ANCHOR(S) MAY BE ENCOUNTERED
LUTAK RD. 1.2 MILE	311+21	80	
LUTAK RD. 1.2 MILE	311+25	80	
LUTAK RD. 2.1 MILE	359+34	54	
LUTAK RD. 2.4 MILE	373+20	59	DEADMAN ANCHOR(S) MAY BE ENCOUNTERED
LUTAK RD. 2.4 MILE	373+38	55	DEADMAN ANCHOR(S) MAY BE ENCOUNTERED
LUTAK RD. 3.9 MILE	458+47	60	REMOVE AND DISPOSE OF TYPE I HEADWALL AT INLET
LUTAK RD. 3.9 MILE	458+64	80	END OF PIPES. DEADMAN ANCHORS MAY BE ENCOUNTERED AT OUTLETS.
LUTAK RD. 3.9 MILE	458+71	74	
MUD BAY RD. 6.0 MILE	172+40	81	
TOTALS		699	

DATE: 05/24/06
 PROJECT: SEA NOVEMBER 2005 STORM PERMANENT REPAIRS
 SHEET: D1 OF 36
 DRAWN BY: J. PETROPOULOS
 CHECKED BY: D. STEVENS

ADDENDUM NUMBER:
 ATTACHMENT NUMBER:
 RECORD OF REVISIONS:
 NO. DATE DESCRIPTION

SEA NOVEMBER 2005
 STORM PERMANENT REPAIRS
 69236 / ER-0079(2)

Summary Tables

Project As-Built Drawings have been reviewed by the Project Engineer and represent to the best of my knowledge, the project as constructed.
 Date: 11/24/05
 PE: [Signature]




DESIGNED BY: J. PETROPOULOS
 DRAWN BY: D. STEVENS
 STATE OF ALASKA
 DEPARTMENT OF TRANSPORTATION & PUBLIC FACILITIES
 SOUTHEAST REGION
 SEA NOVEMBER 2005 STORM PERMANENT REPAIRS

Summary Tables


PROJECT DESIGNATION NUMBER:
 69236 / ER-0079(2)
 STATE: ALASKA
 YEAR: 2008
 SHEET NUMBER: D1
 TOTAL SHEETS: 36

P&T:
 07/SEA/ES/22EN/for/rev/1, No. 00000000-0-0
 Thu, 16 Jul 2008 10:05AM
 PLOT:
 69236 / ER-0079(2) (SHEET 14 OF 14)
 TAB: TYPICAL

ADDENDUM NUMBER
ATTACHMENT NUMBER
RECORD OF REVISIONS
NO. DATE DESCRIPTION

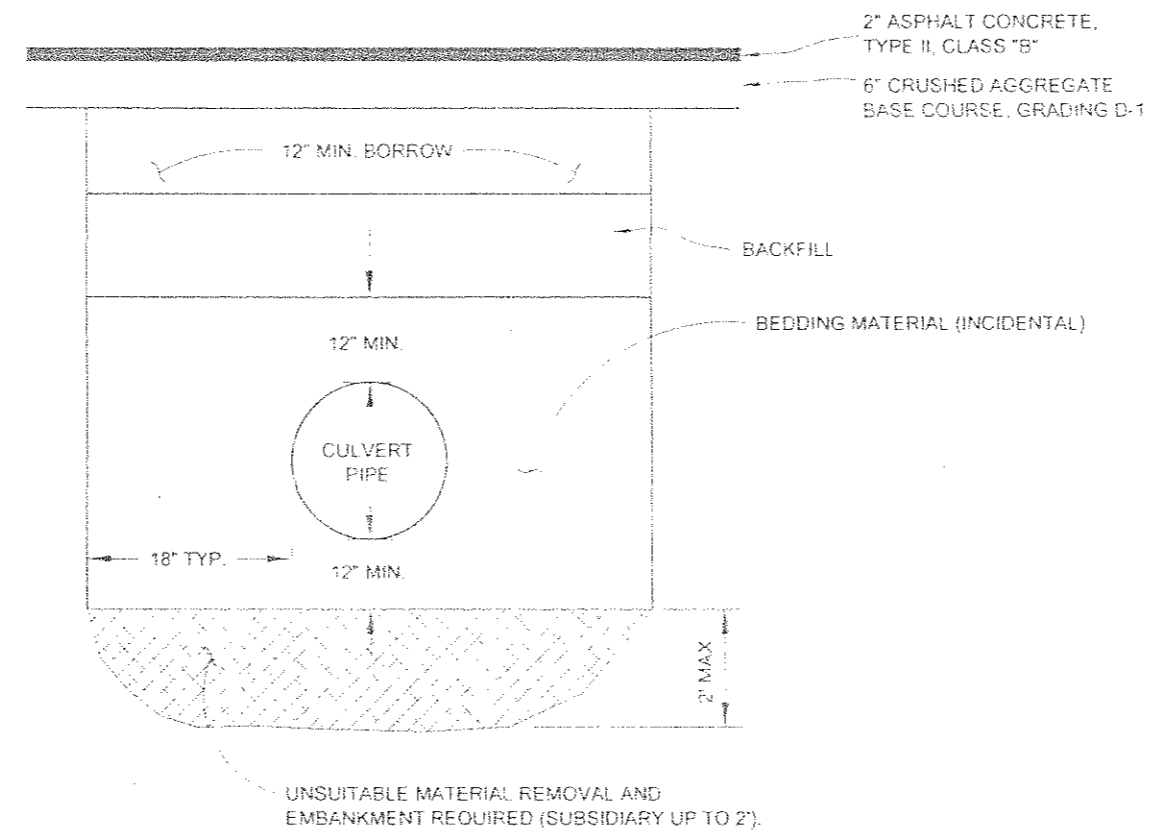

**TYPICAL PIPE TRENCHING & BEDDING
 DETAIL**
 NTS

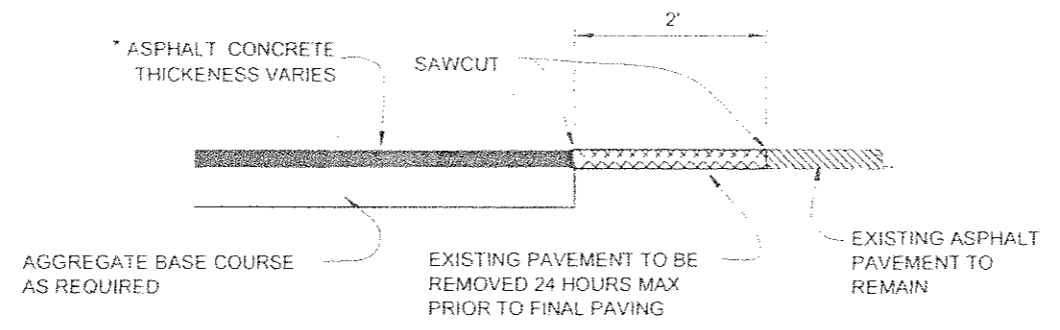

PAVEMENT MATCH JOINT DETAIL
 * HAINES HIGHWAY - 5" ±
 LUTAK RD. & MUDBAY RD. - 2"


SEA NOVEMBER 2005
 STORM PERMANENT REPAIRS
 69236 / ER-0079(2)
MISCELLANEOUS DETAILS



DESIGNED BY: J. PETROPOULOS
 DRAWN BY: E. STEVENSON
 STATE OF ALASKA
 DEPARTMENT OF TRANSPORTATION
 & PUBLIC FACILITIES
 SOUTHEAST REGION
 SEA NOVEMBER 2005
 STORM PERMANENT REPAIRS

**MISCELLANEOUS
 DETAILS**

PROJECT DESIGNATION NUMBER	
69236 / ER-0079(2)	
STATE	YEAR
ALASKA	2008
SHEET NUMBER	TOTAL SHEETS
E1	36

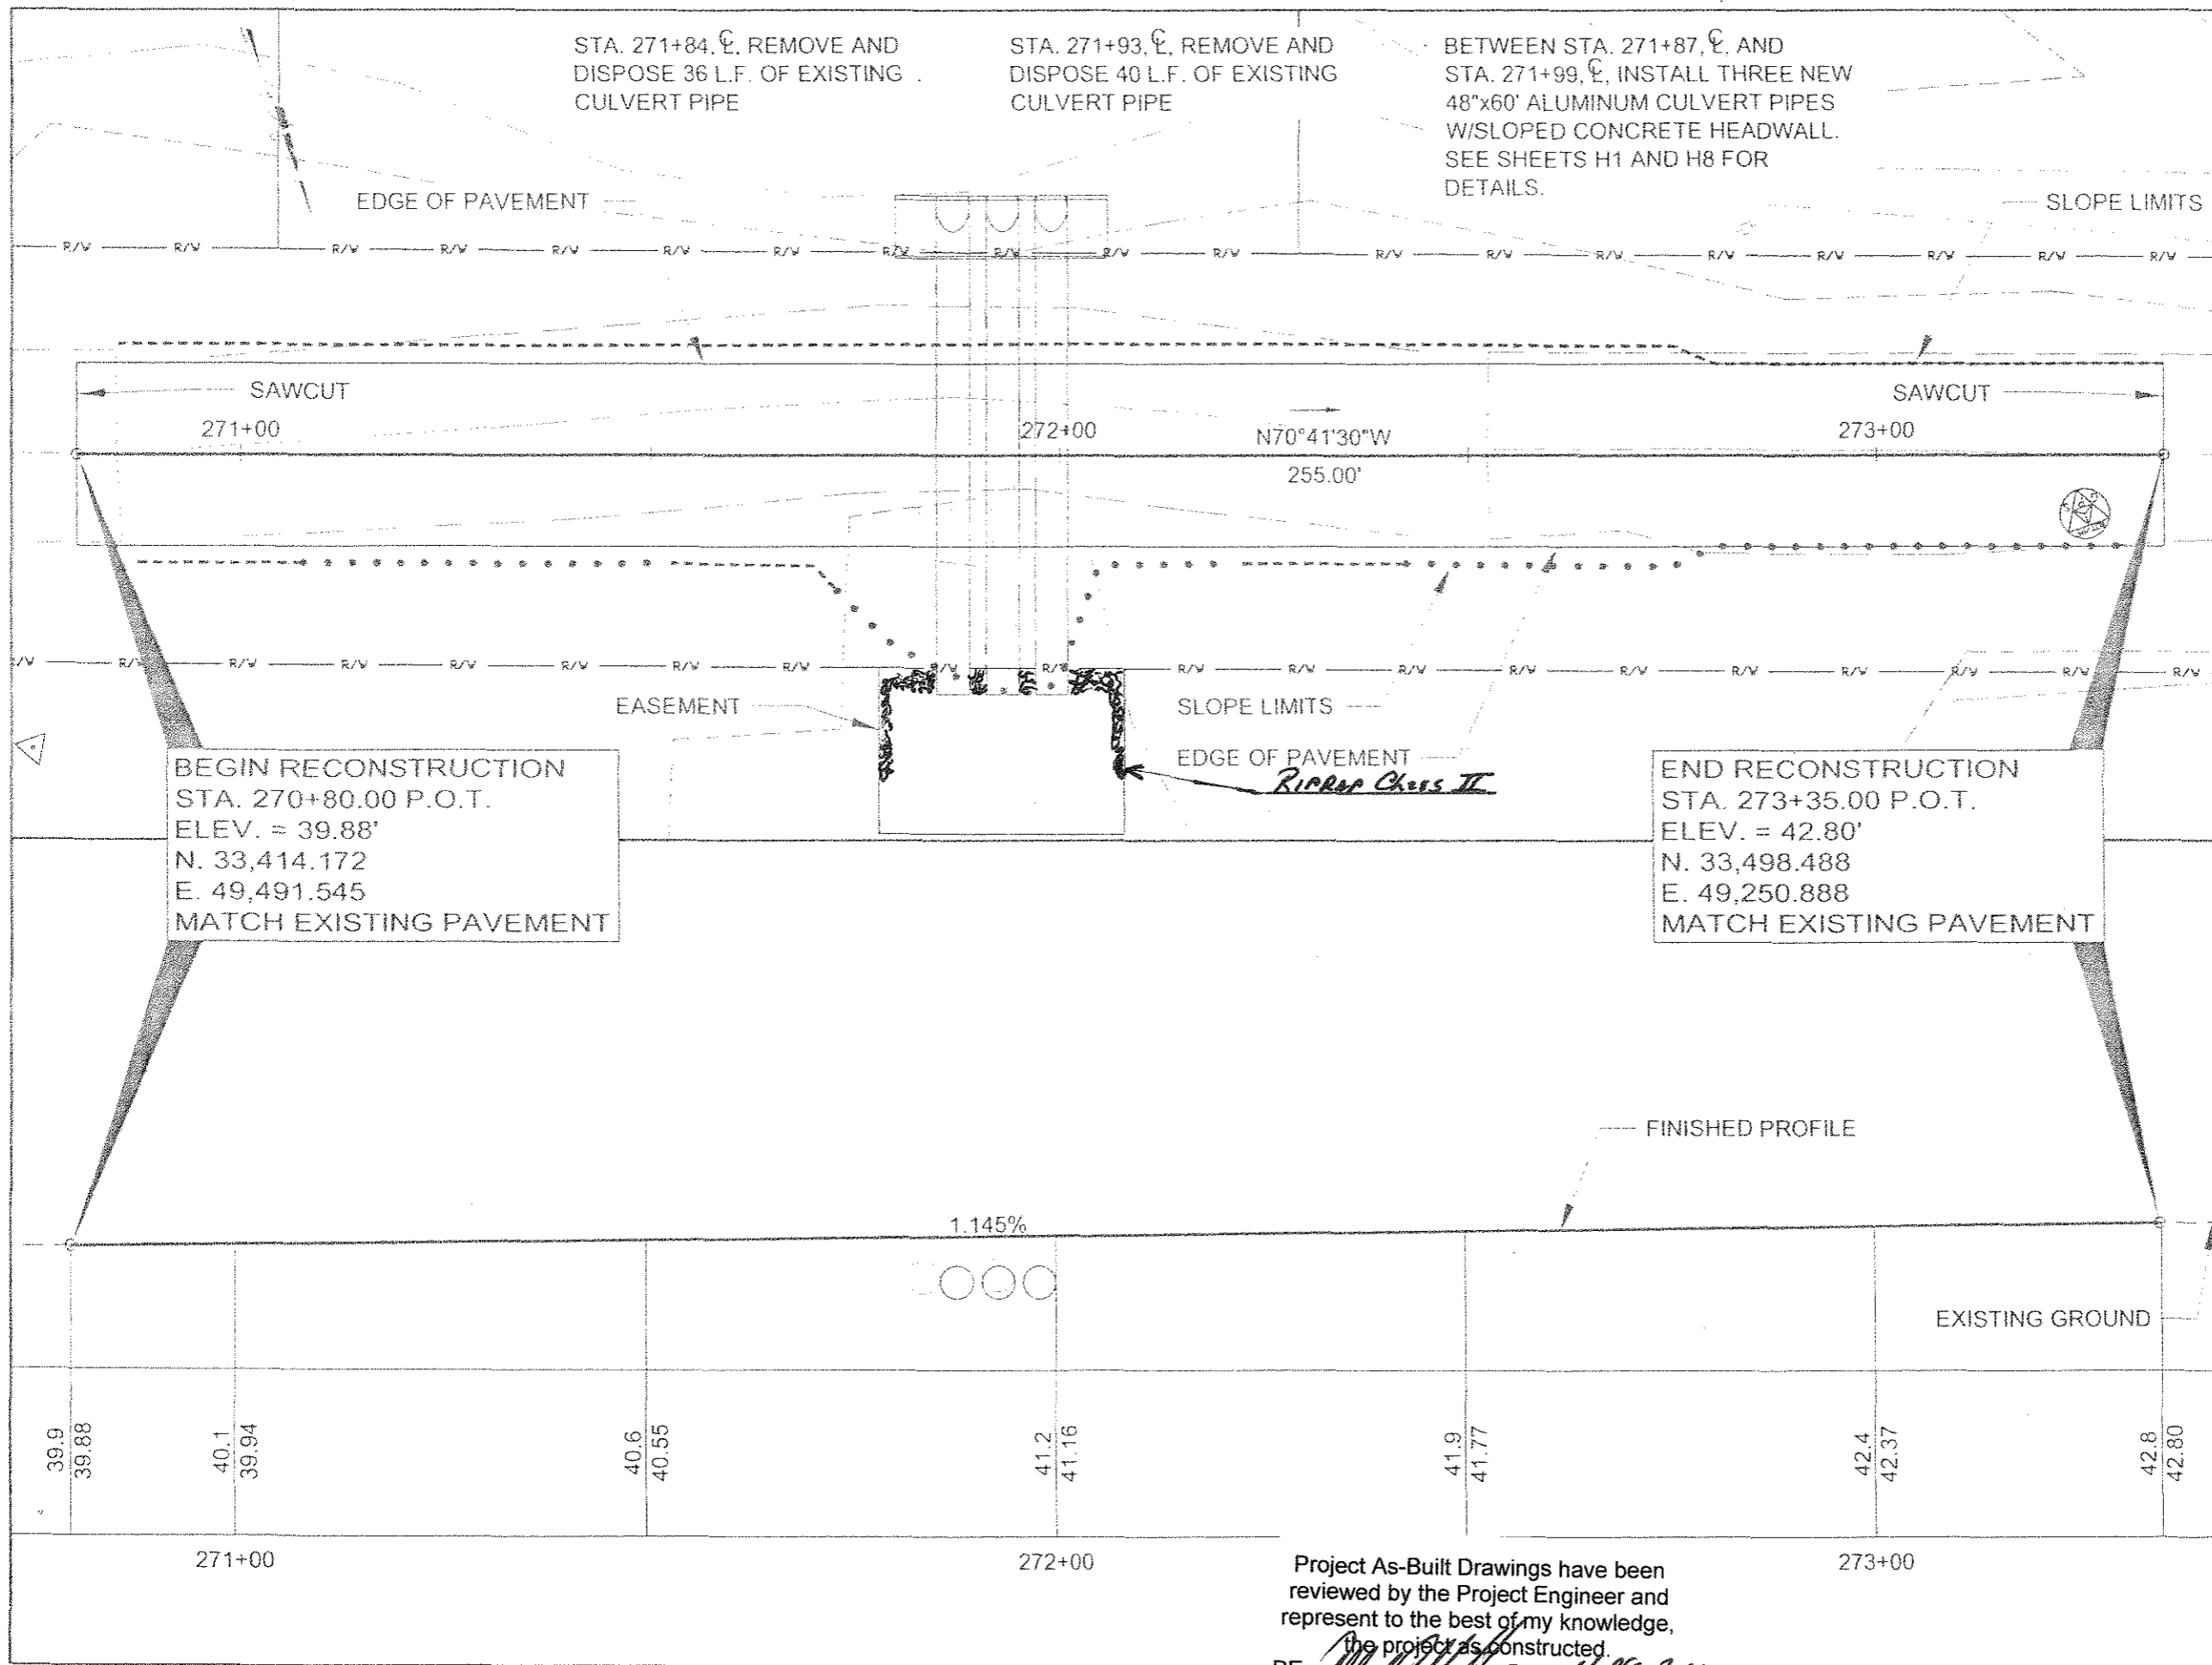

STA. 271+84, \mathcal{C} , REMOVE AND DISPOSE 36 L.F. OF EXISTING CULVERT PIPE

STA. 271+93, \mathcal{C} , REMOVE AND DISPOSE 40 L.F. OF EXISTING CULVERT PIPE


BETWEEN STA. 271+87, \mathcal{C} , AND STA. 271+99, \mathcal{C} , INSTALL THREE NEW 48"x60" ALUMINUM CULVERT PIPES W/SLOPED CONCRETE HEADWALL. SEE SHEETS H1 AND H8 FOR DETAILS.

BEGIN RECONSTRUCTION STA. 270+80.00 P.O.T. ELEV. = 39.88' N. 33,414.172 E. 49,491.545 MATCH EXISTING PAVEMENT

END RECONSTRUCTION STA. 273+35.00 P.O.T. ELEV. = 42.80' N. 33,498.488 E. 49,250.888 MATCH EXISTING PAVEMENT

Project As-Built Drawings have been reviewed by the Project Engineer and represent to the best of my knowledge, the project as constructed.
 PE *[Signature]* Date 4-29-2011

DRAWING NUMBER: 69236 / ER-0079(2) PROJECT NAME: SEA NOVEMBER 2005 STORM PERMANENT REPAIRS SHEET NUMBER: F1 TOTAL SHEETS: 36	
DESIGNER: J. PETROPOLOS DRAWN BY: D. STEVENS	
STATE OF ALASKA DEPARTMENT OF TRANSPORTATION & PUBLIC FACILITIES SEA NOVEMBER 2005 STORM PERMANENT REPAIRS	
LUTAK ROAD 0.3 MILE PLAN AND PROFILE	
PROJECT DESIGNATION NUMBER 69236 / ER-0079(2)	STATE: ALASKA YEAR: 2008
SHEET NUMBER F1	TOTAL SHEETS 36

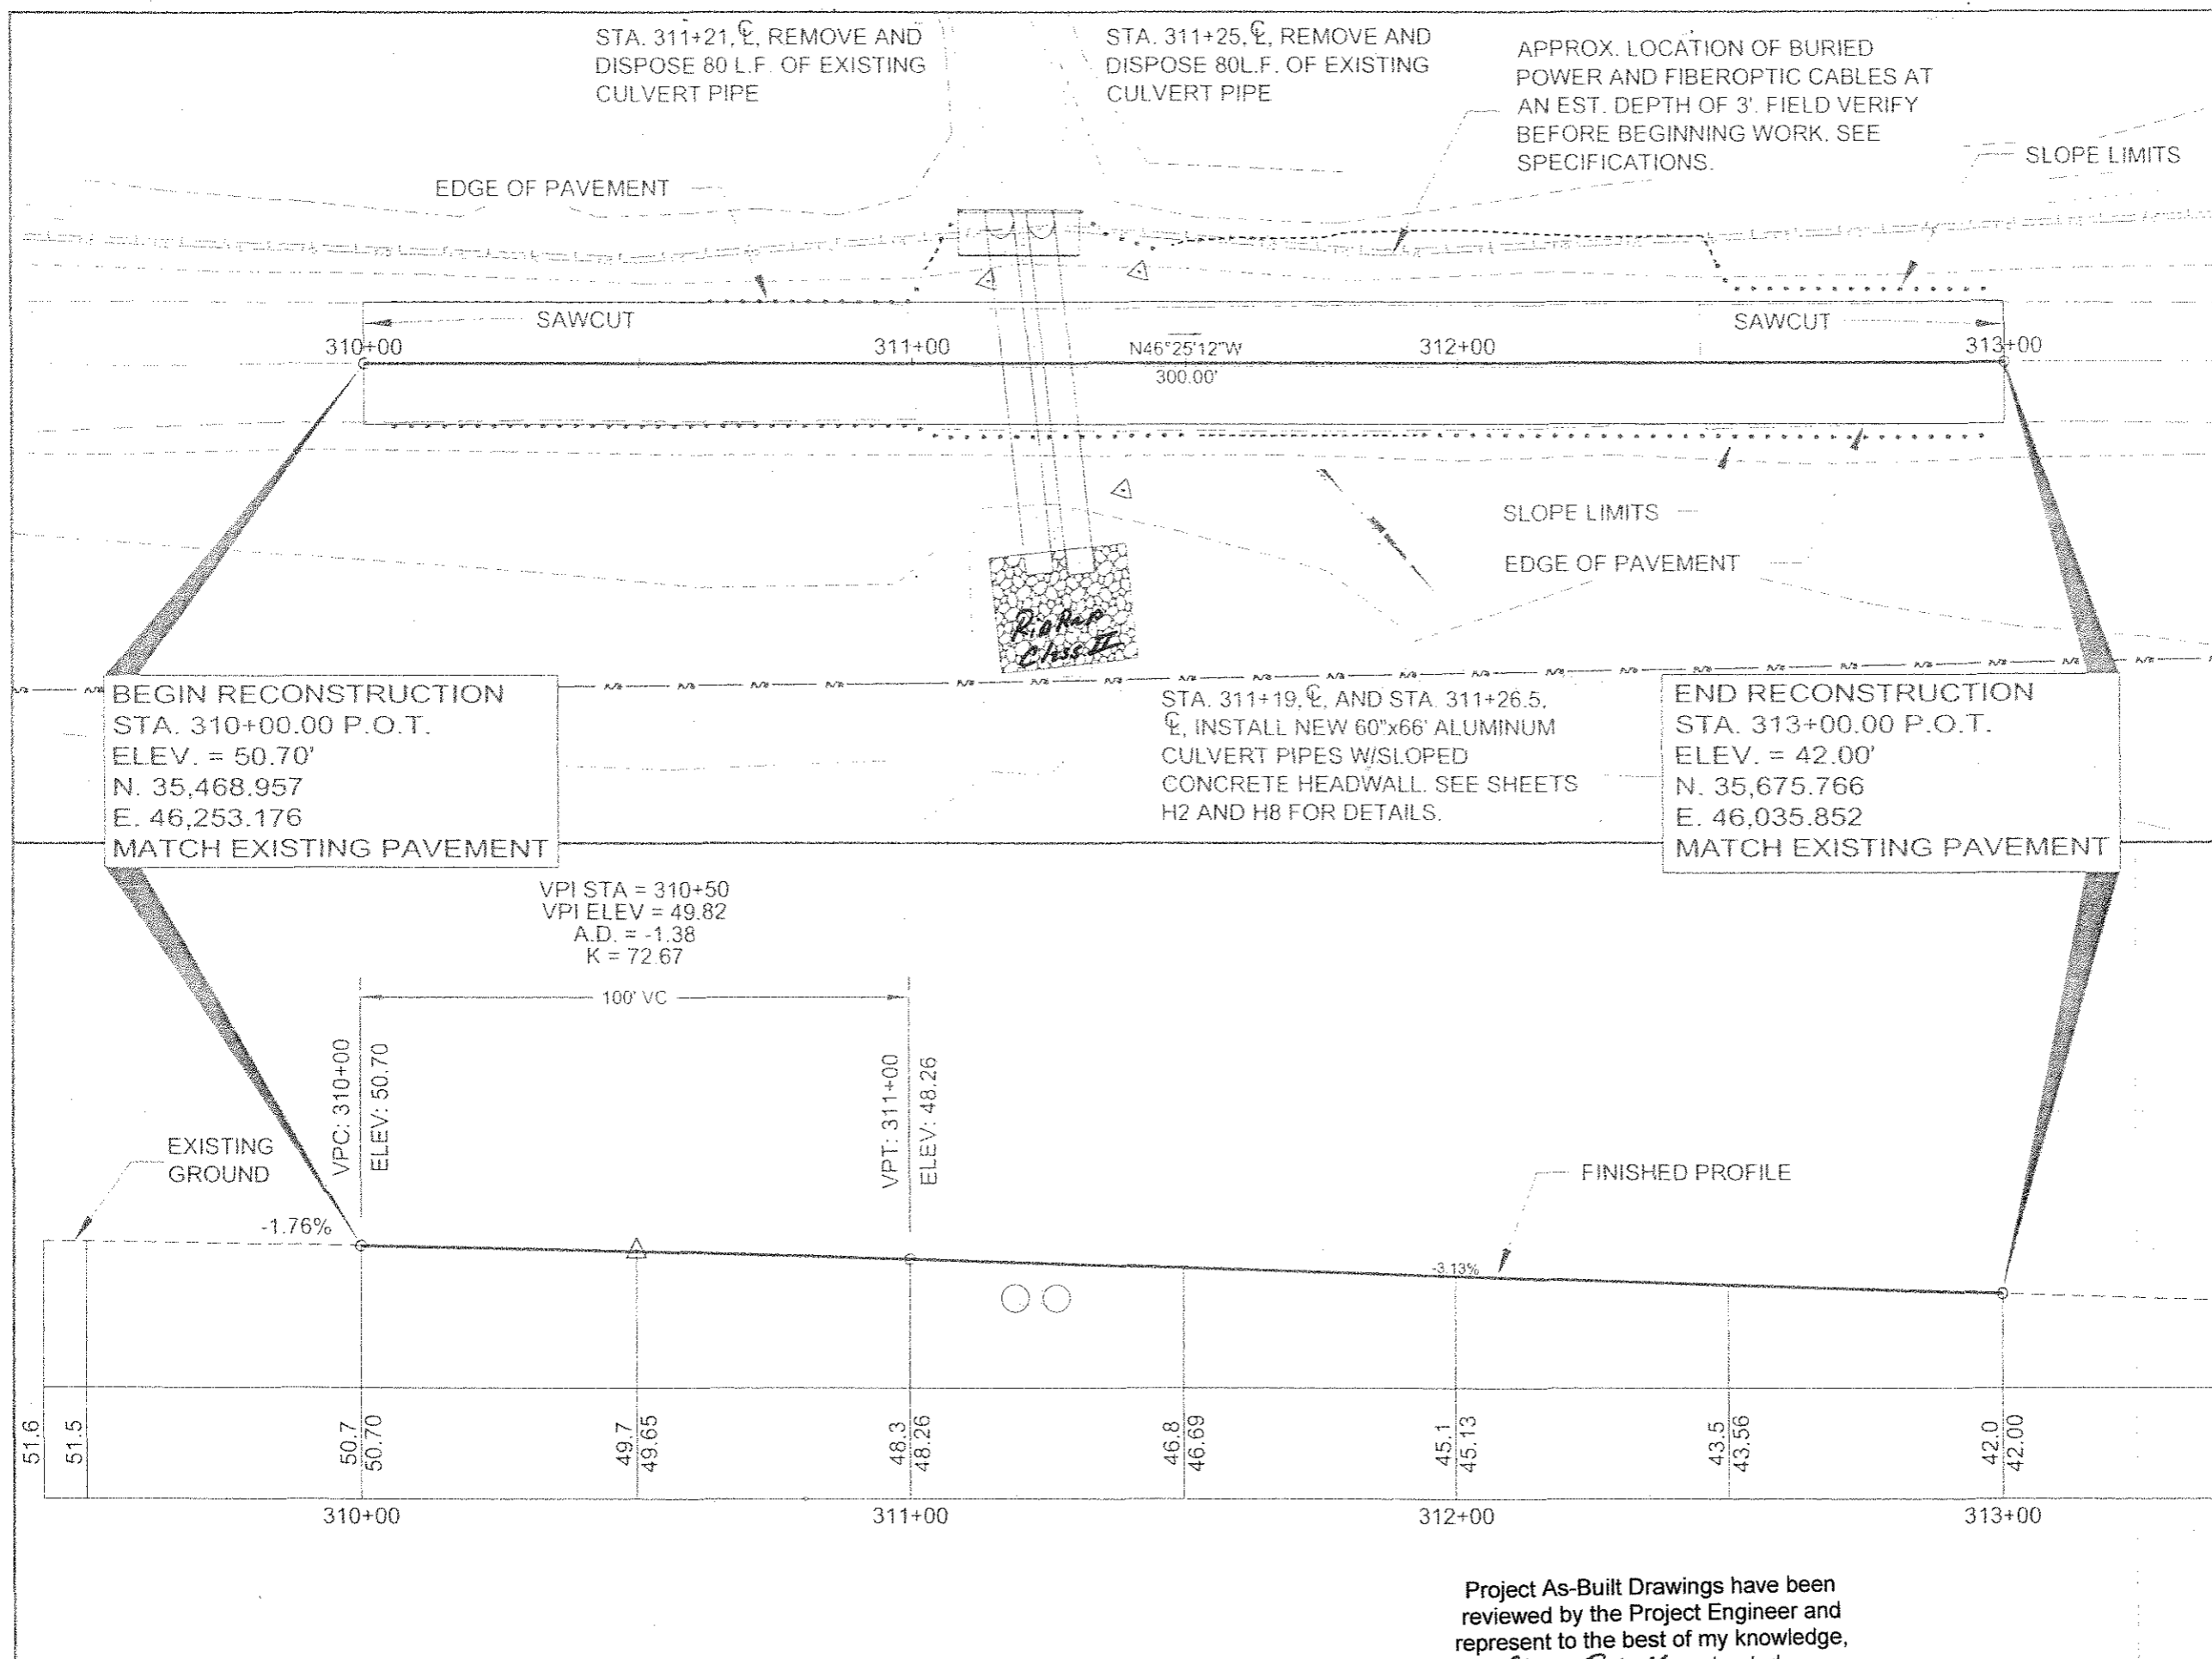

DATE	02/28/11/2008
PROJECT	SEA NOVEMBER 2005 STORM PERMANENT REPAIRS
SCALE	AS SHOWN
APPENDIX NUMBER	
ATTACHMENT NUMBER	
REVISIONS	
NO. DATE DESCRIPTION	

SEA NOVEMBER 2005
STORM PERMANENT REPAIRS
69236 / ER-0079(2)



LUTAK ROAD 1.2 MILE
PLAN AND PROFILE



DESIGNED BY J. PETROPOLIS
DRAWN BY D. STEVENS
STATE OF ALASKA
DEPARTMENT OF TRANSPORTATION
& PUBLIC FACILITIES
SOUTHEAST REGION
SEA NOVEMBER 2005
STORM PERMANENT REPAIRS

LUTAK ROAD 1.2 MILE PLAN AND PROFILE	
PROJECT DESIGNATION NUMBER 69236 / ER-0079(2)	
STATE	YEAR
ALASKA	2008
SHEET NUMBER	TOTAL SHEETS
F2	36

Project As-Built Drawings have been reviewed by the Project Engineer and represent to the best of my knowledge, the project as constructed.
PE *[Signature]* Date 4-29-2011

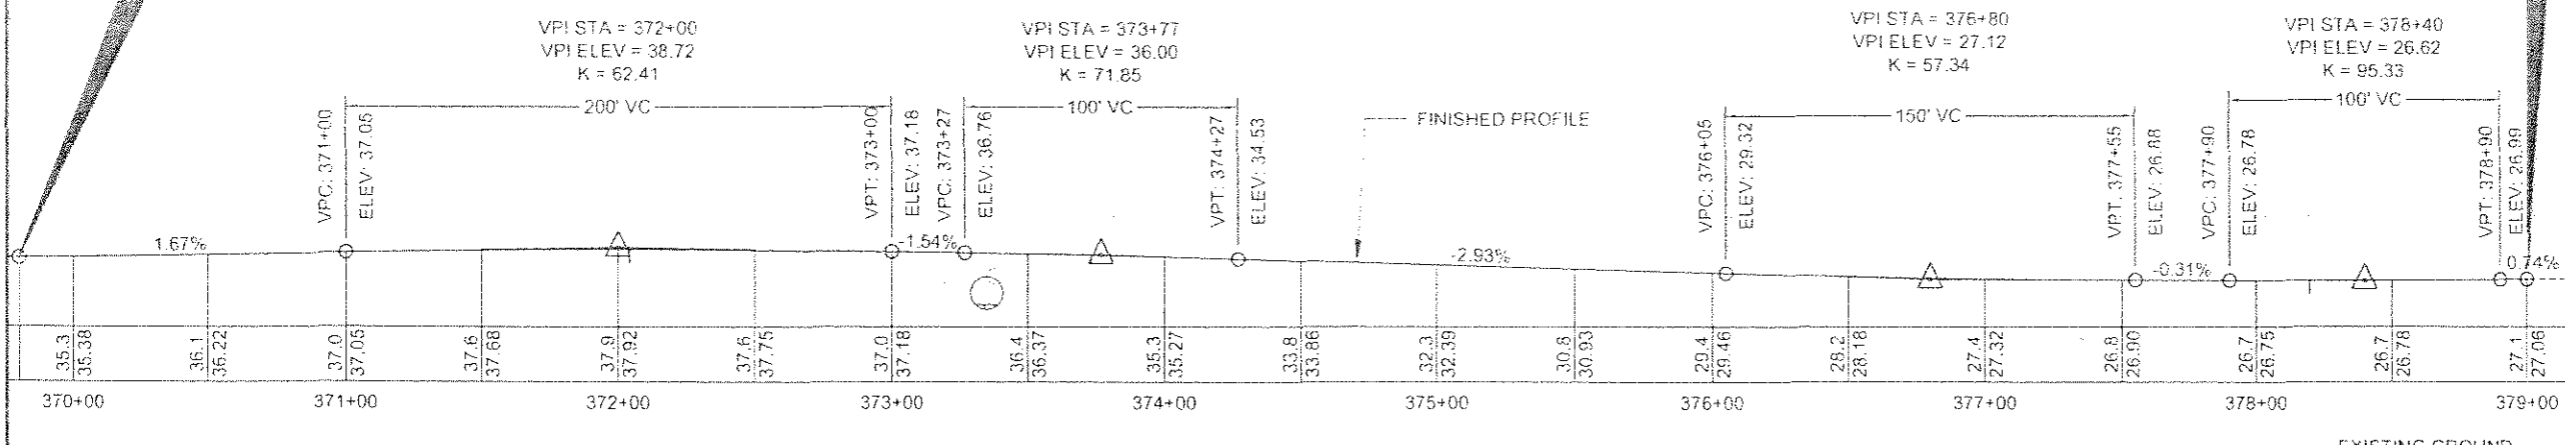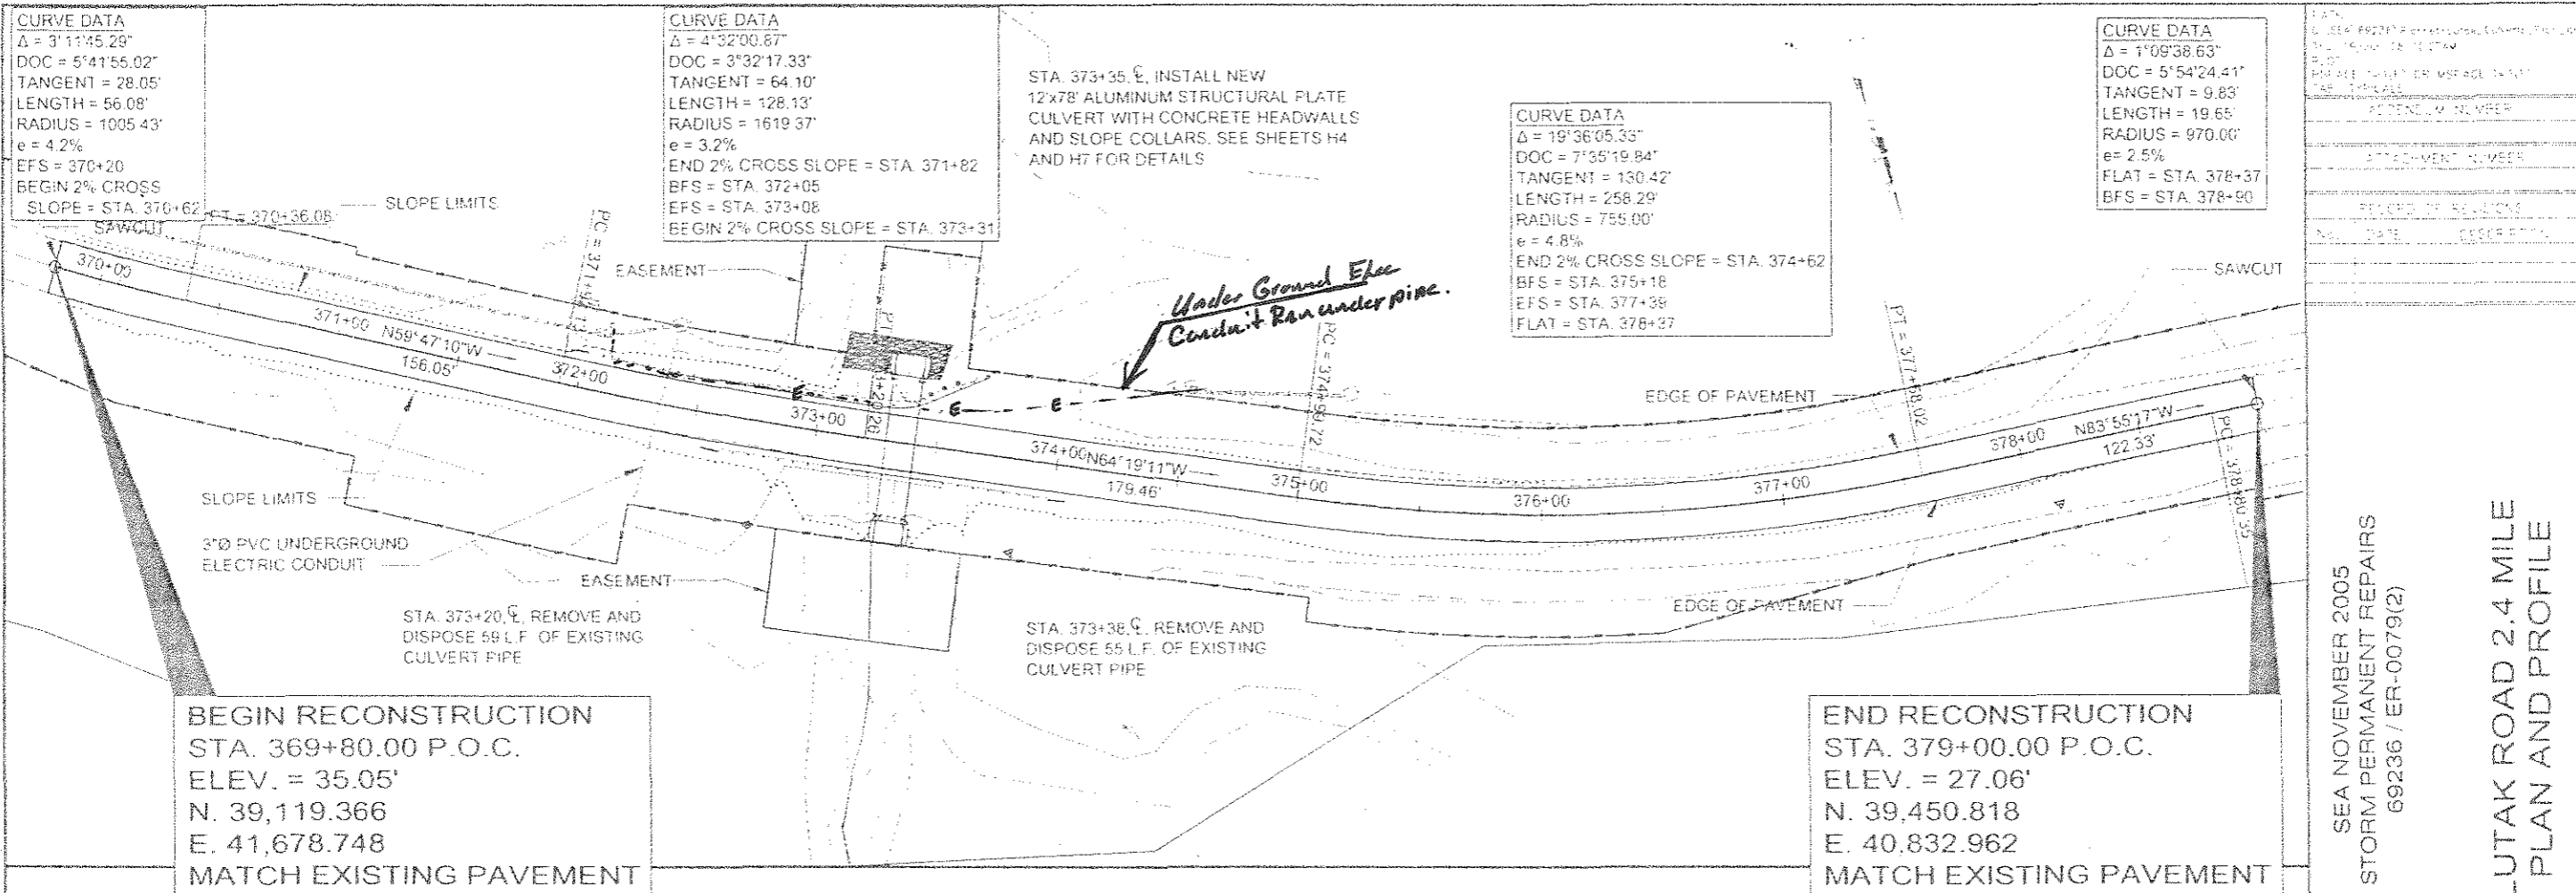


STATE OF ALASKA
 DEPARTMENT OF TRANSPORTATION & PUBLIC FACILITIES
 SEA NOVEMBER 2005 STORM PERMANENT REPAIRS
 PROJECT DESIGNATION NUMBER 69236 / ER-0079(2)
 LUTAK ROAD 2.4 MILE PLAN AND PROFILE
 SHEET NUMBER F4 TOTAL SHEETS 36

SEA NOVEMBER 2005 STORM PERMANENT REPAIRS 69236 / ER-0079(2)

LUTAK ROAD 2.4 MILE PLAN AND PROFILE

Project As-Built Drawings have been reviewed by the Project Engineer and represent to the best of my knowledge, the project as constructed.
 PE *Ally Calvert* Date 4/29/08

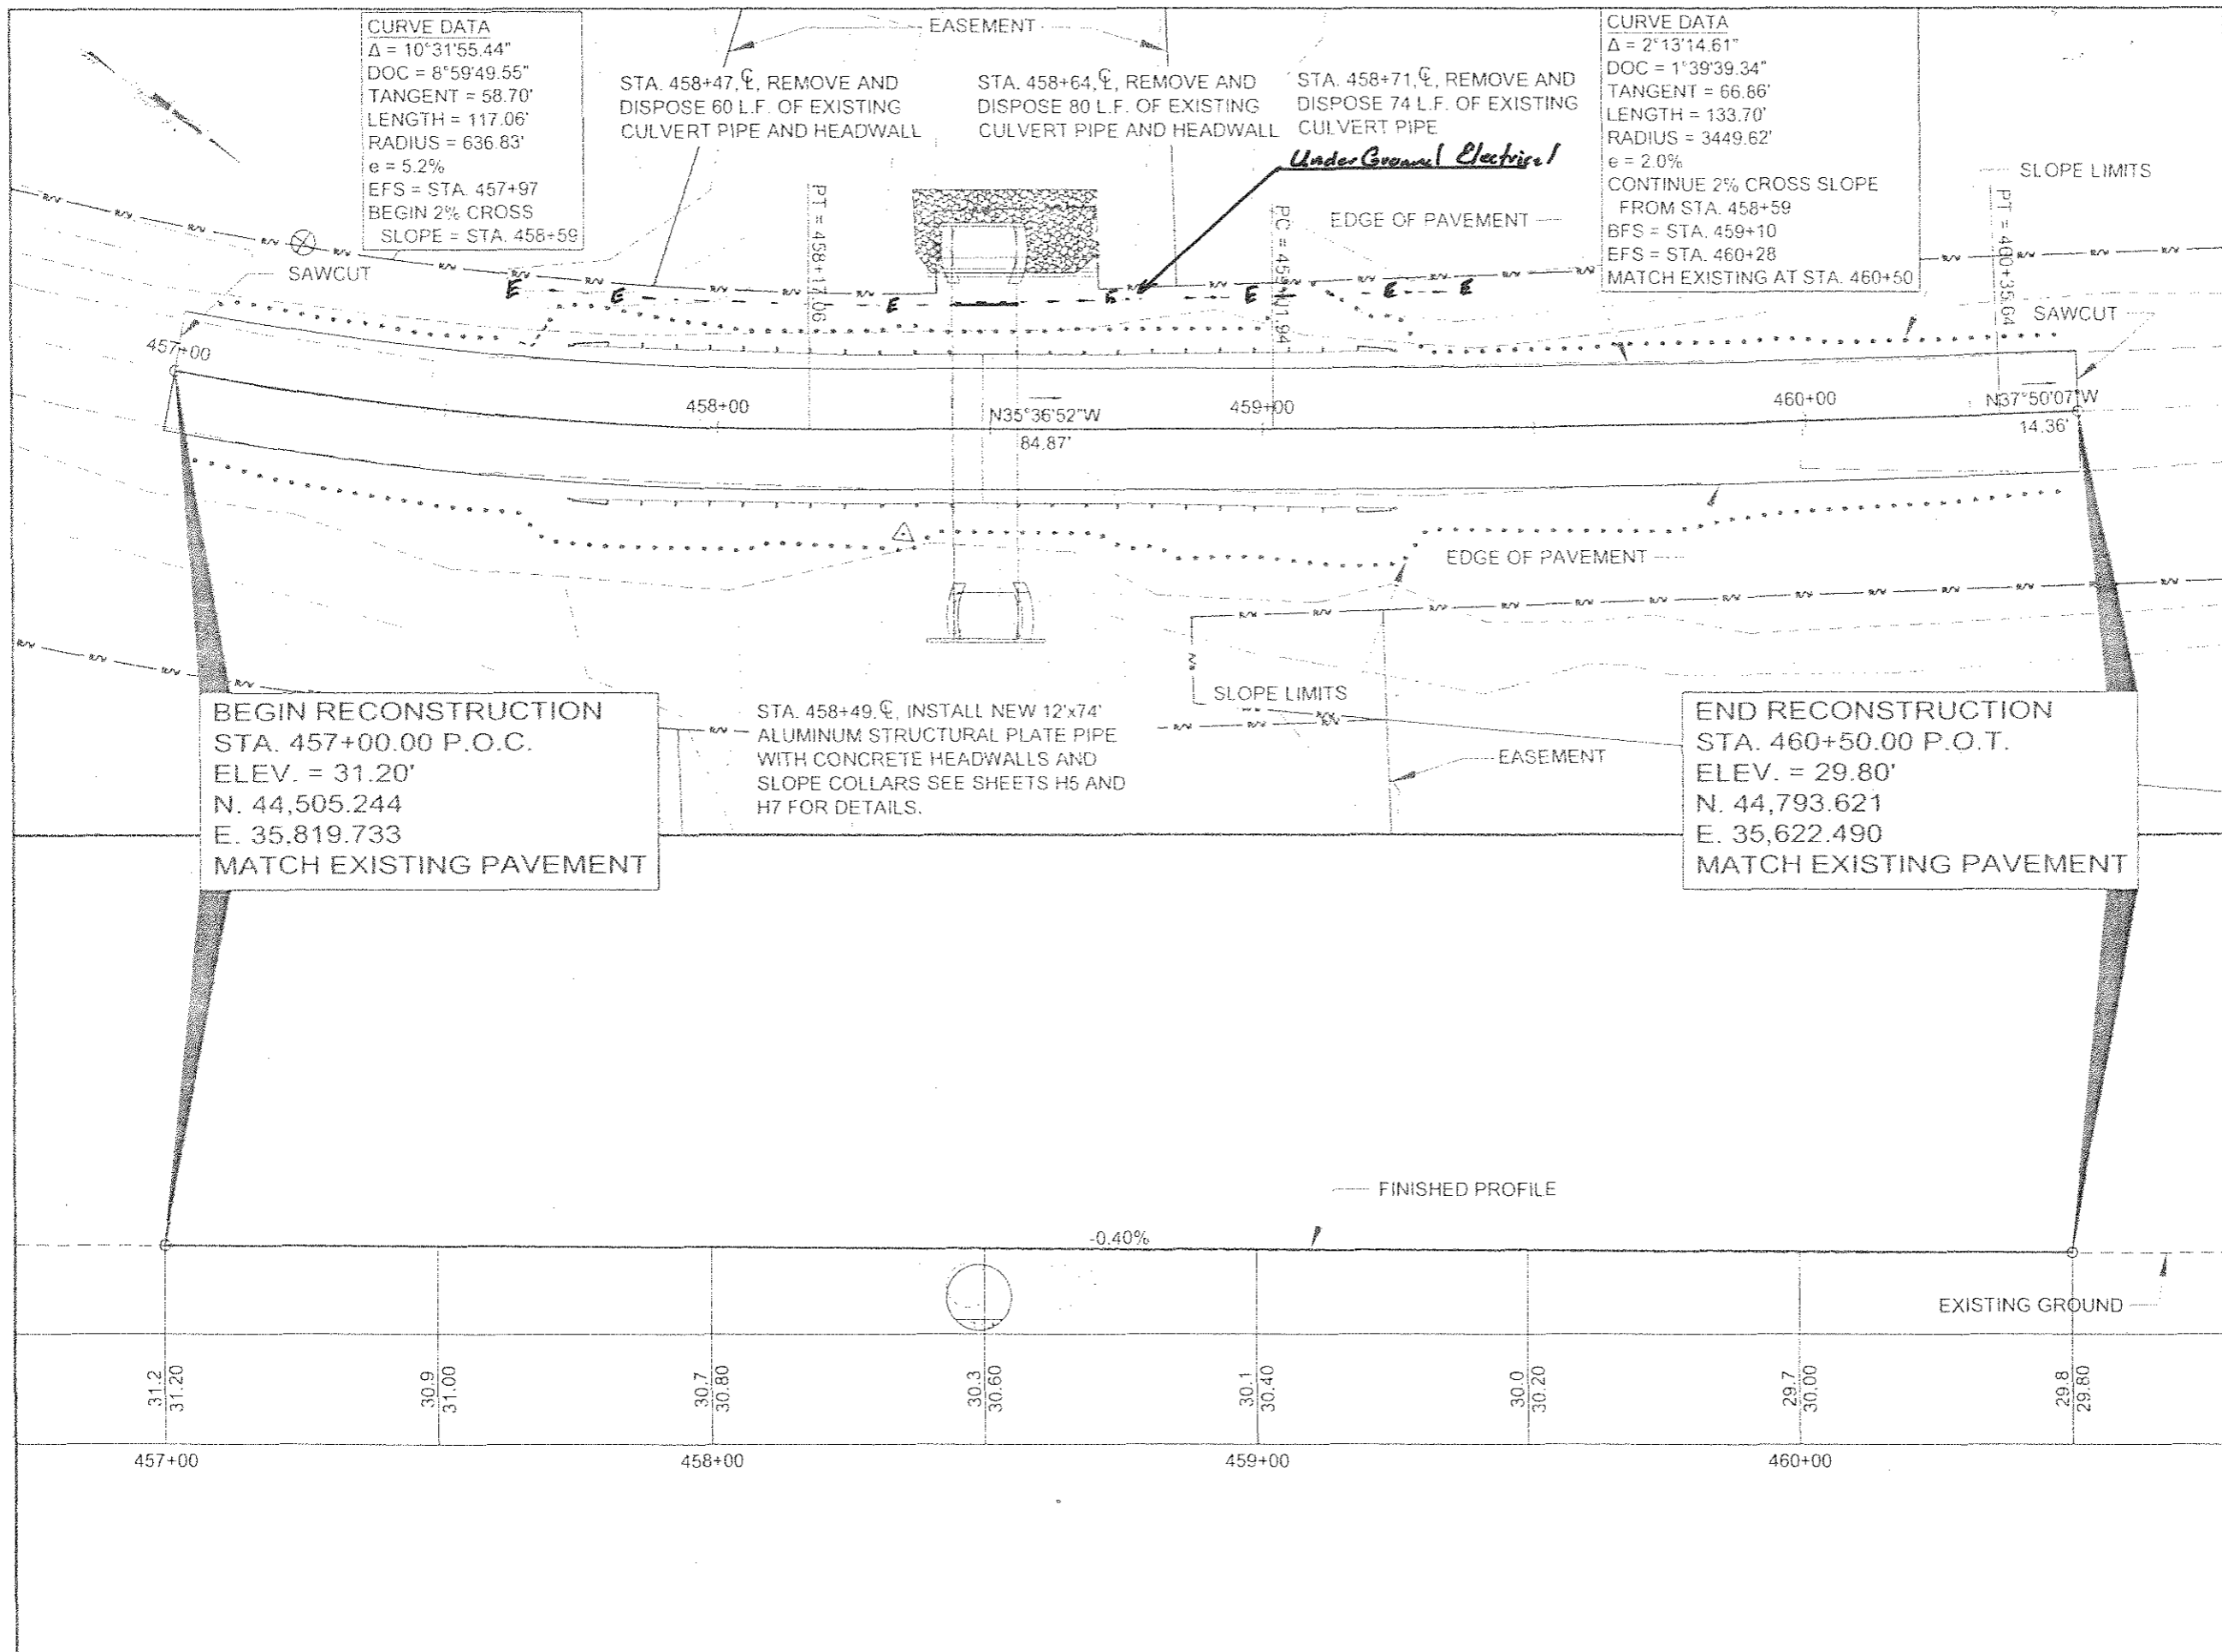


PROJECT NUMBER	
ATTACHMENT NUMBER	
RECORD OF REVISIONS	
DATE	DESCRIPTION

SEA NOVEMBER 2005
 STORM PERMANENT REPAIRS
 69236 / ER-0079(2)

**LUTAK ROAD 3.9 MILE
 PLAN AND PROFILE**

Project As-Built Drawings have been reviewed by the Project Engineer and represent to the best of my knowledge, the project as constructed.
 PE *Alan A. Ball* Date 4/25/2011

DESIGNED BY	J. PETROPOLOU
DRAWN BY	D. STEVENS
STATE OF ALASKA DEPARTMENT OF TRANSPORTATION & PUBLIC FACILITIES SOUTHEAST REGION	
SEA NOVEMBER 2005 STORM PERMANENT REPAIRS	
LUTAK ROAD 3.9 MILE PLAN AND PROFILE	
PROJECT DESIGNATION NUMBER 69236 / ER-0079(2)	
STATE	YEAR
ALASKA	2008
SHEET NUMBER	TOTAL SHEETS
F5	36

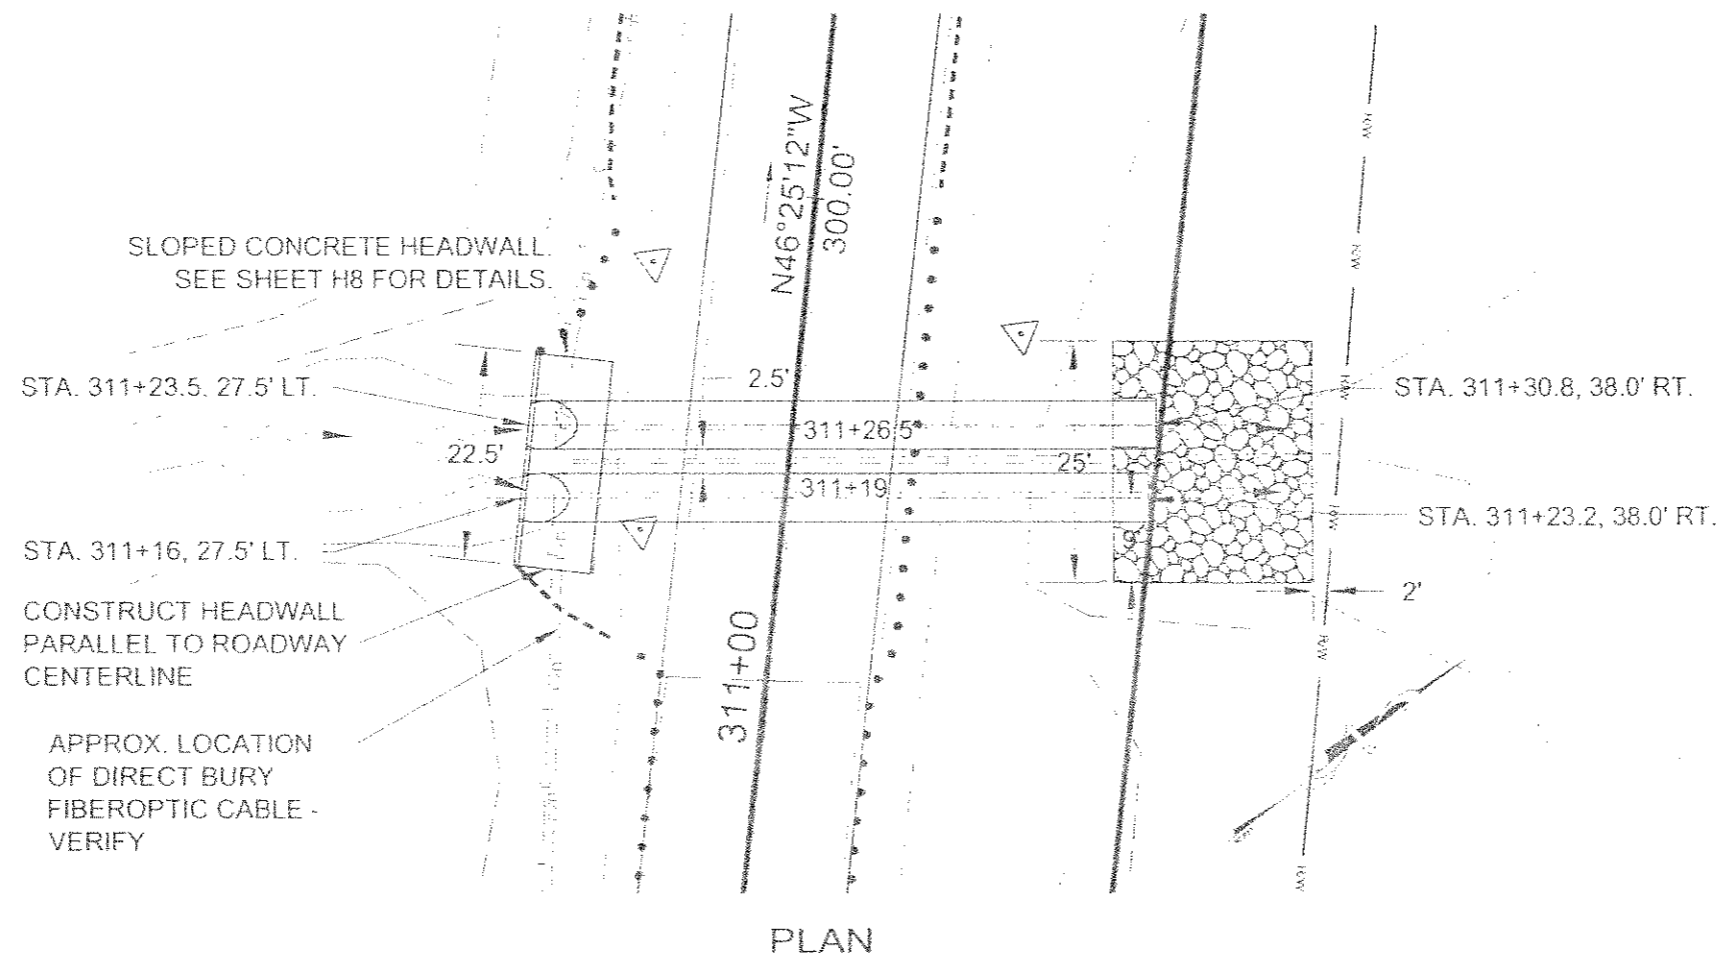

SLOPED CONCRETE HEADWALL.
SEE SHEET H8 FOR DETAILS.

STA. 311+23.5, 27.5' LT.

22.5'

2.5'

311+26.5'

311+19'

25'

311+30.8, 38.0' RT.

2'


STA. 311+23.2, 38.0' RT.

CONSTRUCT HEADWALL
PARALLEL TO ROADWAY
CENTERLINE

APPROX. LOCATION
OF DIRECT BURY
FIBEROPTIC CABLE -
VERIFY

PLAN

HYDRAULIC SUMMARY		
RETURN PERIOD	FLOW RATE (CFS)	HEADWATER ELEVATION (FT)
Q50	66	45.0
Q100	75	45.2
Q500	98	45.7
CAPACITY	50 YEAR	
PURPOSE	STREAM CHANNEL CROSSING WITH MINIMUM Q50 DESIGN CAPACITY. NO FISH PASSAGE PROVISIONS REQUIRED.	
HYDRAULIC NOTES	WATER OVERTOPS ROAD AT 47.6'. OVERFLOWS TO DITCH AT ELEV. 45.0'. ASSUMED 2.5-FT. SEDIMENT BLOCKING FLOW.	

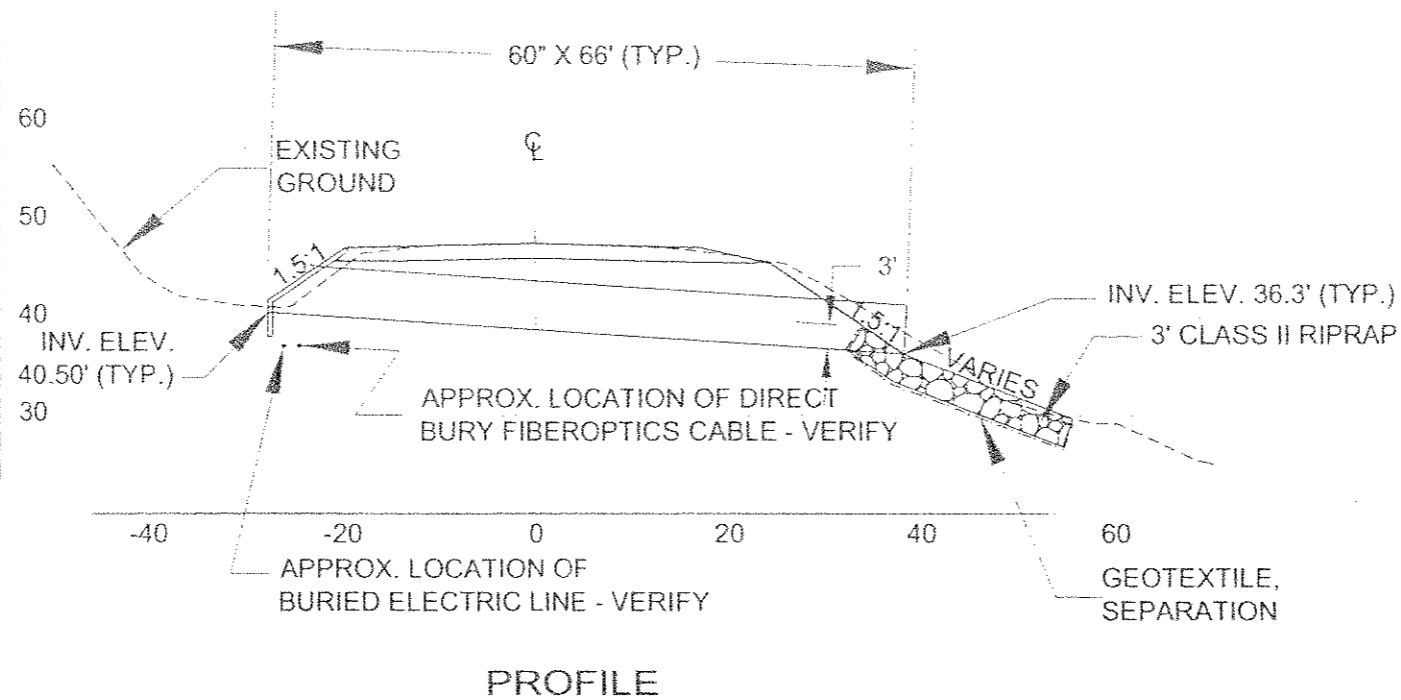


PROFILE

DATE: 11/15/05
DRAWN BY: J. STEVENS
CHECKED BY: J. STEVENS
PROJECT: 69236 / ER-0079(2)

NO.	DATE	DESCRIPTION

SEA NOVEMBER 2005
STORM PERMANENT REPAIRS
69236 / ER-0079(2)

LUTAK RD. 1.2 MILE
CULVERT REPLACEMENT
DETAILS

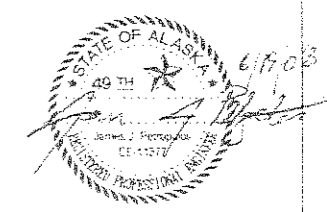

DESIGNED BY: J. STEVENS
DRAWN BY: J. STEVENS
STATE OF ALASKA
DEPARTMENT OF TRANSPORTATION
PUBLIC FACILITIES
SEATTLE REGION
SEA NOVEMBER 2005
STORM PERMANENT REPAIRS

LUTAK RD. 1.2 MILE
CULVERT REPLACEMENT
DETAILS

PROJECT DESIGNATION NUMBER	
69236 / ER-0079(2)	
STATE	YEAR
ALASKA	2008
SHEET NUMBER	TOTAL SHEETS
H2	36

P274
 0:\SEA\69236\Project\Drawings\Drawings.dwg
 Thu 10/26/06 10:29am
 FILED
 E:\SEA\69236\PROJECT\DRAWING\DRAWING
 DATE: 10/26/06

APPENDIX NUMBER
ATTACHMENT NUMBER
RECORD OF REVISIONS
NO. DATE DESCRIPTION

SEA NOVEMBER 2005
 STORM PERMANENT REPAIRS
 69236 / ER-0079(2)

**LUTAK RD. 2.1 MILE
 CULVERT REPLACEMENT
 DETAILS**




DESIGNED BY: J. PETROPOULOS
 DRAWN BY: D. SEVENS
 STATE OF ALASKA
 DEPARTMENT OF TRANSPORTATION
 & PUBLIC FACILITIES
 SOUTHEAST REGION
 SEA NOVEMBER 2005
 STORM PERMANENT REPAIRS



**LUTAK RD. 2.1 MILE
 CULVERT REPLACEMENT
 DETAILS**

PROJECT DESIGNATION NUMBER	
69236 / ER-0079(2)	
STATE	YEAR
ALASKA	2008
SHEET NUMBER	TOTAL SHEETS
H3	36

HYDRAULIC SUMMARY		
RETURN PERIOD	FLOW RATE (CFS)	HEADWATER ELEVATION (FT)
Q50	48	27.6
Q100	54	28.2
Q500	71	28.6
CAPACITY	100 YEAR	
PURPOSE	STREAM CHANNEL CROSSING WITH MINIMUM Q50 DESIGN CAPACITY. NO FISH PASSAGE PROVISIONS REQUIRED.	
HYDRAULIC NOTES	WATER OVERTOPS ROAD AT 28.0'. ASSUMED 1.5-FT. SEDIMENT BLOCKING FLOW.	

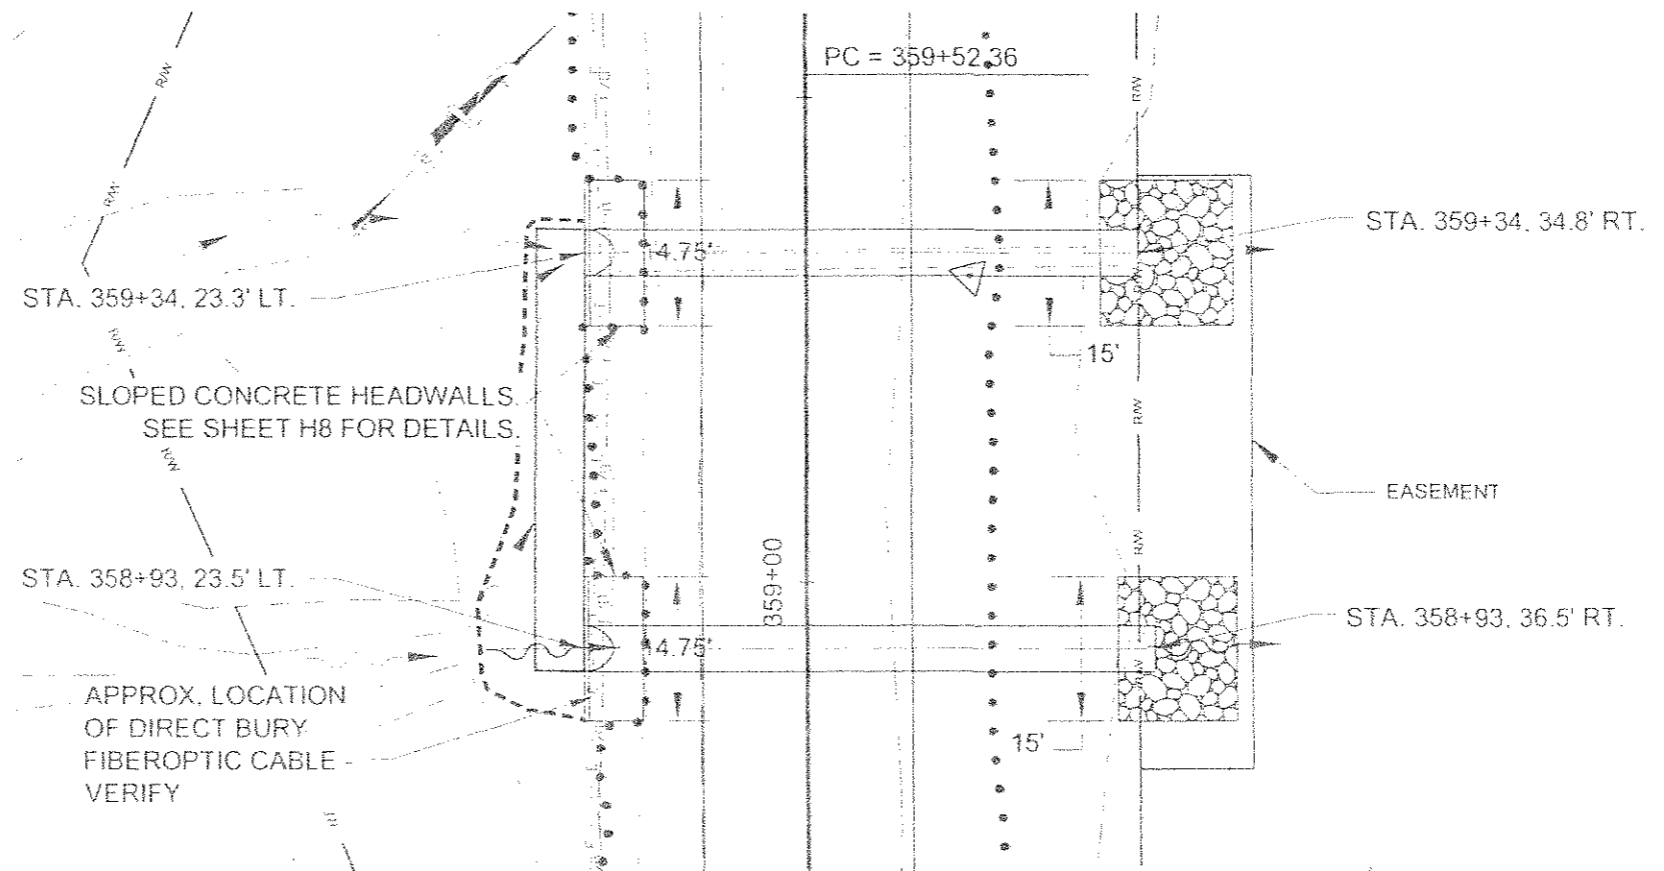

PLAN

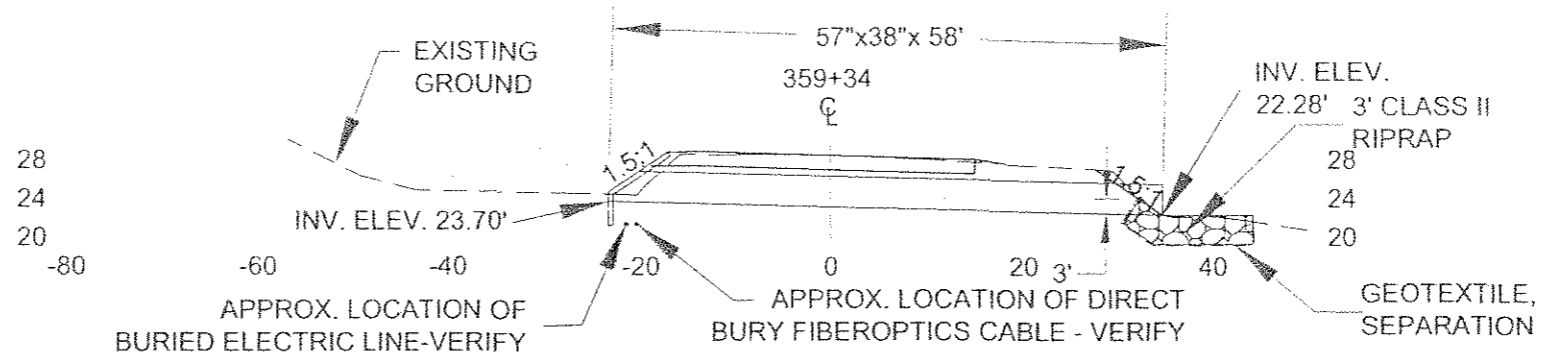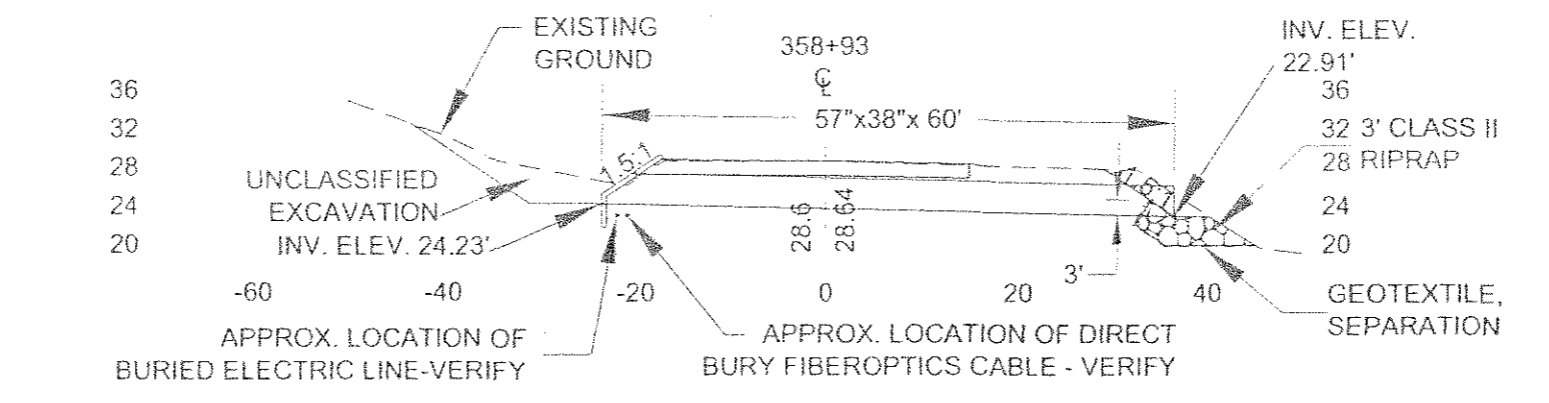


PROFILES

PATH:
 C:\BLA\PROJECTS\Current\Drawings.dwg
 DATE: 06/19/08 10:25AM
 PLOT:
 PSPACE 1/8"=1' OR MSPACE 1/4"=1'(F)
 TWE 1/8"=1'

ACCESSION NUMBER
ATTACHMENT NUMBER
REVISIONS
NO. DATE DESCRIPTION

SEA NOVEMBER 2005
 STORM PERMANENT REPAIRS
 69236 / ER-0079(2)

**LUTAK RD. 2.4 MILE
 CULVERT REPLACEMENT
 DETAILS**

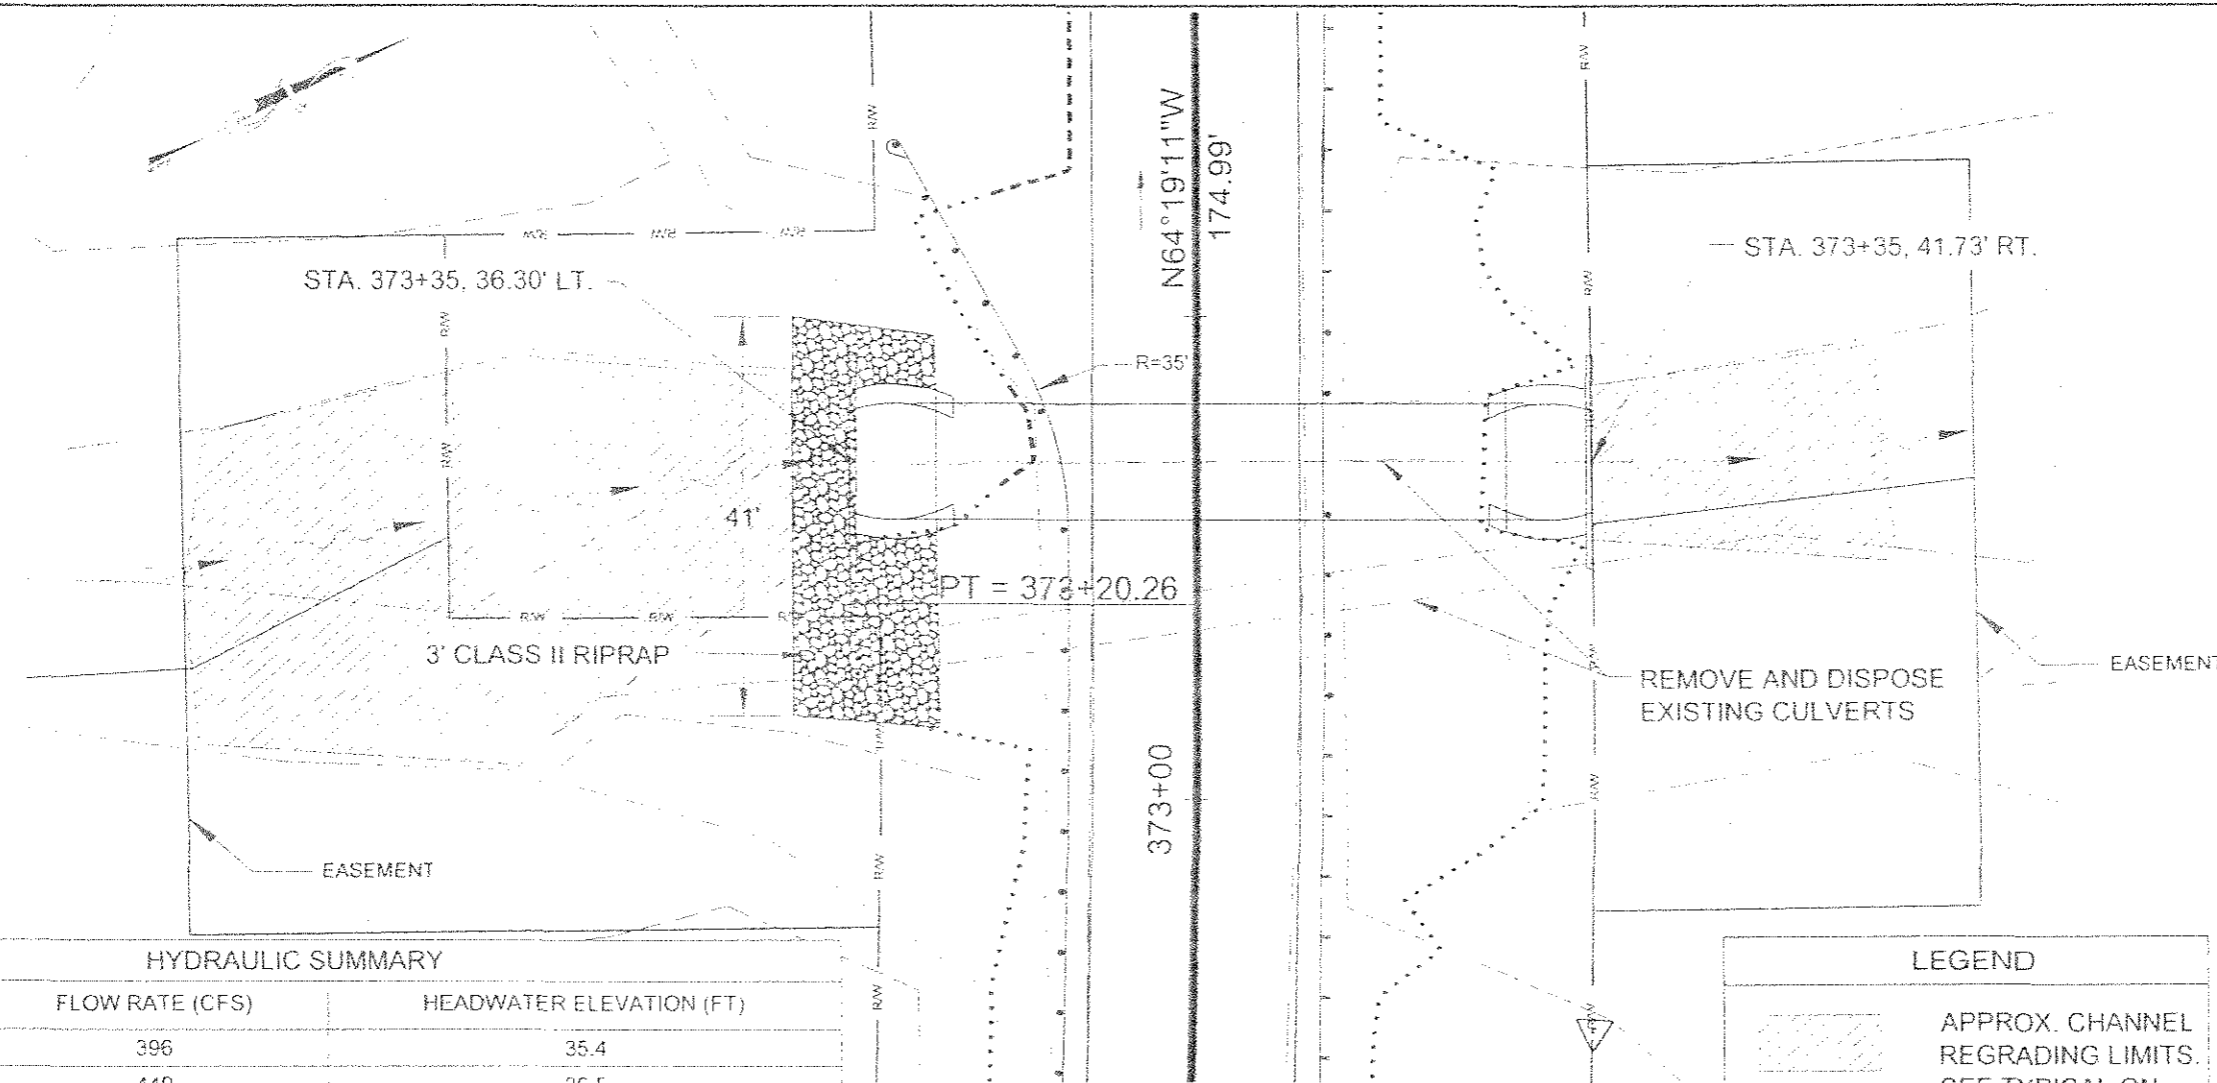


HYDRAULIC SUMMARY

RETURN PERIOD	FLOW RATE (CFS)	HEADWATER ELEVATION (FT)
Q50	396	35.4
Q100	449	36.5
Q500	585	37.1

CAPACITY 50 YEAR
 PURPOSE STREAM CHANNEL CROSSING WITH MINIMUM Q50 DESIGN CAPACITY. NO FISH PASSAGE PROVISIONS REQUIRED.
 HYDRAULIC NOTES WATER OVERTOPS ROAD AT 36.4'. OVERFLOWS TO DITCH AT ELEV. 36.0'. ASSUMED 4-FT. SEDIMENT BLOCKING FLOW ABOVE PAVED INVERT. INVERT PAVING IS FOR M&O EQUIPMENT ACCESS.

LEGEND

	APPROX. CHANNEL REGRADING LIMITS. SEE TYPICAL ON SHT. H5.
--	---

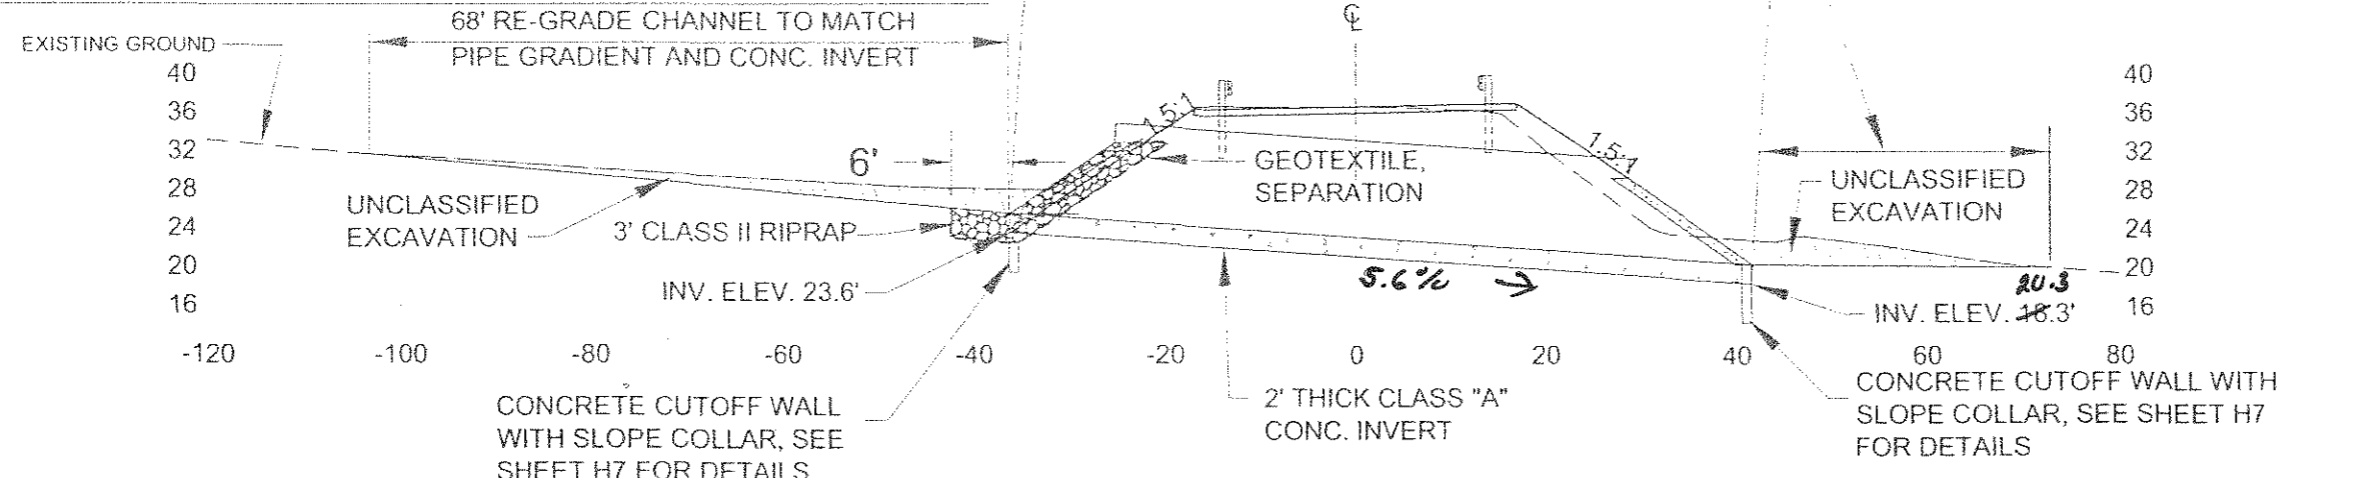

PROFILE



Project As-Built Drawings have been reviewed by the Project Engineer and represent to the best of my knowledge, the project as constructed.
 PE *[Signature]* Date 4-29-2011



DESIGNED BY: J. PETROPOULOS
 DRAWN BY: D. STEVENS
 STATE OF ALASKA
 DEPARTMENT OF TRANSPORTATION
 & PUBLIC FACILITIES
 EAST-PAK REGION
 SEA NOVEMBER 2005
 STORM PERMANENT REPAIRS

**LUTAK RD. 2.4 MILE
 CULVERT REPLACEMENT
 DETAILS**


PROJECT DESIGNATION NUMBER	
69236 / ER-0079(2)	
STATE	YEAR
ALASKA	2008
SHEET NUMBER	TOTAL SHEETS
H4	36

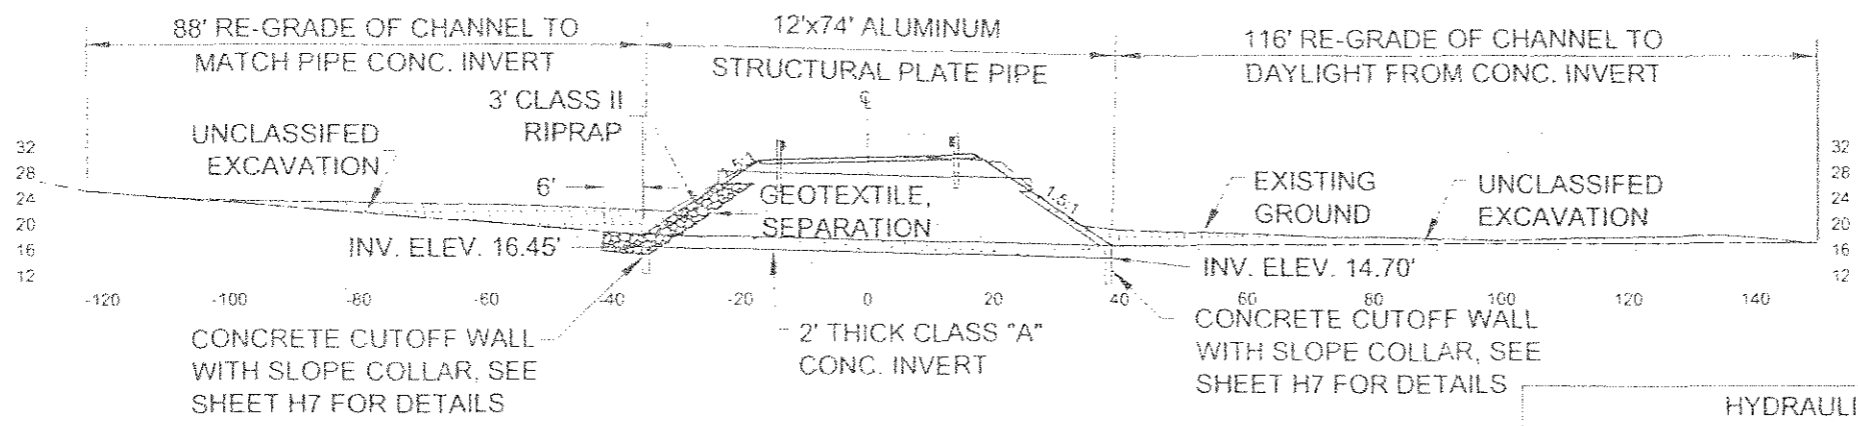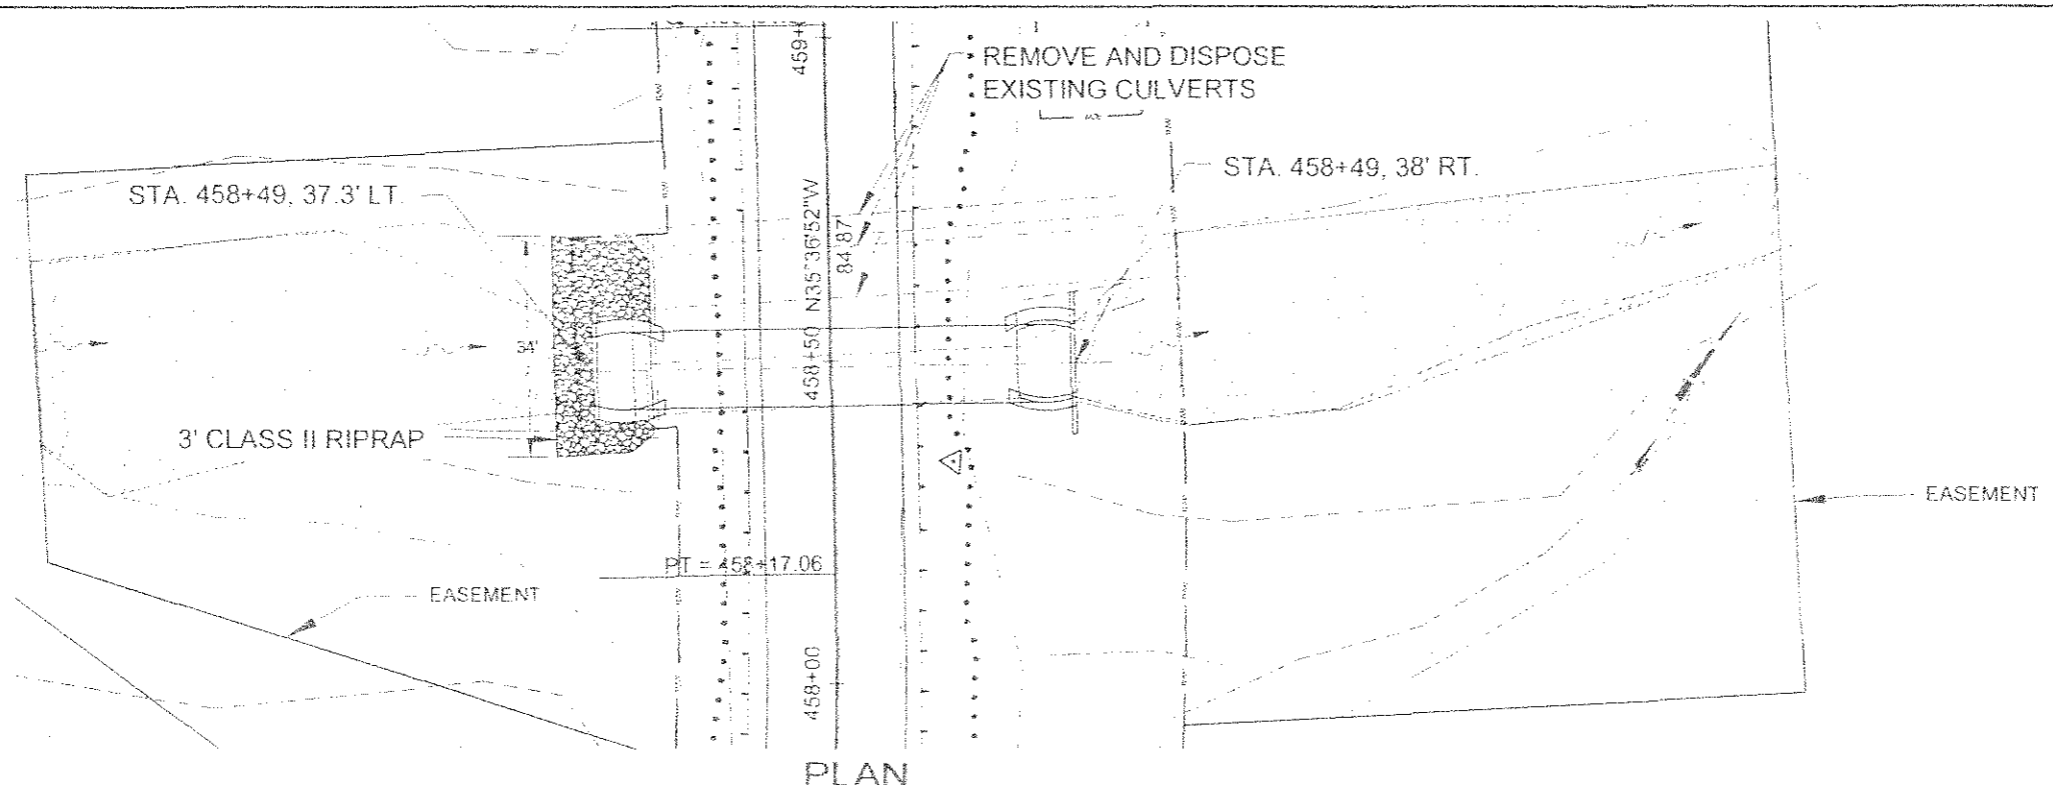

PROFILE

HYDRAULIC SUMMARY		
RETURN PERIOD	FLOW RATE (CFS)	HEADWATER ELEVATION (FT)
Q50	695	30.7
Q100	788	31.3
Q500	1026	32.0
CAPACITY	50 YEAR	
PURPOSE	STREAM CHANNEL CROSSING WITH MINIMUM Q50 DESIGN CAPACITY. NO FISH PASSAGE PROVISIONS REQUIRED.	
HYDRAULIC NOTES	WATER OVERTOPS ROAD AT 30.6' ASSUMED 3-FT. SEDIMENT BLOCKING FLOW ABOVE PAVED INVERT. INVERT PAVING IS FOR M&O EQUIPMENT ACCESS.	

LEGEND	
	APPROX. CHANNEL REGRADING LIMITS. SEE REGRADING TYPICAL

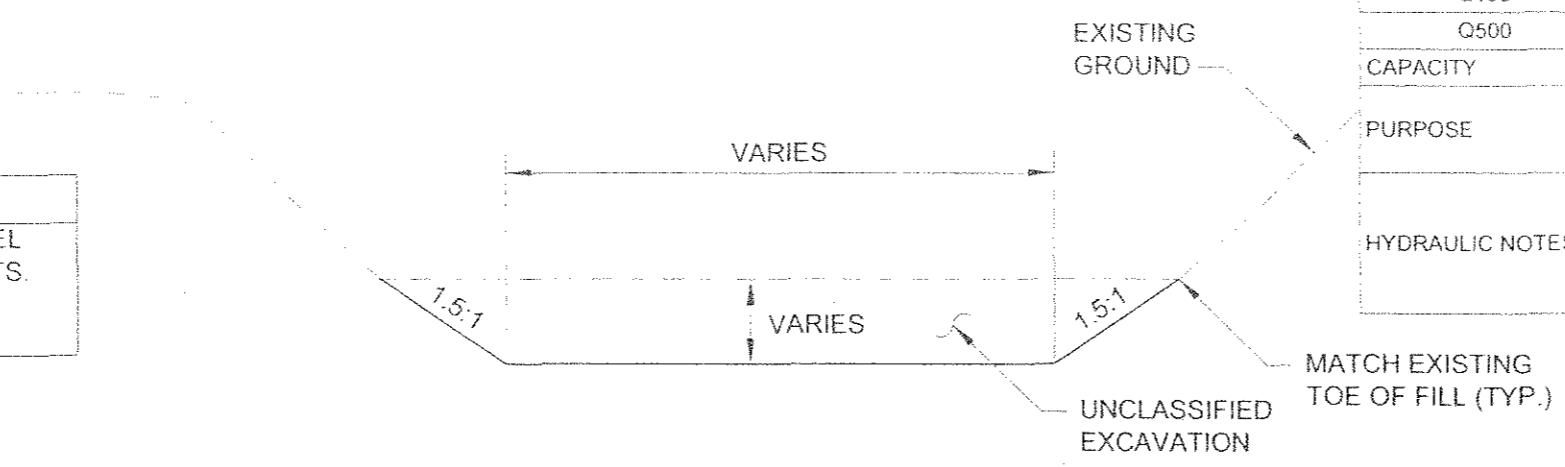

CHANNEL REGRADING TYPICAL

DATE: 06/18/08
 TIME: 10:29AM
 PROJECT: 69236 / ER-0079(2)
 SHEET: H5
 TOTAL SHEETS: 36

SEA NOVEMBER 2005
 STORM PERMANENT REPAIRS
 69236 / ER-0079(2)

**LUTAK RD. 3.9 MILE
 CULVERT REPLACEMENT
 DETAILS**




DESIGNED BY: J. PETROPOULOS
 DRAWN BY: E. STEVENS
 STATE OF ALASKA
 DEPARTMENT OF TRANSPORTATION & PUBLIC FACILITIES
 SOUTHEAST REGION
 SEA NOVEMBER 2005
 STORM PERMANENT REPAIRS

**LUTAK RD. 3.9 MILE
 CULVERT REPLACEMENT
 DETAILS**


PROJECT DESIGNATION NUMBER
 69236 / ER-0079(2)

STATE	YEAR
ALASKA	2008
SHEET NUMBER	TOTAL SHEETS
H5	36

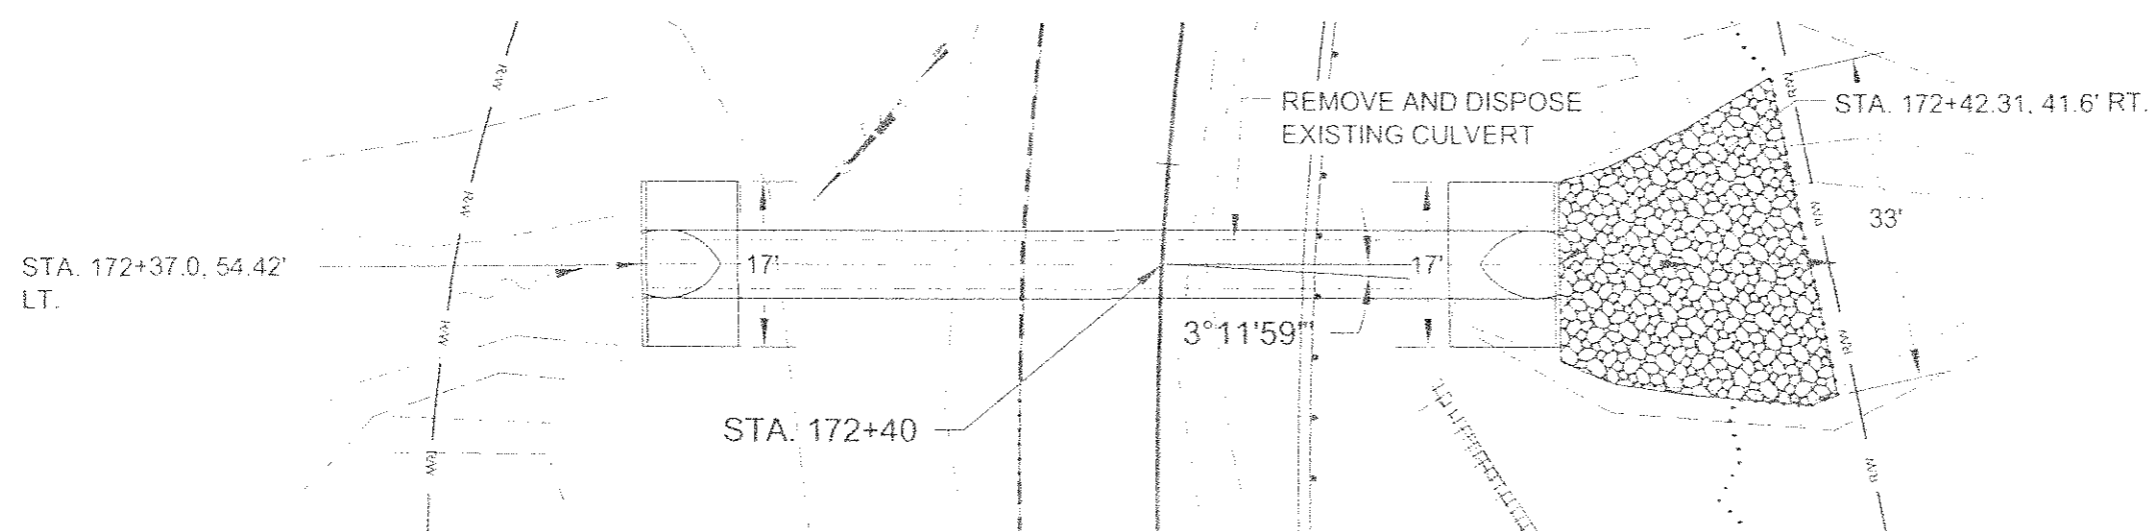

PLAN


HYDRAULIC SUMMARY		
RETURN PERIOD	FLOW RATE (CFS)	HEADWATER ELEVATION (FT)
Q50	191	71.3
Q100	217	72.2
Q500	283	75.2
CAPACITY	100 YEAR	
PURPOSE	STREAM CHANNEL CROSSING WITH MINIMUM Q50 DESIGN CAPACITY. NO FISH PASSAGE PROVISIONS REQUIRED.	
HYDRAULIC NOTES	WATER OVERTOPS ROAD AT 75.0'. OVERFLOWS TO DITCH AT ELEV. 74.0'. ASSUMED 3-FT. SEDIMENT BLOCKING FLOW.	

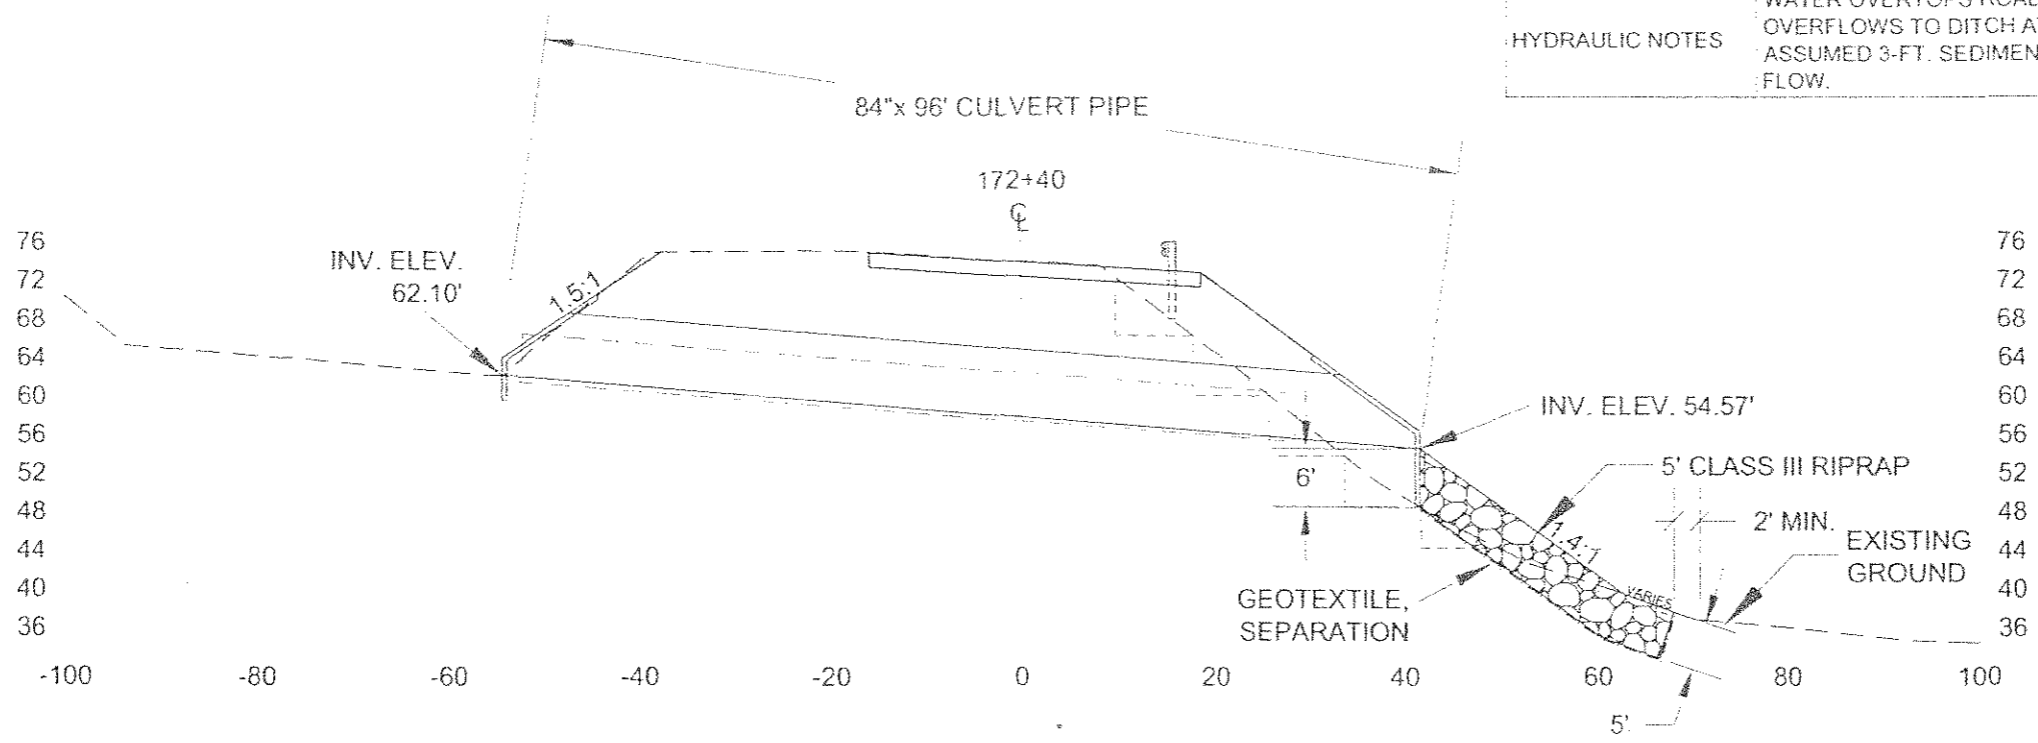

PROFILE

DATE	01/28/08	
PROJECT	SEA NOVEMBER 2005 STORM PERMANENT REPAIRS	
PROJECT NUMBER	69236 / ER-0079(2)	
ATTACHMENT NUMBER		
REPORT OF REVISIONS		
NO.	DATE	DESCRIPTION

SEA NOVEMBER 2005
 STORM PERMANENT REPAIRS
 69236 / ER-0079(2)
**MUD BAY RD. 6.0 MILE
 CULVERT REPLACEMENT
 DETAILS**

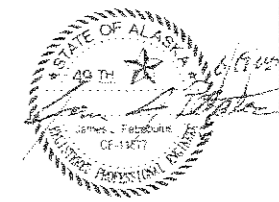


DESIGNED BY: J. PETROPOULOS
 DRAWN BY: D. STEVENS
 STATE OF ALASKA
 DEPARTMENT OF TRANSPORTATION
 & PUBLIC FACILITIES
 EASTERN REGION
 SEA NOVEMBER 2005
 STORM PERMANENT REPAIRS

**MUD BAY RD. 6.0 MILE
 CULVERT REPLACEMENT
 DETAILS**

PROJECT DESIGNATION NUMBER
 69236 / ER-0079(2)


STATE	YEAR
ALASKA	2008
SHEET NUMBER	TOTAL SHEETS
H6	36

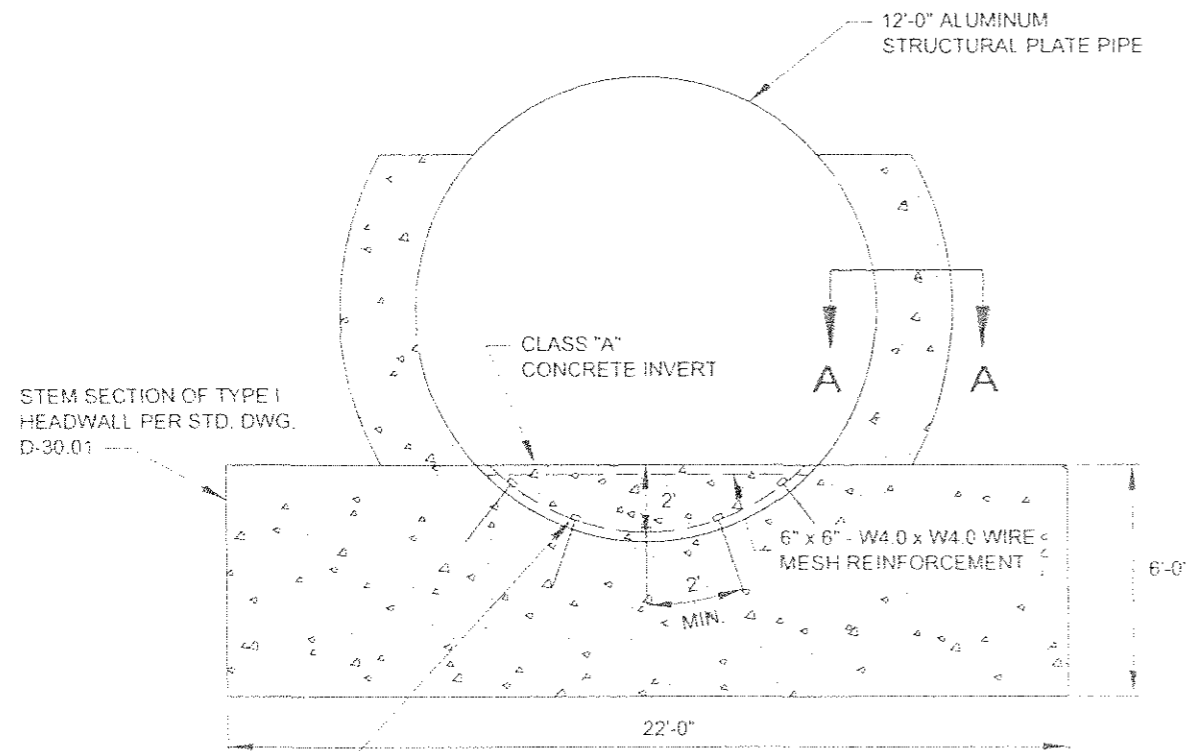


STEM SECTION OF TYPE I HEADWALL PER STD. DWG. D-30.01

ELEVATION

WIRE MESH, CONNECT TO CULVERT WITH SELF TAPPING SCREWS AND NUTS ON 2" MAX. CENTERS, SPACED 4' ALONG LENGTH OF PIPE

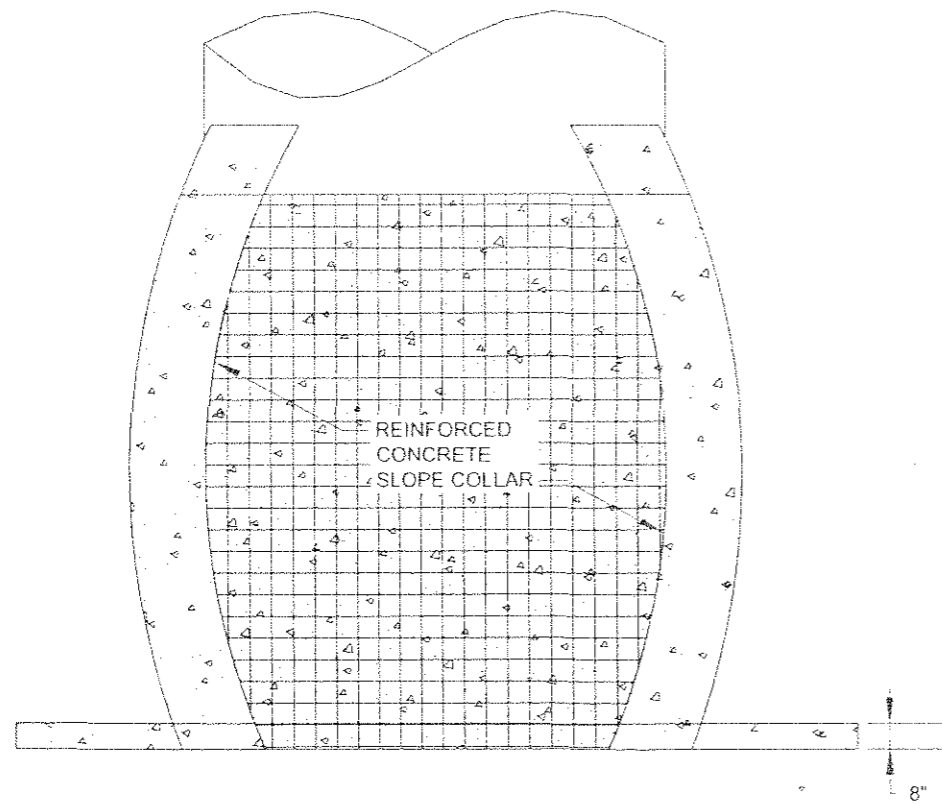


PLAN

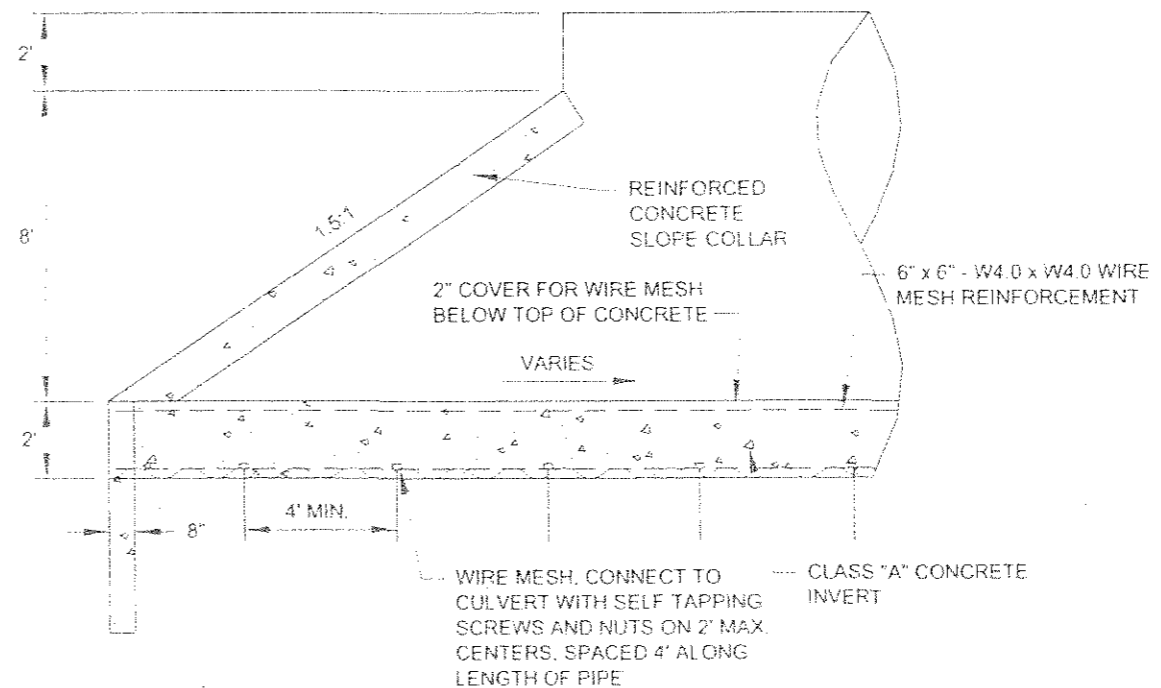

PROFILE

WIRE MESH, CONNECT TO CULVERT WITH SELF TAPPING SCREWS AND NUTS ON 2" MAX. CENTERS, SPACED 4' ALONG LENGTH OF PIPE



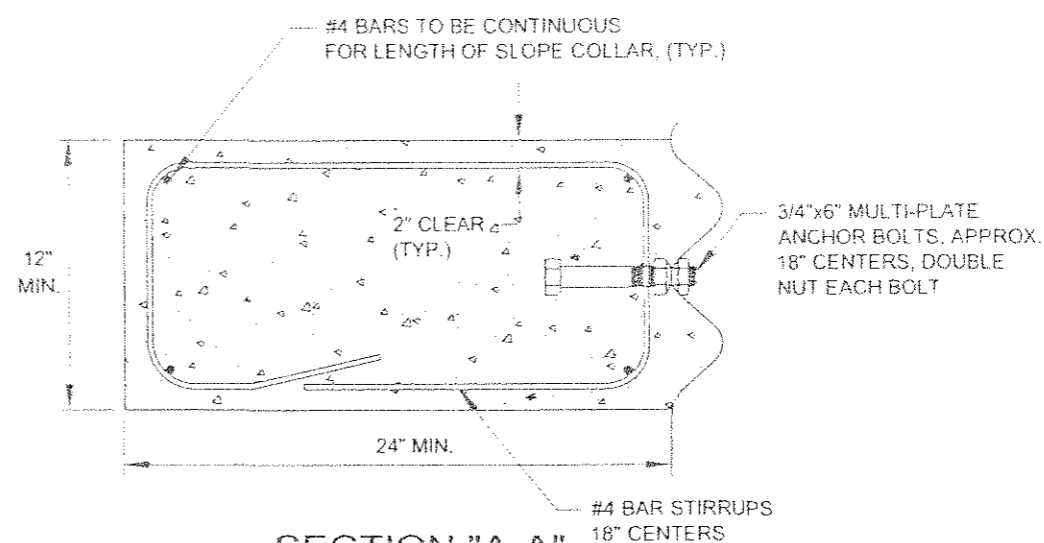


SECTION "A-A"

NOTES:


1. CUTOFF WALL REINFORCING STEEL NOT SHOWN FOR CLARITY. SEE STD. DWG. D-30.01 FOR REINFORCEMENT STEEL PLACEMENT IN STEM SECTION OF HEADWALL TYPE I.
2. CUTOFF WALLS: THE MINIMUM DEPTH SHOWN MAY BE REDUCED IN SOLID ROCK, PROVIDED THE WALL IS KEYED INTO ROCK AT LEAST 12".
3. ANCHOR BOLTS AND NUTS: PROVIDE GALVANIZED WITH ZINC COATING, SUPPLIED BY THE PIPE MANUFACTURER.
4. SELF TAPPING SCREWS AND NUTS: PROVIDE GALVANIZED WITH ZINC COATING, SUPPLIED BY THE PIPE MANUFACTURER.
5. WIRE MESH: PROVIDE GALVANIZED WITH ZINC COATING.

SHEET NO. 36 PROJECT DESIGNATION NUMBER 69236 / ER-0079(2)	
ATTACHMENT NUMBER	
REVISIONS	
NO. DATE DESCRIPTION	
SEA NOVEMBER 2005 STORM PERMANENT REPAIRS 69236 / ER-0079(2)	
ALUMINUM STRUCTURAL PLATE PIPE CUTOFF WALL, SLOPE COLLAR AND PAVED INVERT DETAILS	
DESIGNED BY: J. PETROPOULOS DRAWN BY: D. STEVENS	
STATE OF ALASKA DEPARTMENT OF TRANSPORTATION PUBLIC FACILITIES SOUTHEAST REGION SEA NOVEMBER 2005 STORM PERMANENT REPAIRS	
ALUMINUM STRUCTURAL PLATE PIPE CUTOFF WALL, SLOPE COLLAR AND PAVED INVERT DETAILS	
PROJECT DESIGNATION NUMBER 69236 / ER-0079(2)	
STATE	YEAR
ALASKA	2008
SHEET NUMBER	TOTAL SHEETS
H7	36

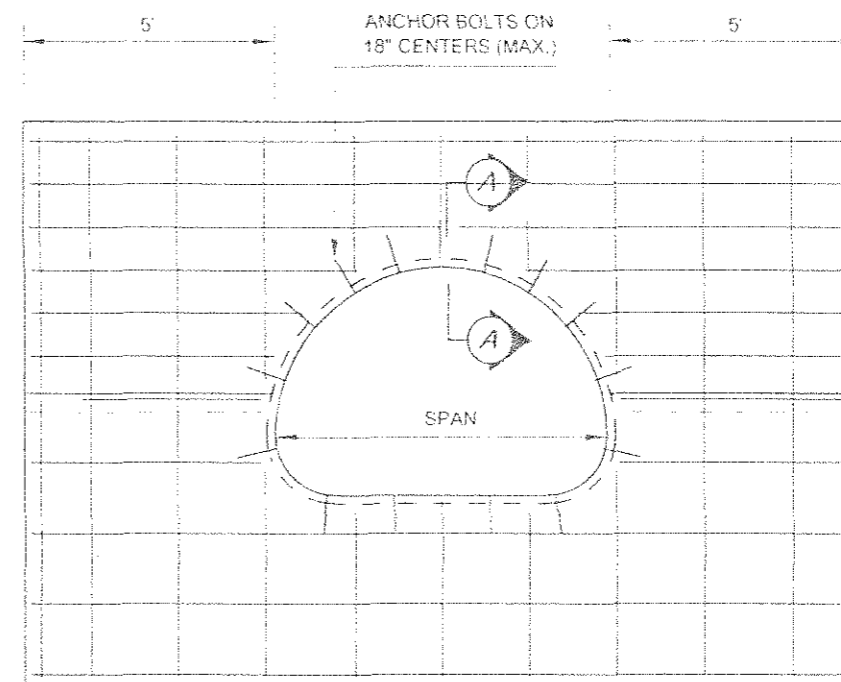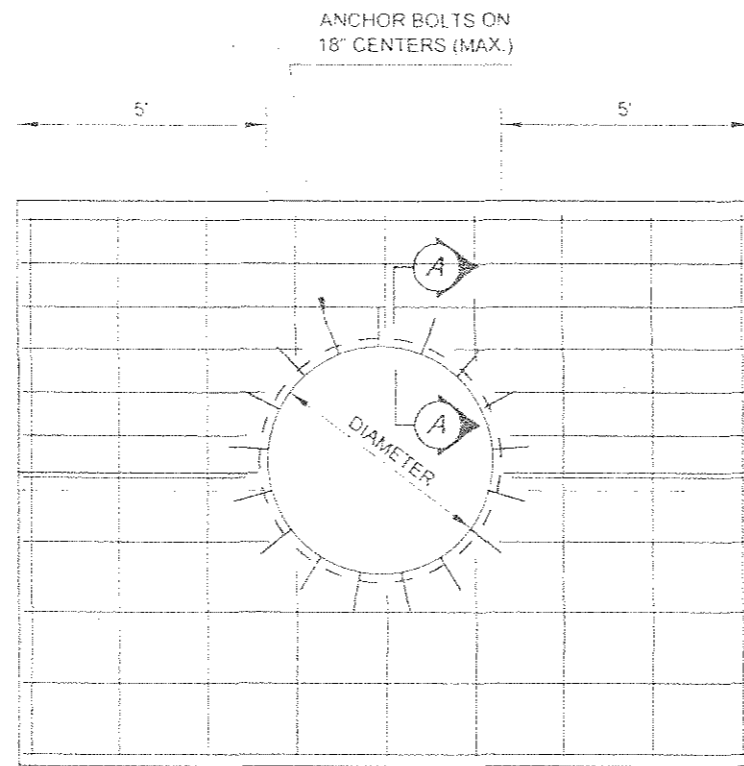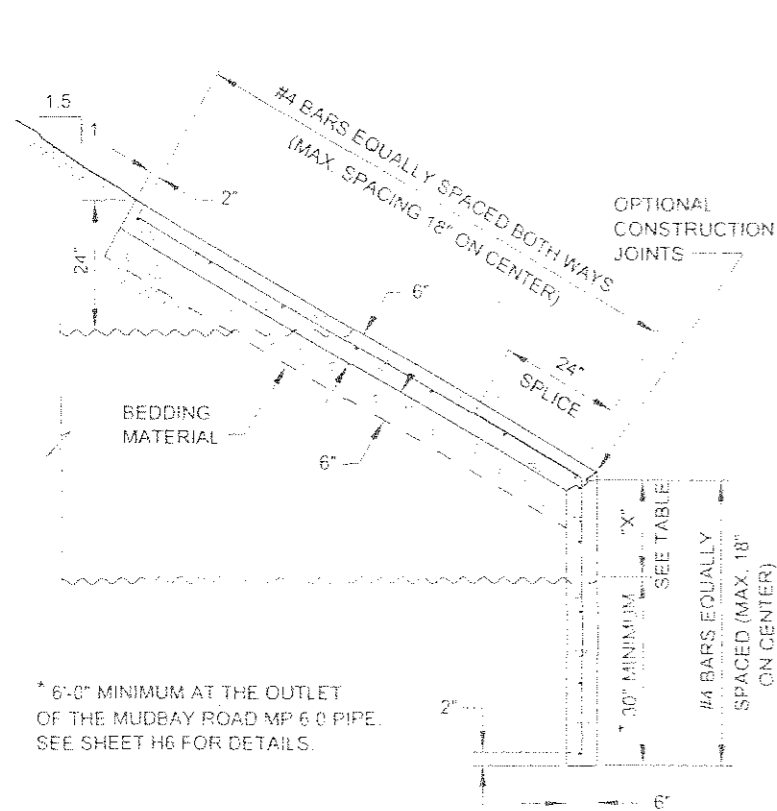


STEP BEVEL FOR ROUND PIPE AND PIPE ARCH

STEP BEVEL FOR PIPE ARCH CULVERT

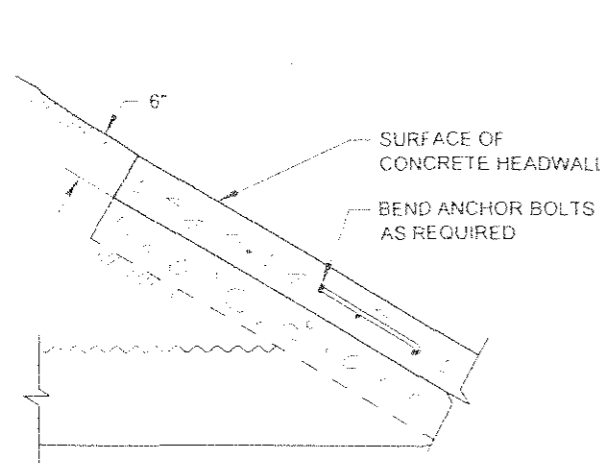

SECTION "A-A"

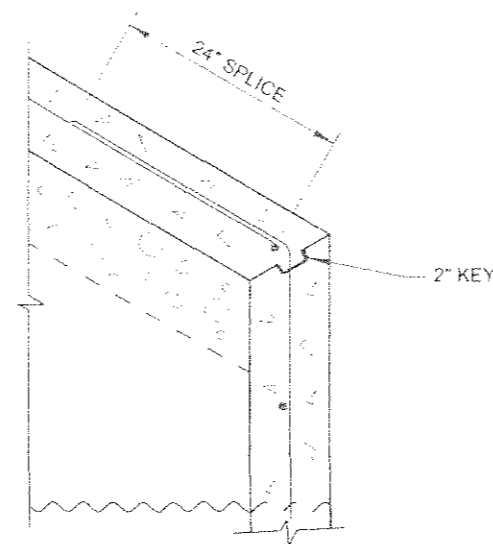

CONSTRUCTION JOINT DETAIL

NOTES:

1. CLASS A CONCRETE: CHAMFER ALL EXPOSED EDGES 3/4".
2. CUTOFF WALLS: THE MINIMUM DEPTH SHOWN MAY BE REDUCED IN SOLID ROCK, PROVIDED WALL IS KEYED INTO THE ROCK AT LEAST 12".
3. HOOK BOLTS: PER STANDARD DRAWING D-30.01.
4. MULTIPLE PIPE INSTALLATION: SPACING PER STANDARD DRAWING D-30.01.
5. ANCHOR BOLTS AND NUTS: PROVIDE GALVANIZED WITH ZINC COATING, SUPPLIED BY THE PIPE MANUFACTURER

STEP BEVEL	
PIPE SIZE (IN.)	"X" (IN.)
48	12
60	15
84	21
57x38	12

DO NOT SCALE FROM THESE DRAWINGS USE DIMENSIONS

DATE: 11/15/08
 DRAWN BY: D. STEVENS
 CHECKED BY: J. PETRUSILLOS
 PROJECT: 69236 / ER-0079(2)
 SHEET: H8 OF 36

ATTACHMENT NUMBER:
 ADDRESS OF REVISIONS:
 NO. DATE DESCRIPTION:

SEA NOVEMBER 2005
 STORM PERMANENT REPAIRS
 69236 / ER-0079(2)

**REINFORCED SLOPED
 CONCRETE HEADWALL**


DESIGNED BY: J. PETRUSILLOS
 DRAWN BY: D. STEVENS

STATE OF ALASKA
 DEPARTMENT OF TRANSPORTATION
 & PUBLIC FACILITIES
 SOUTHEAST REGION

SEA NOVEMBER 2005
 STORM PERMANENT REPAIRS
**REINFORCED
 SLOPED
 CONCRETE
 HEADWALL**

PROJECT DESIGNATION NUMBER:
 69236 / ER-0079(2)

STATE: ALASKA YEAR: 2008
 SHEET NUMBER: H8 TOTAL SHEETS: 36

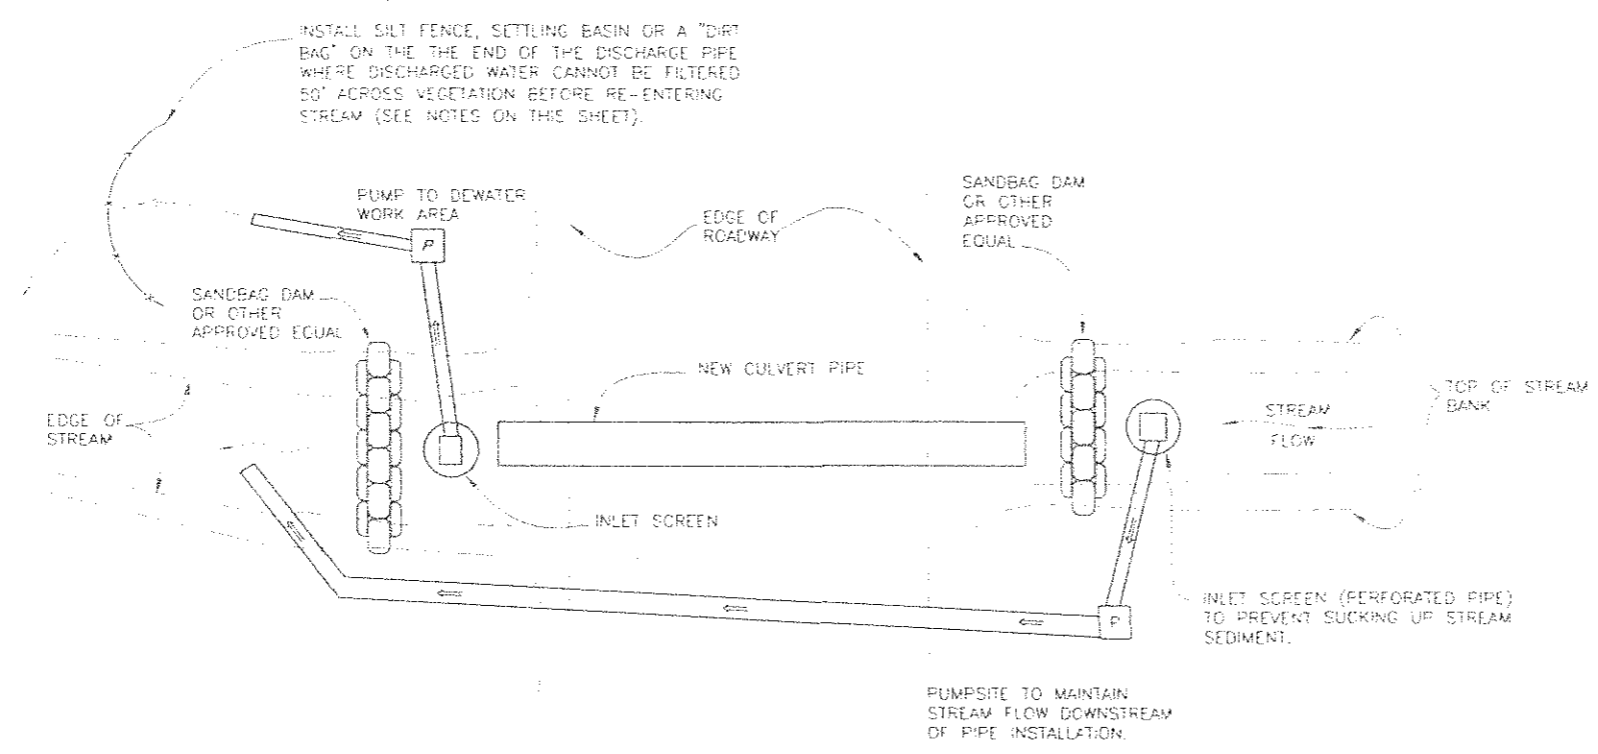


CULVERT REMOVAL/INSTALLATION USING PUMPS

Notes:

1. WHEN INSTREAM WORK AREAS REQUIRE DEWATERING, THE PUMP DISCHARGE SHALL BE PLACED SO THAT THERE IS A MINIMUM OF 50 FEET OF VEGETATED AREAS BETWEEN THE DISCHARGE POINT AND THE STREAM BANK SUCH THAT NO SILT-LADEN WATER ENTERS THE STREAM. THIS MAY REQUIRE FREQUENT REPOSITIONING OF THE DISCHARGE LOCATION AND/OR ADDITIONAL DISCHARGE TREATMENT METHODS.
2. MULTIPLE PUMPS MAYBE NECESSARY TO DEWATER WORK AREAS AND/OR MAINTAIN STREAM BYPASS FLOW. THE CONTRACTOR SHALL PROVIDE ADEQUATE QUANTITIES AND SIZES OF PUMPS.
3. IN LIEU OF USING PUMPS, THE CONTRACTOR MAY ELECT TO DIVERT THE STREAM FLOW TO EXISTING CULVERTS SLATED FOR REMOVAL PROVIDED THEY DON'T HINDER THE PROPER PLACEMENT AND BACKFILL OF NEW CULVERTS AND HEADWALLS, IF ANY.

DATE		
C:\SEA\2005\PermanentRepairs\Drawings\Sheet		
NOV 19 10:40 AM		
PLOT		
PSPACE (11.00) OR MSPACE (11.00)		
DWFNAME (11.00)		
ATTACHMENT NUMBER		
ATTACHMENT NUMBER		
RECORD OF REVISIONS		
NO.	DATE	DESCRIPTION

SEA NOVEMBER 2005
 STORM PERMANENT REPAIRS
 ER-0079(2) / 69236
Culvert Installation Details

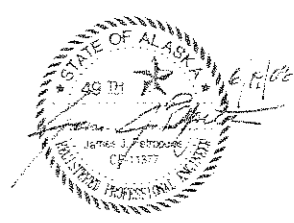

DESIGNED BY: C. PERKINS
 DRAWN BY: D. STEVENS
 STATE OF ALASKA
 DEPARTMENT OF TRANSPORTATION
 & PUBLIC FACILITIES
 STATEwide DESIGN & ENGINEERING
 SERVICES DIVISION
 SEA NOVEMBER 2005
 STORM PERMANENT REPAIRS

Culvert Installation Details	
PROJECT DESIGNATION NUMBER	
ER-0079(2) / 69236	
STATE	YEAR
ALASKA	2008
SHEET NUMBER	TOTAL SHEETS
H9	36

GENERAL NOTES

1. EACH LOOP DETECTOR SHALL CONSIST OF A SINGLE PIECE OF #14 AWG CONDUCTOR INSTALLED IN 1" SCHEDULE 80 PVC CONDUIT FORM ALL LOOPS 6 FEET SQUARE. SOLVENT WELD ALL PVC TO PVC JOINTS. USE TYPE X OUTLET BODIES THAT ARE MADE OF HOT DIP GALVANIZED STEEL TO JOIN THE LOOPS AND TAILS.
2. INSTALL 4 TURNS OF CONDUCTOR IN ALL LOOPS AND PROVIDE TAILS THAT EXTEND TO THE JUNCTION BOX SPECIFIED ON THE PLANS. USE #14 AWG CONDUCTOR IN A POLYETHYLENE TUBE CONFORMING TO IMSA SPECIFICATION 51-6. WIND THE TAIL CONDUCTORS TOGETHER AT A RATE OF 4 TWISTS PER FOOT.
3. INSTALL ALL LOOP DETECTORS PRIOR TO OVERLAYING EXISTING PAVEMENT OR PAVING A NEW ROADWAY.
4. INSTALL ALL LOOP DETECTORS SLOPED TO DRAIN INTO THE JUNCTION BOX THE LOOP TAIL ENTERS.
5. NO MINIMUM CLEARANCE IS REQUIRED BETWEEN A LOOP AND A TAIL OR BETWEEN TAILS. LOOP TAILS SHALL NOT CROSS LOOP CONDUITS.
6. TEST ALL LOOP DETECTORS FOR CONTINUITY AND INSULATION INTEGRITY PRIOR TO SEALING THE LOOPS UNDER ASPHALT.
7. WHEN INSTALLING LOOP DETECTORS IN EXISTING PAVEMENT, CUT THE ASPHALT WITH A SAW AND REMOVE ALL ASPHALT WITHIN THE SAW CUT. MATCH EXISTING PAVEMENT THICKNESS WHEN REPAIRING THE CUTOUT.
8. WHERE EXISTING PAVEMENT WILL NOT BE OVERLAID, ENCLOSE ALL LOOPS THAT ENTER A COMMON JUNCTION BOX WITHIN A TRAPEZOIDAL SAW CUT. CUT TO WITHIN 12" OF THE LANE AND EDGE LINES, PRESERVING THESE PAVEMENT MARKINGS. REMOVE THE ASPHALT TO THE LIP OF THE GUTTER WHEN THERE ARE NO EDGE LINES. CUT ACROSS LANE LINES WHEN LOOPS IN ADJACENT LANES ARE SIDE BY SIDE. CUT TRENCHES A MINIMUM OF 3" WIDE WHEN INSTALLING LOOP TAILS ACROSS A LANE; TRENCHES CROSSING A SHOULDER ONLY MAY BE A MINIMUM 12" WIDE.
9. HEAT AND TACK COAT THE EDGES OF EXISTING PAVEMENT PRIOR TO PAVING THE CUTOUTS. COMPACT THE ASPHALT MIXTURE WITH A SELF PROPELLED STEEL WHEELED ROLLER. THE ASPHALT MIX SHALL CONFORM TO SECTION 401 OF THE SPECIFICATIONS, AND APPROVED FOR USE BY THE ENGINEER.
10. MAINTAIN THE REPLACEMENT ASPHALT MIX AT A TEMPERATURE OF 225° F UNTIL THE TIME OF APPLICATION; IF NECESSARY, STORE THE MIX IN AN INSULATED BOX TO MAINTAIN THE SPECIFIED TEMPERATURE.
11. ALL WORK ASSOCIATED WITH INSTALLING LOOP DETECTORS IS CONSIDERED PART OF ITEM 667(1) AND WILL NOT BE MEASURED SEPARATELY OR PAID FOR DIRECTLY. THIS WORK INCLUDES BUT IS NOT LIMITED TO, LOOP MATERIALS, JUNCTION BOXES, CONDUIT, LOOP LEAD IN CABLE, TESTING, SPLICING, CONDUCTOR LABELING AND SAW CUTTING. ASPHALT REMOVAL AND INSTALLATION OF NEW ASPHALT SHALL BE PAID UNDER THEIR RESPECTIVE PAY ITEMS.
12. DUCT SEAL ALL CONDUITS INSIDE THE JUNCTION BOXES.

HAINES HIGHWAY PERMANANT
 TRAFFIC RECORDER
 NH-095-6(31) - 67778
LOOP DETECTOR DETAILS

CHECKED BY: C. MOFFHOUSE



DESIGNED BY: D. FAUGANT
 DRAWN BY: D. FAUGANT

STATE OF ALASKA
 DEPARTMENT OF TRANSPORTATION
 & PUBLIC SAFETY
 SEVENTH REGION
 HAINES HWY PERMANANT
 TRAFFIC RECORDER

LOOP DETECTOR DETAILS

PROJECT DESIGNATION NUMBER


NH-095-6(31) / 67778

STATE YEAR


ALASKA 2008

SHEET NUMBER TOTAL SHEETS


Q2 36

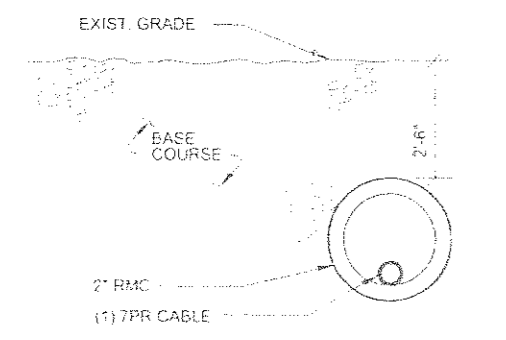


SECTION B-B

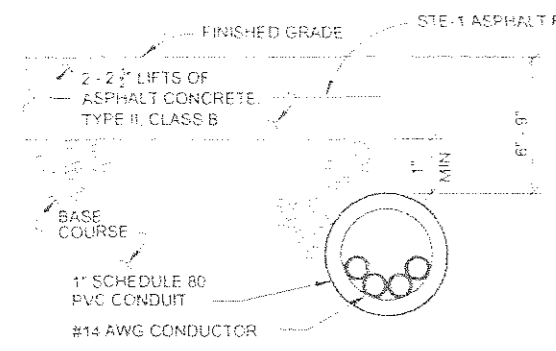


PVC CONDUIT DETAIL
SECTION A-A

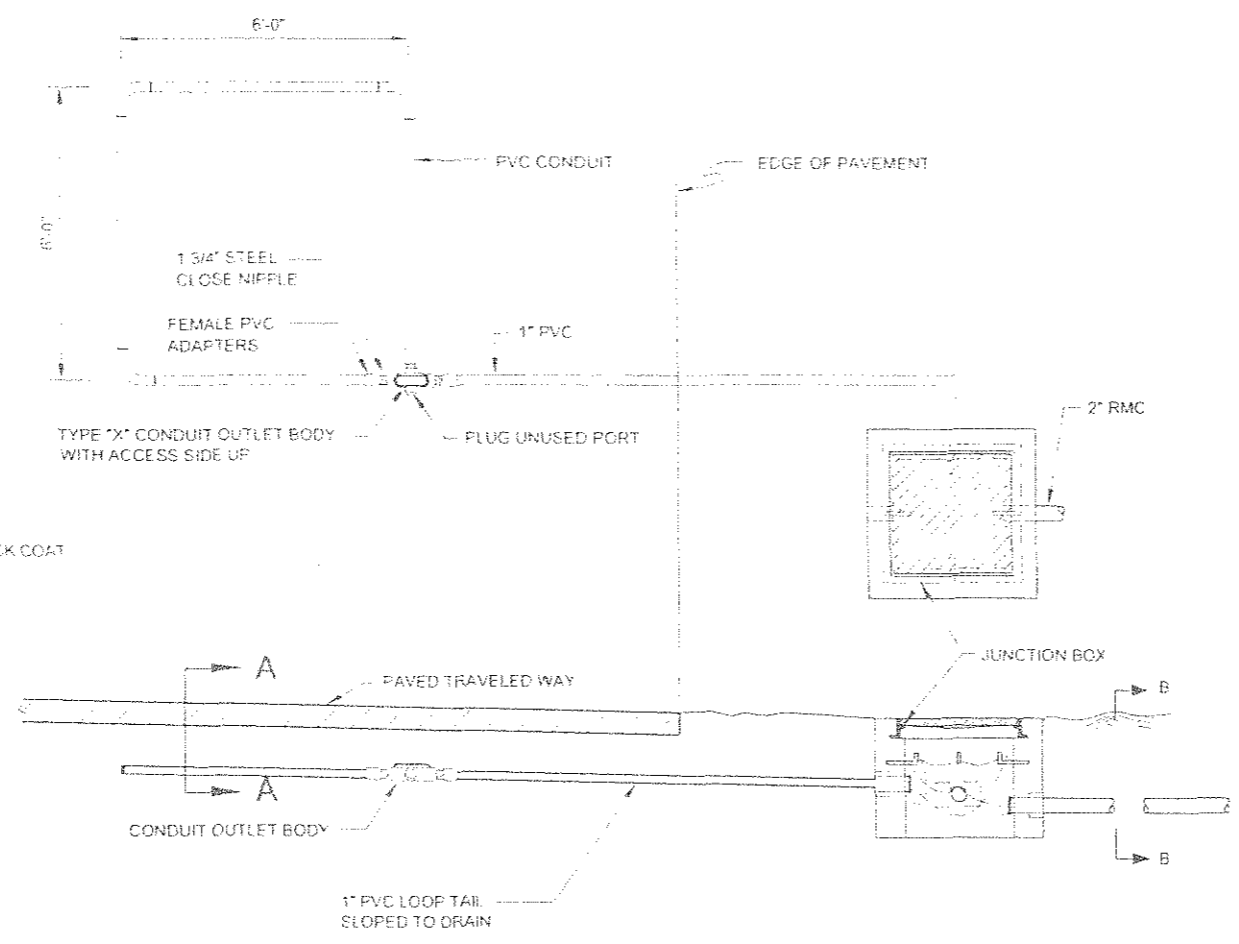

SHOULDER SECTION

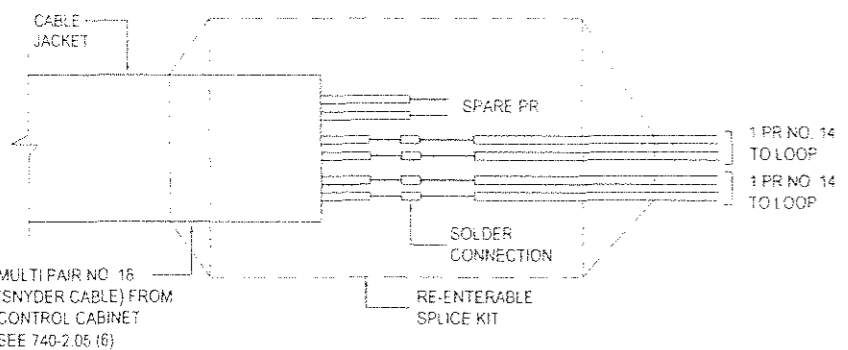

TYPICAL SPLICE DETAILS

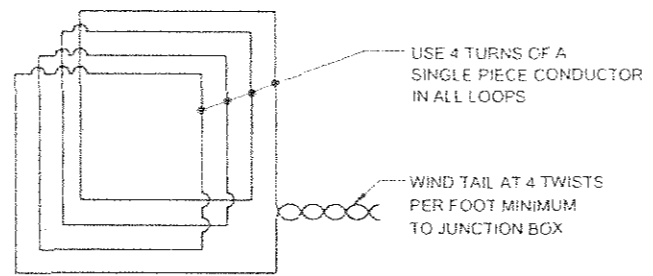


LOOP WIRING DETAIL

TYPICAL PVC CONDUIT ENCASED LOOP DETECTOR INSTALLATION

- NOTES:
1. SCHEMATIC SKETCH SHOWS AN EXAMPLE OF TWO PAIRS USED WITH ONE SPARE
 2. TERMINATE ALL SPARES WITHIN THE SPLICE BODY.
 3. SPLICE BODY TO ENCLOSE ALL CABLE JACKETS.
 4. SOLDER CONNECTIONS. DO NOT USE COMPRESSION CONNECTORS WRAP EACH CONDUCTOR OVER OTHER CONDUCTOR BEFORE SOLDERING.
 5. USE COMMERCIAL SPLICE KITS SIMILAR OR EQUAL TO 3M PRODUCTS, TYPE SCOTCHCAST 78-R.

INDUCTIVE LOOPS


INDUCTIVE LOOPS SHALL BE INSTALLED IMMEDIATELY PRIOR TO PAVING THIS SECTION OF ROADWAY. FINAL LIFT ASPHALT PAVEMENT SHALL BE SMOOTH OVER ALL INDUCTIVE LOOPS AND WITHOUT TRANSVERSE SEAMS, JOINTS, OR ROUGHNESS WITHIN 50' OF THE LOOPS.

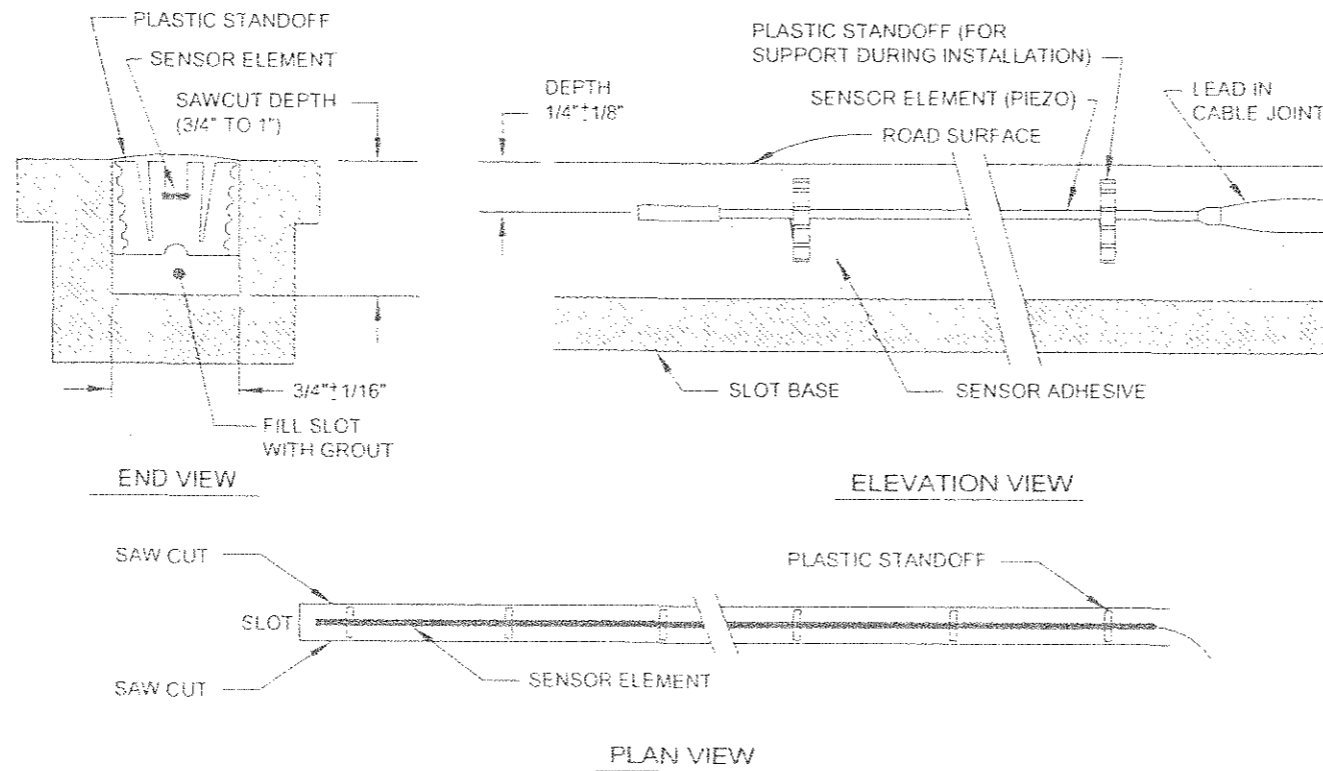

TRAFFIC SENSOR DETAILS:

N.T.S.

NOTE
 THE TRAFFIC SENSOR (PIEZO) SHALL BE INSTALLED PER THE SPECIFICATIONS AND ONLY WHEN A PEEK MANUFACTURER'S REPRESENTATIVE IS PRESENT.

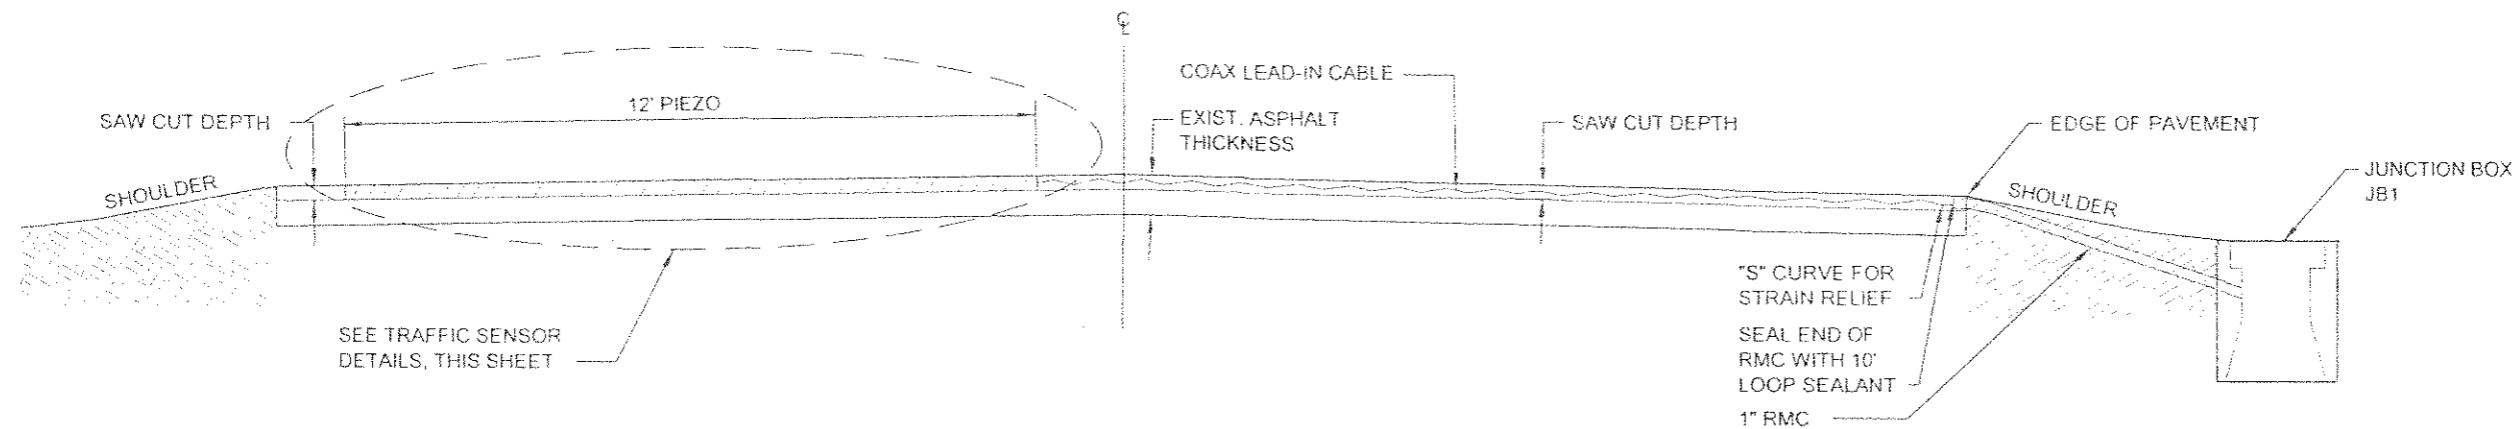

TRAFFIC SENSOR INSTALLATION DETAIL:

N.T.S.

- NOTES:**
1. FOR CLARITY, ONLY FAR LANE PIEZO DETAIL SHOWN. NEAR LANE PIEZO IS SIMILAR.
 2. THE SLOT FOR THE PIEZO SENSOR SHALL BE CUT USING BLADES THAT ARE GANGED TOGETHER.
 3. CLEAN THE SLOT WITH COMPRESSED AIR AND HIGH PRESSURE WATER PER THE MANUFACTURER'S INSTRUCTIONS.
 4. THE SLOT SHALL BE CLEAN AND COMPLETELY DRY BEFORE INSTALLING THE PIEZO SENSOR.
 5. AFTER INSTALLING THE PIEZO SENSOR, THE CONTRACTOR SHALL FOLLOW THE PIEZO MANUFACTURER'S RECOMMENDATIONS TO PROPERLY INSTALL THE GROUT.

PART:
 D:\Projects\67778\Borner\07_Borner_Details.DWG
 THU 10/20/08 10:33AM
 1:00
 PSPACE 14.1181 OR WSPACE 14.1181
 TAB: TYPICALS

APPENDIX NUMBER	
ATTACHMENT NUMBER	
RECORD OF REVISIONS	
No.	DATE DESCRIPTION

HAINES HIGHWAY PERMANENT
 TRAFFIC RECORDER
 NH-095-6(31) - 67778
**PIEZOELECTRIC SENSOR
 DETAILS**

CHECKED BY: C. MOREHOUSE



DESIGNED BY: D. FAGNANT

DRAWN BY: D. FAGNANT

STATE OF ALASKA
 DEPARTMENT OF TRANSPORTATION
 & PUBLIC FACILITIES
 SOUTHWEST REGION
 HAINES HWY PERMANENT
 TRAFFIC RECORDER

**PIEZOELECTRIC
 SENSOR DETAILS**

PROJECT DESIGNATION NUMBER


NH-095-6(31) / 67778

STATE YEAR

ALASKA 2008

SHEET NUMBER TOTAL SHEETS

Q3 36

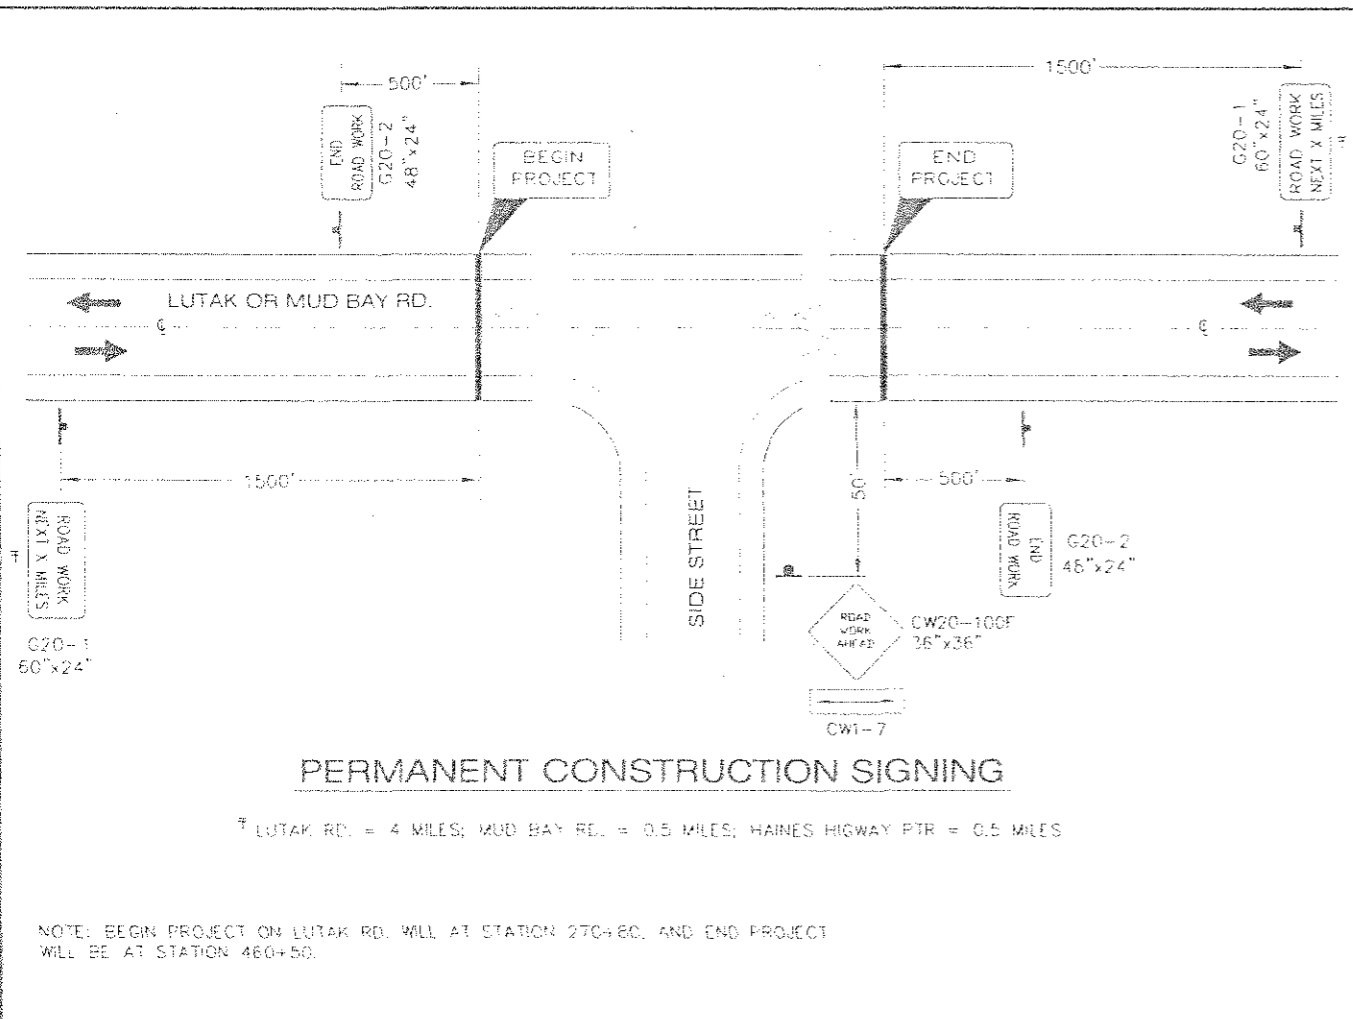

Legend

- SIGN
- CONE
- DRUM
- TYPE III BARRICADE
- FLAGGING STATION

$L = WS$ (45 MPH OR >)
 $L = \frac{WS^2}{60}$ (40 MPH OR <)

WHERE:
 L = LENGTH OF TAPER (FT)
 W = WIDTH OF OFFSET (FT)
 S = SPEED (MPH)

TCP TABLE SETUP			
SPEED (MILES PER HOUR)	BUFFER LENGTH (ft)	CONE/DRUM SPACING ON TAPER (ft)	CONE/DRUM SPACING ON TANGENT (ft)
25	155	25	50
30	200	30	60
35	250	35	70
40	300	40	80
45	360	45	90
50	425	50	100
55	495	55	110
60	570	60	120

Traffic Control Notes:

1. A MINIMUM OF ONE LANE SHALL BE MAINTAINED AT ALL TIMES, THROUGH ALL WORK AREAS.
2. TWO LANES SHALL BE MAINTAINED AT ALL TIMES IN NON-WORK AREAS AND DURING NON-WORK HOURS, UNLESS AN APPROVED TRAFFIC CONTROL SIGNAL HAS BEEN INSTALLED.
3. TEMPORARY DRIVING LANES SHALL HAVE A MINIMUM WIDTH OF 10'-0".
4. CONSTRUCTION SIGNING SHALL BE IN PLACE ONLY WHEN THE CONDITIONS EXIST FOR WHICH THE SIGNS ARE INTENDED. CONSTRUCTION SIGNS SHALL BE PLACED SUCH THAT THEY DO NOT OBSCURE EXISTING TRAFFIC SIGNS.
5. IT IS THE INTENT OF THIS TRAFFIC CONTROL PLAN (TCP) TO ILLUSTRATE SOME, NOT ALL, OF THE TRAFFIC CONTROL SETUPS WHICH WILL BE REQUIRED ON THIS PROJECT. PLANS FOR CONFIGURATIONS NOT COVERED BY THE TCP SHALL BE CREATED BY THE CONTRACTOR AND SUBMITTED TO THE ENGINEER FOR APPROVAL. WHERE APPROPRIATE, THEY SHALL INCORPORATE APPLICABLE PORTIONS OF DETAILS ON THESE SHEETS.
6. MAXIMUM LENGTH OF CONSTRUCTION WITH ONE-LANE ROAD CLOSURE IS 1000'.

PATH:
 D. DEPARTMENT OF TRANSPORTATION
 PROJECT:
 ESTIMATE NUMBER OR VERSION NUMBER:
 TAB. NUMBER:

APPENDIX NUMBER




ATTACHMENT NUMBER

RECORD OF REVISIONS

NO. DATE DESCRIPTION

SEA NOVEMBER 2005
 STORM PERMANENT REPAIRS
 69236 / ER-0079(2)

Traffic Control Plans

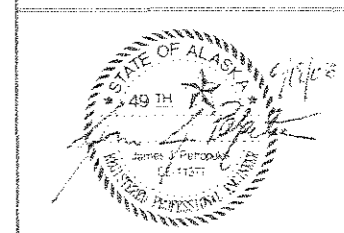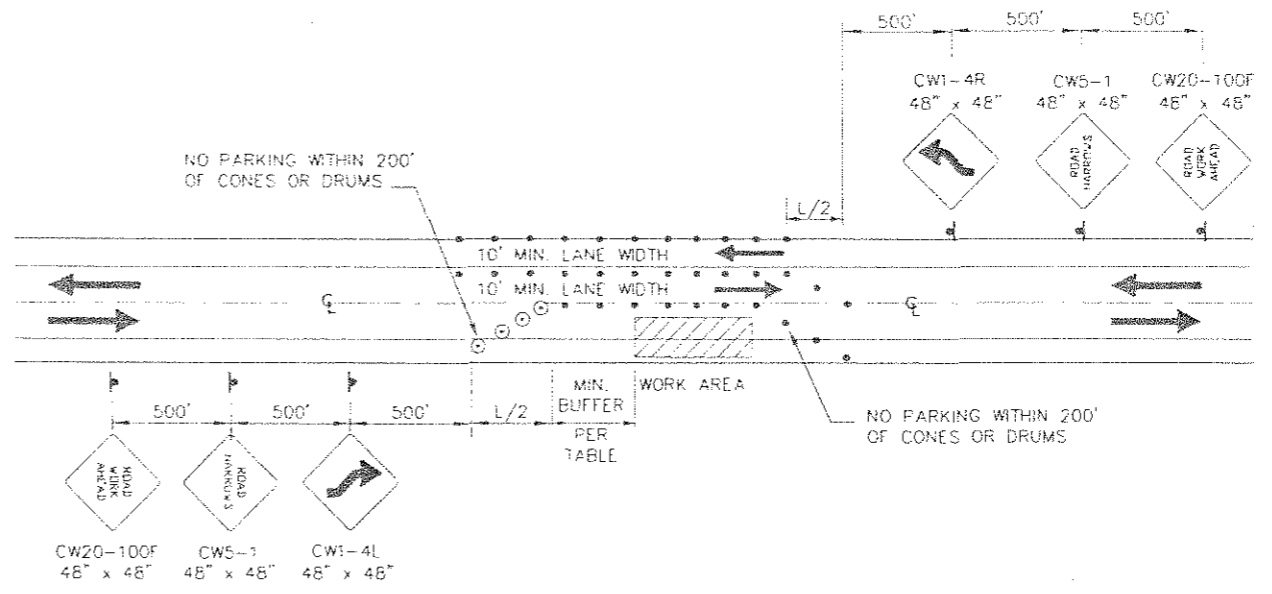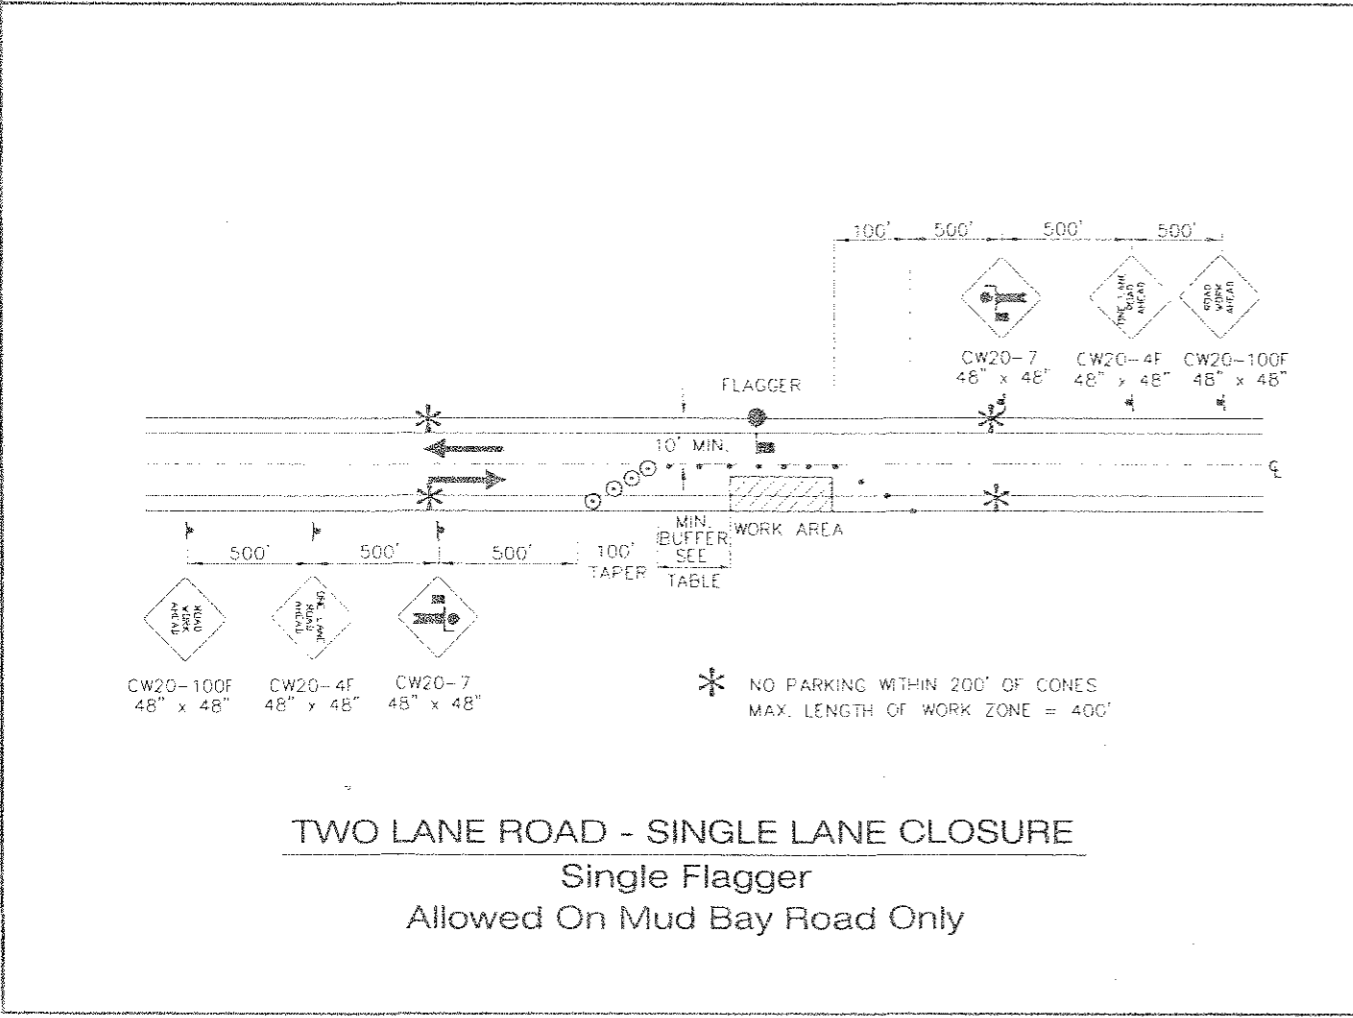

DESIGNED BY: J. PETHOFULKE
 DRAWN BY: E. STEVENS

STATE OF ALASKA
 DEPARTMENT OF TRANSPORTATION
 PUBLIC FACILITIES
 500 EAST BRIDGE
 SEA NOVEMBER 2005
 STORM PERMANENT REPAIRS





Traffic Control Plans

PROJECT DESIGNATION NUMBER
 69236 / ER-0079(2)

STATE	YEAR
ALASKA	2008
SHEET NUMBER	TOTAL SHEETS
51	36

Legend

- SIGN
- CONE
- DRUM
- TYPE III BARRICADE
- FLAGGING STATION

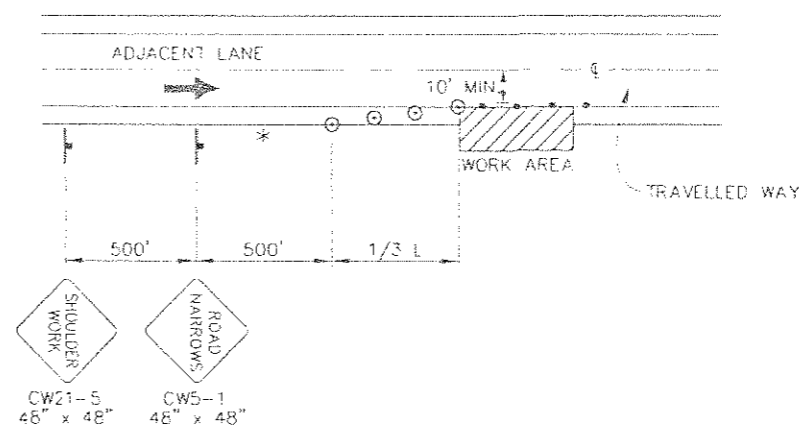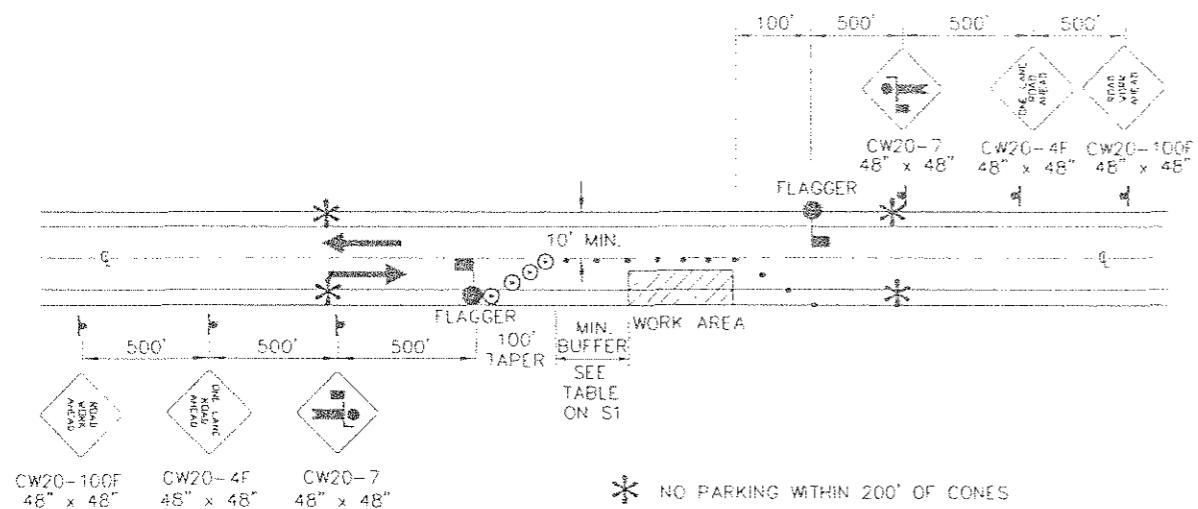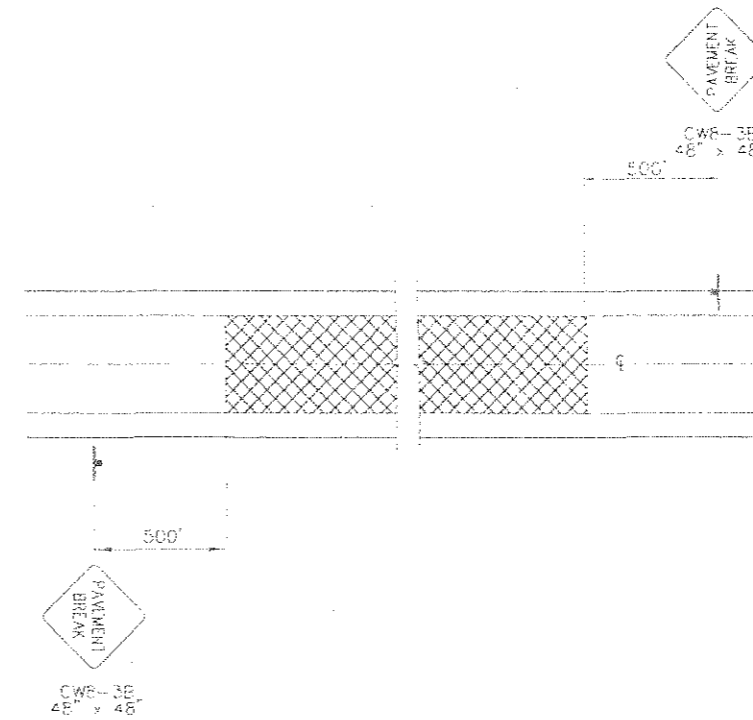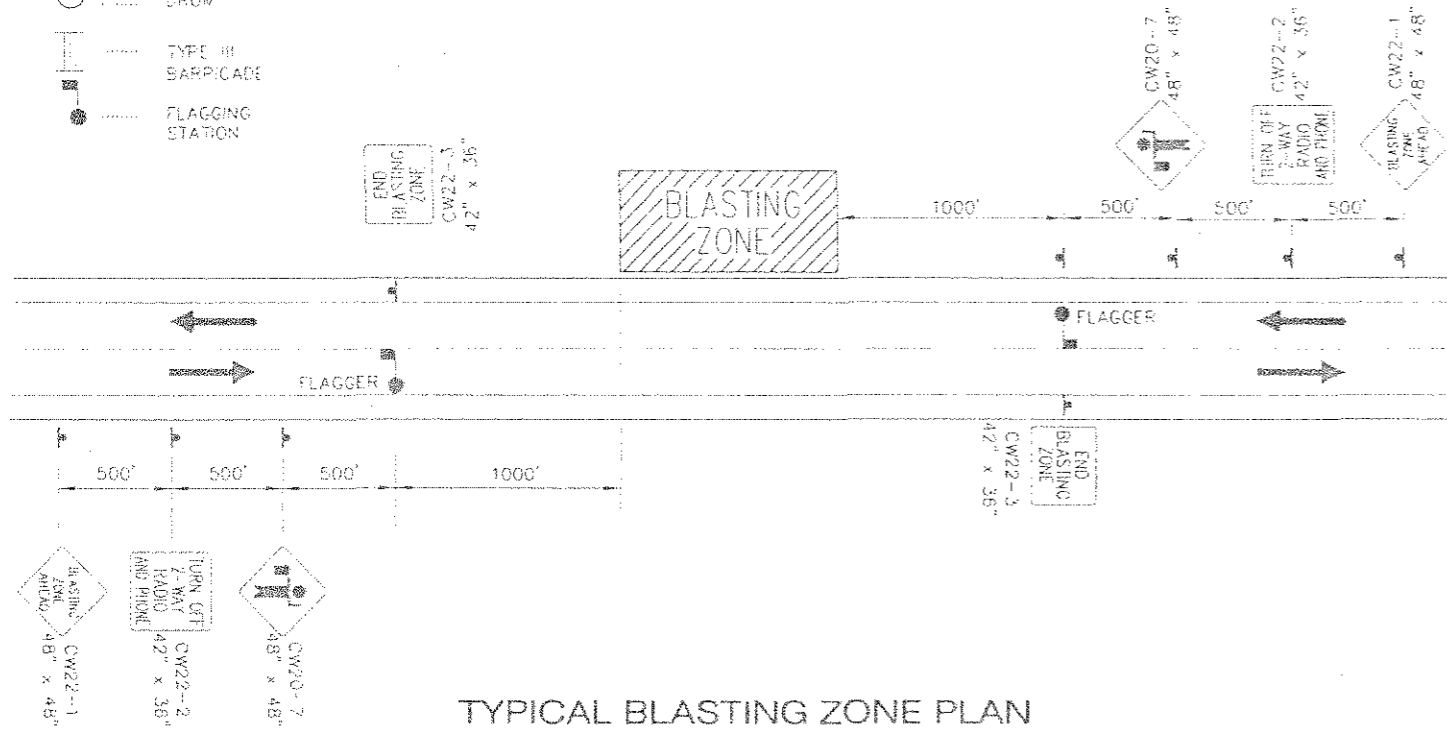


DATE: 11/10/05
 DRAWN BY: J. STEVENS
 CHECKED BY: J. PETROPOULOS
 PROJECT: SEA NOVEMBER 2005 STORM PERMANENT REPAIRS

APPENDIX NUMBER
ATTACHMENT NUMBER
RECORD OF REVISION
NO. DATE DESCRIPTION

SEA NOVEMBER 2005
 STORM PERMANENT REPAIRS
 69236 / ER-0079(2)


Traffic Control Plans

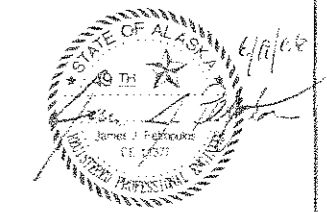

DESIGNED BY: J. PETROPOULOS
 DRAWN BY: J. STEVENS
 STATE OF ALASKA
 DEPARTMENT OF TRANSPORTATION
 & PUBLIC FACILITIES
 SOUTHEAST REGION
 SEA NOVEMBER 2005
 STORM PERMANENT REPAIRS

Traffic Control Plans

PROJECT DESIGNATION NUMBER	
69236 / ER-0079(2)	
STATE	YEAR
ALASKA	2008
SHEET NUMBER	TOTAL SHEETS
S2	36

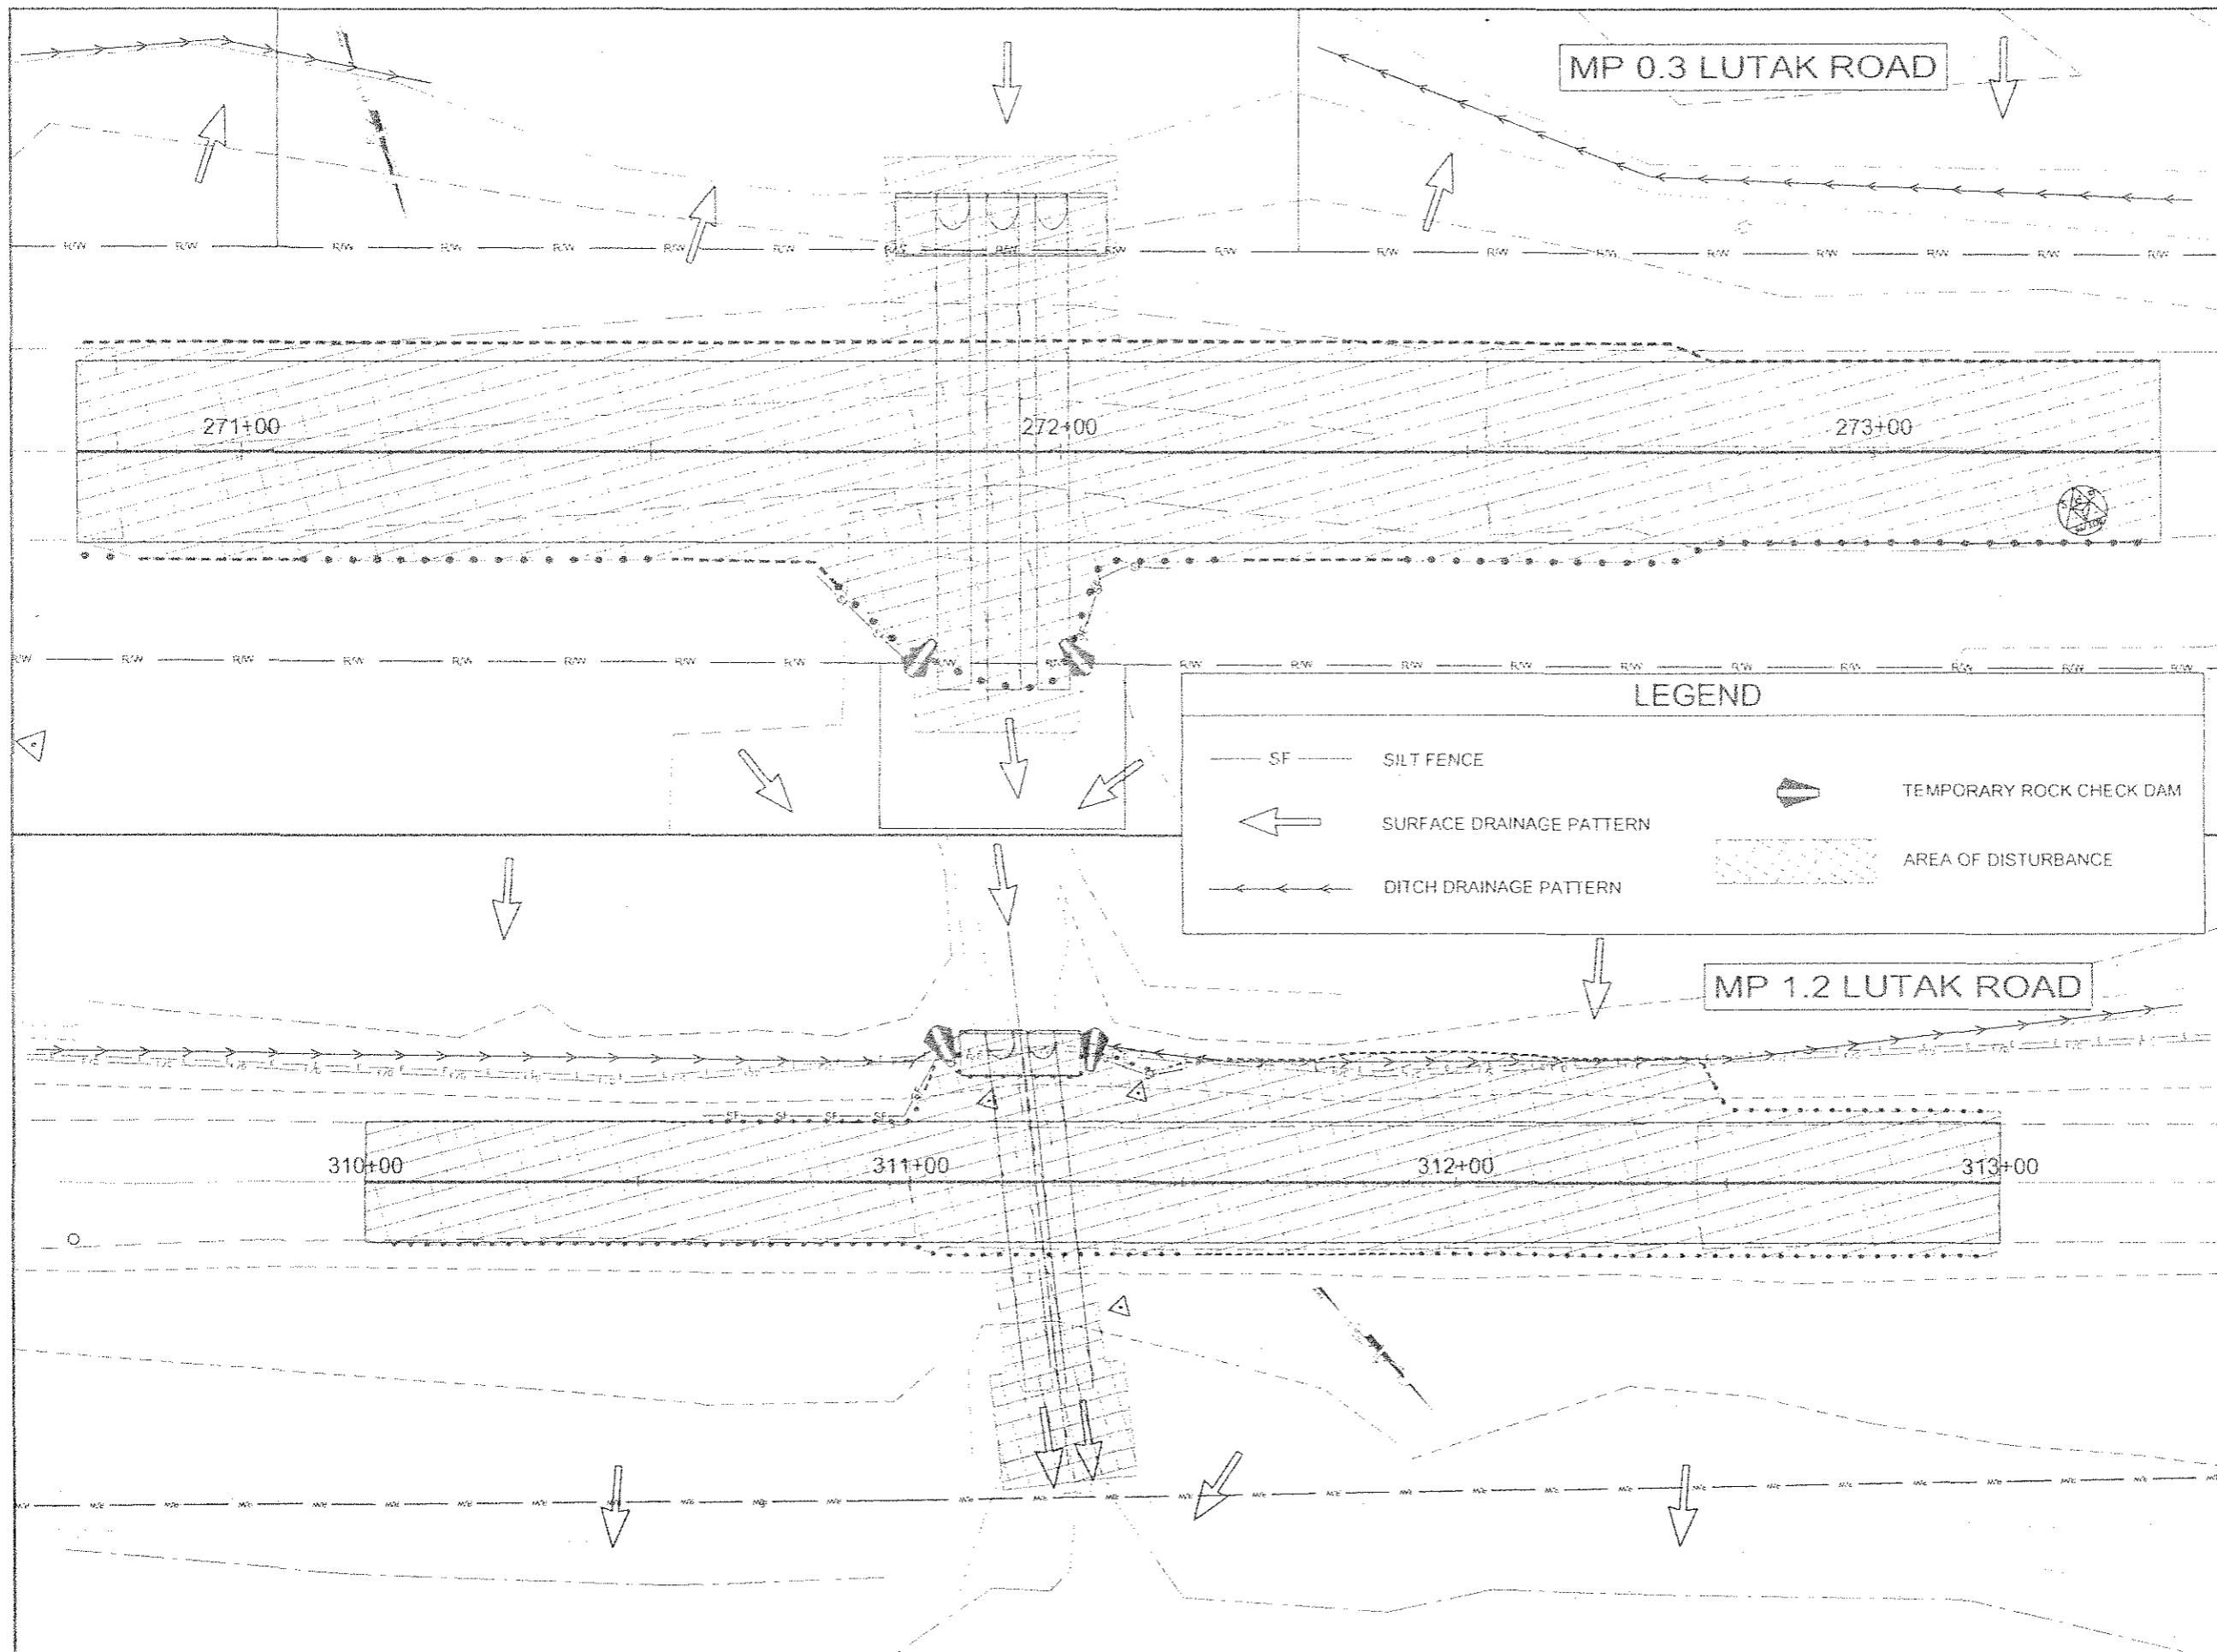


PATH OF SLAVEWORK PROPOSED (SEE PLAN)	
PROJECT NAME (OR WORKSPACE NAME)	
DATE	
ATTACHMENT NUMBER	
REVISIONS	
NO.	DESCRIPTION

SEA NOVEMBER 2005
 STORM PERMANENT REPAIRS
 69236 / ER-0079(2)
EROSION AND SEDIMENT CONTROL PLANS

LEGEND



— SF —	SILT FENCE		TEMPORARY ROCK CHECK DAM
	SURFACE DRAINAGE PATTERN		AREA OF DISTURBANCE
	DITCH DRAINAGE PATTERN		

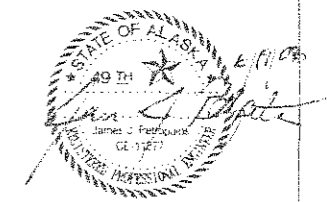

DESIGNED BY: J. PETROPoulos
 DRAWN BY: D. STEVENS
 STATE OF ALASKA
 DEPARTMENT OF TRANSPORTATION
 & PUBLIC FACILITIES
 SOUTHEAST REGION
 SEA NOVEMBER 2005
 STORM PERMANENT REPAIRS

EROSION AND SEDIMENT CONTROL PLANS

PROJECT DESIGNATION NUMBER	
69236 / ER-0079(2)	
STATE	YEAR
ALASKA	2008
SHEET NUMBER	TOTAL SHEETS
T1	36

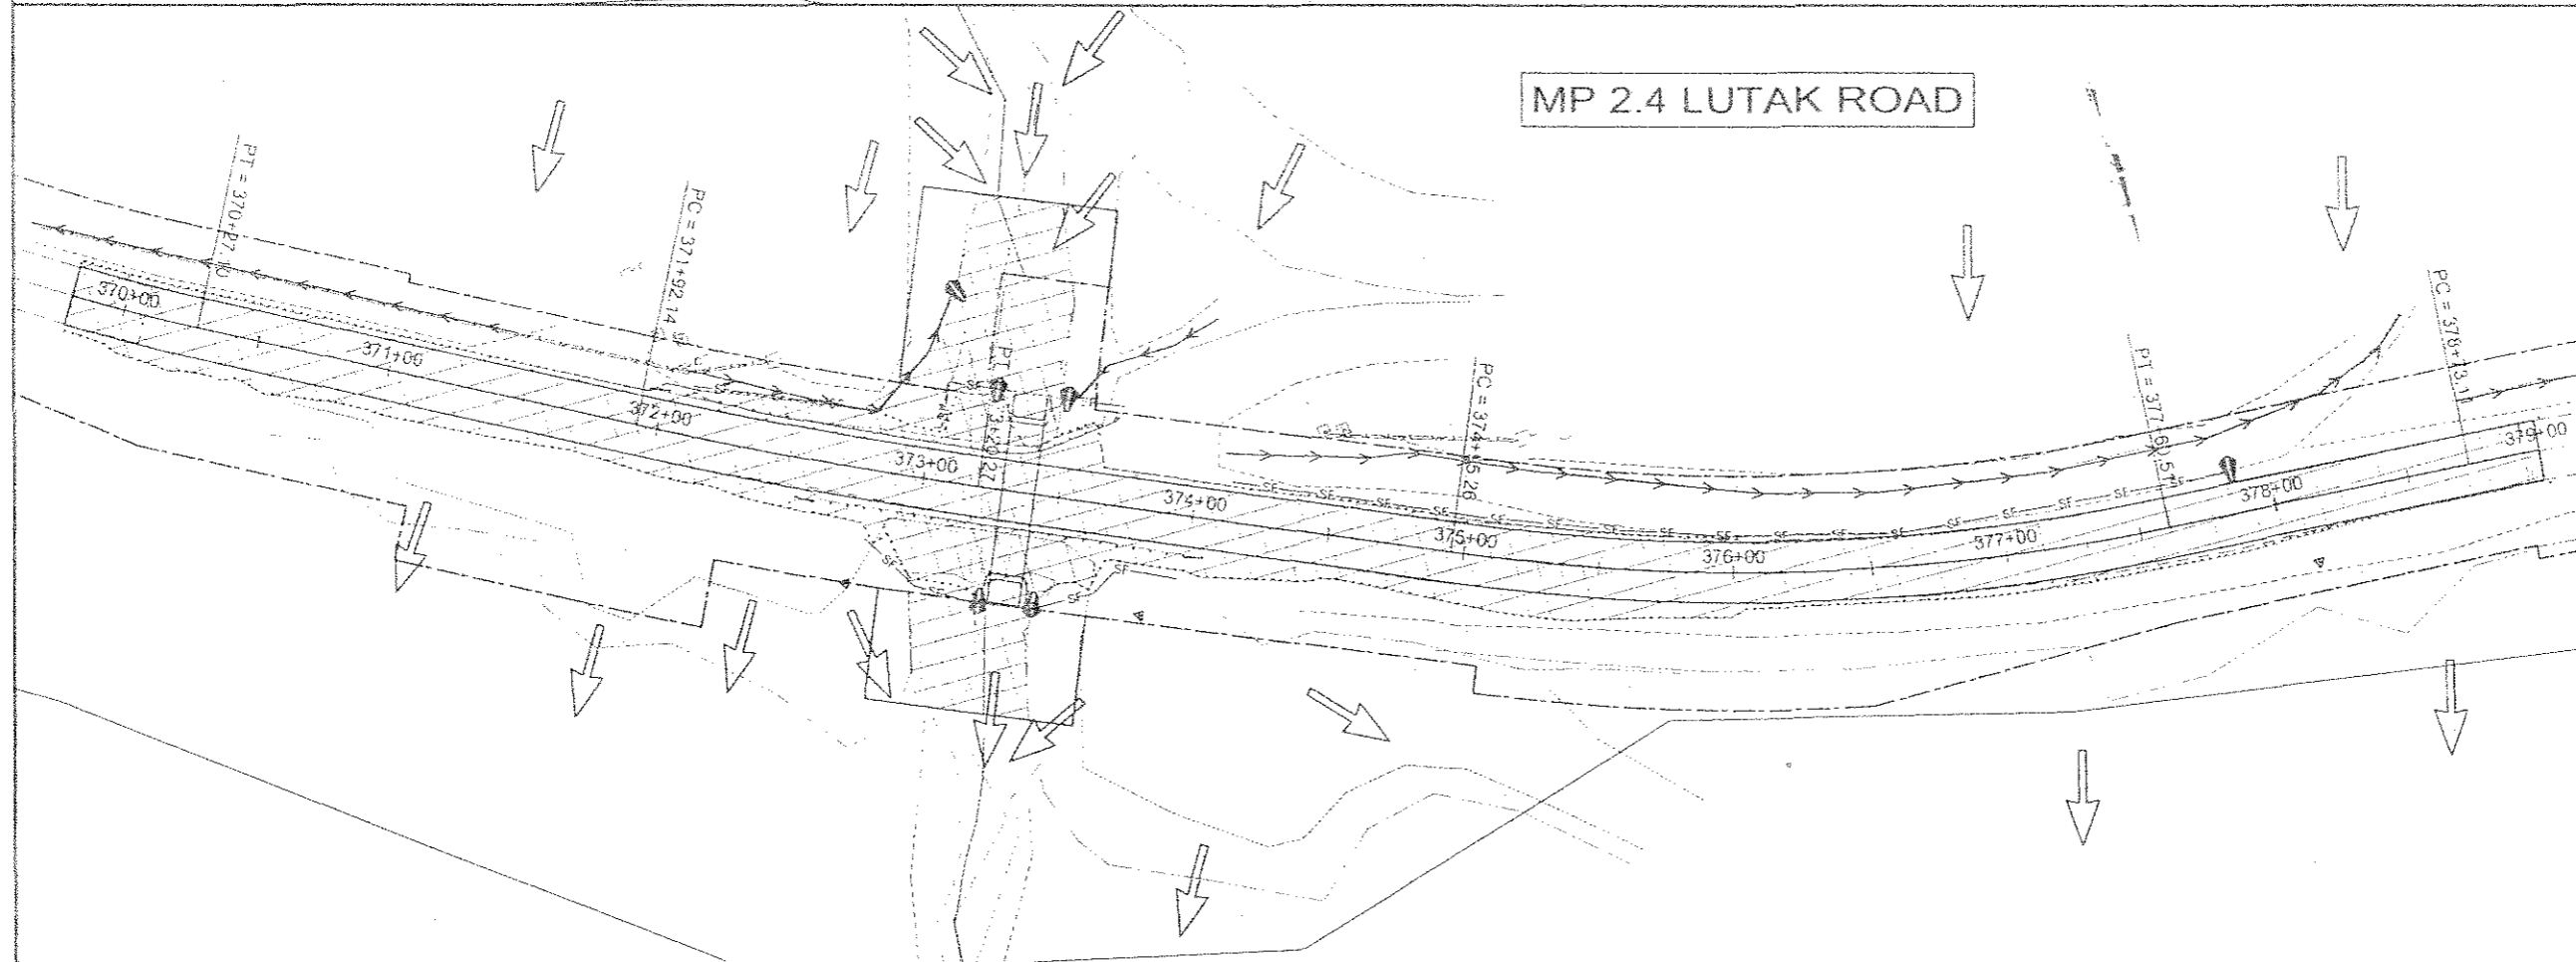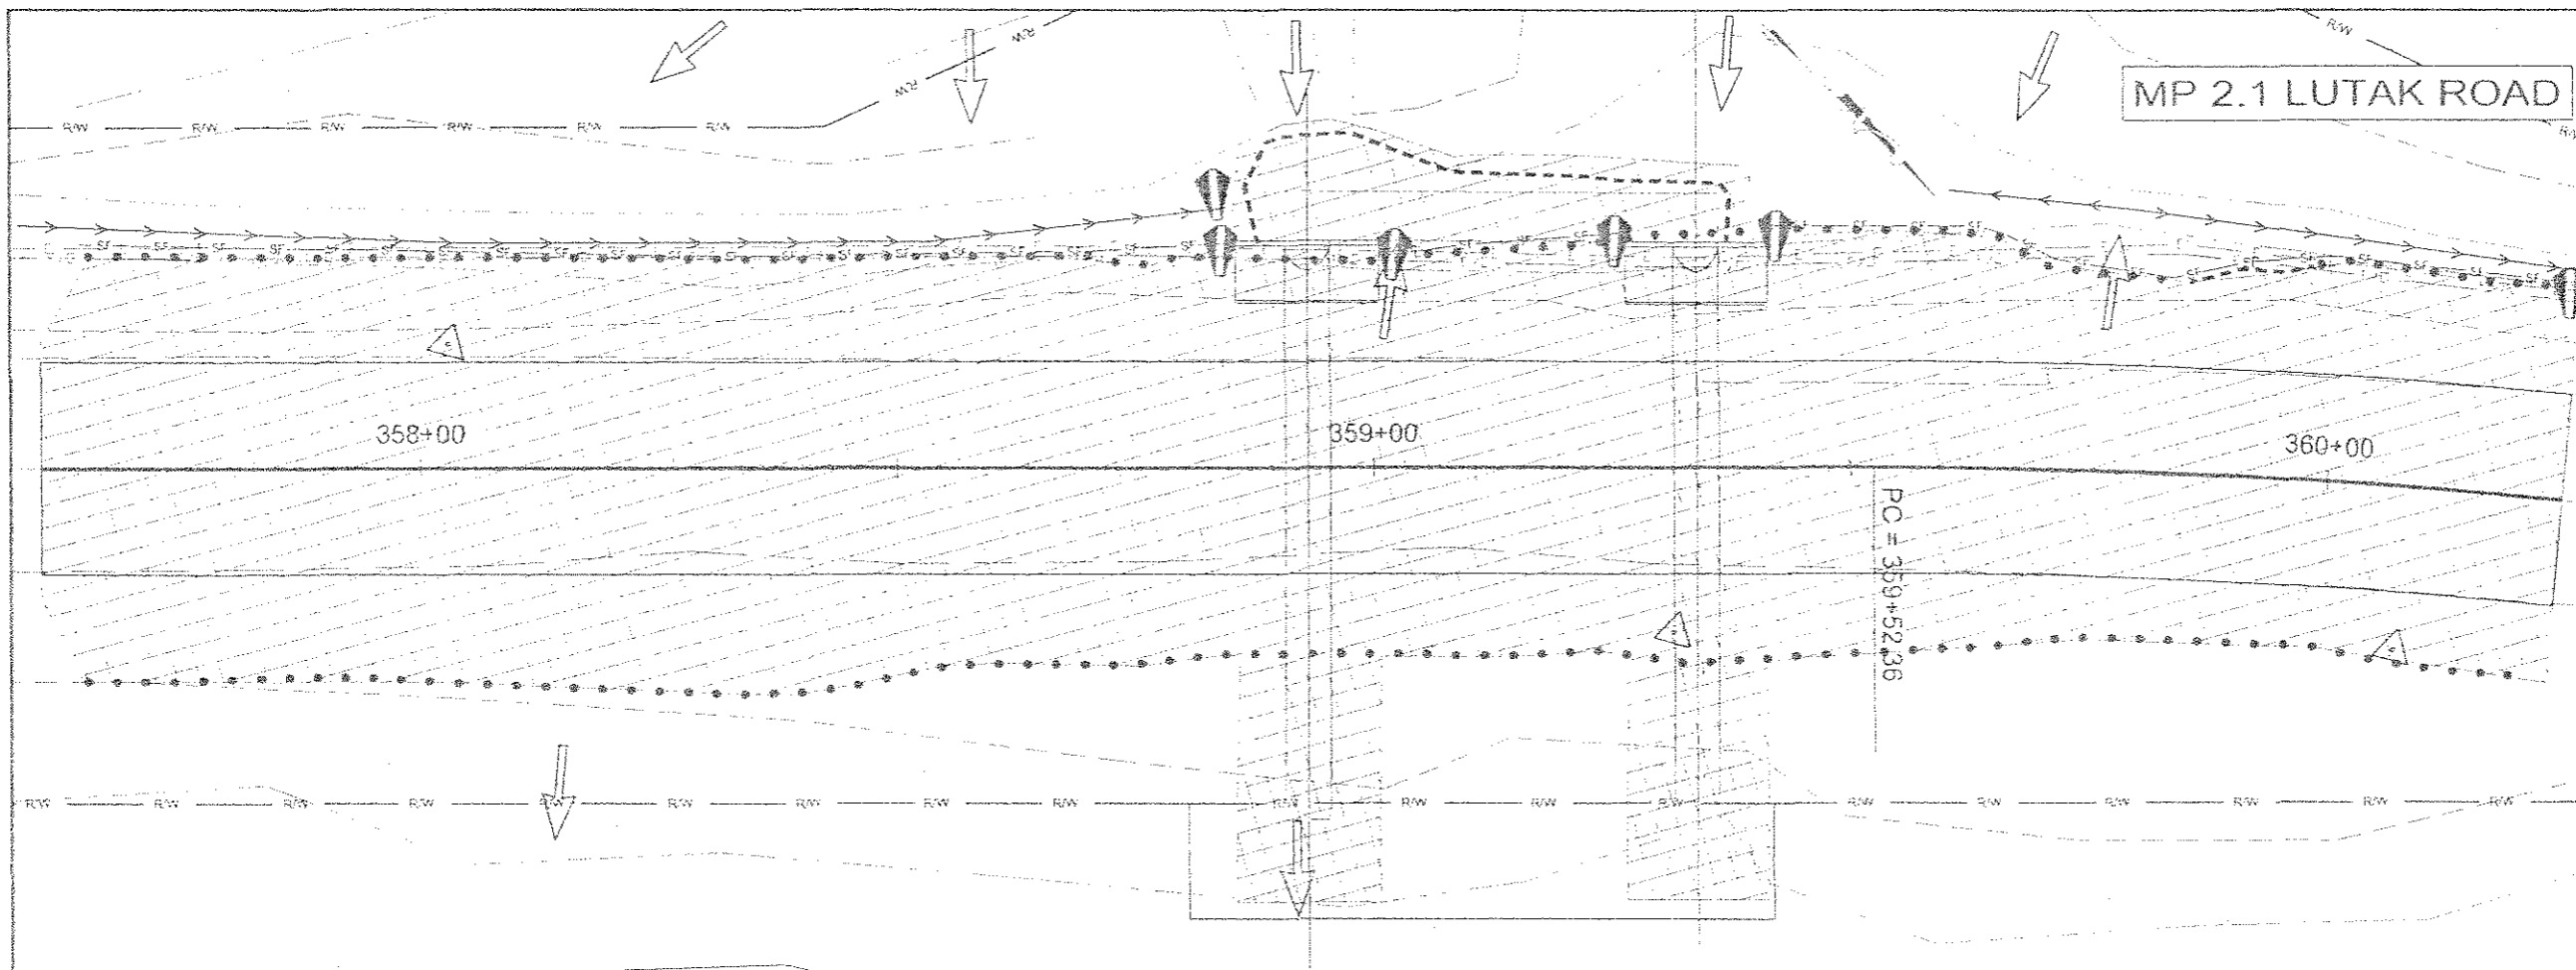


DATE: 11/15/05
 DRAWN BY: J. METROPOLUS
 CHECKED BY: D. STEVENS
 PROJECT: SEA NOVEMBER 2005 STORM PERMANENT REPAIRS

PROJECT DESIGNATION NUMBER	69236 / ER-0079(2)
STATE	ALASKA
YEAR	2008
SHEET NUMBER	T2
TOTAL SHEETS	36

SEA NOVEMBER 2005
 STORM PERMANENT REPAIRS
 69236 / ER-0079(2)


EROSION AND SEDIMENT CONTROL PLANS

DESIGNED BY: J. METROPOLUS
 DRAWN BY: D. STEVENS
 STATE OF ALASKA
 DEPARTMENT OF TRANSPORTATION & PUBLIC FACILITIES
 SOUTH-EAST REGION
 SEA NOVEMBER 2005
 STORM PERMANENT REPAIRS

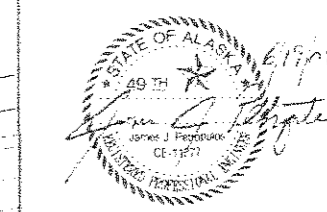


EROSION AND SEDIMENT CONTROL PLANS

PROJECT DESIGNATION NUMBER	69236 / ER-0079(2)
STATE	ALASKA
YEAR	2008
SHEET NUMBER	T2
TOTAL SHEETS	36

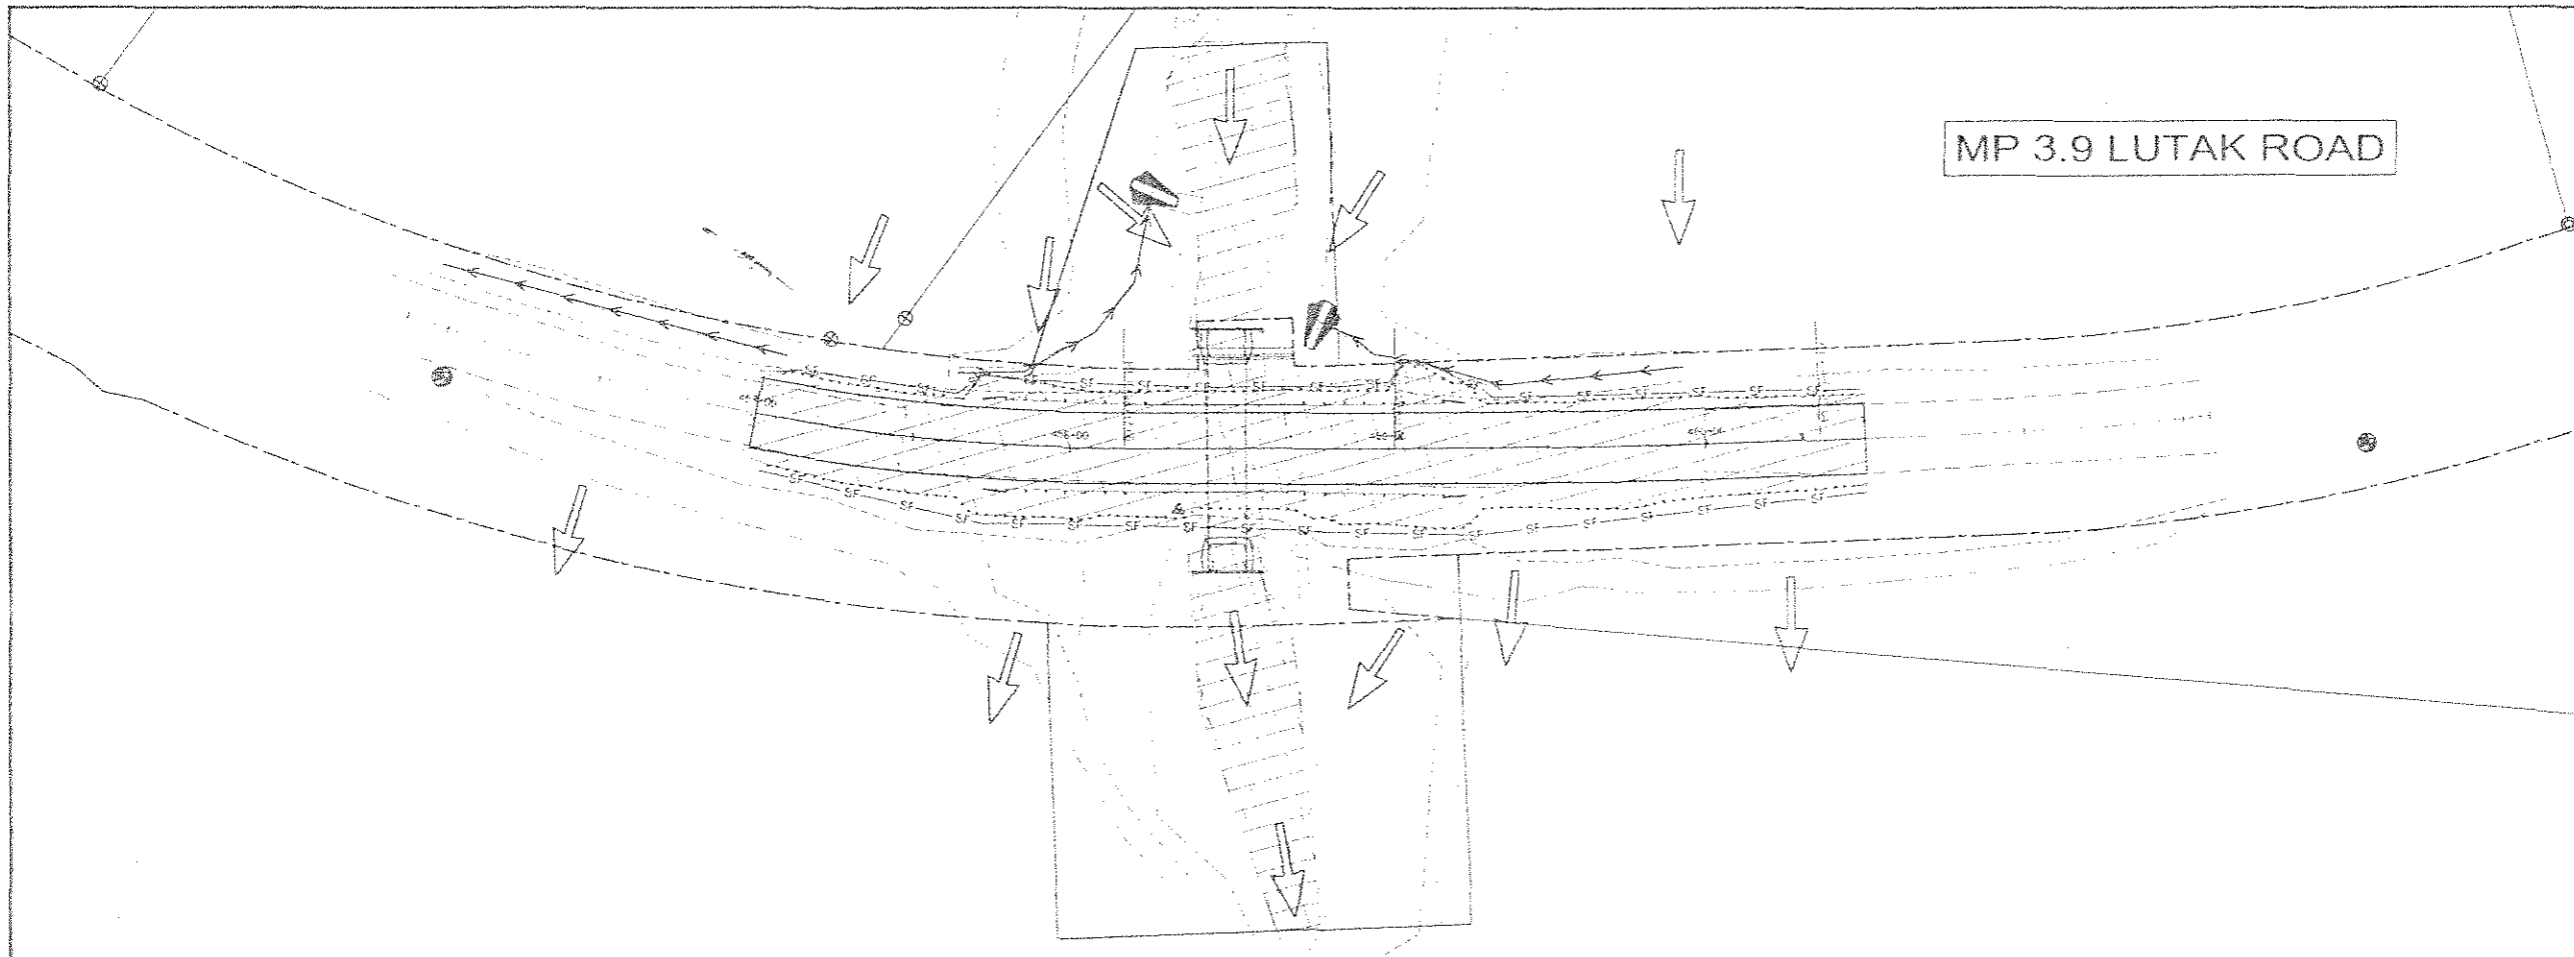

MP 3.9 LUTAK ROAD

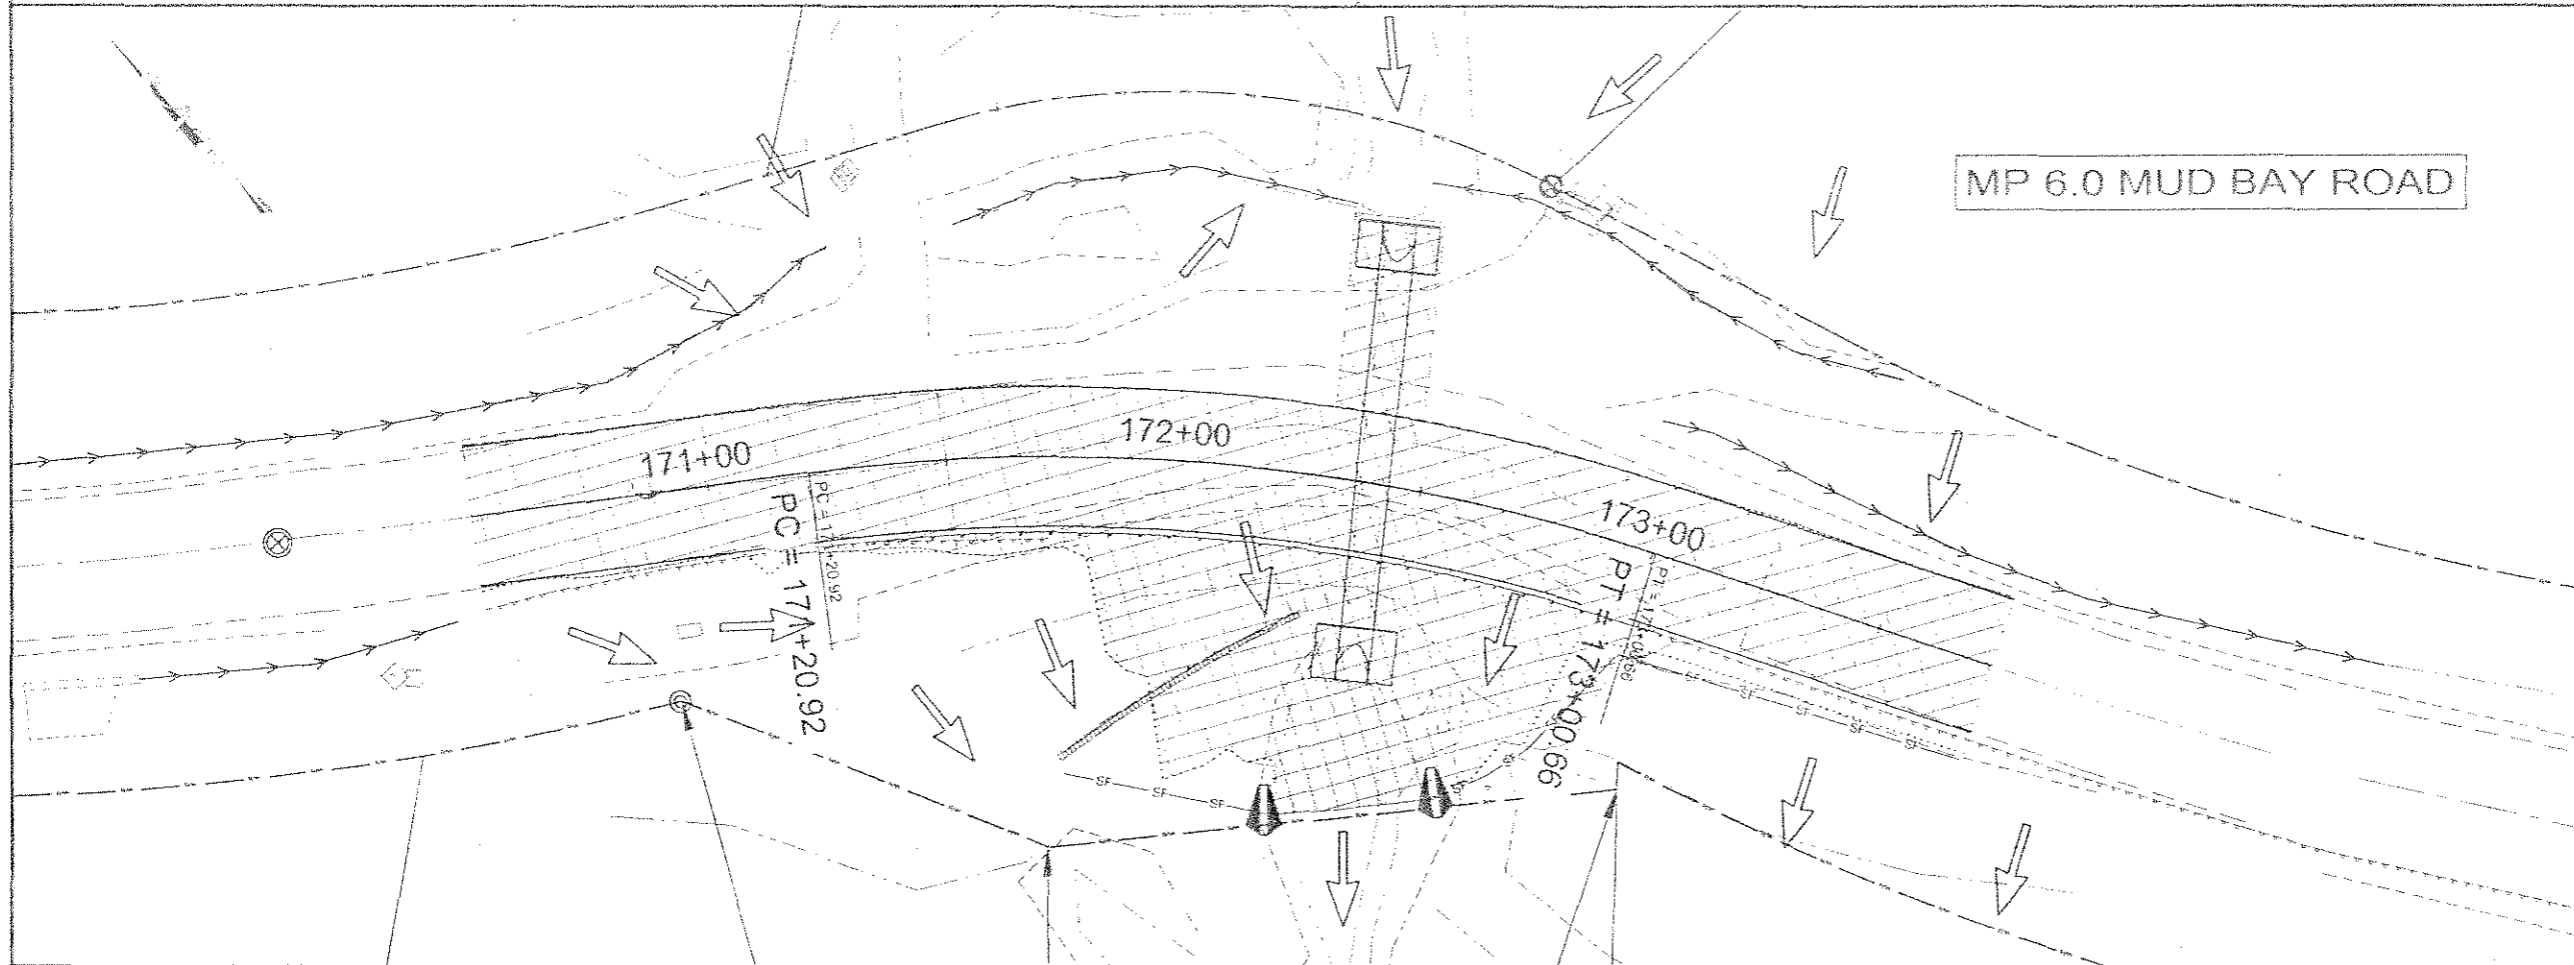

MP 6.0 MUD BAY ROAD

DATE	04/24/08 11:00 AM	
PROJECT	SEA NOVEMBER 2005 STORM PERMANENT REPAIRS	
SCALE	AS SHOWN	
APPENDIX NUMBER		
ATTACHMENT NUMBER		
RECORD OF REVISIONS		
NO.	DATE	DESCRIPTION

SEA NOVEMBER 2005
STORM PERMANENT REPAIRS
69236 / ER-0079(2)

**EROSION AND SEDIMENT
CONTROL PLANS**



DESIGNED BY: D. PETROFILLIS
DRAWN BY: D. STEVENS

STATE OF ALASKA
DEPARTMENT OF TRANSPORTATION
& PUBLIC FACILITIES
SOUTHEAST REGION

SEA NOVEMBER 2005
STORM PERMANENT REPAIRS

**EROSION AND
SEDIMENT CONTROL
PLANS**

PROJECT DESIGNATION NUMBER	
69236 / ER-0079(2)	
STATE	YEAR
ALASKA	2008
SHEET NUMBER	TOTAL SHEETS
T3	36

