

**STATE OF ALASKA
DEPARTMENT OF TRANSPORTATION
&
PUBLIC FACILITIES**

**PLAN AND PROFILE
PROPOSED HIGHWAY PROJECT**

RS-0987(5)-68914-(B-30212)

MUD BAY ROAD—HAINES

STAGE III

**GRADING, DRAINAGE,
SURFACE TREATMENT**

STATE	PROJECT	YEAR	SHEET NO.	TOTAL SHEETS
ALASKA	RS-0987(5)	1985	1	9

68914
(B-30212)

INDEX OF SHEETS

SHEET NO.	DESCRIPTION
1	TITLE SHEET
2	TYPICAL SECTION
3	ESTIMATE OF QUANTITIES
4	TRAFFIC CONTROL & CONSTR. SIGNING
5	DRAINAGE DETAILS, STA. 247+11
6-8	PLAN & PROFILE SHEETS
9	HORIZONTAL CONTROL DIAGRAM


The following Standard Drawings are included in these plans:

- A-1, C-01.01, C-02.00, C-03.01, C-11.01, D-01.00, D-04.10, D-05.10, D-06.01, D-09.00, G-02.00, G-04.01W, G-14.02W, G-18.01, I-40.00, M-16.00, S-00.00, S-05.00, S-30.01, T-20.00.

DESIGN DESIGNATION

- ADT (1985) = 300
- ADT (200) = 450
- DHV 67%
- T.I. 6.0
- D 55-45
- T 4.5%
- 40 M.P.H.

For more information on the justification for the clear zone versus guard rail requirements shown herein, see attachments to memorandum from Ed Cavagnaro thru W.L. Baumgartner, to Mal Linthwaite, and dated 1/3/86.

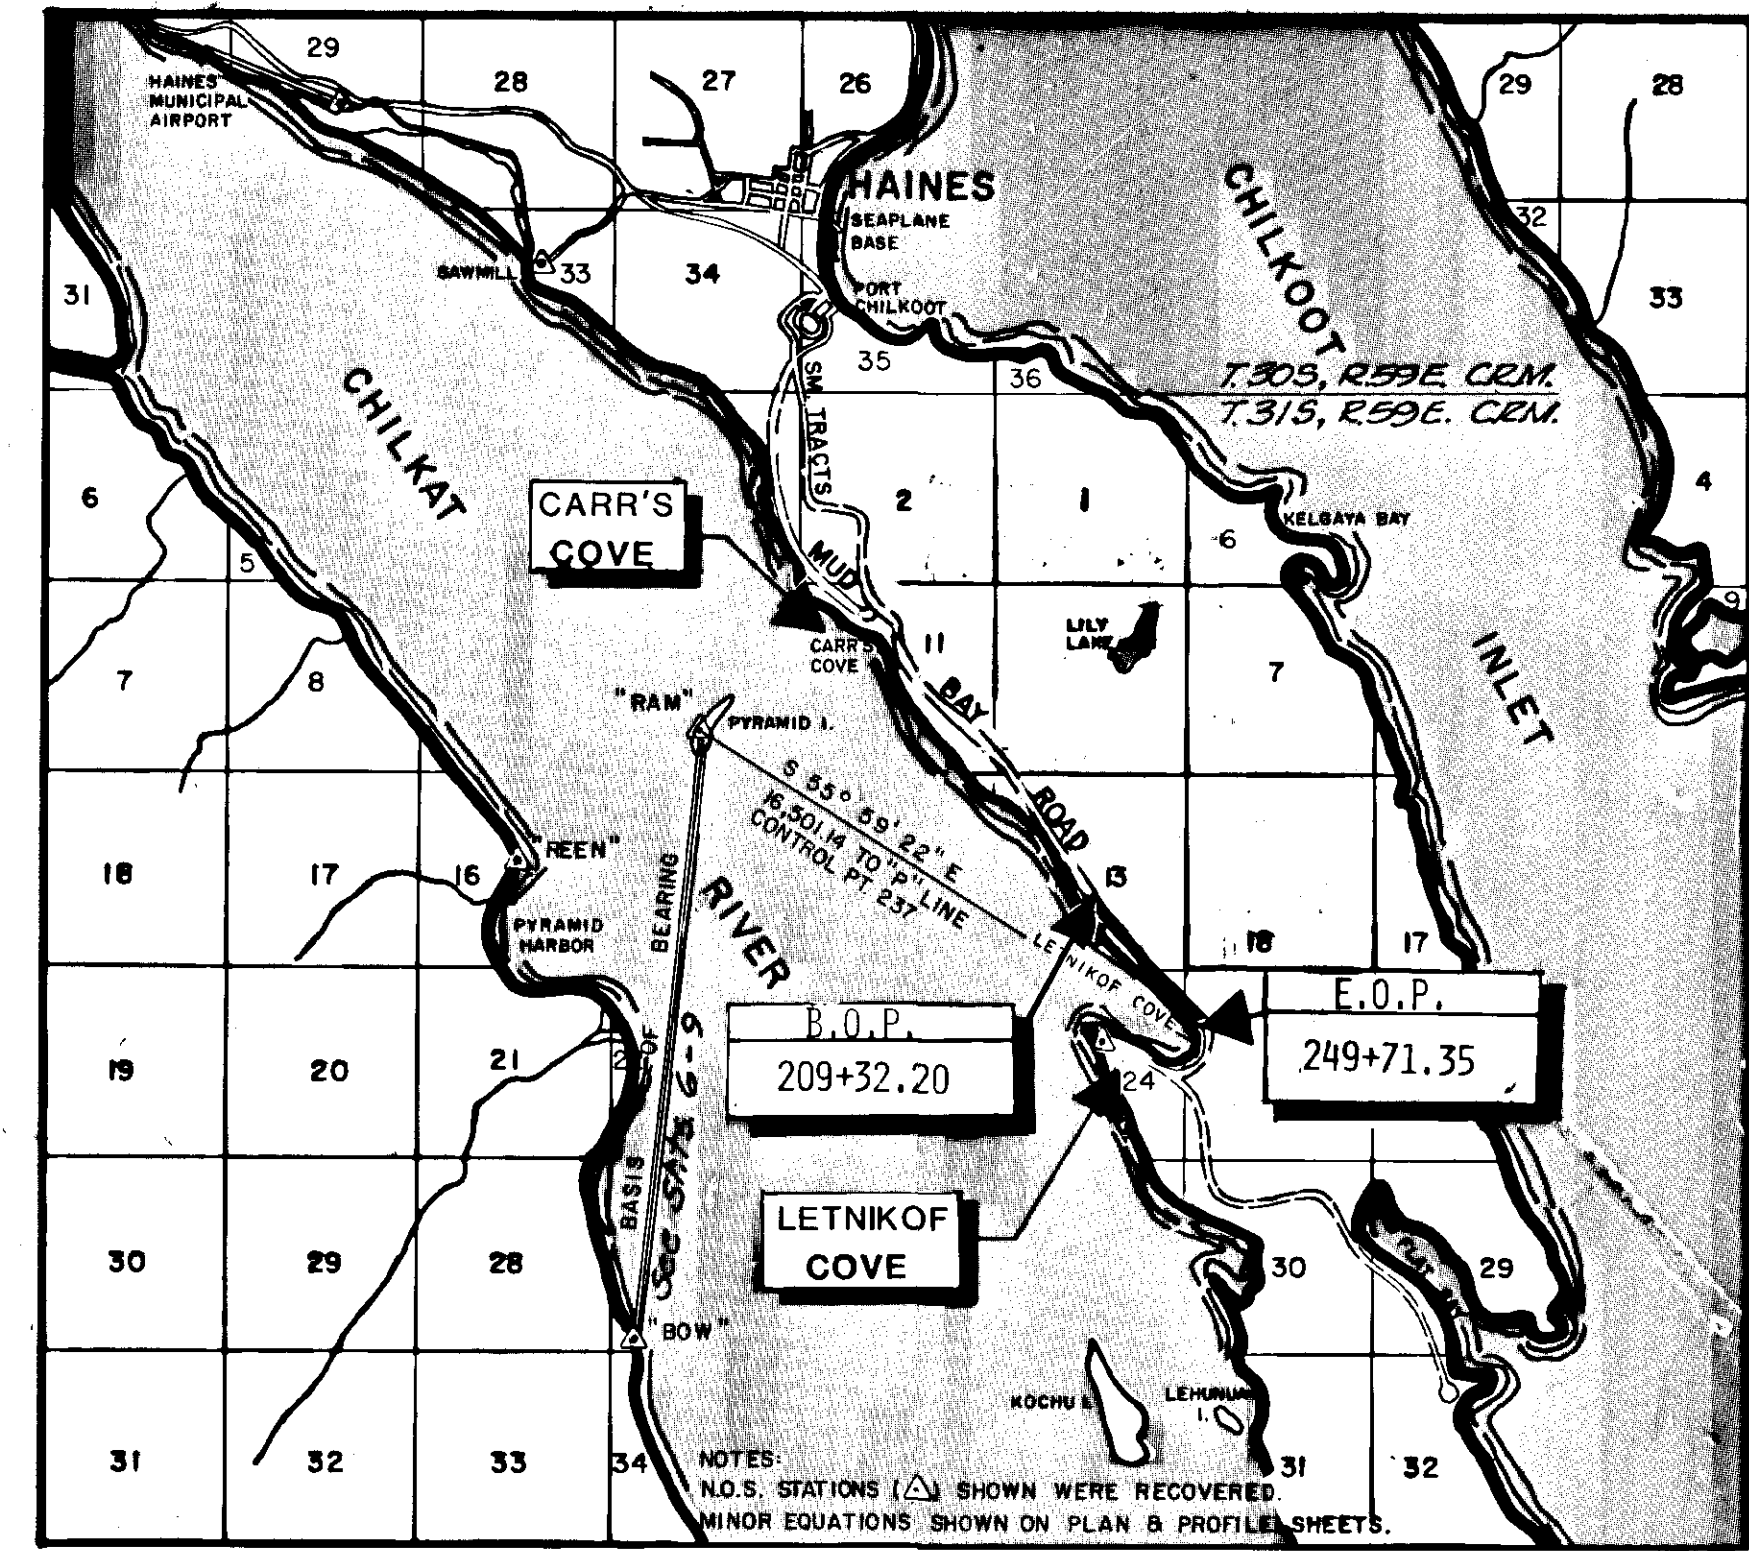

VICINITY MAP




SCALE: 1" = 1 MILE
USGS QUAD MAPS SKAGWAY A-1, A-2, B-1 & B-2 N5900-W 15900 / 15 & 22.5



AS-BUILT
1987
CONTRACTOR Northern Timber Corp.
PROJECT ENGINEER LARRY GEISE
Sept. 1986 - Aug. 1987

PROJECT SUMMARY

WIDTH OF STAGED SURFACE (SURFACE 20)		34.5'
LENGTH OF PROJECT	4039.15 feet	7.6 mi.
LENGTH OF GRADING	4898.35 feet	9.3 mi.
LENGTH OF SURFACE TREATMENT	4898.35 feet	9.3 mi.
LENGTH OF TEMPORARY CONNECTION	859.20 feet	1.6 mi.

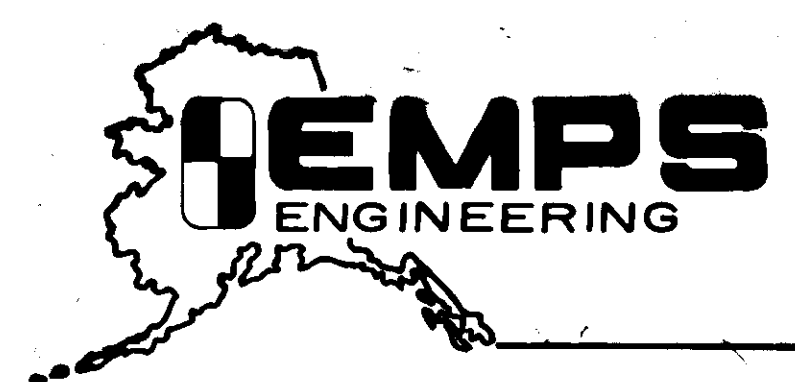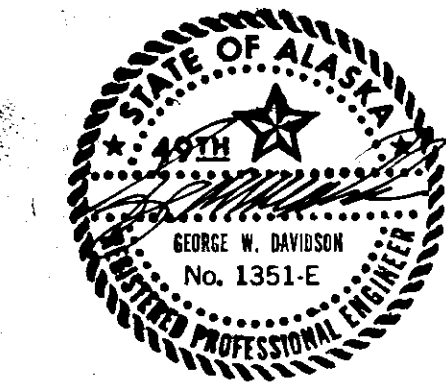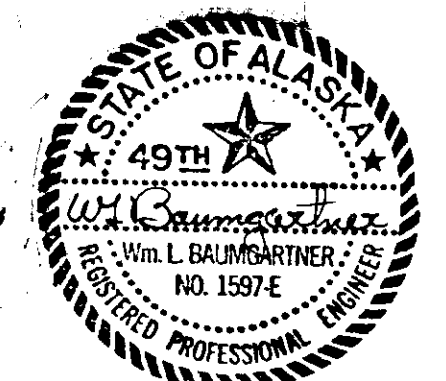


JUNEAU, ALASKA



TYPICAL SECTION OF IMPROVEMENTS

STATE	PROJECT DESIGNATION	YEAR	SHEET NO.	TOTAL SHEETS
ALASKA	RS0987(5)	1985	2	9

68914 (B-30212)

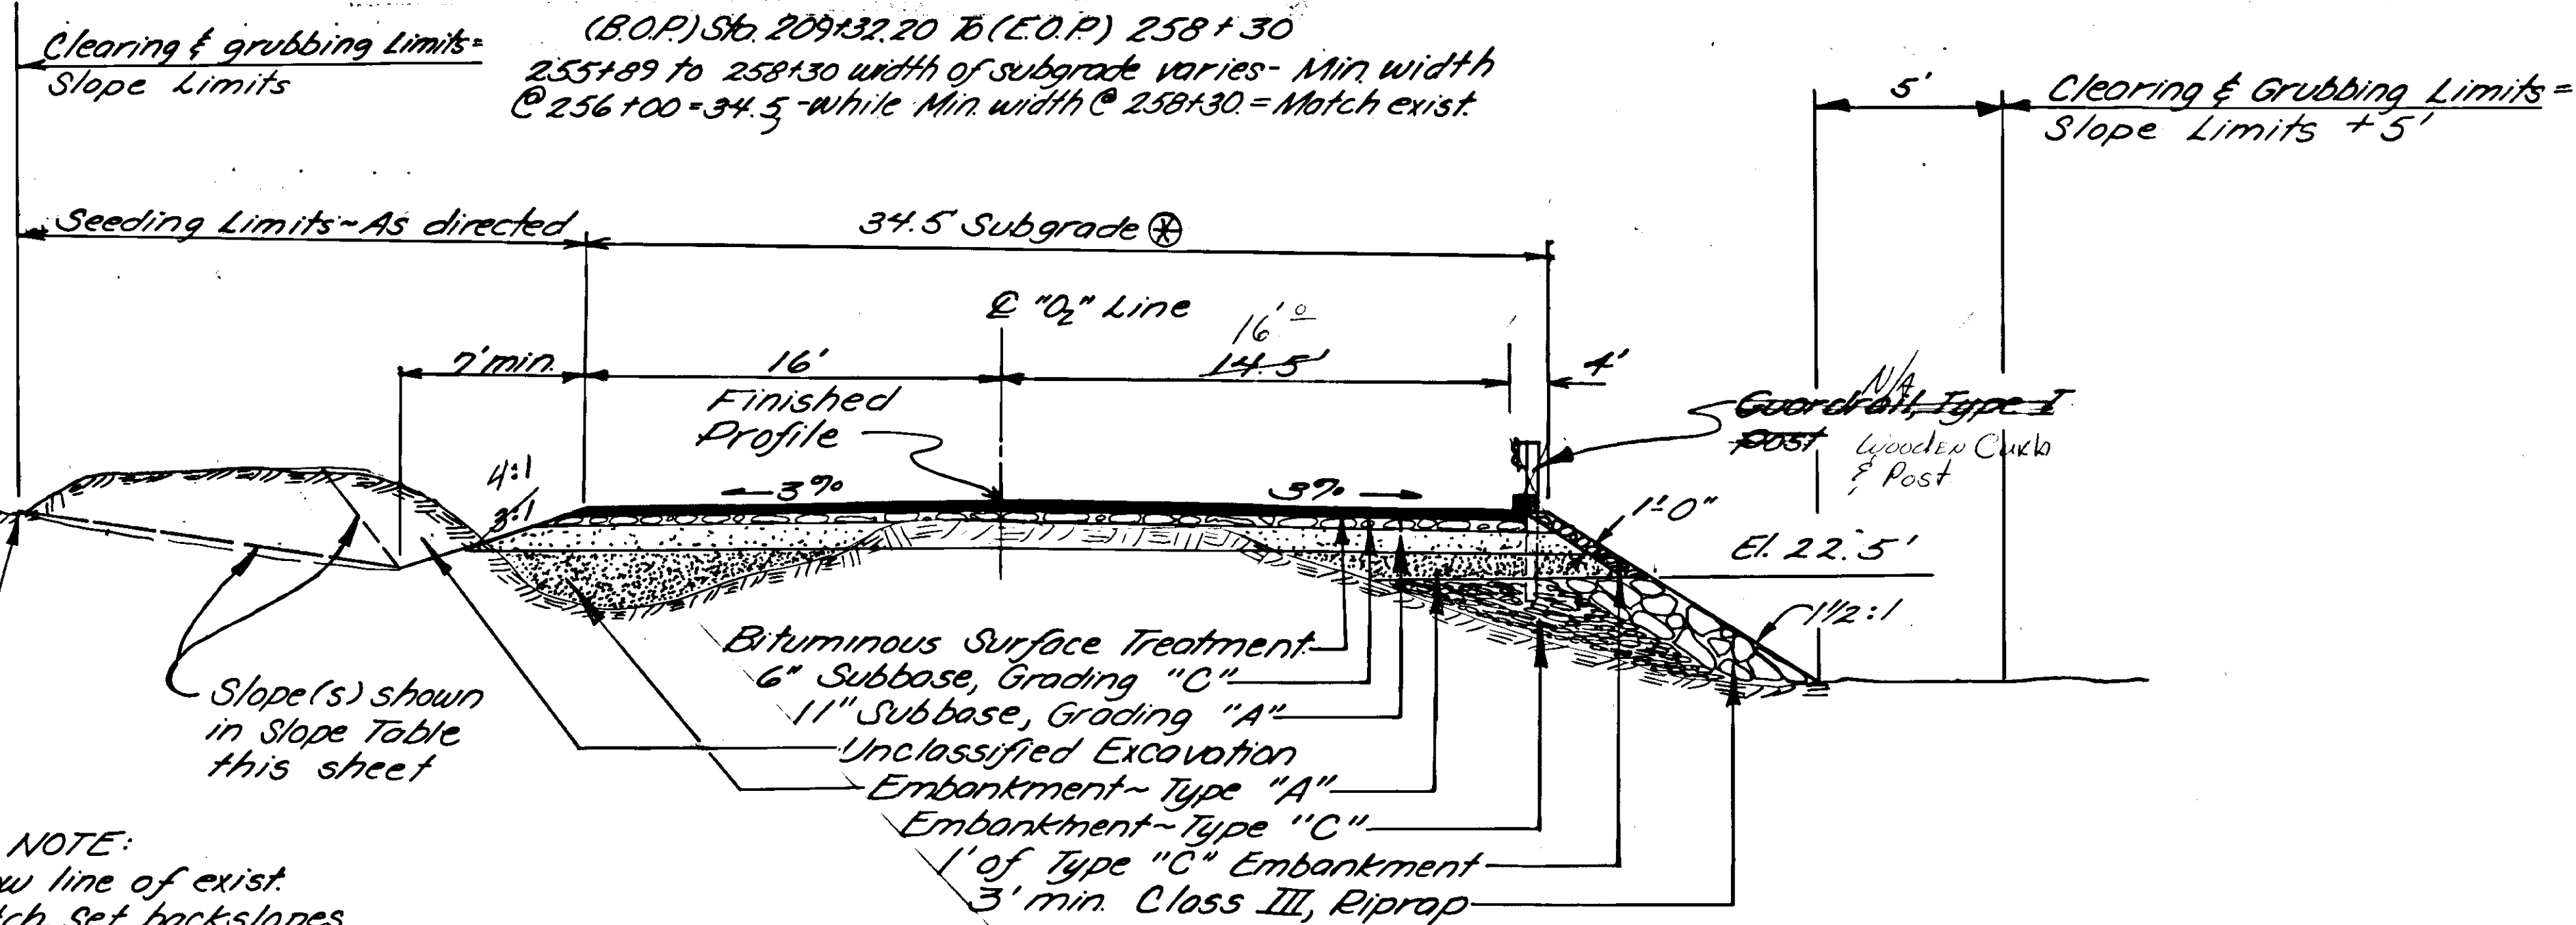

NOTE:
Flow line of exist. ditch. Set backslopes as directed.

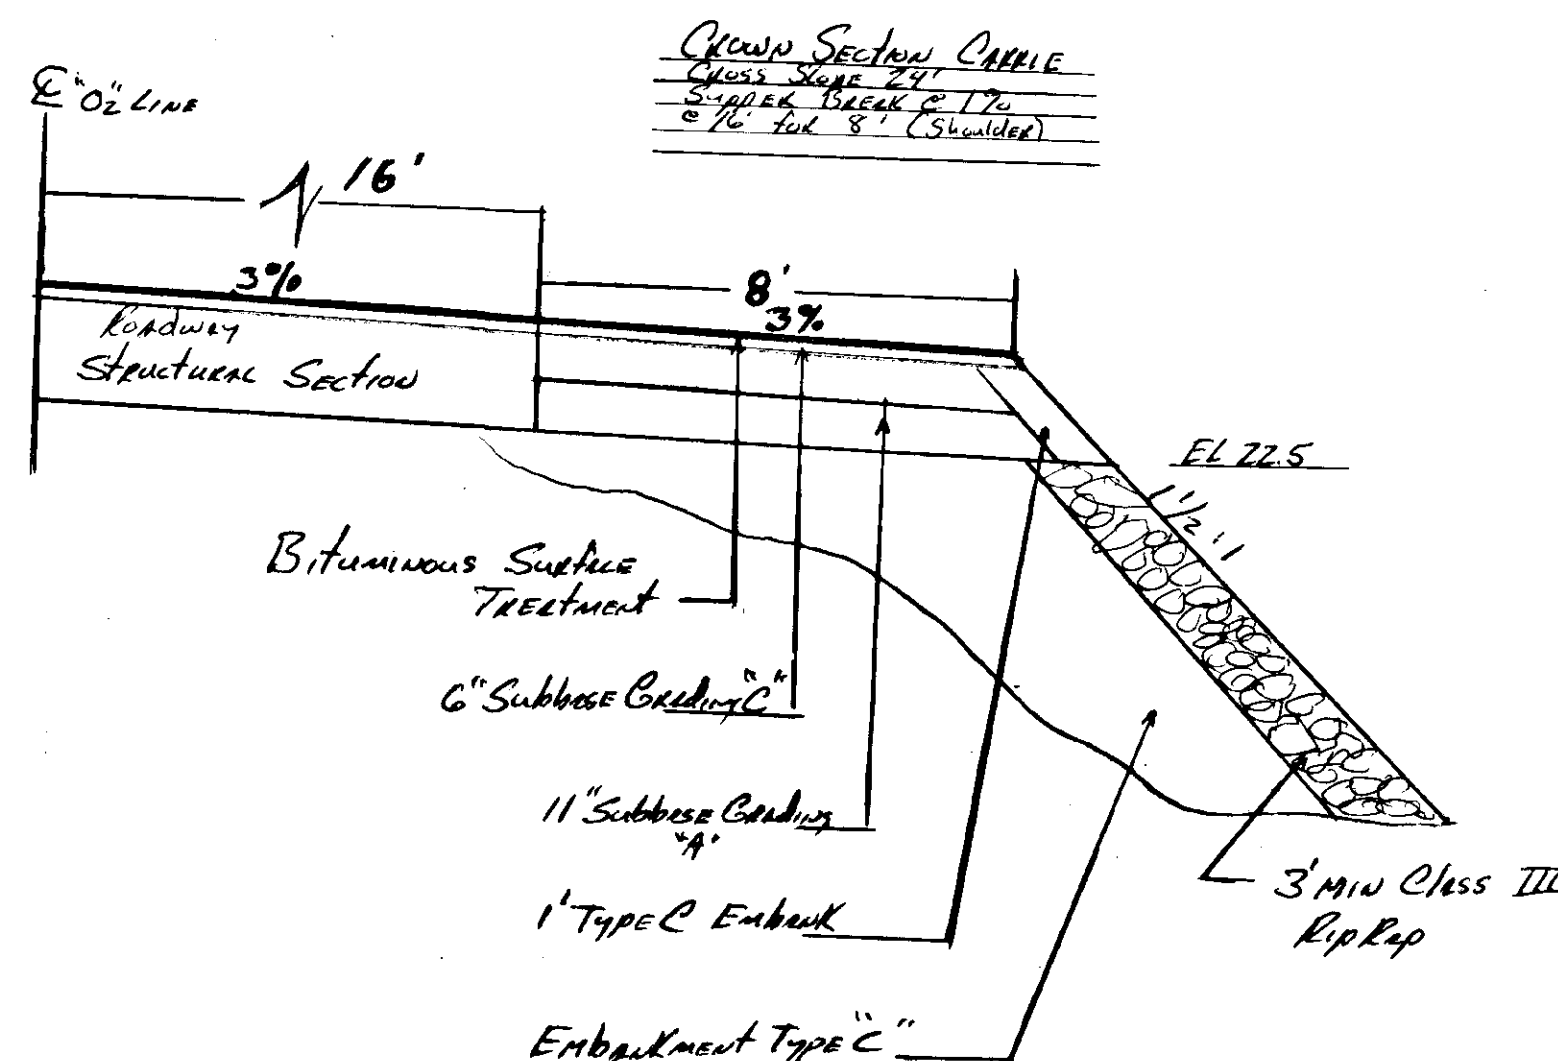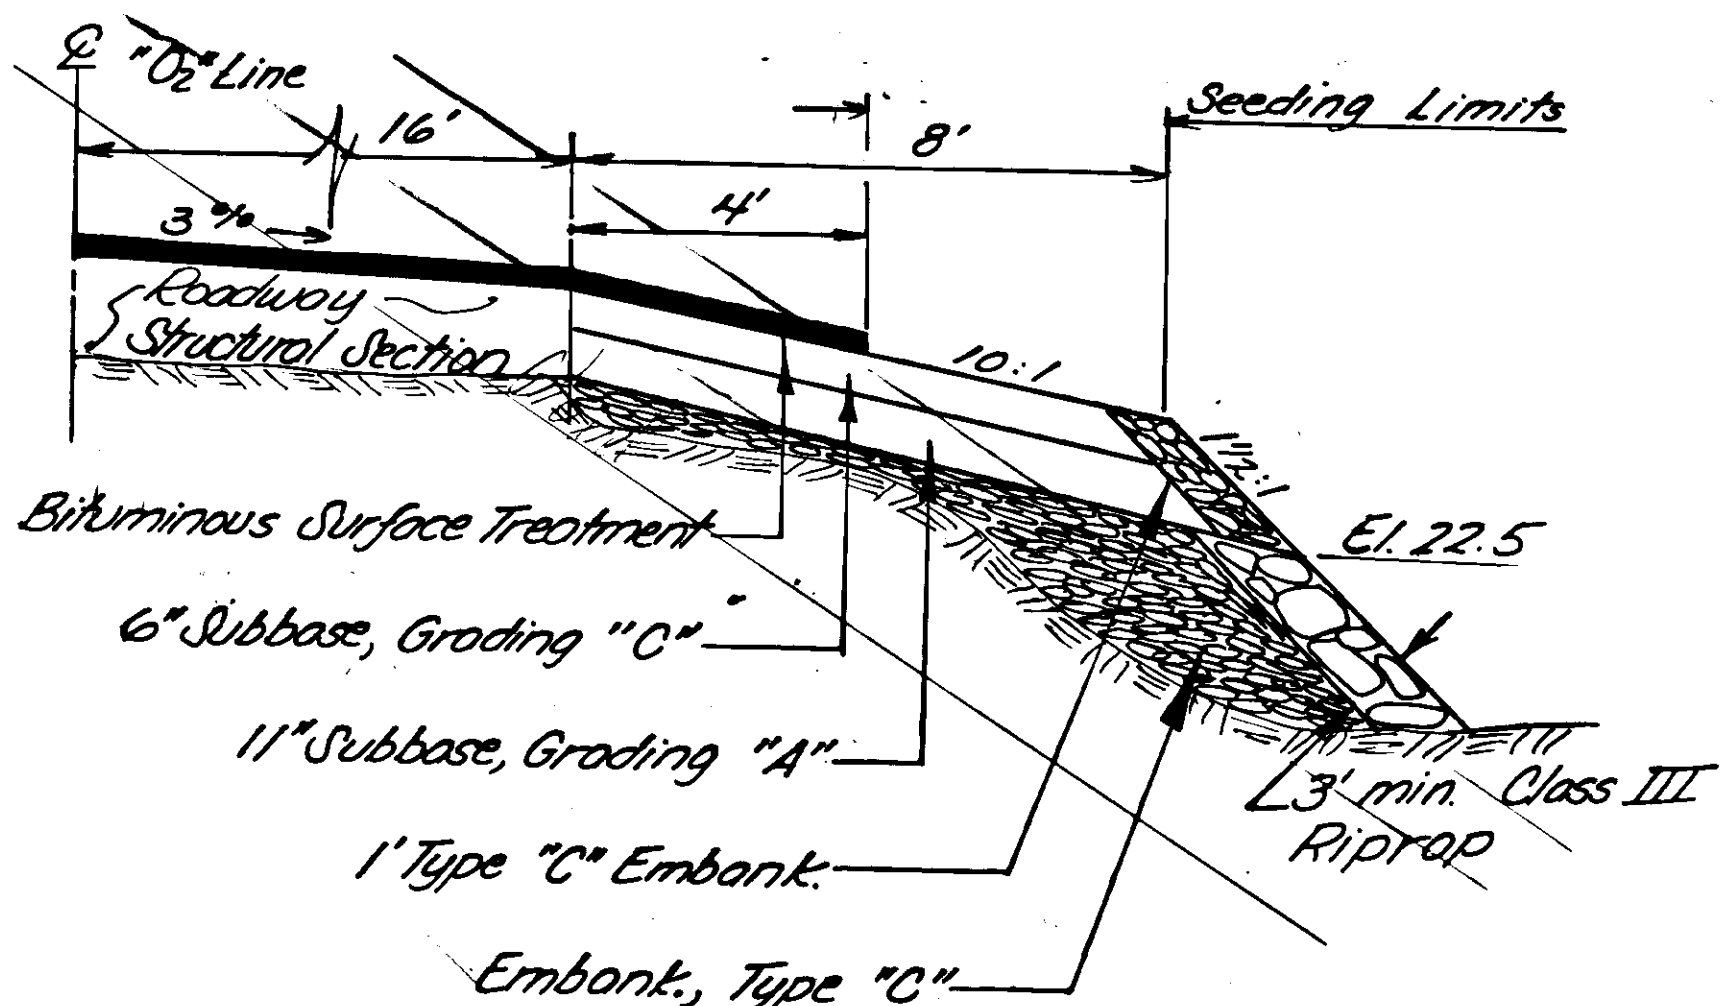

TYPICAL SECTION

ROADWAY WIDENING STA. 209+32.20 TO STA. 240+55

BASIS OF ESTIMATE	
ITEM	ESTIMATING FACTOR
304 (1A, 1C)	2.00 Tons/c.y.
403 (2)	0.25 gal/s.y. 253 gal/ton
405 (1)	1.03 gal/s.y. 241 gal/ton
405 (2A)	48 lb/s.y.
405 (2B)	28 lb/s.y.

REMOVAL OF STRUCTURES AND OBSTRUCTIONS	
STATION	DESCRIPTION
"O ₂ " 214+15 Rt.	Derelict Boat
"O ₂ " 236+15 Rt.	Wood Piling

TABLE OF SLOPES		SLOPE	
STATION	THRU	STATION	CUT FILL
"O ₂ " 209+00 Lt.	"O ₂ " 212+00 Lt.	1/2:1	
"O ₂ " 212+00 Lt.	"O ₂ " 243+50 Lt.	See note above	
"O ₂ " 243+50 Lt.	"O ₂ " 255+90 Lt.	1/4:1	

GUARDRAIL SUMMARY				* REMARKS
STATION	THRU	STATION	LEFT - LINEAL FEET - RIGHT	
"O ₂ " 239+00	"O ₂ " 242+25 Rt.		32.5'	R=50', L=20', R=50', L=20'
"O ₂ " 241+00	"O ₂ " 246+50 Rt.		5.50'	
"O ₂ " 242+80	"O ₂ " 244+95		21.5'	
"O ₂ " 245+00	"O ₂ " 249+00		4.25'	R=30', L=36', R=30', L=36'

NOTES

- Grade & alignment shown on plans are subject to minor revisions.
- Culvert lengths and locations are approximate only and are subject to minor revisions.
- Superelevation rates & length of transition shall be as indicated on the plans or as directed.
- All approaches shall be constructed per Standard Plan I-40.00 unless otherwise noted on the plans, approach grades shall be as directed, surface treatment shall be applied from edge of traveled way to the end of the new construction. Approaches that slope toward centerline shall be crowned as directed.
- See Sht. 9 for bearings & distances between "P" referenced in the field and "O₂" construction centerline, line points.
- The Type I guardrail installations called for on this project shall be installed at 30 inch height versus the 27 inches shown on Standard Drawing G-04.01.
- The parking area & approach roads to the boat harbor located in Letnikof Cove shall not be used as a stockpile area for equipment or materials.
- Structural Section shown for the basic typical shall also apply to the roadway and parking area required between "O₂" 240+00 and "O₂" 248+00 Rt.
- It is recommended that the contractor review the materials report and the gradation requirements for the various types of materials required prior to deciding what to do with the unclassified excavation.



D.H.K.
O₂" 241+10 to 241+54 5+ 18"
O₂" 255+81 7 29" 45'


CULVERT SUMMARY				
STATION	SHEET	SIZE	LNTH	COVER
"O ₂ " 214+14.75	6	24"	80'	5'
"O ₂ " 217+00 57	6	48" B	72'	5'
"O ₂ " 220+33	6	24"	60'	5'
"O ₂ " 222+50	6	24"	60'	5'
"O ₂ " 225+00	7	24"	60'	5'
"O ₂ " 230+31	7	24"	60'	5'
"O ₂ " 232+30.26	7	24"	60'	3'
"O ₂ " 238+84	7	24"	60'	5'
"O ₂ " 247+32	7	54" B & C	116'	3.5'
"O ₂ " 248+57.5	7	24"	110'	5'

B - End section required
C - Requires install of Class "C" embankment of the inlet end of the pipe.

ESTIMATE OF QUANTITIES

ITEM NO.	ITEM	UNIT	SHEET NUMBER				TOTAL
			6	7	8	FINAL	
109(2)	OBE & WBE Adjustments	Cont. Sum					Cont. Sum
110(2)	Mobilization & Demobilization	L.S.				46,000	All Req'd ✓
111(1)	Temporary erosion & pollution control	Cont. Sum					" "
112(1)	Training program in accord w/ FHWA Order I	Man-hr.				324	1,000
113(1)	Flagging	Man-hr.				519	500
114(1)	Construction surveying by contractor	L.S.				16,800	All Req'd ✓
115(1)	Traffic maintenance	L.S.				5,281	" "
115(2)	Construction signs (Approx. quant. 150 sq. ft.)	L.S.				1,872	" "
116(8)	Contractor furnished vehicles	Ea.				17,047	3 x 6,349
201(2B)	Clearing & grubbing	L.S.				7,503	All Req'd ✓
202(1)	Removal of structures & obstructions	L.S.				4,242	" "
202(4)	Removal of culvert pipe	L.F.	135	165	0	318	300
203(3)	Unclassified Excavation	C.Y.	5644	5725	1476	17,105	12,845
203(8)	Embankment	C.Y.	6024	14,289	1513	21,285.8	21,826
304(1A)	Subbase, Grading "A"	Tons	4225	8,178	2408	58,861	14,811
304(1C)	Subbase, Grading "C"	Tons	2149	4,207	1211	10,870	7,567
403(2)	MC-30 Liquid asphalt for prime coat	Tons	5.80	12.0	3.7	23.52	21.5
405(1)	CRS-2 Asphalt for surface treatment	Tons	29.25	49.15	14.50	130.92	92.9
405(2A)	Grading "B" Cover coat material	Tons	1.80	258.5	82.5	54.5	521
405(2B)	Grading "E" Cover coat material	Tons	11.5	144	45.0	57.5	304
603(3-4)	48 Inch Corrugated aluminum pipe	L.F.	62			72	62
603(3-5)	54 Inch Corrugated aluminum pipe	L.F.		82		116	82
603(5-4)	End Section for 48 Inch Corrugated Alum. pipe	Ea.	2			1	2
603(5-5)	End Section for 54 Inch Corrugated Alum. pipe	Ea.		2		1	2
603(2-2)	24 Inch pipe	L.F.	174	328		595	502
606(1)	Beam Type Guardrail, Type I Post	L.F.		1,412.5	100	DELETED	1,512.5
606(6)	End anchorages	Ea.		7	1	DELETED	8
606(10)	Wooden Curb & Post	L.F.				1,434	1,434
611(1)	Riprap, Class III	C.Y.	1019	3858	506	8751	5,383
614(5)	Monument & monument cases	Ea.	4	6			10
615(1)	Standard signs	S.F.			14.75	44.75	14.75
618(2)	Seeding	Acre	1.04	1.41	0.53	2.07	3.0
618(4)	Water for maintenance	m/gal.	2.3	3.1	1.2	0.14	6.6
627(1)	Watering	m/gal.	22.7	36.4	10.6	102.5	69.7
639(1)	Approaches (driveways)	Ea.			1	1	1
670(1)	Painted traffic markings (approx. 3.0 mi. & 28 parking spaces)	L.S.				46,000	All Req'd ✓

SURVEY MONUMENT SUMMARY.				CULVERT REMOVAL SUMMARY			APPROACH SUMMARY	
STATION	POINT	MON	CASE	STATION	SIZE	LENGTH	LOCATION	WIDTH
02+209.32	PC	1	1	02+217+00	48"	45'+	38	02+256+10 L.
02+213+35.37	PT	1	1	02+219+73		45'+		
02+216+28.49	PC	1	1	02+222+30	12"	45'+		
02+219+73.02	PT	1	1	02+229+92	24"	45'+	41	
02+230+10.76	PC	1	1	02+232+30	18"	45'+	40	
02+232+26.78	PT	1	1	02+239+84	18"	45'+	42	
02+234+33.10	PC	1	1	02+247+15	48"	30'+	30	
02+237+96.51	PT	1	1	02+225+00	24"	42'		
02+243+12.36	PC	1	1	02+231+00	24"	40'		
02+246+23.29	PT	1	1					

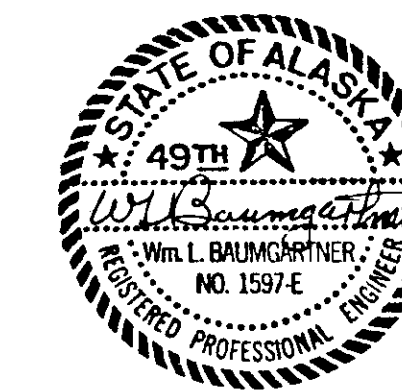

GENERAL NOTES:


- THE CONTRACTOR SHALL DESIGNATE ONE OF HIS EMPLOYEES THE RESPONSIBILITY OF INSTALLING AND MAINTAINING THE REQUIRED TRAFFIC CONTROL ELEMENTS FOR THIS PROJECT. A COPY OF THE DESIGNATION SHALL BE FORWARDED TO THE ENGINEER.
- ALL PROJECT CLOSURES SHALL BE AS SHOWN ON STANDARD DRAWINGS C-01.01, C-02.00, C-03.01. ADDITIONAL REQUIREMENTS ARE SHOWN IN THE MANUAL OF UNIFORM TRAFFIC CONTROL DEVICES ALASKA SUPPLEMENTAL.
- ALL ONE-LANE CLOSURES SHALL BE AS SHOWN ON STANDARD PLAN C-03.01. ALL DETOURS REQUIRED ON THE PROJECT SHALL BE CONSTRUCTED AND CONTINUOUSLY MAINTAINED TO THE FOLLOWING MINIMUM WIDTHS AT ALL TIMES: ONE-WAY TRAFFIC-12'
TWO-WAY TRAFFIC-20'
- ANY ONE-WAY DETOURS DURING DUSK (PD) TO DAWN (AM) WILL REQUIRE TEMPORARY ILLUMINATION. THE MINIMUM LEVEL OF ILLUMINATION SHALL BE 2.0 FOOT-CANDELES ON THE ROADWAY SURFACE
- SHOULDER DROP-OFFS GREATER THAN 1 1/2 INCHES SHALL NOT BE ALLOWED DURING NON-WORKING HOURS.
- THE FOLLOWING CONSTRUCTION SIGNING SCHEDULE SHALL BE CONSIDERED AS THE MINIMUM AMOUNT OF REQUIRED SIGNING. ADDITIONAL SIGNS MAY BE REQUIRED BY THE ENGINEER.
- THE CONTRACTOR SHALL MAINTAIN A MINIMUM OF ONE-WAY TRAFFIC WITH FLAGGING OPERATIONS DURING WORKING HOURS, UNLESS ONE-WAY DETOURS ARE ILLUMINATED, THE CONTRACTOR SHALL MAINTAIN TWO-WAY TRAFFIC THROUGHOUT THE ENTIRE PROJECT
- ALL ROADWAY CLOSURES FOR BLASTING SHALL BE LIMITED TO THREE(3) HOURS TOTAL, TWO(2) HOURS OF TOTAL CLOSURE WILL BE ALLOWED AND ONE (1) HOUR OF ONE-WAY TRAFFIC WITH A FLAGGING OPERATION.
- ALL ROADWAY CLOSURES FOR REMOVAL AND INSTALLATION OF CULVERTS SHALL BE IN ACCORDANCE WITH SECTION 115-3.01 OF THE STANDARD SPECIFICATIONS.
- IN ORDER TO AVOID DELAY TO SCHOOL BUS SCHEDULES NO ROAD CLOSURES WILL BE PERMITTED DURING THE FOLLOWING PERIODS: 6:00 A.M. TO 8:30 P.M. OR 4:00 P.M. TO 6:30 P.M. ADDITIONALLY, NO CLOSURES WILL BE PERMITTED ON FEDERAL OR STATE HOLIDAYS, WEEKENDS, OR DURING THE HAINES SALMON DERBY OR 2 HOURS PRIOR TO ANY FERRY DEPARTURE FROM HAINES.
- 24 HOURS PRIOR TO ANY ROADWAY CLOSURES, THE CONTRACTOR SHALL NOTIFY, IN WRITING, THE FOLLOWING PERSONS AND OR AGENCIES:
- D.O.T. & P.F. ENGINEER.
 - ALL LOCAL FIRE, POLICE AND CITY OFFICIALS
 - PARK RANGERS AT CHILKAT AND CHILKOOT STATE PARKS
 - SCHOOL BUS COMPANY, IF SCHOOL IS IN SESSION.
- THE CONTRACTOR SHALL ALSO BROADCAST THE TIMES OF ANY CLOSURES ON ALL LOCAL RADIO STATIONS. ALL NOTICES OF CLOSURES SHALL BE BROADCAST FOR 24 HOURS PRIOR TO THE CLOSURE. A MINIMUM OF FIVE(5) TIMES PER DAY BETWEEN THE HOURS OF 8:00 A.M. AND 10:00 P.M.
- THE CONTRACTOR SHALL NOTIFY ALL LOCAL PROPERTY OWNERS 24 HOURS IN ADVANCE OF ANY RE CONSTRUCTION OF PRIVATE DRIVEWAYS.
- DURING PLACEMENT OF EACH SURFACE TREATMENT COURSE, THE CONTRACTOR SHALL UTILIZE ONE-WAY TRAFFIC WITH PILOT CARS FOR A MINIMUM OF 8 HOURS. NO TRAFFIC WILL BE ALLOWED ON THE FRESHLY PLACED SURFACE COURSES FOR AN 8 HOUR CURING PERIOD. THE MAX. SPEED ON FRESHLY PLACE SURFACE COURSES SHALL BE 20 MPH.
- A TRAFFIC CONTROL PLAN(TCP) MUST BE FOLLOWED AT ALL TIMES DURING THE LIFE OF THE PROJECT. FOR EACH PHASE OF CONSTRUCTION. THE TCP SHOWN ON THIS SHEET AND STANDARD DRAWING C-01.00 THROUGH C-11.01 IS OFFERED AS A GUIDE: THE CONTRACTOR MAY MODIFY THIS TCP OR USE AN ALTERNATIVE TCP OF HIS OWN DESIGN. HOWEVER, AN APPROVED TCP WILL BE REQUIRED PRIOR TO COMMENCEMENT OF ANY CONSTRUCTION. THE GENERAL INTENT OF THE TCP IS THAT THE CONTRACTOR FOLLOW PROCEDURES WHICH RESULT IN A SAFE TRAVERSABLE FACILITY FOR PUBLIC VEHICULAR AND PEDESTRIAN TRAFFIC. THE TCP SHOWN IS NOT MEANT TO DESIGNATE CONSTRUCTION TECHNIQUE, EQUIPMENT OR SEQUENCE, BUT TO ADDRESS THE CENTRAL ISSUE OF TRAFFIC SAFETY.

LOCATION	QUANTITY	SQ. FT.	CODE	SIZE	LEGEND
①	2	30.0	G20-1	36"x60"	ROAD CONSTRUCTION NEXT-20 MILES
②	2	20.0	G20-2	24"x60"	END CONSTRUCTION
③	2	4.5	CW13-1	18"x18"	20 M.P.H.
④	2	18.0	CW20-1B	36"x36"	ROAD CONSTRUCTION 1000 FT.
⑤	2	12.5	CW8-8	30"x30"	ROUGH ROAD
⑥	2	32.0	CW22-1	48"x48"	BLASTING ZONE 1000 FEET
⑦	2	21.0	CW22-2	36"x42"	TURN OFF 2-WAY RADIO
⑧	2	21.0	CW22-3	36"x42"	END BLASTING
Total sq. ft.		158			


No.	Station	Dist. From Centerline	Code No.	Legend	Size	Thickness	Area S.F.	No. Posts	Type	Size	Length*	Facing Traffic	Remarks
±	0+ 206+99 Rt.	19'	W5-1	Road Narrows	36"x36"	0.08		1	Tube	2"	12.5'	S.E.B.	
⑦	0+ 233+00 Rt.	20'	W1-1R	Symbol	30"x30"		6.25	1	Tube	2"	14'	S.E.B.	
②	0+ 233+00 Rt.	28'	W13-1	25 m.p.h.	18"x18"		2.25	1	—	—	—	S.E.B.	
③	0+ 255+00 Lt.	28'	R2-1	Speed Limit 35	30"x30"		6.25	1	Tube	2"	12.5'	N.W.B.	
⑩	0+ 229+17.42 Lt.			No Over Night Parking	24"x36"		6	1	Tube	2"		Parking Lot	
⑮	0+ 229+17.42 Lt.			Chilkoot State Park 2 Miles	72"x30"		15	2	Tube	2"		S.E.B.	
* Post lengths are approx. only. Verify length after grading has been completed.													
± Remove sign & post assembly 0+ Sta 206+99 Rt, reset at 0+ Sta 249+71.35 Rt. Payment for this work incidental to other items of work.													

GENERAL SIGNING AND STRIPING NOTES.




- Sign locations and post lengths are approximate only and are subject to minor revisions.
- All sign posts shall be square telescoping perforated galvanized steel posts, the 2" size shall be used above ground and the 2-1/4" shall be used below ground for the sleeve.
- All posts shall be installed with the sleeve type embedment in accordance with Standard Drawing S-30.01, except that the 2-1/4" size shall be used for the entire embedment depth.
- Post lengths are from the cut-off in the sleeve to the top of the post. See Standard Drawings S-05.00 & S-30.01
- Painted Traffic Markings shall be in accordance with Standard Drawing T-21.00 for paved shoulder and Section 670 of the Standard Specifications.

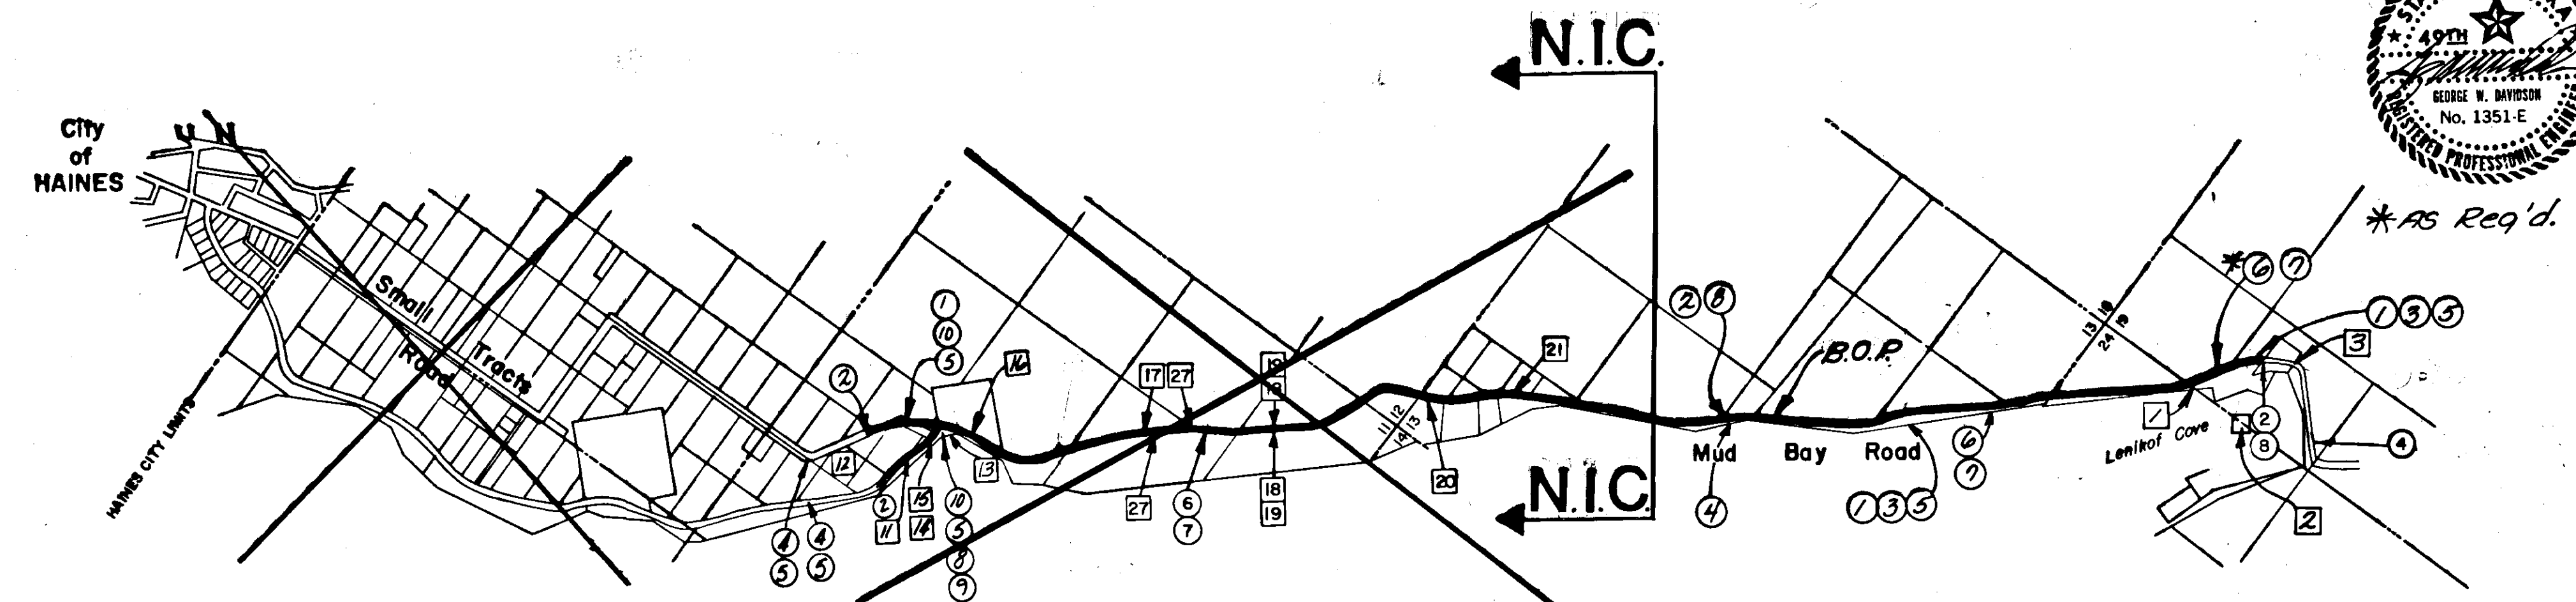

TRAFFIC CONTROL & CONSTRUCTION SIGNING PLAN

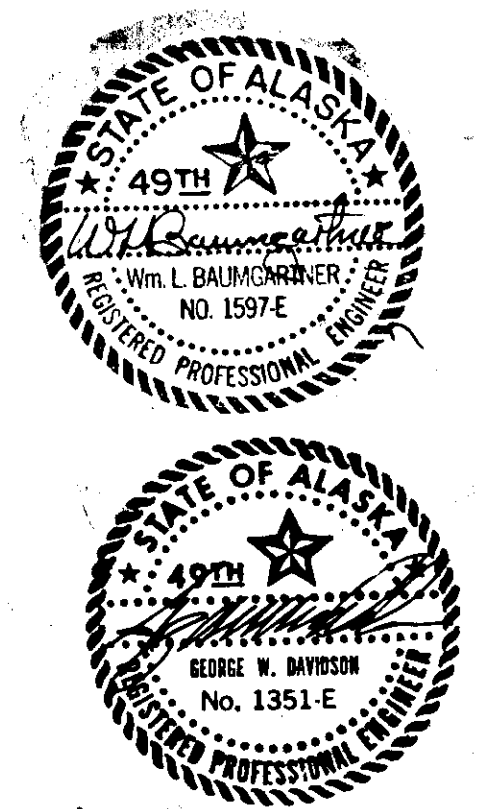

** 241+75 to 242+75 & 245+75 to 246+50, install a 2' wide by 0.5' deep ditch. Grade to drain as directed. Roadway ditch between 241+75 & 245+75 shall be graded to drain to the 24 Inch pipe at 244+75. Min. grade shall be 0.5%.

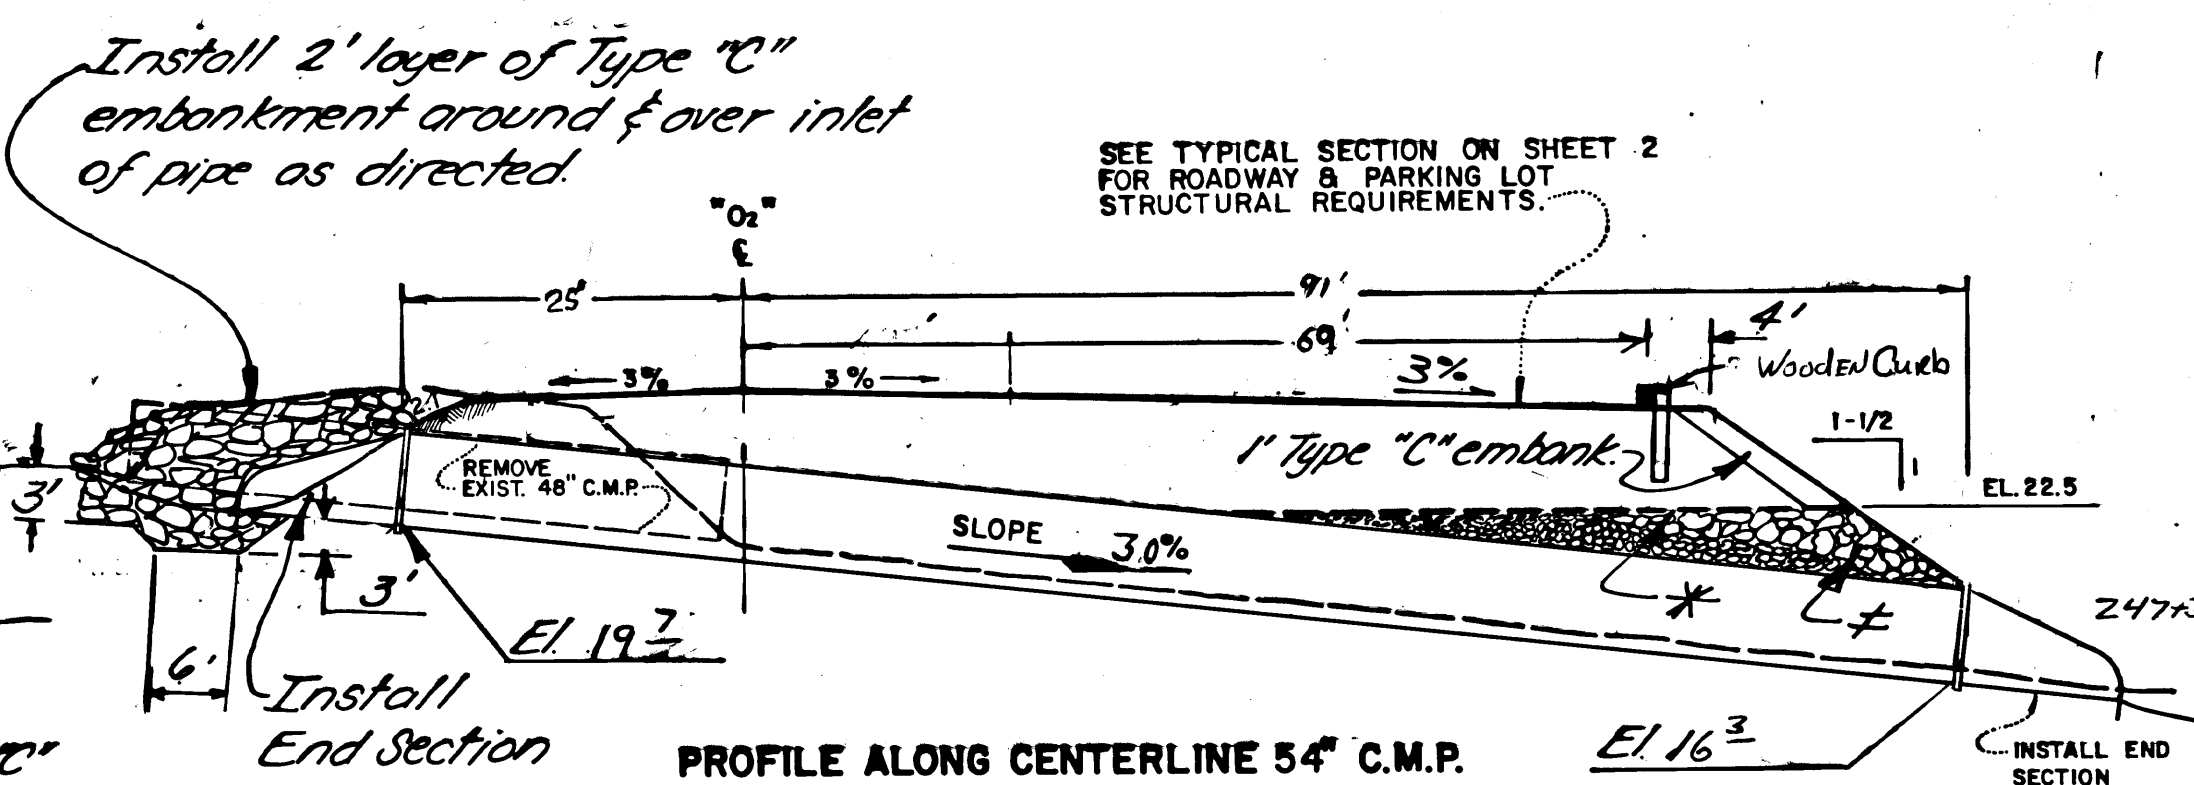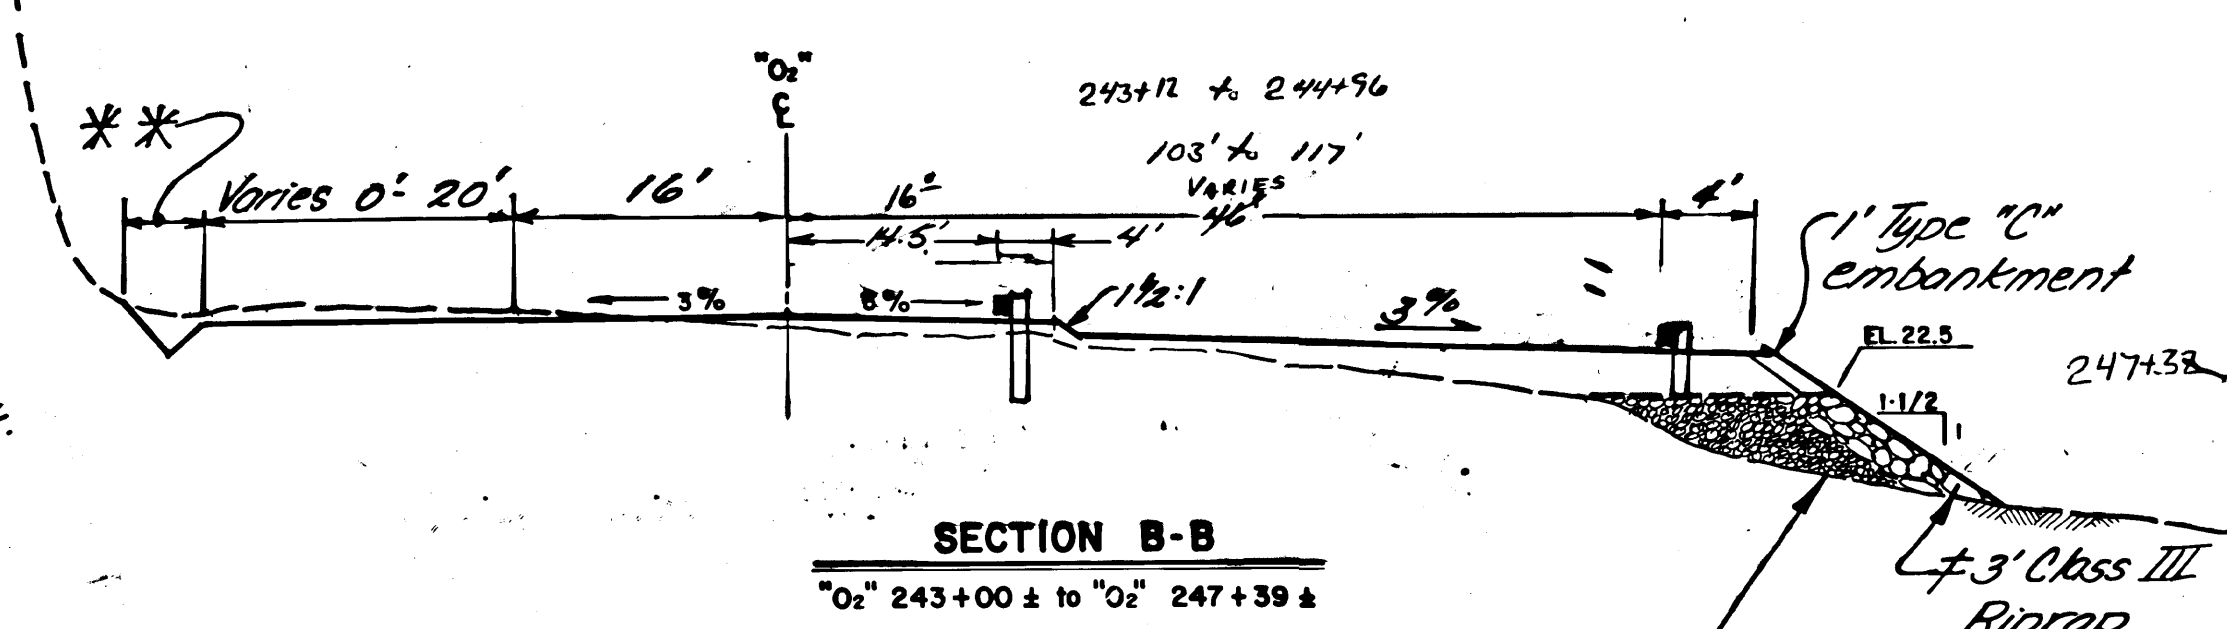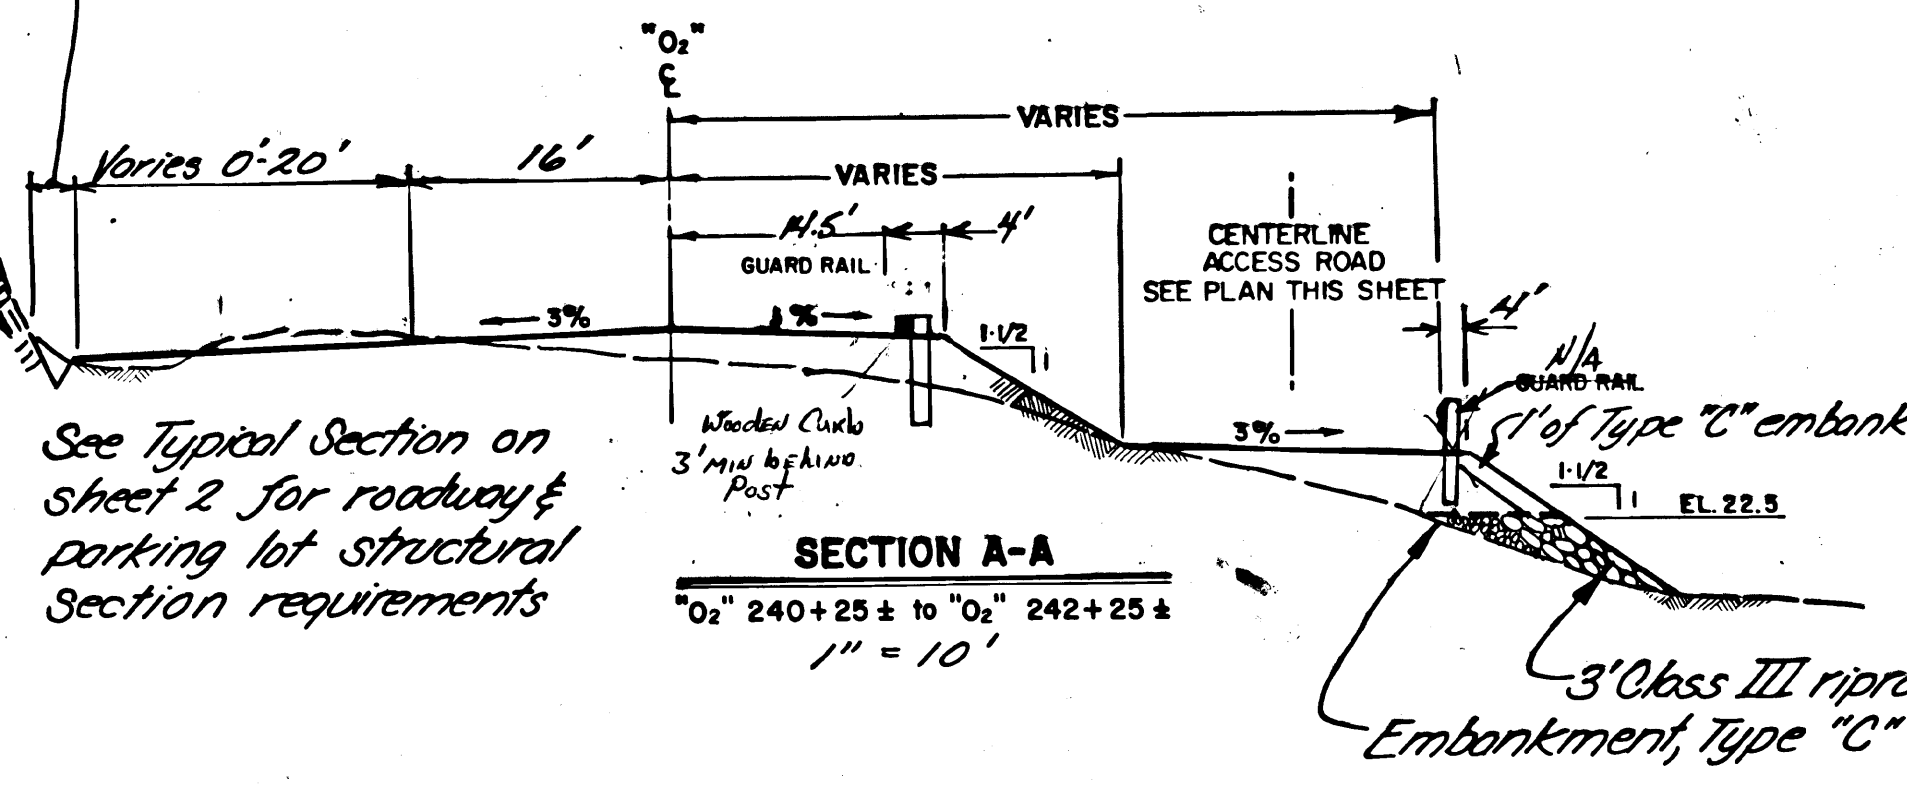


HYDRAULIC & HYDROLOGIC SUMMARY STA 247+00

Flood Frequency	50 year	100 year
Exceedance Probability	2%	1%
Drainage Discharge	0.32 mi ²	0.32 mi ²
Design Discharge	109 cfs	121 cfs
Design Elevation	25.6	26.0
Hydraulic Capacity of the structure equals 100 cfs at Elev. 25.1 which has an Exceedance Probability less than 3%.		
Projected backwater at Q100=5.4 feet.		


NOTES

- Any relocation of public restrooms required to install surfacing shall be considered incidental to other items of work shown in the bid schedule.
- Stripe a total of 23 spaces along the face of the guardrail between 243+00 & 247+50±.
- $N = \frac{L-3}{17}$
N = Number of spaces

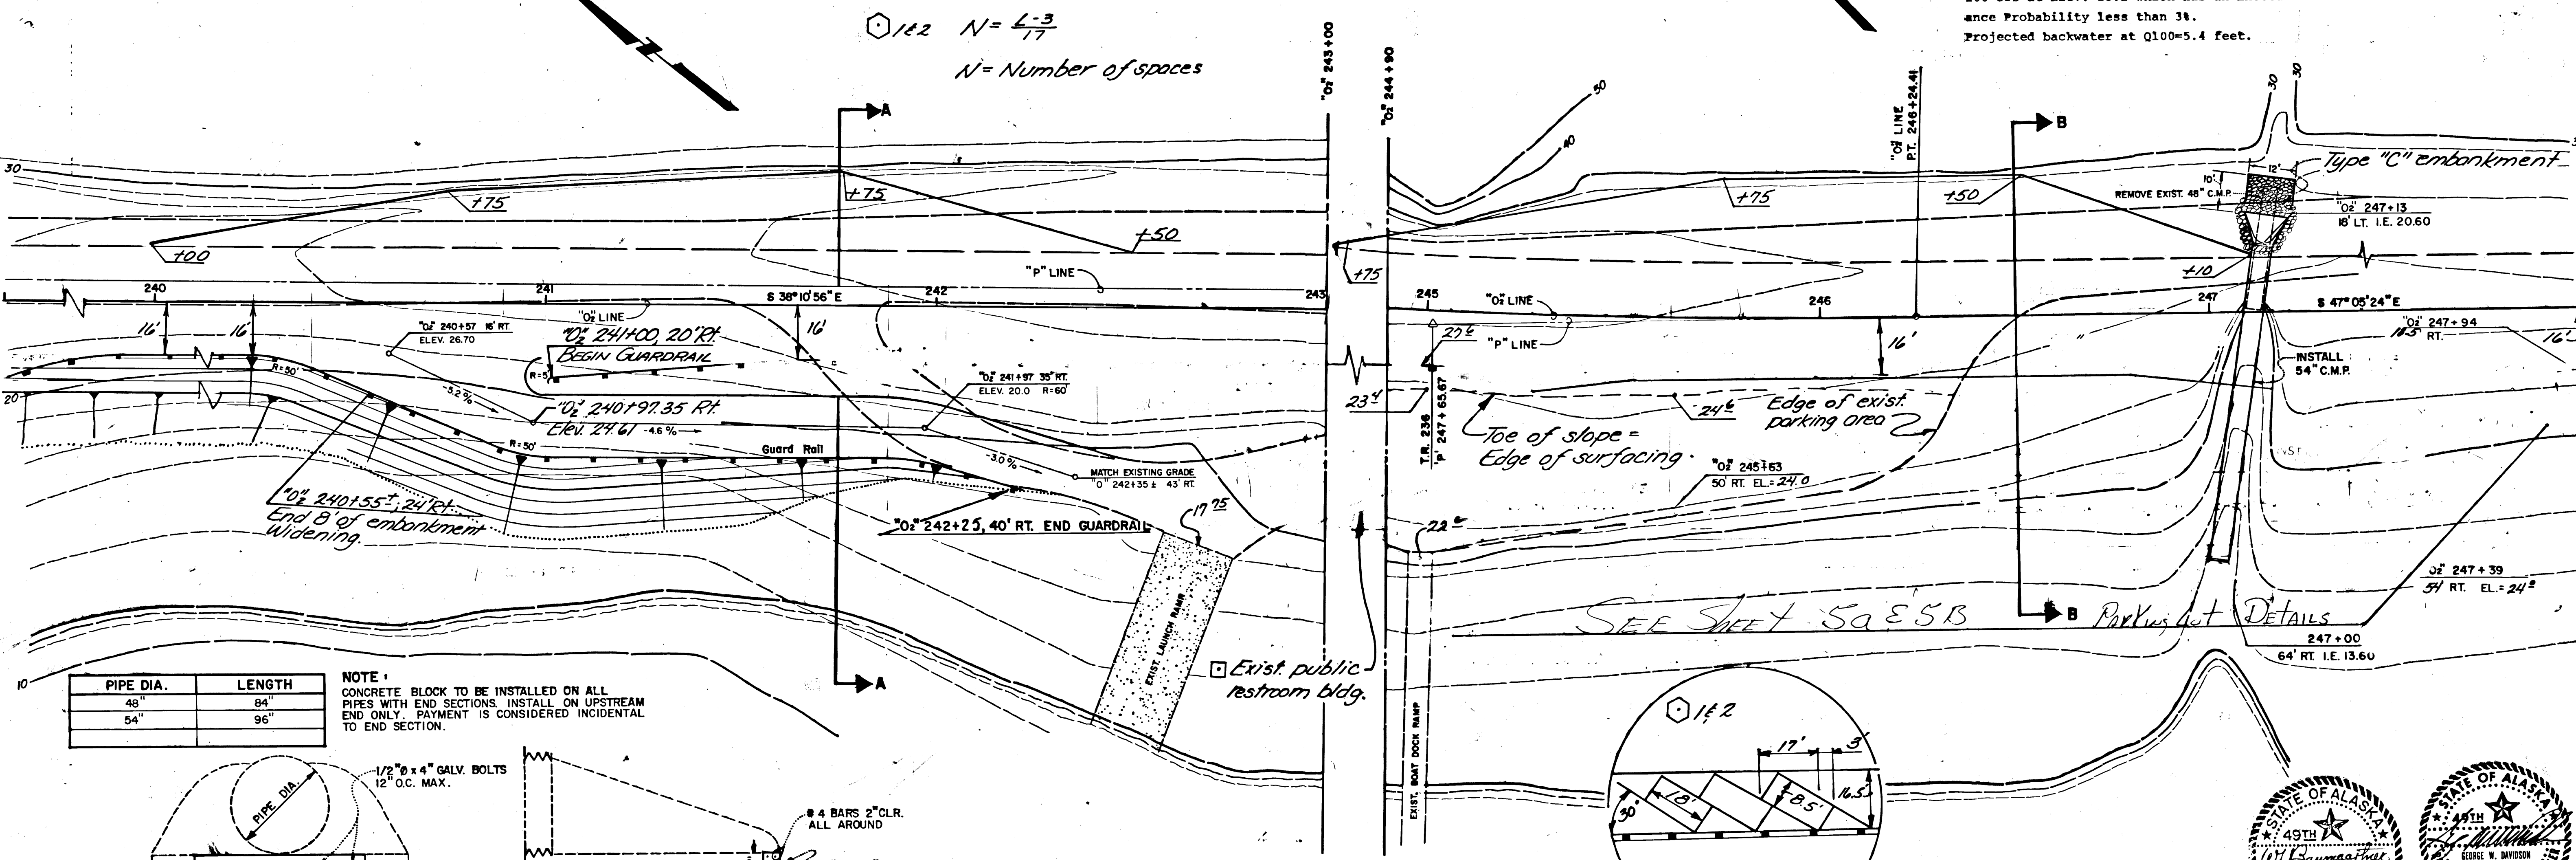


PIPE DIA.	LENGTH
48"	84"
54"	96"

NOTE: CONCRETE BLOCK TO BE INSTALLED ON ALL PIPES WITH END SECTIONS. INSTALL ON UPSTREAM END ONLY. PAYMENT IS CONSIDERED INCIDENTAL TO END SECTION.

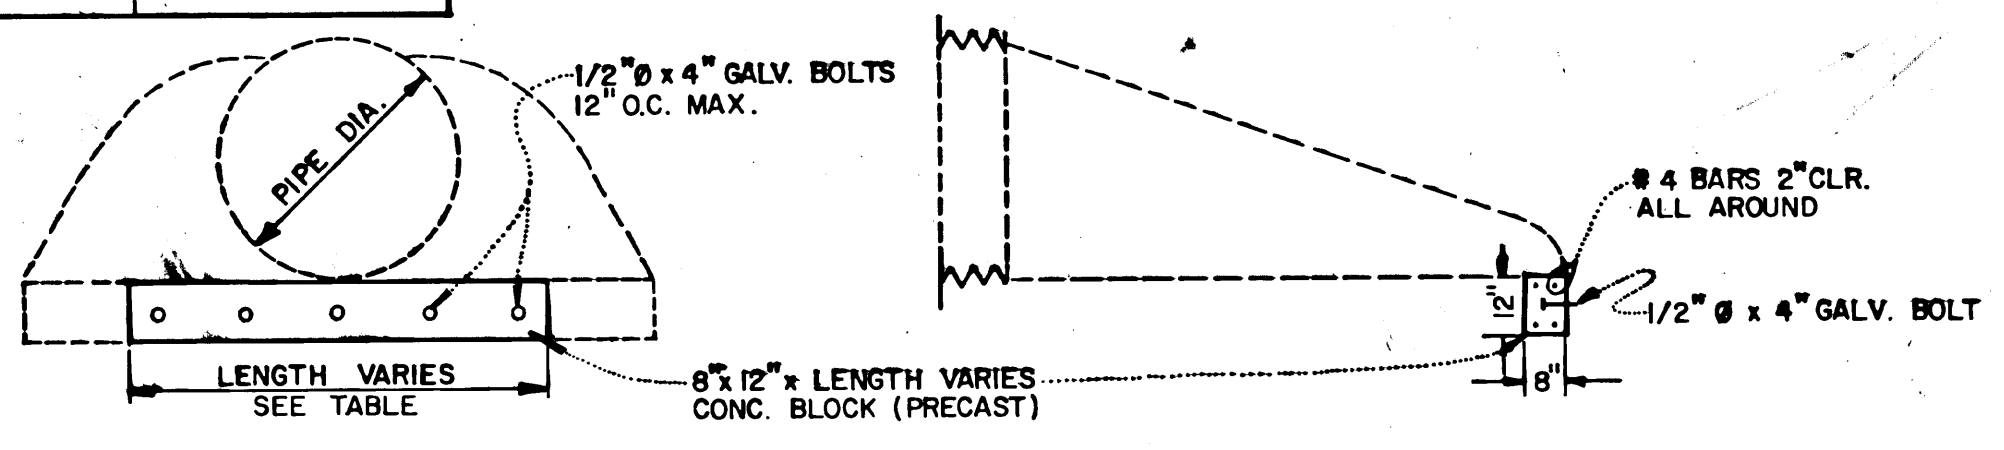


END SECTION TIE-DOWN BLOCK

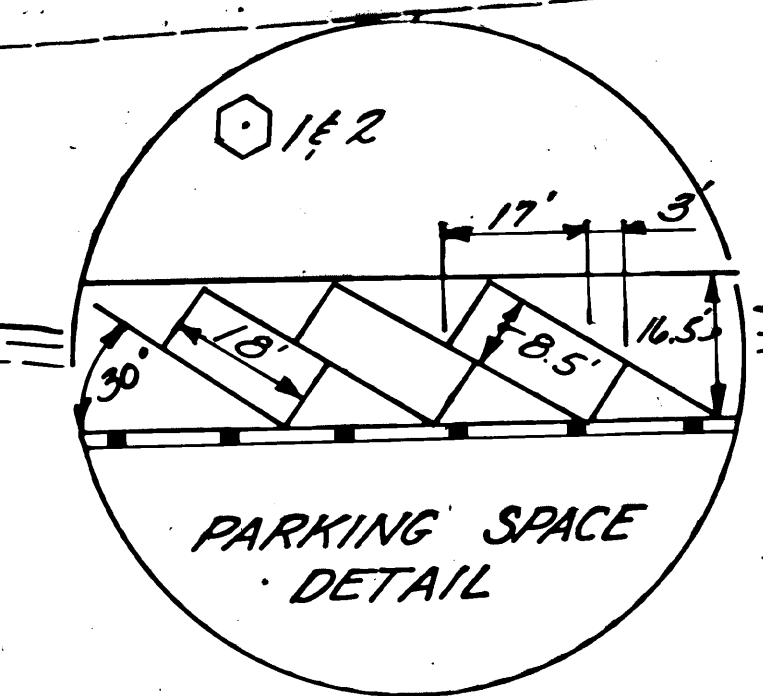


BOAT RAMP PARKING LOT DETAILS


LETNIKOF COVE

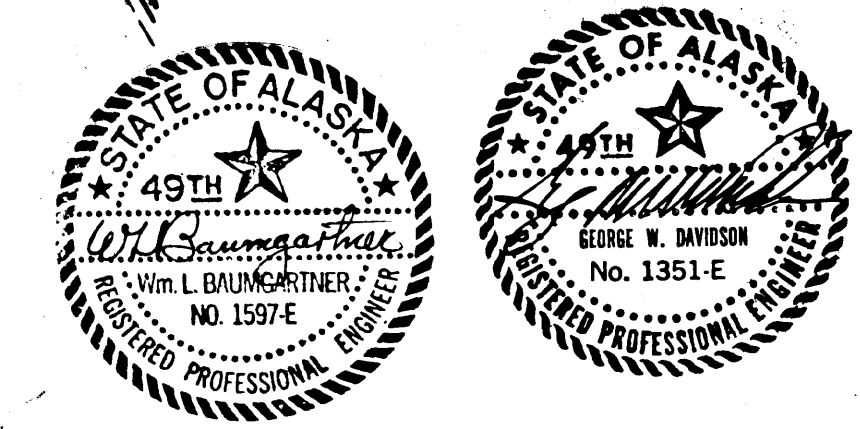

STATE	PROJECT DESIGNATION	YEAR	SHEET NO.	TOTAL SHEETS
ALASKA	RS-0987(5) 62914 (B-3042)	1987	5A	9B

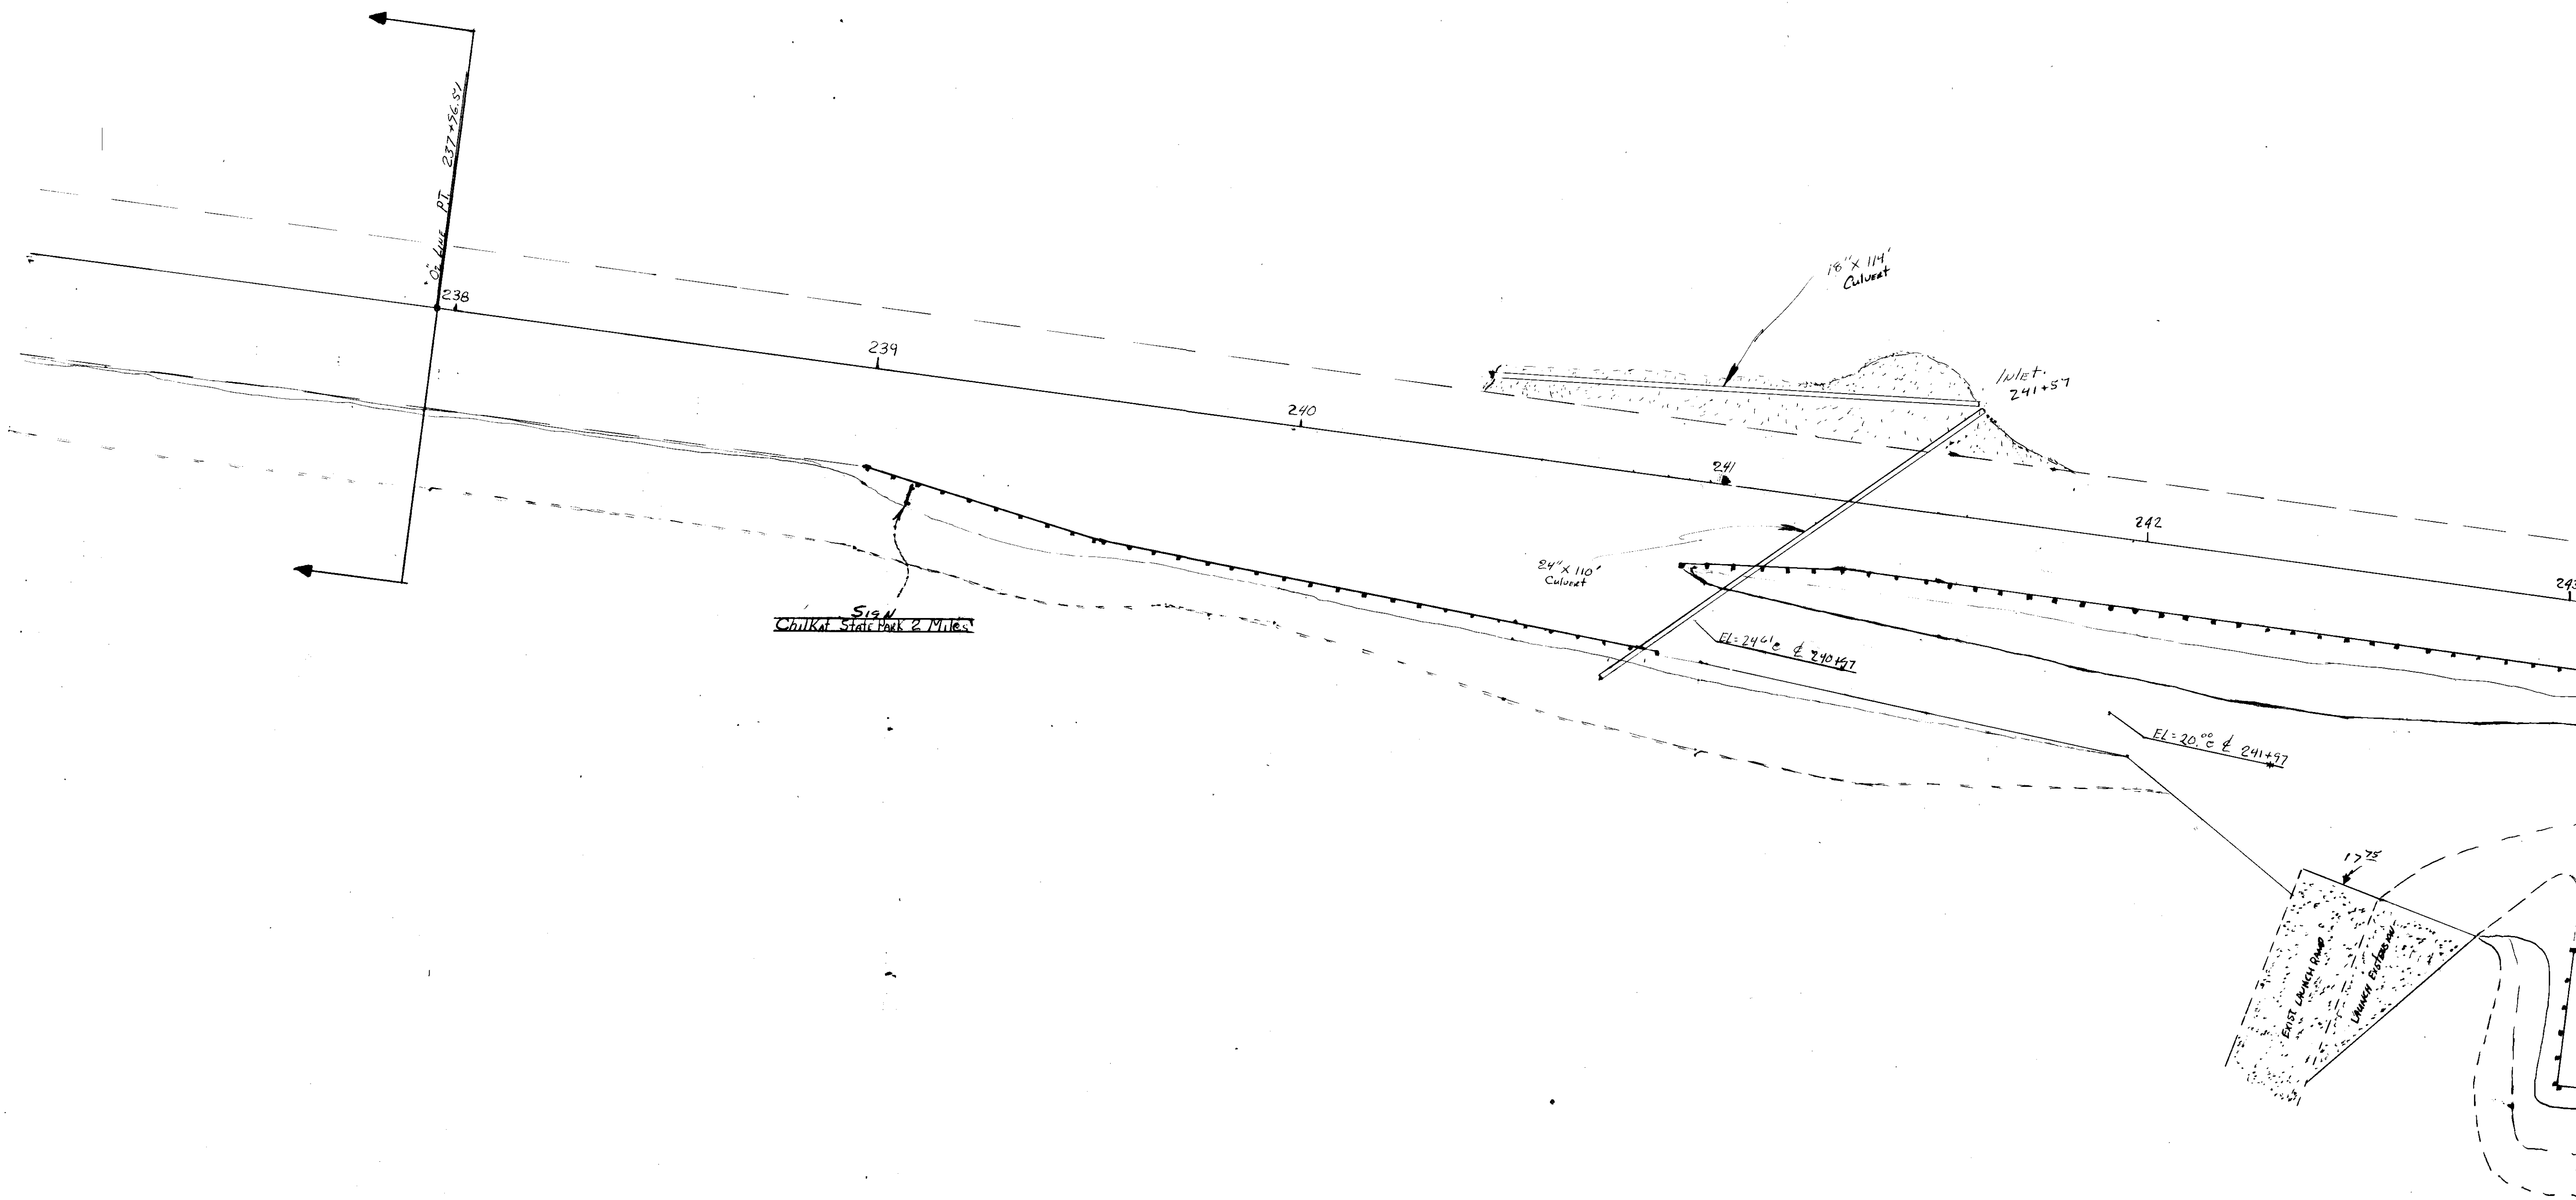

STATE	PROJECT DESIGNATION	YEAR	SHEET NO.	TOTAL SHEETS
ALASKA	RS 0987 (S) 6894 (B-30212)	1987	58	98

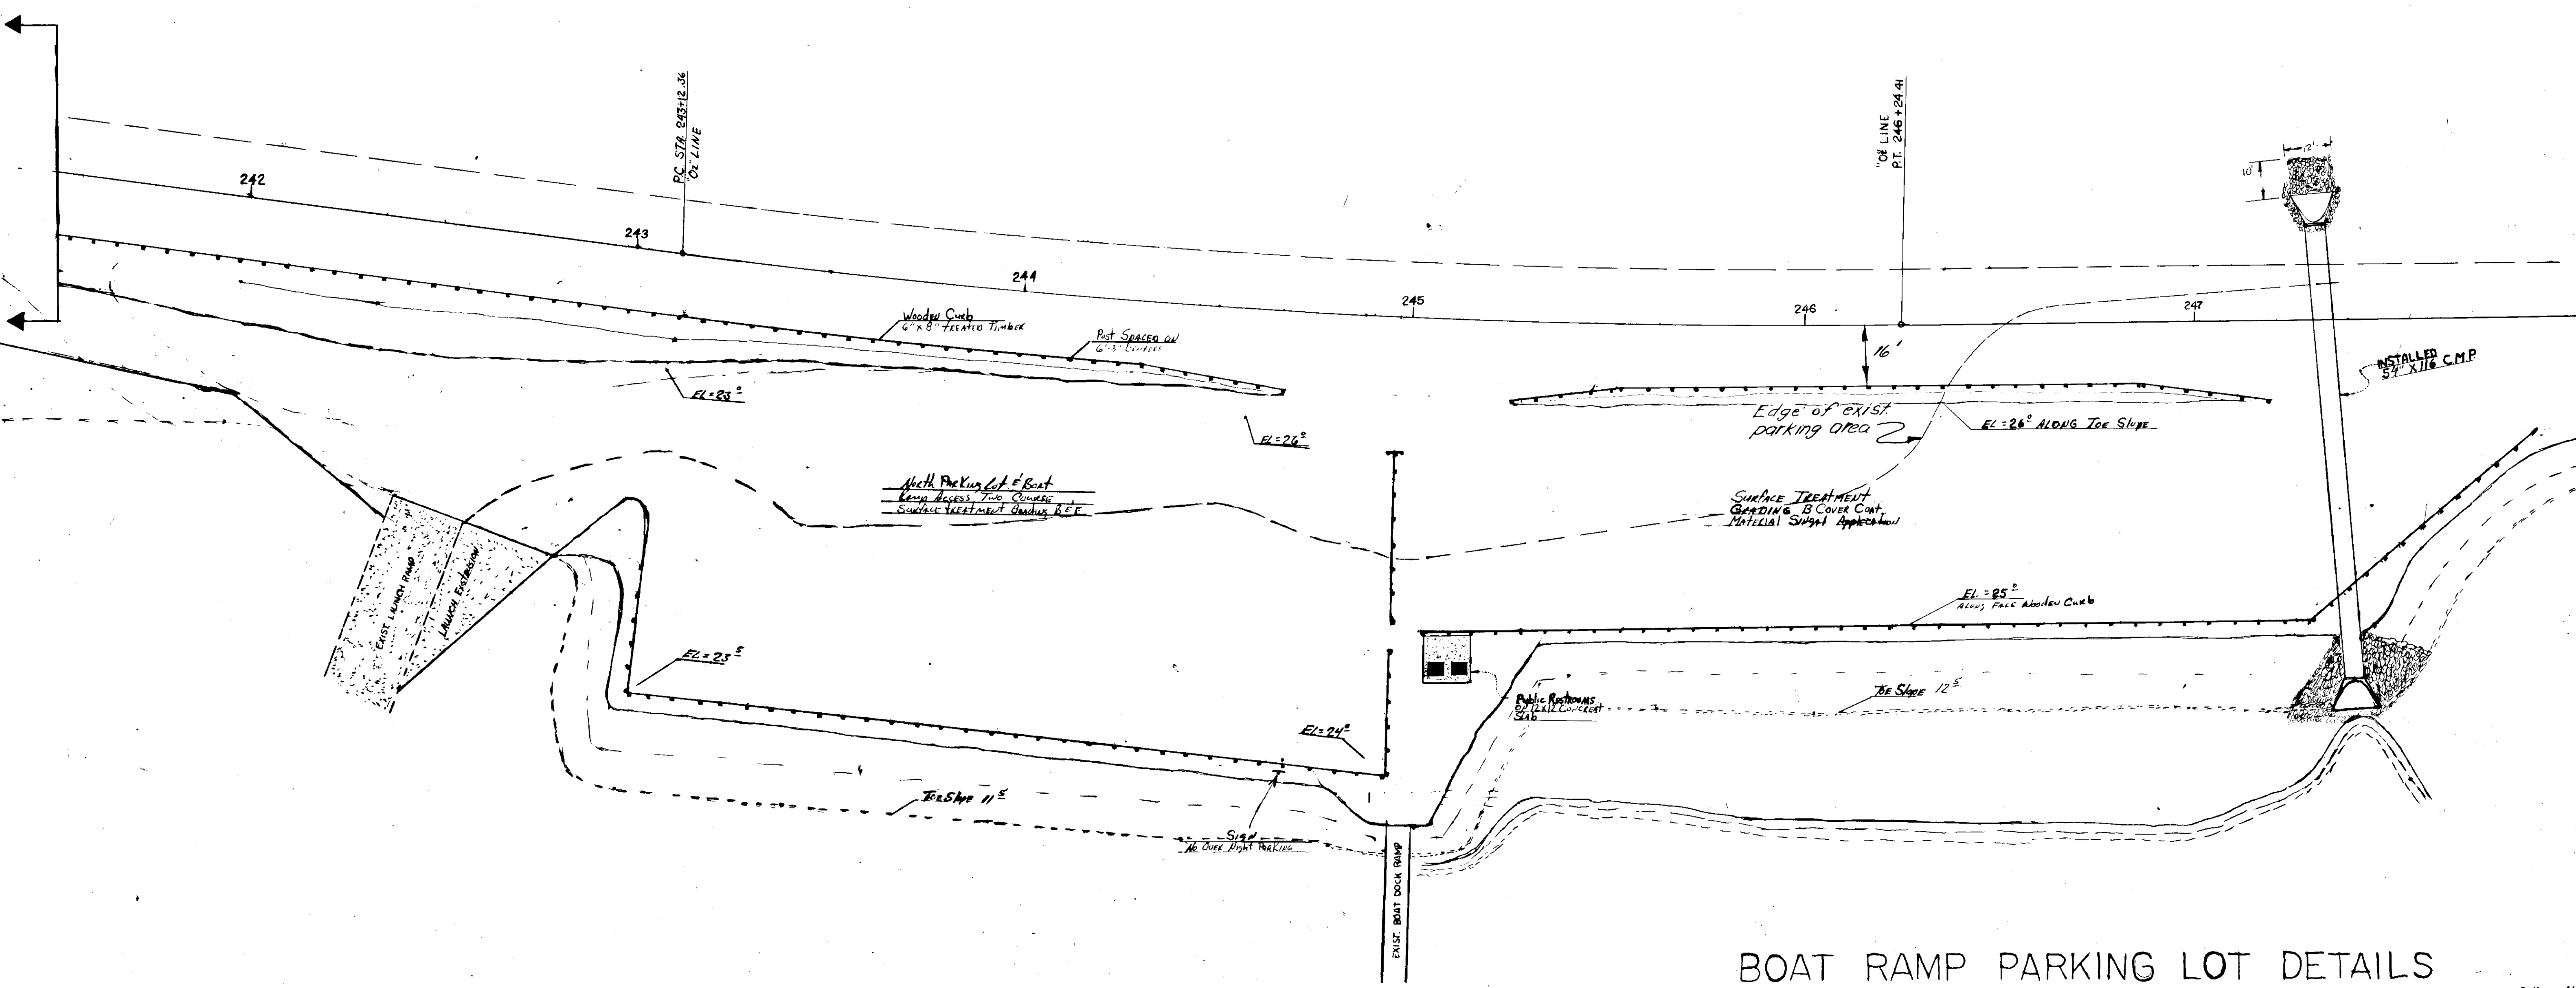

BOAT RAMP PARKING LOT DETAILS

Alan C. Lambert

Sec. 13, T. 31 S., R. 59 E

STATE	PROJECT	YEAR	SHEET NO.	TOTAL SHEETS
ALASKA	RS 0987(5)	1985	6	9

68914 (B-30212)

Dependent Resurvey
Portion Sec. 13

SCENIC TURN OUT

210+70 to 215+00	
210+70	47
211+00	50
211+50	50
212+00	50
212+50	47
213+00	49
214+00	48
215+00	24

B.S.T. "O" 191+66
B.F.S. "O" 193+36
E.F.S. "O" 194+92
E.S.T. "O" 194+92

"O" LINE
R = 1000.00'
Δ = 15° 27' 59" LT
L = 269.94'
T = 135.00'
S = 0.050 FI/FT
D = 5' 43.44"

"O" LINE
R = 2500.00'
Δ = 4° 37' 53" RT
L = 202.16'
T = 101.13'
S = 0.031 FI/FT
D = 2' 17.41"

"O" LINE
R = 2500.00'
Δ = 4° 37' 53" RT
L = 202.16'
T = 101.13'
S = 0.031 FI/FT
D = 2' 17.41"

"O" LINE
R = 2500.00'
Δ = 4° 37' 53" RT
L = 202.16'
T = 101.13'
S = 0.031 FI/FT
D = 2' 17.41"


"O" LINE
R = 2500.00'
Δ = 4° 37' 53" RT
L = 202.16'
T = 101.13'
S = 0.031 FI/FT
D = 2' 17.41"

"O" LINE
R = 2500.00'
Δ = 4° 37' 53" RT
L = 202.16'
T = 101.13'
S = 0.031 FI/FT
D = 2' 17.41"

"O" LINE
R = 2500.00'
Δ = 4° 37' 53" RT
L = 202.16'
T = 101.13'
S = 0.031 FI/FT
D = 2' 17.41"

"O" LINE
R = 2500.00'
Δ = 4° 37' 53" RT
L = 202.16'
T = 101.13'
S = 0.031 FI/FT
D = 2' 17.41"

"O" LINE
R = 2500.00'
Δ = 4° 37' 53" RT
L = 202.16'
T = 101.13'
S = 0.031 FI/FT
D = 2' 17.41"

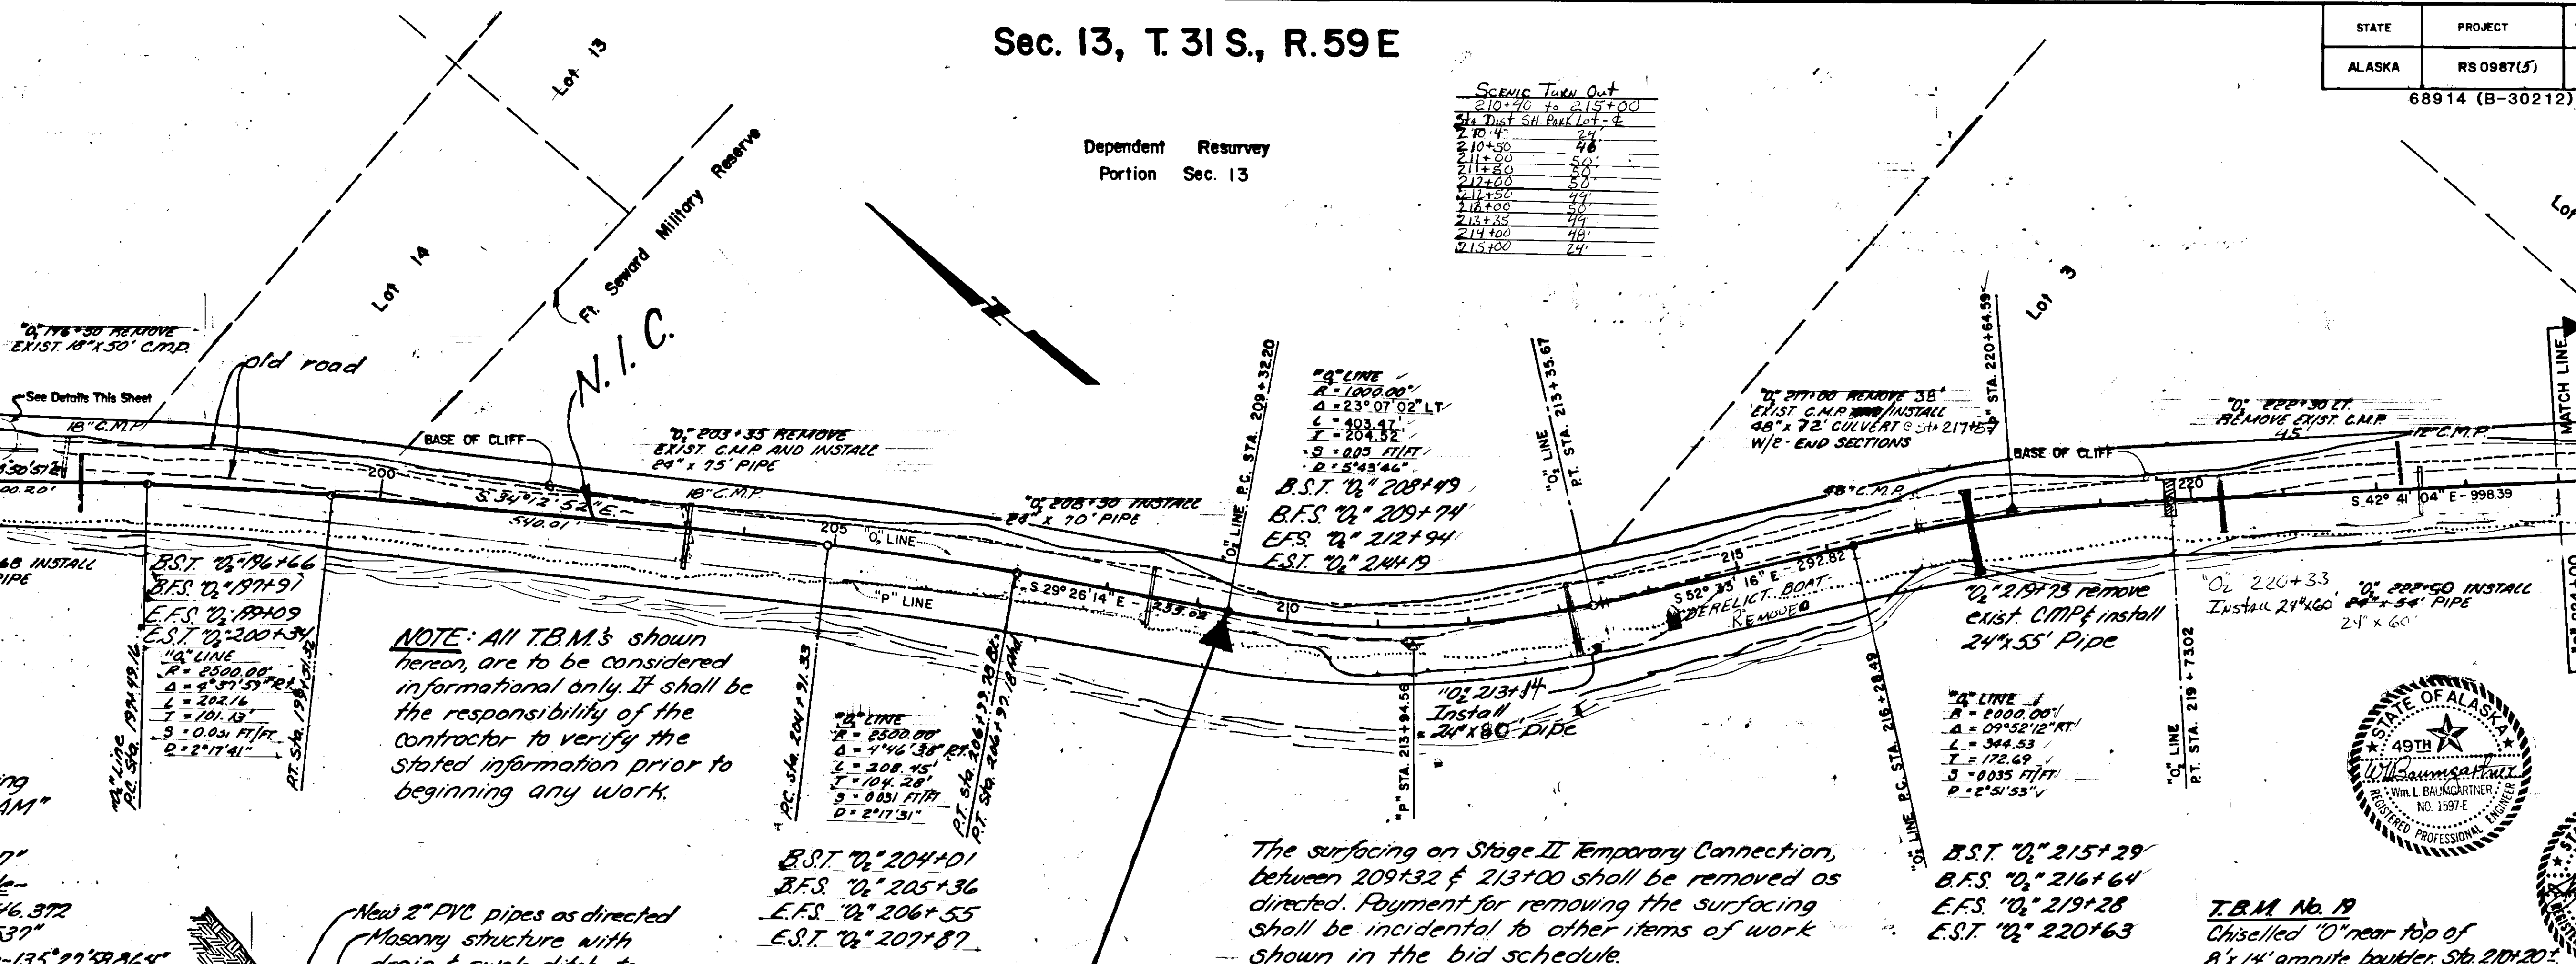

NOTE: All T.B.M.'s shown hereon, are to be considered informational only. It shall be the responsibility of the contractor to verify the stated information prior to beginning any work.


HORIZONTAL CONTROL
Based upon the grid bearing between N.O.S. station "RAM" and "BOW"

"RAM" Latitude - 59° 11' 45.007"
N. 2, 693, 954.563 - Longitude - 135° 27' 25.855", E. 2, 349, 846.372
"BOW" Latitude - 59° 09' 00.537"
N. 2, 677, 304.017; Longitude - 135° 27' 58.864"
E. 2, 347, 685.937


VERTICAL CONTROL
U.S.C. & G.S. Benchmark No. 5 (1943)
Brass cap on Granite Rock, 50' ±
East of E. Front St & 300' ± North of
intersection of Front St. Haines cut-off
road. ELEV. = 27.60 (1961 Datum).

PROJECT COORDINATES
179+86.34 N. 33, 354.567, E. 37, 104.789
271+50.00 N. 25, 928.201, E. 41, 724.099

TYPICAL SECTION
FOR TURNOUT BETWEEN
Sta. 195+00 Lt. & 197+50 Lt.
All reql. used in installing this turnout shall be 2.5'

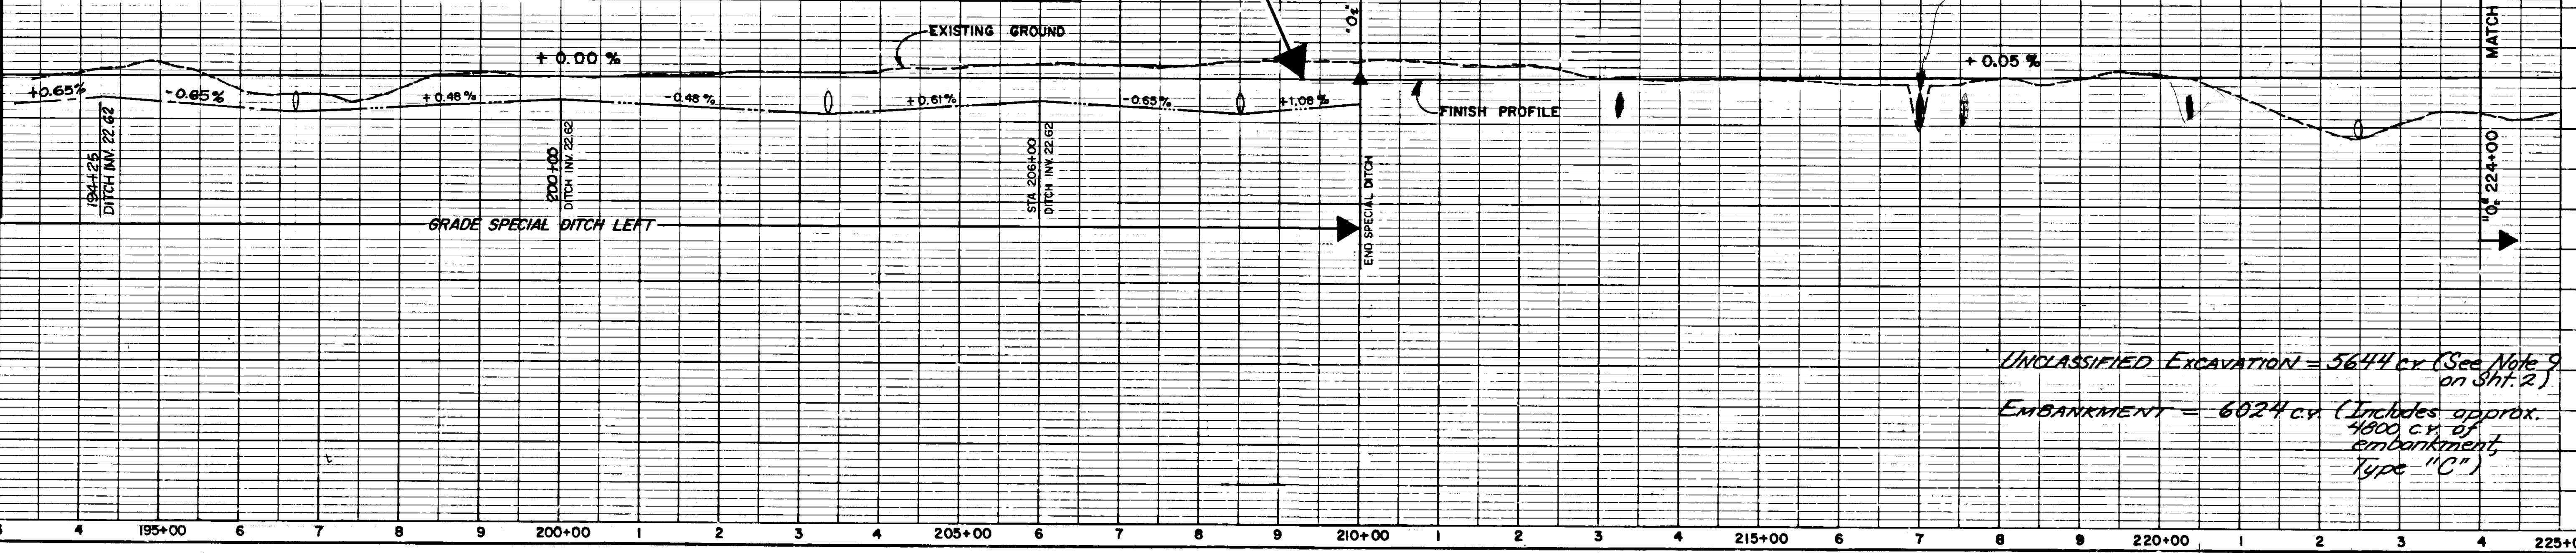


UNCLASSIFIED EXCAVATION = 5644 cy (See Note 9 on Sht. 2)
EMBANKMENT = 6024 cy (Includes approx. 4600 c.y. of embankment, Type "C")

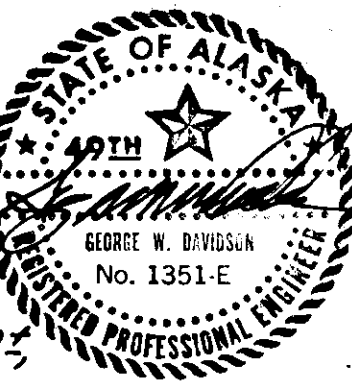

Sec. 19, T. 31S., R. 60E.

STATE	PROJECT	YEAR	SHEET NO.	TOT. SHEETS
ALASKA	RS0987(5)	1975	8	9

68914 (B-30212)

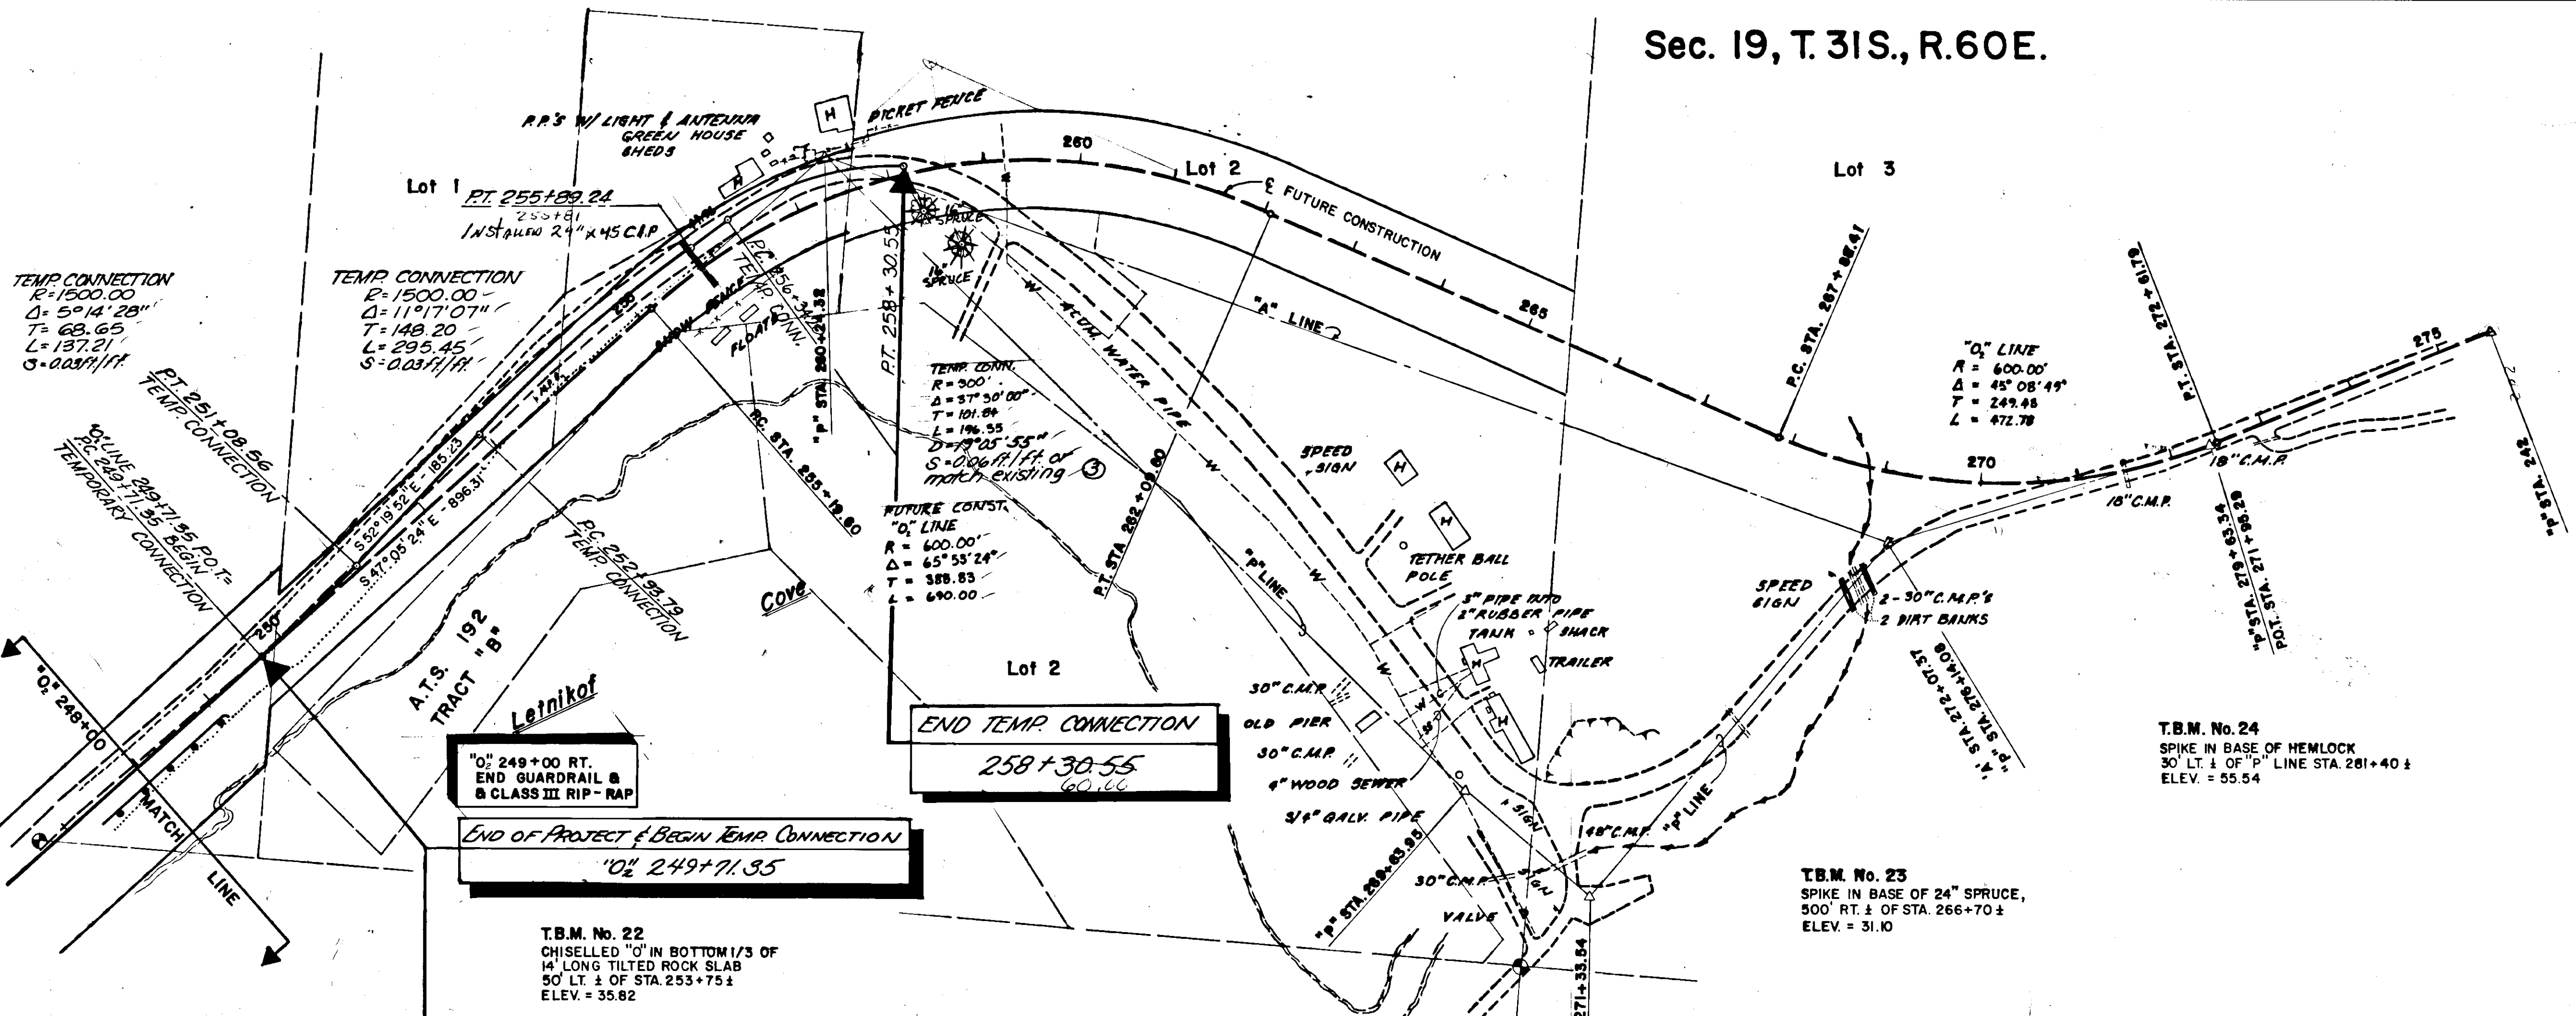

"O" 249+00 RT. END GUARDRAIL & CLASS III RIP-RAP
END OF PROJECT & BEGIN TEMP. CONNECTION
"O" 249+71.35

END TEMP. CONNECTION
258+30.55
60.66


T.B.M. No. 22
 CHISELLED "O" IN BOTTOM 1/3 OF
 14" LONG TILTED ROCK SLAB
 50' LT. ± OF STA. 253+75 ±
 ELEV. = 35.82

T.B.M. No. 24
 SPIKE IN BASE OF HEWLOCK
 30' LT. ± OF "P" LINE STA. 281+40 ±
 ELEV. = 55.54


T.B.M. No. 23
 SPIKE IN BASE OF 24" SPRUCE,
 500' RT. ± OF STA. 266+70 ±
 ELEV. = 31.10

As directed
 Min. length
 120'

B.S.T.	"O" 248+91	"O" 252+01.05
B.F.S.	"O" 250+11	"O" 253+34
E.F.S.	"O" 250+69	"O" 255+49
E.S.T.	"O" 252+01.05	"O" 256+75

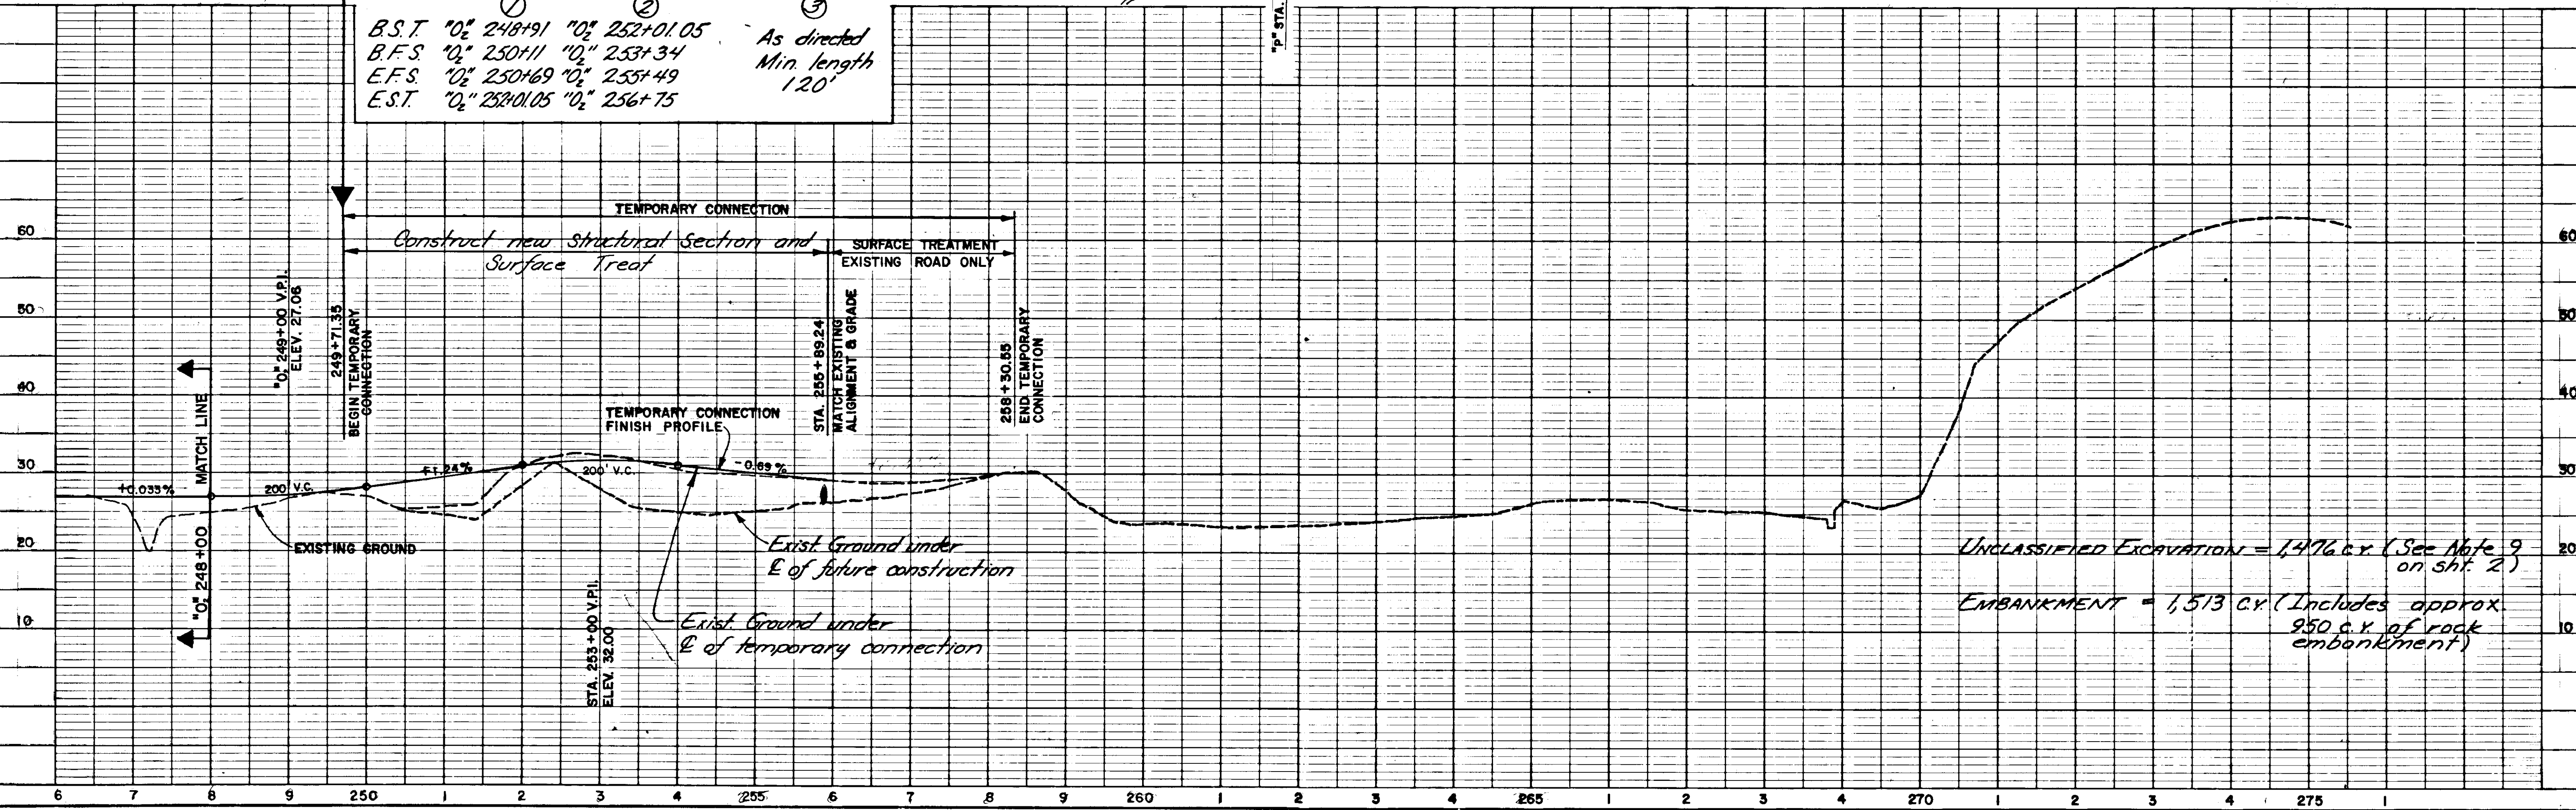

STATE	PROJECT DESIGNATION	YEAR	SHEET NO.	TOTAL SHEETS
ALASKA	RS-0987(5) 68914 (B-30212)	1985	9	9


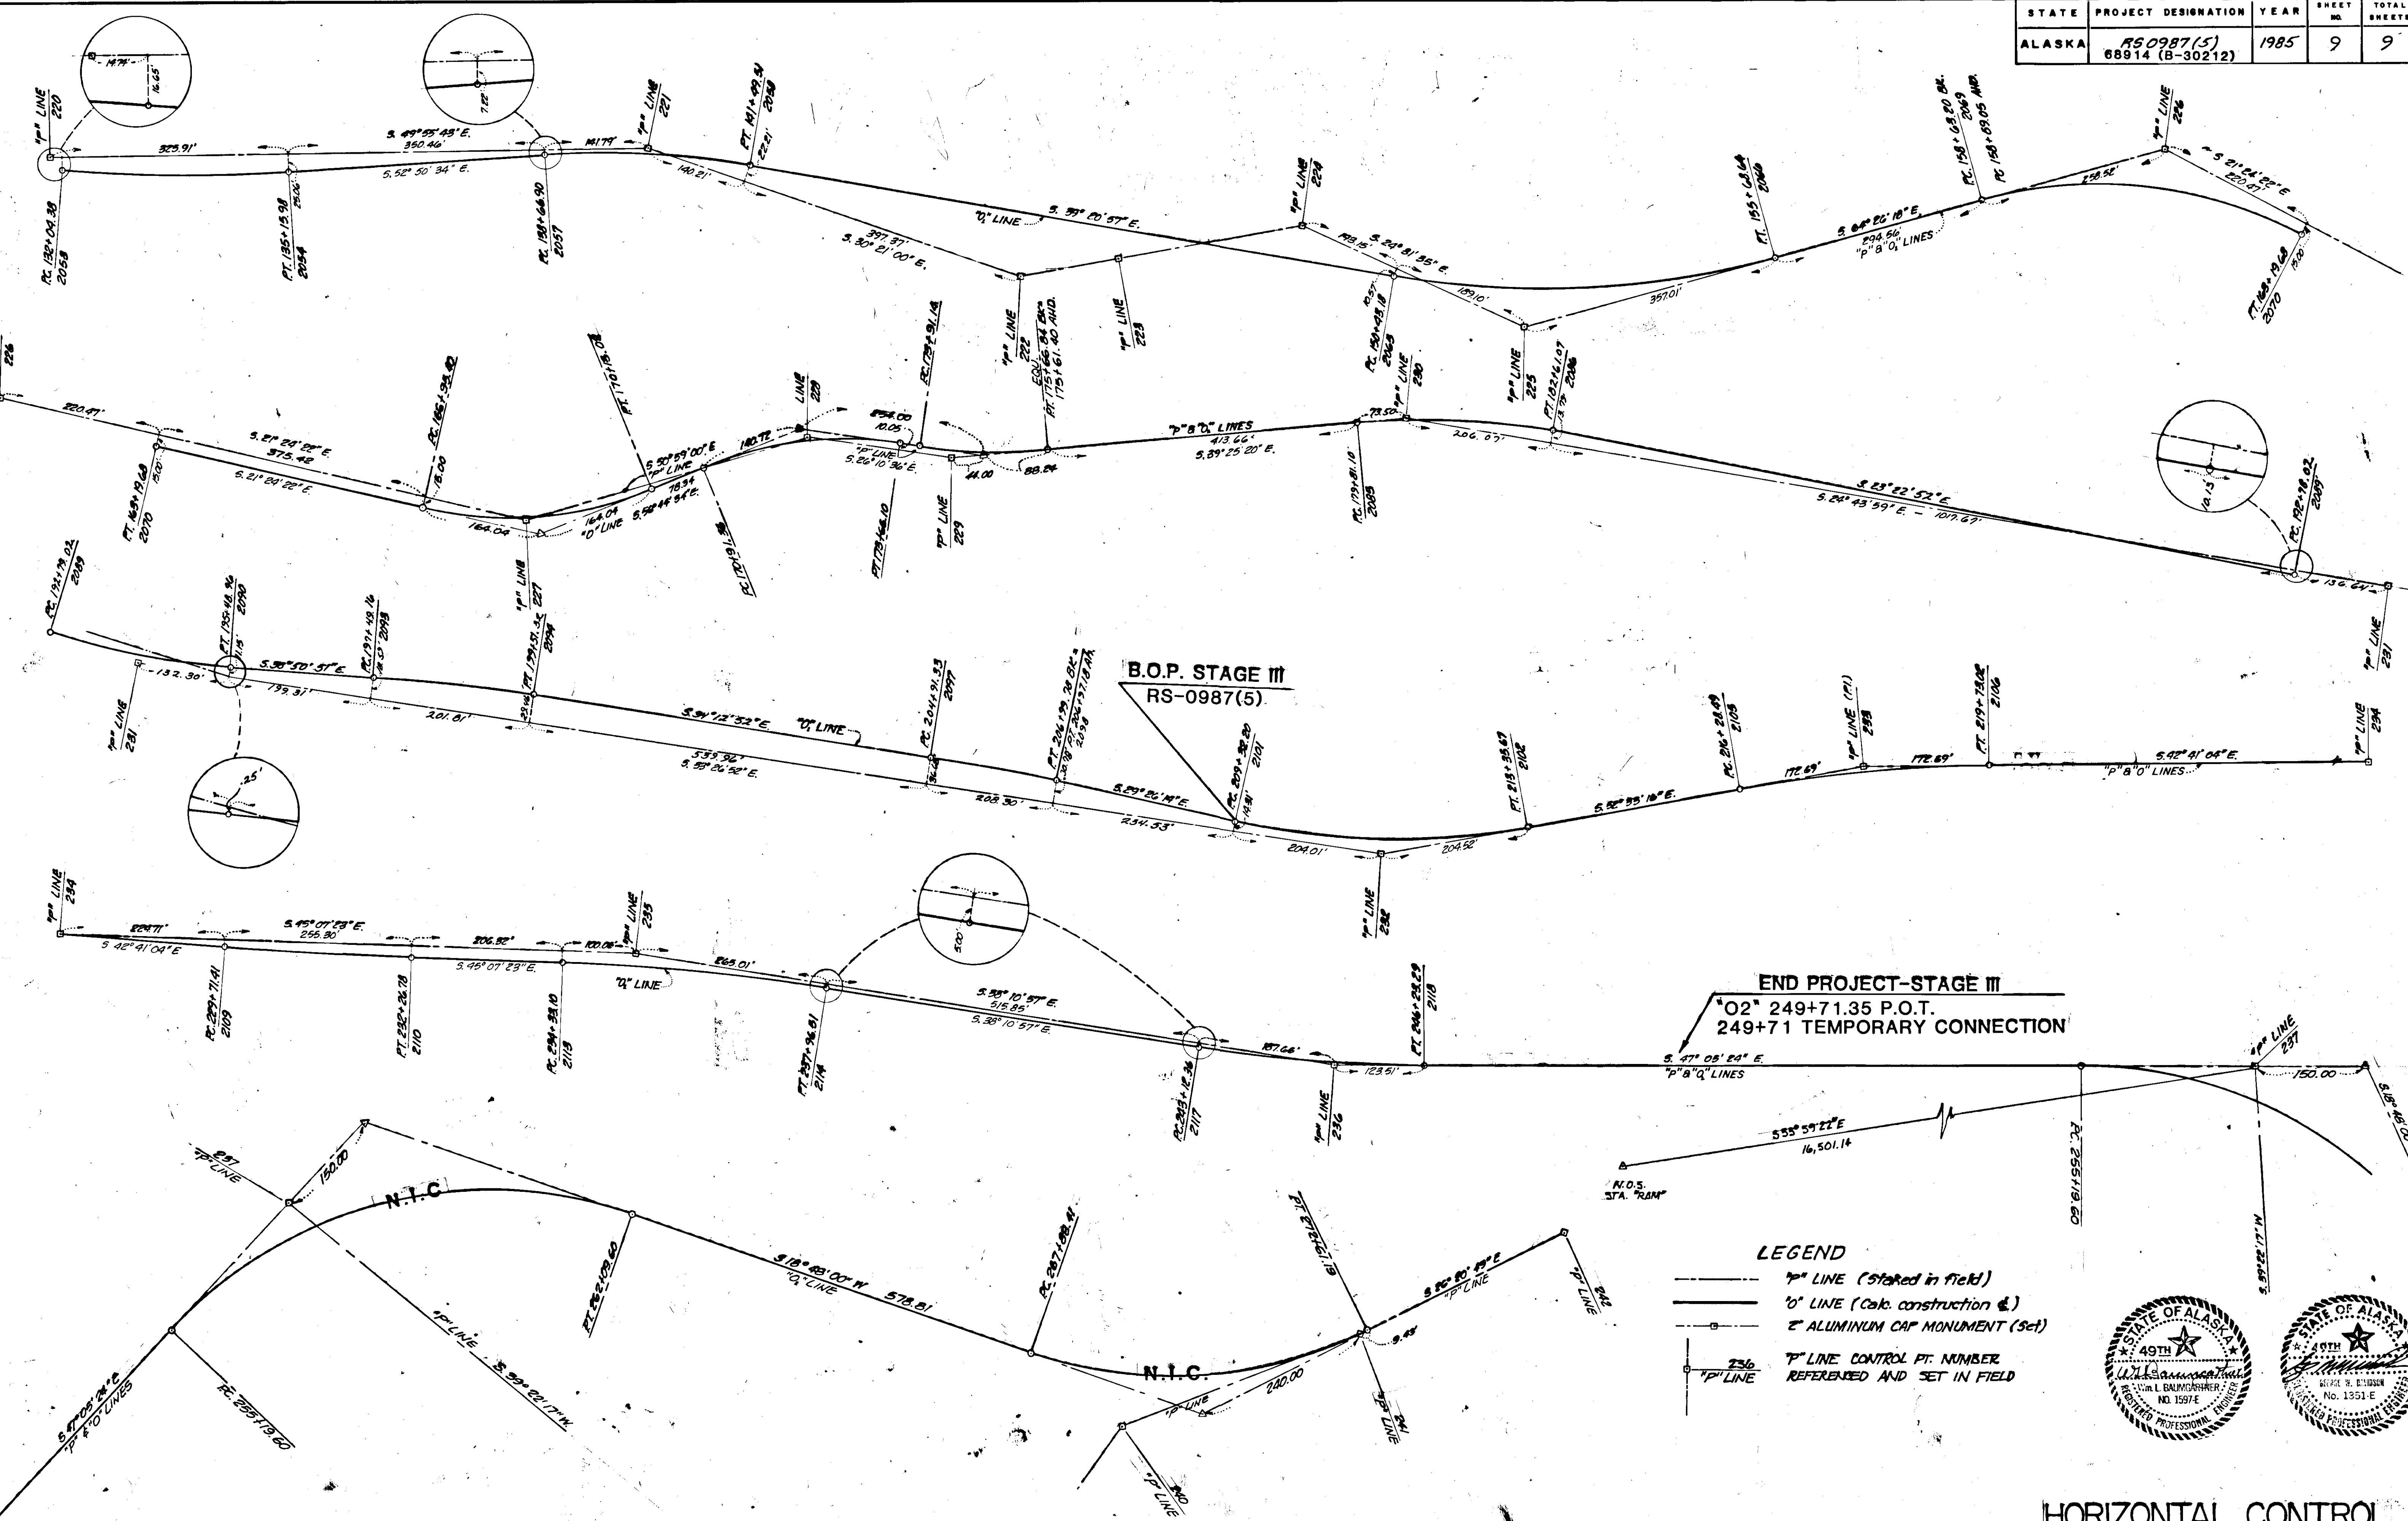


B.O.P. STAGE III
RS-0987(5)

END PROJECT-STAGE III
O2 249+71.35 P.O.T.
249+71 TEMPORARY CONNECTION

LEGEND

- 1st LINE (Set in field)
- 2nd LINE (Calc. construction &)
- 3rd ALUMINUM CAP MONUMENT (Set)
- 4th 7th LINE CONTROL PT. NUMBER REFERENCED AND SET IN FIELD

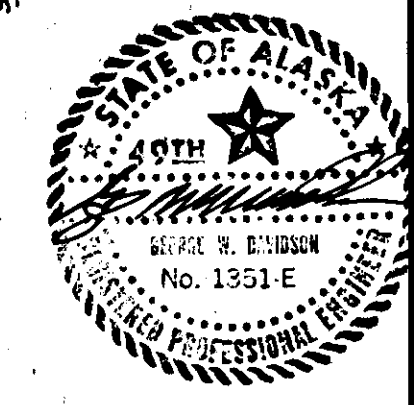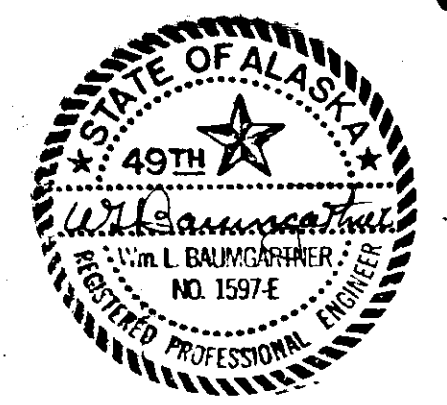

HORIZONTAL CONTROL