


DO NOT SCALE FROM THESE PLANS - USE DIMENSIONS



SHEET NUMBER	TOTAL SHEETS	
F3	28	
STATE	YEAR	
ALASKA	2010	
PROJECT DESIGNATION NUMBERS		
ARRA-0956(032) - NO 68948		
ADDENDUM NUMBER		
ATTACHMENT NUMBER		
DESIGNED BY: DRAWN BY: CHECKED BY:		
NCL WJP NCL		
ELECTRONIC PATHWAY:		
I:\562206\Draws\C\Sheets\F03.dwg		
EDTIME		
MARCH, 2010		
STANDARDS:		
REHABILITATION 3R		
SPECIFICATIONS:		
SSHC 2004		
RECORD OF REVISIONS:		
NO.	DATE	DESCRIPTION
1	3-15-10	C.O. #1
PREPARED BY: USKH INC.		

PLAN AND PROFILE
STATION 212+00 TO E.O.P.

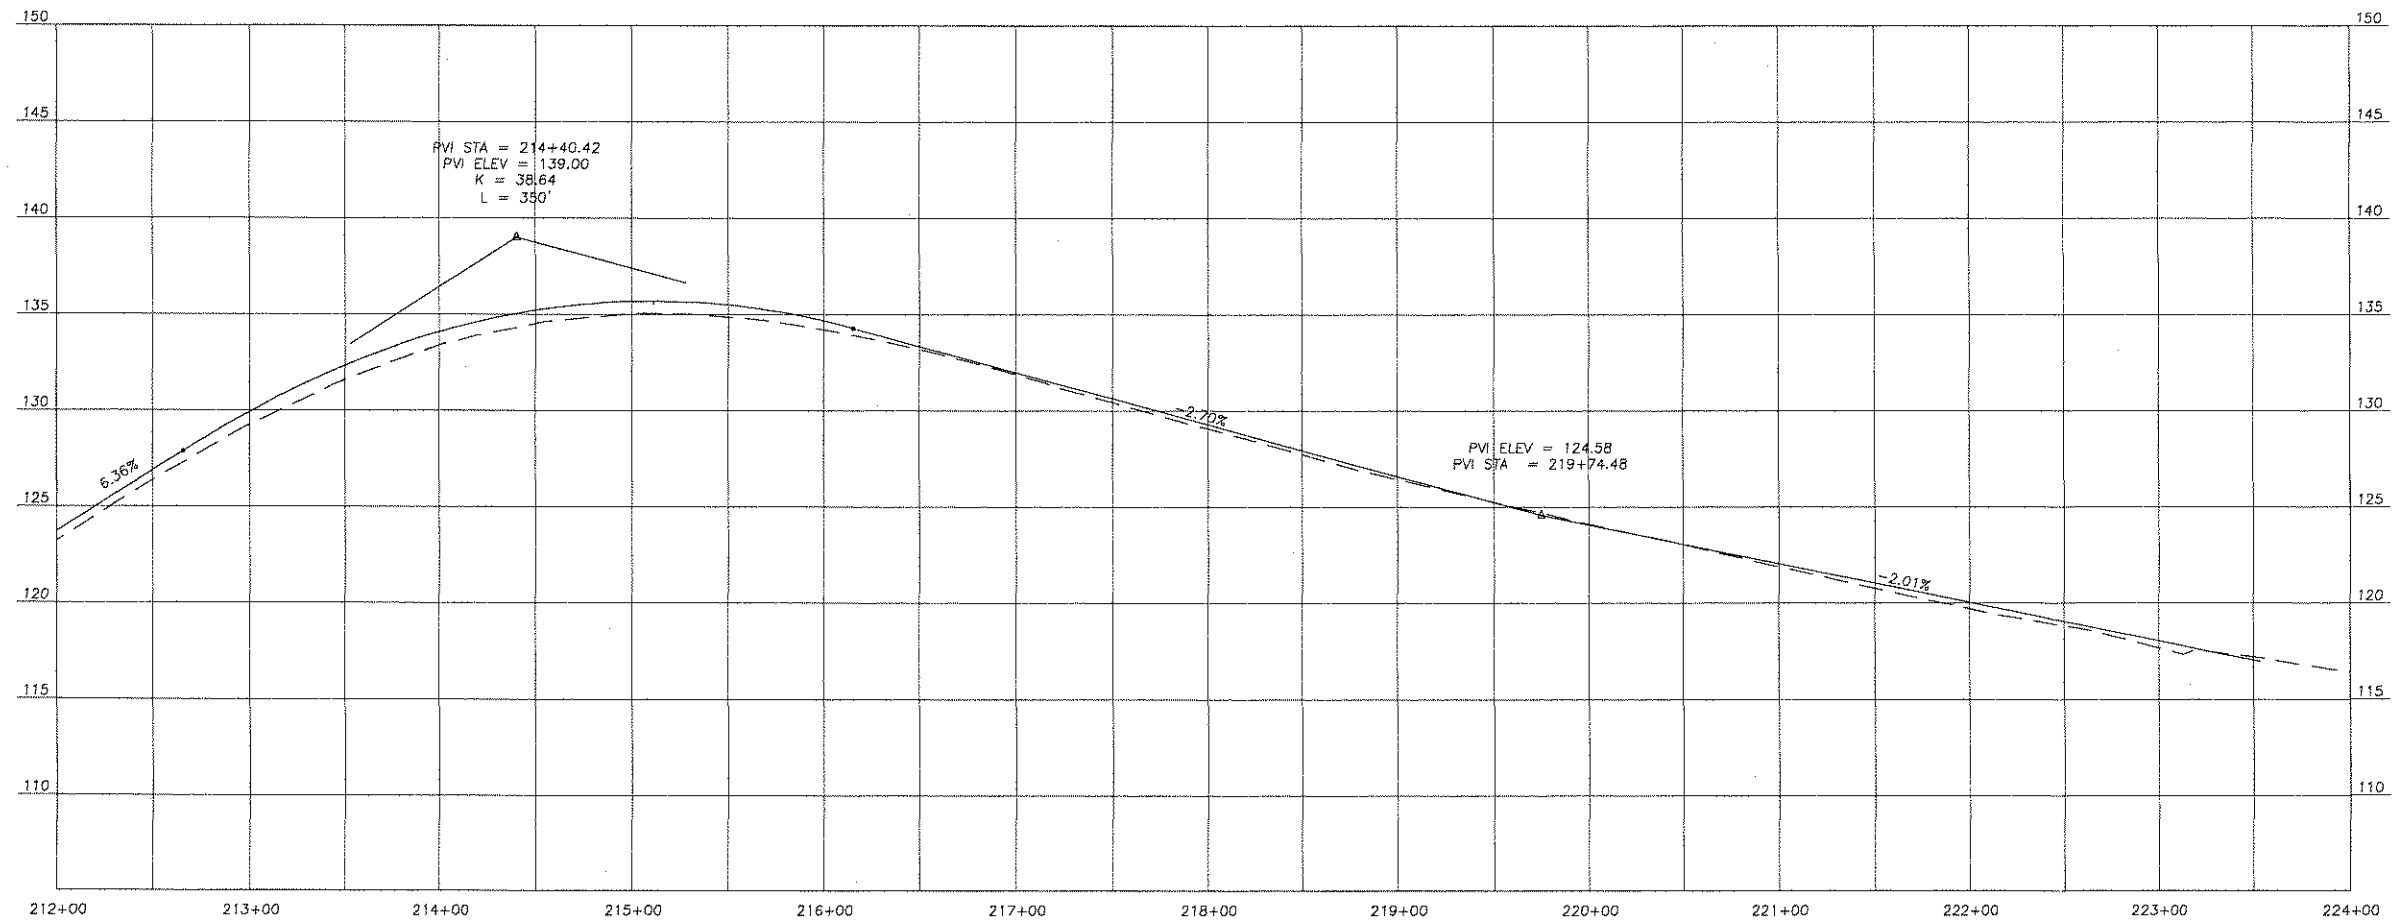

STATE OF ALASKA
DEPARTMENT OF TRANSPORTATION
AND PUBLIC FACILITIES
SOUTHEAST REGION

HAINES HIGHWAY
FRONT STREET TO UNION STREET
REHABILITATION - 3R
FEDERAL NO. ARRA-0956(032)