


STATE OF ALASKA
DEPARTMENT OF TRANSPORTATION
AND
PUBLIC FACILITIES
SOUTHEAST REGION
DESIGN AND CONSTRUCTION DIVISION

HAINES AIRPORT IMPROVEMENTS

CONSTRUCTION OF
100' X 4,000' RUNWAY,
TAXIWAYS, APRON, AND RELATED WORK

A.I.P. NO. 3-02-0112-03
STATE NO. 69523
1990

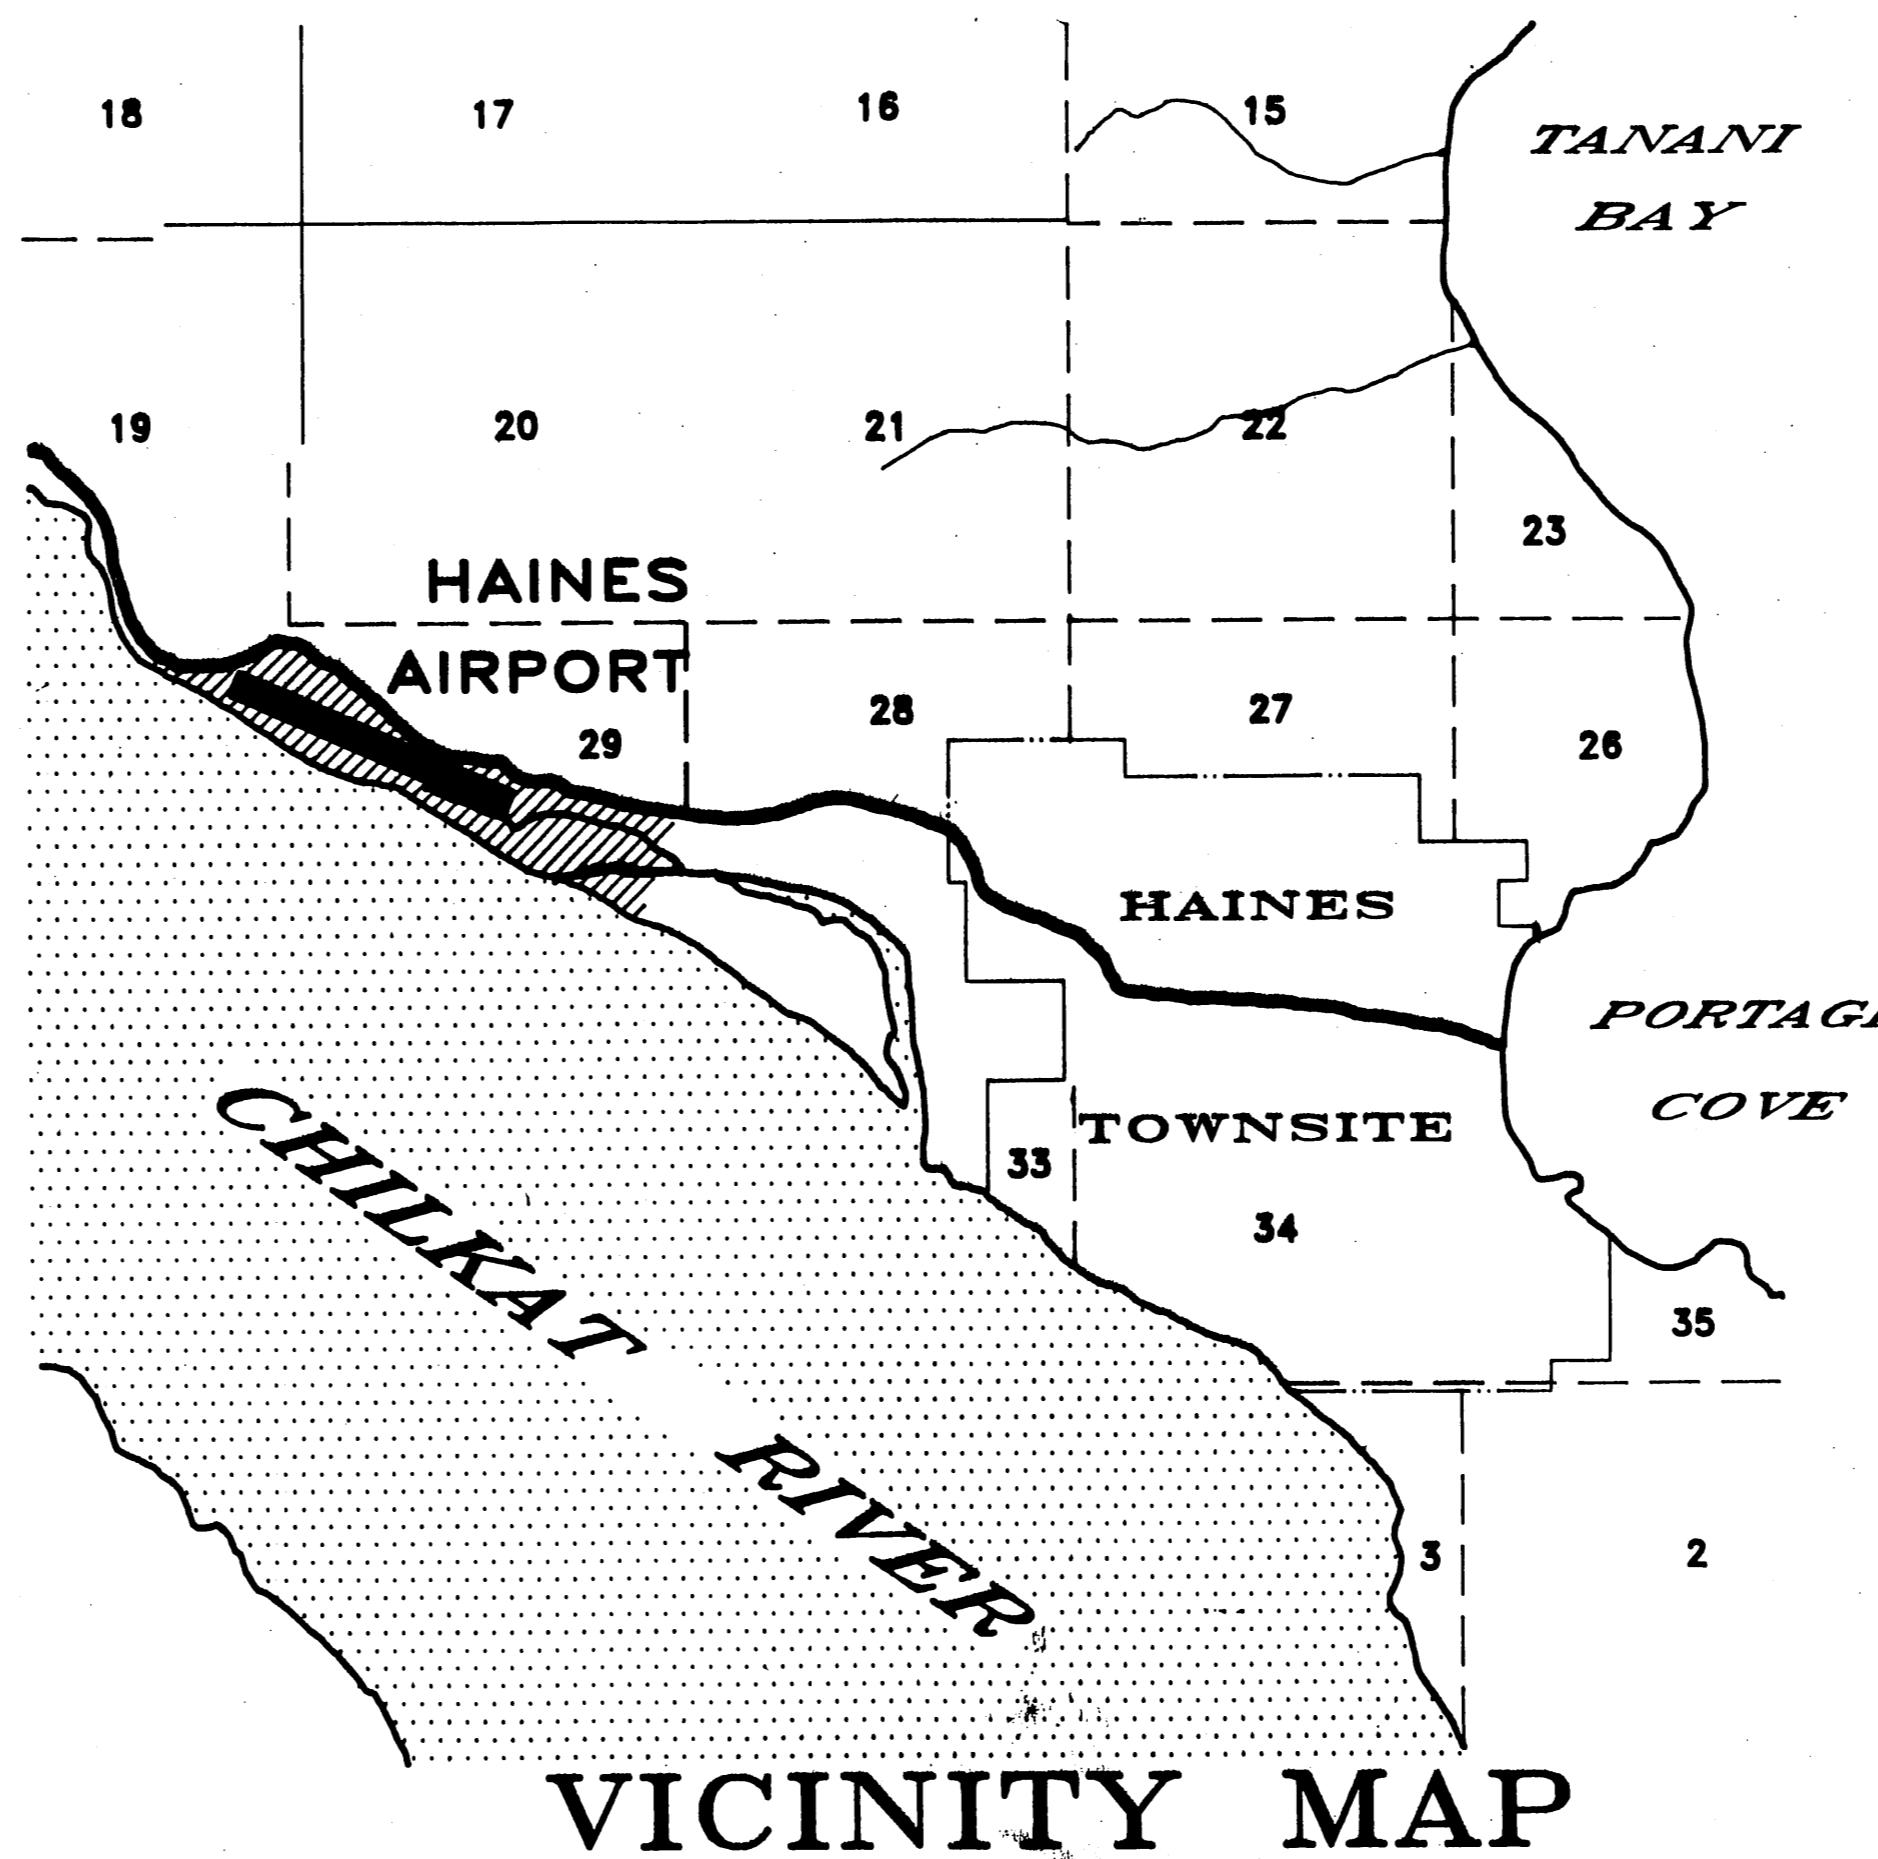

DESIGN DATA

RUNWAY SAFETY AREA	-	150' x 4600'
TAXIWAY SAFETY AREA	-	100' x 4000'
RUNWAY	-	100' x 4000'
TAXIWAY	-	75' x 4000'
AIRPORT CATEGORY	-	GENERAL UTILITY I
RUNWAY SURFACE	-	ASPHALT CONCRETE

INDEX OF SHEETS

SHEET NO.	DESCRIPTION
1	Title Sheet
2	Site Plan
3	Estimate of Quantities
4	Runway Closure Plan
5	Layout Sheet
6	Runway Typical Sections
7-8	Runway Plan & Profiles
9	Taxiway Typical Sections
10	Taxiway Plan & Profile
11	Apron Typical Sections
12	Apron Plan & Profile
13	Airport Tie-Down Plan
14	Parking Typical Sections
15	Parking Layout
16	Miscellaneous Details
17	PAPI Pad Details
18	Material Sites
19	Drainage Details
20	Clearing & Drainage Plan
21	Dike & Riprap Details
22	Striping Plan
23	Segmented Circle & Windcone Details
24	Airport Beacon Details
25	Access Road Plan & Profile
26-29	Airport Fencing Layout
30	Yindastuki Creek Relocation
31	Fisheries Pond Details
32	Yindastuki Creek Details
33	Elec.-Existing Runway Plan
34	Elec.-New Runway Plan
35-38	Electrical Details
39	Elec.-Rotating Beacon Details

AS-BUILT PLANS

CONTRACTOR: NORTHERN TIMBER CORPORATION
ORIGINAL CONTRACT AMOUNT: \$3,812,954.32
PROJECT ENGINEER: GREG BROWNING
START DATE: OCTOBER 1990
END DATE: JULY 1993


STATE OF ALASKA
DEPARTMENT OF TRANSPORTATION
AND
PUBLIC FACILITIES
SOUTHEASTERN REGION DESIGN SECTION

APPROVED
J. Merrill
S.E. Region Design Chief Date 8/10/90

APPROVED
E.W. Darnall
Director, S.E. Region Design & Construction Date 8/10/90

PROJECT NUMBER:	69523
DATE:	AUGUST 1990
SHEET 1 OF 39	

STATE OF ALASKA
49th
Tracey W. Moore
Tracy W. Moore
CE-4032

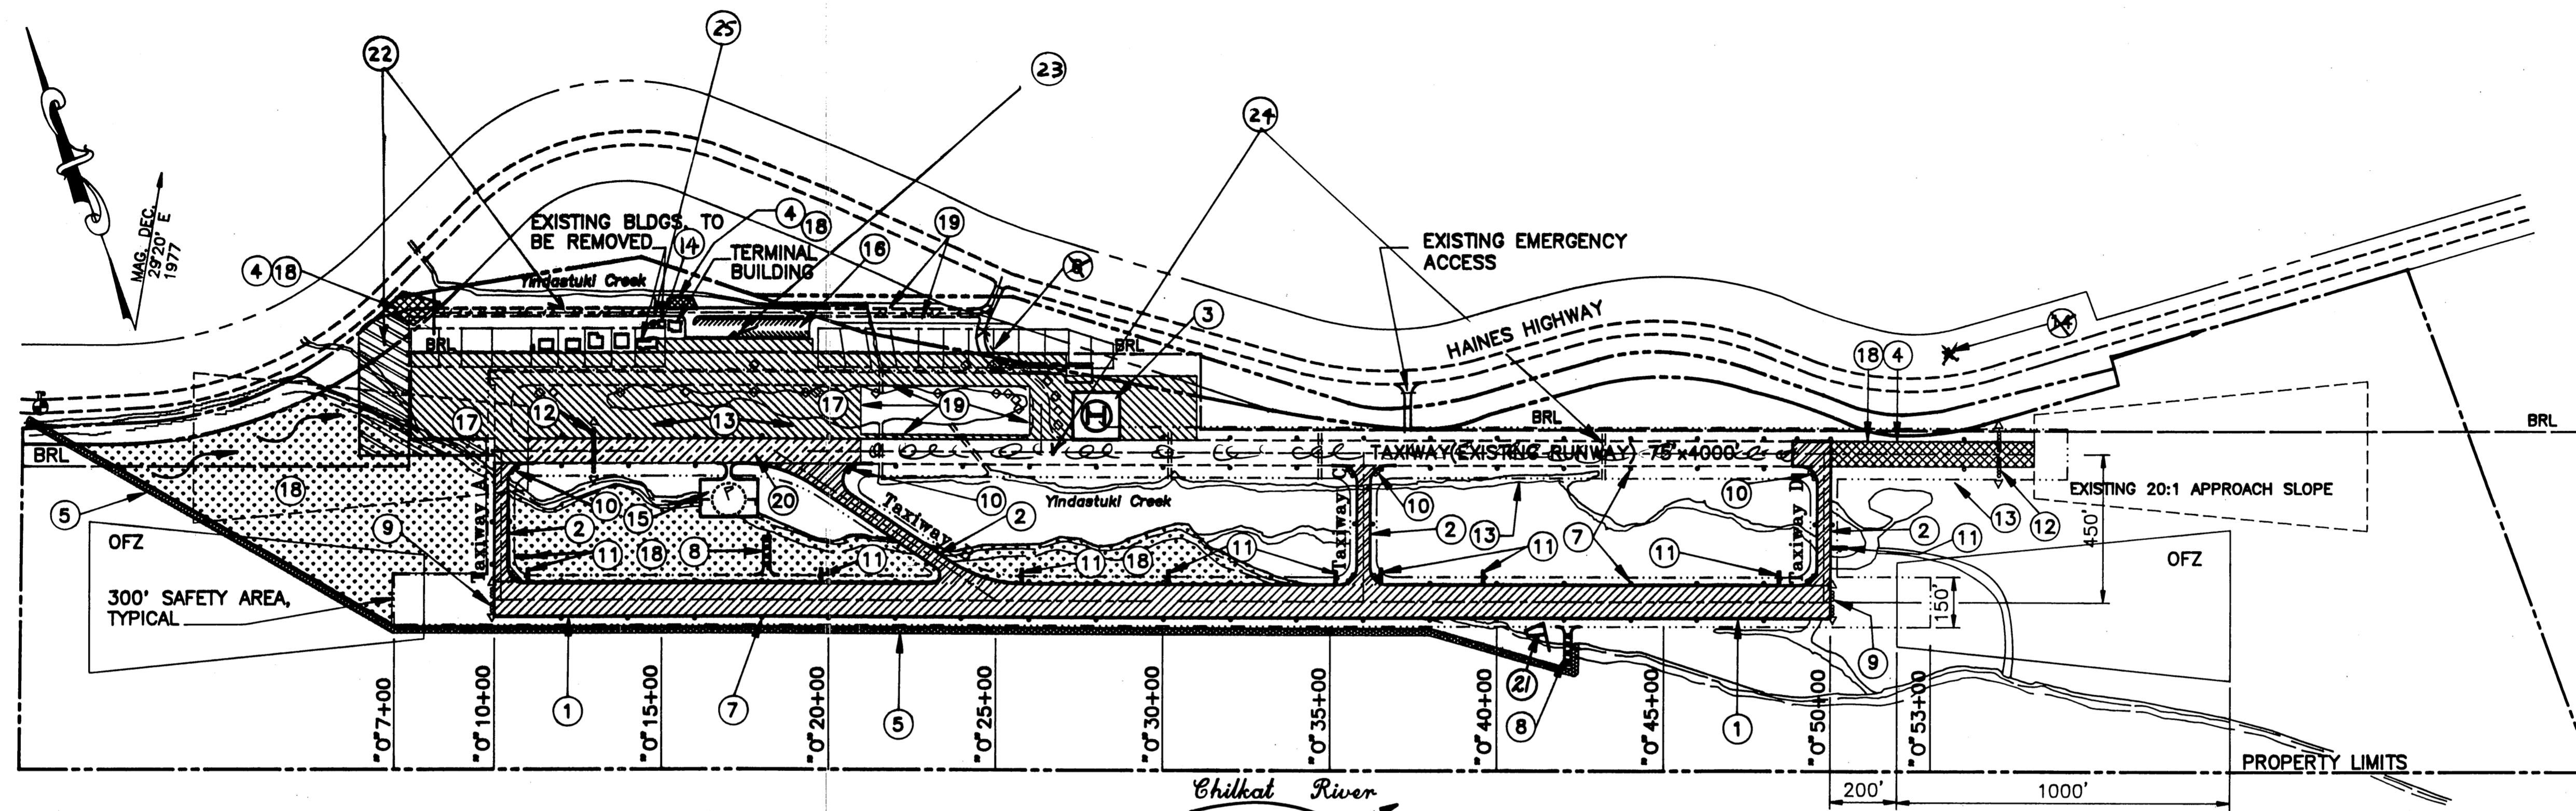


PROPOSED IMPROVEMENTS

- | | |
|----|---|
| 1 | CONSTRUCT NEW RUNWAY 100'x4000' WITH 150'x4600' SAFETY AREA |
| 2 | CONSTRUCT NEW TAXIWAY RAMPS (40' WIDE) (79' SAFETY AREA) |
| 3 | CONSTRUCT HELIPAD |
| 4 | REMOVE EXISTING FILL AND CONVERT TO WETLANDS |
| 5 | CONSTRUCT DIVERSION DIKE |
| 6 | CONSTRUCT NEW ACCESS ROADS |
| 7 | INSTALL NEW MIRL SYSTEM |
| 8 | INSTALL NEW PAPI SYSTEM |
| 9 | INSTALL NEW REIL LIGHTS & THRESHOLD LIGHTS |
| 10 | INSTALL NEW MITL SYSTEM / CONVERT EXISTING MIRL TO MITL |
| 11 | INSTALL NEW RUNWAY / TAXIWAY SIGNS |
| 12 | REMOVE EXISTING REIL LIGHTS & THRESHOLD LIGHTS |
| 13 | REMOVE EXISTING VASI LIGHTS |
| 14 | INSTALL AIRPORT BEACON |
| 15 | RELOCATE LIGHTED WINDCONE AND CONSTRUCT NEW SEGMENTED CIRCLE WITH TRAFFIC PATTERN |
| 16 | CONSTRUCT VEHICLE PARKING AREAS |
| 17 | CONSTRUCT NEW APRON WITH TIE-DOWNS AND DRAINAGE SYSTEM |
| 18 | WETLAND CREATION |
| 19 | SECURITY FENCE |
| 20 | OVERLAY PORTION EXISTING RUNWAY |
| 21 | NEW LIGHTED WINDCONE |
| 22 | APRON EXTENSION & "T" HANGAR AREA + ACCESS ROAD PAVED |
| 23 | KIOSK |
| 24 | CCCC CCC TAXIWAY EXTENSION PAVING |
| 25 | • NEW BEACON LOCATION |

GENERAL NOTES :

1. GRADES AND LAYOUTS AS SHOWN ON THE PLANS ARE SUBJECT TO MINOR REVISIONS.
2. PIPE CONDUIT LENGTHS AND LOCATIONS ARE APPROXIMATE AND ARE SUBJECT TO MINOR REVISIONS.
3. AERIAL TELEPHONE FACILITIES AND UNDERGROUND ELECTRICAL SERVICE WILL BE RELOCATED BY OTHERS DURING THE PROJECT.
4. FISHERY PONDS AND CREEK RELOCATION WORK NOT SHOWN ON THIS DRAWING.
5. LOCATION OF EXISTING OVERHEAD AND UNDERGROUND UTILITIES IS APPROXIMATE AND REQUIRE FIELD VERIFICATION. THE EXISTING POWER SUPPLY TO THE TERMINAL WILL BE RELOCATED BY OTHERS DURING THE CONTRACT.
6. WASTE FILL MATERIAL SHALL BE STOCKPILED IN AREAS DESIGNATED FOR WETLANDS CREATION. ALTERNATE SITES MAY BE USED WITH PRIOR APPROVAL.

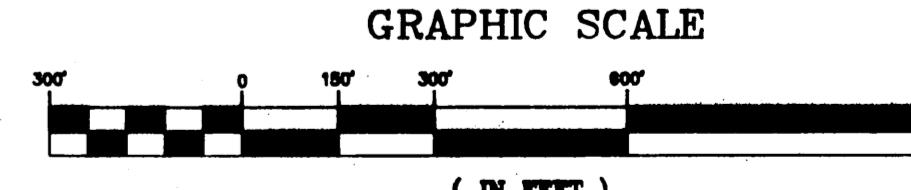


BY:	DATE:	DESCRIPTION OF CHANGE:

RECORD OF REVISIONS

STATE OF ALASKA
DEPARTMENT OF TRANSPORTATION
AND PUBLIC FACILITIES
SOUTHEAST REGION DESIGN & CONSTRUCTION

HAINES AIRPORT SITE PLAN

DESIGNED BY: T.W. MOORE	PROJECT No. 69523
DRAWN BY: AutoCAD / B.W.B.	DATE: AUGUST 1990
CHECKED BY: C. HAKARI	SHEET 2 OF 39

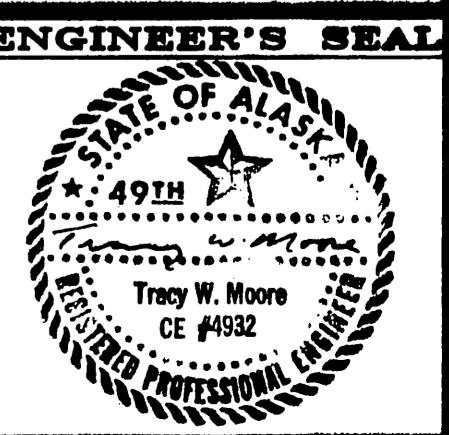

ESTIMATE OF QUANTITIES

Item No.	Description	Unit	Total
100	MOBILIZATION AND DEMOBILIZATION	L.S.	ALL REQ'D.
111	TEMPORARY EROSION AND POLLUTION CONTROL	C.S.	ALL REQ'D.
120	DBE ADJUSTMENT	C.S.	ALL REQ'D.
121	CONSTRUCTION SURVEYING BY THE CONTRACTOR	L.S.	ALL REQ'D.
125	ENGINEERING TRANSPORTATION	L.S.	ALL REQ'D.
200a	CLEARING	ACRE	32.24
121d	SURVEYING FOR CO NO. 2	L.S.	ALL REQ
210a	REMOVAL OF STRUCTURES AND OBSTRUCTIONS	L.S.	ALL REQ'D.
210b	BUILDING DEMOLITION	L.S.	ALL REQ'D.
210c	REMOVAL OF CULVERT PIPE	L.F.	786.886
250a	EXCAVATION & DISPOSAL OF PAVEMENT MATERIAL	S.Y.	18,600 20,149
330a	UNCLASSIFIED EXCAVATION	C.Y.	53,600 24,715
330c	EMBANKMENT	C.Y.	330,000 308,443
330e	FISHERIES POND EXCAVATION	C.Y.	17,000 18,208
330f	SUBSIDENCE PLATFORMS	EACH	18
350a	RIPRAP, CLASS II	C.Y.	14,500 14,118
350b	RIPRAP, CLASS III	C.Y.	6,605 5,700
351	INFILTRATION GALLERY	L.S.	ALL REQ'D.
400a	18-INCH CORRUGATED STEEL PIPE	L.F.	790 924
400b	24-INCH CORRUGATED STEEL PIPE	L.F.	800 854
400c	48-INCH CORRUGATED STEEL PIPE	L.F.	830
405	INLET, TYPE A	EACH	40 72
412	WELL SYSTEM	L.S.	ALL REQ'D.
440a	CHAIN LINK FENCE, 8 FEET HIGH	L.F.	3,600 3,800
440b	DRIVE-THRU SLIDE GATE (8'x20')	EACH	14
440c	PEDESTRIAN GATE (8'x4')	EACH	76
330 H	FOUNDATION REPAIR	L.S.	ALL REQ
441	GATE OPERATOR	EACH	1
440 D	FENCE FOR CO #2	L.F.	873
500a	SUBBASE COURSE	C.Y.	27,600
510a	CRUSHED AGGREGATE BASE COURSE	TON	55,000
551b	GEOTEXTILE, RIPRAP LINER	S.Y.	16,200
551c	CUSHION BLANKET	C.Y.	2,000
600a	BITUMINOUS PRIME COAT, CUTBACK	TON	162
660a	ASPHALT CONCRETE	TON	14,325
660c	ASPHALT CEMENT, AC-5	TON	530
700c	STATE TRAFFIC MARKING PAINT	L.S.	ALL REQ'D.
610	BITUMINOUS TACK COAT, CSS-1	TON	5
722	SEGMENTED CIRCLE	L.S.	ALL REQ'D.
801	CURB AND GUTTER, STD.	L.F.	680
820a	TIE-DOWN ANCHORS	EACH	102
900a	SEEDING	ACRE	24.29
900d	WASTE FILL	M.S.F.	1,010 1,063
910	SURVEY MONUMENTS	EACH	4
920	STANDARD SIGNS	S.F.	2319

ESTIMATE OF QUANTITIES

Item No.	Description	Unit	Total
1000a	NEW REGULATOR, L-828	EACH	1
1000e	NEW MEDIUM INTENSITY RUNWAY MARKER LIGHT, L-861	EACH	38.48
1000f	NEW TAXIWAY MARKER LIGHT, L-861T	EACH	48.55
1000g	NEW HANDHOLE, L-867	EACH	5.10
1000l	2" RIGID STEEL CONDUIT	L.F.	50.85
1000k	2" PVC CONDUIT	L.F.	15,675
1000L	UNDERGROUND CABLE #8 AWG, COPPER, 5KV TYPE "B", L-824	L.F.	19,000
1000m	#8 XHHW INSULATED COPPER GROUND CONDUCTOR	L.F.	14,000
1000o	REMOVE EXISTING RUNWAY LIGHTS	EACH	13.49
1000q	GROUND ROD	EACH	12.19
1000r	LIGHTED RUNWAY / TAXIWAY SIGNS	EACH	13
1000s	TAXIWAY LIGHT LENS	L.S.	ALL REQ'D.
1000t	ADJUST EXISTING HANDHOLE	EACH	6.12
1010a	RELOCATED WIND CONE	L.S.	ALL REQ'D.
1010b	8-FOOT LIGHTED WIND CONE	L.S.	ALL REQ'D.
1025	OMNIDIRECTIONAL REIL L-859	PAIR	2
1030	PAPI-4, L-880, STYLE "A", CLASS II	EACH	2
1040	ADDITIONAL ELECTRICAL	L.S.	ALL REQ

ALTERNATE No. 1

1020	AIRPORT LIGHT BEACON AND BEACON POLE	L.S.	ALL REQ'D.
830a	EMBANKMENT CO #2	C.Y.	10,719
7000	ADDITIONAL STRIPPING	L.S.	ALL REQ
930	KIOSK	L.S.	ALL REQ

ESTIMATING FACTORS

Item No.	Item	Factor
500a	SUBBASE COURSE	2.8 2:13 TONS / C.Y.
510a	CRUSHED AGGREGATE BASE COURSE	2.8 2:13 TONS / C.Y.
600a	BITUMINOUS PRIME COAT, CUTBACK	0.25 GAL/S.Y. & 256 GAL/TON
660a	ASPHALT CONCRETE	1/3 126 LBS. / S.Y.-IN.
660c	ASPHALT CEMENT, AC-5	5.6.5% OF ITEM 660a

REMOVAL OF STRUCTURES & OBSTRUCTIONS

Station	Offset	Description
"A" 15+09	96' LT.	DRAINAGE STRUCTURE
"A" 17+00	93' LT.	DRAINAGE STRUCTURE
"A" 19+00	94' LT.	DRAINAGE STRUCTURE
"A" 11+00	20' RT.	40'x40' CONCRETE PAD
"M" 16+63	25' RT.	4-CONCRETE PEDESTAL GUARD POSTS
"M" 14+85	30' RT.	STORAGE BUILDING
"M" 14+60	90' RT.	2-STORY RESIDENCE
"M" 16+25	32' LT.	WELL, ELEC. WIRE & CONDUIT, WATERLINE-SAVLAGE PUMP

CULVERT REMOVAL SUMMARY

Station	Length	Comments
"M" 16+95, Q	46'	
"A" 15+09, 22' LEFT TO 84' LEFT	72'	
"A" 15+09, 94' LEFT TO 240' LEFT	146'	
"A" 17+00, 12' LEFT TO 80' LEFT	78'	
"A" 19+00, 18' LEFT TO 92' LEFT	74'	
"T" 30+45, 30' LEFT TO 240' LEFT	210'	
"T" 51+85, Q	160'	


AS-BUILT
B.A. 2 - 9-86


BY:	DATE:	DESCRIPTION OF CHANGE:
RECORD OF REVISIONS		

STATE OF ALASKA
DEPARTMENT OF TRANSPORTATION
AND PUBLIC FACILITIES
SOUTHEAST REGION DESIGN & CONSTRUCTION

HAINES AIRPORT
ESTIMATE OF QUANTITIES


DESIGNED BY: T.W. MOORE PROJECT No. 69523
DRAWN BY: AutoCAD / B.W.B. DATE: AUGUST 1990
CHECKED BY: C. HAKARI SHEET 3 OF 39

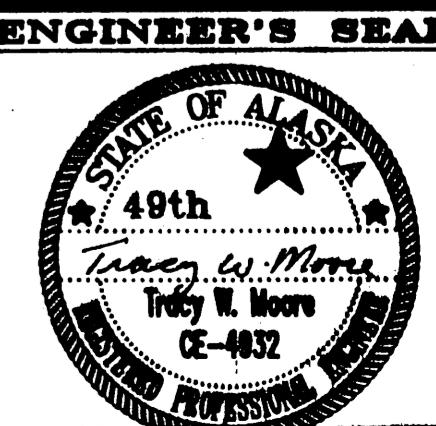

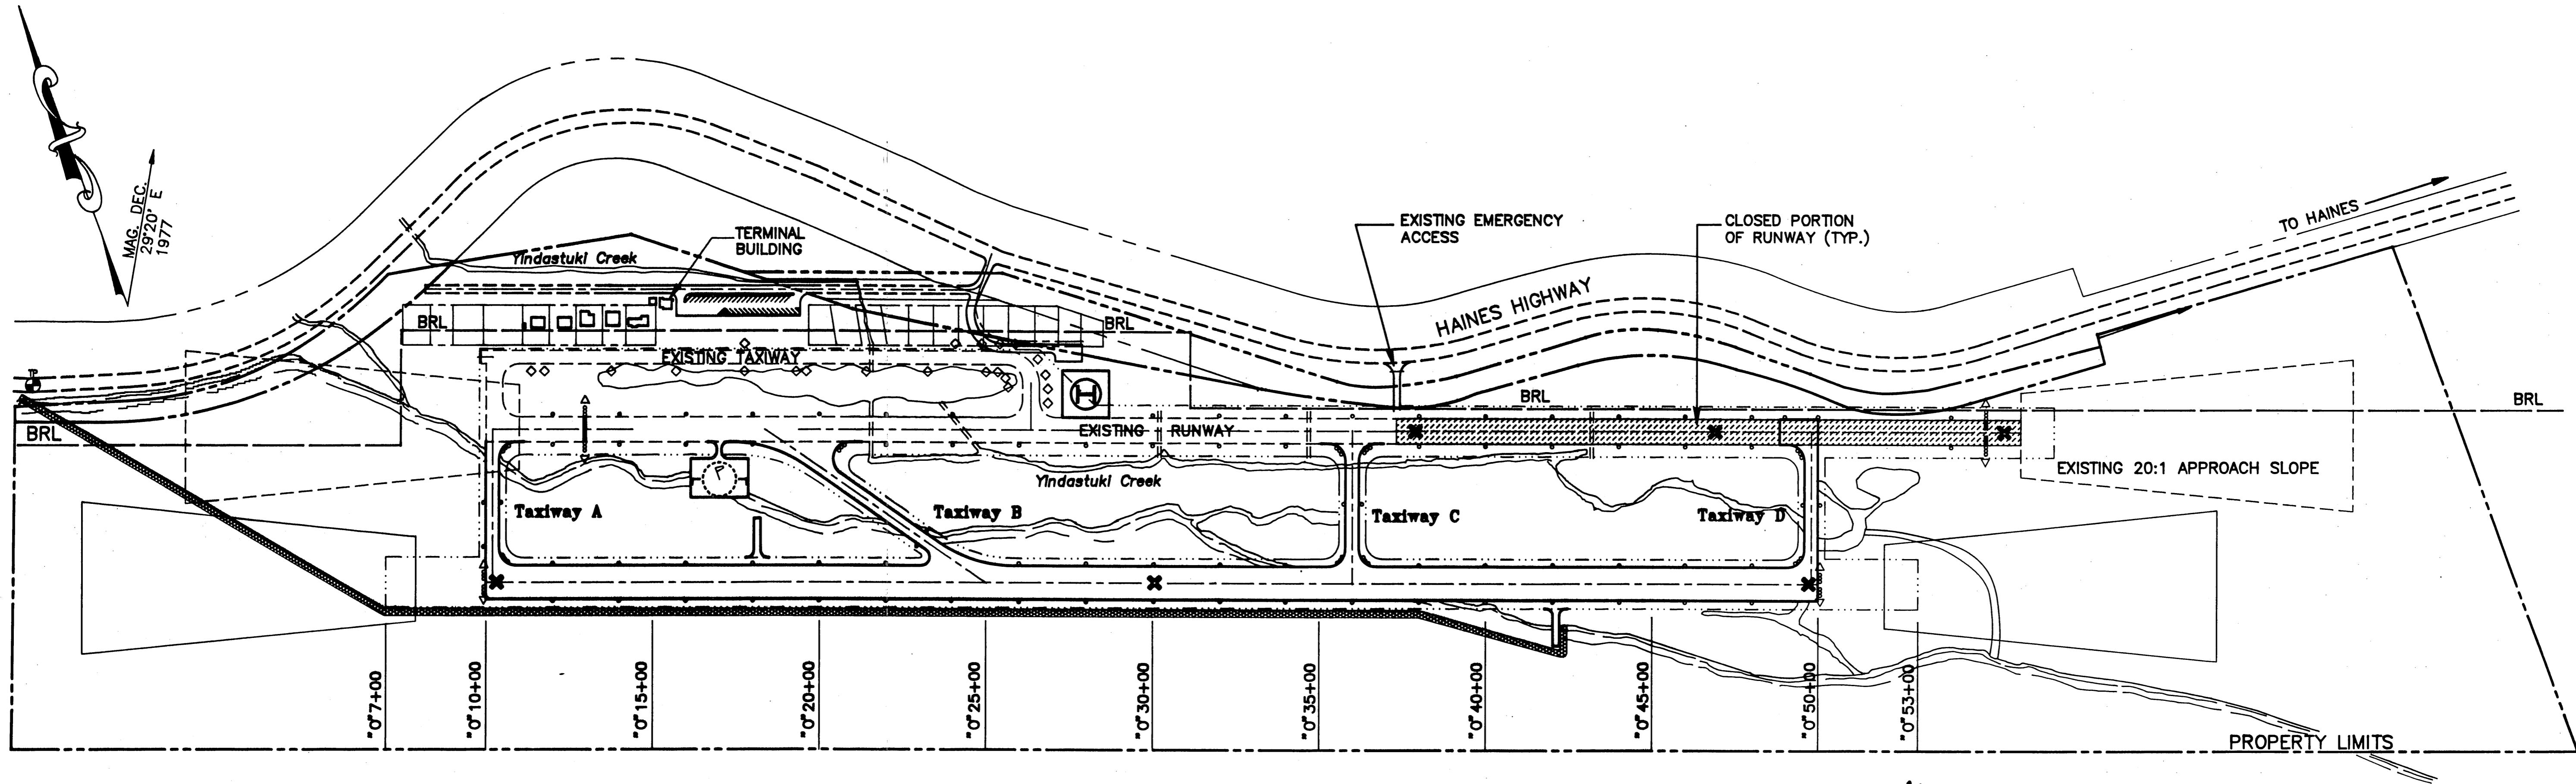

RUNWAY CLOSURE NOTES:


1. AT LEAST A 2,500' X 75' LANDING SURFACE ON THE EXISTING RUNWAY SHALL REMAIN OPEN TO AIRCRAFT TRAFFIC AT ALL TIMES, UNTIL THE NEW RUNWAY IS PAVED AND OPENED.
2. THE WEST 2,500' OF THE EXISTING RUNWAY MUST REMAIN OPEN TO AIRCRAFT TRAFFIC FROM MAY 20 THRU SEPTEMBER 10, UNLESS THE NEW PAVED RUNWAY HAS BEEN OPENED. BOTH EXISTING TAXIWAY RAMPS SHALL REMAIN OPEN THROUGH THE SAME TIME PERIOD.
3. EQUIPMENT SHALL NOT BE ALLOWED ON THE OPEN PORTION OF THE EXISTING RUNWAY, OR WITHIN 200' OF ITS TEMPORARY THRESHOLD. WHEN AIRCRAFT ARE APPROACHING OR DEPARTING, EQUIPMENT SHALL NOT BE WITHIN 100' OF THE OPEN RUNWAY CENTERLINE.
4. RUNWAY LIGHTS AND THRESHOLD LIGHTS ALONG THE OPEN PORTION OF THE RUNWAY SHALL REMAIN OPERATIONAL AT ALL TIMES. EXISTING THRESHOLD LIGHTS SHALL BE RELOCATED BY THE CONTRACTOR, AS NECESSARY TO IDENTIFY THE TEMPORARY RUNWAY LIMITS. RUNWAY LIGHTS ALONG THE CLOSED PORTION OF THE EXISTING RUNWAY SHALL BE REMOVED OR COVERED.
5. EXISTING RUNWAY NUMBERS SHALL BE COVERED OR REMOVED AT THE END OF THE RUNWAY THAT IS CLOSED.

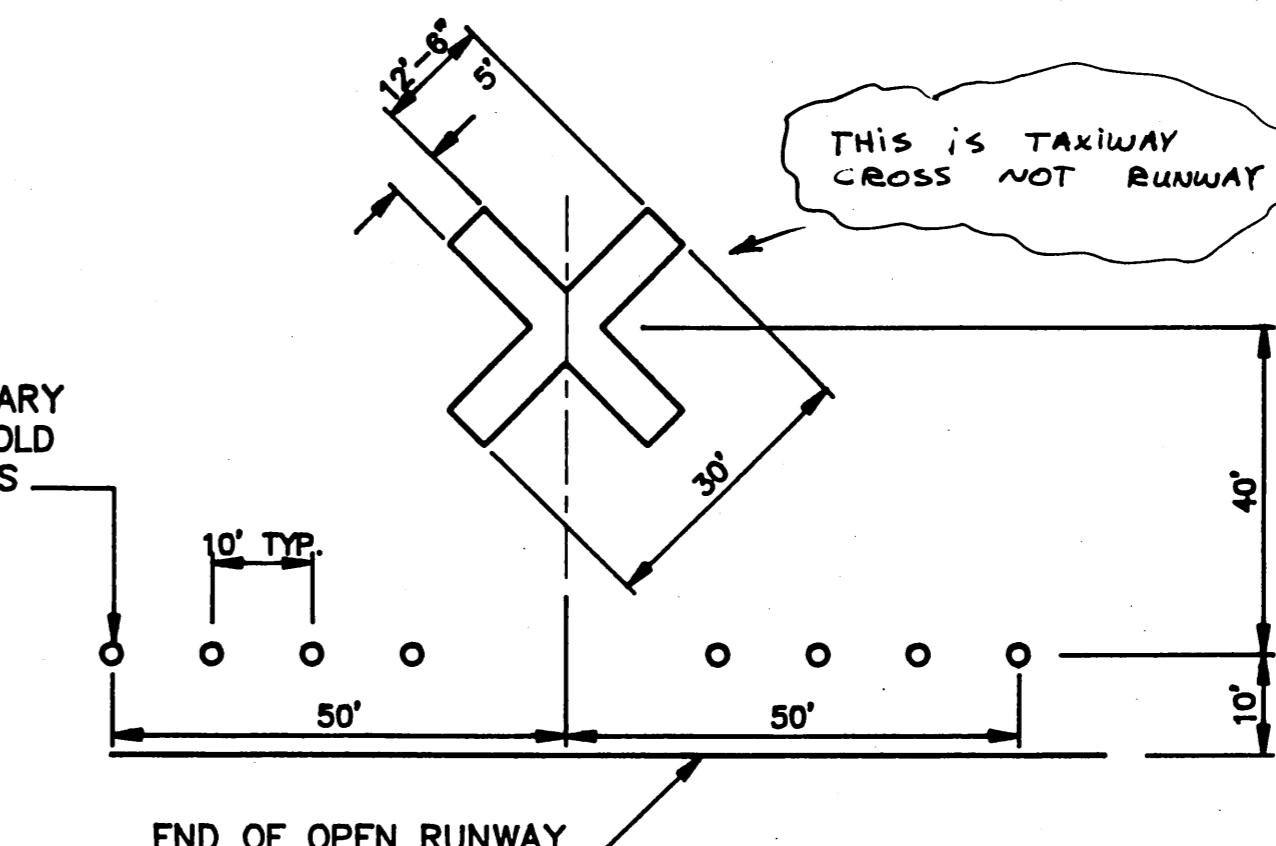

CLOSED RUNWAY MARKER NOTES:

1. CROSSES SHALL BE YELLOW IN COLOR AND MAY BE CONSTRUCTED OF PLASTIC OR OTHER SUITABLE MATERIAL.
2. CROSSES SHALL BE PLACED AT EACH END OF AND IN THE MIDDLE OF THE CLOSED PORTION OF THE EXISTING RUNWAY.
3. CROSSES SHALL BE MAINTAINED ON THE NEW RUNWAY AS CONSTRUCTION PROCEEDS FROM TOP OF EMBANKMENT THROUGH OPENING TO TRAFFIC.

195-BUILT
B.P. 2-9-96

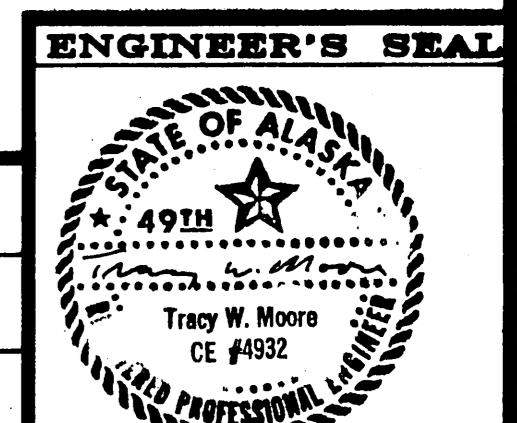


BY:	DATE:	DESCRIPTION OF CHANGE:
RECORD OF REVISIONS		

STATE OF ALASKA
DEPARTMENT OF TRANSPORTATION
AND PUBLIC FACILITIES
SOUTHEAST REGION DESIGN & CONSTRUCTION

HAINES AIRPORT RUNWAY CLOSURE PLAN

DESIGNED BY: T.W. MOORE	PROJECT No. 69623
DRAWN BY: AutoCAD / B.W.B.	DATE: AUGUST 1990
CHECKED BY: C. HAKARI	SHEET 4 OF 39

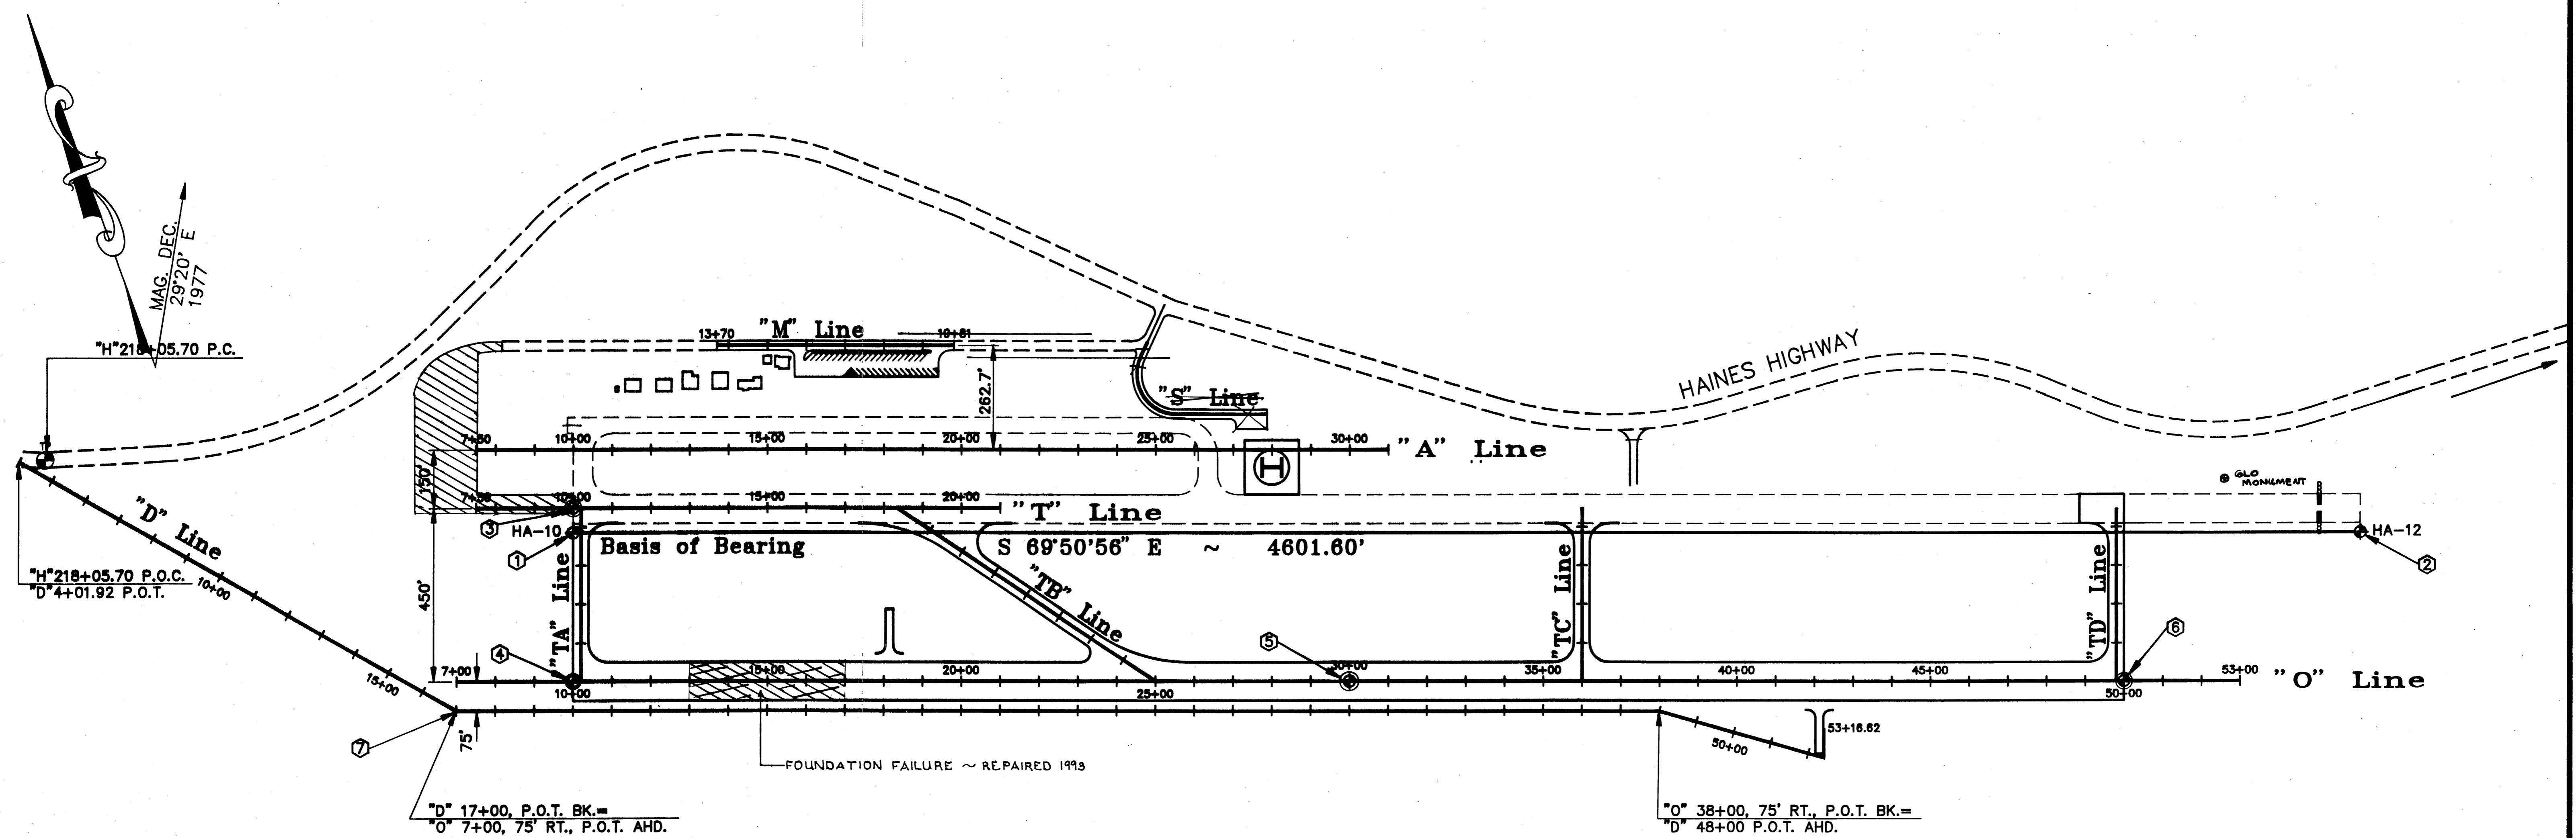

COORDINATE TABLE

Point No.	Northing	Easting	Elevation
①	19985.814	38348.379	18.51
②	18400.584	42668.302	18.02
③	20034.361	38366.215	
④	19611.949	38211.077	23.74
⑤	18922.445	40088.464	22.00
⑥	18232.940	41965.852	20.28
⑦	19644.972	37903.612	21.50

ABBREVIATIONS

REIL	RUNWAY END IDENTIFICATION LIGHT
MIRL	EDIUM INTENSITY RUNWAY LIGHT
PAPI	PRECISION APPROACH PATH INDICATOR
MITL	EDIUM INTENSITY TAXIWAY LIGHT
VASI	VISUAL APPROACH SLOPE INDICATOR
BST	BITUMINOUS SURFACE TREATMENT
TORR	TOP OF RIPRAP
BRL	BUILDING RESTRICTION LINE

LEGEND

- RIPRAP DIKE
- EXISTING MONUMENT
- NEW MONUMENT
- EXISTING GROUND
- EXISTING PROPERTY LINE
- FUTURE PROPERTY LINE
- BUILDING RESTRICTION LINE (BRL)
- SUBSIDENCE PLATFORM

NOTES :

1. FOR "D" LINE LAYOUT, SEE SHEET 21.
2. BASIS OF VERTICAL AND HORIZONTAL CONTROL ARE STATED ON SHEET No. 7.

APRON EXTENSION & T-HANGAR AREA


AS-BUILT
B.B. 2-9-96


BY:	DATE:	DESCRIPTION OF CHANGE:
RECORD OF REVISIONS		

STATE OF ALASKA
DEPARTMENT OF TRANSPORTATION
AND PUBLIC FACILITIES
SOUTHEAST REGION DESIGN & CONSTRUCTION

HAINES AIRPORT
LAYOUT SHEET

DESIGNED BY: C. HAKARI PROJECT No. 69623
DRAWN BY: AutoCAD / B.W.B. DATE: AUGUST 1990
CHECKED BY: T.W. MOORE SHEET 5 OF 39

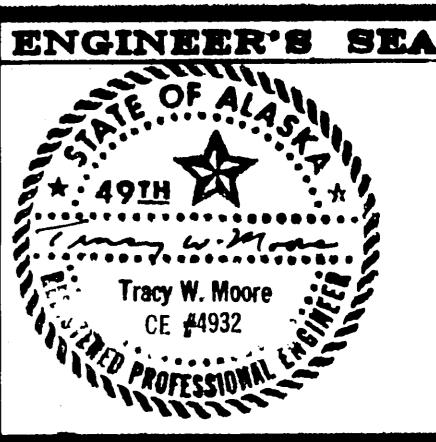

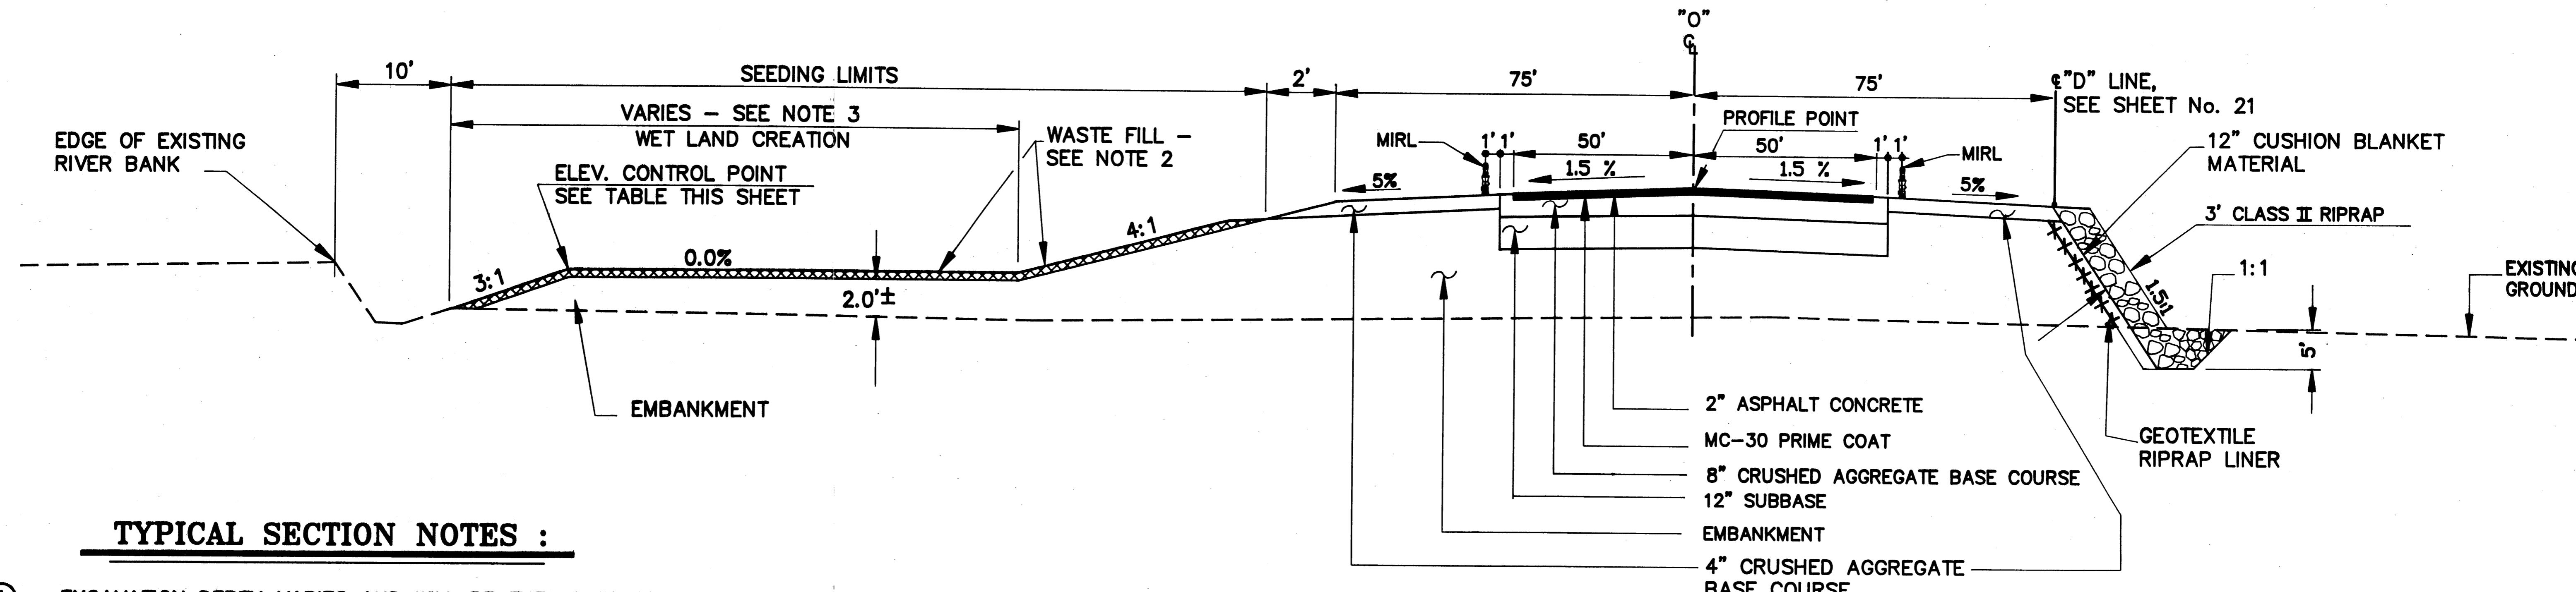


TYPICAL SECTION NOTES :

- ① EXCAVATION DEPTH VARIES AND WILL BE THE LIMITS OF ORGANICS SOILS OR AS DIRECTED.
- ② WASTE FILL - GRUBBING DEBRIS, EXCAVATION OF ORGANIC SOILS AND/OR TOPSOIL - SHALL BE PLACED ON ALL NEW EMBANKMENT SLOPES FOR SEED PROPAGATION. DEPTH SHALL BE 2" MINIMUM.
- ③ WIDENED EMBANKMENT FOR WETLAND CREATION SHALL EXTEND FROM STATION "D" 4+50 TO STATION "D" 17+00 AND STATION "O" 7+00 TO STATION "O" 33+00. SEE SHEETS NO. 2 AND 21.
- ④ IN RUNWAY SAFETY AREAS, STATIONS "O" 7+00 TO "O" 10+00 AND STATIONS "O" 50+00 TO "O" 53+00, PLACE AN ADDITIONAL 2" CRUSHED AGGREGATE BASE IN LIEU OF THE 2" ASPHALT CONCRETE.

ELEVATION CONTROL POINTS	
STATION	ELEVATION
"D" 4+50	15.50
"D" 17+00 = "O" 7+00	15.00
"O" 10+50	15.00
"O" 33+00	14.00

ELEVATIONS SHALL VARY LINEARLY BETWEEN CONTROL POINTS. OFFSETS ARE TO THE LEFT AND ARE VARIABLE. SEE RUNWAY TYPICAL THIS SHEET AND DIKE TYPICAL ON SHEET NO. 21.

RUNWAY
STA. "O" 7+00 TO "O" 42+25

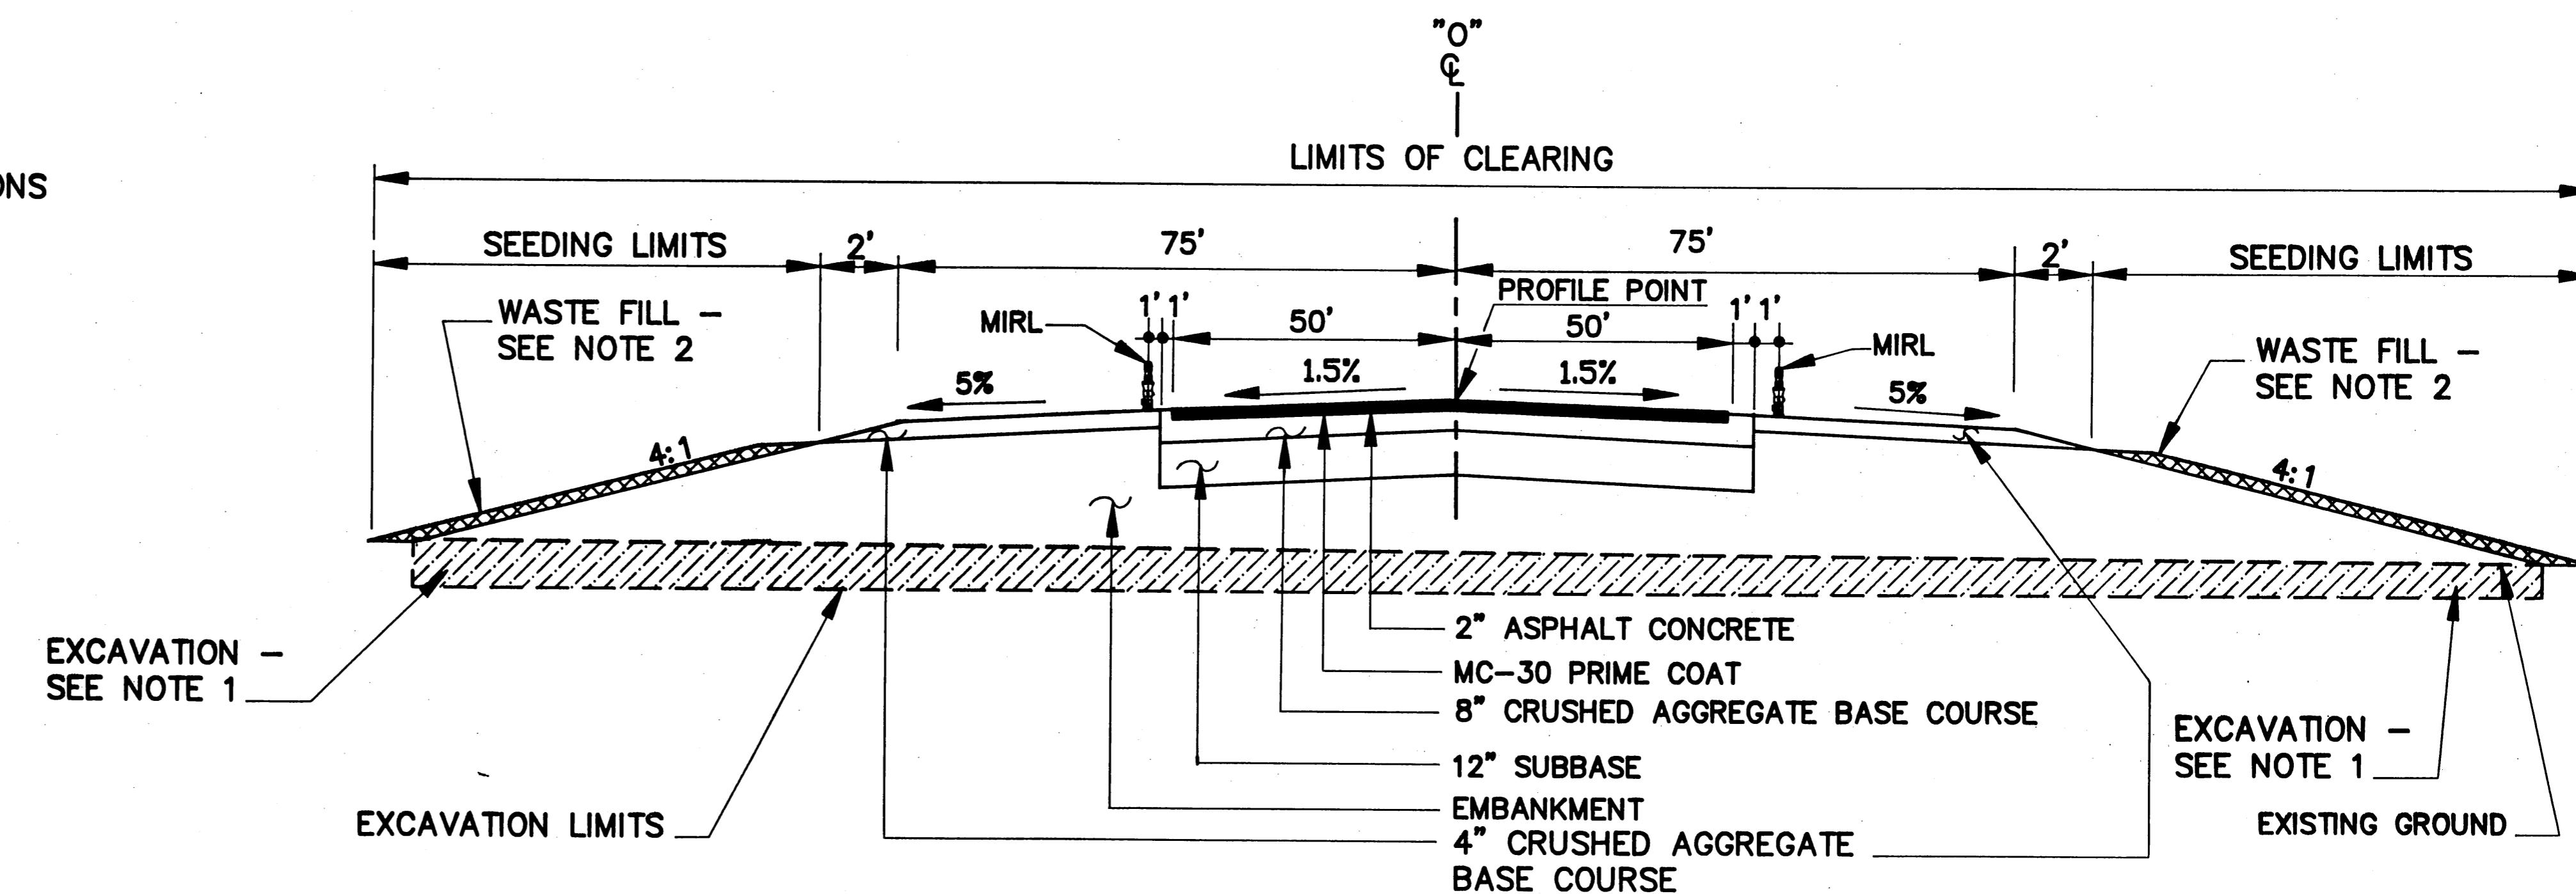

RUNWAY
STA. "O" 42+25 TO "O" 53+00


175 BUILT
3.17. 2-9-90



BY:	DATE:	DESCRIPTION OF CHANGE:
RECORD OF REVISIONS		

STATE OF ALASKA
DEPARTMENT OF TRANSPORTATION
AND PUBLIC FACILITIES
SOUTHEAST REGION DESIGN & CONSTRUCTION

HAINES AIRPORT RUNWAY TYPICAL SECTIONS

DESIGNED BY:	T.W. MOORE	PROJECT No.
DRAWN BY:	AutoCAD / B.W.B.	69523
DATE:	AUGUST 1990	
CHECKED BY:	C. HAKARI	SHEET 6 OF 39

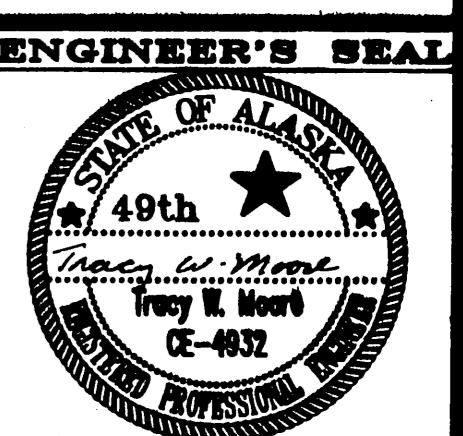

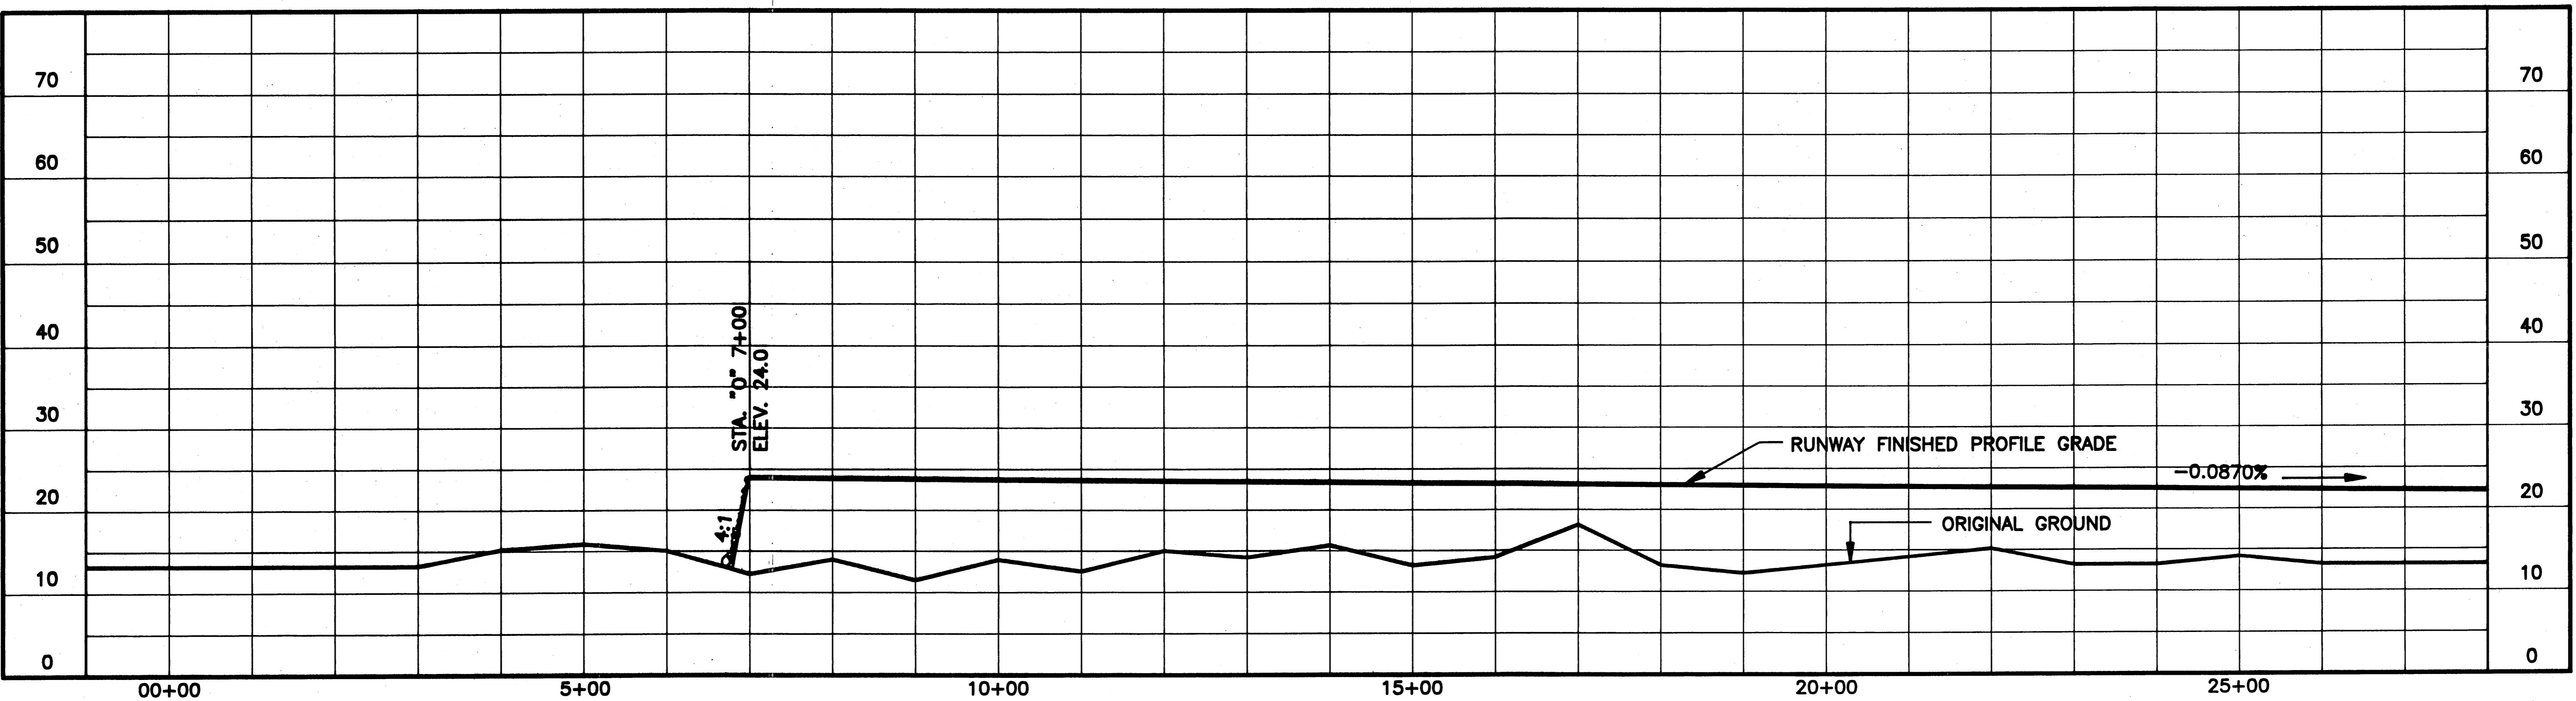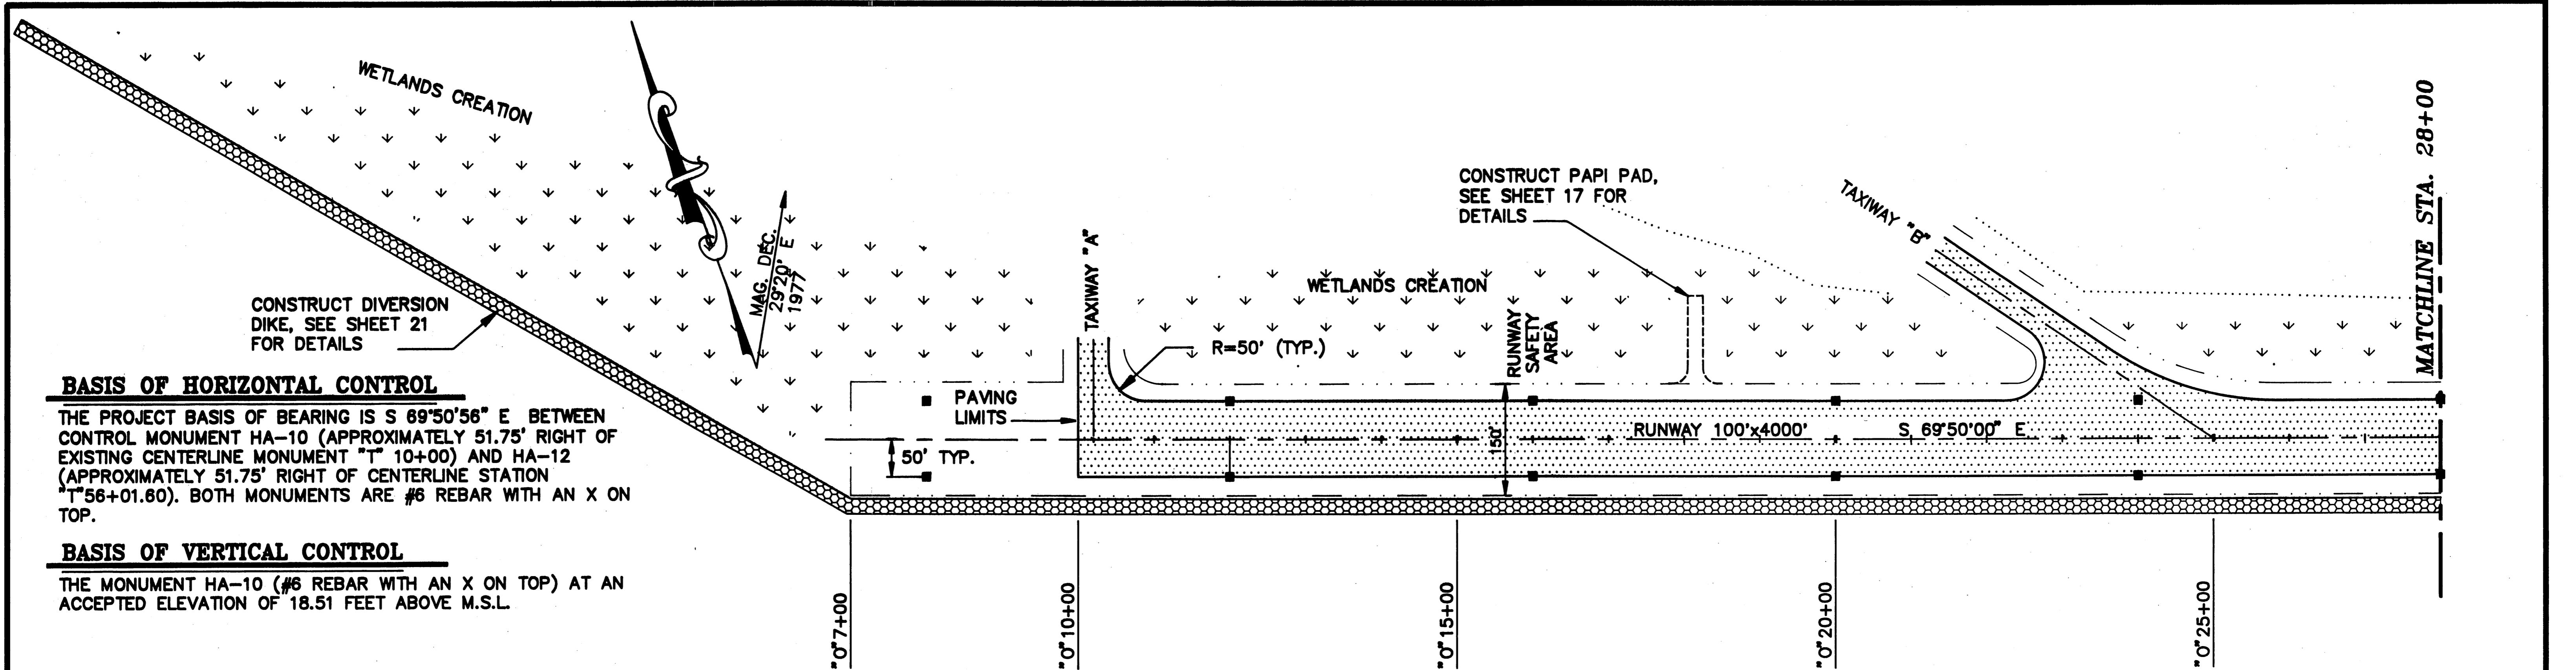

175-BUILT
B.A. 2-9-96


BY:	DATE:	DESCRIPTION OF CHANGE:



RECORD OF REVISIONS

STATE OF ALASKA
DEPARTMENT OF TRANSPORTATION
AND PUBLIC FACILITIES
SOUTHEAST REGION DESIGN & CONSTRUCTION

HAINES AIRPORT RUNWAY PLAN AND PROFILE

DESIGNED BY: T.W. MOORE	PROJECT No. 69623
DRAWN BY: AutoCAD / B.W.B.	DATE: AUGUST 1990
CHECKED BY: C. HAKARI	SHEET 7 OF 39

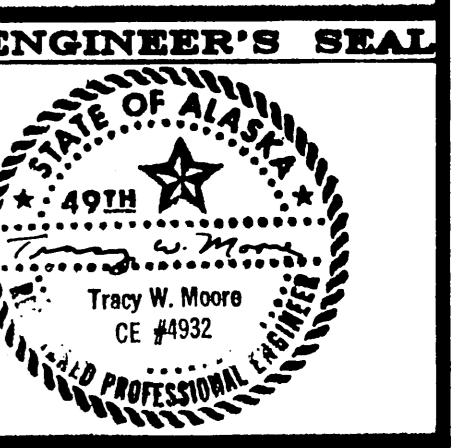

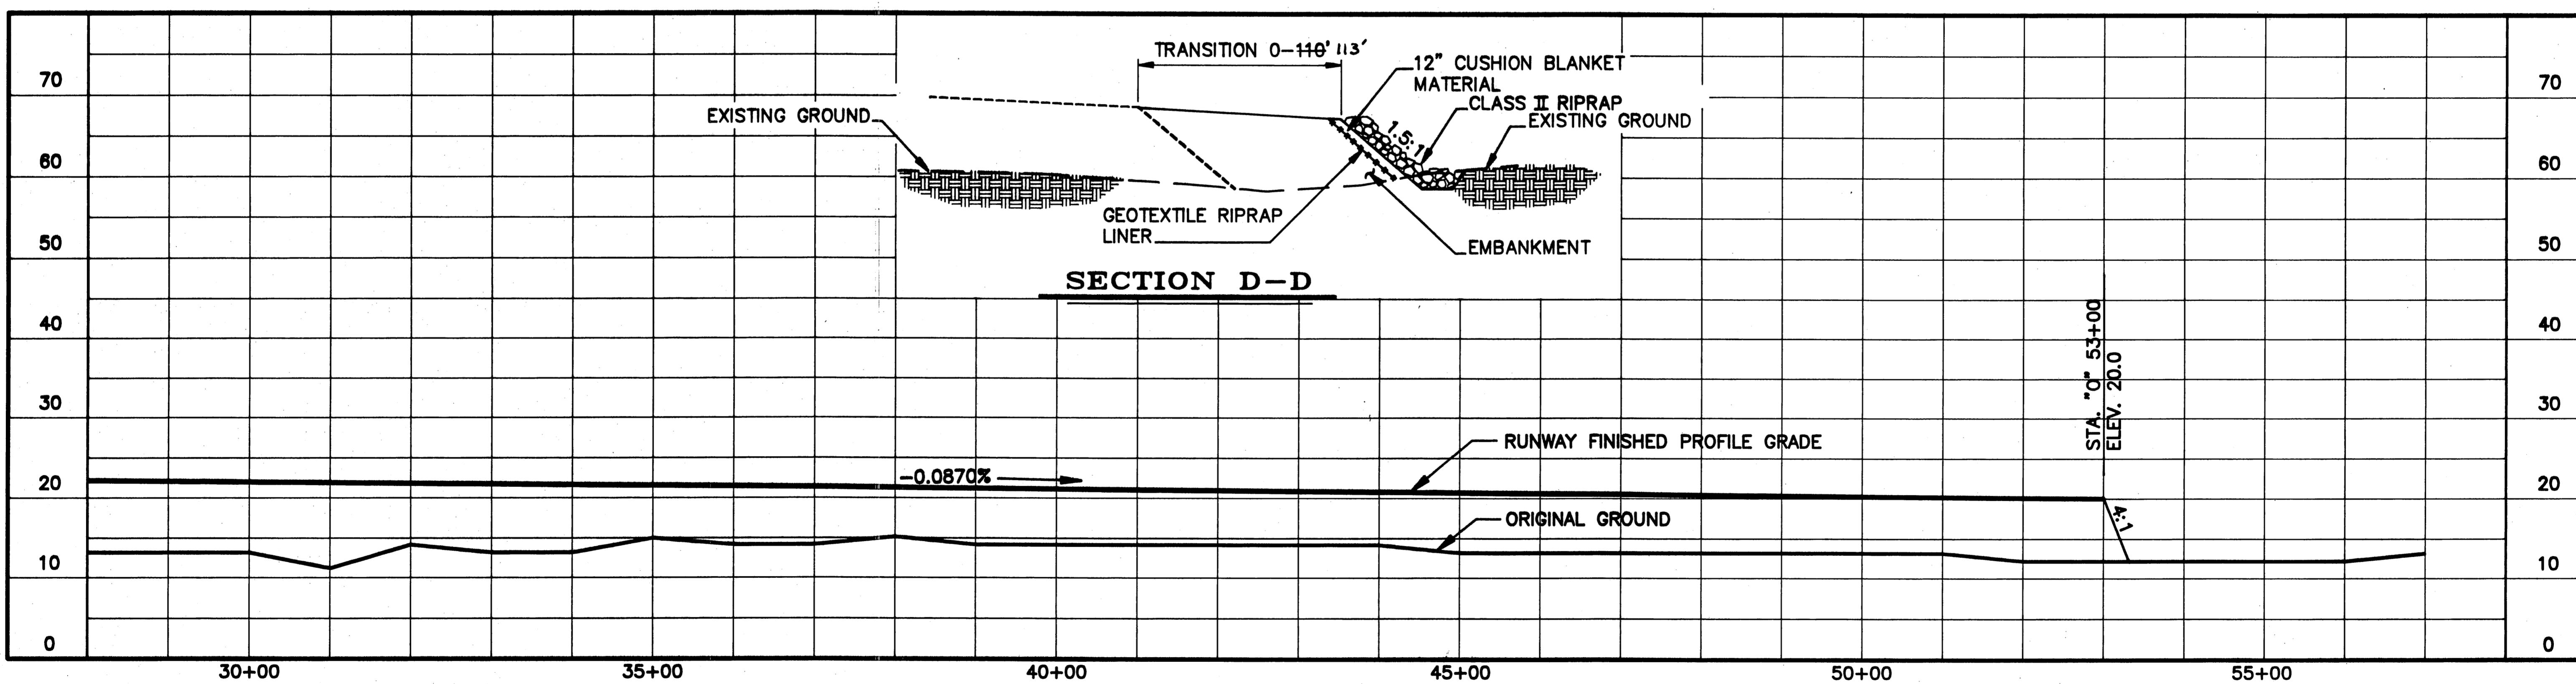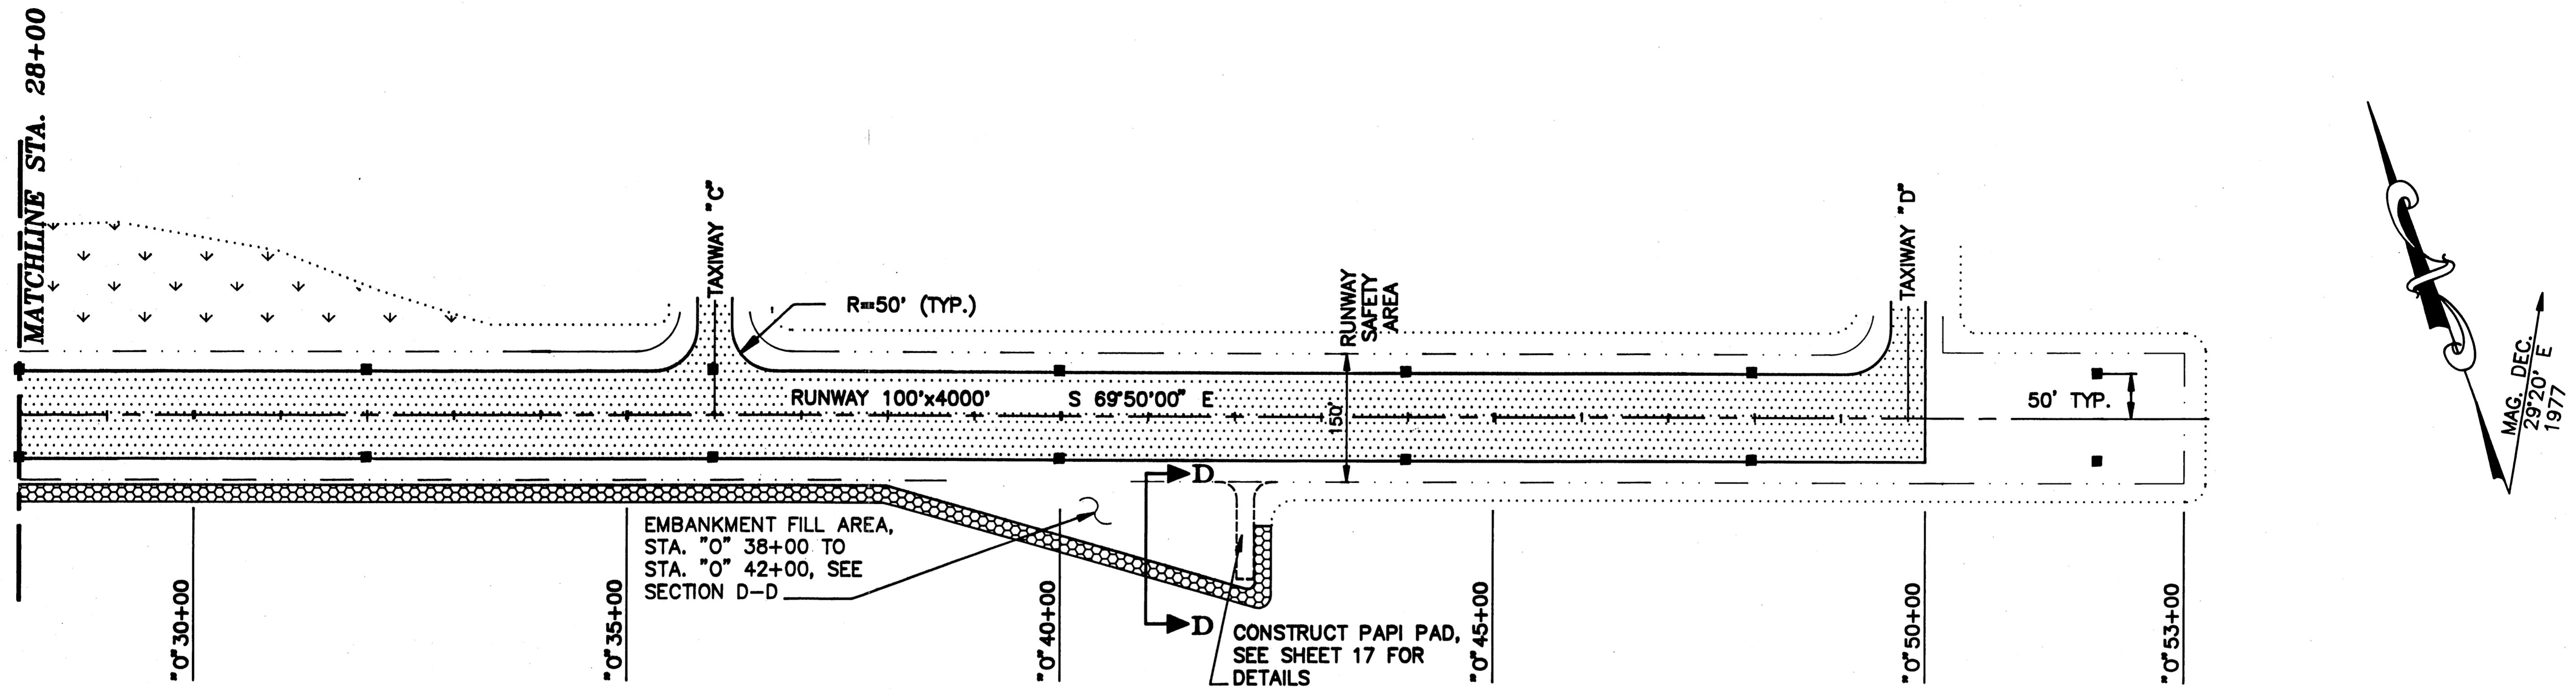

AS-BUILT
B.F. 2-9-96

BY:	DATE:	DESCRIPTION OF CHANGE:

RECORD OF REVISIONS


STATE OF ALASKA
DEPARTMENT OF TRANSPORTATION
AND PUBLIC FACILITIES
SOUTHEAST REGION DESIGN & CONSTRUCTION

HAINES AIRPORT
RUNWAY PLAN AND PROFILE


DESIGNED BY:
T.W. MOORE
PROJECT No.
69523

DRAWN BY:
AutoCAD / B.W.B.
DATE:
AUGUST 1990

CHECKED BY:
C. HAKARI
SHEET 8 OF 39

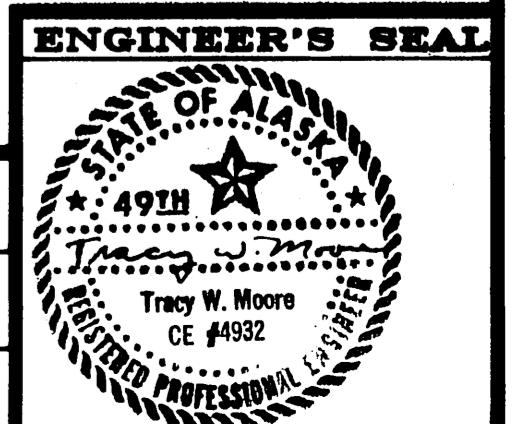



TYPICAL SECTION NOTES :

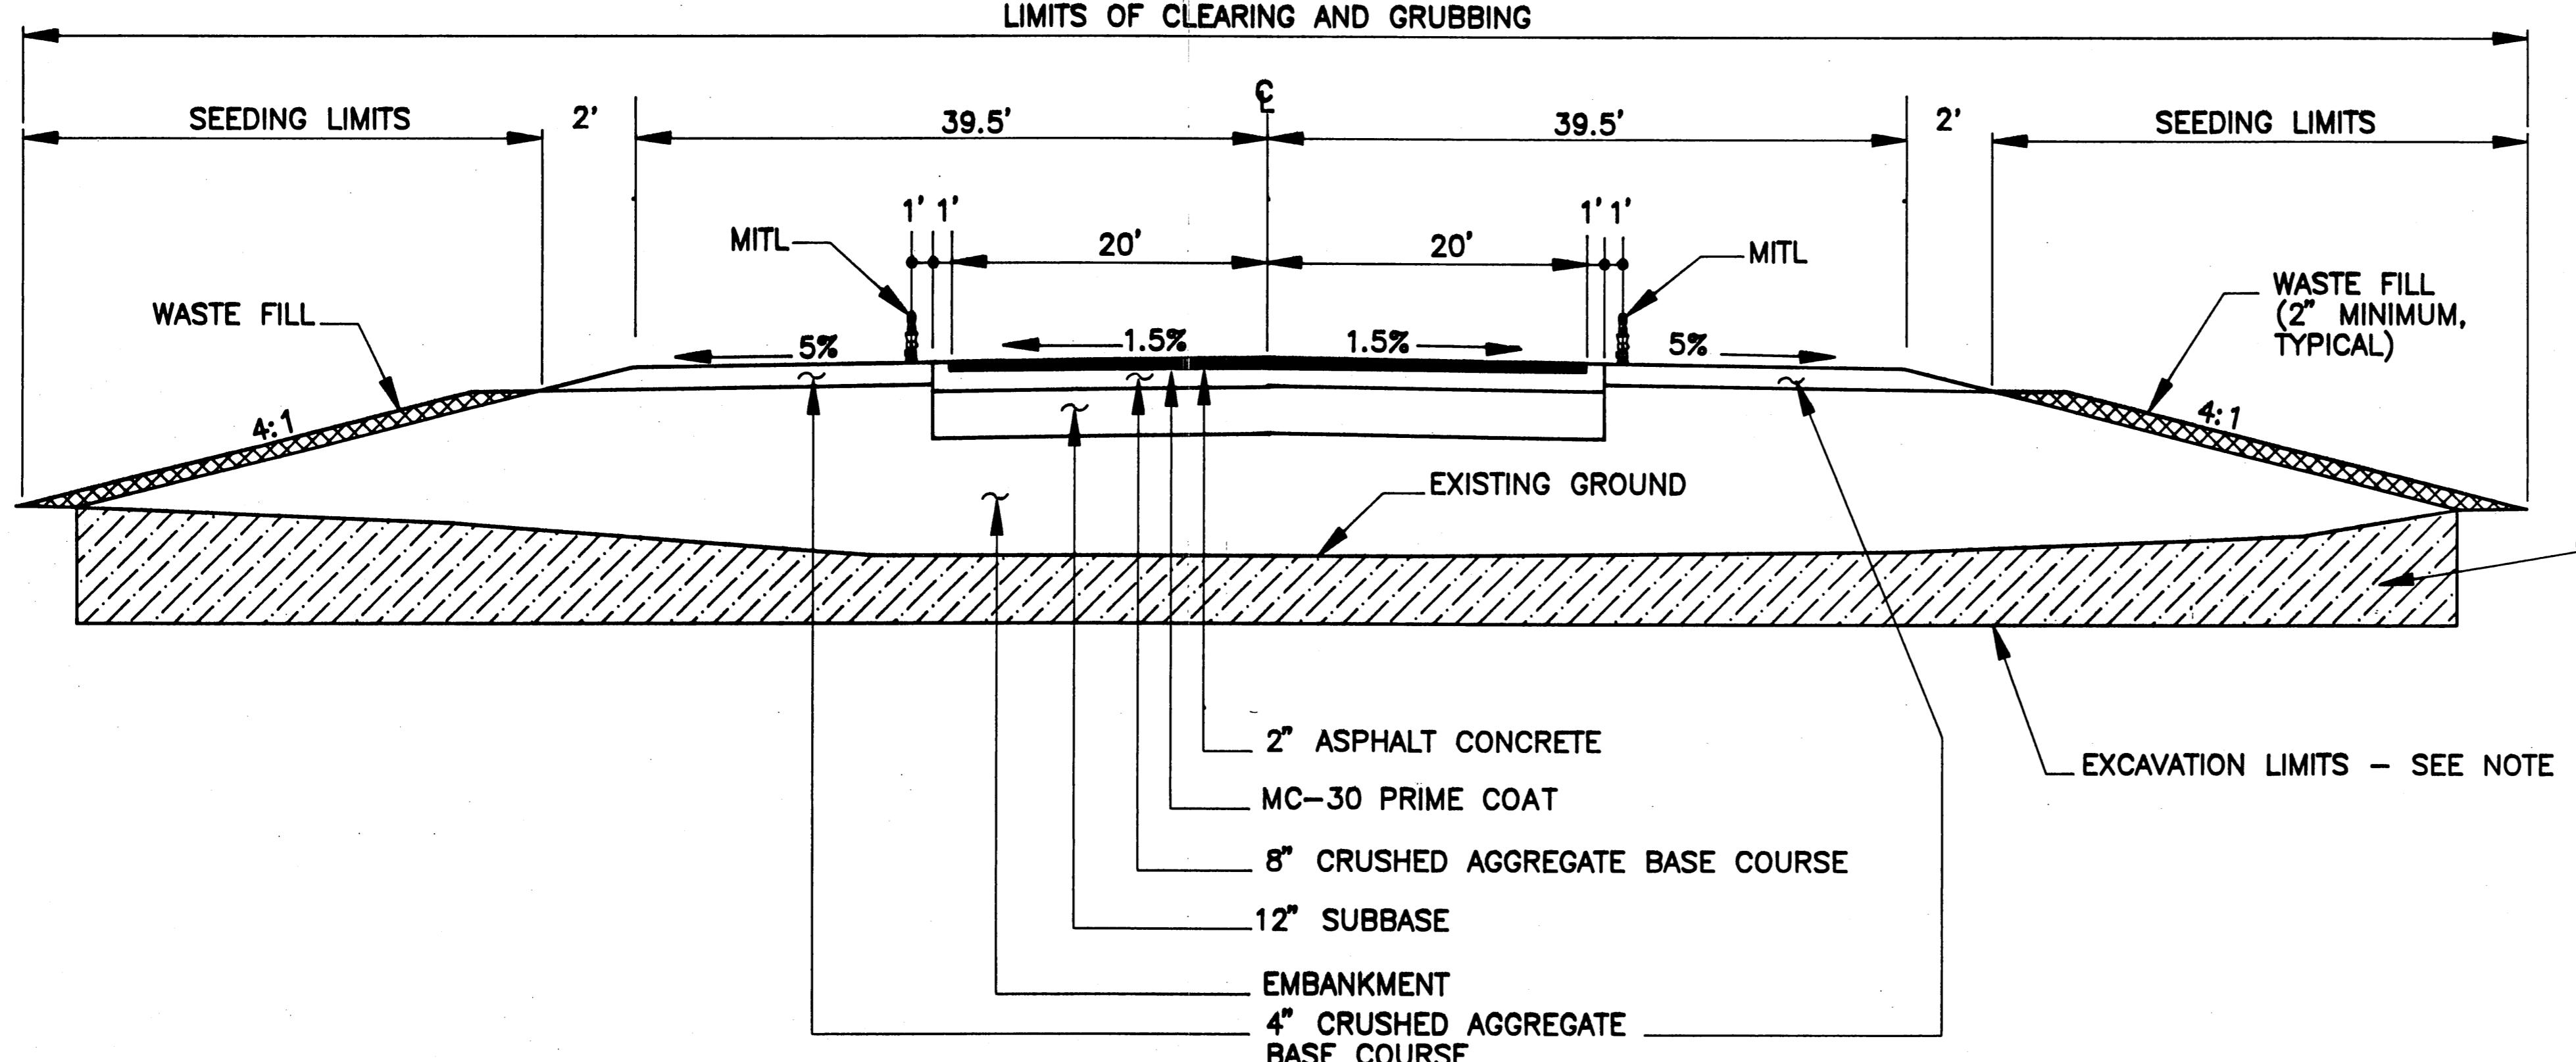

- ① EXCAVATION DEPTH VARIES AND WILL BE THE LIMITS OF ORGANIC SOILS OR AS DIRECTED BY THE ENGINEER.

TAXIWAY

A, B, C, & D

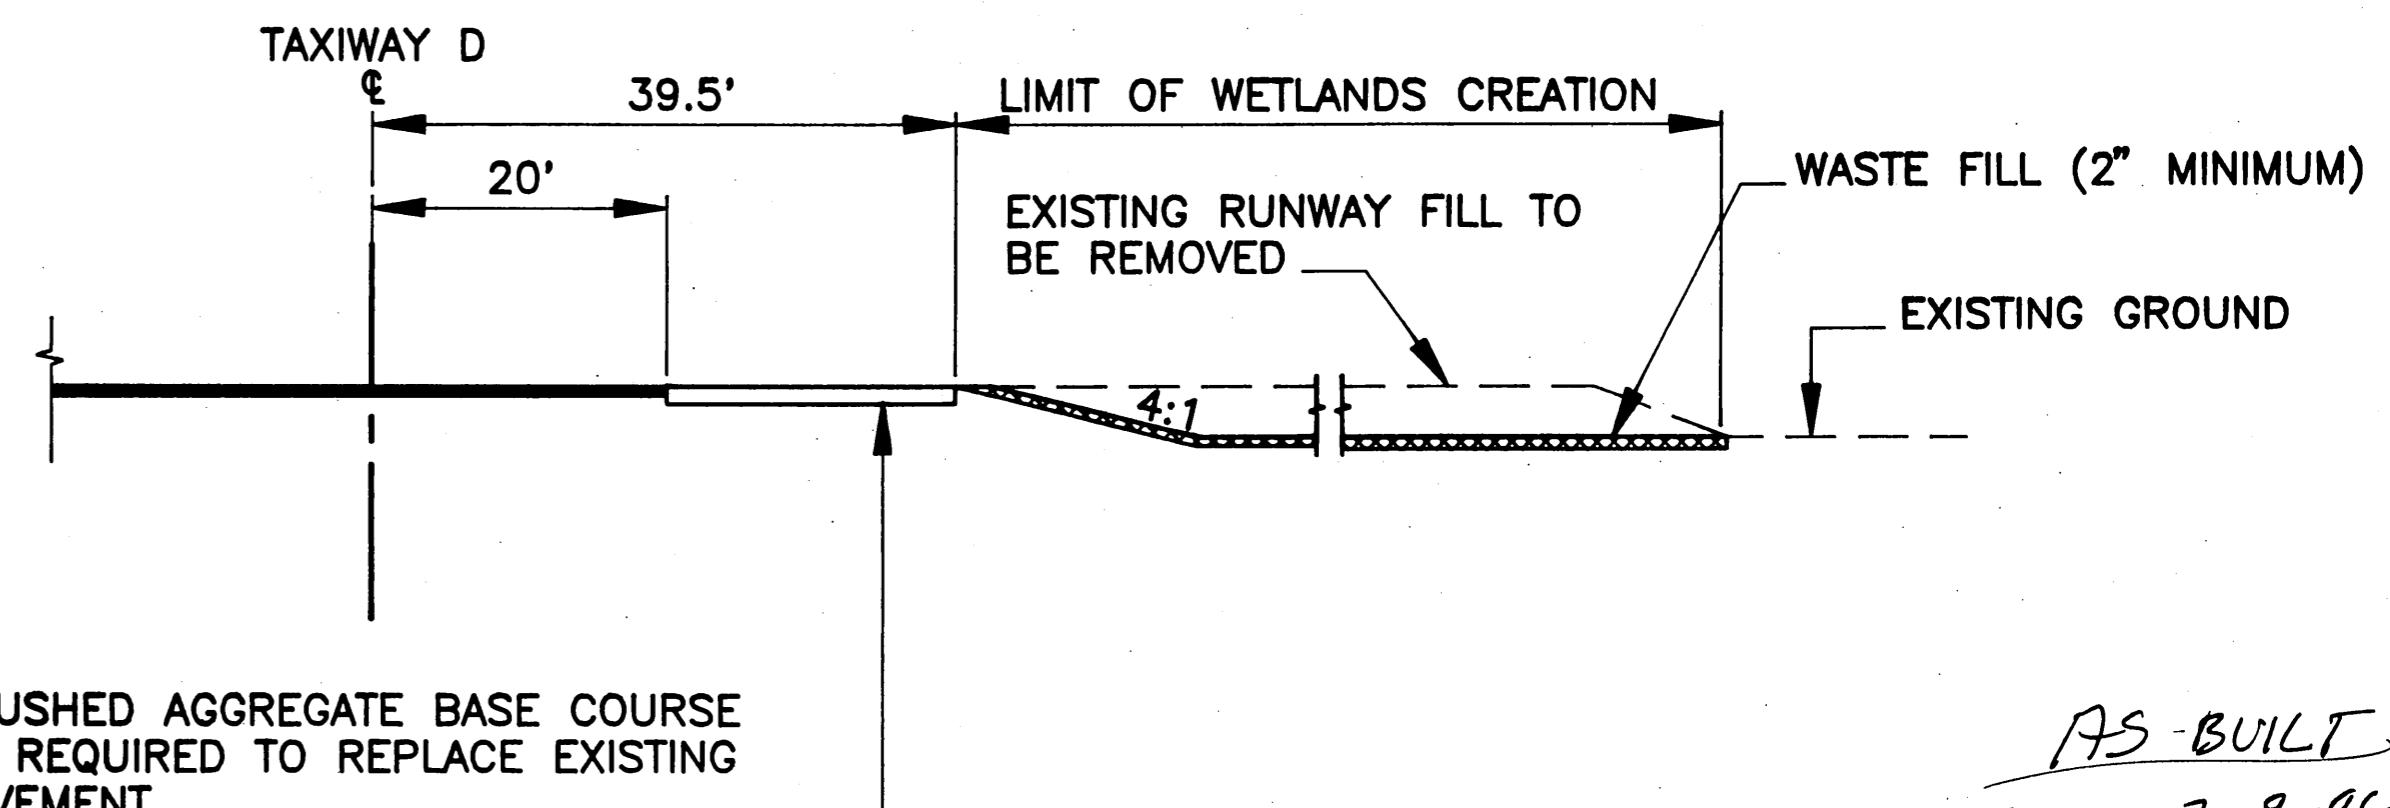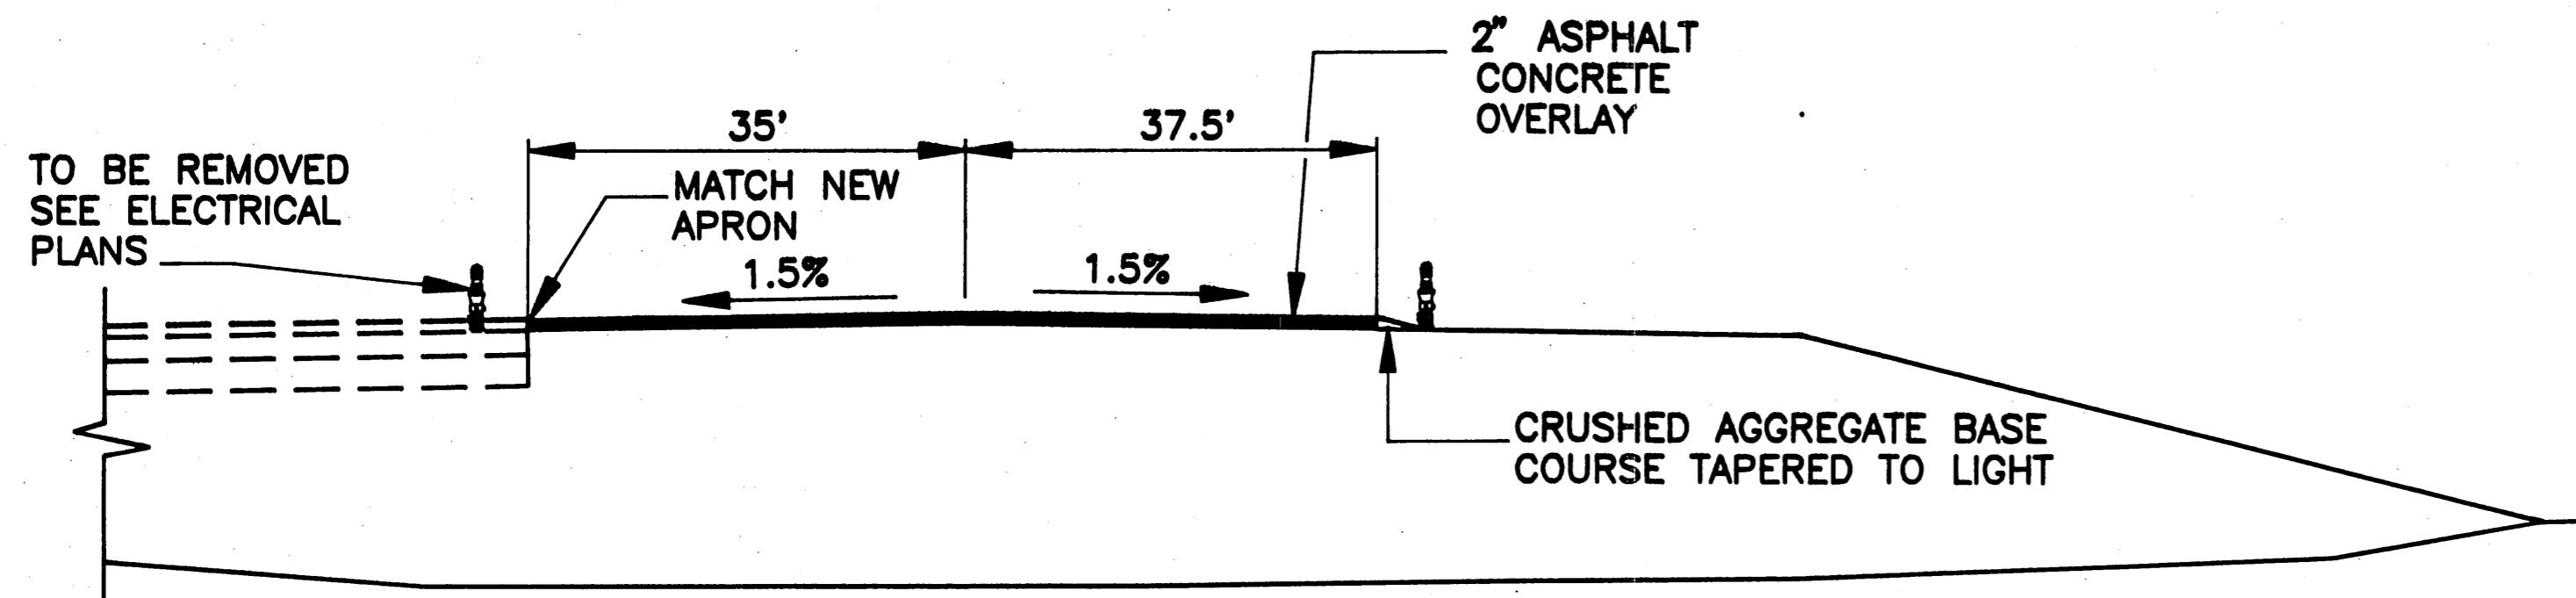

TAXIWAY

STA. "T" 11+00 TO STA. "T" 21+00

SECTION D-D

SEE SHEET 10 FOR PLAN VIEW

AS BUILT
B.A. 2-9-96


BY:	DATE:	DESCRIPTION OF CHANGE:



RECORD OF REVISIONS

STATE OF ALASKA
DEPARTMENT OF TRANSPORTATION
AND PUBLIC FACILITIES
SOUTHEAST REGION DESIGN & CONSTRUCTION

HAINES AIRPORT
TAXIWAY TYPICAL SECTION

DESIGNED BY: T.W. MOORE	PROJECT No. 69523
DRAWN BY: AutoCAD / B.W.B.	DATE: AUGUST 1990
CHECKED BY: C. HAKARI	SHEET 9 OF 39

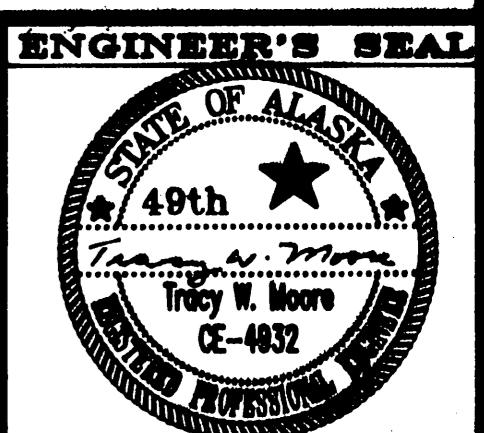

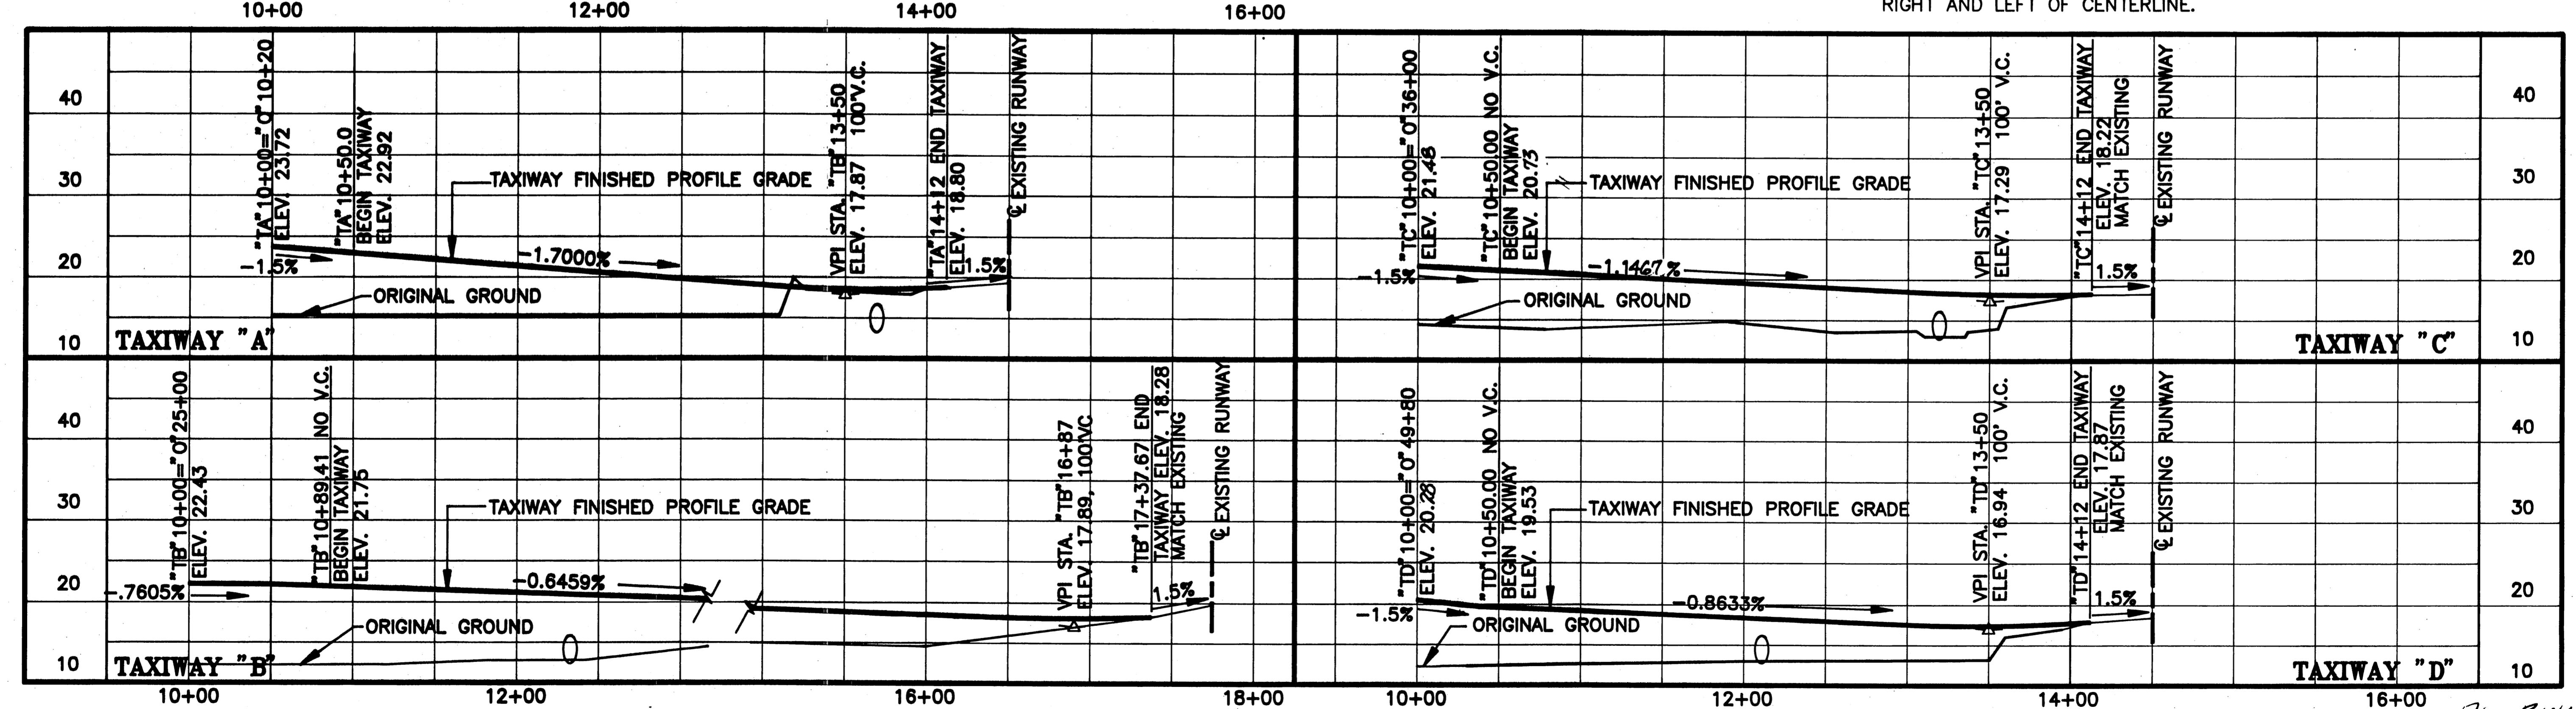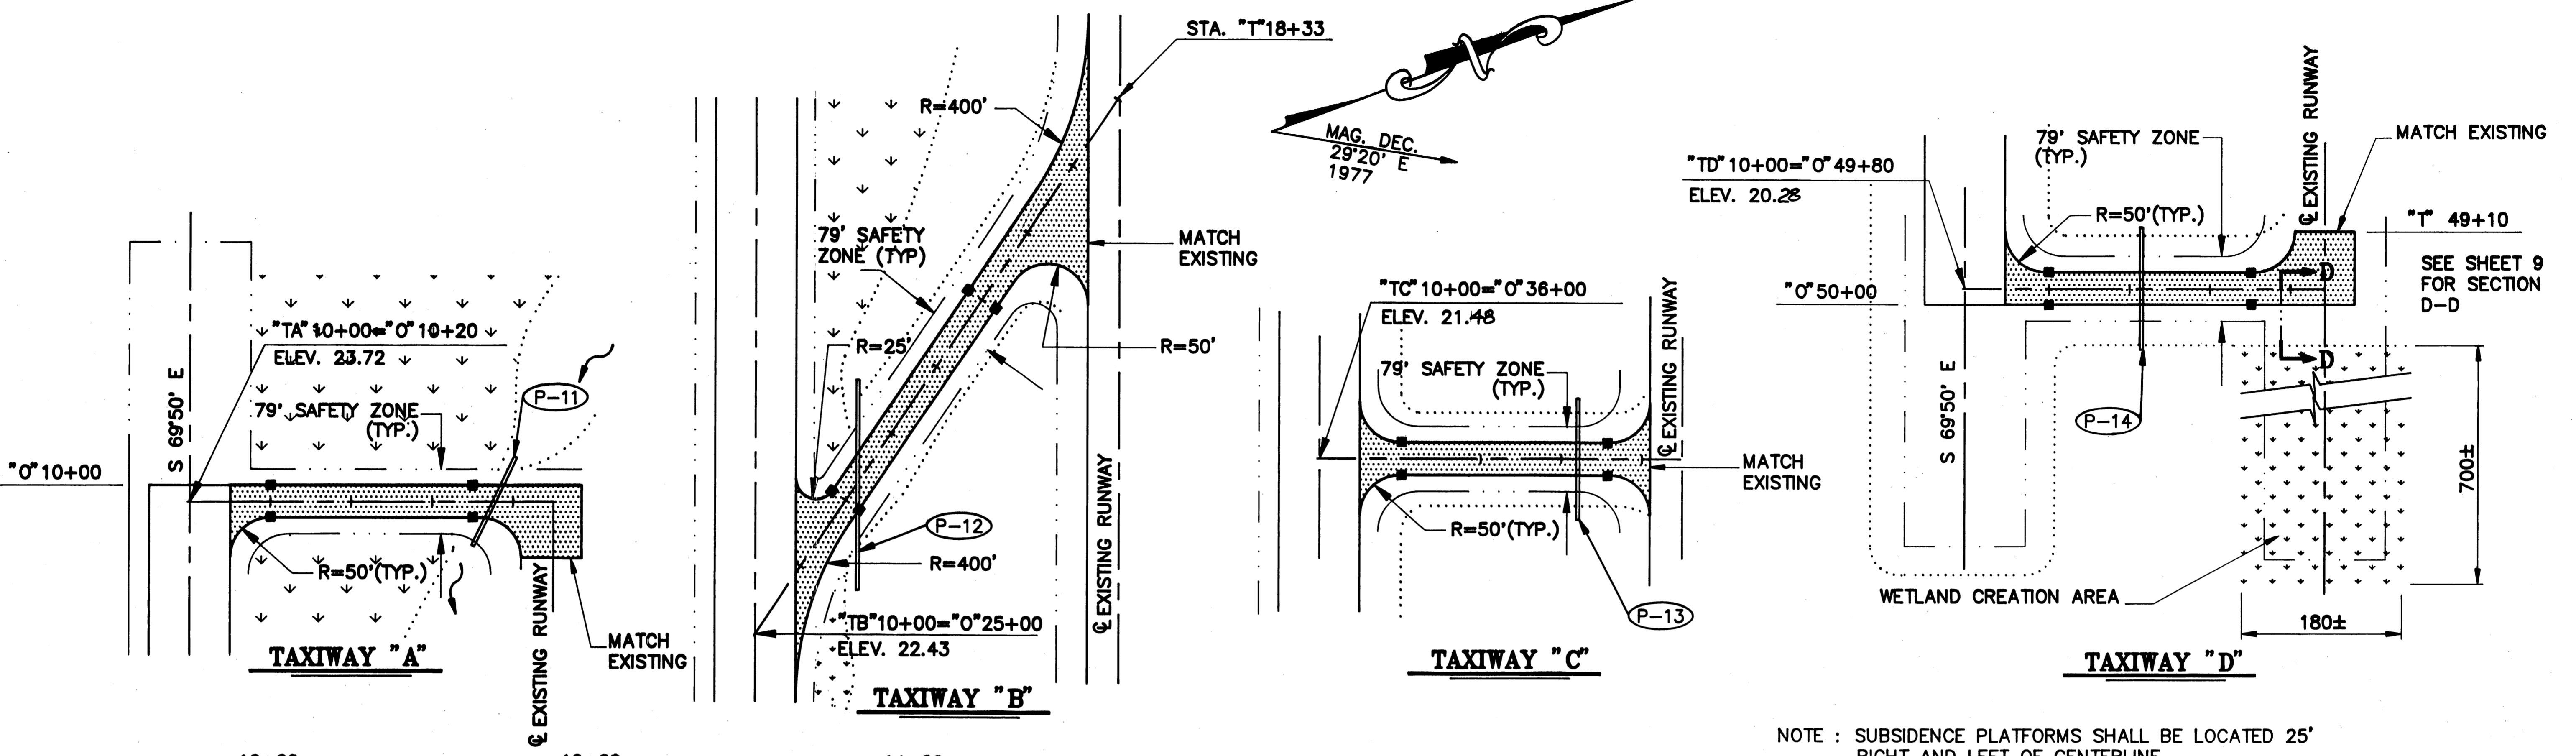


RECORD OF REVISIONS	DATE	DESCRIPTION OF CHANGE:


STATE OF ALASKA
DEPARTMENT OF TRANSPORTATION
AND PUBLIC FACILITIES
SOUTHEAST REGION DESIGN & CONSTRUCTION

HAINES AIRPORT
TAXIWAYS PLAN AND PROFILE

DESIGNED BY: T.W. MOORE PROJECT No. 60523
DRAWN BY: AutoCAD / B.W.B. DATE: AUGUST 1990
CHECKED BY: C. HAKARI SHEET 10 OF 39

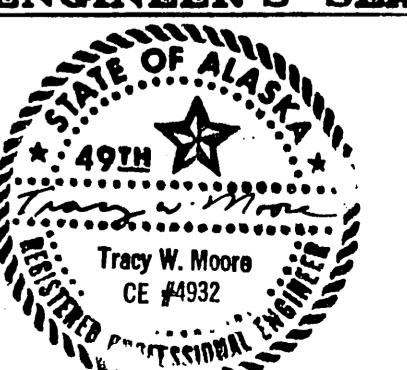


AS-BUILT
3.A. 2-9-96

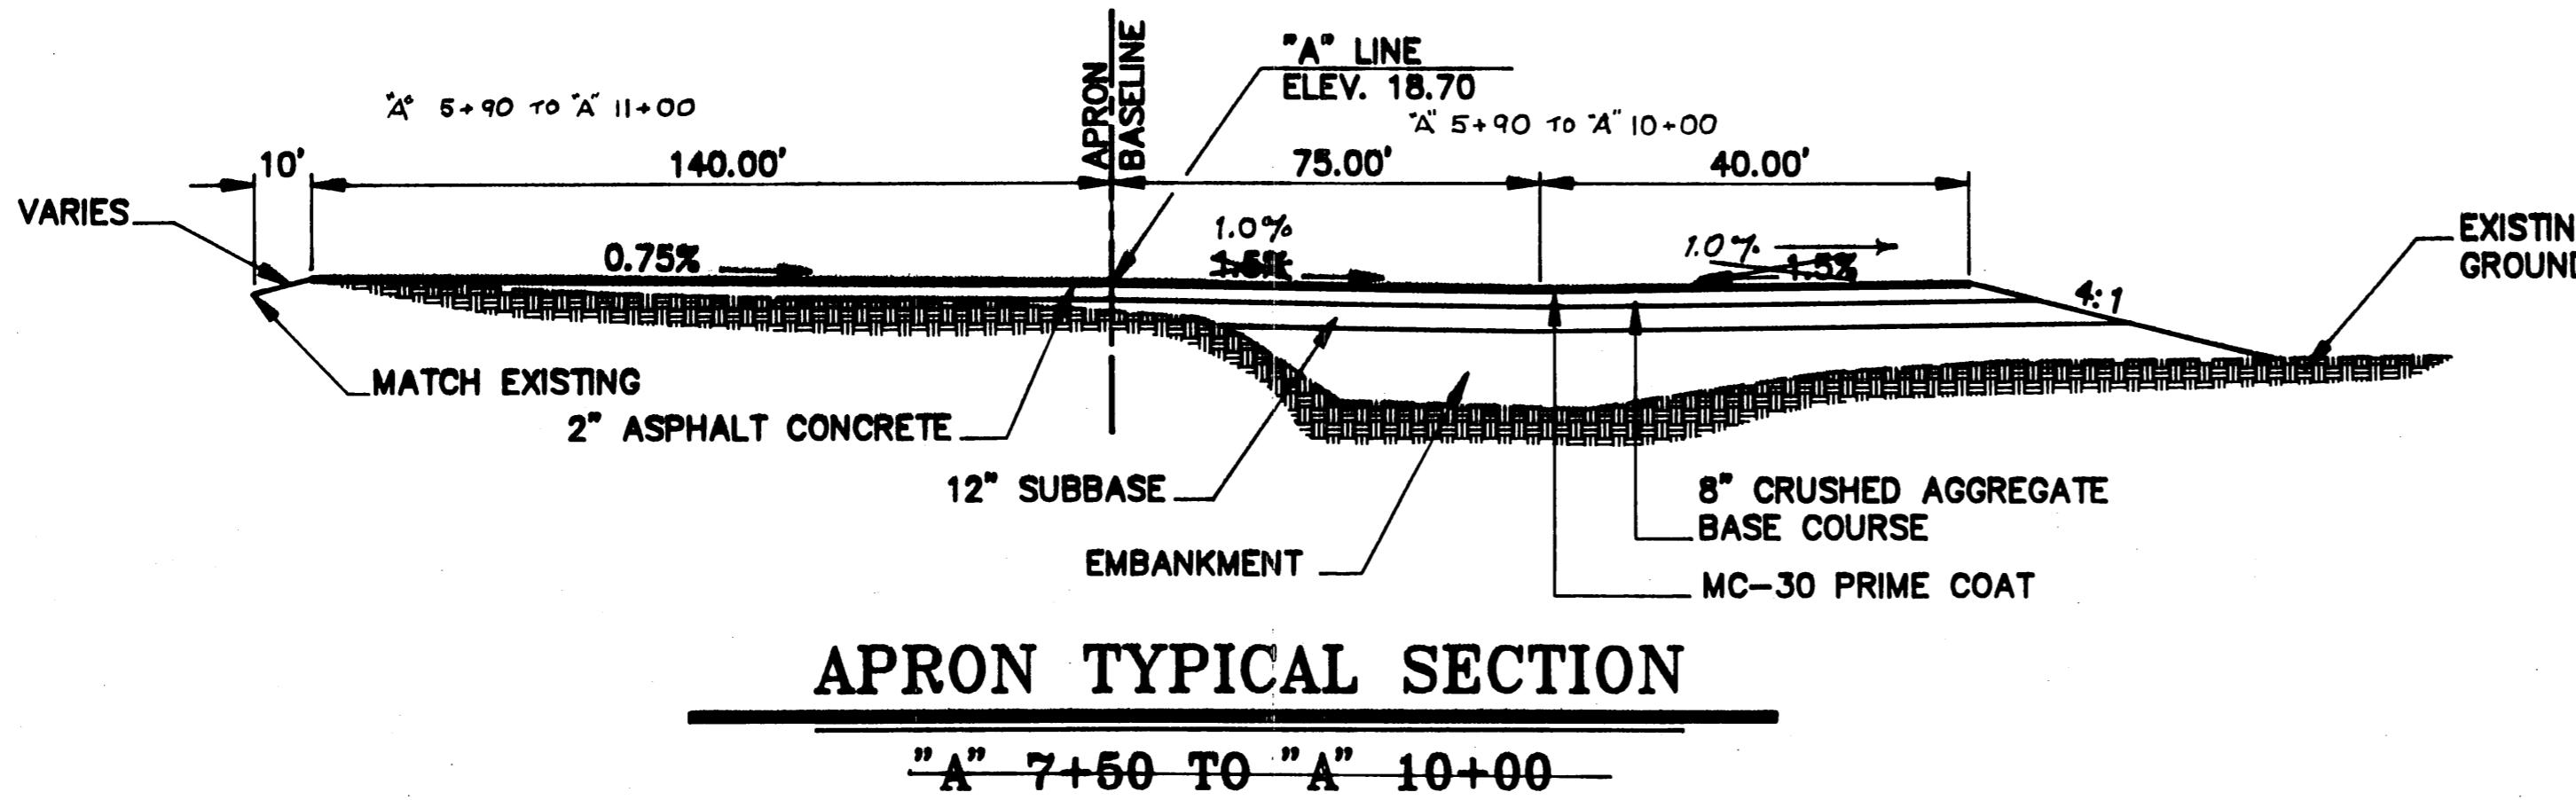

APRON TYPICAL SECTION

~~"A" 7+50 TO "A" 10+00~~

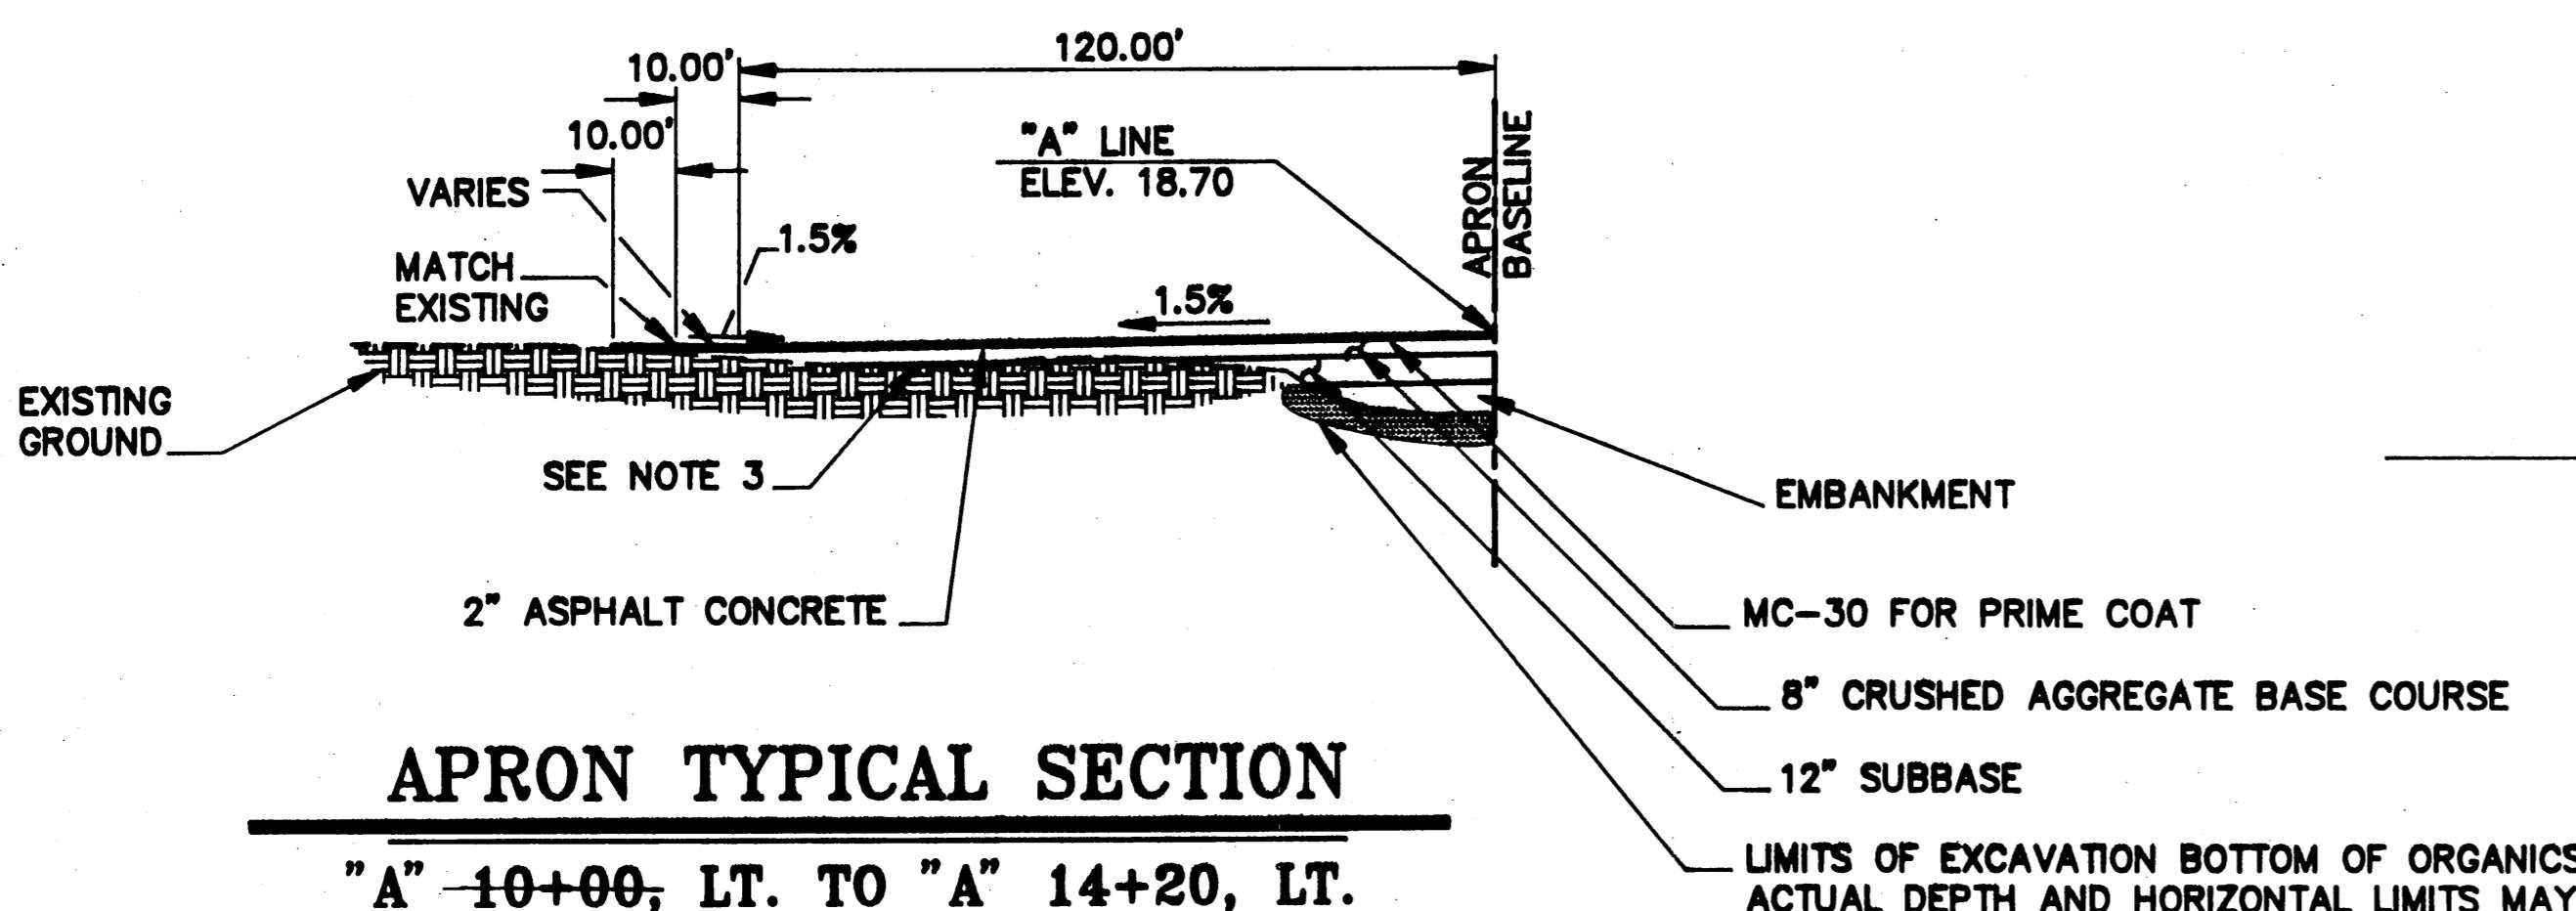

APRON TYPICAL SECTION

"A" - ~~10+00~~, LT. TO "A" 14+20, LT.

PROPOSED PARKING AREA, SEE SHT. 14

EXISTING GROUND

"A" LINE ELEV. 18.70

APRON BASFINE


1.5%

1.0%

SEE NOTE 3


APRON TYPICAL SECTION

"A" 14+20, LT. TO "A" 19+51, LT.

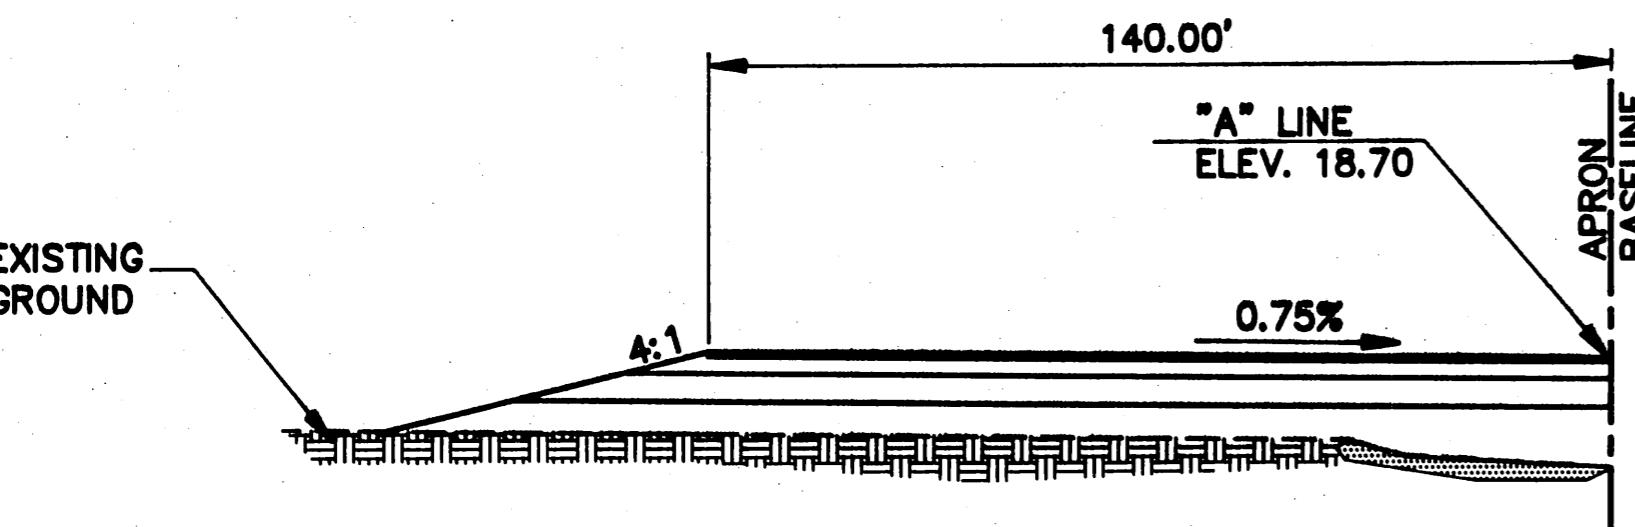

APRON TYPICAL SECTION

"A" 19+51, LT. TO "A" 21+00, LT.

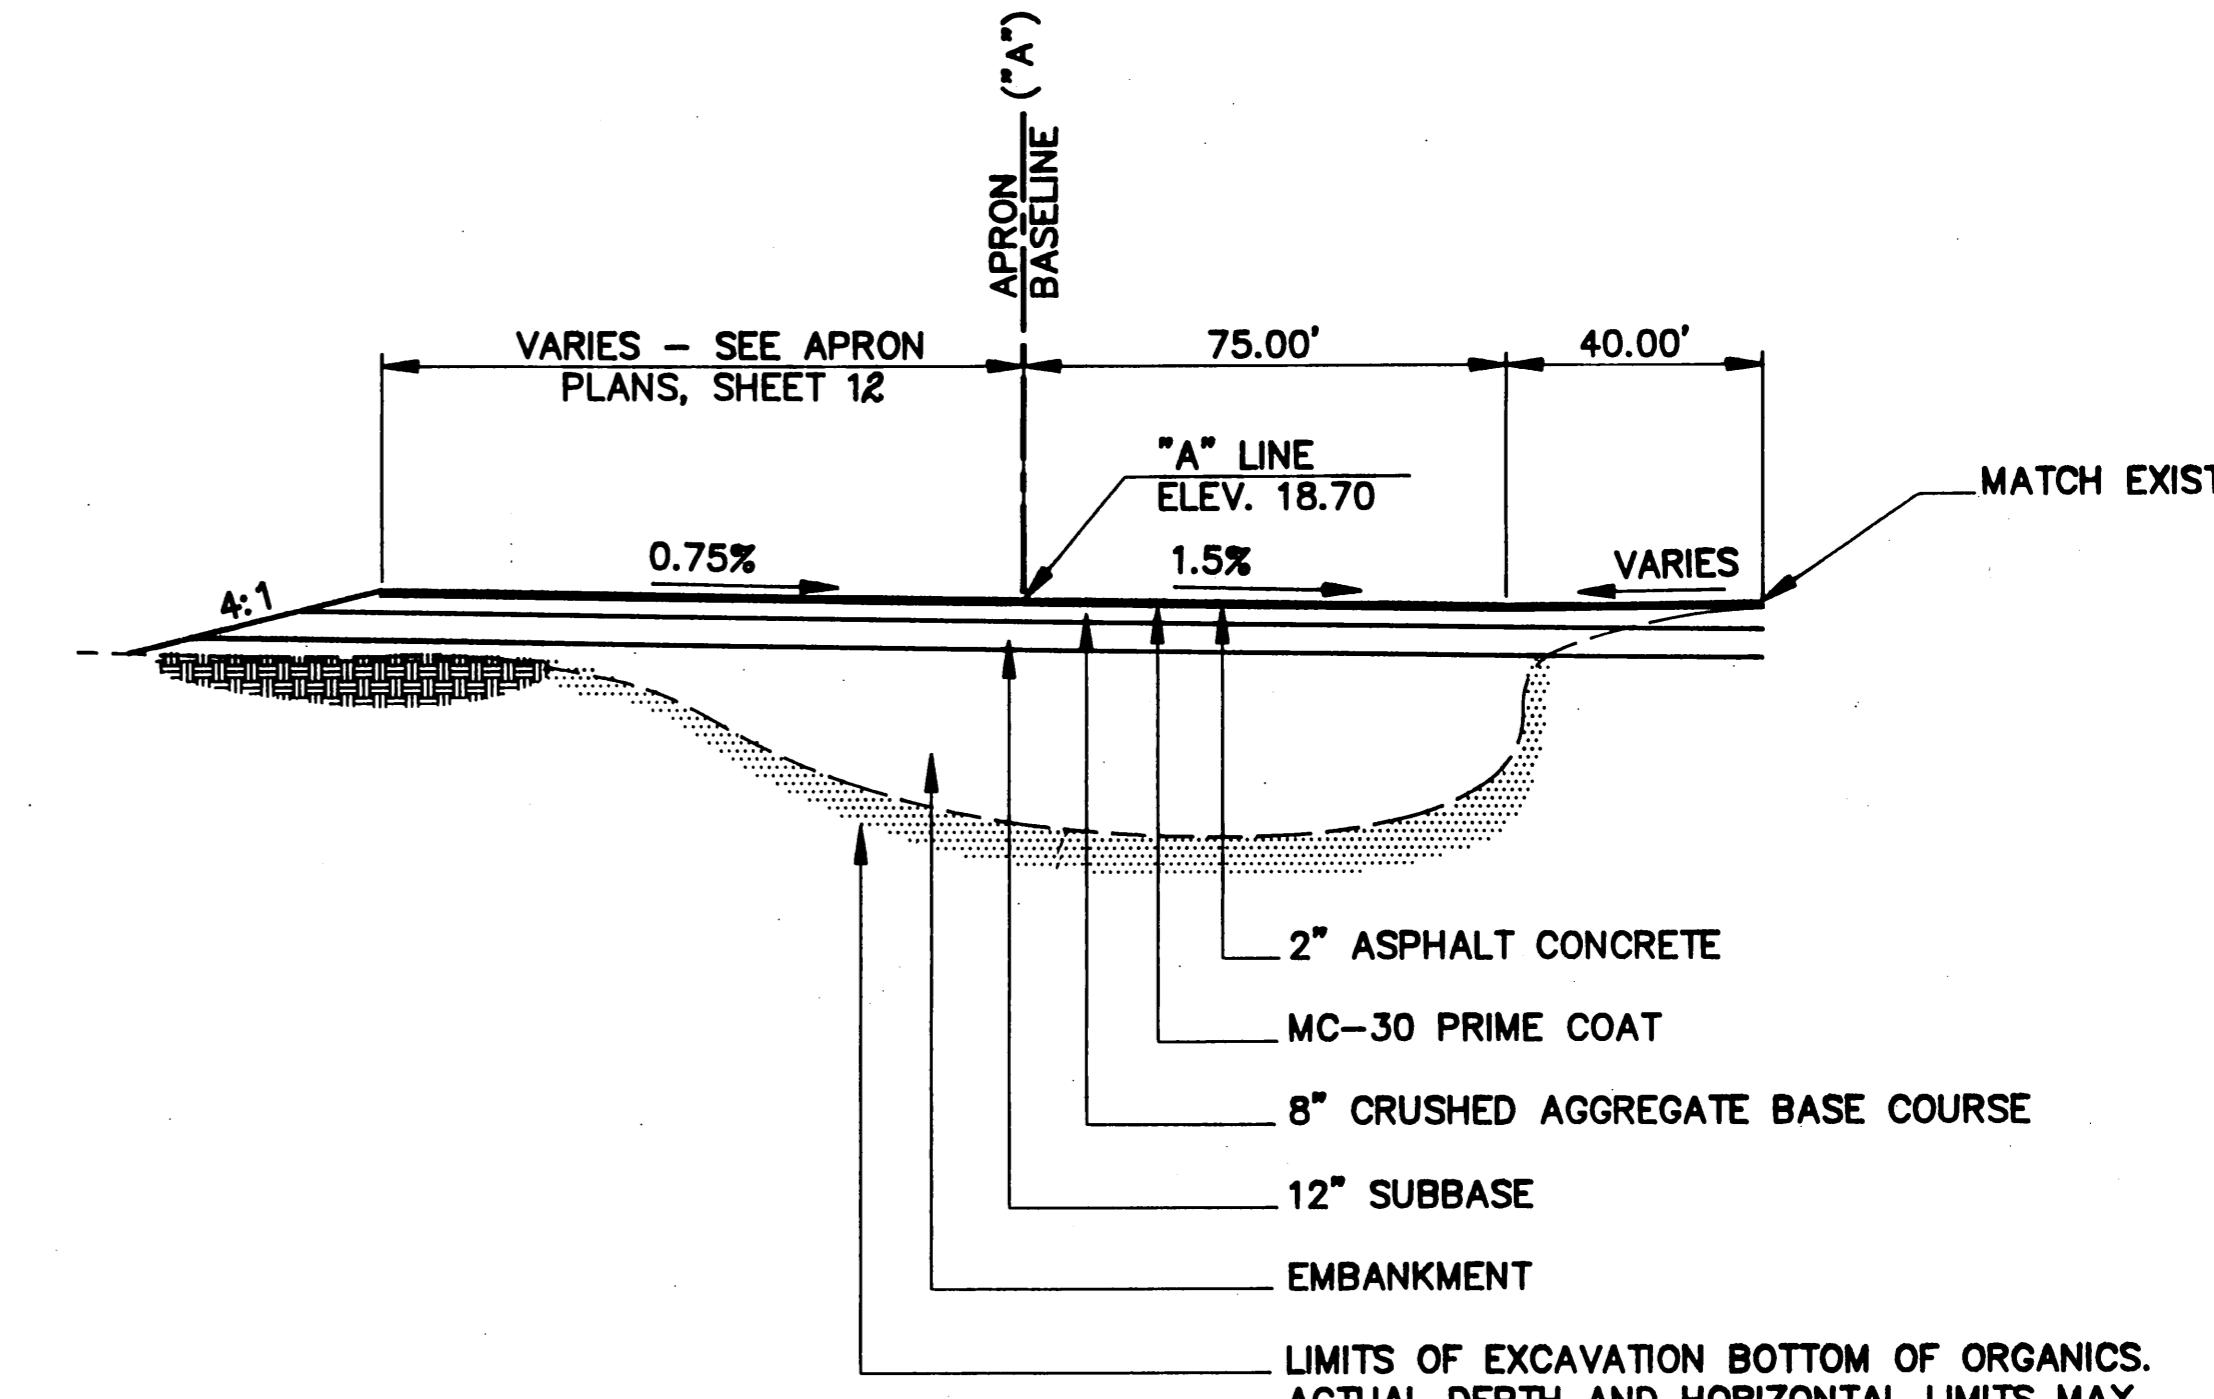


HELIPAD TYPICAL SECTION

"A" 21+00 TO "A" 31+00

NOTES

1. ACTUAL LIMITS OF ASPHALT CONCRETE, PRIME COAT AND CRUSHED AGGREGATE BASE COURSE VARY. SEE APRON PLANS ON SHEET 12 FOR PAVING LIMITS.
 2. TRANSITIONS BETWEEN TYPICALS SHALL BE 100 FEET.
 3. EXCAVATION OF THE EXISTING TAXIWAY AND APRON IS NOT REQUIRED FOR OBTAINING FULL DEPTH STRUCTURAL SECTION. BLEND NEW MATERIAL WITH EXISTING WHERE MATCHING INTO EXISTING STRUCTURAL SECTION.

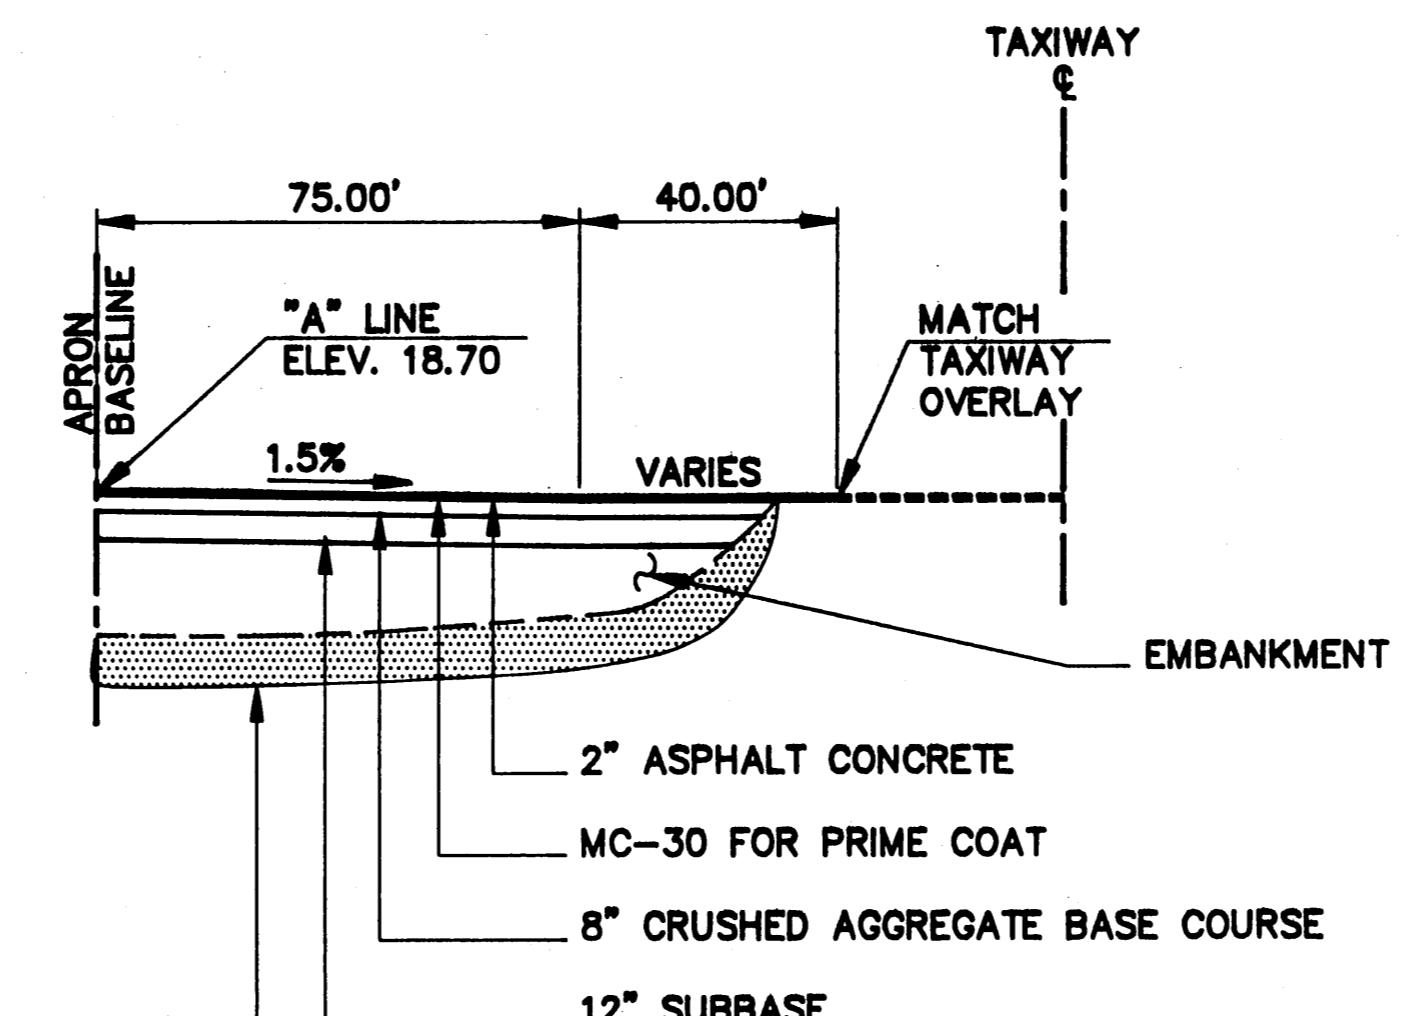

LIMITS OF EXCAVATION BOTTOM OF ORGANICS
ACTUAL DEPTH AND HORIZONTAL LIMITS MAY
VARY AS DIRECTED BY THE ENGINEER.



APRON TYPICAL SECTION

"A" 10+00, RT. TO "A" 21+00, RT.



**STATE OF ALASKA
DEPARTMENT OF TRANSPORTATION
AND PUBLIC FACILITIES
SOUTHEAST REGION DESIGN & CONSTRUCTION**

HAINES AIRPORT APRON TYPICAL SECTIONS

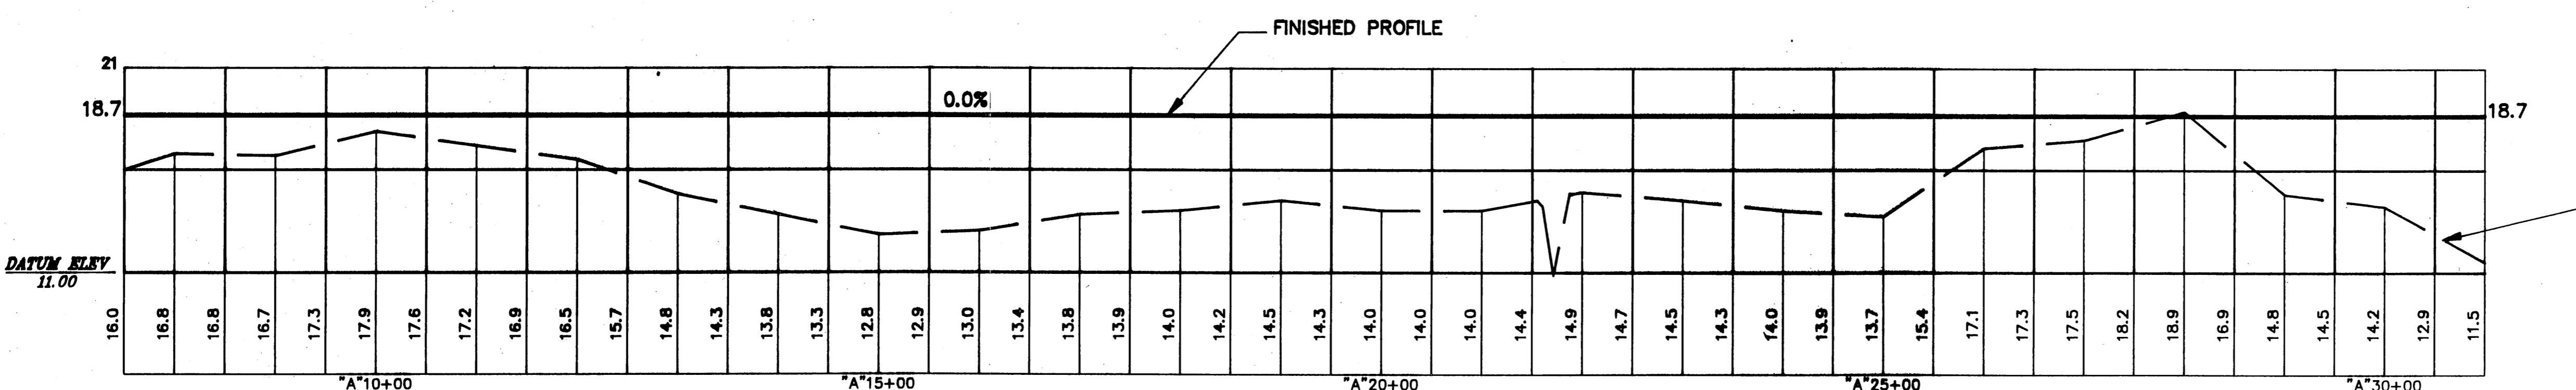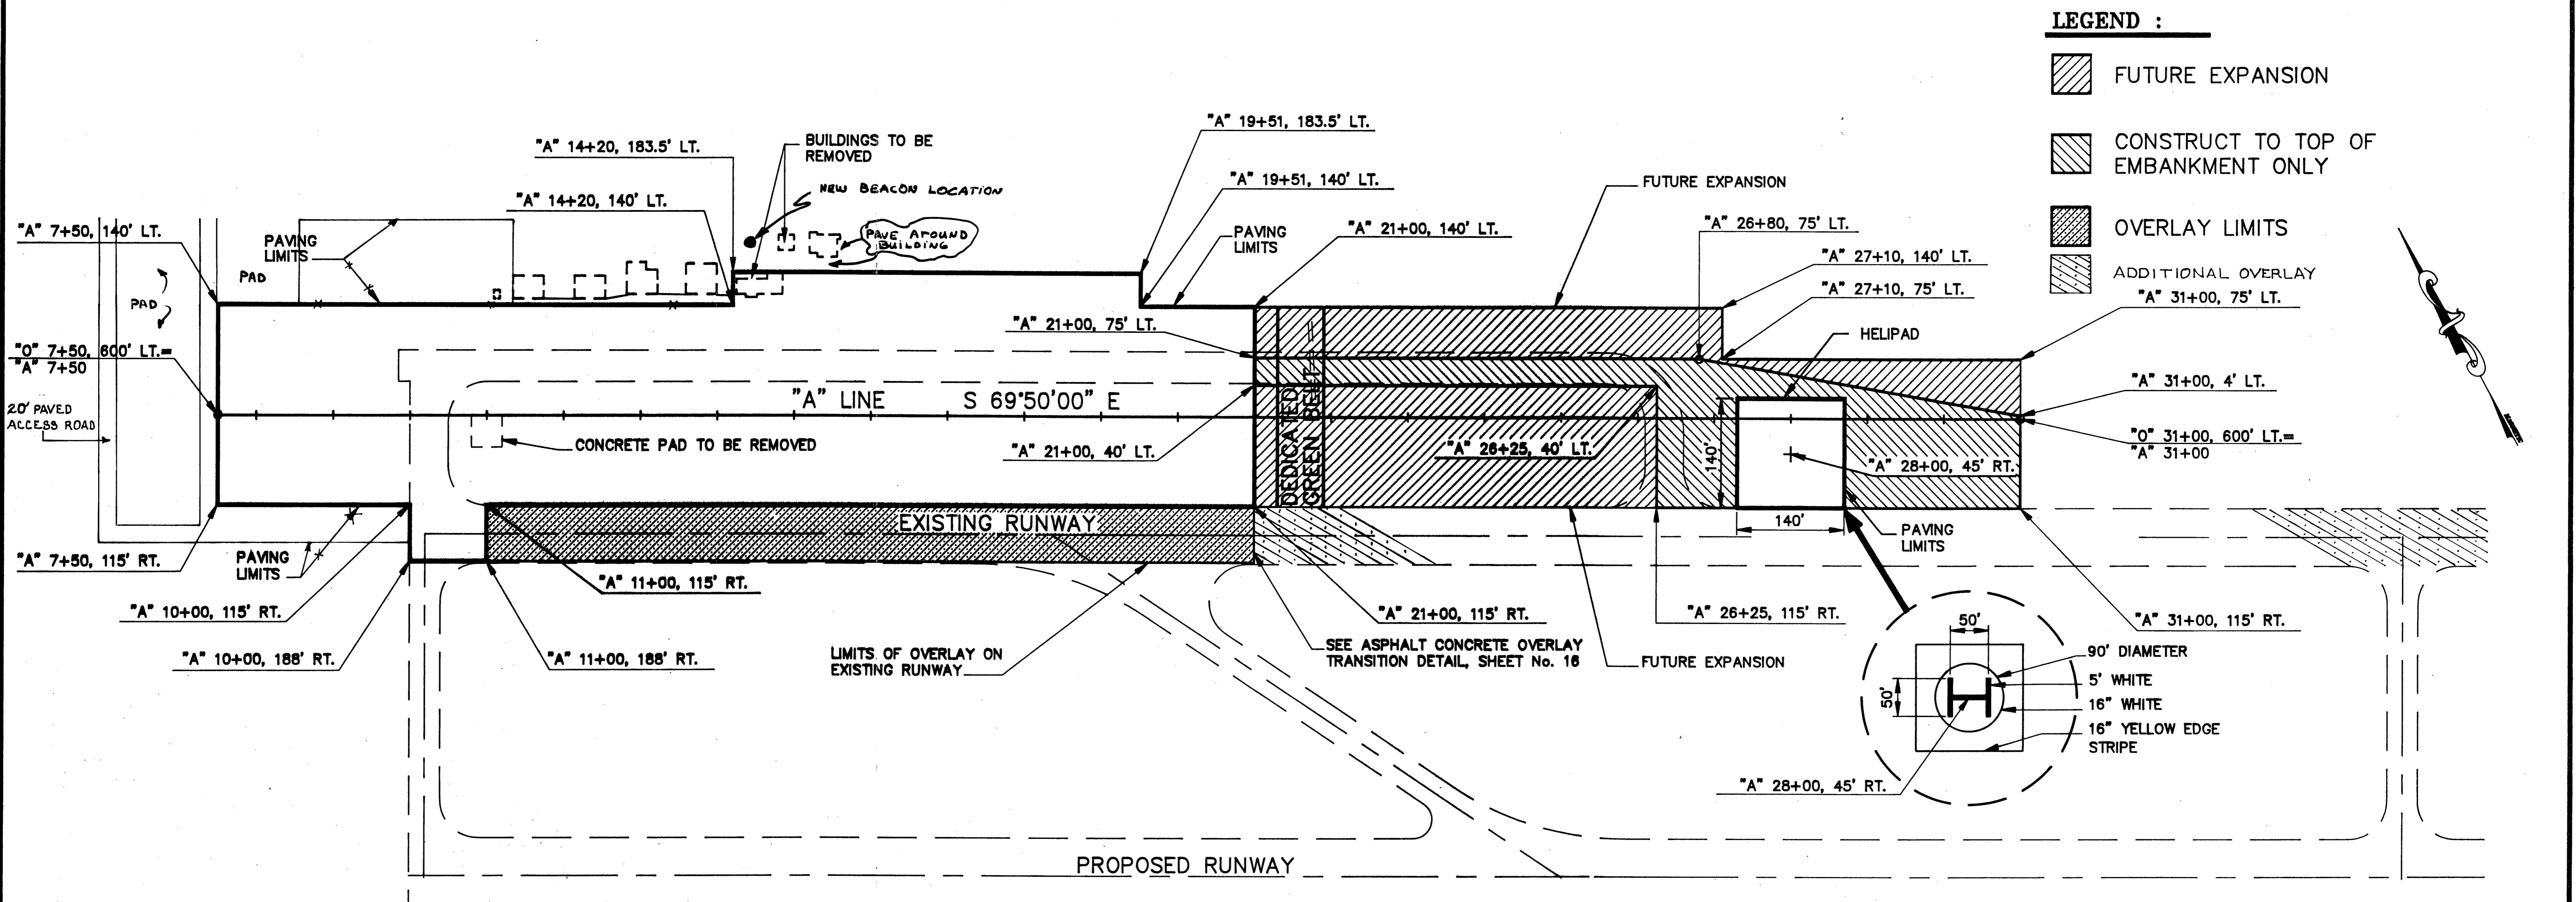

AS-BUILT


BY:	DATE:	DESCRIPTION OF CHANGE:



HAINES AIRPORT

APRON PLAN AND PROFILE


DESIGNED BY: C. HAKARI	PROJECT No. 69523
DRAWN BY: Autocad / B.W.B.	DATE: AUGUST 1990
CHECKED BY: C. HAKARI	SHEET 12 OF 39

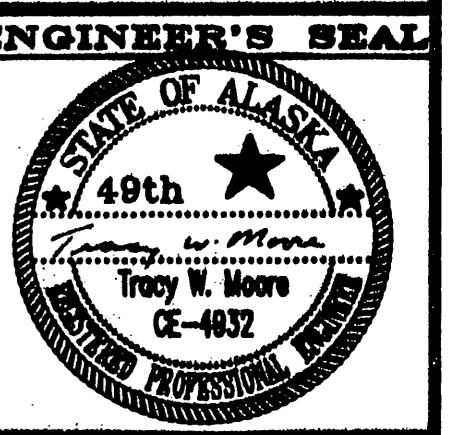

PAVING LIMITS
SEE SHEET #12


TERMINAL BUILDING

APRON PAVING LIMITS,
SEE SHEET 12

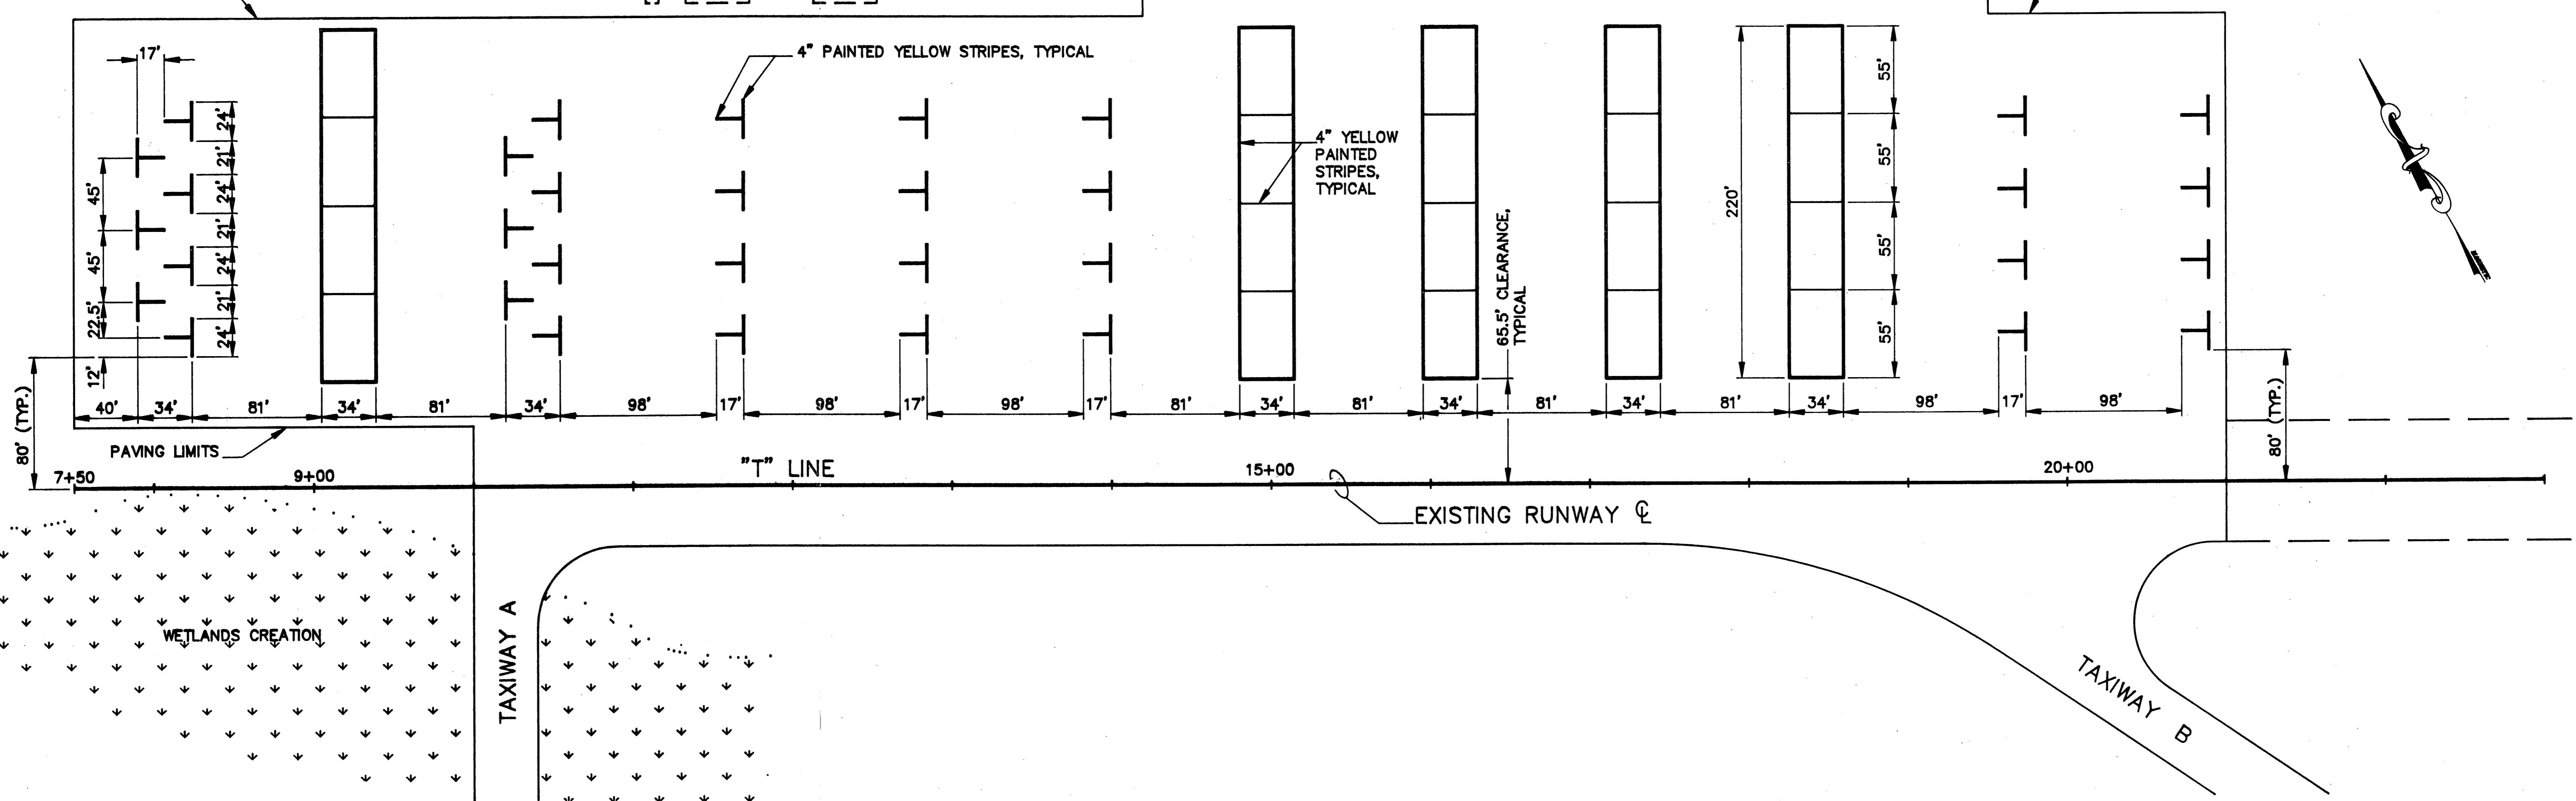


NOTES :

1. ALL LARGE AIR TAXI PARKING SPACES SHALL BE 34'x55'. NO TIE-DOWNS WILL BE PROVIDED.
2. ALL PARKING AND TIE-DOWN SPACES SHALL BE DELINEATED WITH 4 INCH YELLOW STRIPES.
3. CONTROL FOR THE TIE-DOWN PLAN SHALL BE THE TAXIWAY CENTERLINE, STATION "T" 7+90.

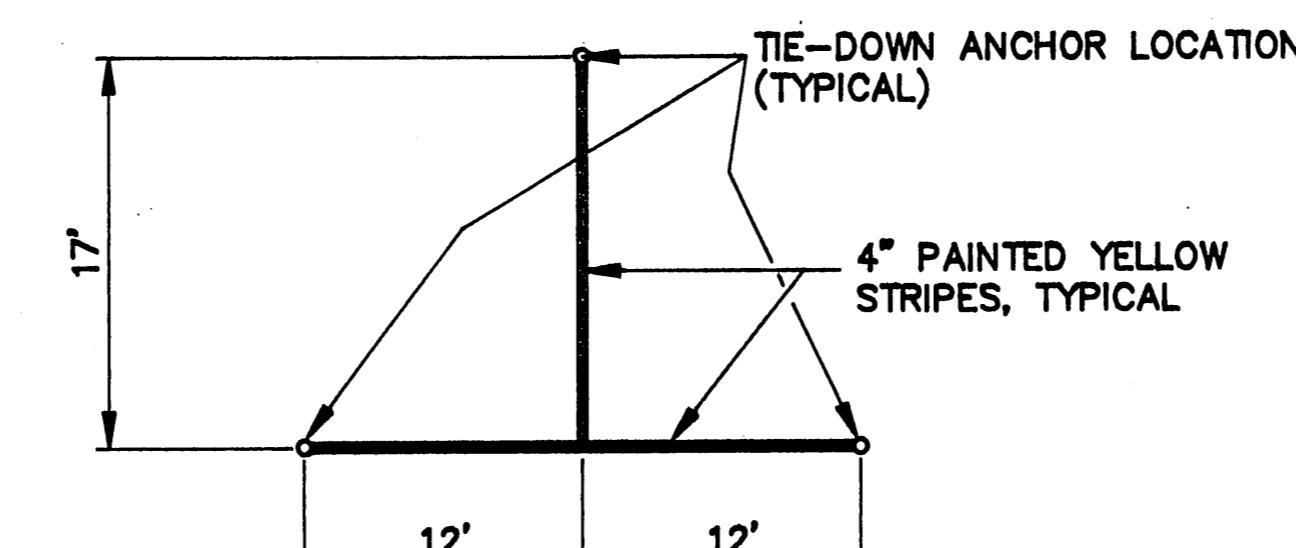

TIE-DOWN TYPICAL

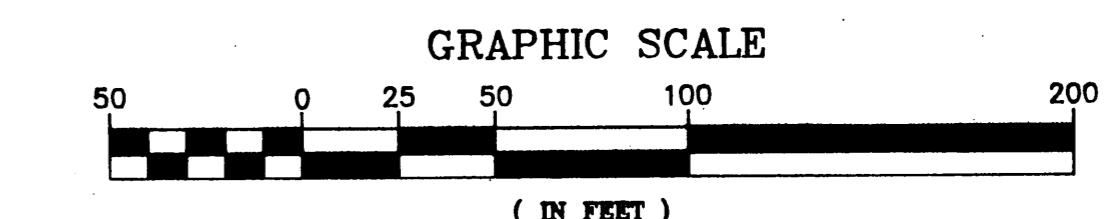

GRAPHIC SCALE
(IN FEET)

BY:	DATE:	DESCRIPTION OF CHANGE:


STATE OF ALASKA
DEPARTMENT OF TRANSPORTATION
AND PUBLIC FACILITIES
SOUTHEAST REGION DESIGN & CONSTRUCTION



HAINES AIRPORT
AIRPORT TIE-DOWN PLAN

DESIGNED BY:
T.W. MOORE
PROJECT No.
69523

DRAWN BY:
AutoCAD / B.W.B.
DATE:
AUGUST 1990

CHECKED BY:
C. HAKARI
SHEET 13 OF 39

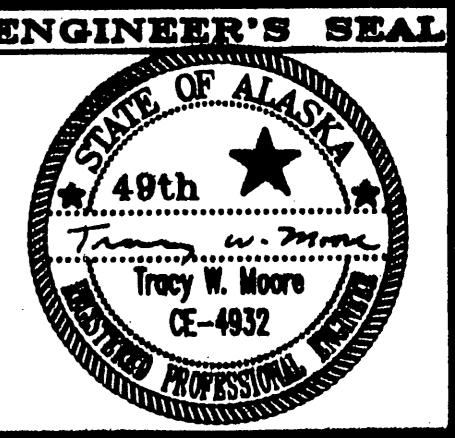


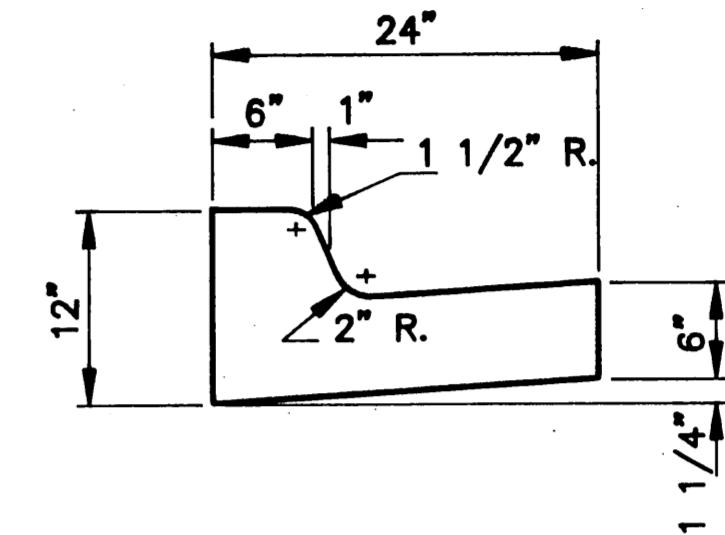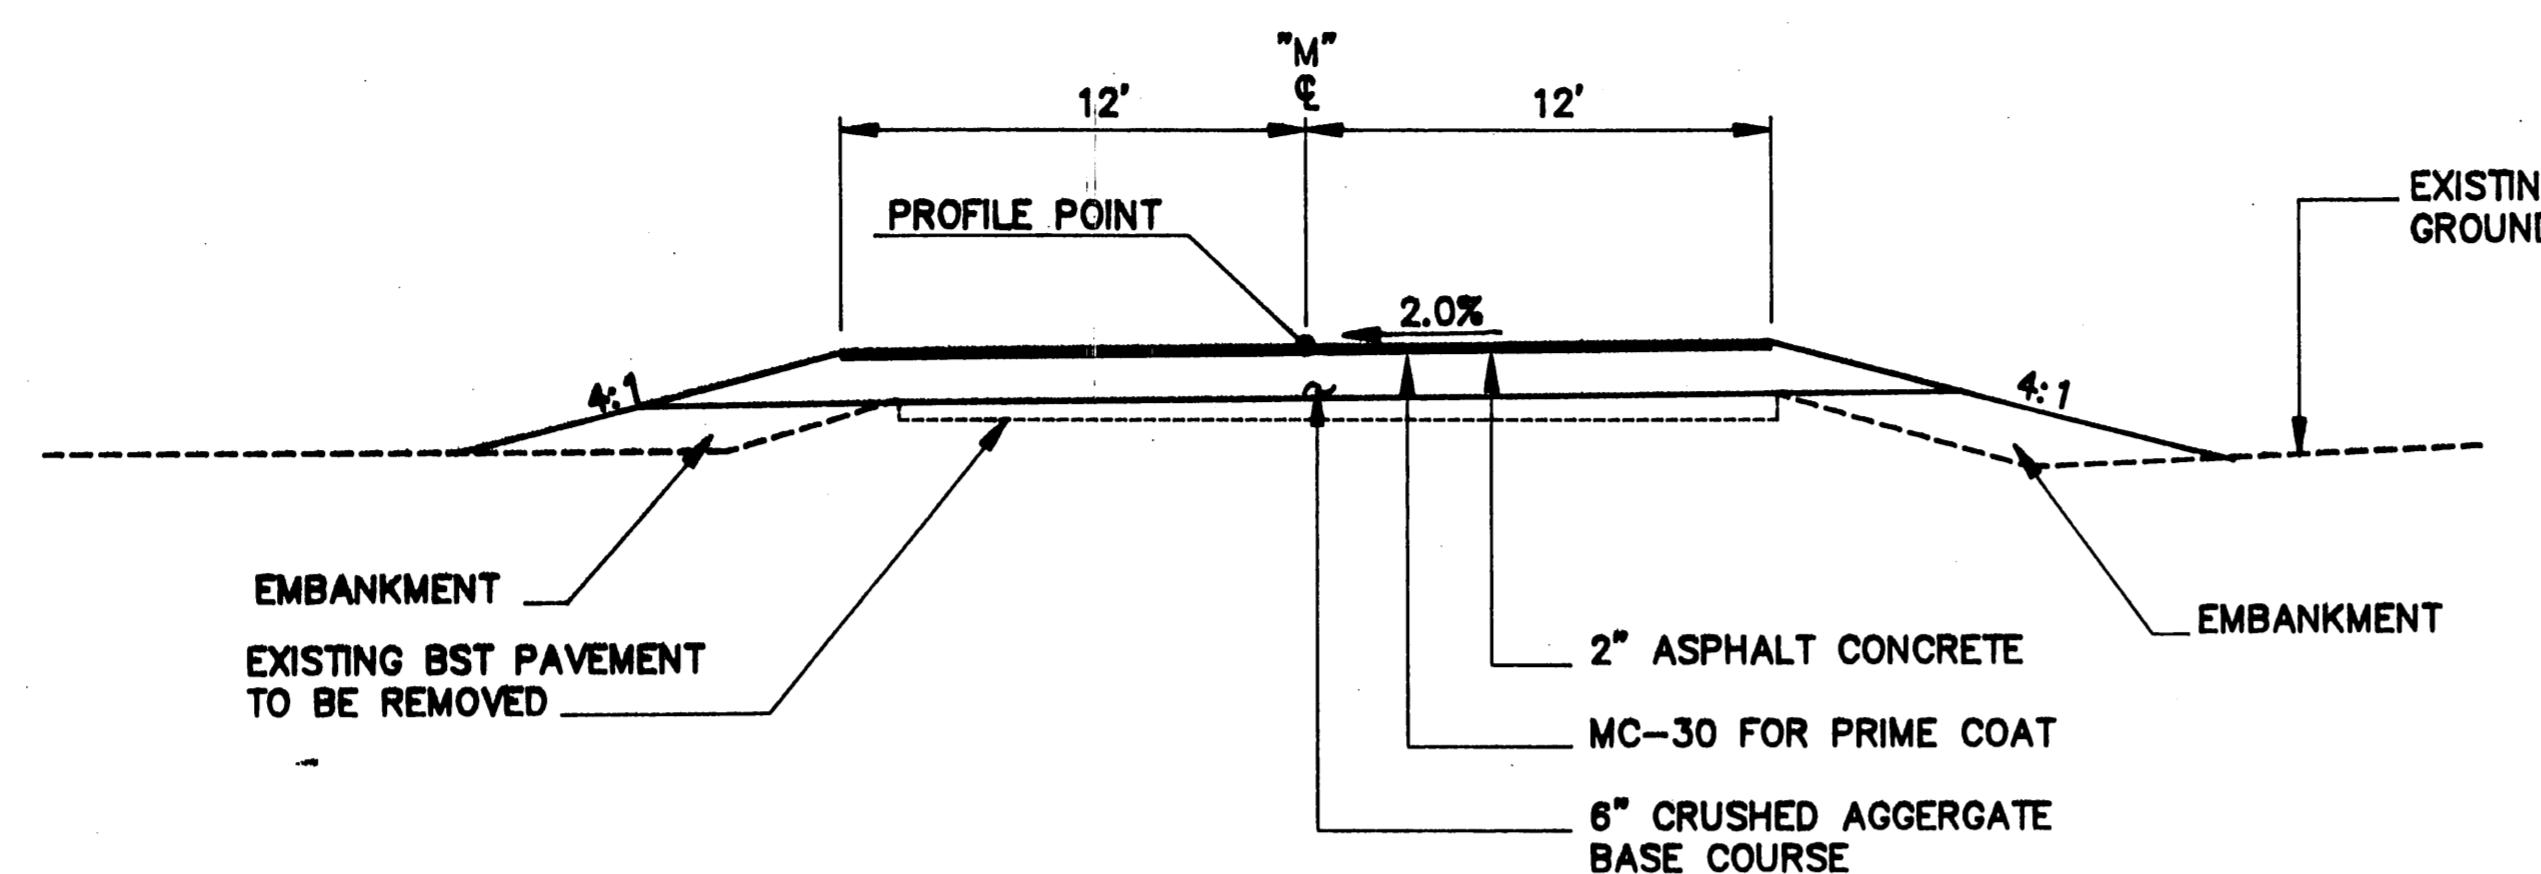

TERMINAL ACCESS ROAD

"M" 13+20 TO "M" 15+80
 "M" 19+51 TO "M" 20+31
 HAINES HWY TO "M" 20+31 (OVERLAY EXISTING
 'M' HANGAR TO "M" 13+20 (BST WITH 2" ASPHALT))

STANDARD CURB & GUTTER

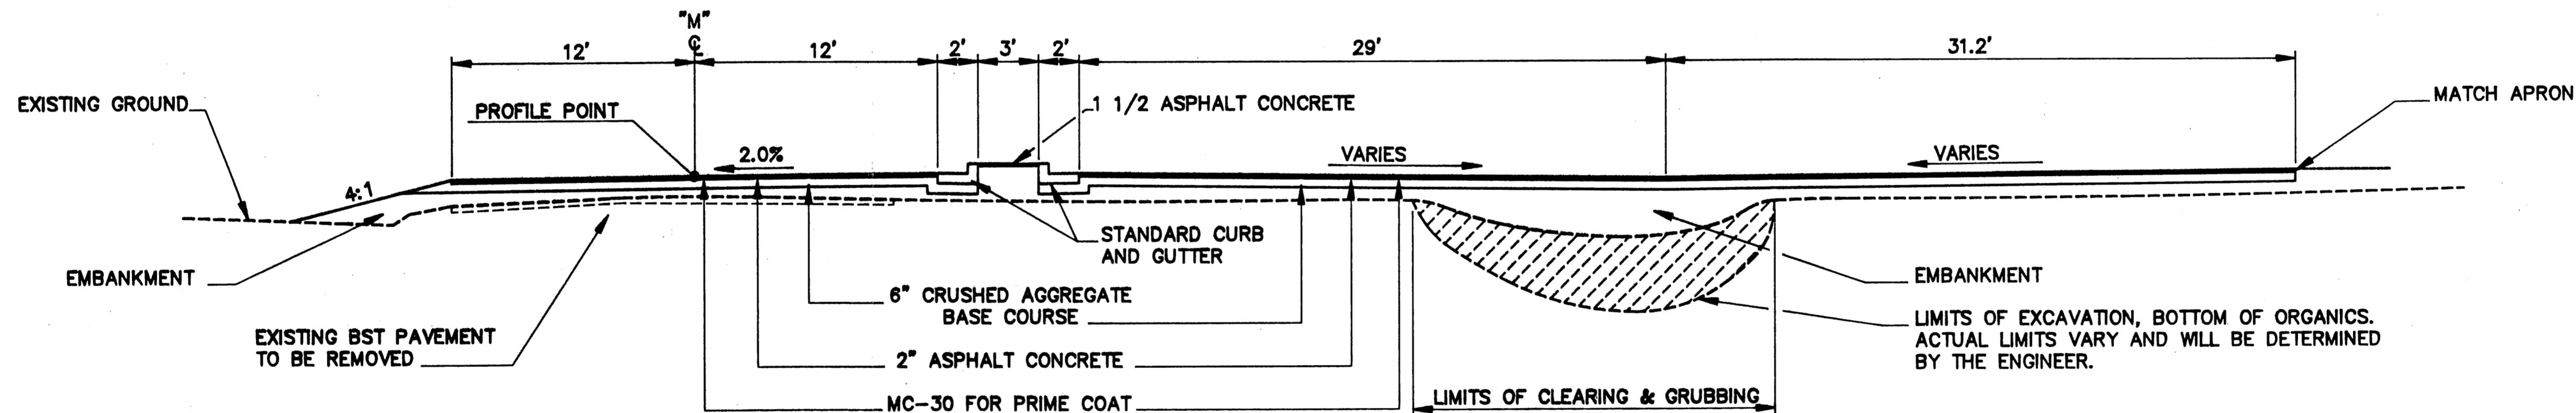

TERMINAL ACCESS ROAD & PARKING AREA TYPICAL

"M" 15+80 TO "M" 19+51


AS-BUILT
B.A. 2-9-96




BY:	DATE:	DESCRIPTION OF CHANGE:
RECORD OF REVISIONS		

STATE OF ALASKA
 DEPARTMENT OF TRANSPORTATION
 AND PUBLIC FACILITIES
 SOUTHEAST REGION DESIGN & CONSTRUCTION

HAINES AIRPORT
 PARKING TYPICAL SECTIONS

DESIGNED BY: C. HAKARI	PROJECT No. 69623
DRAWN BY: AutoCAD / B.W.B.	DATE: AUGUST 1990
CHECKED BY: T.W. MOORE	SHEET 14 OF 39

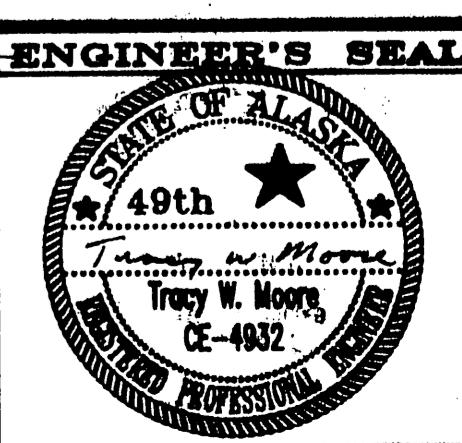

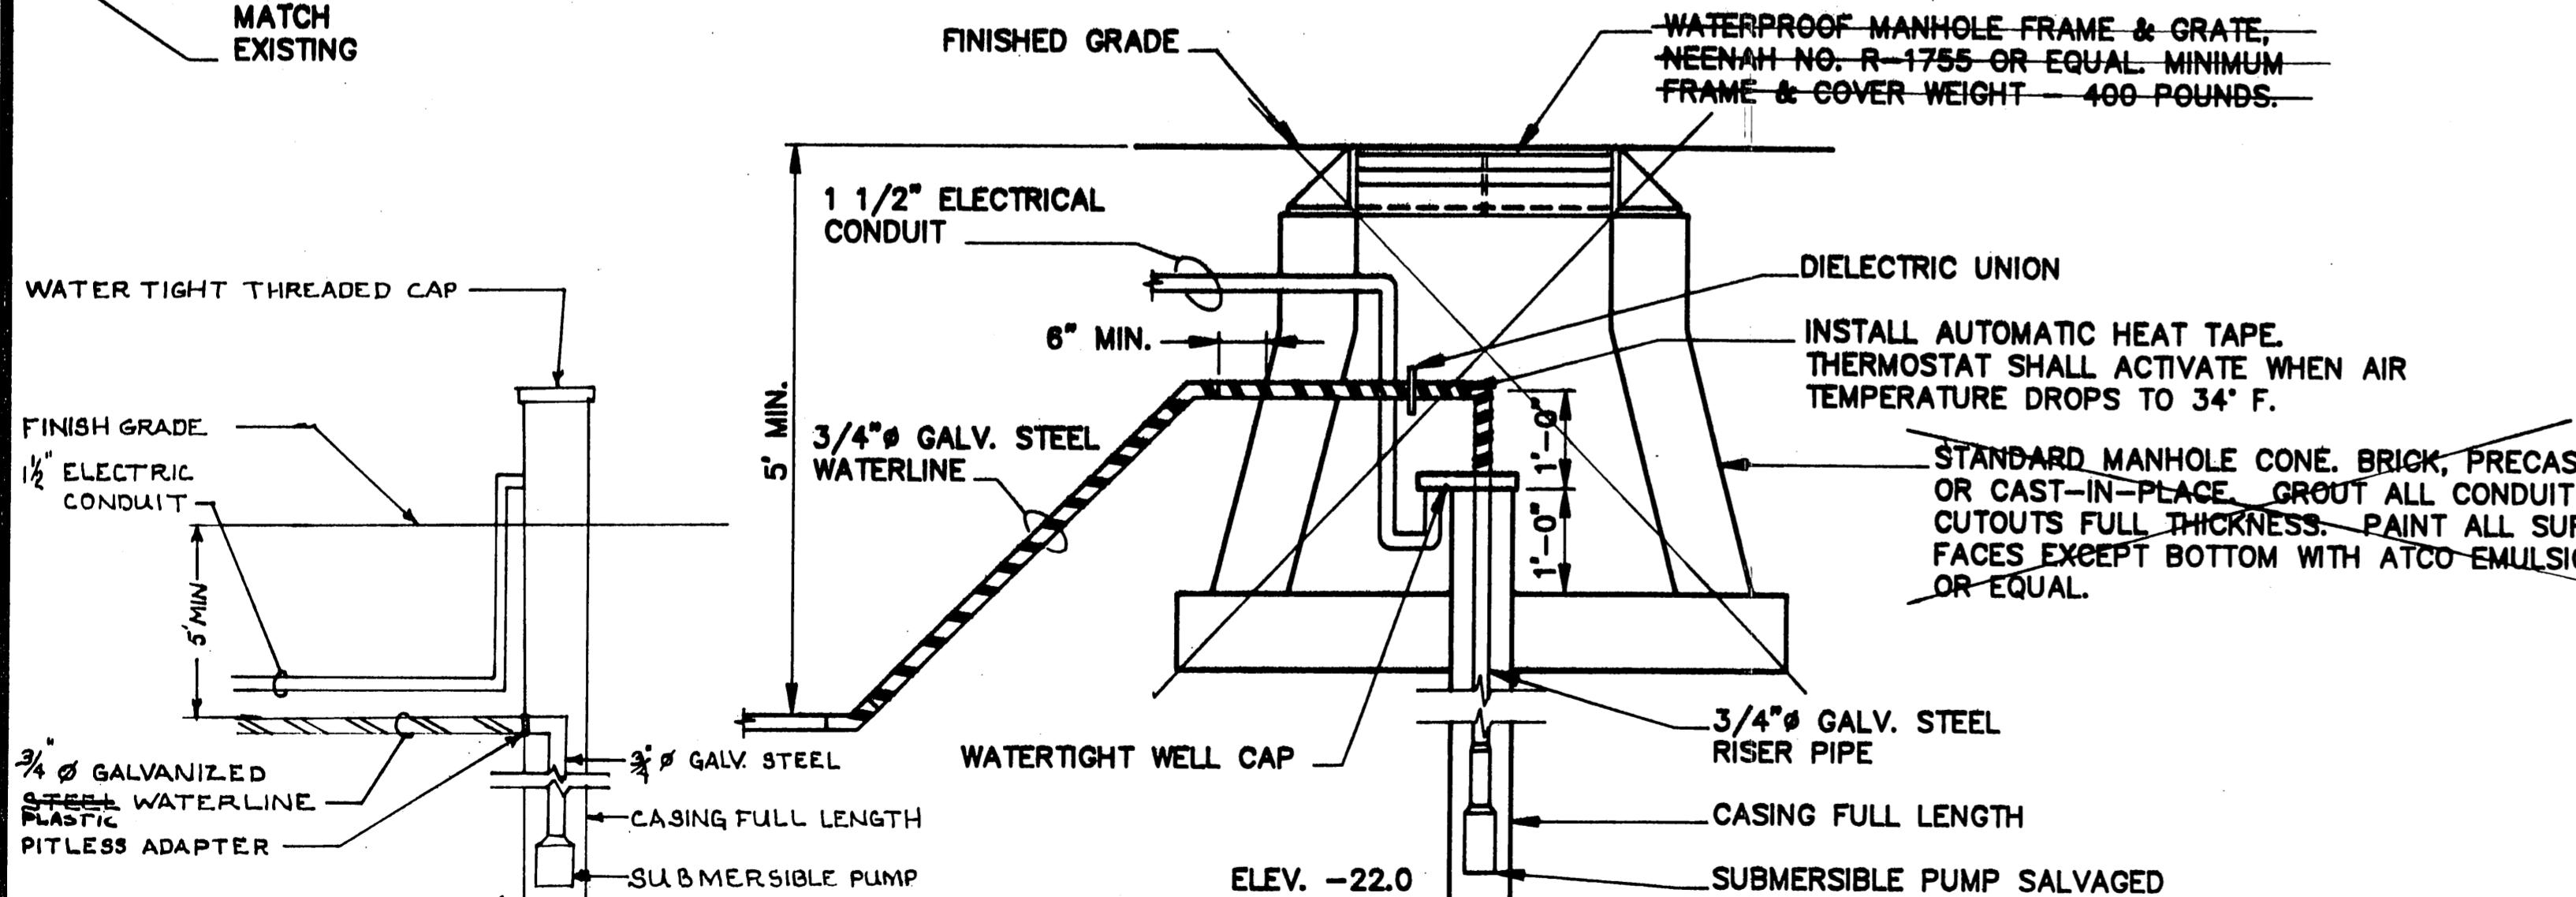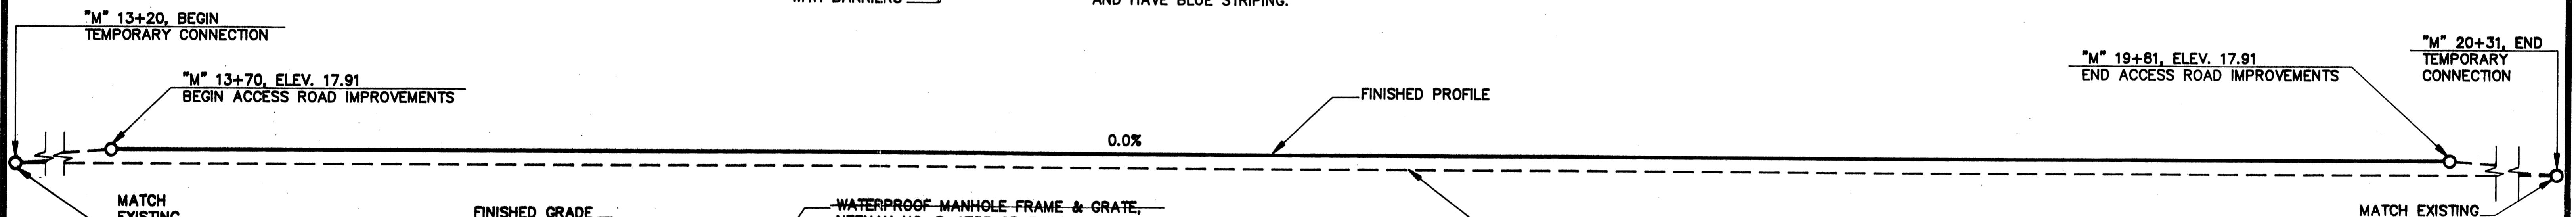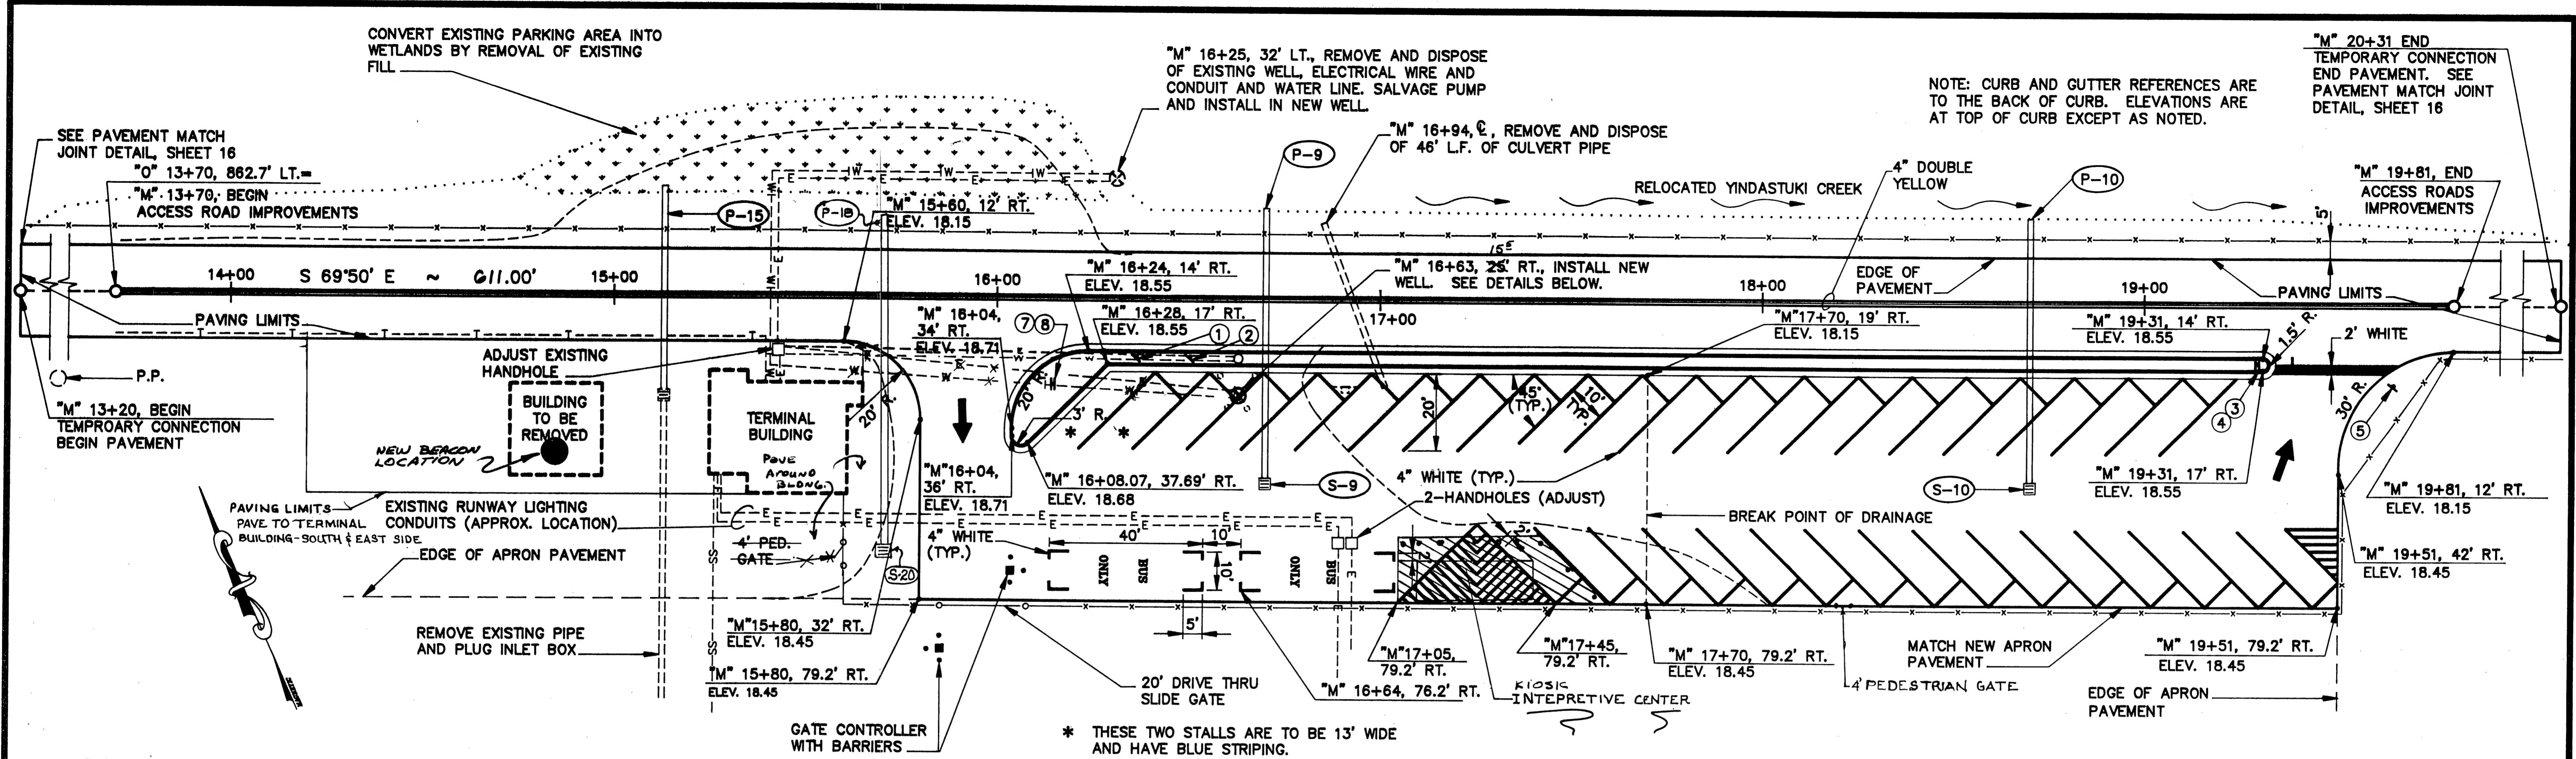

NEW WELL DETAIL


"M" 16+63, 25' RT.
15.E

BY:	DATE:	DESCRIPTION OF CHANGE:
RECORD OF REVISIONS		


STATE OF ALASKA
DEPARTMENT OF TRANSPORTATION
AND PUBLIC FACILITIES
SOUTHEAST REGION DESIGN & CONSTRUCTION

HAINES AIRPORT PARKING LAYOUT


SIGN SUMMARY								
No.	Station	Code No.	Legend	Size	Area S.F.	Pt	Facing Traffic	Remarks
1	"M" 16+35, 15.5' RT.	R7-8RL	Reserved Parking (Handicapped Symbol)	12"x18"	1.5	1	E.B.	
2	"M" 16+49, 15.5' RT.	R7-8RL	Reserved Parking (Handicapped Symbol)	12"x18"	1.5	1	E.B.	
3	"M" 19+30, 15.5' RT.	R6-1R	ONE WAY	12"x36"	3.0	1	W.B.	
4	"M" 19+30, 15.5' RT.	R6-1L	ONE WAY	12"x36"	3.0		E.B.	
5	"M" 19+65, 22' RT.	R1-1	STOP	24"x24"	4.0	1	N.B.	
6	"S" 10+40, 24' LT.	R1-1	STOP	24"x24"	4.0	1	N.B.	
7	"M" 16+15, 25' RT.	R6-1R	ONE WAY	12"x36"	3.0	1	E.B.	
8	"M" 16+15, 25' RT.	R6-1L	ONE WAY	12"x36"	3.0		W.B.	

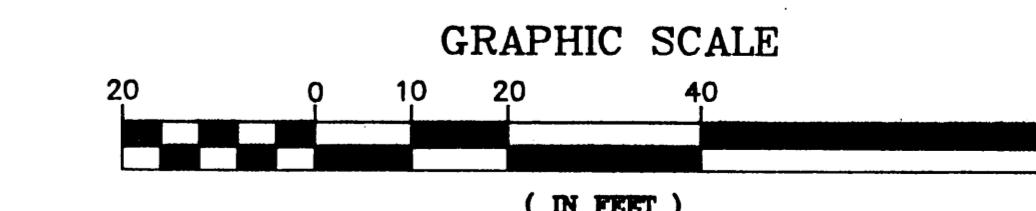


DESIGNED BY: C. HAKARI	PROJECT No. 69523
DRAWN BY: AutoCAD / B.W.B.	DATE: AUGUST 1990
CHECKED BY: T.W. MOORE	SHEET 15 OF 39

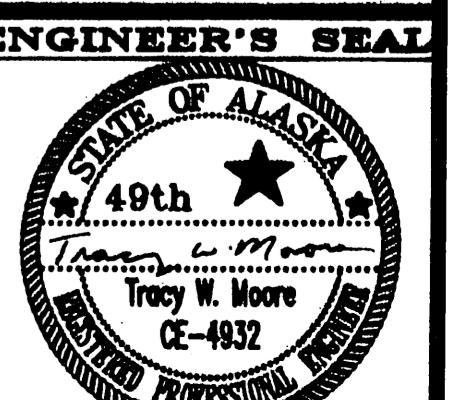


195-BUILT
B.A. 2-12-96

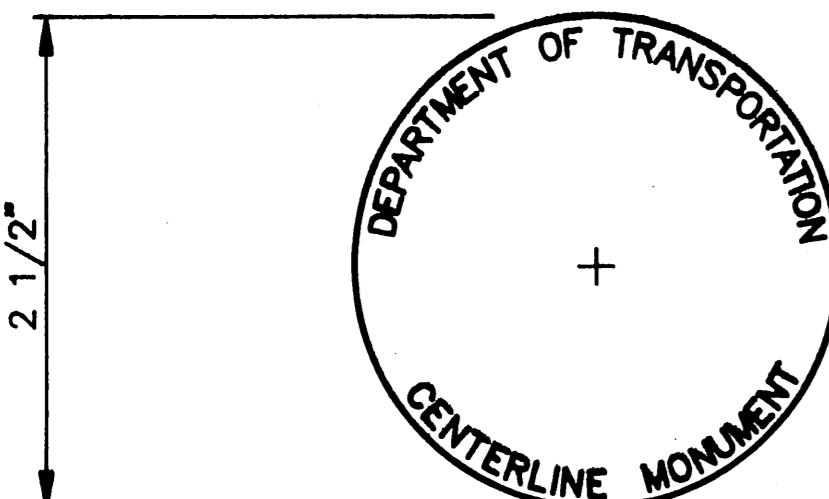

PLAN

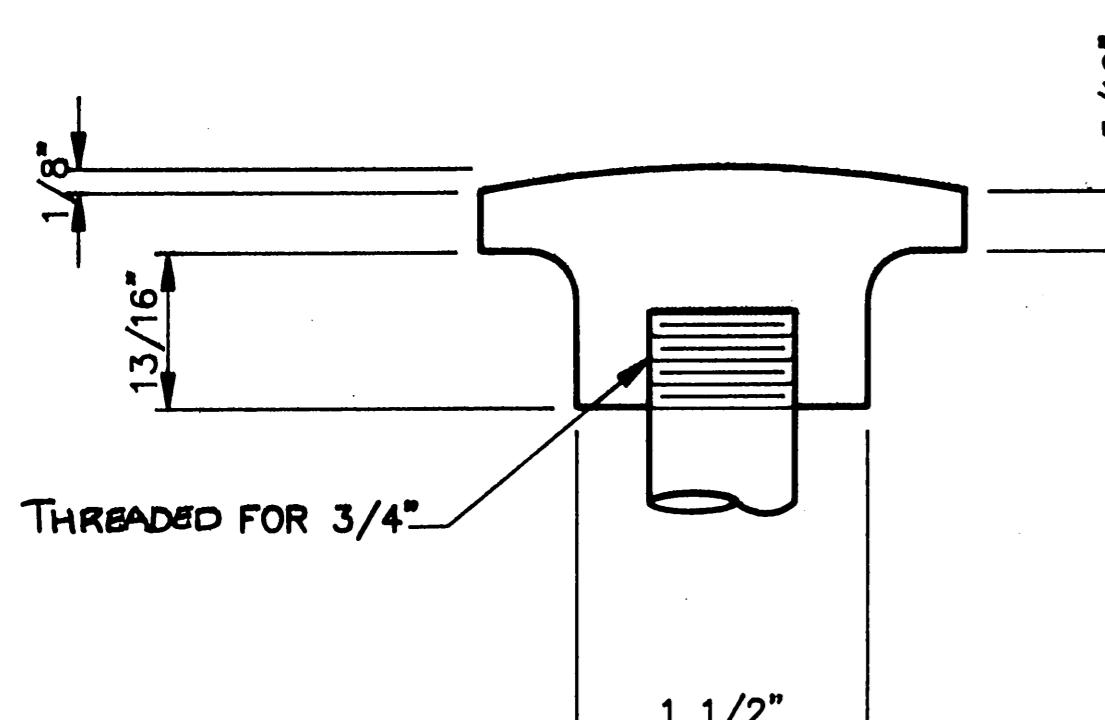

SECTION

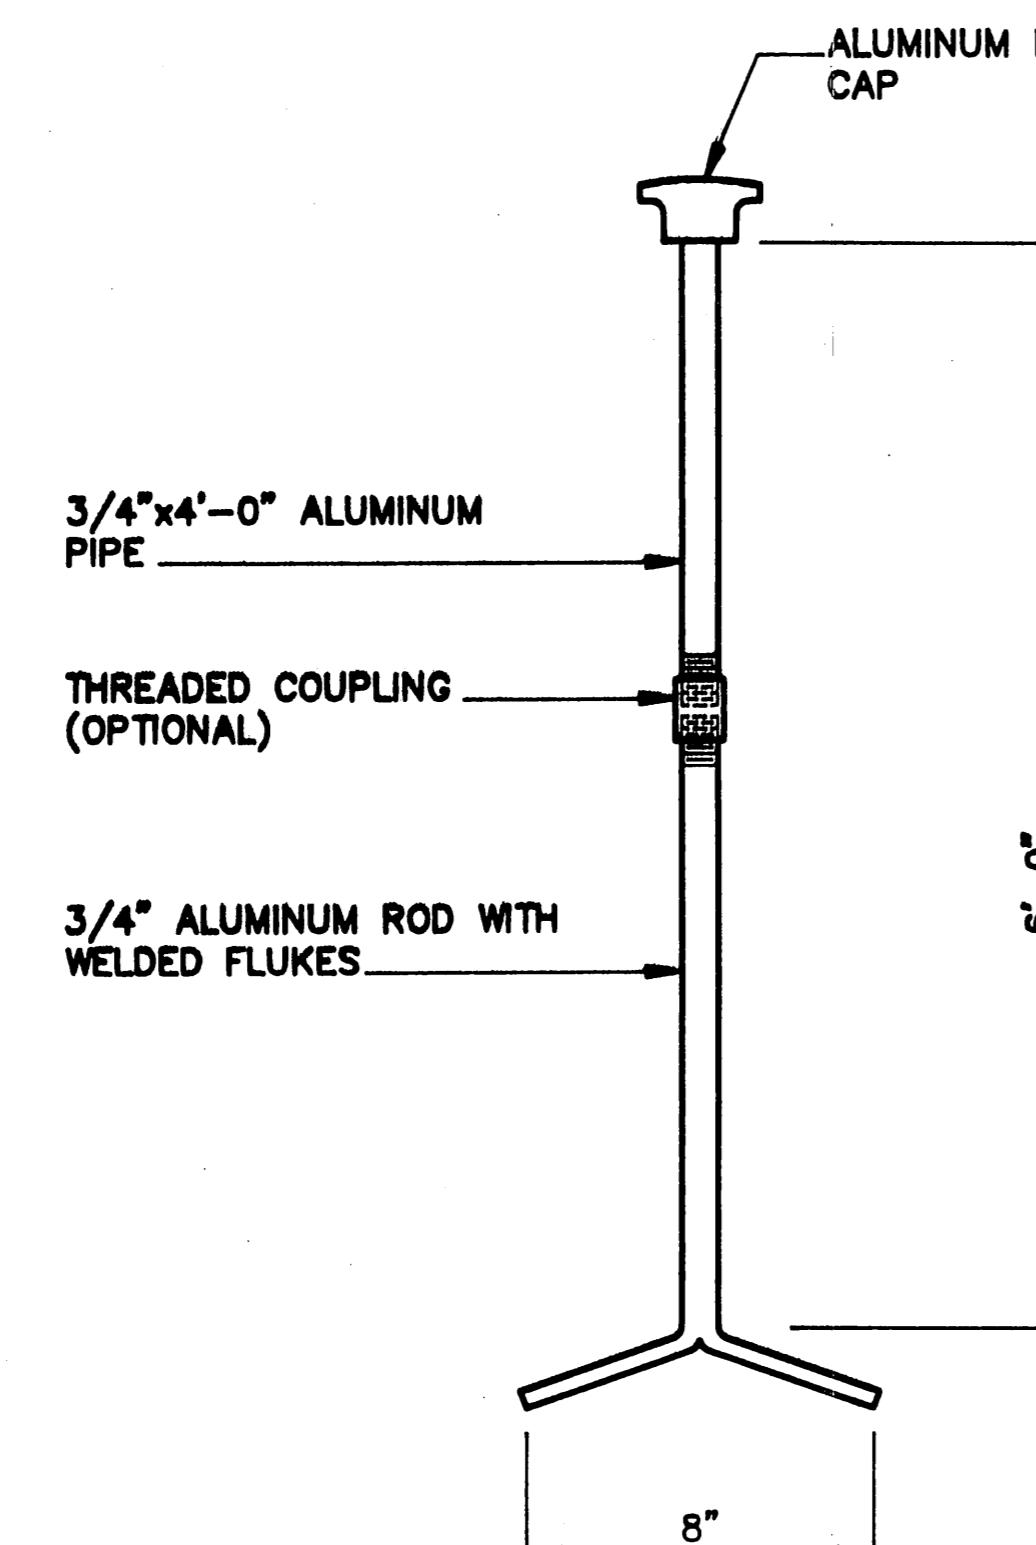


ELEVATION

MONUMENT DETAIL

N.T.S.

MONUMENT DETAIL NOTES:

1. MONUMENT SHALL BE PLACED PRIOR TO PAVING AND COVERED TO PROTECT SURFACE. FINAL POSITIONING AND POINT STAMPING SHALL BE ACCOMPLISHED AFTER PAVEMENT HAS BEEN PLACED AND COMPACTED.
2. MONUMENTS SHALL BE PLACED FLUSH WITH THE FINISHED SURFACE.

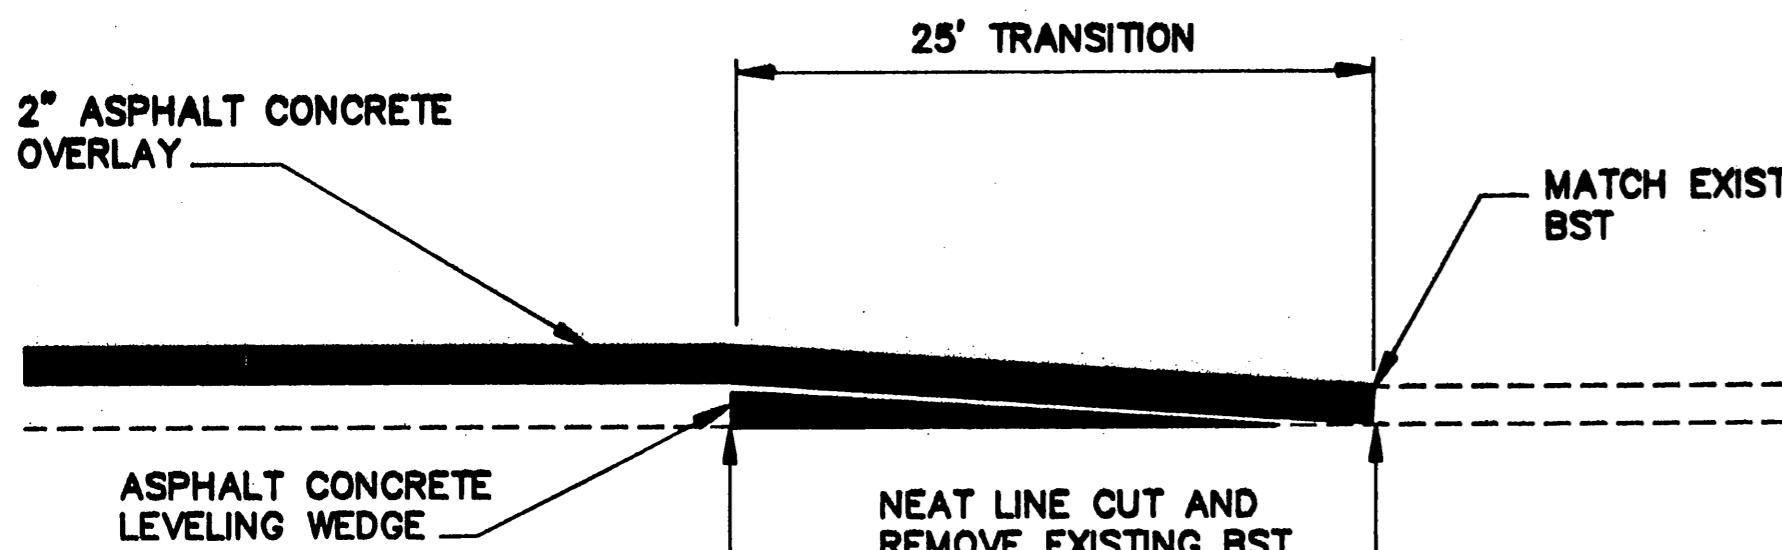


ASPHALT CONCRETE OVERLAY TRANSITION DETAIL


N.T.S.

PAVEMENT MATCH JOINT DETAIL

N.T.S.

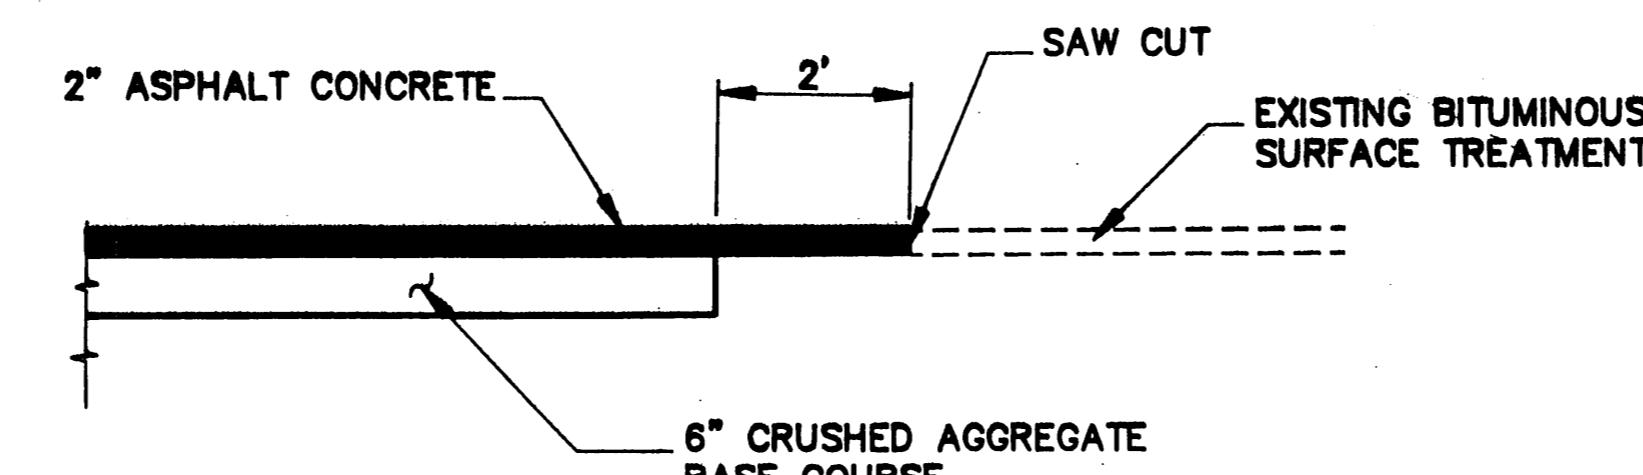


HAINES AIRPORT MISCELLANEOUS DETAILS

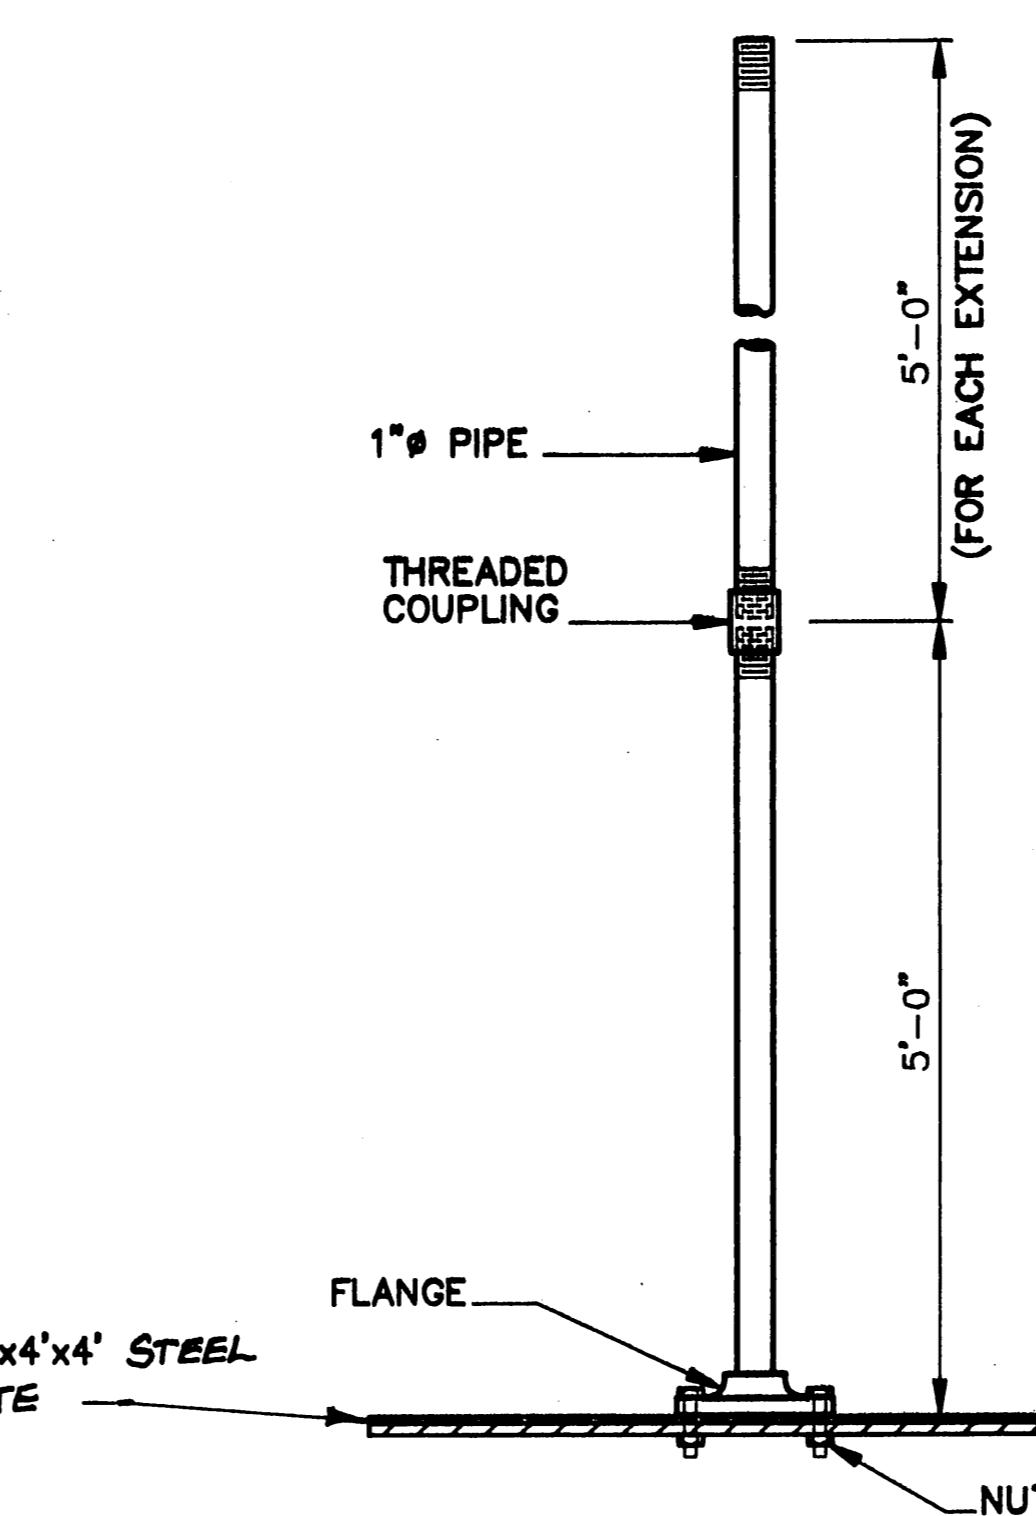

SETTLEMENT PLATFORM DETAIL

N.T.S.

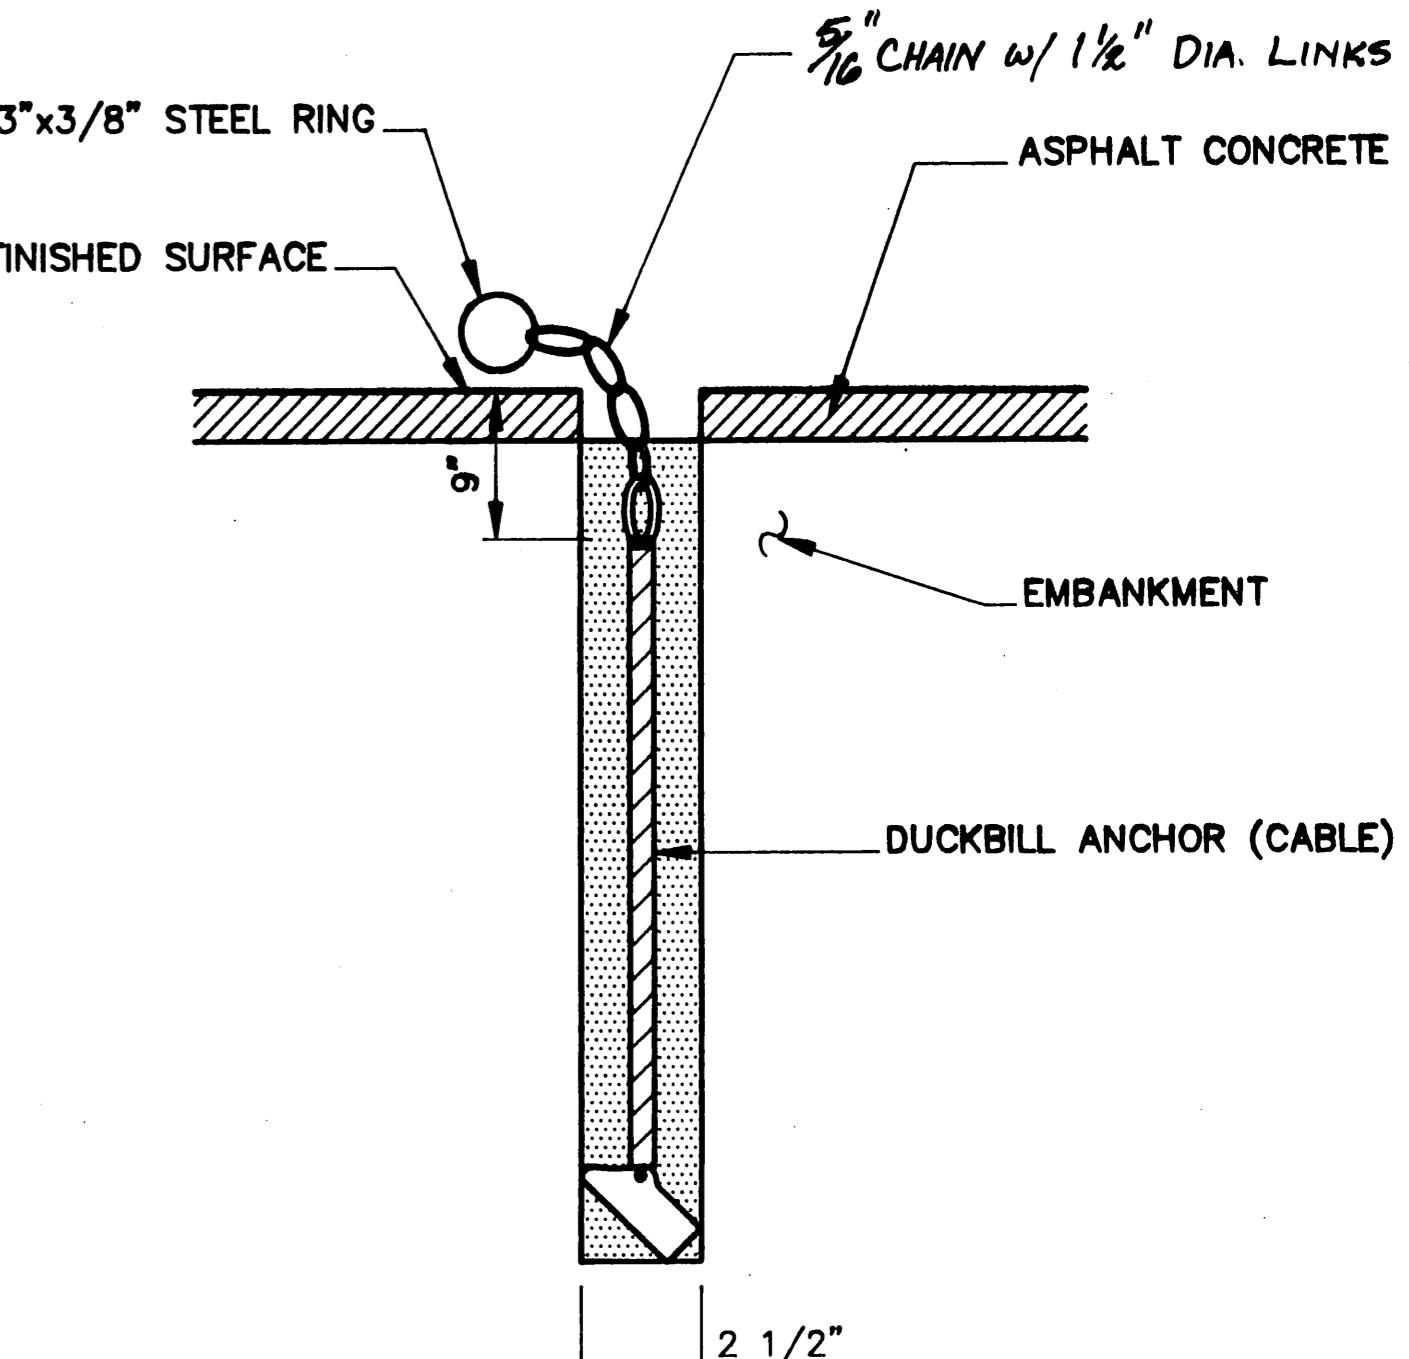


TIE-DOWN ANCHOR DETAIL

N.T.S.

TIE-DOWN ANCHOR NOTES:

1. IT IS THE CONTRACTOR'S RESPONSIBILITY TO VERIFY THE TYPE OF MATERIAL IN THE TIE-DOWNS.
2. DEPTH OF ANCHOR SHALL BE AS REQUIRED TO DEVELOP 5000 LBS. OF PULL-OUT STRENGTH PER ANCHOR.
3. WHEN ROCK IS ENCOUNTERED, ROCK ANCHORS SHALL BE USED. ROD DIAMETER SHALL BE 3/4".
4. ALL EYE-BOLTS SHALL BE ASTM A-36, 40,000 P.S.I. MINIMUM YIELD STRENGTH.

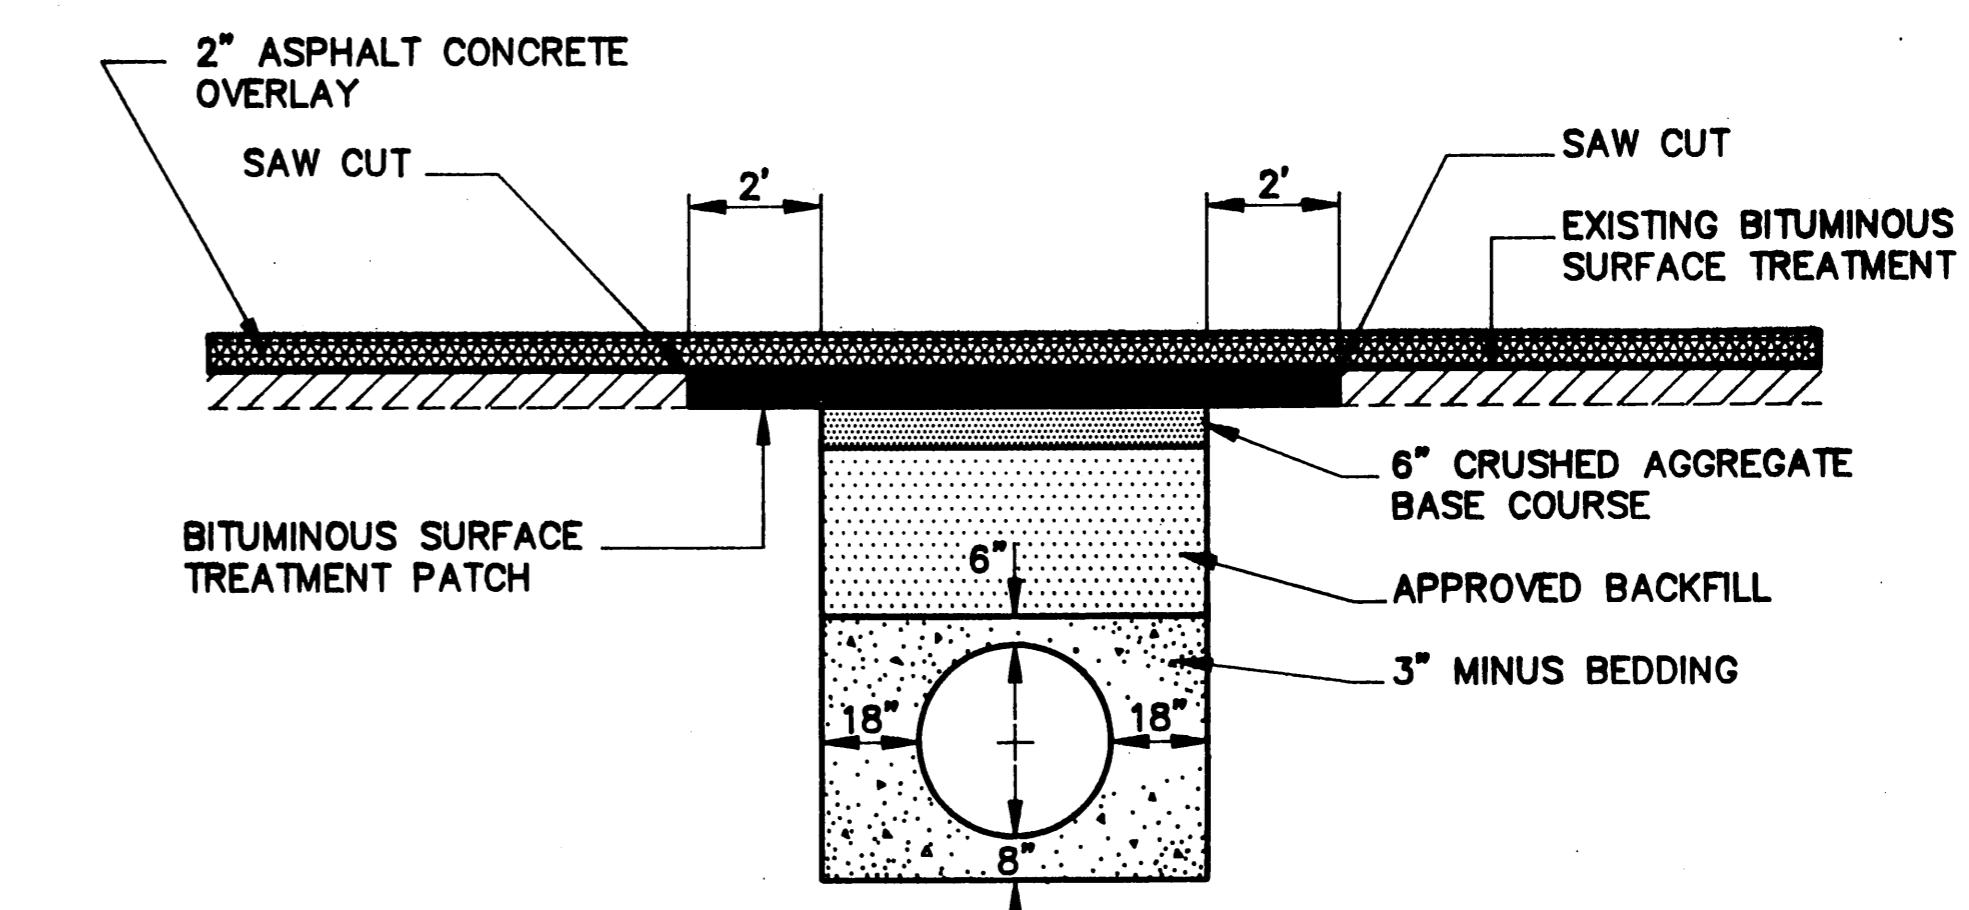

CULVERT BEDDING & PAVEMENT PATCH DETAIL

N.T.S.


*AS-BUILT
B.A. 2-12-96*


BY:	DATE:	DESCRIPTION OF CHANGE:

RECORD OF REVISIONS


STATE OF ALASKA
DEPARTMENT OF TRANSPORTATION
AND PUBLIC FACILITIES
SOUTHEAST REGION DESIGN & CONSTRUCTION

DESIGNED BY: T.W. MOORE	PROJECT No. 69523
DRAWN BY: AutoCAD / B.W.B.	DATE: AUGUST 1990
CHECKED BY: C. HAKARI	SHEET 16 OF 39

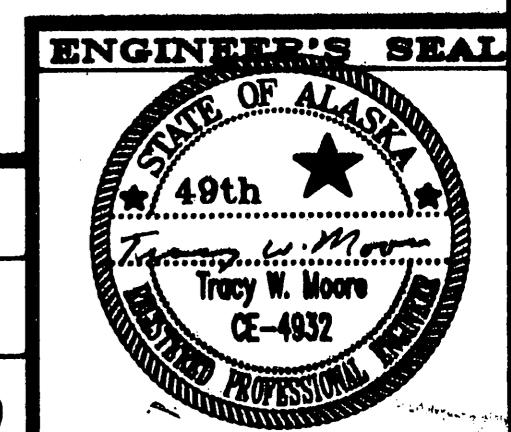


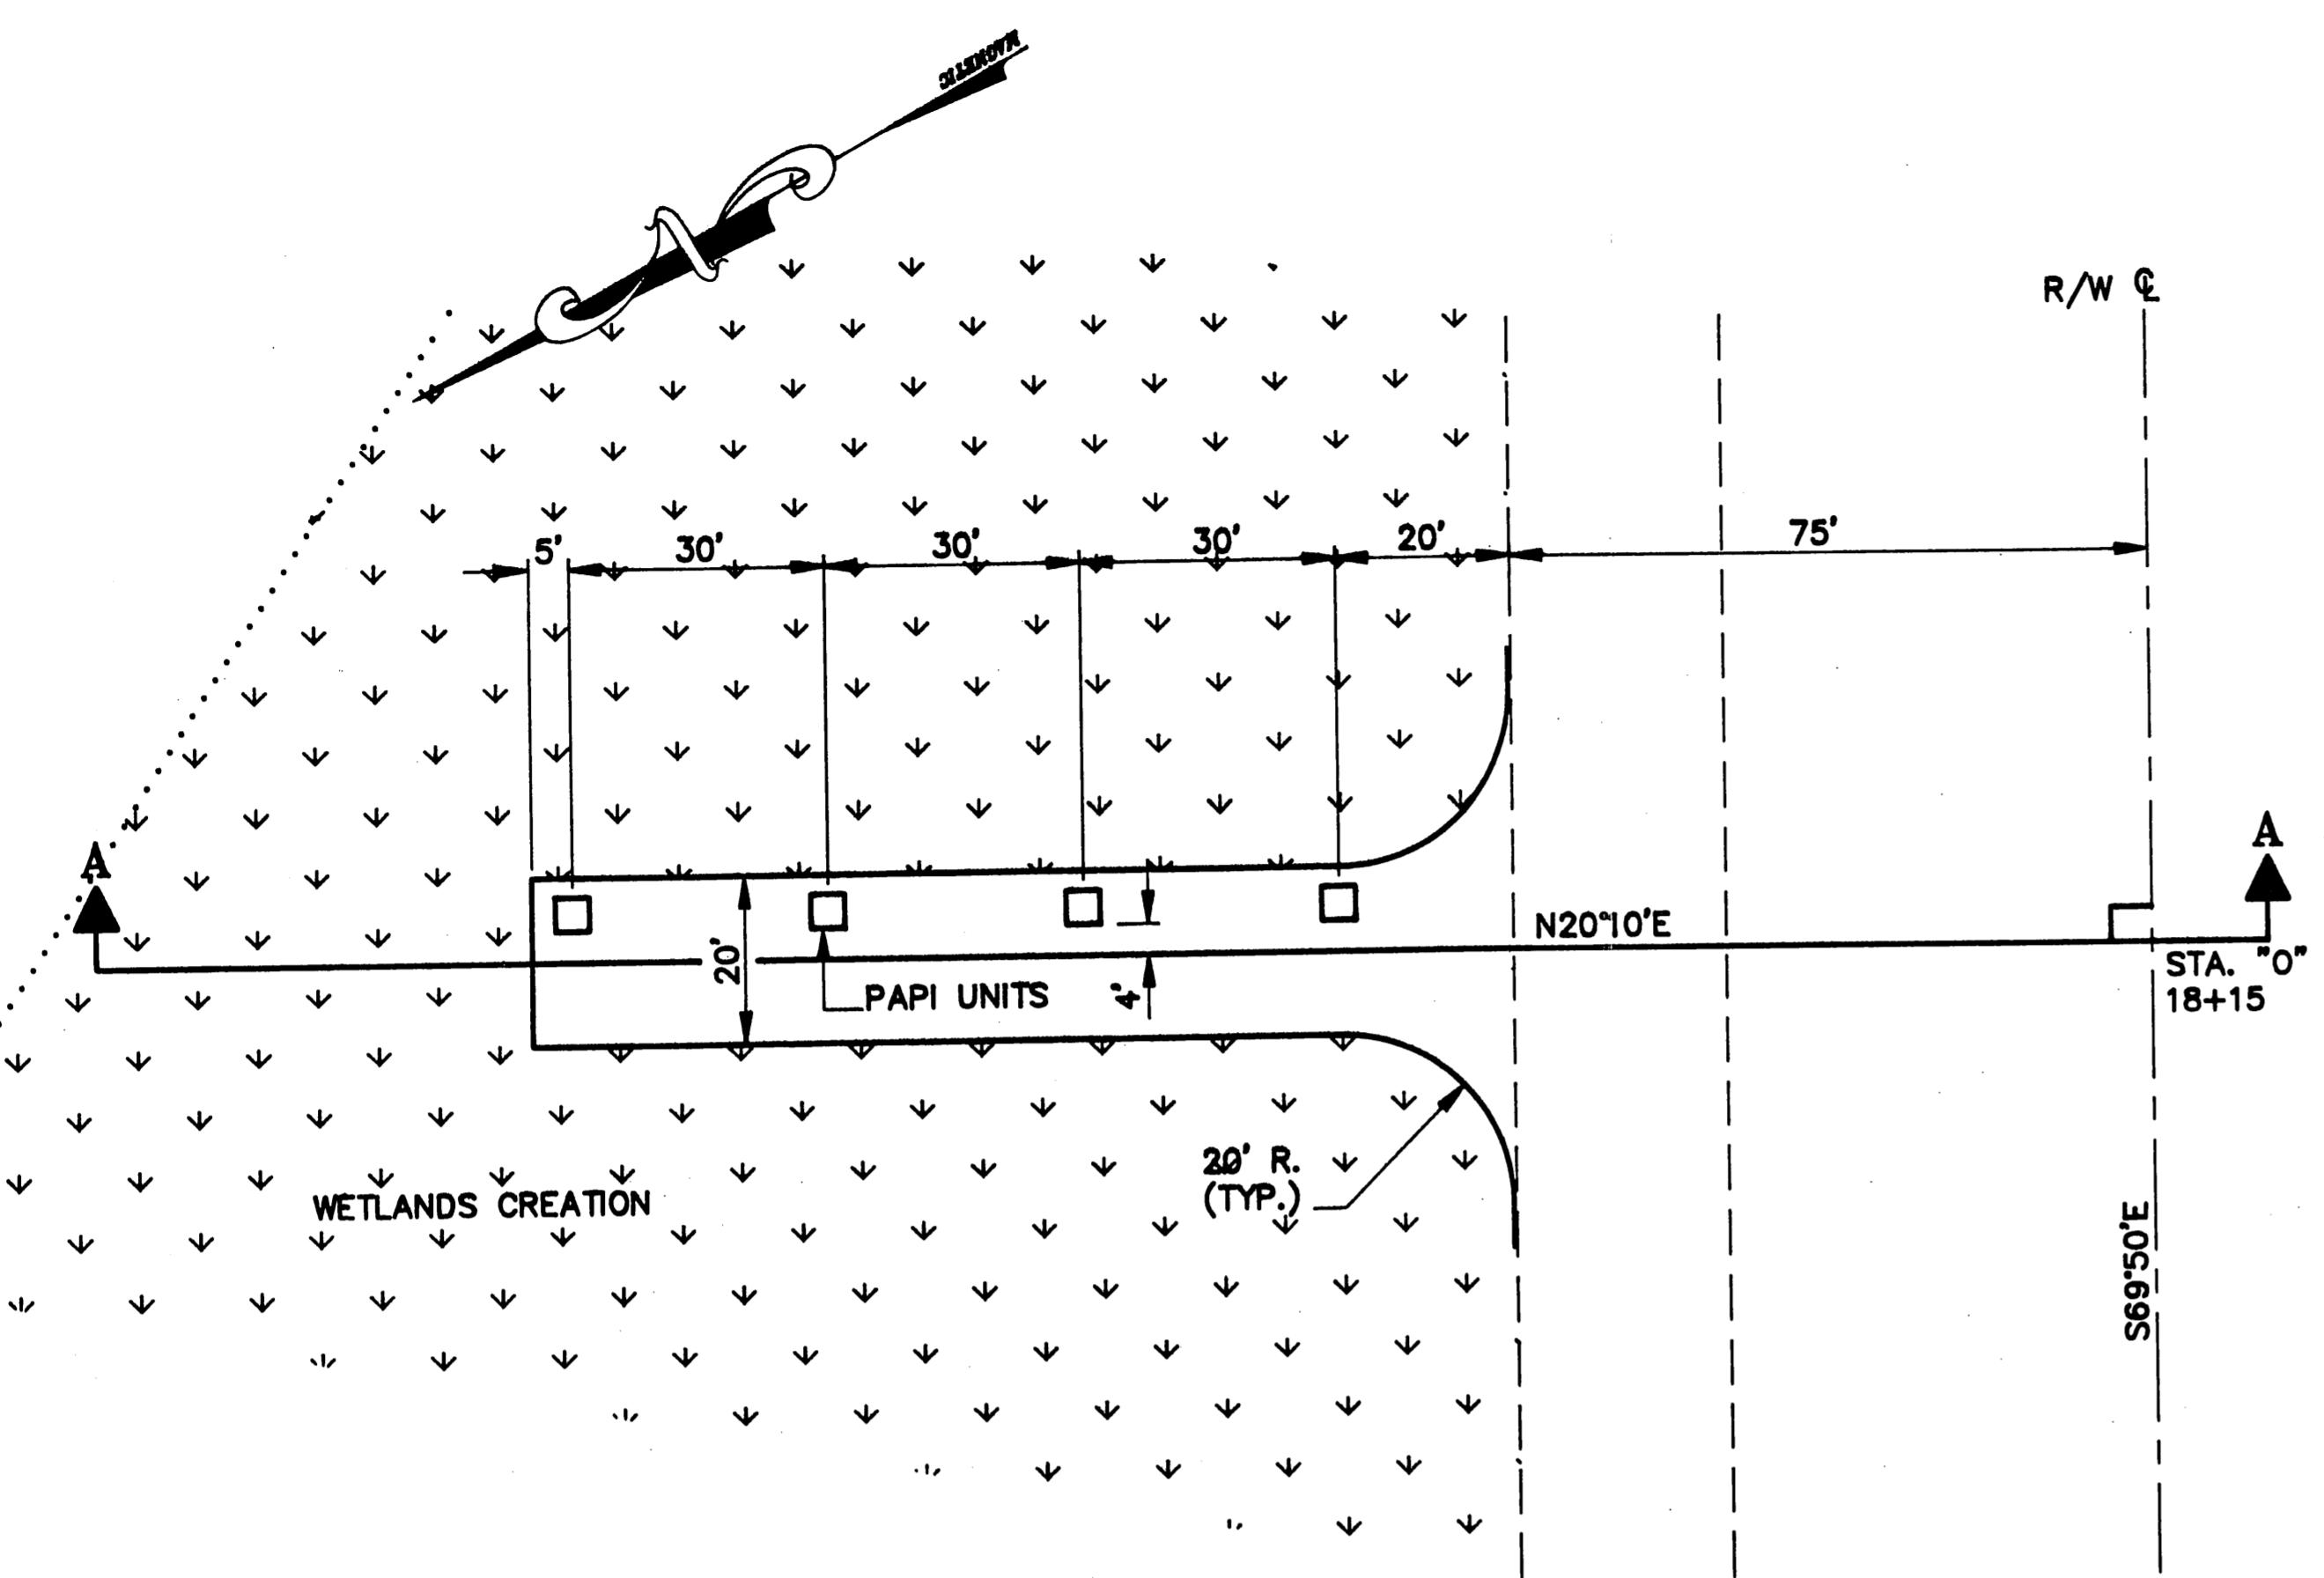


PAPI PAD PLAN
STA. "0" 18+15, LT.

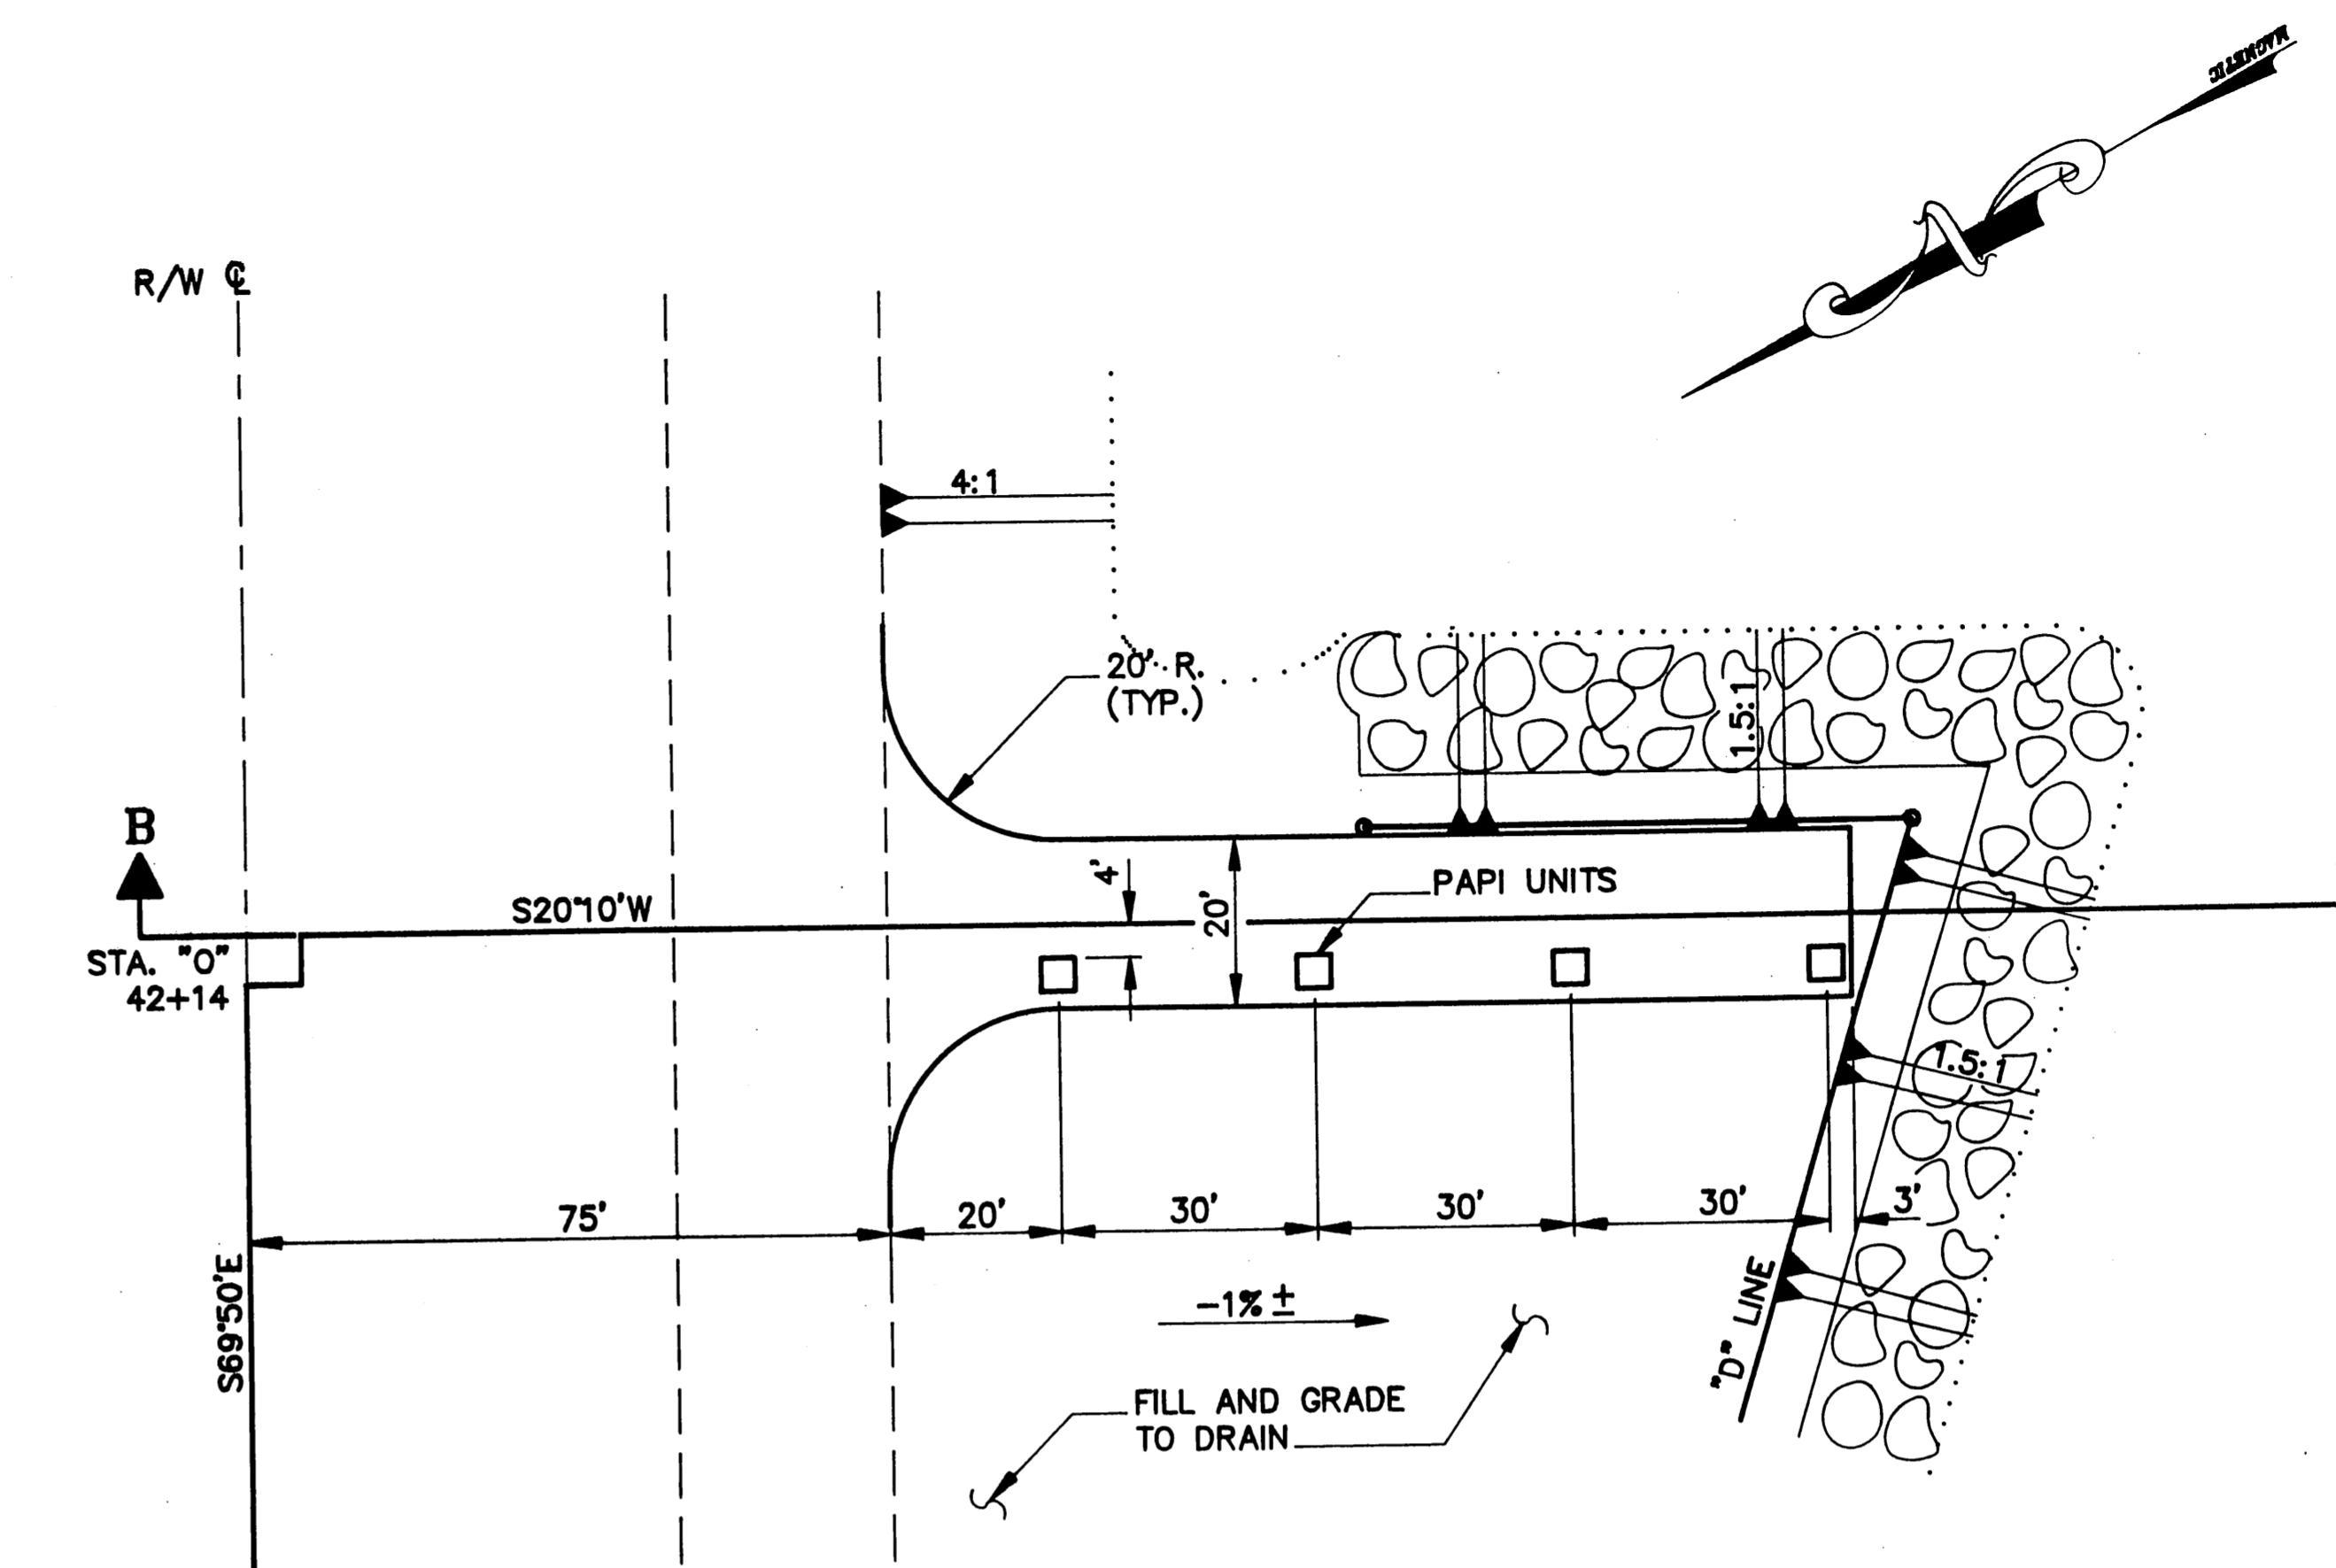


PAPI PAD PLAN
STA. "0" 42+14, RT.

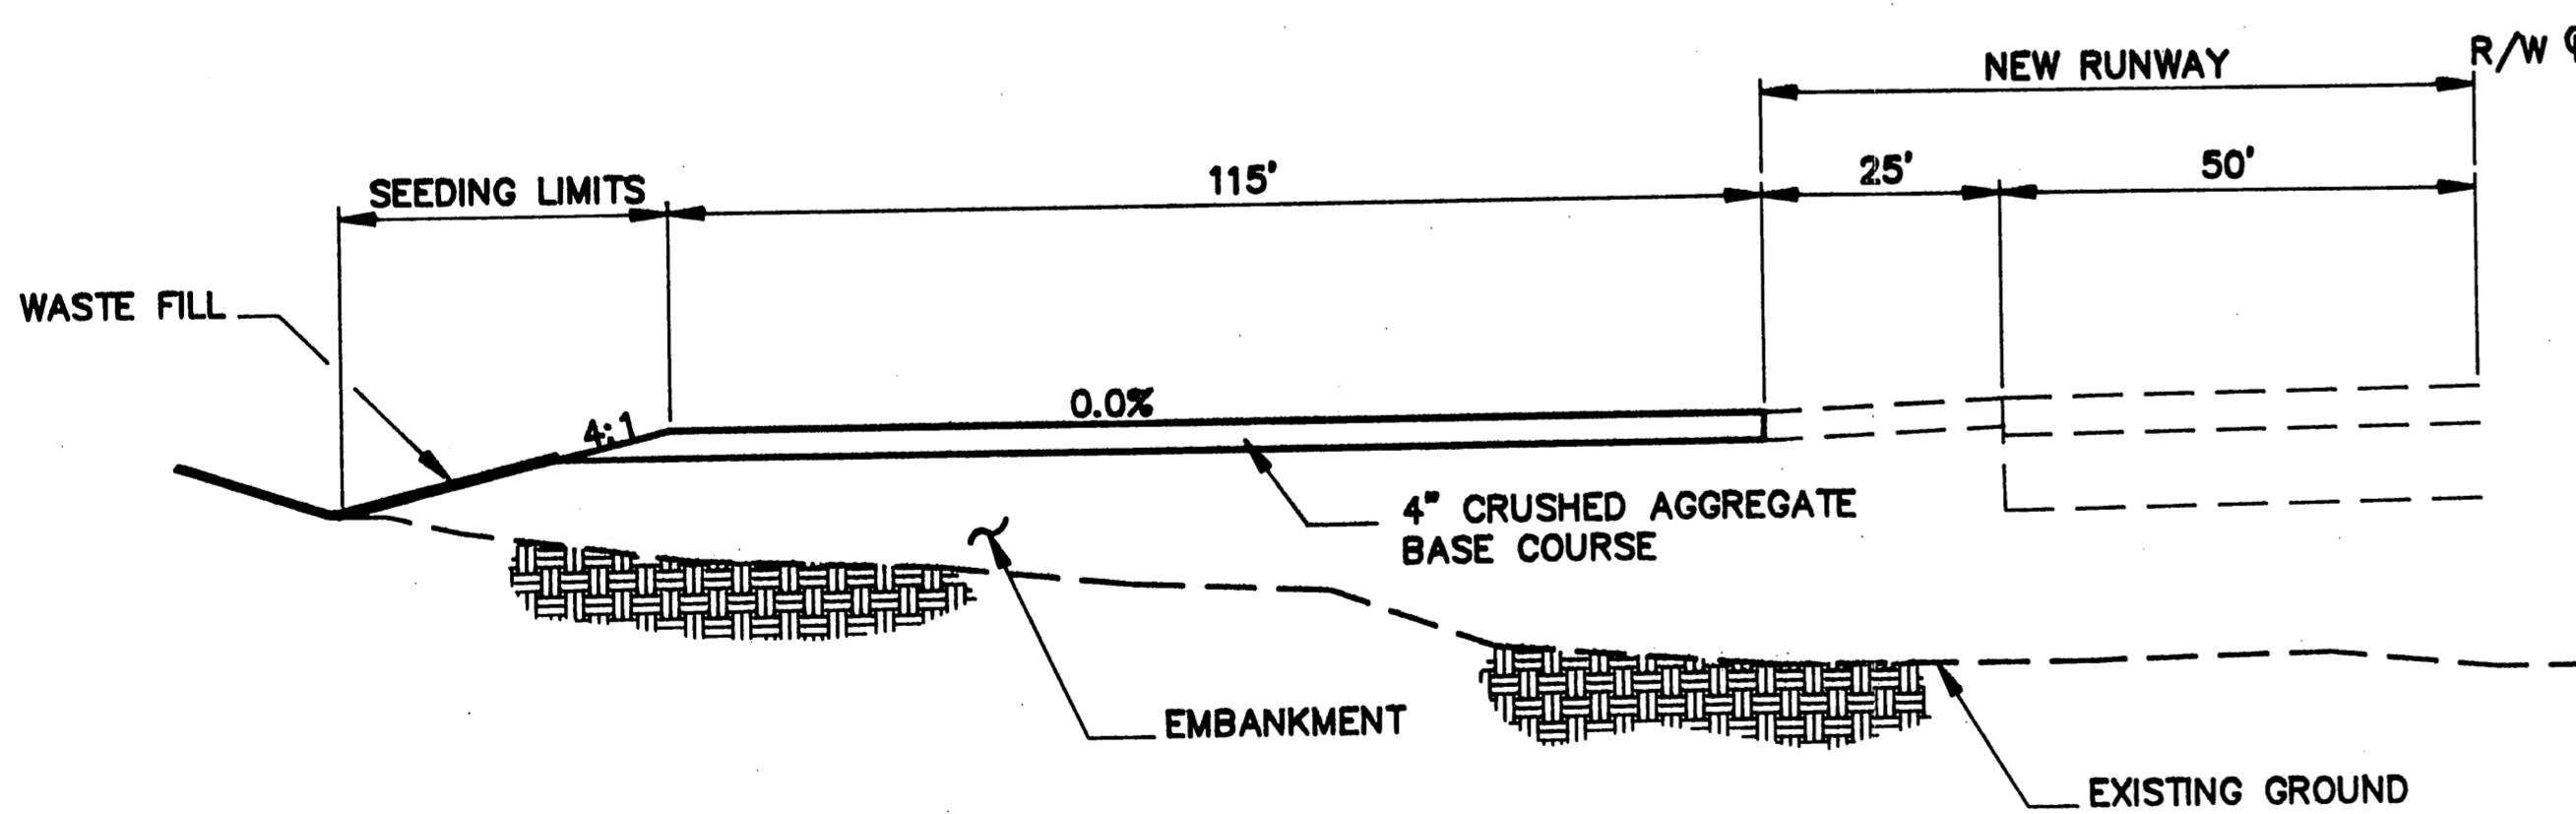


SECTION A-A
STA. "0" 18+15, LT.

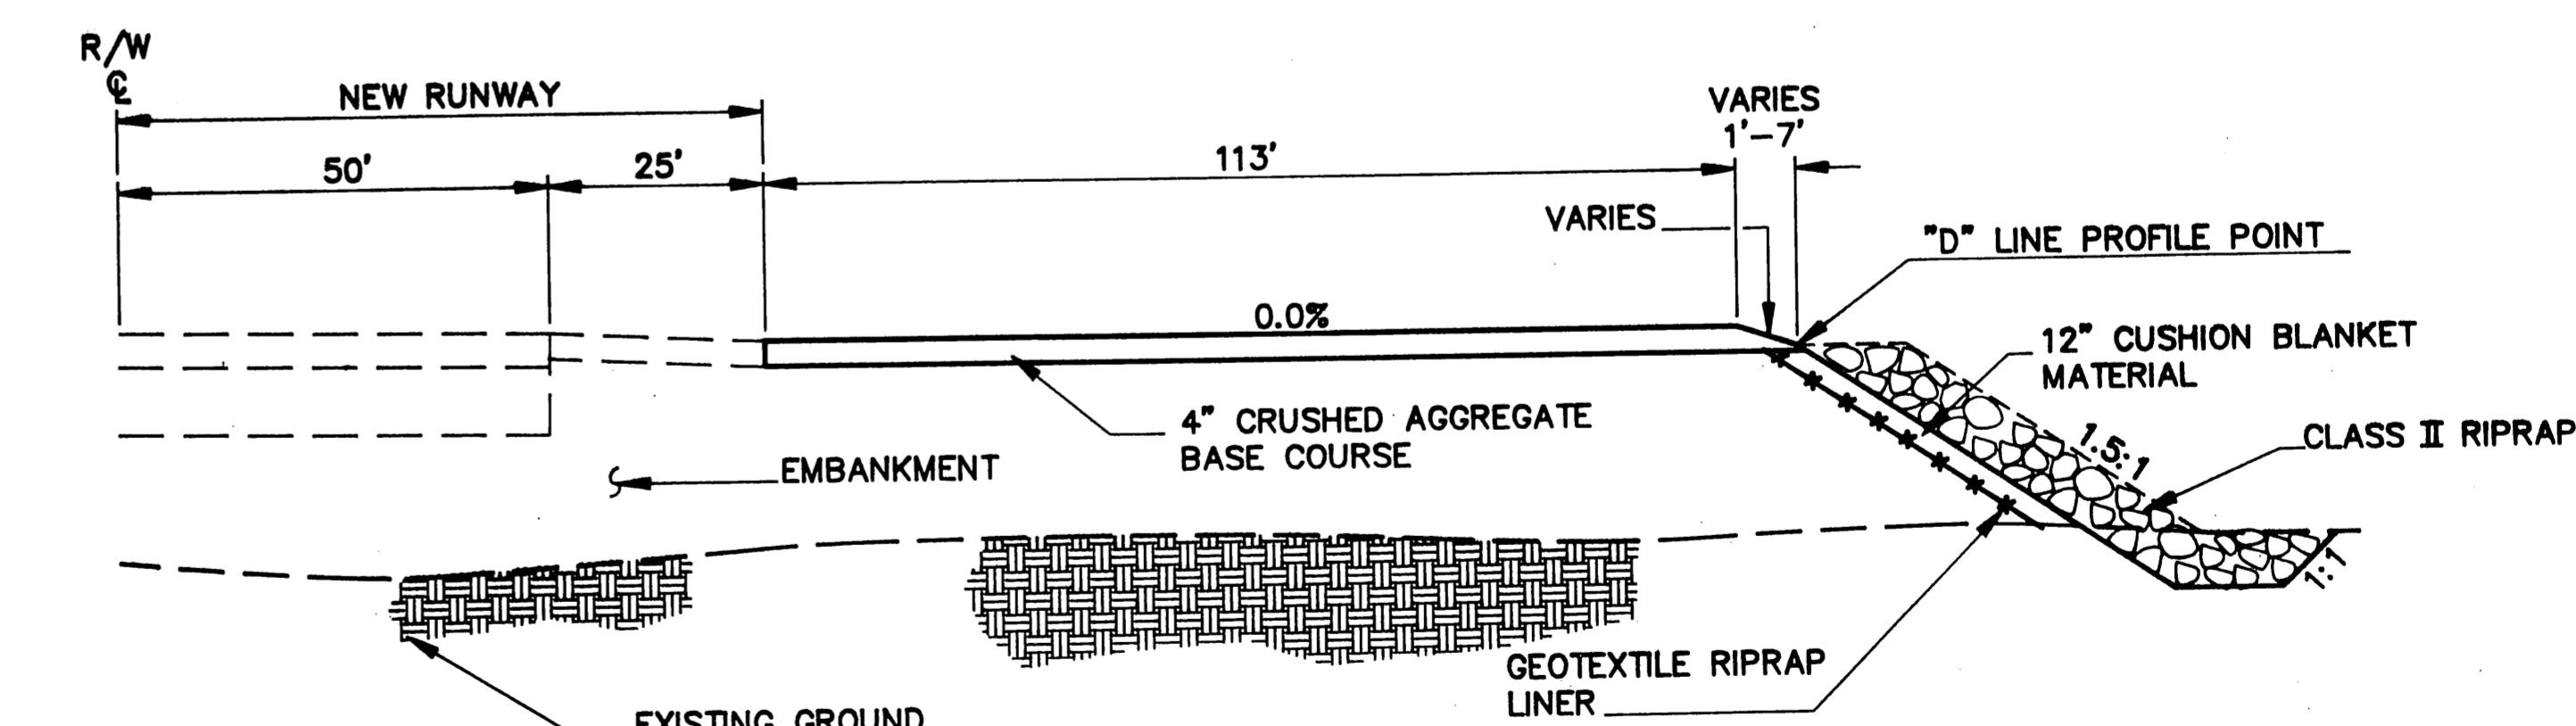

SECTION B-B
STA. "0" 42+14, RT.

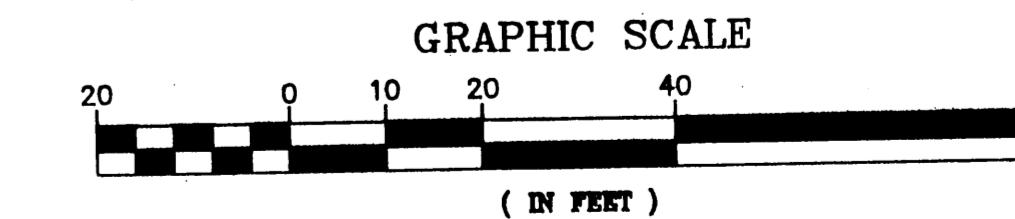

J.S.-BURT
B.F. 2-12-96

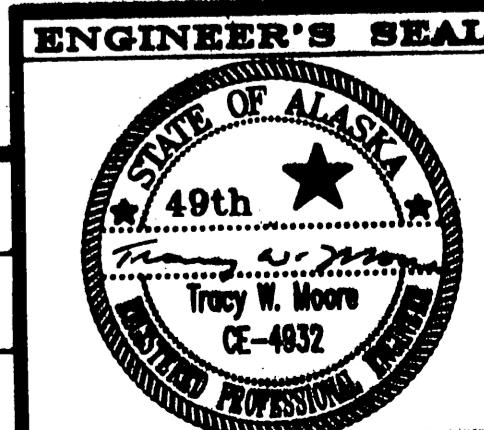


BY:	DATE:	DESCRIPTION OF CHANGE:

RECORD OF REVISIONS

STATE OF ALASKA
DEPARTMENT OF TRANSPORTATION
AND PUBLIC FACILITIES
SOUTHEAST REGION DESIGN & CONSTRUCTION


HAINES AIRPORT
PAPI PAD DETAILS

DESIGNED BY: T.W. MOORE	PROJECT No. 69523
DRAWN BY: AutoCAD / B.W.B.	DATE: AUGUST 1990
CHECKED BY: C. HAKARI	SHEET 17 OF 39

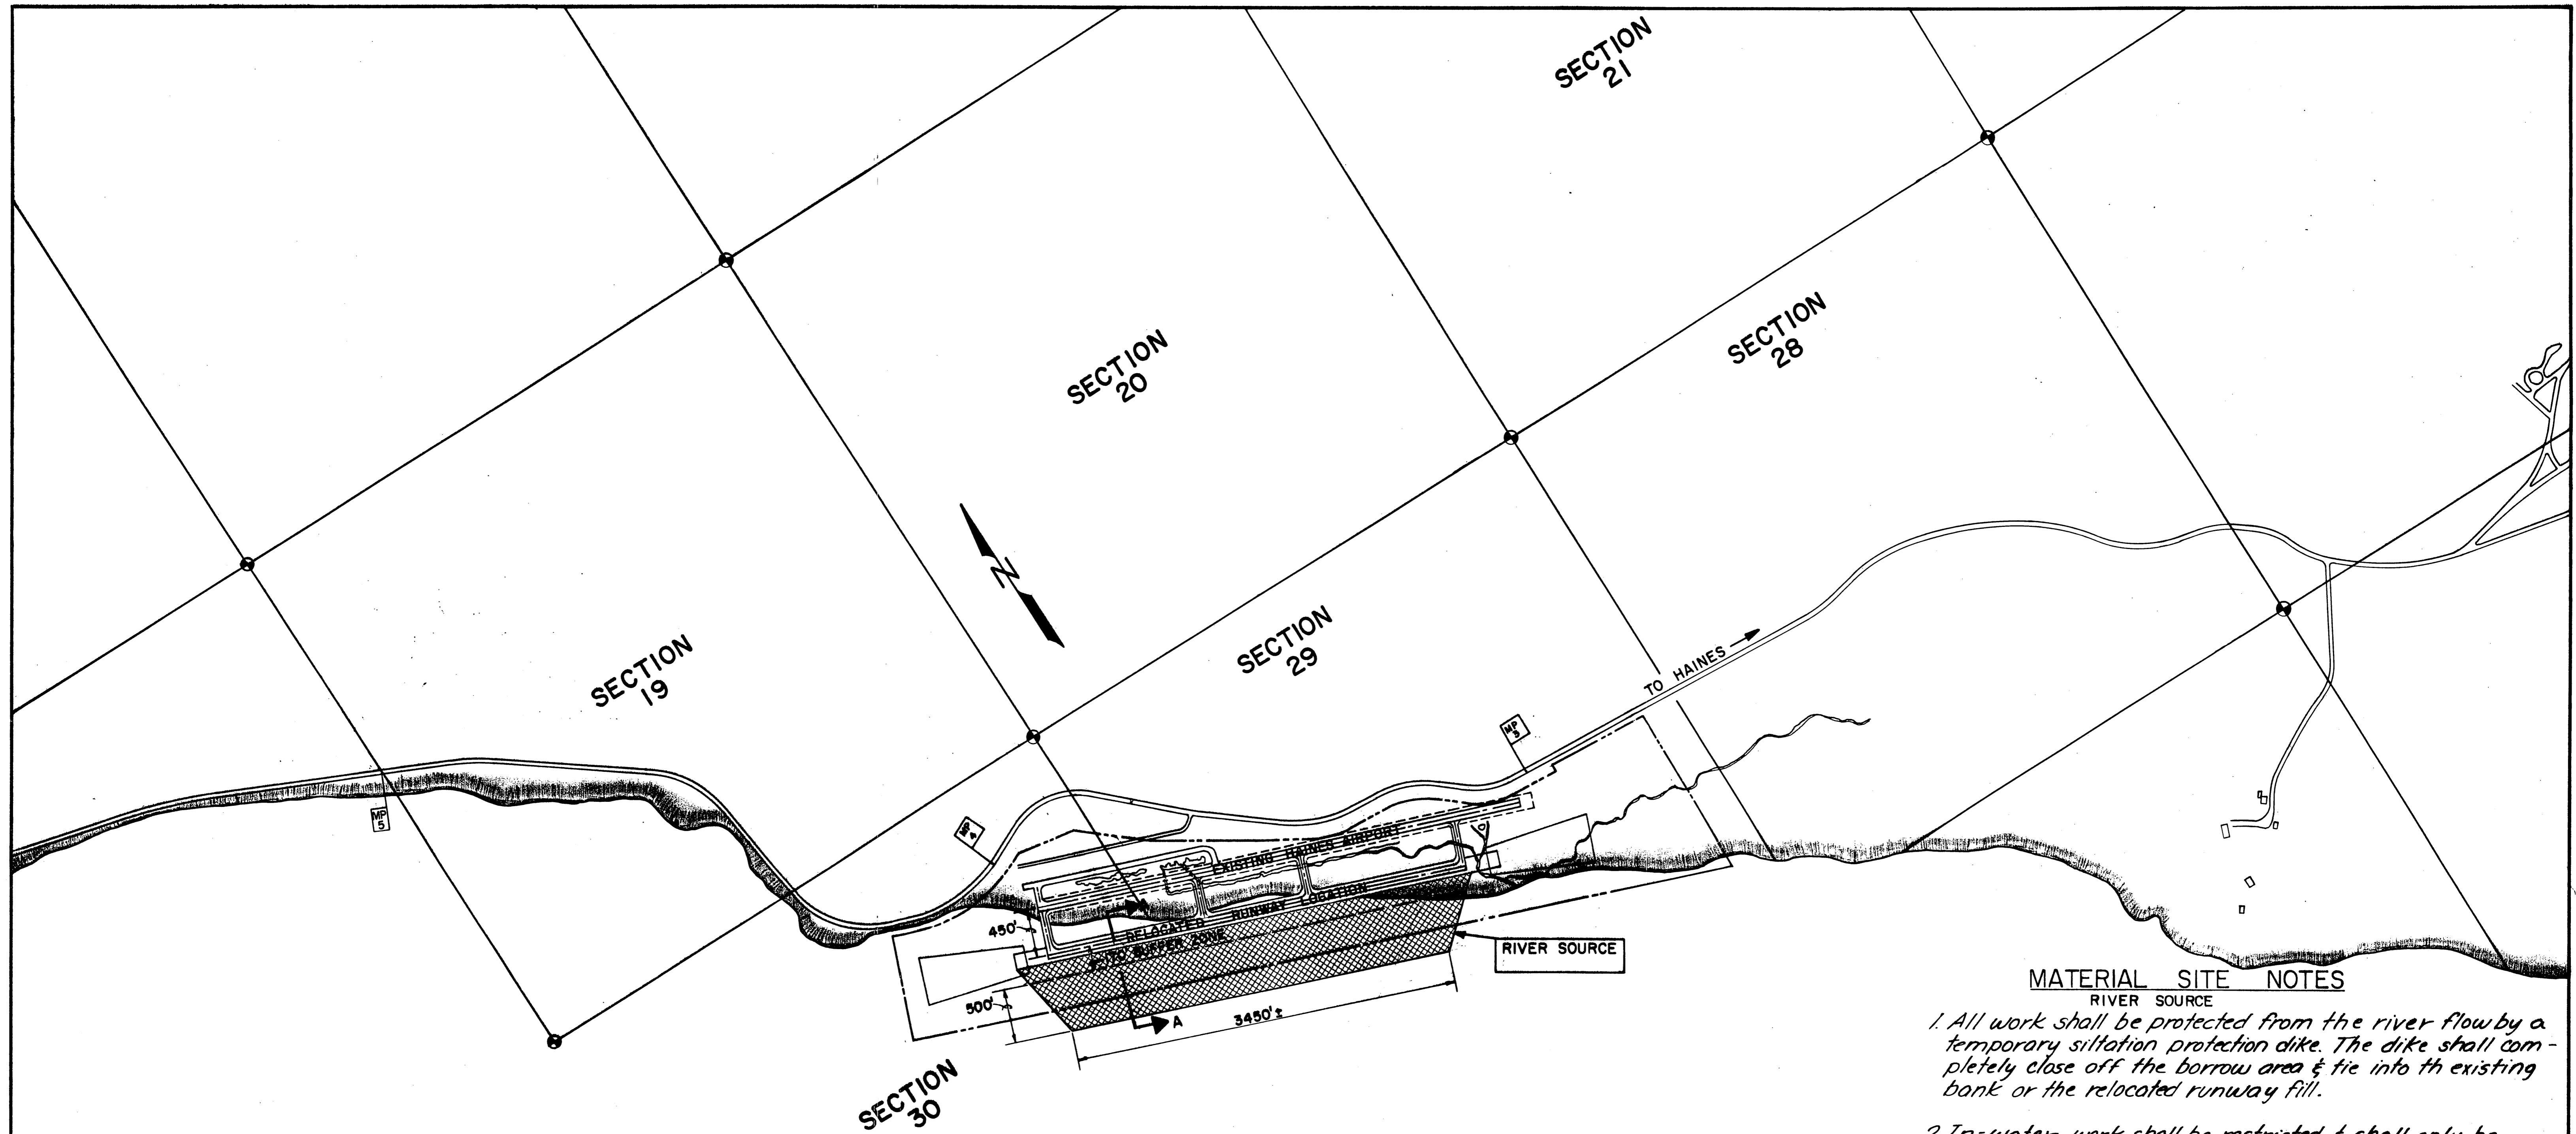

MATERIAL SITE NOTES

1. All work shall be protected from the river flow by a temporary siltation protection dike. The dike shall completely close off the borrow area & tie into the existing bank or the relocated runway fill.
2. In-water work shall be restricted & shall only be performed from Nov. 1st thru March 31st.
3. The temporary dike shall be constructed of river sand & be entirely free of ice chunks & large organics such as tree trunks or stumps.

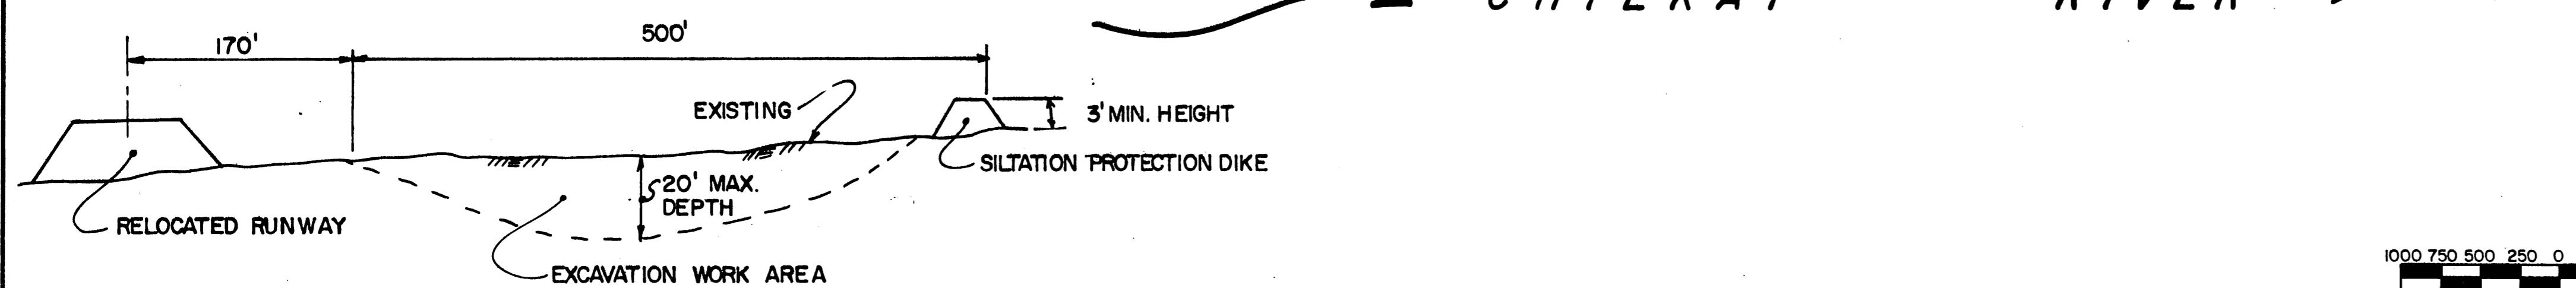

SECTION A-A


RIVER SOURCE M.S.

RECORD OF REVISIONS		
BY	DATE	DESCRIPTION OF CHANGE

STATE OF ALASKA
DEPARTMENT OF TRANSPORTATION & PUBLIC FACILITIES
SOUTHEAST REGION DESIGN & CONSTRUCTION

HAINES AIRPORT MATERIAL SITES

APPROVED BY: RECOMMENDED BY: PREPARED BY:	DESIGN GROUP CHIEF DRAWN BY: DESIGN ENGINEER, GROUP "N" LEAD DESIGNER	DESIGNED BY: DRAWN BY: DESIGN ENGINEER, GROUP "N" LEAD DESIGNER	SCALE: 1" = 700' ±

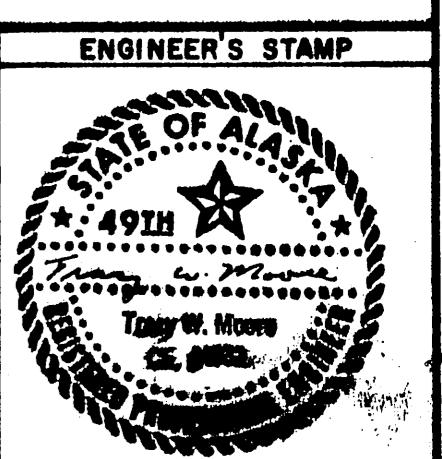


SHEET 18 OF 39

PIPE SUMMARY

PIPE	FROM	TO	LENGTH					INVERT		REMARKS
			18"	24"		48"	60"	Inlet	Outlet	
(P-1)	S-1	S-2	196' 93					14.30	13.80	
(P-2)	S-2	"A" 12+50, 235' RT.		160'				13.30	12.90	
(P-3)	S-3	S-4	196' 93					14.90	13.80	
(P-4)	S-4	"A" 15+00, 235' RT.		180' 61				13.30	12.90	
(P-5)	S-5	S-6	198' 93					14.90	13.80	
(P-6)	S-6	"A" 18+05, 235' RT.		160' 93				13.30	12.90	
(P-7)	S-7	"A" 18+60, 260' RT.		250'				13.30	12.90	
(P-8)	S-8	"A" 9+60, 160' RT.		90' 110				13.30	12.90	
(P-9)	S-9	"M" 10+70, 25' LT.	82' 74					15.35	15.00	
(P-10)	S-10	"M" 18+70, 24' LT.	78' 72					15.35	15.00	
(P-11)	"TA" 14+03, LT.	"TA" 13+50, 55' RT.				120' 50				
(P-12)	"TB" 12+30 E					260'				SKEW 34° LEFT AHEAD
(P-13)	"TC" 13+20 E					150' 20				INVERTS TO BE 1-FOOT BELOW EXIST. STREAM BED
(P-14)	"TD" 12+15 E					150' 20				INVERTS TO BE 1-FOOT BELOW EXIST. STREAM BED
(P-15)	"M" 15+13 20' RT.	"M" 15+13, 24' LT.	50' 52					14.58	14.00	CONNECT TO EXISTING STRUCTURE AT "M" 15+13 RT. CONNECTION INCIDENTAL
(P-16)	"M" 20+48, E					80' 80				SKEW 45° RT. AHEAD
(P-17)	"Y" 31+80					90' 100				
(P-18)	S-20	"M" 15+76 25' LT.	87'					14.14	13.92	
(P-19)	S-21	"M" 12+75 30 L.T.	60'					14.50	14.37	



STRUCTURE SUMMARY

STRUCTURE NO.	STATION	TYPE	TOP OF GRATE ELEVATION	REMARKS
(S-1)	"A"12+50, 120'LT	A	16.80	
(S-2)	"A"12+50, 75'RT.	A	17.47	
(S-3)	"A"15+00, 120'LT.	A	17.40	
(S-4)	"A"15+00, 75'RT.	A	17.47	
(S-5)	"A"17+50, 120'LT.	A	17.40	
(S-6)	"A"17+50, 75'RT.	A	17.47	
(S-7)	"A"20+00, 75'RT.	A	17.47	
(S-8)	"A"10+00, 75'RT.	A	17.47	
(S-9)	"M"16+70, 48'RT.	A	17.85	
(S-10)	"M"18+70, 48'RT.	A	17.85	
(S-20)	"M" 15 + 76 62'RT		17.03	
(S-21)	"M" 12 + 75 30'RT		16.33	ELEVATION ~ TOP OF CONCRETE

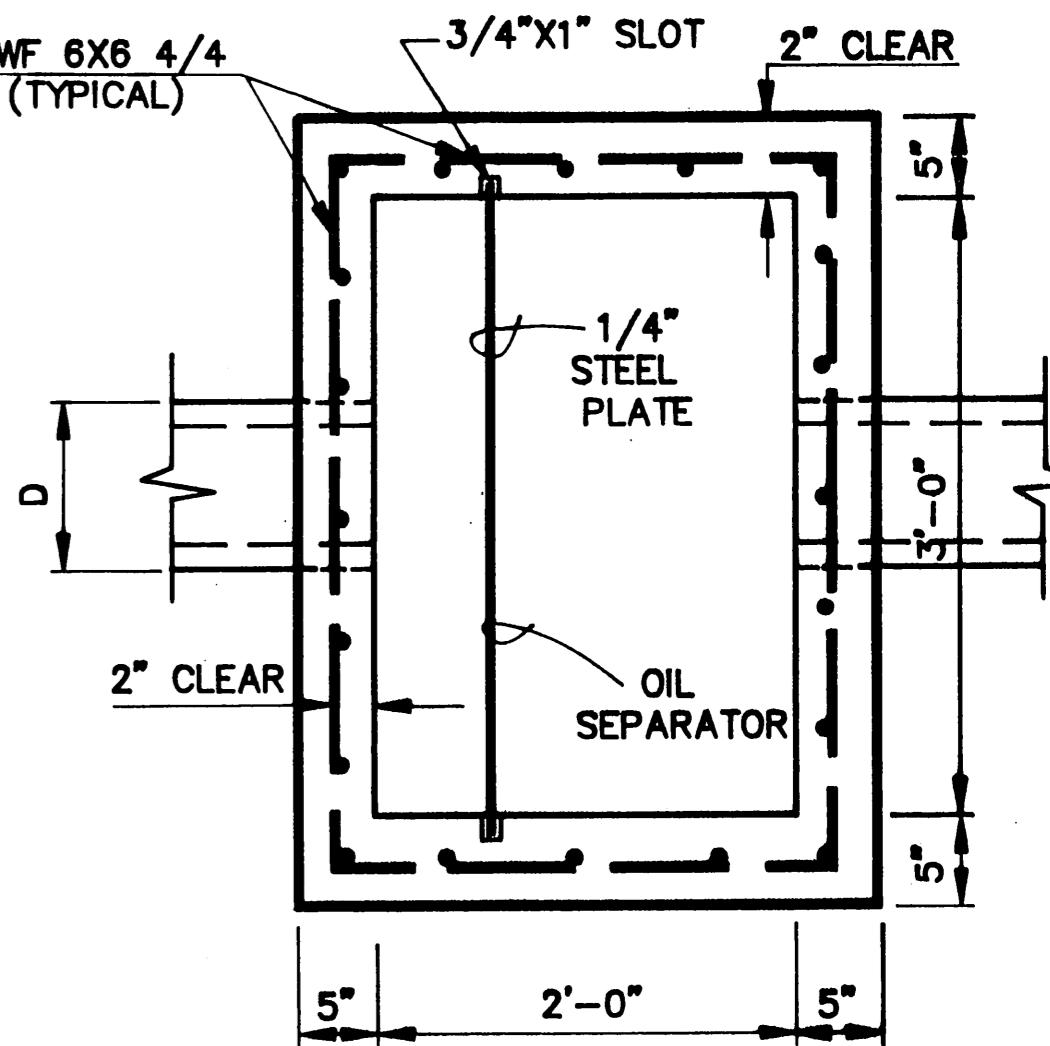

NOTES

1. CAST IN PLACE CONCRETE INLET BOX SHALL BE CLASS "W" CONCRETE.
 2. CONCRETE INLET BOX DEPTH AND LOCATION SHALL BE SHOWN ON THE PLANS, OR AS DIRECTED BY THE ENGINEER.
 3. INLETS SHALL HAVE 18" SUMP.
 4. CONCRETE INLET BOX SHALL BE PARALLEL TO APRON CENTERLINE UNLESS OTHERWISE DIRECTED BY THE ENGINEER.
 5. INLET FRAME AND GRATE SHALL BE AIRPORT APPROVED; NEENAH R-3475 OR APPROVED EQUAL.

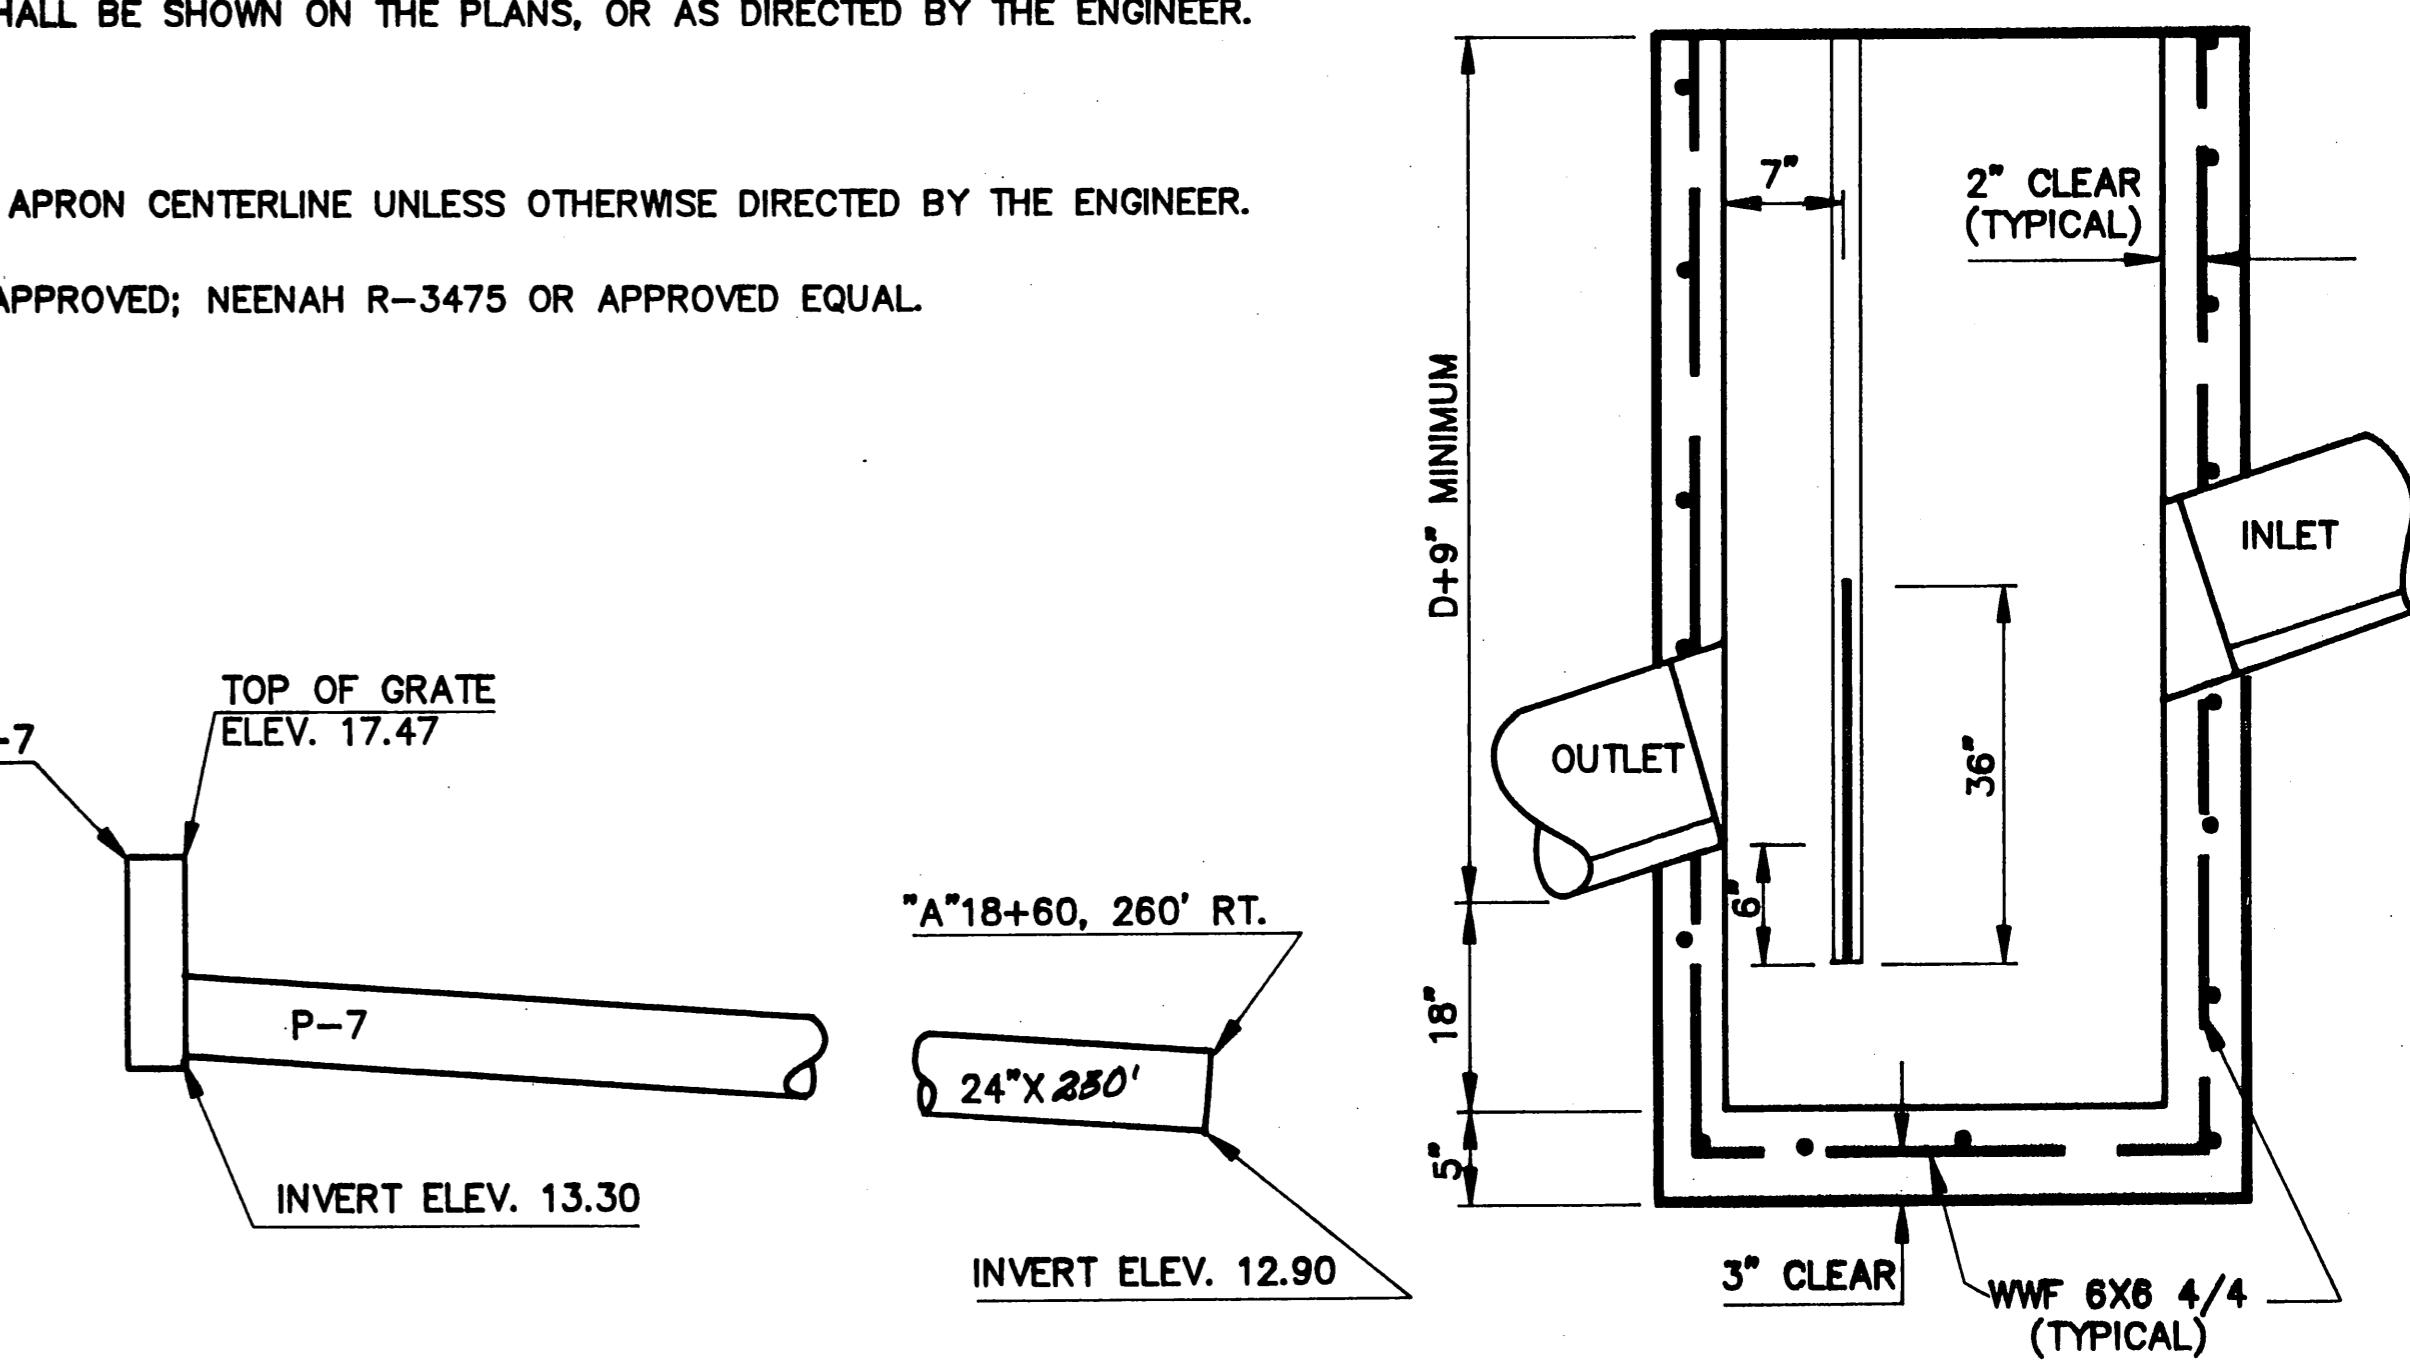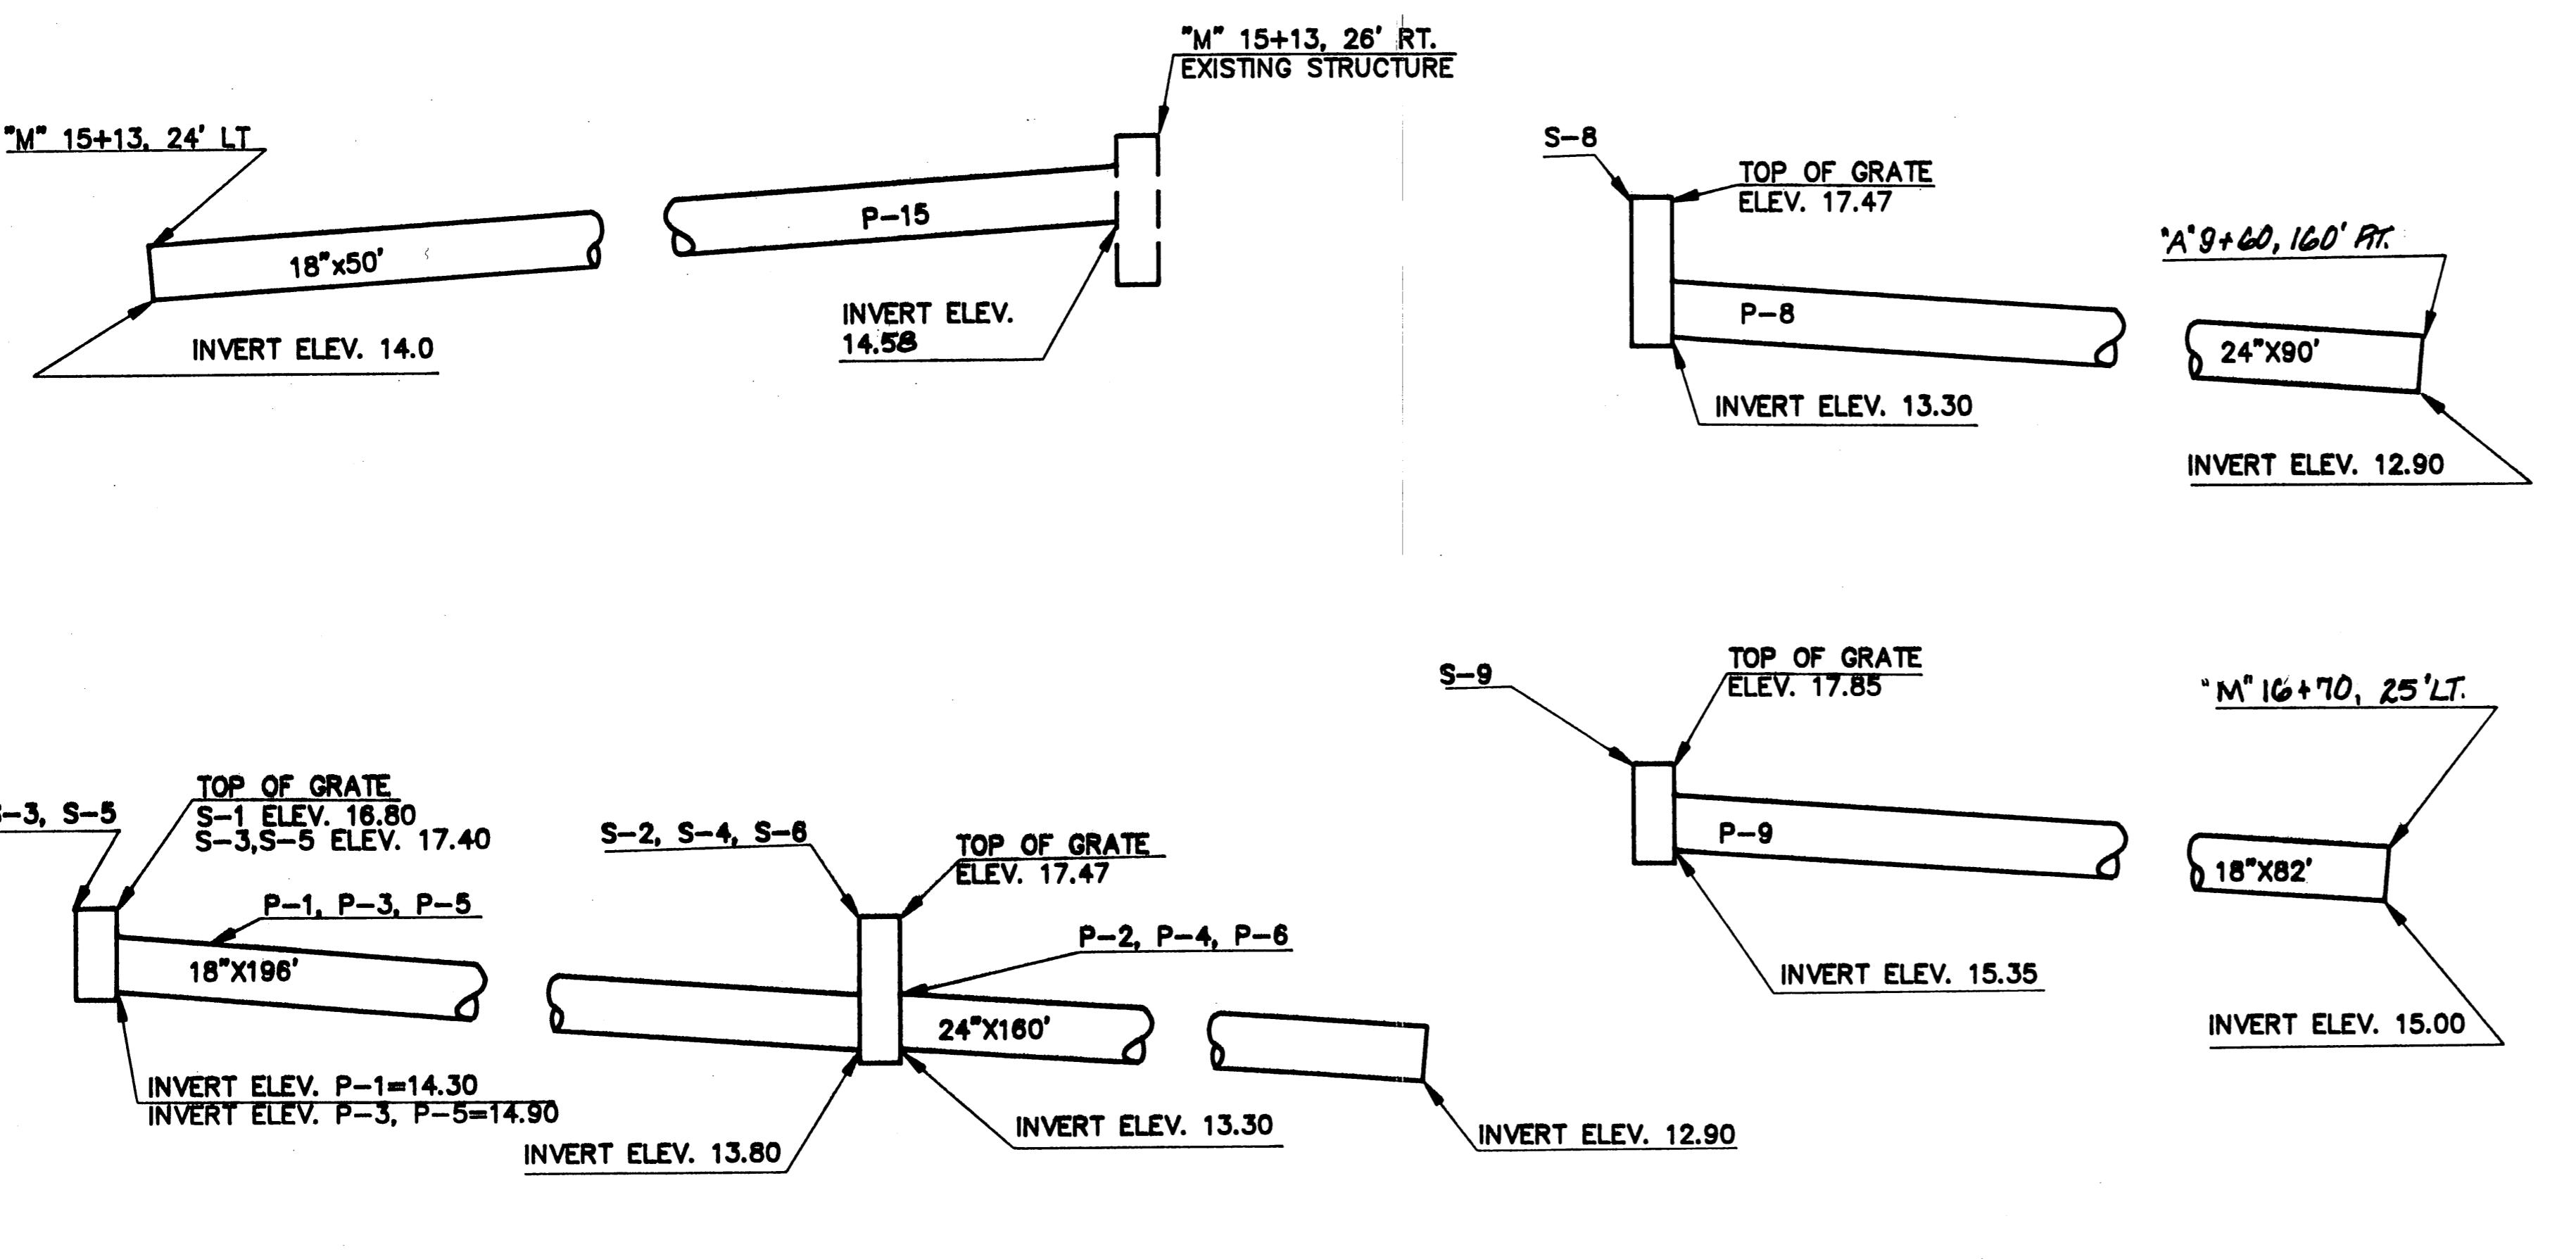

TYPE "A" INLET BOXES

AS-BUILT


BY:	DATE:	DESCRIPTION OF CHANGE:


**STATE OF ALASKA
DEPARTMENT OF TRANSPORTATION
AND PUBLIC FACILITIES
SOUTHEAST REGION DESIGN & CONSTRUCTION**

HAINES AIRPORT

DRAINAGE DETAILS

DESIGNED BY: T.W. MOORE	PROJECT No. 69523
DRAWN BY: AUTOCADD/CSA	DATE: AUGUST 1990
CHECKED BY: C. HAKARI	SHEET 19 OF 39

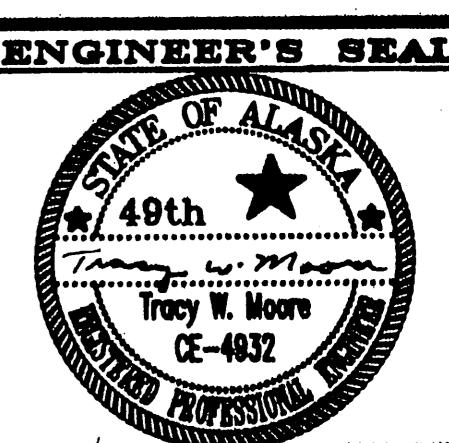

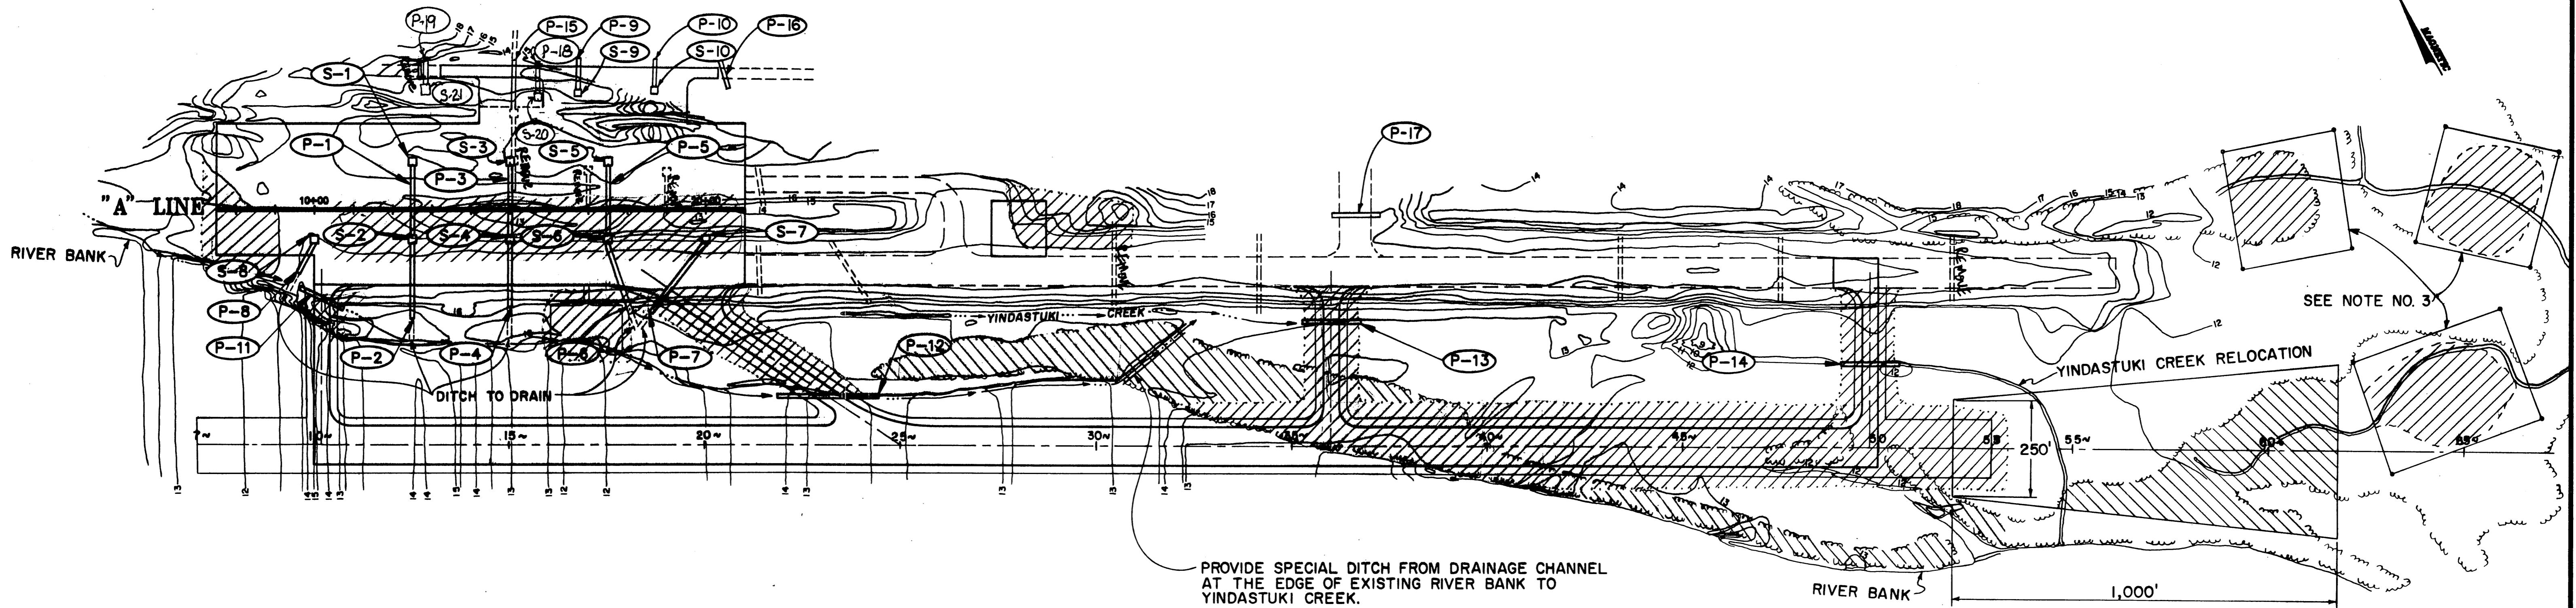


- TREE LINE.
- CLEARING.
- CLEARING IN EXCAVATION & EMBANKMENT AREAS.
- SEE SHEET 18 FOR PIPE AND STRUCTURE DIMENSIONS AND LOCATIONS.

NOTES :

1. ALL EXISTING CMP CROSSING THE TAXIWAY AND APRON, THAT ARE NOT INTENDED TO REMAIN, SHALL BE REMOVED.
2. SPECIAL DITCHING TO DRAIN NEW C.M.P.'S WILL BE PAID FOR AS UNCLASSIFIED EXCAVATION.
3. CLEARING FOR FISHERY PONDS WILL BE LIMITED TO THE STAKED EXCAVATION AREAS AND WASTE BERMS. TWO SITES NOT SHOWN ON THIS SHEET.
4. FROM STA. 38+00 TO STA. 51+00 THE CLEARING SHALL EXTEND TO THE EDGE OF THE RIVER BANK.

AS-BUILT
B.A. 2-12-96

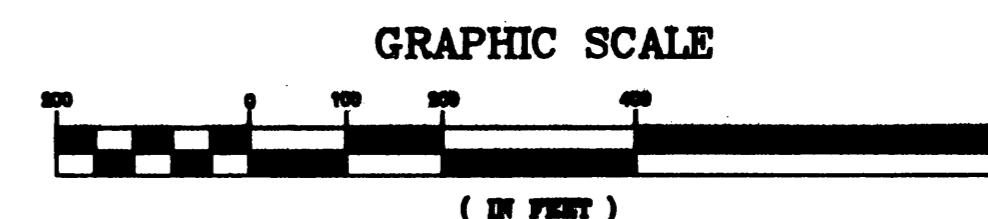


BY:	DATE:	DESCRIPTION OF CHANGE:

RECORD OF REVISIONS

STATE OF ALASKA
DEPARTMENT OF TRANSPORTATION
AND PUBLIC FACILITIES
SOUTHEAST REGION DESIGN & CONSTRUCTION

HAINES AIRPORT
CLEARING AND DRAINAGE PLAN


DESIGNED BY: C. HAKARI	PROJECT No. 69623
DRAWN BY: B.A. AutoCAD / B.W.B.	DATE: APRIL 1990
CHECKED BY: C. HAKARI	SHEET 20 of 39

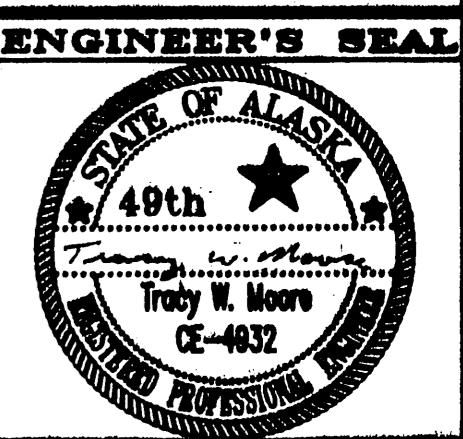

"H" CURVE DATA

Δ = 65°02'45"
 D = 7'00"00"
 T = 521.91'
 L = 929.22'
 R = 818.51'

"H" 218+93.93 P.O.C.=
 "D" 4+01.92

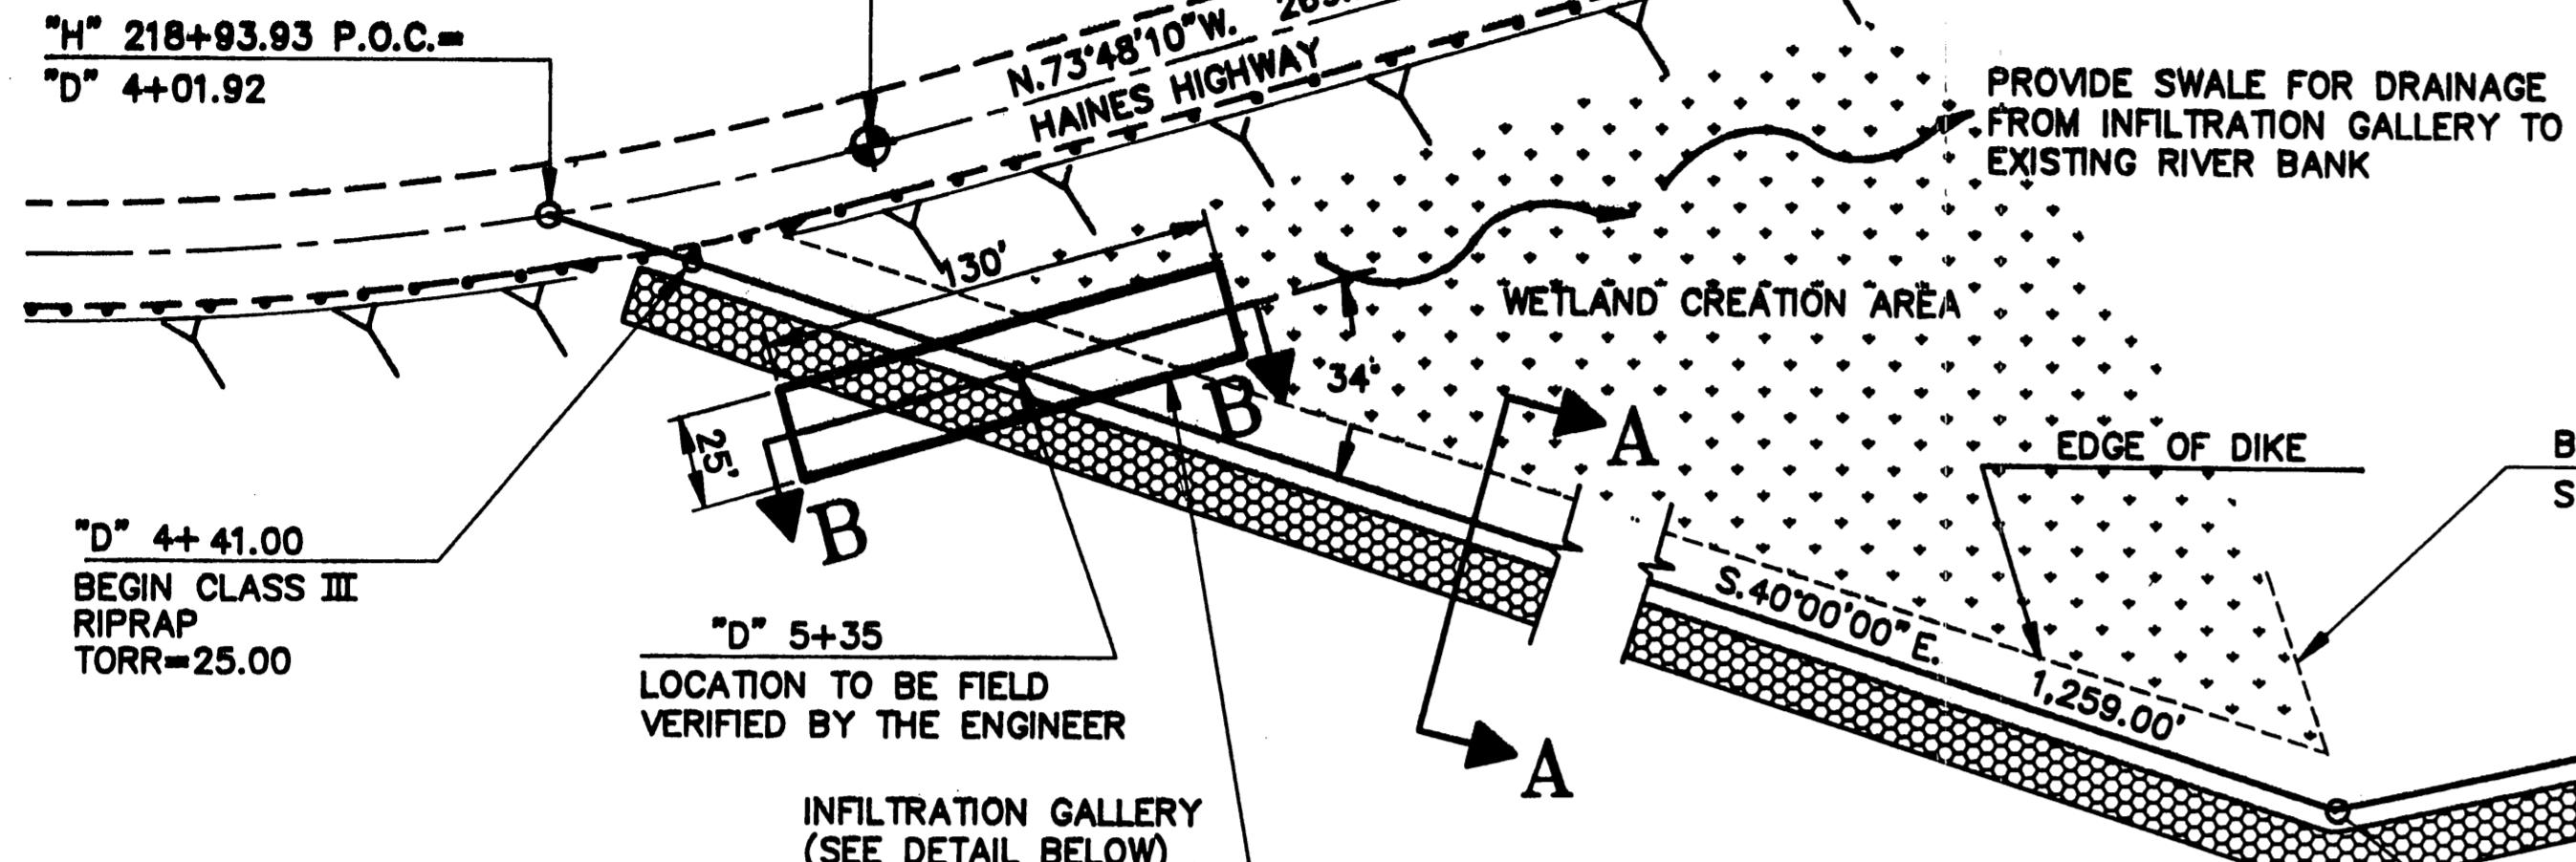

NOTE :

1. THE CLASS III RIPRAP SHALL TRANSITION SMOOTHLY INTO THE CLASS II RIPRAP AT STATION "D" 17+00.

PT. "D" 17+00.00=

"O" 7+00.00, 75' RT.
END CLASS III RIPRAP, BEGIN
CLASS II RIPRAP. TORR=21.50
SEE RUNWAY TYPICAL SECTION,
SHEET 6.

PT. "D" 48+00.00=
"O" 38+00.00, 75' RT.
TORR= 18.80

EDGE OF RUNWAY
SAFETY AREA

S.54°03'58"E.

441.62'

N.20°10'00"E.



75.00'

"D" 53+16.62=
"O" 42+25.00, 120' RT.
END CLASS II RIPRAP
TORR=17.90

PT. "D" 52+41.62=
"O" 42+25.00, 195' RT.
TORR=17.90

"D" LINE LAYOUT

GRAPHIC SCALE

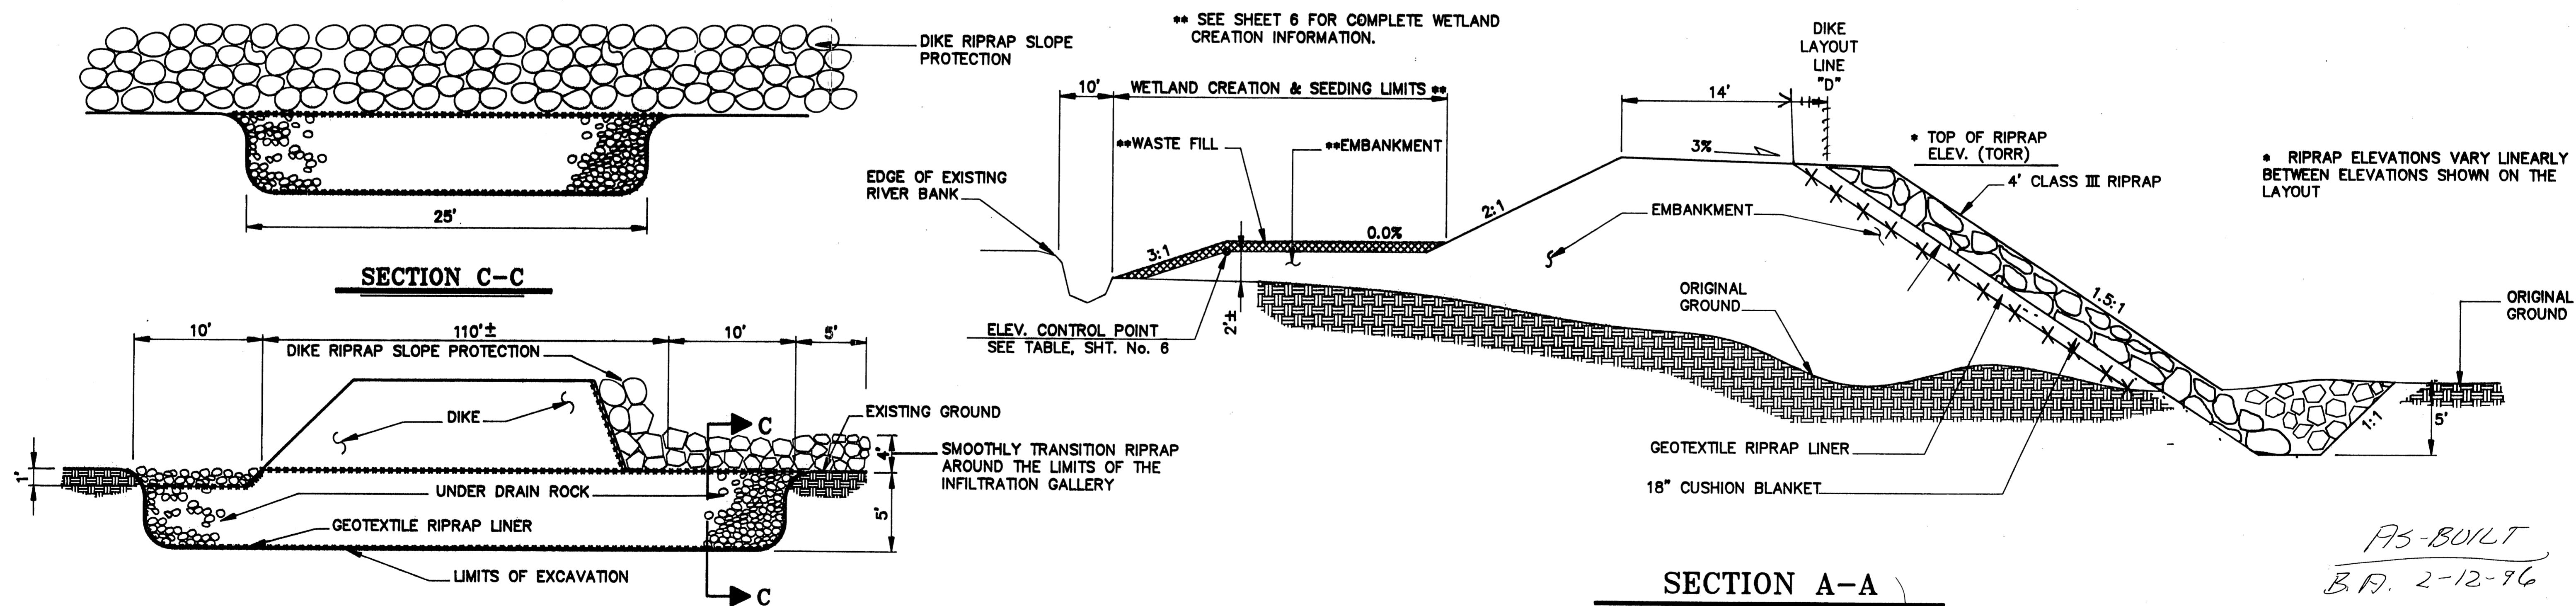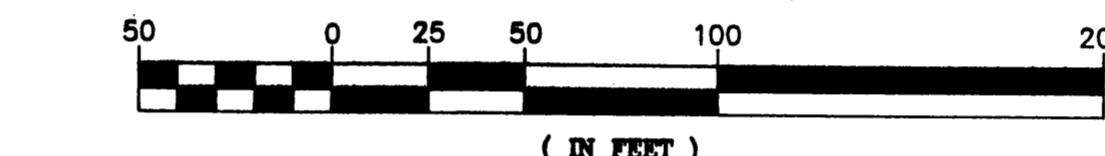

INFILTRATION GALLERY DETAIL

SECTION B-B


BY:	DATE:	DESCRIPTION OF CHANGE:


RECORD OF REVISIONS

STATE OF ALASKA
DEPARTMENT OF TRANSPORTATION
AND PUBLIC FACILITIES
SOUTHEAST REGION DESIGN & CONSTRUCTION


HAINES AIRPORT DIKE & RIPRAP DETAILS

DESIGNED BY: C. CORREA PROJECT No. 69528
DRAWN BY: AutoCAD / C.S.A. DATE: AUGUST 1990
CHECKED BY: T.W. MOORE SHEET 21 OF 39

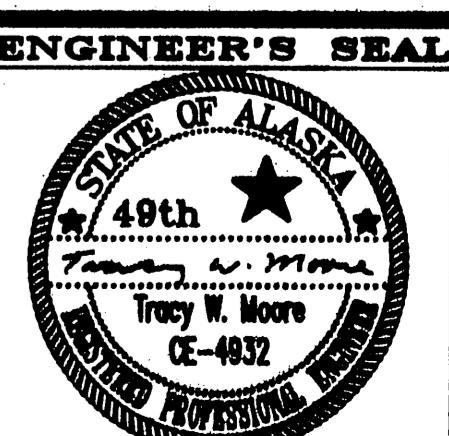

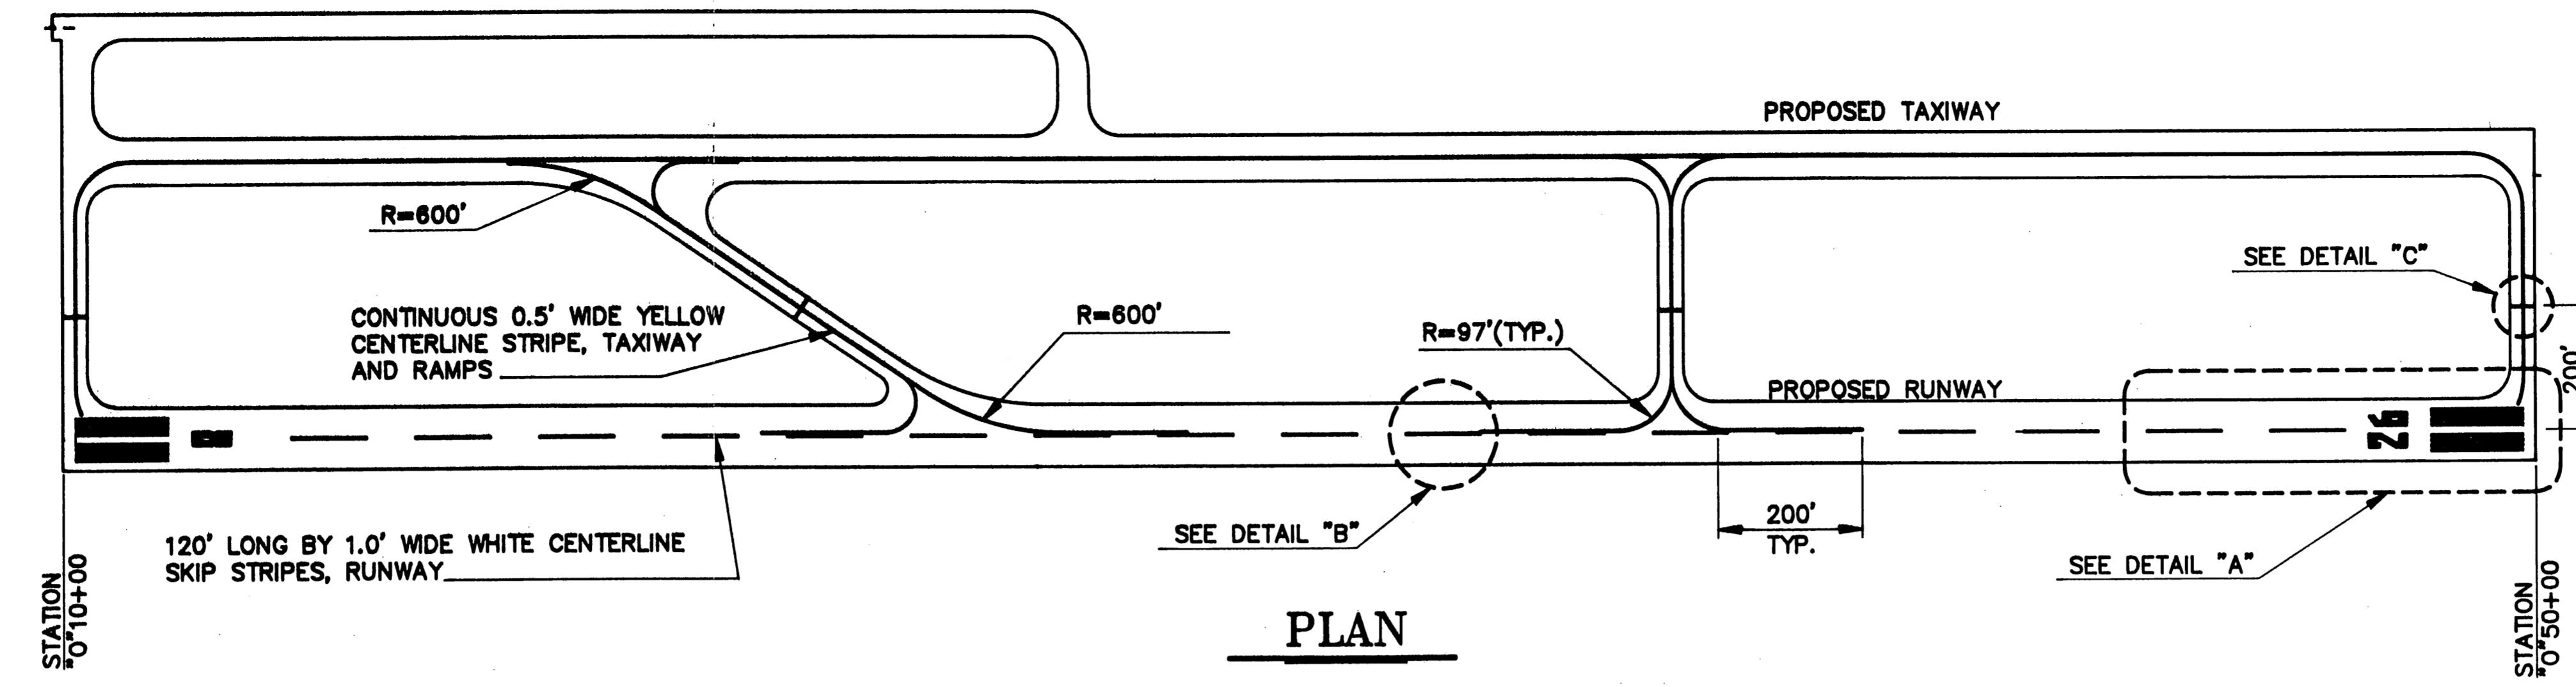


PLAN

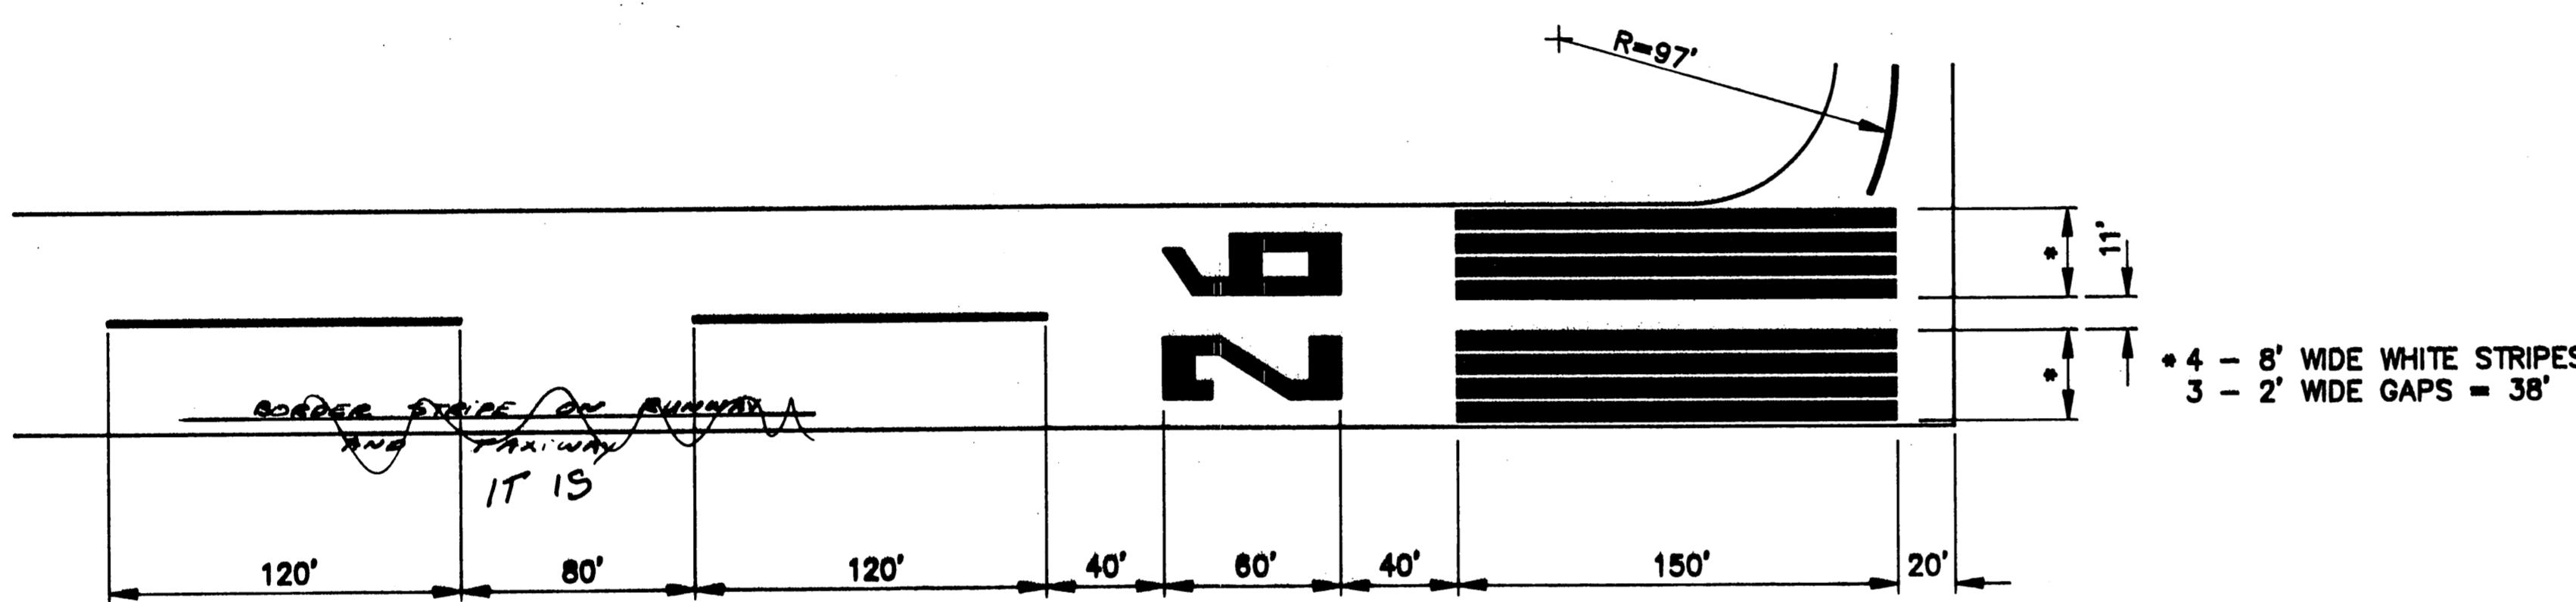


DETAIL "A"

NOTE: WEST END OF RUNWAY IS SIMILAR, EXCEPT
RUNWAY NUMBER IS DIFFERENT.

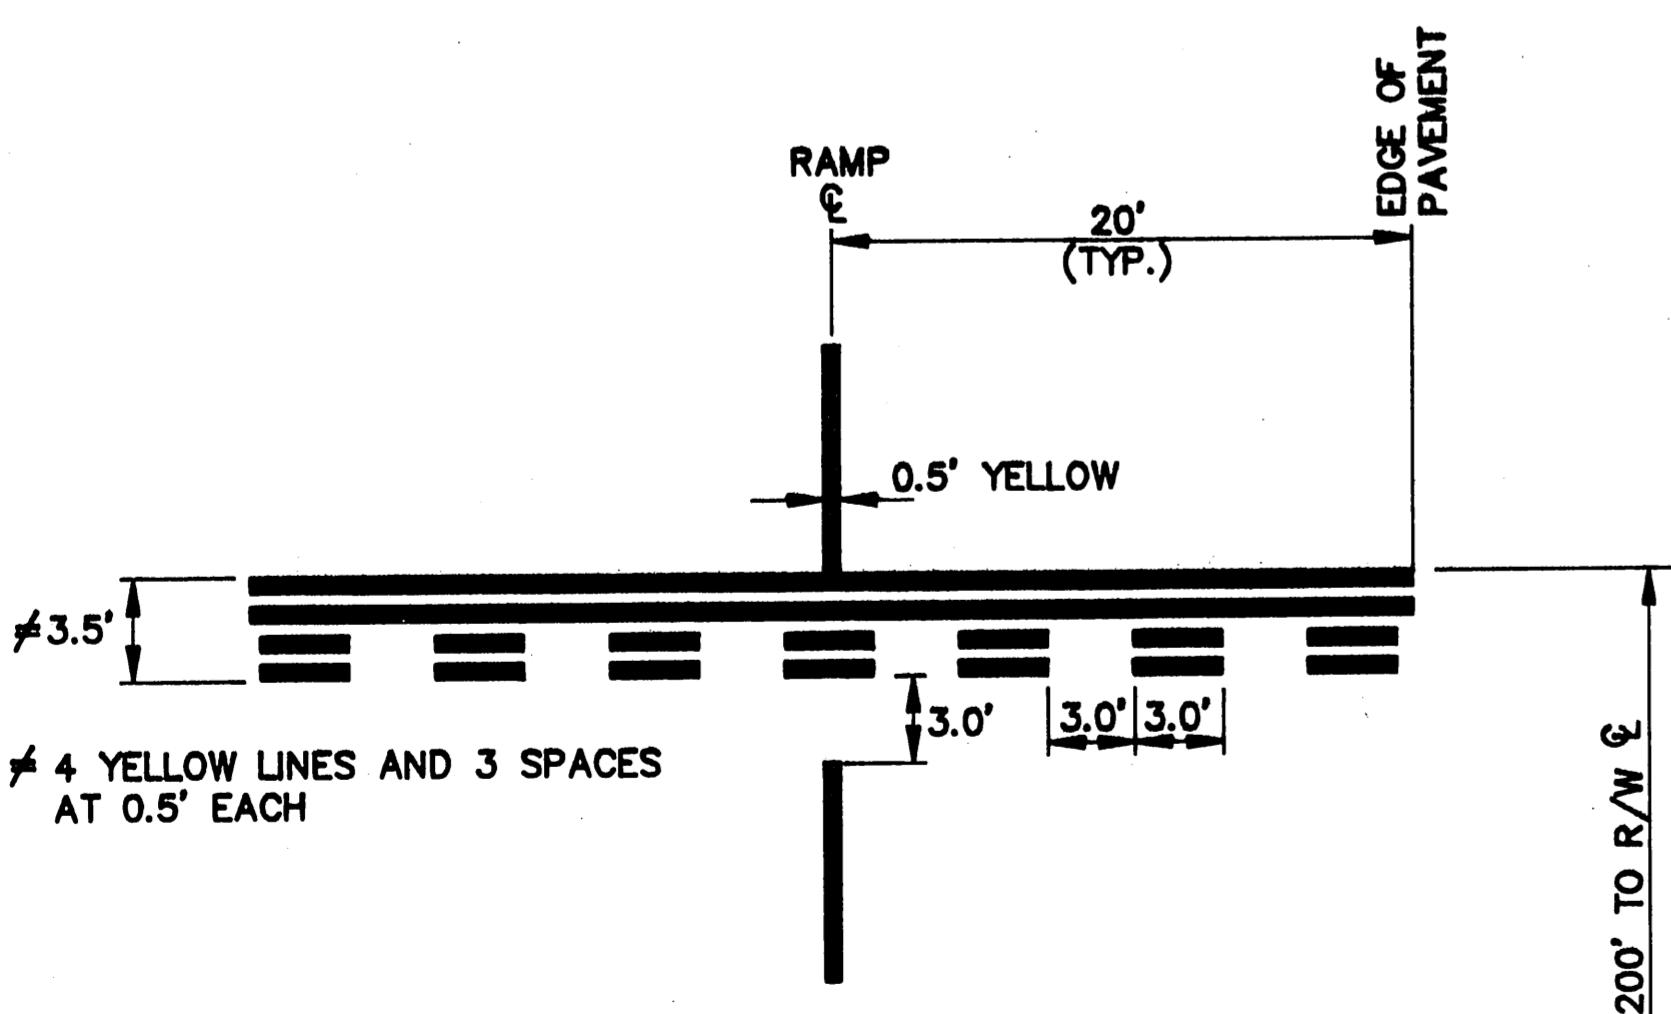


DETAIL "C"


TYPICAL TAXI-HOLDING POSITION MARKING
(4 REQUIRED)

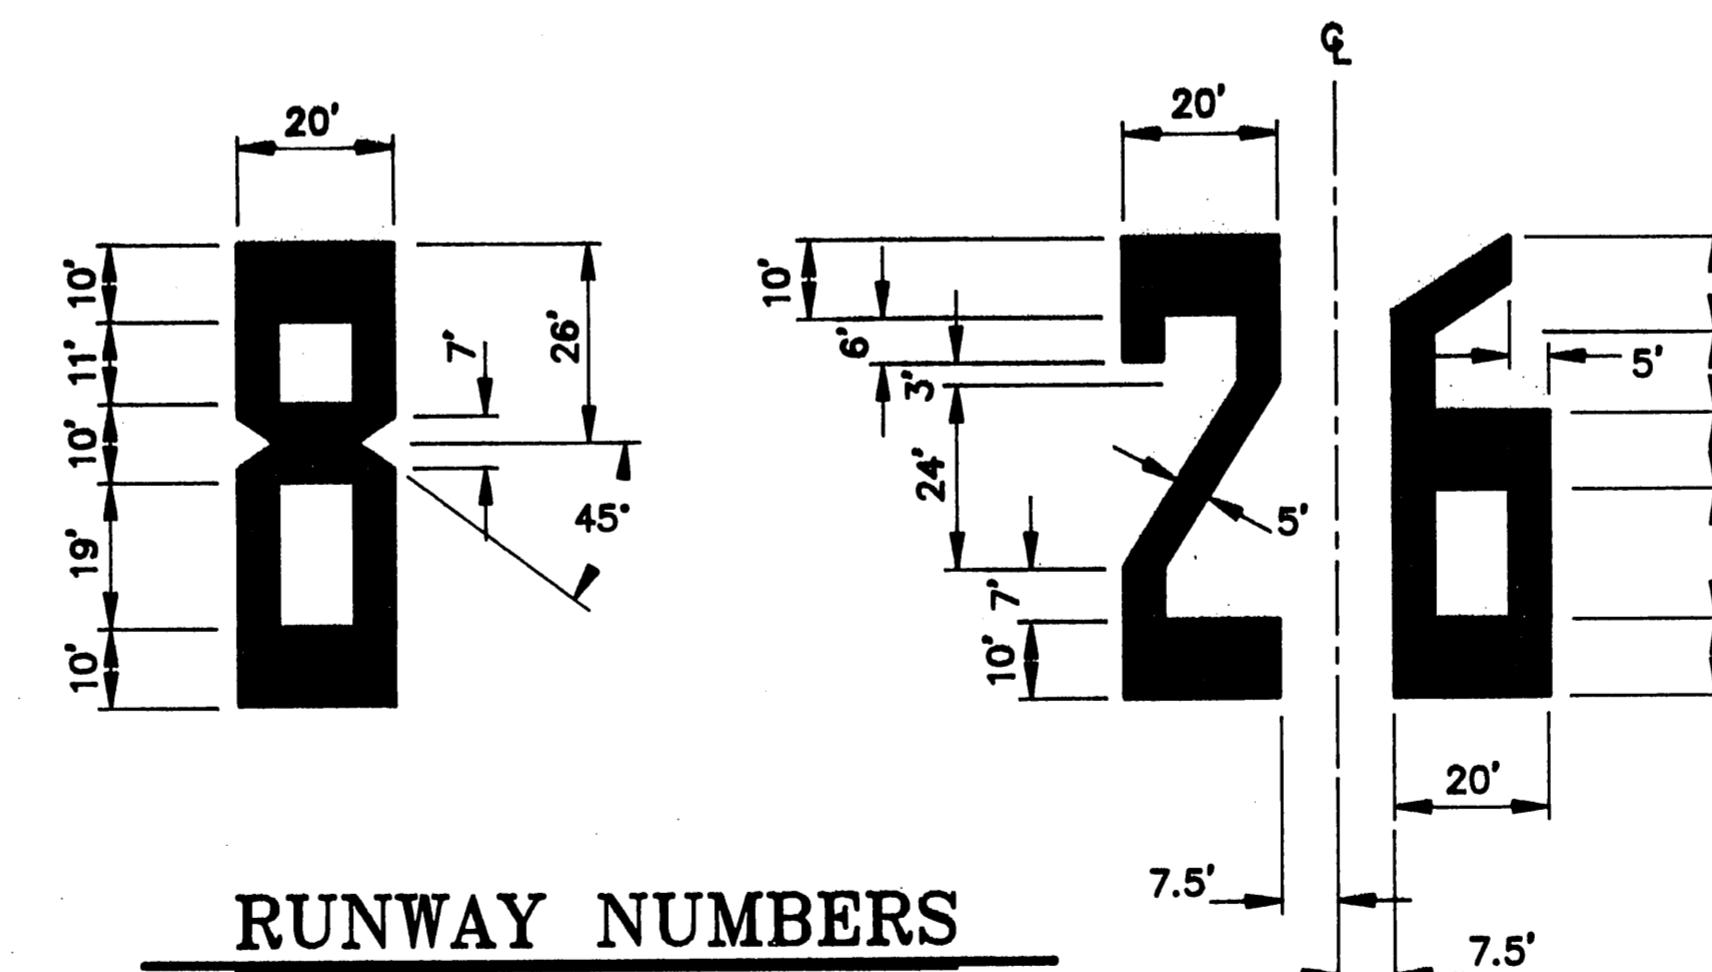

RUNWAY NUMBERS

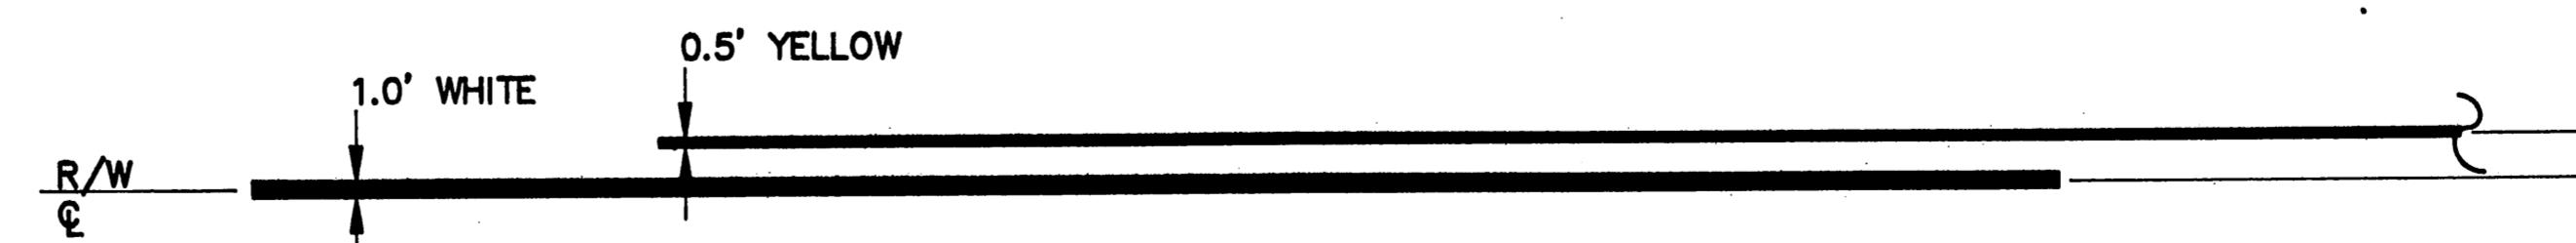

DETAIL "B"

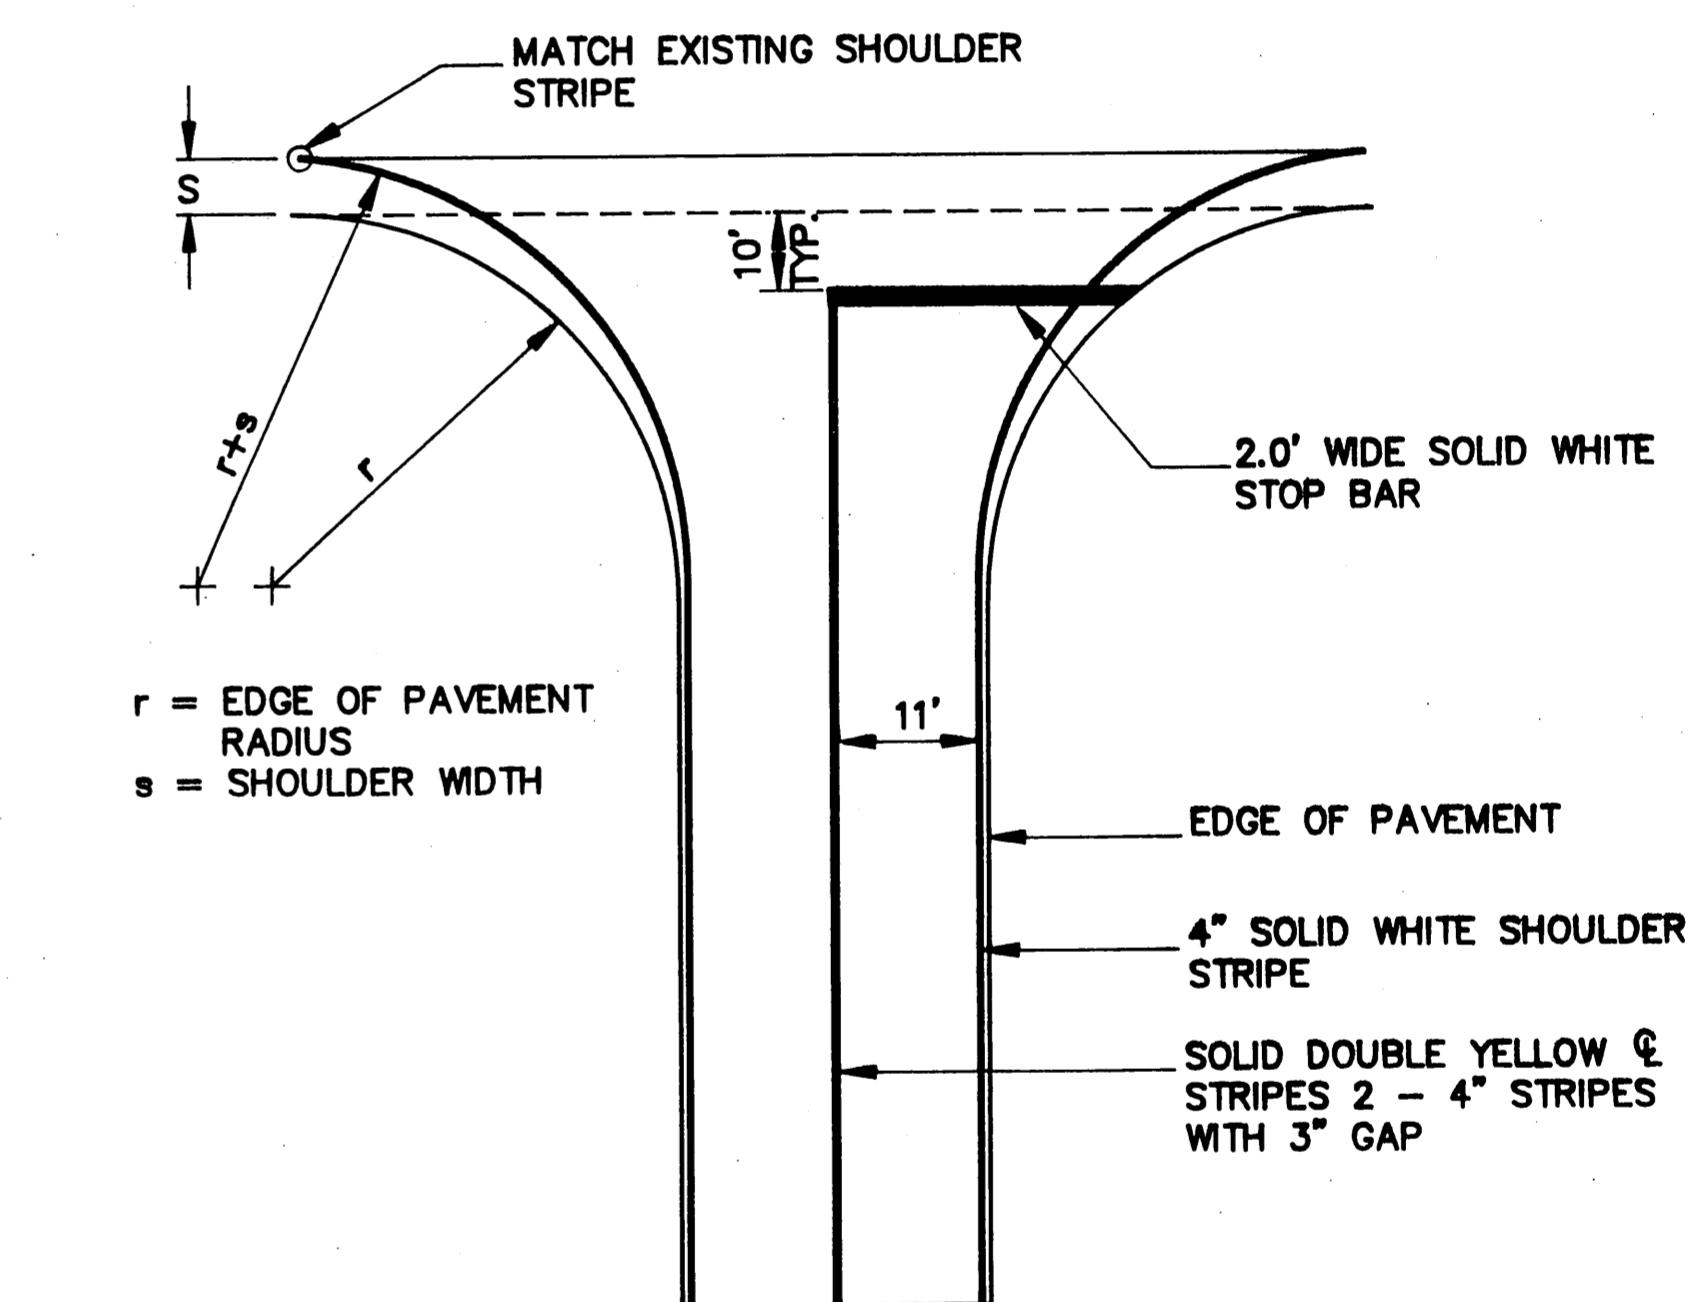

ACCESS ROAD STRIPING TYPICAL

ACCESS ROAD STRIPING REQUIRED:

"M" 9+00 TO "M" 25+79
"S" 10+20 TO "S" 13+24

3 STOP BARS REQUIRED:

"M" 25+69, RT.
"S" 10+56, LT.
"M" 19+50, 16' RT.

AS-BUILT
B.A. 2-12-76


HAINES AIRPORT STRIPING PLAN



BY:	DATE:	DESCRIPTION OF CHANGE:

RECORD OF REVISIONS

STATE OF ALASKA
DEPARTMENT OF TRANSPORTATION
AND PUBLIC FACILITIES
SOUTHEAST REGION DESIGN & CONSTRUCTION



DESIGNED BY:
T.W. MOORE
PROJECT No.
69523
DRAWN BY:
AutoCAD / B.W.B.
DATE:
AUGUST 1990
CHECKED BY:
C. HAKARI
SHEET 22 OF 39

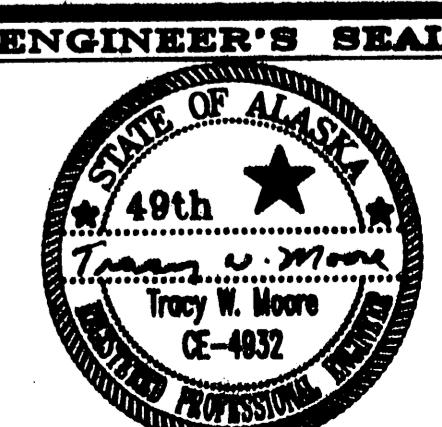

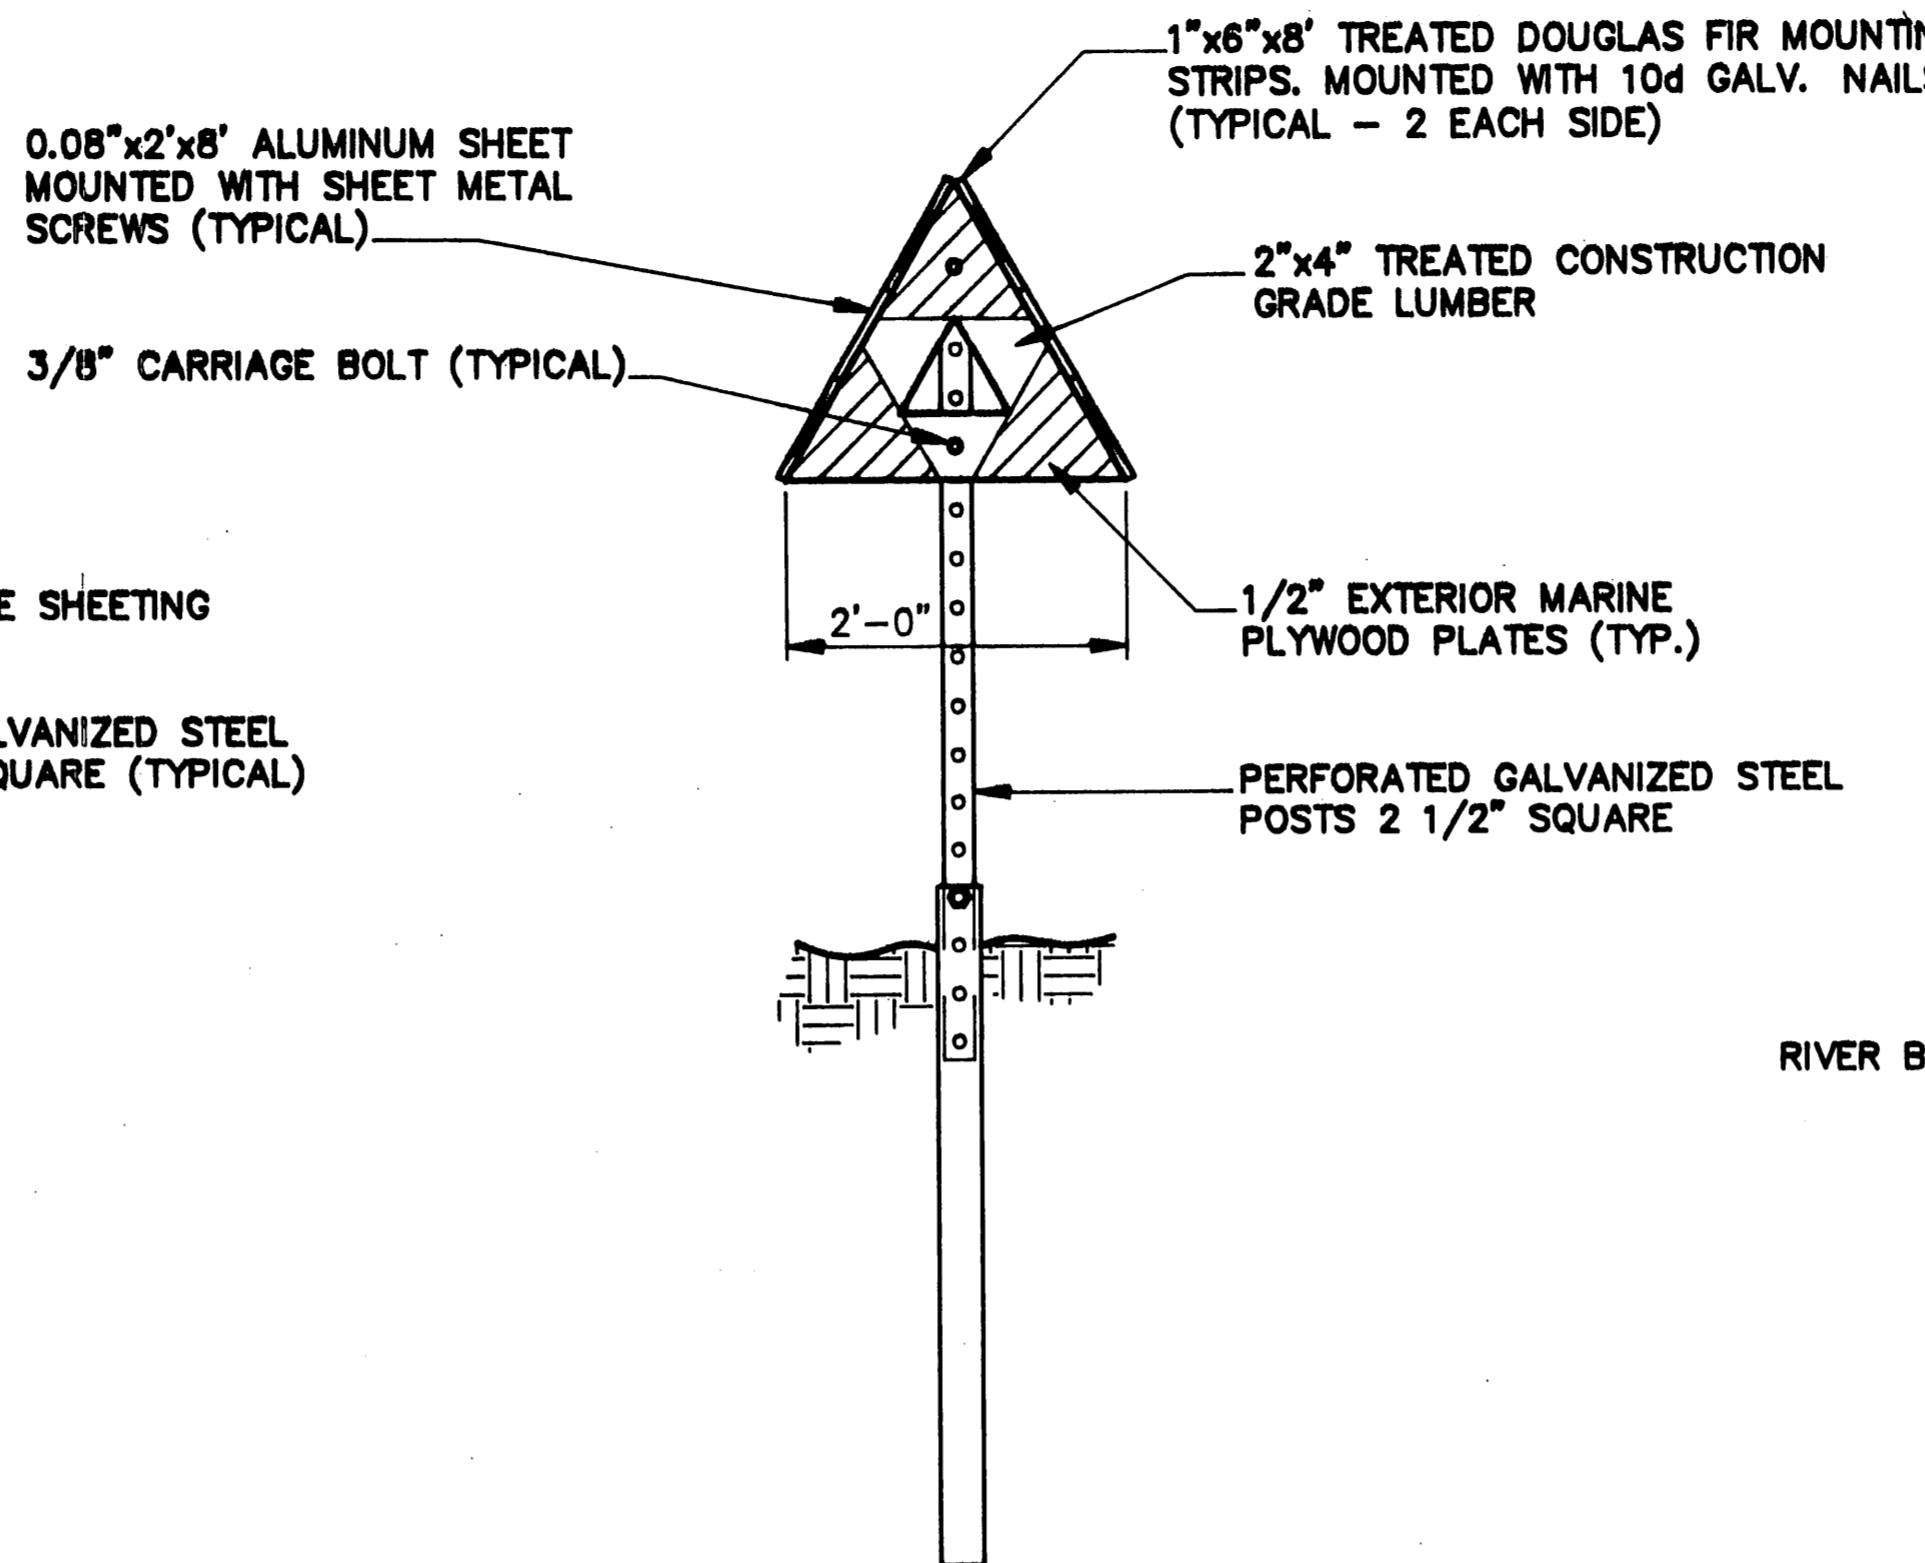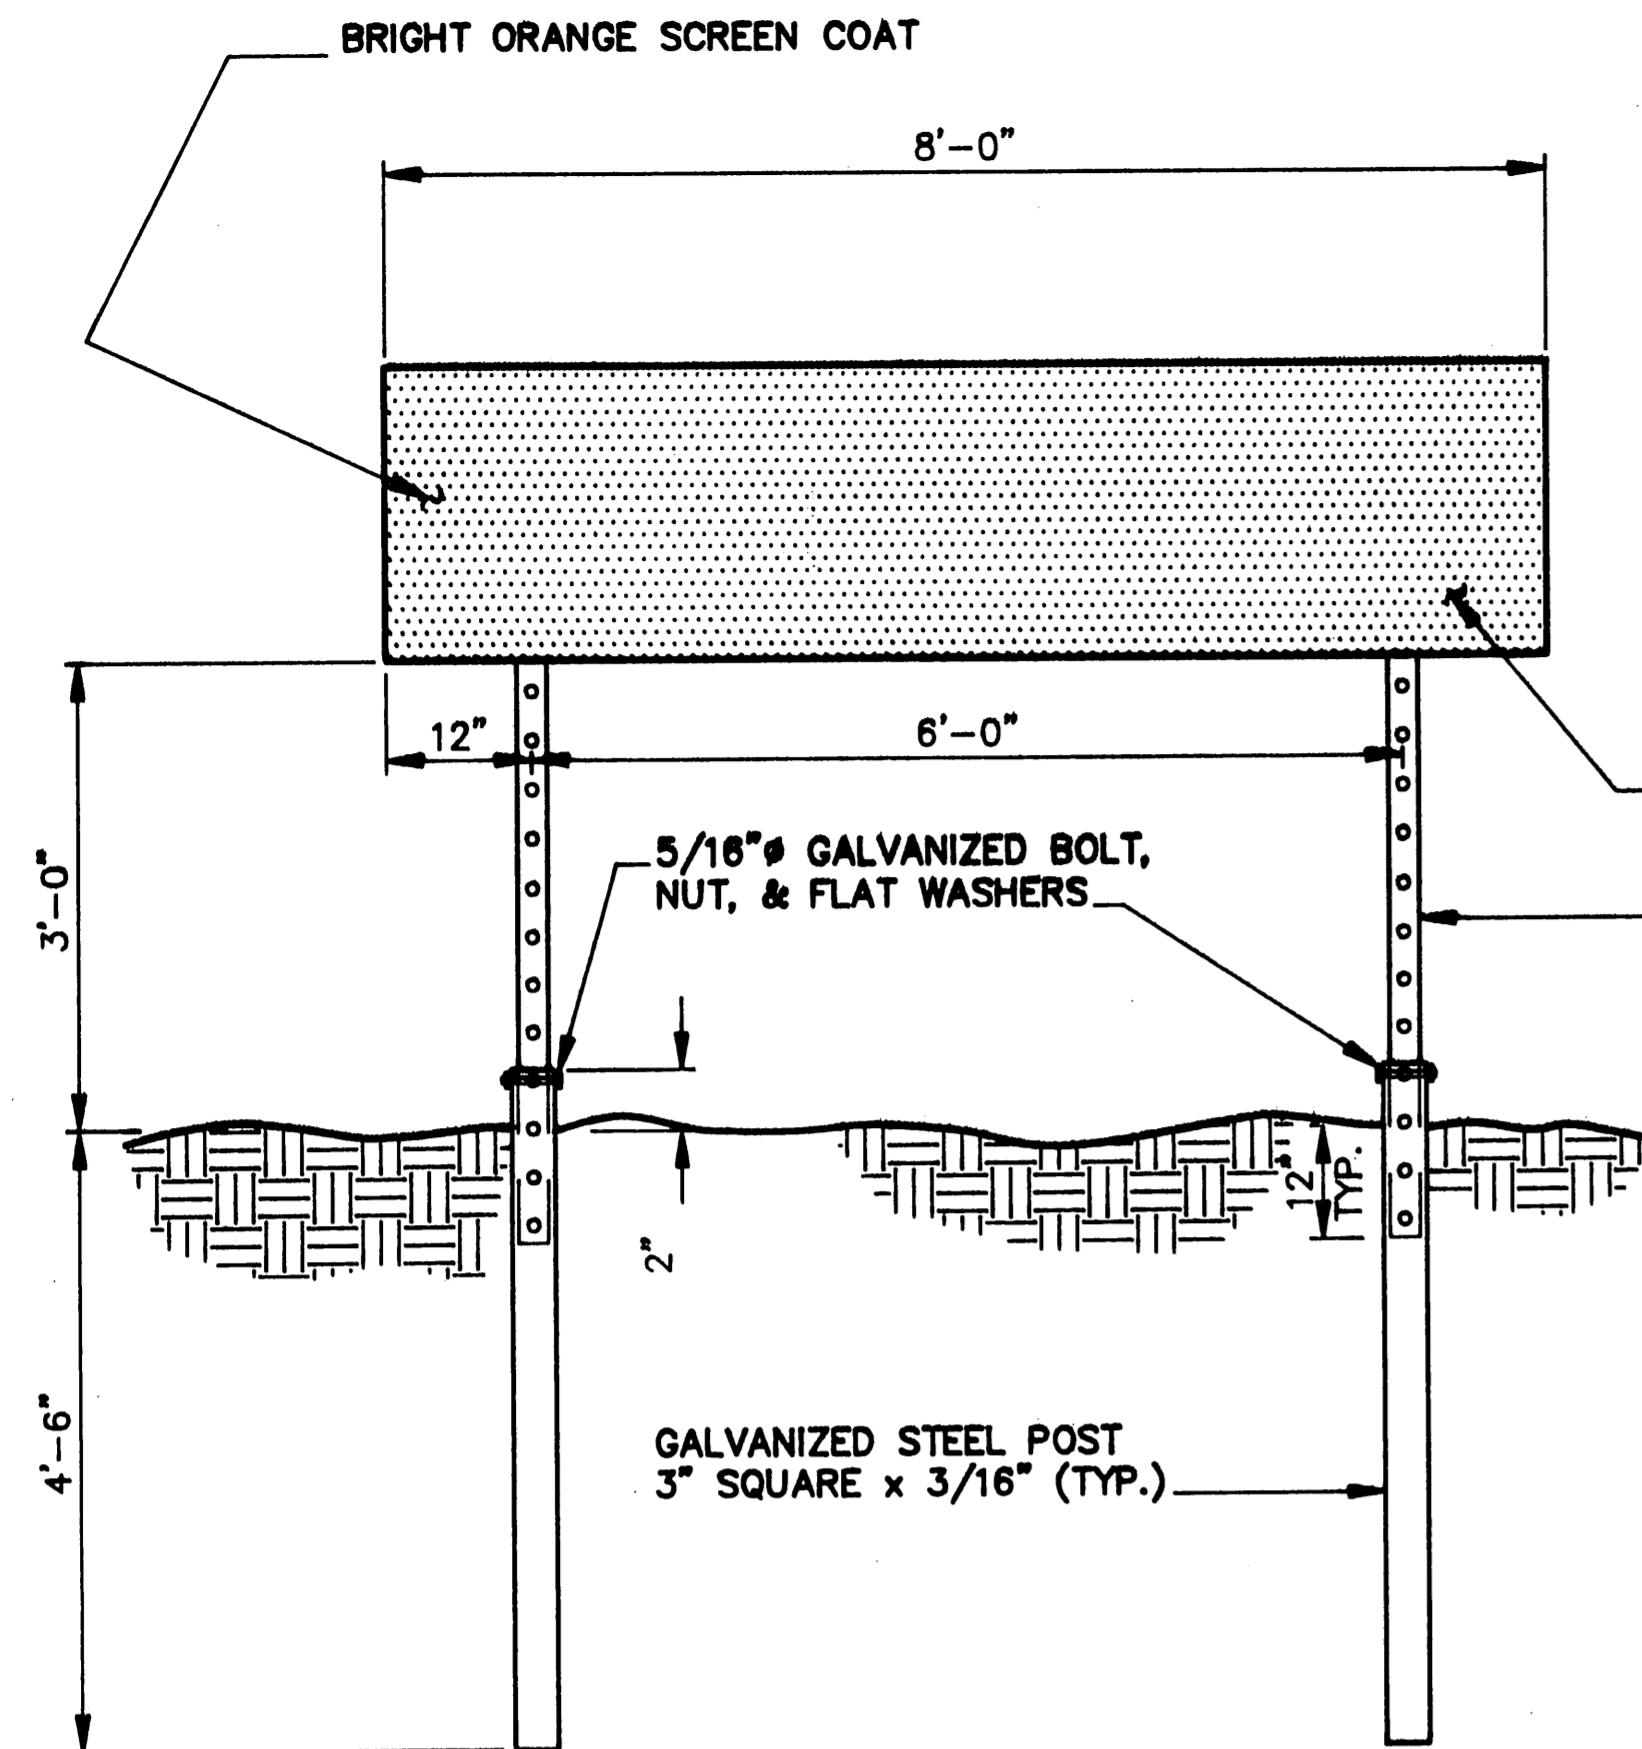

SEGMENTED CIRCLE AND WINDCONE NOTES:

1. THE SEGMENTED CIRCLE TRIANGULAR MOUNTING FRAMES SHALL BE FASTENED TO THE STEEL POSTS WITH TWO 3/8" x 5" GALVANIZED CARRIAGE BOLTS. FASTEN MOUNTING STRIPS TO 2" x 4" FRAME WITH EXTERIOR CEMENT AND GALVANIZED NAILS. PREPUNCH ALUMINUM SHEETS ON 12" CENTERS, 3" FROM TOP TO BOTTOM. FASTEN TO MOUNTING STRIPS WITH 1/2" x #8 PAN HEAD COATED SHEET METAL SCREWS.
2. ALL WOOD USED SHALL BE PAINTED WITH NON-LEADED ENAMEL PAINT, COLOR BLACK.
3. EXISTING LIGHTED WINDCONE SHALL BE SALVAGED AND RELOCATED. PRIOR TO ERECTING, THE HARDWARE SHALL BE CLEANED AND SERVICED.

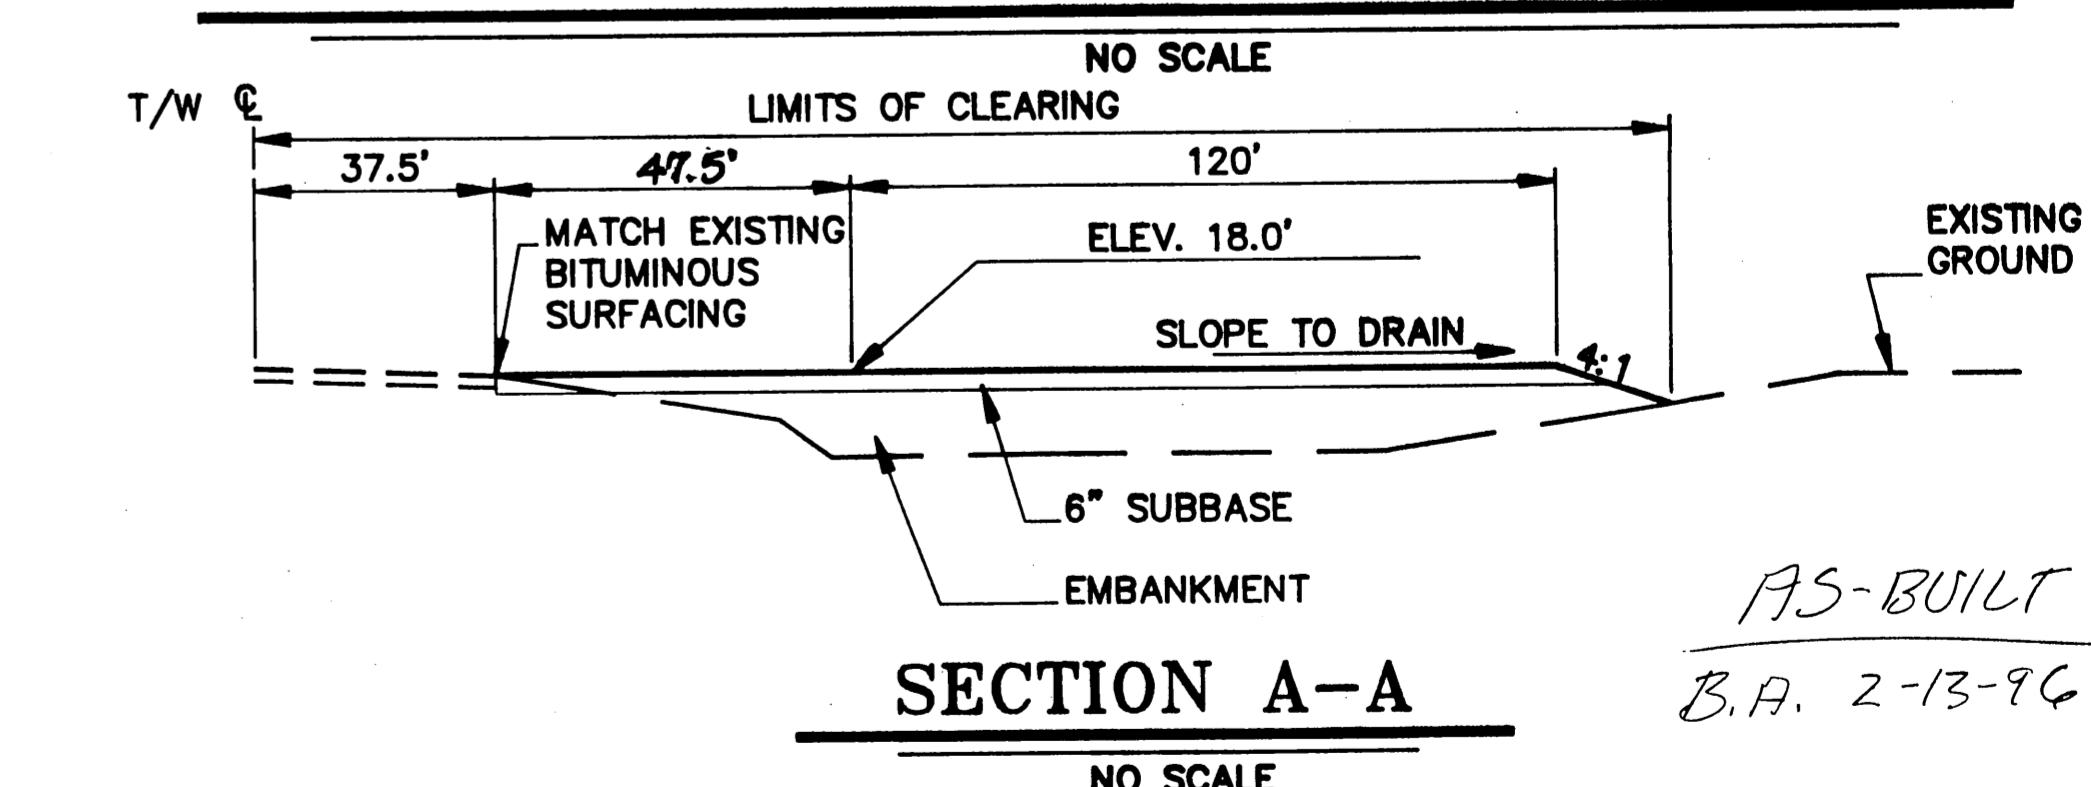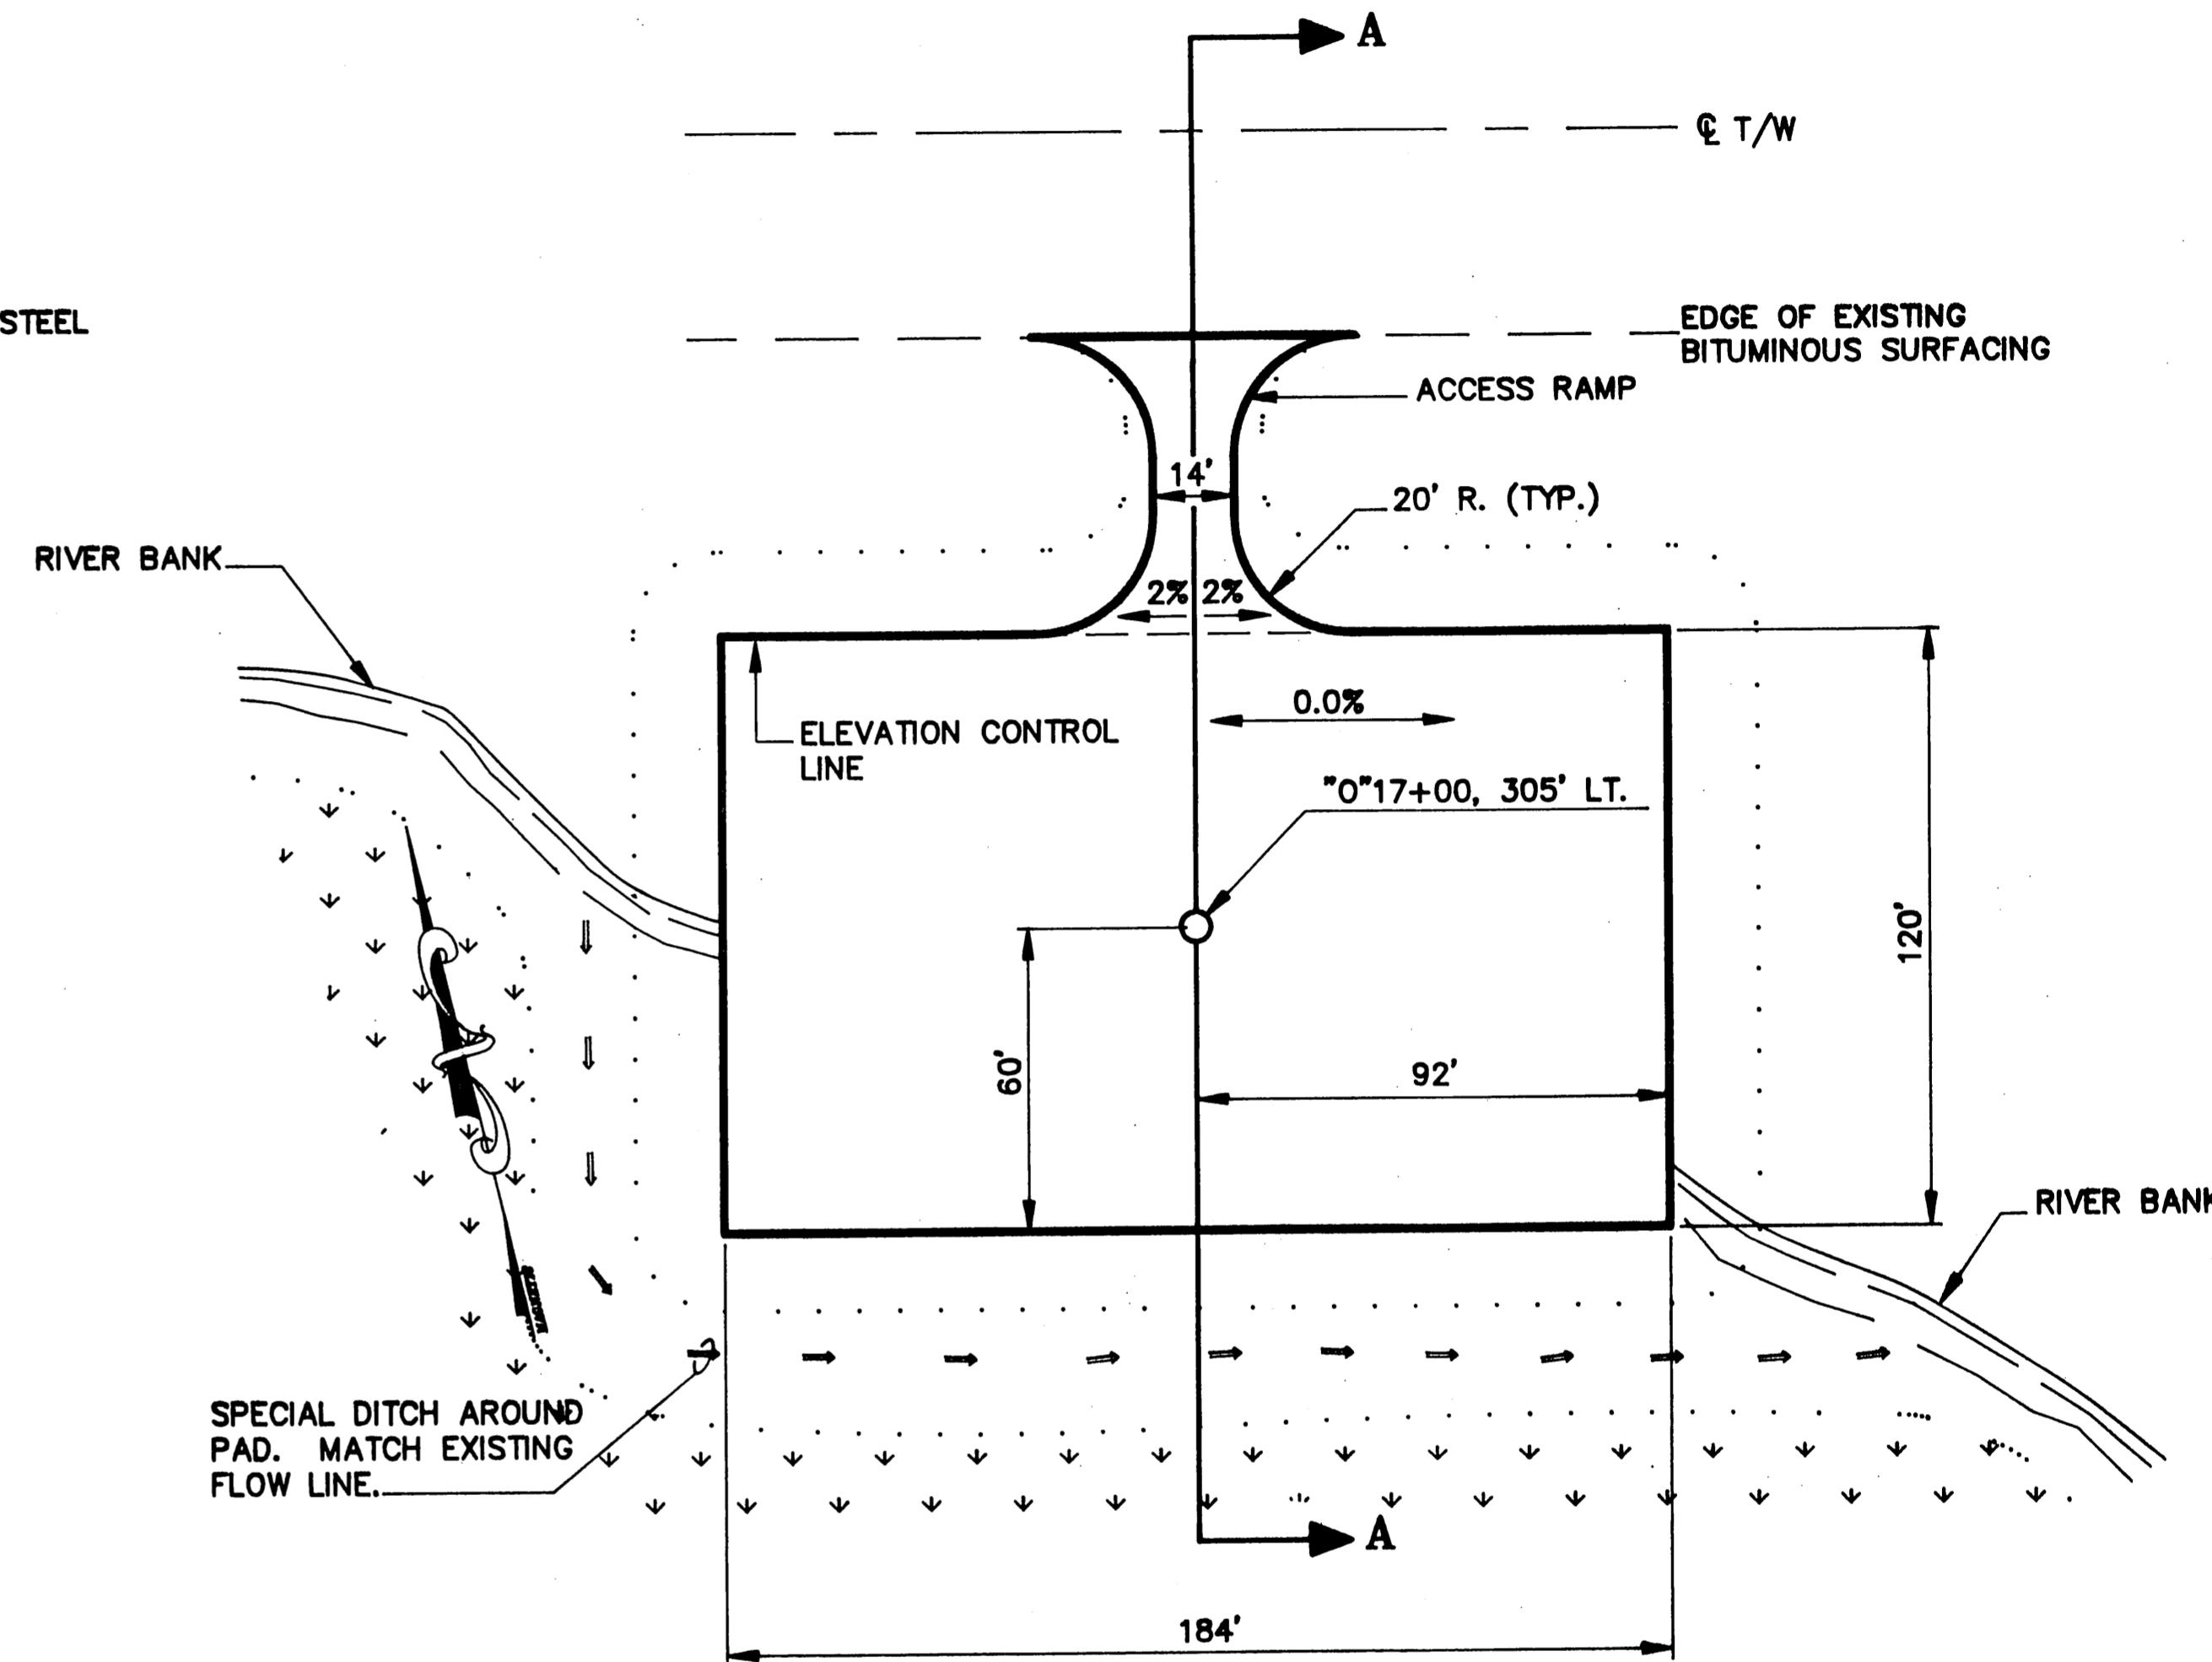

RELOCATED LIGHTED WINDCONE AND
SEGMENTED CIRCLE DETAIL WITH TRAFFIC PATTERN INDICATORS


NO SCALE
STATION "0" 17+00, 305' LT.


BY:	DATE:	DESCRIPTION OF CHANGE:
RECORD OF REVISIONS		

STATE OF ALASKA
DEPARTMENT OF TRANSPORTATION
AND PUBLIC FACILITIES
SOUTHEAST REGION DESIGN & CONSTRUCTION

HAINES AIRPORT
SEGMENTED CIRCLE & WINDCONE DETAILS

DESIGNED BY: T.W. MOORE PROJECT No. 69523
DRAWN BY: AutoCAD / B.W.B. DATE: AUGUST 1990
CHECKED BY: C. HAKARI SHEET 23 OF 39

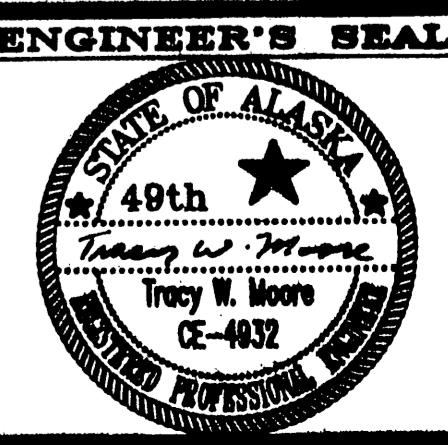


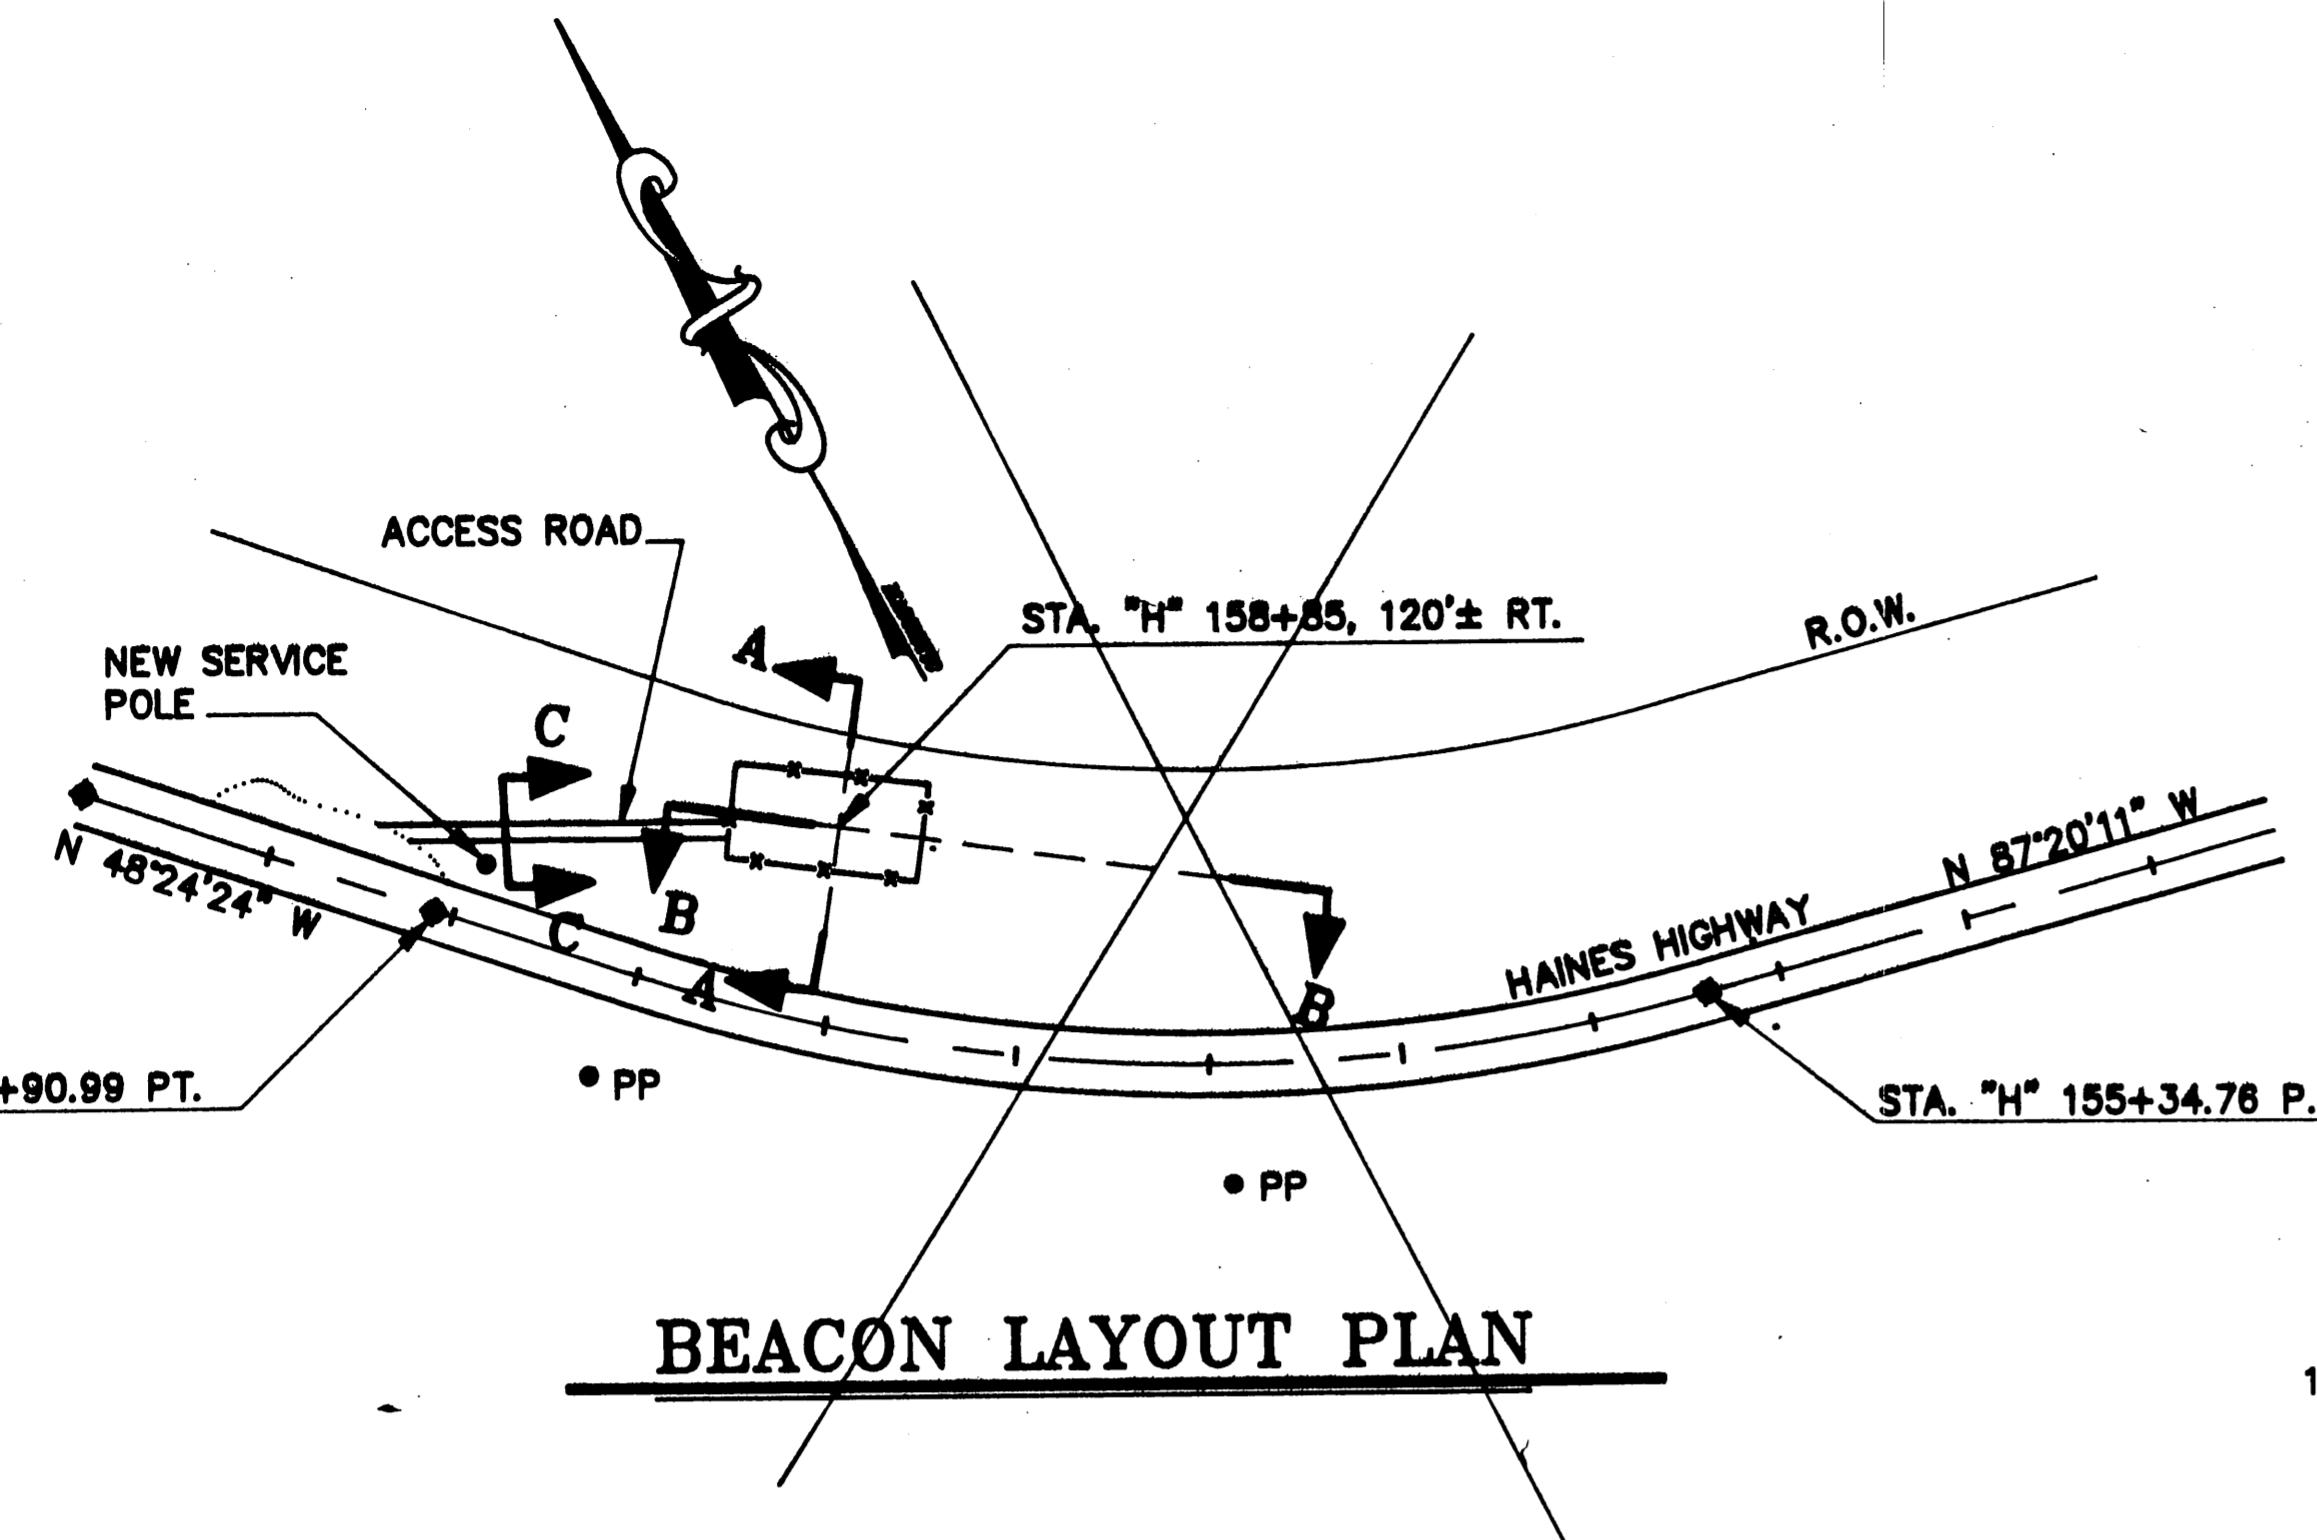

BEACON LAYOUT PLAN


NOTES :

1. THE CONTRACTORS FINAL LOCATION OF THE:
A) ACCESS FENCE GATE (10' SWING GATE)
B) ACCESS ROAD
C) ELECTRICAL SERVICE POLE
SHALL BE APPROVED BY THE ENGINEER PRIOR TO COMMENCEMENT OF
THE WORK. MAXIMUM GRADE 1:6.
2. A TWO WHEEL DRIVE VEHICLE SHALL BE ABLE TO TRAVERSE THE ACCESS
ROAD UPON COMPLETION.
3. ELECTRICAL CONDUCTORS SHALL BE IN CONDUIT FROM THE "DROP POLE"
TO THE BEACON, BURIED 24" BELOW THE FINAL SURFACE GRADE.
4. SEE SHEET 39 FOR FOOTING, POLE AND LIGHTING DETAILS.
5. BEACON CONSTRUCTED IN ACCORDANCE WITH
DIRECTIVE D
6. BEACON RELOCATED BY TERMINAL BUILDING.
FENCE LAYOUT CHANGED. NO ACCESS ROAD
OR PAD NEEDED. EXISTING IN PLACE,
FENCED IN FIELD WITH GATE FOR ACCESS
PAD.

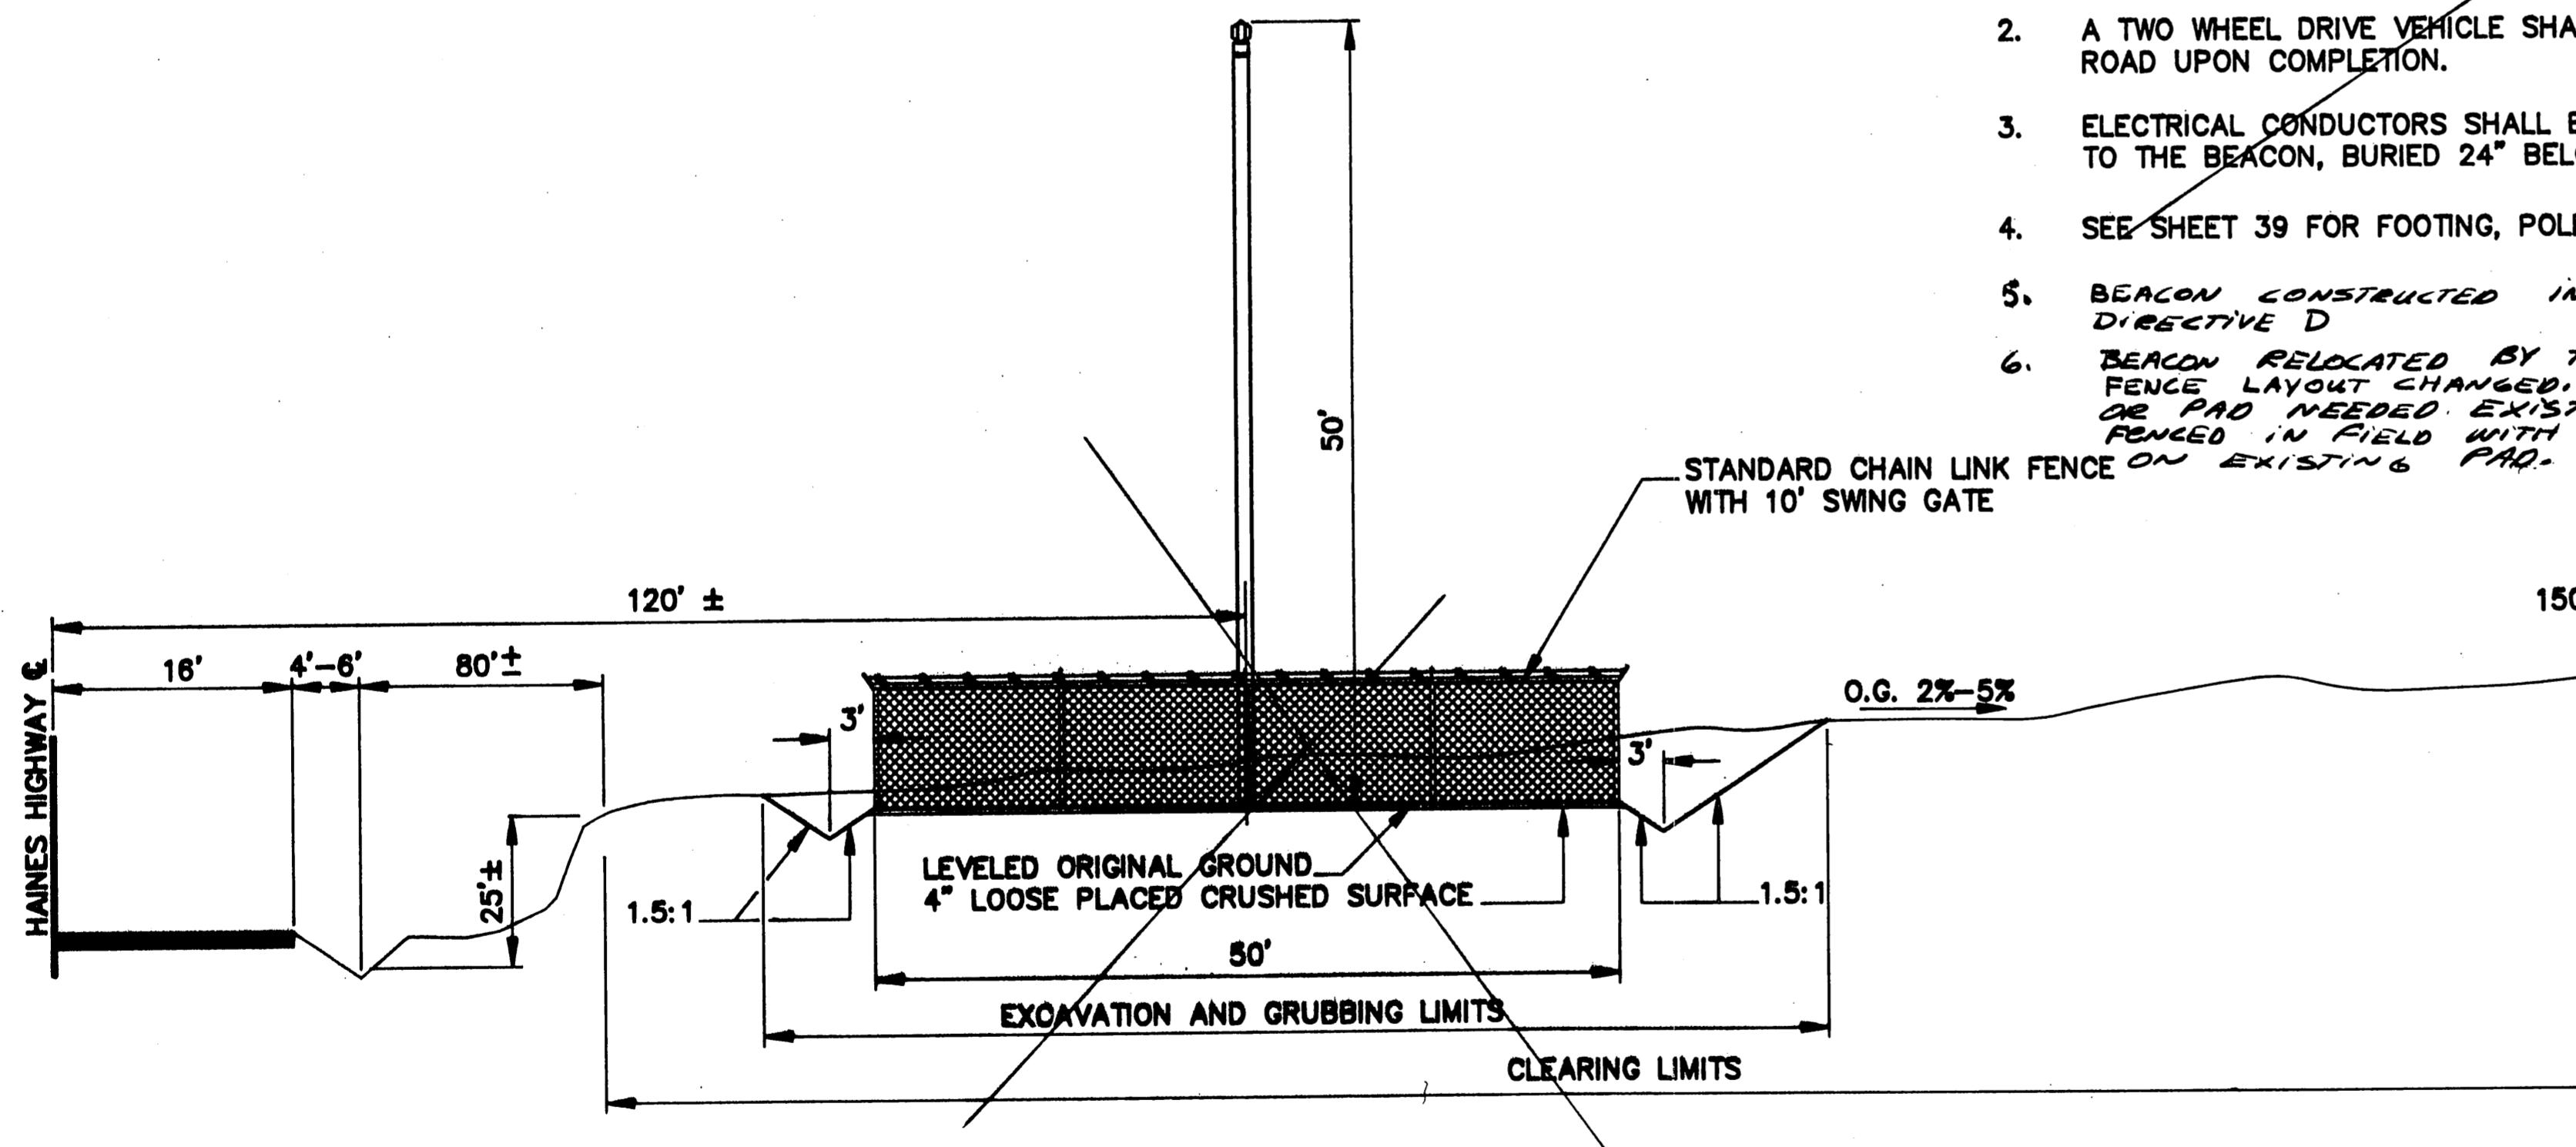

SECTION A-A

(STA. 'H' 158+85)

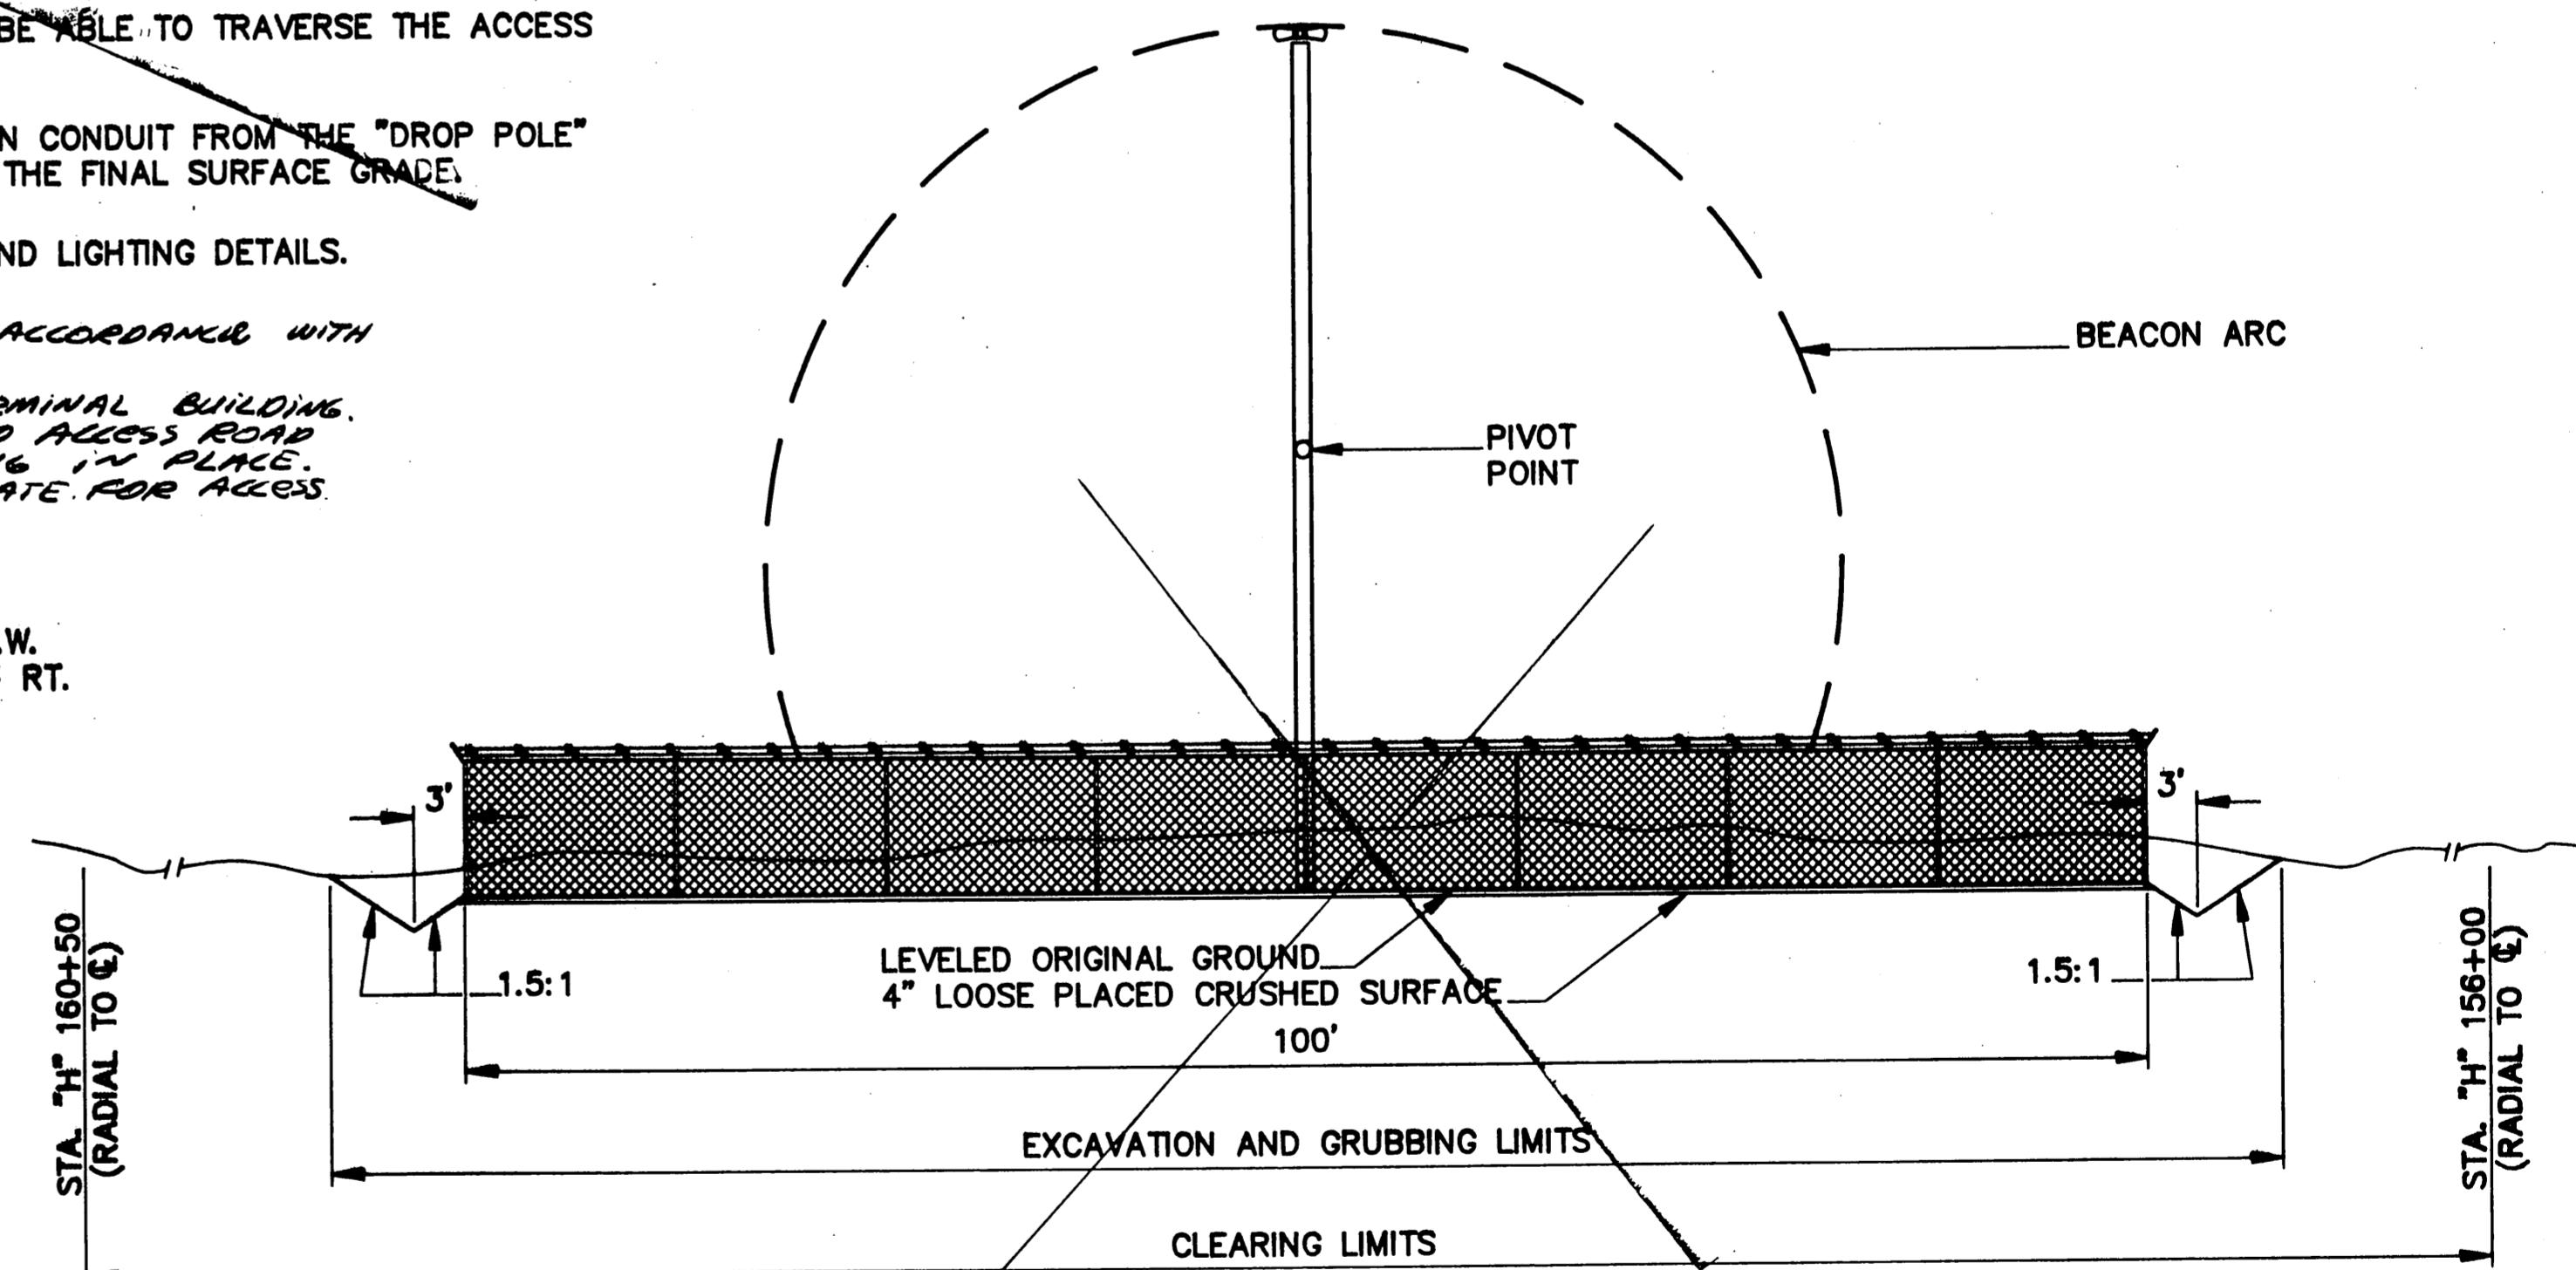

SECTION B-B


195-BUILT
BA. 2-13-96



BY:	DATE:	DESCRIPTION OF CHANGE:

STATE OF ALASKA
DEPARTMENT OF TRANSPORTATION
AND PUBLIC FACILITIES
SOUTHEAST REGION DESIGN & CONSTRUCTION


**HAINES AIRPORT
AIRPORT BEACON DETAILS**

DESIGNED BY: T.W. MOORE	PROJECT No. 69523
DRAWN BY: AutoCAD / B.W.B.	DATE: AUGUST 1990
CHECKED BY: T.W. MOORE	SHEET 24 OF 39

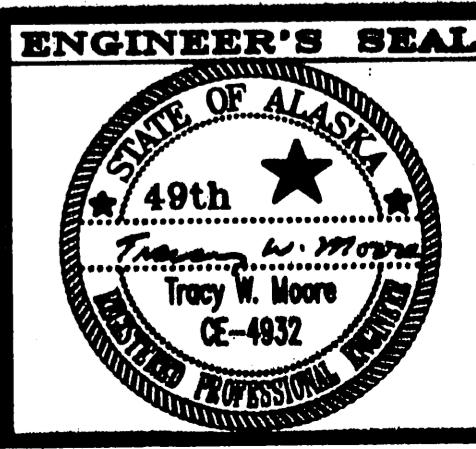


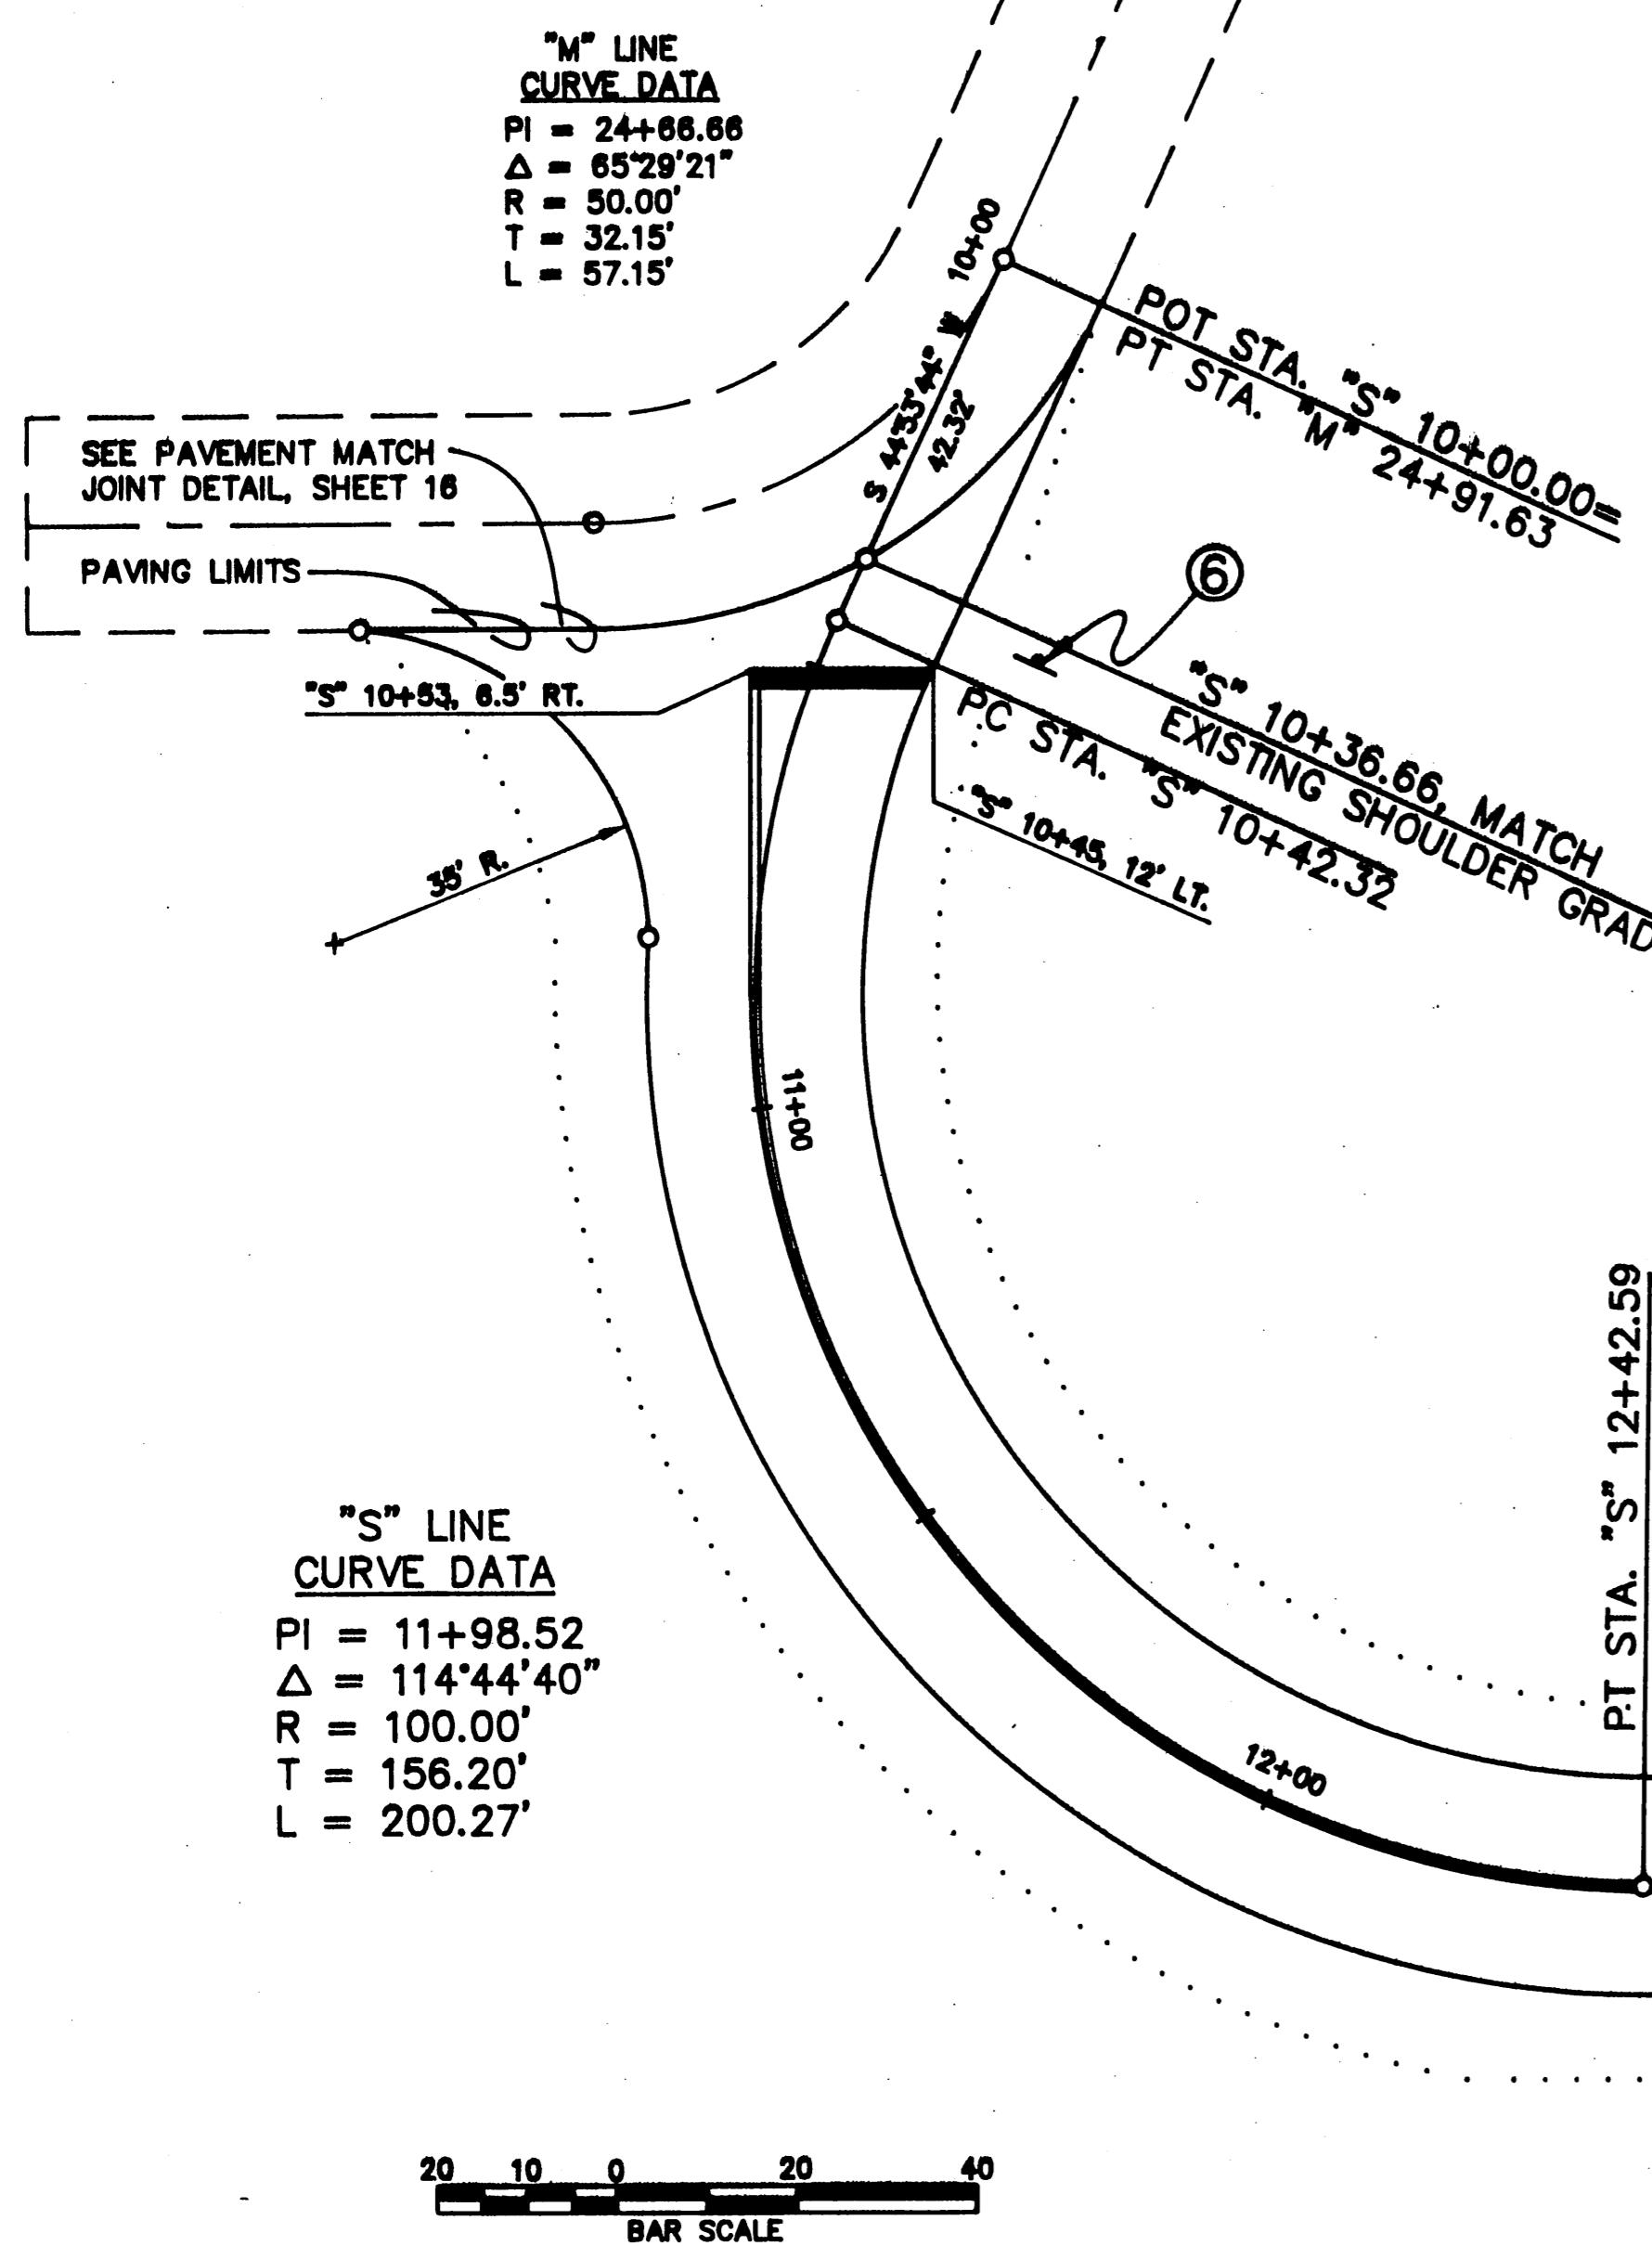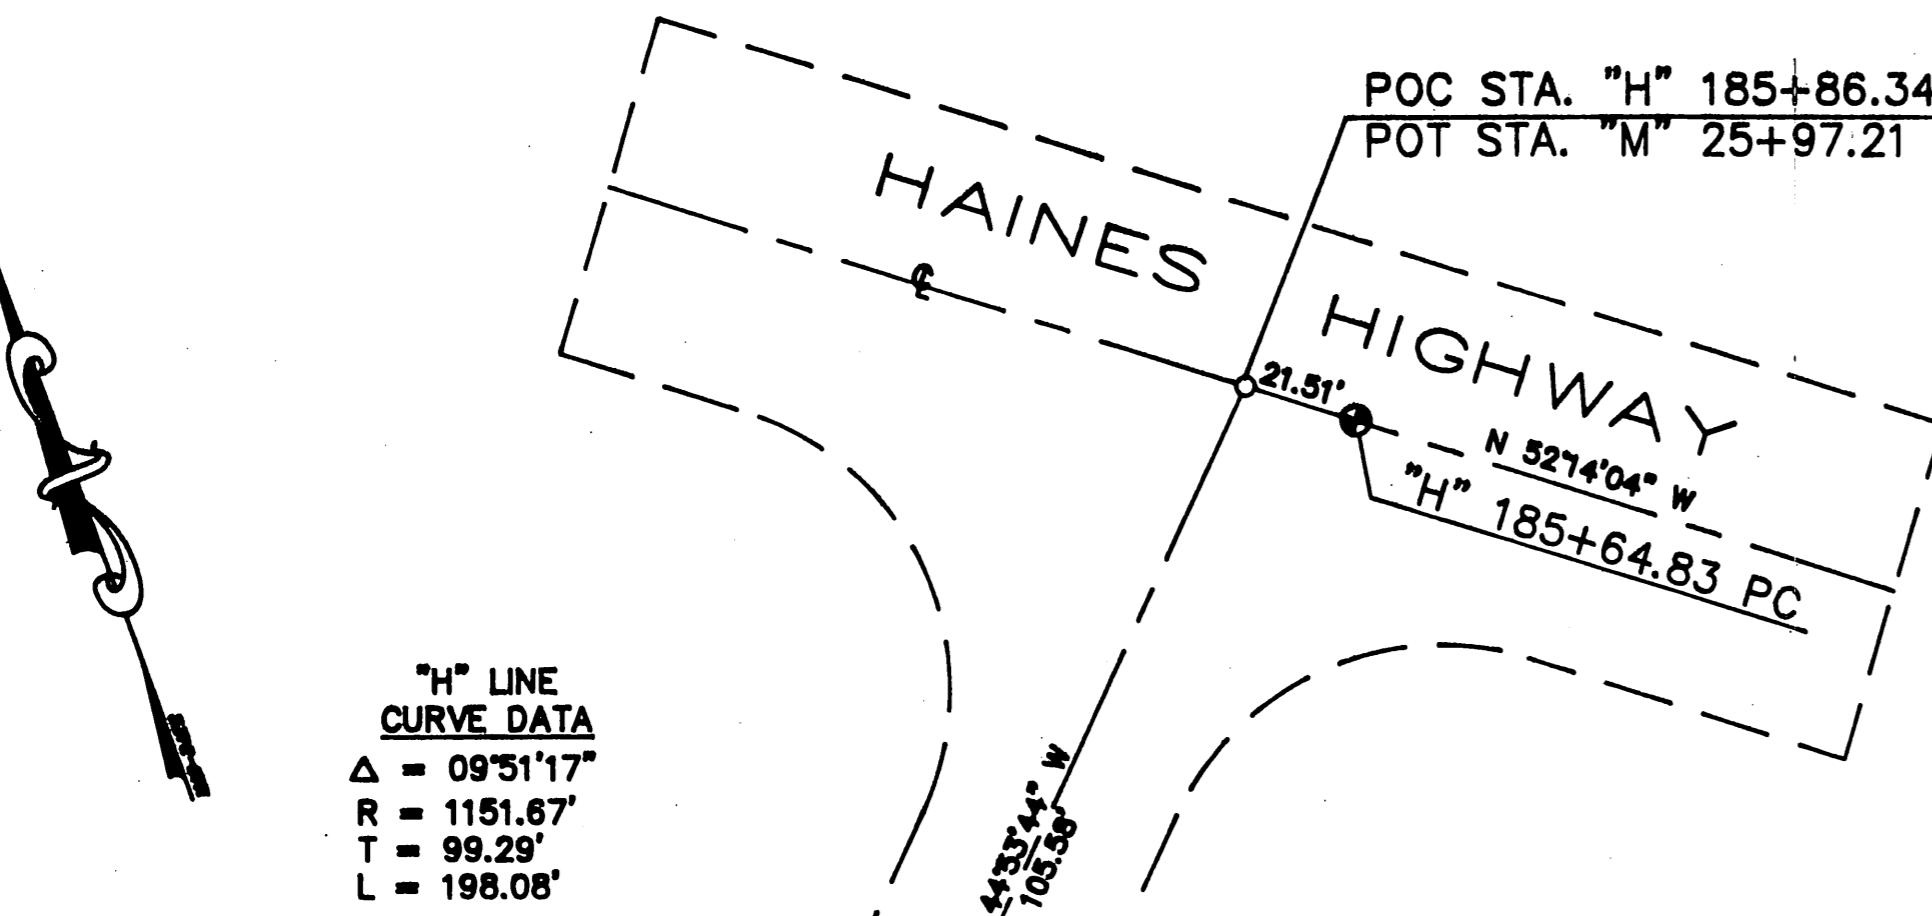

PLAN

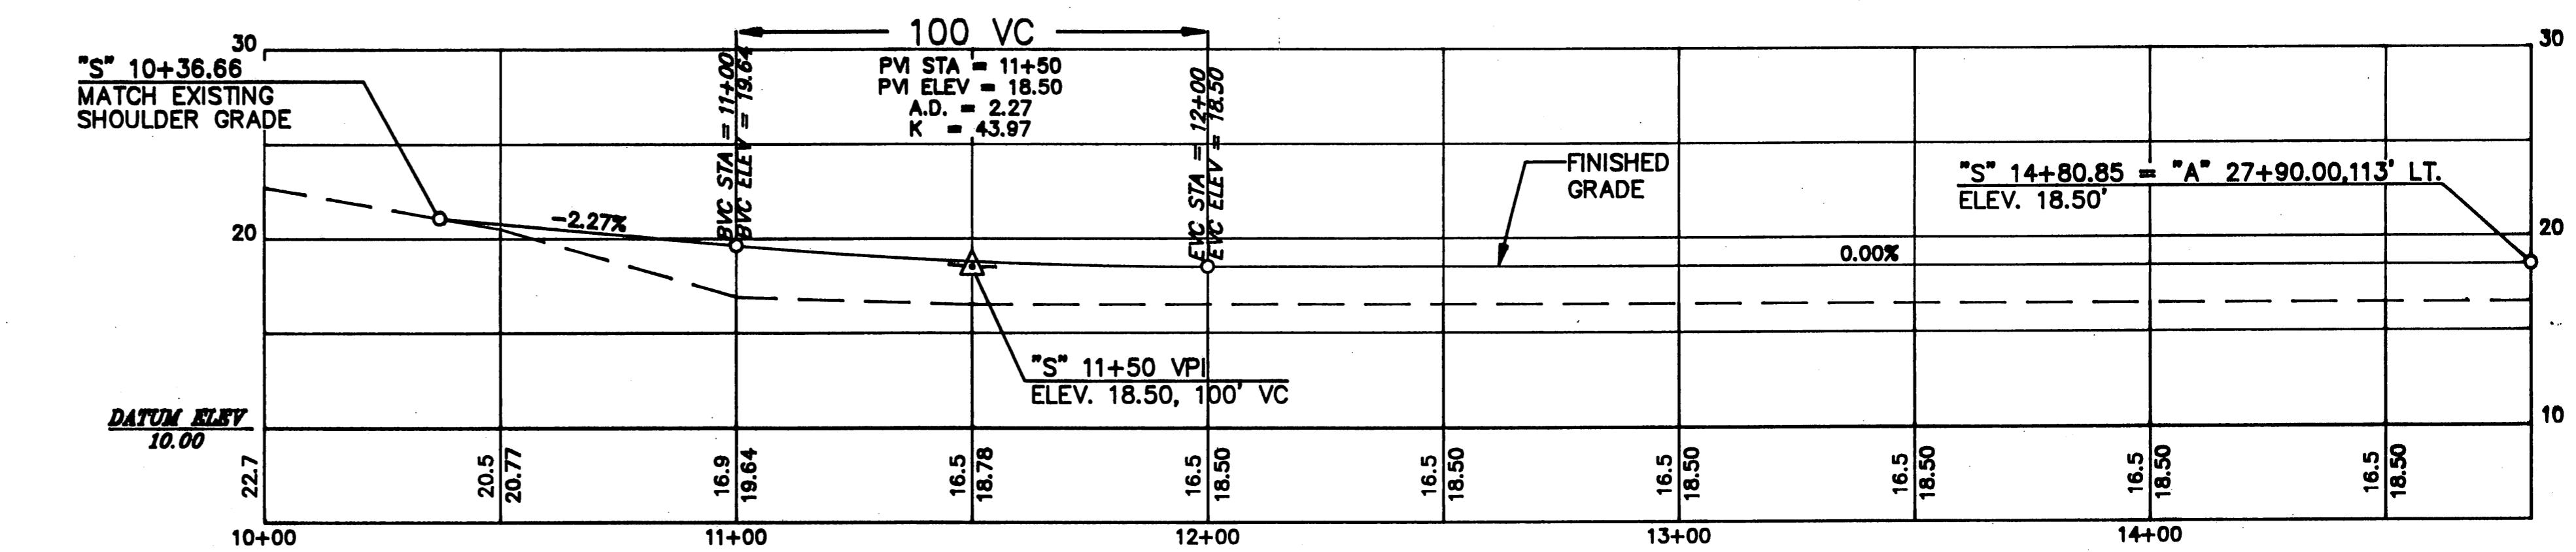


PROFILE

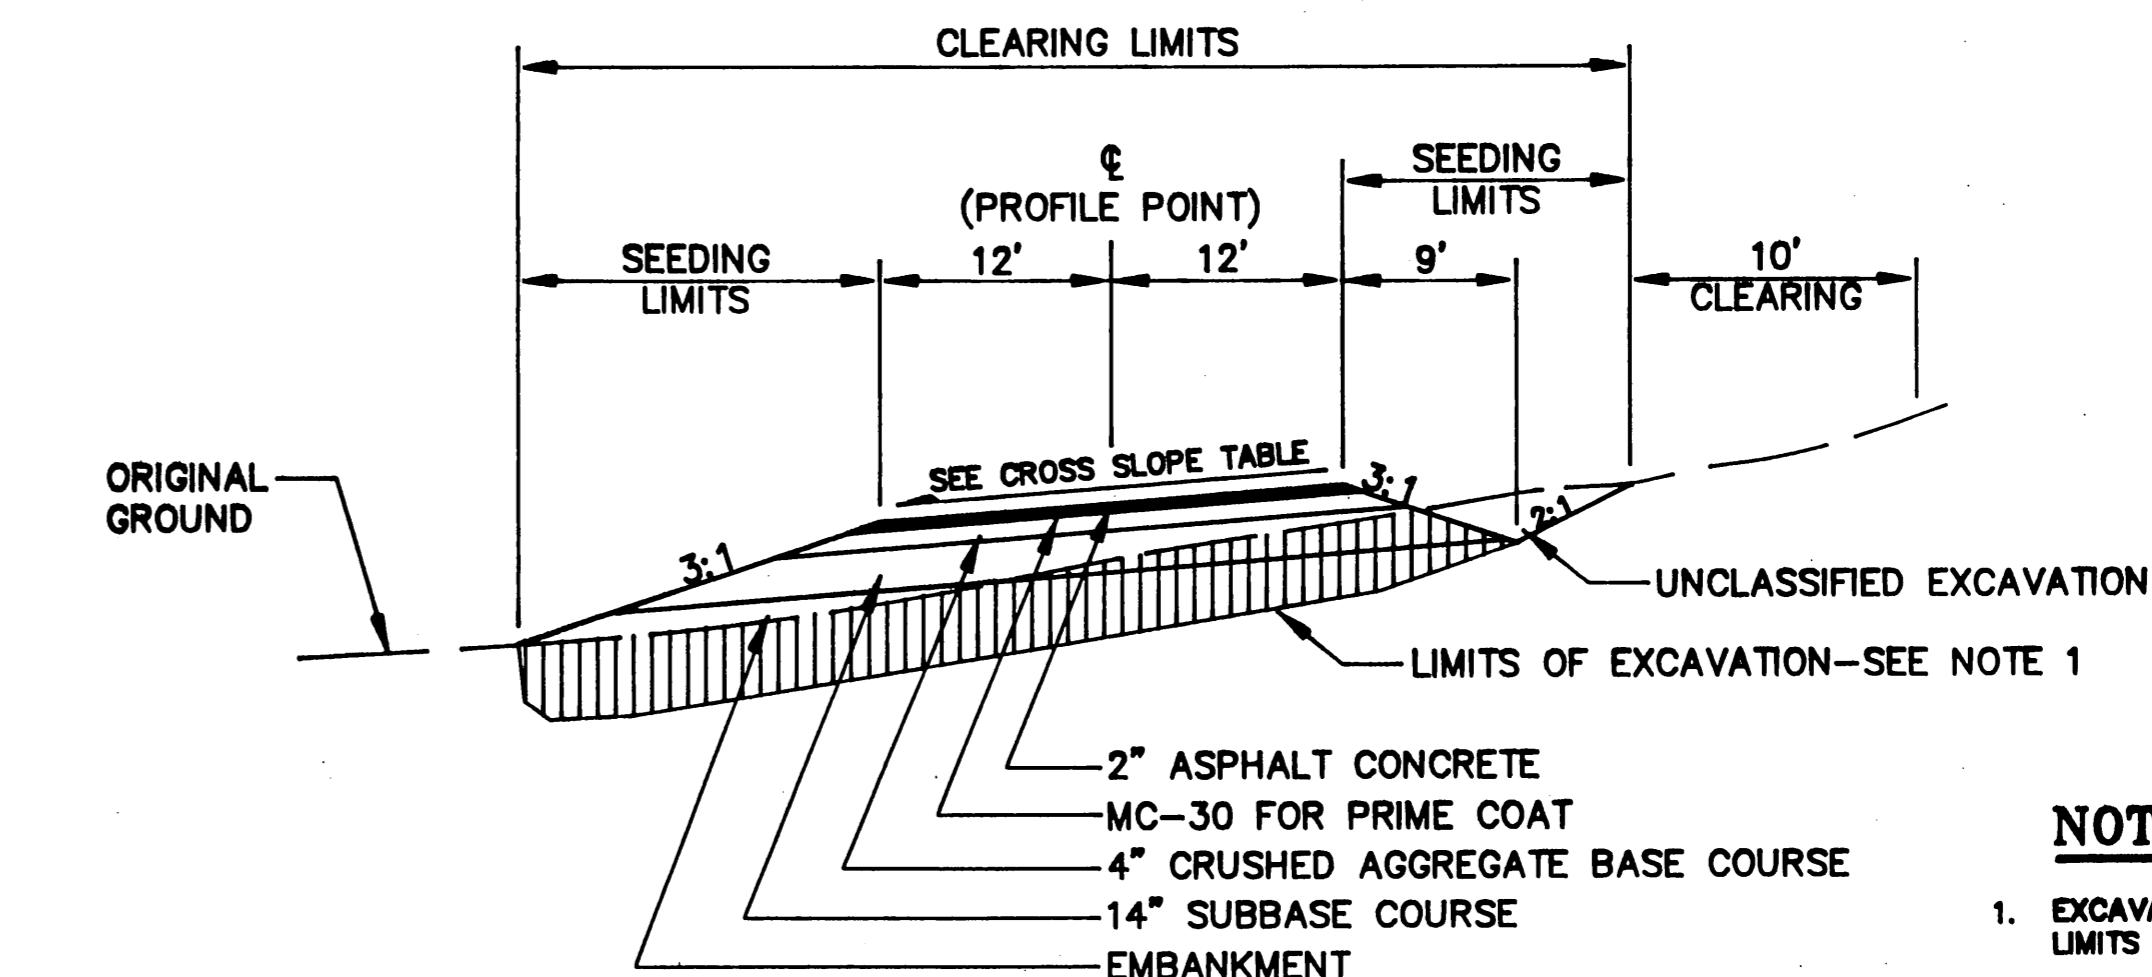

NOTES
1. EXCAVATION DEPTH VARIES AND WILL BE THE LIMITS OF ORGANIC SOILS.

TYPICAL SECTION

ACCESS ROAD "S" 10+19 TO "S" 14+00.85
AND
PARKING PAD "S" 14+00.85 TO "S" 14+80.85
SHALL HAVE SAME STRUCTURAL SECTION AND SIDE SLOPES

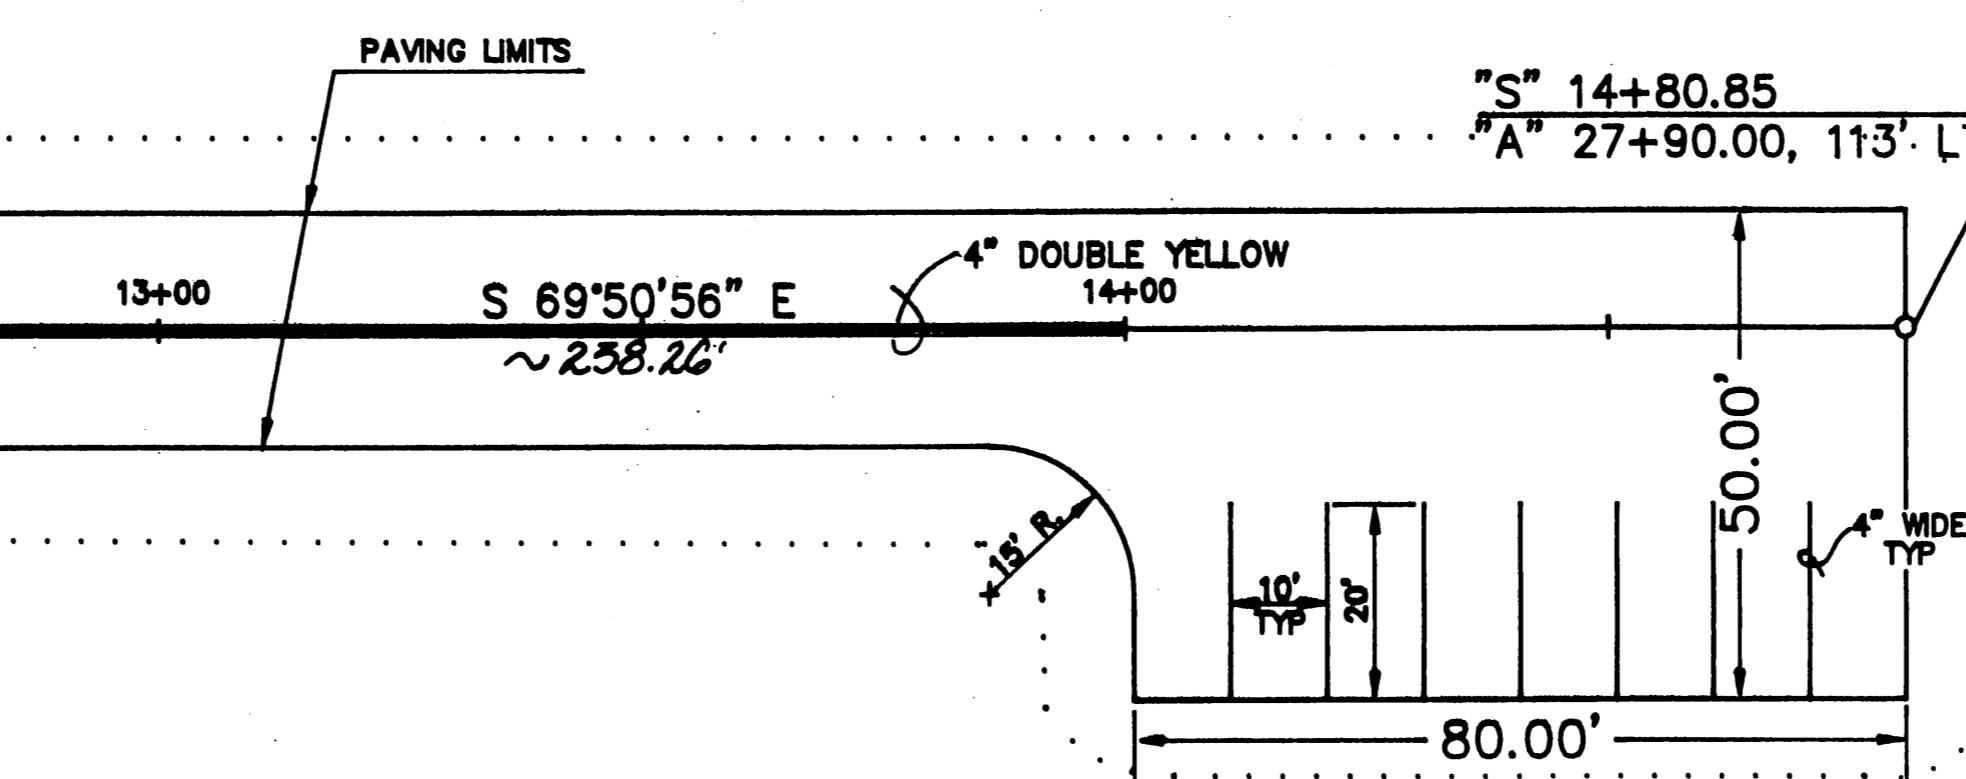

"S" LINE CROSS SLOPE TABLE*		
STATION	LT.	RT.
"S" 10+79	MATCH MAIN ACCESS SHOULDER	
"S" 10+50	FLAT	FLAT
"S" 11+00	-4	+4
"S" 12+10	-4	+4
"S" 12+50	-2	+2
"S" 14+80.85	-2	+2

* CROSS SLOPES SHALL VARY LINEARLY BETWEEN THESE STATIONS


As Built
B.A. 2-13-96


REC'D.	DATE:	DESCRIPTION OF CHANGE:

STATE OF ALASKA
DEPARTMENT OF TRANSPORTATION
AND PUBLIC FACILITIES
SOUTHEAST REGION DESIGN & CONSTRUCTION

**HAINES AIRPORT
ACCESS ROAD PLAN & PROFILE**

DESIGNED BY: C. HAKARI PROJECT No. 69623
DRAWN BY: AutoCAD / R.K.S. DATE:
CHECKED BY: T.W. MOORE SHEET 25 of 39

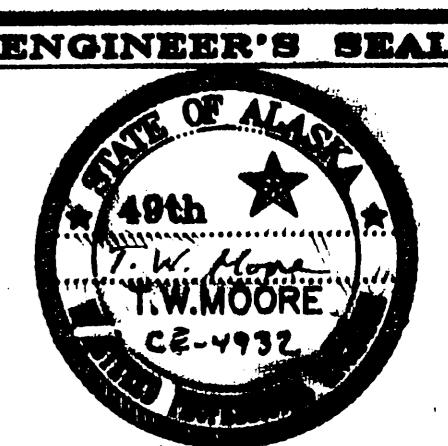

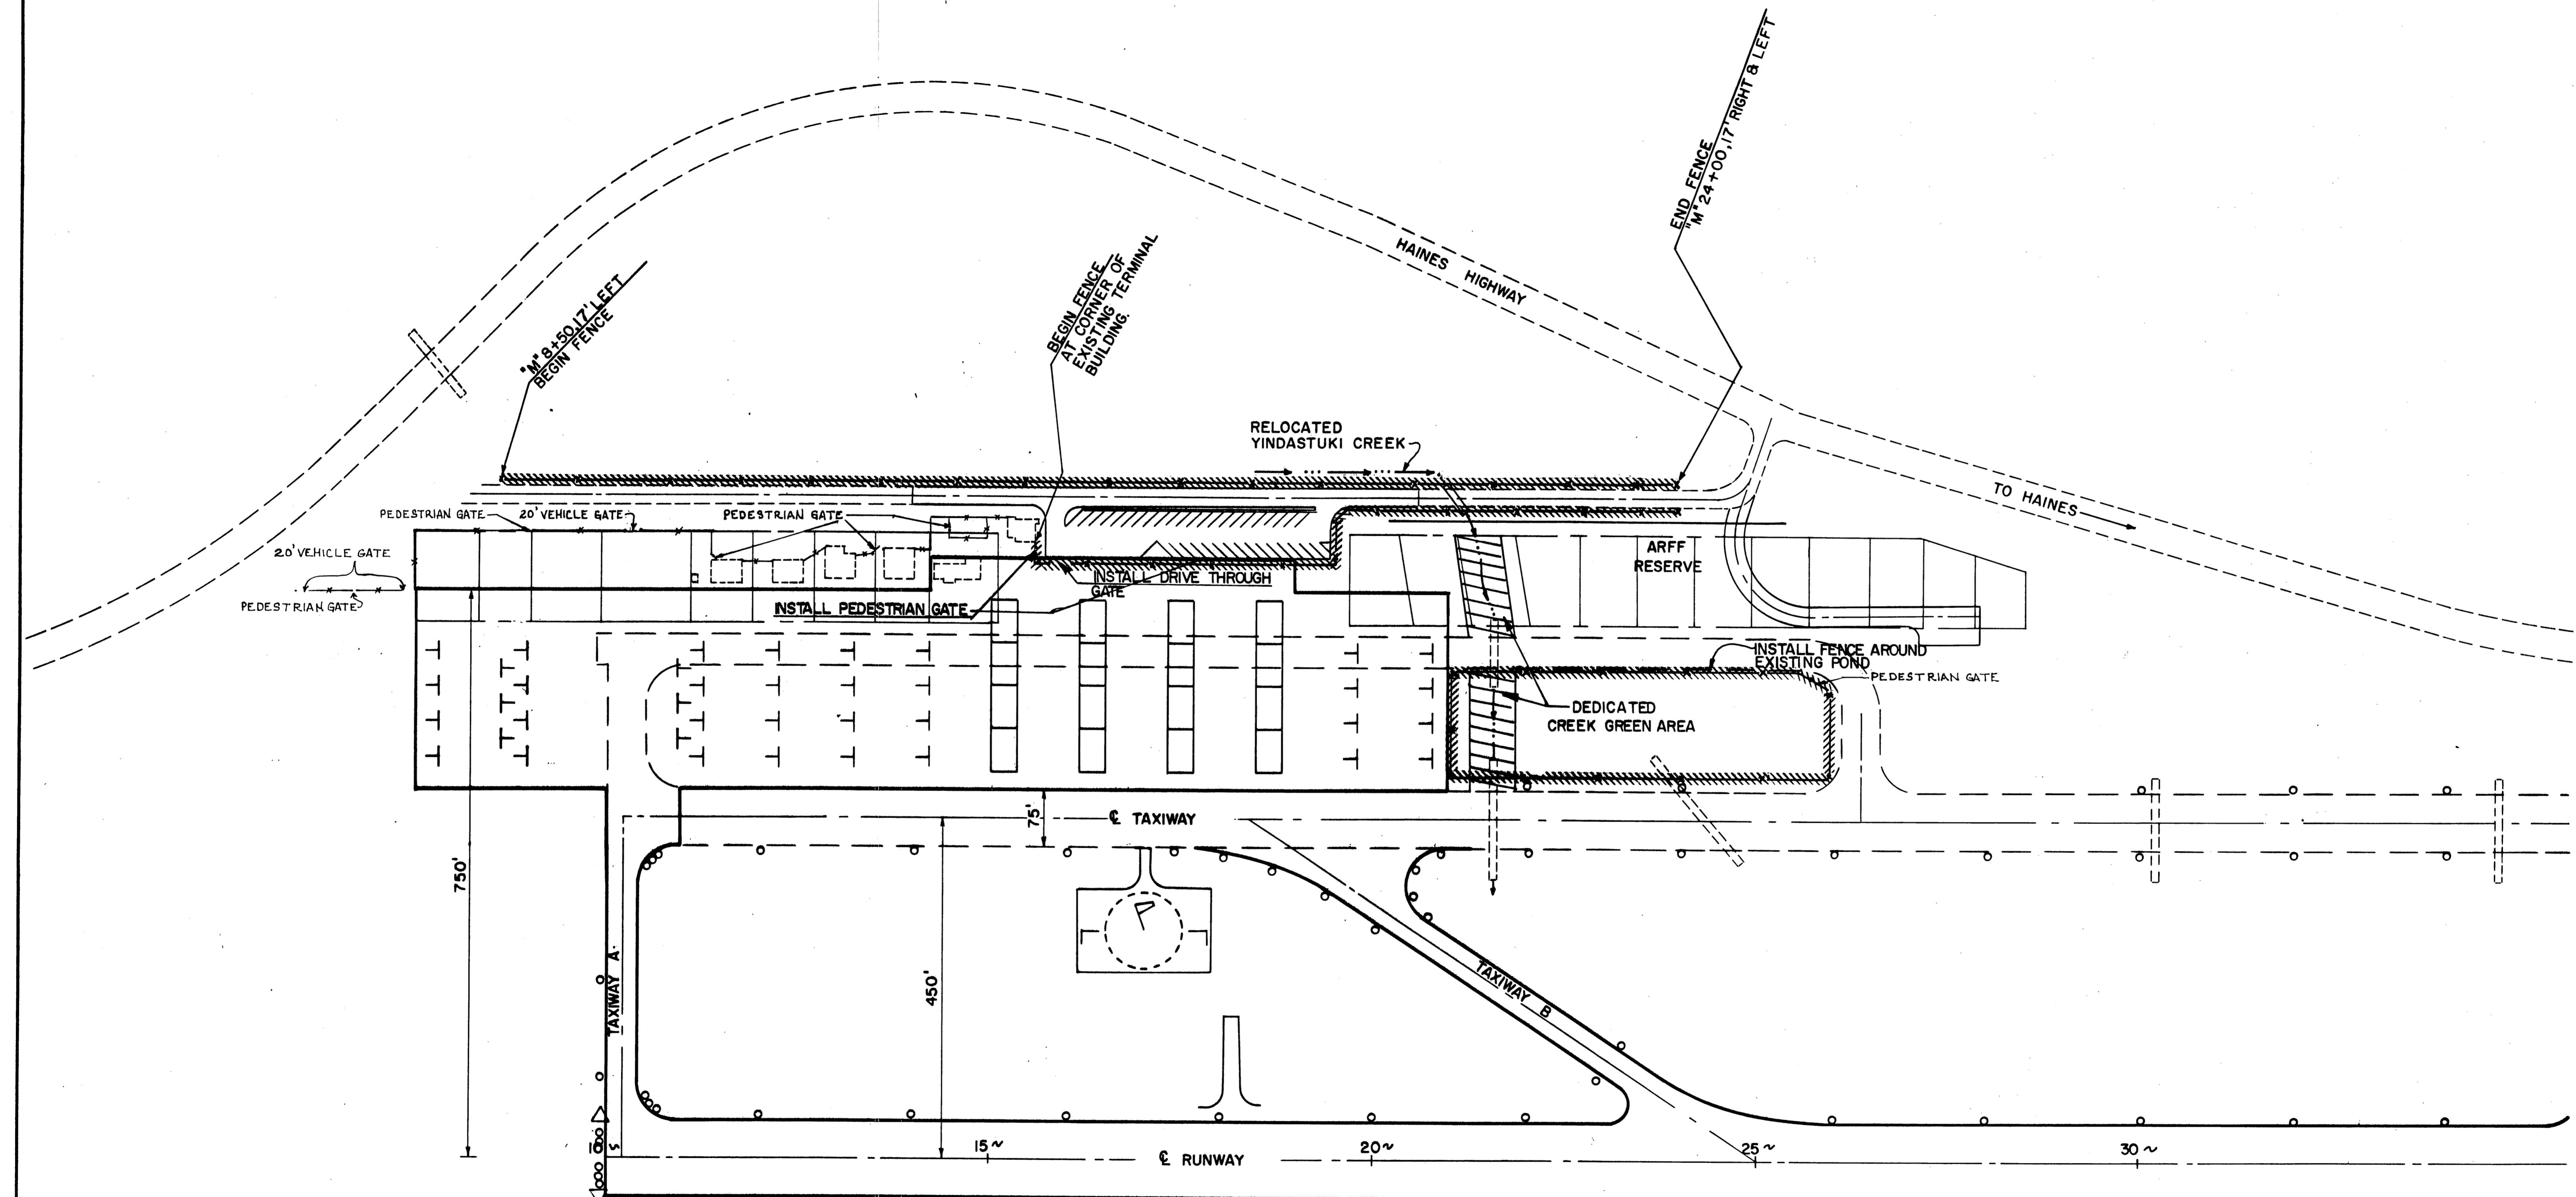

RECORD OF REVISIONS		STATE OF ALASKA DEPARTMENT OF TRANSPORTATION & PUBLIC FACILITIES SOUTHEAST REGION DESIGN & CONSTRUCTION
BY	DATE	DESCRIPTION OF CHANGE

HAINES AIRPORT SECURITY FENCING
GENERAL LAYOUT

APPROVED BY:	DESIGN GROUP CHIEF	DATE	DESIGNED BY:	SCALE:
RECOMMENDED BY:	DESIGN ENGINEER, GROUP	DATE	DRAWN BY:	DATE
PREPARED BY:	PROJECT MANAGER	LEAD DESIGNER	CHECKED BY:	C.H.

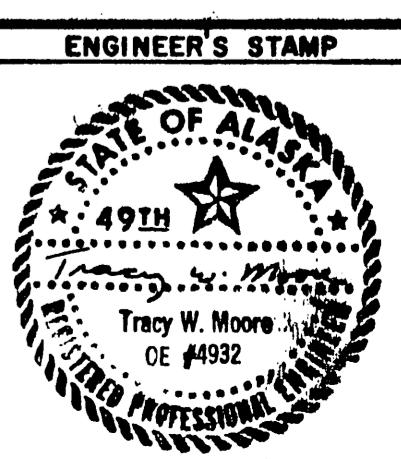



CHART #1
SPECIFICATIONS FOR SINGLE GATES

A-1	B-1	H-1	D-1	E-1	K
SINGLE GATE OPENING	ROLLER POST SPACING	OVERALL LENGTH	FABRIC SECTION OF FRAME	OPEN SECTION OF FRAME	EXTENSION OF FRAME
6'-0"	4'-0"	11'-2"	6'-6"	4'-4"	4"
8'-0"	4'-0"	13'-2"	8'-6"	4'-4"	4"
10'-0"	5'-0"	16'-2"	10'-6"	5'-4"	4"
12'-0"	6'-0"	19'-2"	12'-6"	6'-4"	4"
14'-0"	7'-0"	22'-2"	14'-6"	7'-4"	4"
16'-0"	8'-0"	25'-2"	16'-6"	8'-4"	4"
18'-0"	9'-0"	28'-2"	18'-6"	9'-4"	4"
20'-0"	10'-0"	31'-2"	20'-6"	10'-4"	4"
24'-0"	12'-6"	36'-2"	24'-6"	12'-4"	4"


CHART #2
SPECIFICATIONS GATE HEIGHTS

F	L	J
FENCE HEIGHT	POST HEIGHT TO GRADE	FRAME LENGTH 2" O.D. UPRIGHTS
6'	7'-6"	5'-5 3/4"
7'	8'-6"	6'-5 3/4"
8'	9'-6"	7'-5 3/4"
9'	10'-6"	8'-5 3/4"
10'	11'-6"	9'-5 3/4"
12'	13'-6"	11'-5 3/4"


NOTE:
ALL GATES INSTALLED UNDER THIS CONTRACT SHALL BE 8 FT. IN HEIGHT.

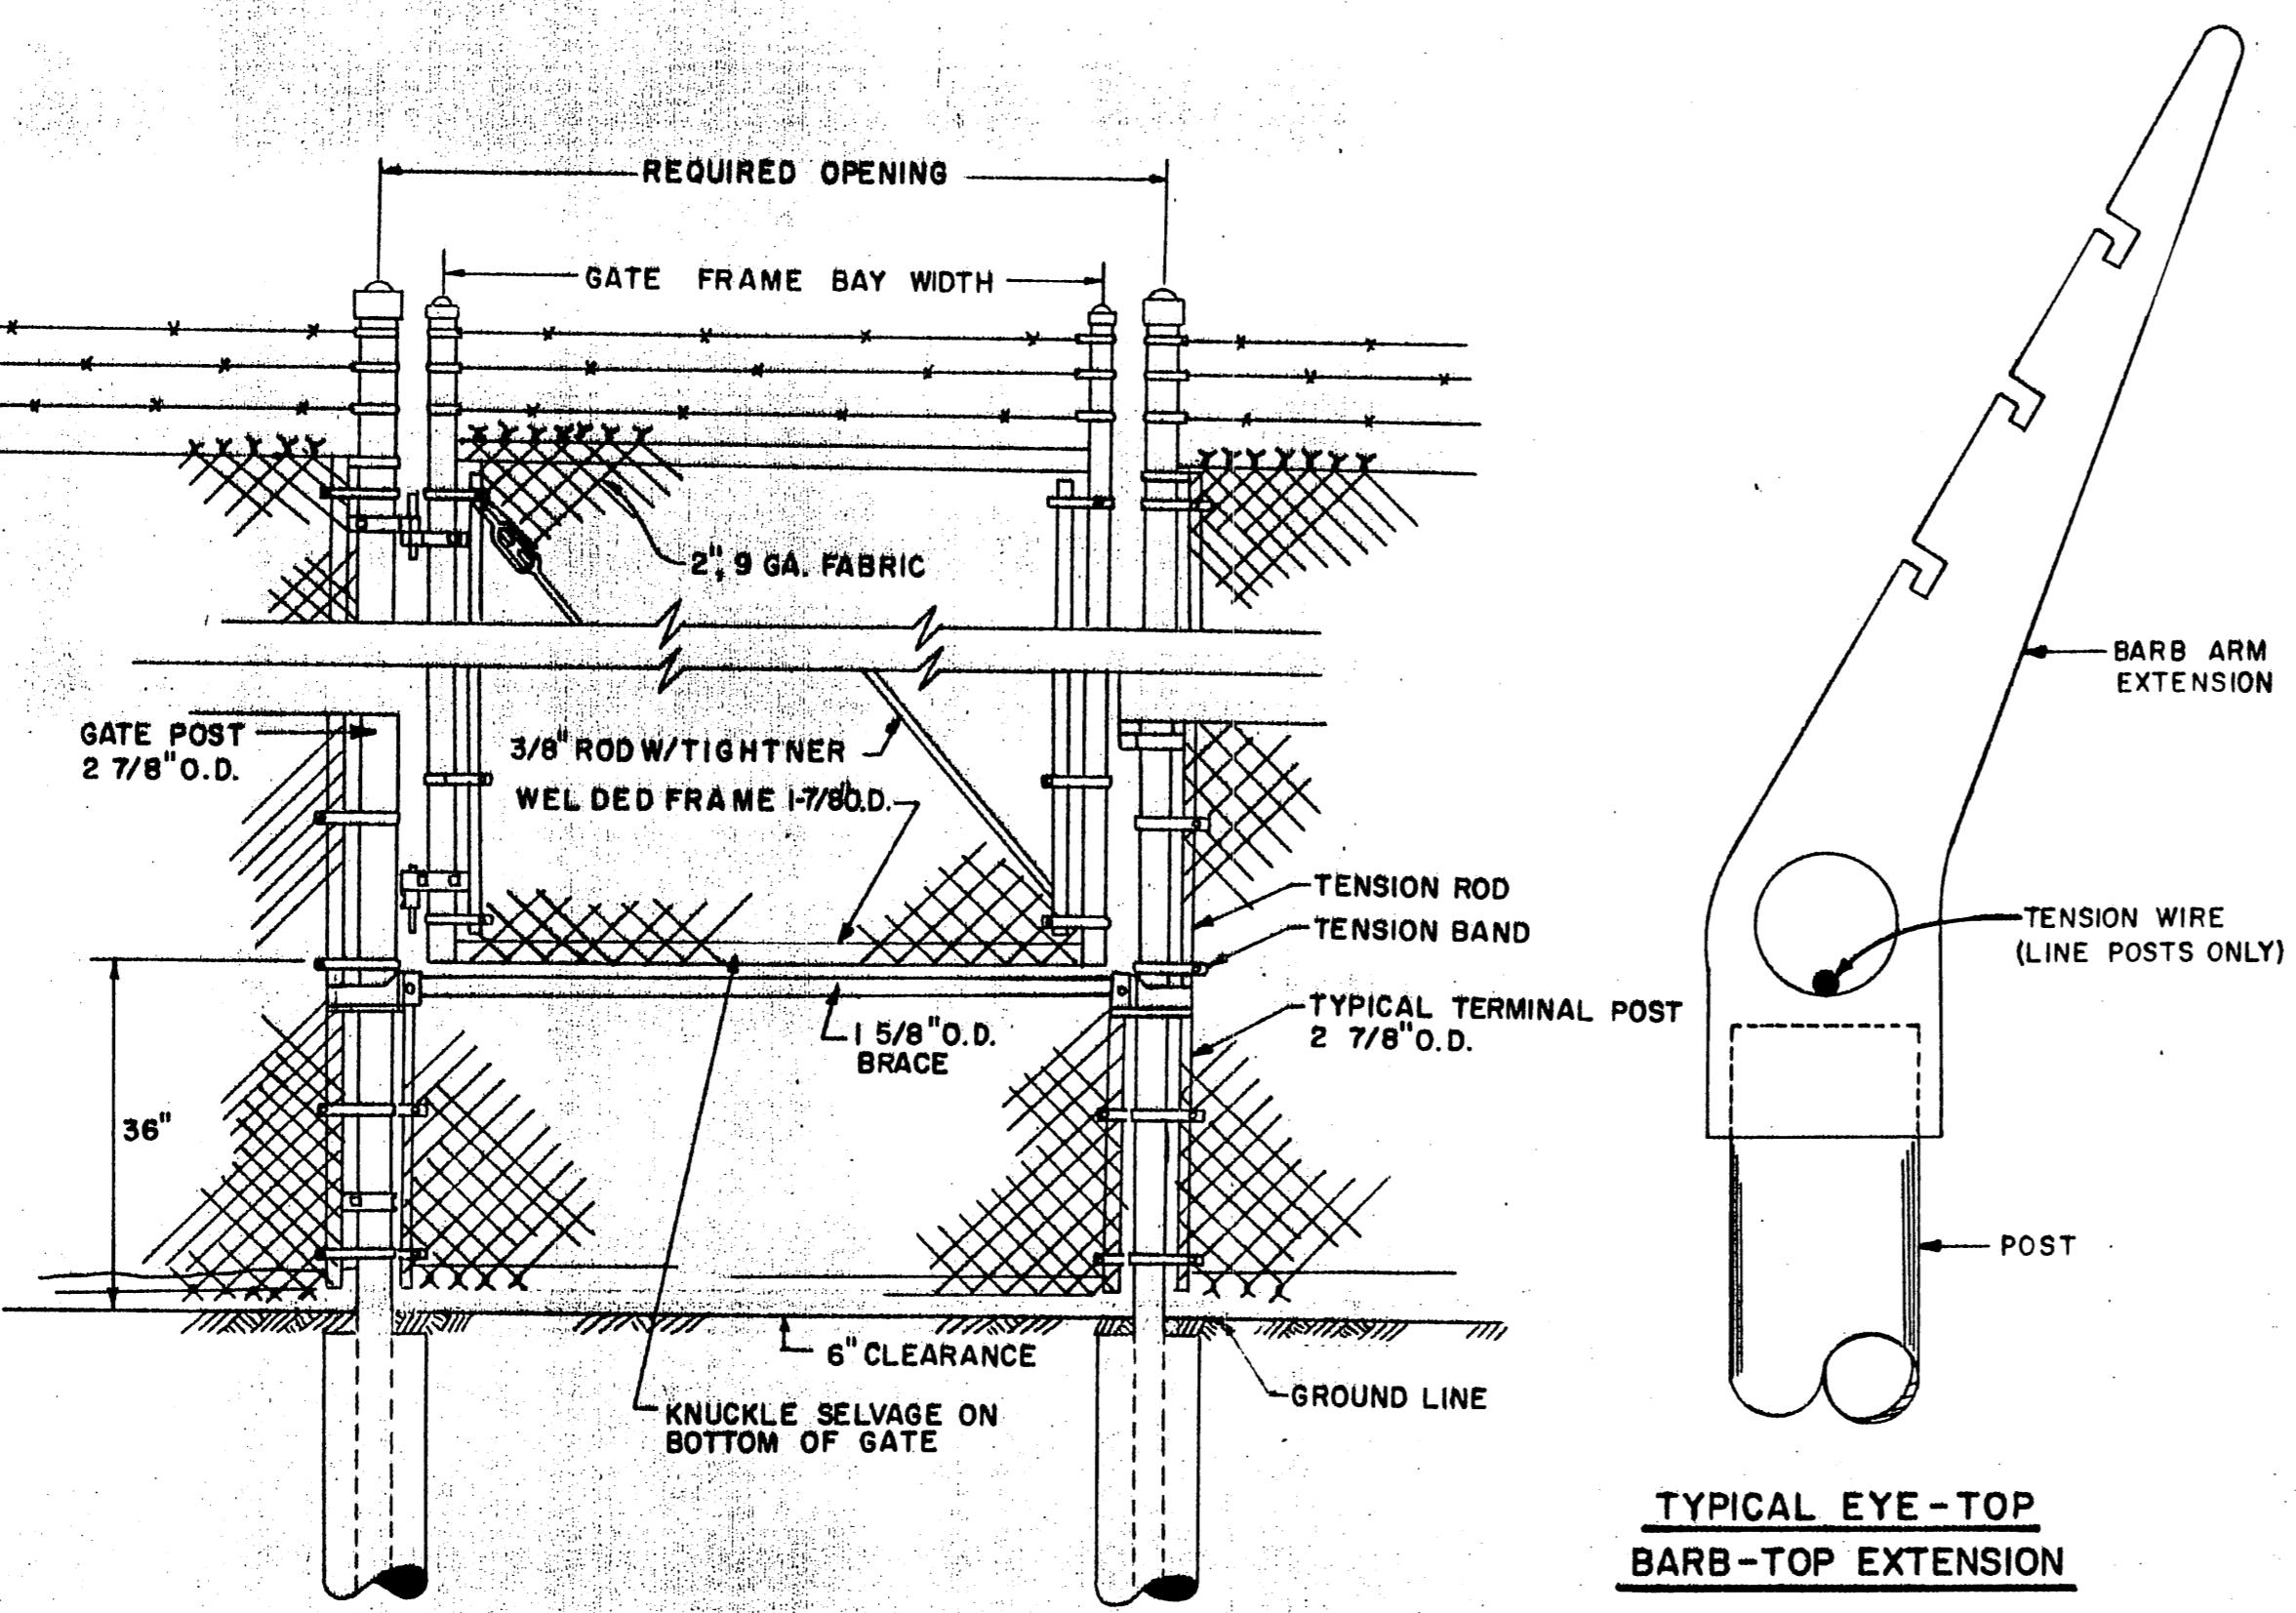


INDUSTRIAL MALLEABLE HINGE
(BALL AND SOCKET TYPE)

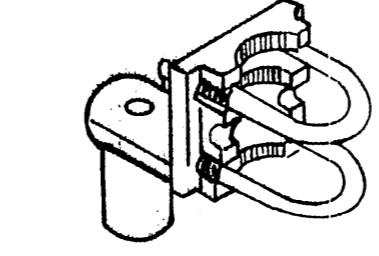


OFFSET ADAPTER

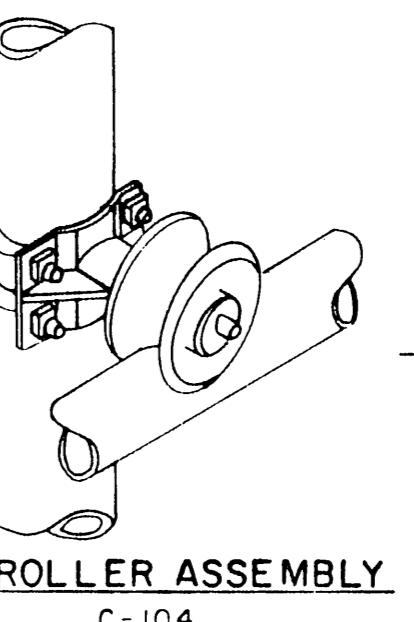

ROLLER ASSEMBLY

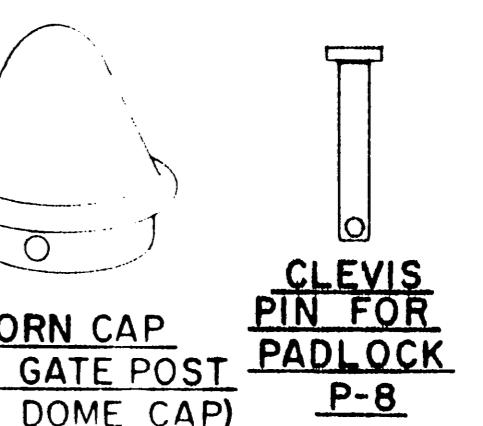


ACORN CAP
FOR GATE POST
(OR DOME CAP)
P-8

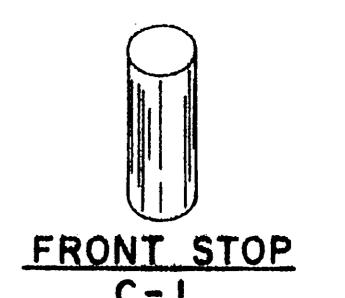


CLEVIS
PIN FOR
PADLOCK
C-1

5'X4'
PEDESTRIAN GATE

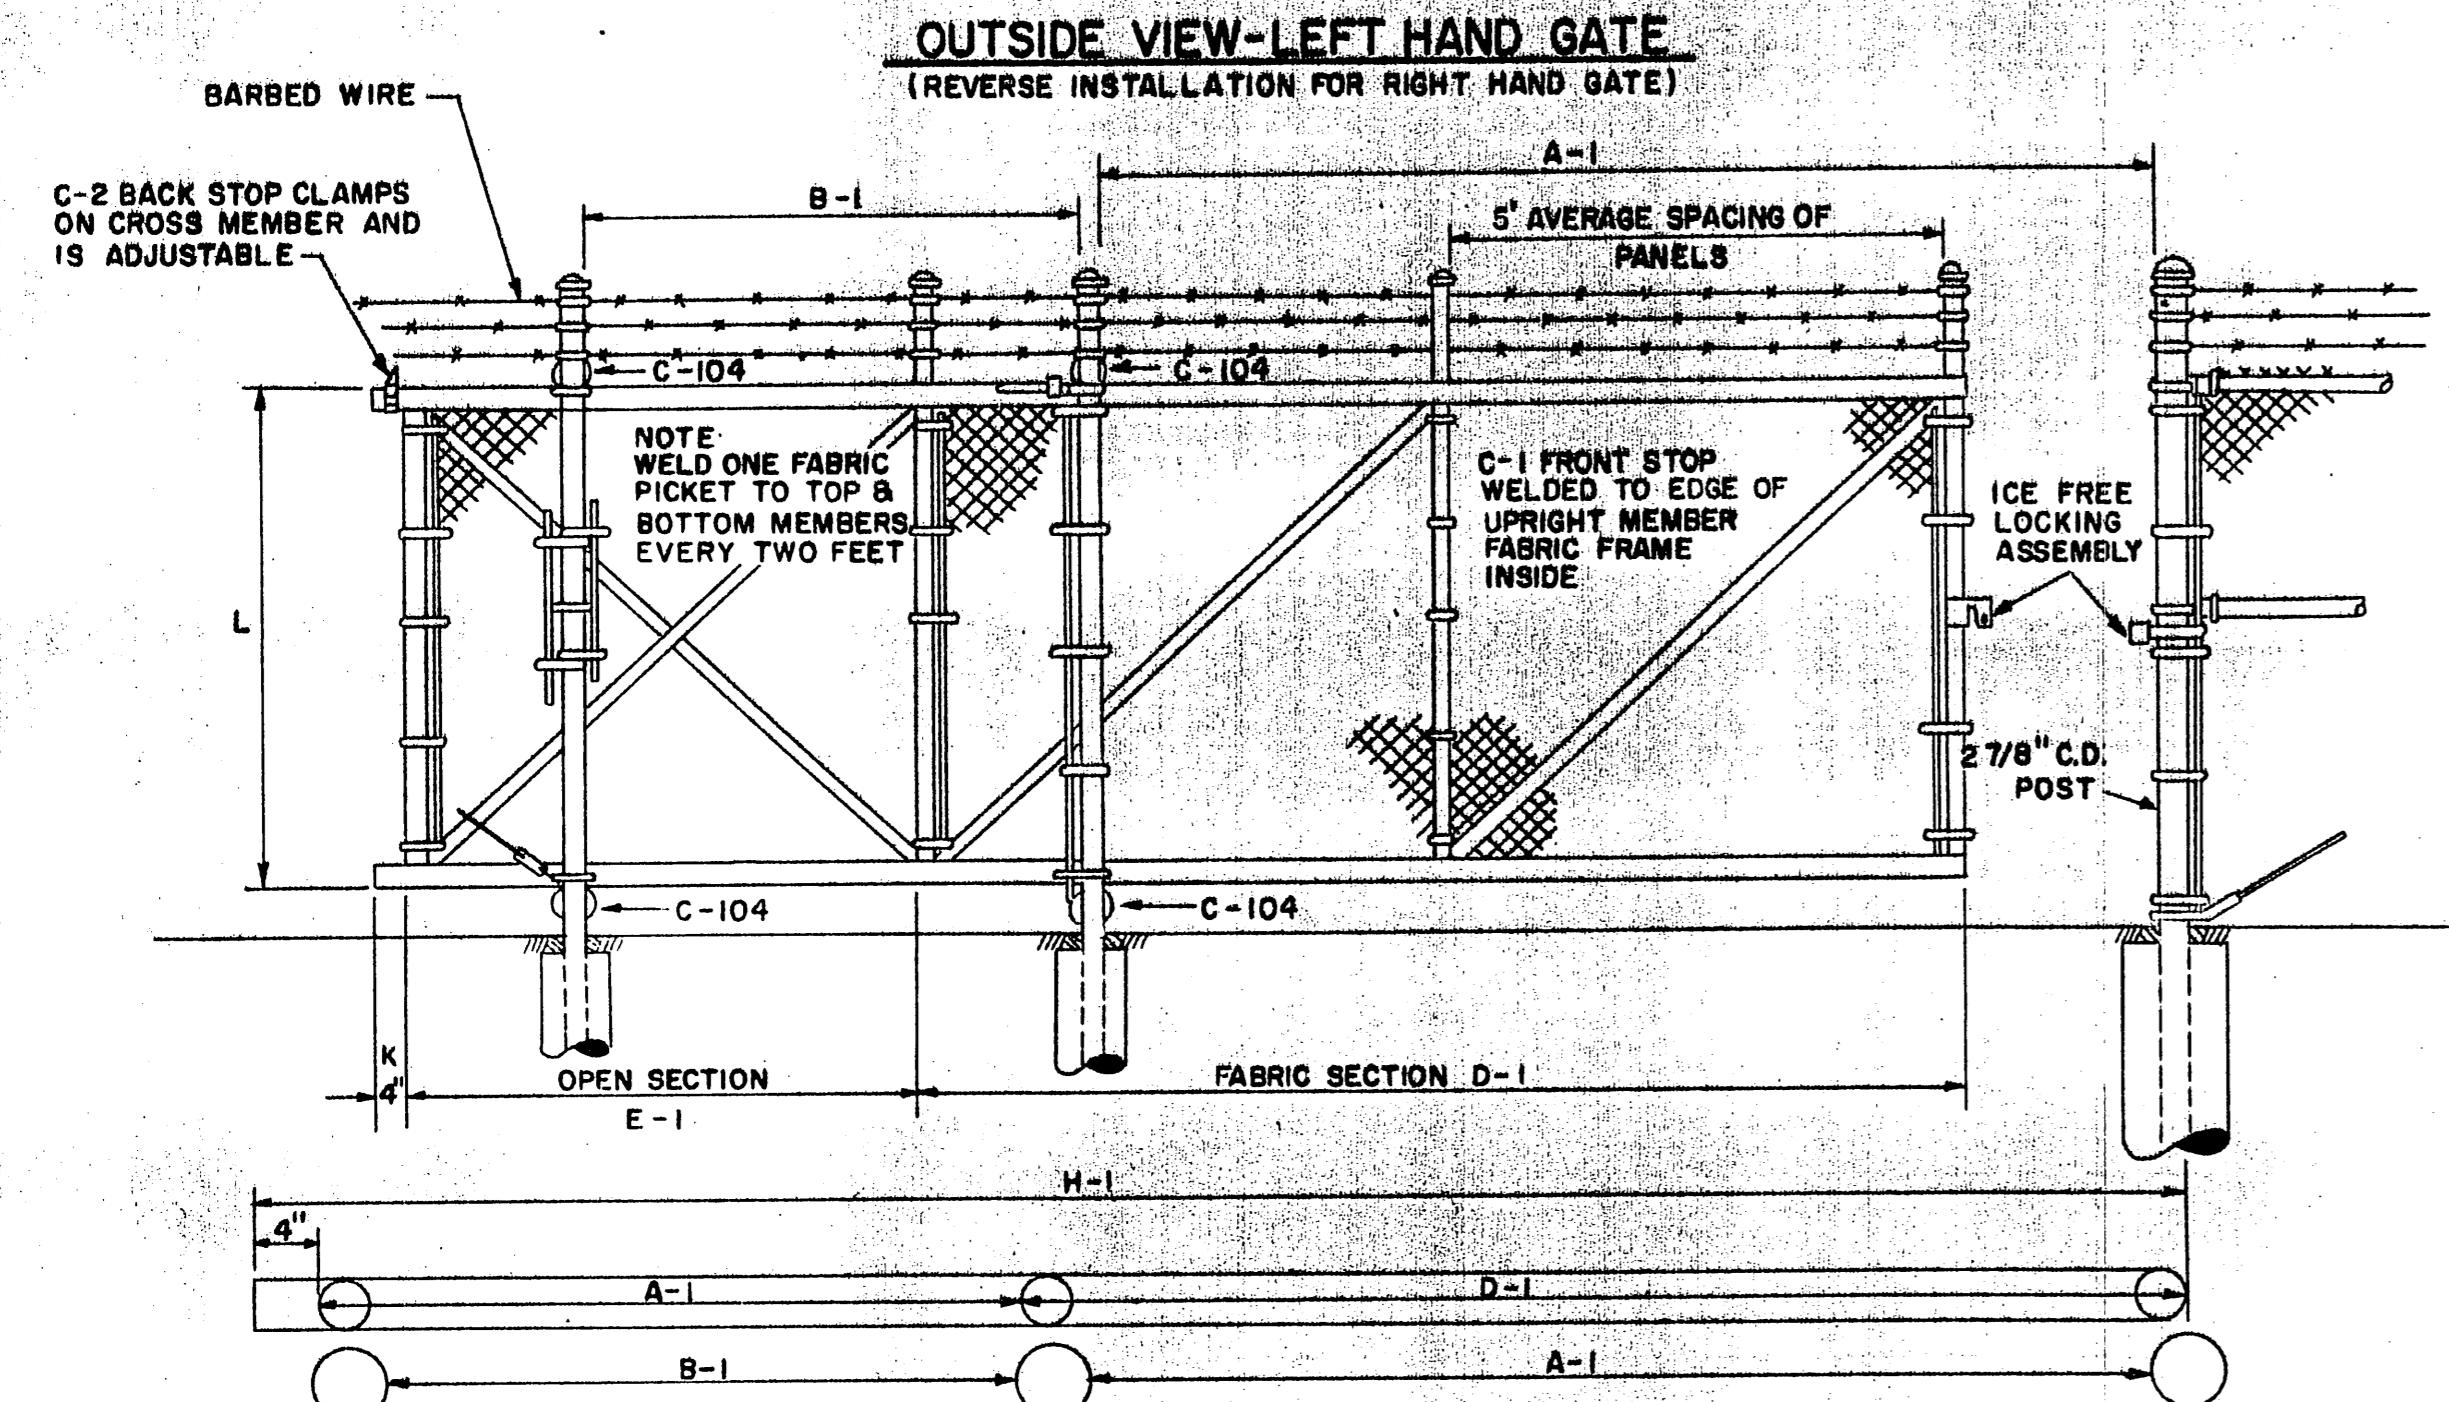

TYPICAL SLIDE GATE

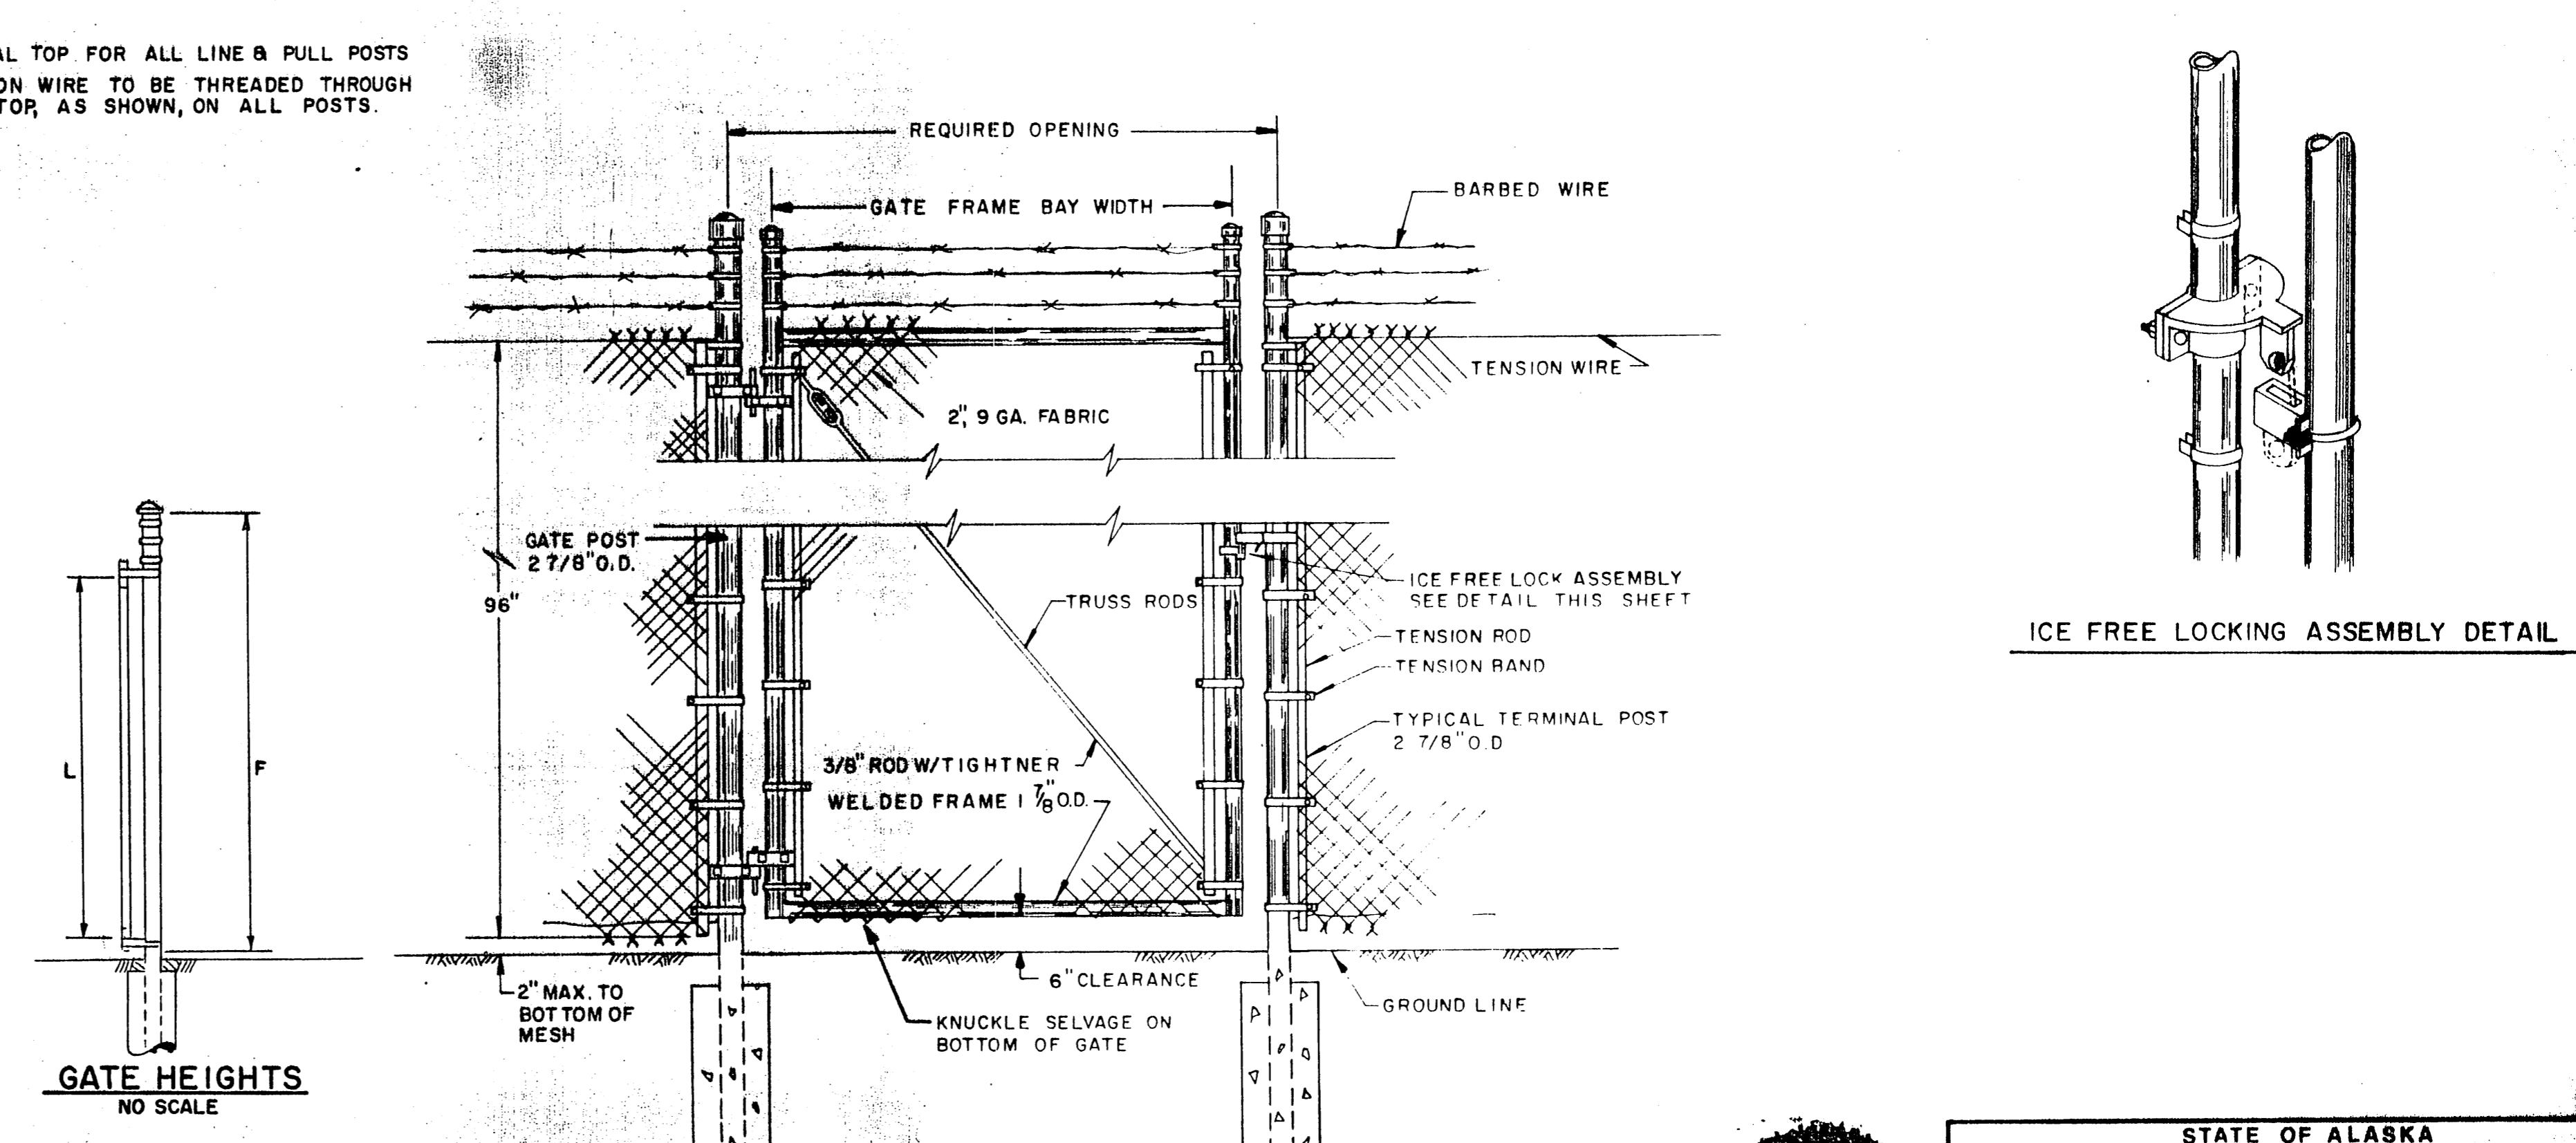

GATE HEIGHTS
NO SCALE

8'X4'
TYPICAL PEDESTRIAN GATE

NOTE:

- FOR GATE POST HEIGHT AND GATE FRAME BAY HEIGHT SEE TABLE 2 SHEET 6




STATE OF ALASKA
DEPARTMENT OF TRANSPORTATION
AND PUBLIC FACILITIES

HAINES AIRPORT
PROJECT NO. 69523


GATE DETAILS

APPROVED	BY	DATE	CHANGE	DESIGNED	DRAWN
REVISIONS	NO. SCALE	CHEM. C.H.	DATE	REVISIONS	NO. SCALE


27 OF 39

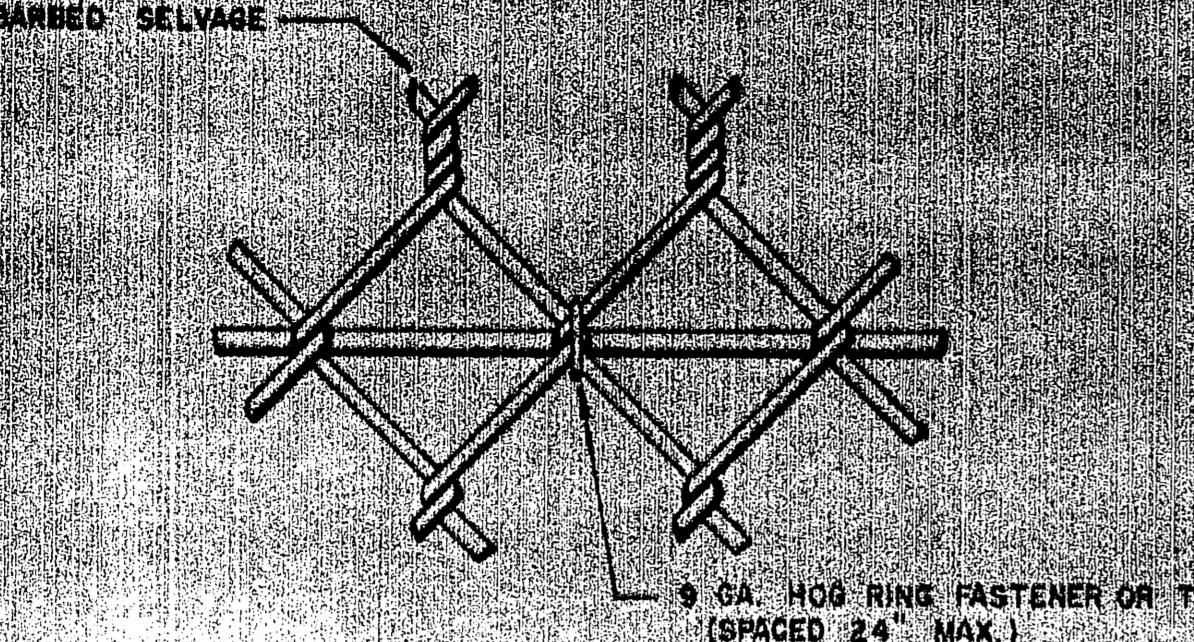


TYPICAL METHOD OF TYING FABRIC TO TENSION WIRE

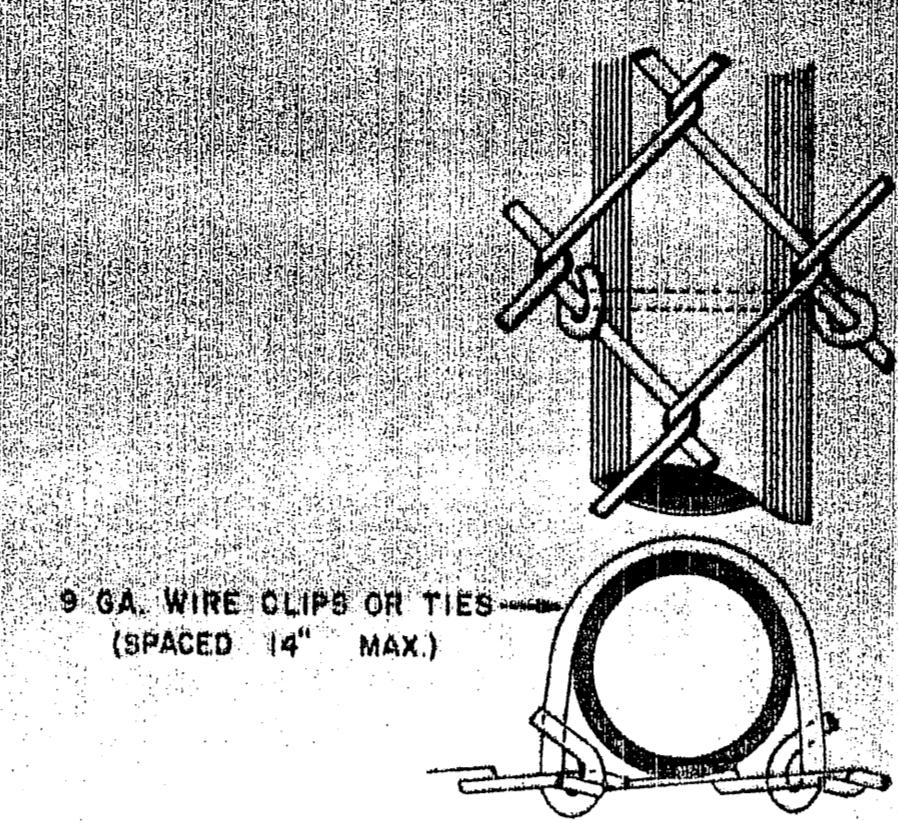


TYPICAL METHOD OF TYING FABRIC TO TUBULAR POSTS

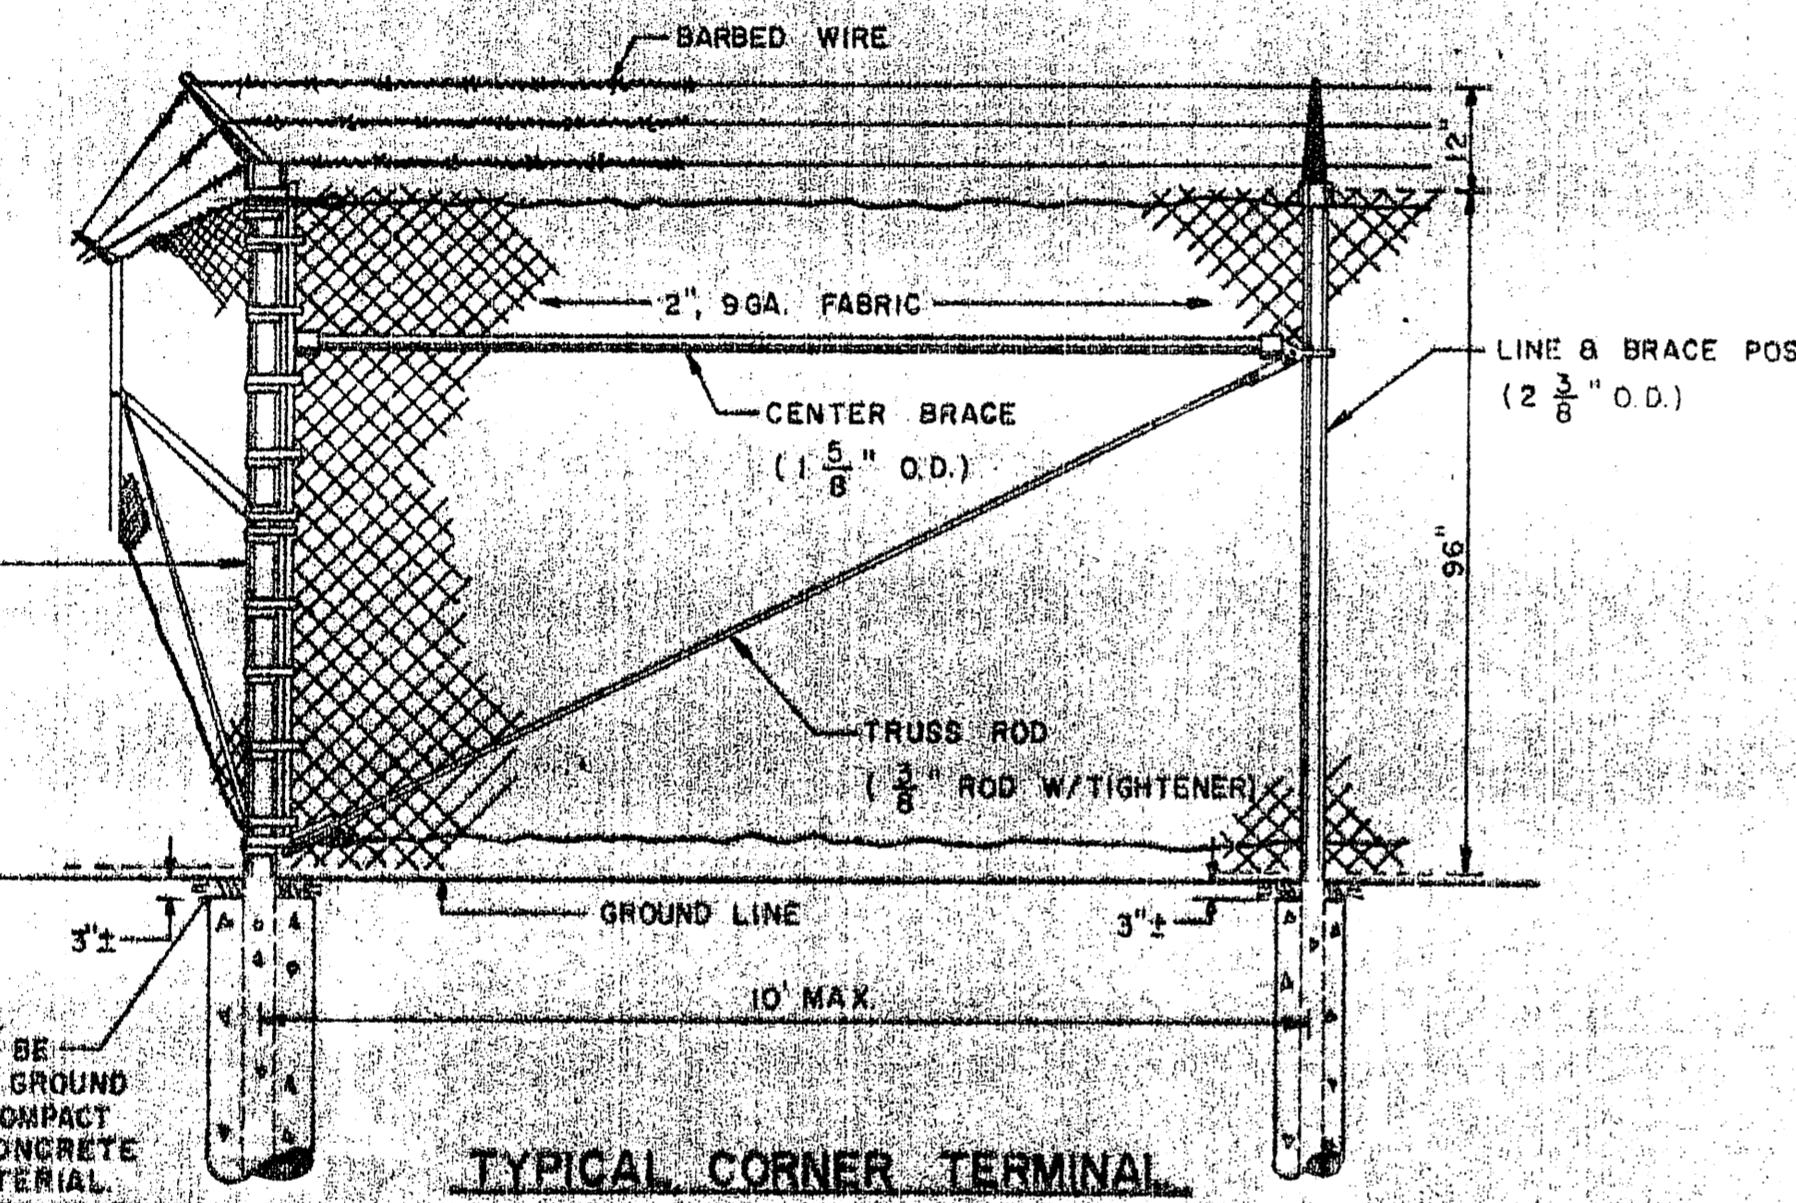


FINISHED CONCRETE TO BE RECESSED BELOW THE GROUND LINE. BACKFILL AND COMPACT AROUND RECESSED CONCRETE WITH EXCAVATED MATERIAL.
(TYPICAL ANGLE CONCRETE POSTS)

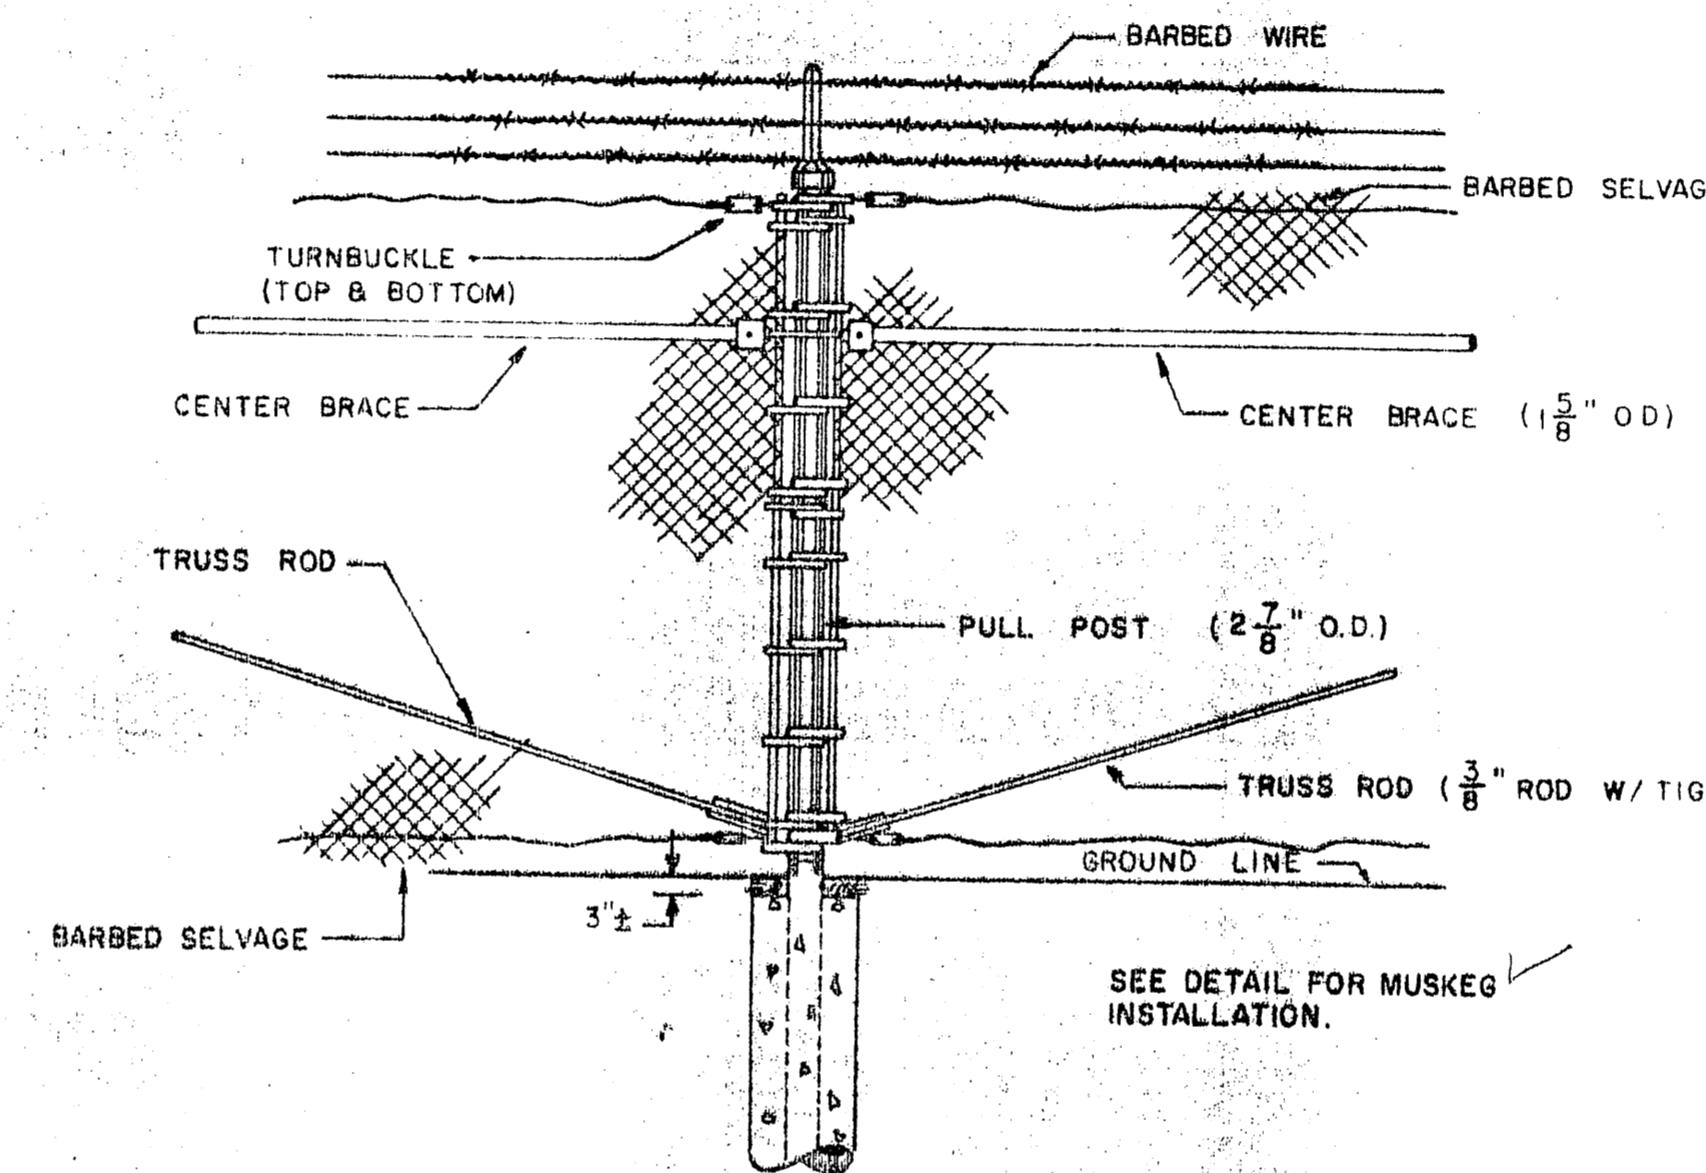

TERMINAL POST

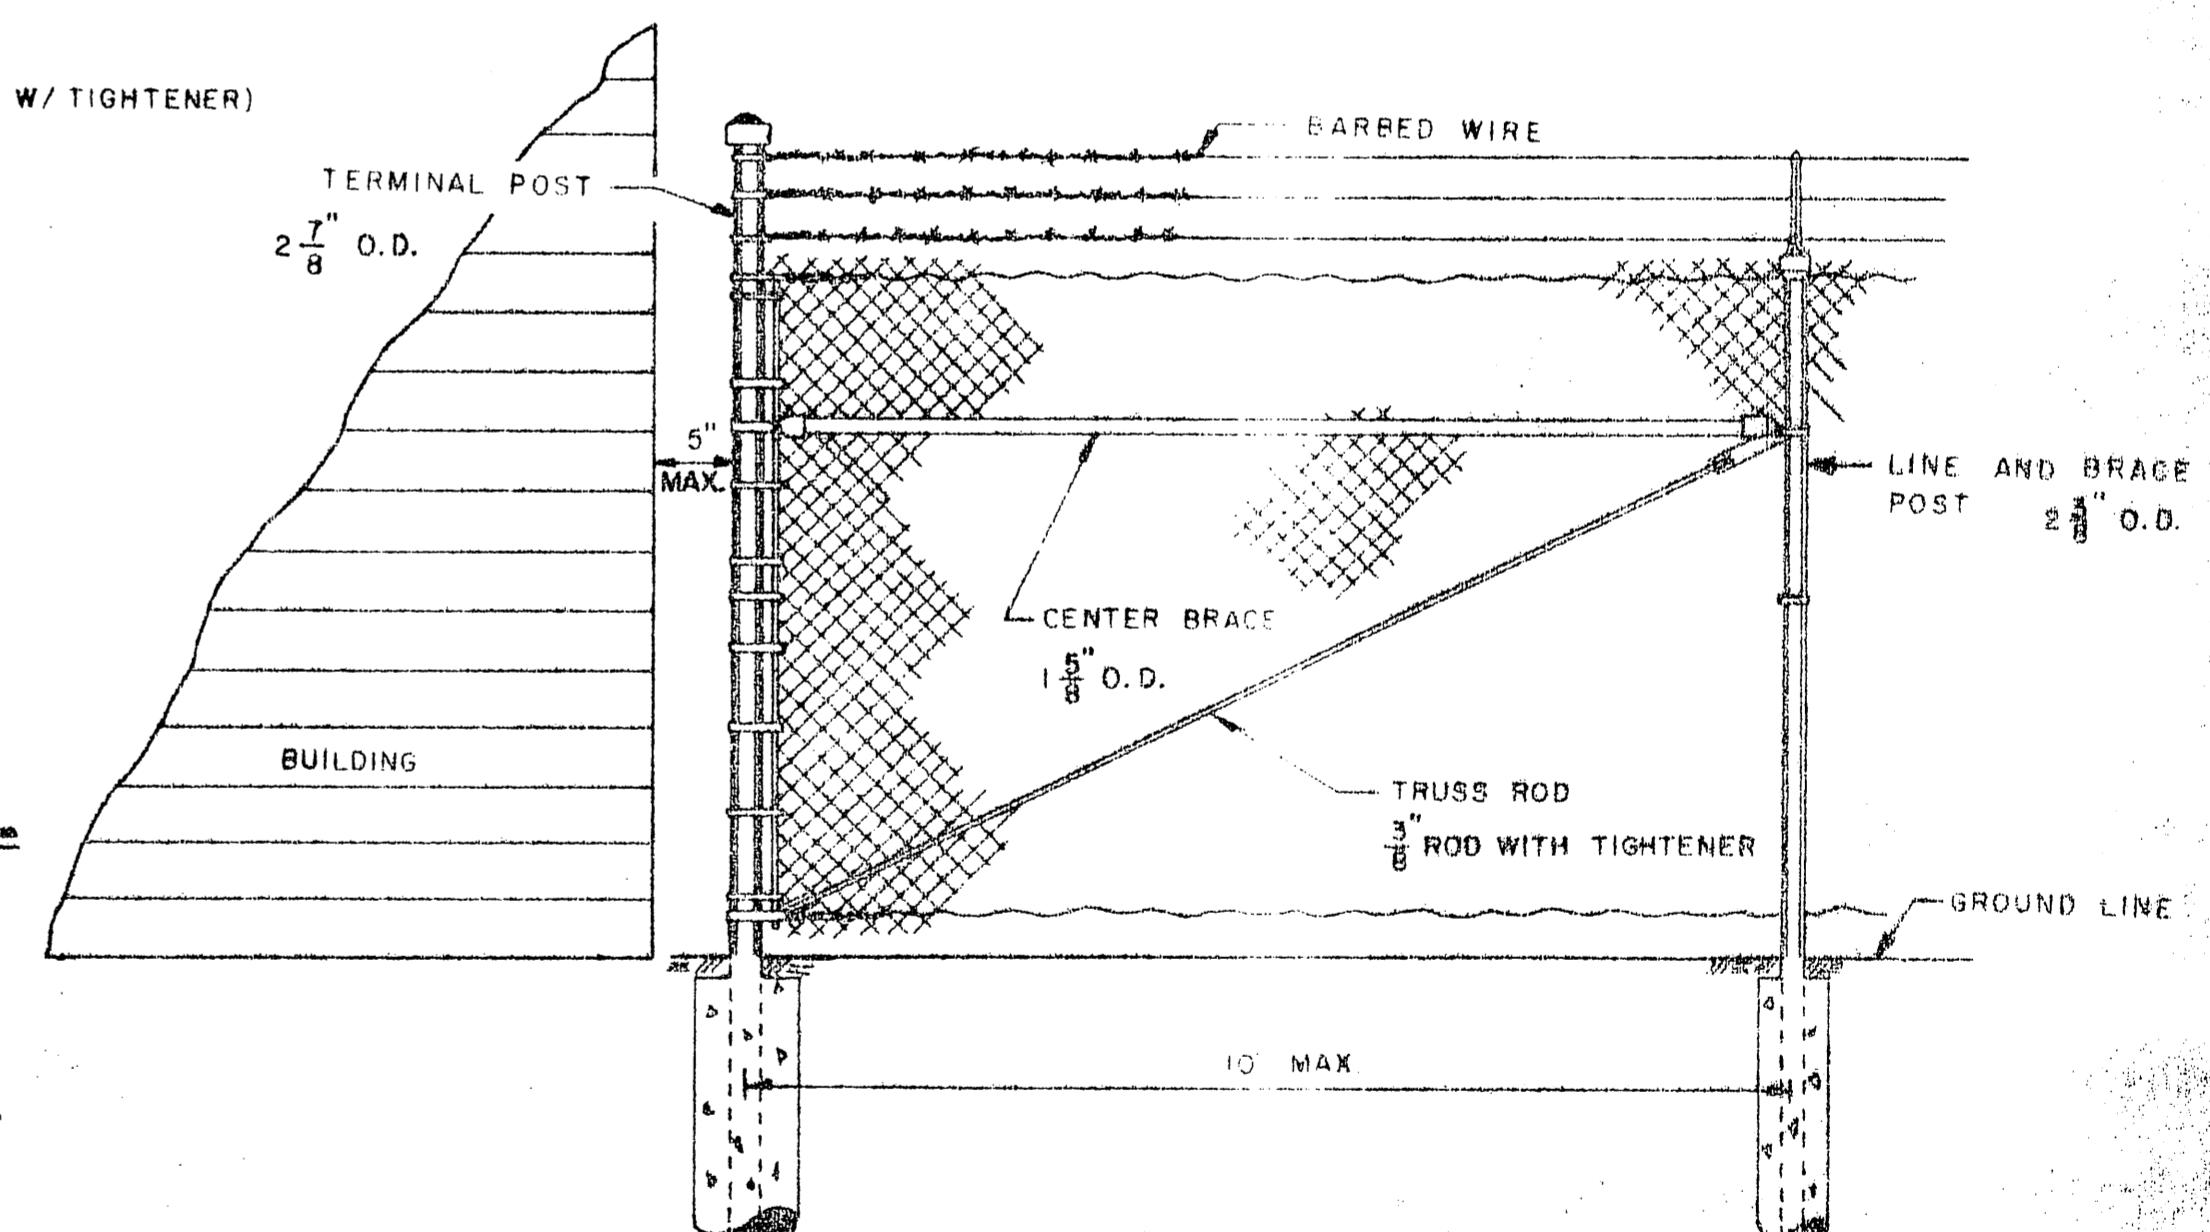

TYPICAL FENCE TERMINUS

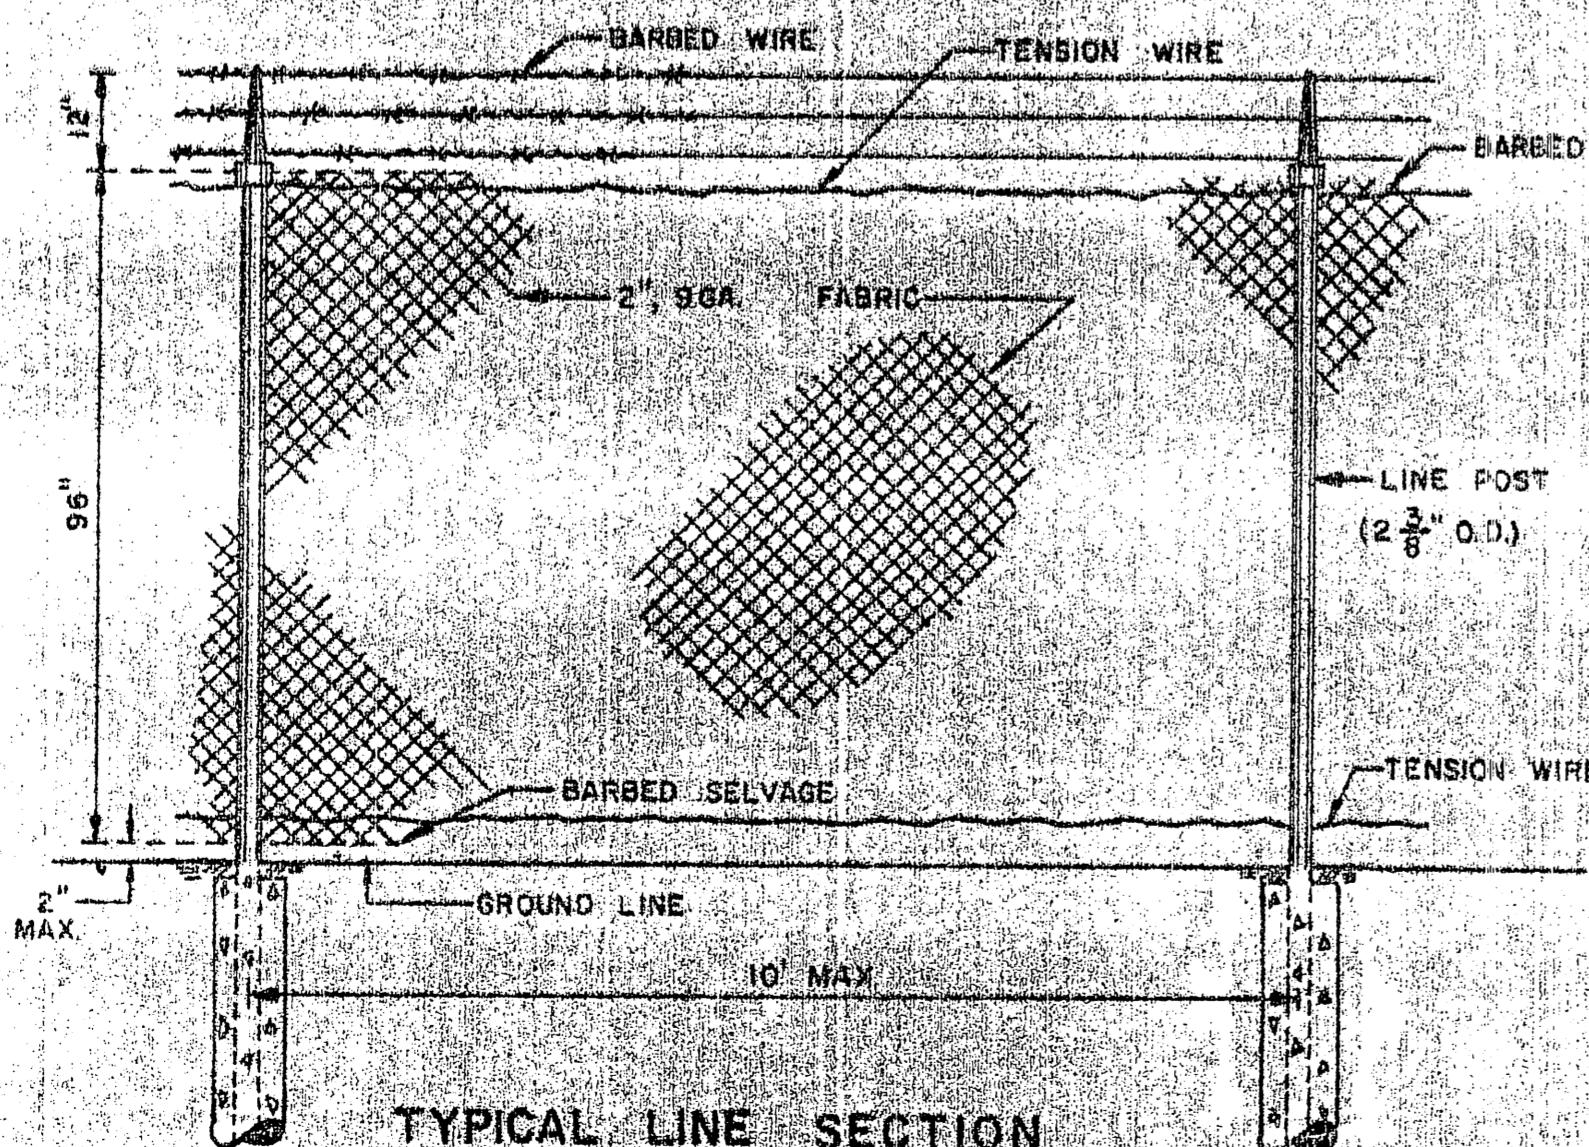


TYPICAL LINE SECTION
AT PAVED SURFACE



**STATE OF ALASKA
DEPARTMENT OF TRANSPORTATION
AND PUBLIC FACILITIES**

HAINES AIRPORT
PROJECT NO. 69523
SECURITY FENCING
AIN-LINK FENCE DETAIL

		<p style="text-align: center;">STATE OF ALASKA DEPARTMENT OF TRANSPORTATION AND PUBLIC FACILITIES</p>		
<p>HAINES AIRPORT PROJECT NO. 69523 SECURITY FENCING CHAIN-LINK FENCE DETAILS</p>				
		APPROVED	DESIGN GROUP CHIEF	
		APPROVED	PROJECT MANAGER	
BY	DATE	NAME	DESIGNED	DRAWN
		NONE	CHEKED CM	DATE
REVISIONS		28-39		

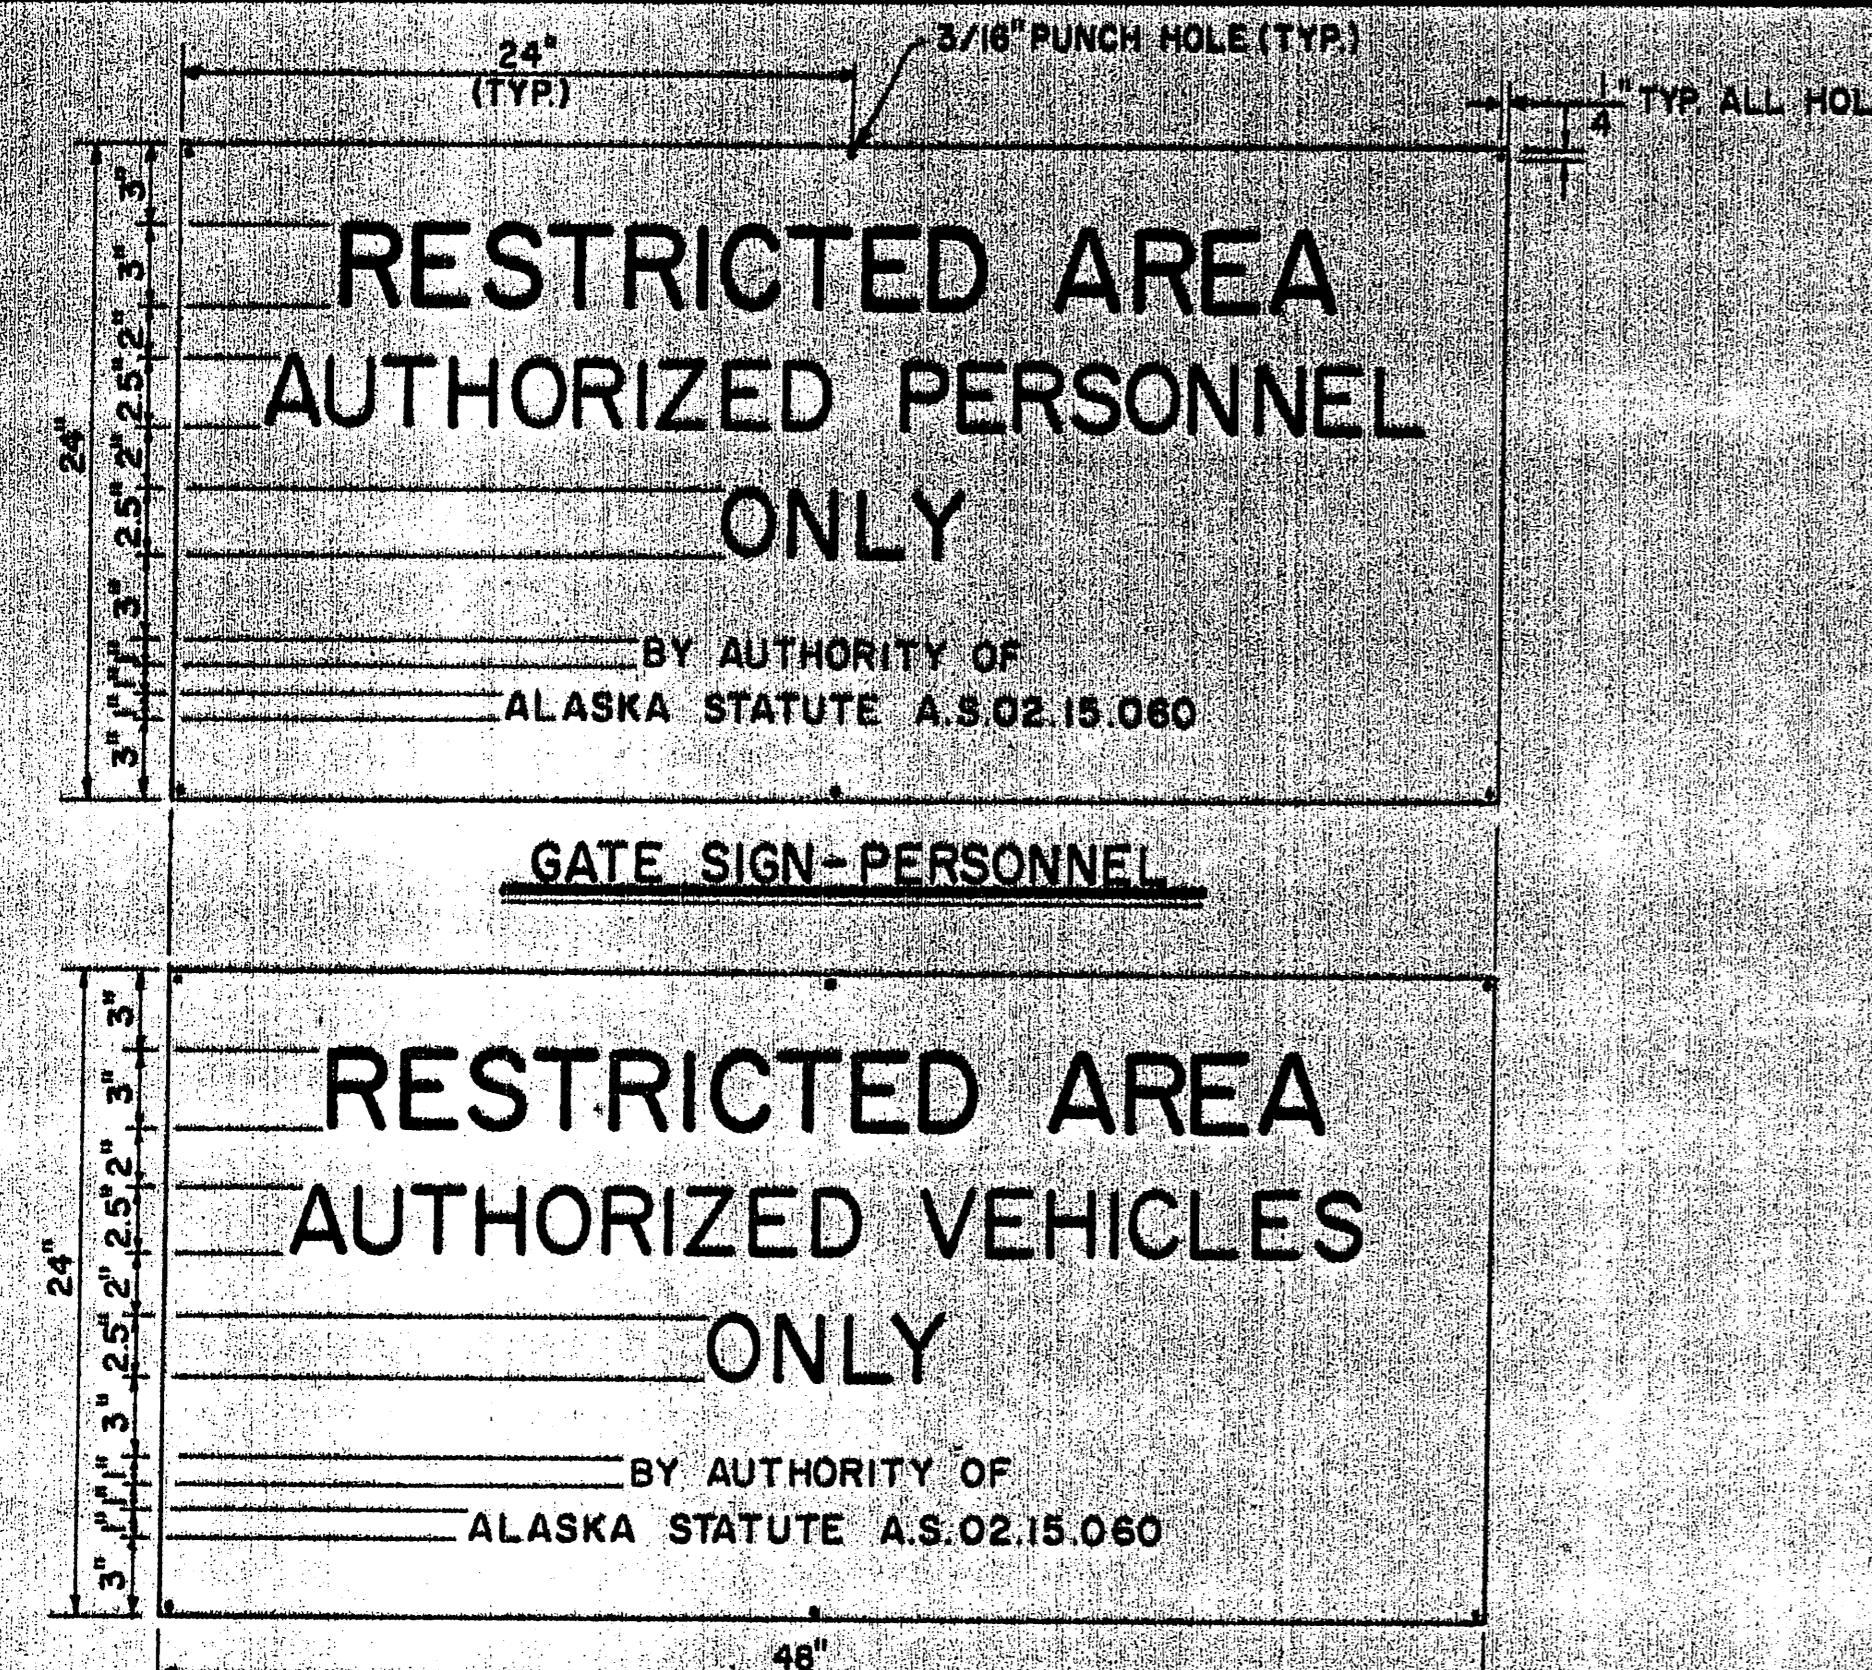


- NOTES:**
1. SIGN PLATES SHALL HAVE ~~RED~~ REFLECTIVE SHEETING WITH WHITE LETTERING.
 2. SIGN PLATES SHALL BE PLACED ON THE FENCE IMMEDIATELY ADJACENT TO GATES INSTALLED UNDER THIS CONTRACT, 4' ABOVE THE GROUND, EXCEPT SLIDE GATES WHICH SHALL HAVE SIGNS ATTACHED IN CENTER OF GATES.
 3. "AUTHORIZED VEHICLES" SIGNS SHALL BE USED ON GATES FOR VEHICULAR ACCESS. "AUTHORIZED PERSONNEL" SIGNS SHALL BE USED ON GATES FOR PERSONNEL ACCESS. BOTH SIGNS SHALL BE USED WHERE VEHICLE / PERSONNEL COMBINATIONS OCCUR.
 4. ALL SIGNS SHALL BE ATTACHED TO FENCE WITH 9 GAGE WIRE.

NOTICE


AIRPORT PROPERTY ---- NO TRESPASSING
VIOLATORS WILL BE PROSECUTED

BOUNDARY SIGN PLATE DETAIL

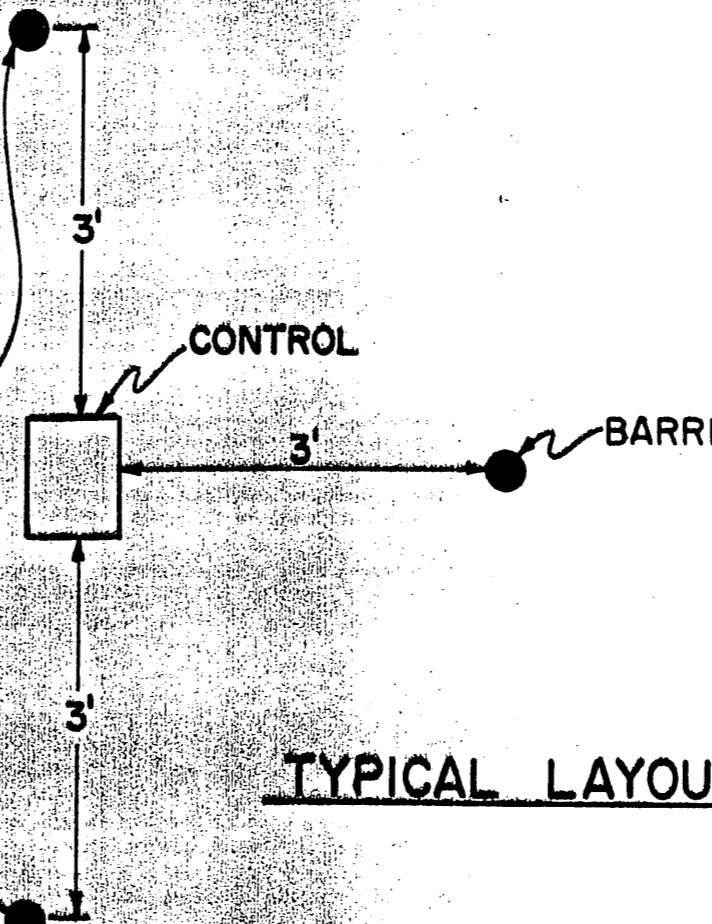

TYPICAL LAYOUT

SLIDE GATE CONTROL DETAIL

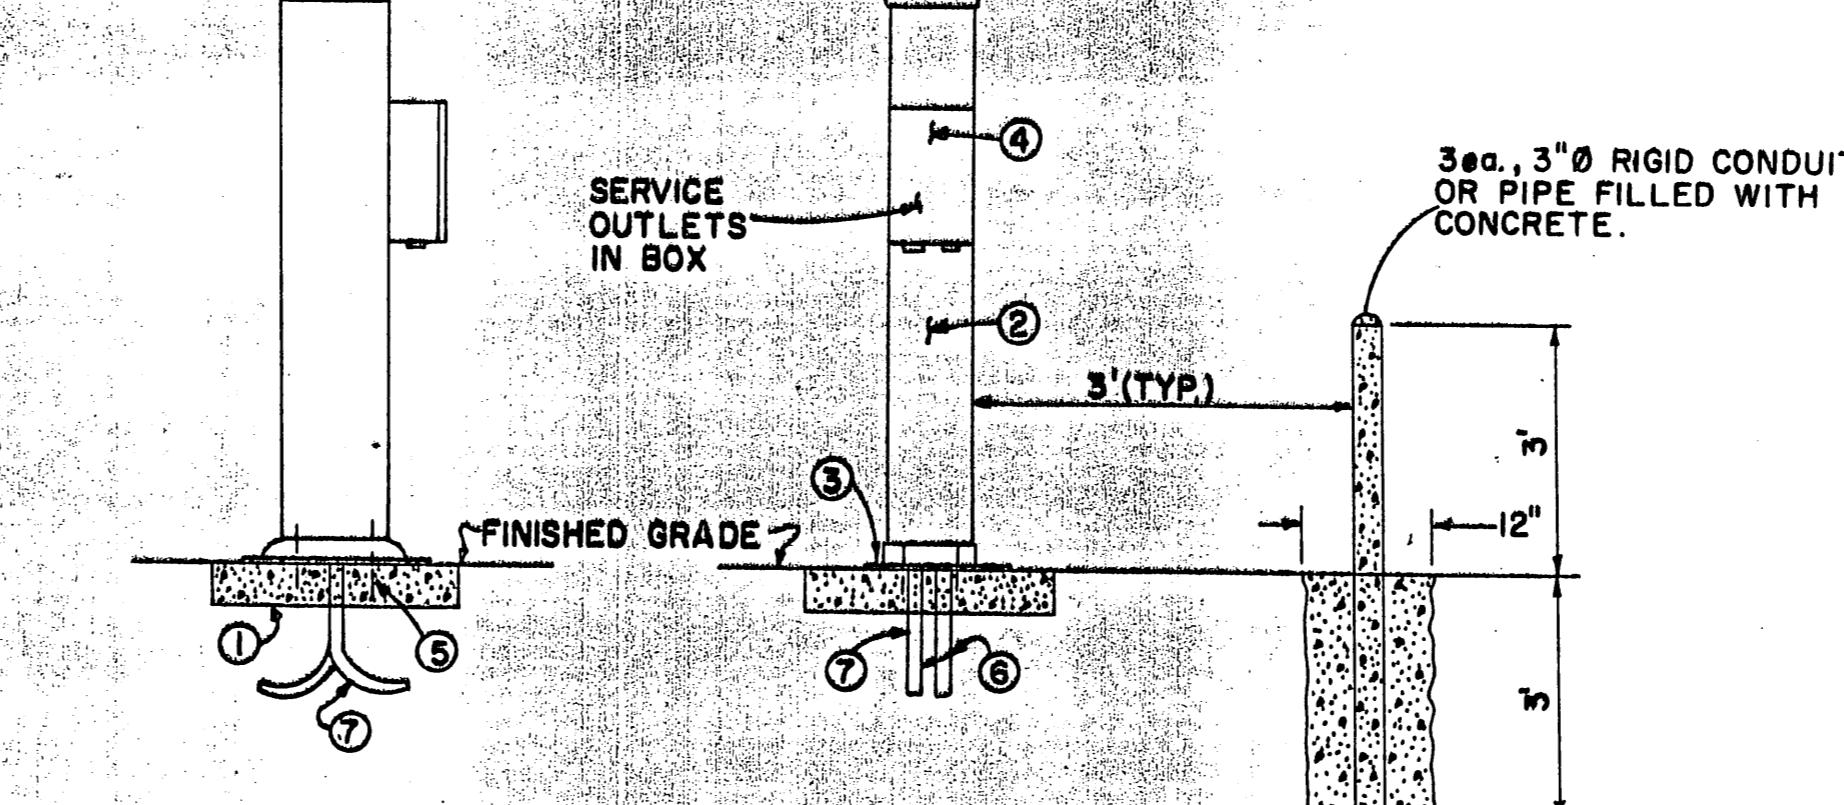

- ① 2'x2'x6" CONCRETE PAD.
- ② 8"x10" PEDESTAL.
- ③ PEDESTAL BASE.
- ④ CIRCUIT BREAKER & RECEPTACLE.
- ⑤ MOUNT W/ 3/4" GALV. BOLTS & WASHERS.
- ⑥ 1-1/2" RIGID STEEL CONDUIT W/90°ELBOW FOR # 2-600V. CABLE.
- ⑦ 1-1/2" CONDUIT TO ELECTRIC GATE.

ELECTRICAL PEDESTAL

TYP. BARRIER

REVISION NUMBER	DATE	DESCRIPTION OF CHANGE	RECORD OF REVISIONS

STATE OF ALASKA
DEPARTMENT OF TRANSPORTATION
8. PUBLIC FACILITIES
SOUTHEAST REGION DESIGN & CONSTRUCTION


PROJECT NO. 69523
HAINES AIRPORT
SECURITY FENCING
SIGNS AND DETAILS

APPROVED BY:
RECOMMENDED BY:
PREPARED BY:
PROJECT MANAGER

DESIGN GROUP CHIEF DATE
DESIGN ENGINEER, GROUP " " DATE
LEAD DESIGNER

DESIGNED BY:
DRAWN BY:
CHECKED BY:
C.H.



SCALE: NONE
DATE:
DATE:
DATE:
DATE:

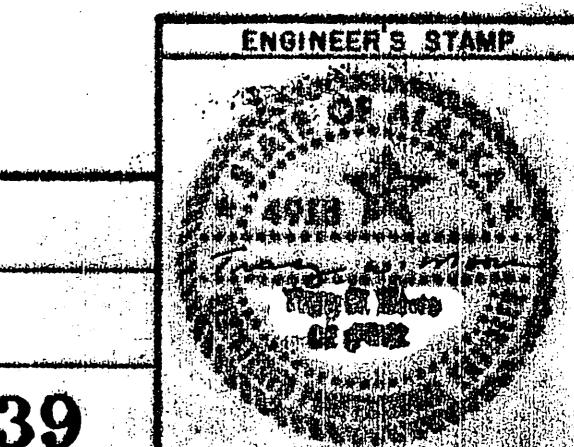

DATE	
BY	
PLAN	SURVEYED PIOTTI NOTE BOOK AUGMENT CHECKED RE. OF WAY CHECKED No.

DATE	
BY	
PROFILE	SURVEYED LOTTO C. CHECKED GAGES CHECKED STRUCTURE INSPECTION CHECKED No.


CREEK REALINEMENT	
DISTANCE	BEARING
(A) 350' ±	S. 70° E.
(A ₂) 300' ±	S. 70° E.
(A ₃) 200' ±	S. 20° E.
(B) 80' ±	N. 70° E.
(C) 200' ±	S. 60° E.
(D) 780' ±	S. 47° E.
(E) 830' ±	S. 70° E.
(F) 210' ±	S. 79° E.
(G) 280' ±	S. 70° E.
(H) 400' ±	S. 62° E.
(I) 300' ±	S. 69° E.
(J) 560' ±	S. 77° E.

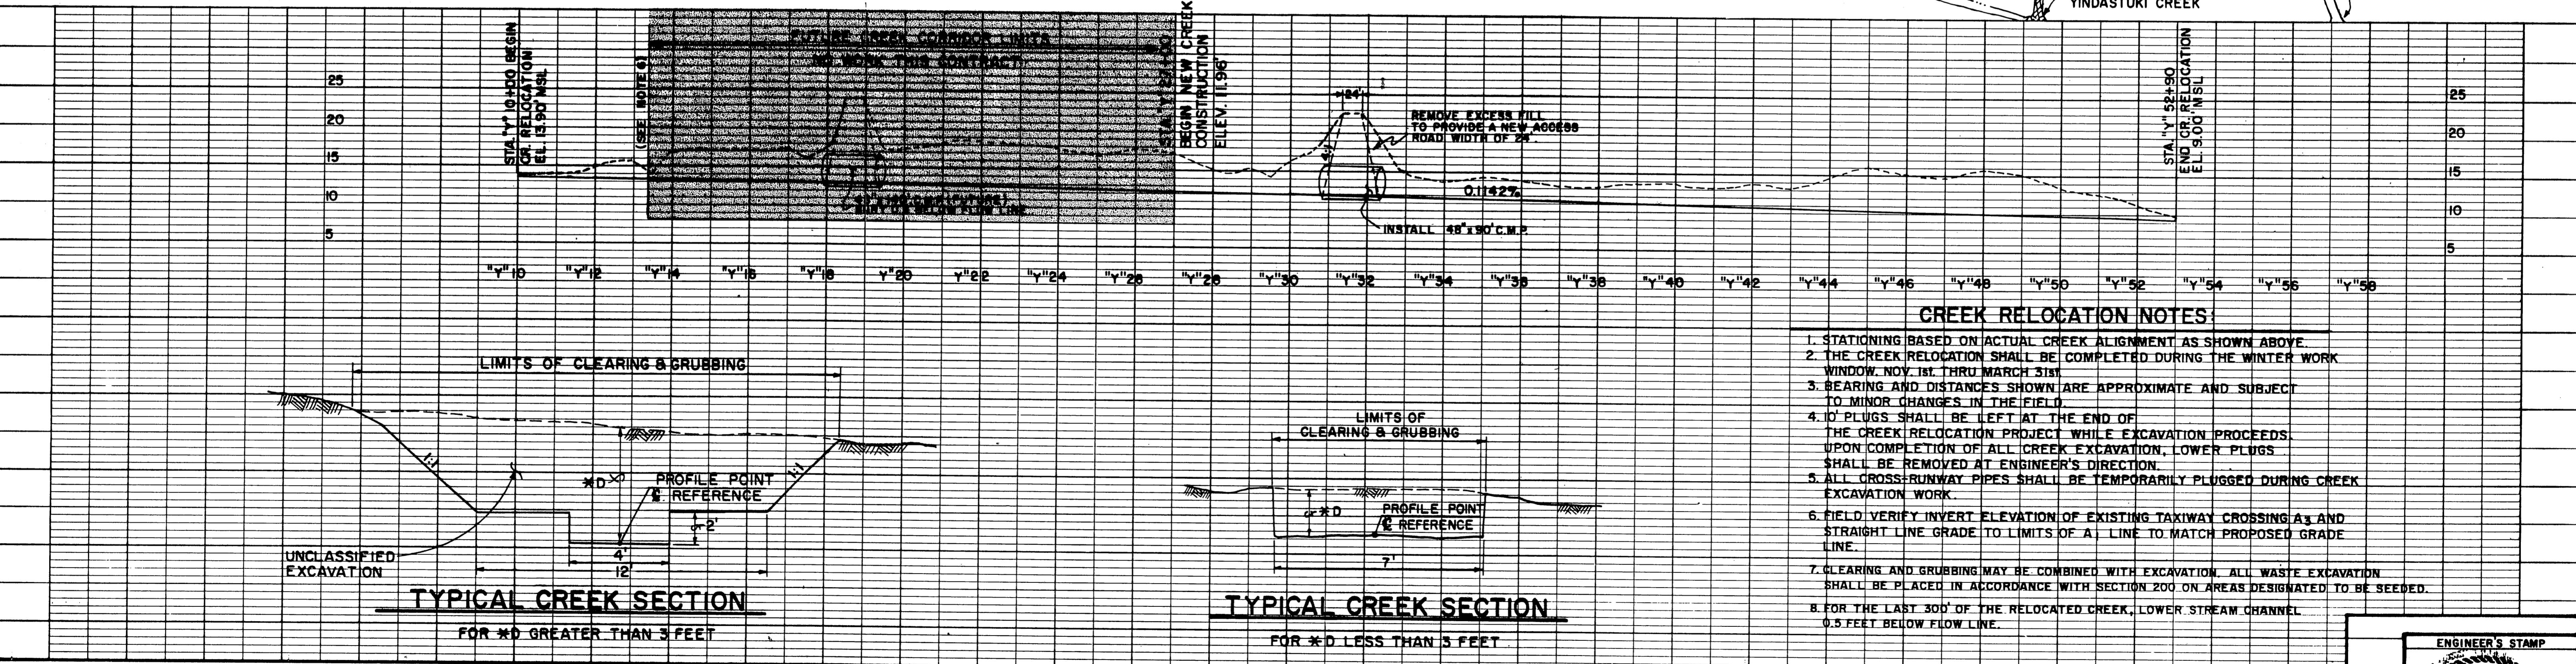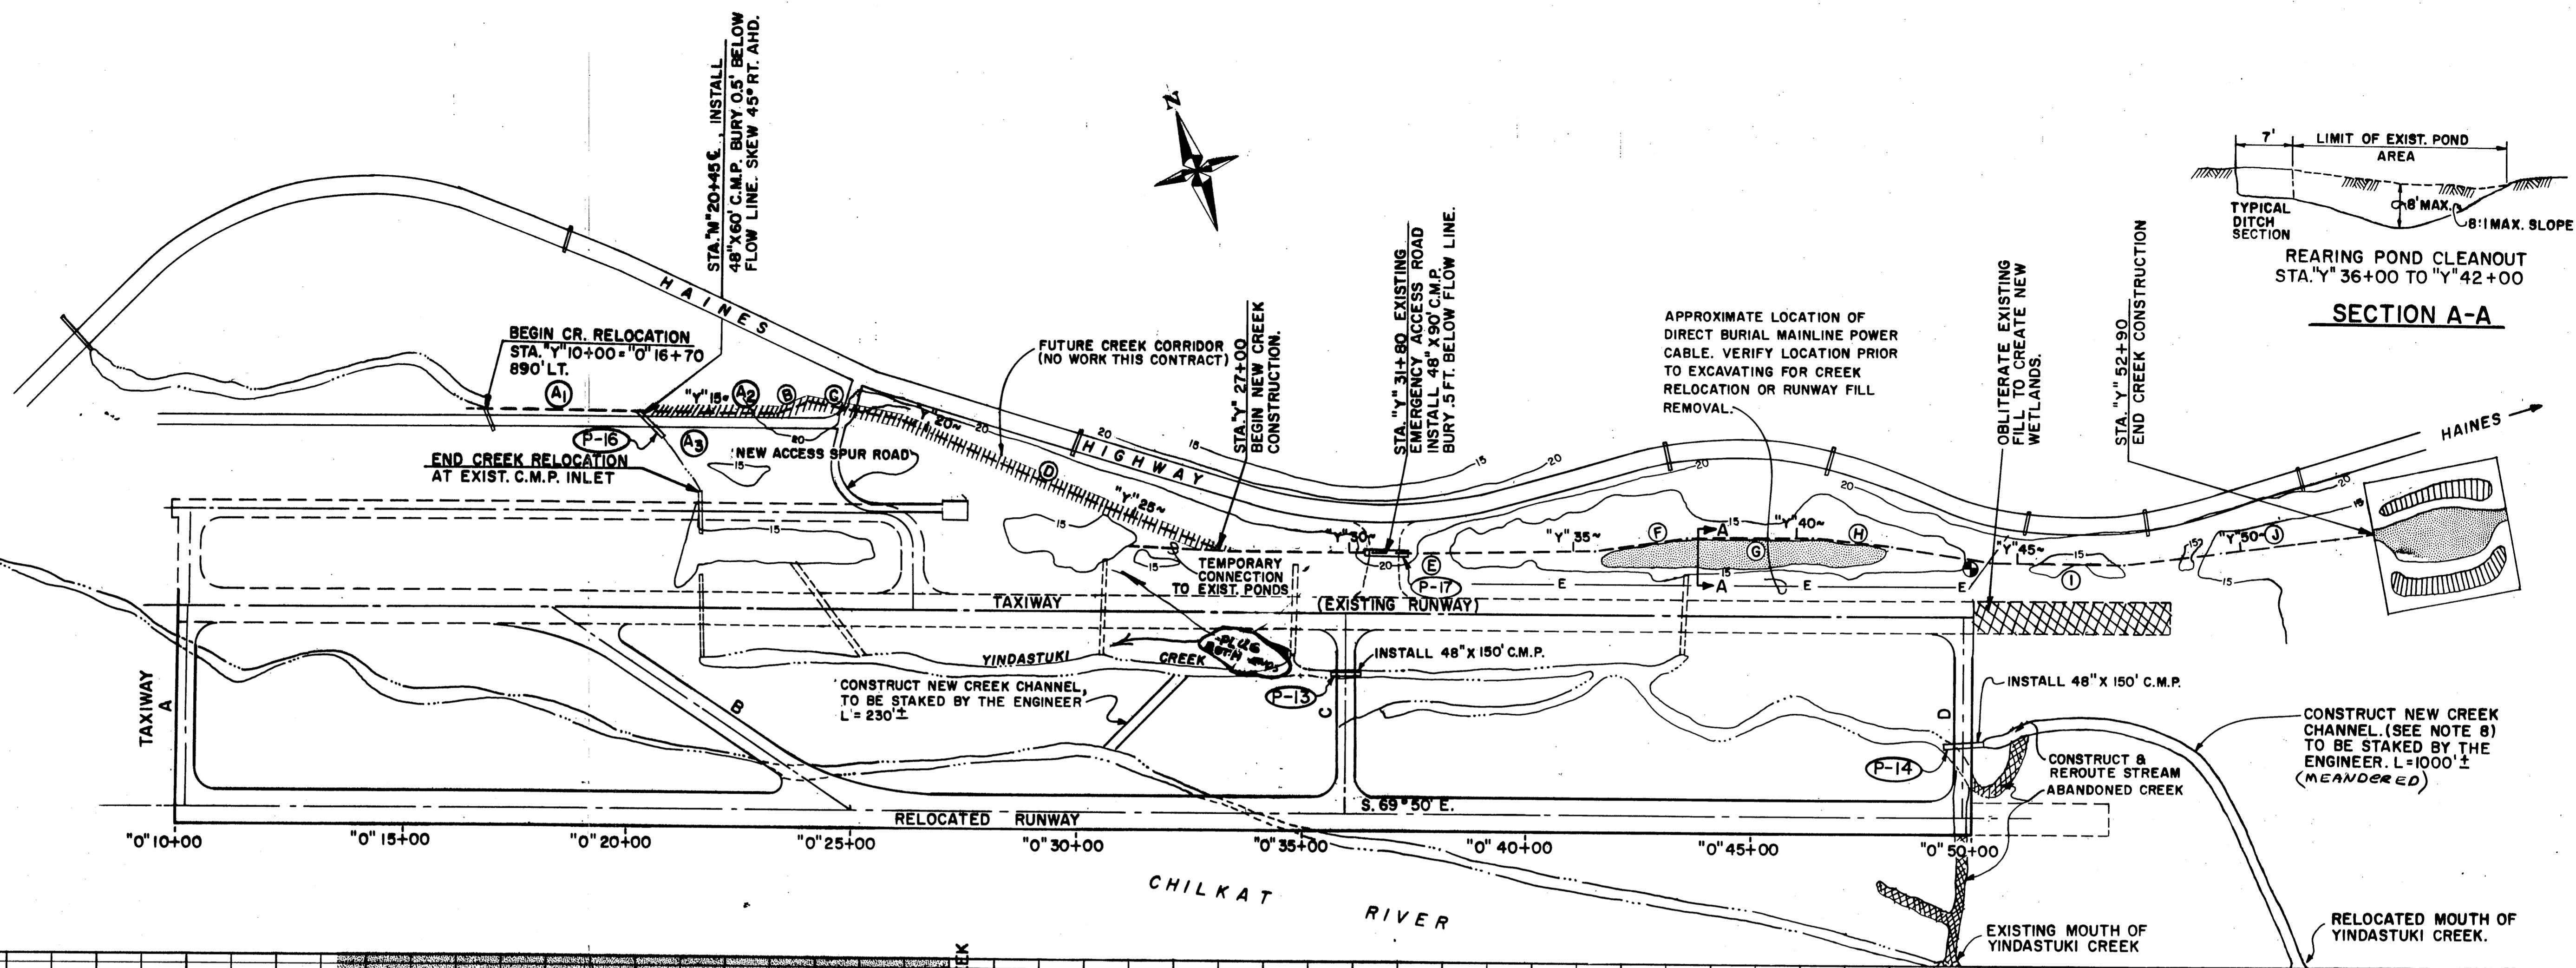


STATE OF ALASKA	DEPARTMENT OF TRANSPORTATION & PUBLIC FACILITIES	SOUTHEAST REGION DESIGN & CONSTRUCTION
RECORD OF REVISIONS	BY DATE	DESCRIPTION OF CHANGE

HAINES AIRPORT
YINDASTUKI CREEK RELOCATION

APPROVED BY: DESIGN GROUP CHIEF RECOMMENDED BY: DESIGN ENGINEER, GROUP " "	DESIGNED BY: T.M. DRAWN BY: W.D.A. PREPARED BY: PROJECT MANAGER LEAD DESIGNER	HORIZ. SCALE: VERT. SCALE: DRAWN BY: W.D.A. CHECKED BY: C.H.
---	---	---

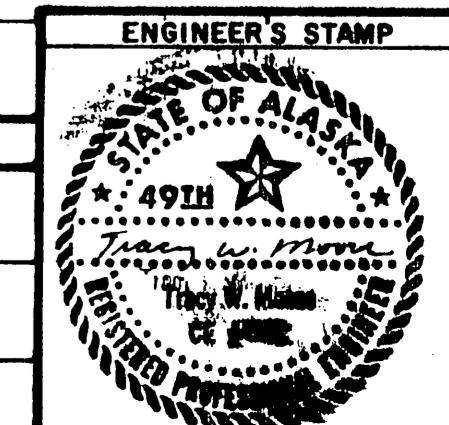

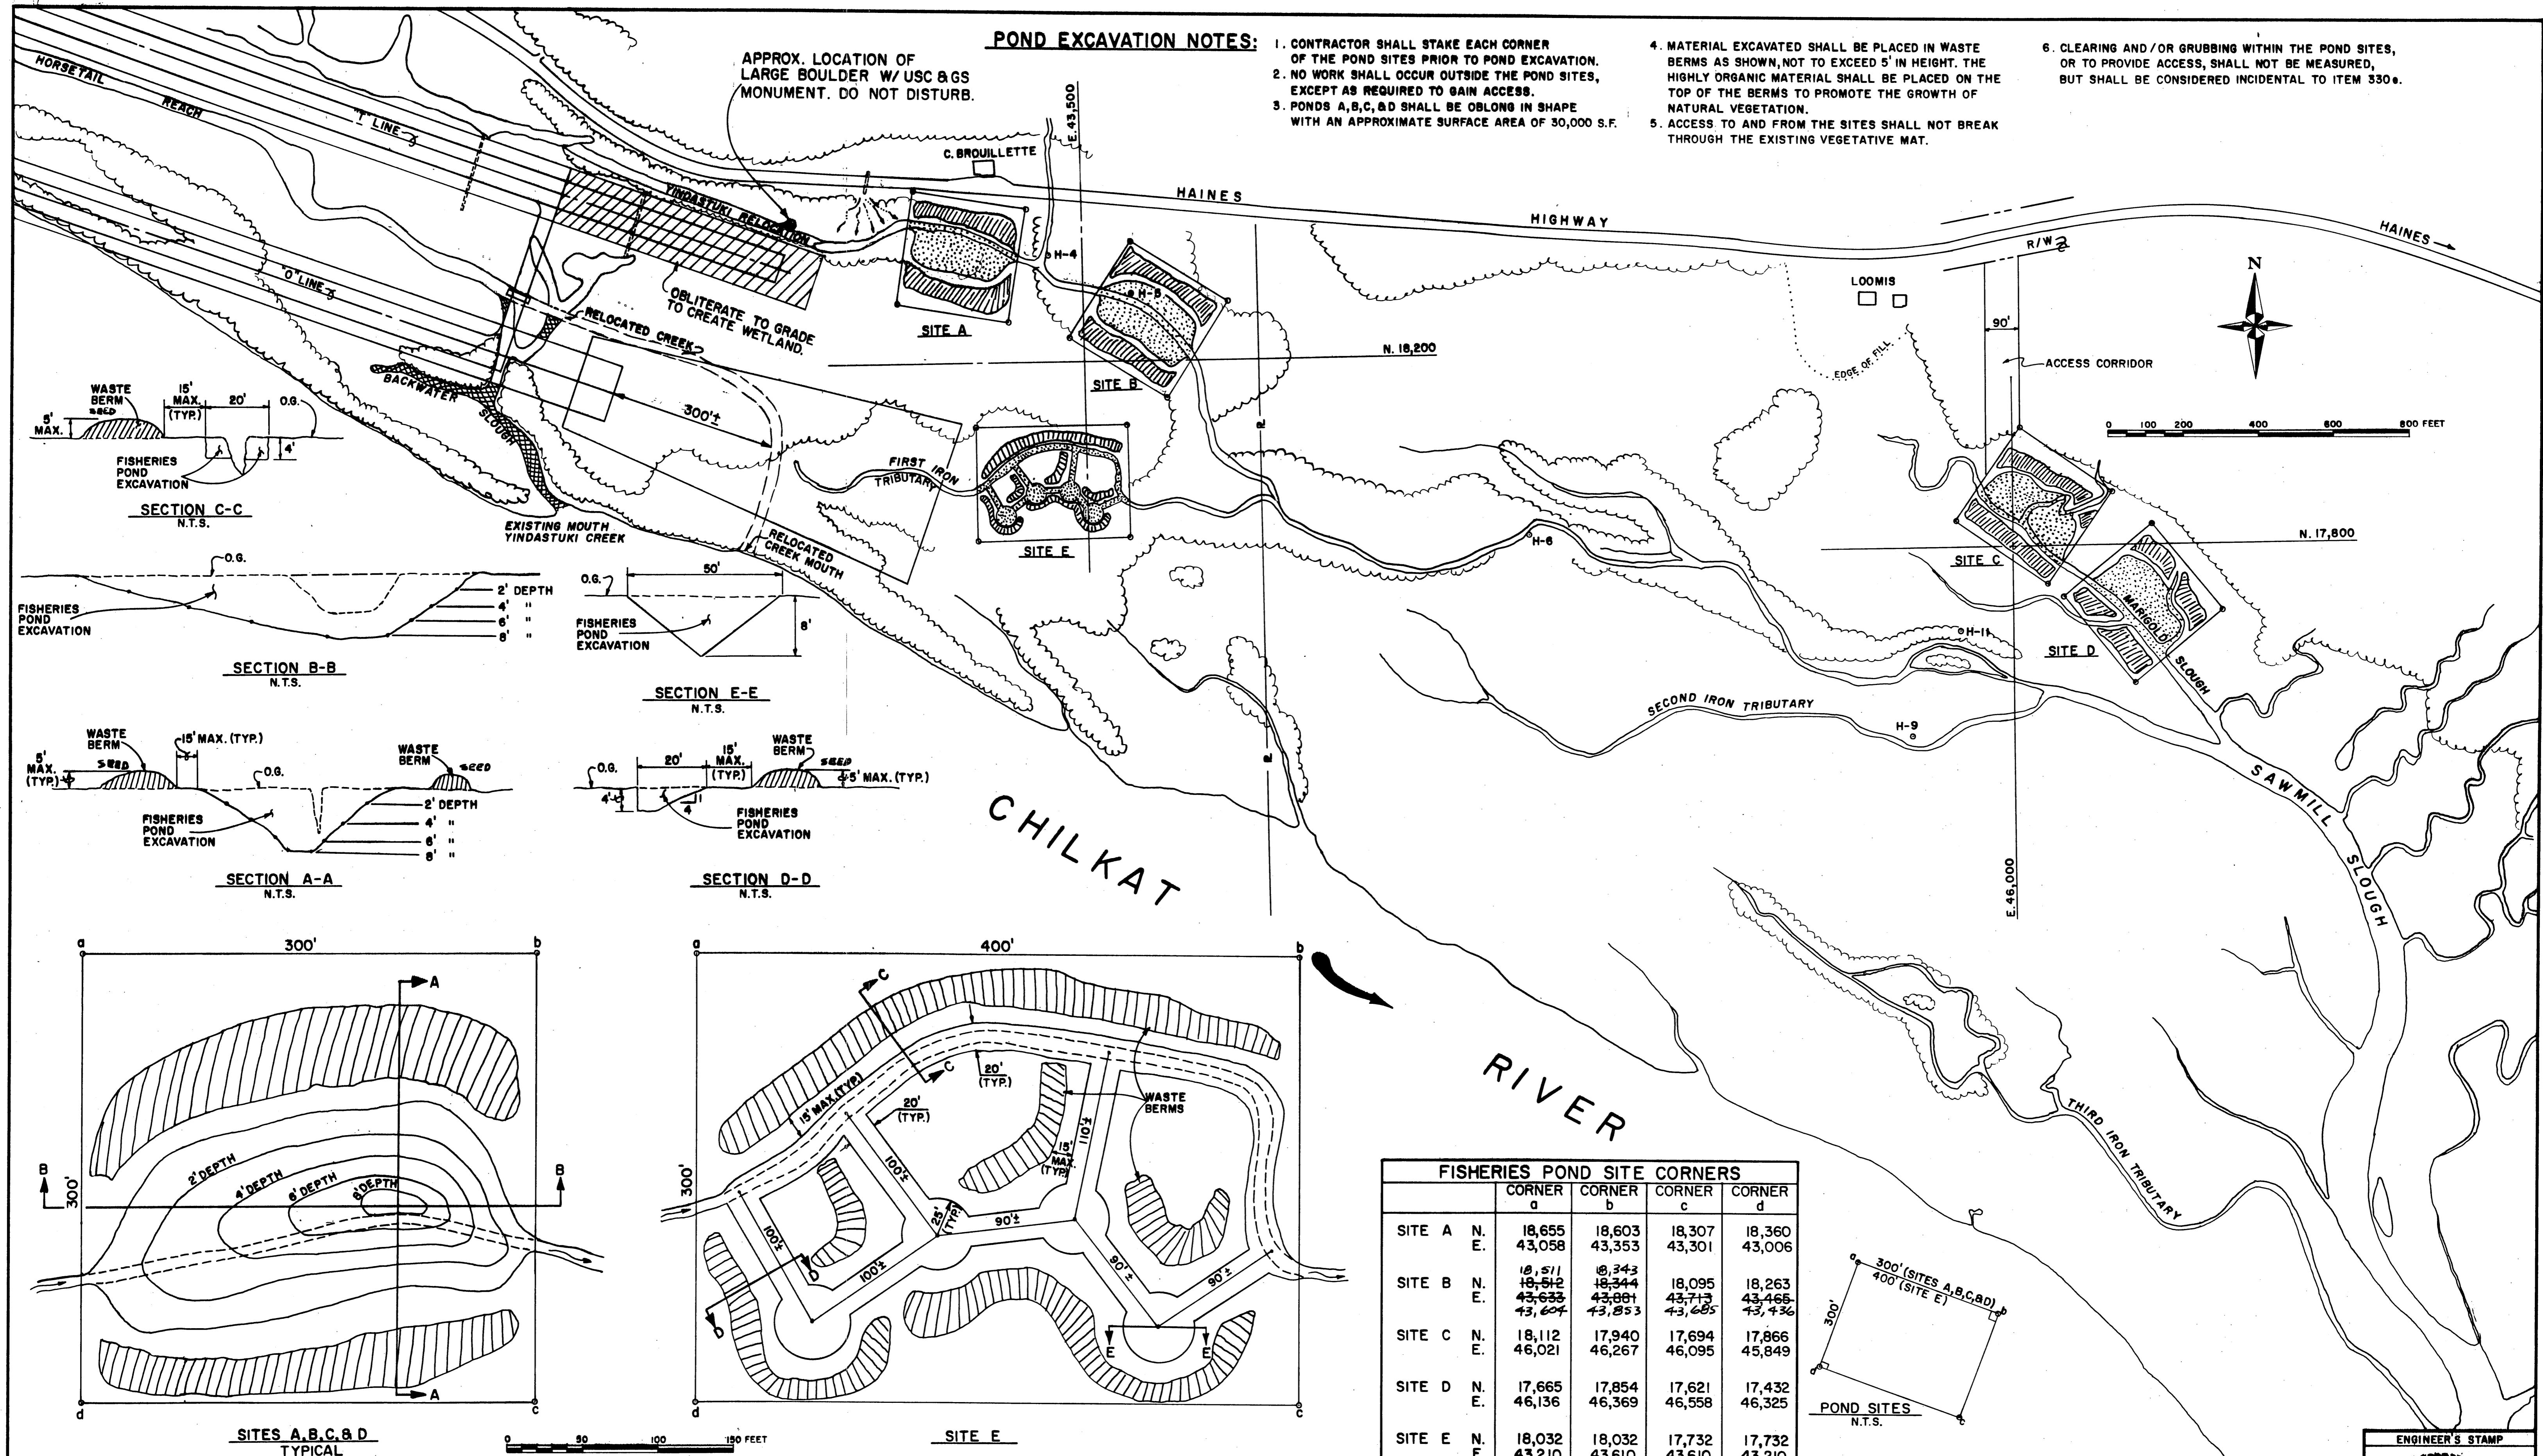

卷之三




**STATE OF ALASKA
DEPARTMENT OF TRANSPORTATION
& PUBLIC FACILITIES
SOUTHEAST REGION DESIGN & CONSTRUCTION**

HAINES AIRPORT FISHERIES PONDS

APPROVED BY:	<hr/>	DESIGN GROUP CHIEF	<hr/> DATE
RECOMMENDED BY:	<hr/>	DESIGN ENGINEER, GROUP " "	<hr/> DATE
PREPARED BY:	<hr/> PROJECT MANAGER	<hr/> LEAD DESIGNER	

A circular engineer's stamp with a decorative border containing the words "REGISTERED PROFESSIONAL ENGINEER". The center features a five-pointed star with "49TH" written above it. The text "STATE OF ALASKA" is curved along the top inner edge, and "May 1986" is written below the star. The name "Tracy W. Moore" is printed in the lower center, and the registration number "CE #4932" is printed below that.

LARGE WOODY DEBRIS

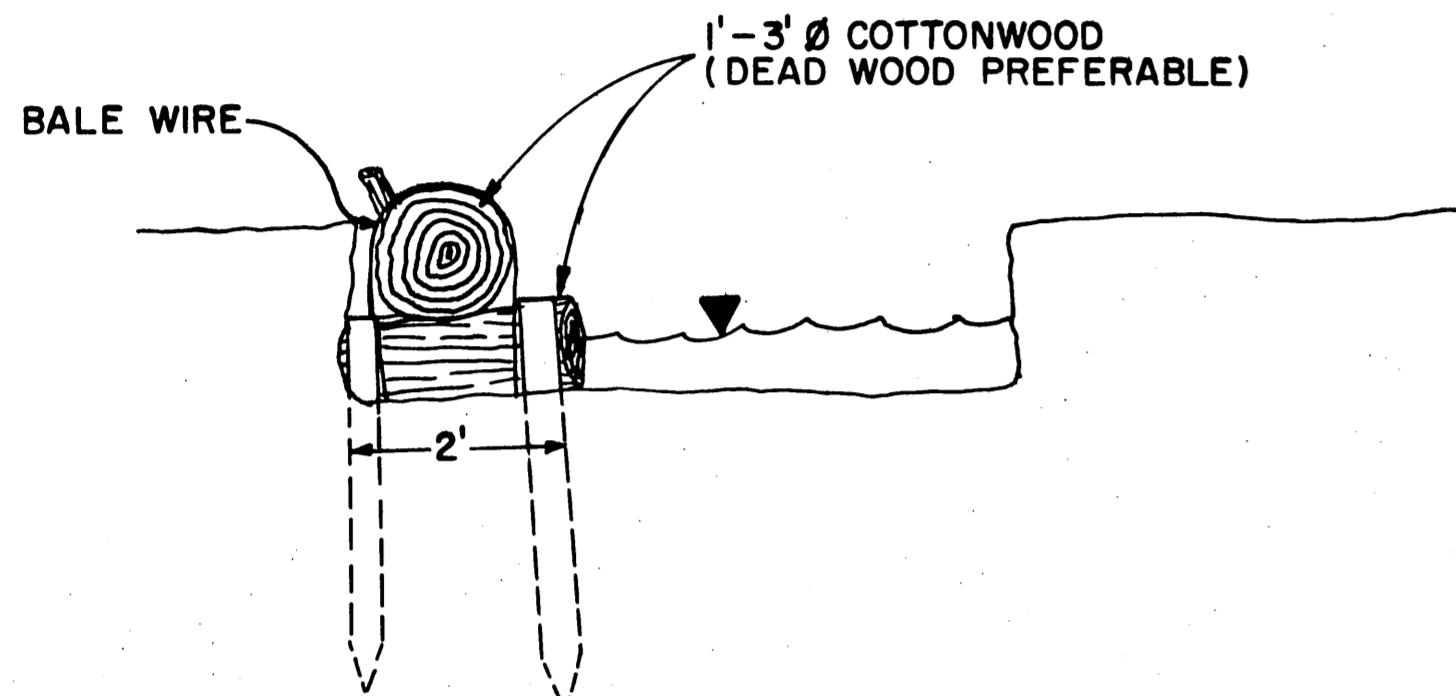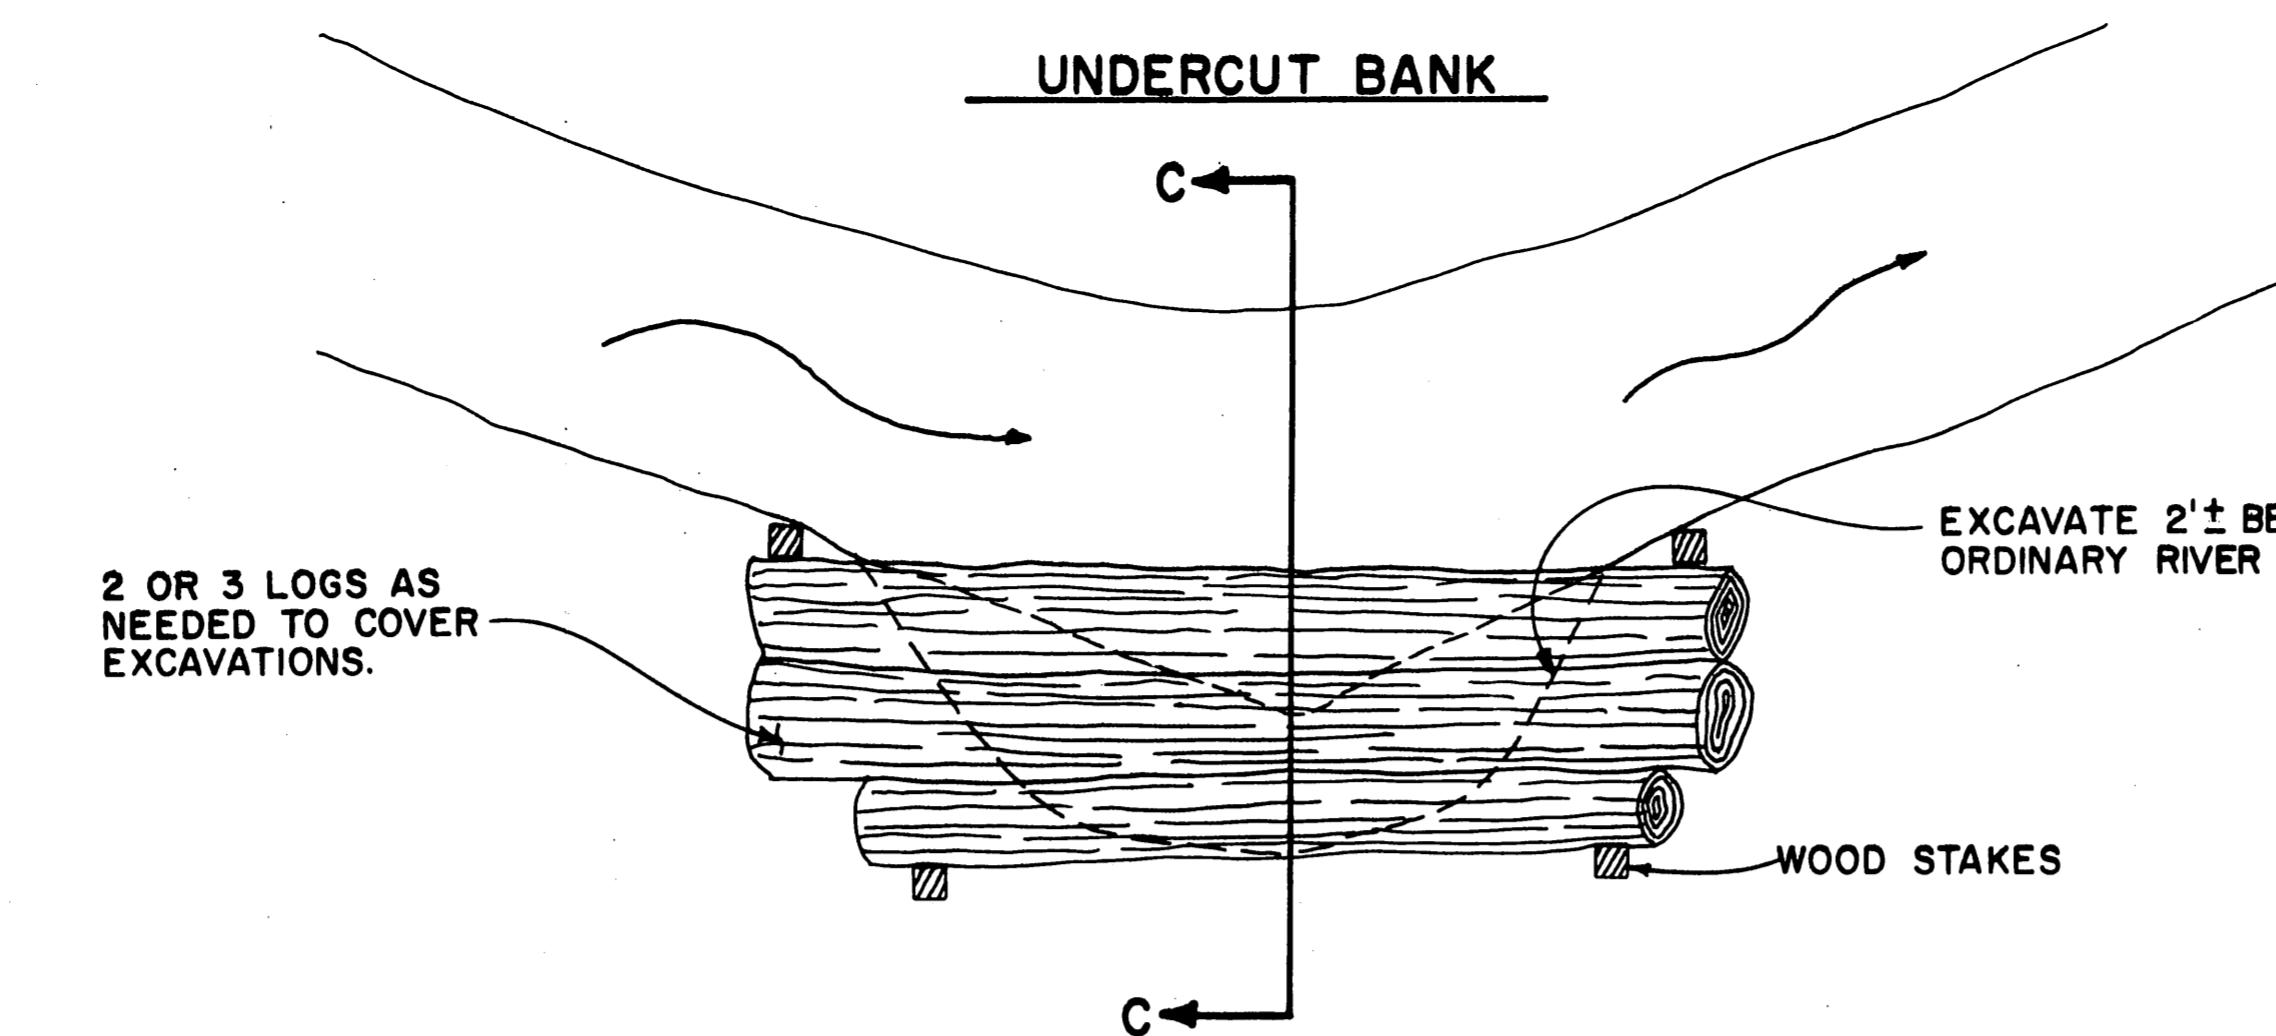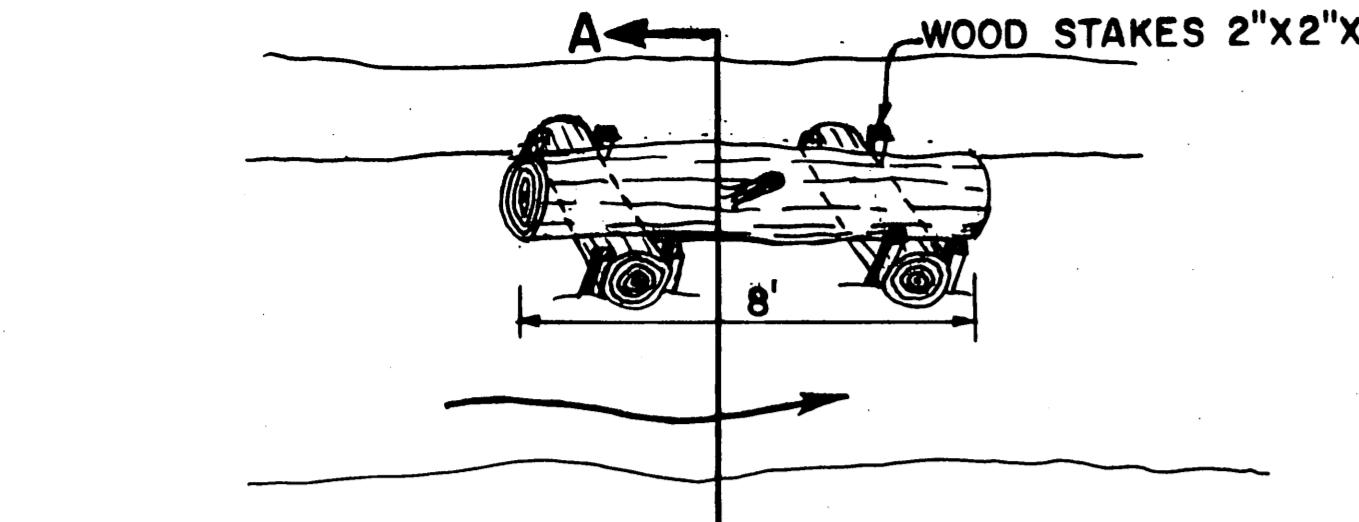



INSTALL EVERY 50' ON ALTERNATE SIDES OF CREEK.

SECTION A-A

INSTALL AT EACH ANGLE POINT ON CREEK.

SECTION C-C


OVERHANGING LOGS

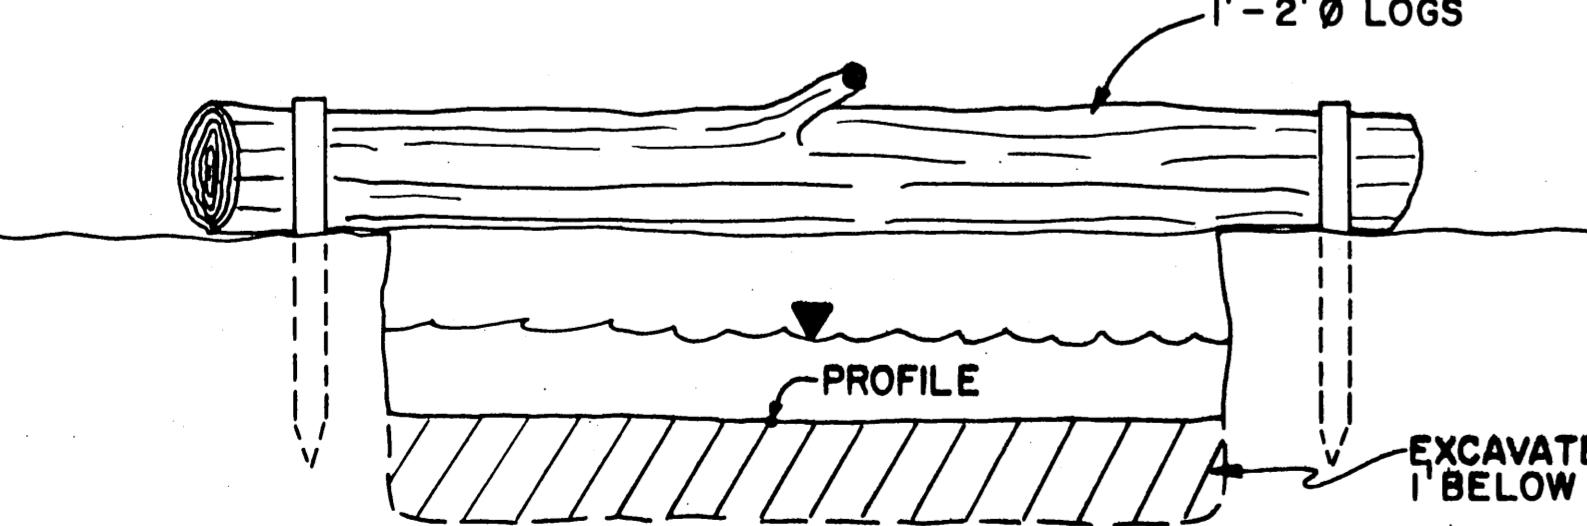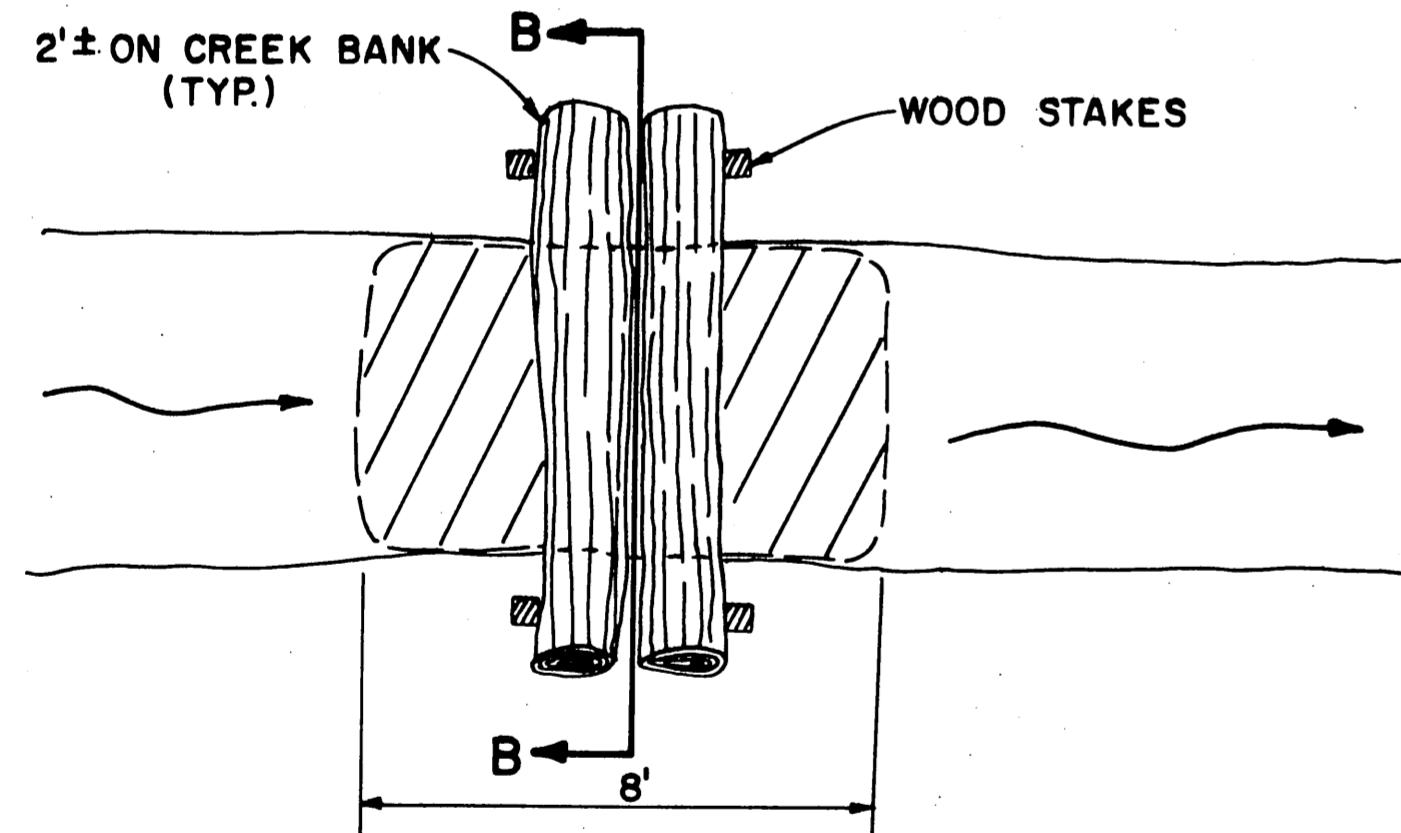

INSTALL EVERY 200' ON CREEK, BETWEEN LARGE WOODY DEBRIS.

SECTION B-B

POND ENHANCEMENT (TYPICAL)

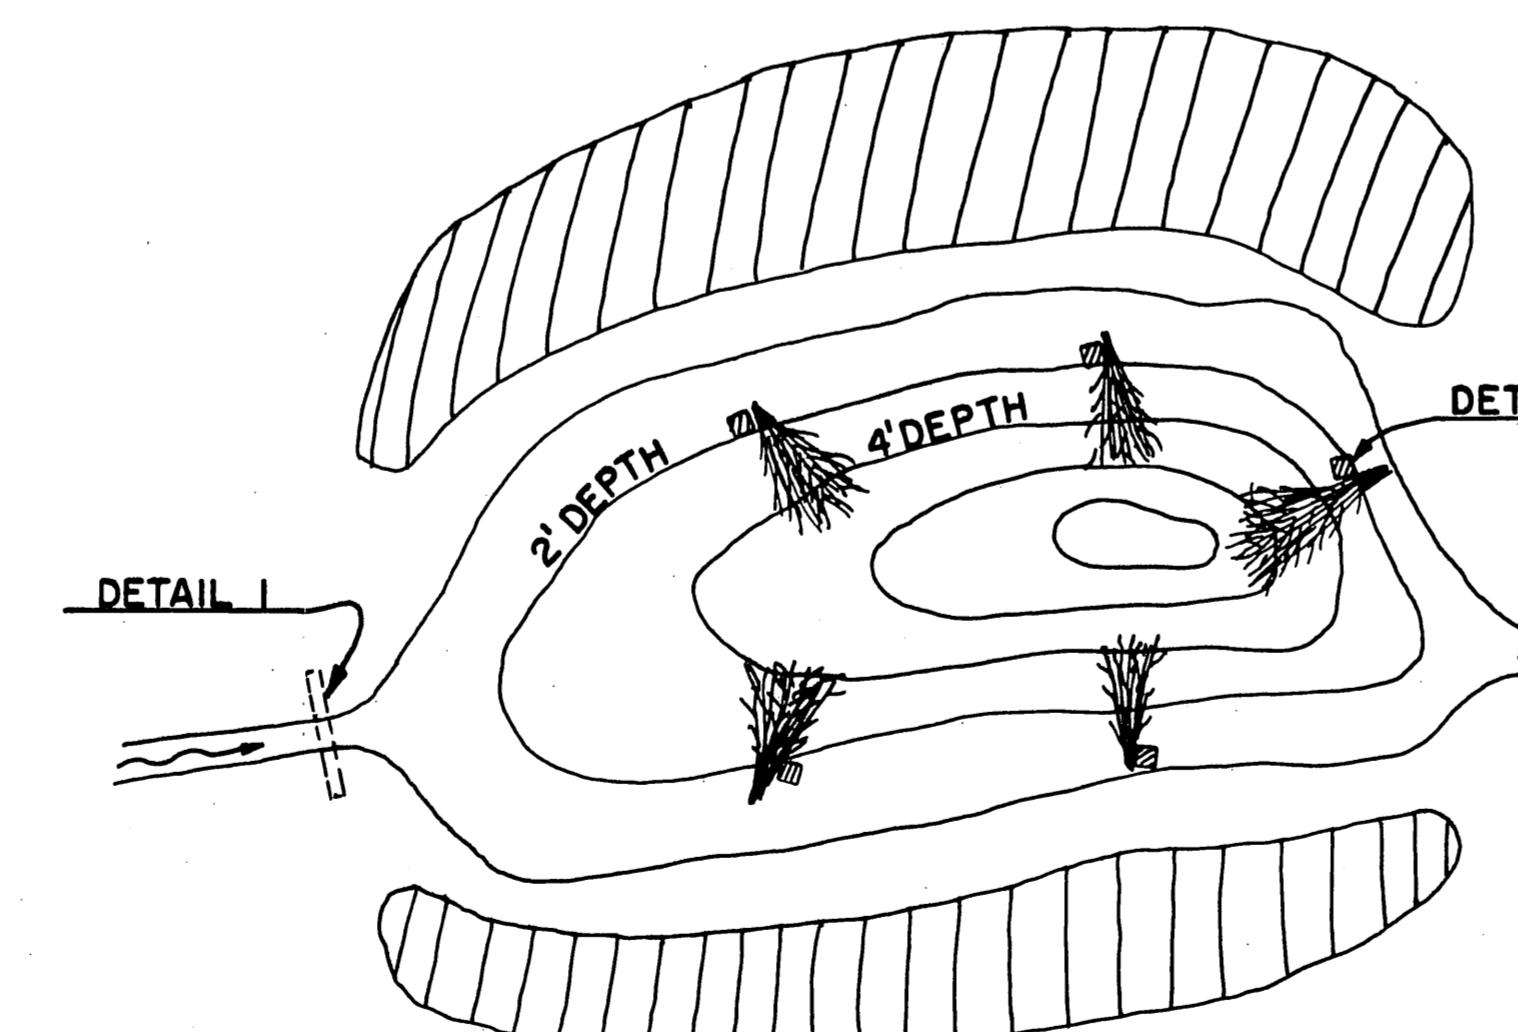

NOTES:


1. THE LARGE WOODY DEBRIS, UNDERCUT BANK, OVERHANG LOGS, AND EROSION BARRIER DETAILS SHALL BE USED ON ALL CREEK & DITCH RELOCATIONS / NEW CONSTRUCTIONS.
2. TEMPORARY COVER SHALL BE USED ON ALL FISHERY POND LOCATIONS.


RECORD OF REVISIONS		
BY	DATE	DESCRIPTION OF CHANGE

STATE OF ALASKA
DEPARTMENT OF TRANSPORTATION
& PUBLIC FACILITIES
SOUTHEAST REGION DESIGN & CONSTRUCTION

HAINES AIRPORT
YINDASTUKI CREEK ENHANCEMENT

APPROVED BY: DESIGN GROUP CHIEF _____ DATE _____	DESIGNED BY: T.M. _____	SCALE: NONE
RECOMMENDED BY: DESIGN ENGINEER, GROUP " " _____ DATE _____	DRAWN BY: B.A. _____	DATE: _____
PREPARED BY: PROJECT MANAGER _____	CHECKED BY: C.H. _____	SHEET 32 OF 39

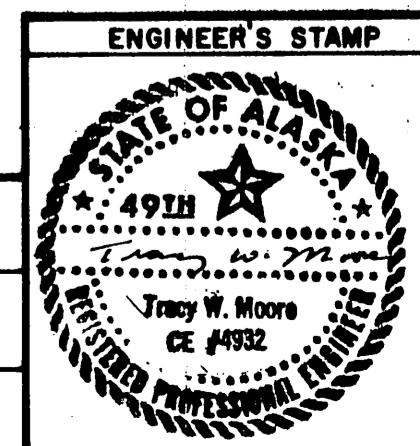

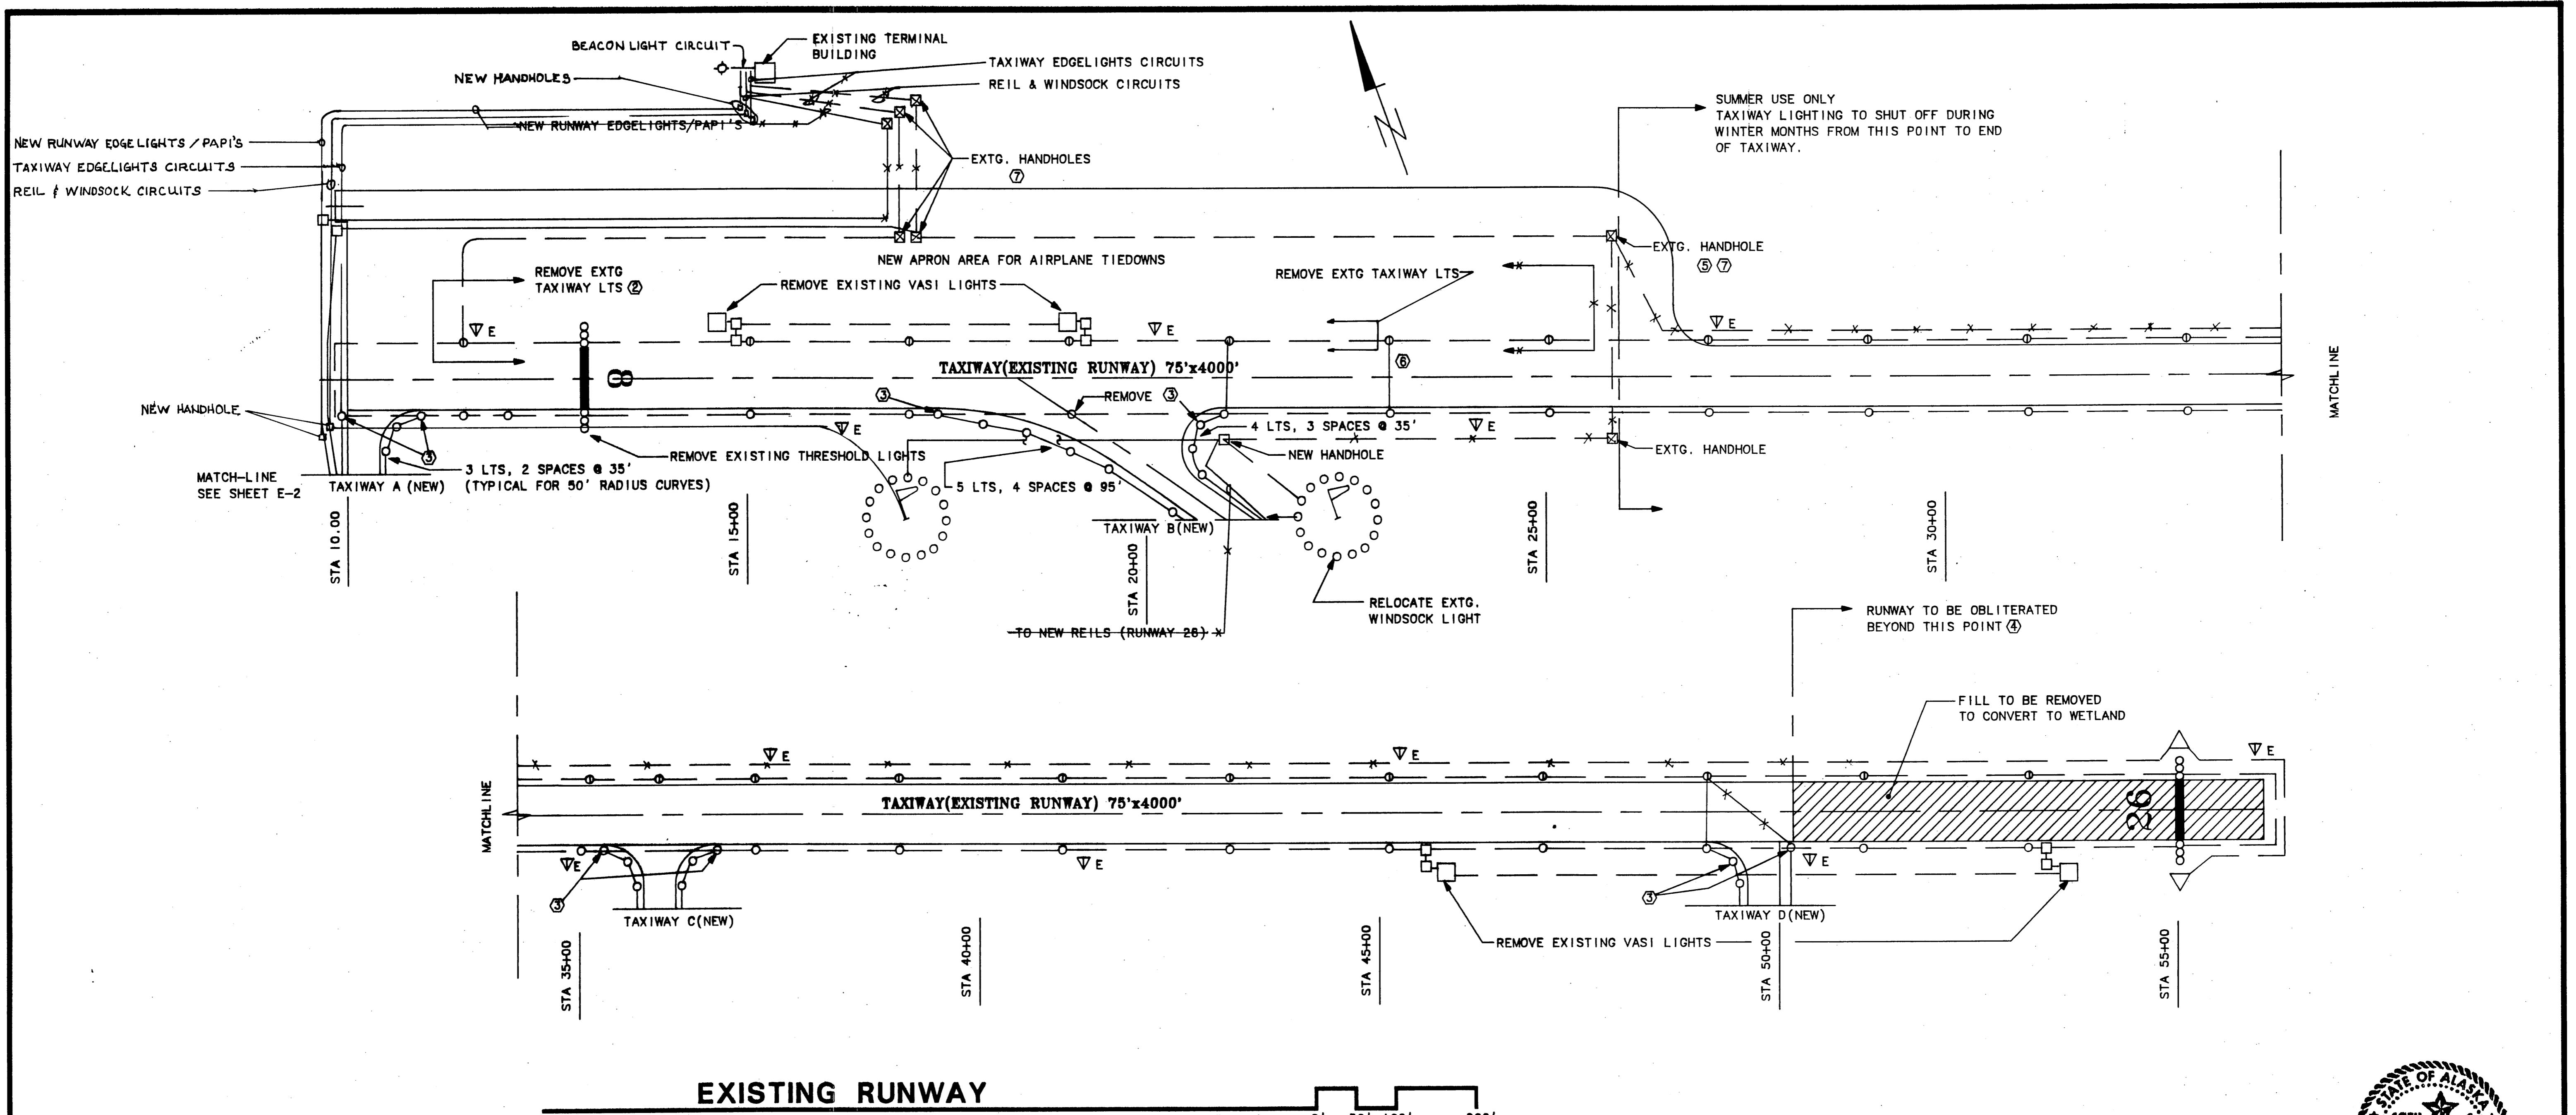



LEGEND

- EXISTING CONDUIT WITH EXISTING RUNWAY EDGE LIGHTS
- NEW CONDUIT WITH TAXIWAY EDGE LIGHT
- NEW CONDUIT WITH RUNWAY EDGE LIGHT
- △○○—○○△ REIL AND RUNWAY THRESHOLD LIGHTS
- ▽ E GROUND ROD (EXISTING)
- ▽ GROUND ROD
- HANDHOLE
- ① LIGHTED TAXIWAY/RUNWAY SIGN IDENTIFICATION NUMBER
- B.C. BARE CONDUCTOR

NOTES

- ① EXISTING RUNWAY IS TO BECOME TAXIWAY FOR NEW RUNWAY. REPLACE EXISTING RUNWAY EDGE LIGHT LENSES WITH BLUE LENSES MARKING NEW TAXIWAY.
- ② REMOVE EXISTING TAXIWAY LIGHTS IN NEW APRON AREA. USE EXISTING LIGHT BASES AS HANDHOLES. PROVIDE NEW STEEL COVER PLATES. REPLACE EXTG TAXIWAY LIGHTING CABLE FROM CONSTANT CURRENT REGULATOR TO FIRST TAXIWAY LIGHT BEYOND APRON AREA.
- ③ NEW TAXIWAY LIGHTS TO MARK RAMP TO NEW RUNWAY. INTERCEPT EXISTING CONDUIT FOR POWER.
- ④ REMOVE EXISTING RUNWAY, REIL, THRESHOLD AND VASI LIGHTS (INCLUDING BASES) MARKING EXISTING RUNWAY TO BE OBLITERATED AND TURN OVER TO DOT MAINTENANCE PERSONNEL.
- ⑤ SPLICING INTO EXISTING REIL LIGHTS WIRING AT EXISTING HANDHOLE TO POWER NEW REIL LIGHTS. ROUTE NEW WIRING THROUGH EXISTING AND NEW CONDUITS AS SHOWN.
- ⑥ CROSS EXISTING RUNWAY WITH NEW CONDUIT FOR CIRCUIT SELECTOR SWITCH WIRING. SEE WIRING DETAIL SHEET E-3.
- ⑦ GRADE TO BE RAISED +/- 1 FT. ADJUST EXTG HANDHOLES TO MEET FINISHED GRADE.
- ⑧ COBBLES AND BOULDERS ARE KNOWN TO EXIST IN THE EXISTING EMBANKMENT AREAS.

REV	DATE	ACTION	DESCRIPTION	BY APVD
E-1				
B.C. Height Consulting Engineers 430 Fourth Street, Juneau, Alaska, (907) 586-8788				
State of Alaska, DOT/PF Haines Airport Runway Lighting Haines, Alaska				
EXISTING RUNWAY PLAN				
PROJECT NUMBER			Scale: AS NOTED	Sheet No
69523			Date: APRIL 80	
Drawn.	PEL	Dsgn.	TSM	Apvd.
				BCH
33 of 39				

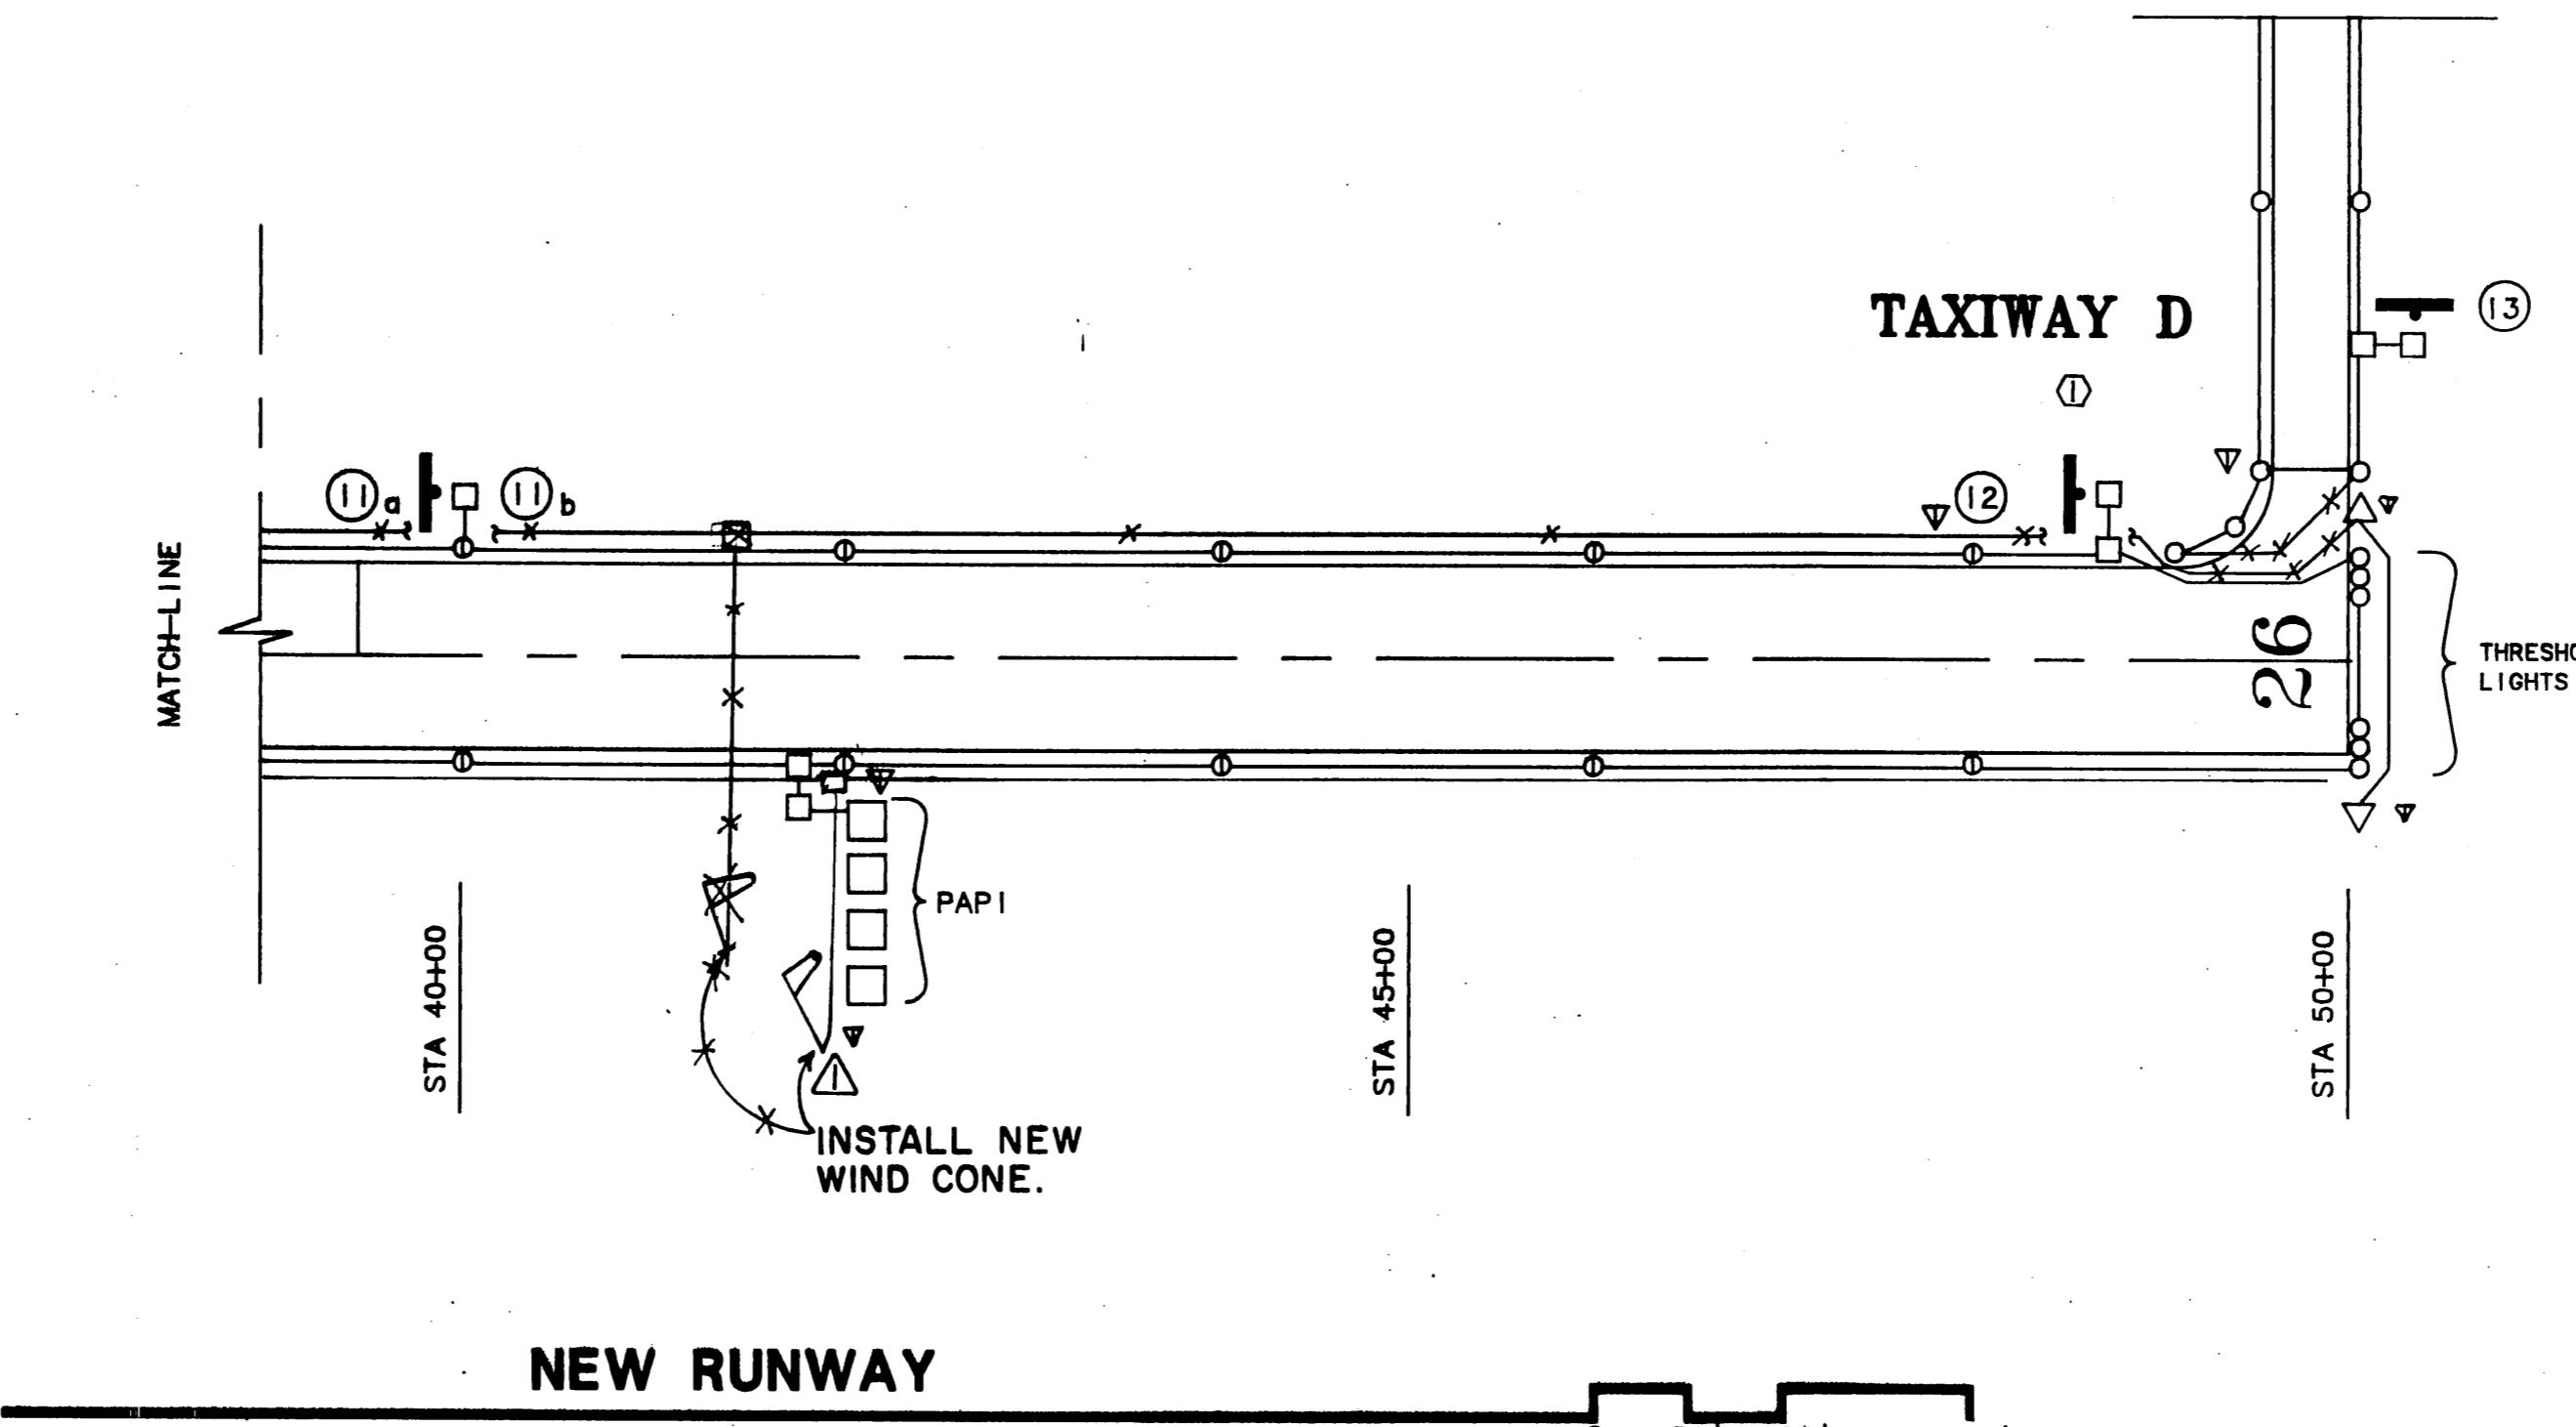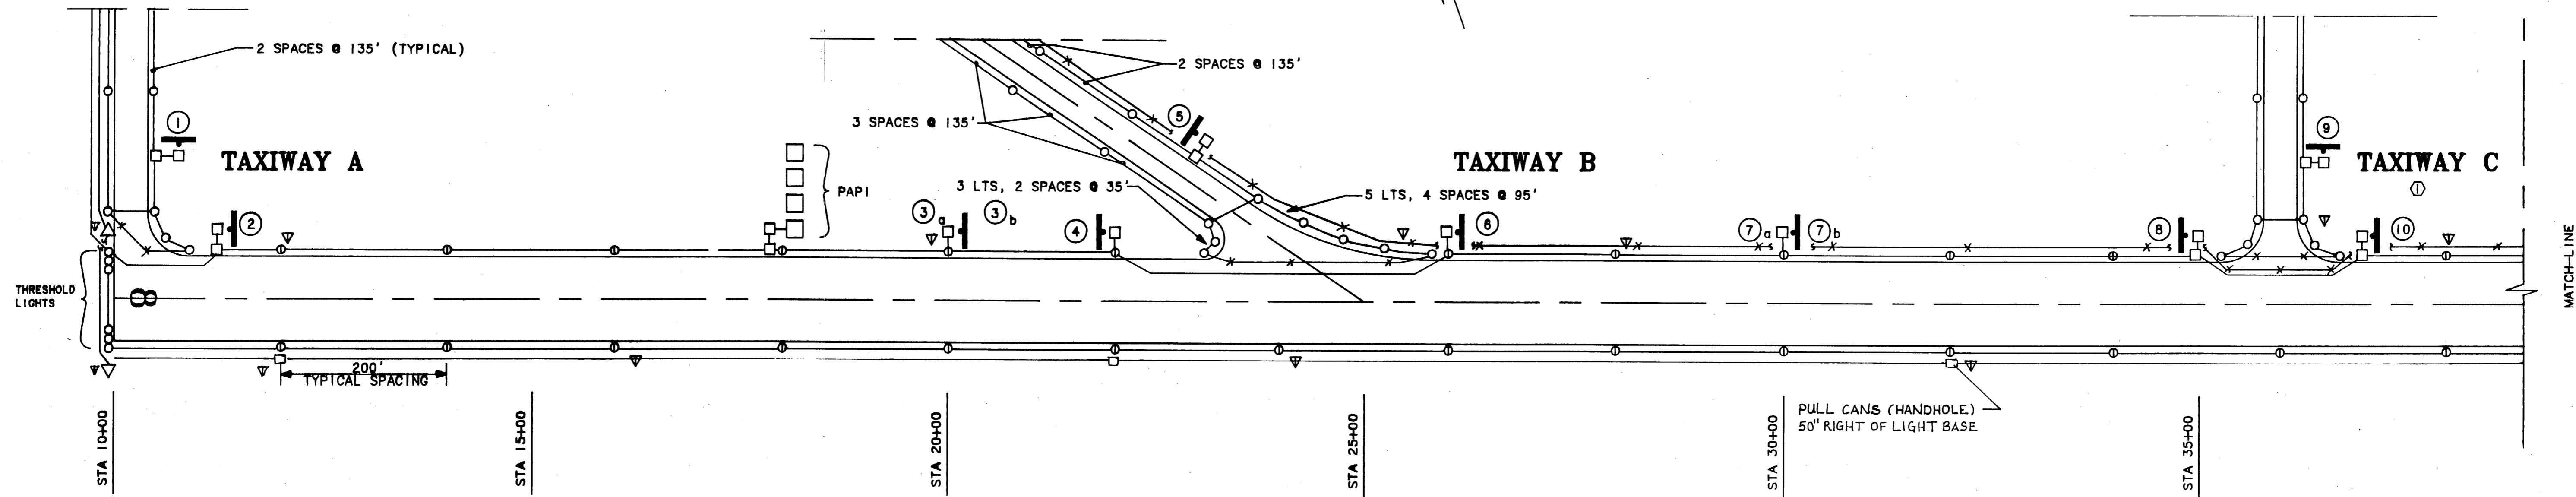


NOTES

① RAMPS C AND D ARE TO BE USED DURING SUMMER MONTHS ONLY.
TAXIWAY LIGHTS FROM RAMP B EAST SHALL BE SHUT OFF BY
THE CIRCUIT SELECTOR SWITCH DURING THE WINTER MONTHS.

State of Alaska, DOT/PF
Haines Airport Runway Lighting
Haines, Alaska


NEW RUNWAY PLAN

PROJECT NUMBER	Scale: AS NOTED	Sheet No.
69523		
Drwn.	Date: APRIL 90	
TSM	Dsgn.	Apvd.
TSM	TSM	BCH
		SH. 34 OF 39

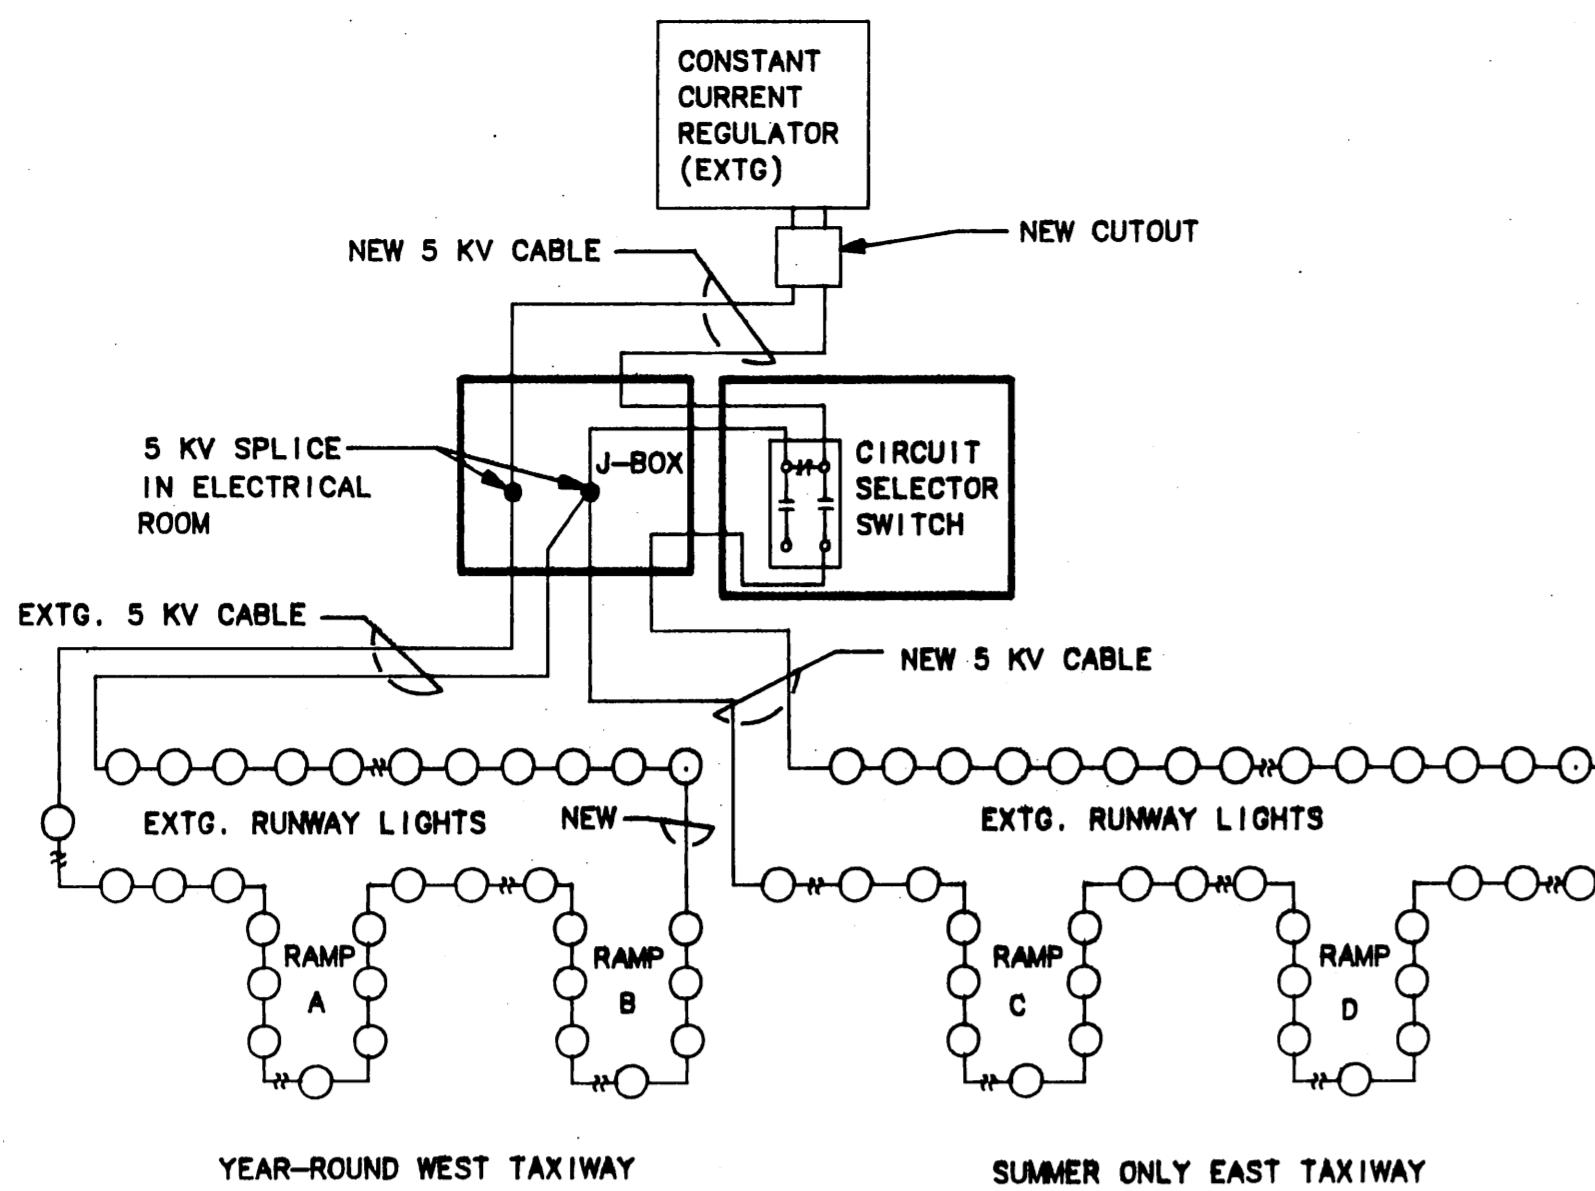


CIRCUIT SELECTOR SWITCH WIRING DETAIL

NO SCALE

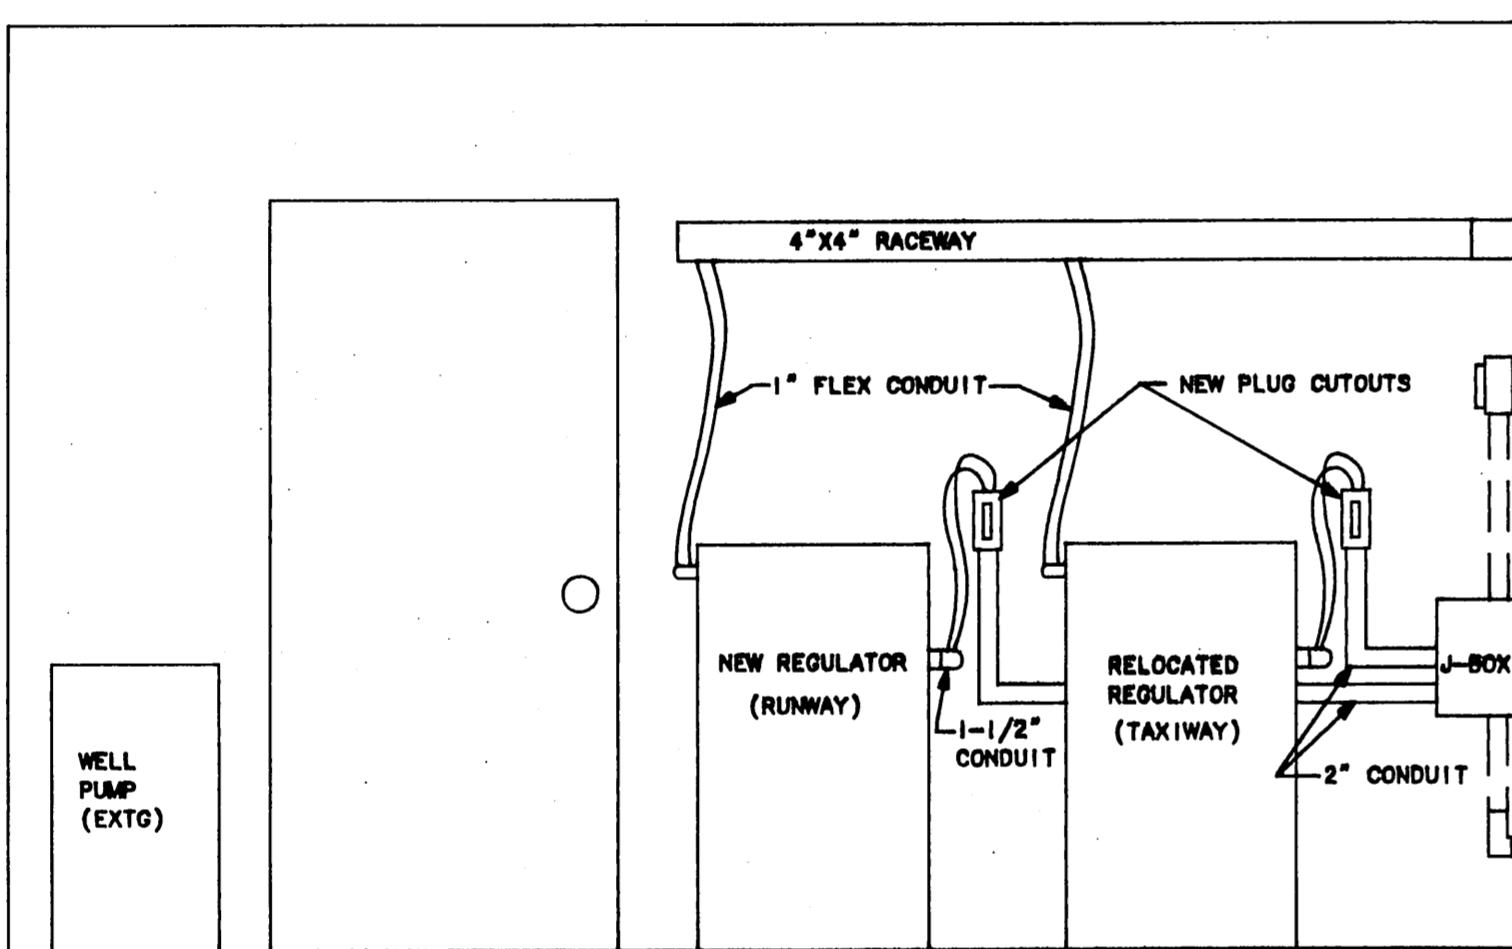


ELECTRICAL ROOM SOUTH ELEVATION

NO SCALE

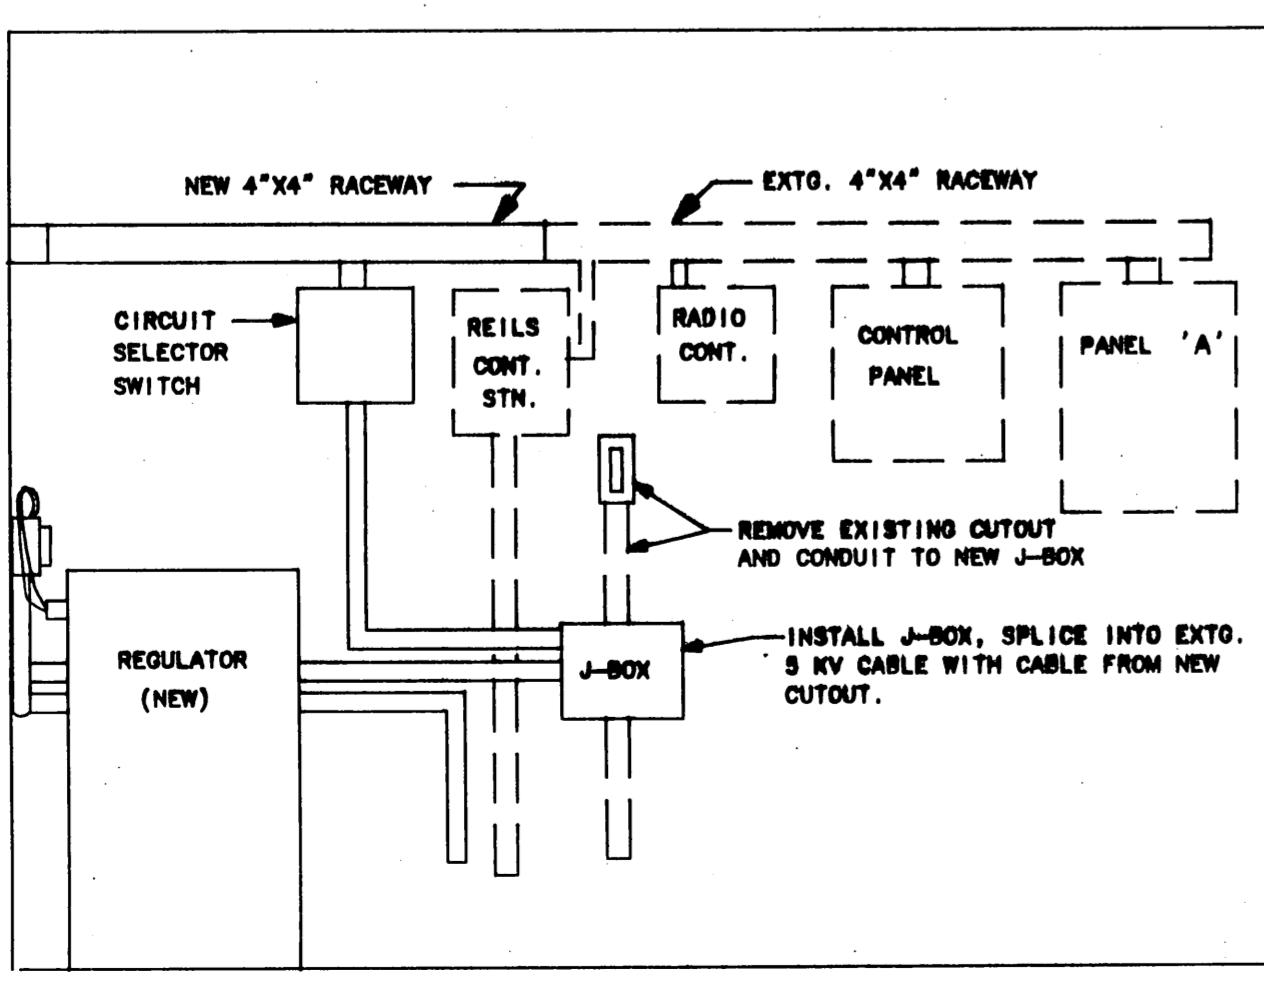

ELECTRICAL ROOM WEST ELEVATION

NO SCALE

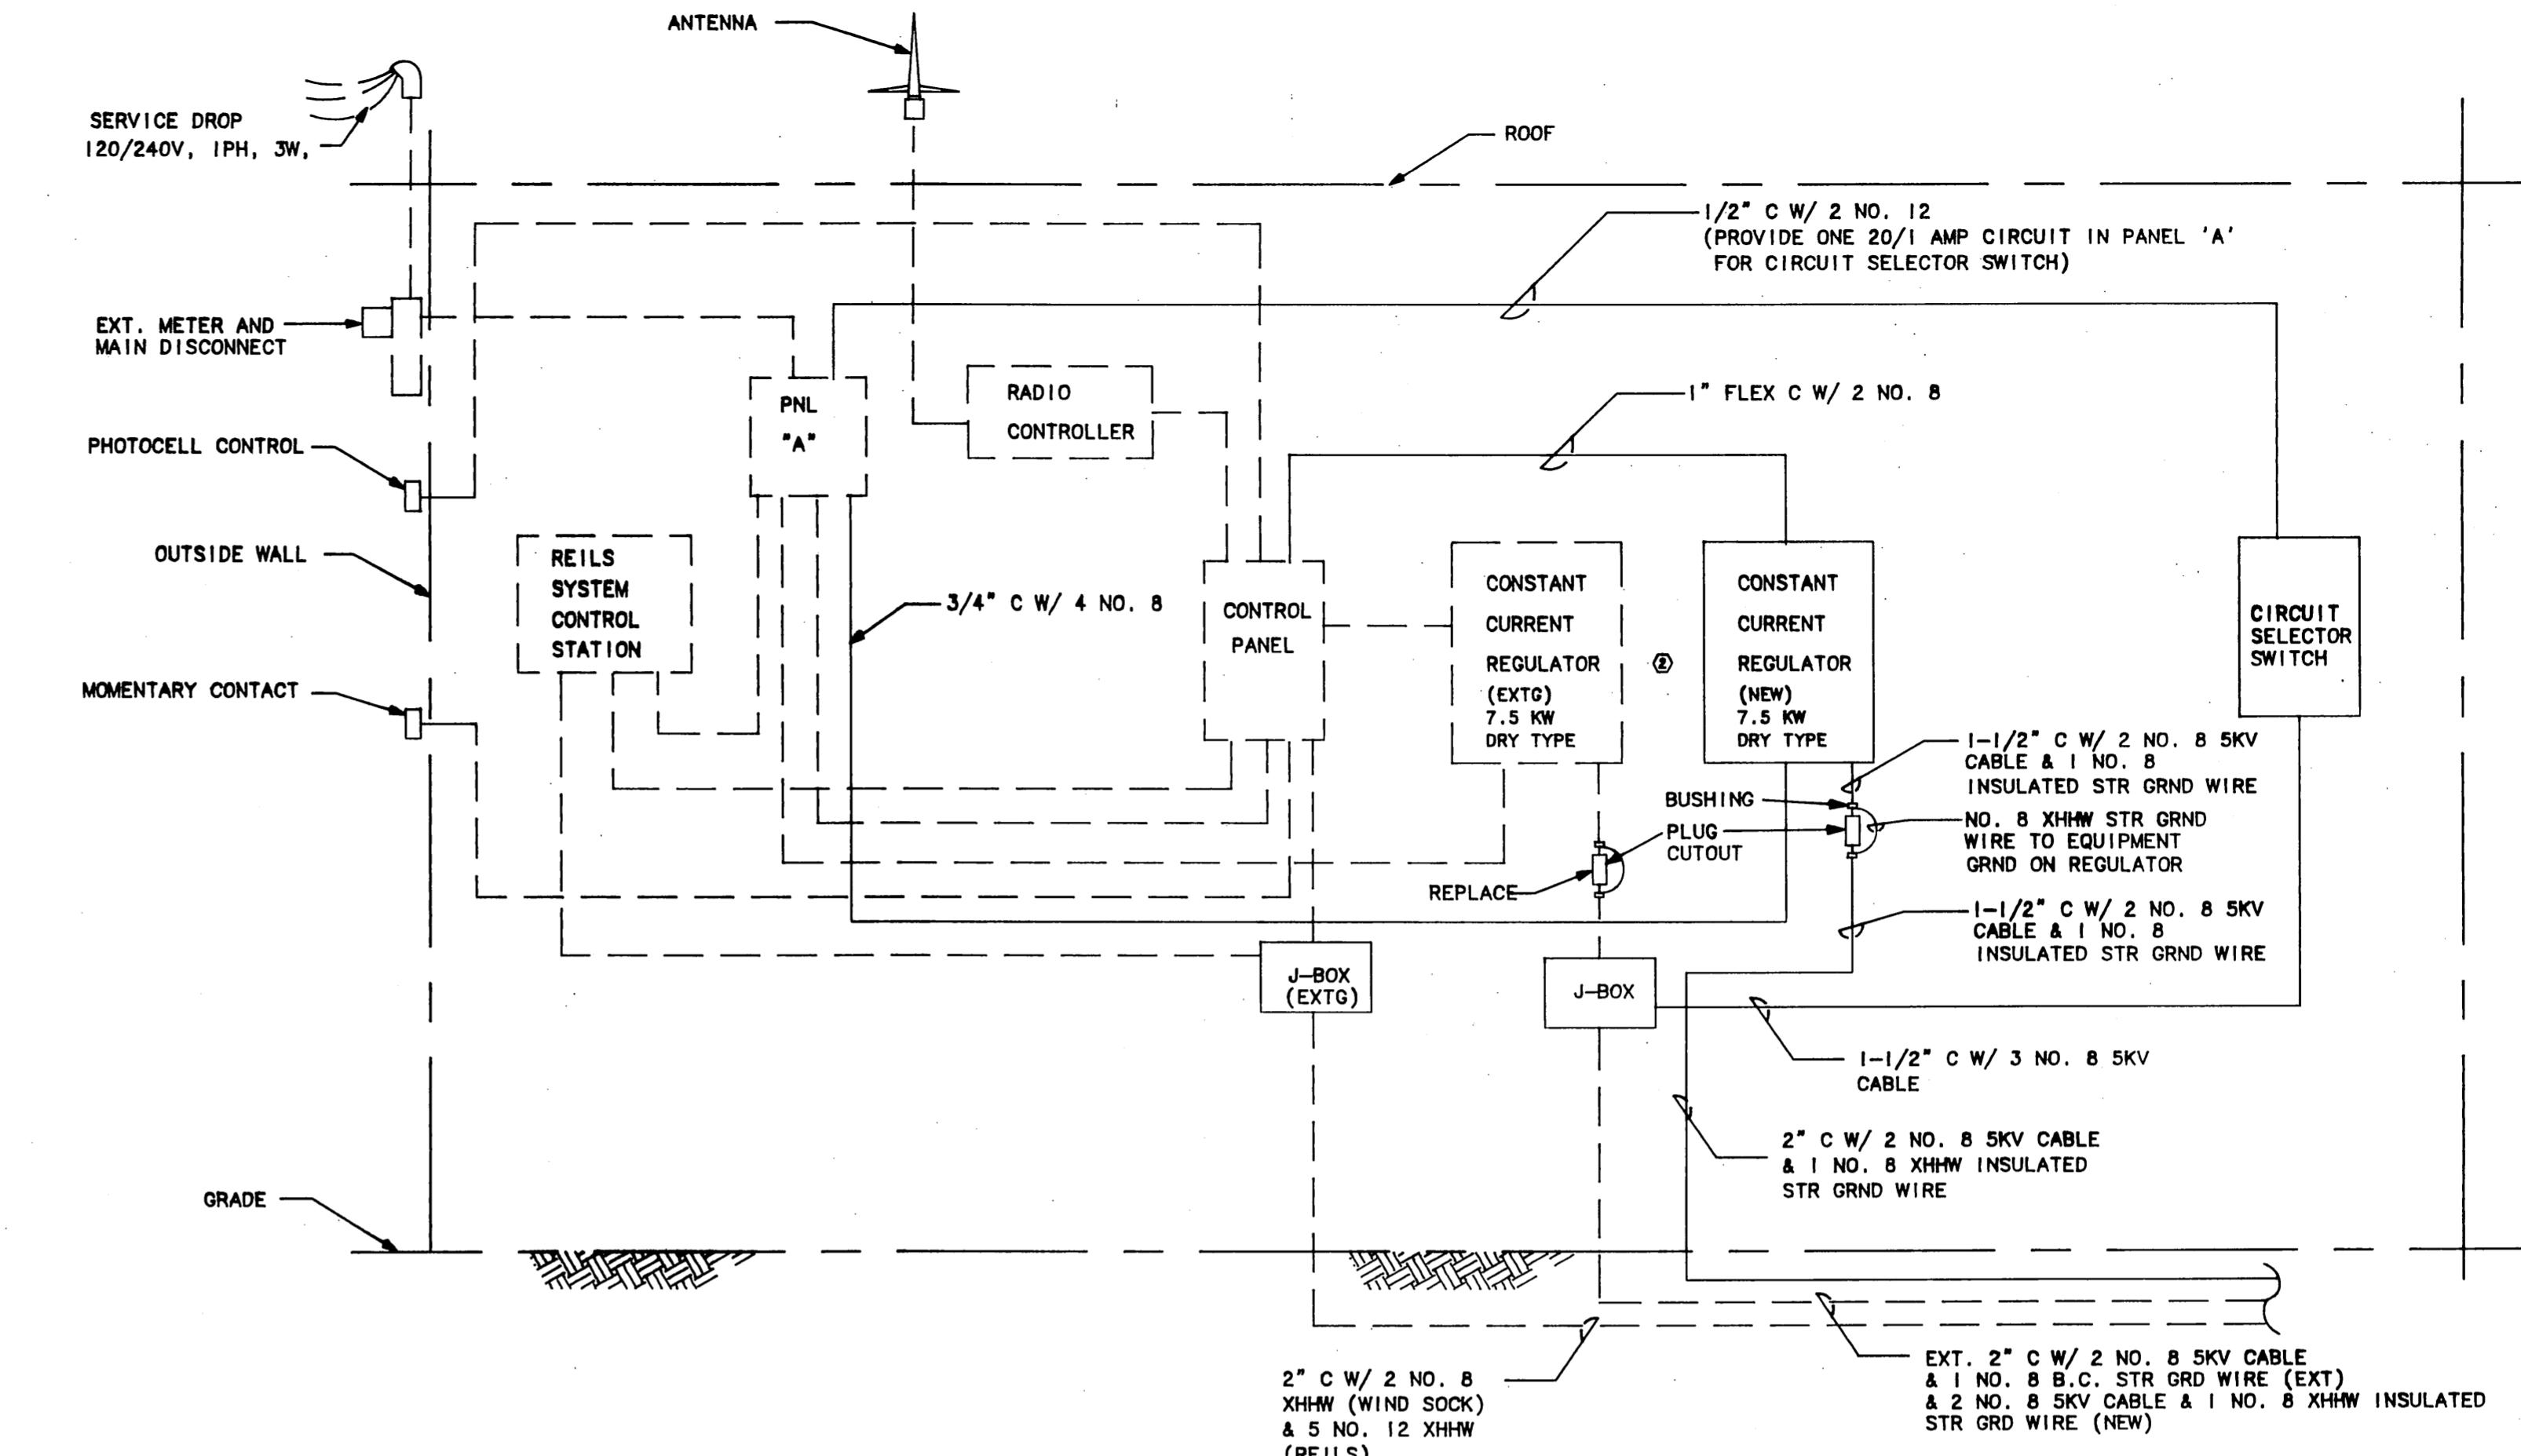


SINGLE LINE DIAGRAM

NO SCALE




NOTES

① DASHED LINE INDICATES EXISTING EQUIPMENT, SOLID LINE INDICATES NEW EQUIPMENT.

② NEW CONSTANT CURRENT REGULATOR SHALL MATCH EXISTING HEAVY DUTY, DRY TYPE, 7.5 KW REGULATOR.

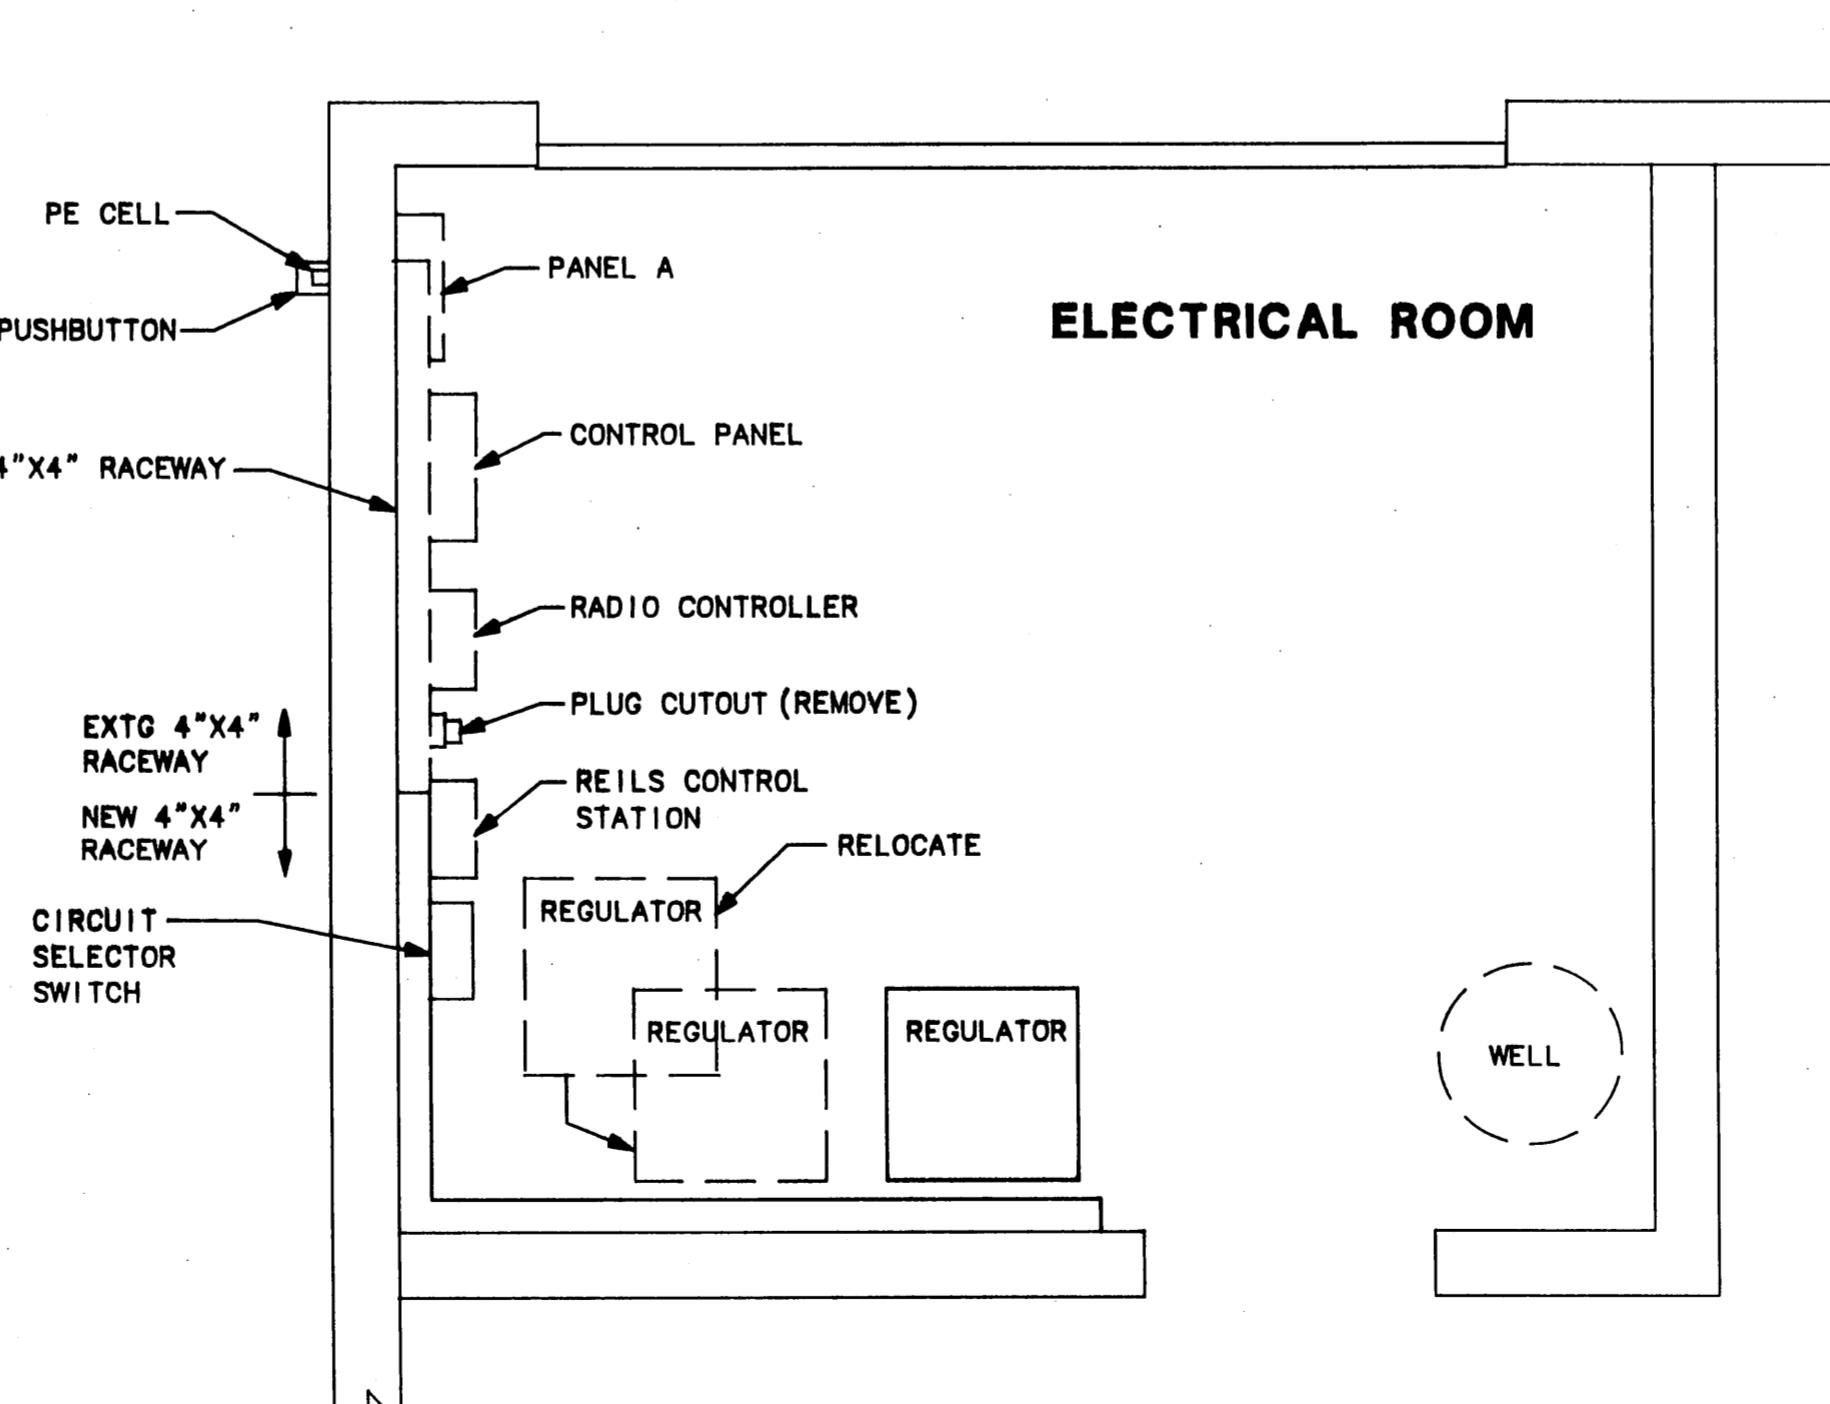

REV	DATE	ACTION	DESCRIPTION	BY APVD
			B.C. Haight Consulting Engineers 430 Fourth Street, Juneau, Alaska, (907) 586-8788	E-3
State of Alaska, DOT/PF Haines Airport Runway Lighting Haines, Alaska				
DETAILS				
PROJECT NUMBER 69523				
Drawn.	TSM	Dsgn.	TSM	Apvd. BCH
Scale: AS NOTED Date: APRIL 80				
SH 35 OF 39				

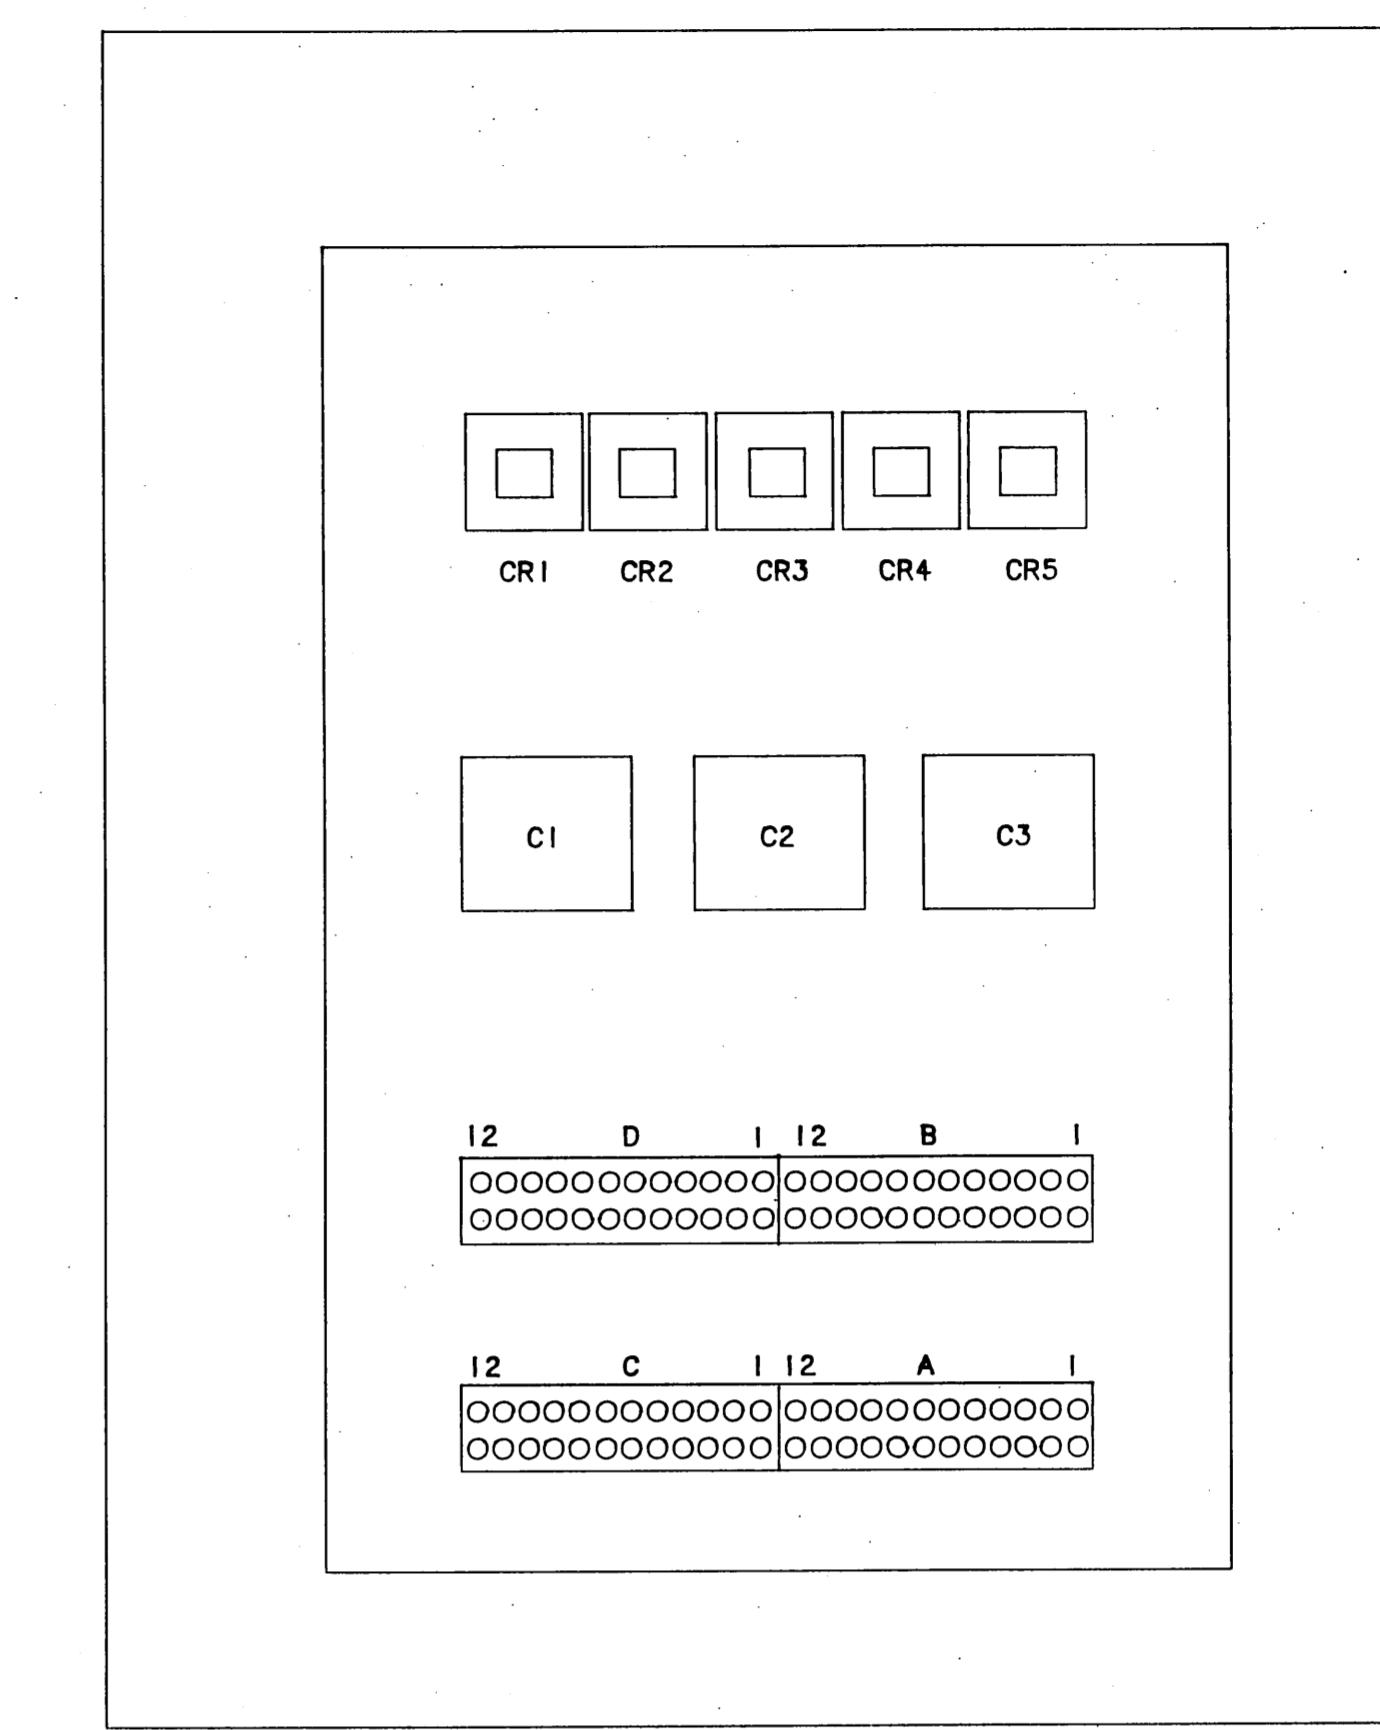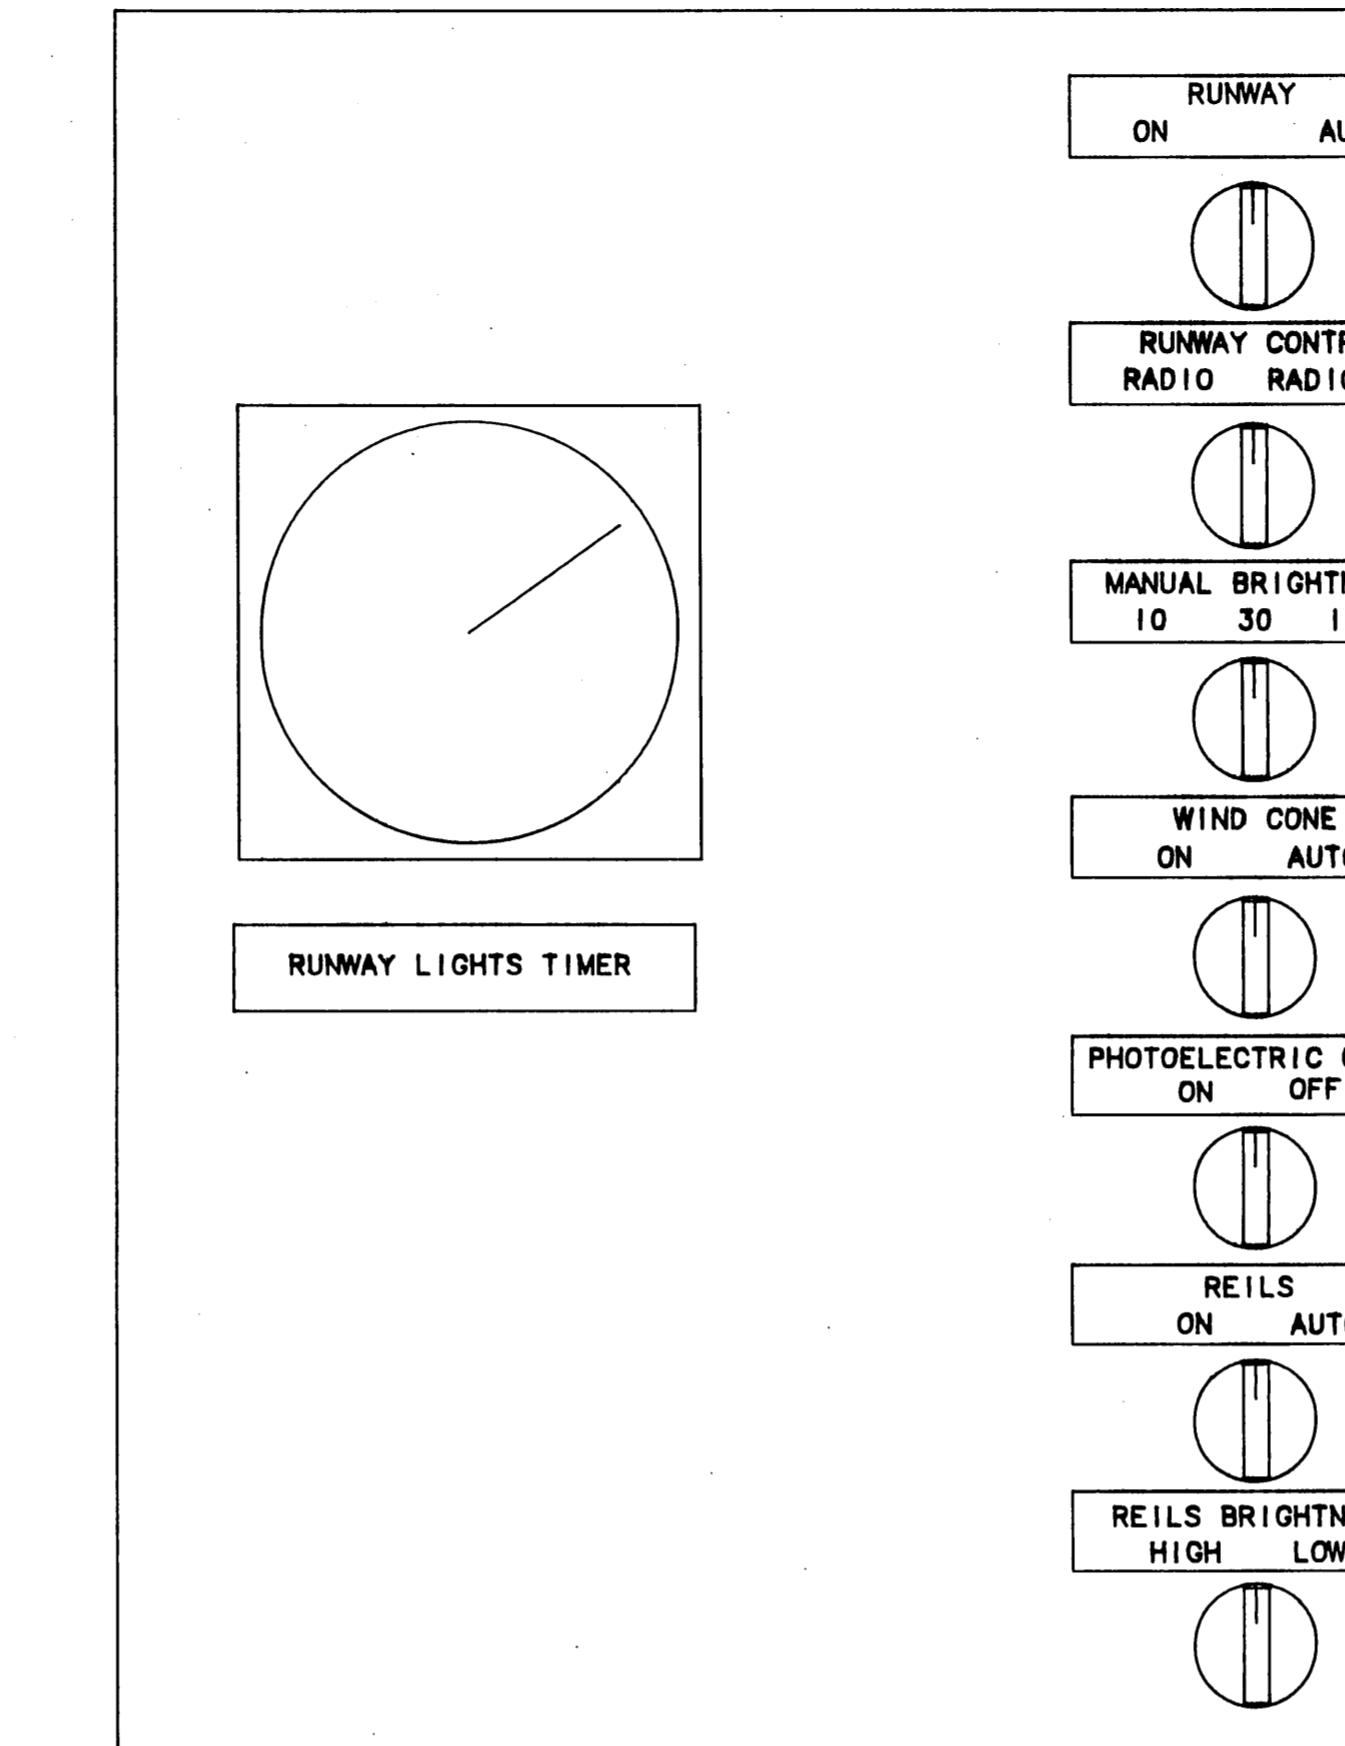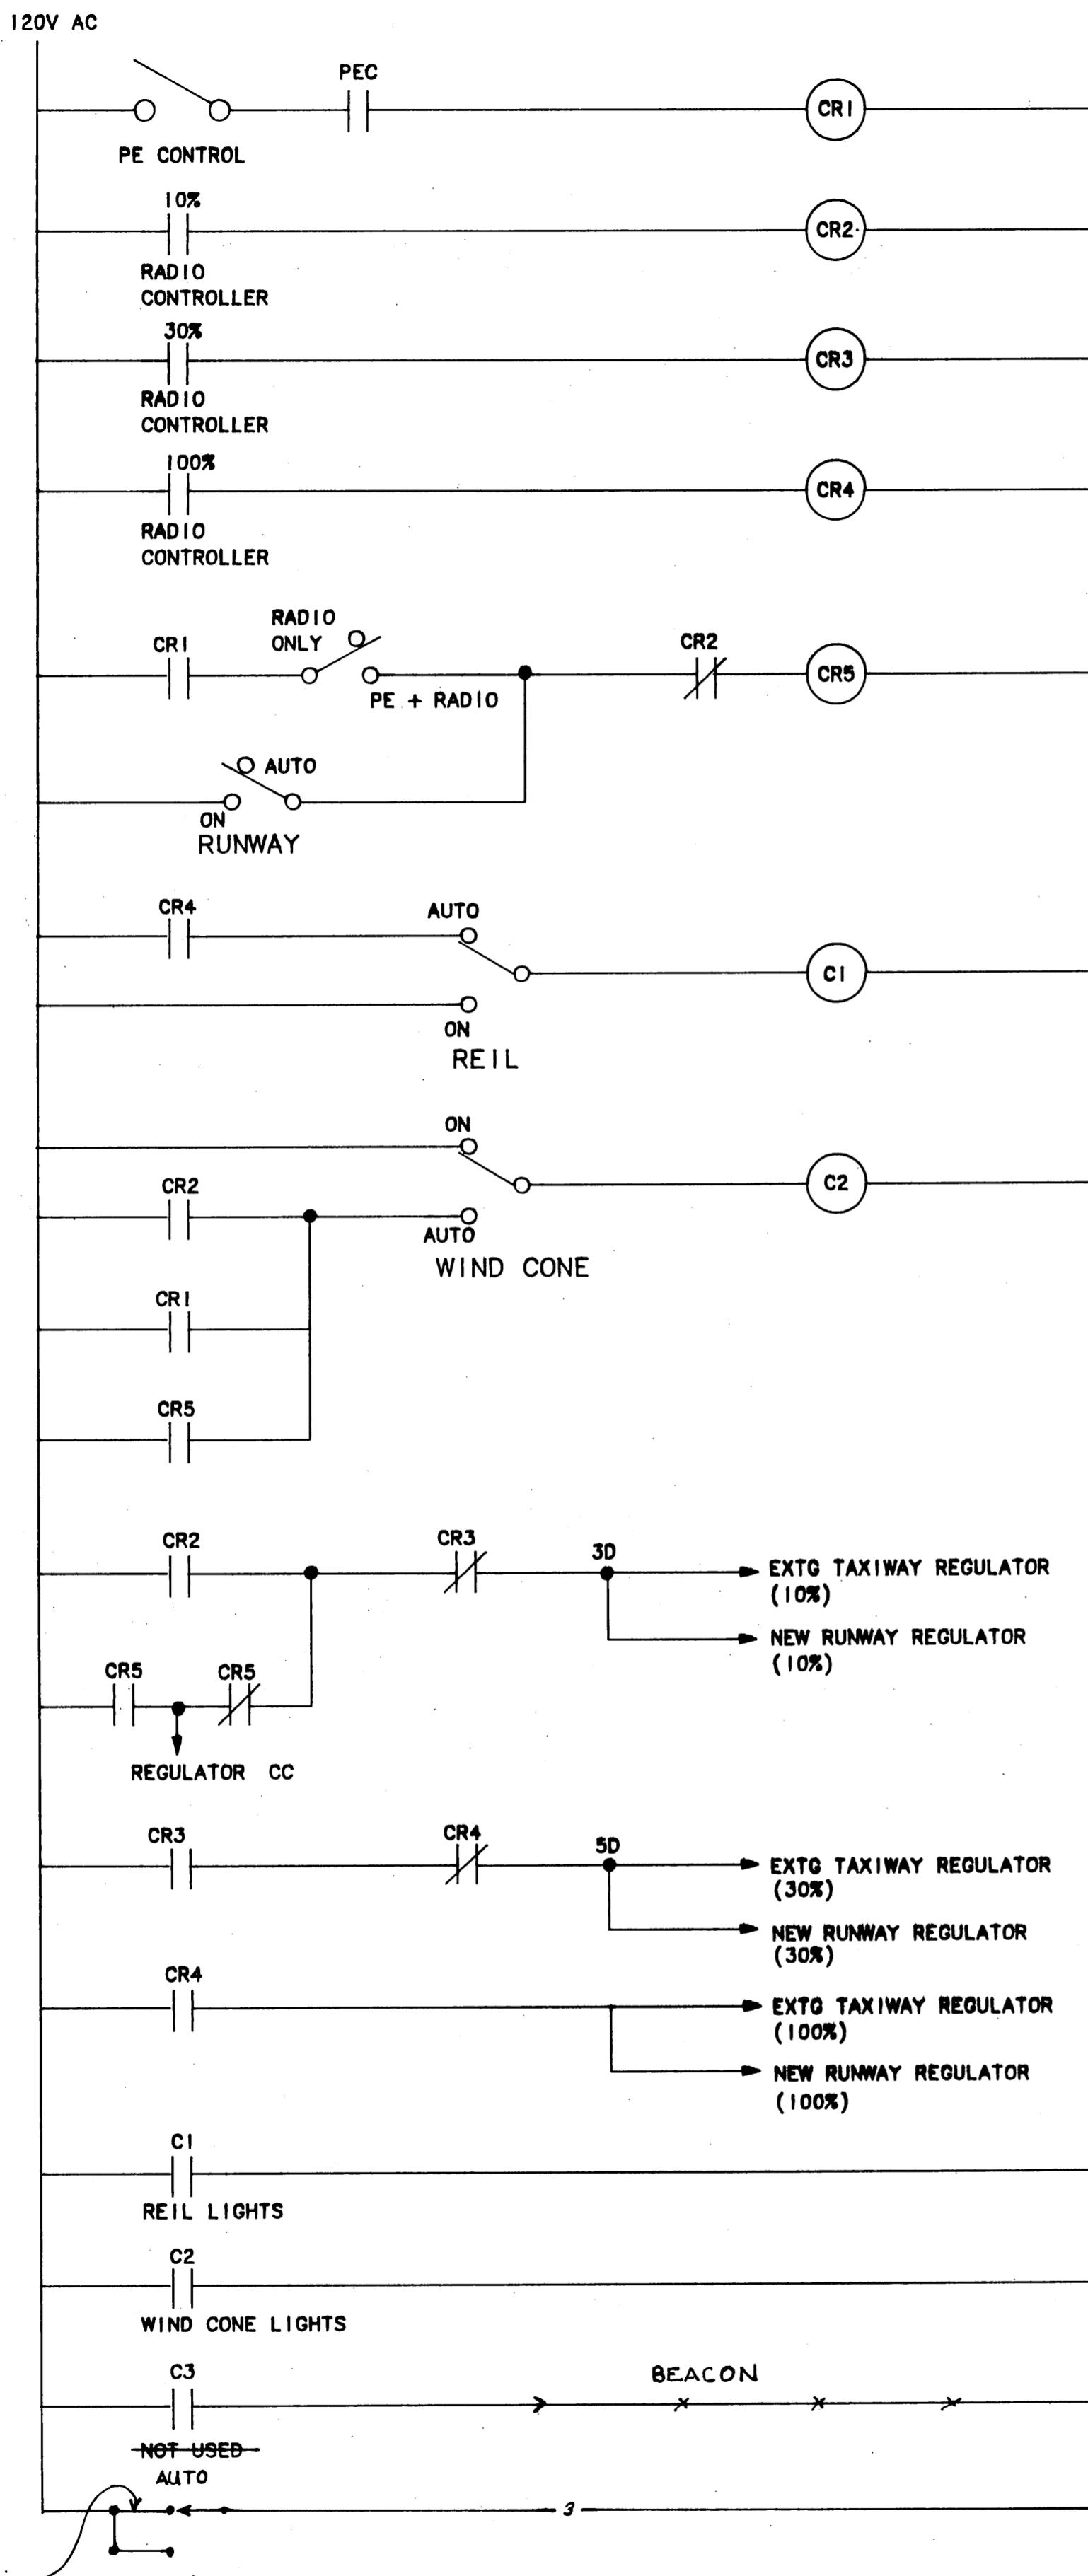


EXISTING AIRPORT LIGHTING CONTROLS

NO SCALE



REV	DATE	ACTION	DESCRIPTION	BY APVD
			B.C. Height Consulting Engineers 430 Fourth Street, Juneau, Alaska, (907) 586-9788	E-4
State of Alaska, DOT/PF Haines Airport Runway Lighting Haines, Alaska				
DETAILS				
PROJECT NUMBER 69523			Scale: AS NOTED	
Date: APRIL 80			Drwn. TSM	Dsgn. TSM
			Apvd. BCH	SH. 36 OF 39

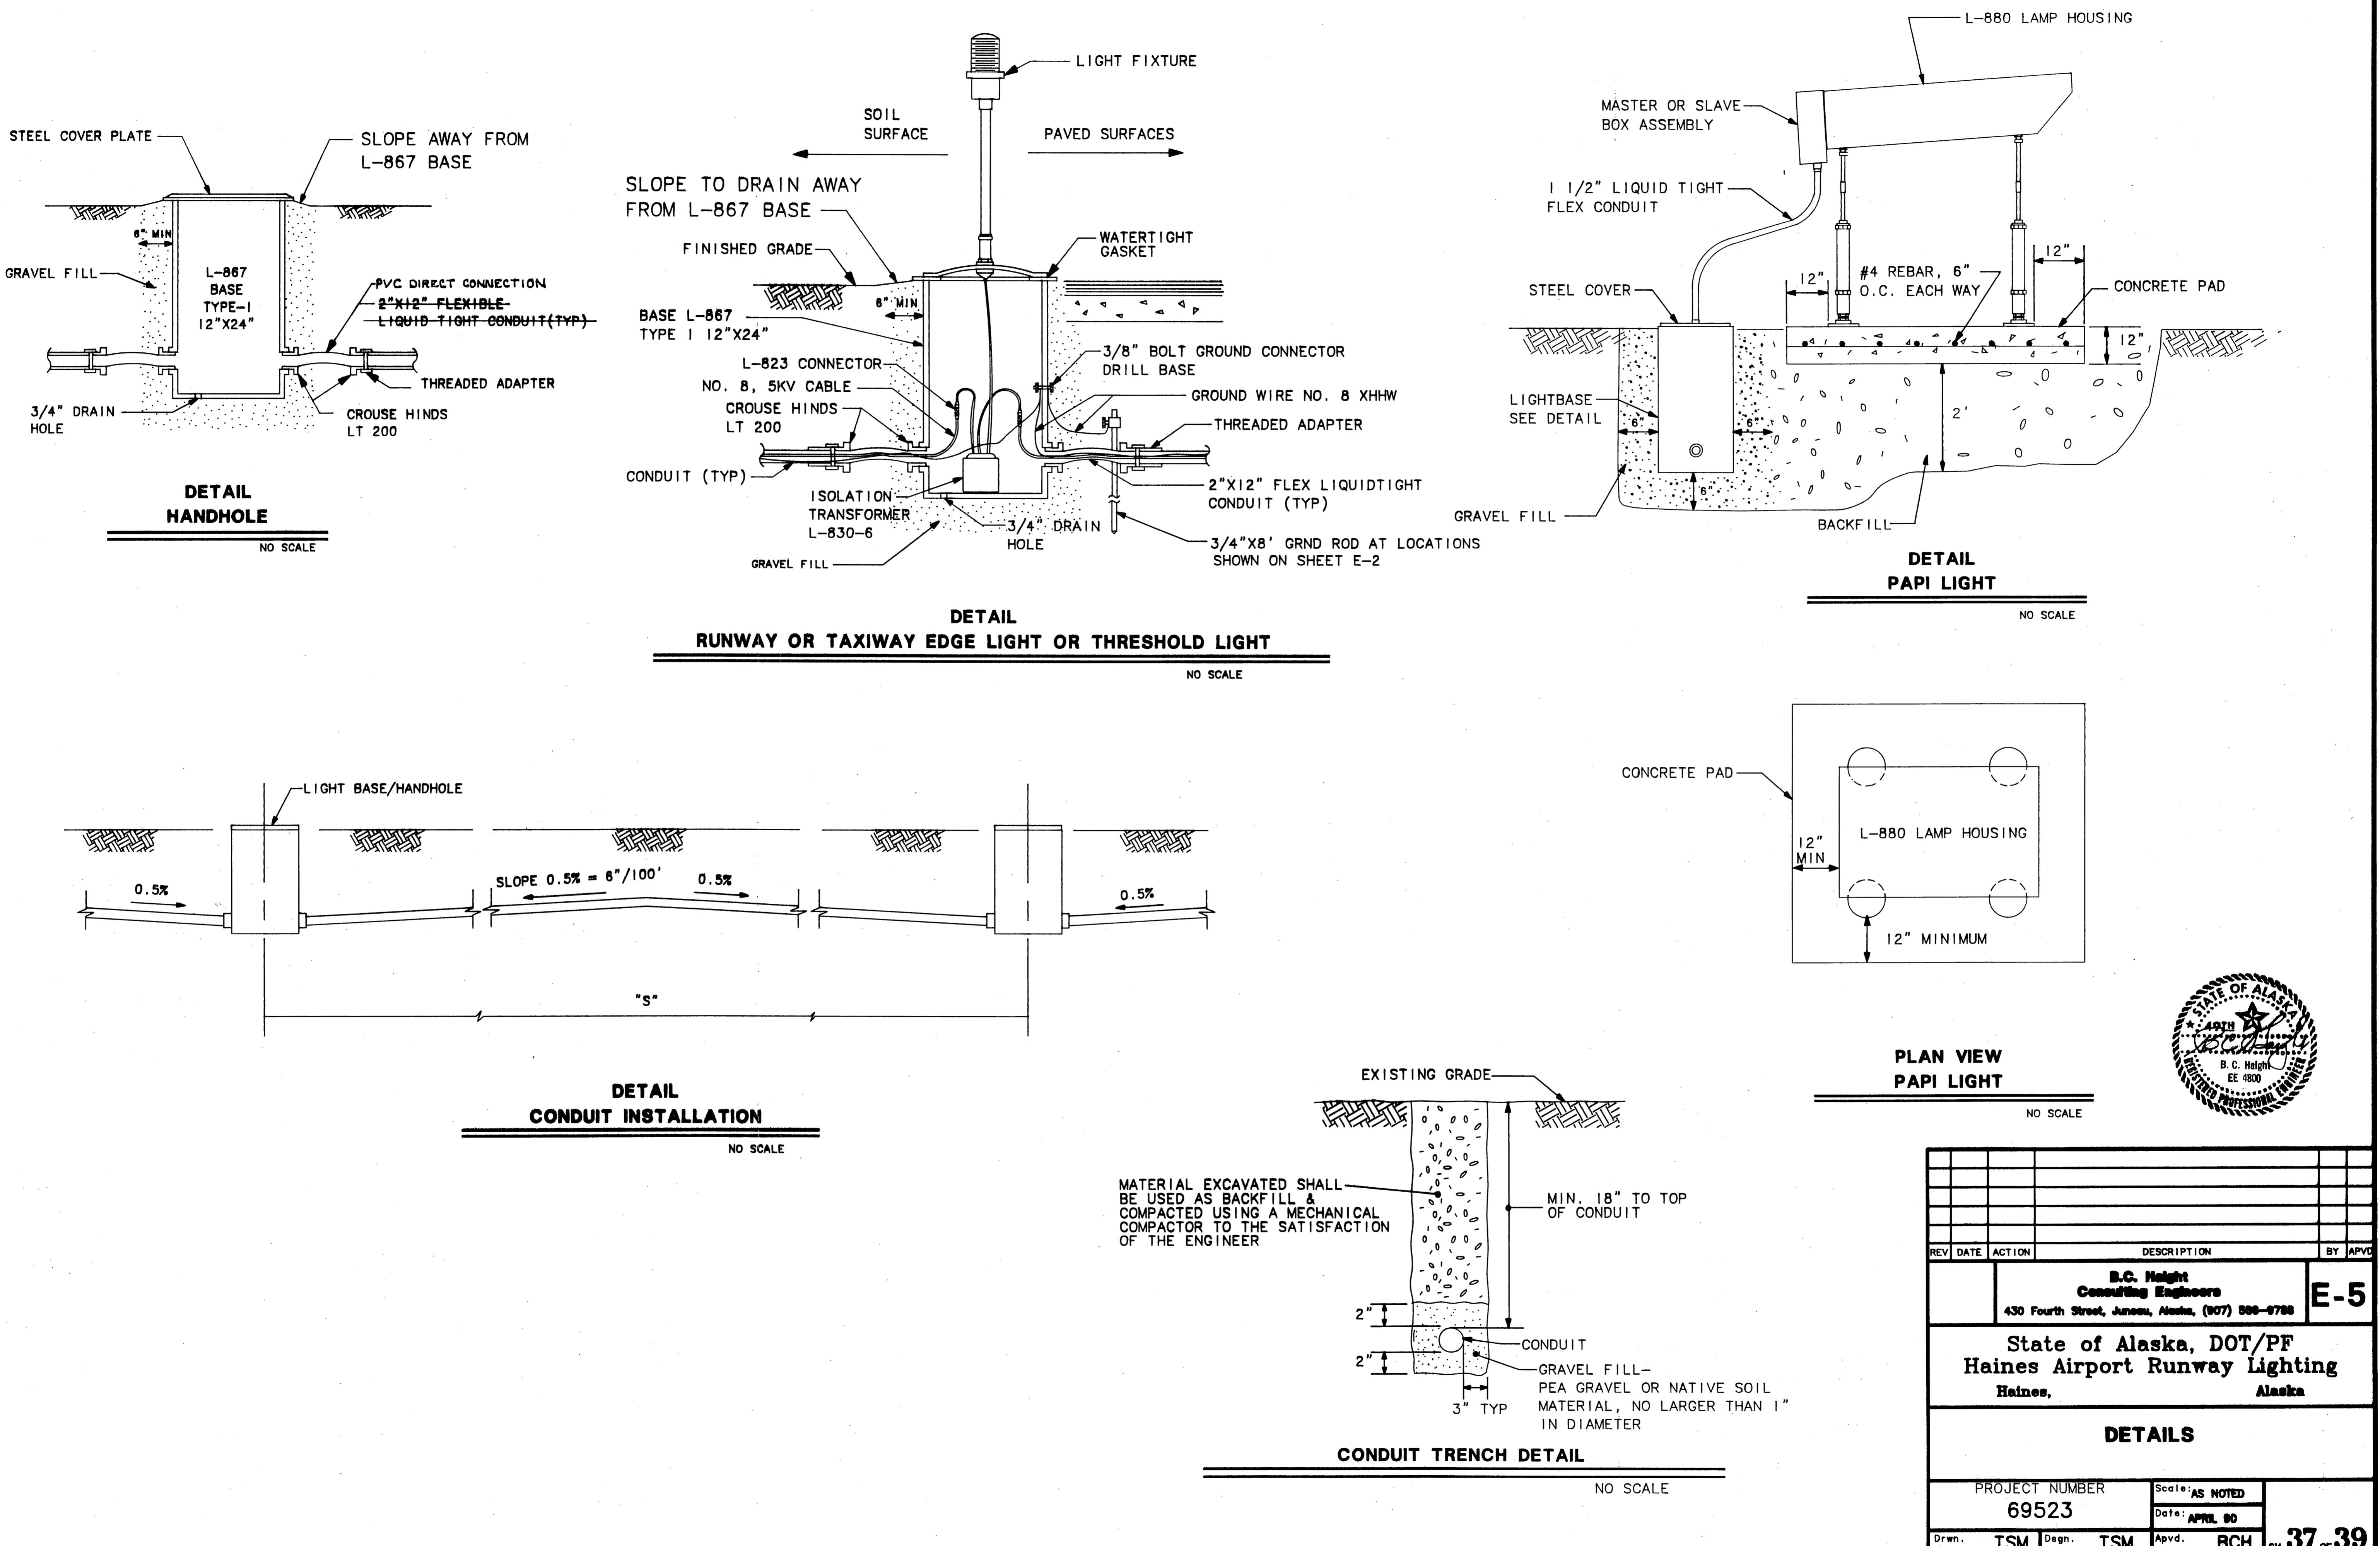

INTERNALLY LIGHTED L-858-Y,
L-858-R, OR L-858-B SIGN WITH
LETTERING AS INDICATED ON
SIGN SUMMARY TABLE, THIS SHEET.

LENGTH AS REQUIRED BY FAA SPECIFICATIONS

HEIGHT AS REQ'D FOR SIZE
OF SIGN SPECIFIED

TETHER

CONCRETE BASE-
SEE DETAIL BELOW

INTERNAL GROUND LUG

L-823 CONNECTOR

NO. 8 BARE GROUND

4" E

6"

GRAVEL FILL


2"X 12" FLEX LIQUIDTIGHT
CONDUIT. SEE RUNWAY LIGHT
DETAIL SHEET E-5

F


L-830-6 TRANSFORMER

LIGHTED SIGN DATA

10 of 10

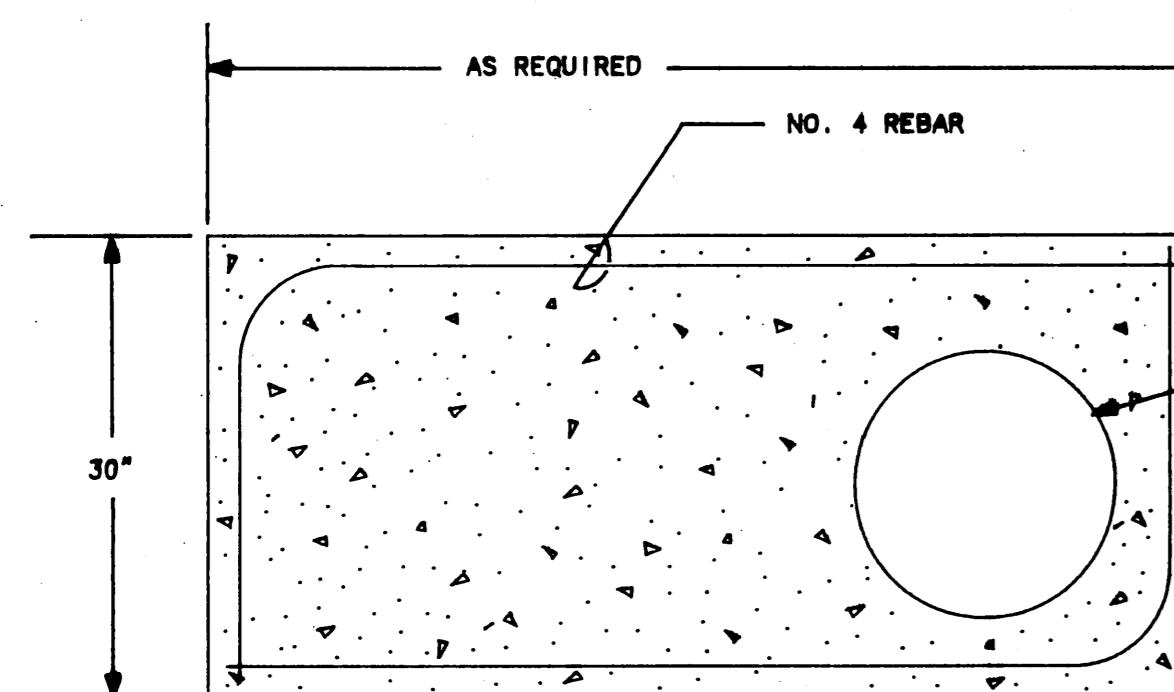


TOP VIEW

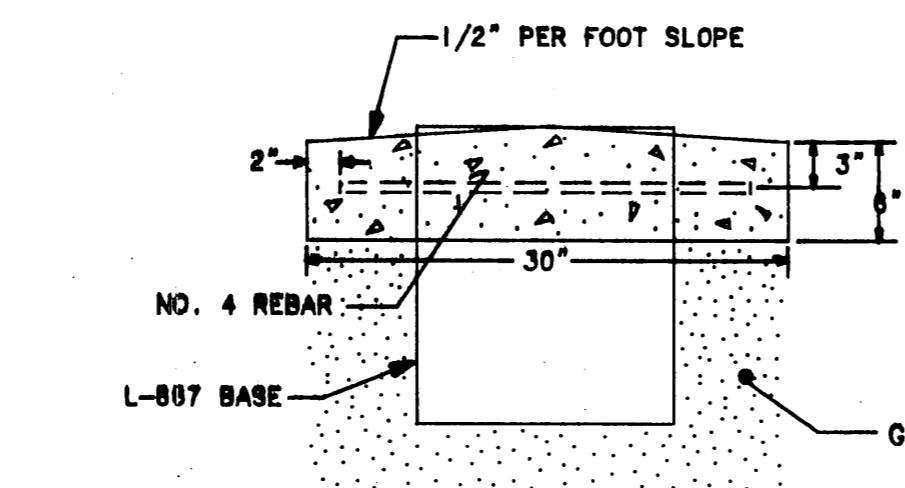

SIDE V

CONCRETE BASE DETAIL

10 of 10

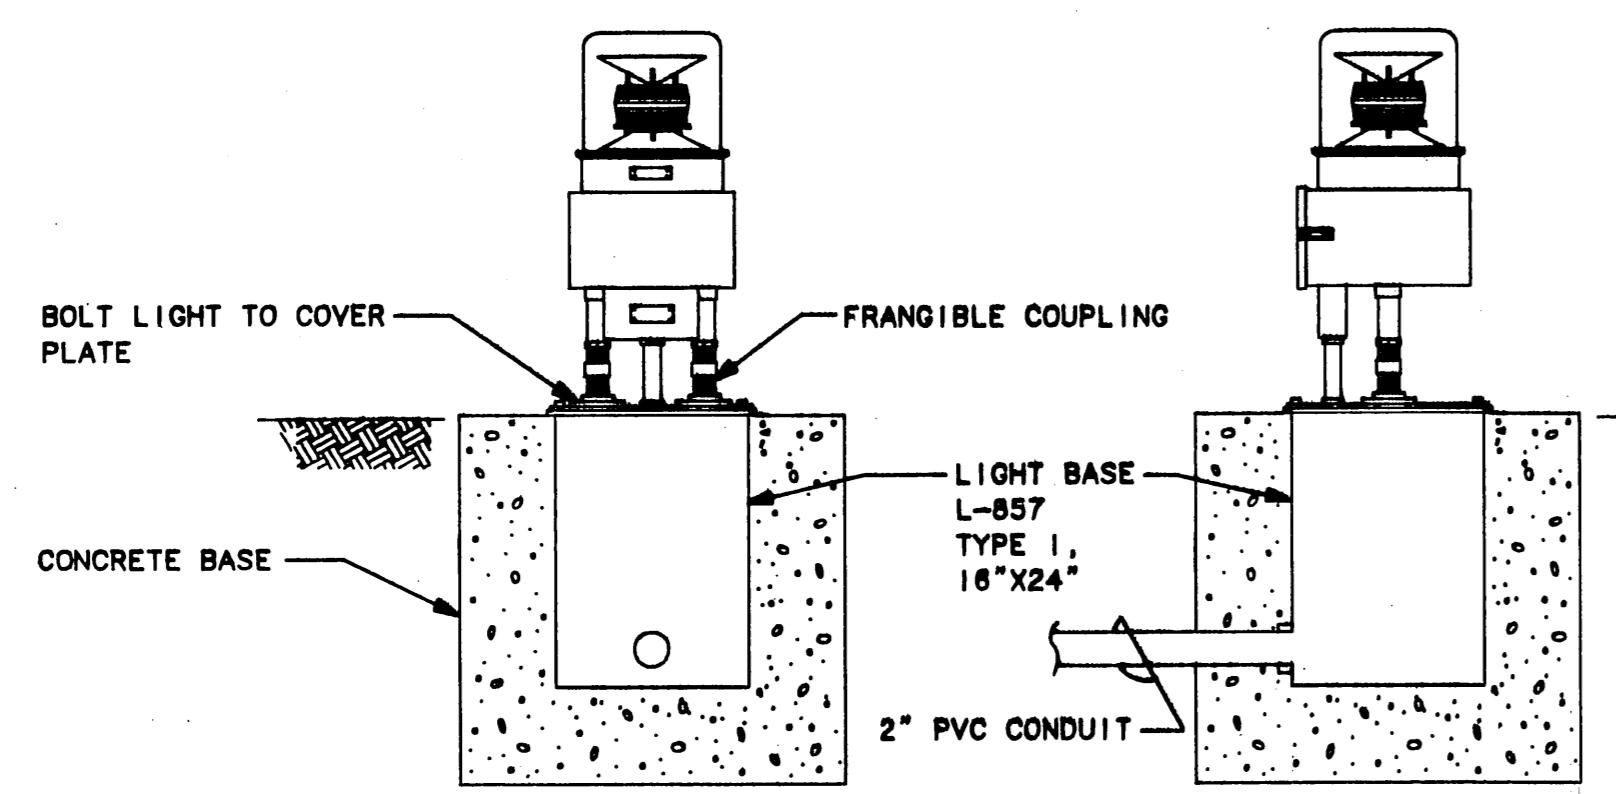

RUNWAY END IDENTIFIER LIGHT DETAIL

10 of 10

SIGN SUMMAR


 M = MANDATOR
I = INFORMAT



**State of Alaska, DOT/PF
Haines Airport Runway Lighting**

DETAILS



PROJECT NUMBER 69523		Scale: AS NOTED	
		Date: APRIL 90	
Drwn.	TSM	Dagn.	TSM
			Apvd. BCH
EW 38 OF 39			

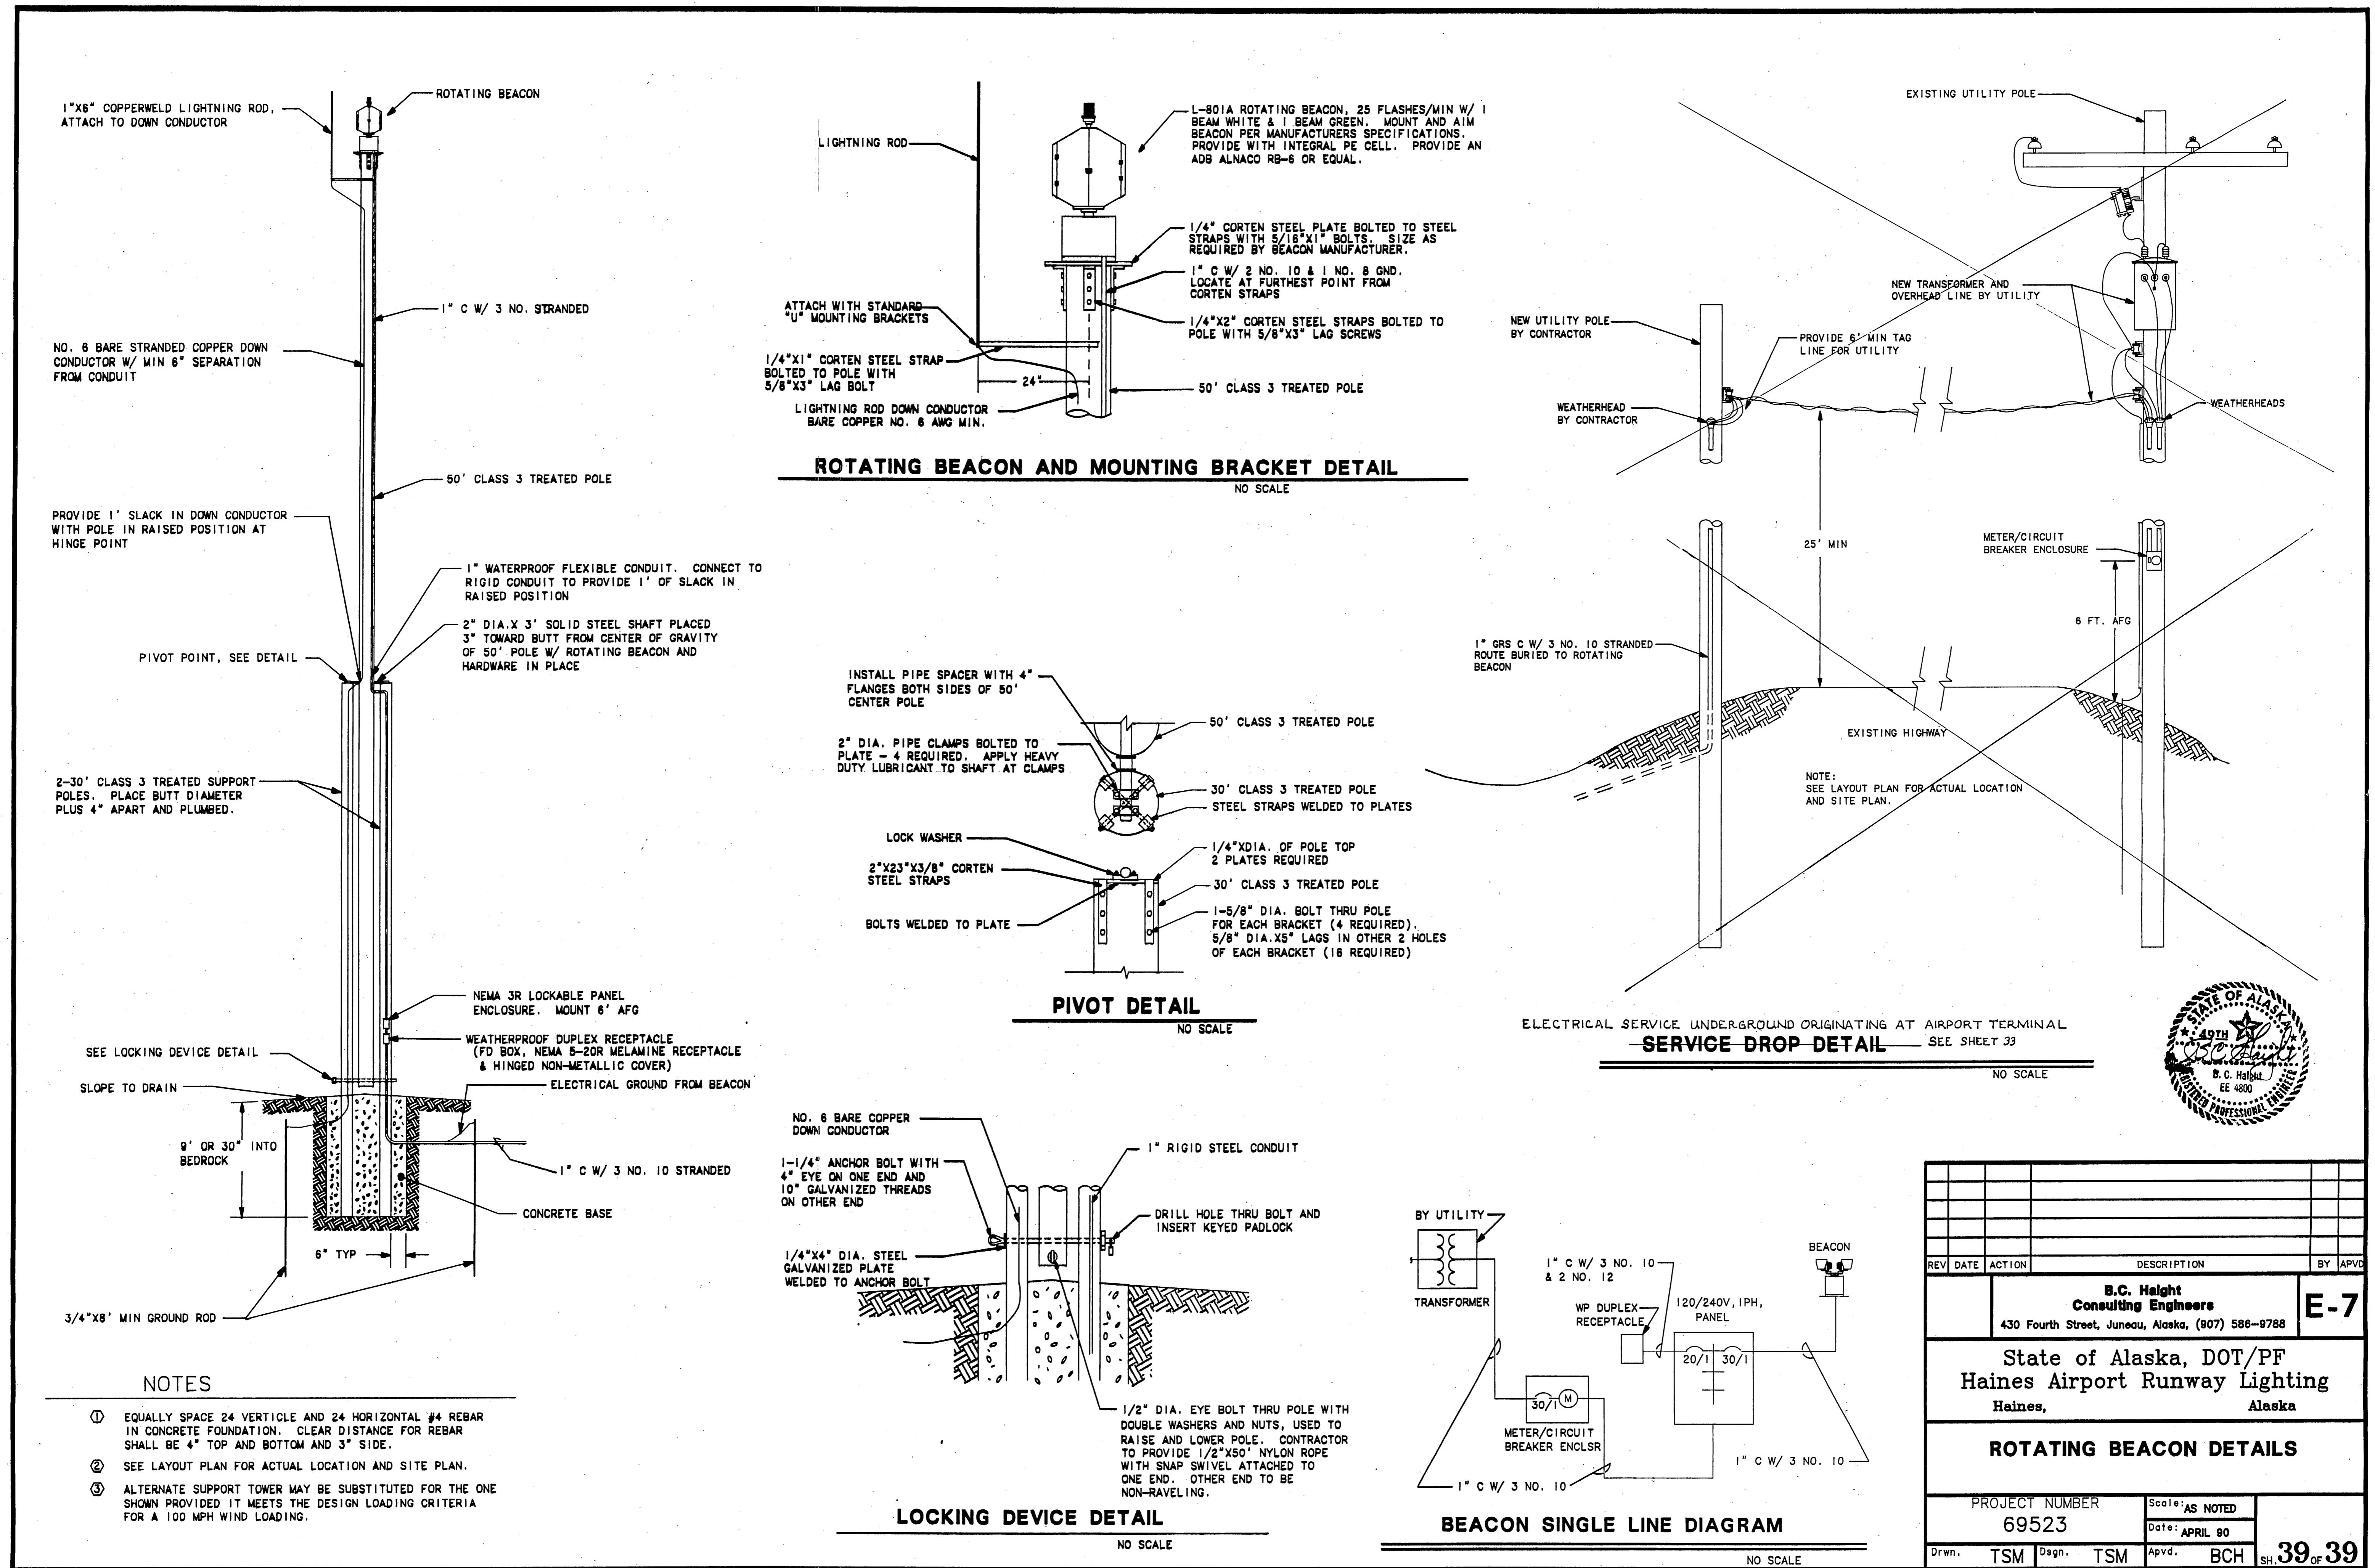

ITEM NO.	ITEM	UNIT	QUANT.
120(1)	DBE ADJUSTMENT	CS	ALL REQ'D.
203(12)	EXCAVATION & COMPACTION	LS	ALL REQ'D.
201(3A)	CLEARING & GRUBBING	ACRE	0.269
301(1)	CRUSHED AGGREGATE BASE COURSE	TON	100466.7
202(2)	REMOVAL OF PAVEMENT	SY	1,844
401(1)	ASPHALT CONCRETE, TYPE II CLASS "B"	TON	570781.2
401(2)	PBA-3 ASPHALT CEMENT	TON	32.0
403(3)	MC-250 LIQUID ASPHALT FOR PRIME COAT	TON	3.5245
203(3)	UNCLASSIFIED EXCAVATIONS	CY	202
203(11)	EMBANKMENT	CY	337
640(1)	MOBILIZATION AND DEMOBILIZATION	LS	ALL REQ'D.
642(1a)	CONSTRUCTION SURVEYING (AIRPORT)	LS	ALL REQ'D.
670(3)	PAINTED AIRPORT MARKINGS	LS	ALL REQ'D.
304(2)	SUBGRADE GRADING "C"	CY	498
401(2A)	AC-5 ASPHALT CEMENT	TON	37.66

GENERAL NOTES

- THE EXISTING 8" TO 10" OF CRUSHED BASE COURSE SHALL BE REMOVED AND STOCKPILED FOR USE IN THE REPAIR AREA AFTER THE EMBANKMENT HAS BEEN RECOMPACTED IN ACCORDANCE WITH SECTION 203.
- ADDITIONAL BASE COURSE, IF REQUIRED, SHALL BE USED TO FILL THE AREA THAT HAS SETTLED. ALL BASE COURSE WORK SHALL CONFORM TO THE SPECIFICATIONS.
- THE VERTICAL AND HORIZONTAL CONTROL SHALL BE A STRAIGHT LINE FROM THE EXISTING CUT EDGES OF ASPHALT CONCRETE. THE RUNWAY WAS CONSTRUCTED AT A UNIFORM LONGITUDINAL GRADE OF -0.0870%.
- AIRPORT CONSTRUCTION PLANS ARE AVAILABLE FOR REVIEW BY CONTACTING GREG BROWNING AT THE HAINES CONSTRUCTION OFFICE, PHONE NO. 1-(907) 766-2887.

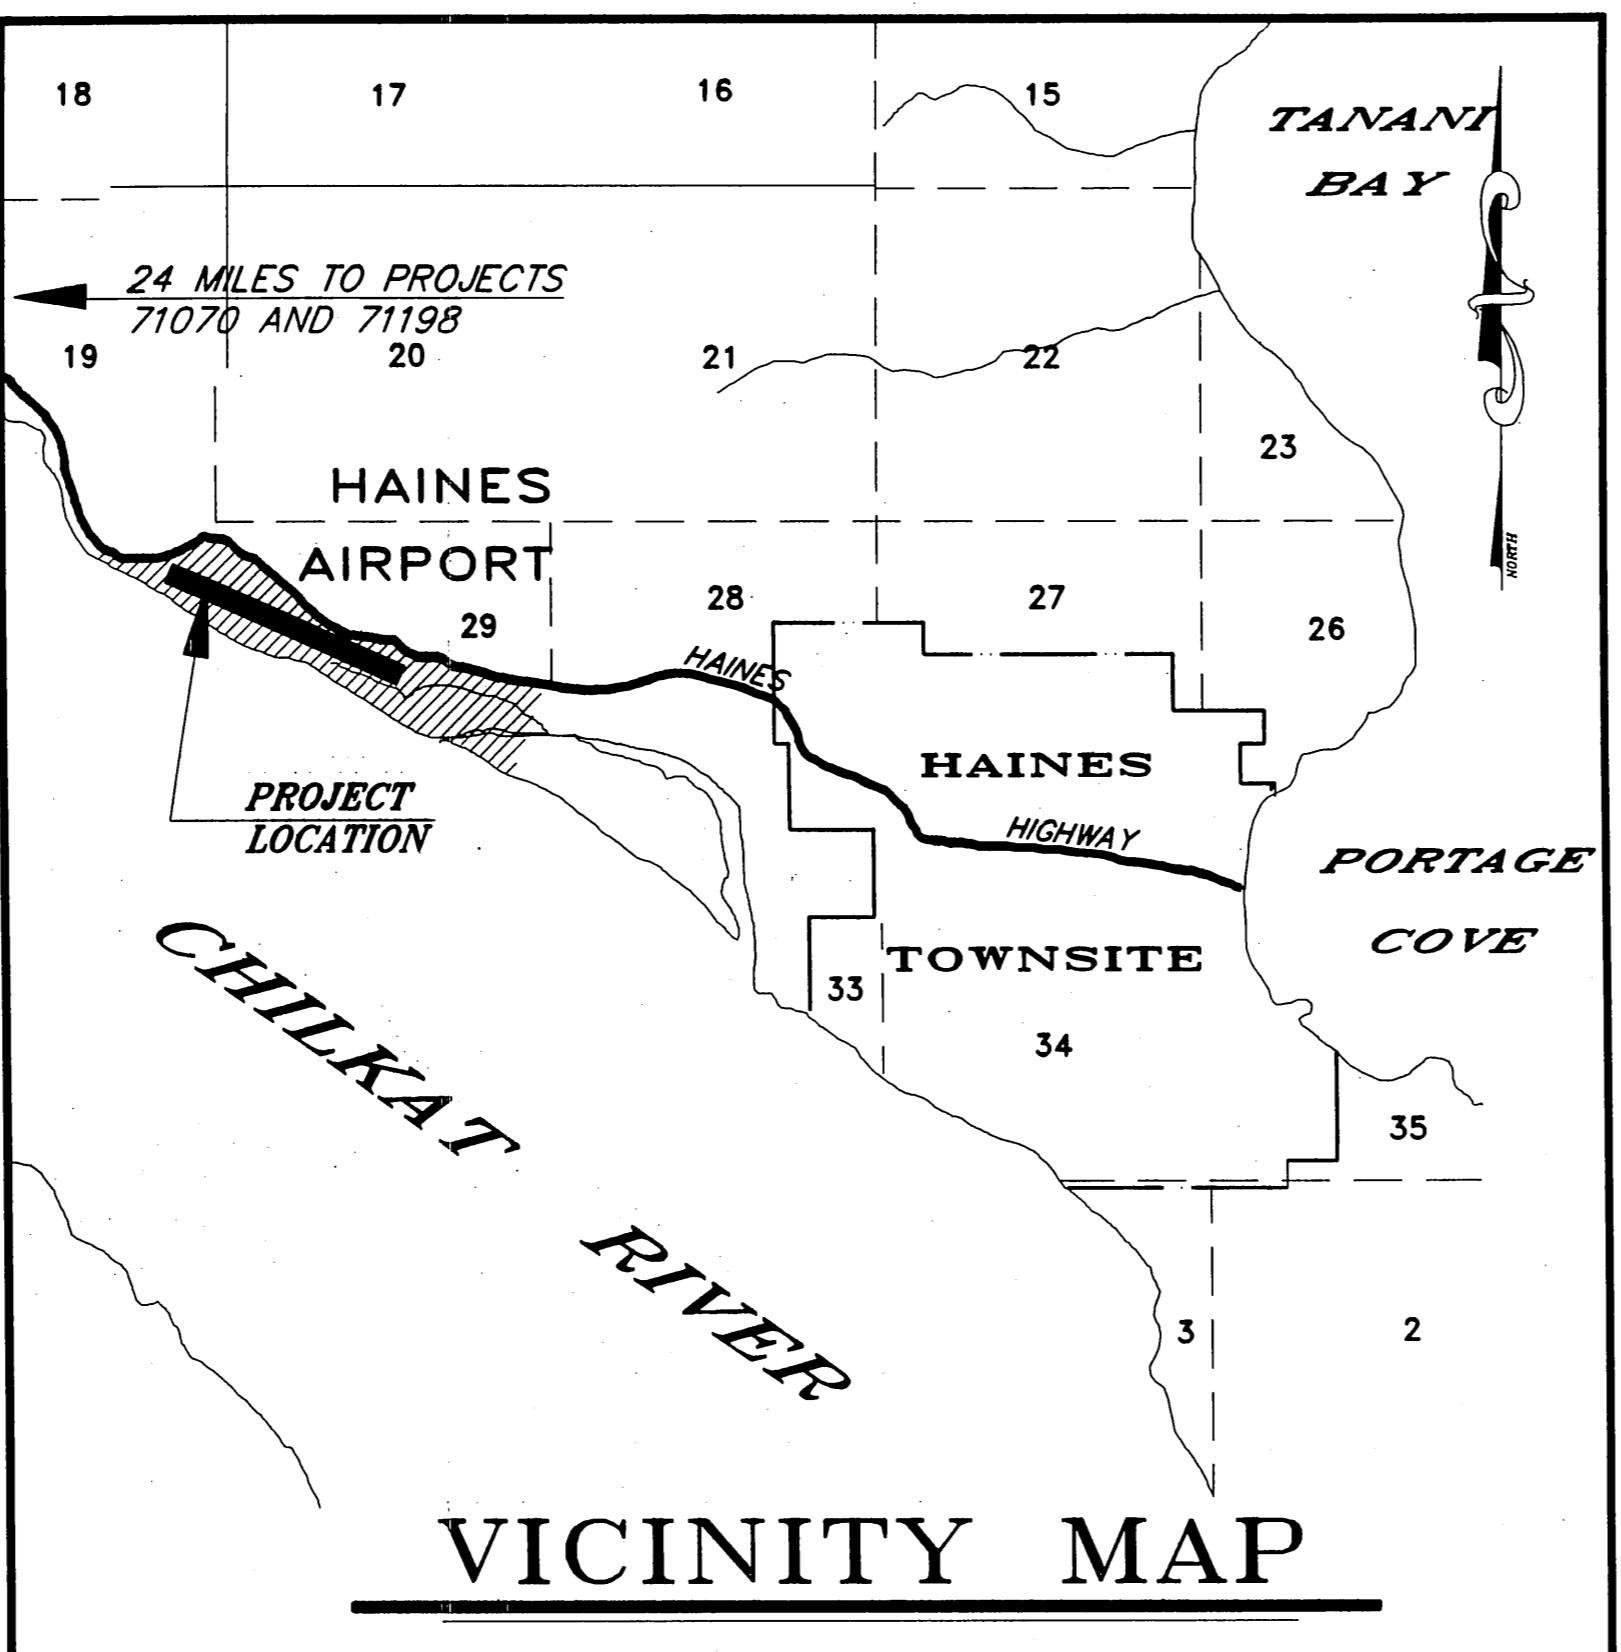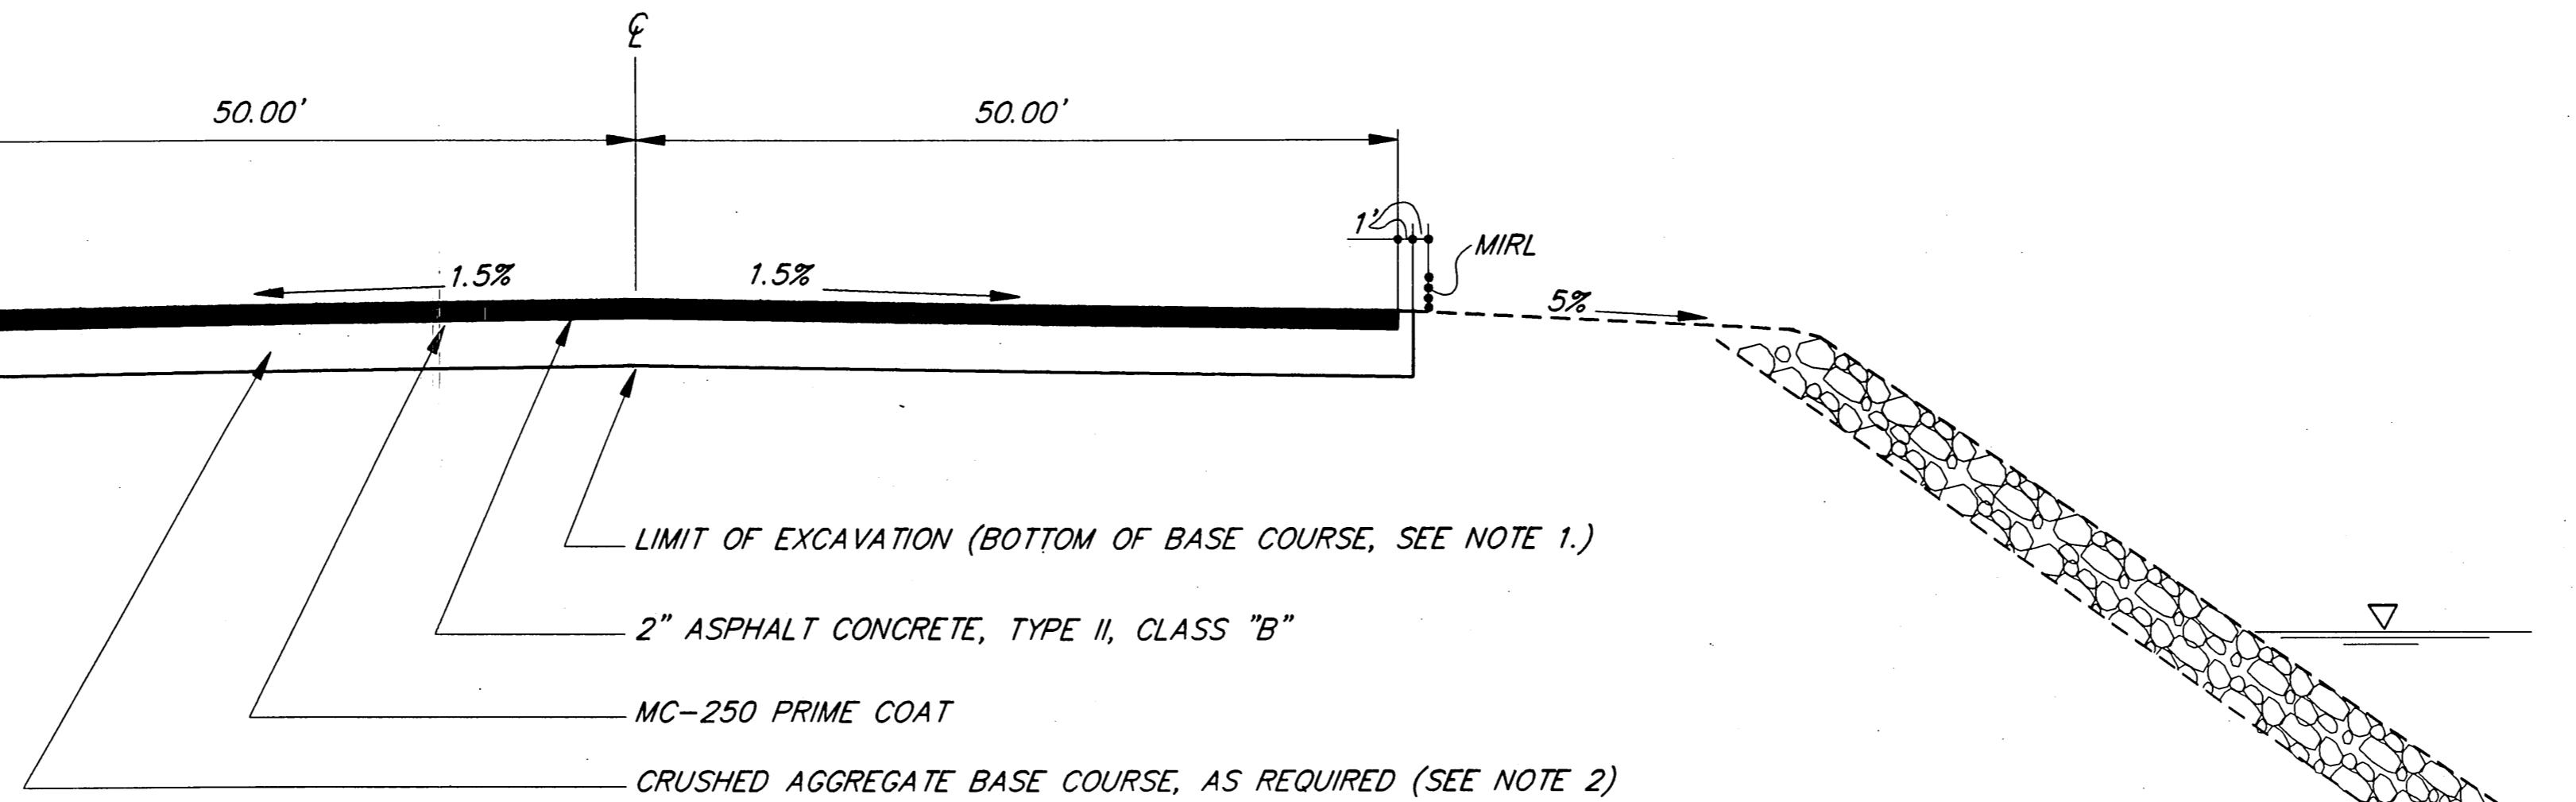

615(1)	STANDARD SIGNS	SF	4
616(4)	TIAW WIRE INSTALLATION	LS	ALL REQ'D.
640(1a)	ADDITIONAL MOBILIZATION & DEMOB.	LS	ALL REQ'D.
642(1b)	ADDITIONAL CONSTRUCTION SURVEYING	LS	ALL REQ'D.
670(1a)	PAINTED AIRPORT MARKINGS	LS	ALL REQ'D.
670(1b)	ADD'L PAINTED TRAFFIC MARKINGS	LS	ALL REQ'D.
603(1g-2i)	21" X 15" PIPE ARCH	LF	30

AS-BUILT
B.A. 2-8-96

NOTE: DO NOT SCALE FROM THESE PLANS-USE DIMENSIONS

BY:	DATE:	DESCRIPTION OF CHANGE:
RECORD OF REVISIONS		

STATE OF ALASKA
DEPARTMENT OF TRANSPORTATION
AND PUBLIC FACILITIES
SOUTHEAST REGION DESIGN & CONSTRUCTION

HAINES

HAINES AIRPORT
A.I.P. NO. 3-02-0112-03, 69523

RUNWAY PAVEMENT REPAIR

ALASKA

DESIGNED BY:

PROJECT NO.

C. HAKARI

DRAWN BY:

DATE:


C. ANDERSON

JAN. 1993

CHECKED BY:

SHEET HA1 OF 1

T.W. MOORE

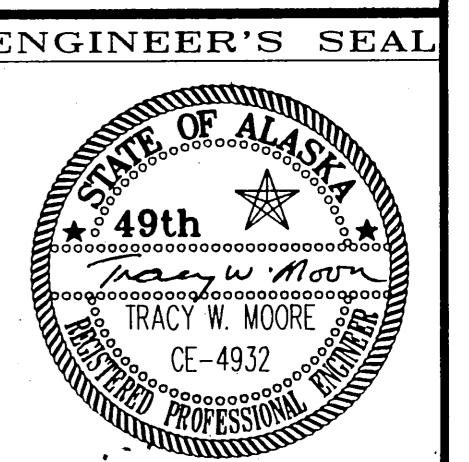

P. HNS 1/24 DR RUNWAY 1=10