
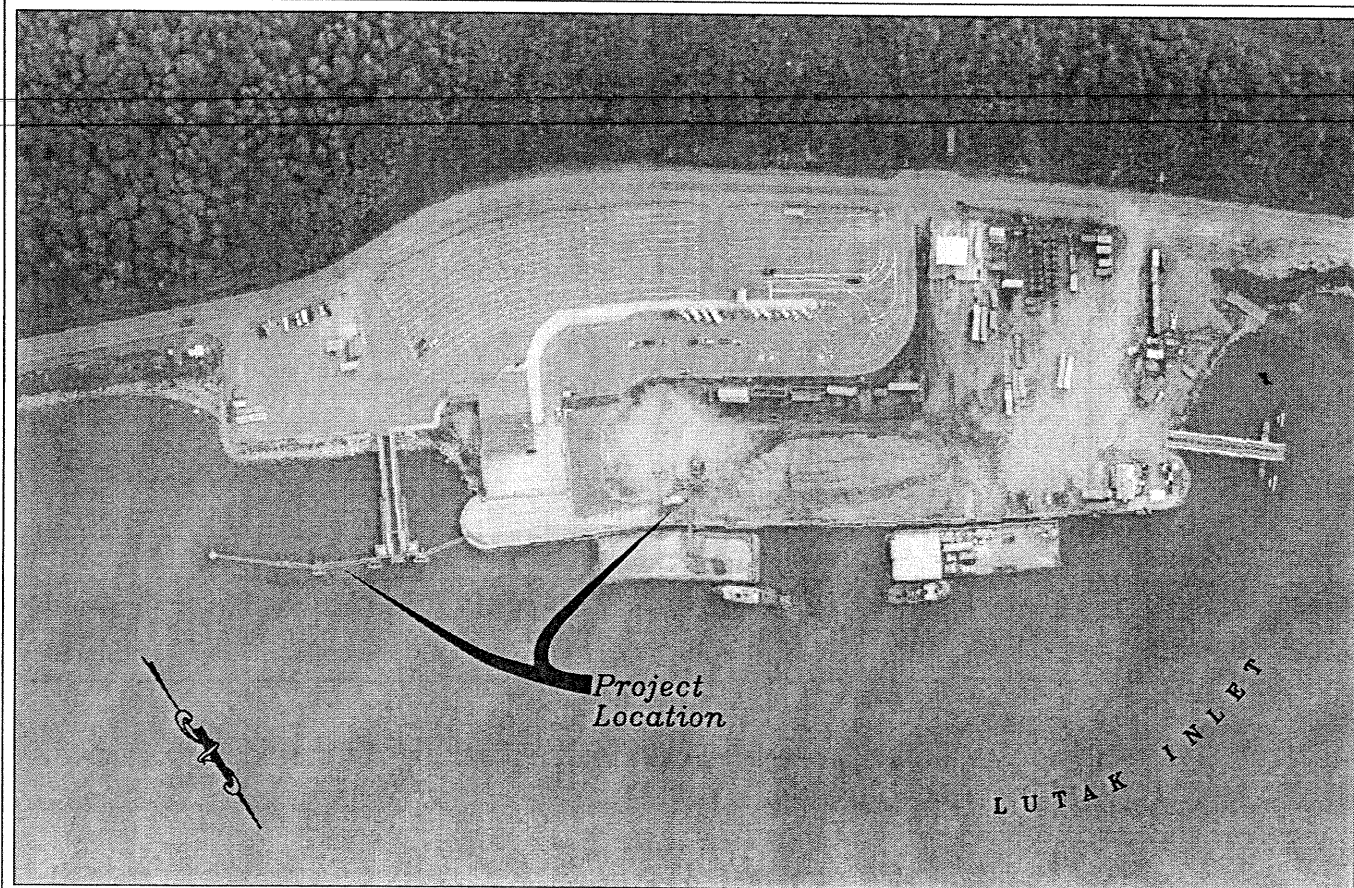


STATE OF ALASKA
DEPARTMENT OF TRANSPORTATION
AND
PUBLIC FACILITIES
SOUTHEAST REGION

A PROJECT AT
HAINES, ALASKA
HAINES MOORING IMPROVEMENTS
NH-095-5(6)
PROJECT NO. 75249

INDEX OF SHEETS	
SHEET NO.	DESCRIPTION
1	Title Sheet
2	Quantities, General Layout & Pile Table
3	General Layout
4	Existing Facilities & Demolition Plan
5	Proposed Marine Site Plan
6-14	Mooring Structures W2, E3, & E4
15	Cathodic Protection System
16	44' Catwalk at W1 to W2
17	32' Gangway at W2 to Dock
18	Existing Dolphin & Catwalk Modifications
19	Dock Cap Shoring
20	Dock Cap Shoring Details
21	Existing Fender Repairs
22-26	Existing Structures
E1-E2	Electrical

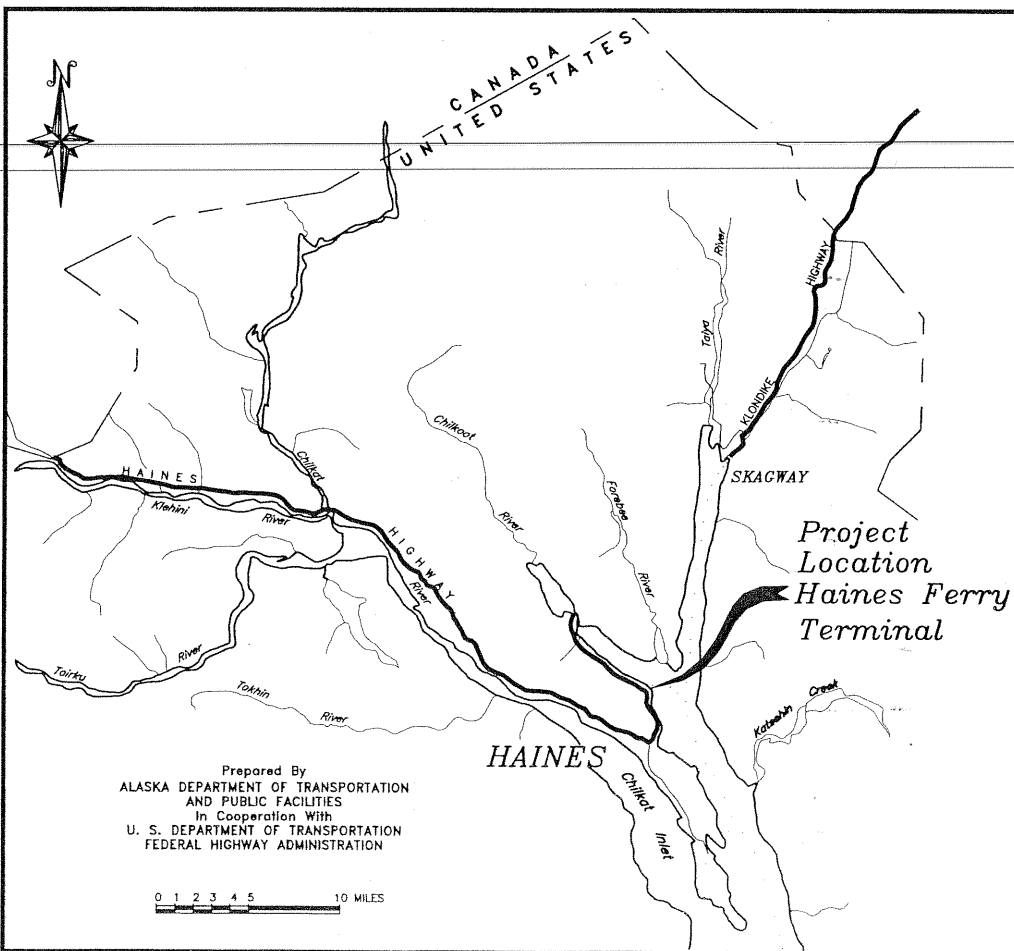

Existing Site Plan

As-Built Drawings
Contractor - Western Dock & Bridge
Project Engineer - Cliff Douglas
Date Began - May 25, 2008
Date Completed - June 5, 2009

STATE OF ALASKA
DEPARTMENT OF TRANSPORTATION
AND
PUBLIC FACILITIES
SOUTHEAST REGION

APPROVED
Jack D. Beedle Date 8/6/07
Regional Preconstruction Engineer
Jack D. Beedle, P.E.

APPROVED
Malcolm A. Menzies Date 8/8/07
Director, S.E. Region
Malcolm A. Menzies, P.E., Ltd.

CERTIFIED TRUE & CORRECT AS-BUILT OF
ACTUAL FIELD CONDITION:

Construction Project Manager _____ Date _____

PROJECT NUMBER:
75249/NH-095-5(6)

DATE:
AUGUST, 2007

SHEET 1 OF 28

0:\AK\175249\Phase-A\04-01-Proj-Title-Index.dwg SCALE: 1" = 1'

GENERAL NOTES

Construction:

Per contract documents for project No. NH-095-5(6) / 75249

Design Basis:

Marine facilities design standards.
AISC Manual of Steel Construction LRFD, 3rd Ed

Design Loads:

Catwalk & Gangway loads:

LL - 65 psf uniform or
10 psf uniform + 500 lb concentrated moving load

Fender and mooring loads:

Vessel Berthing (side berth) - 80 kips
Vessel Mooring (side berth) - 50 kips horizontal

Materials:

ALL STEEL AND IRON PRODUCTS INCORPORATED INTO THIS WORK SHALL BE MANUFACTURED IN THE U.S., SEE SECTION 106-1.01 OF SPECIFICATIONS.

Steel Shapes & Plates:

Plates & misc shapes -- A36 or A572 Gr50, as noted
W-sections -- A992
Tube Sections -- A500 Gr. B
Pipe -- A53, Gr. B, type E or S
Stainless -- A276 Type 302, 304 or 316
Charpy Zone 2 impact requirements shall apply where noted on Plans.

Piling:

30" Dia. x 1/2" Pipe Pile -- API 5L X42 PSL1
30" Dia. x 3/4" Pipe Pile -- API 2B ASTM572/Gr50
All Other Pipe Pile -- ASTM A252 Gr 2
All piling straight seam
Open-end Cutting Shoe -- APF 0-14001 inside flange or approved equal. Shoes req'd on all piling

Pipe:

Mooring structure pipe - ASTM A252 Gr 2, ASTM A53 Gr B, type E or S

Grating:

Welded steel grating, bearing bar size & spacing per Plans

Fasteners:

Steel connections--
< 1 1/2" use A325 bolts or A449 studs
≥ 1 1/2" use A354 Gr BC bolts

Timber connections--

use A307
Stainless steel bolts, hex cap screws, and studs
ASTM F593, Alloy Group 2 (316, 316L), CW

Portland Cement Concrete:

Concrete Class A (see Specifications)

Reinforcement

A706 for welded rebar, A615 elsewhere

UHMW-PE Plastic:

Ultra high molecular wt polyethylene -- ASTM D4020 blend of virgin resin & ground chips, see Specifications

Marine Fenders:

Refer to Specifications

Chain:

Welded stud chain, Grade 2

Sacrificial Anodes:

Aluminum alloy with flat bar core. Potential = -1100mV (ref Cu/CuSO4), actual electrochemical efficiency = 1100 amp-hr/lb

Protective Coatings:

Structural Steel of Dolphins, Fenders, Catwalks & Gangways:

Structures and weldments shall be hot-dip galvanized after fabrication.

Structural Steel of Dock Cap Shoring:


Members and weldments shall be bare steel.

Pipe piles:

30" dia. hot-dip galvanized after fabrication
24" dia. & 16" dia. bare steel

Chain, fasteners & hardware:

Hot-dip galvanized after fabrication

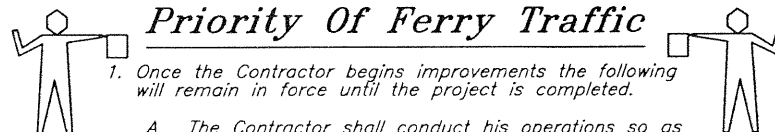

Priority Of Ferry Traffic

1. Once the Contractor begins improvements the following will remain in force until the project is completed.

- A. The Contractor shall conduct his operations so as not to interfere with normal scheduled ferry access or vehicular traffic to and from the existing ferry facilities.
- B. Ferry traffic shall have priority over construction activities. It shall be the Contractor's responsibility to coordinate his activities with ferry arrivals and departures.
- C. Terminal personnel will stage traffic, and operate the transfer equipment.
- D. Contractor shall provide safe access and lighting for terminal personnel to tie up points as required throughout the contract.

2. The Contractor shall not stockpile any materials in the existing staging area without approval of the State's Engineer.

3. The Contractor shall not occupy, tie-up to or in any way obstruct the use of the Lutak Dock in tracts A or C without written permission of the Haines Borough and a waiver of all claims against the State for any damage which may result. Furnish a copy of such permission & waiver of claims to the Engineer before entering these areas.

Project As-Built Drawings have been reviewed by the Project Engineer and represent to the best of my knowledge, the project as constructed.

Proj. Engr C. J. Douglas Date 5/26/09

PILE DRIVING DATA												
Location	No. Ea.	Designation (# x wall)	Ultimate Resistance		Elevations		Tip Elevations		Max Driving Resistance	Total Est. Length		
			Uplift	Bearing	Mudline	Cutoff	Min.	Est.		16"	24"	30"
Structure W2. Note 4)			Note 2)	Note 2)	-12				Note 1)			168
Grid A / Vertical	2	PP30x0.500	315	535	-10	+3.00	-79	-95	645			498
Grid B / Vertical	2	PP30x0.500	385	430	-10	+3.00	-79	-95	645			406
Structure E3:					-7			-79				164
Grid A / Vertical	2	PP30x0.500	490	535	-25	+3.00	-88	-105	620			206
Grid B / Vertical	2	PP30x0.500	600	430	-25	+3.00	-91	-105	670			216
Structure E4. Note 3)					-15			-95				196
Grid A / Vertical	2	PP30x0.500	490	535	-25	+3.00	-88	-105	620			205
Grid B / Vertical	2	PP30x0.500	600	430	-25	+3.00	-91	-105	670			216
Structure S1 & S2:					-21			-102				210
Grid A / Vertical	2	PP24x0.500	0	490	-20	+14.80	-65	-65-52				133
Grid B / Vertical	2	PP24x0.500	75	270	+12	+14.80	-50	-65-41				160
Grid B / Batter 3:1	2	PP16x0.500	180	180	+12	+19.00	-55	-60-16	104	+66		112+60
								Est. Total (LF)		+66	320	7256

Pile Driving Notes:

- 1) Maximum driving resistance is the ultimate bearing capacity plus overdriving to reach minimum tip elevation. Use maximum driving resistance in driveability analysis of proposed pile driving system.
- 2) Basin seafloor will be dredged to Elev -30 in the future. Uplift and bearing resistances shown in the table are the required capacities after dredging.
- 3) The first pile installed in Structure E4 shall be designated as a Dynamic Load Test pile. (See Section 505 Piling for dynamic load testing requirements)
- 4) Drive all (4) piles of Structure W2 to bedrock and install tension pile anchors.

ESTIMATE OF QUANTITIES			
Item No.	Item	Unit	Qty
202(1a)	Removal of Structures and Obstructions (Mooring Structures)	Lump Sum	All Req'd
202(1b)	Removal of Structures and Obstructions (Catwalks)	Lump Sum	All Req'd
202(1c)	Removal of Structures and Obstructions (Dock Fender Module)	Lump Sum	All Req'd
504(1)	4-Pile Mooring Structure (W2, E3, & E4) Cap & Fender System	Each	3
504(2)	44-Ft Catwalk (W1 to W2)	Each	1
504(3)	32-Ft Catwalk (W2 to Dock)	Each	1
504(4)	Dock Cap Shoring (Cell 4)	Lump Sum	All Req'd
504(5)	Refastening Fender Timbers (W1, E1, & E2)	Lump Sum	All Req'd
505(10)	Dynamic Load Test	Each	1
505(12)	30" Dia. x 0.500" wall Pipe Piles, Furnished	Linear Foot	1,256 1149
505(13)	30" Dia. Pipe Piles, Driven	Each	12
505(14)	24" Dia. x 0.500" wall Pipe Piles, Furnished	Linear Foot	320 245
505(15)	24" Dia. Pipe Piles, Driven	Each	4
505(16)	16" Dia. x 0.500" wall Pipe Pile, Furnished	Linear Foot	166 104
505(17)	16" Dia. Pipe Piles, Driven	Each	2
518(1)	Tension Pile Anchors (W2)	Each	4
		Lump Sum	All Req'd
640(1)	Mobilization & Demobilization	Lump Sum	All Req'd
640(4)	Worker Meals and Lodging, or Per Diem	Lump Sum	All Req'd
641(1)	Erosion and Pollution Control Administration	Lump Sum	All Req'd
641(2)	Temporary Erosion and Pollution Control	Cont. Sum	All Req'd
642(1)	Construction Surveying	Lump Sum	All Req'd
644(1)	Field Office	Lump Sum	All Req'd
644(6)	Vehicles	Lump Sum	All Req'd
662(1)	Electrical Lighting System	Lump Sum	All Req'd

LEGEND

Alphabetic reference for Section
Sheet no. reference section is located
Location & direction where section is taken
Section X-X
Location of section view
SECTION ON SAME SHEET
SECTION CROSS REFERENCE FROM/ON DIFFERENT SHEET

Numeric reference for detail
Sheet no. reference detail is located
Detail X-X
Location of detail view
DETAIL ON SAME SHEET
DETAIL CROSS REFERENCE ON/FROM DIFFERENT SHEET

DESIGNED BY: T. Doggett

STATE OF ALASKA
DEPARTMENT OF TRANSPORTATION & PUBLIC FACILITIES
SOUTHEAST REGION

Haines Mooring Improvements
Project 75249


Quantities, General Notes & Pile Table

CHECKED BY: B. Savikko
DRAWN BY: W. Hickok

PATH: Q:\Hns\75249\MF\Phase-B\PlanSet\02-Gen Notes.dwg
PLOT: PSPACE 1=1 TAB: Cap-V02 Thu, 09/Aug/07 06:16PM

REVISIONS			PROJECT DESIGNATION	YEAR	SHEET NO.	TOTAL SHEETS
NO.	DATE	DESCRIPTION				
			75249	2007	2	28


LUTAK INLET

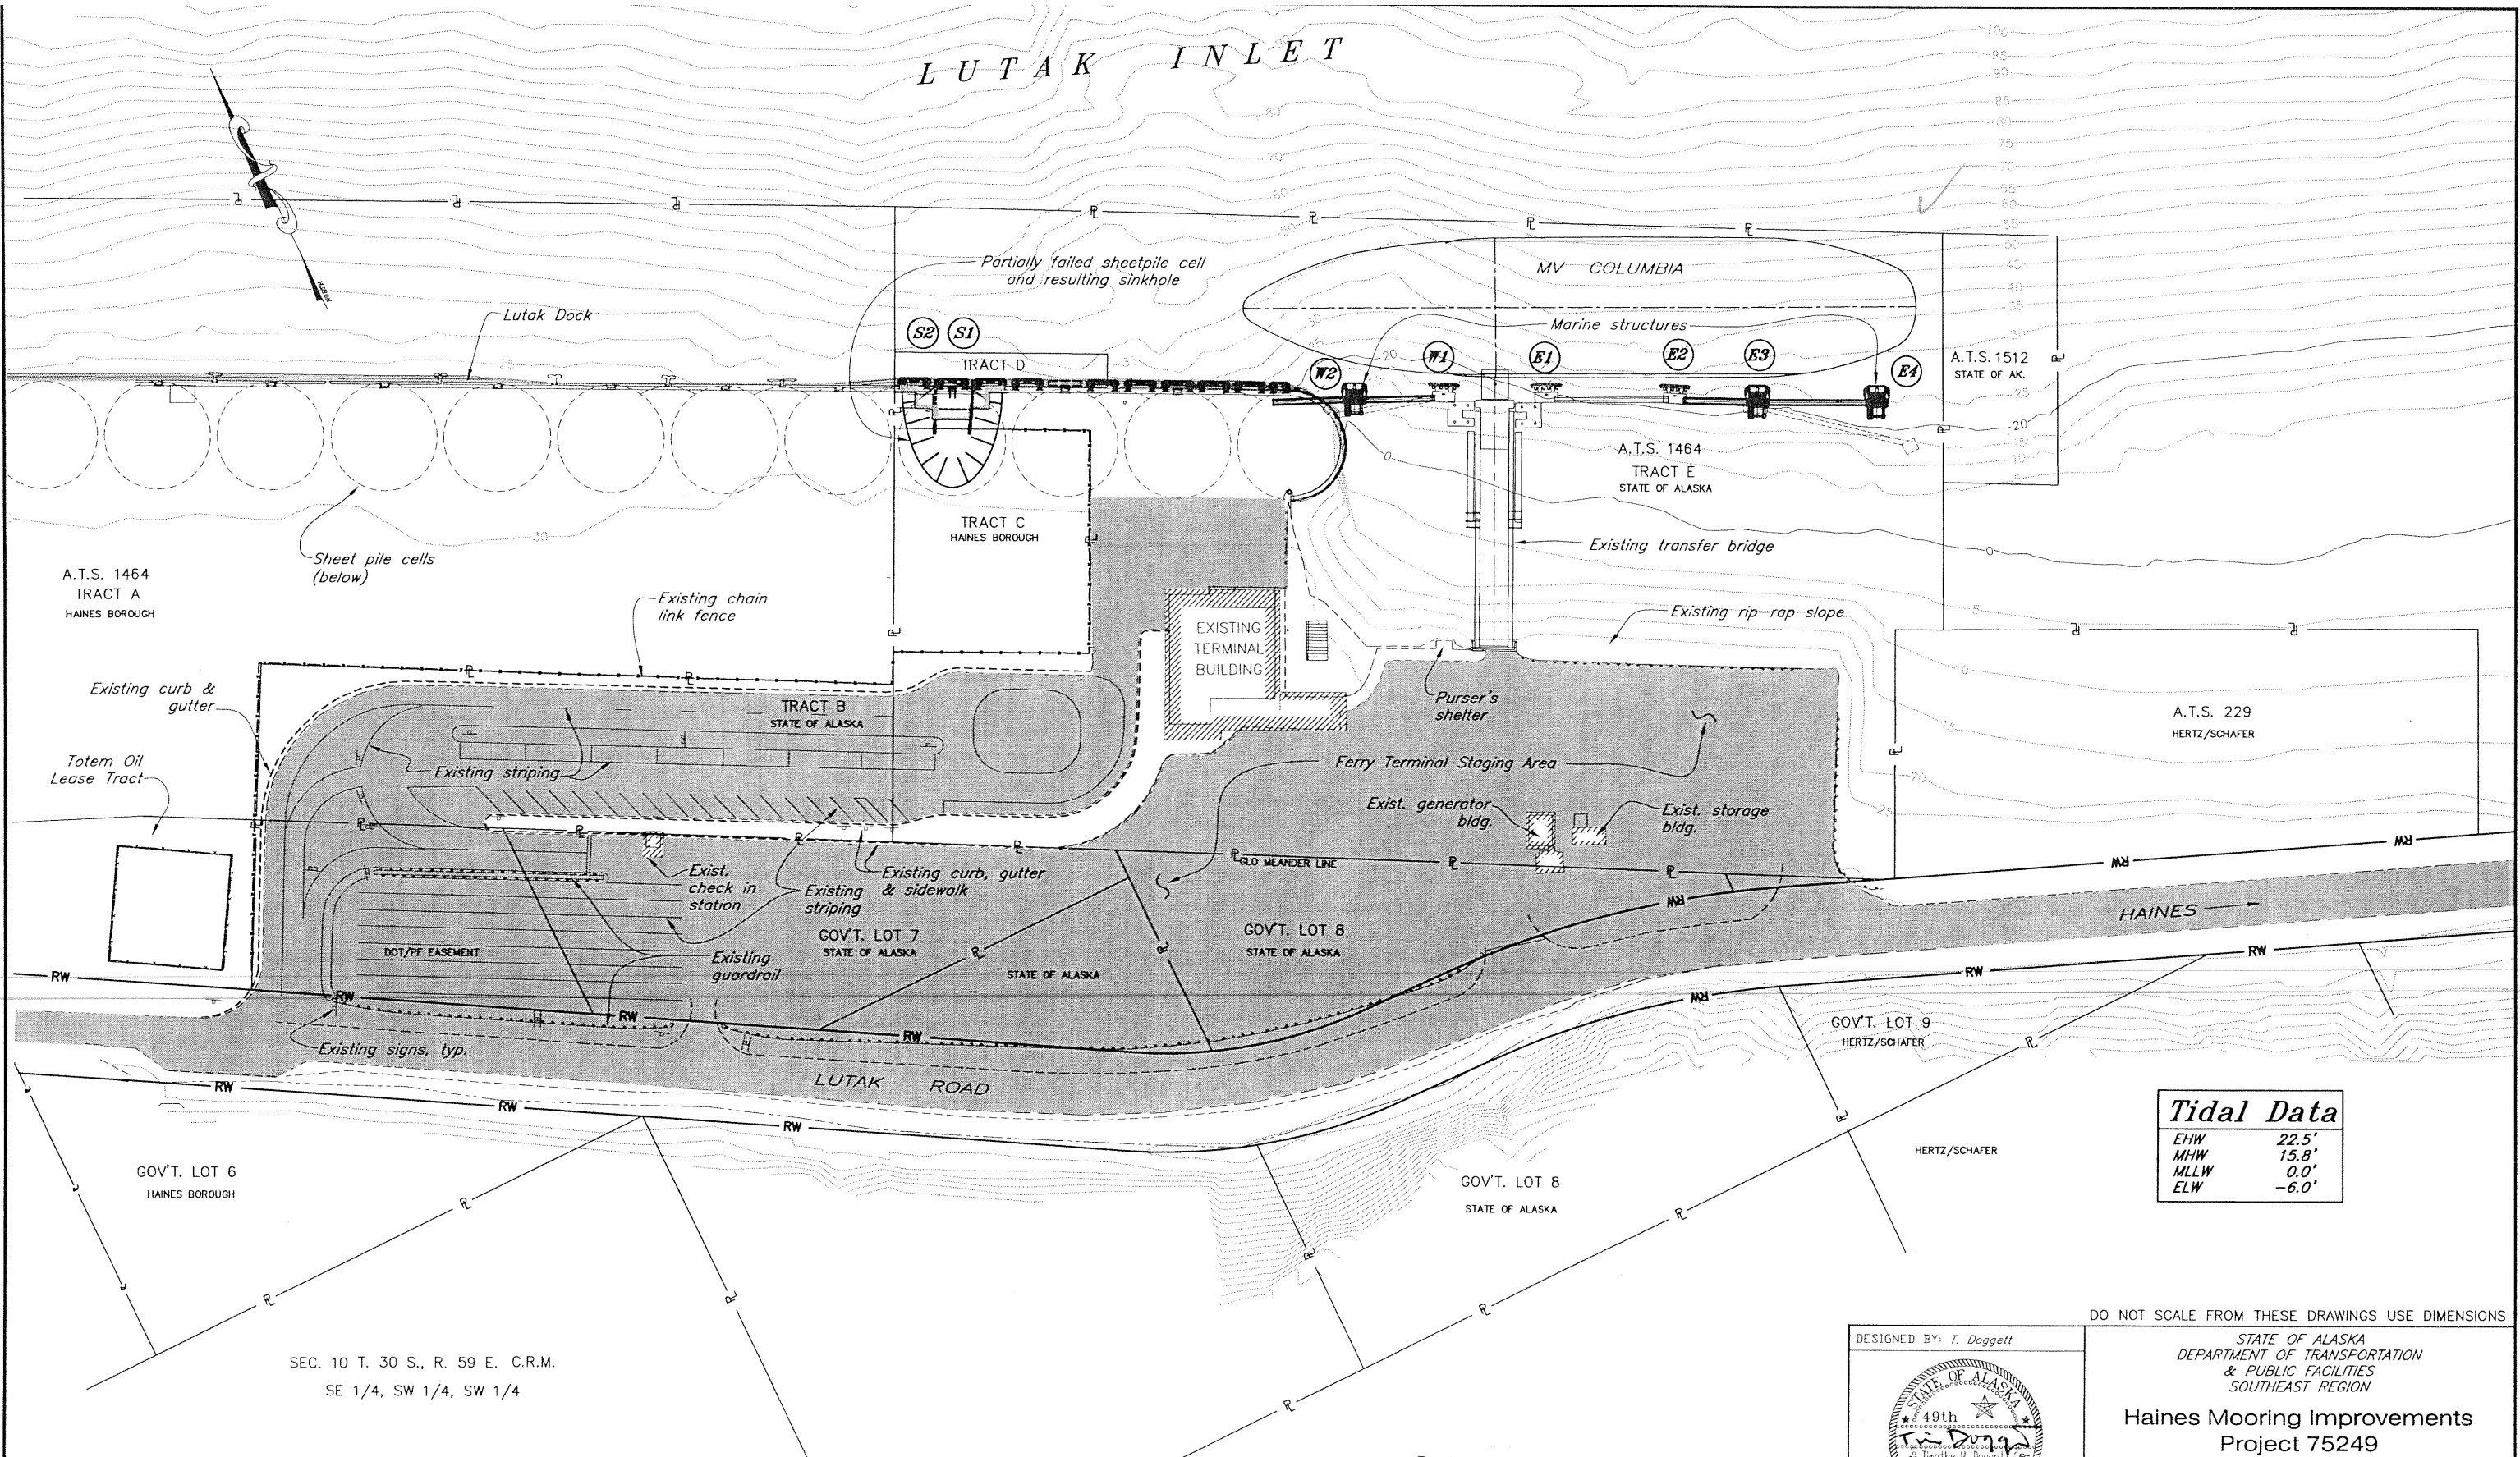

Tidal Data	
EHW	22.5'
MHW	15.8'
MLLW	0.0'
ELW	-6.0'

SEC. 10 T. 30 S., R. 59 E. C.R.M.
SE 1/4, SW 1/4, SW 1/4

Plan

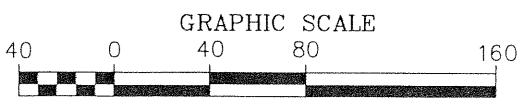

Project As-Built Drawings have been reviewed by the Project Engineer and represent to the best of my knowledge, the project as constructed.

Proj. Engr *[Signature]* Date *5/26/09*

DO NOT SCALE FROM THESE DRAWINGS USE DIMENSIONS

DESIGNED BY: T. Doggett


STATE OF ALASKA
DEPARTMENT OF TRANSPORTATION
& PUBLIC FACILITIES
SOUTHEAST REGION

Haines Mooring Improvements
Project 75249

**Haines Ferry Terminal
General Layout**

CHECKED BY: B. Savikko		PROJECT DESIGNATION		YEAR	SHEET NO.	TOTAL SHEETS
DRAWN BY: W. Hickok		75249		2007	3	28
PATH: Q:\Hns\75249\MF\Phase-B\PlanSet\03-Site Plan.dwg		PLDT: PSPACE 1-1		TAB: Layout1		Wed, 01/Aug/07 09:18AM
NO.	DATE	REVISIONS DESCRIPTION	PROJECT DESIGNATION	YEAR	SHEET NO.	TOTAL SHEETS

LUTAK INLET

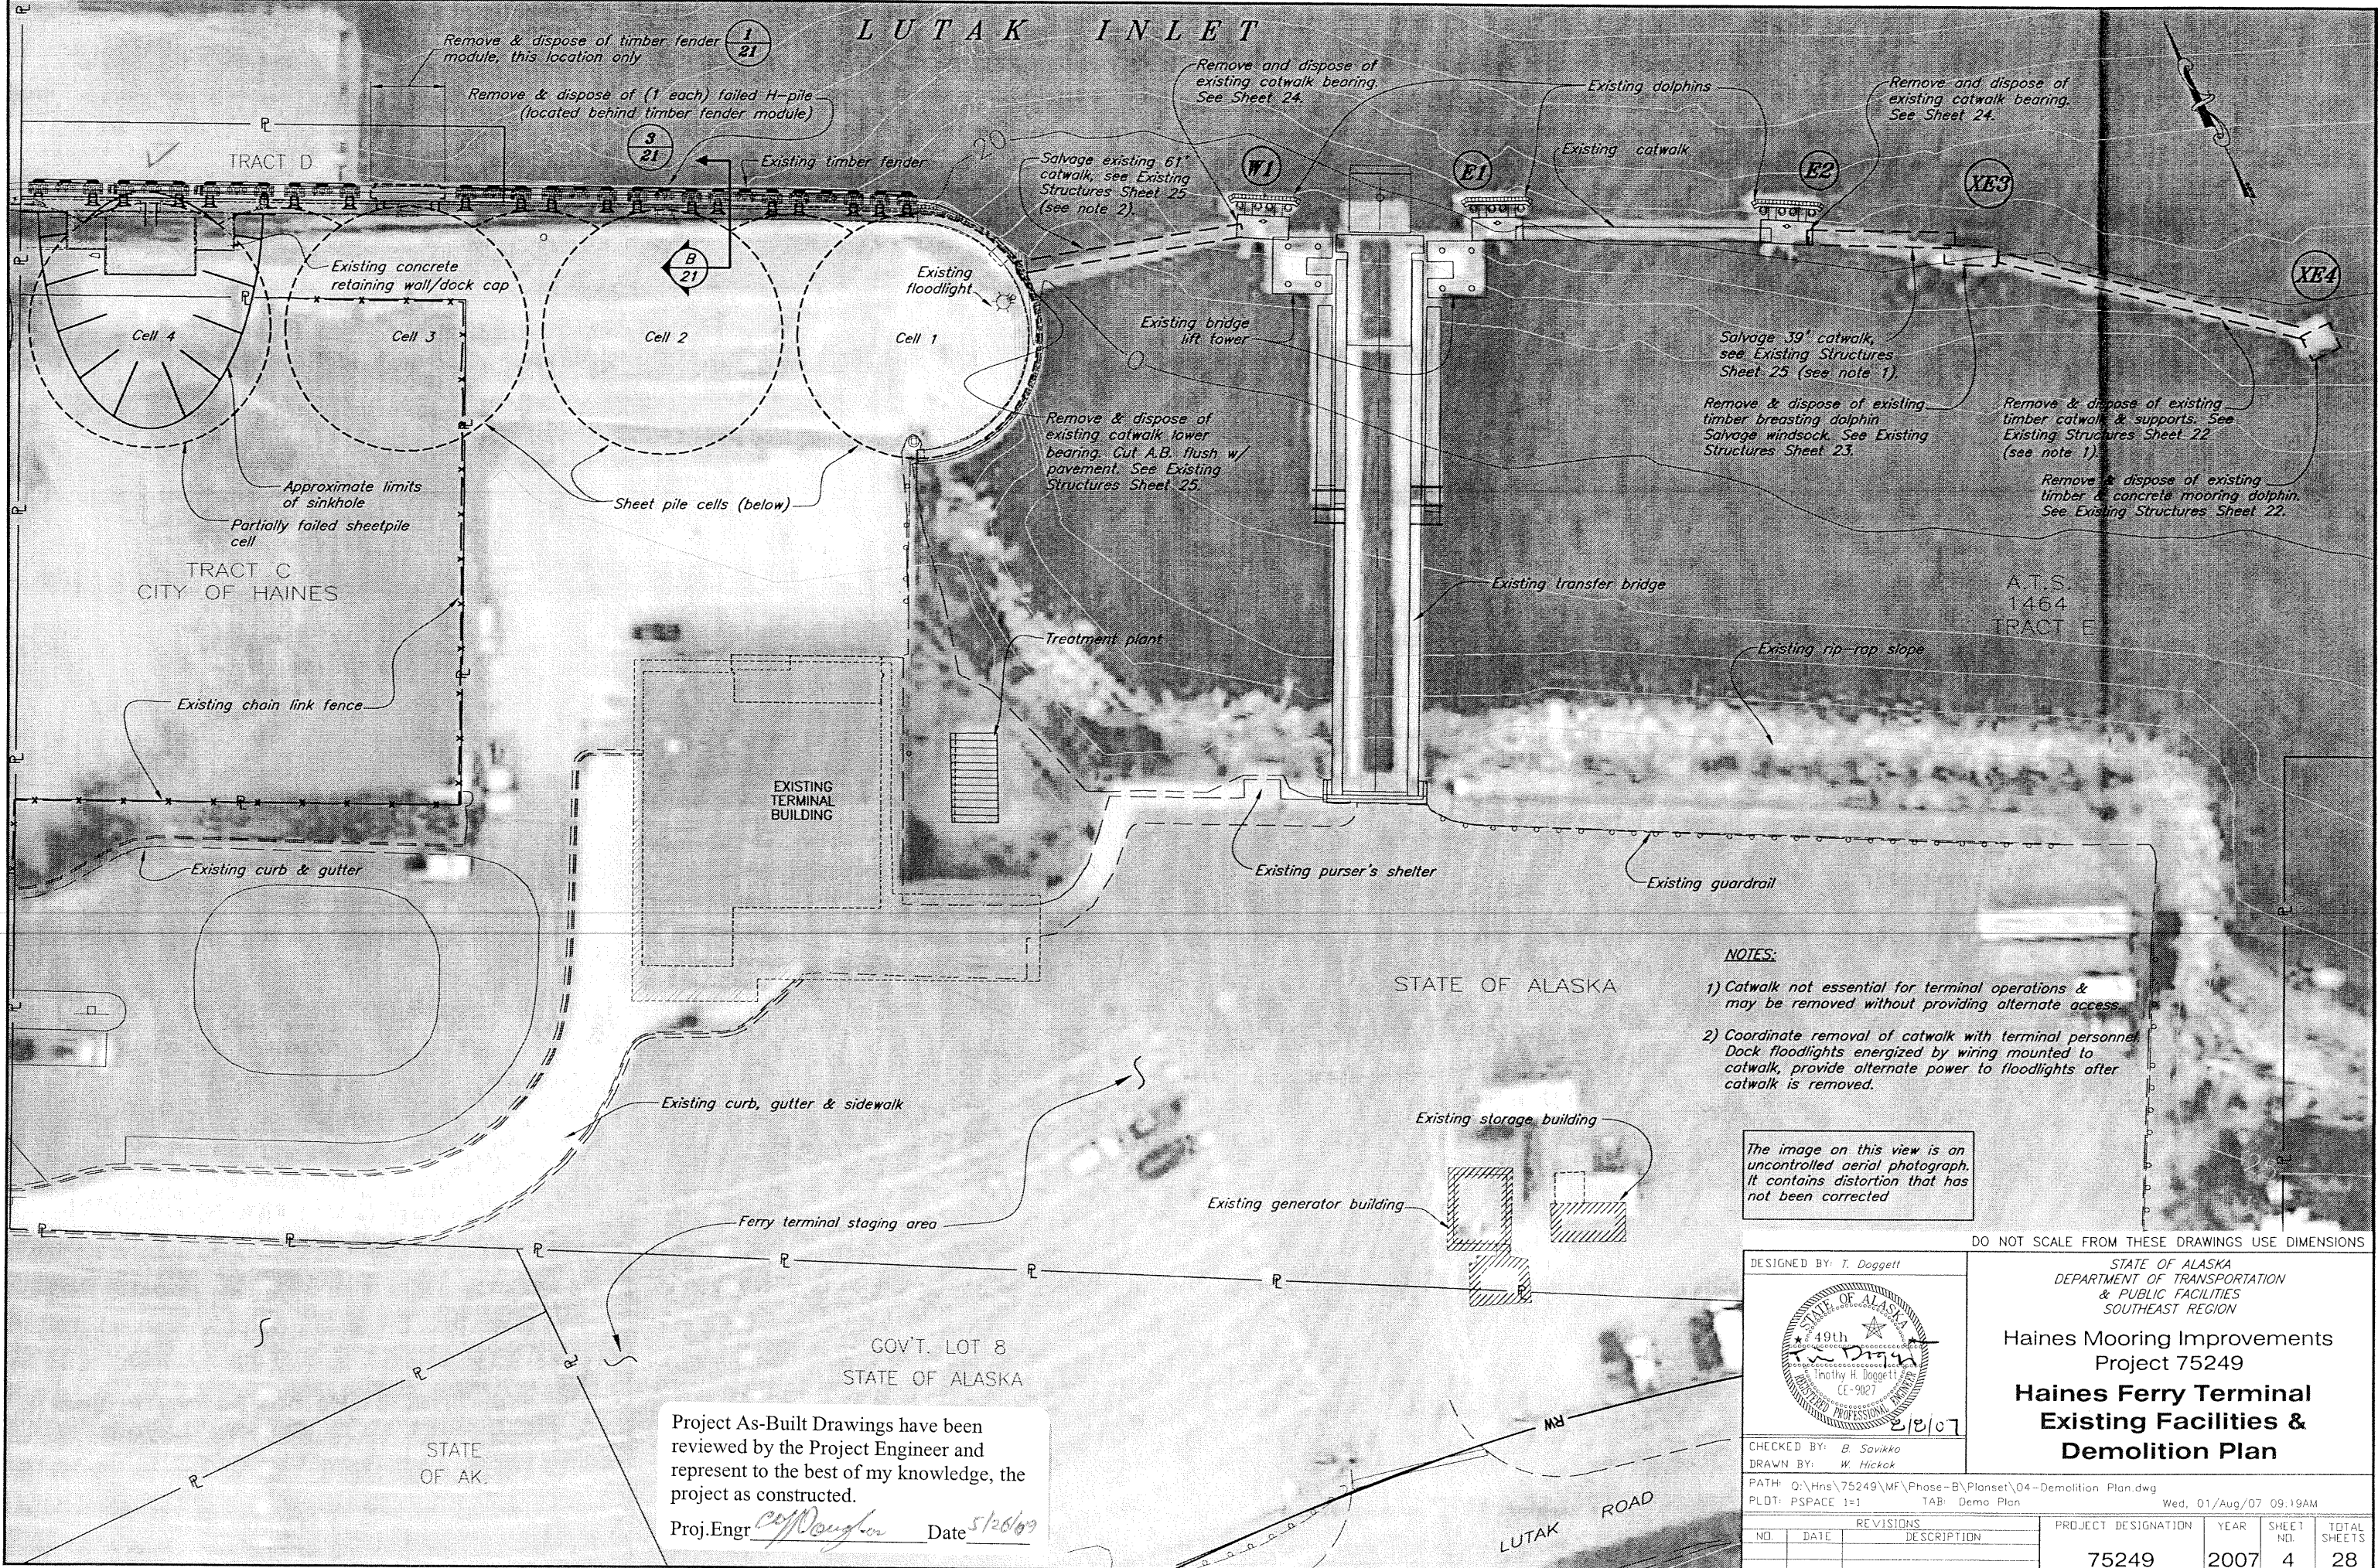

- NOTES:**
- 1) Catwalk not essential for terminal operations & may be removed without providing alternate access.
 - 2) Coordinate removal of catwalk with terminal personnel. Dock floodlights energized by wiring mounted to catwalk, provide alternate power to floodlights after catwalk is removed.

The image on this view is an uncontrolled aerial photograph. It contains distortion that has not been corrected.

DO NOT SCALE FROM THESE DRAWINGS USE DIMENSIONS

DESIGNED BY: T. Doggett

CHECKED BY: B. Savikko
DRAWN BY: W. Hickok

STATE OF ALASKA
DEPARTMENT OF TRANSPORTATION
& PUBLIC FACILITIES
SOUTHEAST REGION

Haines Mooring Improvements
Project 75249

**Haines Ferry Terminal
Existing Facilities &
Demolition Plan**



PATH: Q:\Hns\75249\MF\Phase-B\PlanSet\04-Demolition Plan.dwg
PLDT: PSPACE 1=1 TAB: Demo Plan Wed, 01/Aug/07 09:19AM

REVISIONS			PROJECT DESIGNATION	YEAR	SHEET NO.	TOTAL SHEETS
NO.	DATE	DESCRIPTION				
			75249	2007	4	28


Project As-Built Drawings have been reviewed by the Project Engineer and represent to the best of my knowledge, the project as constructed.

Proj. Engr. *copy Doggett* Date *5/28/07*

LUTAK INLET

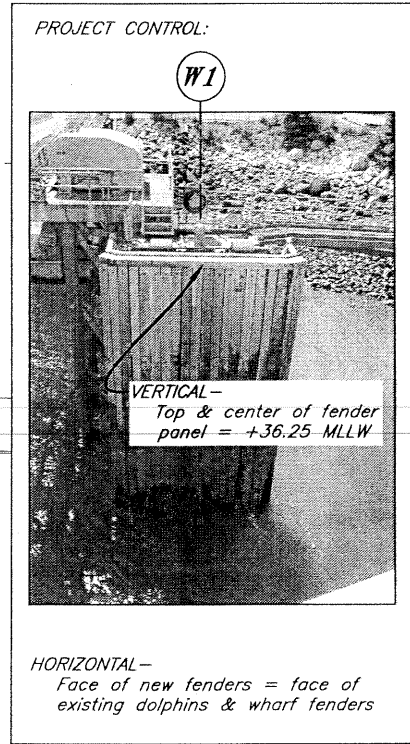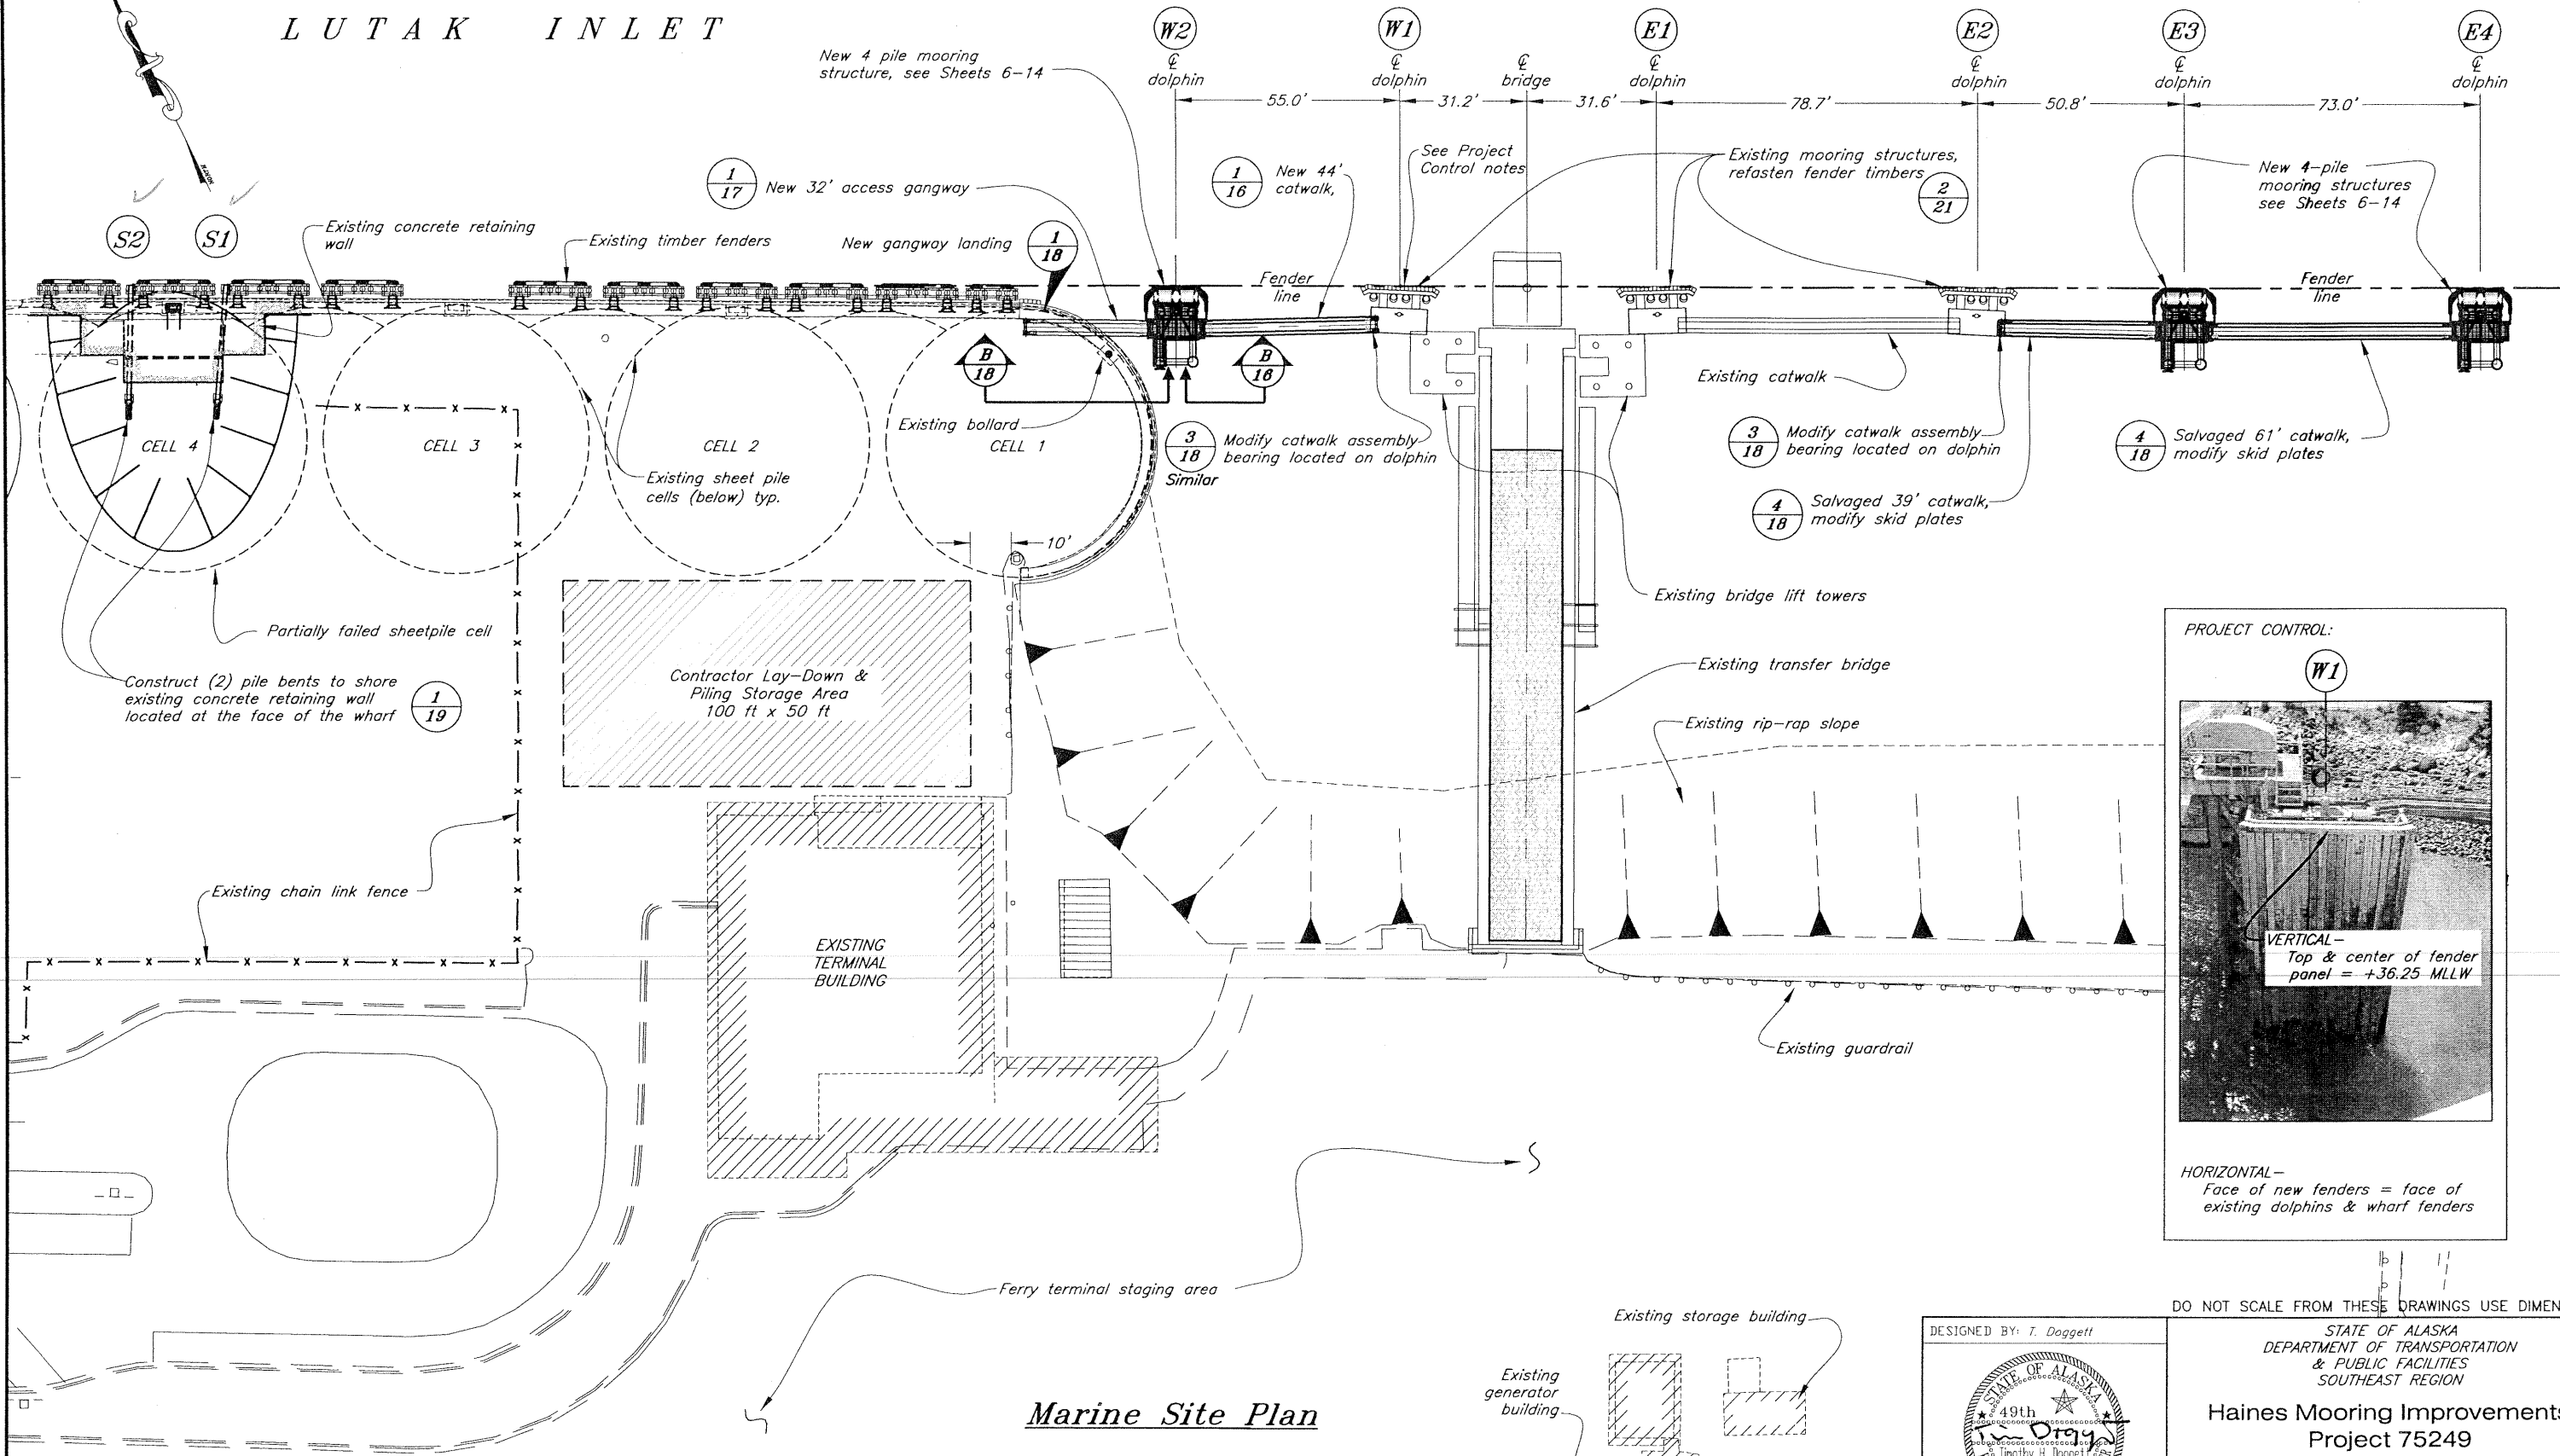

Marine Site Plan

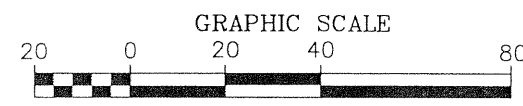

Project As-Built Drawings have been reviewed by the Project Engineer and represent to the best of my knowledge, the project as constructed.

Proj. Engr *C. J. Douglas* Date *5/26/09*

DESIGNED BY: T. Daggett

CHECKED BY: B. Savikko
DRAWN BY: W. Hickok

PATH: Q:\Hns\75249\MF\Phase-B\PlanSet\05- Marine Layout.dwg
PLOT: PSPACE 1=1 TAB: Layout1 Wed, 01/Aug/07 09:19AM


DO NOT SCALE FROM THESE DRAWINGS USE DIMENSIONS

STATE OF ALASKA
DEPARTMENT OF TRANSPORTATION
& PUBLIC FACILITIES
SOUTHEAST REGION

Haines Mooring Improvements
Project 75249

**Proposed
Marine Site Plan**

NO.	DATE	REVISIONS DESCRIPTION	PROJECT DESIGNATION	YEAR	SHEET NO.	TOTAL SHEETS
			75249	2007	5	28

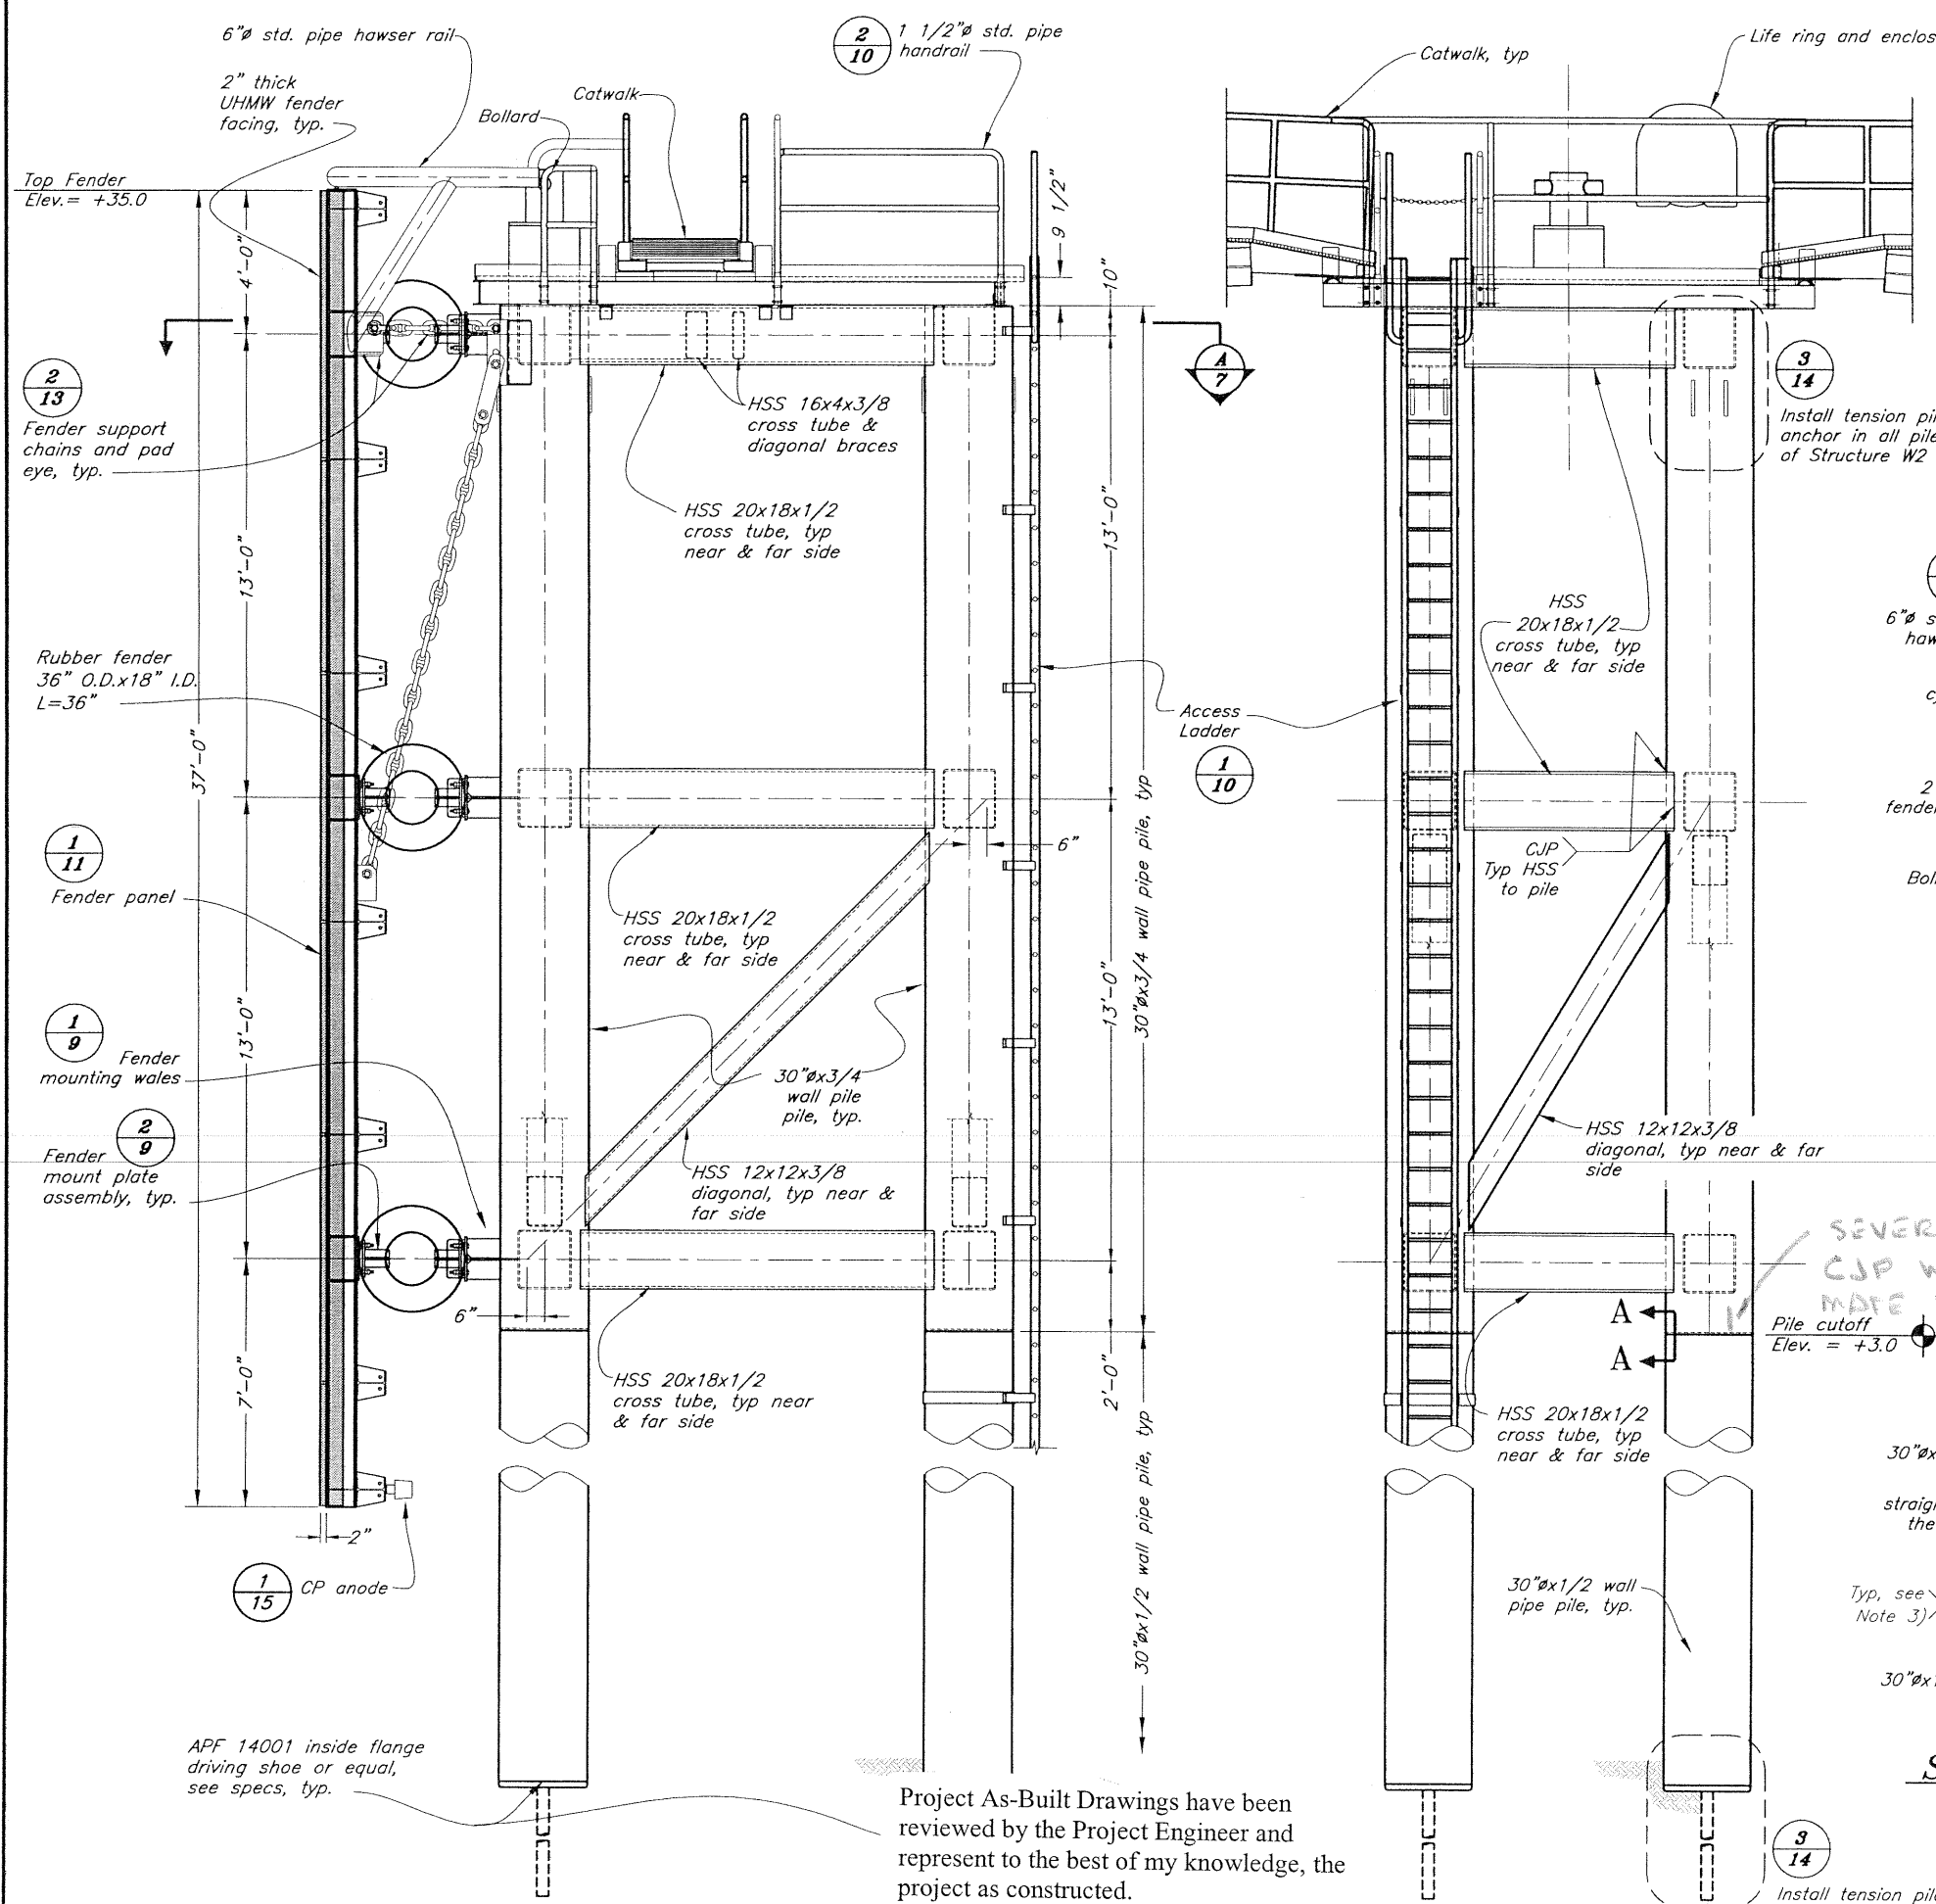


Side Elevation

Back Elevation


Project As-Built Drawings have been reviewed by the Project Engineer and represent to the best of my knowledge, the project as constructed.

Proj. Engr Cliff Douglas Date 5/26/09

- Notes:
- 1) Fender panel not shown.
 - 2) E3 shown, W2 & E4 similar except for catwalks, see layout Sheet 5
 - 3) State furnished QA weld inspection may be required, see Section 504-3.02.9 Field Welding.

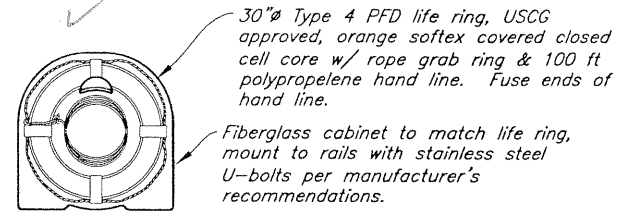


Life Ring Detail 1
(1 life ring per dolphin)

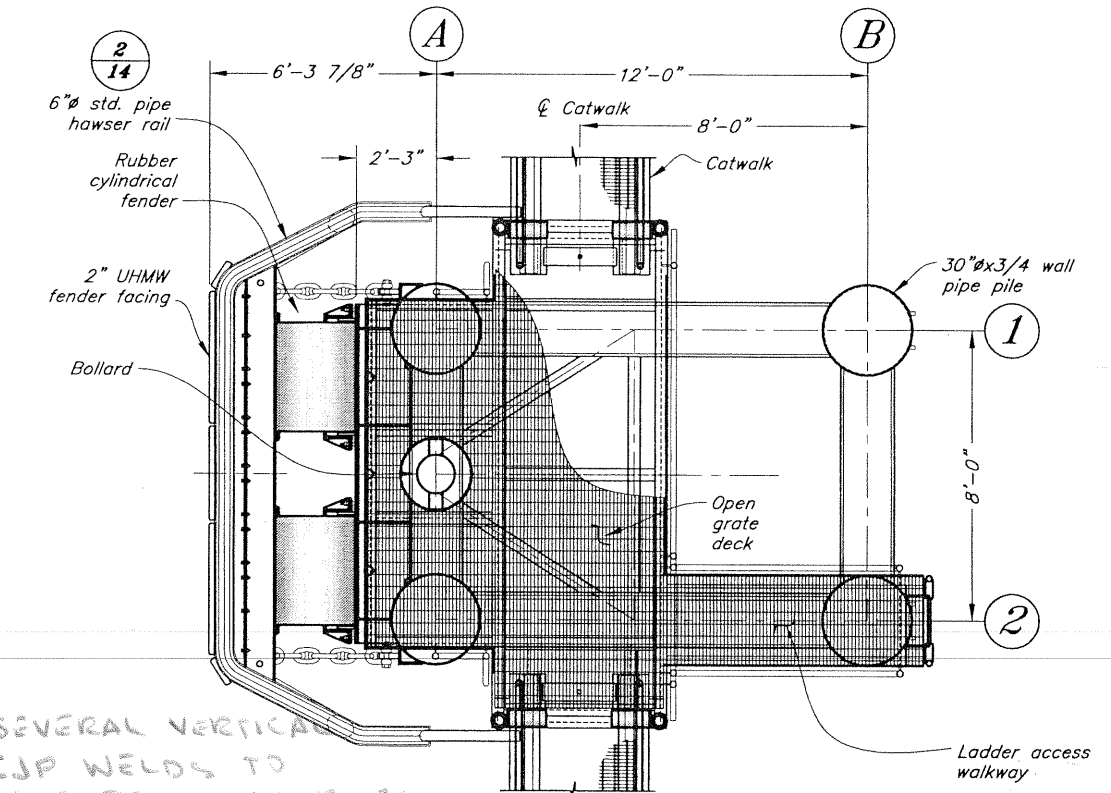

Plan View

NOTE:
Mooring structures W2 & E3 as shown, E4 is similar. See 1/14 for additional guardrail & marker light details of E4.

SEVERAL VERTICAL CJP WELDS TO MAKE FRAME TO PILES

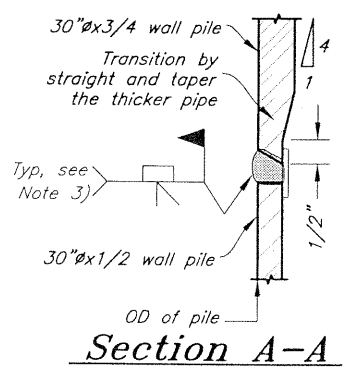

Section A-A

DESIGNED BY: T. Daggett

CHECKED BY: B. Savikko
DRAWN BY: W. Hickok

PATH: Q:\Hns\75249\MF\Phase-B\PlanSet\06-Vert Dolphin Plan & Elev V2.dwg
PLOT: PSPACE 1=1 TAB: Layout1 Mon, 13/Aug/07 08:49AM


DO NOT SCALE FROM THESE DRAWINGS USE DIMENSIONS

STATE OF ALASKA
DEPARTMENT OF TRANSPORTATION & PUBLIC FACILITIES
SOUTHEAST REGION


Haines Mooring Improvements
Project 75249

Mooring Structures W2, E3, & E4


REVISIONS		PROJECT DESIGNATION	YEAR	SHEET NO.	TOTAL SHEETS
NO.	DATE				
		75249	2007	6	28

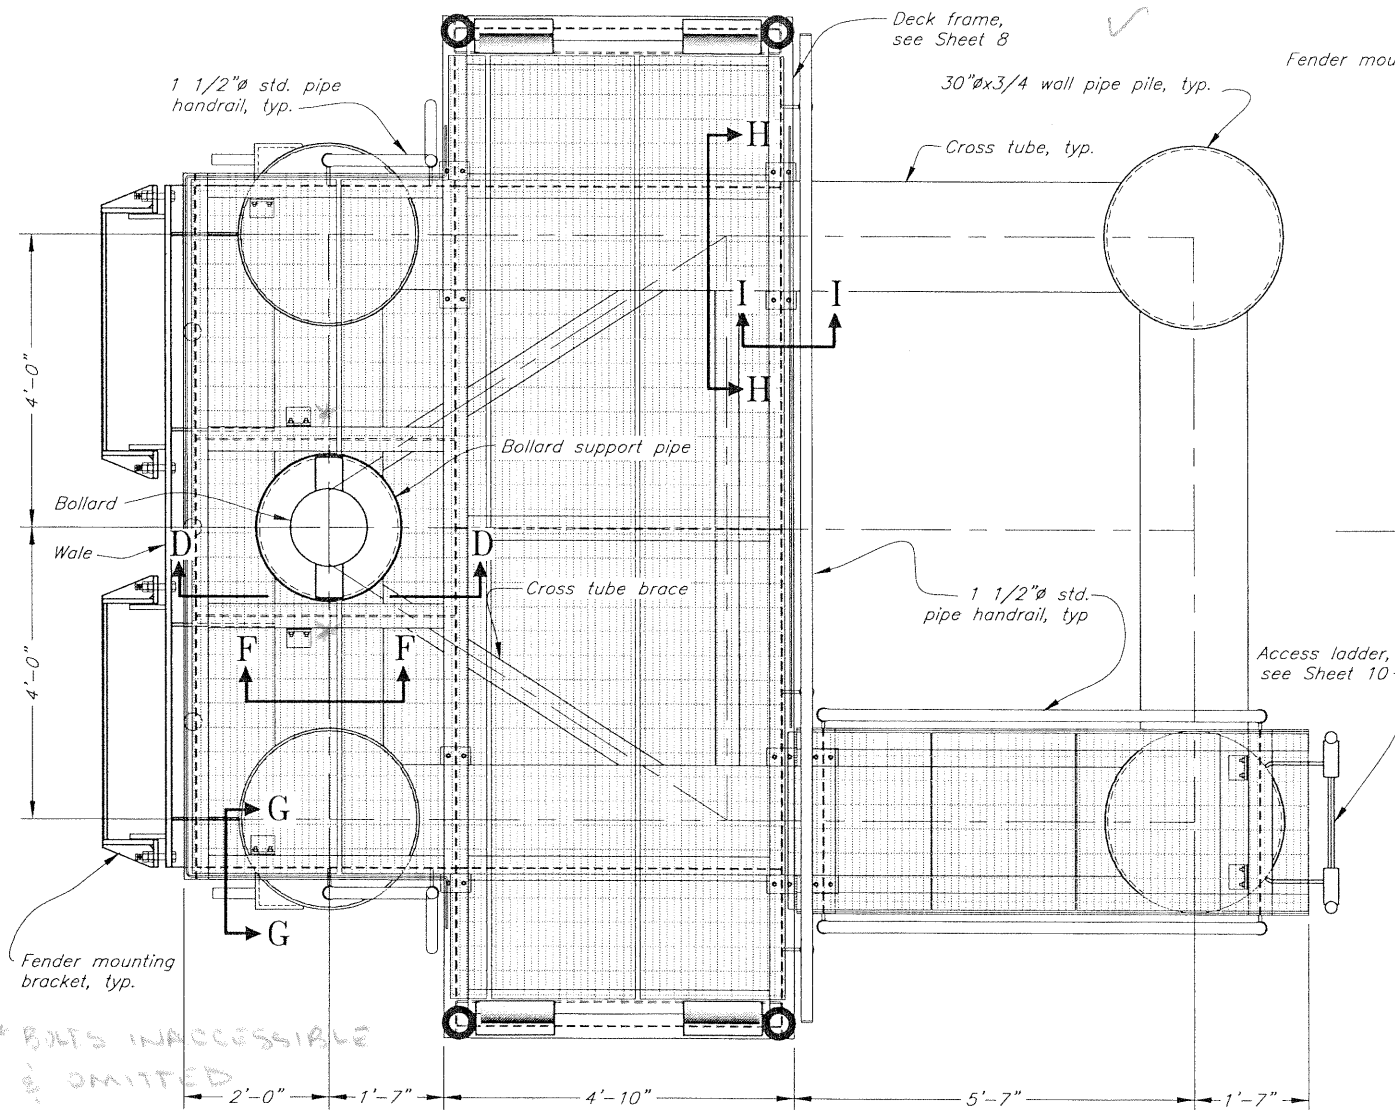

Dolphin Cap Plan

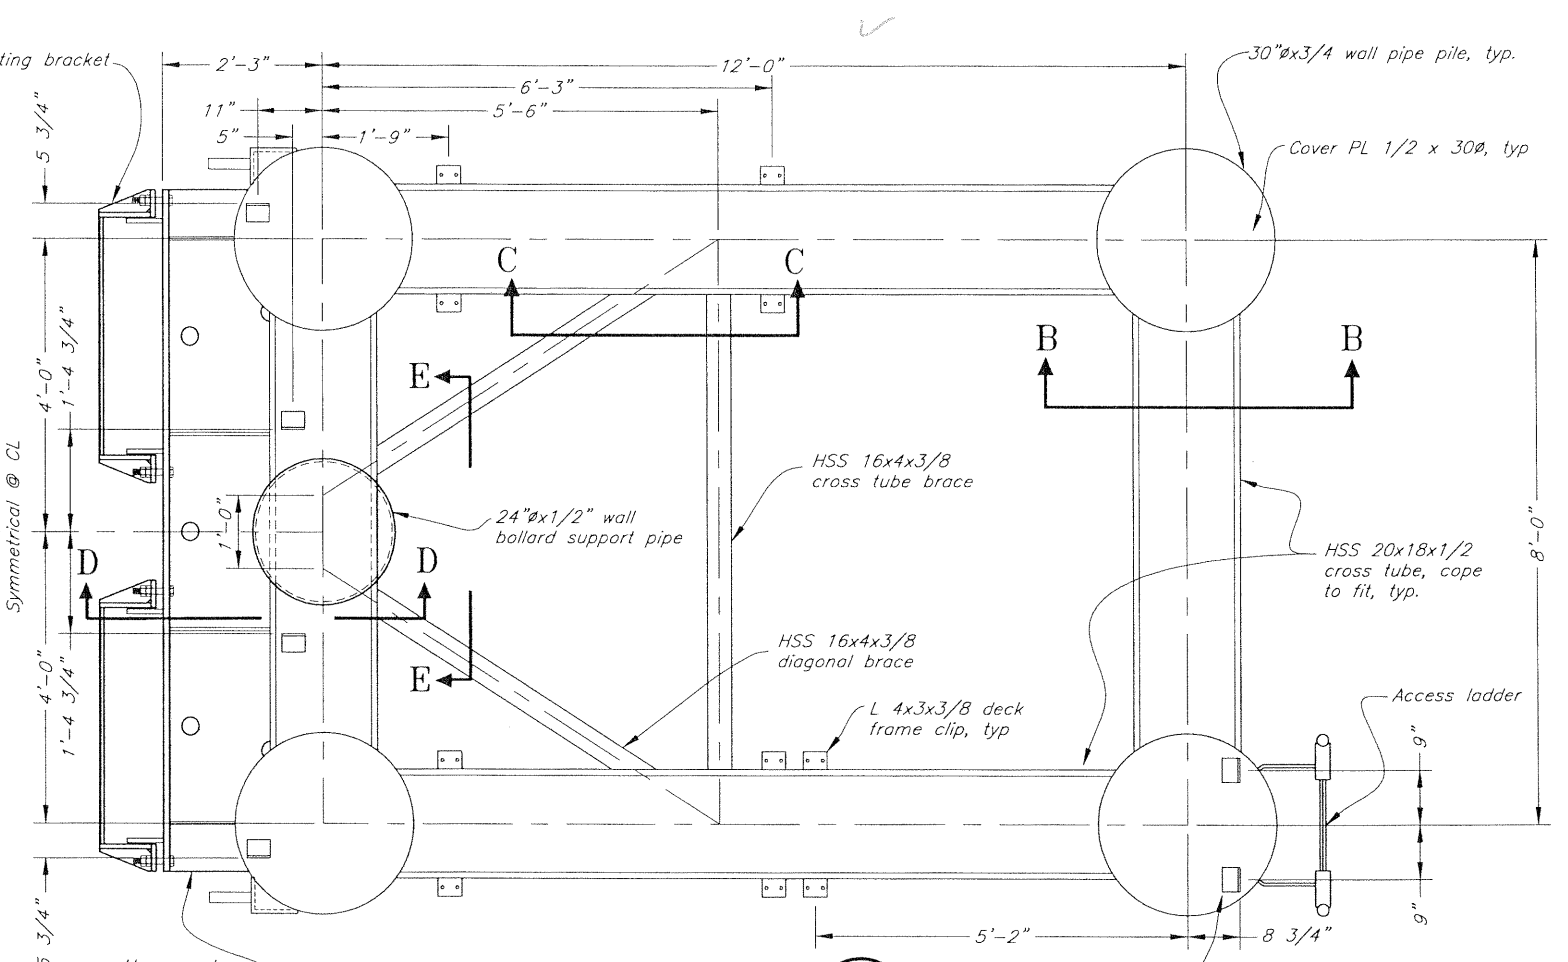

Section A-A

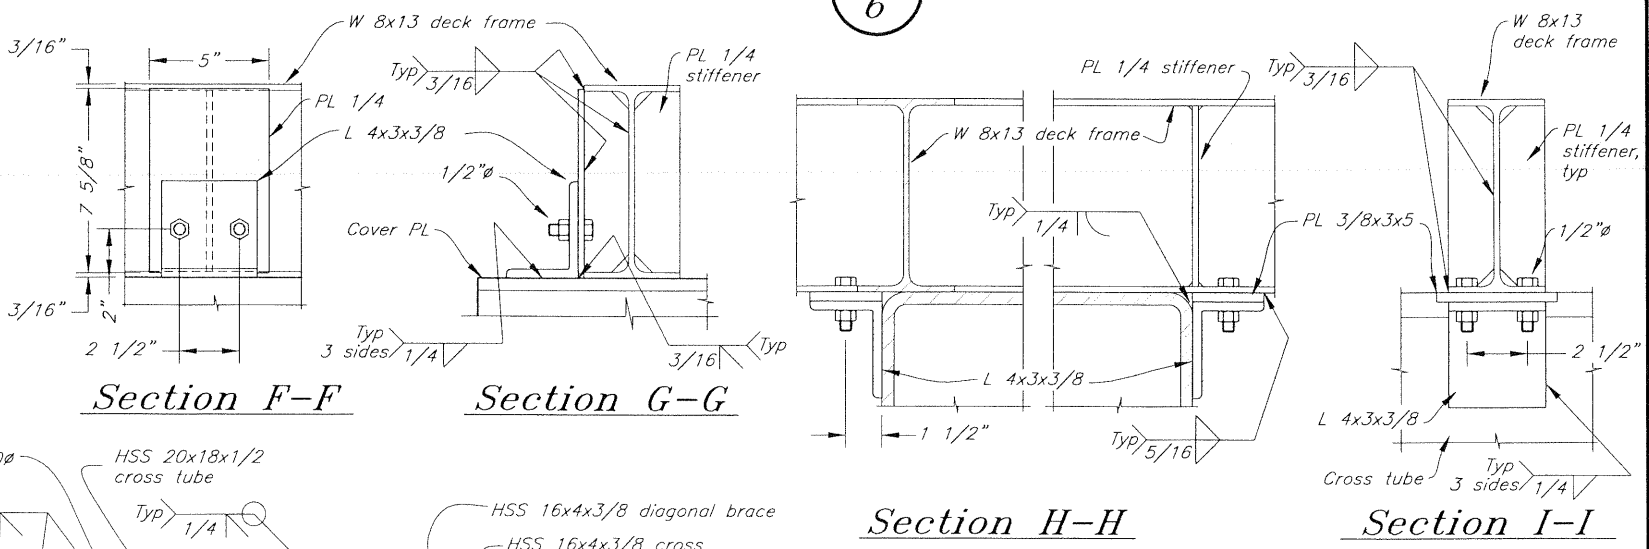

Section F-F


Section G-G

Section H-H


Section I-I

Project As-Built Drawings have been reviewed by the Project Engineer and represent to the best of my knowledge, the project as constructed.


Proj. Engr *Cef/Douglass* Date *5/26/09*

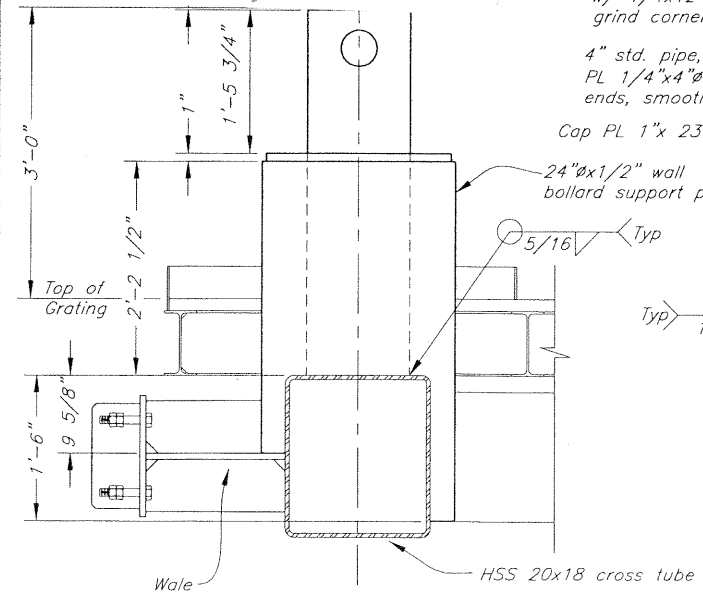


Section D-D

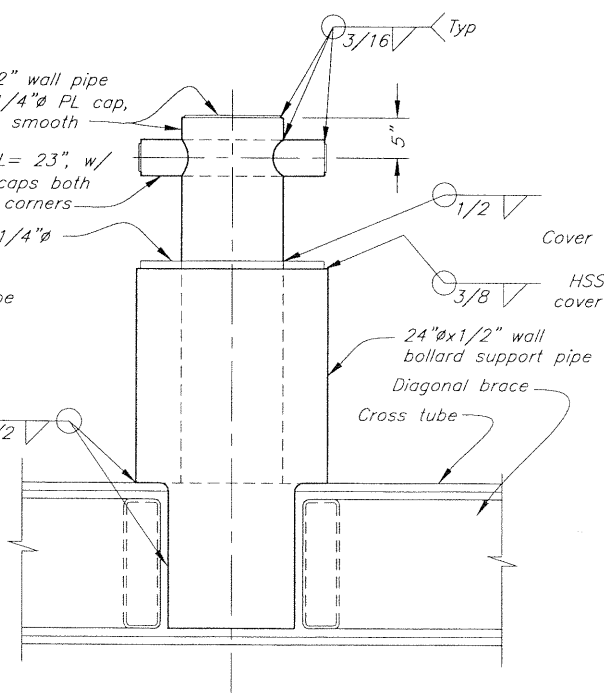

Section E-E

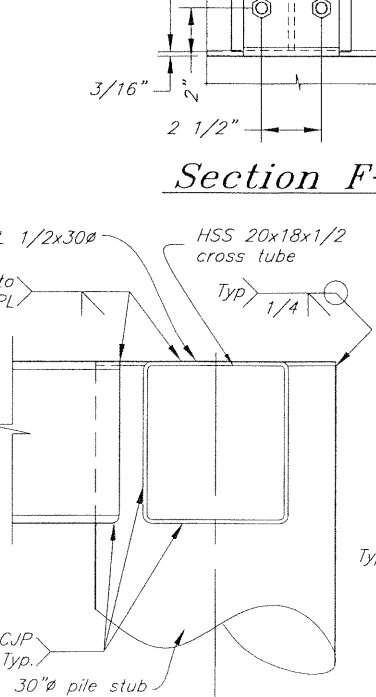

Section B-B

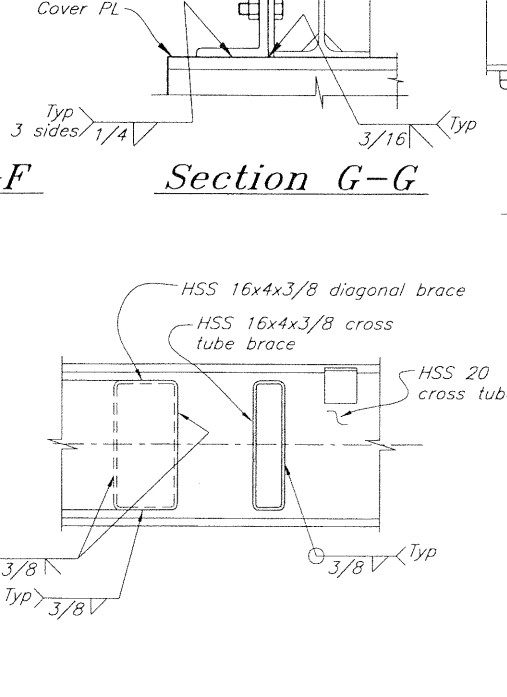

Section C-C

DO NOT SCALE FROM THESE DRAWINGS USE DIMENSIONS

DESIGNED BY: *T. Doggett*

CHECKED BY: *B. Savikko*
 DRAWN BY: *W. Hickok*


PATH: *Q:\Hns\75249\MF\Phase-B\Plans\07-Cap Details v1.dwg*
 PLOT: *PSPACE 1=1 TAB: Cap-V02 Thu, 09/Aug/07 06:28PM*

STATE OF ALASKA
 DEPARTMENT OF TRANSPORTATION
 & PUBLIC FACILITIES
 SOUTHEAST REGION


**Haines Mooring Improvements
 Project 75249**

**Mooring Structures
 W2, E3, & E4
 Cap Details**


REVISIONS		PROJECT DESIGNATION	YEAR	SHEET NO.	TOTAL SHEETS
NO.	DATE				
		75249	2007	7	28

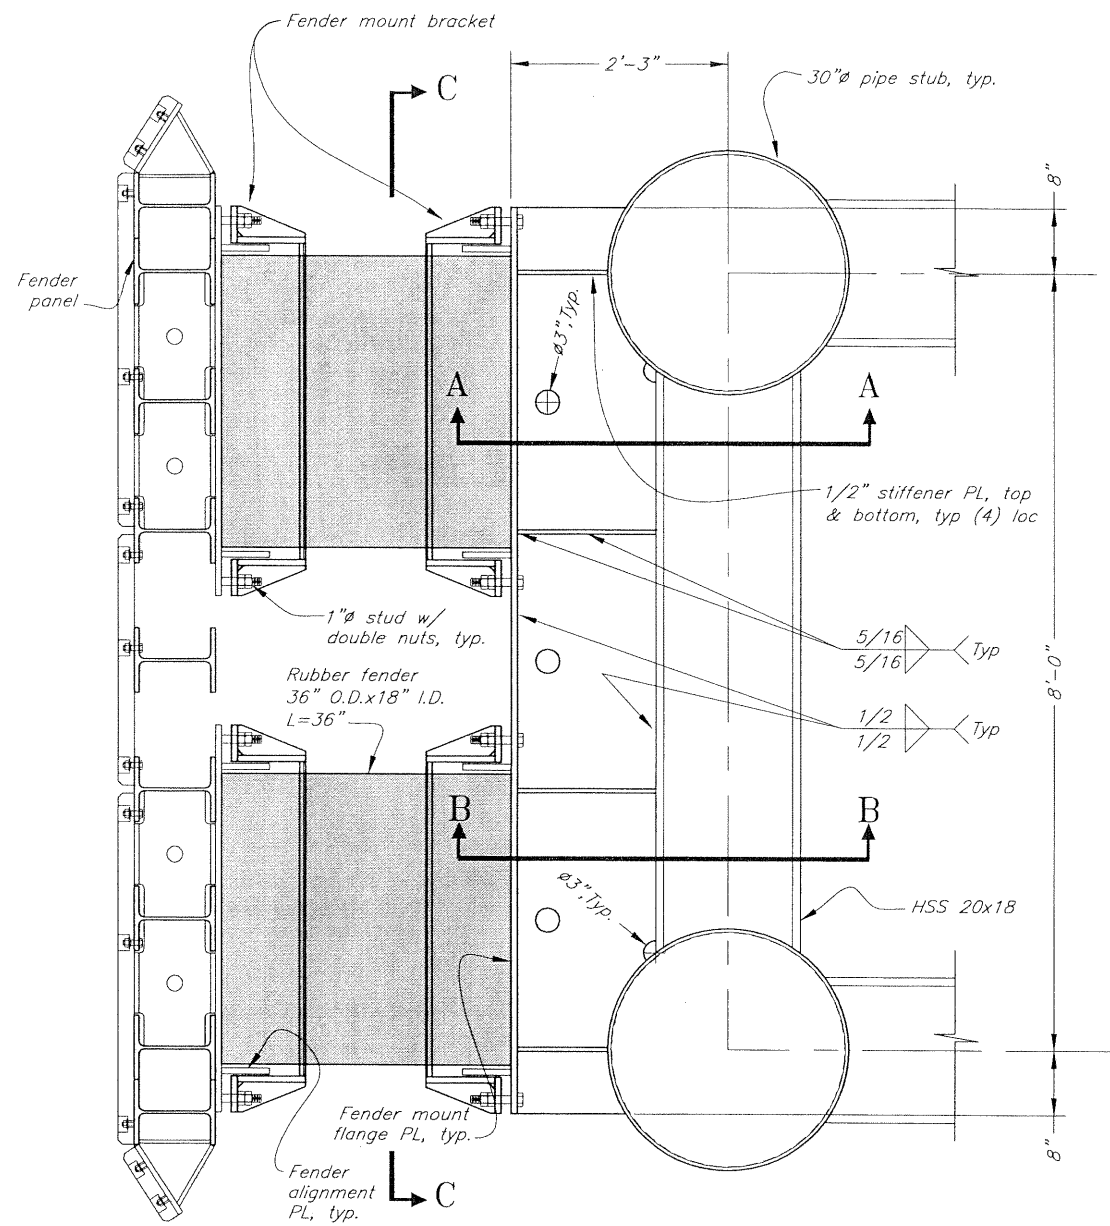


Fender Mounting Wales Plan (1)
Intermediate wale shown, lower wale similar

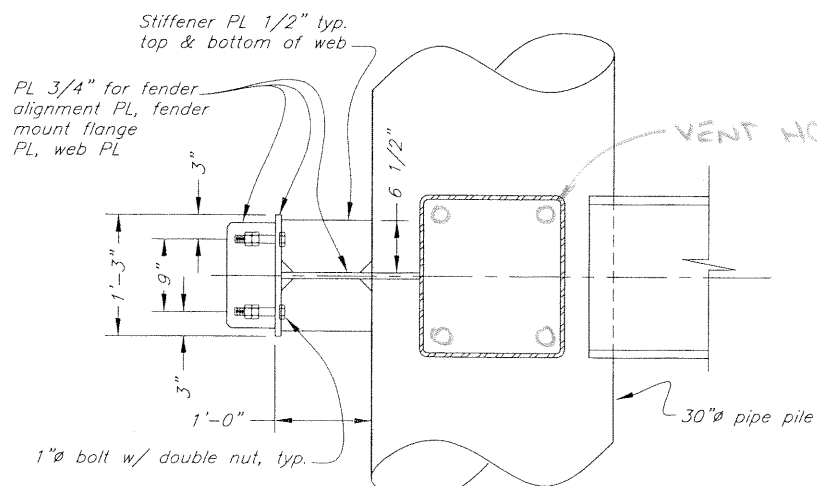


Section A-A

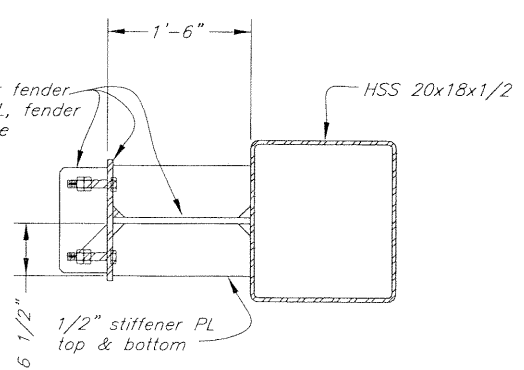


Section B-B

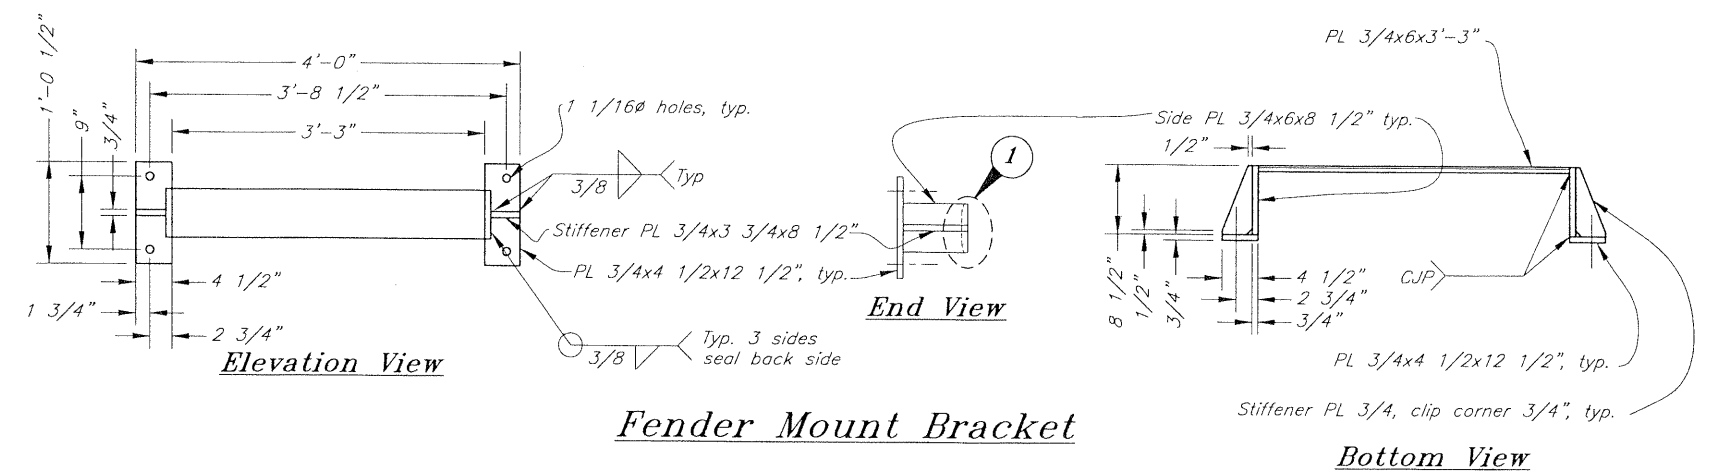


Fender Mount Bracket (2)

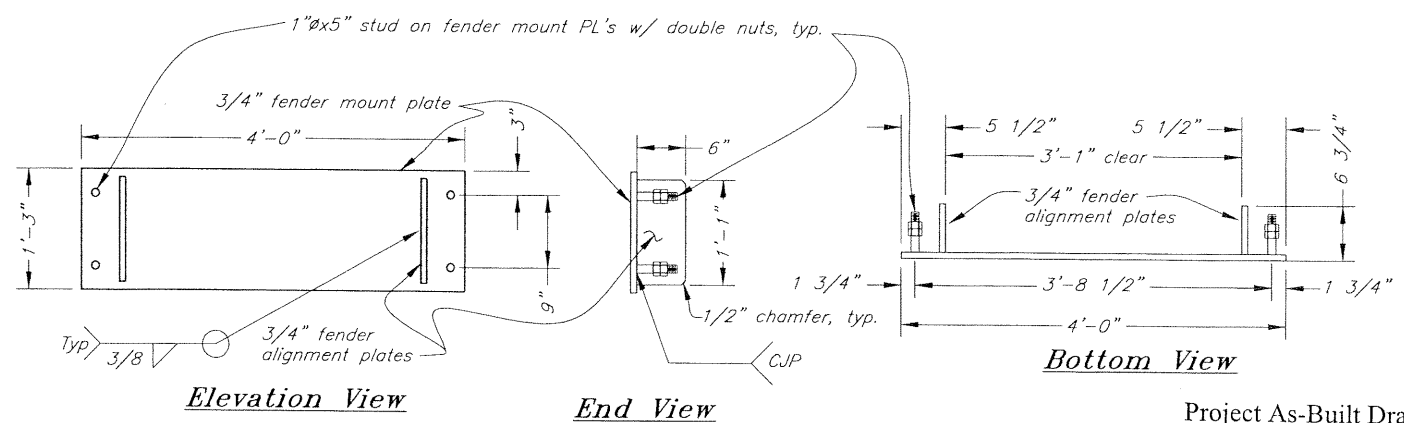

Fender Mounting Plate on Fender Panel (2)

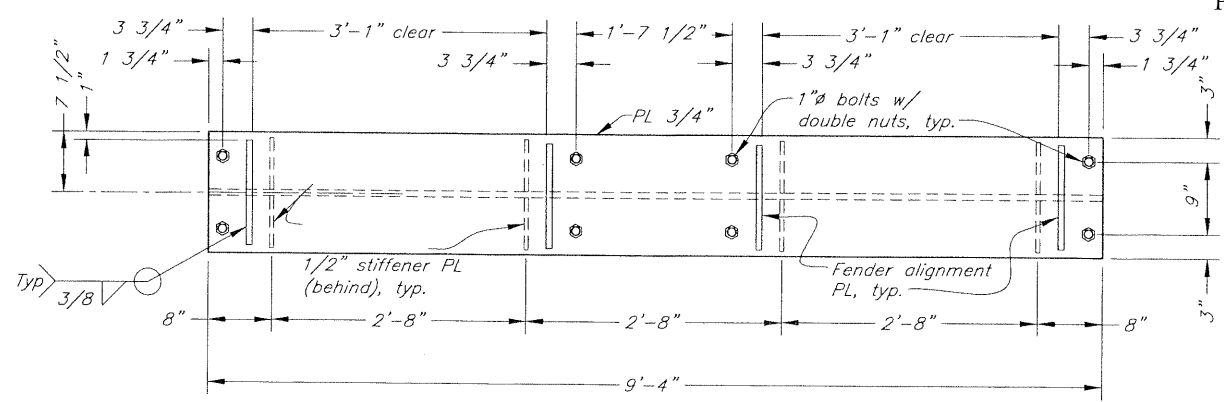

Section C-C

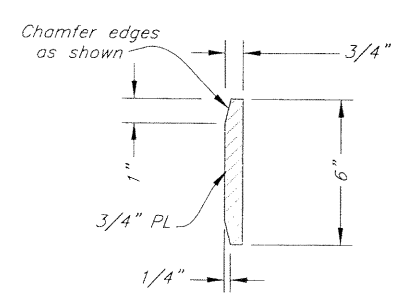


Detail (1)

Project As-Built Drawings have been reviewed by the Project Engineer and represent to the best of my knowledge, the project as constructed.

Proj. Engr. *C. J. Douglas* Date 5/26/09

DO NOT SCALE FROM THESE DRAWINGS USE DIMENSIONS

DESIGNED BY: T. Daggett CHECKED BY: B. Savikko DRAWN BY: W. Hickok		STATE OF ALASKA DEPARTMENT OF TRANSPORTATION & PUBLIC FACILITIES SOUTHEAST REGION Haines Mooring Improvements Project 75249 Mooring Structures W2, E3, & E4 Fender Mounting Wales	
PATH: Q:\Hns\75249\MF\Phase-B\Planset\09-Wales.dwg PLOT: PSPACE 1=1 TAB: Wales-V05		Wed, 01/Aug/07 09:22AM	
REVISIONS NO. DATE DESCRIPTION		PROJECT DESIGNATION 75249	YEAR 2007
		SHEET NO. 9	TOTAL SHEETS 28

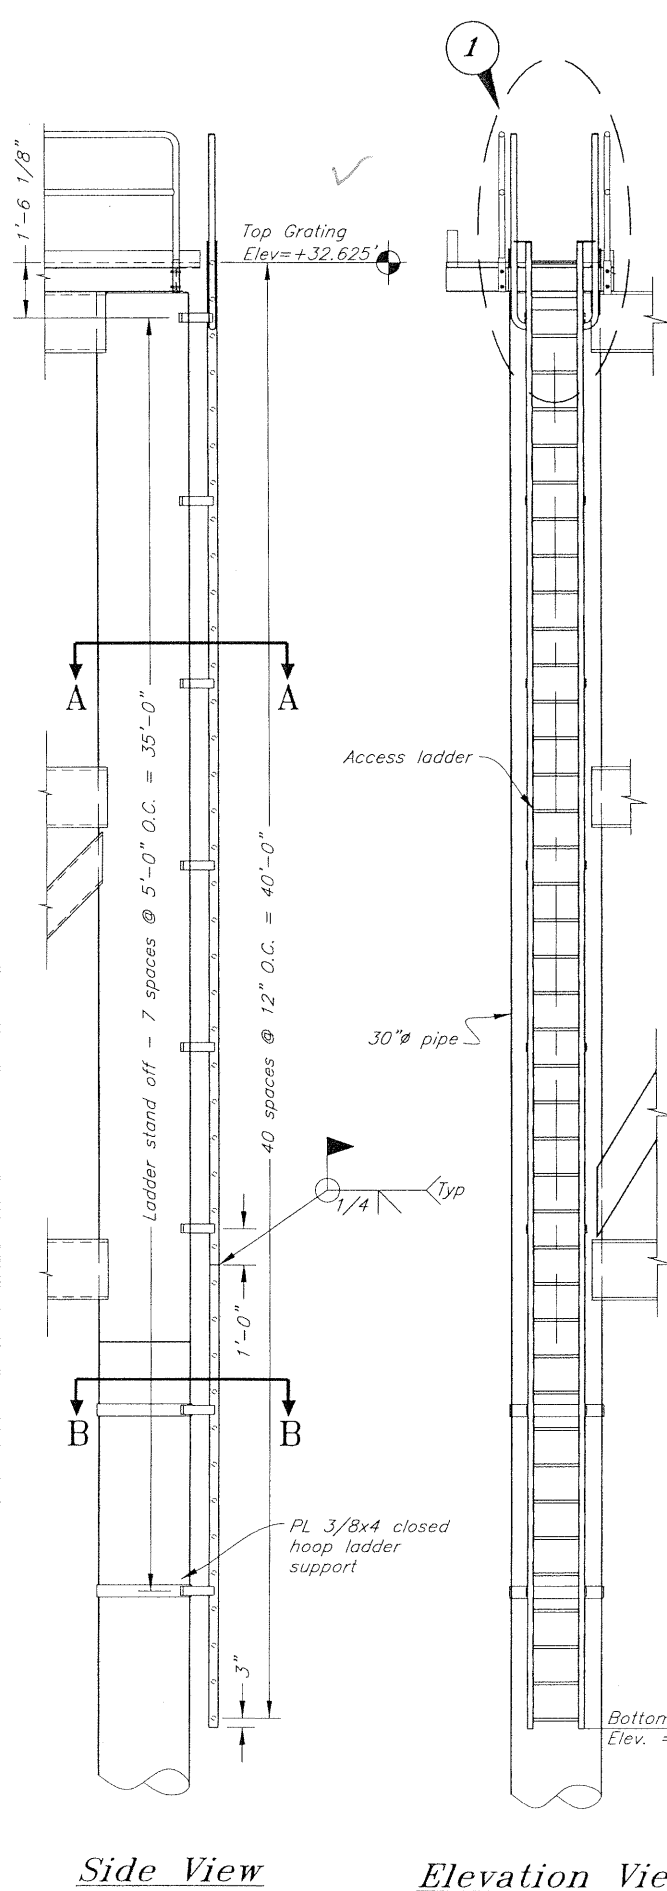


Side View

Elevation View


Access Ladder **1**
6

Project As-Built Drawings have been reviewed by the Project Engineer and represent to the best of my knowledge, the project as constructed.
Proj. Engr *C. J. Douglas* Date *5/28/07*

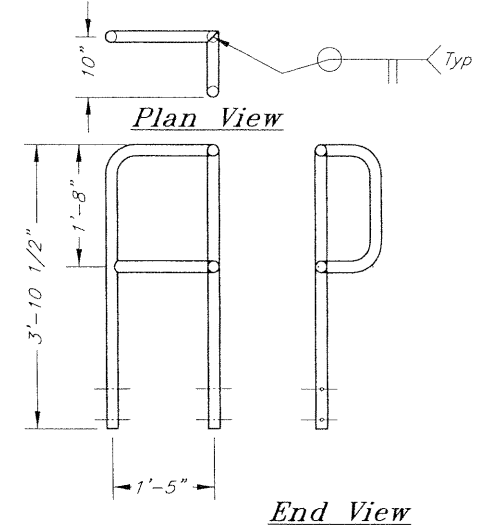


Side Rail
(2 req'd)

End View

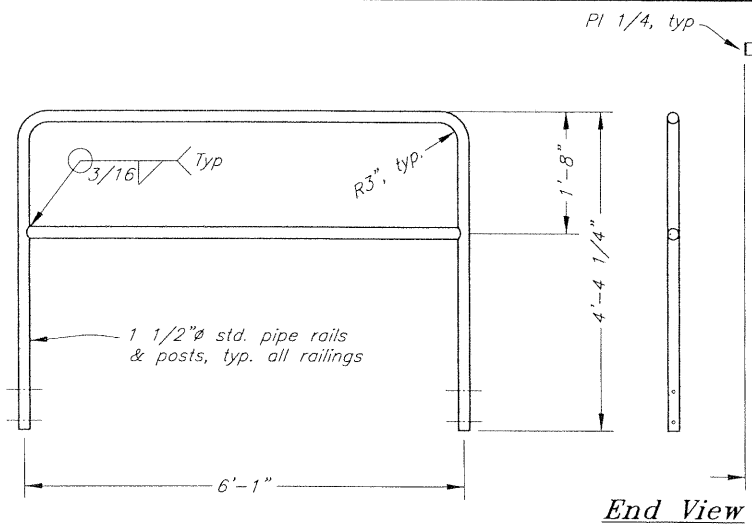


Ladder Access
Walkway Rail
(2 req'd)

End View

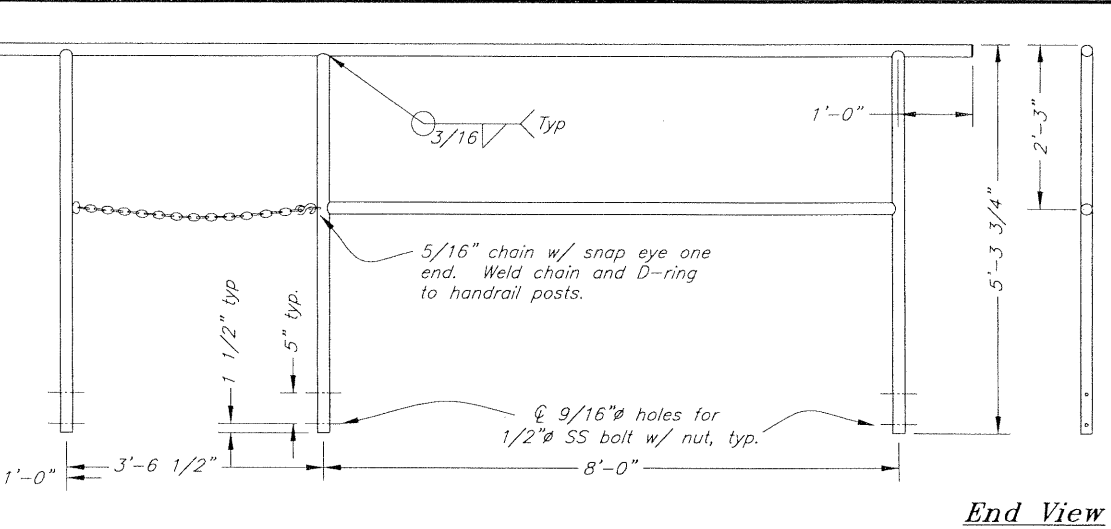


Back Rail

End View

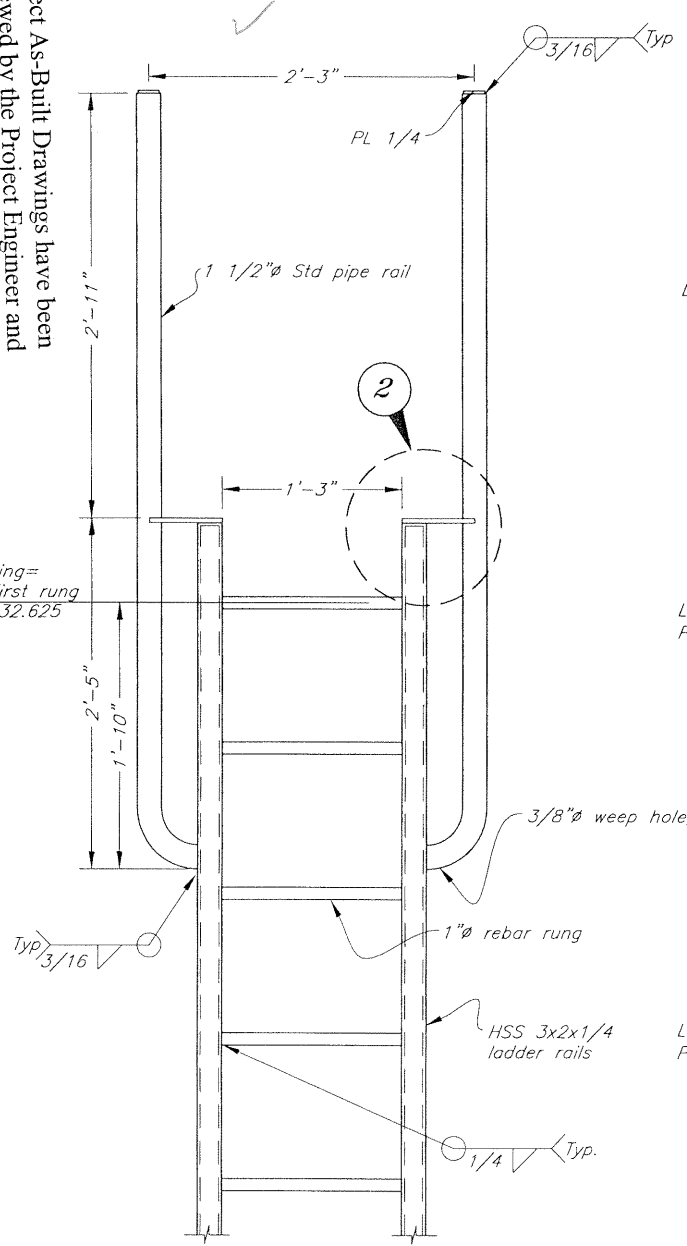


Detail **1**

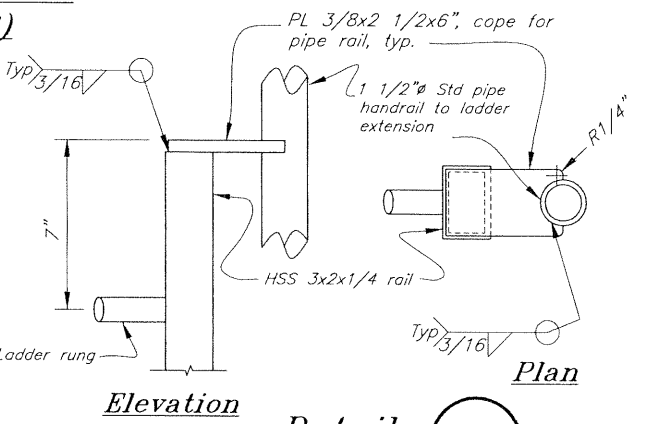


Elevation

Detail **2**

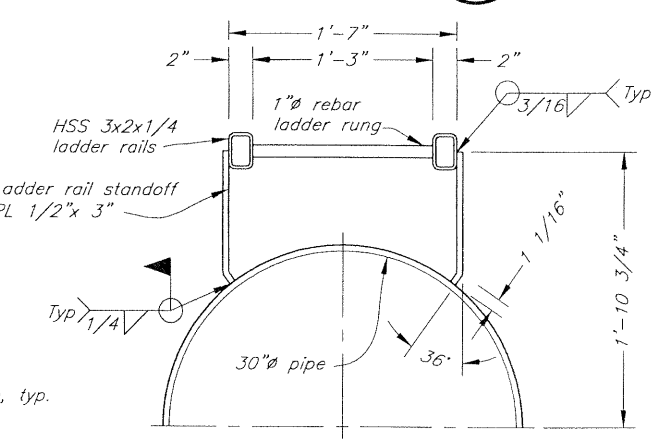


Section A-A

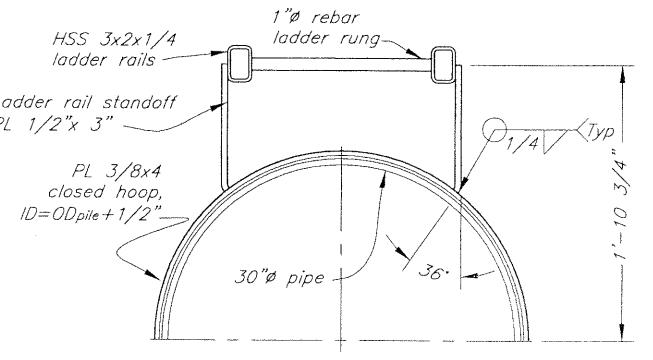

Section B-B

Details not shown, same as Section A-A

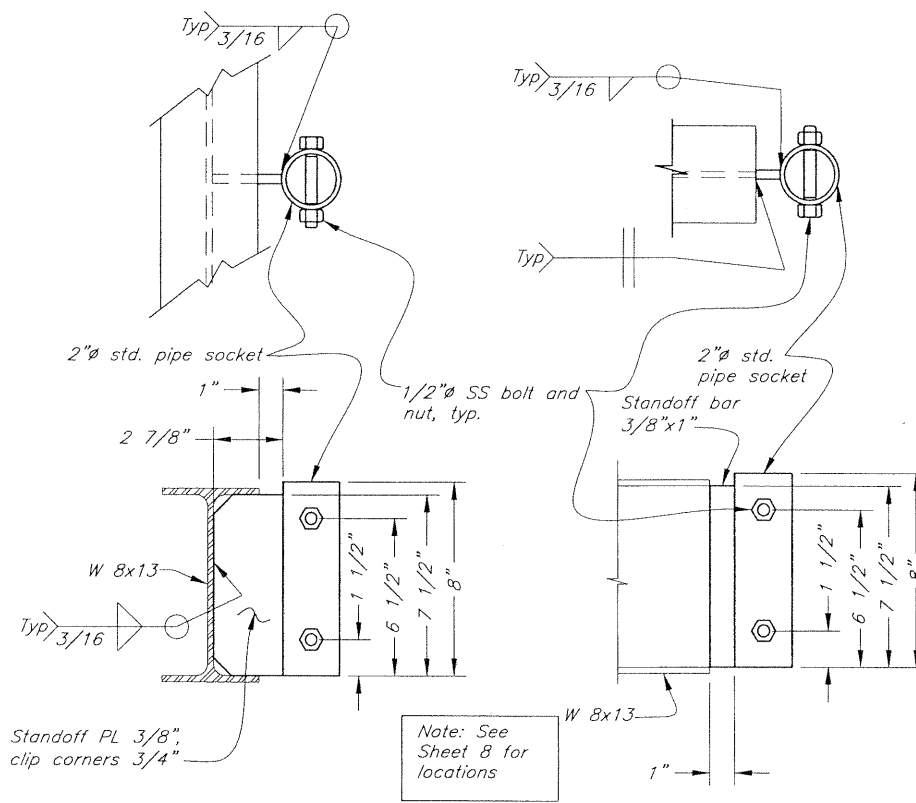


Between Flanges

At End of Web


Handrails & Sockets **2**
6

DO NOT SCALE FROM THESE DRAWINGS USE DIMENSIONS


DESIGNED BY: T. Doggett		STATE OF ALASKA DEPARTMENT OF TRANSPORTATION & PUBLIC FACILITIES SOUTHEAST REGION			
		Haines Mooring Improvements Project 75249			
CHECKED BY: B. Savikko		Mooring Structures W2, E3, & E4 Railing & Ladder			
DRAWN BY: W. Hickok		PATH: O:\Hns\75249\MF\Phase-B\Planset\10-Rails & Ladders.dwg PLOT: PSPACE 1=1 TAB: Rails & Ladder-V04 Wed, 01/Aug/07 09:22AM			
REVISIONS		PROJECT DESIGNATION	YEAR	SHEET NO.	TOTAL SHEETS
NO.	DATE	DESCRIPTION	75249	2007	10
					28

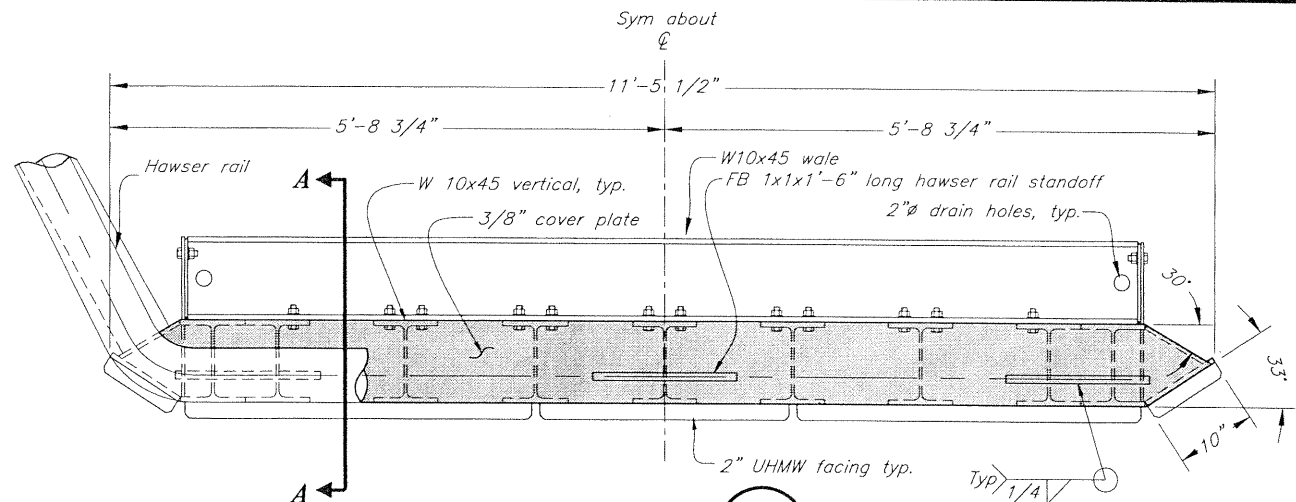


Section A
11

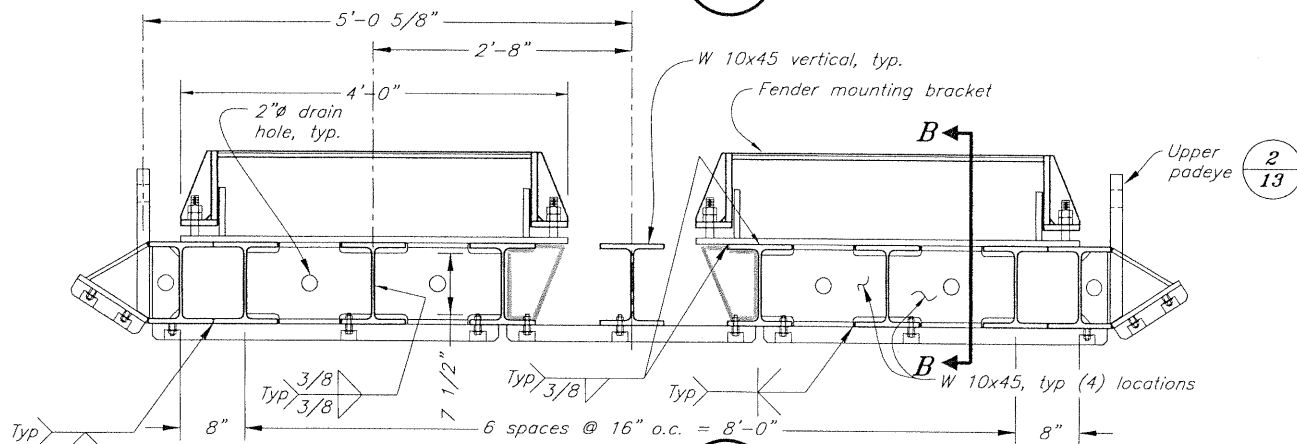


Section B
11

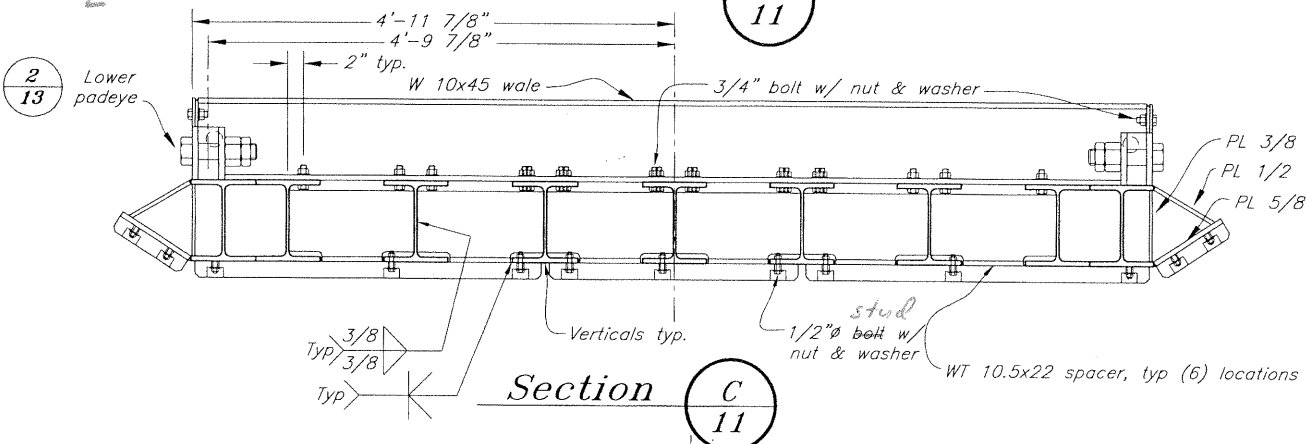


Section C
11

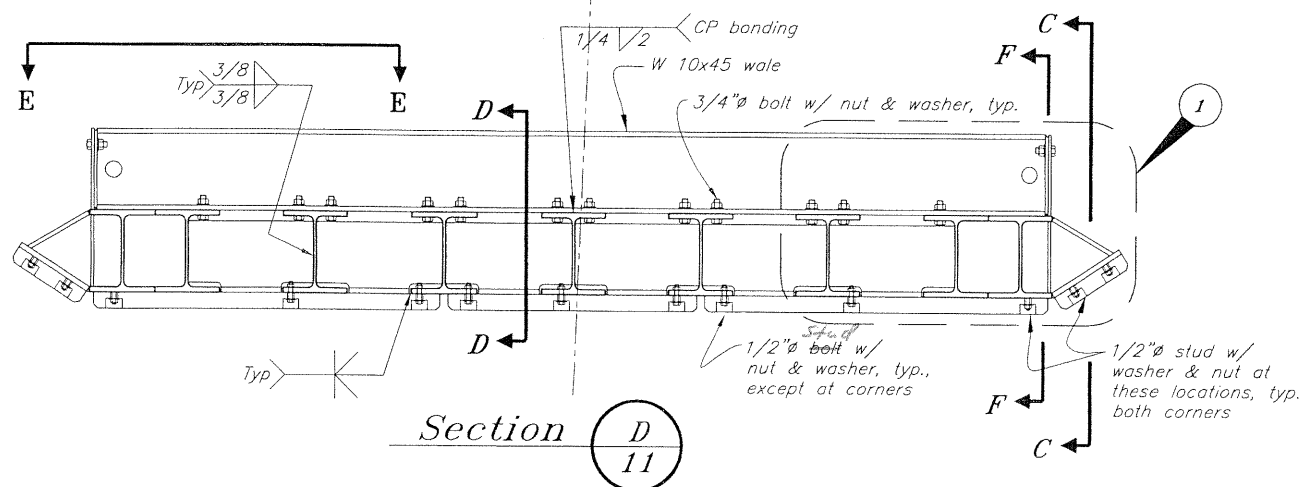


Section D
11

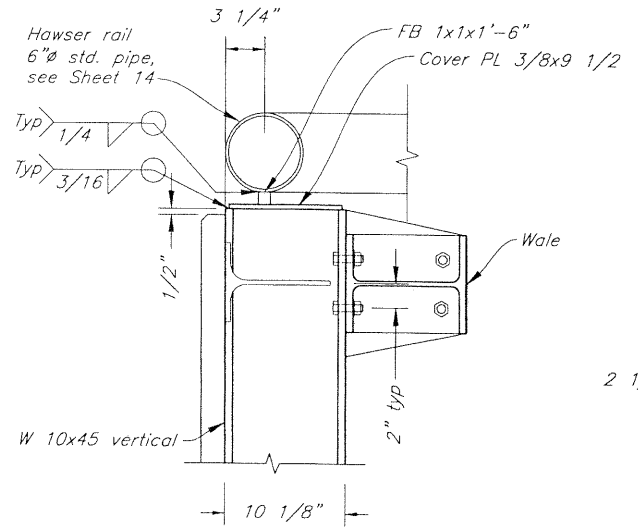


Section A-A

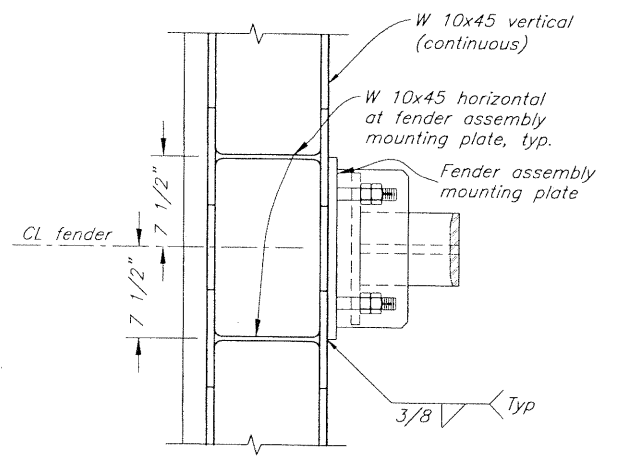


Section B-B

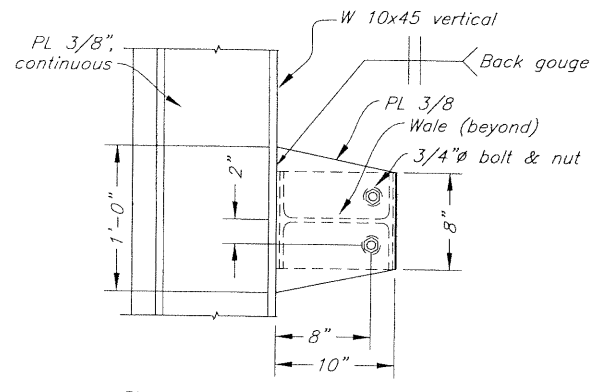


Section C-C

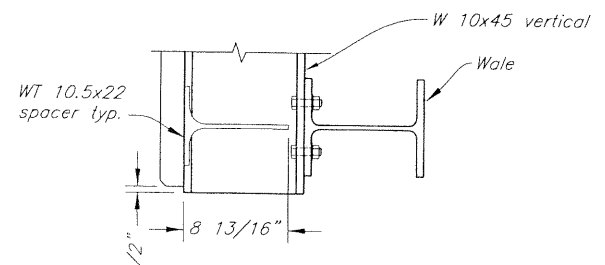


Section D-D

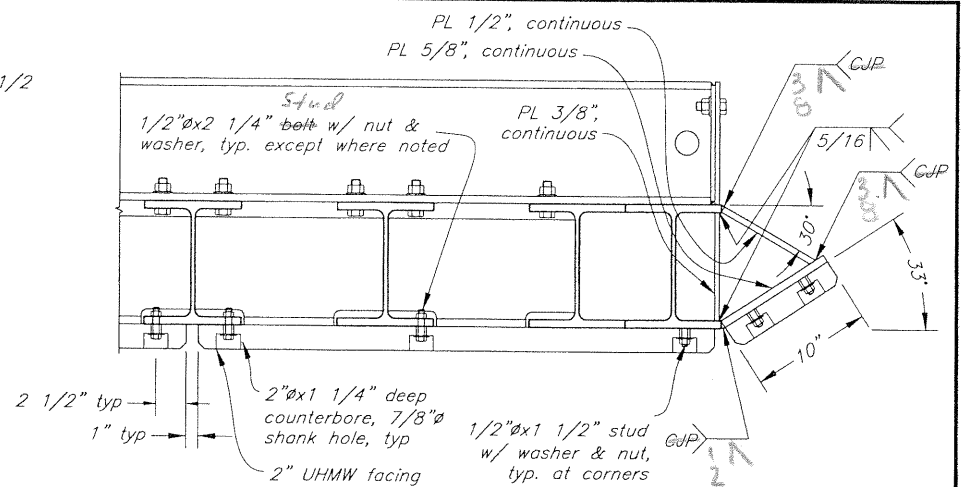

Detail 1

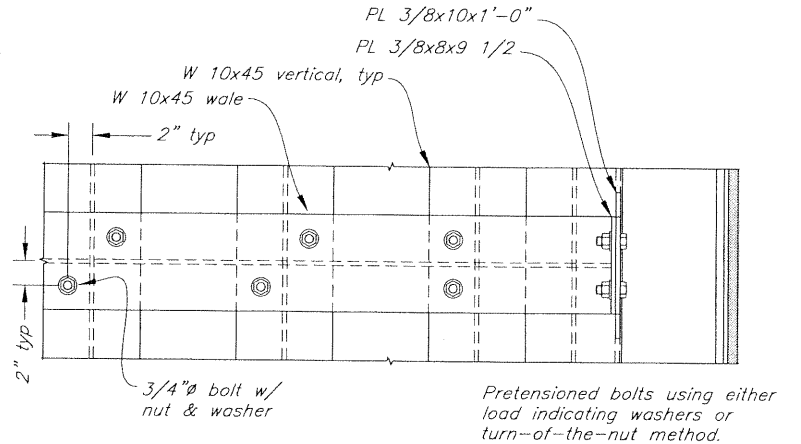

Section E-E

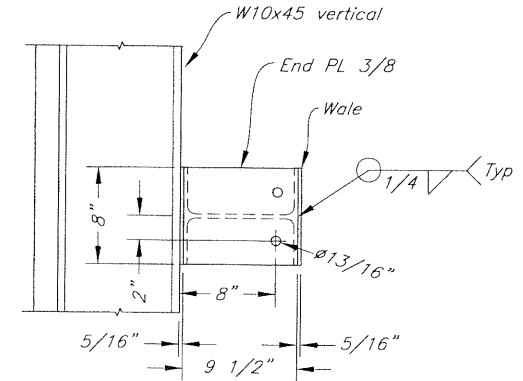

Section F-F

DO NOT SCALE FROM THESE DRAWINGS USE DIMENSIONS

Project As-Built Drawings have been reviewed by the Project Engineer and represent to the best of my knowledge, the project as constructed.

Proj. Engr. *Timothy H. Doggett* Date 5/26/09

DESIGNED BY: T. Doggett

CHECKED BY: B. Savikko
DRAWN BY: W. Hickok

STATE OF ALASKA
49th
Timothy H. Doggett
CE-9027


STATE OF ALASKA
DEPARTMENT OF TRANSPORTATION
& PUBLIC FACILITIES
SOUTHEAST REGION

Haines Mooring Improvements
Project 75249
Mooring Structures
W2, E3 & E4
Fender Panel
Details

8/8/07

PATH: Q:\Hins\75249\MF\Phase-B\PlanSet\12-Fender Panel Frame Details v1.dwg
PLOT: PSPACE 1=1 TAB: 10 Wed, 01/Aug/07 09:22AM


NO.	DATE	REVISIONS DESCRIPTION	PROJECT DESIGNATION	YEAR	SHEET NO.	TOTAL SHEETS
			75249	2007	12	28

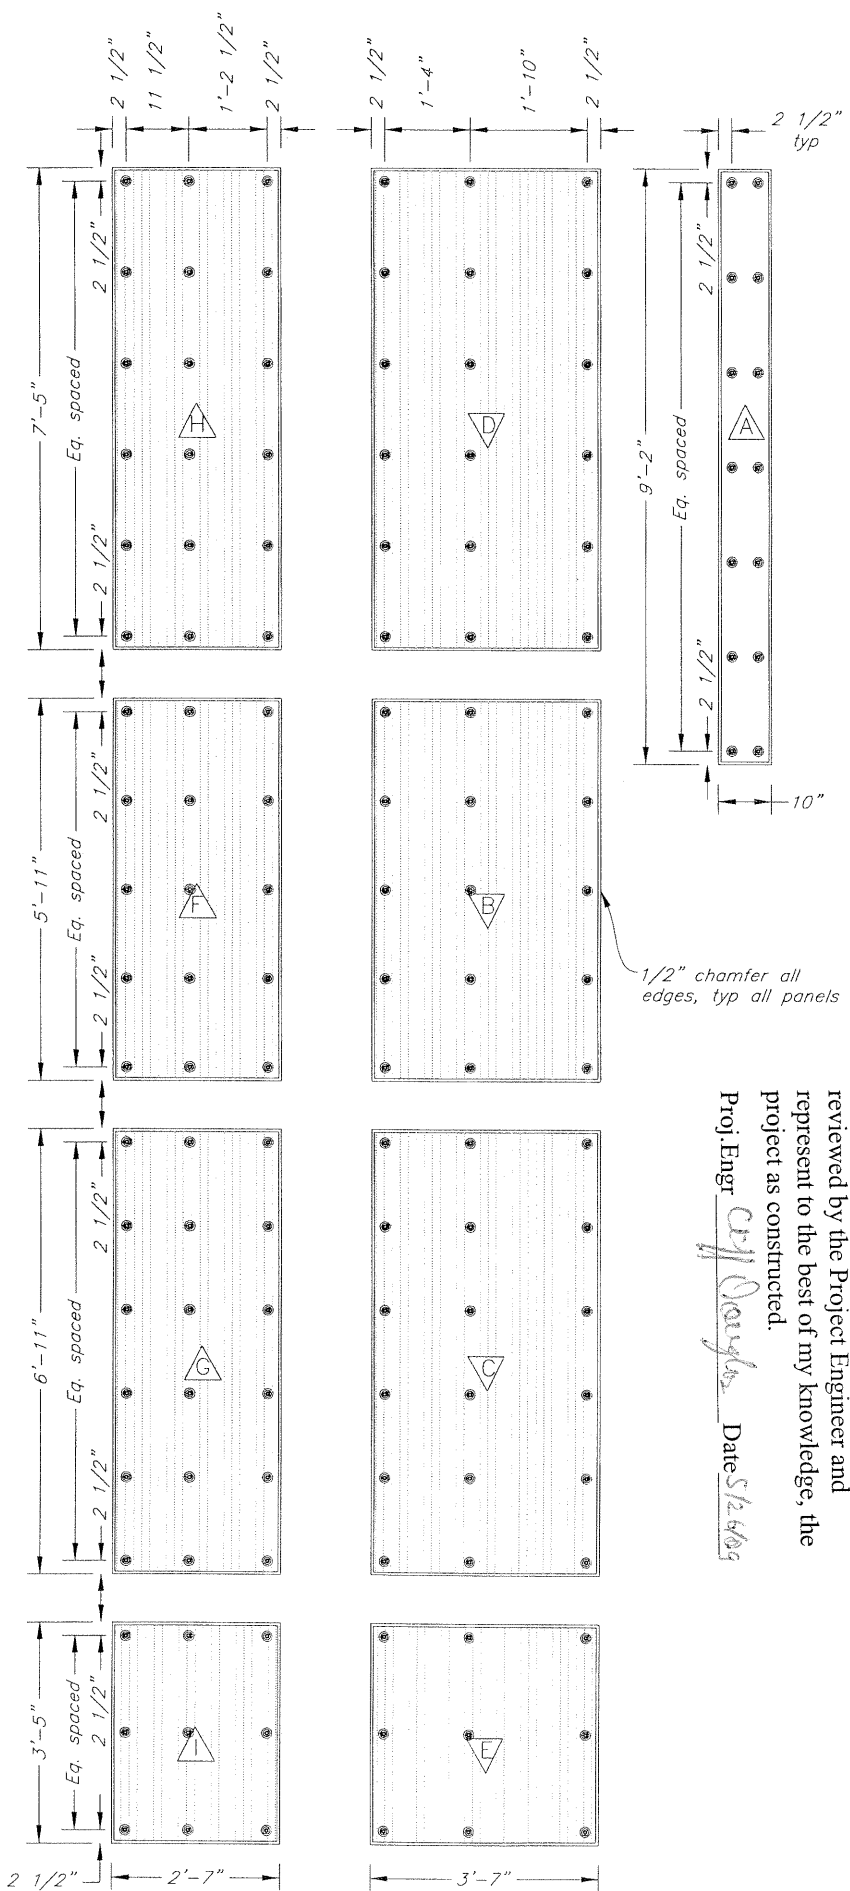


Details - UHMW Facing 1
11

Shaded UHMW panels are the color BLACK, others are YELLOW.


Project As-Built Drawings have been reviewed by the Project Engineer and represent to the best of my knowledge, the project as constructed.
 Proj. Engr. *C. J. Douglas* Date *5/2/09*

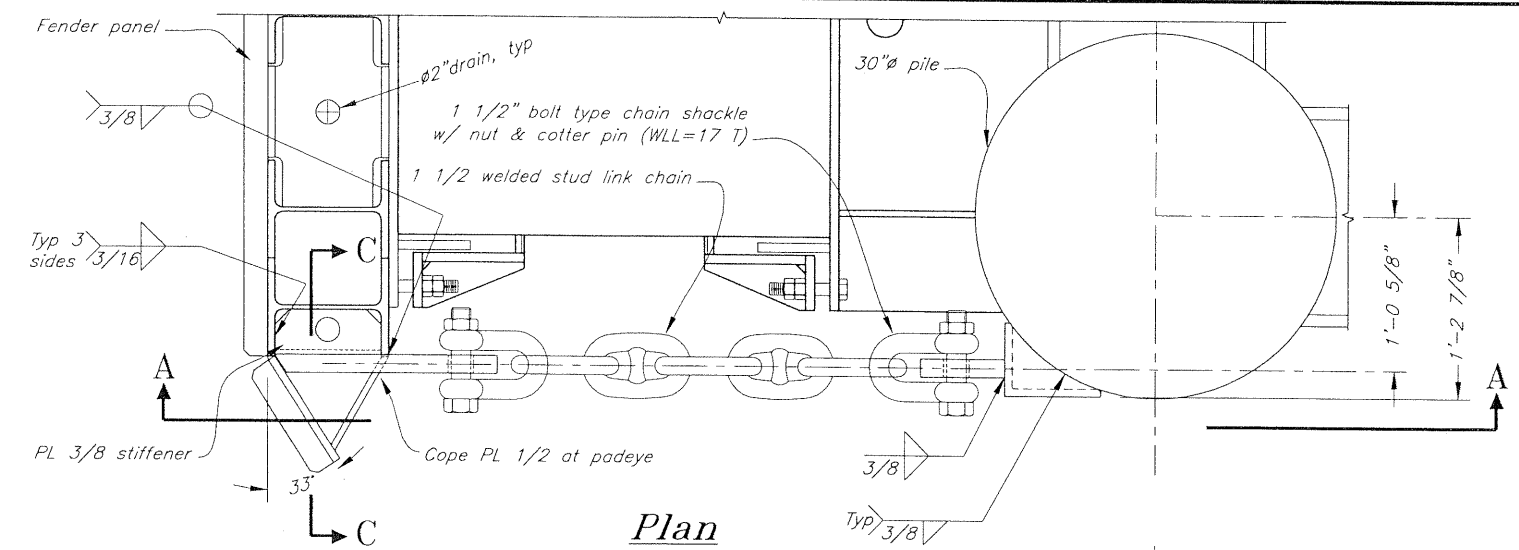

Plan

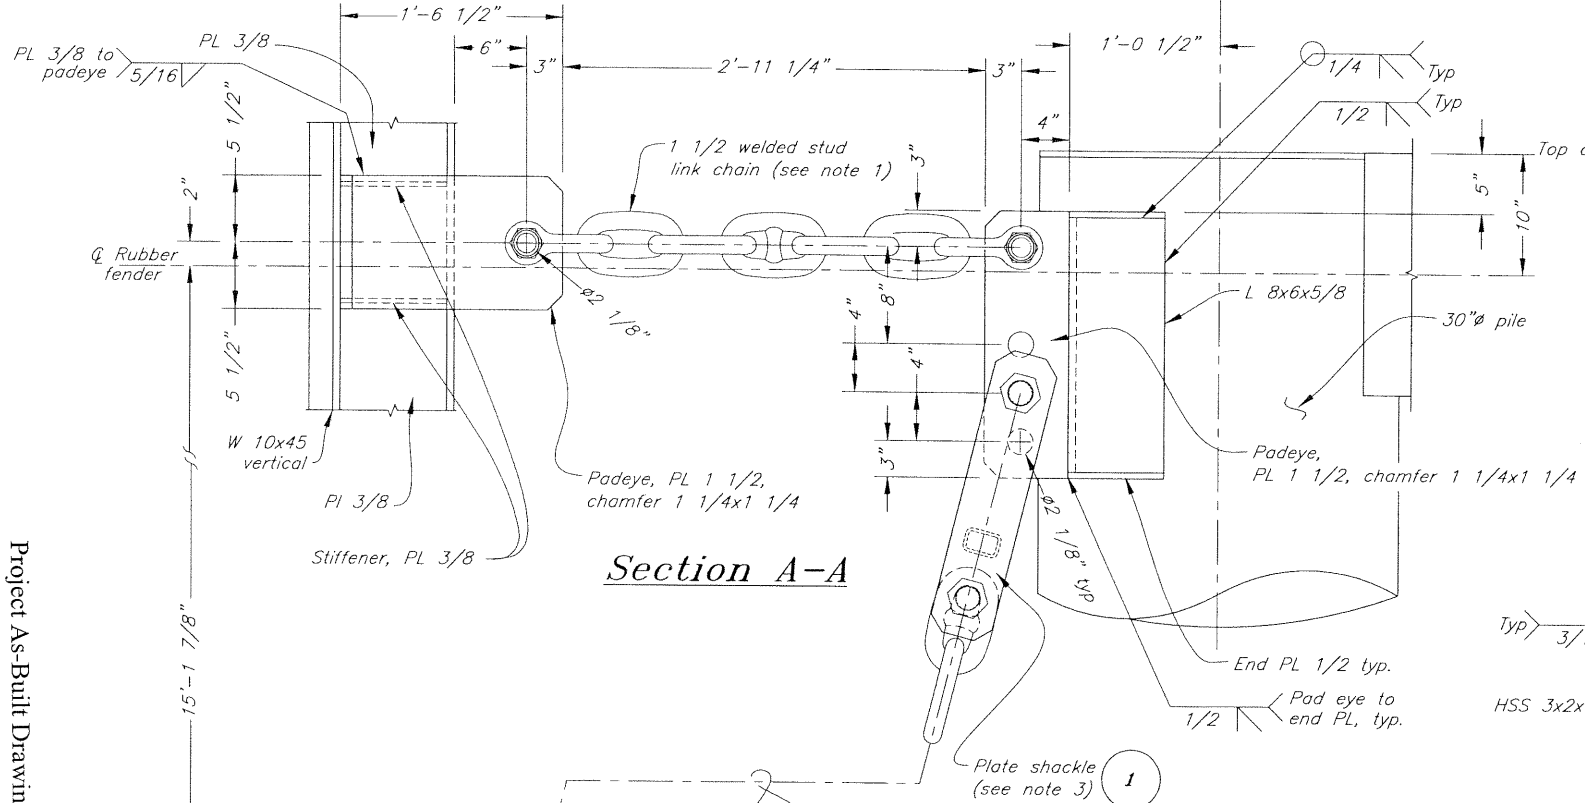

Section A-A

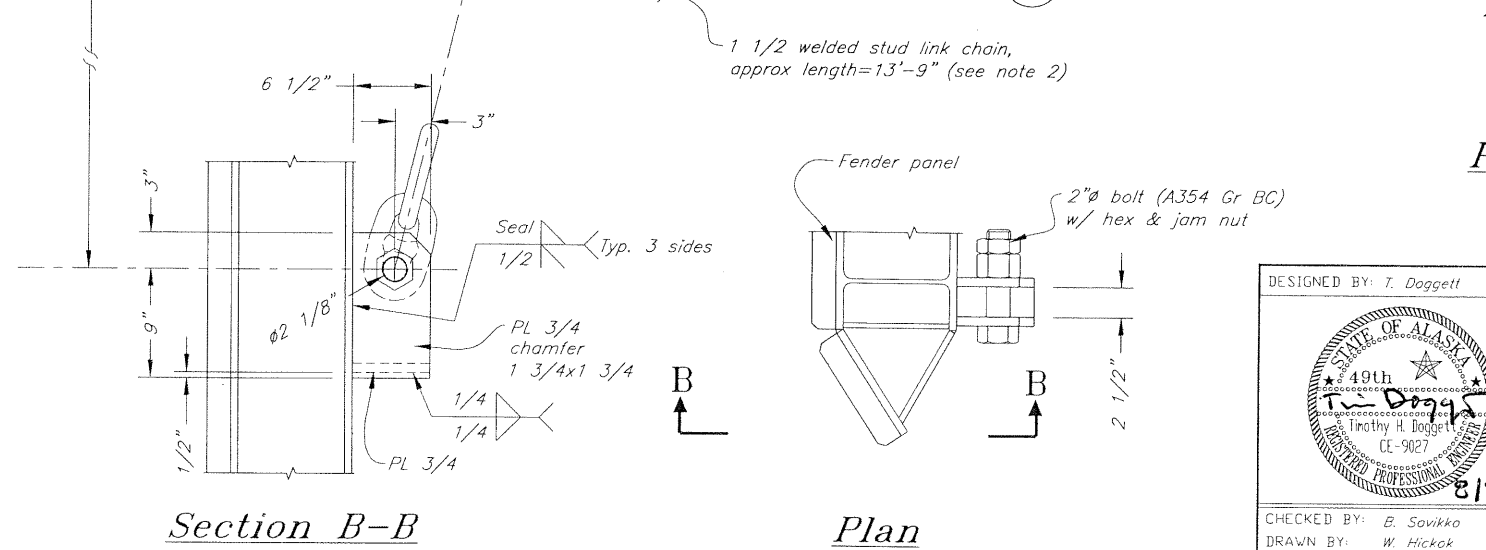


Section B-B

Plan

Fender Support Chains Detail 2
6

- NOTES:
- 1) Stud may be removed in end links of horizontal chain to pass shackle. Do not remove studs in vertical chain.
 - 2) Install chain free of twists. Do not twist chain to adjust length.
 - 3) Field adjust PL shackle and chain so that fender panel is at, or just above, design elevation.

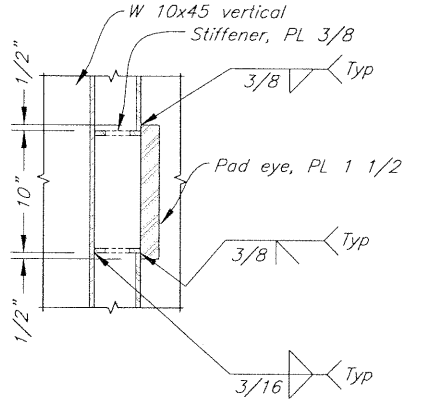

Section C-C


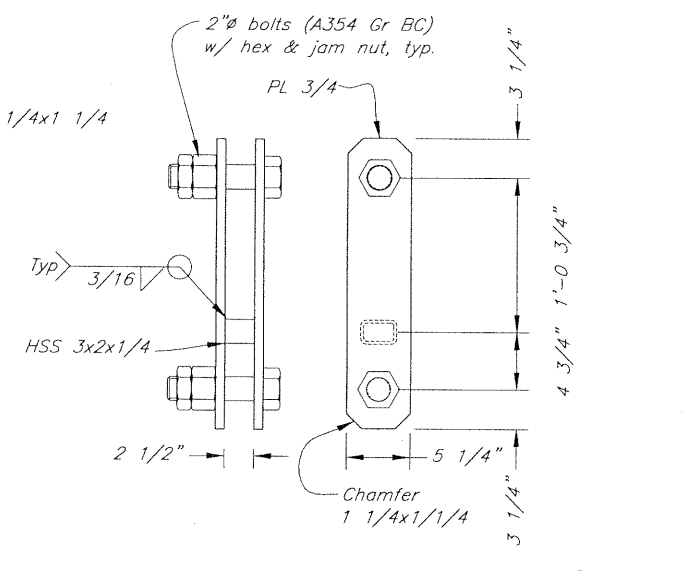



Plate Shackle Detail 1

DO NOT SCALE FROM THESE DRAWINGS USE DIMENSIONS


DESIGNED BY: T. Doggett		STATE OF ALASKA DEPARTMENT OF TRANSPORTATION & PUBLIC FACILITIES SOUTHEAST REGION			
		Haines Mooring Improvements Project 75249 Mooring Structures W2, E3 & E4 Fender Panel UHMW & Pad Eye Details			
CHECKED BY: B. Sovikko		PROJECT DESIGNATION	YEAR	SHEET NO.	TOTAL SHEETS
DRAWN BY: W. Hickok		75249	2007	13	28
PATH: Q:\Hns\75249\MF\Phase-B\Planset\13-UHMW & Pad Eyes v1.dwg					
PLOT: PSPACE 1=1 TAB: Hawsor Rail & Padeye Wed, 01/Aug/07 09:23AM					
REVISIONS					
NO.	DATE	DESCRIPTION			

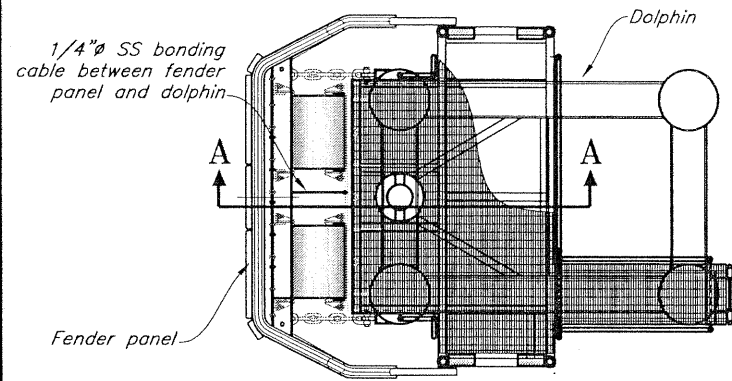

Plan

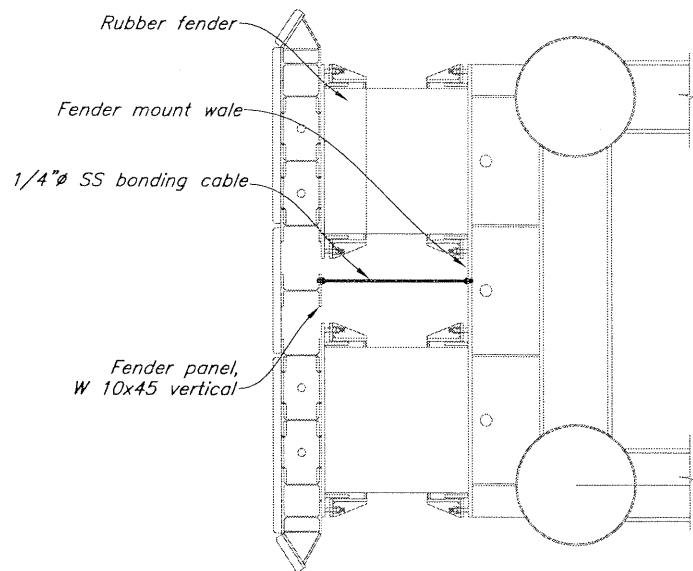


Section B-B

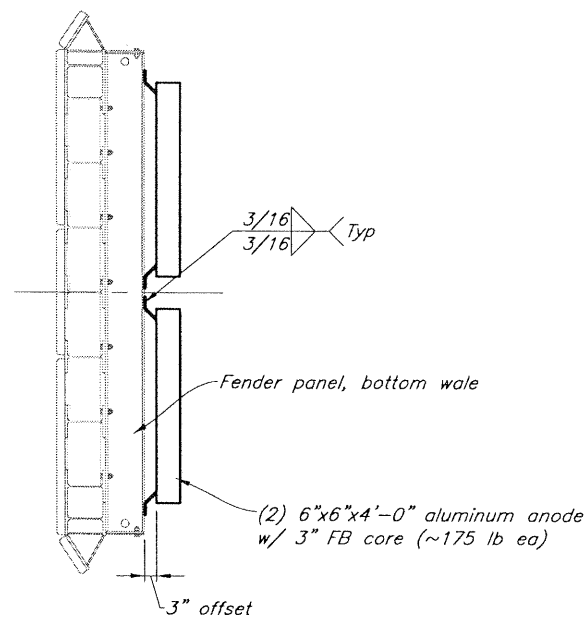


Section C-C


Two anodes required per fender panel

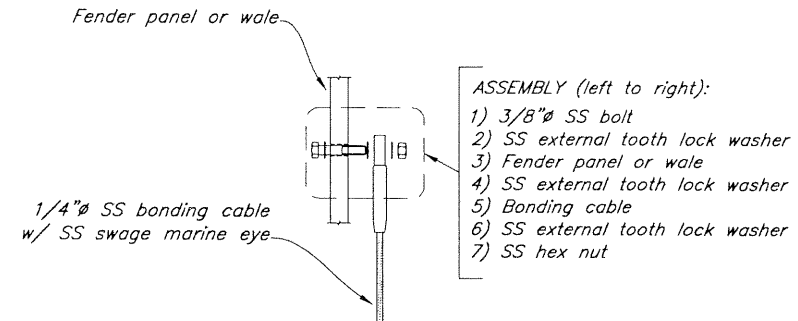


Bonding Cable Connection Detail 1

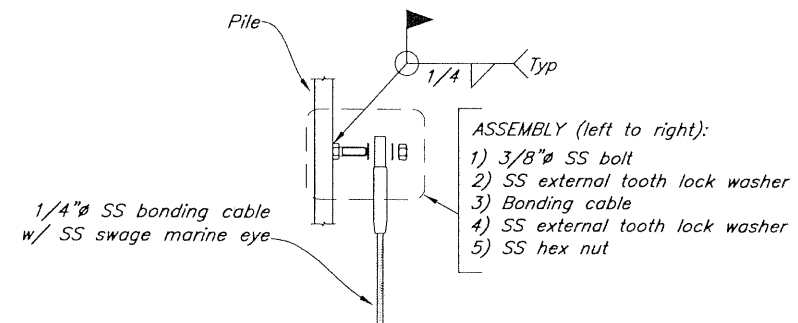


Bonding Cable Connection Detail 2

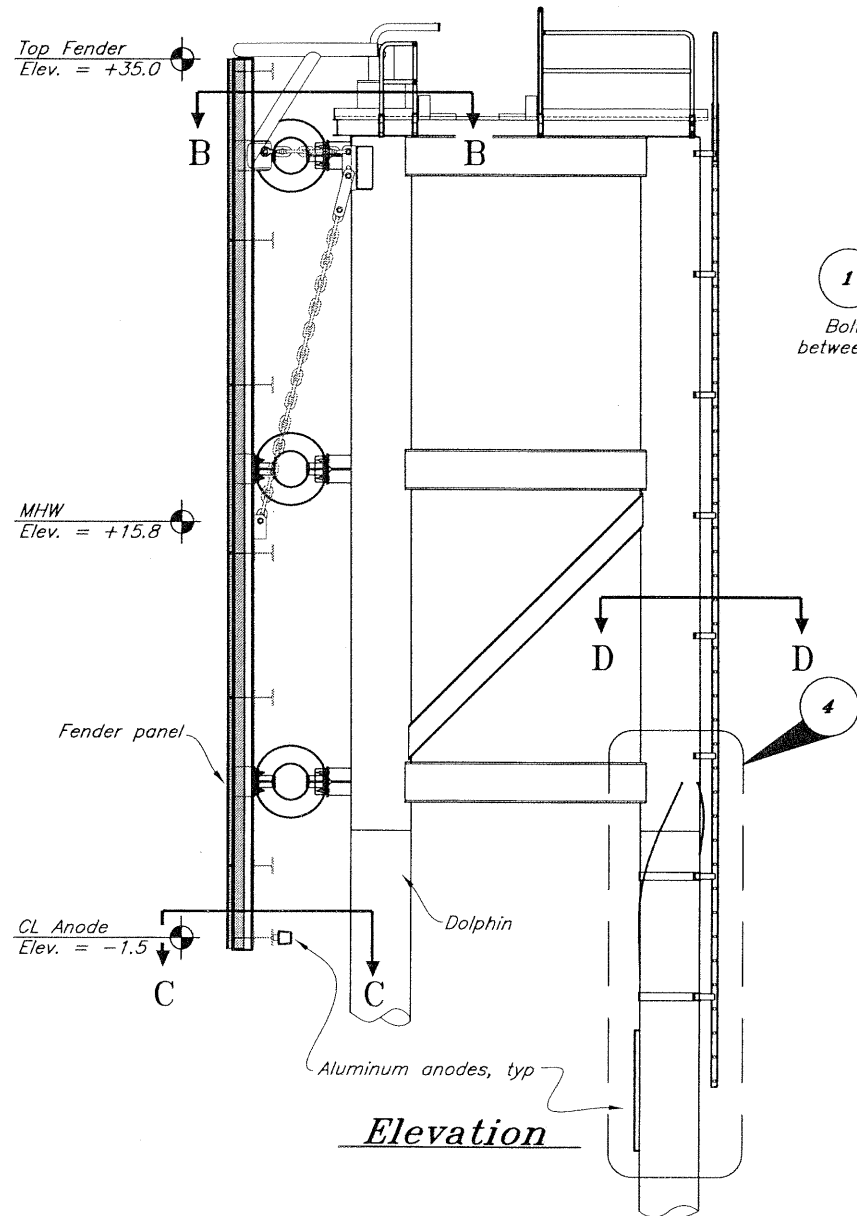

Elevation

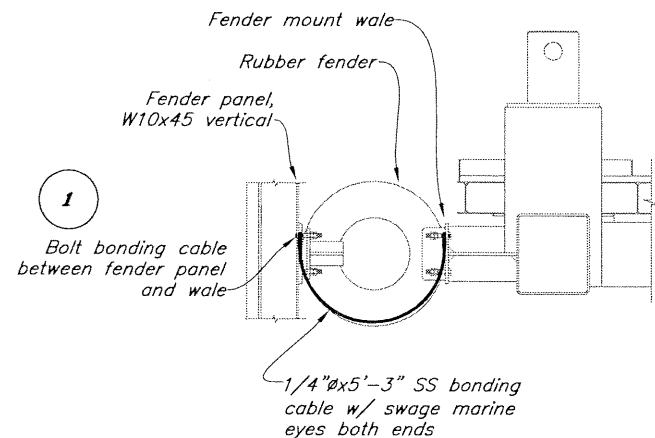


Section A-A

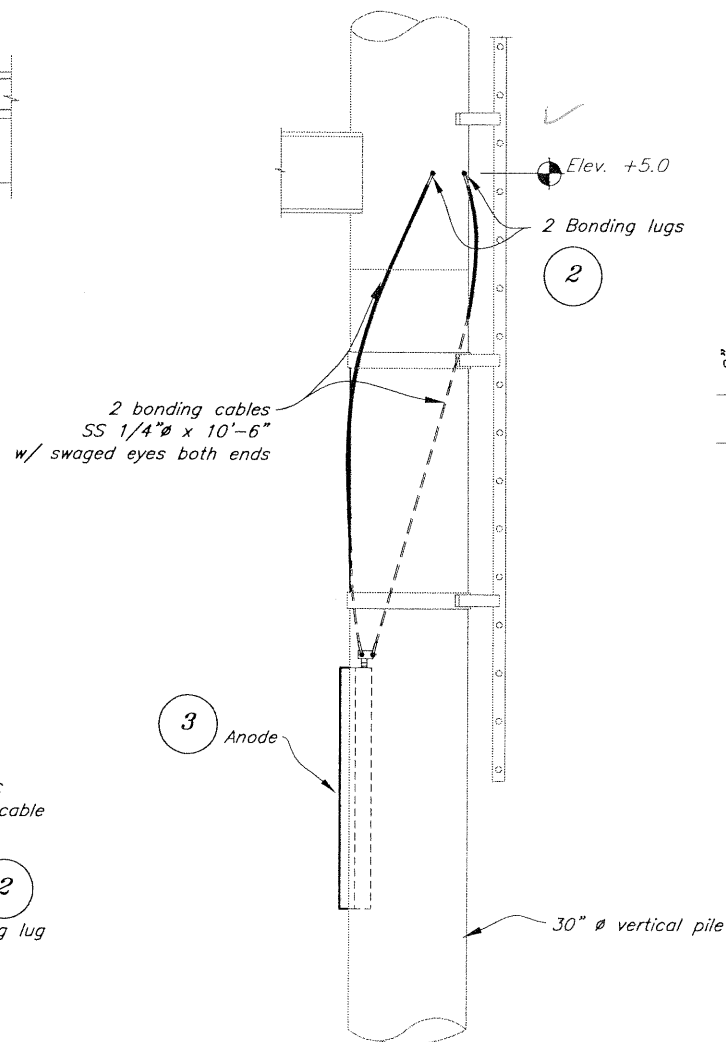

Dolphin Anode Installation Typical Elevation


One anode required per dolphin

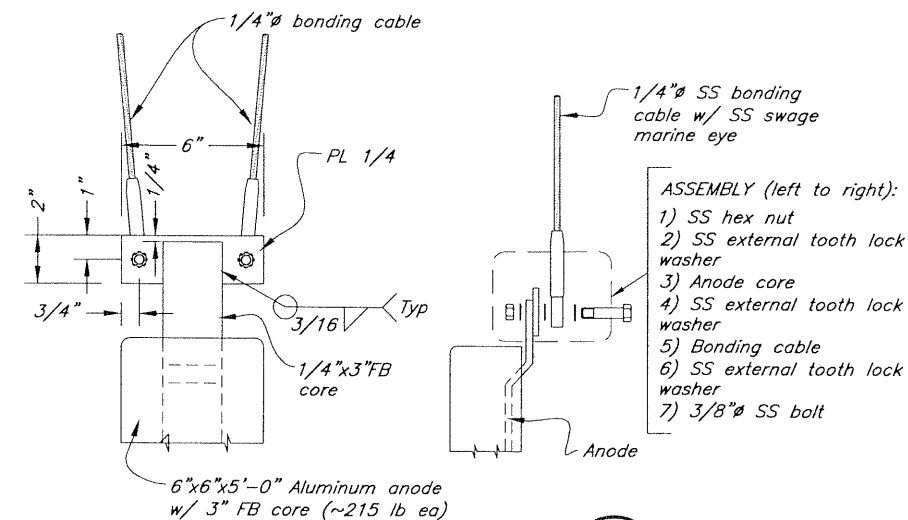

Anode & Cable Connection Detail 3

Project As-Built Drawings have been reviewed by the Project Engineer and represent to the best of my knowledge, the project as constructed.

Proj. Engr *Cliff Douglas* Date *5/26/09*

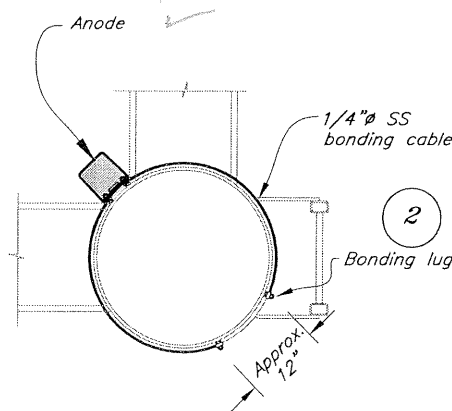

Section D-D

Cathodic Protection System

1/6

DO NOT SCALE FROM THESE DRAWINGS USE DIMENSIONS

DESIGNED BY: T. Doggett



STATE OF ALASKA
 DEPARTMENT OF TRANSPORTATION
 & PUBLIC FACILITIES
 SOUTHEAST REGION

Haines Mooring Improvements
 Project 75249


Cathodic Protection System

CHECKED BY: B. Savikko
 DRAWN BY: W. Hickok


PATH: Q:\Hns\75249\MF\Phase-B\Plonset\15-CP System.dwg
 PLOT: PSPACE 1=1 TAB: Layout1

Wed, 01/Aug/07 09:24AM


NO.	DATE	REVISIONS DESCRIPTION	PROJECT DESIGNATION	YEAR	SHEET NO.	TOTAL SHEETS
			75249	2007	15	28

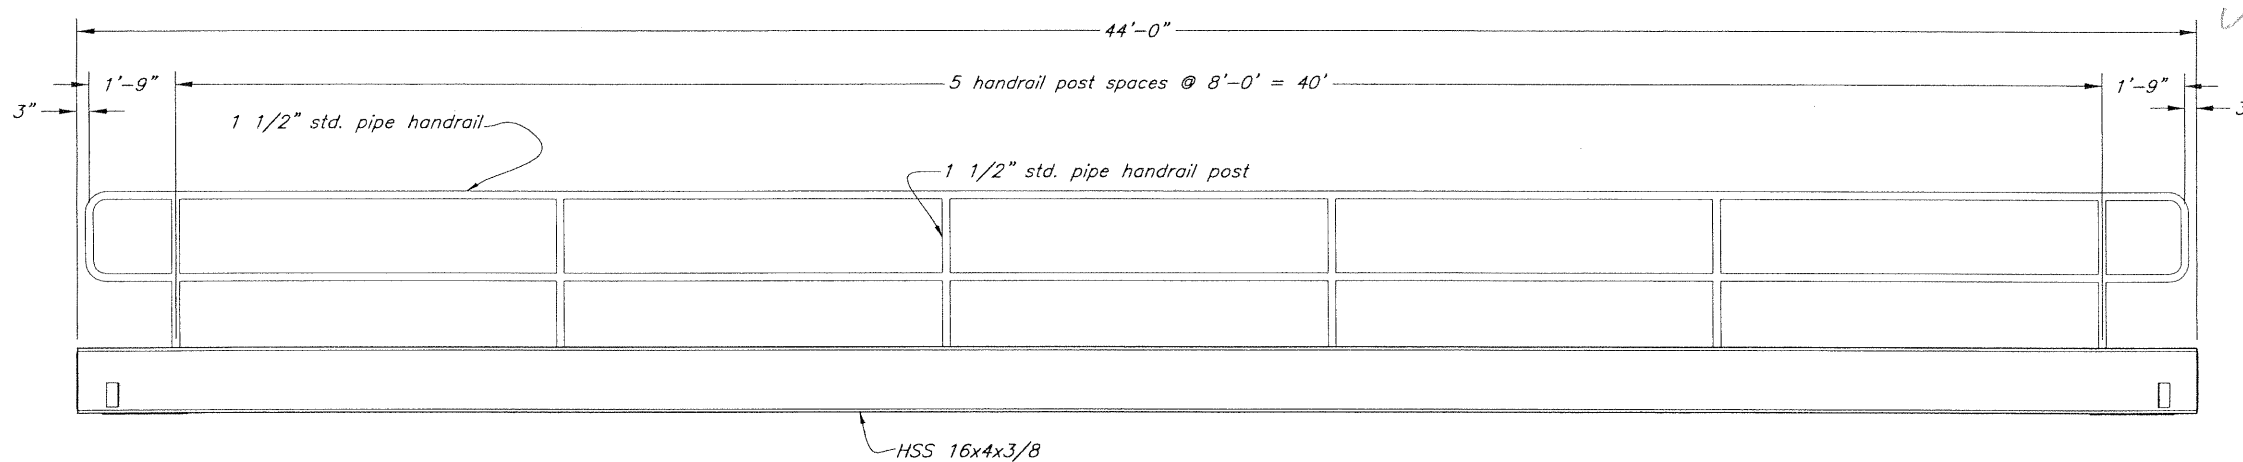


Elevation

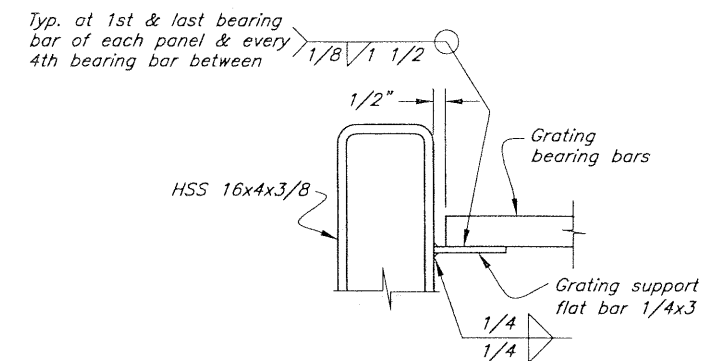

Section B-B

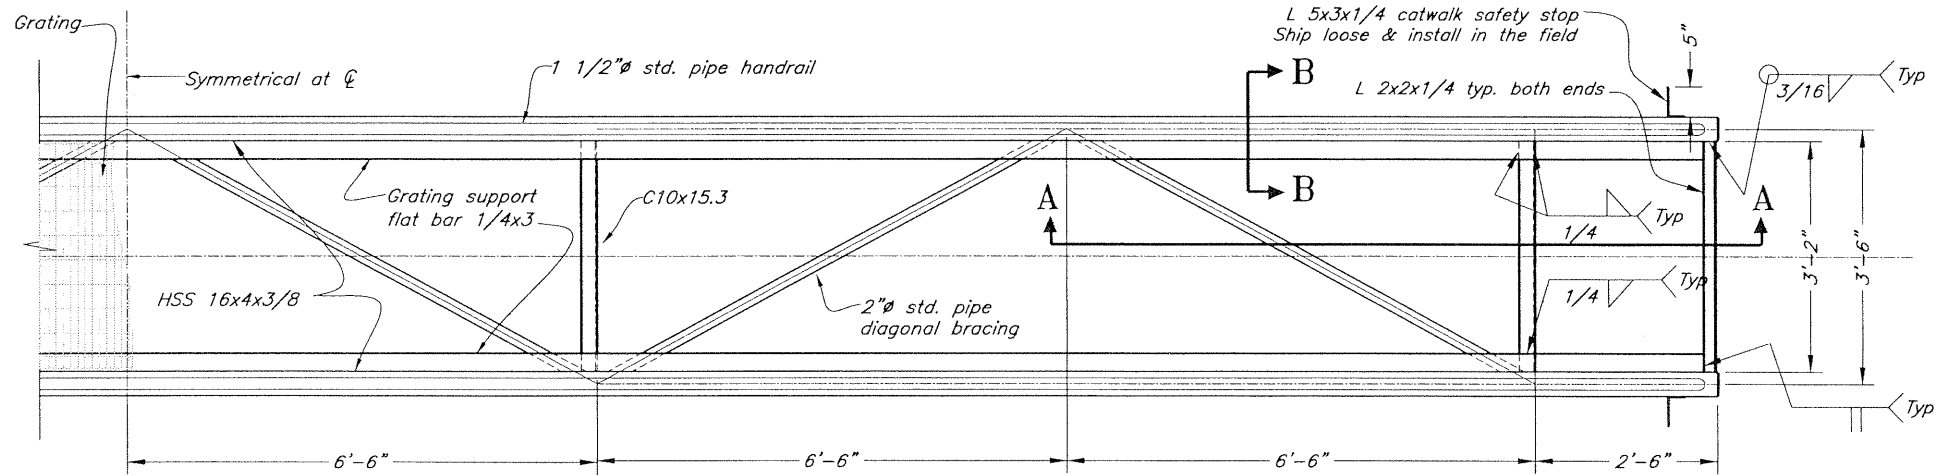


Plan

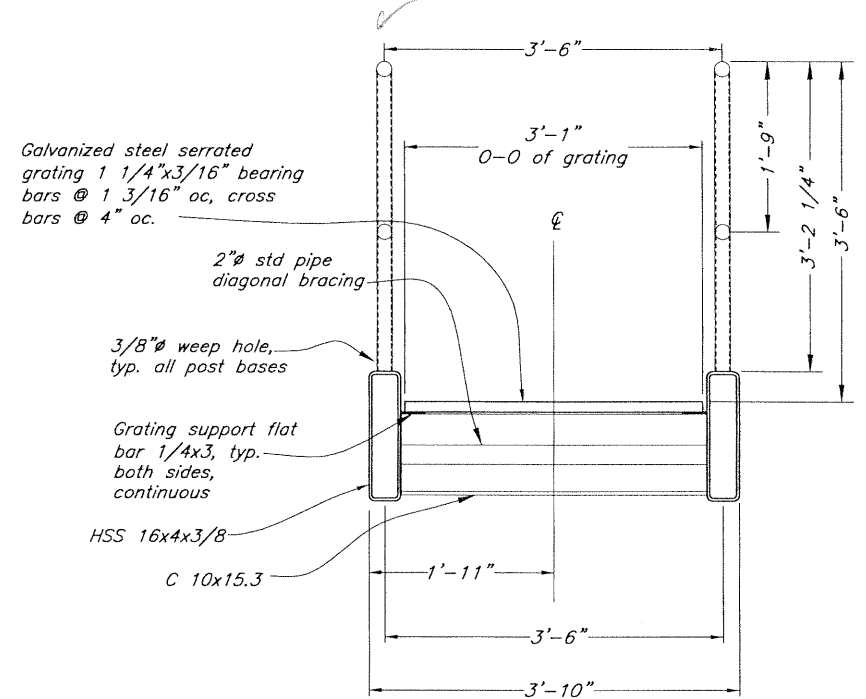


Typical Section

44' Catwalk 1
5

Project As-Built Drawings have been reviewed by the Project Engineer and represent to the best of my knowledge, the project as constructed.
 Proj. Engr *Cliff Douglas* Date *5/26/09*

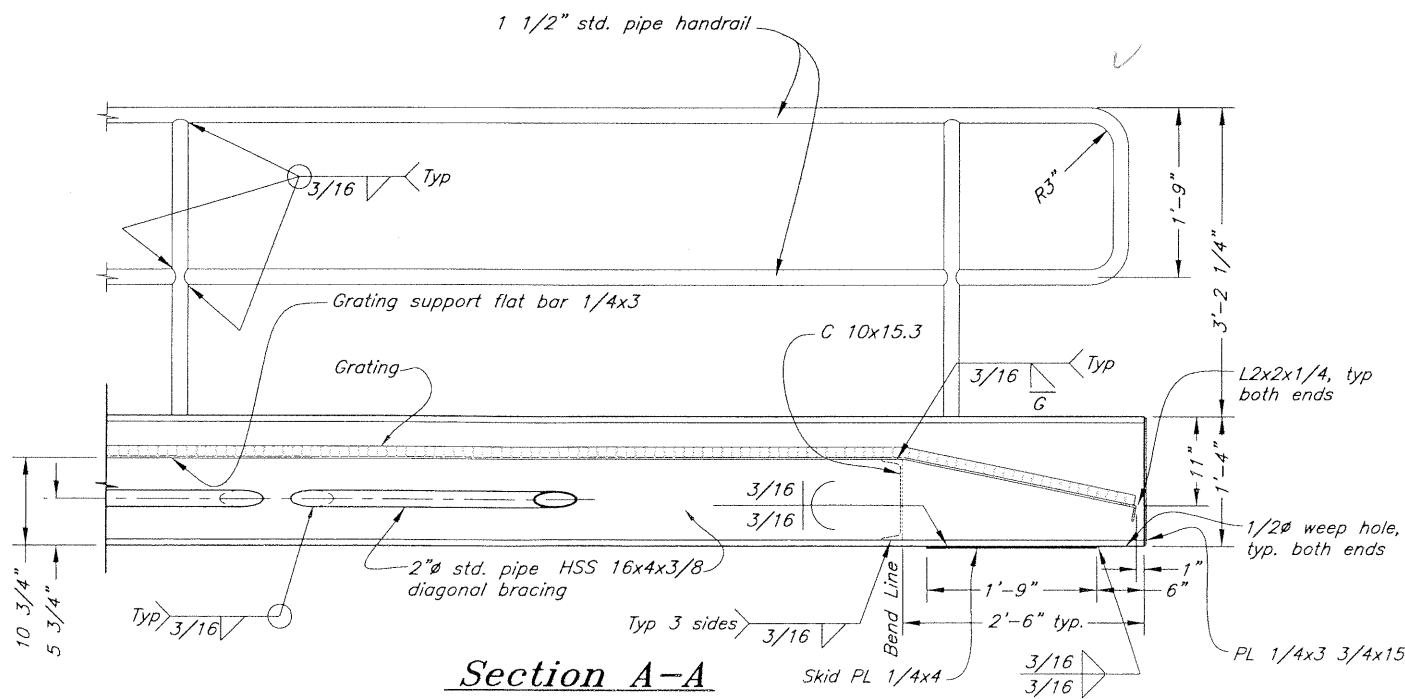


Section A-A

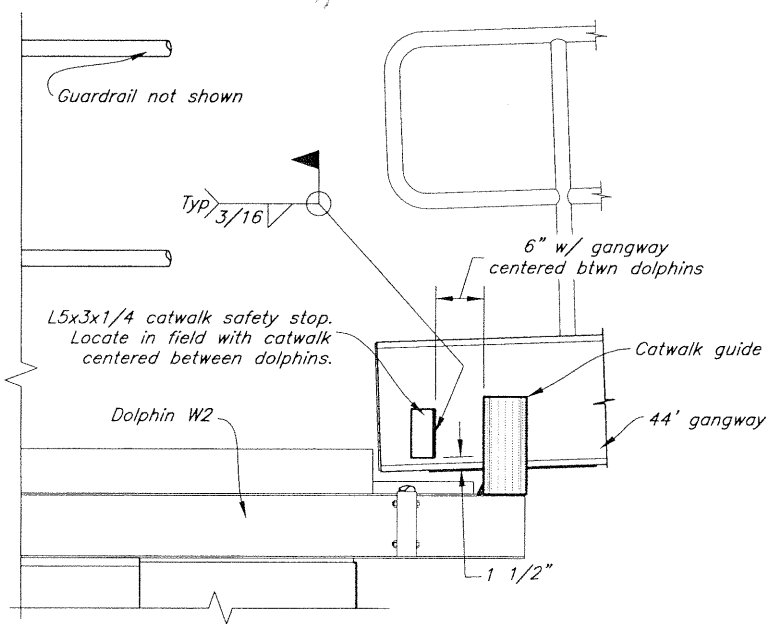


Section B
 (Dolphin W2 shown, Dolphin W1 Similar) B
5

Notes:
 1) Approximate weight of 44'-0" catwalk = 6,550 pounds.
 2) Provide camber to compensate for dead load deflection (approximately 1" at center of 44'-0" catwalk).

DO NOT SCALE FROM THESE DRAWINGS USE DIMENSIONS

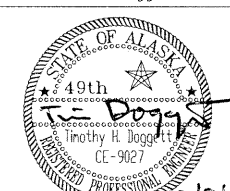
DESIGNED BY: T. Doggett  CHECKED BY: B. Savikko DRAWN BY: W. Hickok	STATE OF ALASKA DEPARTMENT OF TRANSPORTATION & PUBLIC FACILITIES SOUTHEAST REGION Haines Mooring Improvements Project 75249 44' Catwalk at W1 to W2														
PATH: Q:\Hns\75249\MF\Phase-B\PlanSet\16-44' catwalk.dwg PLOT: PSPACE 1=1 TAB: Layout1 Wed, 01/Aug/07 09:25AM															
<table border="1" style="width: 100%; border-collapse: collapse;"> <thead> <tr> <th colspan="2">REVISIONS</th> </tr> <tr> <th>NO.</th> <th>DESCRIPTION</th> </tr> </thead> <tbody> <tr> <td> </td> <td> </td> </tr> </tbody> </table>	REVISIONS		NO.	DESCRIPTION			<table border="1" style="width: 100%; border-collapse: collapse;"> <thead> <tr> <th>PROJECT DESIGNATION</th> <th>YEAR</th> <th>SHEET NO.</th> <th>TOTAL SHEETS</th> </tr> </thead> <tbody> <tr> <td style="text-align: center;">75249</td> <td style="text-align: center;">2007</td> <td style="text-align: center;">16</td> <td style="text-align: center;">28</td> </tr> </tbody> </table>	PROJECT DESIGNATION	YEAR	SHEET NO.	TOTAL SHEETS	75249	2007	16	28
REVISIONS															
NO.	DESCRIPTION														
PROJECT DESIGNATION	YEAR	SHEET NO.	TOTAL SHEETS												
75249	2007	16	28												

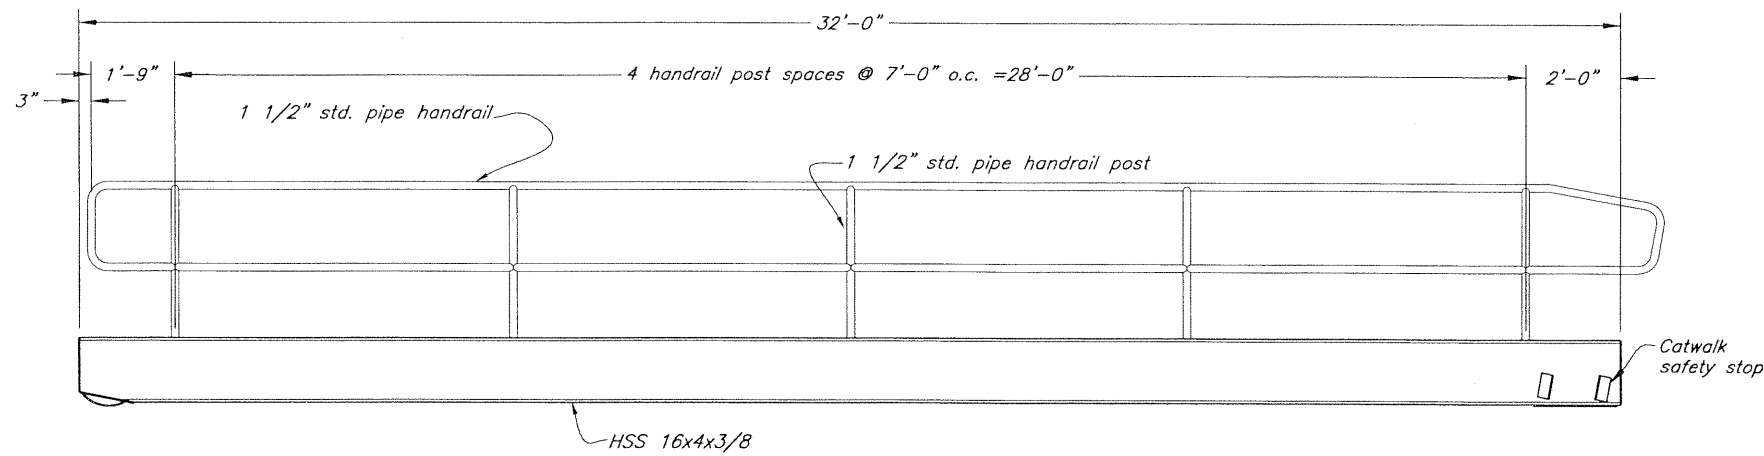

Lower End
(at Dock)

Elevation

Upper End
(at Dolphin W2)

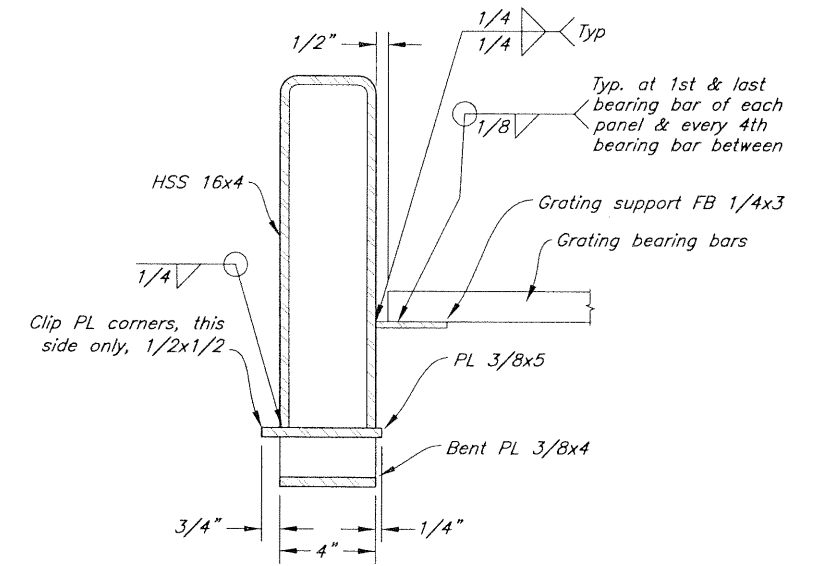

Section B-B

Galvanized steel serrated grating 1 1/4"x3/16" bearing bars @ 1 3/16" oc, cross bars @ 4" oc.


2" std pipe diagonal bracing
3/8" weep hole, typ. all post bases
Grating support flat bar 1/4x3, typ. both sides, continuous
HSS 16x4x3/8
C 10x15.3

Typical Section

Notes:

- 1) Approximate weight of 32'-0" catwalk = 4,800 pounds
- 2) Provide camber to compensate for dead load deflection (approximately 1" at center of 32'-0" catwalk).

DO NOT SCALE FROM THESE DRAWINGS USE DIMENSIONS

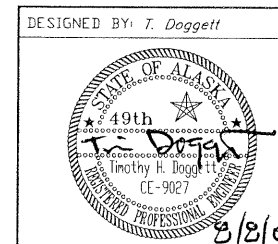

STATE OF ALASKA
DEPARTMENT OF TRANSPORTATION
& PUBLIC FACILITIES
SOUTHEAST REGION

Haines Mooring Improvements
Project 75249

32' Gangway
at W2 to Dock

CHECKED BY: B. Savikko
DRAWN BY: W. Hickok

PATH: Q:\Hns\75249\MF\Phase-B\PlanSet\17-32' gangway.dwg
PLDT: PSPACE 1=1 TAB: 17


Wed, 01/Aug/07 09:53AM

REVISIONS		PROJECT DESIGNATION	YEAR	SHEET NO.	TOTAL SHEETS
NO.	DATE				
		75249	2007	17	28


Project As-Built Drawings have been reviewed by the Project Engineer and represent to the best of my knowledge, the project as constructed.

Proj. Engr *C. J. O'Connell* Date *7/26/09*

32' Gangway 1/5

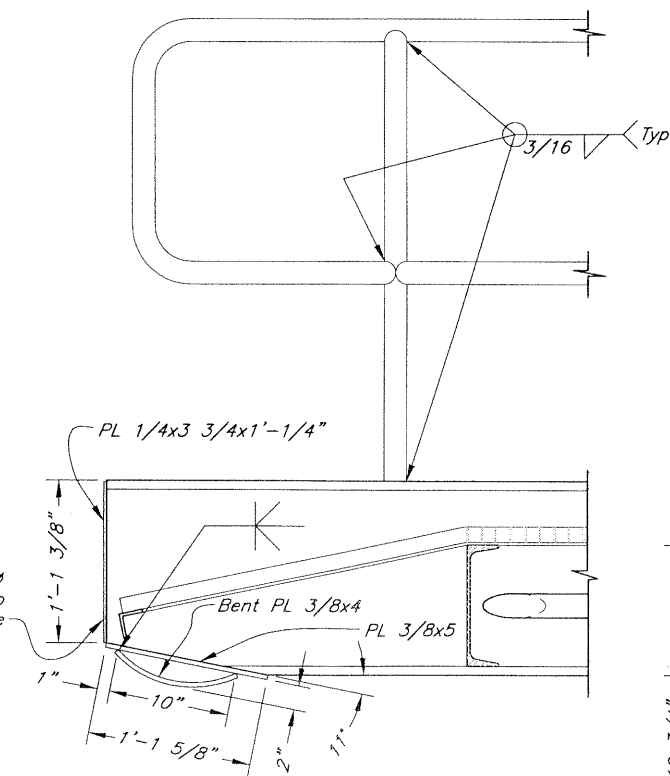

Section A-A

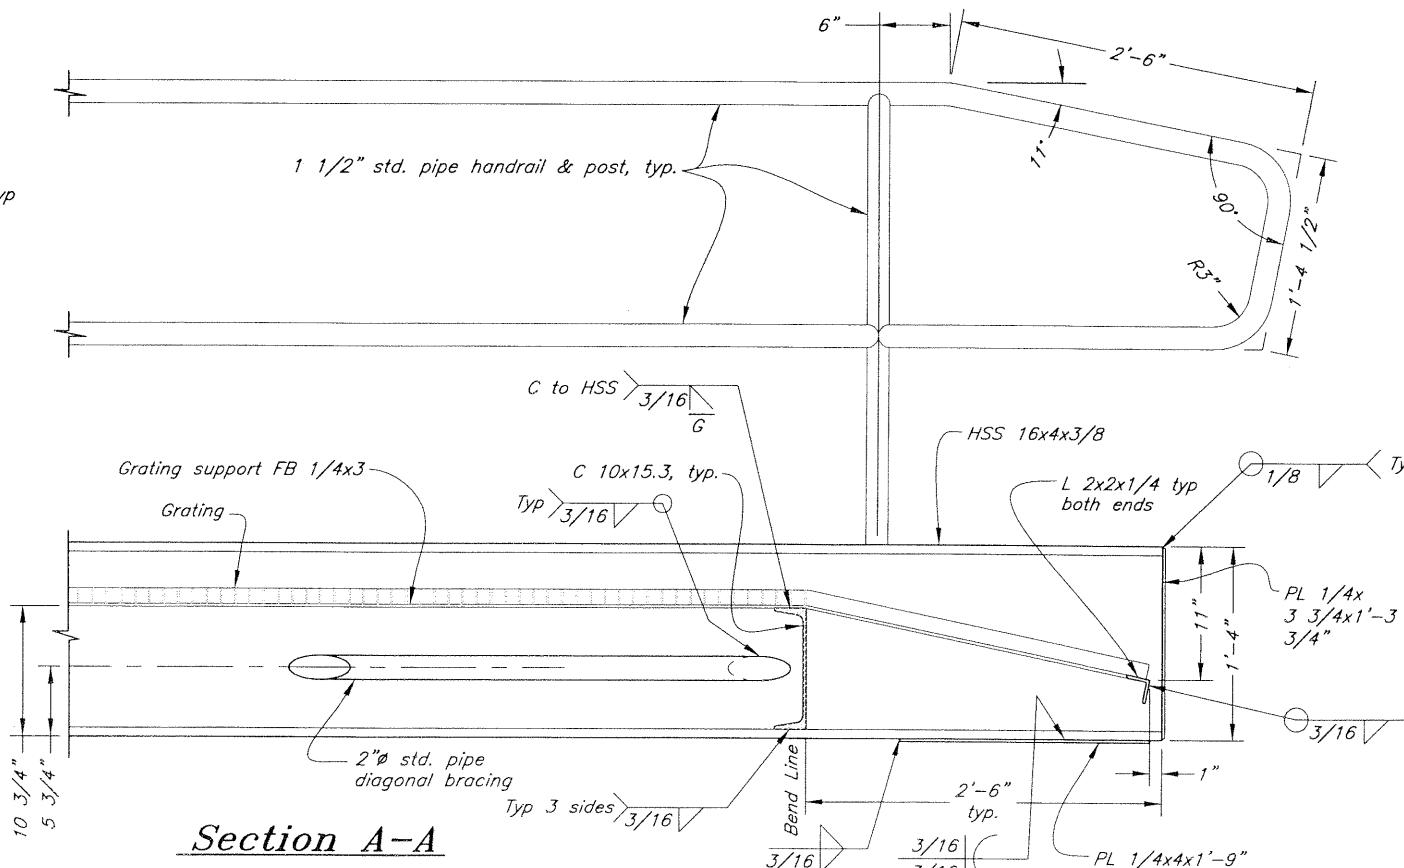


1 1/2" std. pipe handrail & post, typ.

C to HSS 3/16
C 10x15.3, typ.
Typ 3 sides 3/16


HSS 16x4x3/8

L 2x2x1/4 typ both ends
PL 1/4x 3 3/4x1'-3 3/4"

3/16
3/16
PL 1/4x4x1'-9"

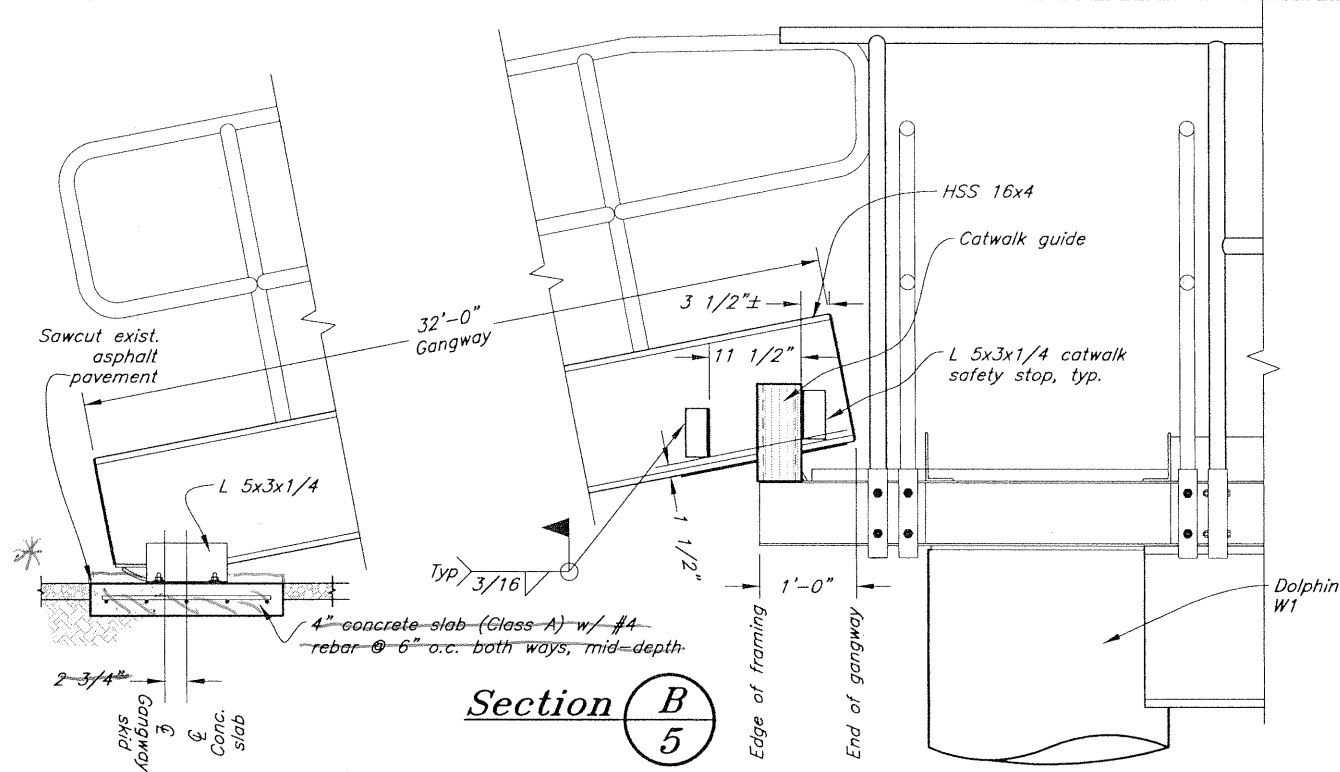


Section B
5

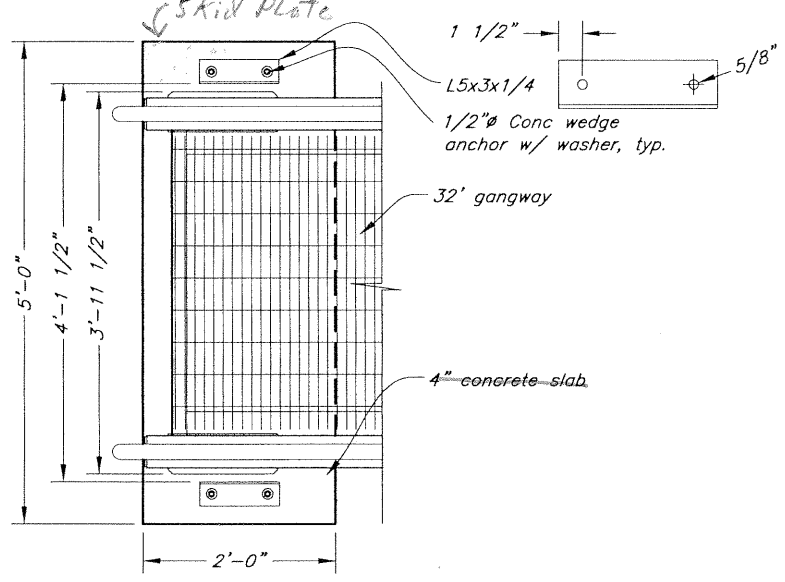


Plan 1
5

* skid plate attached to existing pavement

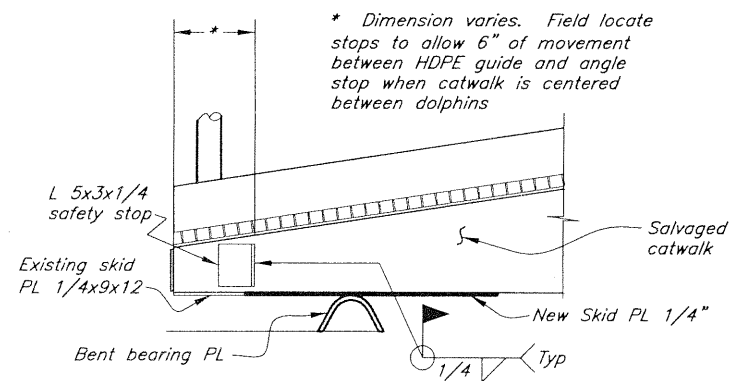


Salvaged Catwalk End Elevation

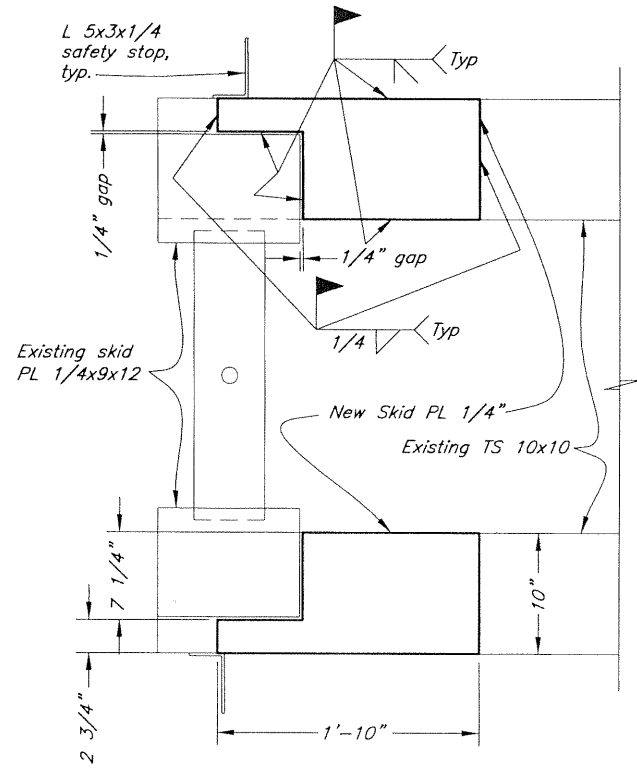


Salvaged Catwalk Bottom View
(Typical both ends of 39' and 61' catwalks)

Catwalk Skid PL Modification 4
5

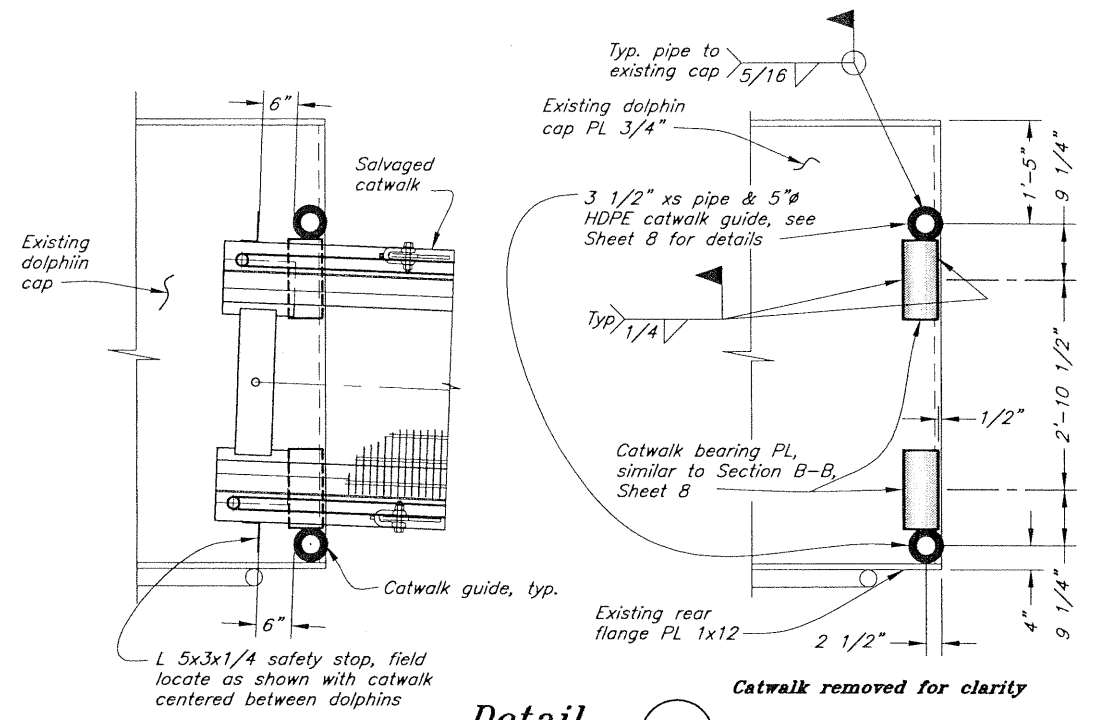

Detail 5

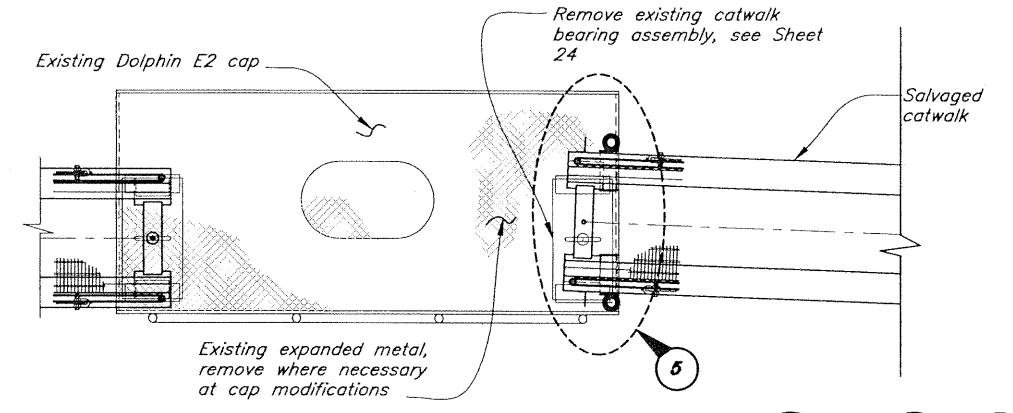

Modification Plan - Dolphin E2 & W1 3
& Salvaged Catwalk 5

Dolphin E2 shown, dolphin W1 similar but opposite hand

Project As-Built Drawings have been reviewed by the Project Engineer and represent to the best of my knowledge, the project as constructed.

Proj. Engr *W. Douglas* Date *5/26/07*

DESIGNED BY: T. Doggett

CHECKED BY: B. Savikko
DRAWN BY: W. Hickok


DO NOT SCALE FROM THESE DRAWINGS USE DIMENSIONS

STATE OF ALASKA
DEPARTMENT OF TRANSPORTATION
& PUBLIC FACILITIES
SOUTHEAST REGION

Haines Mooring Improvements
Project 75249

**Existing Dolphins
& Catwalks
Modifications**

PATH: Q:\Hns\75249\MF\Phase-B\PlanSet\18-Existing Dolphin & Catwalk mods.dwg		YEAR	SHEET	TOTAL		
PLDT: PSPACE 1=1 TAB: Layout1 Wed, 01/Aug/07 09:26AM		75249	18	28		
NO.	DATE	REVISIONS DESCRIPTION	PROJECT DESIGNATION	YEAR	SHEET NO.	TOTAL SHEETS
			75249	2007	18	28

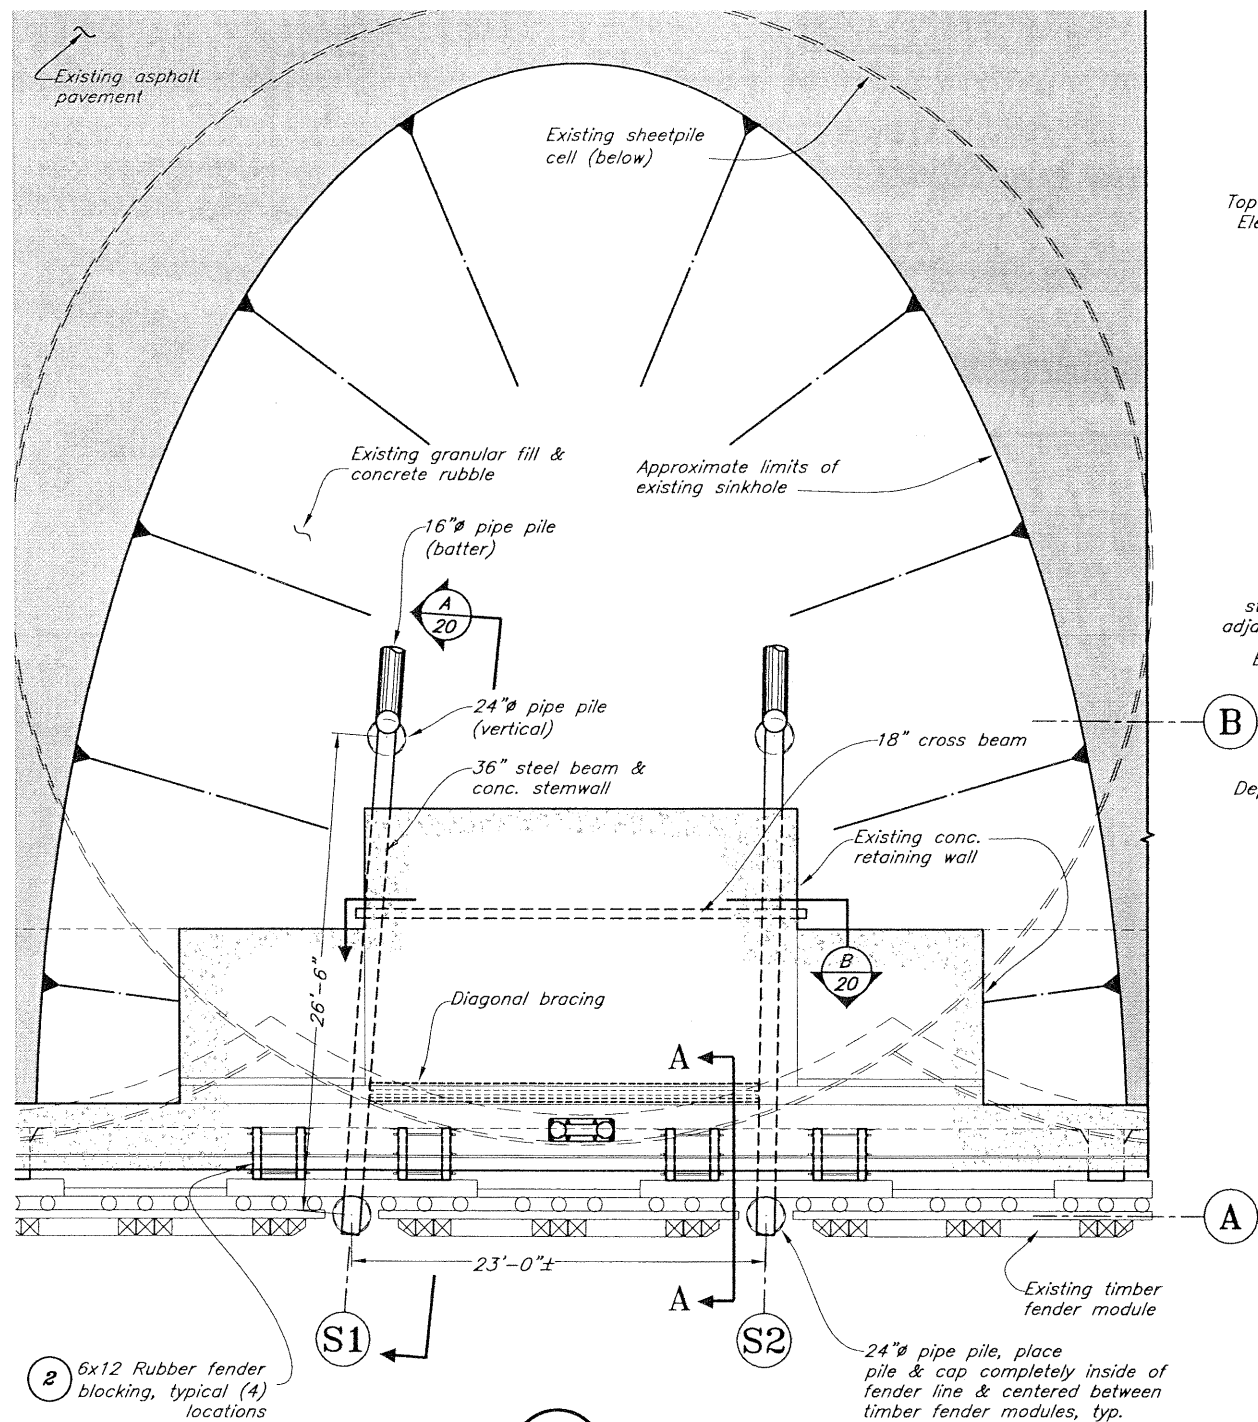

Plan 1/5

2 6x12 Rubber fender blocking, typical (4) locations


Project As-Built Drawings have been reviewed by the Project Engineer and represent to the best of my knowledge, the project as constructed.

Proj. Engr Coff Douglas Date 5/26/09


General Notes:

In October 2004, sheet piles at the face of Cell 4 separated, permitting erosion of the retained fill. A continuous concrete retaining wall and cap structure at the face of the dock was undermined. The concrete retaining wall was designed to bear directly on grade and not intended to span unsupported. An analysis using current codes indicates the retaining wall can not safely support its self weight. The purpose of this work is to stabilize the wall by installing two steel bents and cross beam, as shown on the Plans.


To ensure personnel safety, the Contractor shall provide falsework to support the retaining wall during installation of the bents. Falsework consisting of posts, beams, jacks or other mechanical devices, may be supported by the shoring piling and steel beam if loads do not cause overstressing of the steel. Falsework that is permanently attached to and incorporated into the shoring system may remain in place, unless otherwise directed by the Engineer.

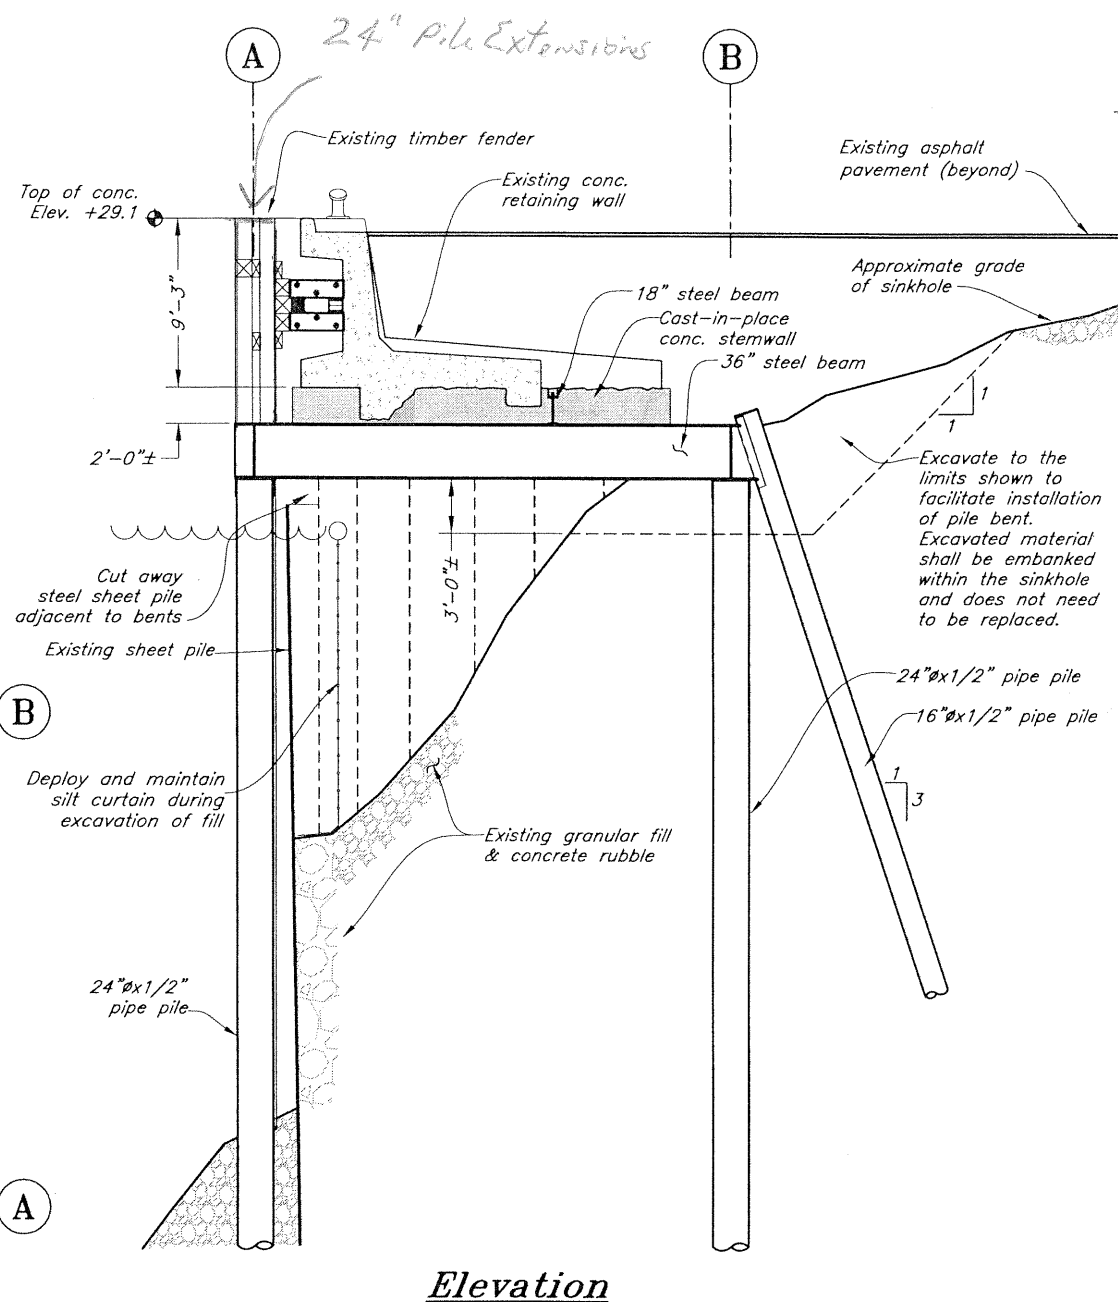


Elevation

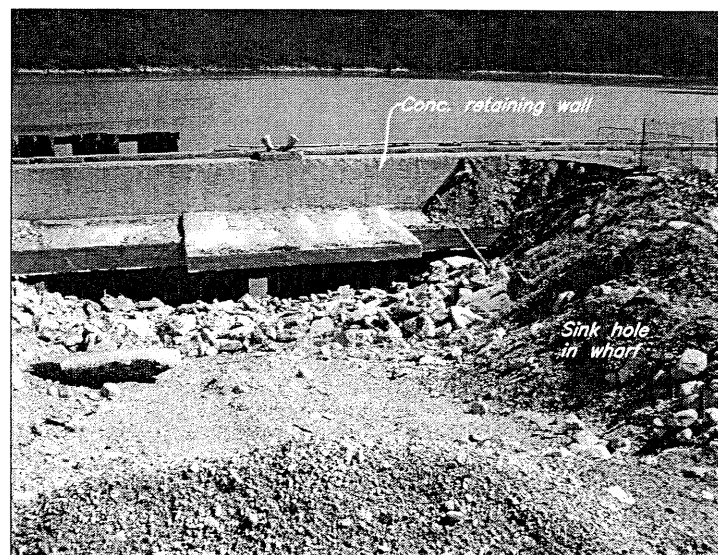

Photograph - Retaining Wall (looking seaward)

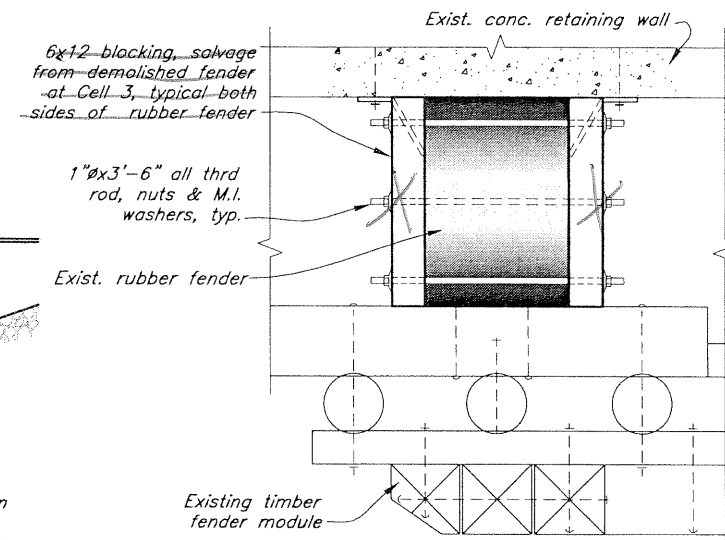


Detail 2

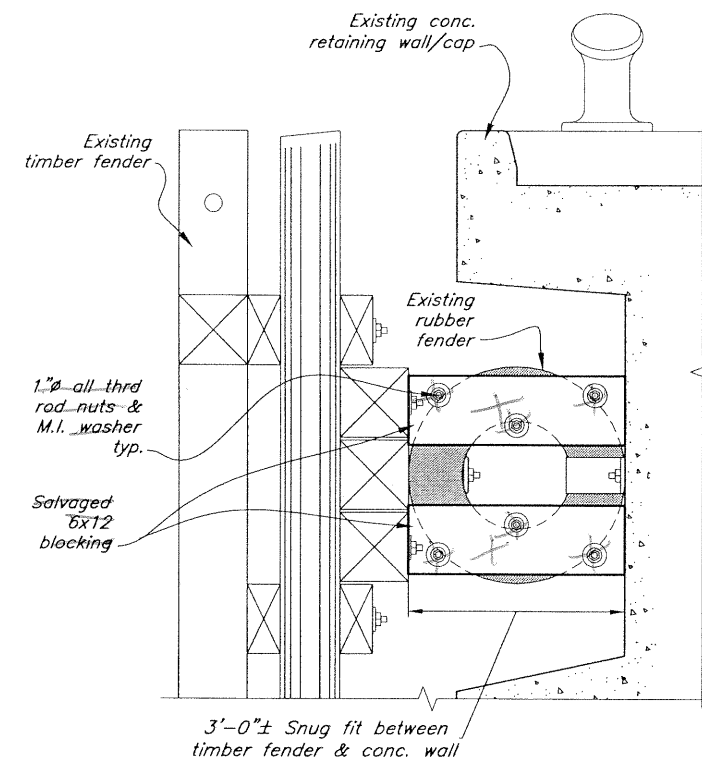


Section A-A

DO NOT SCALE FROM THESE DRAWINGS USE DIMENSIONS

DESIGNED BY: T. Daggett		STATE OF ALASKA DEPARTMENT OF TRANSPORTATION & PUBLIC FACILITIES SOUTHEAST REGION	
		Haines Mooring Improvements Project 75249	
CHECKED BY: B. Savikko		Dock Cap Shoring	
DRAWN BY: W. Hickok		PATH: Q:\Hns\75249\MF\Phase-B\PlanSet\19 Dock Cap Shoring.dwg	
PLDT: PSPACE 1=1		TAB: Layout1 Wed, 01/Aug/07 09:26AM	
REVISIONS		PROJECT DESIGNATION	YEAR
NO.	DATE	DESCRIPTION	SHEET NO.
			TOTAL SHEETS
		75249	2007 19 28

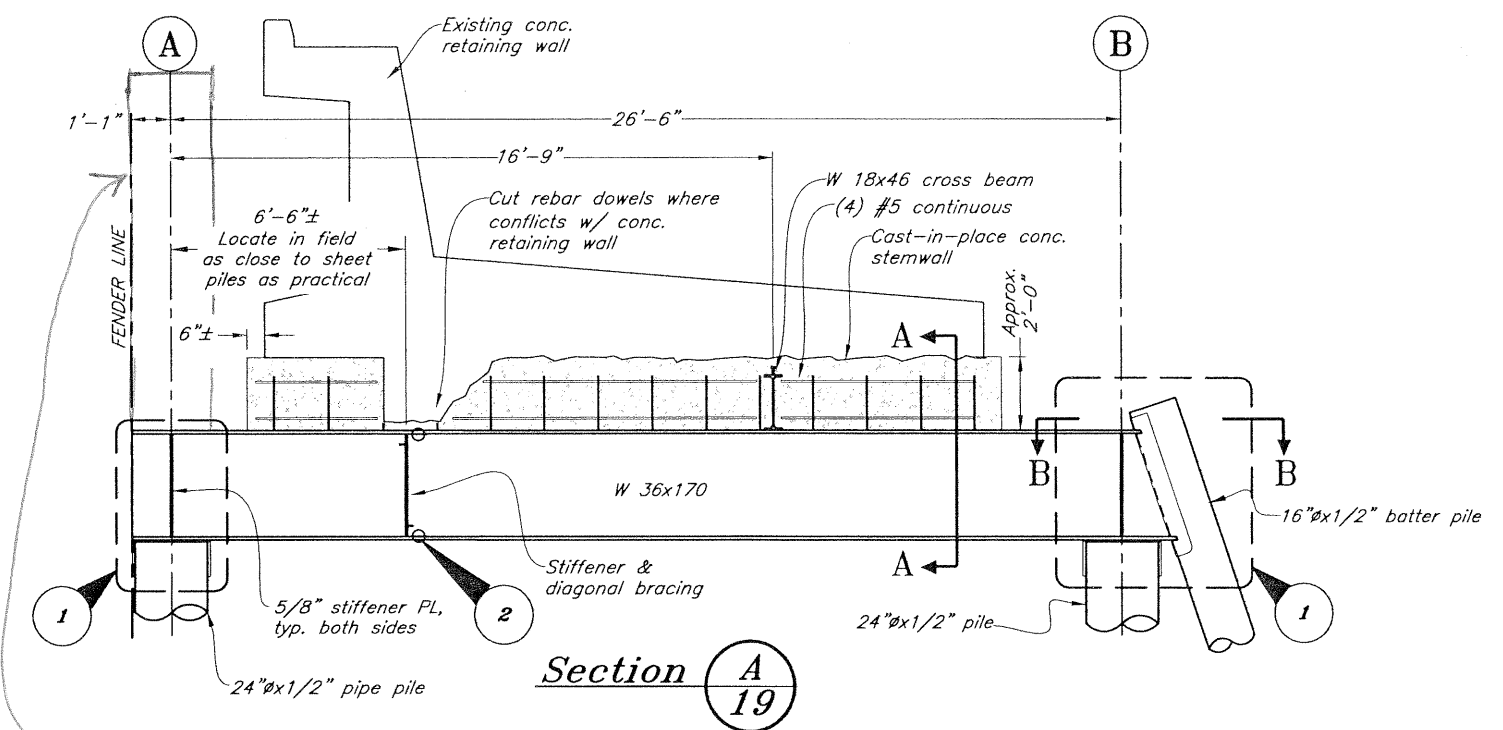


Section A
19

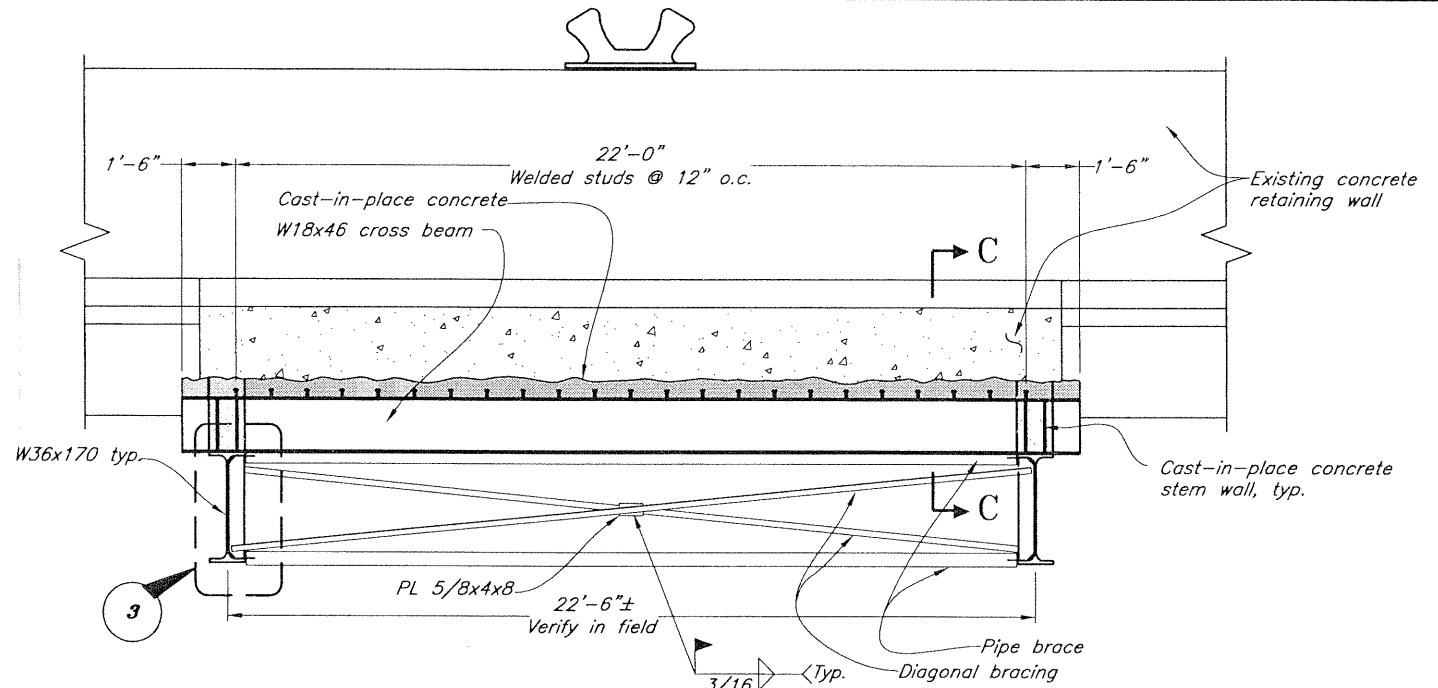


Section B
19


Project As-Built Drawings have been reviewed by the Project Engineer and represent to the best of my knowledge, the project as constructed.
 Proj. Engr Clyde D. Duggan Date 5/26/07

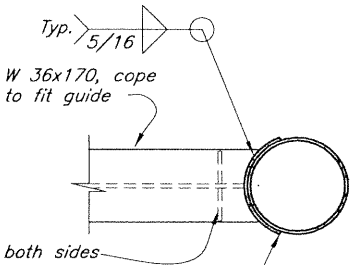

Section B-B

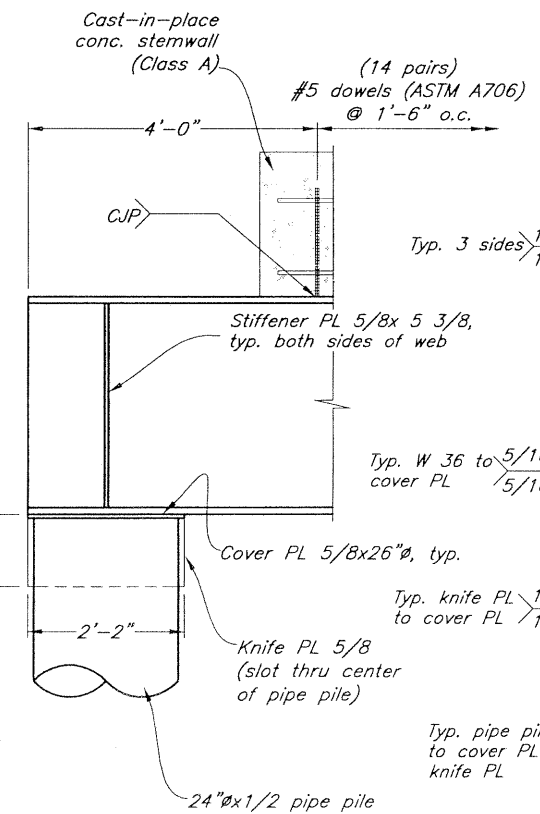


Detail 1

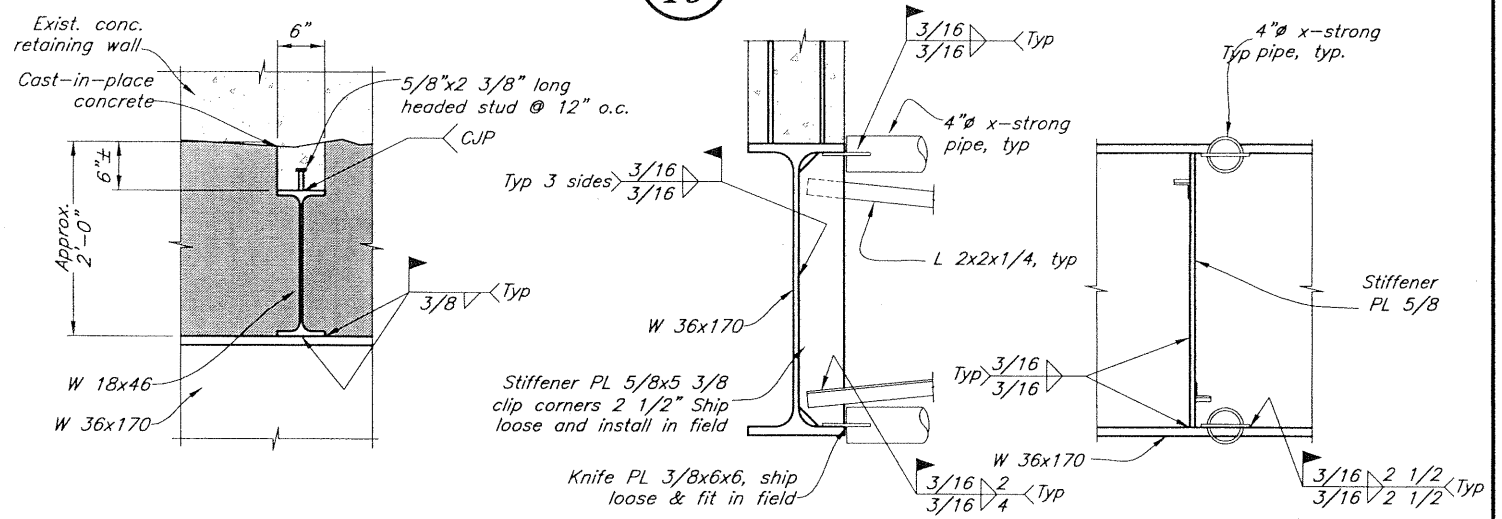

Section C-C

Detail 3

Detail 2

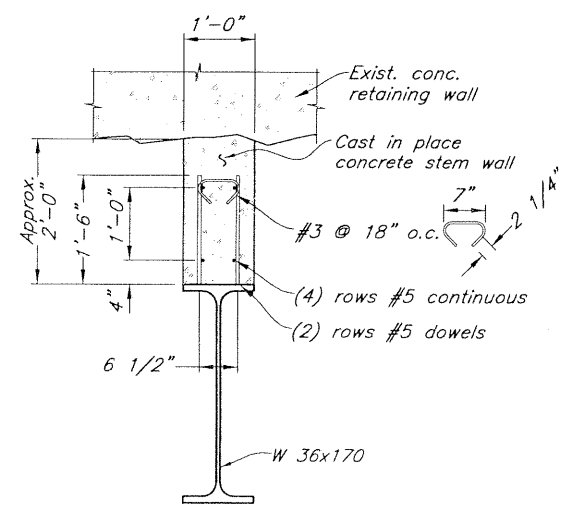

Section A-A

DO NOT SCALE FROM THESE DRAWINGS USE DIMENSIONS

DESIGNED BY: T. Doggett
 49th
 Timothy H. Doggett
 CE-9027
 8/8/07

STATE OF ALASKA
 DEPARTMENT OF TRANSPORTATION
 & PUBLIC FACILITIES
 SOUTHEAST REGION

Haines Mooring Improvements
 Project 75249

**Dock Cap Shoring
 Details**


CHECKED BY: B. Savikka
 DRAWN BY: W. Hickok
 PATH: O:\Hns\75249\MF\Phase-B\PlanSet\20-Shoring Details v1.dwg
 PLOT: PSPACE 1=1 TAB: Layout1 Wed, 01/Aug/07 09:27AM

REVISIONS		PROJECT DESIGNATION	YEAR	SHEET NO.	TOTAL SHEETS
NO.	DATE				


75249 2007 20 28

Project As-Built Drawings have been reviewed by the Project Engineer and represent to the best of my knowledge, the project as constructed.


Proj. Engr *C. J. Dagg* Date *5/26/07*

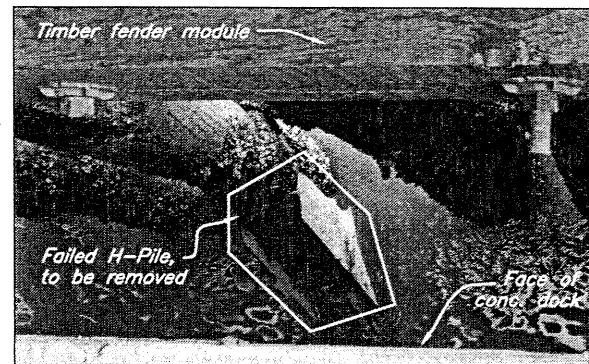


Photograph - H-Pile (3/4)
(Looking down from face of dock)

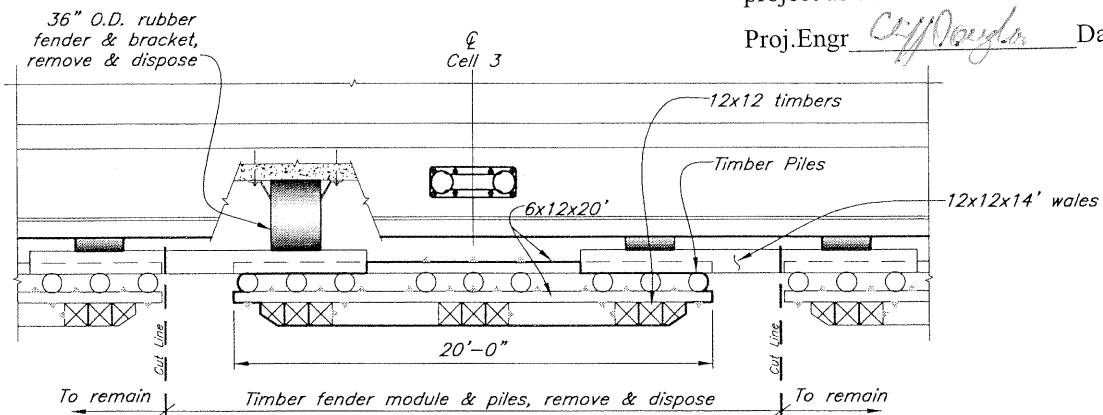


Plan

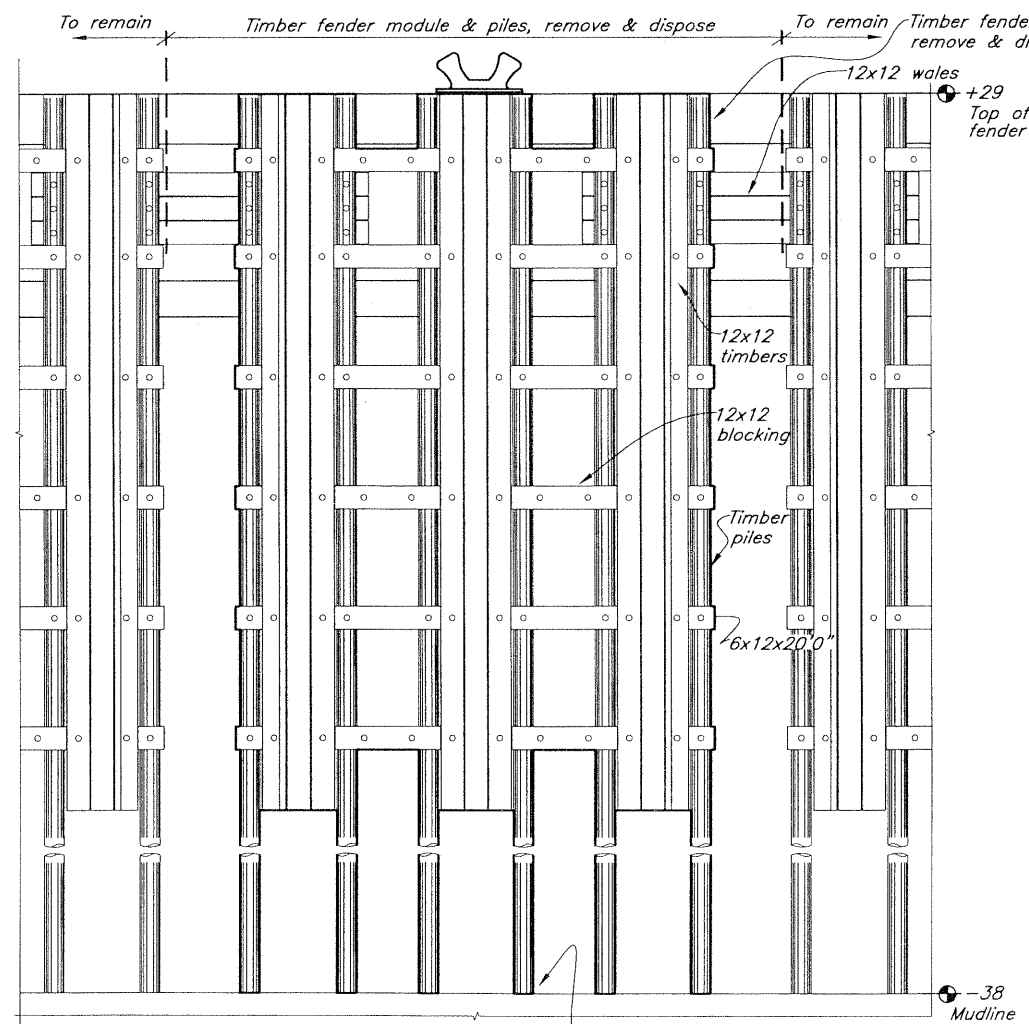


Elevation

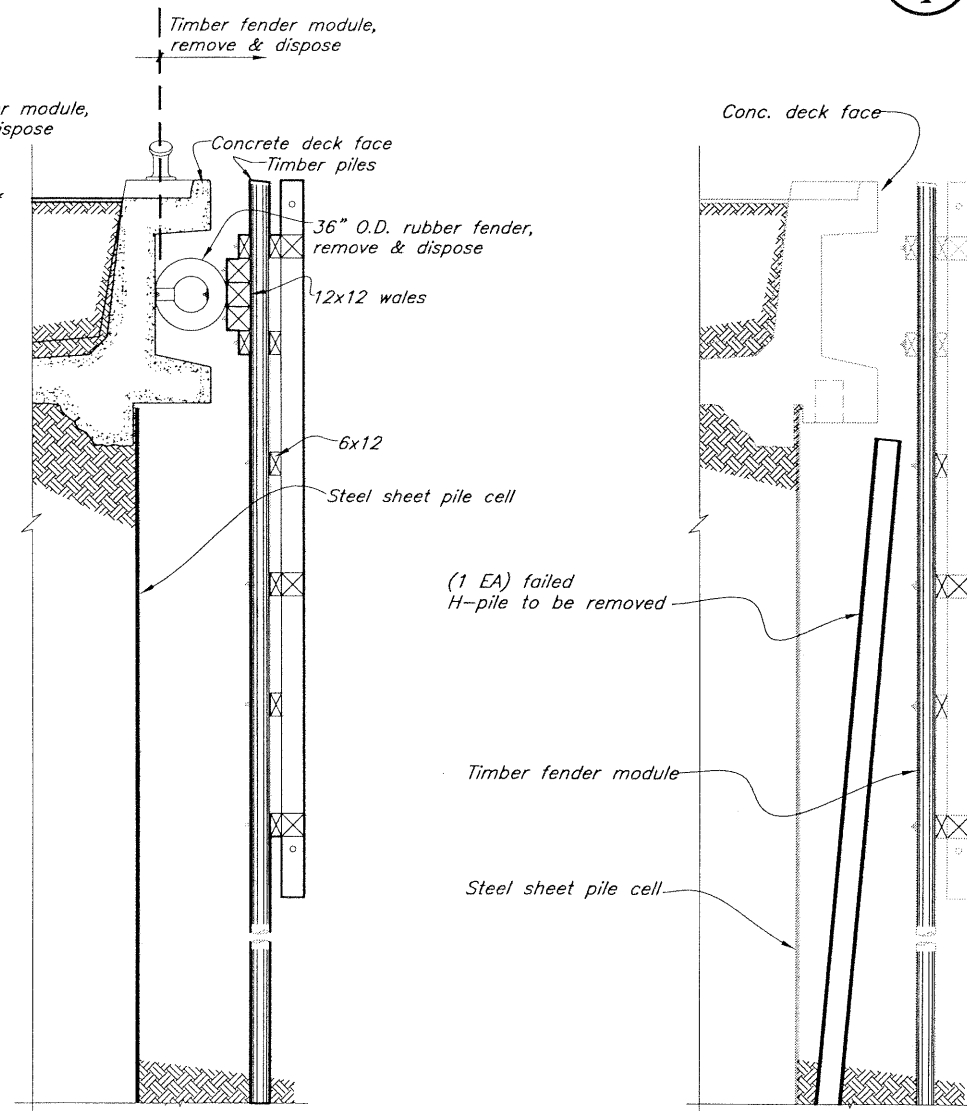


Section

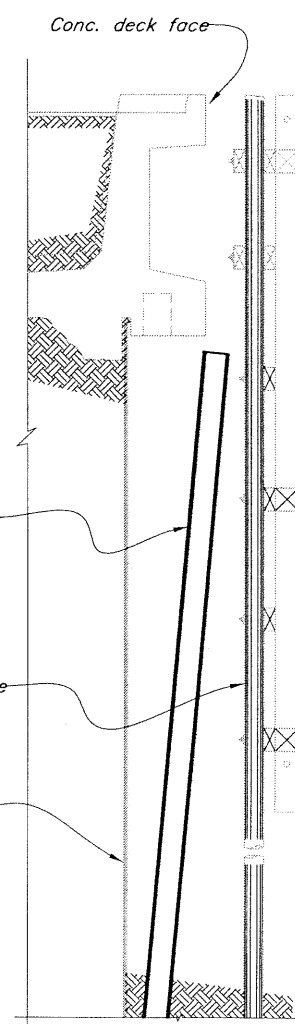

Section

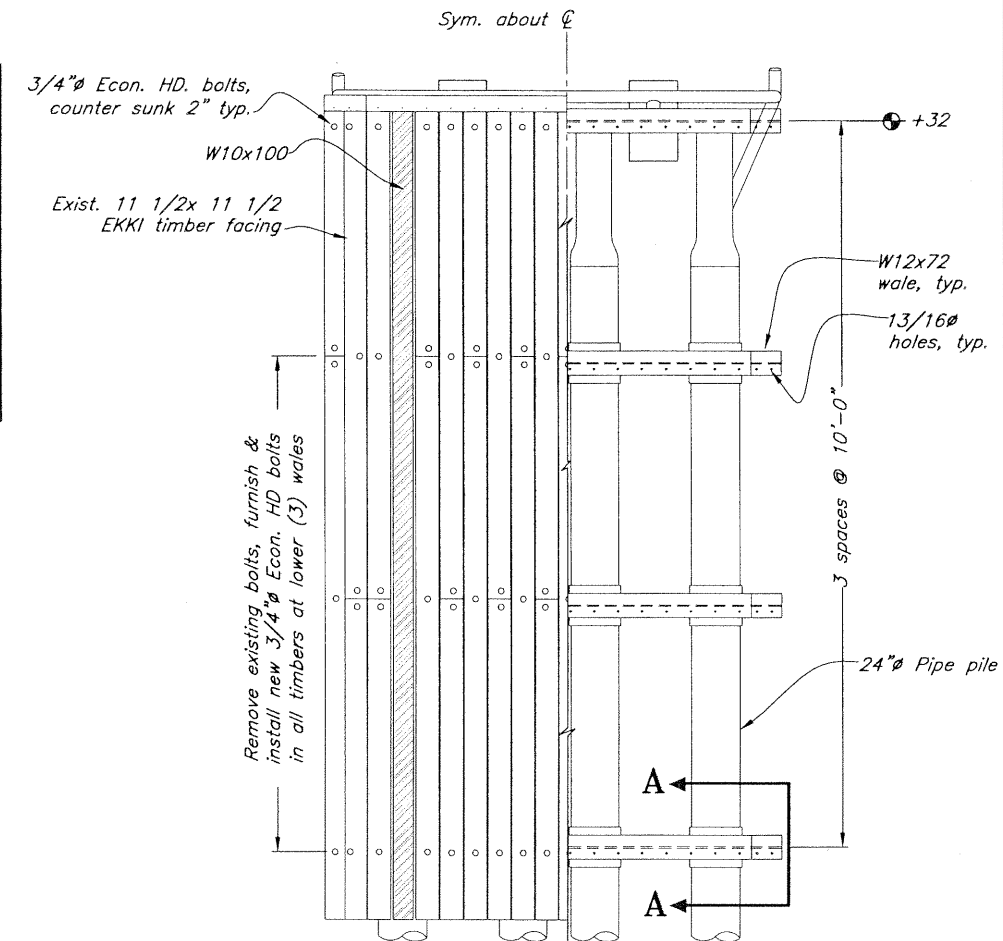

Elevation

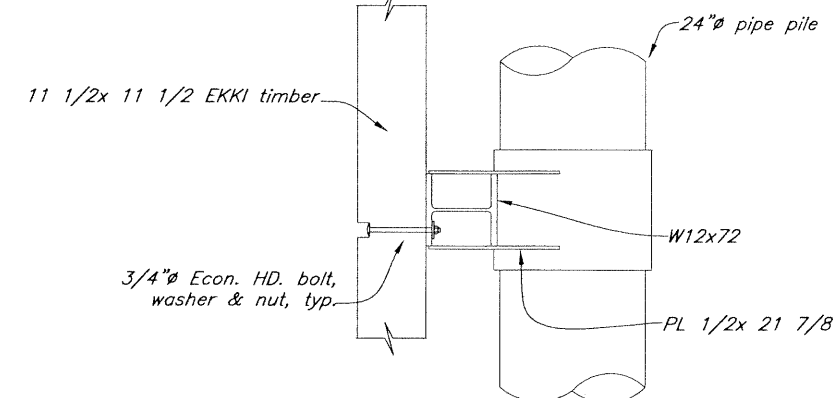

Section A-A

Refastening Fender Timbers Detail (2/5)


NOTE:
All piles & timbers are creosote pressure treated.
Refer to Sheet 26 for As-Built information.

Timber Fender Module Demolition (1/4)

H-Pile Demolition (B/4)

DO NOT SCALE FROM THESE DRAWINGS USE DIMENSIONS

DESIGNED BY: T. Dagggett 		STATE OF ALASKA DEPARTMENT OF TRANSPORTATION & PUBLIC FACILITIES SOUTHEAST REGION Haines Mooring Improvements Project 75249			
CHECKED BY: B. Savikko DRAWN BY: W. Hickok		Existing Fender Repairs			
PATH: Q:\Hns\75249\MF\Phase-B\PlanSet\21-Exist Fender Repairs.dwg PLOT: PSPACE 1=1 TAB: Layout1 Wed, 01/Aug/07 09:27AM		PROJECT DESIGNATION	YEAR	SHEET NO.	TOTAL SHEETS
		75249	2007	21	28

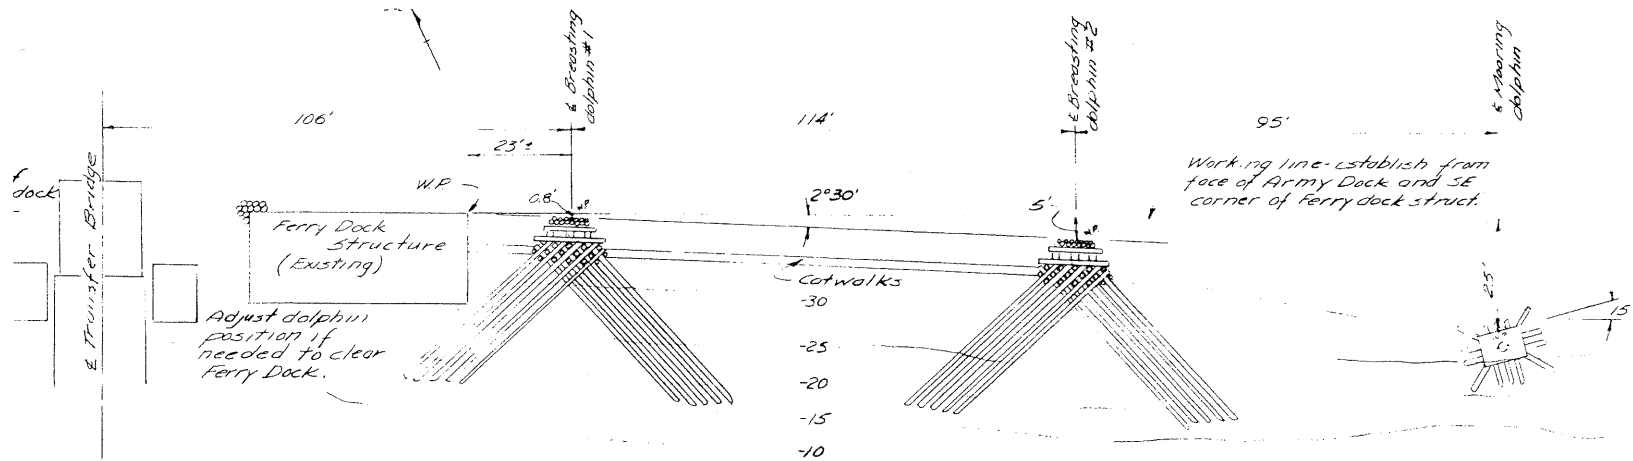


LAYOUT OF DOLPHIN ADDITION
Scale 1"=20'


Note: Site contours from 'Site Plan' by TONER, MORROW dated Feb. 1962. Verify in field if needed.

Project As-Built Drawings have been reviewed by the Project Engineer and represent to the best of my knowledge, the project as constructed.


Proj. Engr. C. J. Douglas Date 5/26/09

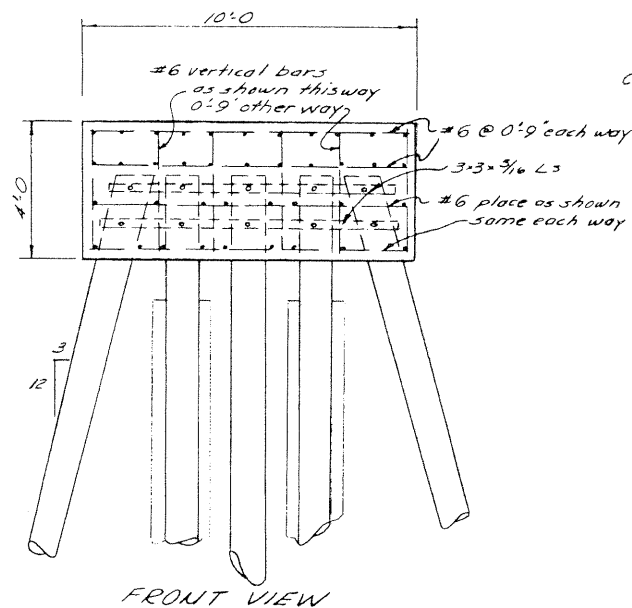

FRONT VIEW

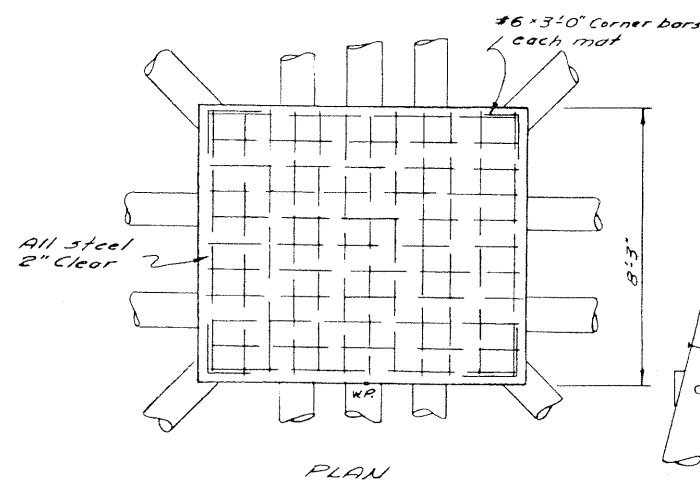


PLAN

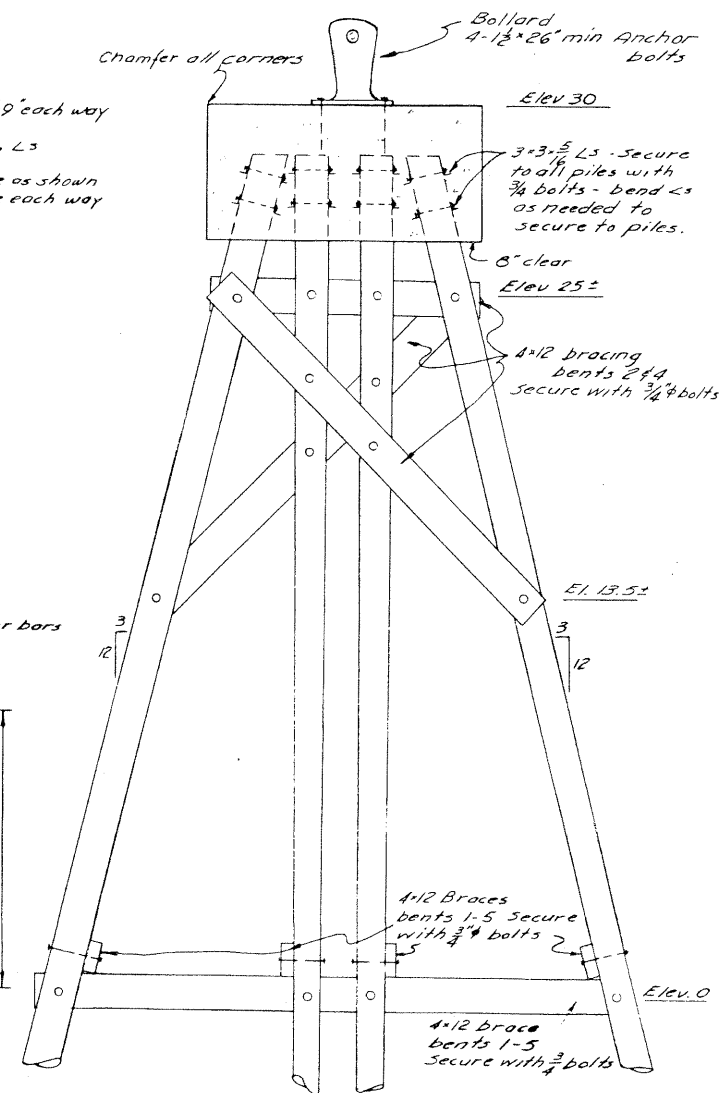

ELEVATION

Dolphin Notes
1. Mooring dolphin piles shall be Class A driven to a minimum penetration of 15' and a bearing value of 25 tons minimum. At least 18 tons of bearing must be developed 5' above final tip elevation during driving.

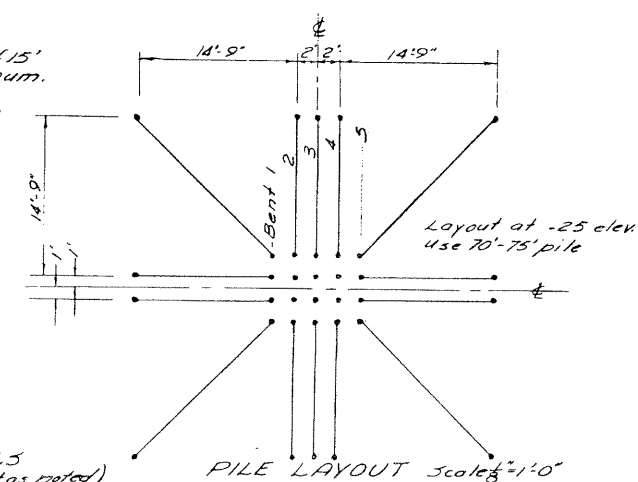


38 PILE DOLPHIN
HAINES FERRY TERMINAL

PROJECT No. MT 95


Scale: As Shown

Nov. 7, 1968

2

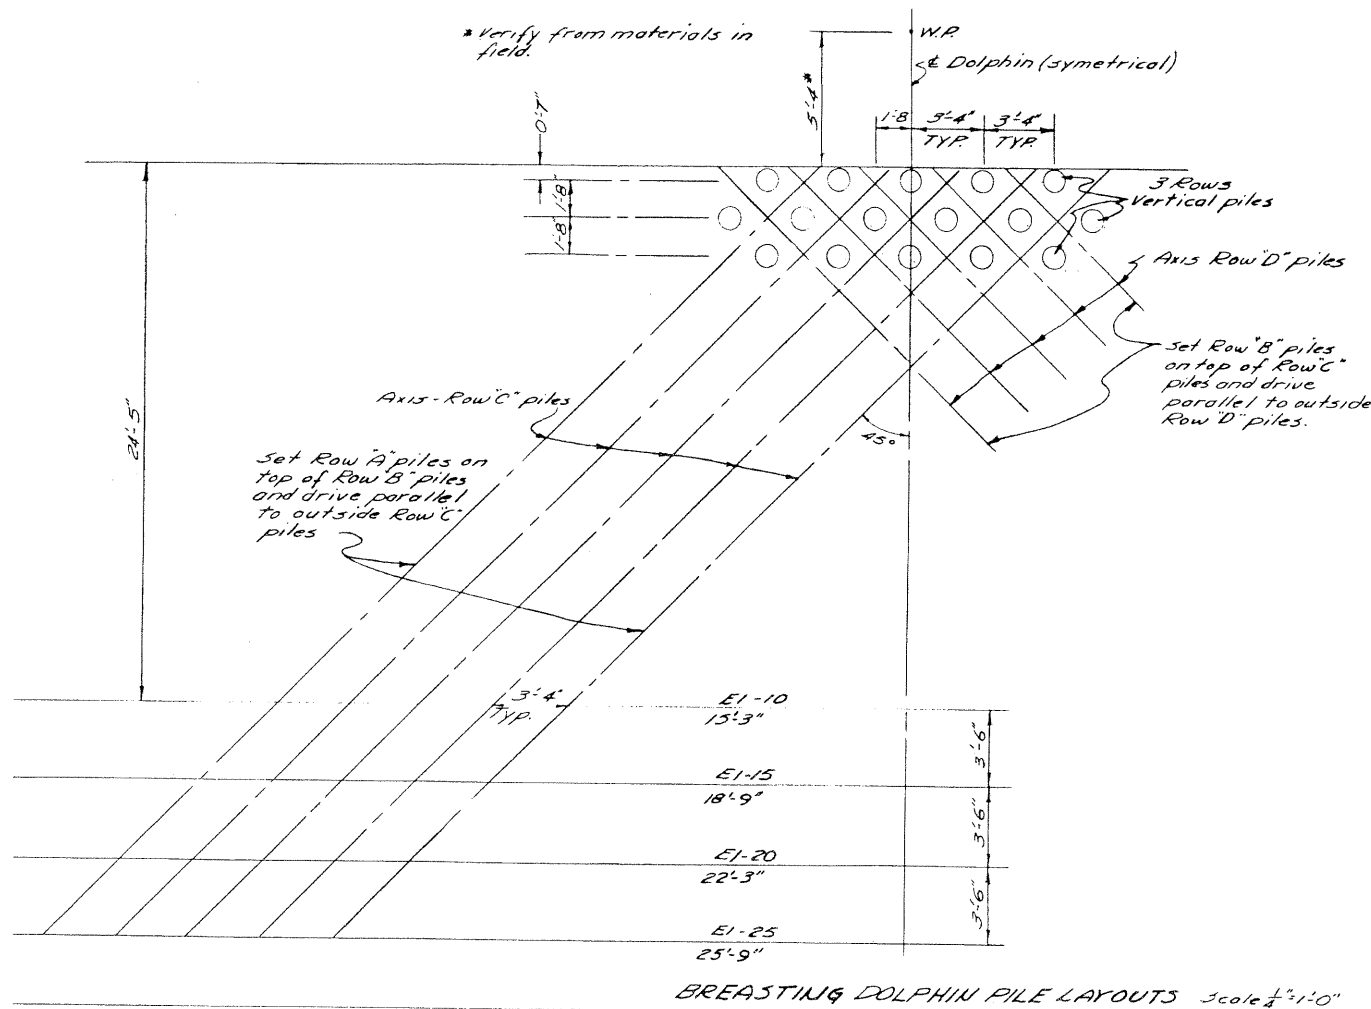

BREASTING DOLPHIN PILE LAYOUTS Scale 1/4"=1'-0"

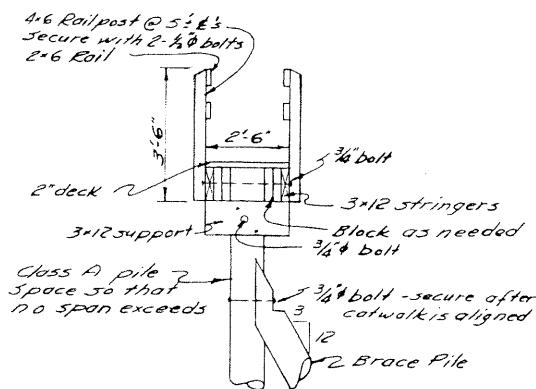


CATWALK DETAILS
Scale 3/8"=1'-0"


NO AS BUILT AVAILABLE

MOORING
DOLPHIN DETAILS
Scale 3/8"=1'-0" (except as noted)


Note: Mooring loads and vessel details not available. Mooring dolphin designed for a 60,000 lbs transverse mooring load and a 25,000 lbs longitudinal springing load. Loads applied simultaneously.
By CAMPBELL & ASSOC.

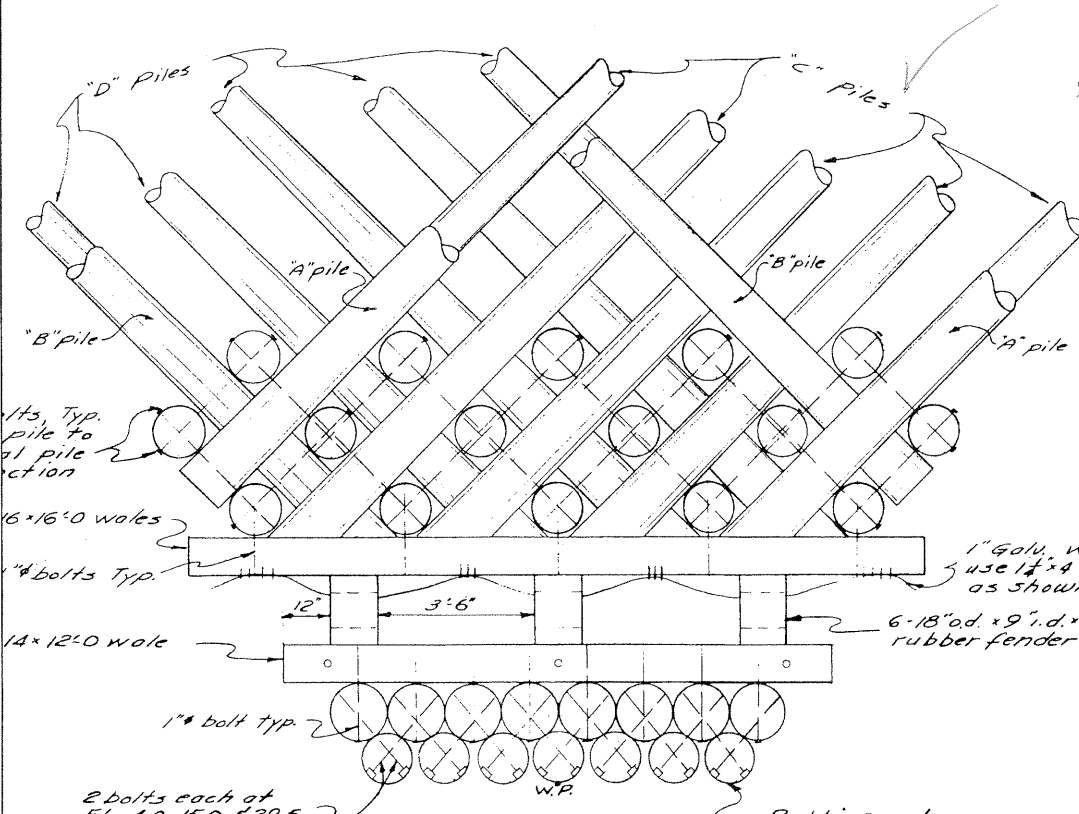


PLAN OF DOLPHIN
Scale 1/2" = 1'-0"

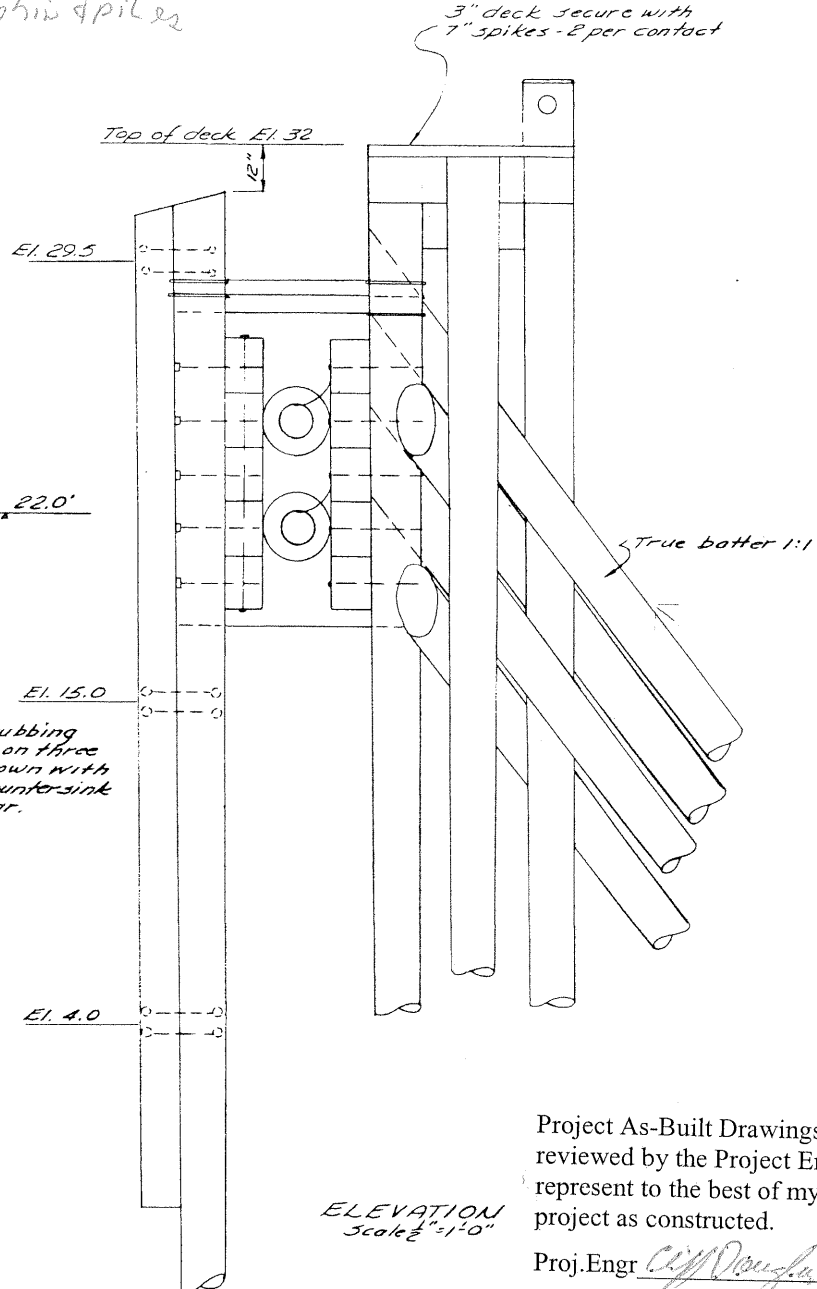


ELEVATION
Scale 1/2" = 1'-0"

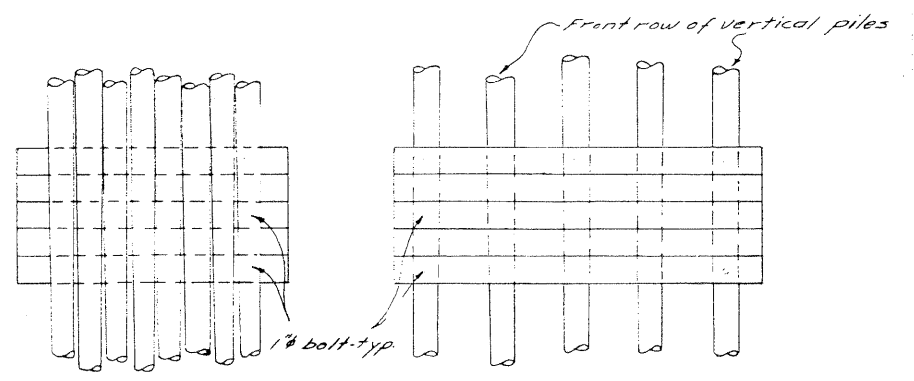

WALE BOLTING DETAILS
Scale 1/2" = 1'-0"

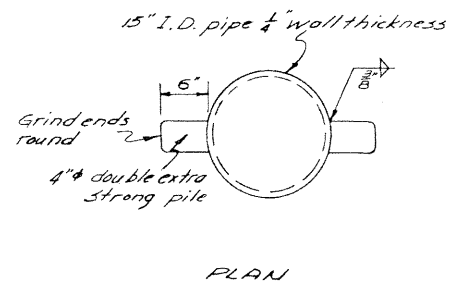


PLAN

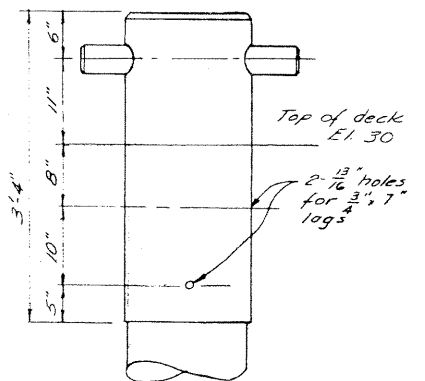


ELEVATION

MOORING PILE DETAILS
Scale 1/2" = 1'-0"

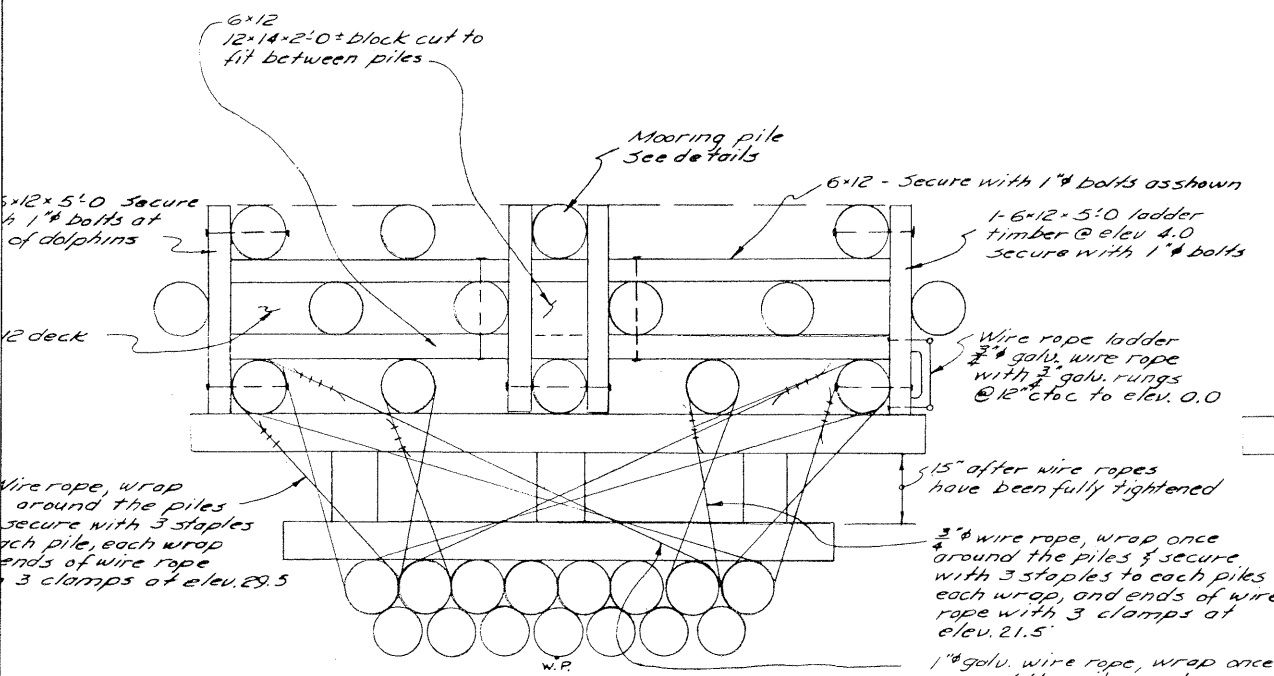

DOLPHIN PLAN - WIRE ROPE AND TIMBERS
Scale 1/2" = 1'-0"

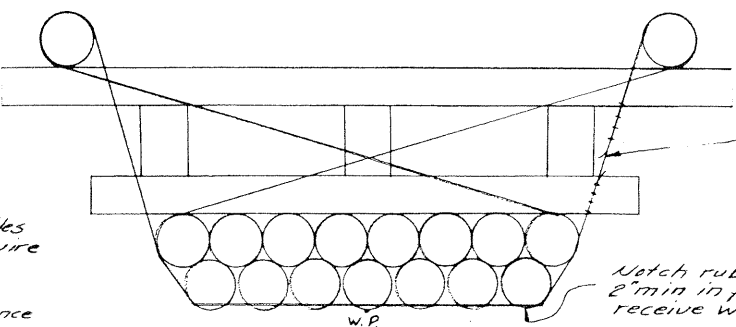

WIRE ROPE ALTERNATIVE
Scale 1/2" = 1'-0"

Project As-Built Drawings have been reviewed by the Project Engineer and represent to the best of my knowledge, the project as constructed.

Proj. Engr. *Cliff Douglas* Date *5/26/09*

- NOTES:
- Whenever a brace pile passes between two vertical piles, the three piles shall be connected with a 1 1/2" bolt. (2 connections per brace pile).
 - The fender holding cables shall be tightened fully and the rubber fender blocks compressed so the distance between wales will measure no more than 16".
 - Use 1/2" washers for all dolphin bolts in the following sizes:
 3/4" x 5" - for 1 1/2" bolts
 1/2" x 4" - for 1" bolts

NO AS BUILT AVAILABLE

Design by Swan-Wooster Engineering
Vancouver, B.C.
Design for: Alaska Barite Co.
Barite Island Development
Elevations revised for use at Haines.

38 PILE DOLPHIN
HAINES FERRY TERMINAL

PROJECT No. MT 95

EXISTING STRUCTURES
Sheet 23 of 28

By CAMPBELL & ASSOC. Scale - As Shown Nov. 7, 1968 2/2

1/4" # econ. hd. bolts countersunk 2" @ ea. waler, typ.

1 1/2" x 1 1/2" EKKI Timber facing W10x100

Note: Provide 1/2" # weep holes between stiffeners on walers.

Note: Angled portion (ends) of fender system not shown for purposes of clarity

6" # std. pipe, typ. 12" # bollard, see detail on sht. 34

Handrail support pieces, see detail, sht. 33. Handrails to be grouted snugly into supports. Keep drain holes open.

R 3/4" x 5 3/8" x 6'-0", ea. end

6" # pipe to be attached to both sides, see detail, sht. 33

1/2" R typ. between piles, see dolphin cap detail, sht. 33


18" # half pile section, spread to 18" I.D.

18" # x 500 wall pipe pile typ. Drive thru opening in cap.


Typ. ea. side of pipe

3/16"

Non-skid surfacing shall be 3.0 lb. galvanized carbon steel expanded structural grating. Open area shall be approx. 60% design openings shall be 1.33" x 5.33". Weld to deck plate @ 6" o.c. @ edge, 12" x 12" spacing for int. welds.

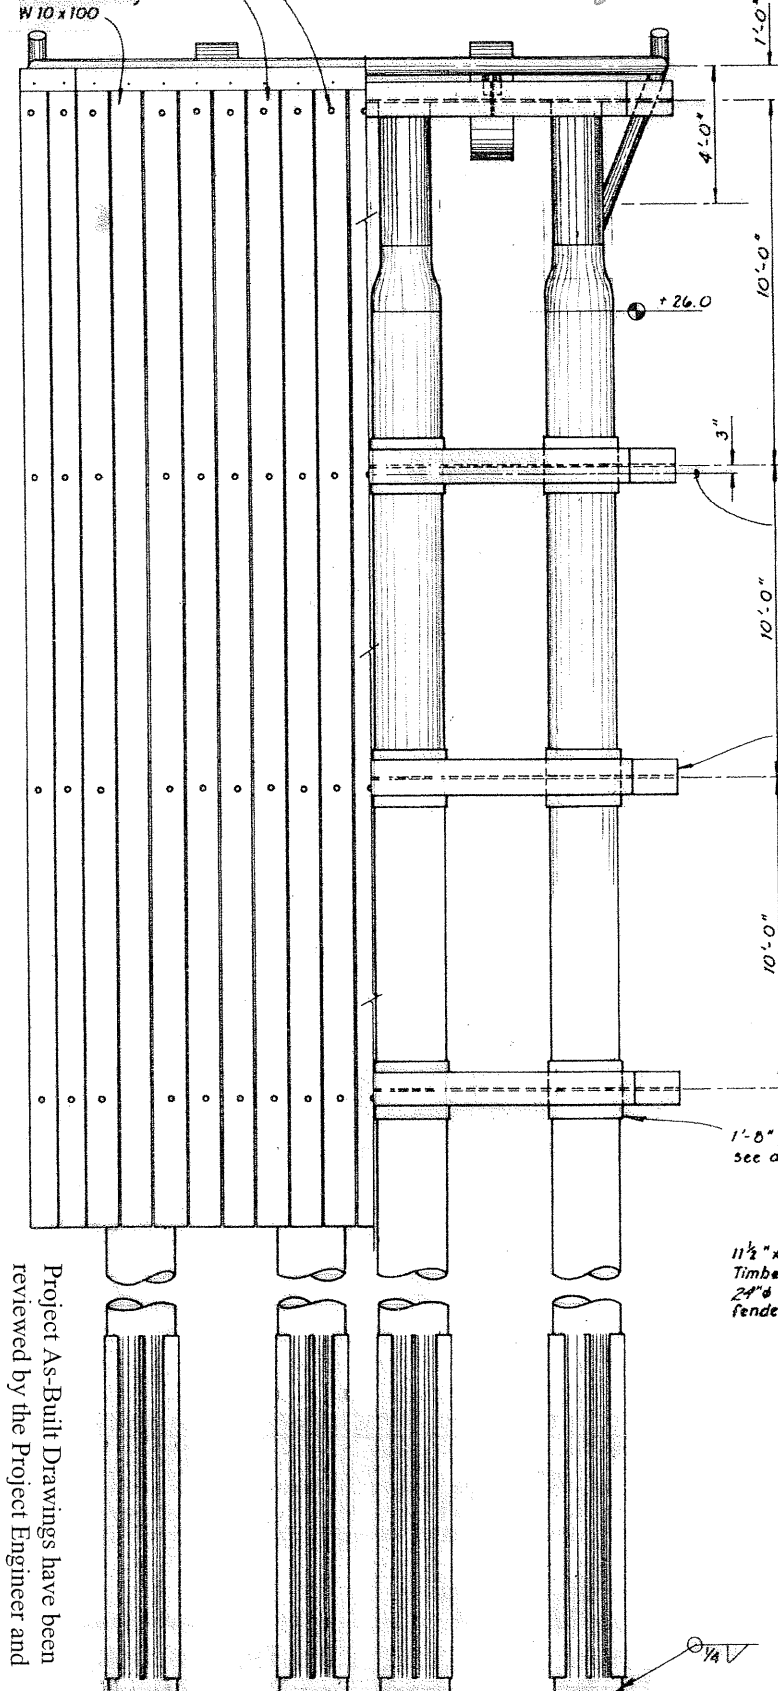


FRONT

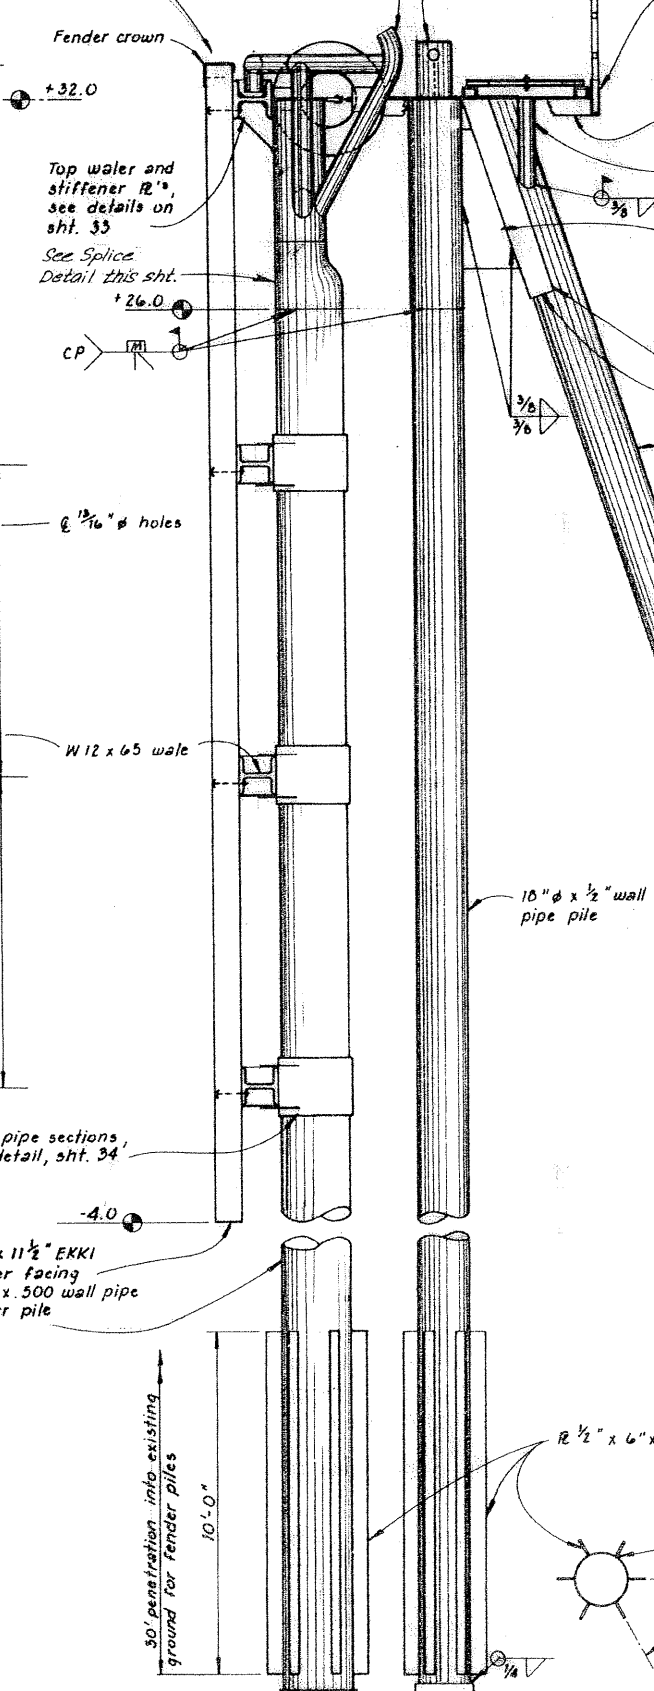

SIDE


DOLPHIN ELEVATIONS
3/8" x 1'-0"

EXISTING STRUCTURES
Sheet 24 of 28

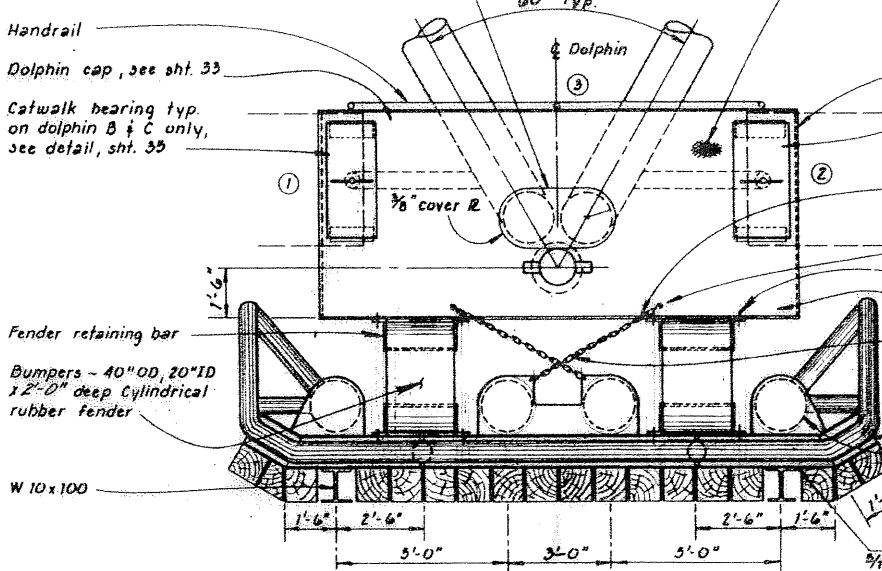


DOLPHIN PLAN
3/8" x 1'-0"

Note: Location of safety ladder for
① Dolphin A
② Dolphin B
③ Dolphin C
See ladder detail sht. 28

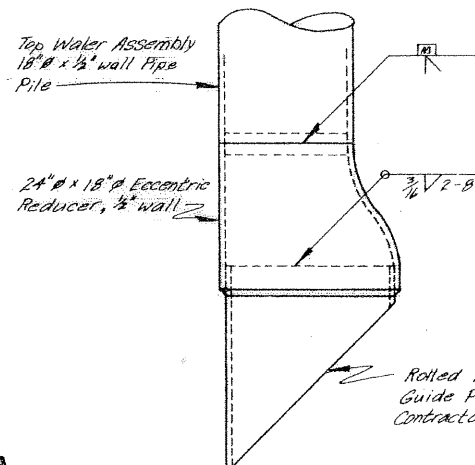

FENDER PILE SPLICE DETAIL
1" x 1'-0"

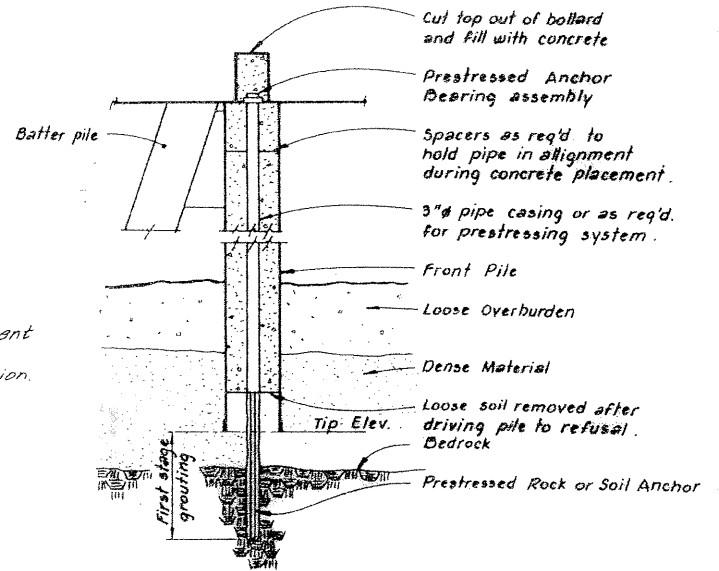

PRESTRESSED PILE ANCHOR
3/4" x 1'-0"

Note: Prestressed Anchor shall be used only when directed by the engineer. 3 may be req'd. in accordance with section 301 & 308

Project As-Built Drawings have been reviewed by the Project Engineer and represent to the best of my knowledge, the project as constructed.
Proj. Engr. *[Signature]* Date: 5/26/09




STAMP		DO NOT SCALE THIS DRAWING - USE DIMENSIONS	
STATE OF ALASKA DEPARTMENT OF TRANSPORTATION AND PUBLIC FACILITIES HARBOR DESIGN AND CONSTRUCTION			
Haines		Alaska	
DOLPHIN PLAN & ELEVATIONS			
SCALE: As Noted	SURVEYED:	APPROVED:	
DESIGNED: HRM	DRAWN: TS		
CHECKED: JB/JOB	DATE: 6-83		
PROJECT NUMBER: A38512 & F-095-5(5)		SHEET 32 OF 37	

PROJECT NO. 75210-HTJ39, Sht 3 of 3	SCALE AS NOTED	DATE 9-30-75	APPROVED
DESIGNED BY JI	DRAWN BY Don Statter	DIRECTOR	
STATE OF ALASKA DEPARTMENT OF PUBLIC WORKS DIVISION OF WATER AND HARBORS			
DOCK FENDER CONSTRUCTION DETAILS AS-BUILT			
DO NOT SCALE THIS DRAWING - USE DIMENSIONS			


NOTES:
 1. All bolts to be economy head type, 1" except as noted.
 2. All hardware to be hot dip galvanized after fabrication.
 3. All piles and timber to be creosote pressure treated to 20/10 cu ft min. retention for piles, 20-lb for timbers.
 4. Piles to be driven tip down to 12" penetration or refusal.
 5. All drilling or fabrication of timber after treatment shall be field treated as noted in Specs.
 6. Malleable iron washers shall be placed between all nut and wood surfaces.
 7. All timber materials to be rough, full dimension.

AS-BUILT Drawing
S126109 CO


AS-Built 8-24-79 DCW

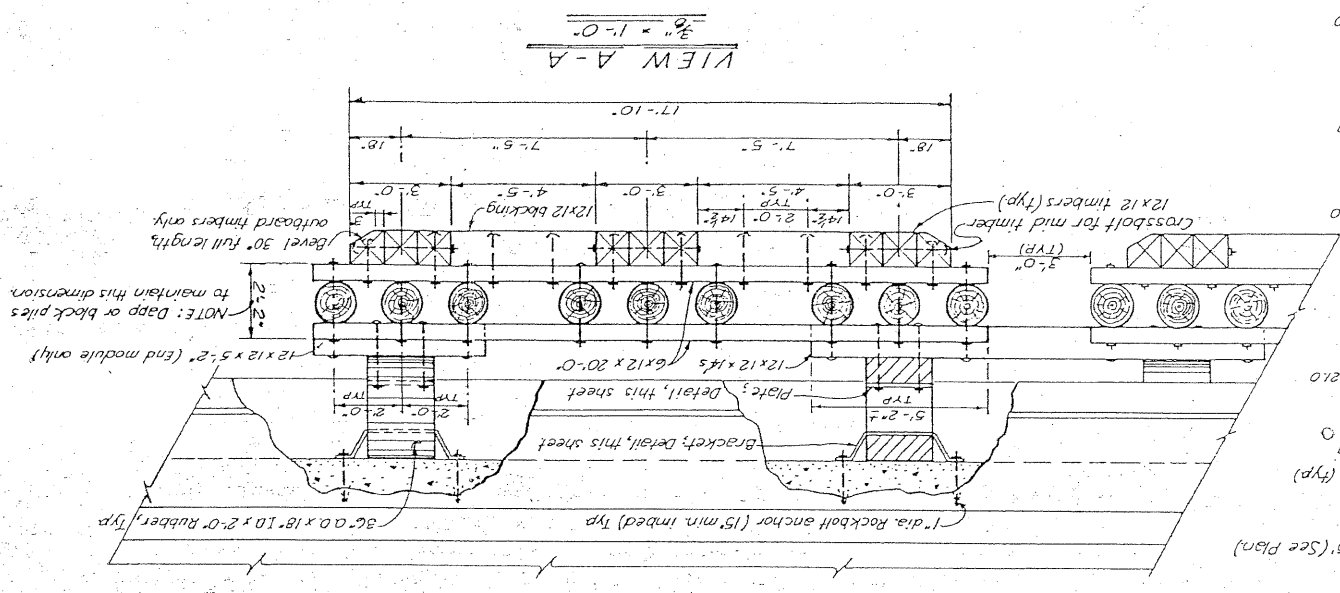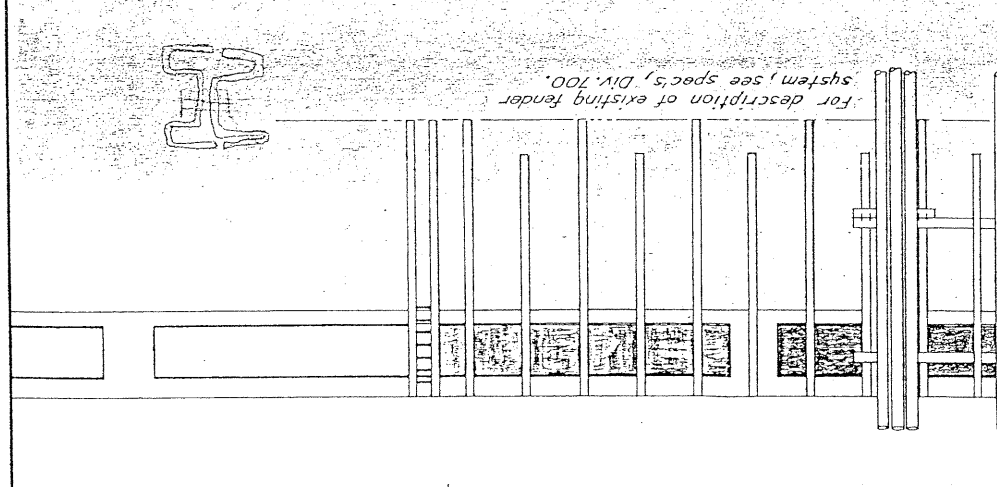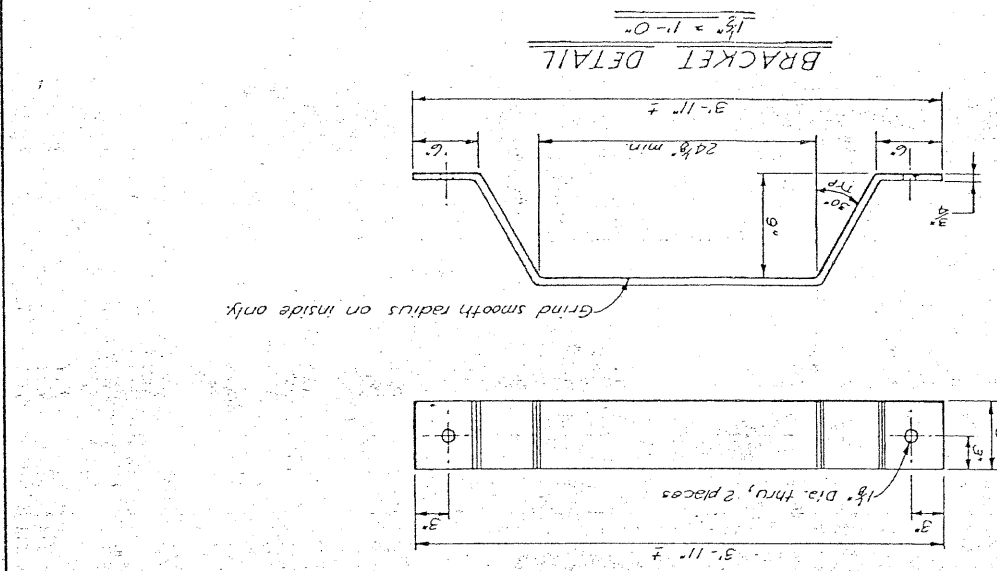

NOTE: Dapp or block piles to maintain this dimension.
 Bevel 30° full length on outboard timbers only.

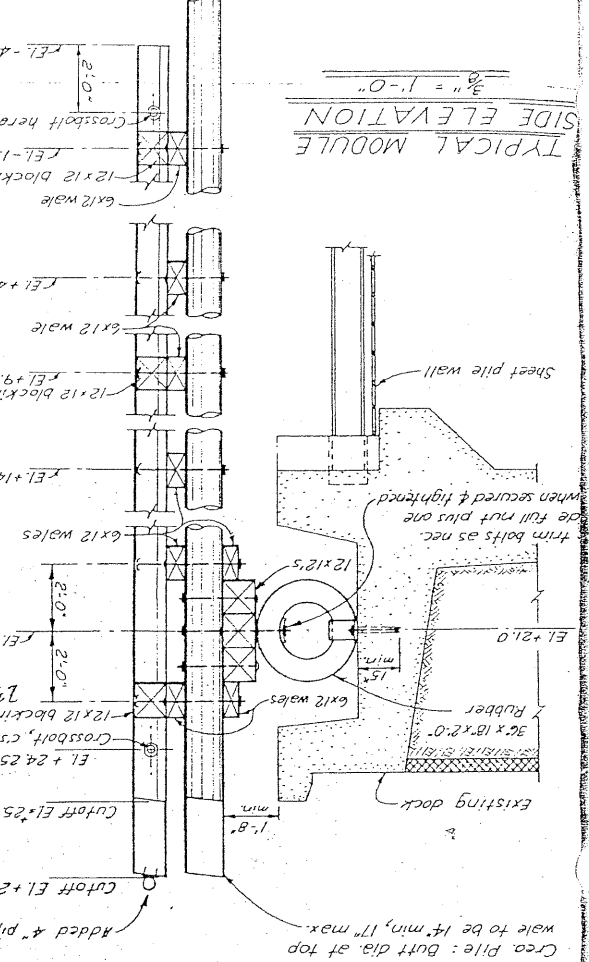

Creca Pile: Butt dia. at top
 wale to be 14" min, 17" max.
 Trim bolts as nec. to full nut plus one when secured & tightened.

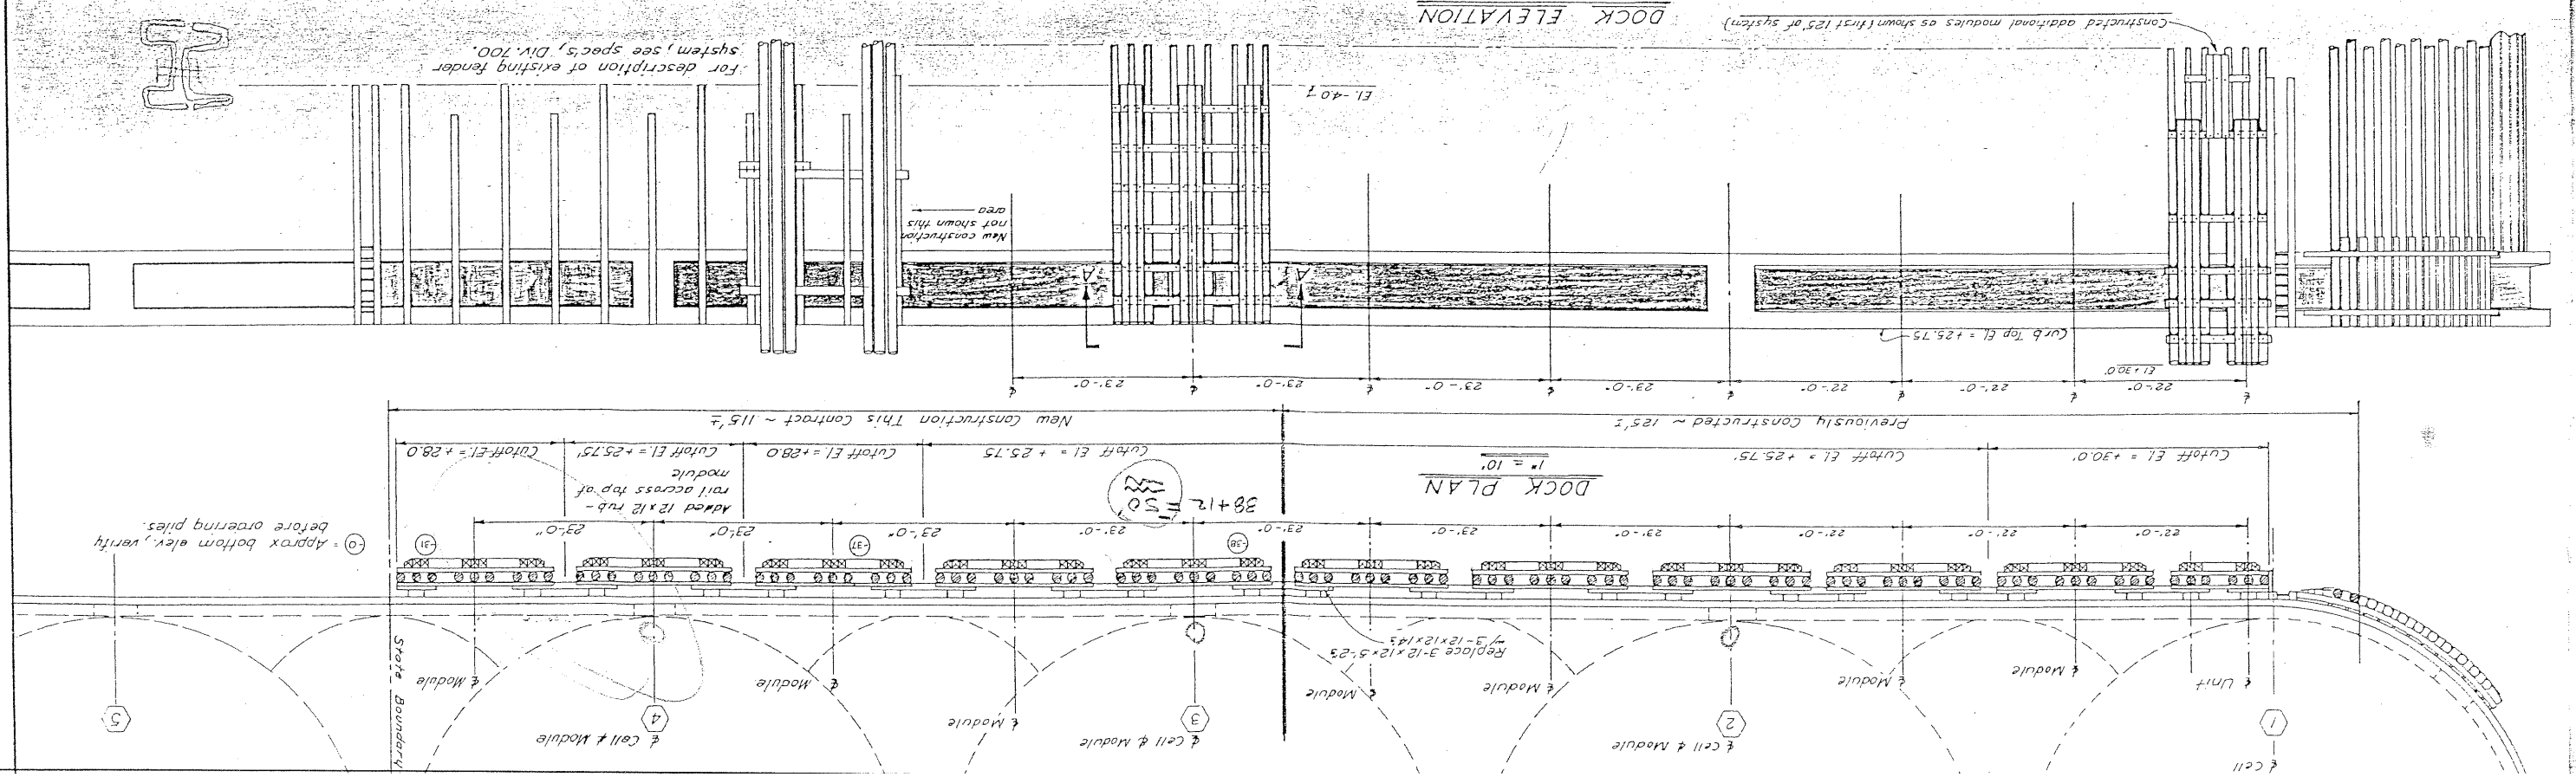

① = Approx bottom elev, verify before ordering piles.

For description of existing fender system, see specs, Div. 100.

PROJECT DESIGNATION	75249	YEAR	2007	SHEET NO.	E1	TOTAL SHEETS	28
DESCRIPTION	Electrical Plan						
REVISIONS							
DATE							
NO.							
DESIGNED BY:	M. Carson						
CHECKED BY:	M. Carson						
DRAWN BY:	M. Carson						
PLT: PSPACE 1=1							
TAB: ELECPLAN							
PATH: C:\Documents and Settings\hndoggett\Desktop\hndoggett\NORTHSTAR ENGR\E1\E1-ElecPlan4-20-07.dwg Wed, 08/Aug/07 12:21PM							

Haines Mooring Improvements
 Project 75249
 STATE OF ALASKA
 DEPARTMENT OF TRANSPORTATION
 & PUBLIC FACILITIES
 SOUTHEAST REGION





DO NOT SCALE FROM THESE DRAWINGS USE DIMENSIONS

Project As-Built Drawings have been reviewed by the Project Engineer and represent to the best of my knowledge, the project as constructed.
 Proj. Engr. *M. Douglas*
 Date *12/6/09*

- LEGEND:
- EXISTING LPS TUBALOID FIXTURE
 - EXISTING POLE AND FIXTURE
 - NEW TYPE C FIXTURE
 - NEW TYPE F FIXTURE WITH RED LIGHT
 - EXISTING ELECTRICAL FACILITY
 - REMOVE EXISTING FACILITY
 - SS JUNCTION BOX
 - EXISTING WIRING AND CONDUIT
 - NEW WIRING AND CONDUIT

- NOTES:
- 1 REMOVE 2-1 1/4" AND 3/4" CONDUITS AND 12"x12"x6" JUNCTION BOX.
 - 2 REMOVE TWO POLE FIXTURES AND SO CORD.
 - 3 RECONNECT EXISTING FLOODLIGHTS TO CATWALK LIGHT CIRCUIT WITH 2 #8 XHHW-2 IN 3/4" RIGID GALVANIZED CONDUIT AND LIQUID TIGHT FLEX TYPE UA. PROVIDE OZ YS-060604 JUNCTION BOX ON 4"x4" WOOD POST AND BURY CONDUIT 18"
 - 4 ALL NEW WIRING SHALL BE 2 #8 XHHW-2 IN 3/4" RIGID DEEP TO NEW LB FITTING IN LIGHT POLE BASE.
 - 5 GALVANIZED CONDUIT. USE 3/4" LIQUID TIGHT TYPE UA BETWEEN DOLPHINS AND CATWALKS. CLAMP CONDUIT TO 1 1/2" RAILING WITH STAINLESS STEEL CLAMPS. PROVIDE RIGID CONDUIT BODIES TO FACILITATE JOINT REPLACEMENT. VERIFY LOAD ON CIRCUIT BREAKERS L 6, 8 & 10 IN PANEL L AND CHANGE FROM 20/1 TO 30/1 SIZE IF NECESSARY.
 - 6 RETAIN EXISTING TYPE A & B LPS TUBALOID FIXTURES. EXCEPT WHERE NEW TYPE C & F FIXTURES ARE SPECIFIED. PROVIDE 2 #8 XHHW-2 IN 3/4" CONDUIT FROM RED LIGHT TO EXISTING 1/2 HP WINCH ENCLOSURE AND CONNECT TO WINCH CIRCUIT FED FROM CIRCUIT BREAKER L-18 (PANEL L).

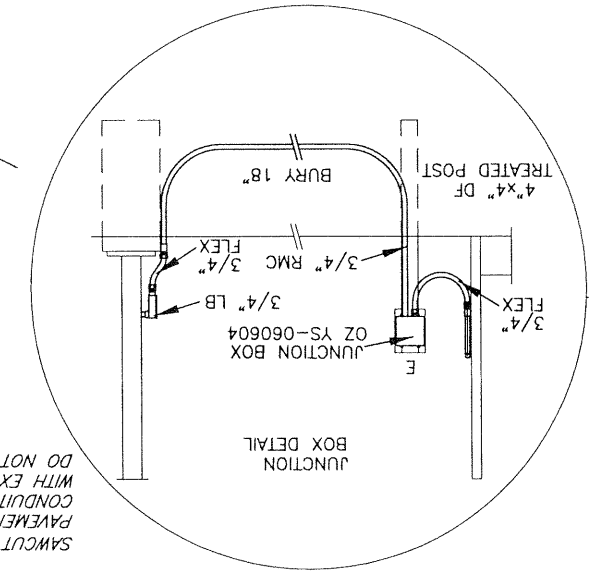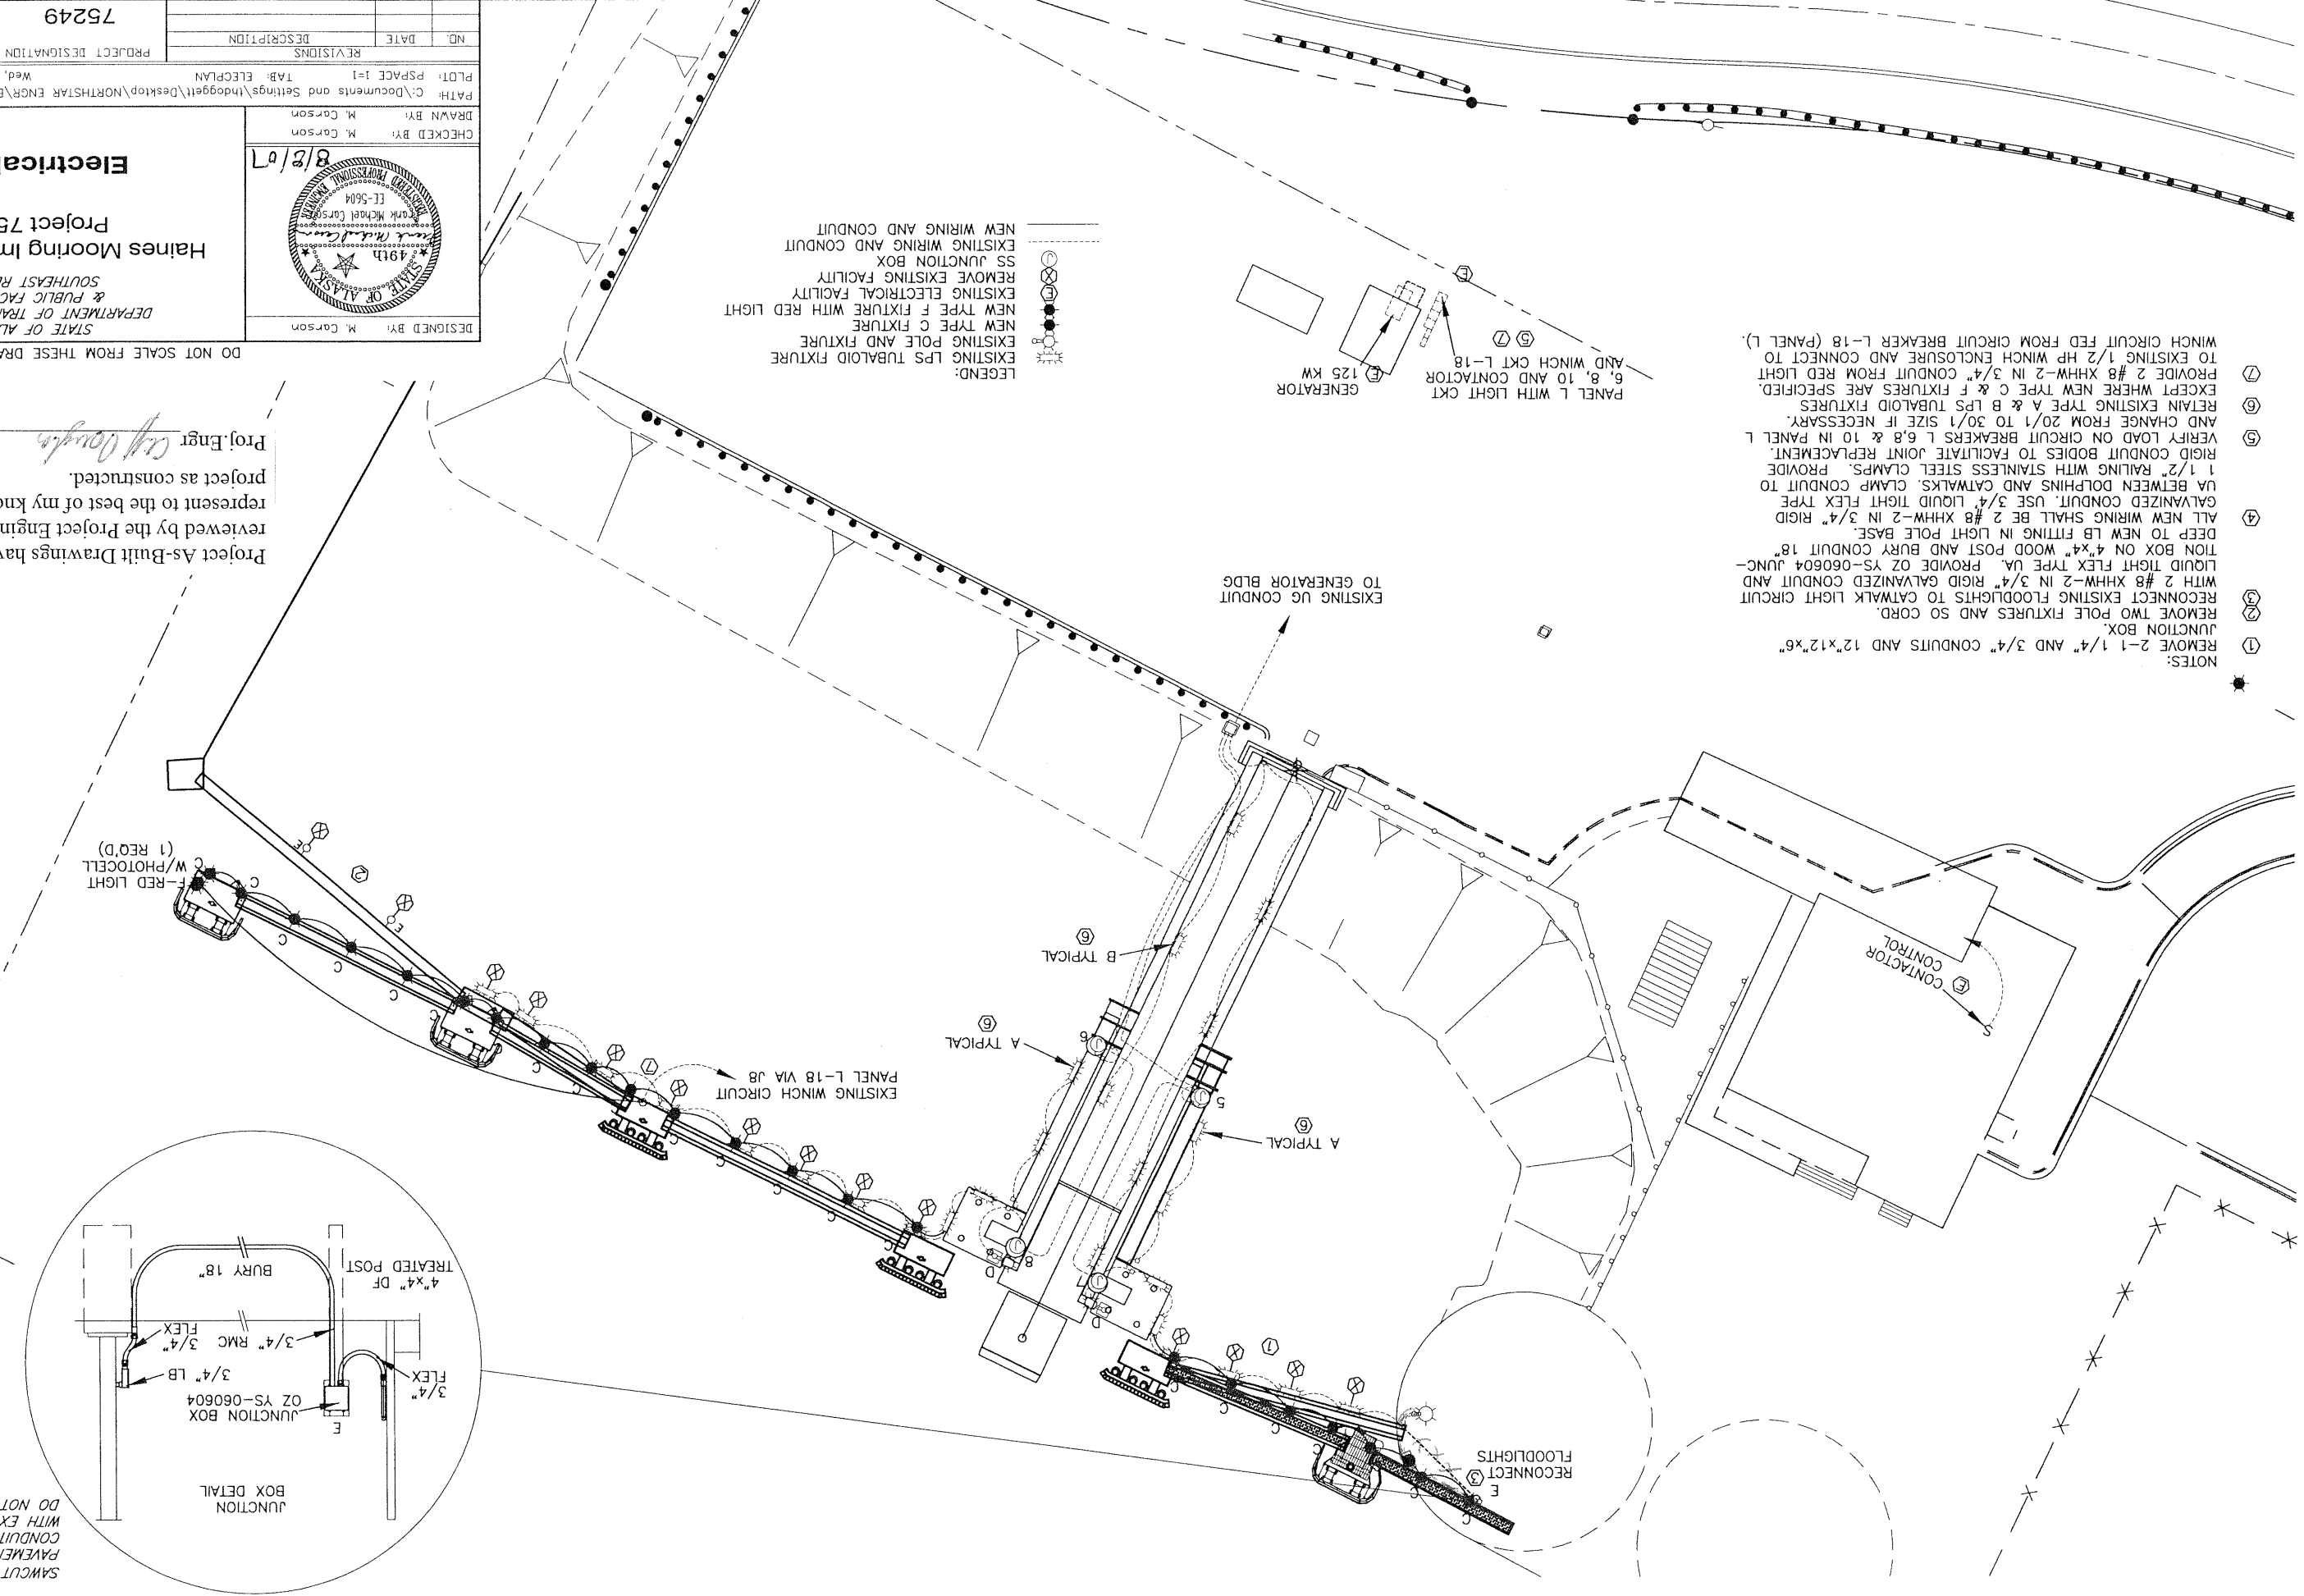


SAWCUT EXISTING ASPHALT
 PAVEMENT 12" WIDE FOR
 CONDUIT TRENCH. BACKFILL
 WITH EXCAVATED MATERIAL.
 DO NOT REPLACE PAVEMENT.

As-Built Drawing 5/26/09 CD


TYPE	MANUFACTURER	REMARKS
A	VOIGT TUBALOID	EXISTING
B	VOIGT TUBALOID	EXISTING
C	PAULUHN23B/CONCH23TV	REPLACE EXIST. FIXTURES
D	EMCO 210	EXISTING 8'-0" POLE
E	UNKNOWN FLOODLIGHTS	EXISTING STEEL POLE
F	PAULUHN 707B-RED	RED PLASTIC LENS, PHOTO-CONTROL

FIXTURE SCHEDULE

U-BOLT DETAIL
(2 ASSEMBLIES REQ'D EA. PLATE)

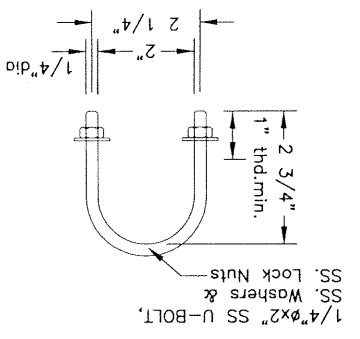

MOUNT PLATE DETAIL

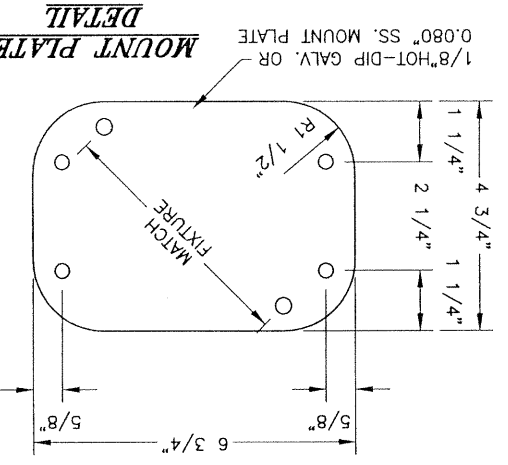

LIQUID TIGHT FLEXIBLE CONDUIT AT ENDS OF CATWALKS, TYP (SEE NOTE 1)

INSTALL 1" RIGID TYPE LL CONDUIT BODIES AT ENDS OF CATWALKS, TYP


3/4" & 1 1/2" GALV. CONDUIT STRAPS-STEEL CITY TYPE 6H BOLT TOGETHER AS REQUIRED

1" GALV. MOGUL CONDUIT BODY 02 TX8100M

3/4" LIQUID TIGHT CONNECTOR
1-3/4" GALV. BUSHINGS(3)


SECURE BODY W/ 2 EA. 5/16" SS. BOLTS

LIGHTING FIXTURE BOTTOM VIEW

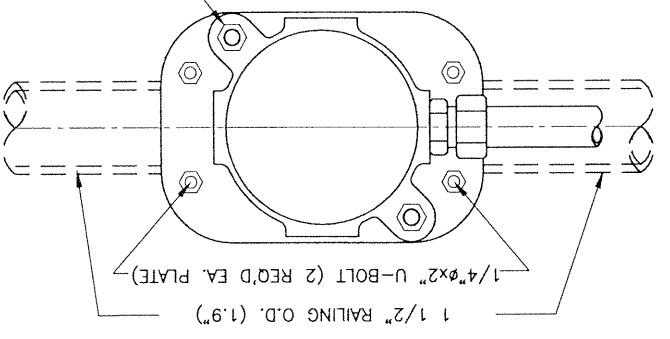

DOLPHIN, CATWALK OR GANGWAY HANDRAIL (SEE STRUCTURAL DRAWINGS)


LIGHTING FIXTURE ELEVATION VIEW

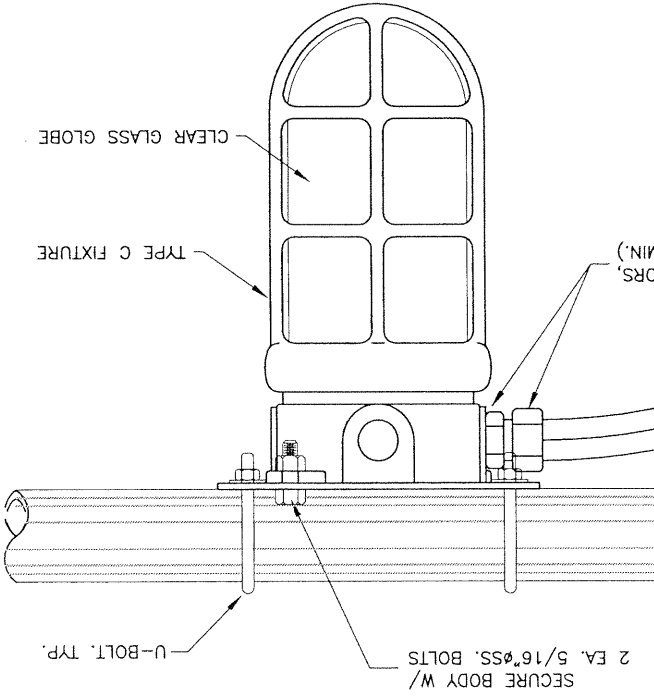

3/4" GALV. RIGID CONDUIT-INSTALL ON EXTERIOR FACE OF HANDRAIL POSTS.


TYPE C LIGHTING FIXTURE, SIDE VIEW
(SUPPLY EITHER FIXTURE)

Marine brass fixture with S.S. PL & U-bolts. Pauluhn Elec Manufacturing Catalog No. 723B or approved equal

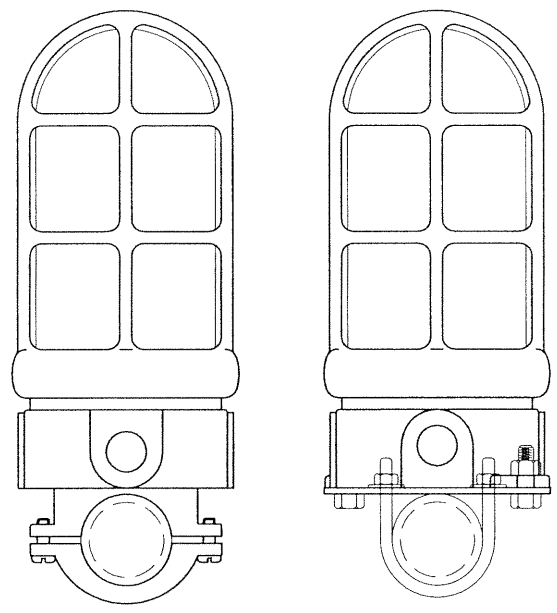

TYPE F RED LIGHTING FIXTURE SIDE VIEW

Marine brass fixture with red glass globe Pauluhn Elec Manufacturing Catalog No. 707B or approved equal

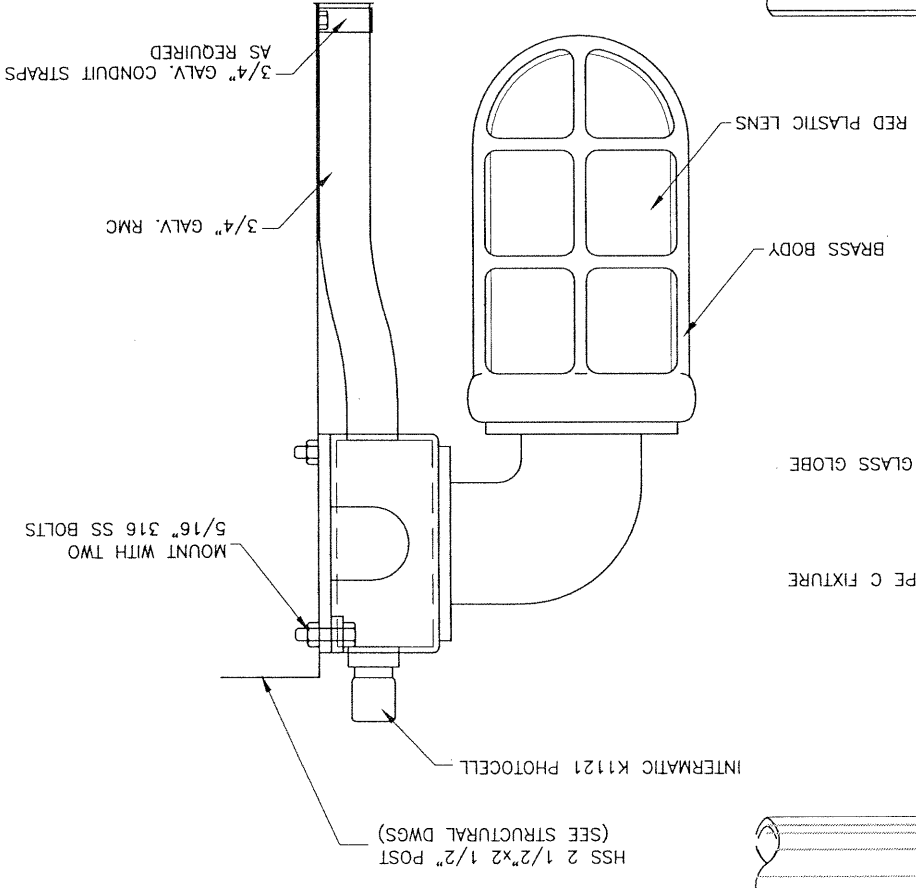

HSS 2 1/2" x 1/2" POST (SEE STRUCTURAL DWGS)

MOUNT WITH TWO 5/16" 316 SS BOLTS

3/4" GALV. CONDUIT STRAPS AS REQUIRED

NOTES:
1) CONTRACTOR SHALL INSTALL LIQUIDTIGHT FLEXIBLE CONDUIT AT CATWALK ENDS TO ALLOW FOR FULL RANGE OF MOVEMENT ALONG SKIDPLATES (APPROXIMATELY 12").

STATE OF ALASKA
DEPARTMENT OF TRANSPORTATION & PUBLIC FACILITIES
SOUTHEAST REGION
Haines Mooring Improvements
Project 75249
Light Fixture/Conduit Mounting Details

DESIGNED BY: M. Carson
CHECKED BY: M. Carson
DRAWN BY: M. Carson

REVISIONS
NO. DATE DESCRIPTION

PROJECT DESIGNATION: 75249
YEAR: 2007
SHEET NO.: E2
TOTAL SHEETS: 28

DO NOT SCALE FROM THESE DRAWINGS USE DIMENSIONS