


STATE	PROJECT	YEAR	SHEET NO.	TOTAL SHEETS
ALASKA	RS 0987(4)	1985	1	13

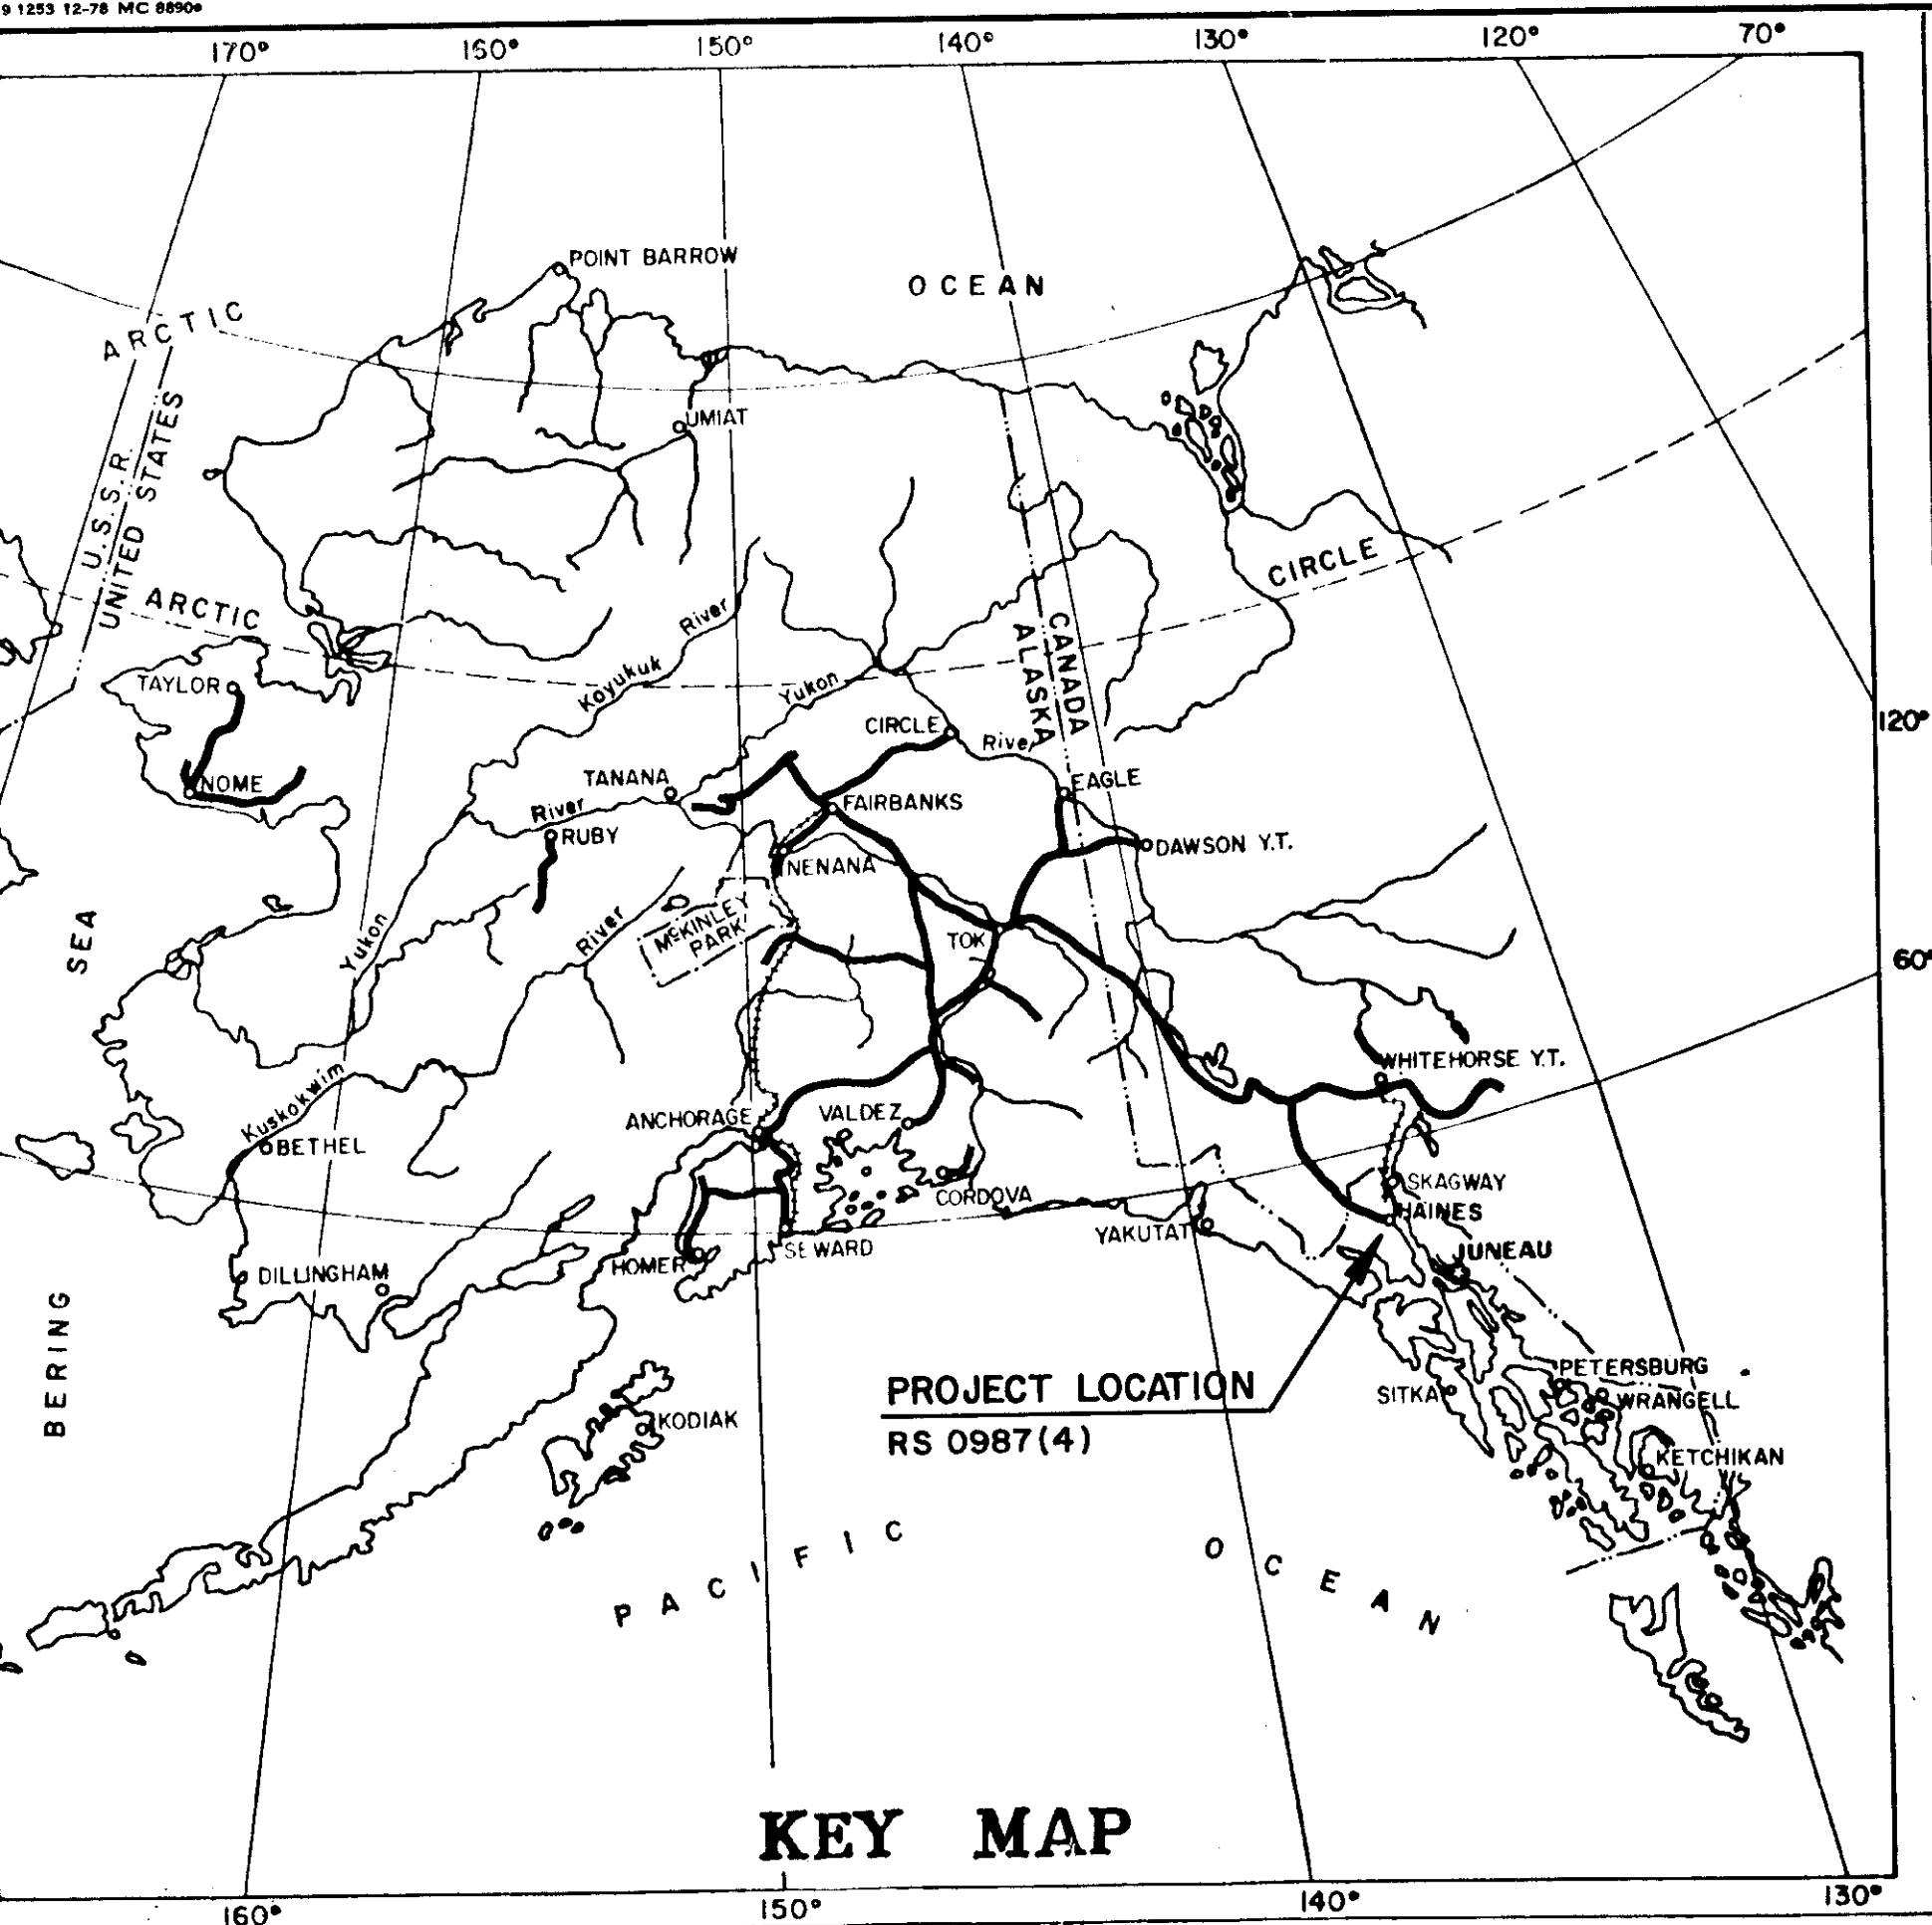

# STATE OF ALASKA DEPARTMENT OF TRANSPORTATION & PUBLIC FACILITIES

## PLAN AND PROFILE PROPOSED HIGHWAY PROJECT RS 0987(4) (B-30142) MUD BAY ROAD—HAINES STAGE II GRADING, DRAINAGE, SURFACE TREATMENT

### INDEX OF SHEETS

SHEET NO.	DESCRIPTION
1	TITLE SHEET
2	TYPICAL SECTION
3	ESTIMATE OF QUANTITIES
4	TRAFFIC CONTROL & CONSTRUCTION SIGNING PLANS
5	DRAINAGE DETAILS, STA. 172+42
6-7	INTERSECTION DETAILS
8-11	PLAN & PROFILE DRAWINGS
12-13	HORIZONTAL CONTROL DIAGRAM

THE FOLLOWING STANDARD DRAWINGS ARE INCLUDED IN THESE PLANS:


- A-1 C-01.01 C-02.00 C-03.01 D-01.00 D-04.01 D-05.01
- D-06.01 D-23.00 D-26.01 D-30.00 D-09.00 G-02.00
- G-04.01W G-14.02W G-18.01 I-40.00
- M-16.00 S-00.00 S-05.00 S-30.01 T-20.00 T-21.00 R-03.00

### DESIGN DESIGNATION

- ADT (1980) = 252
- ADT (2000) = 455
- DHV = 16 %
- T.I. = 6.0
- D = 55-45
- T = 3.5 %
- V = 40 M.P.H.

EXCEPTIONS TO VERTICAL ALIGNMENTS BETWEEN THE FOLLOWING STATIONS; "0" 120+00± to "0" 132+00± AND "0" 162+00± to "0" 177+00± WERE GRANTED BY FHWA ON 3-11-82.

For more information on the justification for the clear zone versus guardrail requirements shown herein, see memorandum to W.L. Baumgartner from Ed Cavagnaro, and dated 5/9/85.

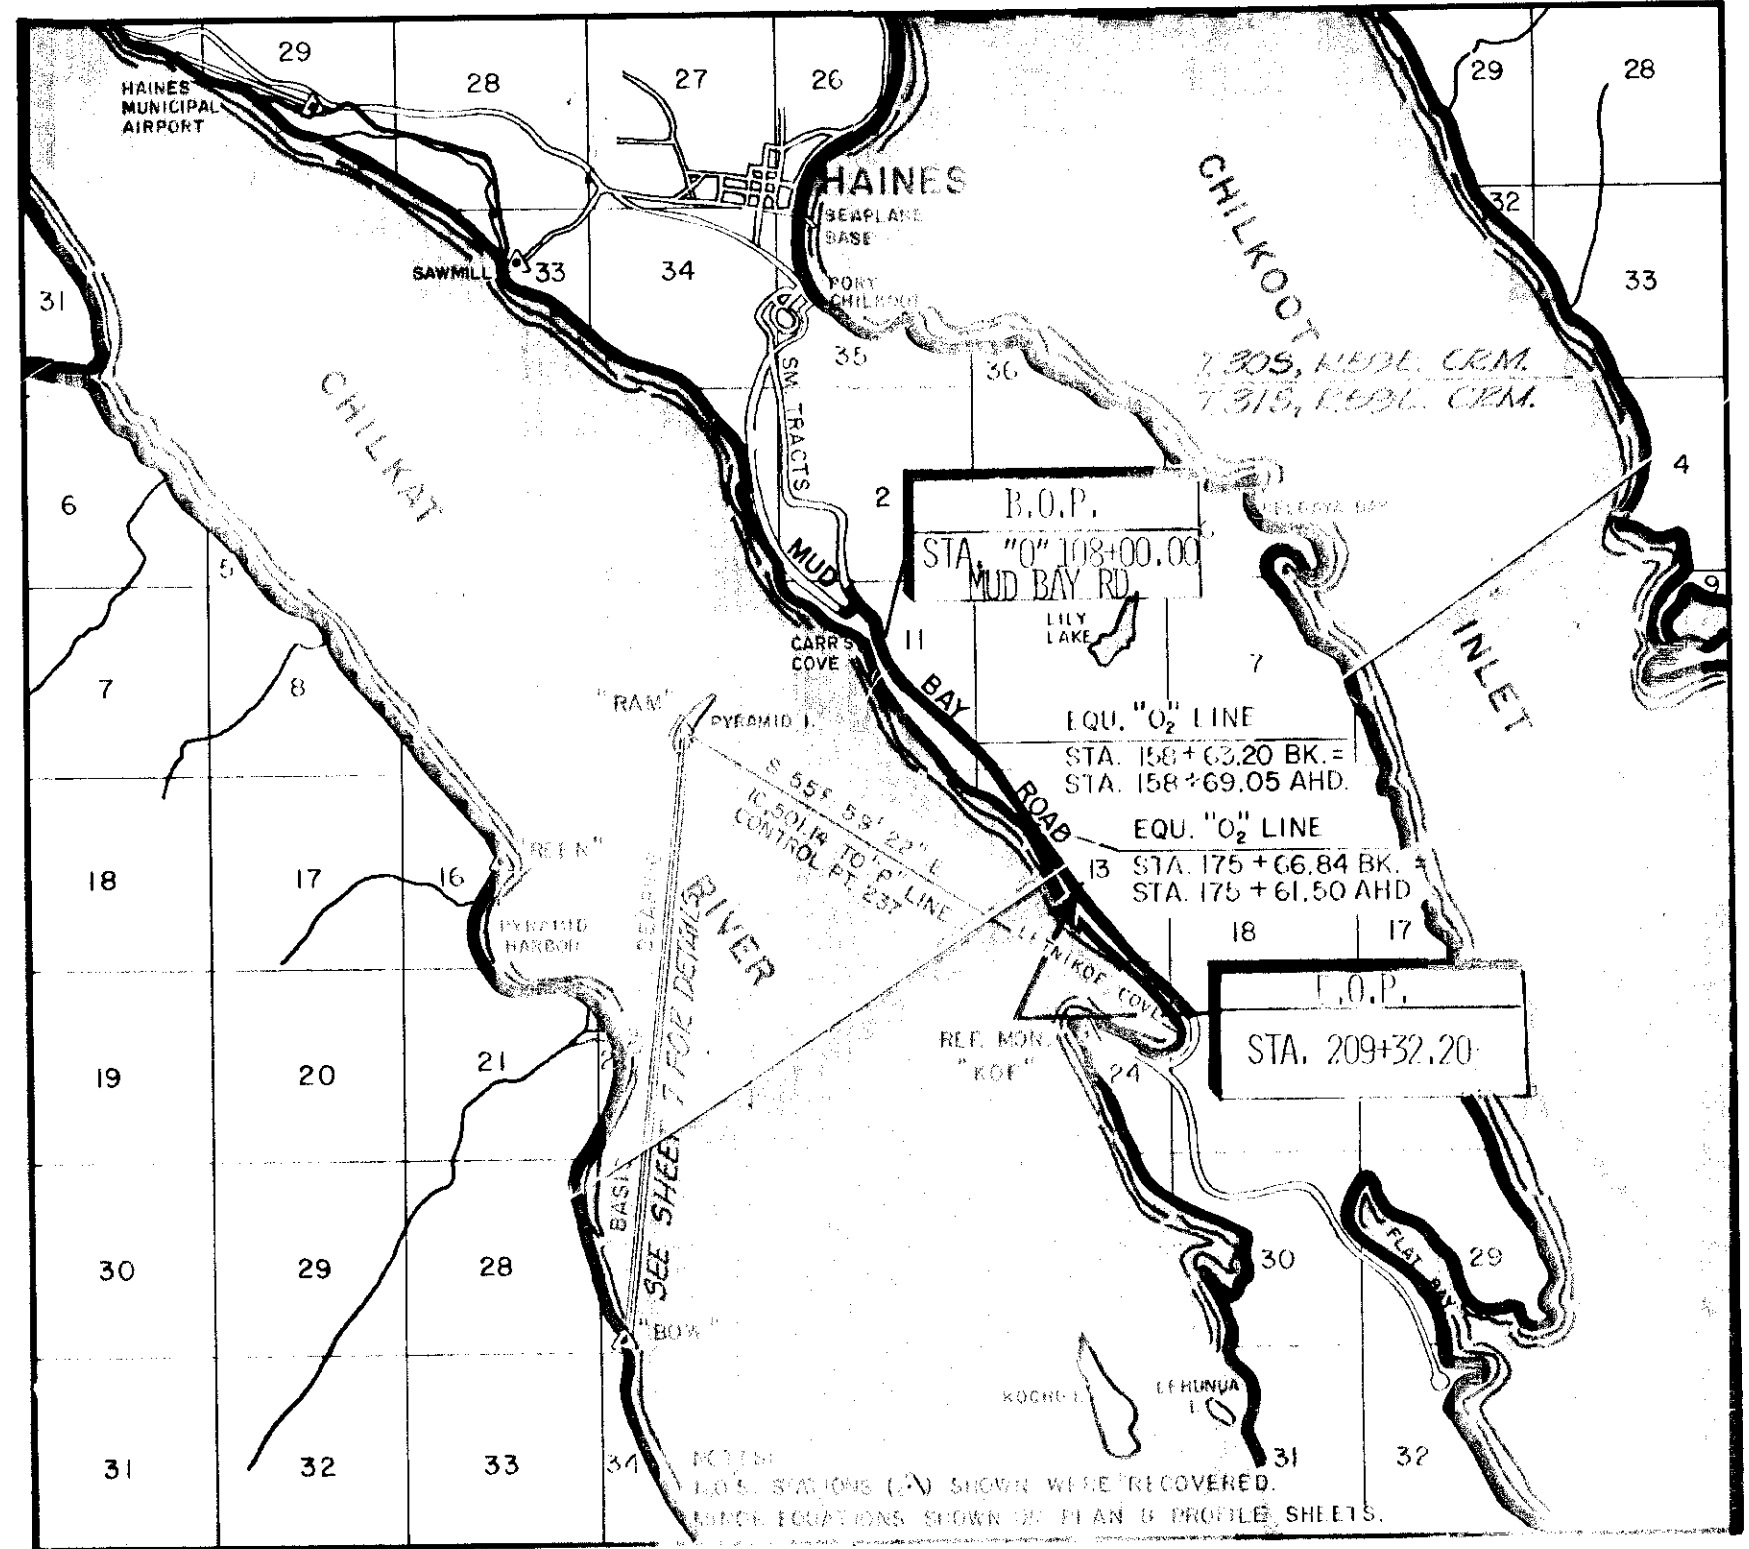

USGS QUAD MAPS SKAGWAY A-1, A-2, B-1, B-2 N:5000 W:13500 / 15x22.5






### "As-Built" Plans

PROJECT ENGR. LARRY GEISE  
CONTRACTOR NORTHERN TIMBER  
BEGIN DATE AUGUST 15, 1985  
END DATE AUGUST 4, 1985


### PROJECT SUMMARY

WIDTH OF SUBGRADE		32'
LENGTH OF PROJECT	10,627.51 FEET	2.01 MILES
LENGTH OF GRADING	11,127.51 FEET	2.11 MILES
LENGTH OF SURFACE TREATMENT	11,127.51 FEET	2.11 MILES
LENGTH OF TEMPORARY CONNECTION	500 FEET	.09 MILES

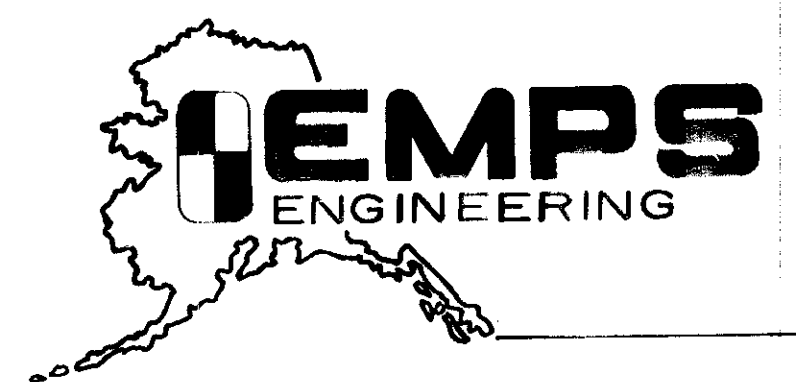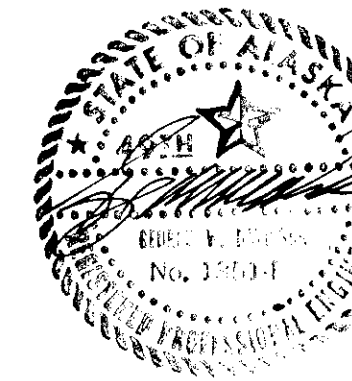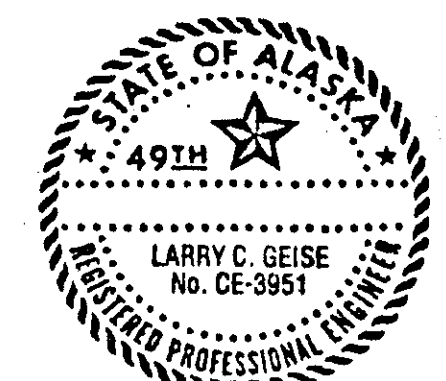


JUNEAU, ALASKA


# TYPICAL SECTIONS OF IMPROVEMENTS

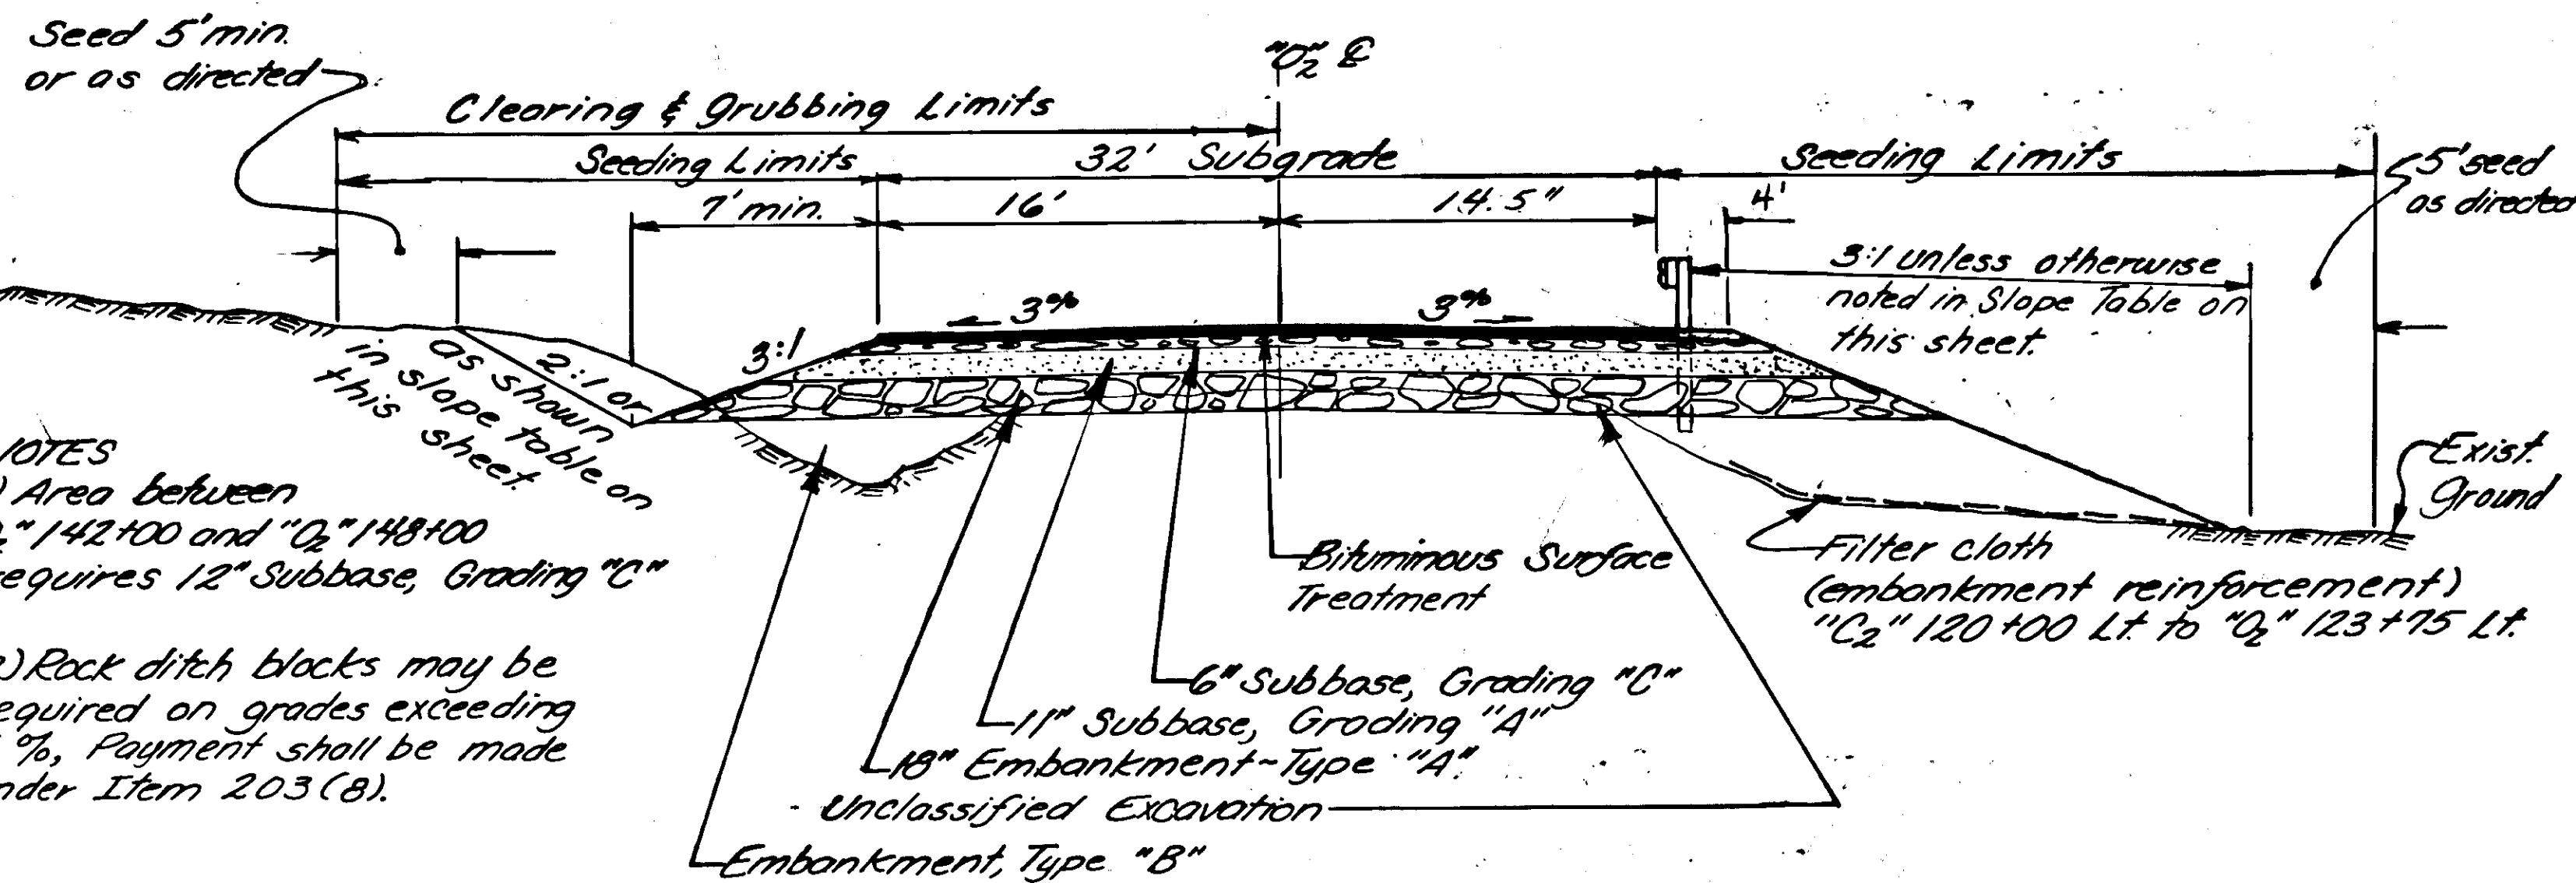

**TYPICAL SECTION "A"**

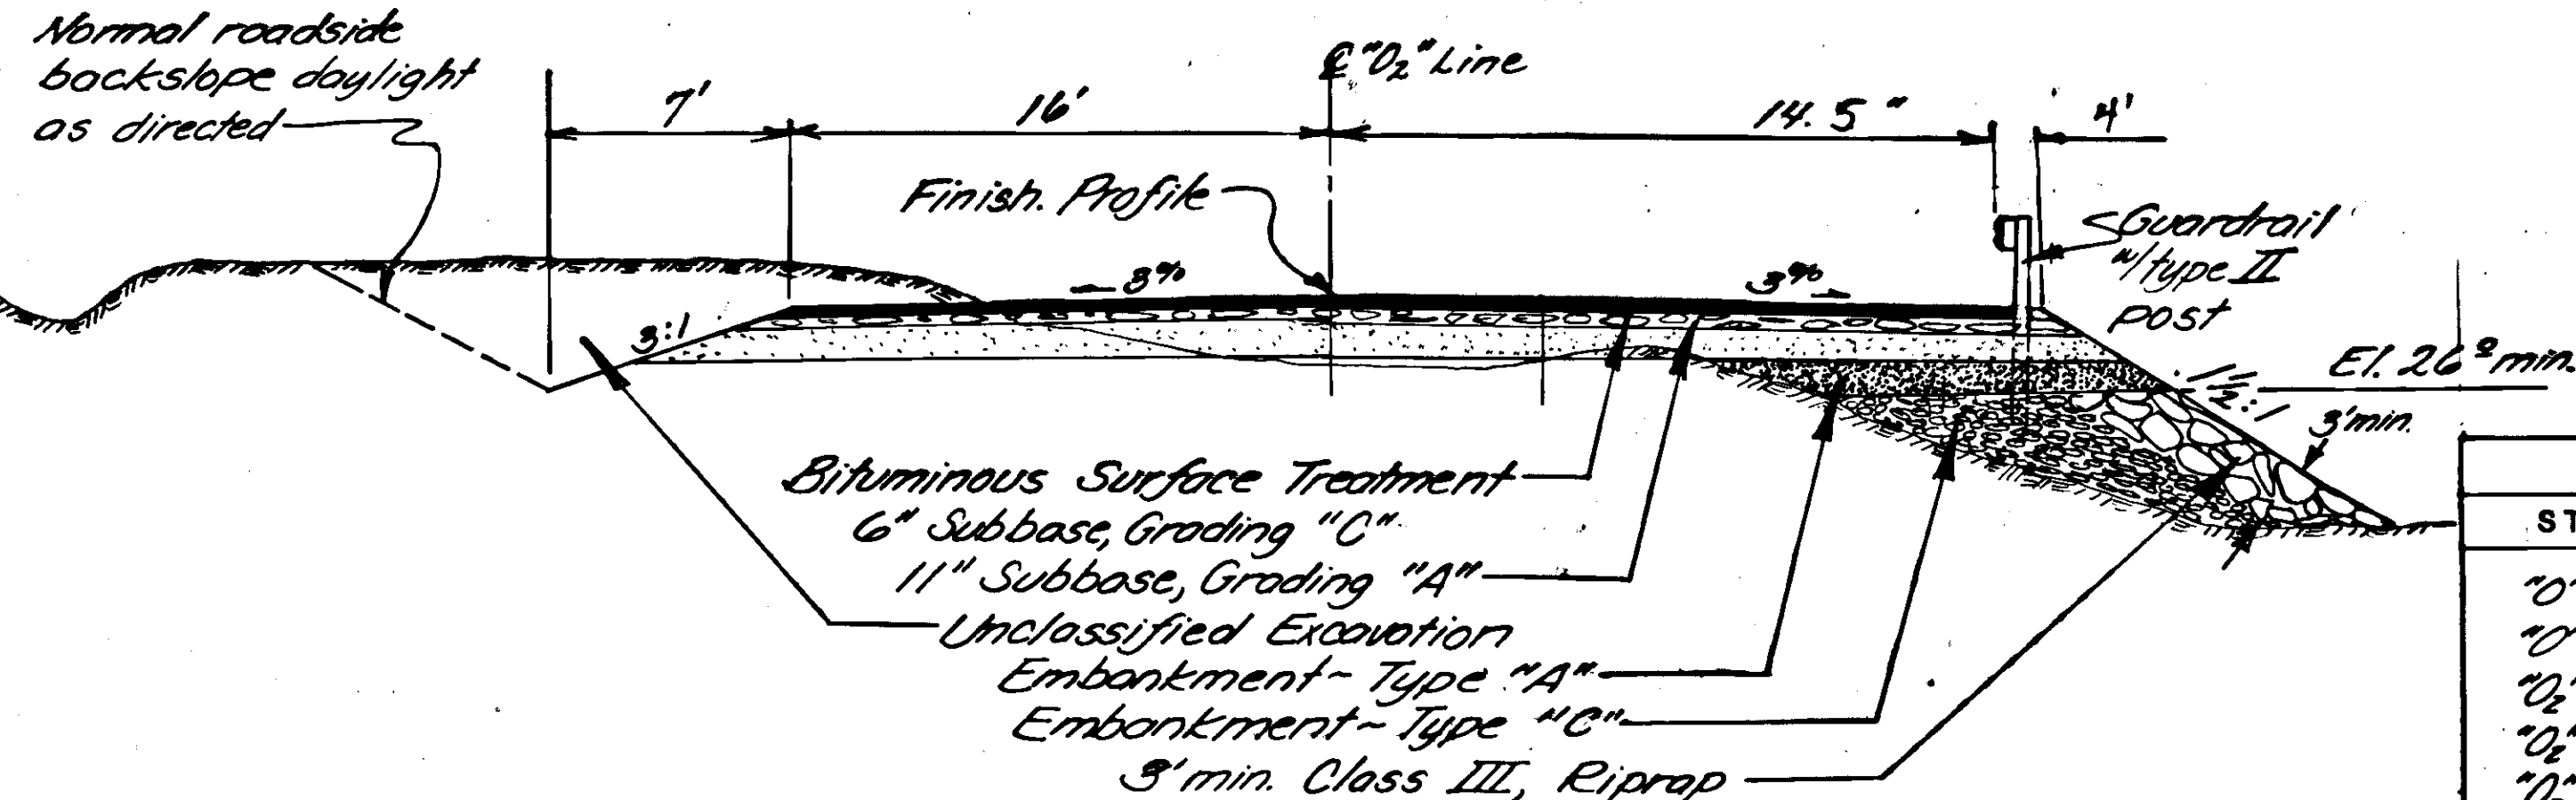

**TYPICAL SECTION "B"**

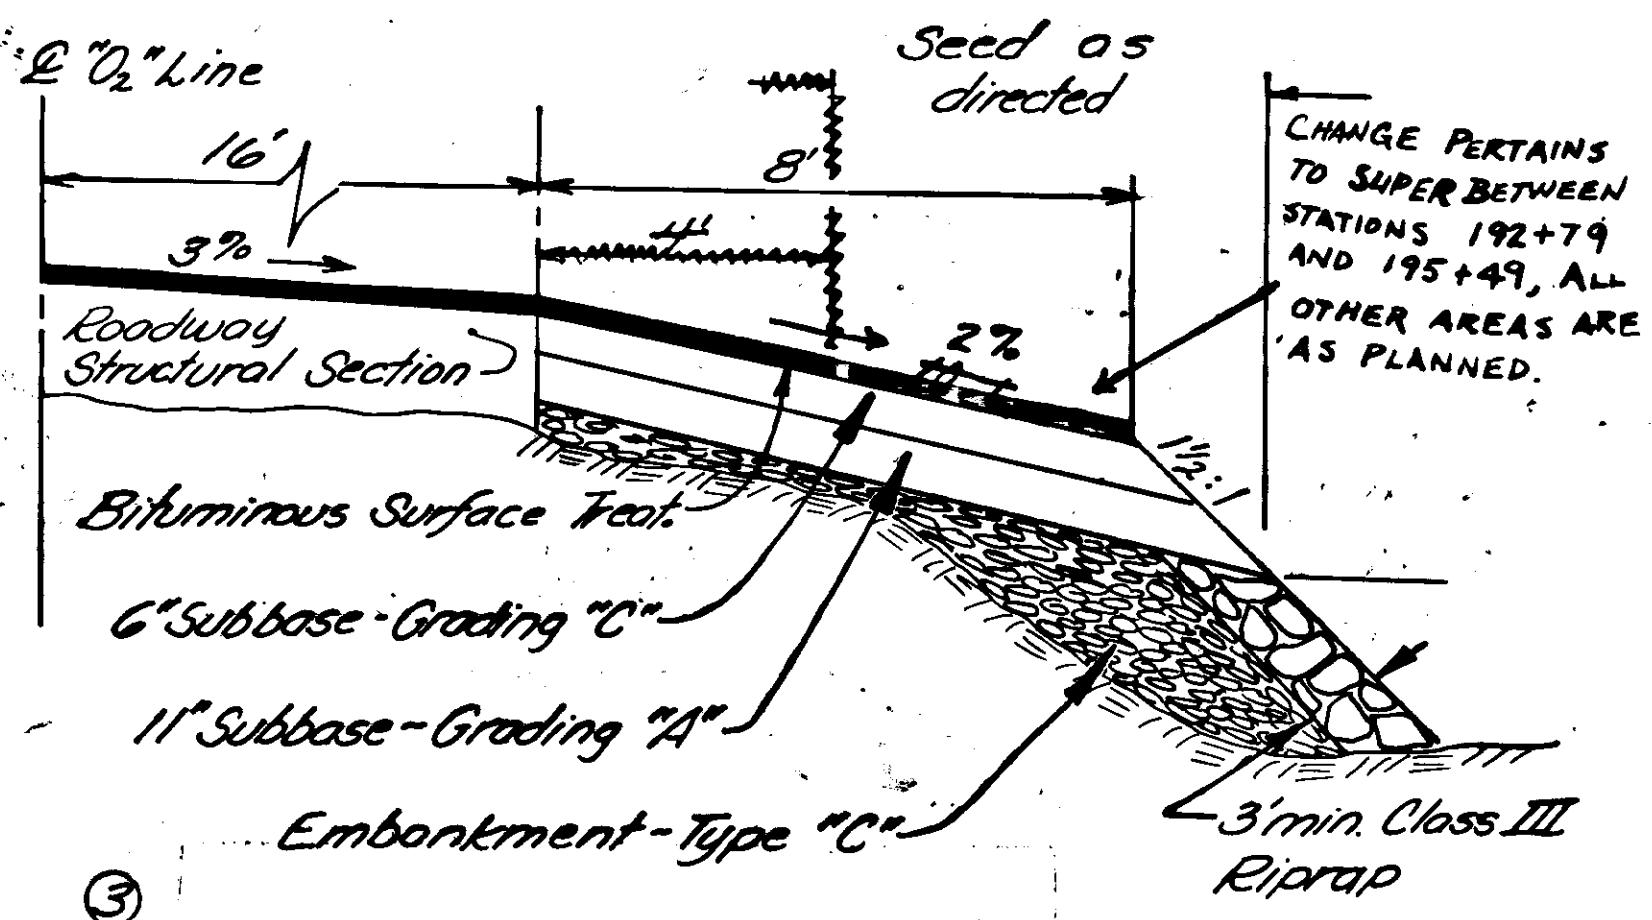

**TYPICAL SECTION**

ROADWAY WIDENING  
Sta 178+50 to 206+99.78 BK= 206+99.78 Ahd.

CULVERT SUMMARY				
STATION	SHEET	SIZE	LENGTH	COVER
"0" 107+20 Rt.	8	18"	40'	18"
"0" 109+25	8	24"	60'	5'
"0" 111+50	7	8"	90'	3'
"0" 112+90	7&8	54" B, C	200'	6'
"0" 112+90	7&8	24"	540'	6'
"0" 115+22	7&8	54" B, C	70'	10'
"0" 117+12	8	24"	60'	18"
"0" 117+83	8	24"	100'	3'
"0" 120+25	8	48" C	86'	5'
"0" 124+20 Rt.	8	18"	40'	18"
"0" 148+60	9	24"	60'	5'
"0" 149+00 Lt.	9	24"	10'	12"
"0" 155+20	9	24"	85'	5'
"0" 157+50	9	24"	70'	5'
"0" 161+20	9	24"	90'	5'
"0" 161+50 Lt.	9	18"	40'	18"
"0" 168+00 Lt.	10	24"	30'	12"
"0" 172+42	5&10	72" A	70'	16'
"0" 175+90	10	36"	82'	5'
"0" 175+90	10	36" 24"	30'	5'
"0" 179+76	10	24"	60'	5'
"0" 180+50	10	24"	100'	5'
"0" 181+18	10	24"	60'	5'
"0" 183+70	10	24"	66'	5'
"0" 196+00 Lt.	11	24"	78'	12"
"0" 196+68	11	24"	75'	5'
"0" 203+35	11	24"	80'	5'
"0" 208+50	11	24"	60'	5'
"0" 217+00	11	48" B, C	52'	5'
"0" 222+48	11	24"	54'	5'
"0" 225+33 Rt.	12	24"	54'	5'
"0" 112+00 Rt.	8	24"	25'	3'
"0" 114+00 Rt.	8	24"	40'	35'
"0" 144+45	6&7	54" B, D	82'	5'
"0" 191+75	10	24"	62'	5'
"0" 150+43	9	24"	66'	5'
"0" 199+76	10	24"	50'	3'

GUARDRAIL SUMMARY				
STATION	THRU STATION	LINEAL FEET		REMARKS
		LEFT	RIGHT	
"0" 104+00	"0" 114+28, 35' Rt.		1170'	R=50', L=74', R=10', L=31'
"0" 112+15	"0" 110+72	137.5'		R=50', L=140'
"0" 104+00	"0" 106+50		250'	
"0" 110+50	"0" 112+00	150'		
"0" 118+50	"0" 124+00		530'	R=40', L=31', R=25', L=31'
"0" 120+25	"0" 125+50	525'		
"0" 160+00	"0" 166+00		600'	
"0" 171+00	"0" 181+00		486' 800	R=15', L=32', R=46', L=40'
"0" 2+50 (Access Rd.)	"0" 181+00		691' 475	R=58', L=80', R=15', L=20'
"0" 244+00	"0" 244+80	N.I.C.		R=50', L=20', R=50', L=20'
"0" 245+00	"0" 249+00	N.I.C.		R=30', L=36', R=30', L=36'

\* All guardrail having a Radius of 150' or less shall be shop fabricated.

TABLE OF SLOPES			
STATION	THRU STATION	SLOPE	
		CUT	FILL
"0" 108+00	"0" 111+00 Rt.		1 1/2:1
"0" 109+00 Rt.	"0" 116+00 Lt. (Mud Bay Rd.)		2:1
"0" 110+50 Rt. (Small Tracts Rd.)	"0" 117+00 Rt.		1 1/2:1
"0" 115+00 Rt.	"0" 148+50 Rt. & Lt.		2:1
"0" 142+50 Rt. & Lt.	"0" 174+50 Rt.		2:1
"0" 148+50 Rt.	"0" 171+00 Lt.	1 1/2:1	
"0" 166+50 Lt.	"0" 174+50 Lt.	1 1/2:1	
"0" 173+00 Lt.	"0" 206+99 Rt.		1 1/2:1
"0" 174+50 Rt.	"0" 195+00 Lt.	1 1/4:1	
"0" 192+50 Lt.	"0" 212+00 Lt.	1 1/2:1	
"0" 209+00 Lt.	"0" 255+90 Lt.	1 1/4:1	
"0" 243+50 Lt.	"0" 113+00 Rt.		2:1
"0" 111+00 Rt.			

REMOVAL OF STRUCTURES & OBSTRUCTIONS	
STATION	DESCRIPTION
"0" 175+70 L.F.	Shed
"0" 214+15	Derelict Boat
"0" 236+15	Wood Piling
"0" 112+80 Lt.	Smoke house
"0" 112+90 Rt.	Smoke house
"0" 112+50 Rt.	Wooden Deck
"0" 114+00 to	Miscellaneous debris
"0" 117+00	


- NOTES
- Area between "0" 142+00 and "0" 148+00 requires 12" Subbase, Grading "C"
  - Rock ditch blocks may be required on grades exceeding 4%. Payment shall be made under Item 203 (B).

- NOTES:
- Grade & alignment shown on plans are subject to minor revisions.
  - Culvert lengths and locations are approximate only and are subject to minor revisions.
  - Superelevation rates & length of transition shall be as indicated or as directed.
  - Contractor shall use wood guardrail posts.
  - All approaches shall be constructed per Std. Plan I-40.00 unless otherwise noted on the plans, approach grades shall be as directed, surface treatment shall be applied to the end of the new construction. Approaches that slope toward centerline shall be crowned as directed.
  - See Sht 14 for bearings & distances between "P" referenced in the field and "0<sub>2</sub>" construction centerline, line points.
  - Small Tracts Road has a Gross Vertical Weight restriction of 24,000 pounds, for through traffic.
  - After initial clearing the contractor shall make the wood available to the public for a period not less than 4 days. The contractor shall notify the public as directed.
  - Payment for reconstruction of storm damage ("0" 104 to 109+00) shall be made under the appropriate item of work performed. No additional payment will be made.

BASIS OF ESTIMATE	
ITEM	ESTIMATING FACTOR
30 A (1 B, 1 C)	2.00 Tons/c.y.
403 (2)	0.25 gal./sq. 253 gal./ton
405 (1)	0.95 gal./sq. 241 gal./ton
405 (2A)	45 lb./s.y.
405 (2B)	25 lb./s.y.

TYPICAL SECTION TABLE		
STATION TO STATION	TYPE A	TYPE B
"0" 104+00 to "0" 111+75	X	⊗
"0" 111+75 to "0" 113+00	X ⊗	
"0" 104+00 to "0" 115+00	X ⊗	
"0" 115+00 to "0" 117+00		X ⊗
"0" 117+00 to "0" 176+00	X ⊗	X ⊗
"0" 176+00 to "0" 206+99.78 BK= 206+99.78 Ahd.	⊗	⊗

- In areas of roadway widening guardrail will not be installed.
- In areas of roadway widening, Riprap Type III will only be required on the edge of fill. Other embankment shall be Type "C".

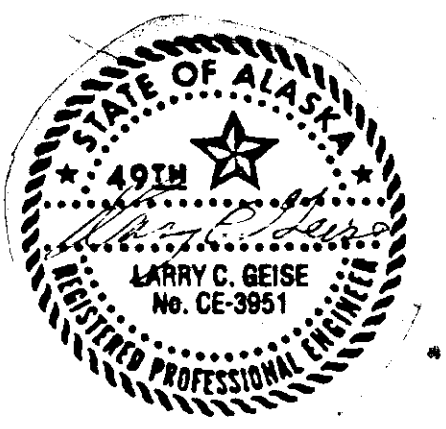

# ESTIMATE OF QUANTITIES

STATE	PROJECT DESIGNATION	YEAR	SHEET NO	TOTAL SHEETS
ALASKA	RS-0987(4)	1985	3	13

ITEM NO.	ITEM	UNIT	SHEET NUMBER					TOTAL	
			8	9	10	11	12		13
110(2)	Mobilization & Demobilization	L.S.							All Req'd.
111(1)	Temporary erosion & pollution control	Cont. S.							2000
112(1)	Training program in accord. w/ FHWA Order, I	Man-Hr.							1500
113(1)	Flagging	Man-Hr.							All Req'd.
114(1)	Construction Surveying by Contractor	L.S.							All Req'd.
115(1)	Traffic maintenance	L.S.							All Req'd.
115(2)	Construction Signs (Approx. Quant. 166.0)	L.S.							All Req'd.
109(2)	DBE & WBE Adjustments	Cont. S.							Cont. Sum
201(2B)	Clearing & Grubbing	L.S.							All Req'd.
202(1)	Removal of structures & obstructions	L.S.							All Req'd.
202(4)	Removal of Culvert Pipe	L.F.	280	180	285	80	160		825 1209
203(3)	Unclassified Excavation	C.Y.	21858	44051	9920	7310	5725	1476	81,739,934
203(8)	Embankment	C.Y.	30,937	18131	17,873	5647	7,285	641	92,508,68,961
207(3)	Filter Cloth	S.Y.	3772		200		4,037		3972 3969.5
304(1A)	Subbase Grading "A"	TONS	8044	6425	9476	7228	7547	2030	31,173
304(1C)	Subbase Grading "C"	TONS	3891	5395	4574	3488	3726	980	17,348 21,010
403(2)	MC-30 Liquid Asphalt for Prime Coat	TONS	11.50	12.03	11.54	553	10.65	3.67	40.6 39.5
405(1)	CRS-2 Asphalt for surface Treatment	TONS	46.07	48.21	51.24	33.17	42.64	14.70	198.0 191.5
405(2A)	Grading "B" Cover Coat Material	TONS	262.0	274.1	289.91	126.00	242.6	83.57	952.0 995
405(2B)	Grading "E" Cover Coat Material	TONS	145.6	152.3	161.03	70.02	134.8	46.43	523.0 588
603(18)	48 inch Corrugated aluminum pipe	L.F.				62			62
603(19-54)	54 inch "	L.F.	270				82		270
603(15-54)	End Section for 48 inch Corrugated Aluminum Pipe	ea.	4				2		4
603(15-54)	" " 54 inch Corrugated Aluminum Pipe	ea.						2	2
603(22-18)	18 inch Pipe	L.F.	80	40					120 150
603(22-24)	24 "	L.F.	320	376	393	320	216		1,453 1,441
603(22-36)	36 "	L.F.			110				110 82
603(22-48)	48 "	L.F.	86						86
603(22-72)	72 "	L.F.			70				70
603(28-48)	End Section for 48 inch pipe	ea.	2						2
603(28-72)	" " 72 inch "	ea.			1				1
604(5)	Type "A" Inlets	ea.	2						23
605(1)	8 inch perforated corrugated steel pipe underdrain	L.F.	370						370 375
606(2)	Beam Type guardrail, Type II post	L.F.	2782.50	200	1877	0	2,570	180	4859.5
606(6A)	End anchorages	ea.	12	1	5	0	6	1	18 17
611(1A)	Riprap, Class II	C.Y.	58	-	49		12		109 393
611(1B)	Riprap, Class III	C.Y.	1057	-	2624	1807	3,400		5488 6536
614(3)	Monuments & Monument Cases	ea.	9	8	10	5	6		32
615(1)	Standard Signs	S.F.	46.30	36.25	10.00		20.50		112.55 132.0
618(2)	Seeding	acre	3.71	6.10	2.66	2.00	1.59	1.46	14.47 9.9
618(4)	Water for maintenance	m/gal.	8.1	13.3	5.8	3.0	8.5	3.2	30.2 117.8
627(1)	Watering	m/gal.	45.9	47.0	52.0	20.0	50.5	30.8	164.2 607.7
636(1)	Gabions	C.F.			11,421				11,421 10,030.5
639(1)	Approaches (driveways)	ea.	5	1	4			1	10 12
670(1)	Painted Traffic markings (approx 94.10.2 mi)	L.S.							All Req'd.
116(8)	Contractor Furnished Vehicles	ea.							5
619(2A)	Soil Stabilization EWD #2	L.S.							All Req'd
605(7)	Modified & Fabric Underdrain EWD #3	L.S.							All Req'd

N.I.C.

**SURVEY MONUMENT SUMMARY**


STATION	POINT	MON.	CASE
0+110+04.63	P.C.	/	/
0+113+27.24	P.T.	/	/
0+106+00.00	P.O.T.	/	/
0+109+71.20	P.C.	/	/
0+117+33.48	P.T.	/	/
0+119+60.95	P.C.	/	/
0+125+24.31	P.T.	/	/
0+126+53.99	P.C.	/	/
0+128+64.49	P.T.	/	/
0+132+04.38	P.C.	/	/
0+135+15.98	P.T.	/	/
0+138+66.90	P.C.	/	/
0+141+49.51	P.T.	/	/
0+146+60.00	P.O.T.	/	/
0+150+43.18	P.C.	/	/
0+155+63.64	P.T.	/	/
0+158+63.20	P.C.	/	/
0+163+19.68	P.T.	/	/
0+166+25.60	P.C.	/	/
0+170+13.02	P.T.	/	/
0+170+91.36	P.C.	/	/
0+173+66.10	P.T.	/	/
0+173+91.14	P.C.	/	/
0+175+66.04	P.T.	/	/
0+179+81.10	P.C.	/	/
0+182+61.07	P.T.	/	/
0+192+79.02	P.C.	/	/
0+195+48.96	P.T.	/	/
0+197+49.16	P.C.	/	/
0+199+51.32	P.T.	/	/
0+204+91.33	P.C.	/	/
0+206+99.78	P.T.	/	/
0+206+97.18	P.C.	/	/
0+209+32.20	P.C.	/	/
0+213+55.37	P.T.	/	/
0+216+28.49	P.C.	/	/
0+219+75.02	P.T.	/	/
0+230+10.76	P.C.	/	/
0+232+26.78	P.T.	/	/
0+234+33.10	P.C.	/	/
0+237+96.51	P.T.	/	/
0+243+12.36	P.C.	/	/
0+246+23.29	P.T.	/	/

**APPROACH SUMMARY**

LOCATION	WIDTH		
0+107+70 R	16'		
0+108+50 L	20'	0+114+00 RT	16'
0+114+50 R	20'		
0+115+75 L	14'		
0+124+25 R 125+75 L	14'		
0+141+50 L	14'x16'	0+165+50 RT	16'
0+146+80 R	14'x16'		
0+168+40 R 167+75 L	10'x14'	0+169+50 RT	16'
0+171+45 L	18'		
0+179+50 R	18'		
0+235+10 L			

**CULVERT REMOVAL SUMMARY**

STATION	SIZE	LENGTH	STATION	SIZE	LENGTH
0+107+80	24"	50'	0+232+30	18"	45'
0+112+90	Barrel	70'	0+238+84	18"	45'
0+115+20	2-24"	60/ea	0+247+45	48"	30'
0+119+50	24"	40'	0+183+70	18"	50'
0+150+60	18"	40'	0+196+50	18"	40'
0+154+90	24"	40'	0+203+35	18"	40'
0+157+50	18"	40'			
0+161+30 L	18"	60'			
0+168+0 L	18"	30'			
0+172+42	60"	80'			
0+175+90	24"	60'			
0+179+96	18"	35'			
0+180+95	18"	30'			

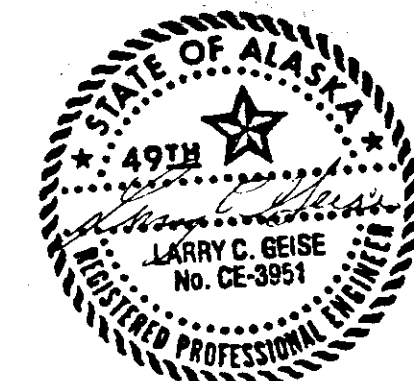

TCP GENERAL NOTES

1. THE CONTRACTOR SHALL DESIGNATE ONE OF HIS EMPLOYEES THE RESPONSIBILITY OF INSTALLING AND MAINTAINING THE REQUIRED TRAFFIC CONTROL ELEMENTS FOR THIS PROJECT. A COPY OF THE DESIGNATION SHALL BE FORWARDED TO THE ENGINEER.
2. ALL PROJECT CLOSURES SHALL BE AS SHOWN ON STANDARD DRAWINGS C-01.01, C-02.00, C-03.01 C-04.00. ADDITIONAL REQUIREMENTS ARE SHOWN IN THE MANUAL OF UNIFORM TRAFFIC CONTROL DEVICES, ALASKA SUPPLEMENT.
3. ALL ONE-LANE CLOSURES SHALL BE AS SHOWN ON STANDARD PLAN C-11.01. ALL DETOURS REQUIRED ON THE PROJECT SHALL BE CONSTRUCTED AND CONTINUOUSLY MAINTAINED TO THE FOLLOWING MINIMUM WIDTHS AT ALL TIMES:  
ONE-WAY TRAFFIC - 12'  
TWO-WAY TRAFFIC - 20'
4. ANY ONE-WAY DETOURS DURING DUST TO DAMN WILL REQUIRE TEMPORARY ILLUMINATION. THE MINIMUM LEVEL OF ILLUMINATION SHALL BE 2.0 FOOT-CANDLES ON THE ROADWAY SURFACE.
5. SHOULDER DROP-OFFS GREATER THAN 1 1/2 INCHES SHALL NOT BE ALLOWED DURING NON-WORKING HOURS.
6. THE FOLLOWING CONSTRUCTION SIGNING SCHEDULE SHALL BE CONSIDERED AS THE MINIMUM AMOUNT OF REQUIRED SIGNING. ADDITIONAL SIGNS MAY BE REQUIRED BY THE ENGINEER.
7. THE CONTRACTOR SHALL MAINTAIN A MINIMUM OF ONE-WAY TRAFFIC WITH FLAGGING OPERATIONS DURING WORKING HOURS. THE CONTRACTOR SHALL MAINTAIN TWO-WAY TRAFFIC THROUGHOUT THE ENTIRE PROJECT.

STATE	PROJECT DESIGNATION	YEAR	SHEET NO	TOTAL SHEETS
ALASKA	RS 0987(4)	1985	4	13

TRAFFIC CONTROL PLAN (T.C.P.) CONSTRUCTION SIGNING SCHEDULE

LOCATION	QUANTITY	SQ. FT.	CODE	SIZE	LEGEND
①	2	30.0	G20-1	36" x 60"	ROAD CONSTRUCTION NEXT 3 MILES
②	2	20.0	G20-2	24" x 60"	END CONSTRUCTION
③	2	4.5	CW13-1	18" x 18"	20 M.P.H.
④	2	18.0	CW20-1B	36" x 36"	ROAD CONSTRUCTION 1000 FT.
⑤	2	12.5	CW 8-8	30" x 30"	ROUGH ROAD
⑥	2	32.0	CW22-1	48" x 48"	BLASTING ZONE 1000 FEET
⑦	2	21.0	CW22-2	36" x 42"	TURN OFF 2-WAY RADIO
⑧	2	21.0	CW22-3	36" x 42"	END BLASTING
⑨	6				Type 3 Barricades
⑩	3	6.75	CW13-1	18" x 18"	* m.p.h.
<b>Total Staff</b>		<b>166</b>			

\* INDICATES ADVISORY SPEED TO BE DETERMINED AT SITE.

STANDARD SIGN SUMMARY


No.	Station	Dist. From Centerline	Code No.	Legend	Size	Thickness	Area S.F.	No. Posts	Type	Size	Length	Facing Traffic	Remarks
[17]	"0 136+00 LT.	26' 2"	W1-4R	SYMBOL	30" x 30"	0.08	6.25	1	TUBE	2"	14'	N.W. B.	
[18]	"0 146+50 RT. & LT.	26'	W1-1	SYMBOL	30" x 30"	0.08	2 @ 6.25	2	TUBE	2"	14'	N.W. & S.E.R.	
[19]	"0 146+50 RT. & LT.	26'	W7-3	9% GRADE	24" x 18"	0.08	2 @ 3.0	-	-	-	-	N.W. & S.E.R.	MOUNT BELOW 18
[20]	"0 158+00 RT.	19'	W1-5R	SYMBOL	30"	0.08	6.25	1	TUBE	2"	8'	S.E. B.	
[21]	"0 177+00 LT.	28'	W1-5R	SYMBOL	30"	0.08	6.25	1	TUBE	2"	14'	N.W. B.	
[22]	"0 206+99 RT.	19'	W5-1	ROAD NARROWS	36"	0.08	9.0	1	TUBE	2"	12.5'	S.E. B.	
[23]	"0 253+00 RT.	26'	W1-1R	SYMBOL	30"	0.08	6.25	1	TUBE	2"	14'	S.E. B.	N.I.C.
[24]	"0 253+00 RT.	26'	W3-1	25 M.P.H.	18"	0.08	2.25	-	-	-	-	S.E. B.	N.I.C.
[25]	"0 255+00 LT.	26'	R2-1	SPEED LIMIT 35	36"	0.08	6.25	1	TUBE	2"	12.5'	N.W. B.	N.I.C.
[26]	AS DIRECTED	24' 19'	D10-1	MILE 3, 4, & 5	10" x 18"	0.08	3.75	3	TUBE	2"	-	N.W. B.	
[27]	"0 141+00 RT.	19'	I-4A	SYMBOL (MT. RILEY TRAIL)	42" x 54"	0.08	15.75	2	TUBE	2"	14'	S.E. B.	
[27]	"0 153+00 LT.	26'	I-4A	SYMBOL (MT. RILEY TRAIL)	42" x 54"	0.08	15.75	2	TUBE	2"	14'	N.W. B.	Replace existing Mileposts with new signs at original location if possible, Total 4 Posts.
[1]	"0 105+50 Rt	19'	W5-1	Road Narrows	36" x 36"	0.08	5.0	1	TUBE	2"	15"	SB	
[2]	"0 106+00 Rt	19'	W8-3A	Pavement ends	36" x 36"		5.0	1	"	2"	15"	SB	
[3]	"0 113+05 Rt	19'	R1-1	Stop	30" x 30"		6.25	1	"	2"	14"	NB	
[4]	"0 114+50 Rt	19'	O1-1	Haines	12" x 48"		4.0	2	"	2"	14' x 16"	NE. B.	
[5]	"0 114+50 Rt	19'	D7-1	Chilkat State Park 5 mi	30" x 72"	0.10	15.0	-	-	-	-	" "	mount below 14
[6]	"0 116+00 Rt	19'	R2-1	Speed Limit 35	24" x 36"	0.08	5.0	1	"	2"	14'	SE. B.	

GENERAL SIGNING AND STRIPING NOTES.

1. Sign locations and post lengths are approximate only and are subject to minor revisions.
2. All sign posts shall be square telescoping perforated galvanized steel posts, the 2" size shall be used above ground and the 2-1/4" shall be used below ground for the sleeve.
3. All posts shall be installed with the sleeve type embedment in accordance with Standard Drawing S-30.01, except that the 2-1/4" size shall be used for the entire embedment depth.
4. Post lengths are from the cut-off in the sleeve to the top of the post. See Standard Drawing S-05.00 & S-30.01
5. Painted Traffic Markings shall be in accordance with Standard Drawing T-21.00 for paved shoulder and Section 670 of the Standard Specifications.




15. A TRAFFIC CONTROL PLAN (TCP) MUST BE FOLLOWED AT ALL TIMES DURING THE LIFE OF THE PROJECT, FOR EACH PHASE OF CONSTRUCTION. THE TCP SHOWN ON THIS SHEET AND STANDARD DRAWING C-00.00 THROUGH C-11.01 IS OFFERED AS A GUIDE: THE CONTRACTOR MAY MODIFY THIS TCP OR USE AND ALTERNATE TCP OF HIS OWN DESIGN. HOWEVER, AN APPROVED TCP WILL BE REQUIRED PRIOR TO COMMENCEMENT OF ANY CONSTRUCTION. THE GENERAL INTENT OF THE TCP IS THAT THE CONTRACTOR FOLLOW PROCEDURES WHICH RESULT IN A SAFE TRAVERSABLE FACILITY FOR PUBLIC VEHICULAR AND PEDESTRIAN TRAFFIC. THE TCP SHOWN IS NOT MEANT TO DESIGNATE CONSTRUCTION TECHNIQUE, EQUIPMENT OR SEQUENCE, BUT TO ADDRESS THE CENTRAL ISSUE OF TRAFFIC SAFETY.

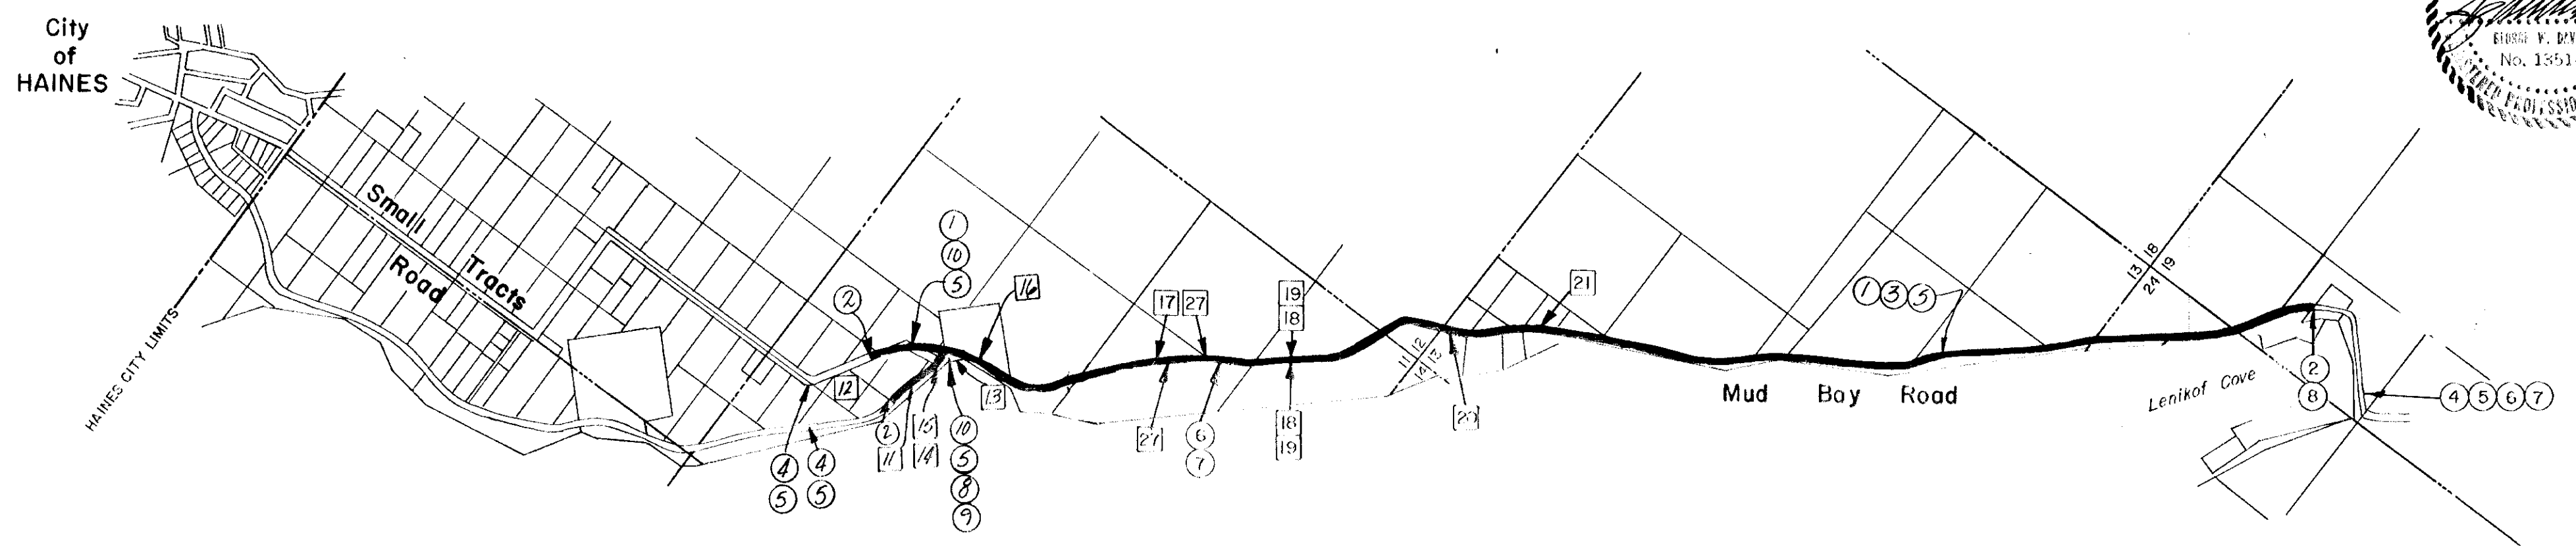

TRAFFIC CONTROL & CONSTRUCTION SIGNING PLAN




STATE	PROJECT	YEAR	SHEET NO.	TOTAL SHEETS
ALASKA	RS 0987(5)	1985	6	13

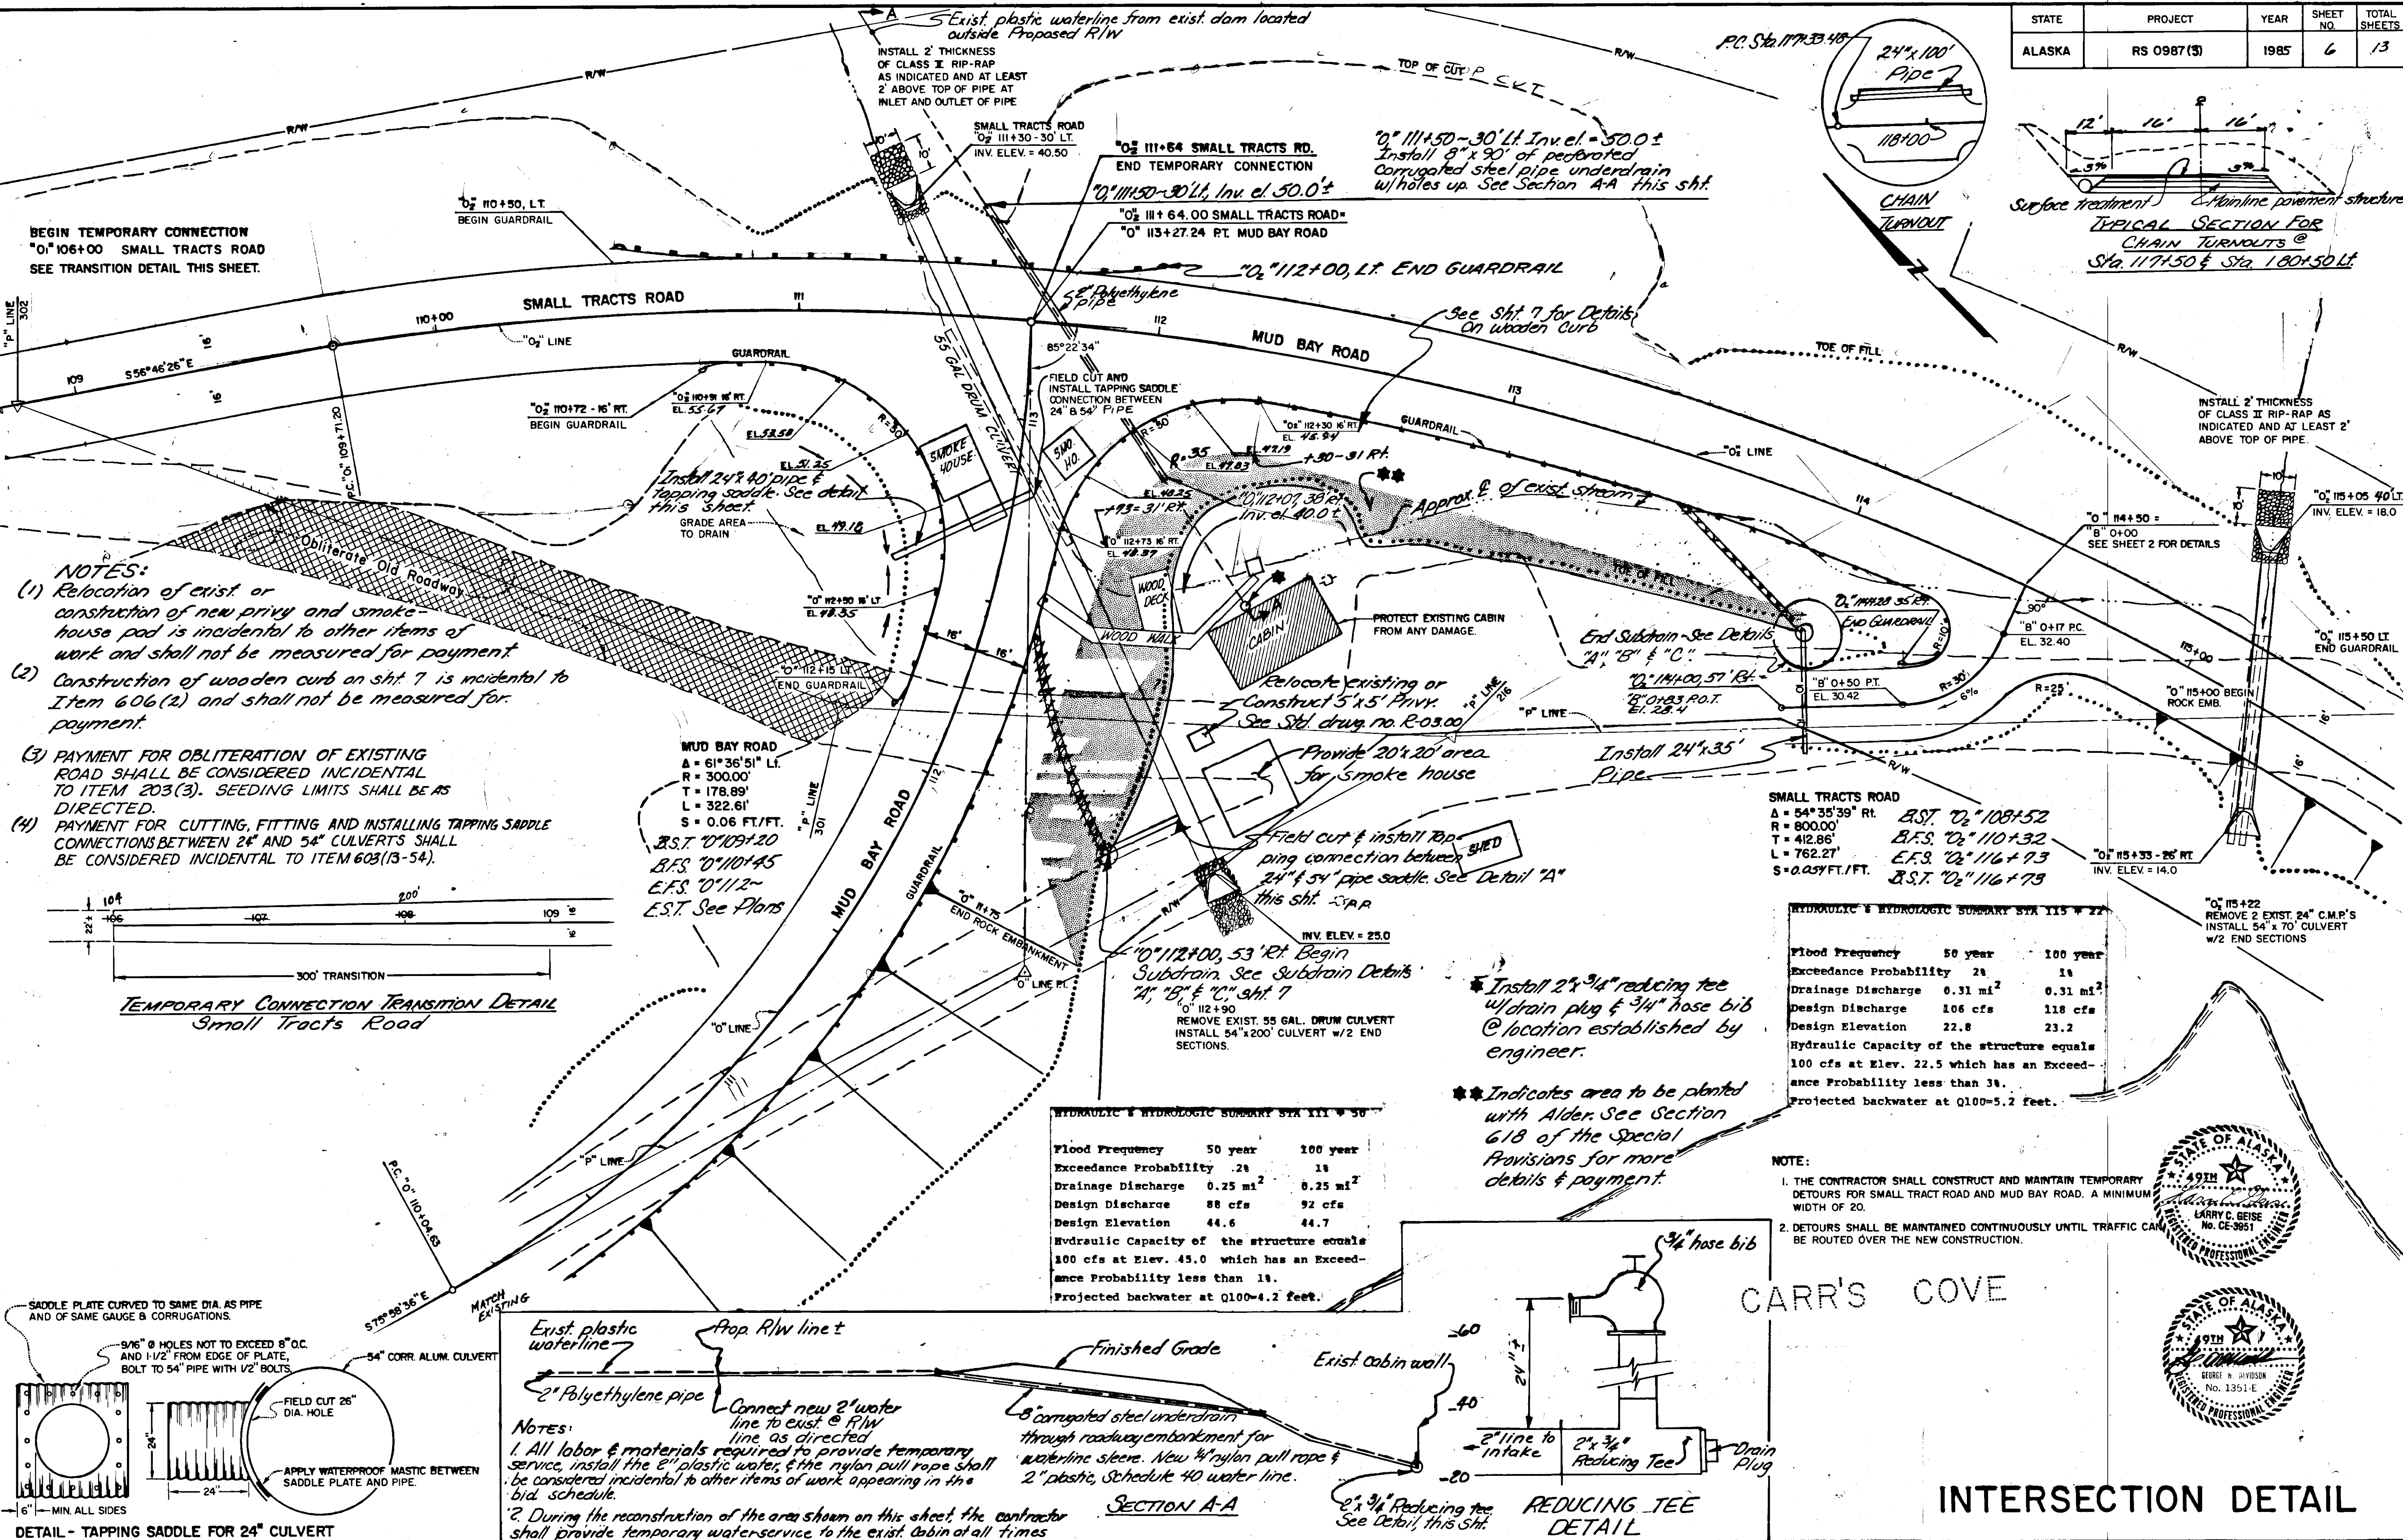

BEGIN TEMPORARY CONNECTION  
"0" 106+00 SMALL TRACTS ROAD  
SEE TRANSITION DETAIL THIS SHEET.

- NOTES:**
- (1) Relocation of exist or construction of new privy and smoke-house pad is incidental to other items of work and shall not be measured for payment.
  - (2) Construction of wooden curb on sheet 7 is incidental to Item 606(2) and shall not be measured for payment.
  - (3) PAYMENT FOR OBLITERATION OF EXISTING ROAD SHALL BE CONSIDERED INCIDENTAL TO ITEM 203(3). SEEDING LIMITS SHALL BE AS DIRECTED.
  - (4) PAYMENT FOR CUTTING, FITTING AND INSTALLING TAPPING SADDLE CONNECTIONS BETWEEN 2" AND 54" CULVERTS SHALL BE CONSIDERED INCIDENTAL TO ITEM 603(13-54).

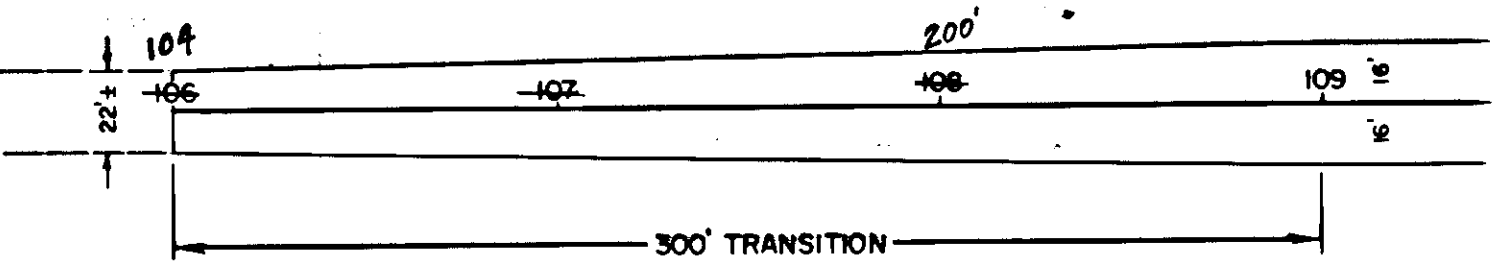

MUD BAY ROAD  
 $\Delta = 61^{\circ}36'51''$  Lt.  
 $R = 300.00'$   
 $T = 178.89'$   
 $L = 322.61'$   
 $S = 0.06$  FT./FT.  
 B.S.T. "0" 109+20  
 B.F.S. "0" 101+45  
 E.F.S. "0" 112+  
 E.S.T. See Plans

**HYDRAULIC & HYDROLOGIC SUMMARY STA 111+50**

	50 year	100 year
Flood Frequency	50	100
Exceedance Probability	.2%	.1%
Drainage Discharge	0.25 mi <sup>2</sup>	0.25 mi <sup>2</sup>
Design Discharge	88 cfs	92 cfs
Design Elevation	44.6	44.7
Hydraulic Capacity of the structure equals	100 cfs at Elev. 45.0 which has an Exceedance Probability less than 1%.	
Projected backwater at Q100=	4.2 feet.	



**SMALL TRACTS ROAD**

$\Delta = 54^{\circ}35'39''$ Rt.	B.S.T. "0" 108+52
$R = 800.00'$	B.F.S. "0" 110+32
$T = 412.86'$	E.F.S. "0" 116+73
$L = 762.27'$	B.S.T. "0" 116+73
$S = 0.057$ FT./FT.	

**HYDRAULIC & HYDROLOGIC SUMMARY STA 115+22**

	50 year	100 year
Flood Frequency	50	100
Exceedance Probability	.2%	.1%
Drainage Discharge	0.31 mi <sup>2</sup>	0.31 mi <sup>2</sup>
Design Discharge	106 cfs	118 cfs
Design Elevation	22.8	23.2
Hydraulic Capacity of the structure equals	100 cfs at Elev. 22.5 which has an Exceedance Probability less than 1%.	
Projected backwater at Q100=	5.2 feet.	

- NOTE:**
1. THE CONTRACTOR SHALL CONSTRUCT AND MAINTAIN TEMPORARY DETOURS FOR SMALL TRACT ROAD AND MUD BAY ROAD. A MINIMUM WIDTH OF 20.
  2. DETOURS SHALL BE MAINTAINED CONTINUOUSLY UNTIL TRAFFIC CAN BE ROUTED OVER THE NEW CONSTRUCTION.

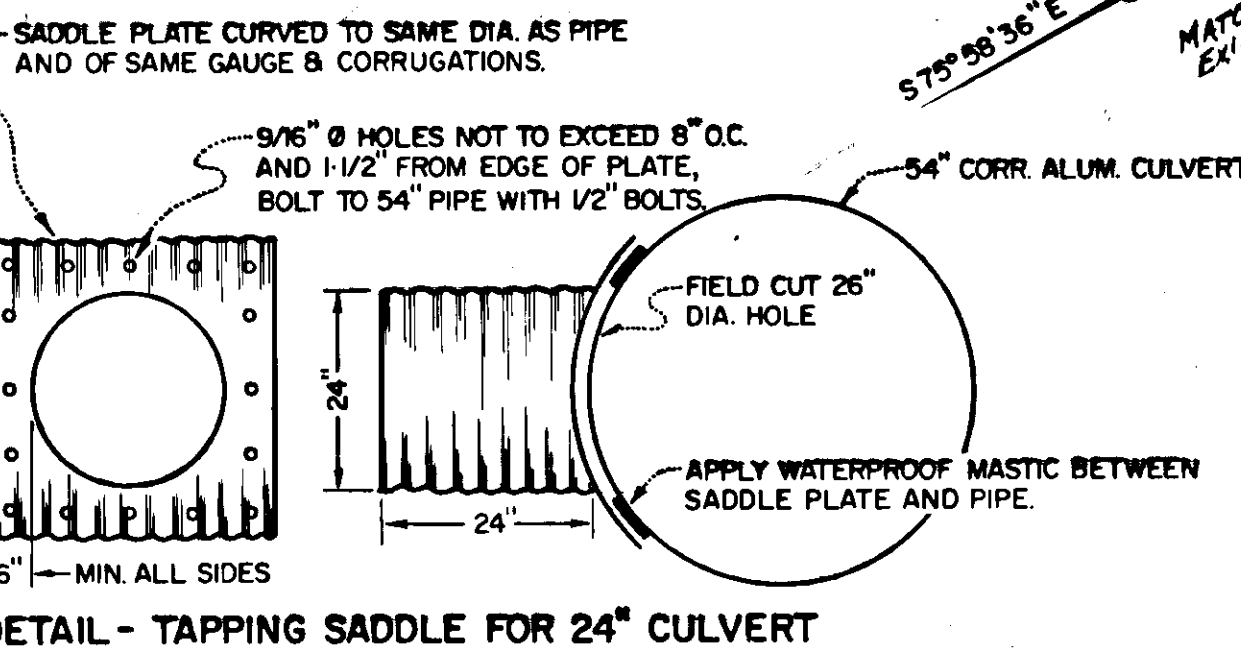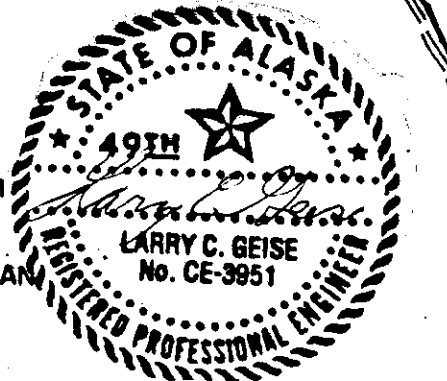

**DETAIL - TAPPING SADDLE FOR 24" CULVERT**

SADDLE PLATE CURVED TO SAME DIA. AS PIPE AND OF SAME GAUGE & CORRUGATIONS.

3/16"  $\phi$  HOLES NOT TO EXCEED 8" O.C. AND 1-1/2" FROM EDGE OF PLATE. BOLT TO 54" PIPE WITH 1/2" BOLTS.

54" CORR. ALUM. CULVERT


FIELD CUT 26" DIA. HOLE

APPLY WATERPROOF MASTIC BETWEEN SADDLE PLATE AND PIPE.


6" MIN. ALL SIDES

**NOTES:**

1. All labor & materials required to provide temporary service, install the 2" plastic water, & the nylon pull rope shall be considered incidental to other items of work appearing in the bid schedule.
2. During the reconstruction of the area shown on this sheet, the contractor shall provide temporary water-service to the exist. cabin at all times.

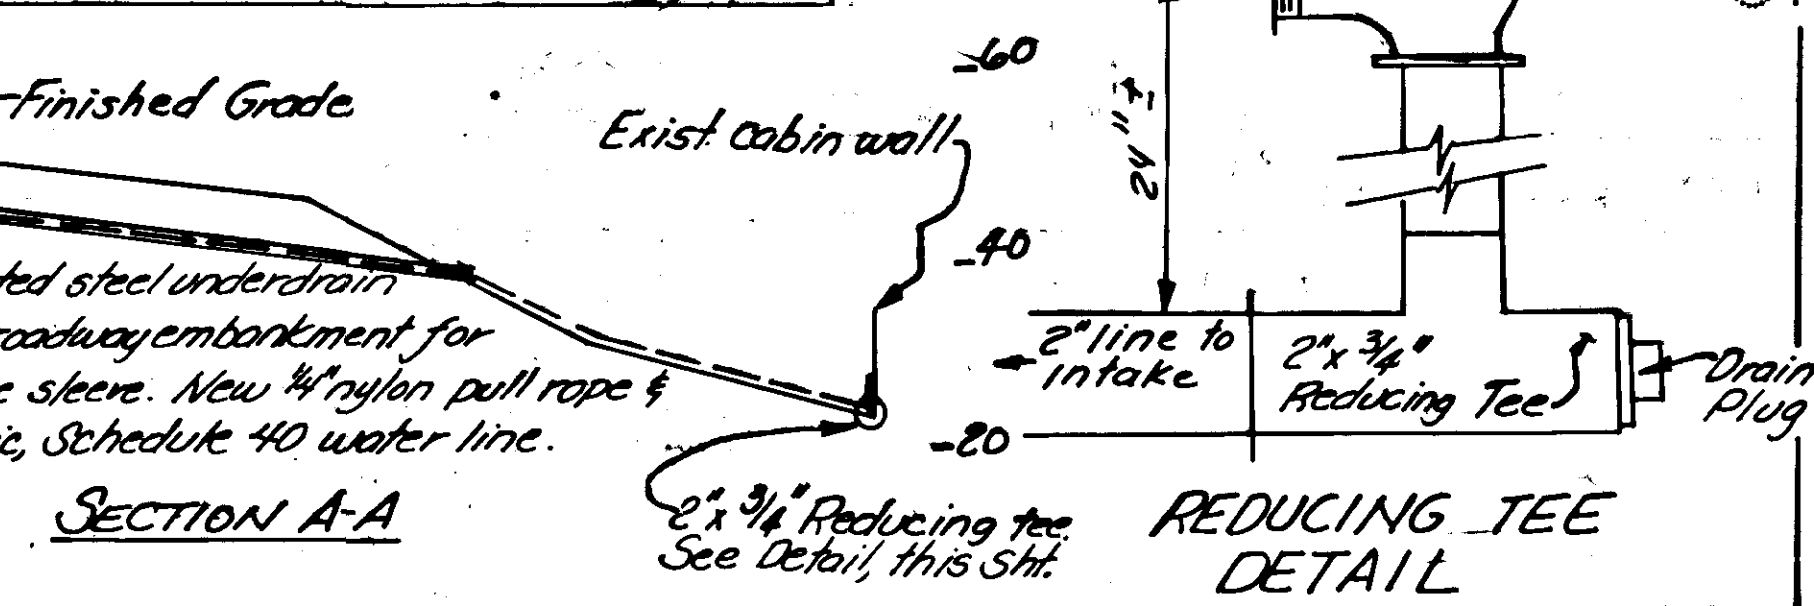


**INTERSECTION DETAIL**

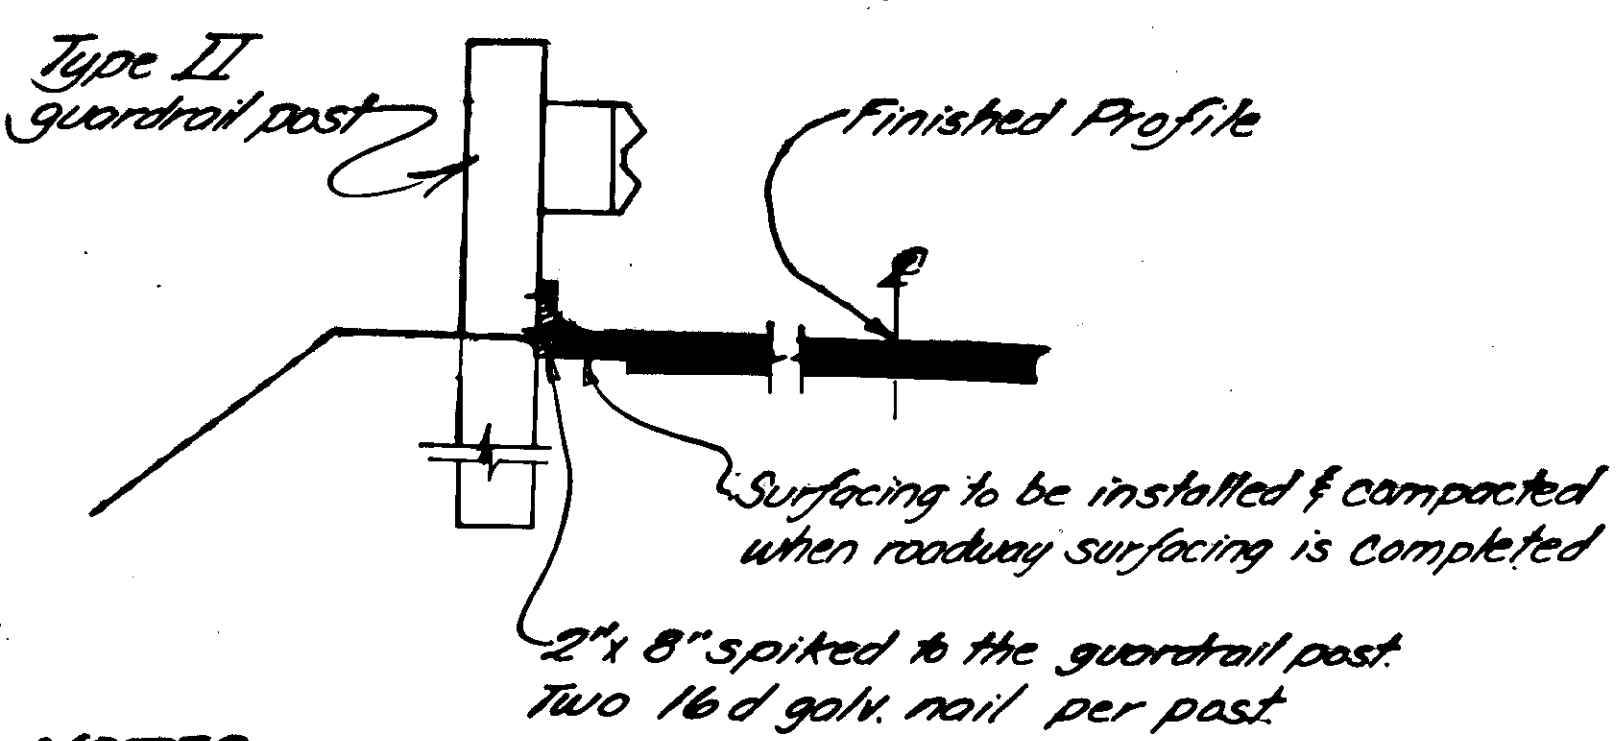

**NOTES:**

- The 2" x 8" backing timber shall be rough sawn Douglas Fir & treated in accordance w/applicable Standards of the American Wood Preservers Assoc.
- Install from "0"112+50, 16' Rf. to "0"113+50, 16' Rf.

**WOODEN CURB DETAIL**




















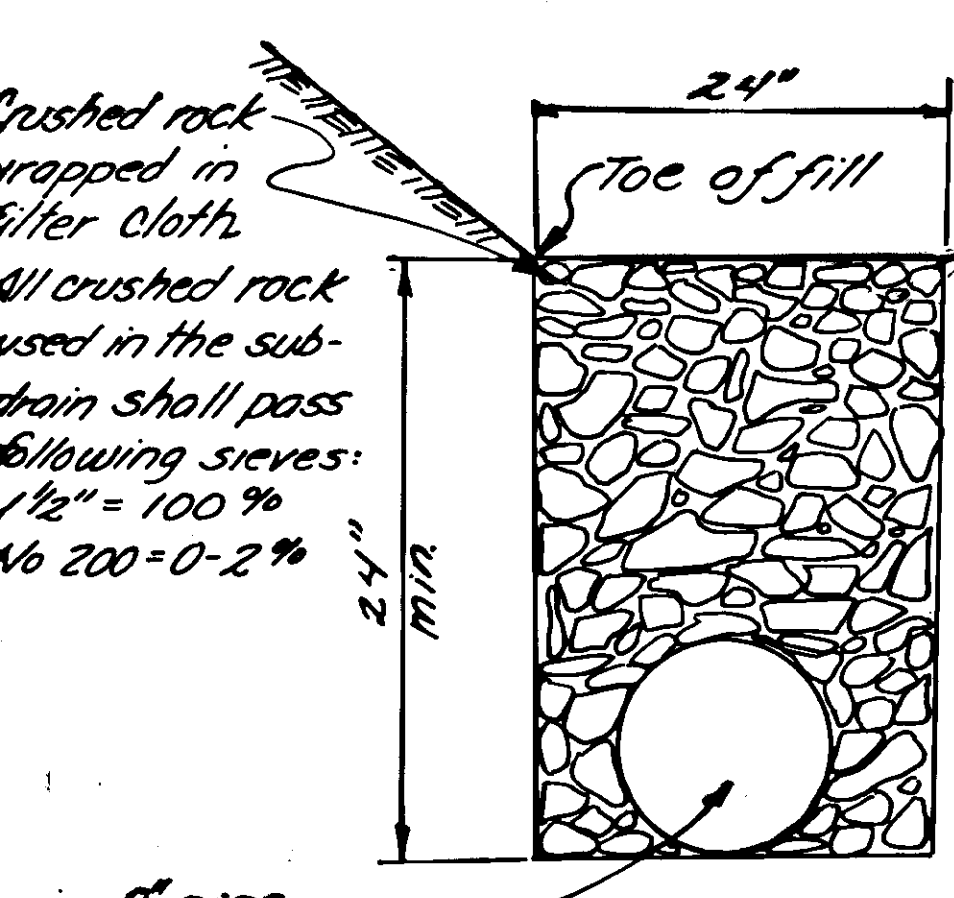


Top of subdrain equal to exist. surface @ "0"112+15, 50' Rf.

Top of subdrain elev. of "0"112+00 & "0"114+00 shown in Detail "B" this sheet.

**NOTES:**

- All labor & materials required to install the subdrain shown in Details "A", "B", & "C" except field inlets & 24" inch pipe, shall be incidental to Items 605(1).
- The type of filter cloth shall be as indicated by the engineer.

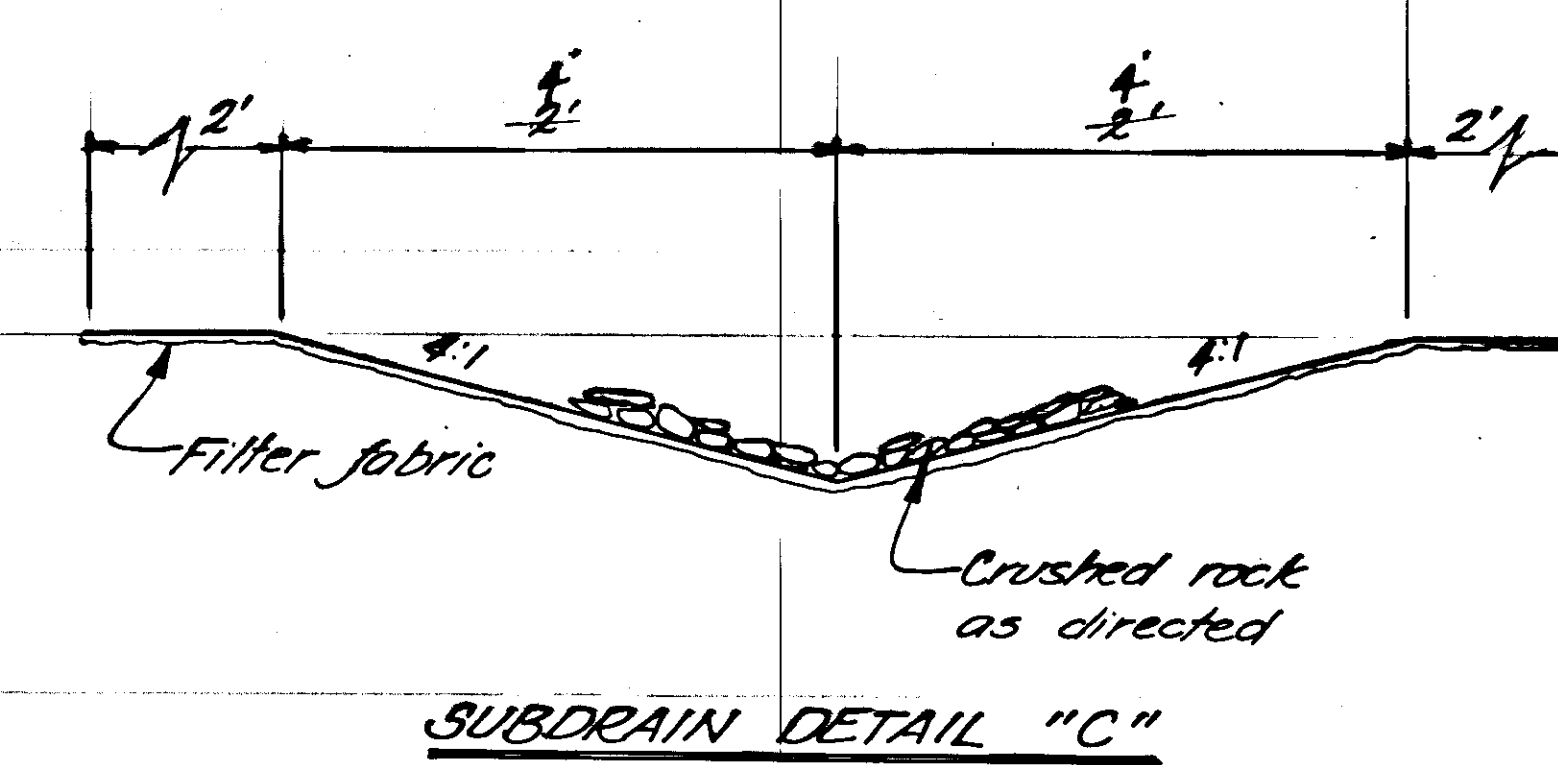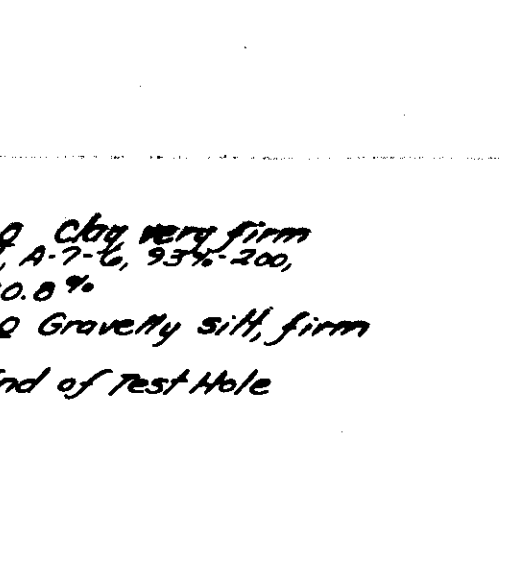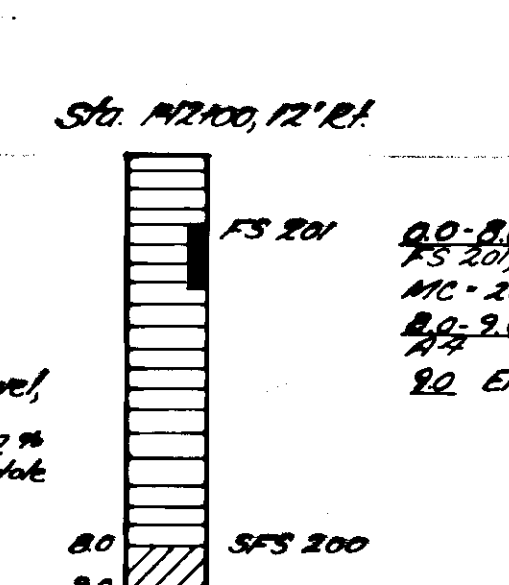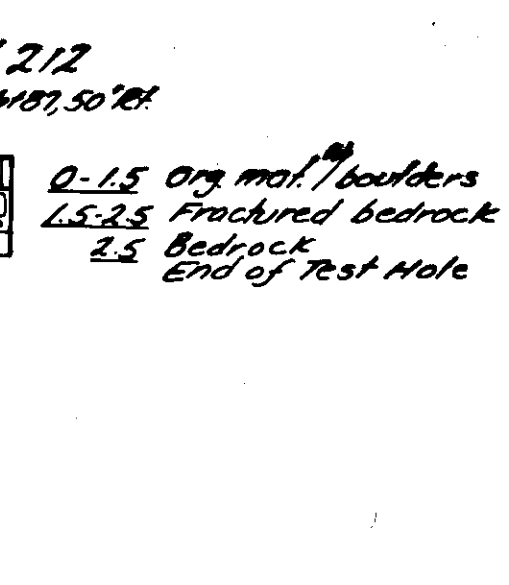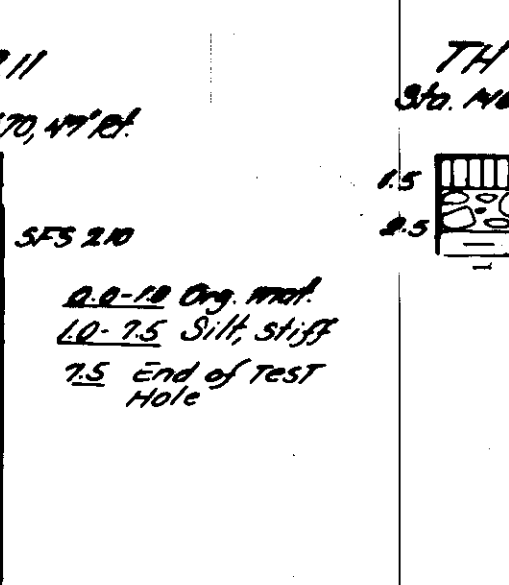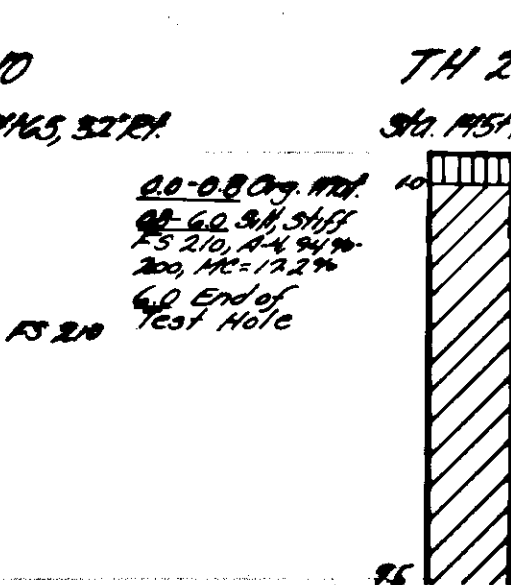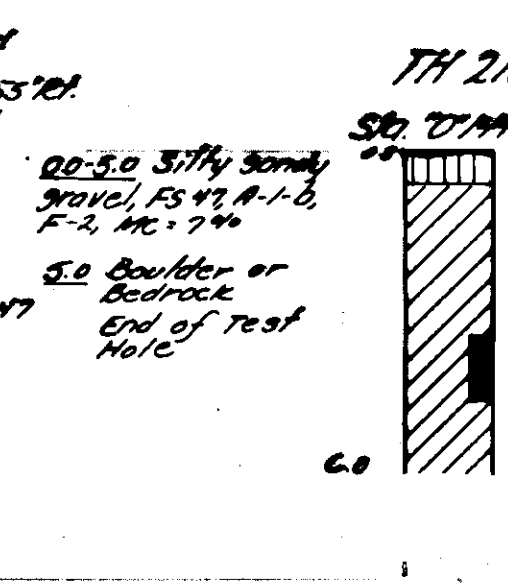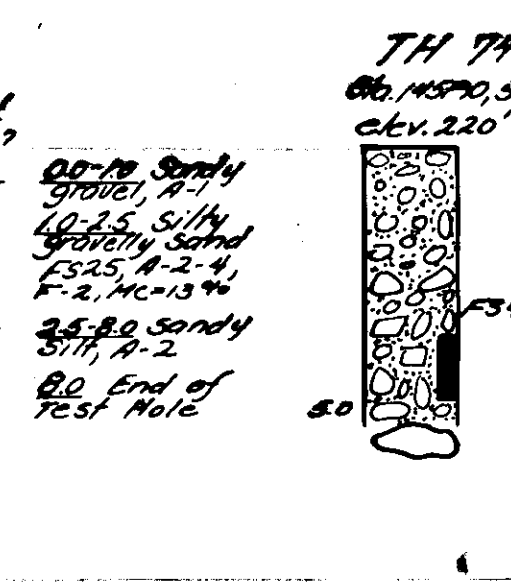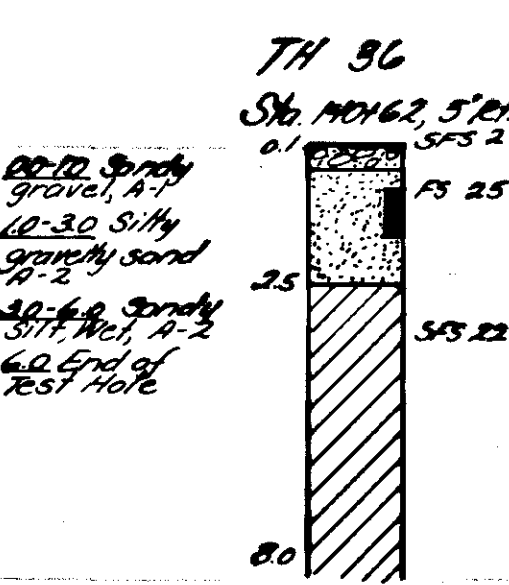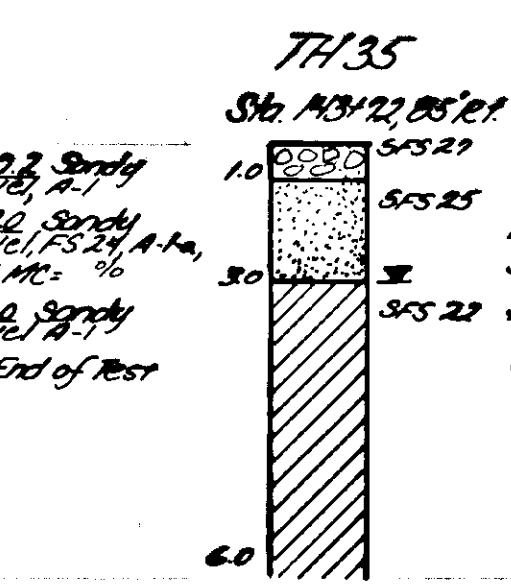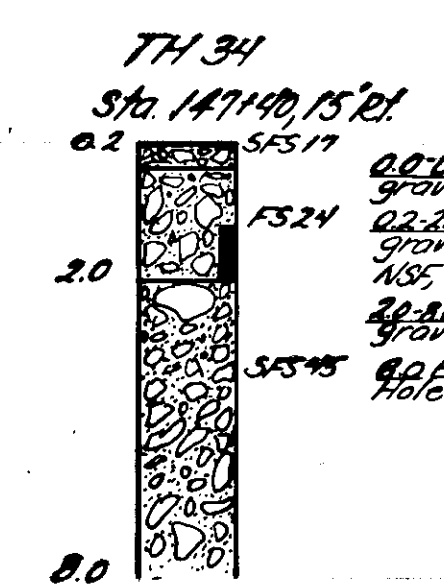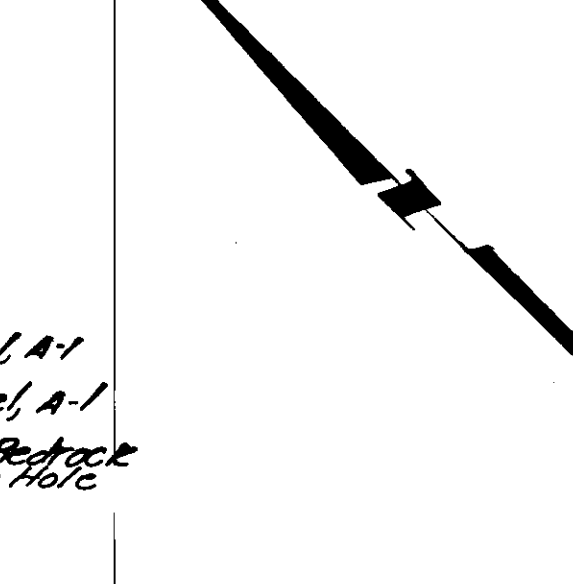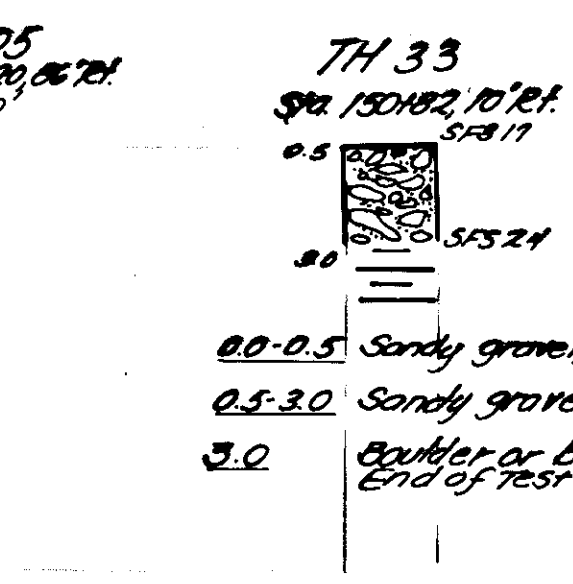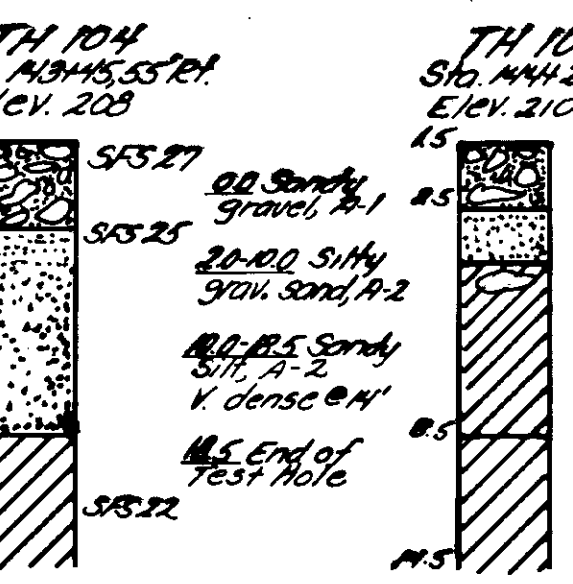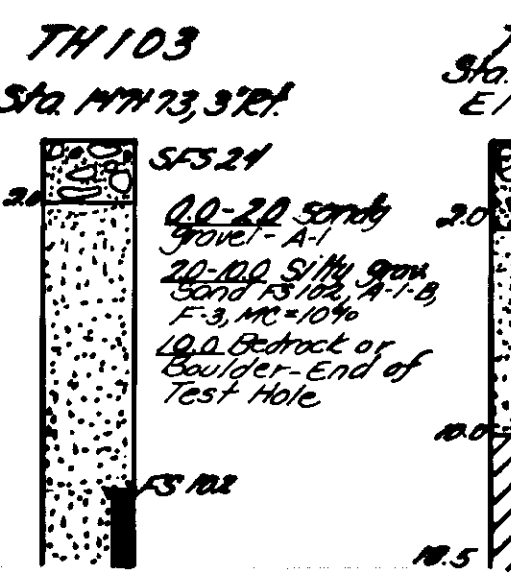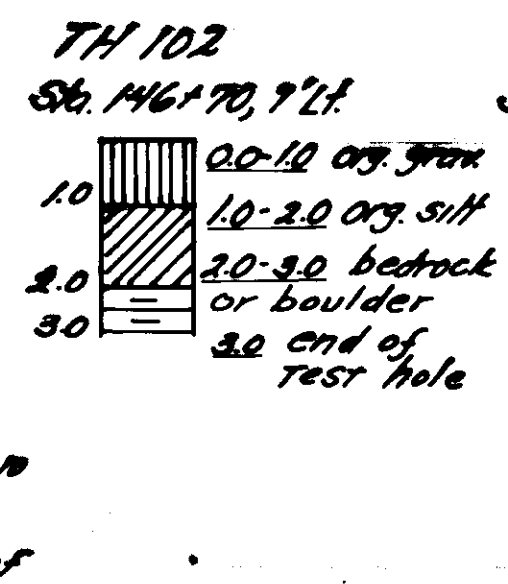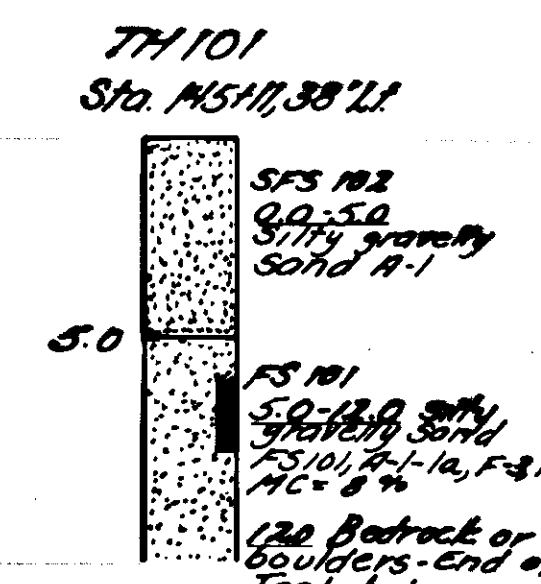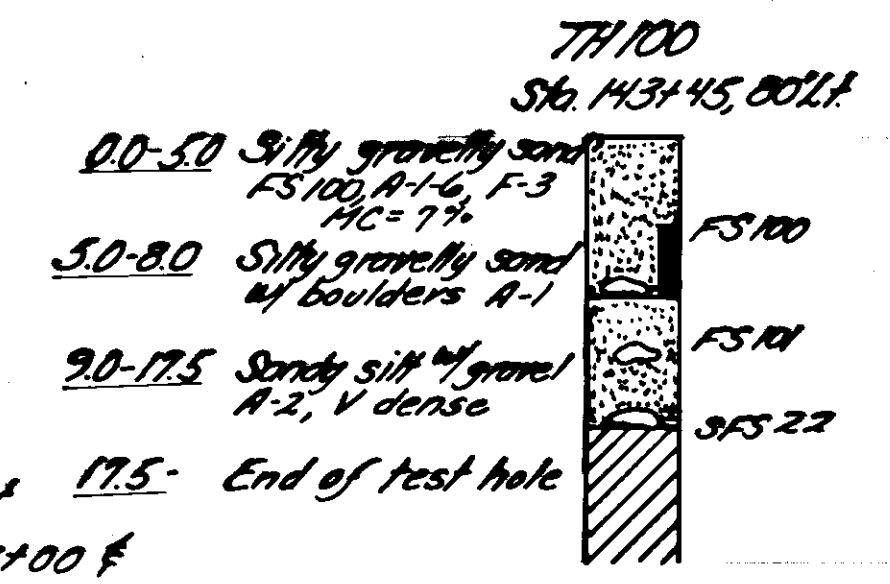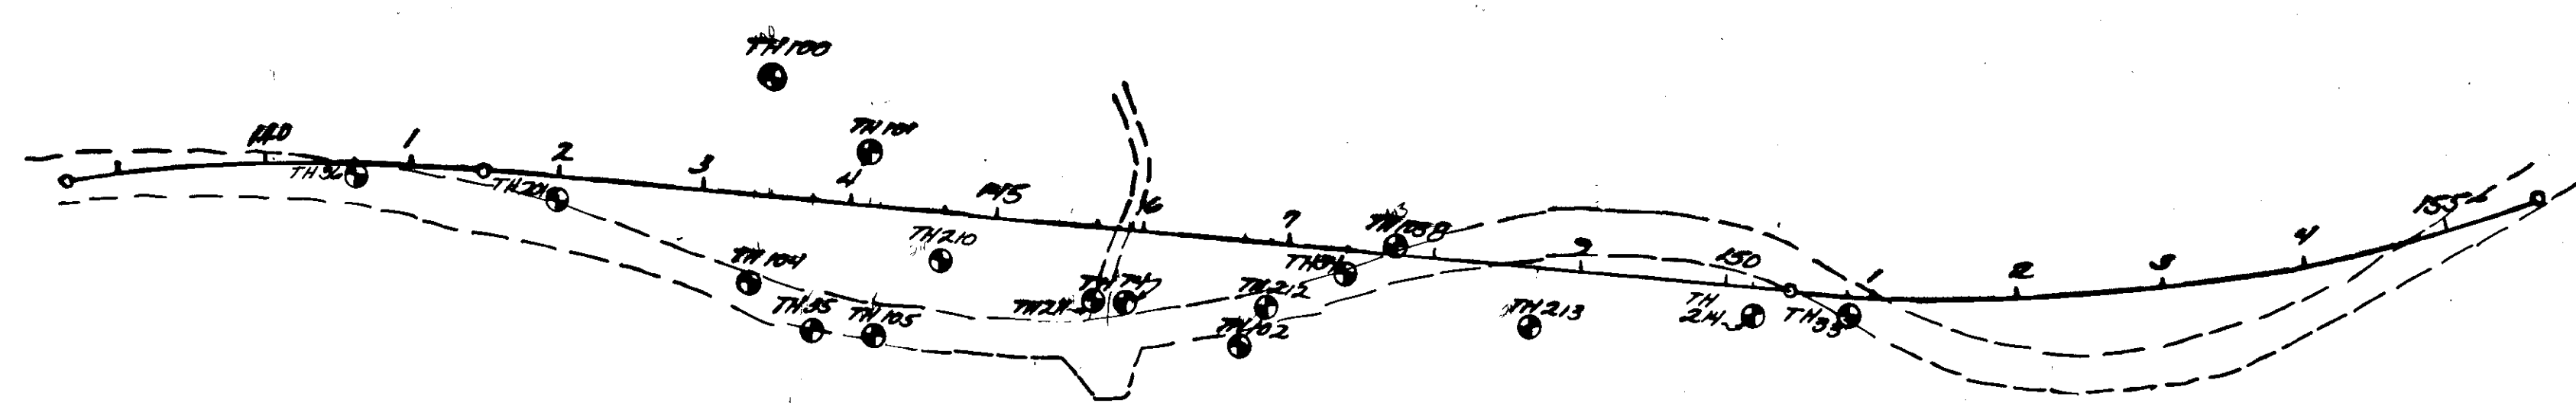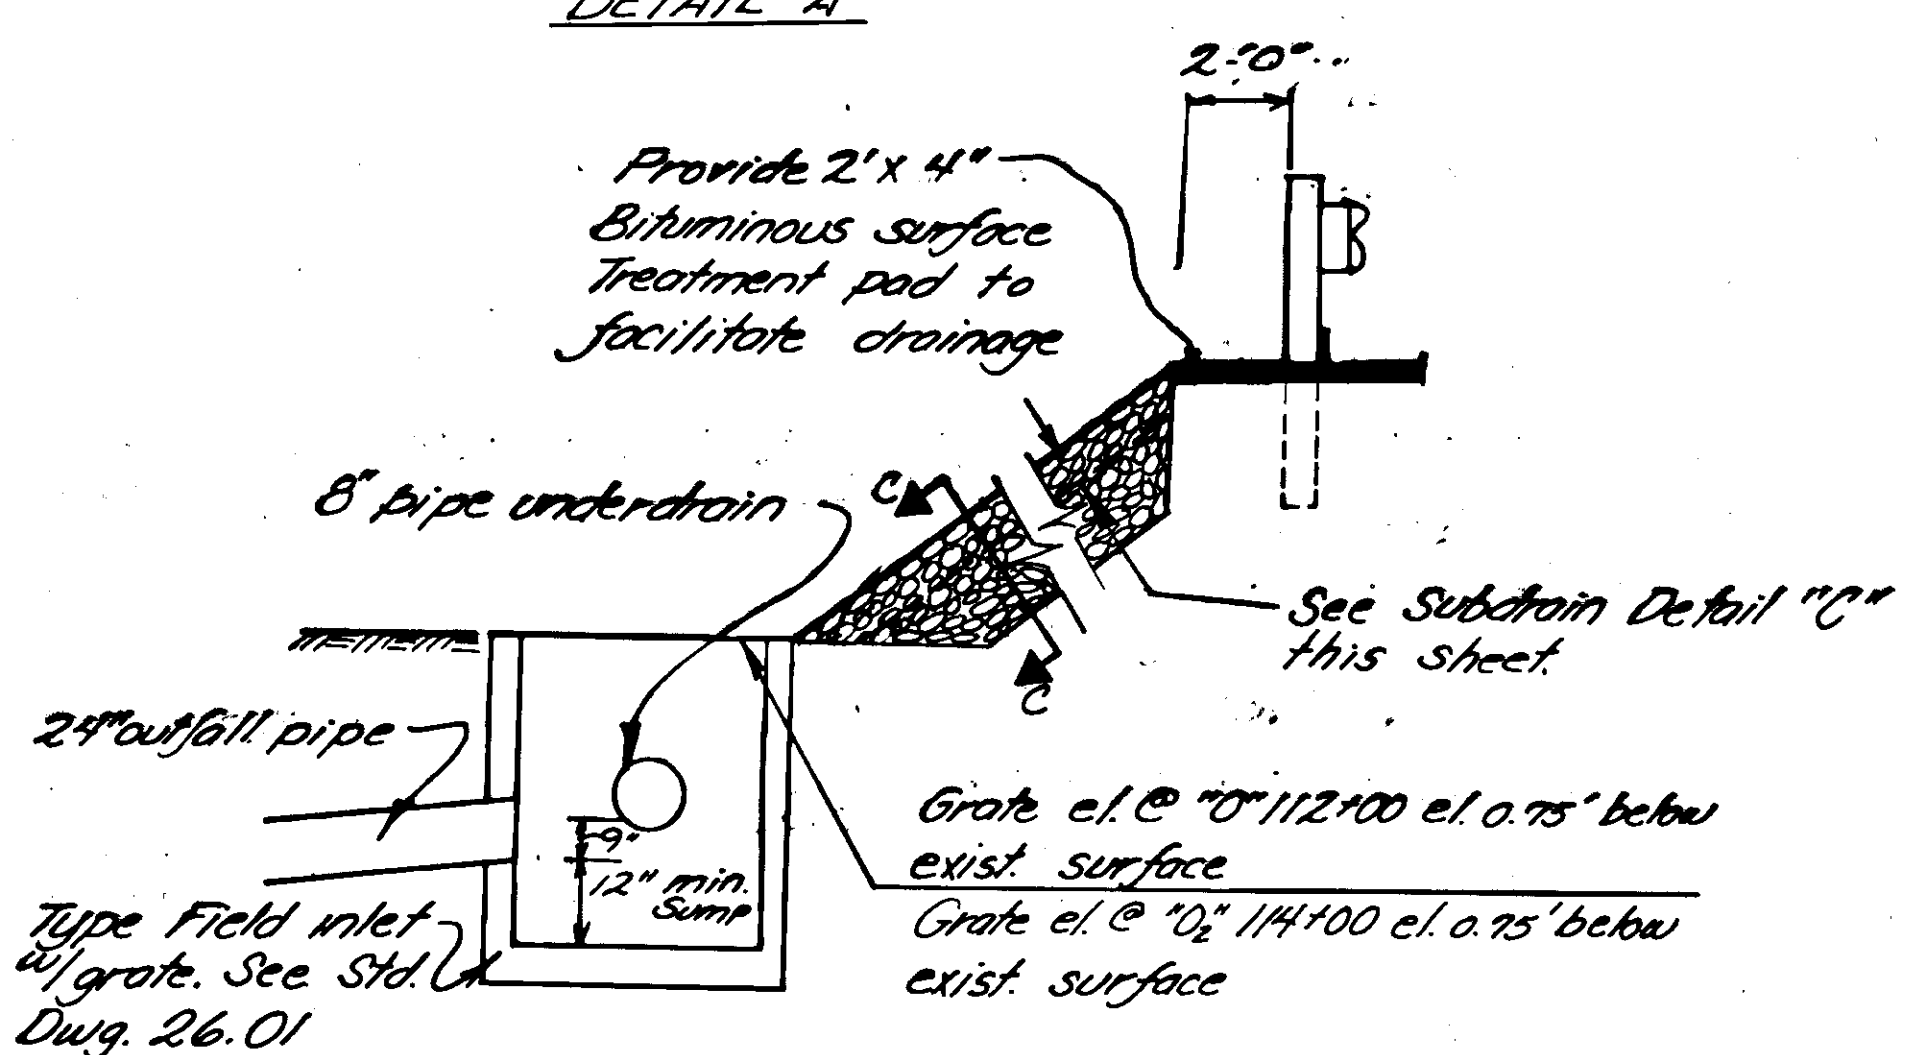

**INFORMATIONAL MATERIALS BORINGS  
STATION 140+00 TO STATION 155+00**






Sec. II, T.31S., R.59E.

Sec. II, T.31S., R.59E.

STATE	PROJECT	YEAR	SHEET NO.	TOTAL SHEETS
ALASKA	RS0987(4)	1985	8	13

HYDRAULIC & HYDROLOGIC SUMMARY STA 120 + 25

Flood Frequency	50 year	100 year
Exceedance Probability	2%	1%
Drainage Discharge	0.20 mi <sup>2</sup>	0.02 mi <sup>2</sup>
Design Discharge	54 cfs	60 cfs
Design Elevation		
Hydraulic Capacity of the structure equals		
73 cfs at Elev. which has an Exceedance Probability less than 1%.		
Projected backwater at Q100=3.5 feet.		

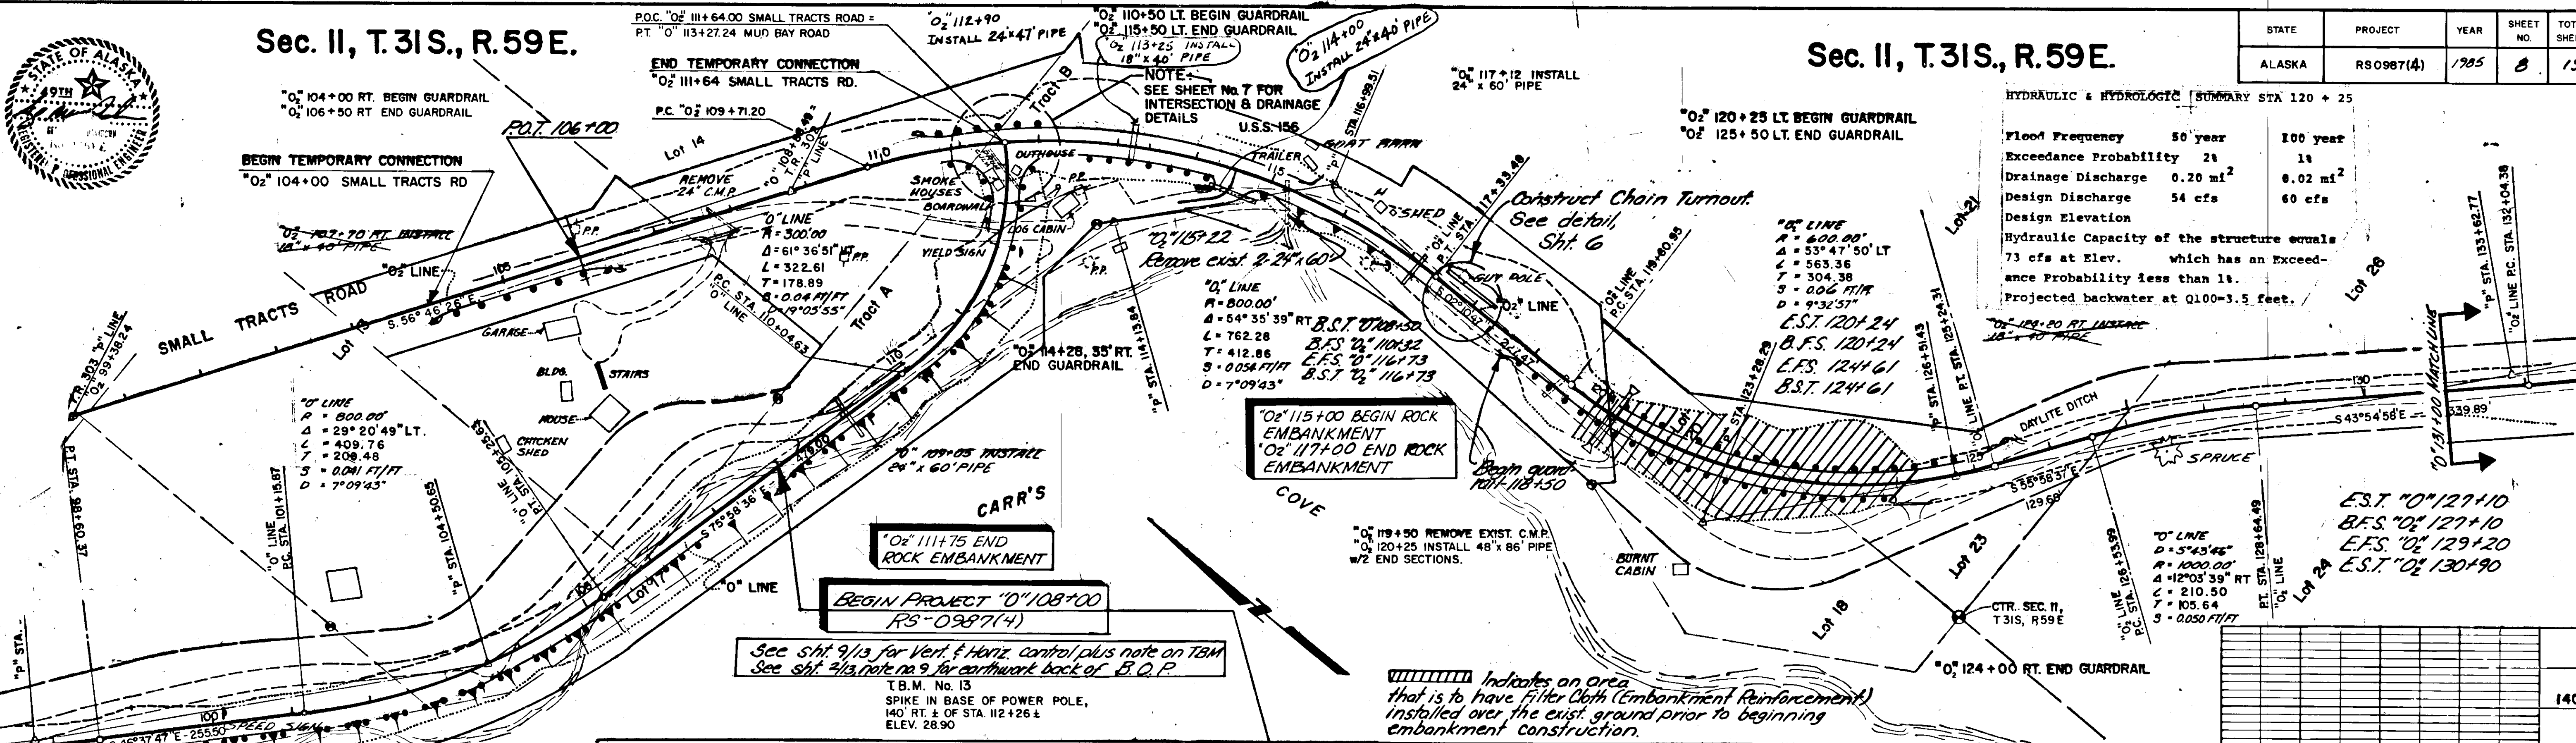


See Sht. 9/13 for Vert. & Horiz. control, plus note on TBM  
 See Sht. 4/13, note no. 9 for earthwork back of B.O.P.


Indicates an area that is to have filter cloth (Embankment Reinforcement) installed over the exist. ground prior to beginning embankment construction.

T.B.M. No. 12  
 CHISELLED "O" ON EAST SIDE OF 6'x10' GRANITE BOULDER, 15' LT. ± OF STA. 100+20 ±  
 ELEV. = 30.86

T.B.M. No. 14  
 SPIKE IN BASE OF 18" DIA. SPRUCE, 40' RT. ± OF STA. 127+40 ±  
 ELEV. = 93.57

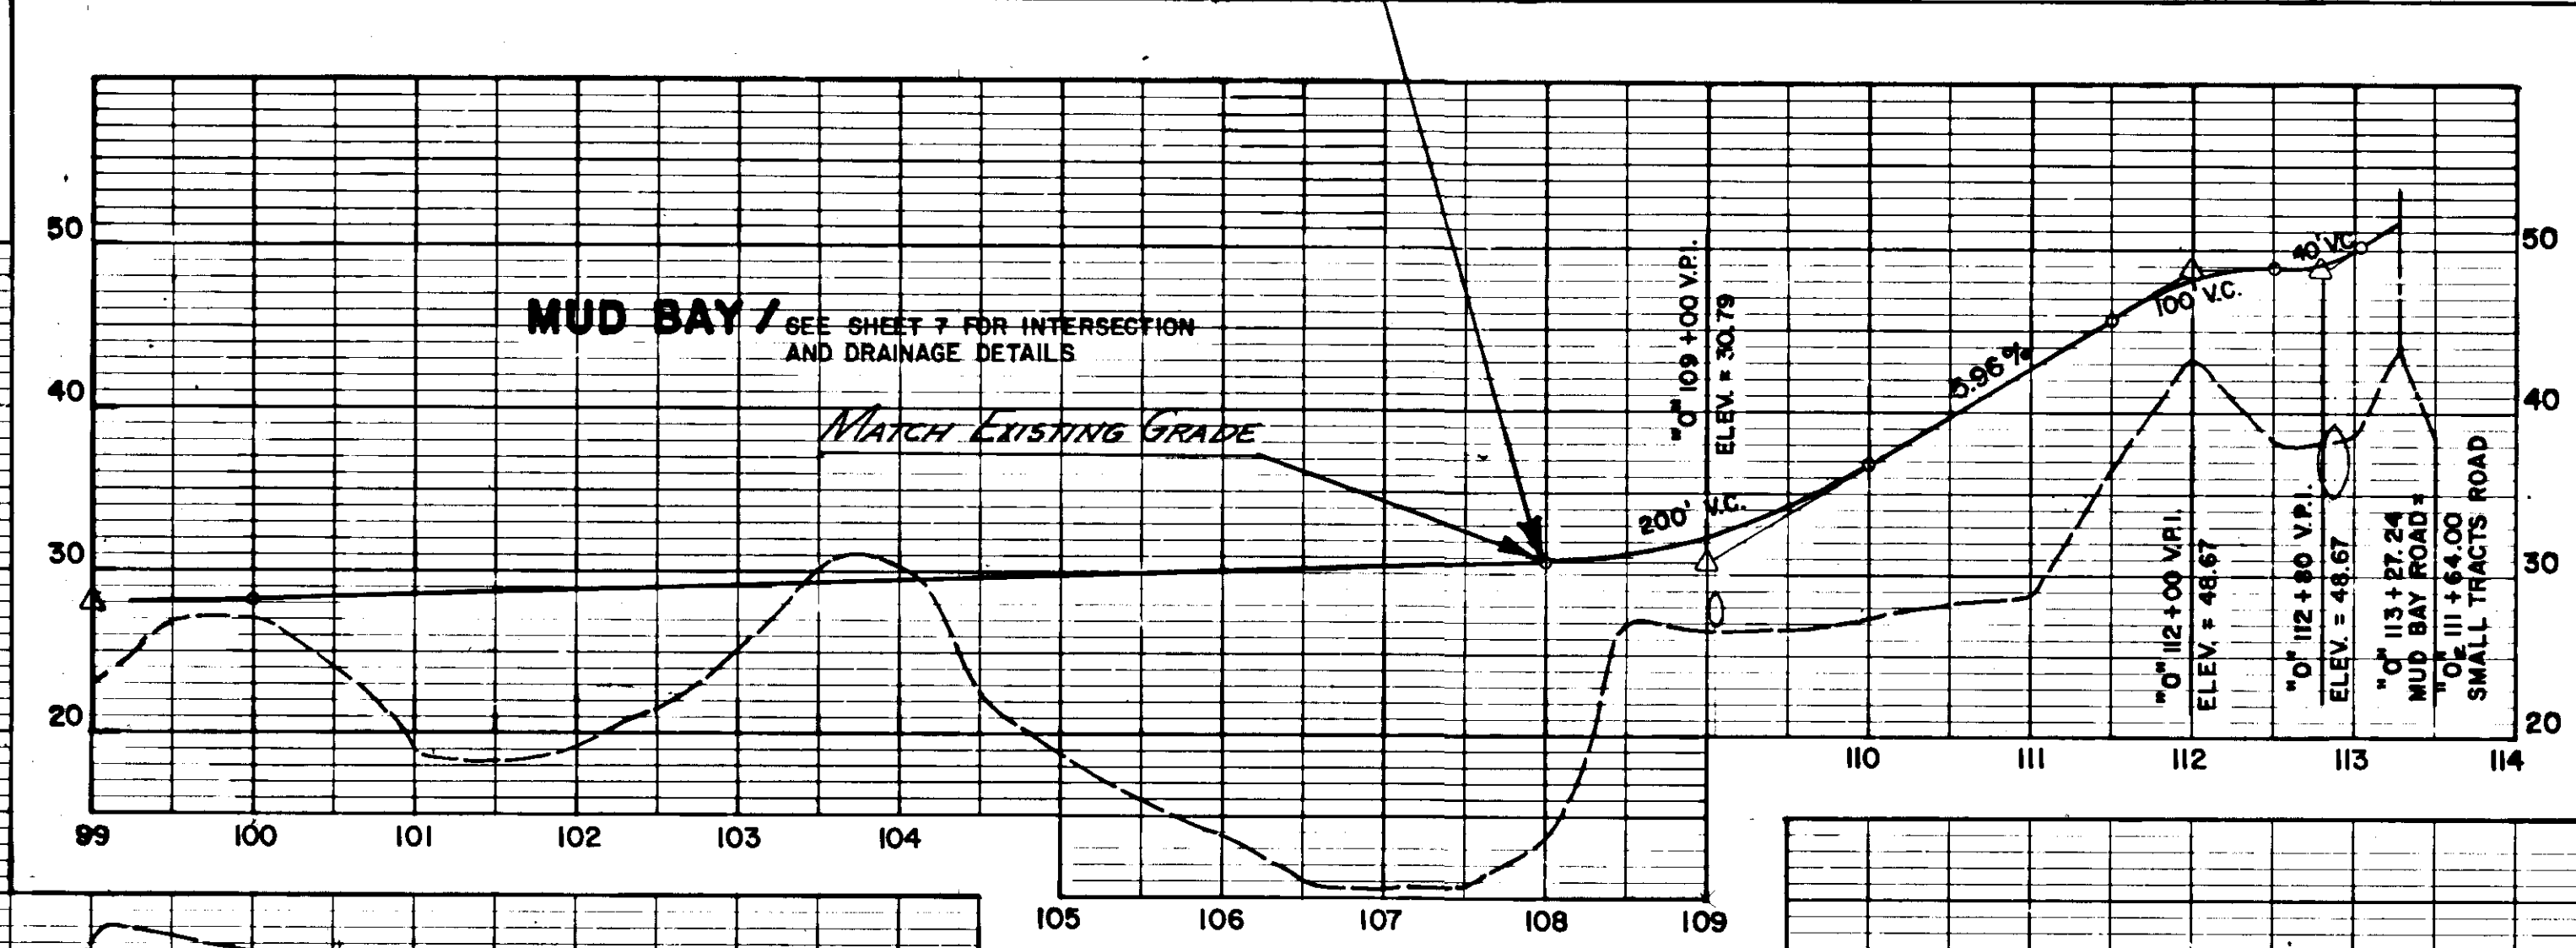


Unclassified Excavation = 2,858  
 Embankment = 30,937  
 (Includes approx. 2,600 cu. of rock embankment)

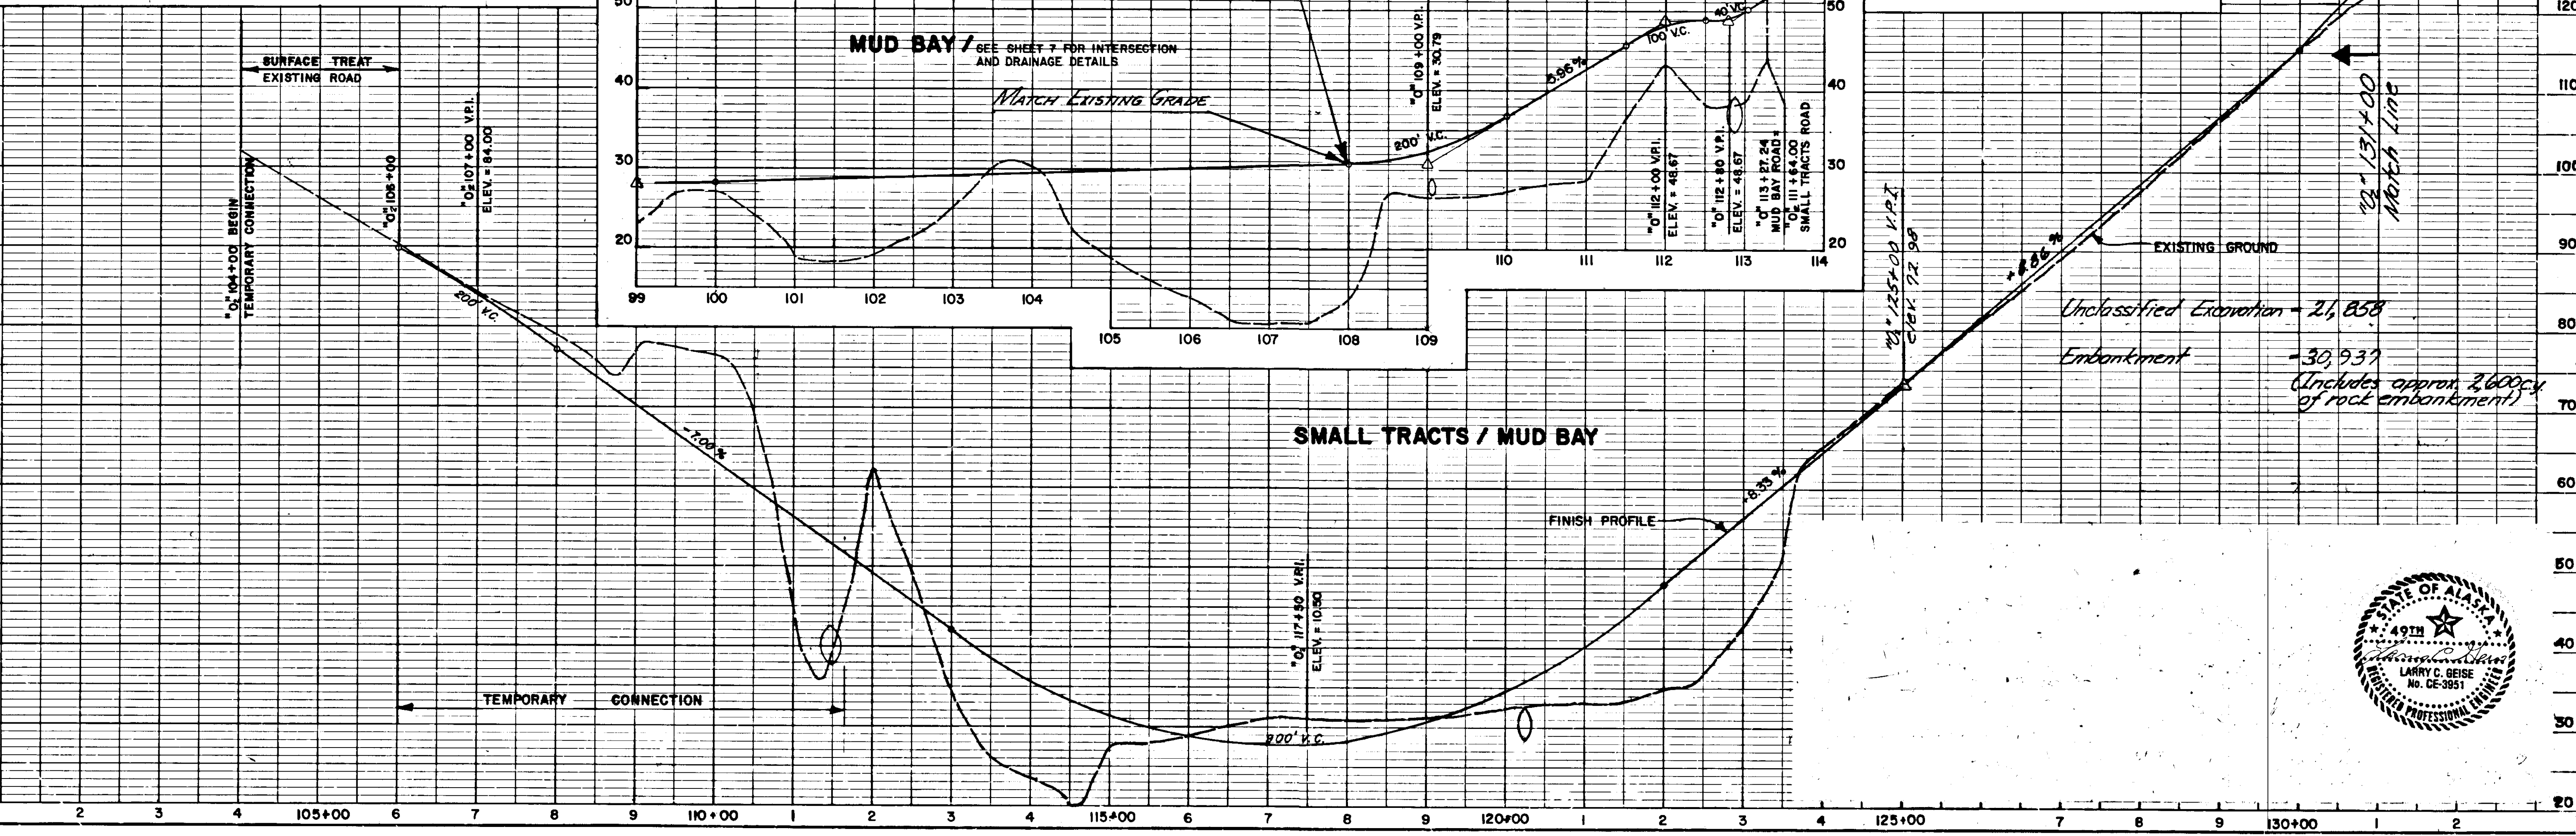




Sec. II, T.31S., R.59E.

STATE	PROJECT	YEAR	SHEET NO.	TOTAL SHEETS
ALASKA	RS0987(4)	1985	9	13

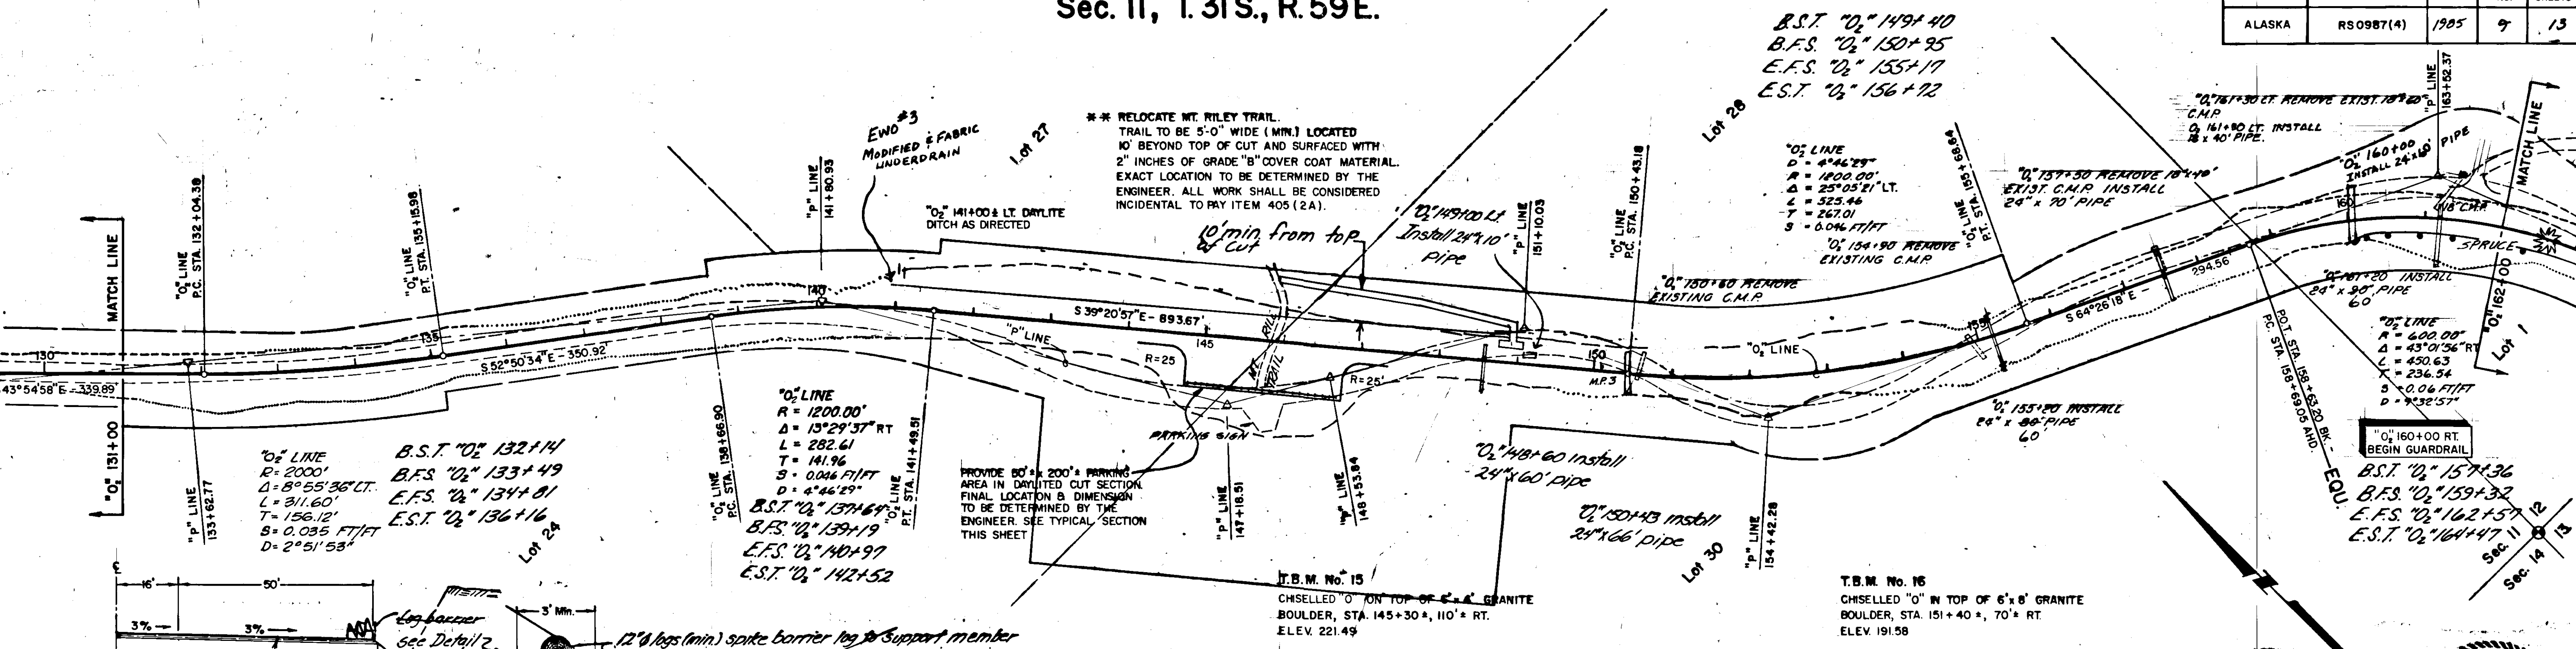

**TYPICAL SECTION**  
Mt. Riley Trail Parking Area  
Structural section for parking area shall match that of existing.


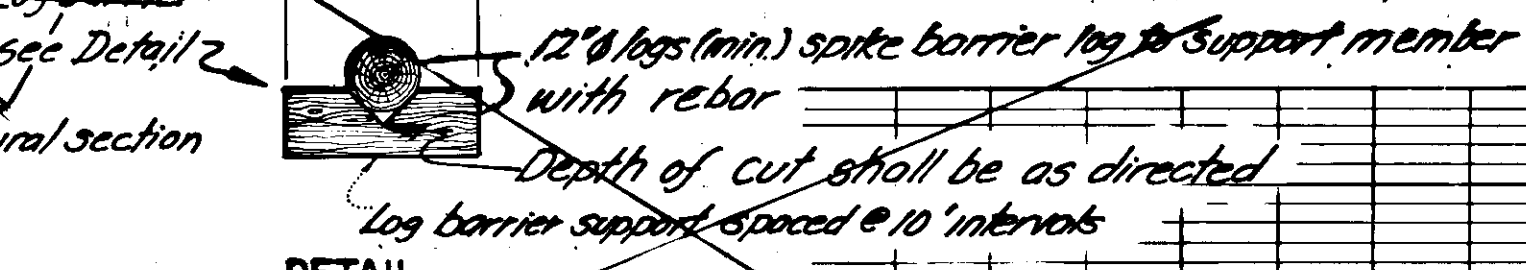


**DETAIL**  
Material for log barrier shall be obtained from selected logs cut during the clearing operation. Logs used shall have bark removed. All work & materials used to const. log barrier shall be considered incidental to Item 20 (2B) Clearing & Grubbing.  
NOTE: ALL T.B.M.'s SHOWN HEREON ARE TO BE CONSIDERED INFORMATIONAL ONLY. IT SHALL BE THE RESPONSIBILITY OF THE CONTRACTOR TO VERIFY THE STATED INFORMATION PRIOR TO BEGINNING ANY WORK.

**VERTICAL CONTROL**  
U.S.C. & G.S. BENCHMARK No. 5 (1943) BRASS CAP ON GRANITE ROCK, 50' ± EAST OF E. FRONT STREET & 300' ± NORTH OF INTERSECTION OF FRONT STREET & HAINES CUT-OFF ROAD. ELEV. = 27.60 (1961 DATUM)

**HORIZONTAL CONTROL**  
BASED UPON THE GRID BEARING BETWEEN N.O.S. STATION "RAM" AND "BOW"  
"RAM" LAT. - 59°11'45.007" LONG. - 135°27'25.855"  
N. 2,693,954.563 E. 2,349,846.372  
"BOW" LAT. - 59°09'00.537" LONG. - 135°27'58.864"  
N. 2,677,304.017 E. 2,347,685.937


**PROJECT COORDINATES**  
179+86.34 N. 33,354.567 E. 37,104.789  
271+50.00 N. 25,928.201 E. 41,724.099

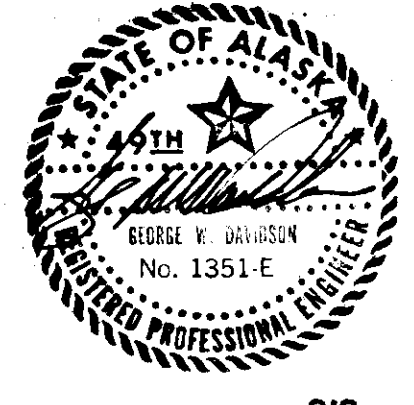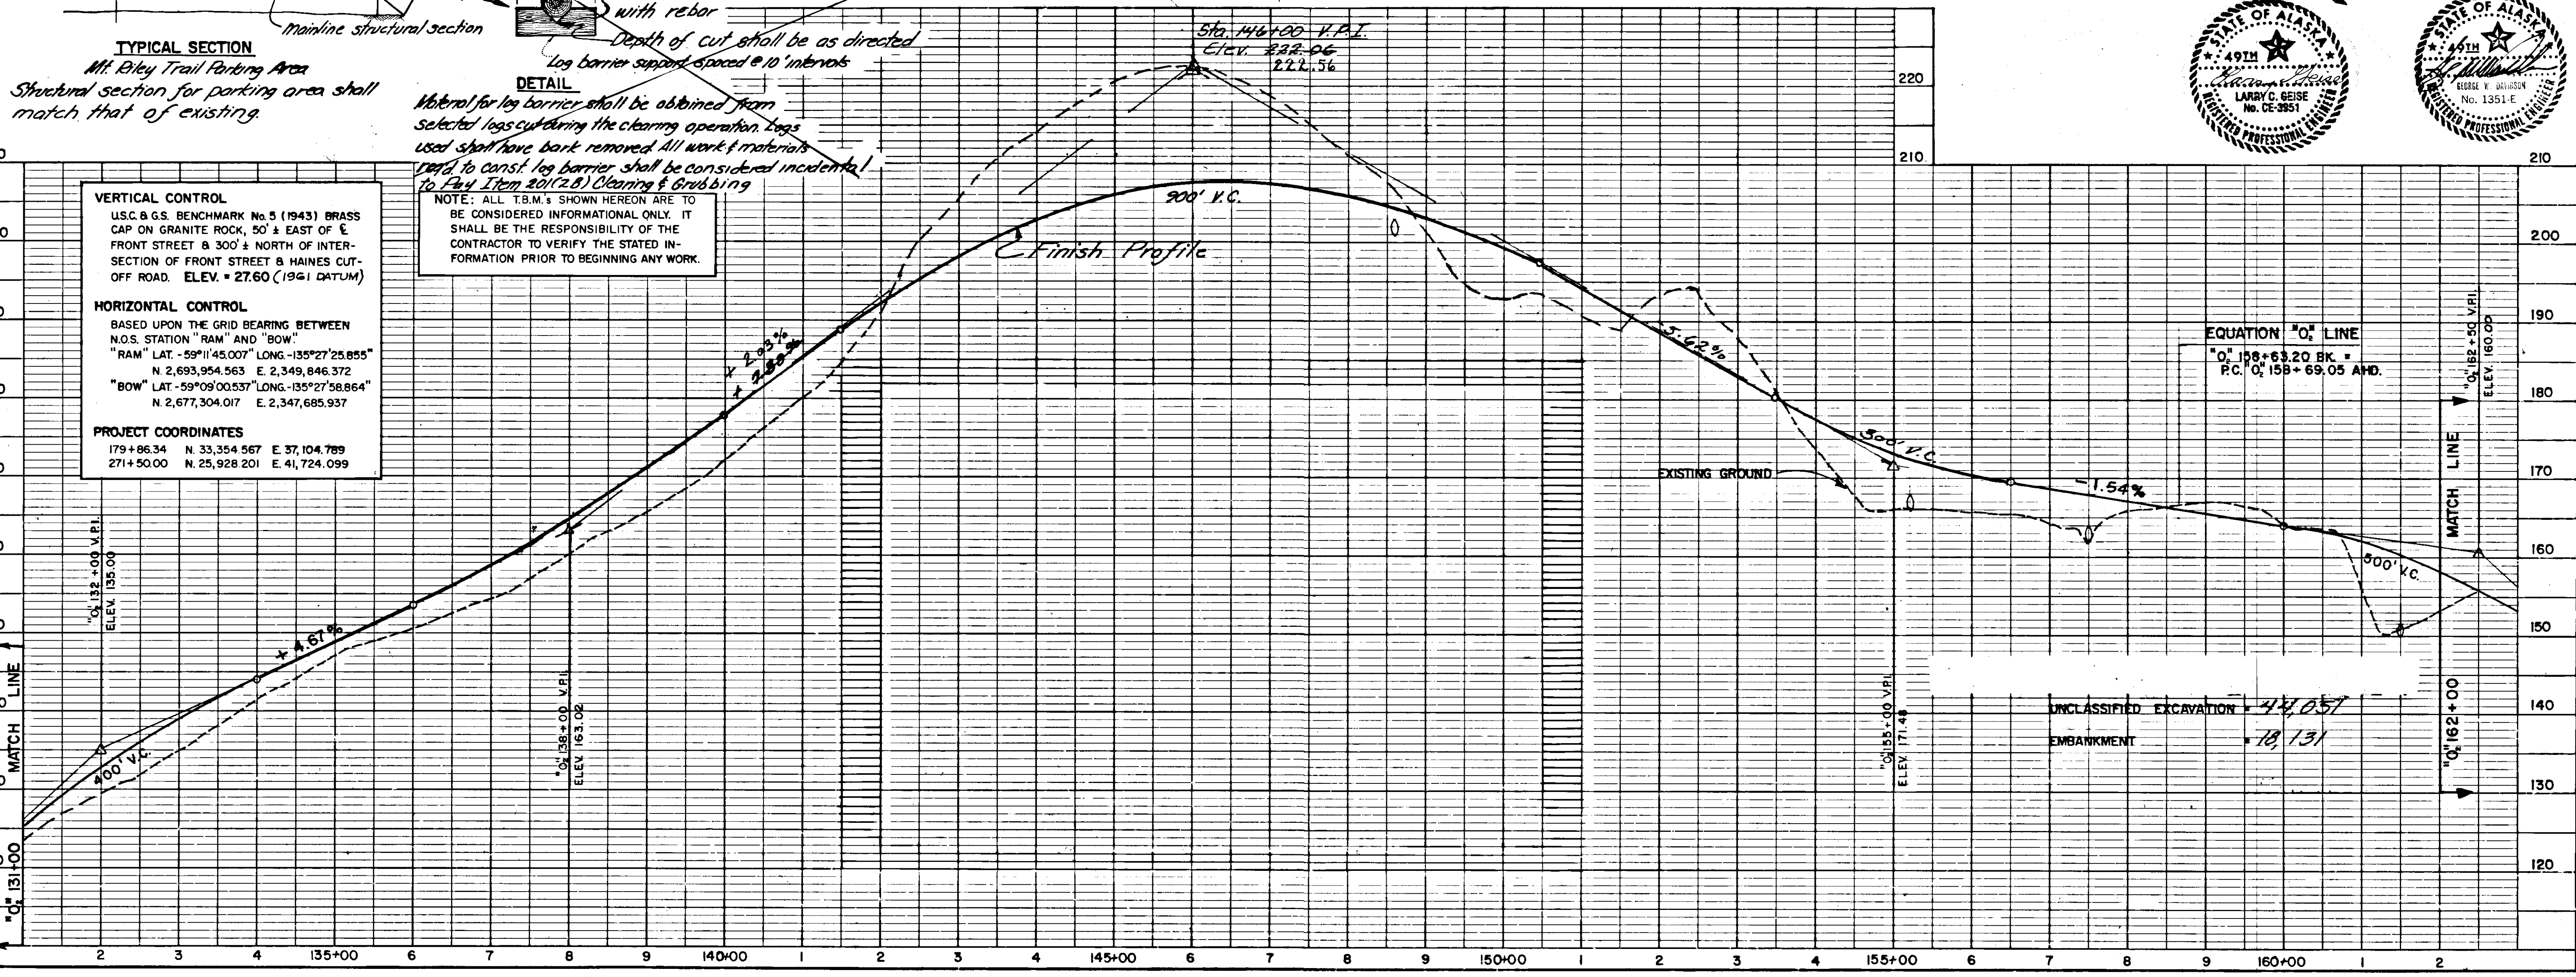

STATE	PROJECT	YEAR	SHEET NO.	TOTAL SHEETS
ALASKA	RS 0987(4)	1985	10	13

Sec. 12, T.31S., R.59E.

Sec. 13, T.31S., R.59E.

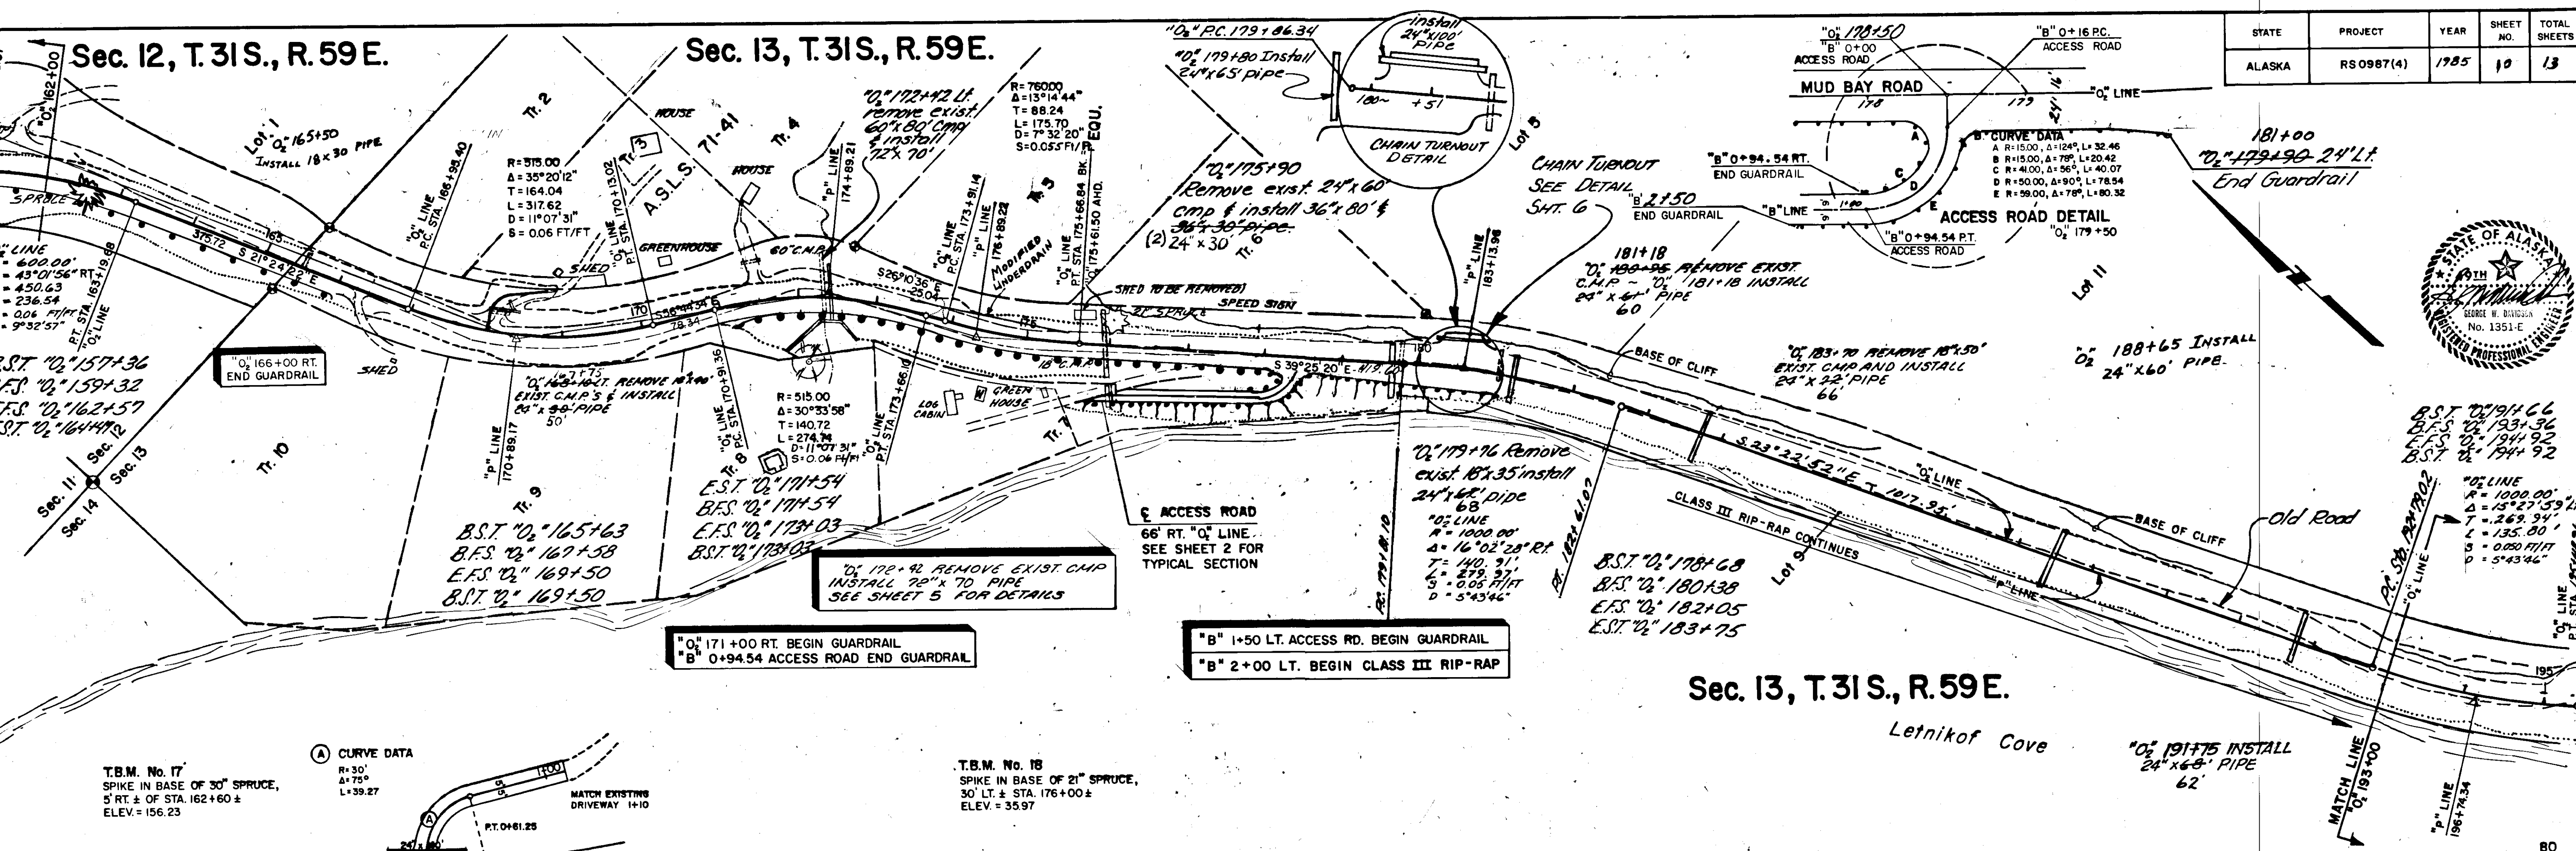


B.S.T. 12/19/66  
 E.F.S. 12/19/66  
 E.F.S. 12/19/66  
 B.S.T. 12/19/66



Sec. 13, T.31S., R.59E.

Letnikof Cove

T.B.M. No. 17  
 SPIKE IN BASE OF 30" SPRUCE,  
 5' RT. ± OF STA. 162+60 ±  
 ELEV. = 156.23

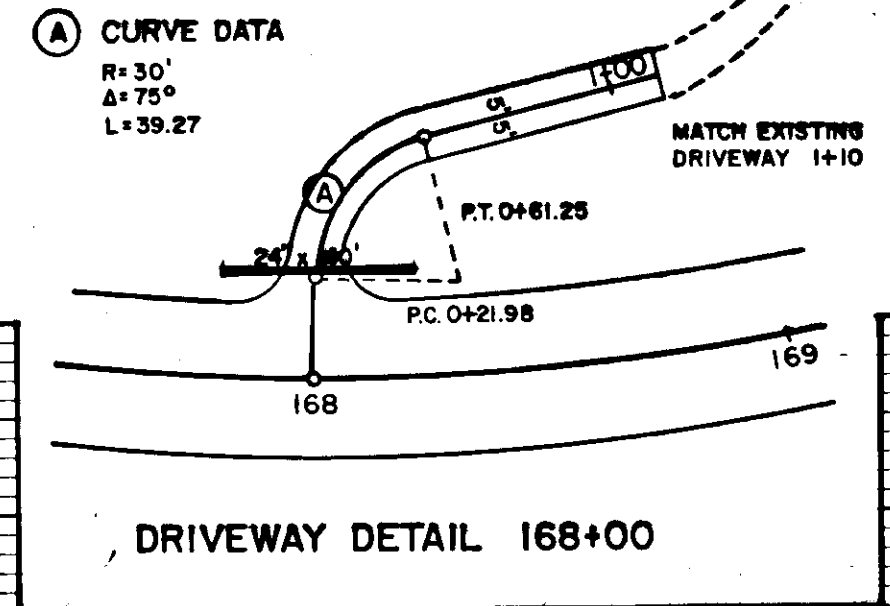

T.B.M. No. 18  
 SPIKE IN BASE OF 21" SPRUCE,  
 30' LT. ± STA. 176+00 ±  
 ELEV. = 35.97

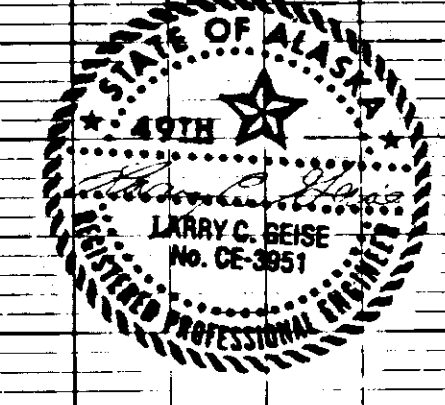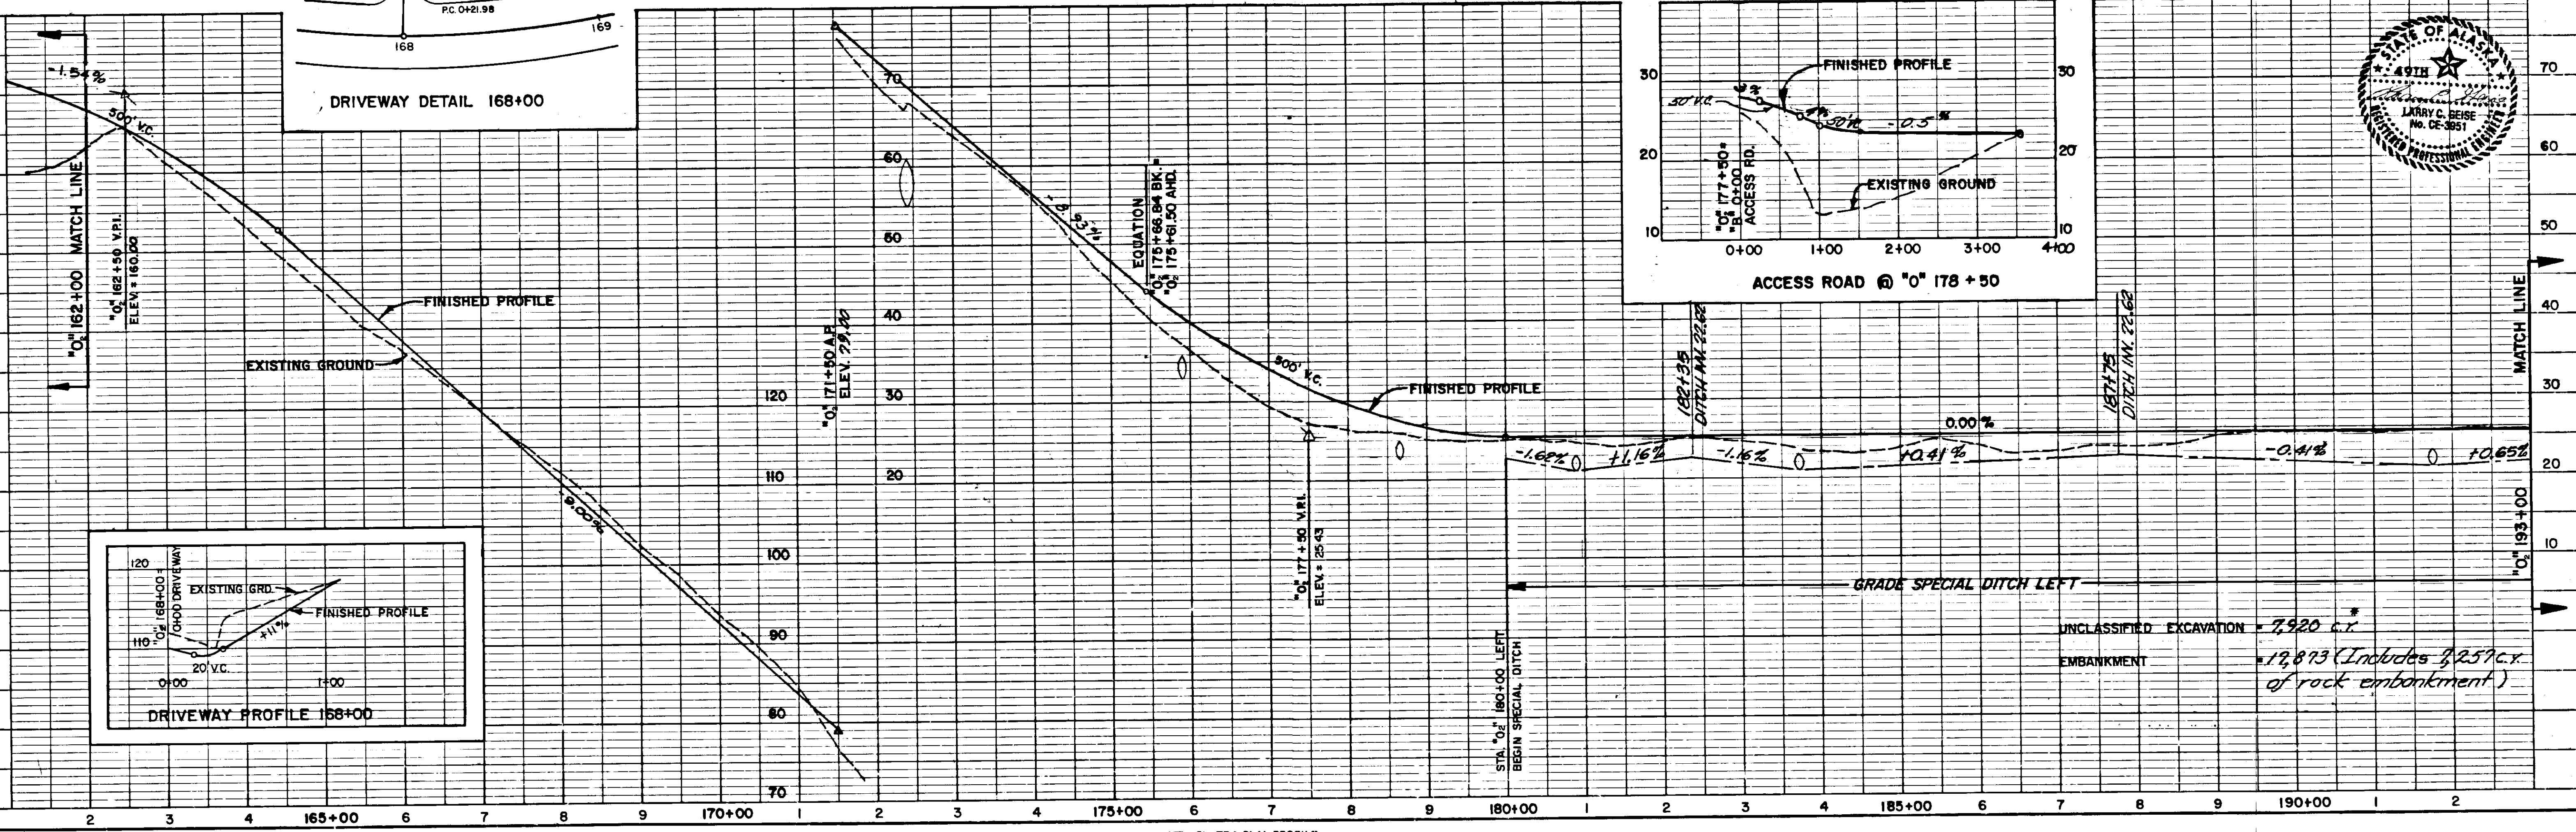

STATE	PROJECT	YEAR	SHEET NO.	TOTAL SHEETS
ALASKA	RS 0987(4)	1985	11	13

Sec. 13, T. 31 S., R. 59 E

Dependent Resurvey  
Portion Sec. 13

T. 31 S. 191+66  
S. 193+36  
R. 194+92  
R. 194+92

"Q" LINE  
R = 1000.00'  
Δ = 15°27'55" LT  
L = 269.94'  
T = 135.00'  
S = 0.050 F/FT  
D = 5°43'46"

"P" LINE  
R = 2500.00'  
Δ = 4°31'53" RT  
L = 202.16'  
T = 101.13'  
S = 0.035 F/FT  
D = 2°17'41"



"Q" LINE  
R = 2500.00'  
Δ = 4°31'53" RT  
L = 202.16'  
T = 101.13'  
S = 0.035 F/FT  
D = 2°17'41"

"P" LINE  
R = 2500.00'  
Δ = 4°31'53" RT  
L = 202.16'  
T = 101.13'  
S = 0.035 F/FT  
D = 2°17'41"

"Q" LINE  
R = 1000.00'  
Δ = 23°07'02" LT  
L = 403.47'  
T = 204.52'  
S = 0.05 F/FT  
D = 5°43'46"

"P" LINE  
R = 2500.00'  
Δ = 4°31'53" RT  
L = 202.16'  
T = 101.13'  
S = 0.035 F/FT  
D = 2°17'41"



"Q" LINE  
R = 2000.00'  
Δ = 09°52'12" RT  
L = 344.53'  
T = 172.69'  
S = 0.035 F/FT  
D = 2°51'53"

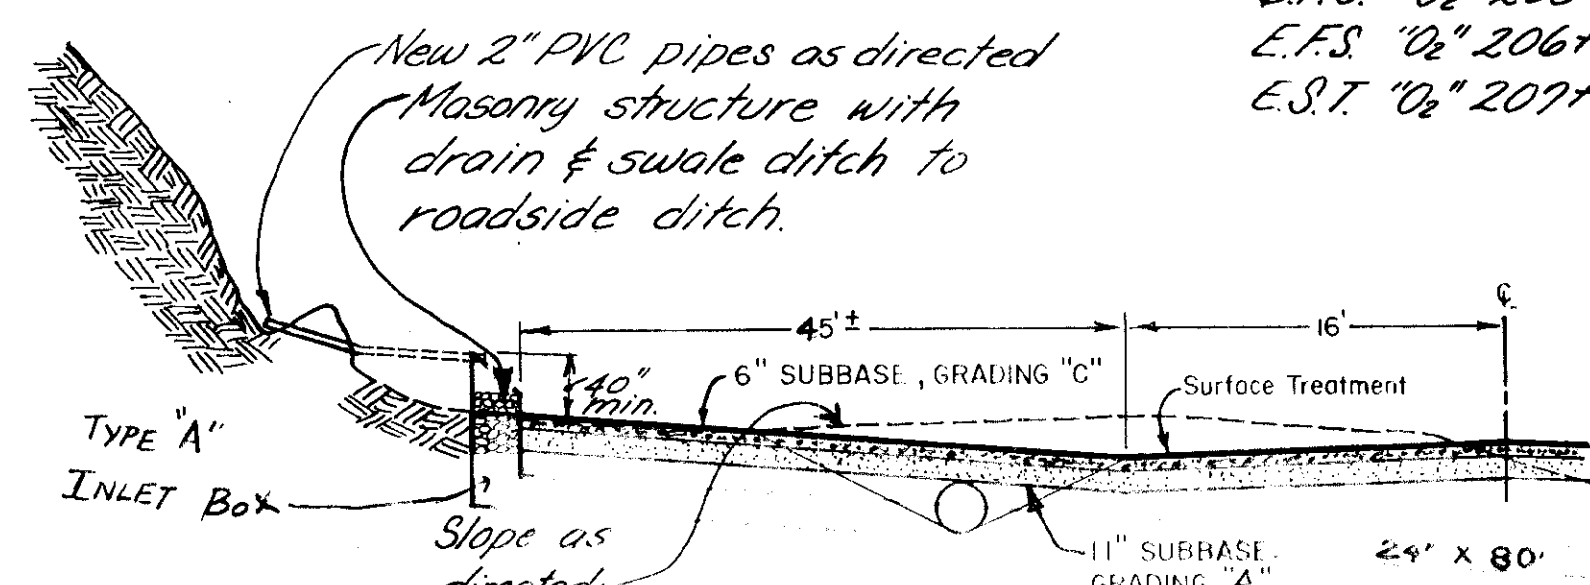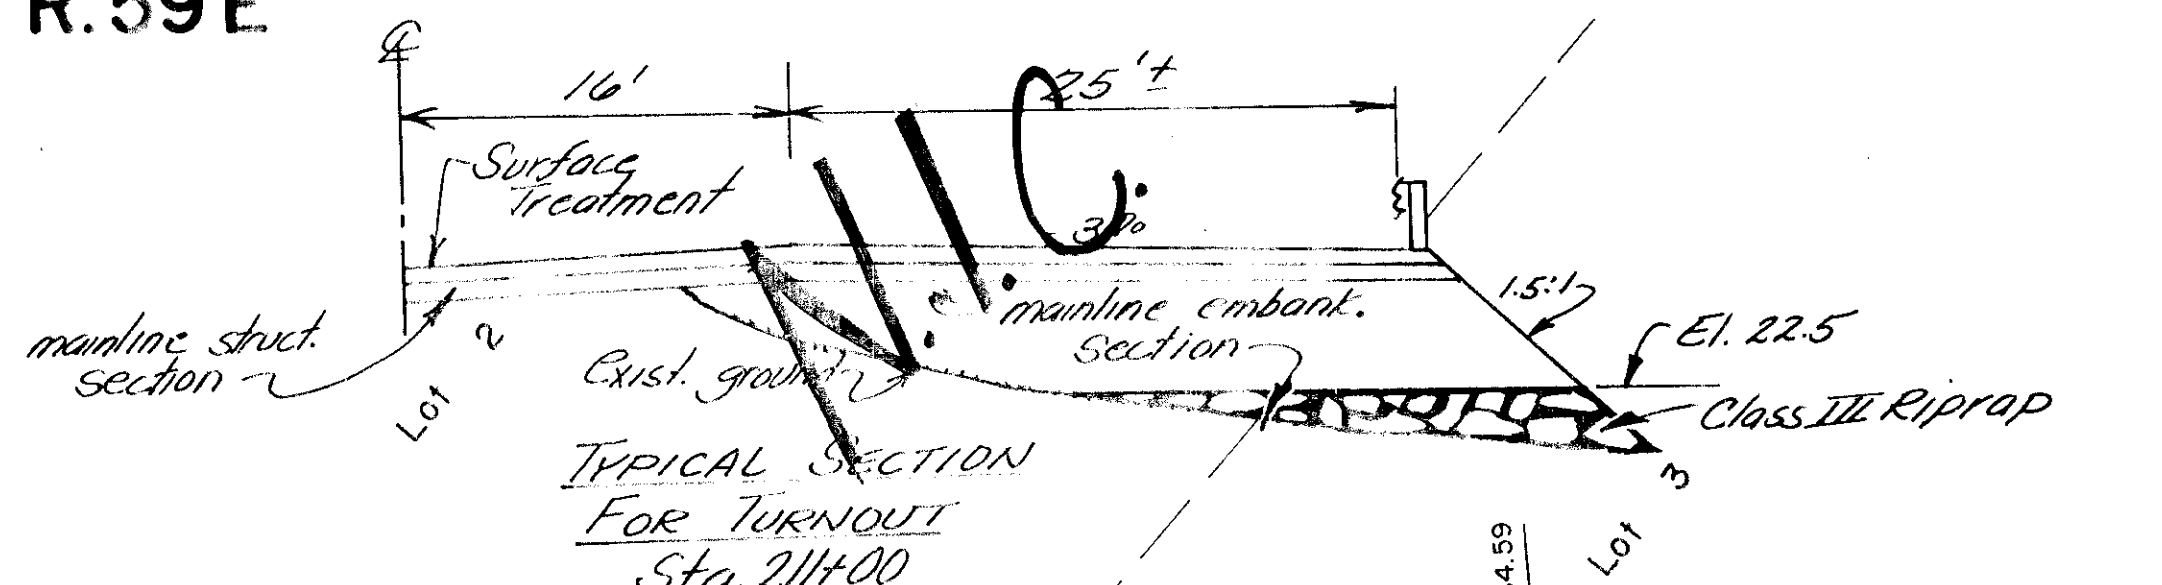


END OF PROJECT  
Beginning of Temporary Transition  
"Q" 209+32.20

END TEMPORARY CONNECTION  
"Q" 213+00 Lt  
Grade & Alignment between E.O.P. & E.T.C. shall be as directed.

T.B.M. No. 19  
Chiselled "O" near top of  
8' x 14" granite boulder, Sta. 210+20',  
120' ± RL elev. 20.67'

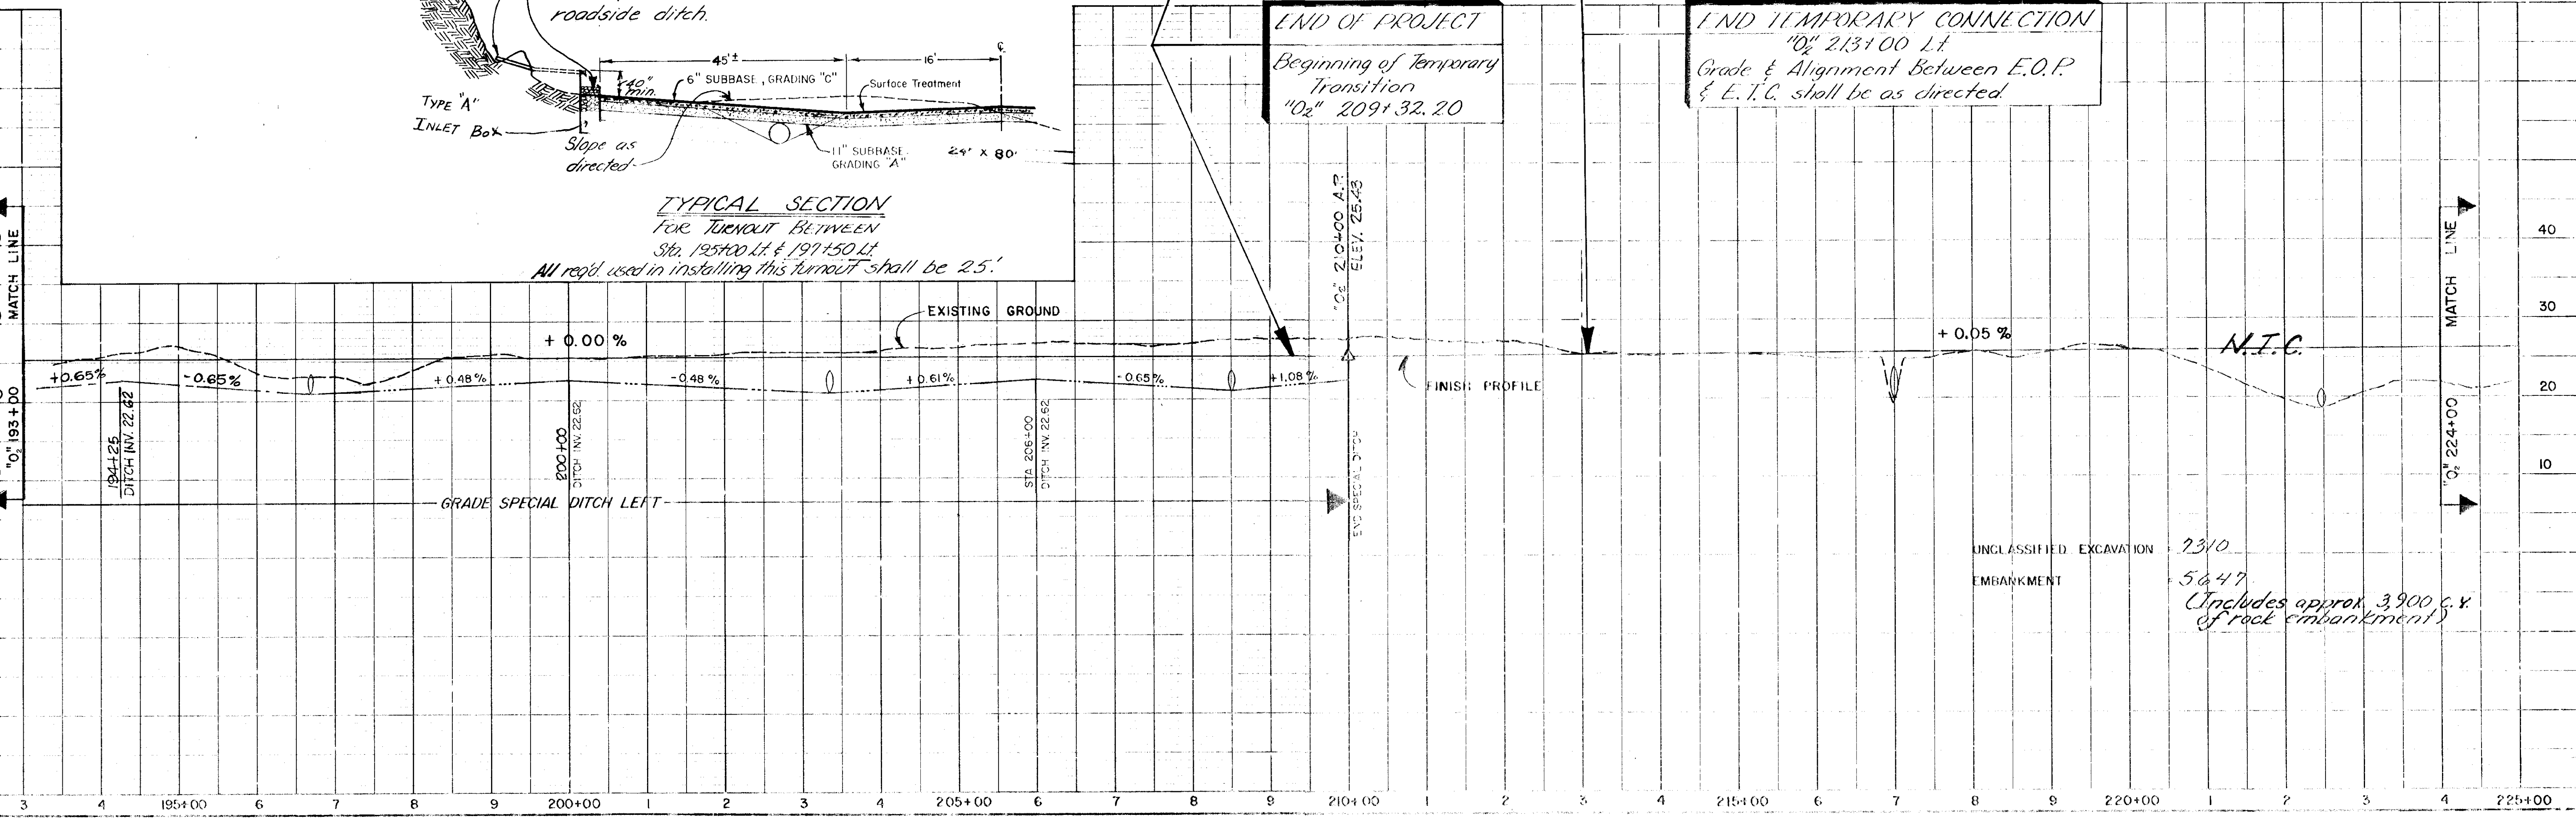
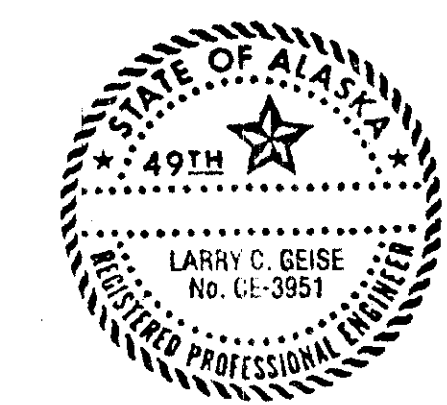


STATE	PROJECT DESIGNATION	YEAR	SHEET NO.	TOTAL SHEETS
ALASKA	RS 0987(3)	1985	12	13

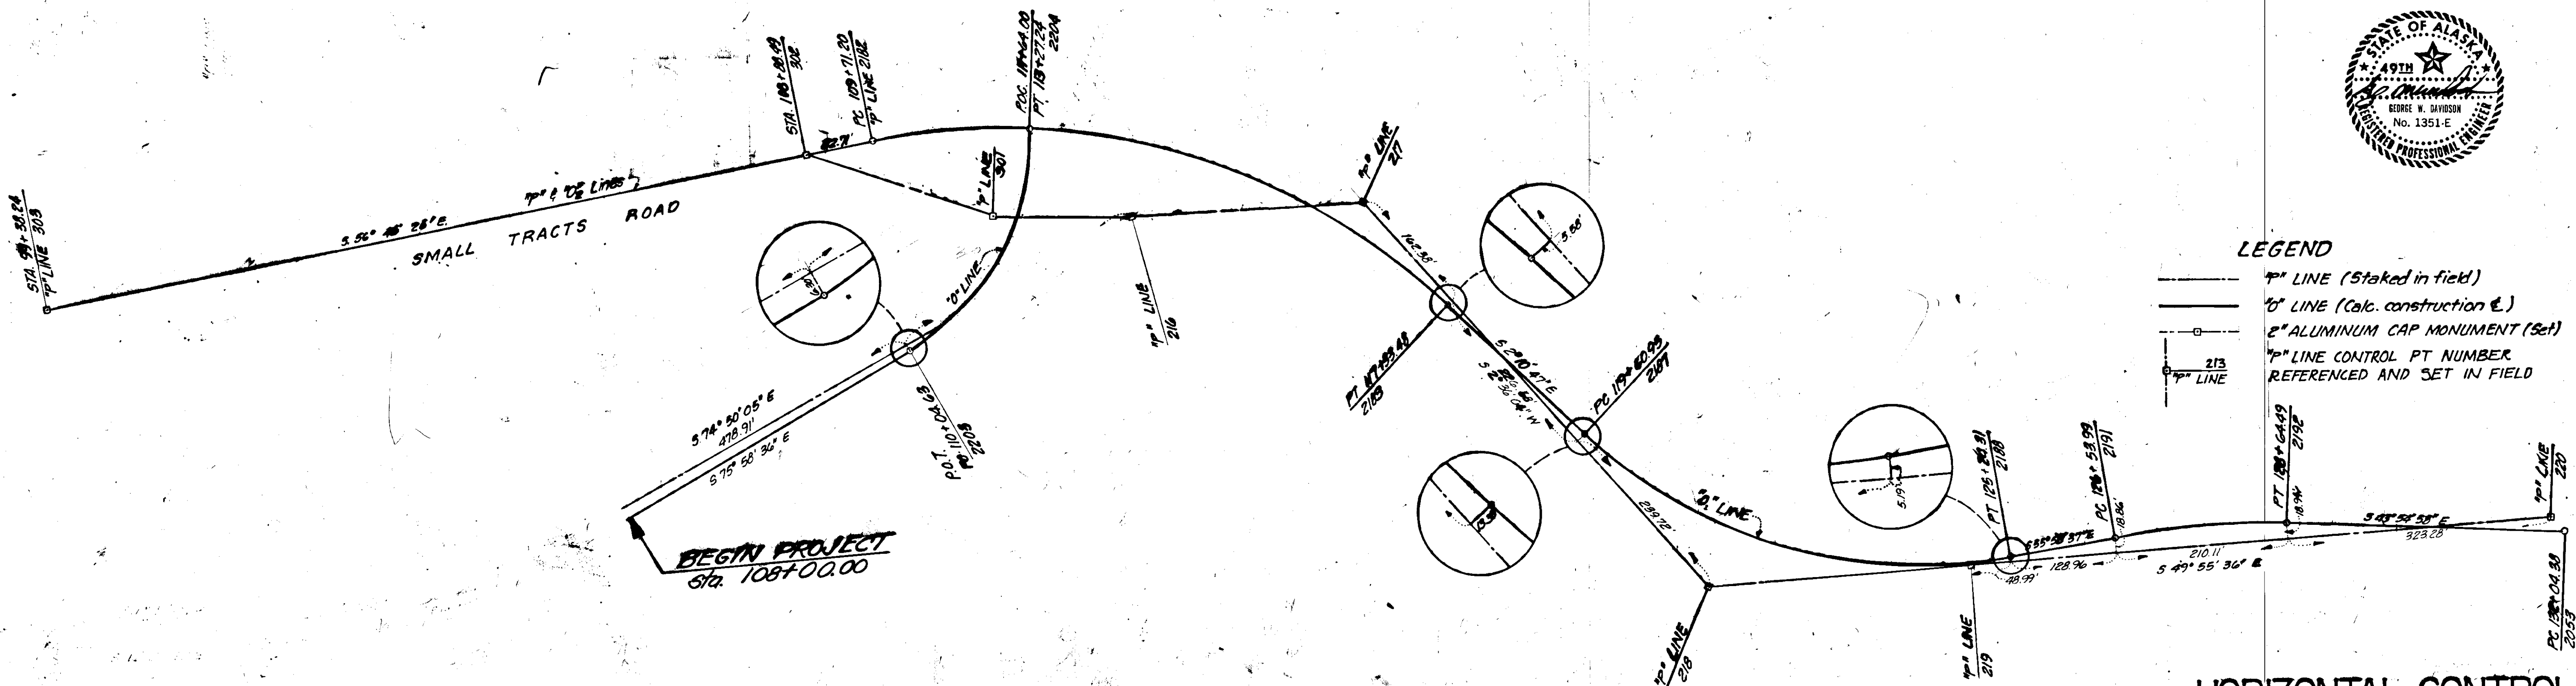


**LEGEND**

- P' LINE (Staked in field)
- - - C' LINE (Calc. construction &)
- ⊕ E' ALUMINUM CAP MONUMENT (Set)
- P' LINE CONTROL PT NUMBER REFERENCED AND SET IN FIELD

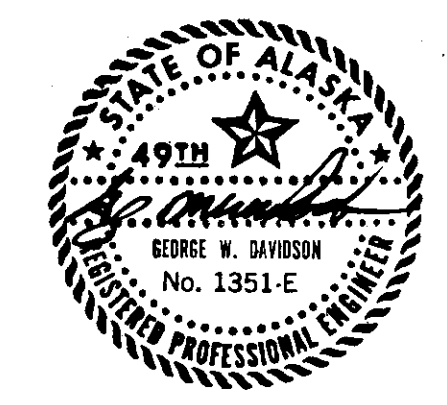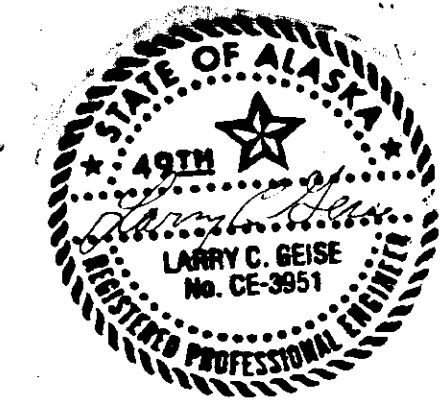

HORIZONTAL CONTROL

STATE	PROJECT DESIGNATION	YEAR	SHEET NO	TOTAL SHEETS
ALASKA	RS0987(4)	1985	13	13

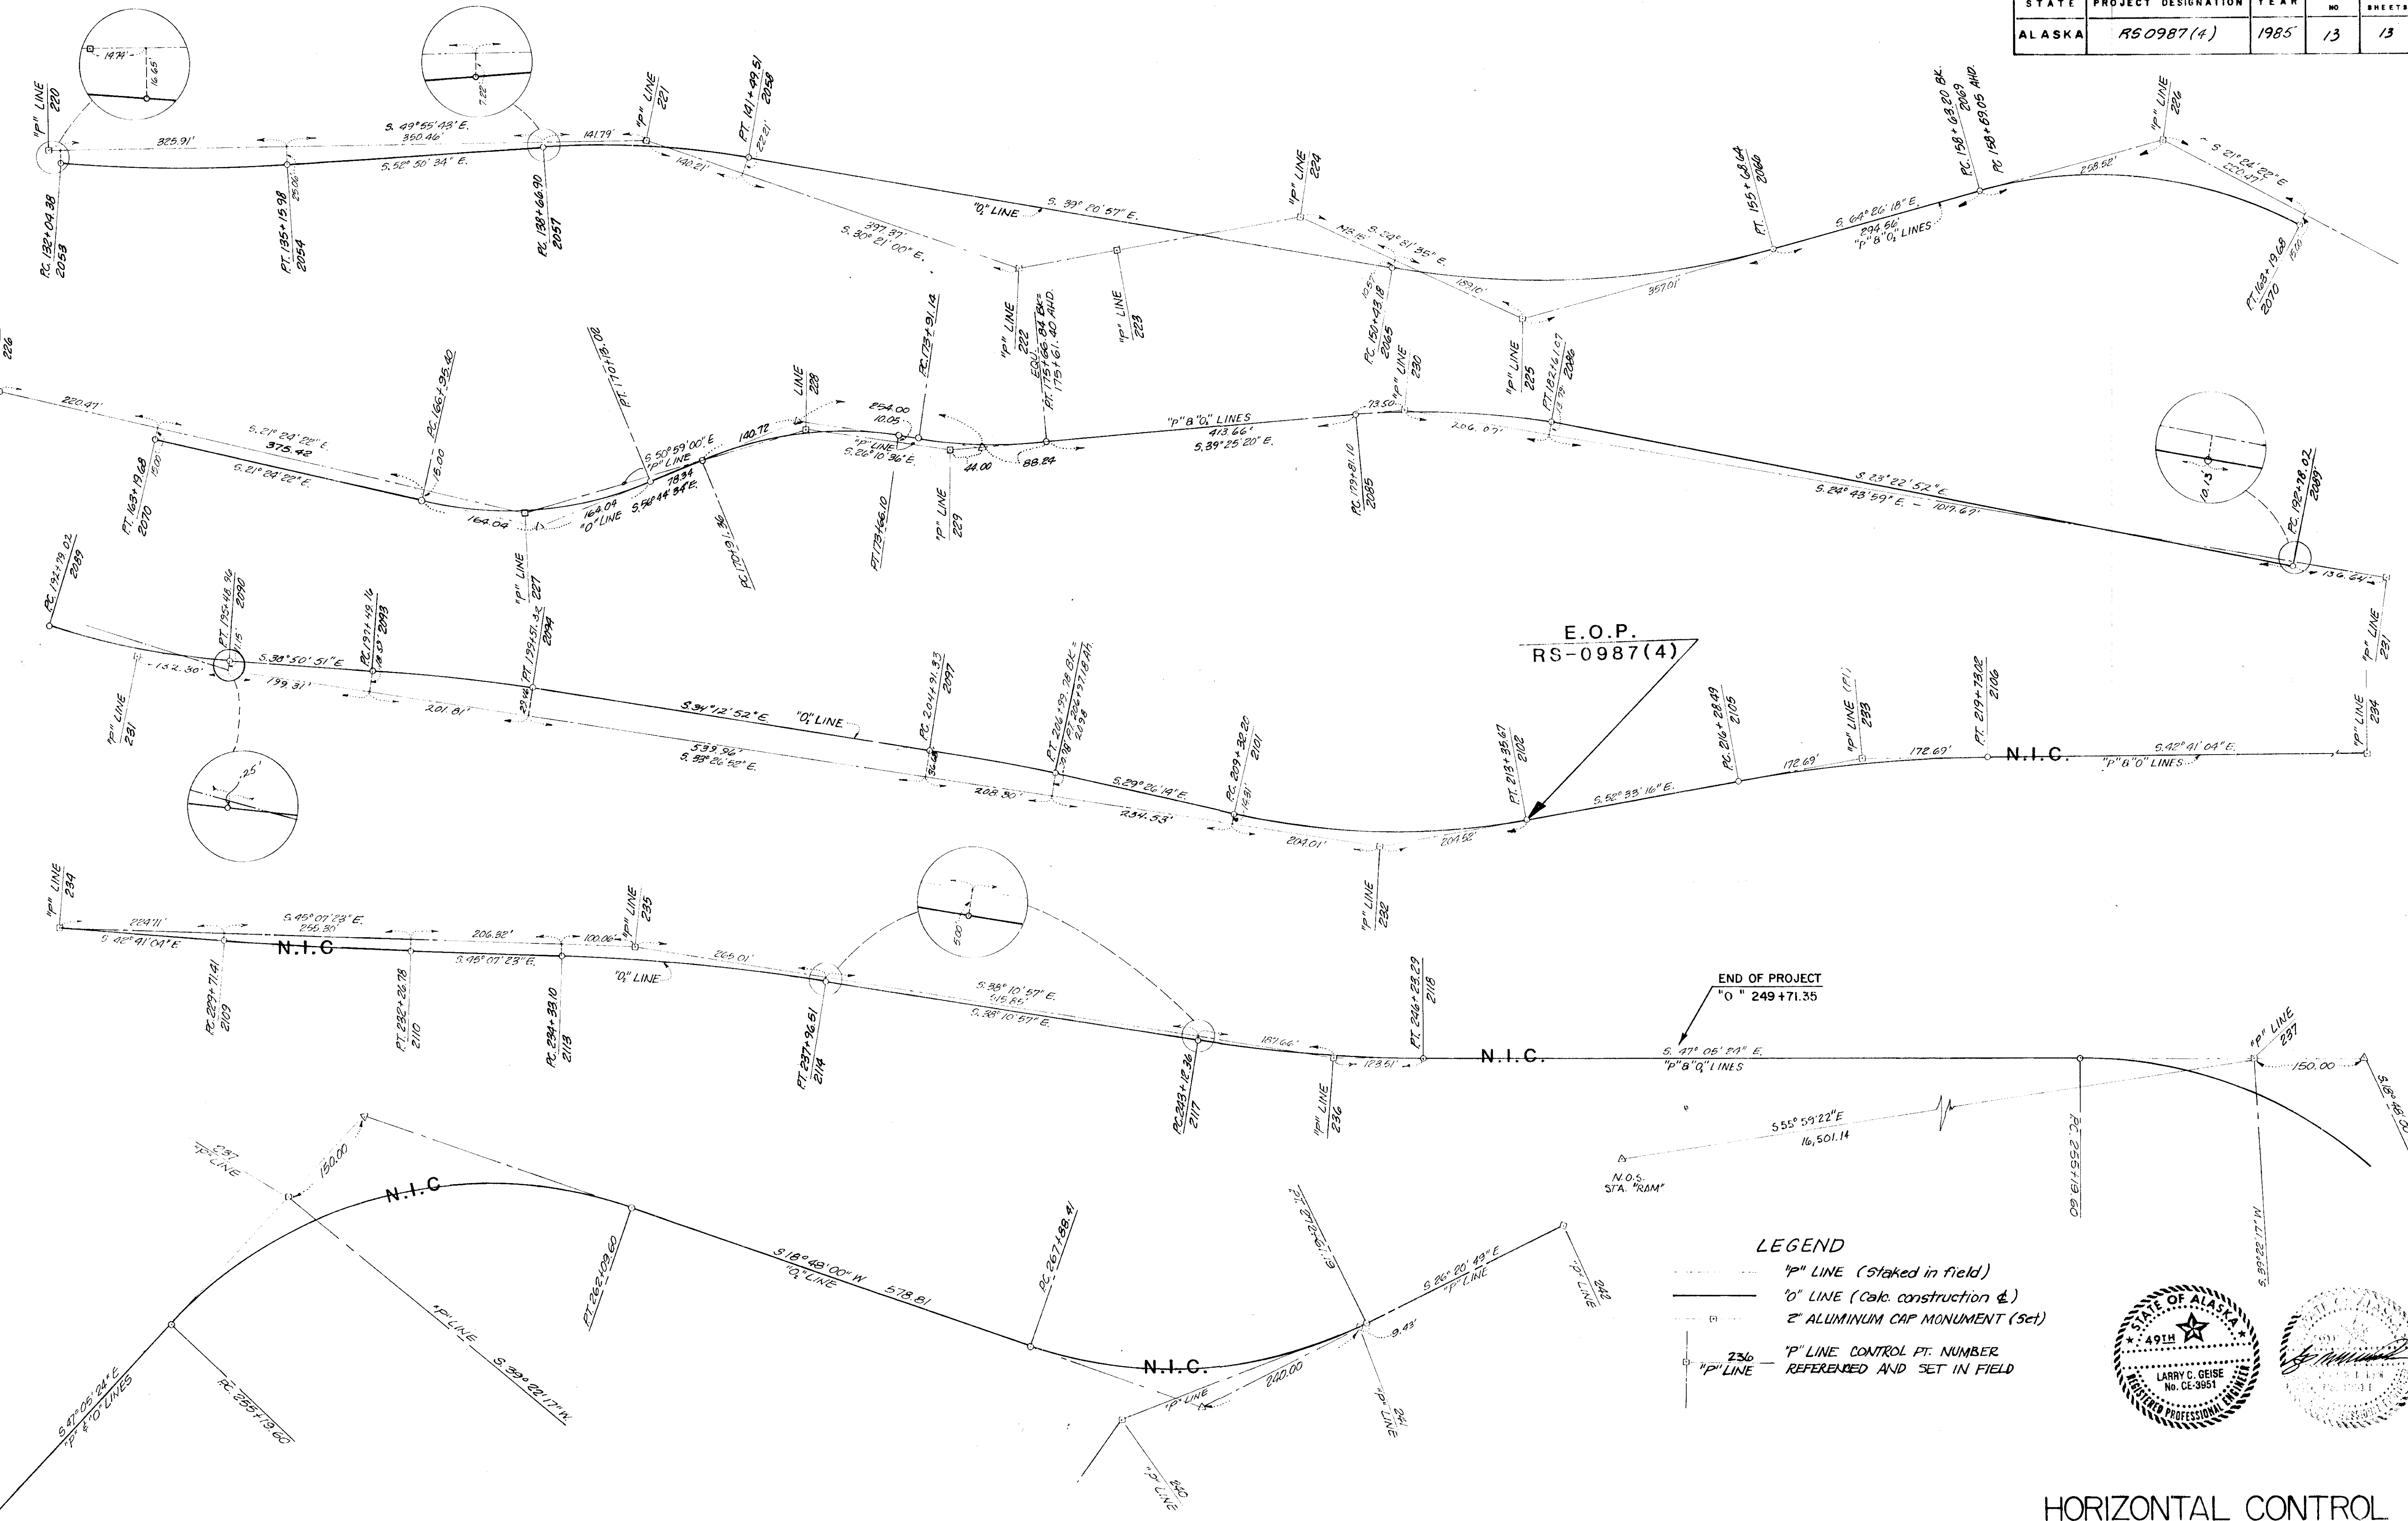

HORIZONTAL CONTROL