



TYPICAL SECTIONS OF IMPROVEMENT

RECONDITION TYPICAL "A"

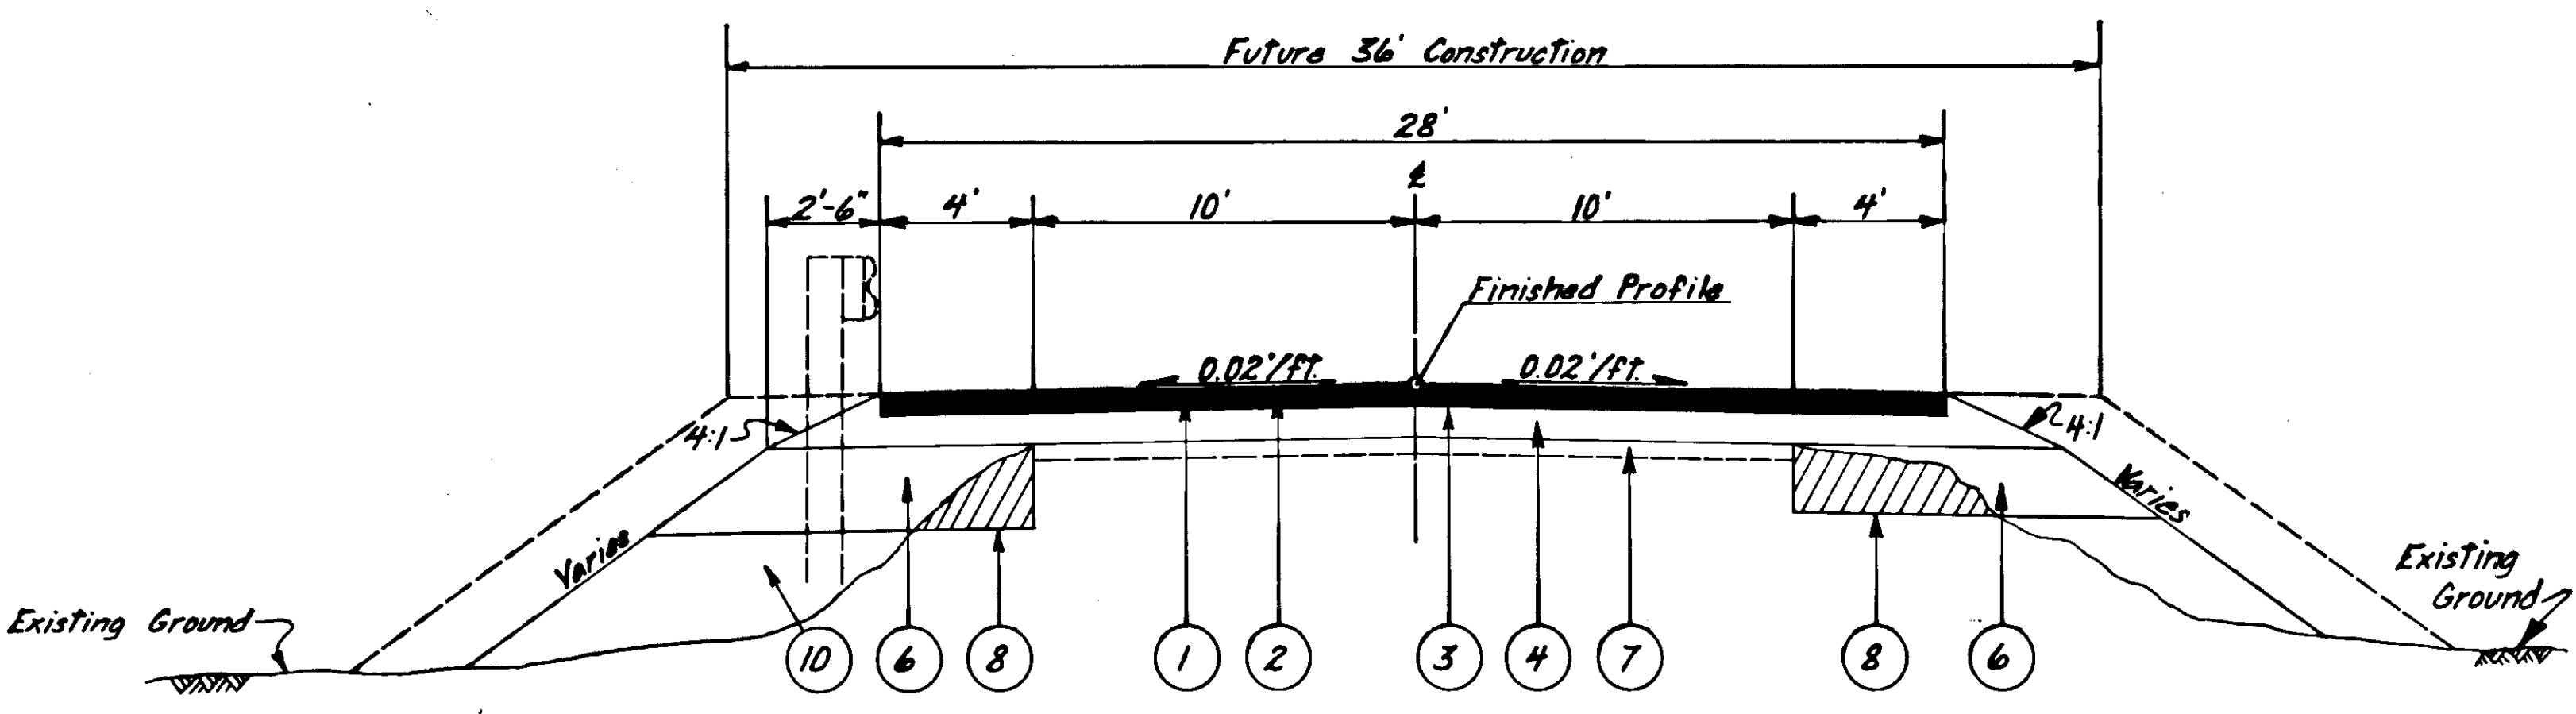


NOTE: Roadway shall be constructed to top of select material prior to reconditioning of existing roadbed.

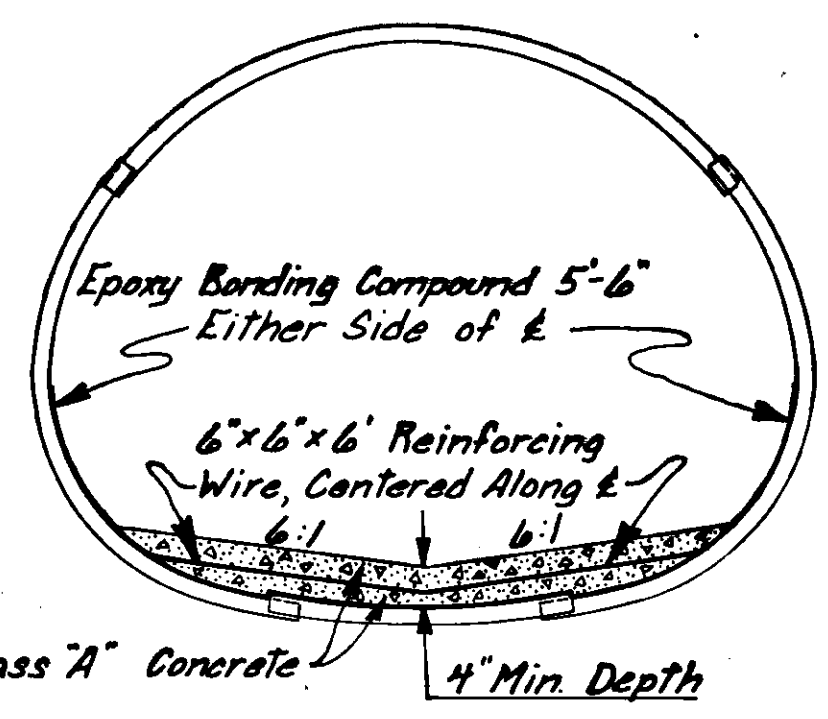

PIPE ARCH LINER DETAIL

RECONSTRUCTION TYPICAL "B"

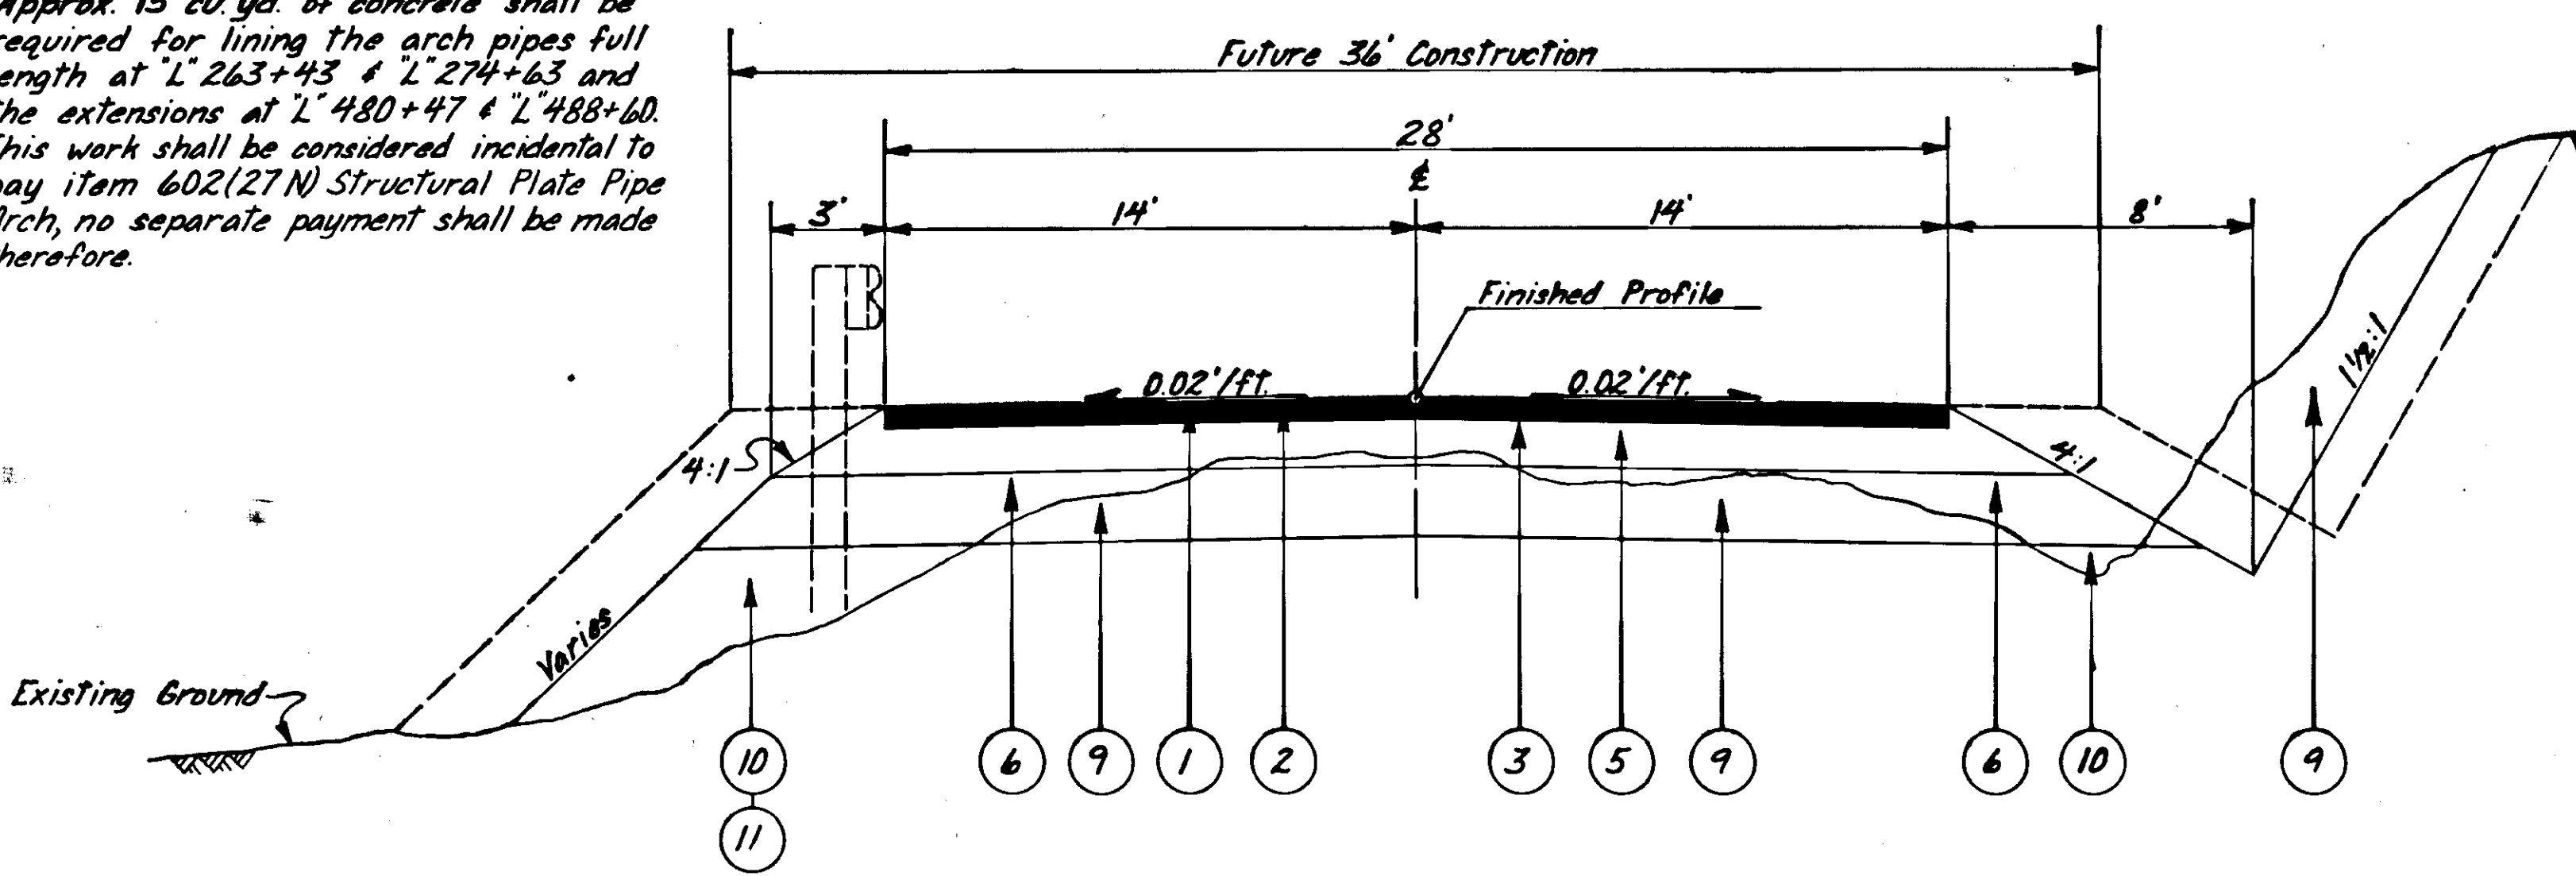

NOTE: Approx. 15 cu. yd. of concrete shall be required for lining the arch pipes full length at L 263+43 & L 274+63 and the extensions at L 480+47 & L 488+60. This work shall be considered incidental to pay item 602(27N) Structural Plate Pipe Arch, no separate payment shall be made therefore.

FILL SLOPE TABLE				
LEFT		RIGHT		
STA - STA	SLOPE	STA - STA	SLOPE	
L 674 ~ L 685	2:1	L 674 ~ L 677+50	3:1	
L 685+50 ~ L 689+50	4:1	L 678 ~ L 731	4:1	
L 690 ~ L 729	1 1/2:1	L 731+50 ~ L 737+50	3:1	
L 729+50 ~ L 736	2:1	L 738 ~ L 741+50	2:1	
L 736+50 ~ L 12	4:1	L 10 ~ L 21	3:1	
L 12+50 ~ L 19	3:1	L 21+50 ~ L 26	4:1	
L 19+50 ~ L 37	4:1	L 26+50 ~ L 29	3:1	
L 37+50 ~ L 41	1 1/2:1	L 29+50 ~ L 35+50	4:1	
L 41+50 ~ L 47	4:1	L 36 ~ L 40	3:1	
L 47+50 ~ L 52+50	3:1	L 40+50 ~ L 54+50	4:1	
L 53 ~ L 56	1 1/2:1	L 55 ~ L 76	3:1	
L 56+50 ~ L 58+50	4:1	L 76+50 ~ L 89	4:1	
L 60+50 ~ L 74	2:1	L 89+50 ~ L 100+50	3:1	
L 74+50 ~ L 87	3:1	L 101 ~ L 106	4:1	
L 87+50 ~ L 93	1 1/2:1	L 106+50 ~ L 110+50	2:1	
L 93+50 ~ L 99	2:1	L 111 ~ L 117	4:1	
L 99+50 ~ L 111	3:1	L 117+50 ~ L 125+50	3:1	
L 111+50 ~ L 114	1 1/2:1	L 126 ~ L 133	2:1	
L 114+50 ~ L 119	3:1	L 133+50 ~ L 138	3:1	
L 119+50 ~ L 124	1 1/2:1	L 138+50 ~ L 143+50	2:1	
L 124+50 ~ L 129+50	3:1	L 144 ~ L 149+50	3:1	
L 130 ~ L 132	1 1/2:1	L 150 ~ L 151	4:1	
L 132+50 ~ L 148	3:1	L 151+50 ~ L 153+50	3:1	
L 148+50 ~ L 170	2:1	L 154 ~ L 159	4:1	
L 170+50 ~ L 172+50	4:1	L 161 ~ L 167	2:1	
L 173 ~ L 179	3:1	L 167+50 ~ L 185	4:1	
L 180 ~ L 190+50	1 1/2:1	L 185+50 ~ L 192+50	2:1	
L 191 ~ L 192+50	4:1	L 193 ~ L 201+50	4:1	
L 193 ~ L 194	1 1/2:1	L 202 ~ L 298	3:1	
L 194+50 ~ L 202	4:1	L 298+50 ~ L 300	2:1	
L 202+50 ~ L 207	1 1/2:1	L 300+50 ~ L 335	3:1	
L 207+50 ~ L 221	3:1	L 335+50 ~ L 340	1 1/2:1	
L 221+50 ~ L 245	2:1	L 340+50 ~ L 351	4:1	
L 245+50 ~ L 263	3:1	L 351+50 ~ L 365	3:1	
L 263+50 ~ L 284	4:1	L 365+50 ~ L 385	2:1	
L 284+50 ~ L 289	2:1	L 385+50 ~ L 401	4:1	
L 289+50 ~ L 333	3:1	L 401+50 ~ L 405+50	2:1	
L 333+50 ~ L 348	4:1	L 406 ~ L 469	3:1	
L 348+50 ~ L 352+50	2:1	L 469+50 ~ L 472+50	2:1	
L 353 ~ L 364	4:1	L 473 ~ L 513+50	3:1	
L 364+50 ~ L 370	2:1	L 514 ~ L 517+50	2:1	
L 370+50 ~ L 375	3:1	L 518 ~ L 532	3:1	
L 375+50 ~ L 384+50	2:1	L 532+50 ~ L 545	2:1	
L 385 ~ L 389	3:1	L 546 ~ L 604	3:1	
L 389+50 ~ L 390	2:1			
L 390+50 ~ L 396	4:1			
L 396+50 ~ L 407	1 1/2:1			
L 407+50 ~ L 412	3:1			
L 412+50 ~ L 436	4:1			
L 436+50 ~ L 454	2:1			
L 454+50 ~ L 463	3:1			
L 463+50 ~ L 472	2:1			
L 472+50 ~ L 492	4:1			
L 492+50 ~ L 498	3:1			
L 498+50 ~ L 510	2:1			
L 510+50 ~ L 532	3:1			
L 532+50 ~ L 566	2:1			
L 567 ~ L 577	4:1			
L 577+50 ~ L 604	3:1			

NOTE: All cut back slopes shall be 1/2:1 except in areas of solid rock. Back slopes in solid rock shall be 1/4:1.

TYPICAL SECTION APPLICATION TABLE				
TYPICAL "A"		TYPICAL "B"		REMARKS
FROM	TO	FROM	TO	
L 674 ~	L 685+05.80			
L 730+10.47	L 14+00.39	L 685+05.80	L 730+10.47	
L 64+05.89	L 68 ~	L 14+00.39	L 64+05.89	
L 80 ~	L 103+30.22	L 68 ~	L 80 ~	
L 130+69.03	L 147+90.98	L 103+30.22	L 130+69.03	
L 206+98.78	L 323+17.09	L 147+90.98	L 206+98.75	
L 360 ~	L 378+19.27	L 323+17.09	L 360 ~	
L 408+87.47	L 604+75.47	L 378+19.27	L 408+87.47	

SHOT ROCK EMBANKMENT SUMM.		
FROM	TO	ESTIMATED QUANTITY
L 640 ~	L 720+19	6308 Cu. Yd.
L 37+50	L 41+50	936 Cu. Yd.
L 52+50	L 55 ~	265 Cu. Yd.

NOTE: All rock embankment is on left.

BASIS OF ESTIMATE		
ITEM NO.	ITEM	FACTOR
301(1)	Crushed Agg. Base Course	2.09 Tons/Cubic Yard
401(1)	Hot Asphalt Pave.(Class I)	121 lbs./Sq.Yd./Inch Depth
401(2)	AC-5 Asphalt Cement	6% of Item 401(1)
201(3B)	Clearing and Grubbing	Approx. 4 Acres
402(2)	CSS-1 Emul. Asph. for Tack	0.1 Gal./Sq.Yd., 253 Gal./Ton
403(1)	MC-30 Liquid Asph. Prime	0.25 Gal./Sq.Yd., 256 Gal./Ton
670(6)	Thermoplastic Pave. Marks	Approx. 62,000 L.F. Striping

LABELING INDEX	
1	3" Hot Asphalt Pavement, (2-1/2" Lifts)
2	CSS-1 Emulsified Asphalt for Tack Coat
3	MC-30 Liquid Asphalt for Prime Coat
4	4" Crushed Aggregate Base Course
5	6" Crushed Aggregate Base Course
6	9" Selected Material
7	Reconditioned Roadbed
8	9" Linear Grading
9	Unclassified Excavation
10	Useable Unclassified Excavation
11	Shot Rock Embankment

STATE	PROJECT DESIGNATION	YEAR	SHEET NO.	TOTAL SHEETS
ALASKA	F-FR-095-6(4)	1980	4	4

NOTE: Riprap shall be placed around the inlets & outlets of structural plate pipe arches at 'L' 263+43 and 'L' 274+68 for a depth of 2' to an elevation of 4' above the pipe, and a width of twice the pipe width. This work shall be considered incidental to the pipe construction.

MONUMENT & CASE SUMMARY					
STATION	OFFSET	POINT	STATION	OFFSET	POINT
L' 676+73.10	£	P.C.	L' 244+72.91	£	P.T.
L' 684+17.92	£	P.T.	L' 251+24.95	£	P.C.
L' 685+93.67 Bk.	£	P.O.T.	L' 257+64.67	£	P.T.
D' 685+93.67 Ahd.	£	P.C.	L' 261+33.81	£	P.C.
D' 694+72.74 Bk.	£	P.T.	L' 266+87.16	£	P.T.
L' 694+72.29 Ahd.	£	P.O.T.	L' 274+17.97	£	P.C.
L' 699+40.06 Bk.	£	P.O.T.	L' 277+95.42	£	P.T.
D' 699+40.06 Ahd.	£	P.C.	L' 294+39.42	£	P.C.
D' 702+60.92	£	P.T.	L' 301+15.93	£	P.T.
D' 703+26.59	£	P.C.	L' 305+03.39	£	P.C.
D' 707+96.82	£	P.T.	L' 311+34.85	£	P.T.
D' 712+35.52	£	P.C.	L' 314+26.34	£	P.C.
D' 717+33.31	£	P.T.	L' 321+13.71	£	P.T.
D' 723+76.42	£	P.C.	L' 324+17.09 Bk.	£	P.O.T.
D' 729+09.39 Bk.	£	P.T.	D' 324+17.09 Ahd.	£	P.C.
L' 729+10.47 Ahd.	£	P.O.T.	D' 333+17.03	£	P.T.
L' 733+12.13	£	P.C.	D' 338+70.23	£	P.C.
L' 741+47.25 Bk.	£	P.T.	D' 344+62.58 Bk.	£	P.T.
L' 9+98.11 Ahd.	£	P.O.T.	L' 344+65.90 Ahd.	£	P.O.S.T.
L' 15+00.39 Bk.	£	P.O.T.	L' 346+53.72	£	P.C.
D' 15+00.39 Ahd.	£	P.C.	L' 350+33.90	£	P.T.
D' 23+90.15	£	P.T.	L' 353+00.18	£	P.C.
D' 26+08.78	£	P.C.	L' 356+23.08	£	P.T.
D' 35+17.64	£	P.T.	L' 358+77.16	£	P.C.
D' 37+36.73	£	P.C.	L' 364+27.47	£	P.T.
D' 41+36.85 Bk.	£	P.T.	L' 366+21.06	£	P.C.
L' 41+17.21 Ahd.	£	P.O.C.	L' 371+34.37	£	P.T.
L' 47+09.47	£	P.C.	L' 374+46.75	£	P.C.
L' 50+73.61	£	P.T.	L' 377+19.27	£	P.T.
L' 54+47.28	£	P.C.	L' 388+49.16	£	P.C.
L' 62+85.94 Bk.	£	P.T.	L' 391+74.13	£	P.T.
L' 63+05.89 Ahd.	£	P.O.C.	L' 393+86.15	£	P.C.
L' 75+48.20	£	P.C.	L' 395+17.32 Bk.	£	P.T.
L' 81+30.53	£	P.T.	L' 395+17.33 Ahd.	£	P.O.T.
L' 104+30.22	£	P.C.	L' 400+27.47	£	P.C.
L' 108+15.46	£	P.T.	L' 407+87.47	£	P.T.
L' 110+12.74	£	P.C.	L' 428+98.35	£	P.C.
L' 115+47.73 Bk.	£	P.T.	L' 433+28.57 Bk.	£	P.T.
L' 115+51.28 Ahd.	£	P.O.T.	L' 433+28.08 Ahd.	£	P.O.T.
L' 119+38.62	£	P.C.	L' 435+05.82	£	P.C.
L' 122+02.83	£	P.T.	L' 439+88.78	£	P.T.
L' 124+30.65	£	P.C.	L' 441+20.15	£	P.C.
L' 129+69.03	£	P.T.	L' 445+79.33	£	P.T.
L' 136+44.00	£	P.C.	L' 447+39.11	£	P.C.
L' 147+00.36	£	P.T.	L' 452+37.40	£	P.T.
L' 148+81.60	£	P.C.	L' 460+82.85	£	P.C.
L' 153+62.78	£	P.T.	L' 466+51.27	£	P.T.
L' 160+62.99	£	P.C.	L' 467+00.42	£	P.C.
L' 168+79.09	£	P.T.	L' 471+76.24	£	P.T.
L' 170+12.26	£	P.C.	L' 478+91.95	£	P.C.
L' 183+44.05	£	P.T.	L' 480+40.08	£	P.T.
L' 184+91.60 Bk.	£	P.O.T.	L' 481+46.12	£	P.C.
D' 184+91.60 Ahd.	£	P.C.	L' 486+14.29 Bk.	£	P.T.
D' 200+16.84	£	P.T.	L' 486+14.46 Ahd.	£	P.O.T.
D' 202+13.26	£	P.C.	L' 500+16.19	£	P.C.
D' 203+90.50 Bk.	£	P.T.	L' 505+97.86	£	P.T.
L' 205+98.78 Ahd.	£	P.O.T.	L' 510+44.77	£	P.C.
L' 208+04.52	£	P.C.	L' 523+50.61	£	P.T.
L' 212+65.81	£	P.T.	L' 543+48.75	£	P.C.
L' 216+63.70	£	P.C.	L' 548+04.06	£	P.T.
L' 223+72.37 Bk.	£	P.T.	L' 562+04.41	£	P.T.
L' 223+72.53 Ahd.	£	P.O.T.	L' 574+47.82	£	P.C.
L' 241+57.47	£	P.C.	L' 579+67.26	£	P.T.
			L' 592+86.39	£	P.C.
			L' 598+66.39	£	P.T.
			L' 604+75.47	£	P.C.-E.O.P.
TOTAL - 112 Monuments & Cases					

CULVERT PIPE REMOVAL SUMMARY			
STATION	LENGTH	STATION	LENGTH
L' 680+08	54'	L' 309+20	45'
L' 690+28	51'	L' 321+76	56'
L' 711+04	54'	AsBIT' 339+68	47'
L' 718+55	50'	AsBIT' 343+46	46'
L' 729+28	54'	L' 345+96	49'
L' 735+90	85'	L' 348+24	47'
L' 735+95	86'	L' 350+39	53'
AsBIT' 26+34	53'	L' 352+50	52'
- 31+17	52'	L' 355+17	52'
AsBIT' 34+12	54'	L' 360+00	53'
D' 34+25-D' 35+75	150'		
AsBIT' 35+05	54'	L' 360+70	52'
- 39+79	46'	L' 372+75	46'
- 48+84	55'	L' 376+41	44'
AsBIT' 61+63	46'	L' 381+02	59'
L' 65+16	52'	L' 383+24	52'
		L' 391~ - L' 396~	500'
L' 68+16	51'	L' 397+54	55'
L' 83+59	47'	L' 405+60	60'
L' 89+54	54'	L' 408+39	58'
L' 94+02	55'	L' 413+84	54'
L' 119+08	47'	L' 418+64	62'
L' 129+29	51'	L' 420+79	60'
L' 136+09	49'	L' 422+88	80'
L' 138+70	53'	L' 424+60	64'
AsBIT' 152+32	76'	L' 428+50	53'
- 160+71	55'	L' 433+19	60'
- 164+70	48'	L' 438+22	50'
- 169+83	47'	L' 443+96	46'
- 181+47	55'	L' 454+17	50'
- 189+19	65'	L' 466+50	52'
- 196+30	64'	L' 472+14	56'
AsBIT' 201+98	45'	L' 476+35	51'
L' 218+39	46'	L' 511+94	54'
L' 223+43	52'	L' 536+97	48'
L' 239+38	47'	L' 537+89	96'
L' 277+96	45'	L' 582+10	42'
L' 299+51	43'	L' 583+05	86'
SUBTOTAL	2,091'	TOTAL	4,581'

408+56	x	14'
237+40	x	14'
214+20	x	14'
215+50	x	14'
227+90	x	14'

APPROACH SUMMARY			
STATION	LEFT	RIGHT	WIDTH
L' 115+00	X		14'
L' 197+88 50		X	14'
L' 198+75 60	X		14'
L' 206+75		X	14'
L' 297+58 35		X	14'
L' 403+18		X	14'
L' 404+50	X		24'
L' 421+50 NOT PAVED		X	14'
L' 431+85 432+00	X		24'
L' 523+00		X	14'
L' 523+00	X		14'
L' 548+28 25	X		14'
L' 577+28 576+80	X		14'
L' 577+58 40		X	14'
L' 580+00	X		14'
L' 588+38 15	X		14'
L' 593+75 594+25	X	Right	14'
L' 597+28 60		X	14'
L' 598+88 60	X		14'
L' 603+88 05	X		14'
571+71	x	14'	
520+40	x	14'	
583+50	x	14'	
497+60 NOT PAVED	x	14'	

RIGID STEEL CONDUIT SUMMARY			
STATION	SIZE	LENGTH	REMARKS
L' 422+00	4"	60'	4' Cover

CULVERT INSTALLATION SUMMARY							
STATION	DIA.	LENGTH	HEIGHT OF COVER	STATION	DIA.	LENGTH	HEIGHT OF COVER
L' 680+08	80	24'	5' 51"	L' 321+76	24"	58' 60"	2.5'
D' 690+28	50	24'	5' 51"	D' 339+68	24"	58' 60"	3'
D' 711+04	18	24"	5' 51"	D' 343+46	24"	58' 60"	2'
D' 718+55	78	24"	5' 51"	D' 345+96	24"	58' 54"	2'
L' 729+28	50	24"	5' 51"	L' 348+24	24"	58' 54"	1.5'
L' 735+90	80	36'	8' 88"	L' 350+39	24"	58' 62"	4.5'
L' 735+95	86	36'	8' 88"	L' 352+50	24"	58' 60"	4'
AsBIT' 26+34	30	24"	8' 72"	L' 355+17	24"	58' 64"	3'
- 31+17	07	24"	5' 80"	L' 360+00	24"	52'	2.5'
AsBIT' 34+12	24"	88' 72"	1.5'	L' 360+70	24"	54'	3.5'
D' 34+25	88	24"	6' 64"	L' 372+75	24"	58' 60"	3.5'
D' 36+28	92	24"	6' 2"	L' 376+41	24"	58' 60"	2.5'
D' 39+79	24"	58' 58"	3.5'	L' 381+02	24"	58' 56"	2.5'
L' 48+84	50	24"	5' 82"	L' 383+24	24"	54'	4.5'
L' 61+63	38	36'	5' 52"	L' 397+54	24"	54'	3'
				403+58	36'	66'	5'
L' 65+16	24"	52'	1.5'	L' 405+60	30'	58'	1.5'
L' 83+59	24"	56'	2'	L' 408+39	24"	56'	3'
L' 89+54	28	24"	5' 40"	L' 413+84	36'	64'	2'
L' 94+02	24"	58' 50"	5'	L' 418+64	24"	60'	1.5'
L' 119+08	00	24"	5' 52"				
				L' 119+08 15	24"	5' 50"	2'
L' 129+29	15	24"	5' 50"	L' 129+29 130+00	24"	52'	2'
L' 136+09	02	24"	52'	L' 136+09 02	24"	52'	3'
L' 138+70	24"	58' 64"	3.5'	L' 138+70	24"	58' 64"	3.5'
AsBIT' 152+32	23	36'	8' 08"	L' 152+32 23	36'	8' 08"	6'
- 160+71							
				L' 160+50	6' 14" 7'	70'	8'
- 164+70				L' 160+50 10	24"	58' 68"	6.5'
- 169+83				L' 179+80	24"	64'	2'
- 181+47				D' 187+25	24"	58' 56"	5'
- 189+19				D' 197+85 193+85	36'	7' 16"	1.5'
- 196+30							
AsBIT' 201+98				D' 199+90	24"	58' 60"	1.5'
L' 218+39				L' 218+39	24"	50'	2'
L' 223+43				L' 223+43 41	24"	58' 52"	3'
L' 239+38				L' 239+38	24"	58' 68"	5'
L' 277+96				L' 263+43	8' 2" 5' 9"	58' 57"	2.5'
L' 299+51				270+68	8' 2" 5' 9"	60'	4'
				L' 274+68	8' 2" 5' 9"	60' 70"	4'
				L' 277+96	36'	52'	2.5'
				L' 299+51	24"	48'	3.5'
				L' 309+20	36'	58' 54"	1.5'
				L' 321+76	24"	58' 60"	2.5'
				D' 339+68	24"	58' 60"	3'
				D' 343+46	24"	58' 60"	2'
				D' 345+96	24"	58' 54"	2'
				L' 348+24	24"	58' 54"	1.5'
				L' 350+39	24"	58' 62"	4.5'
				L' 352+50	24"	58' 60"	4'
				L' 355+17	24"	58' 64"	3'
				L' 360+00	24"	52'	2.5'
				L' 360+70	24"	54'	3.5'
				L' 372+75	24"	58' 60"	3.5'
				L' 376+41	24"	58' 60"	2.5'
				L' 381+02	24"	58' 56"	2.5'
				L' 383+24	24"	54'	4.5'
				L' 397+54	24"	54'	3'
				403+58	36'	66'	5'
				L' 405+60	30'	58'	1.5'
				L' 408+39	24"	56'	3'
				L' 413+84	36'	64'	2'
				L' 418+64	24"	60'	1.5'
				L' 420+79	24"	60'	1.5'
				L' 422+88	24"	58'	4'
				L' 424+60			

SIGNING SCHEDULE

NO.	STATION	OFFSET		CODE NO.	LEGEND	SIGN PANEL		POST			FACING TRAFFIC	REMARKS
		LT.	RT.			SIZE	AREA	NO. of POSTS	LENGTH	EMBED.		
L 674+48			26'	W1-2R W13-1	50 M.P.H.	36" x 36"	9.0	2	15'	3'	W.B.	MOUNT BELOW W1-2R
L 675+79		20'		W1-2R W13-1	50 M.P.H.	36" x 36"	9.0	2	14'	3'	E.B.	MOUNT BELOW W1-2R
L 686+53			26'	M10-2	13	6" x 12 3/4"	0.53	1	9'	3'	W.B.	Milepost
L 687+25			26'	M10-2 W1-2L W13-1	50 M.P.H.	36" x 36"	9.0	2	14'	3'	E.B.	MOUNT BELOW W1-2L
O 700+27			22'	W1-2L W13-1	50 M.P.H.	36" x 36"	9.0	2	13'	3'	W.B.	MOUNT BELOW W1-2L
O 710+97			16'	W1-2R W13-1	50 M.P.H.	36" x 36"	9.0	2	12'	3'	E.B.	INSTALL BEHIND GRADUAL MOUNT BELOW W1-2R
L 739+16			26'	M10-2	14	6" x 12 3/4"	0.53	1	9'	3'	E.B.	Milepost
L 12+00			26'	M10-2 W1-4R W13-1	50 M.P.H.	36" x 36"	9.0	2	14'	3'	W.B.	MOUNT BELOW W1-4R
O 37+44			26'	W1-4R W13-1	50 M.P.H.	36" x 36"	9.0	2	15'	3'	E.B.	MOUNT BELOW W1-4R
L 60+10			26'	M10-2	15	6" x 12 3/4"	0.53	1	9'	3'	E.B.	Milepost
L 101+30			26'	M10-2 W1-5R W13-1	50 M.P.H.	36" x 36"	9.0	2	14'	3'	W.B.	MOUNT BELOW W1-5R
L 112+93			28'	M10-2	16	6" x 12 3/4"	0.53	1	7'	3'	E.B.	Milepost
L 132+69			26'	M10-2 W1-5R W13-1	50 M.P.H.	36" x 36"	9.0	2	15'	3'	E.B.	MOUNT BELOW W1-5R
L 133+44			26'	W1-4R W13-1	50 M.P.H.	36" x 36"	9.0	2	14'	3'	W.B.	MOUNT BELOW W1-4R
L 156+62			26'	W1-4R W13-1	50 M.P.H.	36" x 36"	9.0	2	11'	3'	E.B.	MOUNT BELOW W1-4R
L 157+63			26'	W1-5L W13-1	50 M.P.H.	36" x 36"	9.0	2	11'	3'	W.B.	MOUNT BELOW W1-5L
L 165+59			26'	M10-2	17	6" x 12 3/4"	0.53	1	12'	3'	E.B.	Milepost
L 188+50			26'	M10-2 W11-8	Symbol HORSE X-ING	36" x 36"	9.0	1	12'	3'	W.B.	
L 206+50			26'	W11-8	Symbol HORSE X-ING	24" x 18"	3.0	1	12'	3'	E.B.	
L 208+99			26'	W1-5L W13-1	50 M.P.H.	36" x 36"	9.0	2	12'	3'	E.B.	MOUNT BELOW W1-5L
L 220+30			26'	M10-2	18	6" x 12 3/4"	0.53	1	10'	3'	E.B.	Milepost
L 259+90			26'	M10-2	18	6" x 12 3/4"	0.53	1	10'	3'	W.B.	Milepost
L 261+75			26'	W15-1	SLIDE AREA	36" x 36"	9.0	1	11'	3'	W.B.	
L 272+93			26'	W15-2 M10-2	END SLIDE AREA	36" x 36"	9.0	1	11'	3'	E.B.	
L 278+50			26'	M10-2	19	6" x 12 3/4"	0.53	1	10'	3'	E.B.	Milepost
L 280+25			26'	M10-2	19	6" x 12 3/4"	0.53	1	10'	3'	W.B.	Milepost
L 278+50			26'	W15-2	END SLIDE AREA	36" x 36"	9.0	1	12'	3'	W.B.	
L 280+25			26'	W15-1	SLIDE AREA	36" x 36"	9.0	1	12'	3'	E.B.	
L 291+39			26'	W1-2L W13-1	50 M.P.H.	36" x 36"	9.0	2	13'	3'	W.B.	MOUNT BELOW W1-2L
L 304+16			26'	W1-2R W13-1	50 M.P.H.	36" x 36"	9.0	2	12'	3'	E.B.	MOUNT BELOW W1-2R
O 325+56			26'	M10-2	20	6" x 12 3/4"	0.53	1	9'	3'	W.B.	Milepost
O 335+70			26'	M10-2 W1-4L W13-1	45 M.P.H.	36" x 36"	9.0	2	10'	3'	W.B.	MOUNT BELOW W1-4L
L 353+30			26'	W1-4L W13-1	45 M.P.H.	36" x 36"	9.0	2	13'	3'	E.B.	MOUNT BELOW W1-4L
L 371+47			26'	W1-2L W13-1	50 M.P.H.	36" x 36"	9.0	2	13'	3'	W.B.	MOUNT BELOW W1-2L
L 378+22			26'	M10-2	21	6" x 12 3/4"	0.53	1	9'	3'	E.B.	Milepost
				M10-2	21	6" x 12 3/4"	0.53				W.B.	Milepost

STATE	PROJECT DESIGNATION	YEAR	SHEET NO.	TOTAL SHEETS
ALASKA	F-FR-095-6(4)	1980	5	26


SIGNING SCHEDULE

NO.	STATION	OFFSET		CODE NO.	LEGEND	SIGN PANEL		POST			FACING TRAFFIC	REMARKS
		LT.	RT.			SIZE	AREA	NO. of POSTS	LENGTH	EMBED.		
L 380+19			19'	W1-2R W13-1	50 M.P.H.	36" x 36"	9.0	2	13'	3'	E.B.	MOUNT BELOW W1-2R
L 399+79			24'	DI-1	← KLUKWAN	90" x 24"	15.0	2	11'	3'	W.B.	
L 403+90			26'	RI-1	STOP	30" x 30"	6.25	1	14'	3'	N.B.	
L 410+52			21'	DI-1	KLUKWAN →	90" x 24"	15.0	2	9'	3'	E.B.	
L 430+85			26'	M10-2	22	6" x 12 3/4"	0.53	1	11'	3'	E.B.	Milepost
				M10-2	22	6" x 12 3/4"	0.53				W.B.	Milepost
L 431+82			26'	RI-1	STOP	30" x 30"	6.25	1	16'	3'	N.B.	
L 476+20			26'	W15-1	SLIDE AREA	36" x 36"	9.0	1	13'	3'	W.B.	
L 478+93			26'	W15-2	END SLIDE AREA	36" x 36"	9.0	1	12'	3'	E.B.	
L 483+47			26'	M10-2	23	6" x 12 3/4"	0.53	1	11'	3'	E.B.	Milepost
L 491+42			26'	M10-2	23	6" x 12 3/4"	0.53	1	11'	3'	W.B.	Milepost
L 491+63			26'	W15-1	END SLIDE AREA	36" x 36"	9.0	1	11'	3'	W.B.	
L 507+45			26'	W15-1	SLIDE AREA	36" x 36"	9.0	1	13'	3'	E.B.	
L 524+53			26'	W1-2L W13-1	50 M.P.H.	36" x 36"	9.0	1	15'	3'	W.B.	MOUNT BELOW W1-2L
L 526+51			13'	TI-1	CHILKAT RIVER	24" x 48"	8.0	2	11'	3'	W.B.	
L 529+82			20'	W1-2R W13-1	50 M.P.H.	36" x 36"	9.0	2	13'	3'	E.B.	Mount on Bridge MOUNT BELOW W1-2R
L 536+10			26'	TI-1	CHILKAT RIVER	24" x 48"	8.0	2	9'	3'	E.B.	
L 588+72			26'	M10-2	24	6" x 12 3/4"	0.53	1	12'	3'	E.B.	Milepost
				M10-2	24	6" x 12 3/4"	0.53				W.B.	Milepost
				M10-2	25	6" x 12 3/4"	0.53	1	11'	3'	E.B.	Milepost
				M10-2	25	6" x 12 3/4"	0.53				W.B.	Milepost
TOTAL						441.28 s.f.		74	594			

1. Sign locations and post lengths are approximate only and are subject to minor revisions.
2. All sign posts shall be telescoping perforated galvanized steel posts; the 2" size shall be used above ground and the 2 1/2" size shall be used below ground for the sleeve.
3. All posts shall be installed with sleeve type embedment in accordance with standard drawing S-30.12, except that the 2 1/2" size shall be used for the entire embedment depth.
4. Post lengths are from the cut off in the sleeve to the top of the post. See Standard Drawings S-05.00 & S-30.12.
5. All existing signs shall be dismantled by the contractor and stockpiled at the State of Alaska, DOT&P/F Maintenance Station as directed by the engineer. This work shall be considered incidental to item 615(1) Standard Signs and no separate payment shall be made therefore.
6. All signs shall be unframed.
7. All signs shall be .063" thick.

HORIZONTAL CONTROL: Based on a bearing of N.12°25'14" W. from highway & monument P.T. 657+25.95 to highway & monument P.C. 661+77.78.

VERTICAL CONTROL: Based on U.S.C. & G.S. and G.S.C. bench marks located throughout the project. See plan sheets for locations & elevations.

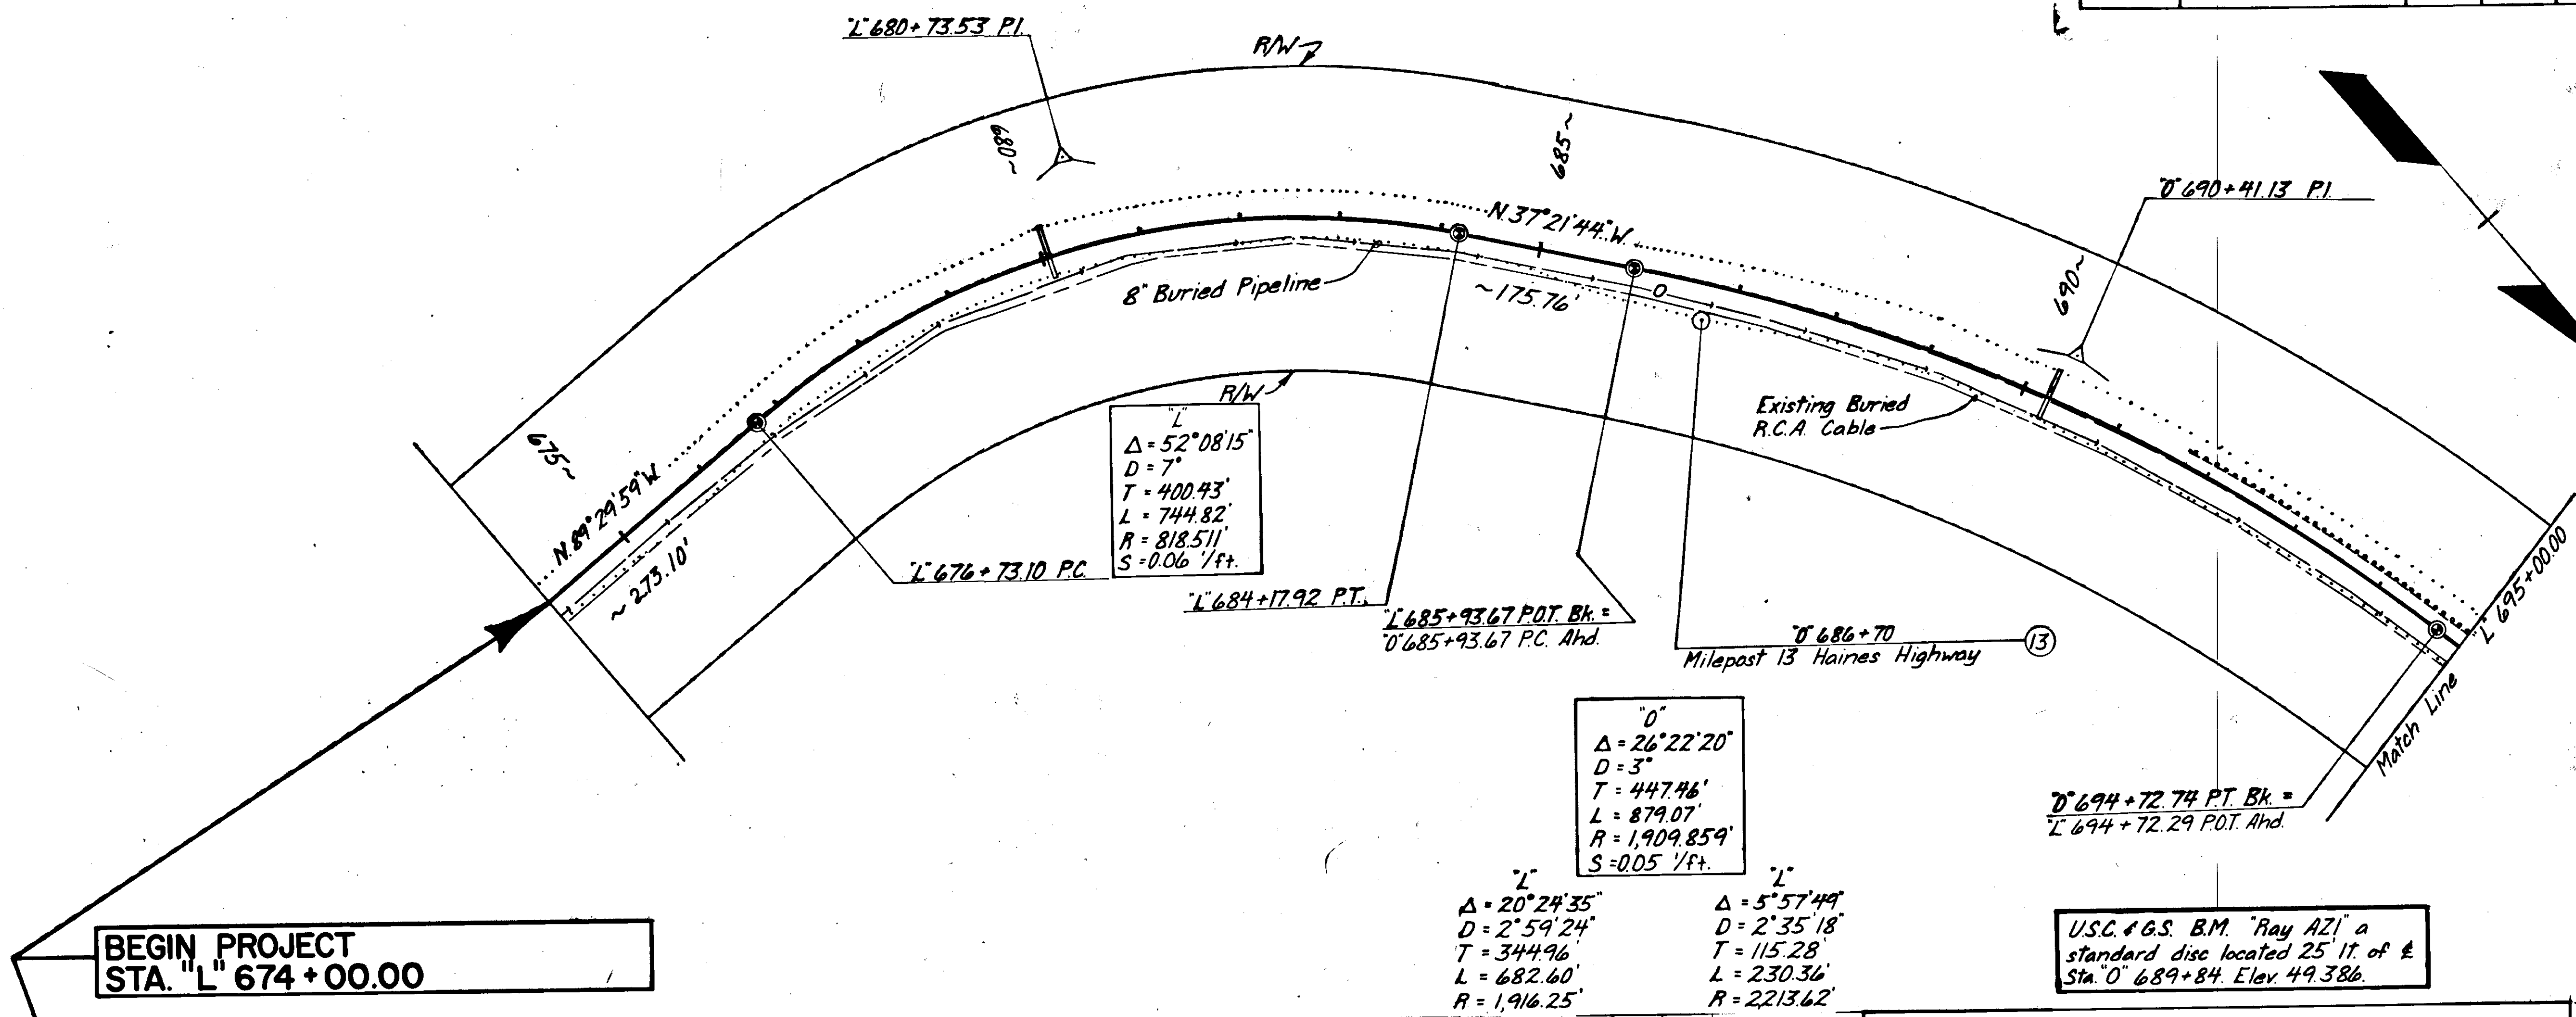

BEGIN PROJECT STA. "L" 674+00.00

Curve Data 1:
 $\Delta = 52^{\circ}08'15''$
 $D = 7'$
 $T = 400.93'$
 $L = 744.82'$
 $R = 818.51'$
 $S = 0.06' / ft.$


Curve Data 2:
 $\Delta = 26^{\circ}22'20''$
 $D = 3'$
 $T = 447.46'$
 $L = 879.07'$
 $R = 1,909.859'$
 $S = 0.05' / ft.$

Curve Data 3:
 $\Delta = 20^{\circ}24'35''$
 $D = 2^{\circ}59'24''$
 $T = 344.96'$
 $L = 682.60'$
 $R = 1,916.25'$



Curve Data 4:
 $\Delta = 5^{\circ}57'49''$
 $D = 2^{\circ}35'18''$
 $T = 115.28'$
 $L = 230.36'$
 $R = 2,213.62'$

U.S.C. & G.S. B.M. "Ray AZI" a standard disc located 25' IT of & Sta. "O" 689+84. Elev. 49.386.



Embankment = 3306 Cu. Yds. (Includes 1331 Cu. Yds. Select Material)
 Unclassified Exc. = 684 Cu. Yds.

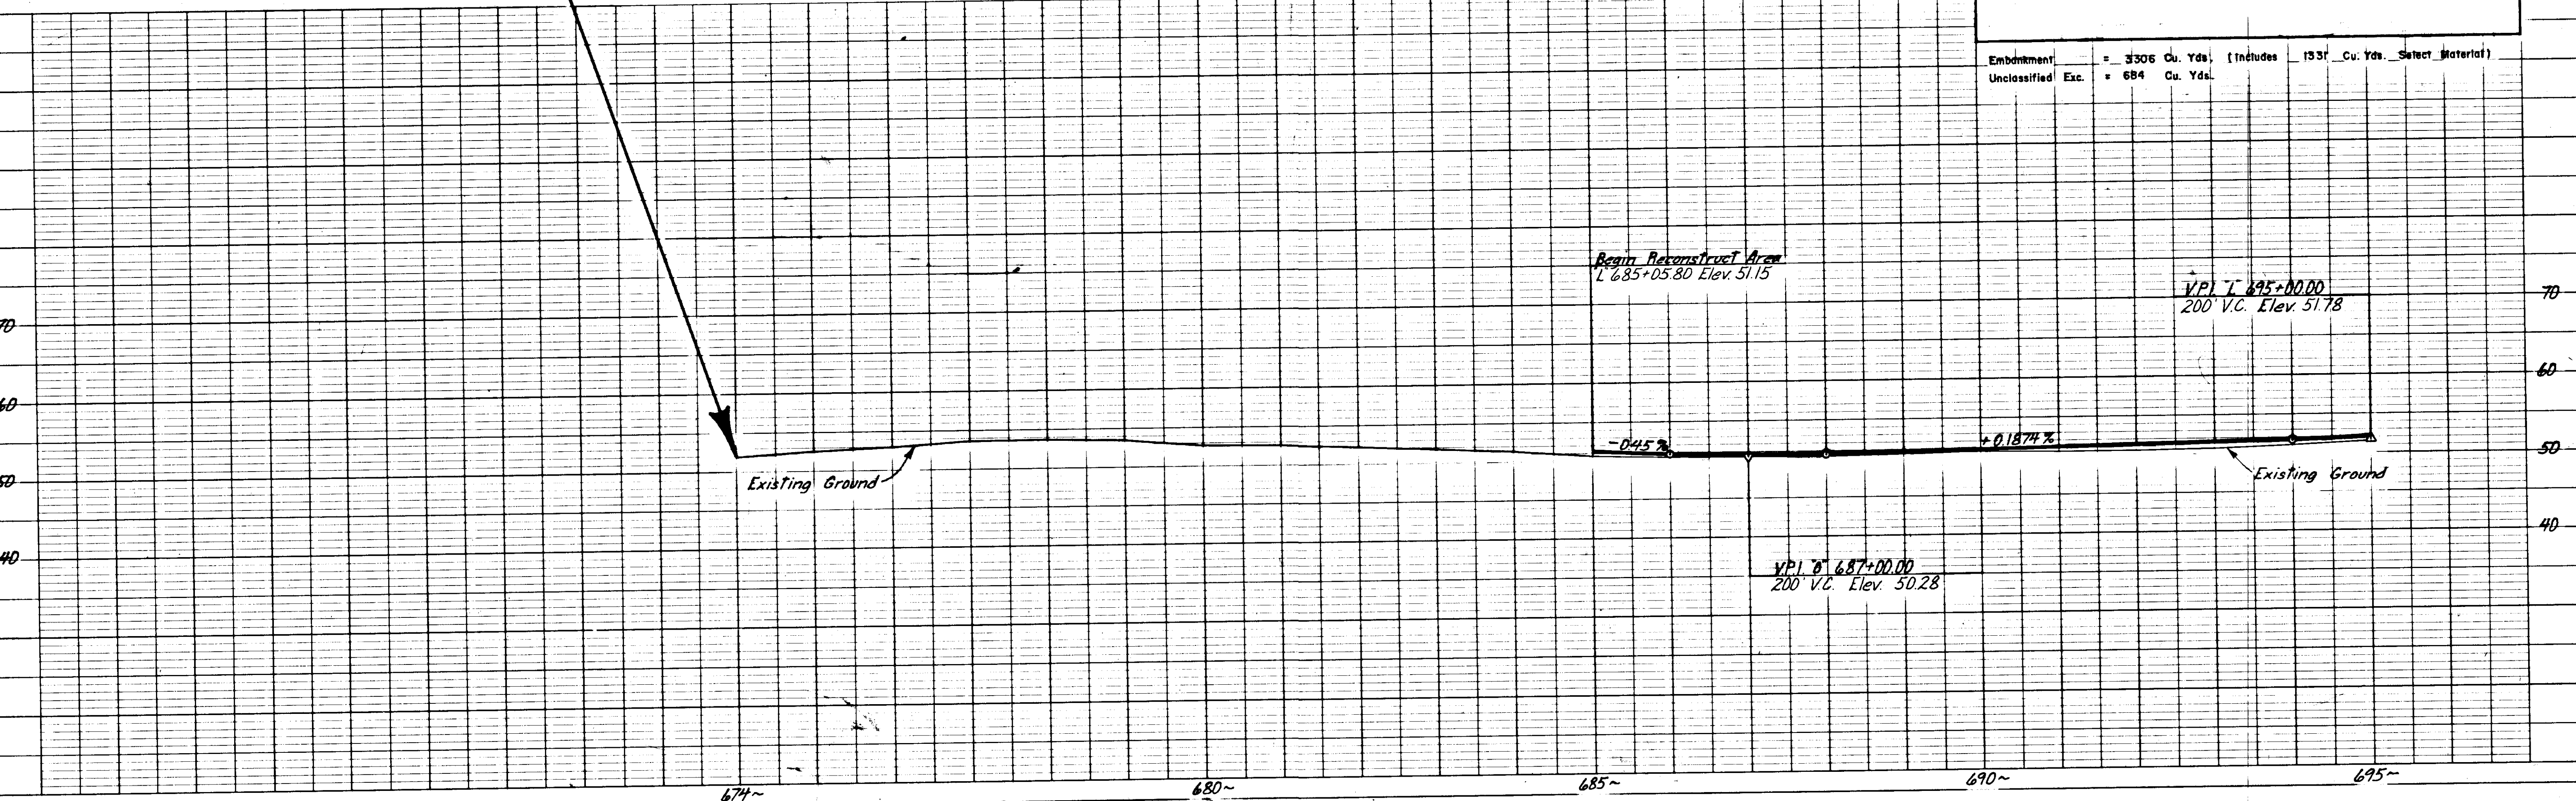


STATE	PROJECT DESIGNATION	YEAR	SHEET NO.	TOTAL SHEETS
ALASKA	F-FR-095-6(4)	1980	7	26

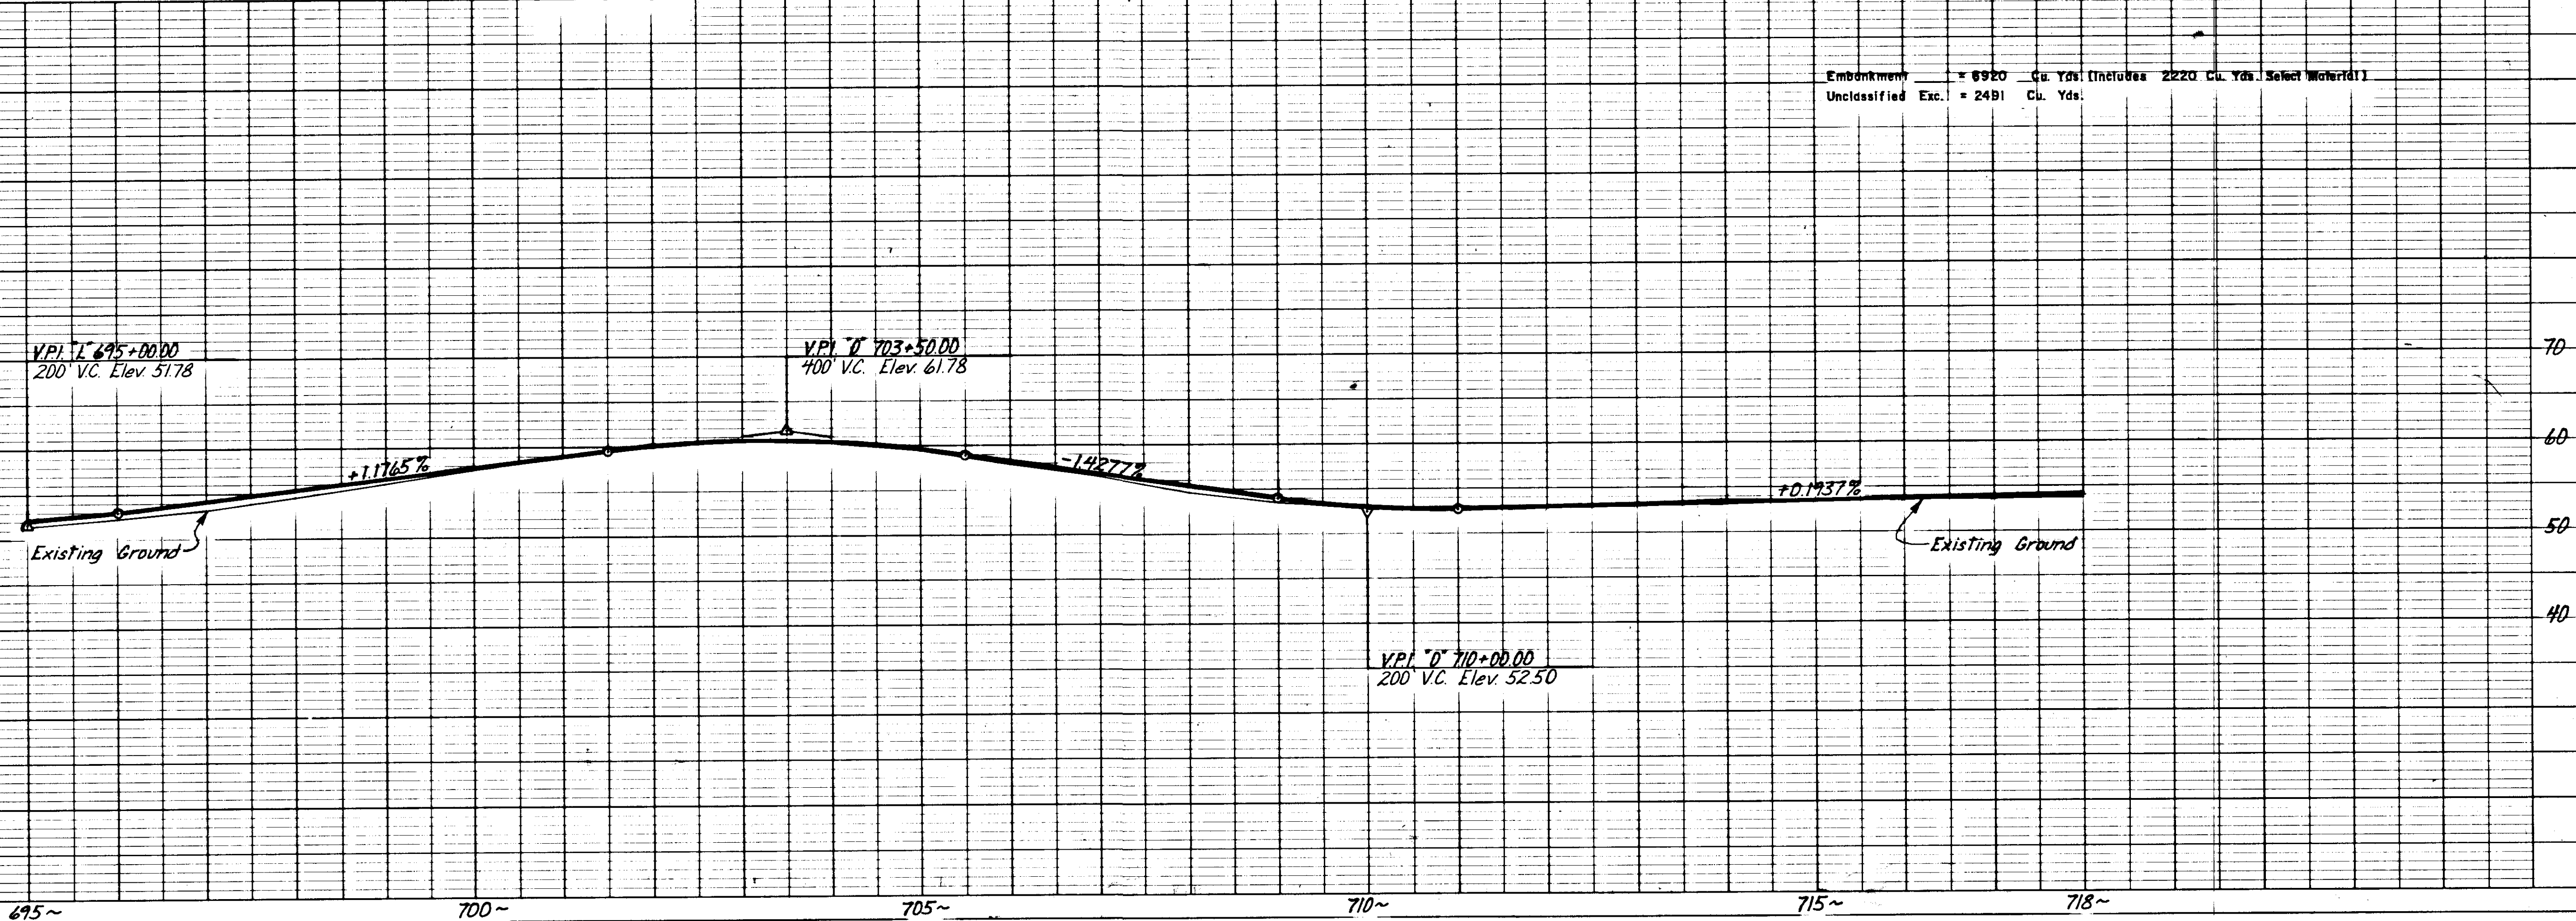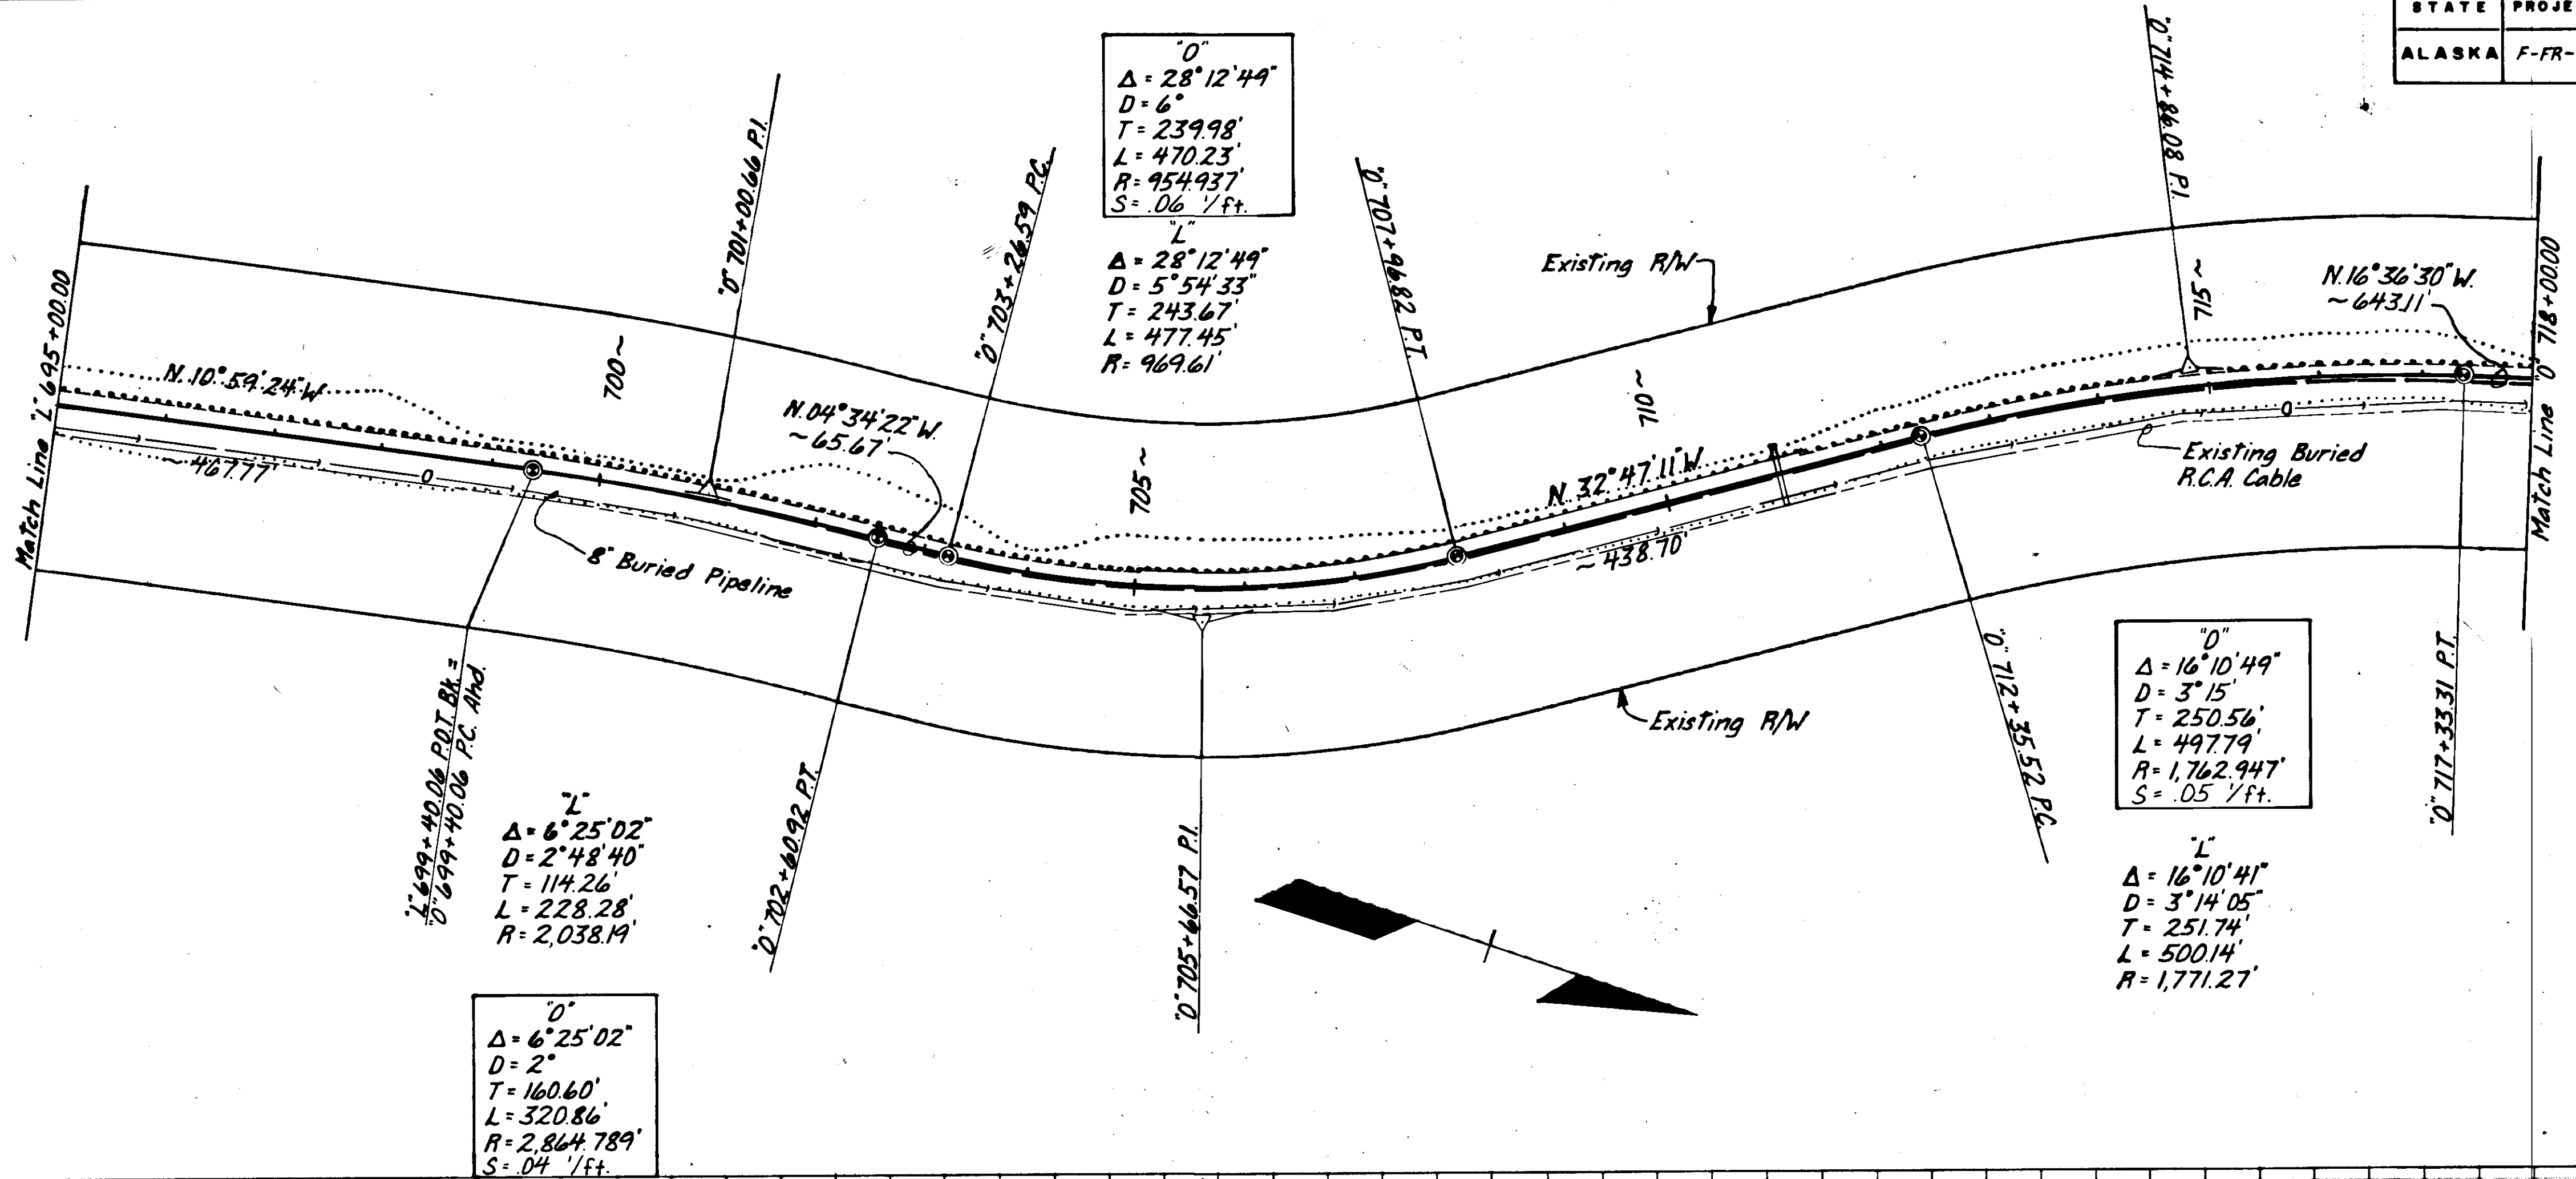

Embankment = 8920 Cu. Yds. (Includes 2220 Cu. Yds. Select Material)
 Unclassified Exc. = 2491 Cu. Yds.

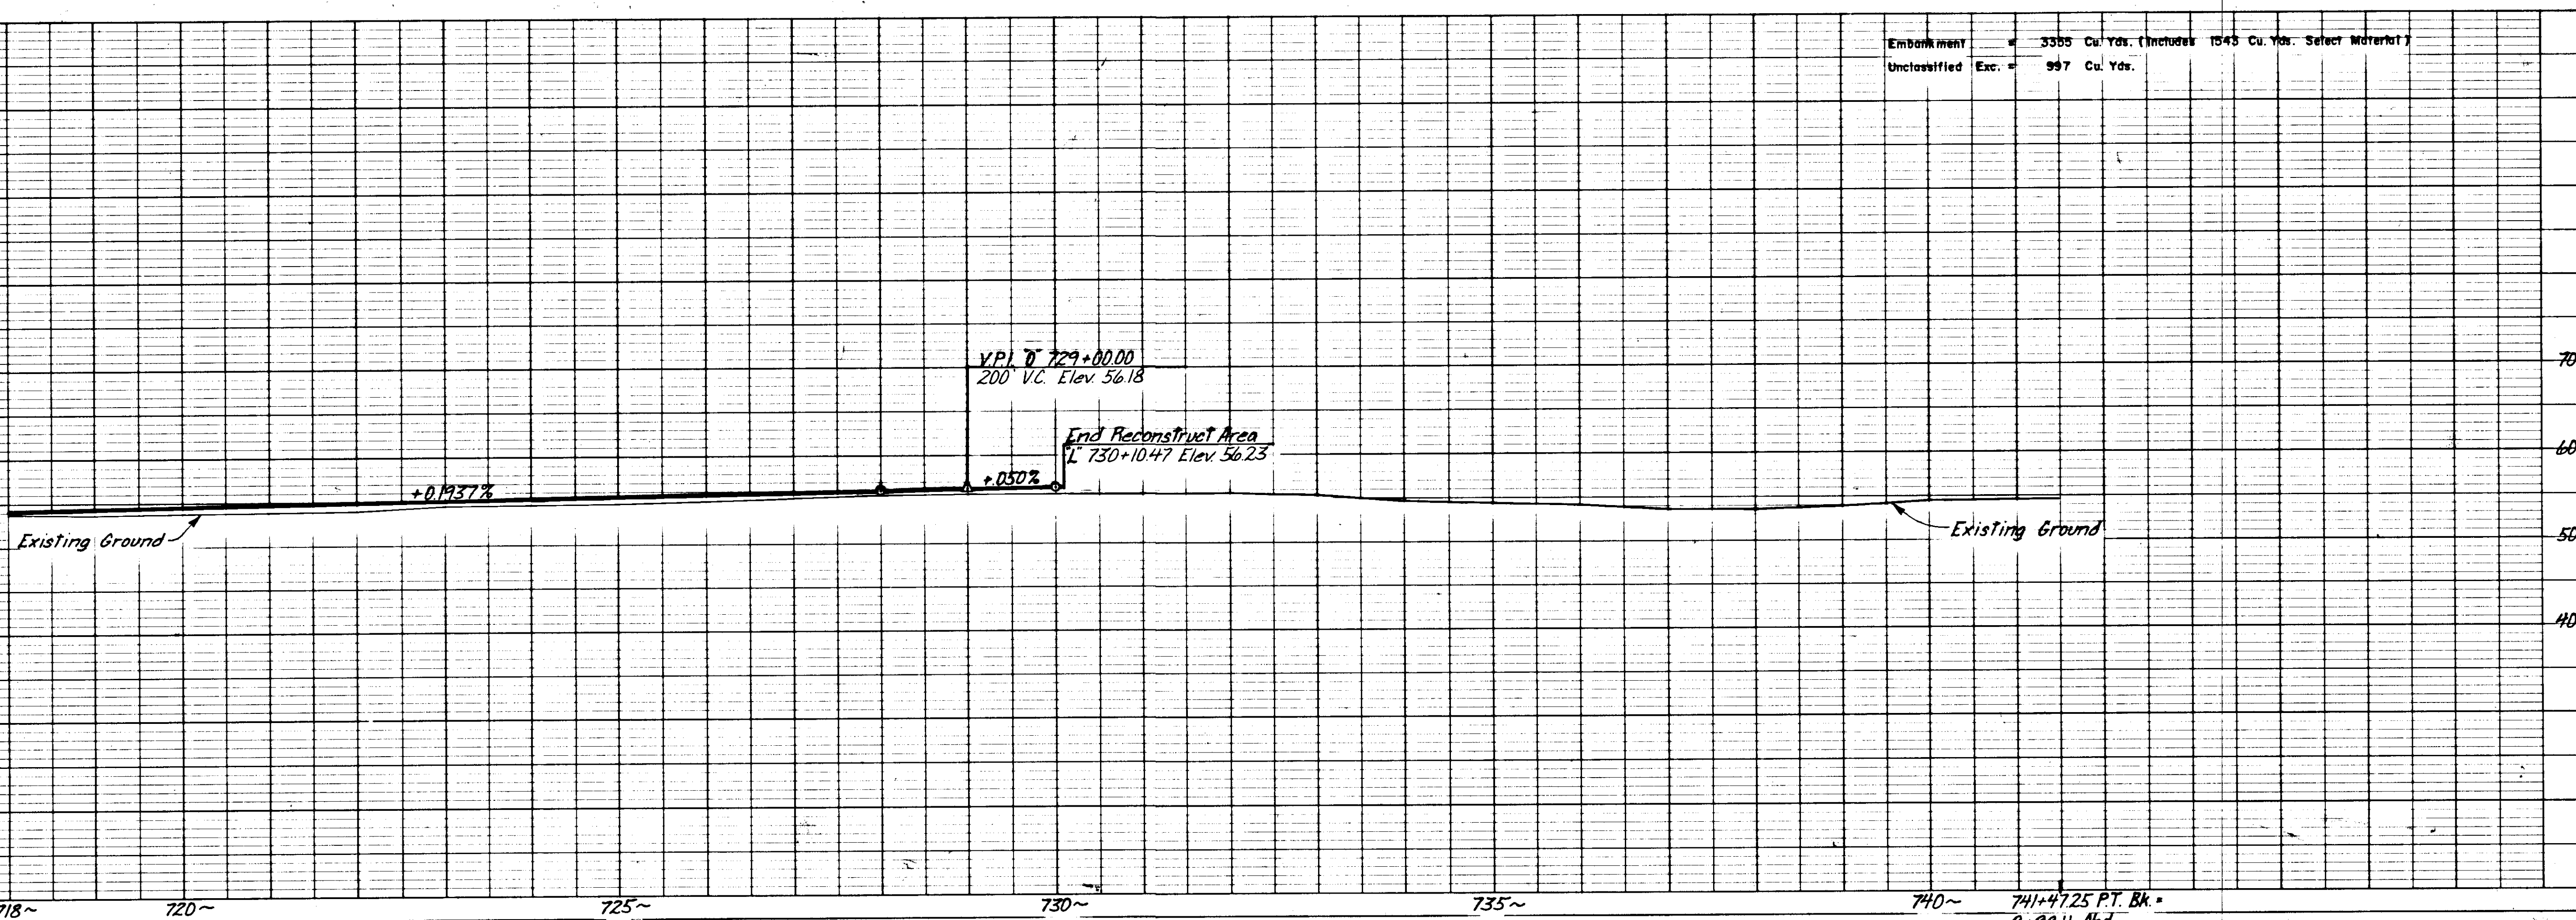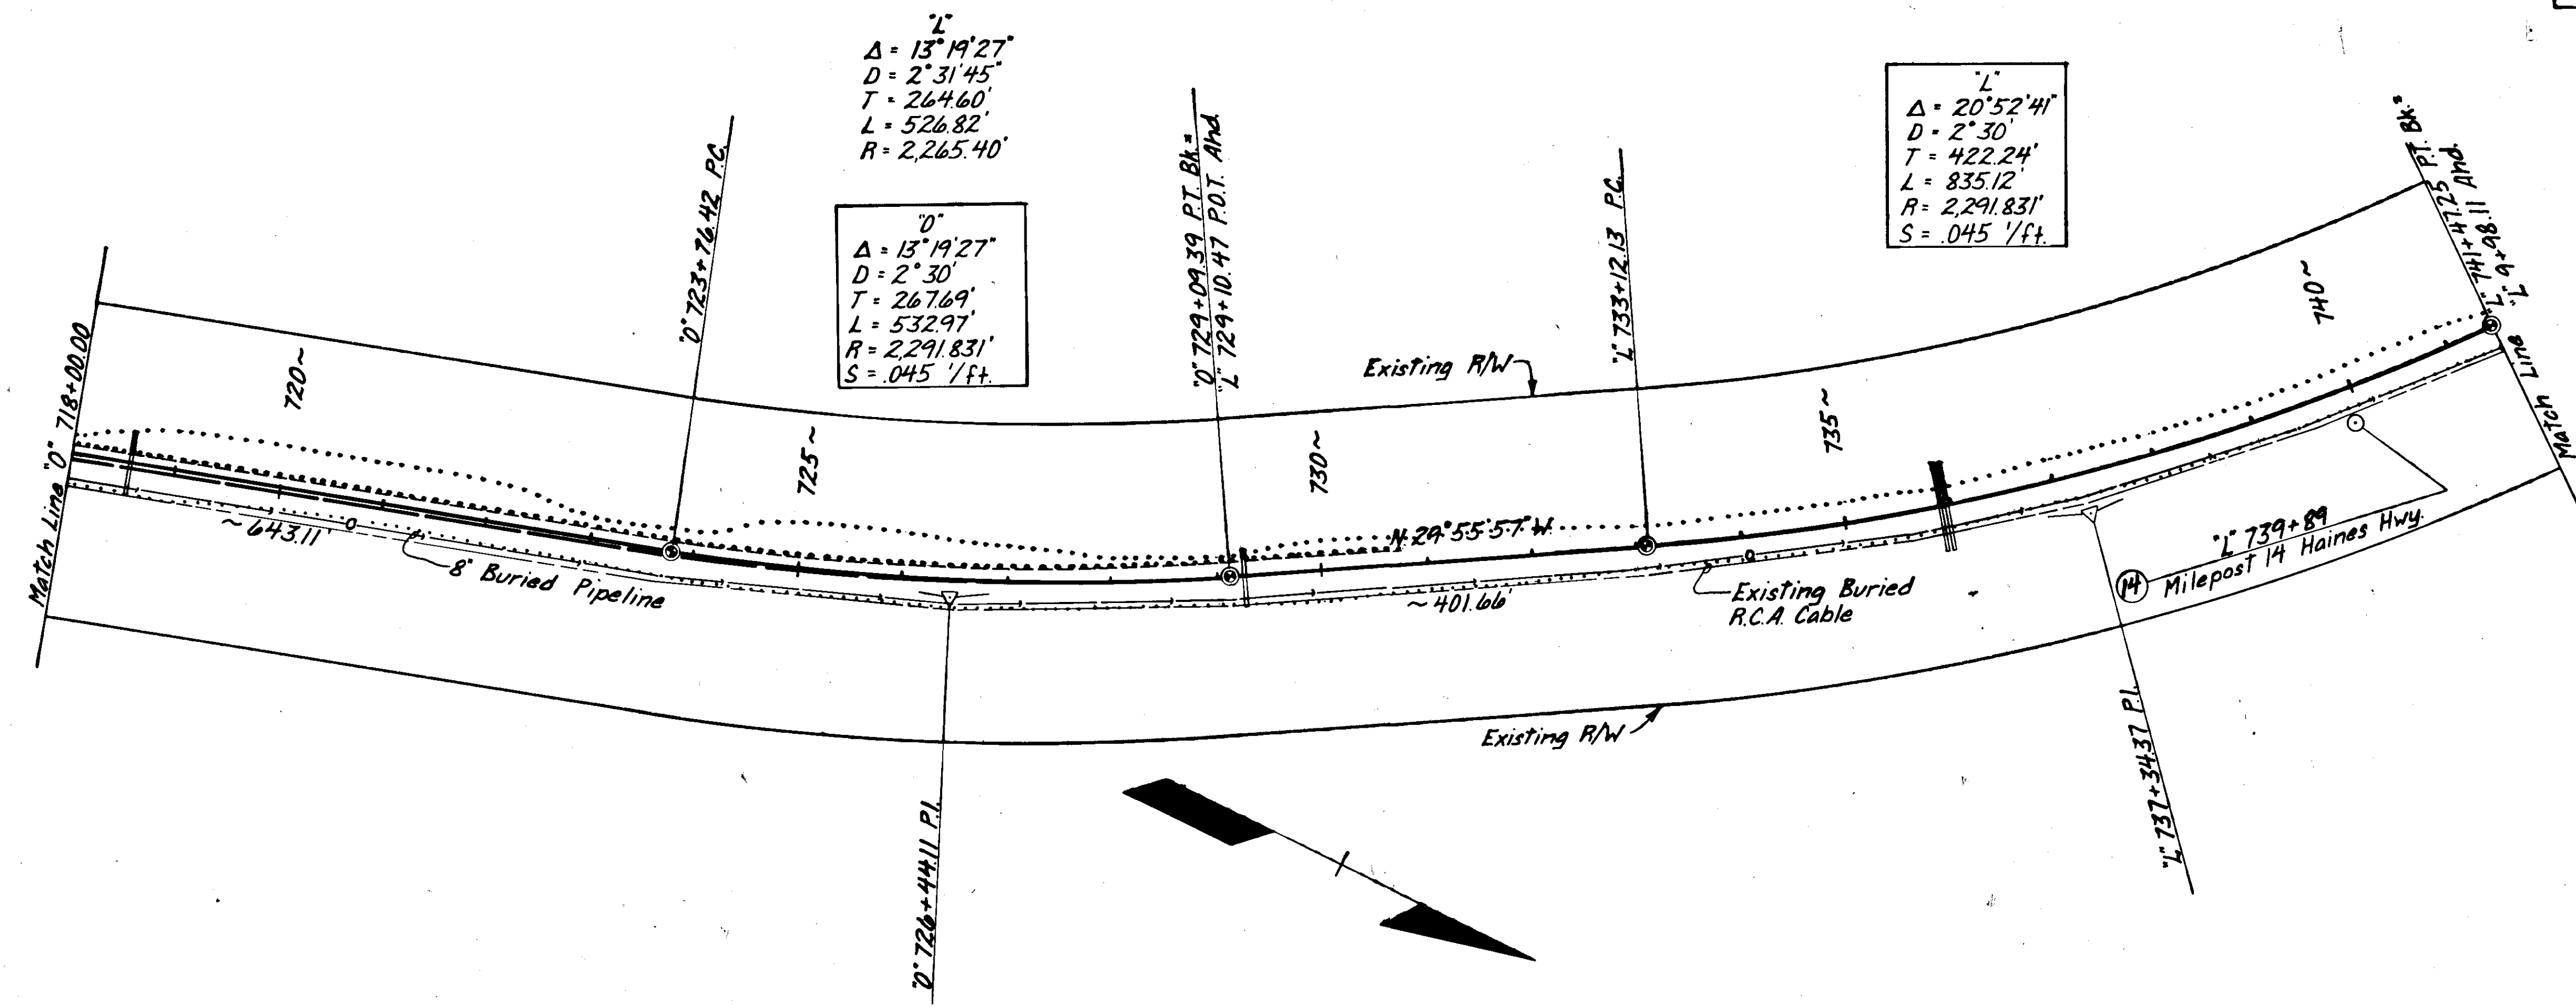


Embankment = 3355 Cu. Yds. (Includes 1545 Cu. Yds. Select Material)
 Unclassified Exc. = 997 Cu. Yds.

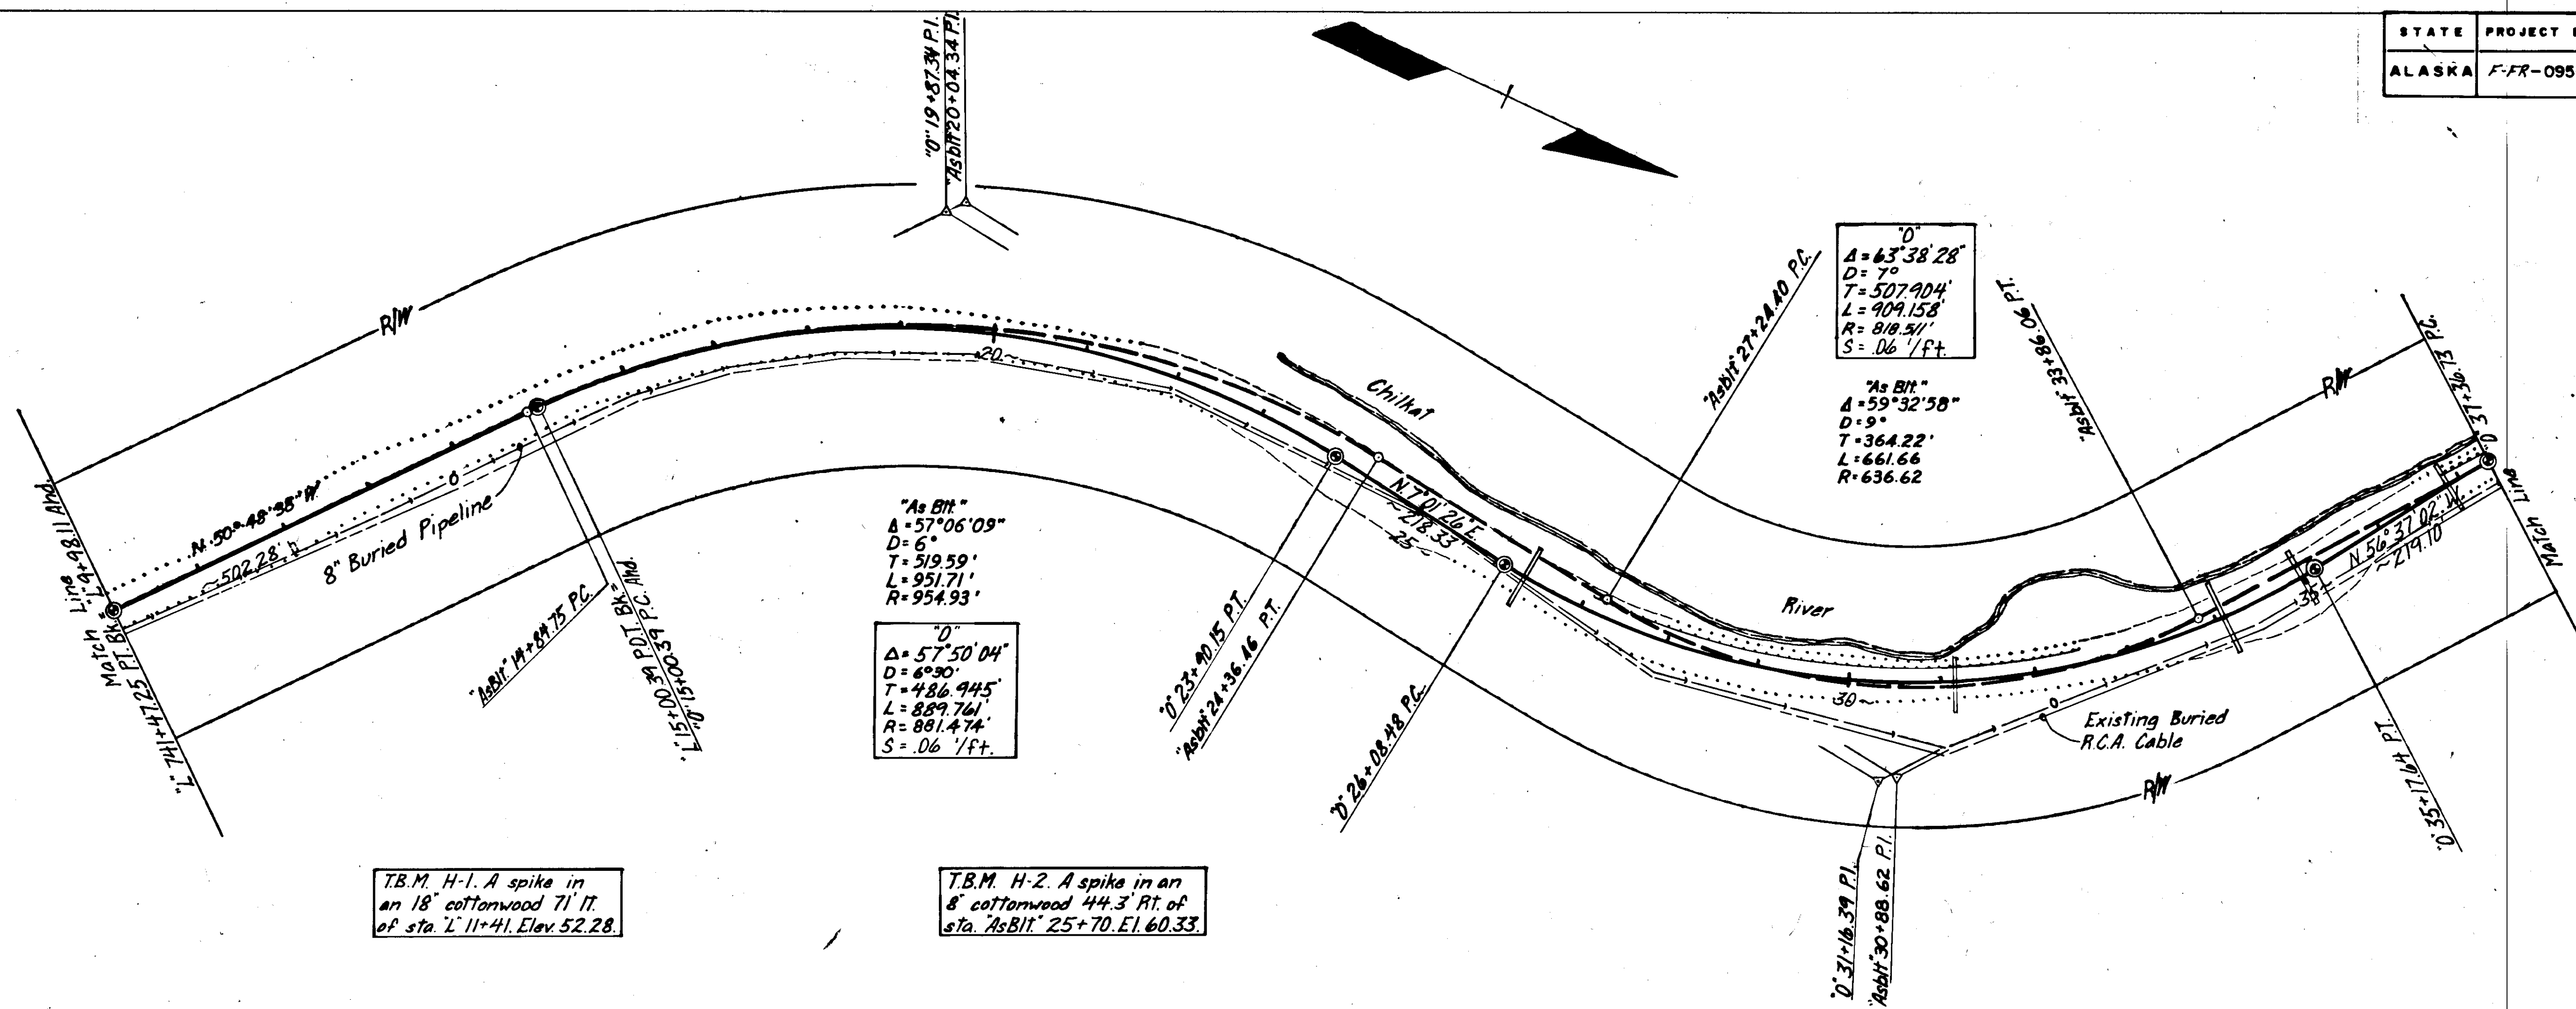


T.B.M. H-1. A spike in an 18" cottonwood 71' ft. of sta. L 11+41. Elev. 52.28.

T.B.M. H-2. A spike in an 8" cottonwood 44.3' ft. of sta. As Bt 25+70. Elev. 60.33.

Embankment = 4108 Cu. Yds. (Includes 2409 Cu. Yds. Select Material)
 Unclassified Exc. = 3303 Cu. Yds.

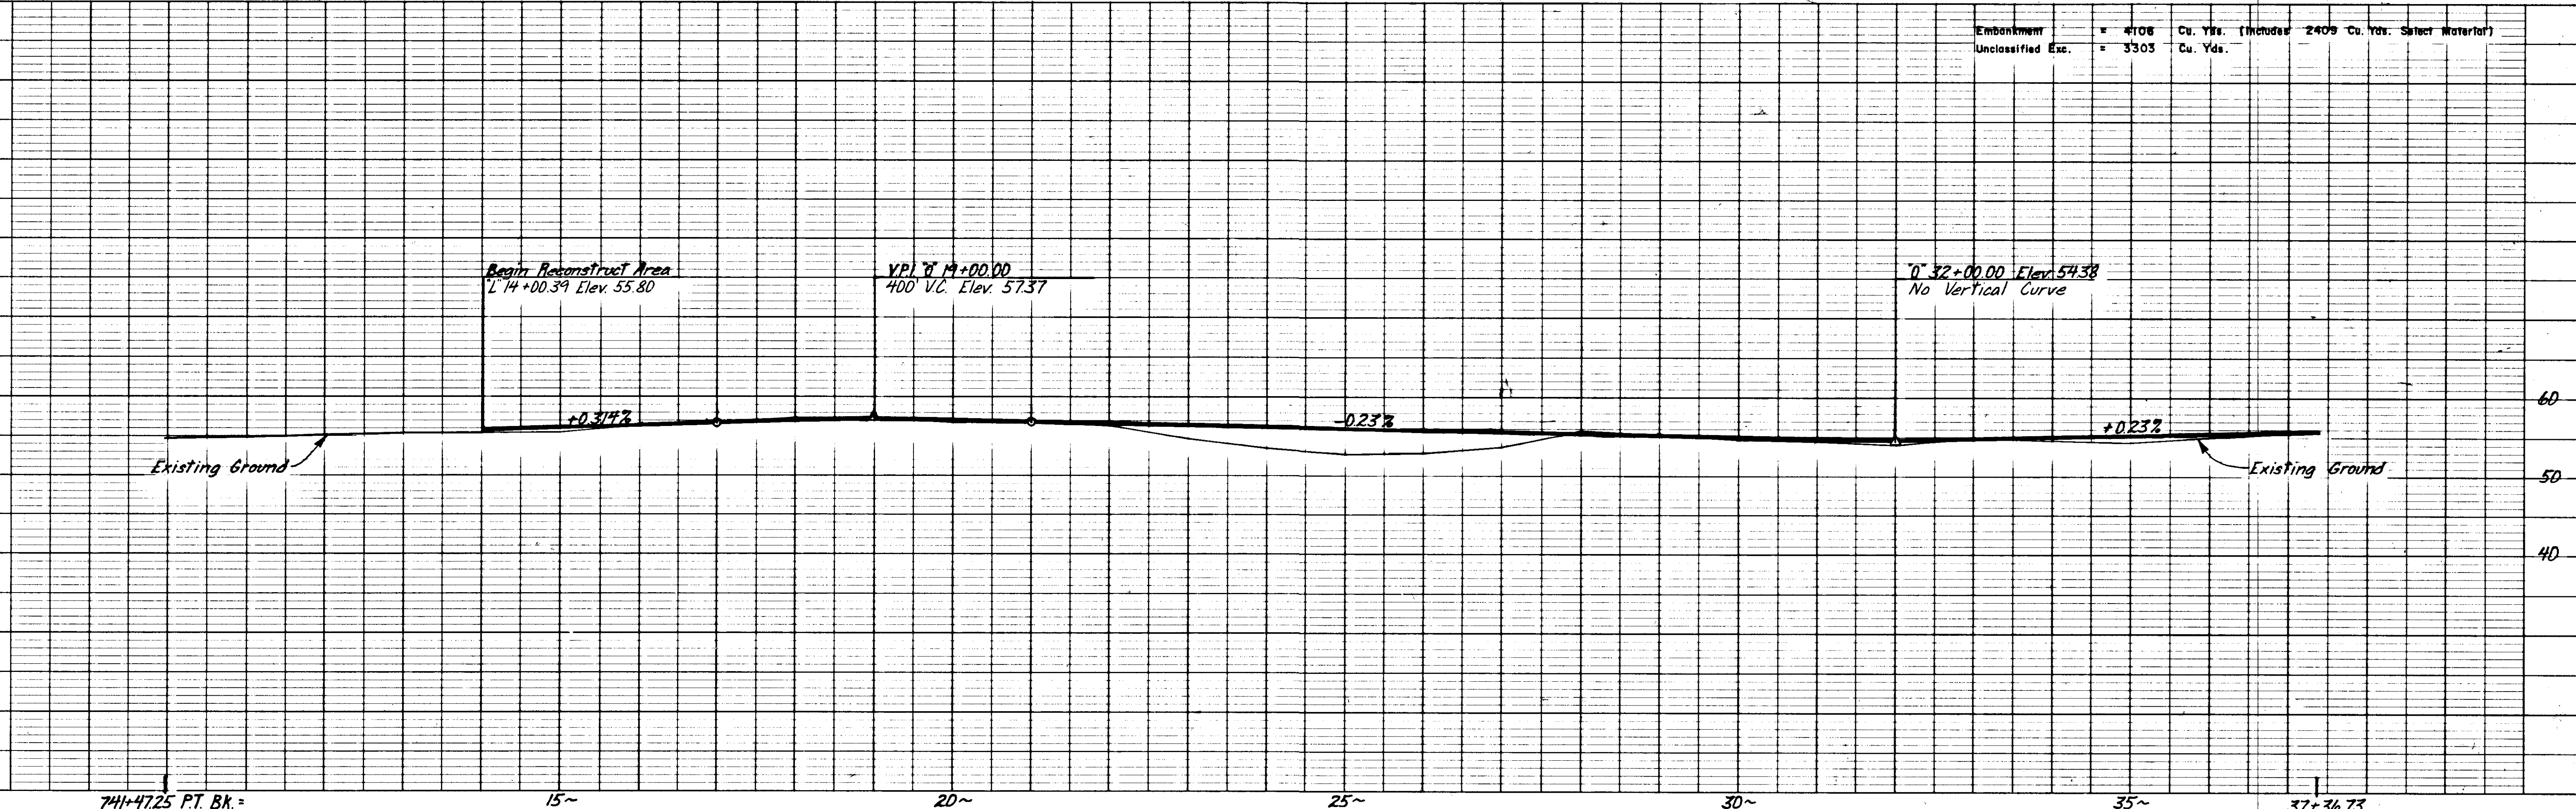

741+47.25 PT. BK. = 9+98.11 Ahd.

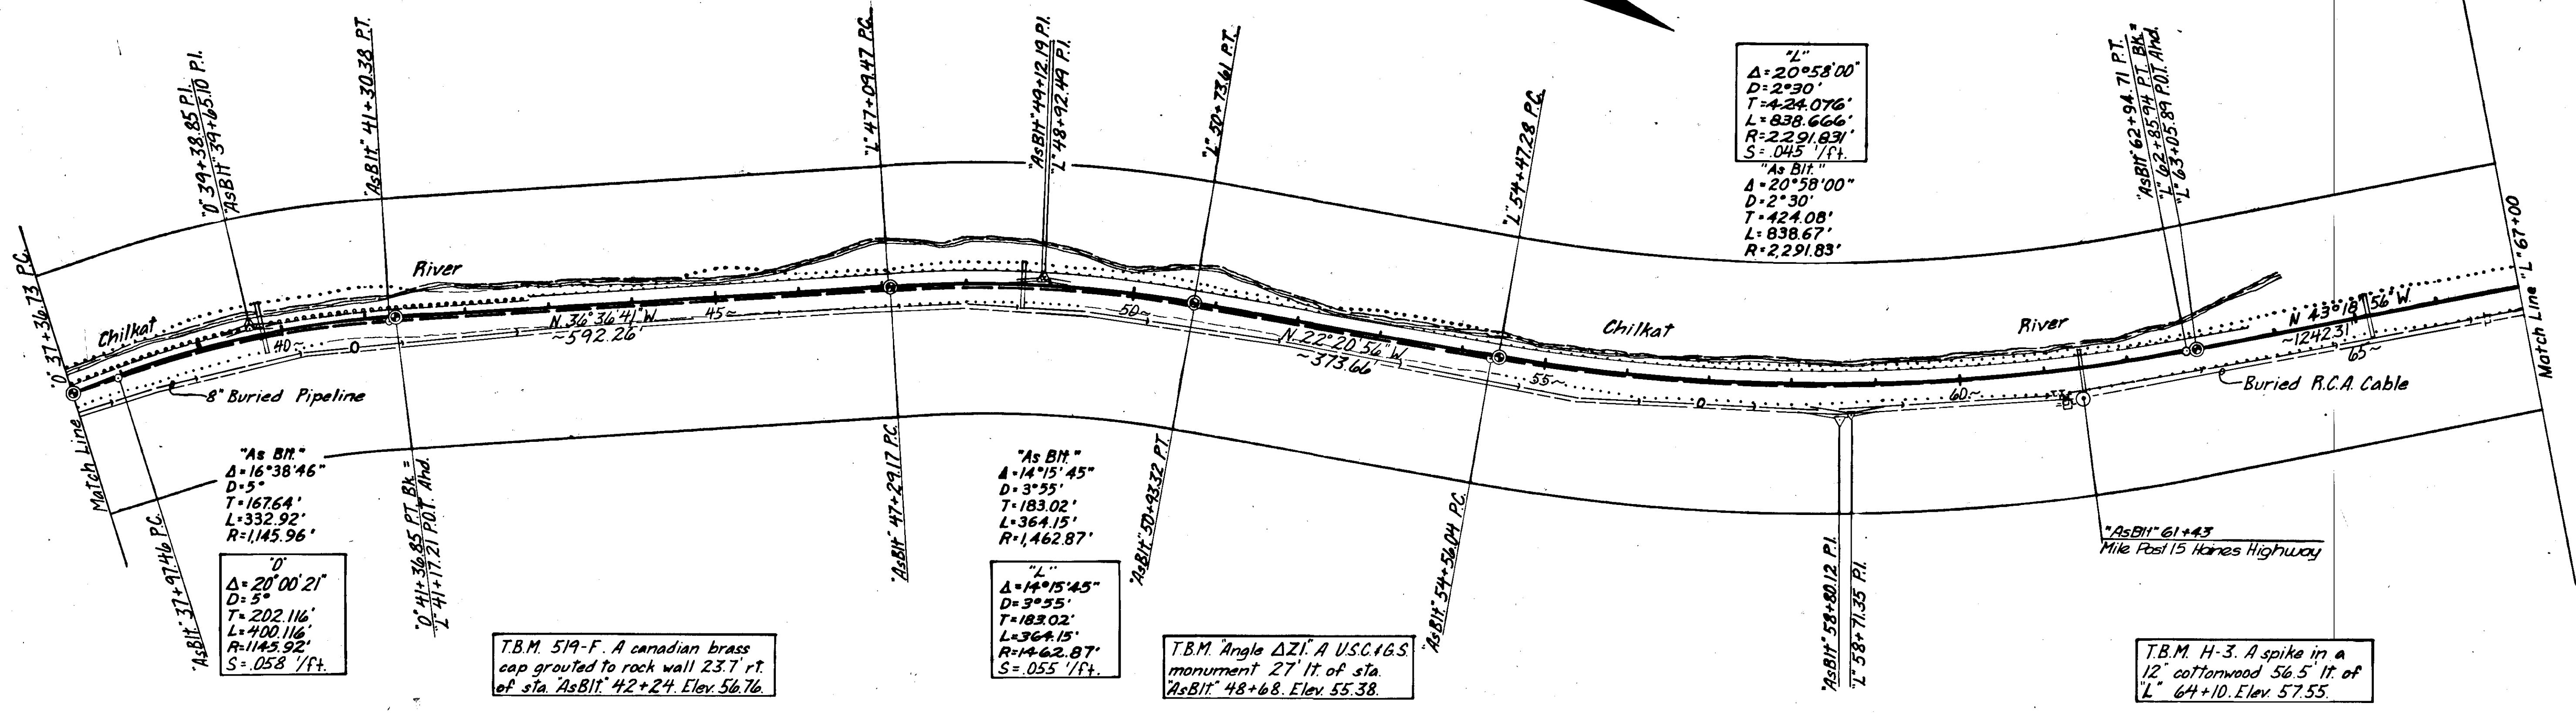

"As Bt"
 $\Delta = 16^{\circ}38'46"$
 $D = 5'$
 $T = 167.64'$
 $L = 332.92'$
 $R = 1145.96'$

"D"
 $\Delta = 20^{\circ}00'21"$
 $D = 5'$
 $T = 202.116'$
 $L = 400.116'$
 $R = 1145.92'$
 $S = .058' / ft.$

T.B.M. 519-F. A canadian brass cap grouted to rock wall 23.7 ft. of sta. AsBt 42+24. Elev. 56.76

"As Bt"
 $\Delta = 14^{\circ}15'45"$
 $D = 3^{\circ}55'$
 $T = 183.02'$
 $L = 364.15'$
 $R = 1462.87'$

"L"
 $\Delta = 14^{\circ}15'45"$
 $D = 3^{\circ}55'$
 $T = 183.02'$
 $L = 364.15'$
 $R = 1462.87'$
 $S = .055' / ft.$

T.B.M. "Angle ΔZI ". A USC 16S monument 27 ft. of sta. AsBt 48+68. Elev. 55.38


"L"
 $\Delta = 20^{\circ}58'00"$
 $D = 2^{\circ}30'$
 $T = 424.076'$
 $L = 838.666'$
 $R = 2291.83'$
 $S = .045' / ft.$

"As Bt"
 $\Delta = 20^{\circ}58'00"$
 $D = 2^{\circ}30'$
 $T = 424.08'$
 $L = 838.67'$
 $R = 2291.83'$



"AsBt" 61+43
 Mile Post 15 Haines Highway

T.B.M. H-3. A spike in a 12" cottonwood 56.5 ft. of "L" 64+10. Elev. 57.55

Embankment	=	4431	Cu Yds. (Includes 2631 Cu Yds. Select Material)
Unclassified Exc.	=	3647	Cu Yds.

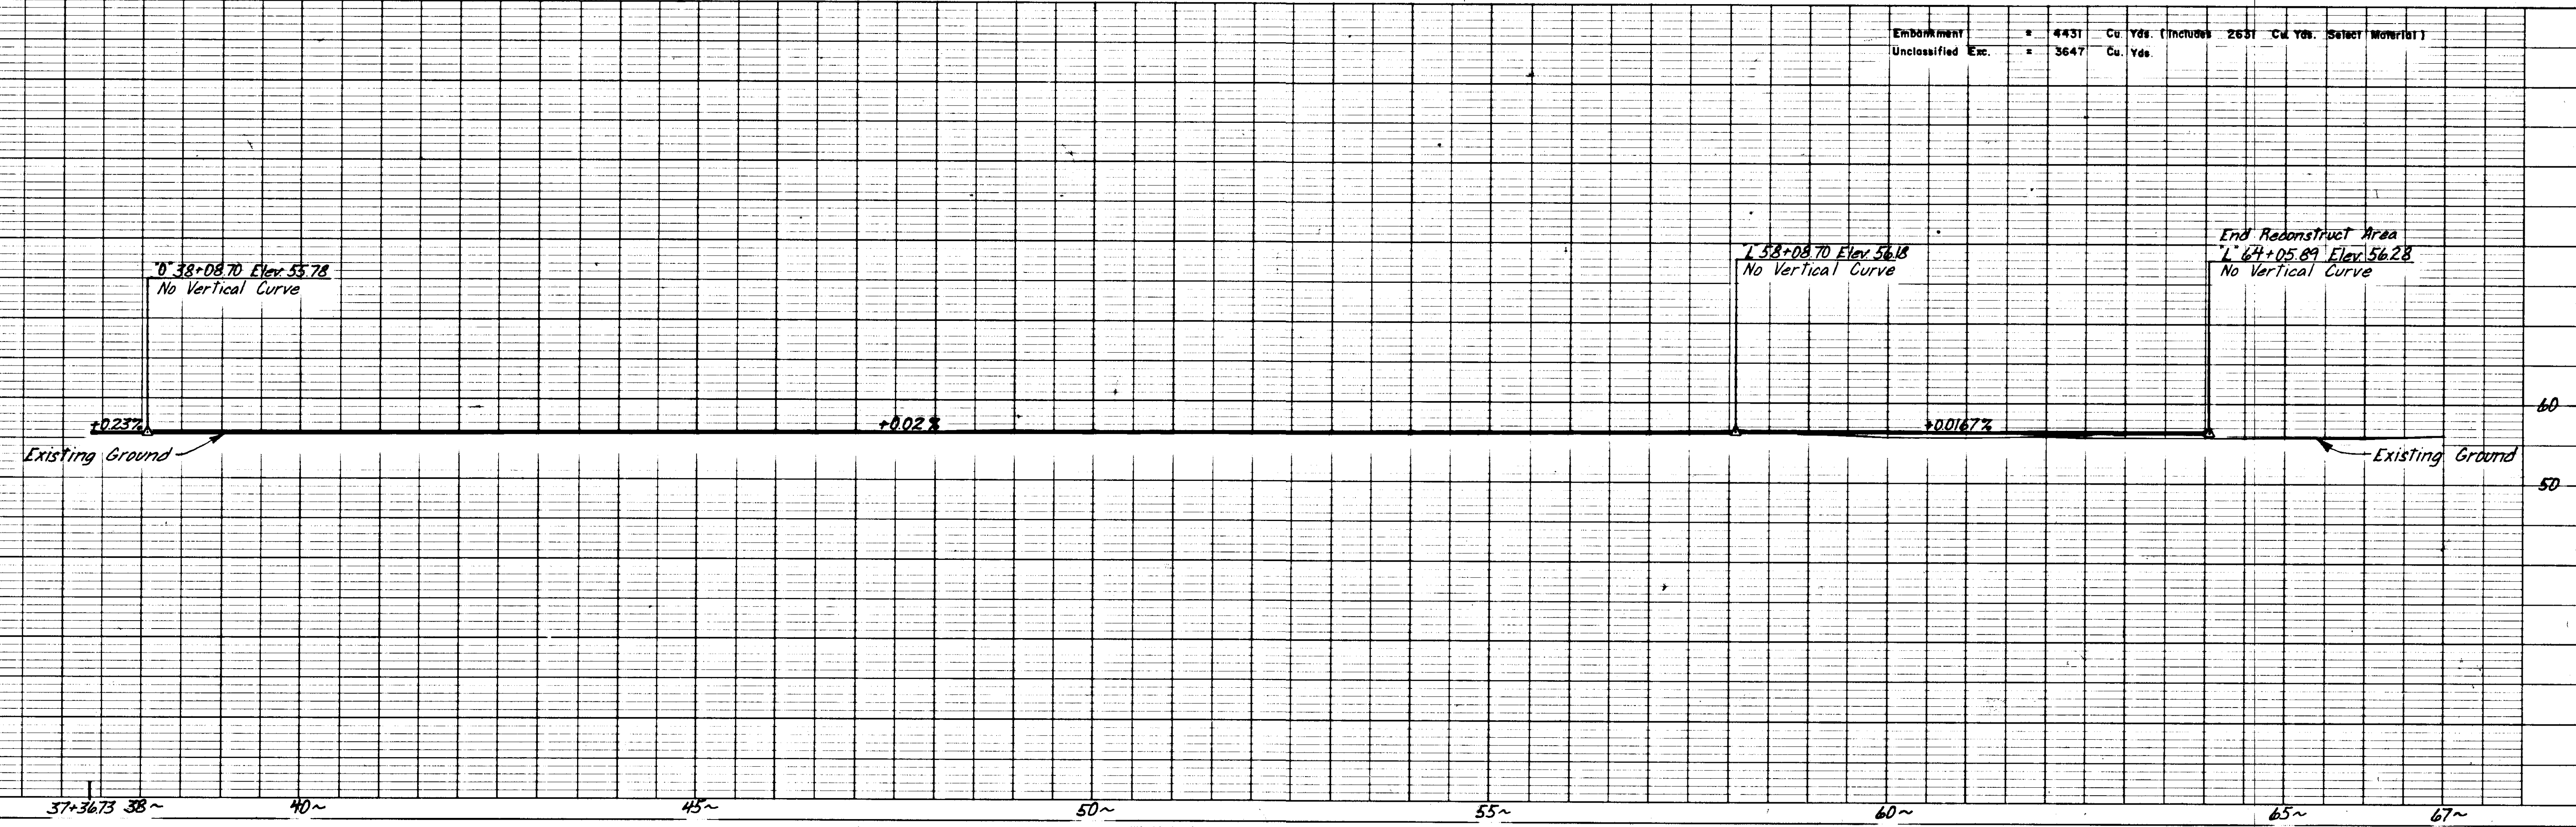


STATE	PROJECT DESIGNATION	YEAR	SHEET NO.	TOTAL SHEETS
ALASKA	F-FR-095-6(4)	1980	11	26

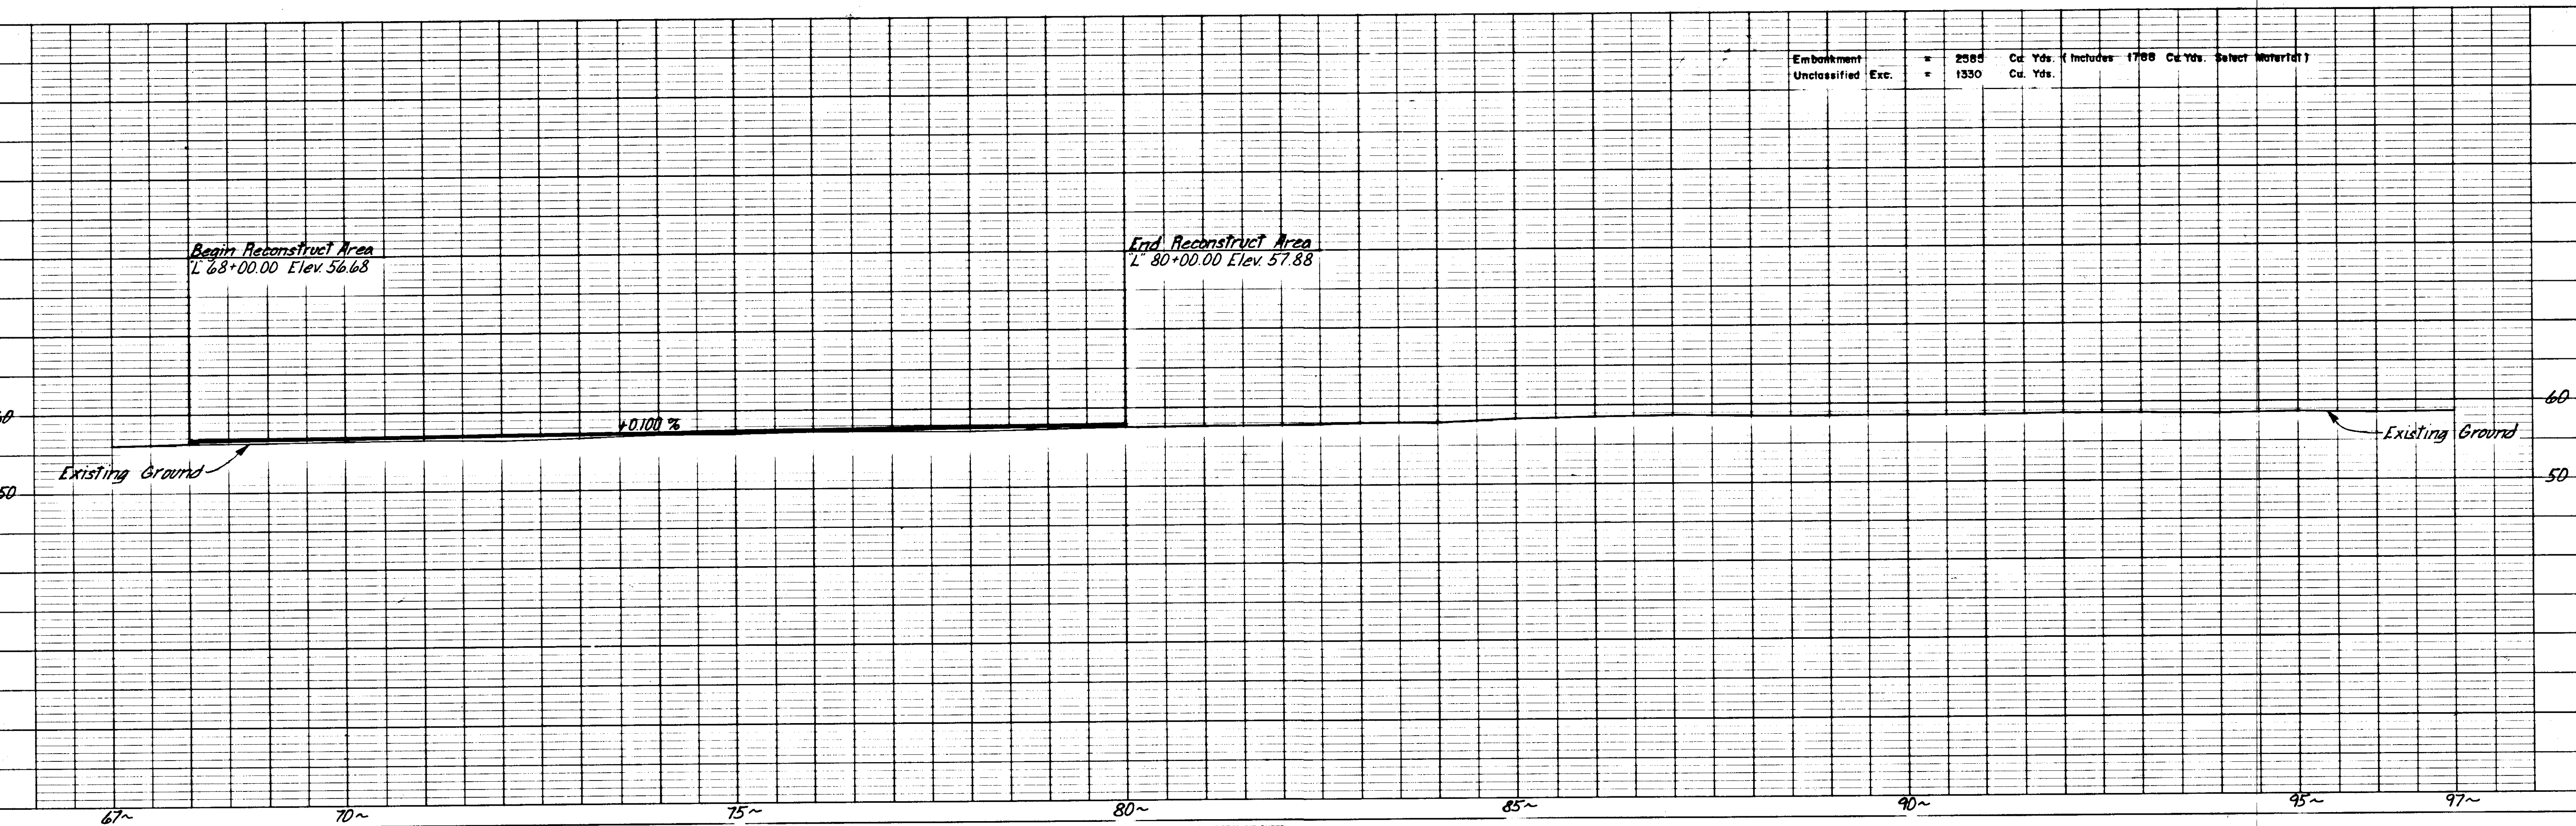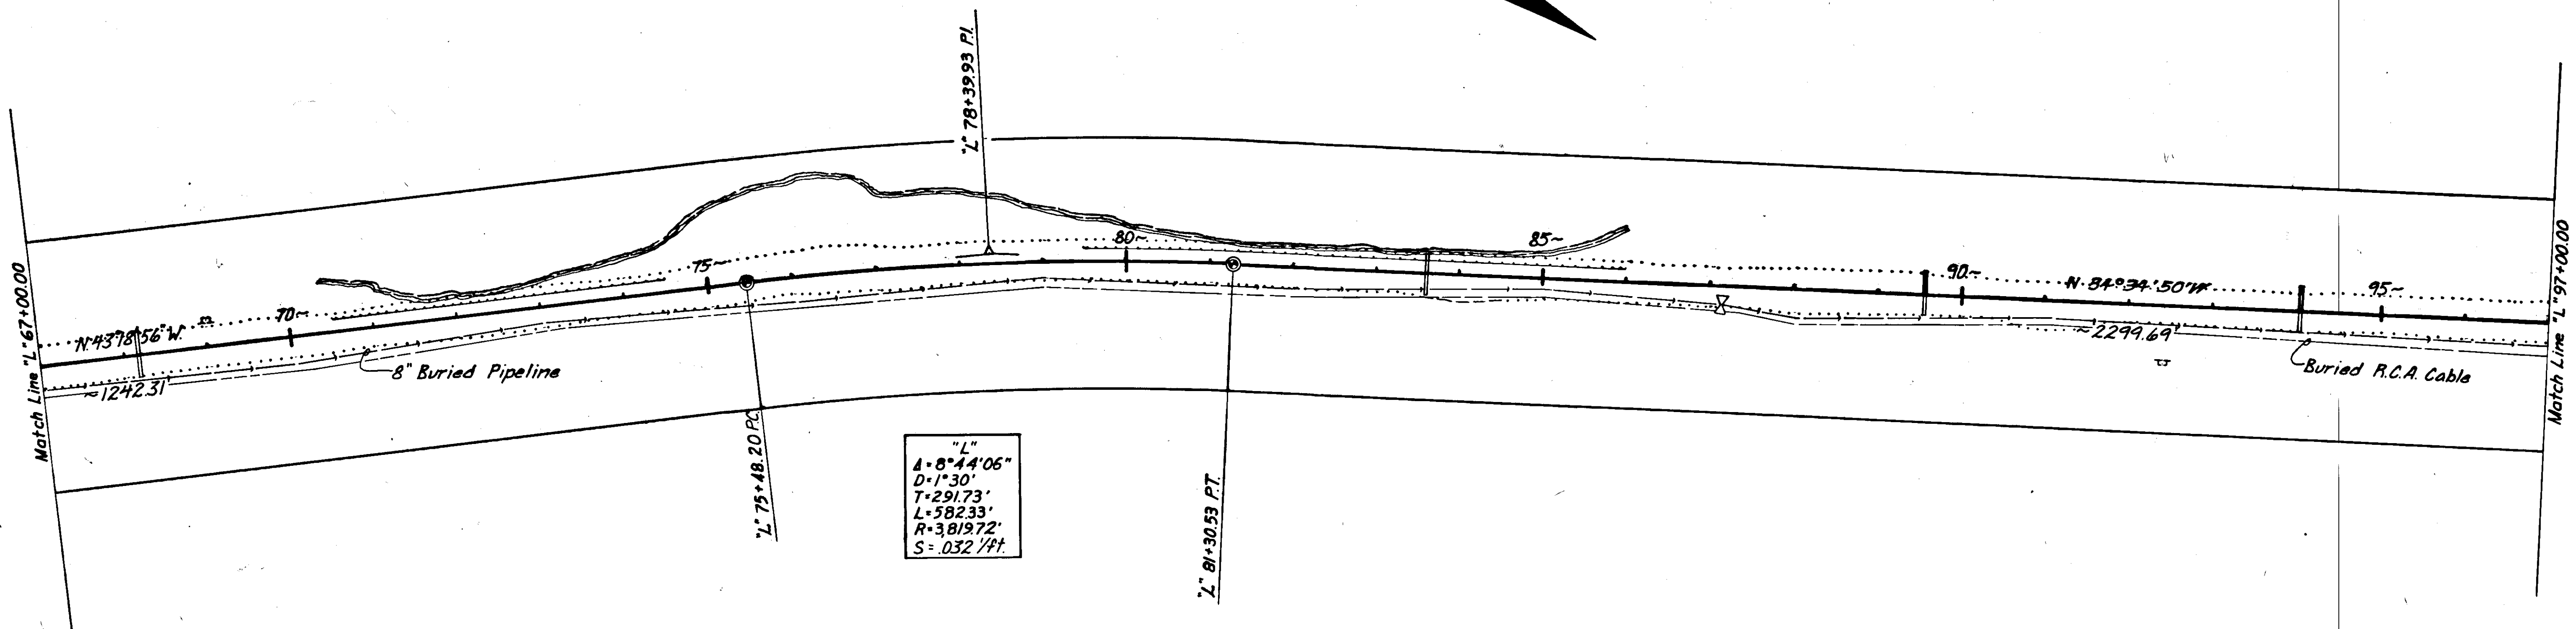


Embankment	=	2585	Cu. Yds. (Includes 1788 Cu. Yds. Select Material)
Unclassified Exc.	=	1330	Cu. Yds.


STATE	PROJECT DESIGNATION	YEAR	SHEET NO.	TOTAL SHEETS
ALASKA	F-FR-095-6(4)	1980	12	26

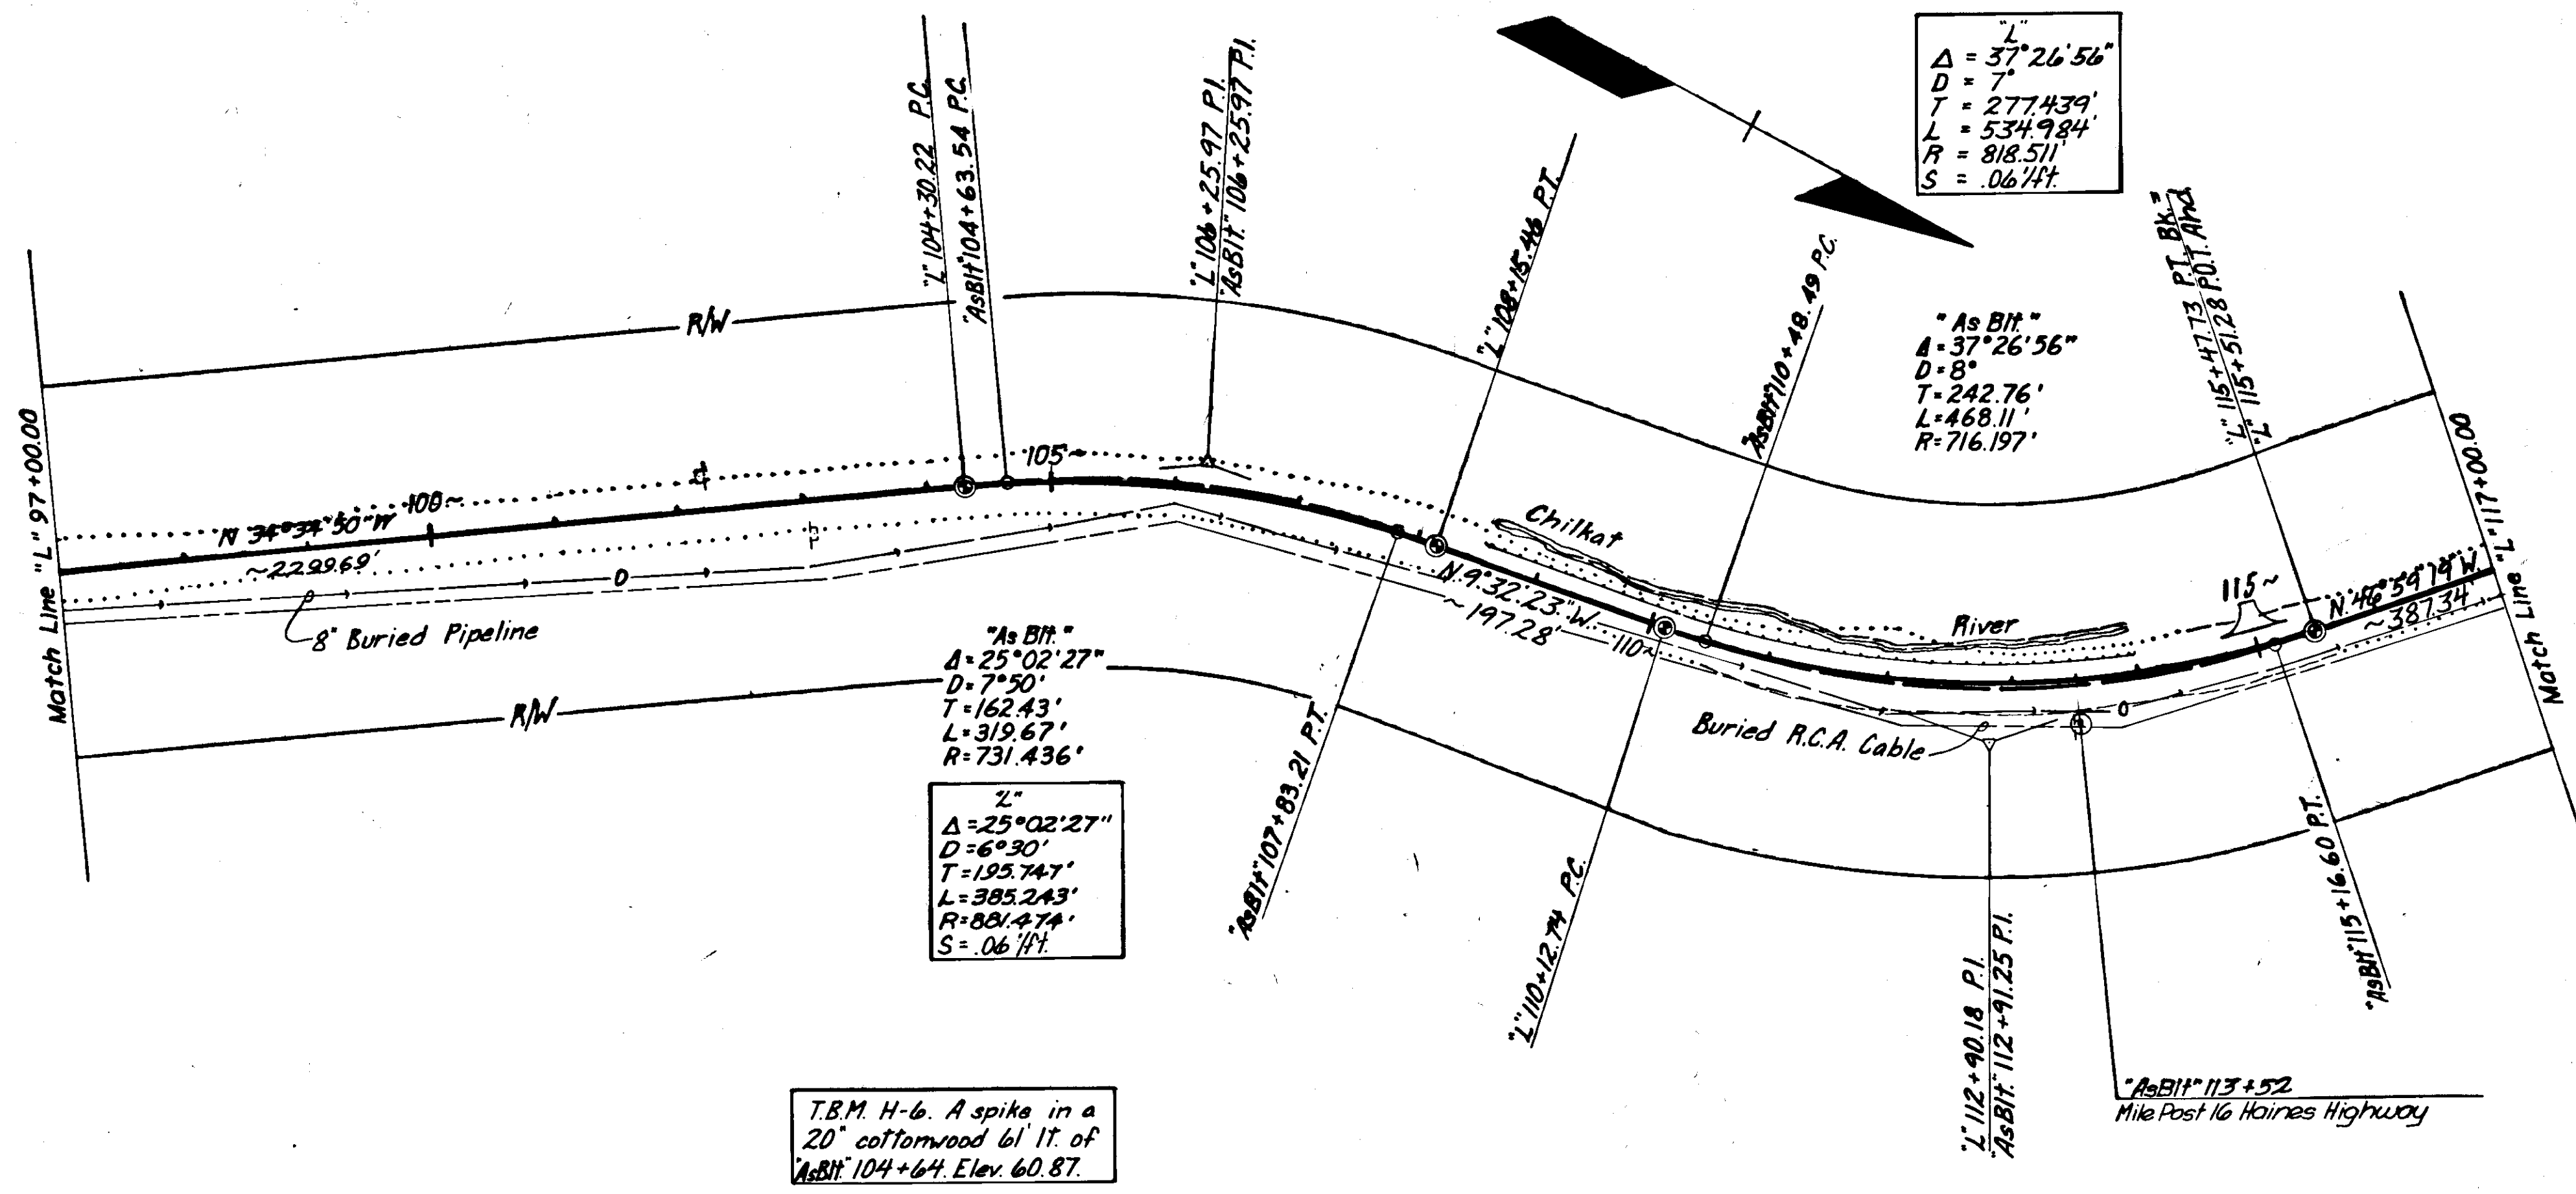

T.B.M. H-6. A spike in a 20" cottonwood 6' ft. of $As Bt' 104+64$ Elev. 60.87.


Embankment	=	2400	Cu. Yds. (includes 1500 Cu. Yds. Select Material)
Unclassified Exc.	=	1594	Cu. Yds.

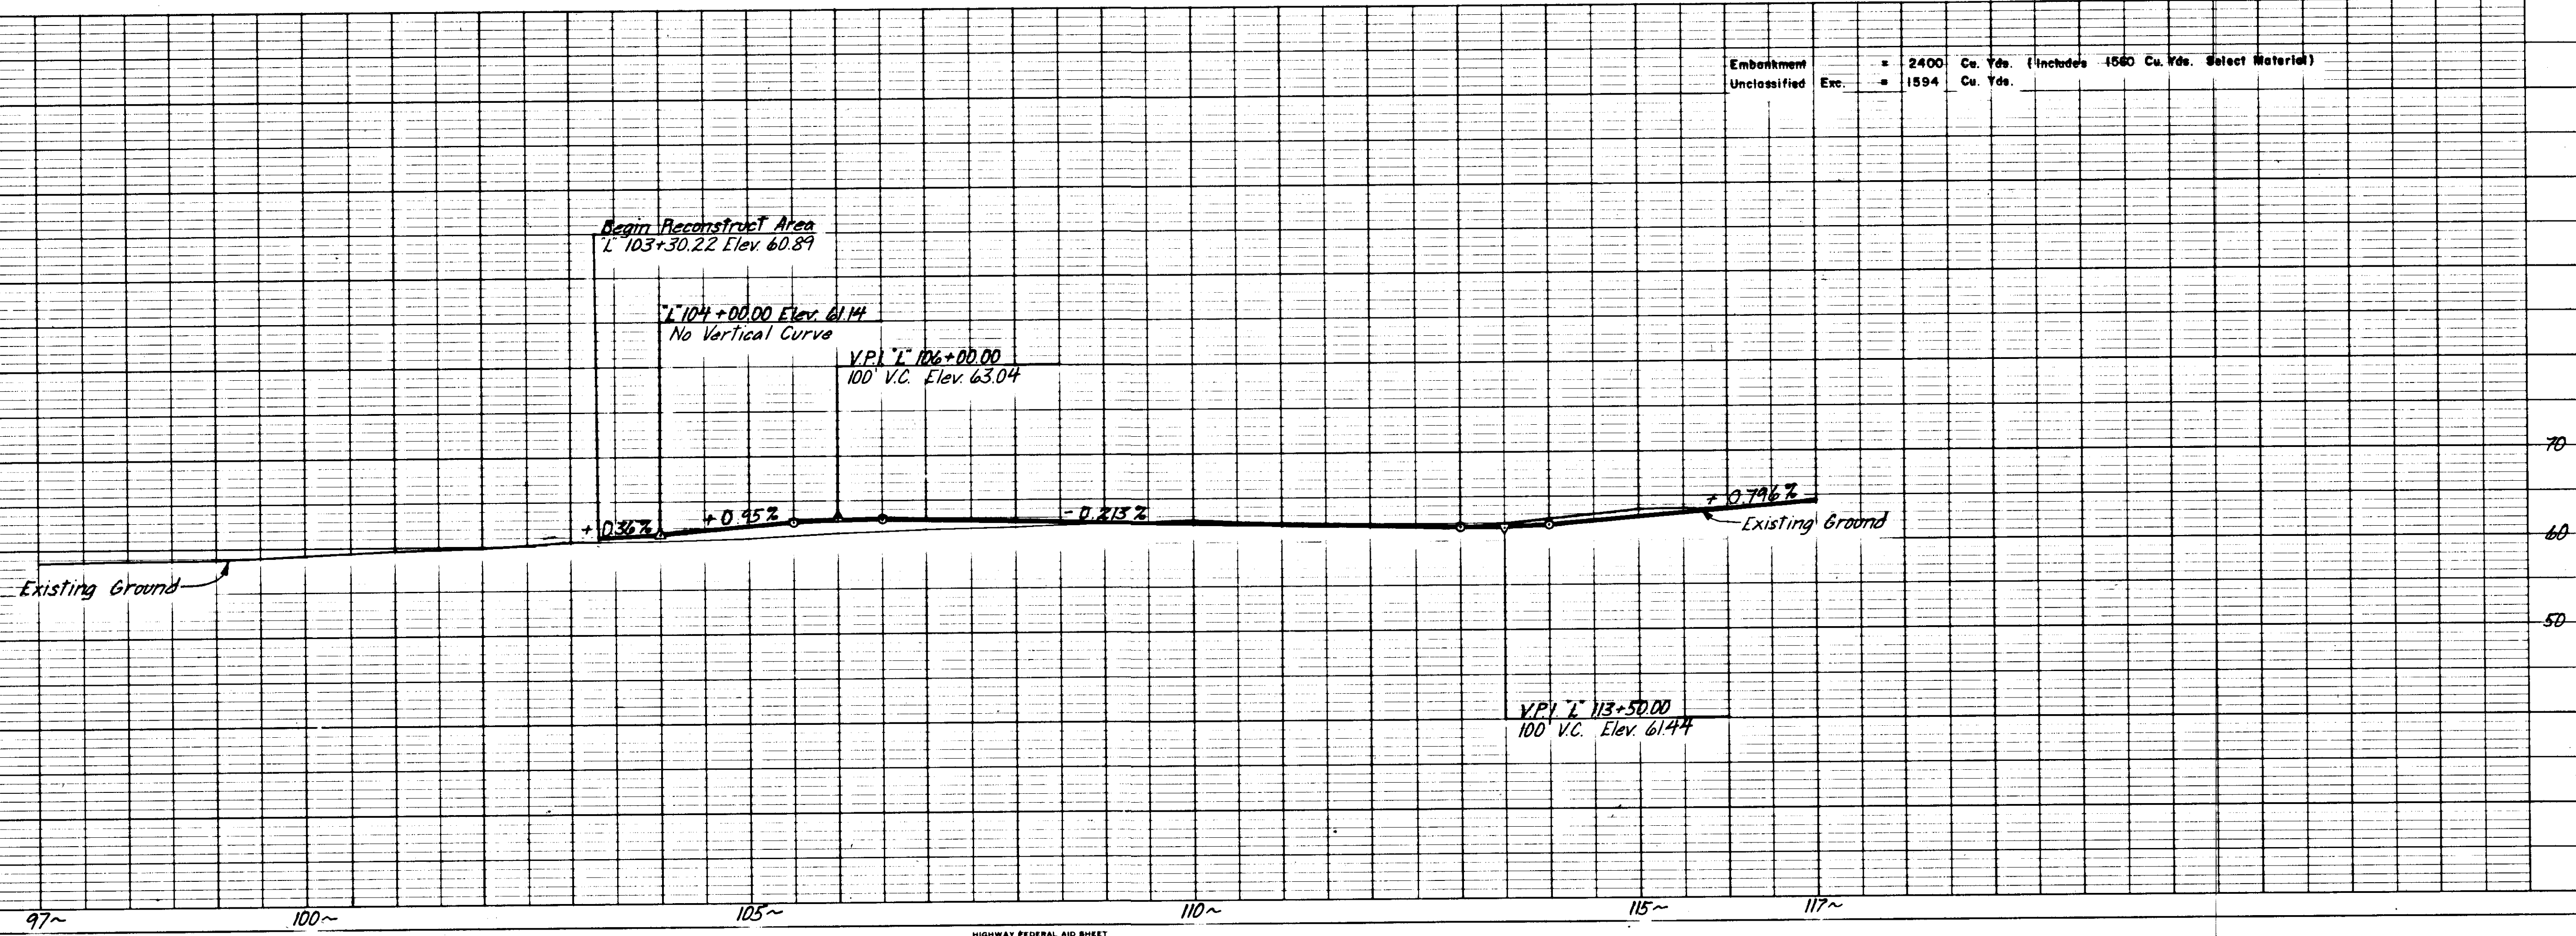


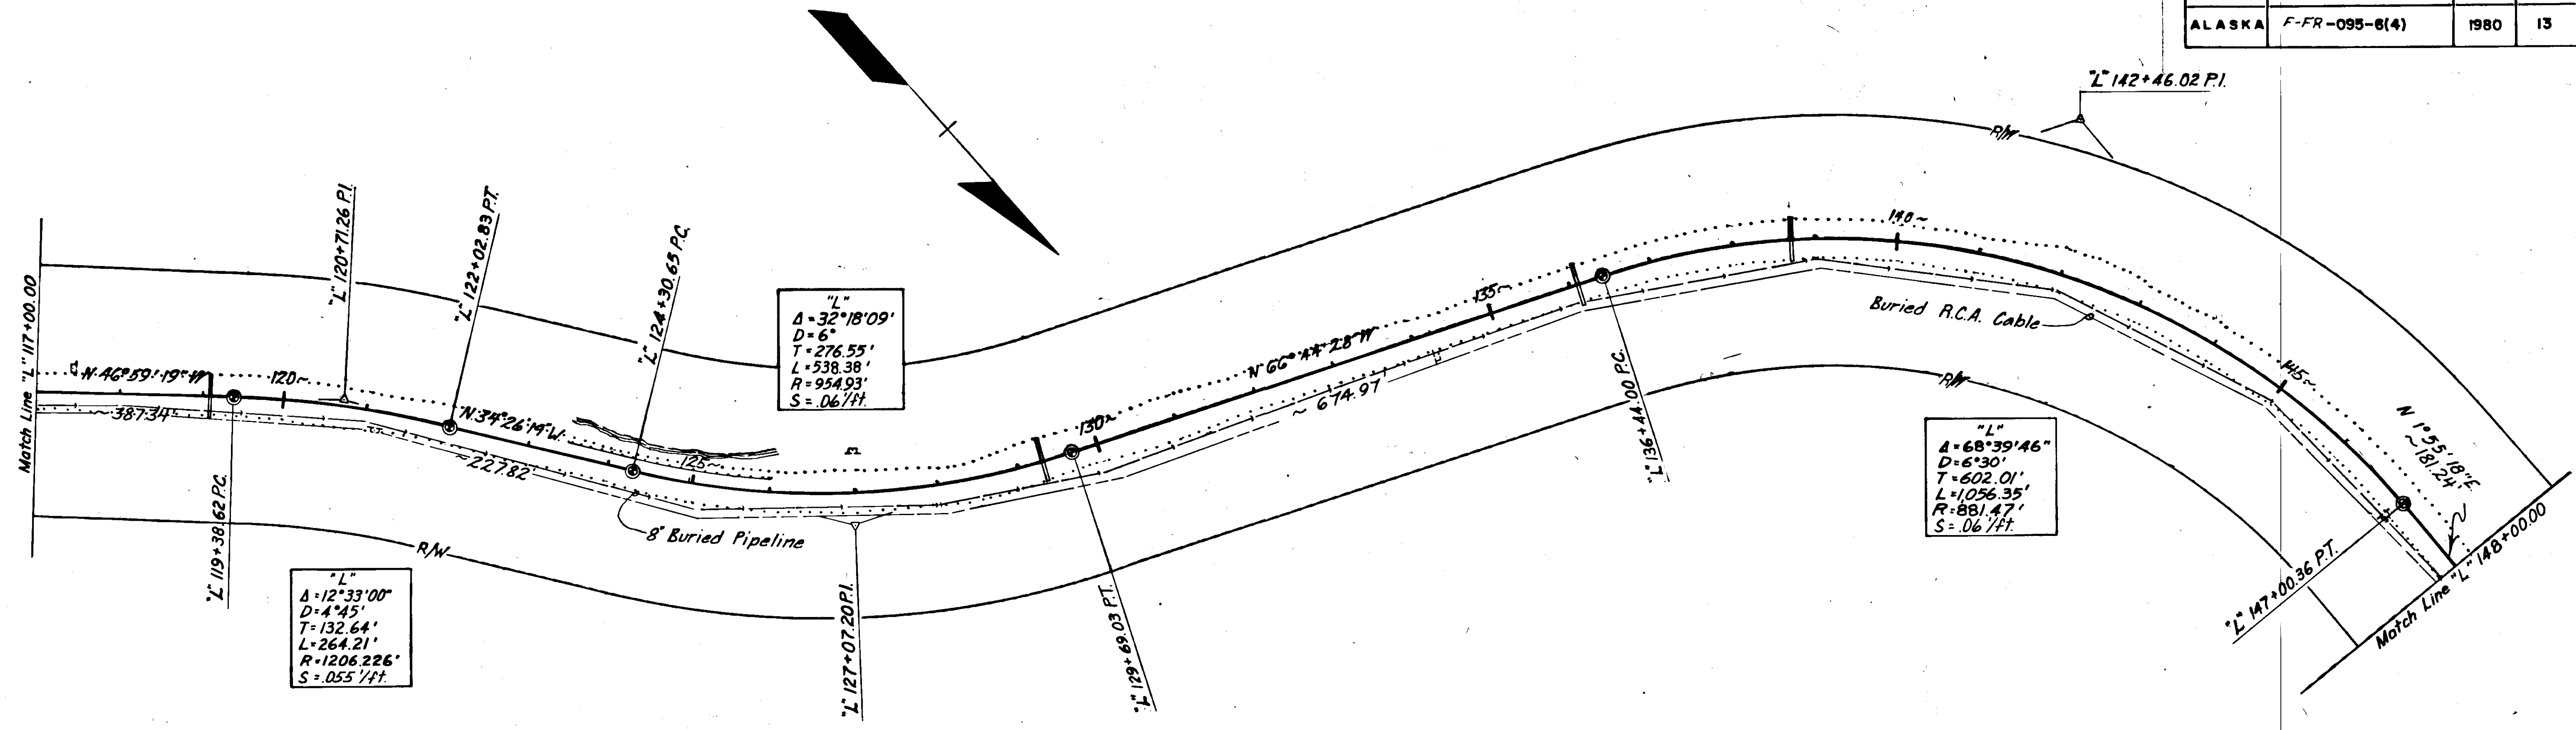


T.B.M. H-7. A spike in a 20" cottonwood 94.6' ft. of sta. L' 117+67. Elev. 62.07



T.B.M. H-9. A spike in a 12" cottonwood 50.5' ft. of sta. L' 143+34. Elev. 79.57.

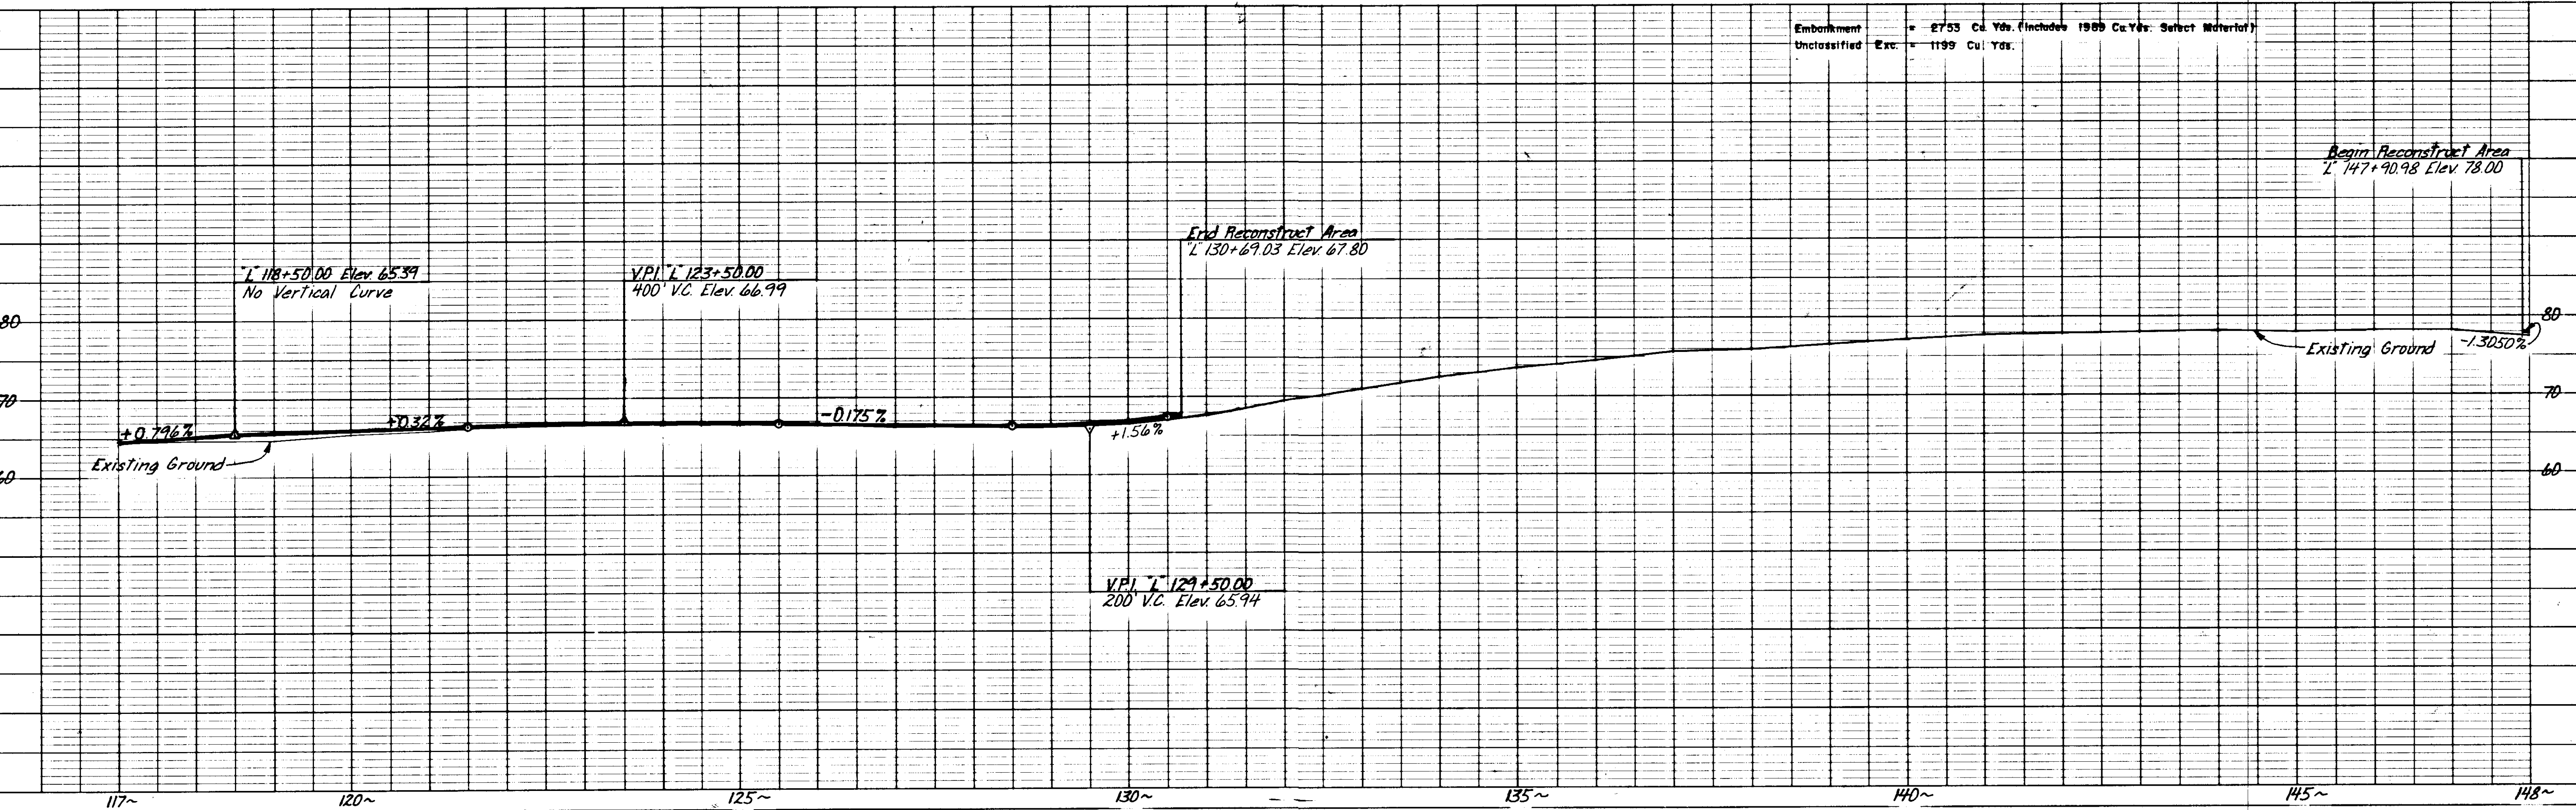



Embankment = 2753 Cu. Yds. (Includes 1989 Cu. Yds. Select Material)
 Unclassified Exc. = 1199 Cu. Yds.

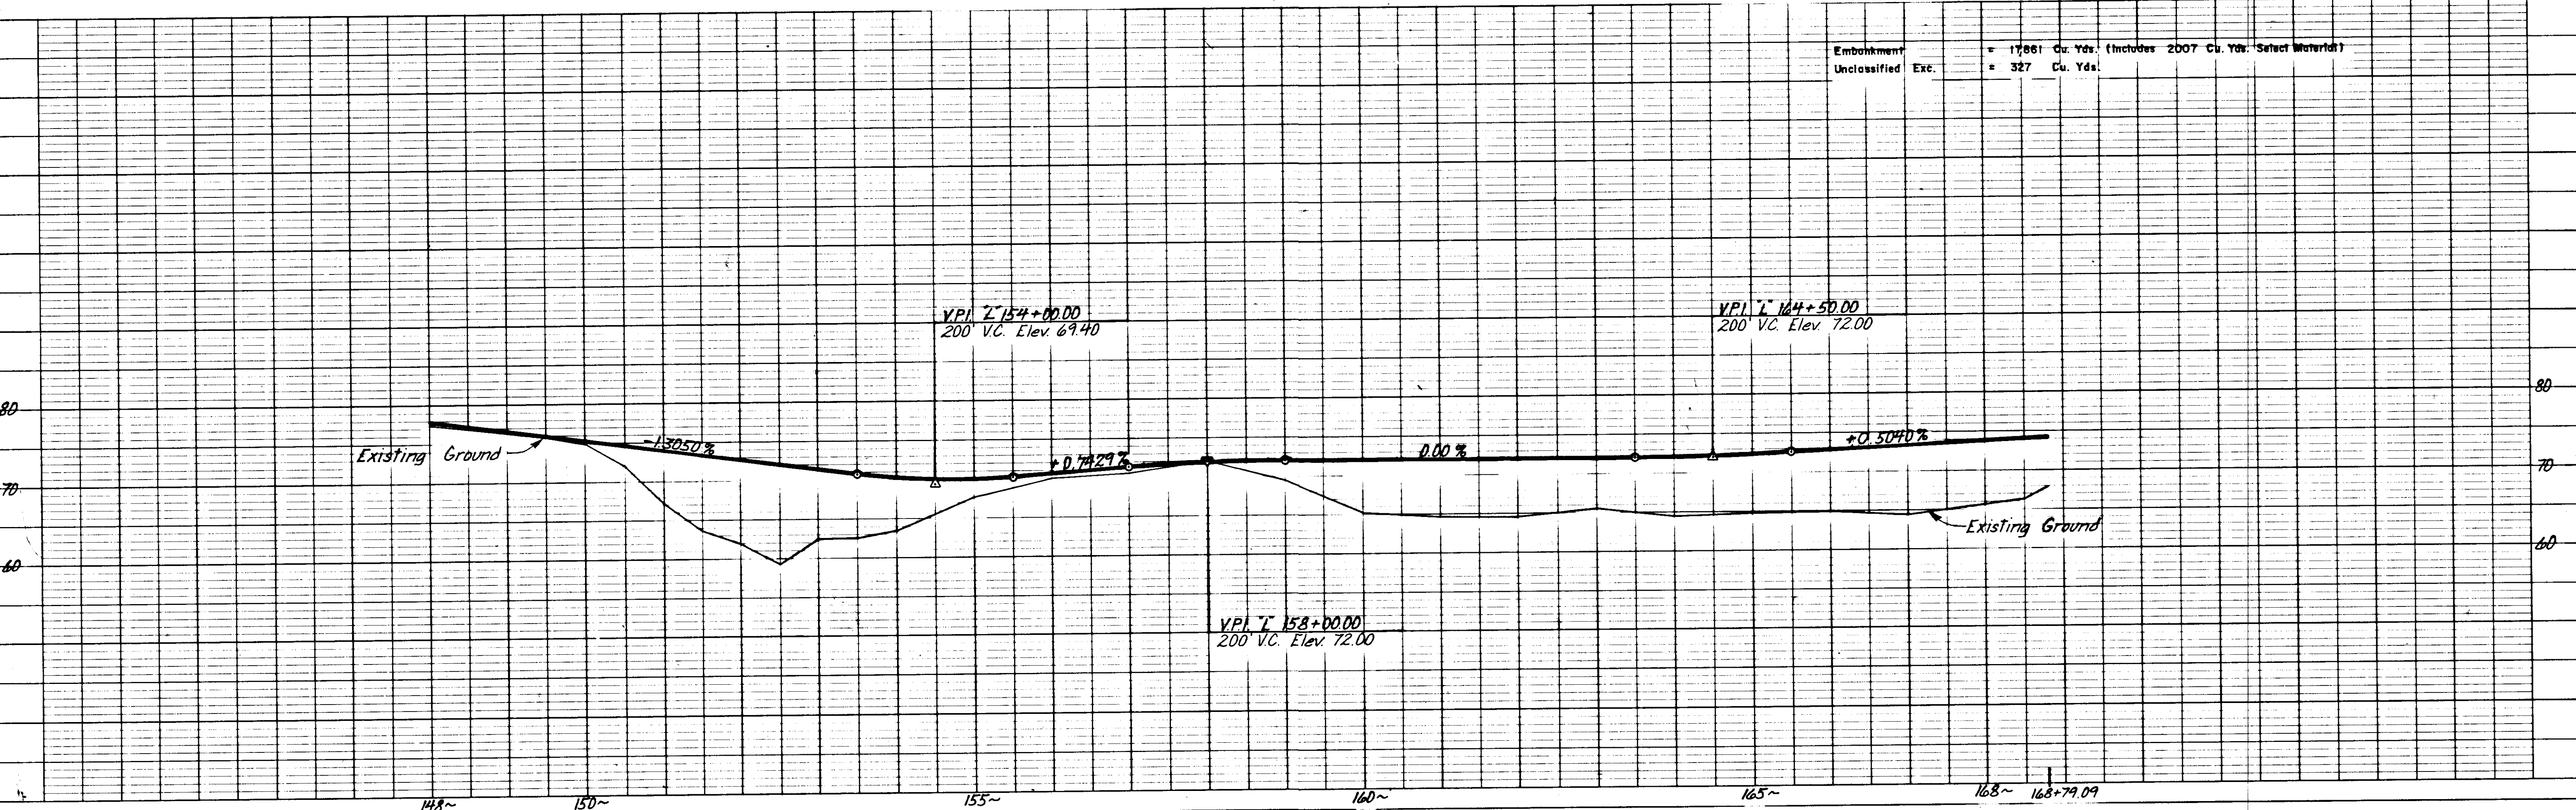
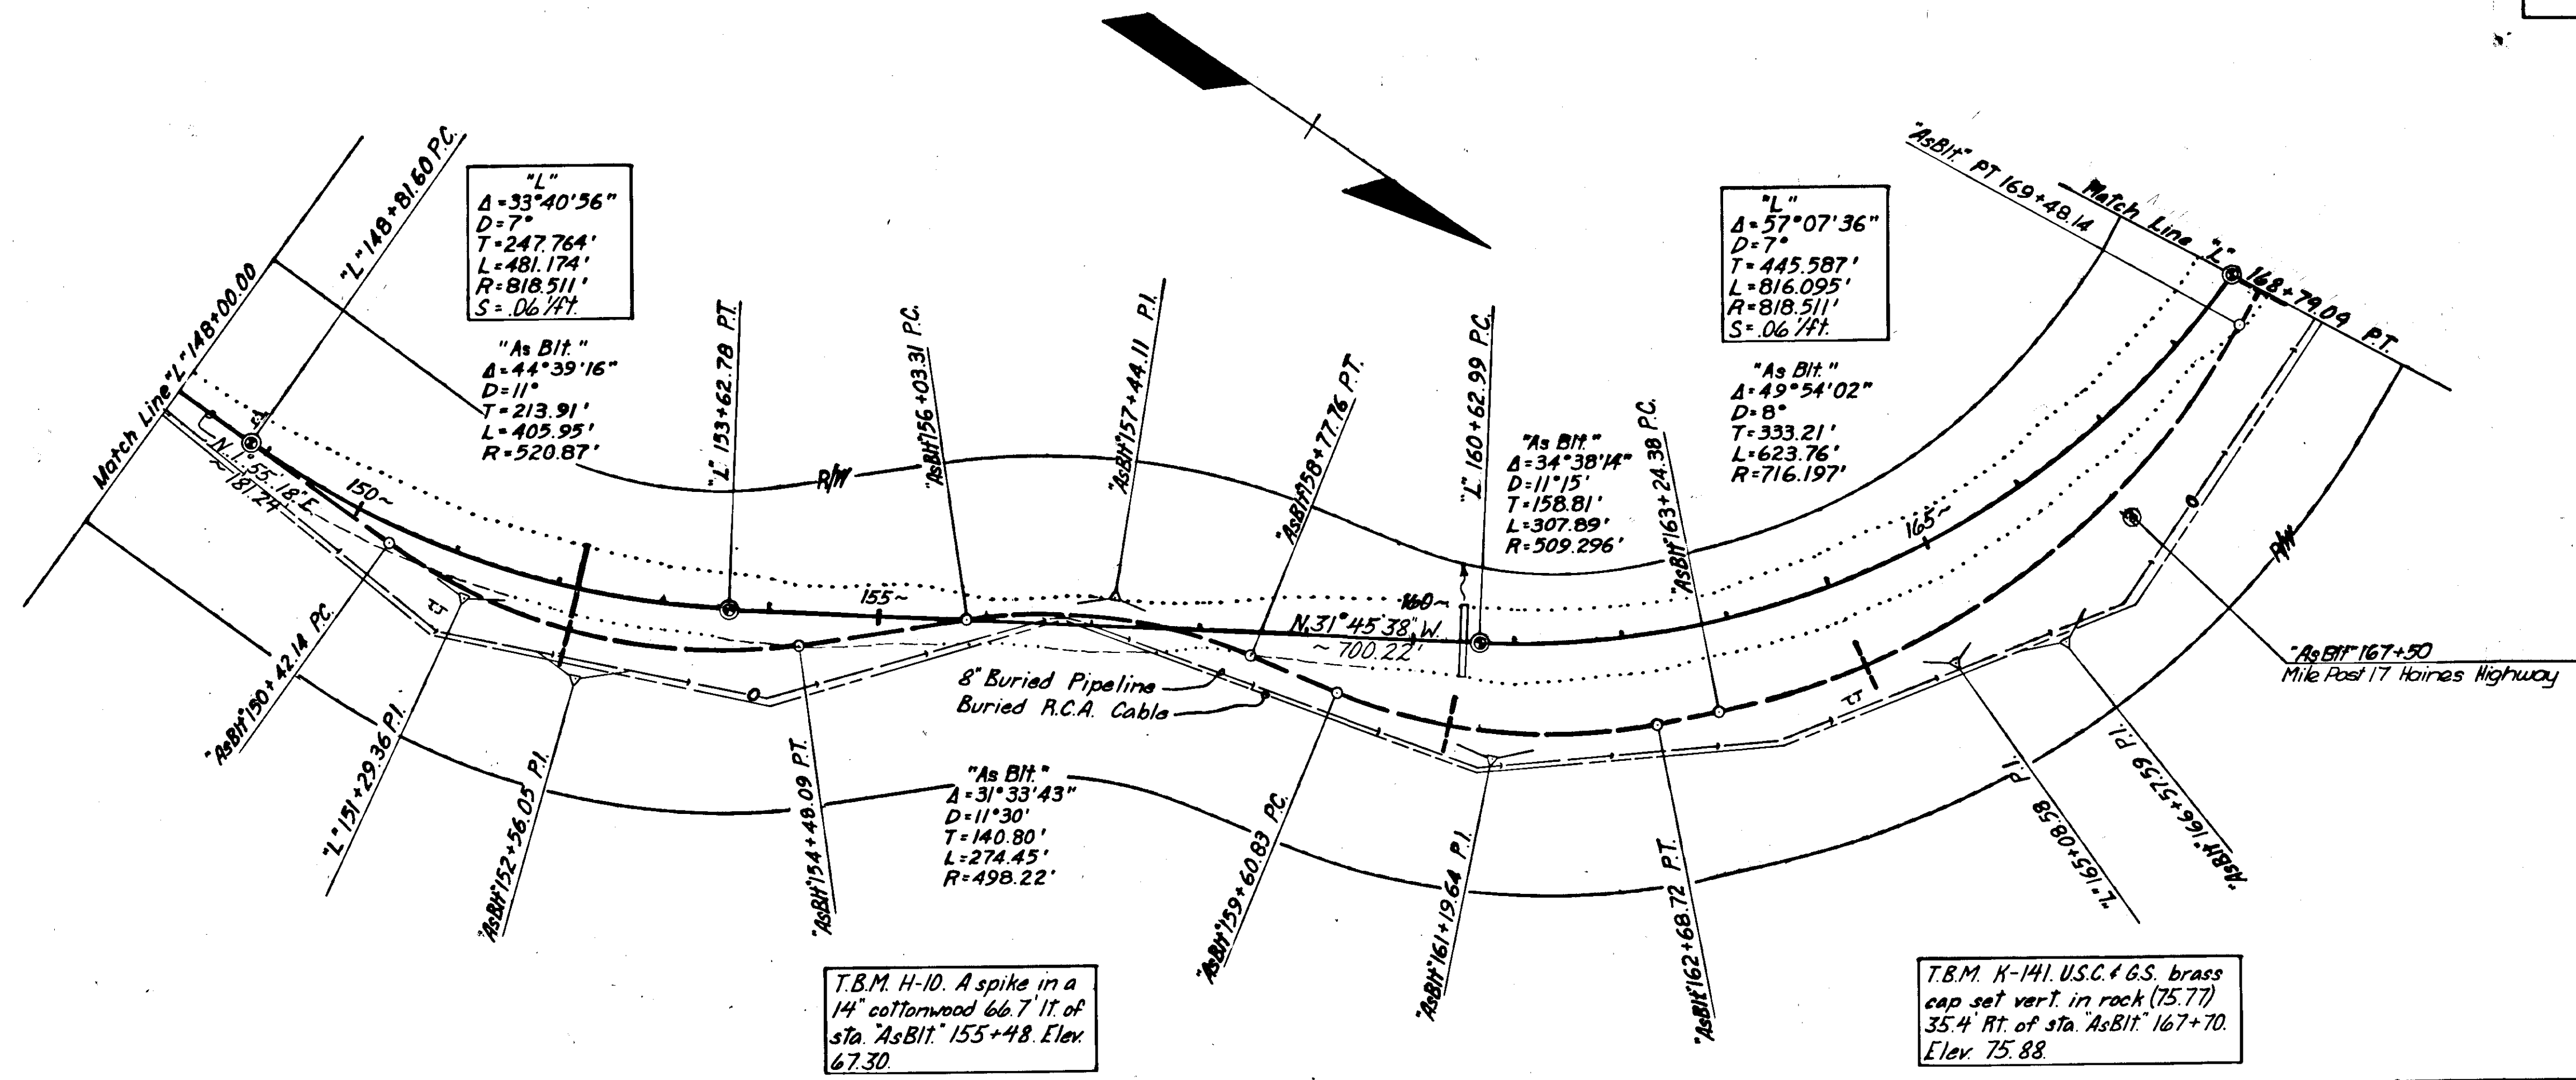


STATE	PROJECT DESIGNATION	YEAR	SHEET NO.	TOTAL SHEETS
ALASKA	F-FR-095-6(4)	1980	15	26

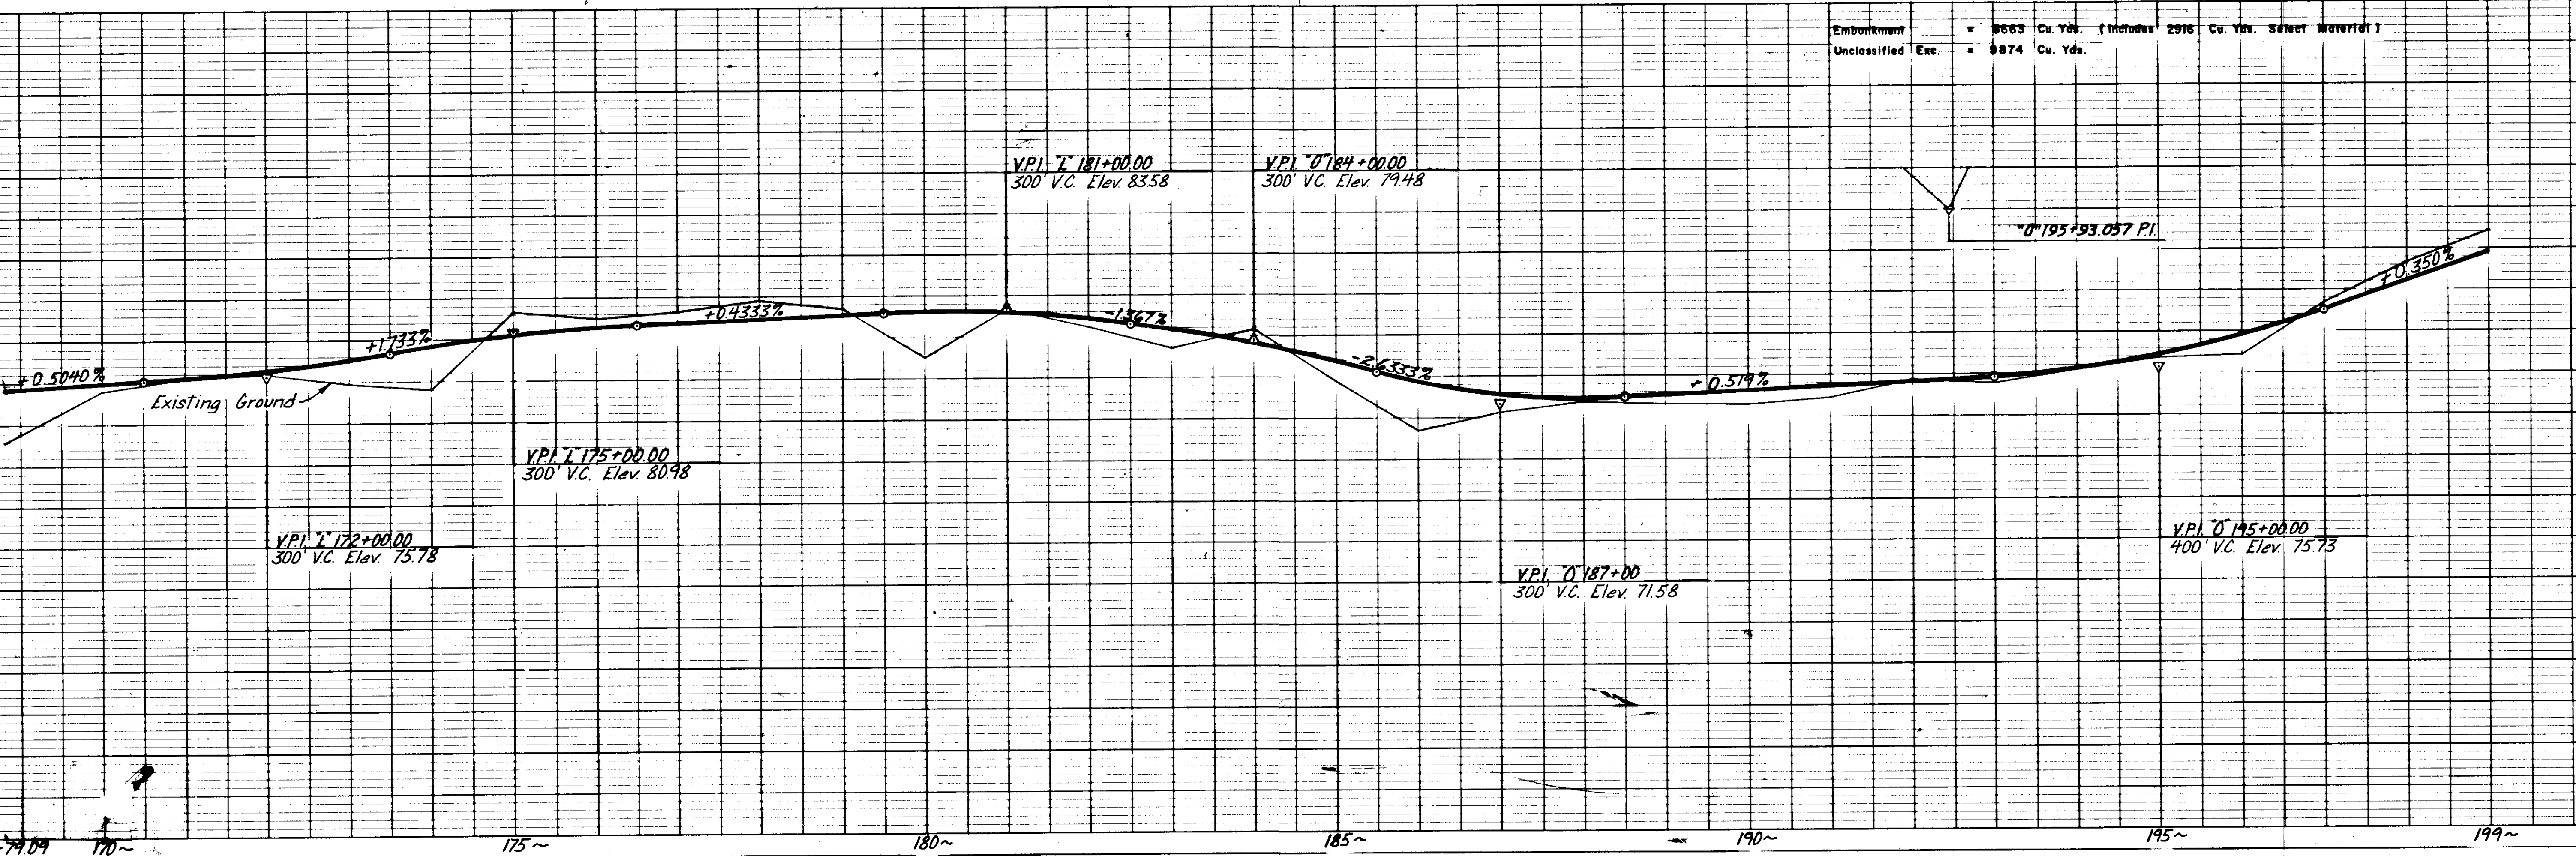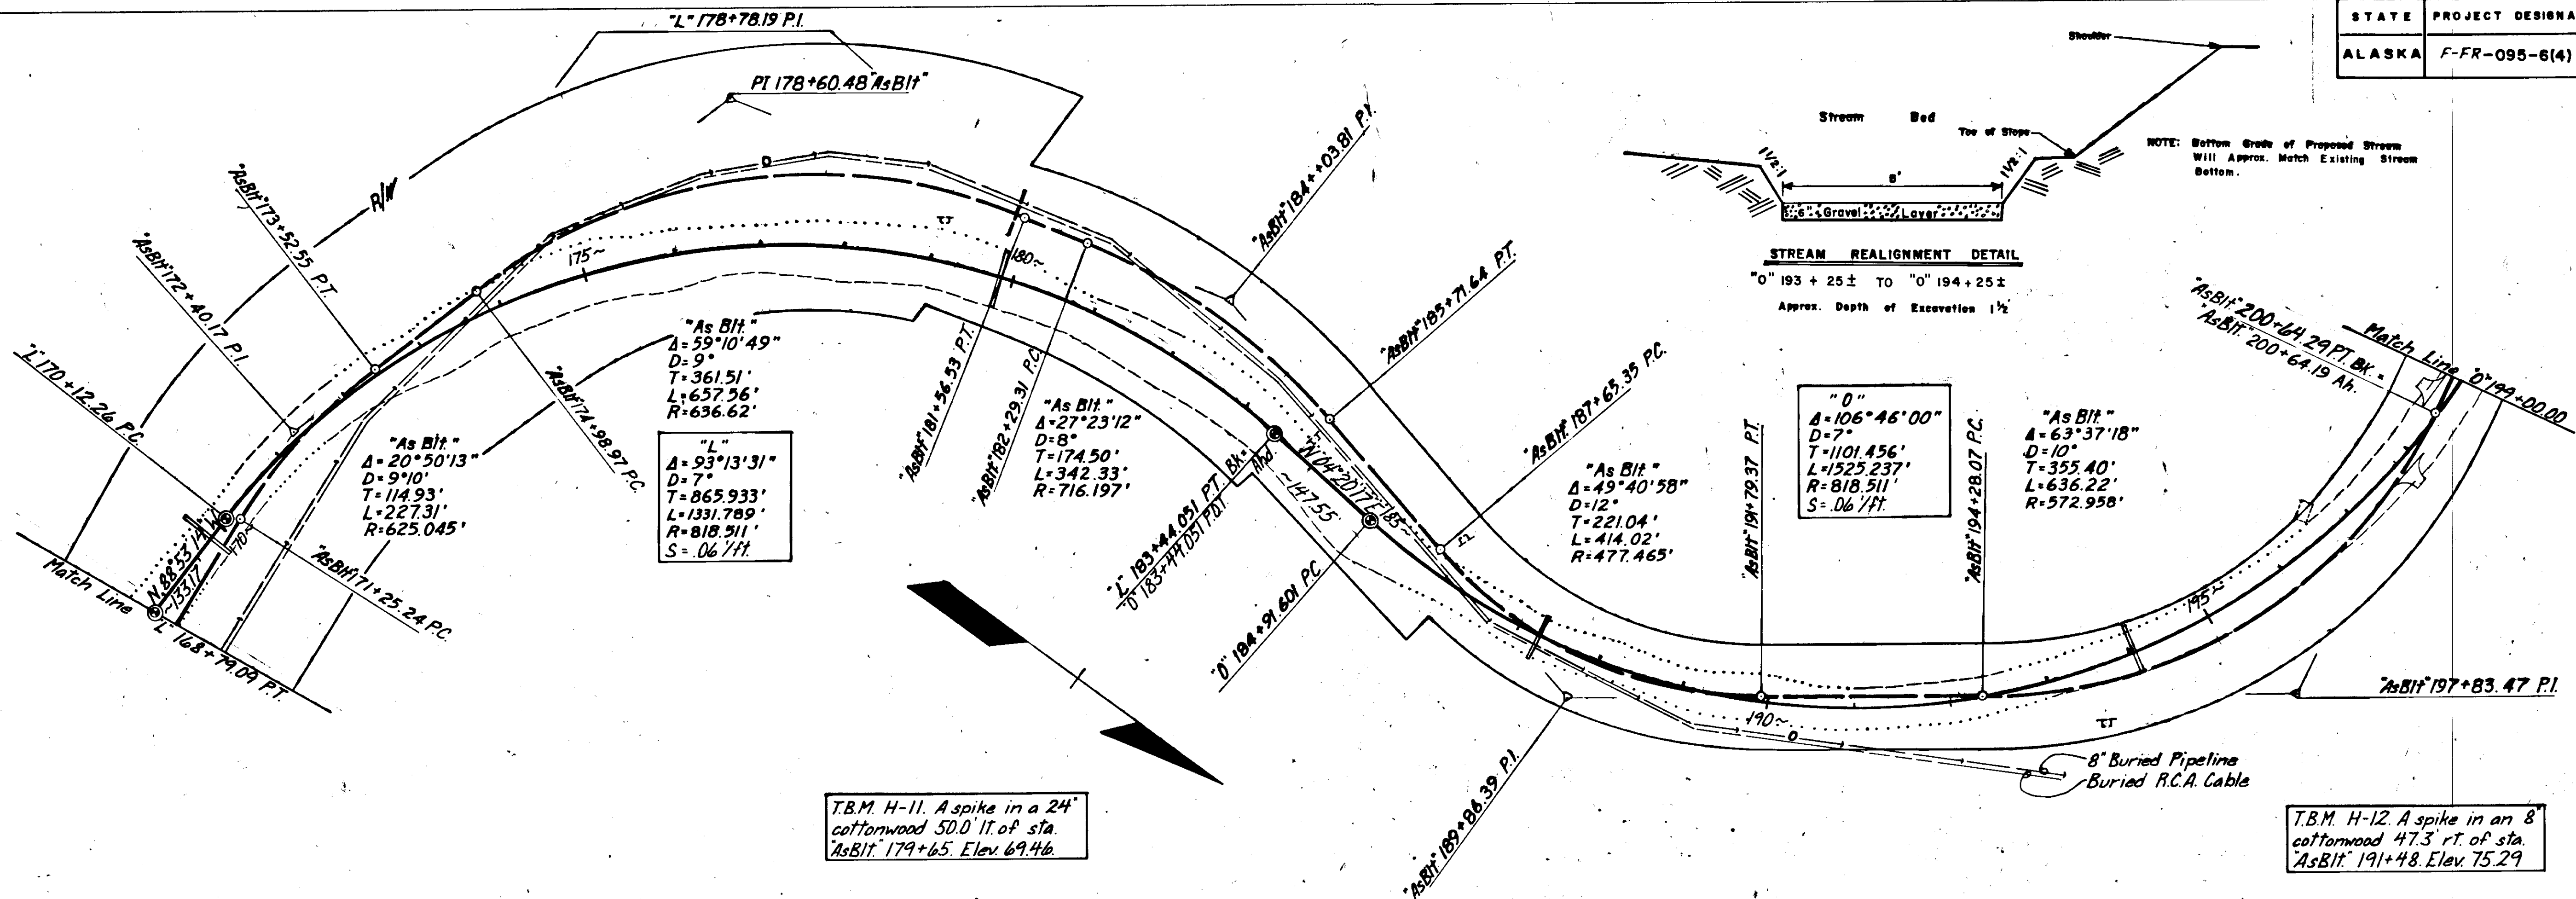



STATE	PROJECT DESIGNATION	YEAR	SHEET NO.	TOTAL SHEETS
ALASKA	F-FR-095-6(4)	1980	16	26

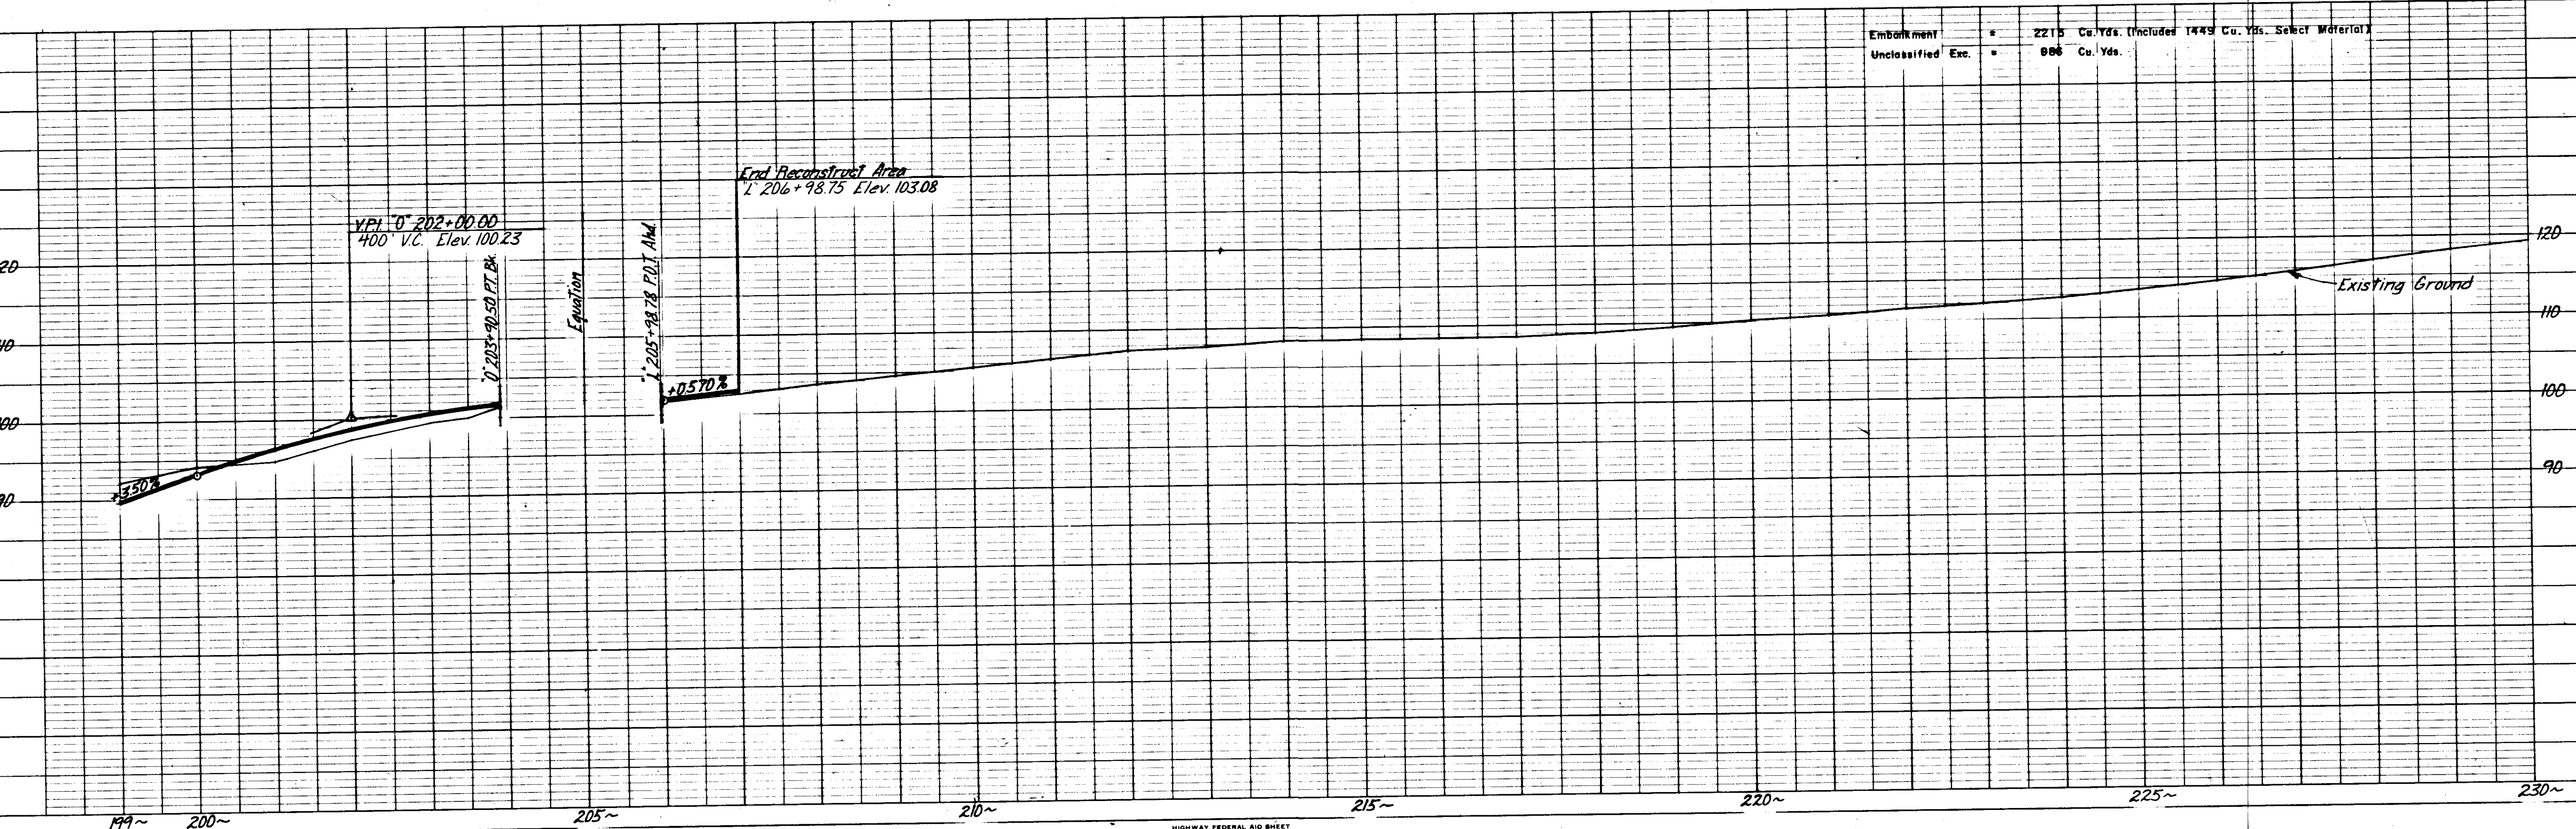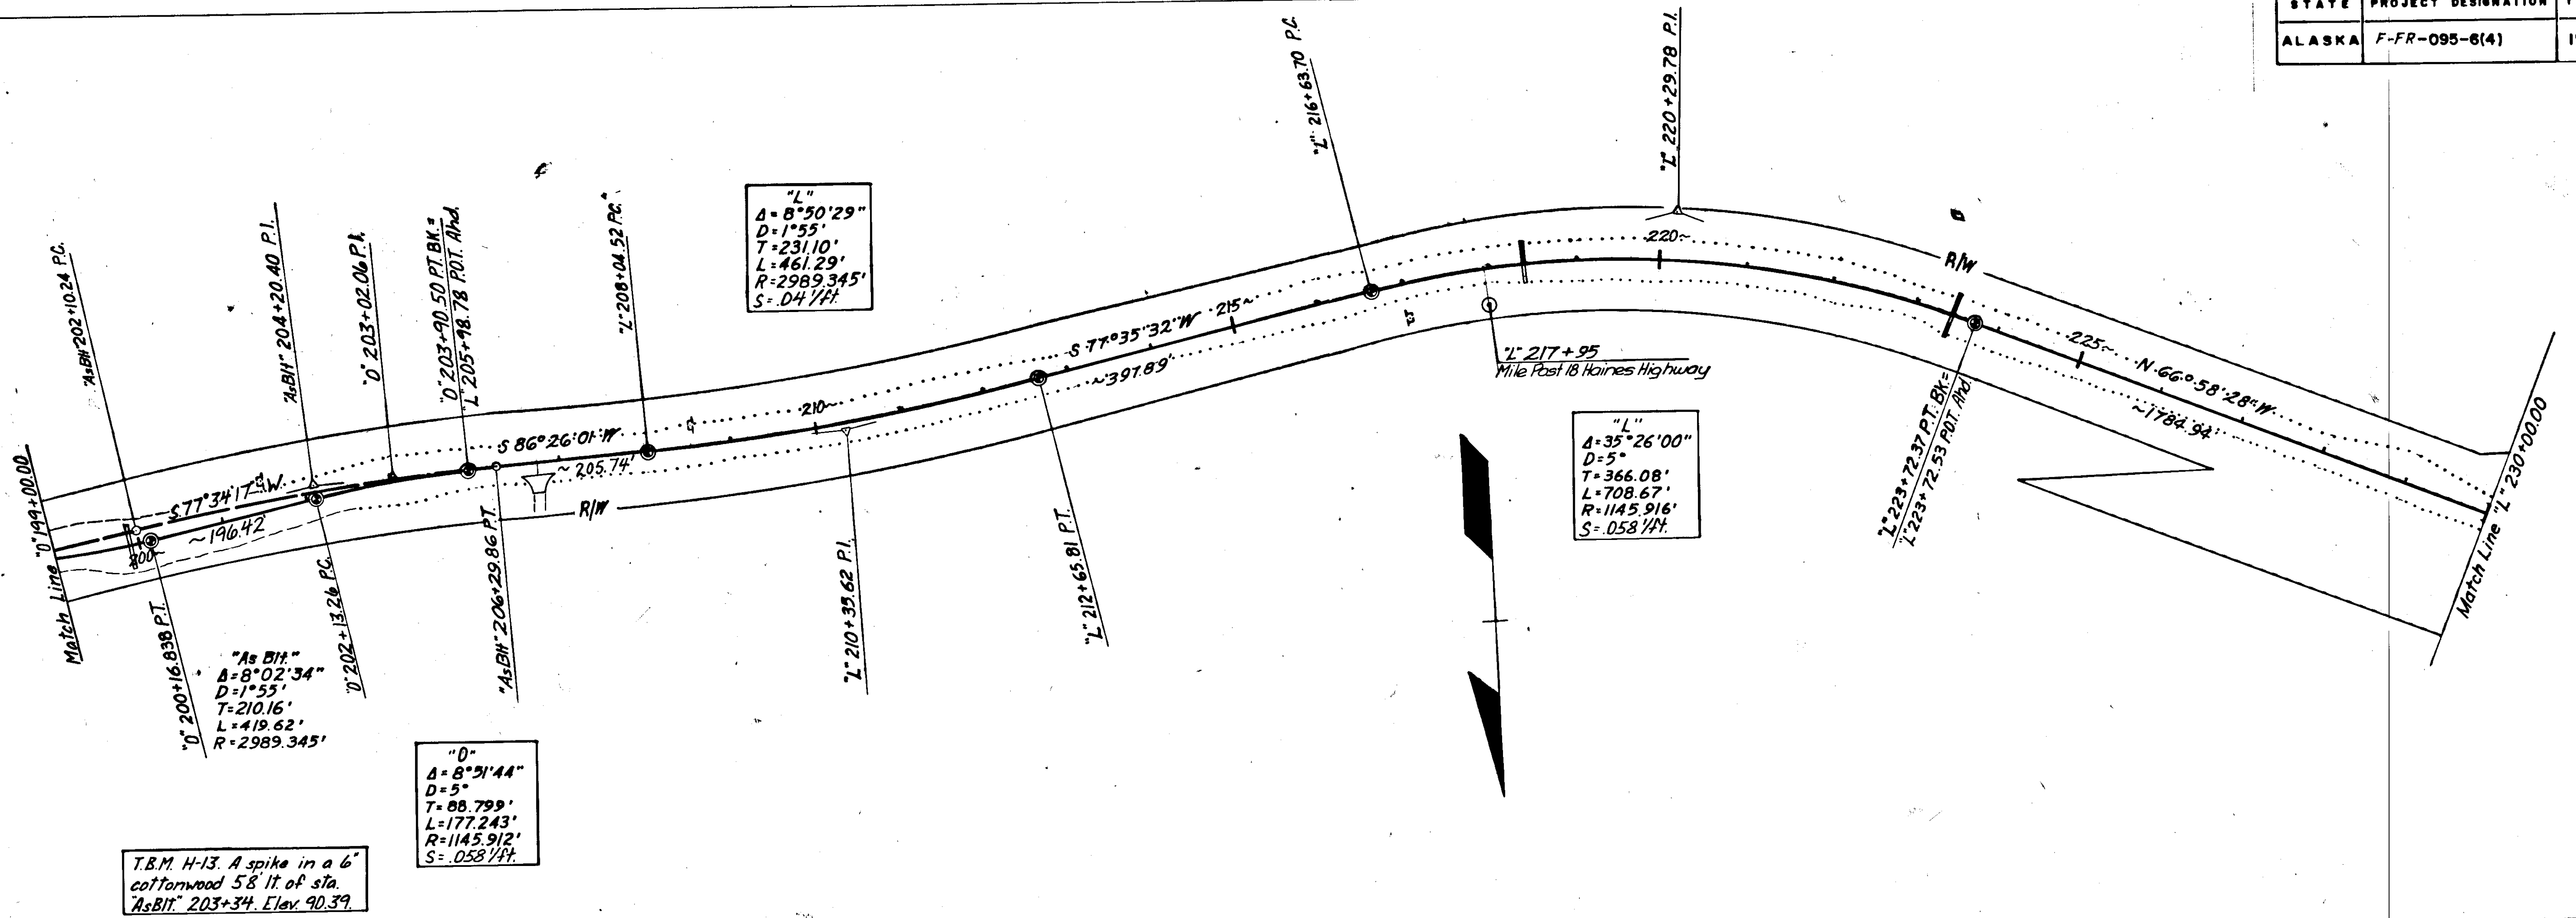

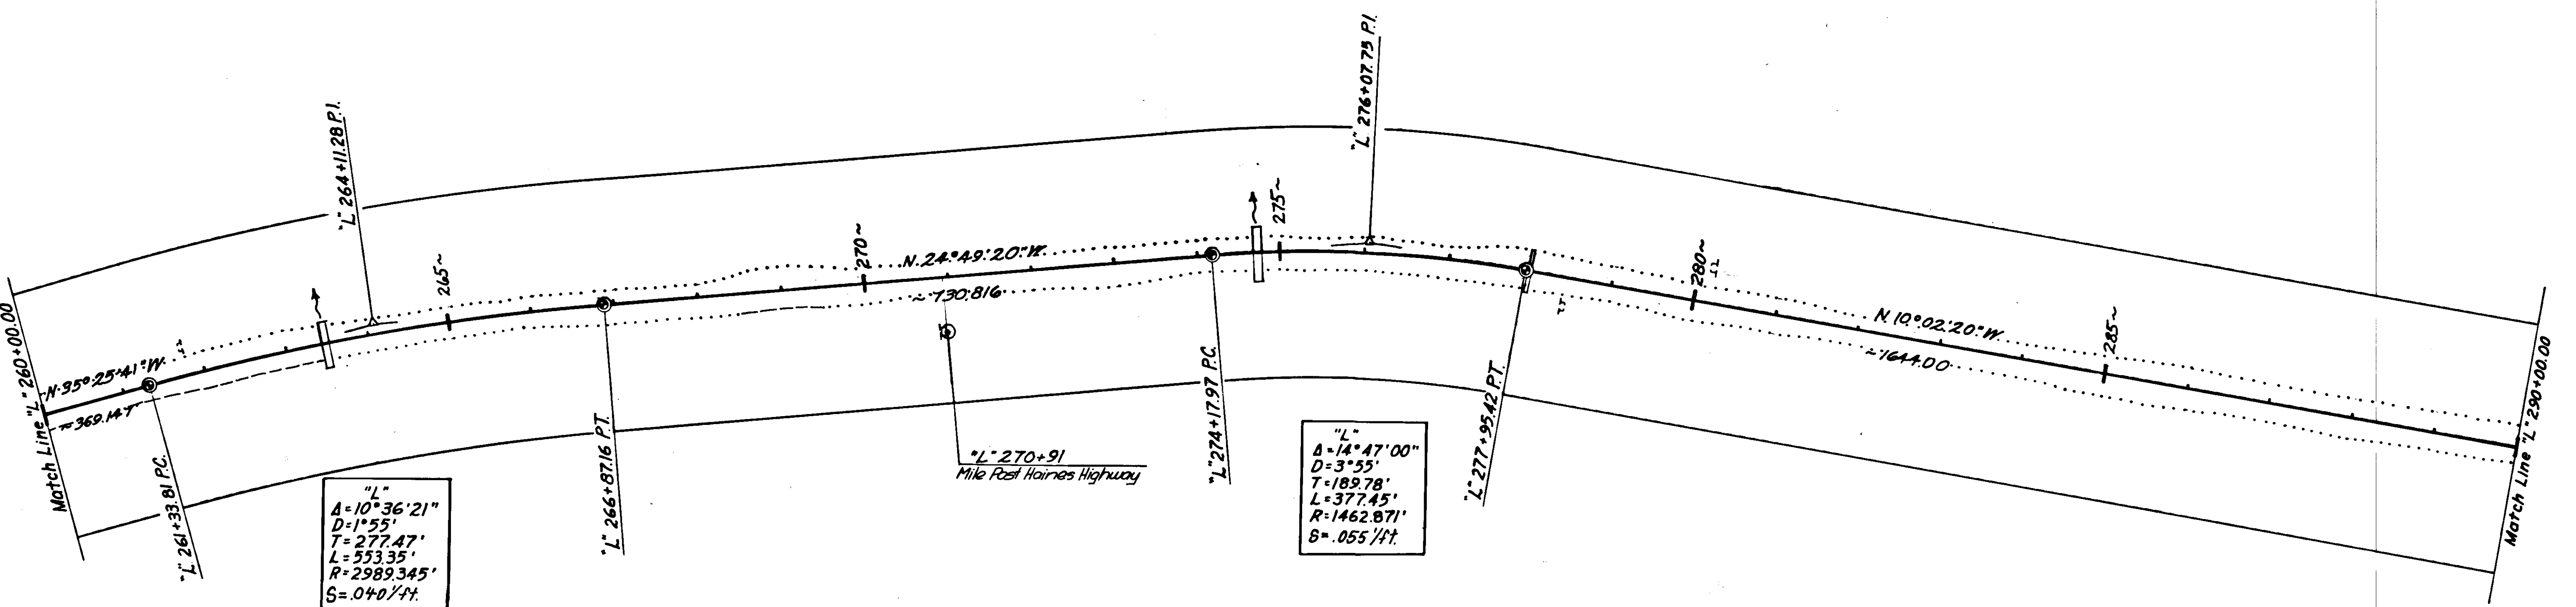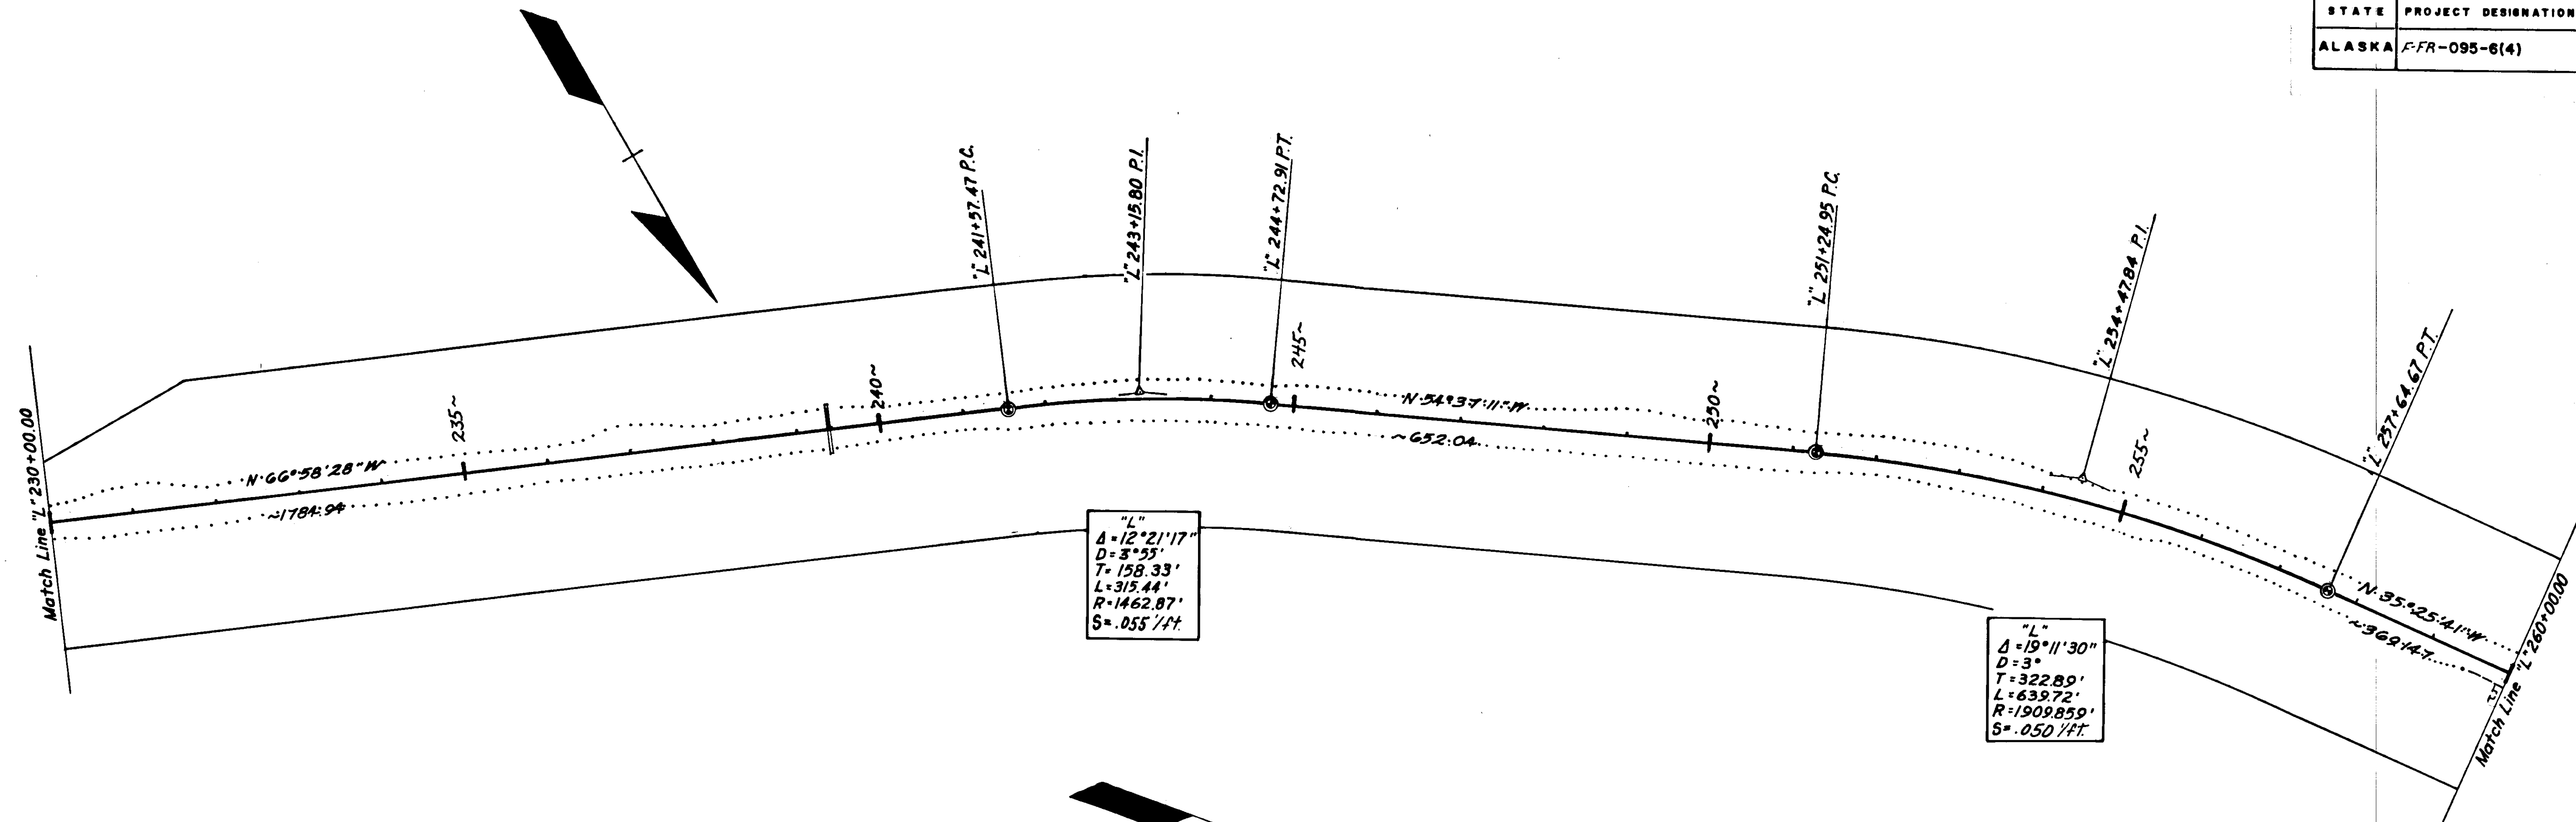



Embankment = 2963 Cu. Yds. (Includes 2291 Cu. Yds. Select Material)
 Unclassified Exc. = 0

STATE	PROJECT DESIGNATION	YEAR	SHEET NO.	TOTAL SHEETS
ALASKA	F-FR-095-6(4)	1980	18	26

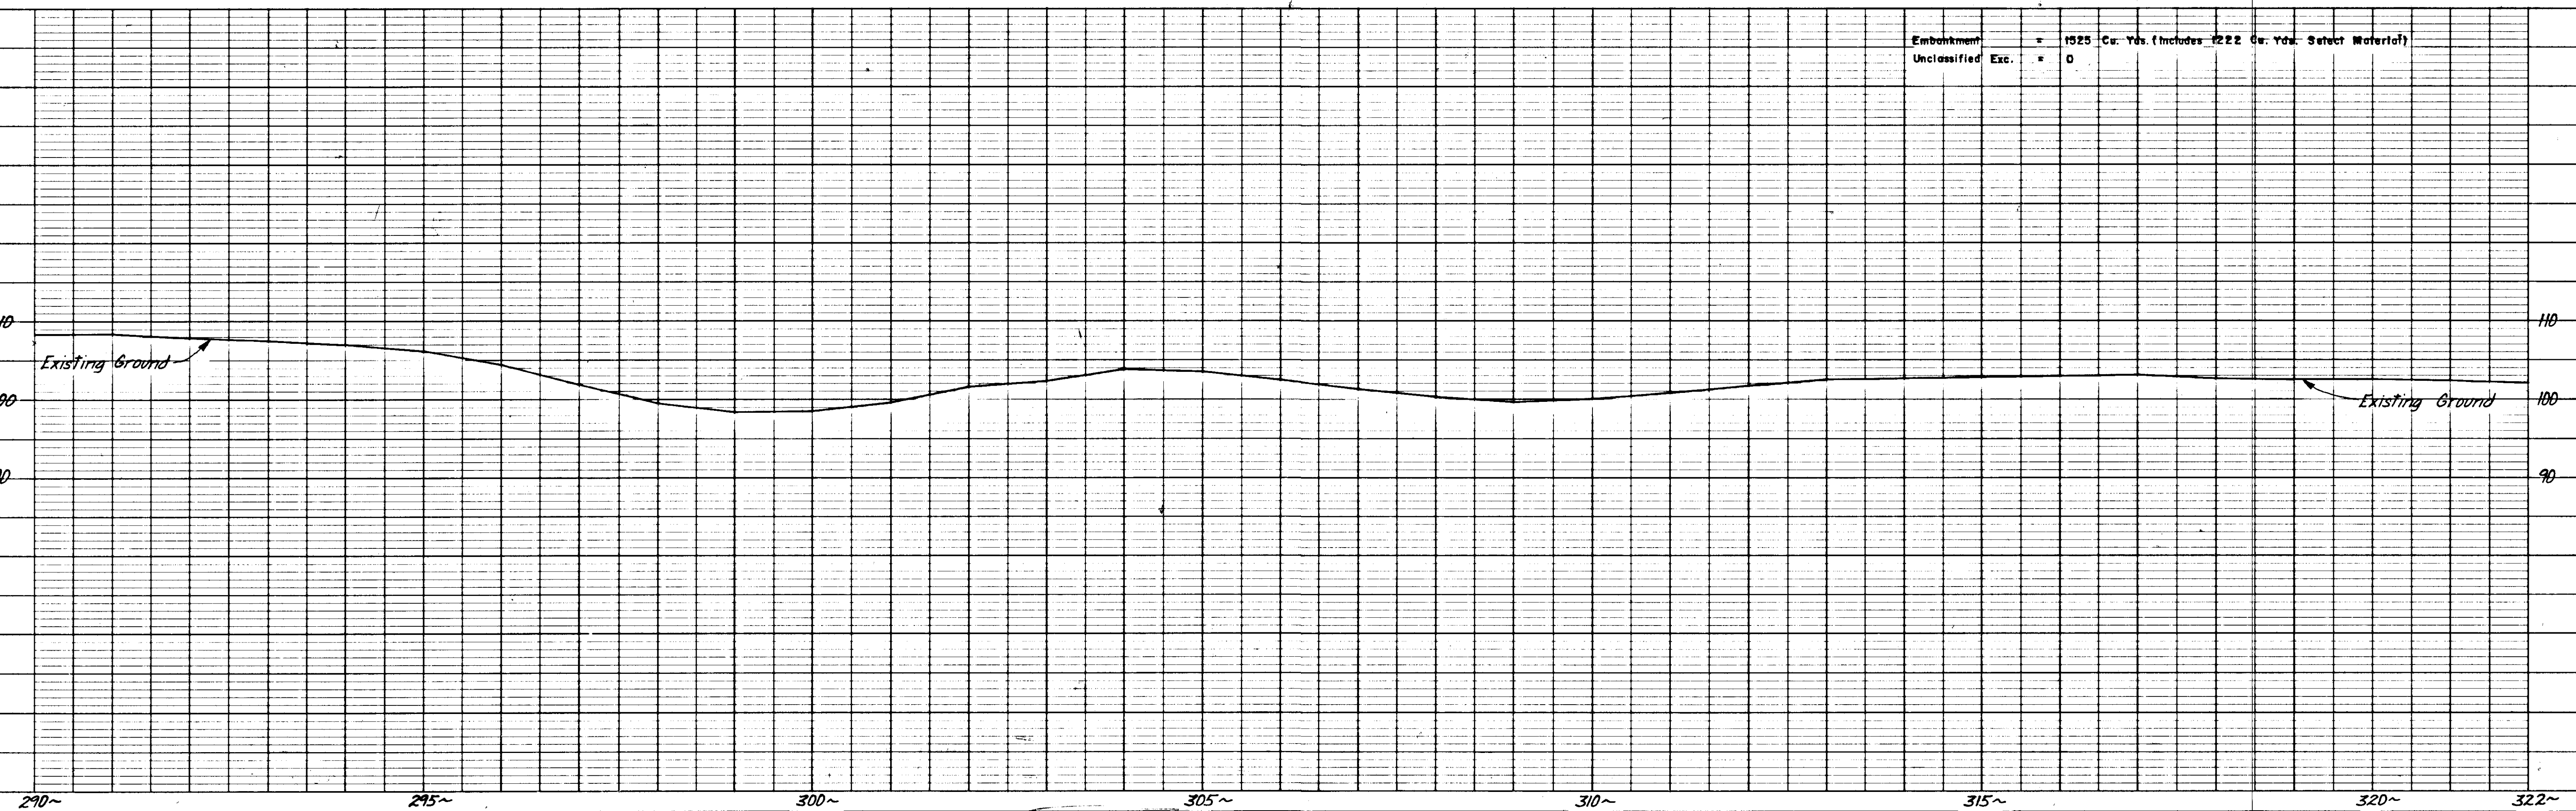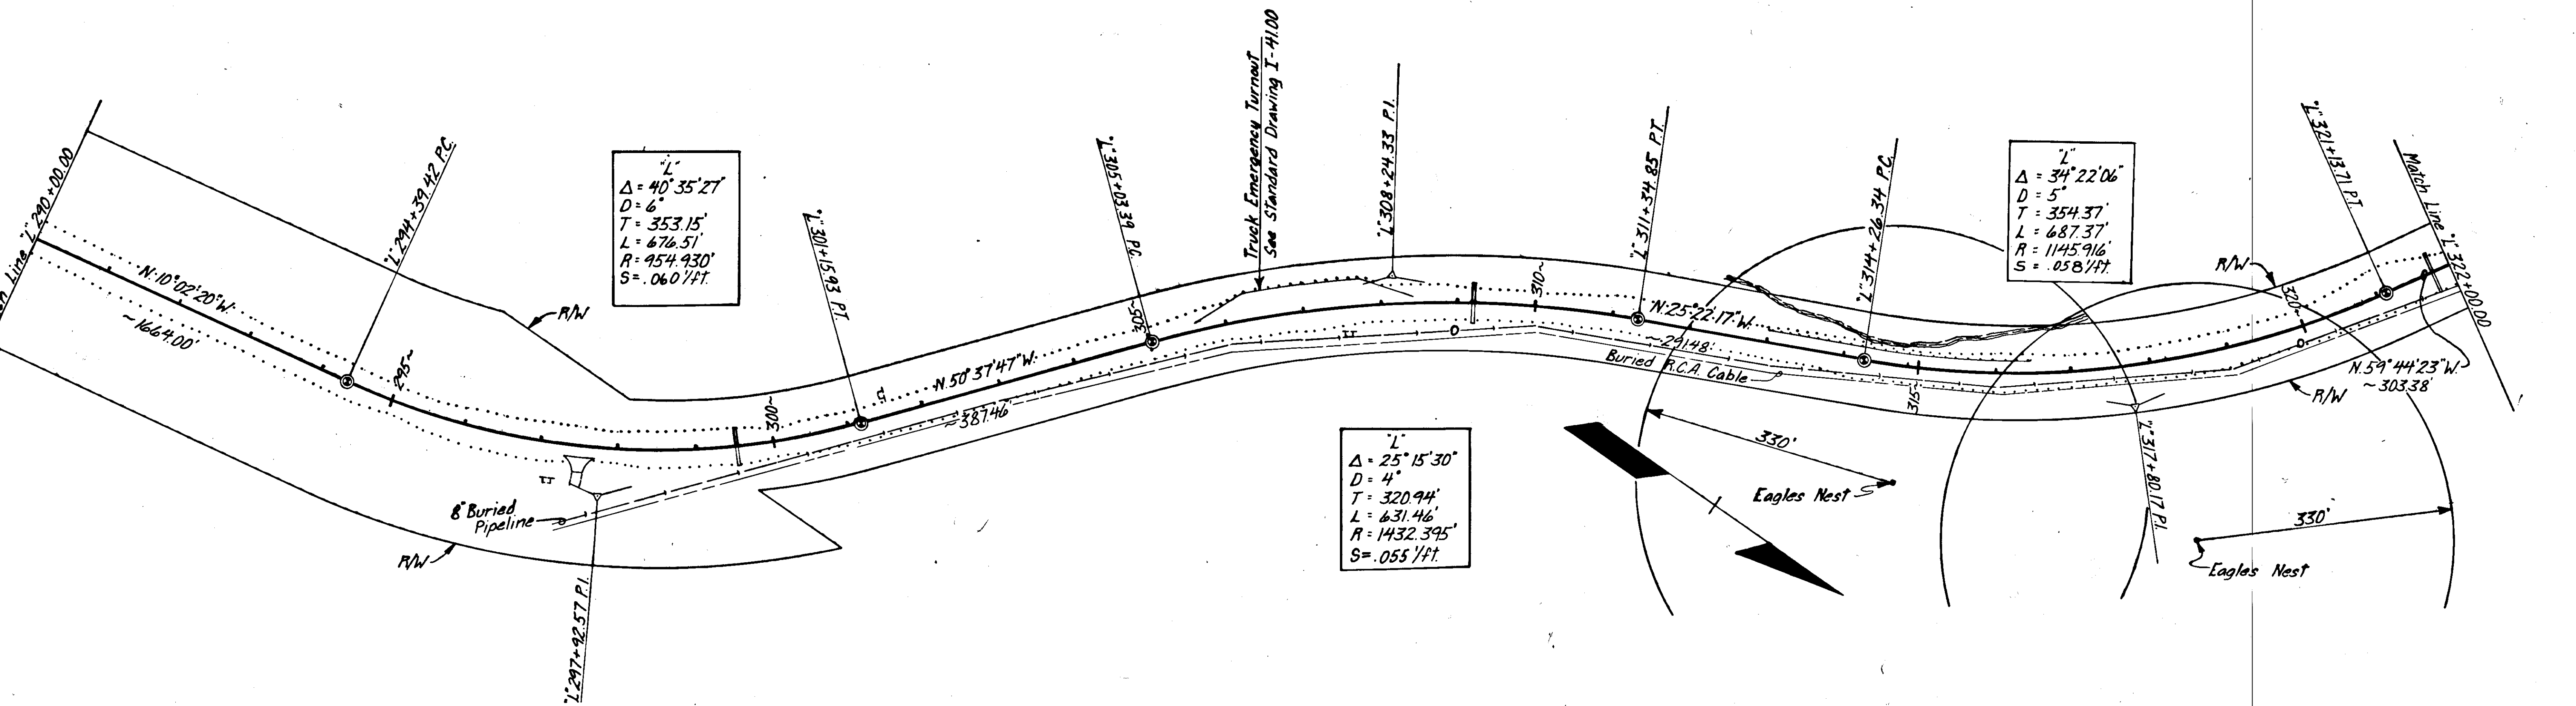



Embankment = 1925 Cu. Yds. (Includes 222 Cu. Yds. Select Material)
 Unclassified Exc. = 0

STATE	PROJECT DESIGNATION	YEAR	SHEET NO.	TOTAL SHEETS
ALASKA	F-FR-095-6(4)	1980	19	26

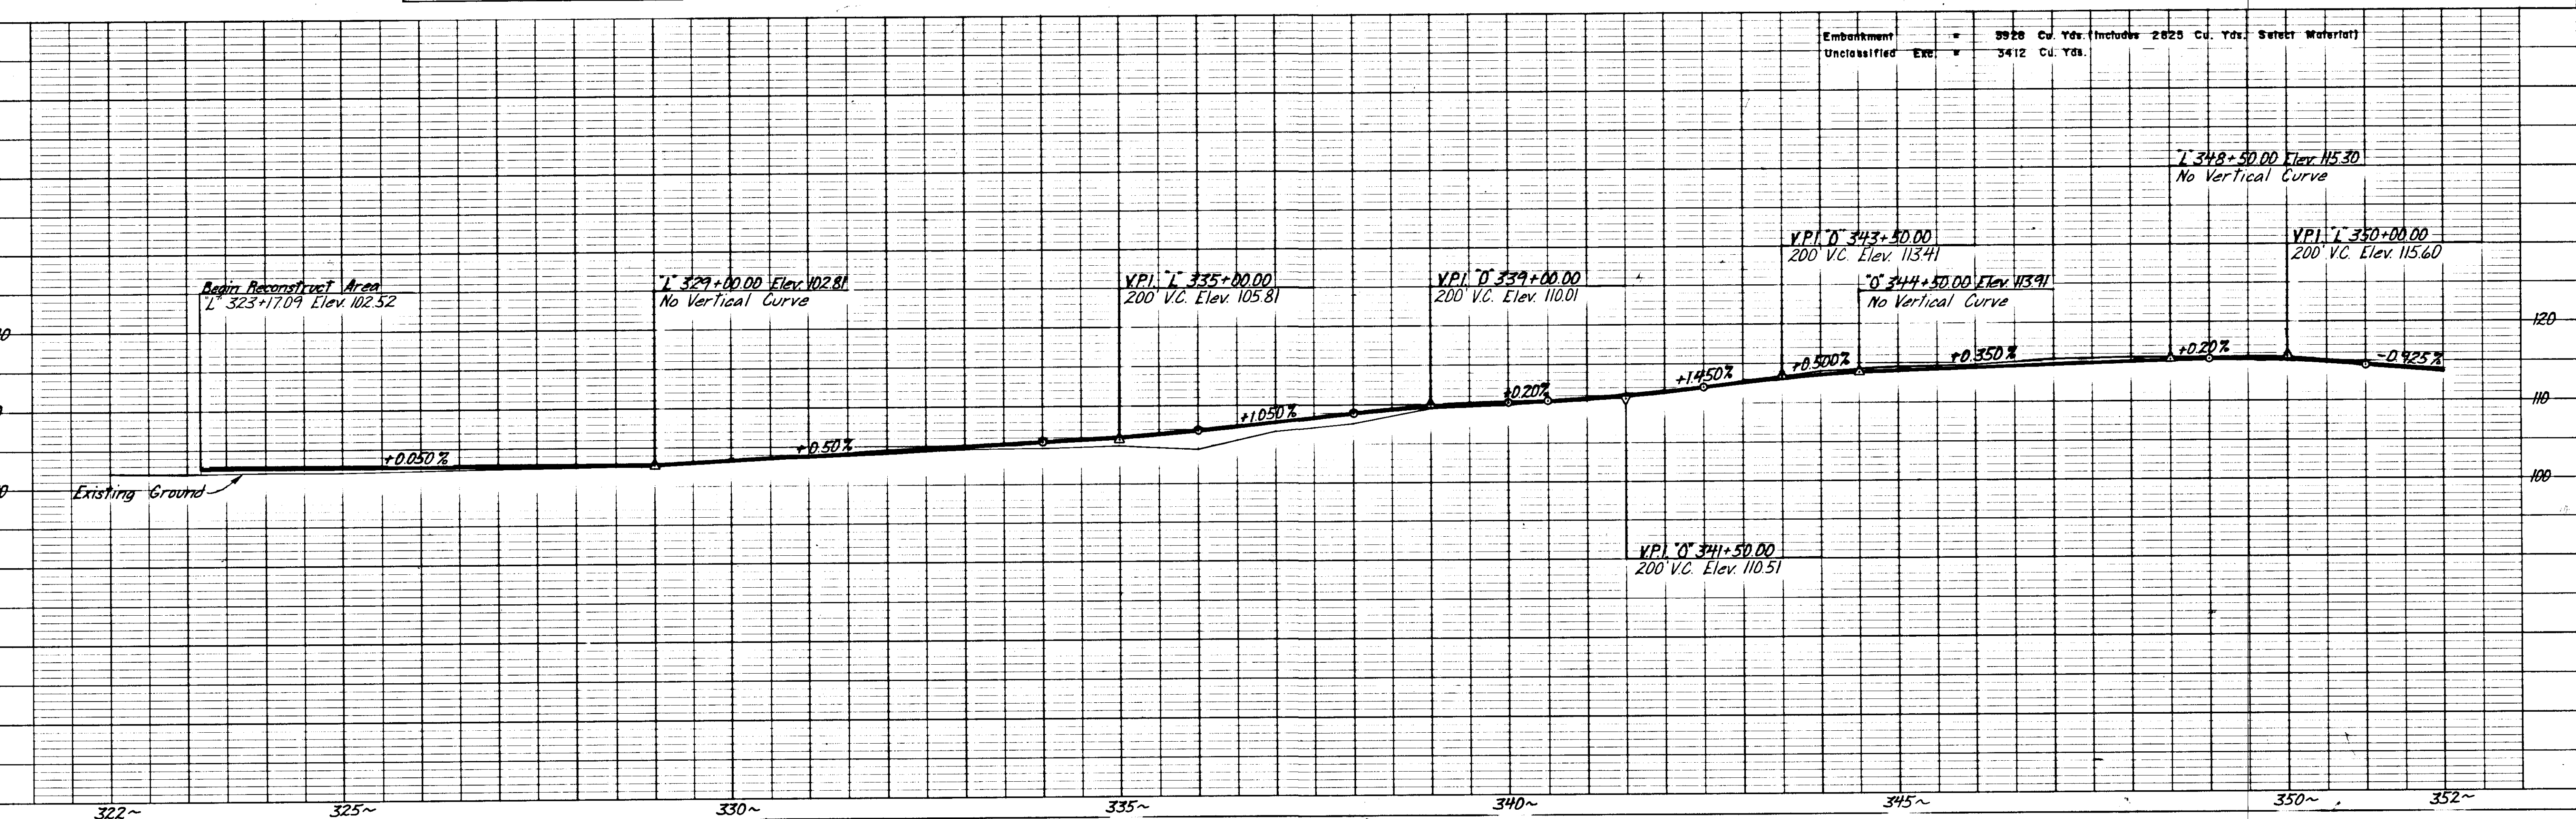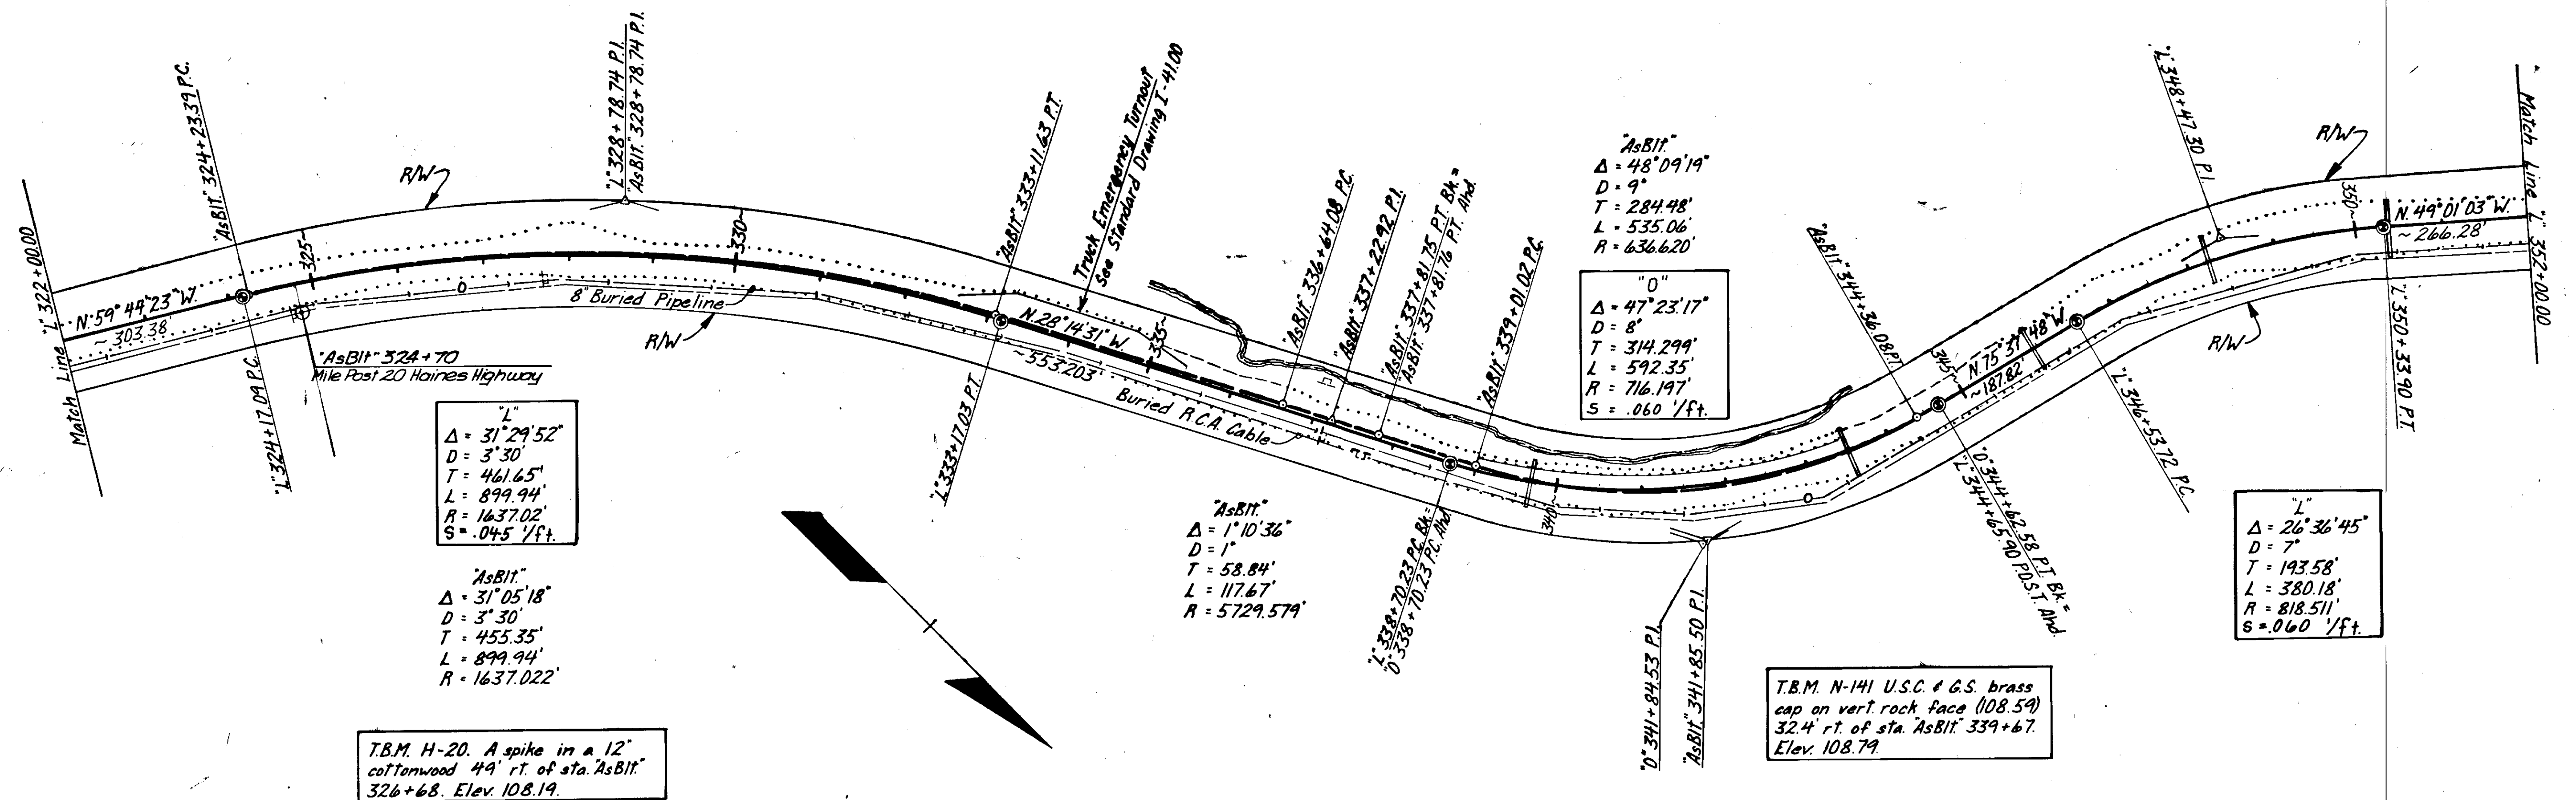


322~ 325~ 330~ 335~ 340~ 345~ 350~ 352~


STATE	PROJECT DESIGNATION	YEAR	SHEET NO.	TOTAL SHEETS
ALASKA	F-FR-095-6(4)	1980	20	26

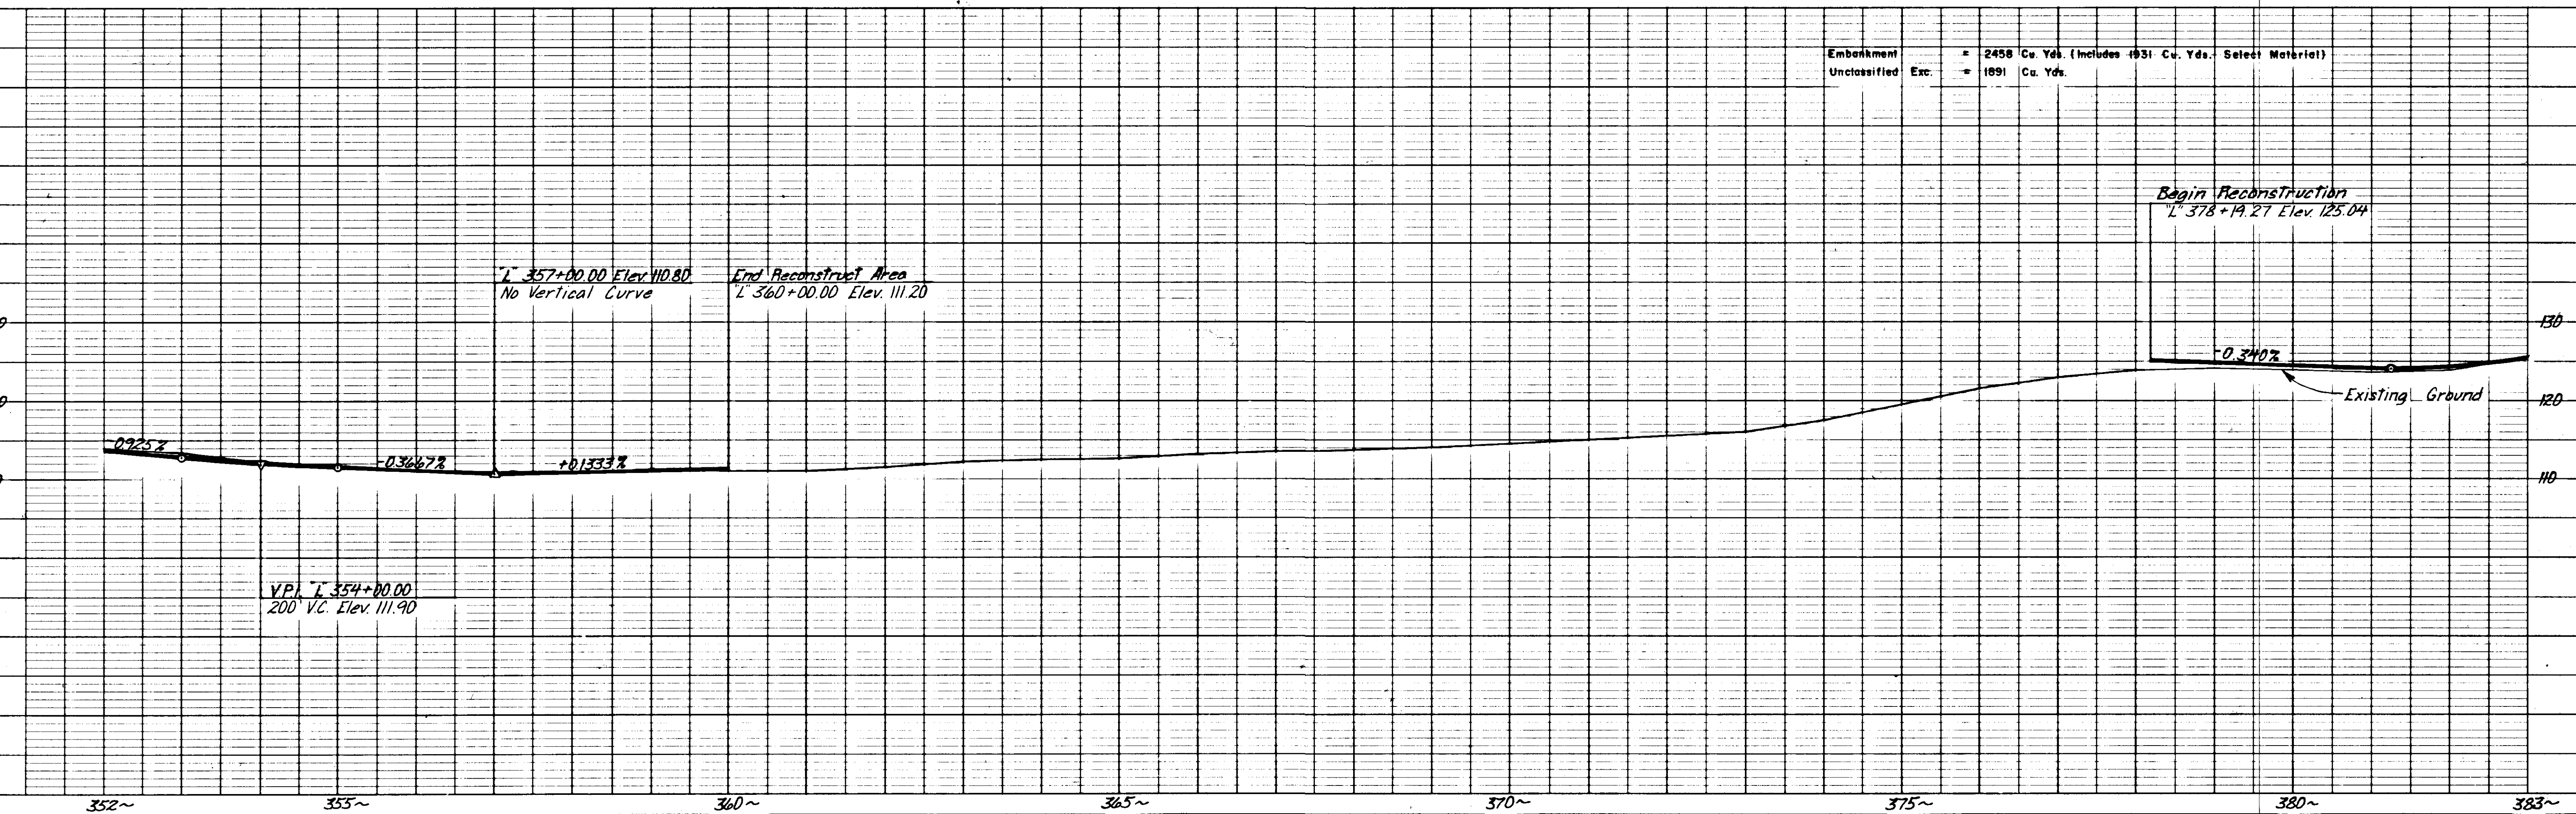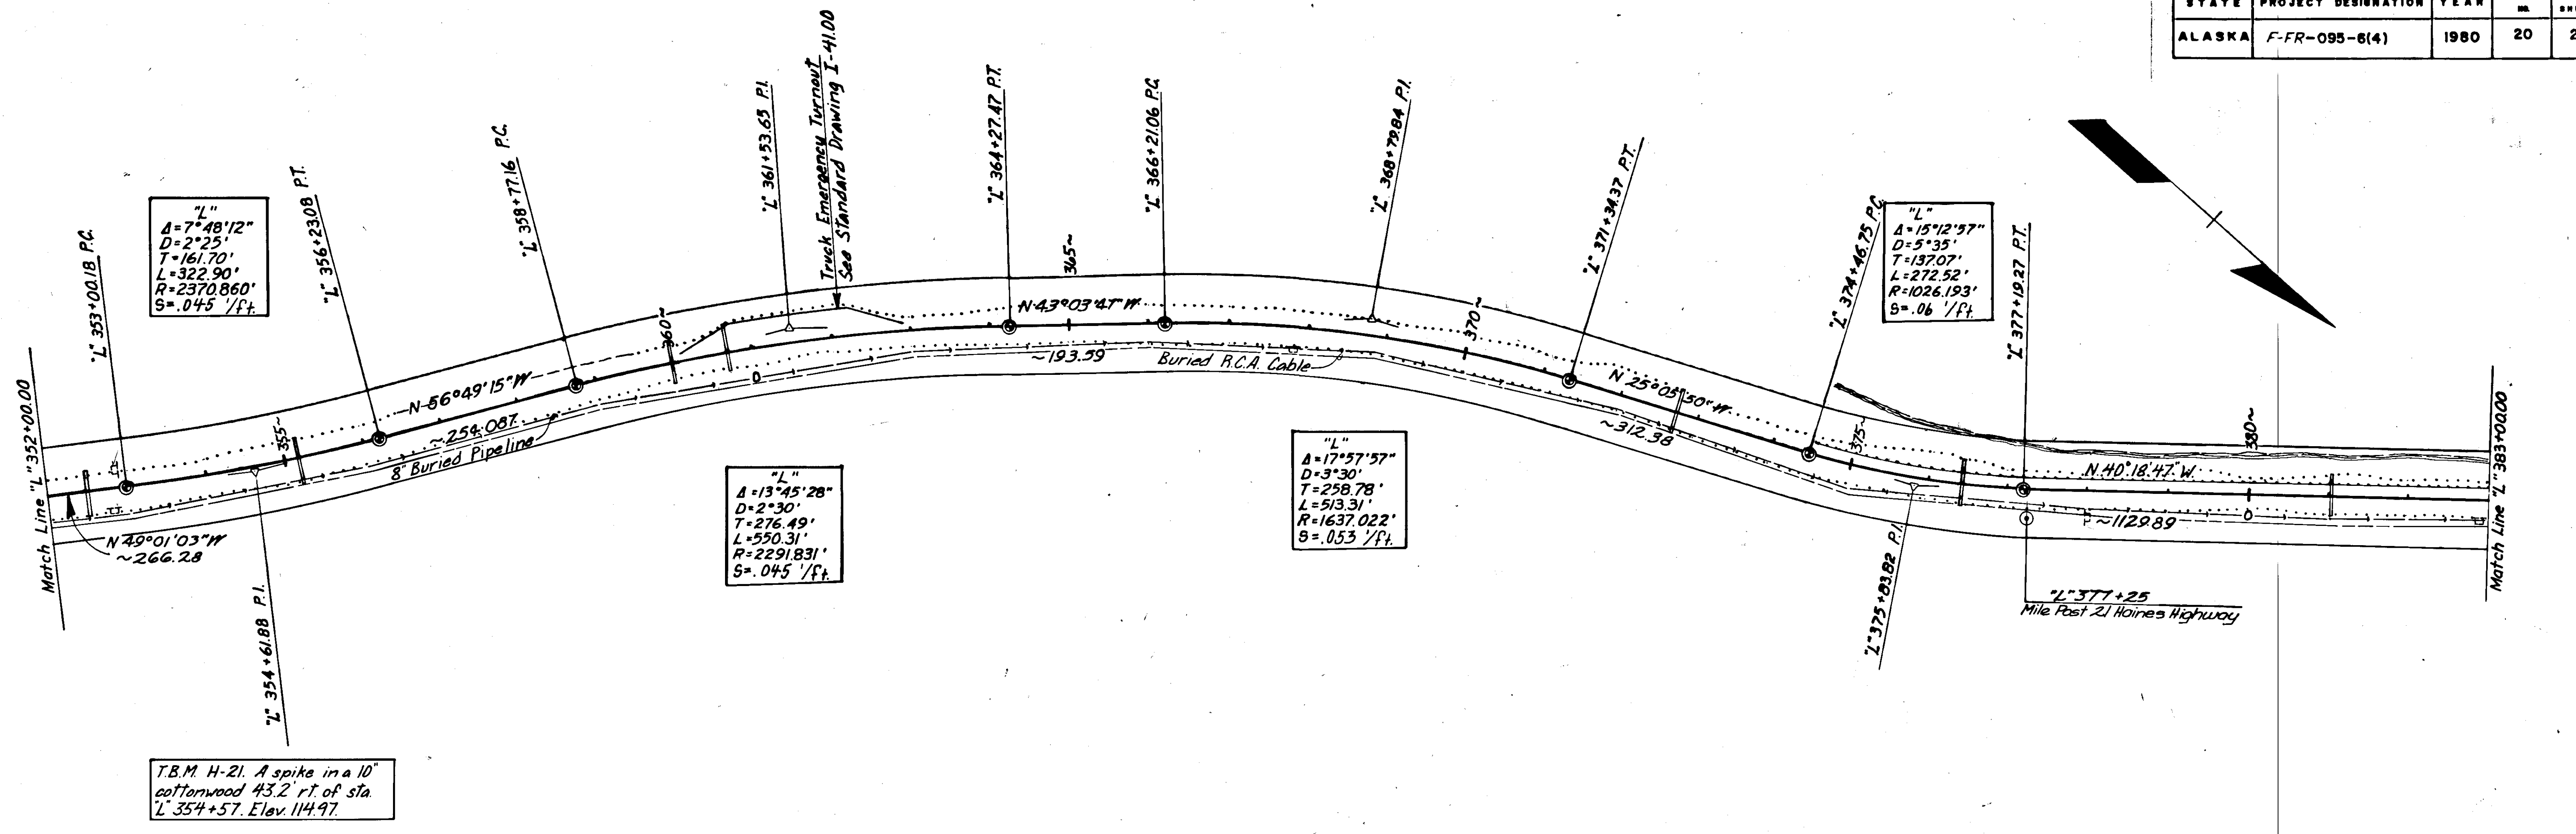


STATE	PROJECT DESIGNATION	YEAR	SHEET NO.	TOTAL SHEETS
ALASKA	F-FR-095-6(4)	1980	21	26

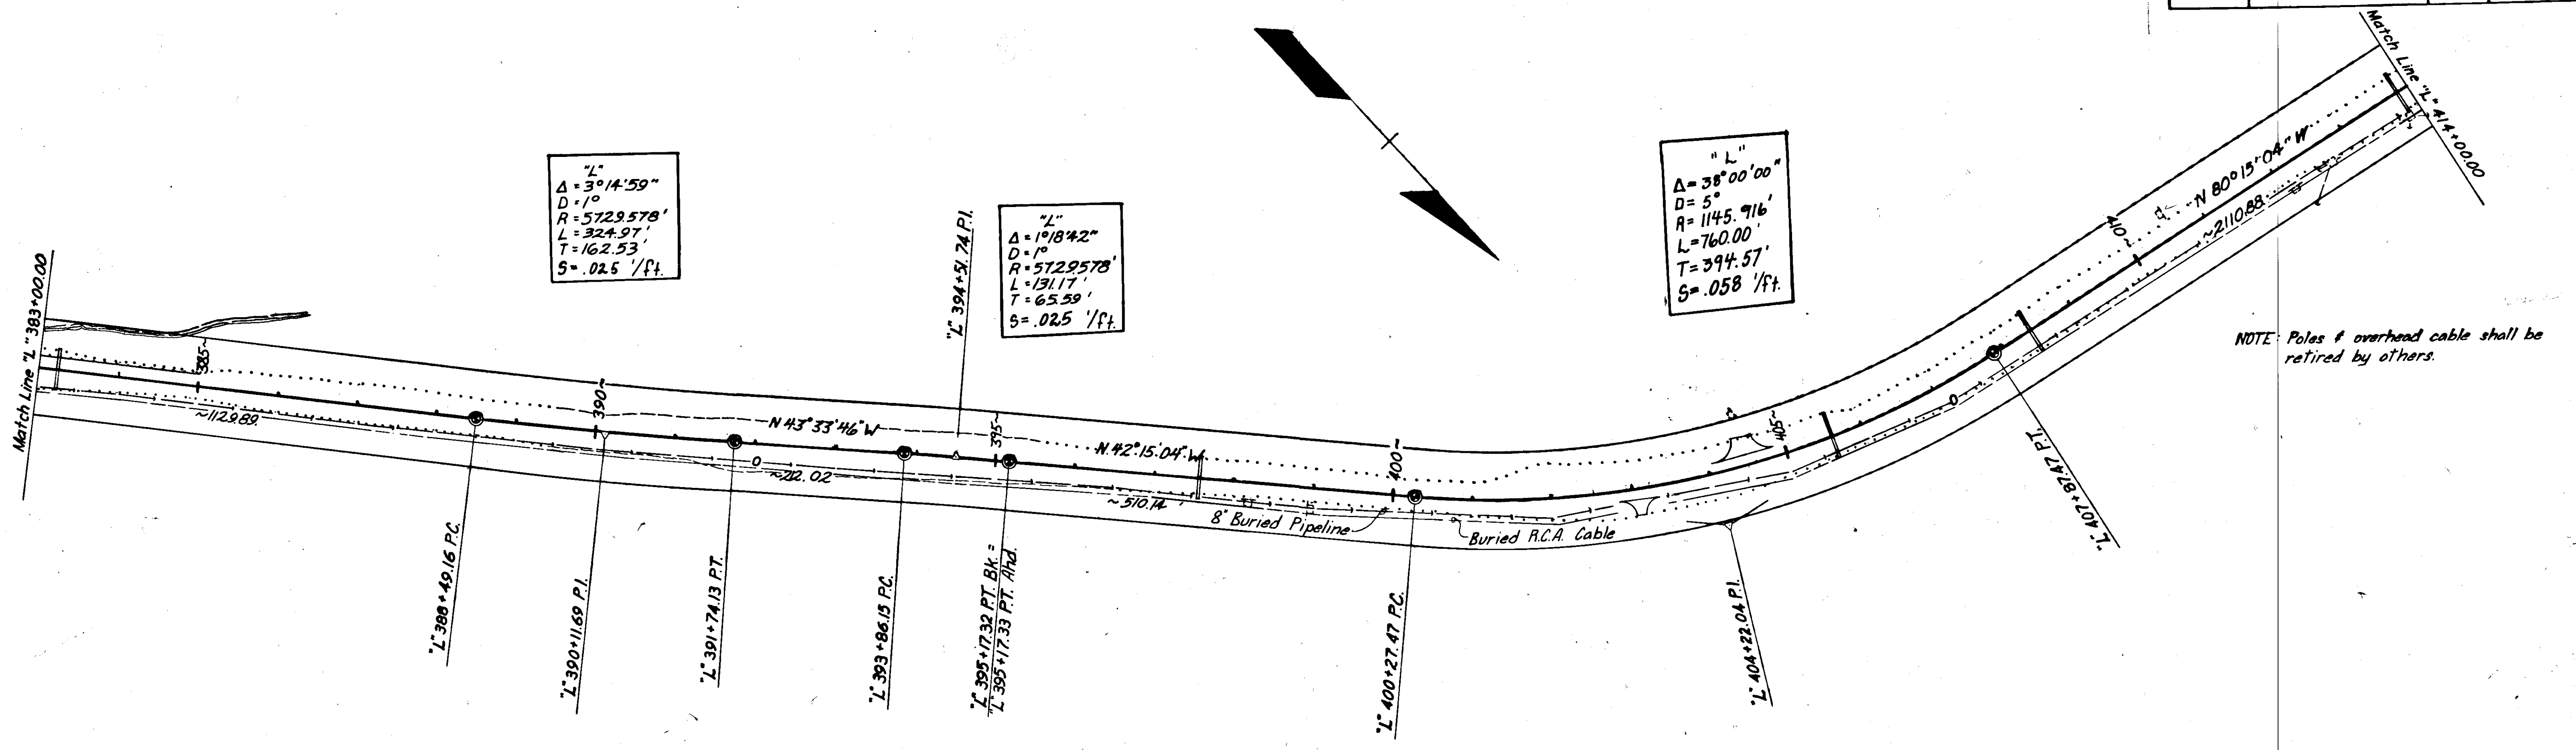


NOTE: Poles & overhead cable shall be retired by others.

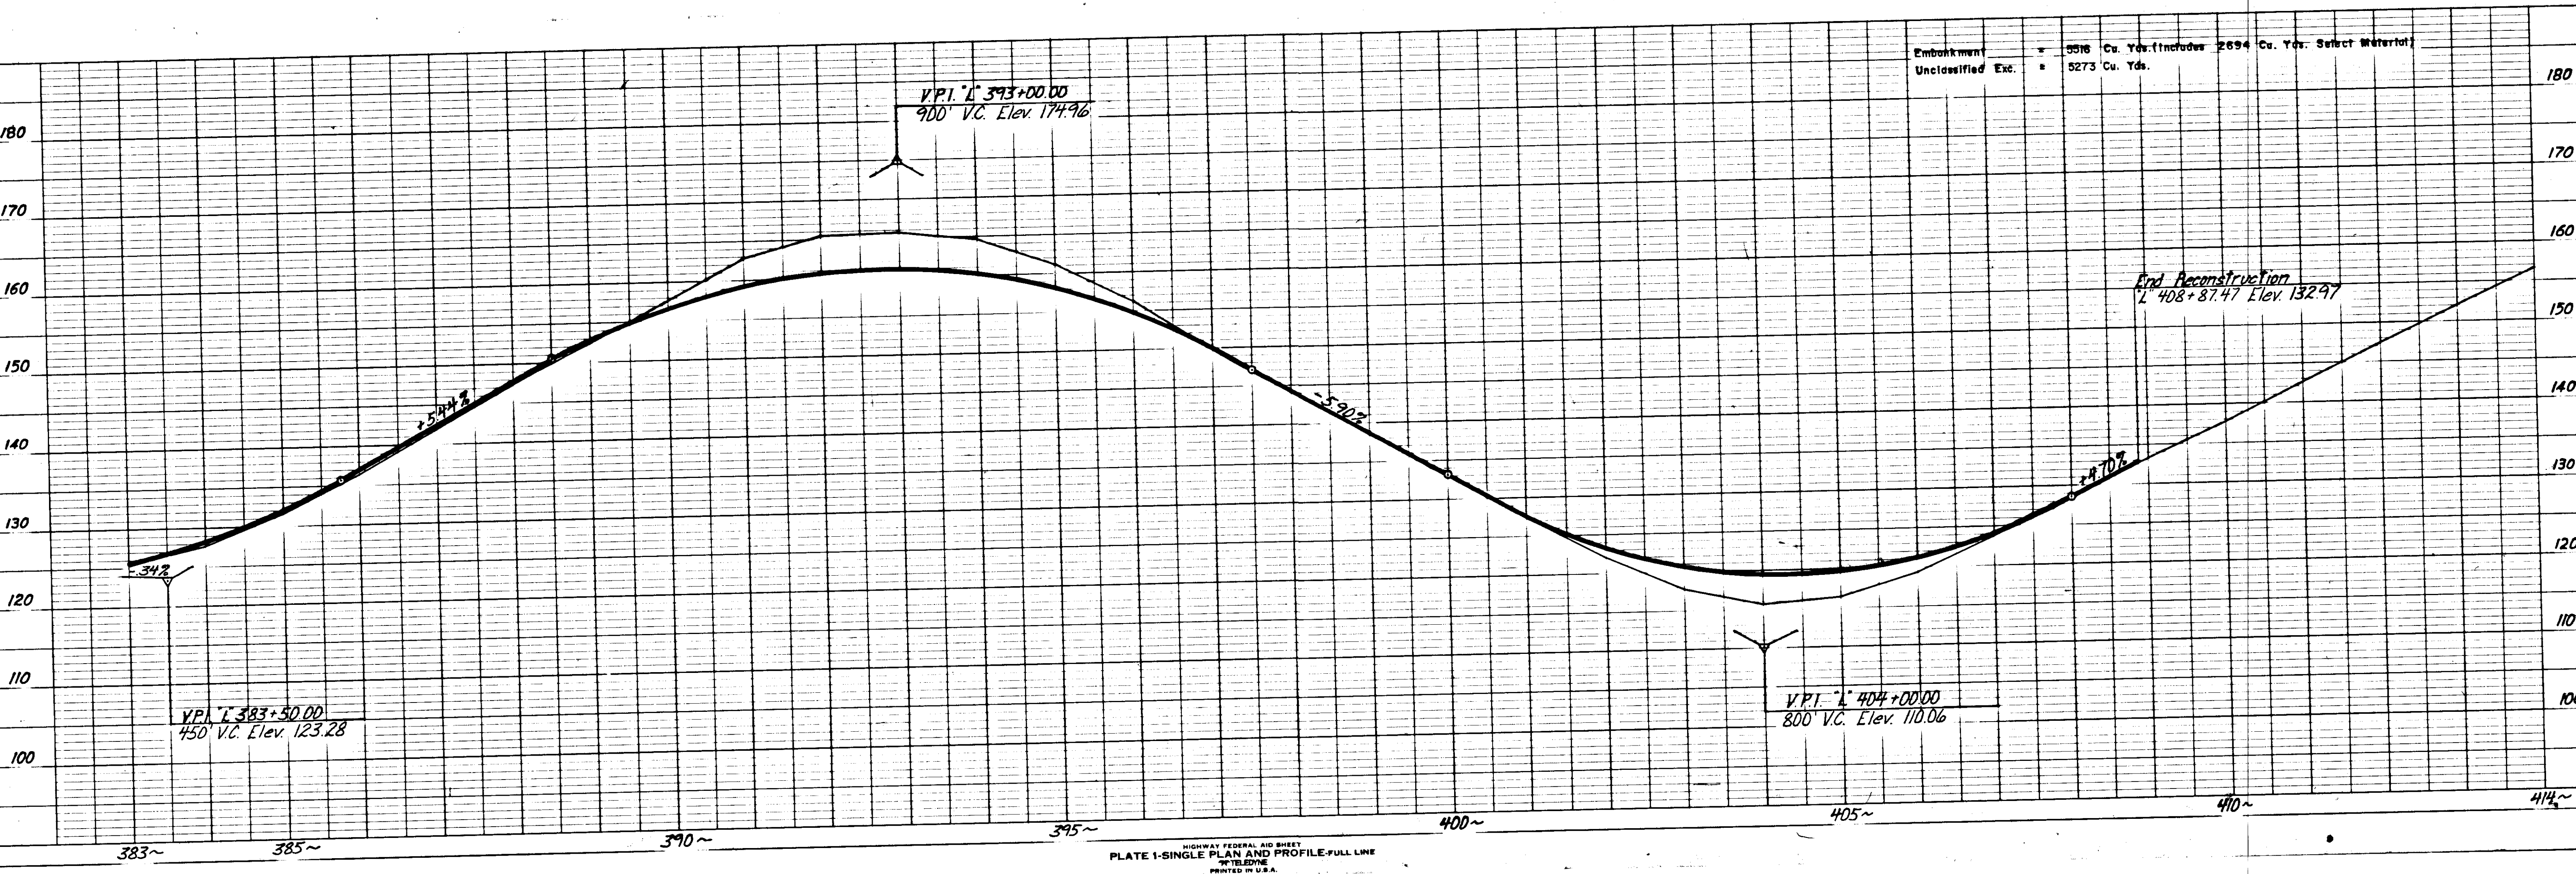


STATE	PROJECT DESIGNATION	YEAR	SHEET NO.	TOTAL SHEETS
ALASKA	F-FR-095-6(4)	1980	22	26

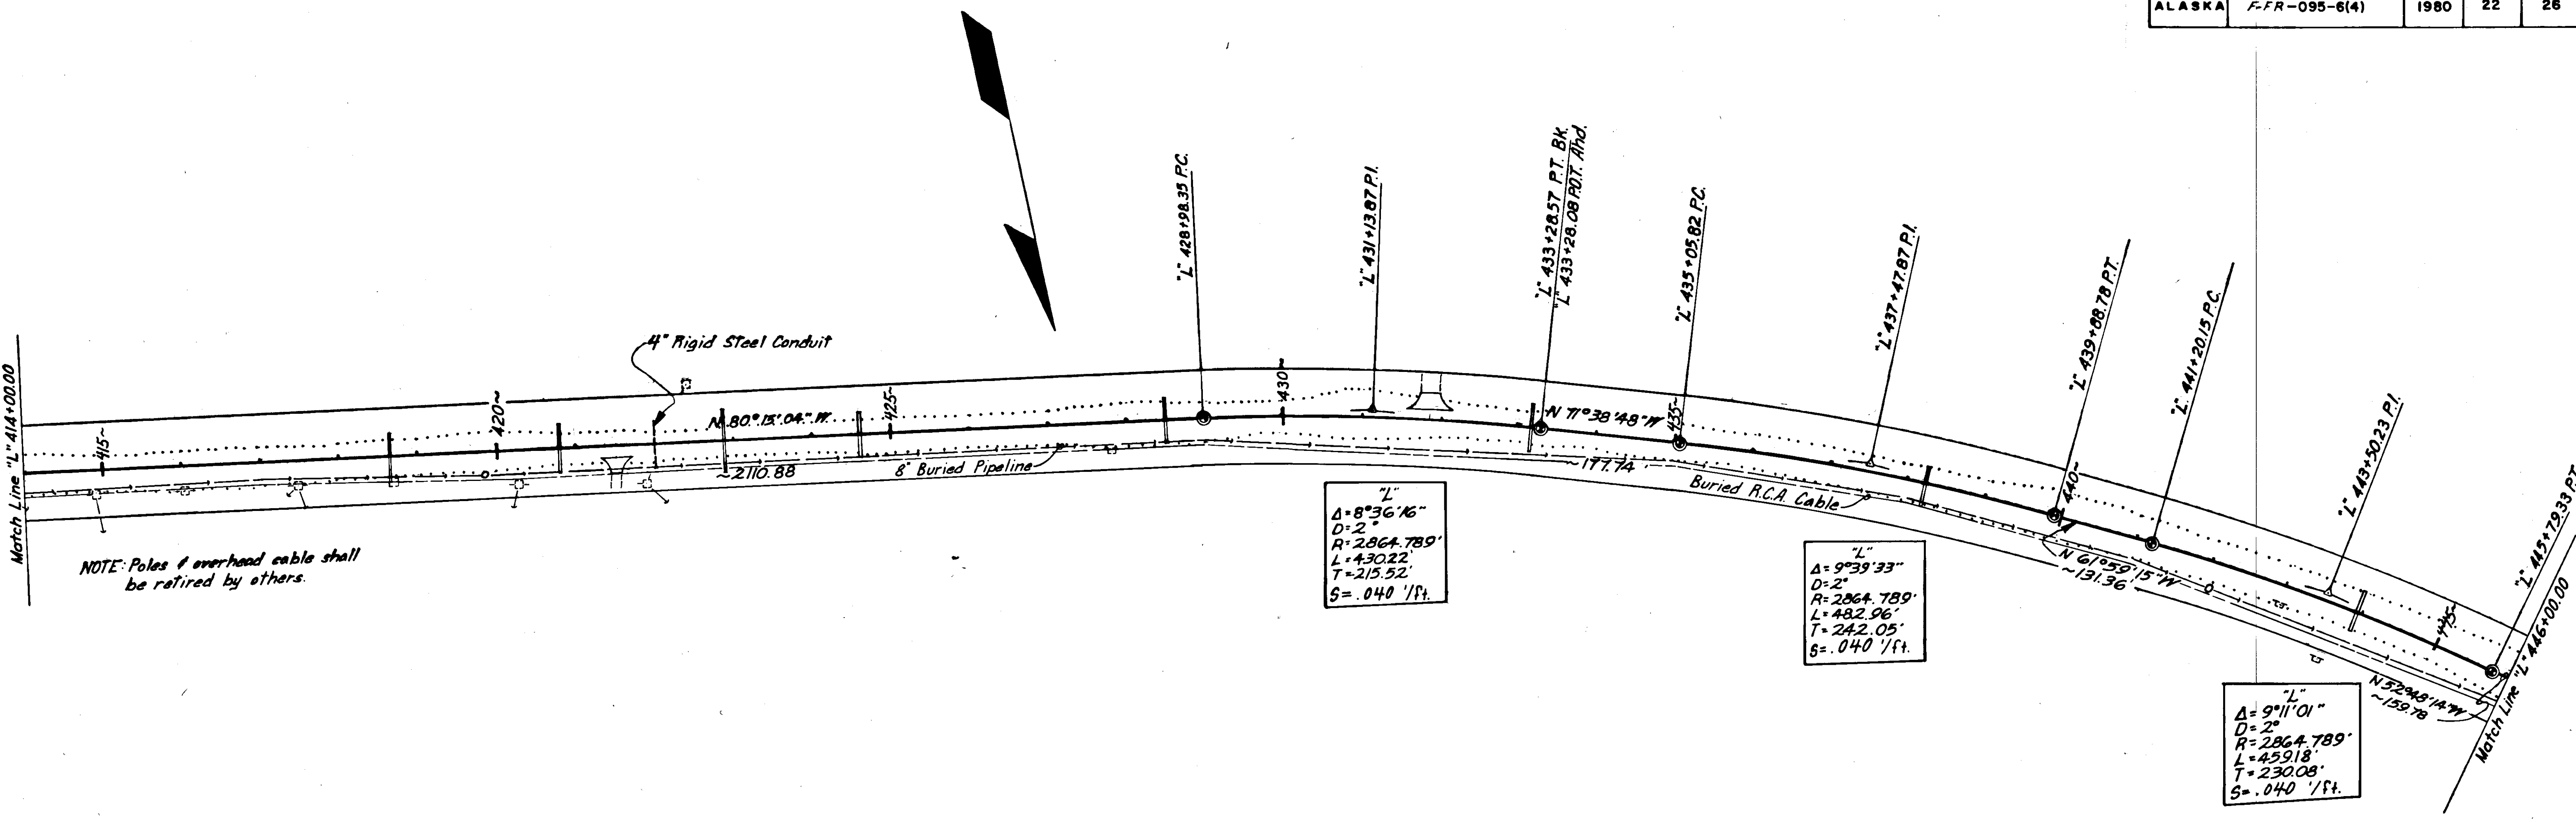

Embankment = 4833 Cu Yds. (Includes 2368 Cu Yds. Select Material)
 Unclassified Exc. = 0

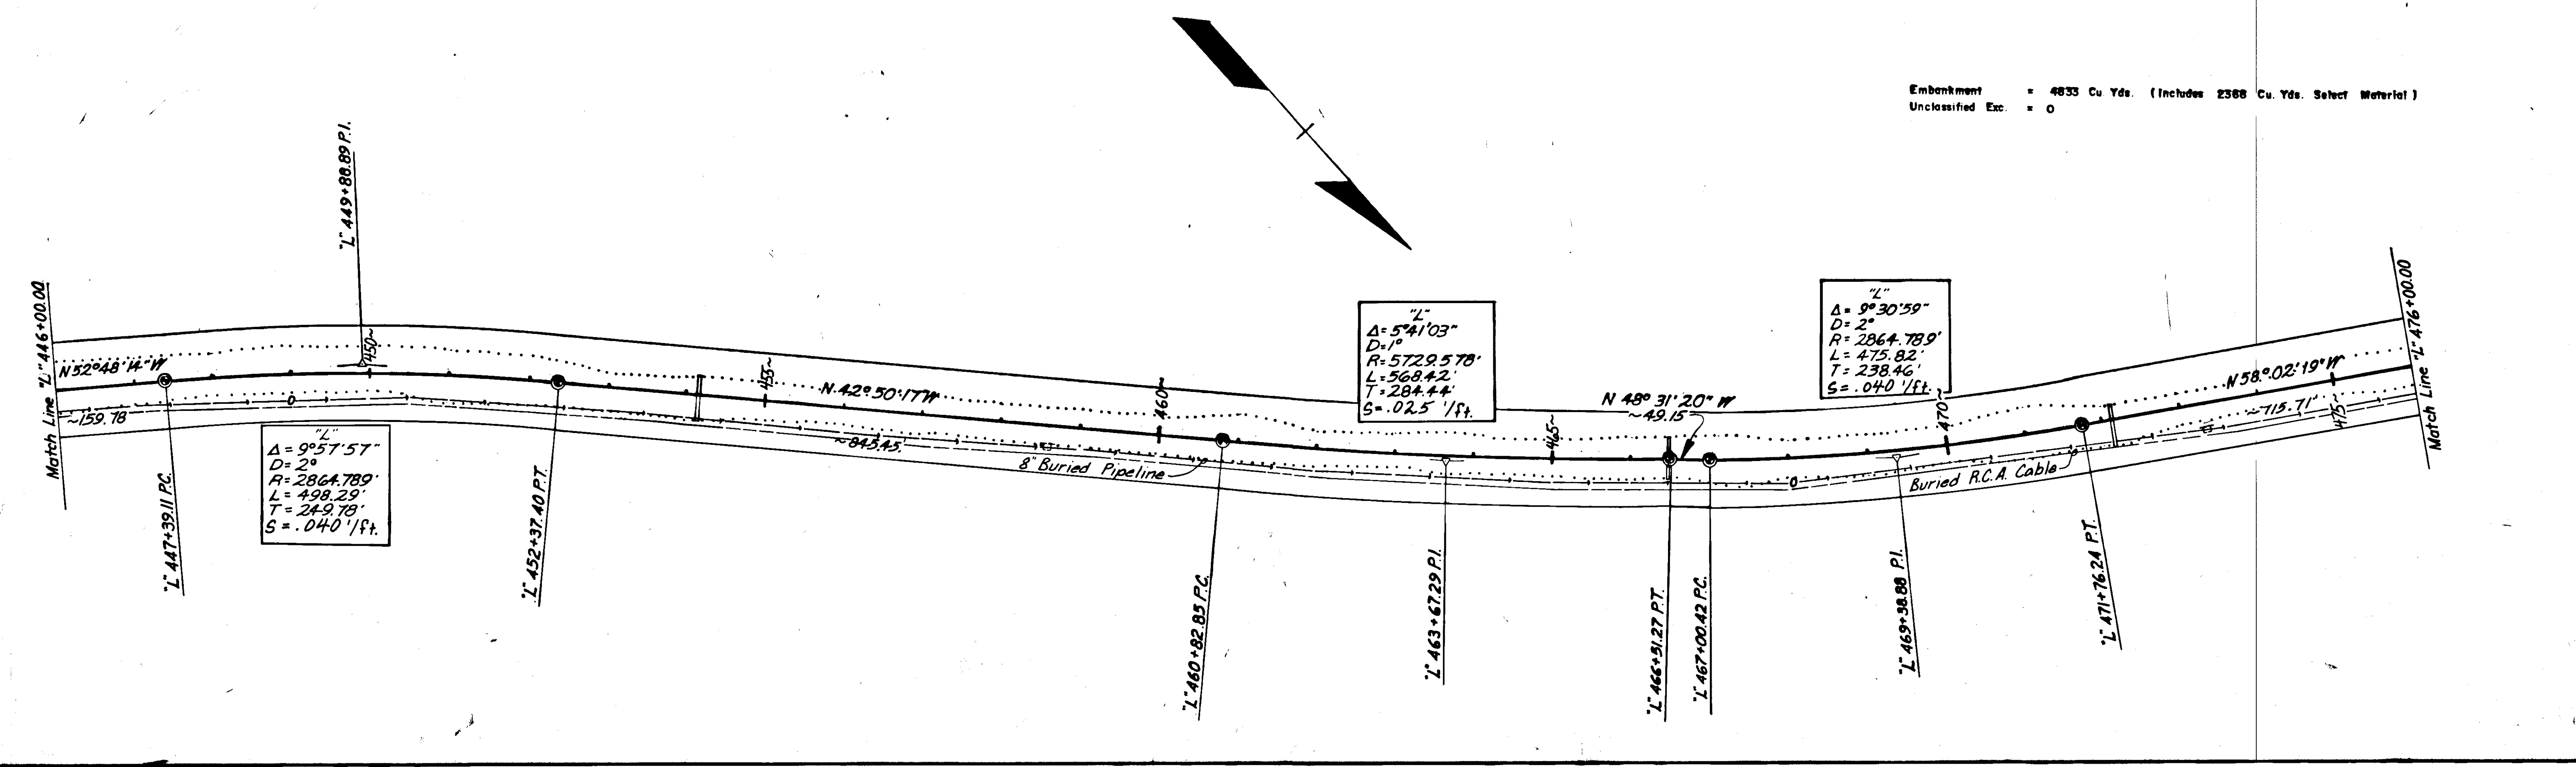


STATE	PROJECT DESIGNATION	YEAR	SHEET NO.	TOTAL SHEETS
ALASKA	F-FR-095-6(4)	1980	24	26

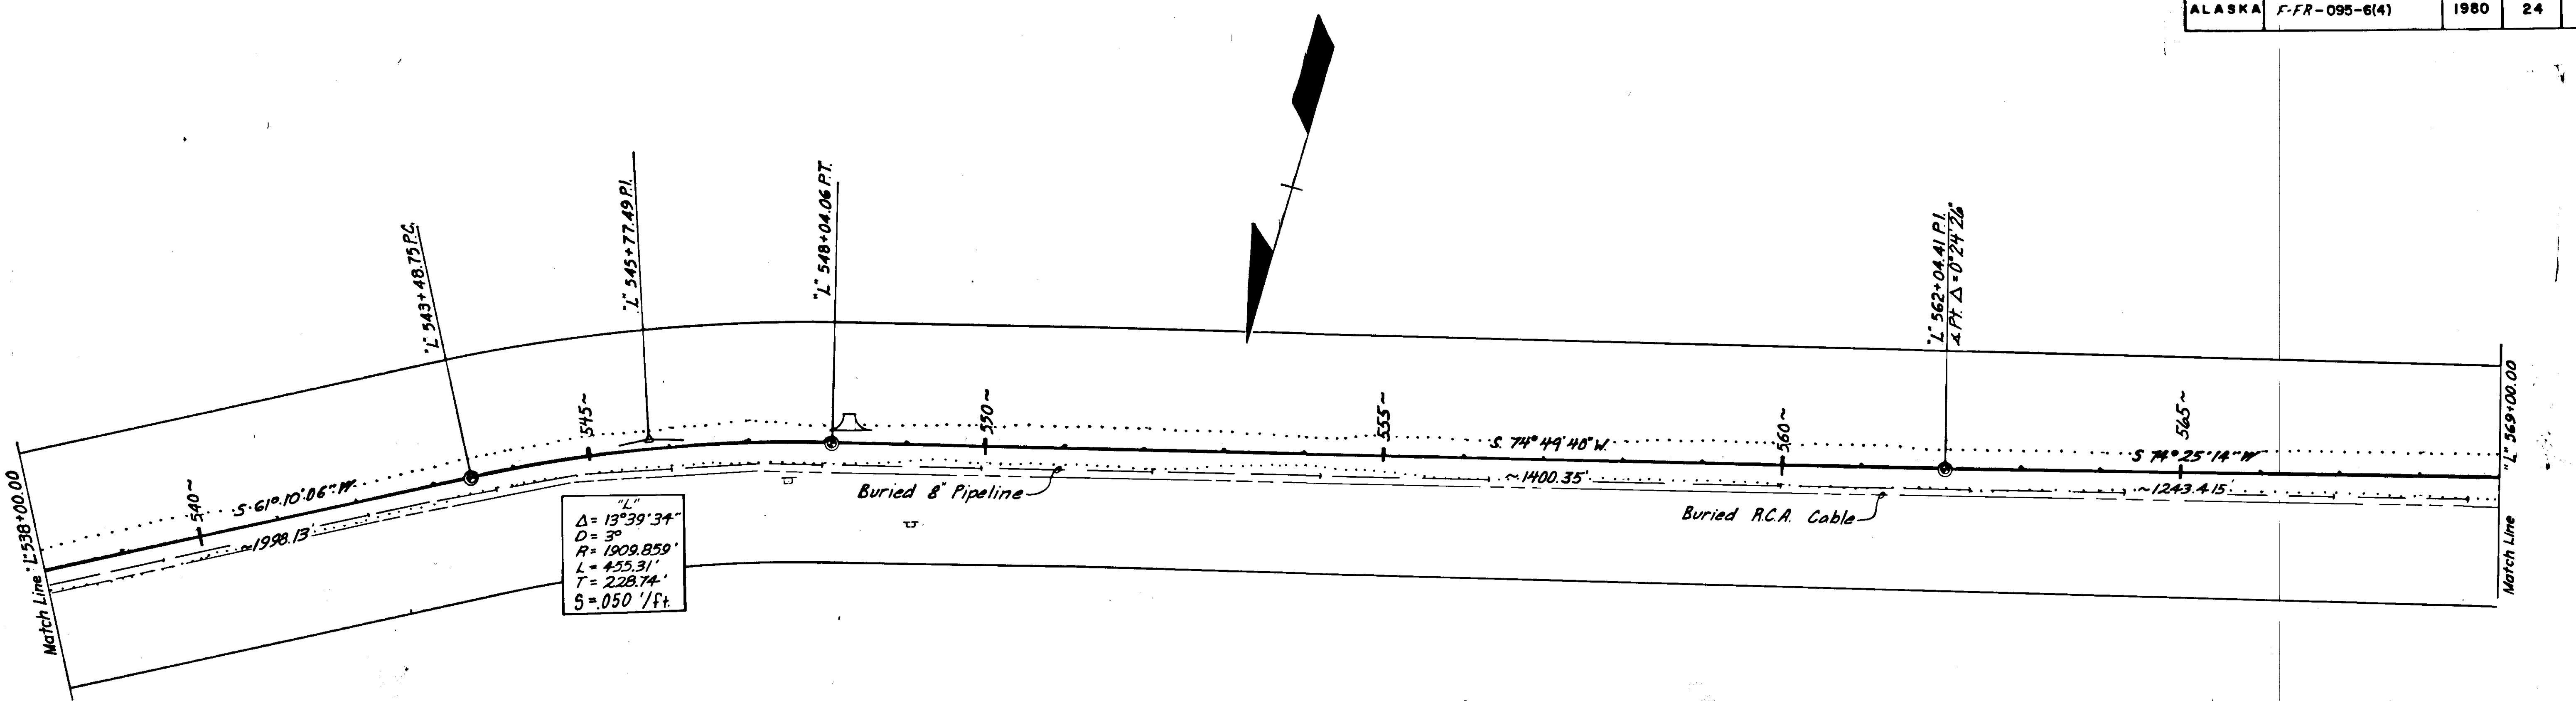

"L"
 $\Delta = 13^{\circ}39'34"$
 $D = 3'$
 $R = 1909.859'$
 $L = 455.31'$
 $T = 228.74'$
 $S = .050' / ft.$

Embankment = 4803 Cu. Yds (Includes 2368 Cu. Yds. Select Material)
 Unclassified Exc. = 0


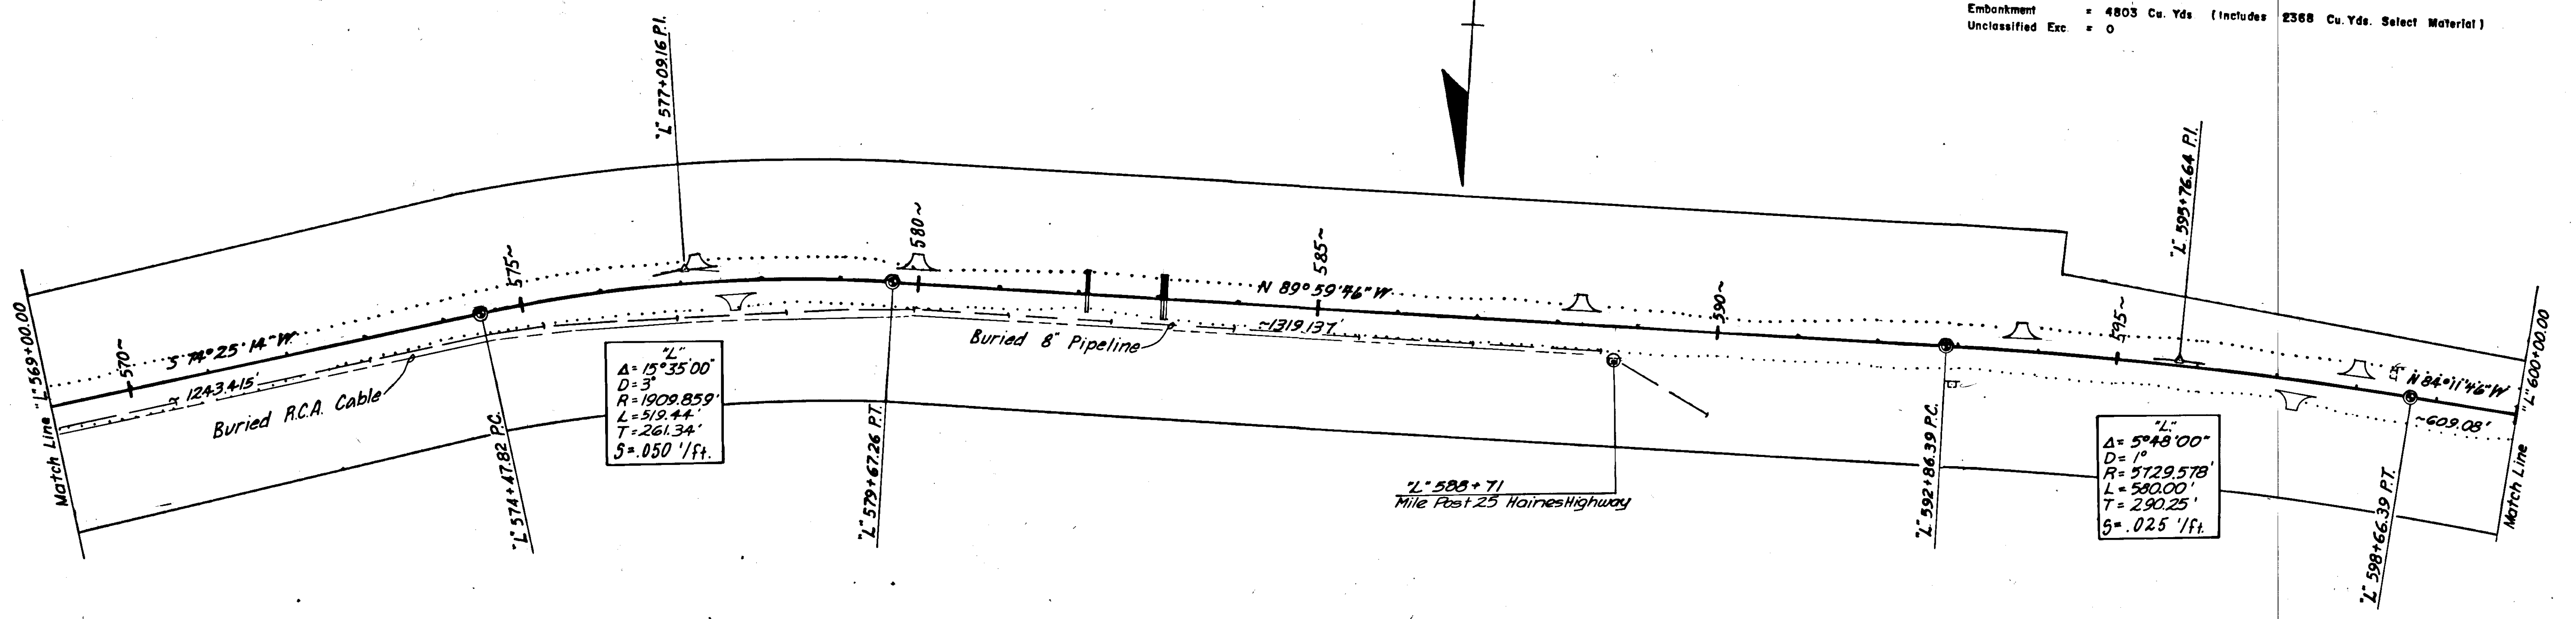


"L"
 $\Delta = 15^{\circ}35'00"$
 $D = 3'$
 $R = 1909.859'$
 $L = 519.44'$
 $T = 261.34'$
 $S = .050' / ft.$


"L"
 $\Delta = 5^{\circ}48'00"$
 $D = 1'$
 $R = 5729.578'$
 $L = 590.00'$
 $T = 290.25'$
 $S = .025' / ft.$

"L" 588+71
 Mile Post 25 Haines Highway


STATE	PROJECT DESIGNATION	YEAR	SHEET NO.	TOTAL SHEETS
ALASKA	F-FR-095-6(4)	1980	25	26

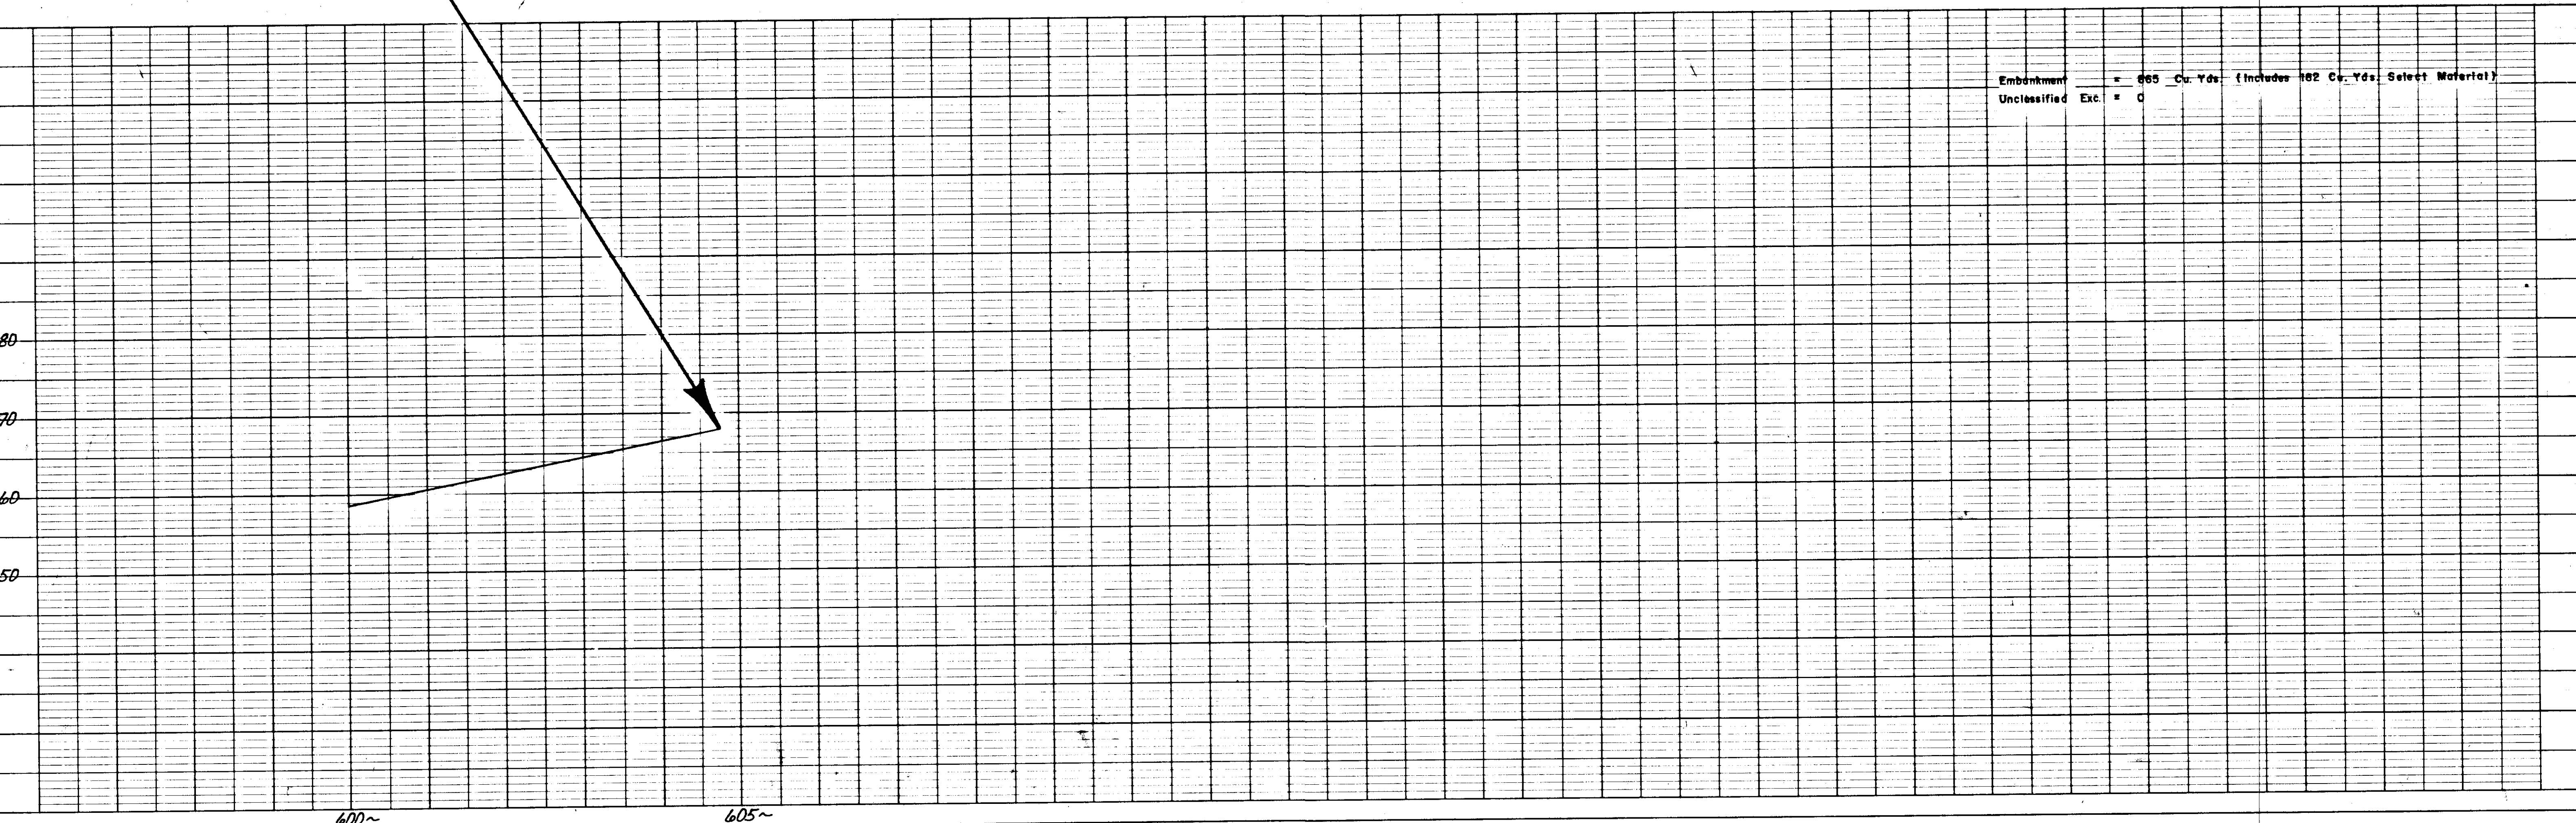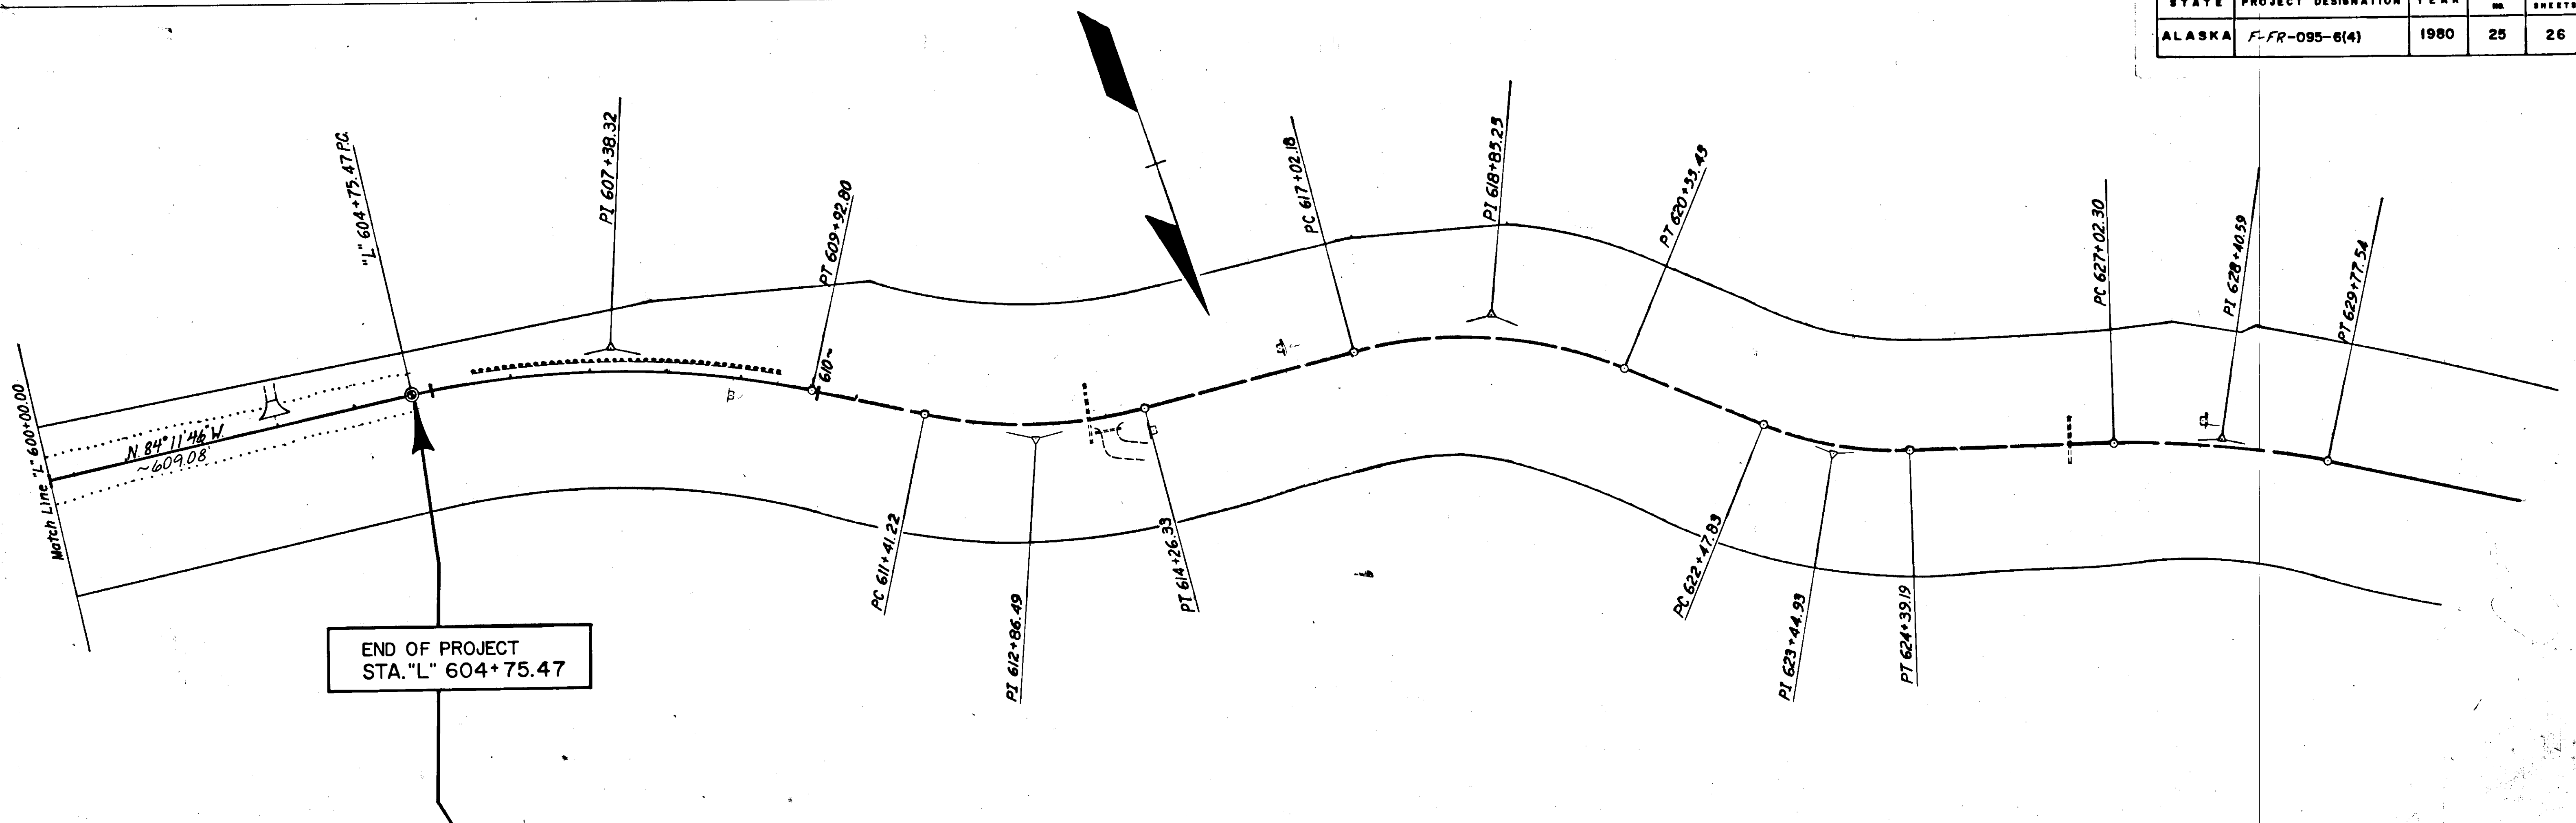


STATE	PROJECT DESIGNATION	YEAR	SHEET NO.	TOTAL SHEETS
ALASKA	FPR-095-6 (4)	1980	26	26

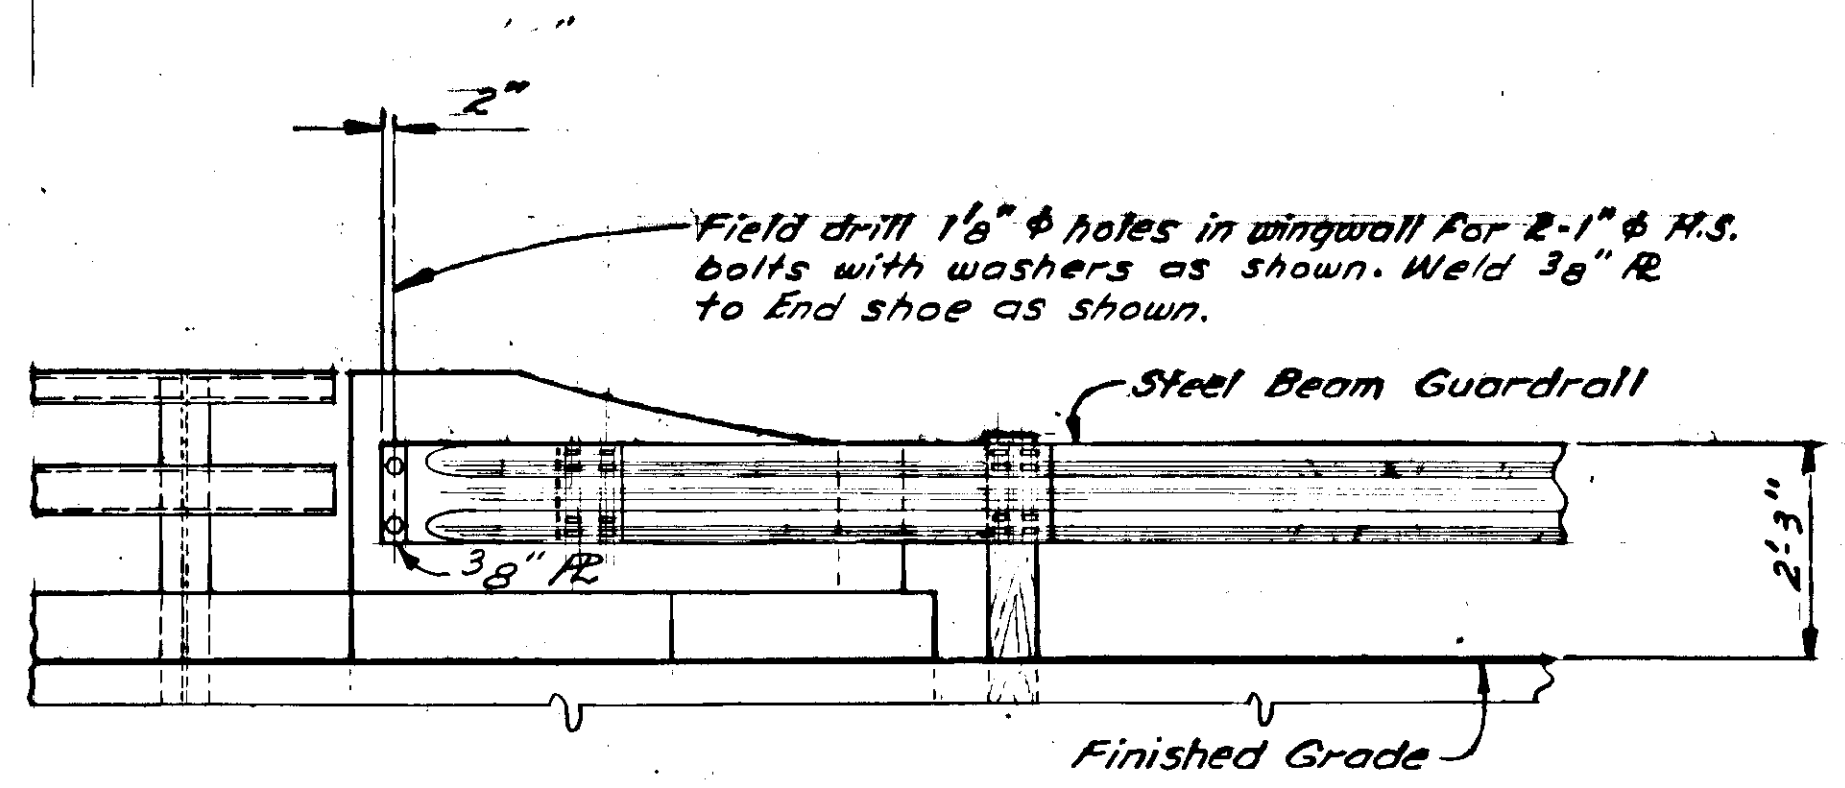

ELEVATION
(No Scale)

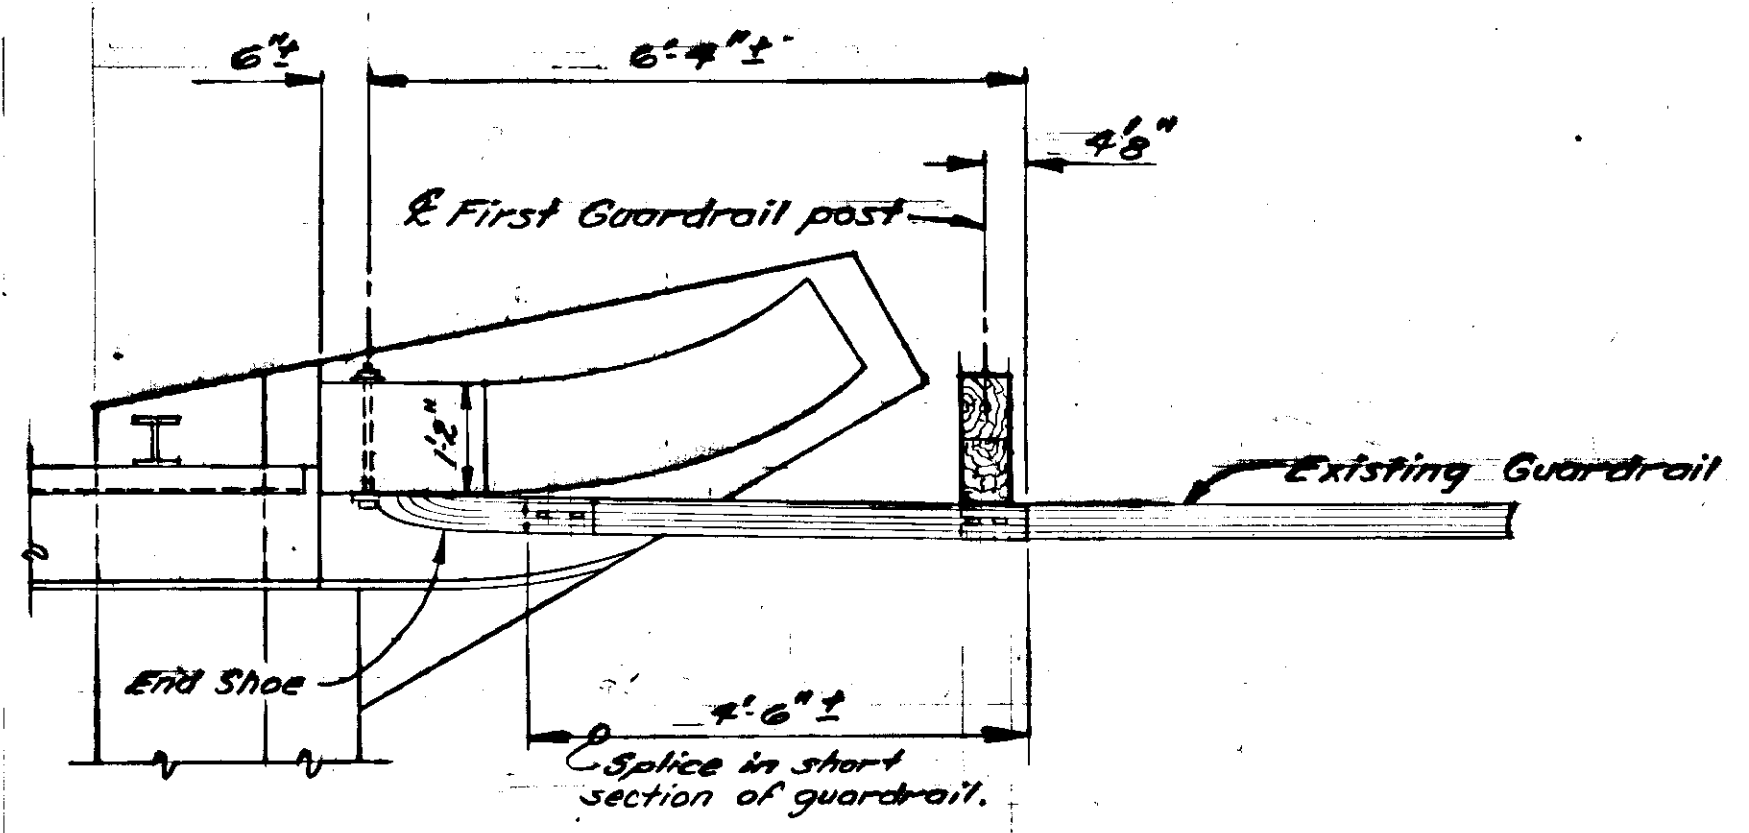

PLAN
(No Scale)

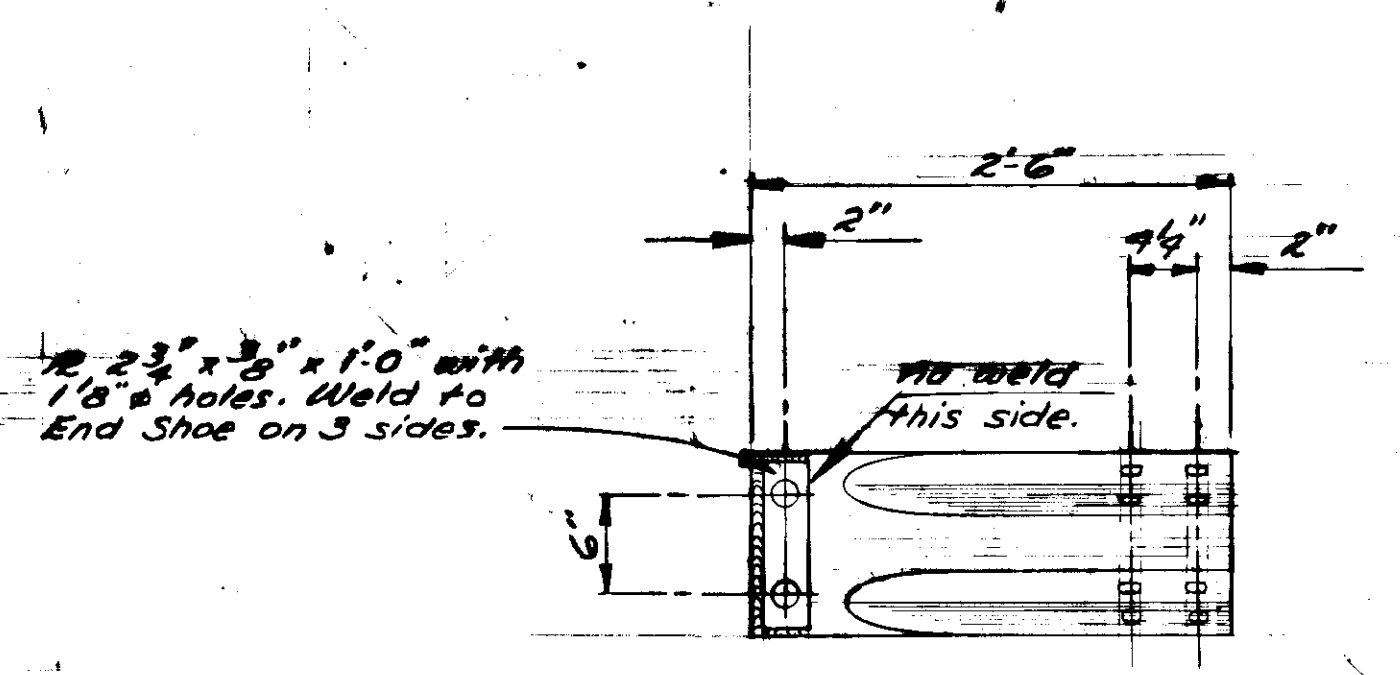

REINFORCED END SHOE DETAIL
(No Scale)

NOTE: Reconstruction of guardrail at Chilkat River Bridge includes 4 terminal sections & 12 additional 10'x10' posts.

CHILKAT RIVER BRIDGE
Route No. FAP-95
GUARDRAIL-MODIFICATIONS

State of Alaska
DEPARTMENT OF TRANSPORTATION
and PUBLIC FACILITIES
Juneau, Alaska

Date 4-28-80
Approved *[Signature]*



BRIDGE NO. 742
DWG. NO.