

STATE OF ALASKA DEPARTMENT OF TRANSPORTATION & PUBLIC FACILITIES

PLAN AND PROFILE PROPOSED HIGHWAY PROJECT FR-F-095-6(3) HAINES M.P. 4 TO M.P. 14 GRADING, PAVING, & DRAINAGE

NOTE: Equations are shown on the plan & profile sheets

INDEX OF SHEETS	
1	TITLE SHEET
2	TYPICAL SECTIONS
3	ESTIMATE OF QUANTITIES, SUMMARY TABLES
4	SIGNING SCHEDULE, MISC. DETAILS
5	STATE FURNISHED MATERIALS SITE
6 - 14	PLAN SHEETS

THE FOLLOWING STANDARD DRAWINGS SHALL APPLY TO THIS PROJECT:
A-1, C-0004, C-10.03, C-11.03, D-02.02, D-06.10, G-04.13, G-04.32, G-13.12,
G-14.04, G-18.00, I-80.00, M-16.03, S-00.11, S-05.00, S-20.10, S-30.11,
T-21.02, and I-40.10.

PROJECT SUMMARY

WIDTH OF PAVEMENT = 28'

LENGTH OF PAVING = 53,476.14' = 10.126 mi.

LENGTH OF PROJECT = 53,476.14' = 10.126 mi

DESIGN DESIGNATION

ADT (1979) = 450


ADT (1999) = 2,300

DHV (13%) = 300

D = 60-40

T = 9%

V = 50

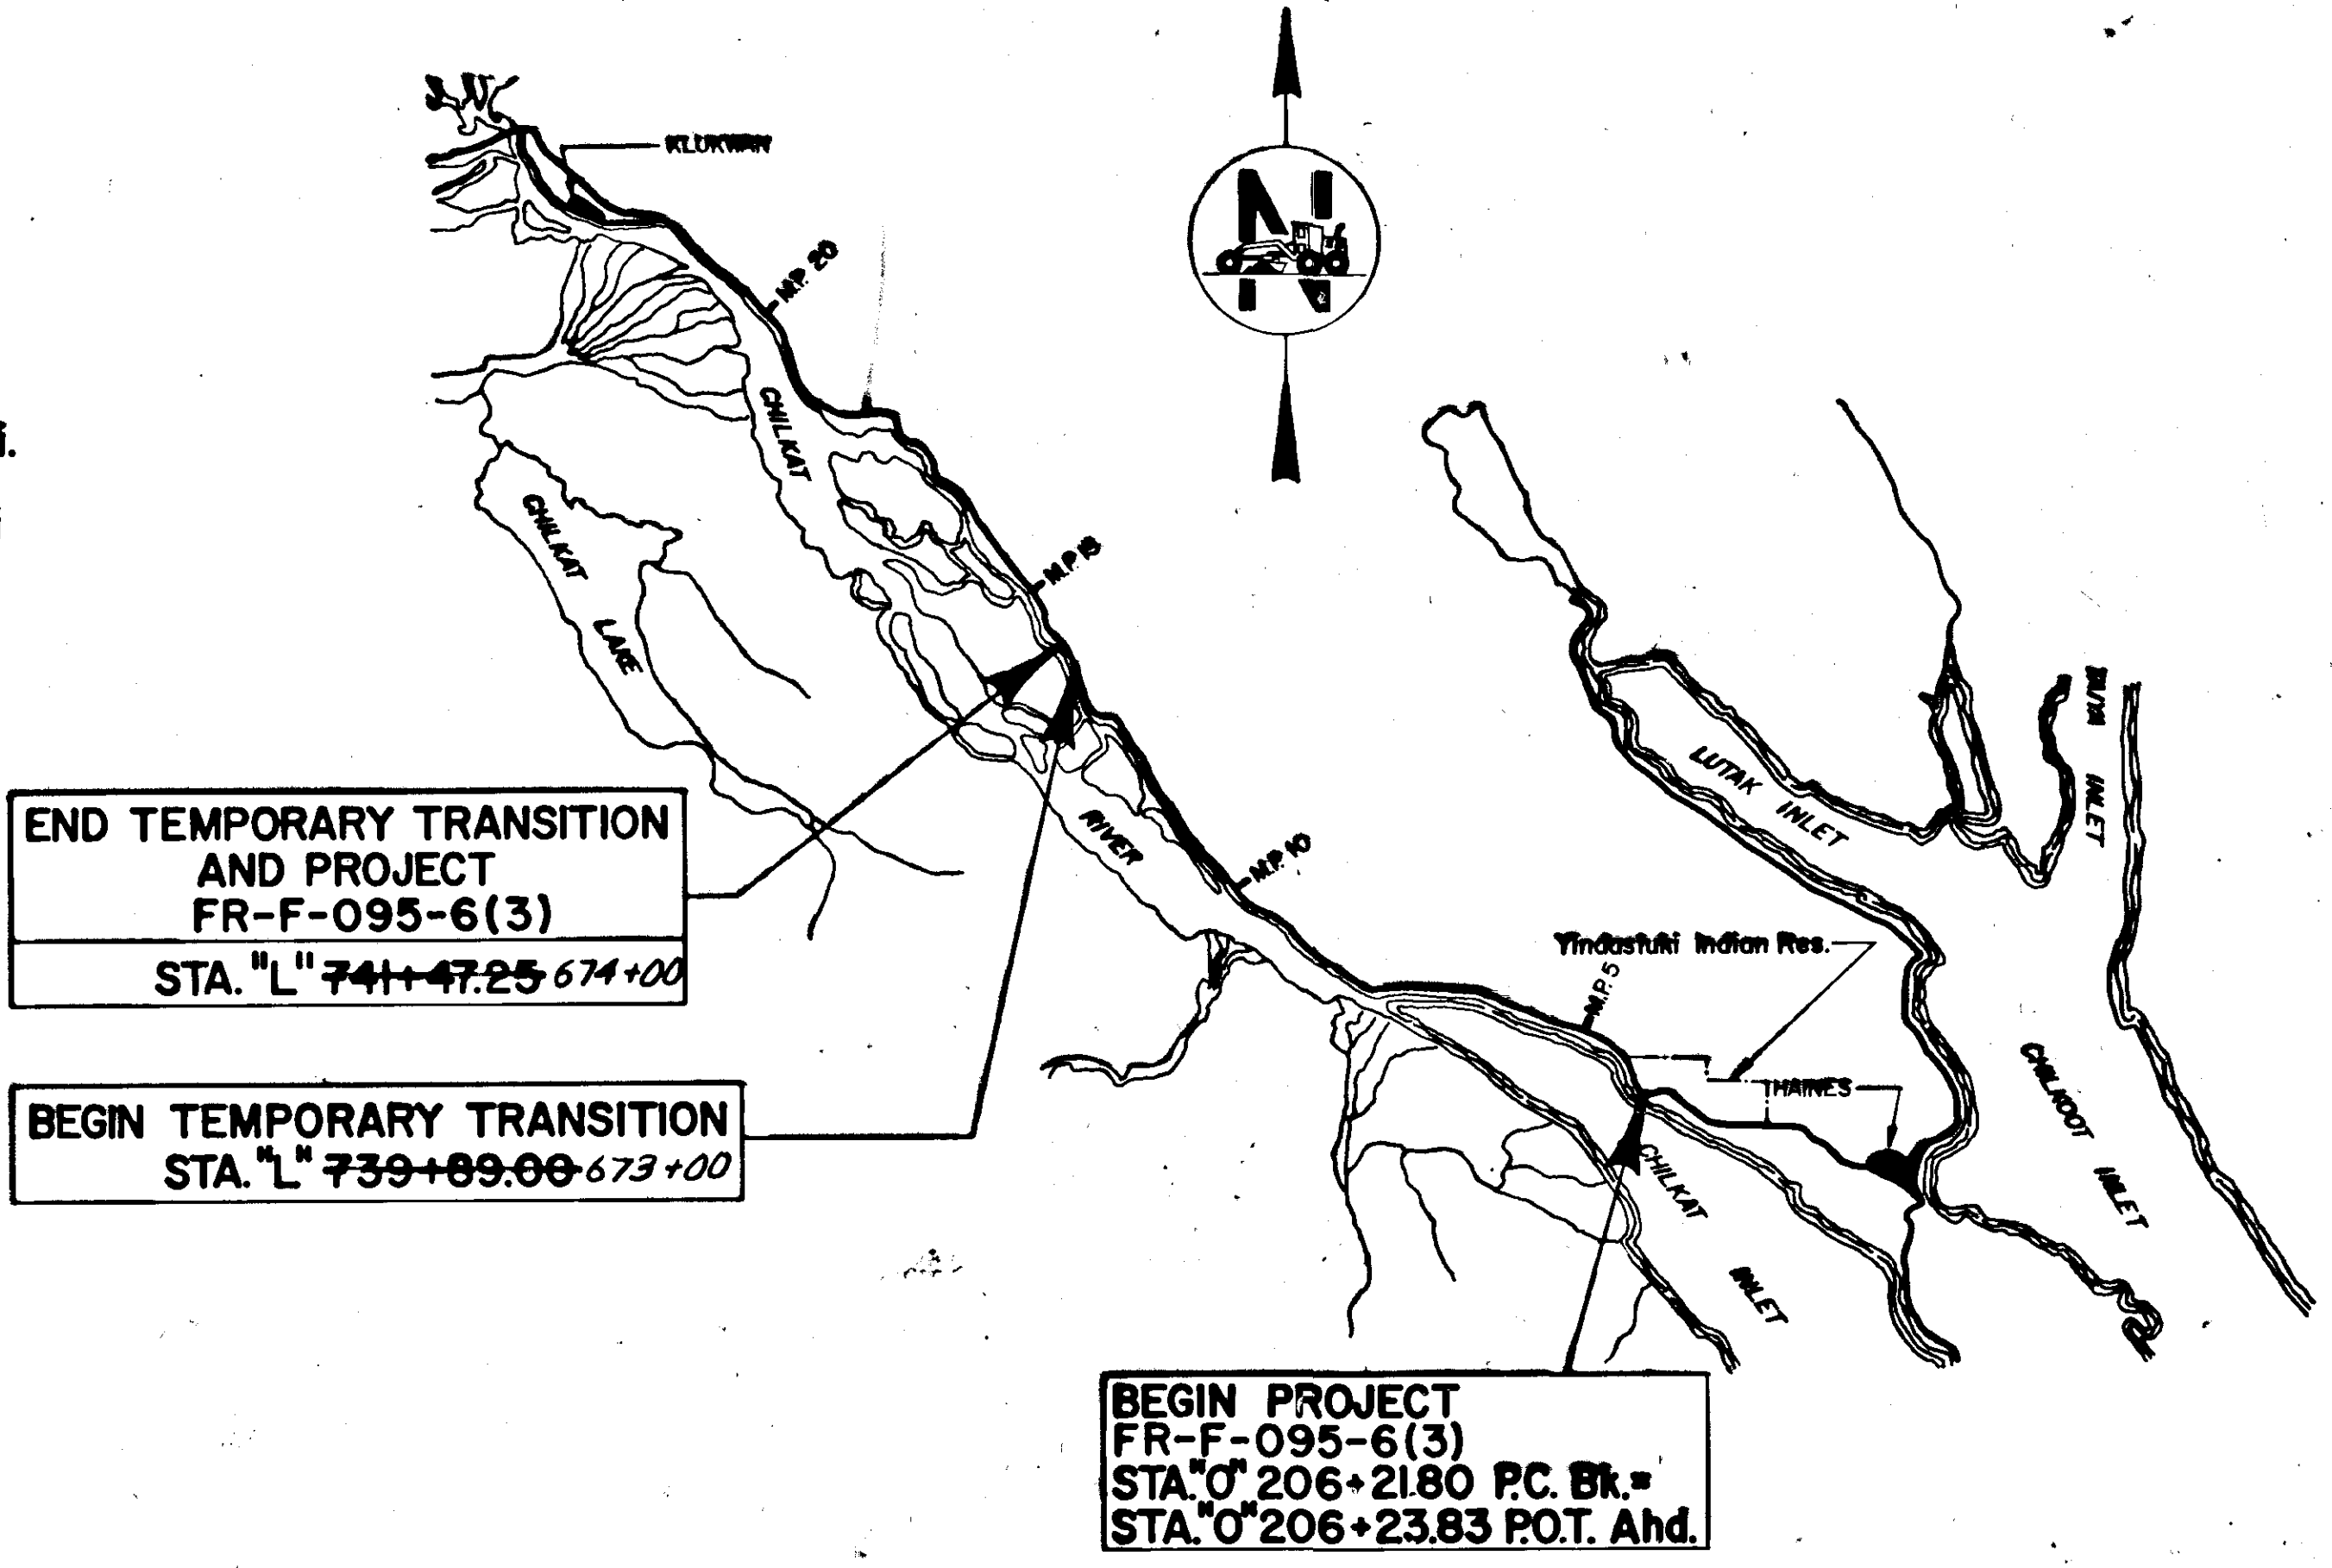

AS BUILT PLANS

Contractor: Associated Sand and Gravel Inc.
Project Engineer: Larry Geise
Beginning Date: 7-12-79
Completion Date: 6-10-80

STATE OF ALASKA
DEPARTMENT OF TRANSPORTATION
&
PUBLIC FACILITIES


APPROVED
Wallace K. Williams Date 2/11/79
SOUTHEASTERN REGION
DESIGN/CONSTRUCTION ENGINEER

STATE OF ALASKA
DEPARTMENT OF TRANSPORTATION
&
PUBLIC FACILITIES

APPROVED
Donald M. Miller Date 4-17-79
DIRECTOR-HIGHWAY DESIGN & CONSTRUCTION

TYPICAL SECTIONS OF IMPROVEMENT

STATE	PROJECT DESIGNATION	YEAR	SHEET NO.	TOTAL SHEETS
ALASKA	FR-F-095-6 (3)	1979	2	14

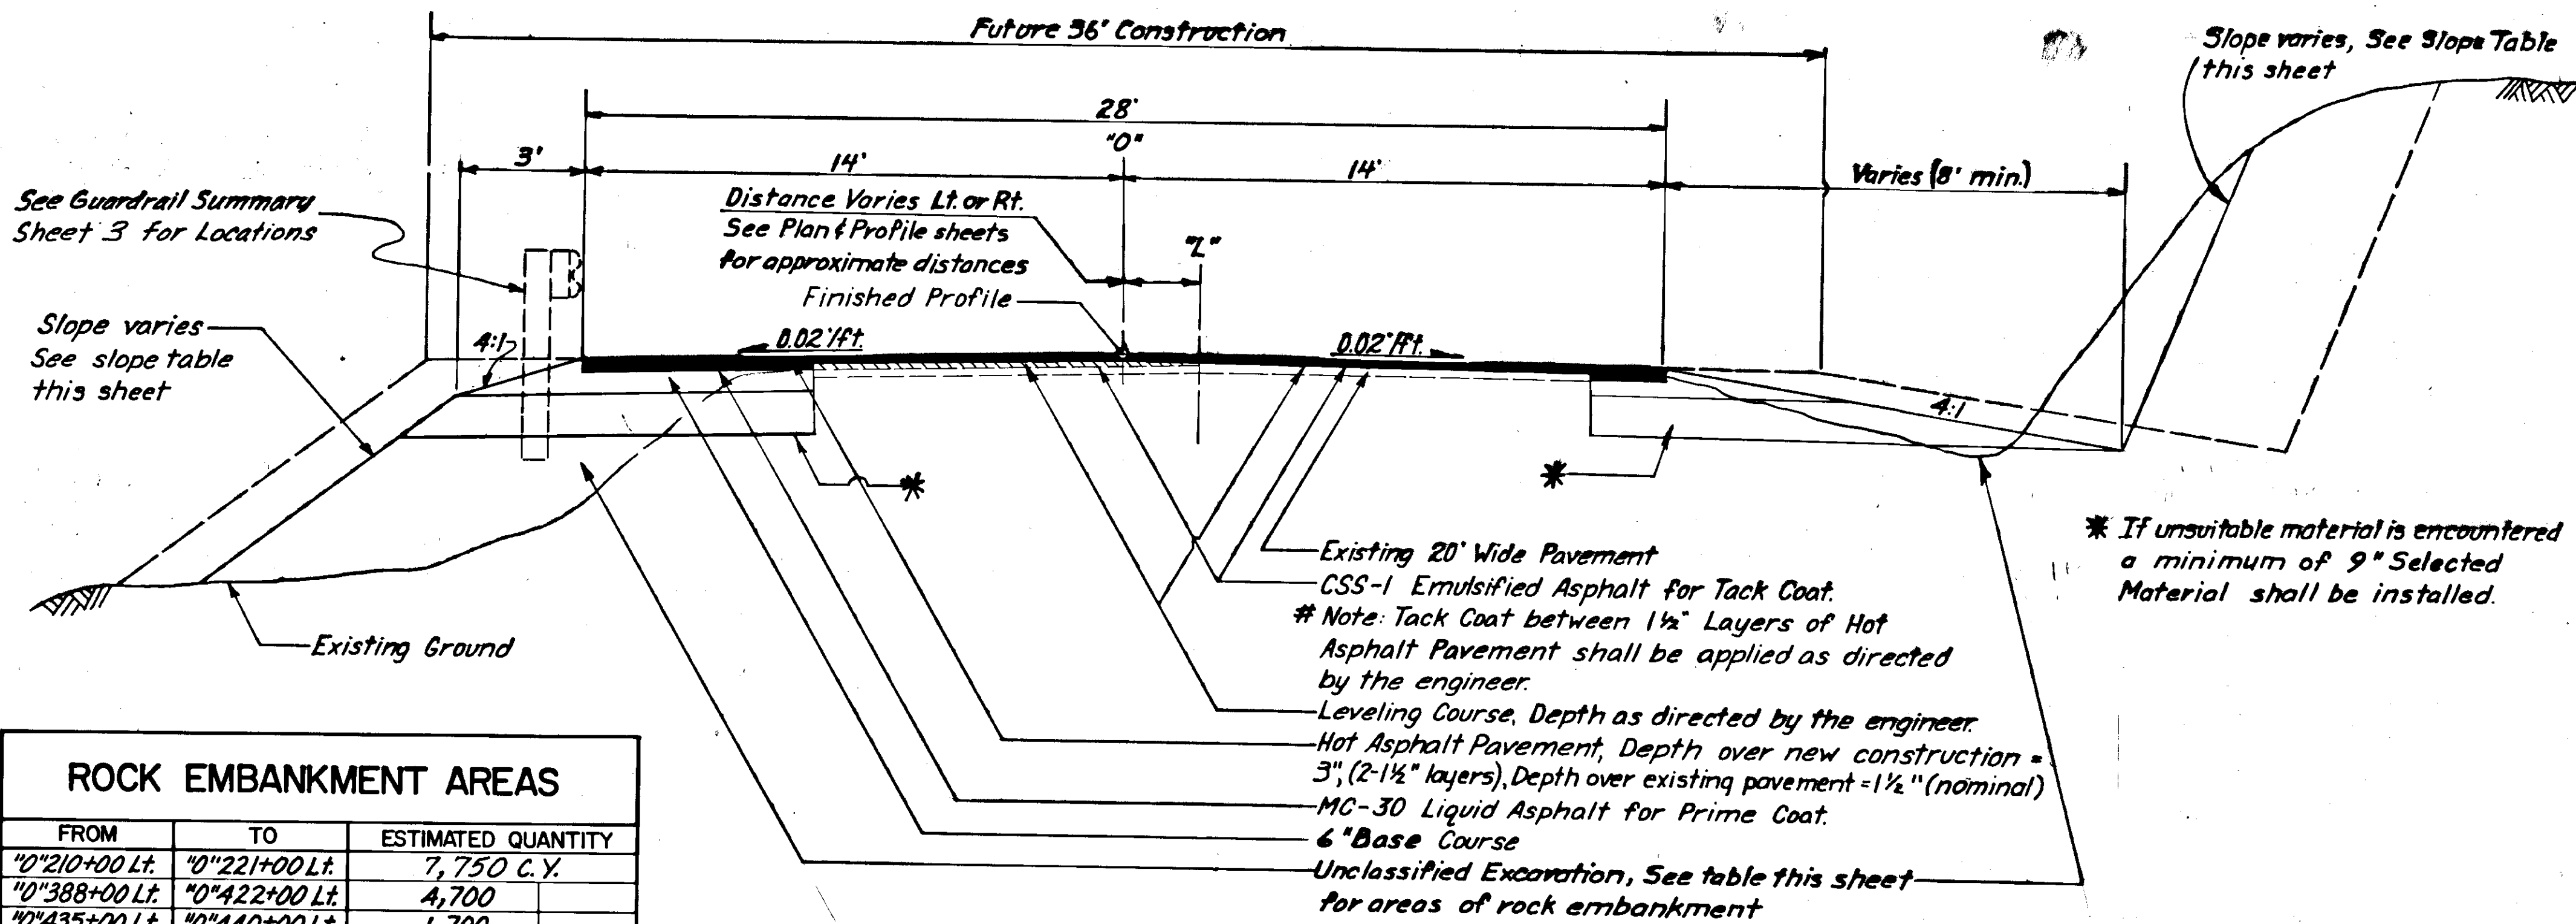

TYPICAL A

(For Areas, See Application table this sheet)


ROCK EMBANKMENT AREAS

FROM	TO	ESTIMATED QUANTITY
"0'210+00 Lt.	"0'221+00 Lt.	7,750 C.Y.
"0'388+00 Lt.	"0'422+00 Lt.	4,700
"0'435+00 Lt.	"0'440+00 Lt.	1,700
"0'473+00 Lt.	"0'476+00 Lt.	200
"0'592+00 Lt.	"0'596+00 Lt.	150
"0'610+00 Lt.	"0'613+00 Lt.	100
"0'663+00 Lt.	"0'672+00 Lt.	2,600
"0'690+00 Lt.	"0'730+00 Lt.	4,700

NOTE: Rock Embankment to be placed in the above areas shall consist only of shot rock.

TYPICAL SECTION APPLICATION TABLE				
TYPICAL A		TYPICAL B		REMARKS
FROM	TO	FROM	TO	
"0' 206+23	"0' 208+00	"0' 208+00	"L' 230+00	
"L' 230+00	"0' 286+25			
"0' 286+25	"0' 346+89			See Note Below
"0' 346+89	"0' 385+00			
"0' 396+50	"0' 422+00	"0' 385+00	"0' 396+50	See Note Below
"0' 427+50	"0' 435+20	"0' 422+00	"0' 427+50	See Note Below
"0' 438+54	"0' 452+12	"0' 435+20	"0' 438+54	See Note Below
"0' 452+12	"0' 473+00			
"0' 482+00	"0' 526+40	"0' 473+00	"0' 482+00	
"0' 537+50	"0' 616+52	"0' 526+40	"0' 537+50	
"0' 616+52	"L' 641+69			See Note Below
"0' 641+69	"0' 651+54			See Note Below
"0' 651+54	"0' 657+00			
"0' 671+30	"L' 685+94	"0' 657+00	"0' 671+30	
"L' 685+94	"0' 694+73			See Note Below
"0' 694+73	"L' 699+40			See Note Below
"0' 699+40	"0' 729+09			
"0' 729+09	"0' 741+47			

NOTE: The only new slope work intended on the Right shall be, regrading of the fore slope and the flow line of the existing ditch.

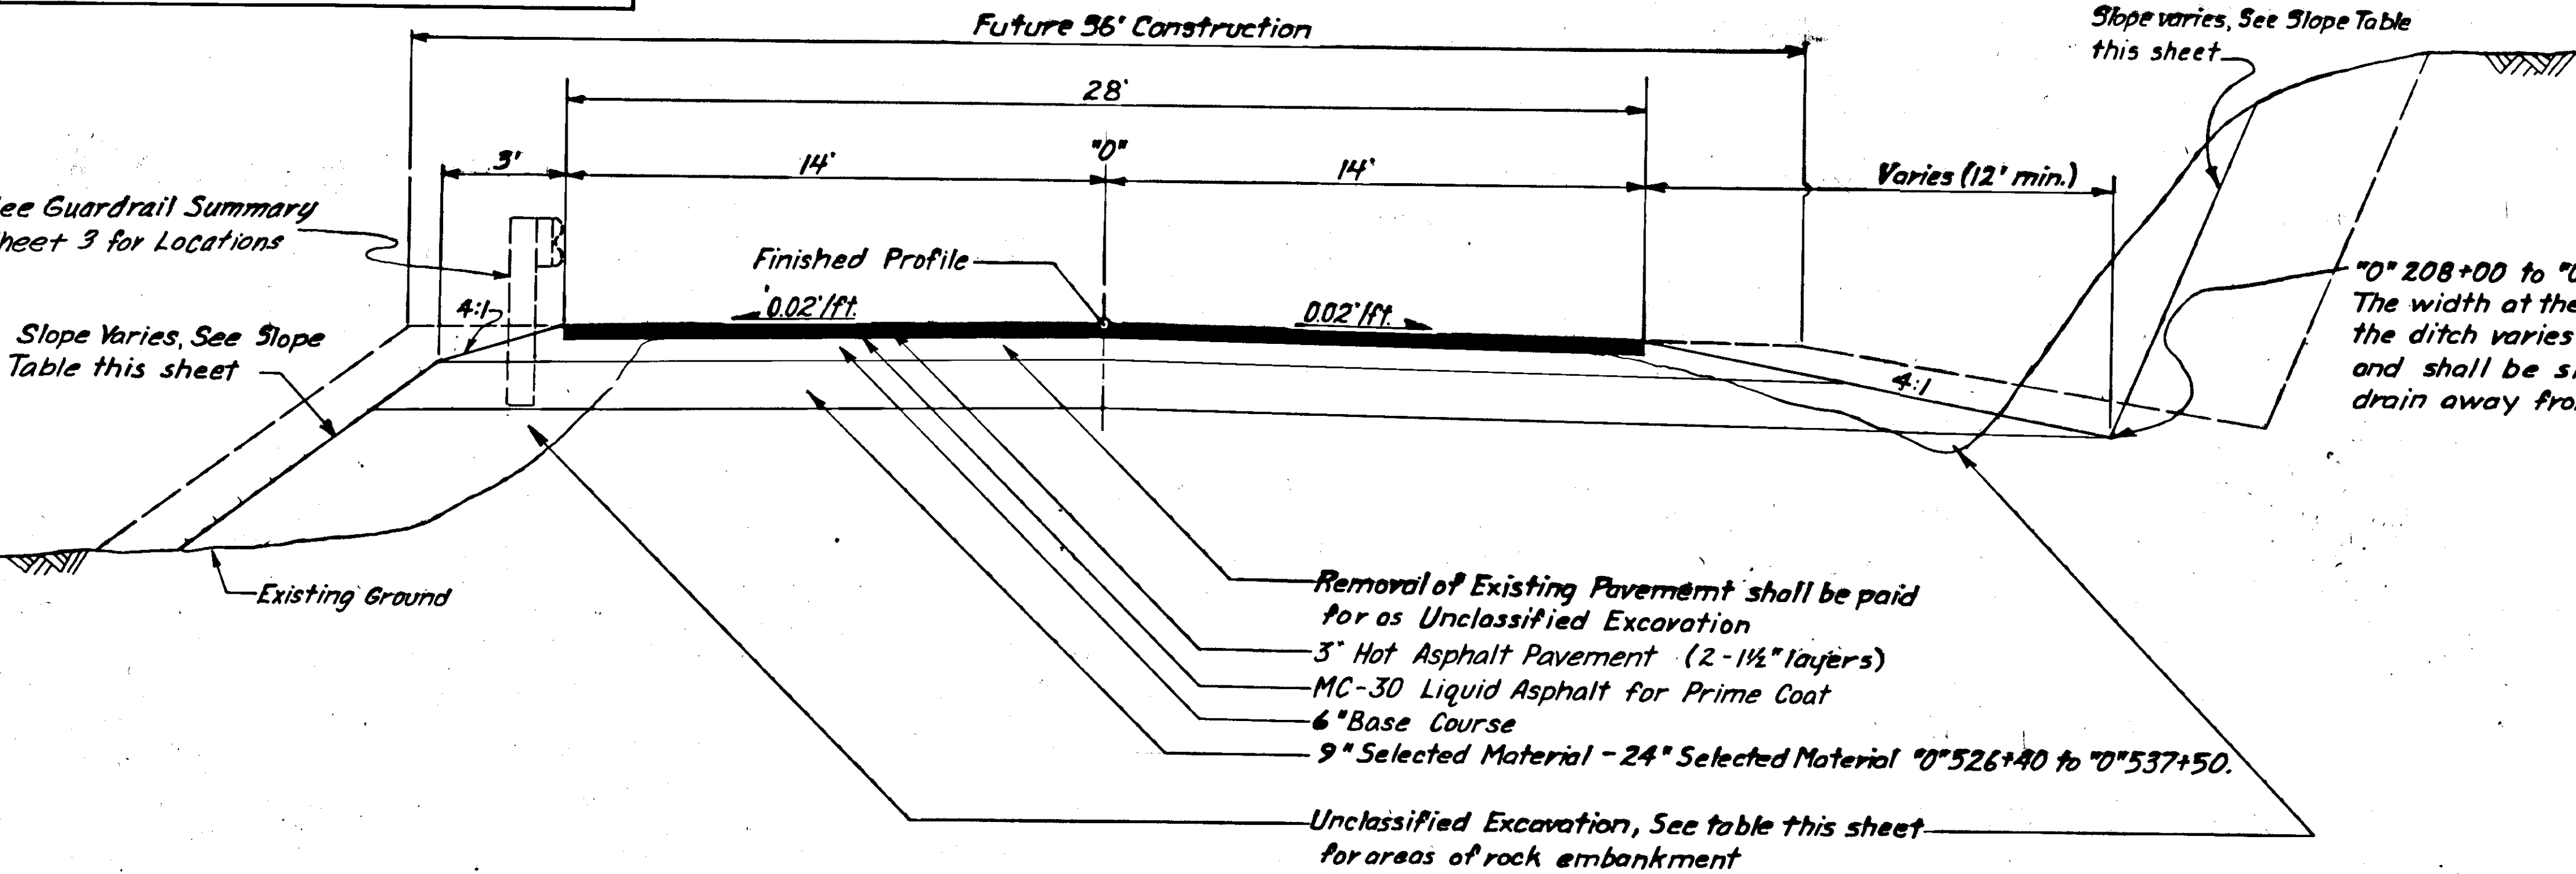

TYPICAL B

(For Areas, See Application table this sheet)

SLOPE TABLE

FILL		CUT	
HEIGHT OF FILL	SLOPE	HEIGHT OF CUT	SLOPE
0-5'	4:1	All Slopes in Solid Rock	4:1
5-10'	2:1		
10' and over	1 1/2:1	All Others	2:1
All Rock Embankment Slopes	1 1/2:1		

ESTIMATE OF QUANTITIES

ITEM NO.	DESCRIPTION	UNIT	QUANTITY
1	Furnishing and Maintaining Engineering Facilities	L. S.	All Req'd
110(1)	Mobilization	L. S.	All Req'd
111(1)	Temporary Erosion and Pollution Control	C. S.	All Req'd
115(1)	Traffic Maintenance	L. S.	All Req'd
201(3B)	Clearing and Grubbing	L. S.	All Req'd
204(4)	Removal and Disposal of Culvert Pipe	L. F.	3,736
203(3)	Unclassified Excavation	C. Y.	48,828
301(1)	Crushed Aggregate Base Course	Ton	29,557
114(1)	Construction Engineering by Contractor	L. S.	All Req'd
401(1)	Hot Asphalt Pavement, Class I	Ton	26,062
401(2)	AC-5 Asphalt Cement	Ton	1,573.7
401(4)	Anti-Stripping Additive	C. S.	All Req'd
402(3)	CSS-1 Emulsified Asphalt for Tack Coat	L. S.	All Req'd
403(1)	MC-30 Liquid Asphalt for Prime Coat	Ton	63.1
603(22G)	24" Pipe Conduit	L. F.	3,030
603(22I)	36" Pipe Conduit	L. F.	428
603(22K)	48" Pipe Conduit	L. F.	130
603(28K)	End Section for 48" Pipe Conduit	Ea.	4
606(1)	Beam Type Guardrail, Type I Post	L. F.	6,975
606(3)	Removal and Reconstruction of Guardrail	L. F.	3,375
614(1)	Survey Monuments	Ea.	7±
614(7)	Monument Cases	Ea.	7±
615(1)	Standard Sign	S. F.	545.76
627(1)	Watering	M. Gal.	800
670(1)	Painted Traffic Markings	L. S.	All Req'd

BASIS OF ESTIMATE

ITEM NO.	ESTIMATING FACTOR
301(1)	1.96 Tons per Cu. Yd.
401(1)	118 lbs. per S.Y./Inch Depth
402(3) *#	0.08 Gal. per S.Y. - 240 Gals. per Ton @ 60°F
403(1)	0.25 Gal. per S.Y. - 256 Gals. per Ton @ 60°F

*Estimated Quantity - 90 Tons
(of diluted mixture)

APPROACH SUMMARY

STATION	LEFT	RIGHT	WIDTH
"L" 279+00		X	24'
"O" 317+54	X		24'
"O" 318+00		X	20'
"O" 319+10	X		24'
"O" 341+90		X	14'
"L" 367+90		X	24'
"O" 391+30		X	14'
"O" 400+40		X	20'
"O" 418+15		X	14'
"O" 418+75		X	14'
"O" 445+27		X	14'
"L" 491+40		X	14'
"O" 539+60		X	30'
"O" 541+10		X	30'
"O" 581+80	X		30'
"O" 587+90	X		24'
"O" 620+00		X	14'
"O" 238+55		X	24'
"O" 230+00	X		14'
"O" 258+00		X	14'

See Standard Drawing I-40.10 for more details.

GUARDRAIL SUMMARY

FROM STATION	TO STATION	OFFSET Lt. Rt.	REMOVE & DISPOSE	Reconstruct	INSTALL	REMARKS
209+25	220+50		X		X	
285+00	289+00		X		X	
501+00	312+00		X		X	
319+00	325+25		X		X	
372+00	414+50		X		X	
418+00	494+00		X		X	
501+00	508+00		X	X		Existing Posts are Wood
513+50	521+50			X		Existing Posts are Wood
581+00	589+75		X		X	
608+75	614+25		X		X	
630+00	650+00		X		X	
638+00	673+50		X		X	
			X			Existing Posts are Wood
			X	X		Existing Posts are Wood

1. Removal and Disposal of guardrail shall be considered incidental to Item 606(1) Beam Type Guardrail, Type I Post, and no separate payment will be made therefor.
2. "O" 690+75 to "O" 730+75 no steel posts shall be used in the installations. No terminal posts or end section shall be required in this section.
3. Guardrail lengths and locations are approximate only and are subject to minor revisions.

MONUMENTS & CASES

STATION	LOCATION	POINT	STATION	LOCATION	POINT
"O" 207+10.36	CL	P. C.	"L" 525+24.41 Bk=	CL	P. O. T.
"O" 215+36.44	CL	P. T.	"O" 525+24.41 Ahd	CL	P. C.
"O" 218+05.58	CL	P. C.	"O" 532+48.89	CL	P. T.
"O" 227+34.81	CL	P. T.	"O" 534+87.66	CL	P. C.
"O" 227+35.13	CL	P. O. T.	"O" 538+40.12	CL	P. T.
"L" 238+47.54	CL	P. C.	"O" 542+35.74	9.83' Rt	P. I.
"L" 244+88.33	CL	P. T.	"O" 546+28.52	CL	P. C.
"L" 261+56.36	7.78' Rt	P. I.	"O" 553+36.10 Bk=	CL	P. T.
"L" 286+25.10 Bk=	CL	P. O. T.	"O" 553+36.07 Ahd	CL	P. O. T.
"O" 286+25.10 Ahd	CL	P. C.	"O" 563+15.64	2.07' Rt	P. I.
"O" 292+96.32	CL	P. T.	"O" 571+83.37	3.76' Rt	P. I.
"O" 303+29.72	1.75' Lt	P. I.	"O" 576+37.92	7.84' Lt	P. I.
"O" 321+79.85	.80' Rt	P. I.	"O" 583+03.67	5.83' Lt	P. I.
"O" 330+05.18	11.29' Lt	P. I.	"O" 594+40.06	8.66' Rt	P. I.
"O" 341+97.23	CL	P. C.	"O" 605+75.41	CL	P. C.
"O" 346+86.80 Bk=	CL	P. T.	"O" 616+51.94 Bk=	CL	P. T.
"O" 346+86.80 Ahd	CL	P. O. T.	"L" 616+80.67 Ahd	CL	P. C.
"L" 380+39.70	6.81' Lt	P. I.	"L" 629+49.73	6.40' Lt	P. I.
"O" 389+70.50	12.21' Rt	P. I.	"L" 636+94.05	13.70' Rt	P. I.
"O" 400+59.22	1.27' Lt	P. I.	"L" 641+68.51 Bk=	CL	P. O. T.
"O" 407+18.35	3.56' Rt	P. I.	"O" 641+68.51 Ahd	CL	P. C.
"O" 416+82.40	CL	P. C.	"O" 651+54.02 Bk=	CL	P. T.
"O" 422+75.75	CL	P. T.	"L" 651+55.11 Ahd	CL	P. C.
"O" 433+61.26	4.92' Lt	P. I.	"O" 657+25.95	CL	P. T.
"O" 436+62.01	CL	P. C.	"O" 661+77.78	CL	P. C.
"O" 439+66.18	CL	P. T.	"O" 672+78.91 Bk=	CL	P. T.
"O" 448+16.17	CL	P. C.	"L" 673+05.17 Ahd	CL	P. O. T.
"O" 451+94.49	CL	P. T.	"L" 676+73.10	CL	P. C.
"O" 454+97.15	CL	P. C.	"L" 684+17.92	CL	P. T.
"O" 458+78.97 Bk=	CL	P. T.	"L" 685+93.67 Bk=	CL	P. O. T.
"O" 458+78.97 Ahd	CL	P. O. T.	"L" 685+93.67 Ahd	CL	P. C.
"L" 462+05.78	2.25' Lt	P. I.	"O" 694+72.74 Bk=	CL	P. T.
"L" 465+64.52	4.10' Lt	P. I.	"L" 694+72.29 Ahd	CL	P. O. T.
"L" 471+11.81	10.27' Lt	P. I.	"O" 701+00.66	4.50' Lt	P. T.
"O" 484+65.63	6.71' Lt	P. I.	"O" 703+26.59	CL	P. C.
"L" 501+84.91	2.10' Lt	P. I.	"O" 707+96.02	CL	P. T.
"L" 504+74.57 Bk=	CL	P. O. T.	"O" 712+35.52	CL	P. C.
"O" 504+74.57 Ahd	CL	P. C.	"O" 717+33.31	CL	P. T.
"O" 507+81.53 Bk=	CL	P. T.	"O" 723+26.42	CL	P. C.
"L" 507+82.16 Ahd	CL	P. O. T.	"O" 729+09.39 Bk=	CL	P. T.
"O" 512+62.84 Bk=	CL	P. O. T.	"L" 729+10.47 Ahd	CL	P. O. T.
"O" 512+62.84 Ahd	CL	P. C.	"L" 733+12.13	CL	P. C.
"O" 515+91.71 Bk=	CL	P. T.	"L" 741+47.25	CL	P. T.
"O" 515+92.38 Ahd	CL	P. O. T.			
"O" & "L" 518+81.00	6.84' Rt	P. I.			

GENERAL NOTES

1. Those sections of the typical sections shown for Future Construction are not part of this contract.
2. Alignment as shown on these plans is subject to minor revisions.
3. Stationing with "L" designation refers to the alignment as staked in the field. Stationing with "O" designation refers to a designed alignment.
4. Sections of the existing roadway which are to be abandoned, shall be obliterated and graded to drain as directed by the engineer. All material removed from these sections shall be utilized on the project unless otherwise directed by the engineer.
5. The proposed finished profile shall match the existing profile as close as possible, actual finished profile elevations for Q shall be as provided by the engineer.
6. In all areas utilizing typical section B, the superelevation shall be in accordance with standard drawing I-80.00, case 11, Table 2, e=0.060. In all other areas of work, the superelevation shall be dictated by the existing superelevation rate or as directed by the engineer.
7. Clearing and Grubbing limits shall be 10' beyond slope limits in cut areas and 5' beyond slope limits in fill areas, or to the R.O.W., whichever is less.
8. Culvert lengths and locations are approximate only, and are subject to minor revisions.
9. All waste material shall be disposed of outside the R/W limits shown on the plans.
10. The removal of existing pavement shown herein shall be paid for as unclassified excavation. All cuts made in existing pavement shall be made in a neat workmanship manner.
11. Benching or "Keying In" shall be required in the placement of all rock embankment where the slope of the existing embankment warrants such work.
12. The location of the 8" pipeline as shown on the plans is approximate and it shall be the contractor's responsibility to locate it prior to any work which may result in damage to the utility. With the exception of the following areas the contractor shall repair all damage to the pipeline at his own expense.

Areas estimated for pipeline removal:
Station "O" 659+00 to "O" 665+00

Areas estimated for pipeline abandonment:
Station "O" 216+50 to "O" 228+00
Station "O" 422+00 to "O" 430+00
Station "O" 526+00 to "O" 533+00

Following the slope staking of the above areas the engineer will designate specific locations at which the pipeline shall be cut and the section of pipeline remaining will be capped. It is anticipated that only one cut and cap will be required at the beginning and end of each of the areas listed above. Caps shall consist of 1/2" steel plate, welded all the way around, to the ends of the pipe and painted with 2 coats of approved rust resistant paint. All work shall be subject to the approval of the engineer.

Disposal of sections of pipeline designated for removal shall be paid for as Removal & Disposal of Culvert Pipe.

No direct payment will be made for any work associated with the cutting and capping of various sections of the 8" pipeline as it will be considered incidental to Item 202(2) Removal & Disposal of Culvert Pipe.
13. The location of the buried telephone cable as shown on the plans is approximate and it shall be the contractor's responsibility to locate it prior to any work which may result in damage to the utility. Help in locating the cable may be obtained from the manager of the "General Telephone Co. of Alaska" in Haines. The contractor shall have all damages to the cable repaired by the General Telephone Co. of Alaska, at his expense.
14. After clearing, grubbing, and slope staking of the following areas is completed the telephone company shall relocate the cable outside the construction zone at no expense to the contractor.

Station "O" 221+00 to Station "O" 228+00
Station "O" 422+00 to Station "O" 430+00
Station "O" 526+00 to Station "O" 533+00
Station "O" 659+00 to Station "O" 665+00
14. Painted traffic markings shall be applied in accordance with Alaska Traffic Manual, Standard Drawing T-21.02, and as directed by the engineer. See the unpaved shoulder or no shoulder portion of the standard T-21.02 drawing for color and width of strips. The shoulder strips shall be 12" either side of the centerline and no passing zones are estimated to be 30 percent of the project length.

CULVERT PIPE INSTALLATION

STATION	SIZE	LENGTH	HEIGHT OF COVER	STATION	SIZE	LENGTH	HEIGHT OF COVER
* "O" 212+59.58	24"	72' 70"	8'	* "O" 507+48.36	48"	64'	6'
* "O" 219+14.08	24"	66' 74"	6'	* "O" 537+05.536+86	24"	72'	4'
* "O" 235+51.52	24"	58' 60"	4'	"O" 537+05.536+91	24"	72'	4'
* "O" 237+49.51	24"	58' 60"	4'	"O" 542+52.31	24"	60'	2'
* "O" 246+01.02	48"	66'	3'	"O" 549+16.548+88	24"	40'	2'
* "L" 252+03.55	24"	70' 60"	3'	"O" 555+58.36	24"	48'	3'
"L" 263+01.93	24"	70' 60"	4'	"O" 564+66.41	24"	50'	4'
"L" 268+80.73	36"	52' 60"	4'	"O" 571+54.31	24"	56'	3'
"L" 272+00	24"	56' 58"	4'	"O" 581+75.53	24"	50'	3'
"O" 316+80.46	24"	50'	2'	"O" 594+40.593+79	24"	52'	2'
"O" 316+85.50	24"	48' 0"	2'	"O" 596+80.62	24"	48' 0"	2'
"O" 322+00.19	24"	52' 56"	3'	"O" 601+32.08	24"	44'	2'
"O" 323+44.54	24"	48' 56"	3'	"O" 604+75.50	24"	52'	4'
"O" 338+35.30	24"	52' 56"	2'	"L" 614+08.613+80	24"	50'	2'
"O" 342+62.73	36"	48' 56"	2'	"L" 614+13.613+85	24"	50'	2'
"L" 348+16.30	24"	44' 48"	2'	"L" 621+24.37	24"	58'	4'
"L" 348+41.51	24"	44' 48"	2'	"L" 631+85.88	24"	58'	5'
"L" 373+28.53	24"	56'	2'	"L" 651+08.Deleted	24"	52'	4'
"O" 390+84.09	24"	58' 56"	2'	"L" 651+13.18	24"	52'	4'
"O" 392+41.69	24"	52'	2'	"O" 667+60.667+57	24"	72' 66"	6'
"O" 396+12.07	24"	58' 56"	3'	"O" 672+66.672+37	36"	54' 58"	5'
"O" 408+09.105+81	36"	50'	3'	"O" 672+72.672+47	36"	54' 58"	5'
"O" 427+24.27	24"	64'	3'	"L" 680+08	24"	54'	3'
"O" 431+38.39	24"	58'	2'	"L" 690+28	24"	68'	4'
"O" 434+52	24"	52'	2'	"O" 711+04	24"	58'	3'
"O" 443+15.80	24"	56'	2'	"O" 718+55	24"	58'	4'
"O" 443+28.84	24"	56'	2'	"L" 729+28	24"	56'	5'
"L" 457+27.01	24"	64'	2'	* "L" 735+90	36"	84'	7'
"O" 472+28.473+16	24"	52' 58"	3'				
"O" 476+00.477+44	24"	52' 62"	2'				
"L" 486+52.74	24"	56' 52"	2'				
"L" 497+56.493+85.24	24"	58' 60"	2'				
* "L" 501+68.63	24"	58' 60"	3'				

* Denotes installation of end sections.
* All culvert pipes less than 48" in dia. shall have three ends cut to conform to the finished slope after installation. Payment shall be considered incidental to Item 603(22) "Pipe Conduit".
For all installations see sh. #4 for more details.

CULVERT PIPE REMOVAL SUMMARY

STATION	LENGTH	STATION	LENGTH
"L" 209+95	62' 52"	"L" 497+56.493+85	50'
"L" 218+71.89	59'	"L" 507+48.36	55' 56"
"L" 235+51	55'	"L" 537+05.536+85	47' 44"
"L" 237+49.51	66'	"L" 537+05.536+91	47' 44"
"L" 246+01	65'	"L" 542+52.31	42' 46"
"L" 252+03.54	56'	"L" 549+16.548+88	58' 50"
"L" 263+01.94	50'	"L" 555+58.36	42' 44"
"L" 267+80.268+74	50'	"L" 564+66.41	46' 50"
"L" 272+06.418+48	32"	"L" 571+54.31	54' 54"
"L" 316+80.48	44'	"L" 581+75.53	42'
"L" 316+80.50	44'	"L" 594+40.593+79	48' 48"
"L" 322+00.19	52'	"L" 596+80.62	44' 42"
"L" 323+44.51	45'	"L" 601+32.08	46'
"L" 331+30.330+44	81' 42"	"L" 604+75.50	50'
"L" 338+35.30	58' 48"	"L" 614+08.613+83	54'
"L" 342+62.71	47' 48"	"L" 614+13.613+87	54'
"L" 342+62.75	47' 48"	"L" 621+24.37	50'
"L" 348+16.30	39' 40"	"L" 631+85.88	54'
"L" 348+41.51	38'	"L" 651+08.Deleted	48'
"L" 3			

SIGNING SCHEDULE

STATION	DIST. FROM		CODE NO.	LEGEND	SIGN PANEL THICKNESS			AREA in S.F.	NO. of POSTS	POST				FACING TRAFFIC	REMARKS
	LT.	RT.			SIZE	UNFRAMED	FRAMED			TYPE	SIZE	LENGTH	EMBEDMENT		
"0" 210+95		26'	M10-2	Mile 4	6" X 8"	0.063	0.33	1	Tube	2"	10'	3'	WB		
"0" 210+95		26'	M10-2	Mile 4	6" X 8"	0.063	0.33						EB		
"0" 215+36		26'	W1-2R	Curve Right	3' X 3'	0.063	9.00	2	Tube	2"	16'	3'	WB	Mount Below W1-2R	
"0" 215+36		26'	W13-1	50 M. P. H.	2' X 2'	0.063	4.00						EB	Mount Below W1-2L	
"L" 230+81	26'		W1-2L	Curve Left	3' X 3'	0.063	9.00	2	Tube	2"	16'	3'	WB	Mount Below W1-2L	
"L" 230+81	26'		W13-1	50 M. P. H.	2' X 2'	0.063	4.00						EB	Mount Below W1-2L	
"L" 235+56		26'	W1-2L	Curve Left	3' X 3'	0.063	9.00	2	Tube	2"	16'	3'	WB	Mount Below W1-2L	
"L" 235+56		26'	W13-1	50 M. P. H.	2' X 2'	0.063	4.00						EB	Mount Below W1-2L	
"L" 247+98	26'		W1-2R	Curve Right	3' X 3'	0.063	9.00	2	Tube	2"	16'	3'	WB	Mount Below W1-2R	
"L" 247+98	26'		W13-1	50 M. P. H.	2' X 2'	0.063	4.00						EB	Mount Below W1-2R	
"L" 264+55		26'	M10-2	Mile 5	6" X 8"	0.063	0.33	1	Tube	2"	10'	3'	WB		
"L" 264+55		26'	M10-2	Mile 5	6" X 8"	0.063	0.33						EB		
"0" 315+62		26'	M10-2	Mile 6	6" X 8"	0.063	0.33	1	Tube	2"	10'	3'	WB		
"0" 315+62		26'	M10-2	Mile 6	6" X 8"	0.063	0.33						EB		
"0" 338+82		26'	W1-2L	Curve Left	3' X 3'	0.063	9.00	2	Tube	2"	16'	3'	WB		
"0" 338+82		26'	W13-1	50 M. P. H.	2' X 2'	0.063	4.00						EB	Mount Below W1-2R	
"L" 349+80	26'		W1-2R	Curve Right	3' X 3'	0.063	9.00	2	Tube	2"	16'	3'	WB	Mount Below W1-2R	
"L" 349+80	26'		W13-1	50 M. P. H.	2' X 2'	0.063	4.00						EB	Mount Below W1-2R	
"L" 368+63		26'	M10-2	Mile 7	6" X 8"	0.063	0.33	1	Tube	2"	10'	3'	WB		
"L" 368+63		26'	M10-2	Mile 7	6" X 8"	0.063	0.33						EB		
"0" 385+28		26'	W1-2L	Curve Left	3' X 3'	0.063	9.00	2	Tube	2"	16'	3'	WB	Mount Below W1-2L	
"0" 385+28		26'	W13-1	50 M. P. H.	2' X 2'	0.063	4.00						EB	Mount Below W1-2L	
"0" 394+10	26'		W1-2R	Curve Right	3' X 3'	0.063	9.00	2	Tube	2"	16'	3'	WB	Mount Below W1-2R	
"0" 394+10	26'		W13-1	50 M. P. H.	2' X 2'	0.063	4.00						EB	Mount Below W1-2R	
"0" 413+83		26'	W1-2R	Curve Right	3' X 3'	0.063	9.00	2	Tube	2"	16'	3'	WB	Mount Below W1-2R	
"0" 413+83		26'	W13-1	50 M. P. H.	2' X 2'	0.063	4.00						EB	Mount Below W1-2R	
"0" 420+88		26'	M10-2	Mile 8	6" X 8"	0.063	0.33	1	Tube	2"	10'	3'	WB		
"0" 420+88		26'	M10-2	Mile 8	6" X 8"	0.063	0.33						EB		
"0" 425+76	26'		W1-2L	Curve Left	3' X 3'	0.063	9.00	2	Tube	2"	16'	3'	WB	Mount Below W1-2L	
"0" 425+76	26'		W13-1	50 M. P. H.	2' X 2'	0.063	4.00						EB	Mount Below W1-2L	
"0" 429+72		26'	W1-4R	Reverse Curve	3' X 3'	0.063	9.00	2	Tube	2"	16'	3'	WB	Mount Below W1-4R	
"0" 429+72		26'	W13-1	50 M. P. H.	2' X 2'	0.063	4.00						EB	Mount Below W1-4R	
"0" 442+66	26'		W1-4R	Reverse Curve	3' X 3'	0.063	9.00	2	Tube	2"	16'	3'	WB	Mount Below W1-4R	
"0" 442+66	26'		W13-1	50 M. P. H.	2' X 2'	0.063	4.00						EB	Mount Below W1-4R	
"0" 451+95		26'	W1-2L	Curve Left	3' X 3'	0.063	9.00	2	Tube	2"	16'	3'	WB	Mount Below W1-2L	
"0" 451+95		26'	W13-1	50 M. P. H.	2' X 2'	0.063	4.00						EB	Mount Below W1-2L	
"L" 461+89	26'		W1-2R	Curve Right	3' X 3'	0.063	9.00	2	Tube	2"	11'	3'	WB	Mount Below W1-2R	
"L" 461+89	26'		W13-1	50 M. P. H.	2' X 2'	0.063	4.00						EB	Mount Below W1-2R	
"L" 466+82		26'	W1-2R	Curve Right	3' X 3'	0.063	9.00	2	Tube	2"	14'	3'	WB	Mount Below W1-2R	
"L" 466+82		26'	W13-1	50 M. P. H.	2' X 2'	0.063	4.00						EB	Mount Below W1-2R	
"0" 474+66		26'	M10-2	Mile 9	6" X 8"	0.063	0.33	1	Tube	2"	10'	3'	WB		
"0" 474+66		26'	M10-2	Mile 9	6" X 8"	0.063	0.33						EB		
"0" 475+40	16'		W1-2L	Curve Left	3' X 3'	0.063	9.00	2	Tube	2"	14'	3'	WB	Install Back of Gdrail	
"0" 475+40	16'		W13-1	50 M. P. H.	2' X 2'	0.063	4.00						EB	Mount Below W1-2L	
"0" 480+61		26'	W1-2L	Curve Left	3' X 3'	0.063	9.00	2	Tube	2"	16'	3'	WB	Mount Below W1-2L	
"0" 480+61		26'	W13-1	50 M. P. H.	2' X 2'	0.063	4.00						EB	Mount Below W1-2L	
"L" 488+72	26'		W1-2R	Curve Right	3' X 3'	0.063	9.00	2	Tube	2"	15'	3'	WB	Mount Below W1-2R	
"L" 488+72	26'		W13-1	50 M. P. H.	2' X 2'	0.063	4.00						EB	Mount Below W1-2R	
"L" 501+75		26'	W1-2L	Curve Left	3' X 3'	0.063	9.00	2	Tube	2"	16'	3'	WB	Mount Below W1-2L	
"L" 501+75		26'	W13-1	50 M. P. H.	2' X 2'	0.063	4.00						EB	Mount Below W1-2L	
"L" 509+63		26'	W1-4R	Reverse Curve	3' X 3'	0.063	9.00	2	Tube	2"	16'	3'	WB	Mount Below W1-4R	
"L" 509+63		26'	W13-1	50 M. P. H.	2' X 2'	0.063	4.00						EB	Mount Below W1-4R	
"L" 510+82	26'		W1-2R	Curve Right	3' X 3'	0.063	9.00	2	Tube	2"	16'	3'	WB	Mount Below W1-2R	
"L" 510+82	26'		W13-1	50 M. P. H.	2' X 2'	0.063	4.00						EB	Mount Below W1-2R	
"L" 522+24		26'	W1-4R	Reverse Curve	3' X 3'	0.063	9.00	2	Tube	2"	16'	3'	WB	Mount Below W1-4R	
"L" 522+24		26'	W13-1	50 M. P. H.	2' X 2'	0.063	4.00						EB	Mount Below W1-4R	
"L" 522+86	18'		W1-4R	Reverse Curve	3' X 3'	0.063	9.00	2	Tube	2"	15'	3'	WB	Mount Below W1-4R	
"L" 522+86	18'		W13-1	50 M. P. H.	2' X 2'	0.063	4.00						EB	Mount Below W1-4R	
"0" 530+50		26'	M10-2	Mile 10	6" X 12 3/4"	0.063	0.53	1	Tube	2"	11'	3'	WB		
"0" 530+50		26'	M10-2	Mile 10	6" X 12 3/4"	0.063	0.53						EB		
"0" 546+61	26'		W1-4R	Reverse Curve	3' X 3'	0.063	9.00	2	Tube	2"	16'	3'	WB	Mount Below W1-4R	
"0" 546+61	26'		W13-1	50 M. P. H.	2' X 2'	0.063	4.00						EB	Mount Below W1-4R	
"0" 568+05		26'	W1-2L	Curve Left	3' X 3'	0.063	9.00	2	Tube	2"	15'	3'	WB	Mount Below W1-2L	
"0" 568+05		26'	W13-1	50 M. P. H.	2' X 2'	0.063	4.00						EB	Mount Below W1-2L	
"0" 575+61	26'		W1-2R	Curve Right	3' X 3'	0.063	9.00	2	Tube	2"	16'	3'	WB	Mount Below W1-2R	
"0" 575+61	26'		W13-1	50 M. P. H.	2' X 2'	0.063	4.00						EB	Mount Below W1-2R	
"0" 579+00		26'	M10-2	Mile 11	6" X 12 3/4"	0.063	0.53	1	Tube	2"	11'	3'	WB		
"0" 579+00		26'	M10-2	Mile 11	6" X 12 3/4"	0.063	0.53						EB		
"0" 579+06		26'	W1-2R	Curve Right	3' X 3'	0.063	9.00	2	Tube	2"	16'	3'	WB	Mount Below W1-2R	
"0" 579+06		26'	W13-1	50 M. P. H.	2' X 2'	0.063	4.00						EB	Mount Below W1-2R	
"0" 587+00	26'		W1-2L	Curve Left	3' X 3'	0.063	9.00	2	Tube	2"	16'	3'	WB	Mount Below W1-2L	
"0" 587+00	26'		W13-1	50 M. P. H.	2' X 2'	0.063	4.00						EB	Mount Below W1-2L	
"0" 613+52		26'	W1-2R	Curve Right	3' X 3'	0.063	9.00	2	Tube	2"	16'	3'	WB	Mount Below W1-2R	
"0" 613+52		26'	W13-1	50 M. P. H.	2' X 2'	0.063	4.00						EB	Mount Below W1-2R	
"L" 624+46	26'		W1-2L	Curve Left	3' X 3'	0.063	9.00	2	Tube	2"	16'	3'	WB	Mount Below W1-2L	
"L" 624+46	26'		W13-1	50 M. P. H.	2' X 2'	0.063	4.00						EB	Mount Below W1-2L	
"L" 632+43	26'		W1-2L	Curve Left	3' X 3'	0.063	9.00	2	Tube	2"	16'	3'	WB	Mount Below W1-2L	
"L" 632+43	26'		W13-1	50 M. P. H.	2' X 2'	0.063	4.00						EB	Mount Below W1-2L	


STATE	PROJECT DESIGNATION	YEAR	SHEET NO.	TOTAL SHEETS
ALASKA	FR-F-095-6(3)	1979	4	14

SIGNING SCHEDULE

STATION	DIST. FROM		CODE NO.	LEGEND	SIGN PANEL THICKNESS			AREA in S.F.	NO. of POSTS	POST				FACING TRAFFIC	REMARKS
	LT.	RT.			SIZE	UNFRAMED	FRAMED			TYPE	SIZE	LENGTH	EMBEDMENT		
"L" 633+50		26'	M10-2	Mile 12	6" X 12 3/4"	0.063	0.53	1	Tube	2"	11'	3'	WB		
"L" 633+50		26'	M10-2	Mile 12	6" X 12 3/4"	0.063	0.53						EB		
"L" 641+42	26'		W1-2R	Curve Right	3' X 3'	0.063	9.00	2	Tube	2"	16'	3'	WB	Mount Below W1-2R	
"L" 641+42	26'		W13-1	50 M. P. H.	2' X 2'	0.063	4.00						EB	Mount Below W1-2R	
"0" 648+55		26'	W1-2R	Curve Right	3' X 3'	0.063	9.00	2	Tube	2"	15'	3'	WB	Mount Below W1-2R	
"0" 648+55		26'	W13-1	50 M. P. H.	2' X 2'	0.063	4.00						EB	Mount Below W1-2R	
"0" 658+78		26'	W1-2L	Curve Left	3' X 3'	0.063	9.00	2	Tube	2"	16'	3'	WB	Mount Below W1-2L	
"0" 658+78		26'	W13-1	50 M. P. H.	2' X 2'	0.063	4.00						EB	Mount Below W1-2L	
"0" 660+26	26'		W1-2L	Curve Left	3' X 3'	0.063	9.00	2	Tube	2"	14'	3'	WB	Mount Below W1-2L	
"0" 660+26	26'		W13-1	50 M. P. H.	2' X 2'	0.063	4.00						EB	Mount Below W1-2L	
"0" 673+48		20'	W1-2R	Curve Right <i>Road Narrows</i>	3' X 3'	0.063	9.00	2	Tube	2"	16'	3'	WB	Mount Below W1-2R	
"0" 673+48		20'	W13-1	50 M. P. H.	2' X 2'	0.063	4.00						EB	Mount Below W1-2R	
"0" 675+79	20'		W1-2R	Curve Right	3' X 3'	0.063	9.00	2	Tube	2"	16'	3'	WB	Mount Below W1-2R	
"0" 675+79	20'		W13-1	50 M. P. H.	2' X 2'	0.063	4.00						EB	Mount Below W1-2R	
"0" 686+70		26'	M10-1	Mile 13	6" X 12 3/4"	0.063	0.53	1	Tube	2"	11'	3'	WB		
"0" 686+70		26'	M10-1	Mile 13	6" X 12 3/4"	0.063	0.53						EB		
"0" 687+25	26'		W1-2L	Curve Left	3' X 3'	0.063	9.00	2	Tube	2"	16'	3'	WB	Mount Below W1-2L	
"0" 687+25	26'		W13-1	50 M. P. H.	2' X 2'	0.063	4.00						EB	Mount Below W1-2L	
"0" 700+27		22'	W1-2L	Curve Left	3' X 3'	0.063	9.00	2	Tube	2					

STATE	PROJECT DESIGNATION	YEAR	SHEET NO.	TOTAL SHEETS
ALASKA	FR-F-095-6(3)	1979	5	14

STATE FURNISHED MATERIALS SITE

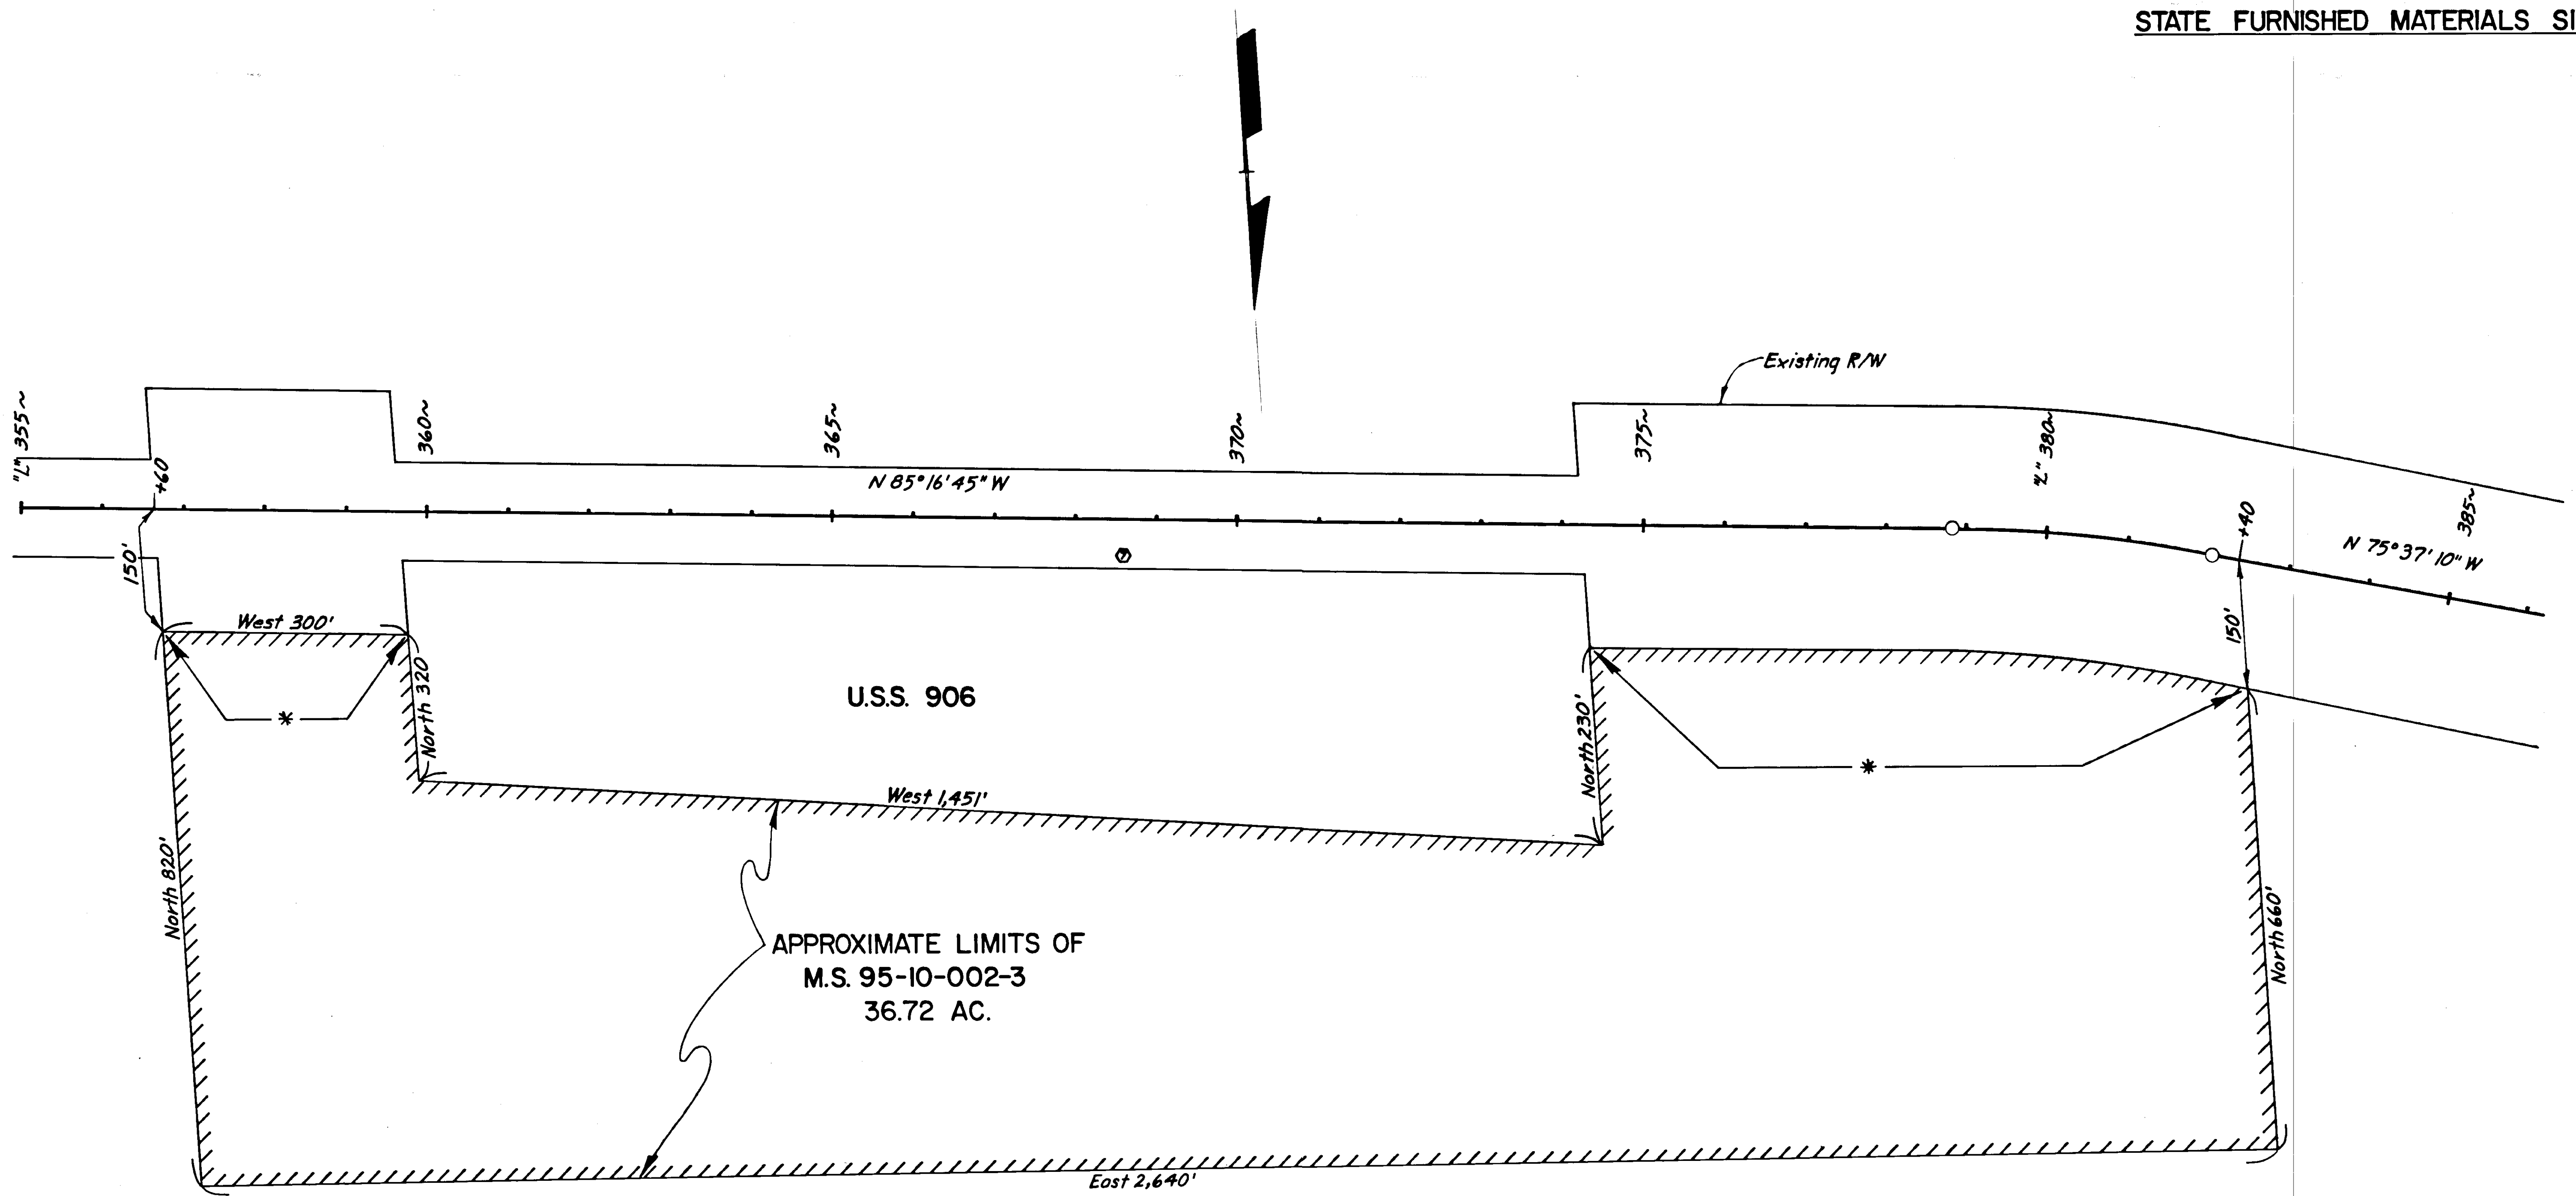

APPROXIMATE LIMITS OF
M.S. 95-10-002-3
36.72 AC.



* In developing access to M.S. 95-10-002-3
the contractor shall use only those
areas shown above.

BEGIN PROJECT
 FR-F-095-6(3)
 STA. "O" 206+21.80 P.C. Bk.
 STA. "O" 206+23.83 P.O.T. Ahd.

0'206+23 to 0'208+23 transition the existing 36' finished width to a 28' finished width.
 0'206+23 to 0'206+43 install pavement transition. See sheet No. 4 for details.


Horizontal Control: Based on a bearing of N61°06'10"W from U.S.C. & G.S. "Mill" to U.S.C. & G.S. "Yind" with State Plane Coordinates: Mill: N 2,707,632.43 E 2,346,447.75
 Yind: N 2,713,937.85 E 2,335,024.21
 A scale factor of 0.99995591 was used to convert grid distances to ground distances.

Vertical Control: Based on U.S.C. & G.S. & G.S.C. Bench Marks located throughout the project. See sheets 6-14 for locations.
 U.S.C. & G.S. is United States Coast & Geological Survey. G.S.C. is Geological Survey of Canada.

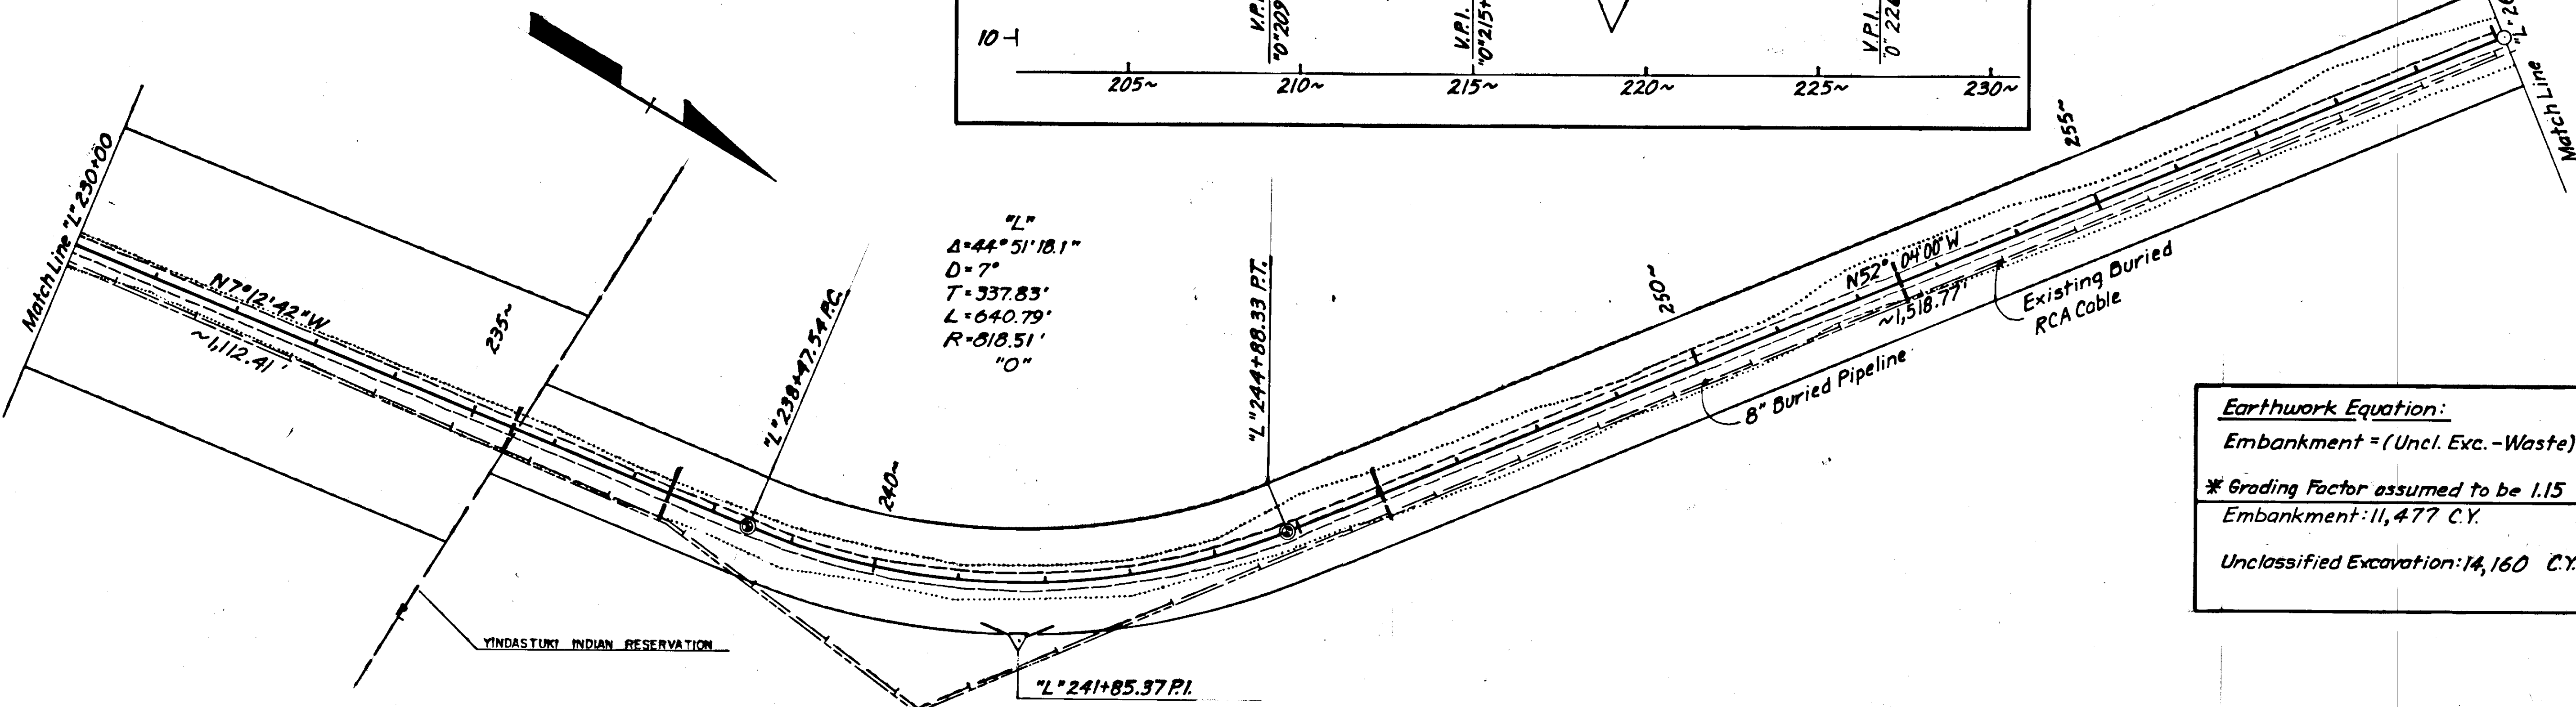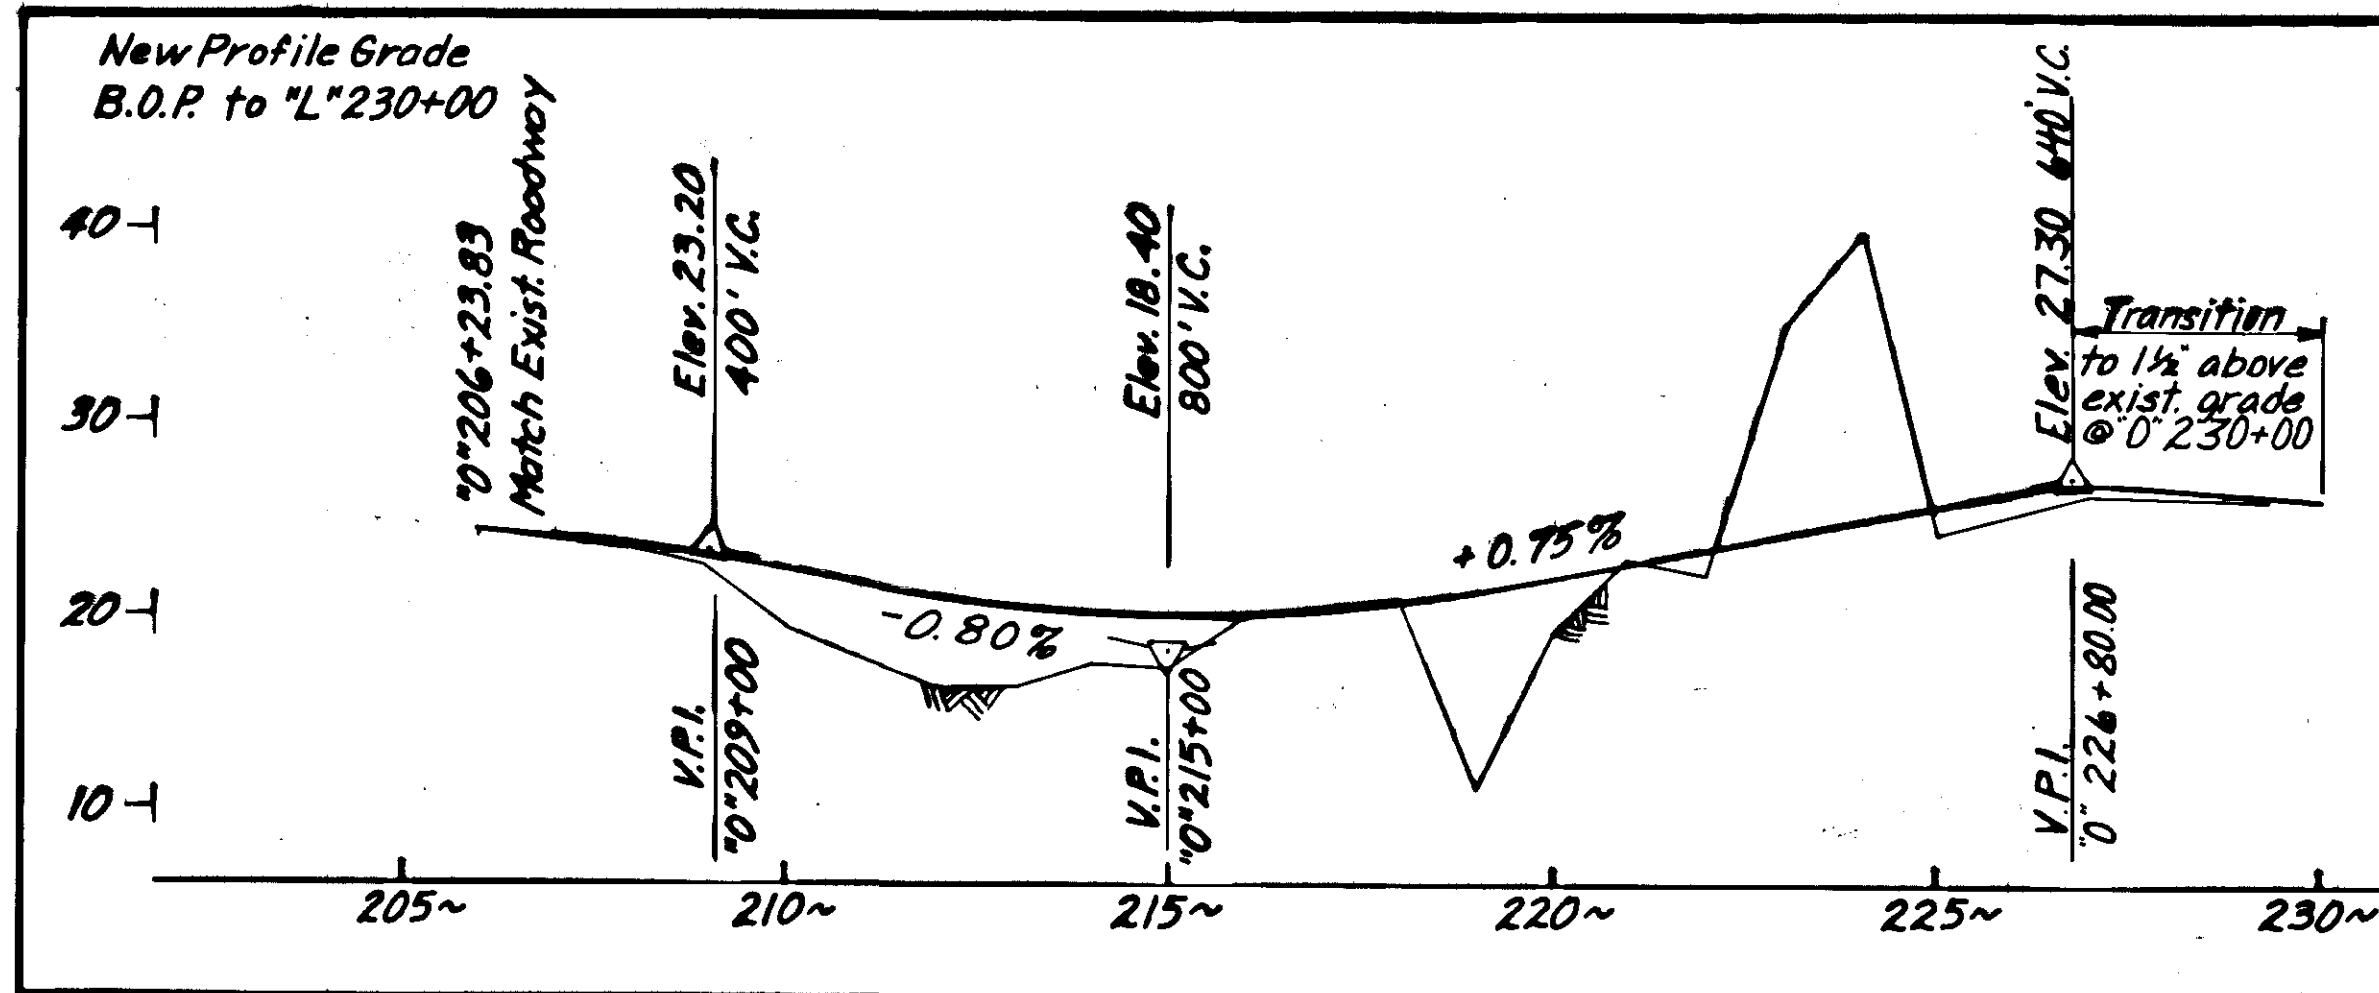


Earthwork Equation:
 Embankment = (Uncl. Exc. - Waste) x Grading Factor
 * Grading Factor assumed to be 1.15 in rock
 Embankment: 11,477 C.Y.
 Unclassified Excavation: 14,160 C.Y. (No Waste)

YINDASTUKI INDIAN RESERVATION

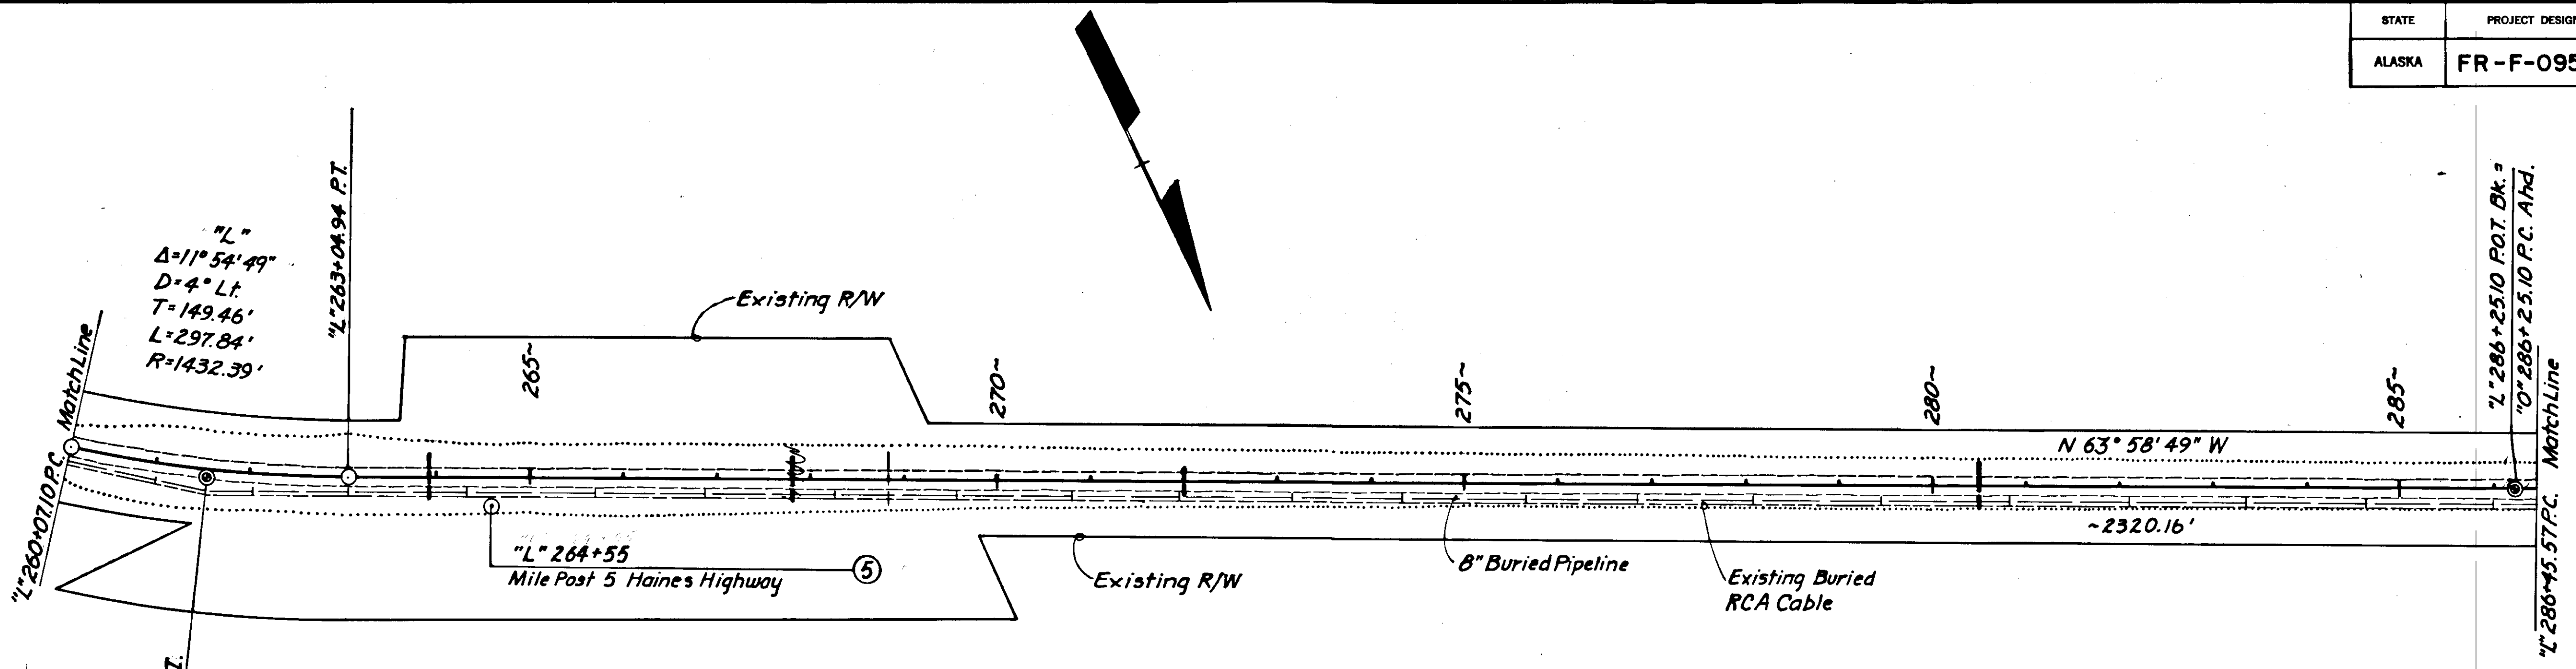


Embankment: 4,795 C.Y.
 Unclassified Excavation: 820 C.Y. (No Waste)

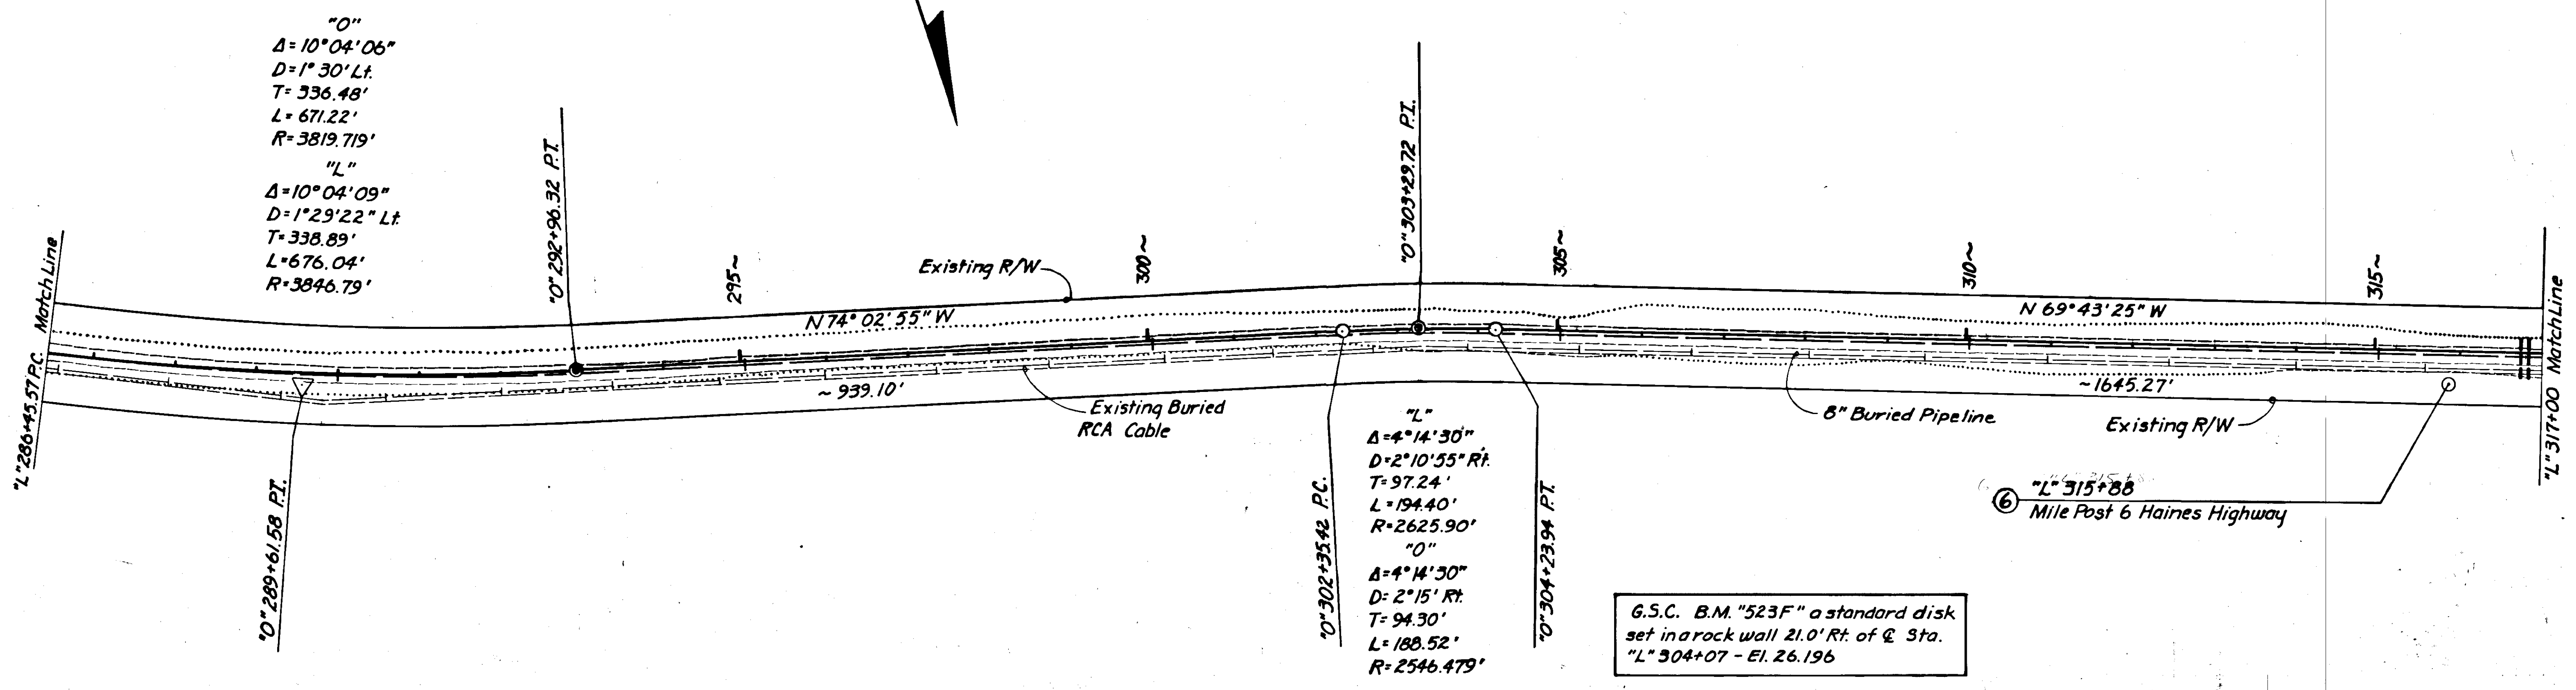

G.S.C. B.M. "523F" a standard disk set in a rock wall 21.0' Rt. of & Sta. "L" 304+07 - El. 26.196


STATE	PROJECT DESIGNATION	YEAR	SHEET NO.	TOTAL SHEETS
ALASKA	FR-F-095-6(3)	1979	8	14

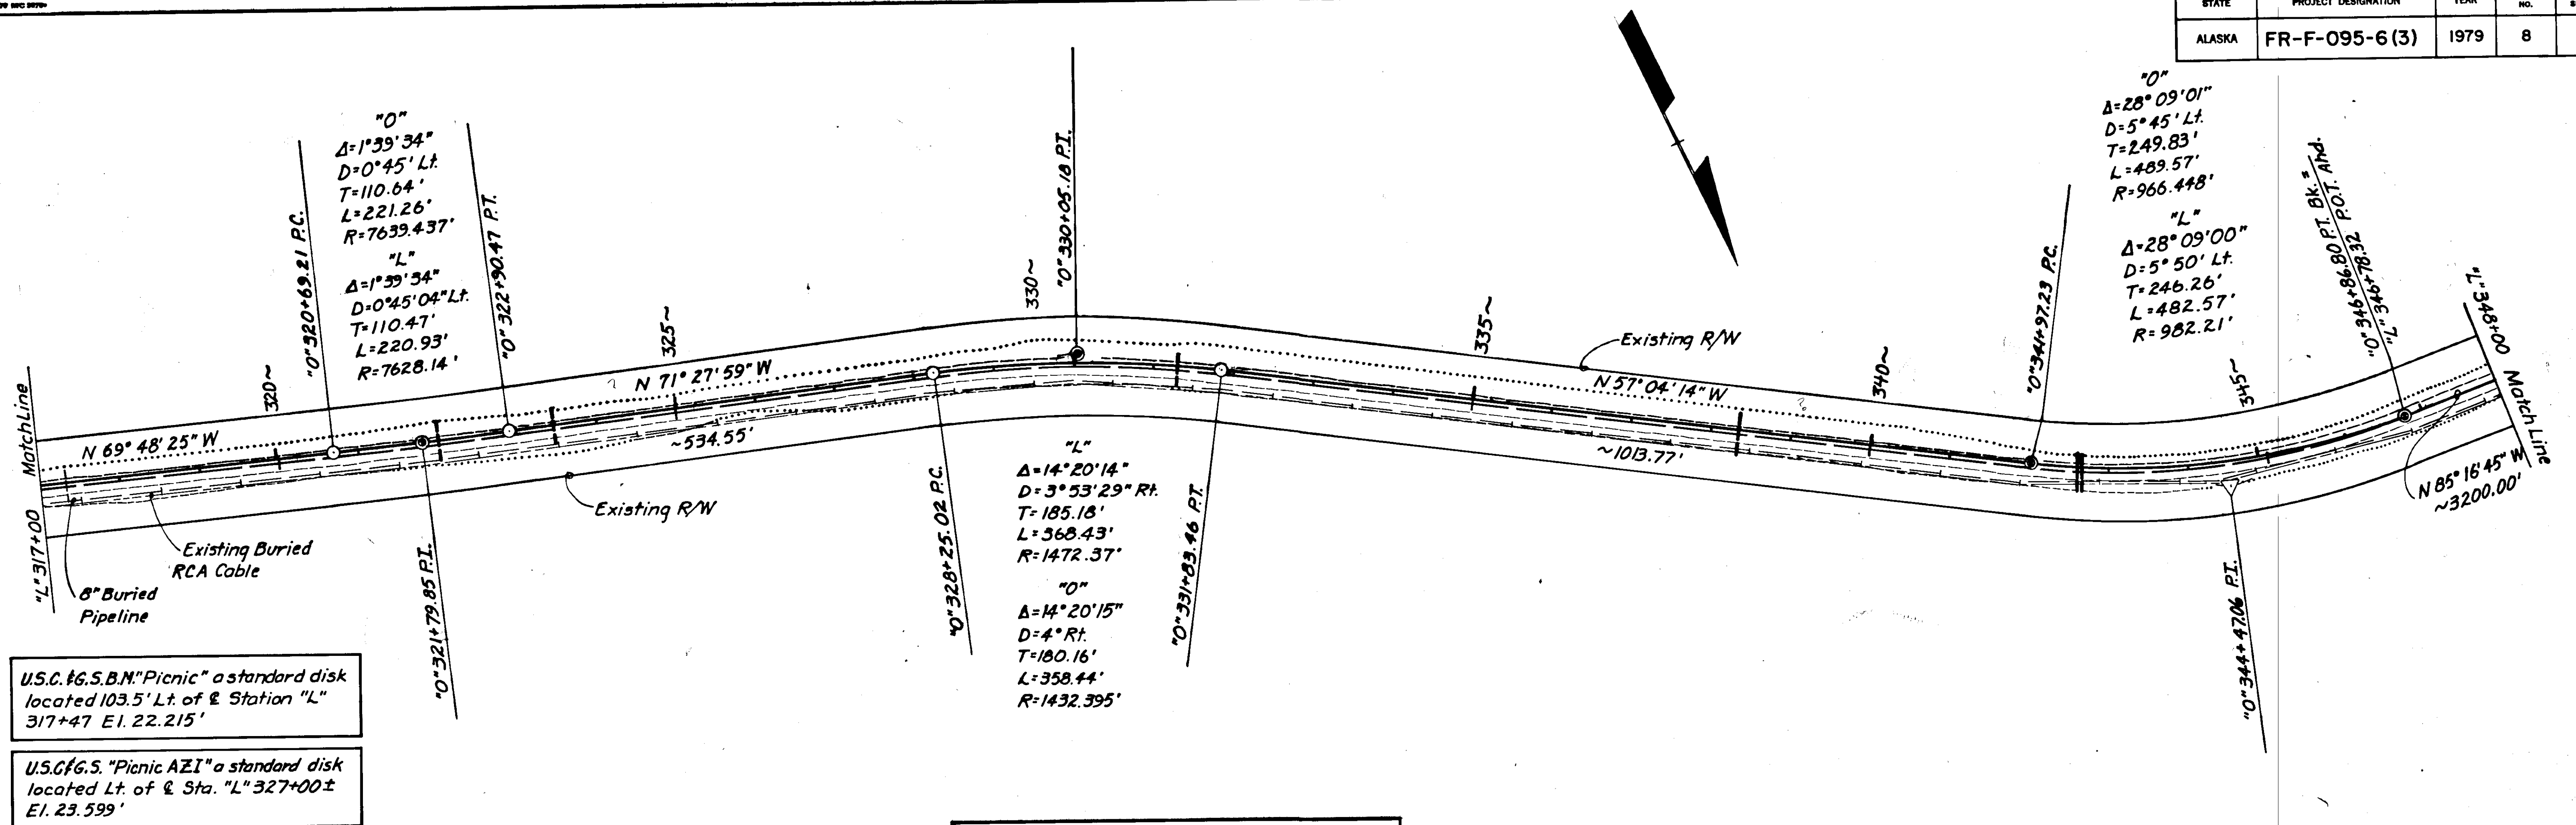

U.S.C. & G.S.B.M. "Picnic" a standard disk located 103.5' Lt. of & Station "L" 317+47 El. 22.215'

U.S.C. & G.S. "Picnic AZI" a standard disk located Lt. of & Sta. "L" 327+00± El. 23.599'


Embankment: 2,494 C.Y.
Unclassified Excavation: 1,084 C.Y. (No Waste)

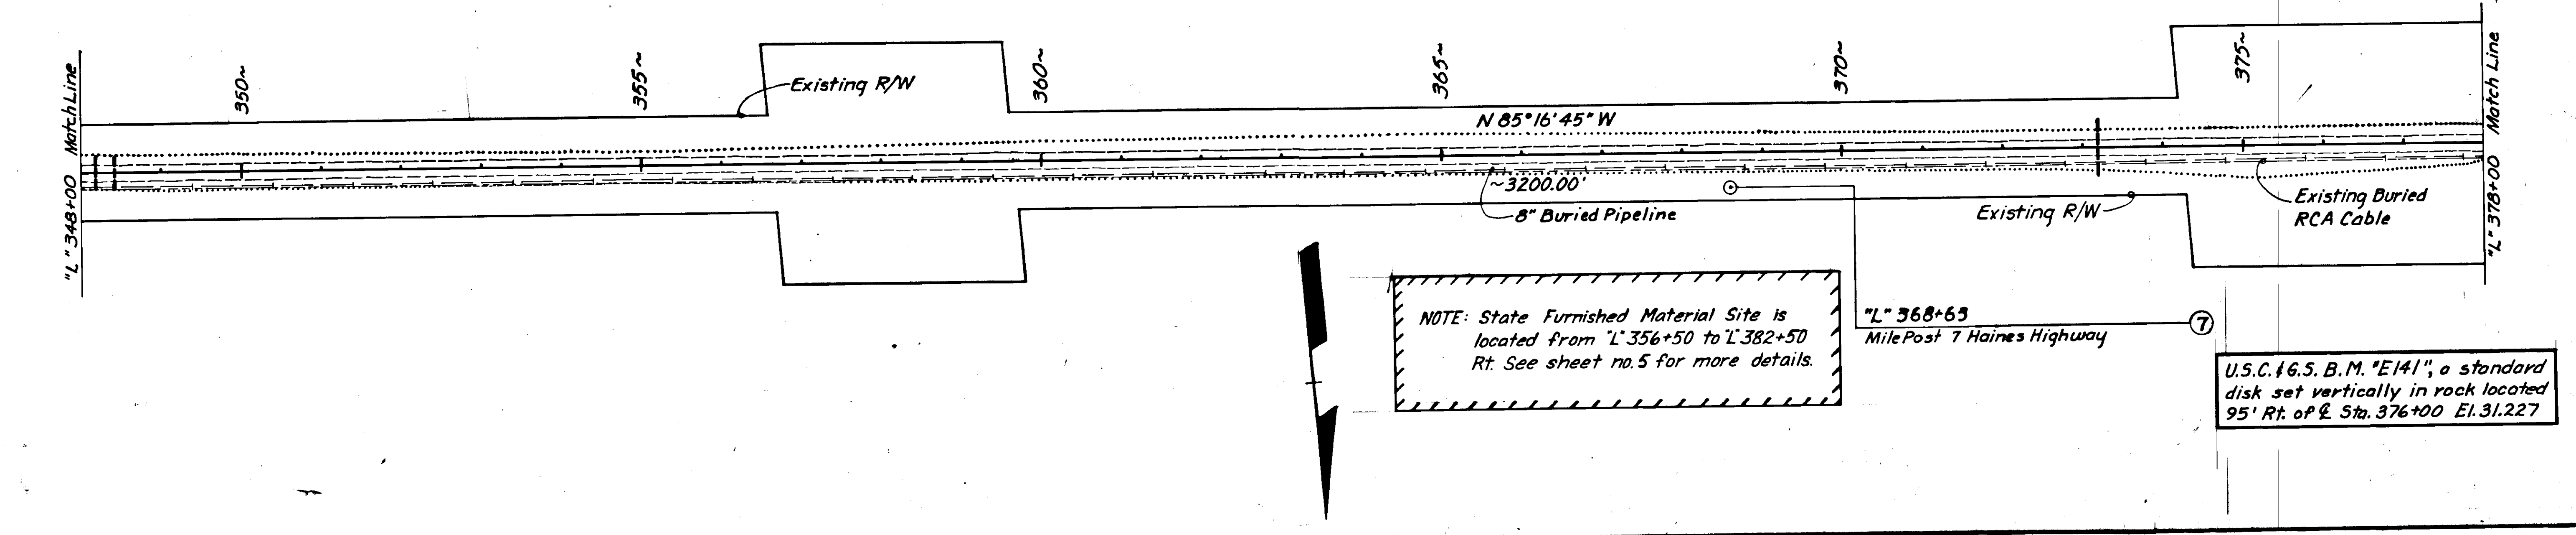

NOTE: State Furnished Material Site is located from "L" 356+50 to "L" 382+50 Rt. See sheet no. 5 for more details.

"L" 368+65
Mile Post 7 Haines Highway

U.S.C. & G.S. B.M. "E141", a standard disk set vertically in rock located 95' Rt. of & Sta. 376+00 El. 31.227

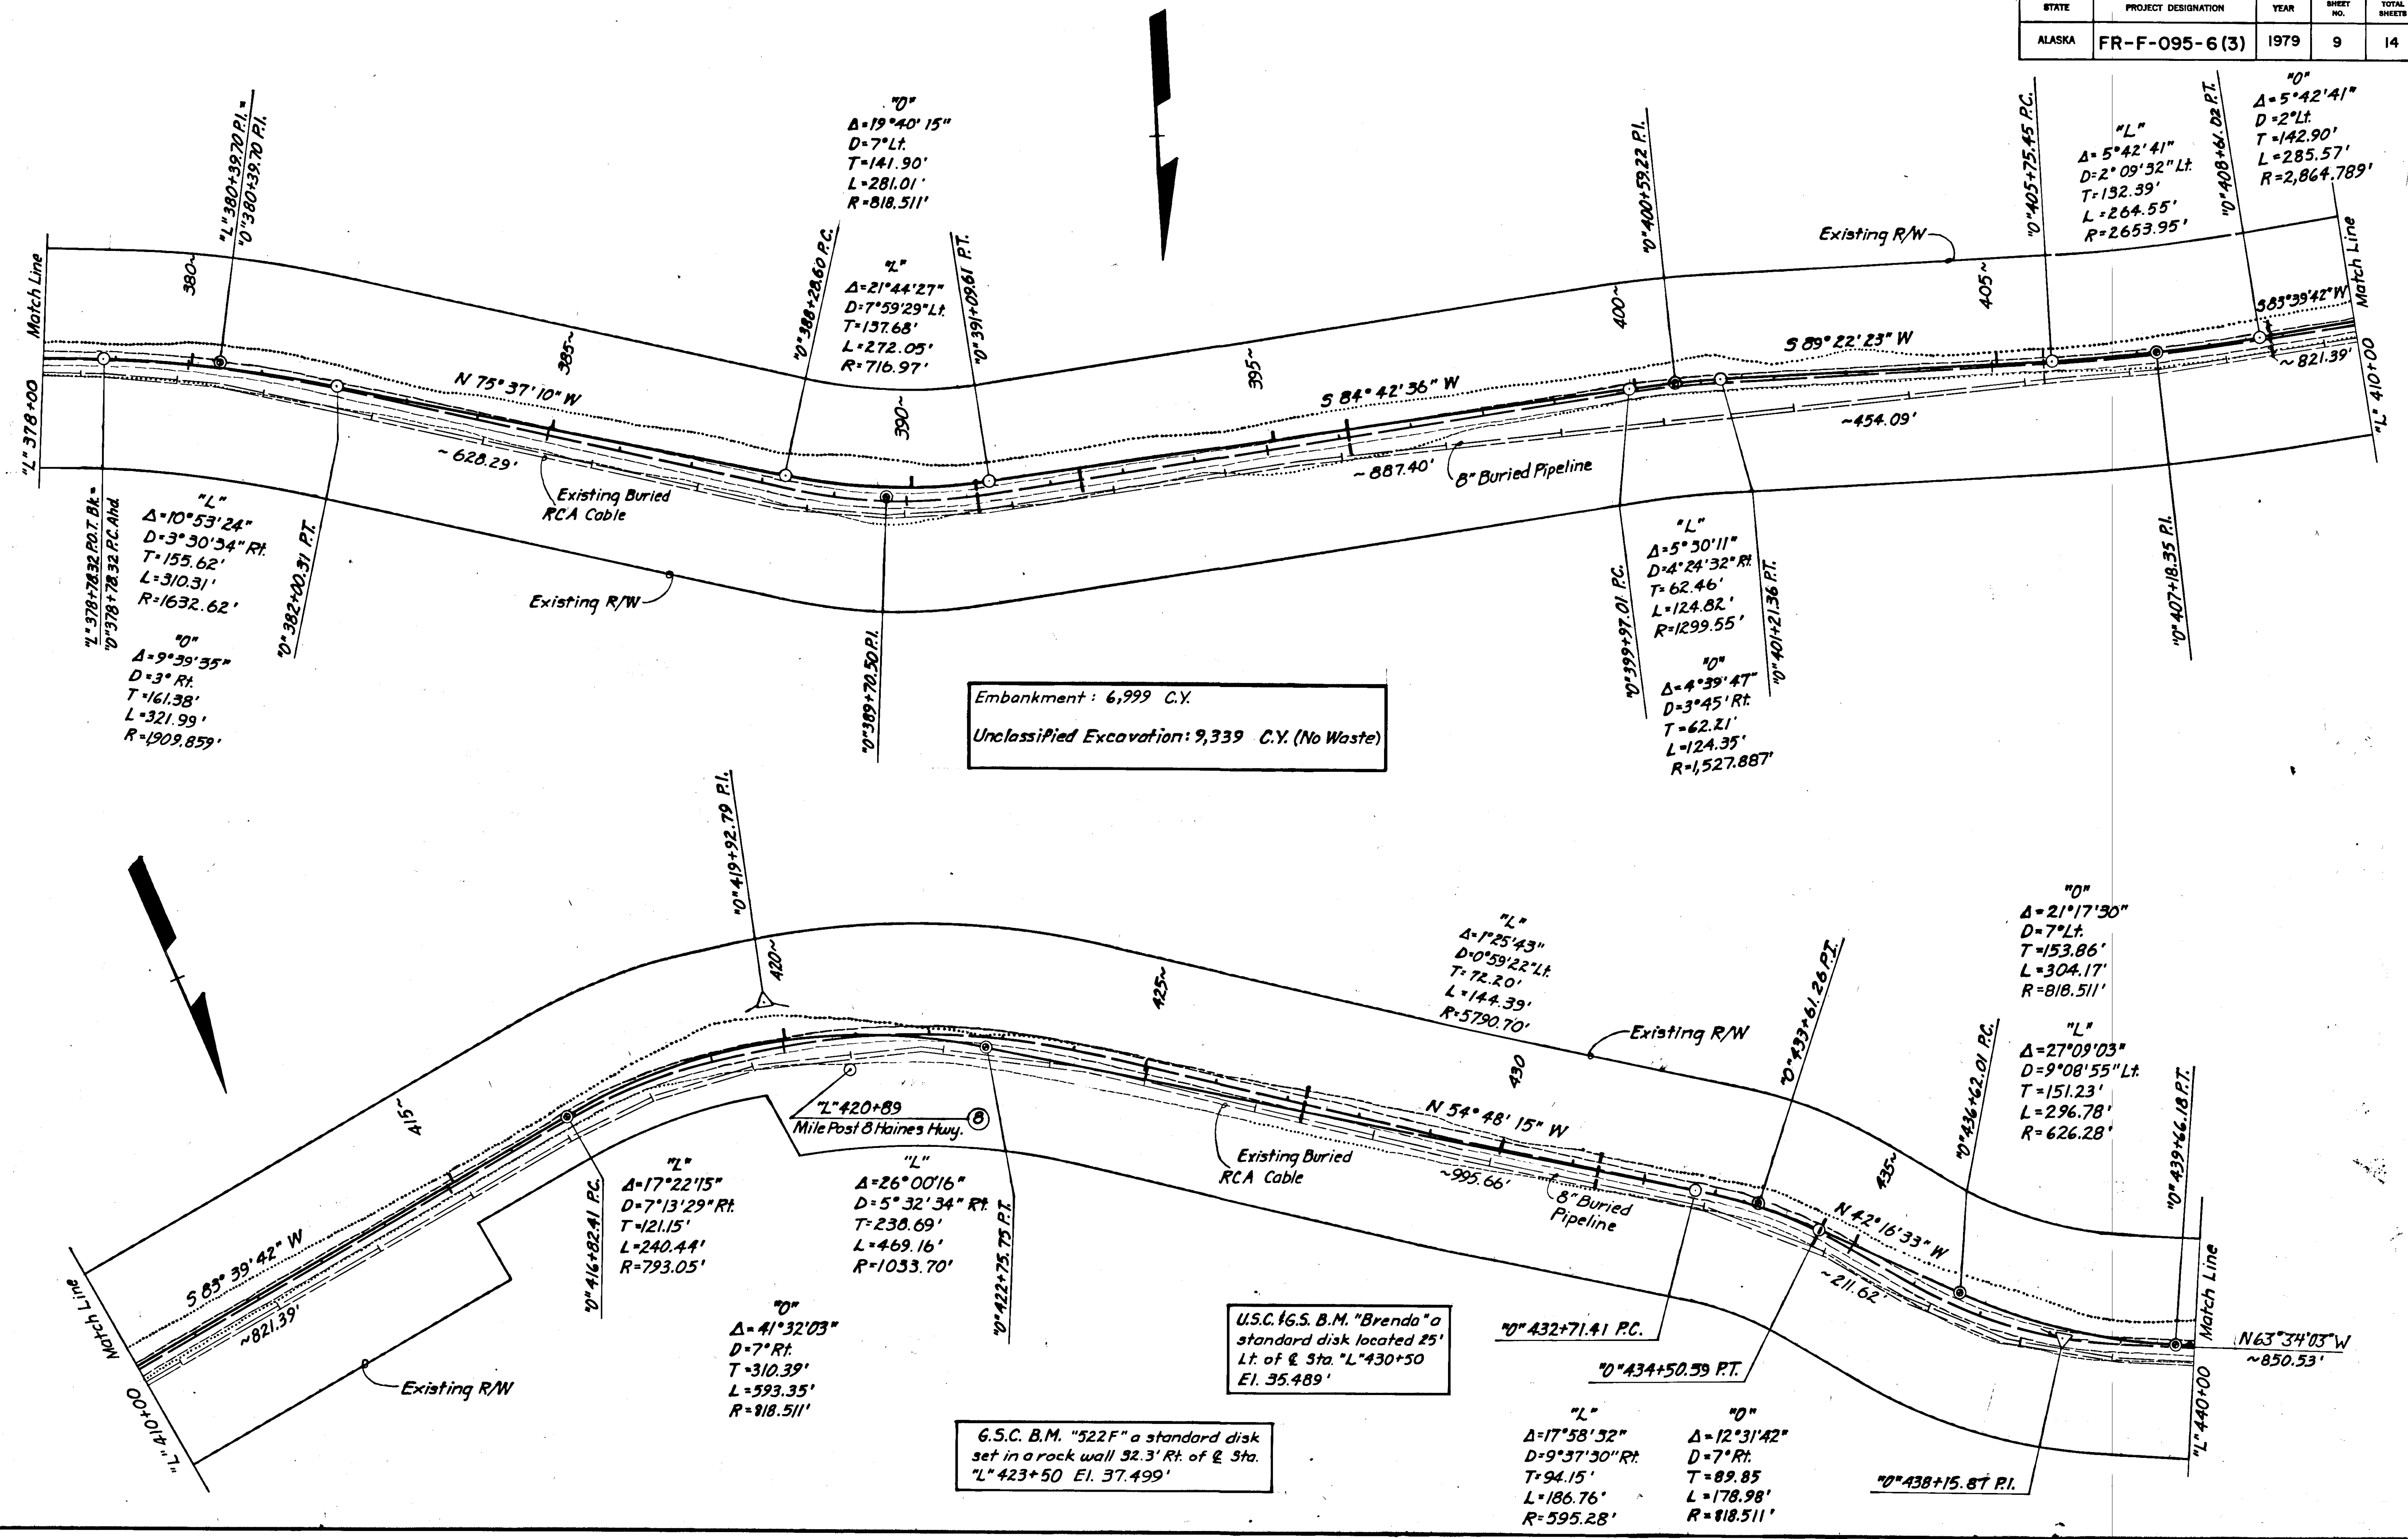

"L"
 $\Delta = 10^{\circ} 53' 24''$
 $D = 3^{\circ} 30' 34''$ Rt.
 $T = 155.62'$
 $L = 310.31'$
 $R = 1632.62'$

"O"
 $\Delta = 9^{\circ} 39' 35''$
 $D = 3^{\circ}$ Rt.
 $T = 161.38'$
 $L = 321.99'$
 $R = 1909.859'$

"O"
 $\Delta = 19^{\circ} 40' 15''$
 $D = 7^{\circ}$ Lt.
 $T = 141.90'$
 $L = 281.01'$
 $R = 818.511'$

"L"
 $\Delta = 21^{\circ} 44' 27''$
 $D = 7^{\circ} 59' 29''$ Lt.
 $T = 157.68'$
 $L = 272.05'$
 $R = 716.97'$

"L"
 $\Delta = 5^{\circ} 30' 11''$
 $D = 4^{\circ} 24' 32''$ Rt.
 $T = 62.46'$
 $L = 124.82'$
 $R = 1299.55'$

"O"
 $\Delta = 4^{\circ} 39' 47''$
 $D = 3^{\circ} 45'$ Rt.
 $T = 62.21'$
 $L = 124.35'$
 $R = 1,527.887'$

"L"
 $\Delta = 5^{\circ} 42' 41''$
 $D = 2^{\circ} 09' 32''$ Lt.
 $T = 132.39'$
 $L = 264.55'$
 $R = 2653.95'$

"O"
 $\Delta = 5^{\circ} 42' 41''$
 $D = 2^{\circ}$ Lt.
 $T = 142.90'$
 $L = 285.57'$
 $R = 2,864.789'$

"L"
 $\Delta = 1^{\circ} 25' 43''$
 $D = 0^{\circ} 59' 22''$ Lt.
 $T = 72.20'$
 $L = 144.39'$
 $R = 5790.70'$

"O"
 $\Delta = 21^{\circ} 17' 30''$
 $D = 7^{\circ}$ Lt.
 $T = 153.86'$
 $L = 304.17'$
 $R = 818.511'$

"L"
 $\Delta = 27^{\circ} 09' 03''$
 $D = 9^{\circ} 08' 55''$ Lt.
 $T = 151.23'$
 $L = 296.78'$
 $R = 626.28'$

"L"
 $\Delta = 17^{\circ} 22' 15''$
 $D = 7^{\circ} 13' 29''$ Rt.
 $T = 121.15'$
 $L = 240.44'$
 $R = 793.05'$

"L"
 $\Delta = 26^{\circ} 00' 16''$
 $D = 5^{\circ} 32' 34''$ Rt.
 $T = 238.69'$
 $L = 469.16'$
 $R = 1033.70'$

"O"
 $\Delta = 41^{\circ} 32' 03''$
 $D = 7^{\circ}$ Rt.
 $T = 310.39'$
 $L = 593.35'$
 $R = 918.511'$

"O" 432+71.41 P.C.

"O" 434+50.59 P.T.


"L"
 $\Delta = 17^{\circ} 58' 32''$
 $D = 9^{\circ} 37' 50''$ Rt.
 $T = 94.15'$
 $L = 186.76'$
 $R = 595.28'$

"O"
 $\Delta = 12^{\circ} 31' 42''$
 $D = 7^{\circ}$ Rt.
 $T = 89.85'$
 $L = 178.98'$
 $R = 818.511'$

"O" 438+15.87 P.I.

"L" 440+00
 $N 63^{\circ} 34' 03''$ W
 $\sim 850.53'$

STATE	PROJECT DESIGNATION	YEAR	SHEET NO.	TOTAL SHEETS
ALASKA	FR-F-095-6(3)	1979	10	14

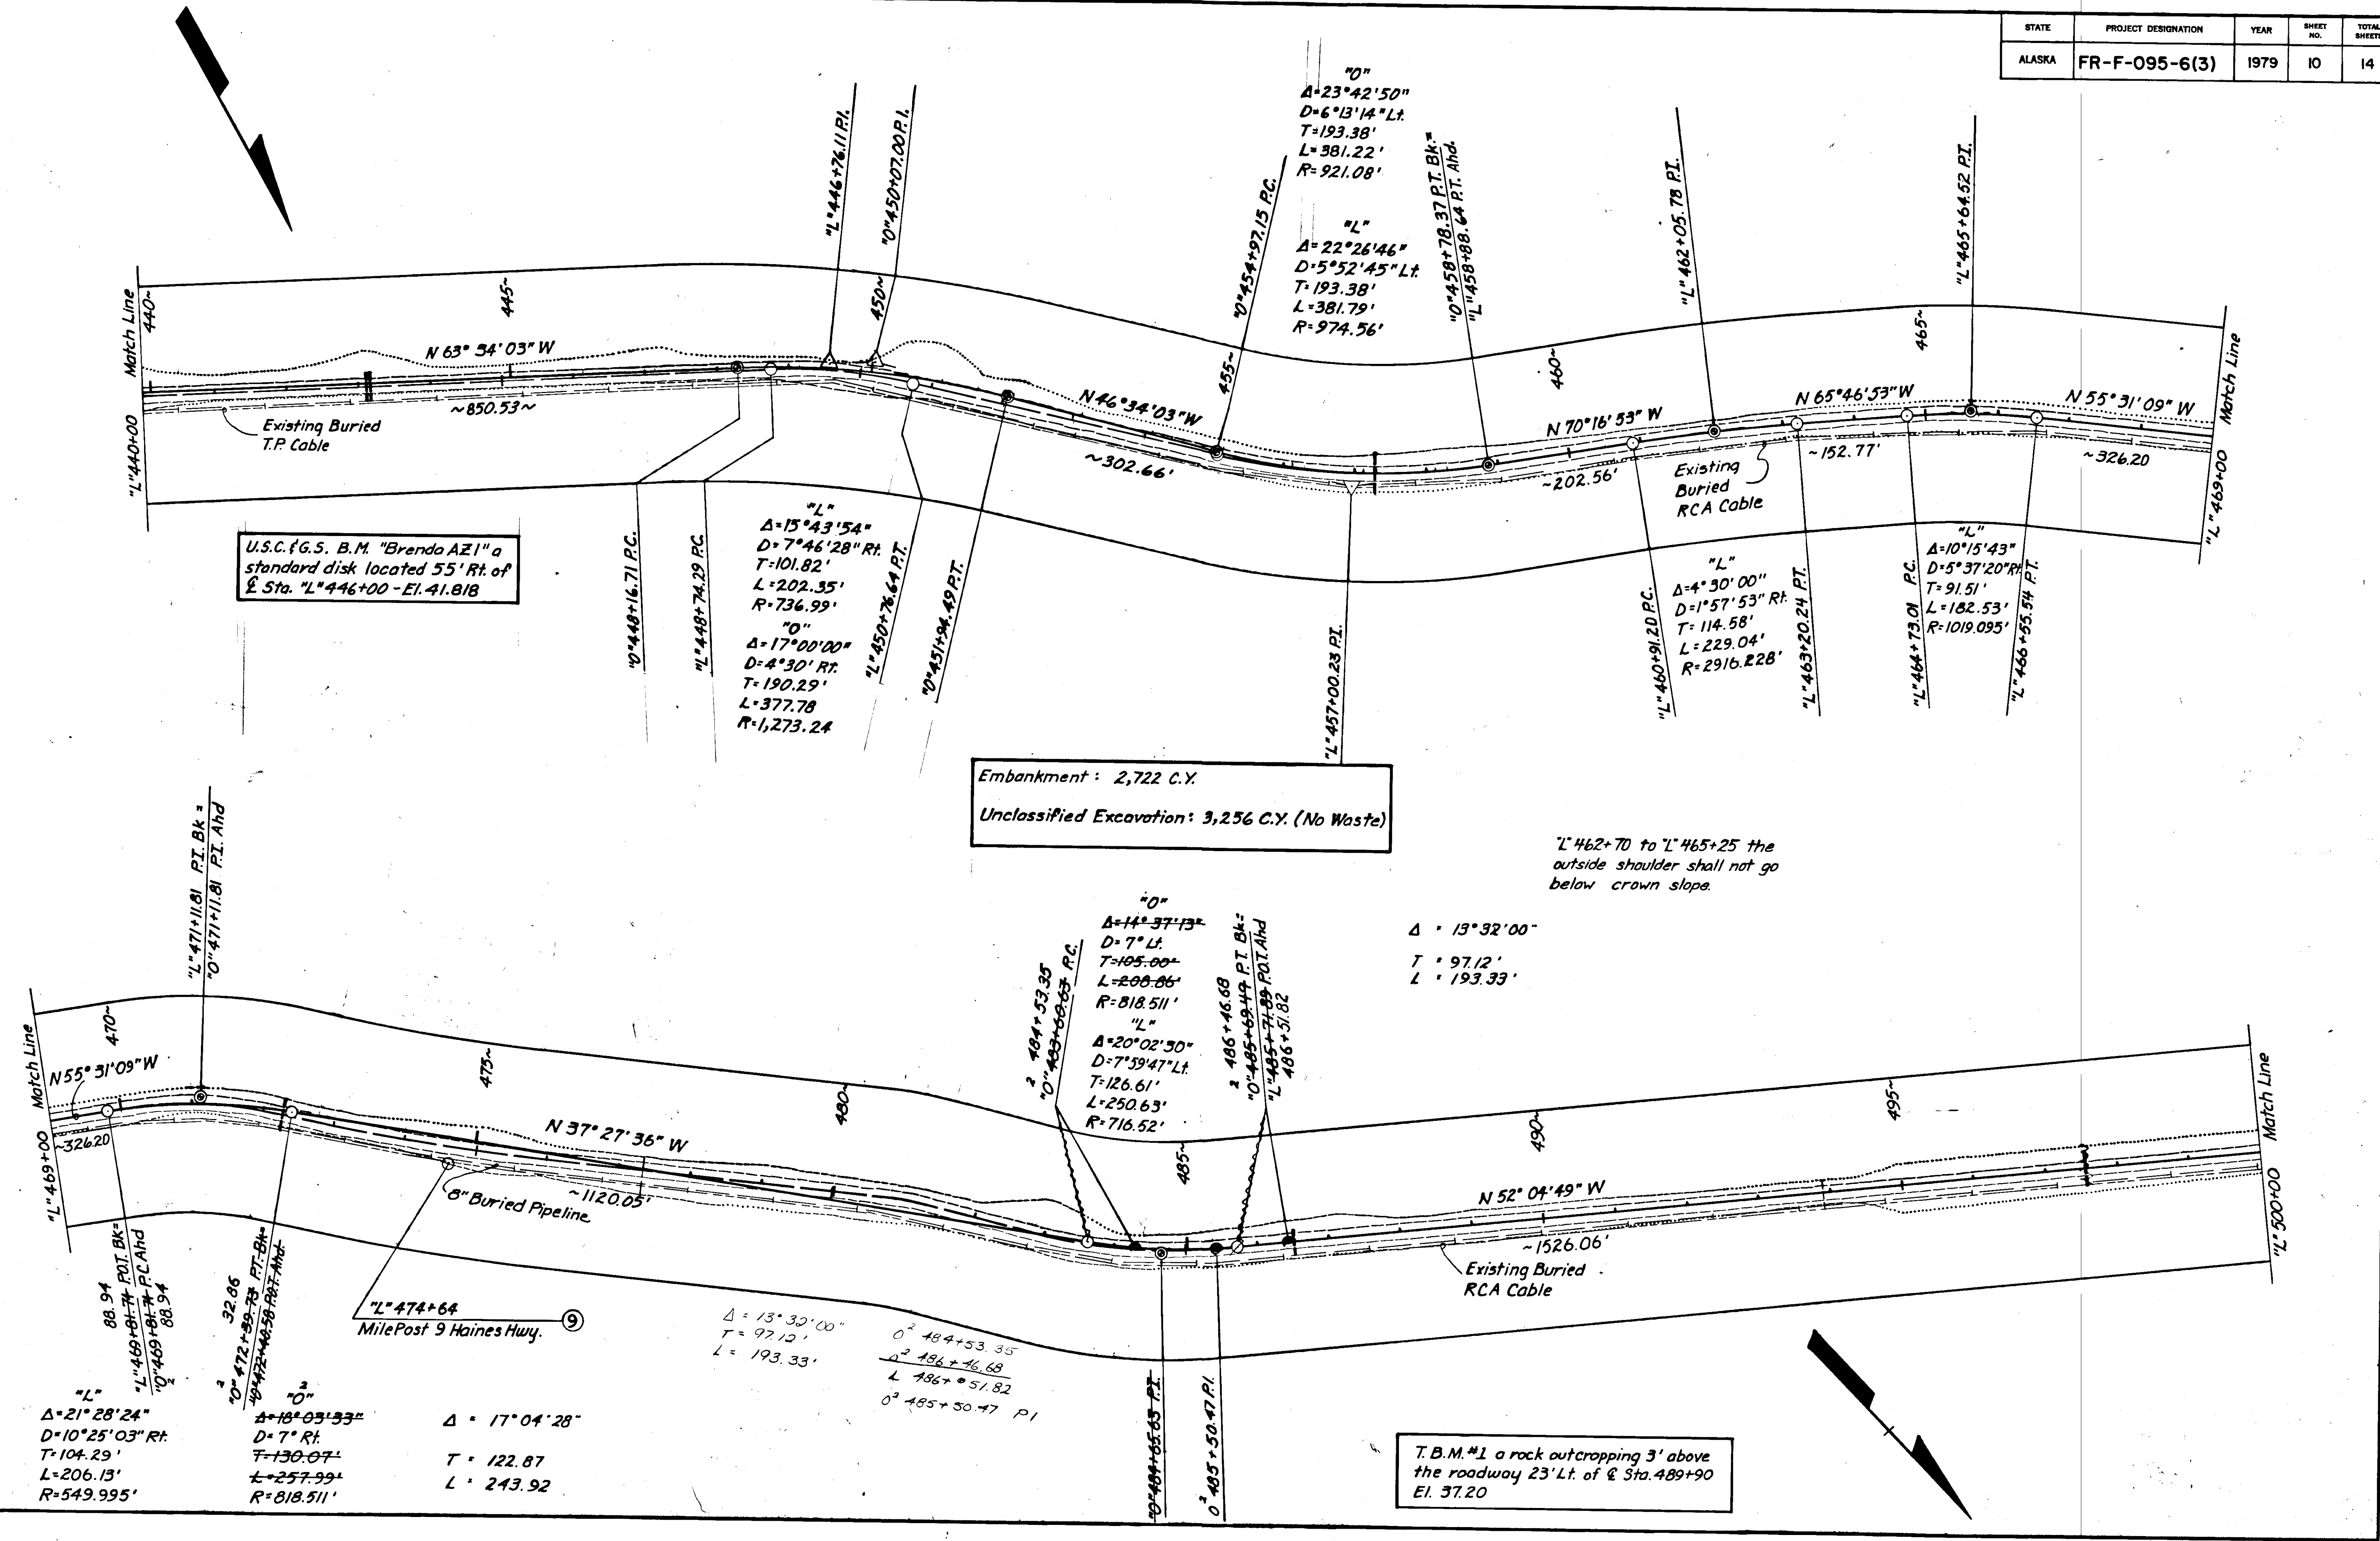

U.S.C. & G.S. B.M. "Brenda AZ1" a standard disk located 55' Rt. of Sta. "L" 446+00 - El. 41.818

Embankment: 2,722 C.Y.
Unclassified Excavation: 3,256 C.Y. (No Waste)

"L" 462+70 to "L" 465+25 the outside shoulder shall not go below crown slope.

$\Delta = 13^{\circ}32'00''$
 $T = 97.12'$
 $L = 193.33'$

T.B.M. #1 a rock outcropping 3' above the roadway 23' Lt. of Sta. 489+90 El. 57.20

"L"
 $\Delta = 21^{\circ}28'24''$
 $D = 10^{\circ}25'03''$ Rt.
 $T = 104.29'$
 $L = 206.13'$
 $R = 549.995'$

"O"
 $\Delta = 18^{\circ}03'33''$
 $D = 7^{\circ}$ Rt.
 $T = 130.07'$
 $L = 257.99'$
 $R = 818.511'$

$\Delta = 17^{\circ}04'28''$
 $T = 122.87$
 $L = 243.92$

$\Delta = 13^{\circ}32'00''$
 $T = 97.12'$
 $L = 193.33'$

$\Delta = 20^{\circ}02'50''$
 $D = 7^{\circ}59'47''$ Lt.
 $T = 126.61'$
 $L = 250.63'$
 $R = 716.52'$

"O"
 $\Delta = 14^{\circ}37'13''$
 $D = 7^{\circ}$ Lt.
 $T = 105.00'$
 $L = 208.86'$
 $R = 818.511'$

"L"
 $\Delta = 20^{\circ}02'50''$
 $D = 7^{\circ}59'47''$ Lt.
 $T = 126.61'$
 $L = 250.63'$
 $R = 716.52'$

"O"
 $\Delta = 23^{\circ}42'50''$
 $D = 6^{\circ}13'14''$ Lt.
 $T = 193.38'$
 $L = 381.22'$
 $R = 921.08'$

"L"
 $\Delta = 22^{\circ}26'46''$
 $D = 5^{\circ}52'45''$ Lt.
 $T = 193.38'$
 $L = 381.79'$
 $R = 974.56'$


"L"
 $\Delta = 15^{\circ}43'54''$
 $D = 7^{\circ}46'28''$ Rt.
 $T = 101.82'$
 $L = 202.35'$
 $R = 736.99'$

"O"
 $\Delta = 17^{\circ}00'00''$
 $D = 4^{\circ}30'$ Rt.
 $T = 190.29'$
 $L = 377.78$
 $R = 1,273.24$

"L"
 $\Delta = 4^{\circ}30'00''$
 $D = 1^{\circ}57'53''$ Rt.
 $T = 114.58'$
 $L = 229.04'$
 $R = 2916.228'$

"L"
 $\Delta = 10^{\circ}15'43''$
 $D = 5^{\circ}37'20''$ Rt.
 $T = 91.51'$
 $L = 182.53'$
 $R = 1019.095'$

STATE	PROJECT DESIGNATION	YEAR	SHEET NO.	TOTAL SHEETS
ALASKA	FR-F-095-6(3)	1979	11	14

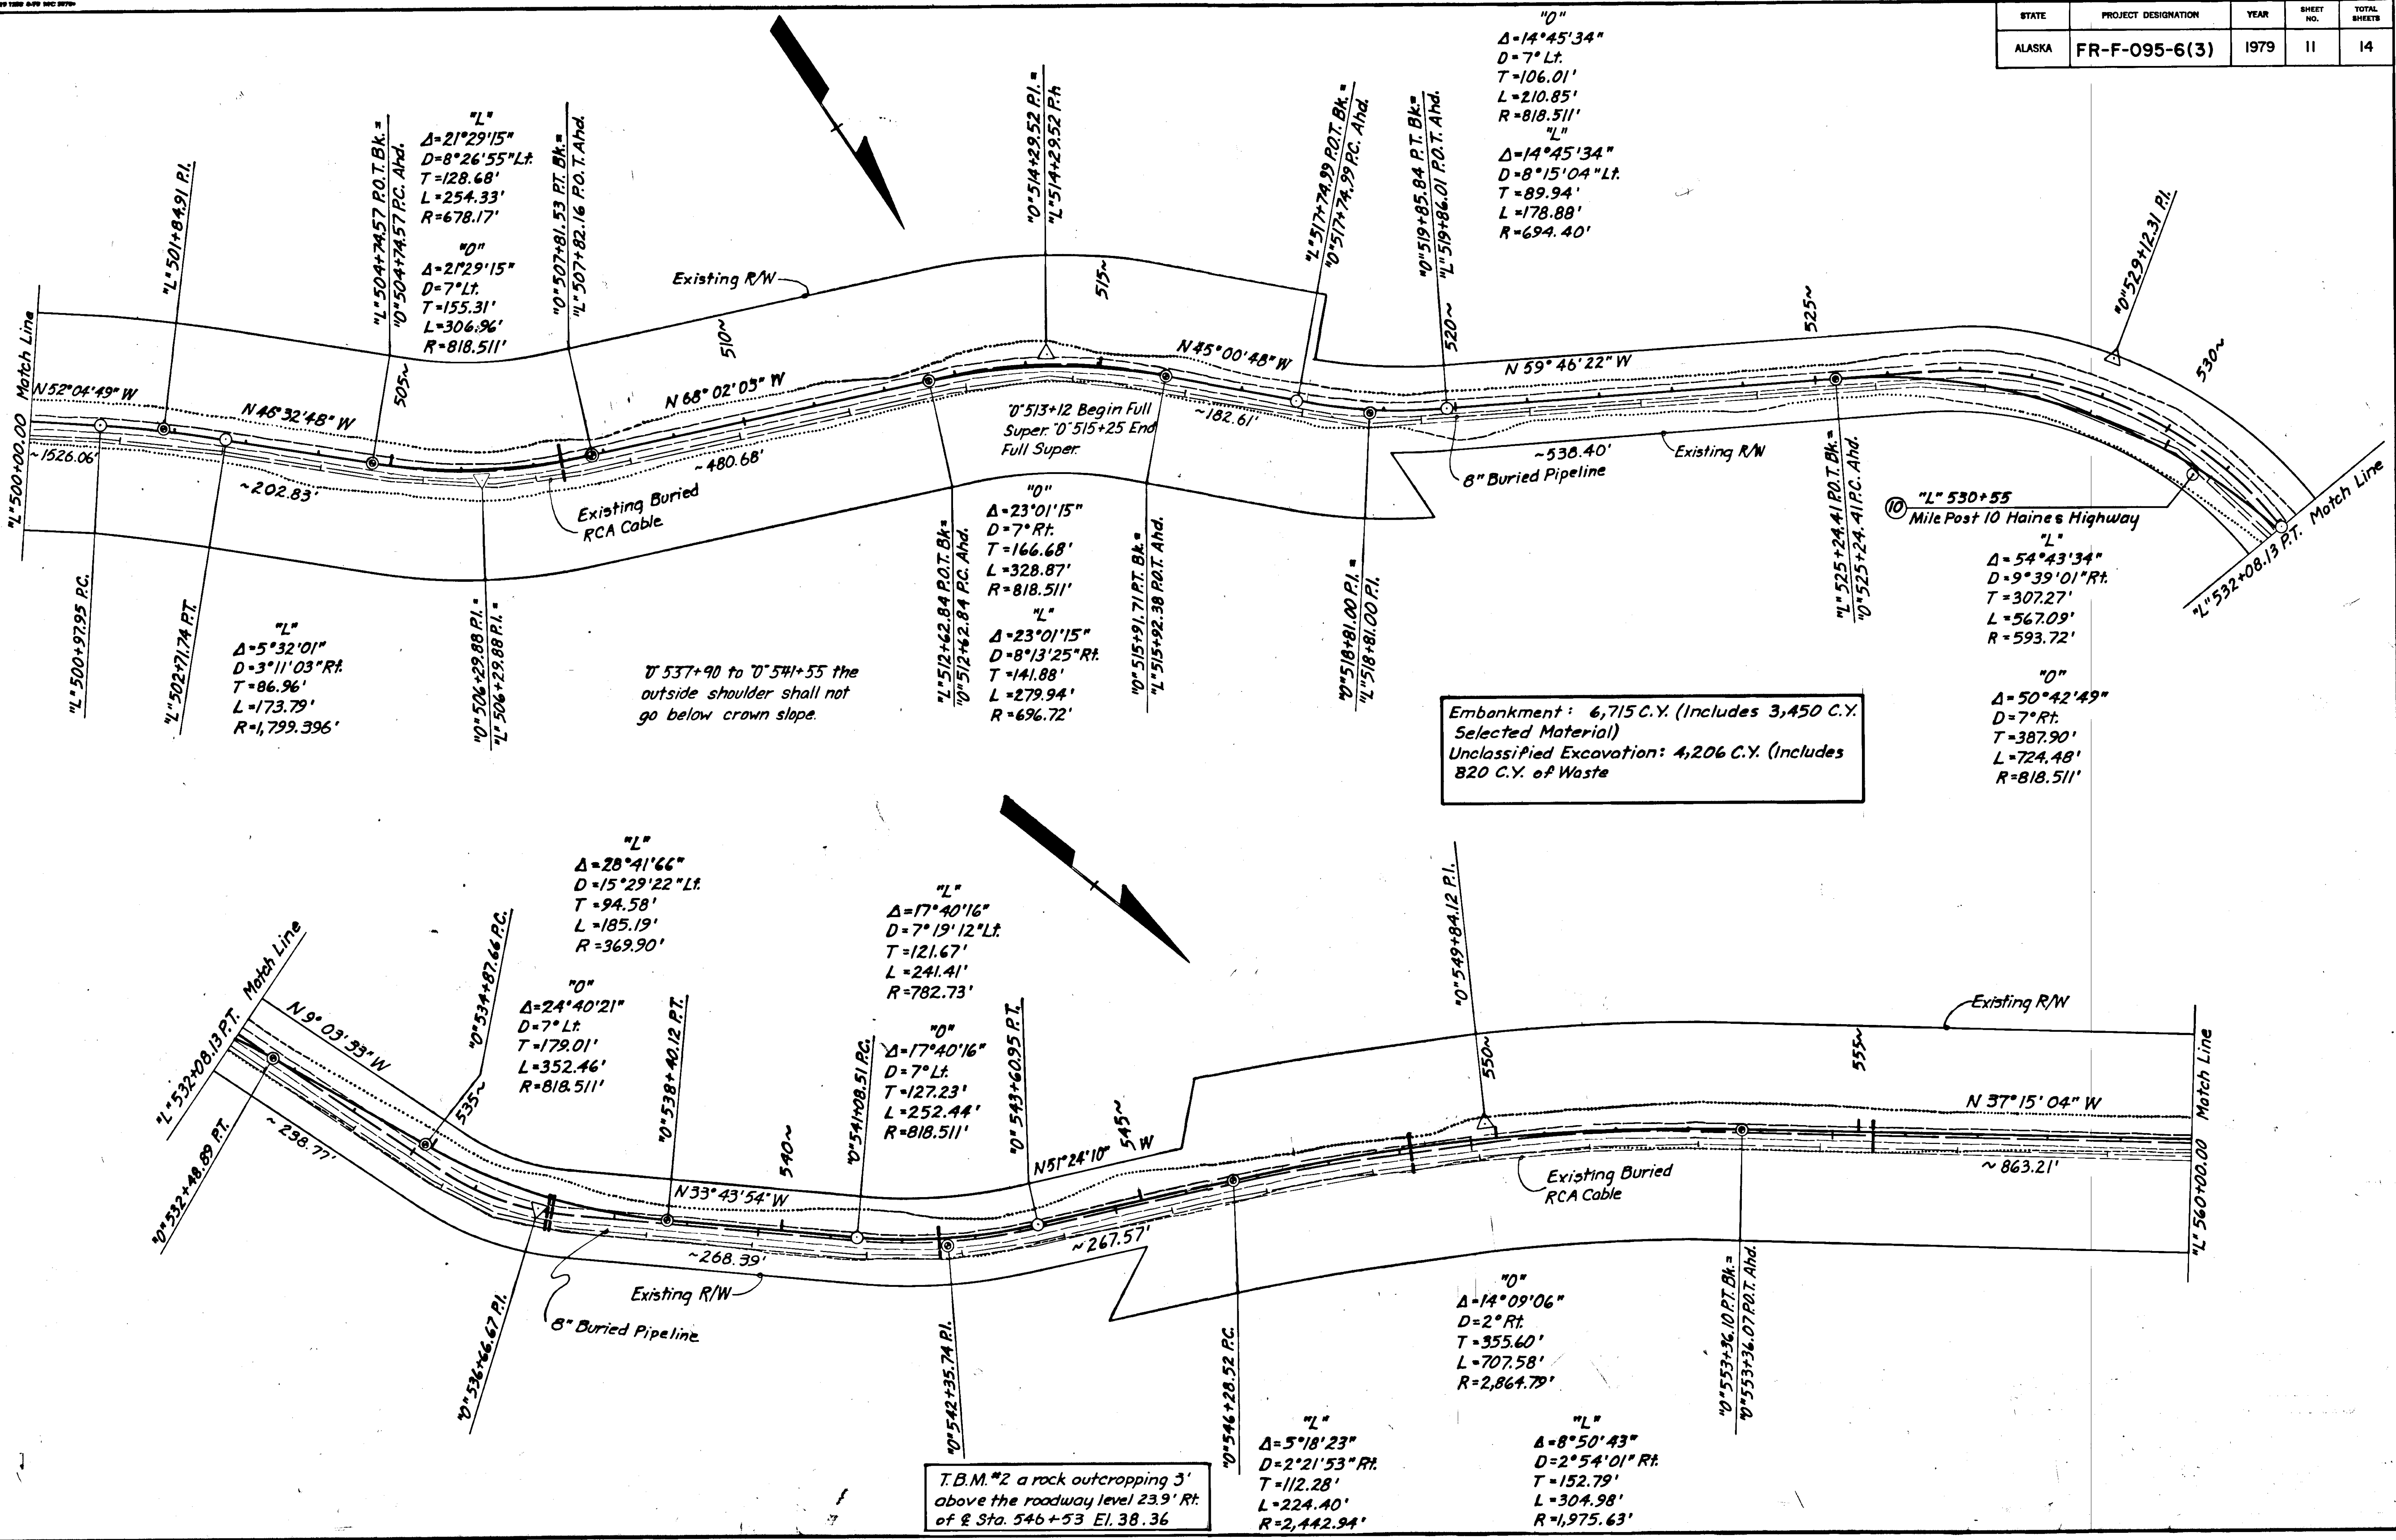

Embankment: 6,715 C.Y. (Includes 3,450 C.Y. Selected Material)
 Unclassified Excavation: 4,206 C.Y. (Includes 820 C.Y. of Waste)

T.B.M. #2 a rock outcropping 3' above the roadway level 23.9' Rt. of Sta. 546+53 El. 38.36

⑩ "L" 530+55
 Mile Post 10 Haines Highway
 "L"
 Δ = 54°43'34"
 D = 9°39'01" Rt.
 T = 307.27'
 L = 567.09'
 R = 593.72'

"0"
 Δ = 50°42'49"
 D = 7° Rt.
 T = 387.90'
 L = 724.48'
 R = 818.511'

"0"
 Δ = 14°09'06"
 D = 2° Rt.
 T = 355.60'
 L = 707.58'
 R = 2,864.79'

"L"
 Δ = 5°18'23"
 D = 2°21'53" Rt.
 T = 112.28'
 L = 224.40'
 R = 2,442.94'

"L"
 Δ = 8°50'43"
 D = 2°54'01" Rt.
 T = 152.79'
 L = 304.98'
 R = 1,975.63'

"0"
 Δ = 14°45'34"
 D = 7° Lt.
 T = 106.01'
 L = 210.85'
 R = 818.511'
 "L"
 Δ = 14°45'34"
 D = 8°15'04" Lt.
 T = 89.94'
 L = 178.88'
 R = 694.40'

"0"
 Δ = 23°01'15"
 D = 7° Rt.
 T = 166.68'
 L = 328.87'
 R = 818.511'
 "L"
 Δ = 23°01'15"
 D = 8°13'25" Rt.
 T = 141.88'
 L = 279.94'
 R = 696.72'

"L"
 Δ = 28°41'66"
 D = 15°29'22" Lt.
 T = 94.58'
 L = 185.19'
 R = 369.90'

"L"
 Δ = 17°40'16"
 D = 7°19'12" Lt.
 T = 121.67'
 L = 241.41'
 R = 782.73'


"0"
 Δ = 24°40'21"
 D = 7° Lt.
 T = 179.01'
 L = 352.46'
 R = 818.511'

"0"
 Δ = 17°40'16"
 D = 7° Lt.
 T = 127.23'
 L = 252.44'
 R = 818.511'

"L"
 Δ = 21°29'15"
 D = 8°26'55" Lt.
 T = 128.68'
 L = 254.33'
 R = 678.17'
 "0"
 Δ = 21°29'15"
 D = 7° Lt.
 T = 155.31'
 L = 306.96'
 R = 818.511'

"L"
 Δ = 5°32'01"
 D = 3°11'03" Rt.
 T = 86.96'
 L = 173.79'
 R = 1,799.396'

From 537+90 to 541+55 the outside shoulder shall not go below crown slope.

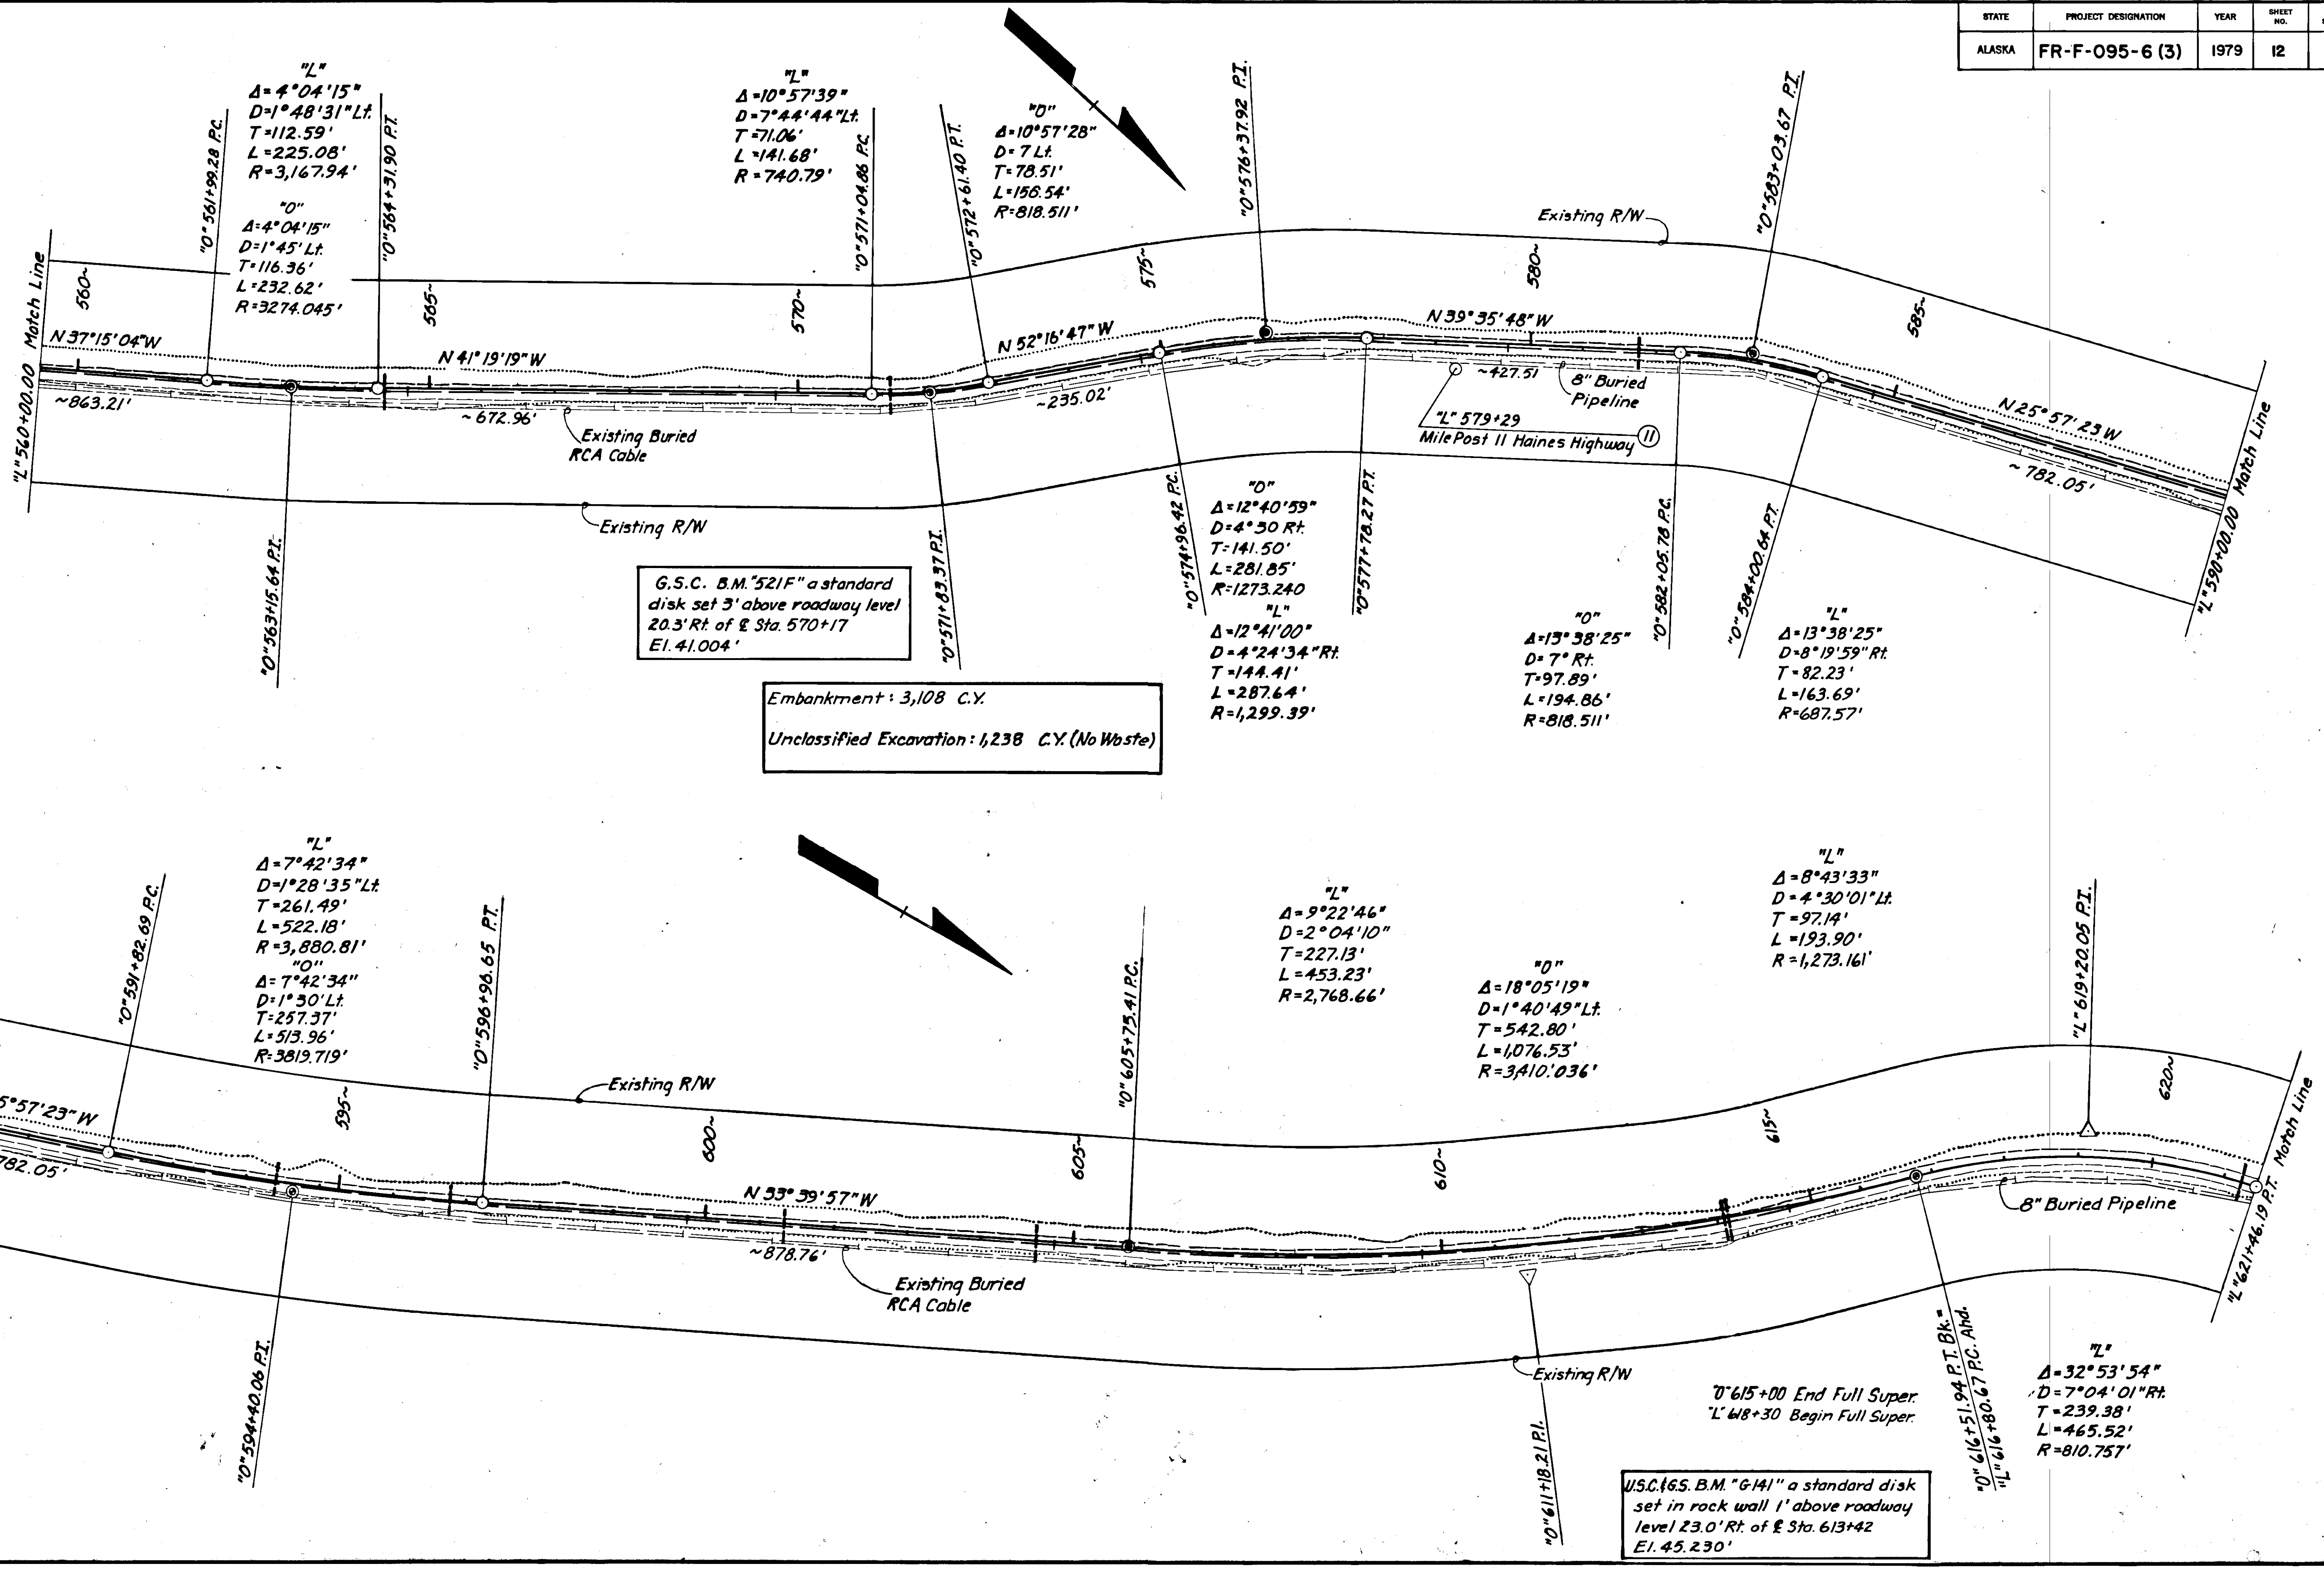


G.S.C. B.M. "521F" a standard disk set 3' above roadway level 20.3' Rt. of Sta. 570+17 El. 41.004'

Embankment: 3,108 C.Y.
Unclassified Excavation: 1,238 C.Y. (No Waste)


U.S.C. 65 B.M. "G-141" a standard disk set in rock wall 1' above roadway level 23.0' Rt. of Sta. 613+42 El. 45.230'

0+615+00 End Full Super.
0+618+30 Begin Full Super.



STATE	PROJECT DESIGNATION	YEAR	SHEET NO.	TOTAL SHEETS
ALASKA	FR-F-095-6(3)	1979	13	14

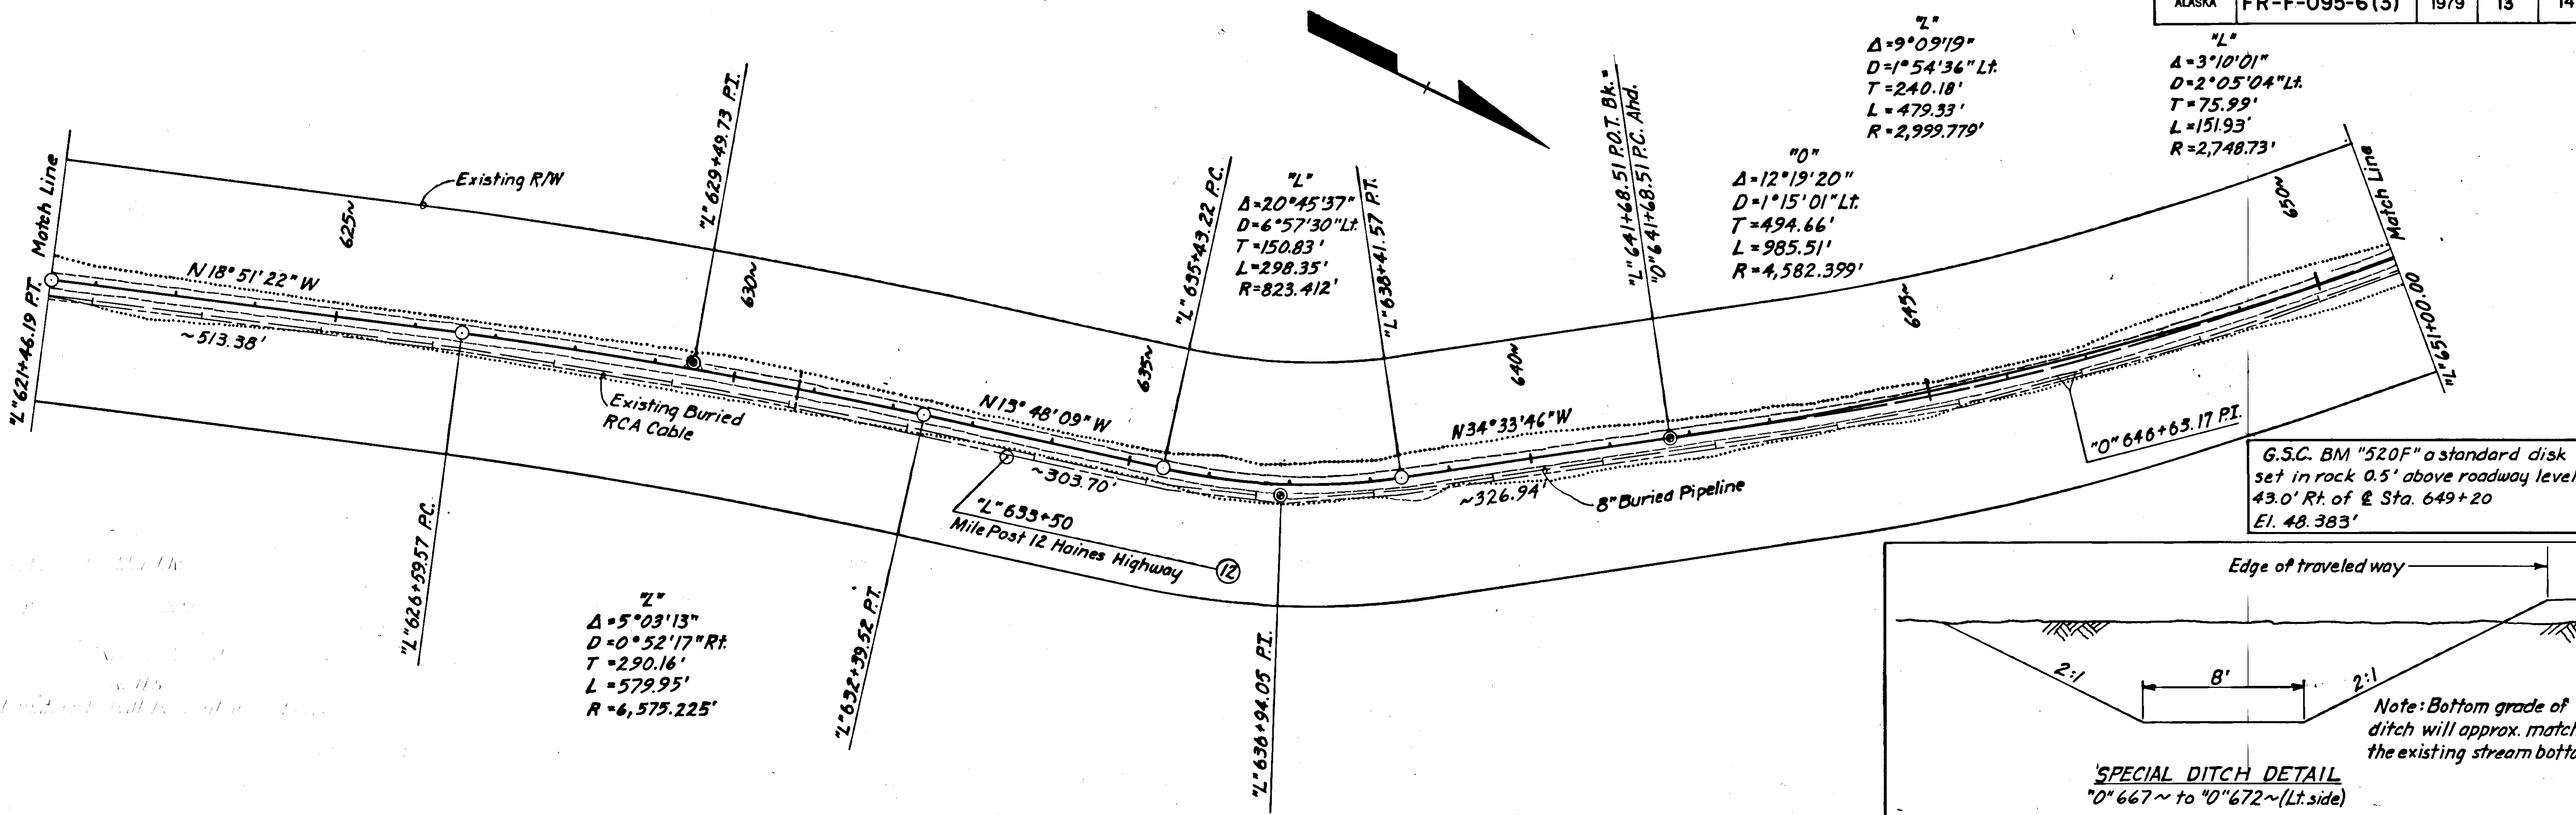

G.S.C. BM "520F" a standard disk set in rock 0.5' above roadway level 43.0' Rt. of C Sta. 649+20 El. 48.383'

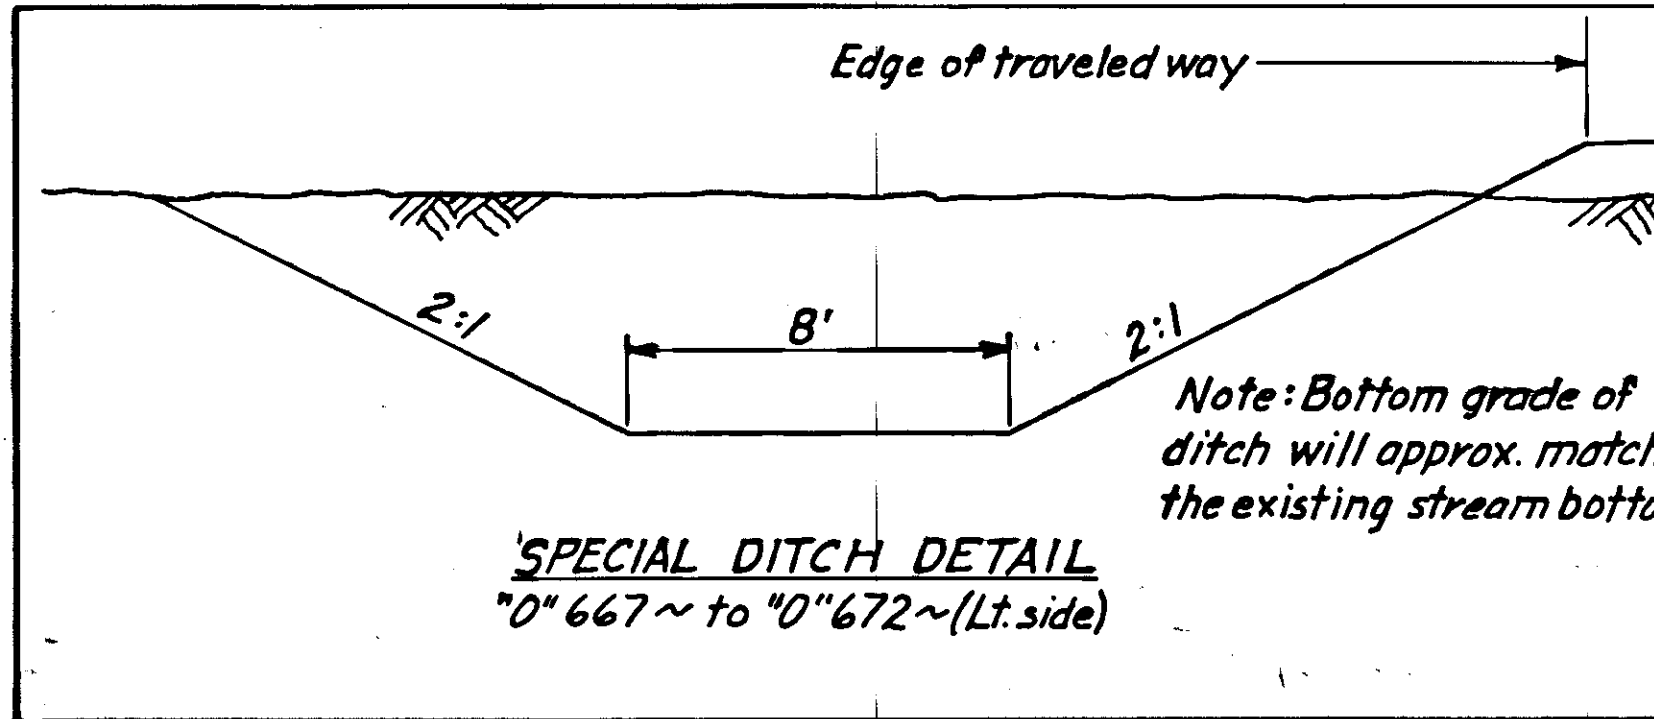


Embankment: 4,259 C.Y.
Unclassified Excavation: 13,122 C.Y. (No Waste)

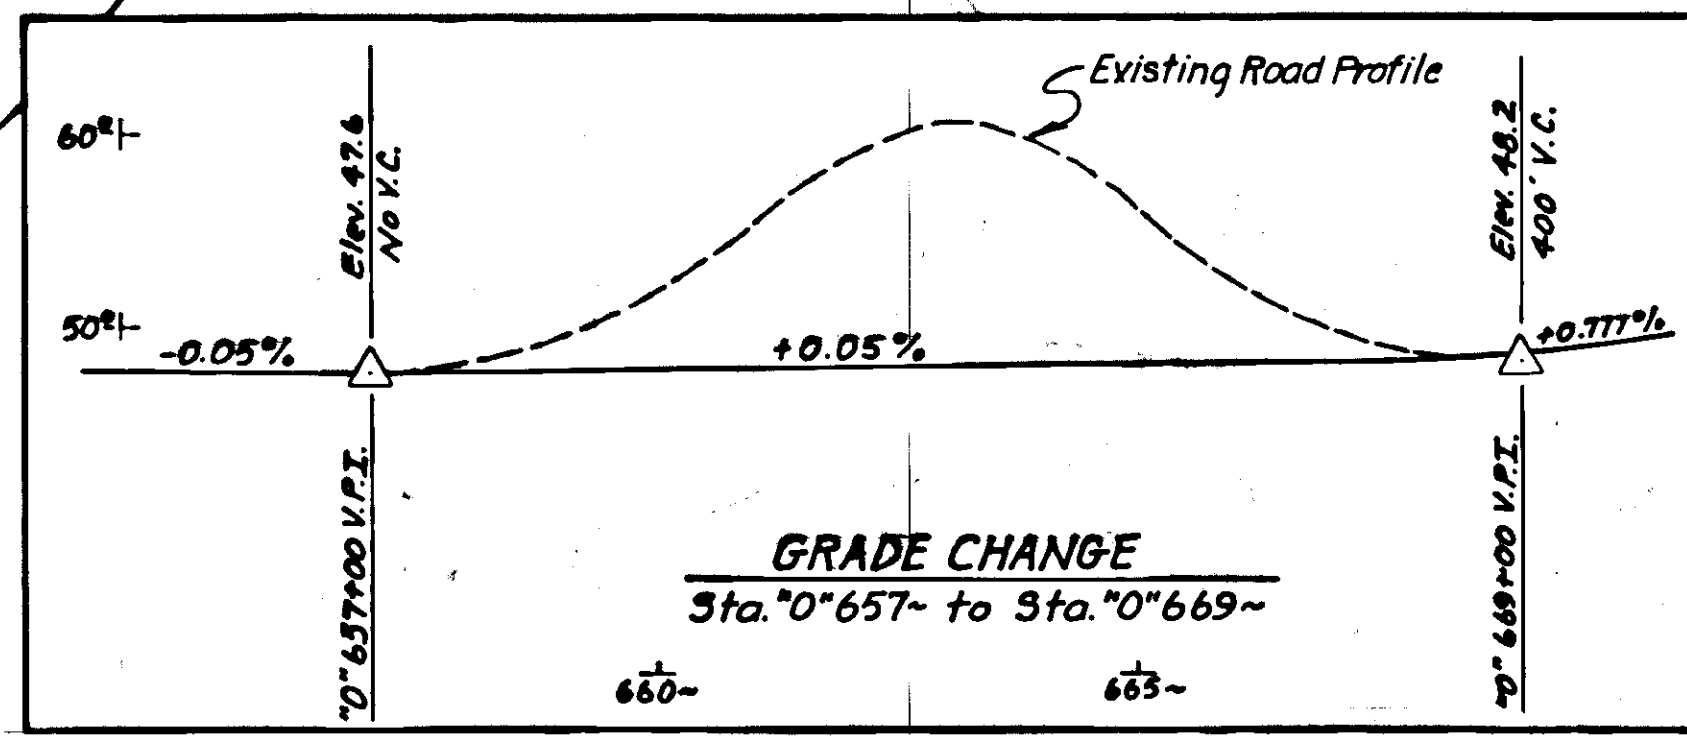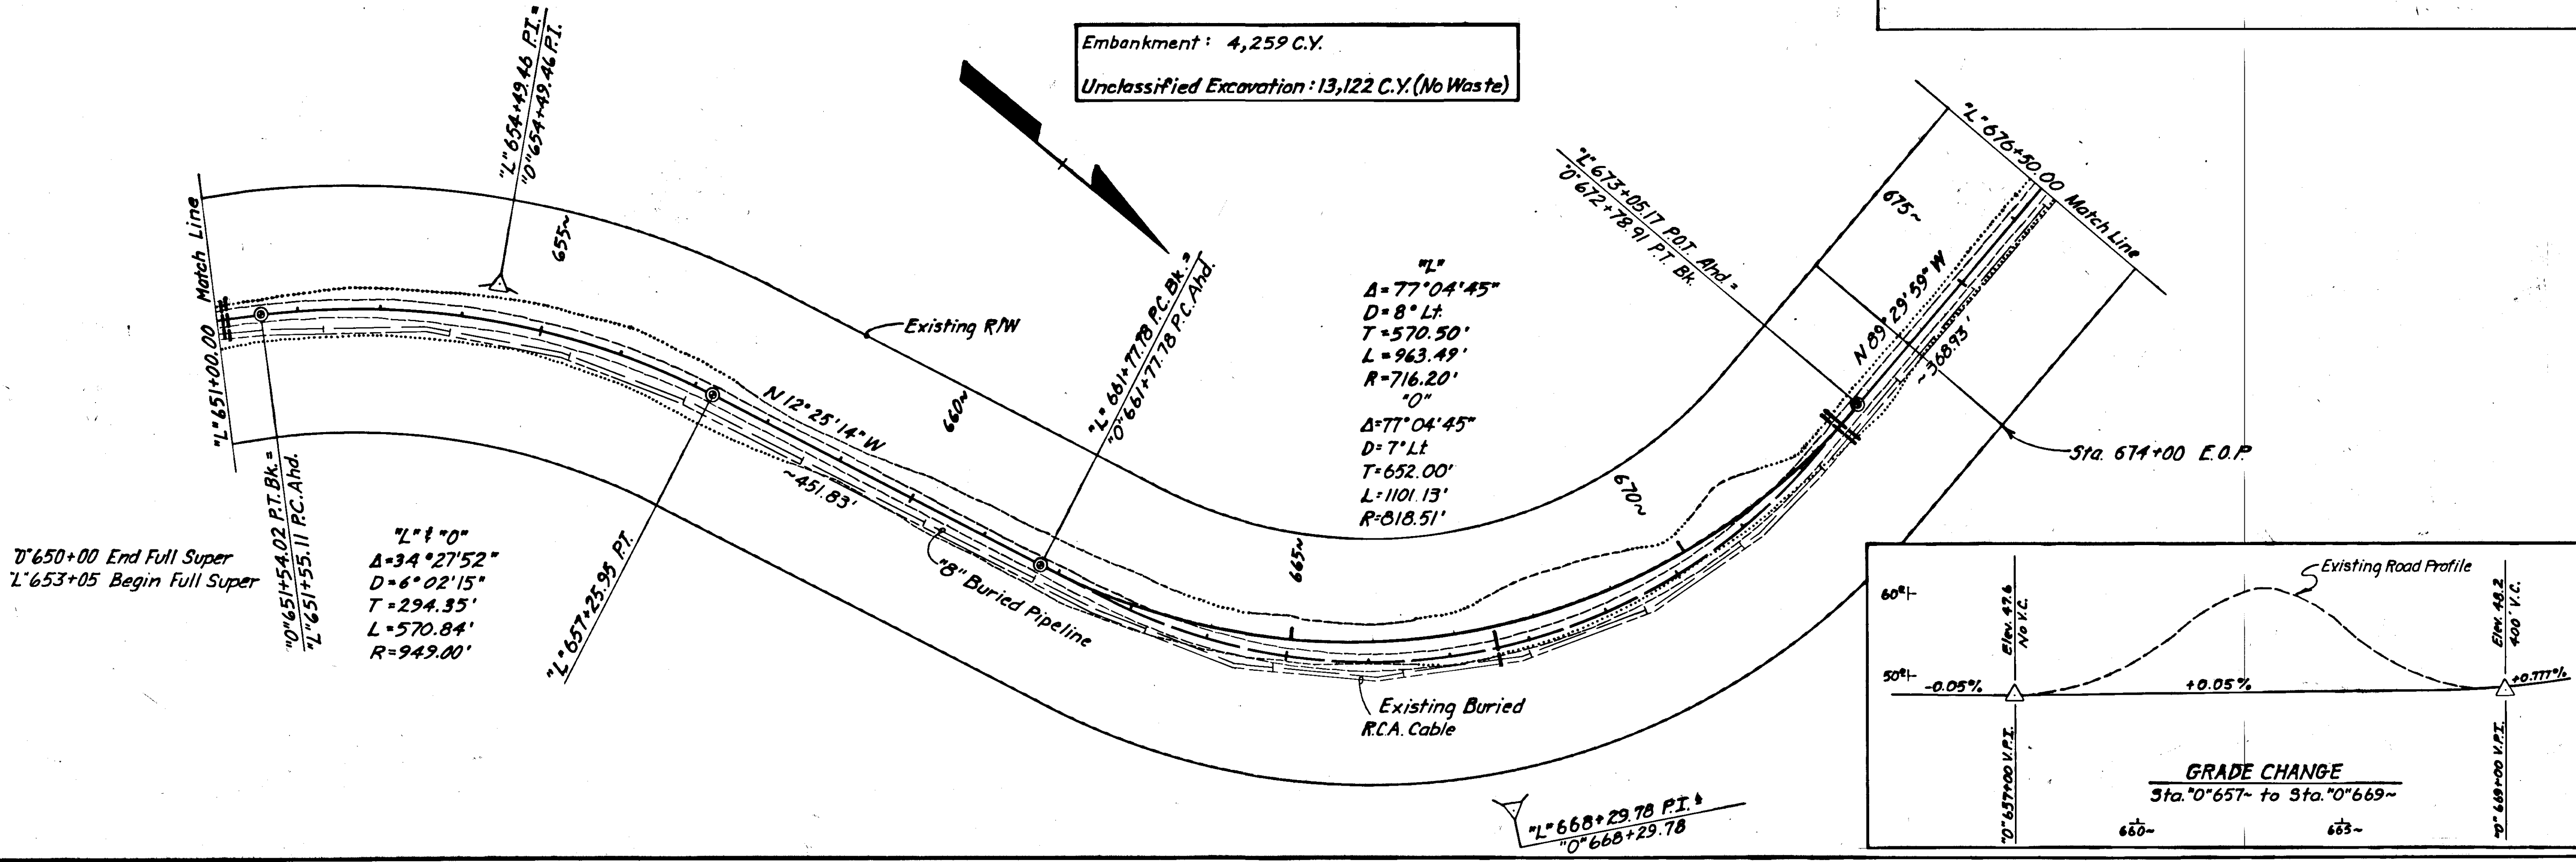

U.S.C. & G.S. B.M. "Ray AZ1" a standard disk located 25' Lt. of Sta. 689+84 El. 49.386'

STATE	PROJECT DESIGNATION	YEAR	SHEET NO.	TOTAL SHEETS
ALASKA	FR-F-095-6(3)	1979	14	14

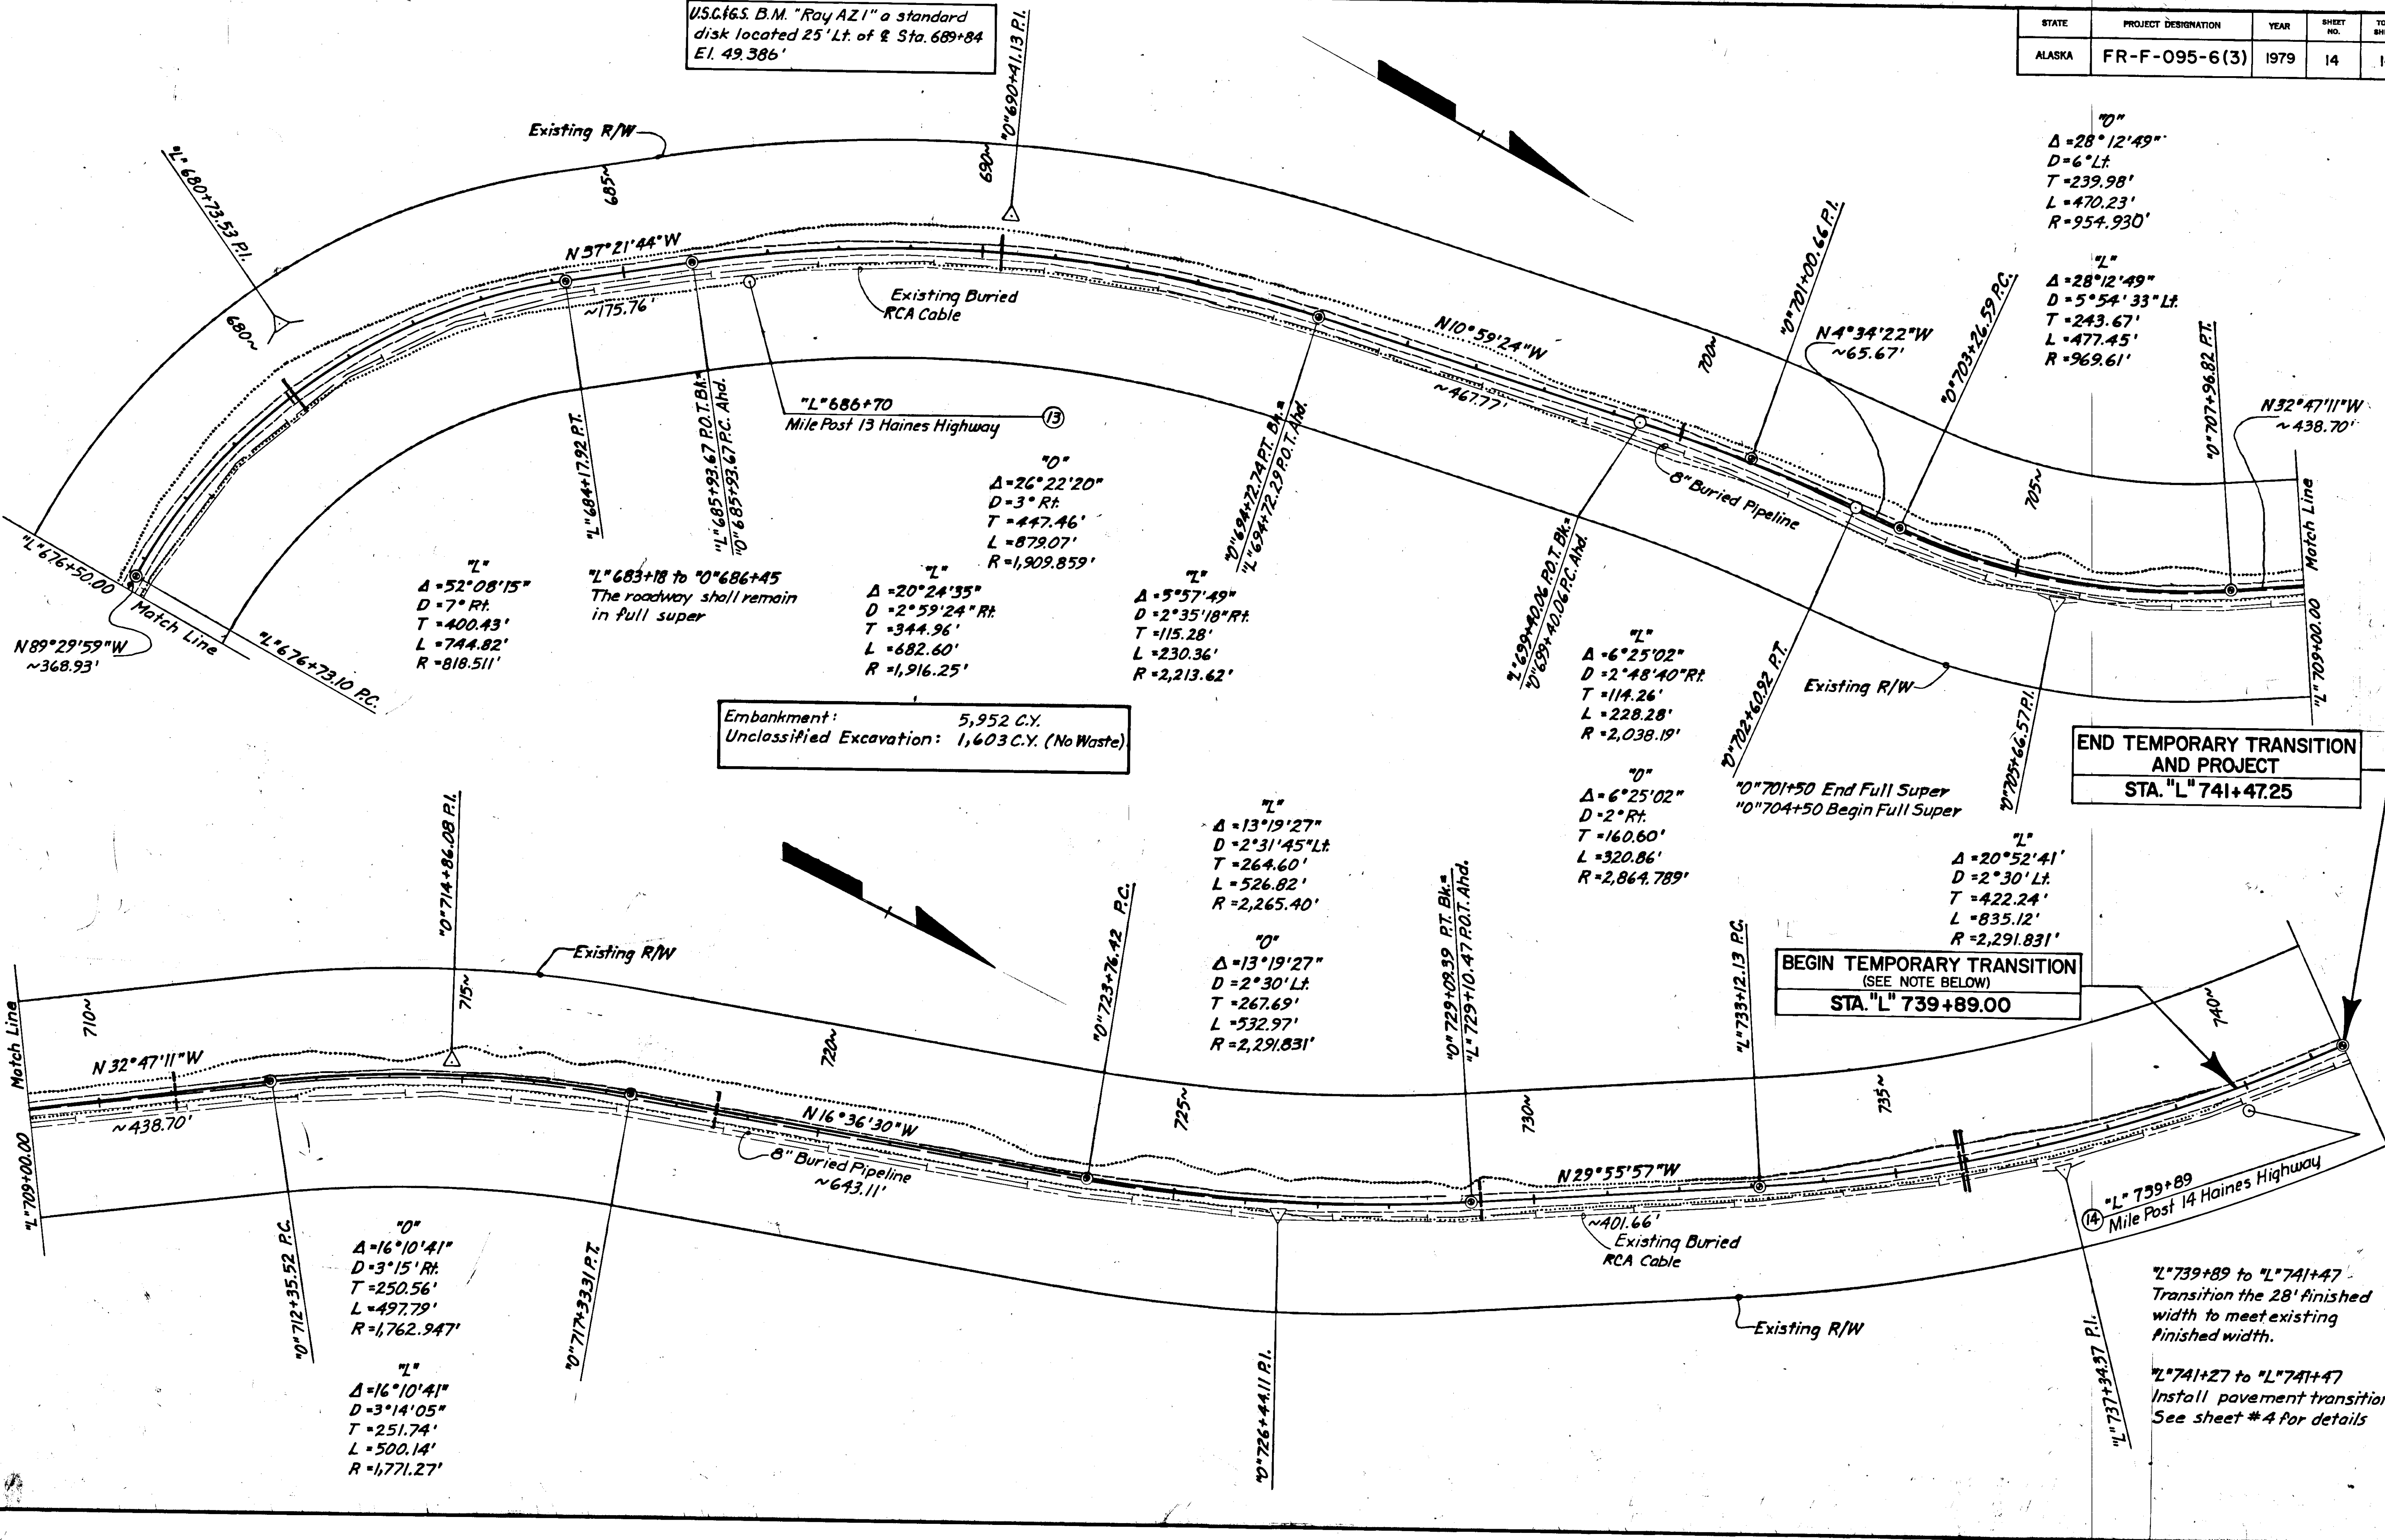

Embankment: 5,952 C.Y.
Unclassified Excavation: 1,603 C.Y. (No Waste)

END TEMPORARY TRANSITION AND PROJECT
STA. "L" 741+47.25

BEGIN TEMPORARY TRANSITION
(SEE NOTE BELOW)
STA. "L" 739+89.00

"L" 739+89 to "L" 741+47
Transition the 28' finished width to meet existing finished width.

"L" 741+27 to "L" 741+47
Install pavement transition.
See sheet # 4 for details