



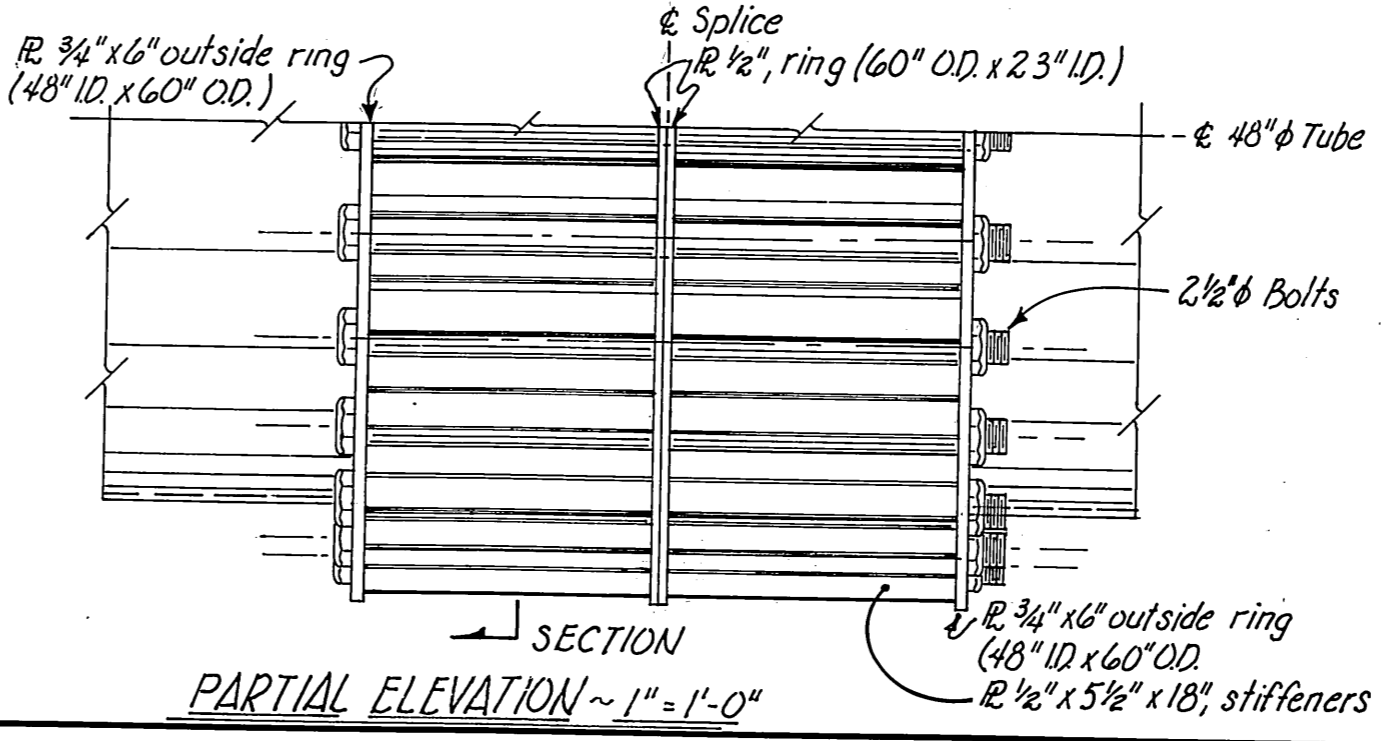


45  
 46  
 47  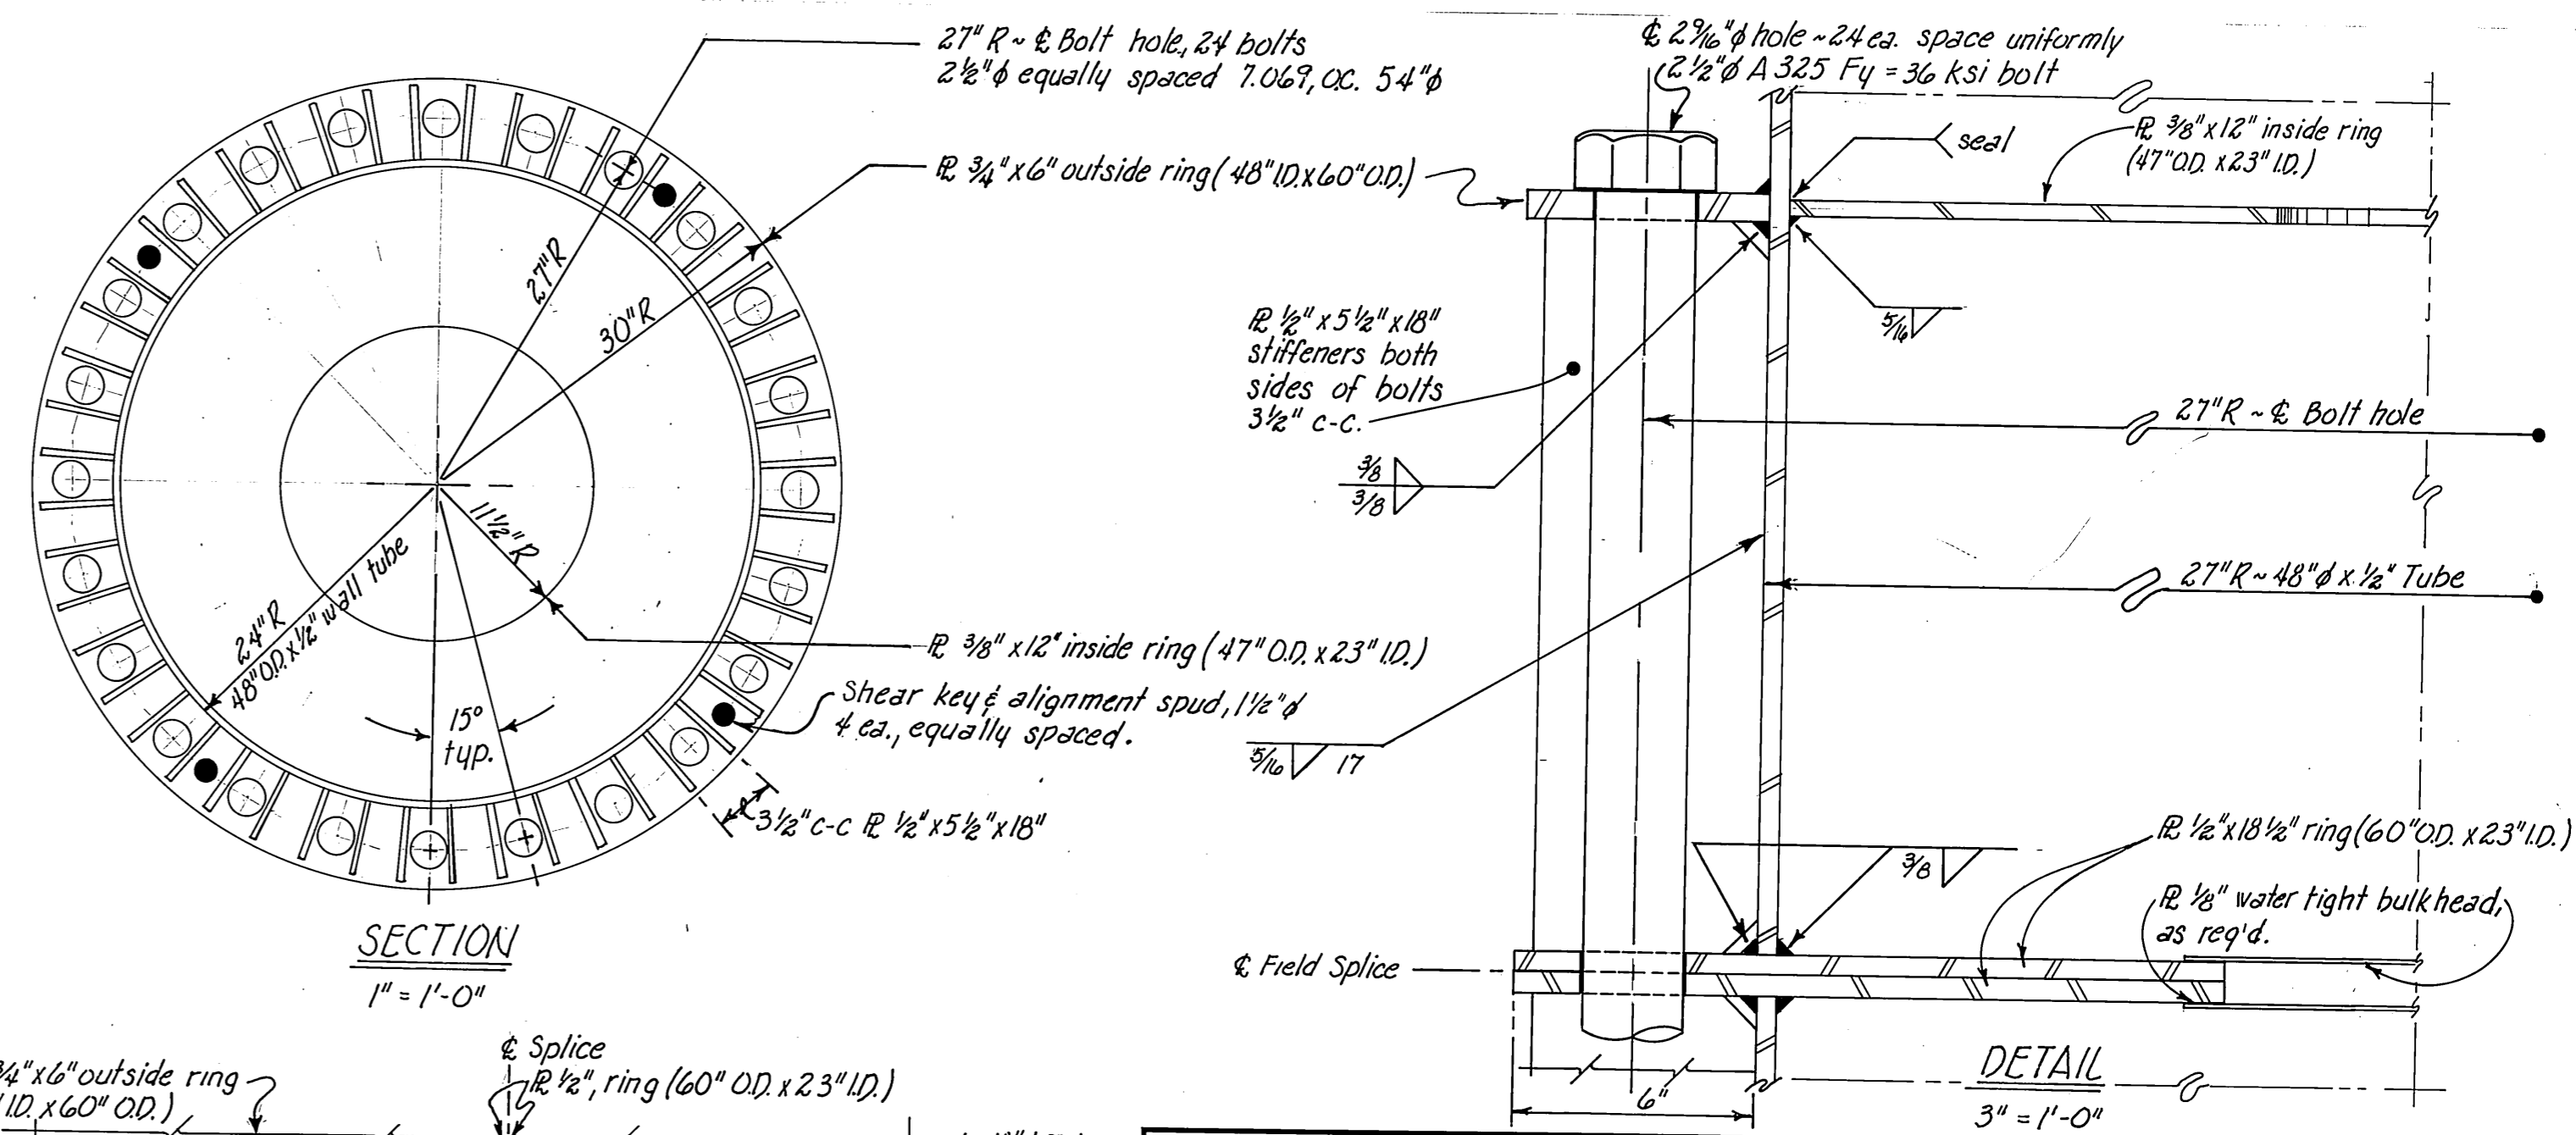
STAMP		DO NOT SCALE THIS DRAWING - USE DIMENSIONS	
STATE OF ALASKA DEPARTMENT OF TRANSPORTATION AND PUBLIC FACILITIES DIVISION OF HARBOR DESIGN AND CONSTRUCTION			
LETNIKOF COVE			
ALTERNATE FLANGE JOINT DETAIL NOT USED			
SCALE <i>As Noted</i>	SURVEYED	APPROVED	
DESIGNED <i>HM</i>	DRAWN <i>GRF</i>	<i>Robert P. Beck</i> DIRECTOR	
CHECKED	DATE <i>11-79</i>		
PROJECT NUMBER <i>K39189</i>	SHEET <i>1</i> OF <i>1</i>		

# LETNIKOF COVE FLOAT K39189

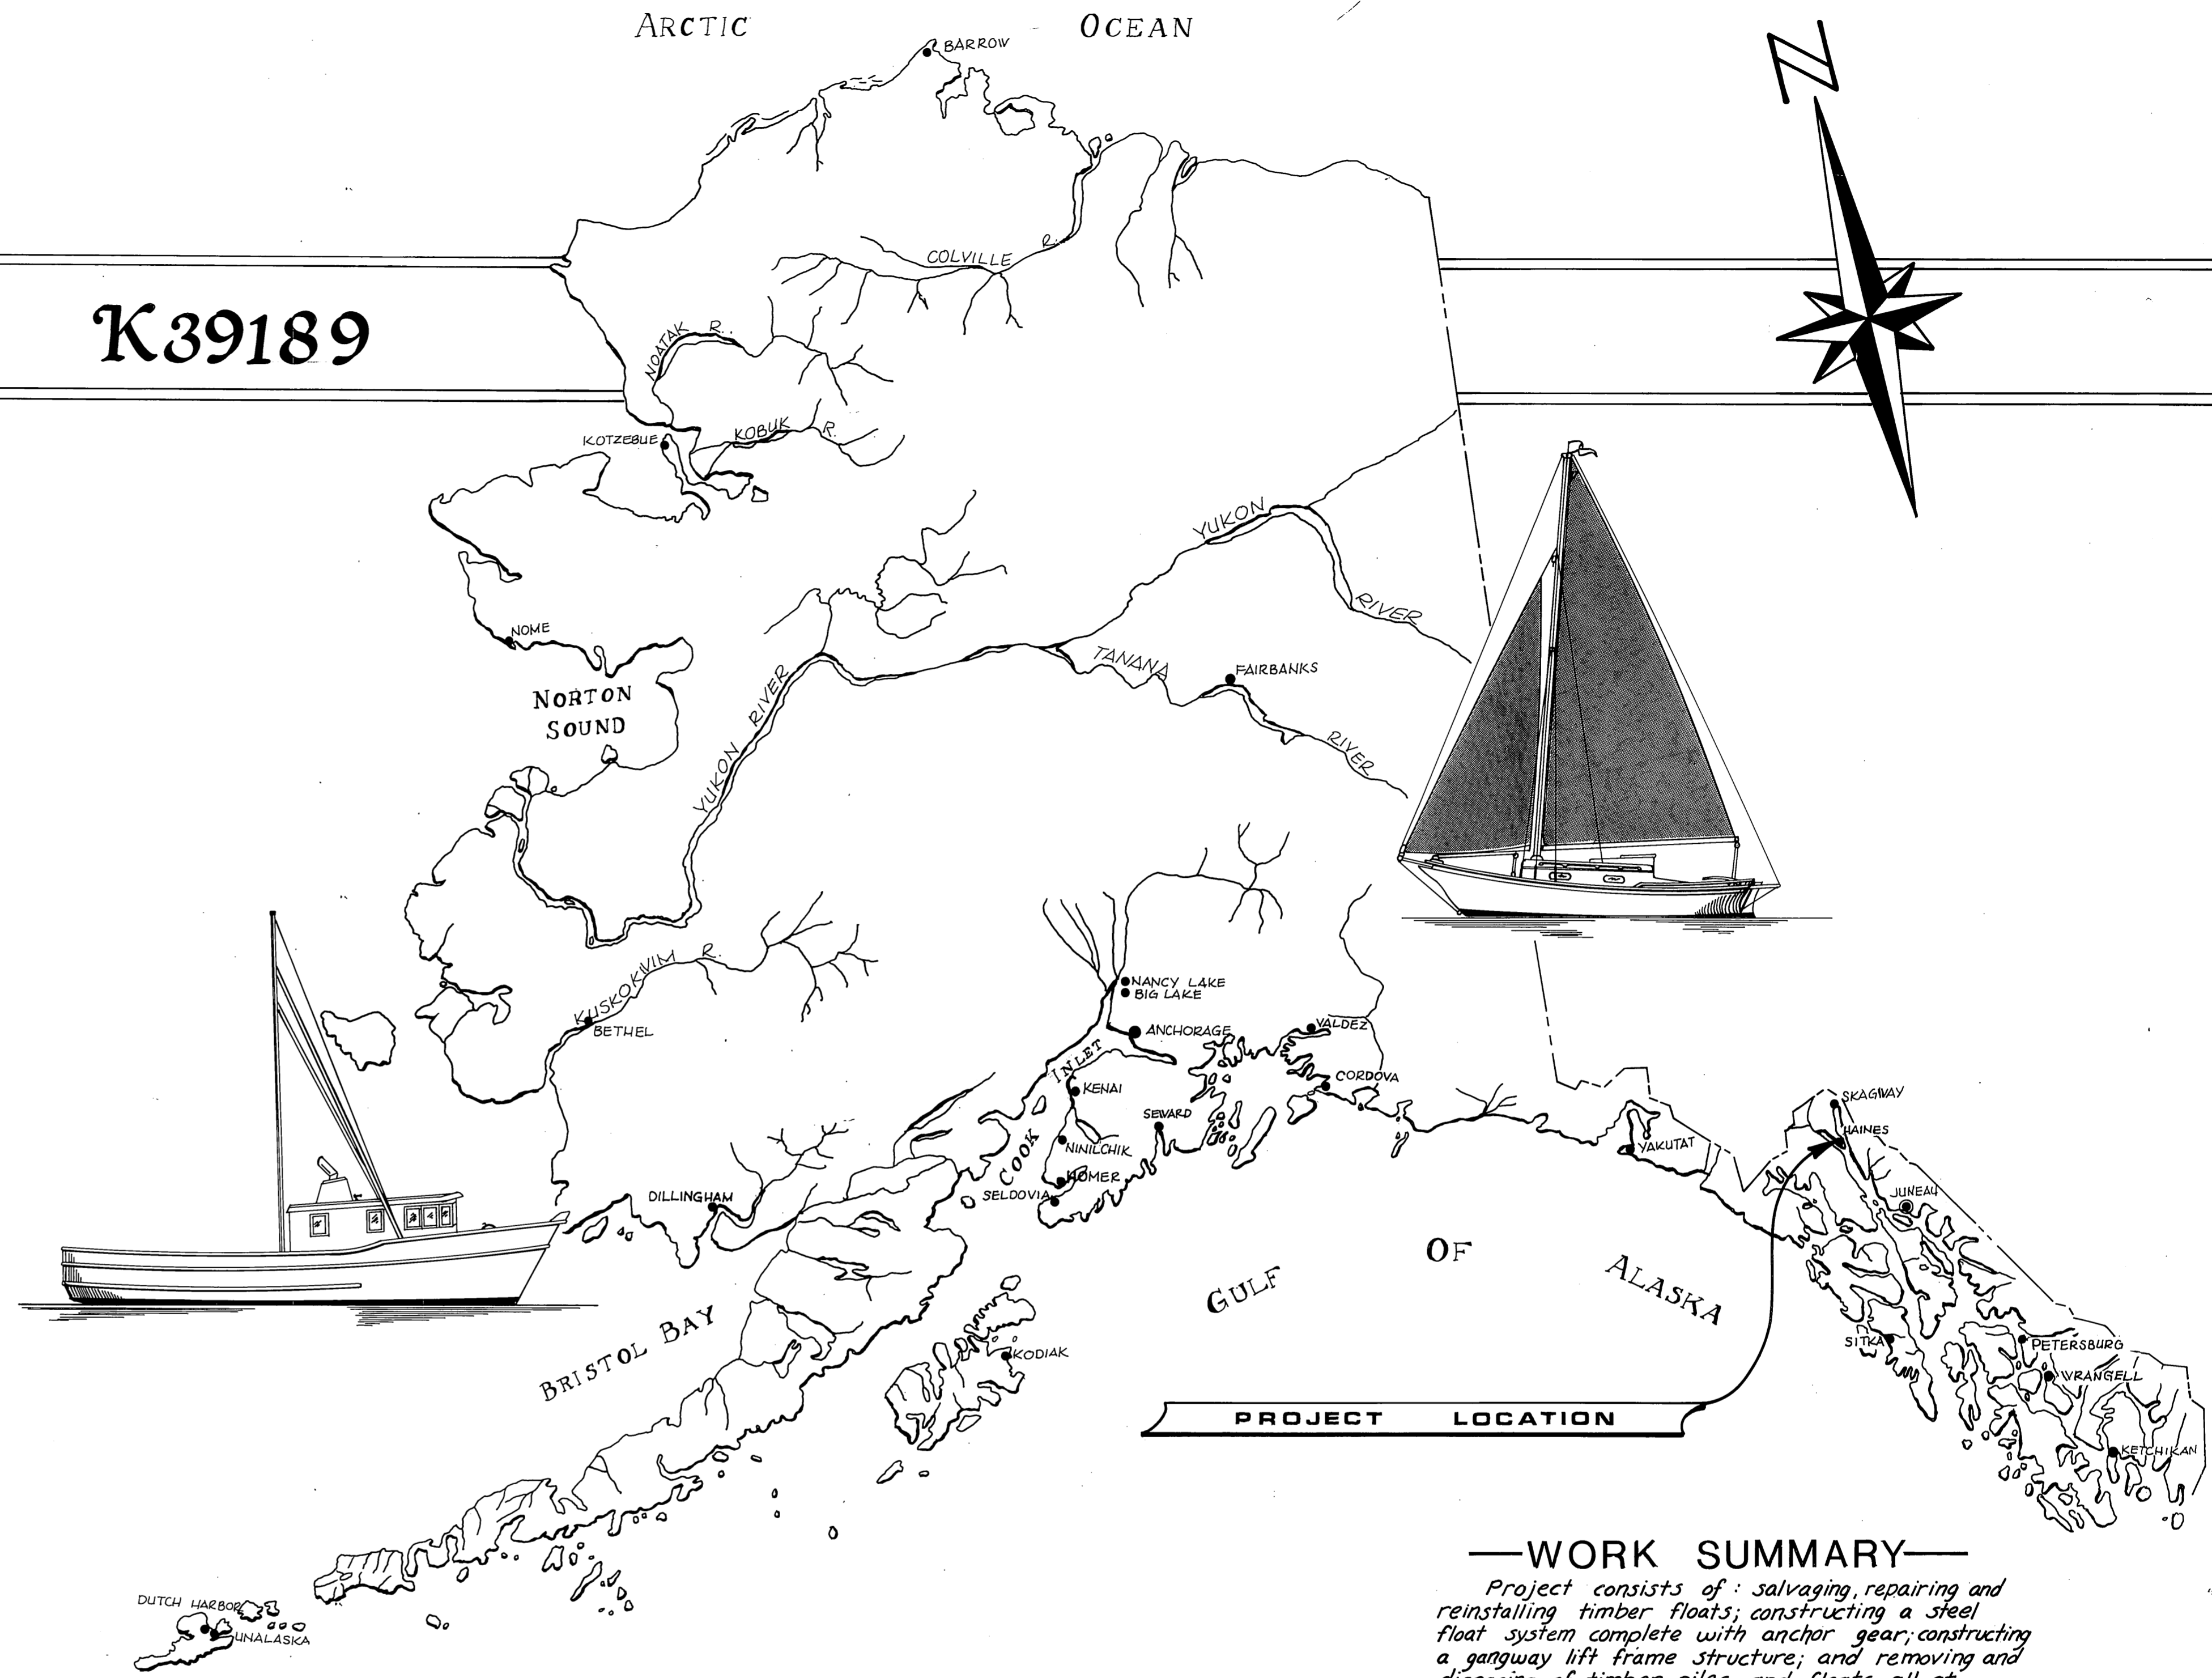

**—WORK SUMMARY—**  
 Project consists of: salvaging, repairing and reinstalling timber floats; constructing a steel float system complete with anchor gear; constructing a gangway lift frame structure; and removing and disposing of timber piles and floats, all at Letnikof Cove, Haines, Alaska.




*As Built - 6-81 DCW*

INDEX TO SHEETS	
1	Title Sheet
2	Project Layout
3	Main Float Layout & Typical Details
4	Pipe Intersection & Rigid Frame Details
5	Float Connections & Misc. Details
6	Anchor Details
7	Gangway Support Bent

**STATE  
OF  
ALASKA**

DEPARTMENT OF TRANSPORTATION & PUBLIC FACILITIES  
**DIVISION OF HARBOR  
 DESIGN & CONSTRUCTION**

**APPROVED**  
*Robert T. Seck*  
 Don STATTER  
 DIRECTOR  
 DATE Sept 28, 1979  
 SHEET **1** OF

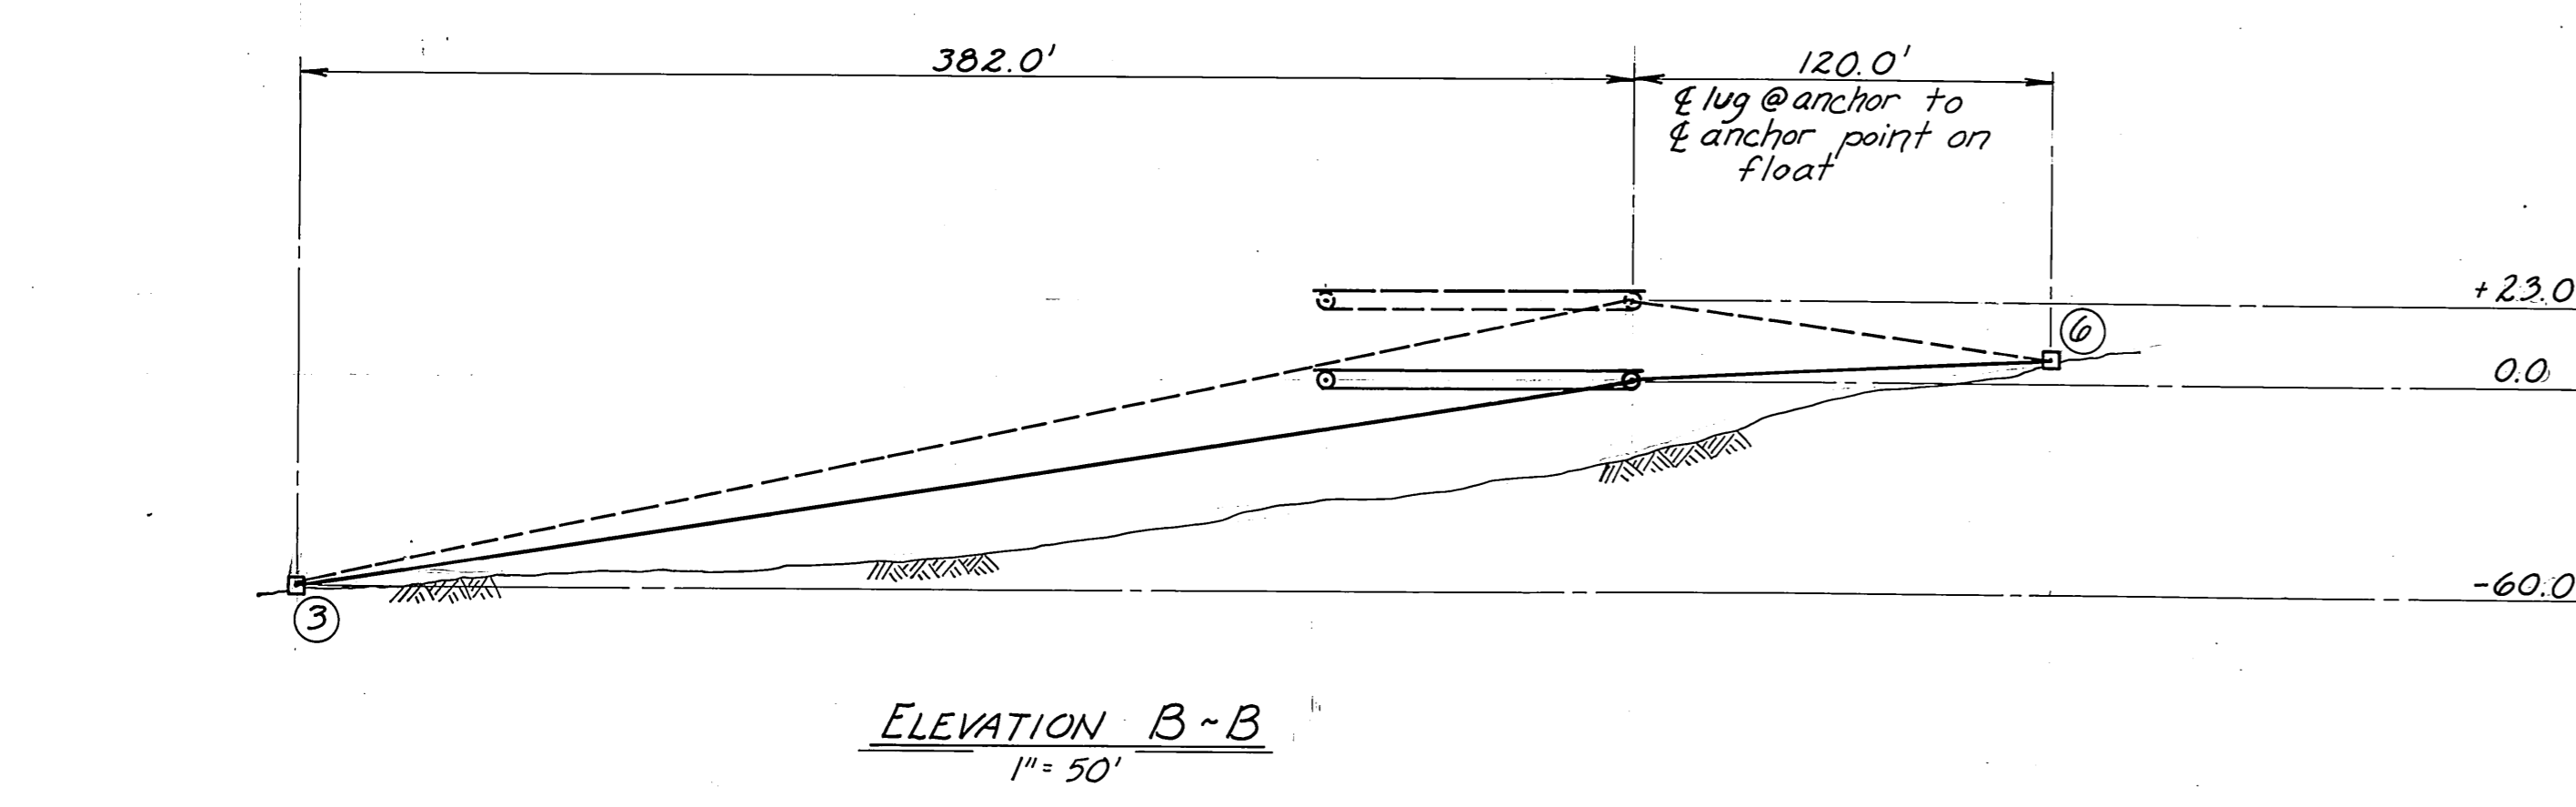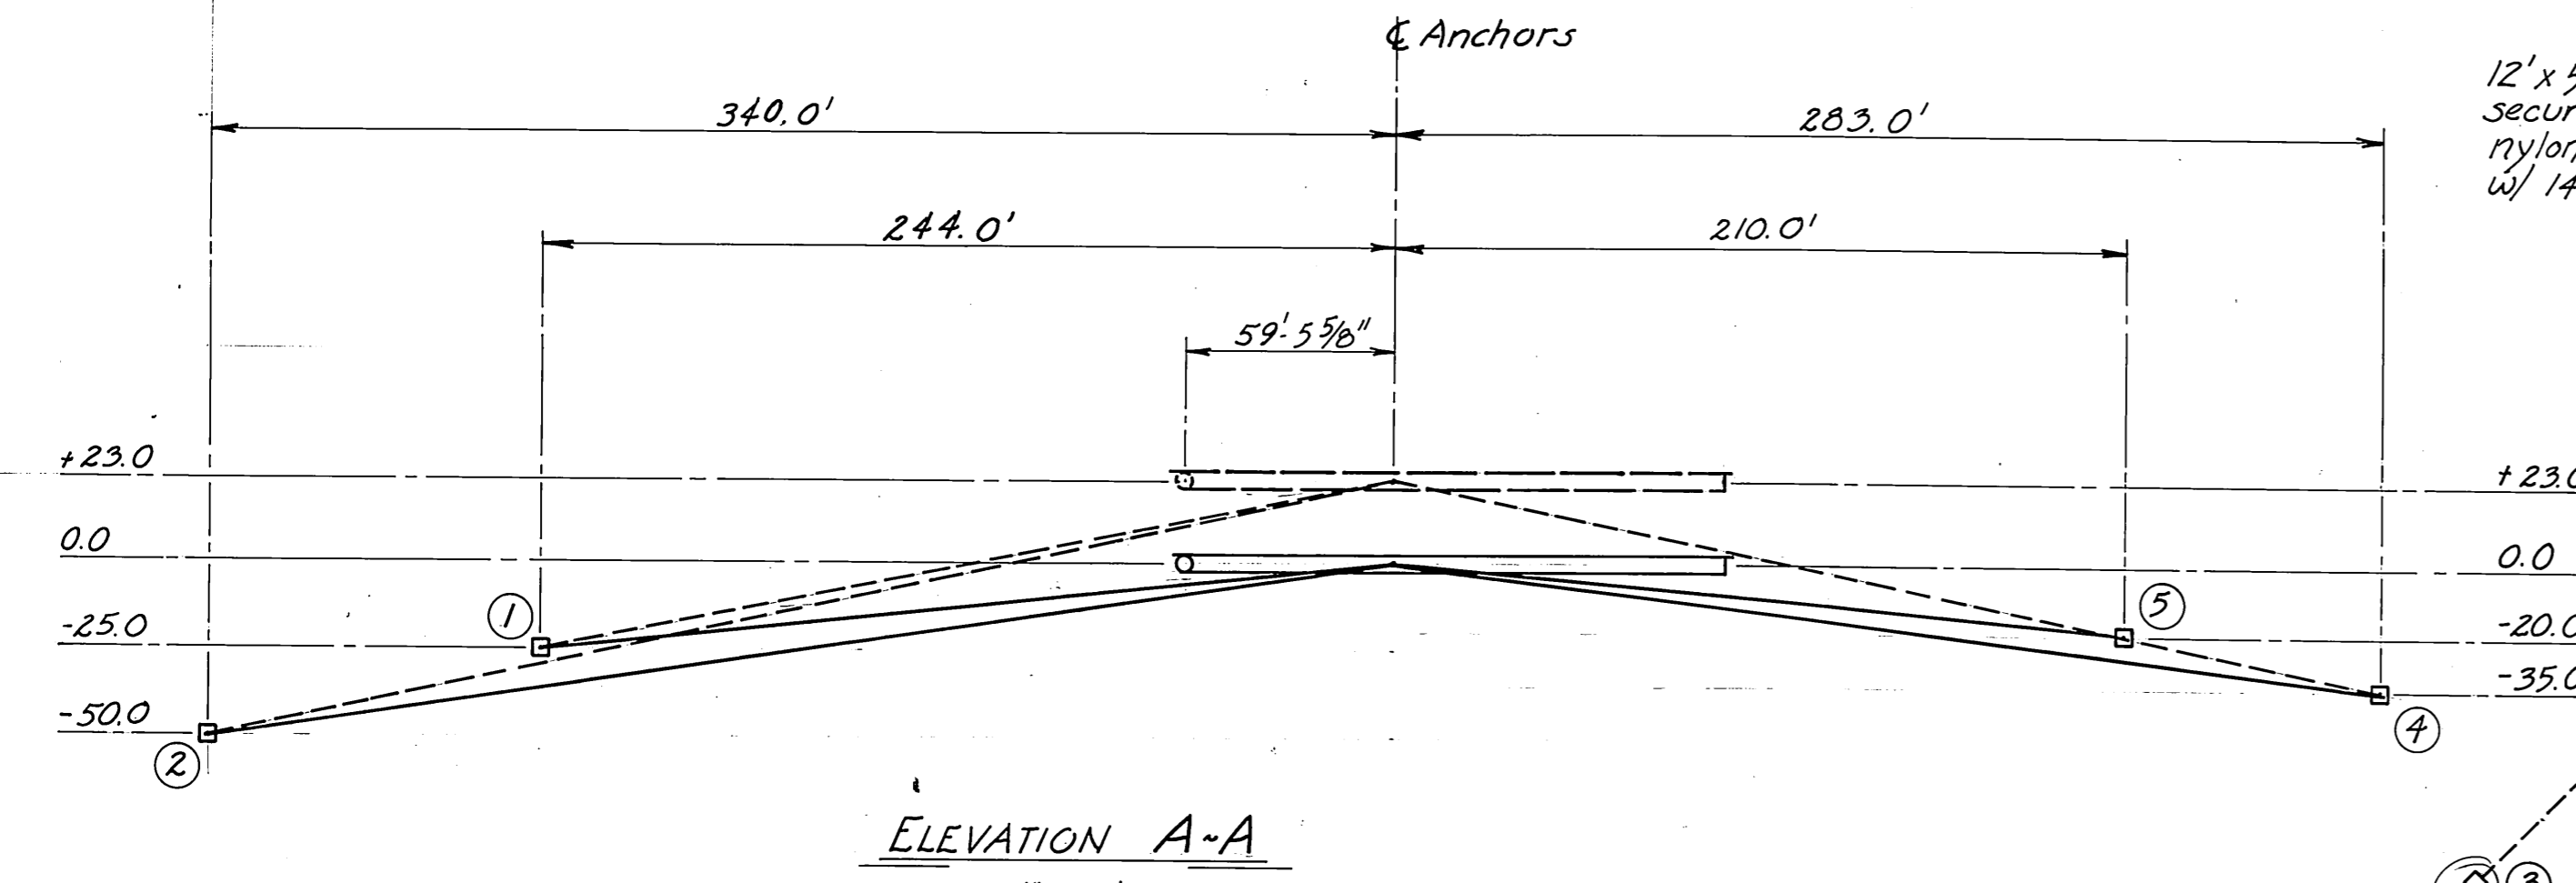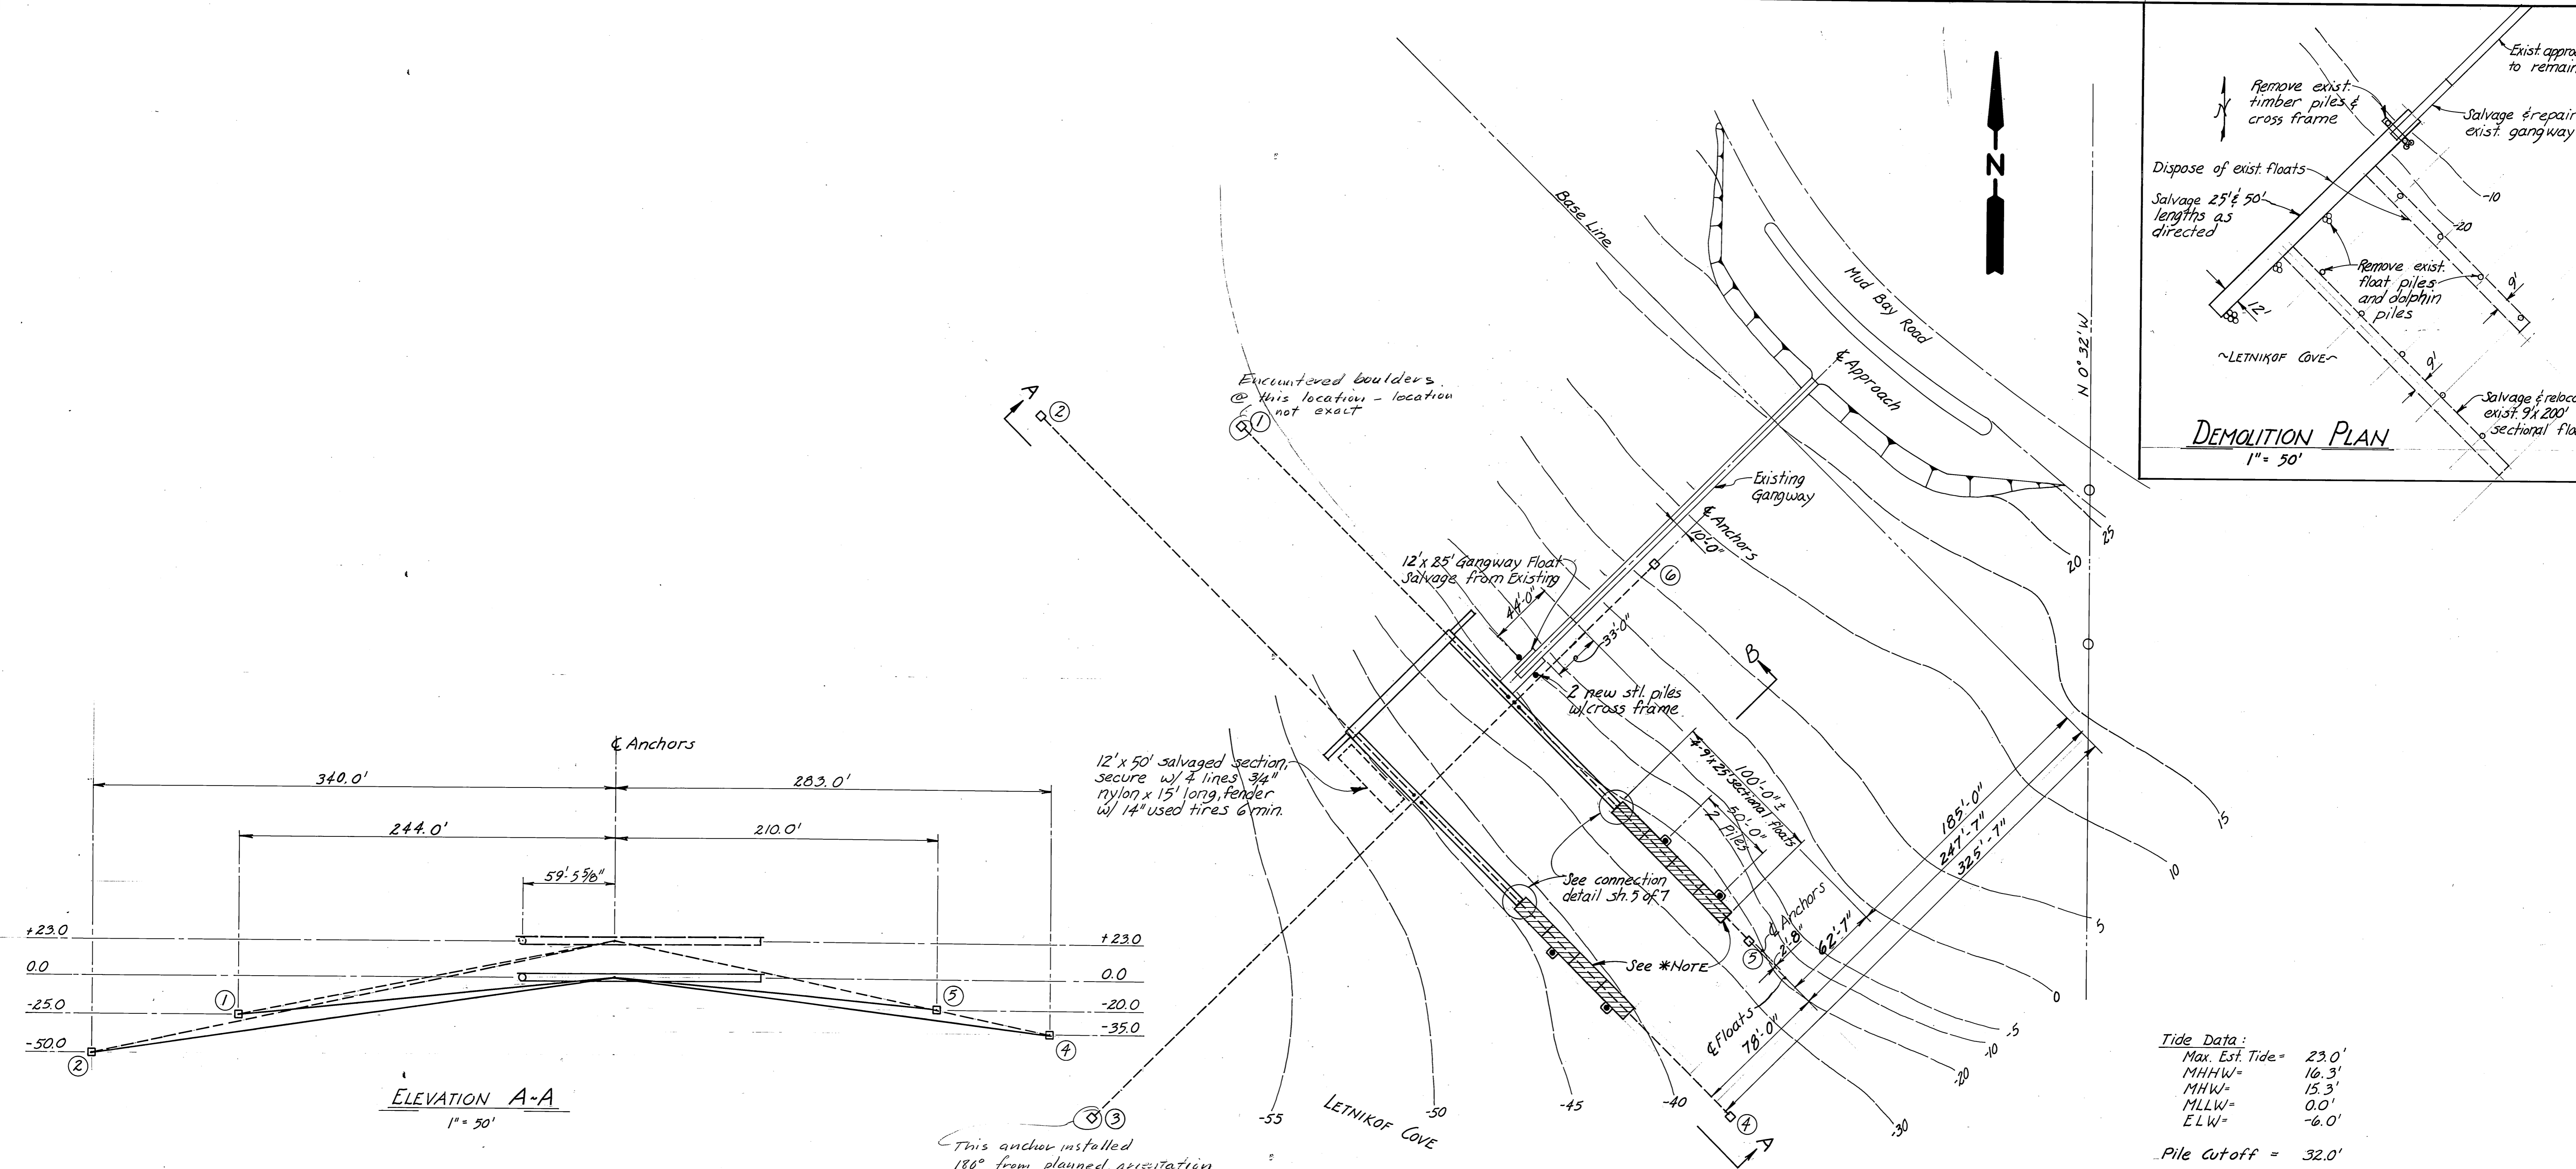

NOTE: Elevations at anchors are only approximate. Actual depth to be measured. Adjust chain length accordingly by the following table where  $D_H$  = actual depth below MLLW + 22.0':

Anchor No.	Type	Chain Length = $L_{estimated}$	Chain Size	Strength (Proof)	Chain Length L computed
①	CB/SP	$\sqrt{245^2 + D_H^2} = 255'$	1 1/4"	130,000	
②	CB/SP	$\sqrt{341^2 + D_H^2} = 355'$	1 1/4"	130,000	
③	SP	$\sqrt{383^2 + D_H^2} = 396'$	1 1/8"	106,000	
④	SP	$\sqrt{284^2 + D_H^2} = 296'$	1 1/4"	130,000	
⑤	SP	$\sqrt{211^2 + D_H^2} = 221'$	1 1/4"	130,000	
⑥	RA	$\sqrt{121^2 + D_H^2} = 125'$	1 1/8"	106,000	

\*LEGEND:  
 CB = Concrete Block 37.5 Ton  
 SP = Stake Pile HP 14x73  
 RA = Rock Anchor

Tide Data:  
 Max. Est. Tide = 23.0'  
 MHHW = 16.3'  
 MHW = 15.3'  
 MLLW = 0.0'  
 E.L.W. = -6.0'

Pile cutoff = 32.0'

\*NOTE: Existing floats to be relocated as shown. Drive 4 timber piles, 15' penetration req'd. on seaward piles, 20' penetration req'd. on shoreward piles. Use salvaged piles.

STAMP

DO NOT SCALE THIS DRAWING - USE DIMENSIONS

STATE OF ALASKA  
 DEPARTMENT OF TRANSPORTATION AND PUBLIC FACILITIES  
 DIVISION OF HARBOR DESIGN AND CONSTRUCTION

LETNIKOF COVE ALASKA


PROJECT LAYOUT

SCALE As Noted  
 DESIGNED HM  
 CHECKED RB

SURVEYED SJS  
 DRAWN SJS  
 DATE Sept, 1979

APPROVED  
 Chief of Design

PROJECT NUMBER K39189 SHEET 2 OF 7

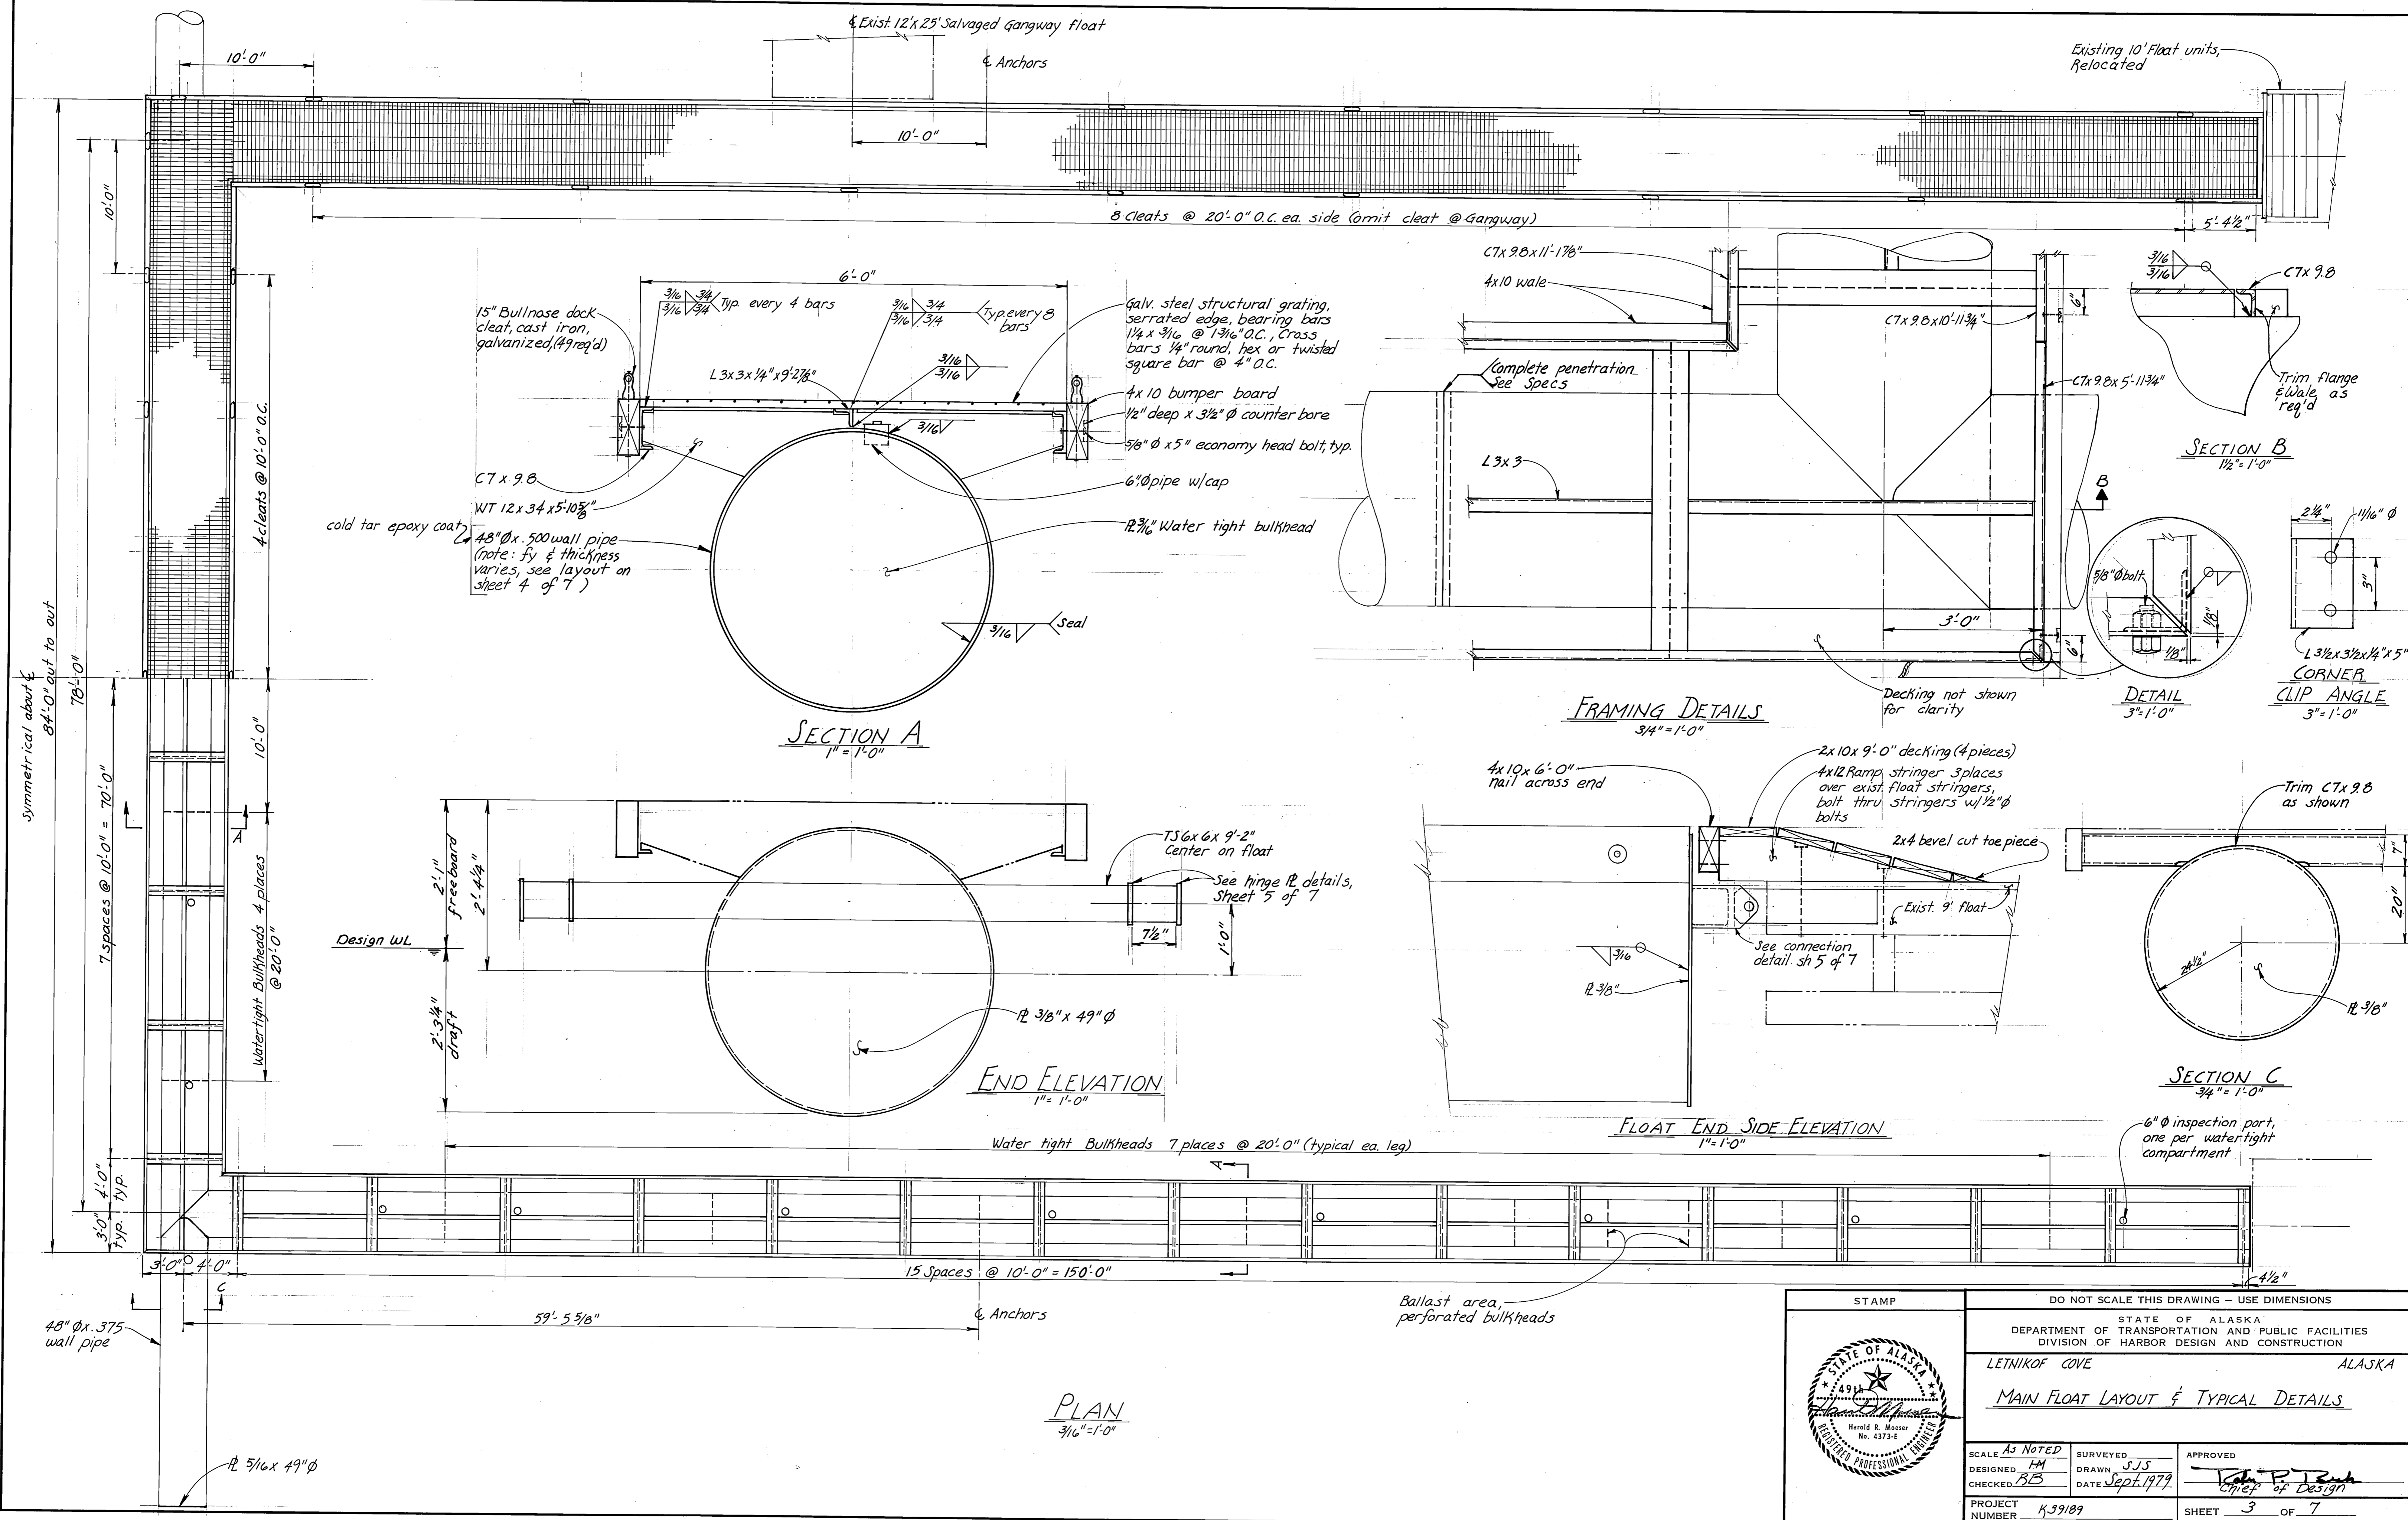

**SECTION A**  
1" = 1'-0"


**FRAMING DETAILS**  
3/4" = 1'-0"

**END ELEVATION**  
1" = 1'-0"


**FLOAT END SIDE ELEVATION**  
1" = 1'-0"

**SECTION C**  
3/4" = 1'-0"




**PLAN**  
3/16" = 1'-0"

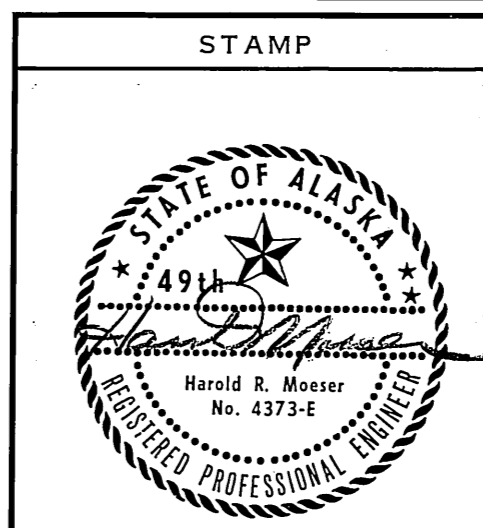

DO NOT SCALE THIS DRAWING - USE DIMENSIONS STATE OF ALASKA DEPARTMENT OF TRANSPORTATION AND PUBLIC FACILITIES DIVISION OF HARBOR DESIGN AND CONSTRUCTION LETNIKOF COVE ALASKA <b>MAIN FLOAT LAYOUT &amp; TYPICAL DETAILS</b>		
SCALE AS NOTED DESIGNED HM CHECKED RB	SURVEYED SJS DRAWN SJS DATE SEPT 1979	APPROVED John P. Reed Chief of Design
PROJECT NUMBER K-39189	SHEET 3 OF 7	


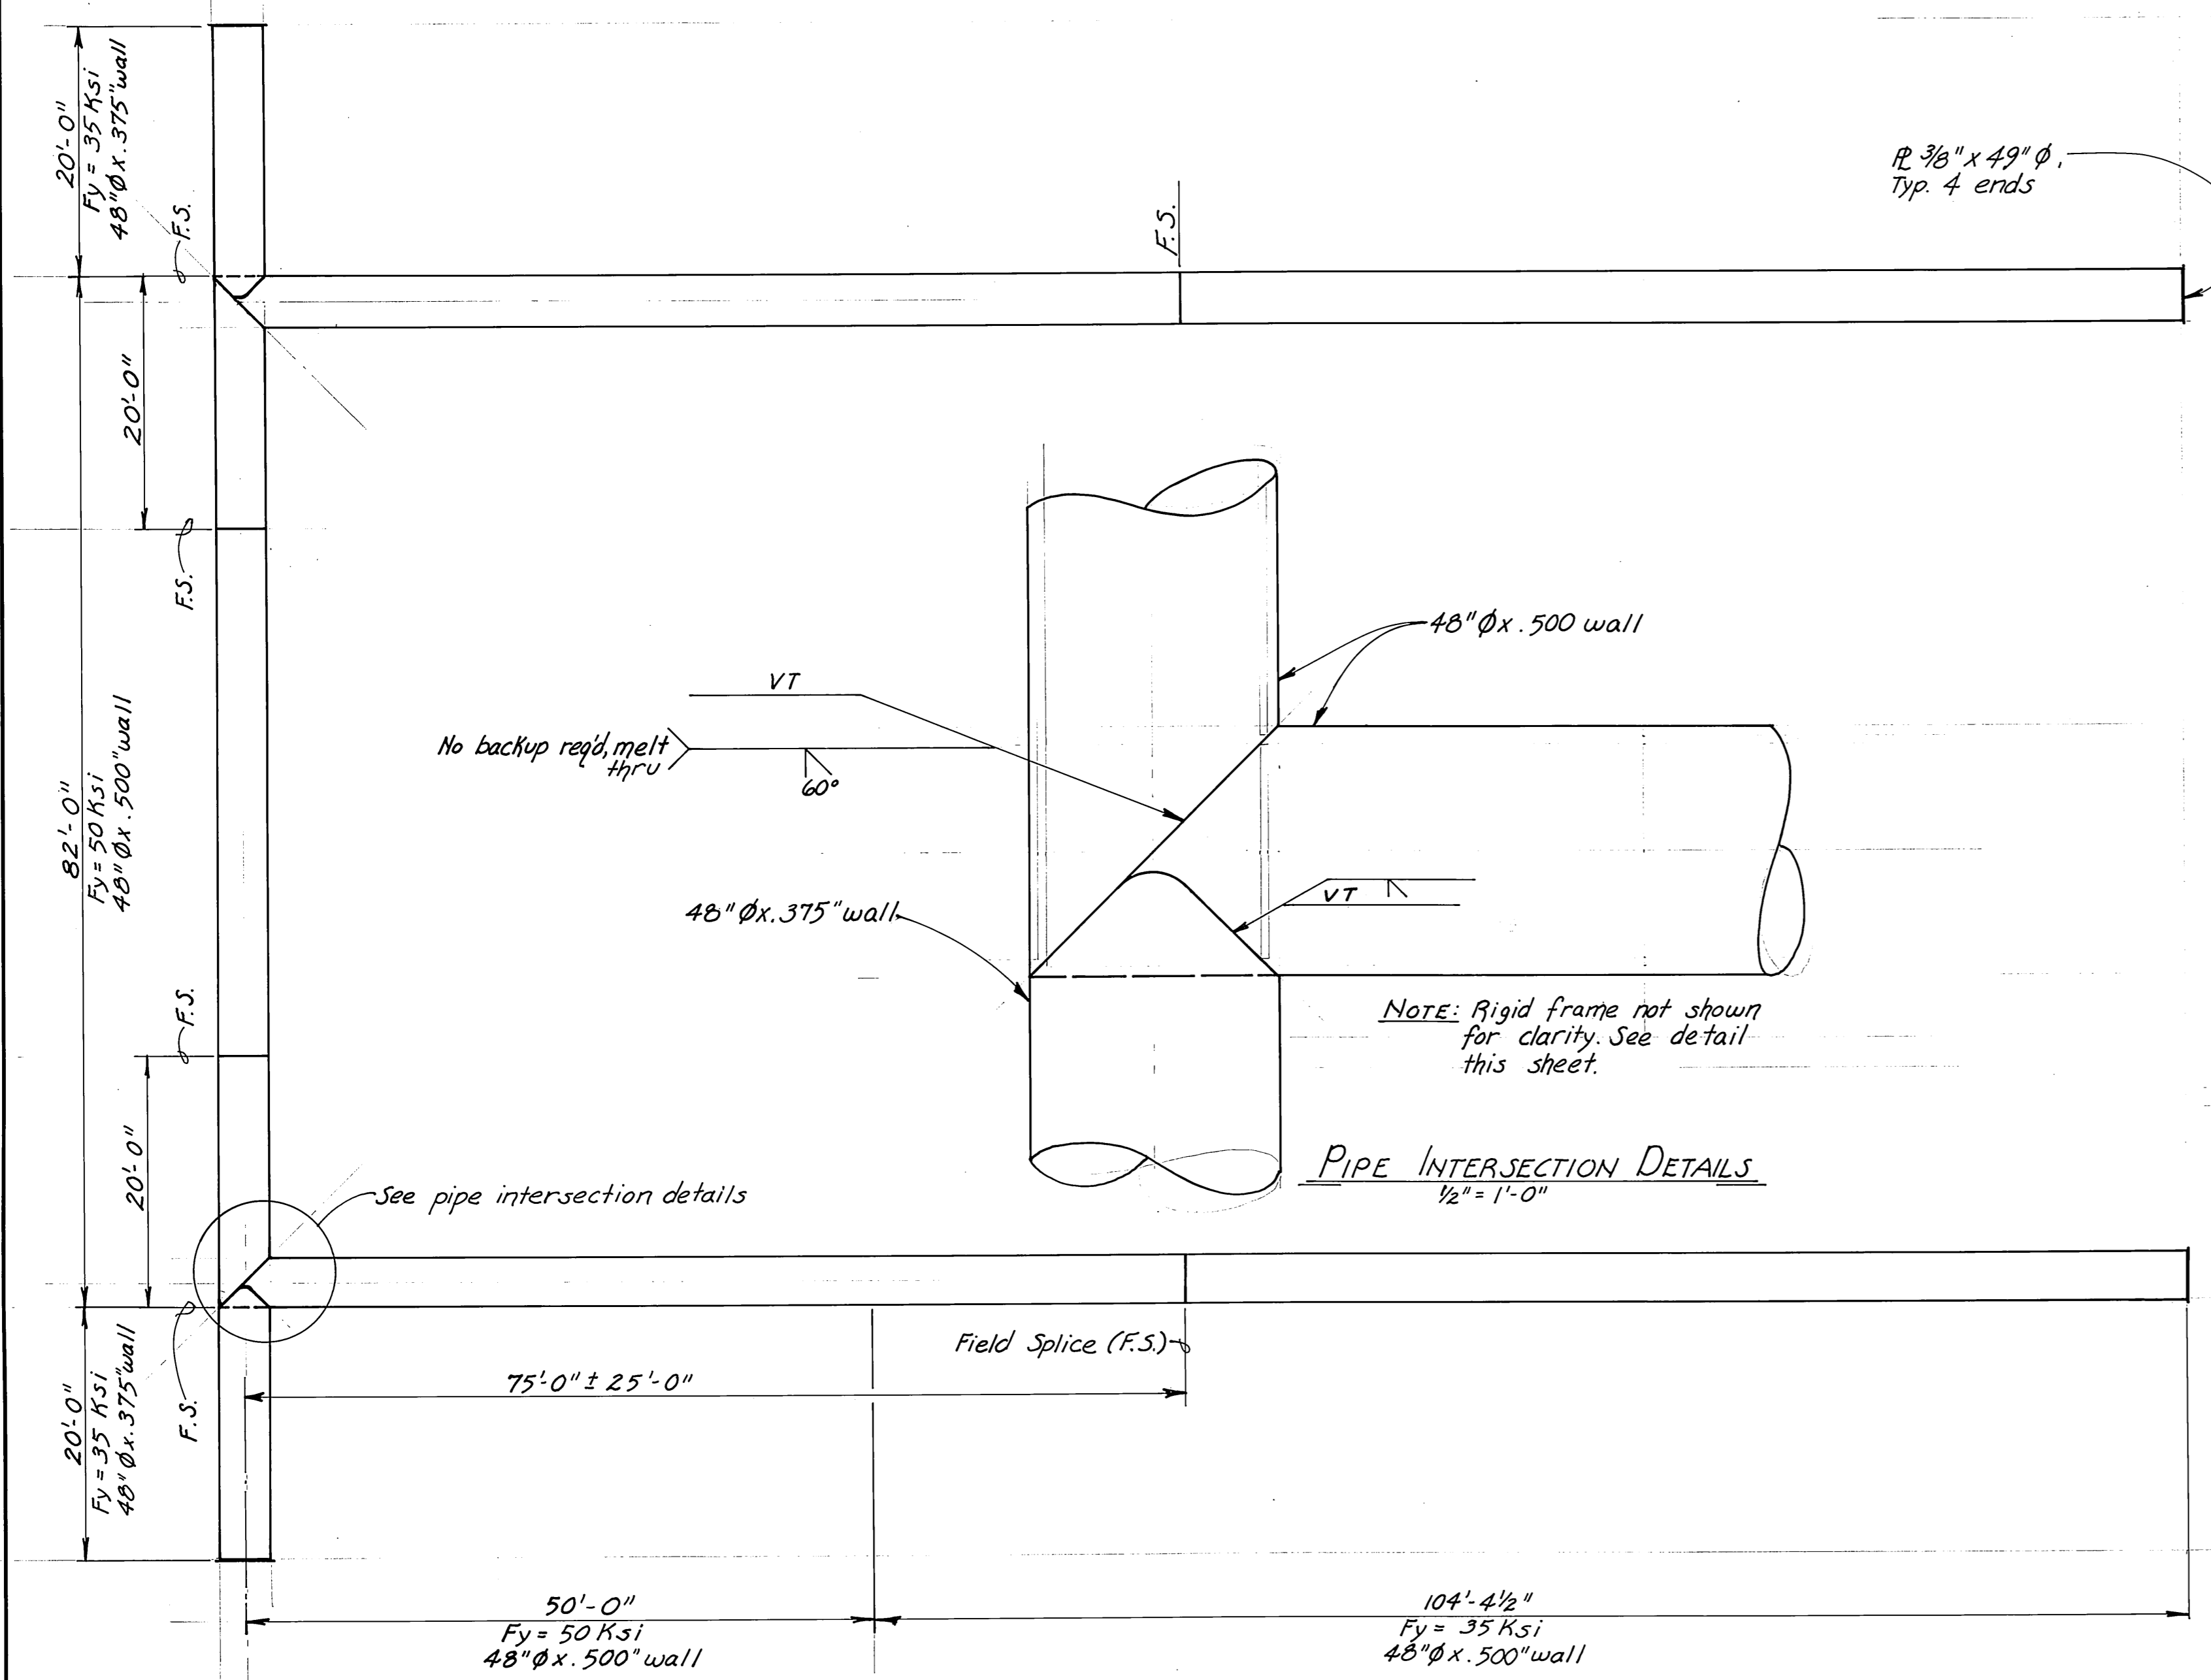


- NOTE:**
1. Minimum yield strength material specified, substitutions of greater  $F_y$  are acceptable.
  2. Field splices shown are preferred locations, contractor may eliminate as many field splices as his equipment will allow.
  3. Shop welds will be subject to inspection noted on weld symbol.
  4. All fillet welds will be subject to visual inspection.

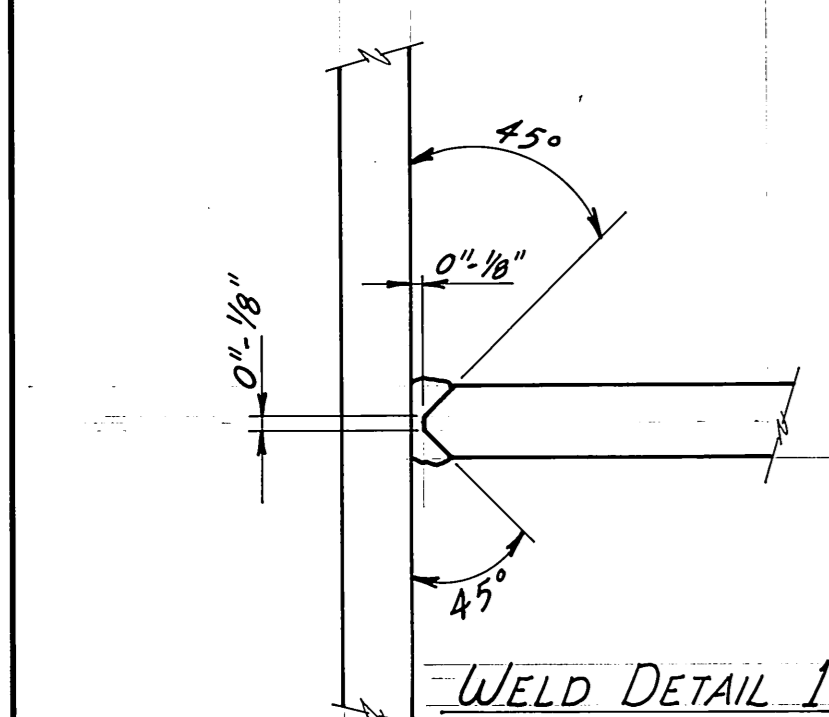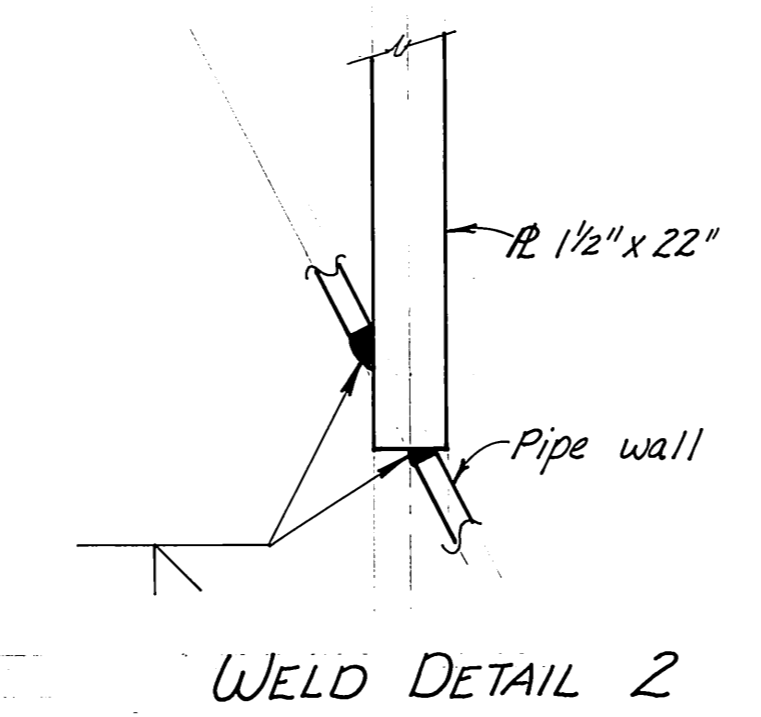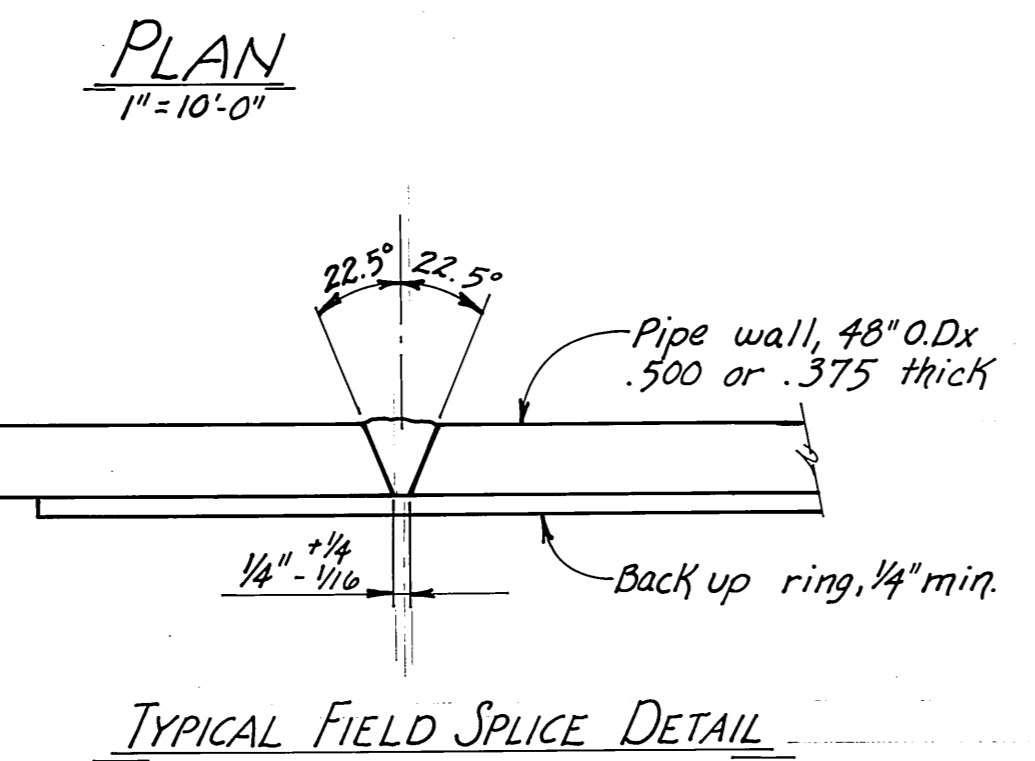

**WELD DETAILS**  
(No Scale)



$R \frac{3}{8}'' \times 49'' \phi$ ,  
Typ. 4 ends

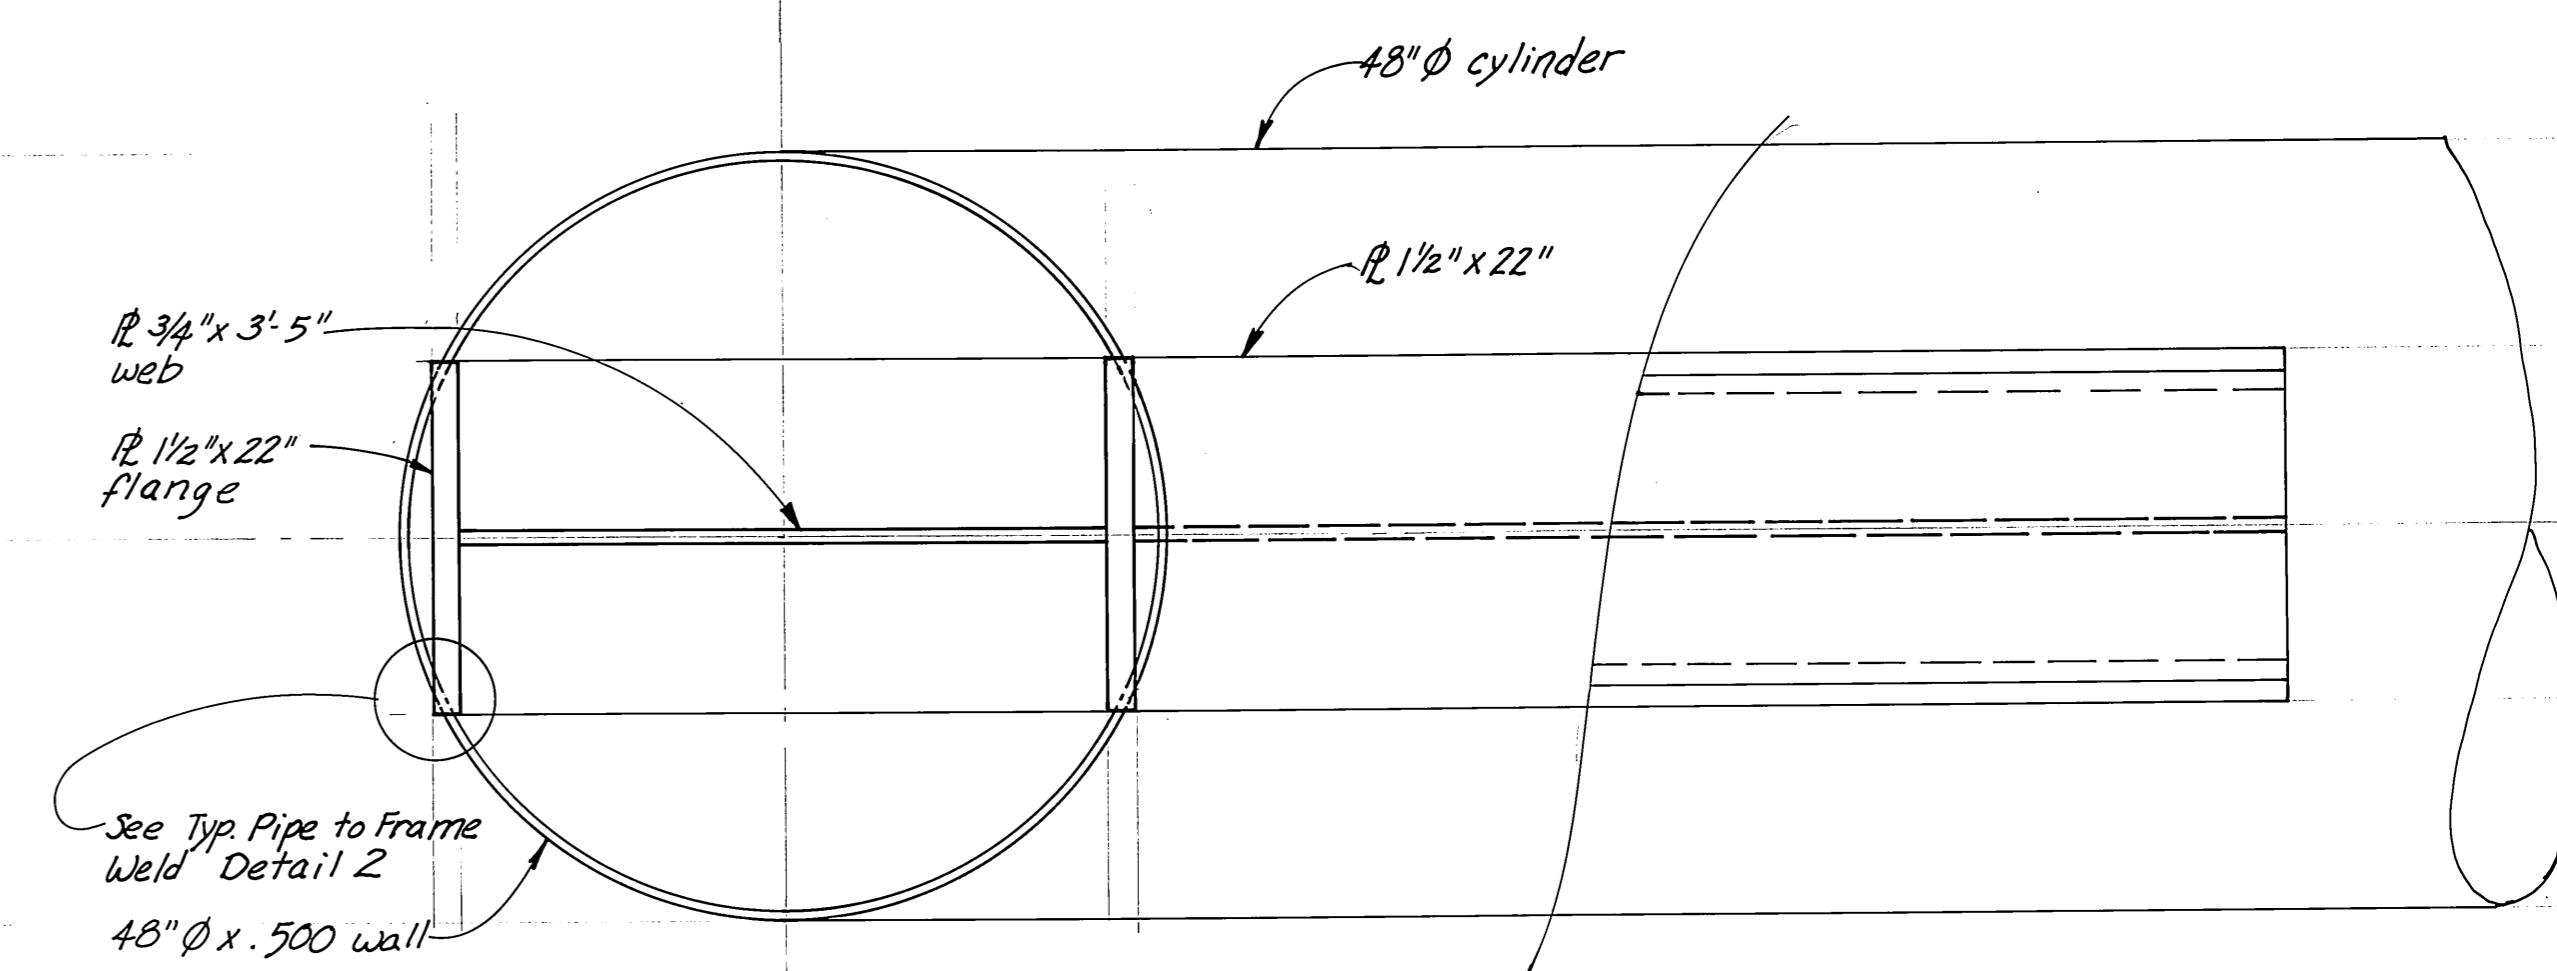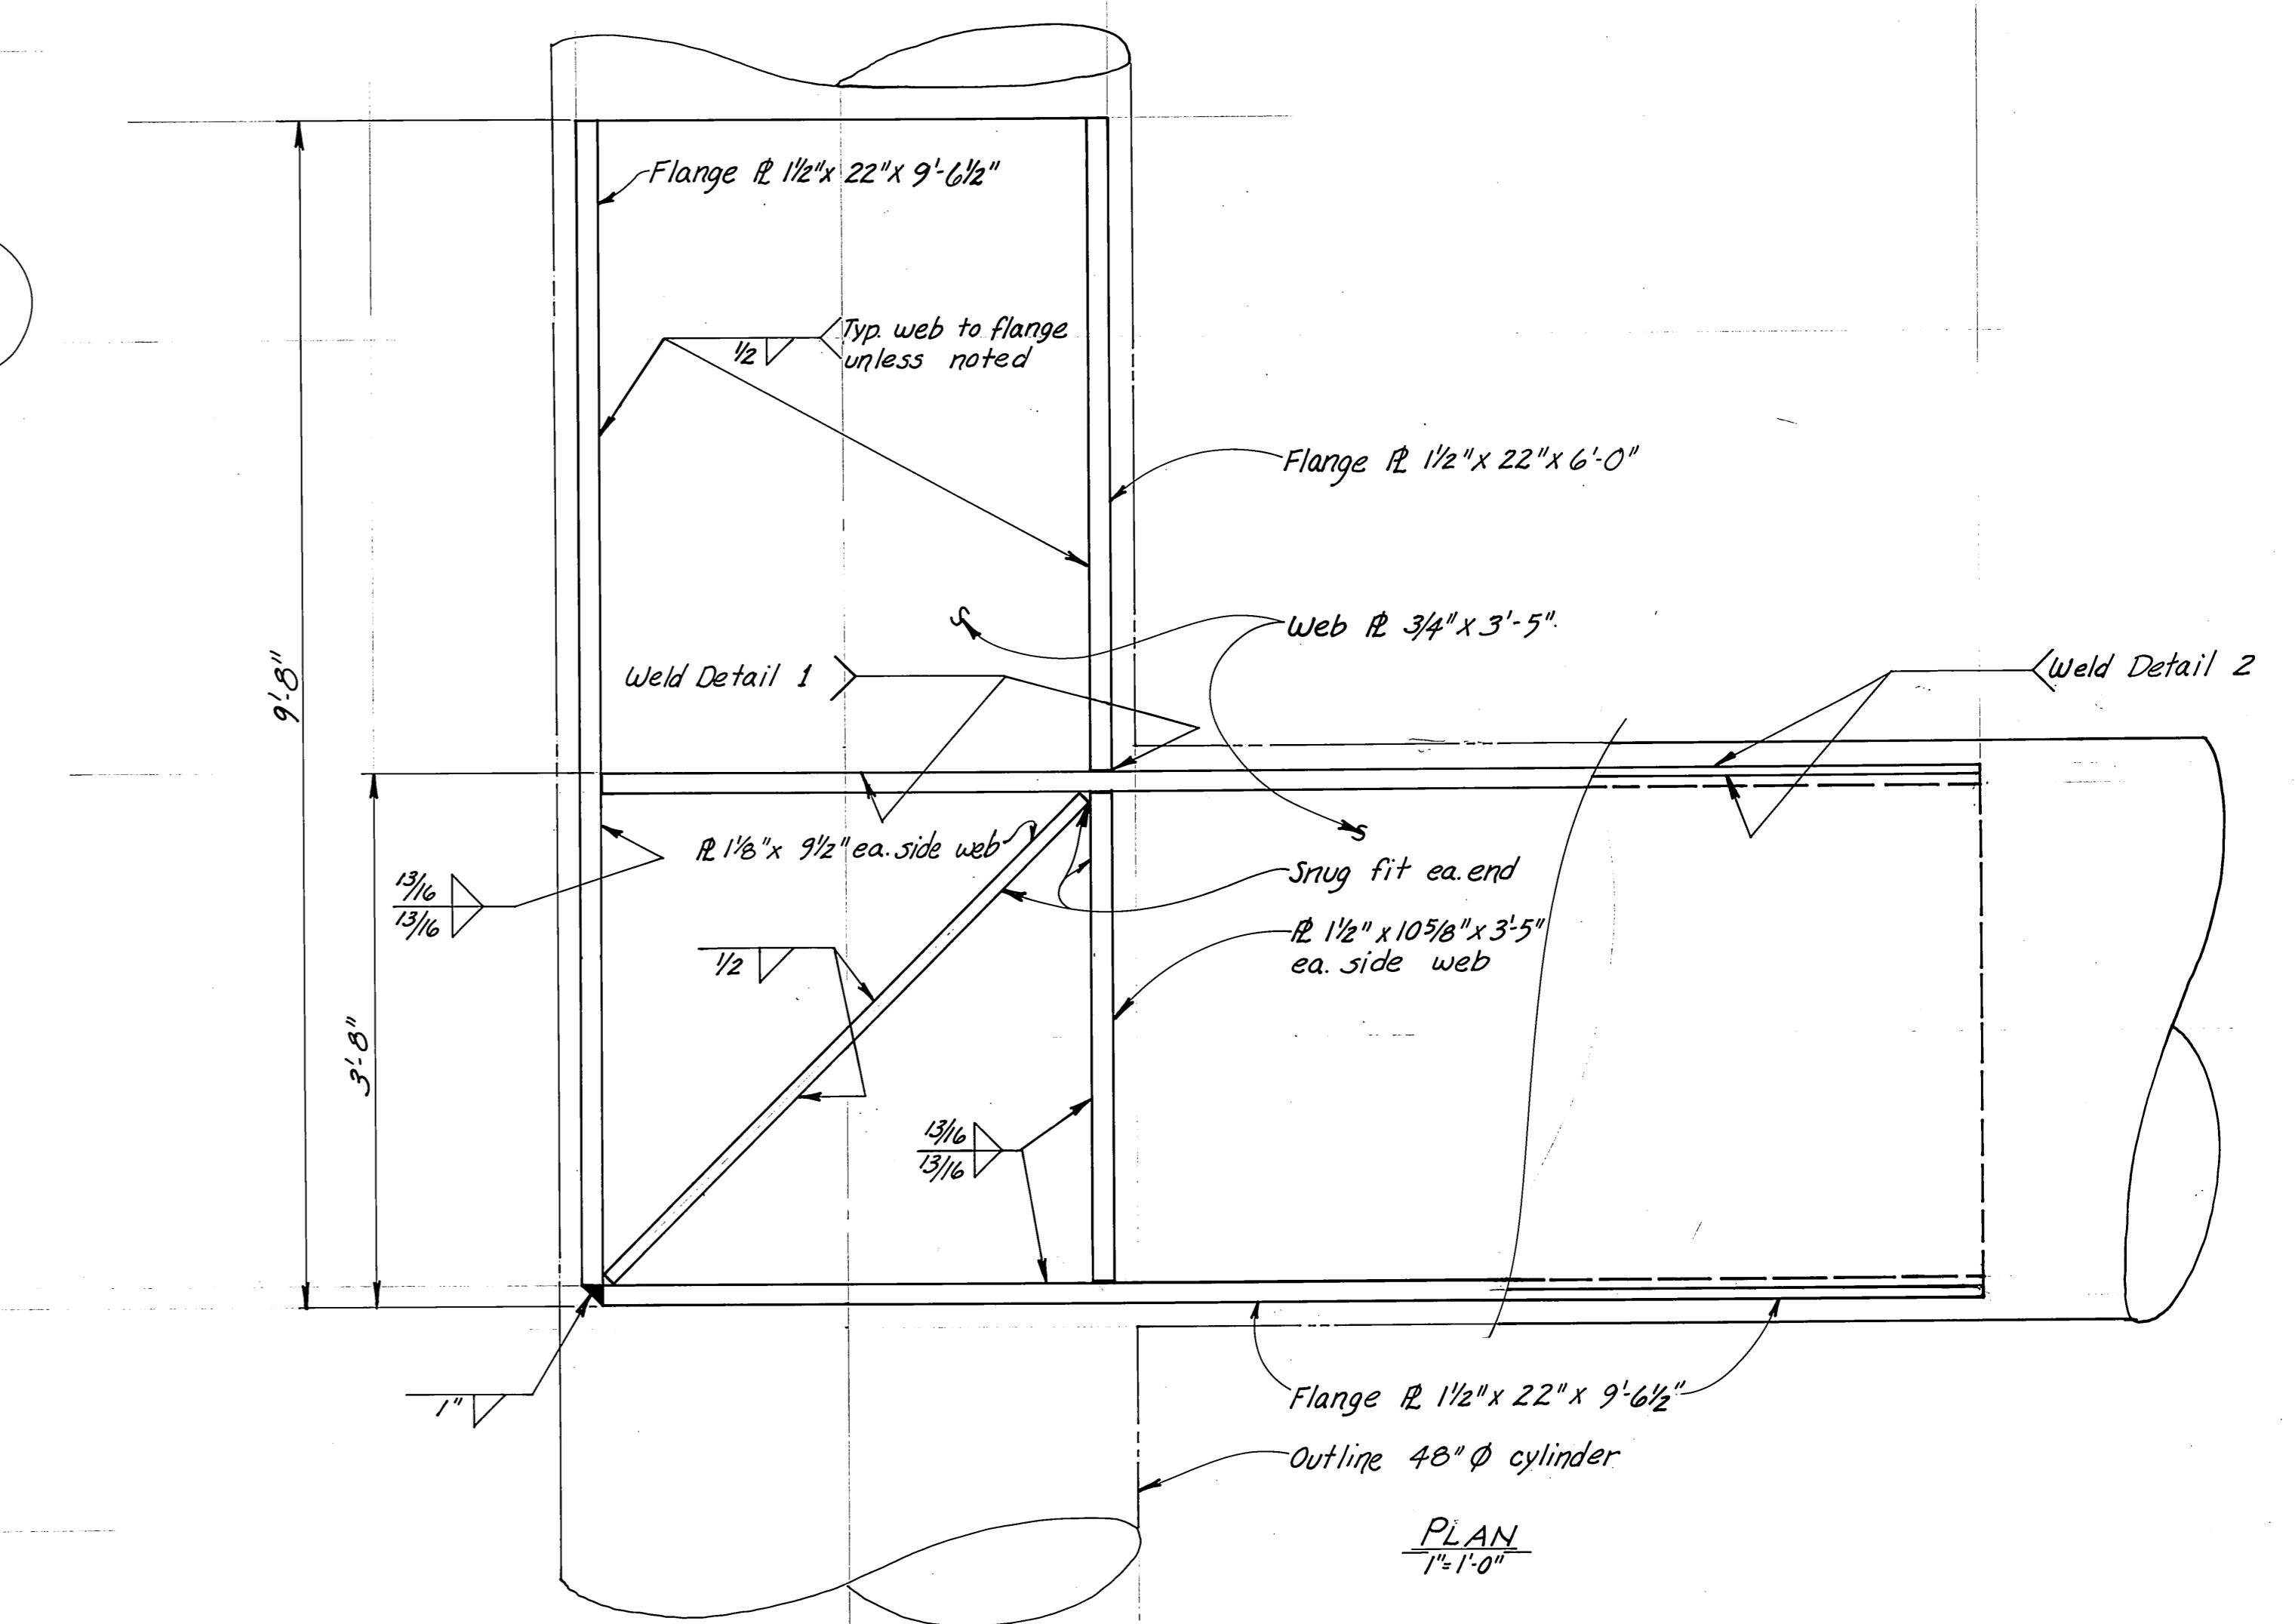

**SECTION**  
 $1'' = 1'-0''$   
**RIGID FRAME DETAILS**

STAMP		DO NOT SCALE THIS DRAWING - USE DIMENSIONS	
STATE OF ALASKA DEPARTMENT OF TRANSPORTATION AND PUBLIC FACILITIES DIVISION OF HARBOR DESIGN AND CONSTRUCTION			
LETNIKOF COVE		ALASKA	
<b>PIPE INTERSECTION &amp; RIGID FRAME DETAILS</b>			
SCALE <i>NOTED</i>	SURVEYED	APPROVED	
DESIGNED <i>HM</i>	DRAWN <i>S/S</i>	<i>John P. J. [Signature]</i> Chief of Design	
CHECKED <i>RB</i>	DATE <i>Sept. 1979</i>		
PROJECT NUMBER <i>K39189</i>		SHEET <i>4</i> OF <i>7</i>	




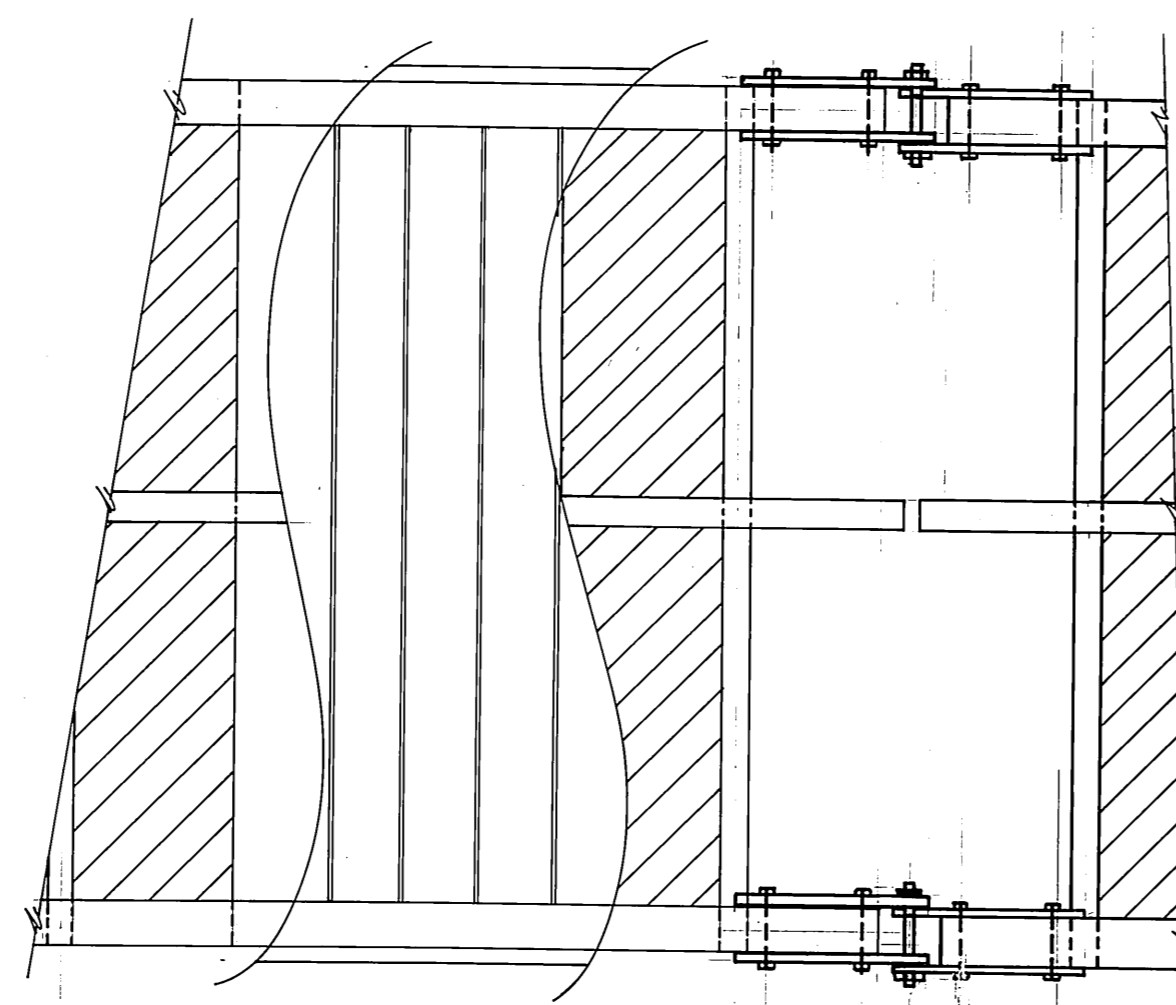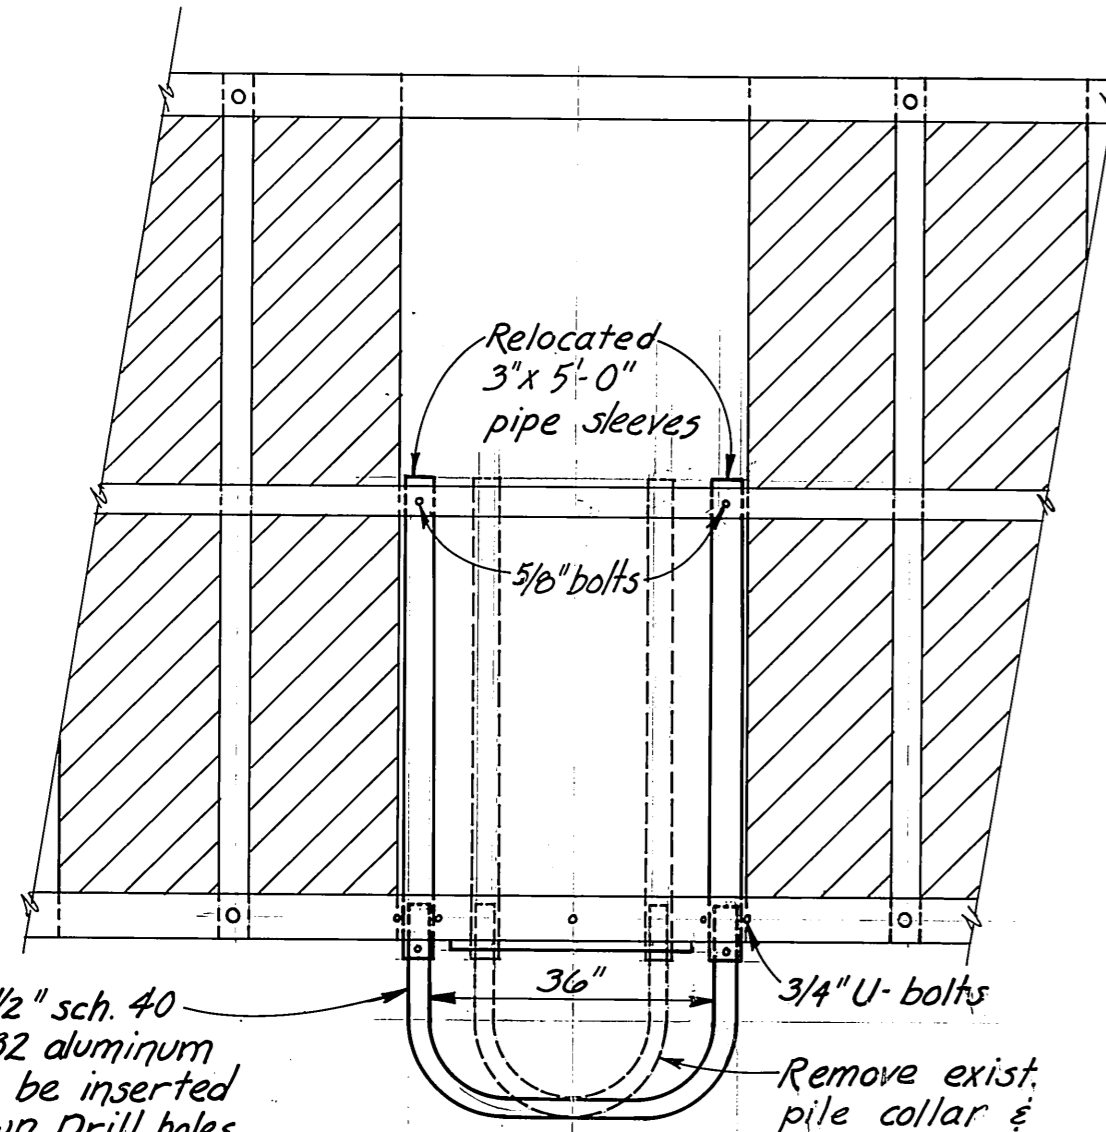

Remove exist. pile collar & Relocate sleeves as shown, salvage 2 collars for 12' float (gangway)


NOTE: Reuse exist. hardware (Hinges, U-bolts & pipe sleeves)

PLAN 1/2" = 1'-0"

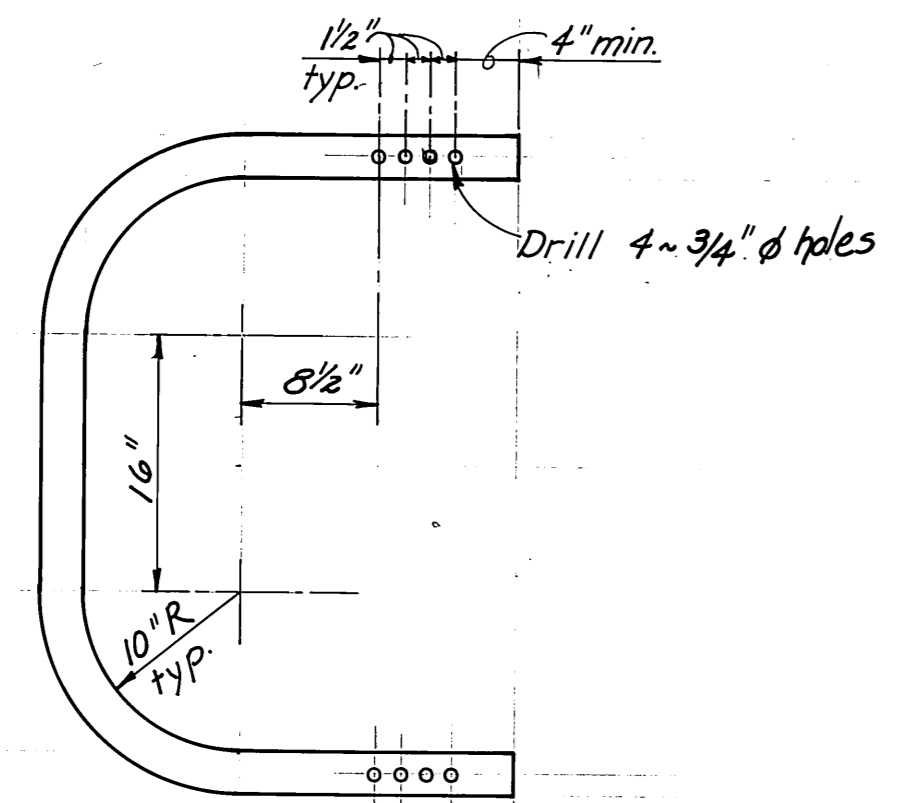

DETAIL 1" = 1'-0"


PIPE PILE COLLAR DETAILS

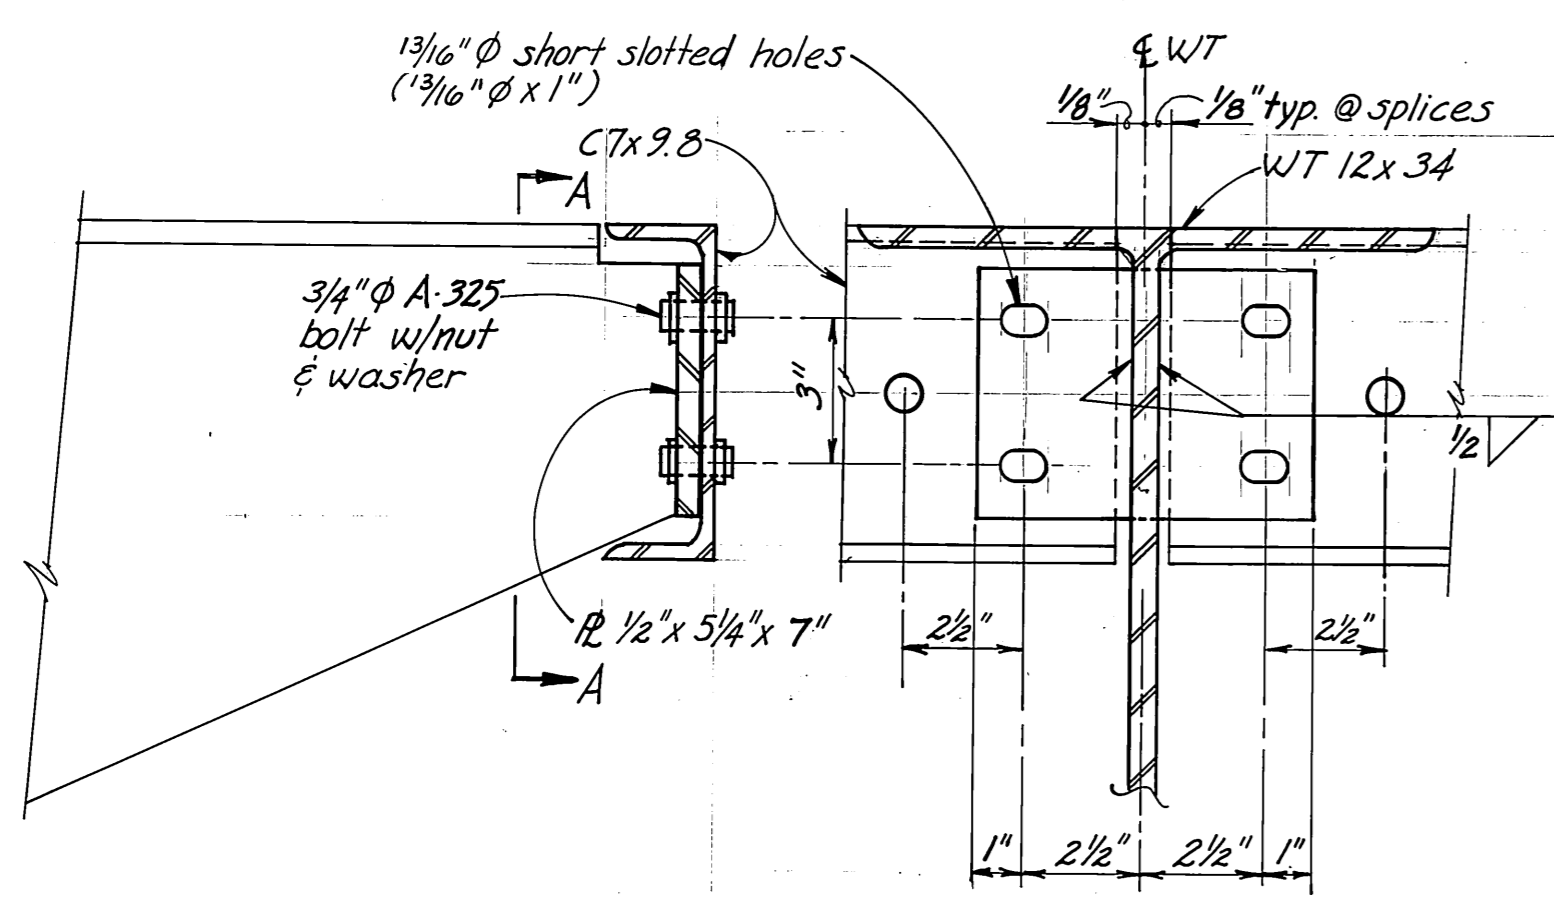


SECTION A-A

CHANNEL CONNECTION DETAILS

3" = 1'-0"

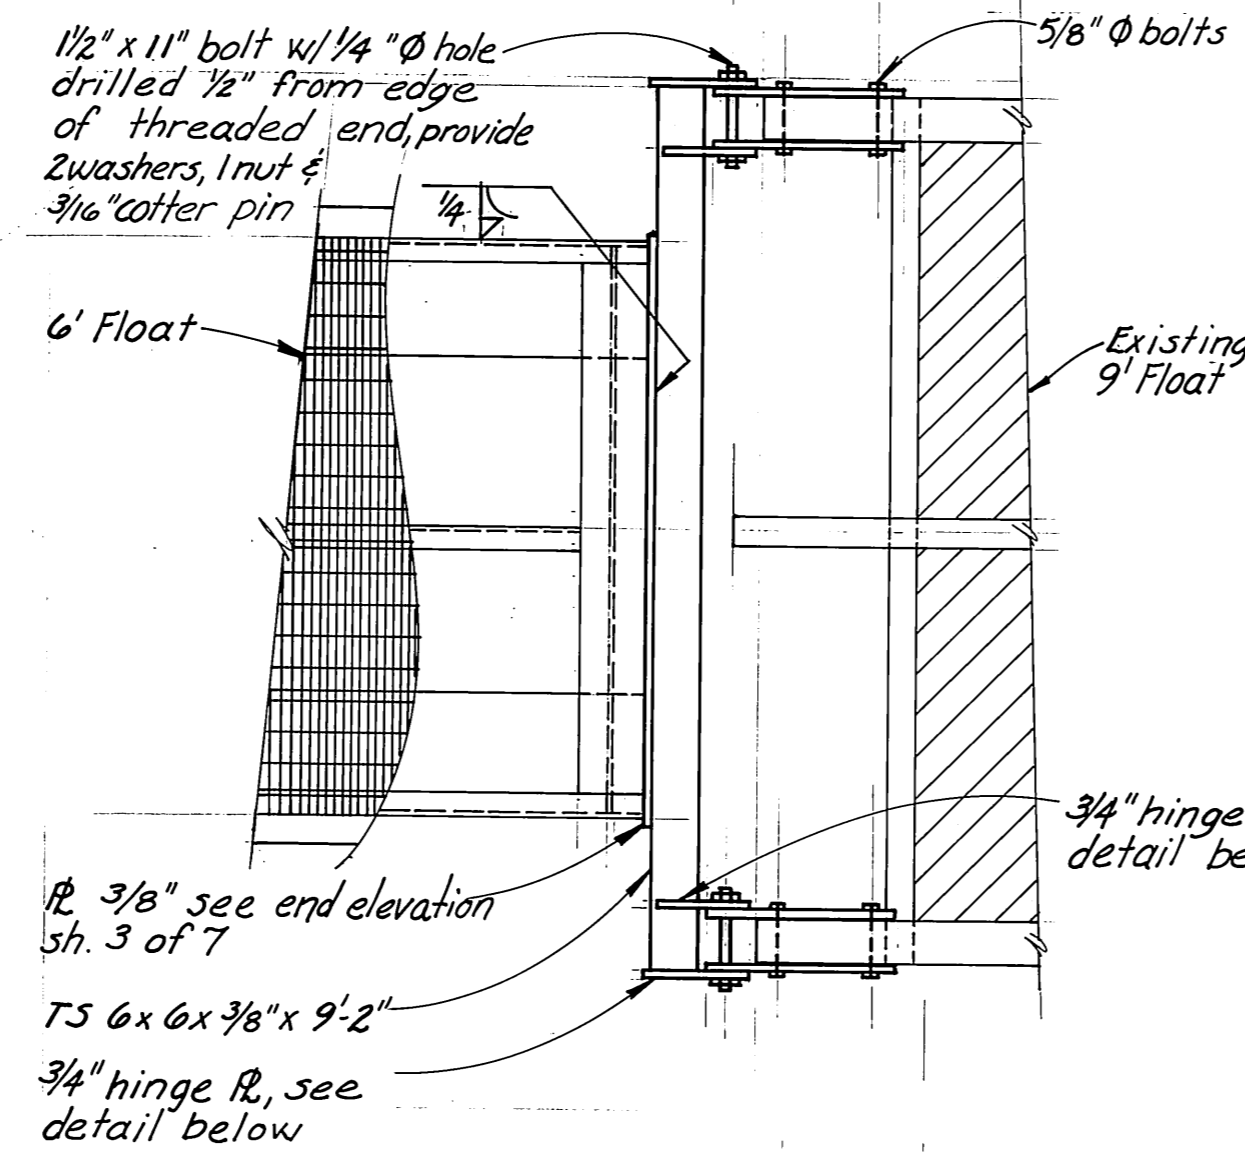


6' to 9' FLOAT CONNECTION

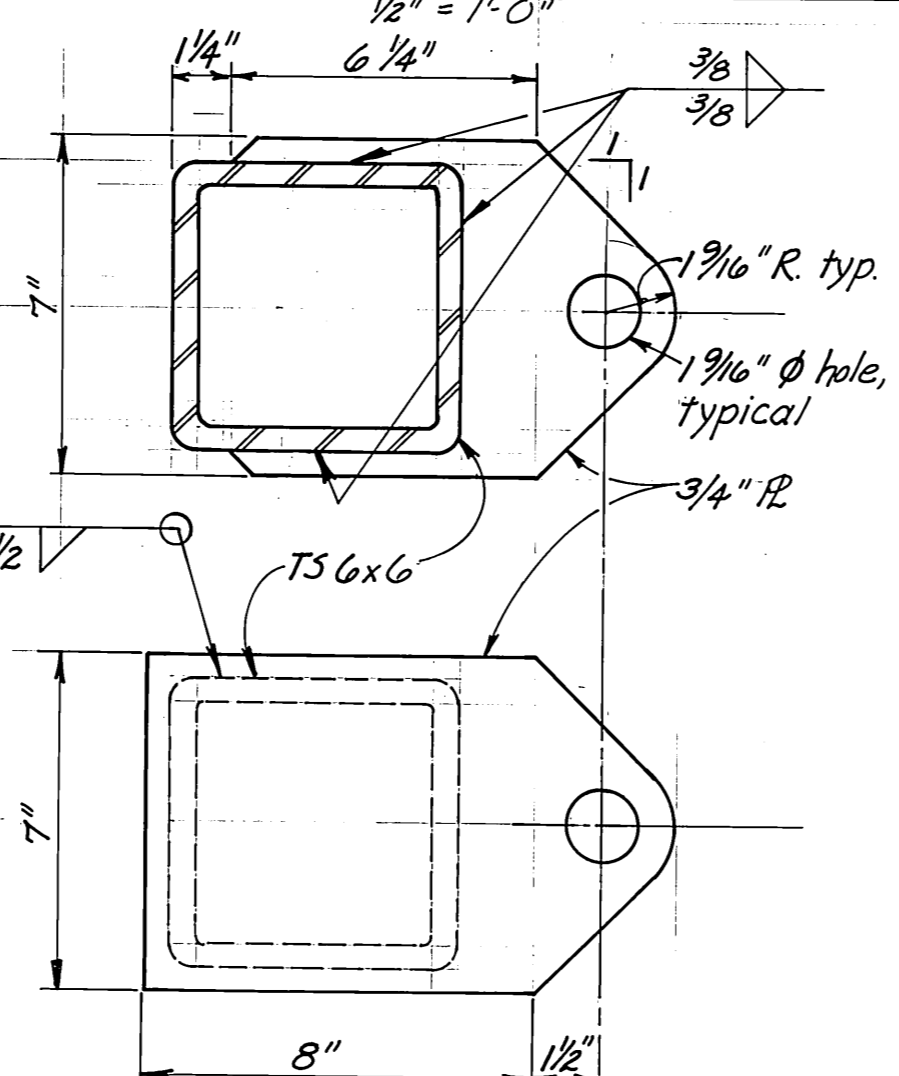


HINGE PLATE DETAILS

3" = 1'-0"

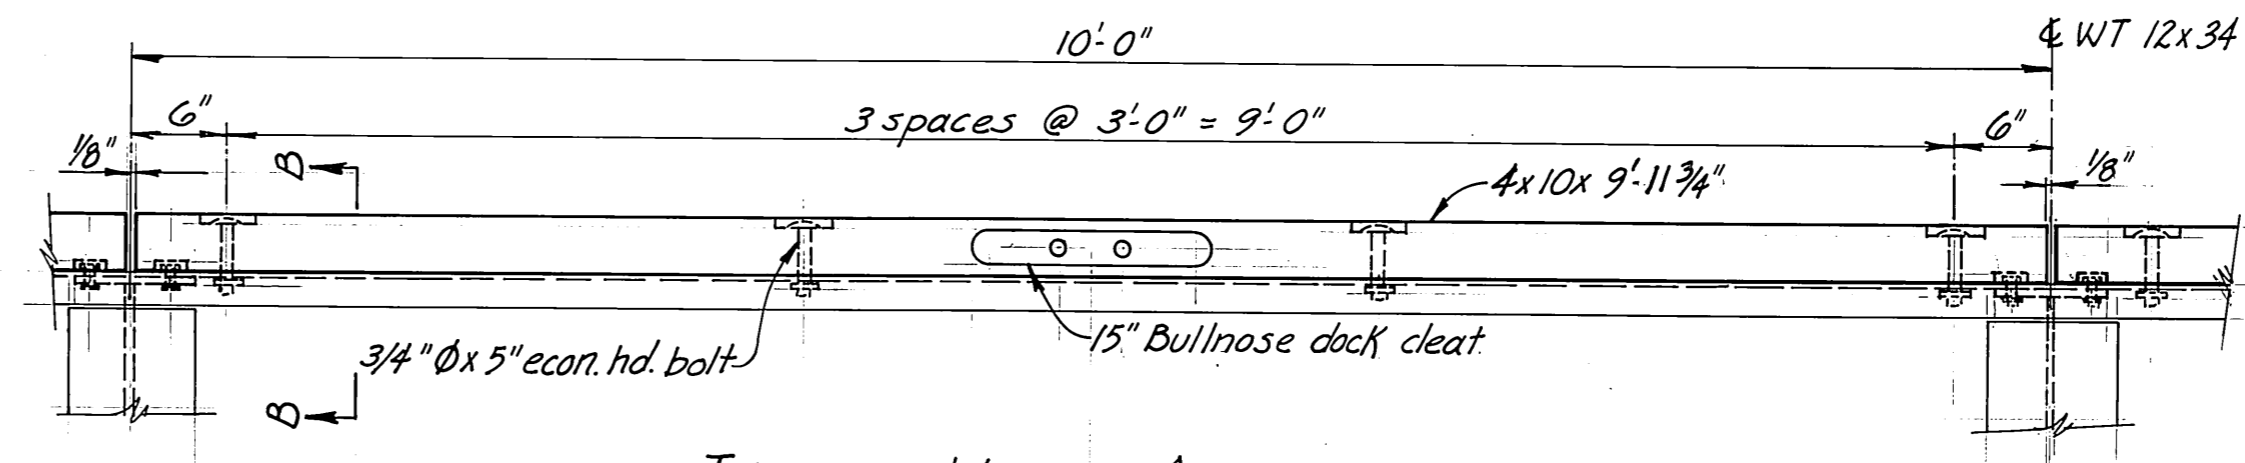

TYPICAL WALE ASSEMBLY


1" = 1'-0"

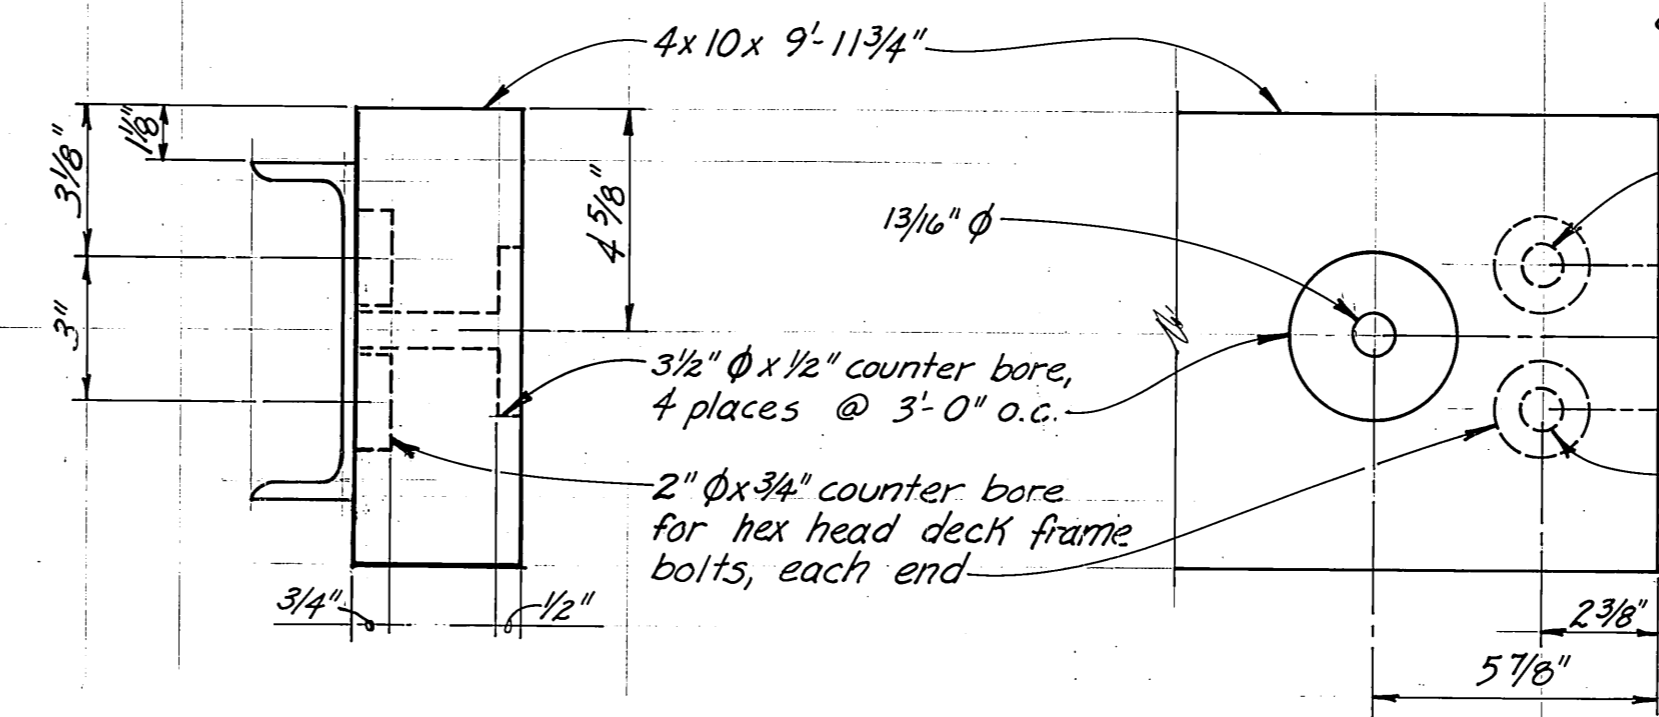

SECTION B-B


3" = 1'-0"

WALE DETAILS

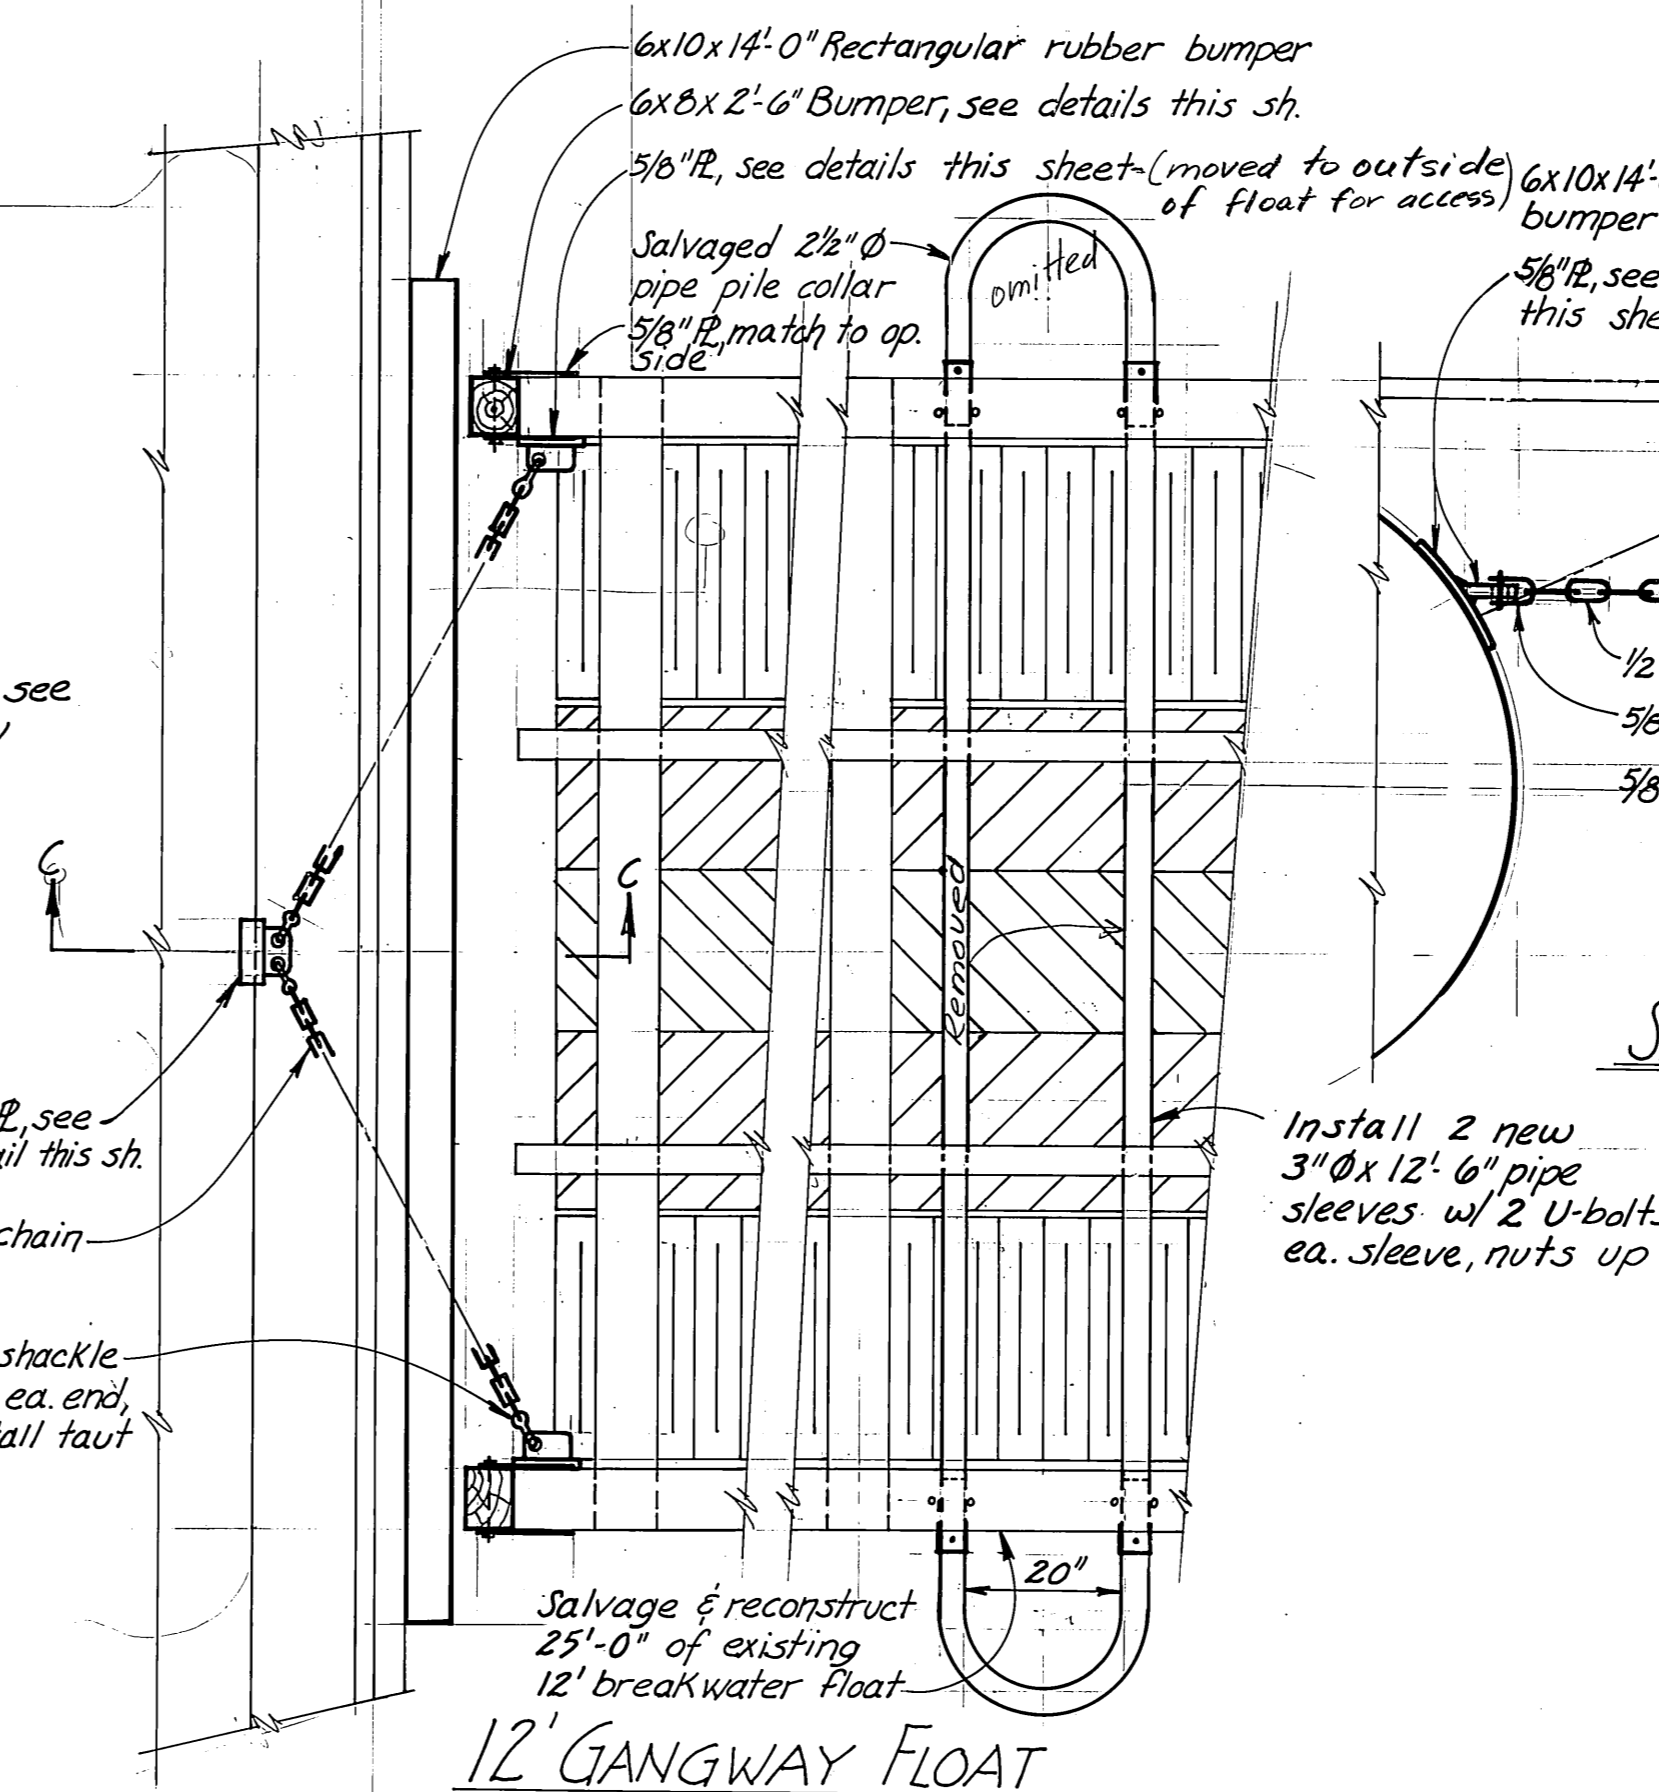


12' GANGWAY FLOAT CONNECTION

1/2" = 1'-0"

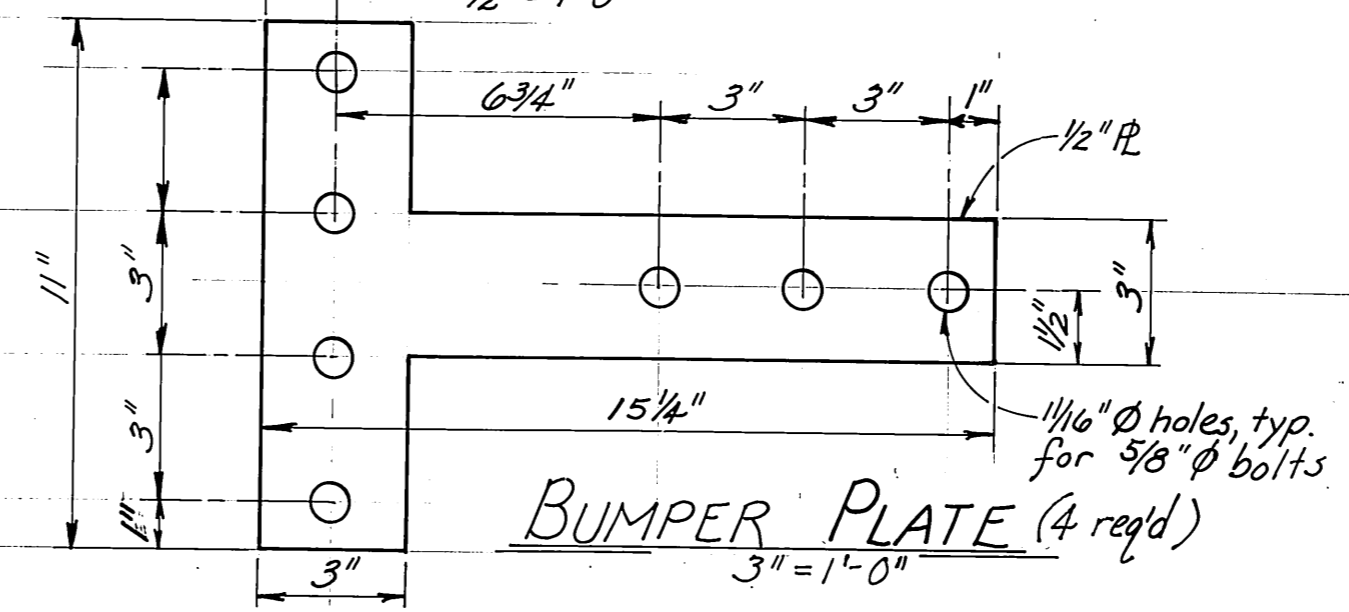


BUMPER PLATE (4 req'd)

3" = 1'-0"

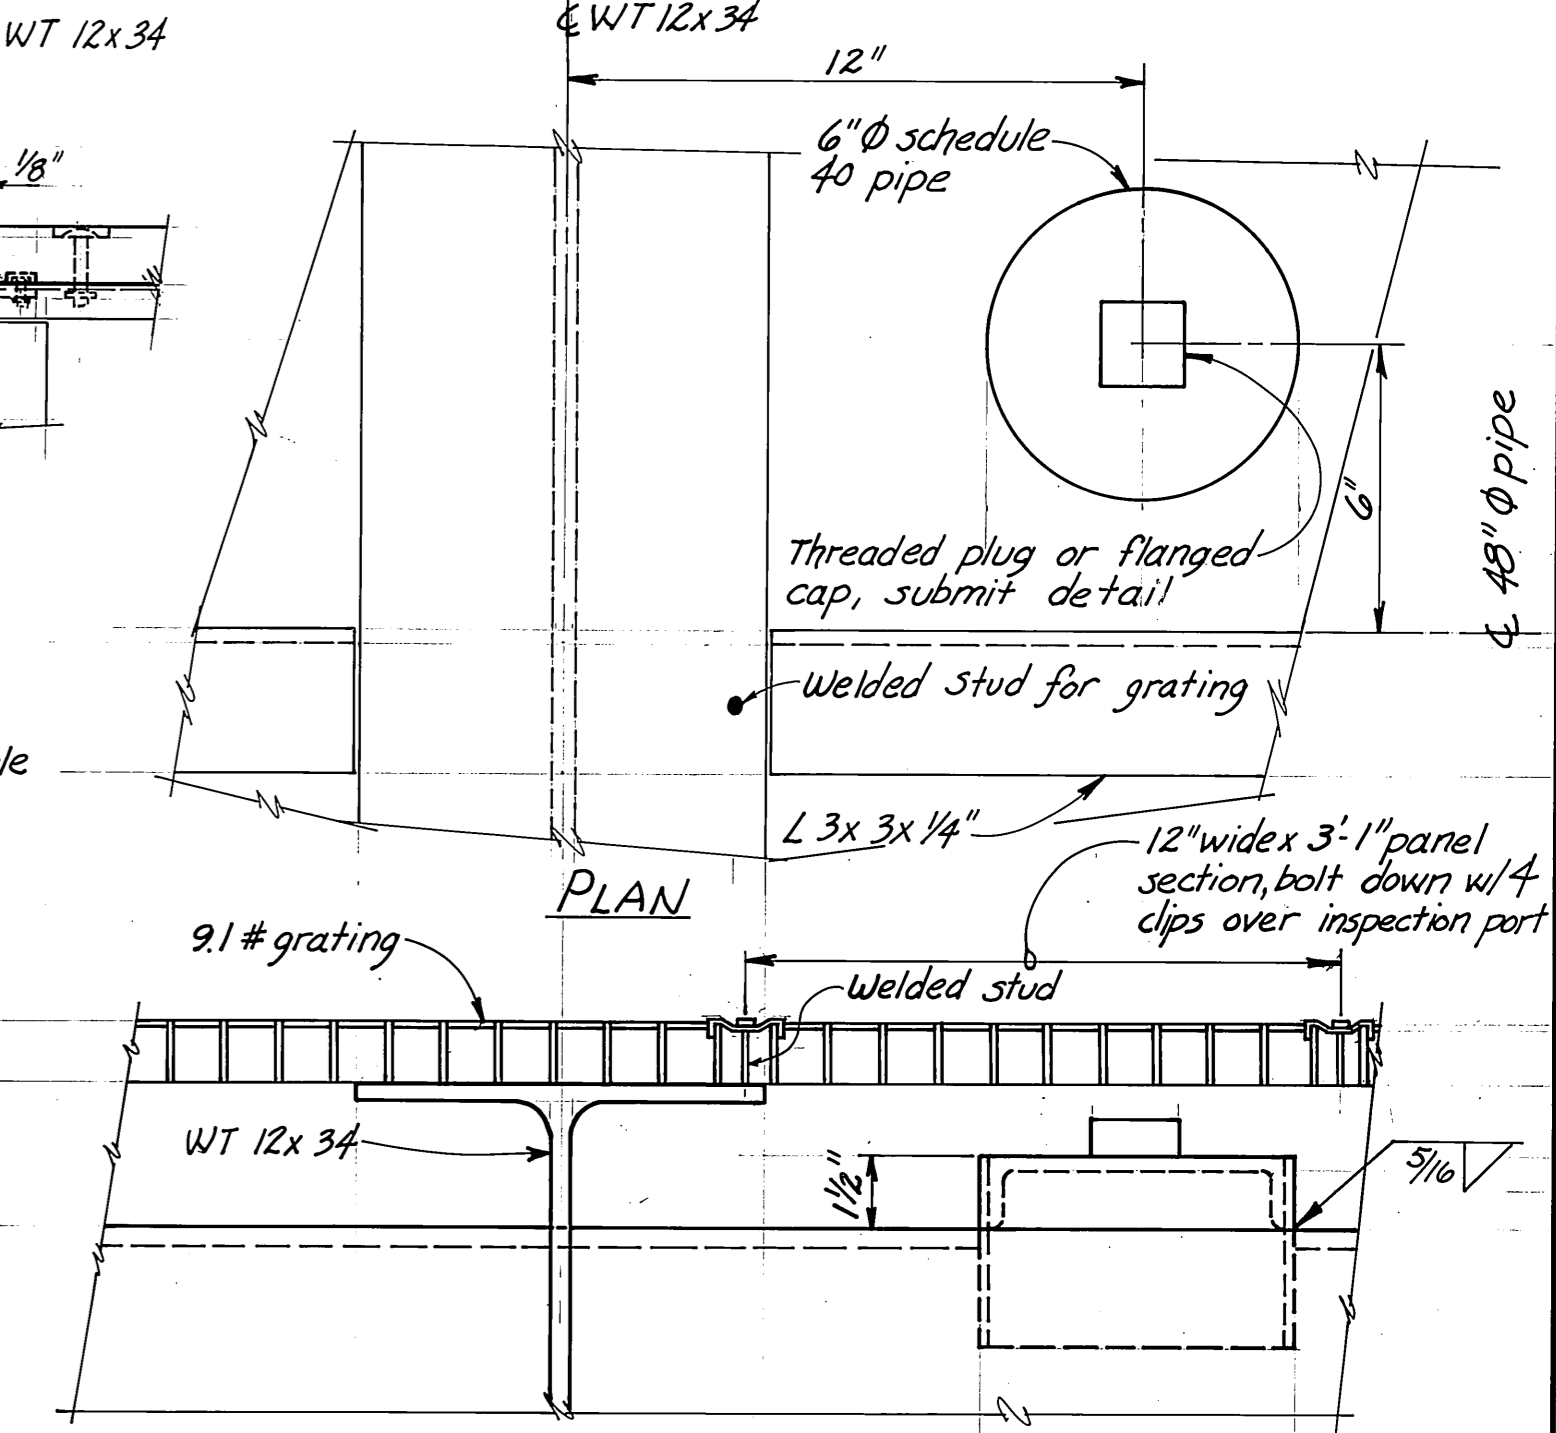

INSPECTION PORT DETAILS


3" = 1'-0"

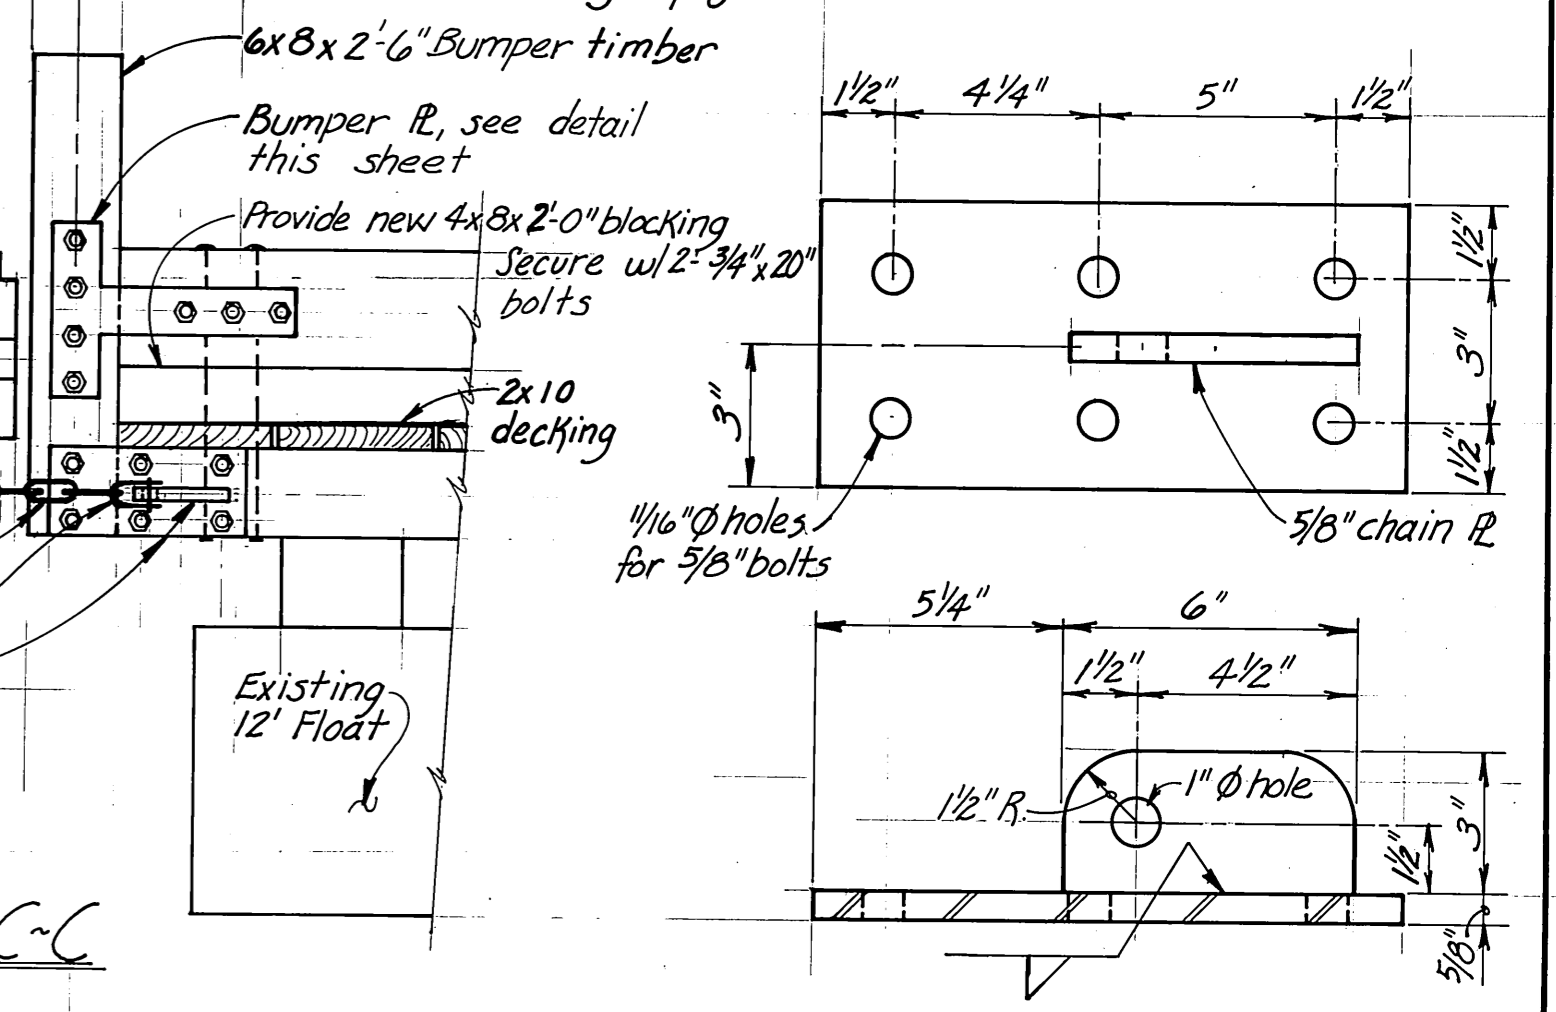


CHAIN CONNECTION R DETAILS

3" = 1'-0"


STAMP		DO NOT SCALE THIS DRAWING - USE DIMENSIONS	
		STATE OF ALASKA	
		DEPARTMENT OF TRANSPORTATION AND PUBLIC FACILITIES DIVISION OF HARBOR DESIGN AND CONSTRUCTION	
LETNIKOF COVE		ALASKA	
<b>FLOAT CONNECTIONS &amp; MISCELLANEOUS DETAILS</b>			
SCALE AS NOTED	SURVEYED HM	APPROVED	
DESIGNED RB	DRAWN JJJ	DATE Sept. 1979	
CHECKED RB	DATE		
PROJECT NUMBER K39189		SHEET 5	OF 7

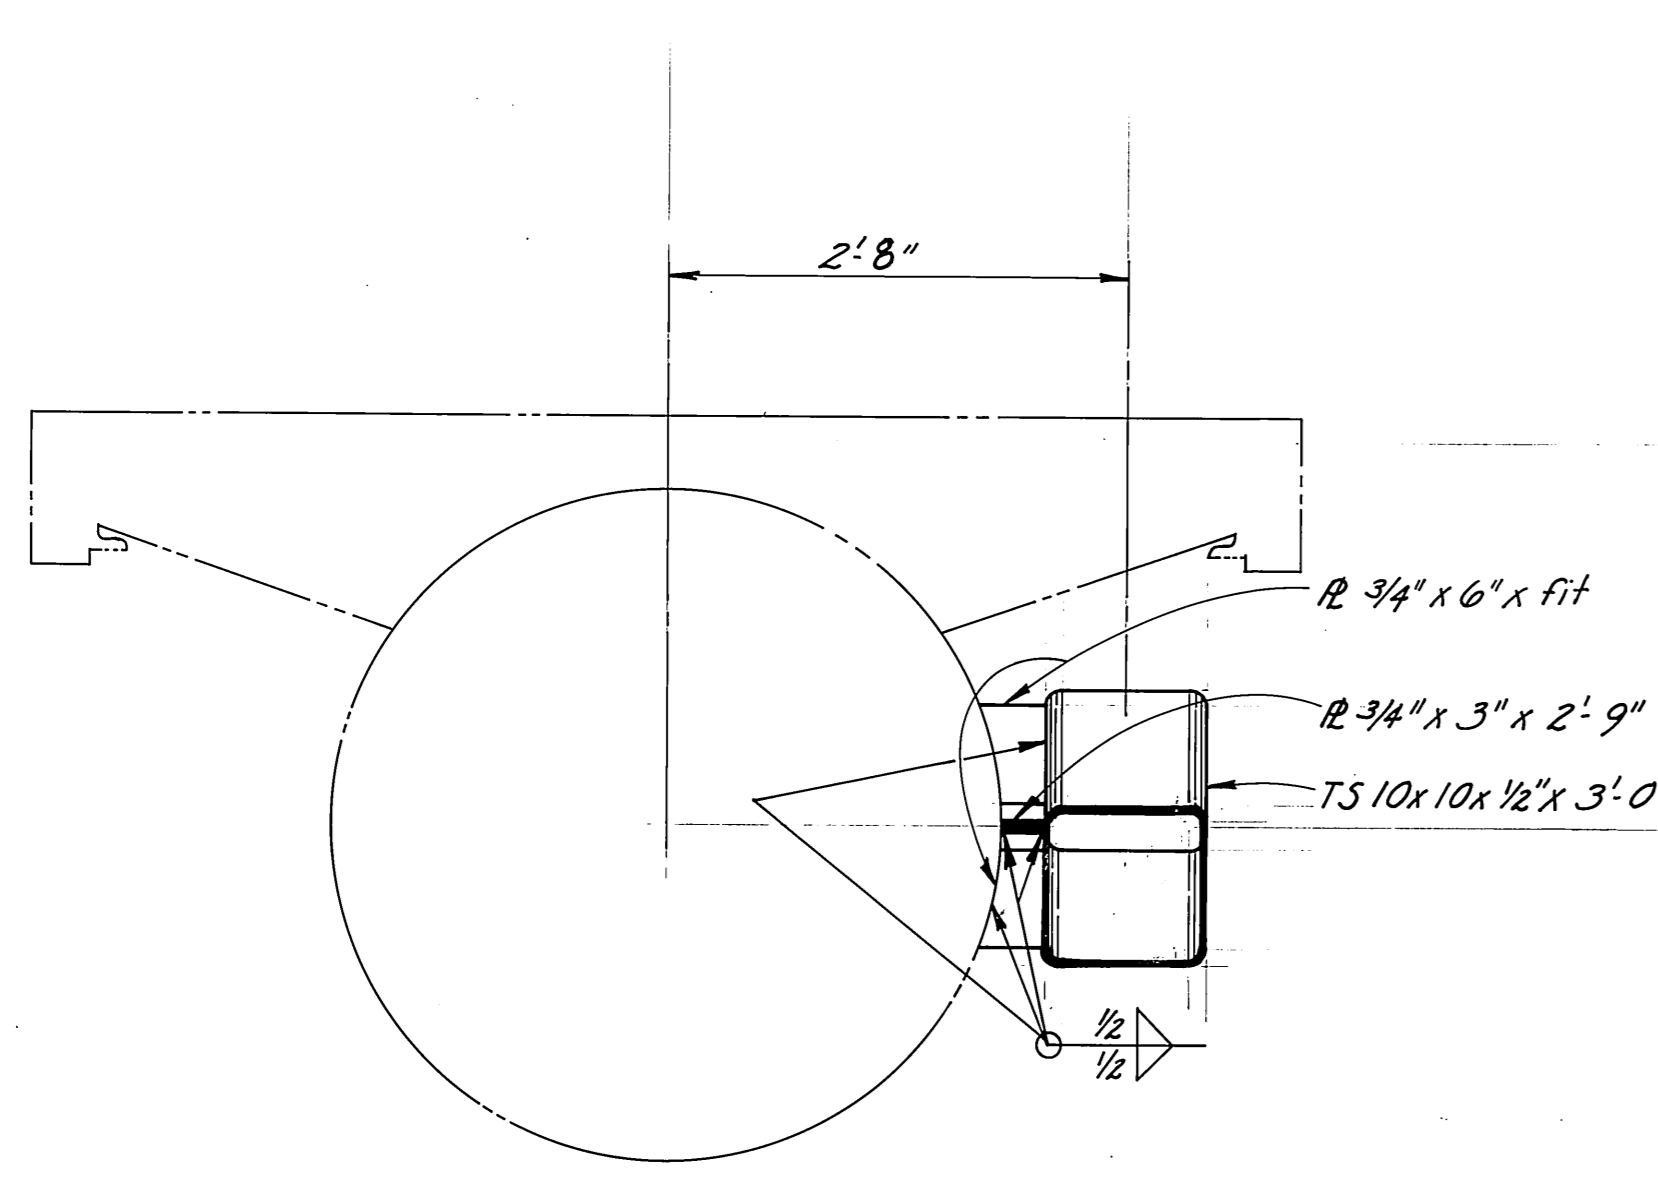

SECTION - ANCHORS 1, 2, 4 & 5

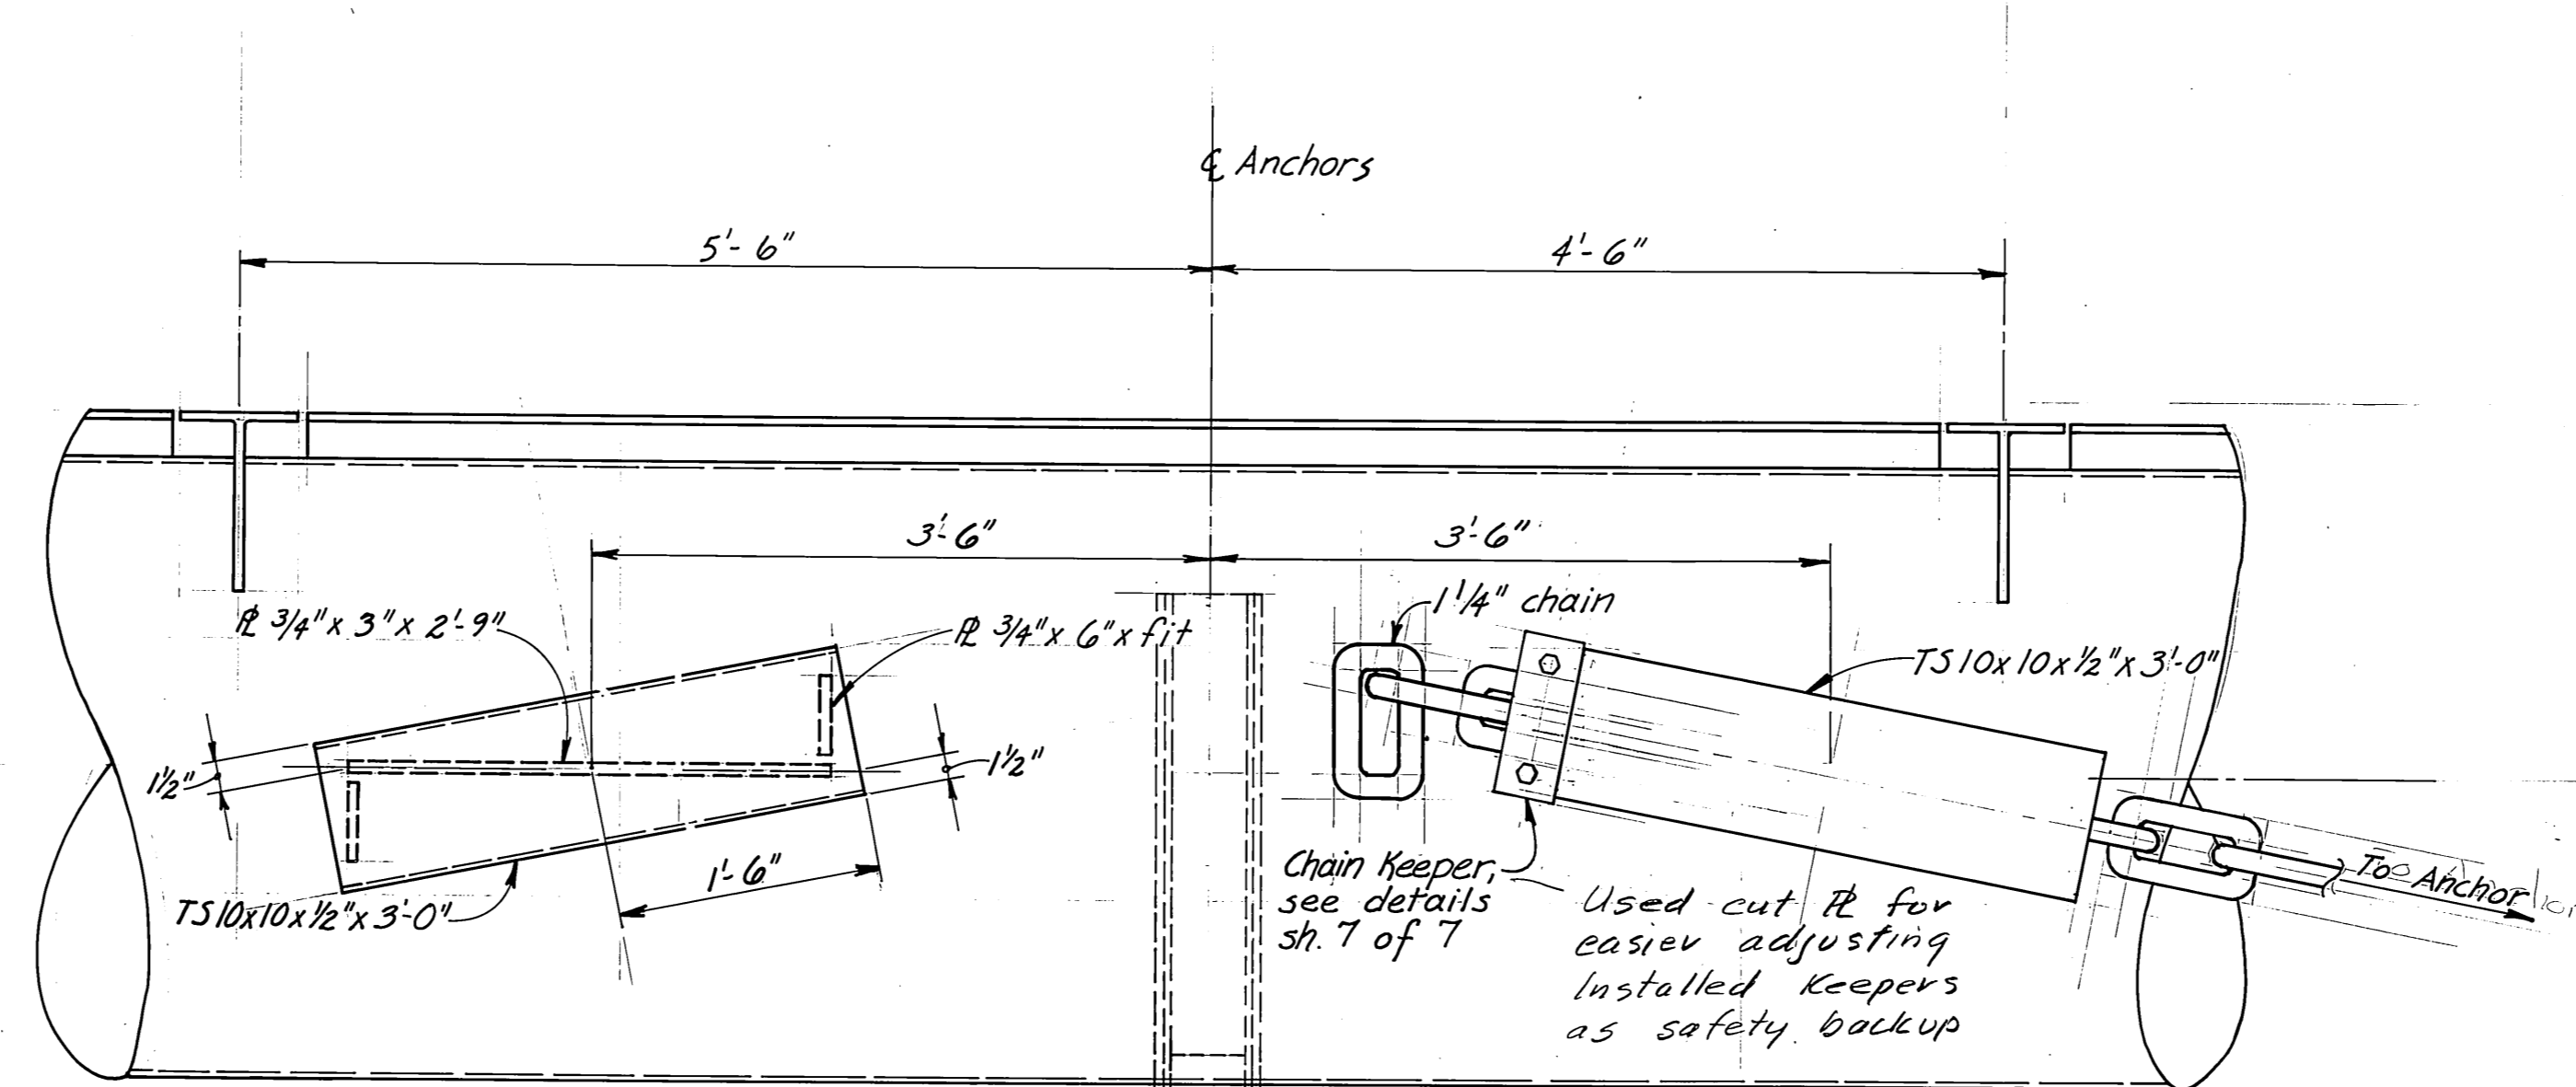


ELEVATION - ANCHORS 1, 2, 4 & 5

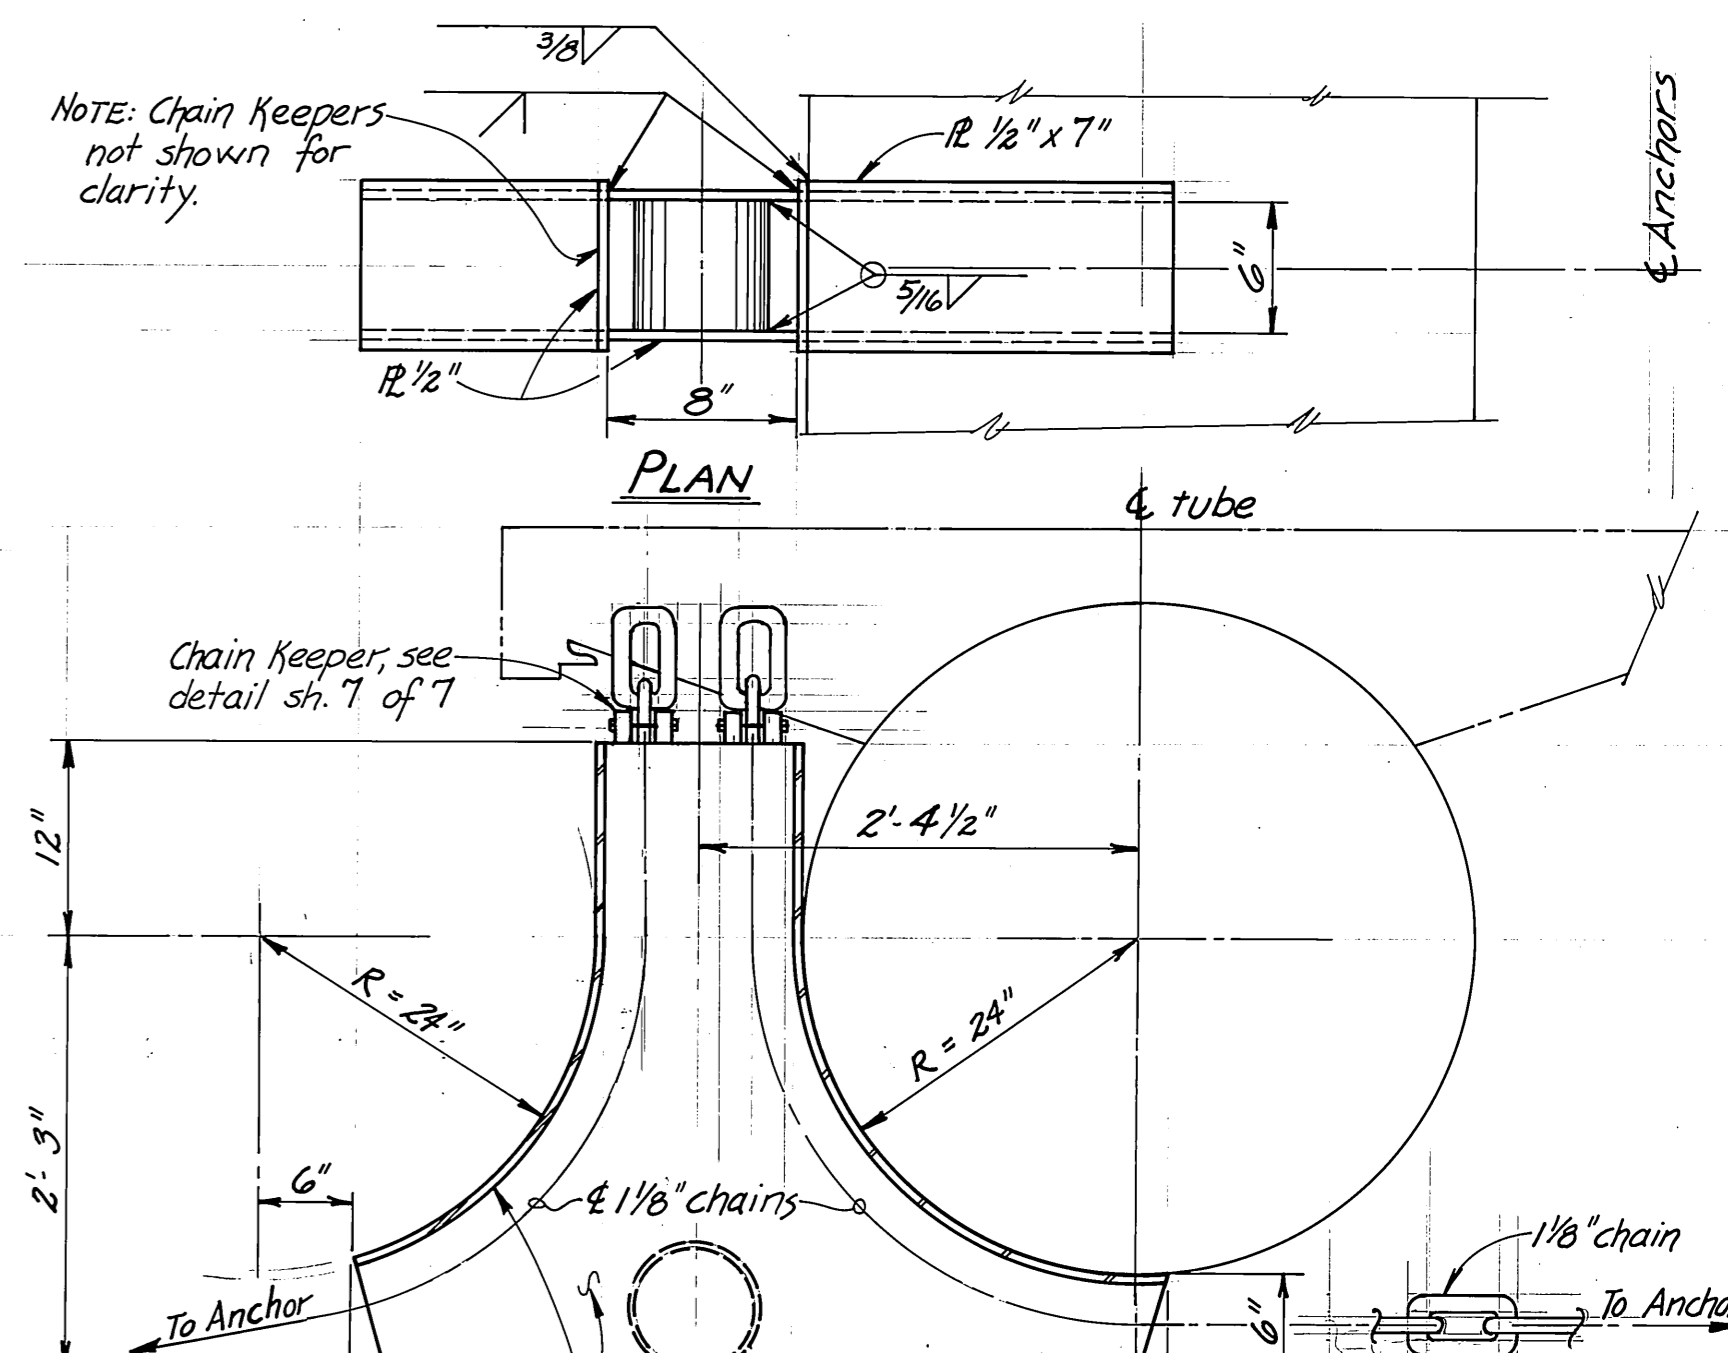


SECTION - ANCHORS 3 & 6


HAWSER PIPE DETAILS  
1" = 1'-0"

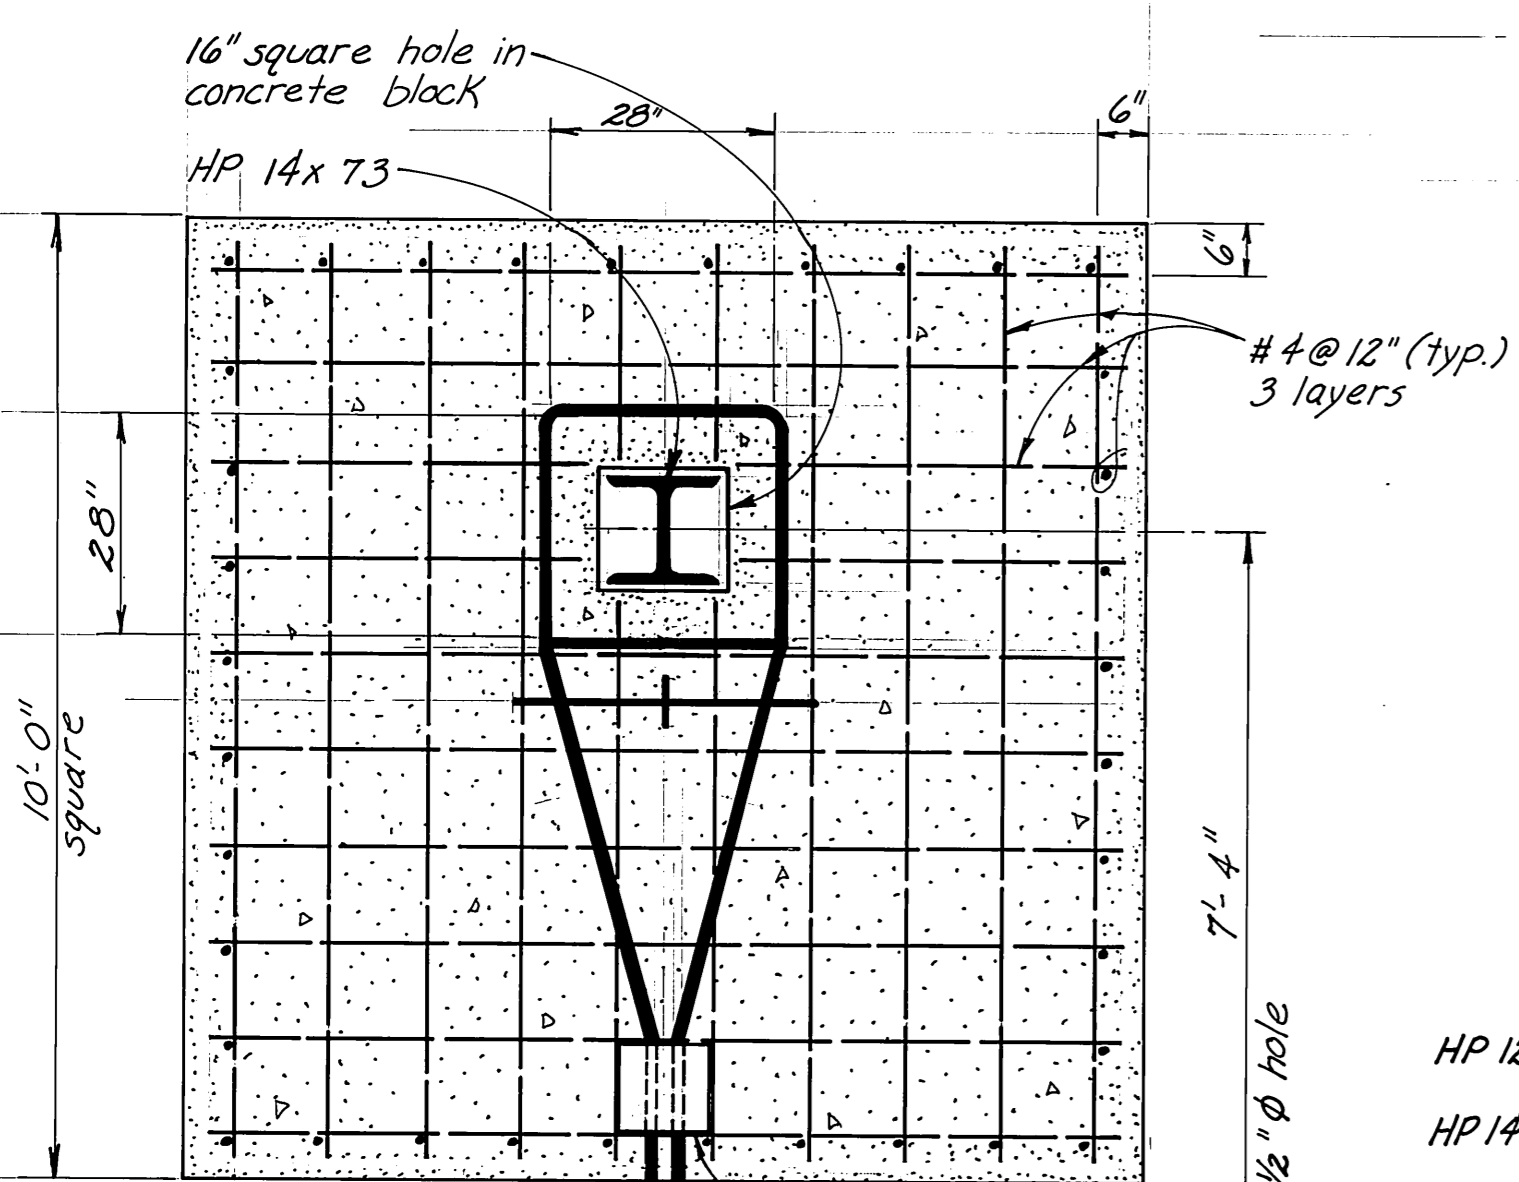


PLAN

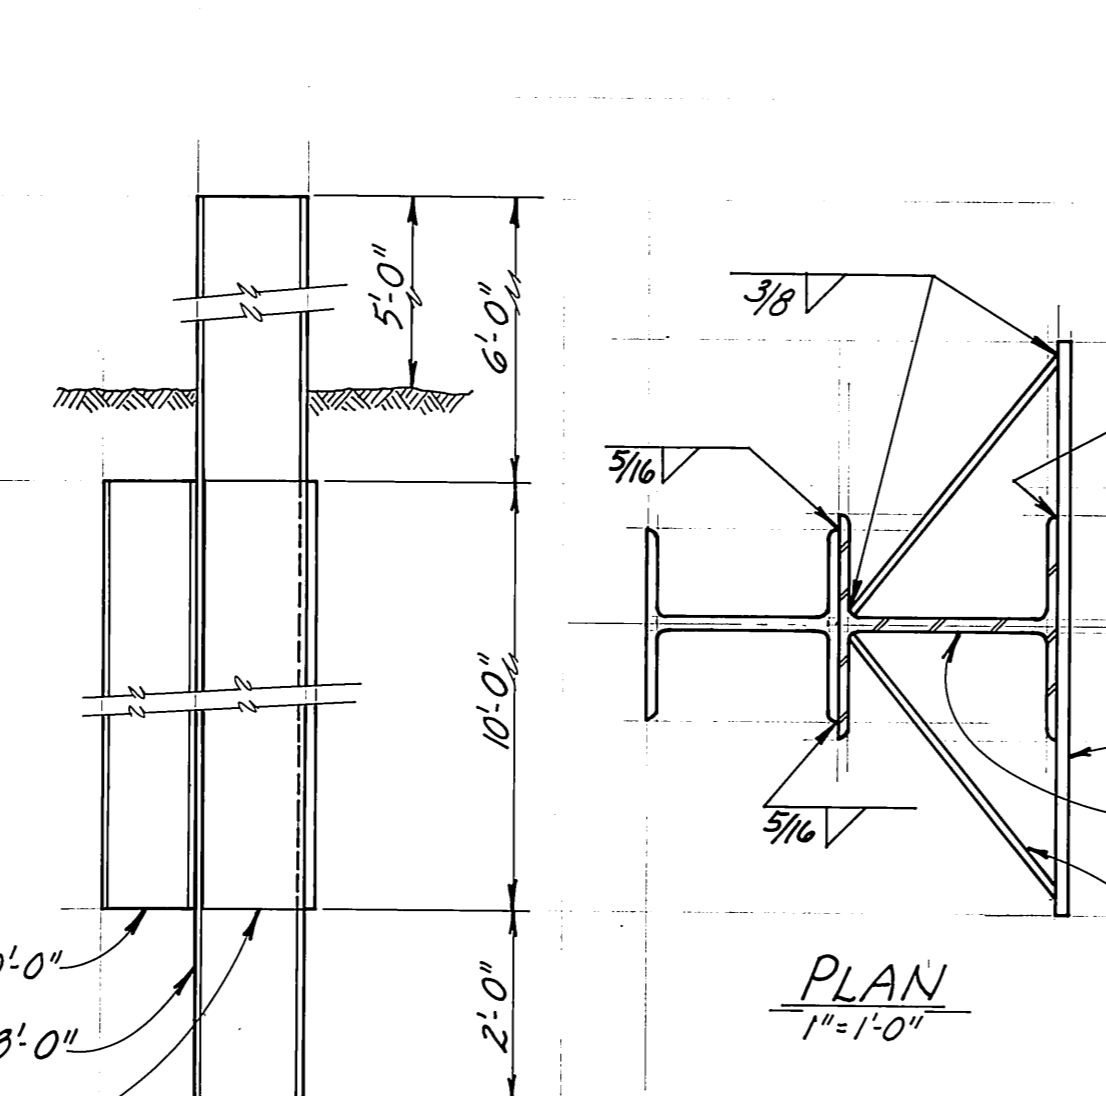


ELEVATION (@ Anchors 1 & 2)

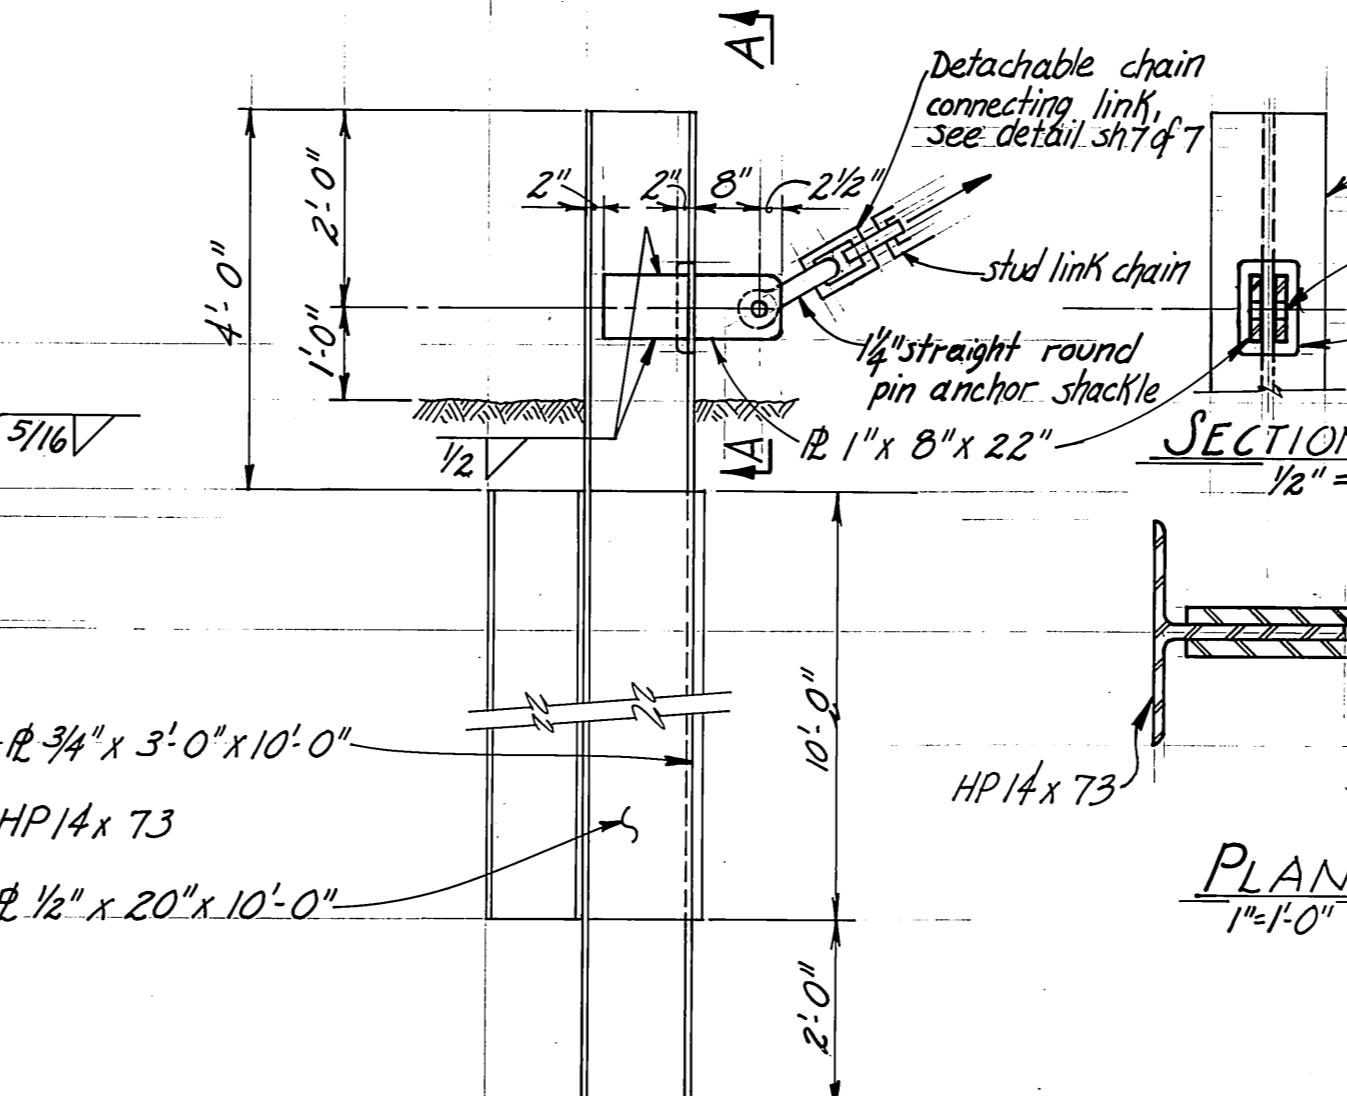

ELEVATION (@ Anchors 3, 4 & 5)

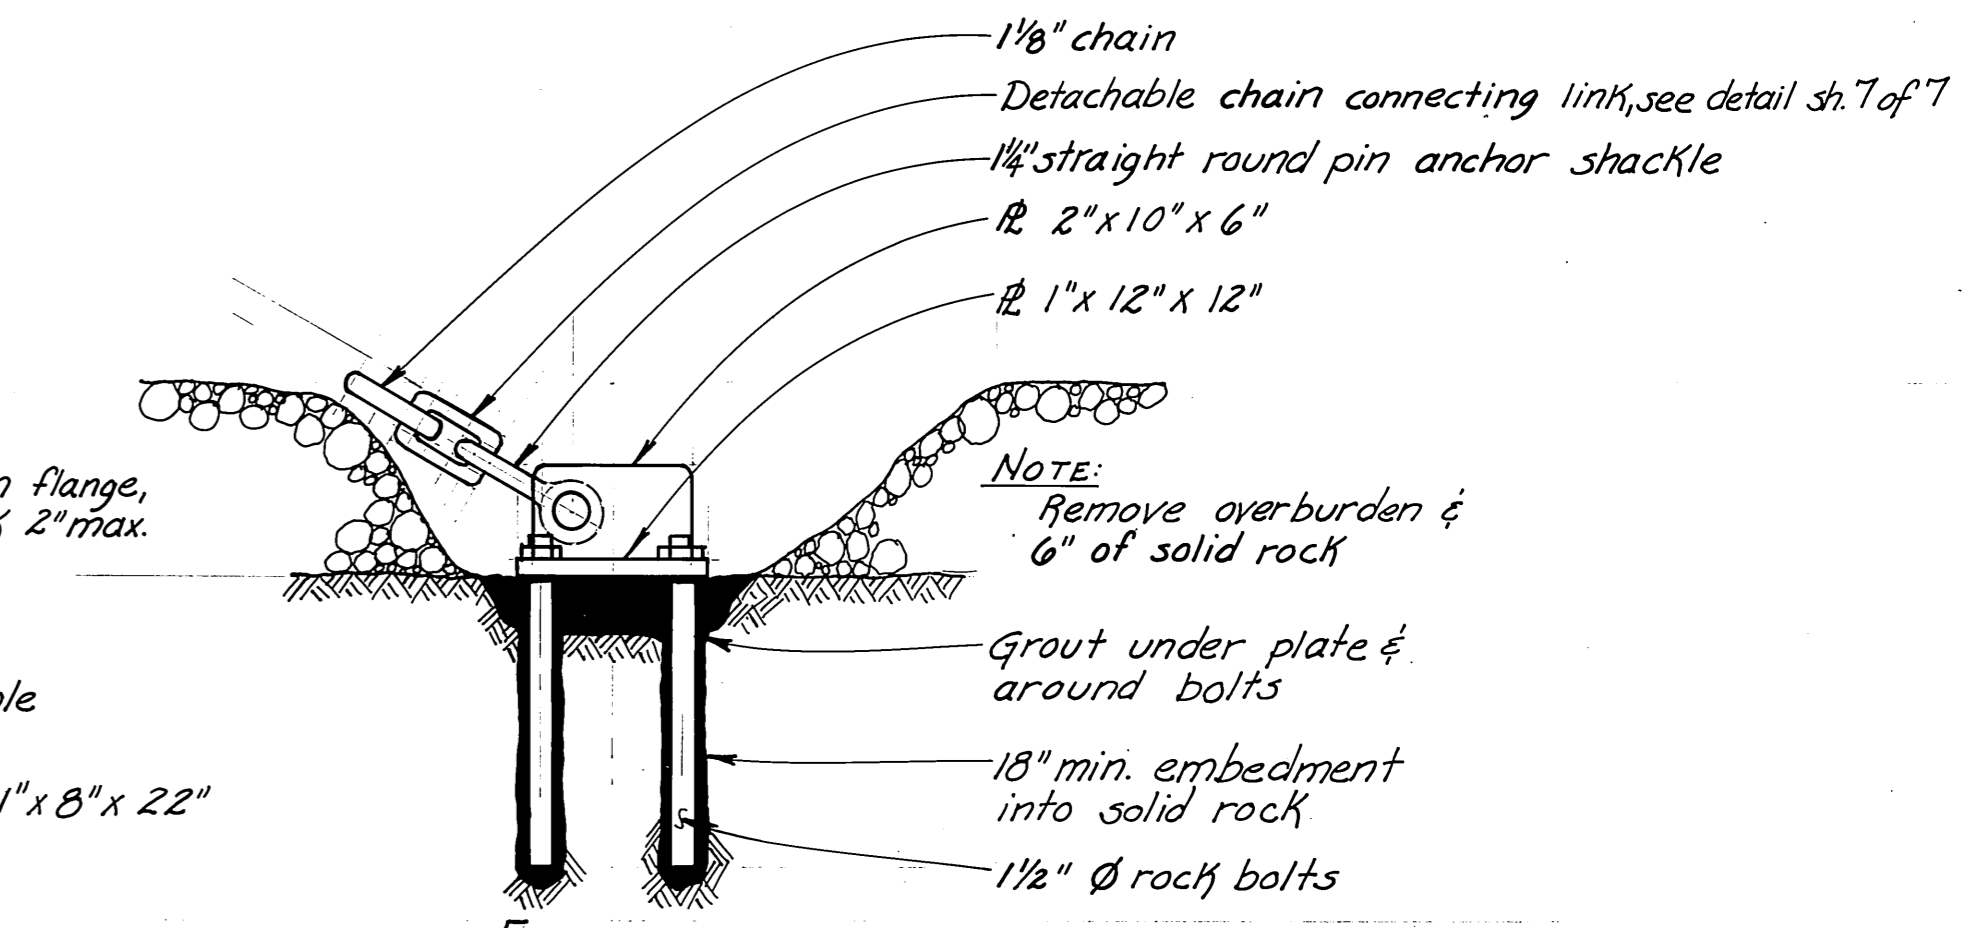

ELEVATION

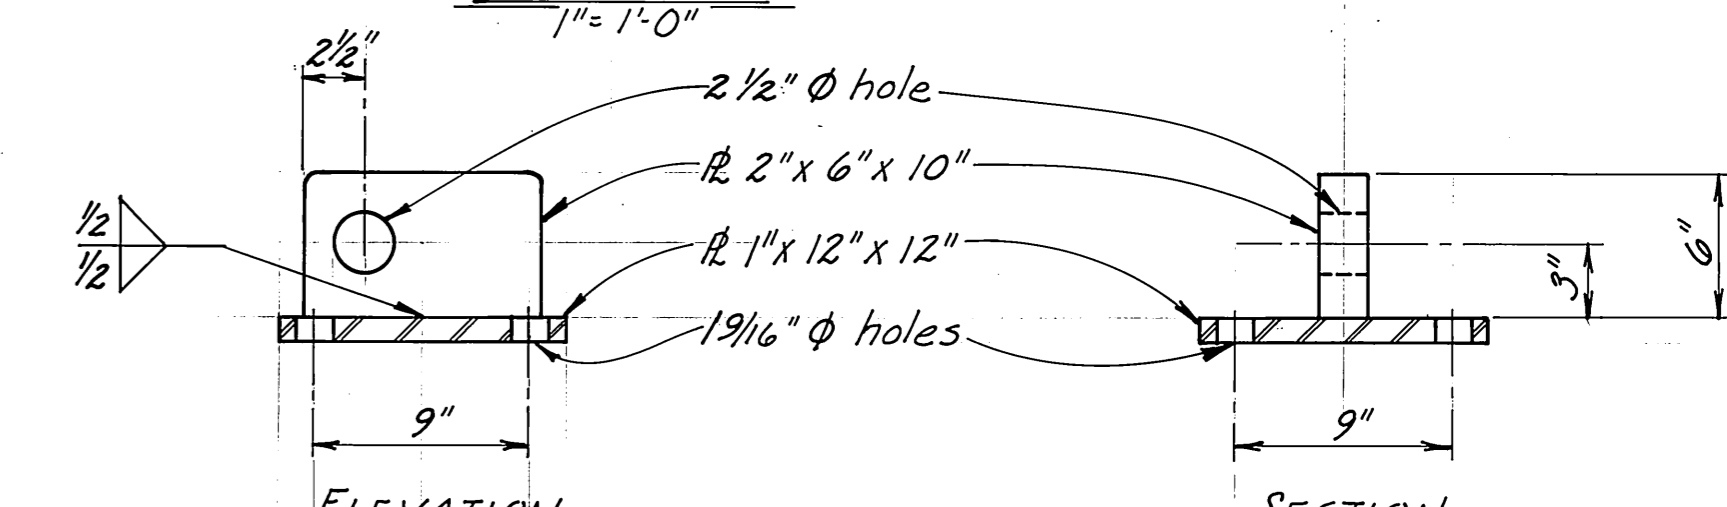


SECTION


ROCK ANCHOR DETAILS  
(@ Anchor 6)

NOTE: Galvanize all steel

STAKE PILE DETAILS  
1" = 1'-0"

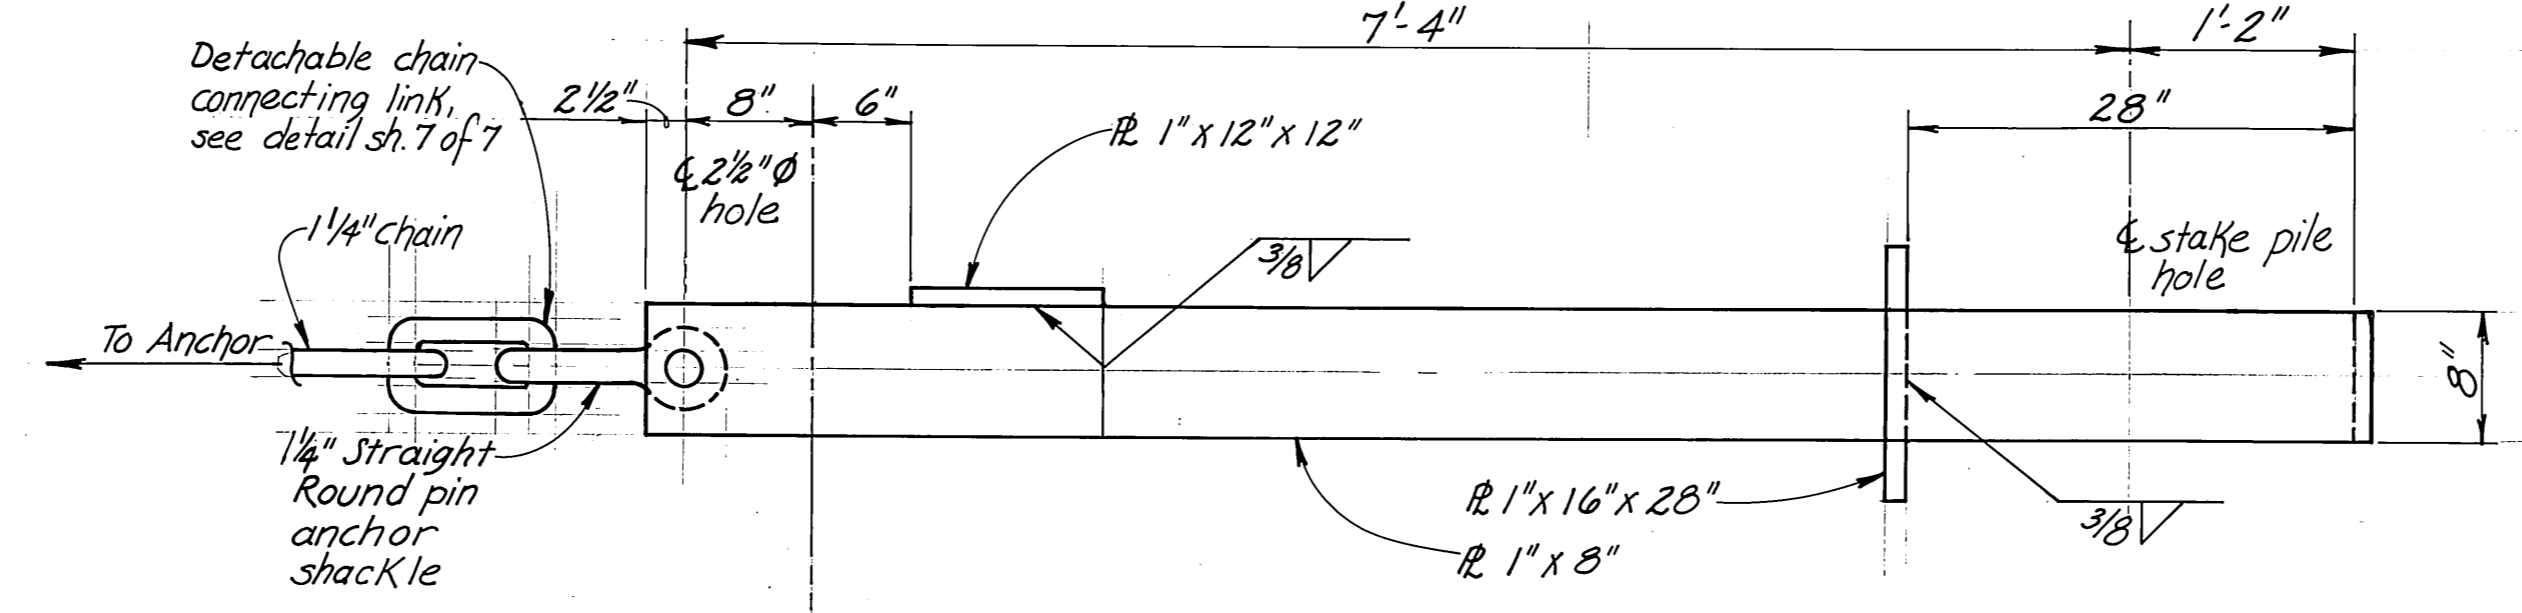


ANCHOR LUG DETAIL  
1" = 1'-0"

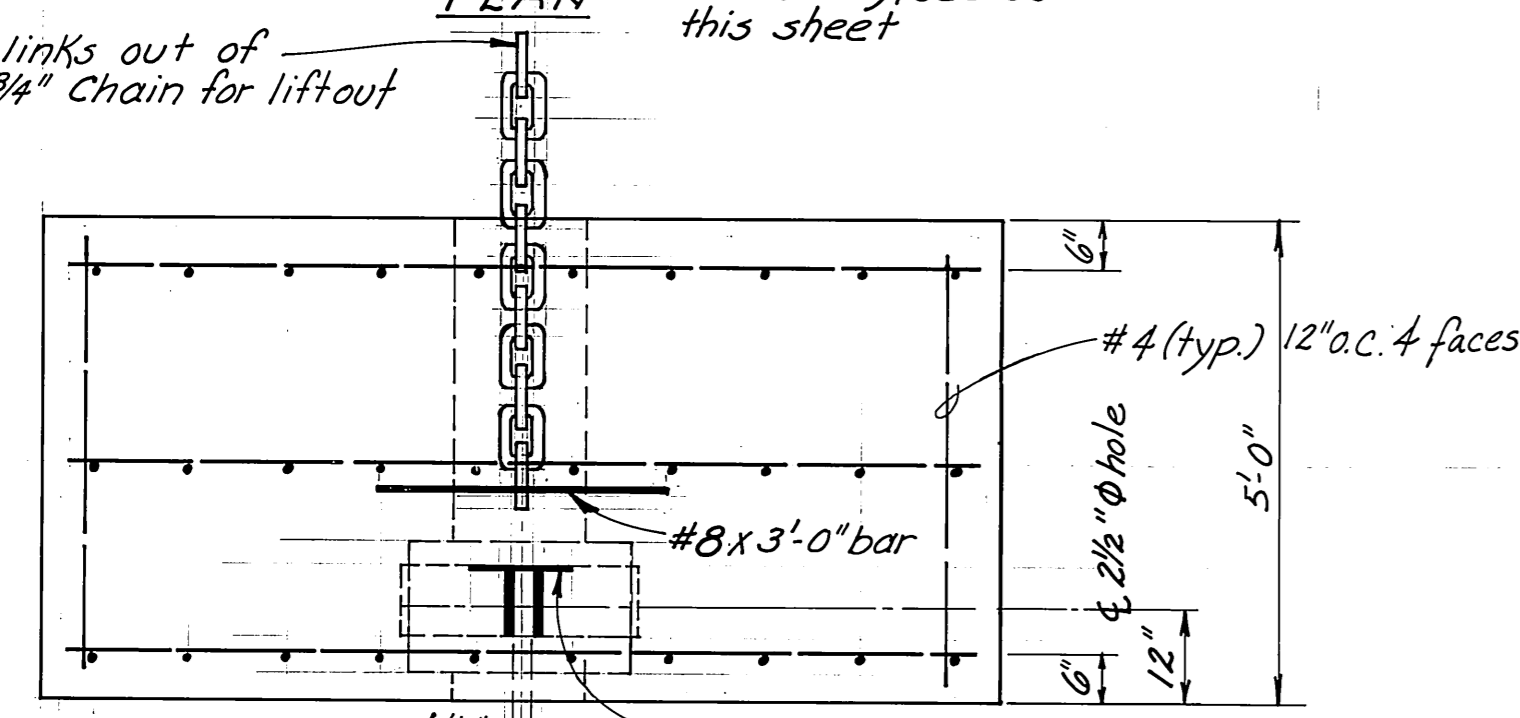







ELEVATION

CONCRETE ANCHOR BLOCK (@ Anchors 1 & 2)

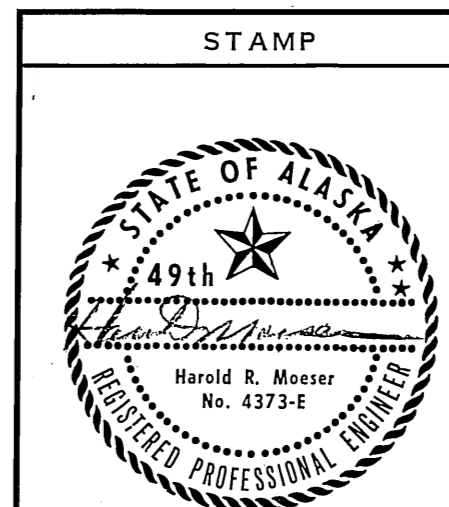

DO NOT SCALE THIS DRAWING - USE DIMENSIONS		
STATE OF ALASKA DEPARTMENT OF TRANSPORTATION AND PUBLIC FACILITIES DIVISION OF HARBOR DESIGN AND CONSTRUCTION		
LETNIKOF COVE		ALASKA
<b>ANCHOR DETAILS</b>		
SCALE AS NOTED	SURVEYED SJS	APPROVED
DESIGNED HM	DRAWN SJS	<i>John P. Seal</i> Chief of Design
CHECKED RB	DATE Sept. 1979	
PROJECT NUMBER K39189	SHEET 6 OF 7	




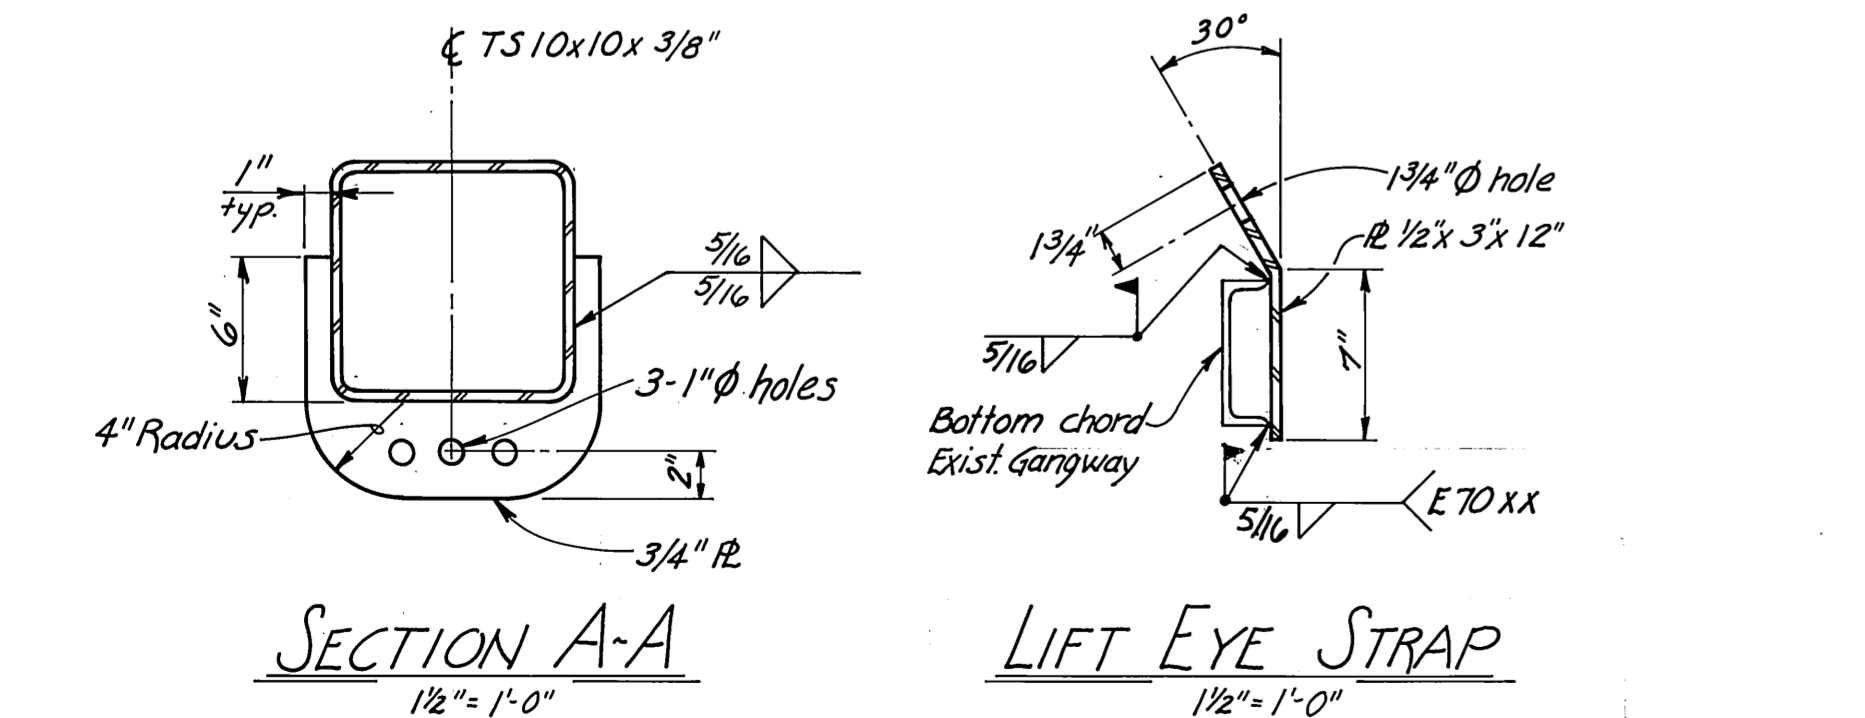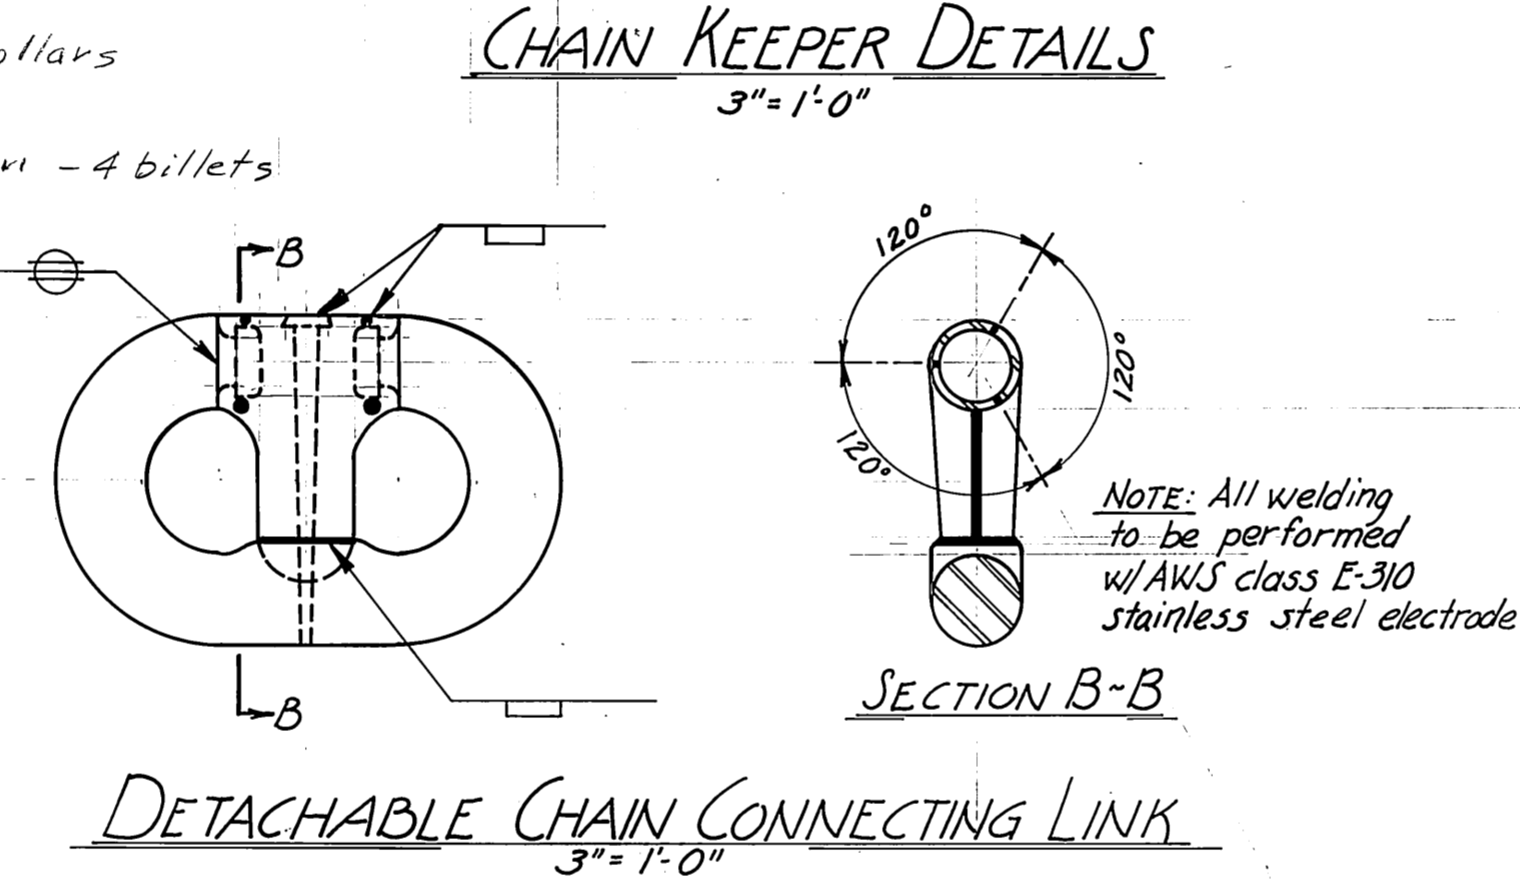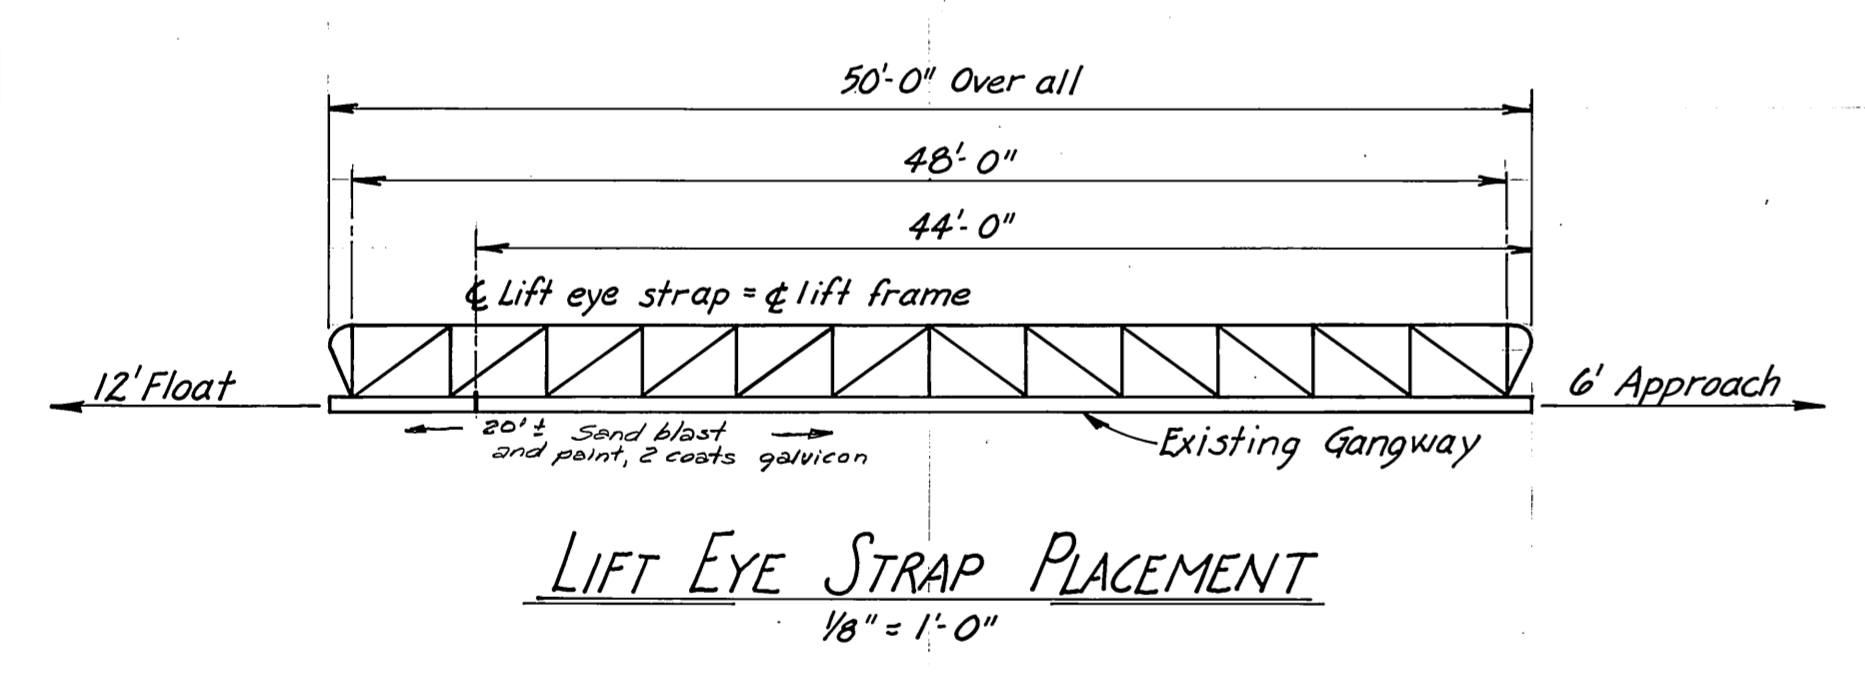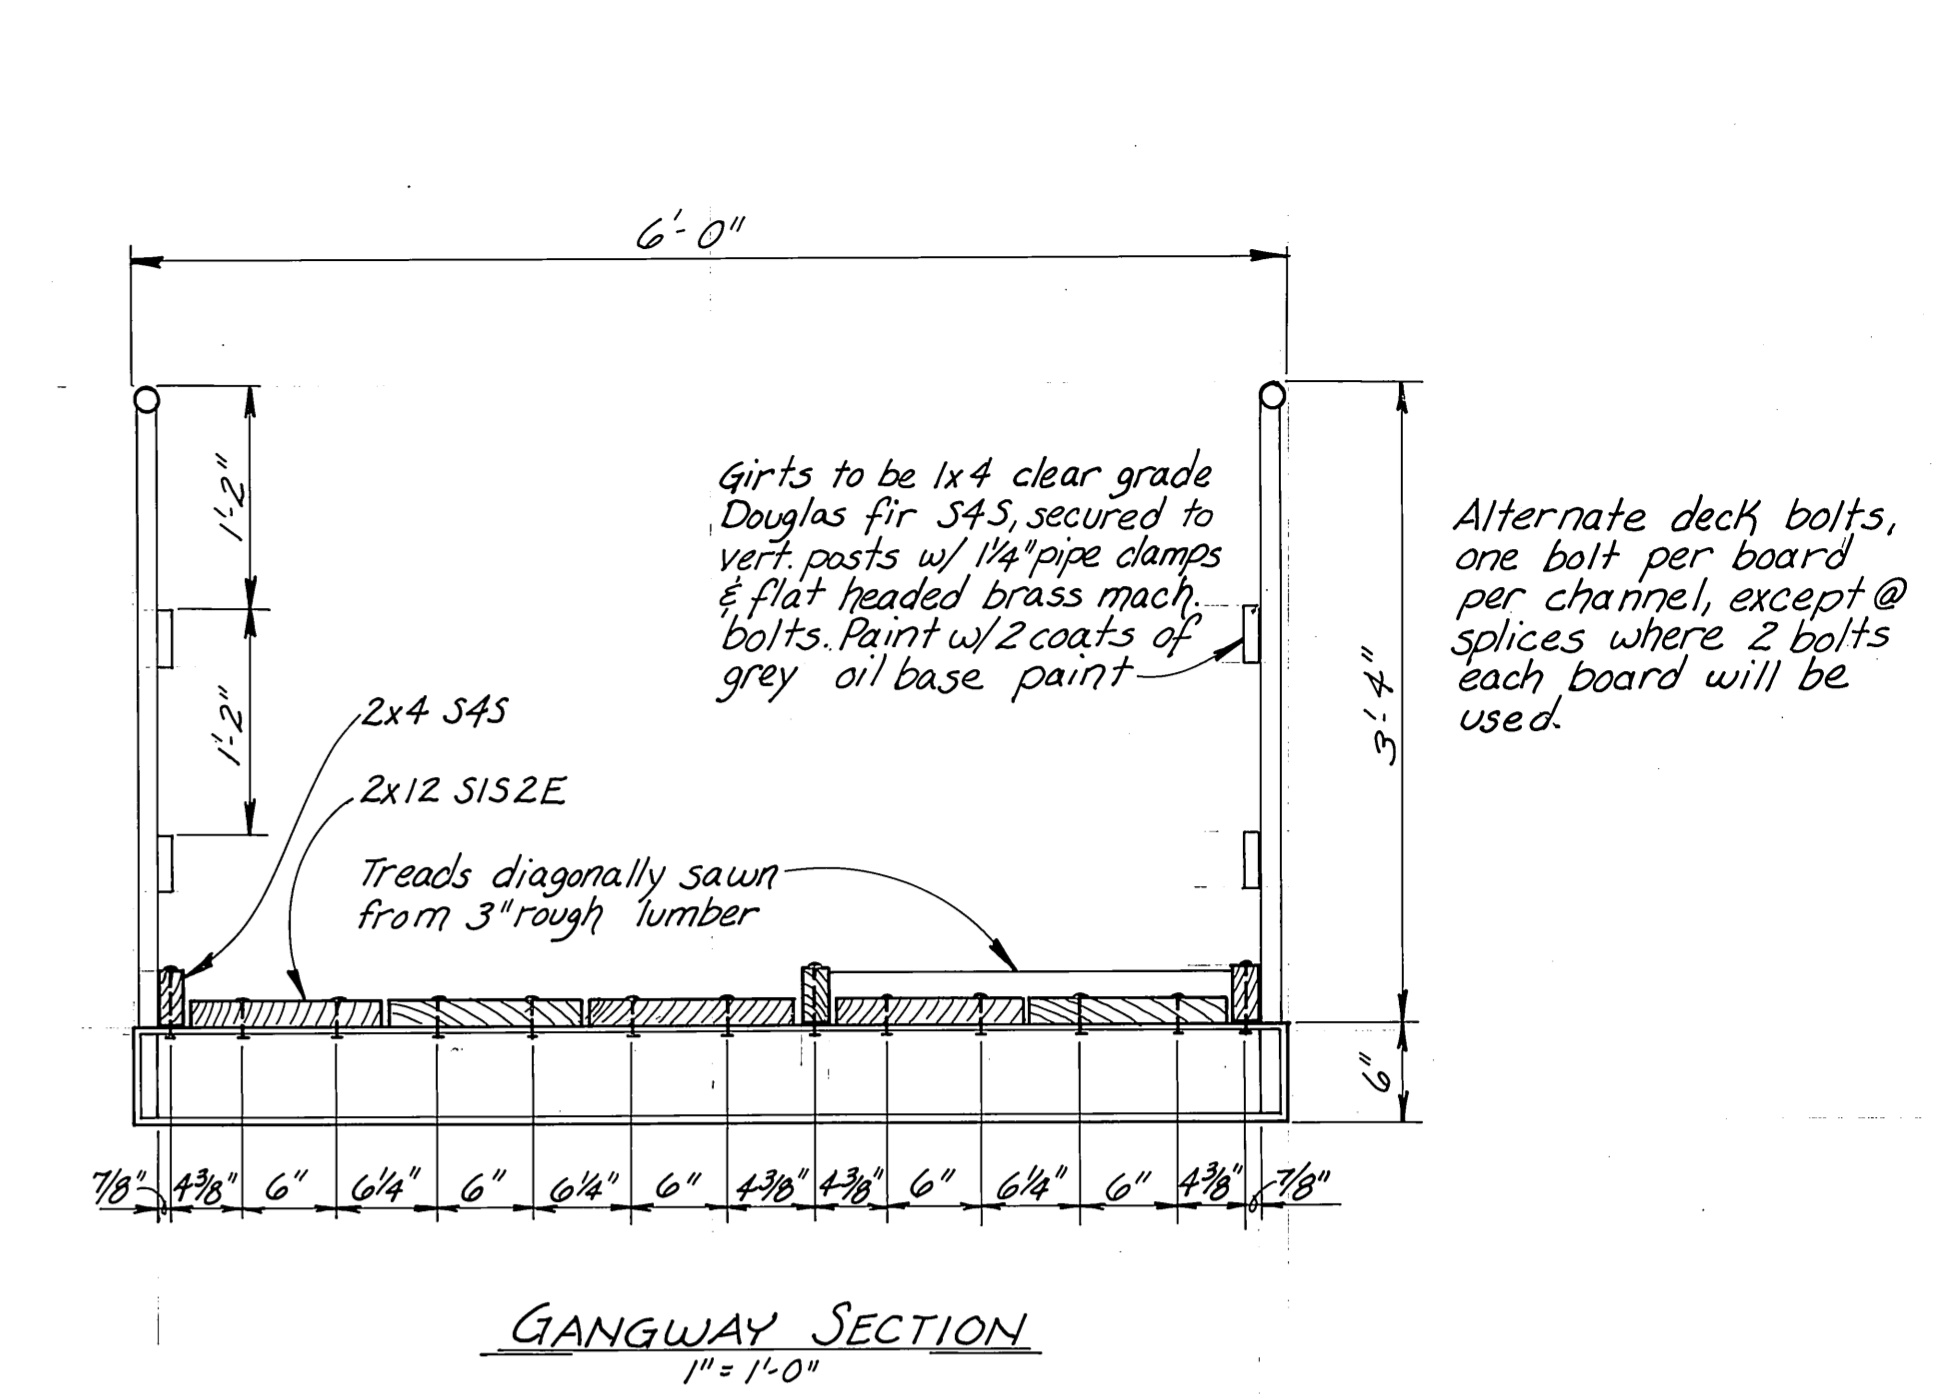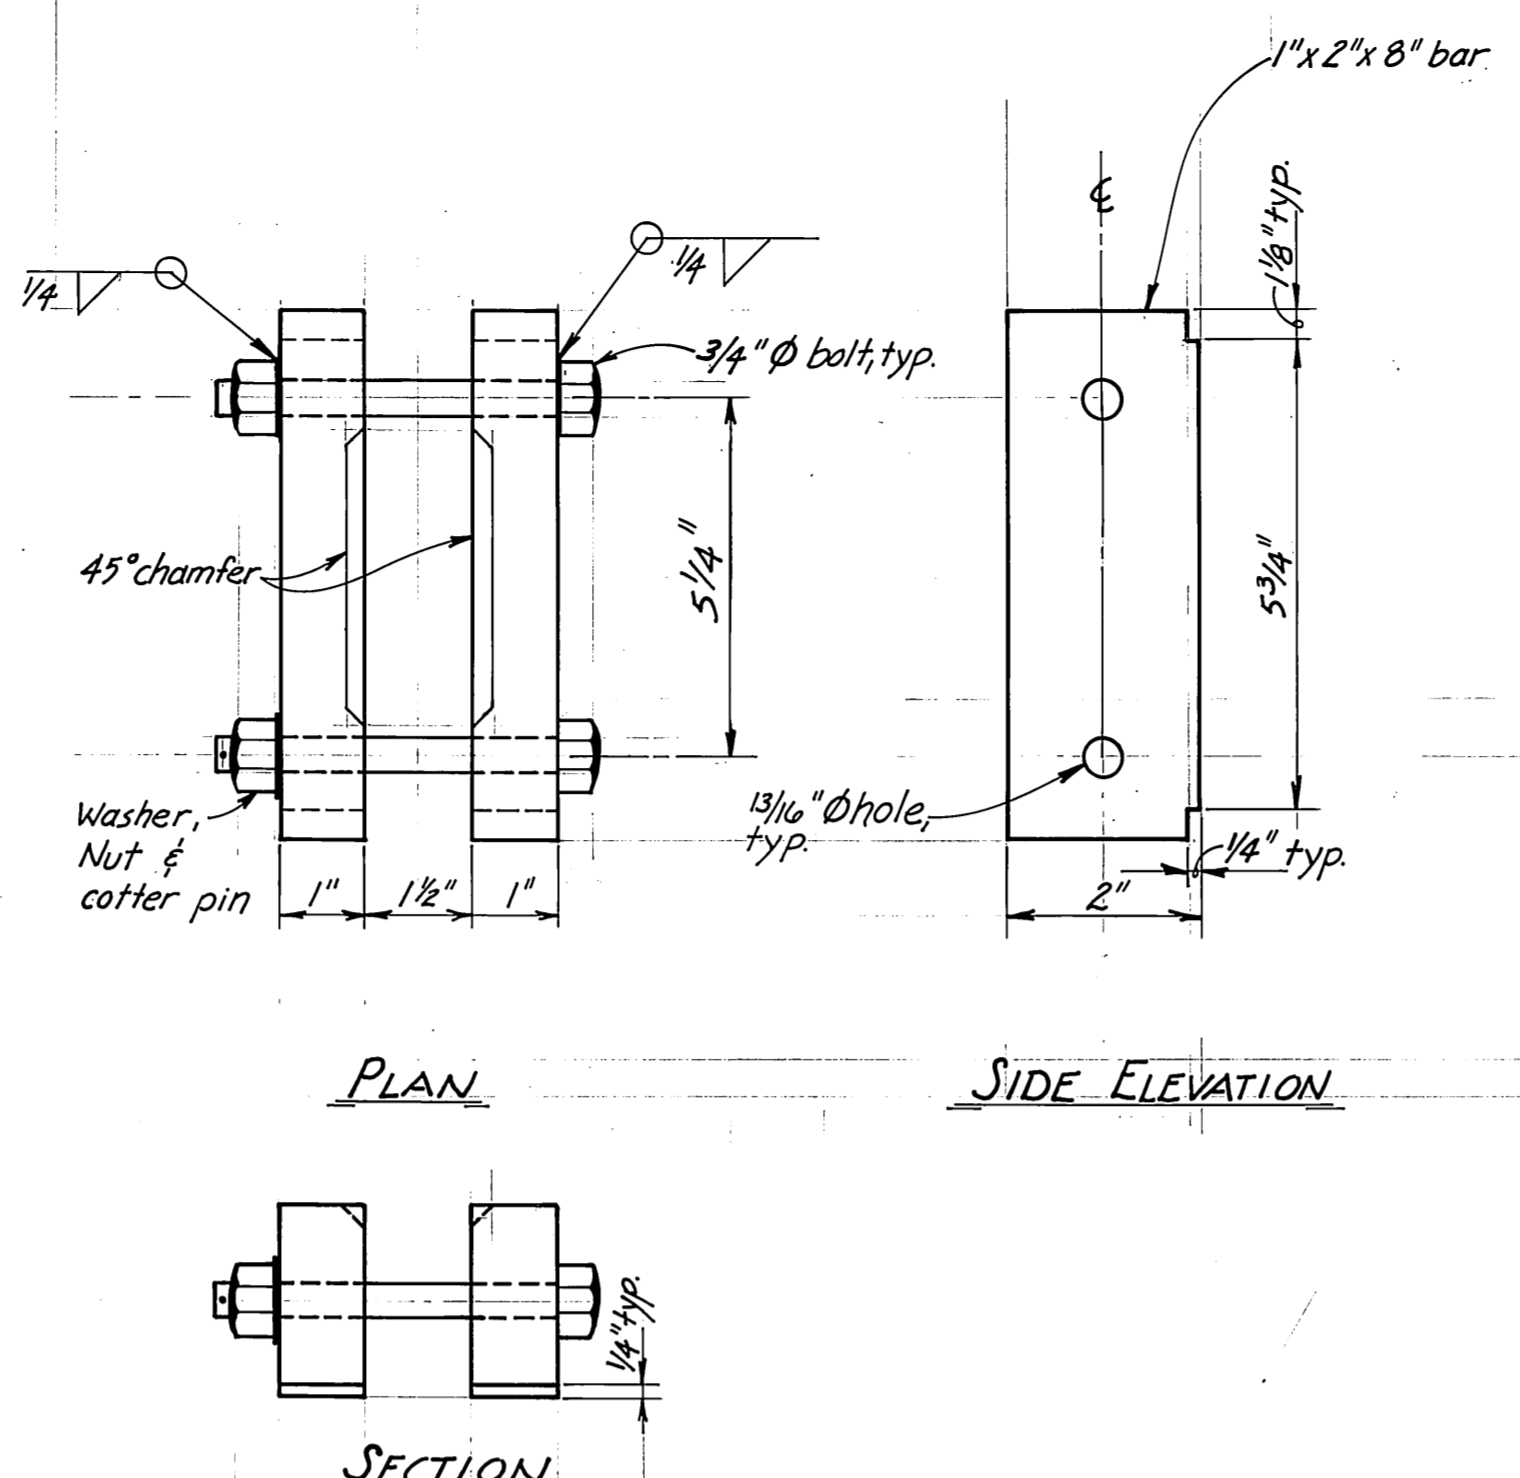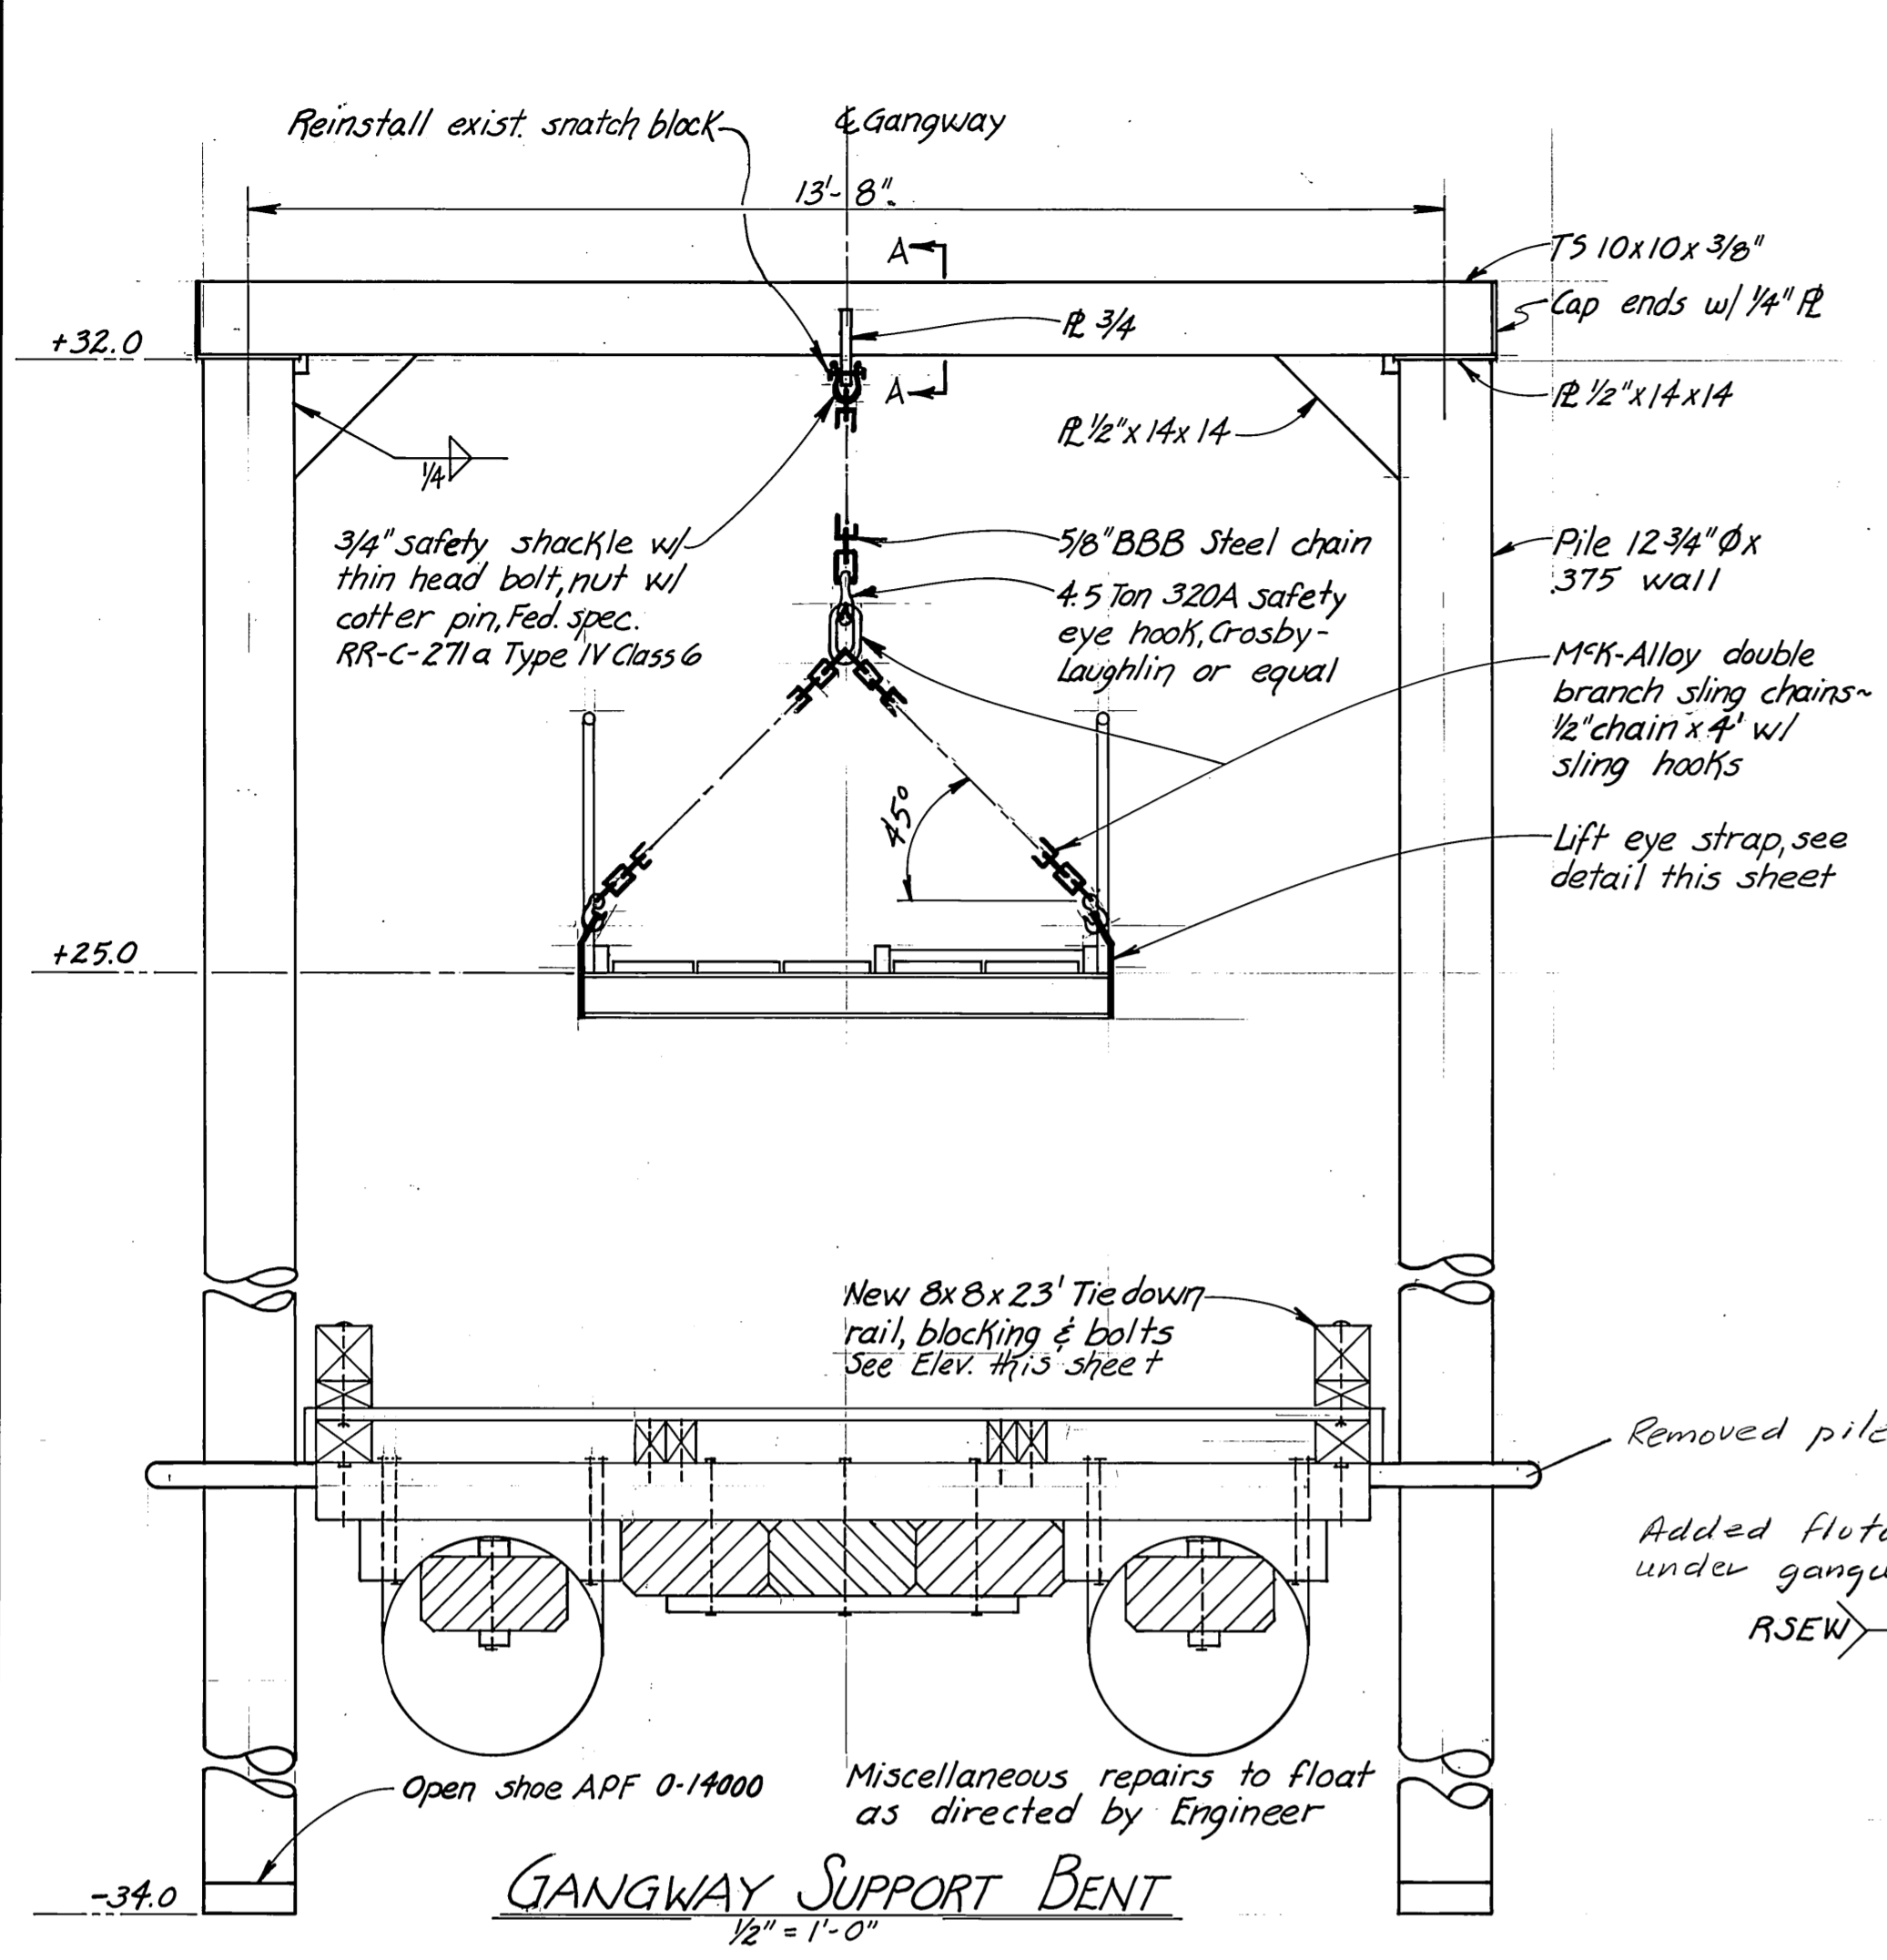

9'-0"	17'-0"	20'-0"	20'-0"	21'-0"	13'-0"
9'-0"	17'-0"	20'-0"	20'-0"	21'-0"	13'-0"
9'-0"	17'-0"	17'-0"	20'-0"	20'-0"	13'-0"
9'-0"	17'-0"	20'-0"	20'-0"	21'-0"	13'-0"

2x4  
 2x12 decking

Provide 39 - 3/8" Ø x 5" mushroom headed steel bolts for 2x4s  
 & 105 - 3/8" Ø x 3" mushroom headed steel bolts for 2x12 decking

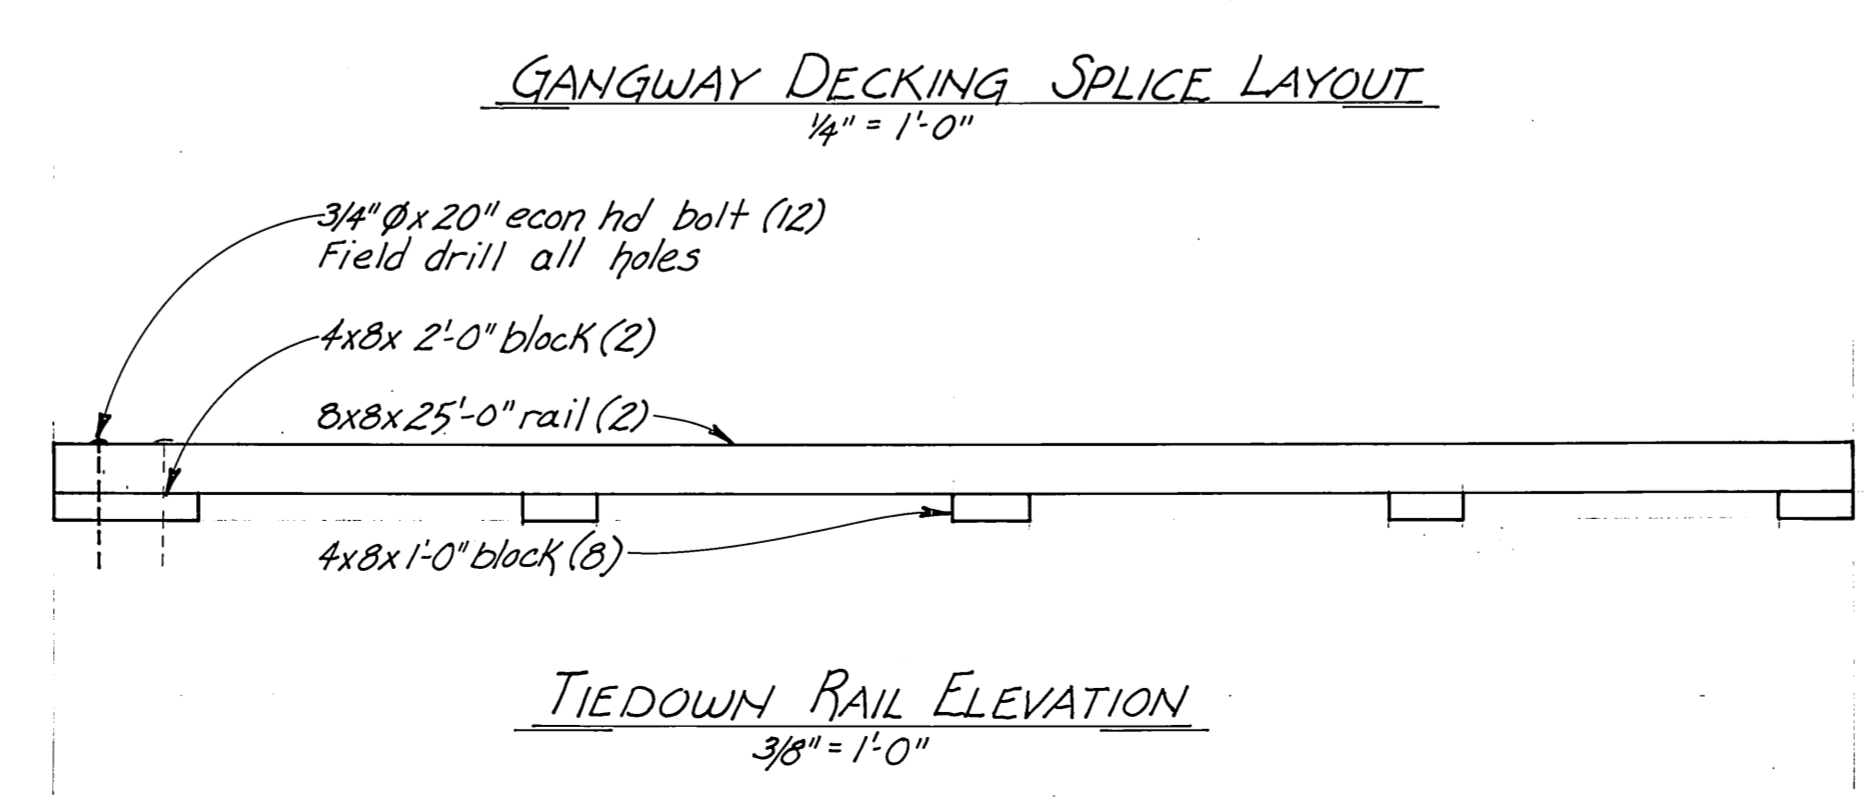

STAMP		DO NOT SCALE THIS DRAWING - USE DIMENSIONS	
		STATE OF ALASKA DEPARTMENT OF TRANSPORTATION AND PUBLIC FACILITIES DIVISION OF HARBOR DESIGN AND CONSTRUCTION	
		LETNIKOF COVE ALASKA	
		GANGWAY SUPPORT BENT & MISCELLANEOUS DETAILS	
SCALE As NOTED	SURVEYED	APPROVED	
DESIGNED HM	DRAWN SJS		
CHECKED RB	DATE Sept. 1979		
PROJECT NUMBER K-39189		SHEET 7 OF 7	