

STATE OF ALASKA  
DEPARTMENT OF PUBLIC WORKS  
DIVISION OF HIGHWAYS

PLAN AND PROFILE  
PROPOSED HIGHWAY PROJECT

NO. S-0990(I)  
MAIN ST., CITY OF HAINES  
GRADING, DRAINAGE & PAVING

MICROFILMED

By *V. J. Thraw* DATE 9-8-66

STATE	PROJECT DESIGNATION	YEAR	SHEET NO.	TOTAL SHEETS
ALASKA	S-0990 (I)	1961	1	25
TYPE 6201 IMPROVEMENT				



INDEX OF SHEETS

SHEET NO.	DESCRIPTION
1	TITLE SHEET
2	TYPICAL SECTIONS & ESTIMATE OF QUANTITIES
3-8	PLAN AND PROFILE SHEETS
9	LIGHTING & RETAINING WALL DETAILS & EARTHWORK SUMMARY
10	INTERSECTION DETAIL
11	SIDEWALK STEPS & DETAILS
12-15	CULVERTS & MISCELLANEOUS WORK
16	SUMMARY OF STANDARD MONUMENT CASES
17	SUMMARY OF STANDARD SIGNS
S 1	STANDARD CULVERTS
S 2	STANDARD END SECTIONS
S 3	STANDARD APPROACHES
S 5	STANDARD BARRICADE
S 6	STANDARD IDENTIFICATION SIGNS
S 7	TYPICAL SIGNS
S 8	STANDARD BEAM GUARD RAIL
S 10	STD DROP INLETS, CATCH BASINS & MANHOLES

DESIGN DESIGNATION  
ADT (1959) = 354  
ADT (1980) = 1400  
DHV = 182  
D = 60%  
T = 5%  
V = 30MPH

Field reports of the foundation soils and the type of materials found in the listed pits for this project are available for inspection in the Dept. of Public Works, Division of Highways, Headquarters office at Juneau.  
Detail cross sections for this project are available for inspection in the Headquarters office at Juneau.

PROJECT	SUMMARY
WIDTH OF SUBGRADE	60'
WIDTH OF PAVEMENT	26.5' & 41'
LENGTH OF GRADING	2,819.18' = 0.534 MI.
LENGTH OF PAVING	2,819.18' = 0.534 MI.
LENGTH OF PROJECT	2,819.18' = 0.534 MI.

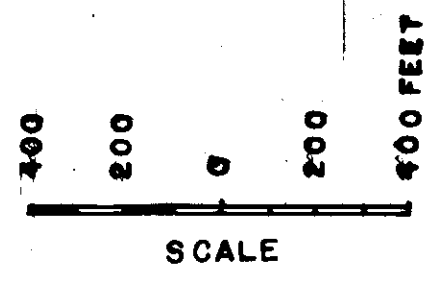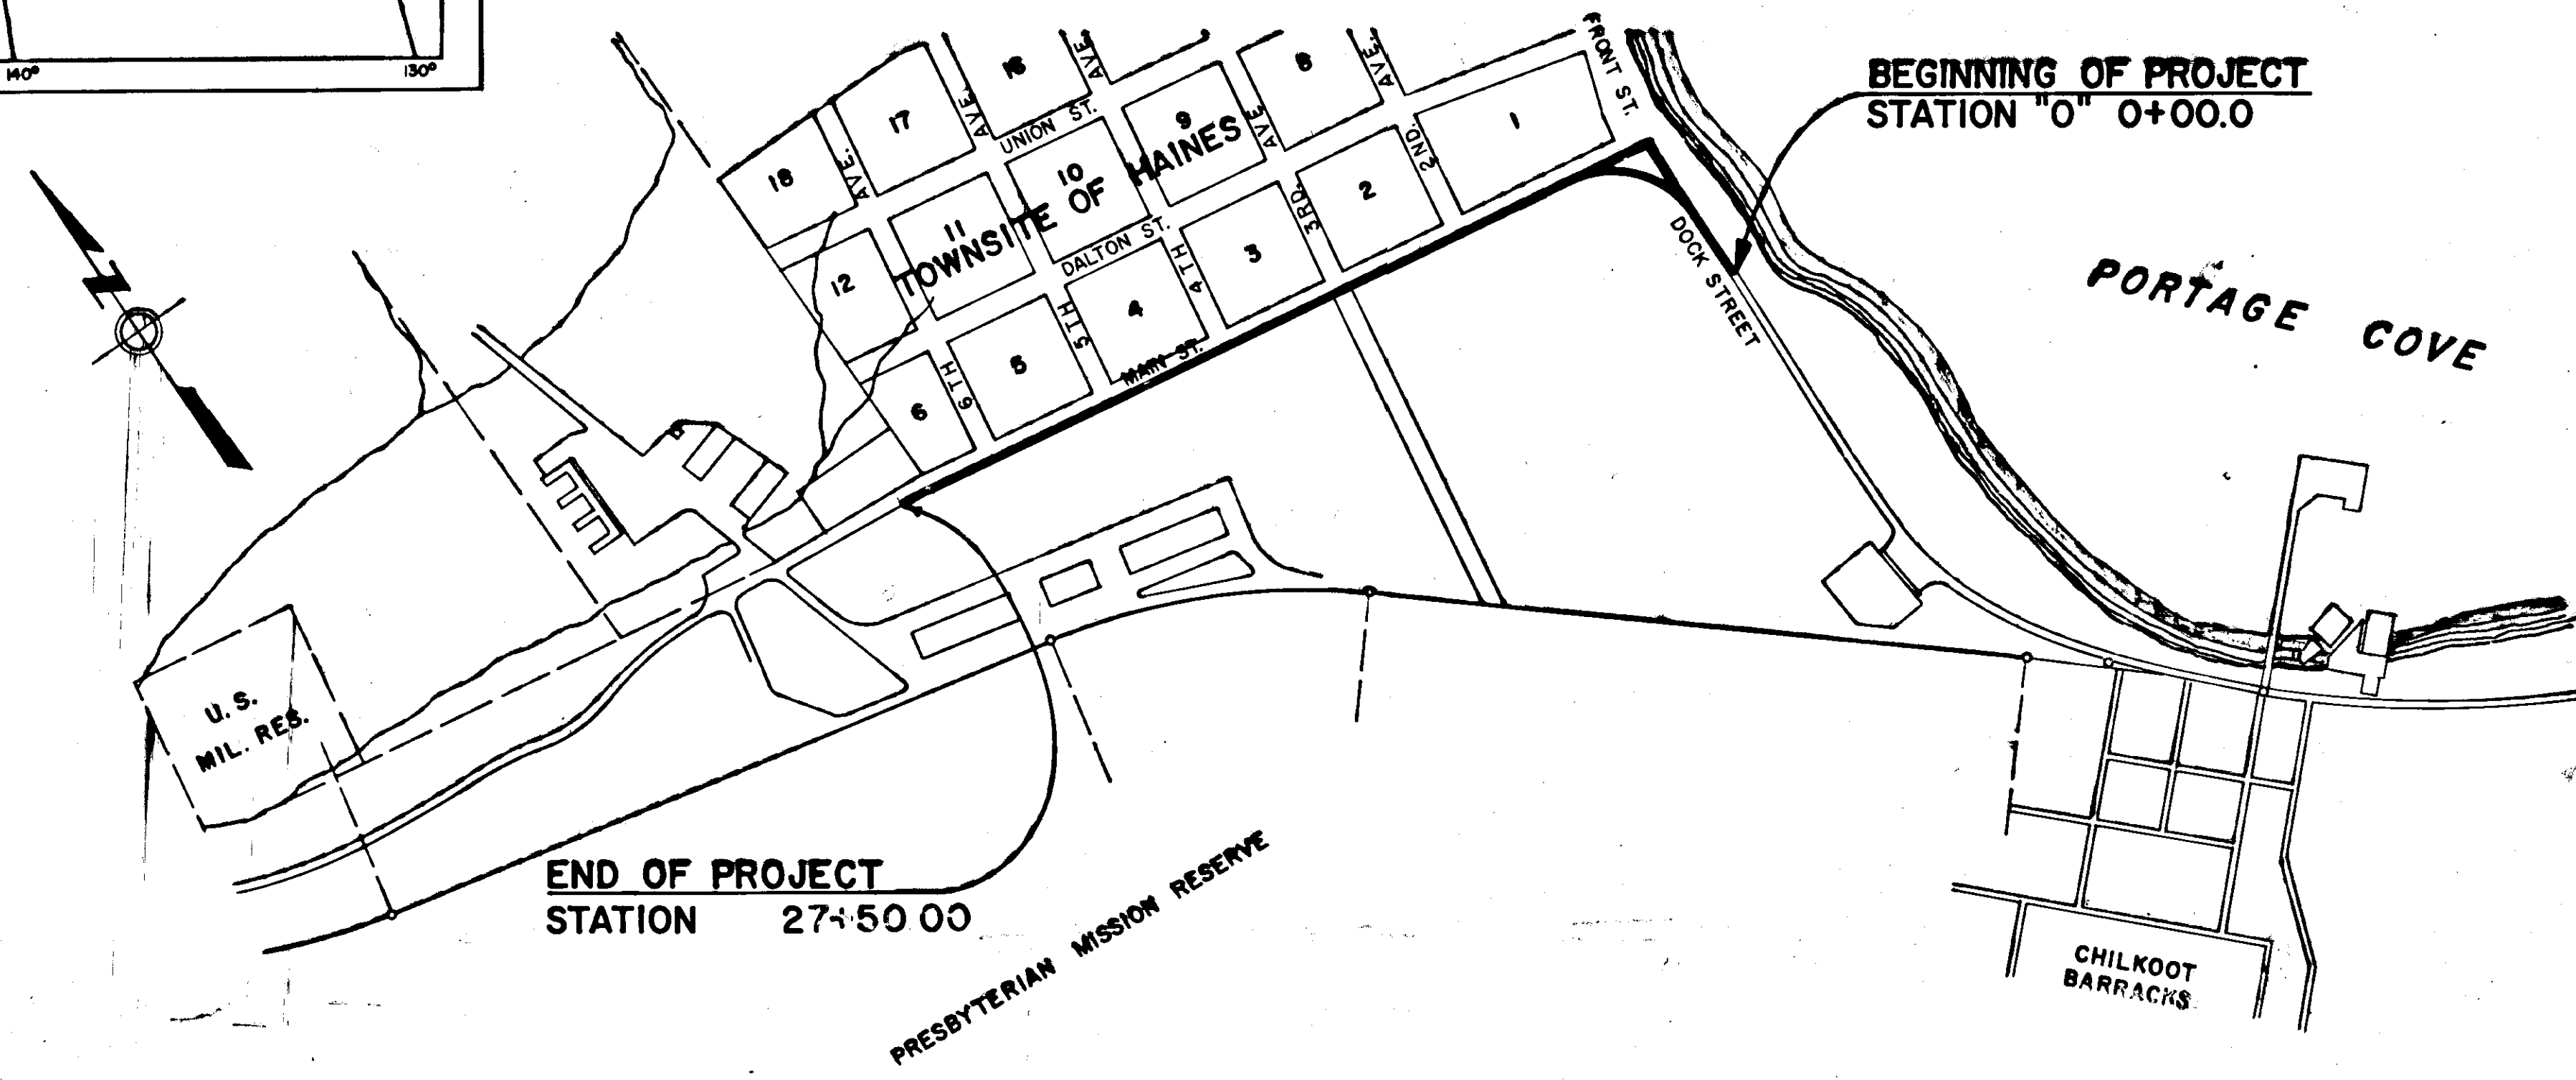

CONVENTIONAL SIGNS

PROPOSED CONSTRUCTION CENTERLINE	[Symbol]
NEW PERFORATED PIPE DRAINAGE LINE	[Symbol]
EXISTING WATER LINE	[Symbol]
EXISTING SEWER LINE	[Symbol]
CURB INLET	[Symbol]
POWER POLE	[Symbol]
HYDRANT	[Symbol]
STREET MONUMENT	[Symbol]
CORR. METAL PIPE	[Symbol]
VALVE BOX	[Symbol]
MANHOLE	[Symbol]
EXISTING METER BOX	[Symbol]
EXISTING UT LIDOR	[Symbol]
RIGHT-OF-WAY LINE	[Symbol]
CURB CUT	[Symbol]
U.S. UNDERGROUND CABLE	[Symbol]

AS BUILTS

Contractor: ROGERS CONST. & BABLER BROS.  
Pro. Engineer: FRANK DARNIELL  
Began Project: 8-8-61  
Ended Project: 8-31-62

STATE OF ALASKA  
DEPT. OF PUBLIC WORKS  
DIVISION OF HIGHWAYS


APPROVED  
*J. D. Sheridan* Date 5/12/61  
DIRECTOR, DIVISION OF HIGHWAYS

APPROVED \_\_\_\_\_ Date \_\_\_\_\_  
REGIONAL ENGINEER  
BUREAU OF PUBLIC ROADS  
REGION TEN

As built entered 4-2-65 by R.Ward

Title Sheet

STATE	PROJECT DESIGNATION	YEAR	SHEET NO.
ALASKA	S-0990(1)	1961	2

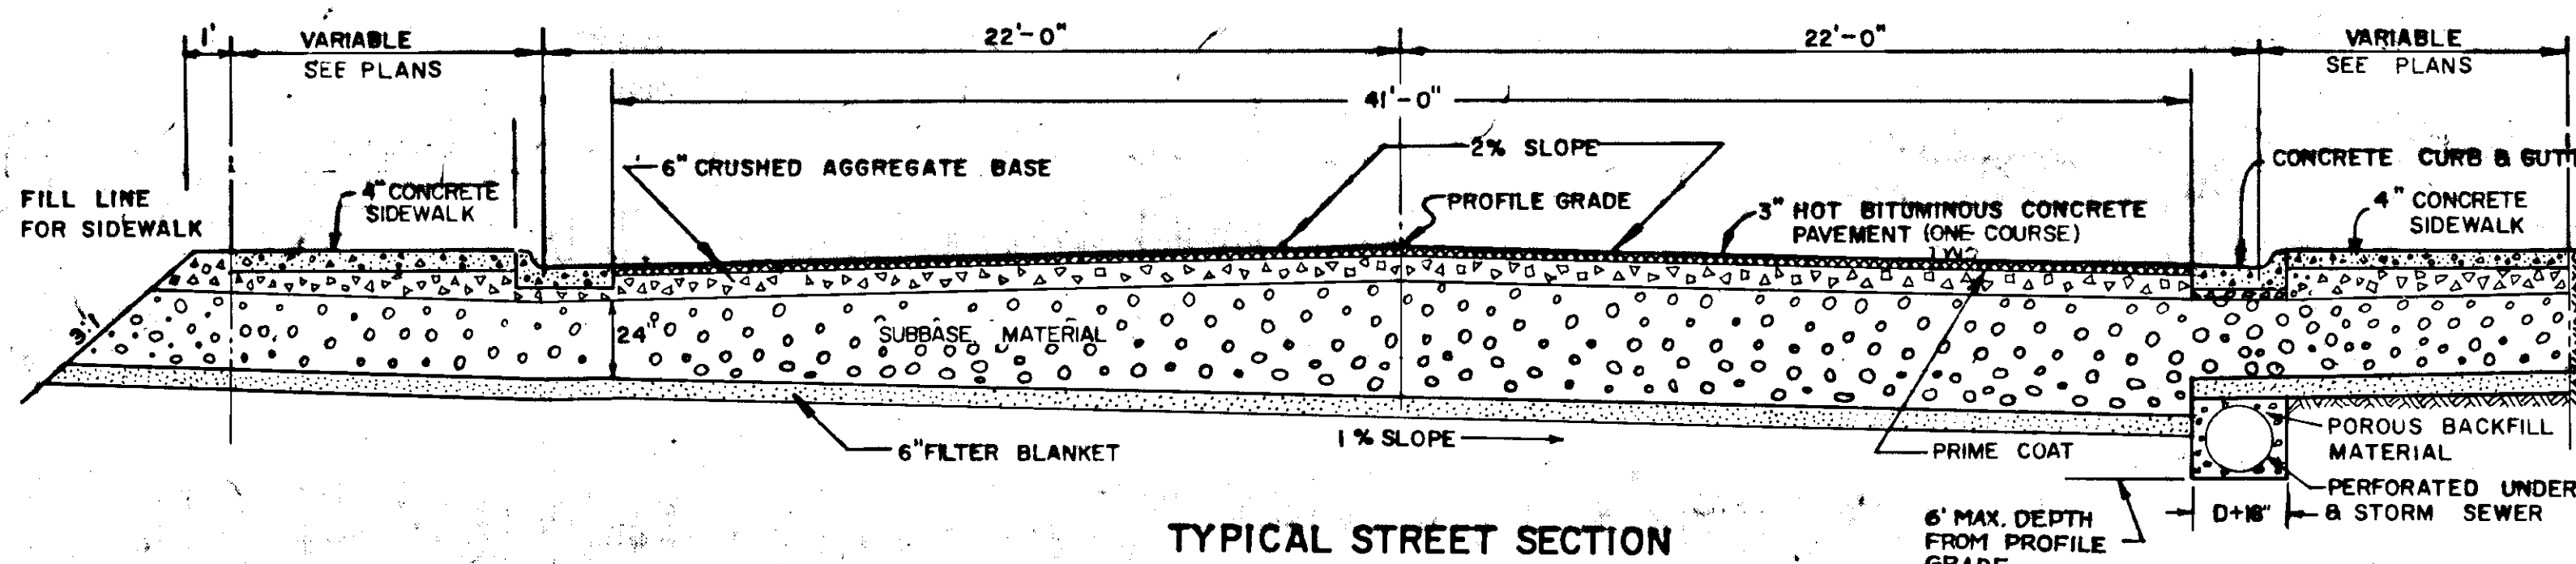

TYPICAL STREET SECTION



STA. 0+3+18.12 - STA. 25+62.82

NOTE: FOR TYPICAL SECTION STA. 0+0+00 - STA. 0+3+18.12 SEE BELOW. FOR STA. 25+62.82 TO STA. 27+50 SEE SHEET 9


NOTE: MAIN LINE OF PERFORATED PIPE UNDERDRAIN FALLS DIRECTLY UNDER GUTTER AS SHOWN ON TYPICAL SECTION, SHOWN OTHERWISE ON PLANS FOR CLARITY.

TYPICAL SIDEWALK & METER BOX SECTION


SCALE 1/2" = 1'-0"

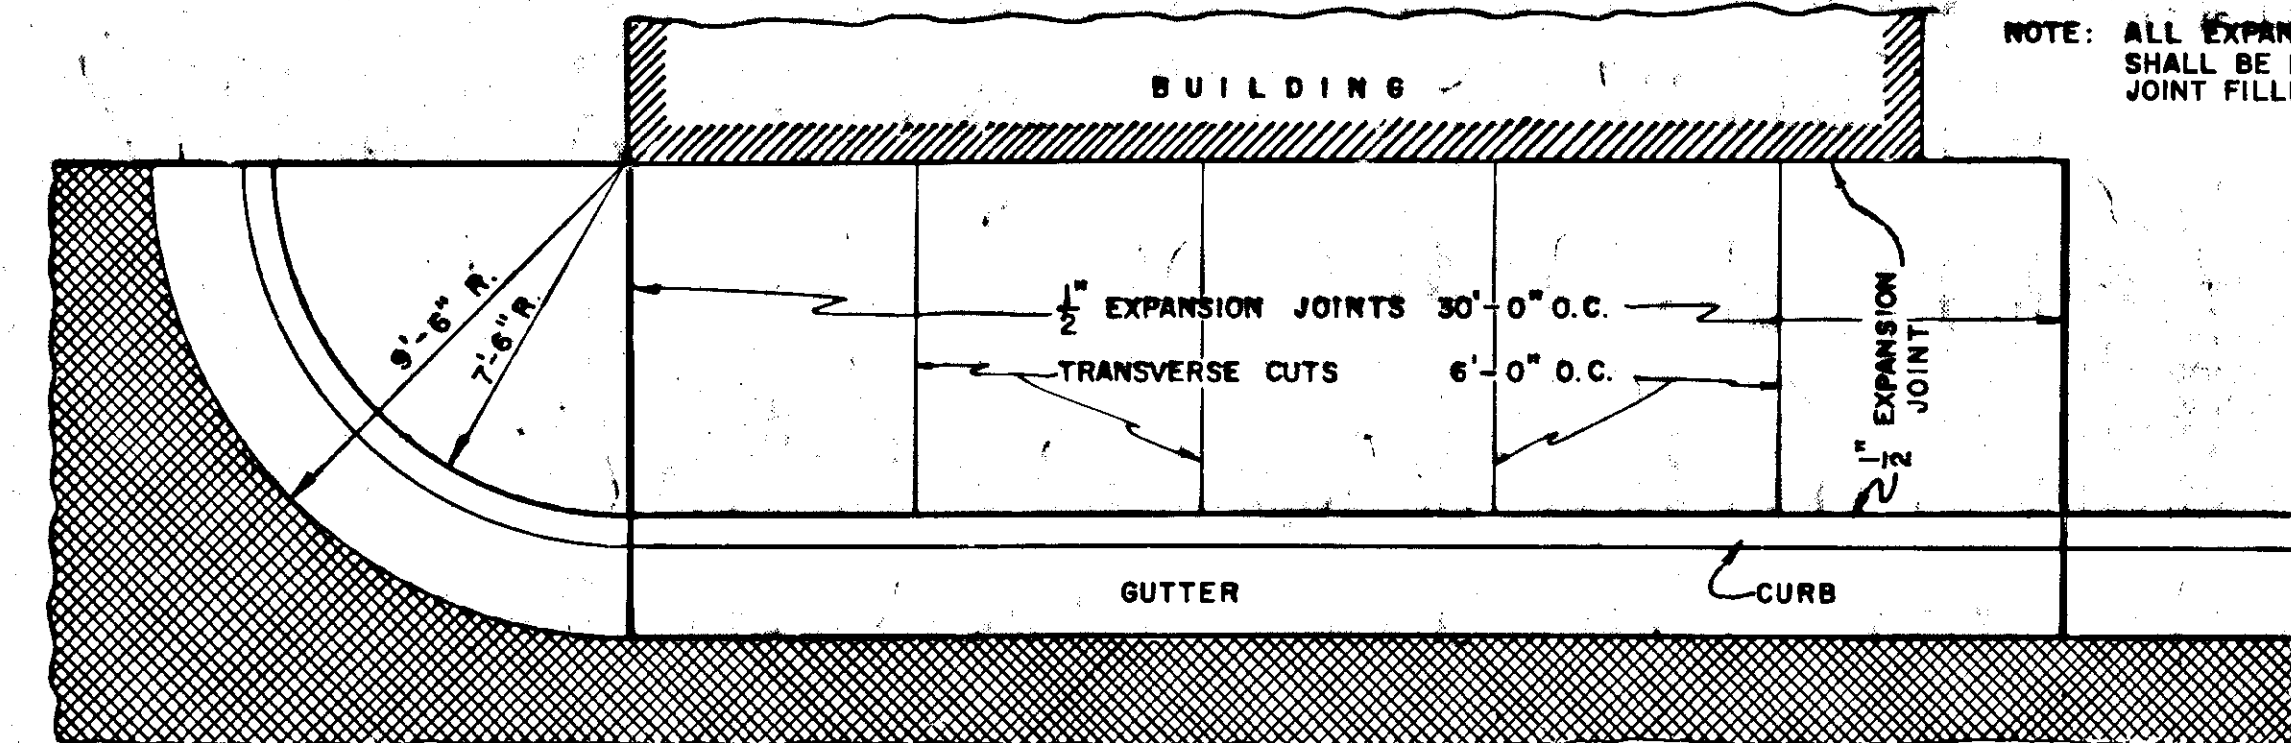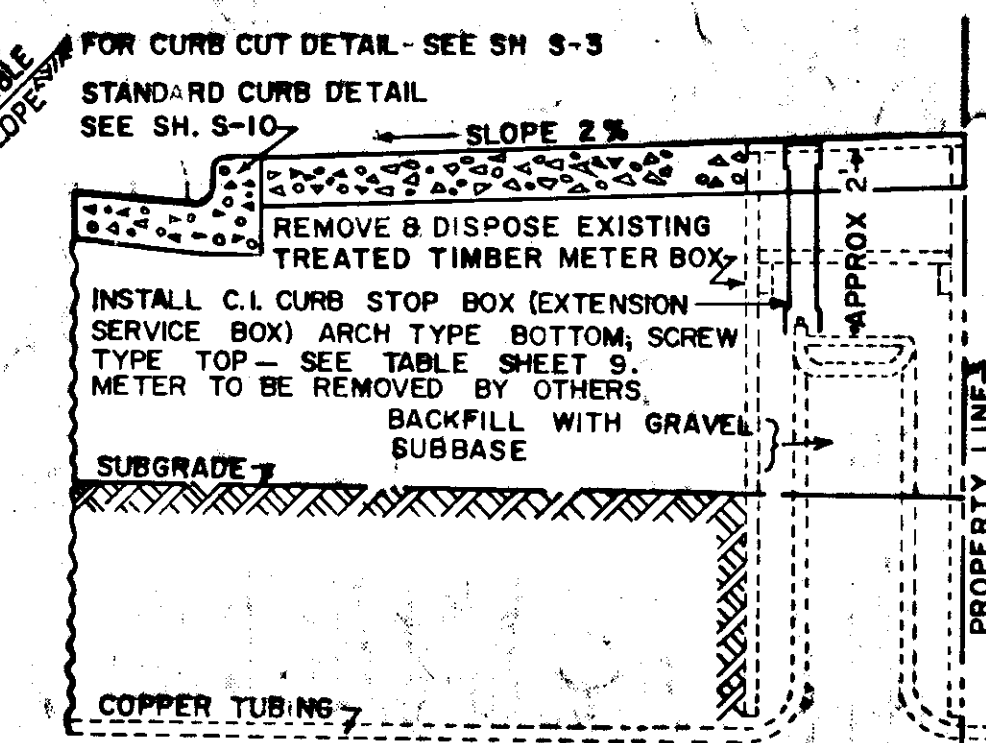


TYPICAL EXPANSION & CONTRACTION JOINT DETAILS

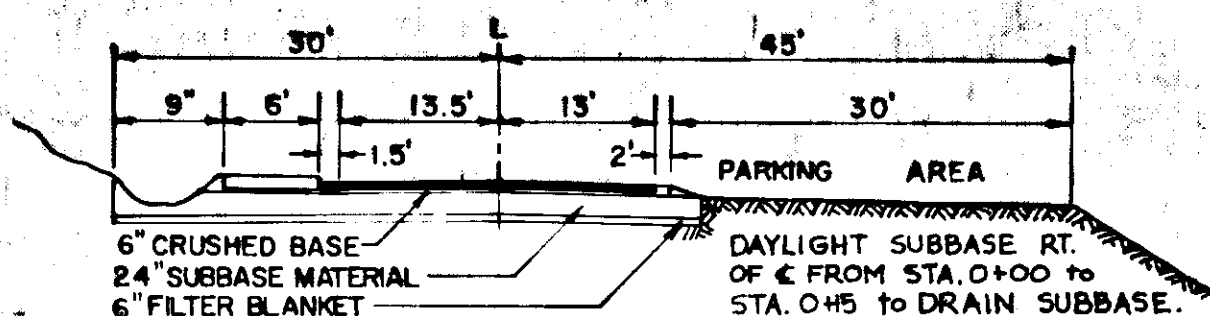

TYPICAL SECTION  
Sta. 0+0+00 to Sta. 0+3+18.12

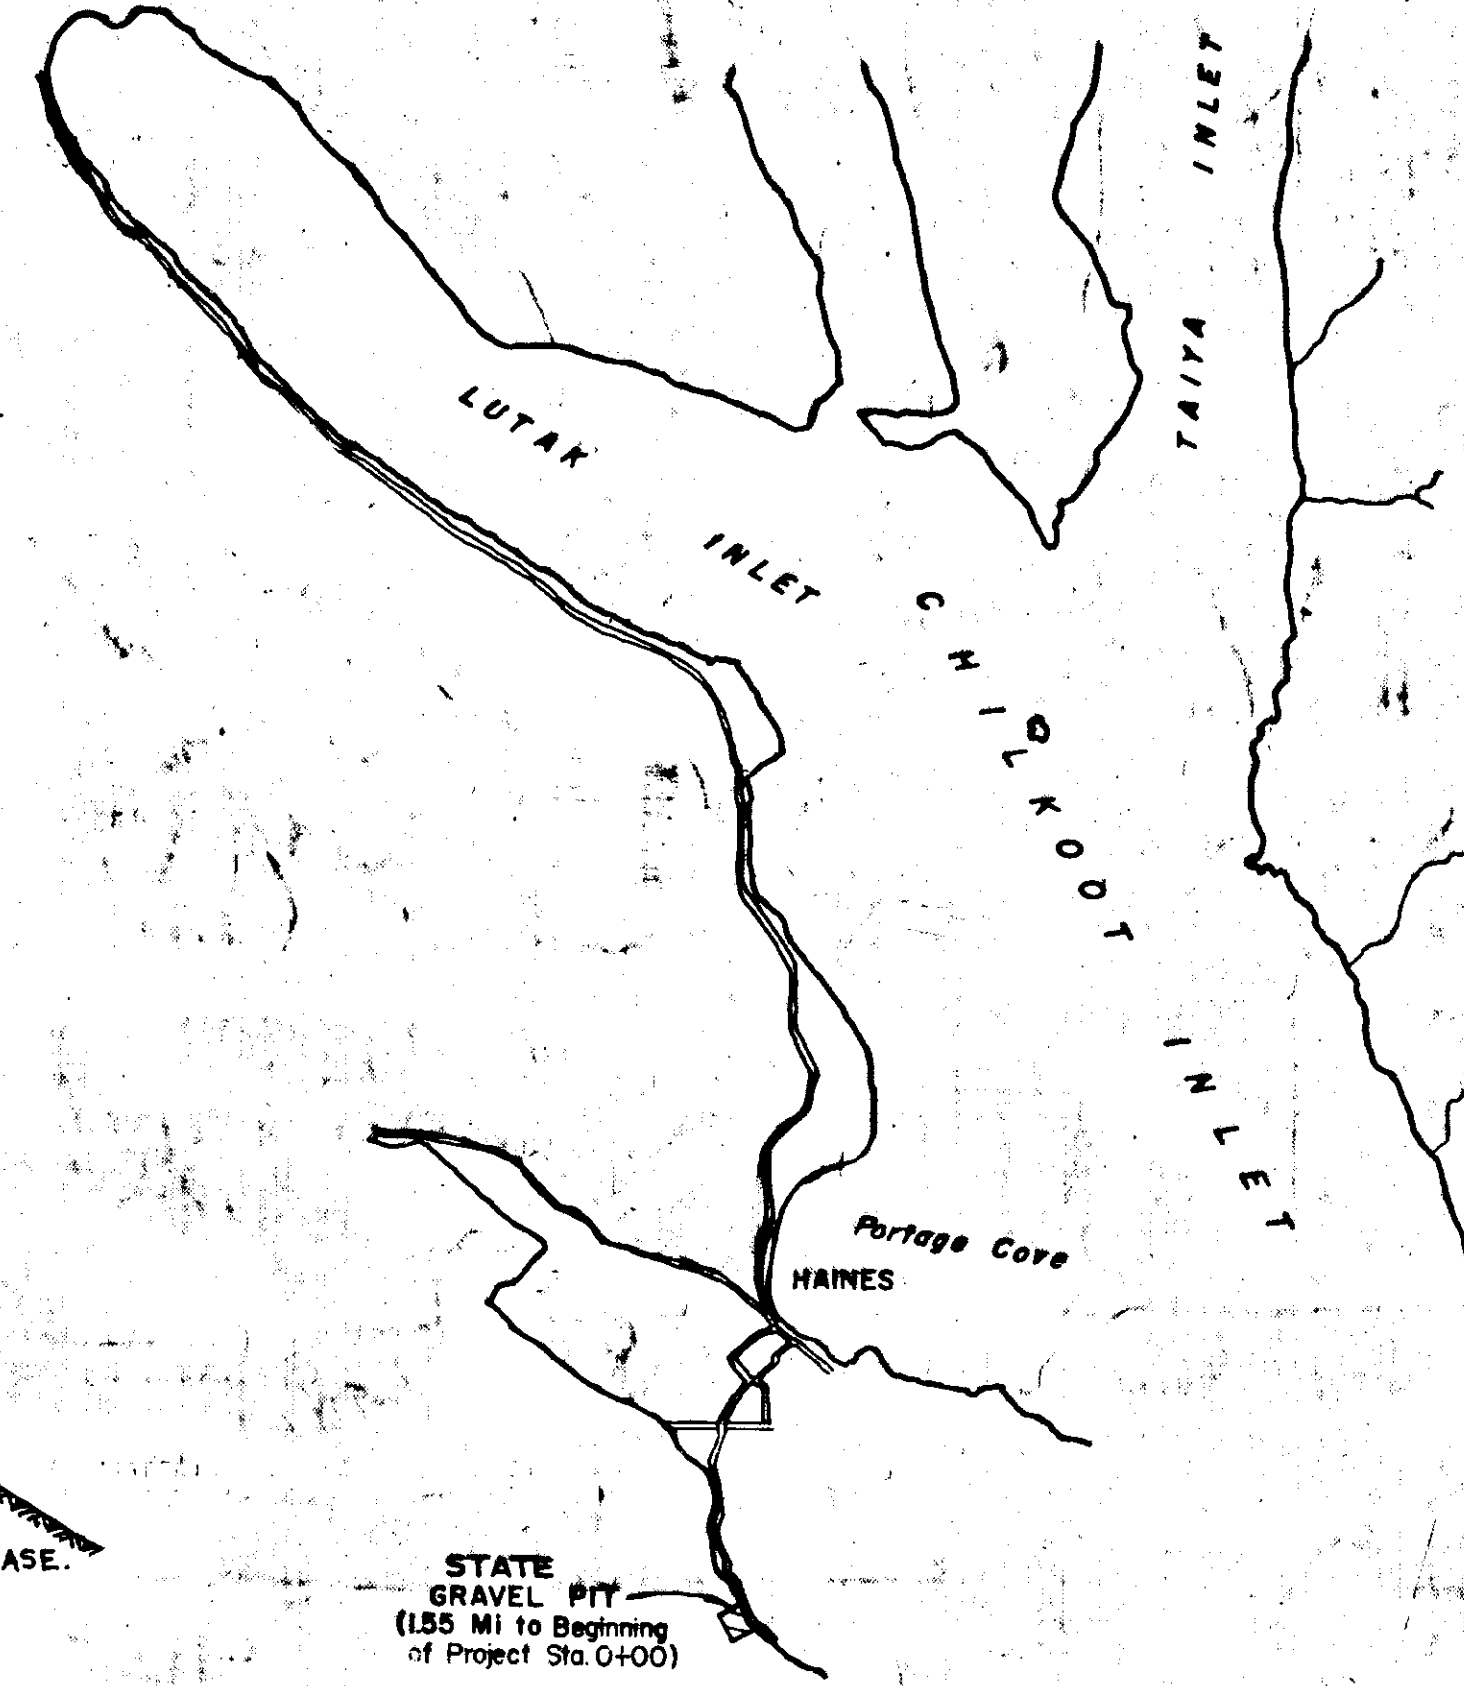


LISTED BORROW SOURCE

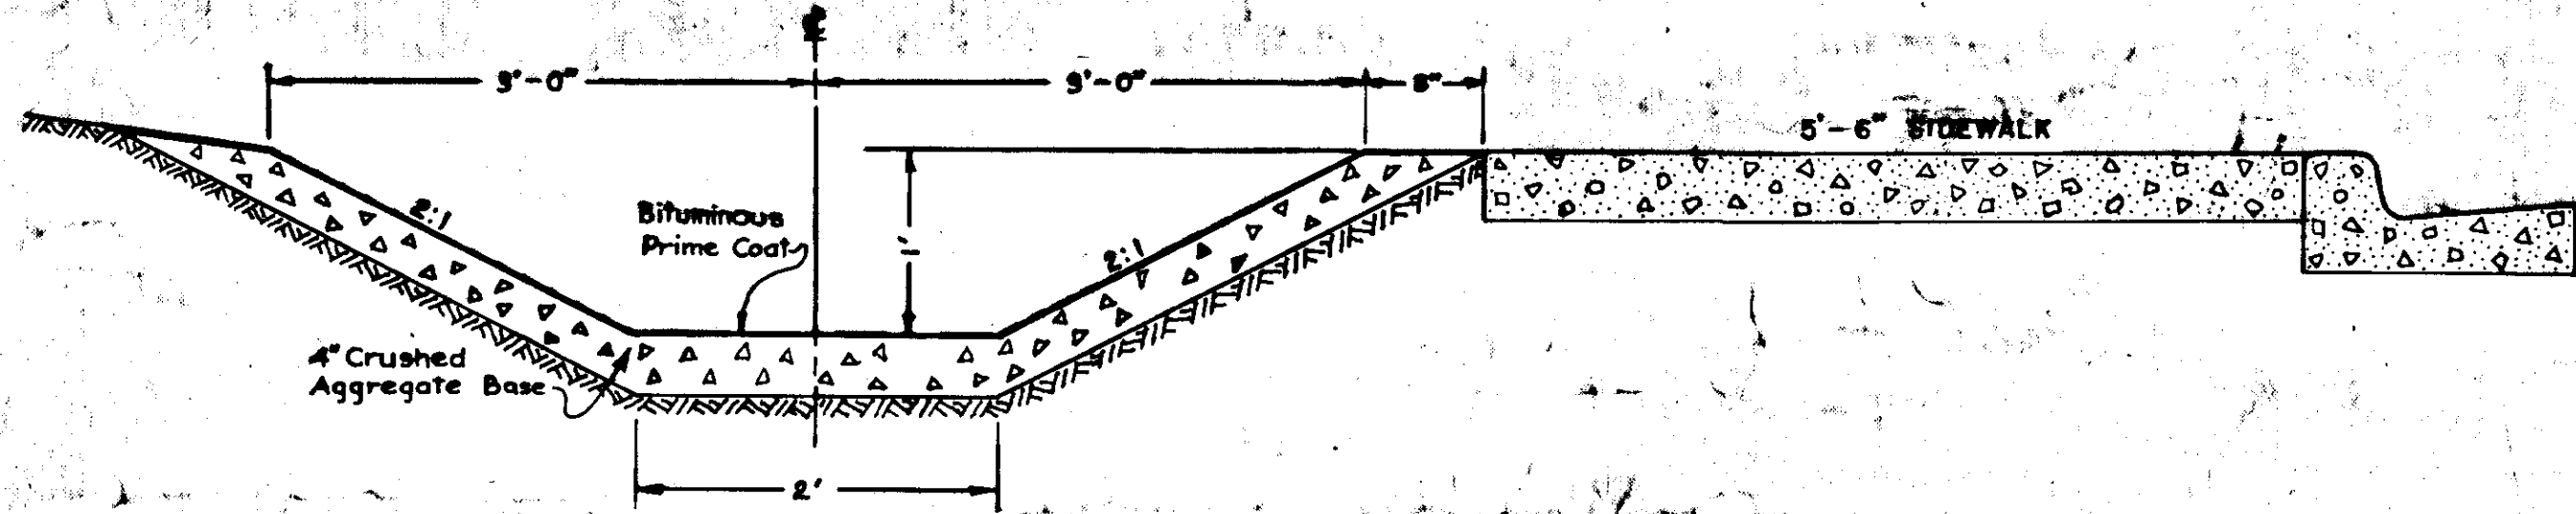

TYPICAL DITCH SECTION

STA. 0+0+09 - STA. 6+2+30

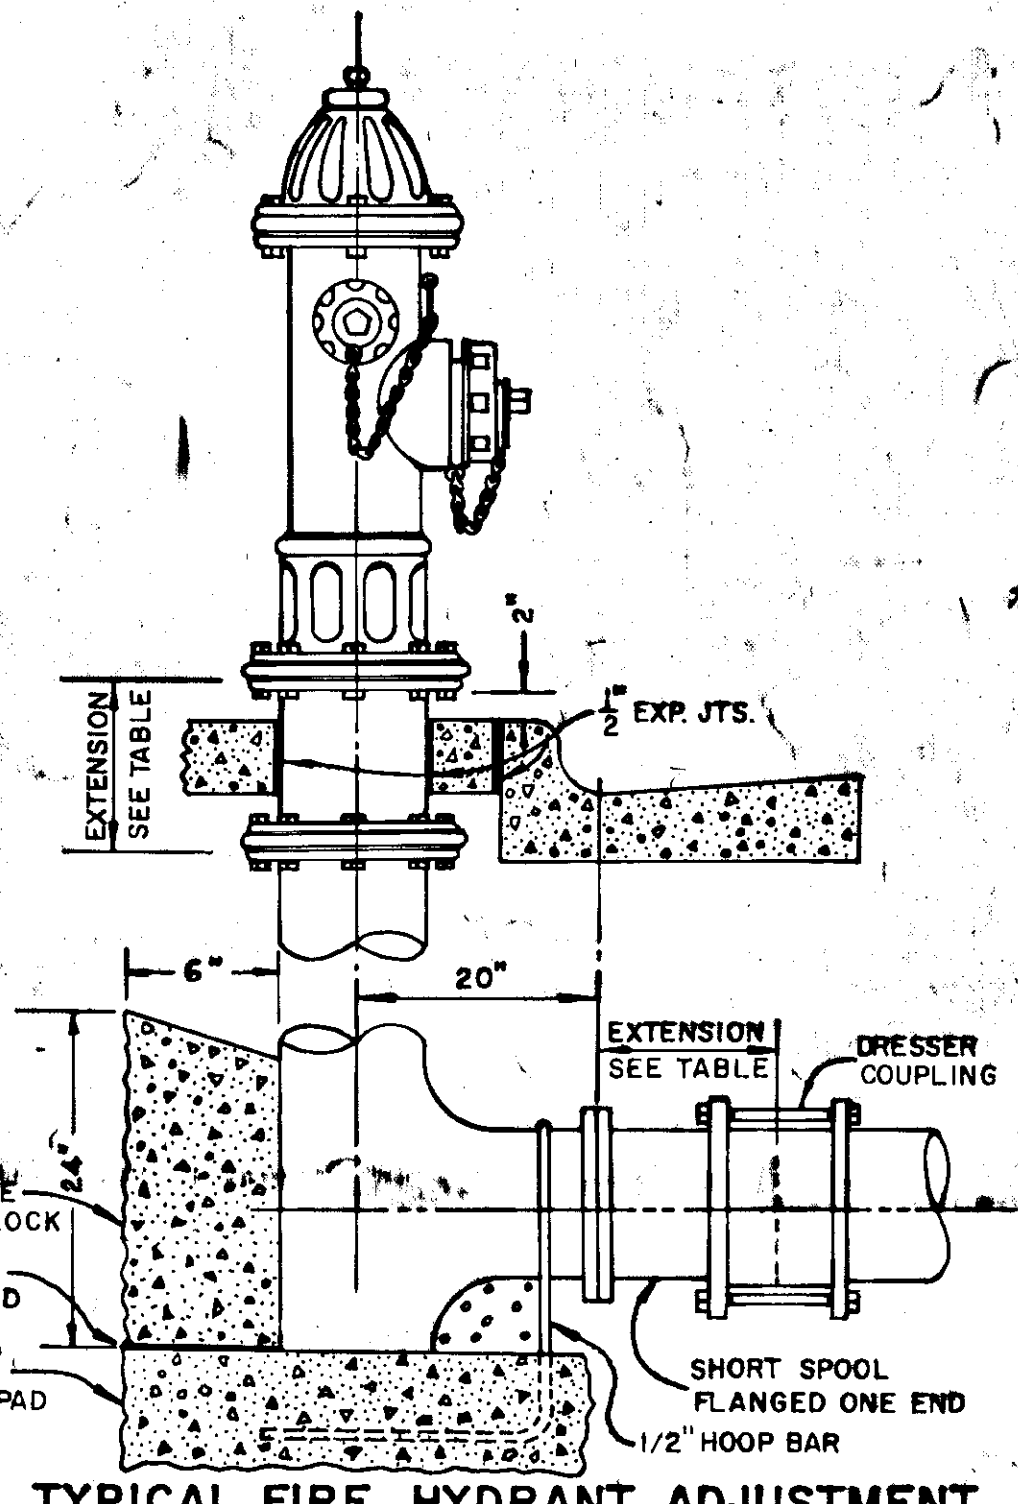

TYPICAL FIRE HYDRANT ADJUSTMENT

ESTIMATE OF QUANTITIES AS BUILT

ITEM NO.	QUANTITY	UNIT	ITEM
10	All Req'd.	L.S.	Force account as provided in Article 9.5
102(1)	26,400	Cu.Yd.	Unclassified excavation
102(5)	13,600	Cu.Yd.	Borrow excavation, Case 2
102(12)	3,000	Cu.Yd.	Filter Blanket, Case 2
103(1)	3,000	Cu.Yd.	Excavation for structures
200(4)	6,000	Ton	Crushed aggregate base, grading D-1
310(3)	4,000	Gal.	Asphalt, grade MC-O, prime coat
322(1)	2,200	Ton	Hot bituminous concrete pavement
322(2)	31,000	Gal.	Asphalt cement, 120-150 penetration
406(1)	25	Cu.Yd.	Class "A" concrete
453(5C)	346	Lin.Ft.	12" Asbestos-bonded paved invert C.M.P., 16 gage
453(5E)	496	Lin.Ft.	24" Asbestos-bonded paved invert C.M.P., 14 gage
457(1)	305	Lin.Ft.	Removal of pipe culverts
460(26)	2	Each	Bituminous-coated metal end sections for 24" pipe culverts
513(1)	7	Each	Adjusting fire hydrants
514(1)	5300	Lin.Ft.	2" Electrical conduit
515(1)	30	Each	Curb stop box (2" I.D. upper section)
515(2)	1	Each	Curb stop box (4 1/4" I.D. upper section)
520(5C)	554	Lin.Ft.	12" Bituminous-coated perforated C.M.P. underdrain, 16 gage
520(5D)	594	Lin.Ft.	15" Bituminous-coated perforated C.M.P. underdrain, 16 gage
520(5E)	682	Lin.Ft.	18" Bituminous-coated perforated C.M.P. underdrain, 16 gage
520(5F)	640	Lin.Ft.	21" Bituminous-coated perforated C.M.P. underdrain, 16 gage
521(1)	9	Each	Manholes
521(2)	23	Each	Inlets, Type B
521(3)	1	Each	Catch Basin, Type B
521(10)	17	Each	Adjusting manholes, valve boxes and clearouts
524(3)	4700	Sq.Yd.	Concrete curb & gutter, 6" depth
530(1)	2900	Sq.Yd.	Concrete sidewalk, 4" depth
530(2)	140	Sq.Yd.	Concrete sidewalk and driveway, 6" depth
561(1)	6	Each	Monument cases
583(1)	25	Lin.Ft.	Beam-type guardrail
584(1)	9	Each	Standard signs
305(1)	3,500	Cu.Yd.	Stockpiled material, Section 200, Grading D-1
305(3)	3,000	Cu.Yd.	Stockpiled Special Sand

HYDRANT ADJUSTMENTS

LOCATION	DISTANCE TO E. OF STREET	HORIZONTAL ADJUSTMENT REQUIRED	VERTICAL EXTENSION REQUIRED	HYDRANT MANUFACTURER & SIZE	REMARKS
STA. 4+44.7					REMOVE
STA. 4+84.6	20'-8 1/2"	38"	-6"	6" PACIFIC	
STA. 7+63.4	22'-10"	12"	+6"	6" PACIFIC	
STA. 10+53.1	22'-9"	14"	0	6" PACIFIC	
STA. 14+27.5	23'-1"	10"	0	4" COREY	
STA. 18+02.5	21'-7 1/4"	26"	-6"	6" PACIFIC	
STA. 21+78.6	21'-7 1/2"	26"	-36"	6" PACIFIC	

GENERAL NOTES  
 ALL UTILITY POLES SHALL BE MOVED BY OTHERS  
 ALL VALVE BOXES, MANHOLES, & CLEANOUTS SHALL BE ADJUSTED TO GRADE  
 MONUMENTS WILL BE REFERENCED BY THE ENGINEER  
 CONTRACTOR SHALL MOVE & RESET.  
 REMOVED SIDEWALK WILL BE USED FOR RIPRAP AT STA. 1+27.24  
 ALL BURIED TANKS SHALL BE REMOVED BY OWNERS.  
 FOR SUMMARY OF EARTHWORK SEE SHEET 9.  
 CULVERT LENGTHS ARE APPROXIMATE ONLY AND ARE SUBJECT TO MINOR REVISIONS  
 GRADES AND ALIGNMENT SHOWN ON THESE PLANS ARE SUBJECT TO MINOR REVISIONS.  
 ON SHEETS WITH DOUBLE PLAN & PROFILE, UPPER PLAN SHOWS CONSTRUCTION DETAILS WHILE LOWER PLAN SHOWS UTILITIES.  
 UNDERCUT SIDE STREET APPROACHES AS STAKED BY THE ENGINEER BACKFILL WITH BORROW CASE 2.  
 ALL PREMOULDED EXPANSION JOINT MATERIAL SHALL MEET THE REQUIREMENTS OF AASHTO M35-48.  
 WASTE MATERIAL PLACED IN SCHOOL YARD SHALL BE ROUGH GRADED AS DIRECTED BY THE ENGINEER.


TABLE OF APPROACHES

STATION	DESCRIPTION
"F"0+42	Type 1A Approach Rt.
"F"0+93	Type 1A Approach Rt.
"O"3+28	Type 2 Curb Cut Rt.
"O"3+27	Type 2 Curb Cut Lt.
3+98	Type 1 Curb Cut Rt.
4+64	Type 2 Curb Cut Rt.
5+00	Type 1 Curb Cut Lt.
10+9	Type 1 Curb Cut Rt.
13+77	Type 2 Curb Cut Rt.
15+12	Type 1 Curb Cut Rt.
19+24	Type 1 Curb Cut Lt.
21+00	Type 2 Curb Cut Rt.
20+13	Type 1 Curb Cut Lt.
21+62	Type 1 Curb Cut Lt.





STATE	PROJECT DESIGNATION	YEAR	SHEET NO.	TOTAL SHEETS
ALASKA	S-0990(1)	1961	5	26

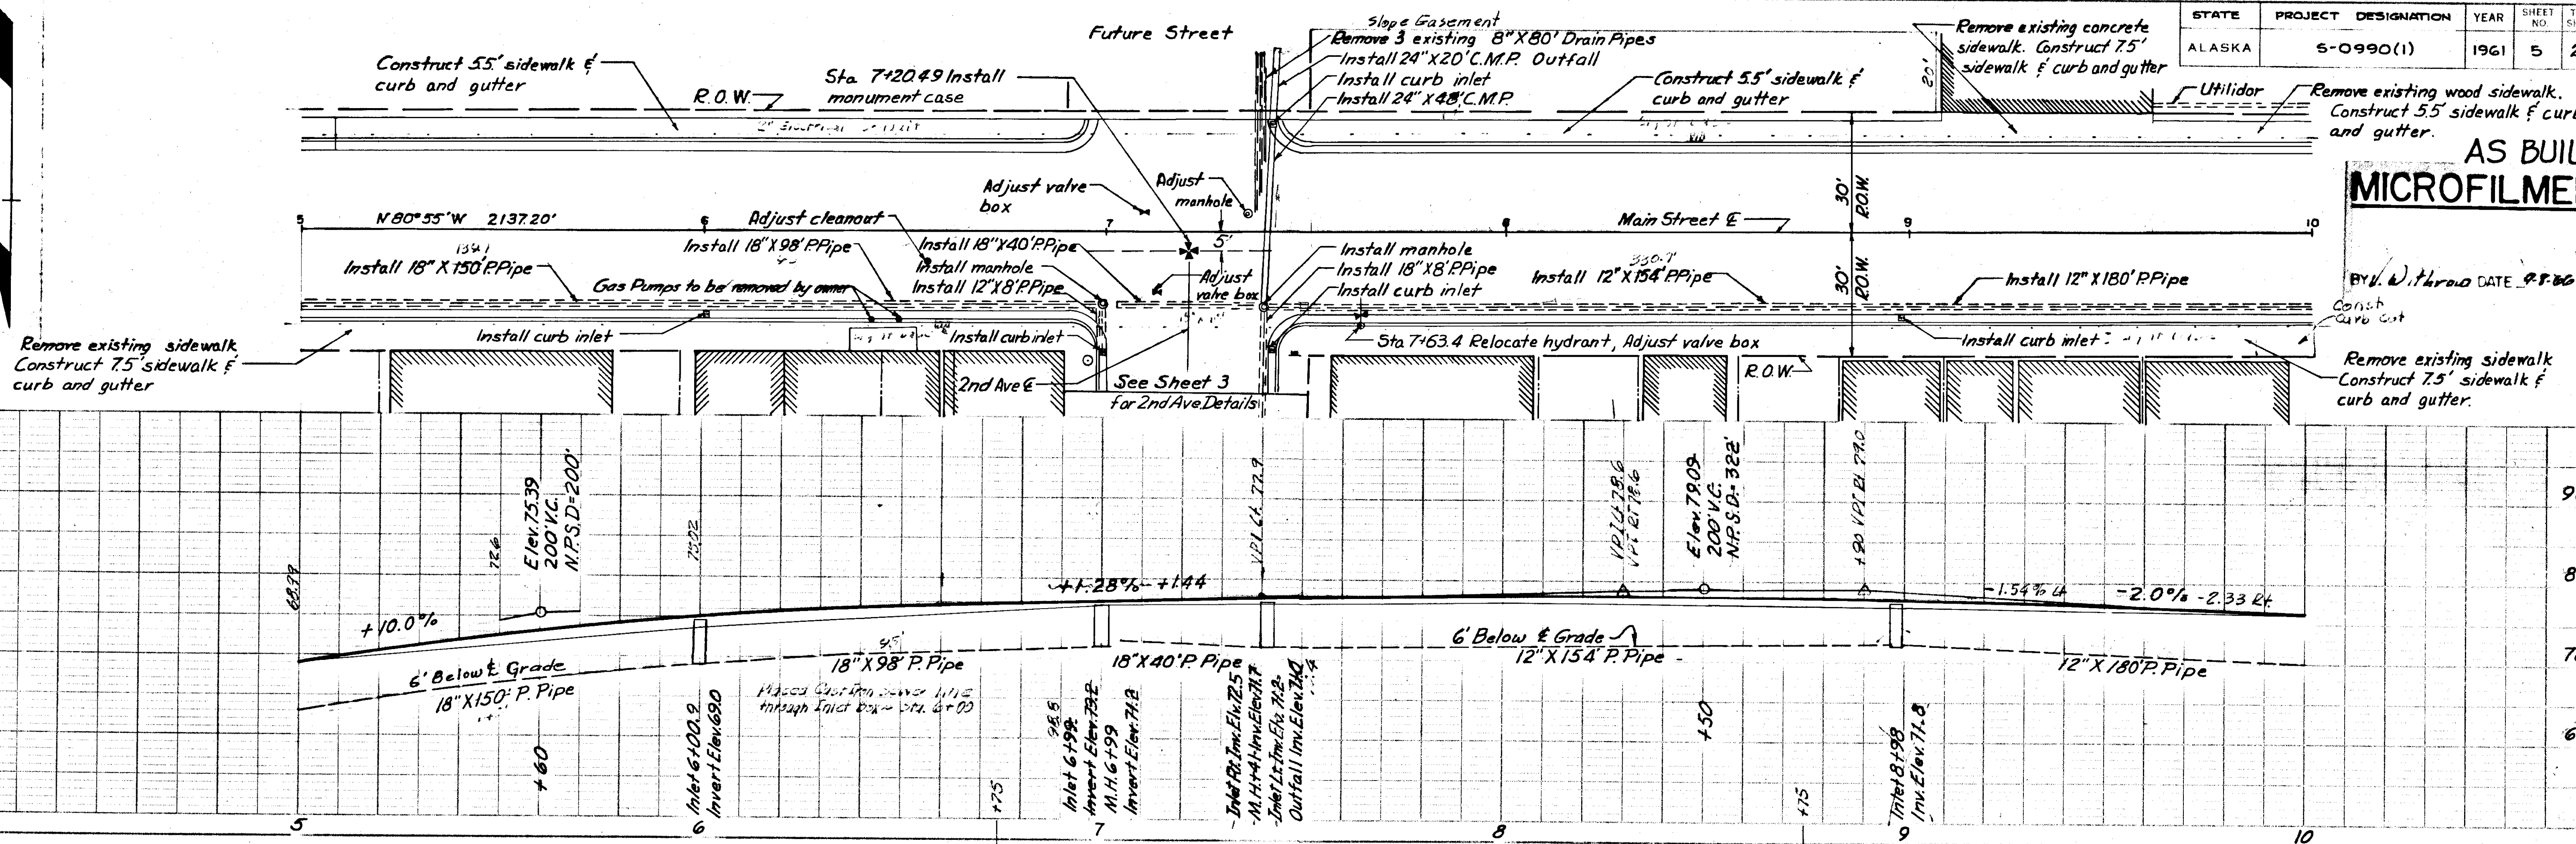


**AS BUILT  
MICROFILMED**

BY: *[Signature]* DATE: 9-8-66



Remove existing sidewalk. Construct 5.5' sidewalk & curb and gutter.

Note: Grade change from Sta 7+50 to Sta. 10+50. Grades shown are top curb.

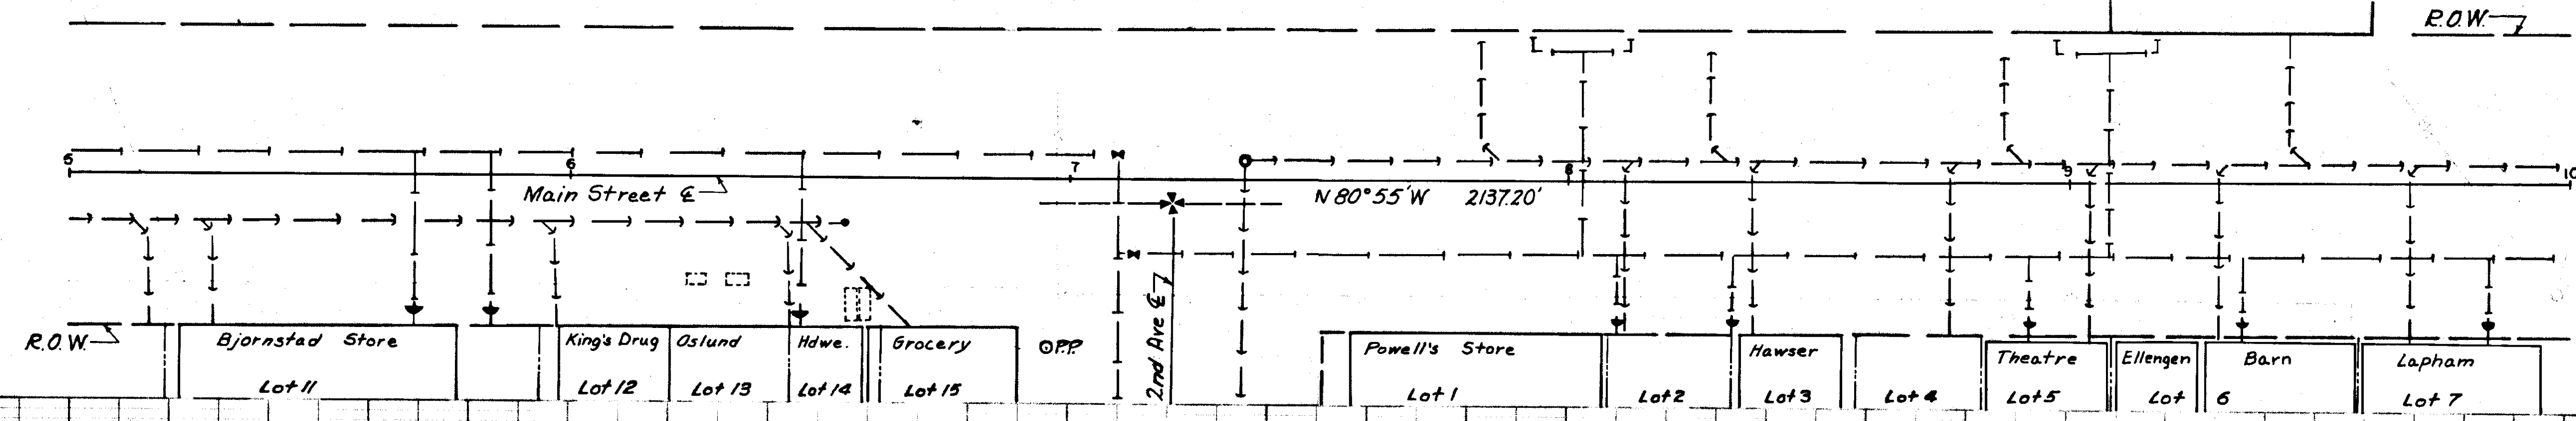

Note: See Sheet 3 for 2nd Ave. Details






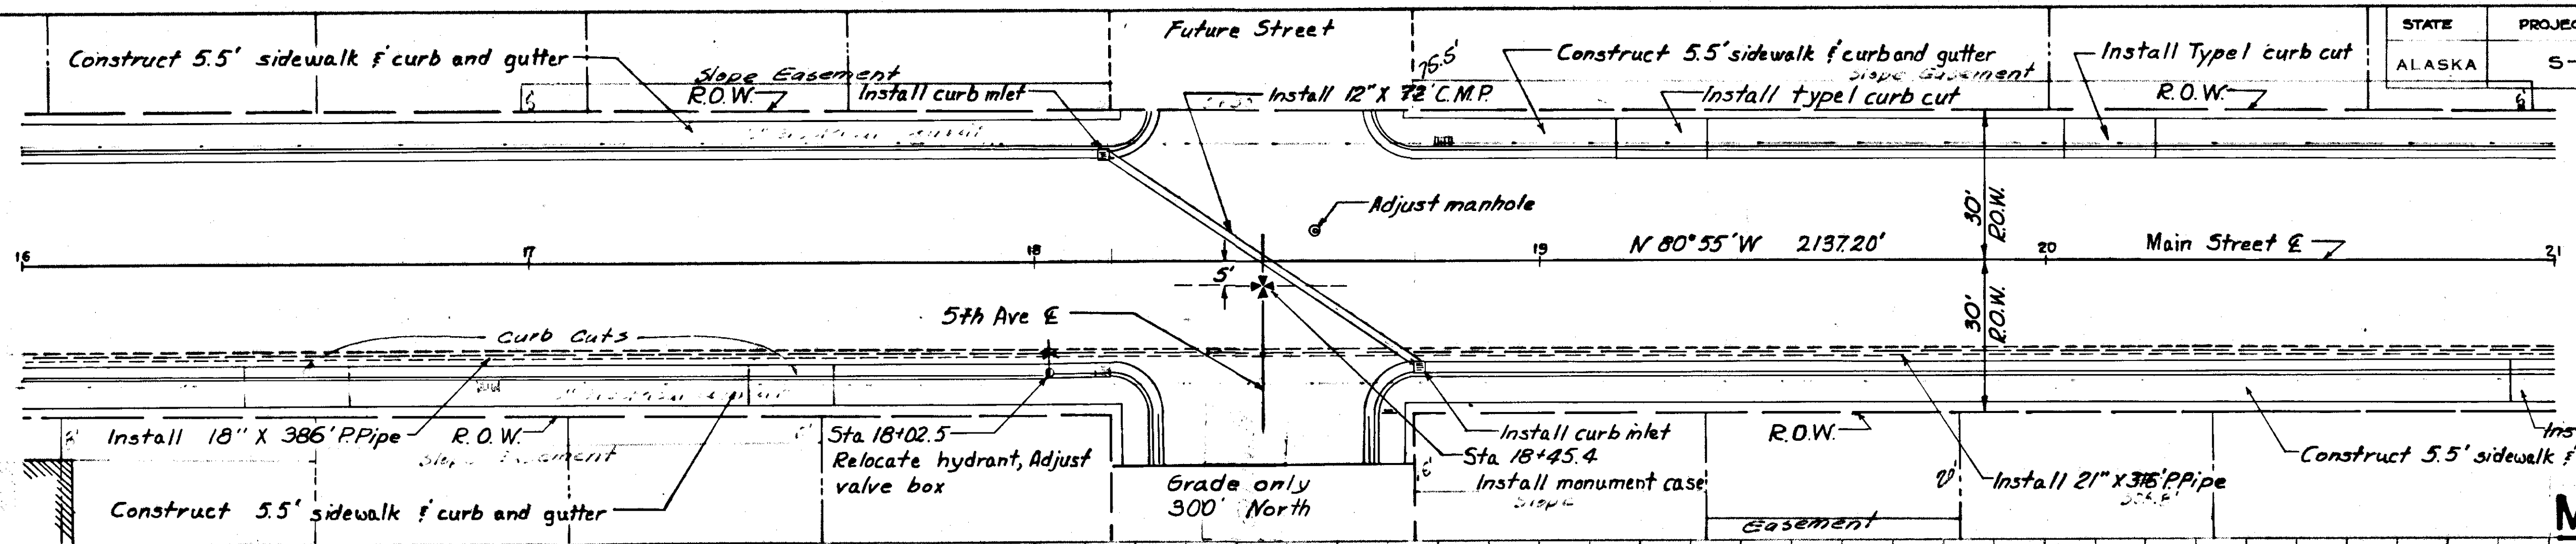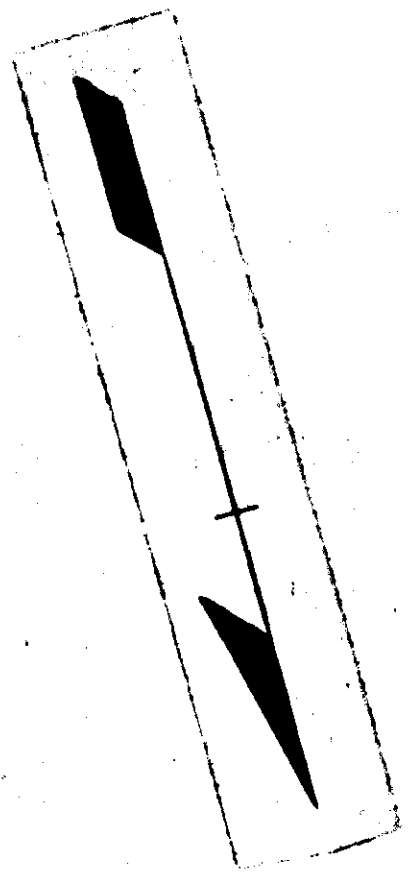

STATE	PROJECT DESIGNATION	YEAR	SHEET NO.	TOTAL SHEETS
ALASKA	S-0990(1)	1961	7	2






Note: A.C.S. Underground cable to be protected at all times. Relocation or adjustment of cable if needed, will be paid for under item 10. See below for approximate location AS BUILT

**MICROFILMED**

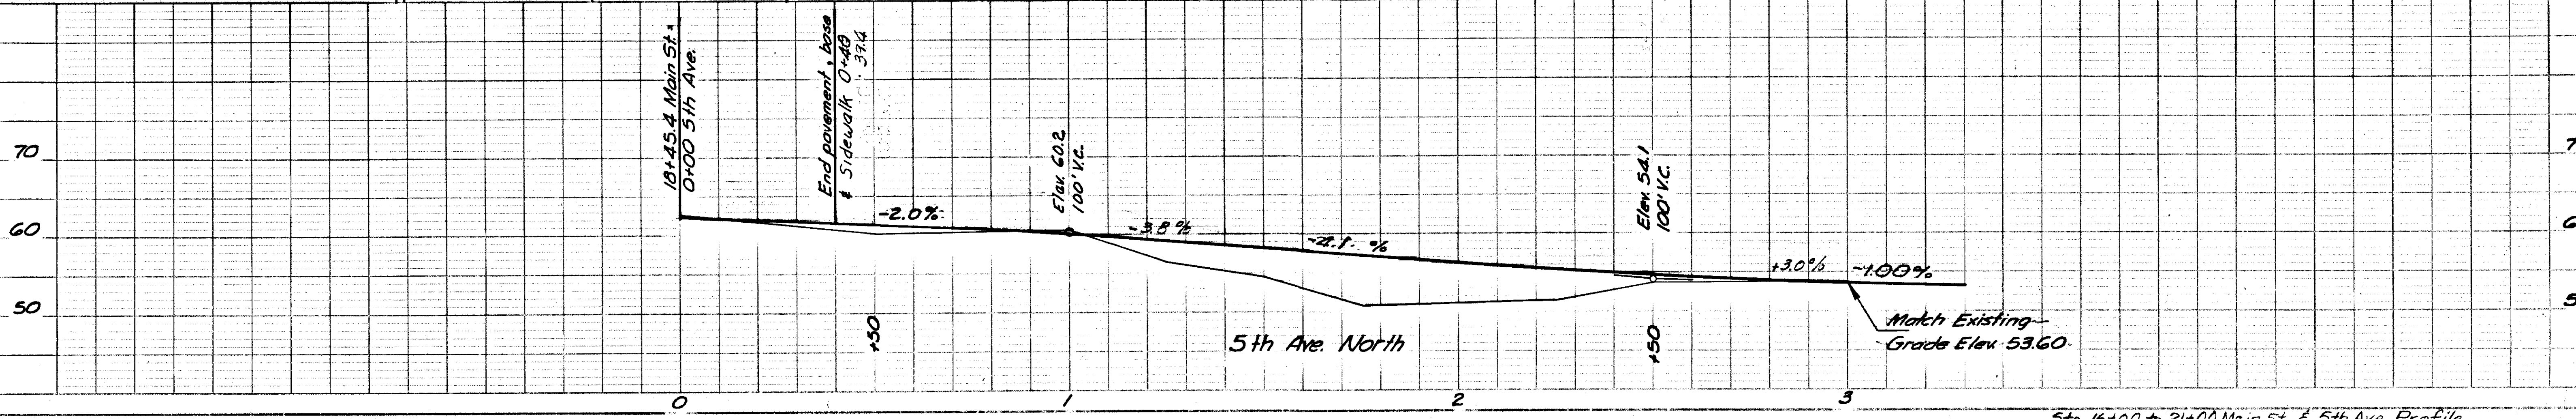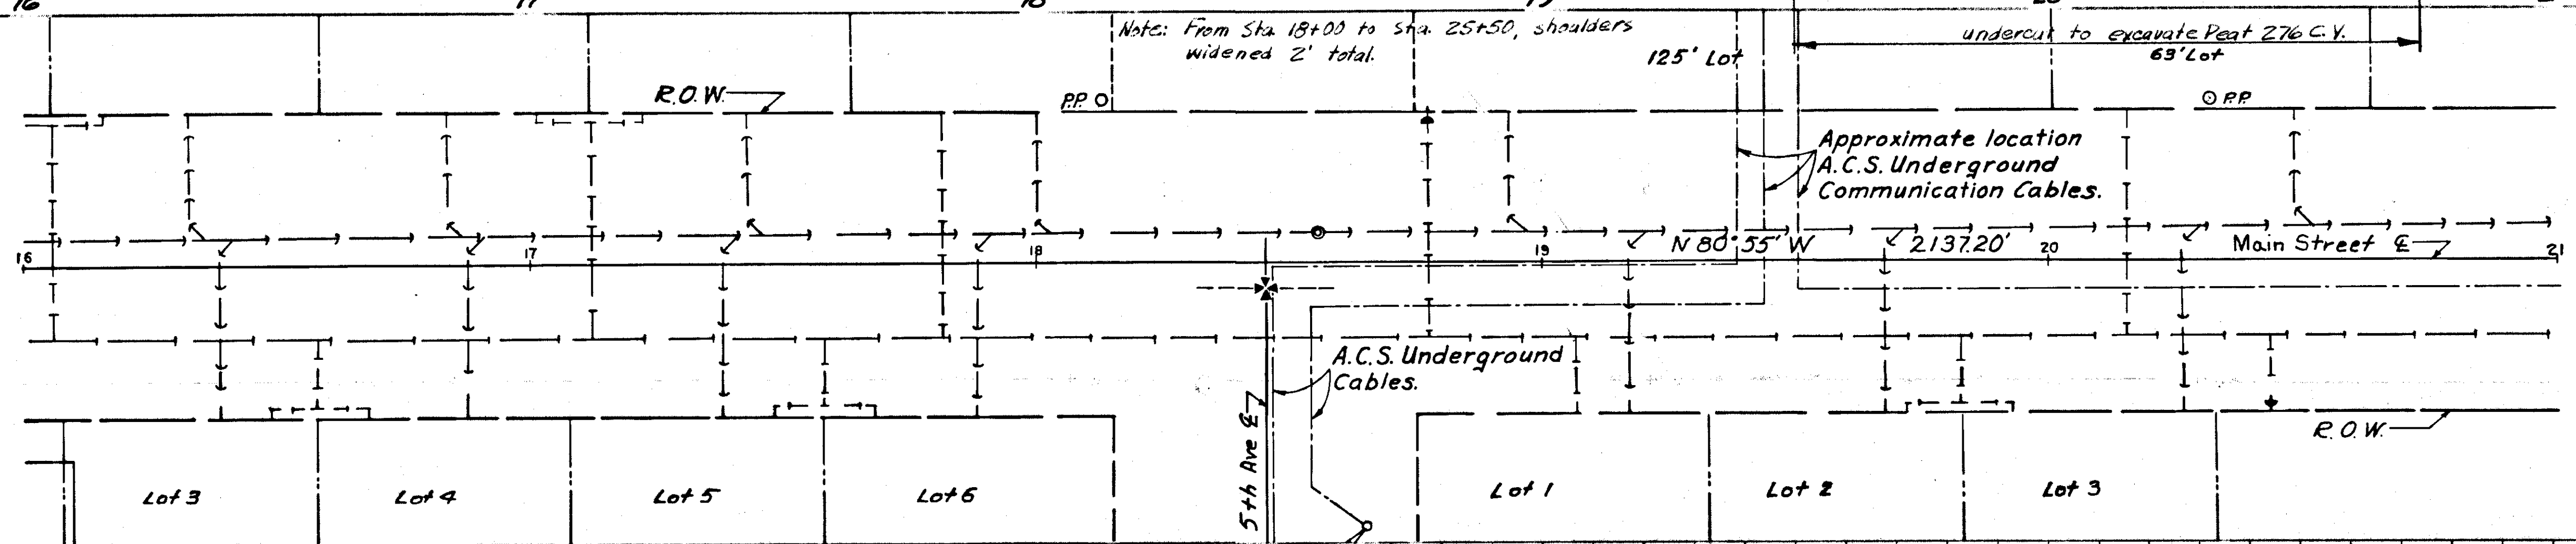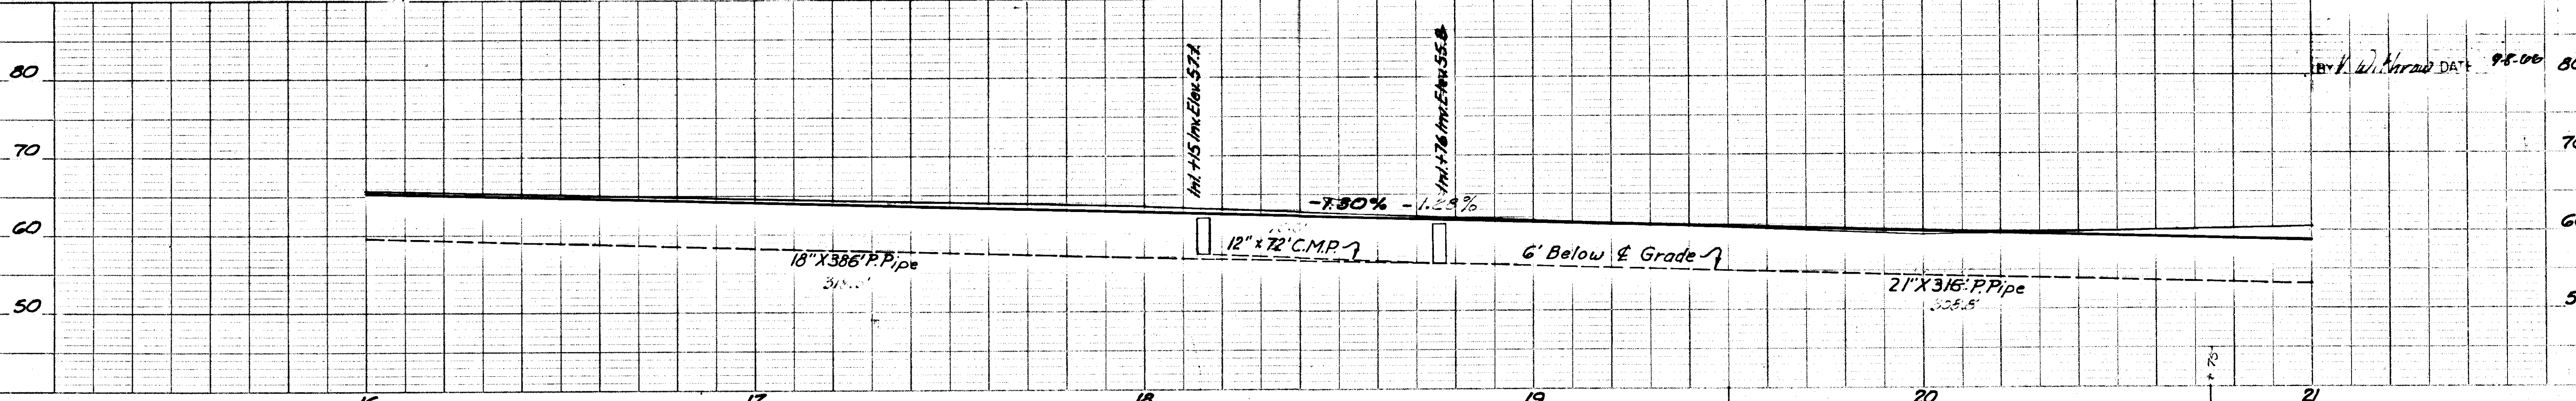

Sta 16+00 to 21+00 Main St. & 5th Ave Profile

STATE	PROJECT DESIGNATION	YEAR	SHEET NO.	TOTAL SHEETS
ALASKA	5-0990(1)	1961	8	26

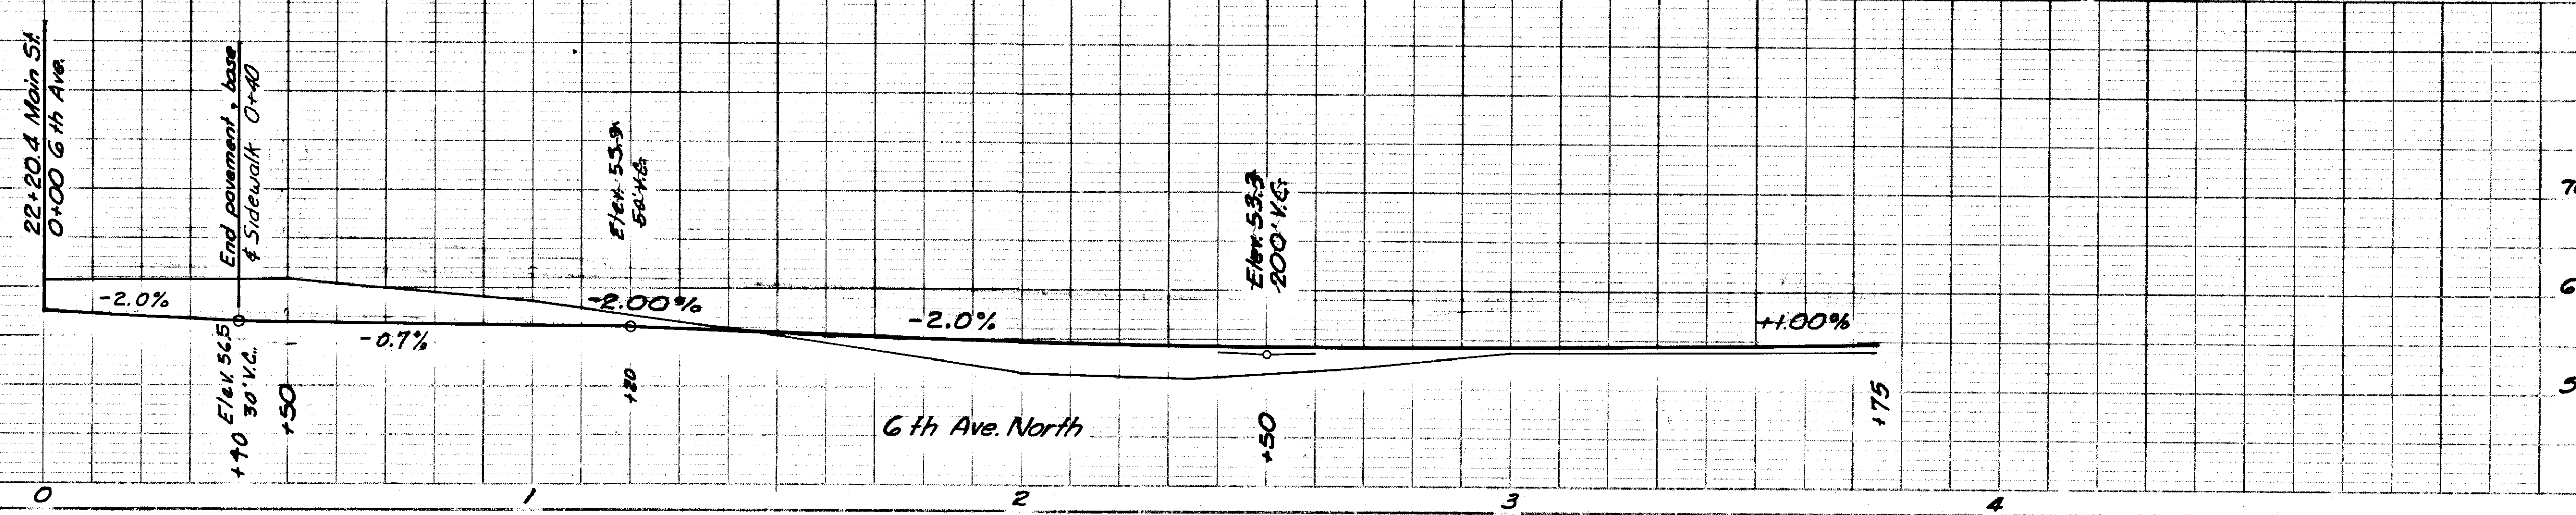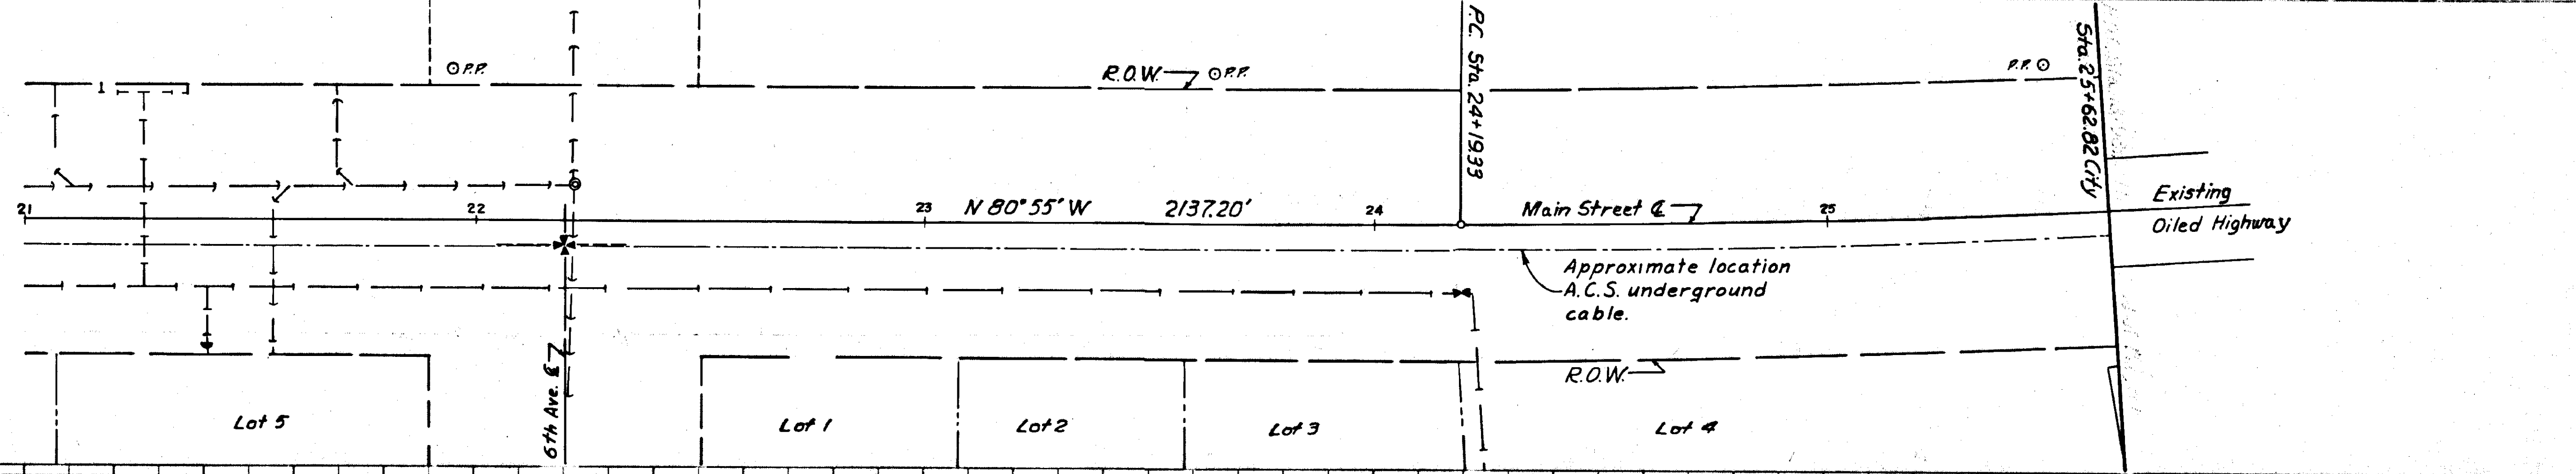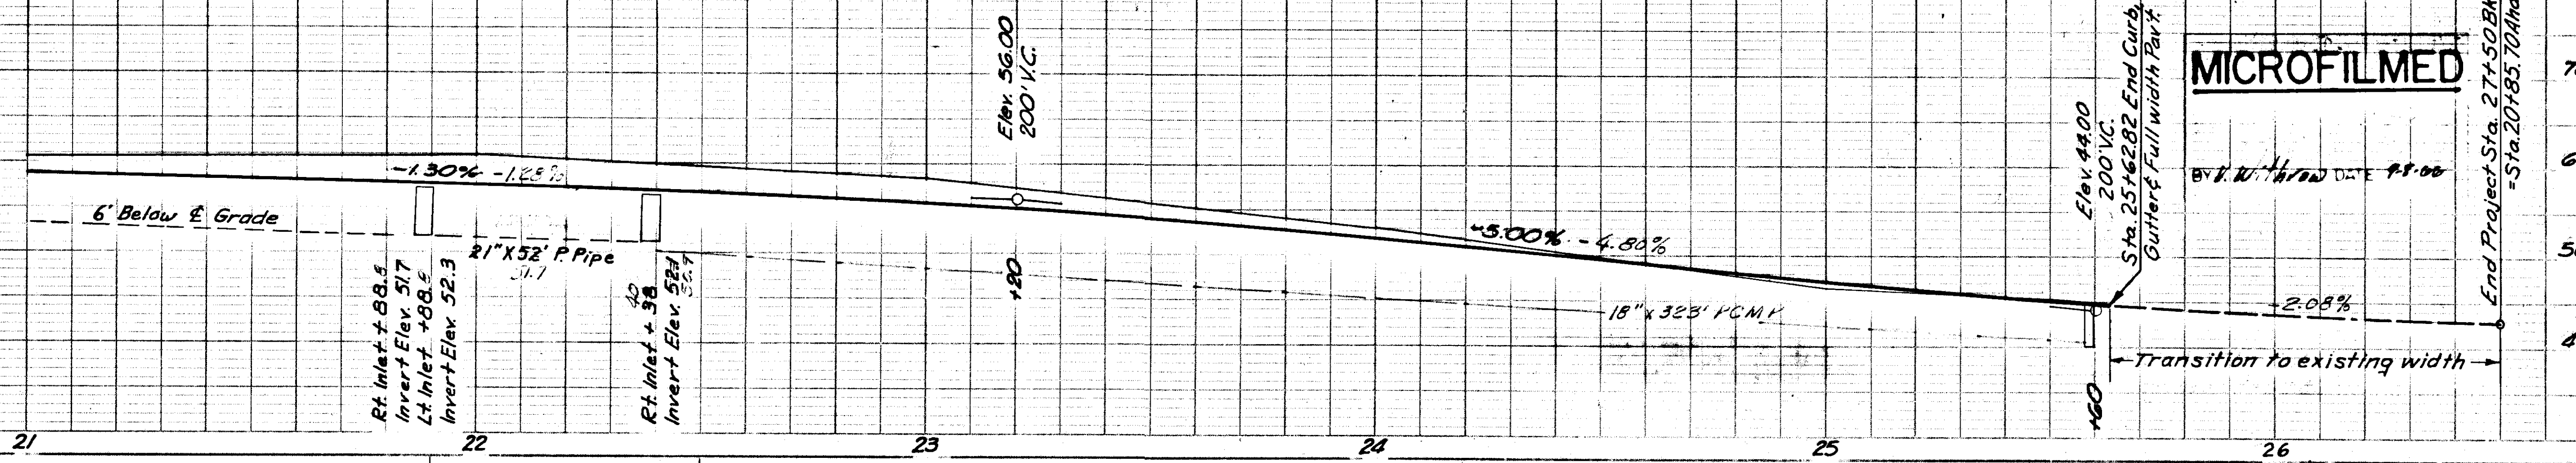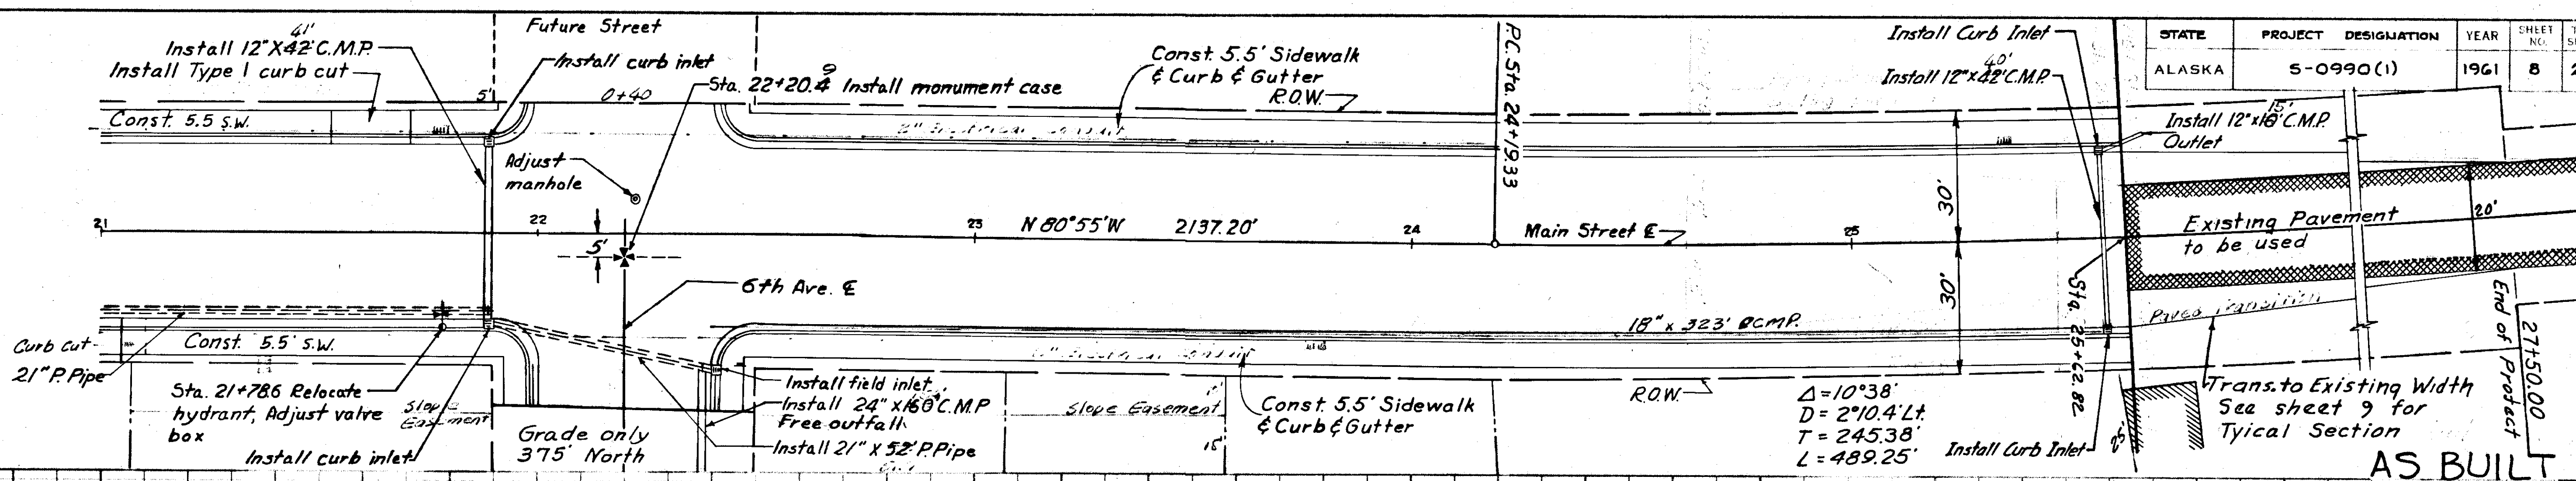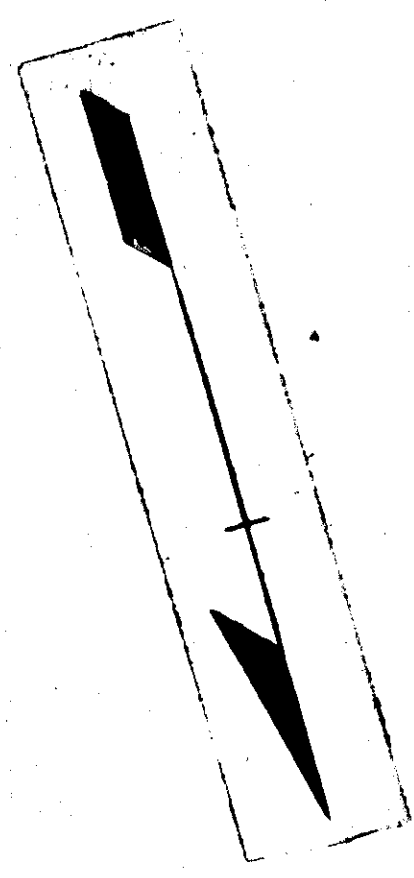

**MICROFILMED**

BY K. W. H. DATE 11-00


AS BUILT




STATE	PROJECT DESIGNATION	YEAR	SHEET NO.	TOTAL SHEETS
ALASKA	S-0990(1)	1961	9	26

SUMMARY OF EARTHWORK			
Station Limits	Unclassified Exc. Cu. Yds.	Borrow Exc. Case 2 Cu. Yds.	Filter Blanket Cu. Yds.
0+00 to 0+3+18.12	3586	1262	303
0+3+18.12 to 10+50	5026	3364	816
10+50 to 24+00	12,080	5801	1433
24+00 to 25+62.8	793	700	174
<b>2nd. Ave. North</b>			
	437	279	
<b>3rd. Ave. North</b>			
	512	557	
<b>3rd. Ave. South</b>			
	7	0	
<b>4th. Ave. North</b>			
	119	140	
<b>5th. Ave. North</b>			
	244	209	
<b>6th. Ave. North</b>			
	786	383	
<b>Front Street</b>			
	468	107	24

AS BUILT			
LOCATION OF CURB STOP BOXES			
Station	Left	Right	Size
0+2+90		28'	2"
3+38	25'		4 1/4"
"0+3+51.31 P.O.T = 2+82.13 P.T			
2+97		28'	2"
3+48		28'	2"
3+65	25'		2"
4+06		27'	2"
4+37	25'		2"
4+47		28'	2"
4+76		27'	2"
5+69		27'	2"
5+84		27'	2"
6+46		27'	2"
8+10		28'	2"
8+33		28'	2"
8+92		28'	2"
9+35		28'	2"
9+84		28'	2"
10+32		28'	2"
10+35	28'		2"
11+52		28'	2"
11+92		28'	2"
12+24	28'		2"
12+29		28'	2"
13+13		28'	2"
13+58		28'	2"
15+23	28'		2"
15+25		28'	2"
15+85		28'	2"
18+77	28'		2"
20+44		28'	2"
21+40		28'	2"

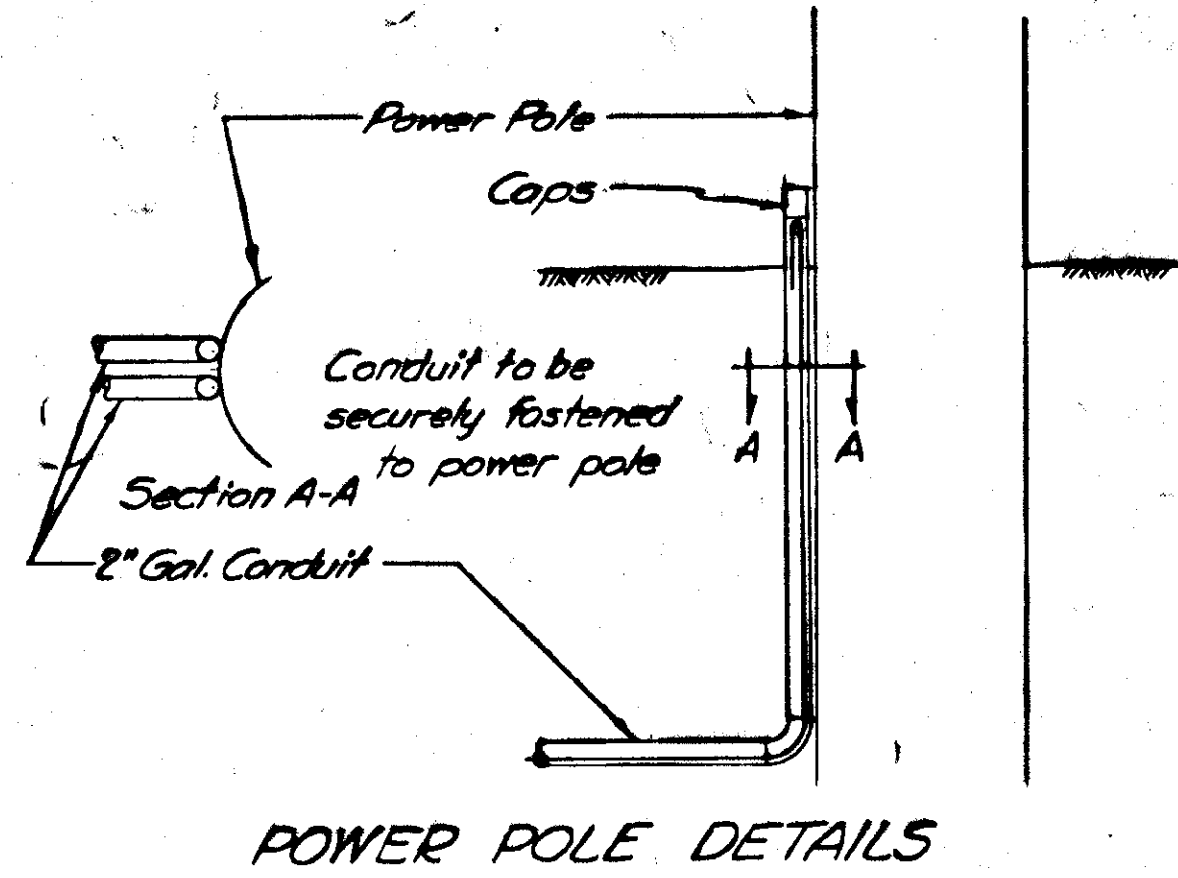


STREET LIGHTING PLANS DETAILS & RETAINING WALL DETAIL

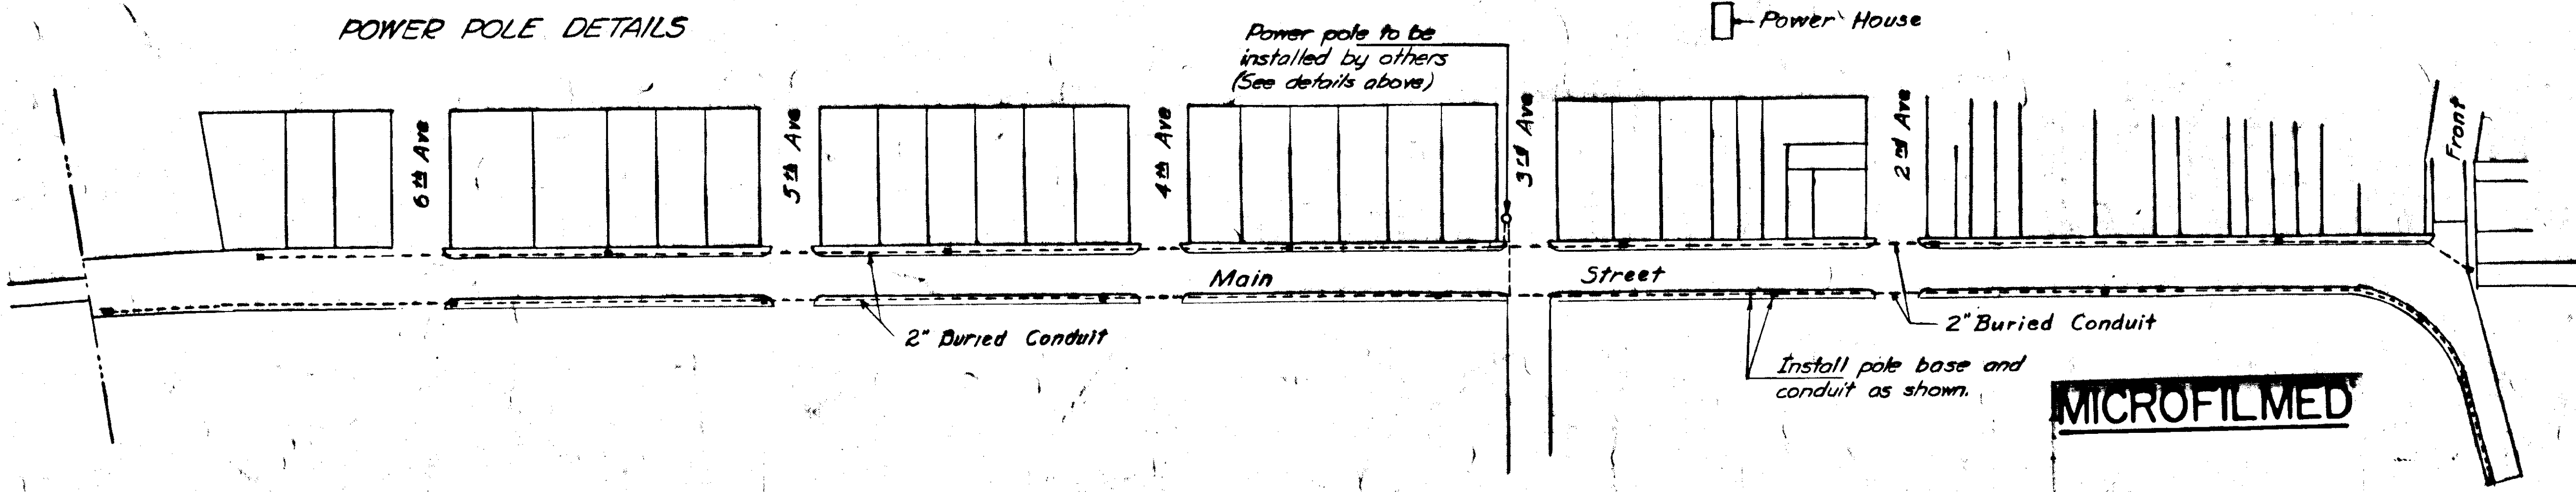


Plan for Mercury Vapor Ovalite Luminaires


LIGHT POLE LOCATIONS	
Left	Right
0+00	0+2+25
"G" 1+86	3+20
5+00	6+90
8+50	10+00
11+90	13+40
15+30	16+90
18+70	20+40
21+90	23+80
25+45	

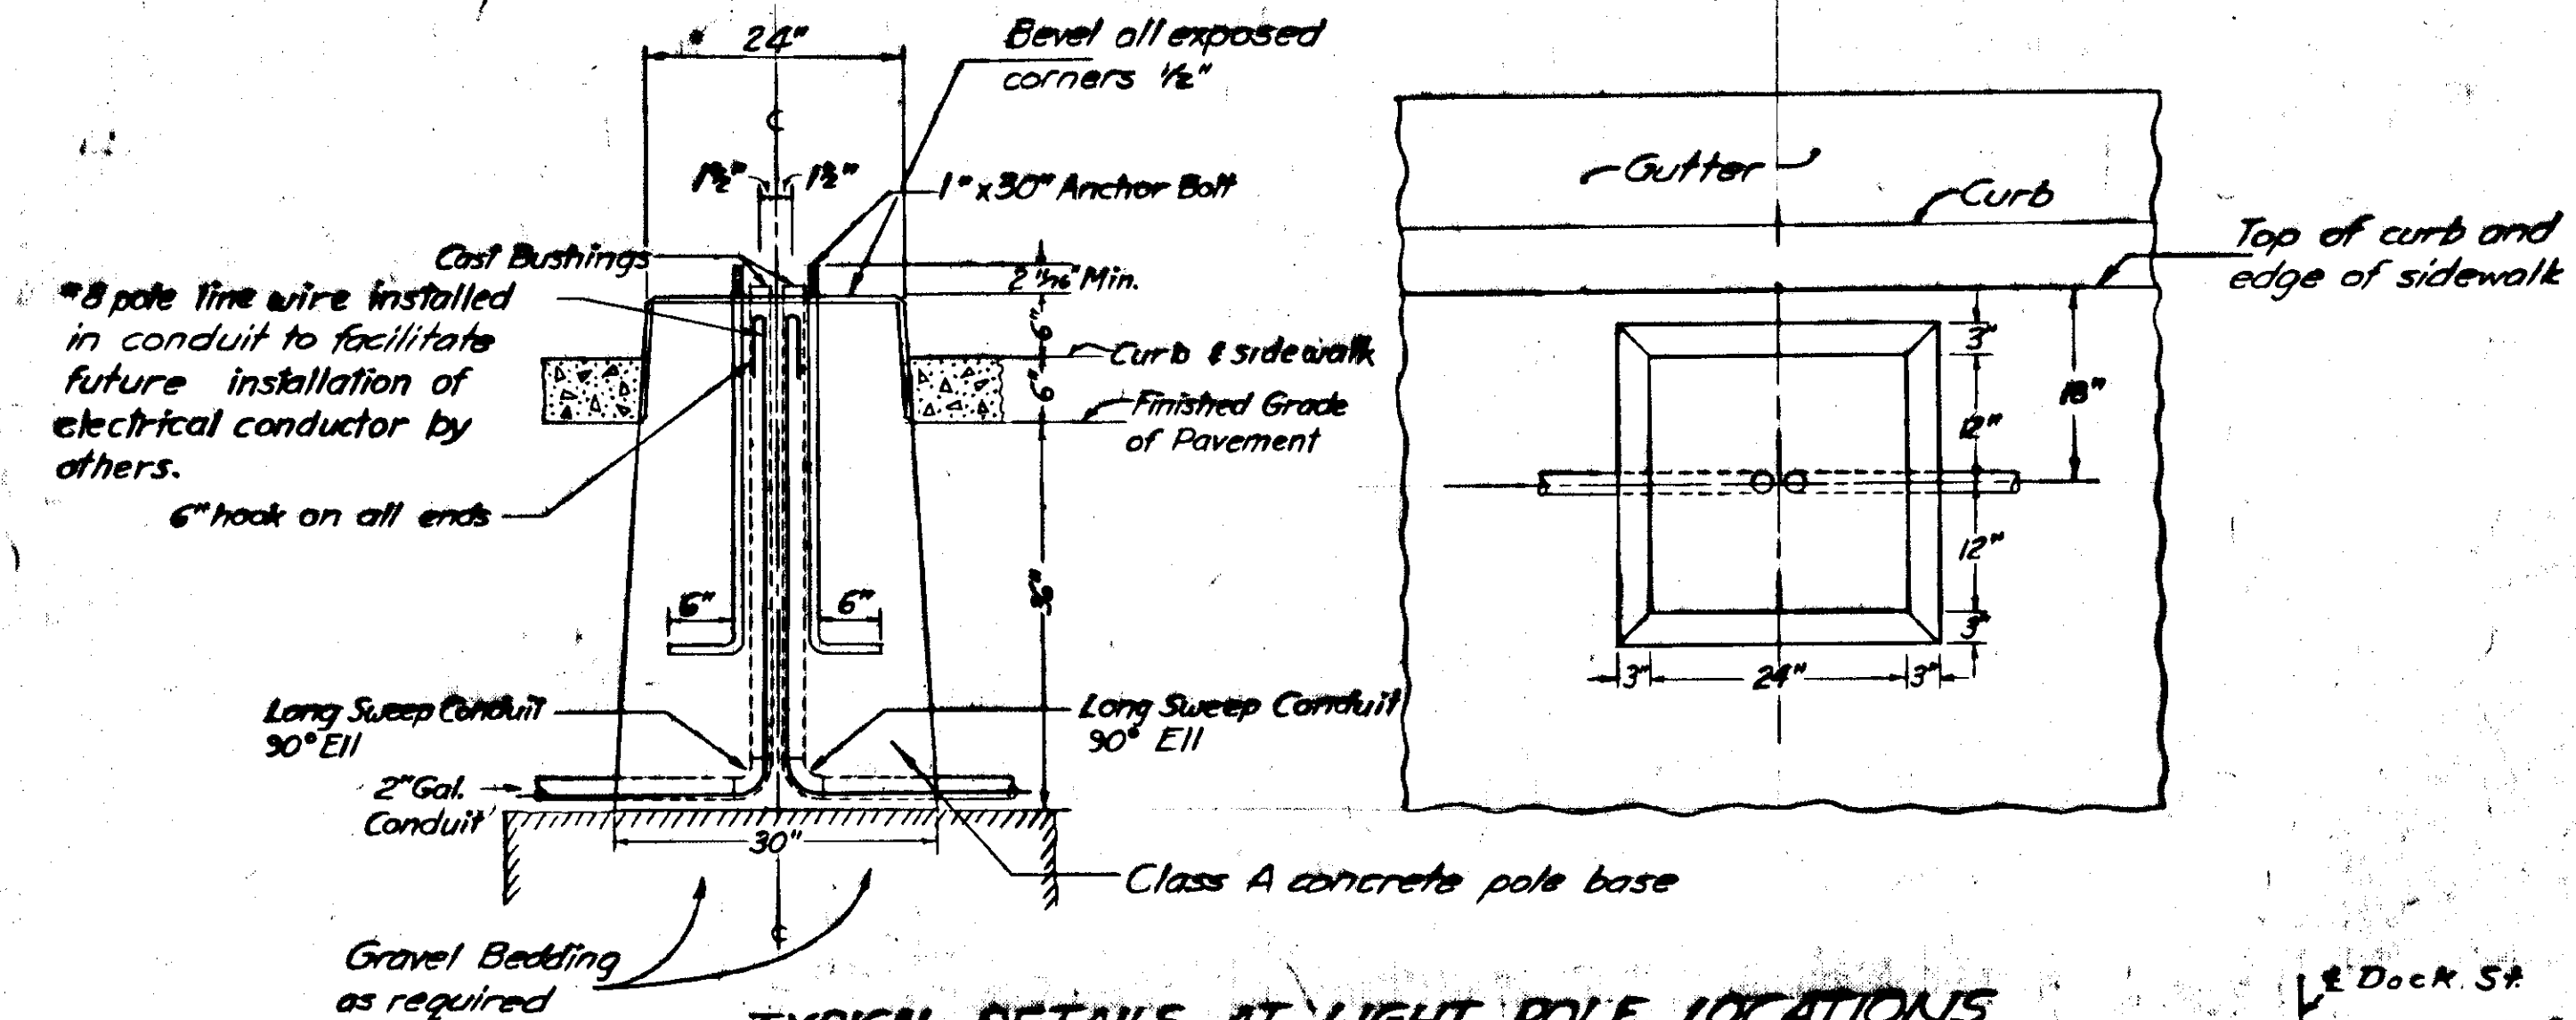

TYPICAL DETAILS AT LIGHT POLE LOCATIONS  
NOTE: All conduit to be 2" Rigid Screwed Galvanized-Sherardized. Anchor bolt template to be furnished by the Engineer.

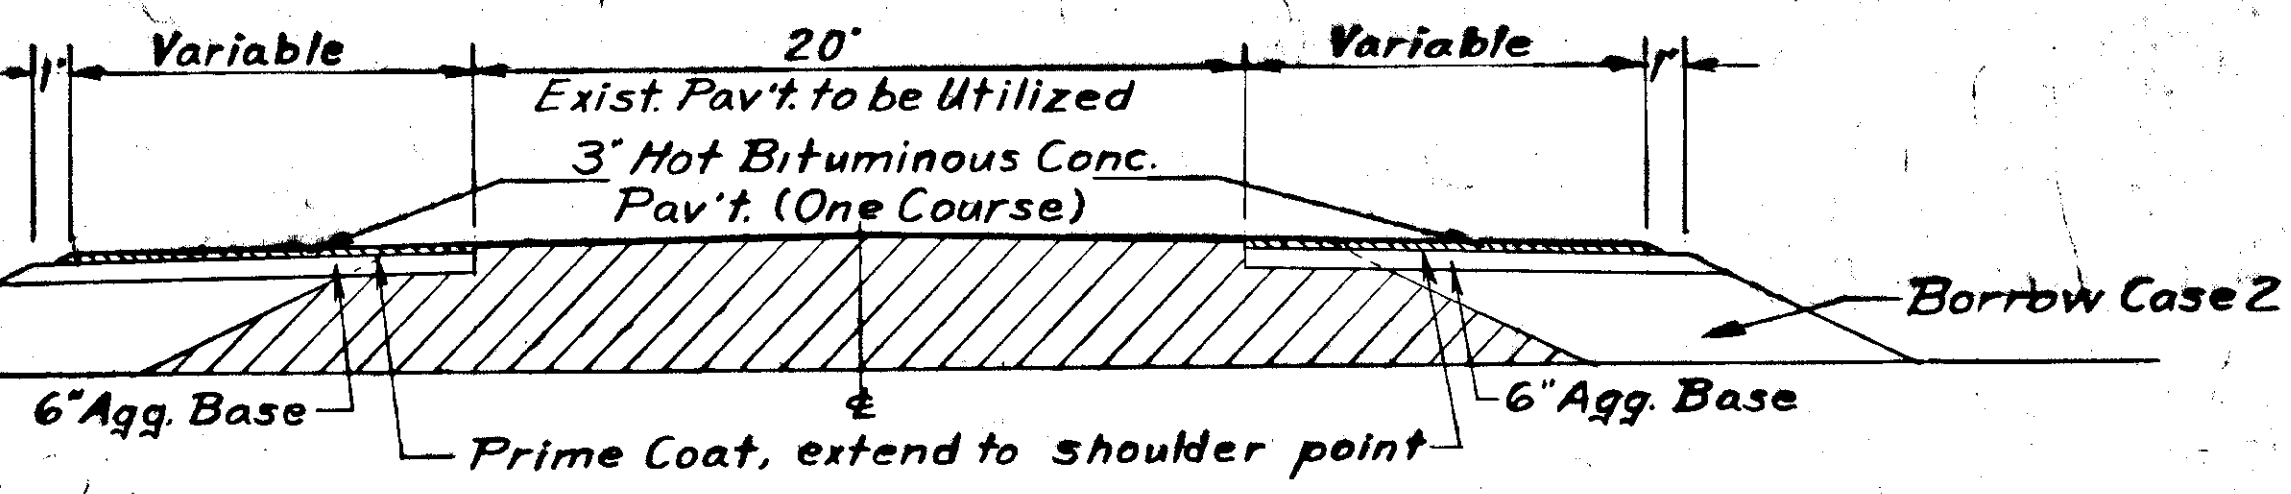

Sta. 25+62.82 to Sta. 27+50, Transition to 20' Width  
TYPICAL STREET SECTION

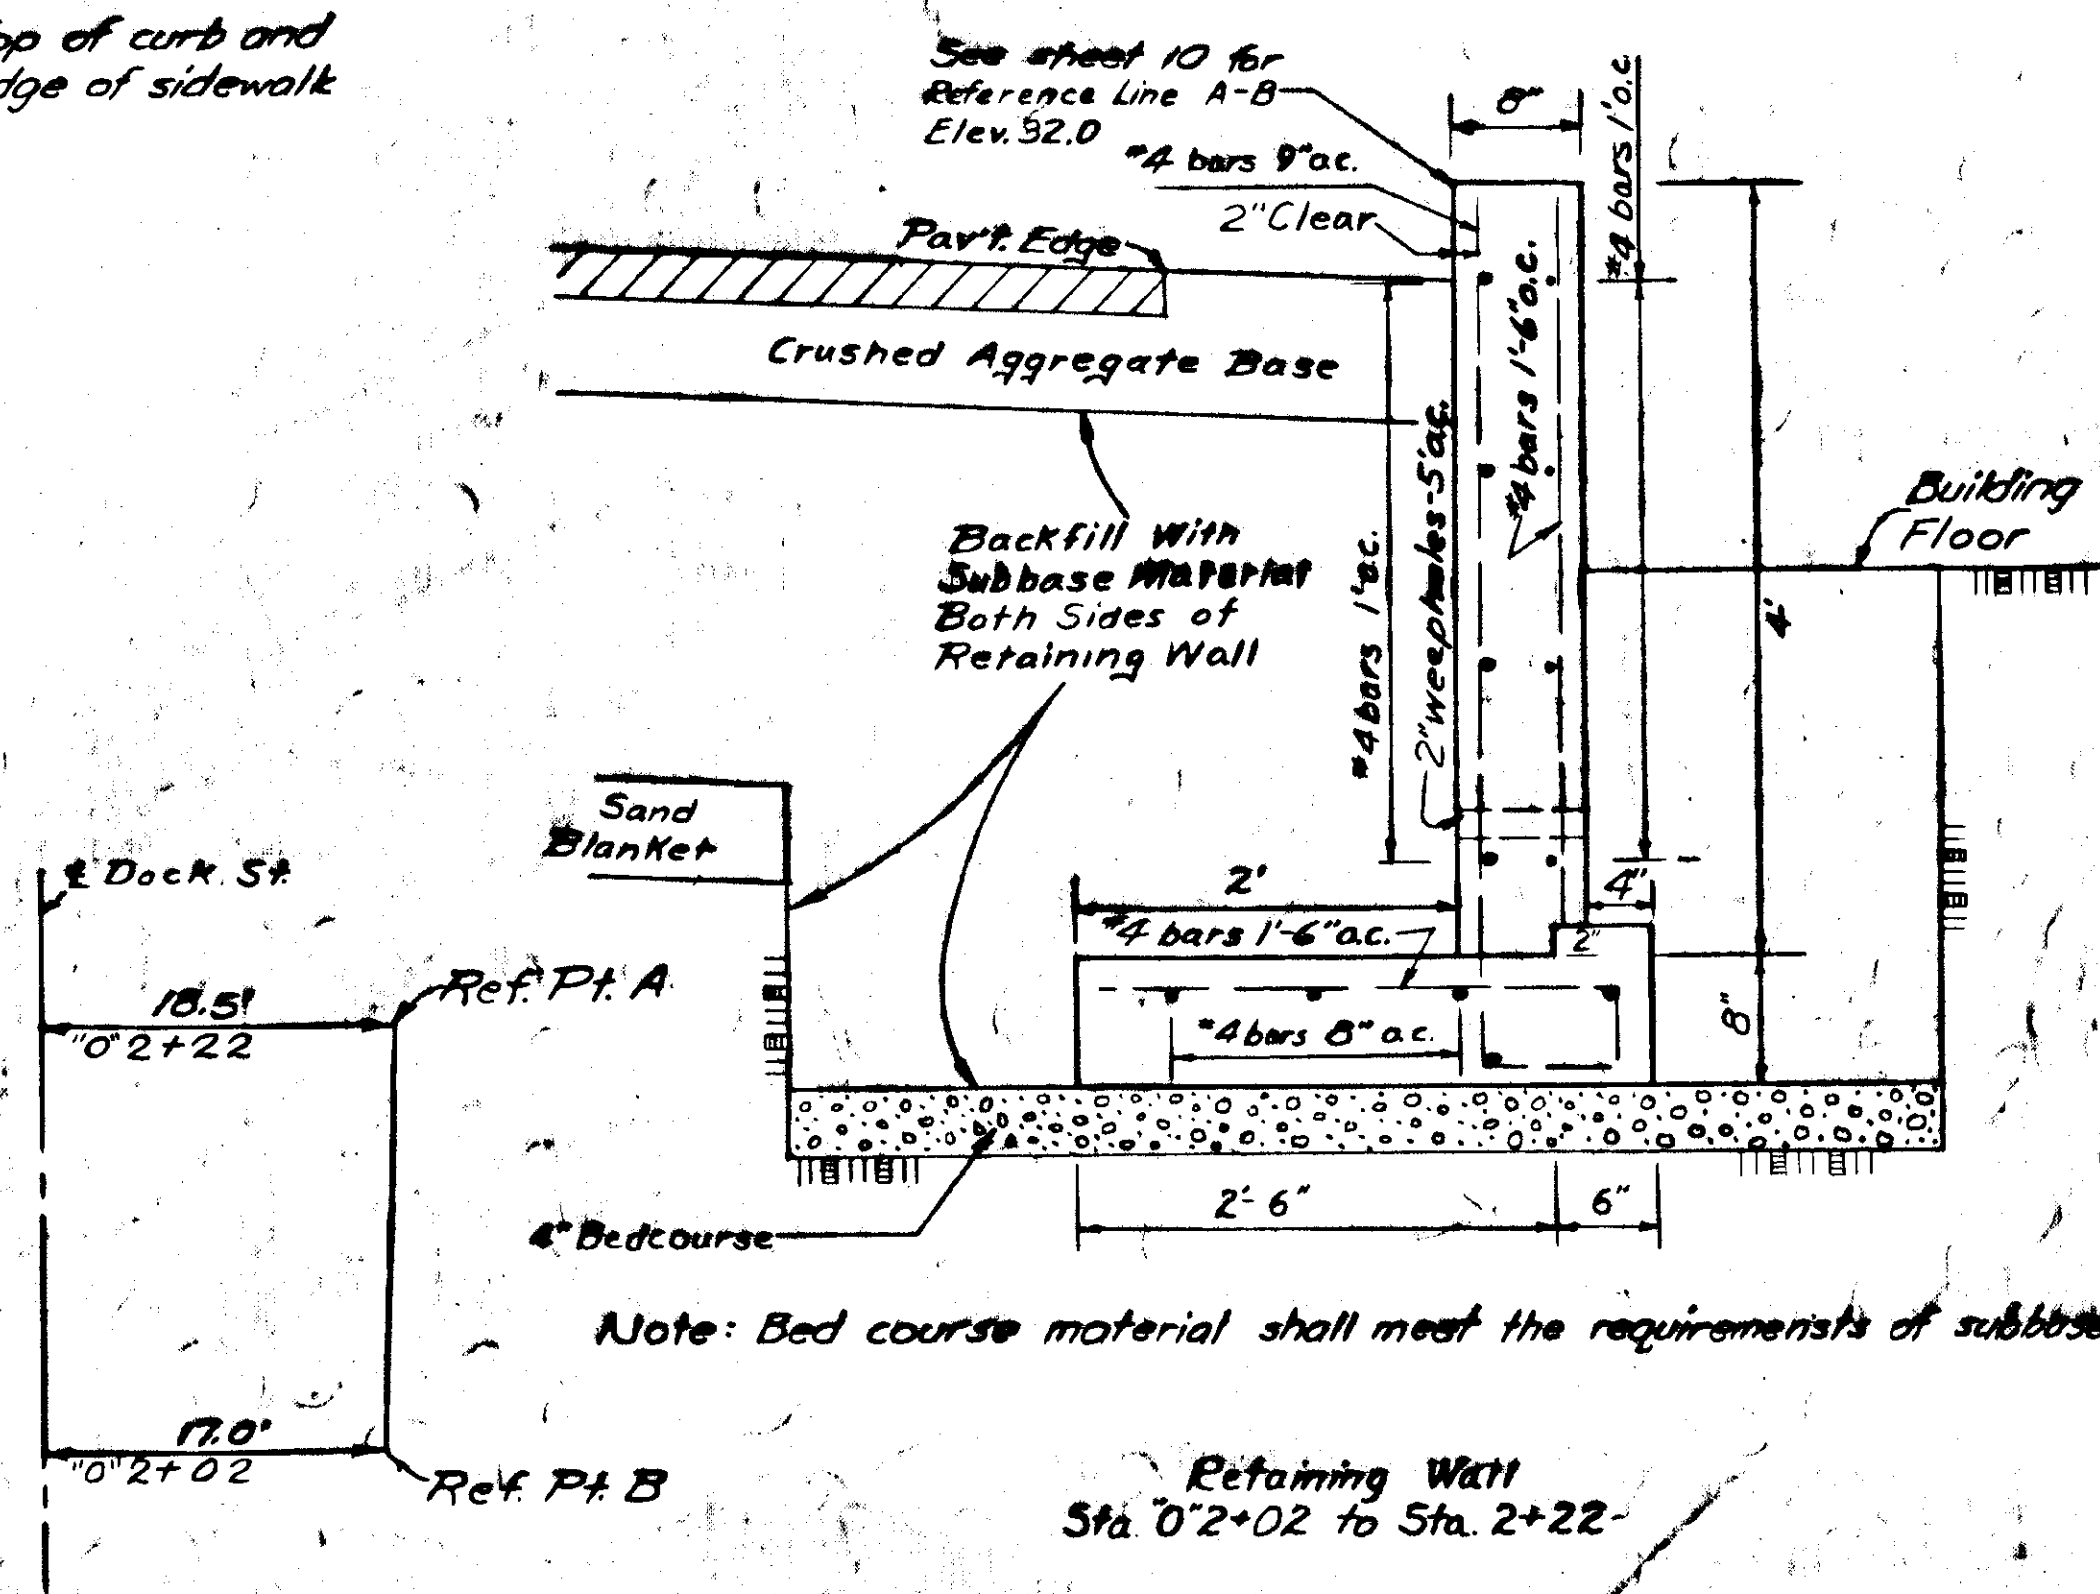


RETAINING WALL LOCATION  
Street lighting & Retaining Wall Details


STATE	PROJECT DESIGNATION	YEAR	SHEET NO.	TOTAL SHEETS
ALASKA	S-0990(1)	1961	10	26

**MICROFILMED AS BUILT**

BY *V. W. Withrow* DATE 9-5-06

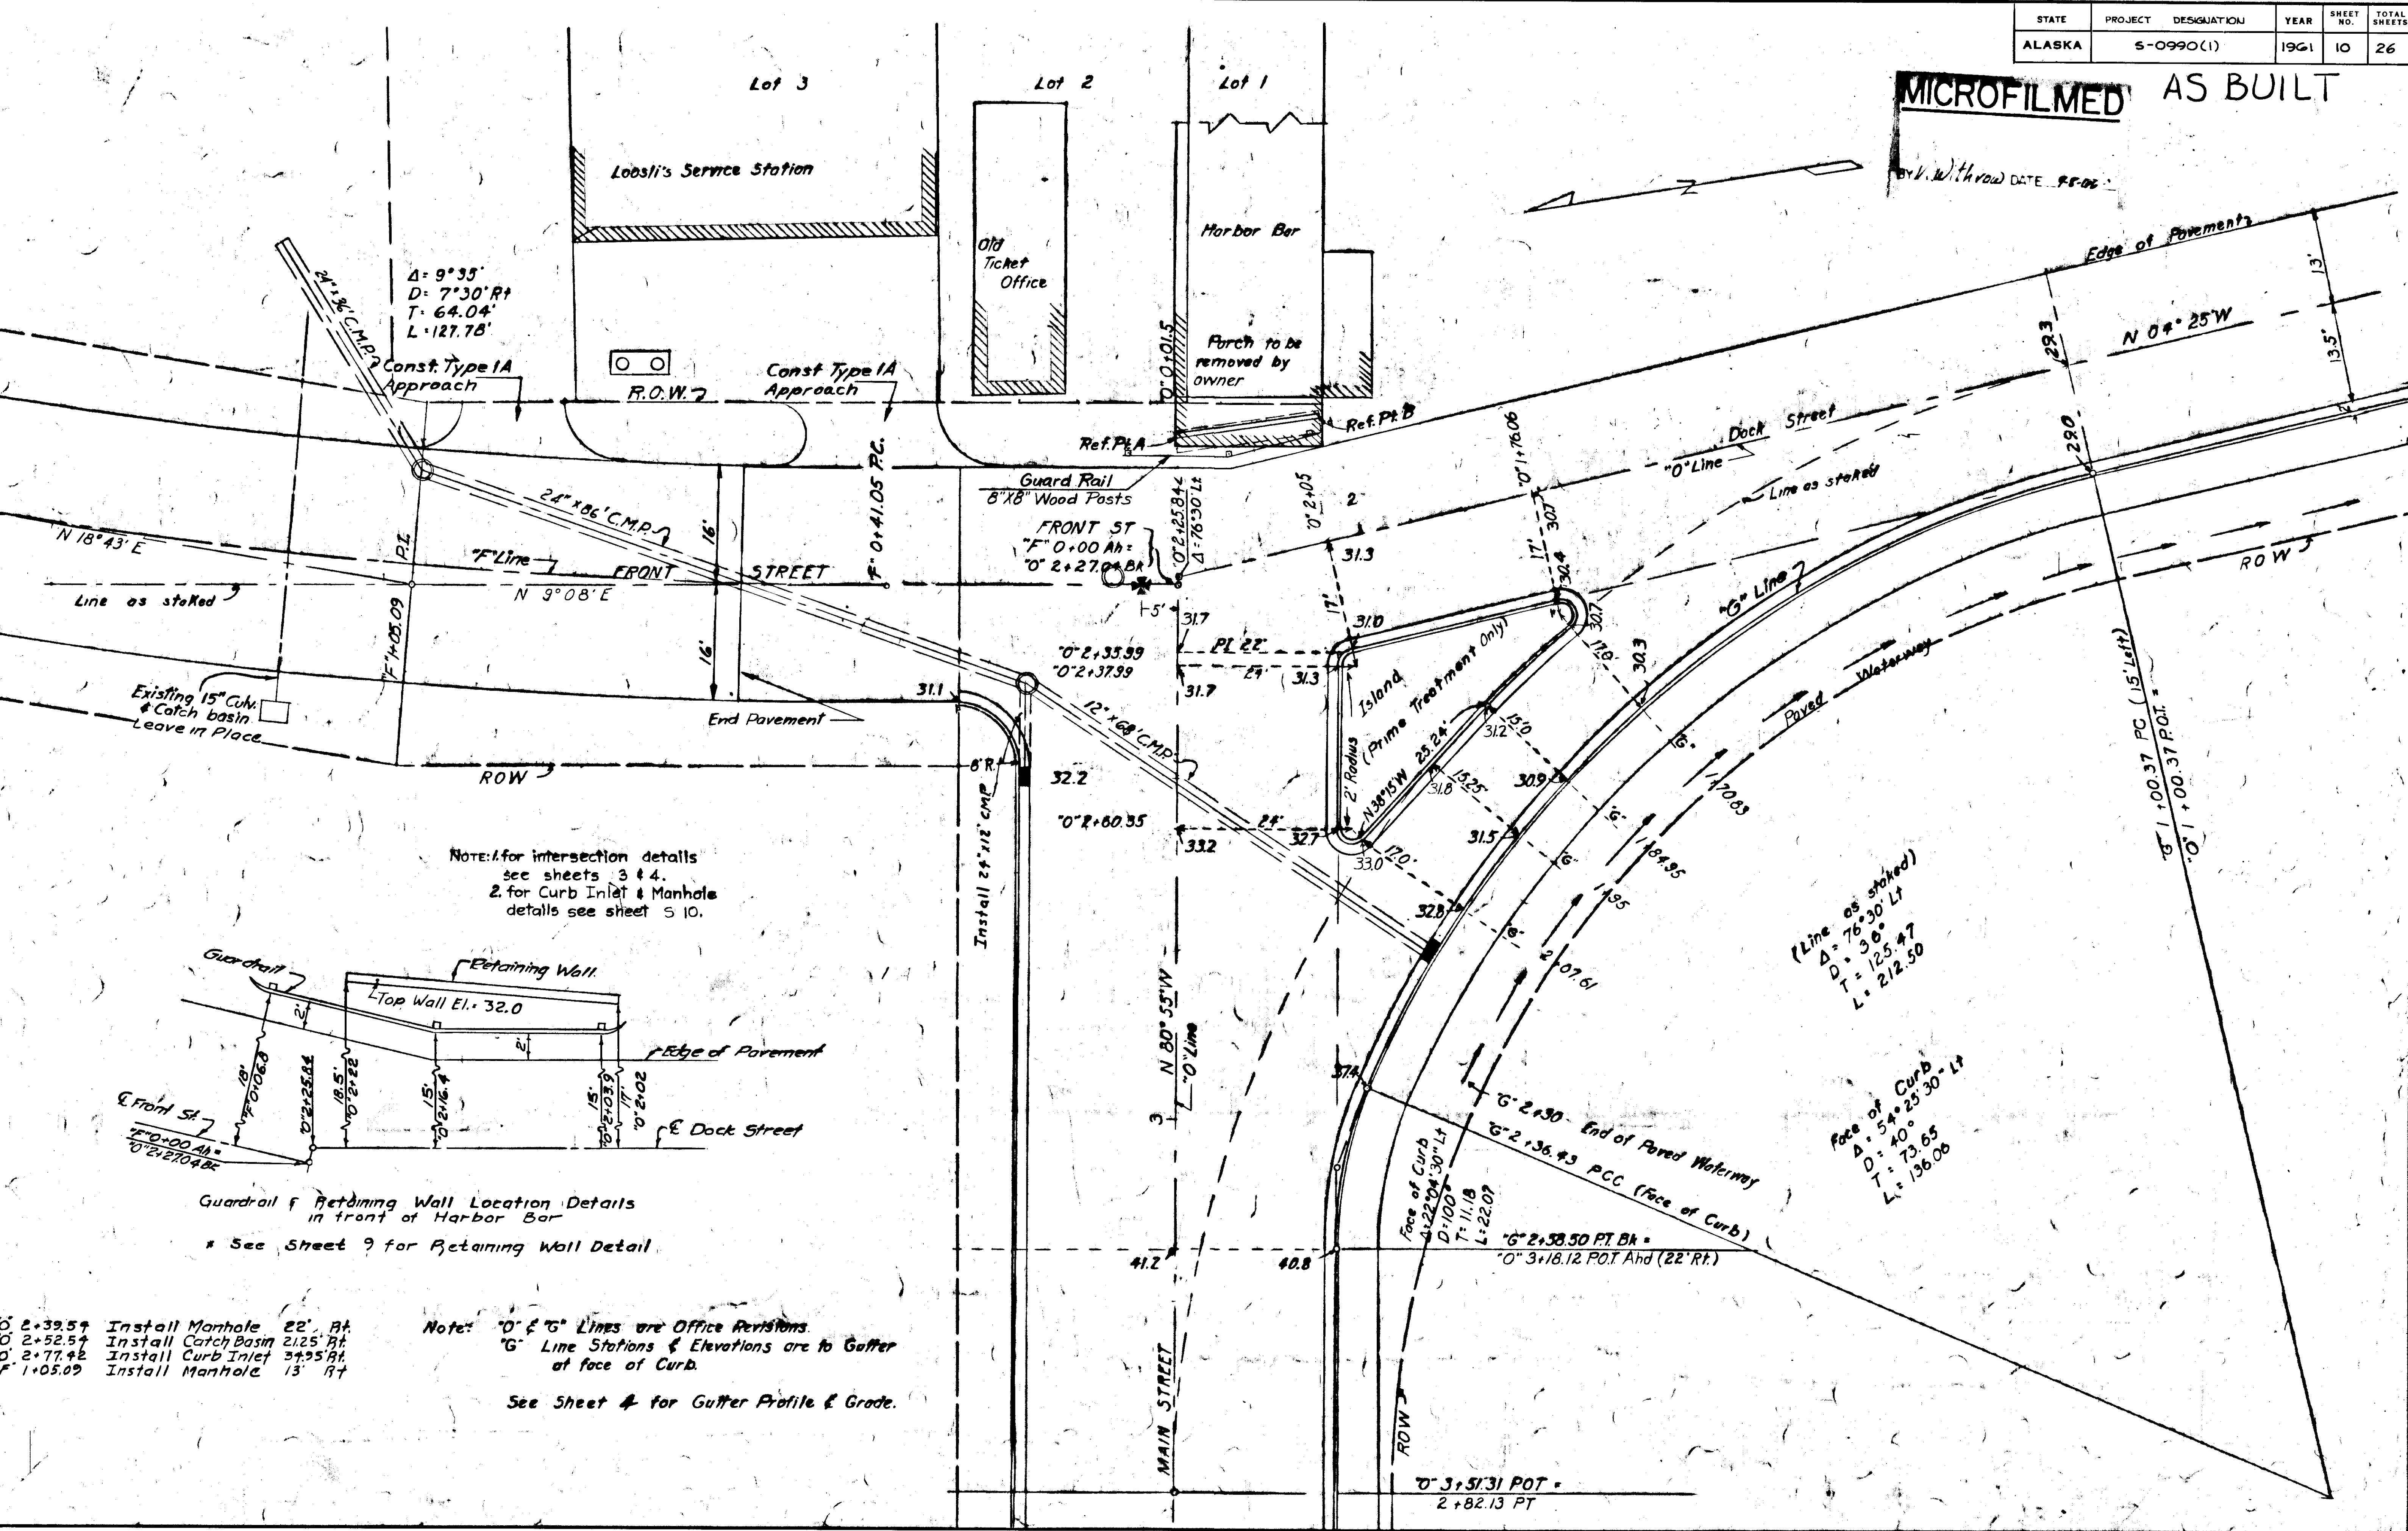

NOTE: 1. for intersection details see sheets 3 & 4.  
2. for Curb Inlet & Manhole details see sheet 5 10.

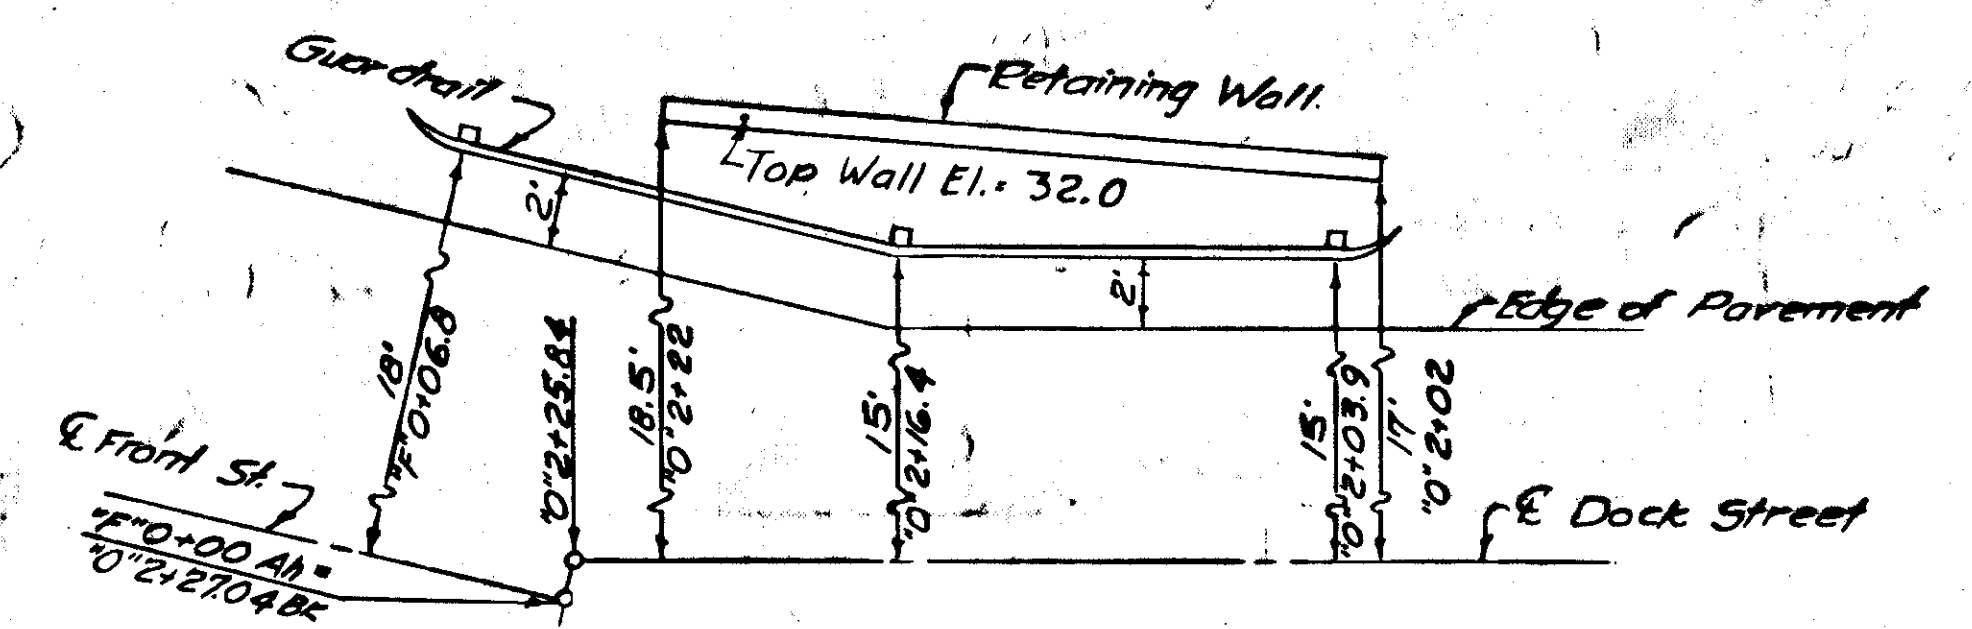

Guardrail & Retaining Wall Location Details in front of Harbor Bar  
\* See Sheet 9 for Retaining Wall Detail

- 0+39.57 Install Manhole 22' Rt
- 0+52.57 Install Catch Basin 2125' Rt
- 0+77.42 Install Curb Inlet 3+95' Rt
- F+1.05.09 Install Manhole 13' Rt

Note: "O" & "G" Lines are Office Revisions.  
"G" Line Stations & Elevations are to Gutter at face of Curb.

See Sheet 4 for Gutter Profile & Grade.


(Line as staked)  
D = 76.30' Lt  
T = 30.0'  
L = 125.47  
L = 212.50

Face of Curb  
D = 54.30' Lt  
D = 40.0'  
T = 73.65  
L = 136.06

AS BUILT





MICROFILMED

Withdrawal DATE 9-8-66

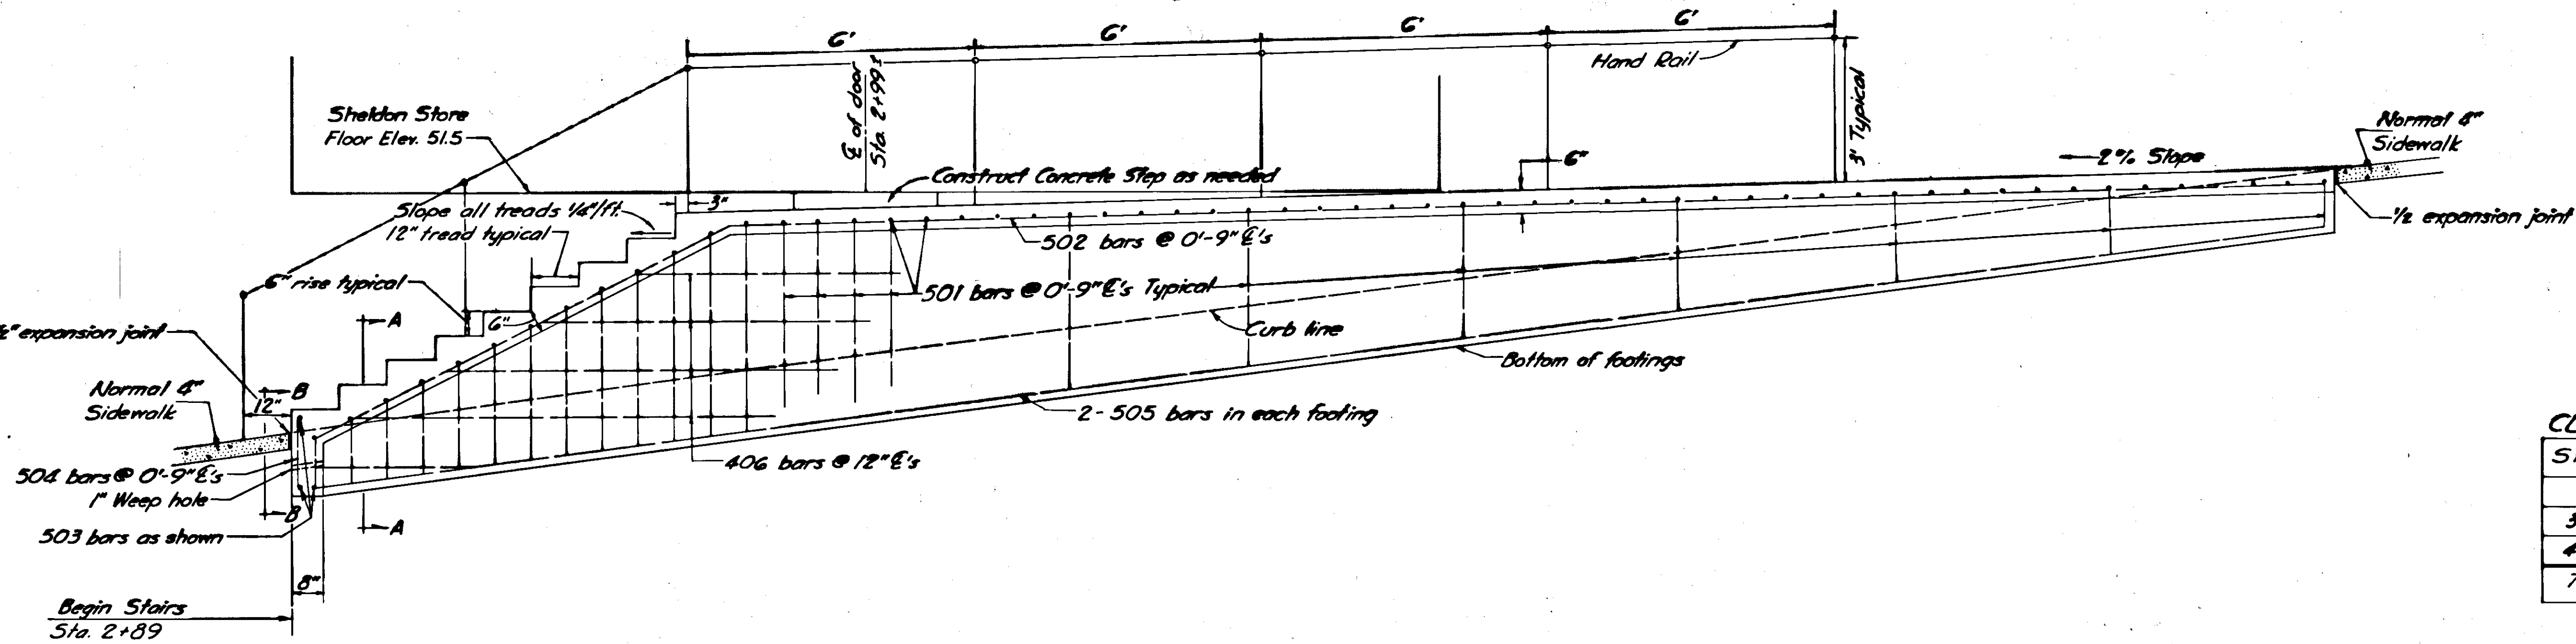

**CLASS A CONCRETE**

Station	Cubic Yards
2+99	12
3+59.5	4
4+43.5	6
Total	22

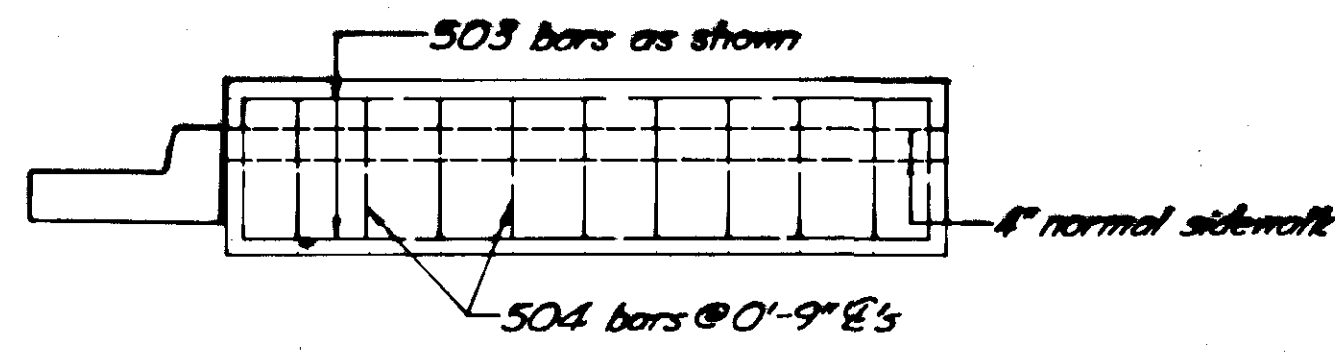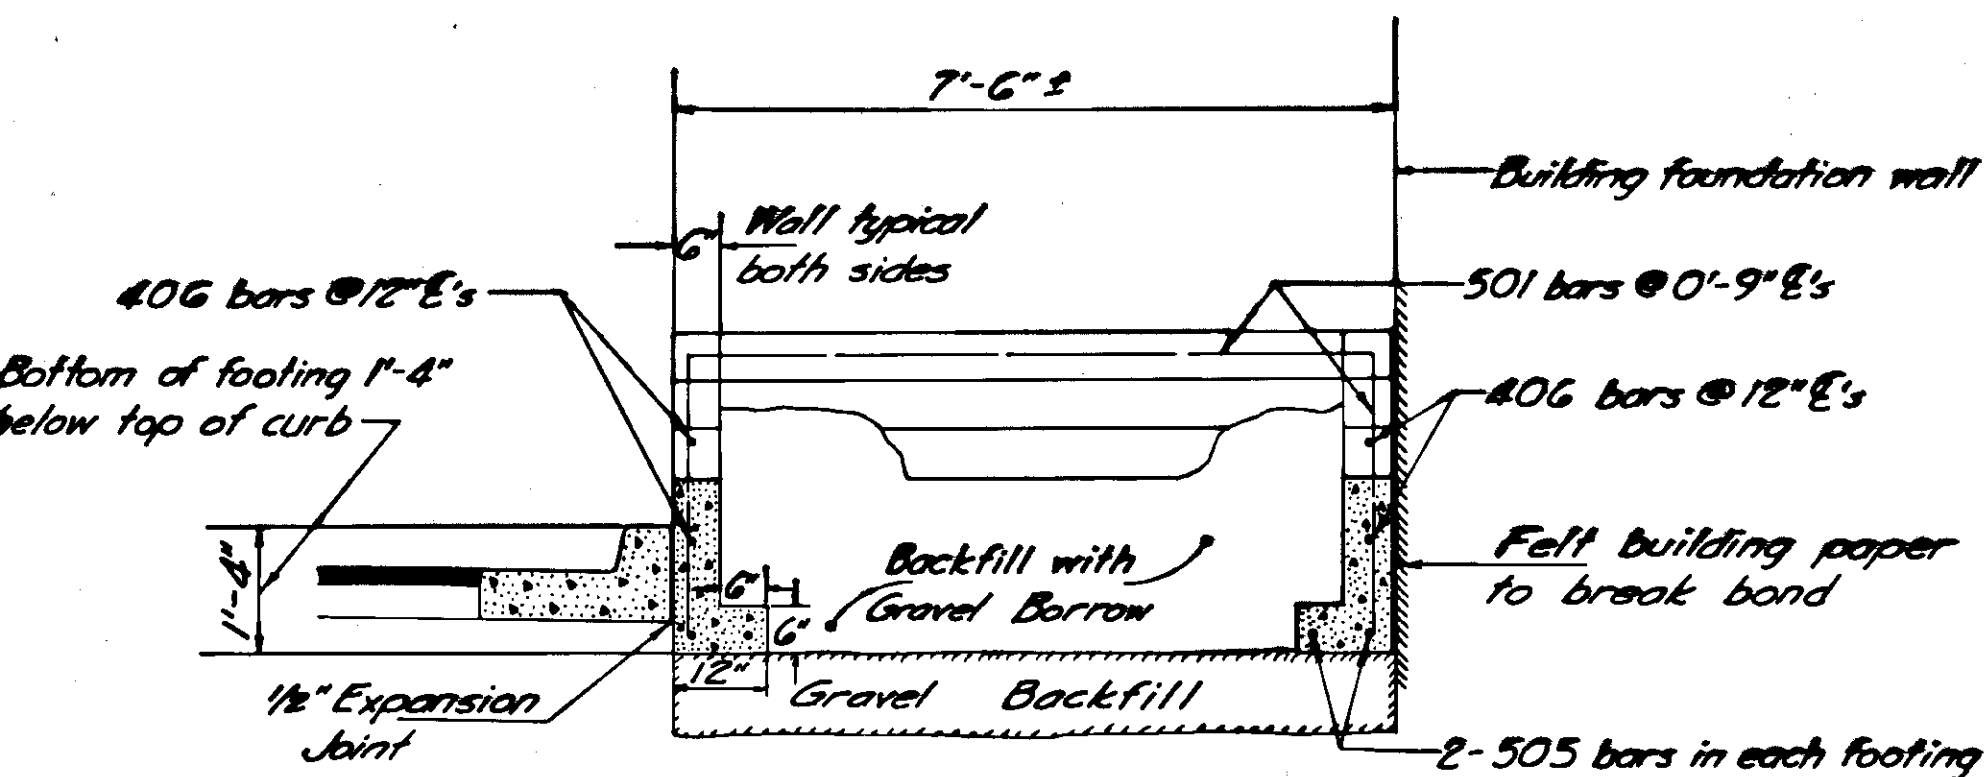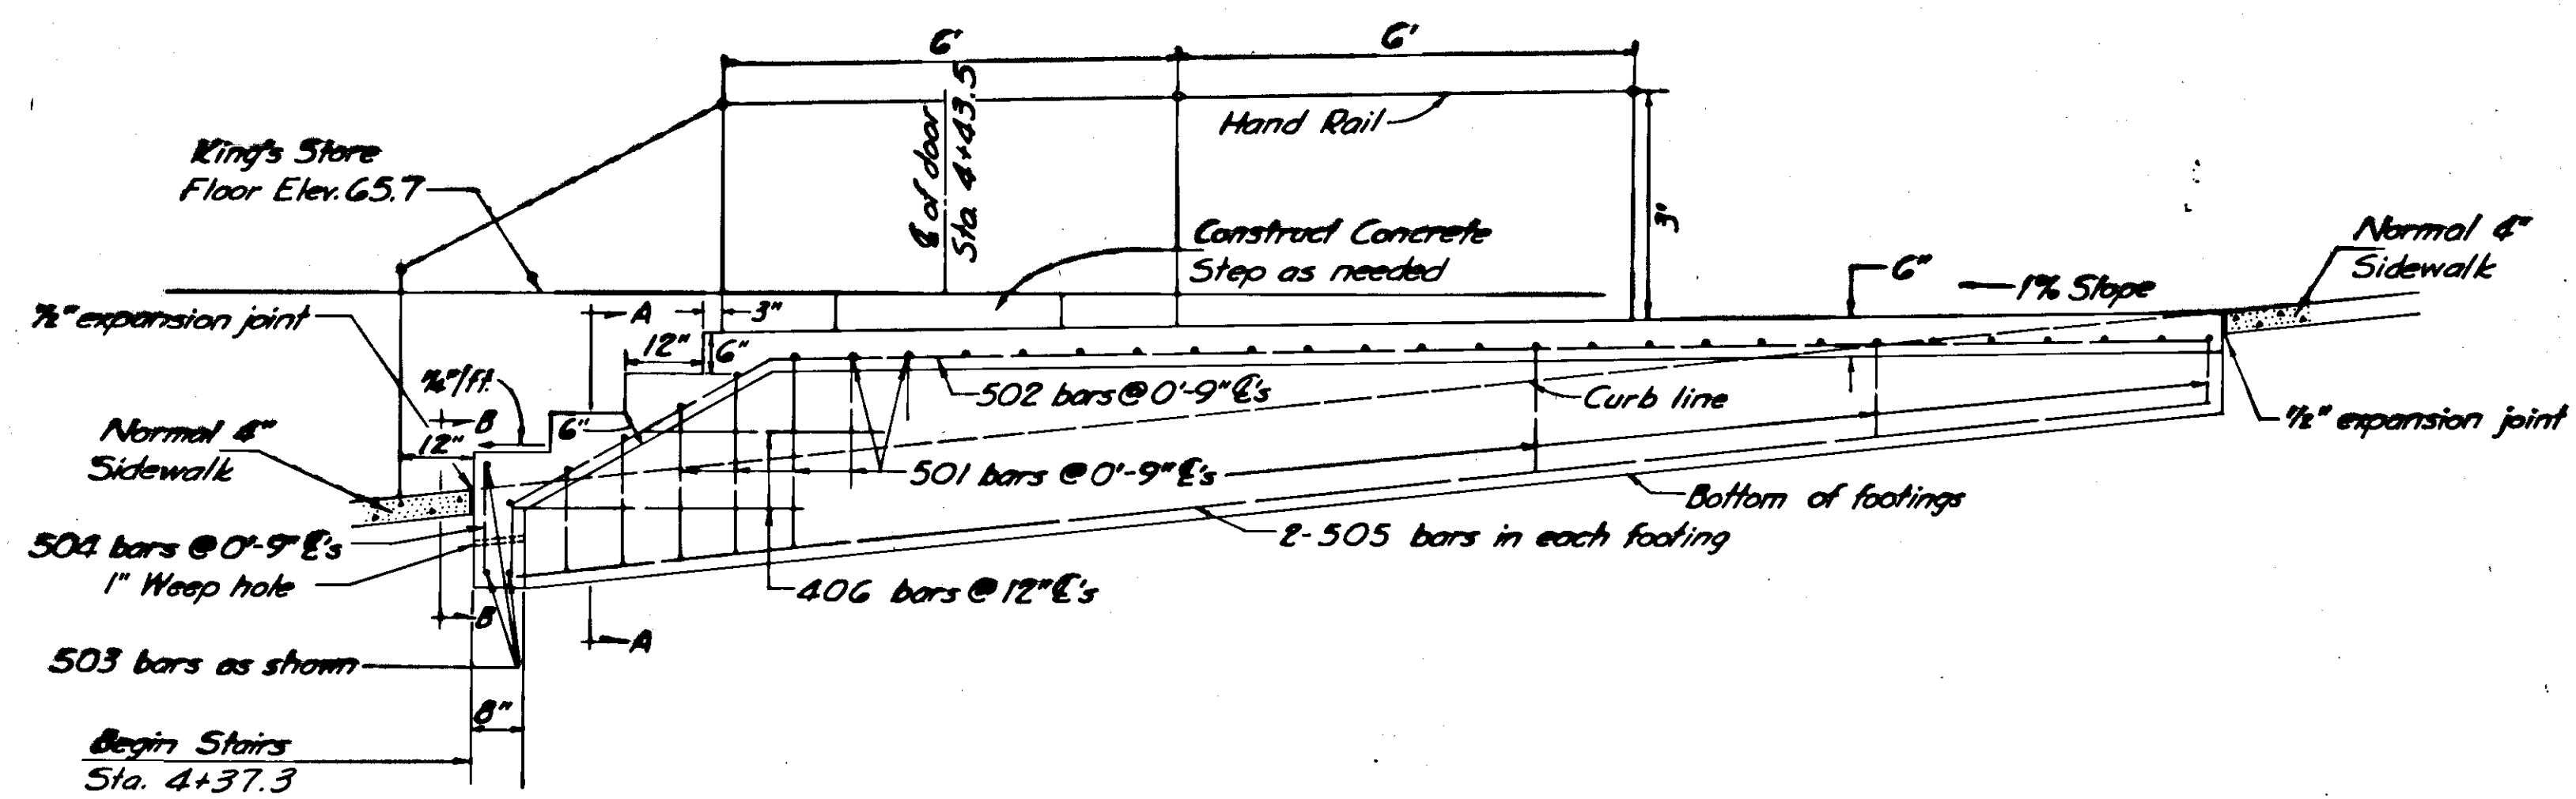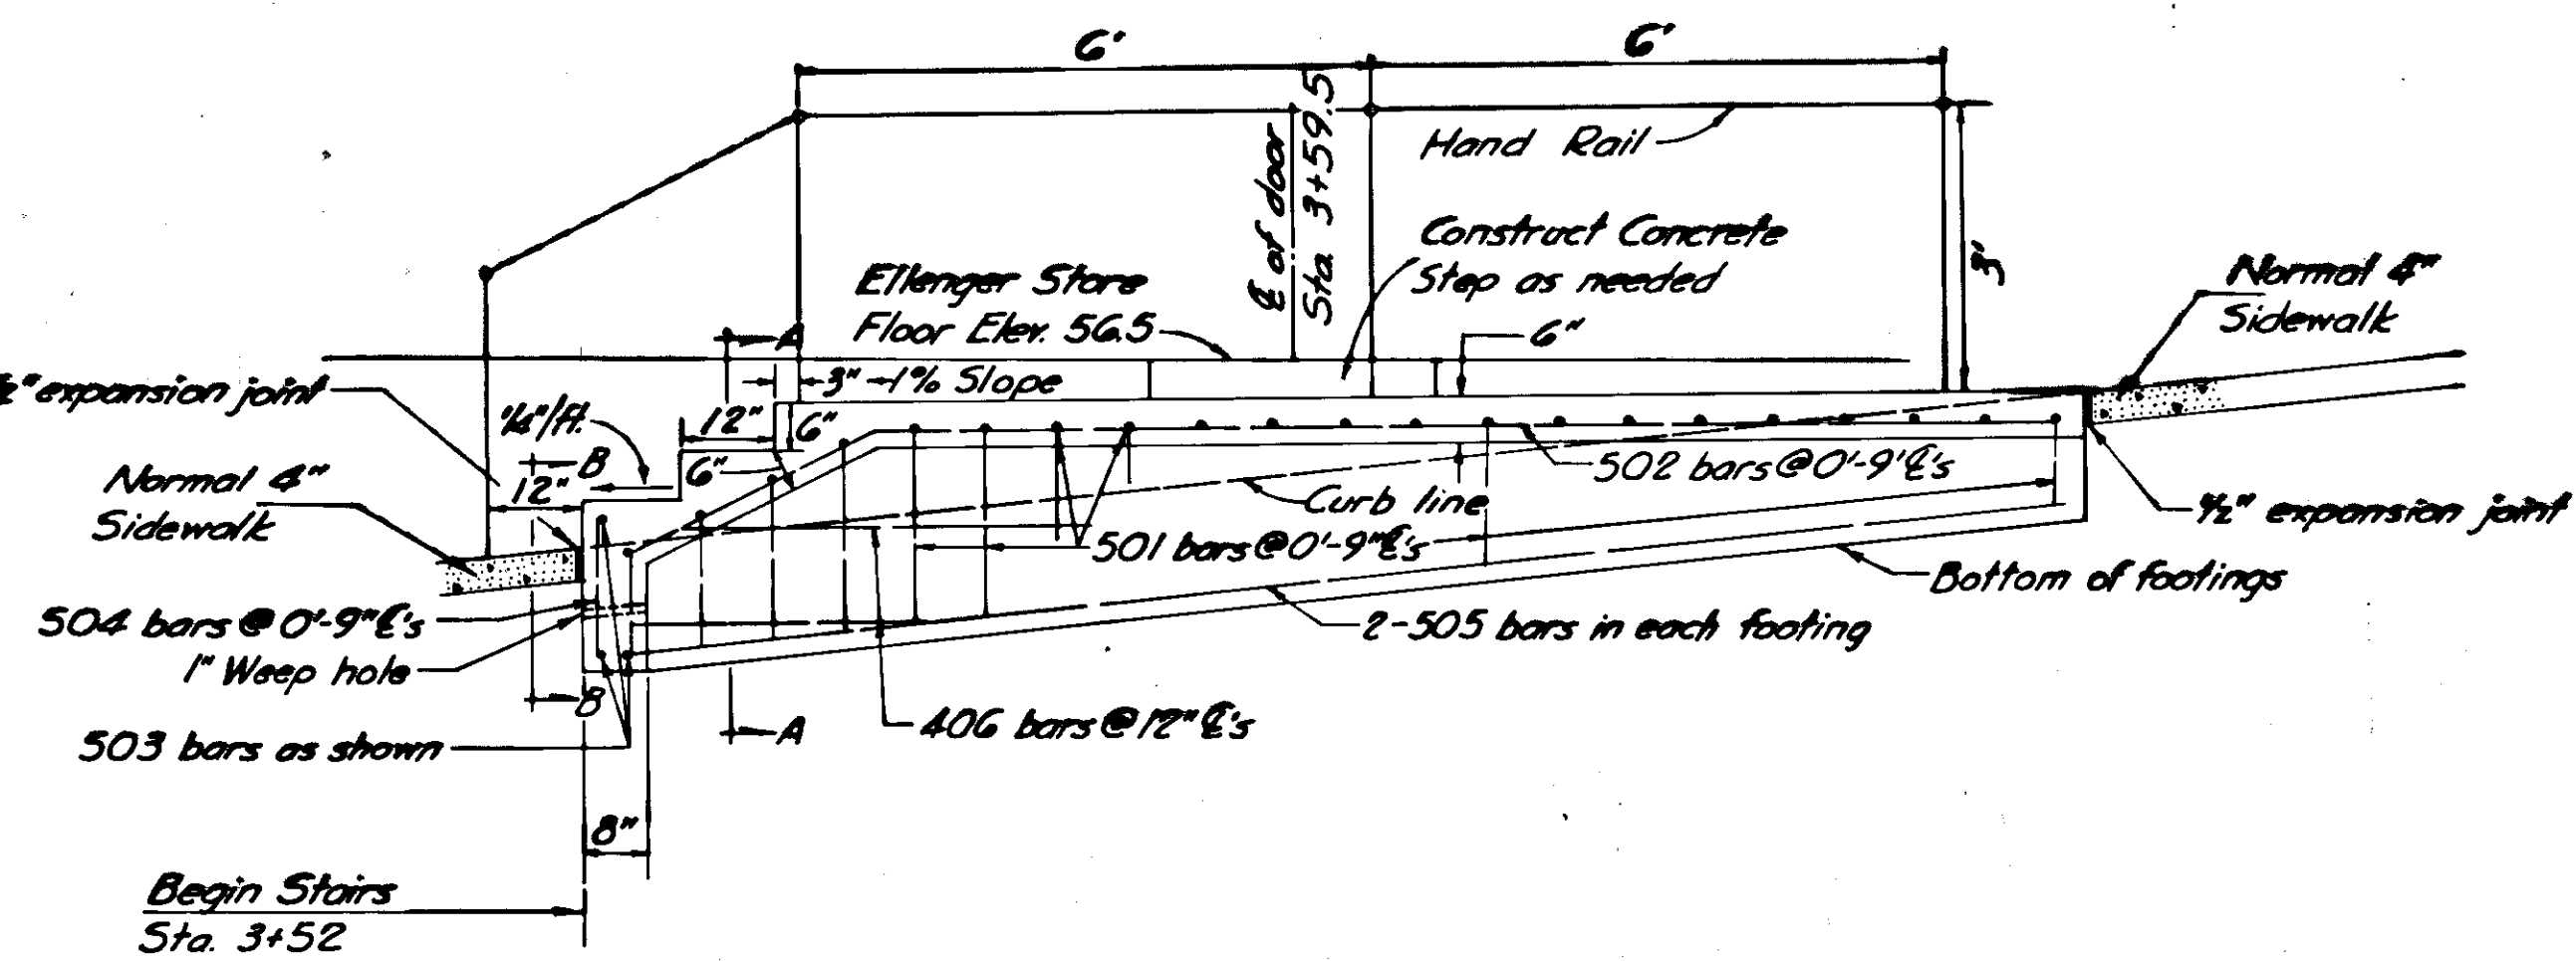

SECTION A-A

VIEW B-B

**GENERAL NOTES**

All concrete shall be Class A air entrained.  
 All reinforcement to be 2" clear from face of concrete.  
 All reinforcement bar splices to lap 20 diameters.  
 All dimensions, stations and elevations shall be verified in the field.  
 The first figure of each bar number indicates the bar diameter in 1/8's.  
 One and one half inch diameter wrought iron pipe shall be used for railing and posts. Fittings shall be of the malleable iron adjustable type. Welded joints (ground smooth) may be substituted for the malleable iron adjustable type. Posts shall be set in 2 1/2" galvanized iron pipe sockets and calked or poured with lead. After setting, the railing shall be painted with a primer coat of red lead ready-mixed paint (AASHO M 72) and two field coats of white and tinted ready-mixed paint (AASHO M 70, Type 1, Class B).

# LIST OF CULVERTS AND MISCELLANEOUS WORK

		STATE	ROUTE	SECTION	YEAR	SHEET NO.									
		ALASKA	0980		1961	12									
STATION	DESCRIPTION	453(50) 12" Asbestos-laminate Reinforced Invert CMP	453(50) 24" Asbestos-laminate Reinforced Invert CMP	457(11) Reinforced Paper Culvert	456(2) Metal End Sections for 24" Pipe Culverts	20(50) 12" Aluminum-coated Perforated CMP Under- drains, 12' L.	20(50) 12" Aluminum-coated Perforated CMP Under- drains, 12' L.	20(50) 12" Aluminum-coated Perforated CMP Under- drains, 12' L.	20(50) 12" Aluminum-coated Perforated CMP Under- drains, 12' L.	521(1) Manholes, Each	521(2) Inlets, Each	521(3) Type B Catch Basins, Each	521(10) Adjusting Manholes Valve Boxes and Cleanouts, Each	523(1) Beam-Type Guardrail, 12' L.	REMARKS
- (0+08)	INSTALL 24"x74' CMP SKEW 30° LT. AMD. W/1 END SECTION	74			1										
0 + 00	INSTALL CURB INLET LT.									1					
0 + 09	INSTALL FIELD INLET LT.									1					
"G" 2+15	INSTALL CURB INLET									1					
"F" 0+62.5	INSTALL 24"x86' CMP	86													
"F" 1+05.09	INSTALL MANHOLE RT.									1					
"F" 1+05.09	INSTALL 24"x36' CMP RT. W/1 END SECTION	36			1										
"O" 2+03.9-															
"F" 0+06.8	STEEL BEAM GUARD RAIL WITH 6"x6" WOOD POSTS													25	
"O" 2+26	ADJUST MANHOLE RT.									1					
"O" 2+28	ADJUST VALVE BOX LT.											1			
"O" 2+39.5	INSTALL MANHOLE RT.									1					
"O" 2+39.5	INSTALL 24"x12' CMP	12													
"O" 2+53.1	INSTALL CURB INLET CATCH BASIN RT. (2' SUMP)										1				
"O" 2+53.9	INSTALL 12"x68' CMP	68													
3 + 90	ADJUST MANHOLE RT.												1		
4+58	INSTALL CURB INLETS LT. & RT. INSTALL 12" x 42' C. M. P.	42								2					
4 + 84.6 6 + 00	ADJUST VALVE BOX RT. INSTALL CURB INLET RT.									1			1		
6 + 55	ADJUST CLEANOUT RT.												1		

# LIST OF CULVERTS AND MISCELLANEOUS WORK

STATE	ROUTE	SECTION	YEAR	SHEET NO.	TOTAL SHEETS
ALASKA	0990		1961	13	26

STATION	DESCRIPTION	453(5C)	453(5G)	457(1)	460(2G)	520(5C)	520(5D)	520(5E)	520(5F)	521(1)	521(2)	521(3)	521(10)	583(1)	REMARKS	
		12" Asbestos-Bonded Paved Invert CMP, Lin. Ft.	24" Asbestos-Bonded Paved Invert CMP, Lin. Ft.	Remove and Dispose Existing Pipe Culvert, Lin. Ft.	Metal End Sections for 24" Pipe Culverts, Each	12" Bituminous-Coated Perforated CMP Underdrain, Lin. Ft.	15" Bituminous-Coated Perforated CMP Underdrain, Lin. Ft.	18" Bituminous-Coated Underdrain, Lin. Ft.	Perforated CMP Underdrain, Lin. Ft.	21" Bituminous-Coated Perforated CMP Underdrain, Lin. Ft.	Manholes, Each	Inlets, Each Type B	Type B Catch Basins, Each	Adjusting Manholes Valve Boxes and Cleanouts, Each	Beam-Type Guardrail, Lin. Ft.	
6+99	INSTALL CURB INLET RT. INSTALL MANHOLE RT.										1	1				
7+10	ADJUST VALVE BOX LT.												1			
7+14	ADJUST VALVE BOX RT.												1			
7+35	ADJUST MANHOLE LT.												1			
7+41	INSTALL MANHOLE RT.										1					
	INSTALL MANHOLE AT 2ND & DALTON ST.										1					
	INSTALL CURB INLETS LT. & RT.											2				
	INSTALL 24" x 48' CMP		48													
	INSTALL 24" x 20' CMP OUTFALL		20													
	REMOVE & DISPOSE 3 - 8" x 80' DRAIN PIPES			240												
7+63.4	ADJUST VALVE BOX RT.												1			
8+98	INSTALL CURB INLET RT.										1					
10+5.1	ADJUST VALVE BOX RT.										1		1			
10+75	INSTALL MANHOLE RT.										1					
	INSTALL CURB INLETS LT. & RT.											2				
	REMOVE & DISPOSE 18" x 65' C.M.P.			65												
	INSTALL 24" x 52' C.M.P. & 24" x 8' C.M.P.		60													
11+04	ADJUST MANHOLE LT.												1			
11+15	INSTALL MANHOLE RT.										1					
	INSTALL CURB INLET RT.											1				
14+27.5	ADJUST VALVE BOX RT.												1			
14+39	INSTALL CURB INLET LT. INSTALL 12"x68' C.M.P.68												1			
14+50	INSTALL MANHOLE RT.										1					
	INSTALL CURB INLET RT.											1				
14+80	ADJUST MANHOLE LT.												1			
14+92	INSTALL MANHOLE RT.										1					
	INSTALL CURB INLET RT.											1				
18+02.5	ADJUST VALVE BOX RT.												1			
18+15	INSTALL CURB INLET LT.											1				

J-4

# LIST OF CULVERTS AND MISCELLANEOUS WORK

		STATE ALASKA	ROUTE 0990	SECTION	YEAR 1961	SHEET NO. 14	TOTAL SHEETS 26								
STATION	DESCRIPTION	453(50) 12" Asbestos-bonded Paved Invert CMP, Lin. Ft.	453(50) 24" Asbestos-bonded Paved Invert CMP, Lin. Ft.	457(1) Remove and Dispose Existing Pipe Culvert, Lin. Ft.	460(2) Metal and Sections for 24" Pipe Culverts Each	520(50) 18" Bituminous-coated Perforated CMP Under- drain, Lin. Ft.	520(50) 15" Bituminous-coated Perforated CMP Under- drain, Lin. Ft.	520(50) 18" Bituminous-coated Perforated CMP Under- drain, Lin. Ft.	520(50) 21" Bituminous-coated Perforated CMP Under- drain, Lin. Ft.	521(1) Manholes, Each	521(2) Inlets, Each Type B	521(3) Type B Catch Basins, Each	521(4) Adjusting Manholes Valve Boxes and Cleanouts, Each	521(5) Tee-Type Guardrail, Man. Ft.	REMARKS
18 + 46	INSTALL 12" x 74' CMP	74													
18 + 55	ADJUST MANHOLE LT.												1		
18 + 76	INSTALL CURB INLET RT.										1				
21 + 78.6	ADJUST VALVE BOX RT.												1		
21 + 88	INSTALL CURB INLETS RT. & LT. INSTALL 12" x 42' CMP	42									2				
22 + 22	ADJUST MANHOLE LT.												1		
22 + 40	INSTALL FIELD INLET RT. INSTALL 24" x 160' CMP		160								1				
25+58	INSTALL CURB INLETS RT. & LT. INSTALL 12"x42' CMP & 12"x10' CMP OUTLET LT.	52									2				

J-6



# LIST OF CULVERTS AND MISCELLANEOUS WORK

STATION	DESCRIPTION	STATE												ROUTE	SECTION	YEAR	SHEET NO.	TOTAL SHEETS
		ALASKA												0990		1961	15	26
		453(50)	453(50)	457(1)	460(2)	520(50)	520(50)	520(50)	520(50)	521(1)	521(2)	521(3)	521(10)	588(1)				
	SEE TABLE SHEET 2 FOR DETAIL AT FIRE HYDRANTS																	
OVER	ENTIRE PROJECT																	
	INSTALL 12" BITUMINOUS-COATED PERFORATED CMP UNDERDRAIN					554												
	INSTALL 15" BITUMINOUS-COATED PERFORATED CMP UNDERDRAIN						534											
	INSTALL 18" BITUMINOUS-COATED PERFORATED CMP UNDERDRAIN							682										
	INSTALL 21" BITUMINOUS-COATED PERFORATED CMP UNDERDRAIN								640									
	<b>TOTALS</b>	346	496	305	2	554	534	682	640	9	23	1	17	25				

REMARKS

# STANDARD BRASS CAP MONUMENT & MONUMENT CASE




STATE	ROUTE	YEAR	SHEET NO.	TOTAL SHEETS
ALASKA	0990	1961	16	26

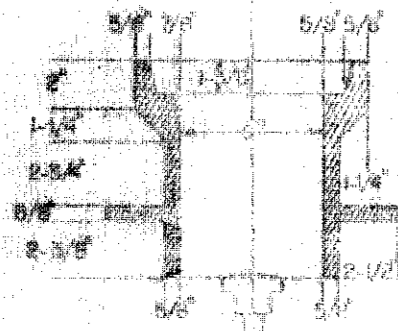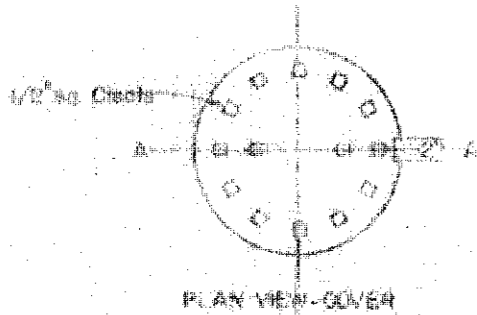

NOTE:  
 When monument cases are to be placed in a bituminous paved or surfaced road, the top of the case shall be the same elevation as the top of the roadway.  
 When monument bases are to be placed in a gravel surfaced roadway the top of the case shall be placed 1-0" below the top of the surface of the roadway.

## SUMMARY OF BRASS CAP MONUMENTS & MONUMENT CASES

STATION	MON	MON/CASE	REMARKS	STATION	MON	MON/CASE	REMARKS
2+27.04		1					
7+20.49		1					
10+95.4		1					
14+70.4		1					
18+45.4		1					
22+20.4		1					
TOTAL		6					

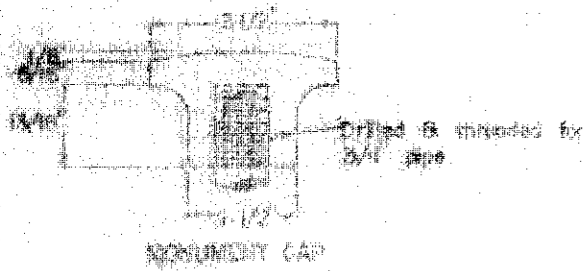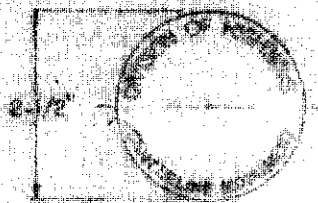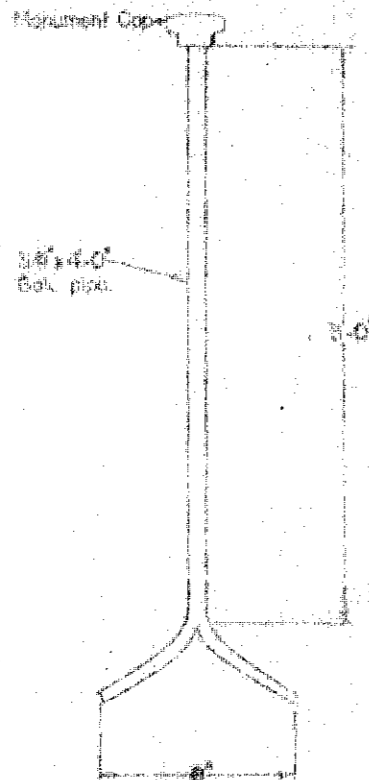

NOTE:  
 In solid rock, drill 2" into a minimum of 1-0", fill with mortar and set cap 3/4" dia. pipe, designated length when set in mortar. The top of the monument shall be the same elevation as the bottom of the monument case.

J-4



**SUMMARY OF STANDARD SIGNS**

STATION	Dist. from C in ft.		SIGN NO.	TYPE OF SIGN	STATION	Dist. from C in ft.		SIGN NO.	TYPE OF SIGN	STATION	Dist. from C in ft.		SIGN NO.	TYPE OF SIGN
	LEFT	RIGHT				LEFT	RIGHT				LEFT	RIGHT		
1 + 77	17		R-39	YIELD										
2 + 00		15	R-1	STOP										
7 + 46		30	R-1	STOP										
10 + 72	30		R-1	STOP										
11 + 19		30	R-1	STOP										
14 + 94		30	R-1	STOP										
18 + 70		30	R-1	STOP										
22 + 44		30	R-1	STOP										
0 + 32 (FRONT ST.)	17		R-1	STOP										

NOTE: DISTANCES AND STATIONS ARE APPROXIMATE ONLY;  
EXACT LOCATION TO BE STAKED BY THE ENGINEER