
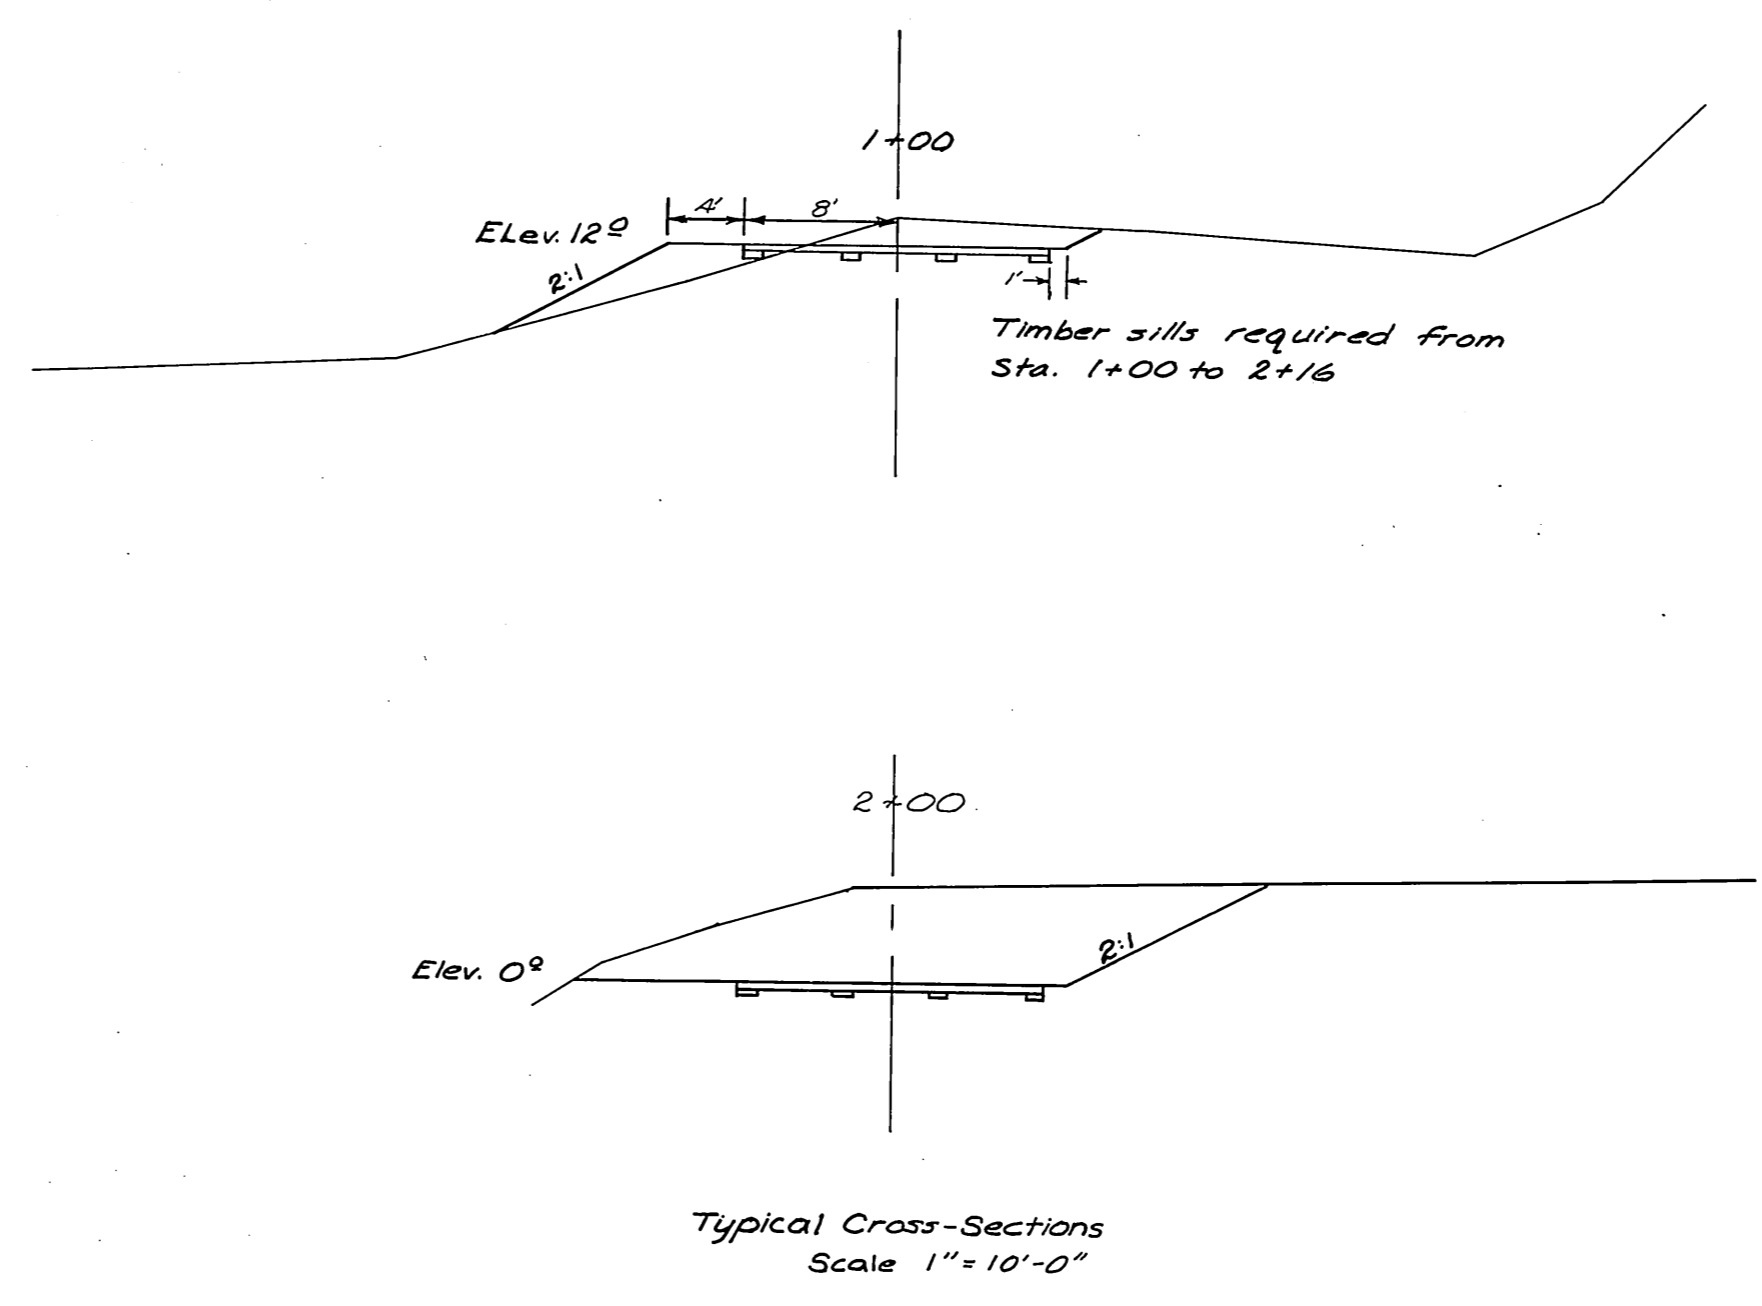


DETAILS - PRECAST LAUNCHING RAMP PLANKS

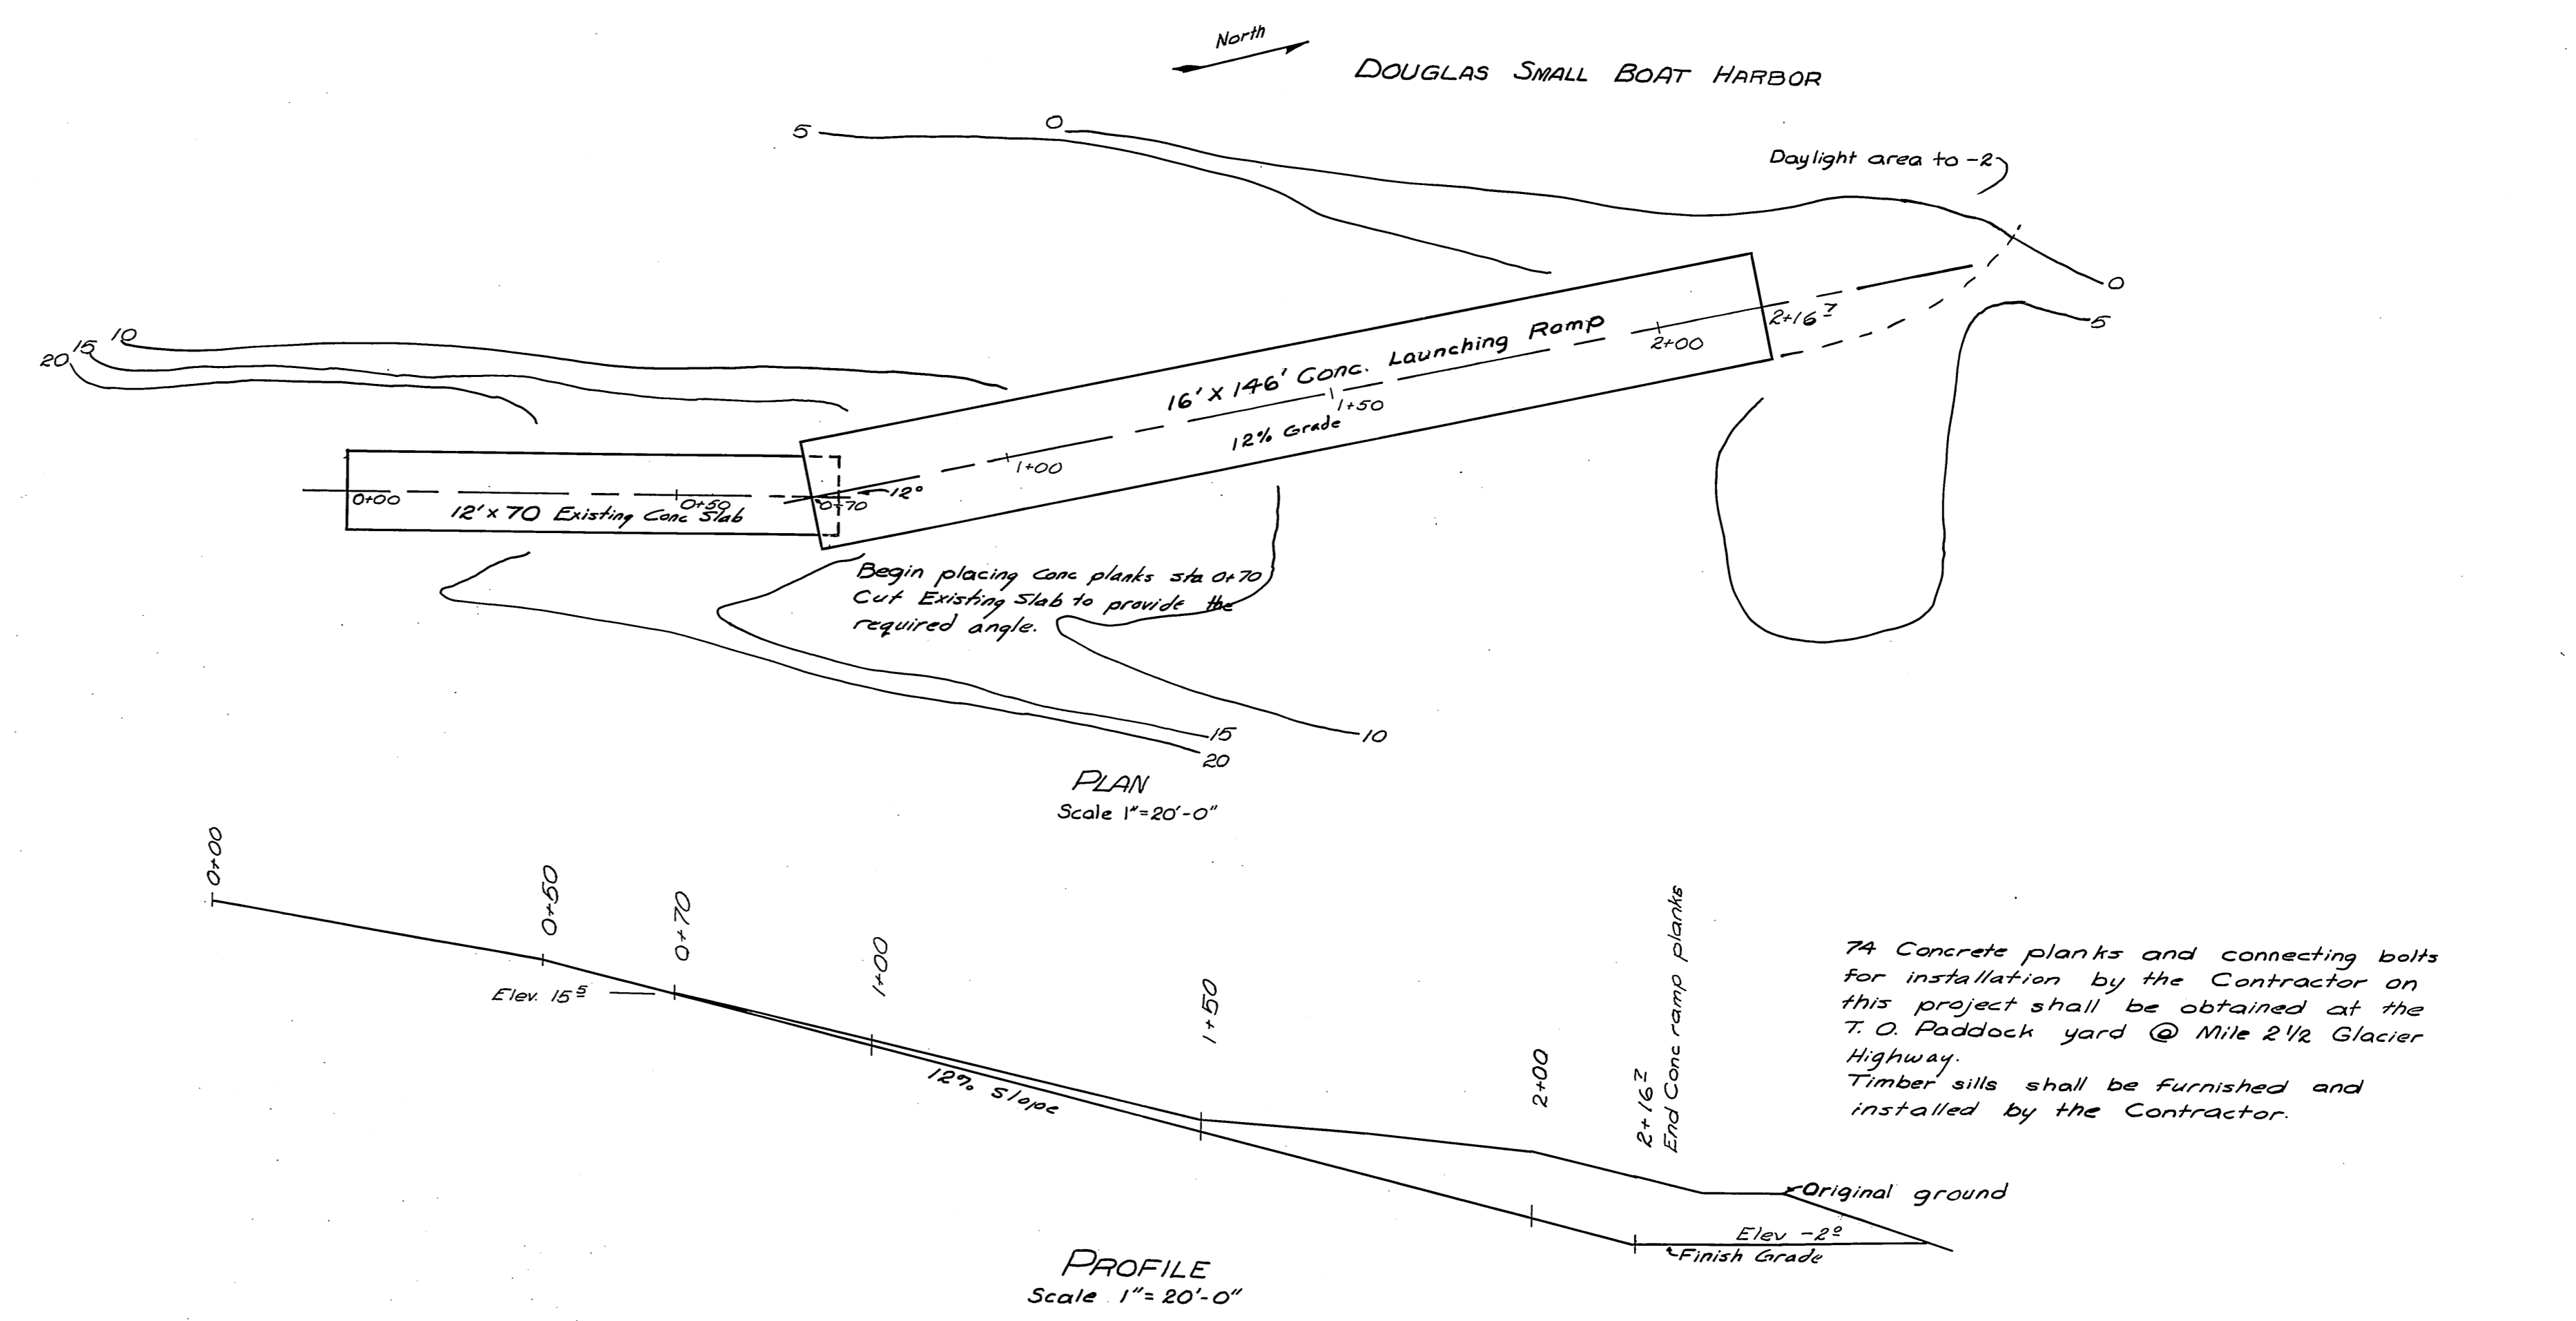

DO NOT SCALE THIS DRAWING - USE DIMENSIONS		
STATE OF ALASKA DEPARTMENT OF PUBLIC WORKS DIVISION OF WATER AND HARBORS		
DOUGLAS BOAT LAUNCHING RAMP		
SCALE <i>As noted</i>	SURVEYED <i>---</i>	APPROVED
DESIGNED <i>JDB</i>	DRAWN <i>JET</i>	<i>Don Statter</i> DIRECTOR
CHECKED <i>---</i>	DATE <i>22 Jul 71</i>	
PROJECT NUMBER <i>3-72179</i>	SHEET <i>1</i> OF <i>1</i>	