


JUNEAU AURORA HARBOR FACILITIES

PROJECT NO. 3-72180

JUNEAU HARRIS HARBOR GRID REPAIR

PROJECT NO. 3-72145

SEE AURORA FOR
MYLARS

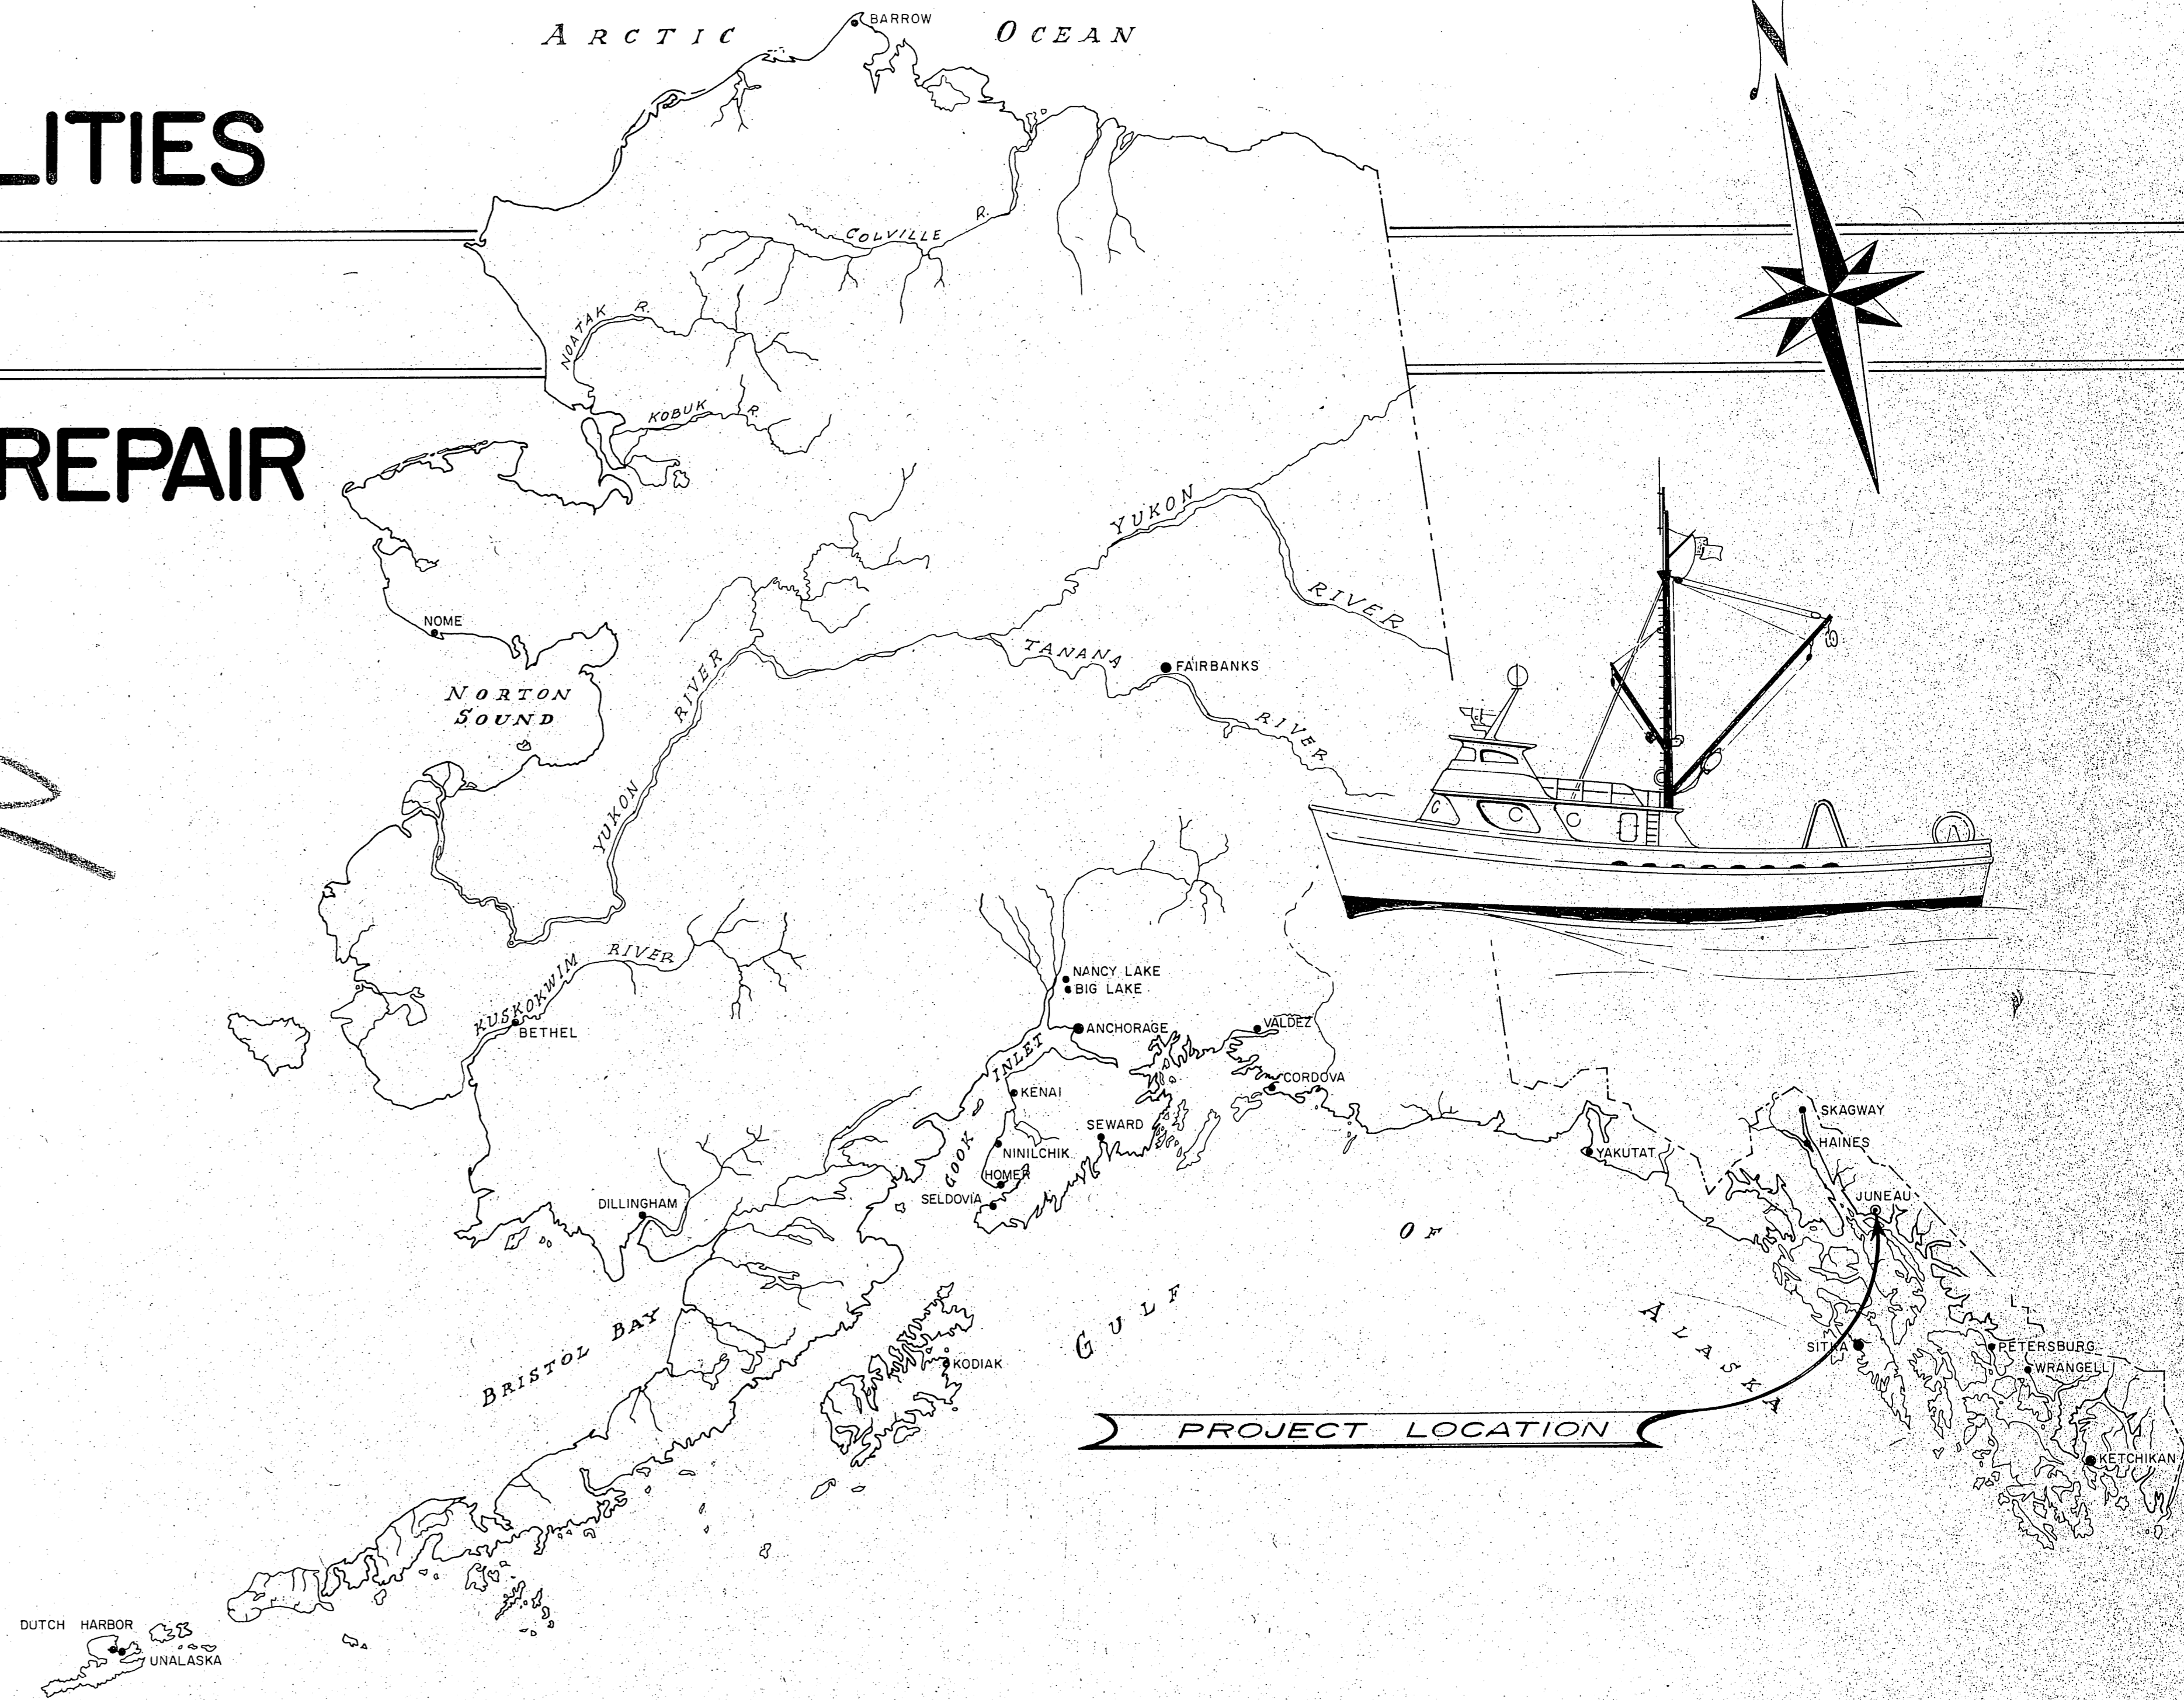

WORK SUMMARY


Items of work include: Pulling and redriving 10 float piles and relocating the existing 12 stall seaplane float within Aurora Harbor. Furnishing and installing 9425 sq. ft. of concrete mooring floats and furnishing and installing 16 piles (1024 L.F.) in Aurora Harbor. Repairing the grid in Harris Harbor.

INDEX TO SHEETS


1.	TITLE SHEET	
2.	AURORA & HARRIS HARBORS LAY-OUT	
3.	CONCRETE FLOAT DETAILS	
4.	CONC. FLOATS, TYP ASSBS & MISC. DET.	
5.	CONC. FLOATS, STANDARD DETAILS	
6.	HARRIS HARBOR WALKWAY	

STATE OF ALASKA — DEPARTMENT OF PUBLIC WORKS
DIVISION OF WATER & HARBORS


APPROVED
Gray A. Kaldor
 Acting Commissioner
 DATE 8-3-71
 SHEET 1 OF 6

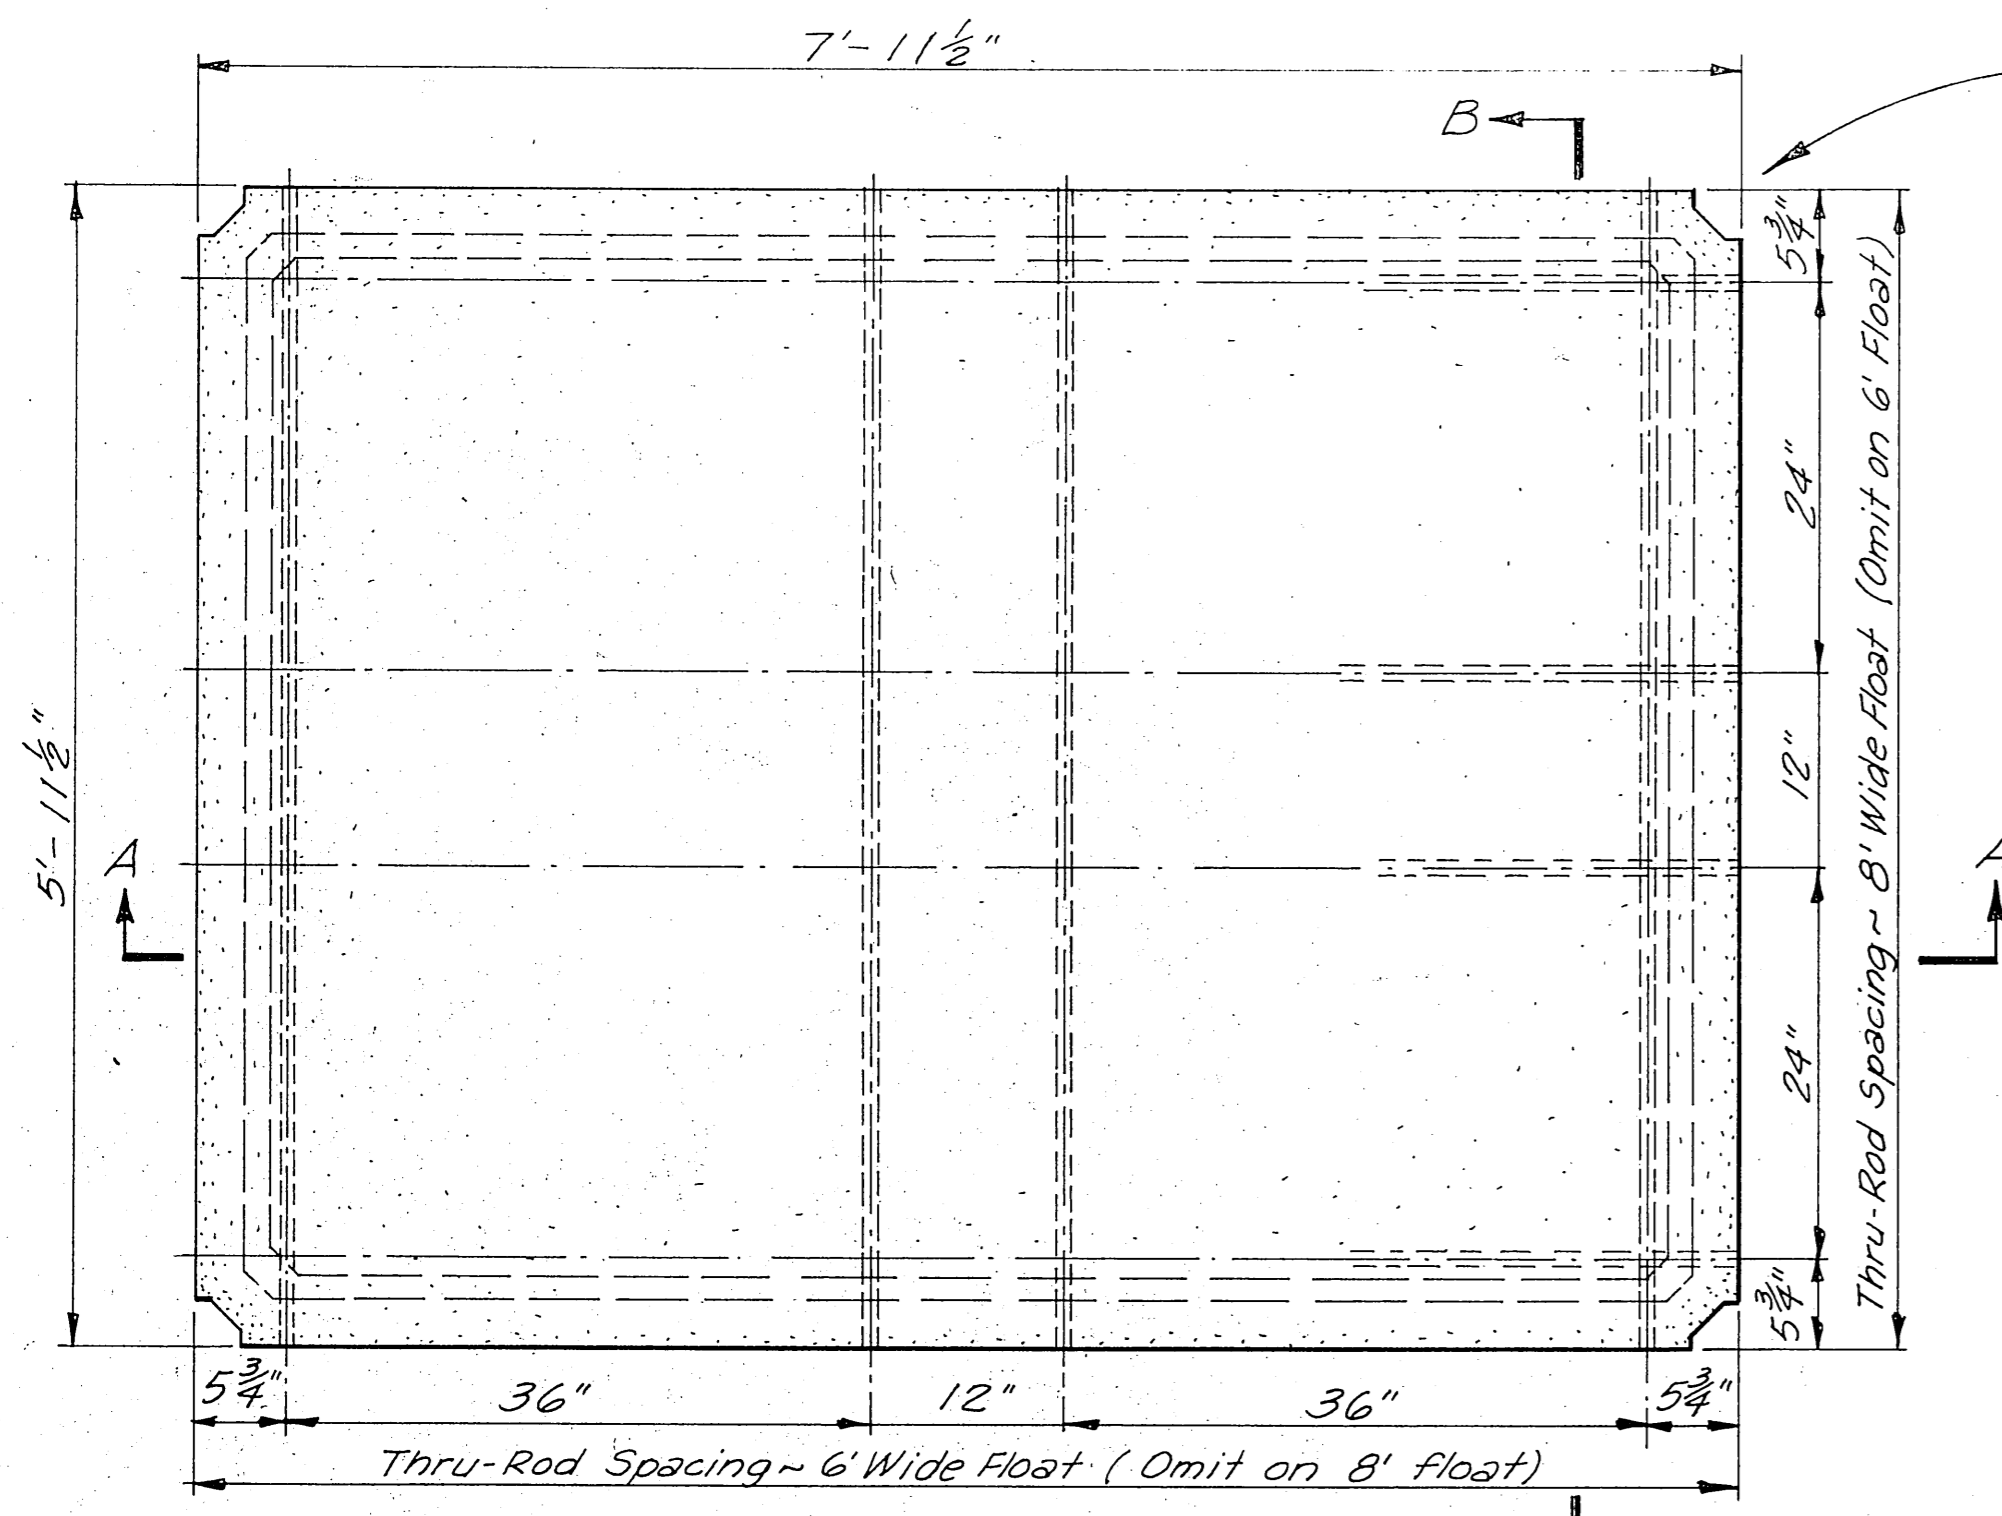


PLAN

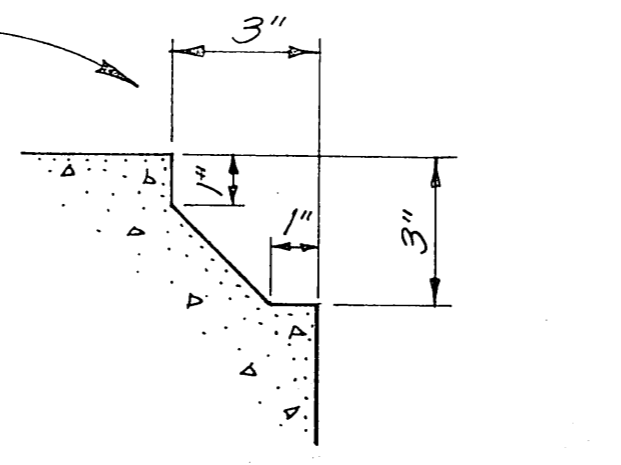


Block out all 4 corners as shown.

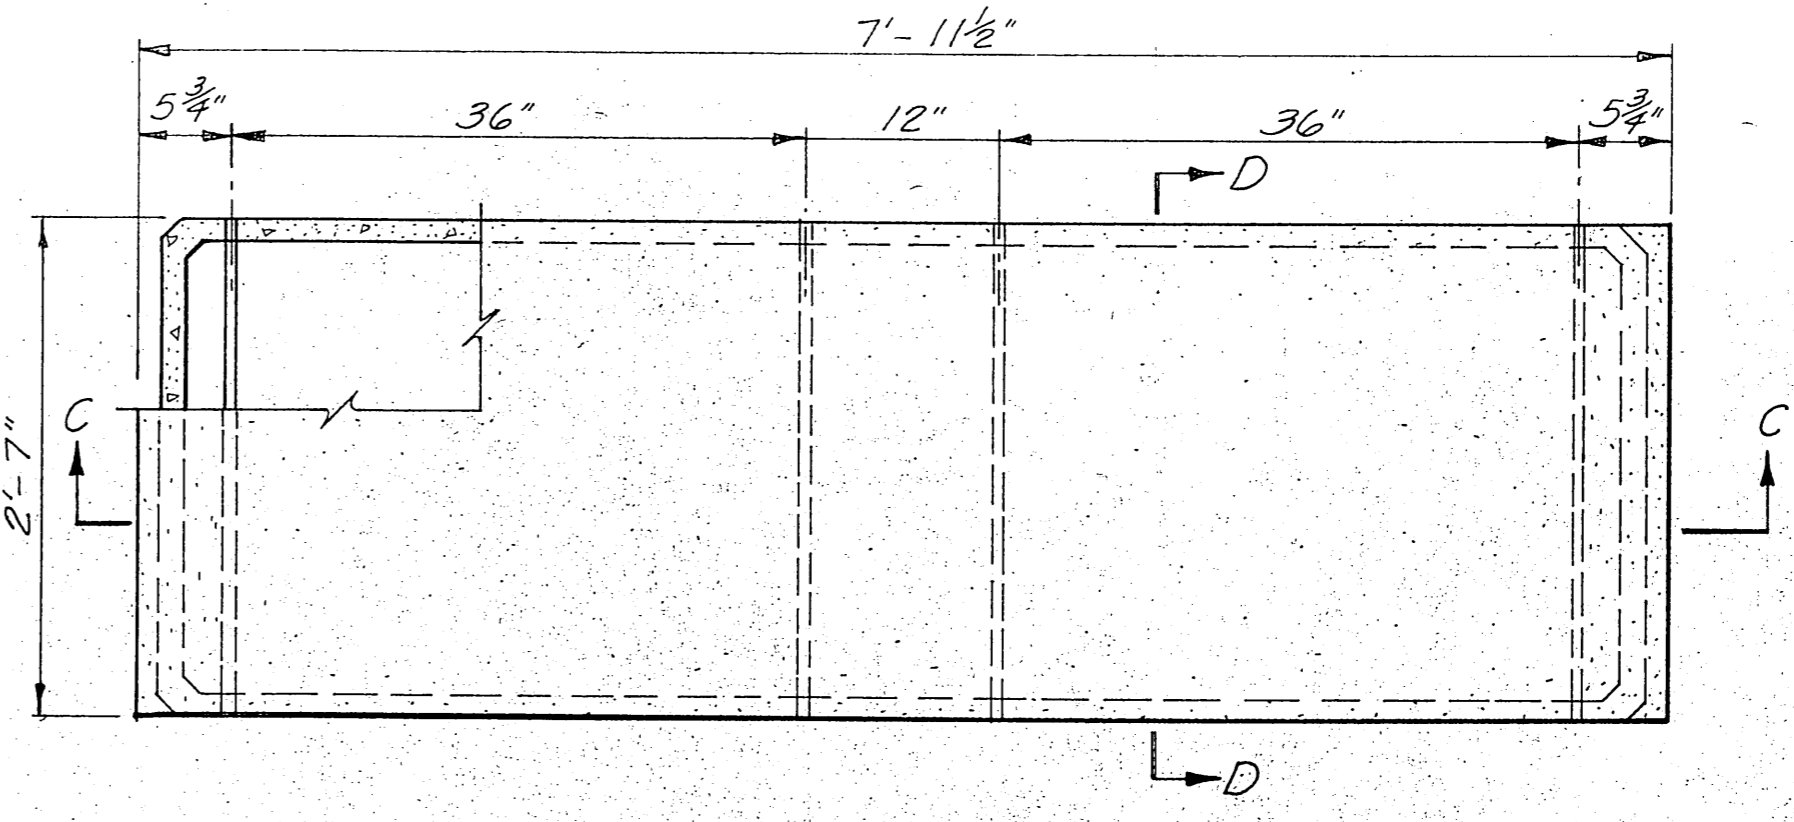


PLAN

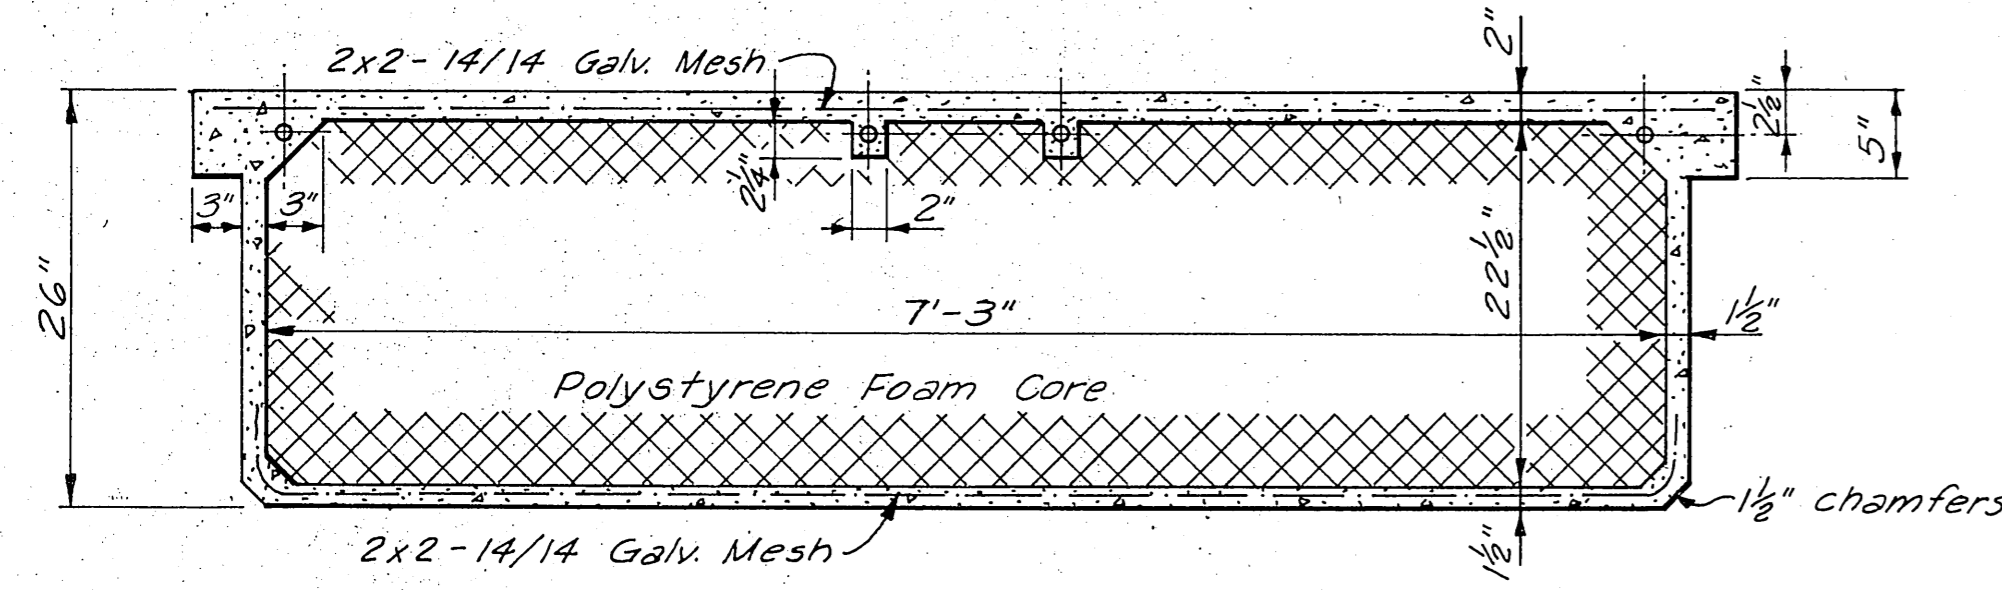

SECTION A-A

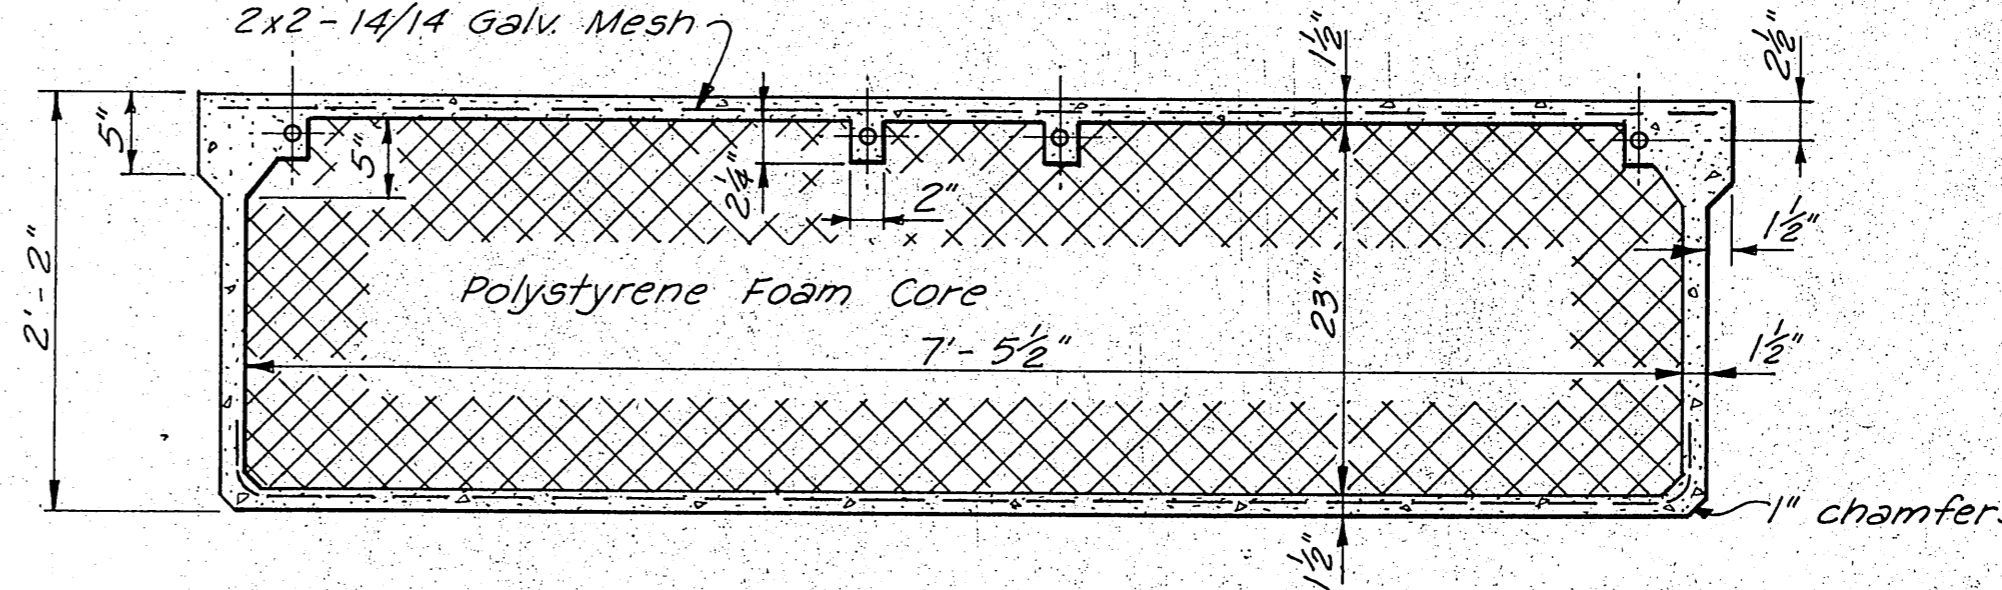

SECTION C-C

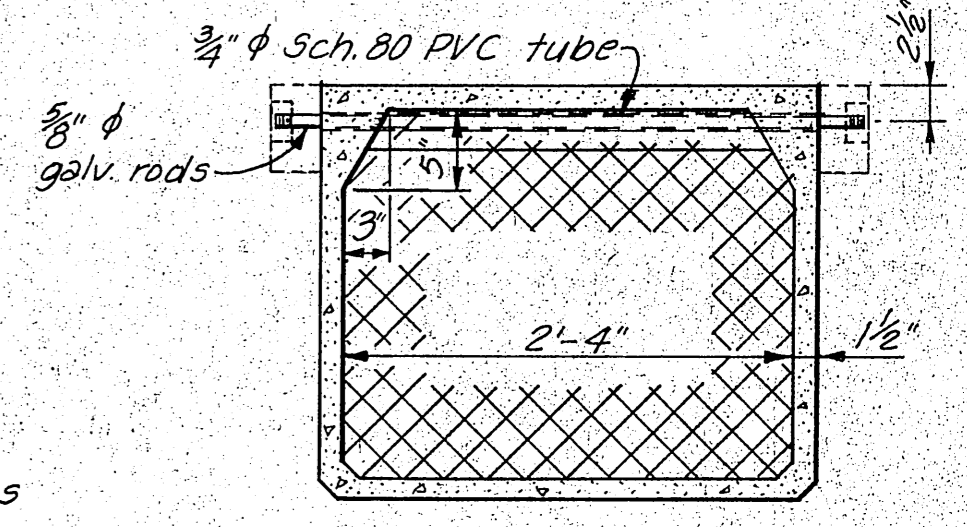


SECTION D-D

3' x 8' FLOAT DETAILS
1" = 1'-0"


NOTES:

- Floats to be cast lightweight concrete 100#/ft³ max. with min. compr. strength of 3000 PSI @ 7 days.
- Inner core to be 1.1"/ft³ polystyrene foam per ASTM D-1621-59T.
- Portland cement shall comply with ASTM C-150 for Type III.
- Expanded shale shall comply with ASTM C-330.
- Galv. wire mesh shall comply with ASTM A-185.
- Free board shall be 15" with all dead load applied. Dead load to consist of thru rods, wales, connection hinges & plates; pile collars, electrical conduit, outlet boxes and light standards; and 3/4" galv. steel waterline with hose bibs. Utilities will be placed to balance float.


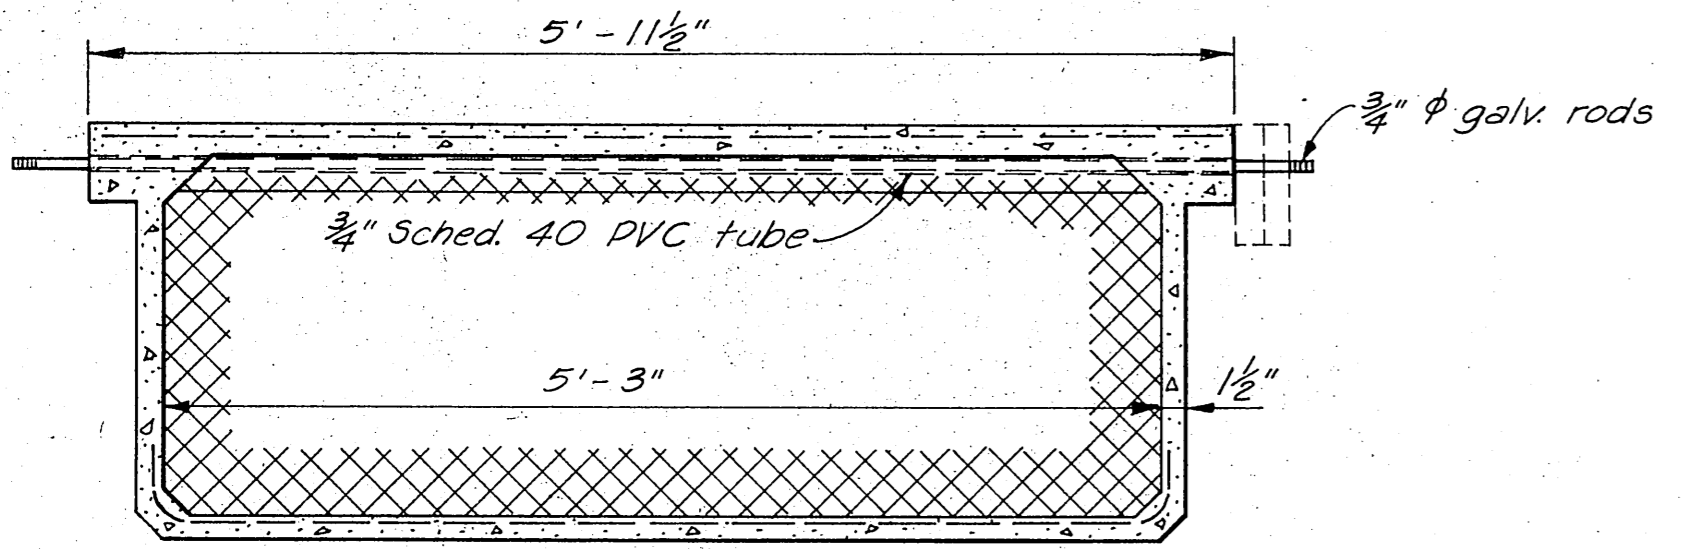


SECTION B-B


6' x 8' FLOAT
1" = 1'-0"

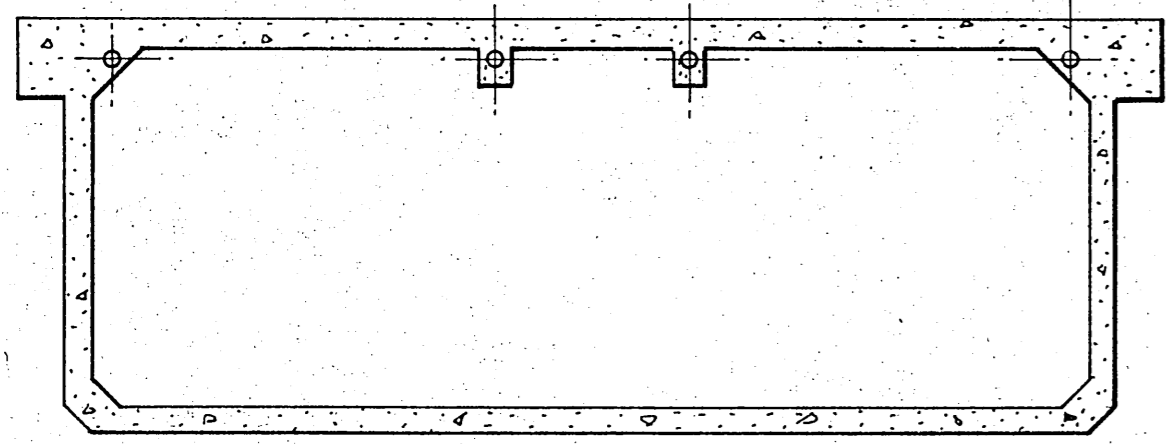


ALT. SECTION B-B
(8'-WIDE FLOAT)

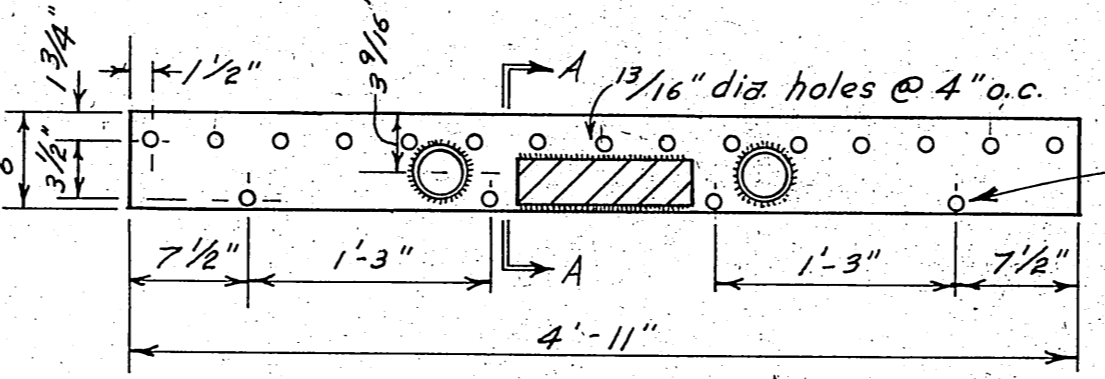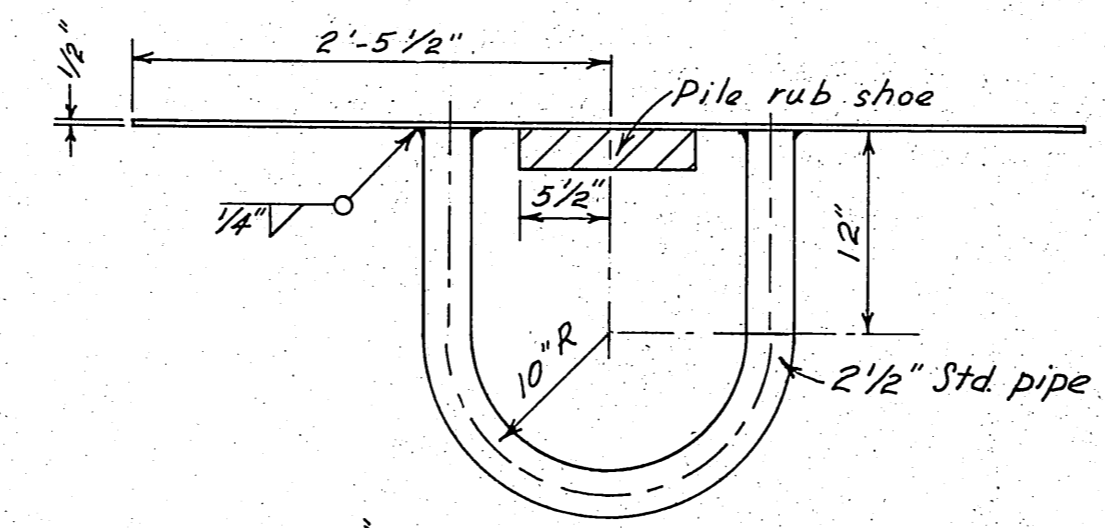

ASSEMBLY
1" = 1'-0"

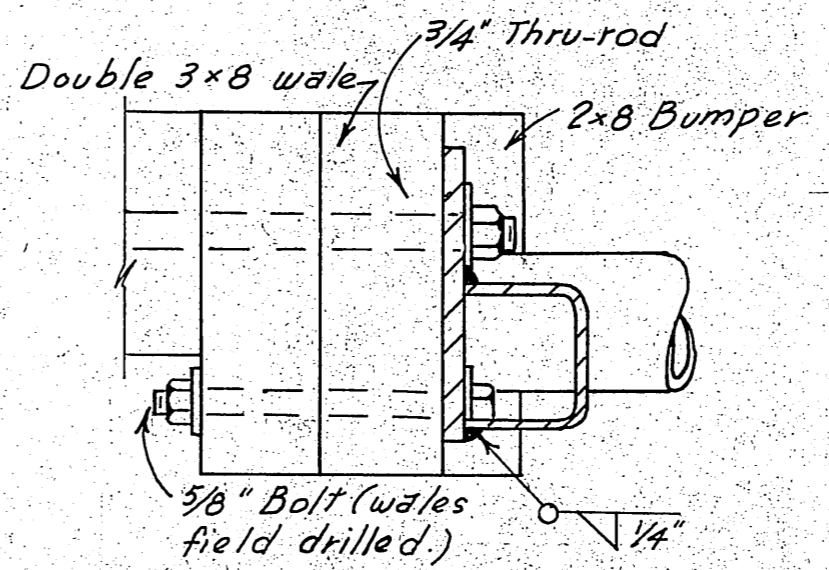





SECTION A-A
3" = 1'-0"

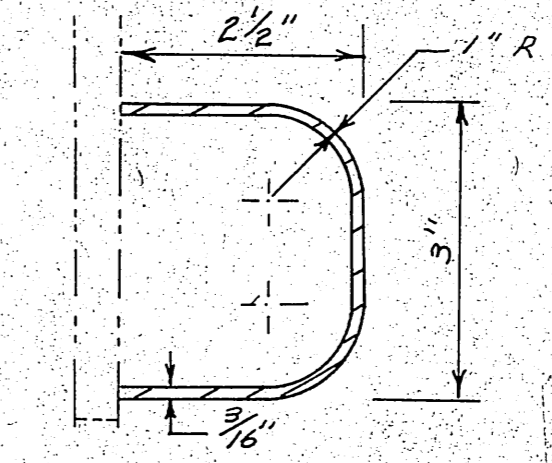




PILE RUB SHOE
half scale

OUTSIDE PILE COLLAR


DO NOT SCALE THIS DRAWING - USE DIMENSIONS		
STATE OF ALASKA DEPARTMENT OF PUBLIC WORKS DIVISION OF WATER AND HARBORS		
OUTSIDE PILE COLLAR & CONCRETE FLOAT DETAILS		
SCALE As Shown	SURVEYED	APPROVED
DESIGNED	DRAWN C.D. JET.	DON STATTER
CHECKED	DATE	DIRECTOR
PROJECT NUMBER Juneau 3-72180	SHEET 3	OF 6

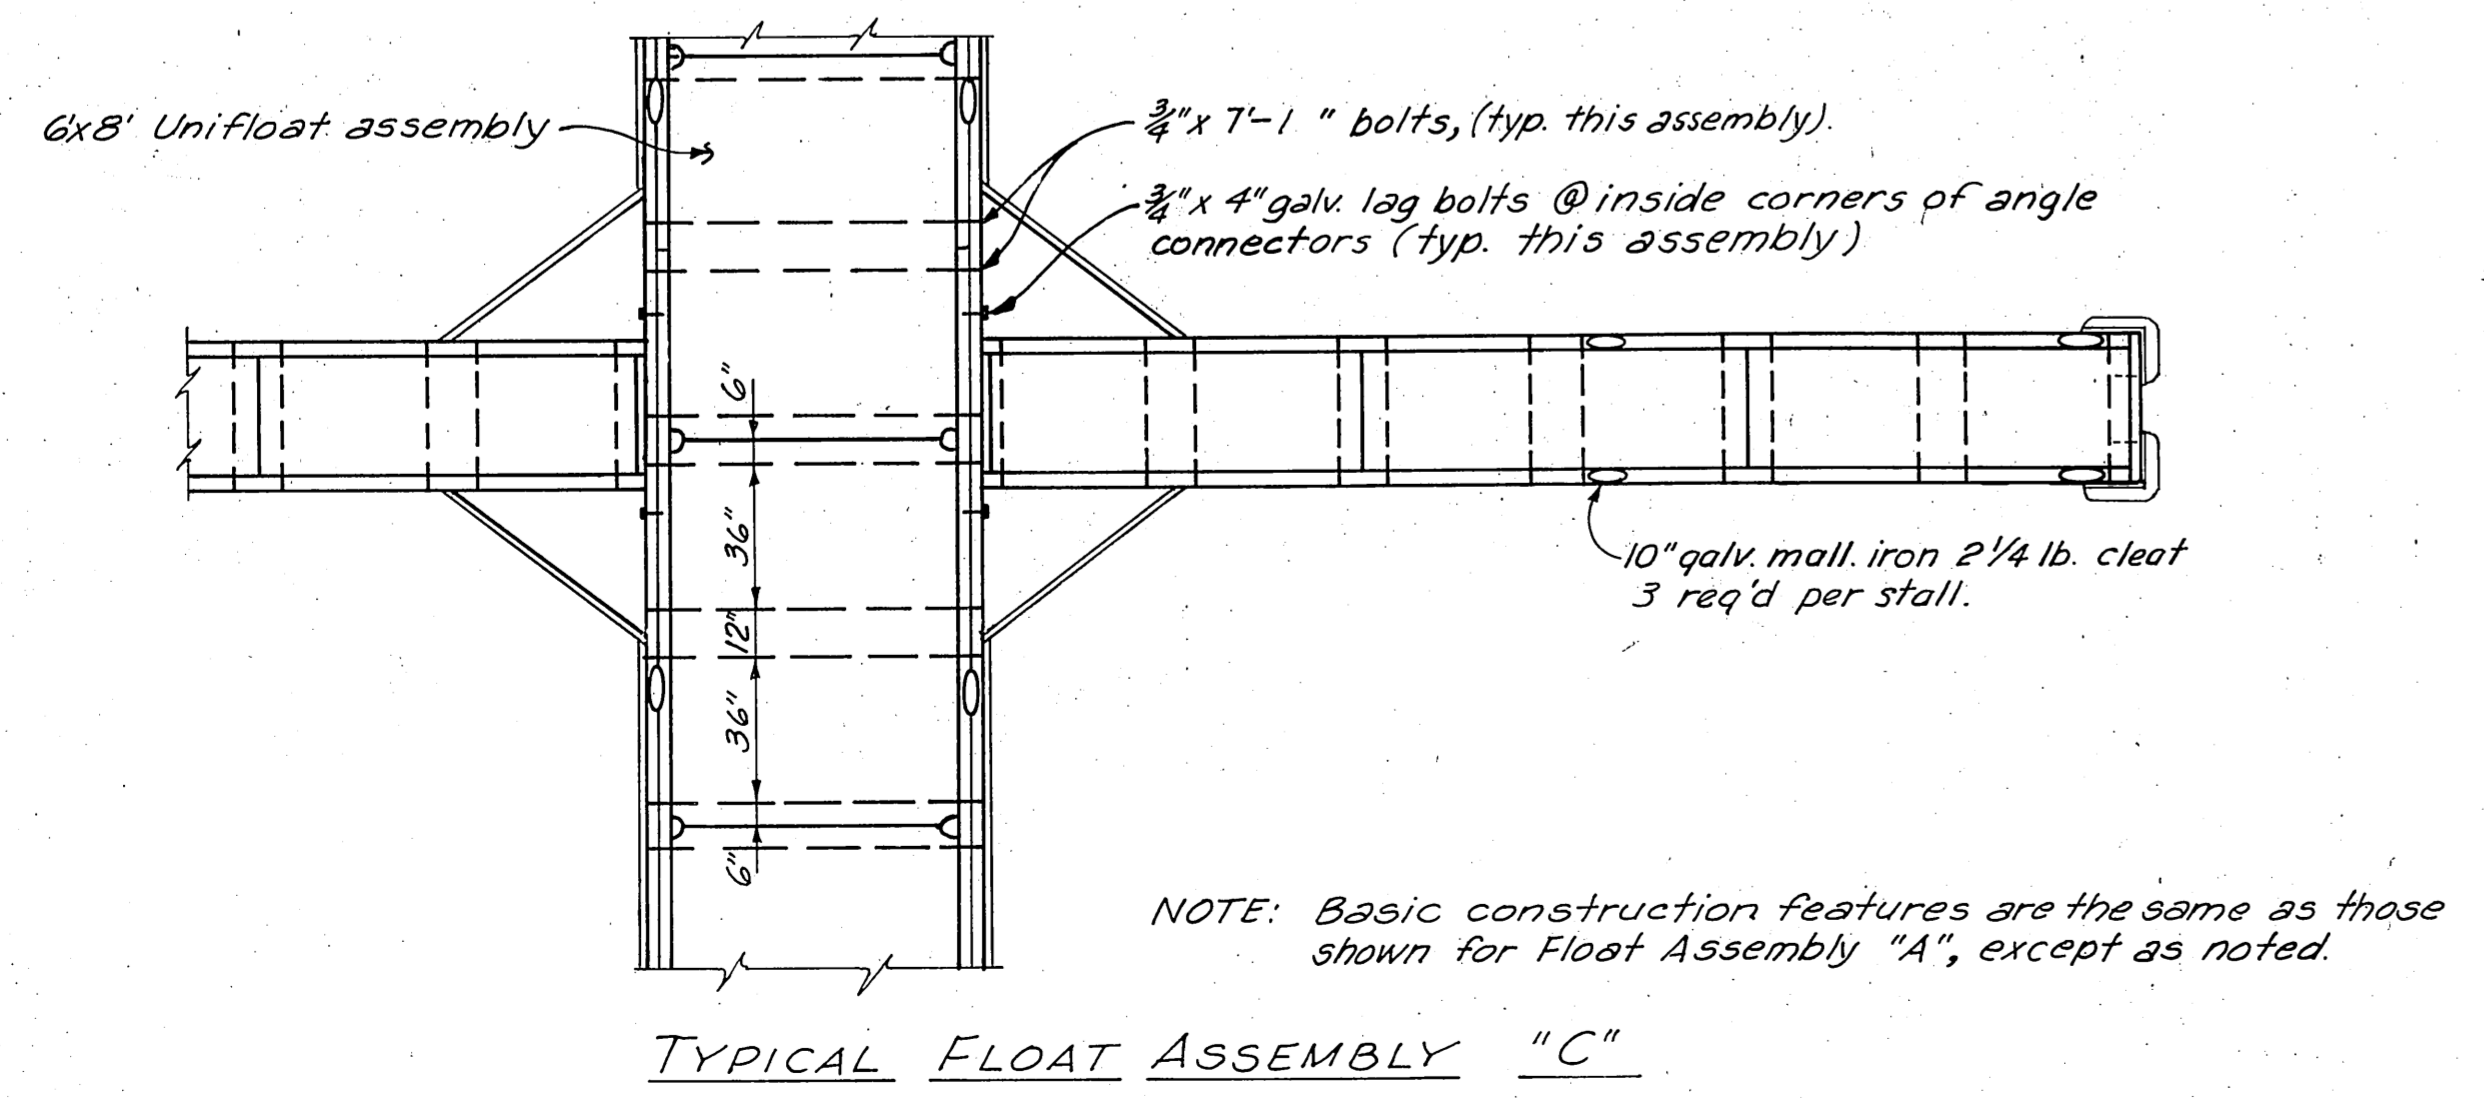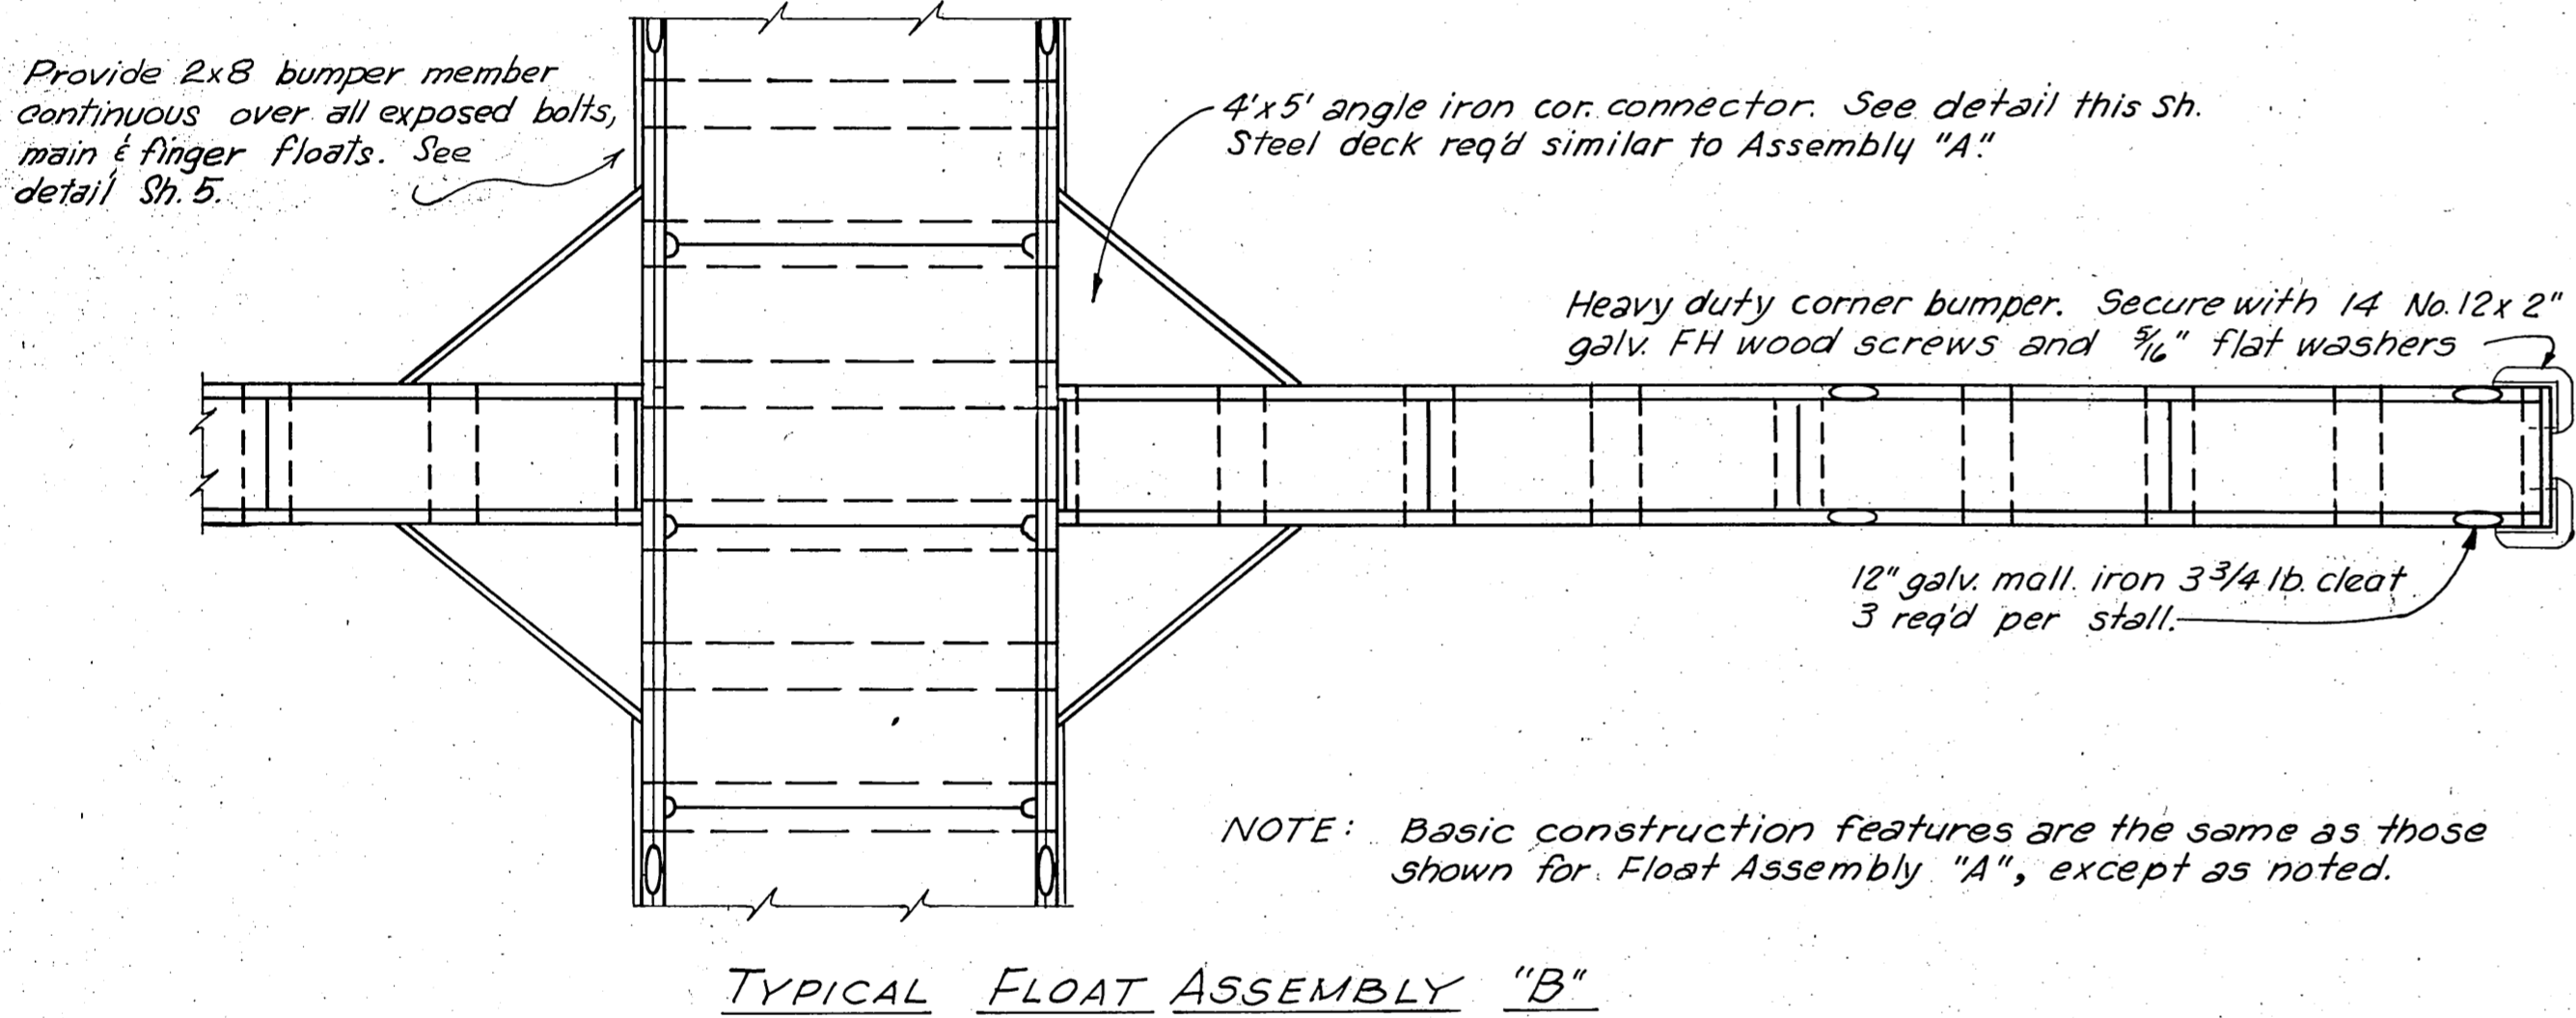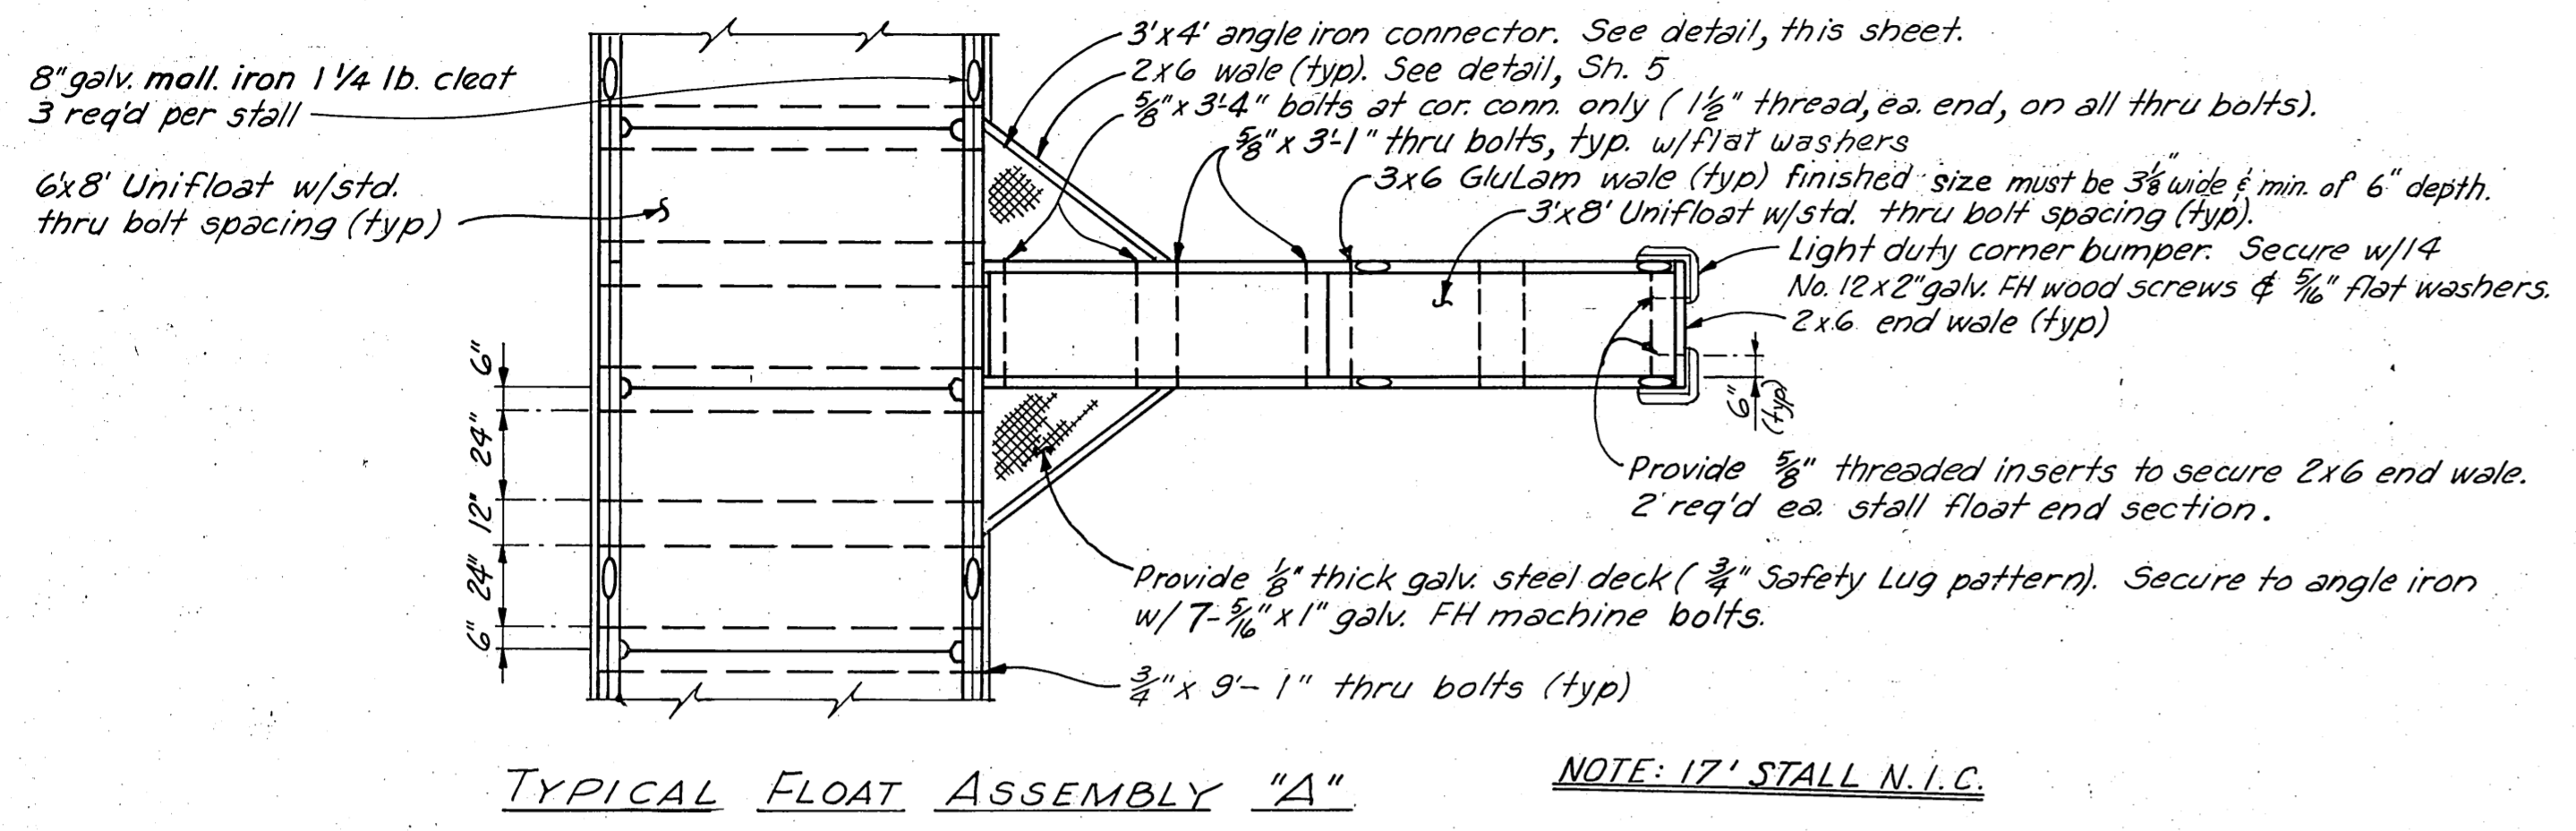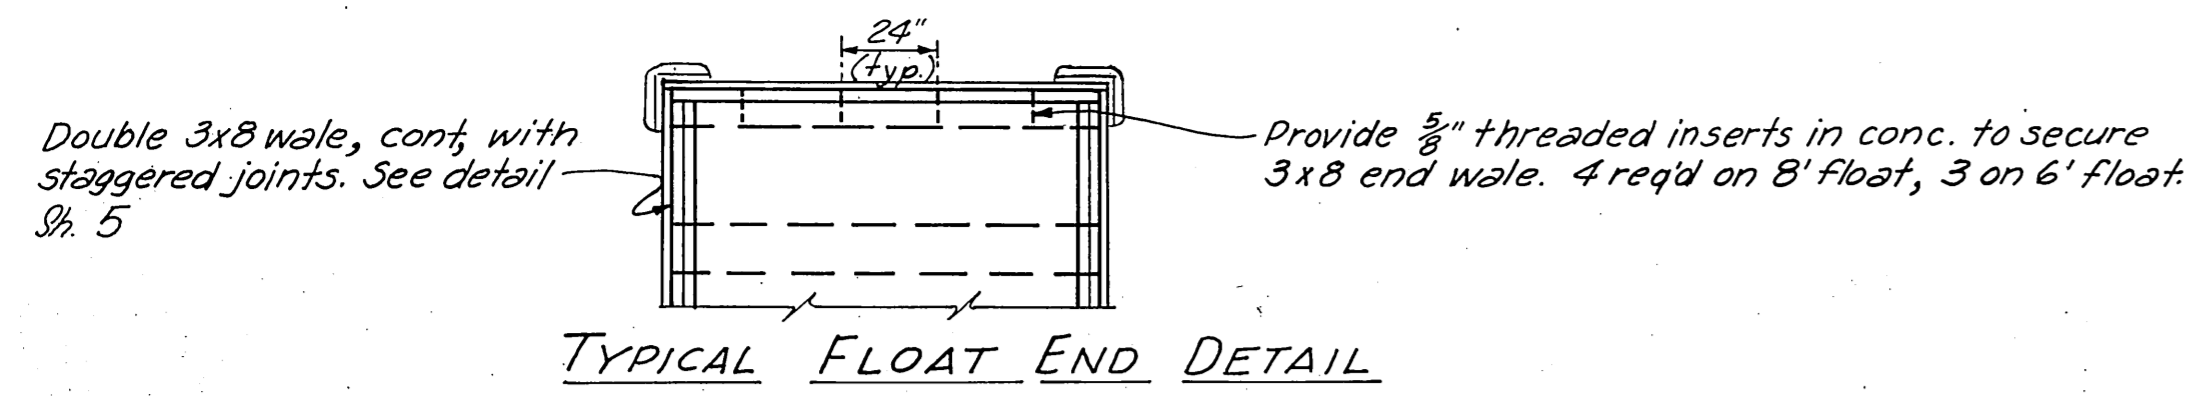


FLOAT ASSEMBLY DETAILS
1/4" = 1'-0"

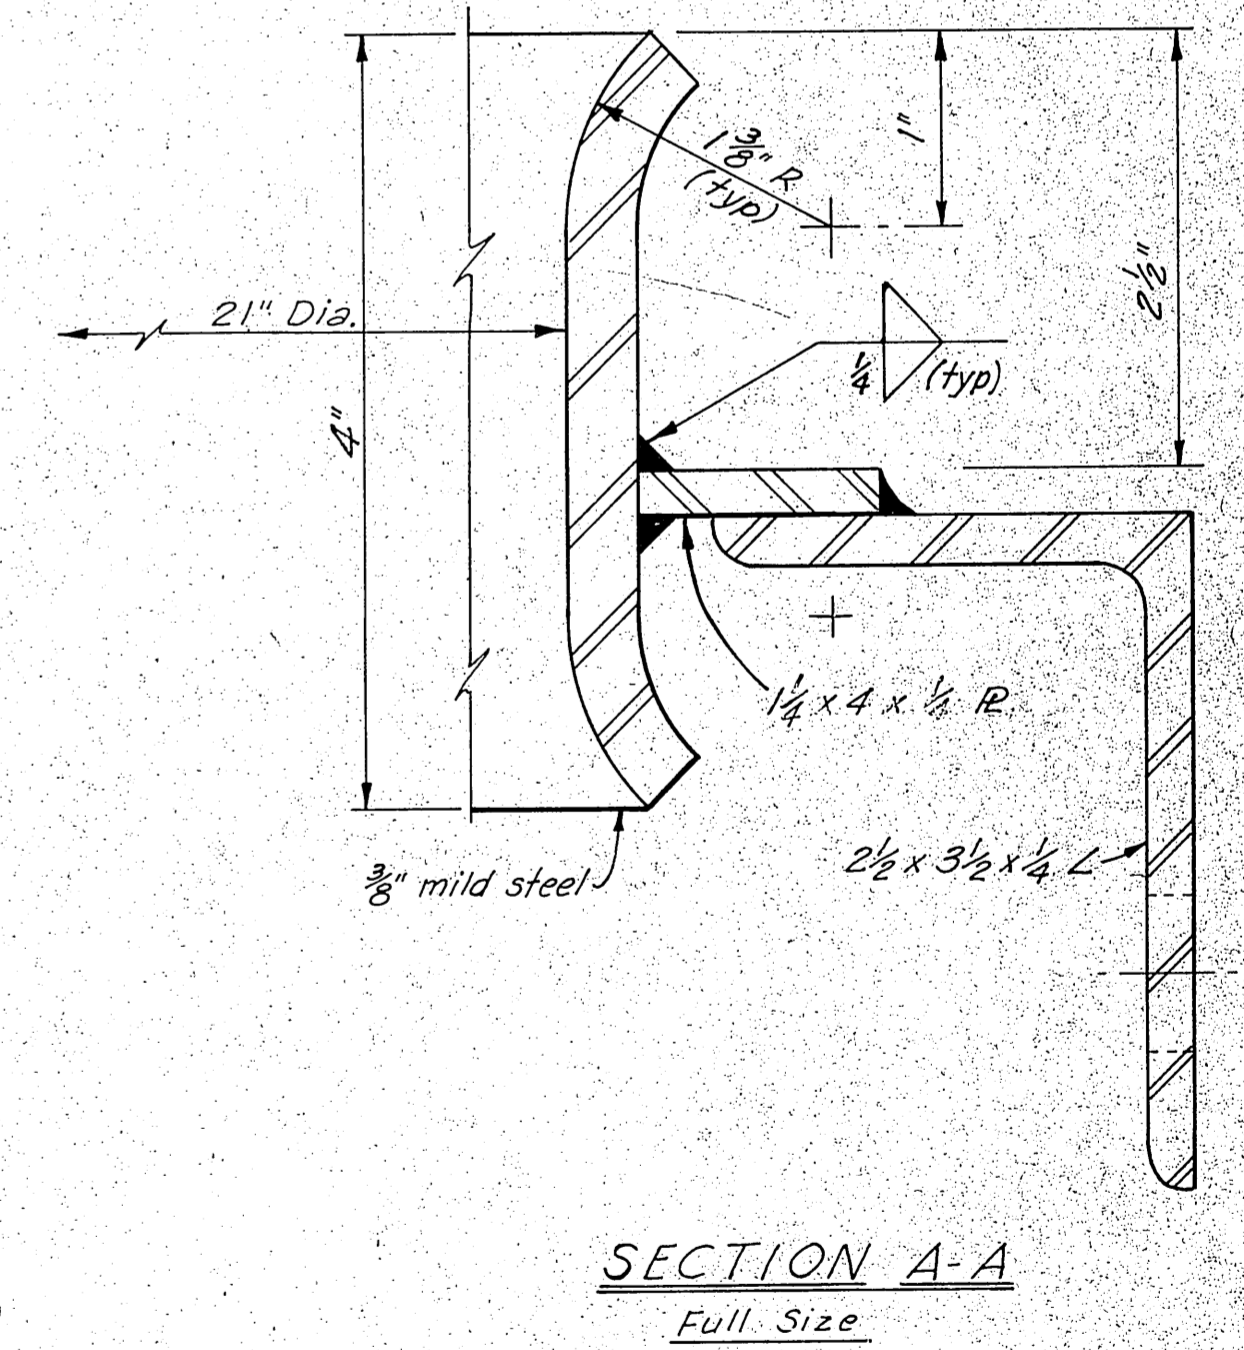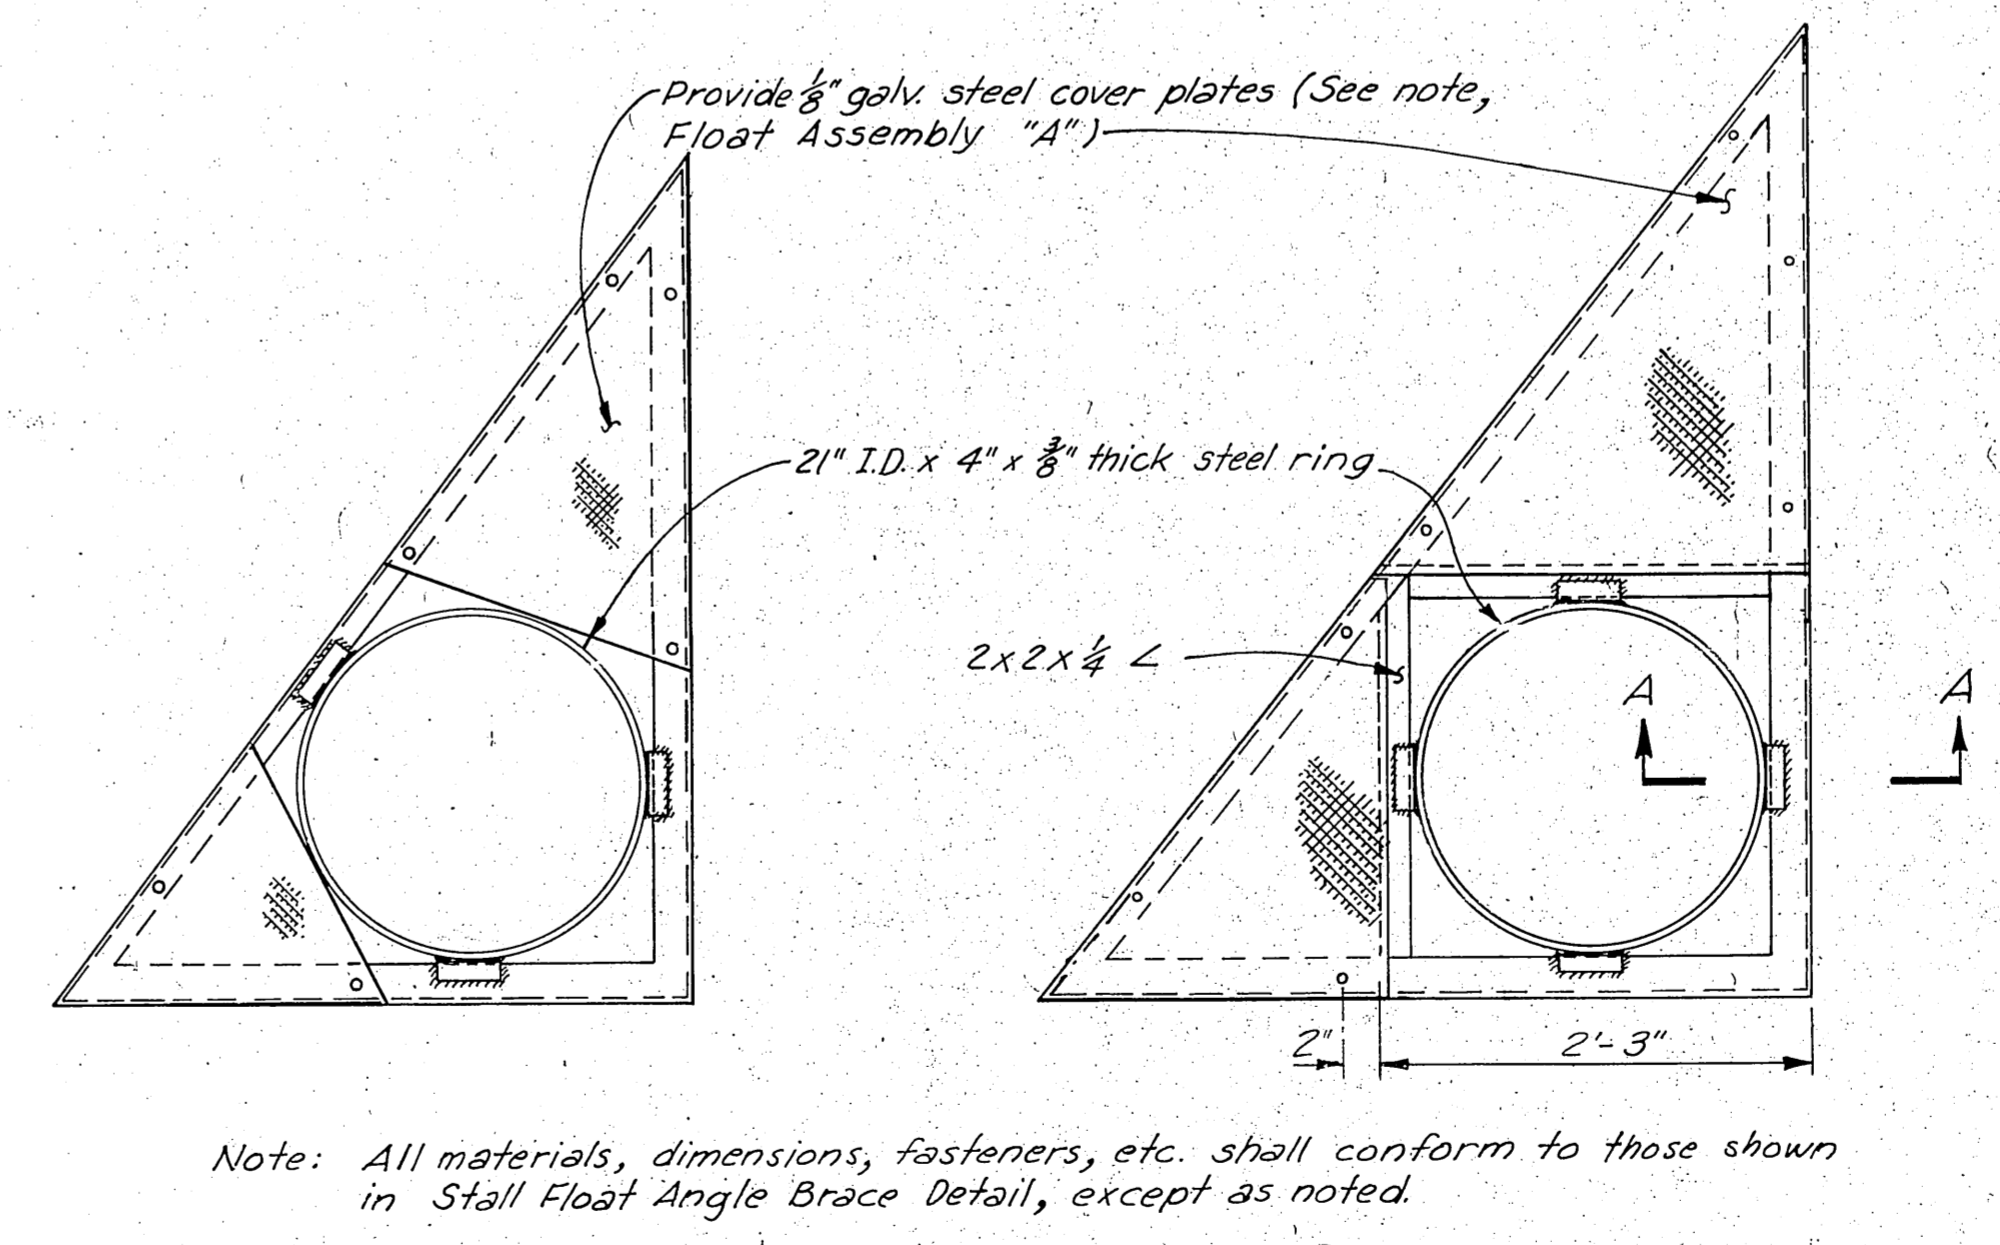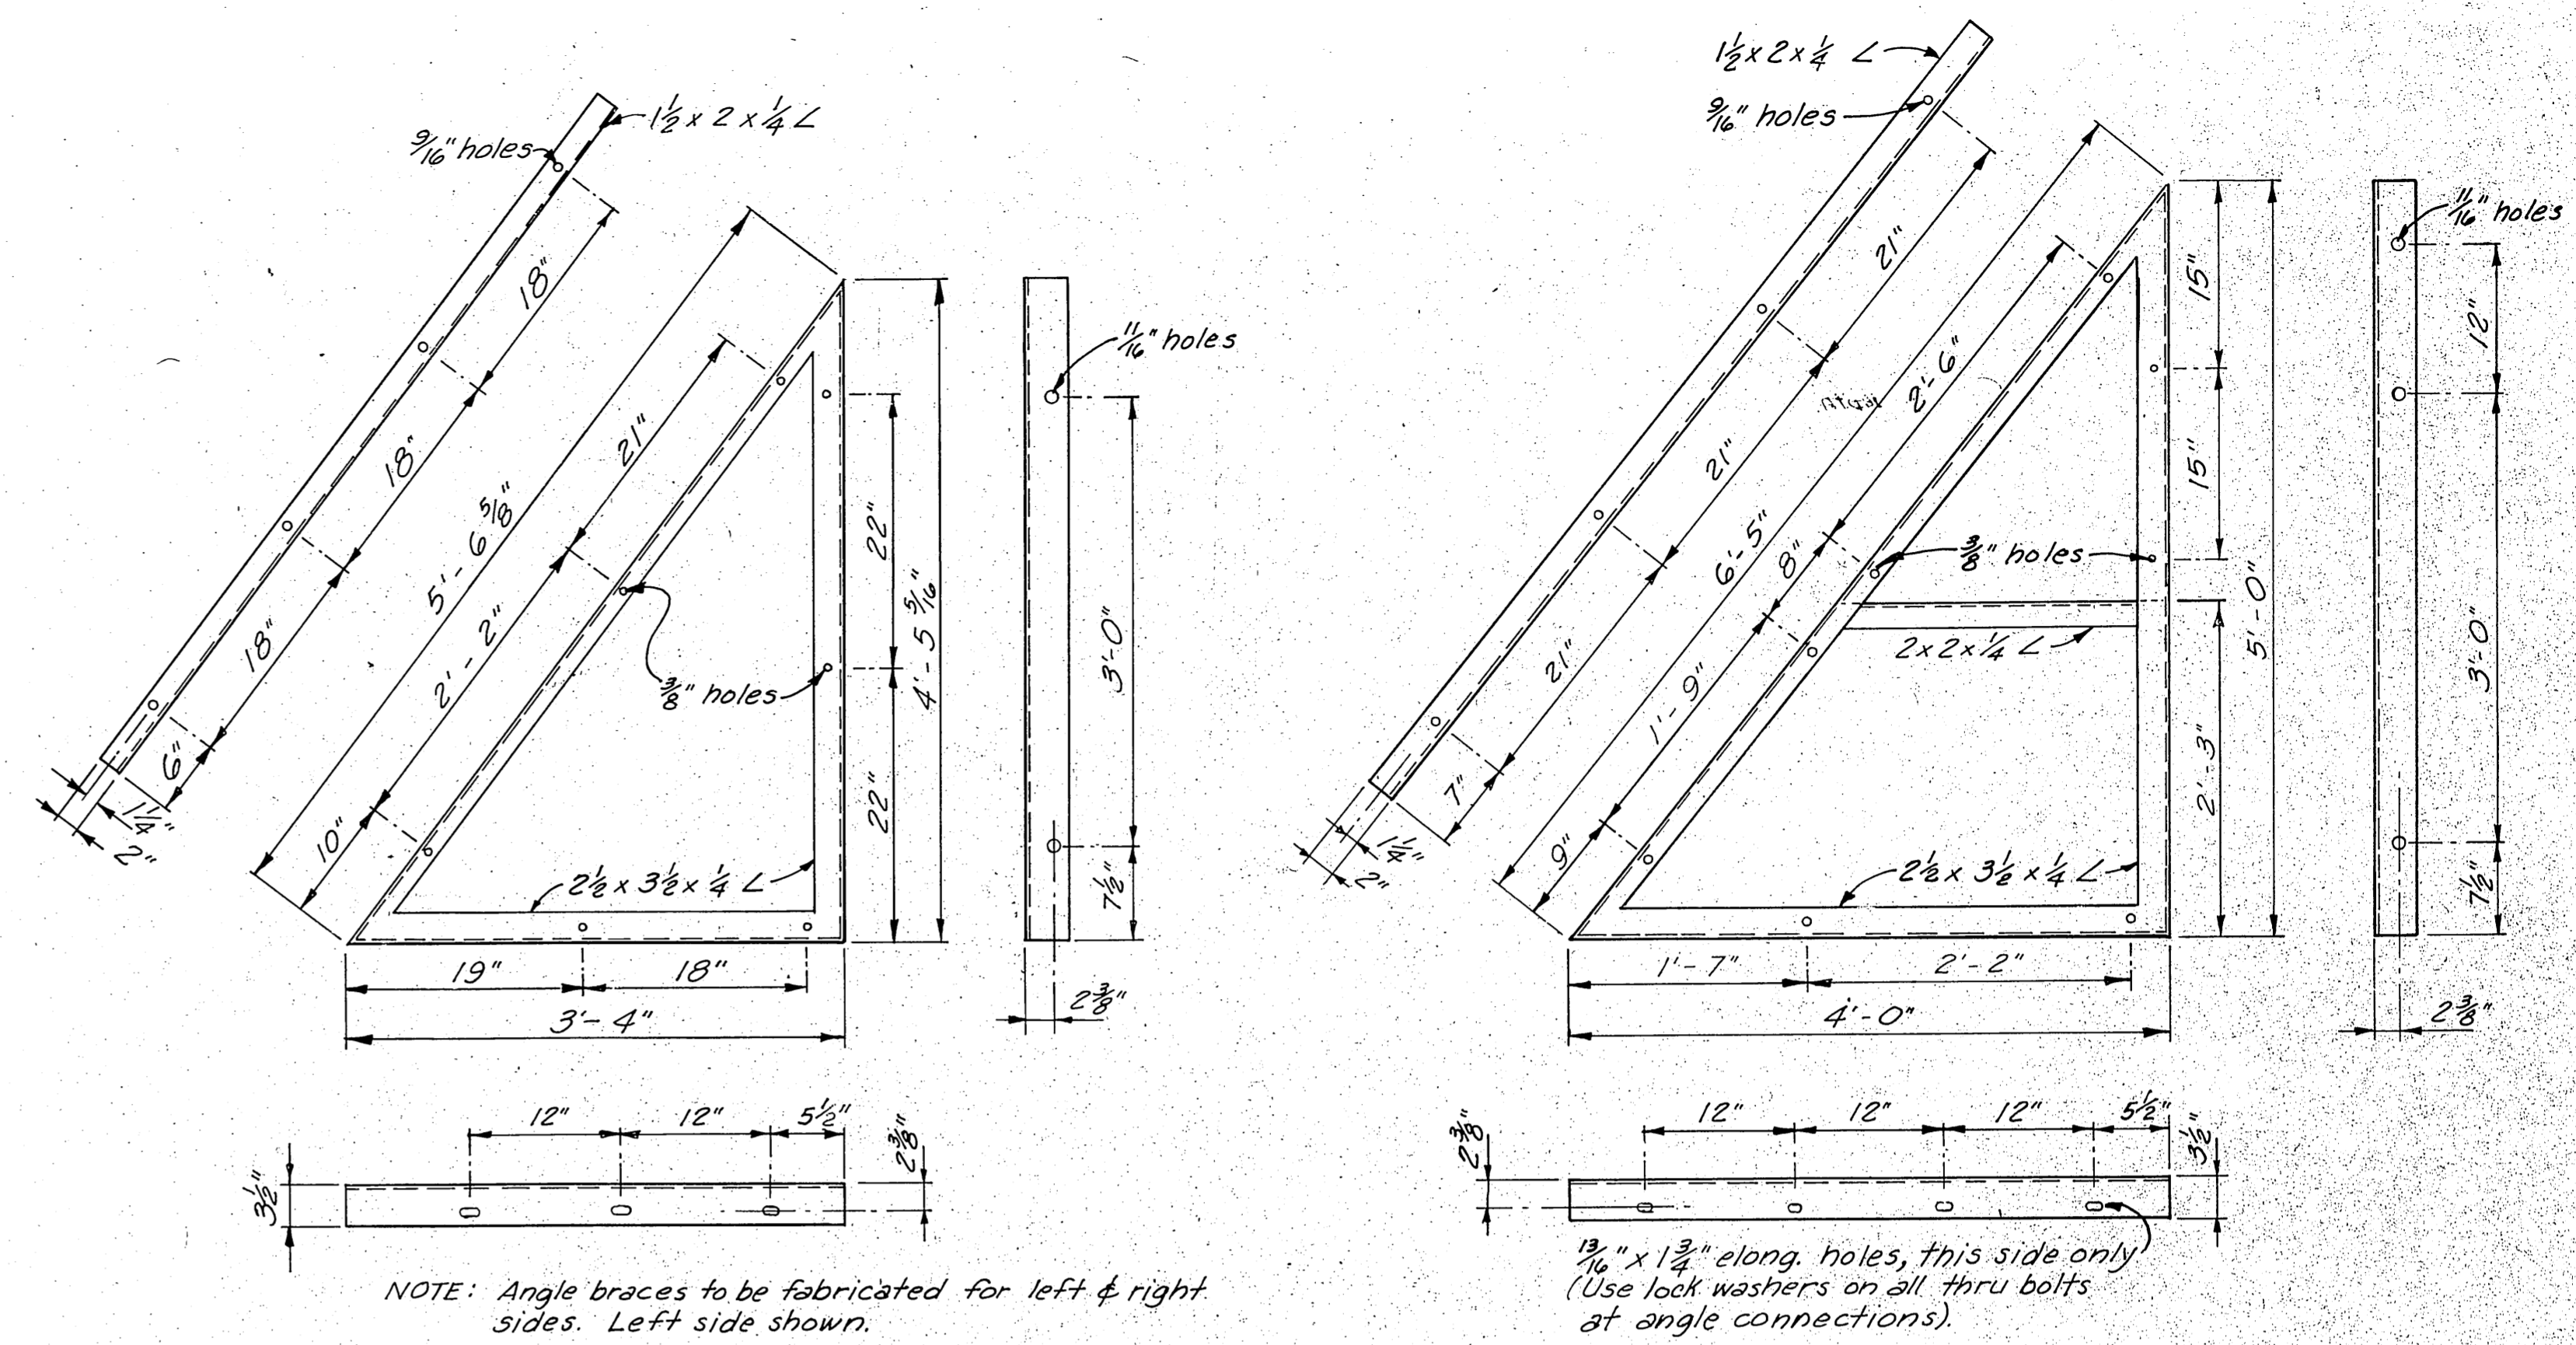


DO NOT SCALE THIS DRAWING - USE DIMENSIONS		
STATE OF ALASKA DEPARTMENT OF PUBLIC WORKS DIVISION OF WATER AND HARBORS		
CONCRETE FLOATS TYPICAL ASSEMBLIES & MISC. DETAILS		
SCALE As shown	SURVEYED	APPROVED
DESIGNED DS/MLB/RE	DRAWN JET	Don Statter
CHECKED	DATE 3-10-70	DIRECTOR
PROJECT NUMBER 3-72180	SHEET 4 OF 6	

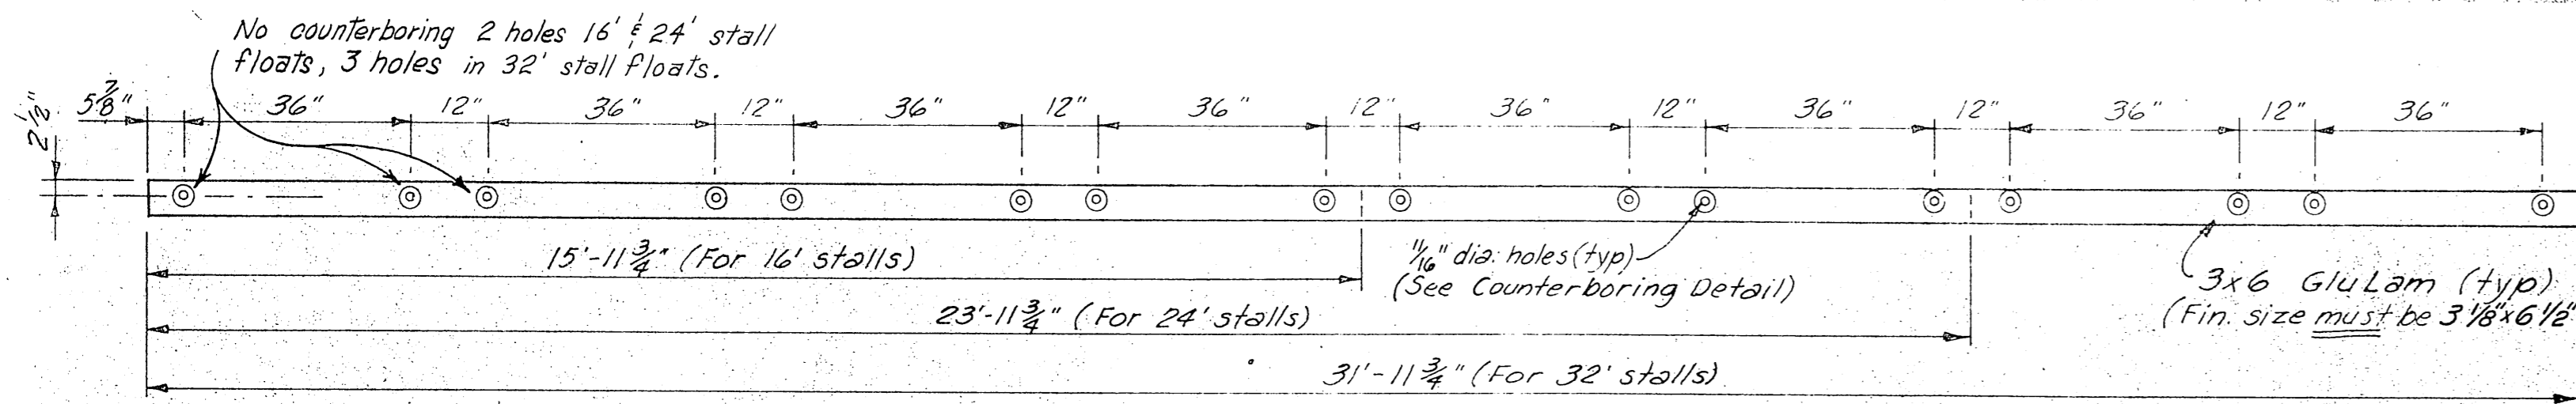

STALL FLOAT WALE

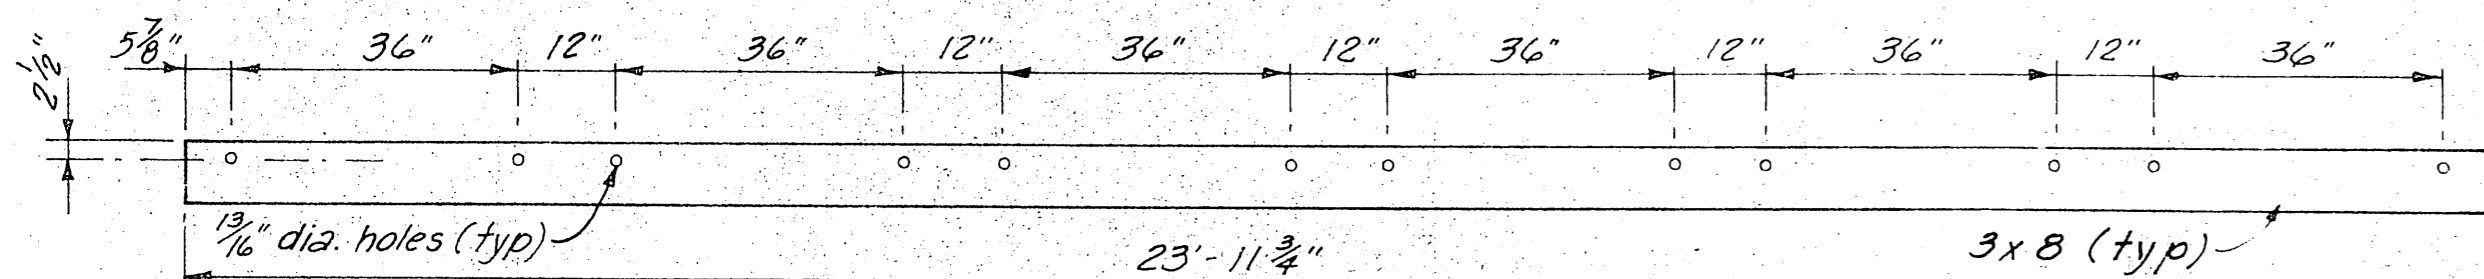

WALE FOR 6'-WIDE FLOATS

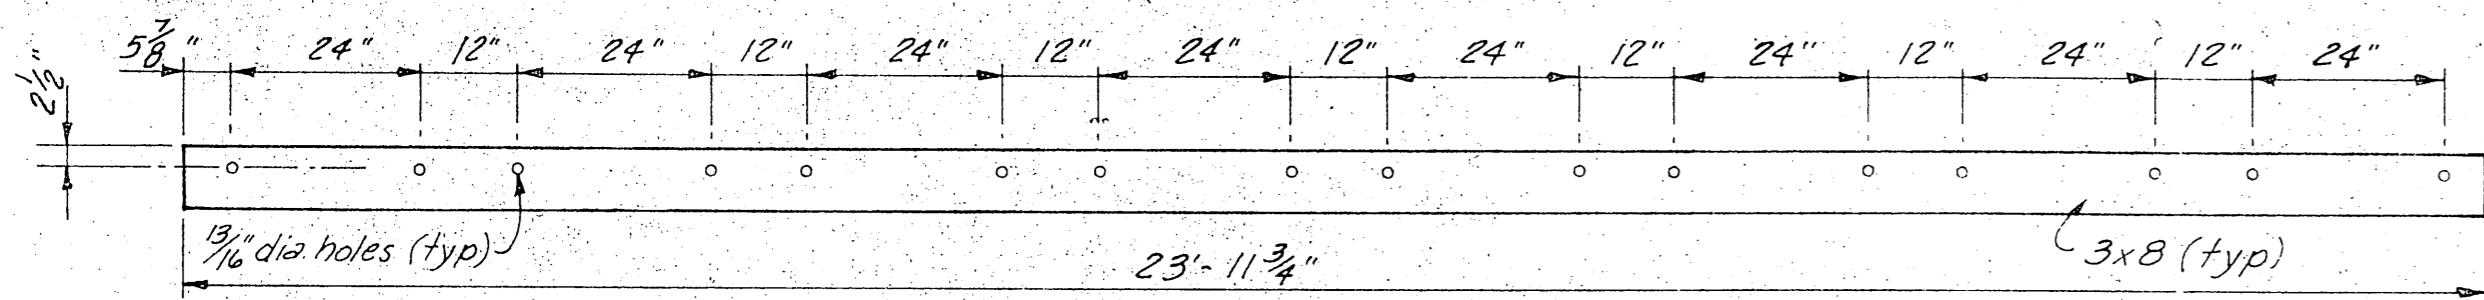


WALE FOR 8'-WIDE FLOATS

NOTE: ALL HOLES MUST BE IN STRAIGHT LINE.


TYPICAL WALES

1/2" = 1'-0"

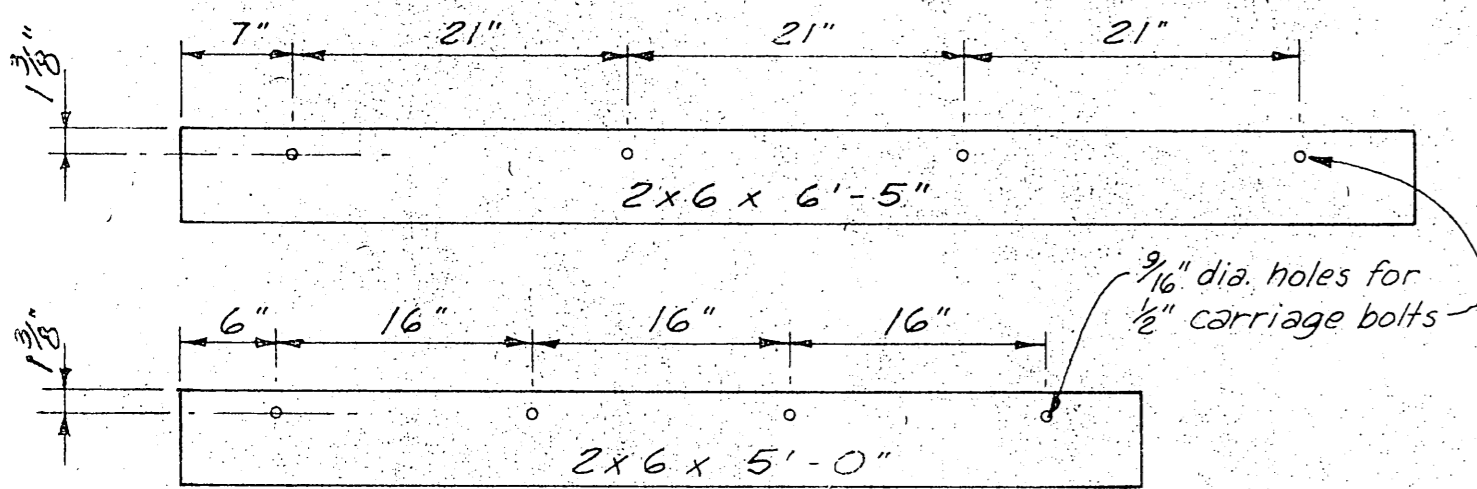


ANGLE CONNECTOR WALES

1" = 1'-0"

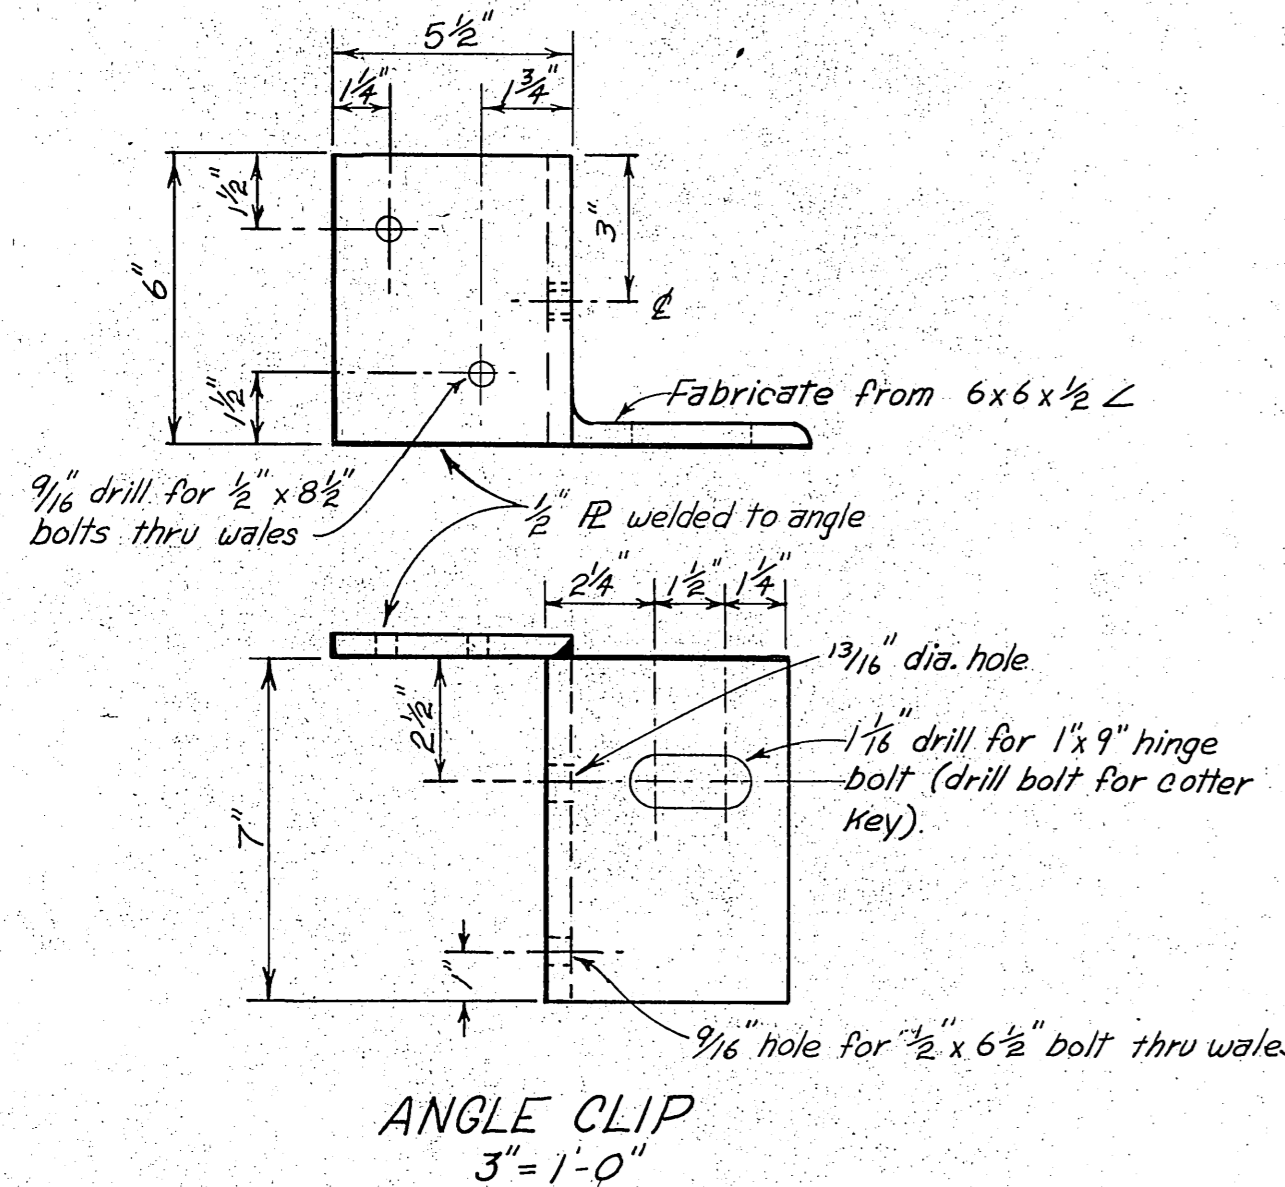


ANGLE CLIP

3" = 1'-0"

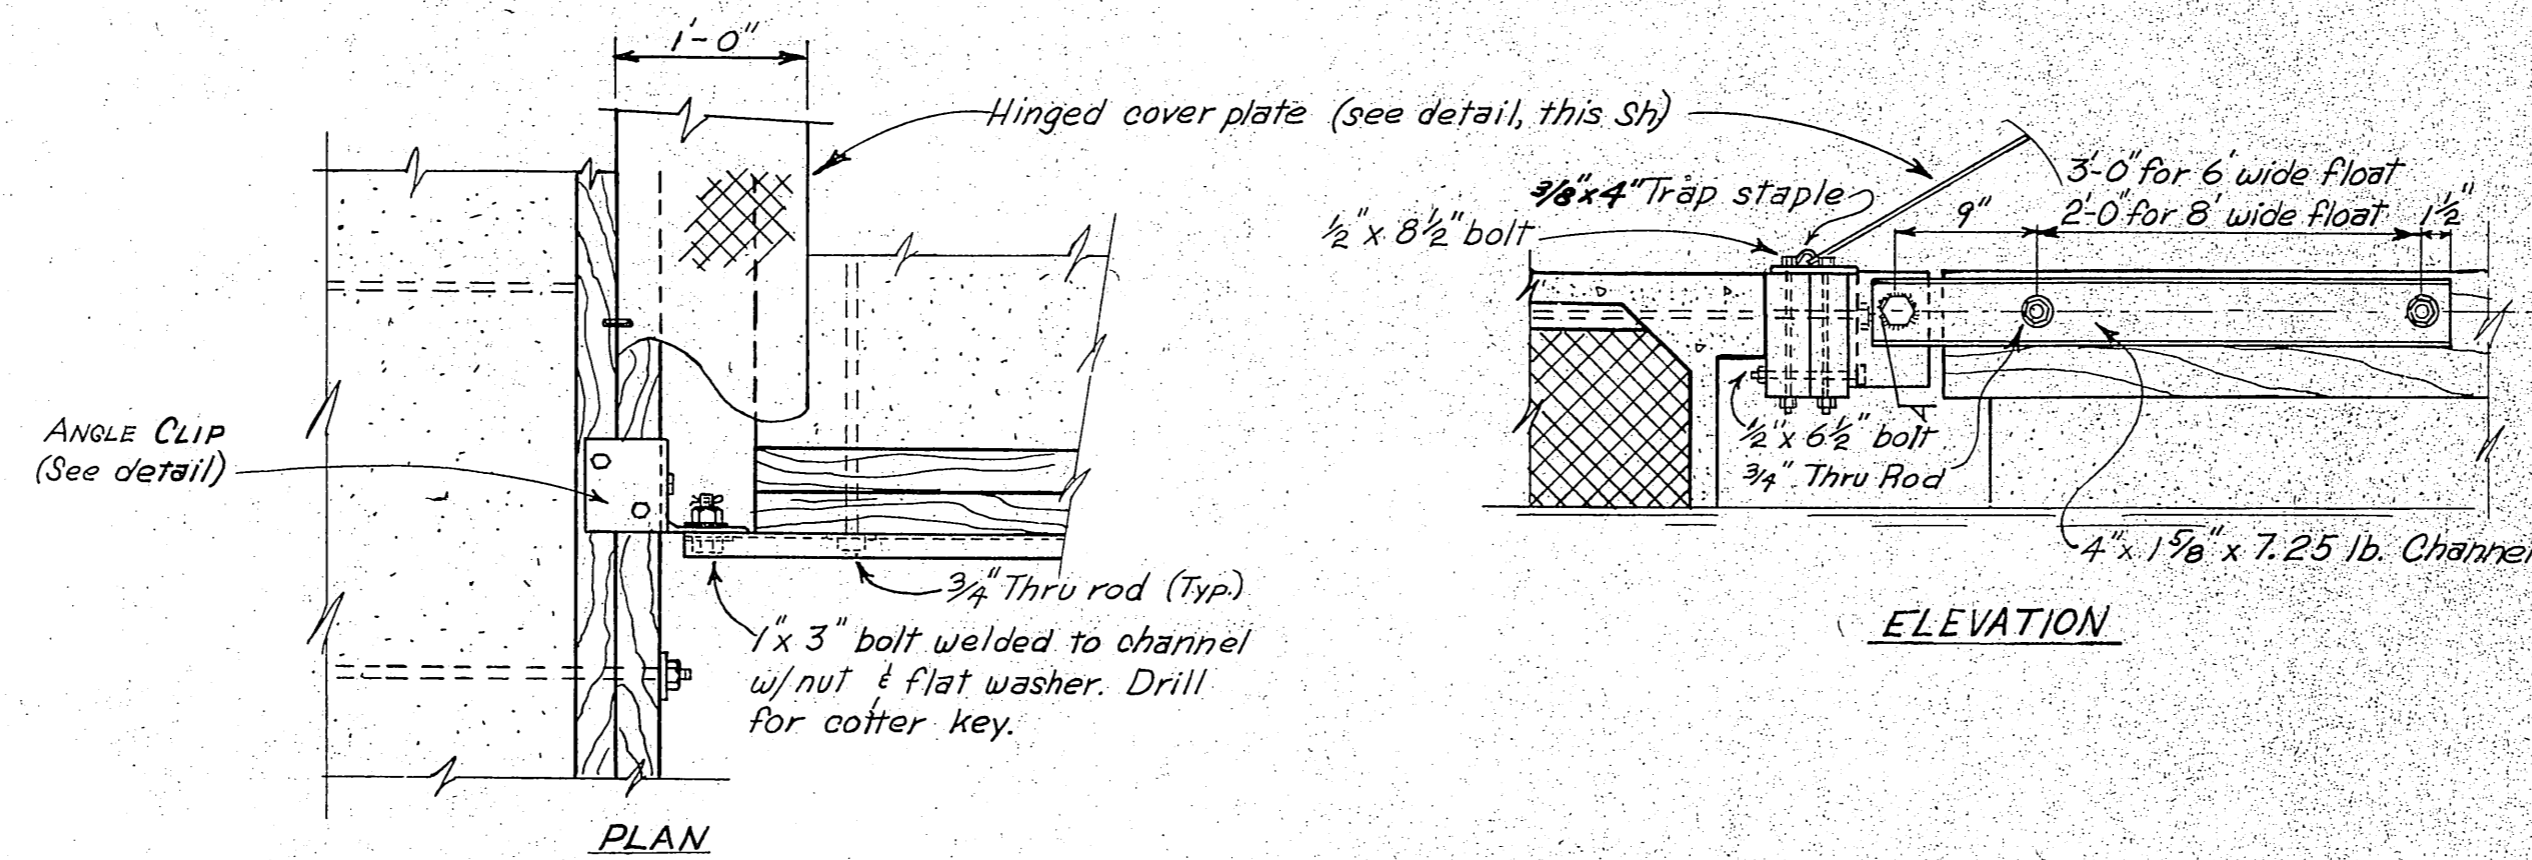


TYPICAL RIGHT ANGLE CONNECTION

1" = 1'-0"

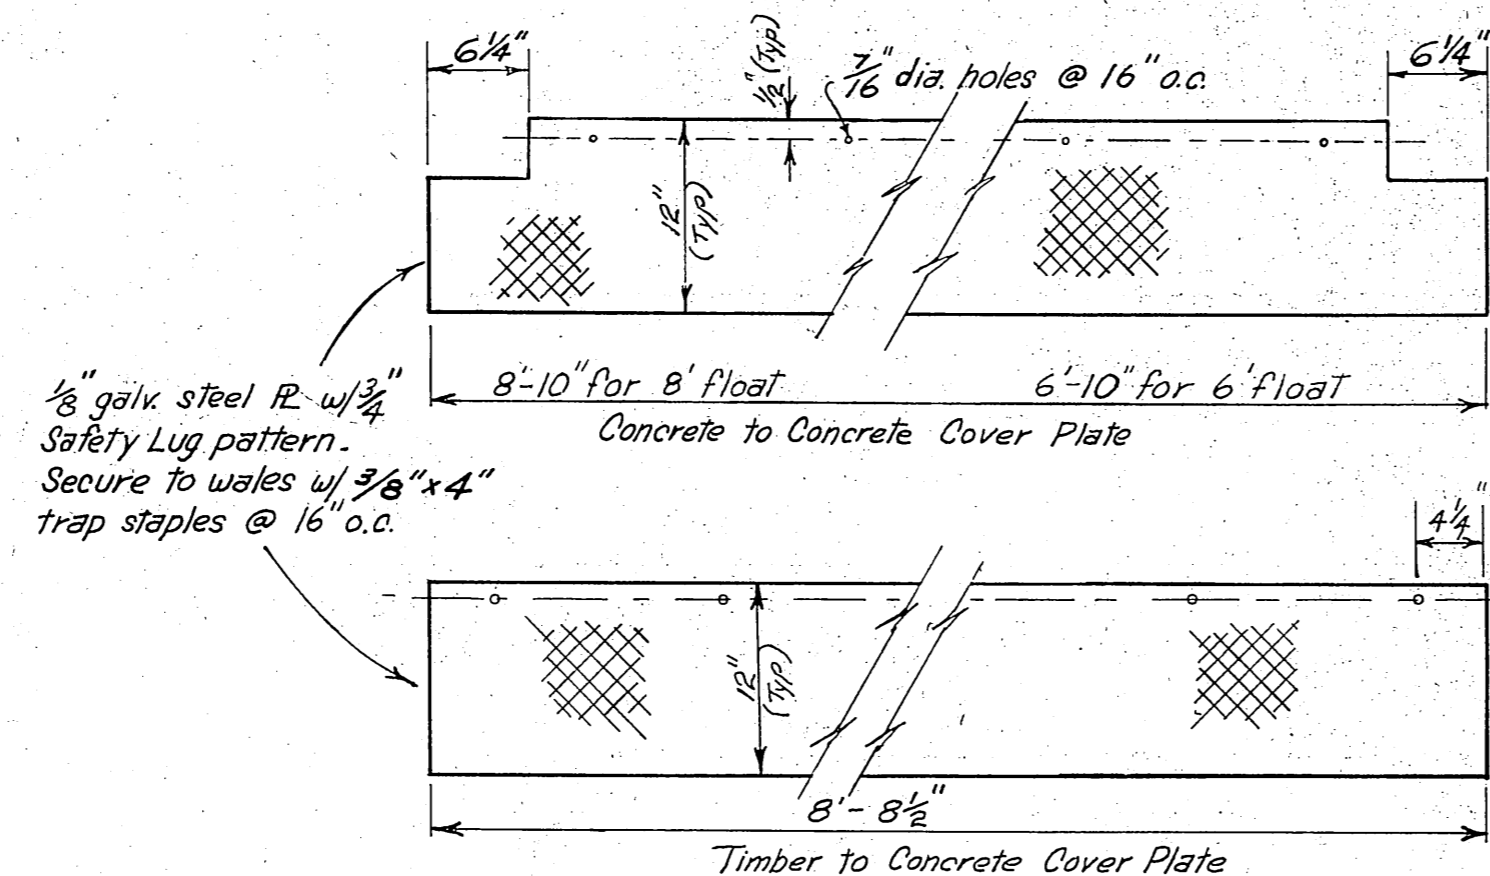


COVER PLATE DETAILS

Scale: 1" = 1'-0"

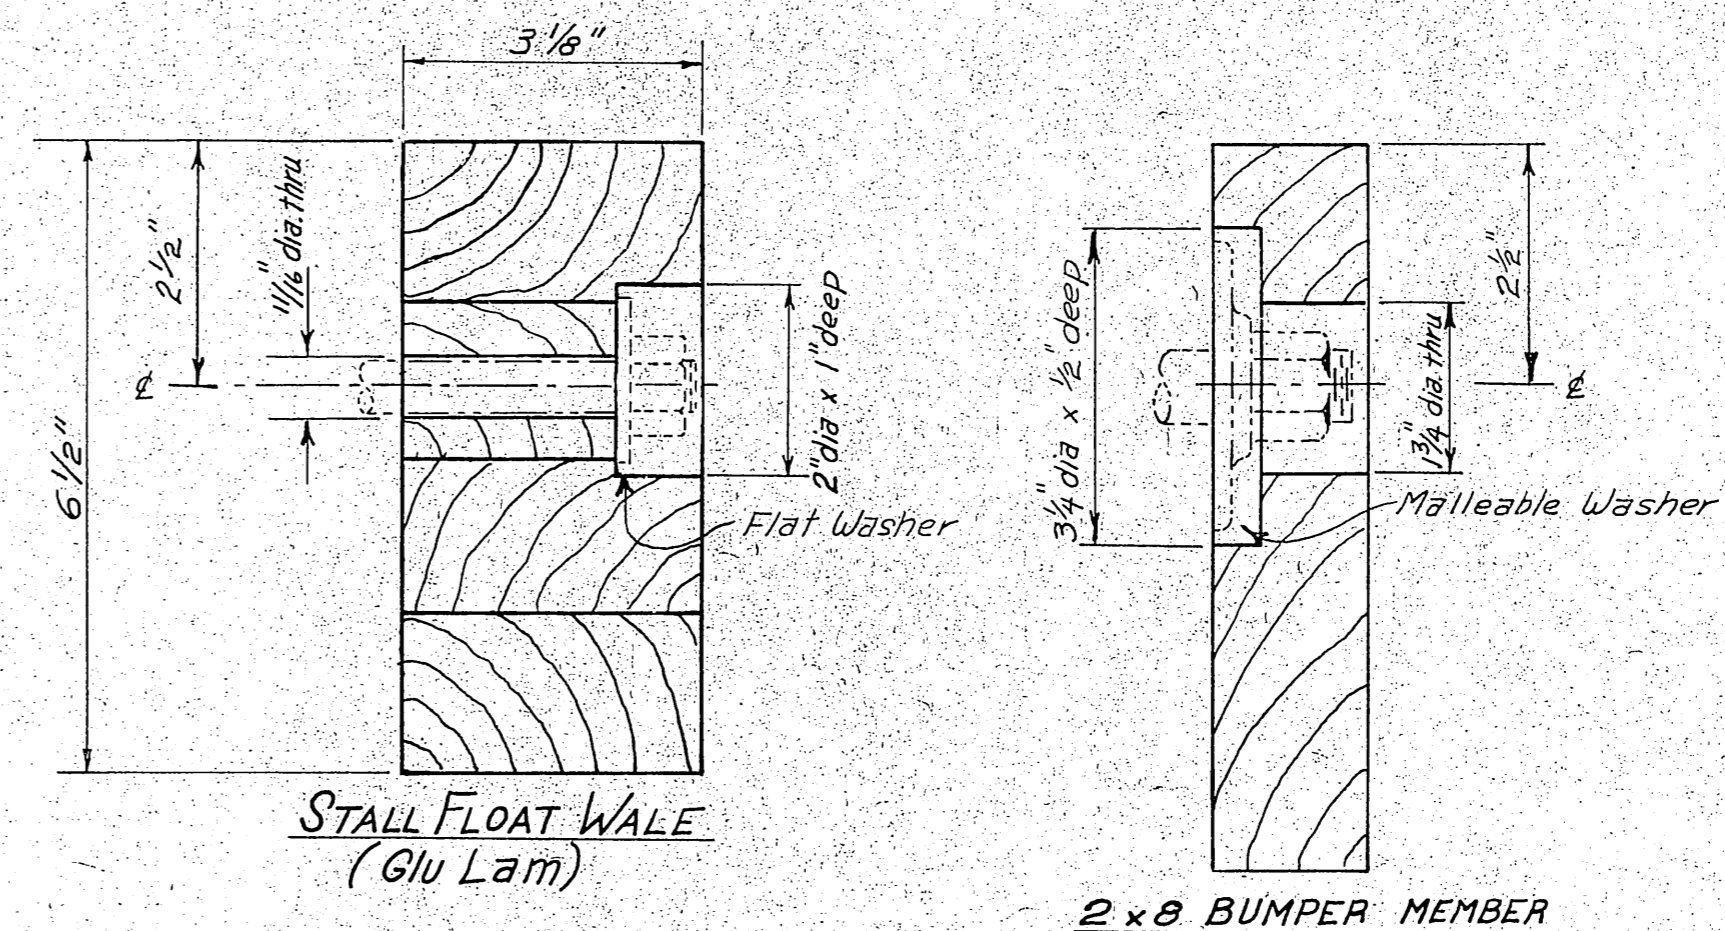


TYPICAL COUNTERBORING DETAIL

Half Size

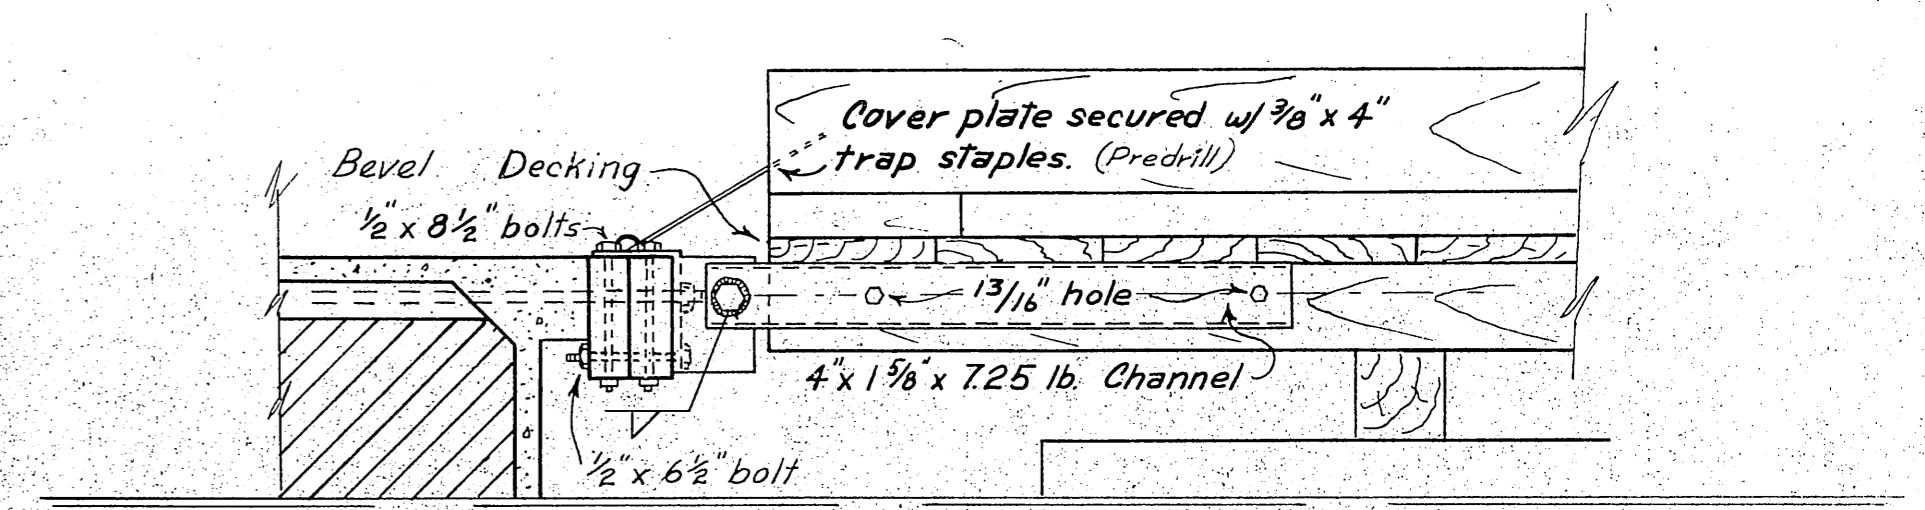


ELEVATION

1" = 1'-0"

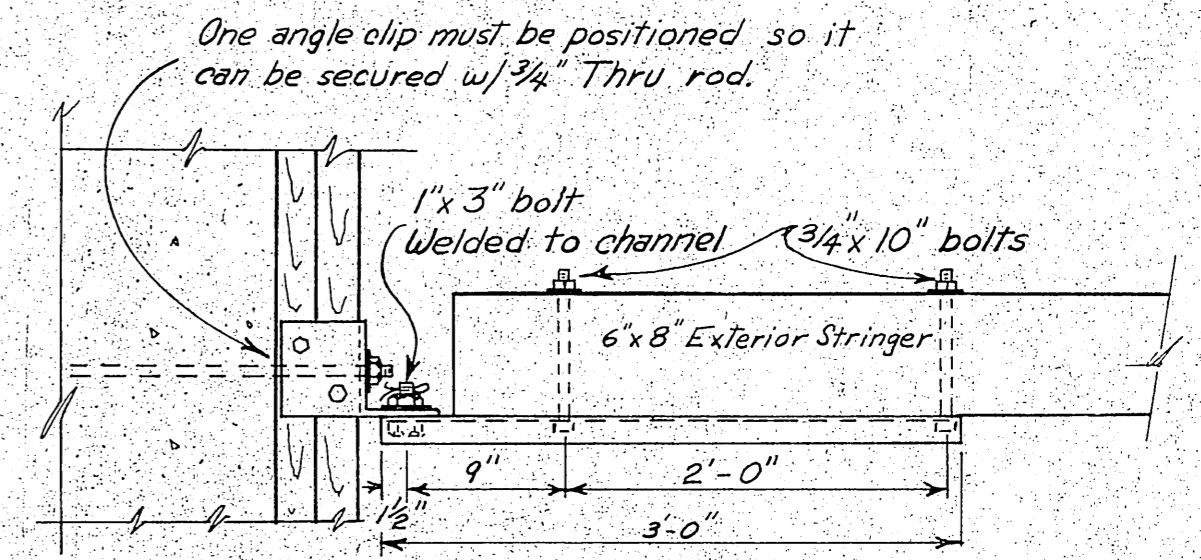

RIGHT ANGLE CONNECTION - TIMBER TO CONCRETE


1" = 1'-0"

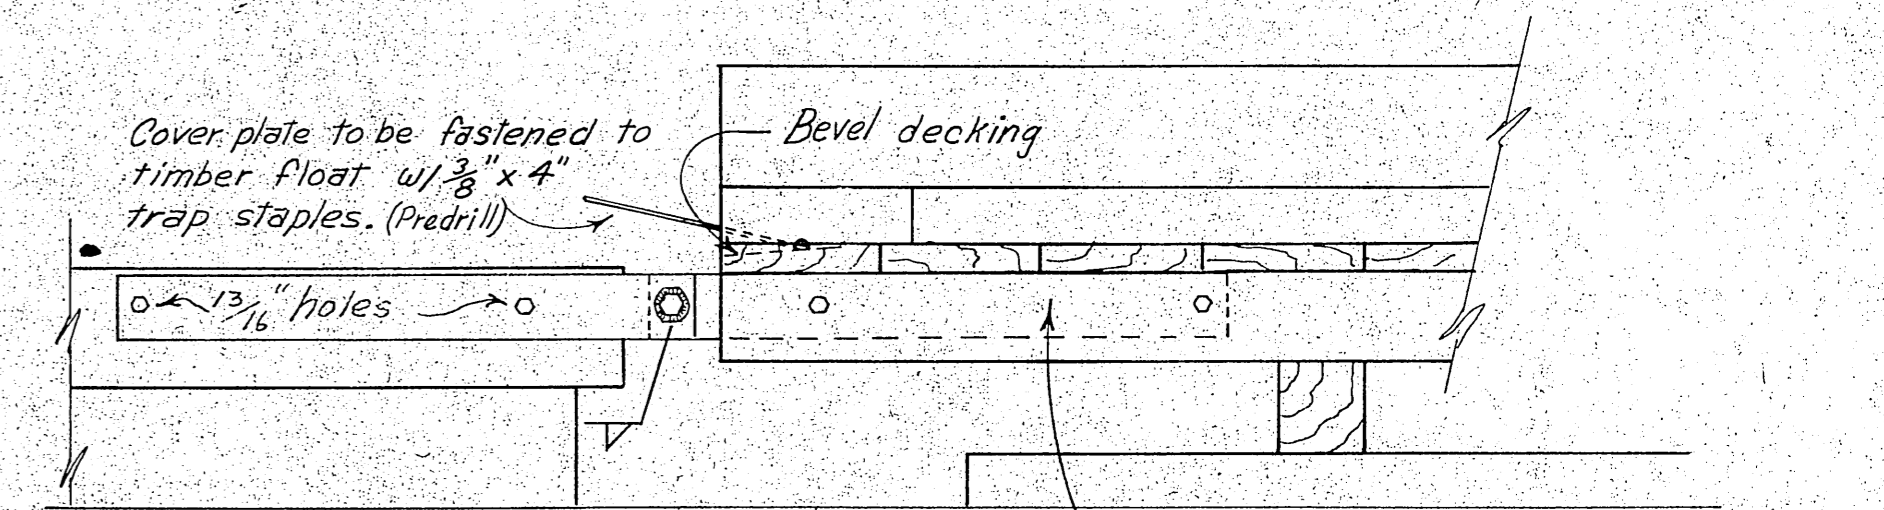

ELEVATION

1" = 1'-0"

Channel which is bolted to inside of exterior stringer to be fabricated with 1" x 3" hole, omitting the 1" x 3" welded bolt. Two (2) such pieces required.

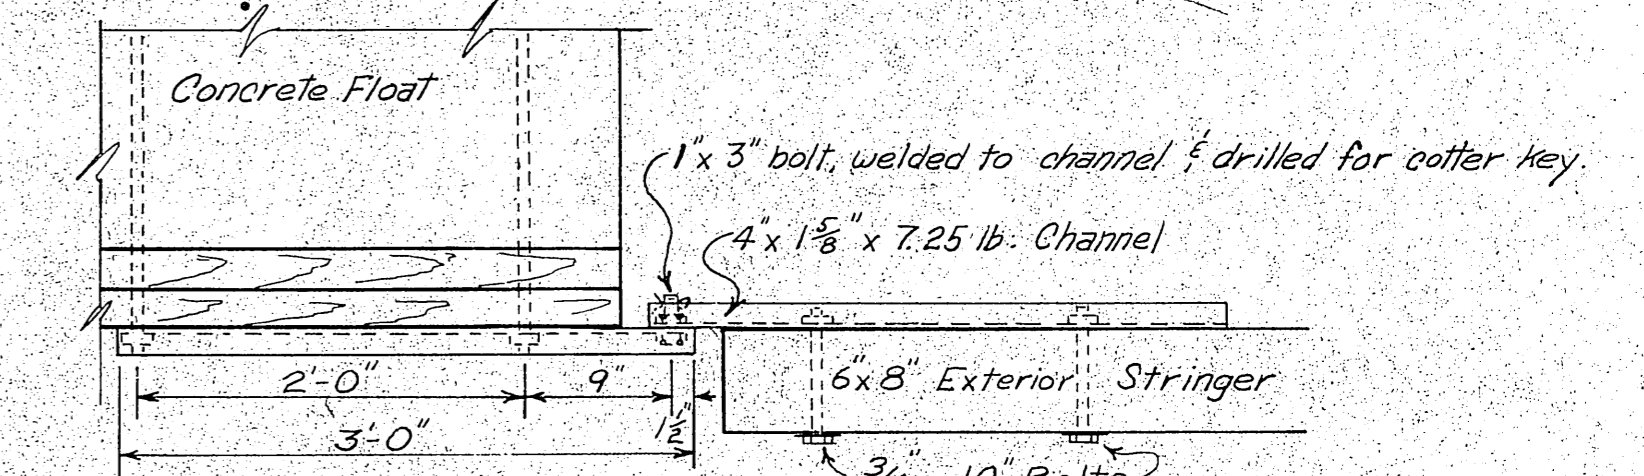

END TO END CONNECTION - TIMBER TO CONCRETE


1" = 1'-0"

DO NOT SCALE THIS DRAWING - USE DIMENSIONS.


STATE OF ALASKA
DEPARTMENT OF PUBLIC WORKS
DIVISION OF WATER AND HARBORS

CONCRETE FLOATS
STANDARD DETAILS


SCALE: As Shown	SURVEYED: C.E.D.	APPROVED: DON STATTER
DESIGNED: C.E.D.	DRAWN: 7/15/71	DIRECTOR
CHECKED:		
PROJECT NUMBER: 3-72180		SHEET 5 OF 6

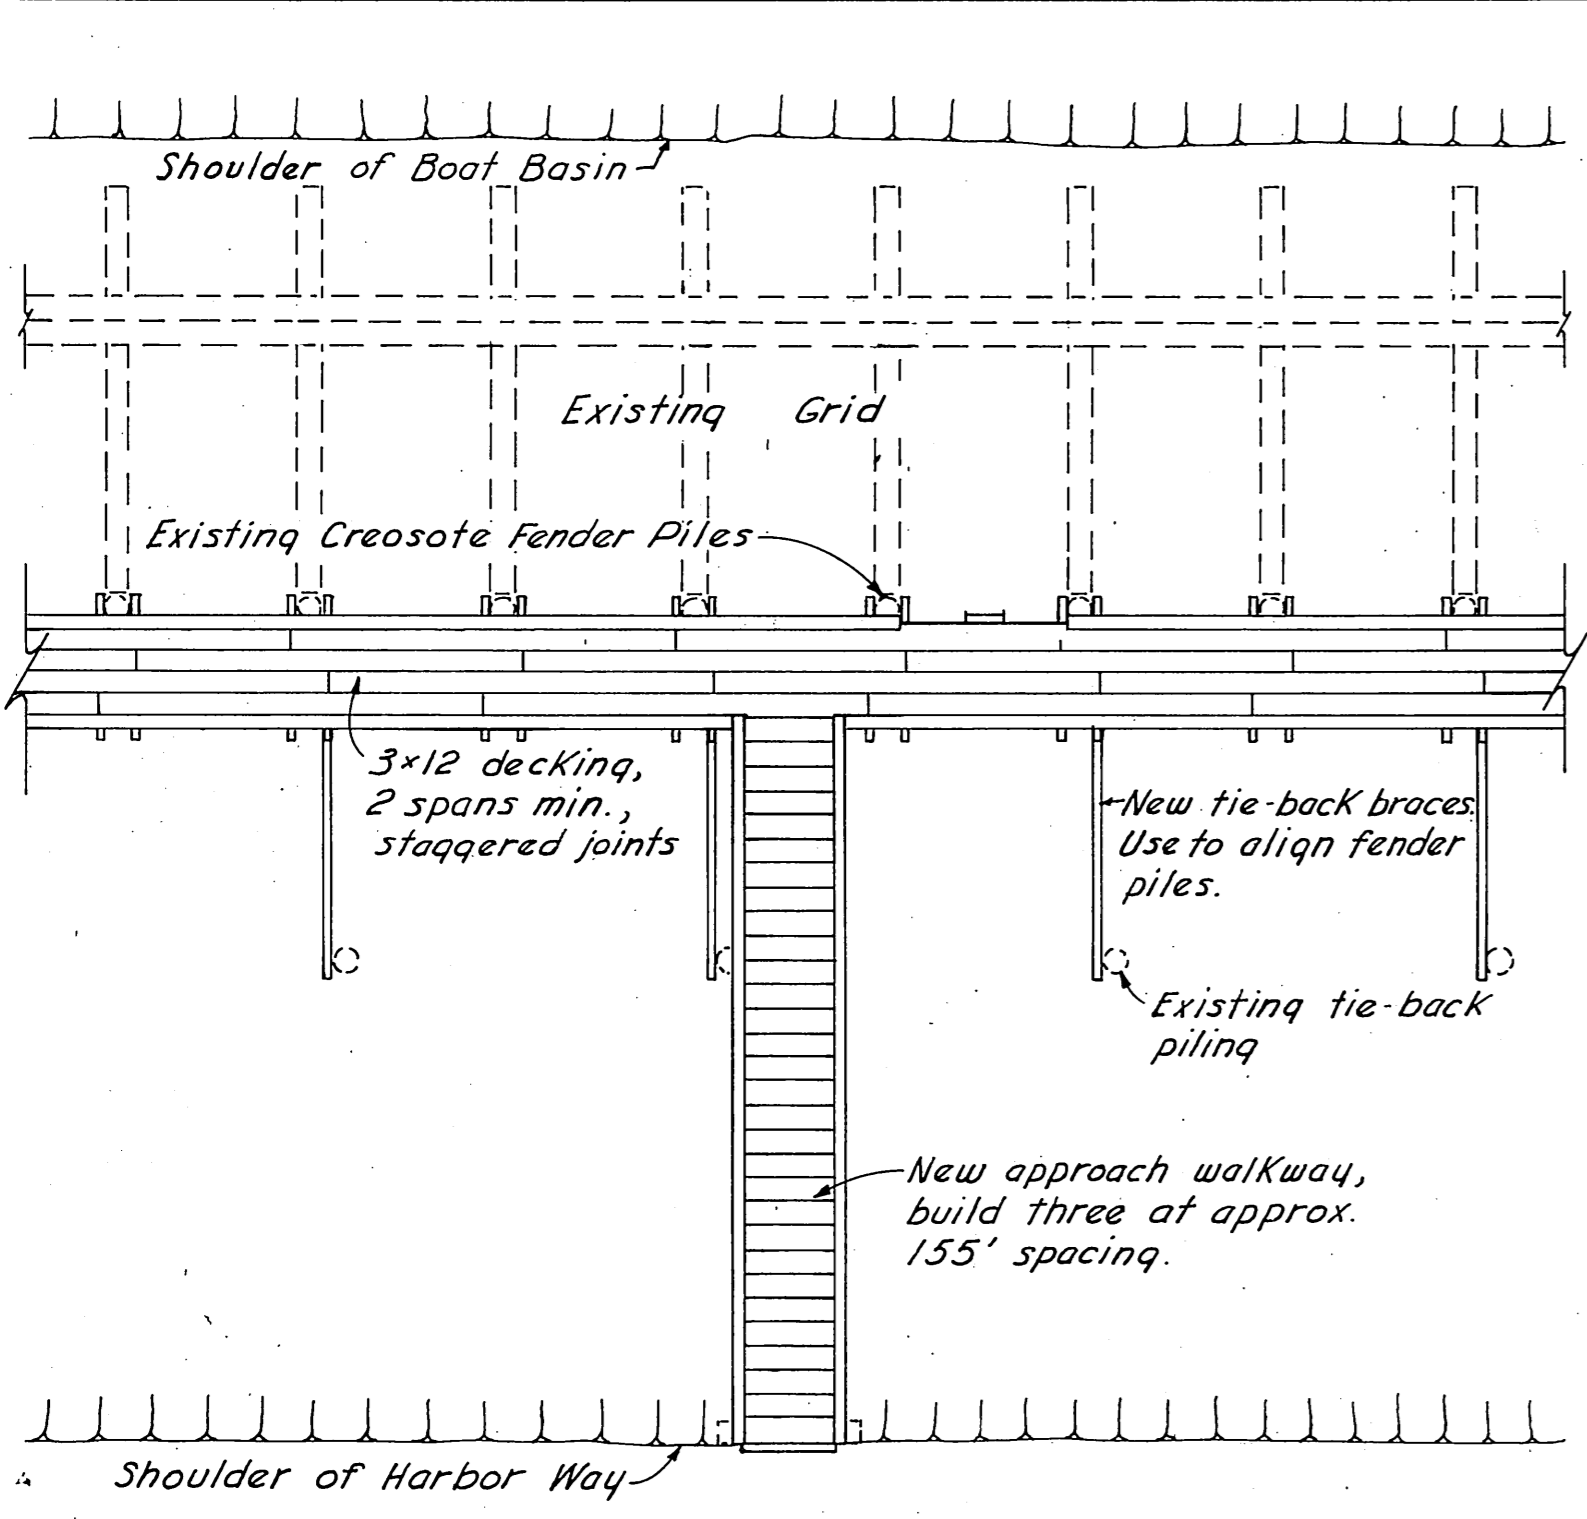

PARTIAL PLAN
1/8" = 1'-0"

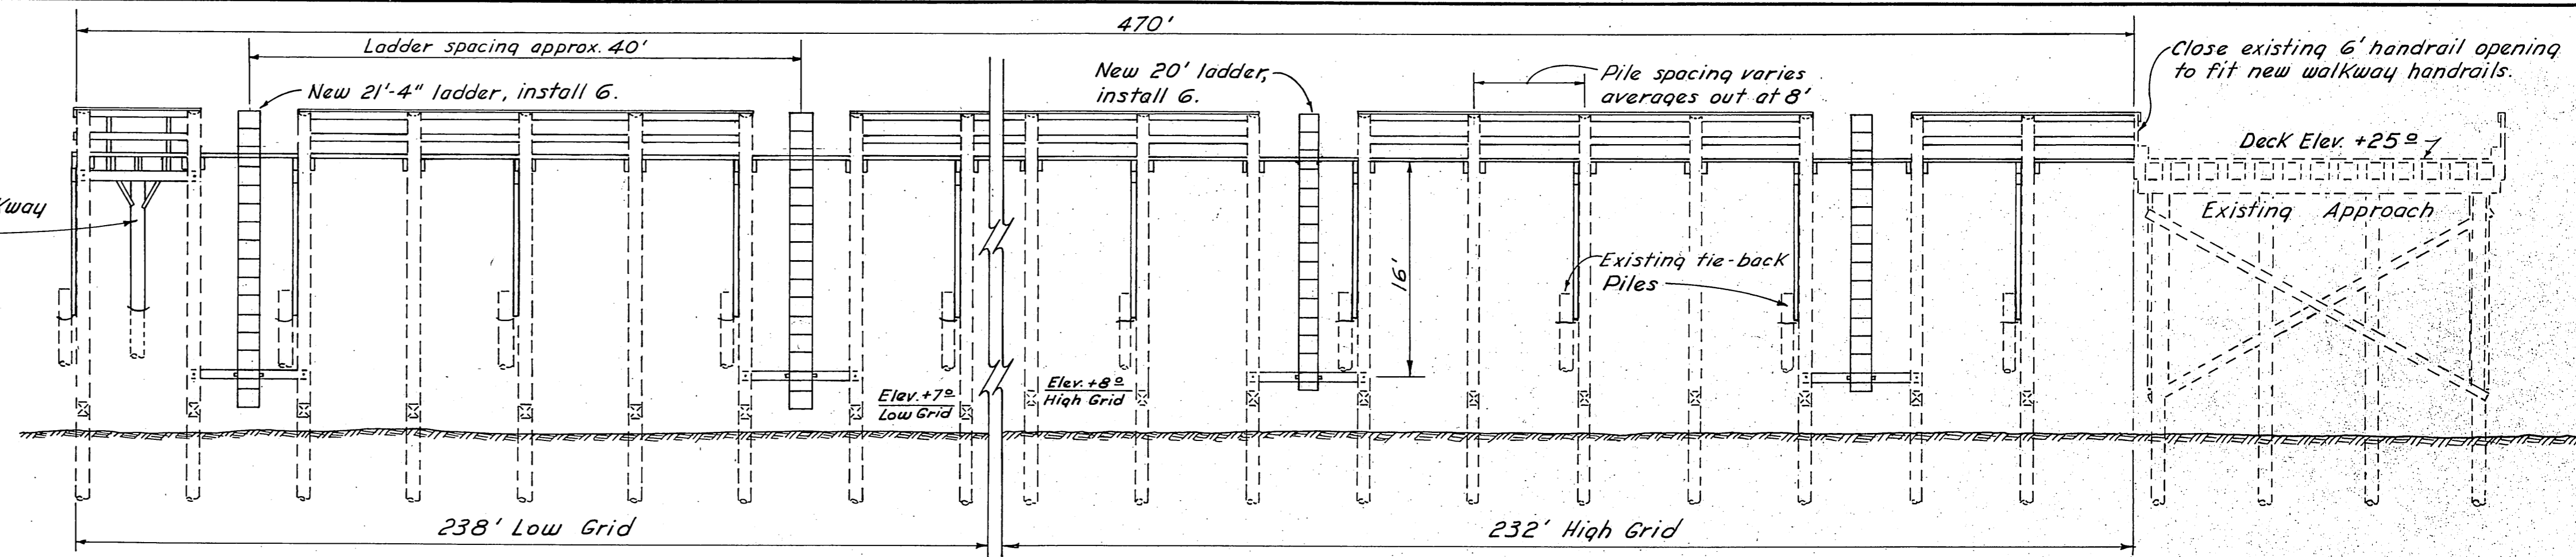


ELEVATION
1/8" = 1'-0"

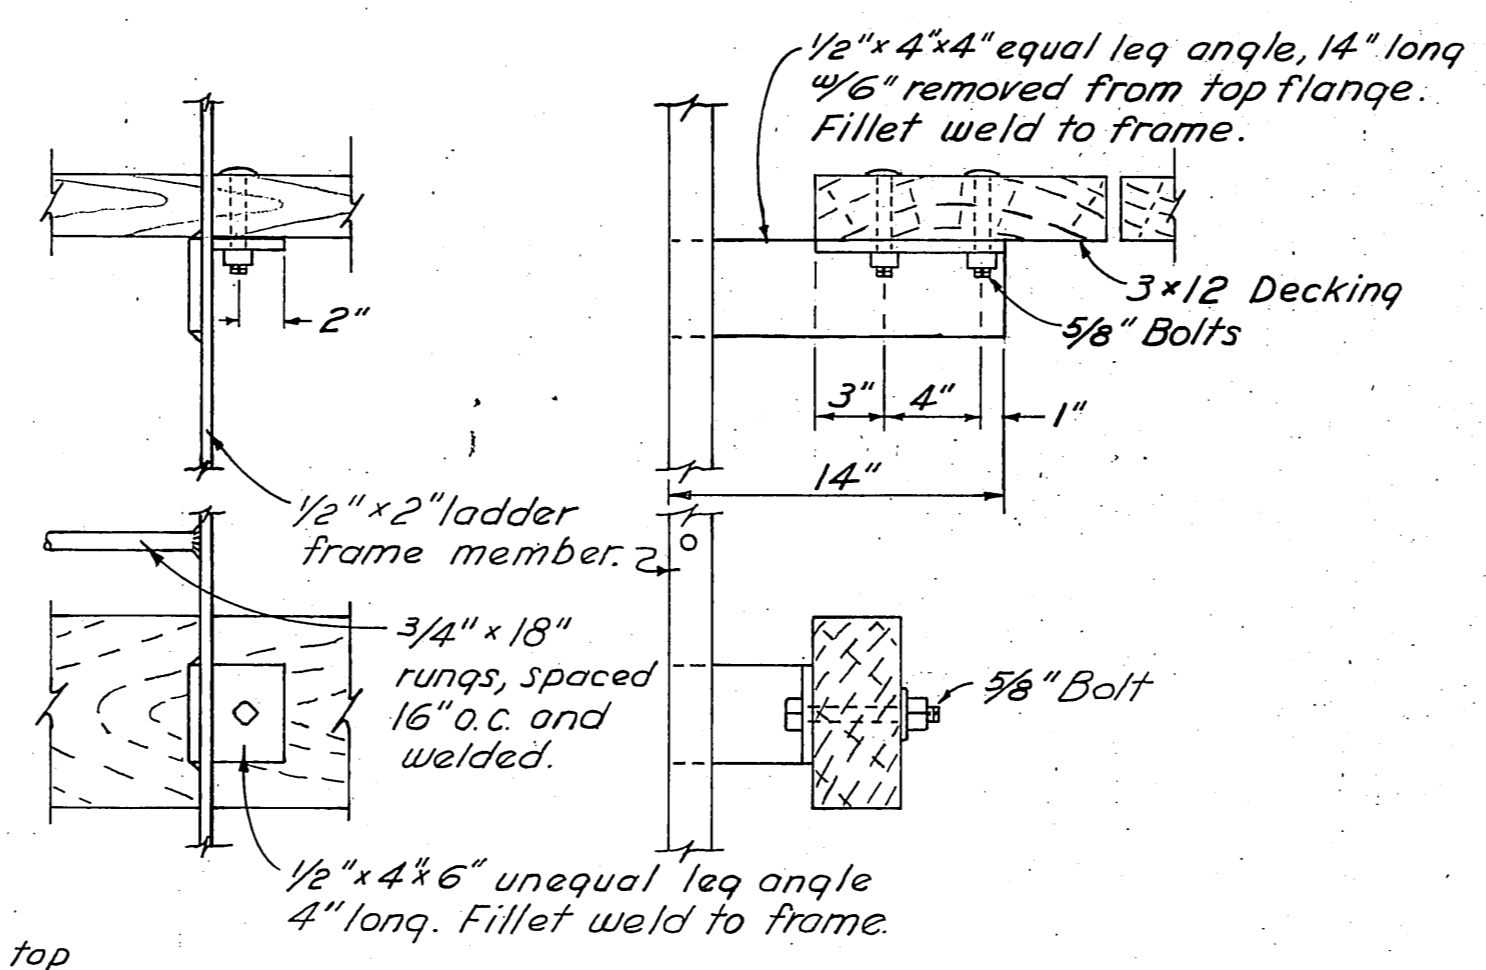

LADDER DETAILS
1/8" = 1'-0"

MATERIALS		
Item	Dressing	Treatment
Piling	Class A	12" Creo.
Mud Sills	Rough	"
Braces	"	"
Ladder Supp.	S4S	8" Creo.
Split Caps	"	"
Stringers	"	"
Decking	SISPE	"
H.R. Posts	S4S	"
Handrail	"	0.5" Penta
Girts	"	"

- NOTES:**
1. Remove & dispose of existing 4x4 handrail, 6x8 ledger strip, 3/4" fire alarm conduit, 1" water line, tie-back brace stubs, wooden ladders, and fastenings. Save 1" electrical conduit.
 2. 3" decking secured 1/2" - 60d nails ea. cap.
 3. 2" decking secured 1/2" - 40d nails ea. stringer.
 4. Handrails & girts secured to posts & piles 1/2" - 20d & each other 1/2" - 16d nails 32" o.c.
 5. All field cuts & holes in creosote material shall be treated 1/2" hot creosote oil before final assembly.
 6. Penta. treated material shall be treated 1/2" penta. solution where field cut or drilled.

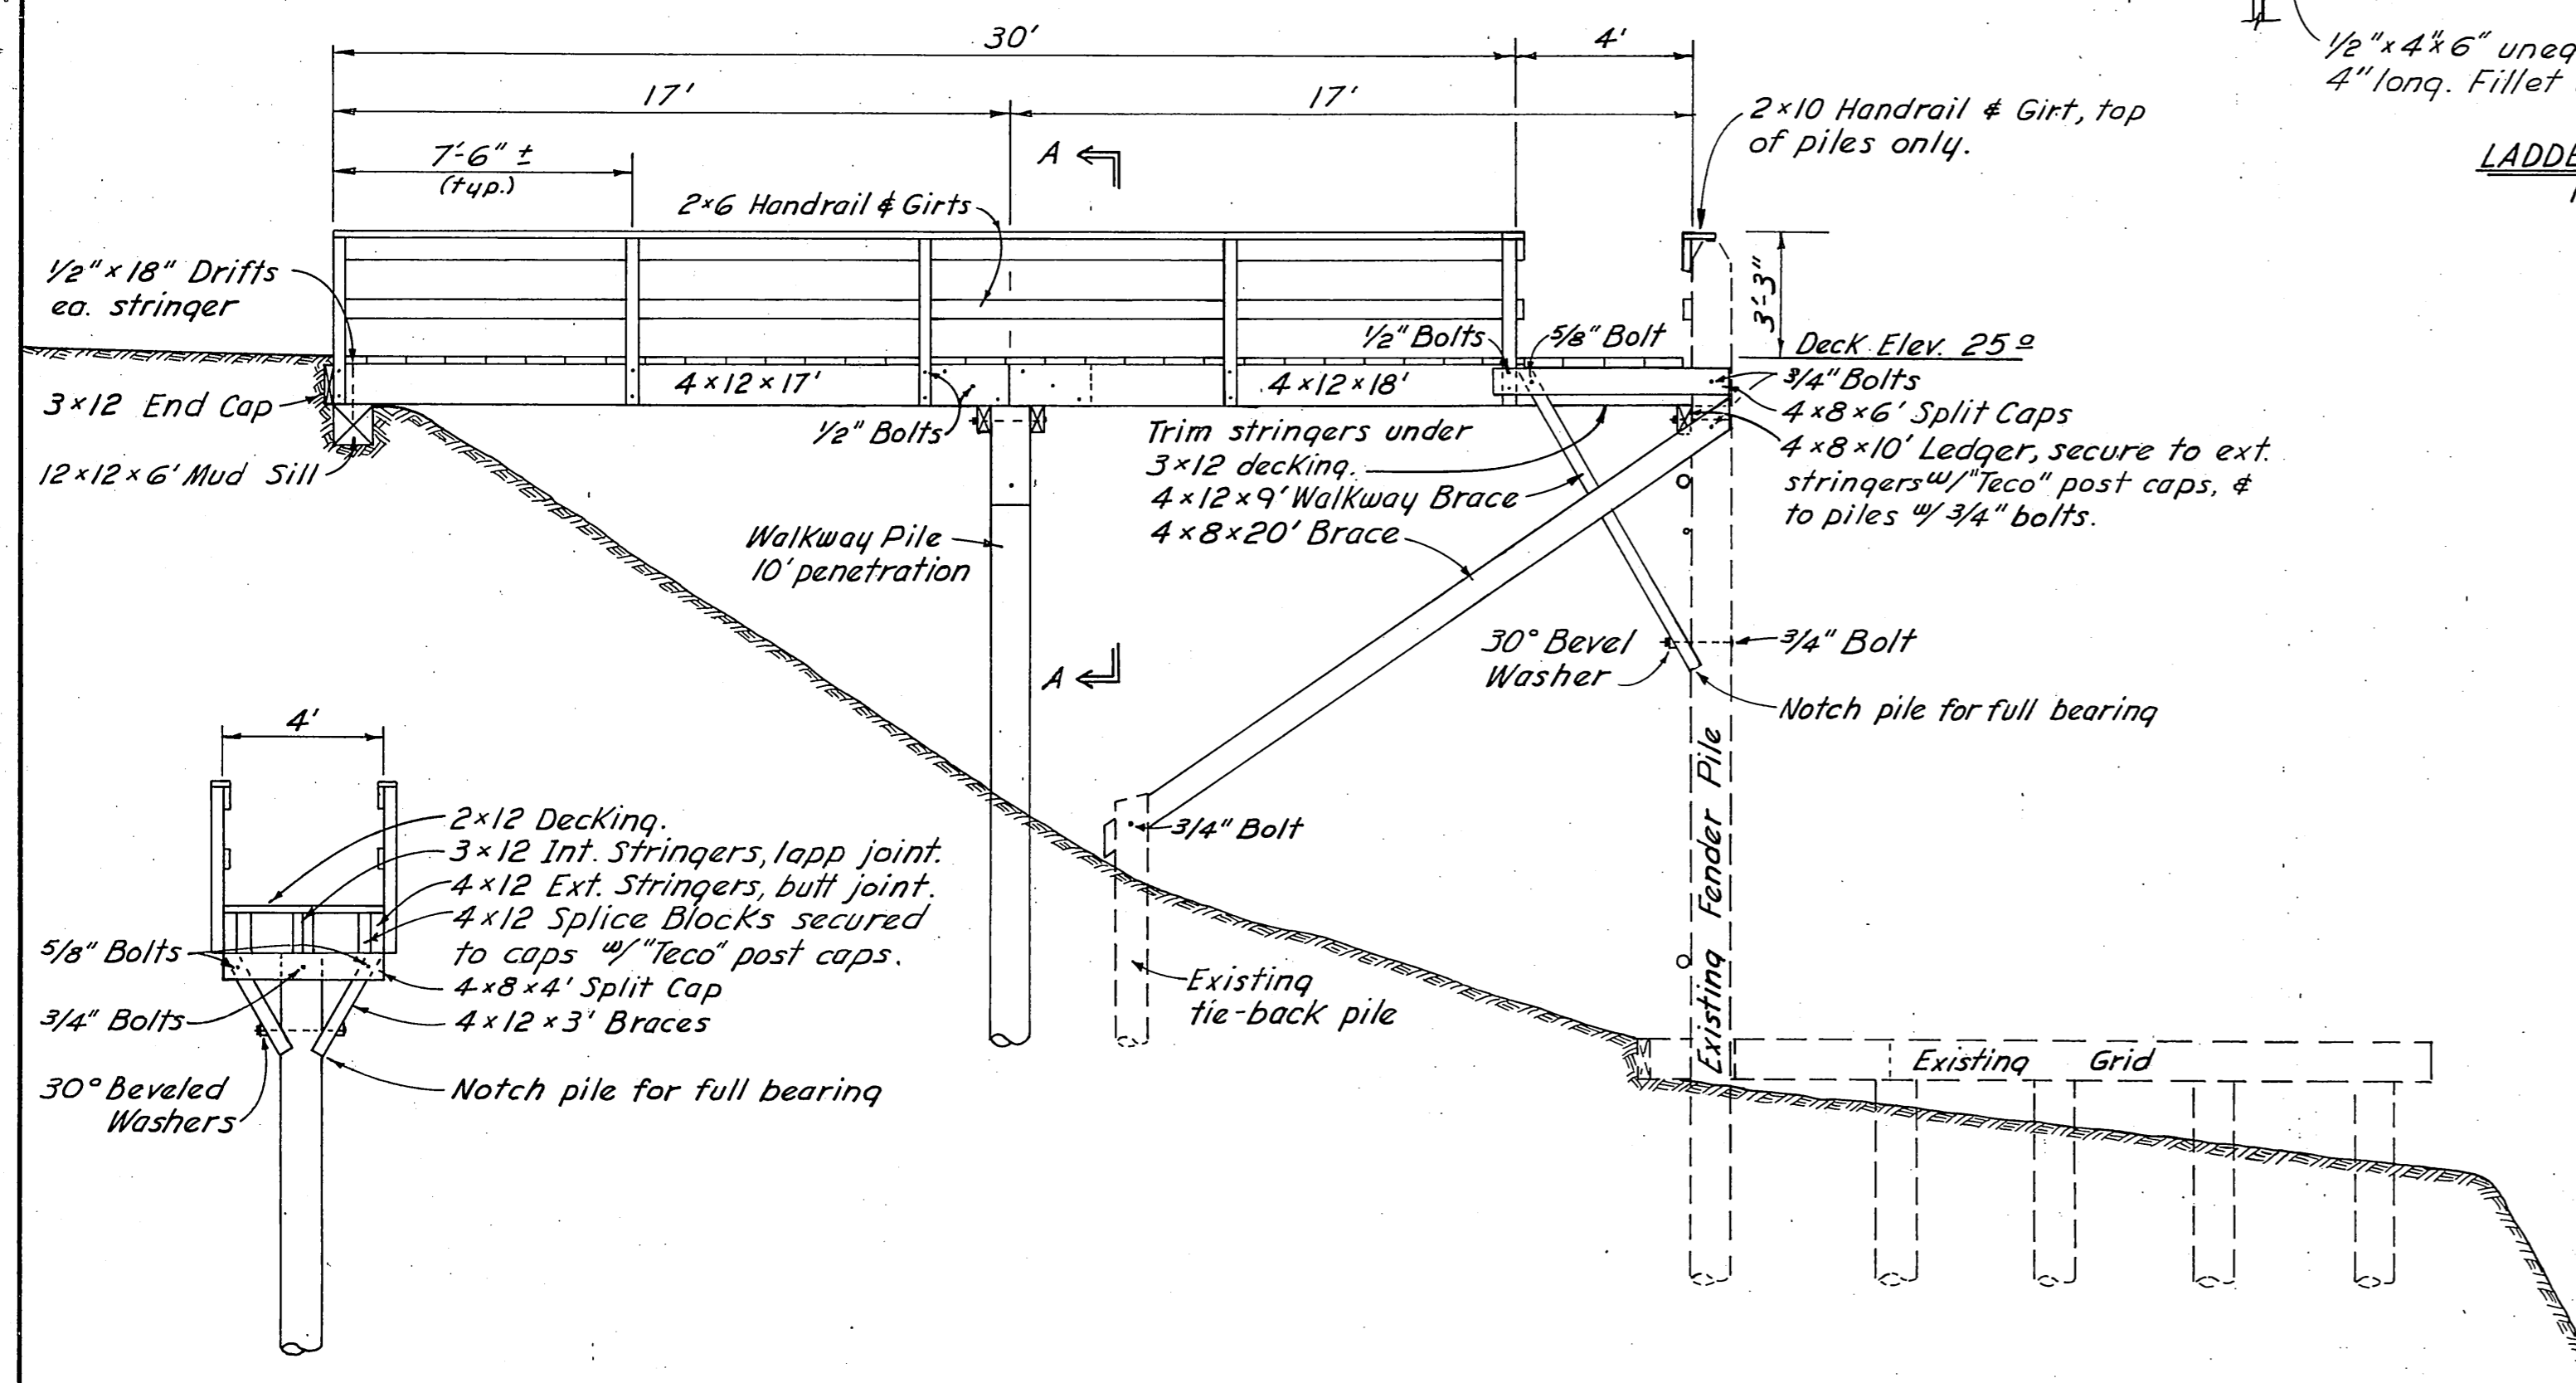

SECTION
1/4" = 1'-0"

DO NOT SCALE THIS DRAWING - USE DIMENSIONS

STATE OF ALASKA
DEPARTMENT OF PUBLIC WORKS
DIVISION OF WATER AND HARBORS

HARRIS HARBOR

GRID WALKWAY DETAILS

SCALE AS SHOWN	SURVEYED	APPROVED
DESIGNED	DRAWN ELS	DON STATTER
CHECKED	DATE 7/22/71	DIRECTOR
PROJECT NUMBER 3-72160	SHEET 6 OF 6	