

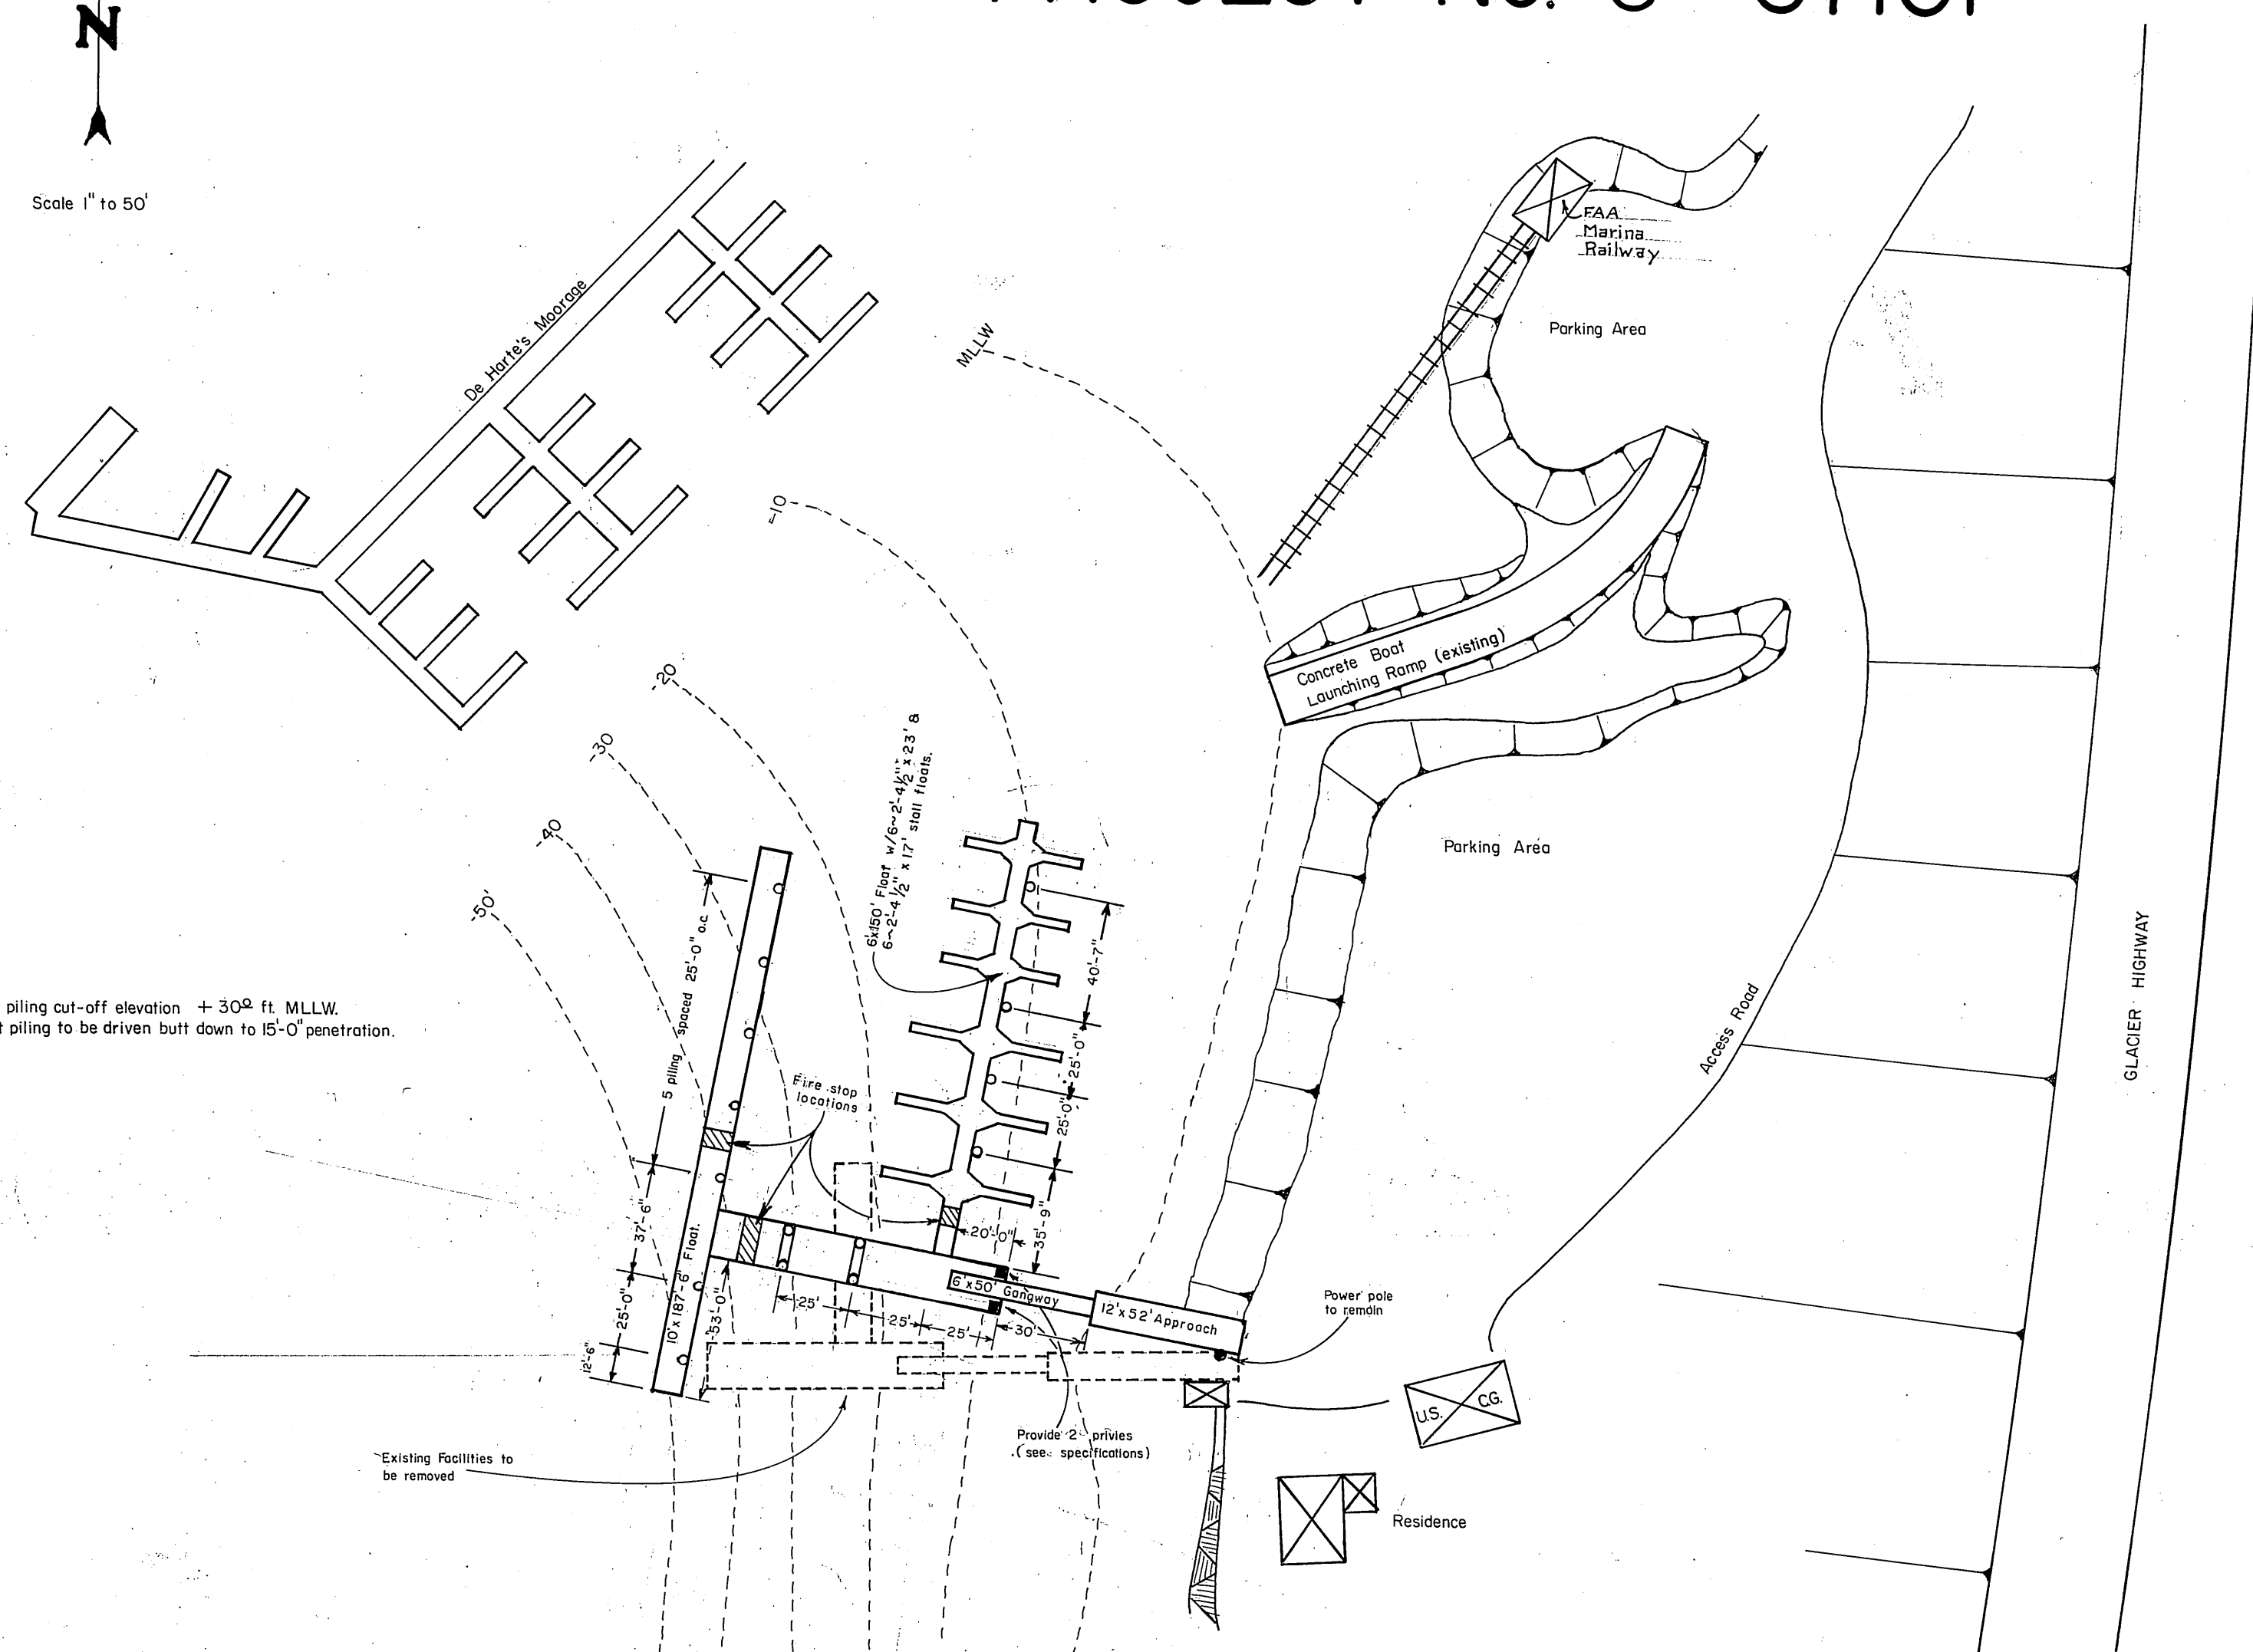


STATE OF ALASKA
DEPARTMENT OF PUBLIC WORKS
DIVISION OF WATER & HARBORS
AUKE BAY FLOAT FACILITIES
PROJECT No. 5-67101

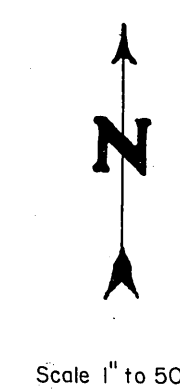

- Notes:
1. Float piling cut-off elevation: +30.2 ft. MLLW.
 2. Float piling to be driven butt down to 15'-0" penetration.

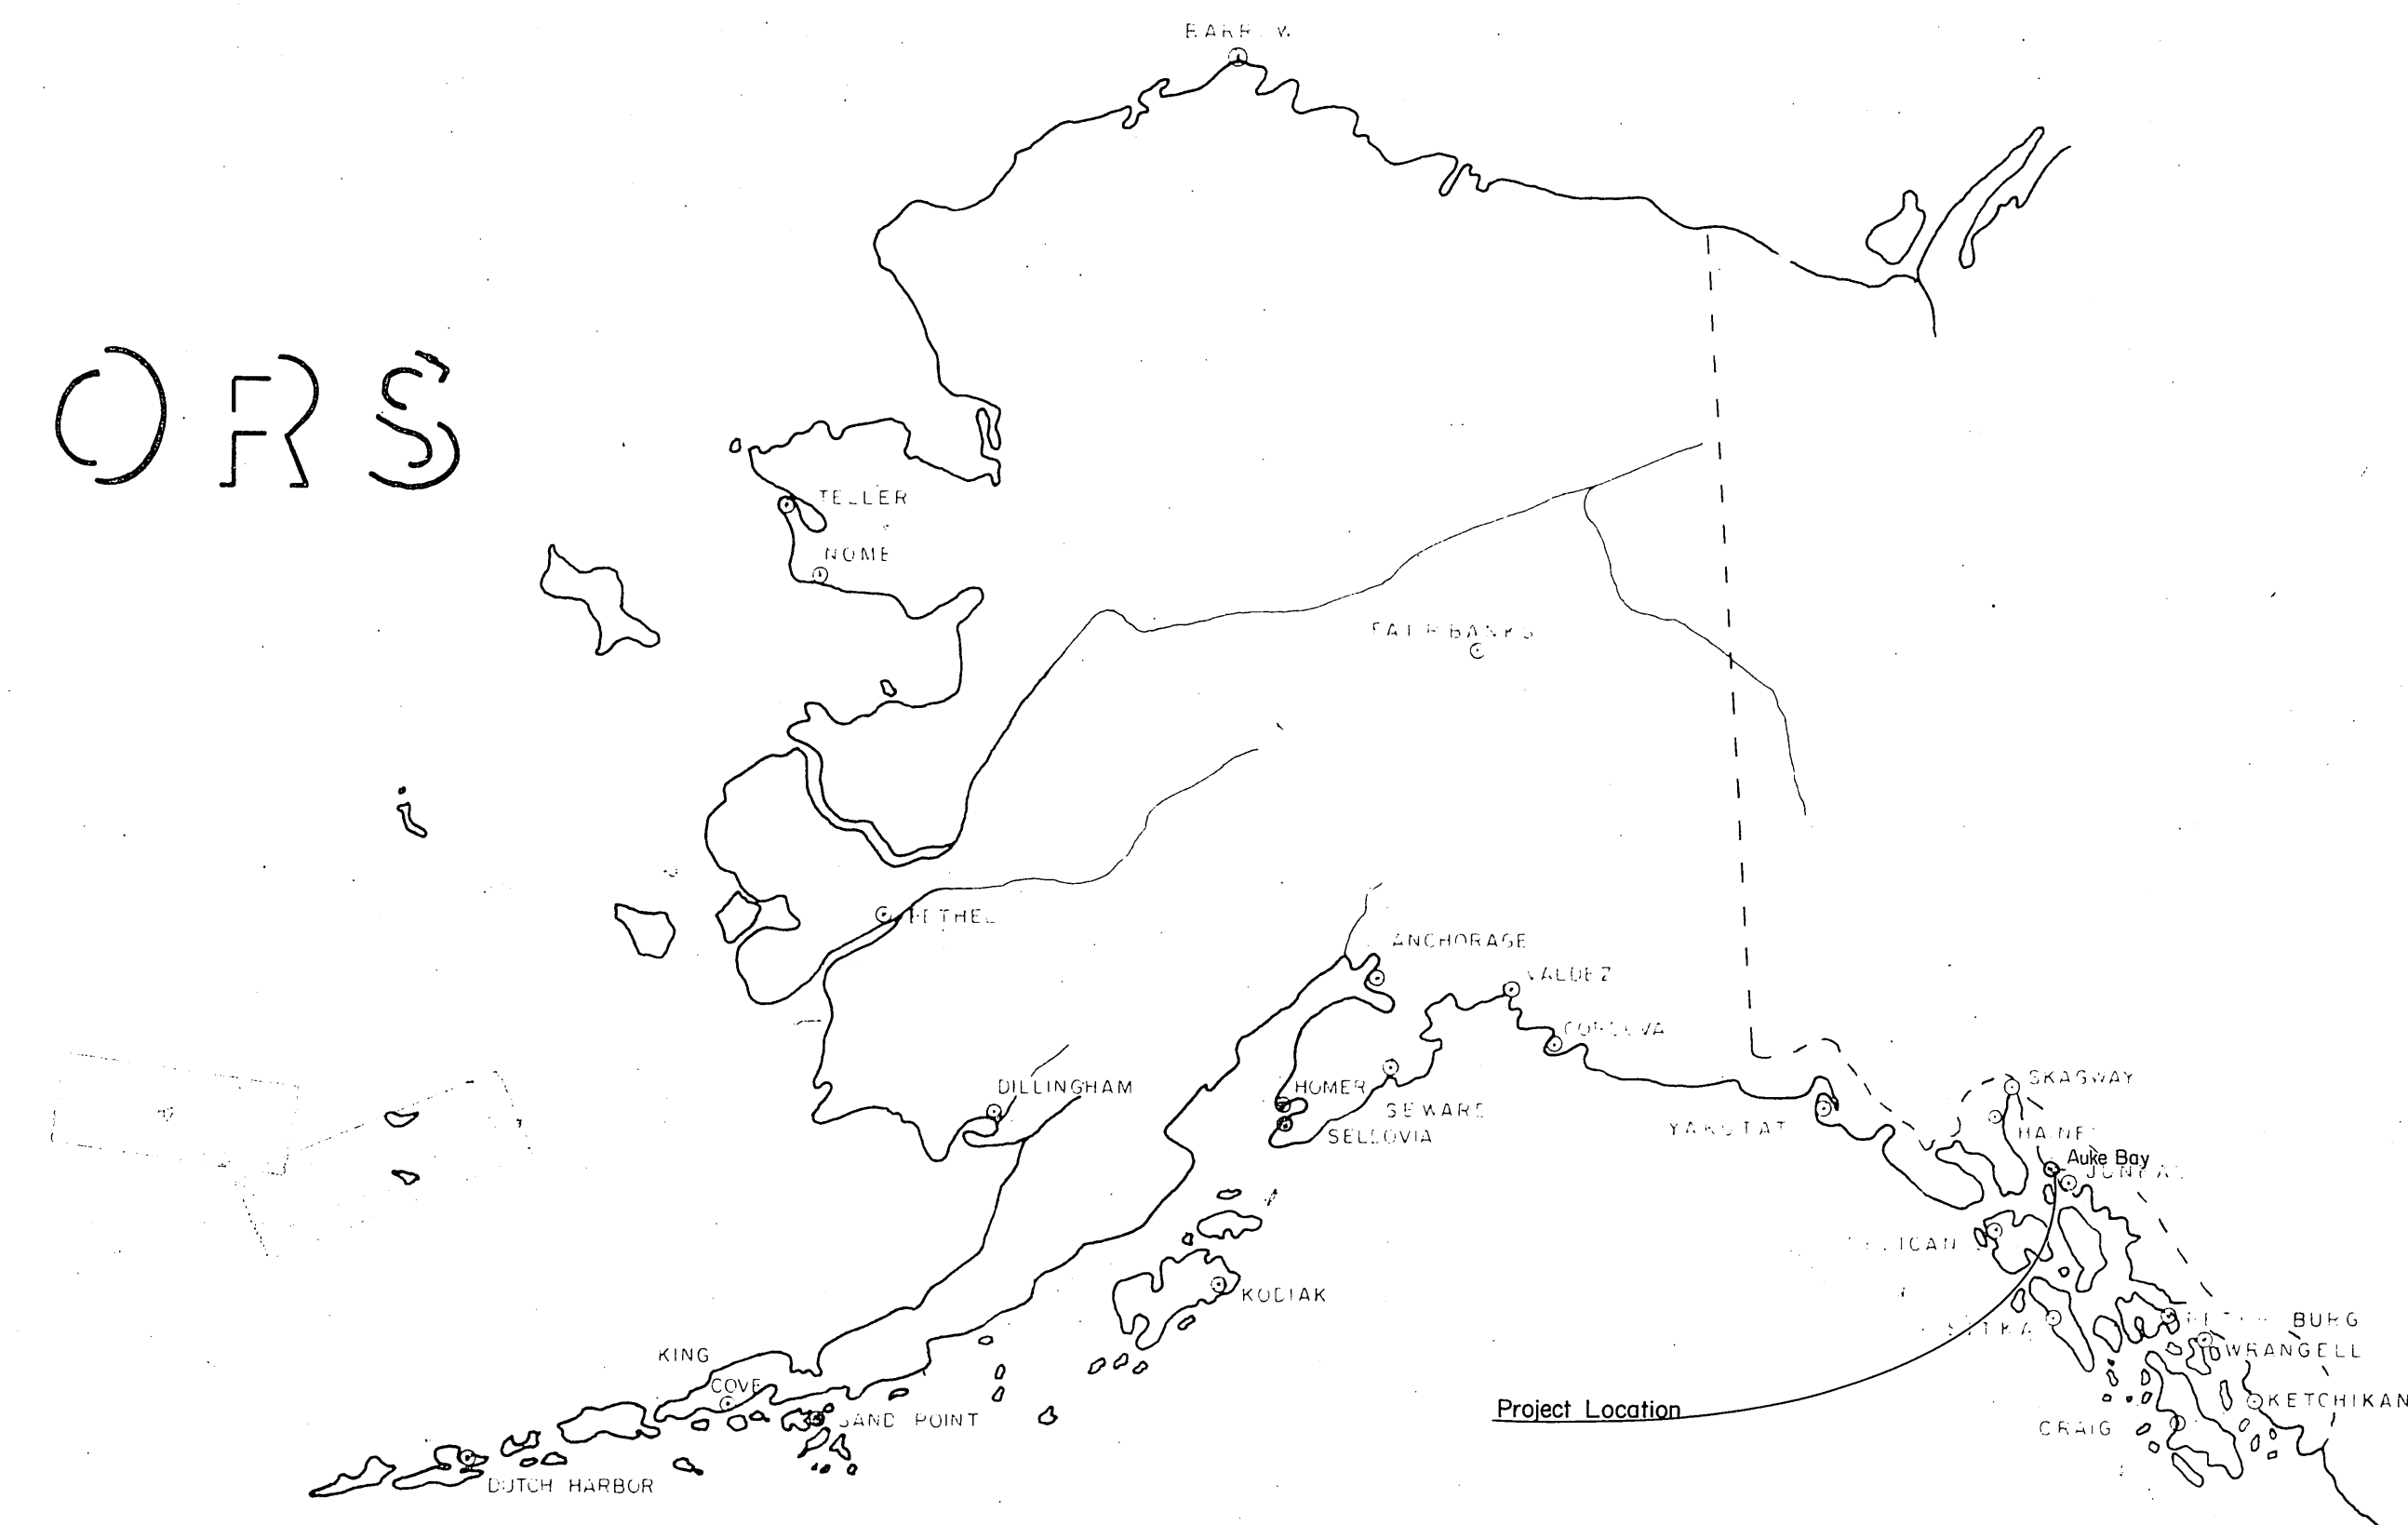






WORK SUMMARY

Major units of this project shall consist of removing and disposing of approximately 140 lin. ft. of existing log floats, a 5'x50' wooden gangway, and an 8'x65' timber approach, pulling 10 creosote piling, furnishing and driving 14 creosote piling (1008 lin. ft.), construction and installation of 5,107 S.F. of polystyrene floats, furnishing and constructing 624 S.F. of timber approach structure and constructing & installing a 6'x50' steel gangway.


INDEX TO SHEETS

TITLE SHEET & PROJECT LAYOUT	SHEET	No.
TYPICAL FLOATS	"	2
TYPICAL 6' FLOAT W/ INTEGRAL STALLS	"	3
TYPICAL 12' APPROACH DETAILS	"	4
TYPICAL STEEL GANGWAY	"	5
TYPICAL HINGE CONNECTION DETAILS	"	6
STRINGER & TIEDOWN RAIL DETAILS, 16' FLOAT CONSTRUCTION DETAILS	"	7


AS BUILT

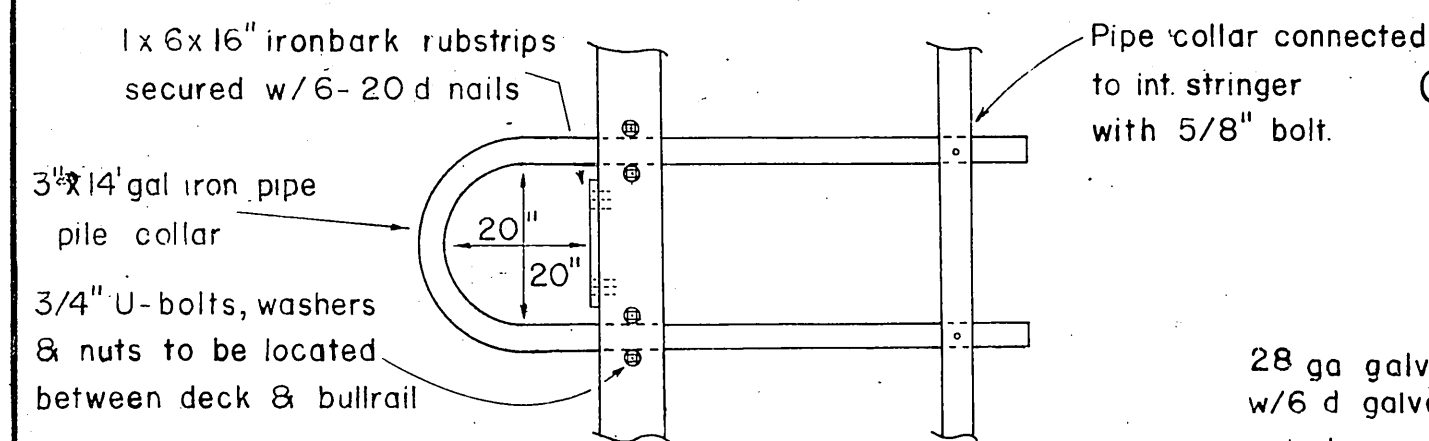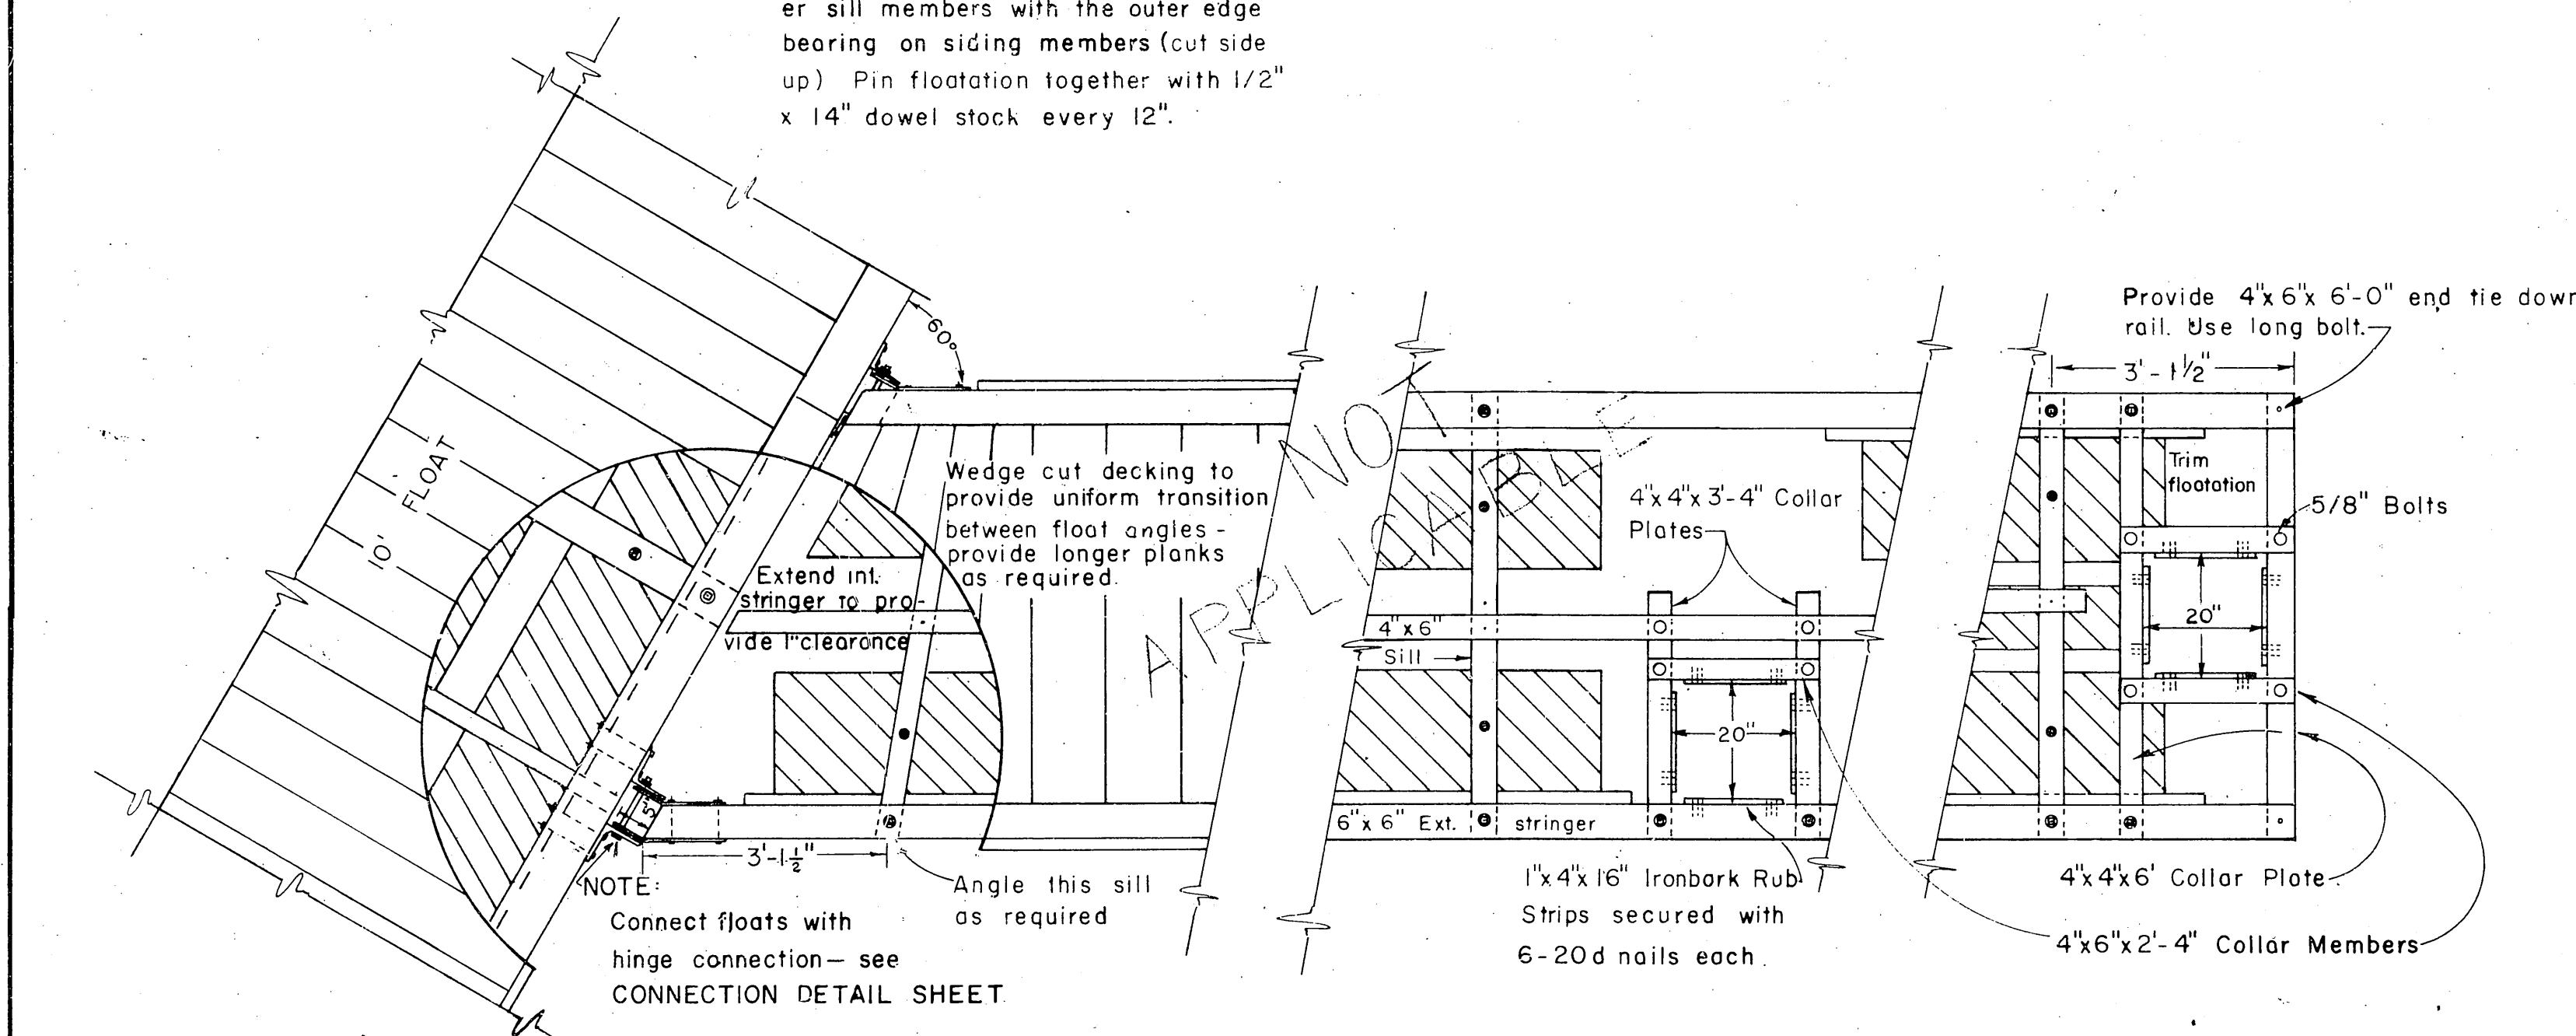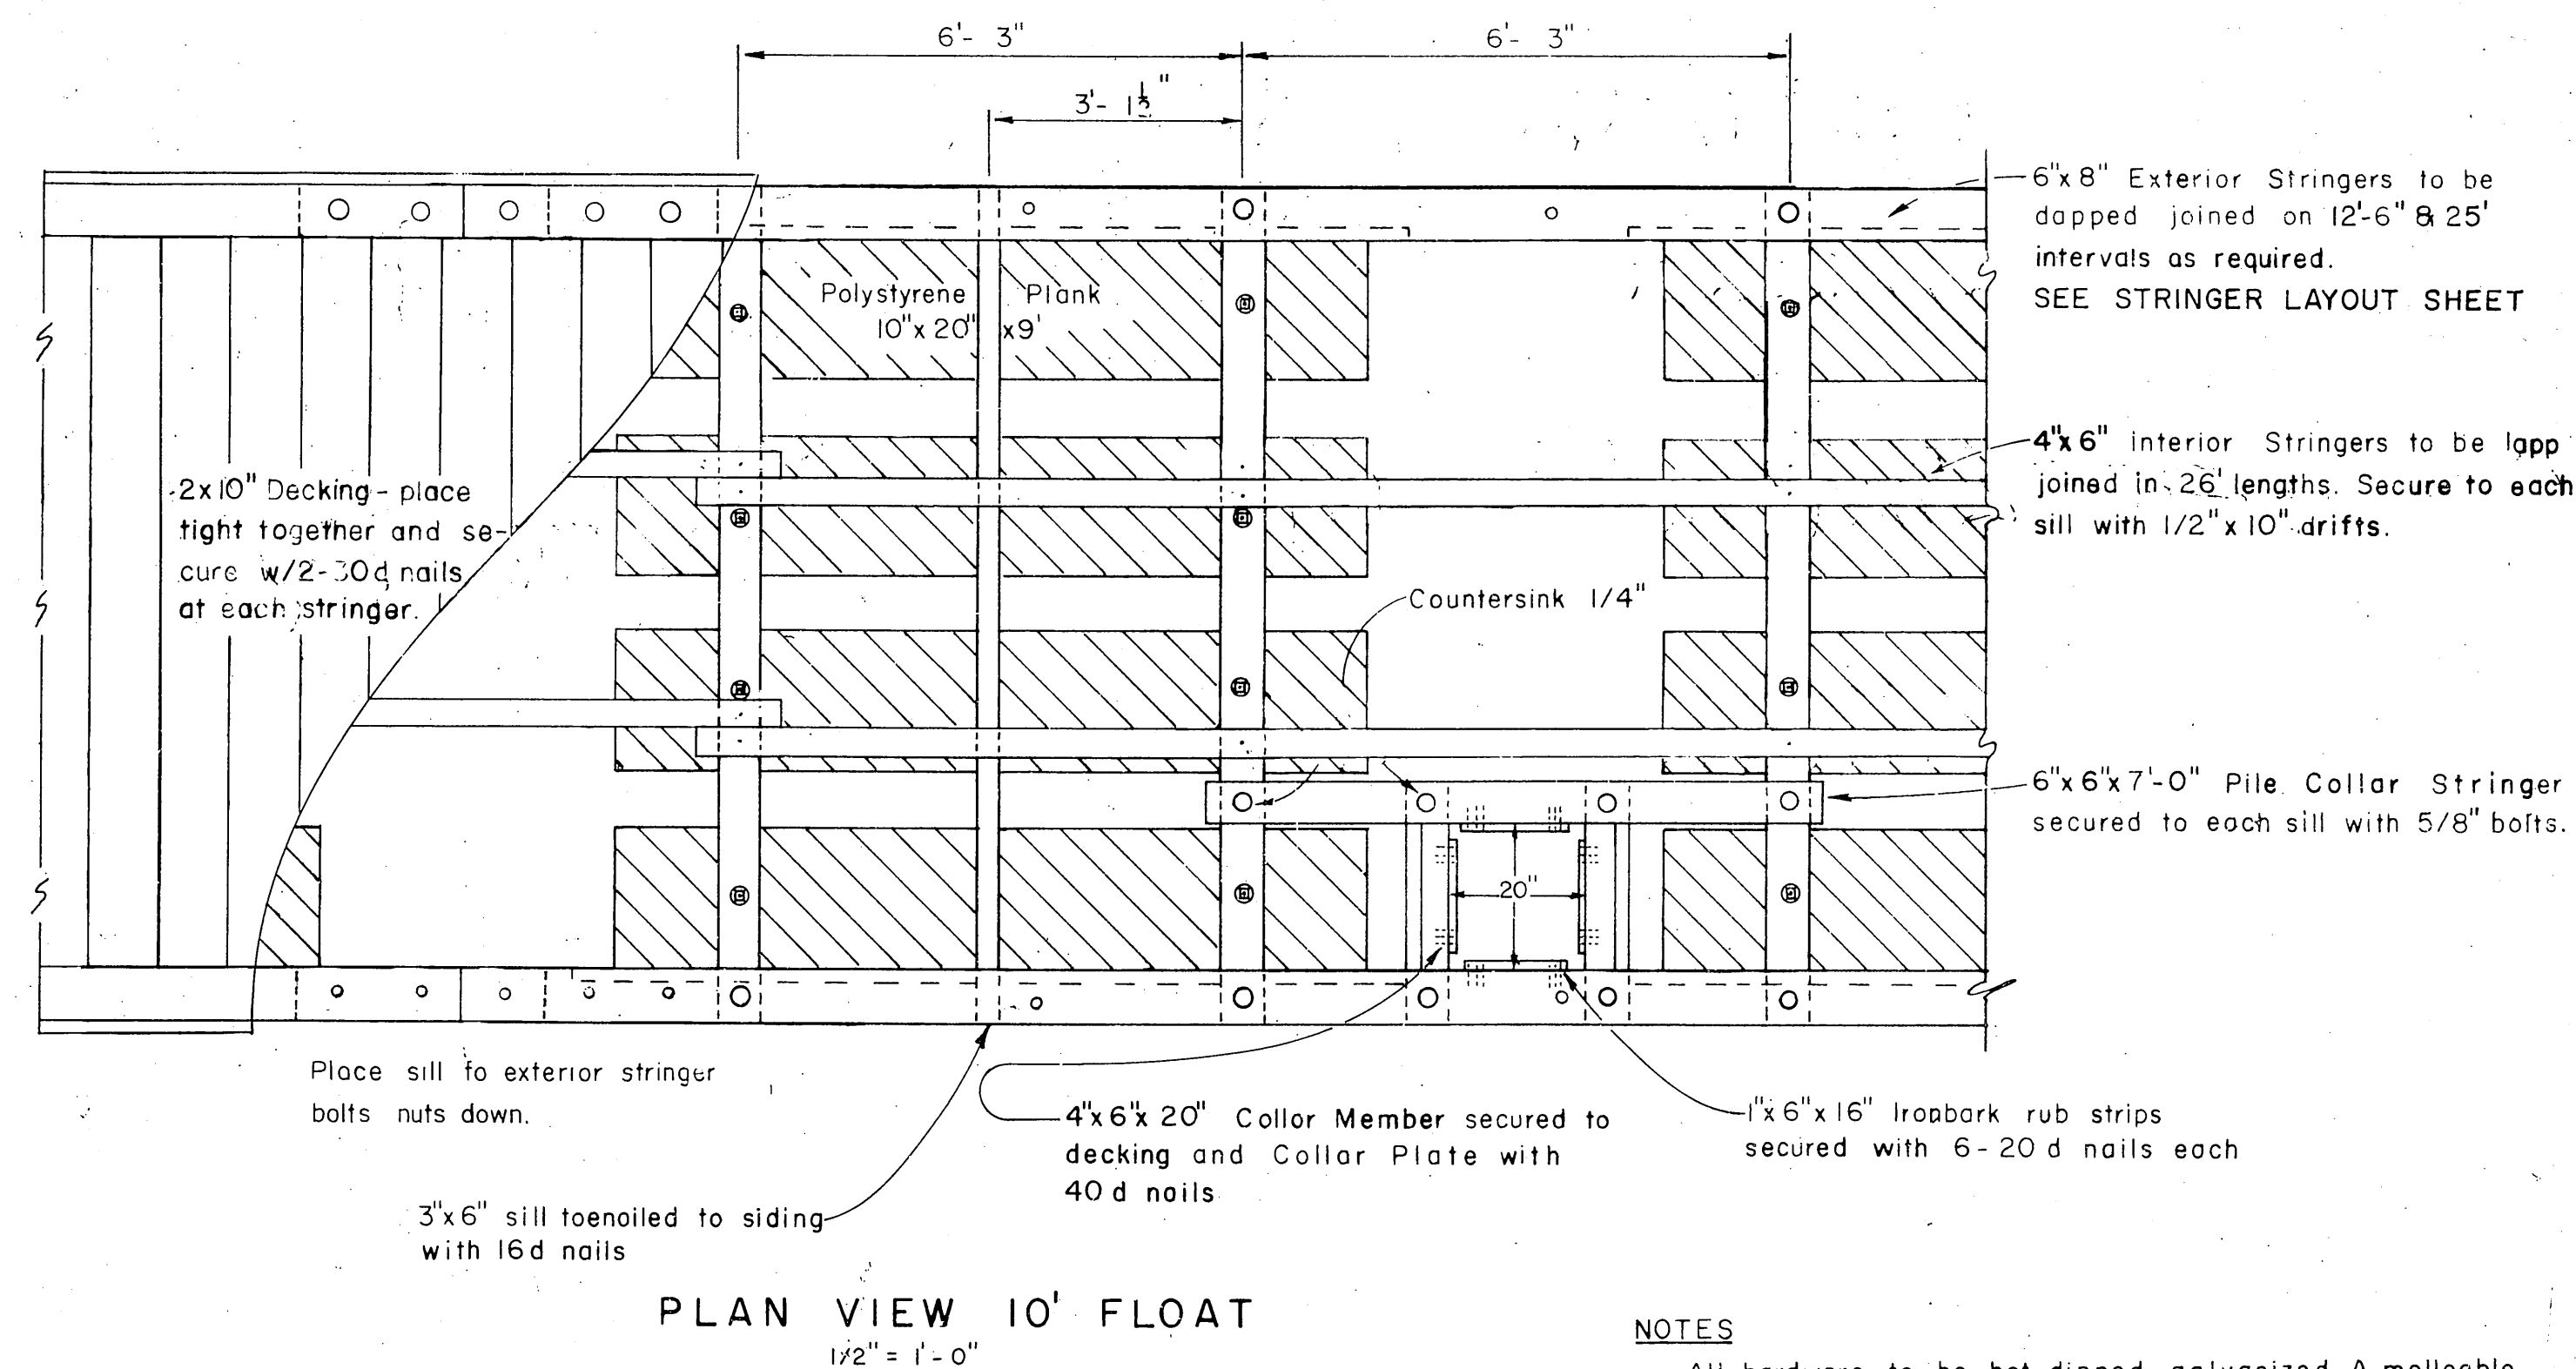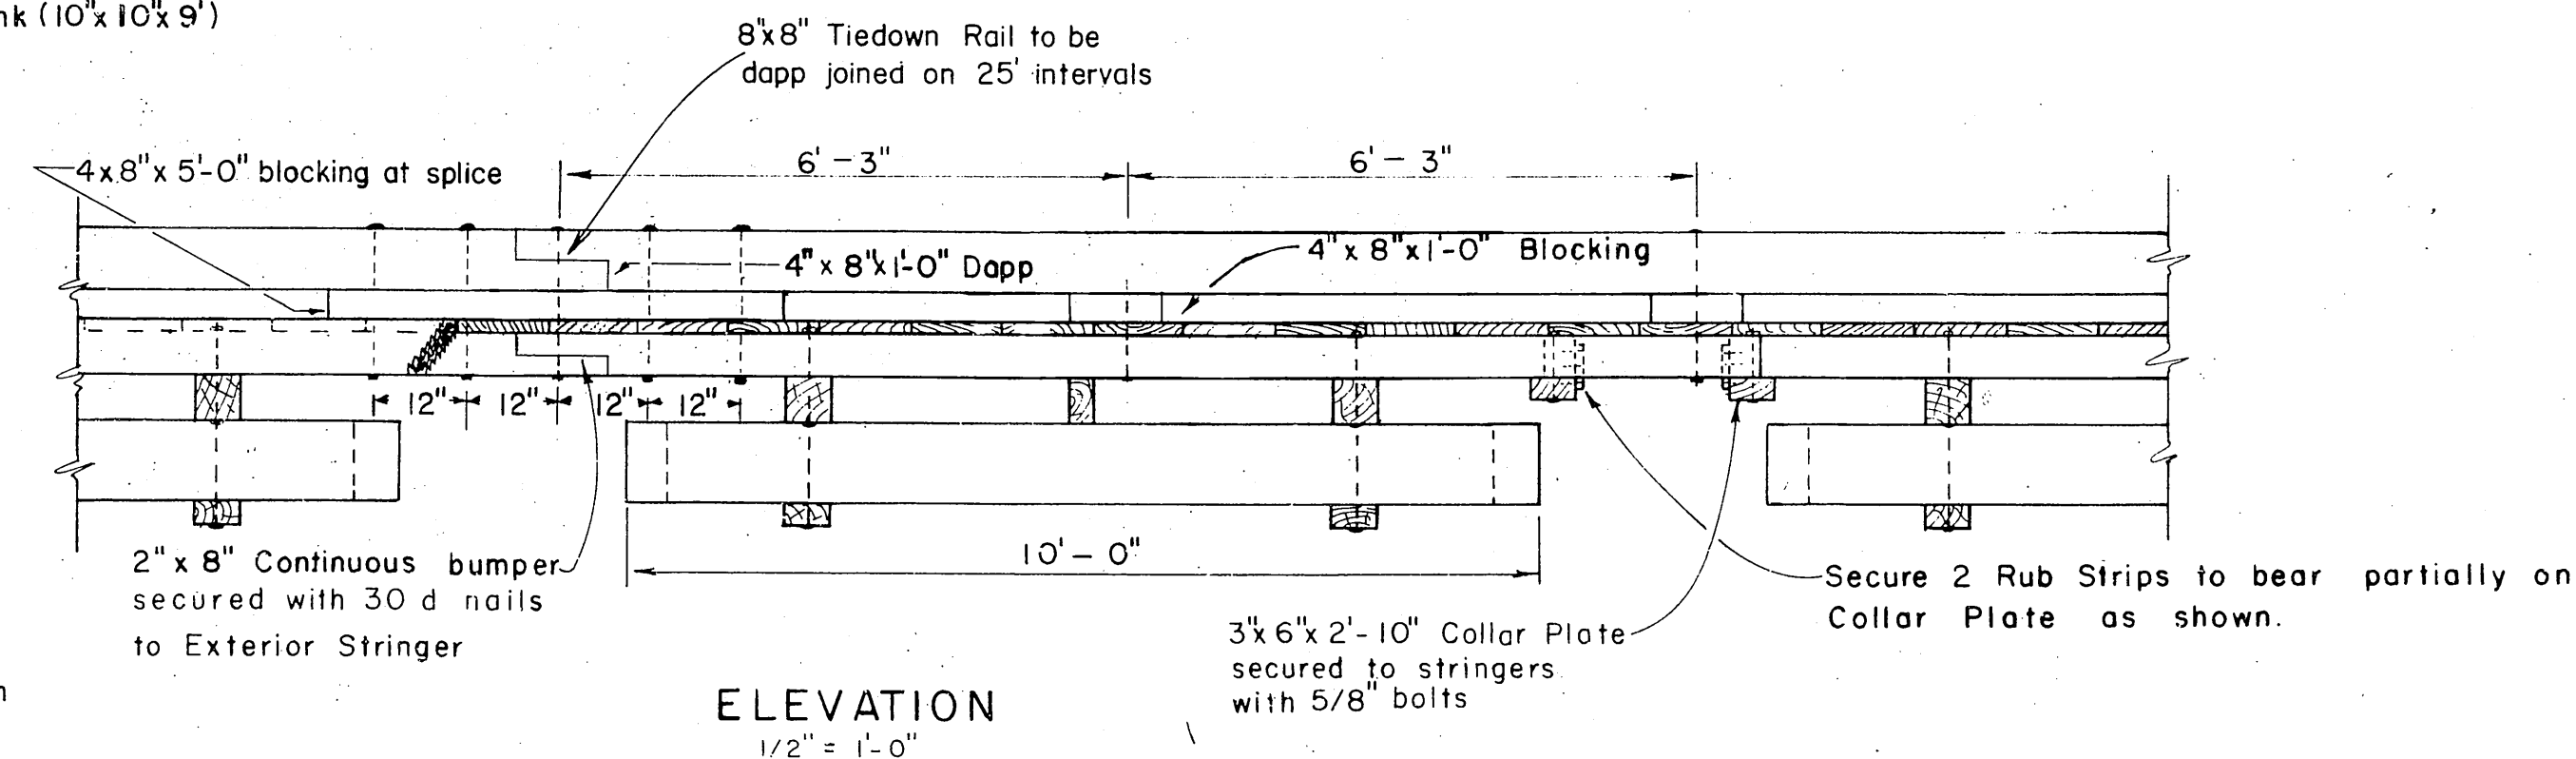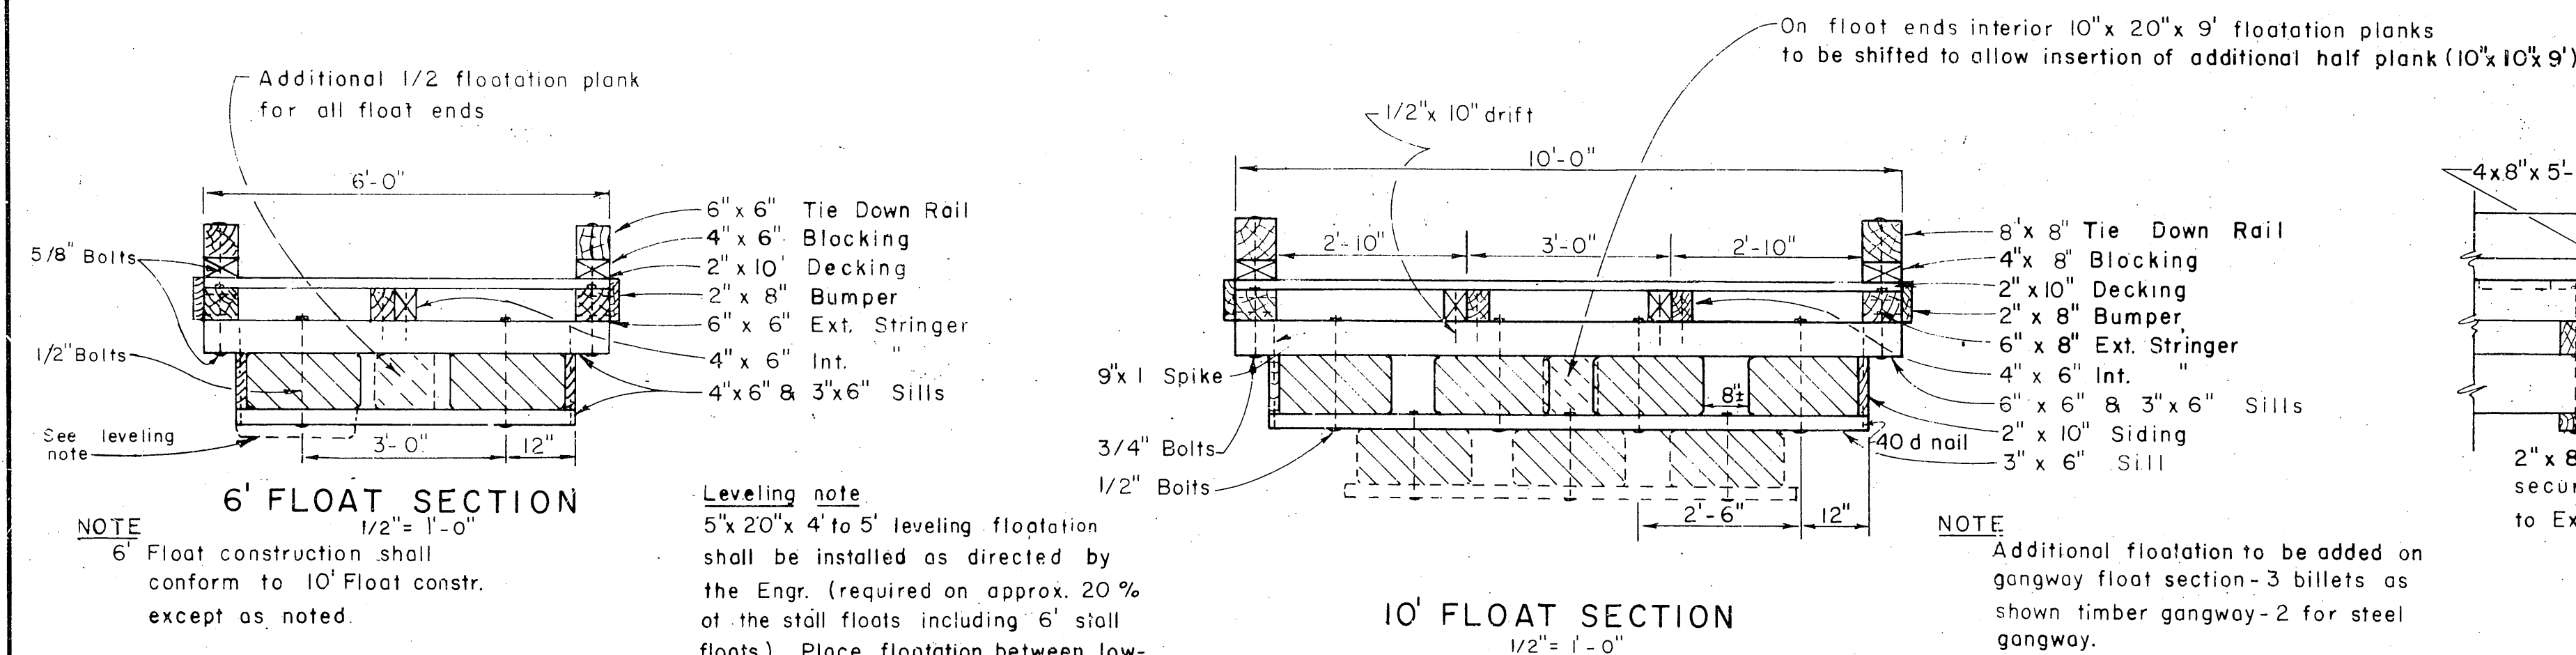

PIPE PILE COLLAR DETAIL

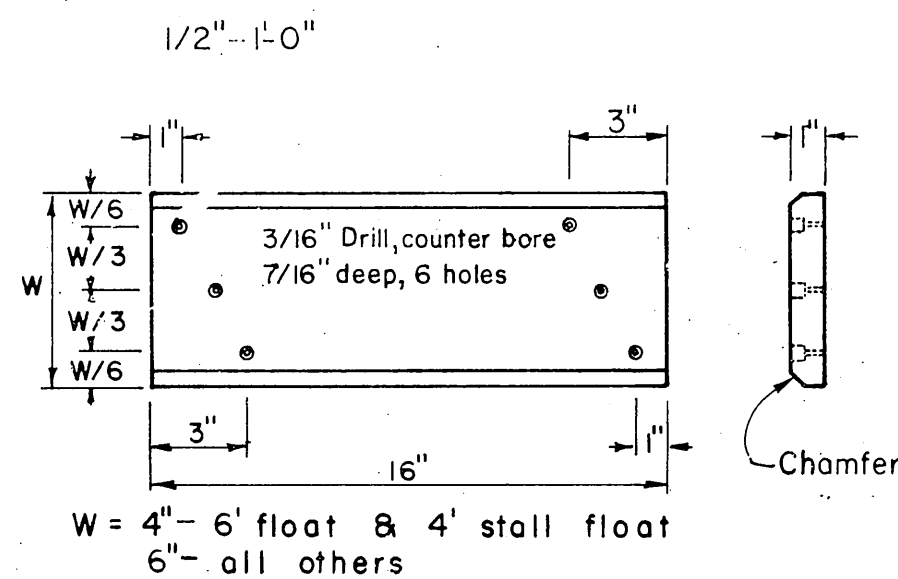

IRONBARK RUB STRIP

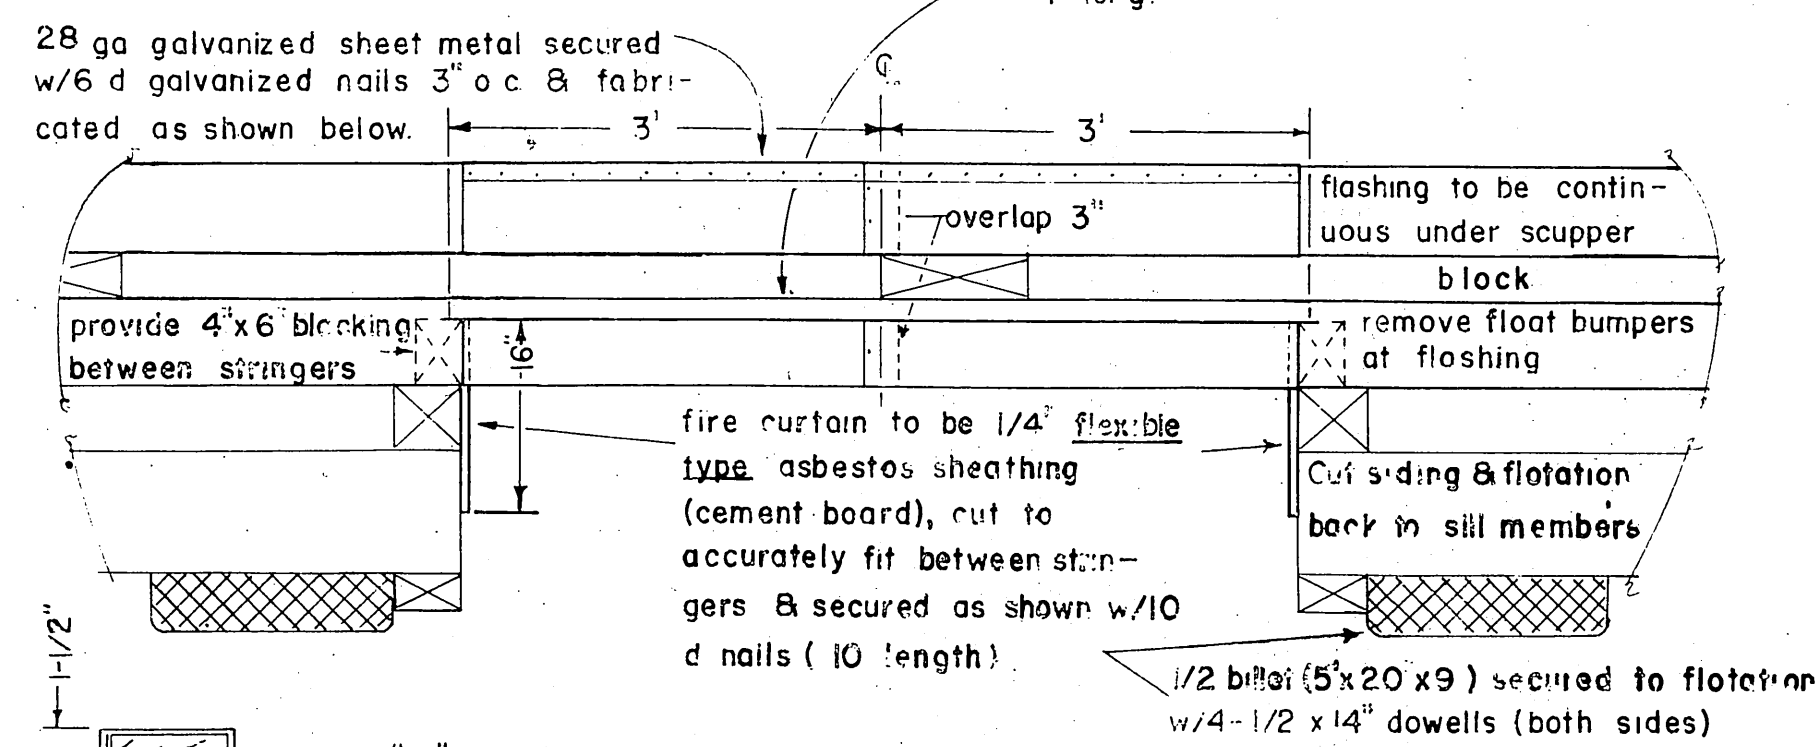

FIRE STOP DETAILS

NOTES
Prepunch 1/16" holes 2" o.c. 1/4" from long edges. 1/16" holes 8" o.c. 1/4" from ends, and 4 evenly spaced rows of 1/16" holes, 8" o.c. throughout sheet.
Provide 2 rows, 4 per row, spaced 12" of 6" x 24 non stud obstructions on fire deck.

* Exact width to conform to width of floatation material

MATERIALS		
ITEM	DRESSING	TREATMENT
3x6 - 4x6 & 6x6 upper sill	S-1-E 1/8" off	12 lbs. ret.
2x10 Siding	2x10 1/2"	" "
3x6 Lower Sill	Rough	" "
4x4 & 3x6 Collar Plates	Rough	8 lbs. ret.
4x6 Collar Members	S-2-E	" "
4x6 Interior Stringers	" "	" "
6x6 & 6x8 Ext. Stringers	S-4-S	" "
6x6 Collar Stringers	" "	" "
2x10 Decking	S-1-S-2-E	" "
4x6 & 4x8 Blocking	S-4-S	" "
6x6 & 8x8 Rail	" "	" "
2x8 Bumper	" "	" "

All material to be construction grade Douglas Fir
All piling will be Class A creosoted to 12 lbs. retention
All 12 lb. ret. creosoted treatment to be Full Cell
All 8 " " " " Empty Cell

PRE-DRILLED BOLT HOLES

COLLAR MEMBERS - all holes
SILLS - holes for floatation plank bolts
STRINGERS - 1. holes for stringer to sill bolts

TIE DOWN RAIL - all holes
PILE COLLAR STRINGER - 10' FLOAT - all holes
FIELD DRILLED BOLT HOLES
SILLS - 1. holes for stringer to sill bolts
2. pile collar stringer to sill
PILE COLLAR INT. STRINGER - 6' FLOAT - all holes
RAIL BLOCKING - all holes
COLLAR PLATES - all holes
EXT. STRINGER - 1. holes for tie down rail bolts
2. " " pile collar plate bolts

REVISIONS MARCH 1965

- Omit end plates.
- Clarified pre-drilling note.
- Change decking gap from 1/2" to 3/4"
- Change 2'x10' rough siding members to 2'x10 1/2" actual size.
- Change 3'x6", 4'x6" and 6'x6" upper sills from rough to S-1-E 1/8" off.
- Revised hinge connection and 6' float pile collar.
- Change sill spacing from 6'-0" to 6'-3".

REVISIONS JAN 1966

- Add polyethylene barrier note
- Delete reference to extruded polystyrene billets
- Change deck nails from 20d to 30d

NOTES

All hardware to be hot-dipped galvanized. A malleable iron washer shall be placed between all nut and wood surfaces. All bolts to be of the economy headed type. Bolt holes to be drilled true size except sill bolt holes for floatation planks 1/8" oversize. Drift holes to be drilled 1/16" undersize. All field drill holes shall be treated with hot creosote oil. All pressure treated creosote material shall be cut to size prior to treatment. Tie down rails shall extend across all float ends except under gangway. All bolt heads facing decking shall be countersunk 1/4" inch previous to treatment. Field drill all drift bolt holes. A barrier of 6 mil black polyethylene shall be placed between the contact surfaces of all creosote timber and floatation material (except float siding members)

REVISIONS JUNE 1966

1. Change deck to 2x10 placed tight together.


AUG. 1966

1. Change stringer & rail splice locations - delete splice block


STATE OF ALASKA
DEPARTMENT OF PUBLIC WORKS
DIVISION OF WATER AND HARBORS

TYPICAL FLOATS


SCALE AS SHOWN	APPROVED <u>DON STATTER</u>
DATE <u>March 1965</u>	DIRECTOR
PROJ. NO. _____	CHECKED BY D.S.
DESIGNED BY RPH-DS	DRAWN BY D.W.

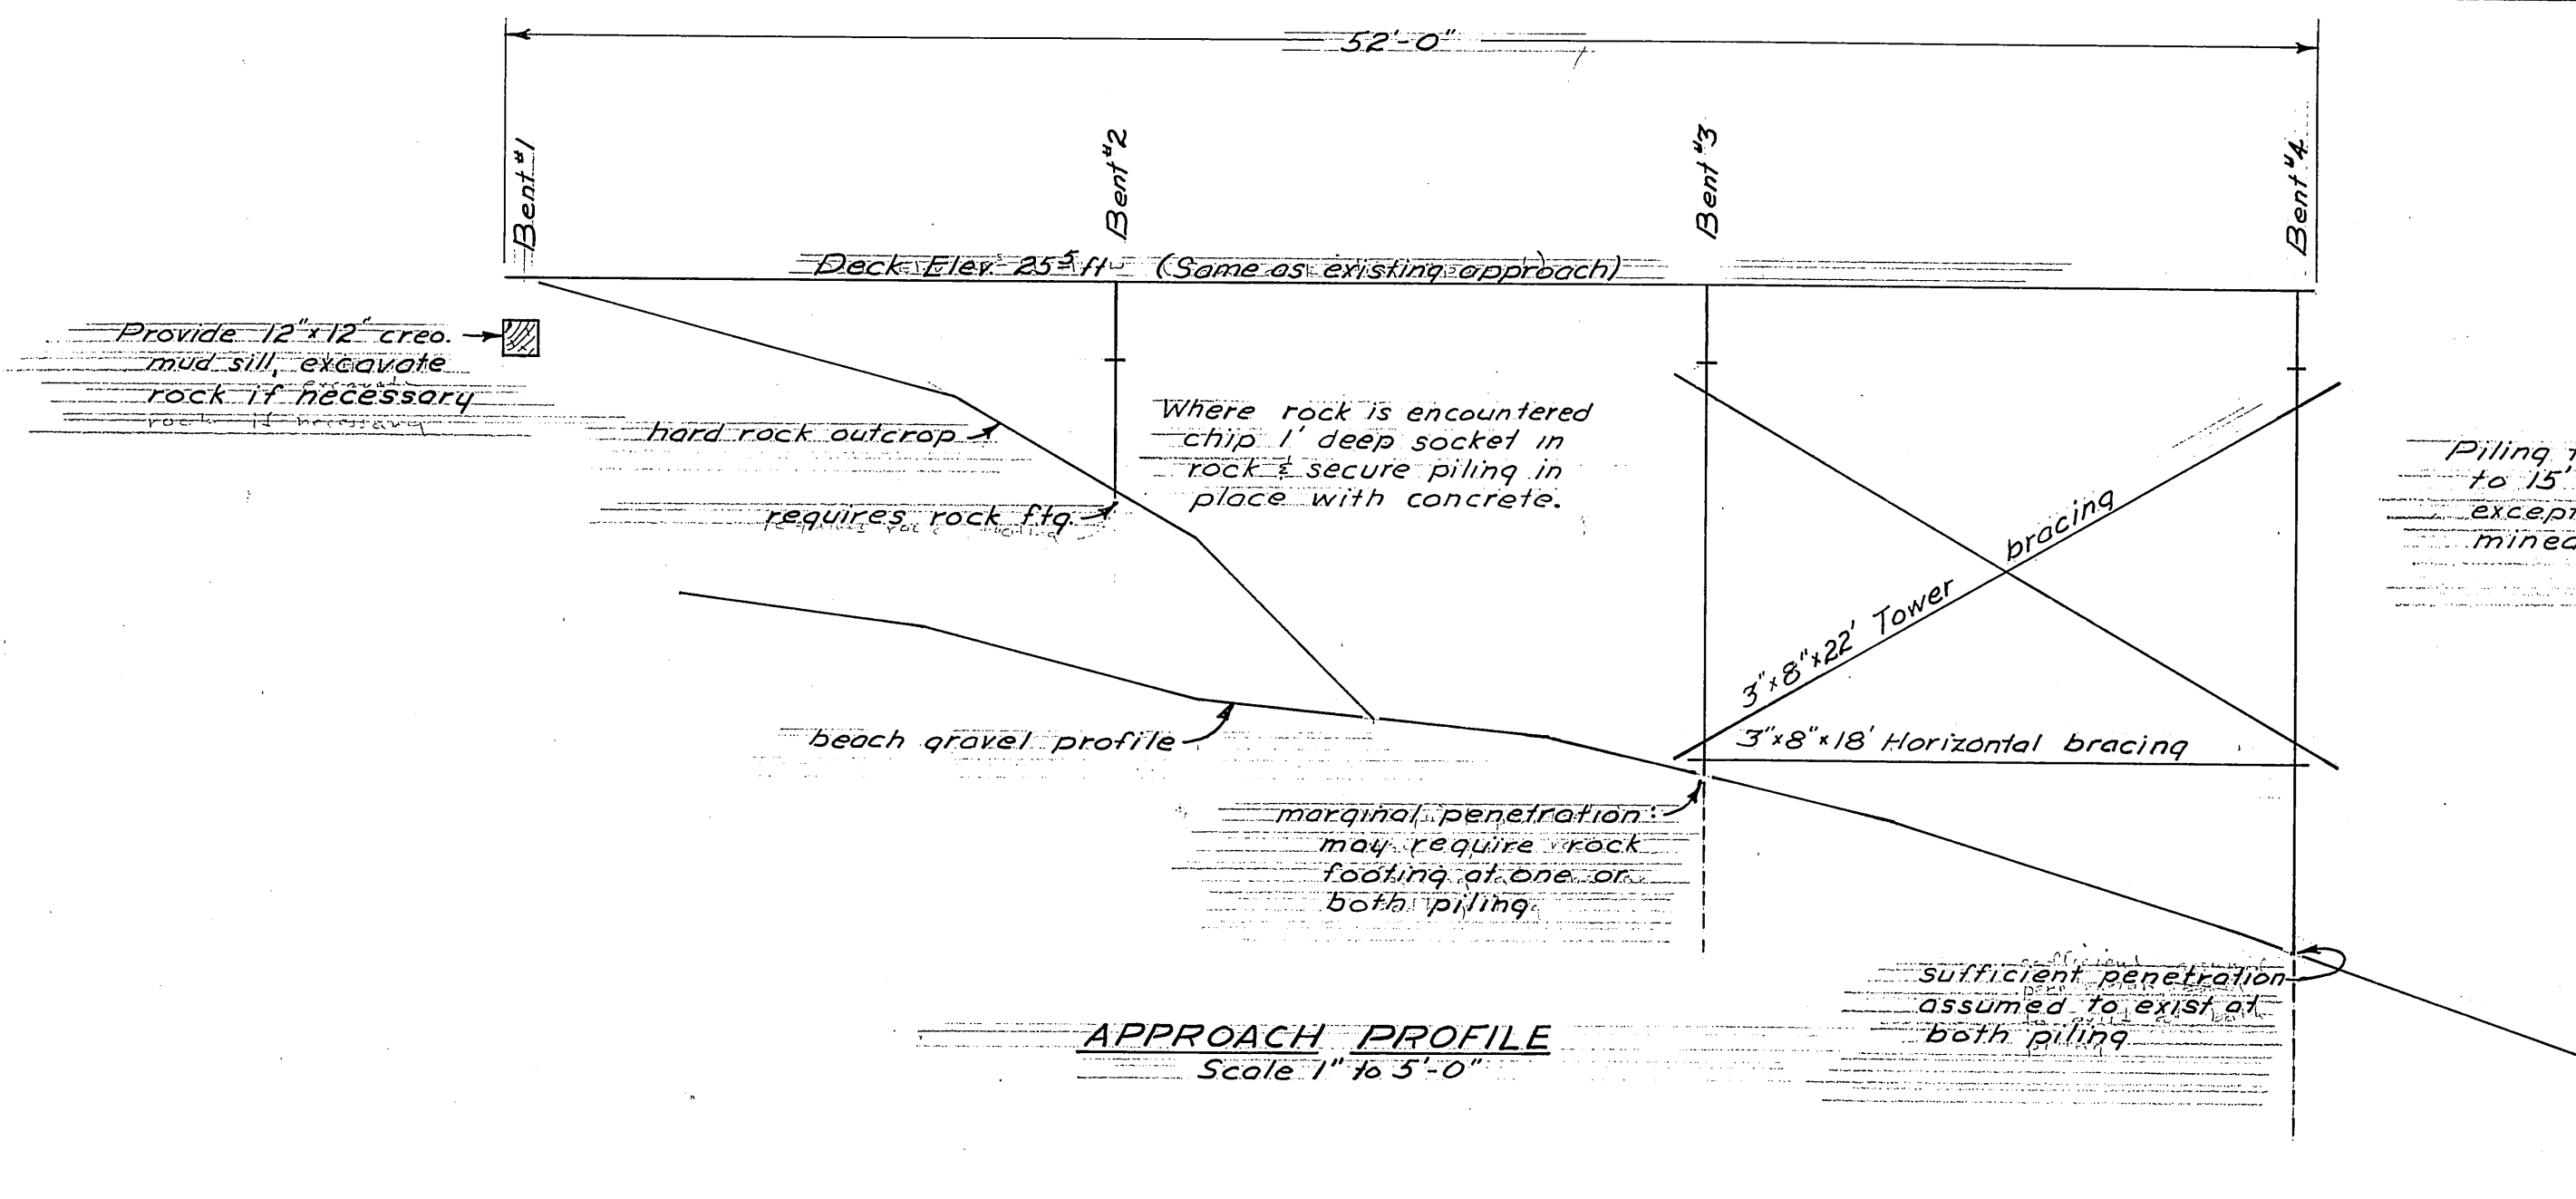

Piling to be driven butt down to 15' penetration or refusal except as noted or as determined by engineer.

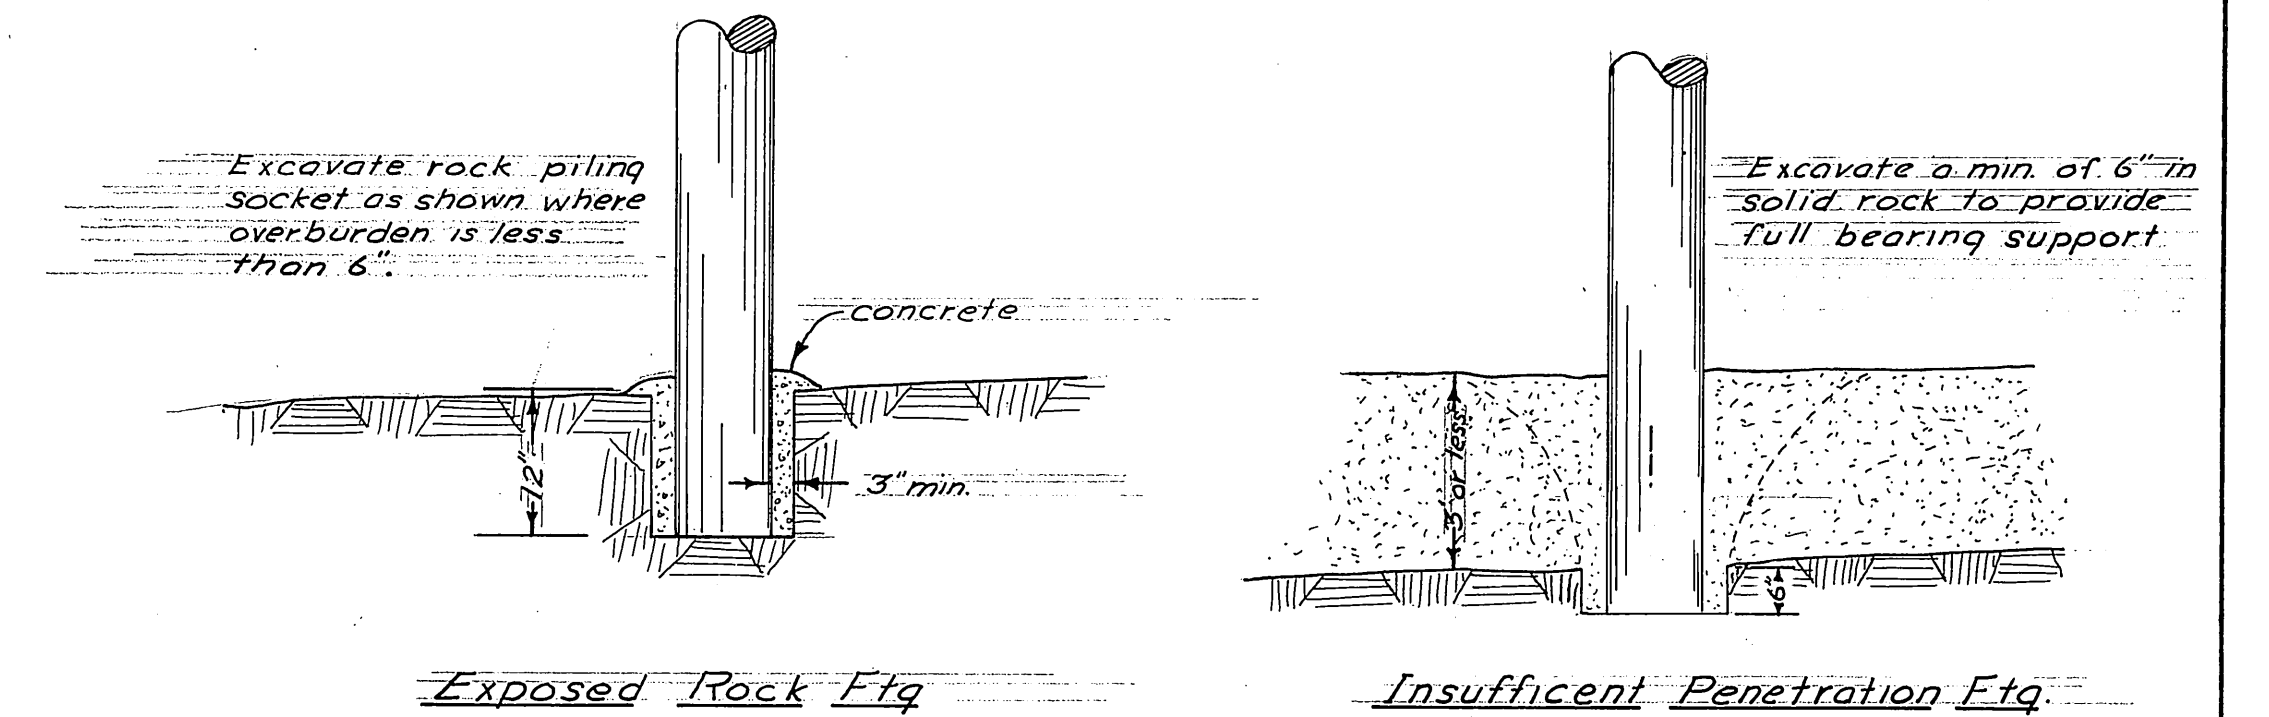


ROCK FOOTINGS
Scale 1" to 2'-0"

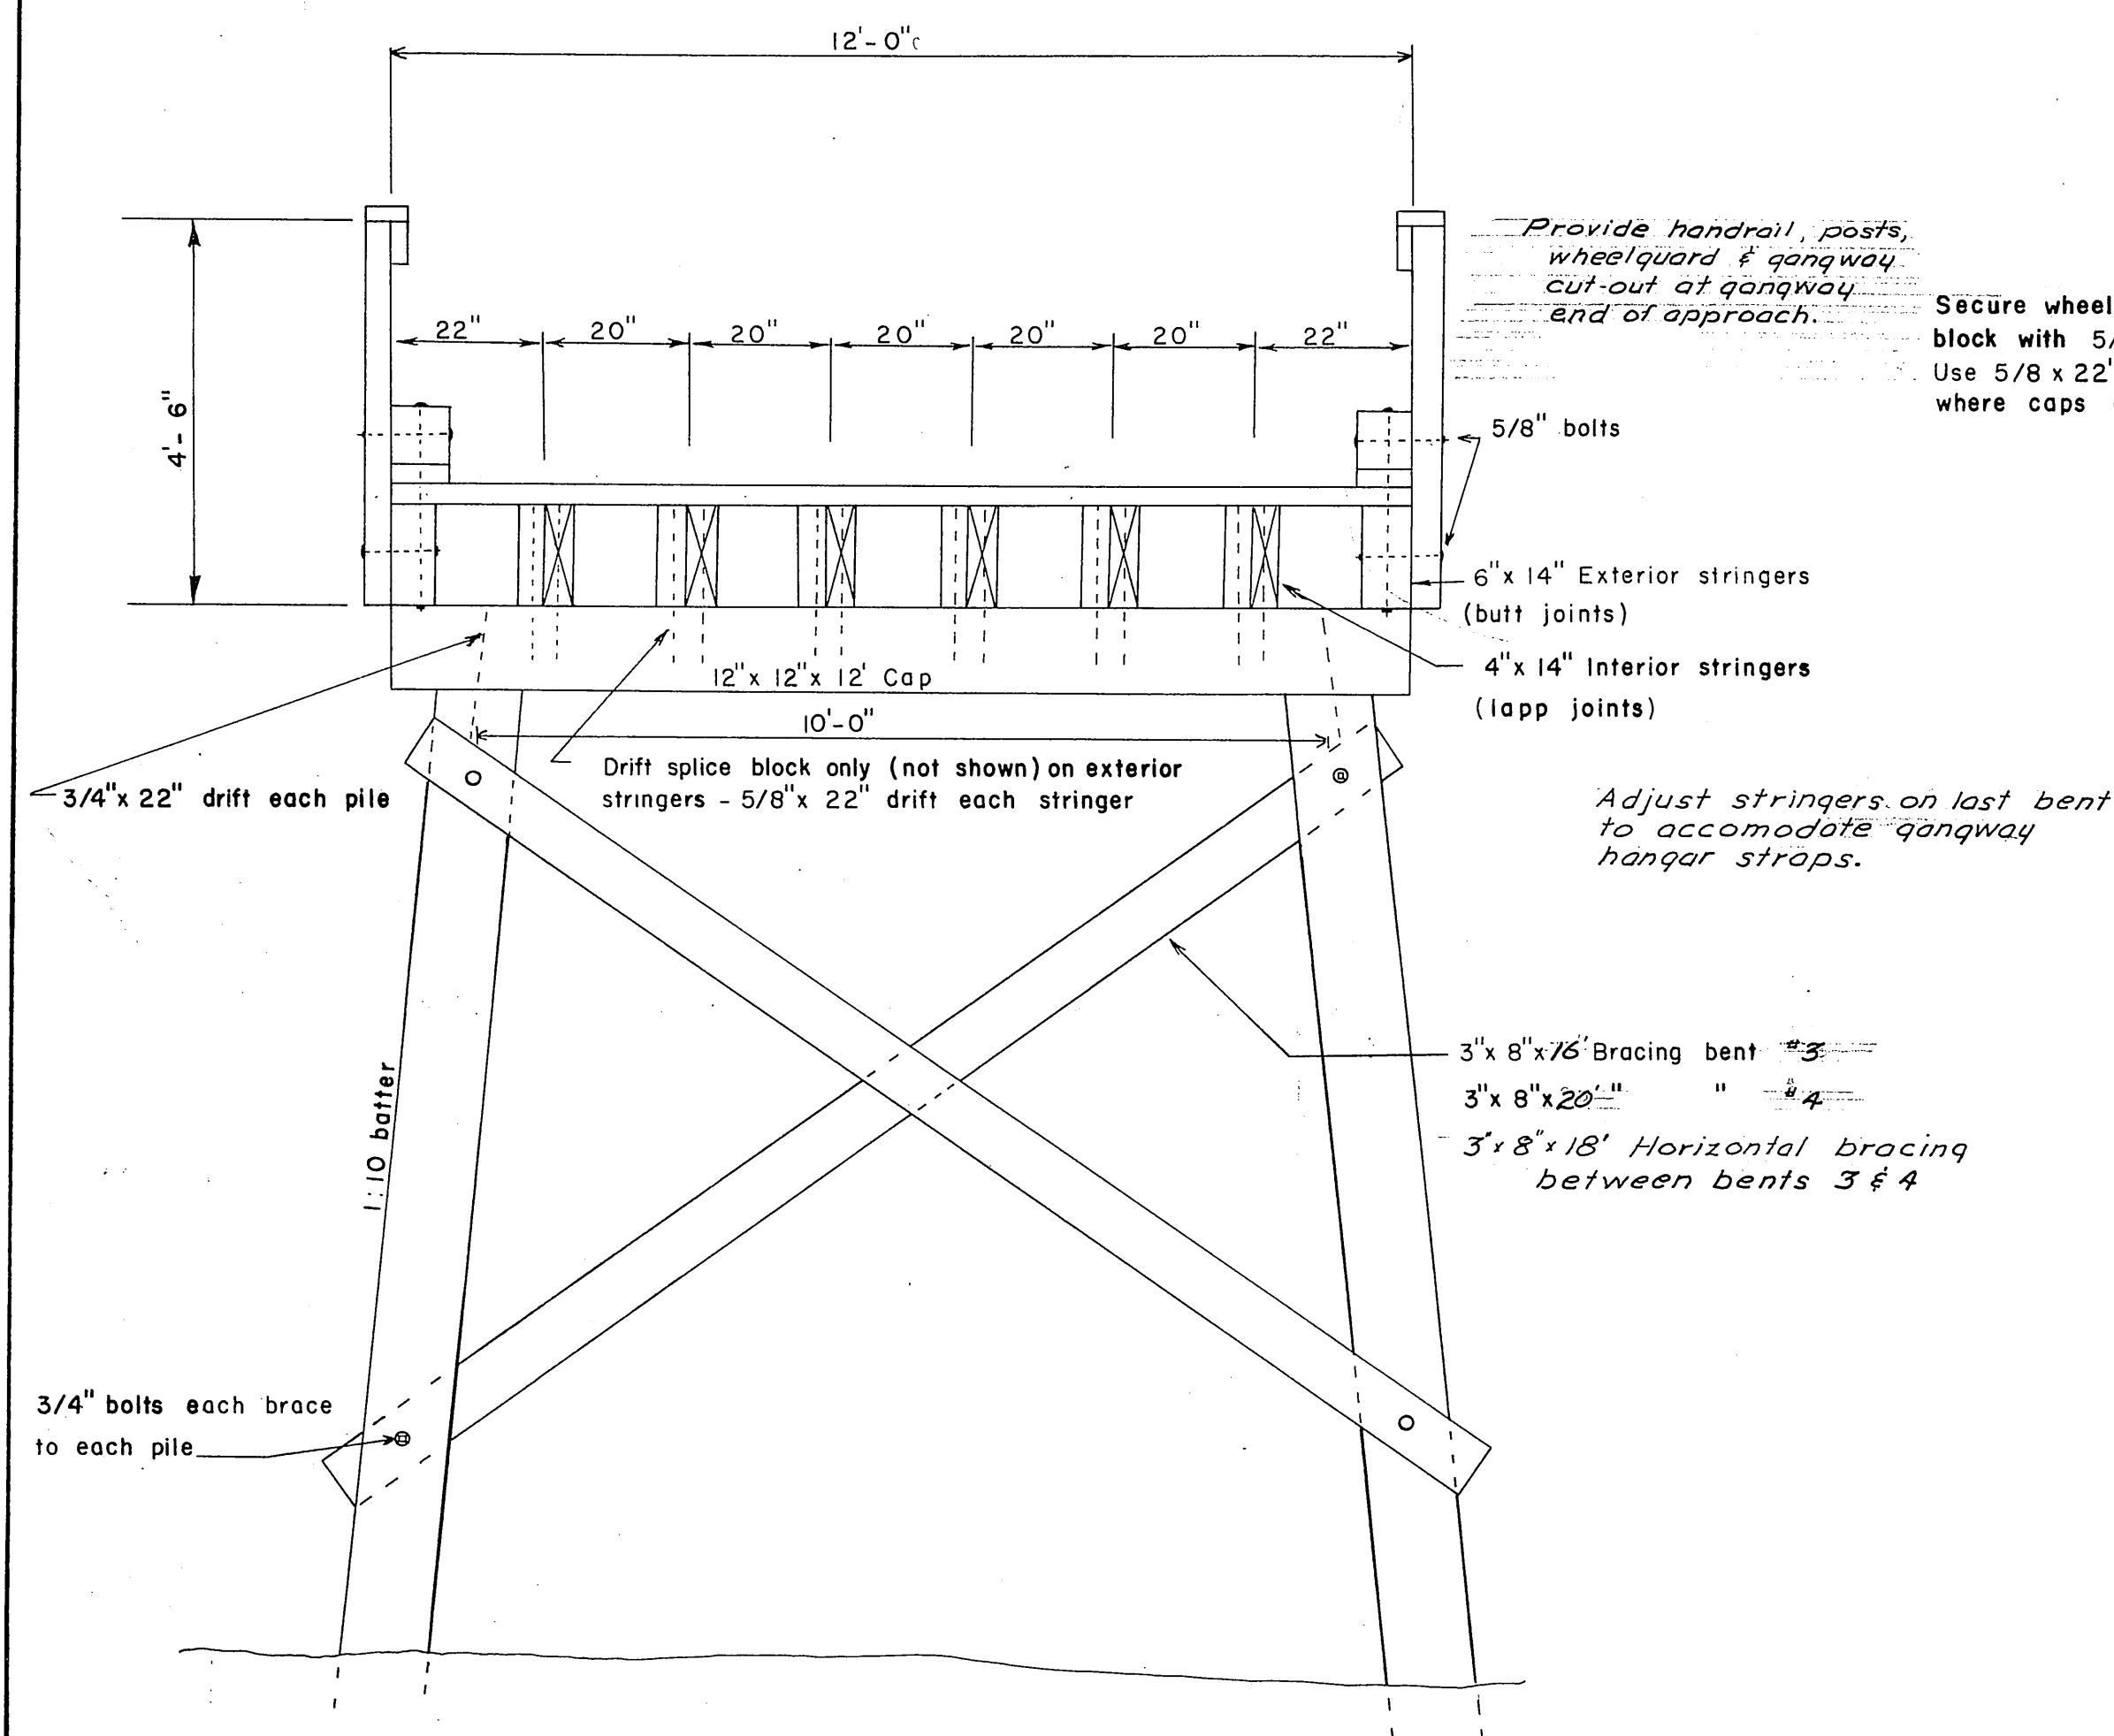

TYPICAL APPROACH SECTION

SCALE 1/2" = 1'-0"

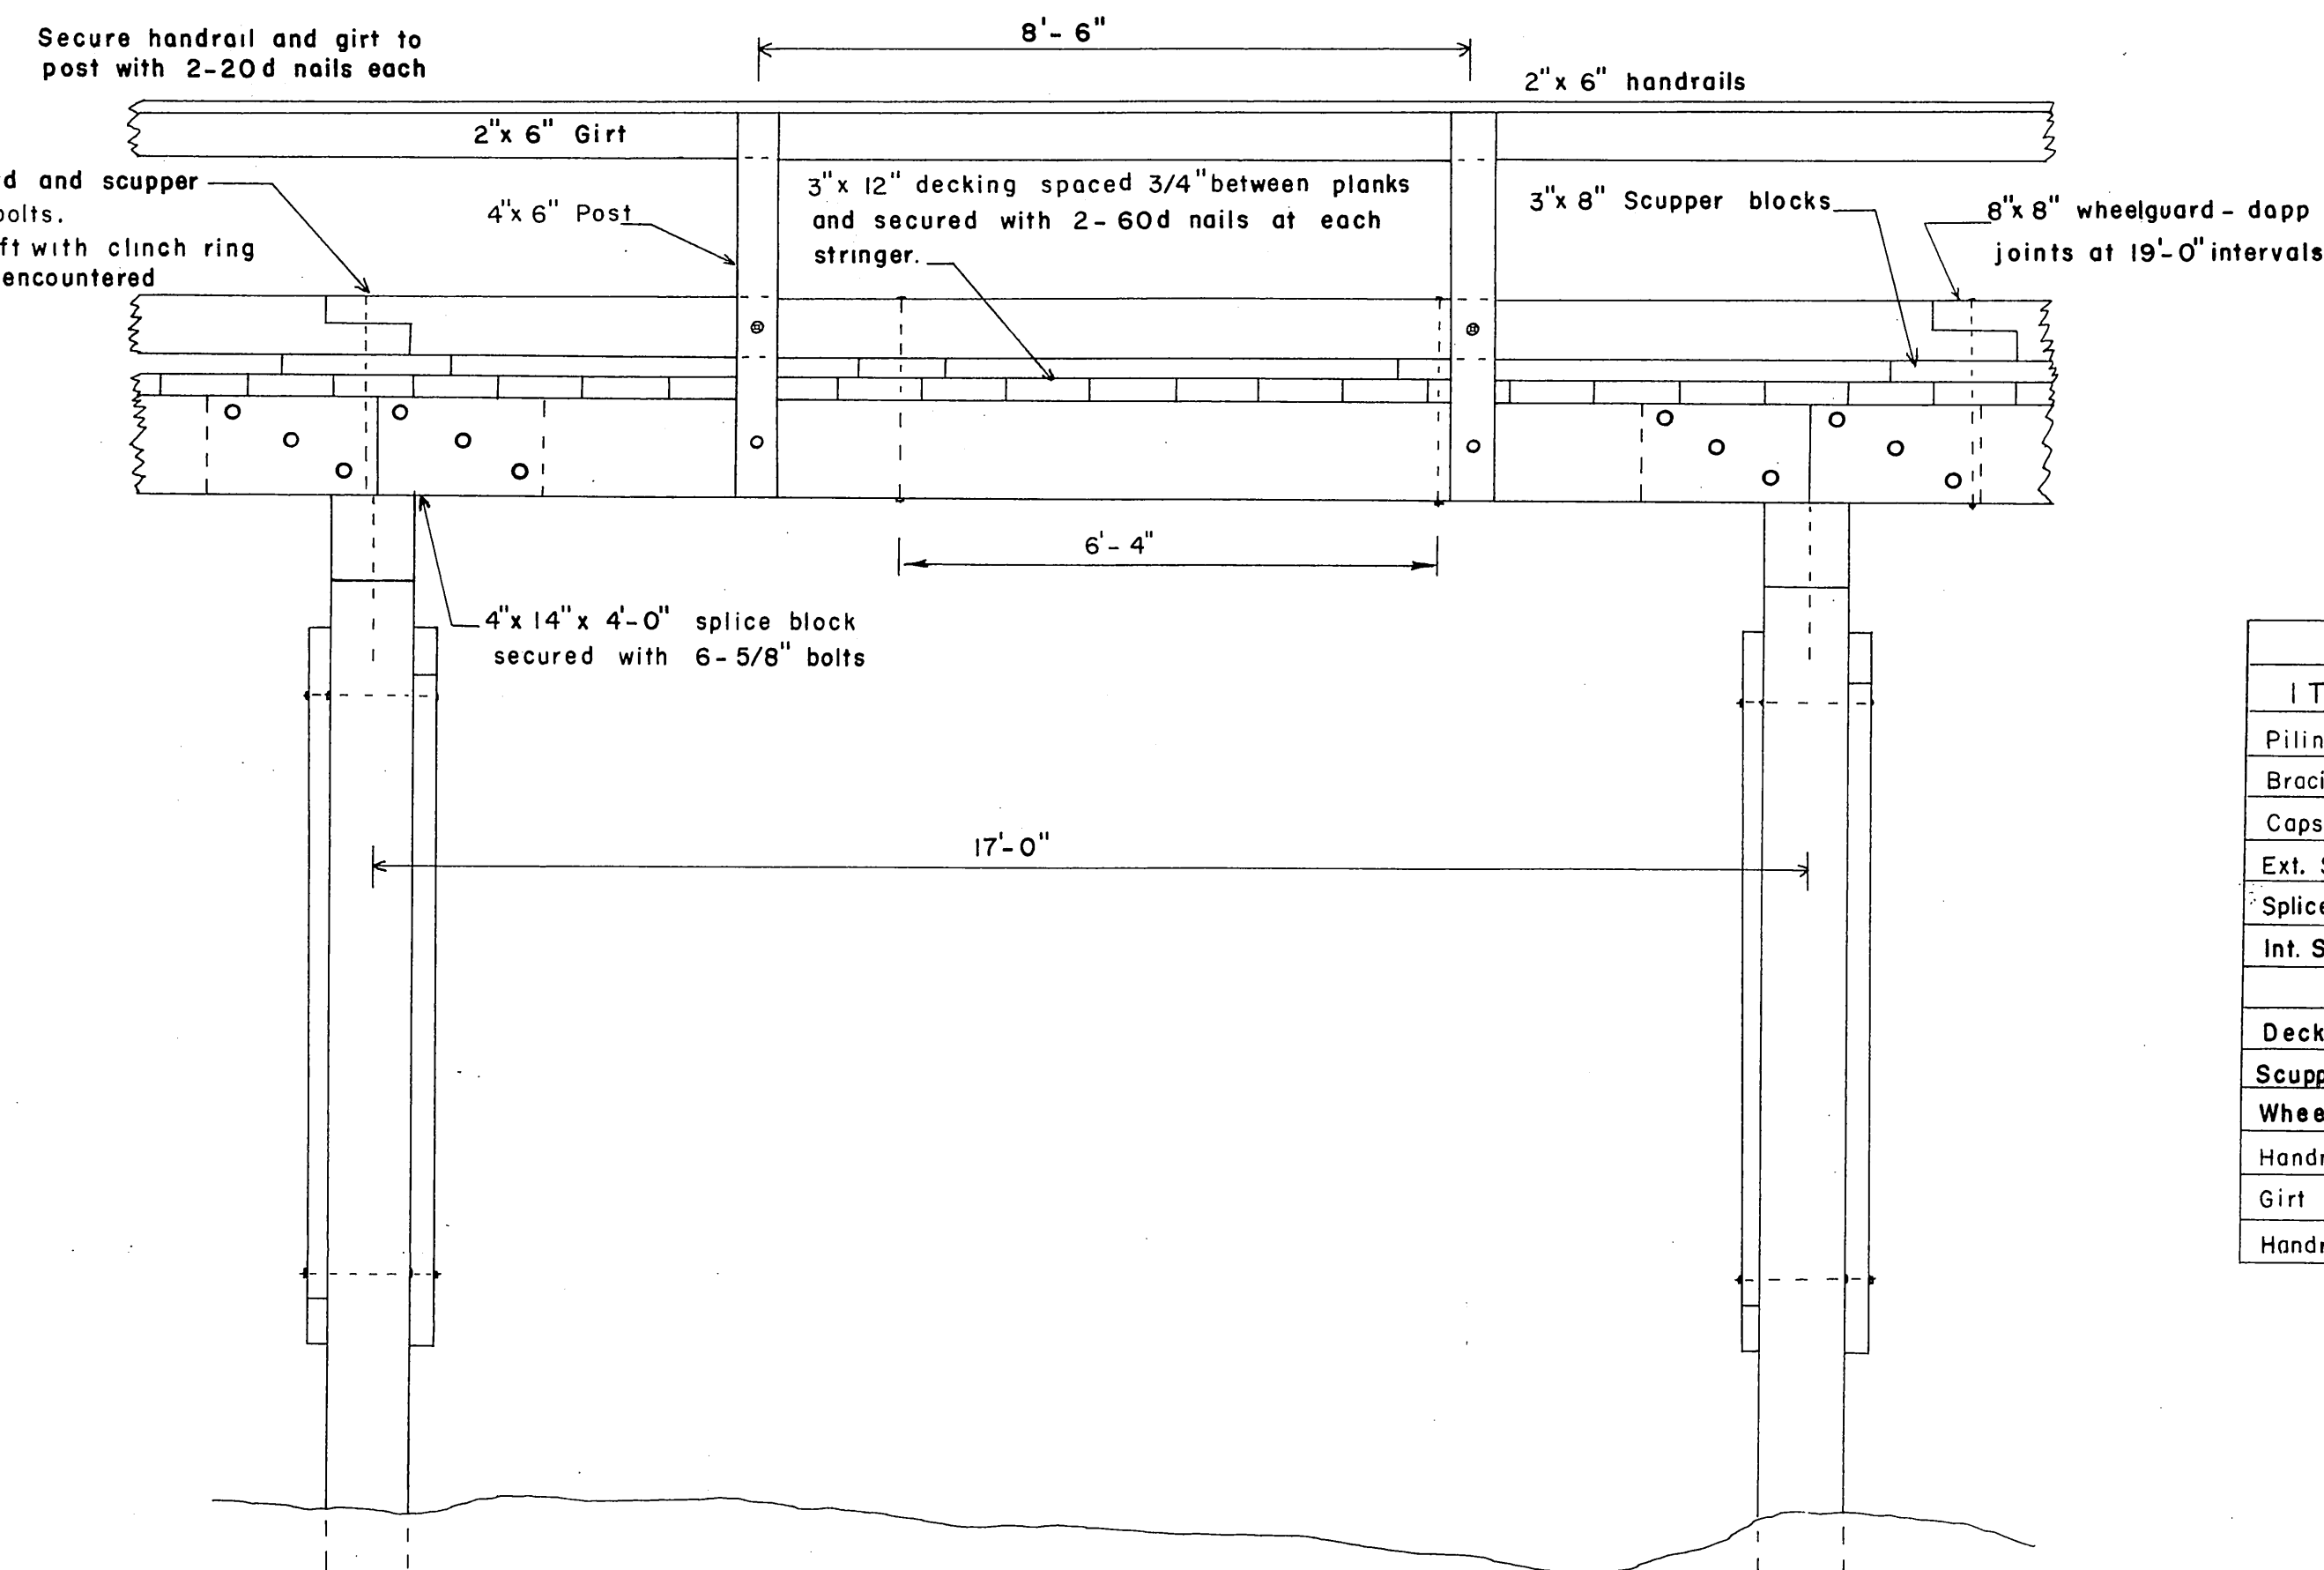

TYPICAL APPROACH ELEVATION

SCALE 1/2" = 1'-0"


NOTES

All hardware to be galvanized with malleable iron washers between nut and wood surfaces. All bolts to be of mushroom head type. Bolt holes to be drilled true size. Drift holes to be drilled 1/16" undersize. All drill holes to be treated with hot creosote oil. All pressure treated creosote material shall be cut to size prior to treatment.


MATERIALS				
ITEM	GRADE	DRESSING	CREO. TREAT.	TYPE
Piling	Class B		12" Ret.	Douglas Fir
Bracing	Construction	Rough	"	"
Caps	"	S 4 S	8"	"
Ext. Stringers	"	"	"	"
Splice Blocks	"	S 2 E	"	"
Int. Stringers	"	"	"	"
Decking	"	S 1 S 2 E	"	"
Scupper Block	"	S 4 S	"	"
Wheelguard	"	"	"	"
Handrail Post	"	"	"	"
Girt	"	"	"	"
Handrail	"	"	"	"

STATE OF ALASKA DEPARTMENT OF PUBLIC WORKS DIVISION OF WATER AND HARBORS	
TYPICAL 12'-0" APPROACH CONSTRUCTION DETAILS	
SCALE - AS SHOWN DATE - Aug '66 PROJ. NO. 5-67101	APPROVED - DON STATTER DIRECTOR DESIGNED BY - B DRAWN BY - WO CHECKED BY - DS


All cotter keys to be 3/16" x 1 3/4" -
drill holes located 1/2" from end of bolt.

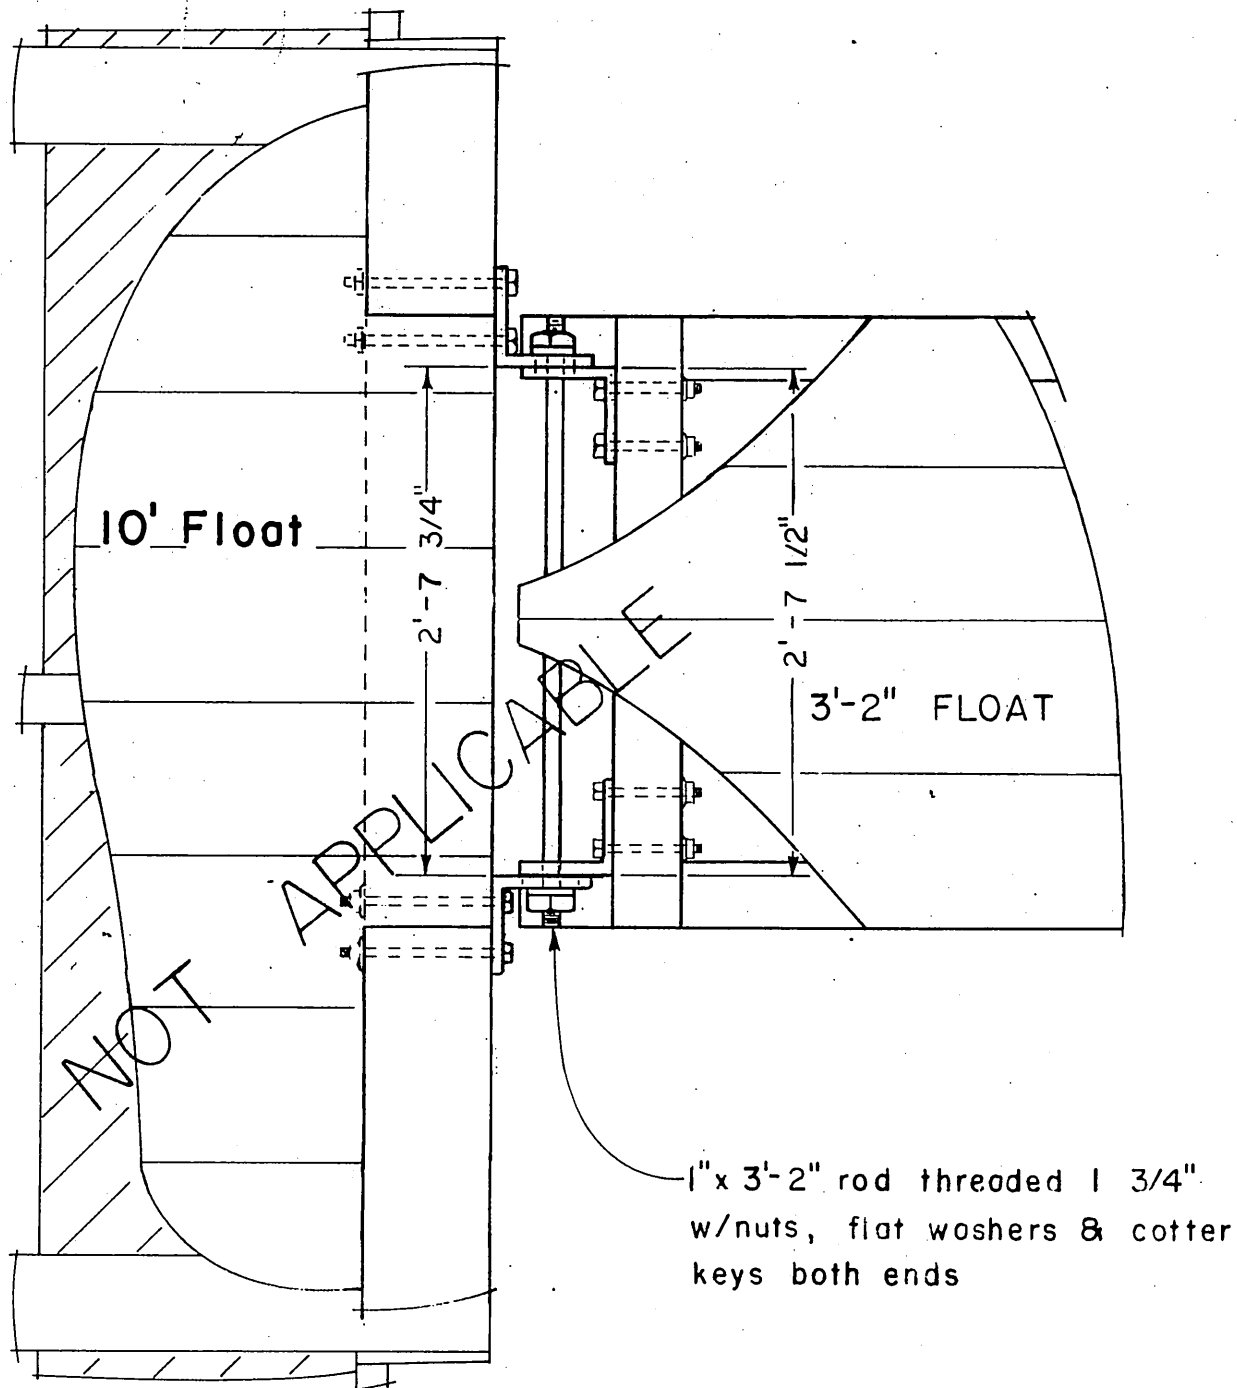


Plan - cutaway view

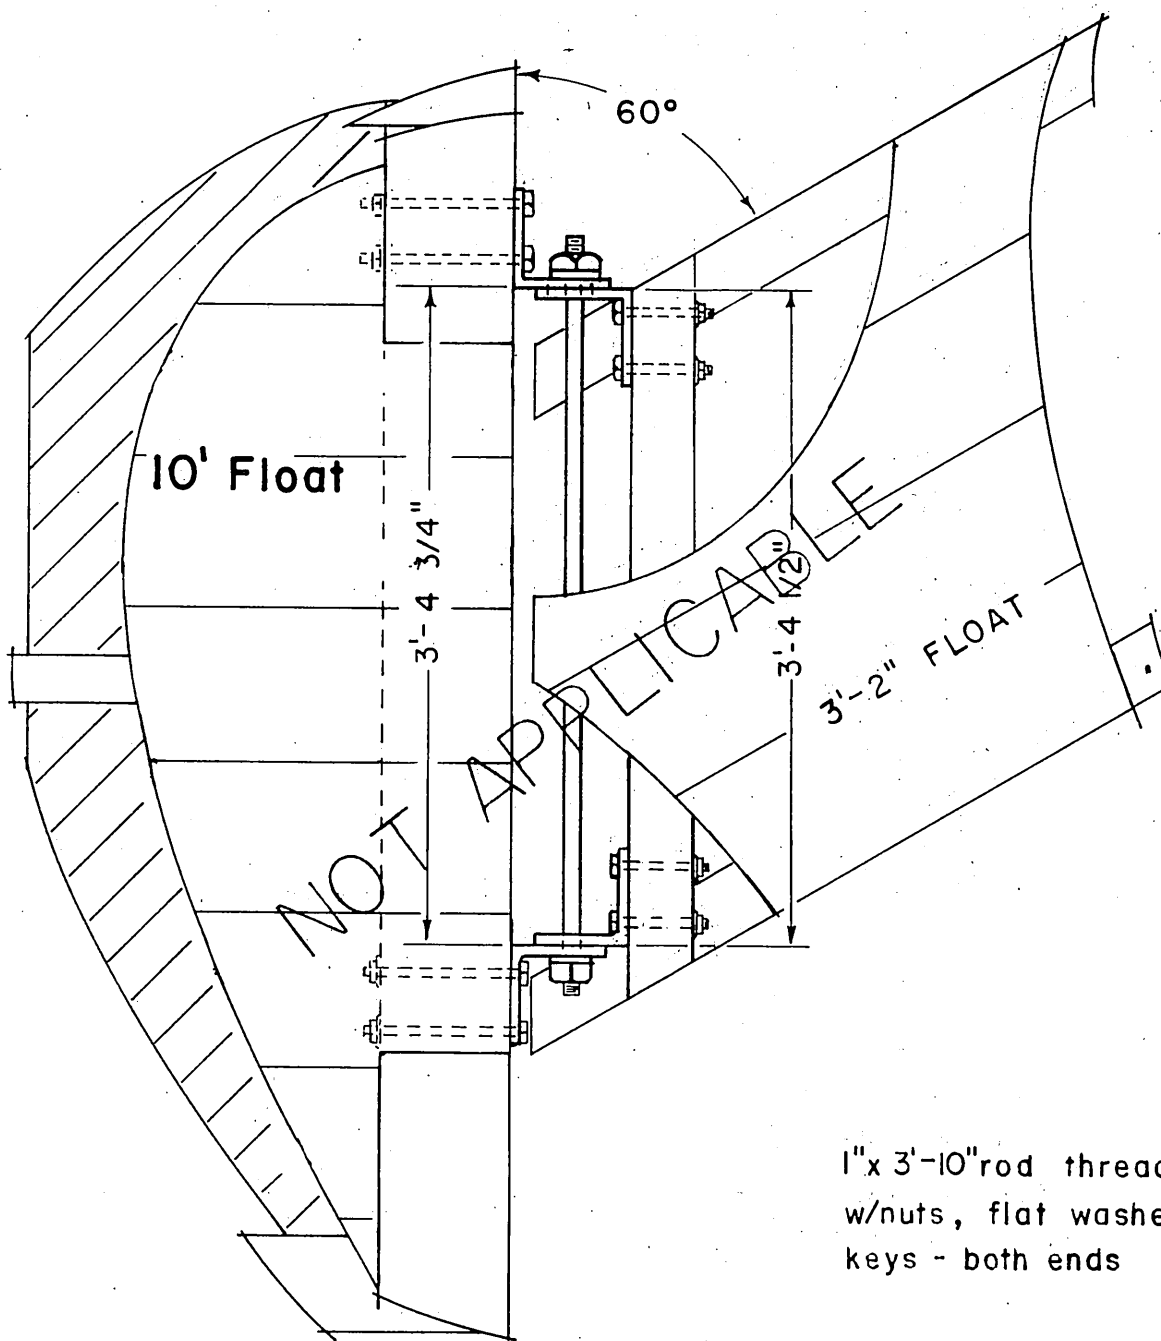





Plan - cutaway view

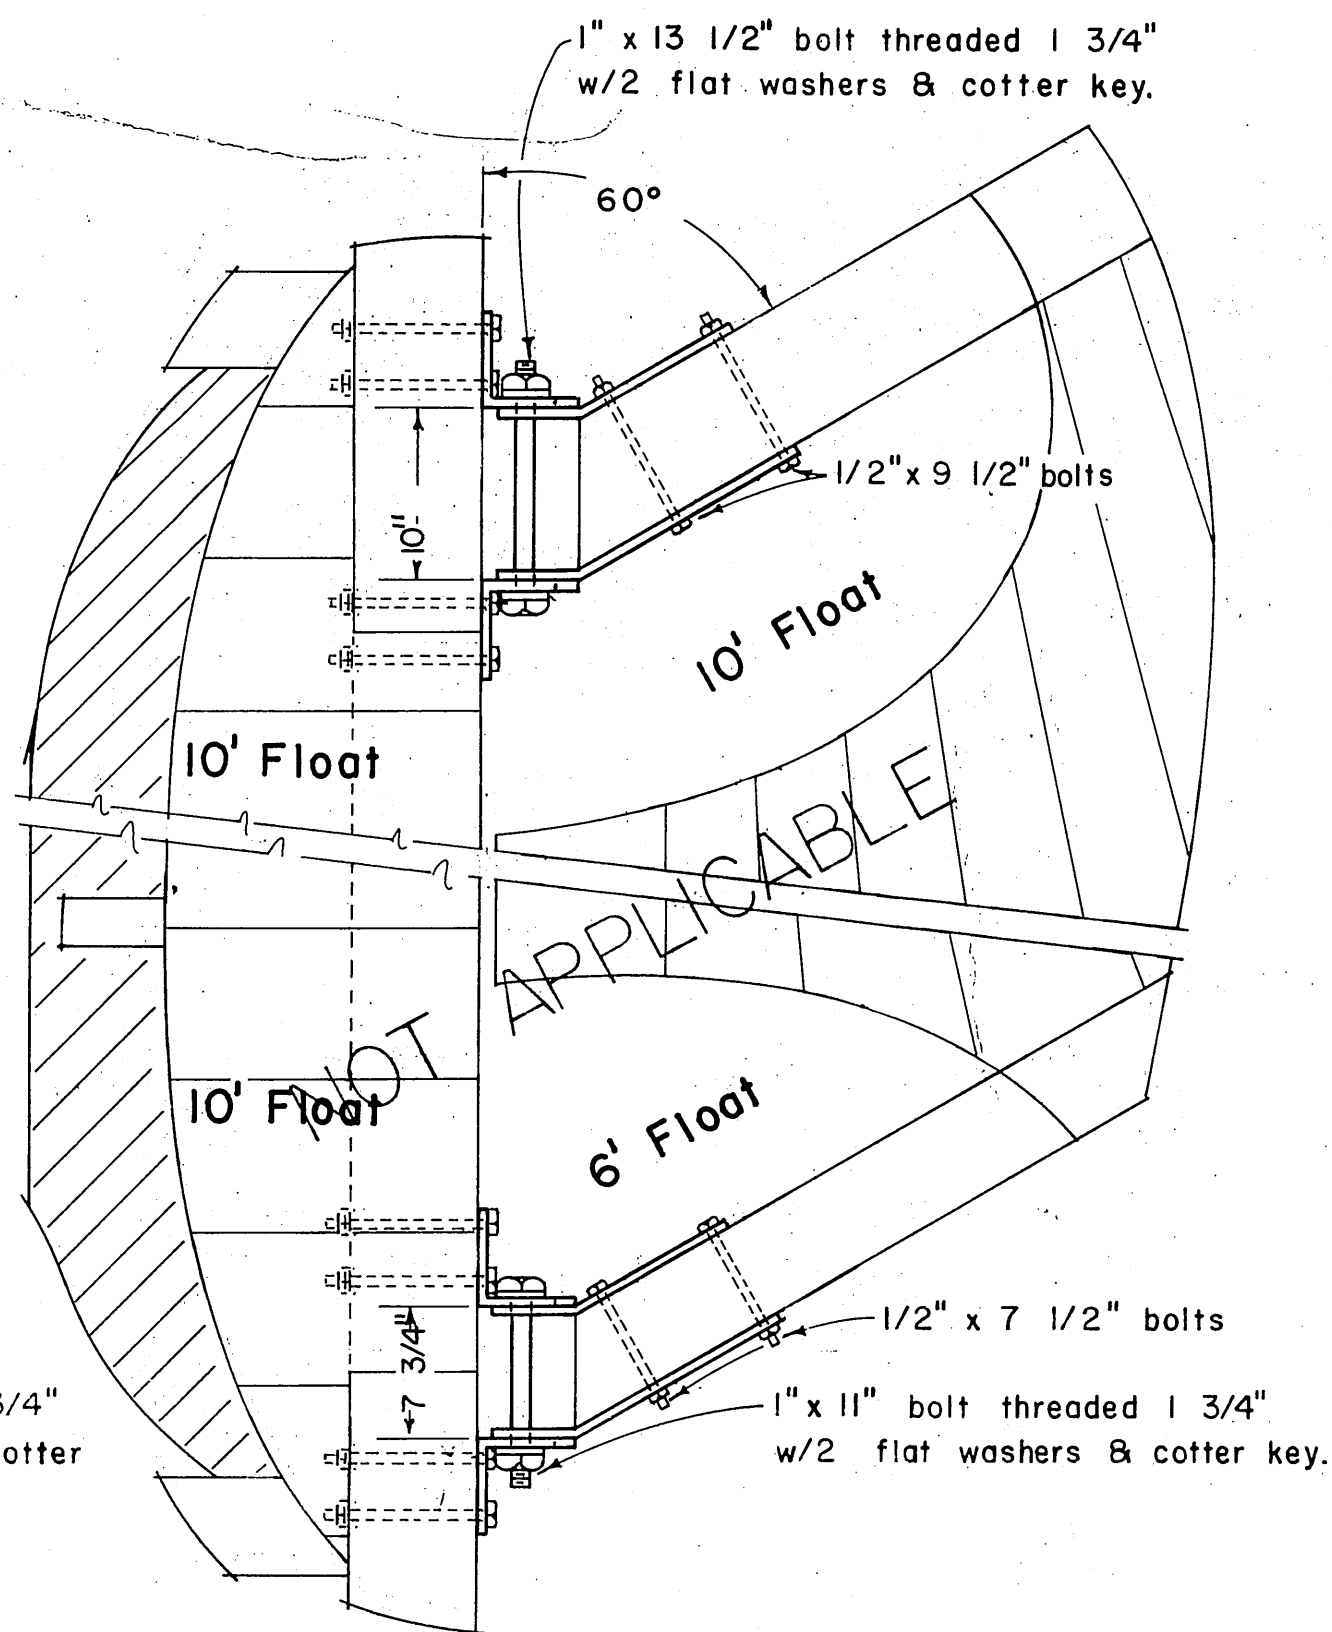

Plan - cutaway views

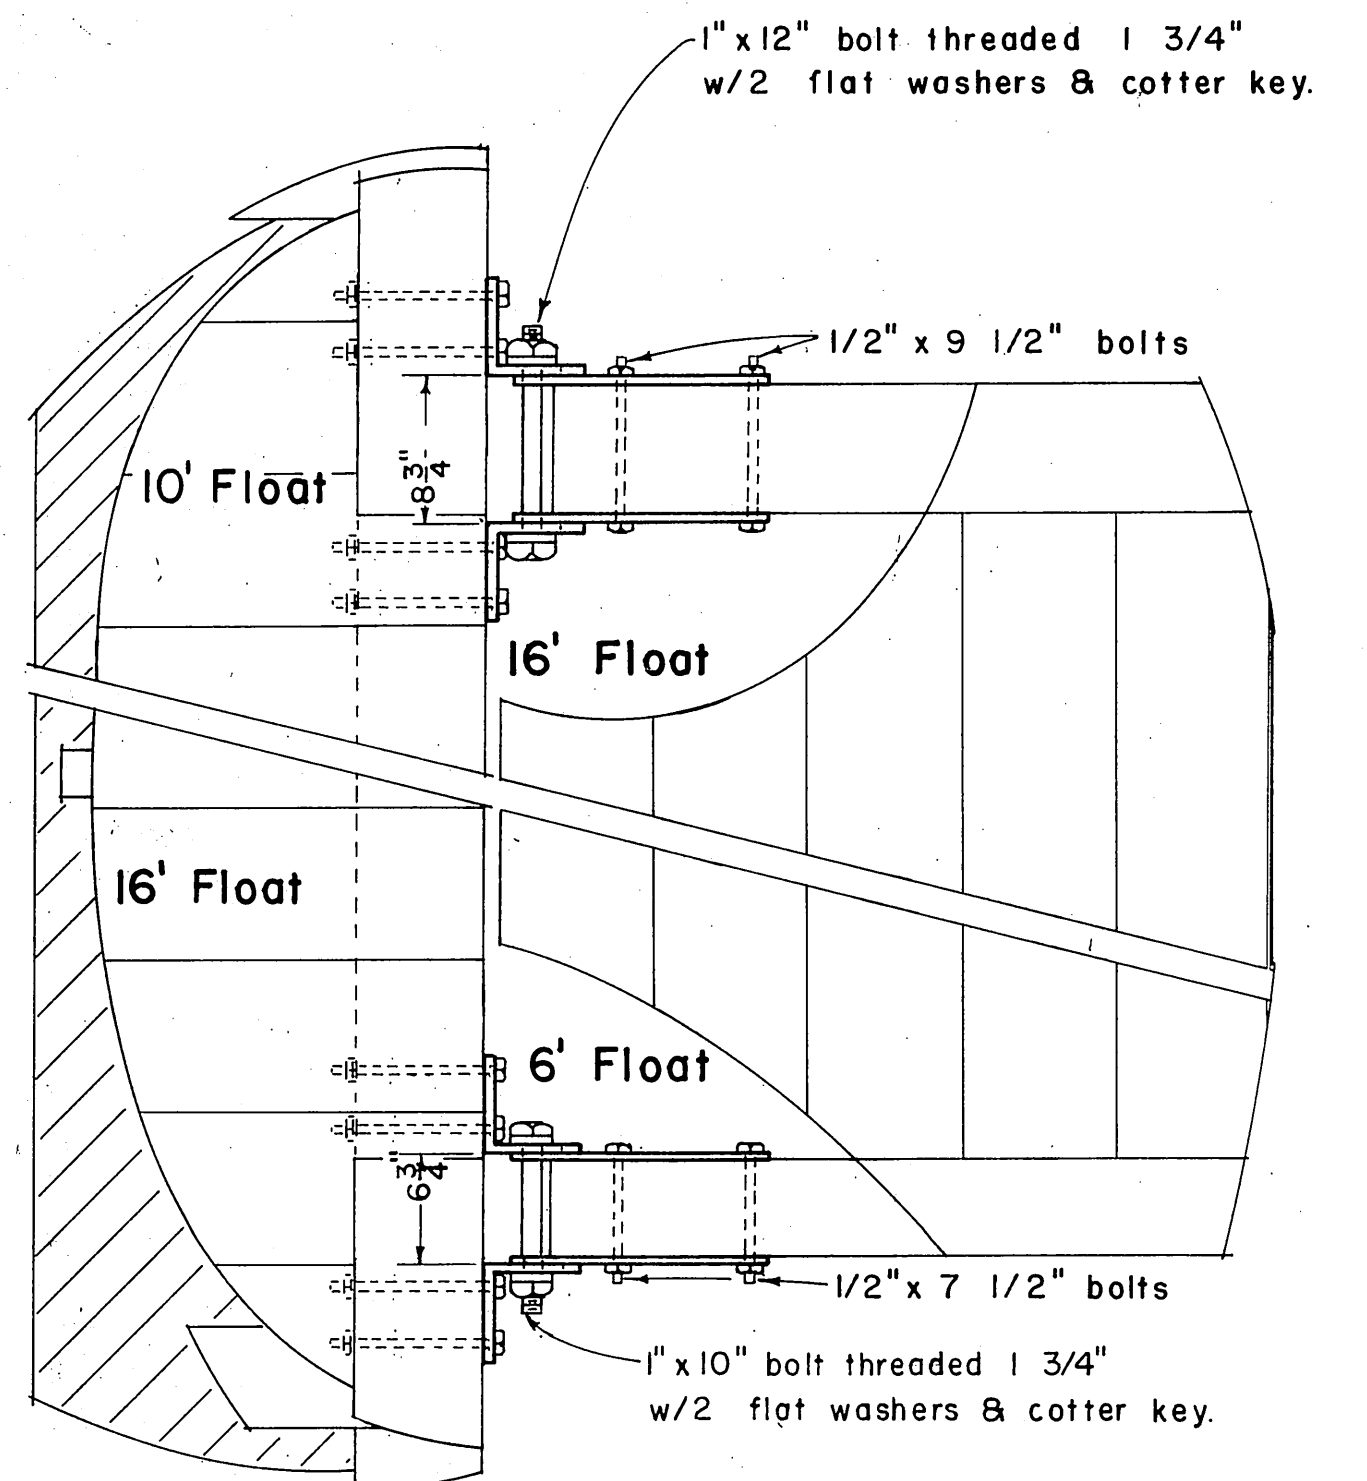

Plan- cutaway views

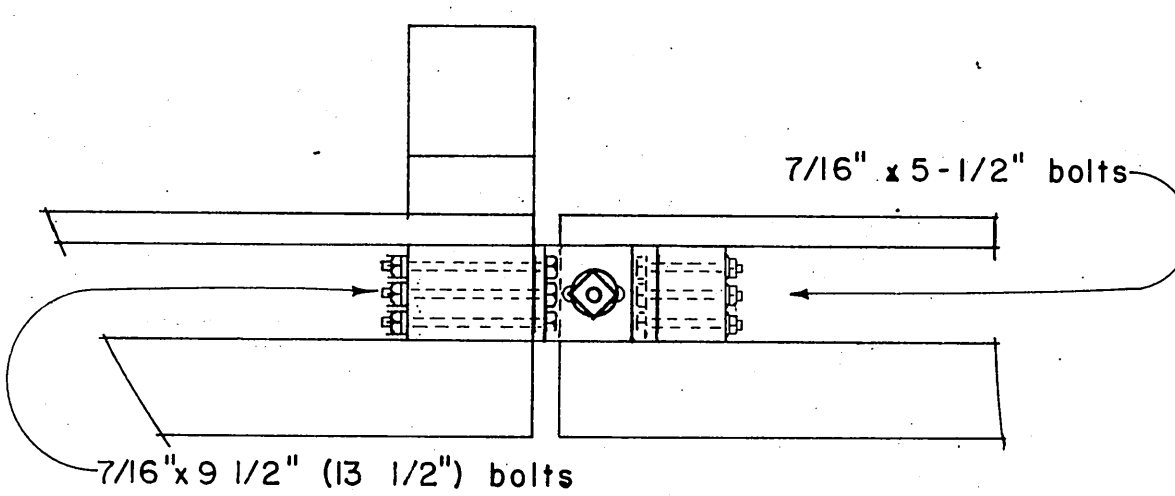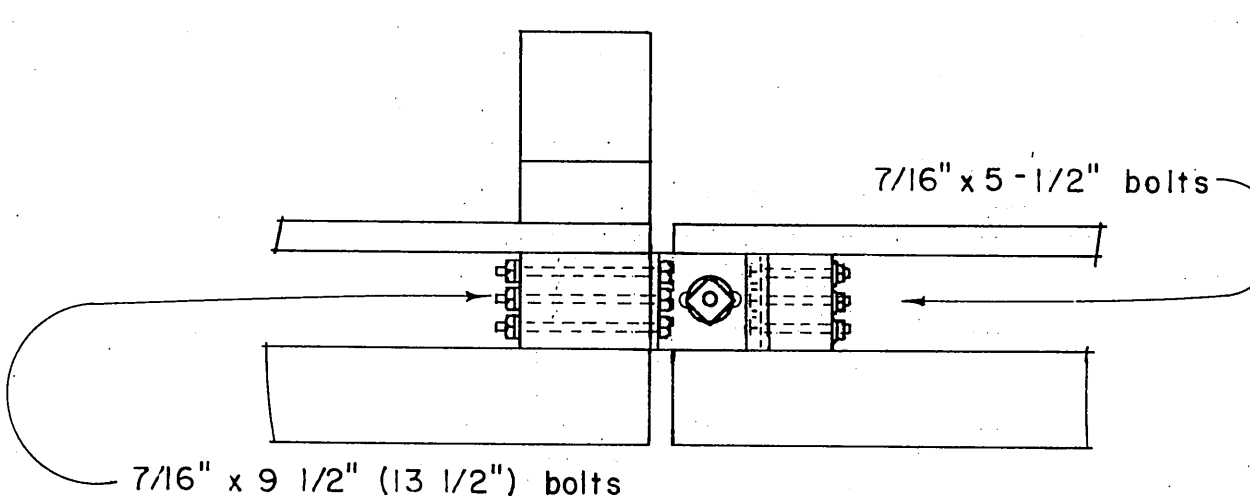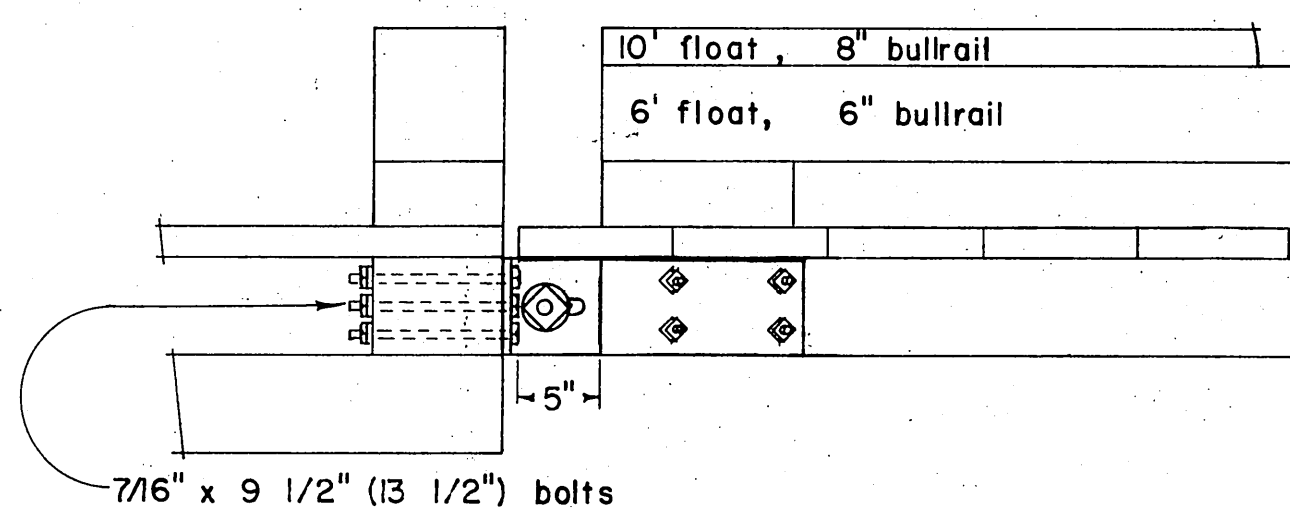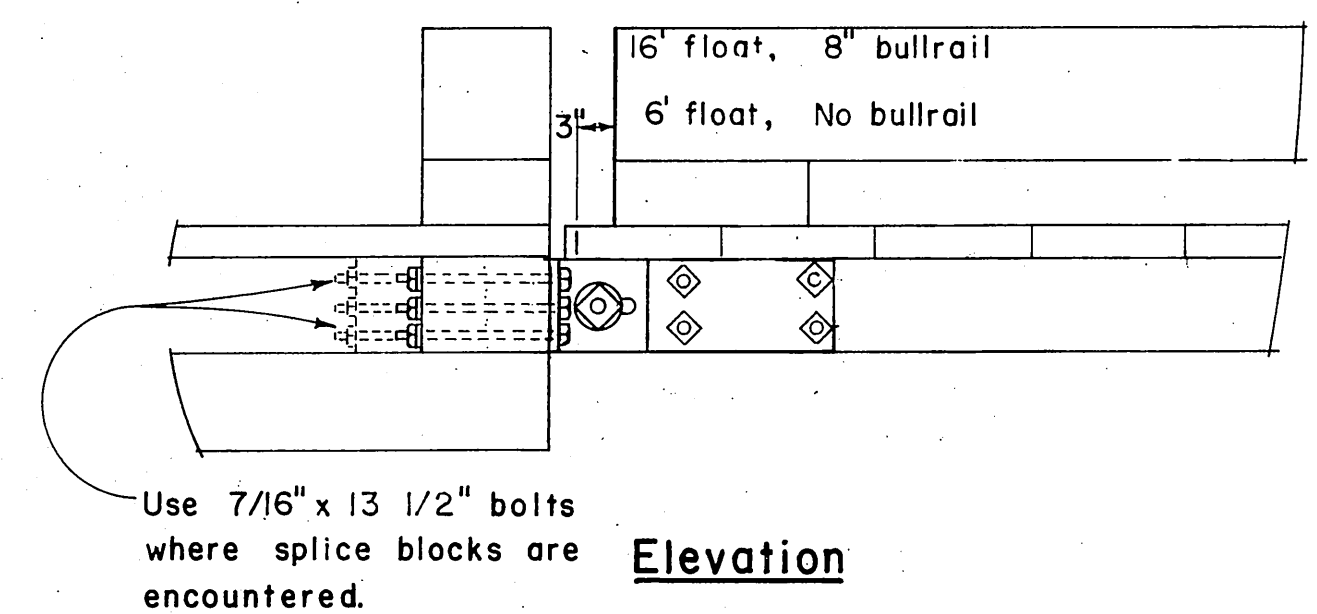ElevationElevationElevation


Elevation

4' FLOAT
Right angle connection
Scale 1" to 1'-0"


4' FLOAT
60° angle connection
Scale 1" to 1'-0"

6' & 10' FLOATS
60° angle connection
Scale 1' to 1" - 0"

6' & 10' FLOATS
Right angle connections
Scale 1' to 1'-0"

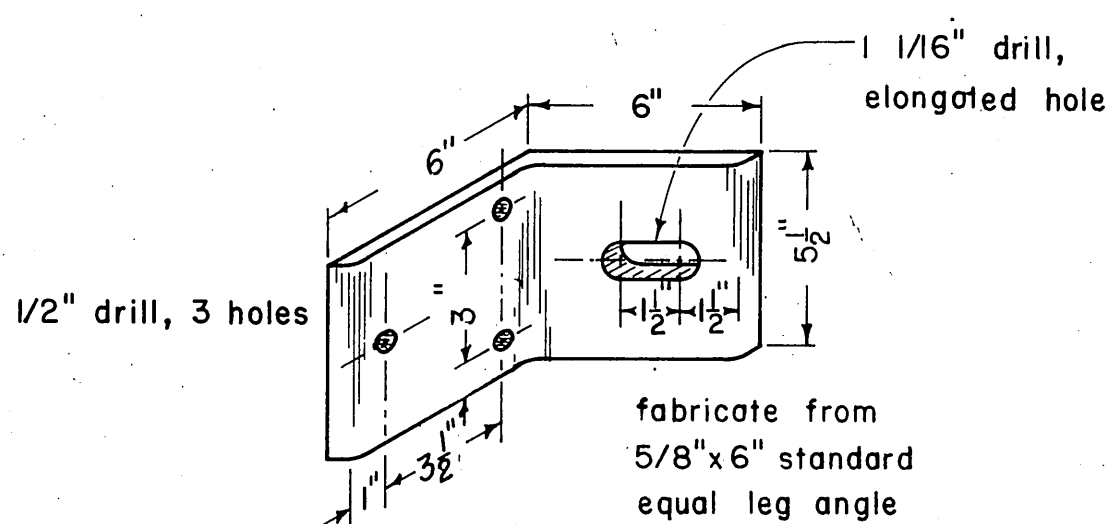


ANGLE CLIP DETAILS

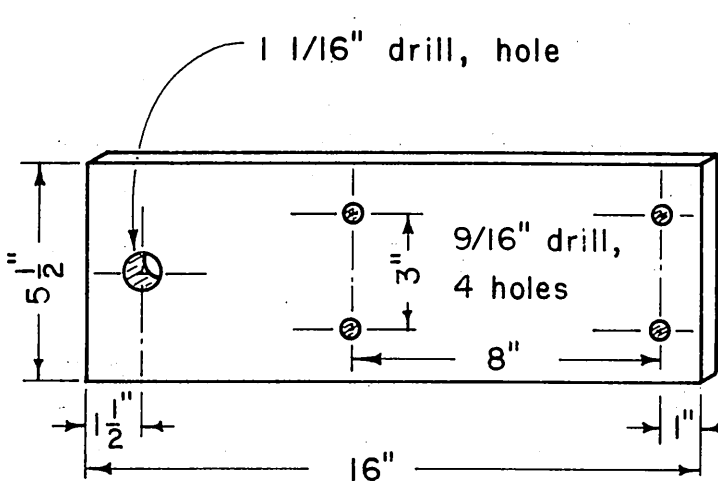

STANDARD PLATE DETAILS

Scale 1" to 5"

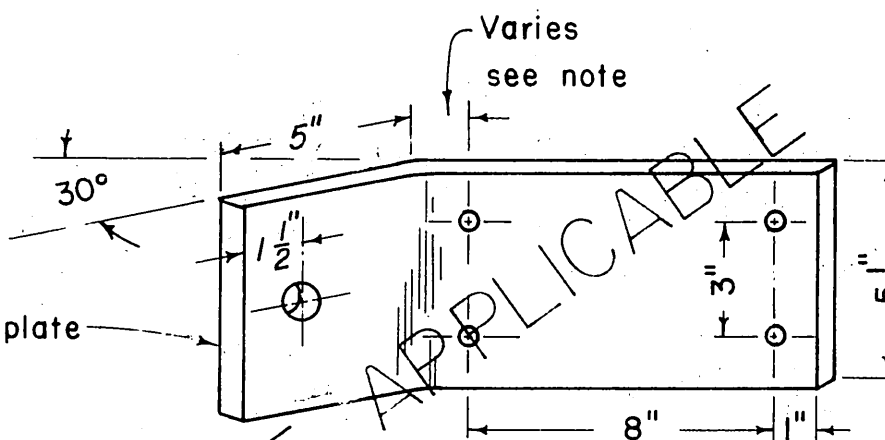

BENT PLATE DETAILS

Variable dimension note:
dimension to be -
2" all short side plates; for 16" plate
5 1/2" outside plates 6' angled float, for 19 1/2" plate
6 5/8" outside plates 10' angled float, for 20 5/8" plate

STATE OF ALASKA	
DEPARTMENT OF PUBLIC WORKS	
DIVISION OF WATER AND HARBORS	
TYPICAL HINGE CONNECTION DETAILS	
Scale <u>As shown</u>	Approved <u>Don Statter</u> Director
Date <u>April 1965</u>	
Proj. No. _____	
Designed by <u>DS</u>	Drawn by <u>JB</u> Checked by <u>DS</u>

